

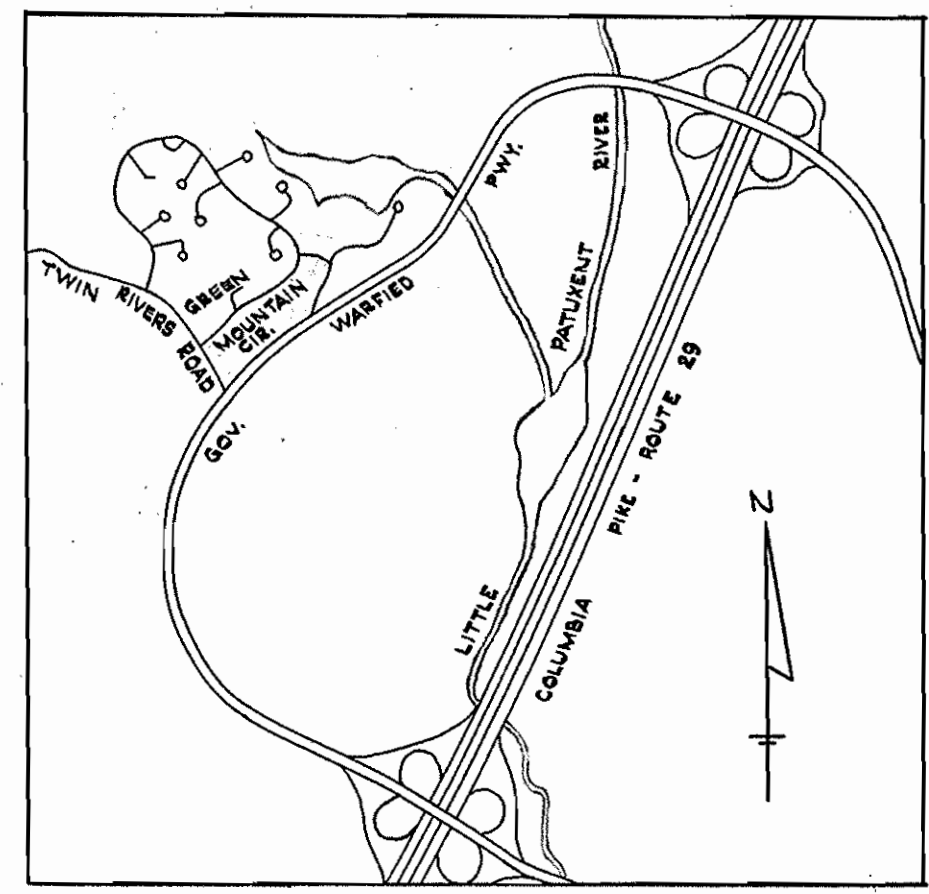


GENERAL NOTES

1. Approximate location of existing mains are shown. The Contractor shall take all necessary precautions to protect existing mains and services and maintain uninterrupted supply. Any damage incurred shall be repaired immediately.
2. All pipe elevations shown are invert elevations.
3. The Contractor shall locate existing utilities a minimum of two weeks in advance of construction operations in vicinity of utilities.
4. For all standard details see standards bound in Specifications.
5. All water mains to be C.I.P. or D.I.P. and have a minimum of 3/4' cover.
6. Block all fittings with concrete, see standard details bound in Specifications.
7. Bury line elevations on fire hydrants shall be set to elevations shown on drawings.
8. All Fire Hydrants shall be buttressed with concrete in accordance with Standard Detail W-4
9. Clear all utilities by a minimum of 6', clear all poles by 2'-0" minimum or tunnel as required.
10. The Contractor shall provide a joint in all sewer mains within 2'-0" of exterior manhole walls.
11. All fittings used for double water house connections to be included in the unit price bid for furnishing and laying water house connections.

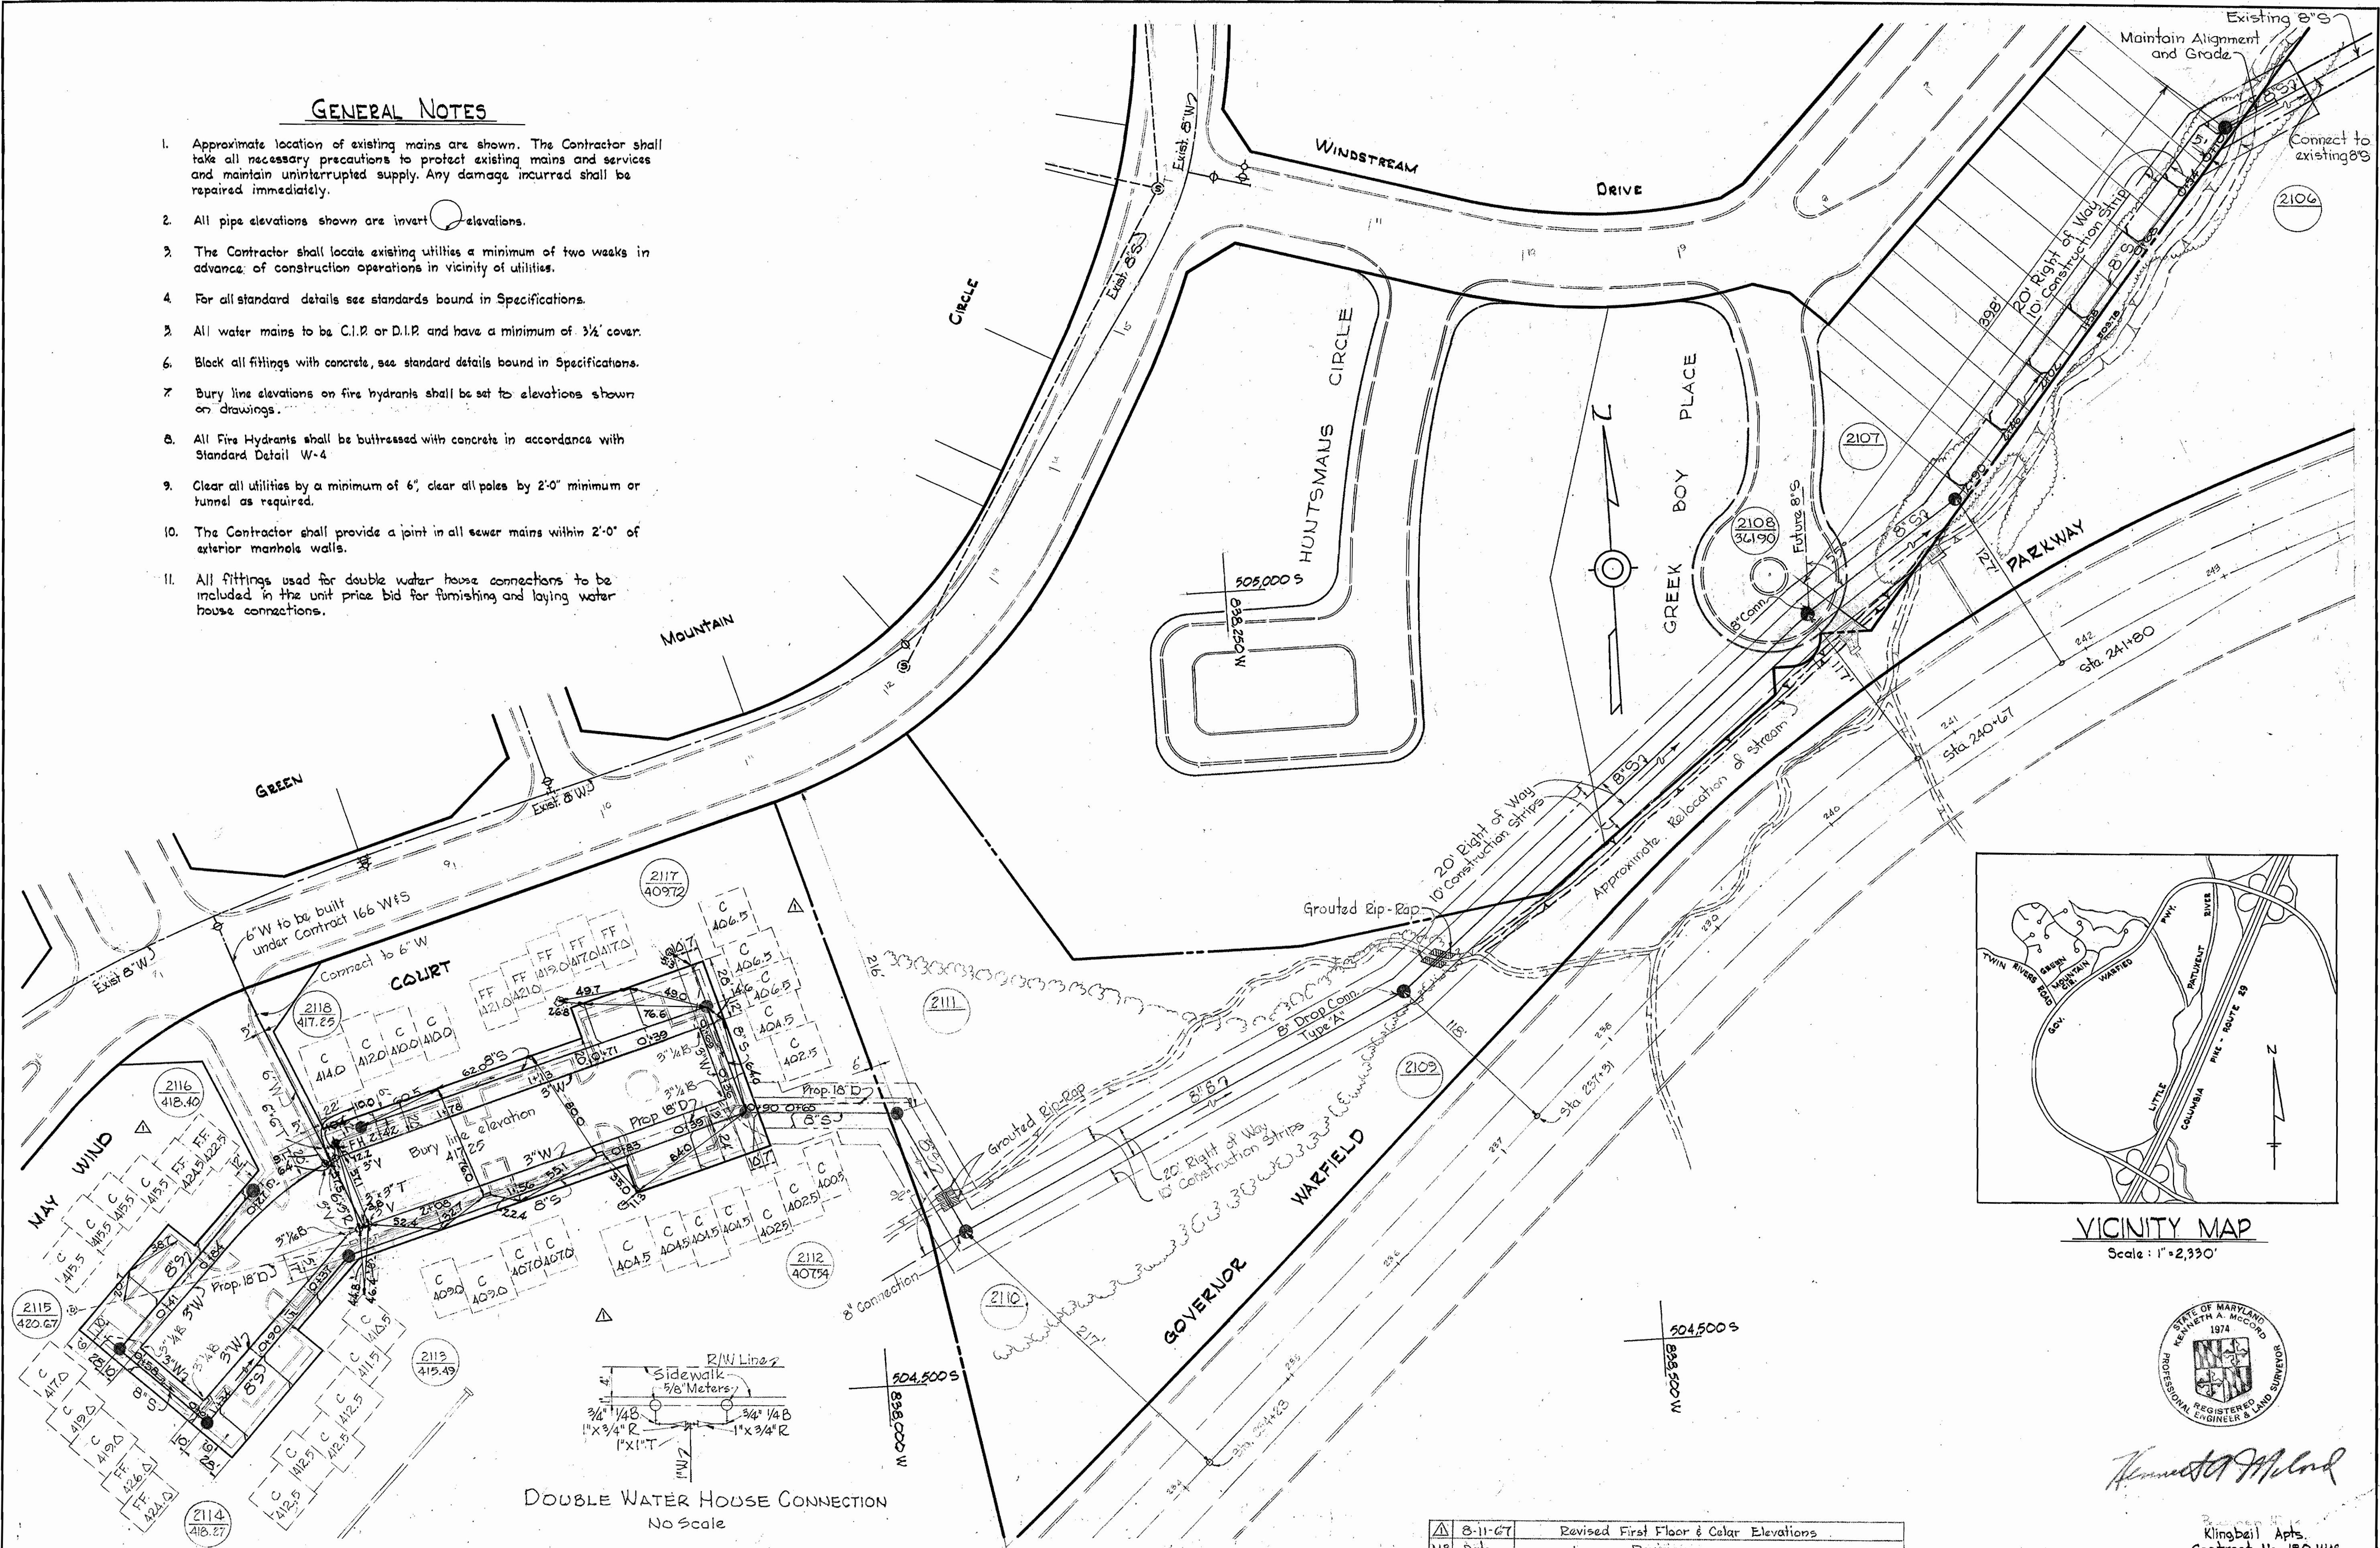

VICINITY MAP
Scale: 1" = 2,390'

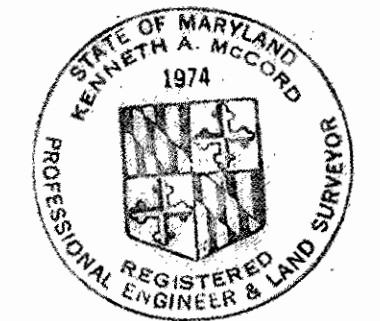

Kenneth A. McLeod


Klingbeil Apts.
Contract No. 180 W & S

8-11-67	Revised First Floor & Cellar Elevations
NS	Date
	Revisior





<p>WHITMAN, REQUARDT & ASSOCIATES ENGINEERS 1304 ST. PAUL ST. BALTIMORE, MARYLAND</p>	<p>HOWARD COUNTY METROPOLITAN COMMISSION DATE: 6-8-67 <i>W. O. Pitt</i> CHIEF ENGINEER</p>	<p>CONTRACT NO. 180 W & S</p>	<p>PLAN OF WATER & SEWER MAINS</p>	<p>COLUMBIA VILLAGE OF WILDE LAKE ELECTION DISTRICT-CLARKSVILLE No.5</p>	<p>DRAWING NO. 1 OF 2</p>	<p>SCALE 1" = 50'</p>
--	---	--	---	---	----------------------------------	------------------------------

W. O. 5737-2


AS BUILT AUG. 4, 1967

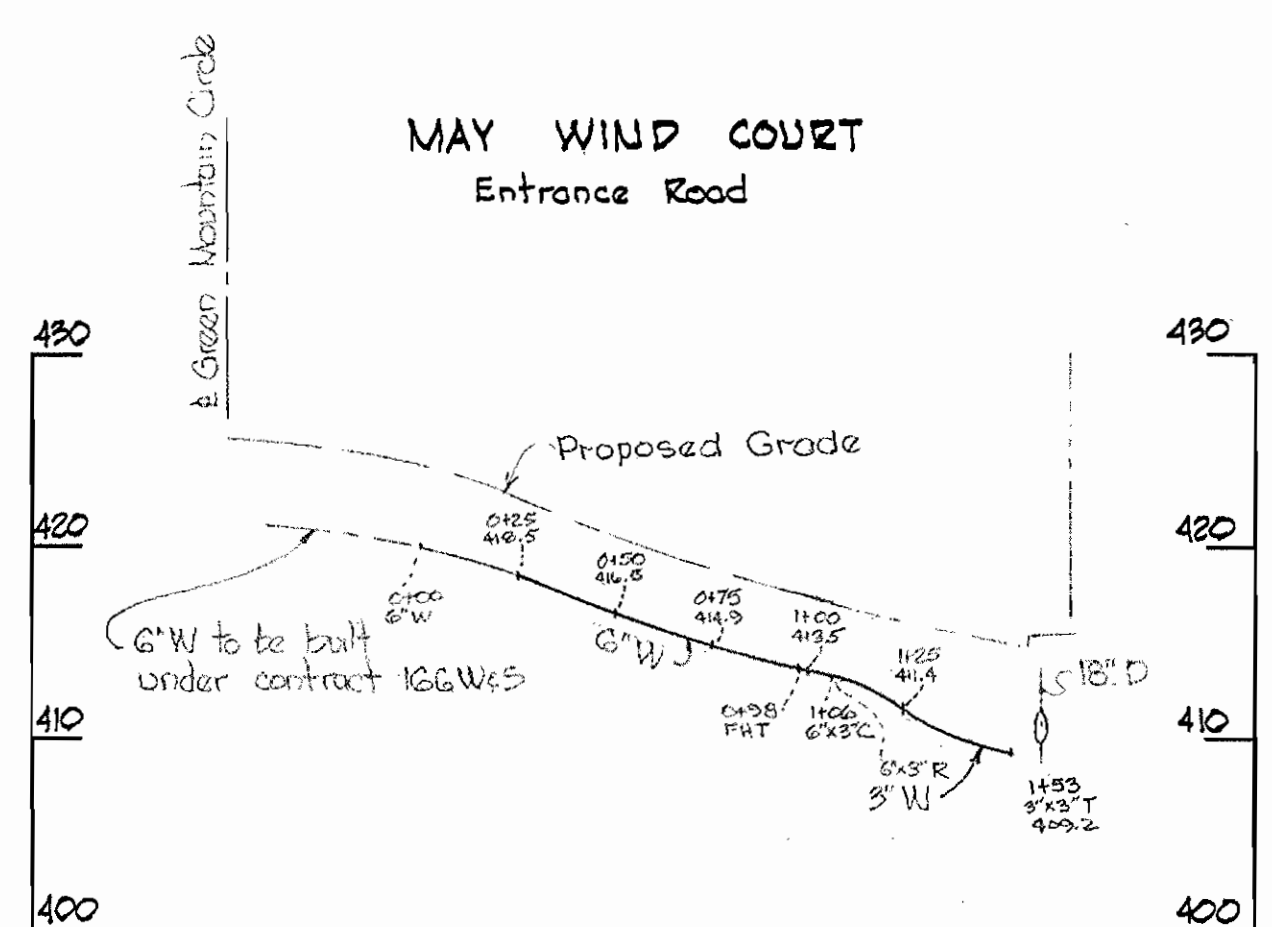



PROFILE
Scale: Hor. 1"=50'
Vert. 1"=10'

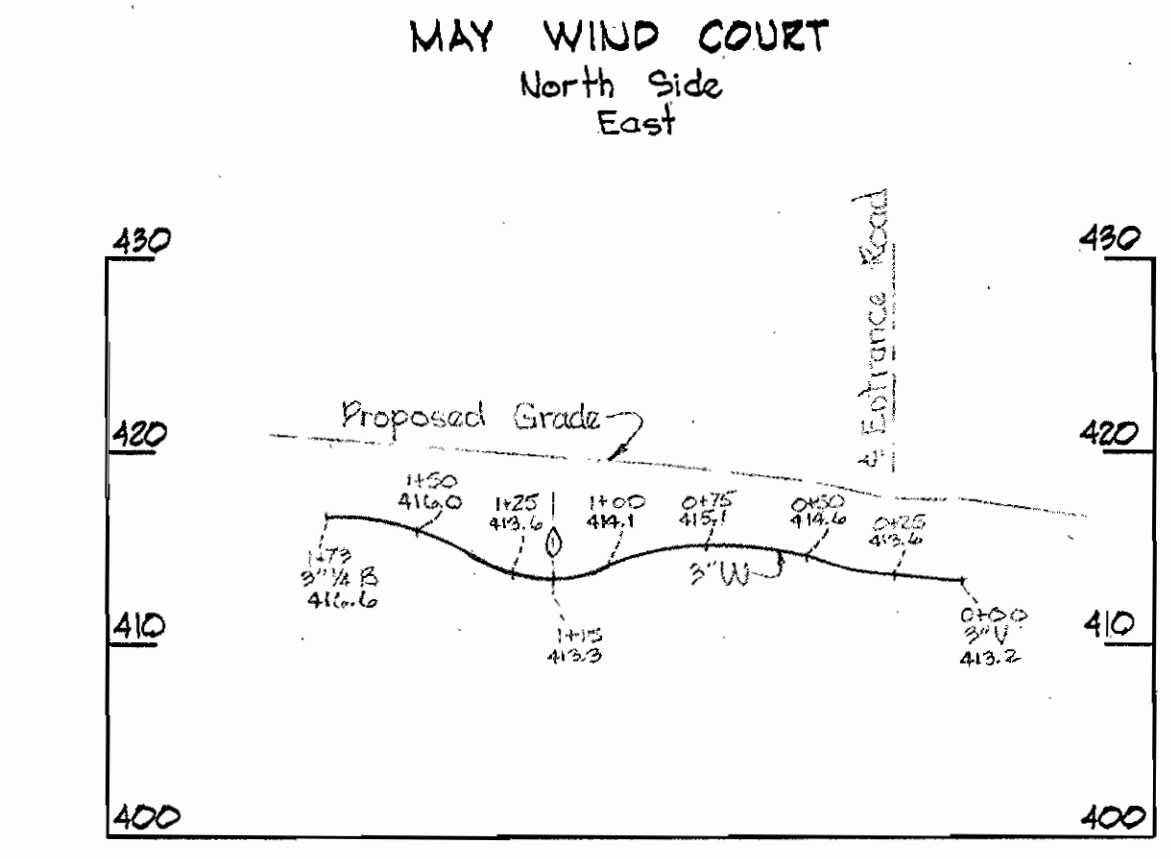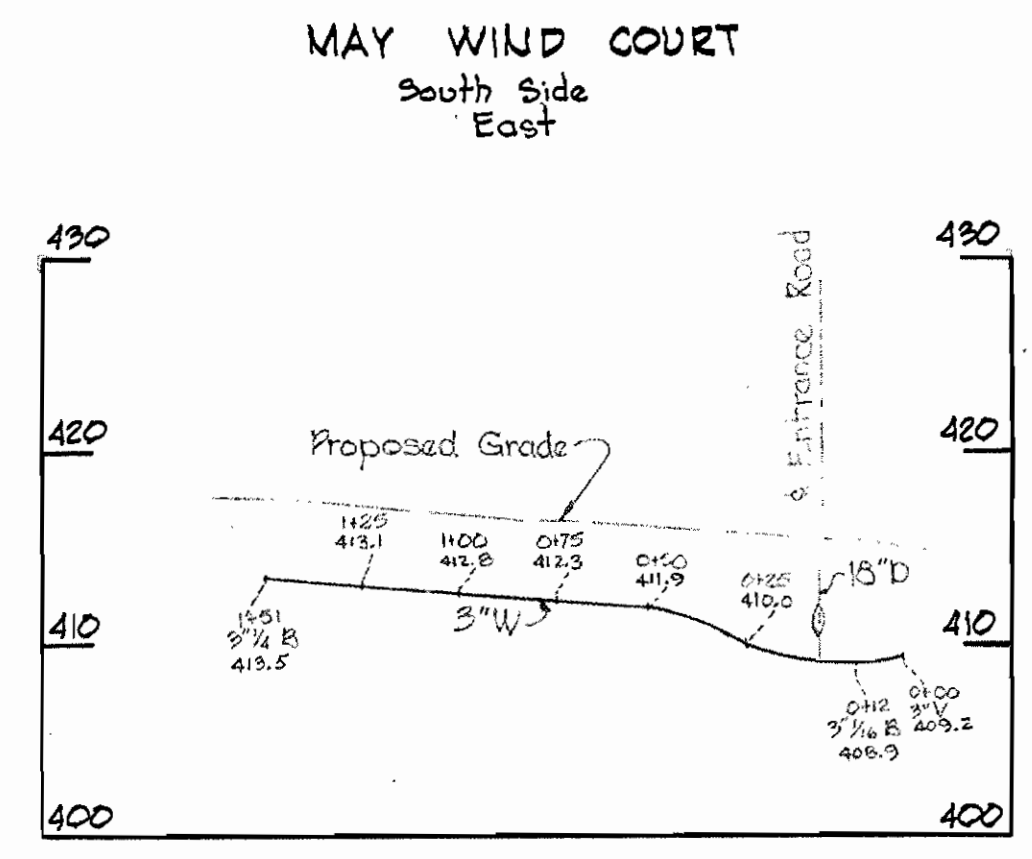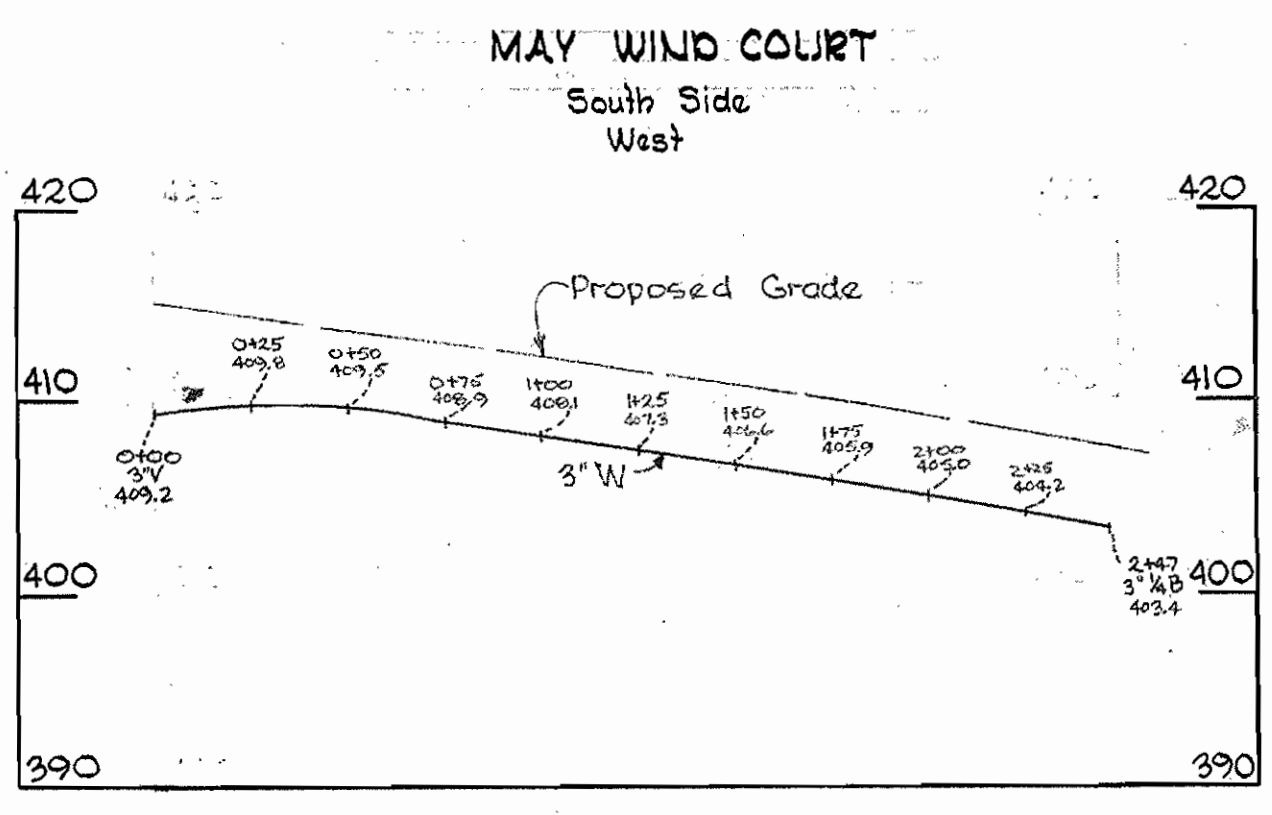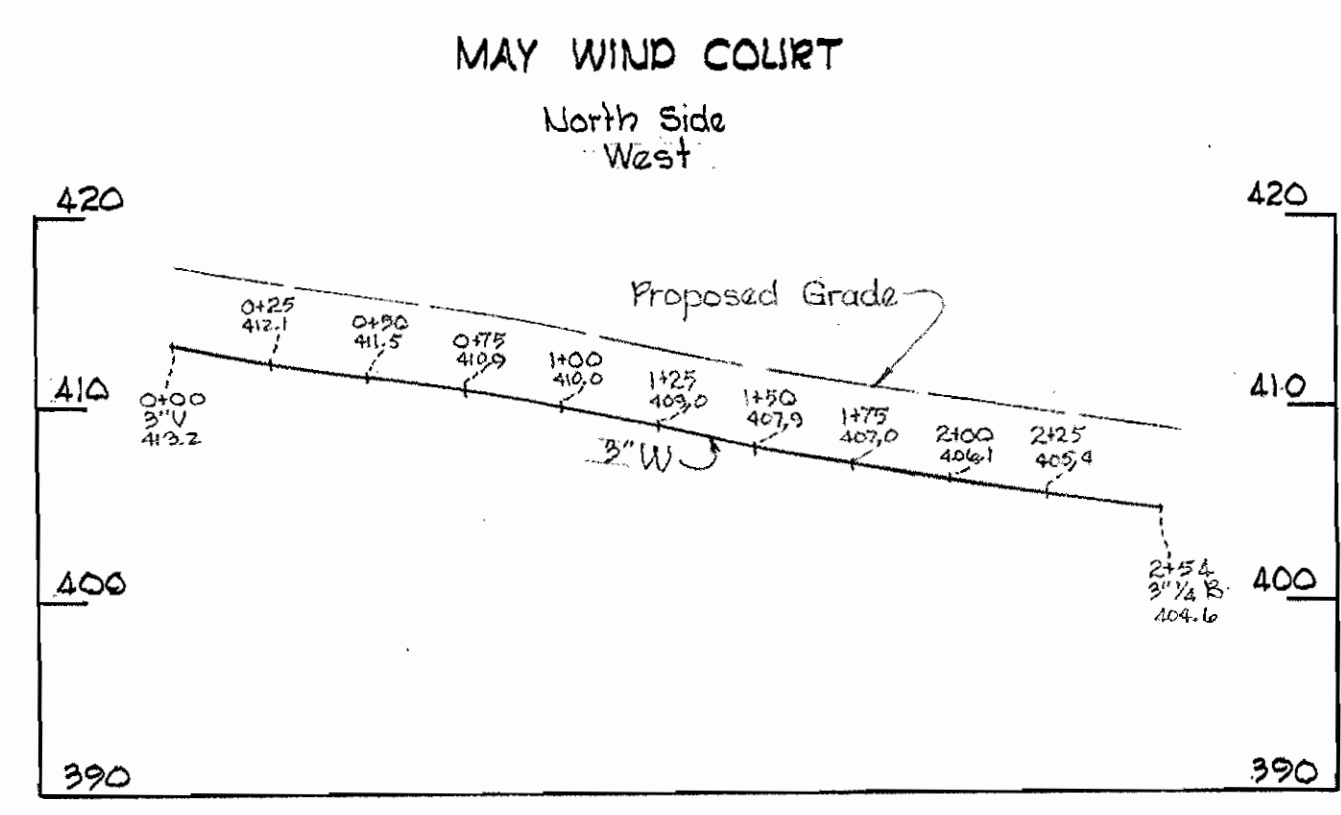


PROFILE
Scale: Hor. 1"=50'
Vert. 1"=10'

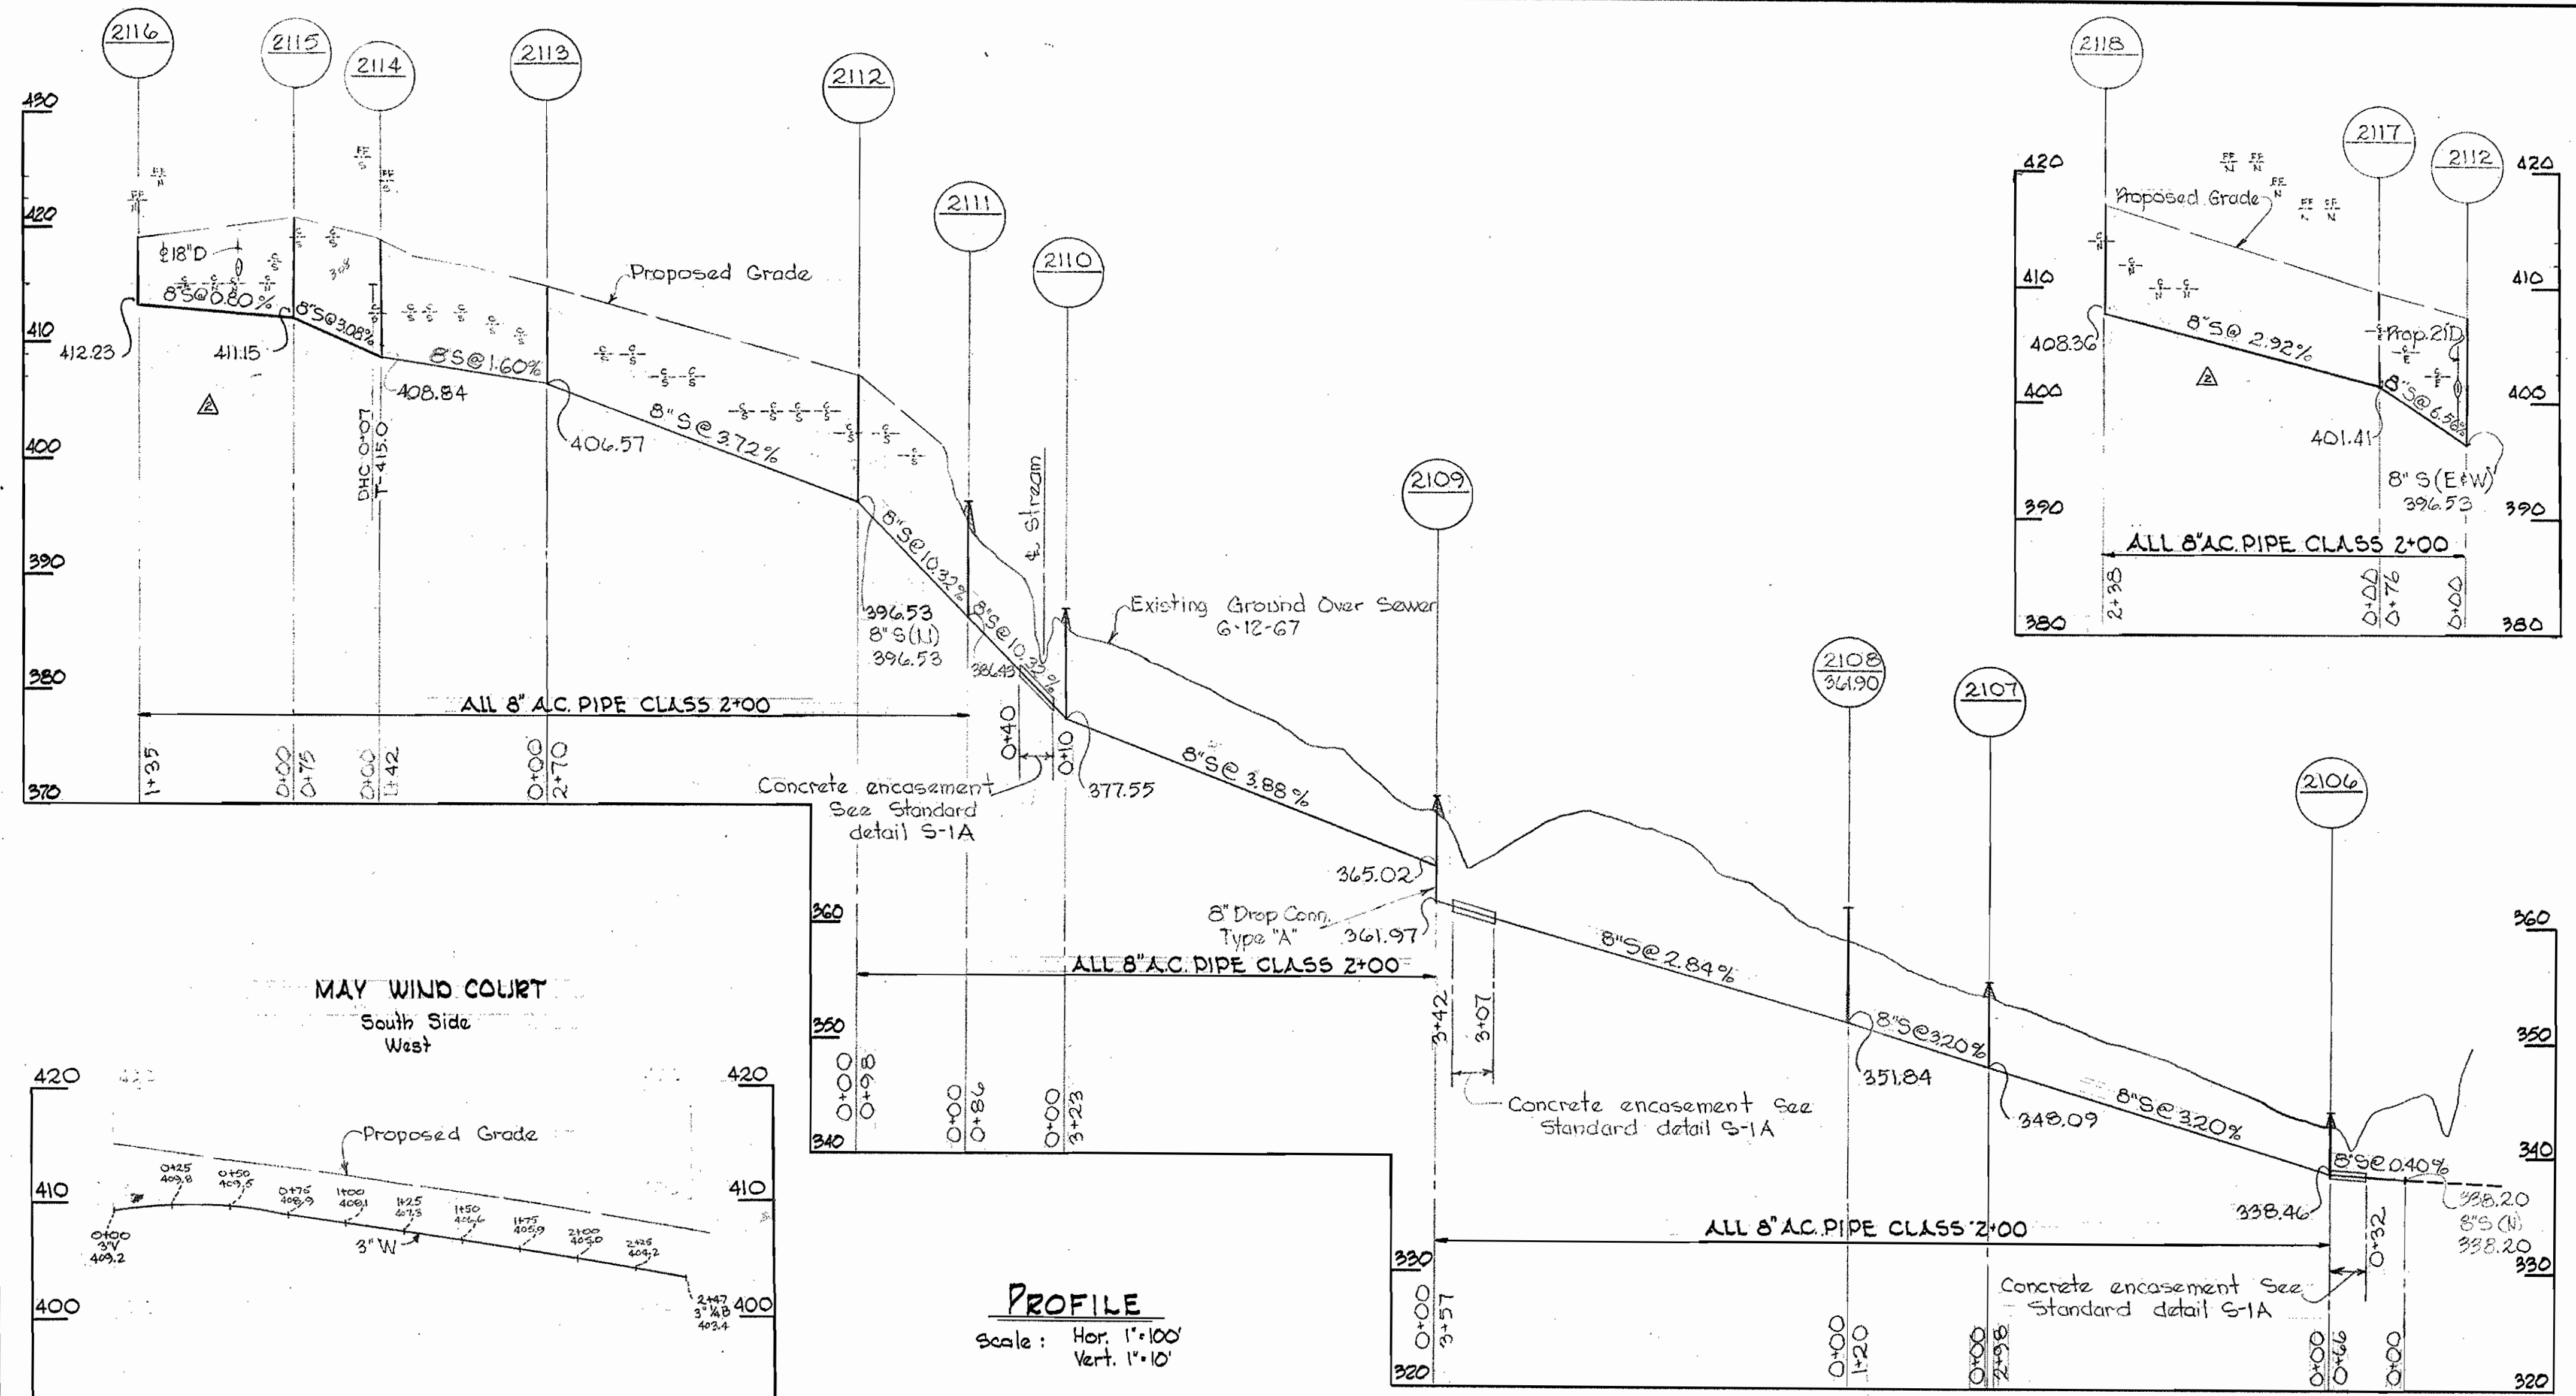

PROFILE
Scale: Hor. 1"=100'
Vert. 1"=10'

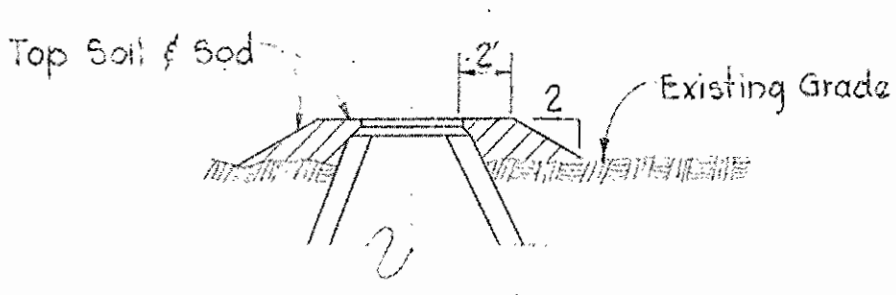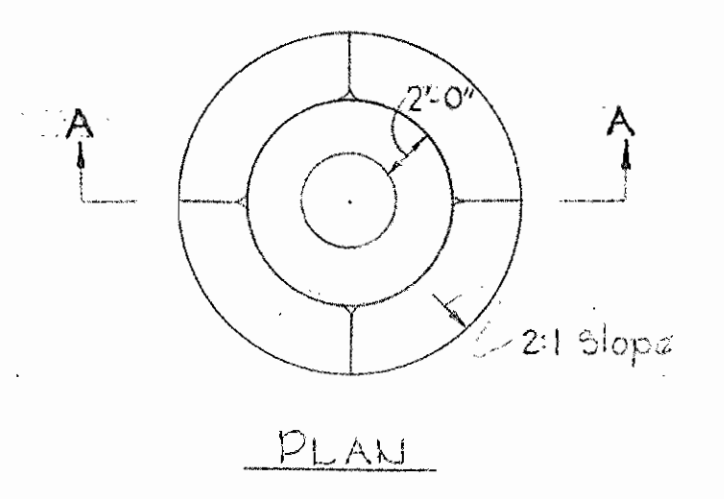


SECTION 'A-A'
DETAIL - FILL
AT MANHOLES
Scale: 1/8"=1'0"

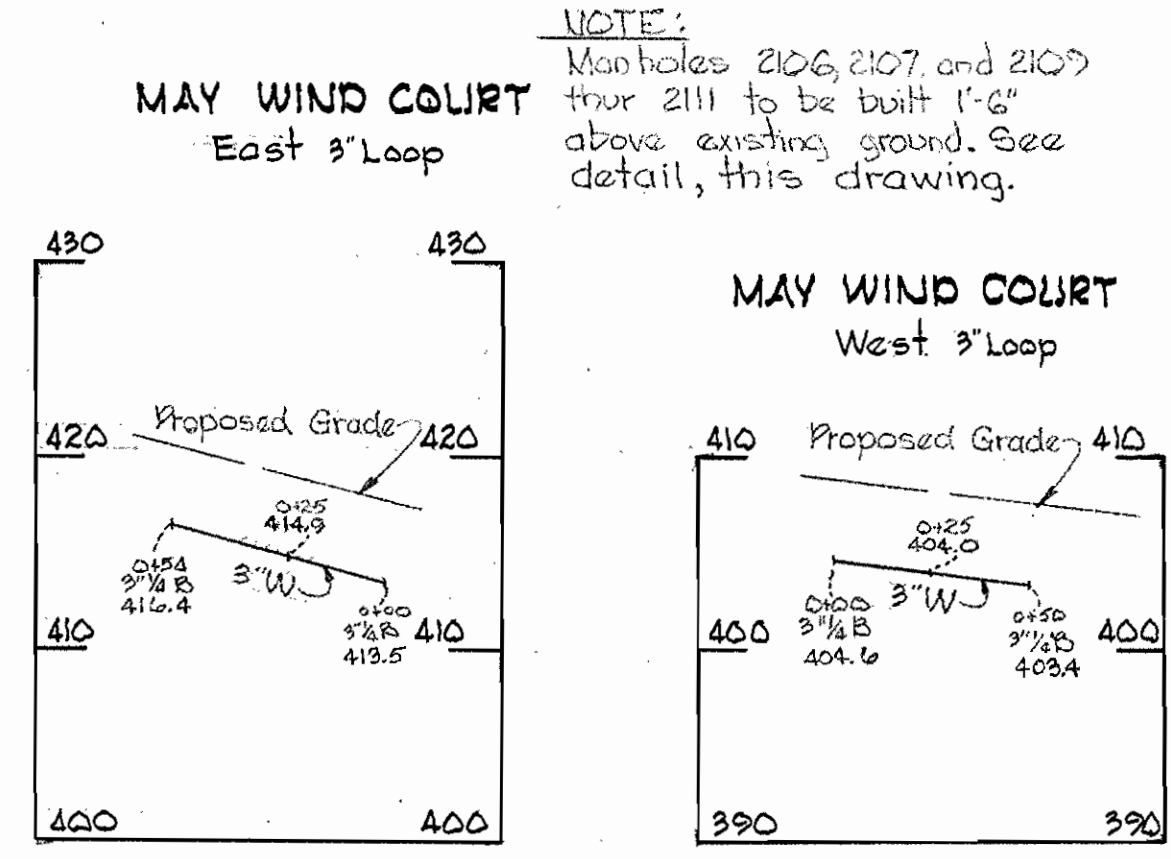

PROFILE
Scale: Hor. 1"=100'
Vert. 1"=10'

NOTE:
Man holes 2106, 2107, and 2109
for 2111 to be built 1'-6"
above existing ground. See
detail, this drawing.

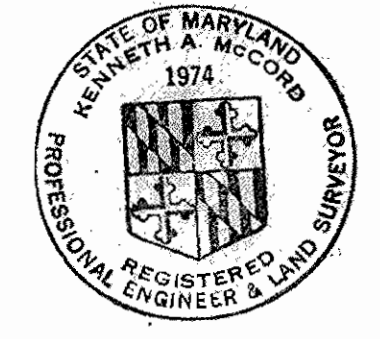

Kenneth A. McLeod

8-11-67	Revised Profiles
N ^o Date	Revision

WHITMAN, REQUARDT & ASSOCIATES ENGINEERS 1304 ST. PAUL ST. BALTIMORE, MARYLAND	HOWARD COUNTY METROPOLITAN COMMISSION DATE: 6-8-67 <i>W. O. Libbert</i> CHIEF ENGINEER	CONTRACT NO. 180 W&S	PROFILES OF WATER & SEWER MAINS	COLUMBIA VILLAGE OF WILDE LAKE ELECTION DISTRICT-CLARKSVILLE No.5	DRAWING NO. 2	SCALE AS SHOWN
					OF 2	SHOWN

Klingbeil Apts
Contract No. 186 W&S