


VICINITY MAP  
Scale: 1"=2000'

GENERAL NOTES

1. Approximate location of existing mains are shown. The Contractor shall take all necessary precautions to protect existing mains and services and maintain uninterrupted supply. Any damage incurred shall be repaired immediately.
2. All pipe elevations shown are invert elevations.
3. The Contractor shall locate existing utilities a minimum of two weeks in advance of construction operations in vicinity of utilities.
4. For all standard details see standards bound in Specifications.
5. Clear all utilities by a minimum of 6', clear all poles by 2'-0" minimum or tunnel as required.
6. All proposed and existing grades are from State Roads Commission Contract No. HO-314-42-771 Cross-Sections.

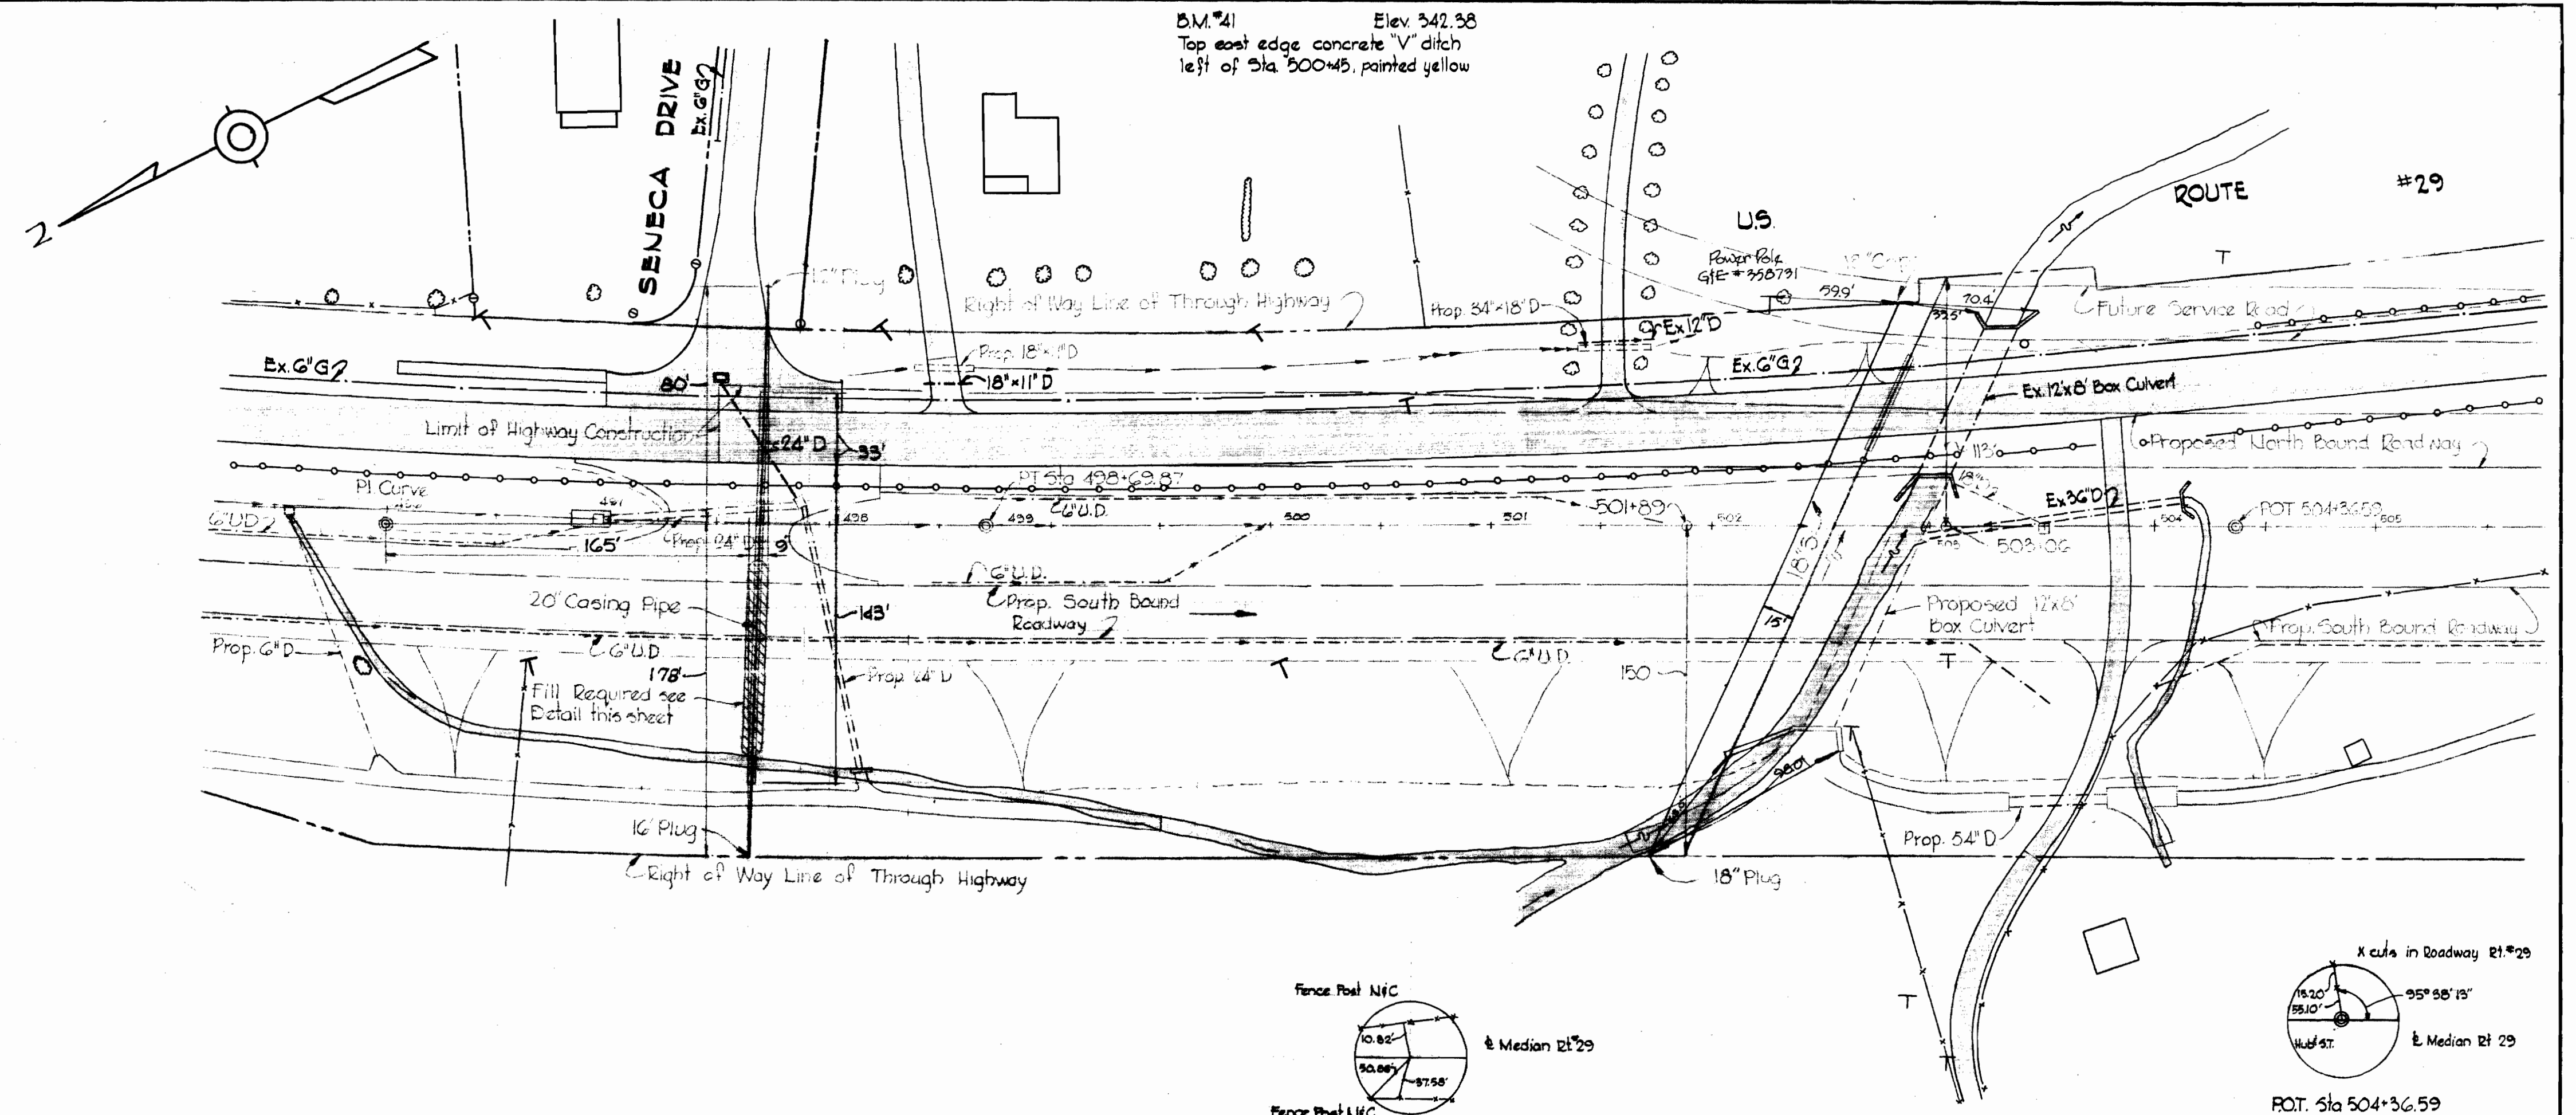


PLAN


Scale: 1"=50'

PLAN

Scale: 1"=50'

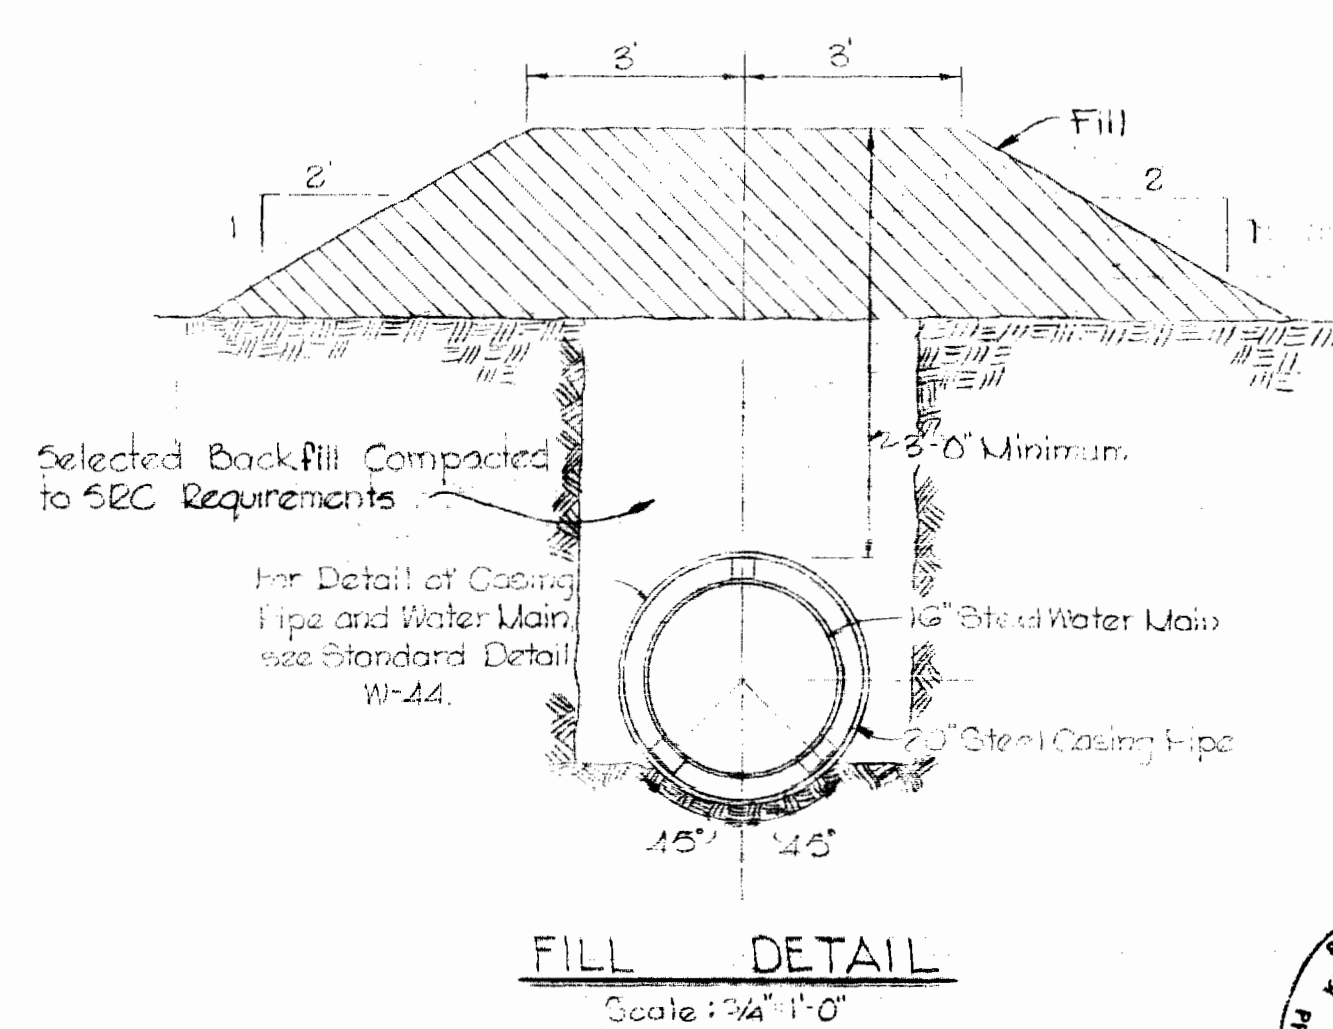


FILL DETAIL  
Scale: 1/4"=1'-0"

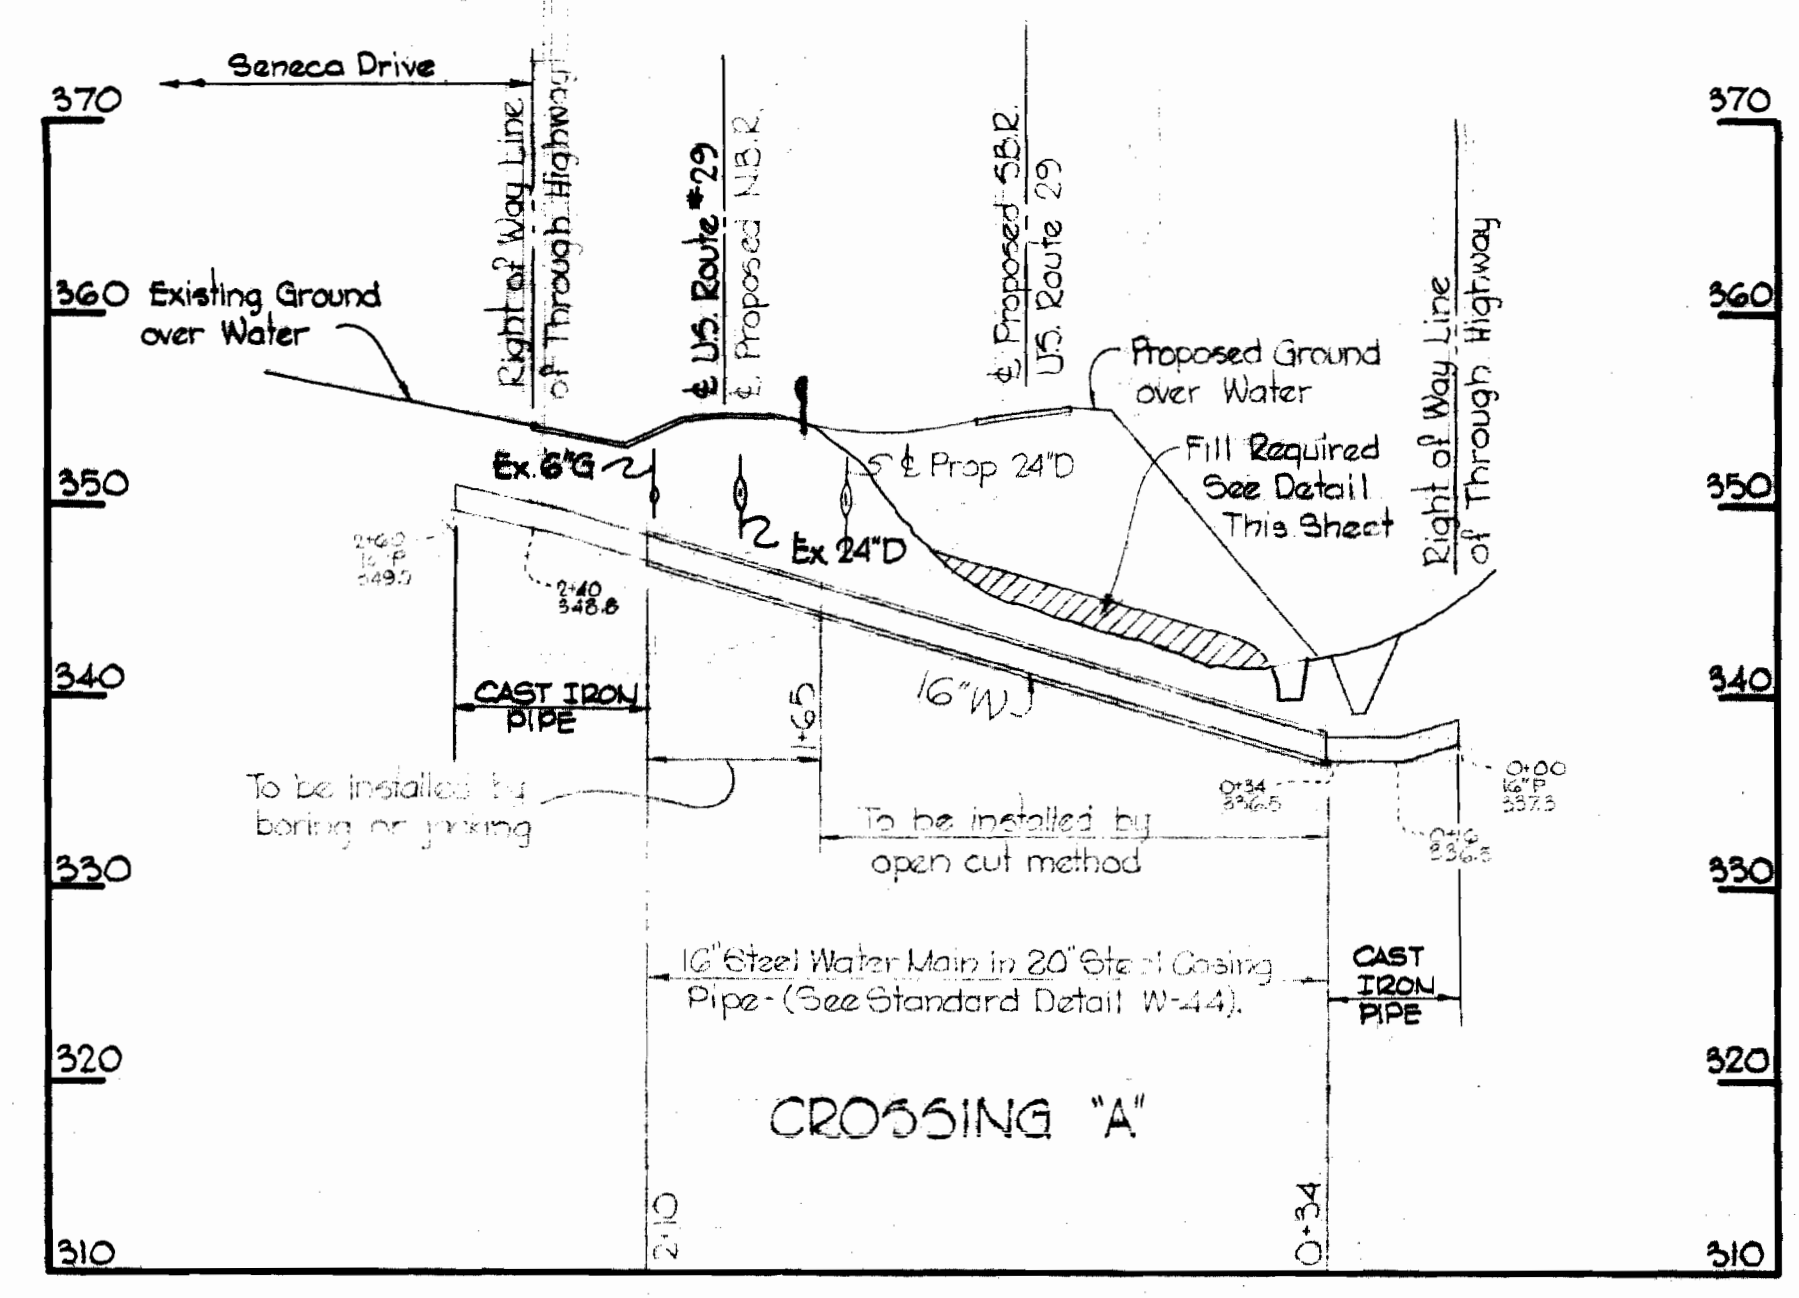

PROFILE

Scale: H=1"=50' V=1"=10'

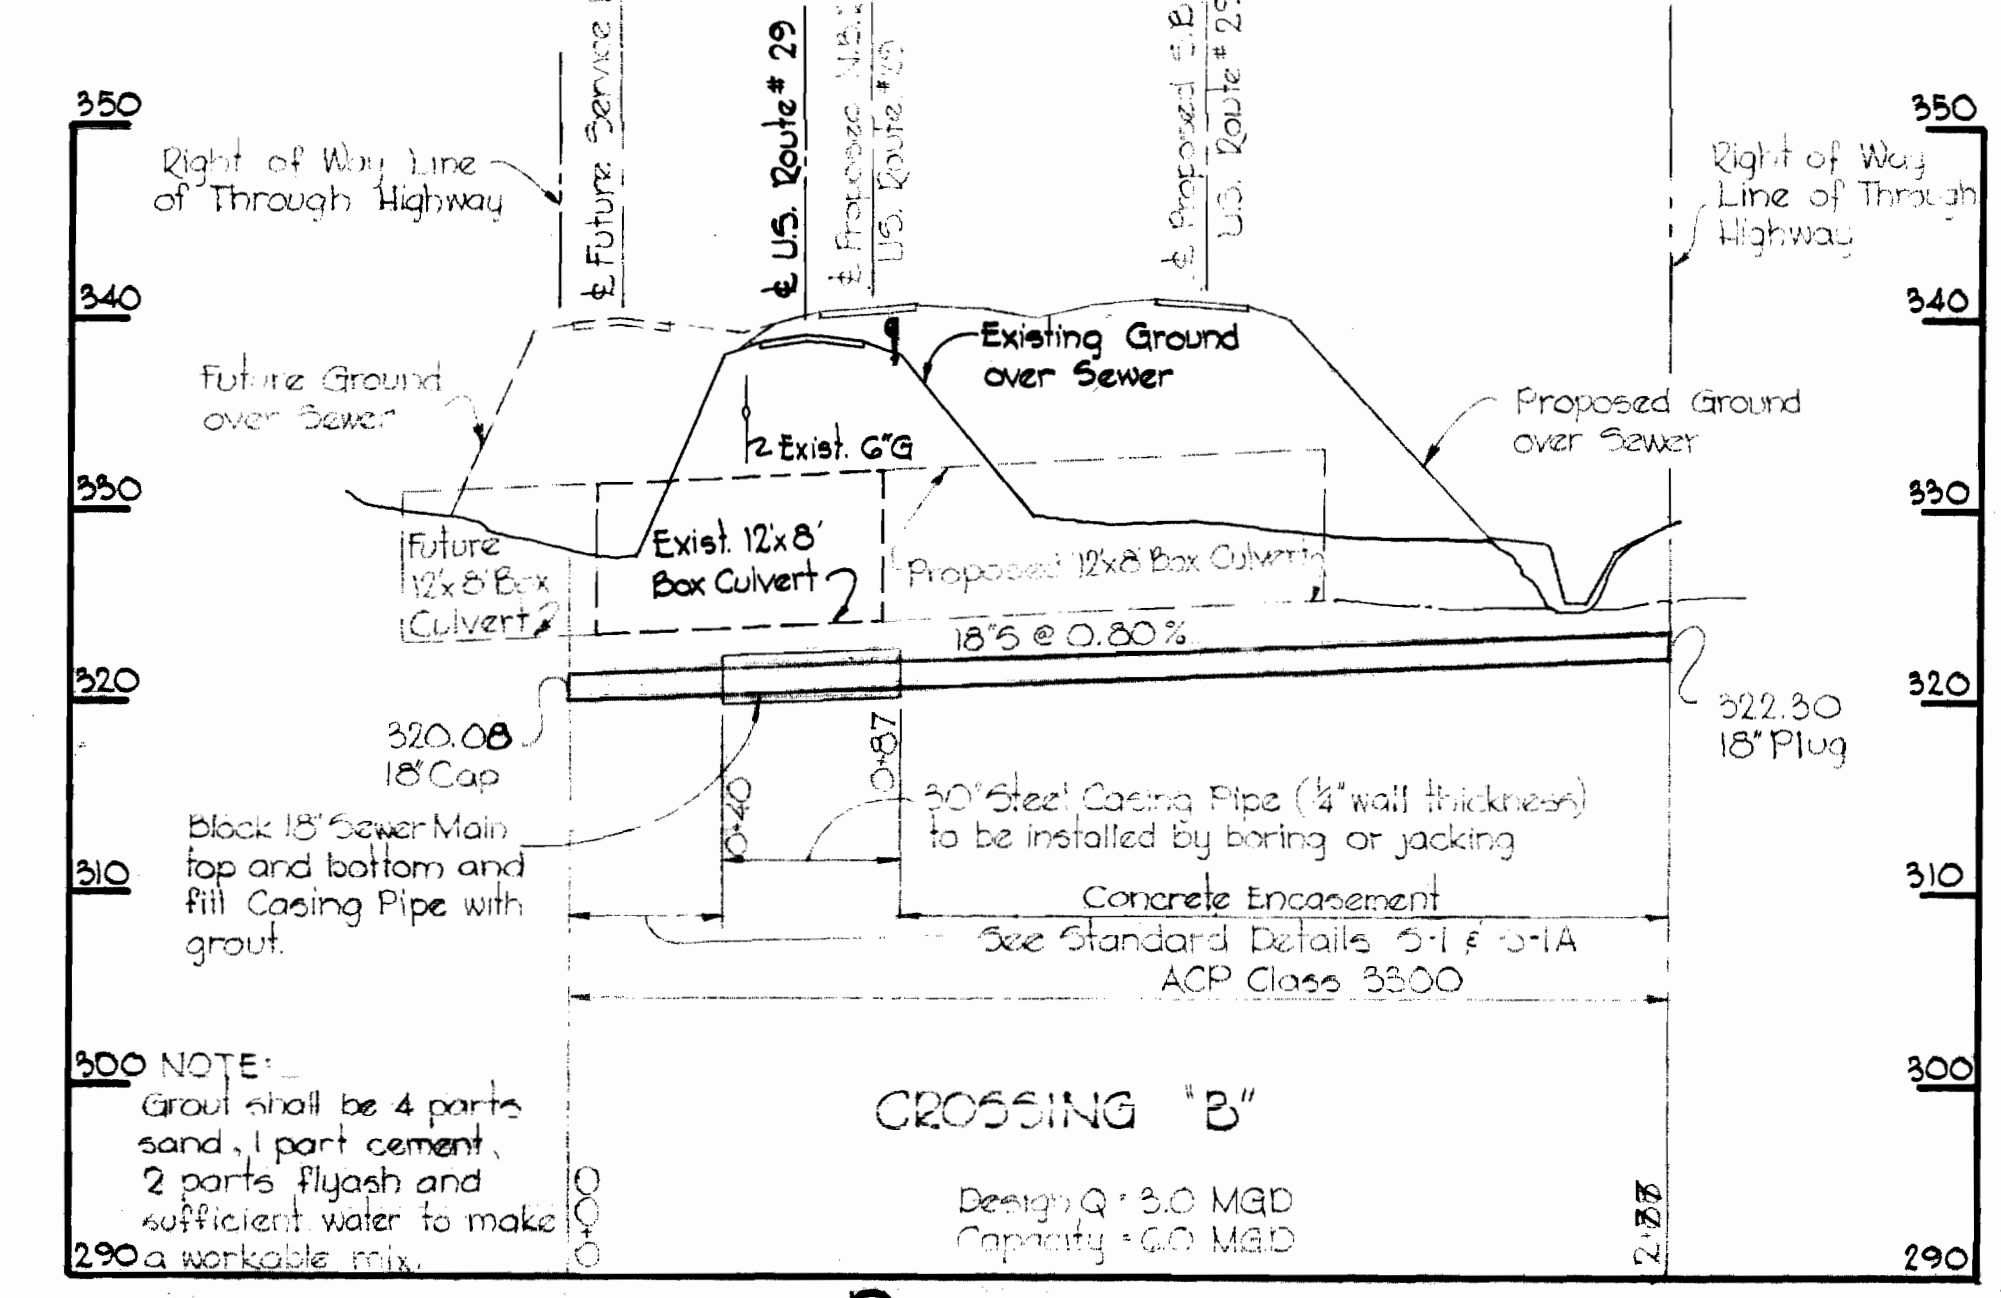

PROFILE

Scale: H=1"=50' V=1"=10'



*Kenneth A. McCord*

WHITMAN, REQUARDT & ASSOCIATES  
ENGINEERS  
1304 ST. PAUL ST.  
BALTIMORE, MARYLAND

HOWARD COUNTY METROPOLITAN COMMISSION  
DATE: 5-21-69  
W.O. Palbat  
CHIEF ENGINEER

CONTRACT NO. 318-W/5

PLAN AND PROFILE OF  
SEWER MAINS

ELECTION DISTRICT  
CLARKSVILLE NO.5


CONTRACT NO. 318-W/5  
DRAWING NO. 1 OF 2  
SCALE AS SHOWN

AS BUILT JULY 15, 1970


WS 318-W/5/1

Bench Mark #42 Elev. 347.56  
 Square cut at N.W. corner walk around Dairy Treat. Left of Sta 542+


Bench Mark #45 Elev. 376.64  
 N.W. Anchor Bolt on North Yard Lt. Easo station. Left Sta 540+

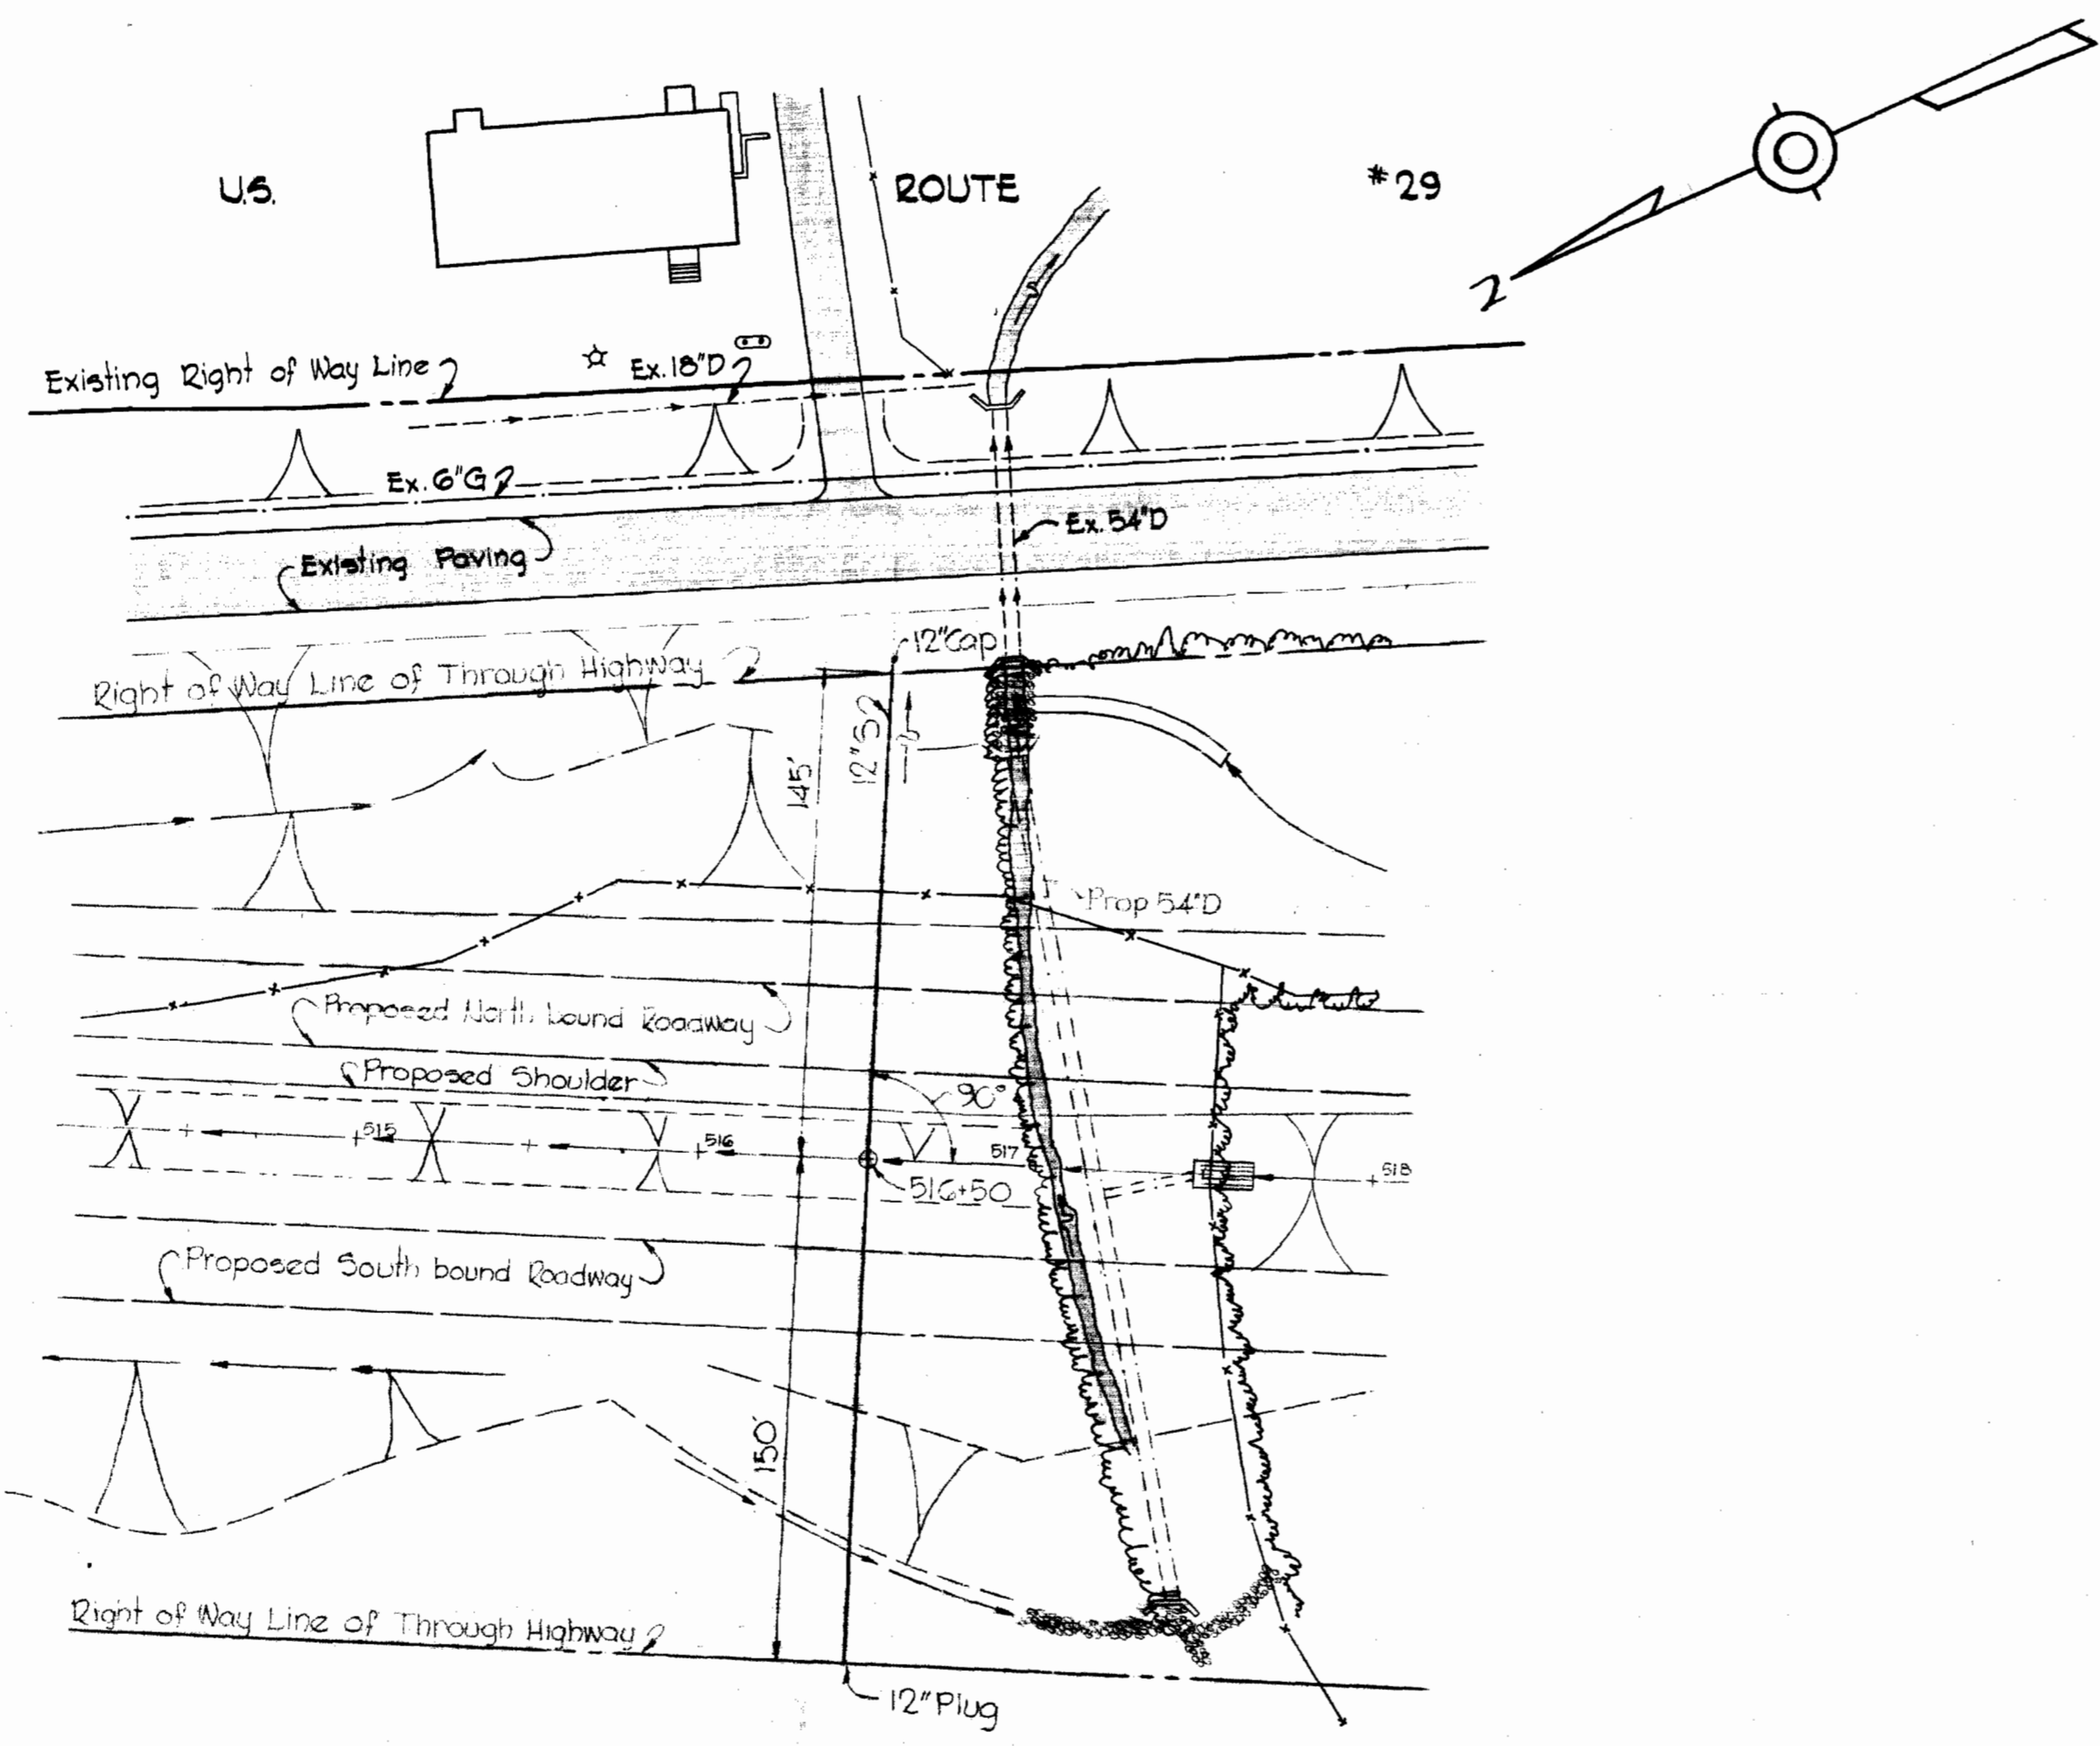

PLAN  
 Scale: 1"=50'

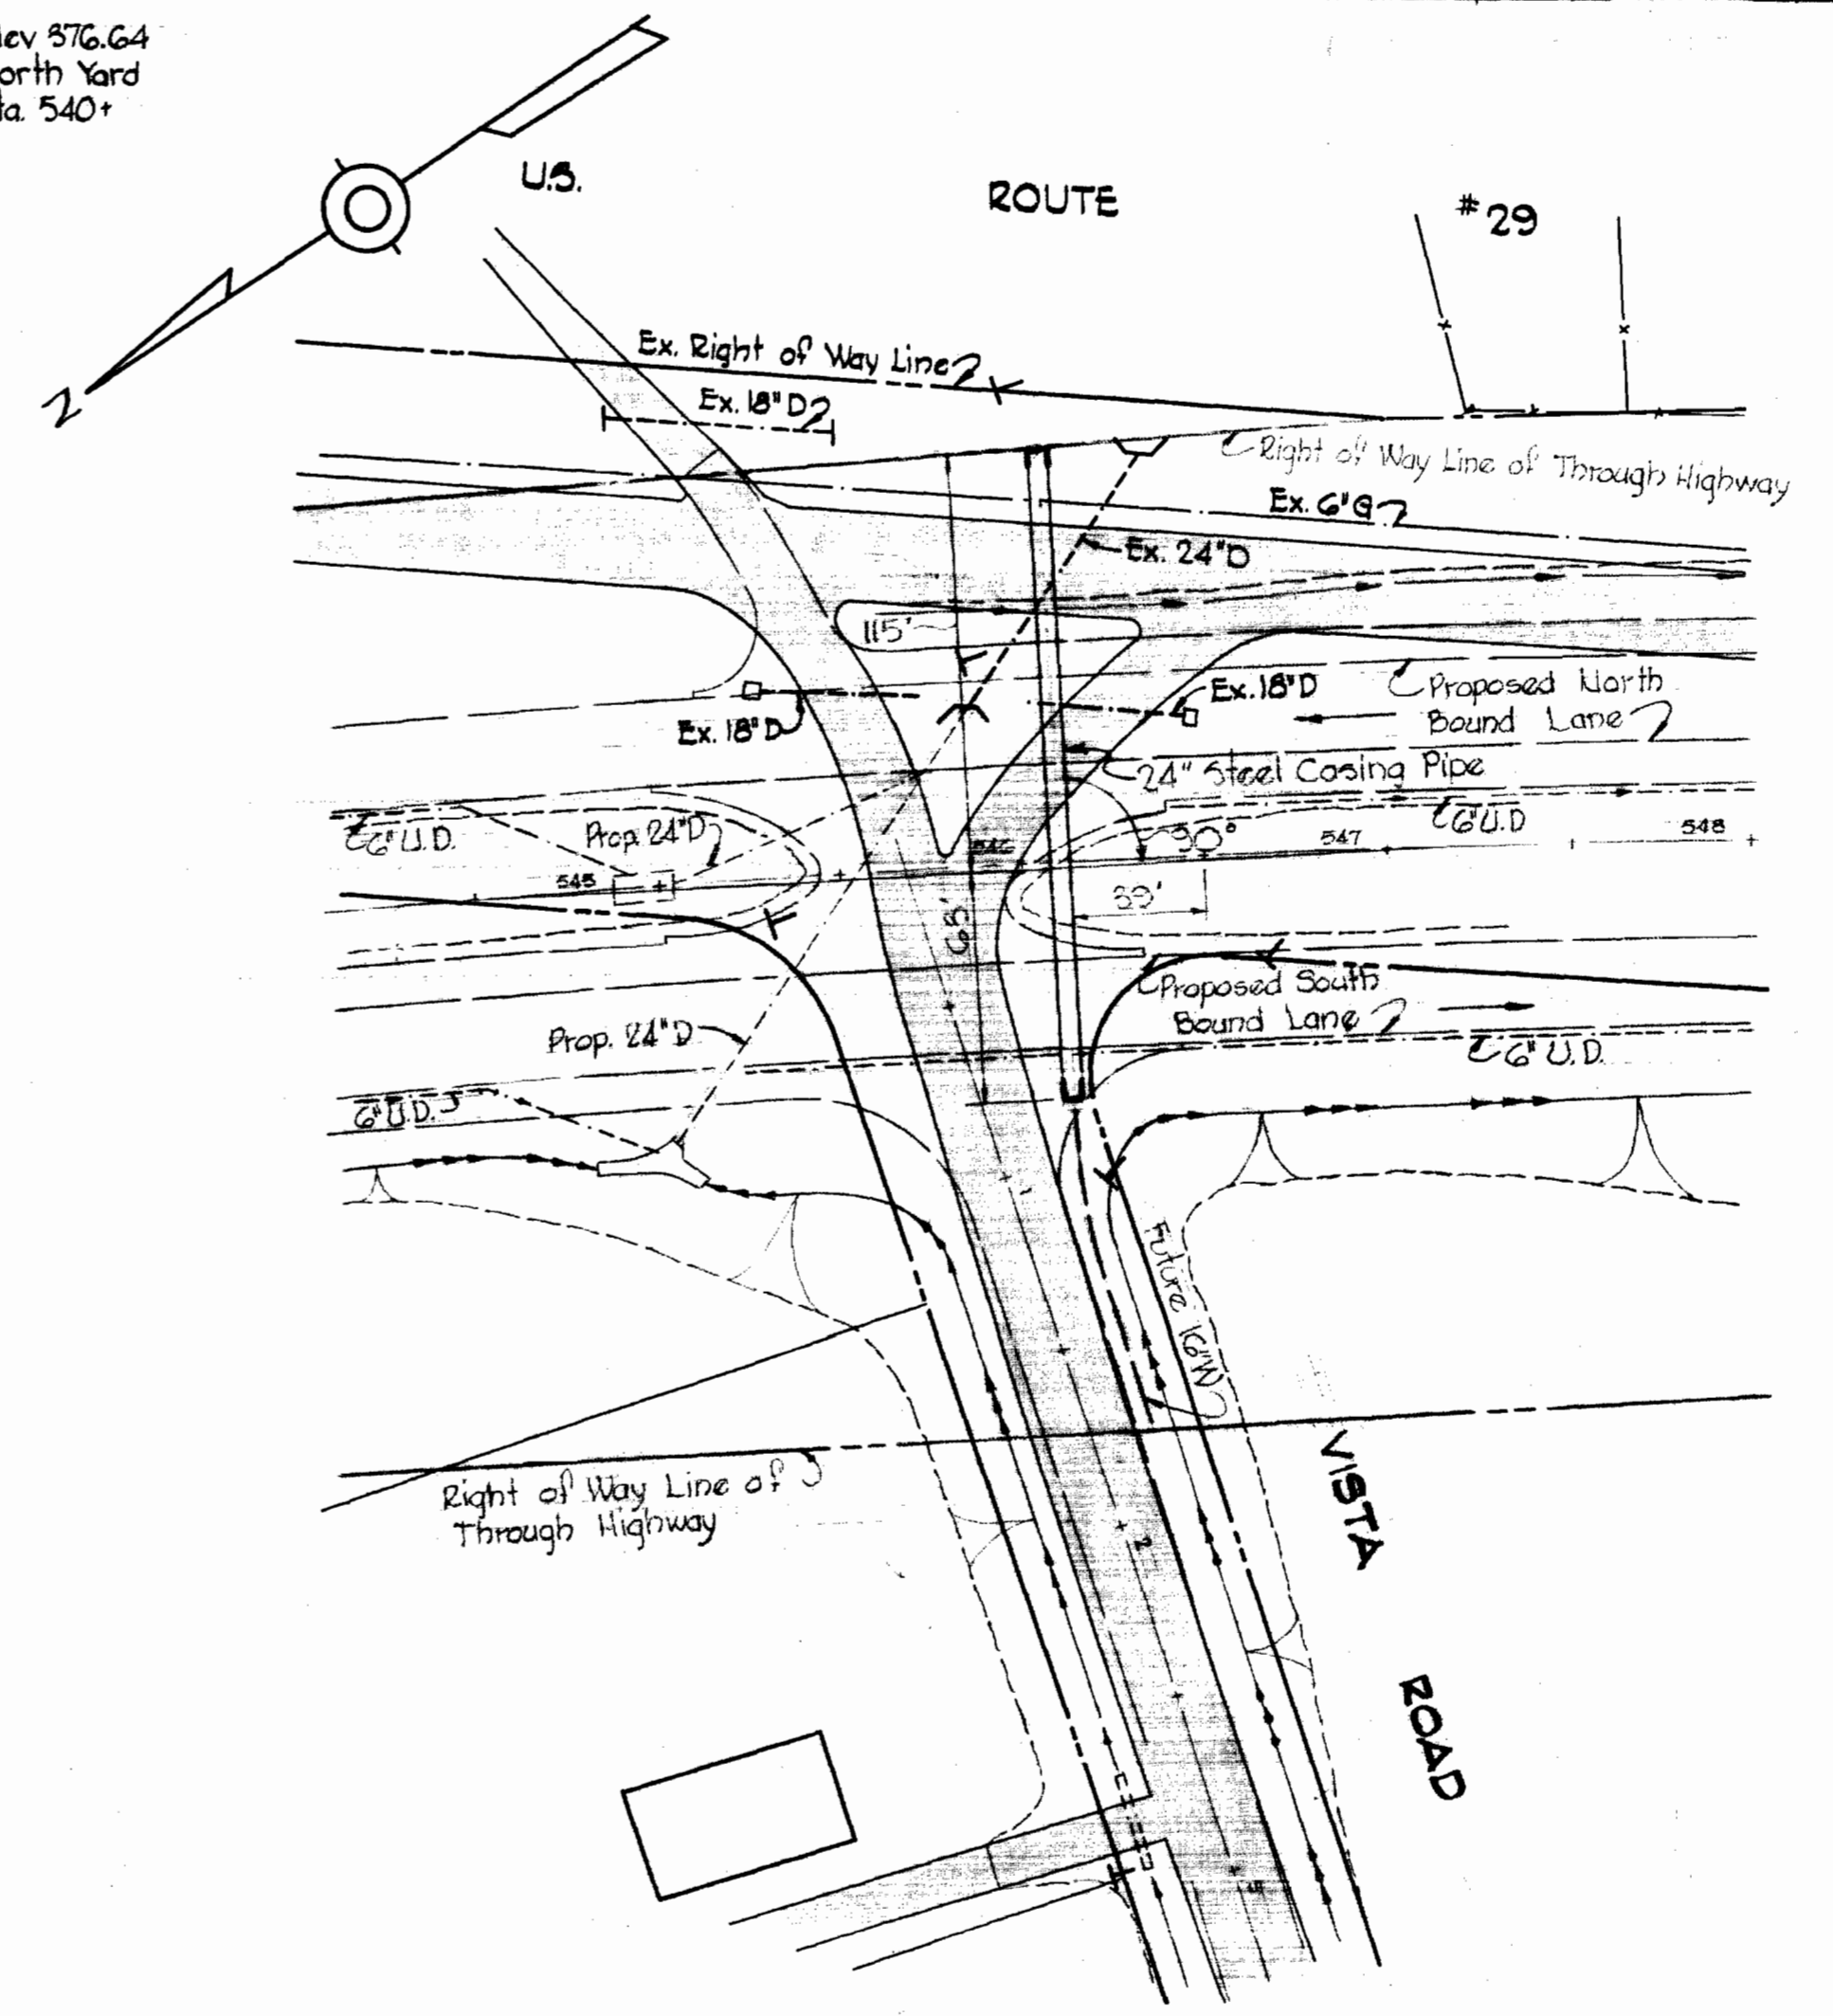


PLAN  
 Scale: 1"=50'

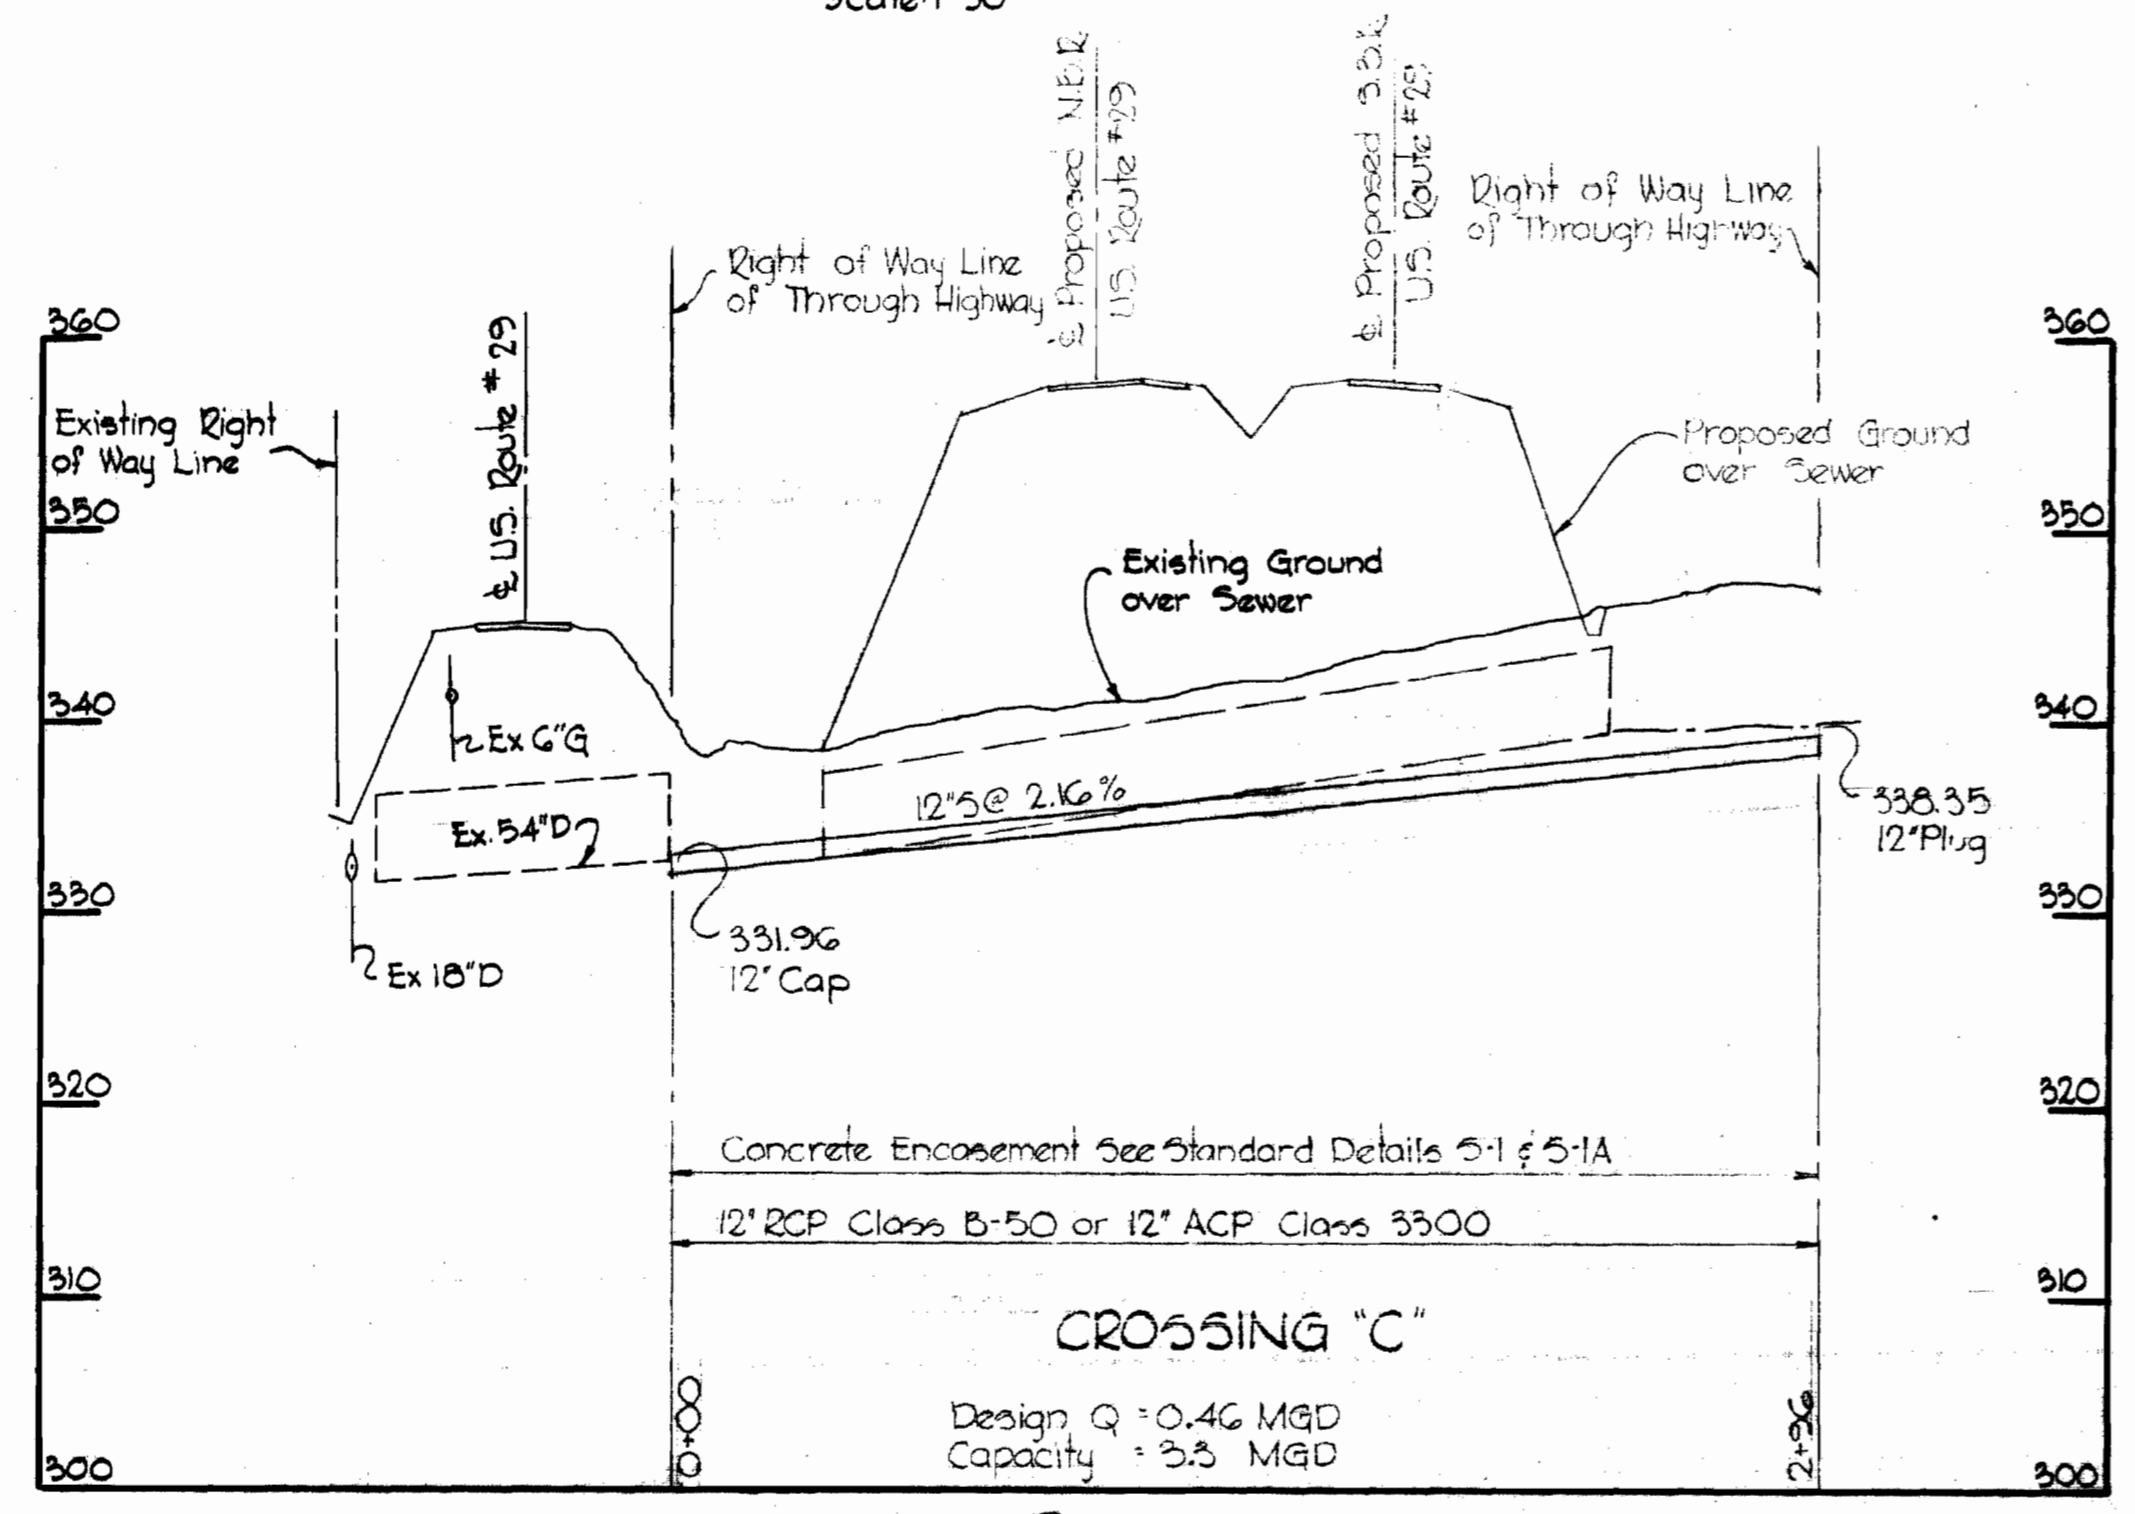

PROFILE  
 Scale: H: 1"=50'  
 V: 1"=10'

This Section Not Constructed as of 1-15-70

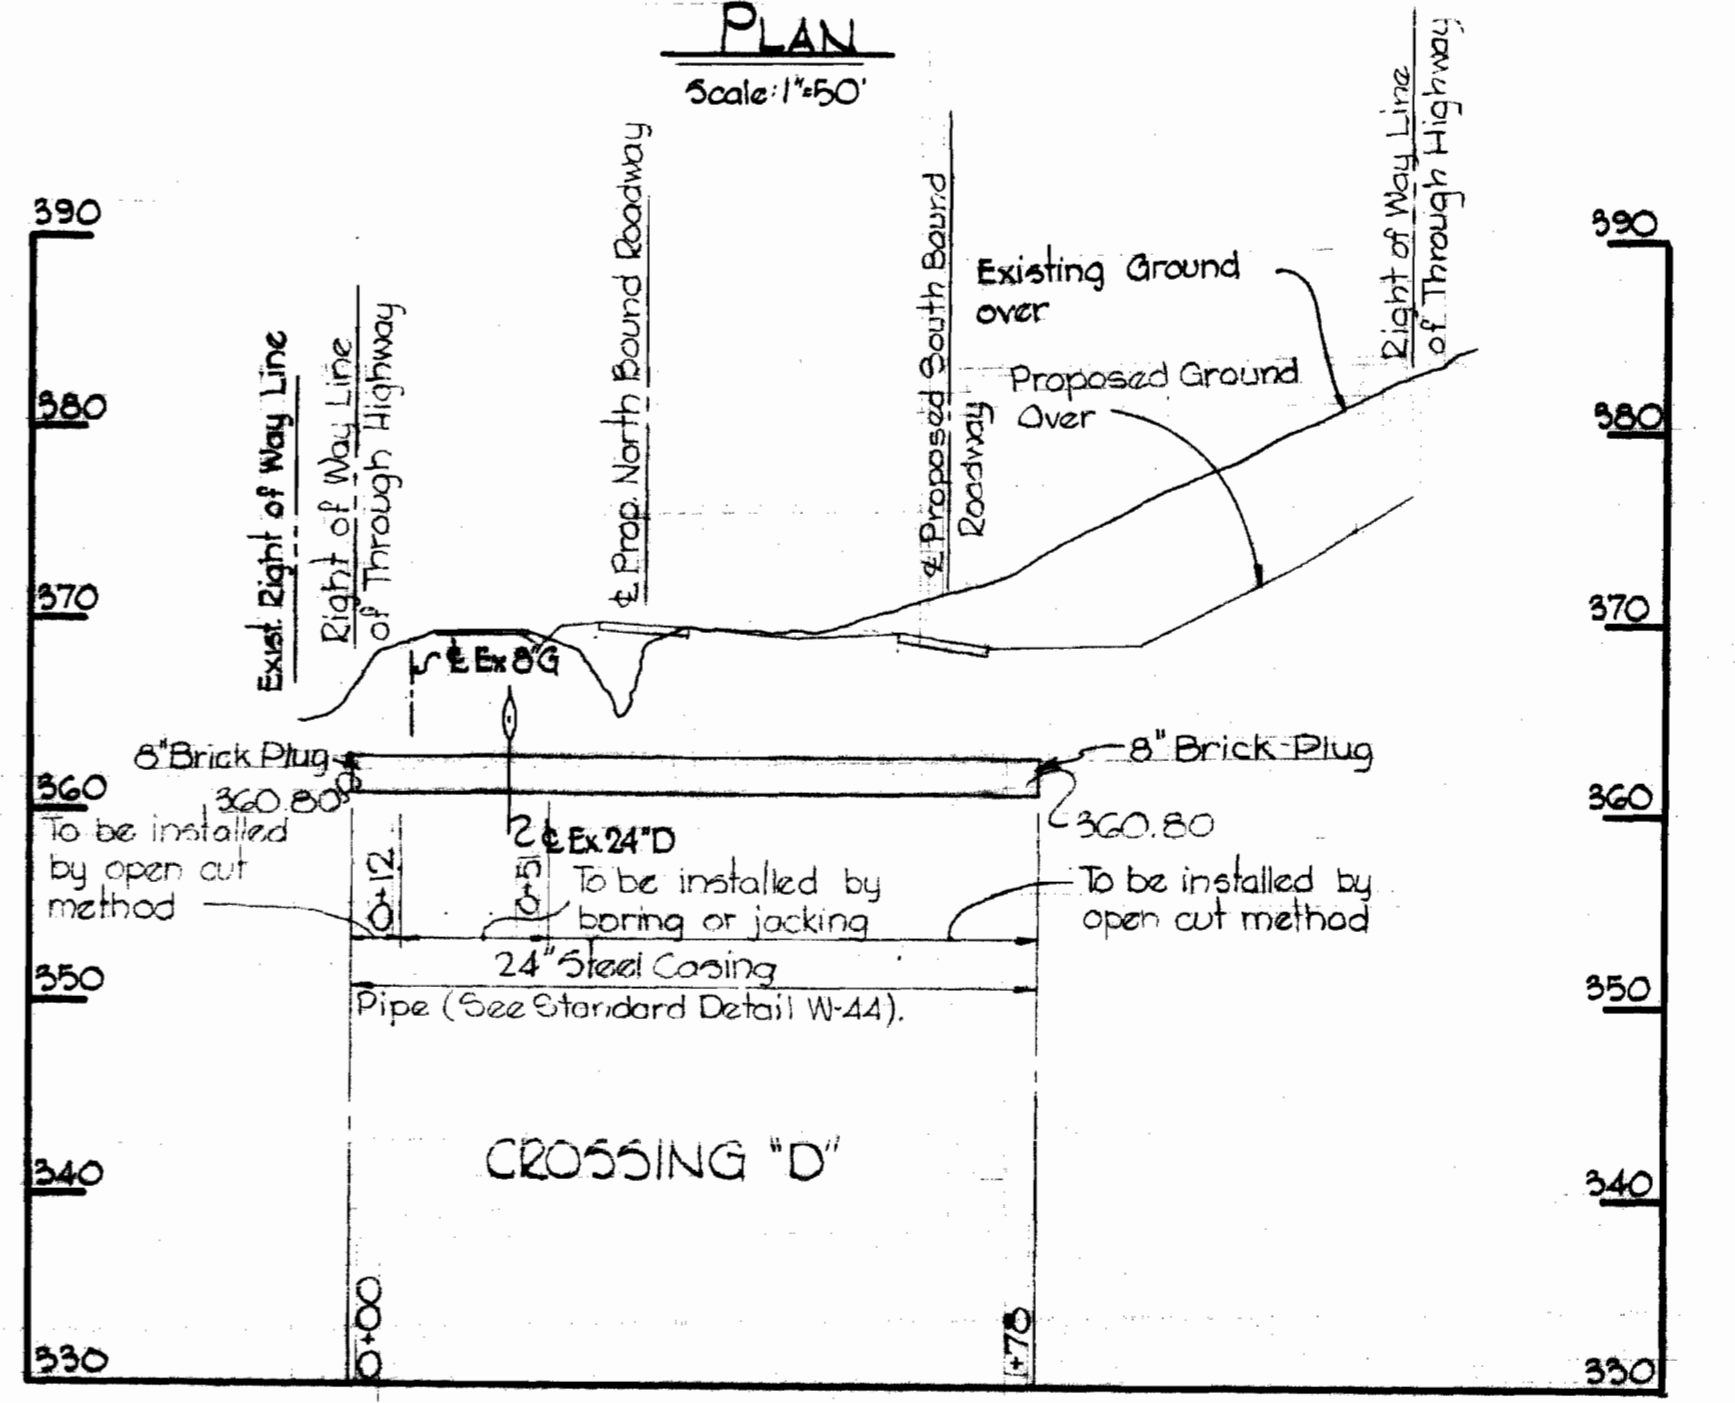

PROFILE  
 Scale: H: 1"=50'  
 V: 1"=10'



*Kenneth A. McLeod*

WS 318-W&S/2

WHITMAN, REQUARDT & ASSOCIATES ENGINEERS 1304 ST. PAUL ST. BALTIMORE, MARYLAND	HOWARD COUNTY METROPOLITAN COMMISSION 5-27-69 <i>W.O. Falbert</i> CHIEF ENGINEER	CONTRACT NO. 318-W&S	PLAN AND PROFILE OF SEWER MAINS	ELECTION DISTRICT CLARKSVILLE NO. 5	DRAWING NO. 2 OF 2 SCALE AS SHOWN
---	---	----------------------	------------------------------------	--	--------------------------------------