
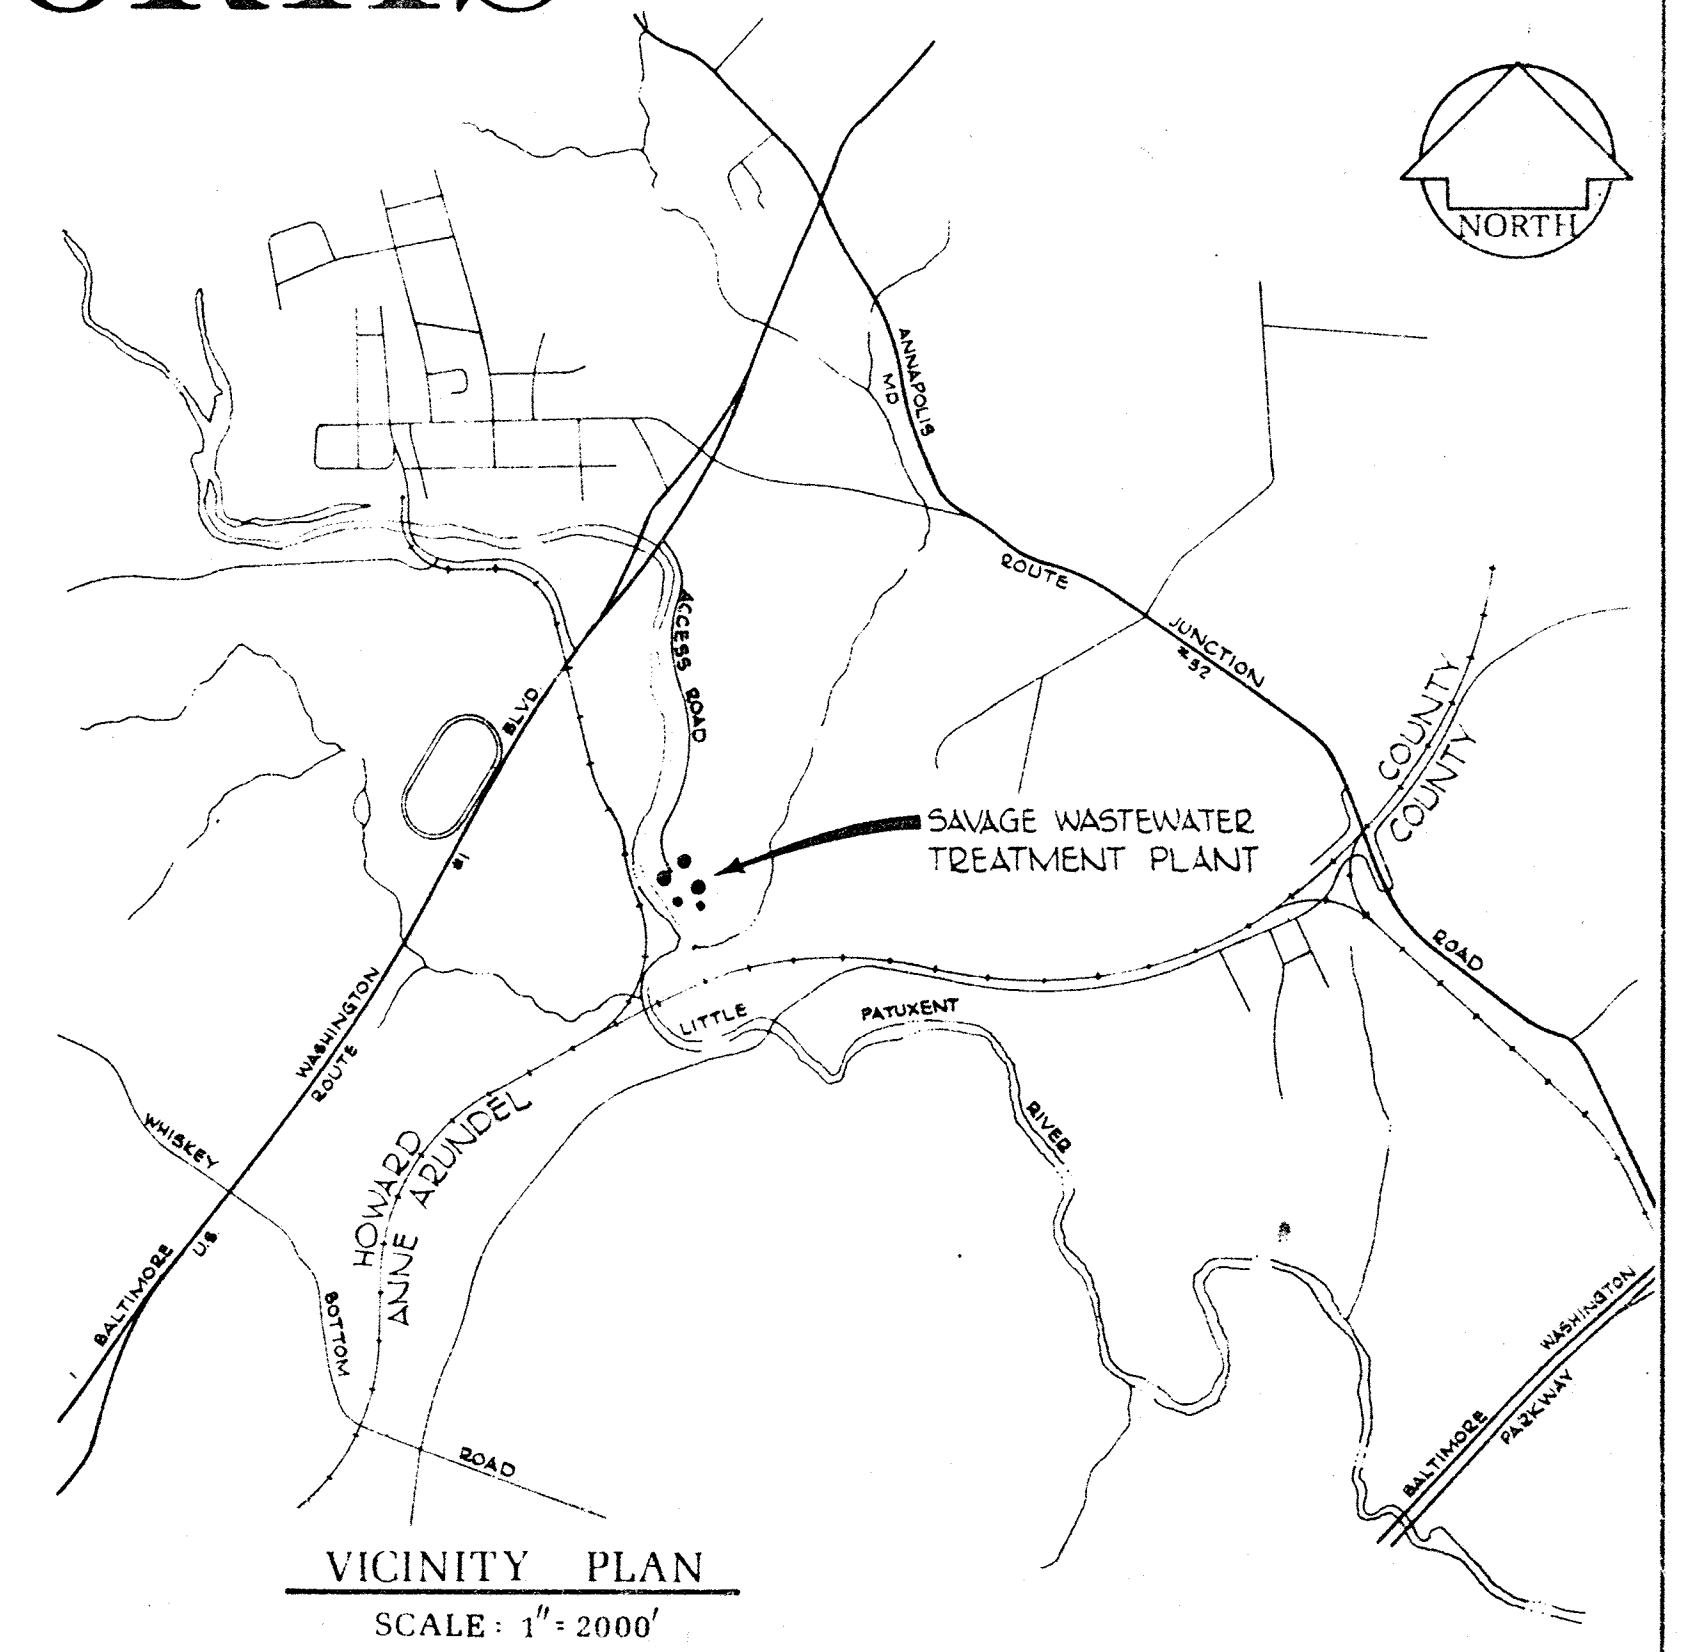
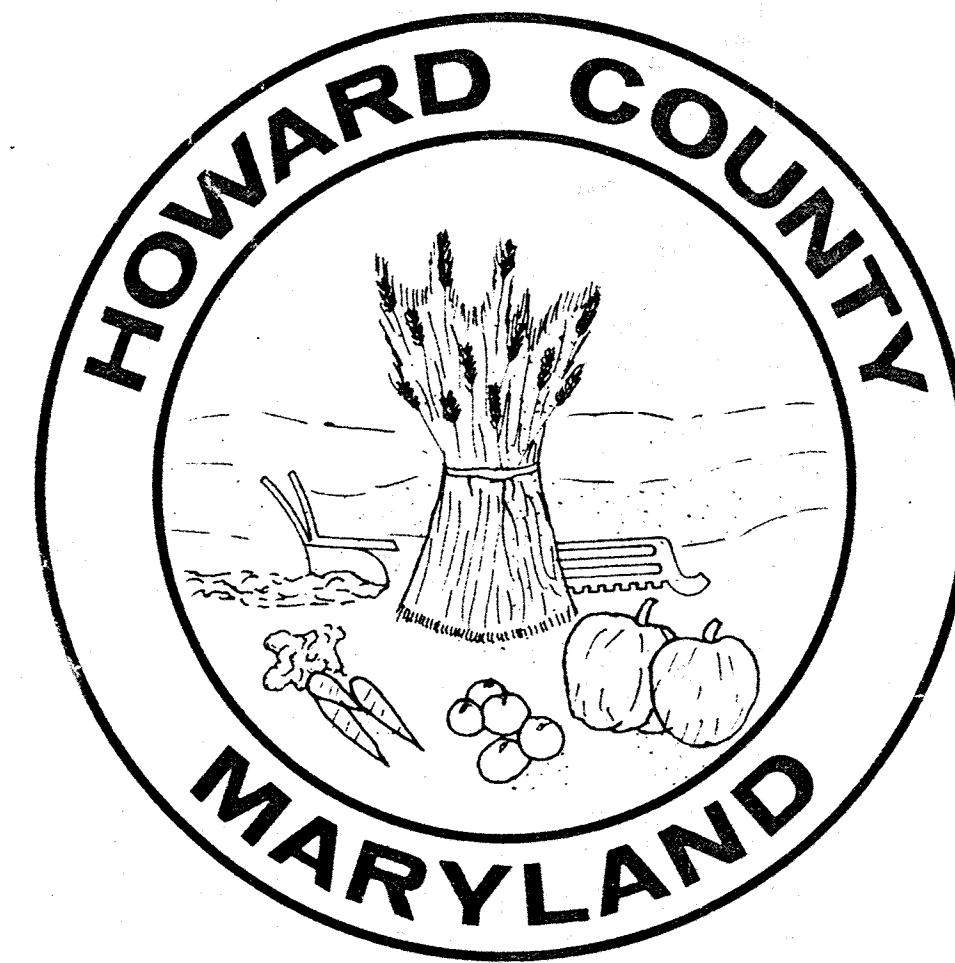


# HOWARD COUNTY, MARYLAND

## DEPARTMENT OF PUBLIC WORKS

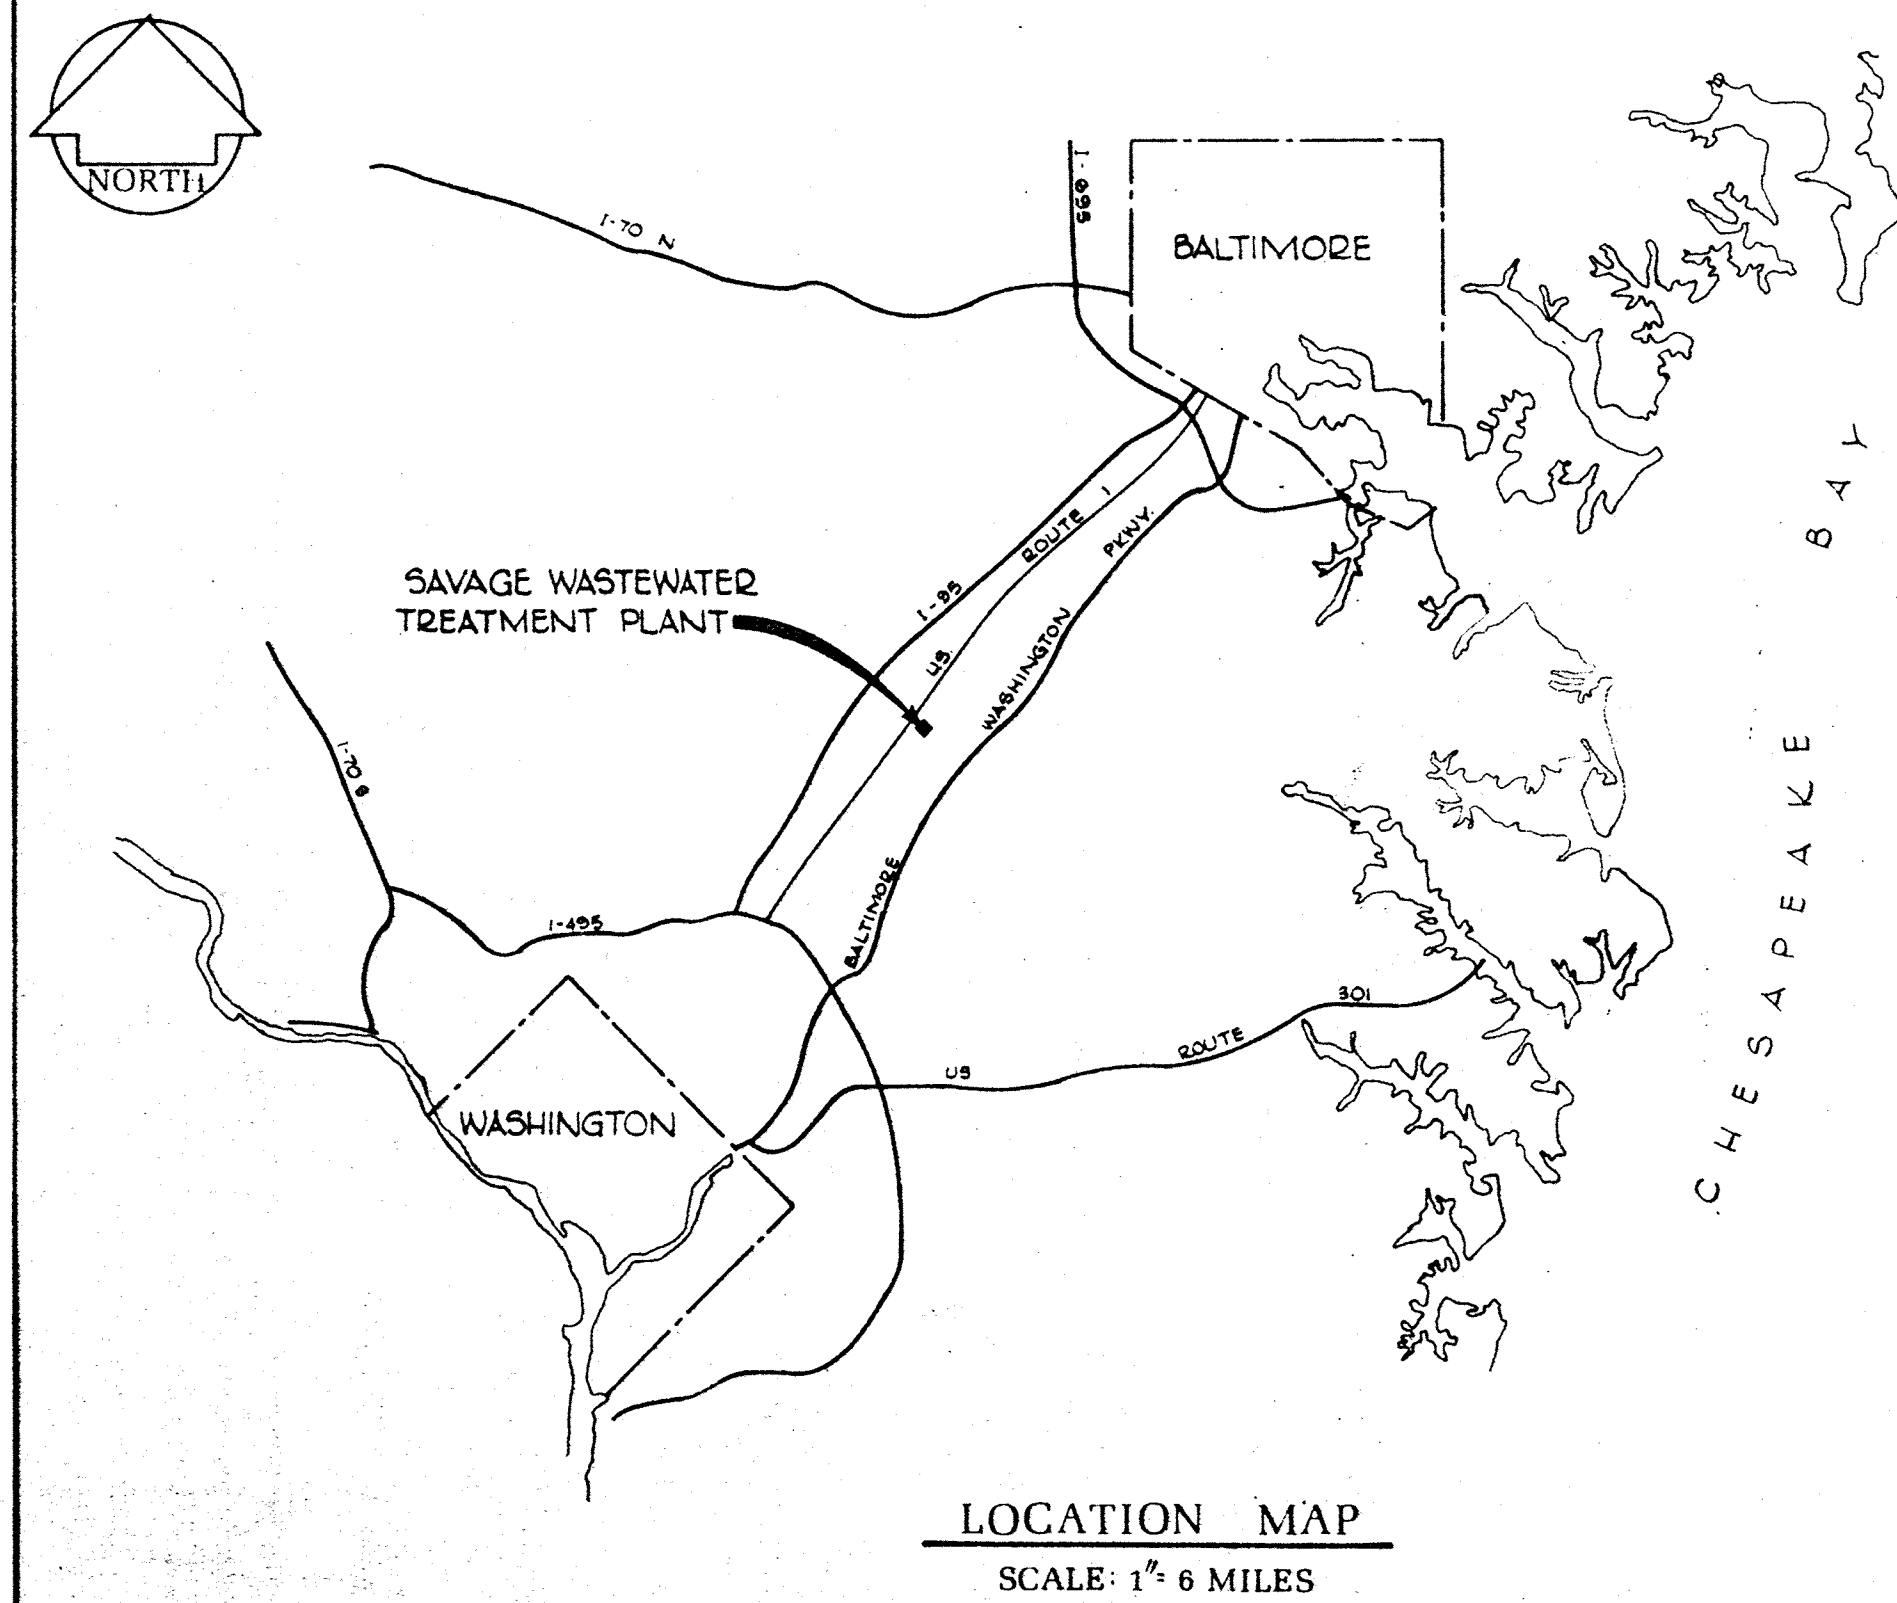


# SAVAGE WASTEWATER TREATMENT PLANT


ADDITION NO. 3


CONTRACT 525-S

HOWARD COUNTY

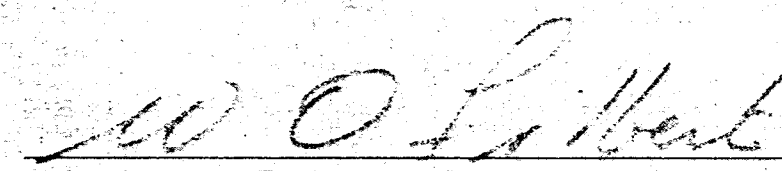  
WILLIAM O. FILBERT - CHIEF - BUREAU OF ENGINEERING

WHITMAN, REQUARDT & ASSOCIATES - ENGINEERS

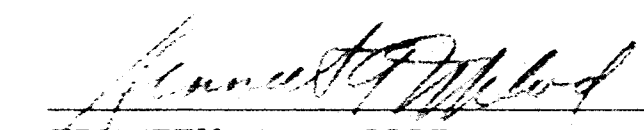  
KENNETH A. McCORD

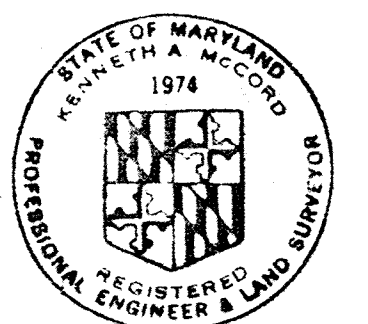

**SAVAGE WASTEWATER TREATMENT PLANT  
LIST OF DRAWINGS**

GENERAL		
DRAWING & SHEET NO.		DESCRIPTION
1	G-1	TITLE SHEET
2	G-2	LIST OF DRAWINGS AND DESIGN DATA
CIVIL		
3	C-1	SITE PLAN AND REFERENCES
4	C-2	UTILITY PLAN
5	C-3	GRADING PLAN AND TYPICAL SECTIONS
6	C-4	PROFILES
7	C-5	PROFILES AND DETAILS
ARCHITECTURAL		
8	A-1	SLUDGE OXIDATION BUILDING - PLAN AND SCHEDULES
9	A-2	SLUDGE OXIDATION BUILDING - ROOF PLAN AND ELEVATIONS
10	A-3	SLUDGE OXIDATION BUILDING - SECTIONS
11	A-4	SLUDGE OXIDATION BUILDING - DETAILS
STRUCTURAL		
12	S-1	SLUDGE OXIDATION BUILDING - FOUNDATIONS
13	S-2	SLUDGE OXIDATION BUILDING - FLOOR PLAN (ELEVATION 145)
14	S-3	SLUDGE OXIDATION BUILDING ROOF PLAN (ELEVATION 158)
15	S-4	PRIMARY CLARIFIER - PLAN AND DETAILS
16	S-5	PRIMARY CLARIFIER - SECTIONS AND DETAILS
MECHANICAL		
17	M-1	HYDRAULIC PROFILE
18	M-2	SETTLED SEWAGE DISTRIBUTION CHAMBERS - PLAN, SECTIONS AND DETAILS
19	M-3	SLUDGE OXIDATION BUILDING - PLAN AND SECTIONS
20	M-4	SLUDGE OXIDATION BUILDING - PLAN AND SECTIONS
21	M-5	SLUDGE PROCESS DIAGRAM
22	M-6	MISCELLANEOUS DETAILS
ELECTRICAL		
23	E-1	ONE LINE WIRING DIAGRAM
24	E-2	GENERAL ELECTRICAL NOTES AND ELECTRICAL LEGEND
25	E-3	SLUDGE OXIDATION BUILDING
26	E-4	MOTOR CONTROL CENTER
27	E-5	ELECTRICAL SITE PLAN AND MISCELLANEOUS DETAILS
28	E-6	WIRING DIAGRAMS AND MISCELLANEOUS DETAILS
28-A	SC-1	SEDIMENT CONTROL PLAN

**SAVAGE WASTEWATER TREATMENT PLANT  
DESIGN CRITERIA**

DESIGN YEAR - 1978  
 EXPECTED AVERAGE DAILY SEWAGE FLOW  
 - JANUARY 1973 - 3.2 MGD  
 - APRIL 1974 - 5.0 MGD (EXISTING CAPACITY)  
 - MID 1978 - 10.0 MGD (DESIGN CAPACITY - 3rd ADDITION)  
 - 2000 - 25.0 MGD (ULTIMATE CAPACITY)

INSTALLED PUMPING CAPACITY - 24 MGD  
 DESIGN PUMPING CAPACITY - 19 MGD (ONE PUMP OUT OF SERVICE)

PRIMARY CLARIFIER - 105 FOOT DIAMETER  
 CAPACITY - 7.0 MGD AVERAGE DAILY FLOW  
 DESIGN OVERFLOW RATE - 800 GPD/SF (W/O RECYCLE)  
 DETENTION TIME - 3.7 HOURS  
 WEIR RATE - 21,200 GPD/L.F.

AERATION BASIN  
 CONTACT STABILIZATION - 3 UNITS FOR 5MGD (EXISTING)  
 (FUTURE CONVERSION OF 1MGD UNIT TO THICKENER - DIGESTER)  
 DESIGN ACTIVATED SLUDGE - TWO-PASS TANK FOR 5 MGD  
 DETENTION TIME - 6 HOURS

SECONDARY CLARIFIERS  
 CONTACT STABILIZATION - TWO - 57' Ø UNITS FOR 5MGD (EXISTING)  
 - DETENTION TIME - 2.0 HOURS  
 - OVERFLOW RATE - 1980 GPD/SF (W/FLOW MODULES)  
 WEIR RATE - 9200 GPD/LINEAR FOOT  
 DESIGN ACTIVATED SLUDGE - ONE - 90' Ø FOR 5 MGD  
 - DETENTION TIME - 3.65 HOURS  
 - DESIGN OVERFLOW RATE - 800 GPD/SF  
 - WEIR RATE - 12,000 GPD/L.F.

CHLORINATION - INTERIM LAGOON FOR 30 MGD PEAK FLOW  
 - DESIGN DETENTION TIME - 15 MINUTES - PEAK FLOW  
 - DESIGN DOSAGE - 10 PPM  
 - 1250 POUNDS / DAY / 15 MGD

SLUDGE OXIDATION - DESIGN CAPACITY 230 GPM AT 2.5% SUSPENDED SOLIDS

**ABBREVIATIONS**

PIPELINE		MISCELLANEOUS	
A	AIR	B	BASELINE
ABI	AERATION BASIN INFLUENT	C	CENTERLINE
CCBI	CHLORINE CONTACT BASIN INFLUENT	EX	EXISTING
CL <sub>2</sub>	CHLORINE	FF	FIRST FLOOR
CS	CONTACT STABILIZATION	MH	MANHOLE
D	DRAIN	INV. ELEV.	INVERT ELEVATION
DB	DUCTBANK	PC	POINT OF CURVATURE
FM	FORCE MAIN	PI	POINT OF INTERSECTION
IS	INCINERATOR SLUDGE	PT	POINT OF TANGENCY
OS	OXIDIZED SLUDGE	N	NORTH
Pr	PROFILE	E	EAST
S	SEWER OR INTERCEPTOR	S	SOUTH
TD	TANK DRAIN	W	WEST
TSE	THICKENED SLUDGE EFFLUENT		
UD	UNDERDRAIN		
W	WATER		
WS	WASTE SLUDGE		
PCI	PRIMARY CLARIFIER INFLUENT		
APPURTENANCES			
T	TEE		
V	VALVE		
HB	HORIZONTAL BEND		
VB	VERTICAL BEND		
R	REDUCER / INCREASER (CONCENTRIC)		
ER	REDUCER / INCREASER (ECCENTRIC)		

WHITMAN, REQUARDT & ASSOCIATES  
 ENGINEERS  
 1304 ST. PAUL ST.  
 BALTIMORE, MARYLAND

DEPARTMENT OF PUBLIC WORKS  
 HOWARD COUNTY, MARYLAND

CONTRACT NO. 525-S

LIST OF DRAWINGS AND  
 DESIGN DATA


SAVAGE WASTEWATER  
 TREATMENT PLANT ADDITION NO. 3

DRAWING NO. 2  
 OF 28  
 SCALE AS SHOWN


W. O. 6538-2

Construction Modification

SHEET G-2

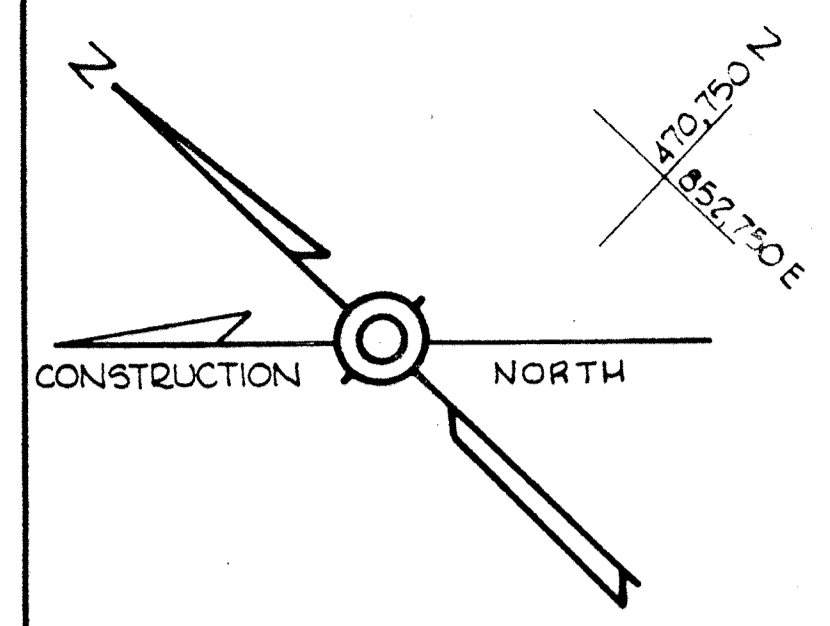

B-1		B-2		B-3		B-4		B-5		B-10	
0-5	0-10	0-5	0-10	0-5	0-10	0-5	0-10	0-5	0-10	0-5	0-10
<p>LOGS OF TEST BORINGS</p> <p>NOTE: Test borings and Soil Classifications by Raymond International Incorporated</p>											

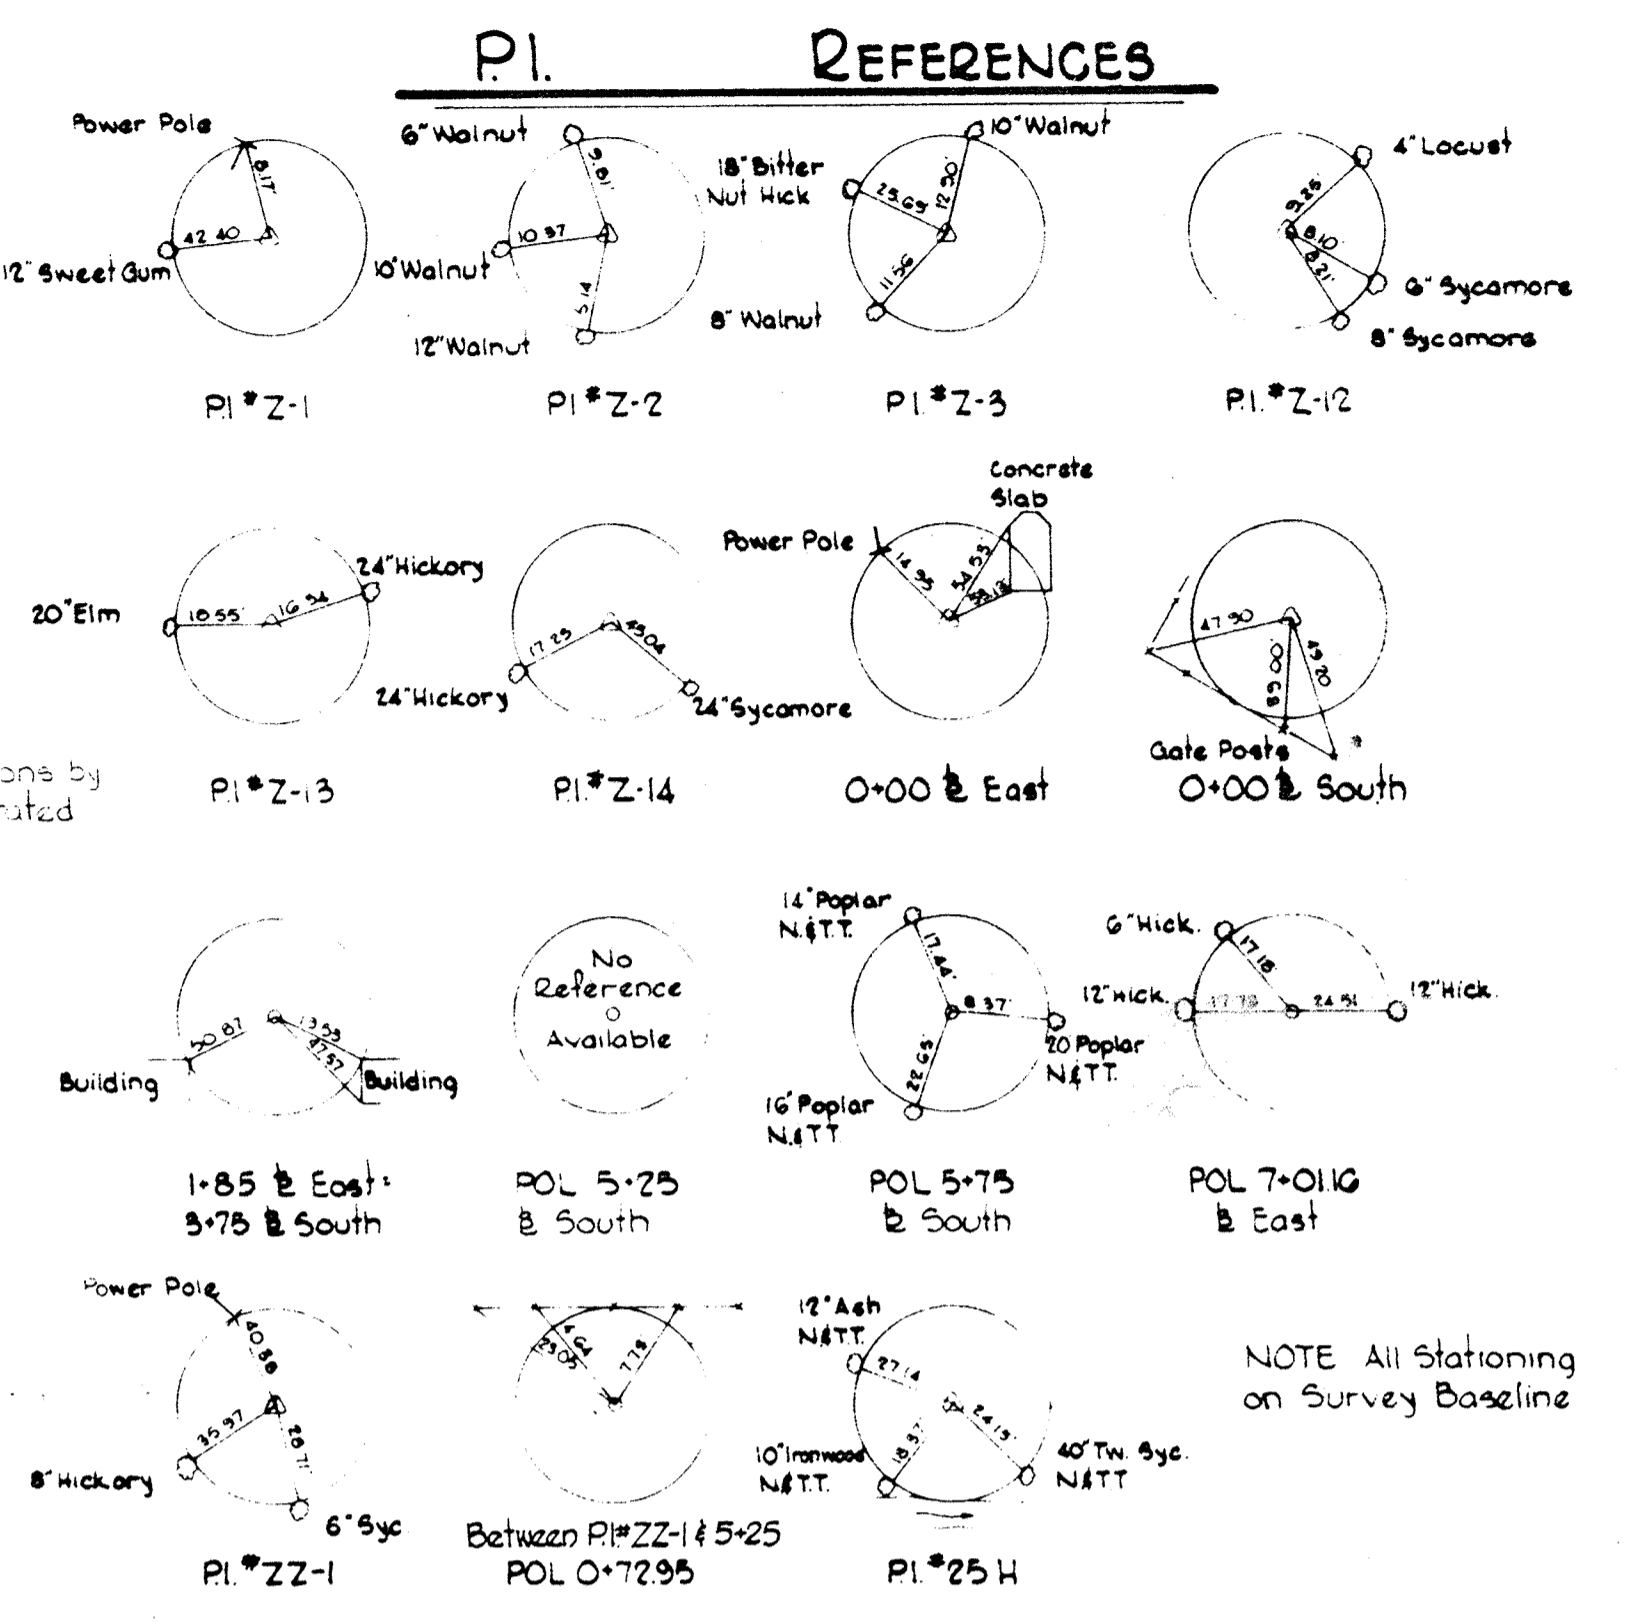

**BENCH MARKS**

W.R.#A B.M. Blaine Elev 139.06  
 X-cut on flange bolt of fire hyd.  
 40'± 21' of E Sta 2+25± S South


W.R.#A B.M.\*1-A Elev 127.65  
 2.2 Spike in 30" Oak 8' Lt of PI\*19-H  
 (not shown on Plan)

**GENERAL NOTES**

1. Approximate location of existing mains are shown. The Contractor shall take all necessary precautions to protect existing mains and services and maintain uninterrupted supply. Any damage incurred shall be repaired immediately.
2. All pipe elevations shown are invert (I) elevations.
3. The Contractor shall locate existing utilities a minimum of two weeks in advance of construction operations in vicinity of utilities.
4. The location of all valves, fittings etc. have been located in plan and dimensions shall be strictly adhered to unless otherwise directed by the Engineer.
5. For all standard details see standards bound in Specifications.
6. Block all fittings with concrete, or use restraining devices- See Specifications.
7. Pipelines shall be of the material listed in the Specifications. All airlines shall have a minimum of 2' cover and all sewer and water shall have a minimum of 5/2' cover unless otherwise noted by profiles or elevations on the plans.
8. Clear all utilities by a minimum of 6' vertically. All parallel pipe systems to have 2'-0" minimum horizontal clearance.
9. The Contractor shall provide a joint in all sewer mains within 2'-0" of exterior walls.
10. Elevations and coordinates are based on the Maryland State Datum and Grid System.
11. All existing valve boxes, manhole frames and covers and existing appurtenances shall be adjusted to finished grade.
12. All outside valves in sewer lines up to and including 12" diameter shall be plug valves. All outside valves in sewer line 16" and larger shall be gate valves. All buried water valves shall be gate valves. All buried valves will have roadway boxes with concrete slabs in all areas other than paved areas. All valves to be of same size as pipeline unless otherwise indicated.
13. All structures, buildings, roadways, pipelines, etc. are located by construction coordinates. Zero base for the coordinate system is as noted on sheet C-1 @ intersection of survey base lines.
14. For the exact location of utilities entering buildings see mechanical and electrical drawings.
15. Existing valve boxes and associated concrete slabs and manhole frames and covers shall be adjusted to grade as required.
16. Existing parking checks along the east side of the Plant Access Road will be relocated as shown or as directed by the Engineer.
17. Connection of new to existing pipeline may be made by tapping existing pipelines, or by sleeves and spacers or by other means approved by the Engineer. Attention is directed to specifications for Plant operational requirements while making connections.
18. All pipelines that are capped or plugged shall be flagged with striped 2'x4' set 36" into ground and identified with all-weather markings.


**REFERENCES:**

- 1) For Utility Plan and Structure Location see sheet C-2
- 2) For Grading Plan see sheet C-3
- 3) For Legend see sheet C-2
- 4) For Abbreviations See sheet G-2

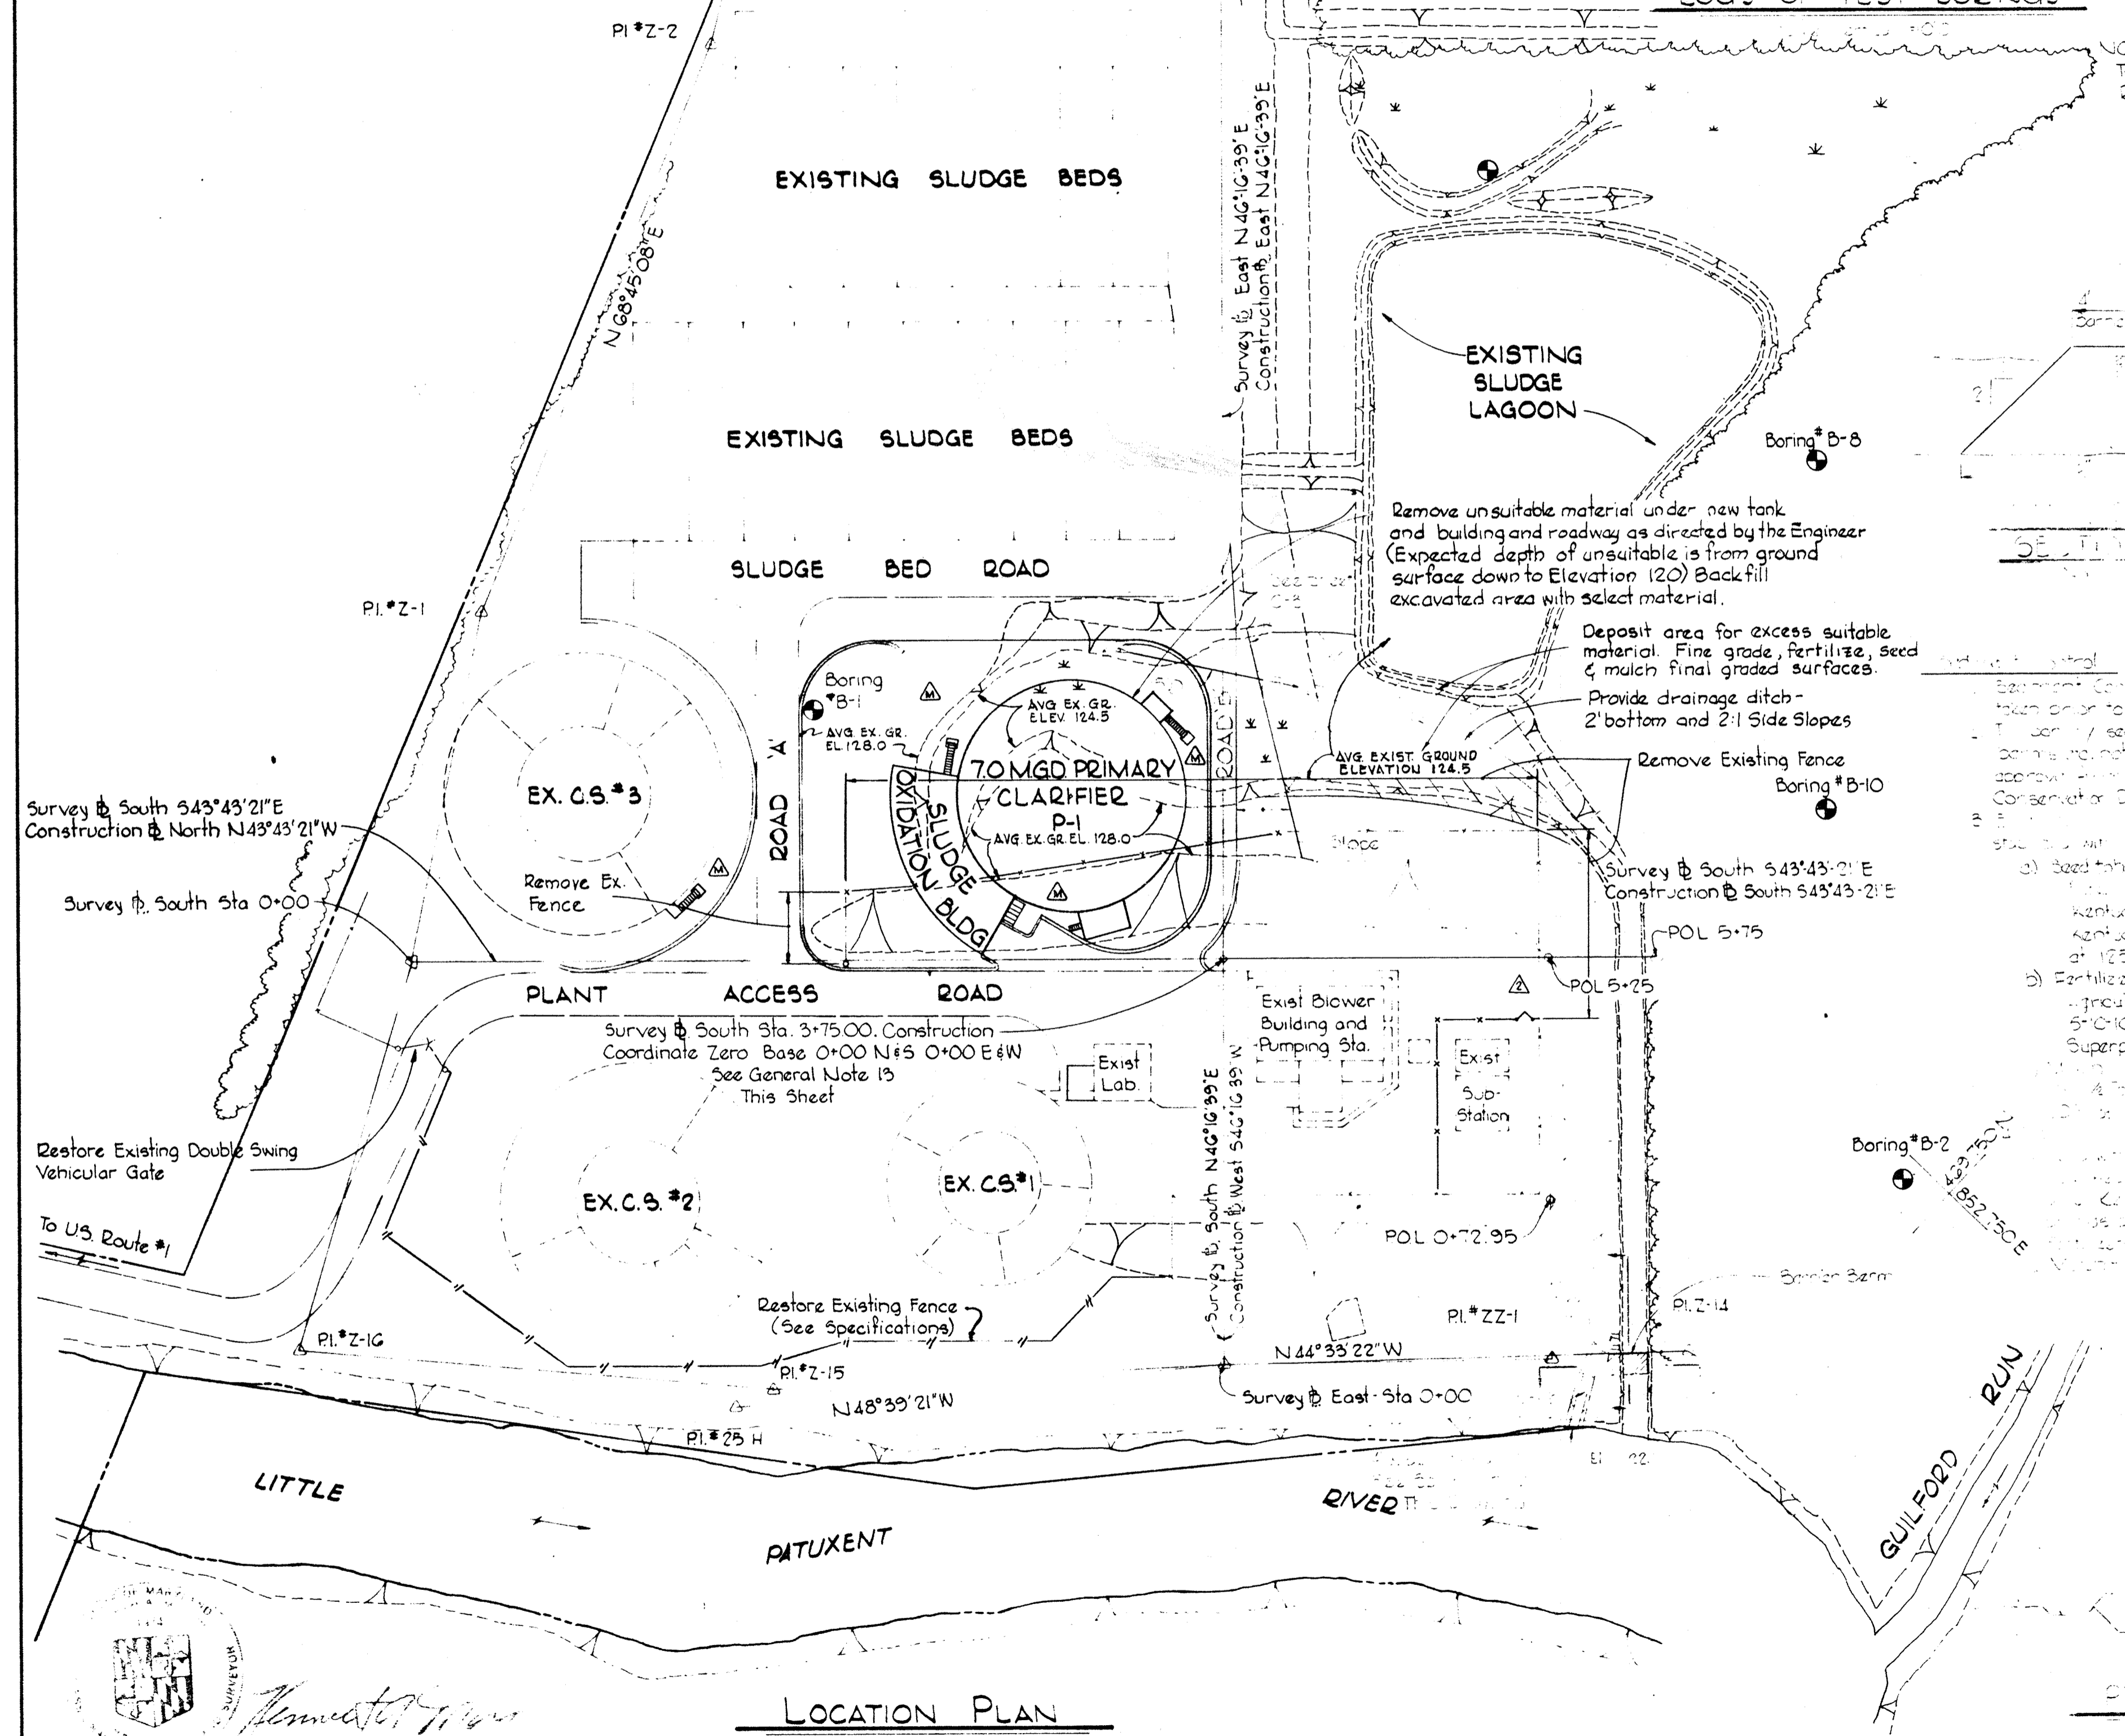

WHITMAN, REQUARDT & ASSOCIATES ENGINEERS 1304 ST. PAUL ST. BALTIMORE, MARYLAND	DEPARTMENT OF PUBLIC WORKS HOWARD COUNTY, MARYLAND <i>W.D. Gilbert</i> CHIEF - BUREAU OF ENGINEERING	CONTRACT NO. <u>525-S</u>	LOCATION PLAN AND REFERENCES	SAVAGE WASTEWATER TREATMENT PLANT ADDITION NO. 3	DRAWING NO. <u>3</u> OF <u>28</u>	SCALE 1"=50' 430-455 470-487 492-498	SHEET C-1
--	---	---------------------------	------------------------------	--	-----------------------------------	--	-----------

Addendum  
Construction Modification

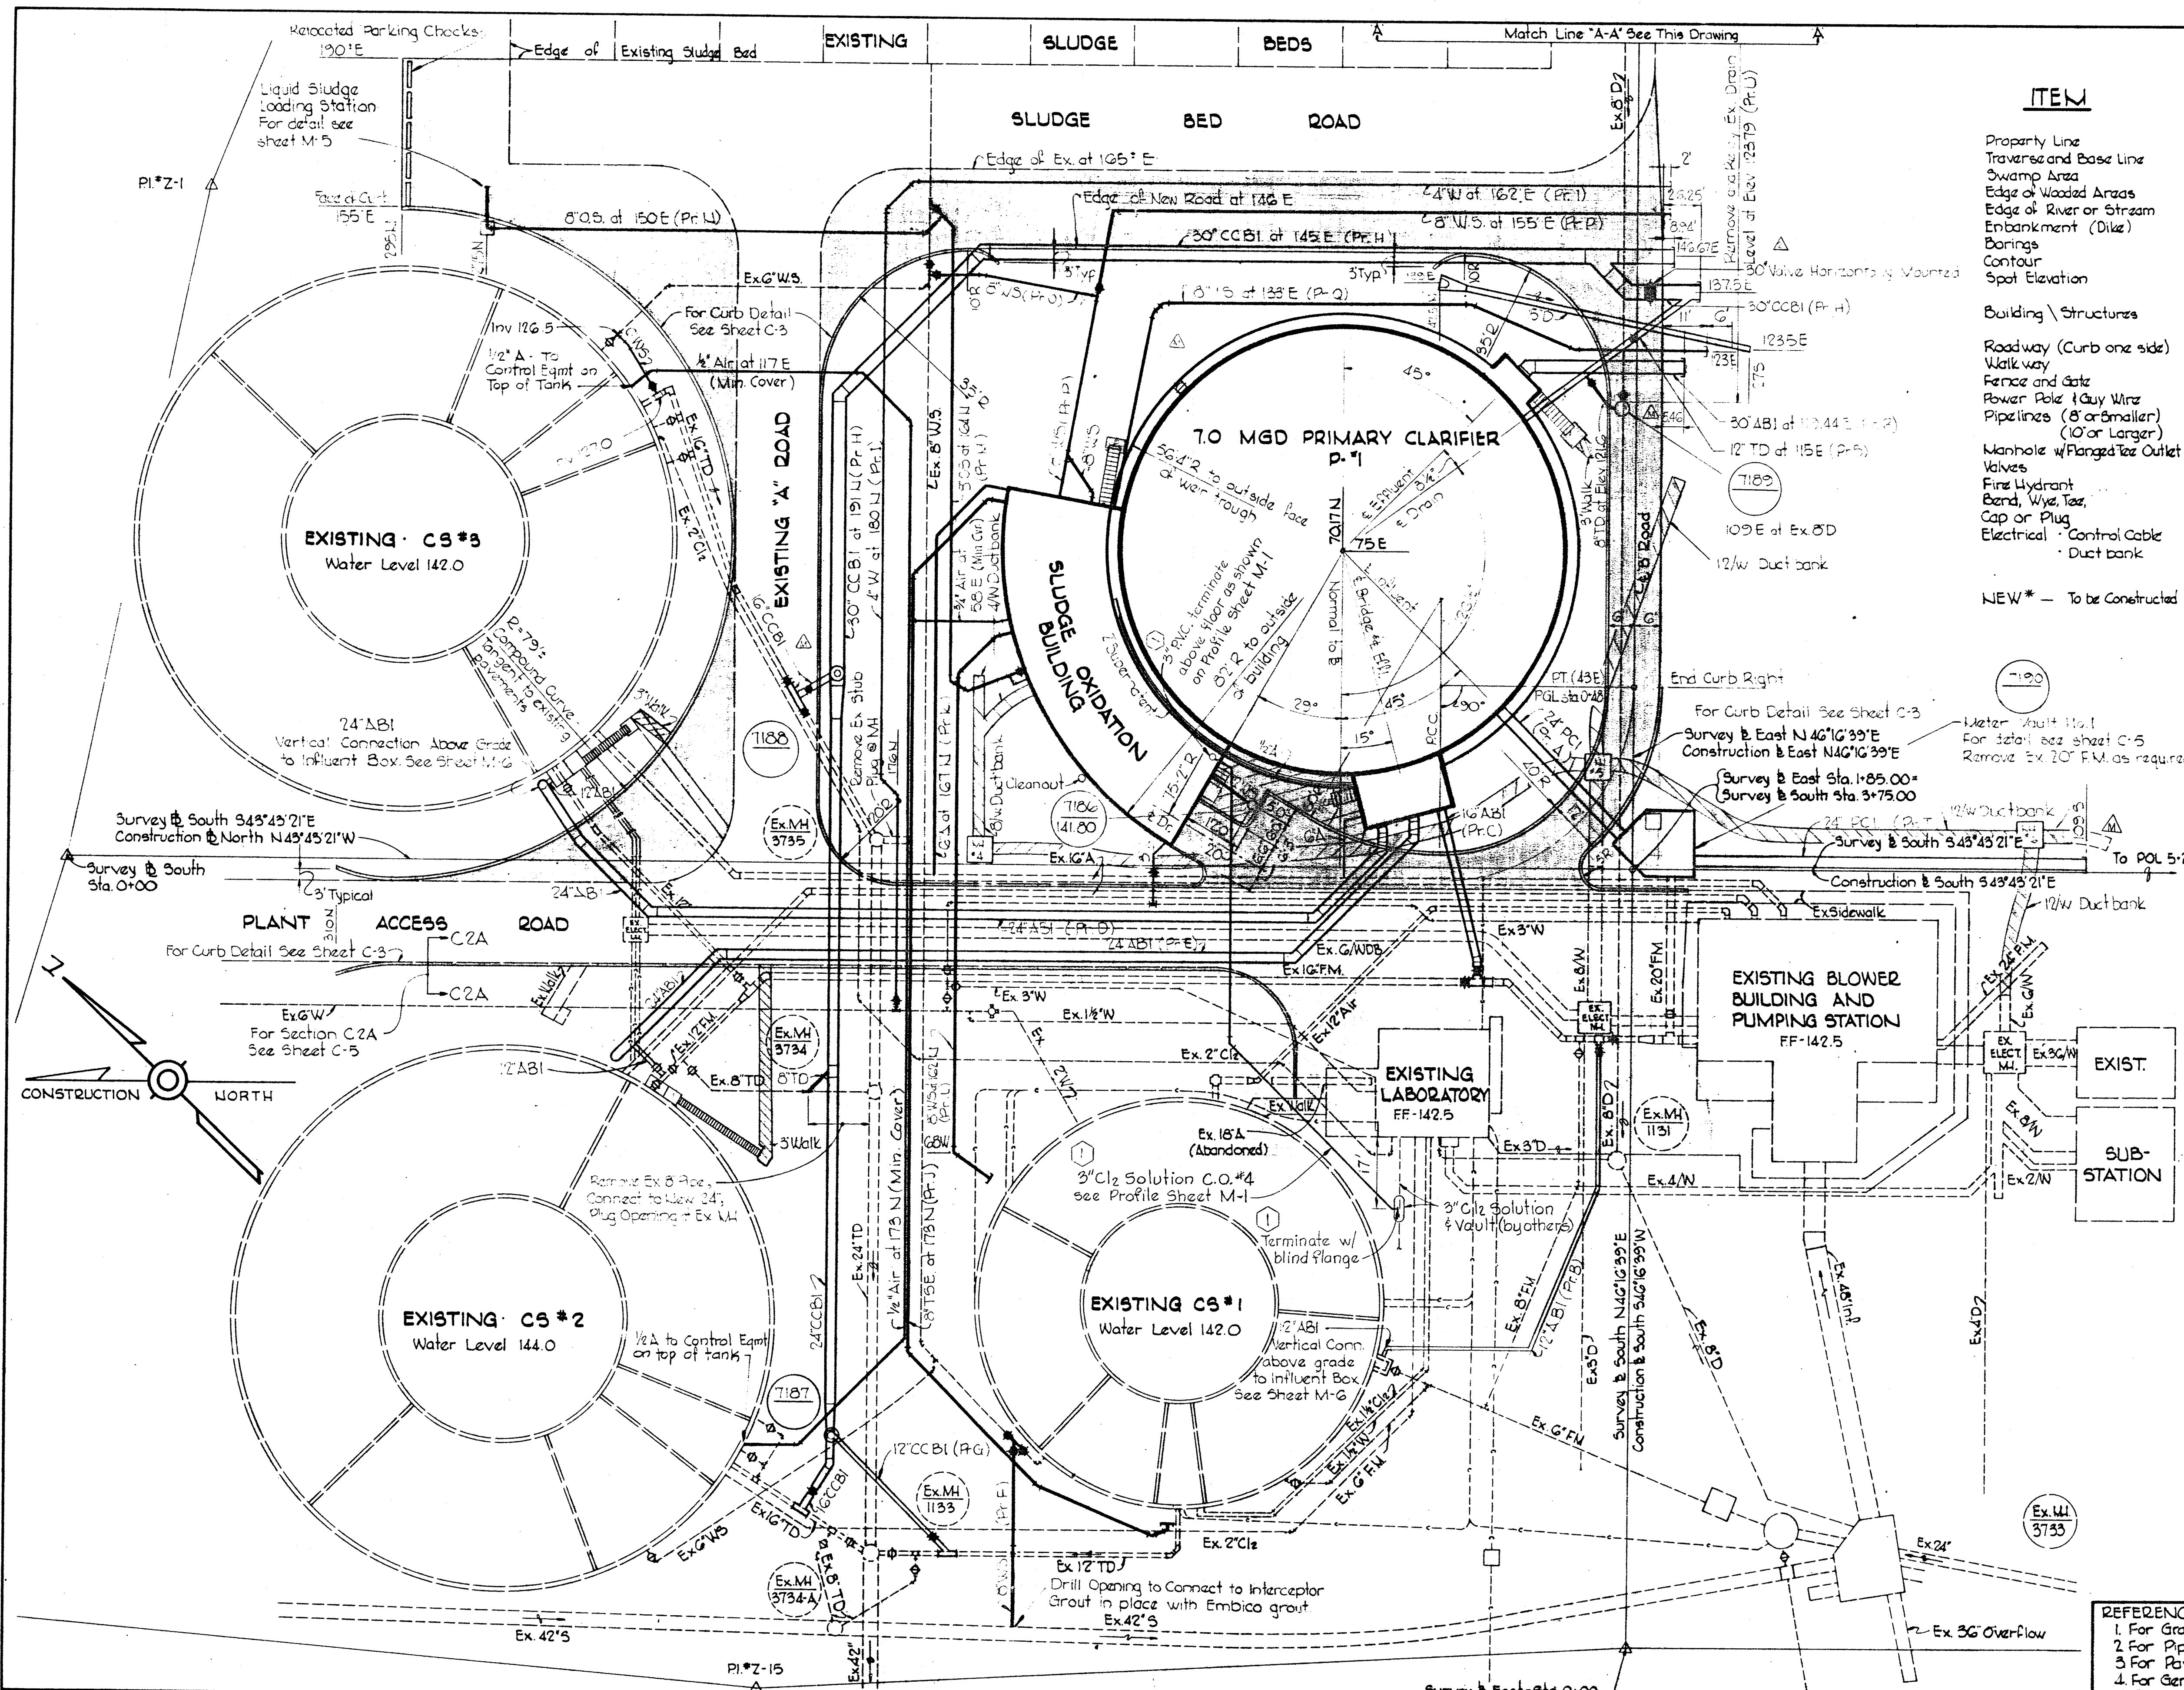

**LEGEND**


ITEM	EXISTING	NEW*
Property Line	---	---
Traverse and Base Line	---	---
Swamp Area	---	---
Edge of Wooded Areas	---	---
Edge of River or Stream	---	---
Embankment (Dike)	---	---
Borings	⊙ B-1	---
Contour	---	---
Spot Elevation	125.53	---
Building / Structures	---	---
Roadway (Curb one side)	---	---
Walk way	---	---
Fence and Gate	---	---
Power Pole (Guy Wire)	---	---
Pipelines (8" or smaller)	---	---
(10" or Larger)	---	---
Manhole w/ Flanged Tee Outlet	⊙	⊙
Valves	⊙	⊙
Fire Hydrant	⊙	⊙
Band, Wire, Tag	---	---
Cap or Plug	---	---
Electrical - Control Cable	---	---
Duct bank	---	---

NEW\* - To be Constructed Under This Contract

**MANHOLE SCHEDULE**

NO.	TYPE	INVERT
7186	34" Terminal Manhole w/ Flange & Cover	125.83
7187	34" U.L. 3" Flow Invert	121.06
7188	34" U.L. 3" Flow Invert	121.30
7189	34" U.L. 3" Manhole w/ Flange & Cover	123.72

Note: Entry part into pipeline of Manhole 7187 and 7188 shall consist of vertical tee one size smaller than pipeline with blind flange.

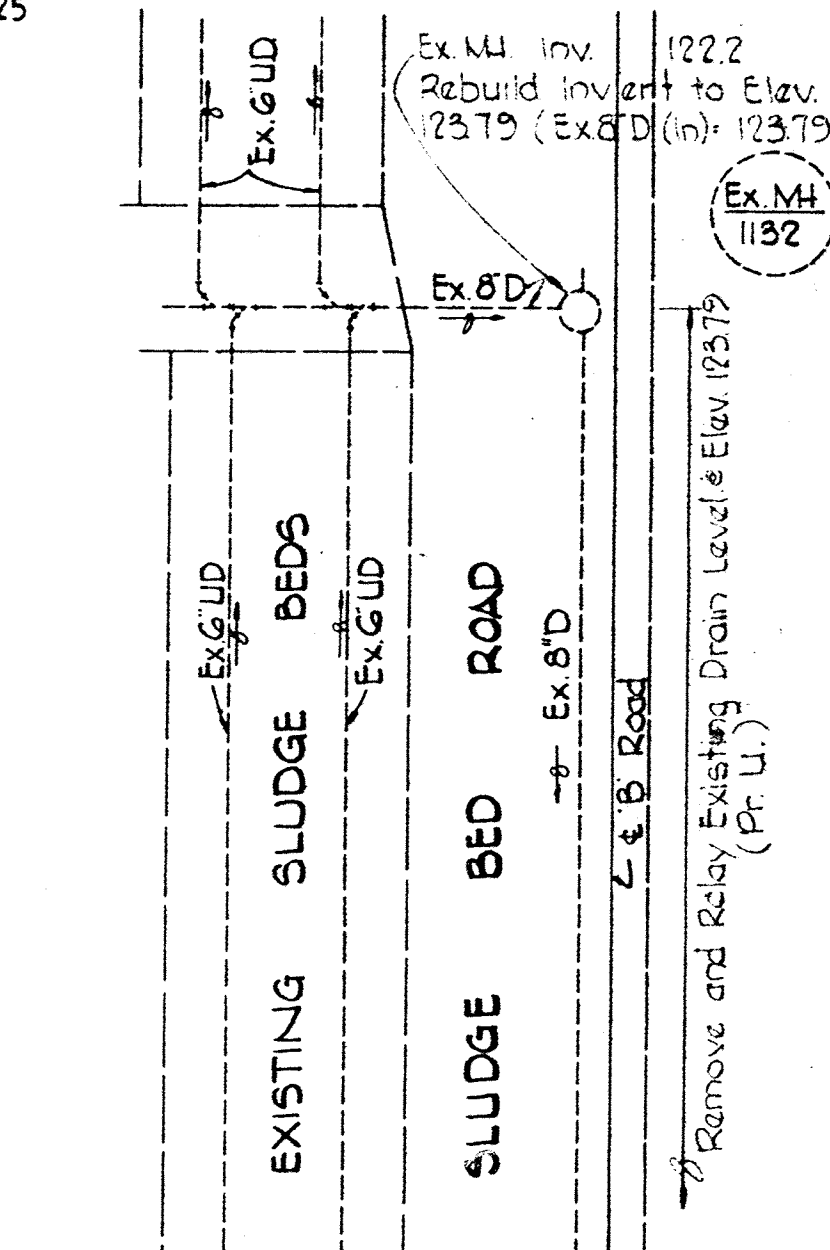

Match Line "A-A" See This Drawing




STATE OF MARYLAND  
DEPARTMENT OF PUBLIC WORKS  
BUREAU OF SURVEYING

*Kenneth A. ...*

- REFERENCES:**
1. For Grading Plan, See Sheet C-3
  2. For Pipeline Profiles See Sheet C-4 and C-5
  3. For Pavement and Curb Details See Sheet C-3
  4. For General Notes See Sheet C-1
  5. For Abbreviations See Sheet G-2


<b>WHITMAN, REQUARDT &amp; ASSOCIATES</b> ENGINEERS 1304 ST. PAUL ST. BALTIMORE, MARYLAND	<b>DEPARTMENT OF PUBLIC WORKS</b> HOWARD COUNTY, MARYLAND DATE: 2/1/73 CHIEF - BUREAU OF ENGINEERING	<b>CONTRACT NO. 525-S</b>	<b>UTILITY PLAN</b>	<b>SAVAGE WASTEWATER</b> <b>TREATMENT PLANT ADDITION NO. 3</b>	<b>DRAWING NO. 4</b>	<b>SCALE 1" = 20'</b>
					<b>OF 28</b>	FB# 9249 FB# 5044 FB# 4501
W. O. 6538-2    Change Order No. 4    2-19-74    Relocated Ductbank    4-15-74					<b>SHEET C-2</b>	

BRUNING 44-510 14778

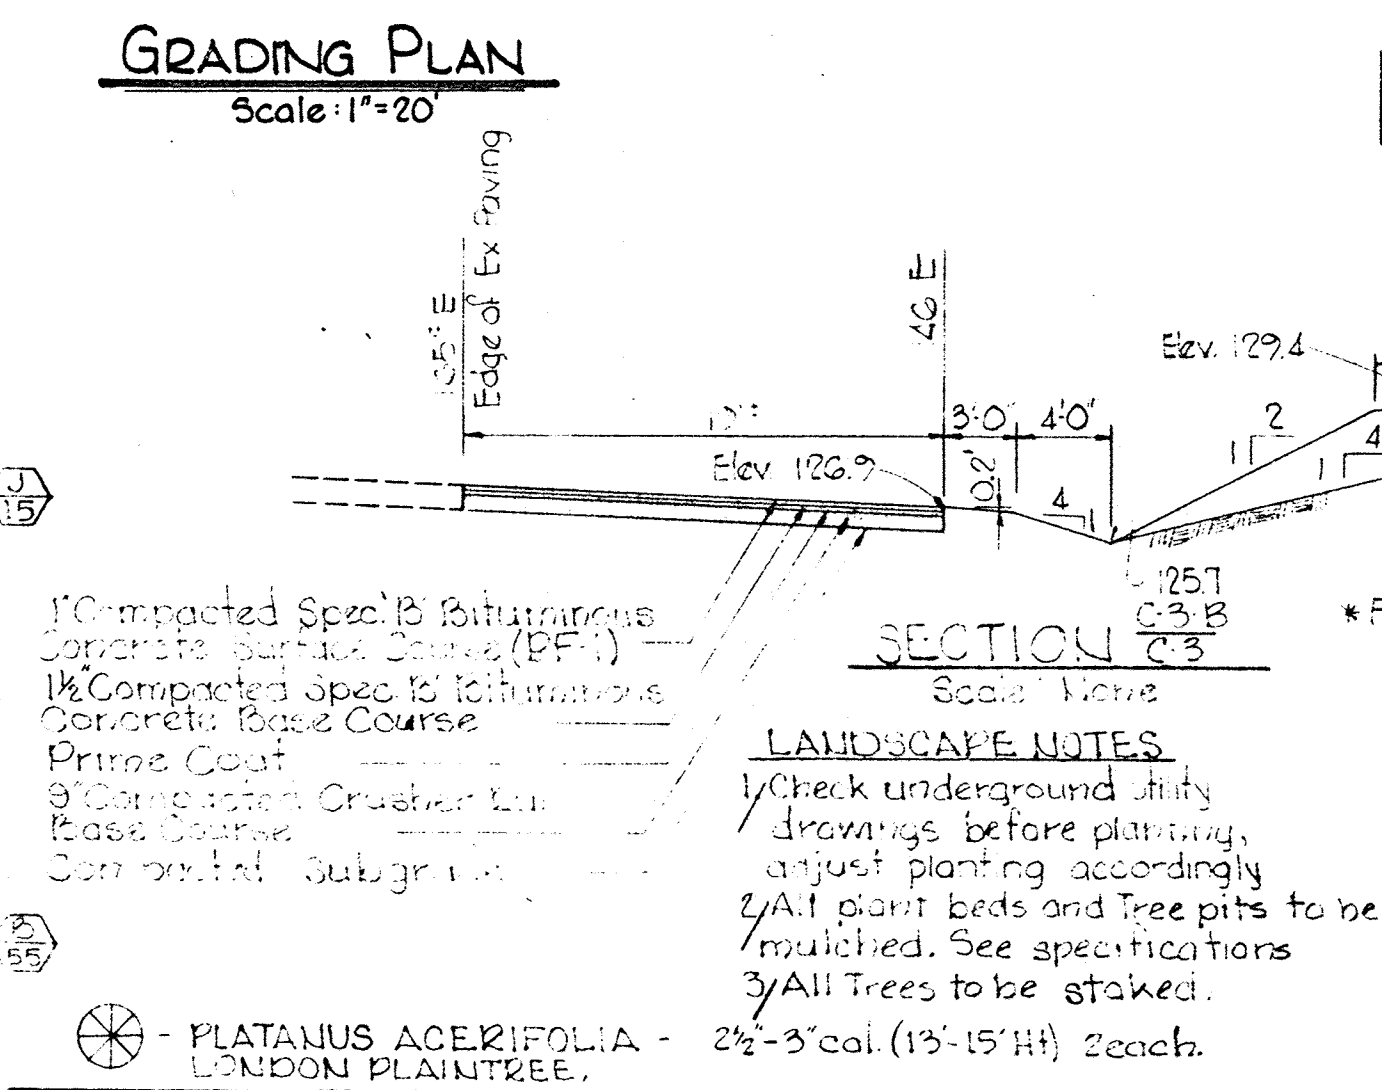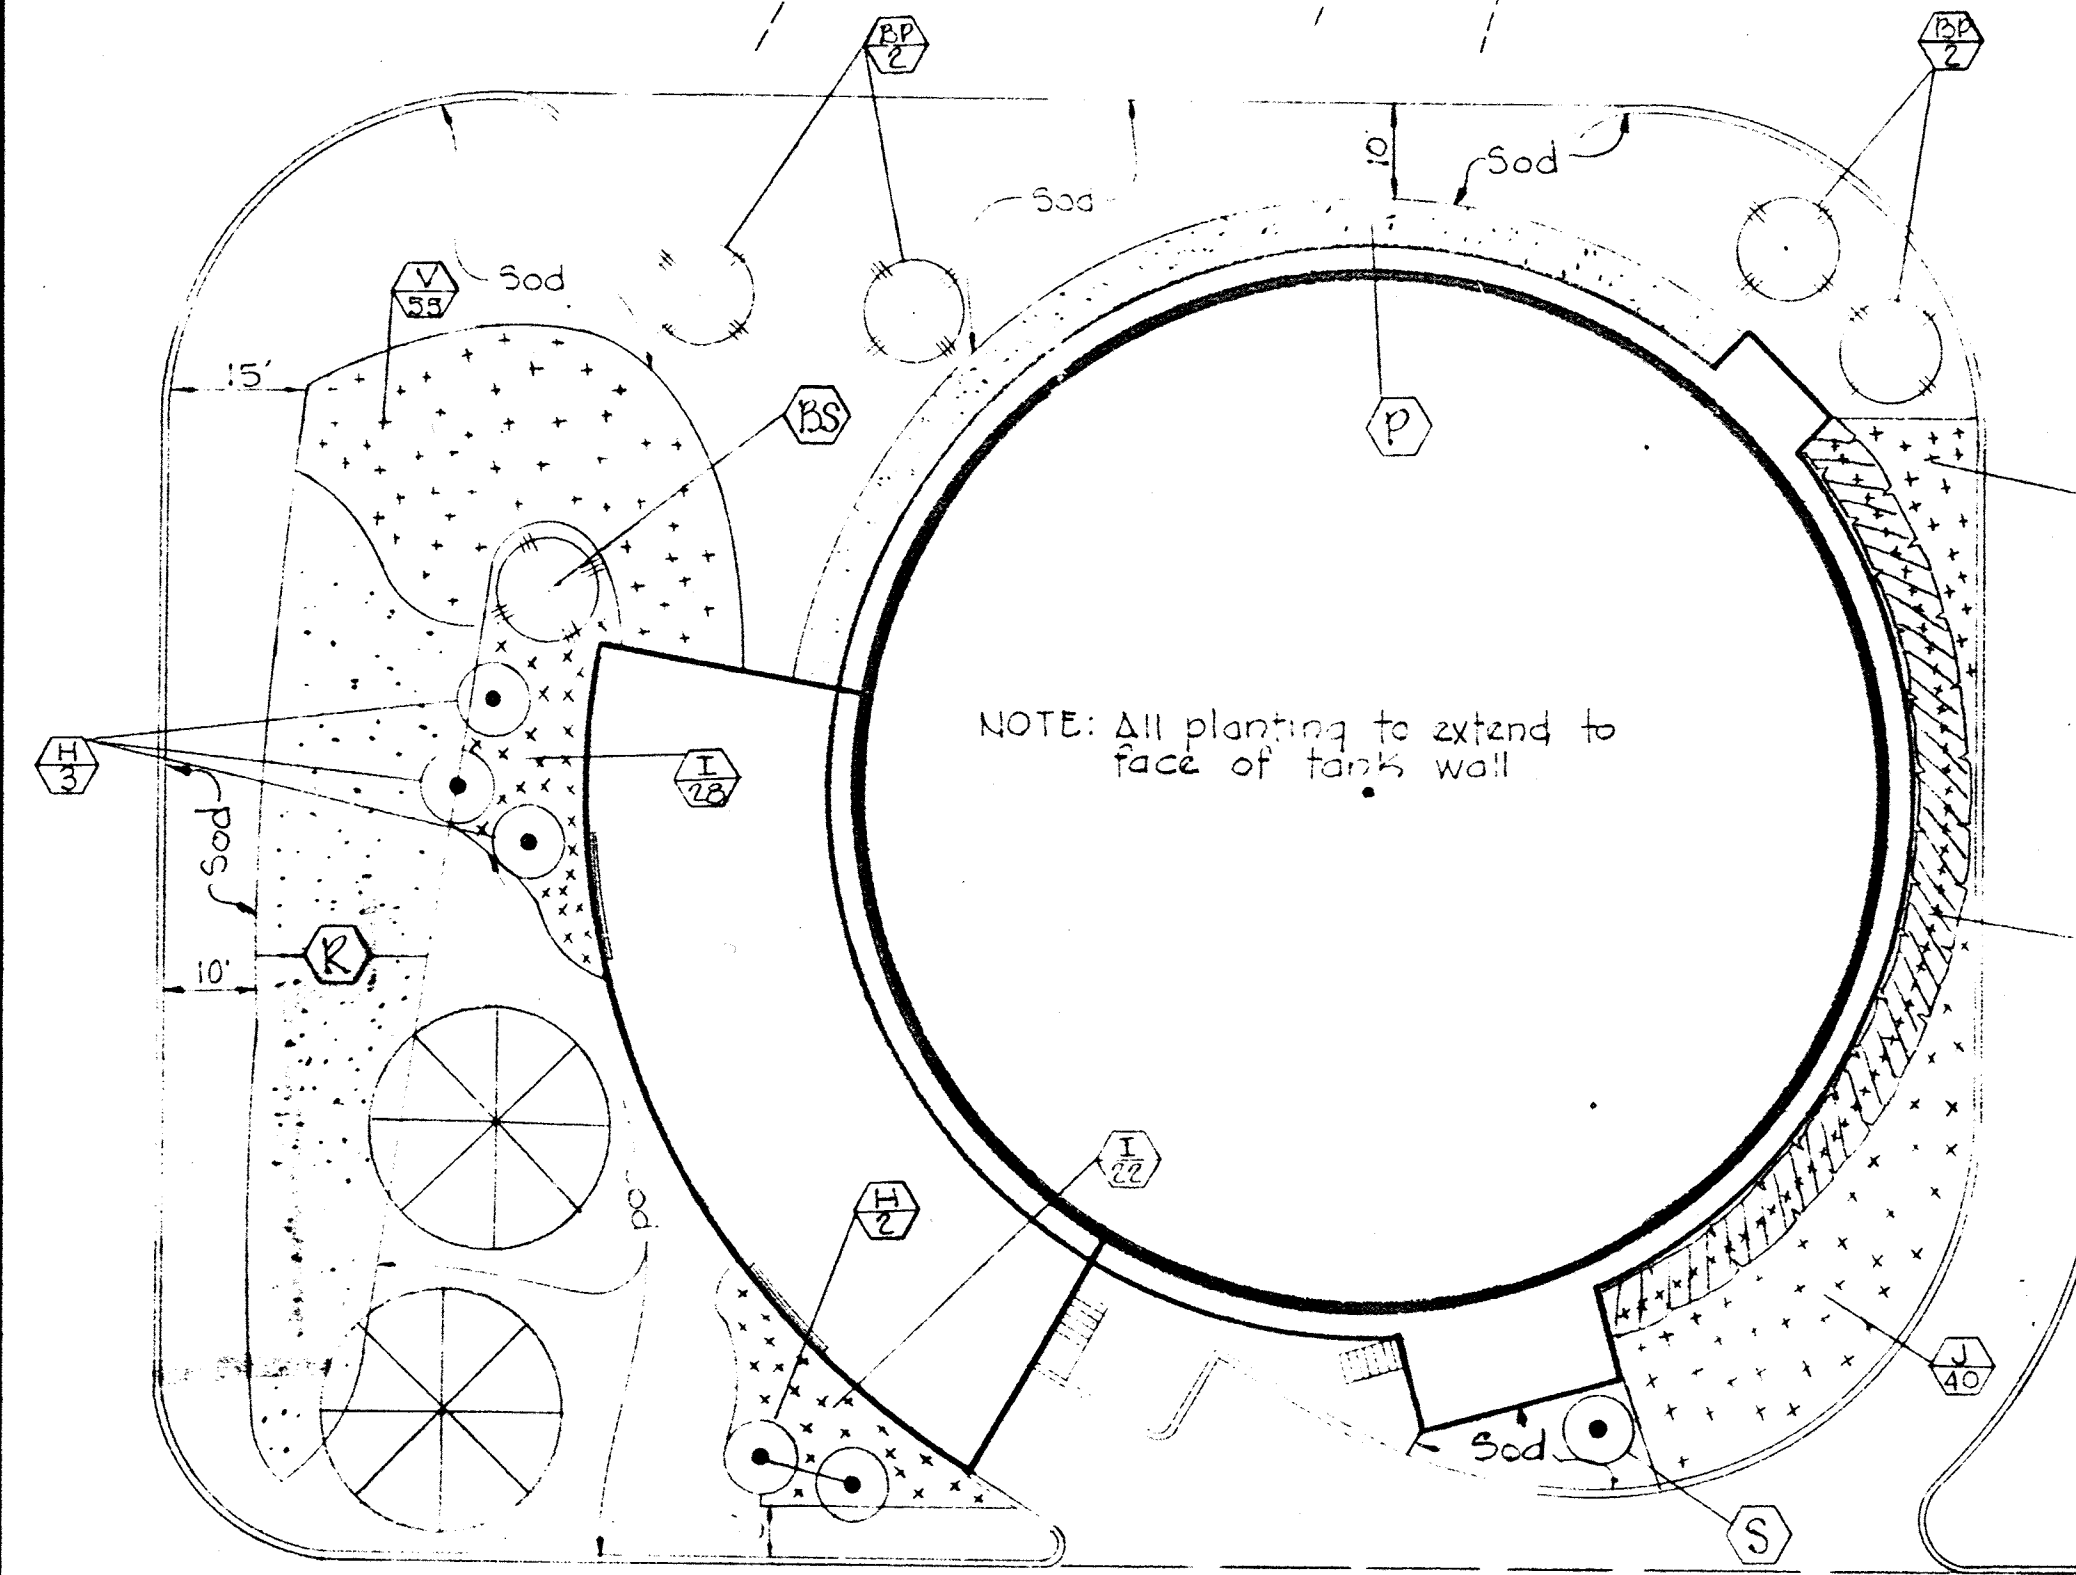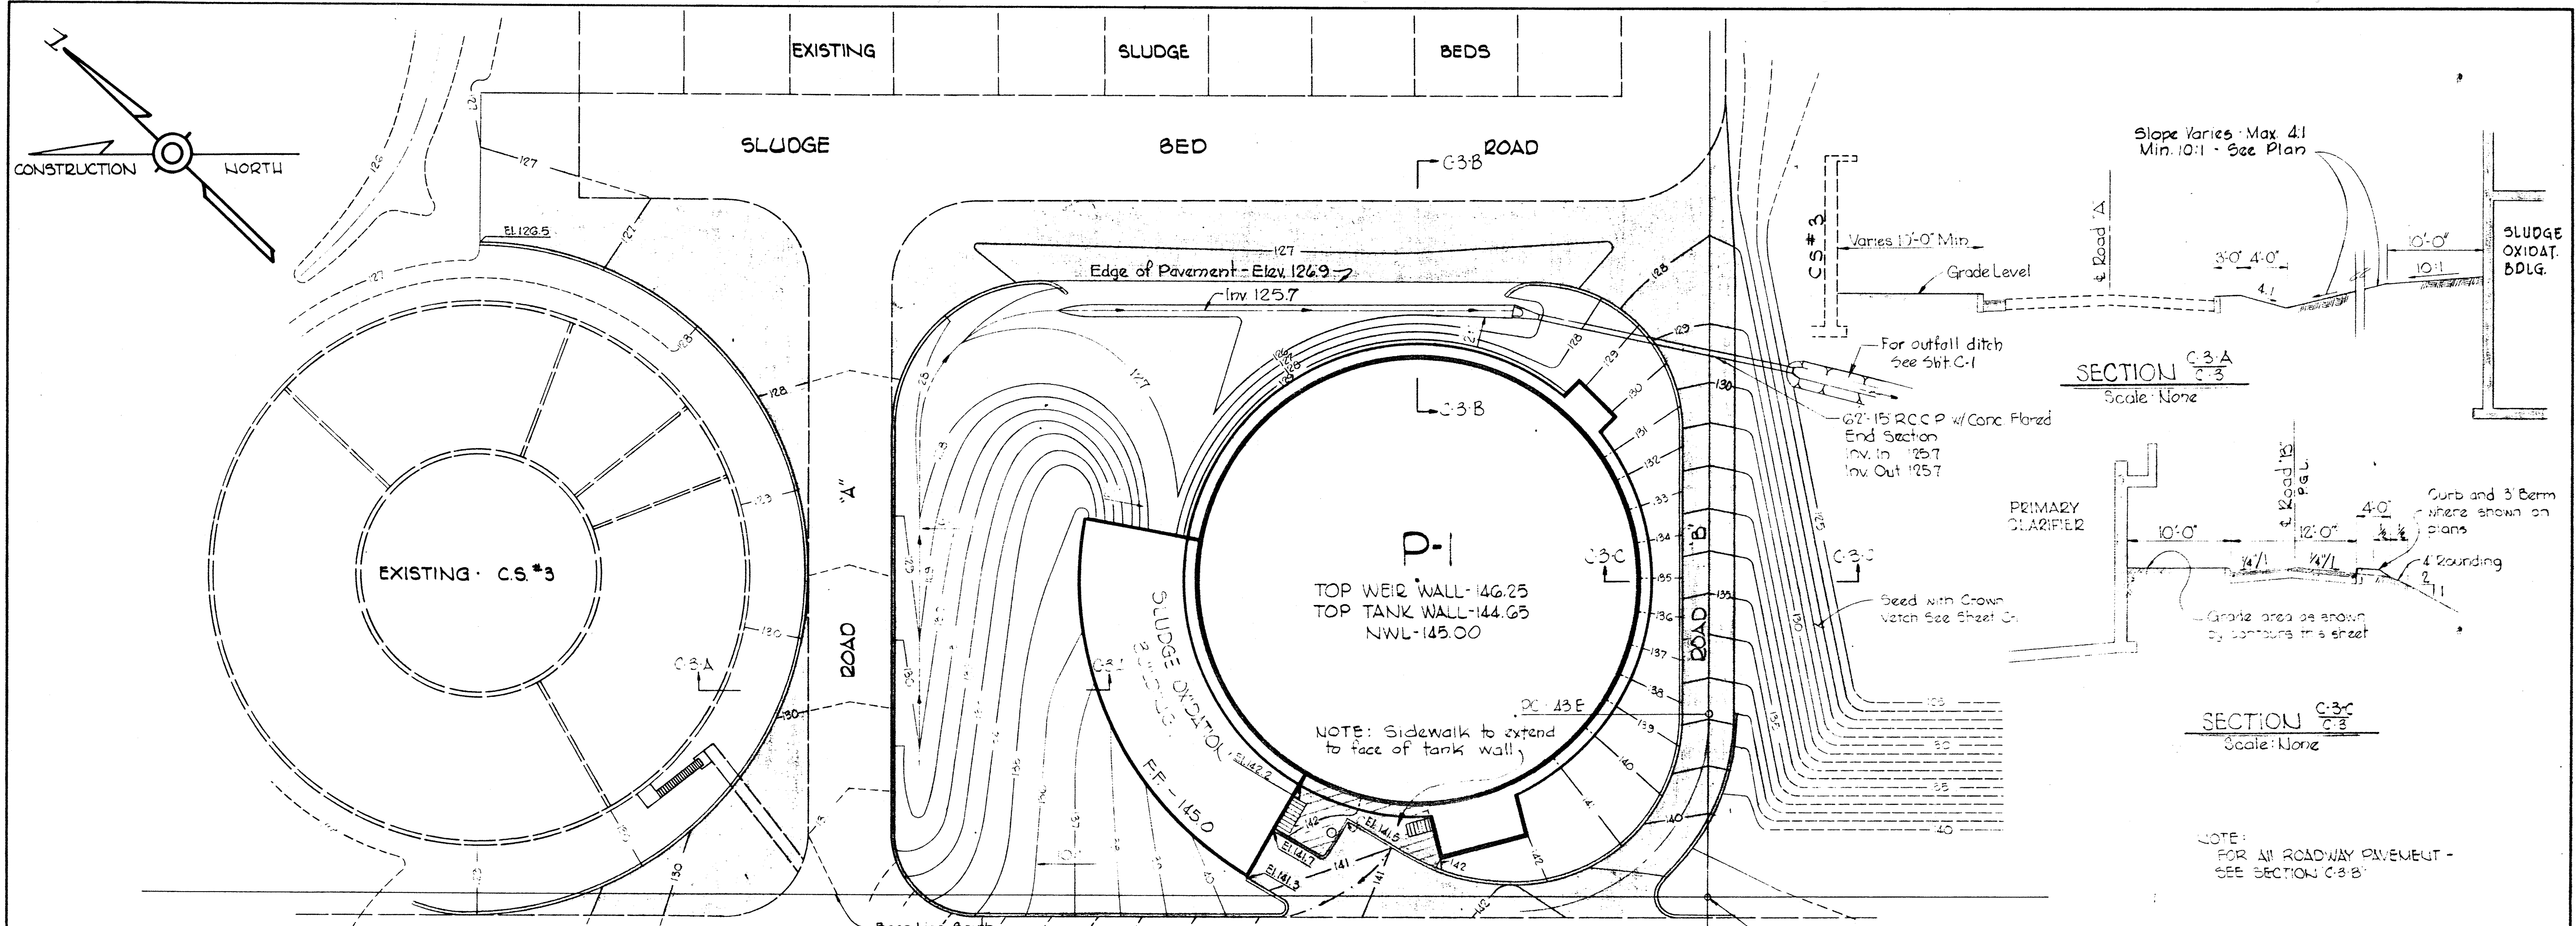

**PLANT LIST**

SYMBOL	CODE	ABBREVIATION	SIZE	QUANT.	REMARKS
H		CRATAEGUS PHAENOPYRUM - HOENHOUTS THORN	8'-10' HT.	5	HEAVY-BRANCHED
S		XYLOPIA AEGYPTIACA - SOLRANCO	10'-12' HT.	1	STRAIGHT TRUNK
BS		PIGEA PINASTRIS - BLUE SPARLE	6'-8' HT.	1	SPECIMEN
SP		PARUS TRIMBERSII - CALDWELL'S STARLING	8'-10' HT.	4	HEAVY SPECIMENS
B		SERPENTINA JULIANAE - WINTER GREEN BARBERY	18'-24' HT.	55	PLANT 2' c/c
I		EVER GREENS ROUNDLEAF HOLLY	30'-36' HT.	50	PLANT 4' c/c
J		JUNIPERUS SARGENTI - SARGENT JUNIPER	12'-15' SP.	55	PLANT 4' c/c
V		YARROWIA VANDERHOEFTI - YARROWIA	2'-3' HT.	55	PLANT 4' c/c
R		ROSA WICHURANIANA - WINGED ROSE	3'-12' HT.	1000	PLANT 18' c/c
P		VINCA MINOR - PERIWINKLE	2yr. No 2	800	3 RUNNERS







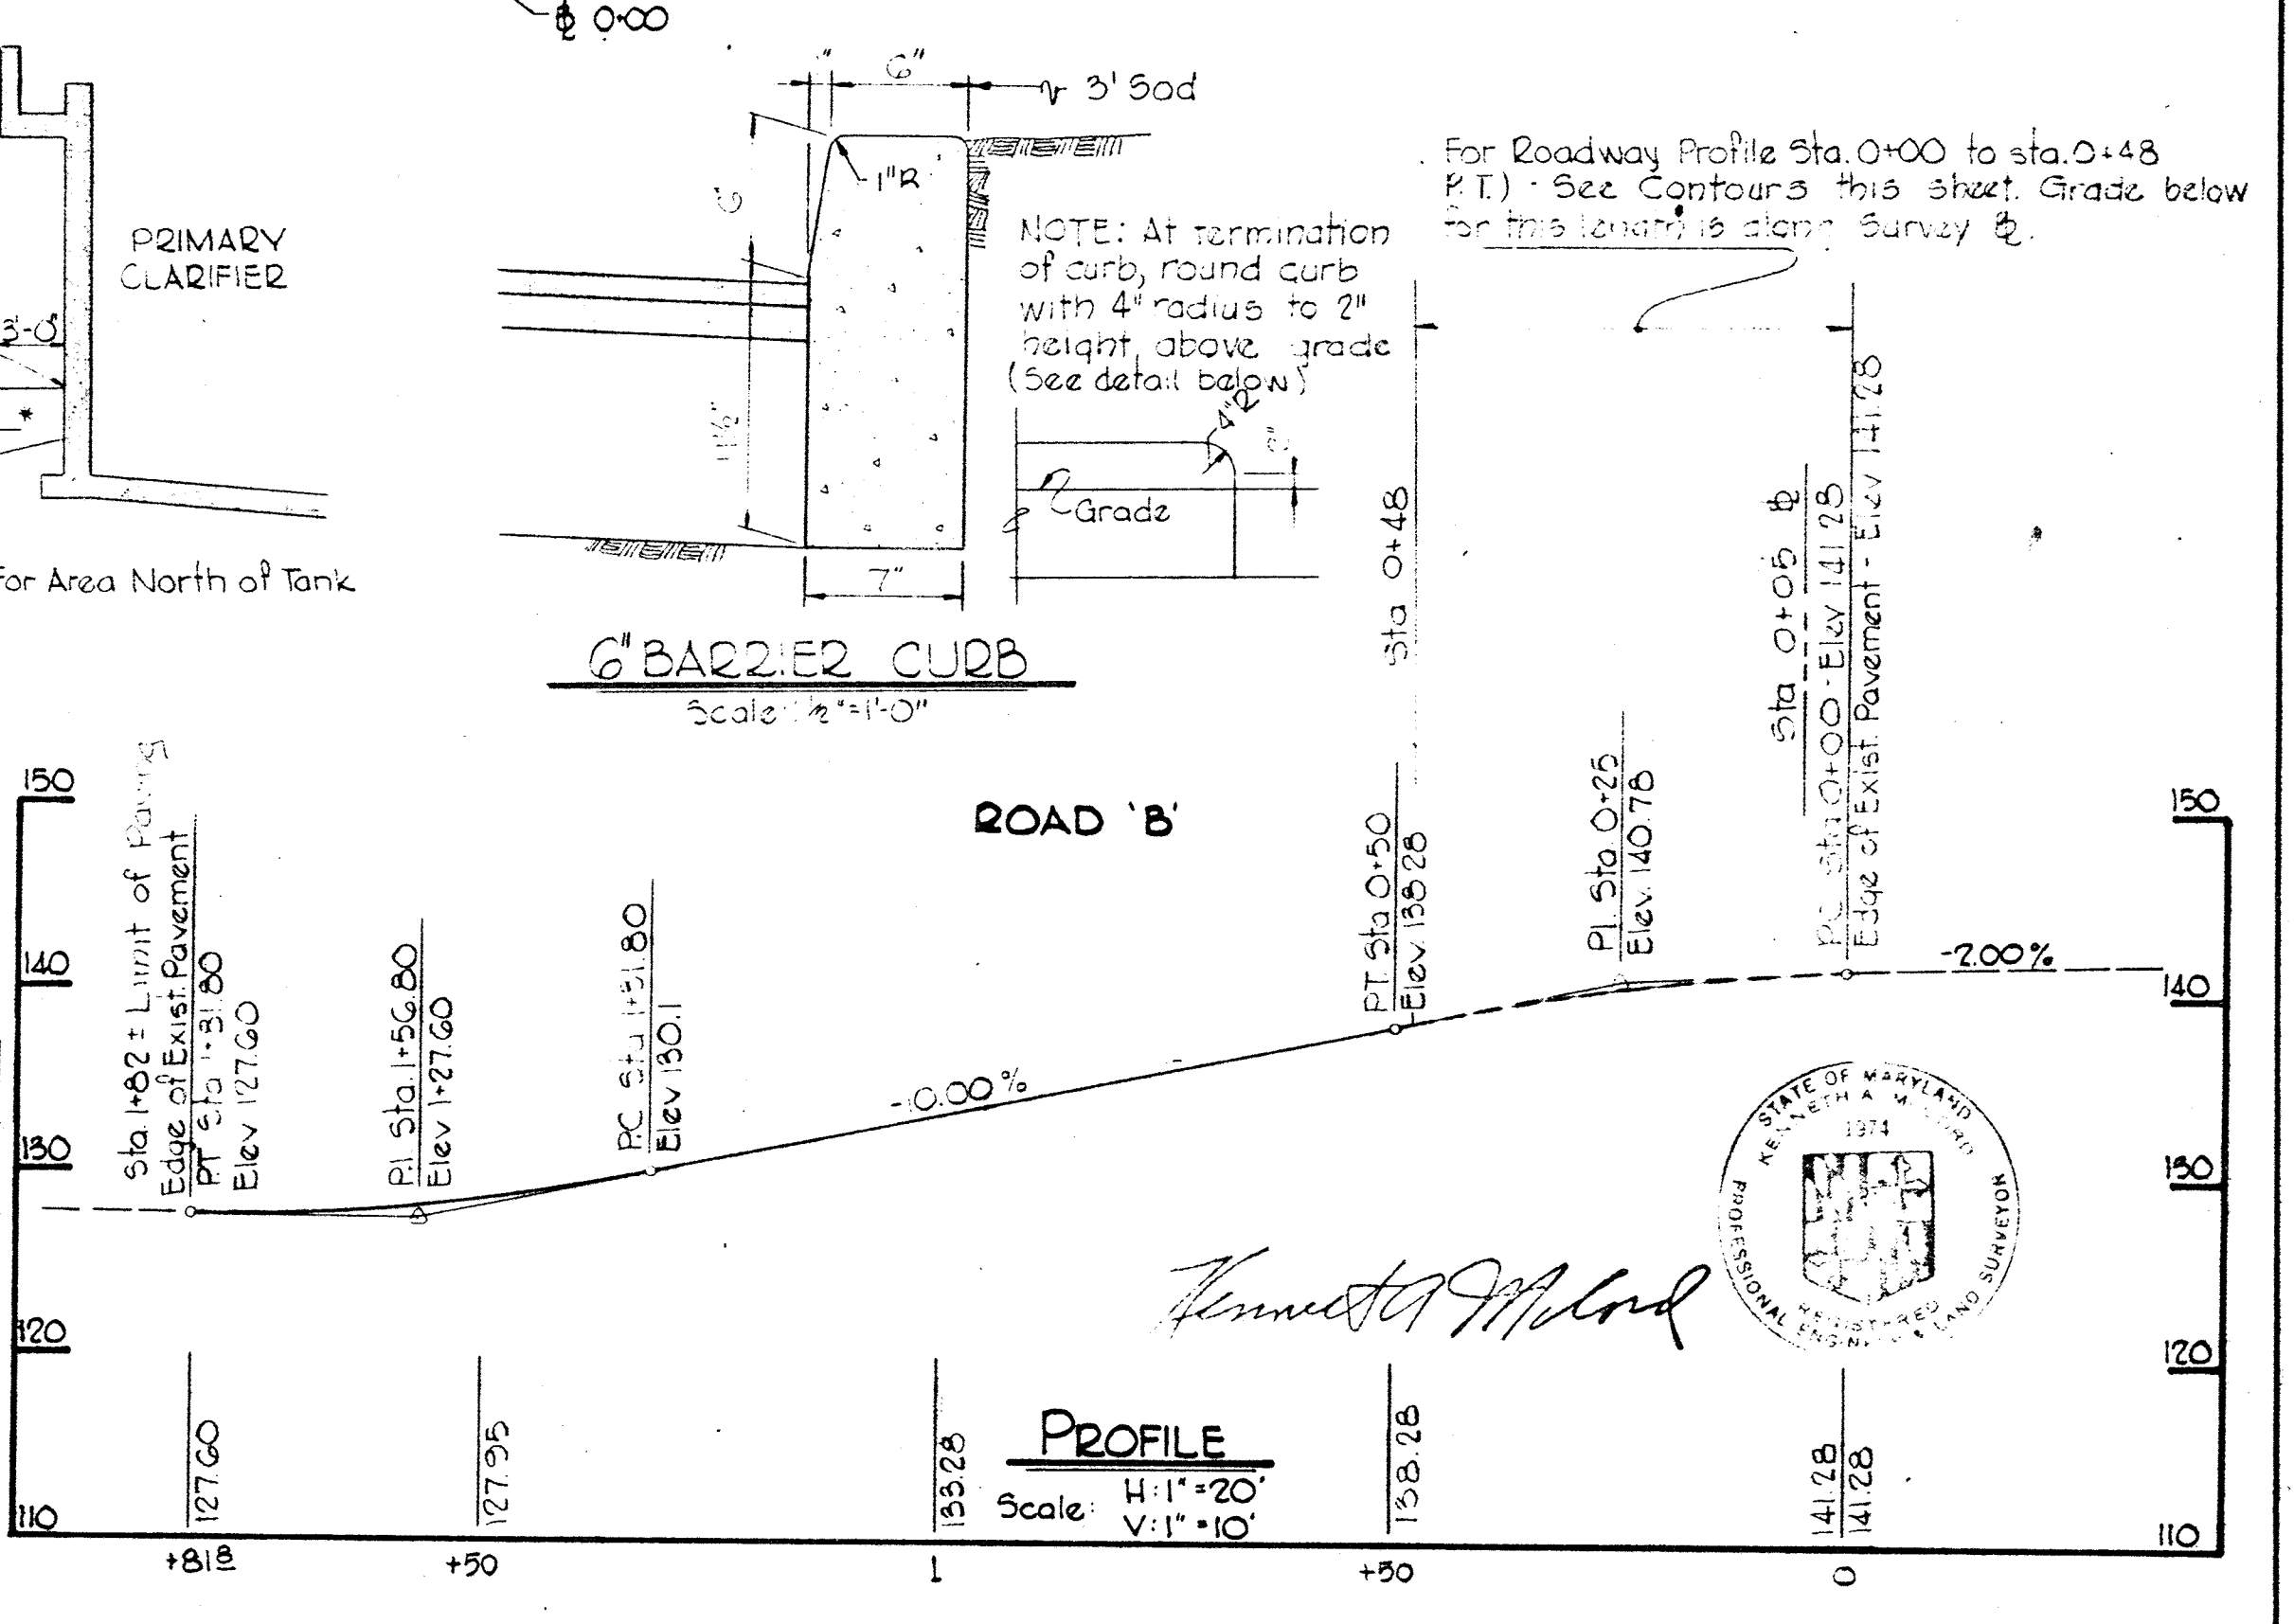


<p><b>WHITMAN, REQUARDT &amp; ASSOCIATES</b> ENGINEERS 1304 ST. PAUL ST. BALTIMORE, MARYLAND</p>	<p><b>DEPARTMENT OF PUBLIC WORKS</b> HOWARD COUNTY, MARYLAND 2/1/73 DATE</p> <p><i>W.O. Gilbert</i> CHIEF - BUREAU OF ENGINEERING</p>	<p><b>CONTRACT NO. 525-S</b></p>	<p><b>GRADING PLAN AND TYPICAL SECTIONS</b></p>	<p><b>SAVAGE WASTEWATER TREATMENT PLANT ADDITION NO. 3</b></p>	<p><b>DRAWING NO. 5 OF 28</b></p> <p><b>SCALE AS SHOWN</b></p>
--	---	----------------------------------	---	--	--

W. O. 6538-2


SHEET C-3

BRUNING 44.510 14778

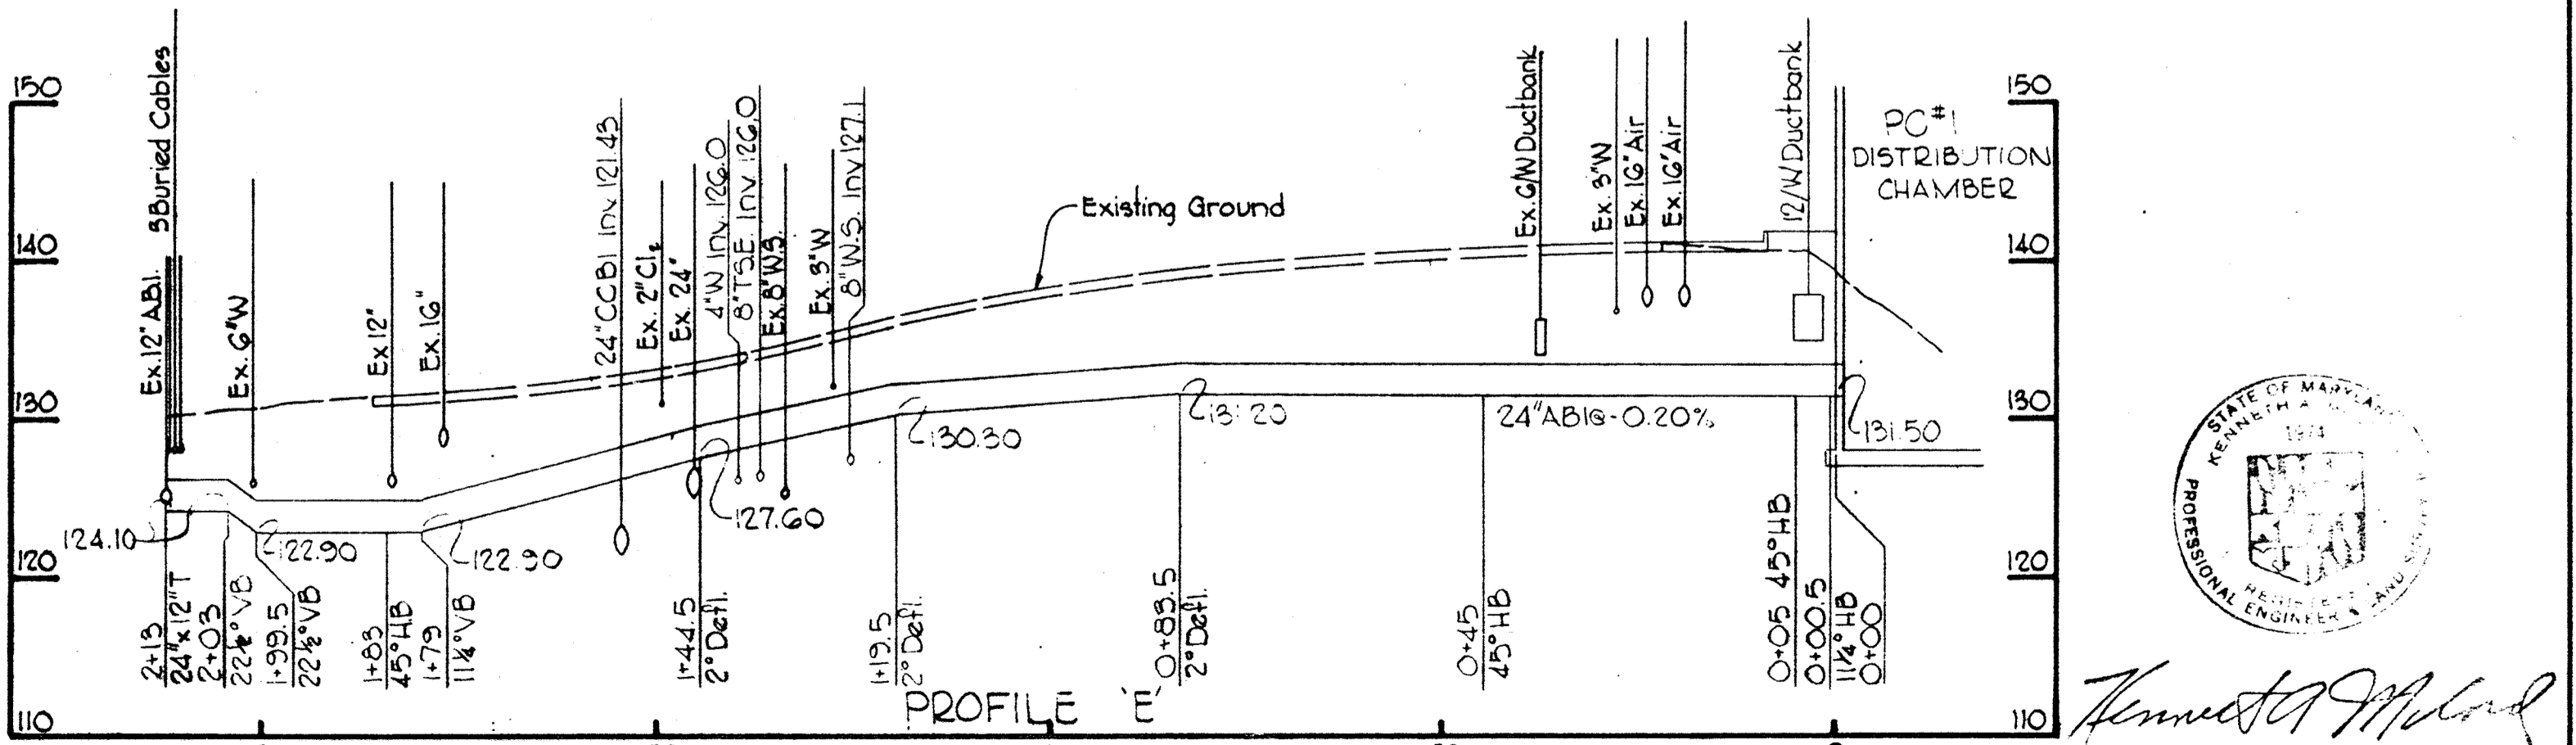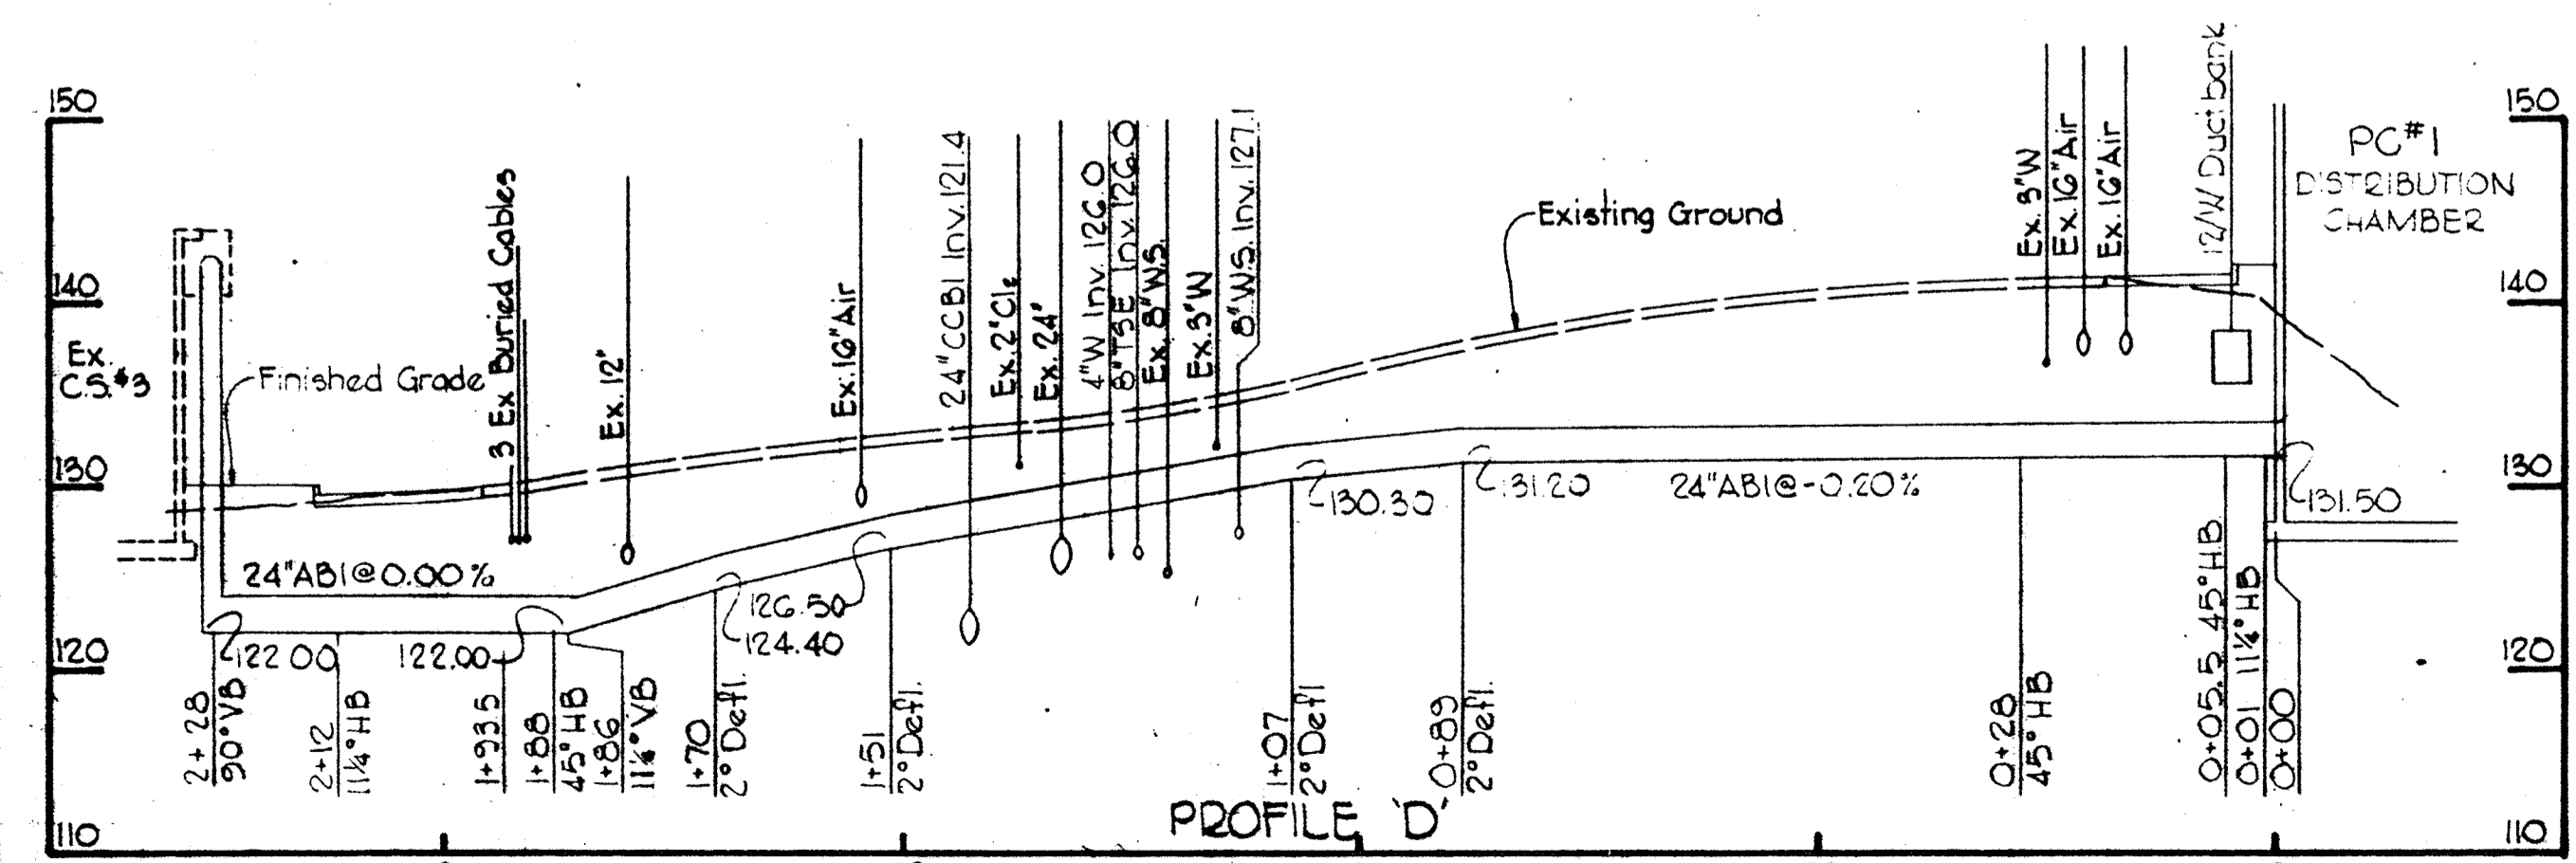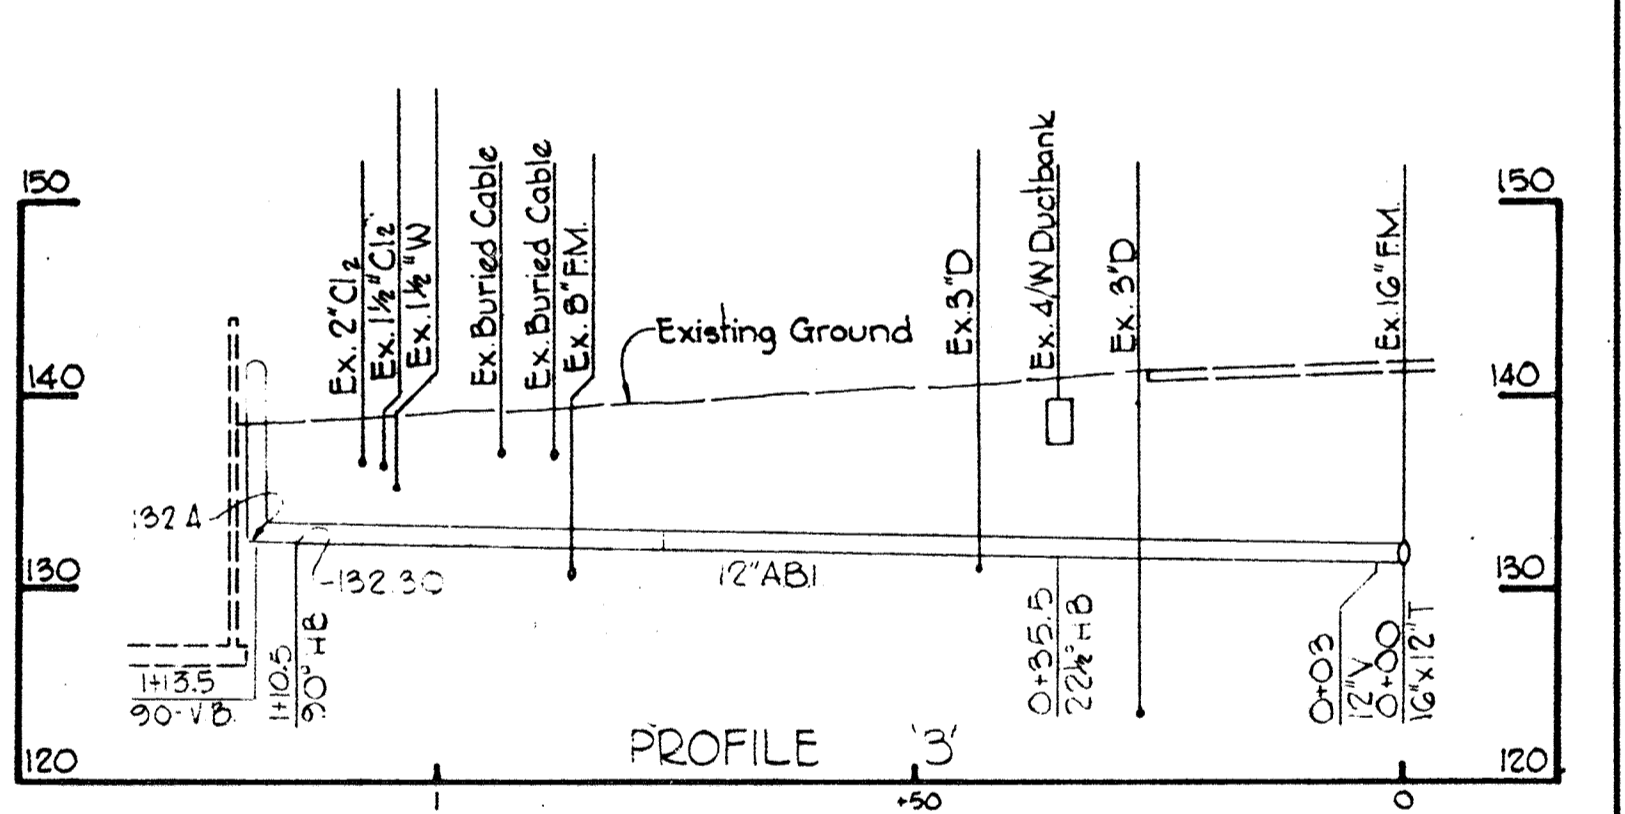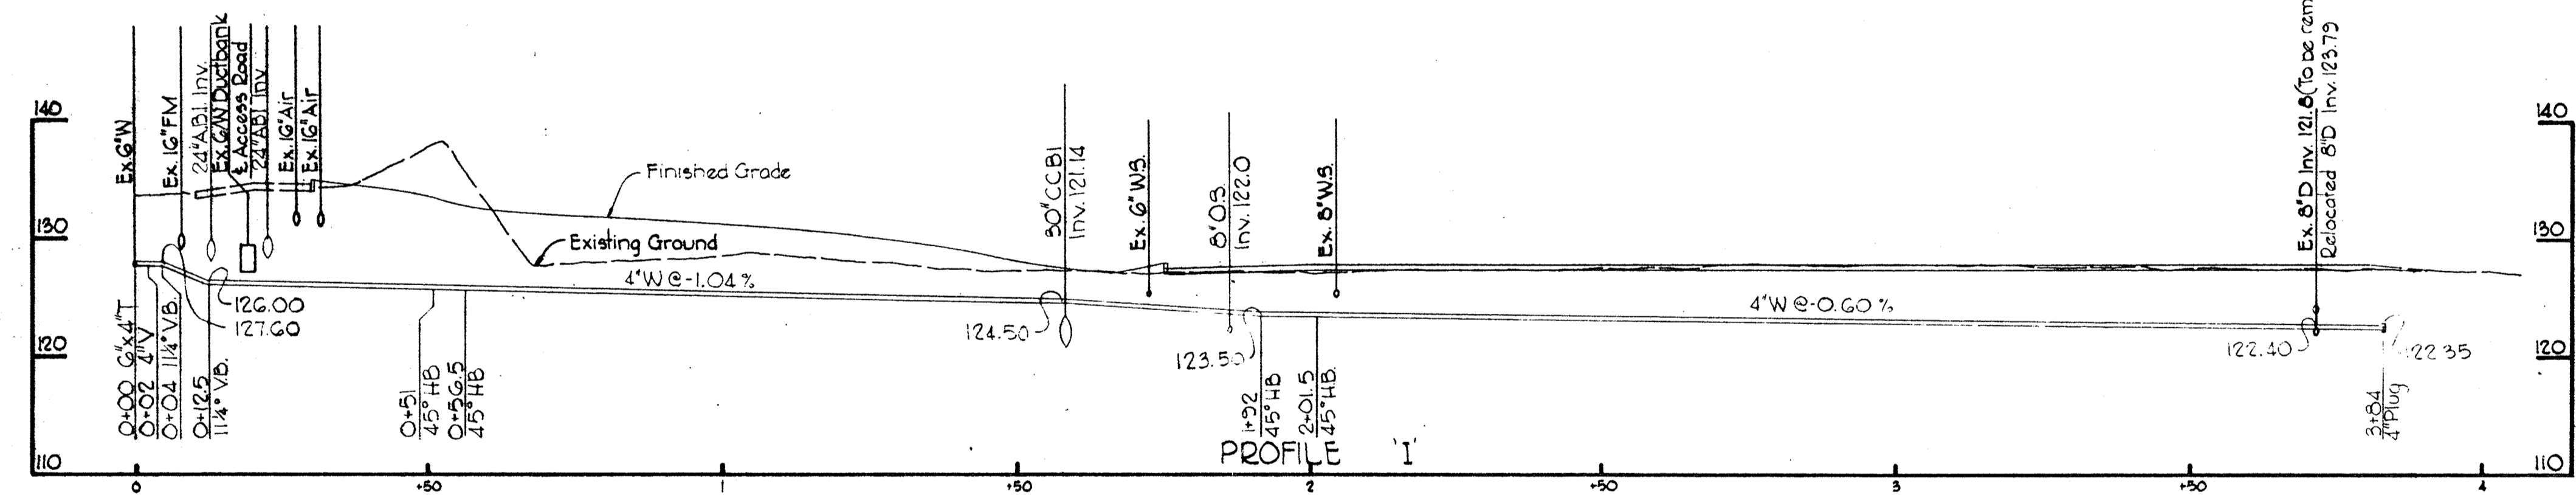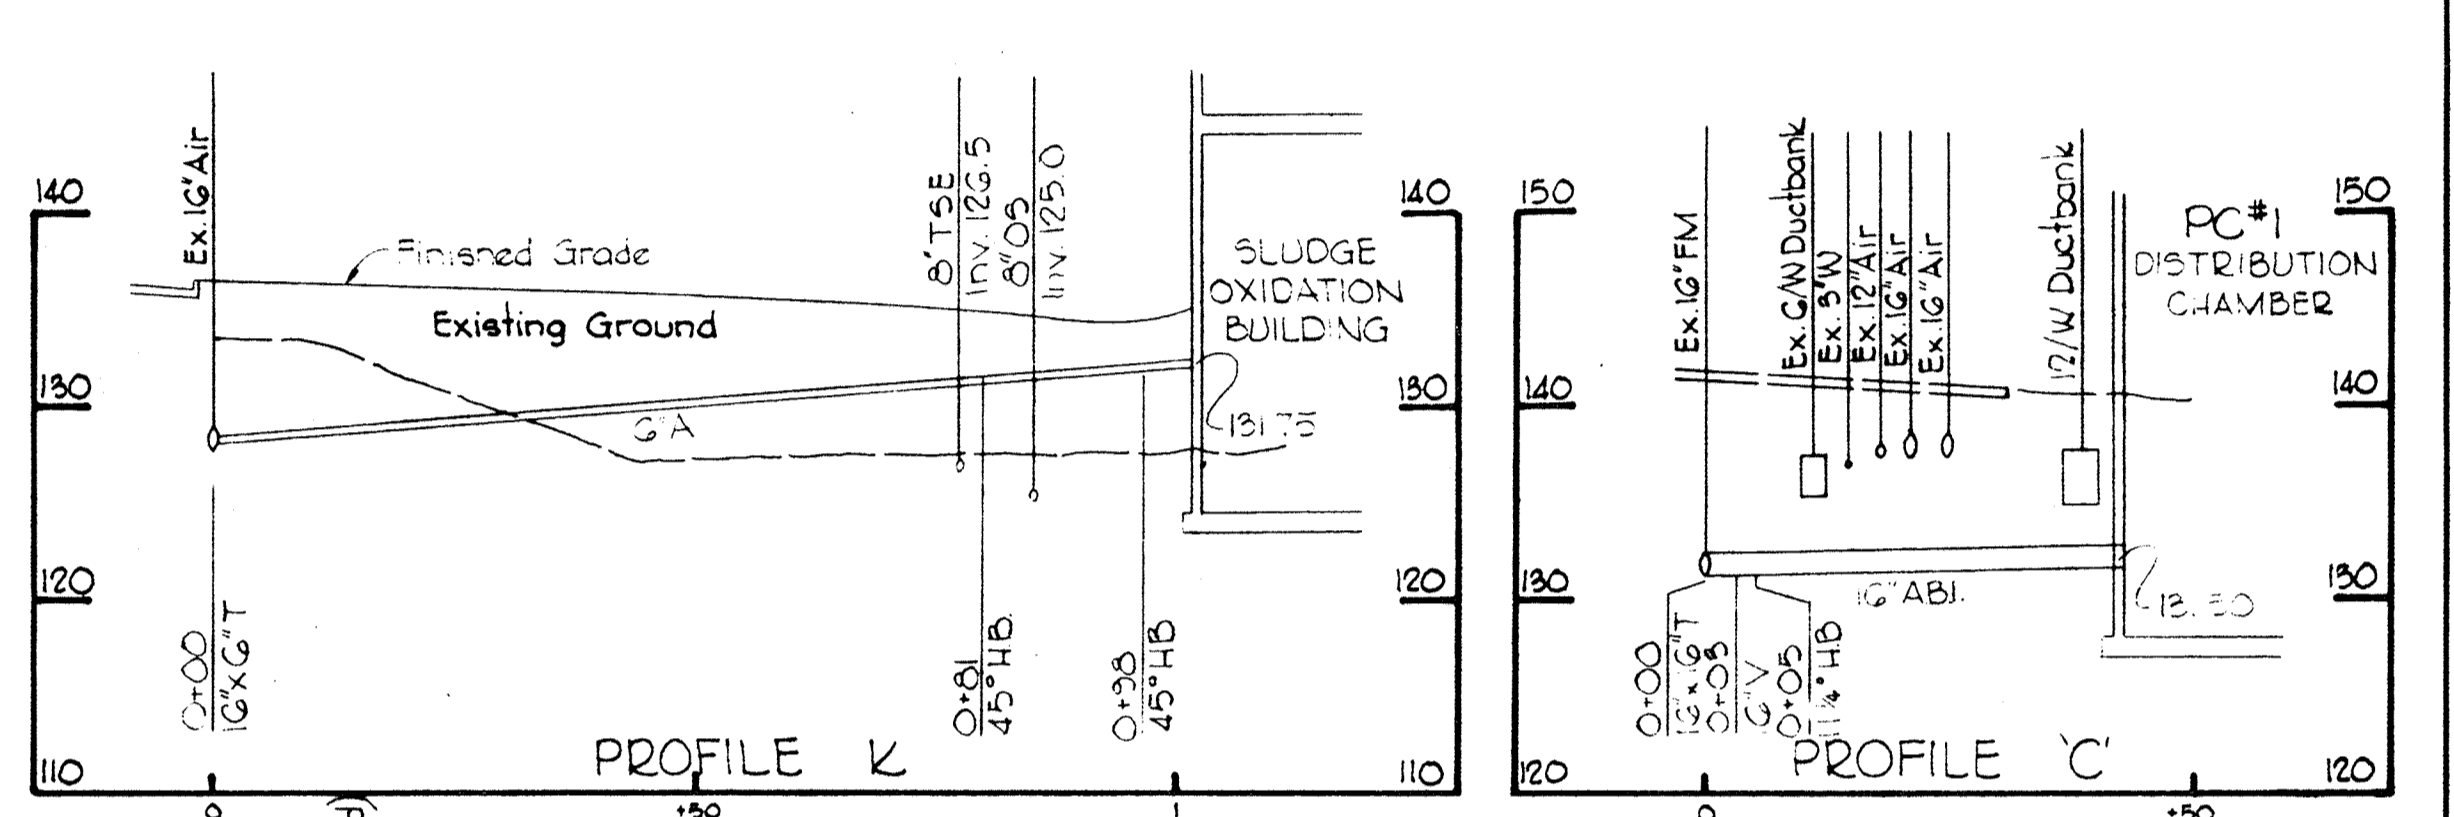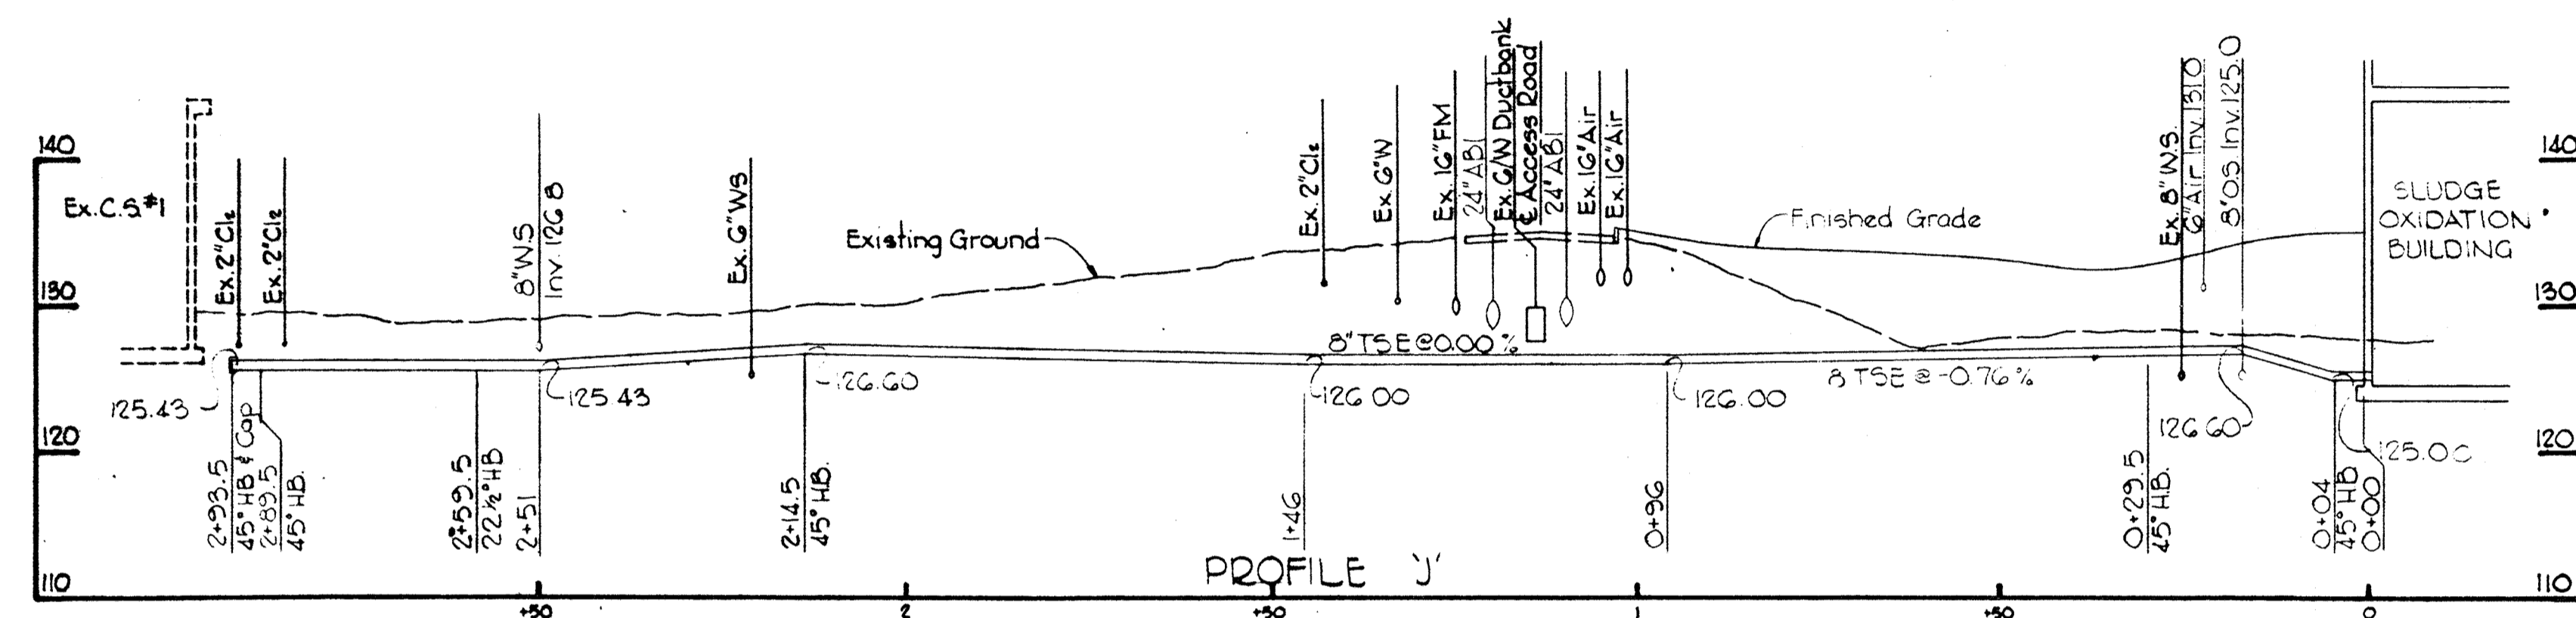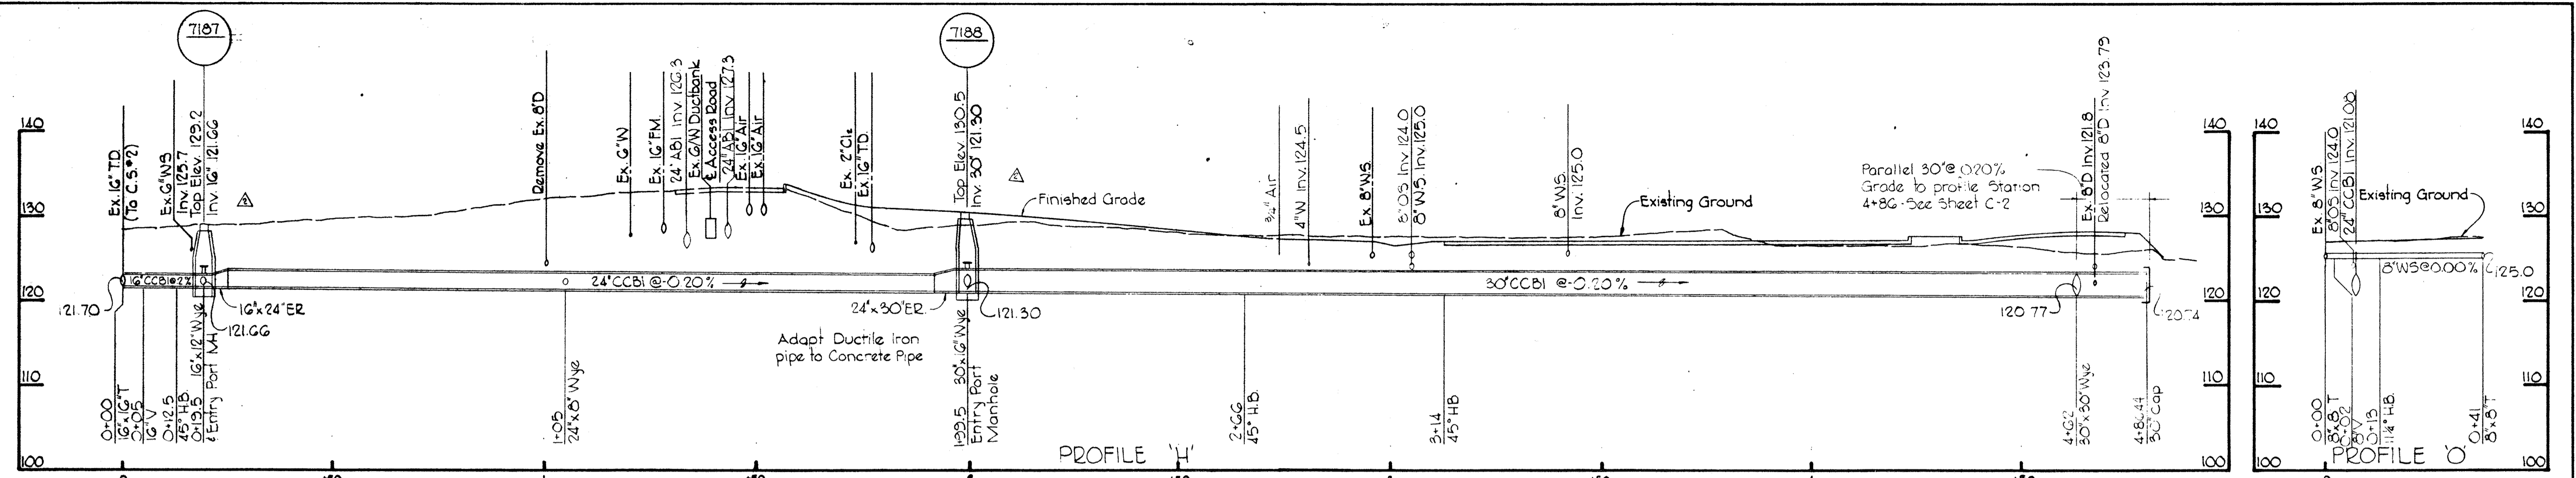

*Kenneth A. Milrod*

WHITMAN, REQUARDT & ASSOCIATES ENGINEERS 1304 ST. PAUL ST. BALTIMORE, MARYLAND	DEPARTMENT OF PUBLIC WORKS HOWARD COUNTY, MARYLAND DATE: 2/1/73 CHIEF - BUREAU OF ENGINEERING	CONTRACT NO. 525-S	PROFILES	SAVAGE WASTEWATER TREATMENT PLANT ADDITION NO. 3	DRAWING NO. 6 OF 28	SCALE H-1"=20' V-1"=10'
					Addendum A	

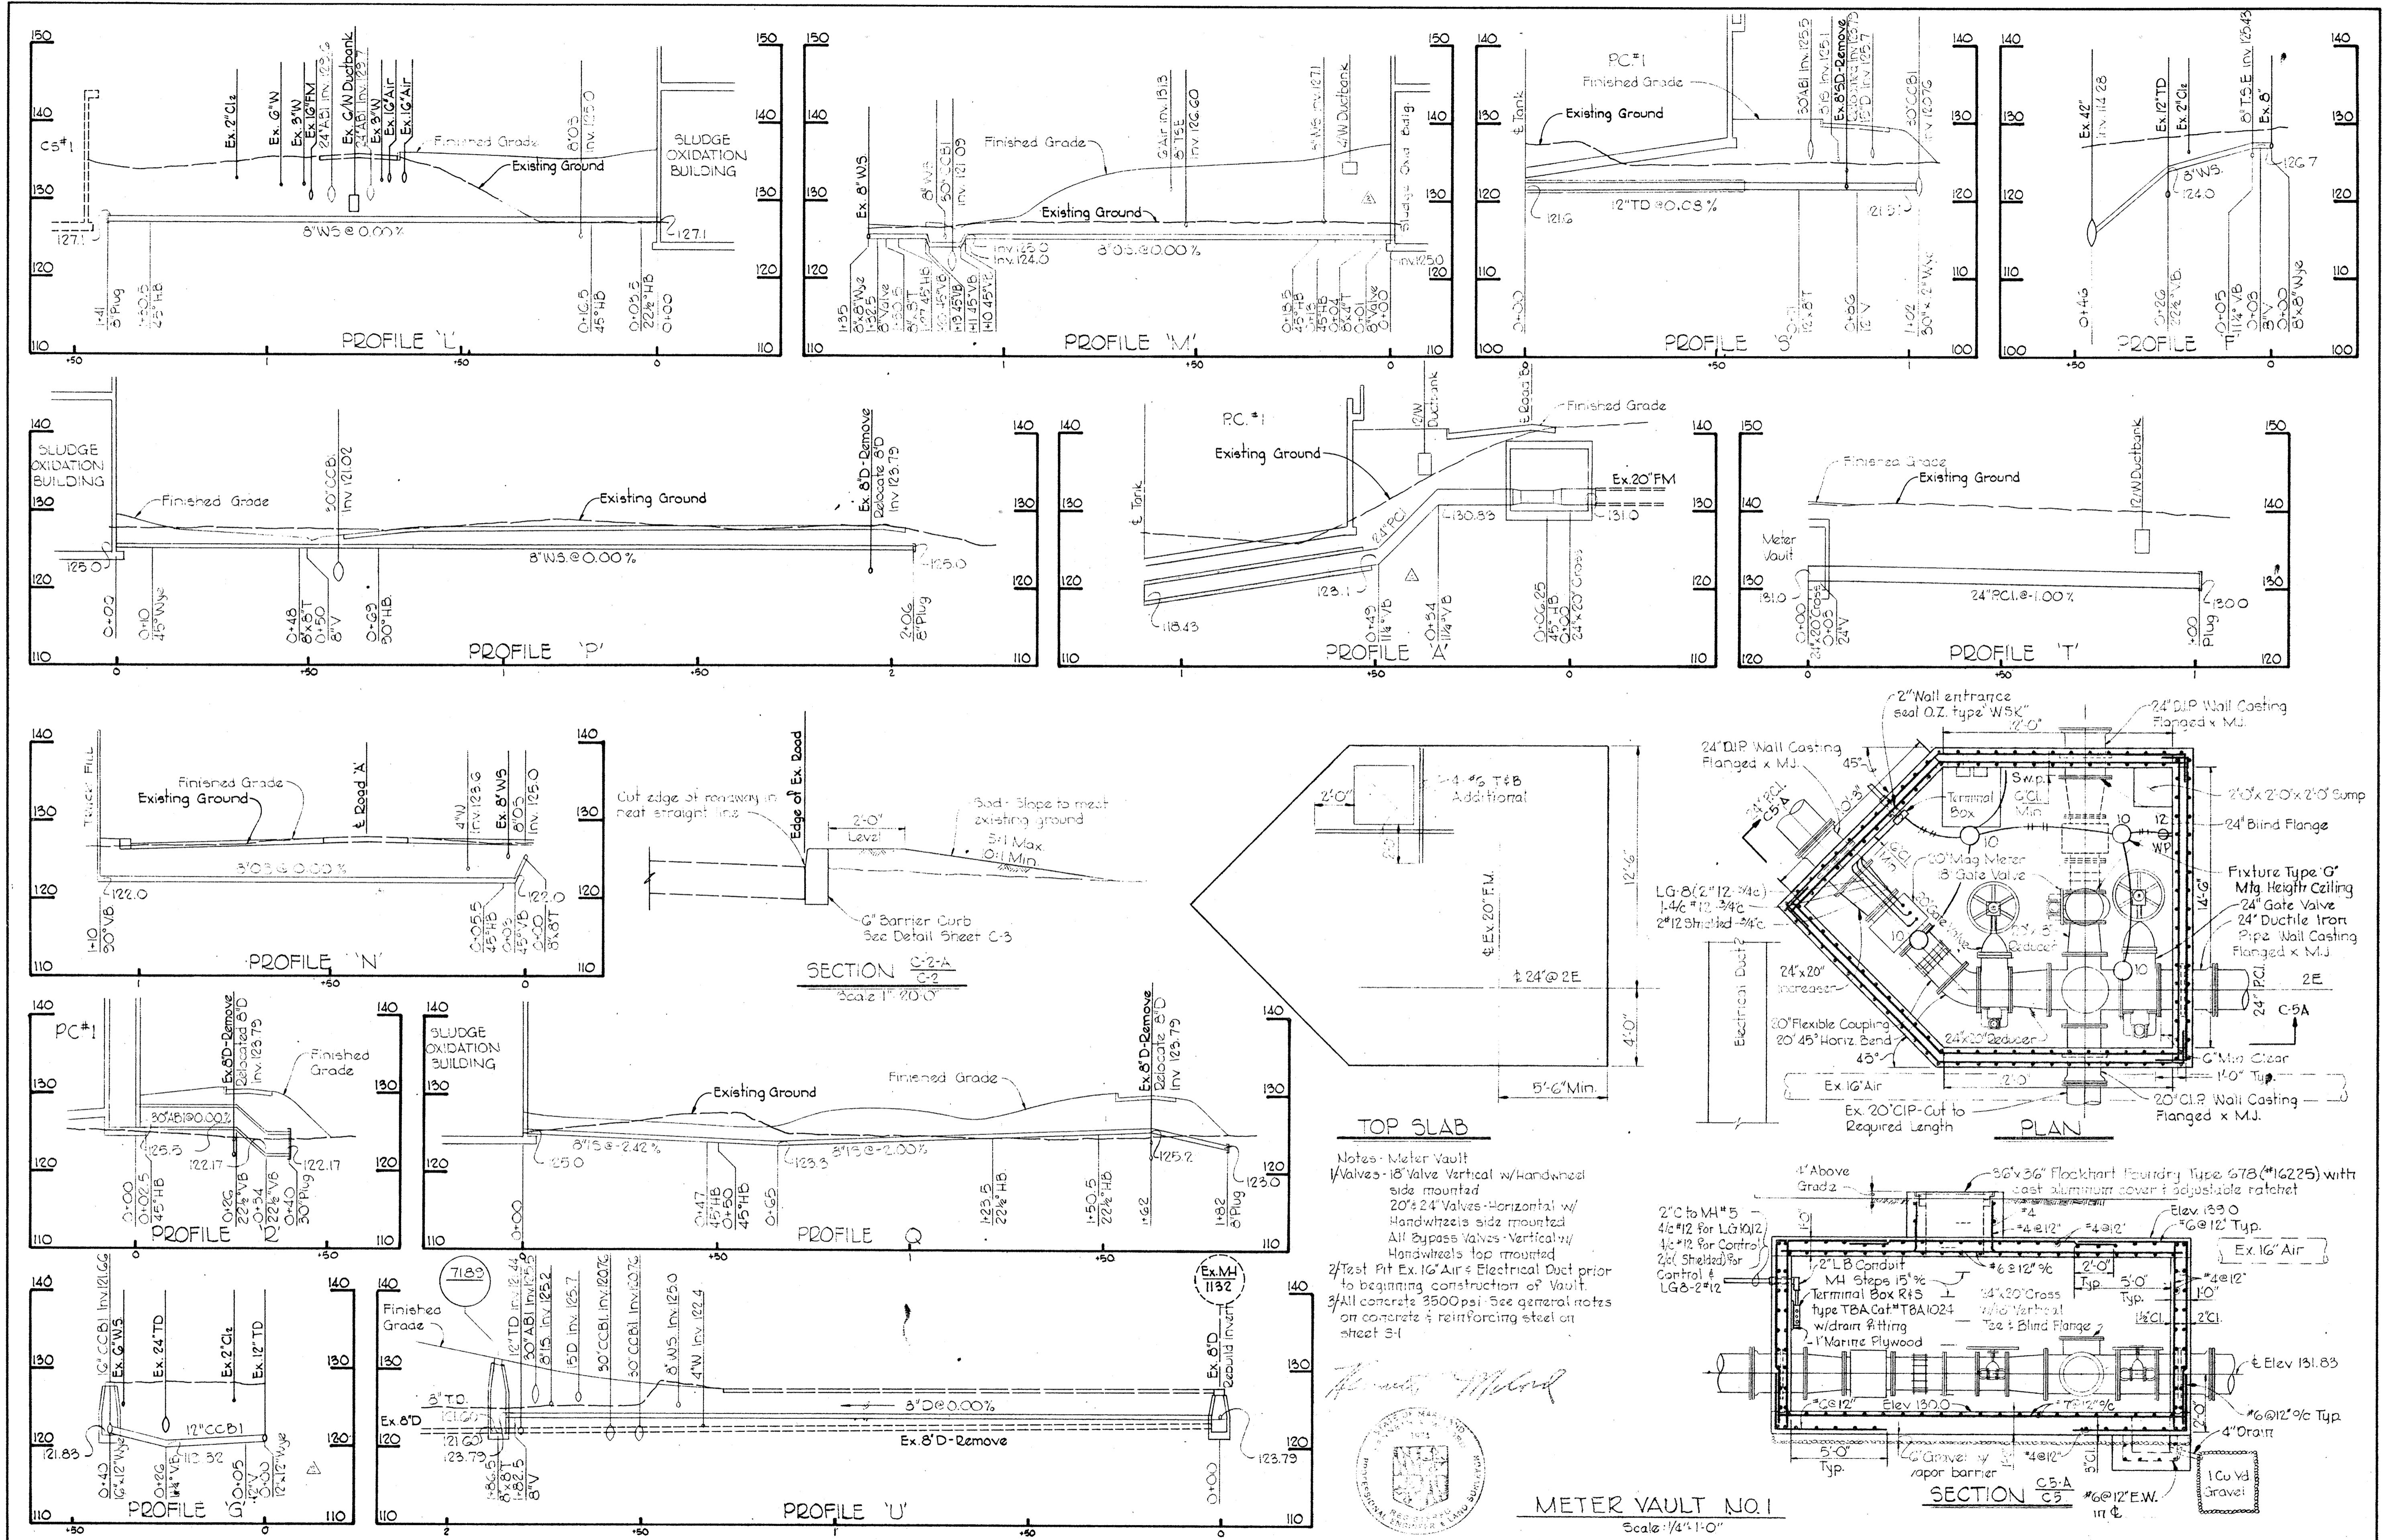

WHITMAN, REQUARDT & ASSOCIATES  
 ENGINEERS  
 1304 ST. PAUL ST.  
 BALTIMORE, MARYLAND

DEPARTMENT OF PUBLIC WORKS  
 HOWARD COUNTY, MARYLAND  
 DATE 2/1/73  
 W. O. Whitman  
 CHIEF - BUREAU OF ENGINEERING

CONTRACT NO. 525-S

DETAILS AND PROFILES


SAVAGE WASTEWATER  
 TREATMENT PLANT ADDITION NO. 3

DRAWING NO. 7 OF 28  
 SCALE AS SHOWN  
 SHEET C-5

W. O. 6538-2

Addendum A

BRUNING 44510 14778

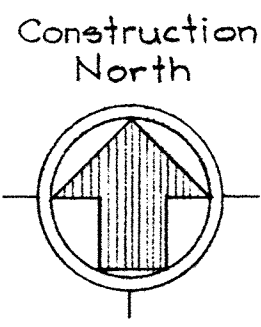


- NOTES:**
- Where base is concrete, it shall be painted
  - Except where concrete occurs it shall be painted
  - Glazed Concrete Masonry Units shall be Spectra-Glaza or Decor-Glaza or an approved equal


FINISH SCHEDULE					
Room	F/C	Floor	Base	Wall	Ceiling
Chlorine Room	F/C	CFH	CCMU	CCMU	Conc
Sludge Operations Rm	F/C	CFH	CCMU	CCMU	Conc
Chamber #1	F/C	Conc	Conc	Conc	Conc
Chamber #2	F/C	Conc	Conc	Conc	Conc
Chamber #3	F/C	Conc	Conc	Conc	Conc
Chamber #4	F/C	Conc	Conc	Conc	Conc

- ABBREVIATIONS:**
- F - Finish
  - C - Color
  - CFH - Clear Floor Hardener
  - Conc - Concrete
  - CCMU - Concrete Masonry Unit
  - S.C.M.U. - Glazed Concrete Masonry Unit (3)
  - P - Painted


Note: All Dimension On Curved Surfaces Are Measured On The Arc At The Face Of Brick

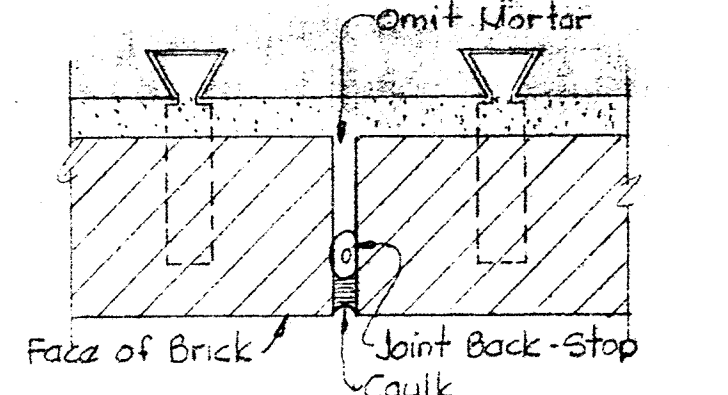

**CONTROL JOINT DETAIL A-1-D**  
Scale: 3/8" = 1'-0"

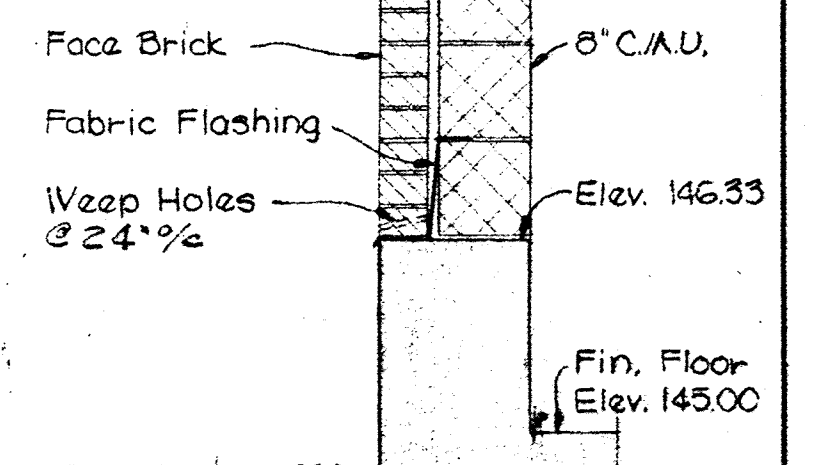


**SECTION A-1-C**  
Scale: 3/8" = 1'-0"

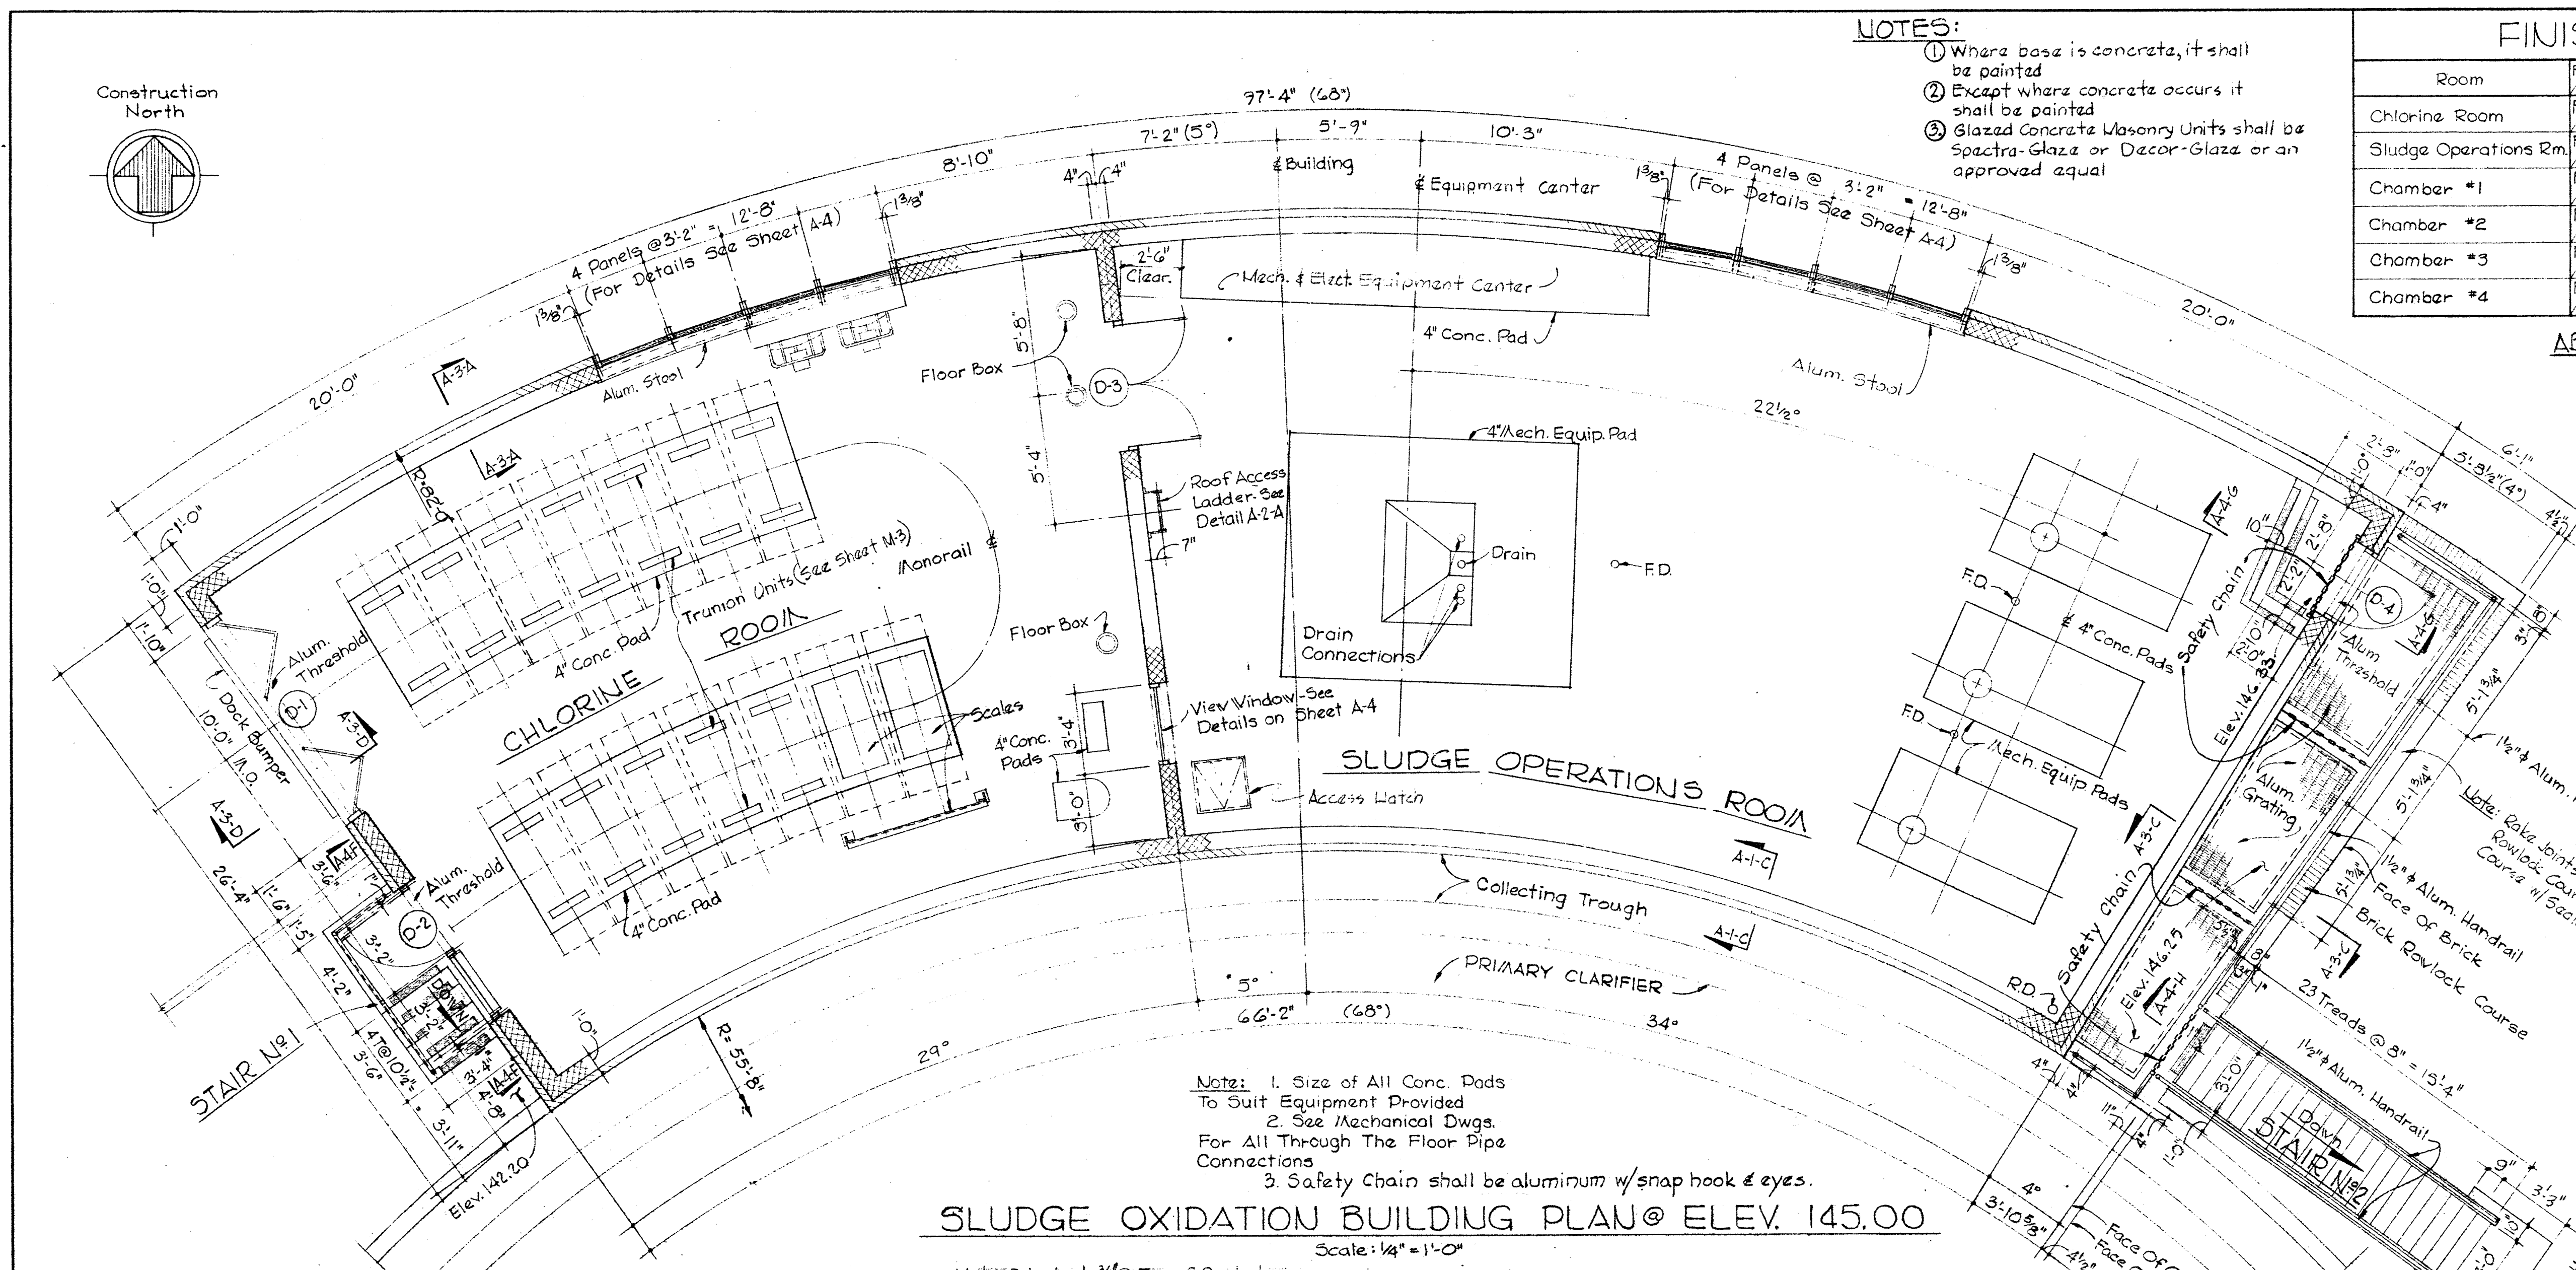


- Notes:**
- Size of All Conc. Pads To Suit Equipment Provided
  - See Mechanical Dwg. For All Through The Floor Pipe Connections
  - Safety Chain shall be aluminum w/ snap hook & eyes.


**SLUDGE OXIDATION BUILDING PLAN @ ELEV. 145.00**  
Scale: 1/8" = 1'-0"

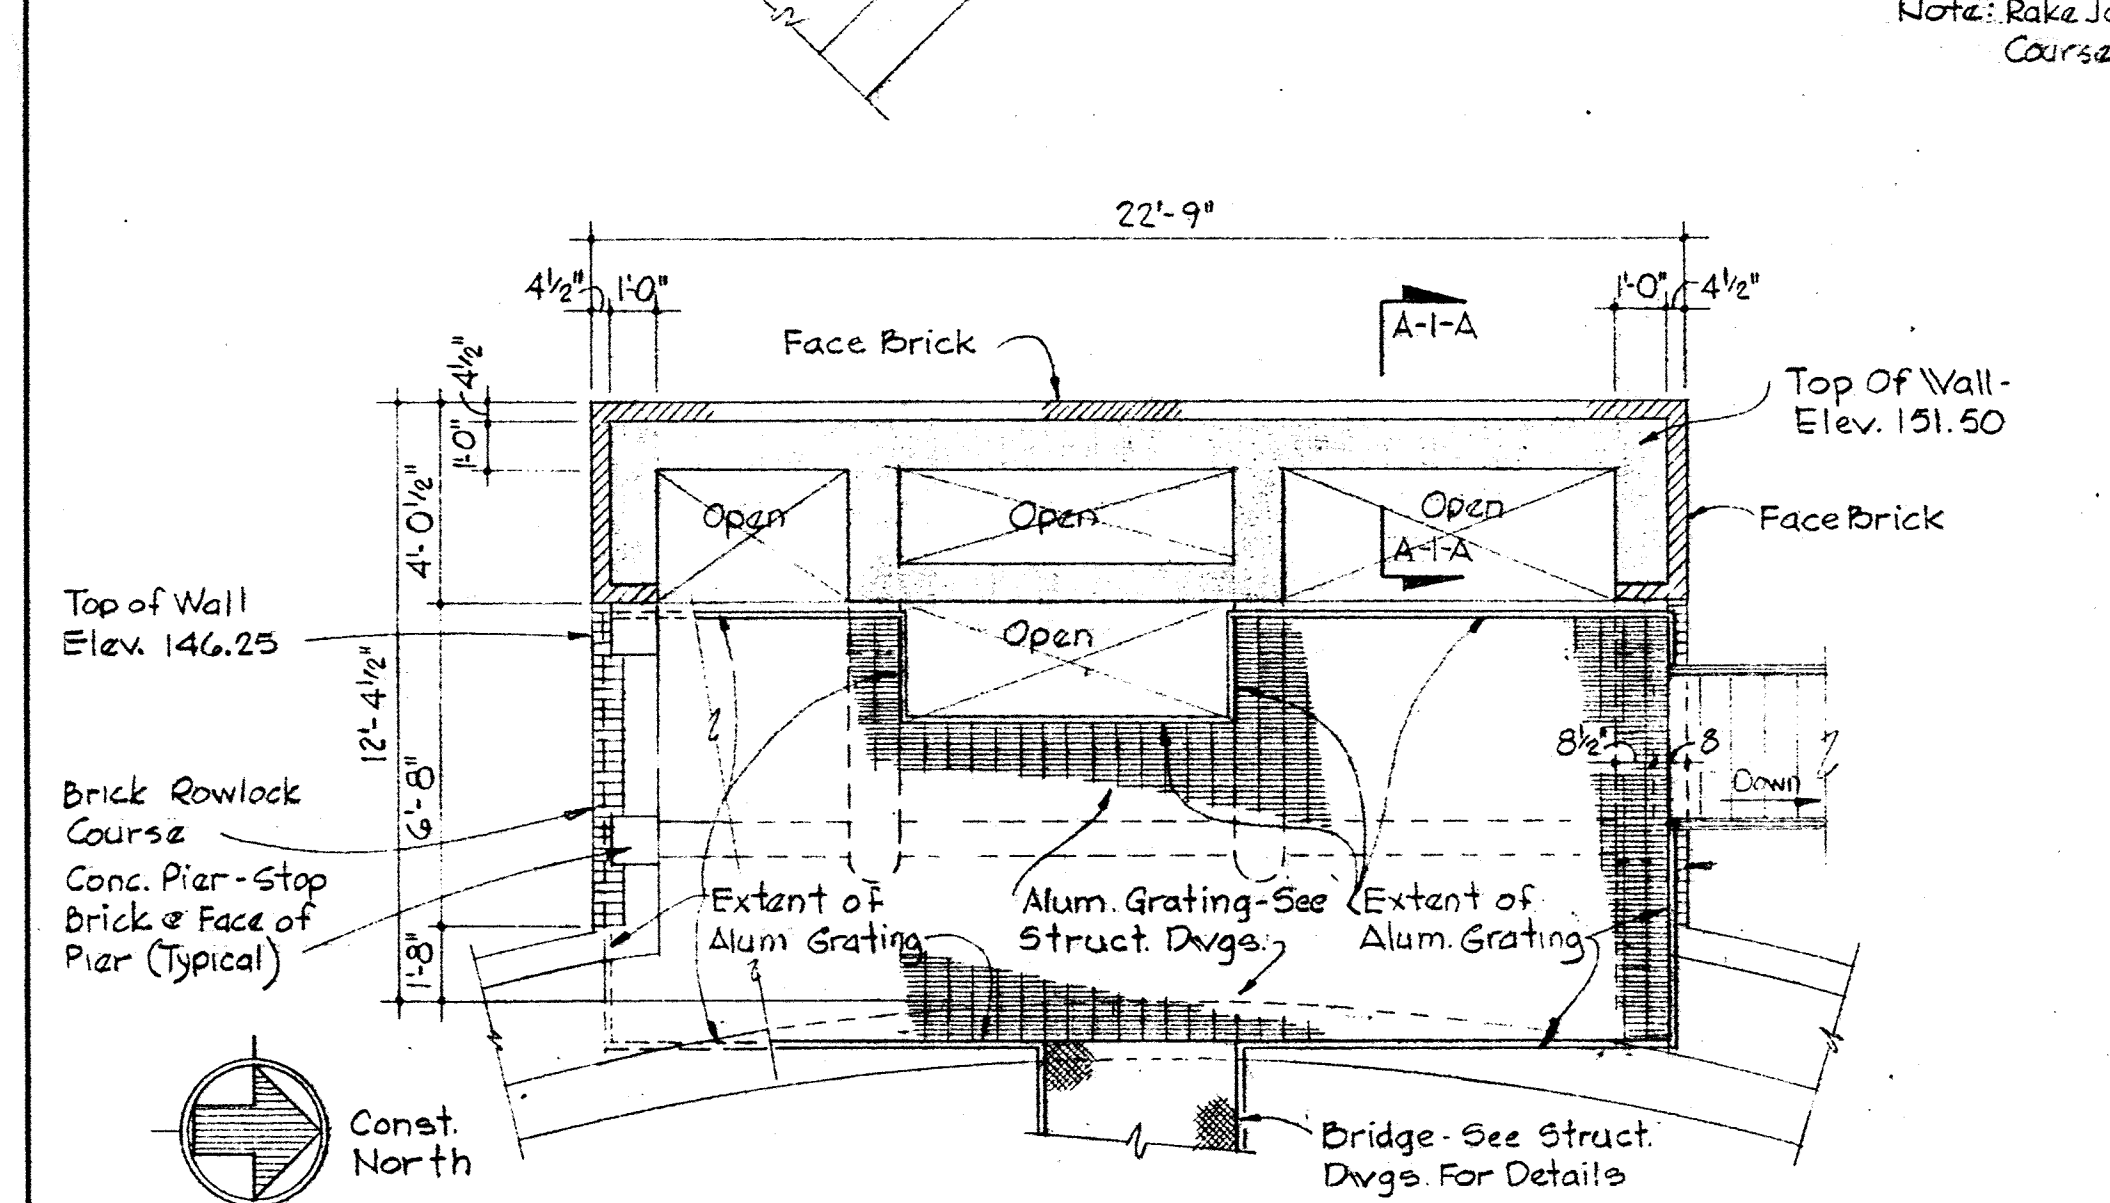

**PLAN @ ELEV. 150.00 - EFFLUENT CHAMBER NO. 2**  
Scale: 1/4" = 1'-0"

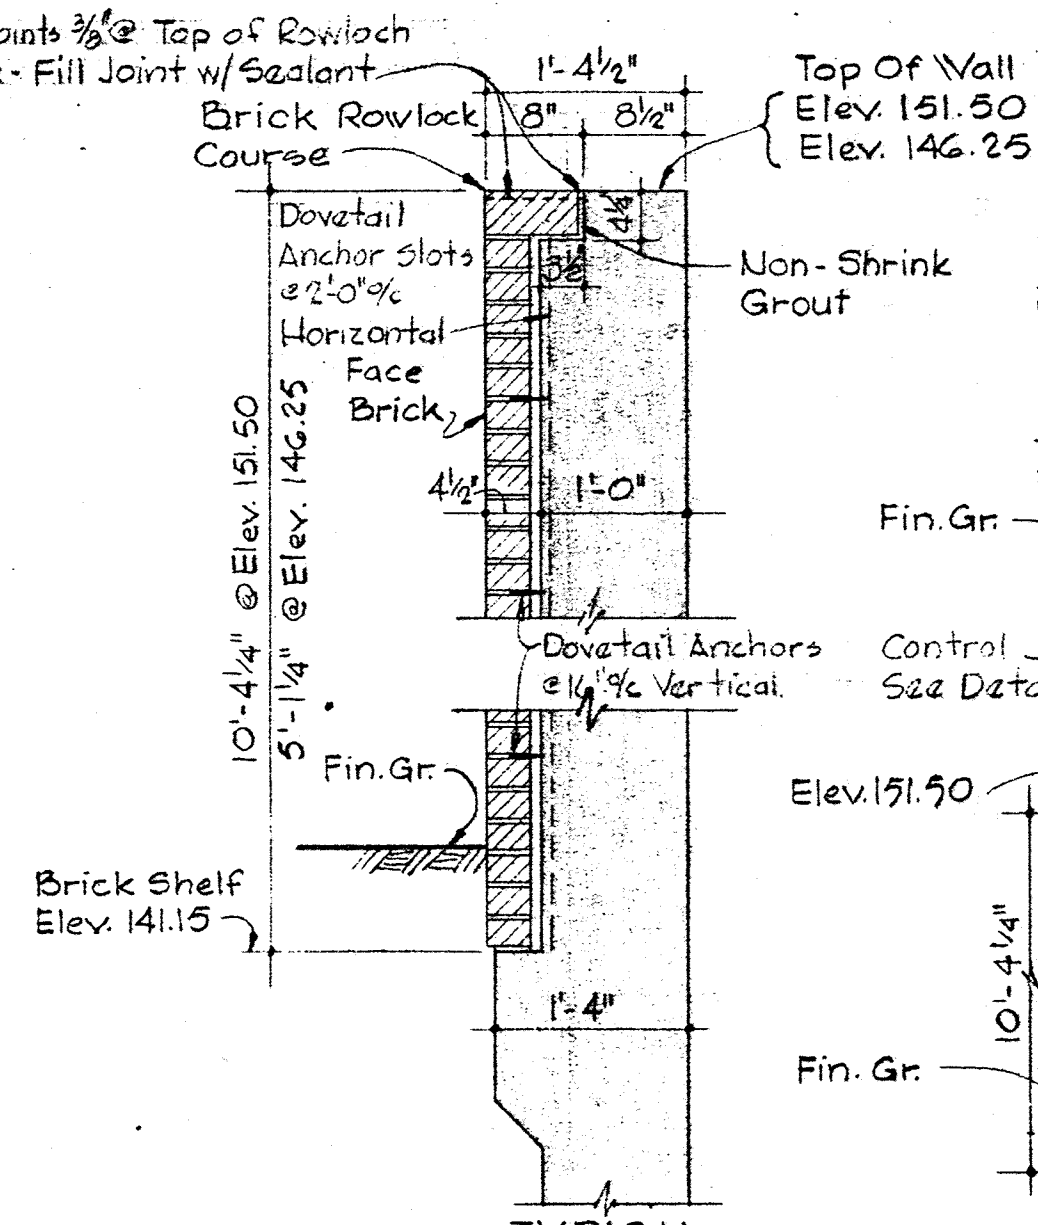


**TYPICAL SECTION A-1-A**  
Scale: 3/4" = 1'-0"

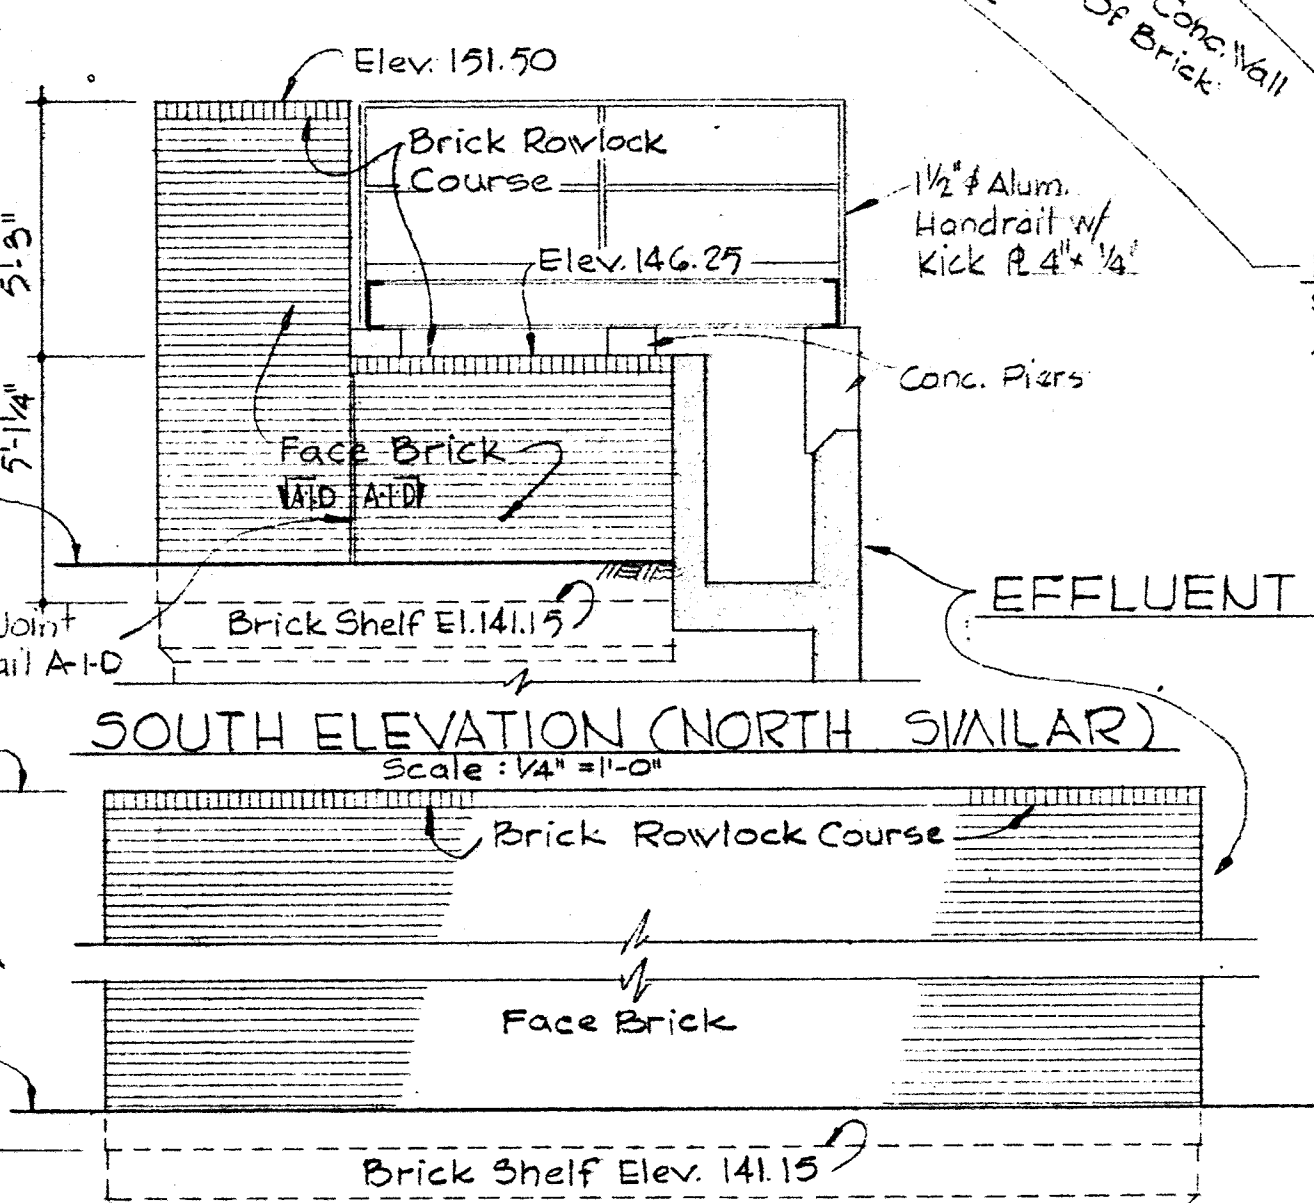

**SOUTH ELEVATION (NORTH SIMILAR)**  
Scale: 1/4" = 1'-0"

**WEST ELEVATION**  
Scale: 1/4" = 1'-0"

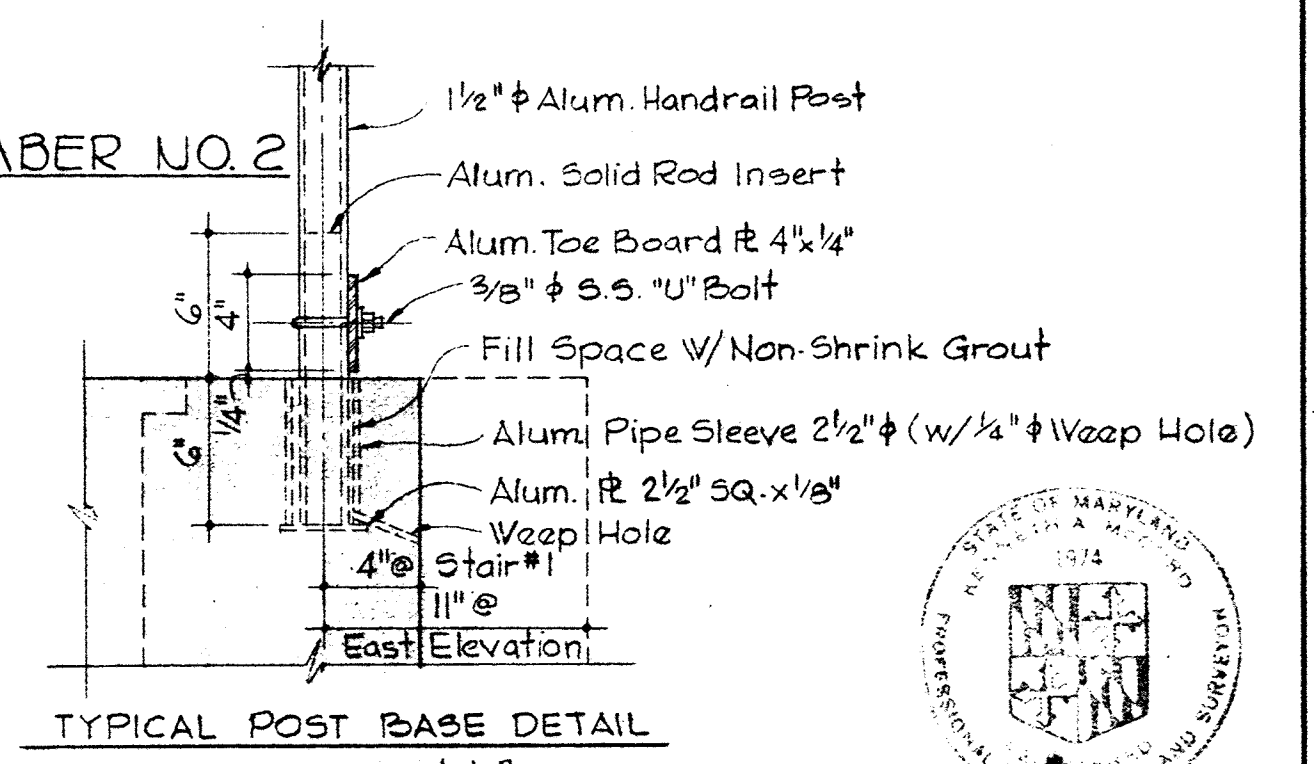

**TYPICAL POST BASE DETAIL**  
Scale: 1/2" = 1'-0"

WHITMAN, REQUARDT & ASSOCIATES  
ENGINEERS  
1304 ST. PAUL ST.  
BALTIMORE, MARYLAND

DEPARTMENT OF PUBLIC WORKS  
HOWARD COUNTY, MARYLAND  
2/1/73  
DATE

CONTRACT NO. 525-S













SLUDGE OXIDATION BUILDING  
PLAN AND SCHEDULES

SAVAGE WASTEWATER  
TREATMENT PLANT ADDITION NO. 3


DRAWING NO. 8 OF 28

SCALE AS SHOWN  
SHEET A-1



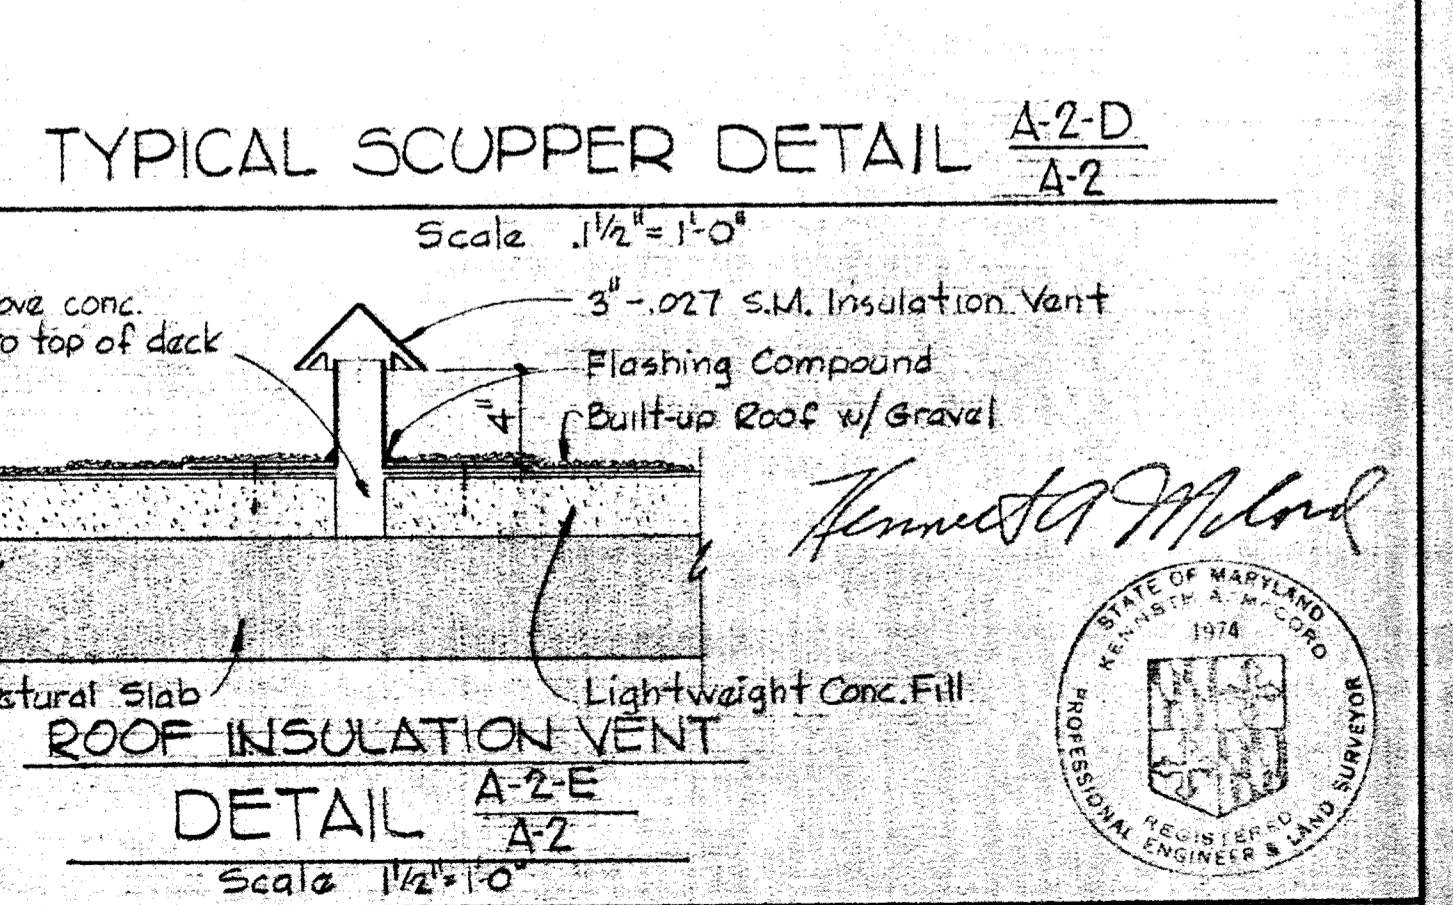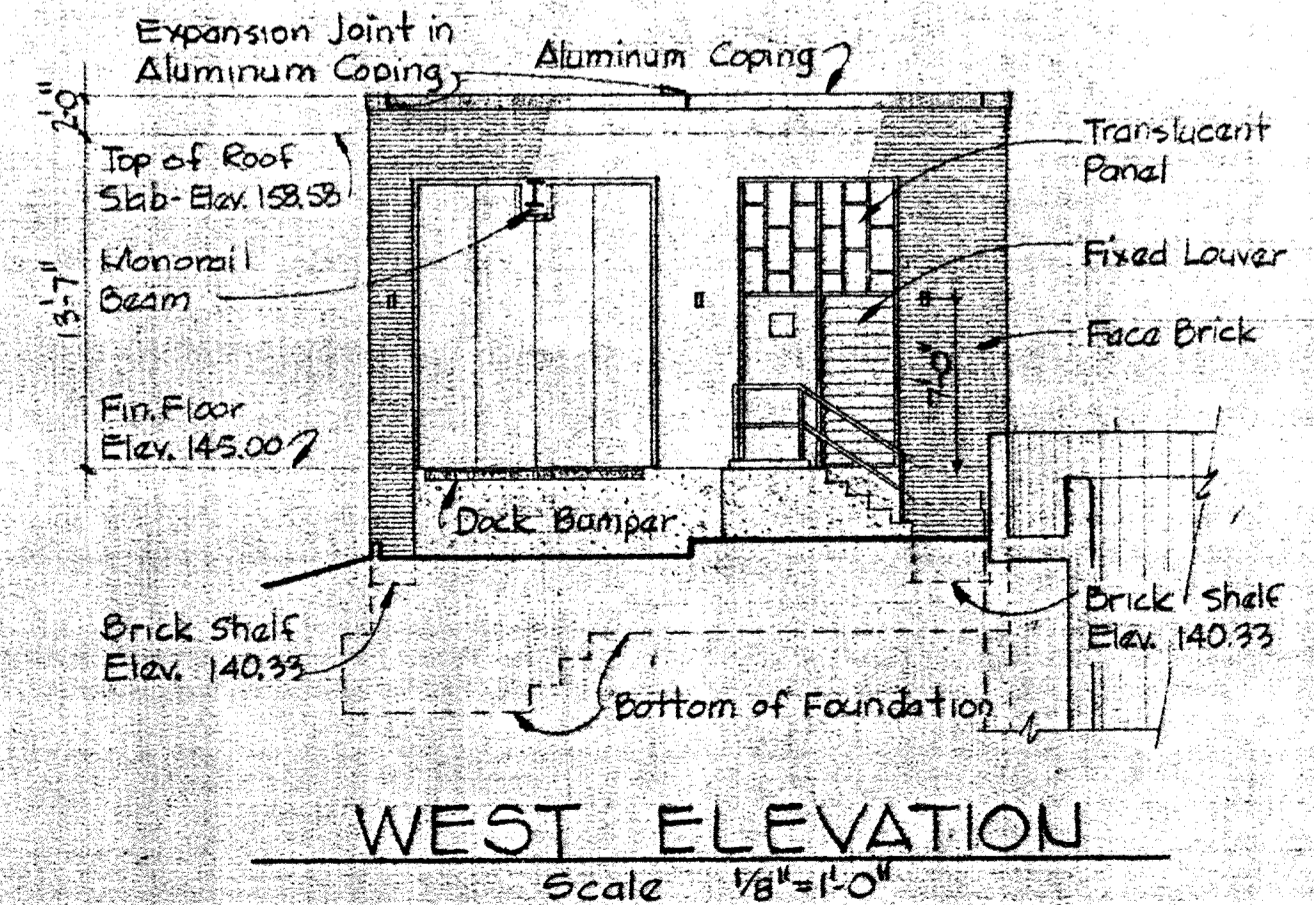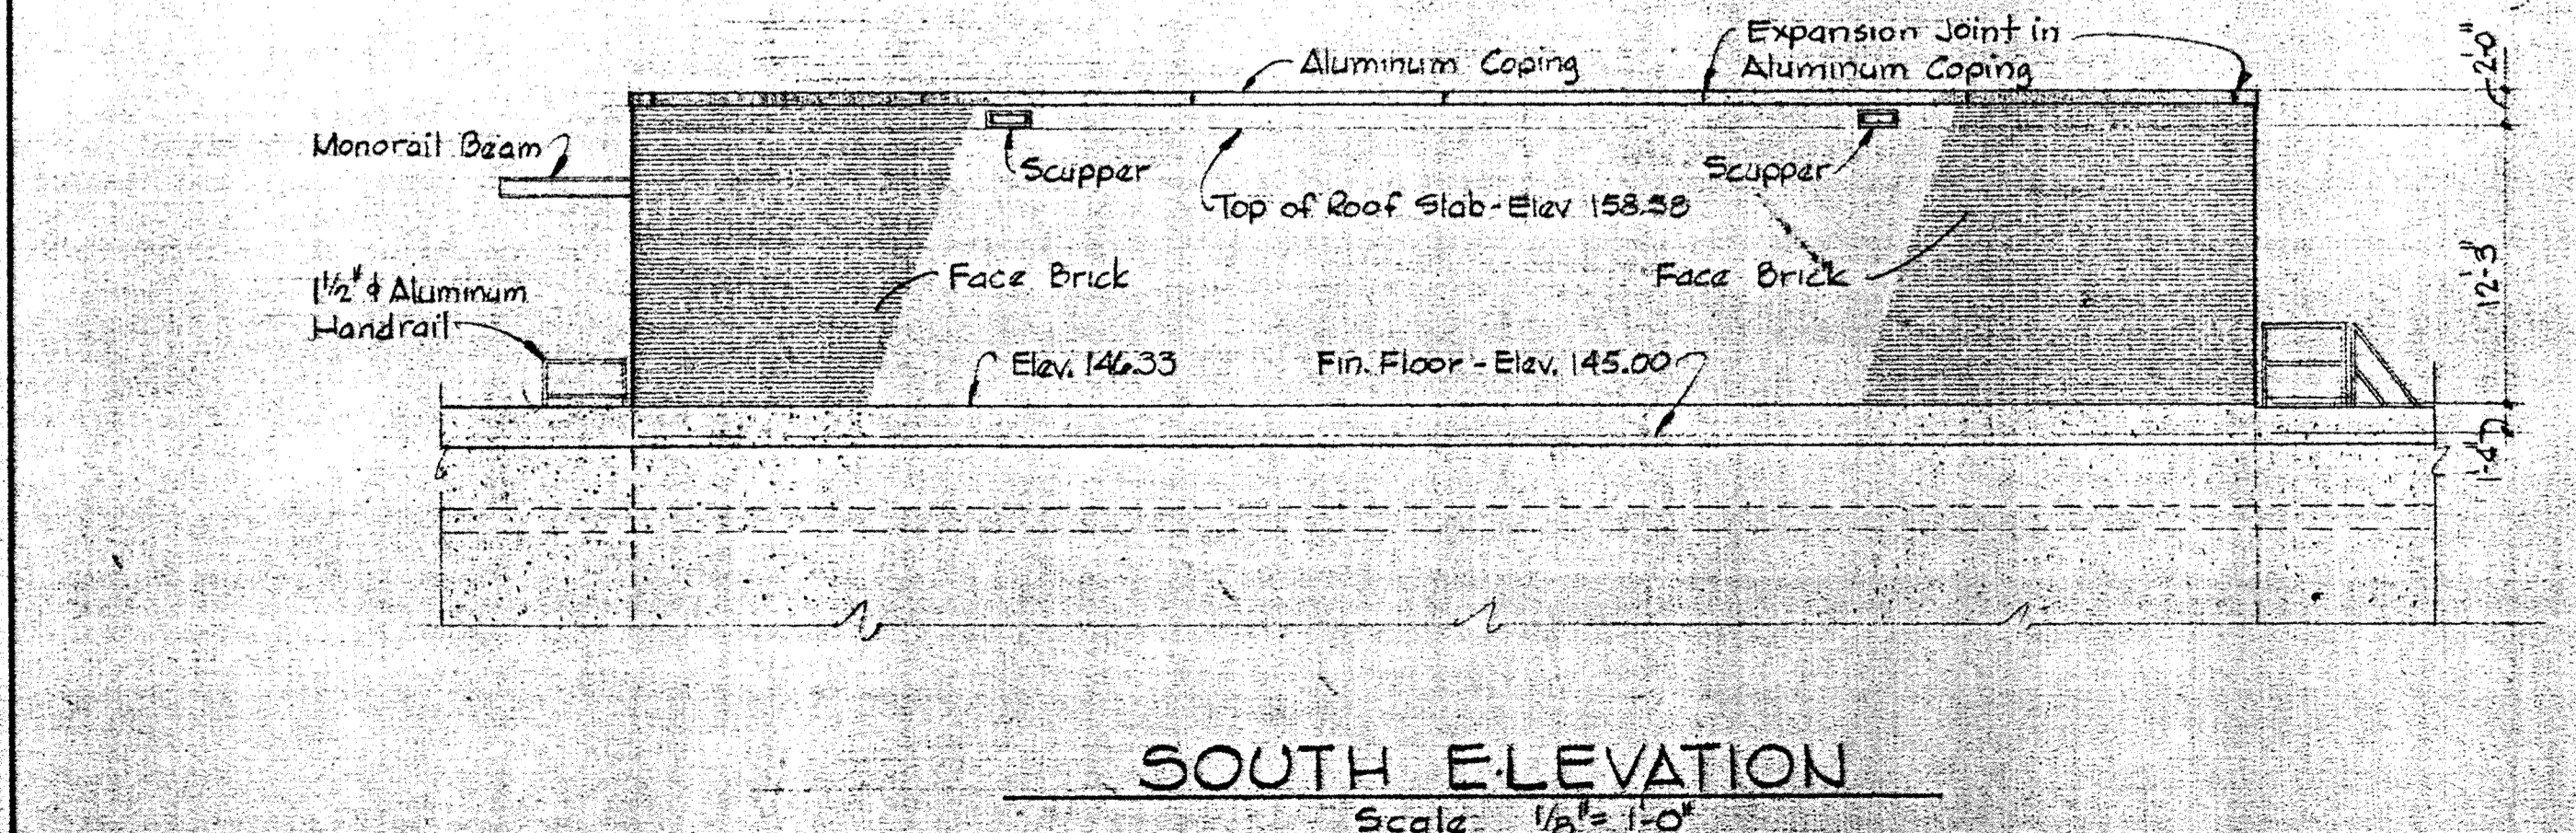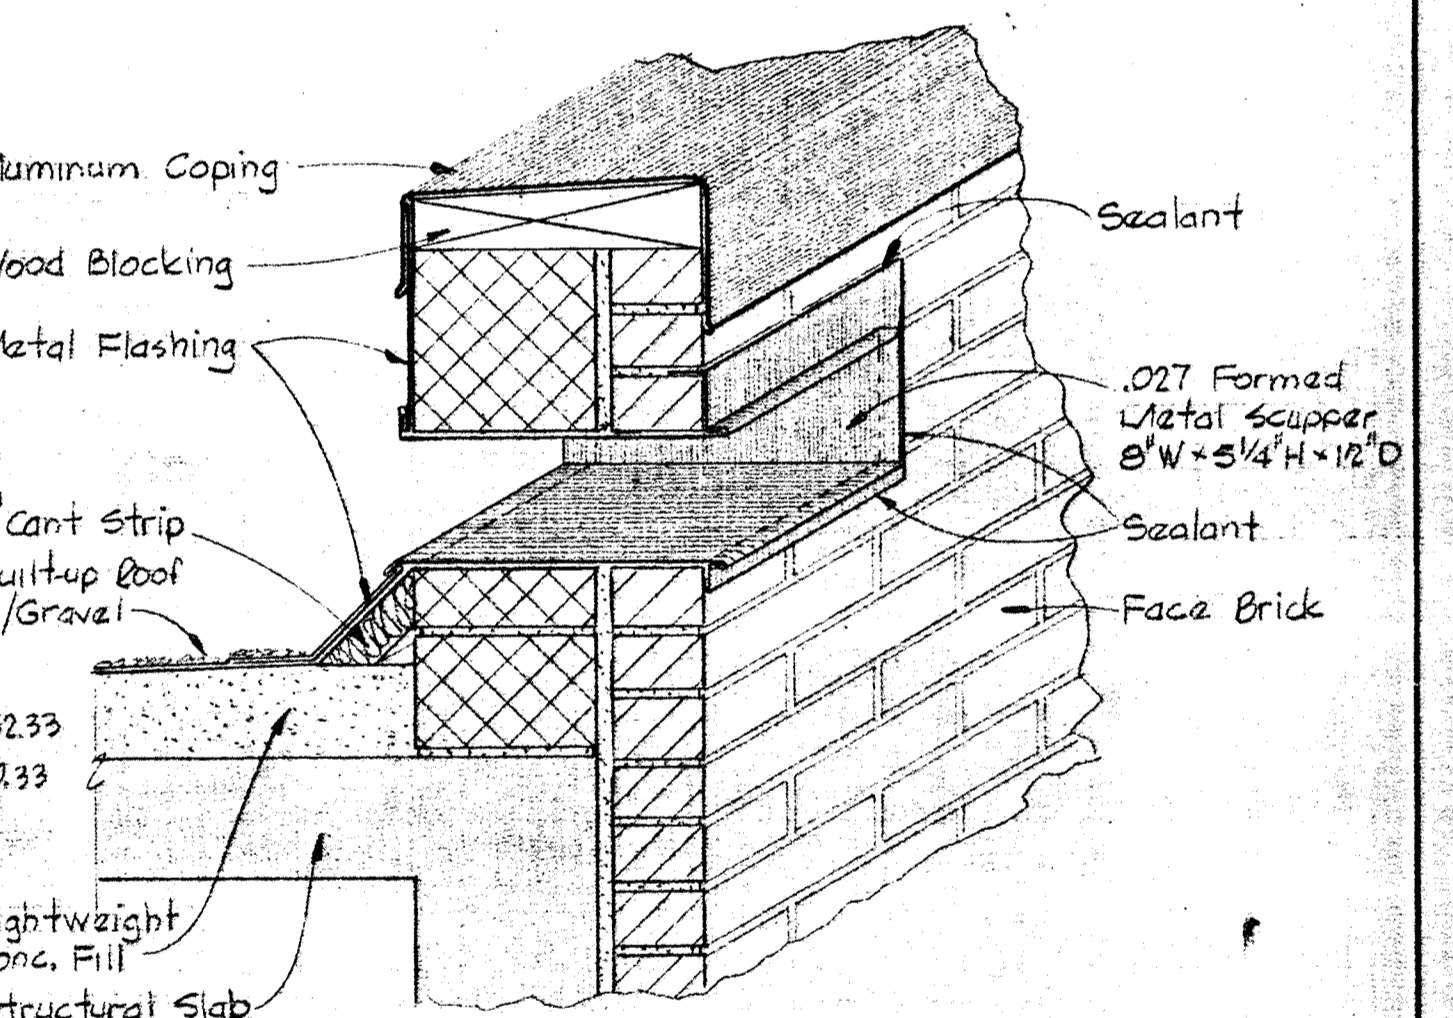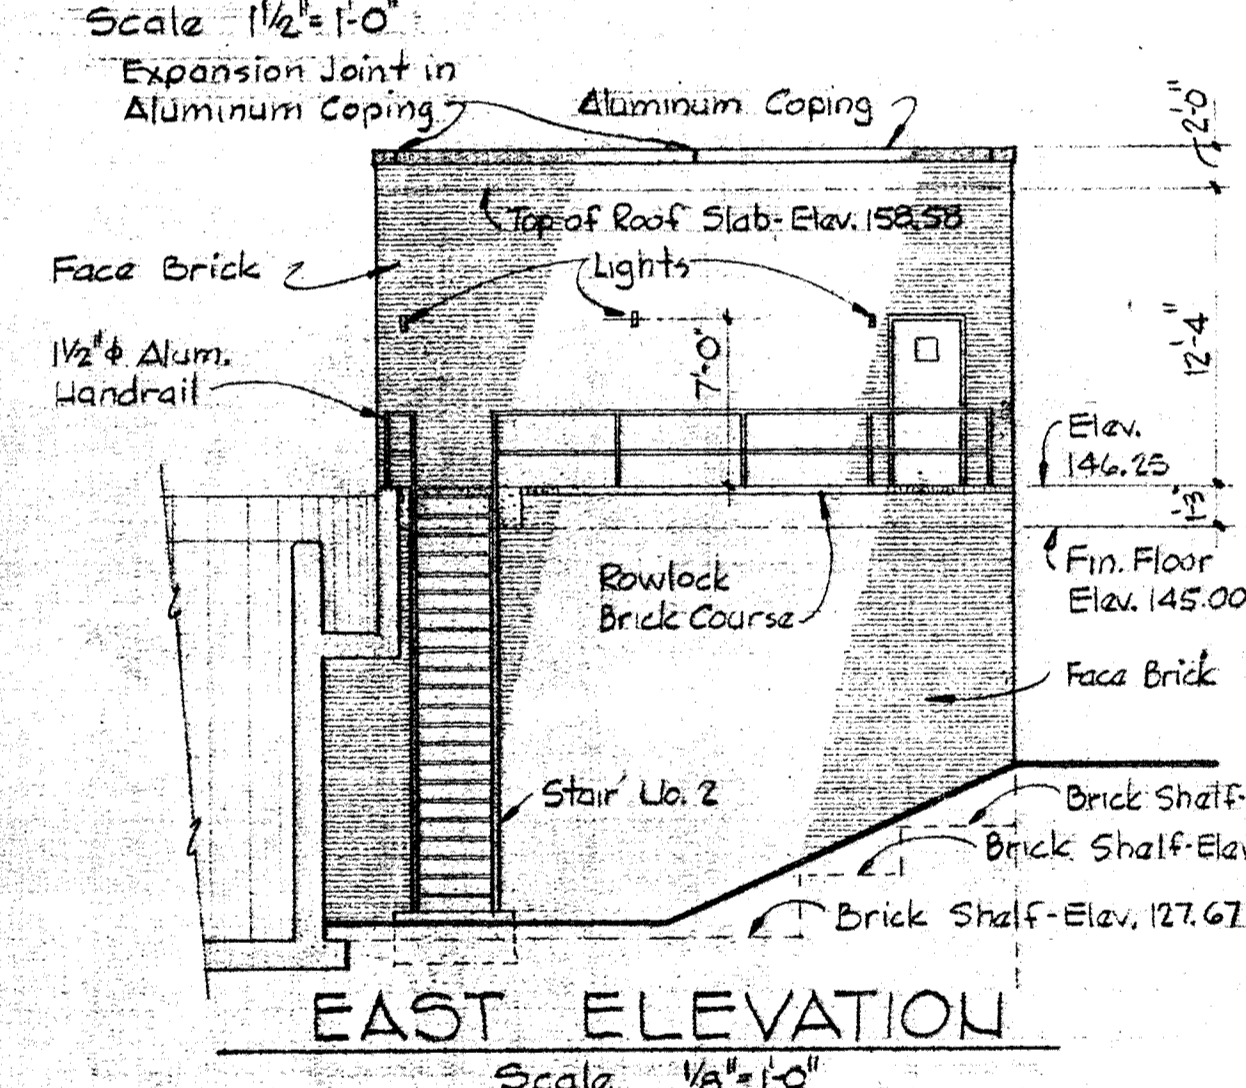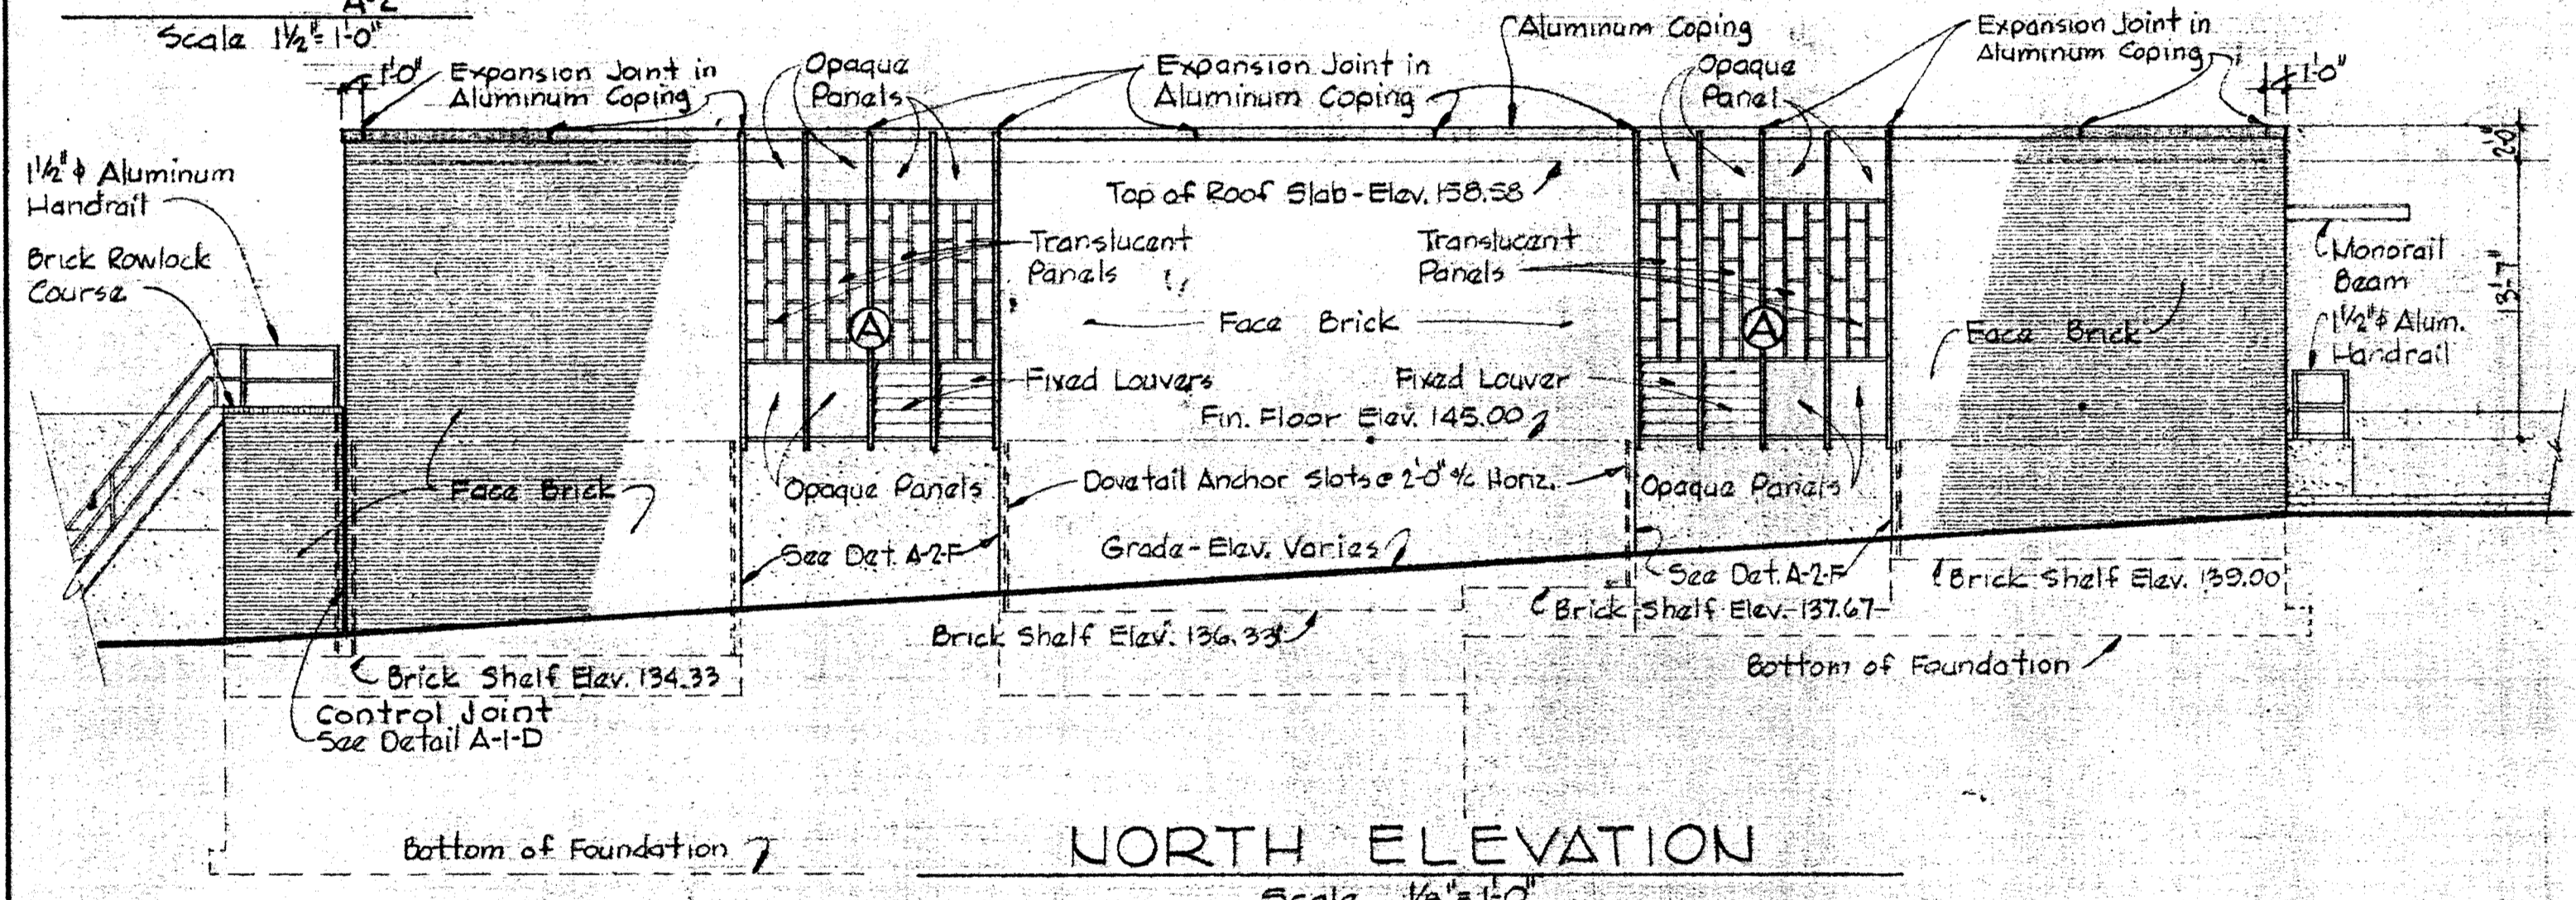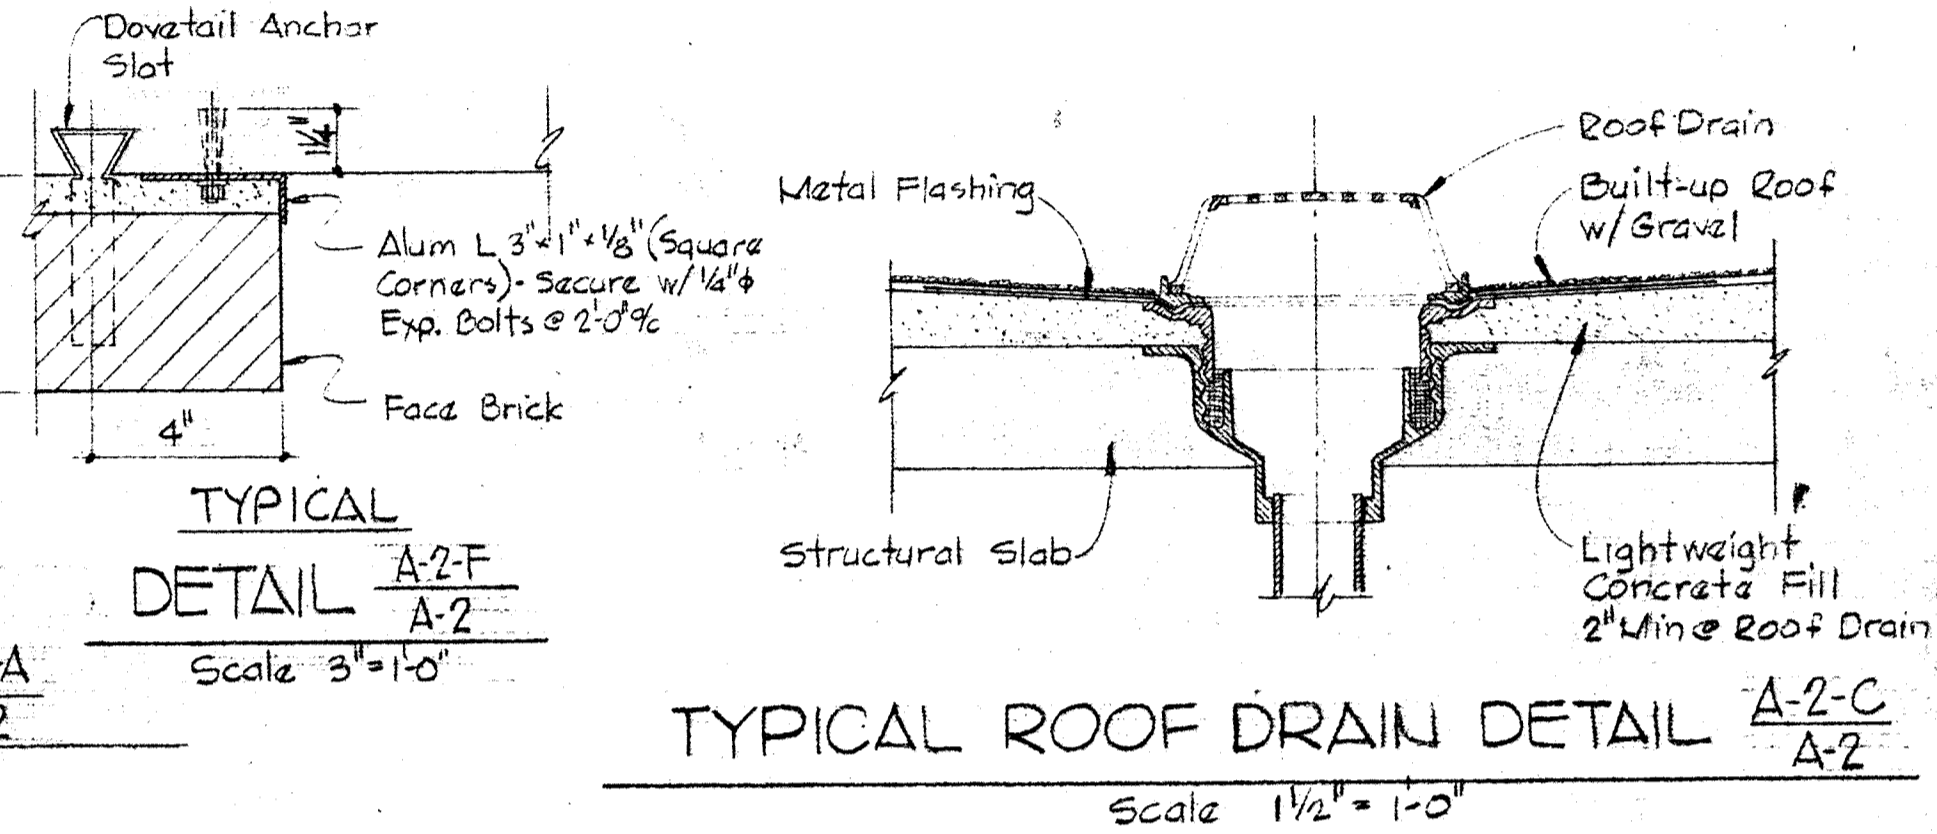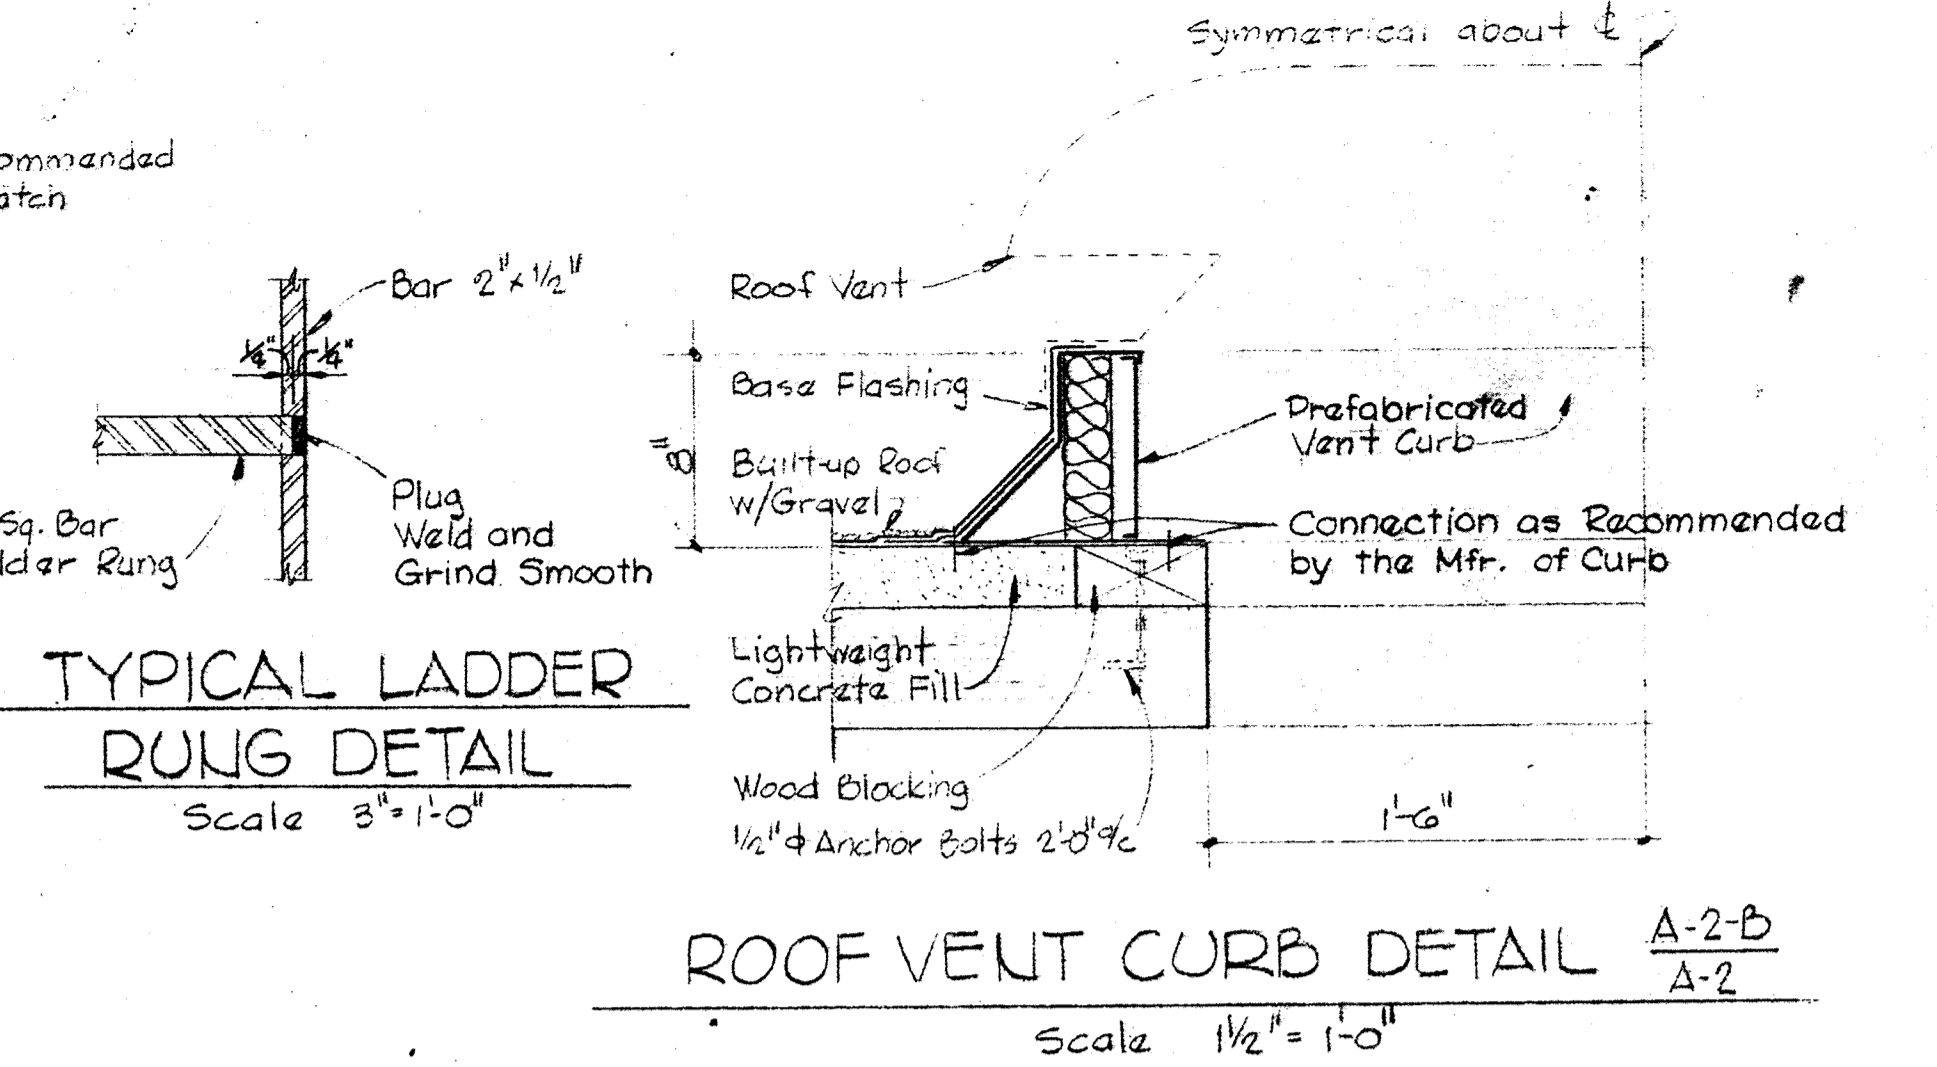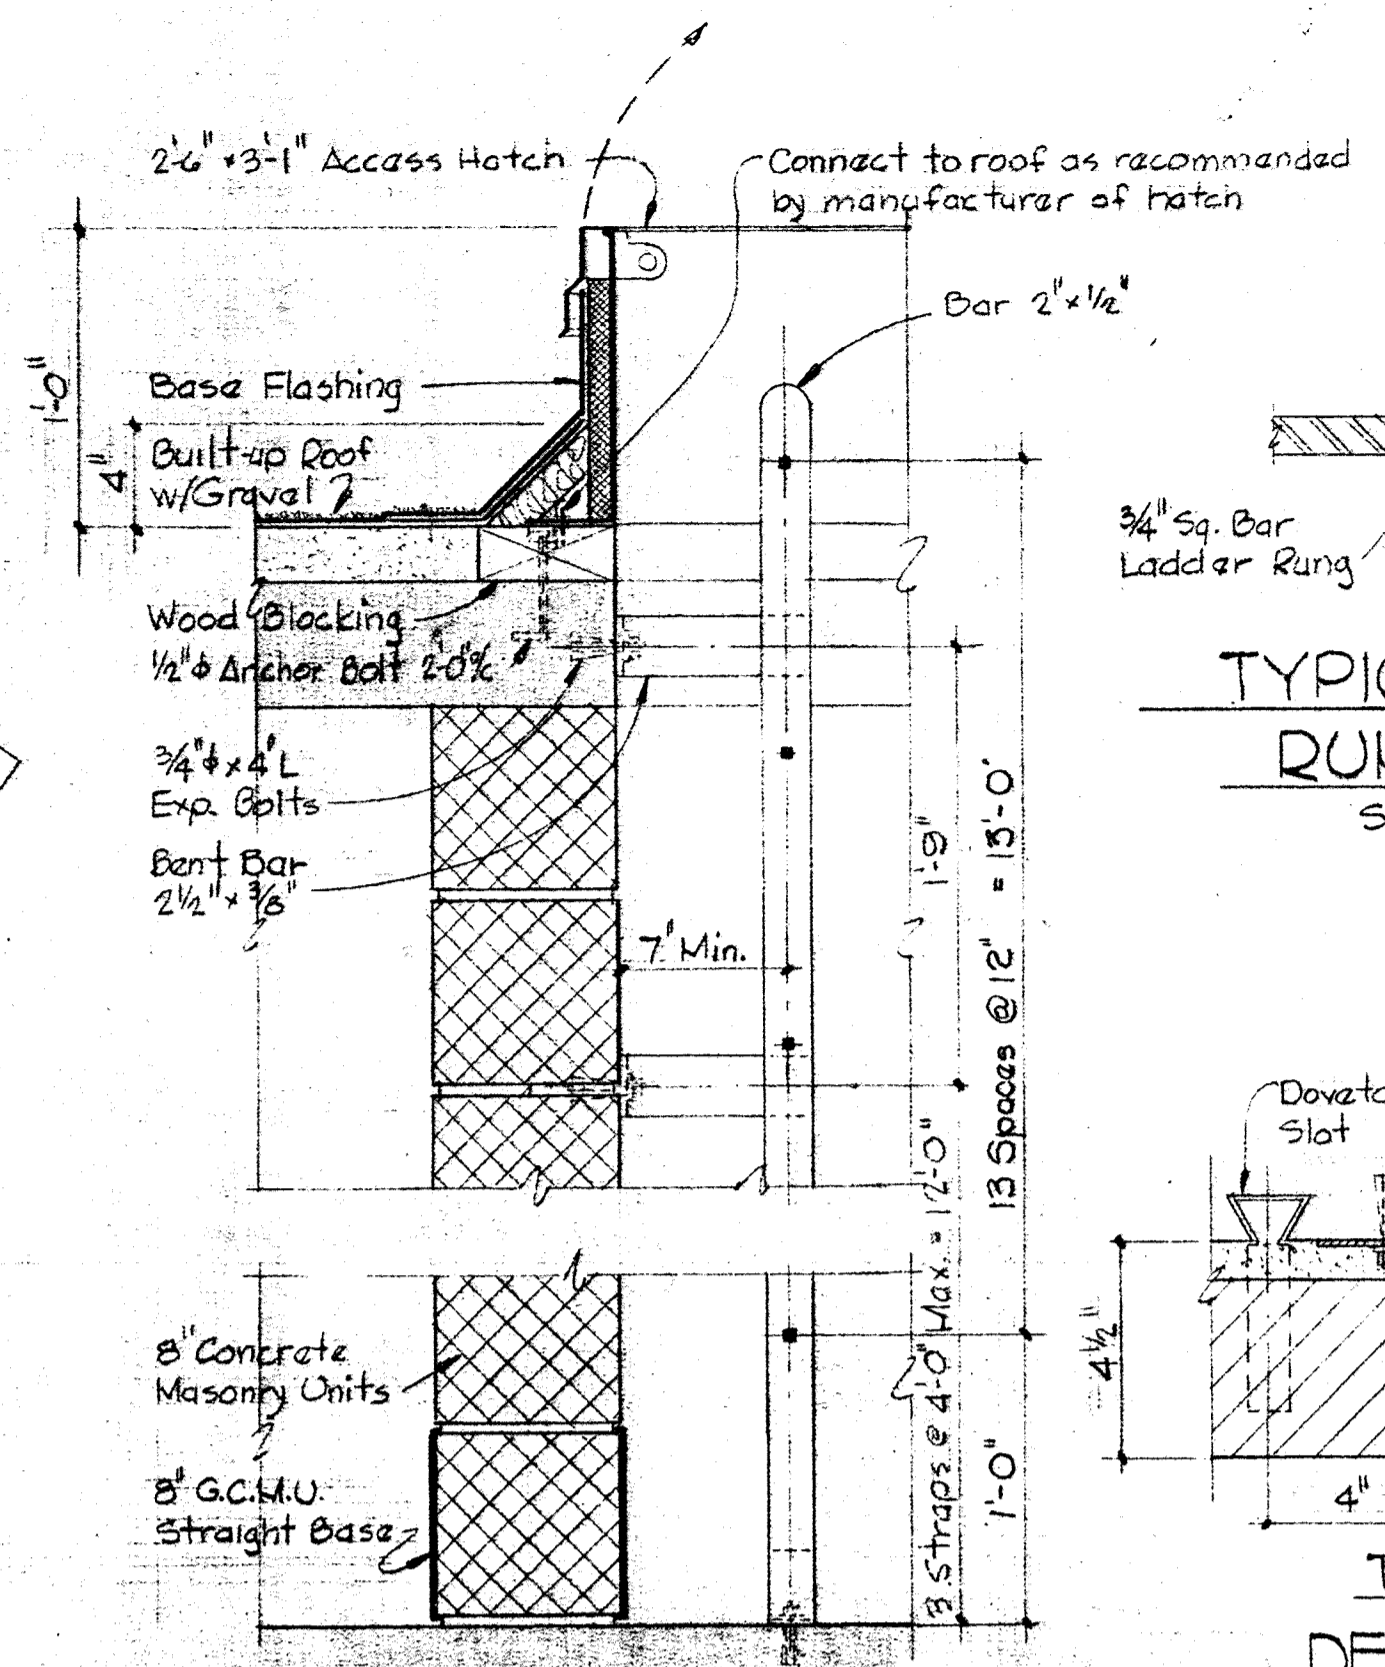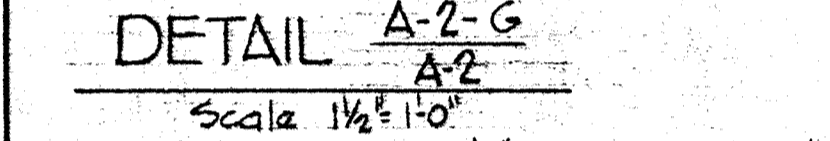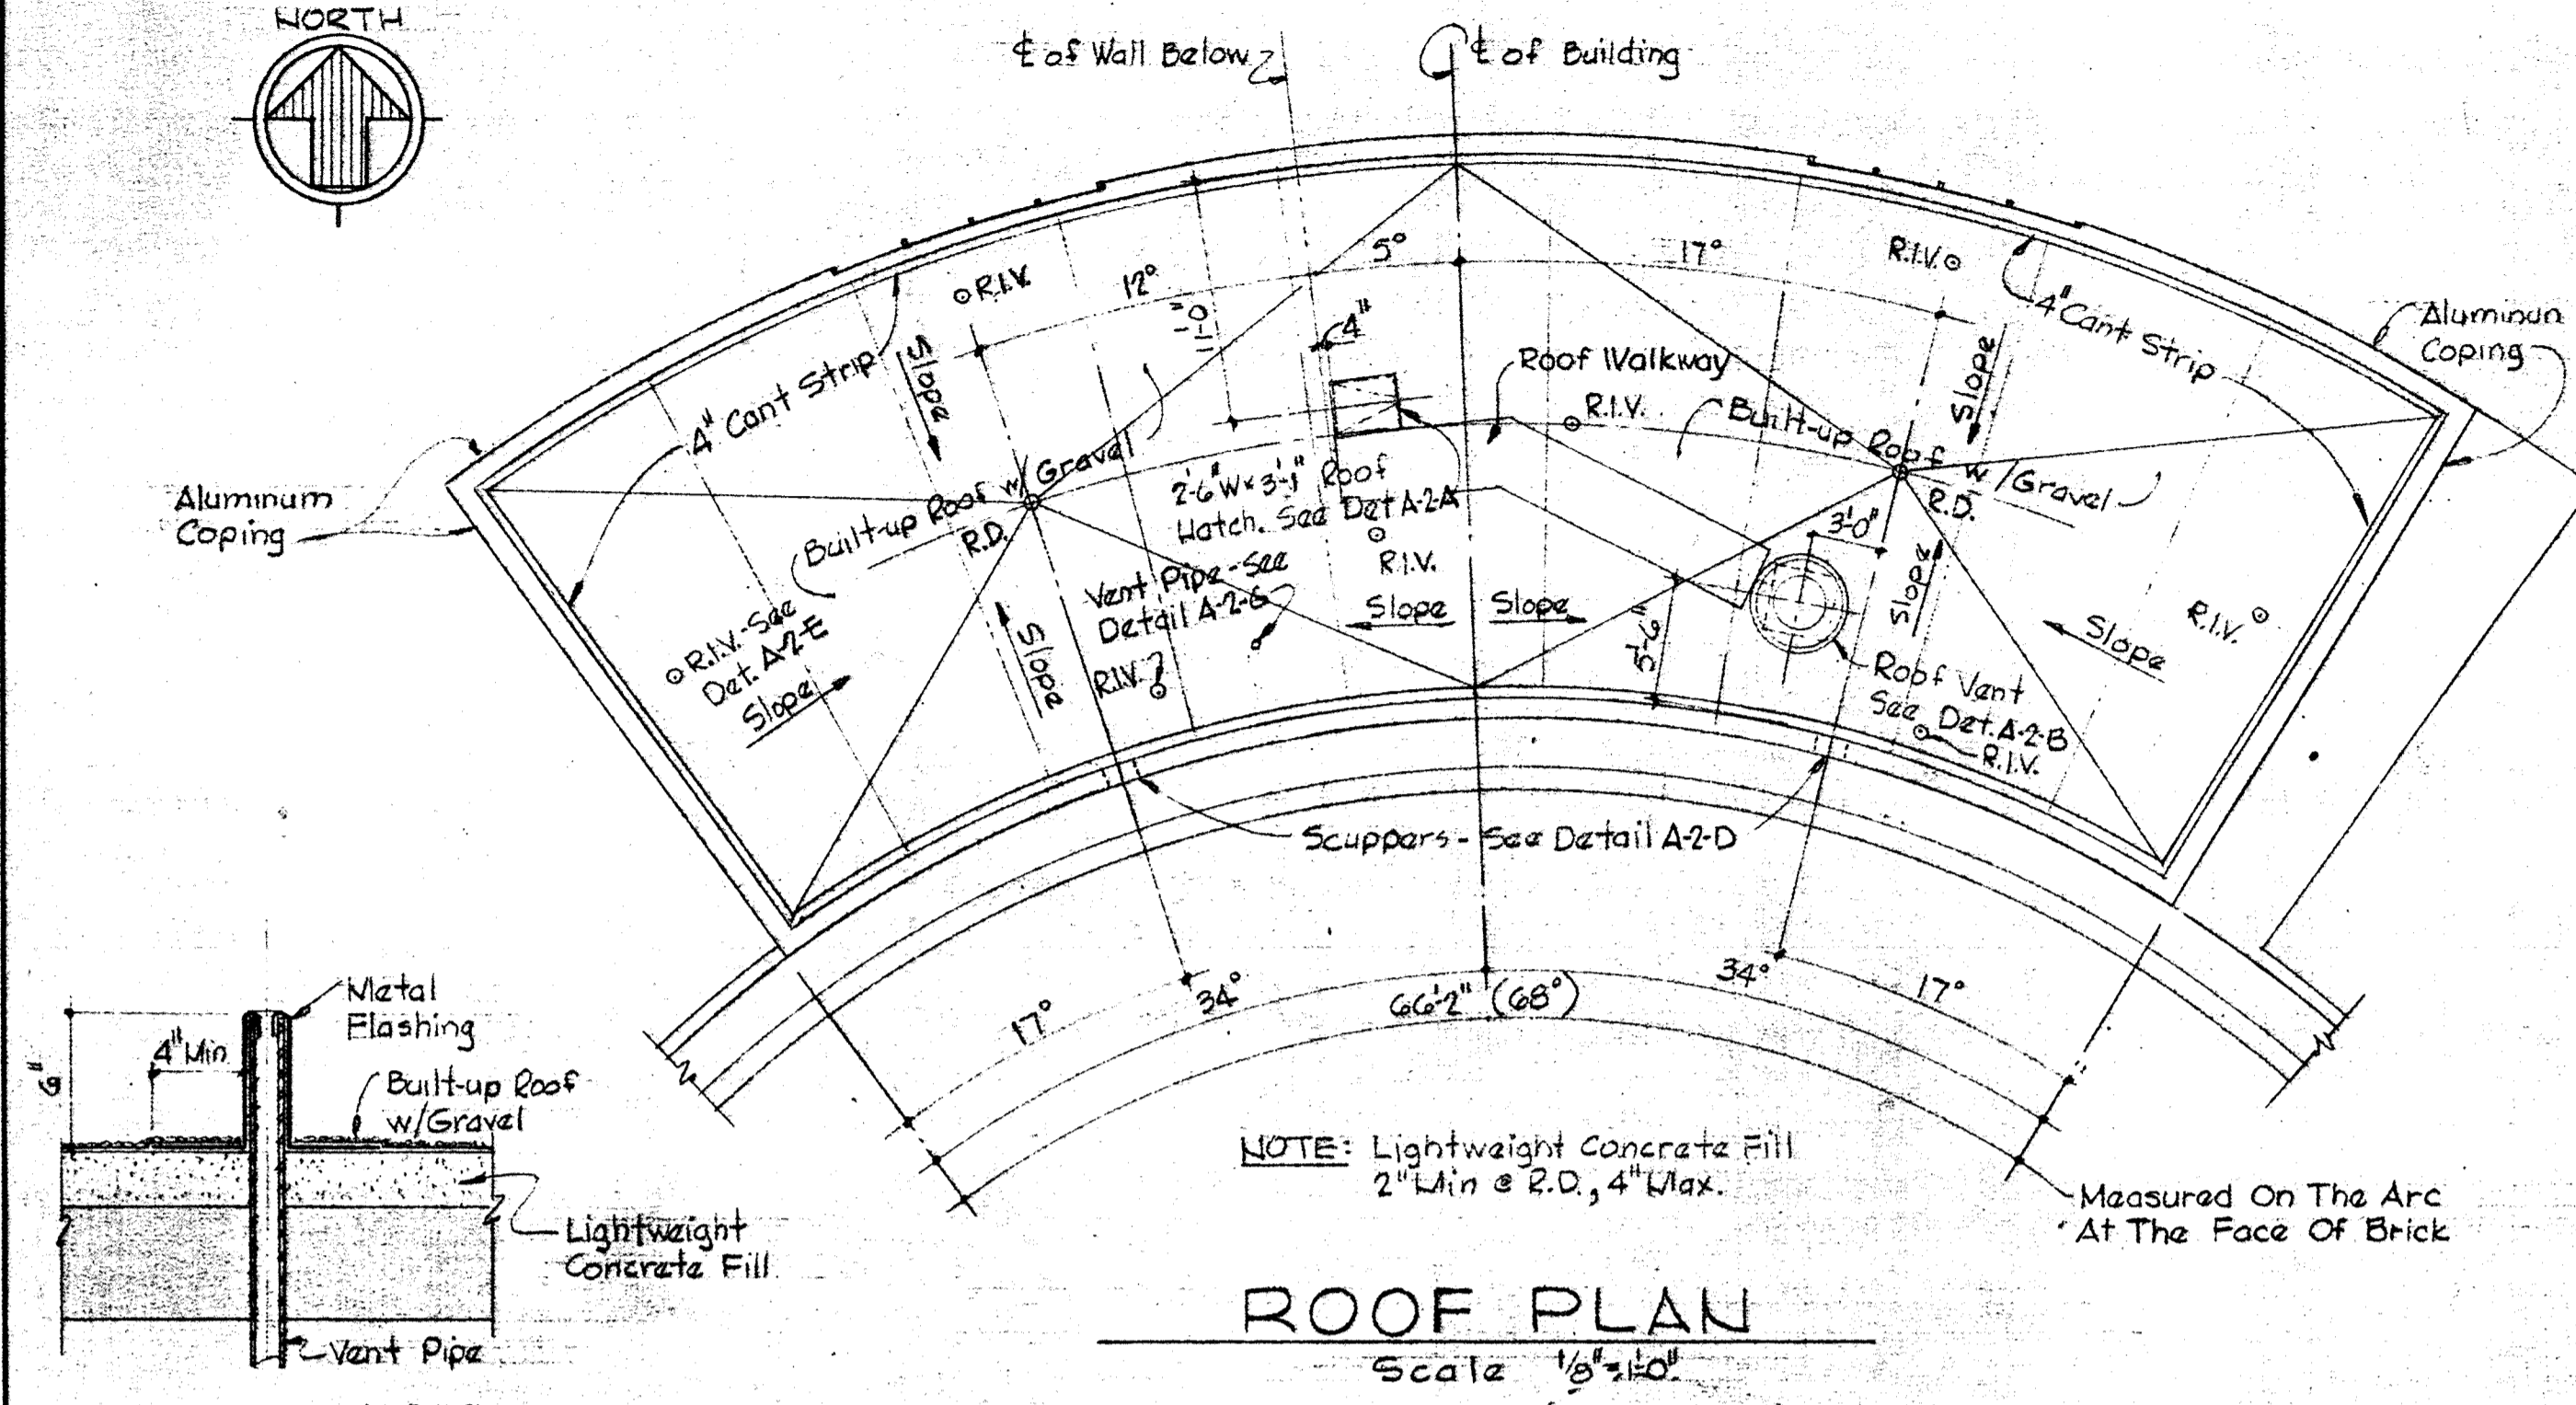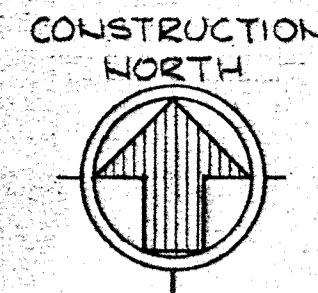

WHITMAN, REQUARDT & ASSOCIATES ENGINEERS 1304 ST. PAUL ST. BALTIMORE, MARYLAND	DEPARTMENT OF PUBLIC WORKS HOWARD COUNTY, MARYLAND 2/1/73 DATE	CONTRACT NO. 525-S W.O. Gilbert CHIEF - BUREAU OF ENGINEERING	SLUDGE OXIDATION BUILDING SECTIONS	SAVAGE WASTEWATER TREATMENT PLANT ADDITION NO. 3	DRAWING NO. 9 OF 28 SCALE AS SHOWN SHEET A-2
---	---	---	---------------------------------------	---	--

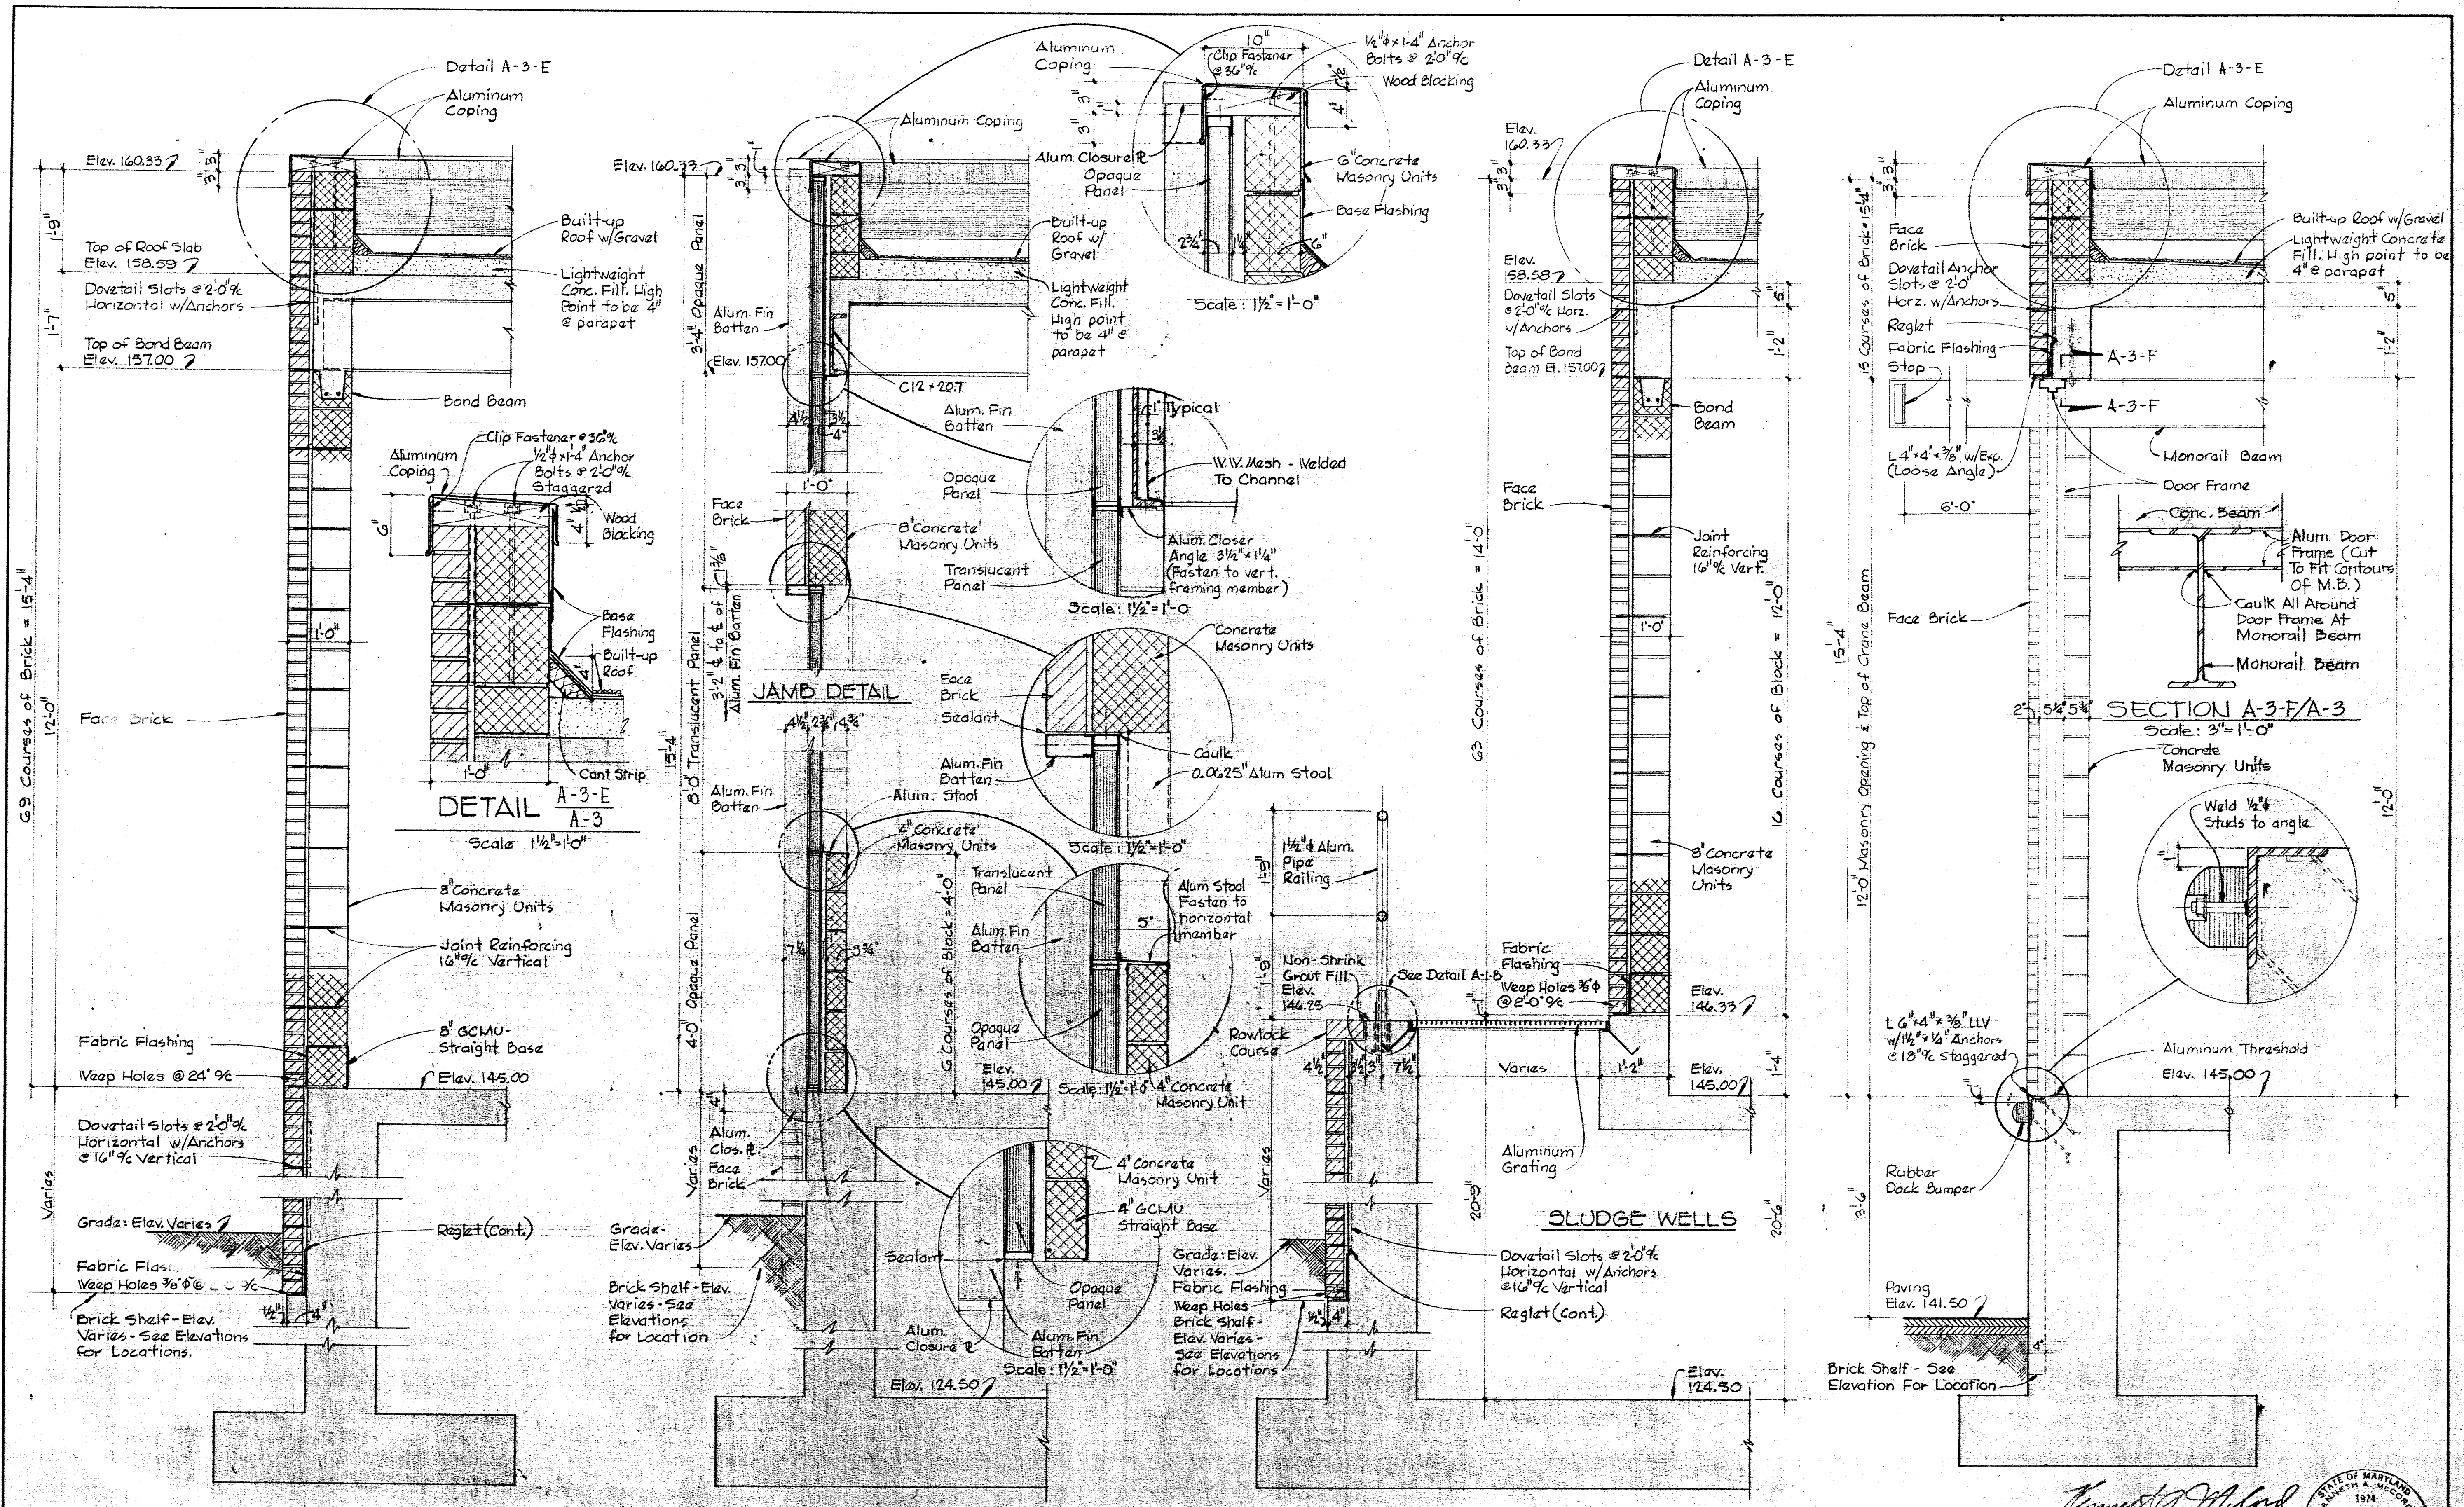

WHITMAN, REQUARDT & ASSOCIATES  
ENGINEERS  
1304 ST. PAUL ST.  
BALTIMORE, MARYLAND

DEPARTMENT OF PUBLIC WORKS  
HOWARD COUNTY, MARYLAND  
2/1/73  
DATE

CONTRACT NO. 525-S

SLUDGE OXIDATION BUILDING  
SECTIONS


SAVAGE WASTEWATER  
TREATMENT PLANT ADDITION NO. 3

DRAWING NO. 10  
OF 28

SCALE AS SHOWN

W. O. 6538-2


AS BUILT JAN 1 1977

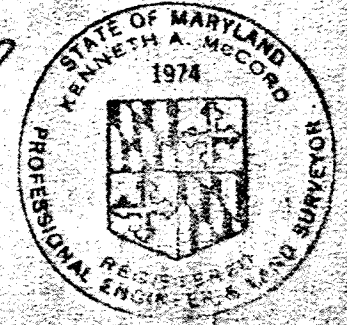

SHEET A-3


DOOR SCHEDULE

DOOR NO.	SWING	SIZE	MAT'L	TYPE	HEAD	JAMB	HARDWARE
D1	Bi-fold	9'-8" x 11'-10" x 1 3/4"	Alum.	1	H-1	J-1	HV-1
D2	LHR	3'-0" x 7'-2" x 1 3/4"	Alum.	2	H-2	J-2	HV-2
D3	RHR	2'-2" x 7'-2" x 1 3/4"	Alum.	3	H-3	J-3	HV-3
D4	RHR	3'-0" x 7'-2" x 1 3/4"	Alum.	2	H-4	J-2	HV-4

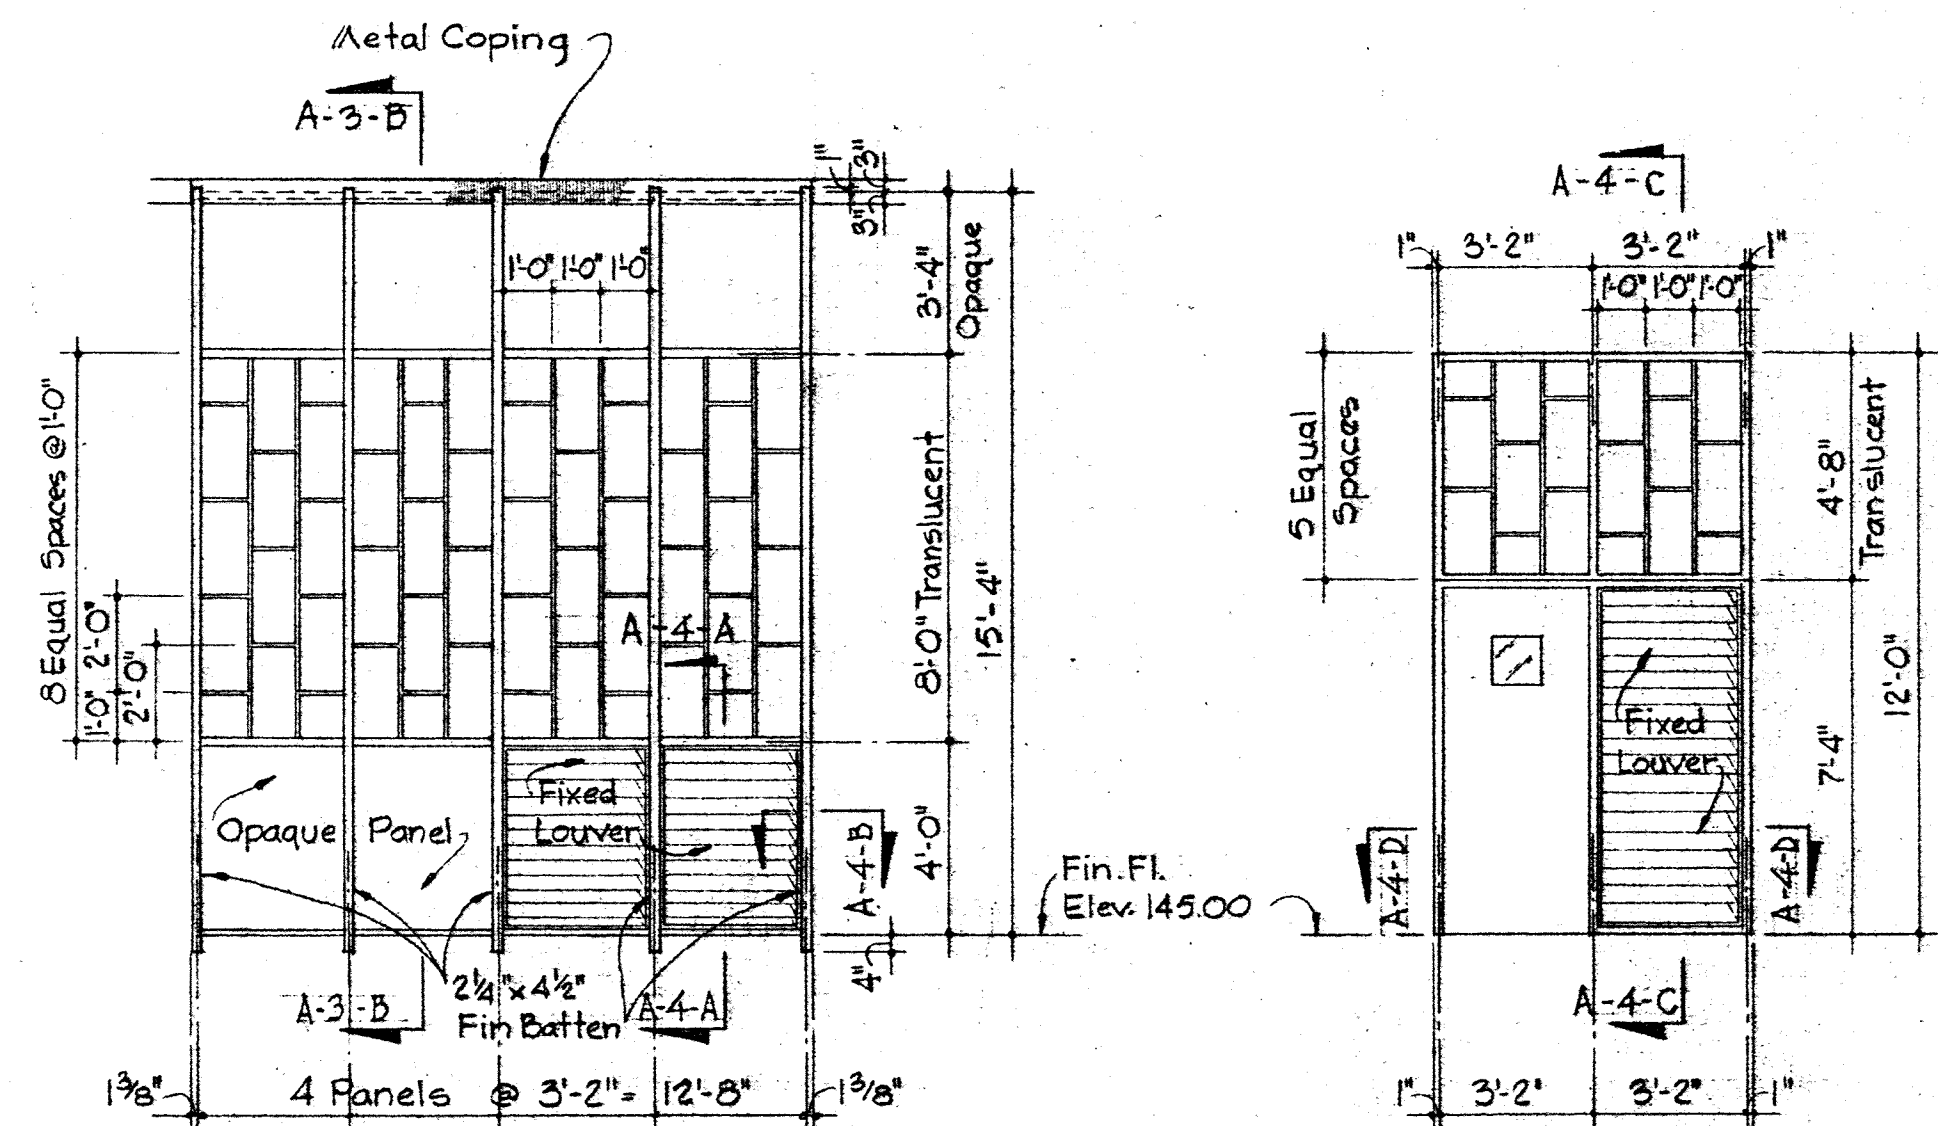


TYPICAL NORTH ELEVATION

PANEL TYPES  
Scale: 1/4" = 1'-0"

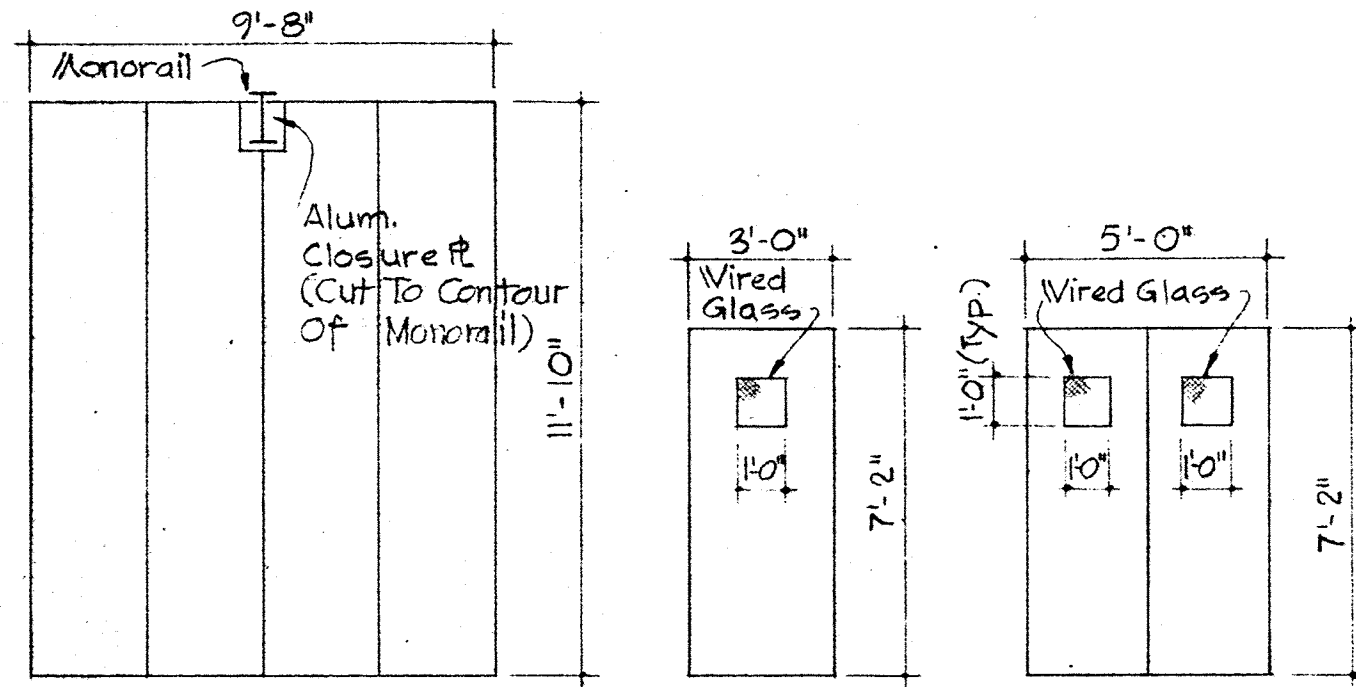


DOOR TYPES  
Scale: 1/4" = 1'-0"


VIEW WINDOW  
Scale: 1/4" = 1'-0"

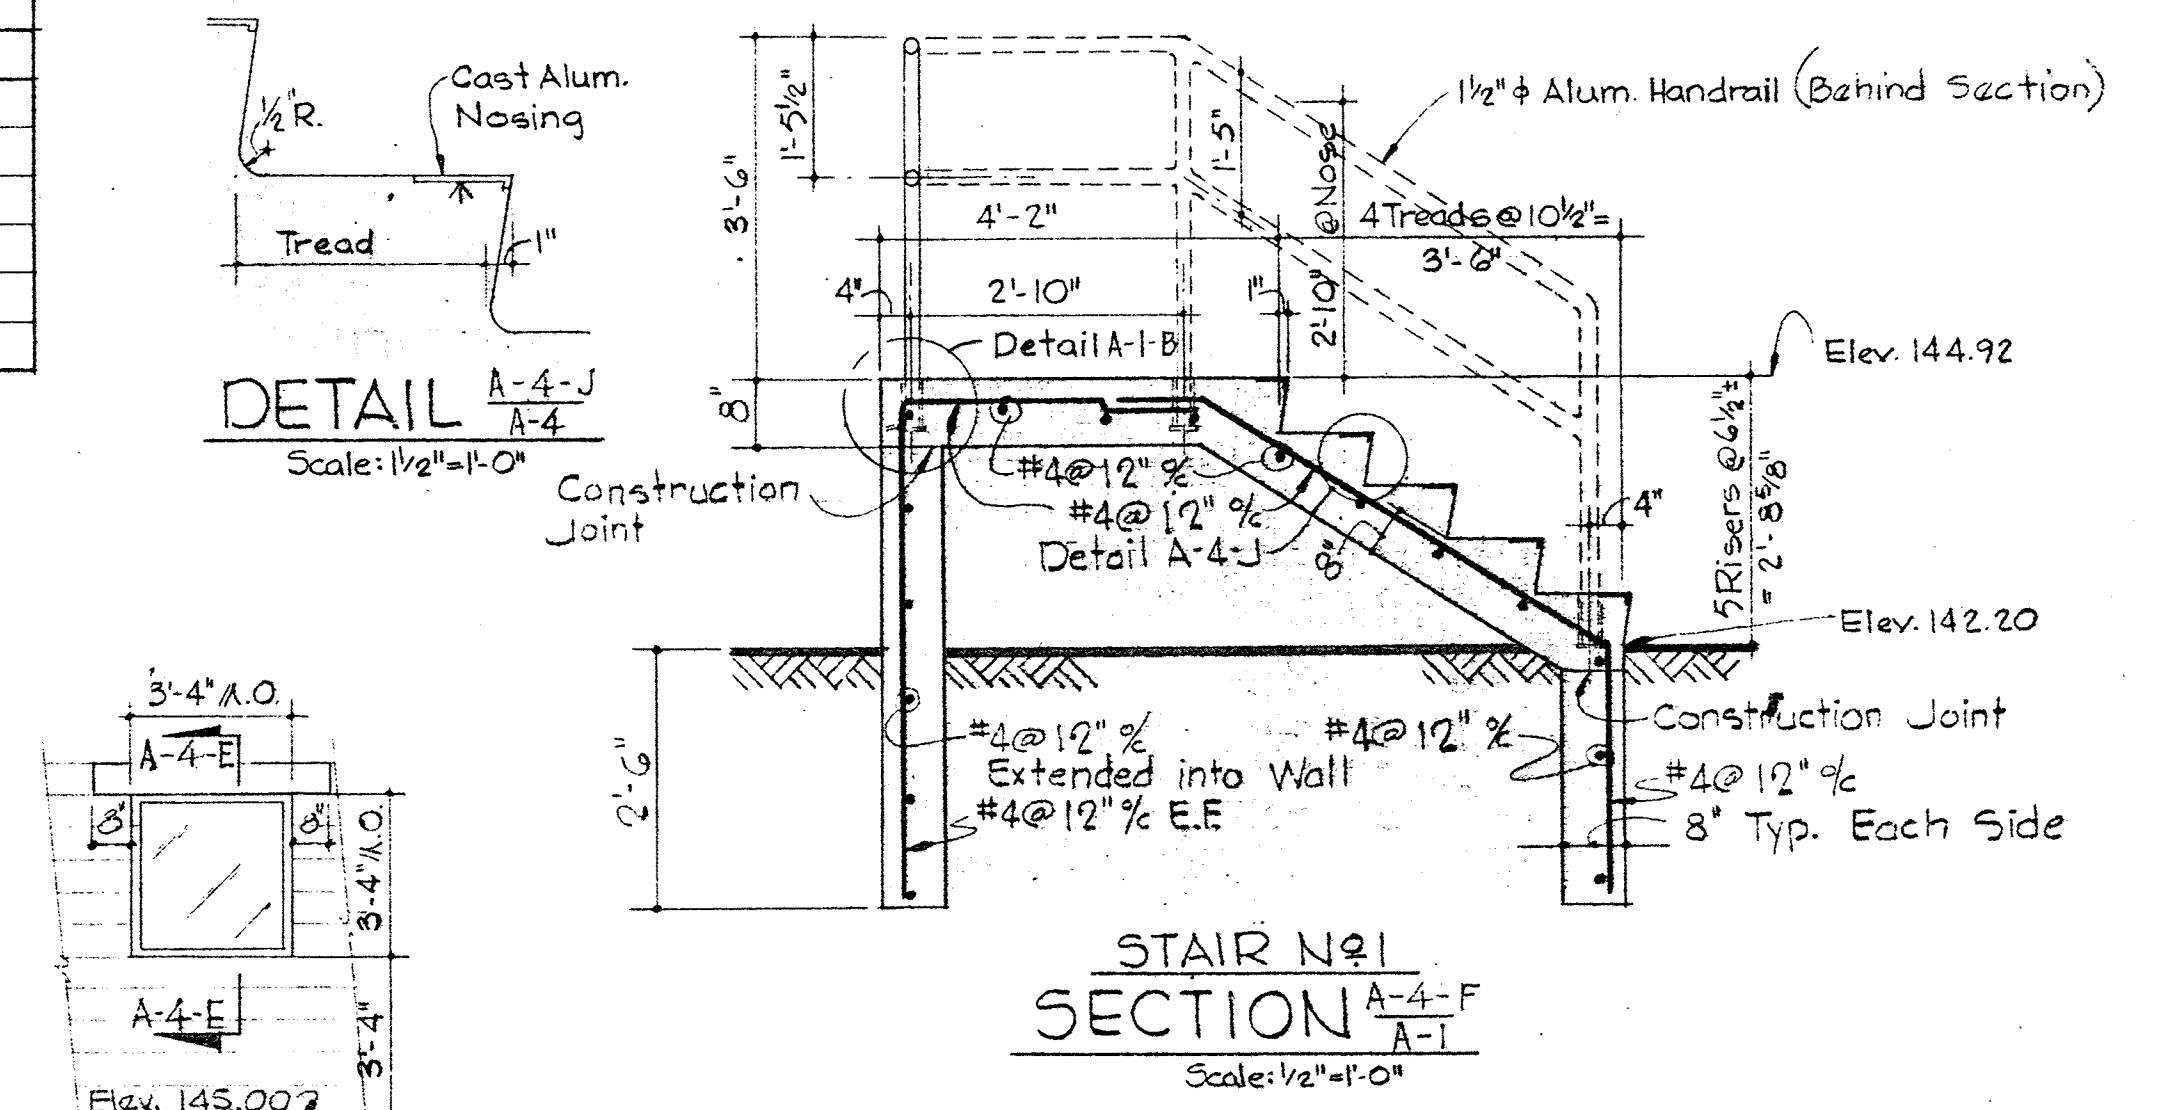


STAIR #1 SECTION A-4-F  
Scale: 1/2" = 1'-0"

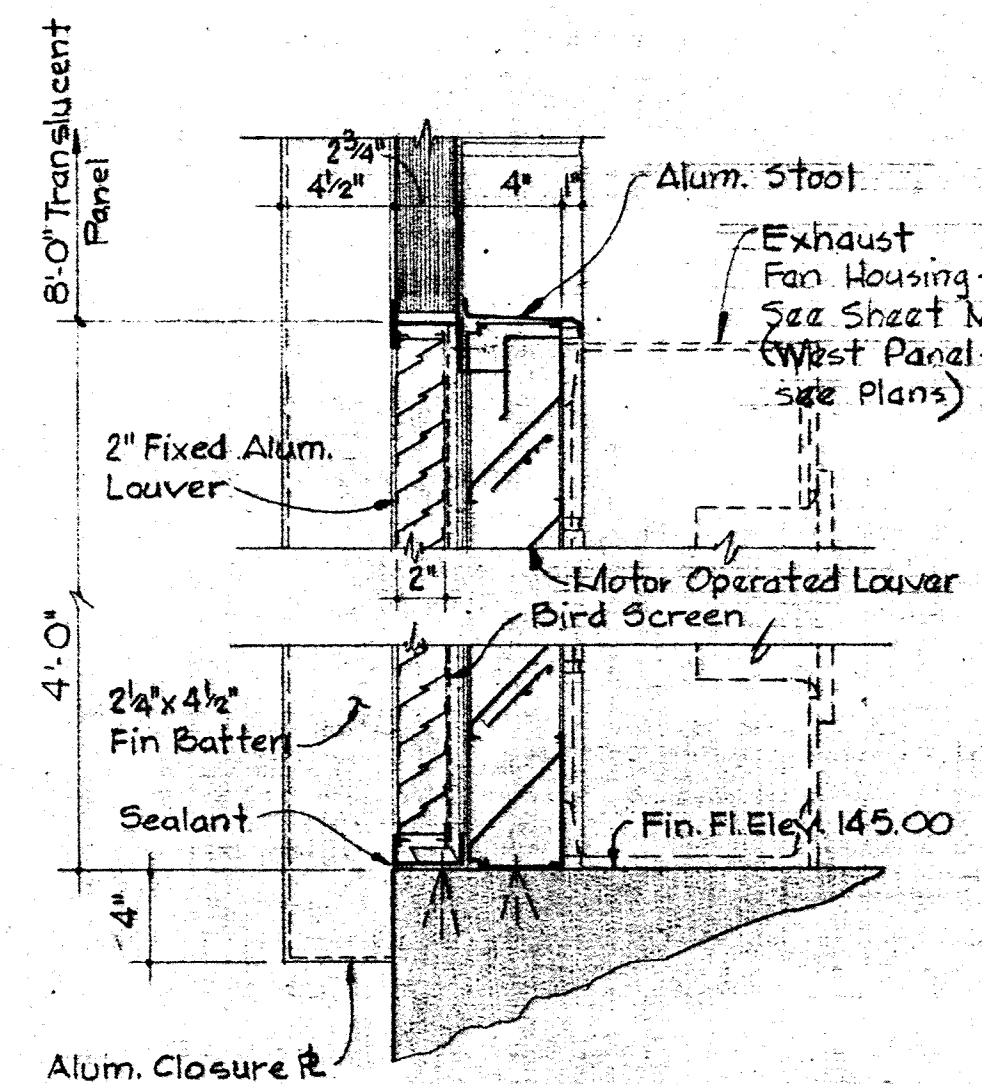


SECTION A-4-A  
Scale: 1/2" = 1'-0"

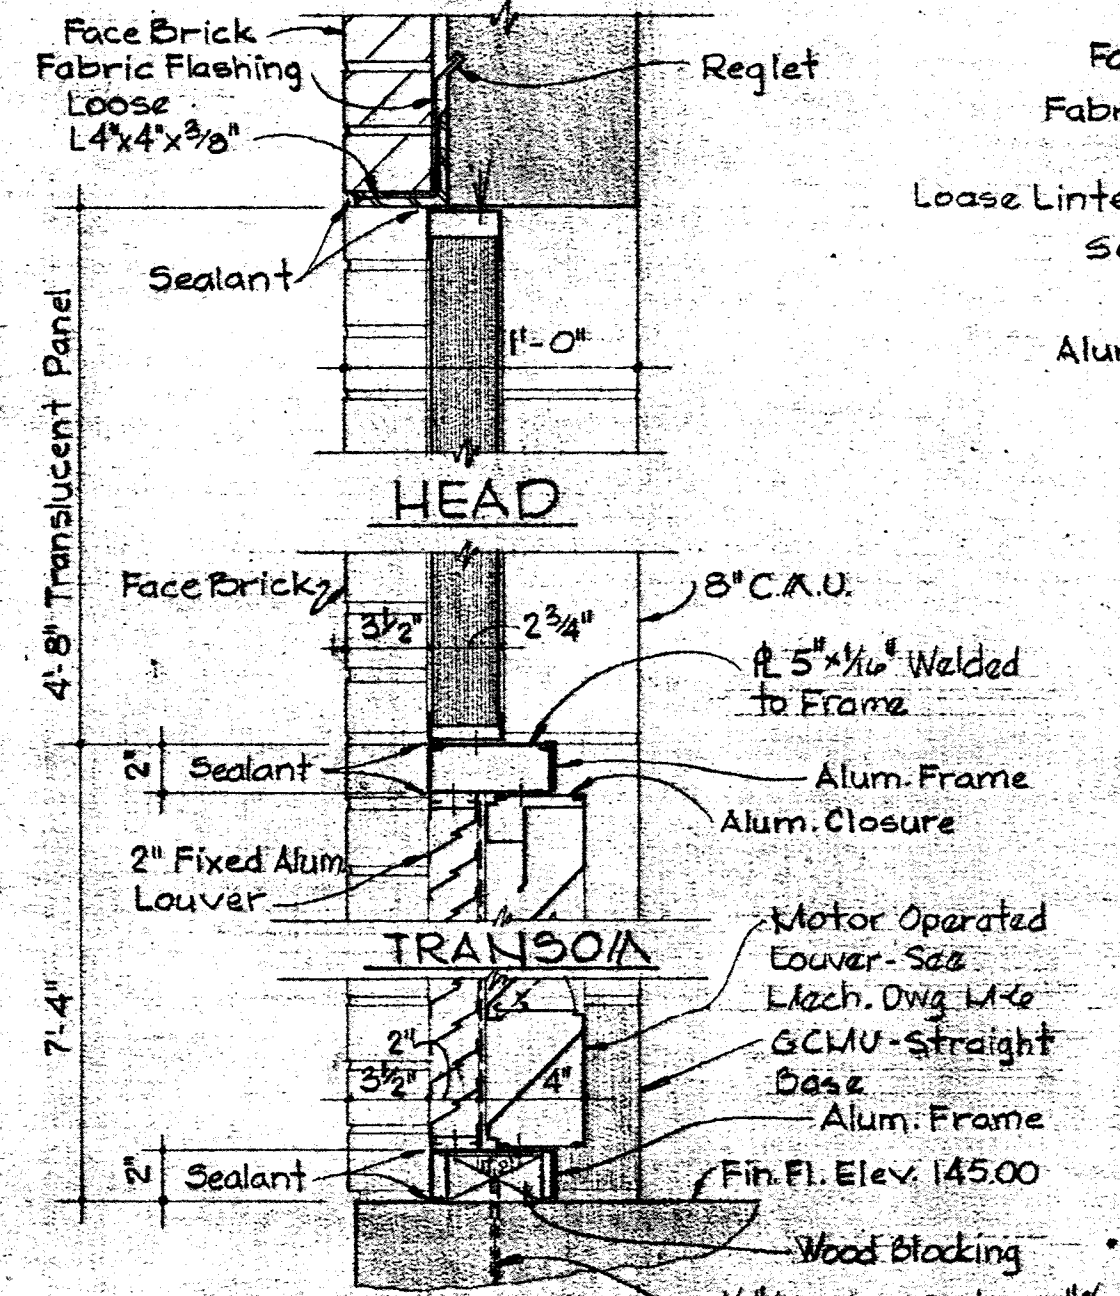


SECTION A-4-C  
Scale: 1/2" = 1'-0"

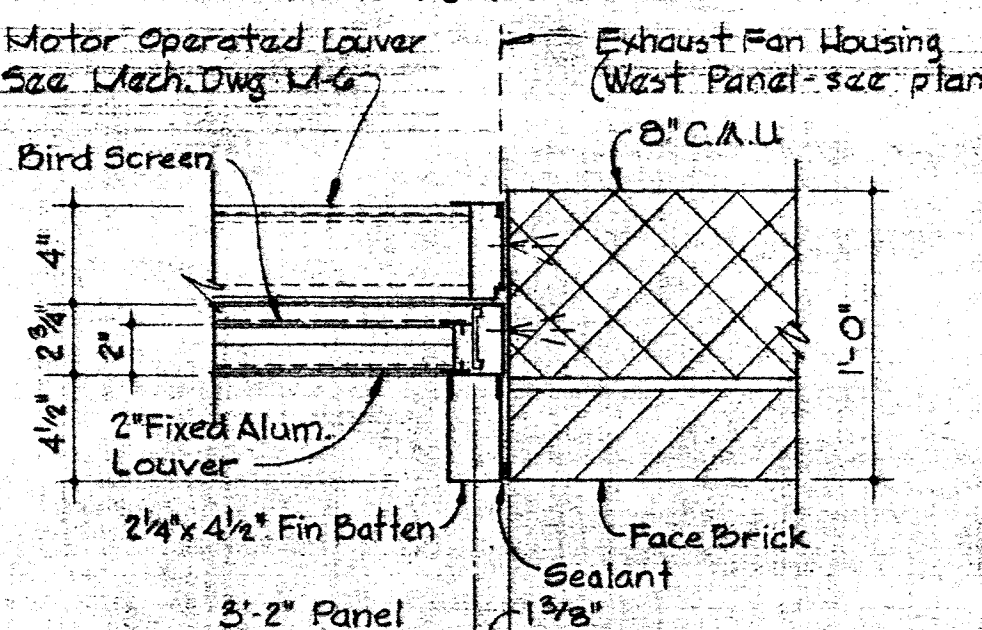


SECTION A-4-B  
Scale: 1/2" = 1'-0"

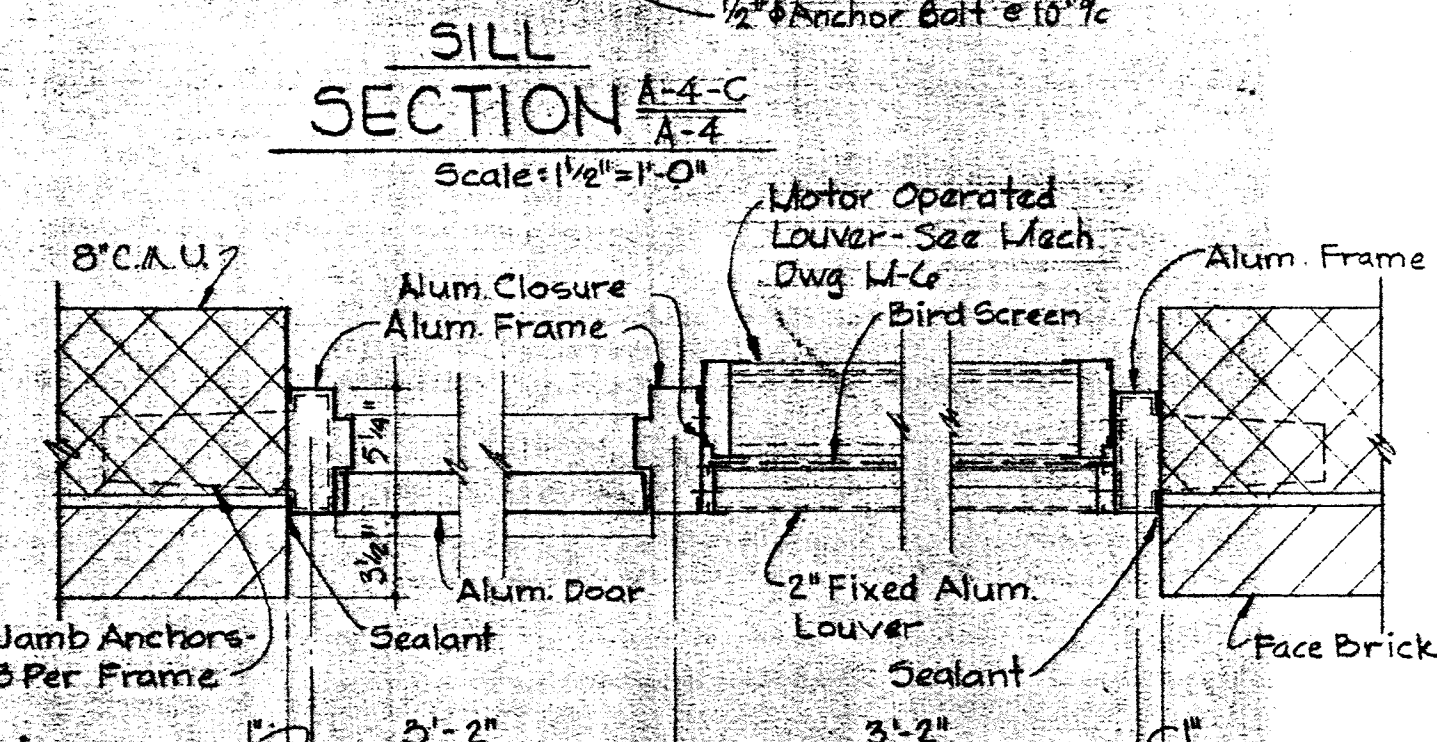


SECTION A-4-D  
Scale: 1/2" = 1'-0"

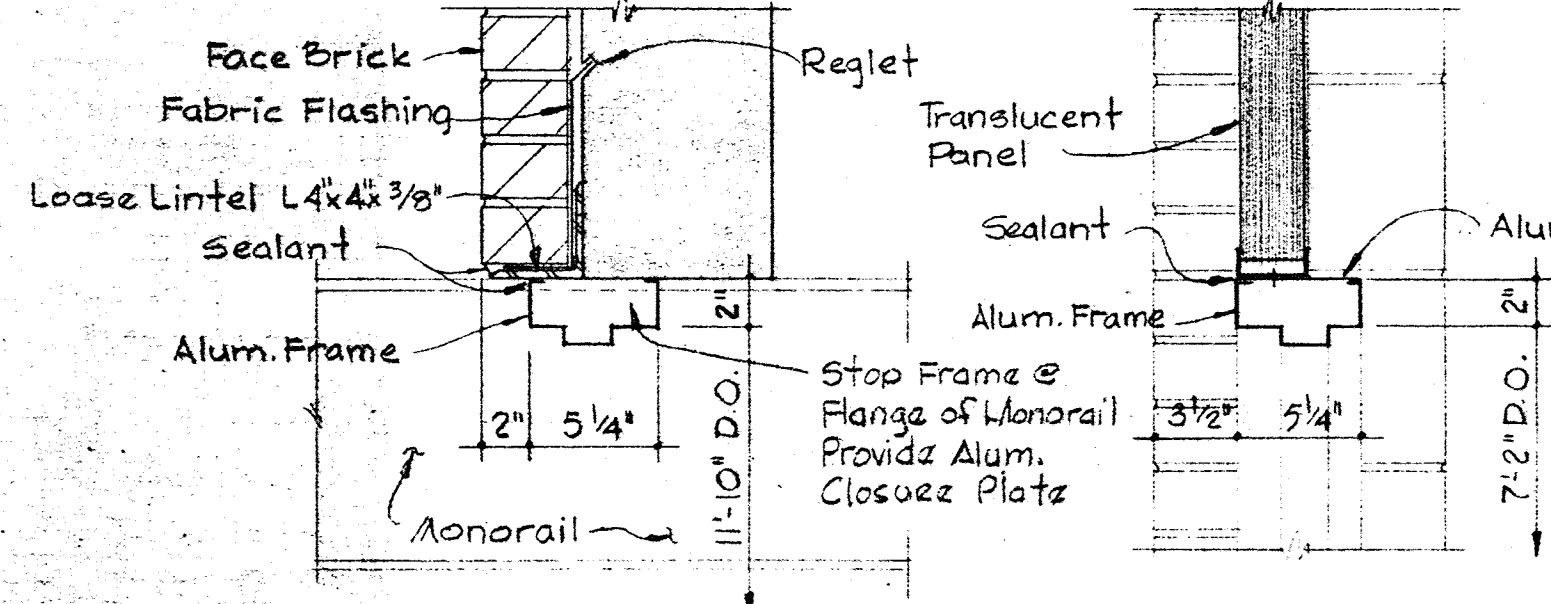


HEAD DETAILS  
Scale: 1/2" = 1'-0"

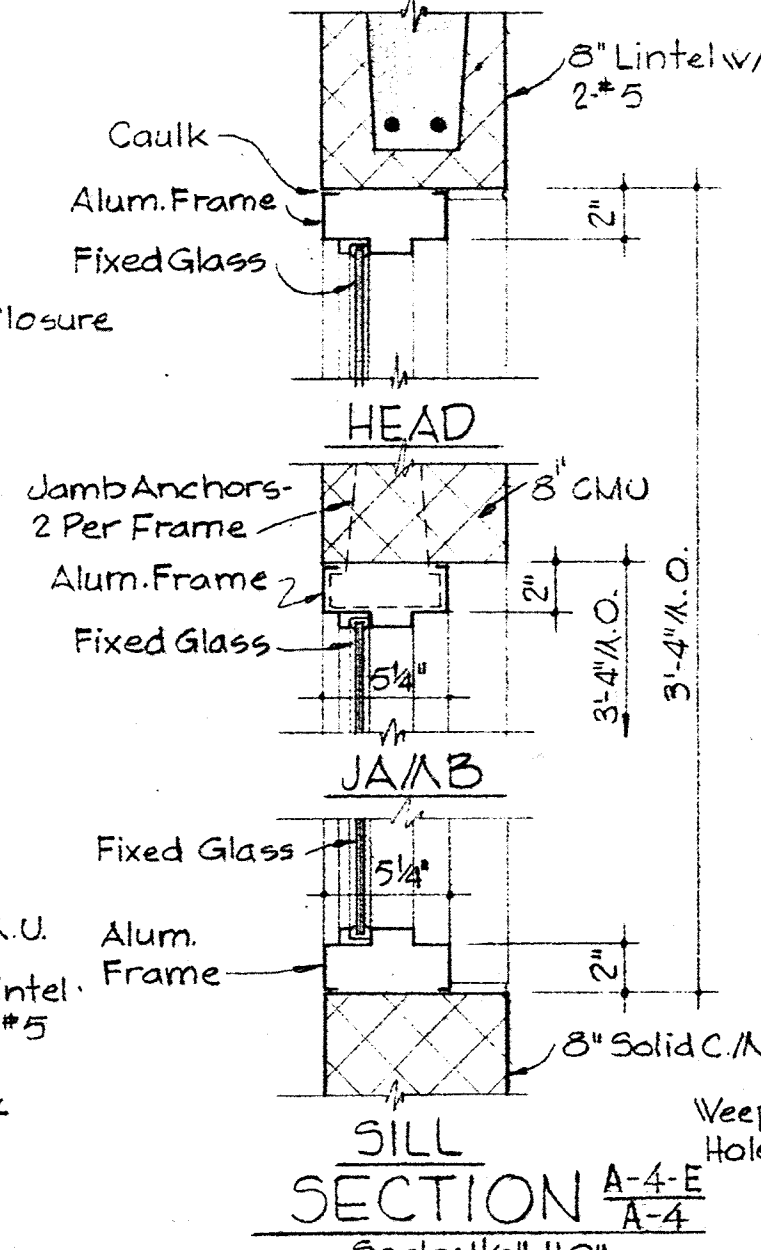

JAMB DETAILS  
Scale: 1/2" = 1'-0"

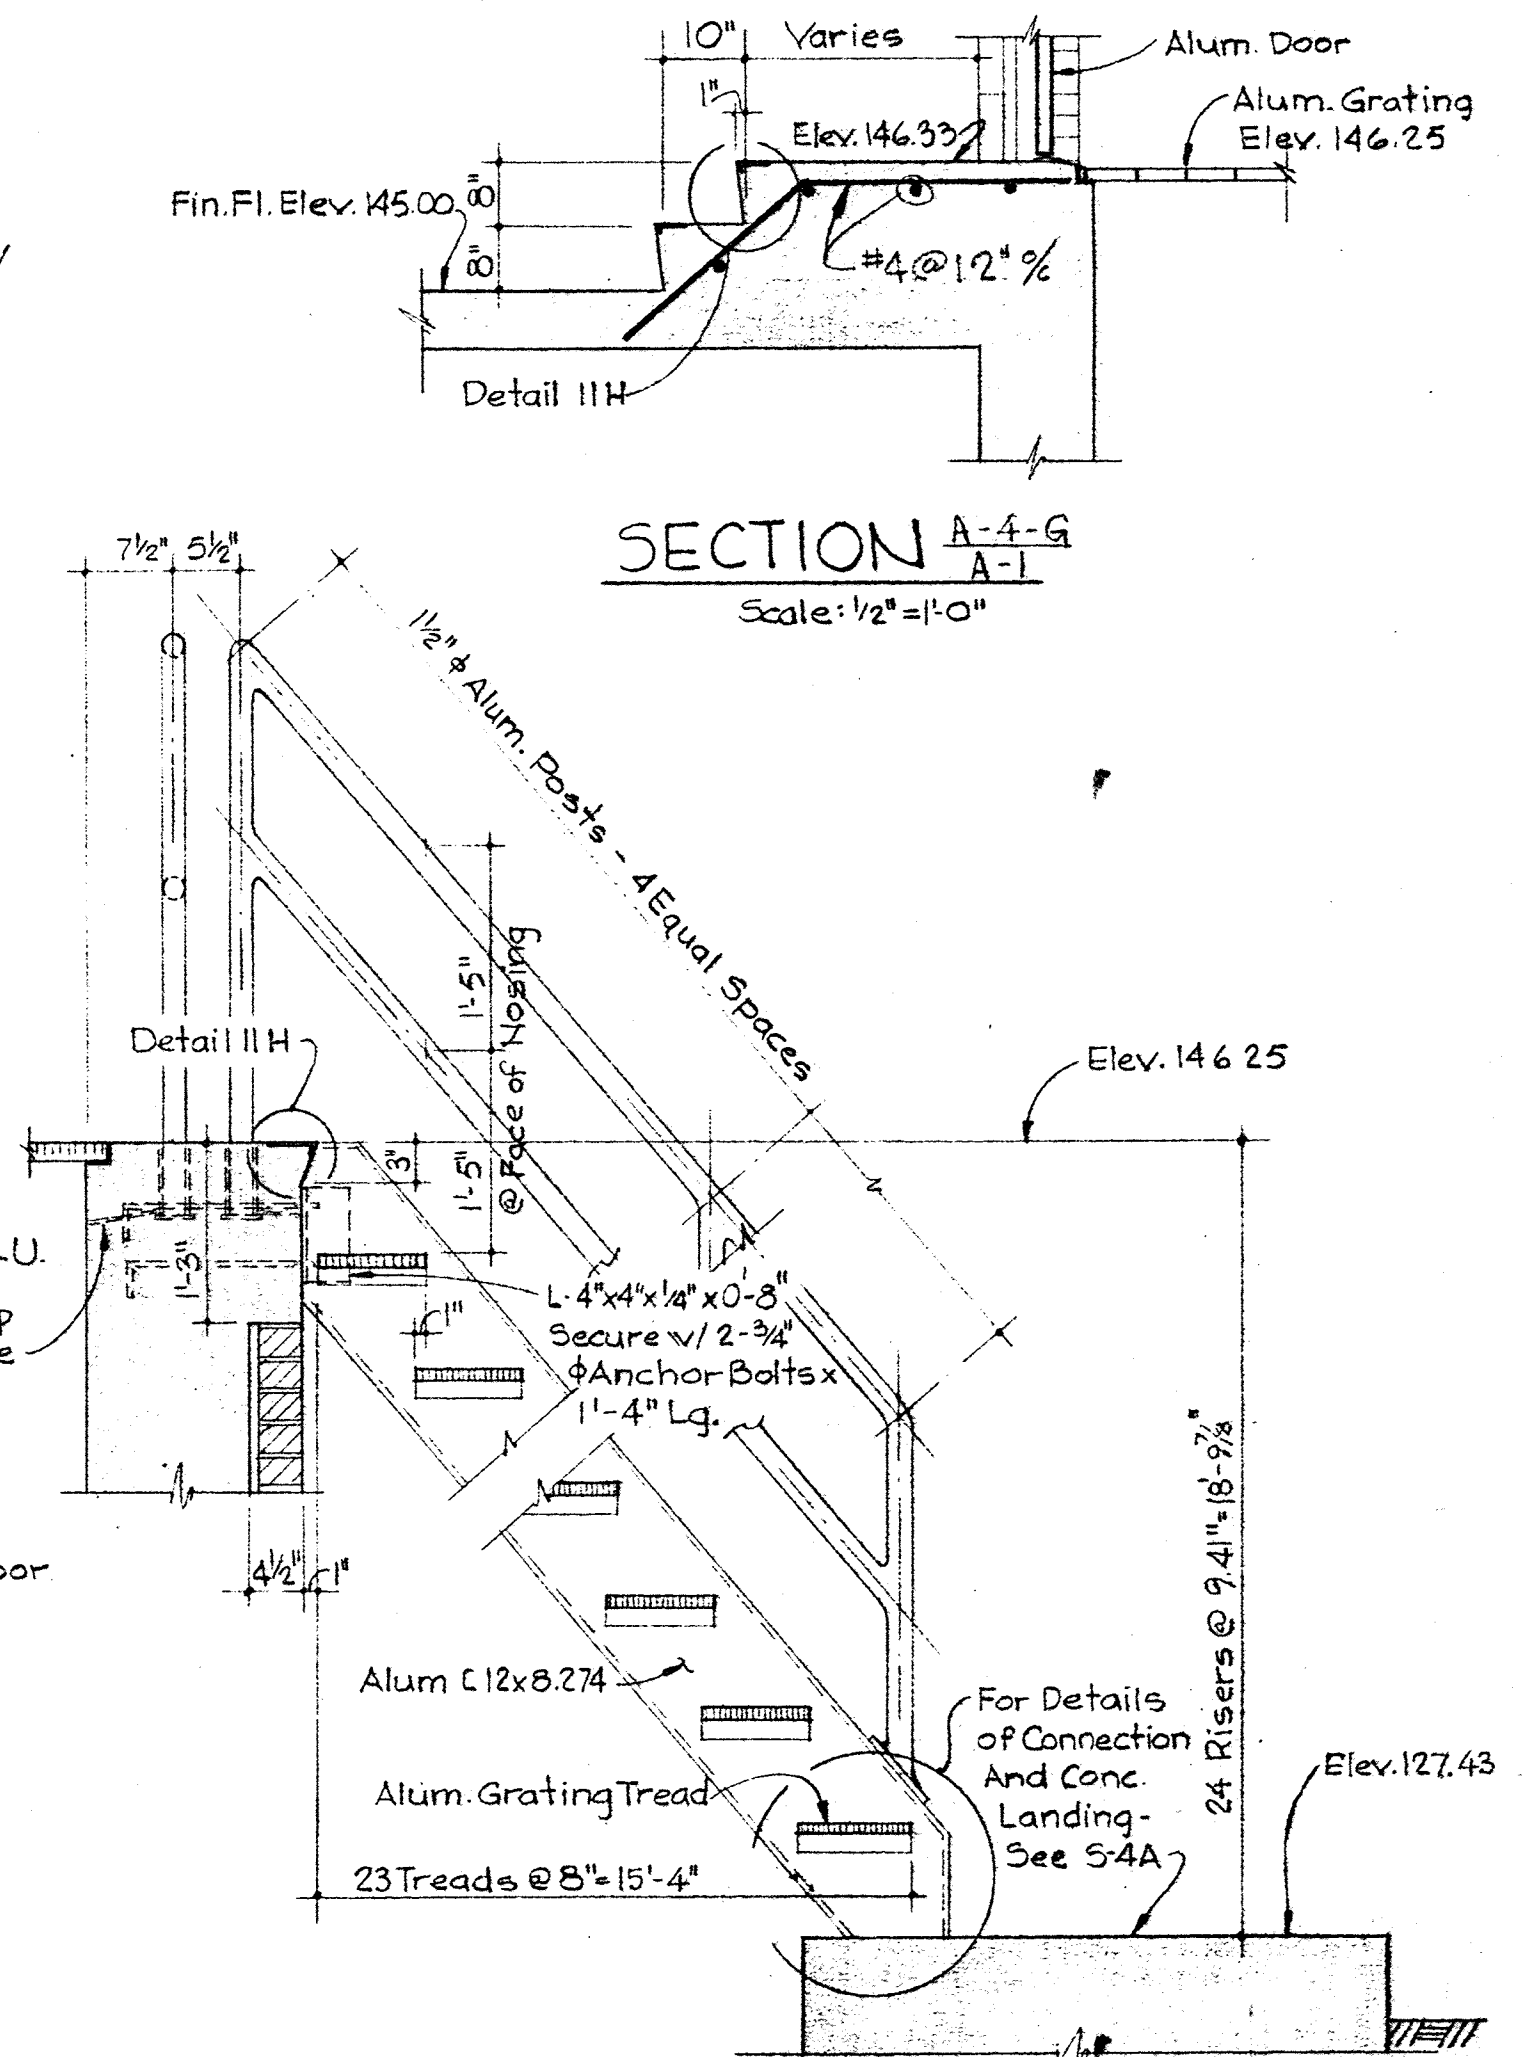

SECTION A-4-G  
Scale: 1/2" = 1'-0"

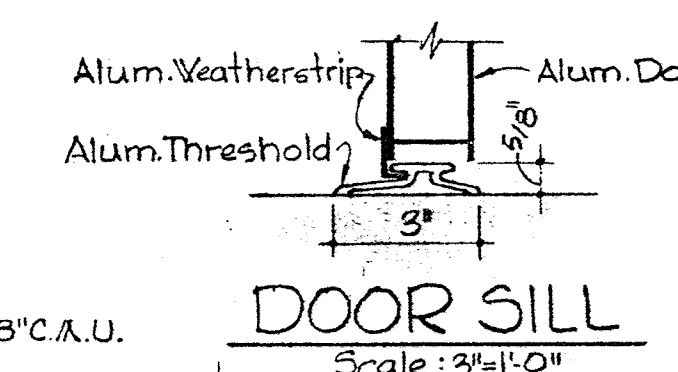

DOOR SILL  
Scale: 3/4" = 1'-0"

WHITMAN, REQUARDT & ASSOCIATES  
ENGINEERS  
1304 ST. PAUL ST.  
BALTIMORE, MARYLAND

DEPARTMENT OF PUBLIC WORKS  
HOWARD COUNTY, MARYLAND  
W.O. Gilbert  
CHIEF BUREAU OF ENGINEERING

CONTRACT NO. 525-S

SLUDGE OXIDATION BUILDING  
DETAILS







SAVAGE WASTEWATER  
TREATMENT PLANT ADDITION NO. 3

DRAWING NO. 11  
OF 28

SCALE AS SHOWN  
SHEET A-4

W. O. 6538-2

AS BUILT 4/11/77

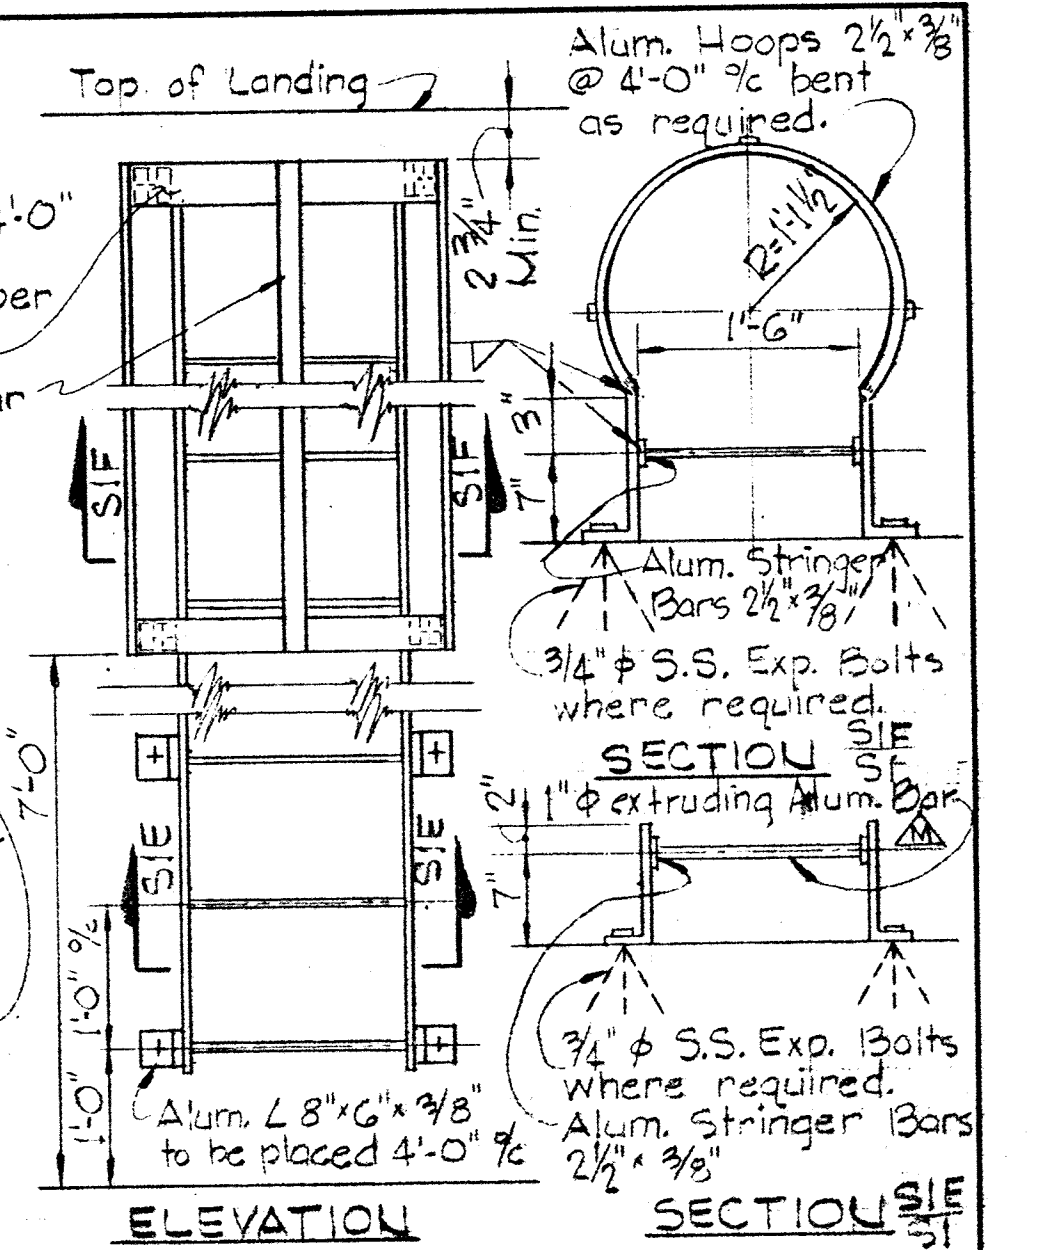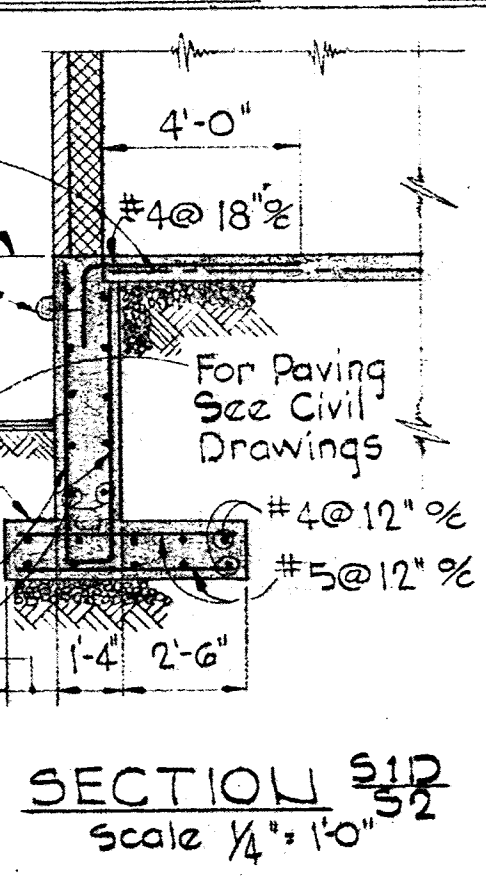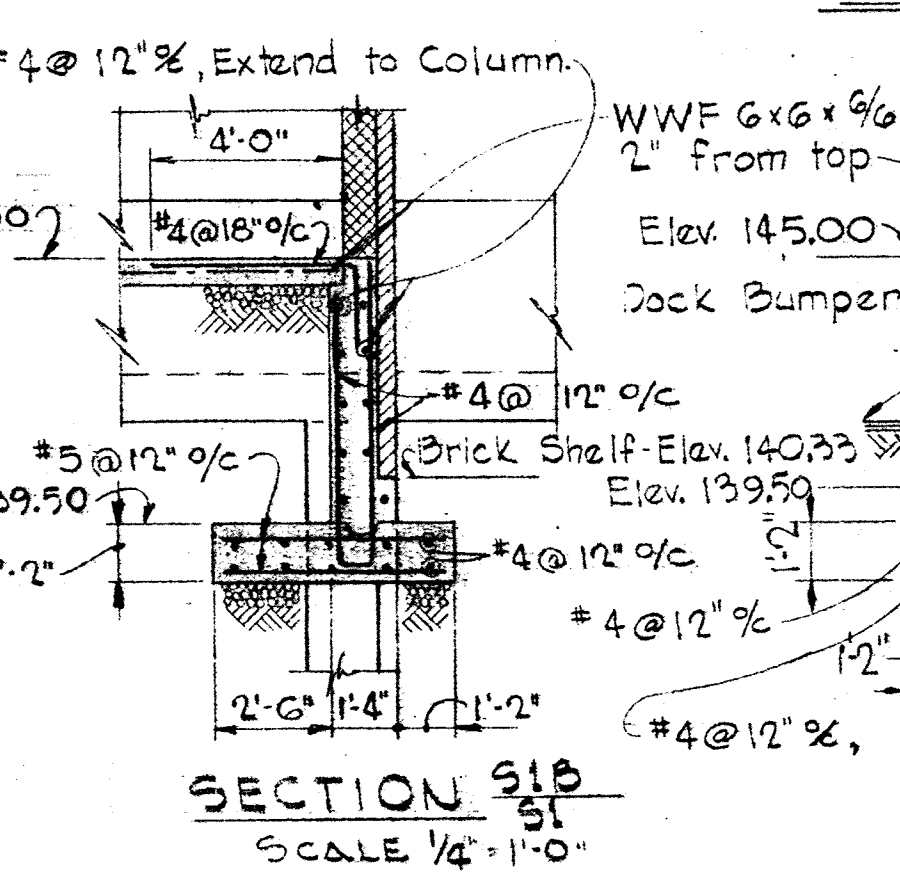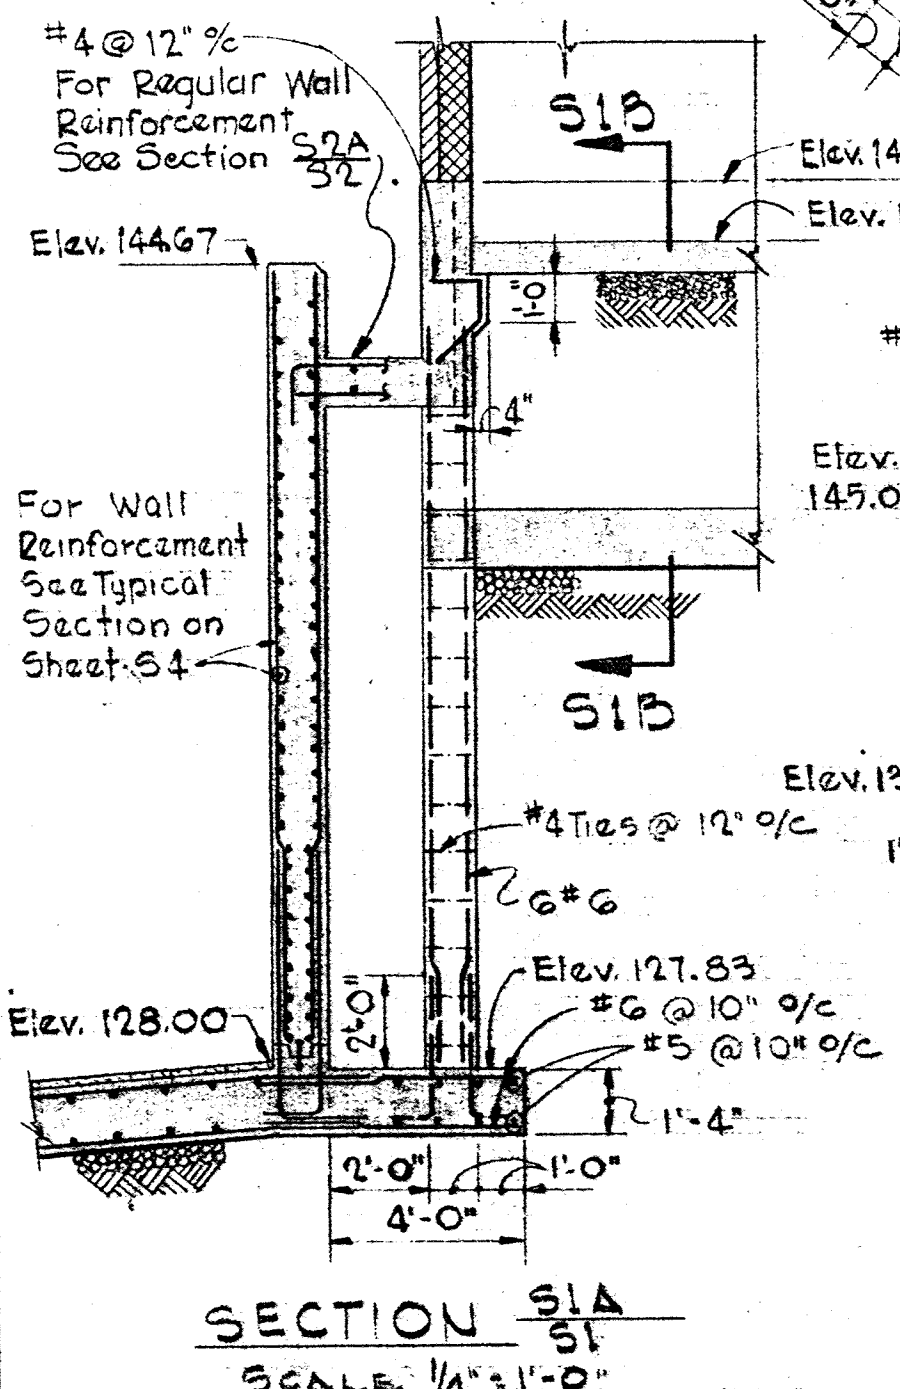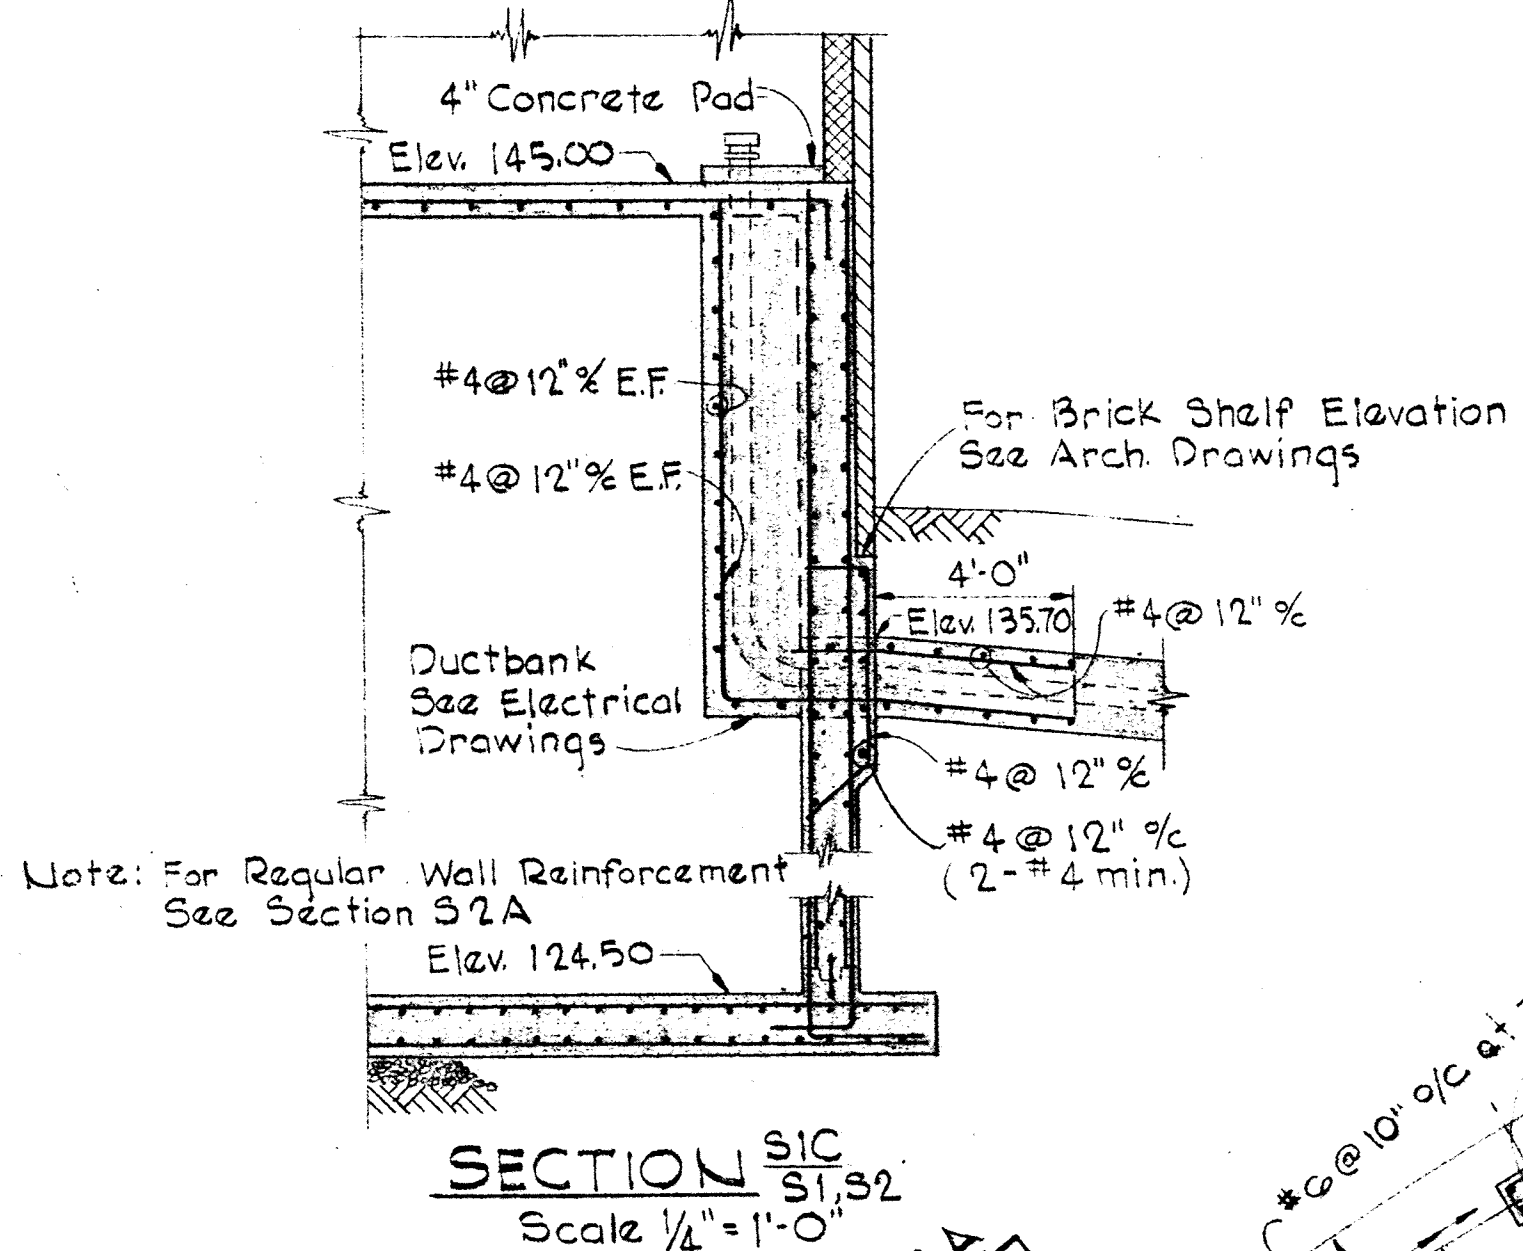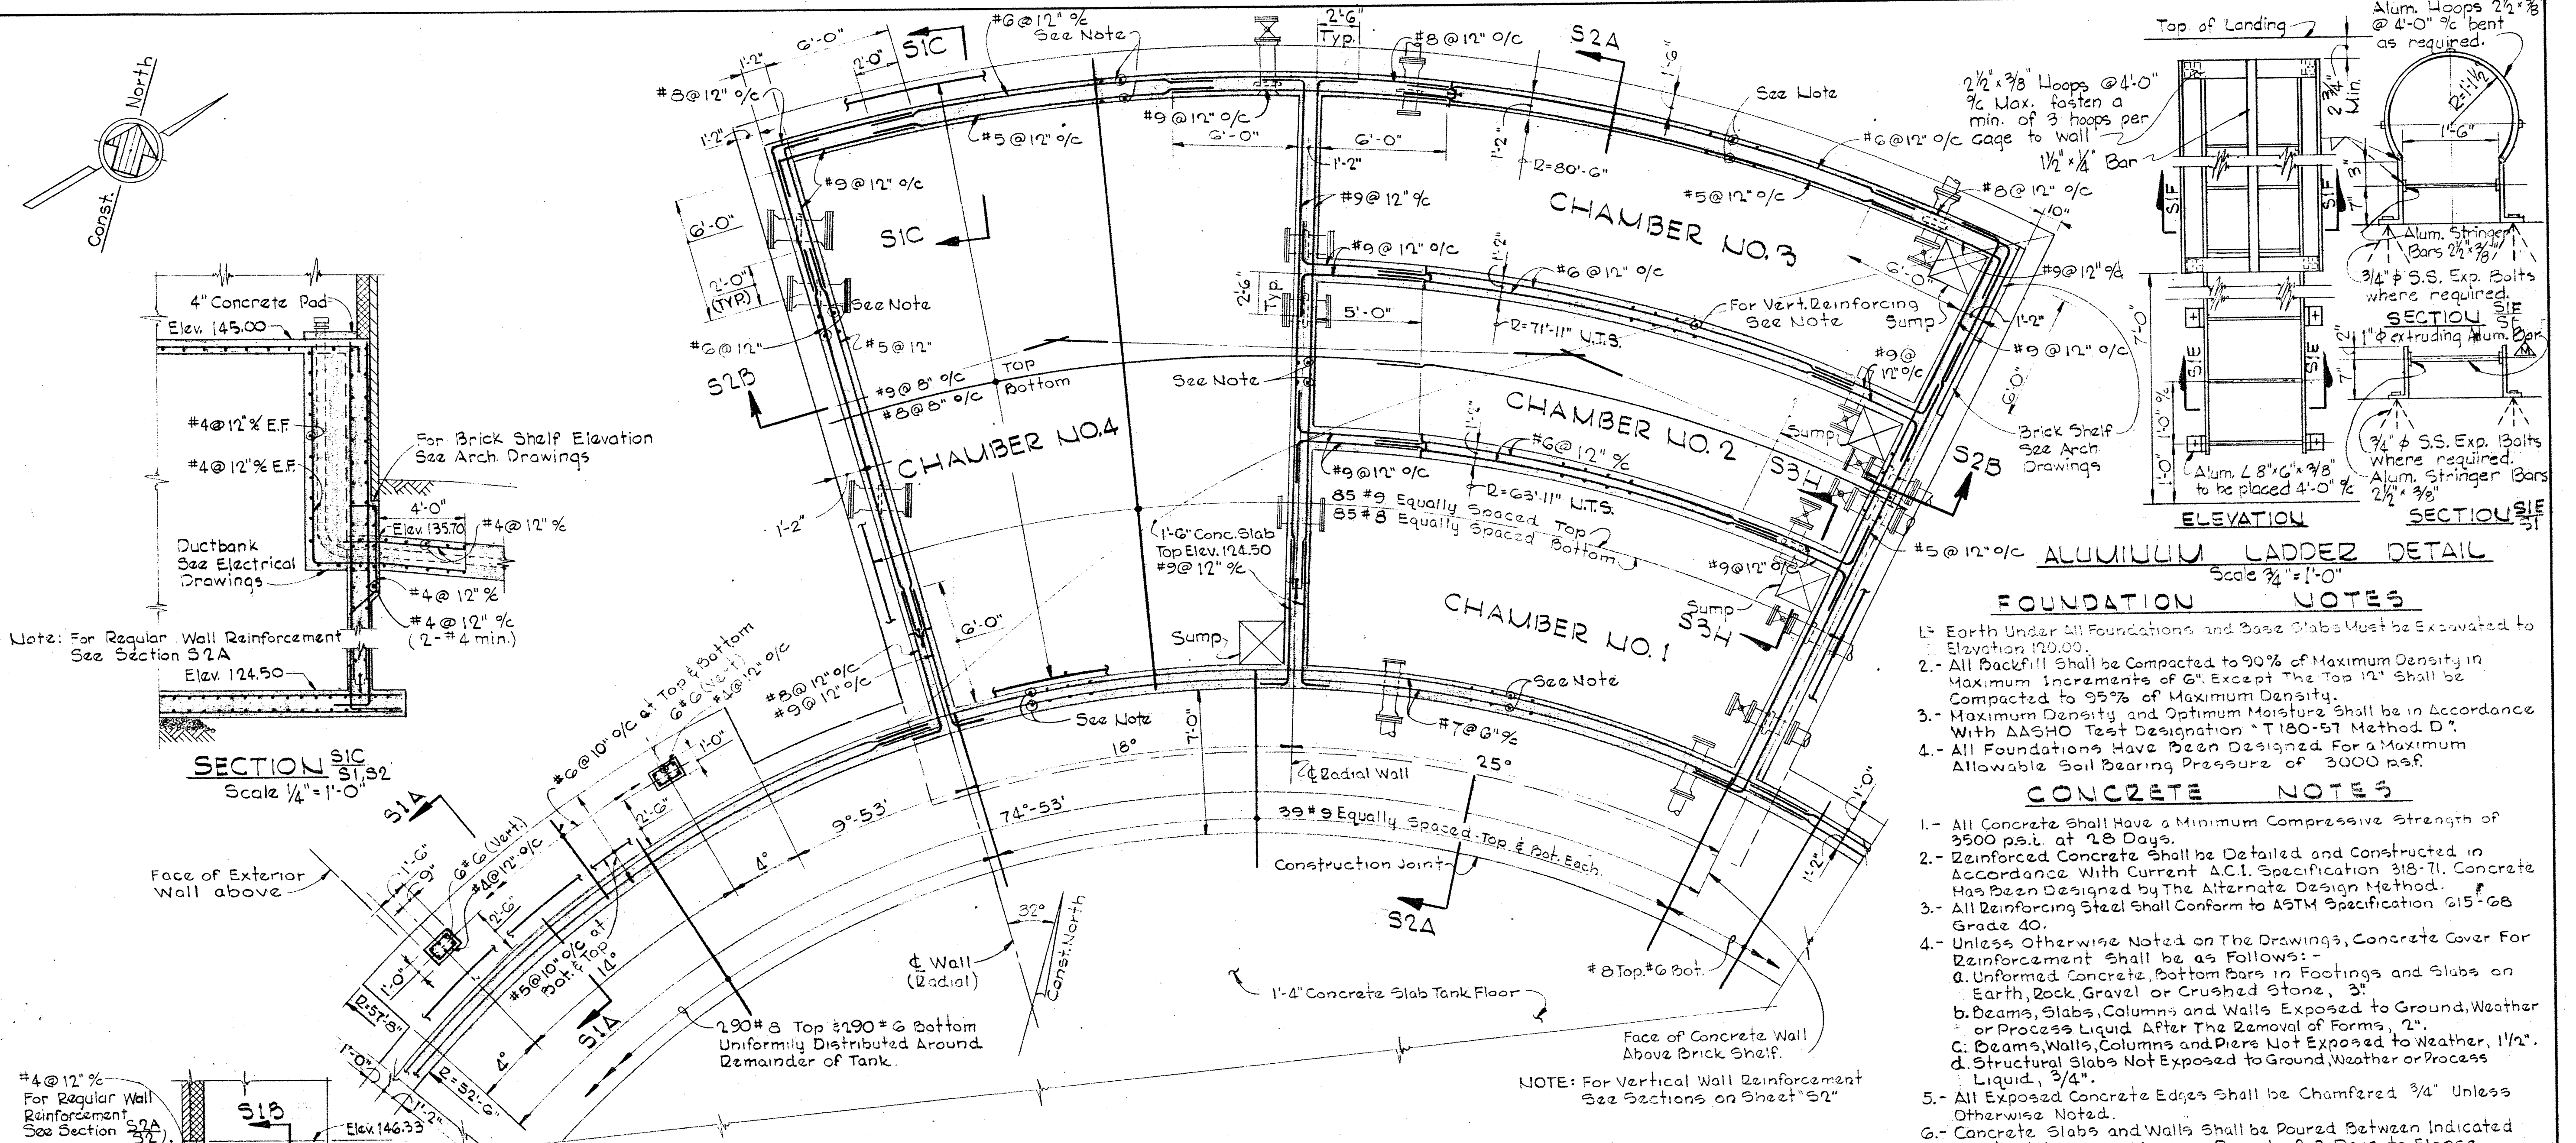

**FOUNDATION NOTES**

1. Earth Under All Foundations and Base Slabs Must be Excavated to Elevation 120.00.
2. All Backfill Shall be Compacted to 90% of Maximum Density in Maximum Increments of 6". Except the Top 12" Shall be Compacted to 95% of Maximum Density.
3. Maximum Density and Optimum Moisture Shall be in Accordance With AASHTO Test Designation "T 180-57 Method D".
4. All Foundations Have Been Designed For a Maximum Allowable Soil Bearing Pressure of 3000 psf.

**CONCRETE NOTES**

1. All Concrete Shall Have a Minimum Compressive Strength of 3500 psf. at 28 Days.
2. Reinforced Concrete Shall be Detailed and Constructed in Accordance With Current A.C.I. Specification 318-TI. Concrete Has Been Designed by the Alternate Design Method.
3. All Reinforcing Steel Shall Conform to ASTM Specification A15-68 Grade 40.
4. Unless Otherwise Noted on The Drawings, Concrete Cover For Reinforcement Shall be as Follows:
  - a. Unformed Concrete, Bottom Bars in Footings and Slabs on Earth, Rock, Gravel or Crushed Stone, 3"
  - b. Beams, Slabs, Columns and Walls Exposed to Ground, Weather or Process Liquid After The Removal of Forms, 2"
  - c. Beams, Walls, Columns and Piers Not Exposed to Weather, 1 1/2"
  - d. Structural Slabs Not Exposed to Ground, Weather or Process Liquid, 3/4"
5. All Exposed Concrete Edges Shall be Chamfered 3/4" Unless Otherwise Noted.
6. Concrete Slabs and Walls Shall be Poured Between Indicated Joints Allowing a Minimum Period of 3 Days to Elope Between Adjacent Pours.
7. Construction, Expansion and Contraction Joints Shall be as Detailed on the Drawings and no Additional Joints Shall be Used Nor any Omitted Except by Written Authorization of The Engineer.
8. The Contractor Shall Submit Shop Details of Reinforcing Steel Before Proceeding With Fabrication.
9. Unless Otherwise Noted, All Reinforcing Bar Laps Shall be as Follows:
  - a. Sizes #3 to #5 - 24 Bar Diameters
  - b. Sizes #6 to #8 - 32 Bar Diameters
  - c. Sizes #9 to #11 - 44 Bar Diameters
10. Anchor Bolts and Equipment Pedestals Shall be Sized and Located as Required to Suit Equipment Furnished.
11. See Civil, Architectural, Mechanical and Electrical Drawings For All Embedded Items, Such as Sleeves, Anchors, Electrical Conduits, Openings, Chases Etc. Which Interfere With Concrete Construction.
12. For Horizontal Reinforcing Bars of Wall, All Bar Laps Shall be Increased 40% of the Laps Stated in Item 9.

**STRUCTURAL STEEL NOTES**

1. All Structural Steel Shall Conform to ASTM Designation "A-36".
2. All Shop Connections Shall be Welded With A133 Class E-70 Series Electrodes. All Field Connections Shall be High Strength Bolted Using A325 Bolts Except Where Otherwise Noted.
3. All Structural Steel is Designed by Elastic Analysis and Shall be Fabricated in Accordance With Current A.I.S.C. Specifications For Buildings.
4. The Contractor Shall Submit Erection Plans and Shop Details Before Starting Fabrication.
5. All Structural Steel Shall be Given One Shop Coat of Paint. See Specifications.
6. All Steel Anchor Bolts Shall be Stainless Steel. See Specifications for Additional Requirements.

**STRUCTURAL ALUMINUM NOTES**


1. All Aluminum in Contact With Concrete Shall, Before Erection, be Heavily Coated as Specified.
2. All Structural Aluminum Shall be Alloy 6061-T6. Aluminum Handrails Shall be Alloy 6063-T6. Except Handrail Posts Shall be Alloy 6061-T6.
3. All Structural Aluminum is Designed and Shall be Fabricated in Accordance With The Current Specifications of The Aluminum Association.
4. All Aluminum Grating, Shall be Capable of Supporting 150 psf.

WHITMAN, REQUARDT & ASSOCIATES ENGINEERS 1304 ST. PAUL ST. BALTIMORE, MARYLAND	DEPARTMENT OF PUBLIC WORKS HOWARD COUNTY, MARYLAND DATE 2/1/73 W. O. Gilbert CHIEF - BUREAU OF ENGINEERING	CONTRACT NO. 525-S	SLUDGE OXIDATION BUILDING FOUNDATIONS	SAVAGE WASTEWATER TREATMENT PLANT ADDITION NO. 3	DRAWING NO. 12 OF 28 SCALE AS SHOWN SHEET S-1
---	--	--------------------	--	---	---

W. O. 6538-2

Construction Modification AS BUILT


BRUNING 44510 14778

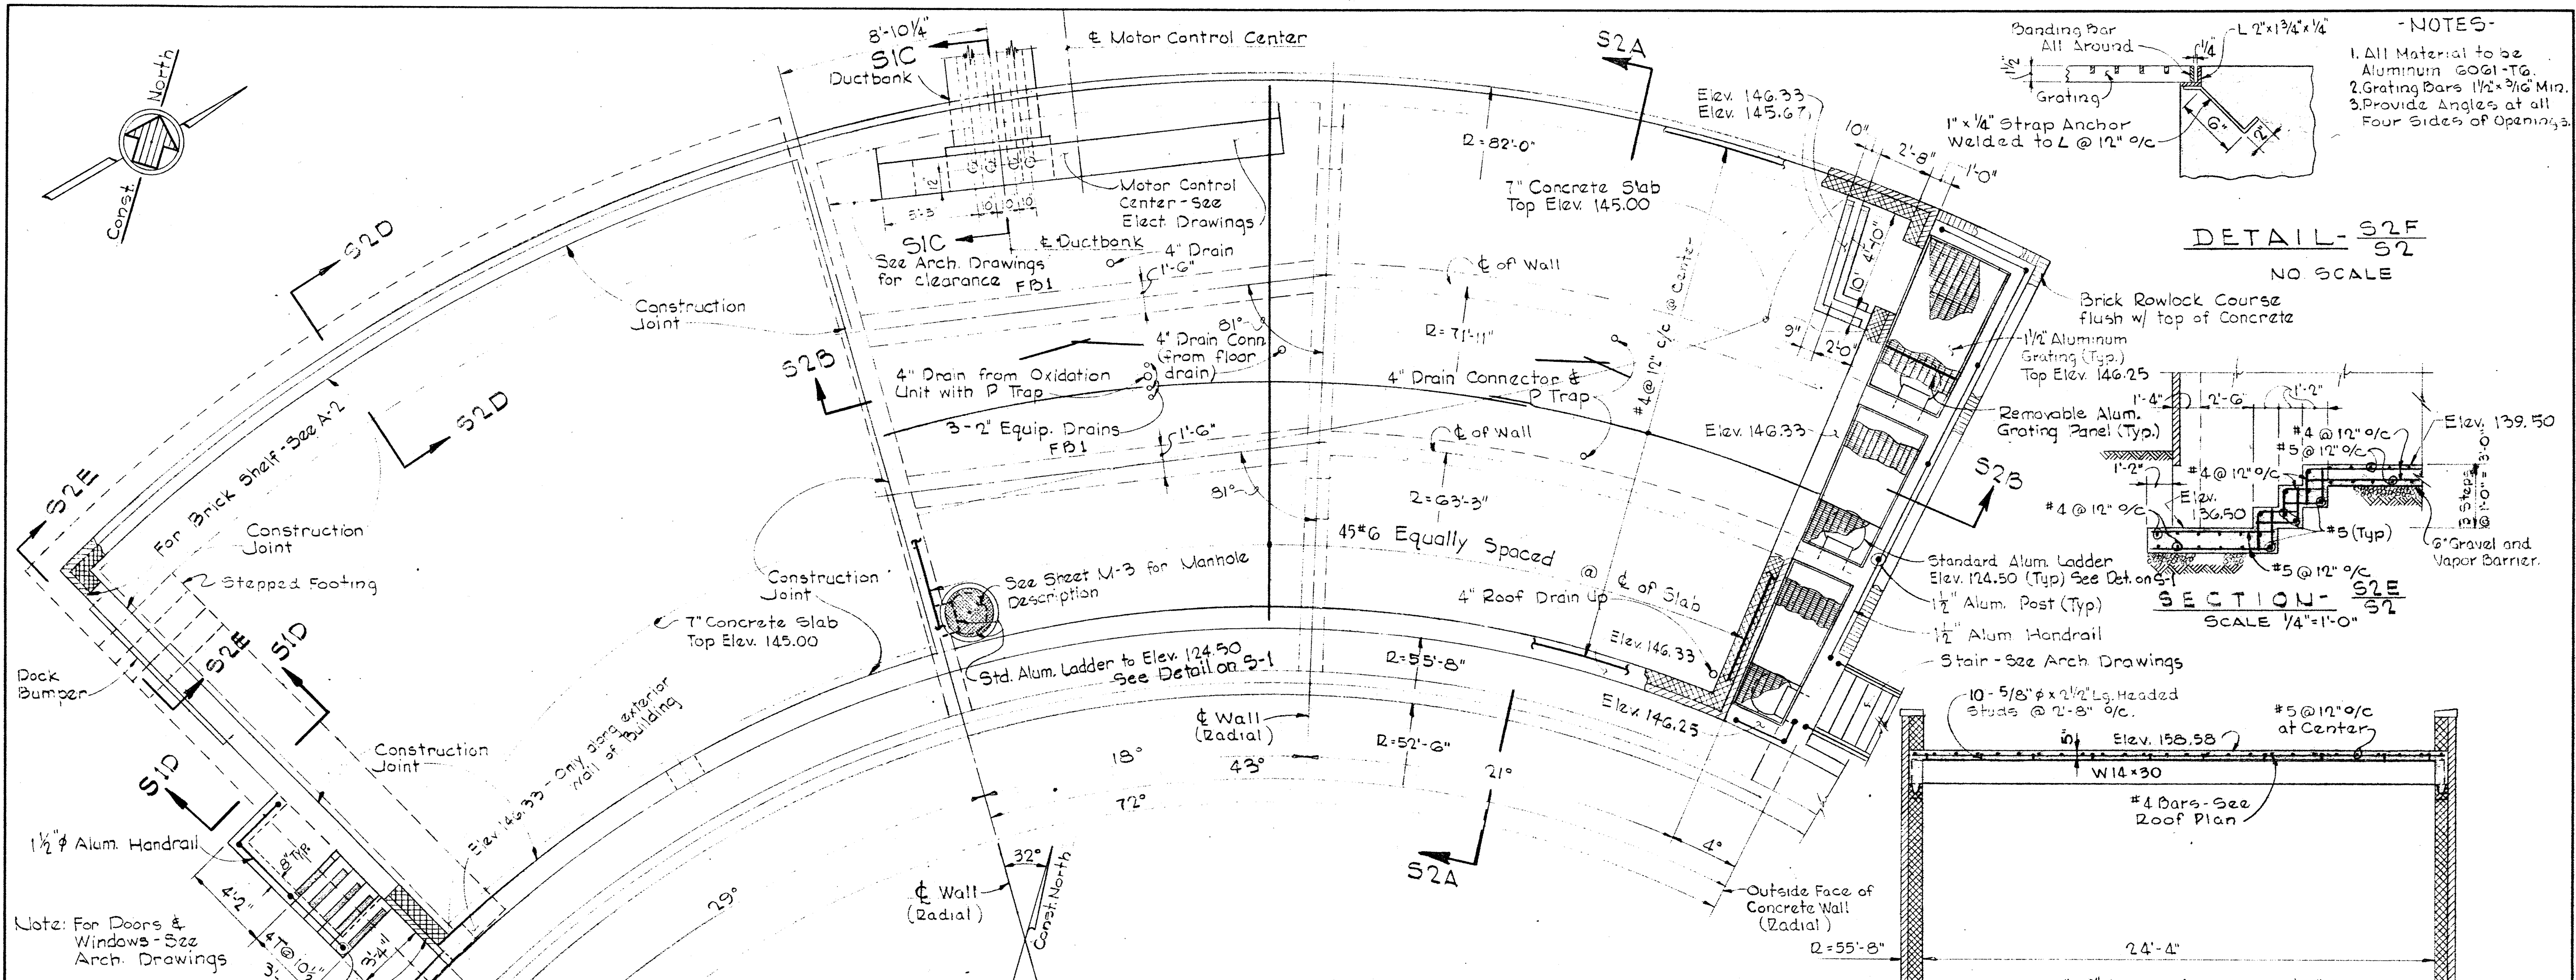



**PLAN AT ELEVATION 145.00**  
Scale 1/4" = 1'-0"

- NOTES-**
1. All Material to be Aluminum 6061-T6.
  2. Grating Bars 1 1/2" x 1/2" Min.
  3. Provide Angles at all Four Sides of Openings.

**DETAIL - S2F**  
NO SCALE

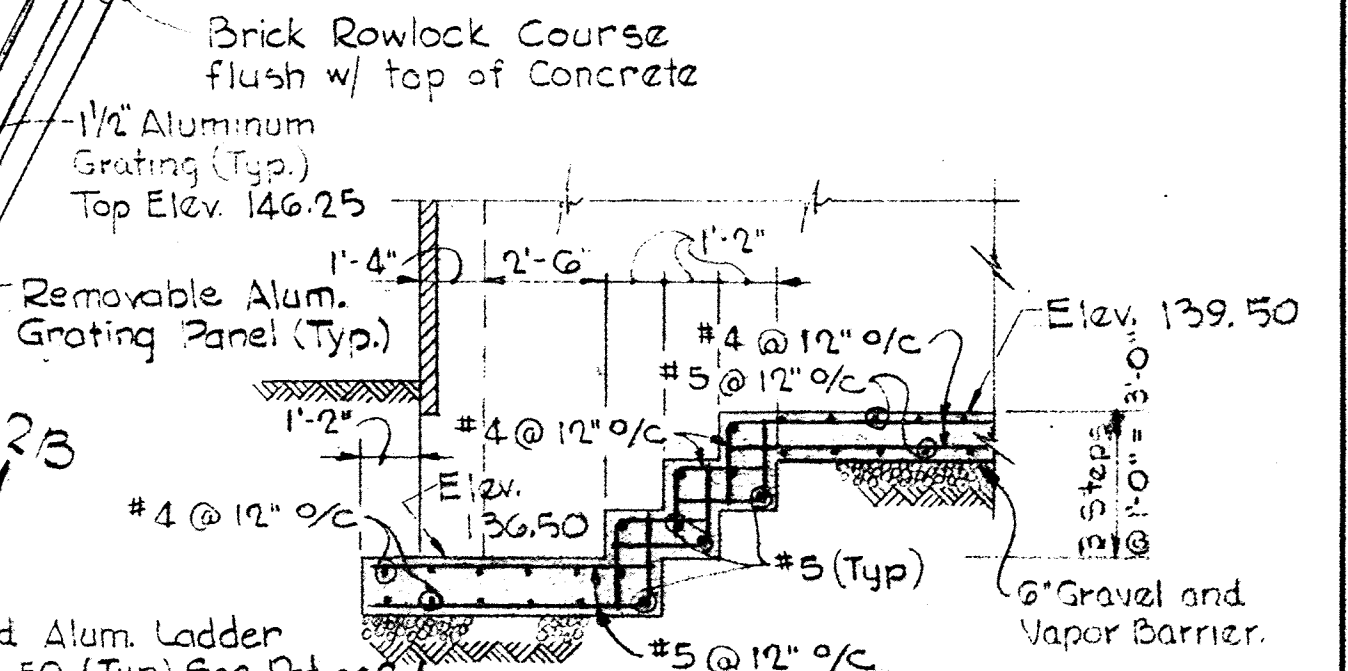

**SECTION - S2E**  
SCALE 1/4" = 1'-0"

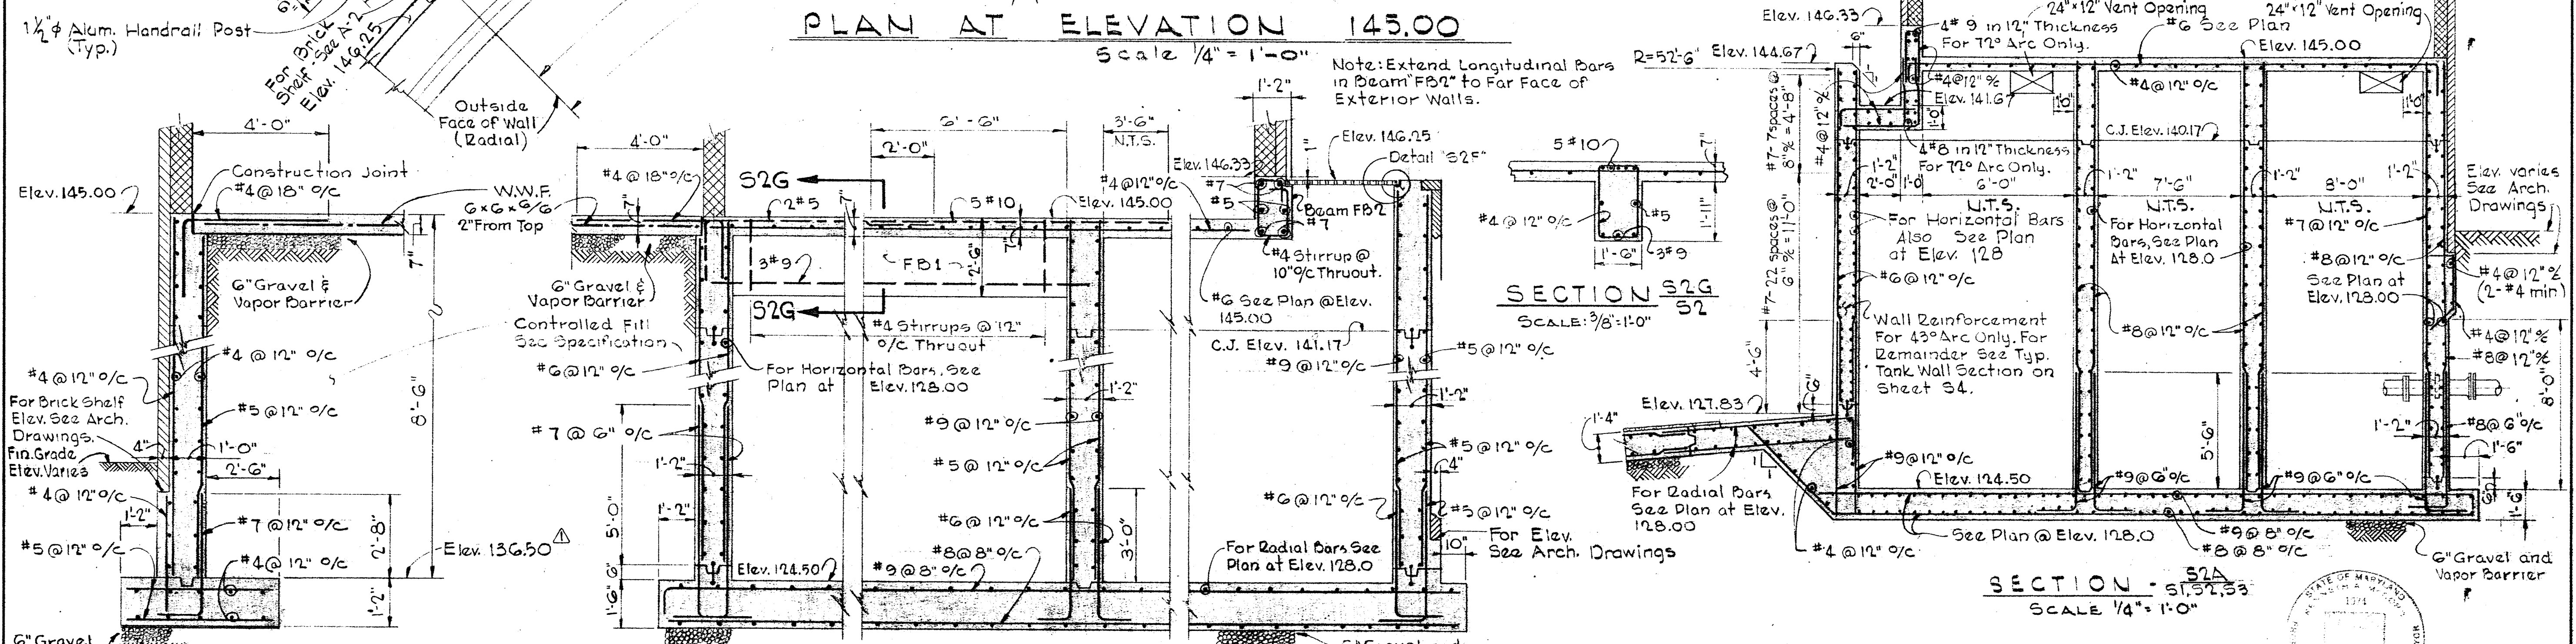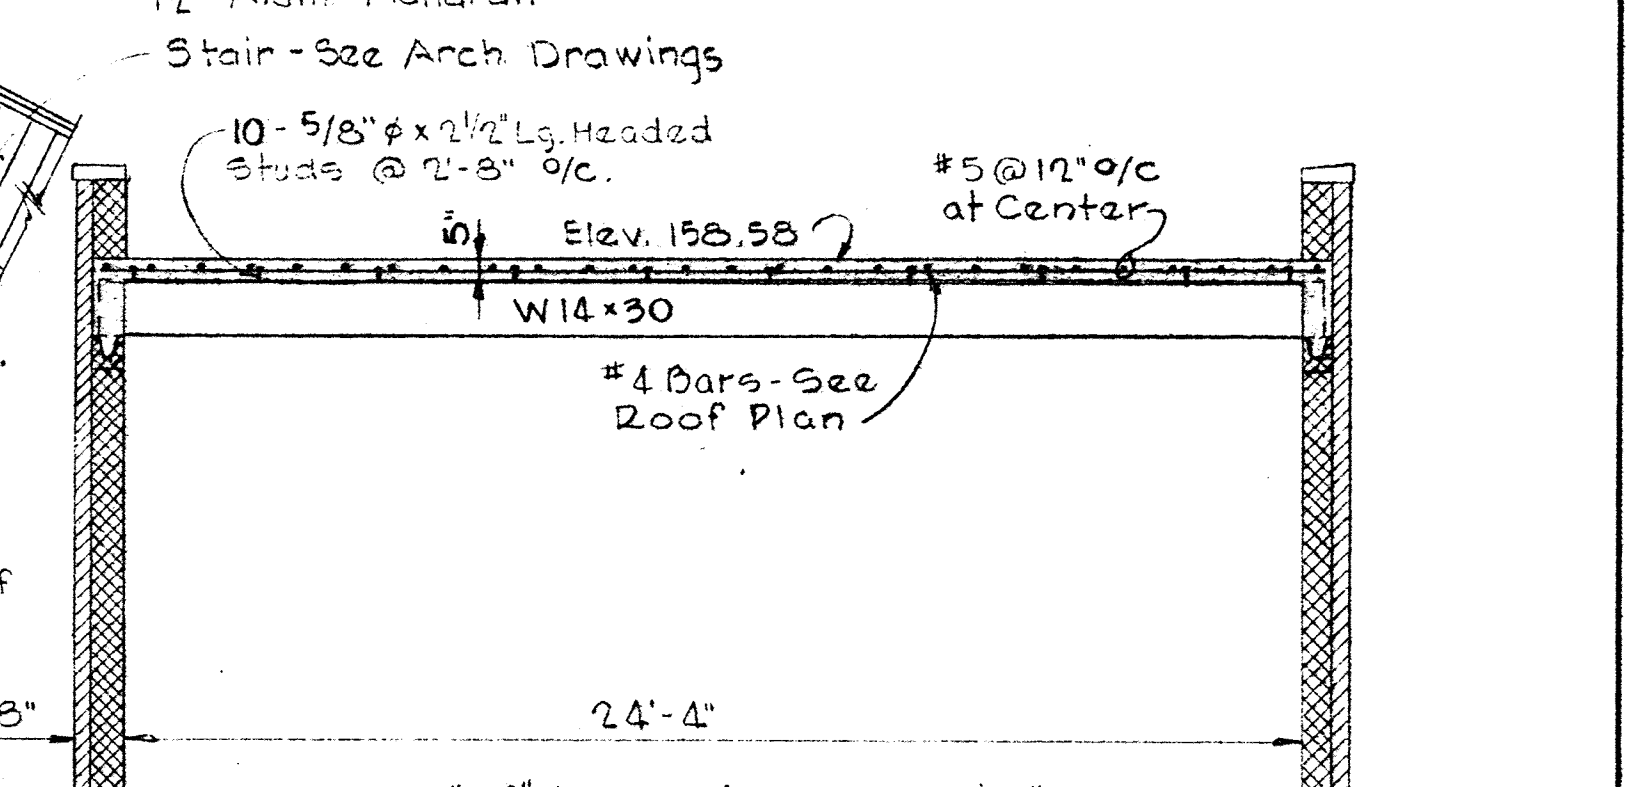

**SECTION S2D**  
Scale 3/8" = 1'-0"

**SECTION S2G**  
SCALE 3/8" = 1'-0"

**SECTION - S2A**  
SCALE 1/4" = 1'-0"

<p><b>WHITMAN, REQUARDT &amp; ASSOCIATES</b> ENGINEERS 1304 ST. PAUL ST. BALTIMORE, MARYLAND</p>	<p><b>DEPARTMENT OF PUBLIC WORKS</b> HOWARD COUNTY, MARYLAND <i>W. O. Libart</i> DATE 2/1/73 CHIEF - BUREAU OF ENGINEERING</p>	<p><b>CONTRACT NO. 525-S</b></p>	<p><b>SLUDGE OXIDATION BUILDING</b> FLOOR PLAN (ELEVATION 145)</p>	<p><b>SAVAGE WASTEWATER</b> TREATMENT PLANT ADDITION NO. 3</p>	<p><b>DRAWING NO. 13 OF 28</b> SCALE AS SHOWN</p>
--	--	----------------------------------	--	--	---


W. 0.6538-2

Addendum A


AS BUILT JAN 1 1977

SHEET S-2


BRUNING 44-510 14778

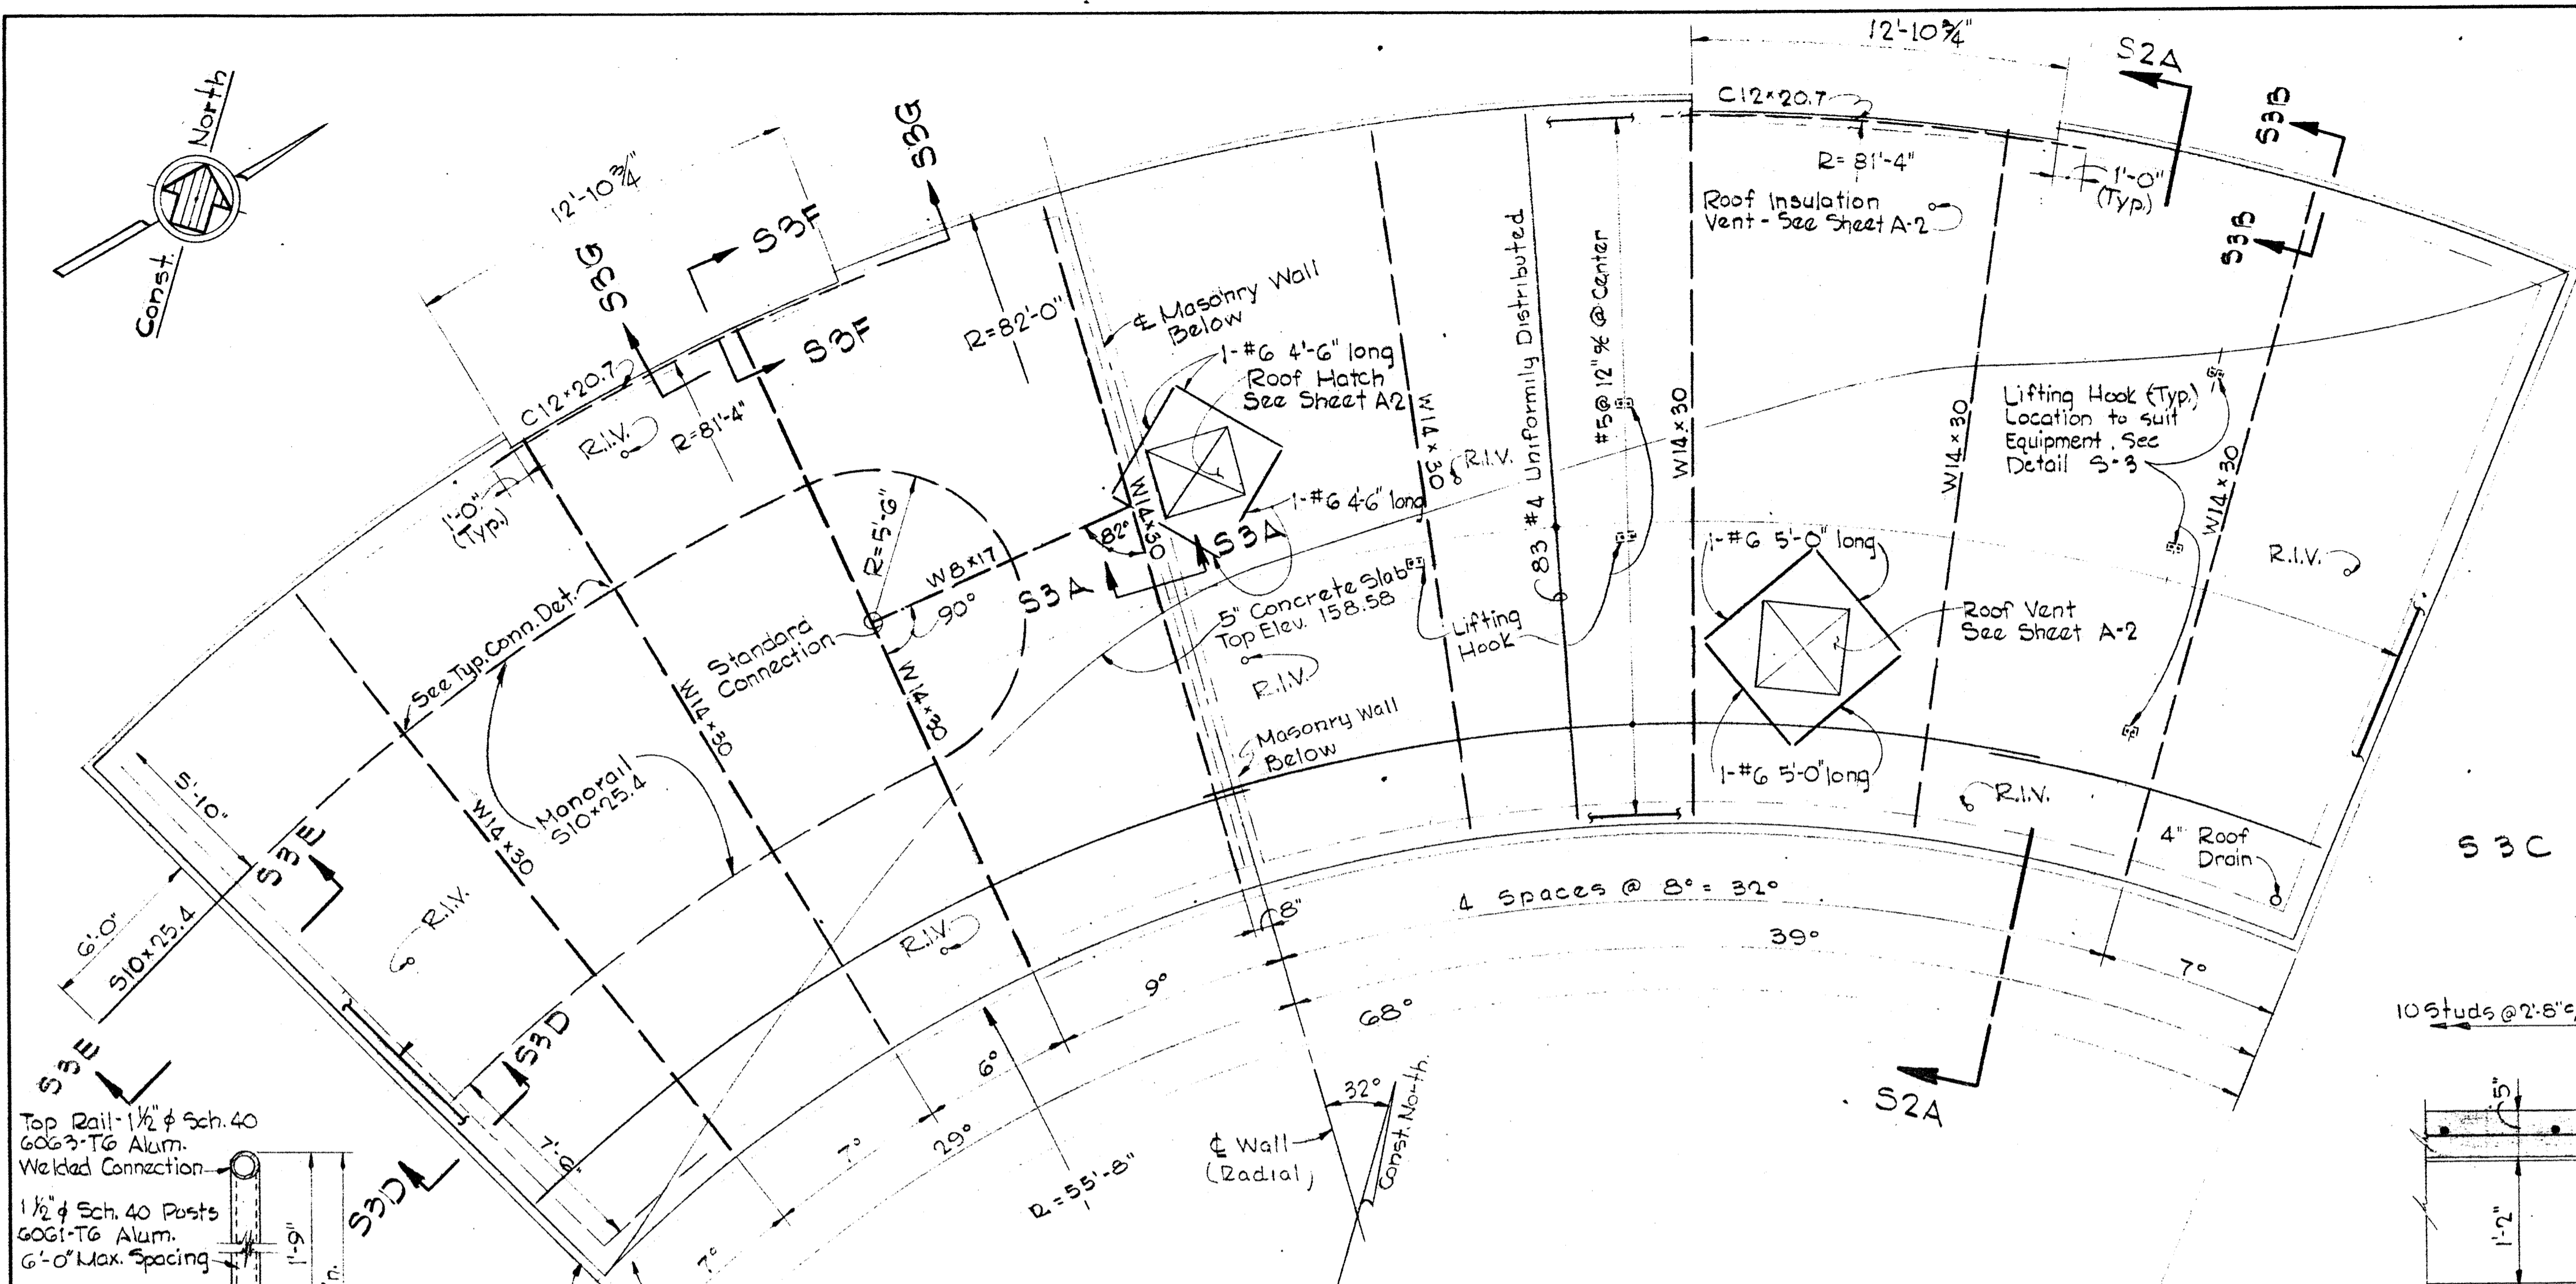

**ROOF PLAN AT ELEVATION 158.58**  
SCALE: 1/4" = 1'-0"

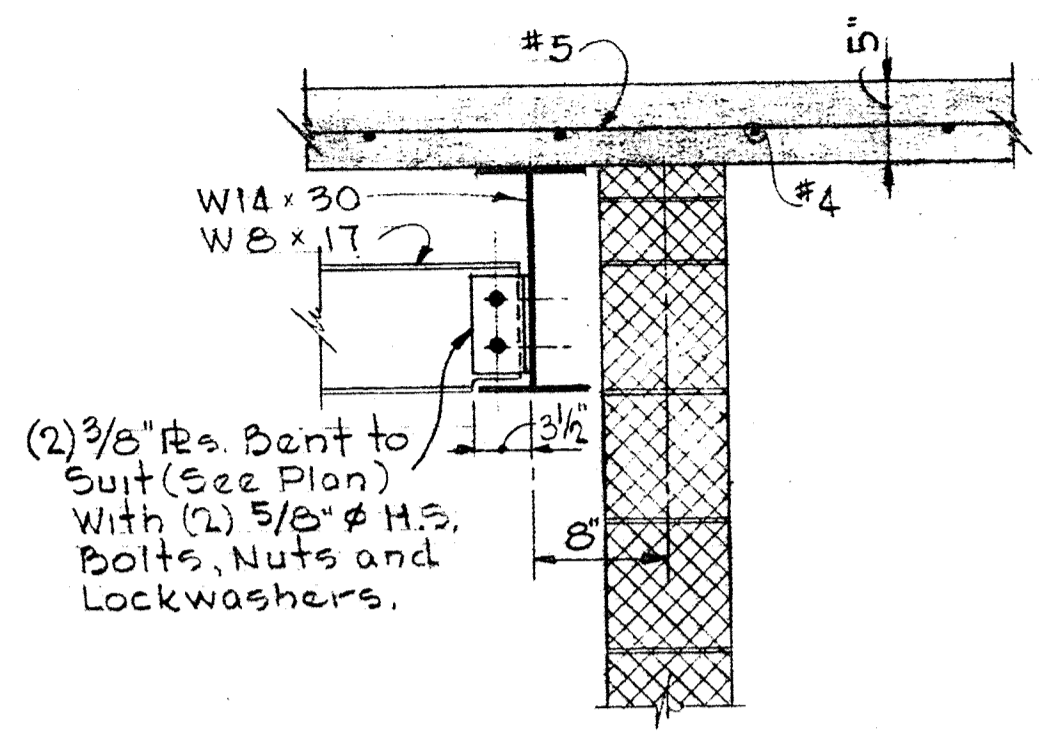


**SECTION S3A**  
SCALE: 1" = 1'-0"

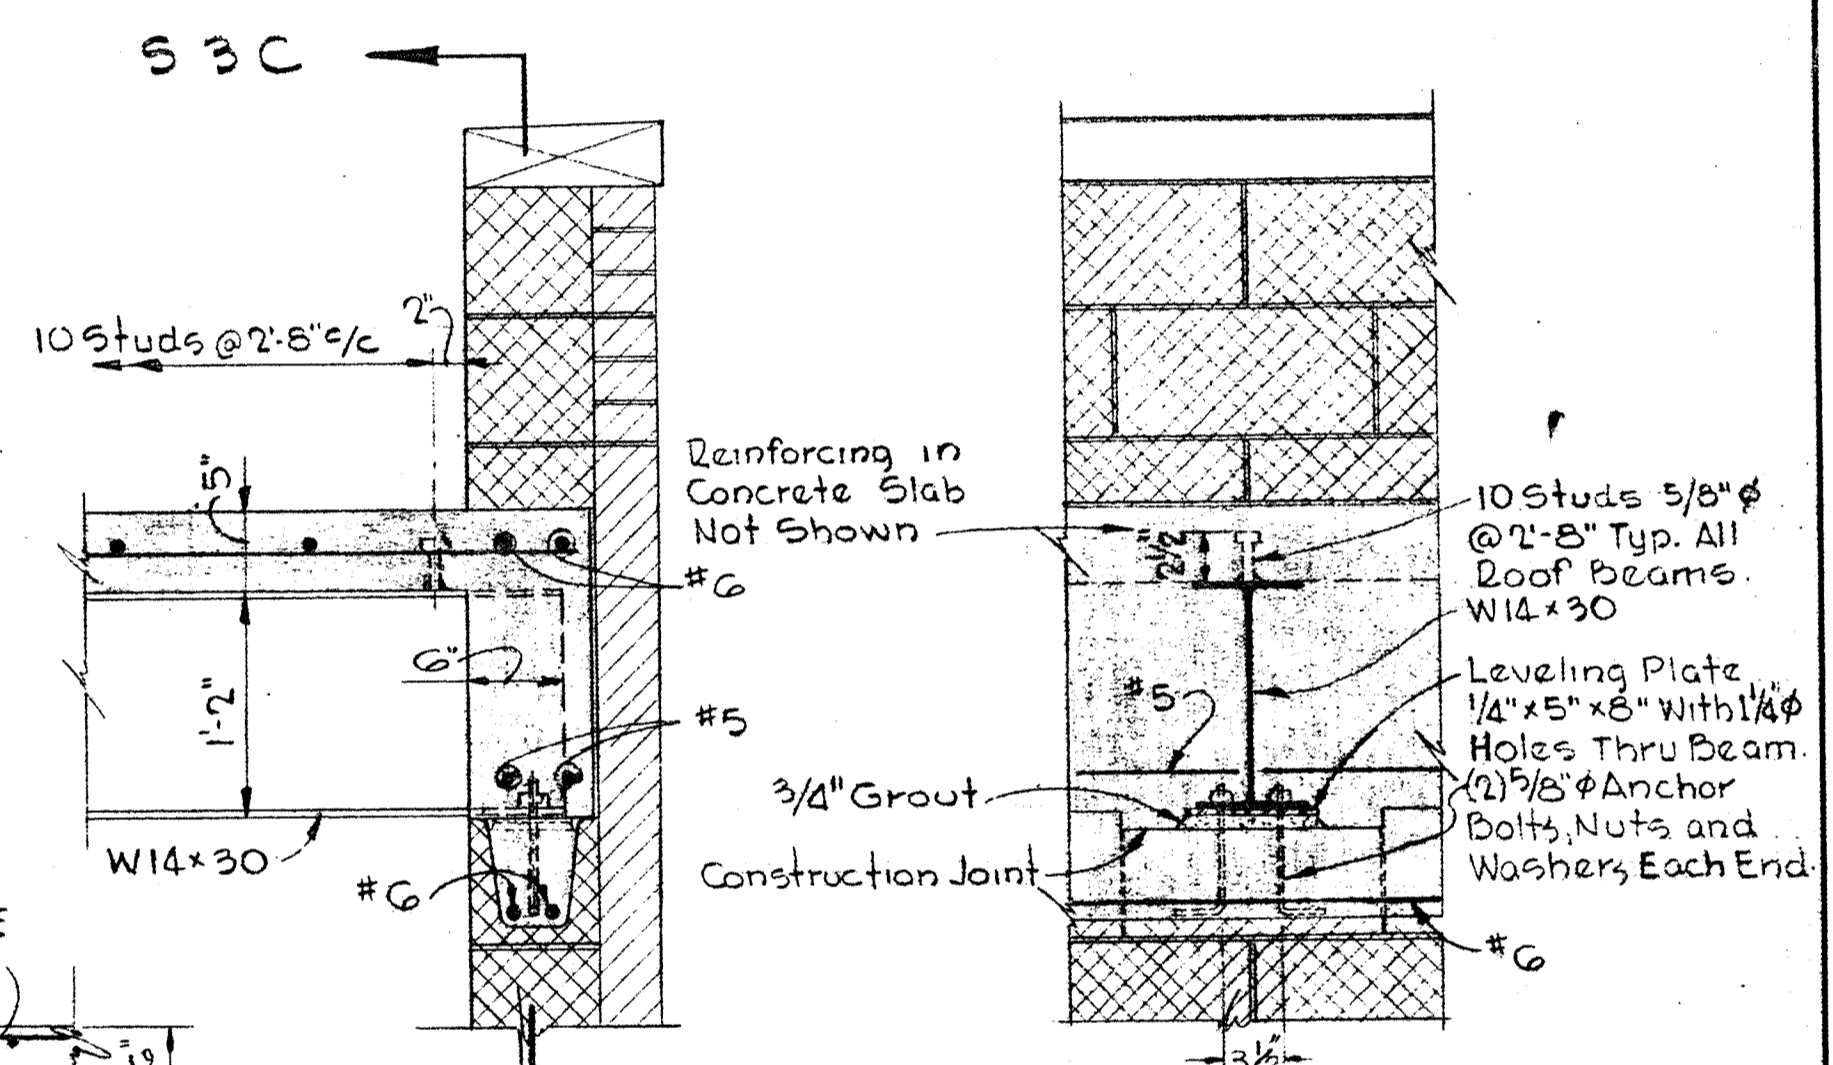


**SECTION S3B**  
SCALE: 1" = 1'-0"


**SECTION S3C**  
SCALE: 1" = 1'-0"

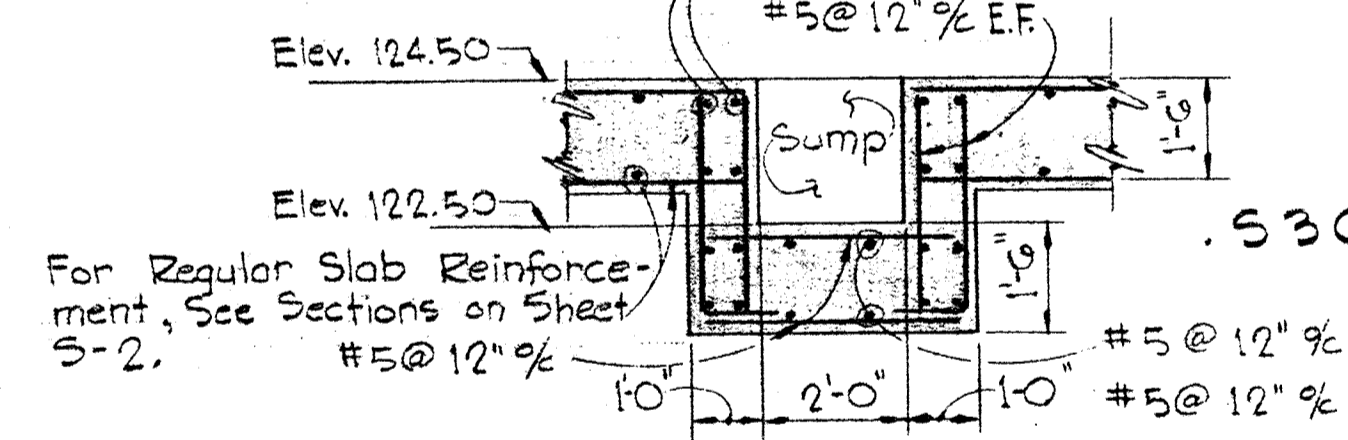


**SECTION S3D**  
SCALE: 3/8" = 1'-0"

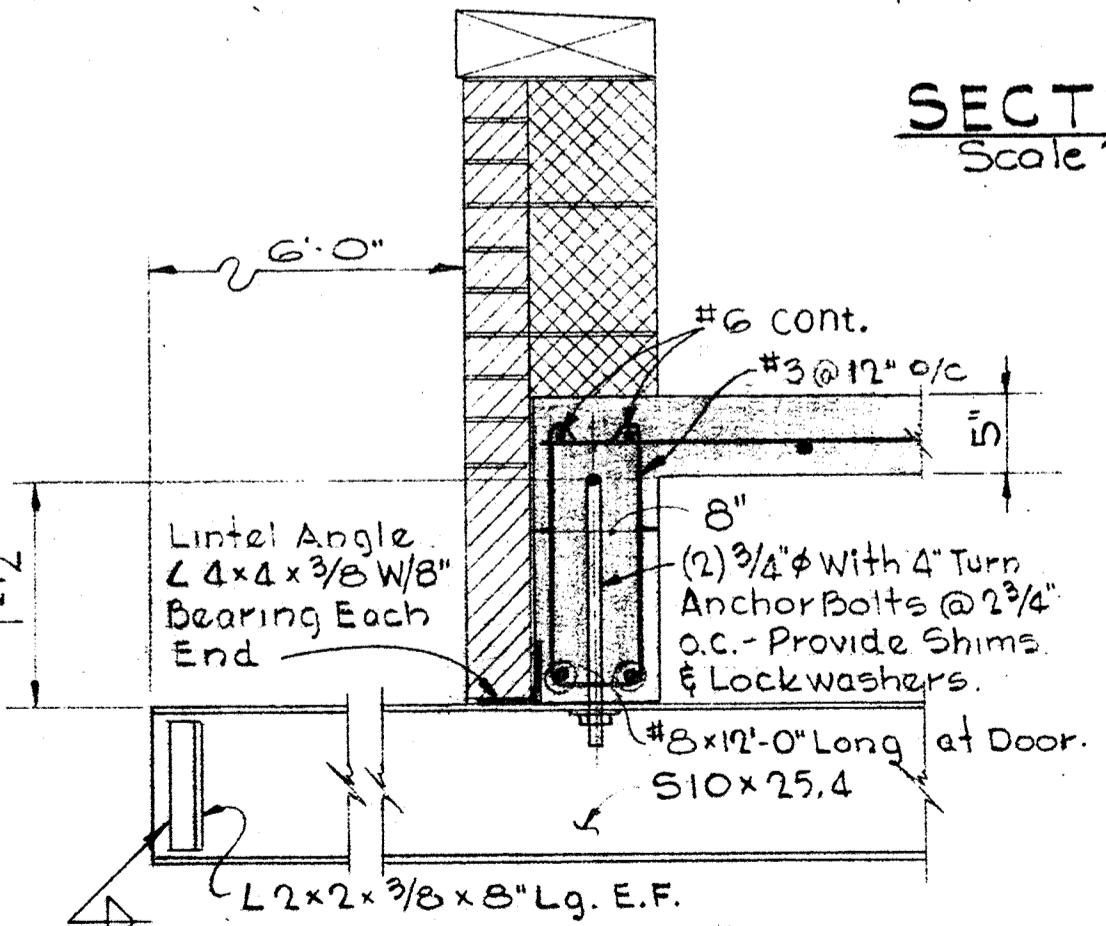


**SECTION S3E**  
SCALE: 1" = 1'-0"

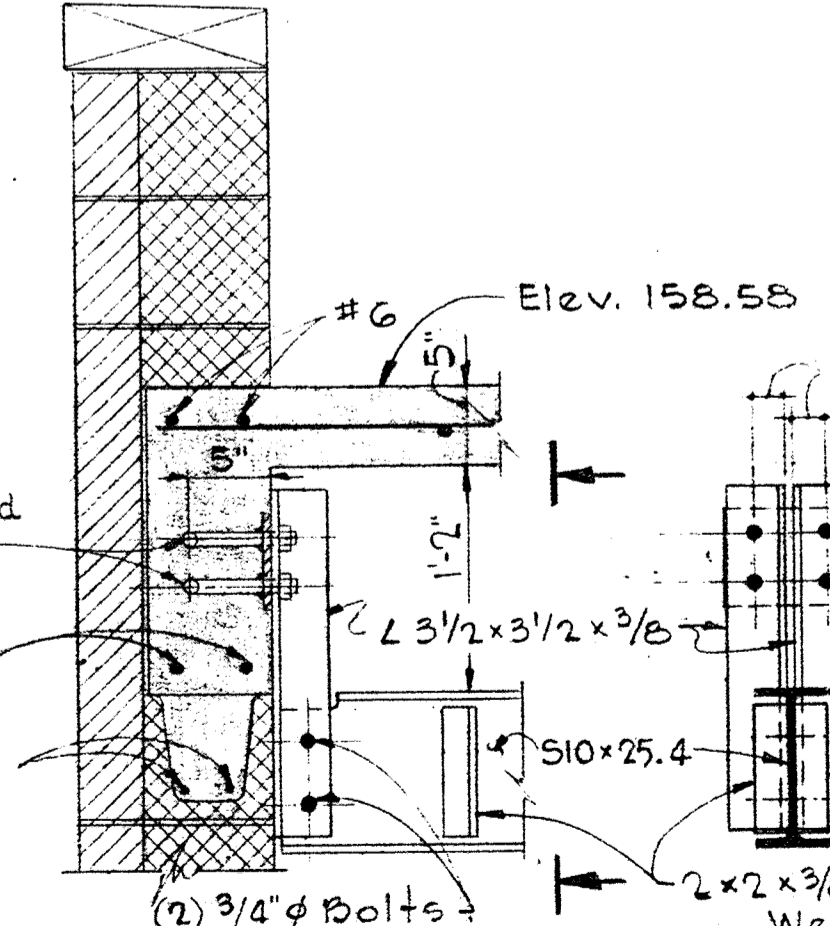


**SECTION S3F**  
SCALE: 1" = 1'-0"

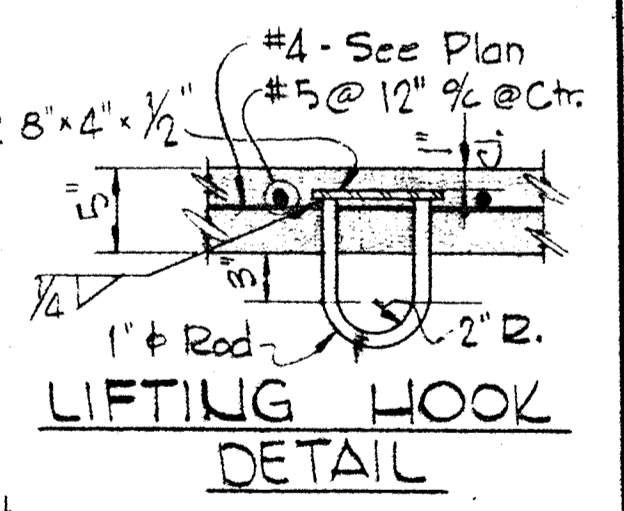


**LIFTING HOOK DETAIL**  
No Scale  
Note: Lifting Hook Capacity 3,000 lbs.

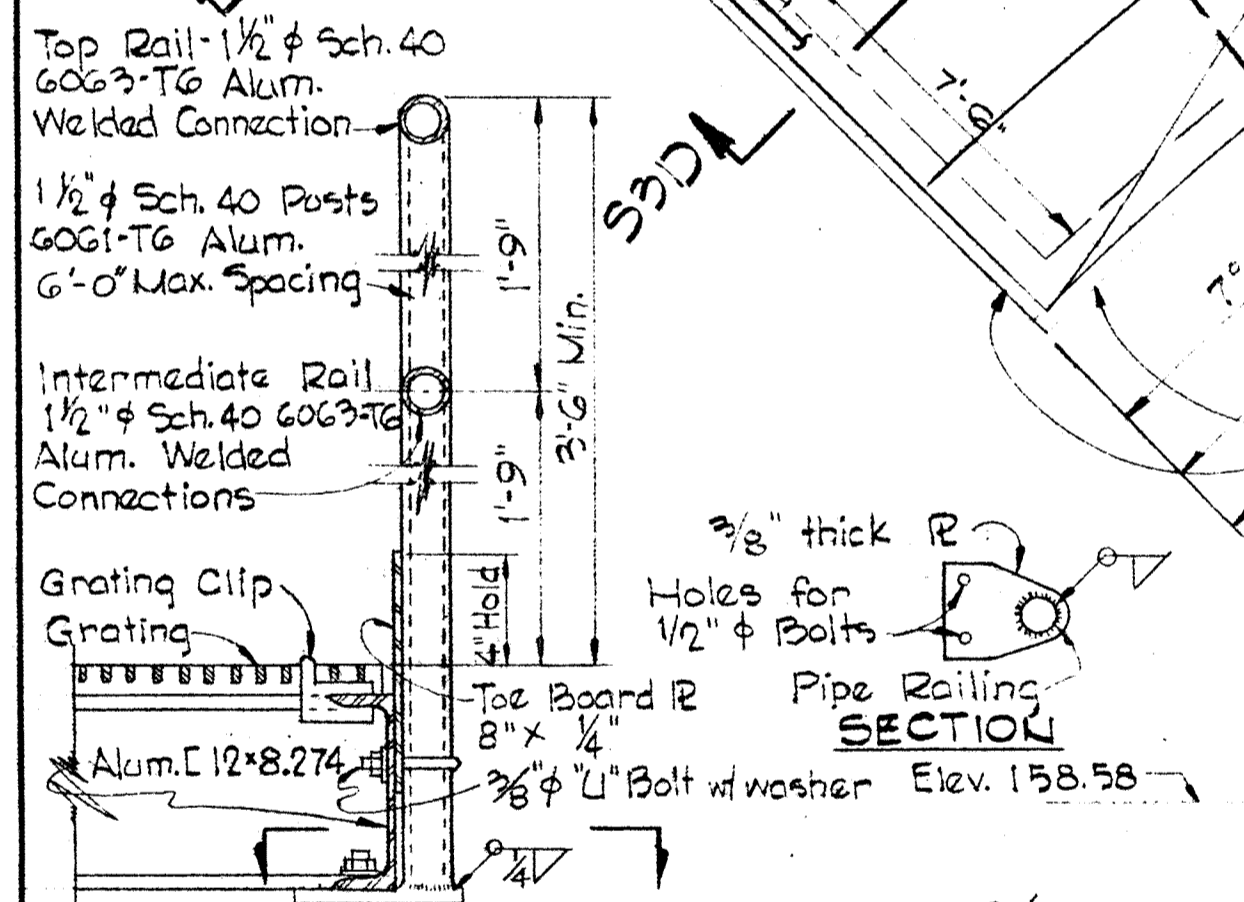

**TYPICAL HANDRAIL CONNECTION**  
No Scale

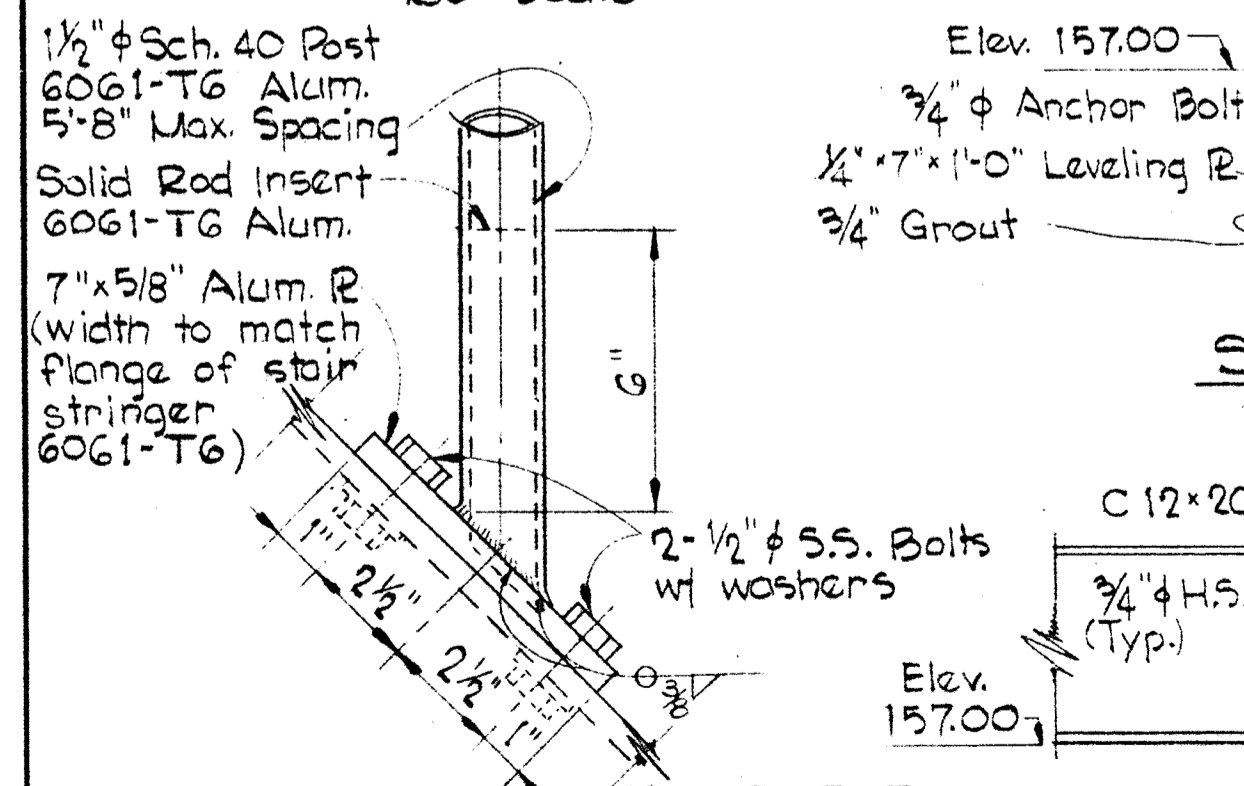

**TYPICAL HANDRAIL POST CONNECTION ON STRINGER**  
No Scale

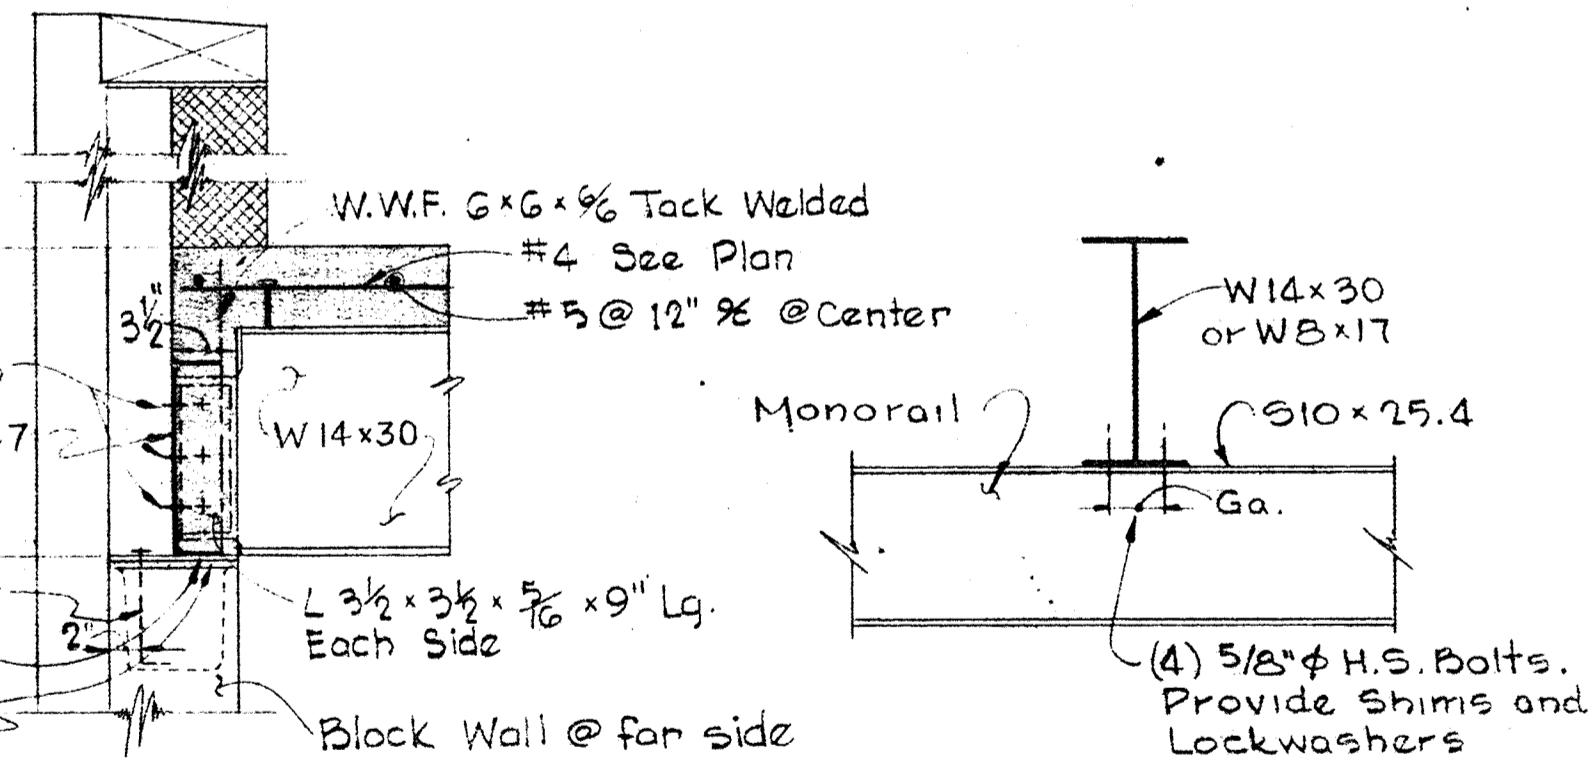

**TYPICAL MONORAIL CONNECTION**  
SCALE 1" = 1'-0"

- NOTES-**
1. All W14x30 Beams are in Radial Direction.
  2. The Monorail is to be Connected at All Roof Beams.
  3. The Monorail Capacity is 2 Tons

**WHITMAN, REQUARDT & ASSOCIATES ENGINEERS**  
1304 ST. PAUL ST.  
BALTIMORE, MARYLAND









**DEPARTMENT OF PUBLIC WORKS**  
HOWARD COUNTY, MARYLAND  
2/1/73  
DATE

**CONTRACT NO. 525-S**

**SLUDGE OXIDATION BUILDING**  
ROOF PLAN (ELEVATION 158)

**SAVAGE WASTEWATER TREATMENT PLANT ADDITION NO. 3**

**DRAWING NO. 14 OF 28**  
**SCALE AS SHOWN**

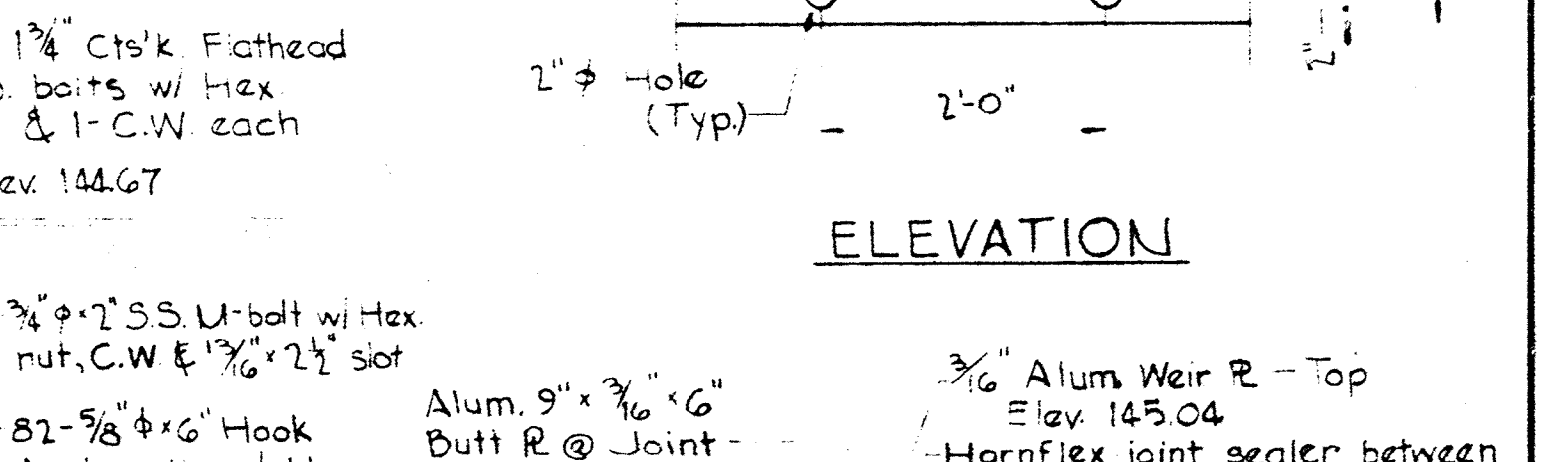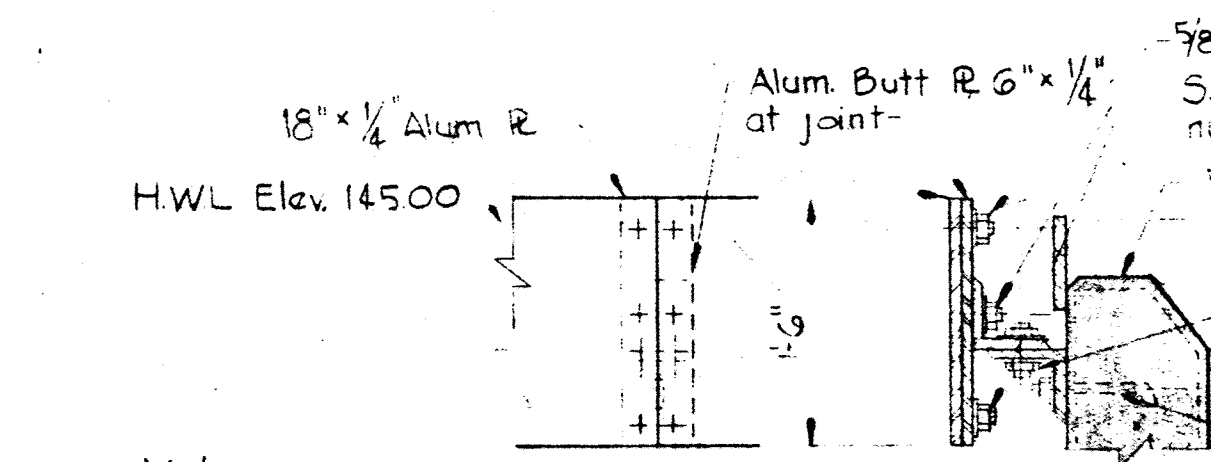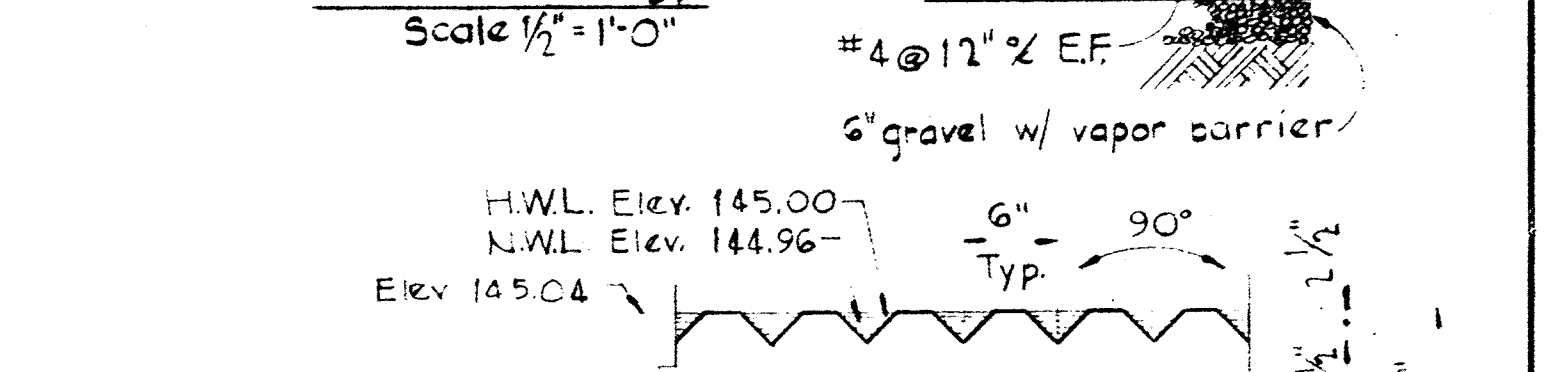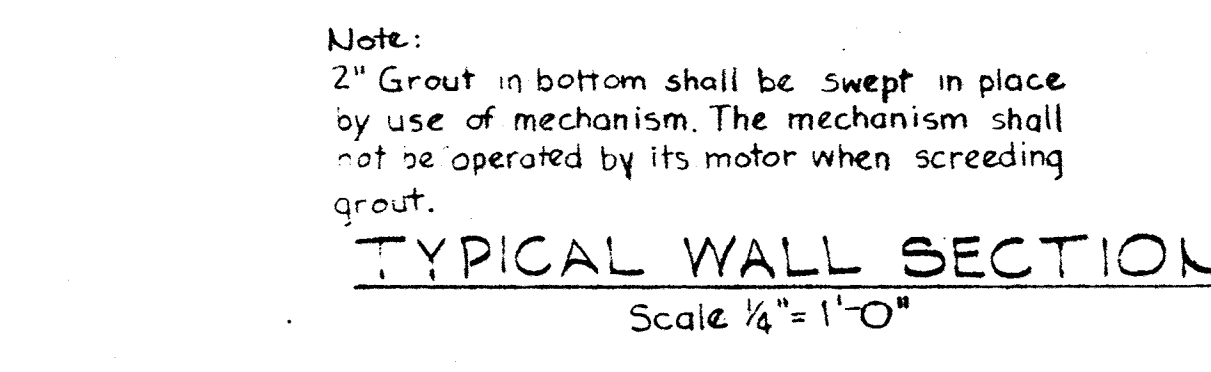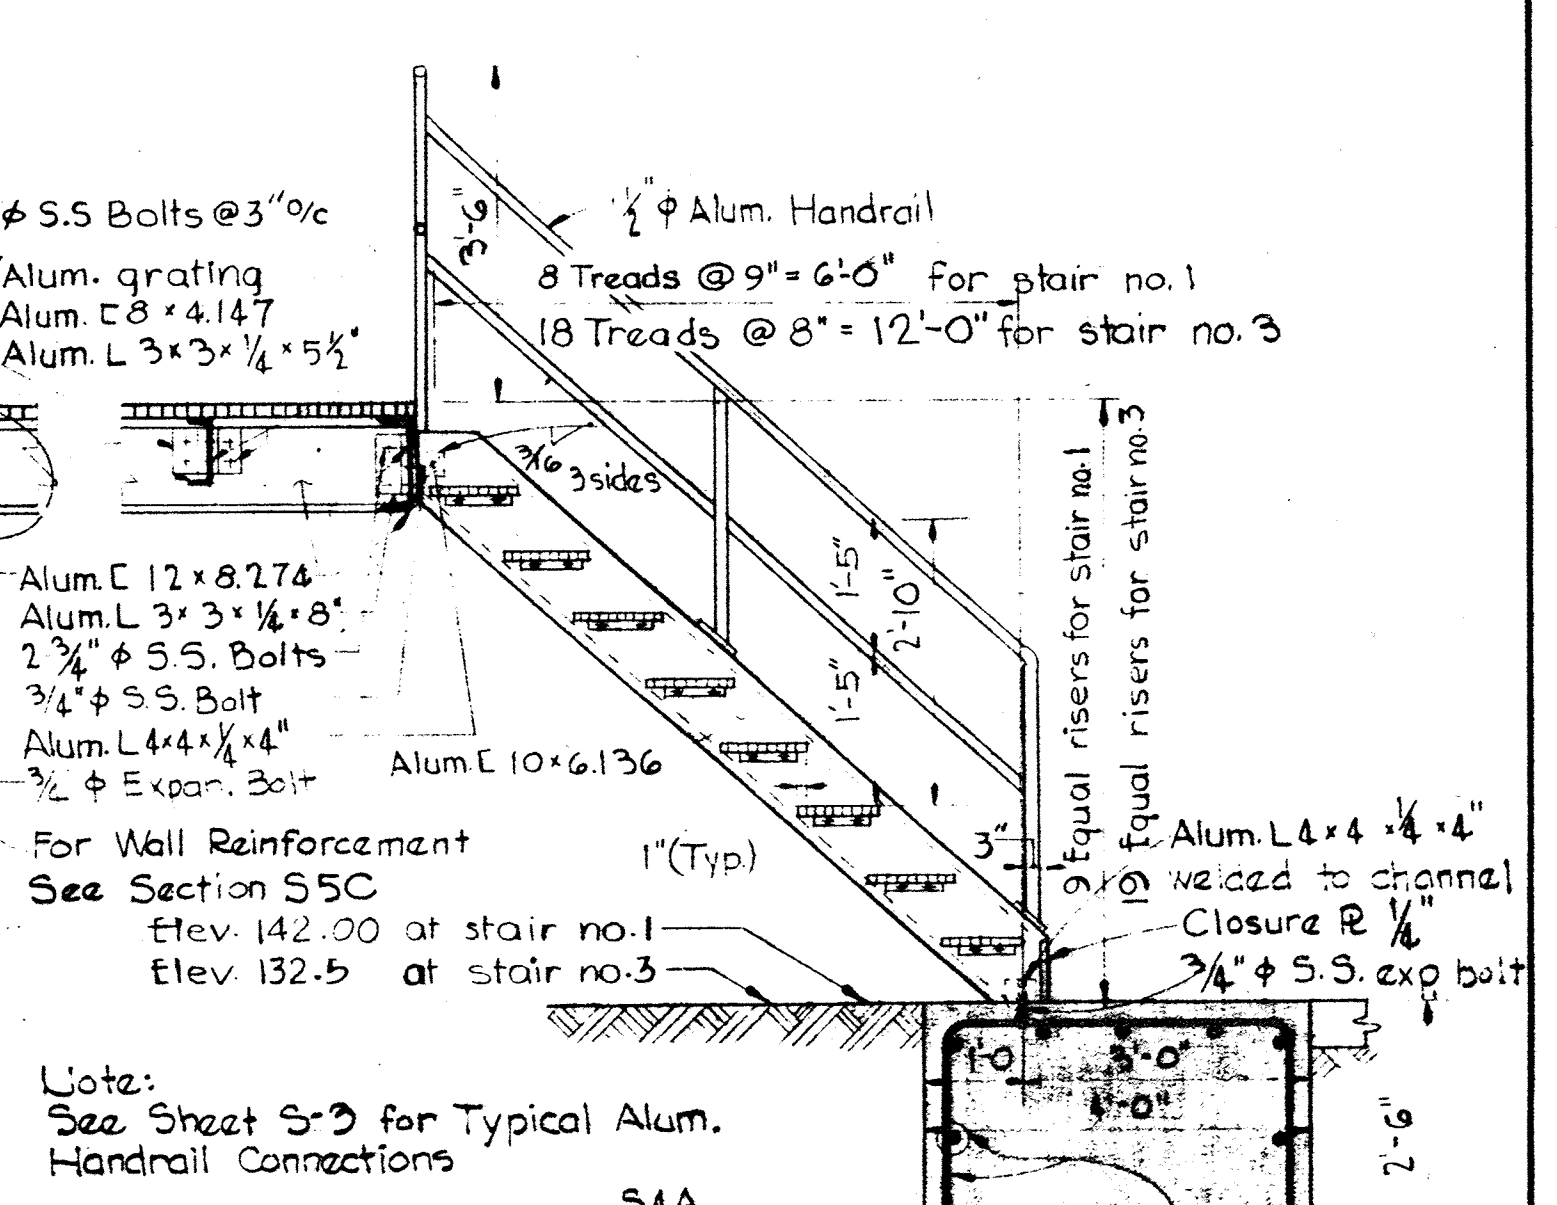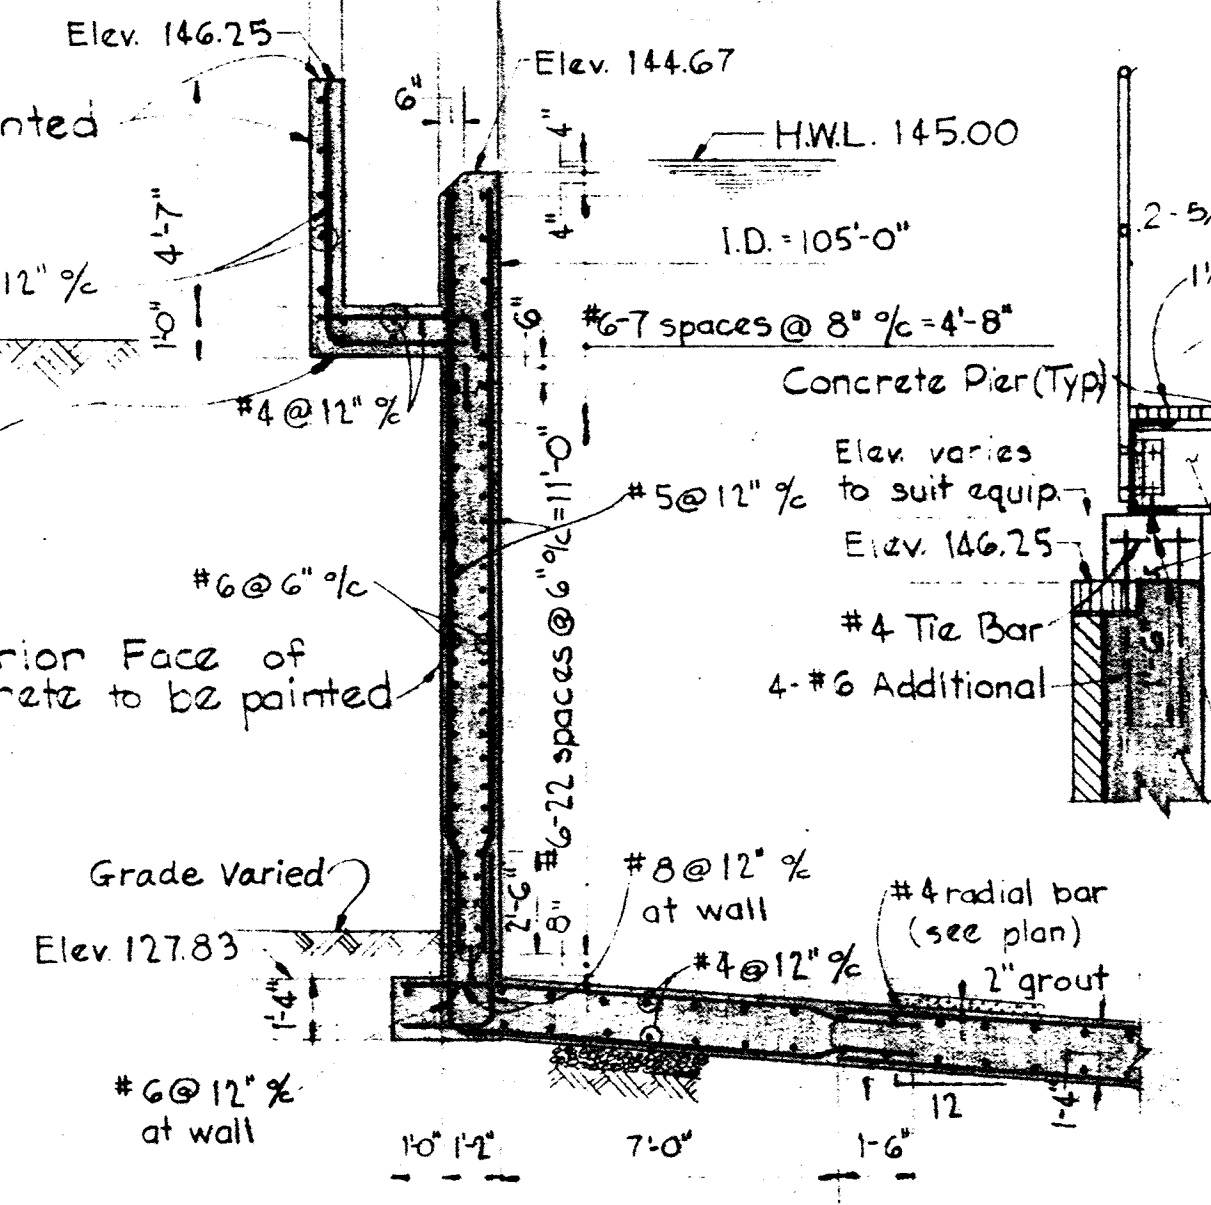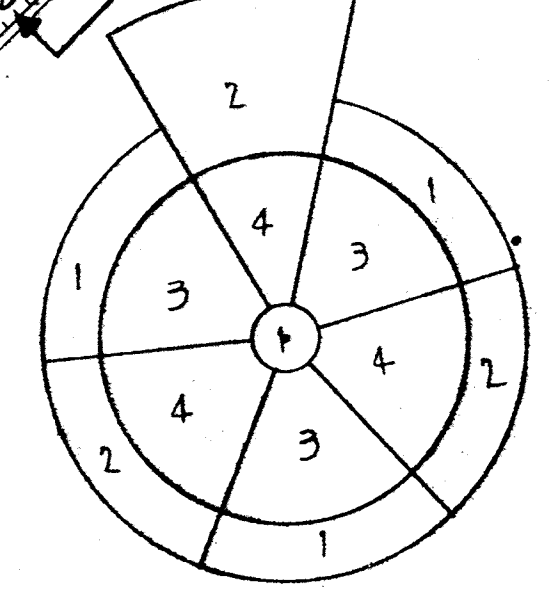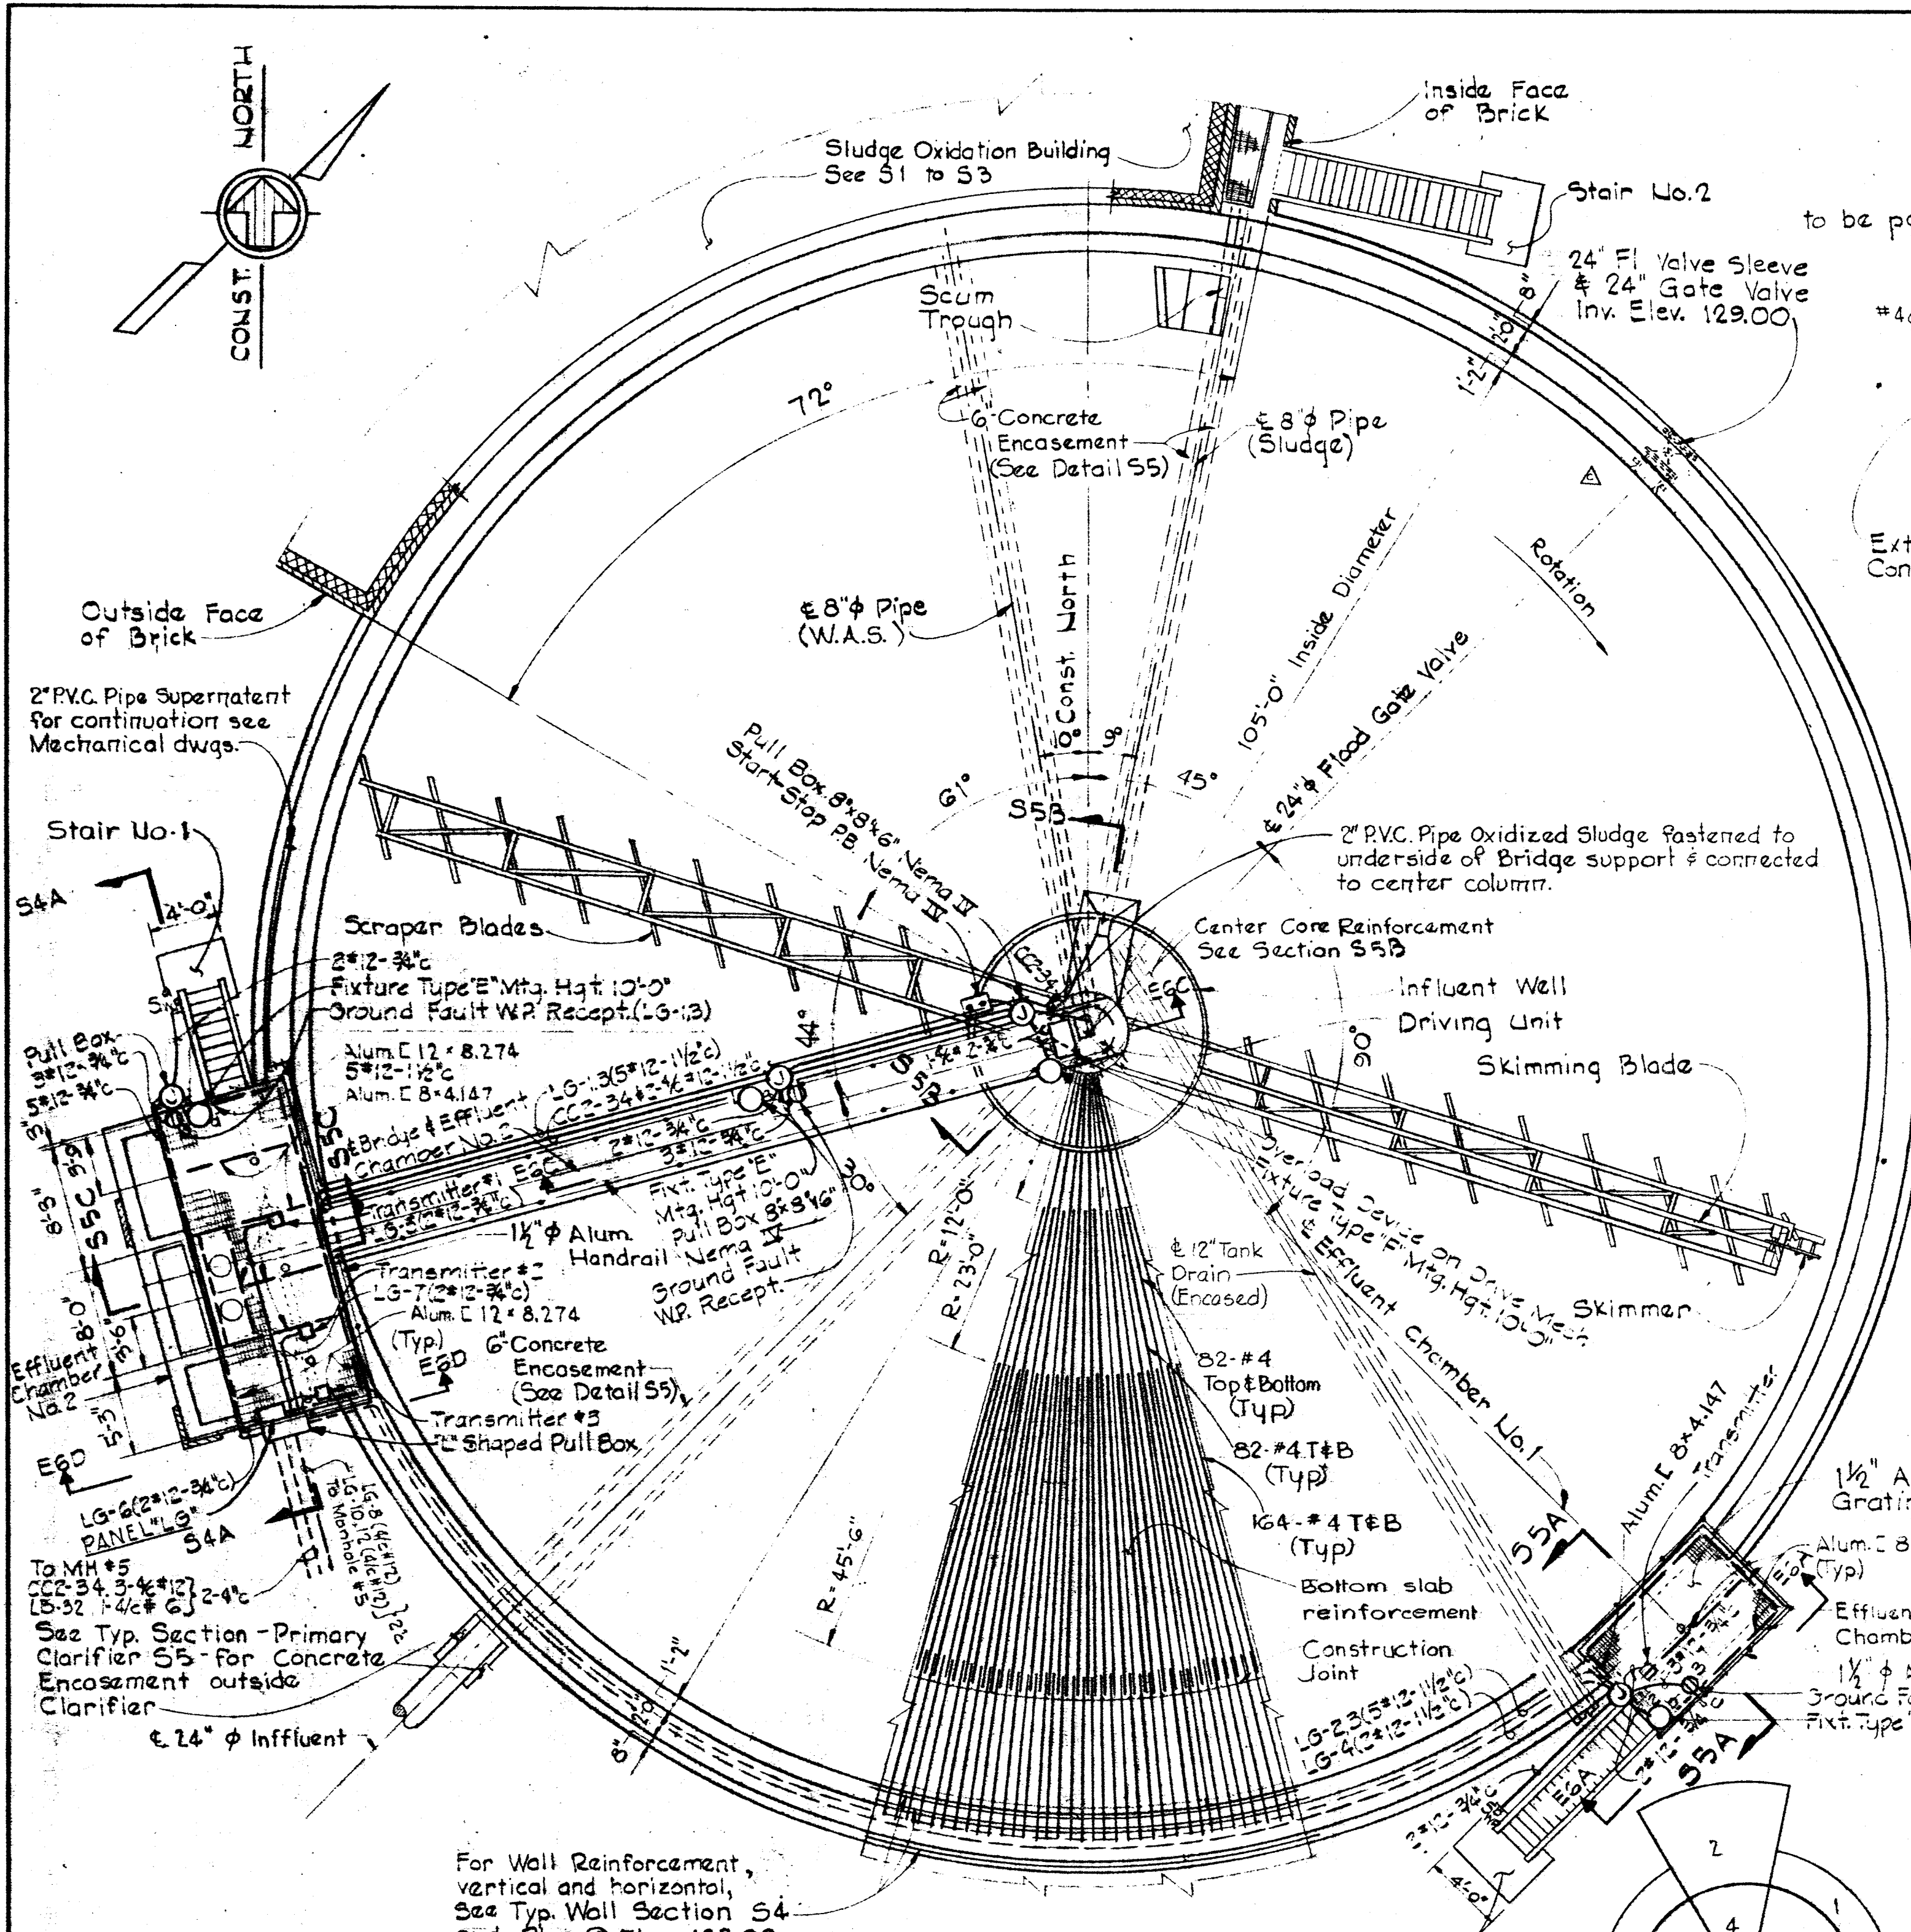

- NOTES:**
1. For Concrete and Foundation Notes - See Sheet S1.
  2. Bottom Slab of Clarifier shall be poured in alternate segments - See Pouring Sequence Plan.
  3. All Aluminum Beams on Effluence Chambers shall have 3" clearance from outside edge of concrete to the back of channel, unless otherwise noted.
  4. Aluminum Grating on top of both Effluence Chambers shall be 1/2" in thickness and with no projection from back of Exterior Channels, except where otherwise noted.

PLAN OF PRIMARY CLARIFIER  
Scale 1/8" = 1'-0"

POURING SEQUENCE PLAN  
No Scale

DETAILS OF SCUM BAFFLE  
No Scale

DETAILS OF EFFLUENT WEIR  
No Scale

WHITMAN, REQUARDT & ASSOCIATES  
ENGINEERS  
1304 SP. PAUL ST.  
BALTIMORE, MARYLAND

DEPARTMENT OF PUBLIC WORKS  
HOWARD COUNTY, MARYLAND  
2/1/73  
DATE

CONTRACT NO. 525-S

PRIMARY CLARIFIER  
PLAN AND DETAILS

SAVAGE WASTEWATER  
TREATMENT PLANT ADDITION NO.3

DRAWING NO. 15  
OF 28


SCALE AS SHOWN

Construction Modification


SHEET S-4

W. O. 6538-2


DRAWING 44-310 14778

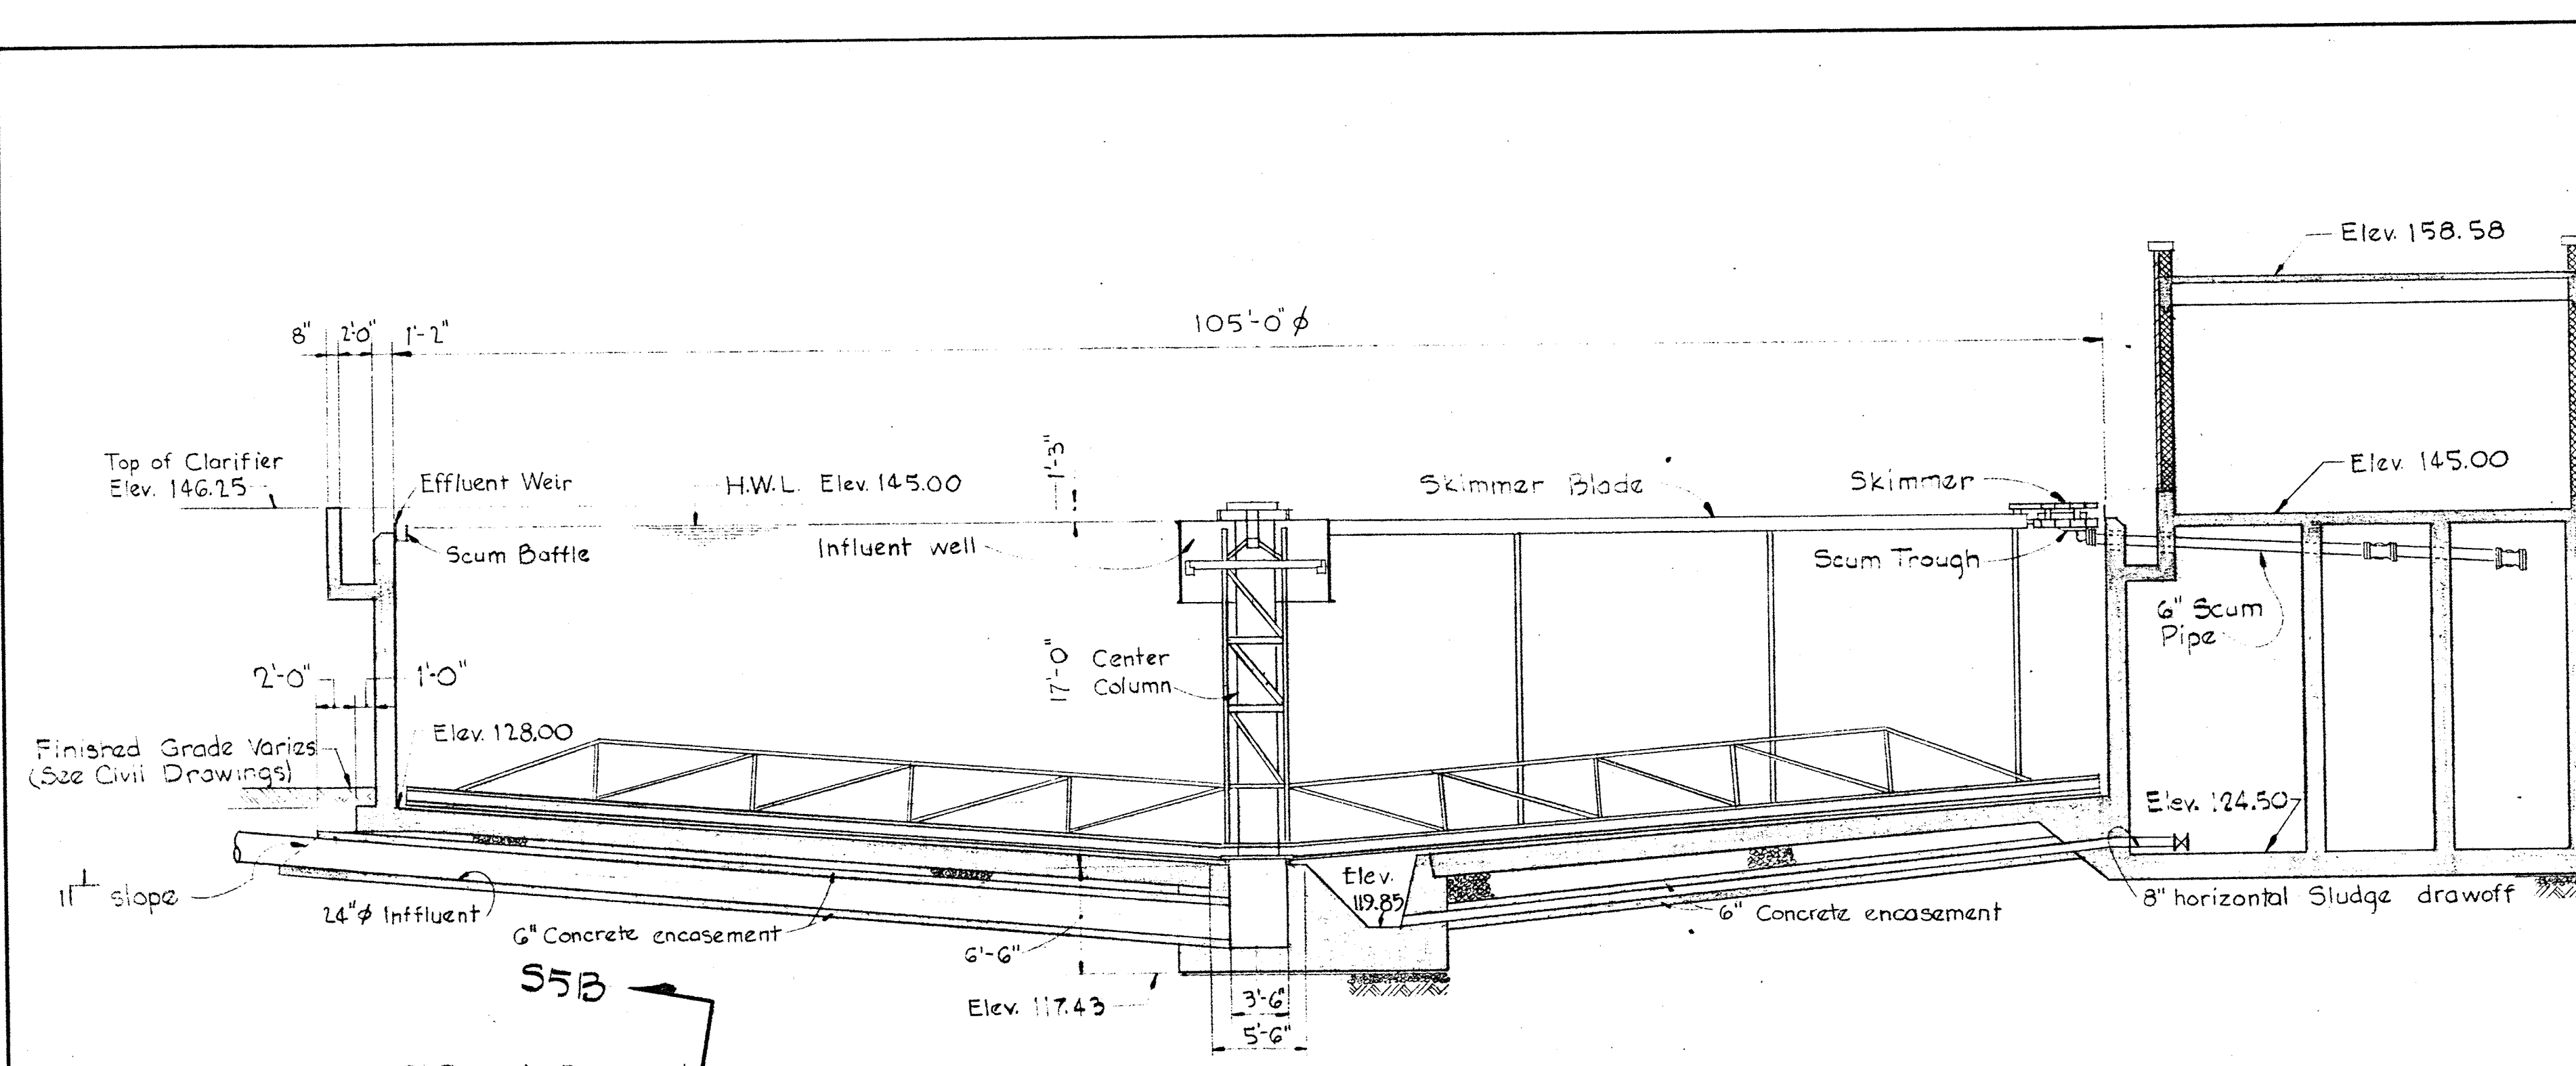


TYPICAL SECTION OF PRIMARY CLARIFIER  
Scale 1/8" = 1'-0"

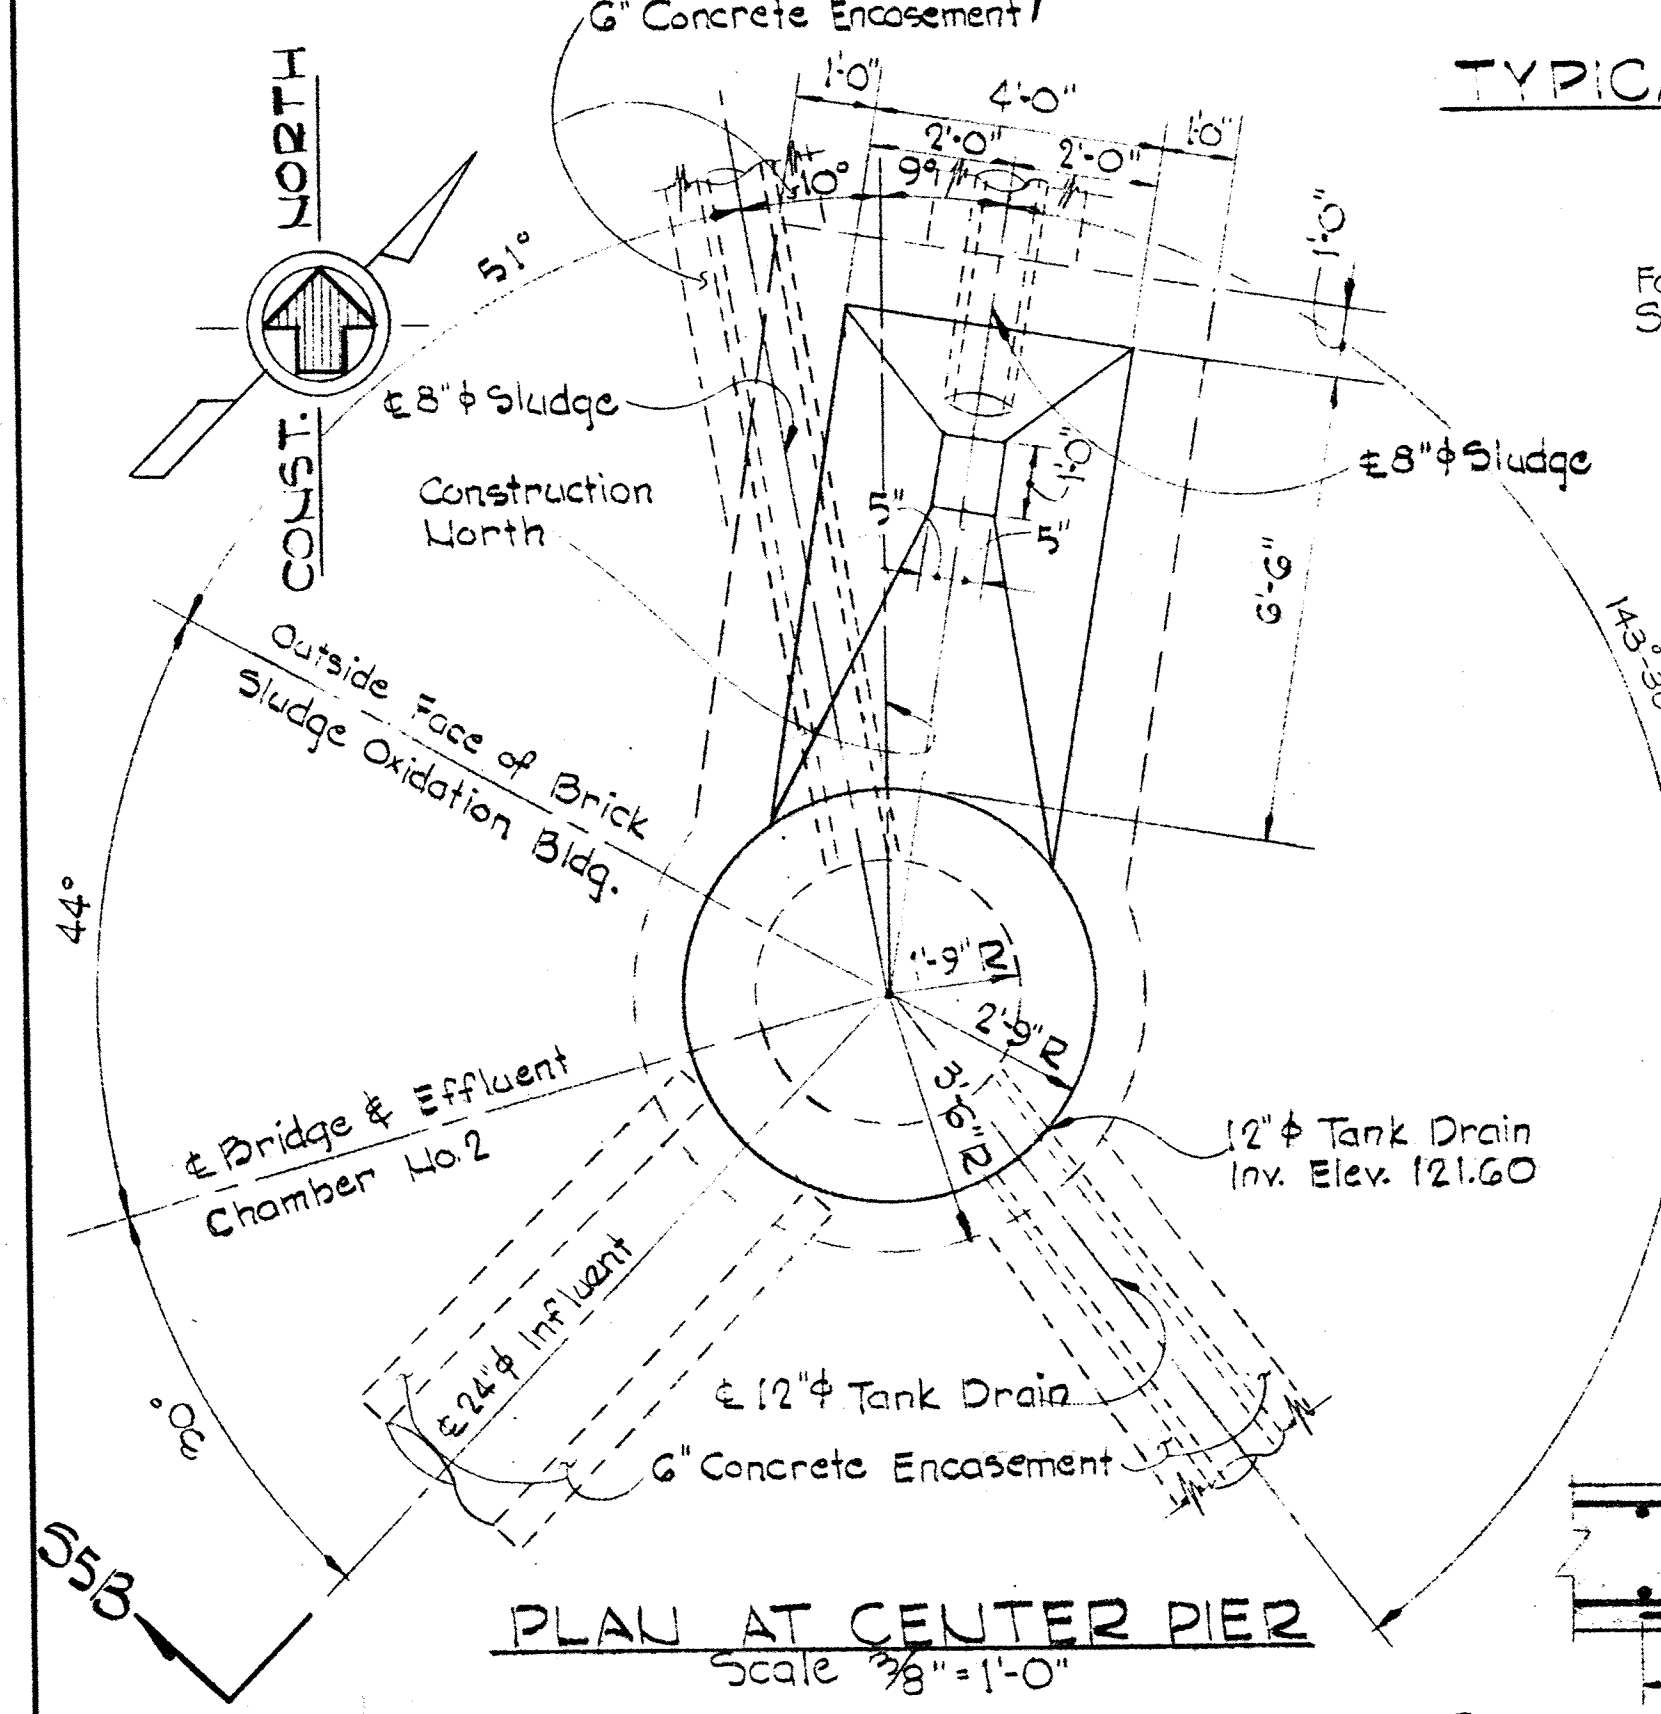


PLAN AT CENTER PIER  
Scale 3/8" = 1'-0"

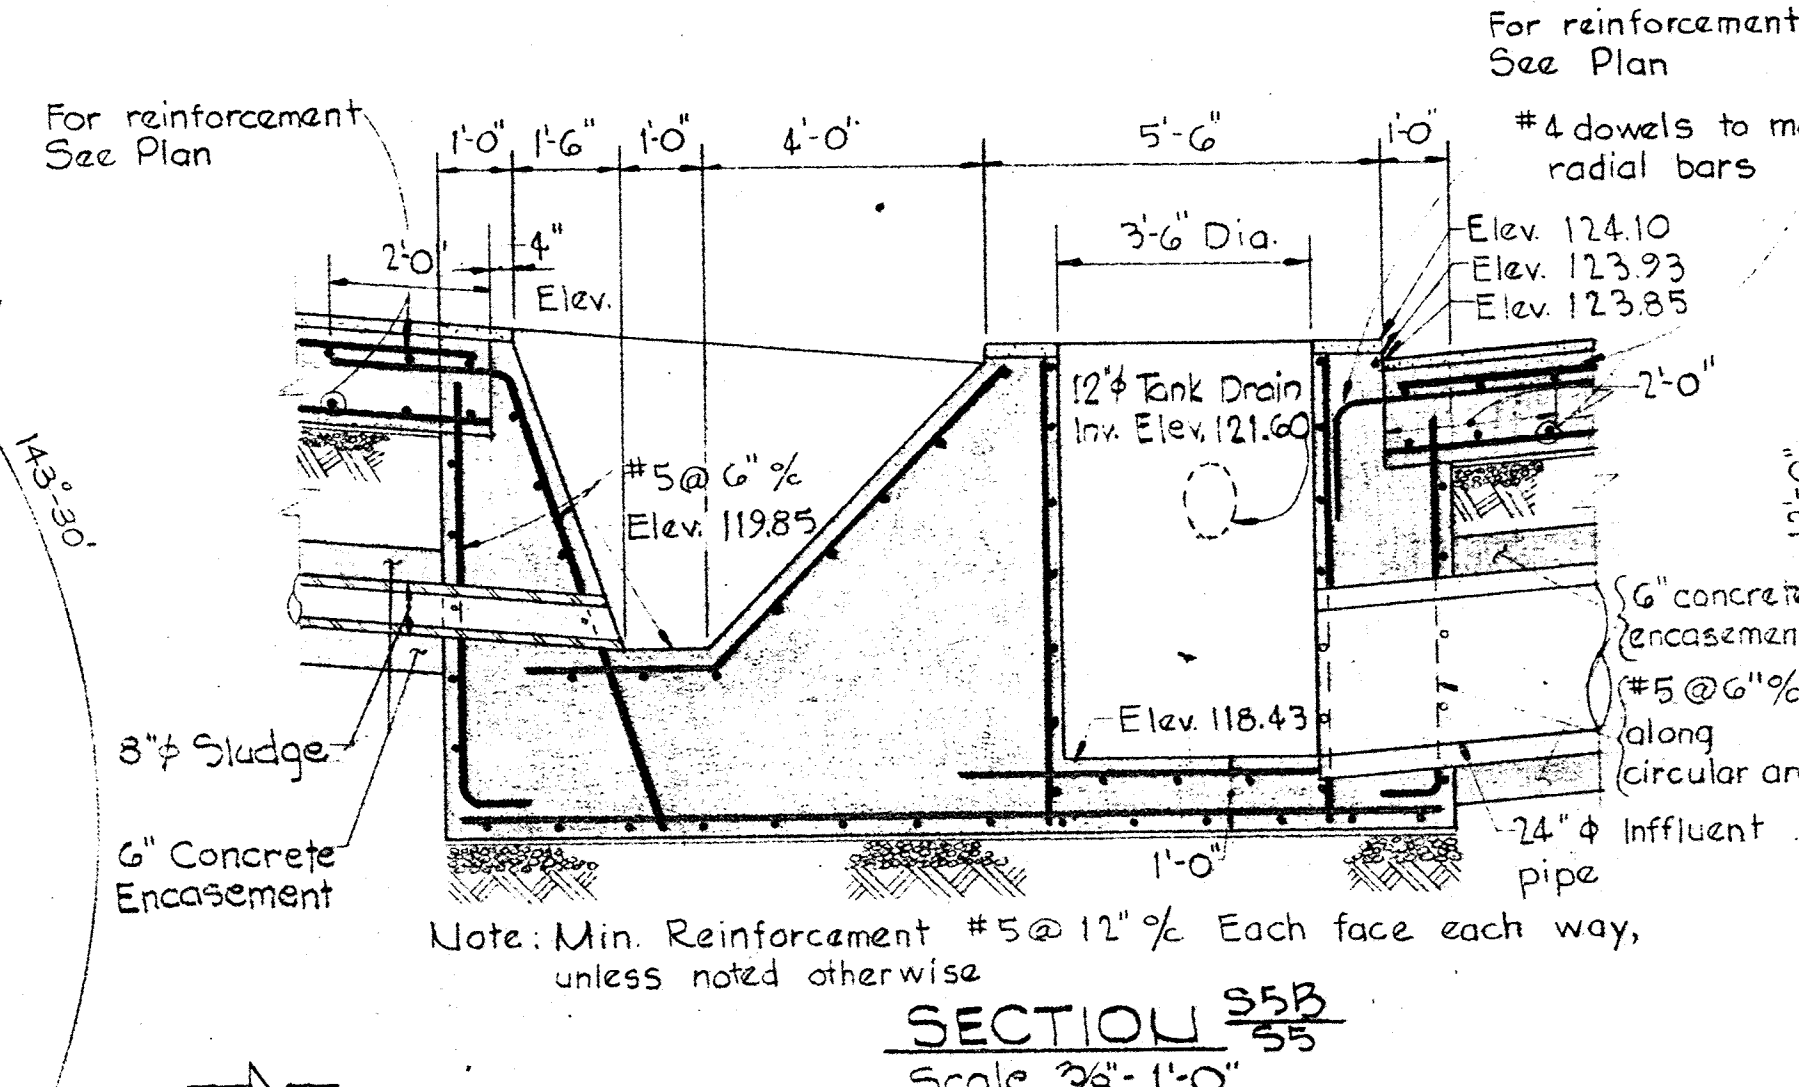


SECTION S5B  
Scale 3/8" = 1'-0"

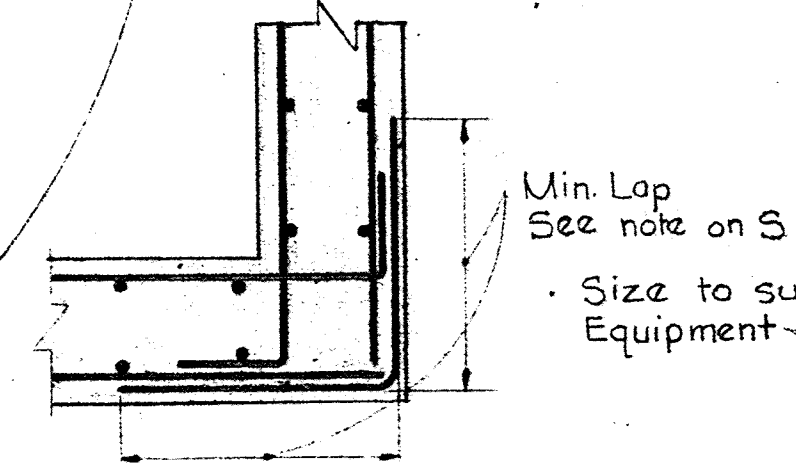


REINFORCING DETAIL AT CORNER  
No Scale

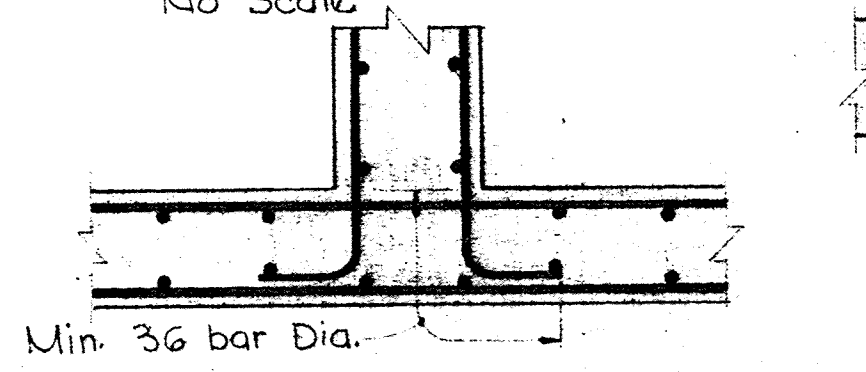


REINFORCING DETAIL AT WALL INTERSECTION  
No Scale

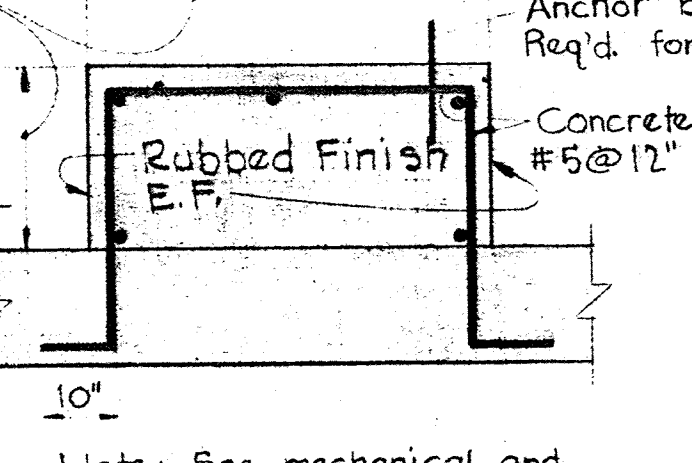


TYPICAL EQUIPMENT OR ROUND OPENINGS IN WALLS OR SLABS  
No Scale

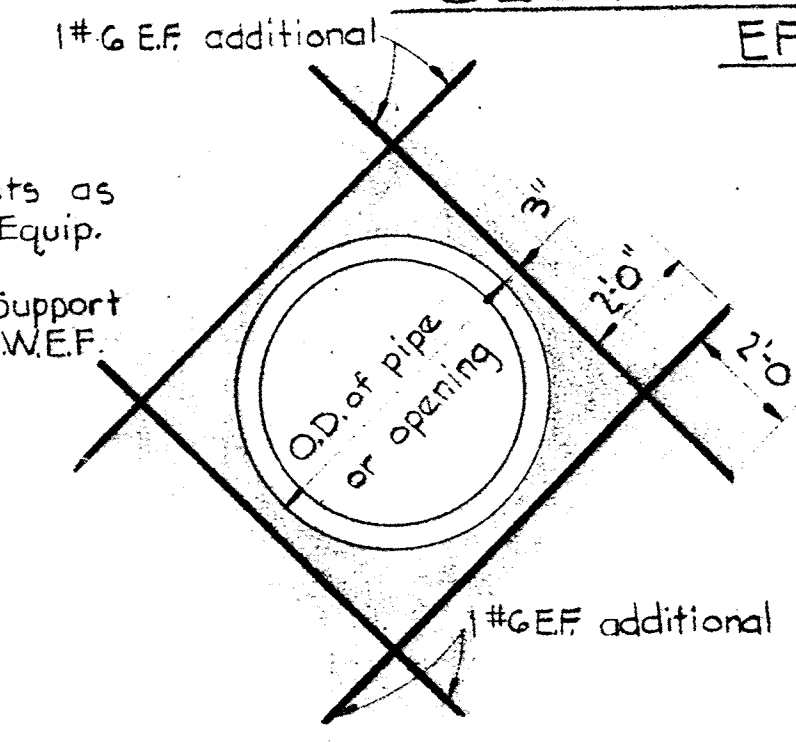


REINFORCING AROUND PIPES CONSTRUCTION JOINT IN WALL AND SLAB  
No Scale

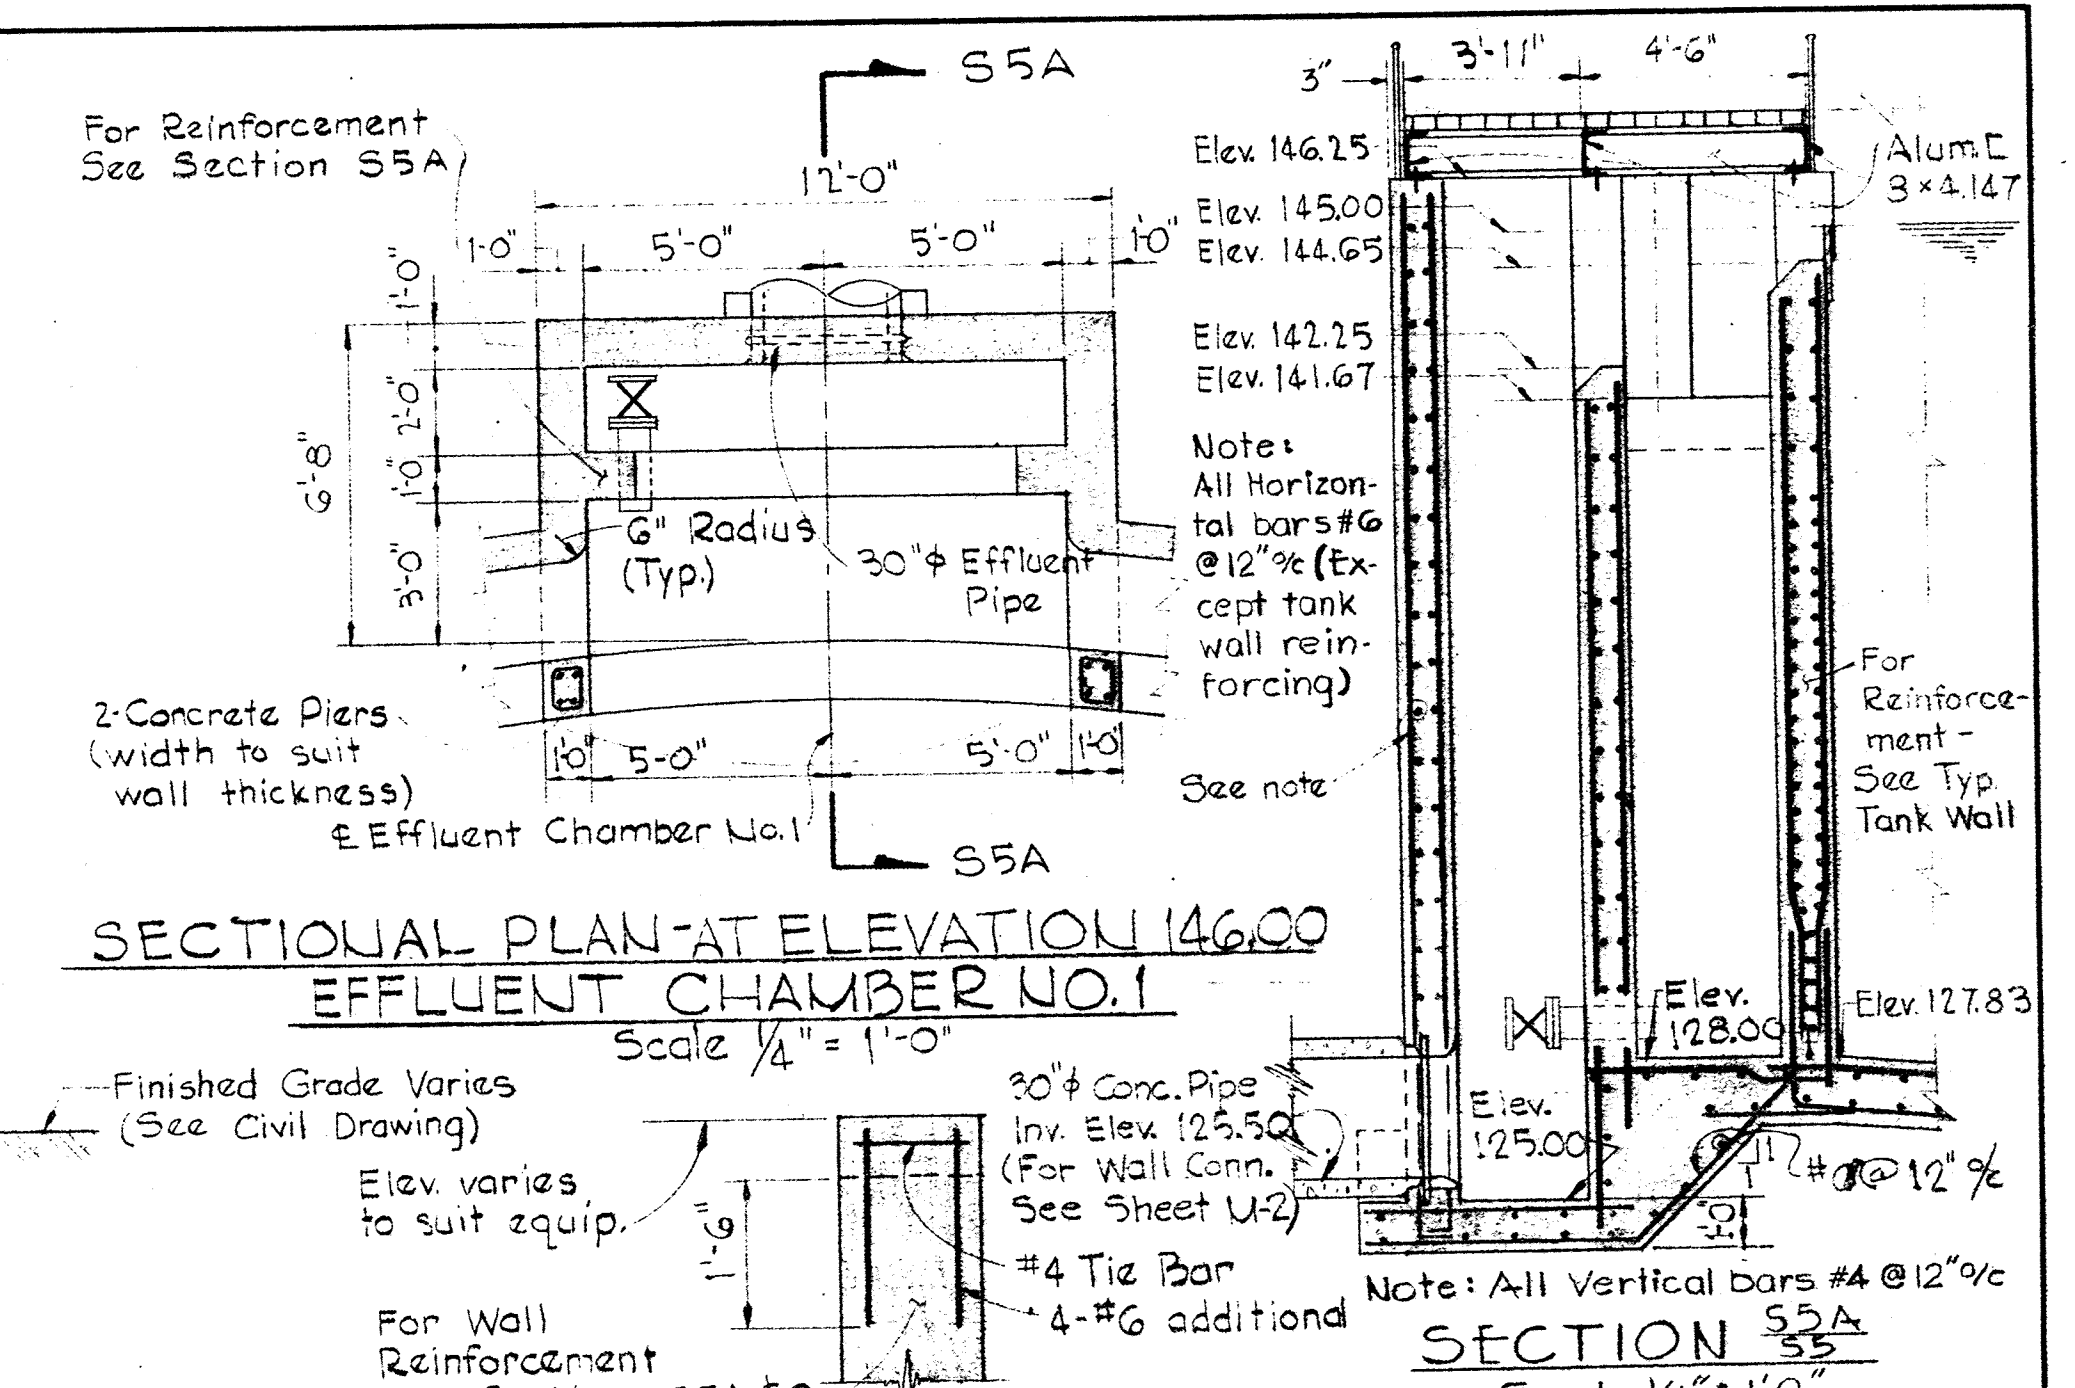

SECTIONAL PLAN AT ELEVATION 146.00  
EFFLUENT CHAMBER NO. 1  
Scale 1/4" = 1'-0"

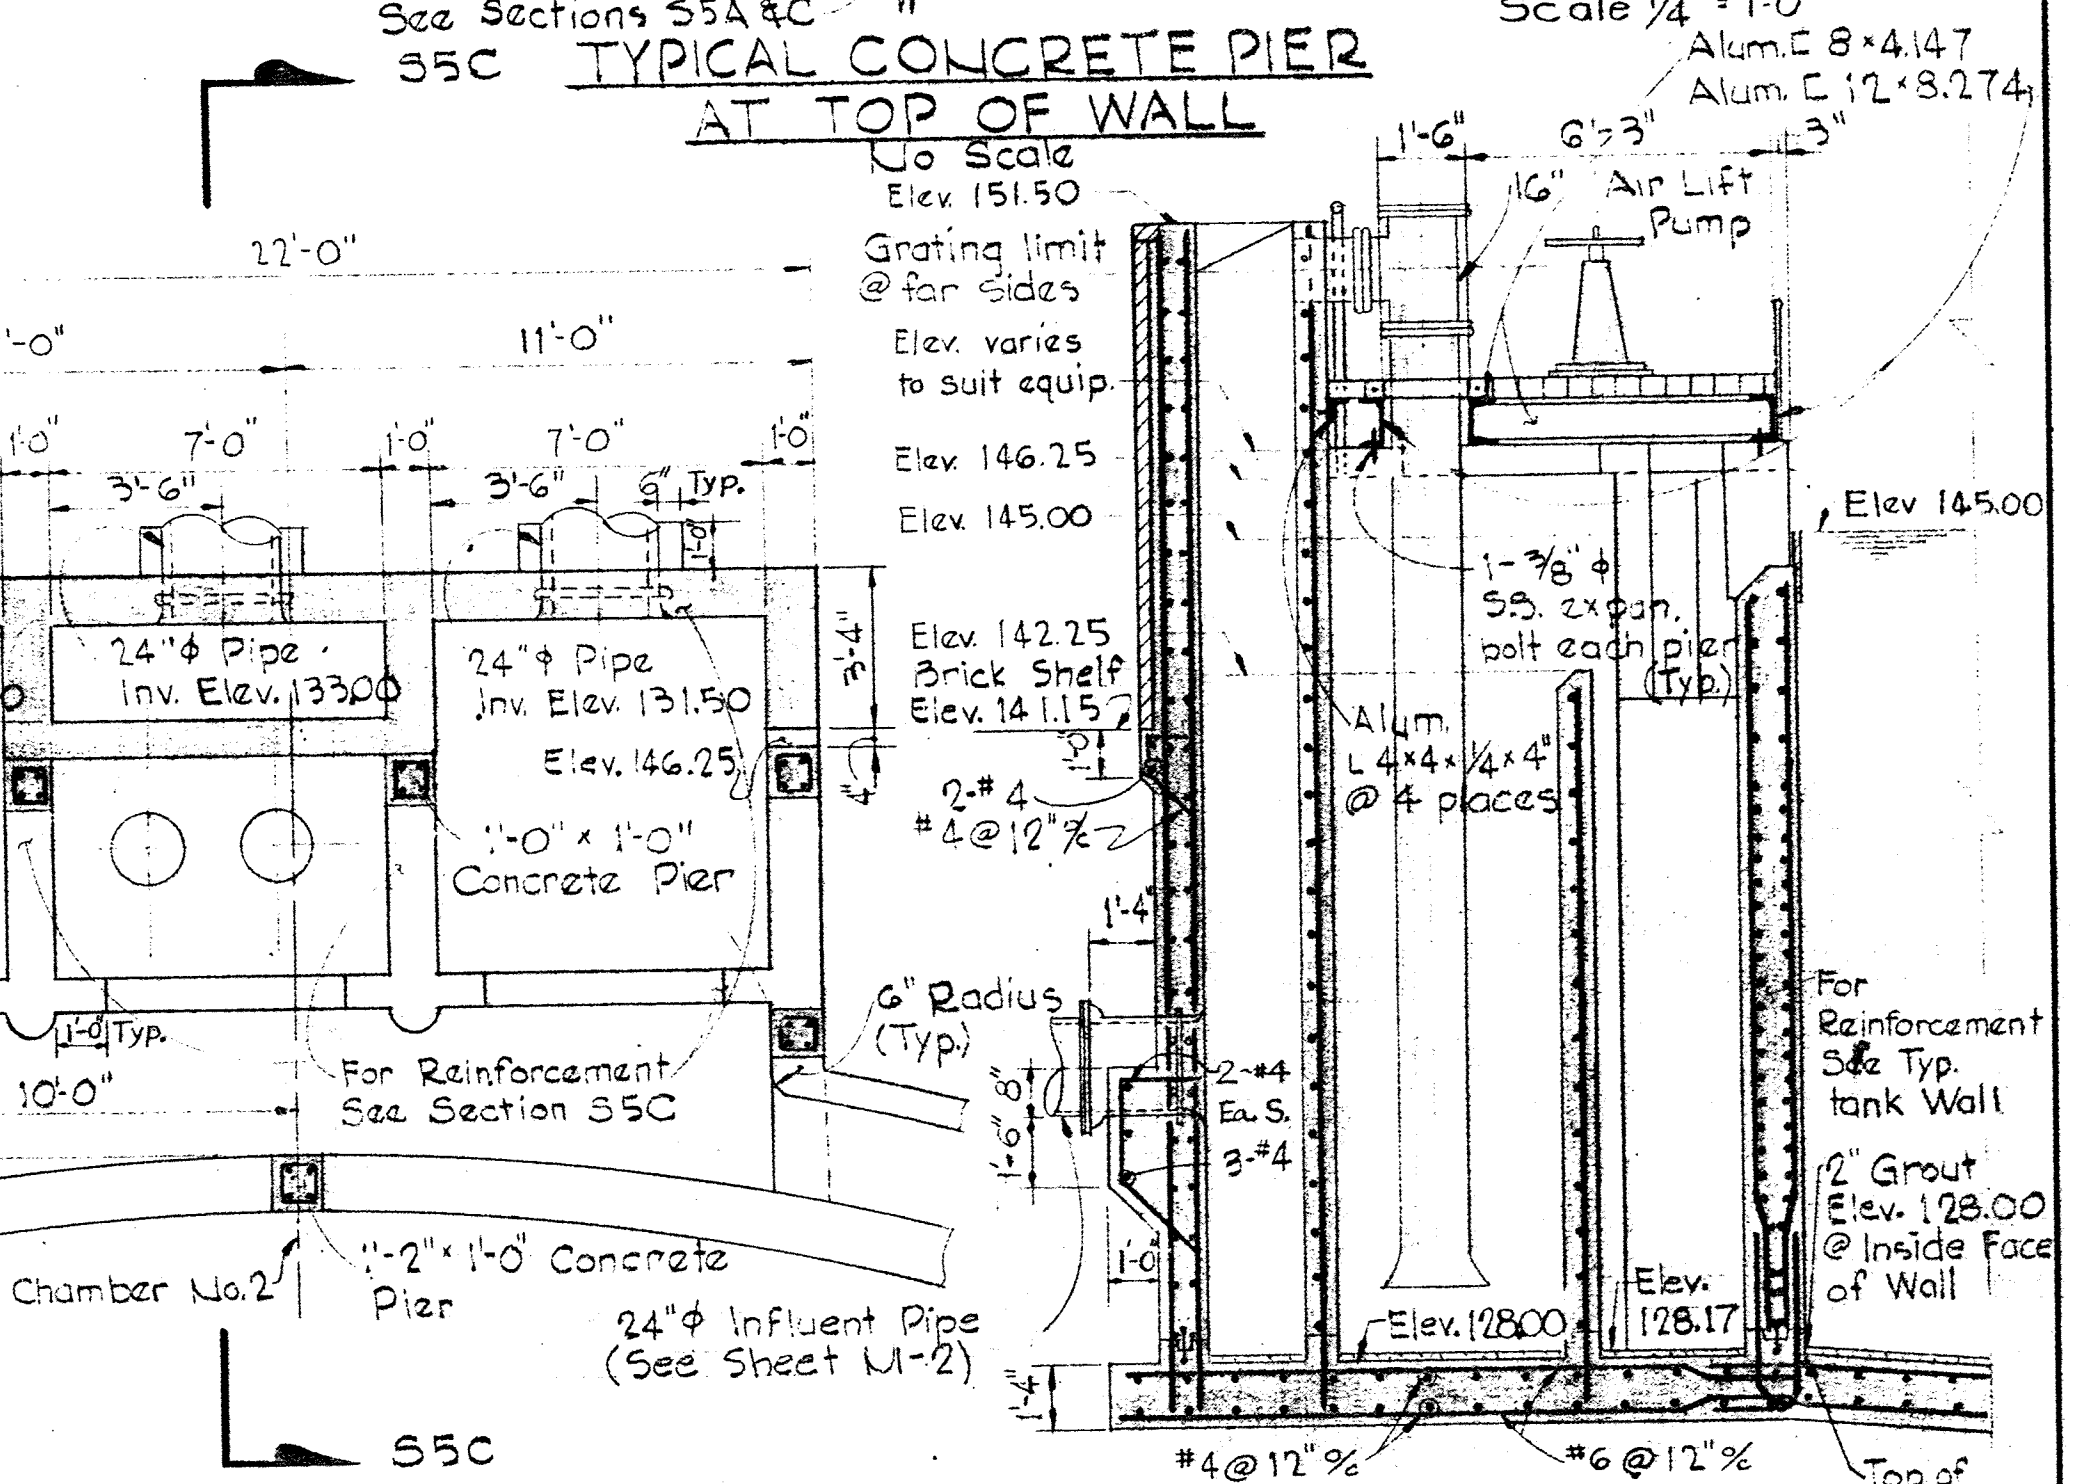

SECTIONAL PLAN AT ELEVATION 146.50  
EFFLUENT CHAMBER NO. 2  
Scale 1/4" = 1'-0"

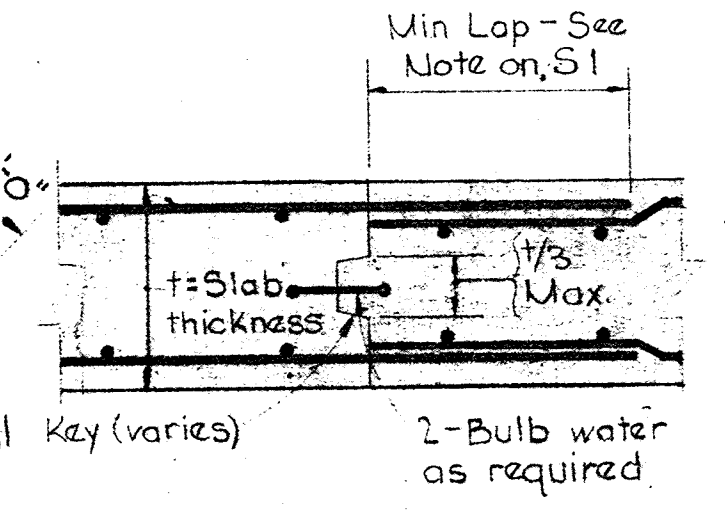



TYPICAL CONCRETE ENCASEMENT AROUND PIPE  
No Scale

WHITMAN, REQUARDT & ASSOCIATES ENGINEERS 1304 ST. PAUL ST. BALTIMORE, MARYLAND	DEPARTMENT OF PUBLIC WORKS HOWARD COUNTY, MARYLAND 2/1/73 DATE	CONTRACT NO. 525-S	PRIMARY CLARIFIER SECTIONS AND DETAILS	SAVAGE WASTEWATER TREATMENT PLANT ADDITION NO. 3	DRAWING NO. 16 OF 28 SCALE AS SHOWN SHEET S-5
---	---	--------------------	---	---	---

W.O. 6538-2


BRUNING 44-510 14278



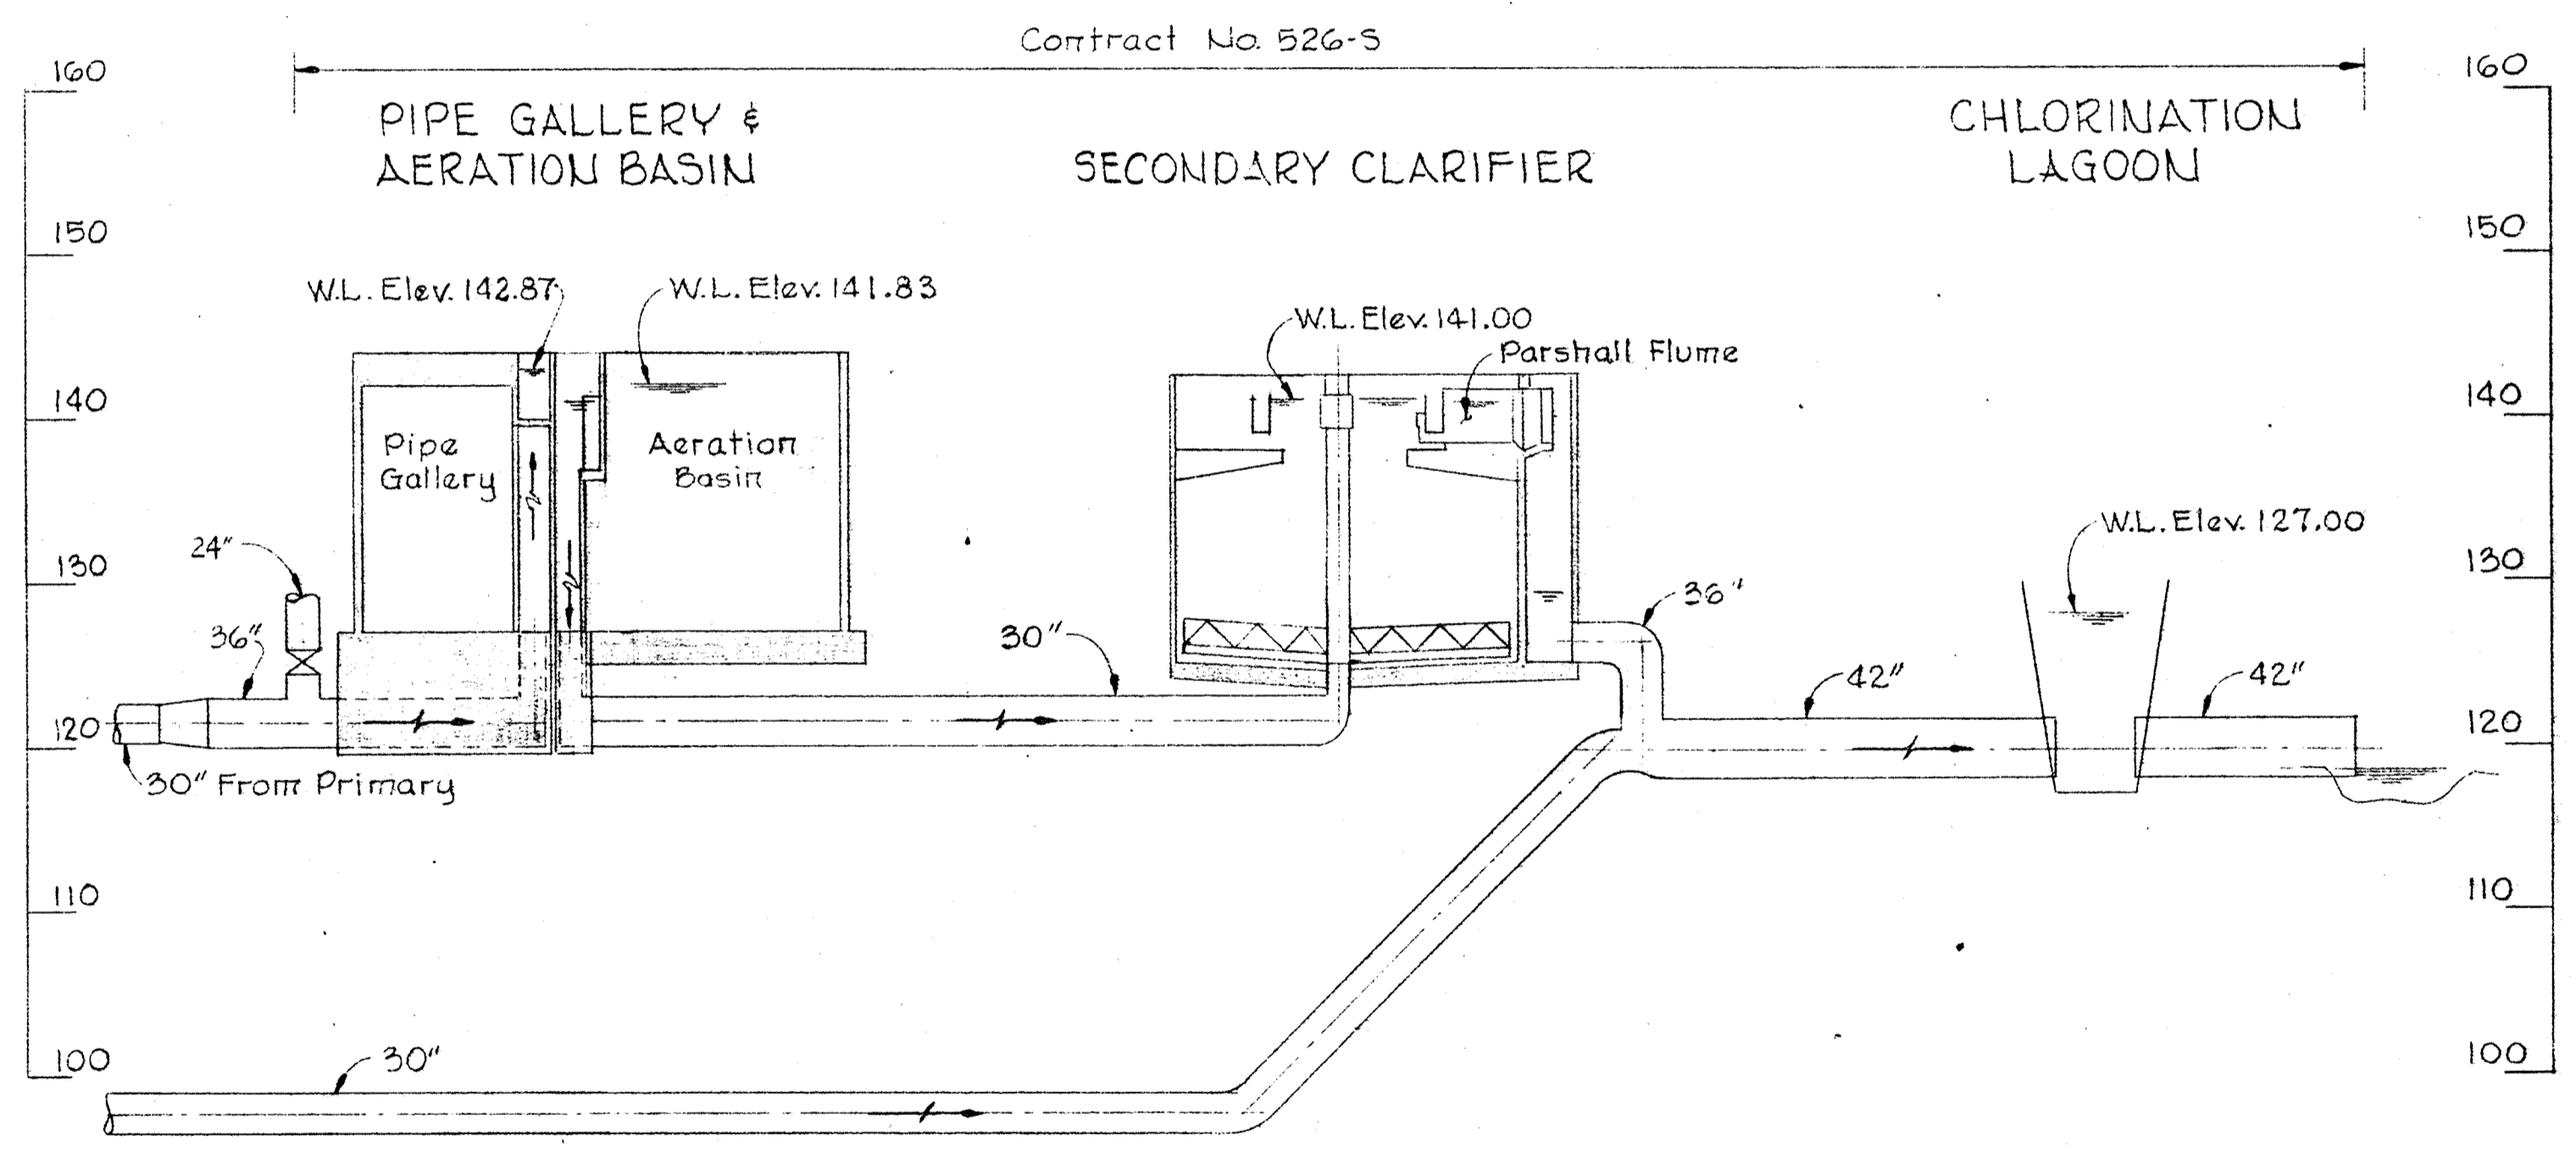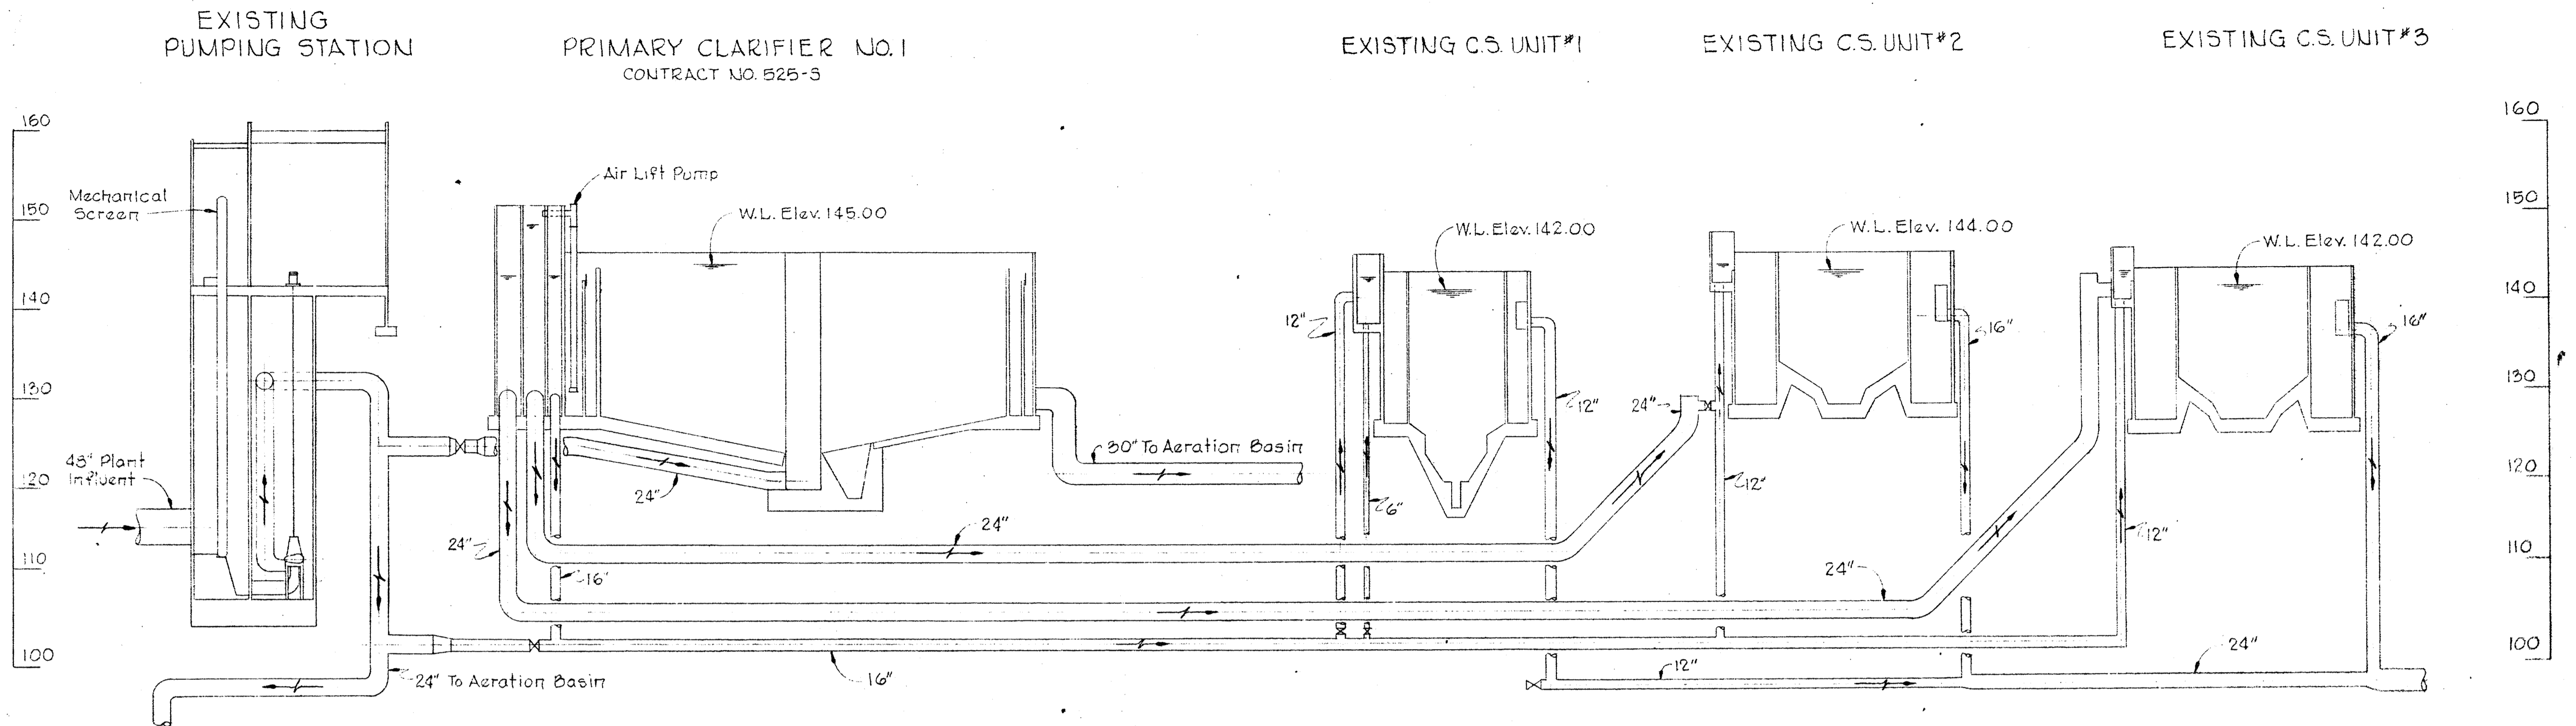

**LEGEND**


— C.W. —	Cold Water
— W.L. —	Water Level
— A —	Control Air
— M —	Gate Valve
— P —	Plug Valve
— B —	Ball Valve (Chlorine Service)
— P.V.C. —	Polyvinyl Chloride Pipe
— C.I.P. —	Cast Iron Pipe or Ductile Iron Pipe
— C.S. —	Contact Stabilization
— A.S. —	Activated Sludge
— W.A.S. —	Waste Activated Sludge
— R.A.S. —	Return Activated Sludge
⊙	Pressure Gage

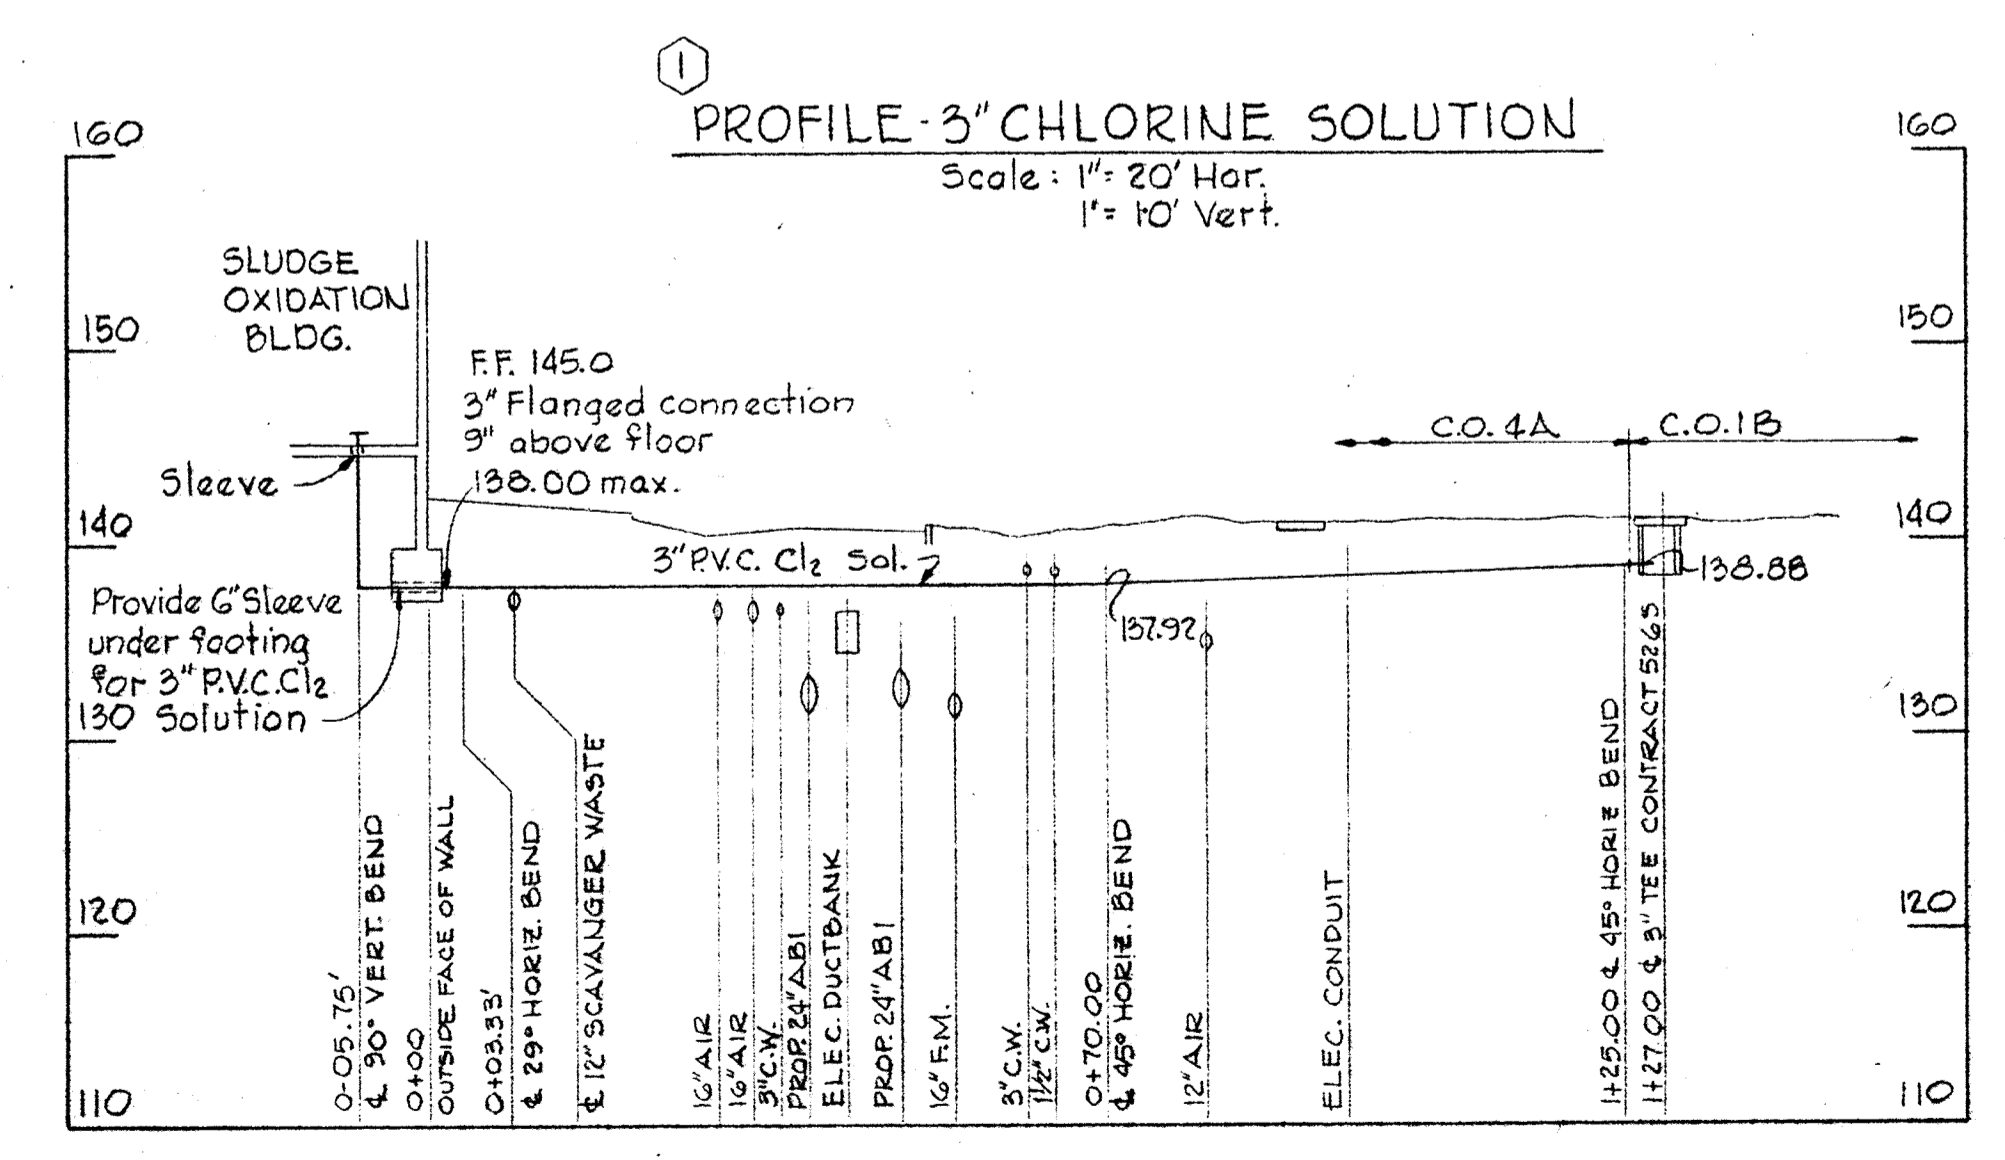








**NOTE:**  
 1. Pipe shown diagrammatic. For exact arrangement, elevations, and connections see civil and mechanical drawings.  
 2. Elevations shown for water levels are at maximum flows.

<b>WHITMAN, REQUARDT &amp; ASSOCIATES</b> ENGINEERS 1304 ST. PAUL ST. BALTIMORE, MARYLAND	<b>DEPARTMENT OF PUBLIC WORKS</b> HOWARD COUNTY, MARYLAND <i>W.O. Gilbert</i> CHIEF - BUREAU OF ENGINEERING	<b>CONTRACT NO. 525-S</b>	<b>HYDRAULIC PROFILE</b>	<b>SAVAGE WASTEWATER</b> <b>TREATMENT PLANT ADDITION NO.3</b>	<b>DRAWING</b> <b>NO. 17</b> <b>OF 28</b>	<b>SCALE</b> <b>AS</b> <b>SHOWN</b>
--	--	---------------------------	--------------------------	--	---	---

W.O. 6538-2 ⊕ Change Order No. 4 2-19-74

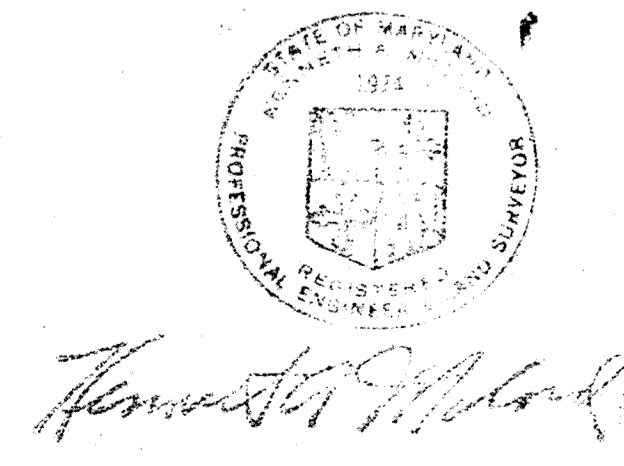

303 BUILT JAN 1 1977 SHEET M-1

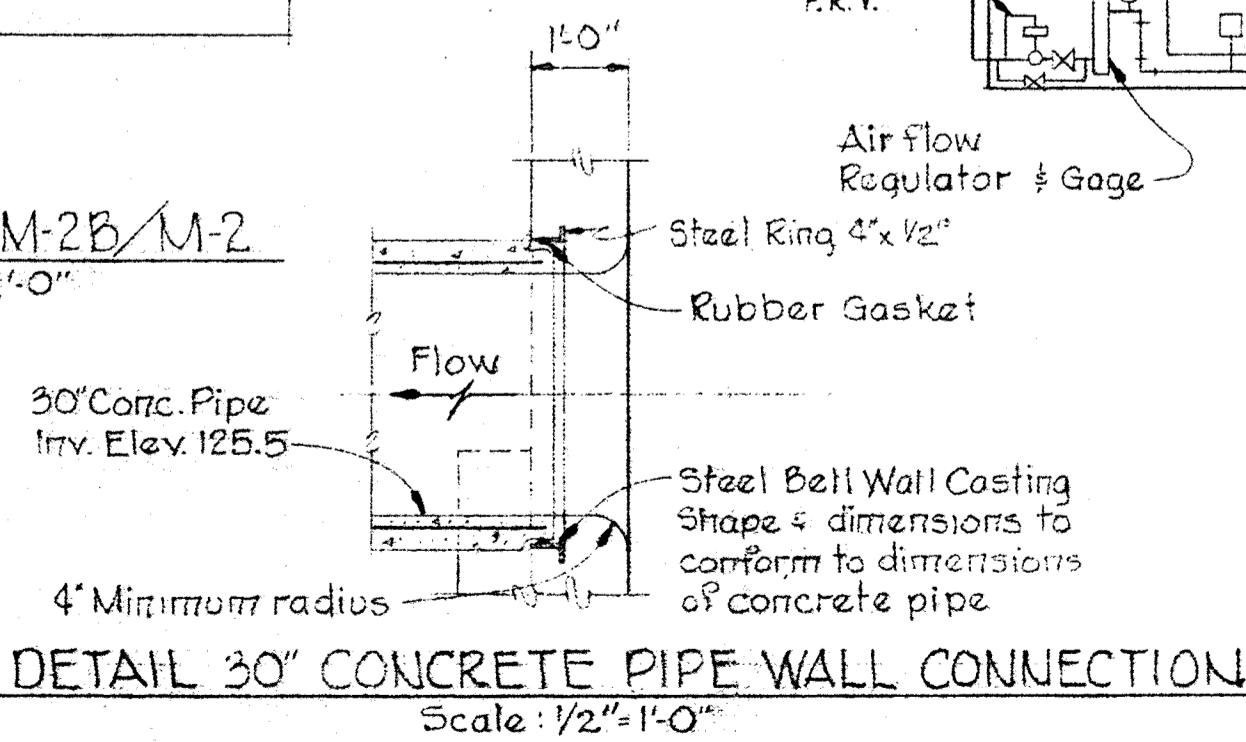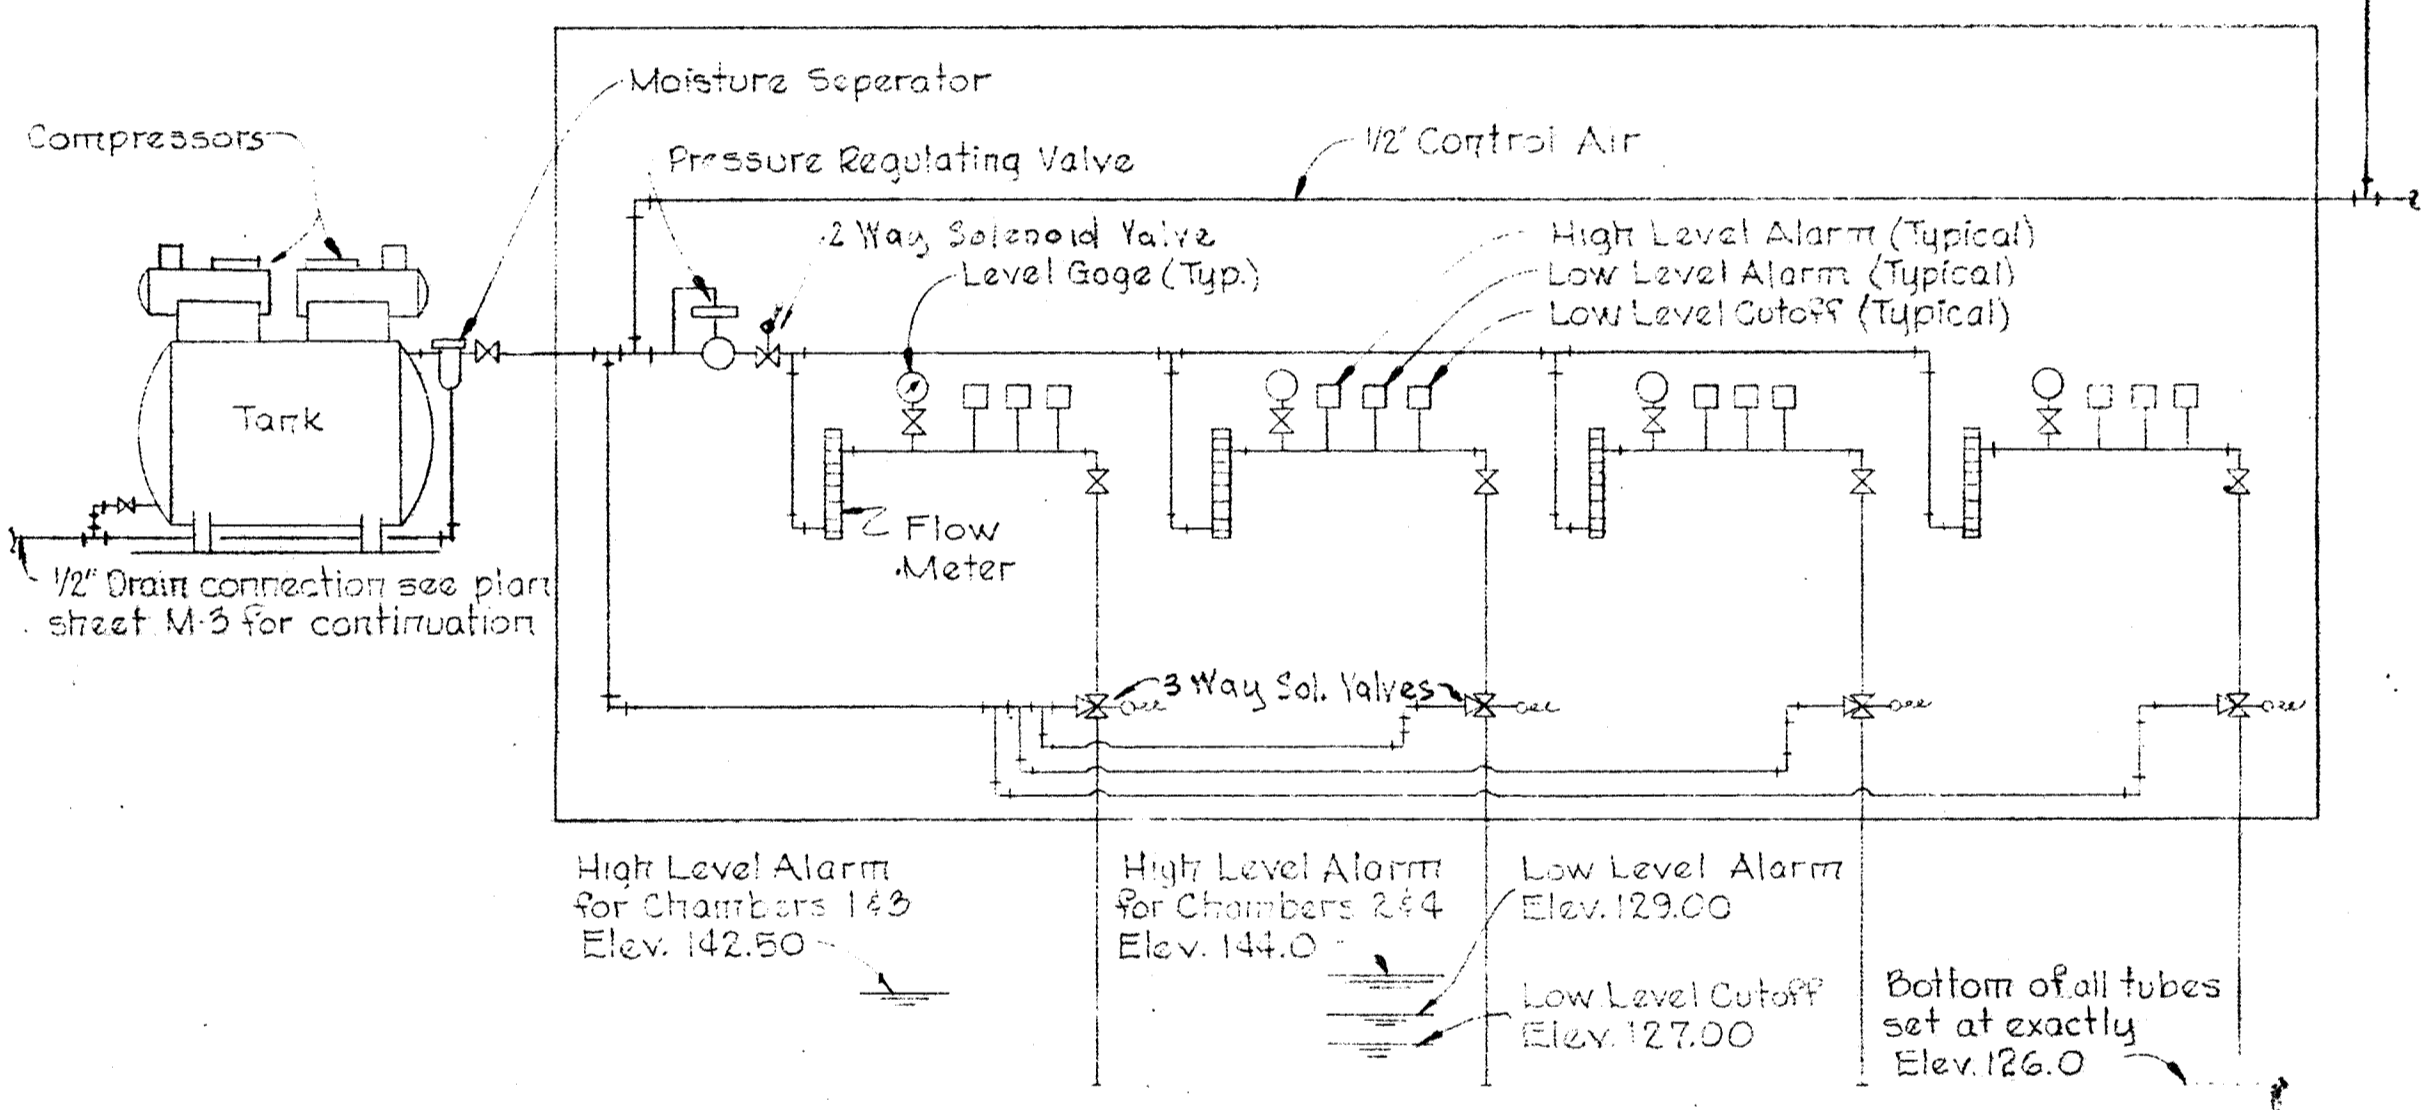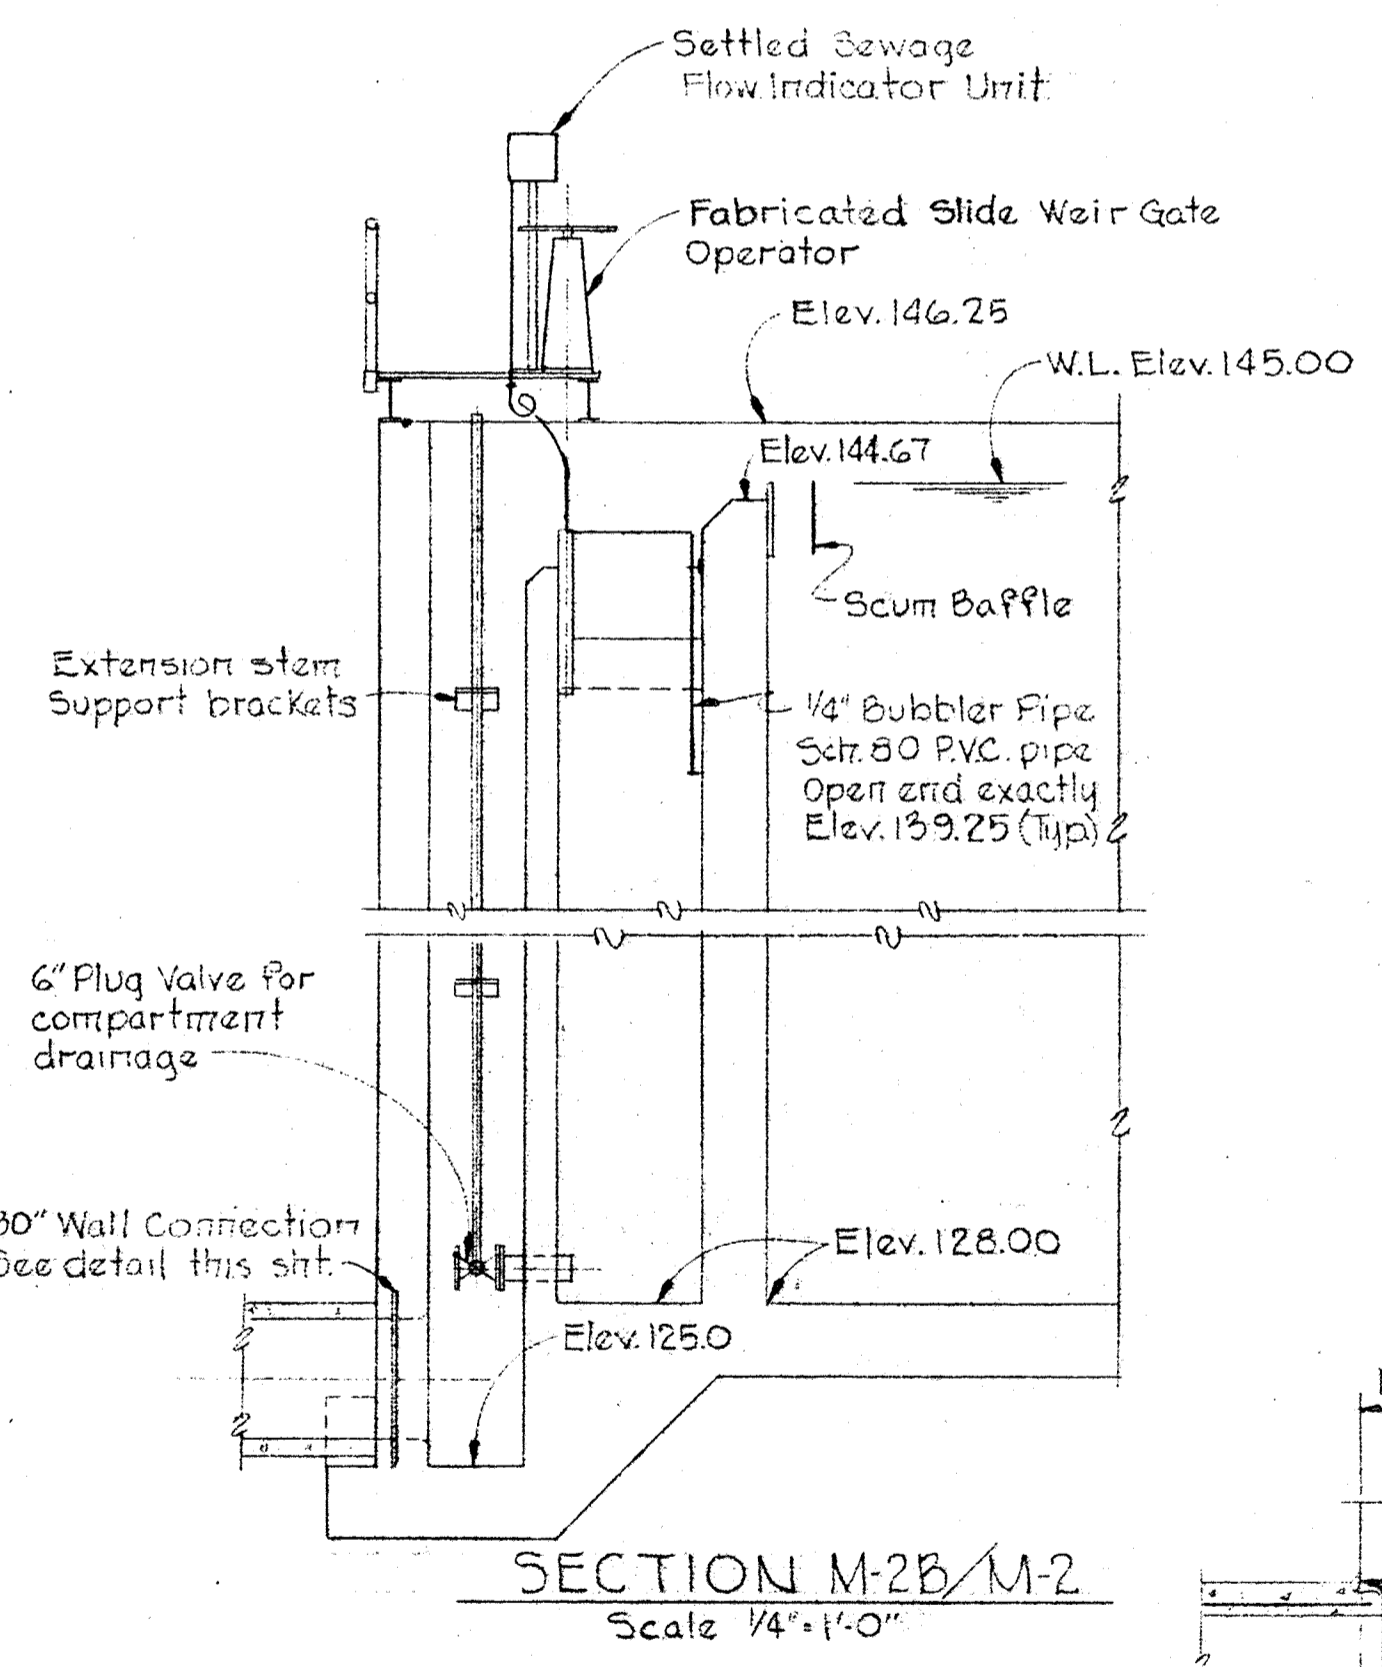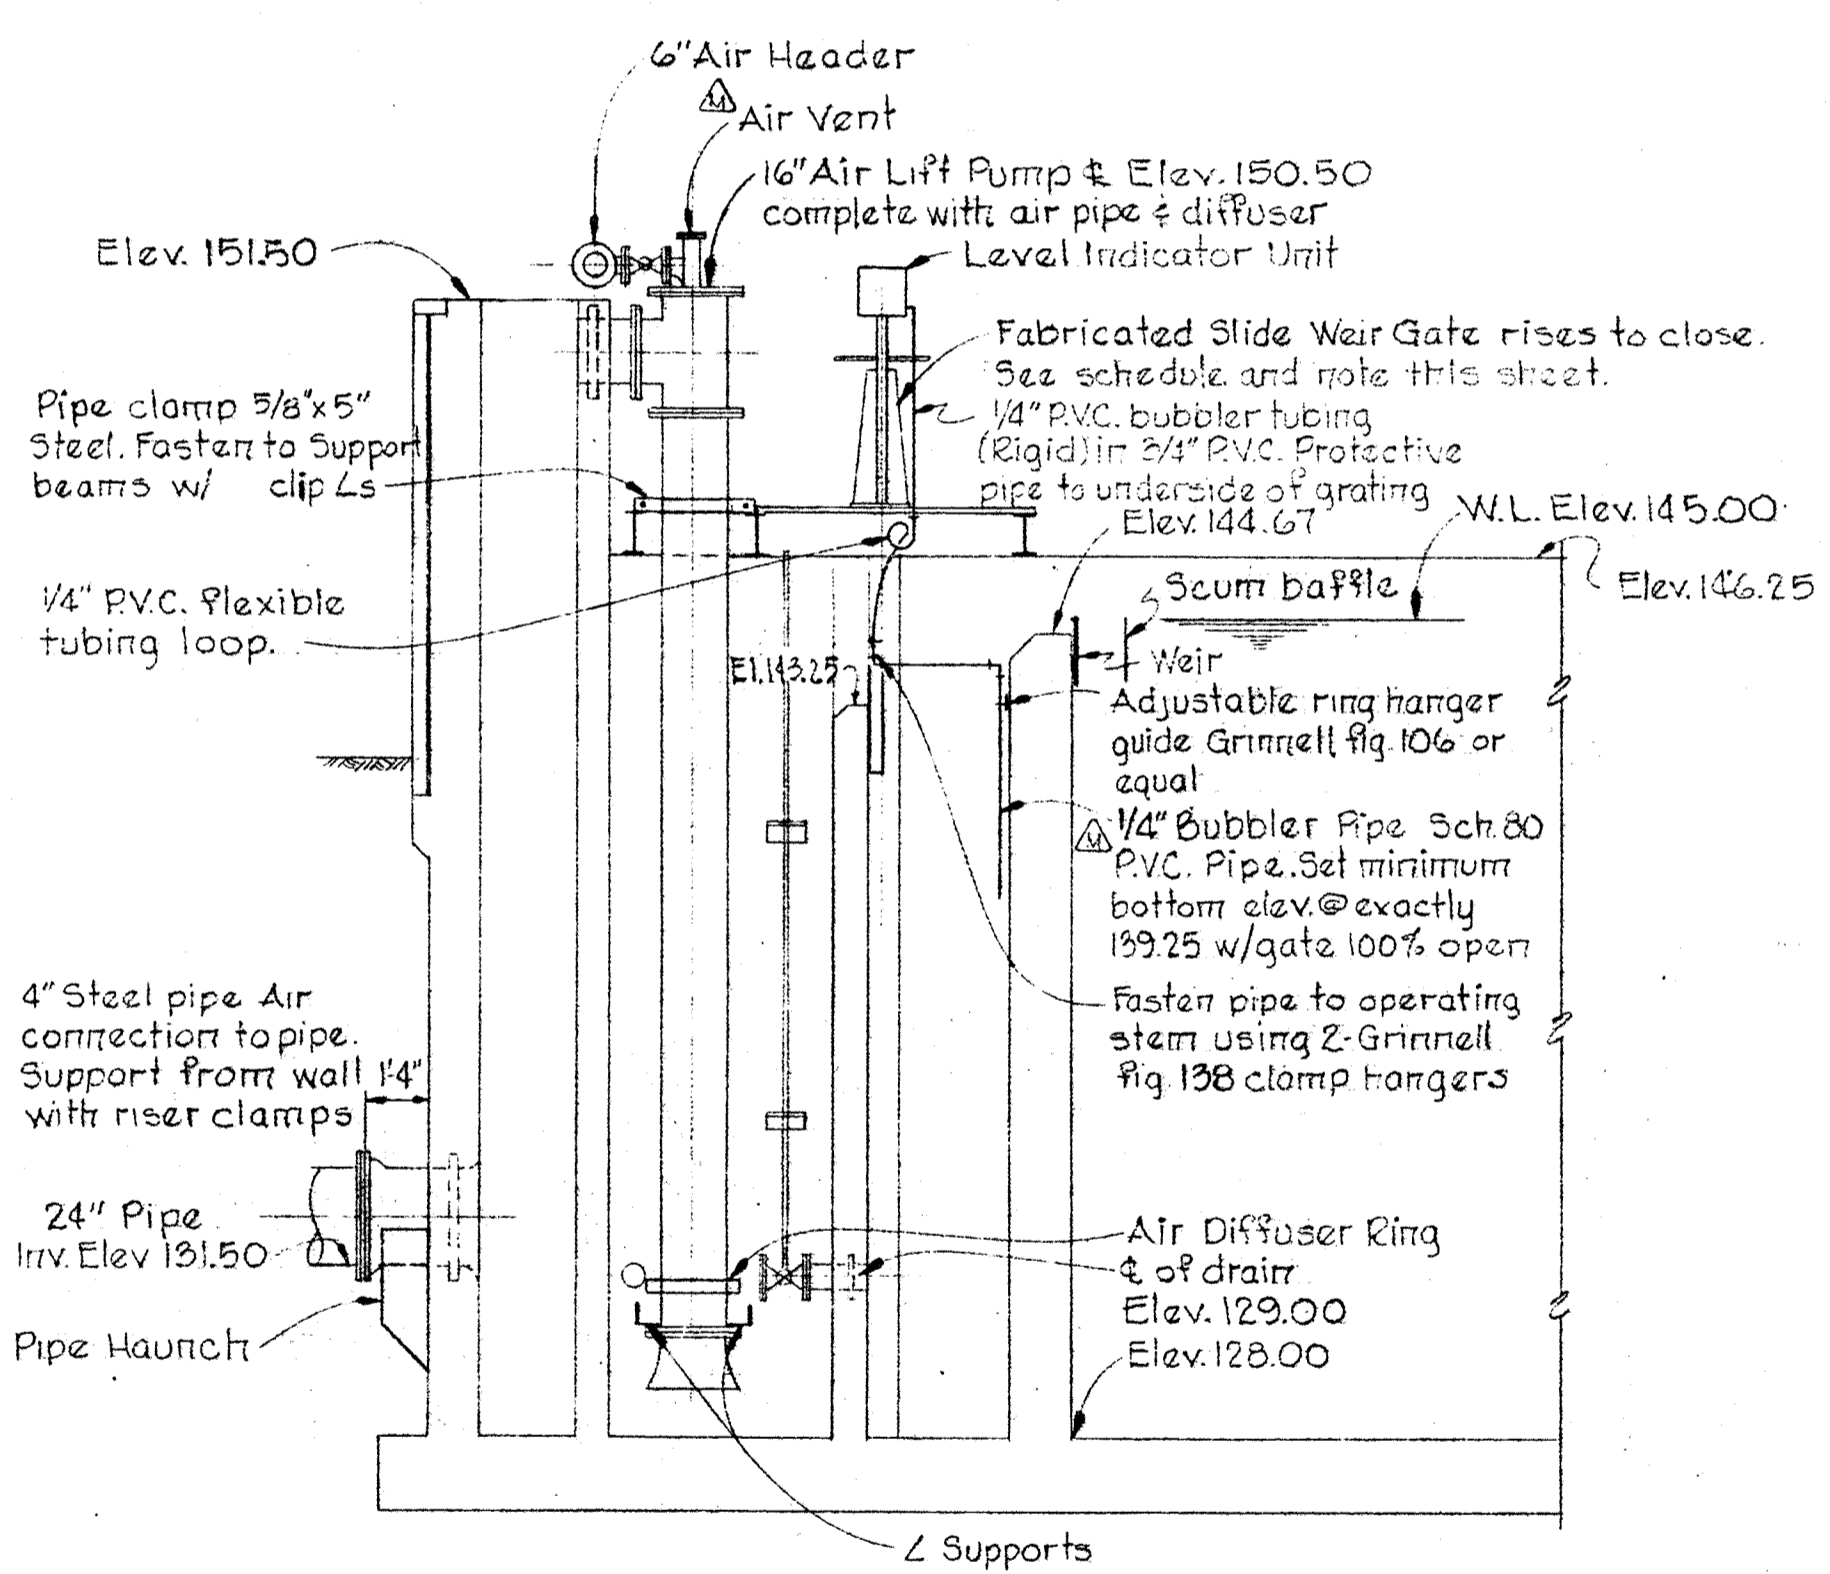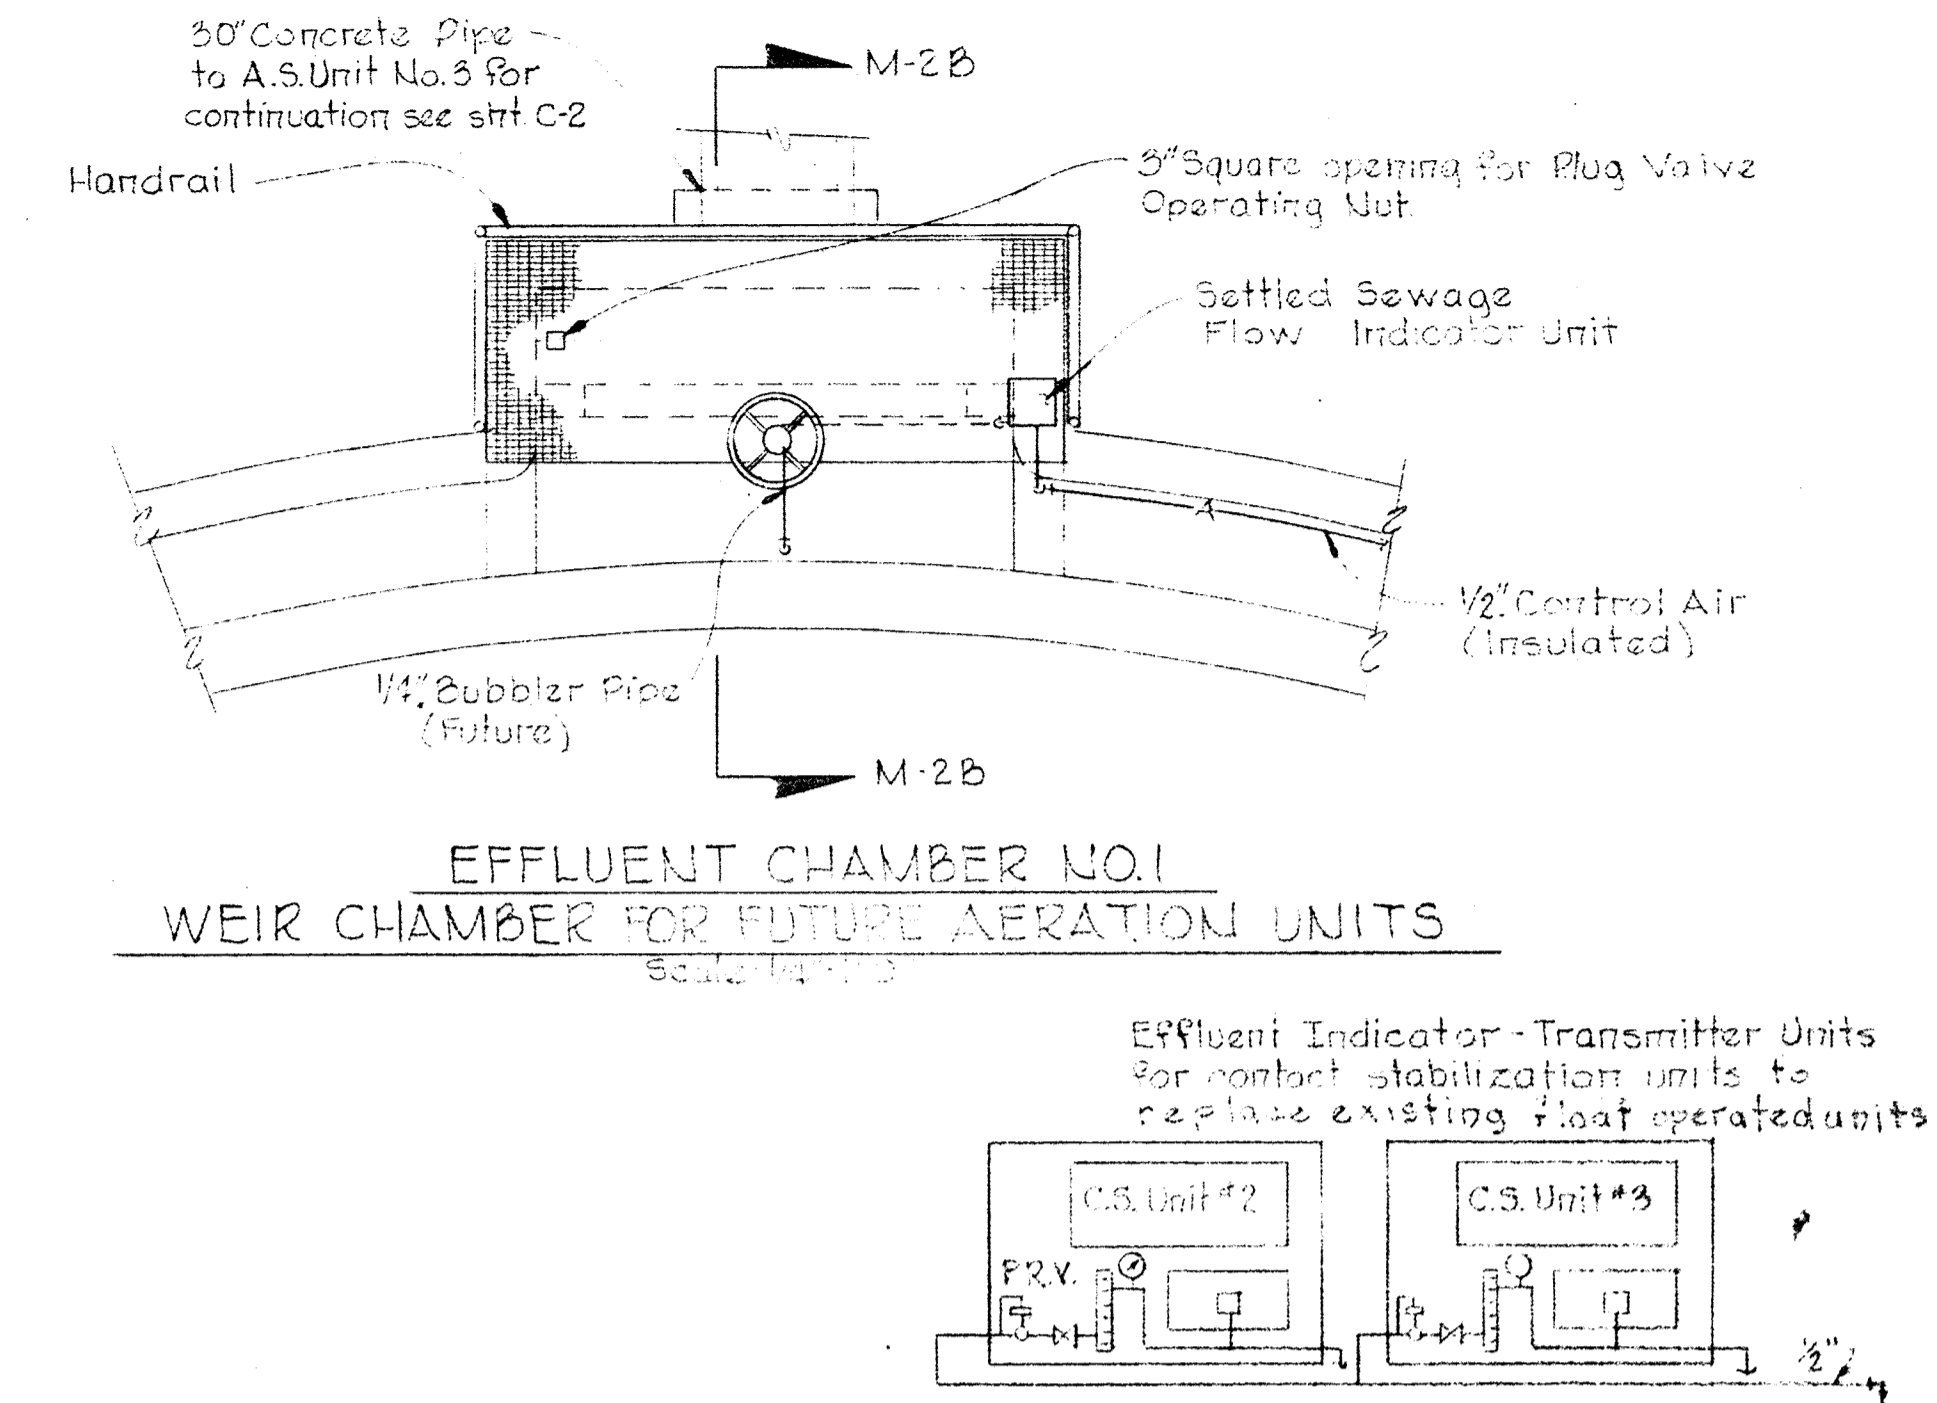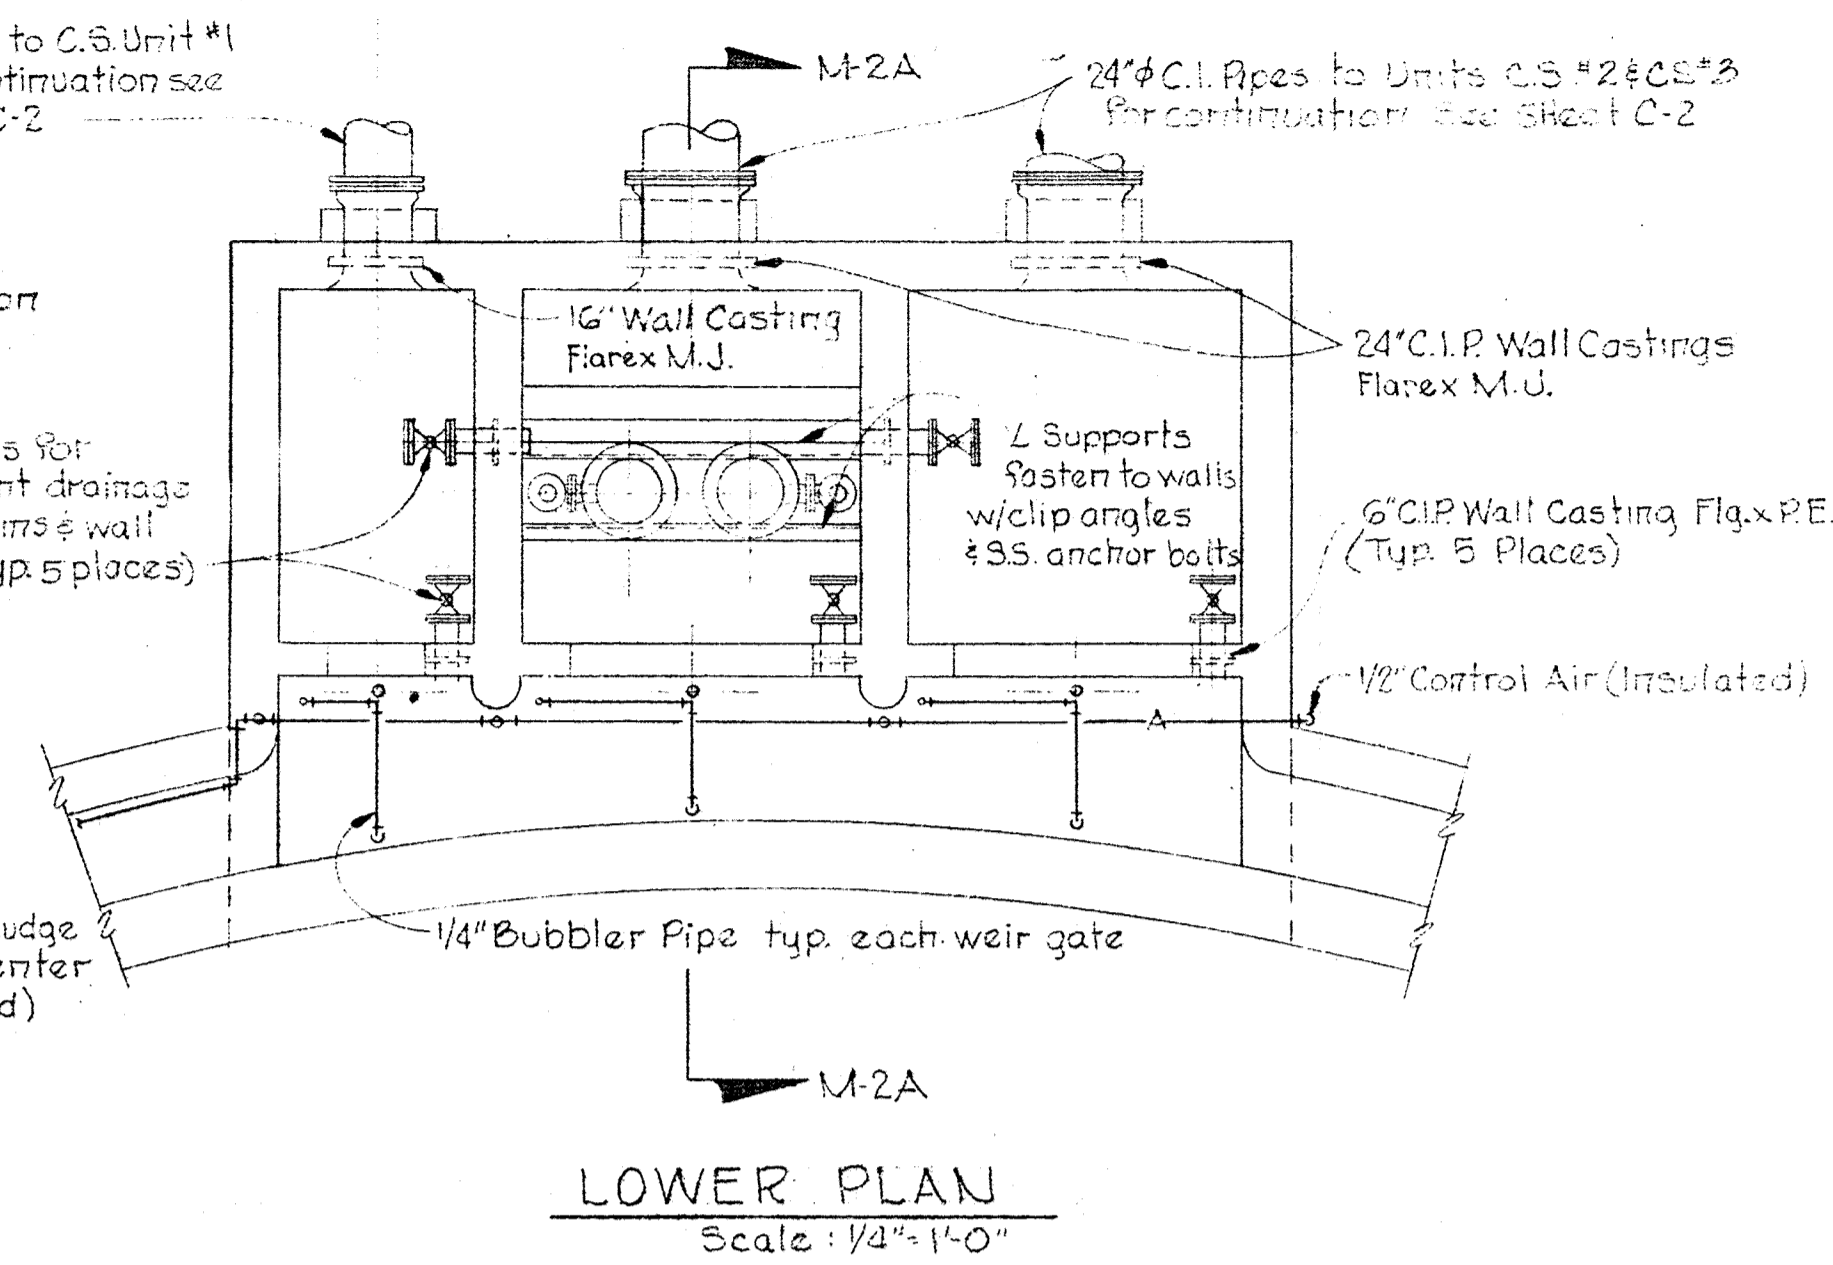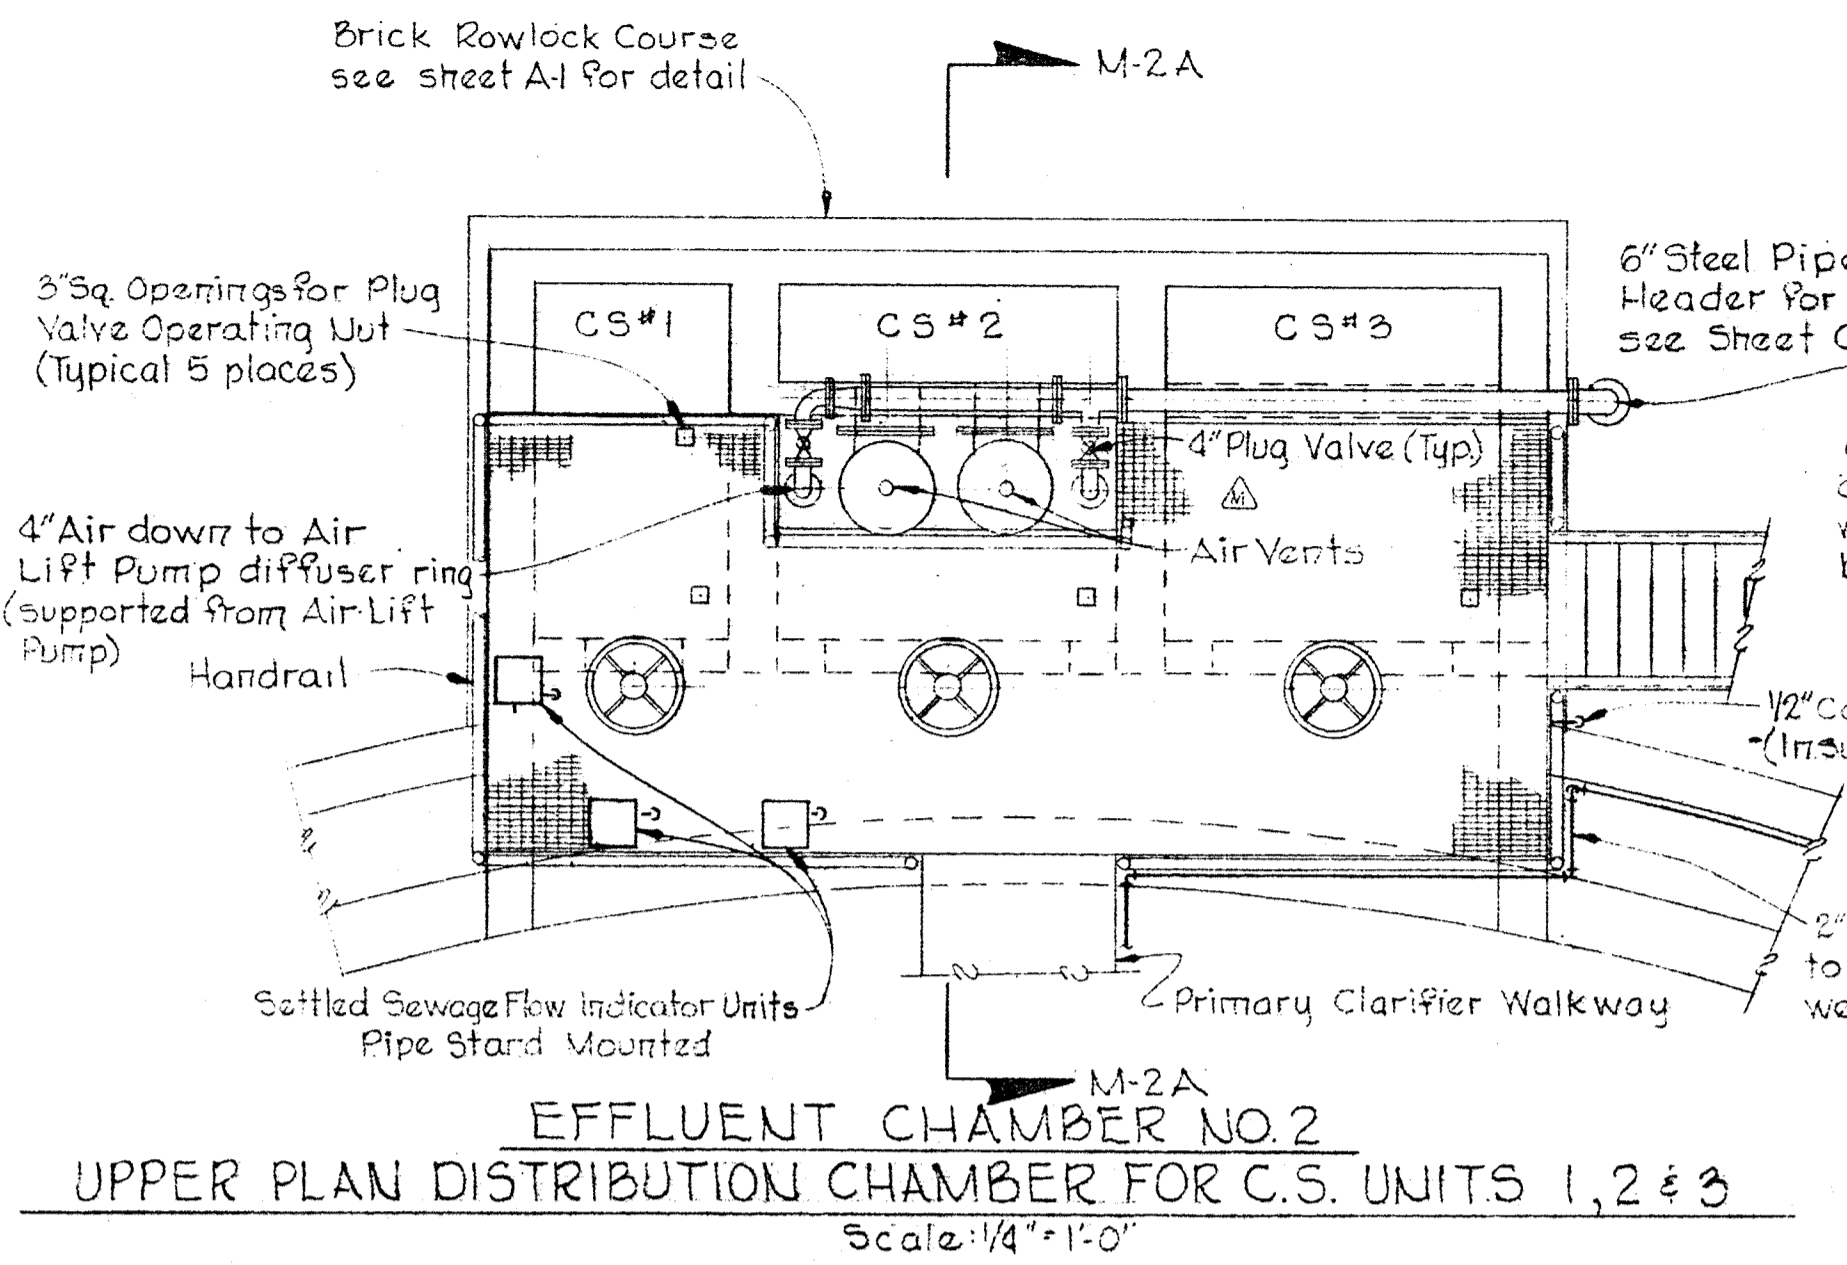


Gate	Size	Max. Flow
CS #1	2'x2'	2 MGD
CS #2	5'x2'	6 MGD
CS #3	5'x2'	6 MGD
AS	8'x2'	14 MGD

Note:  
Maximum elevation for control of flow 144.0. Minimum elevation for control of flow 143.25. Max. Elev. for shut-off 145.25

<b>WHITMAN, REQUARDT &amp; ASSOCIATES</b> ENGINEERS 1304 ST. PAUL ST. BALTIMORE, MARYLAND	DEPARTMENT OF PUBLIC WORKS HOWARD COUNTY, MARYLAND DATE: 2/1/73 <i>W.O. Gilbert</i> CHIEF - BUREAU OF ENGINEERING	CONTRACT NO. 525-S	SETTLED SEWAGE DISTRIBUTION CHAMBERS PLAN, SECTIONS AND DETAILS	SAVAGE WASTEWATER TREATMENT PLANT ADDITION NO. 3	DRAWING NO. 18 OF 28	SCALE AS SHOWN
					Addendum Construction Modification	

W. 0.6538-2

BRUNING 44-510 14778

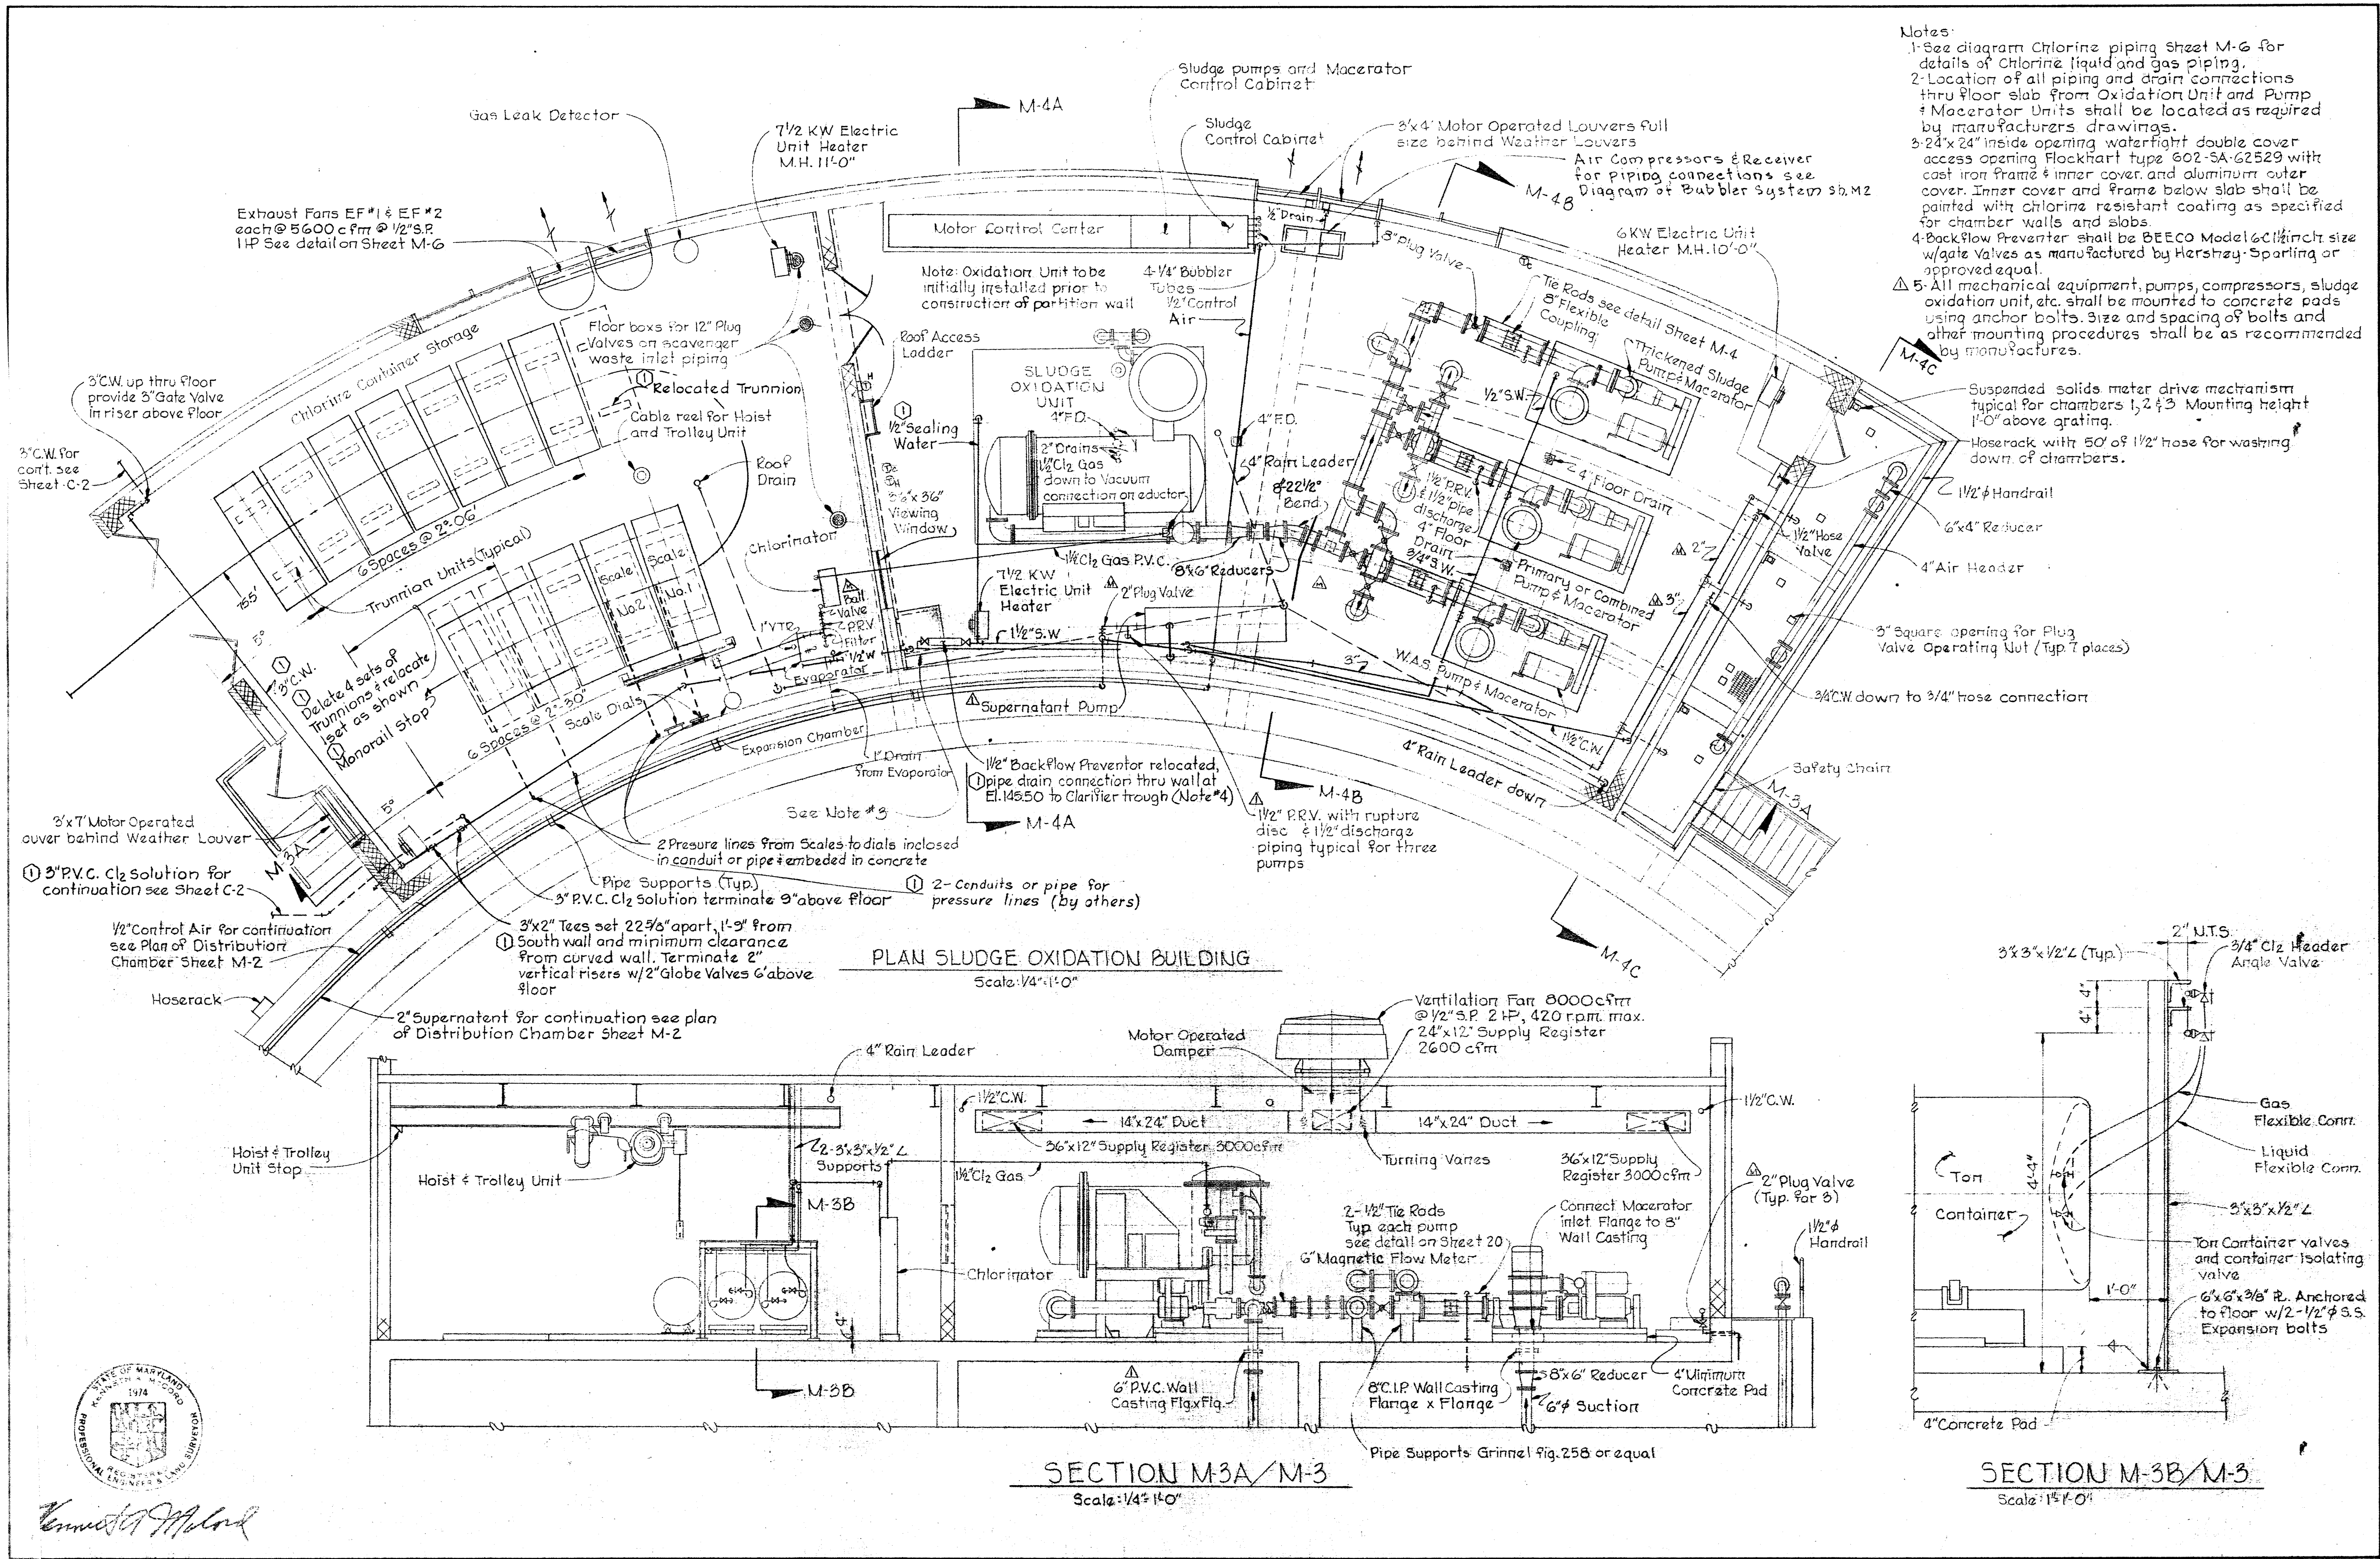

- Notes:
- 1- See diagram Chlorine piping Sheet M-6 for details of Chlorine liquid and gas piping.
  - 2- Location of all piping and drain connections thru floor slab from Oxidation Unit and Pump & Macerator Units shall be located as required by manufacturers drawings.
  - 3- 24" x 24" inside opening watertight double cover access opening Flockhart type 602-SA-62529 with cast iron frame & inner cover, and aluminum outer cover. Inner cover and frame below slab shall be painted with chlorine resistant coating as specified for chamber walls and slabs.
  - 4- Backflow Preventer shall be BEECO Model 6C 1 1/2 inch size w/gate valves as manufactured by Hersey-Sparting or approved equal.
  - 5- All mechanical equipment, pumps, compressors, sludge oxidation unit, etc. shall be mounted to concrete pads using anchor bolts. Size and spacing of bolts and other mounting procedures shall be as recommended by manufactures.

WHITMAN, REQUARDT & ASSOCIATES  
ENGINEERS  
1304 ST. PAUL ST.  
BALTIMORE, MARYLAND

DEPARTMENT OF PUBLIC WORKS  
HOWARD COUNTY, MARYLAND  
2/1/73  
DATE

CONTRACT NO. 525-S

SLUDGE OXIDATION BUILDING  
PLAN AND SECTIONS


SAVAGE WASTEWATER  
TREATMENT PLANT ADDITION NO. 3

DRAWING NO. 19 OF 28  
SCALE AS SHOWN



W O 6538-2-1 Change Order No. 4 2-19-74

Addendum Construction Modification AS BUILT SHEET M-3  
JAN 1 1977


BRUNING 44-510 14774

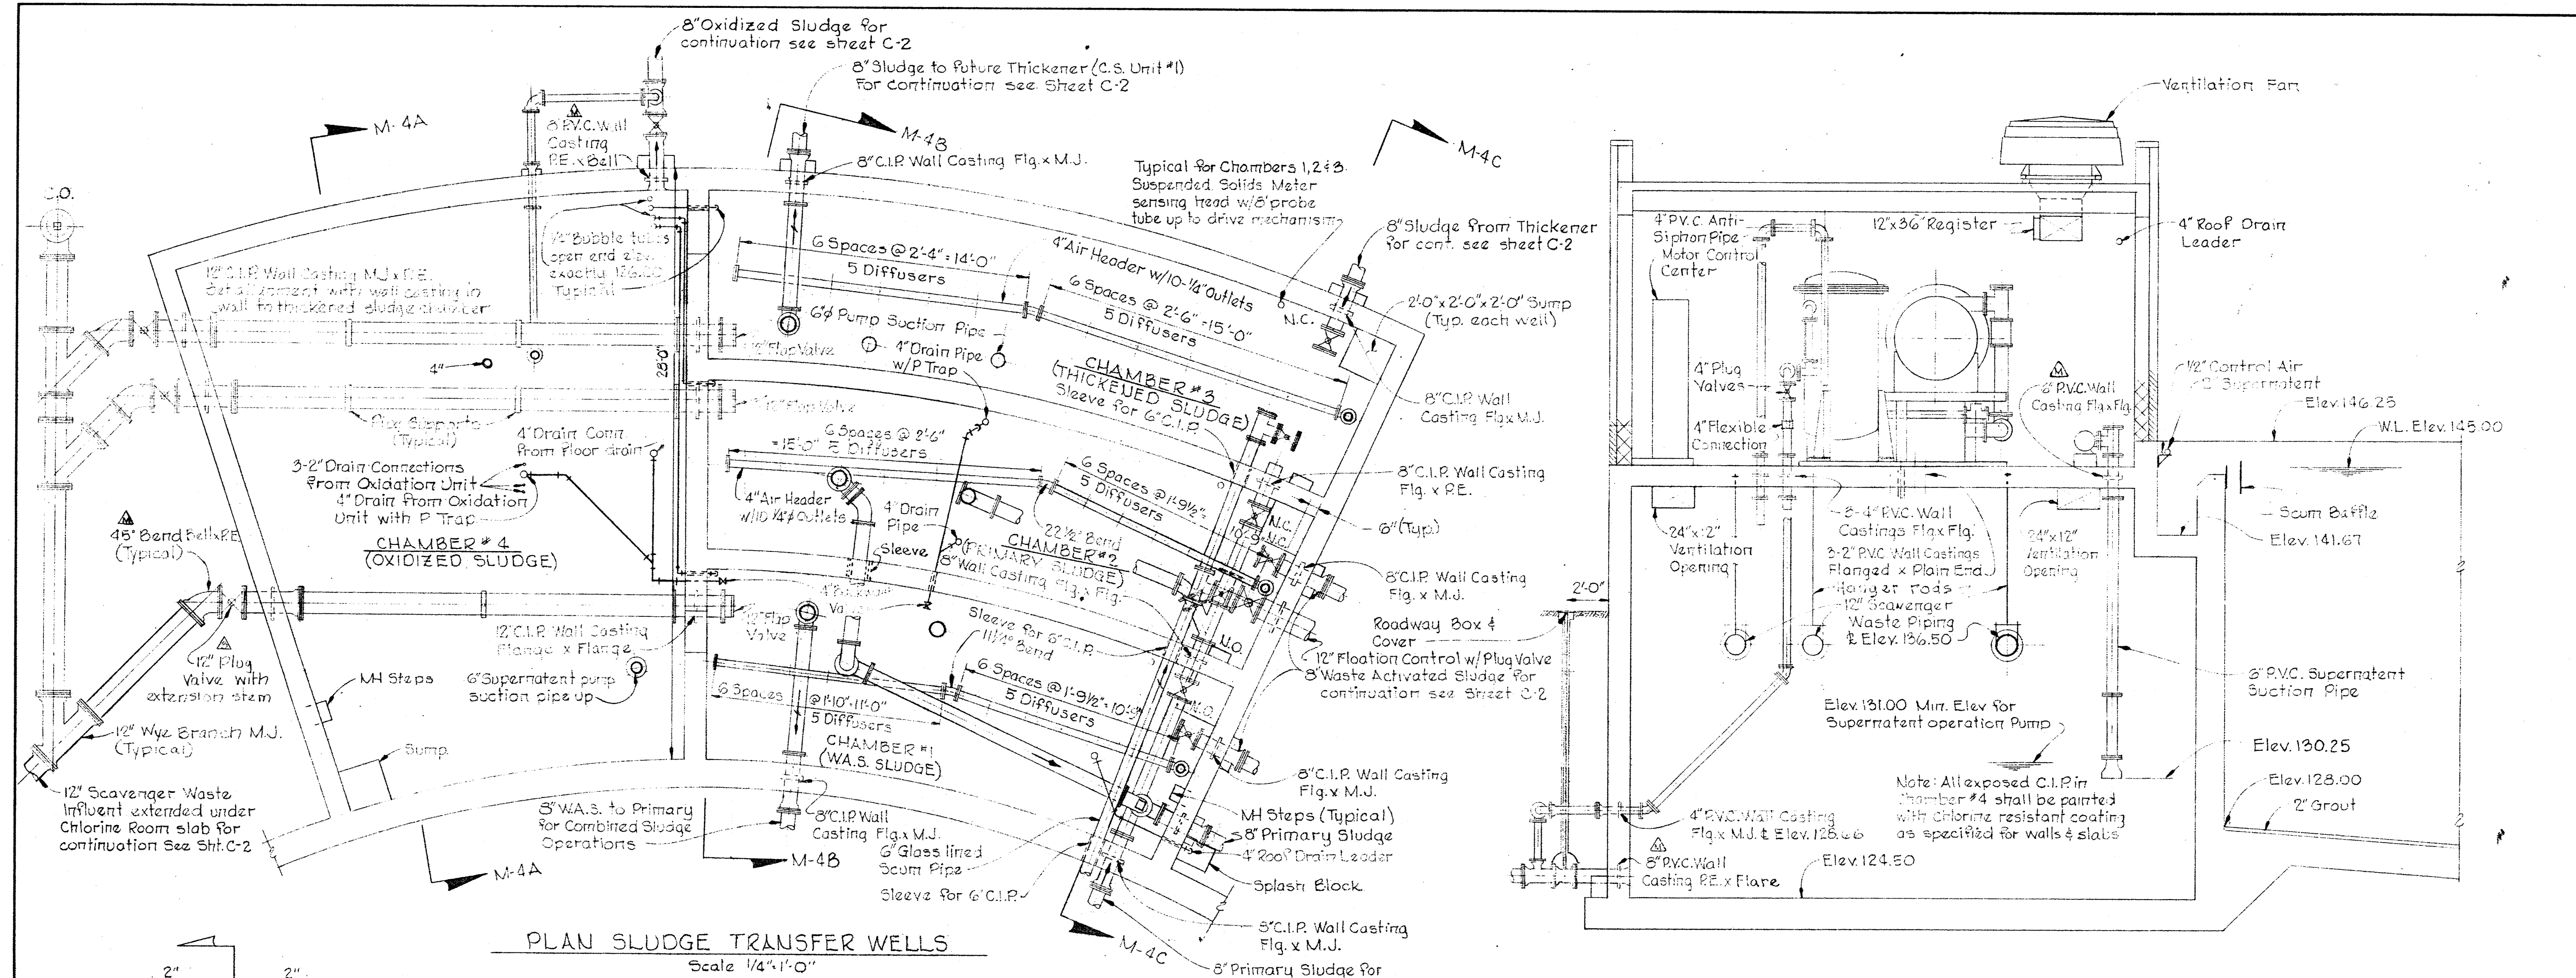


PLAN SLUDGE TRANSFER WELLS  
Scale: 1/4" = 1'-0"

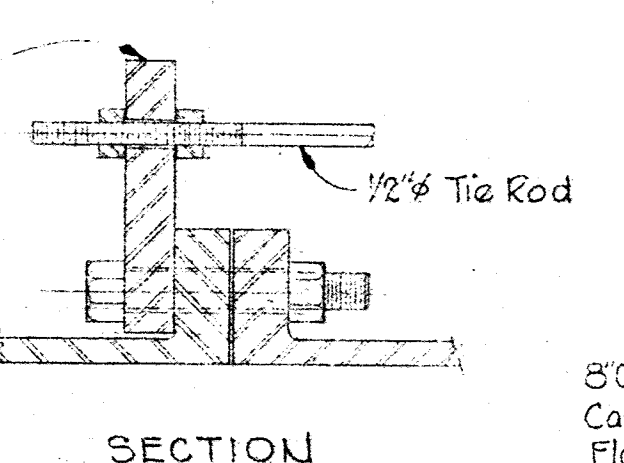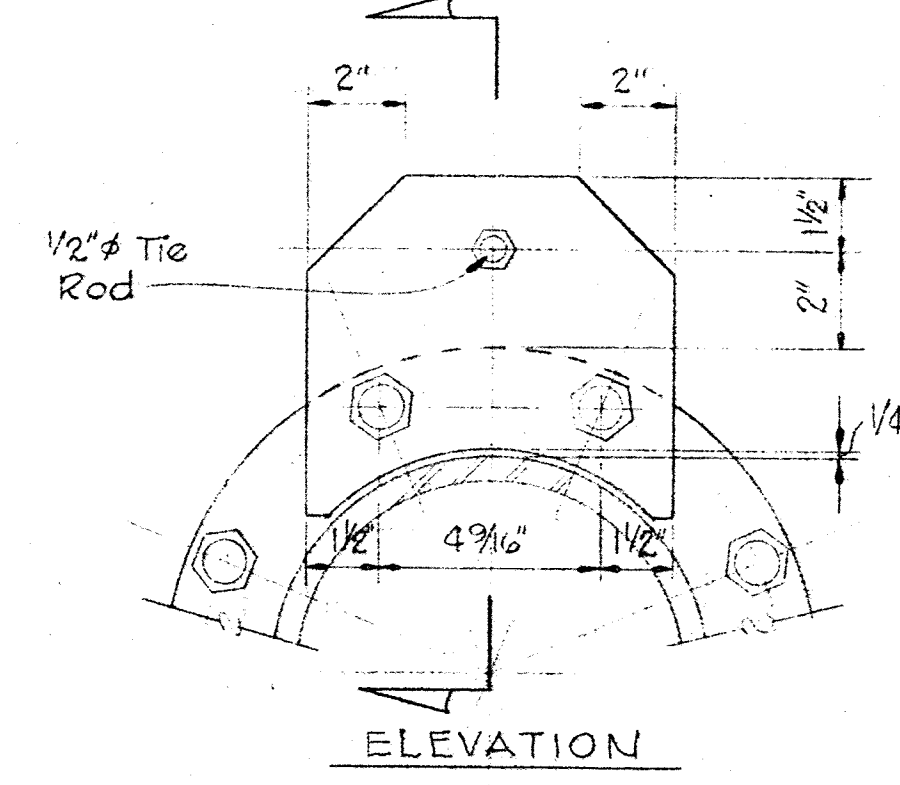

TIE ROD DETAIL  
Scale: 3" = 1'-0"  
Tie rods will be ASTM A193-69 Grade B7 and Lug Plate ASTM A-36-7

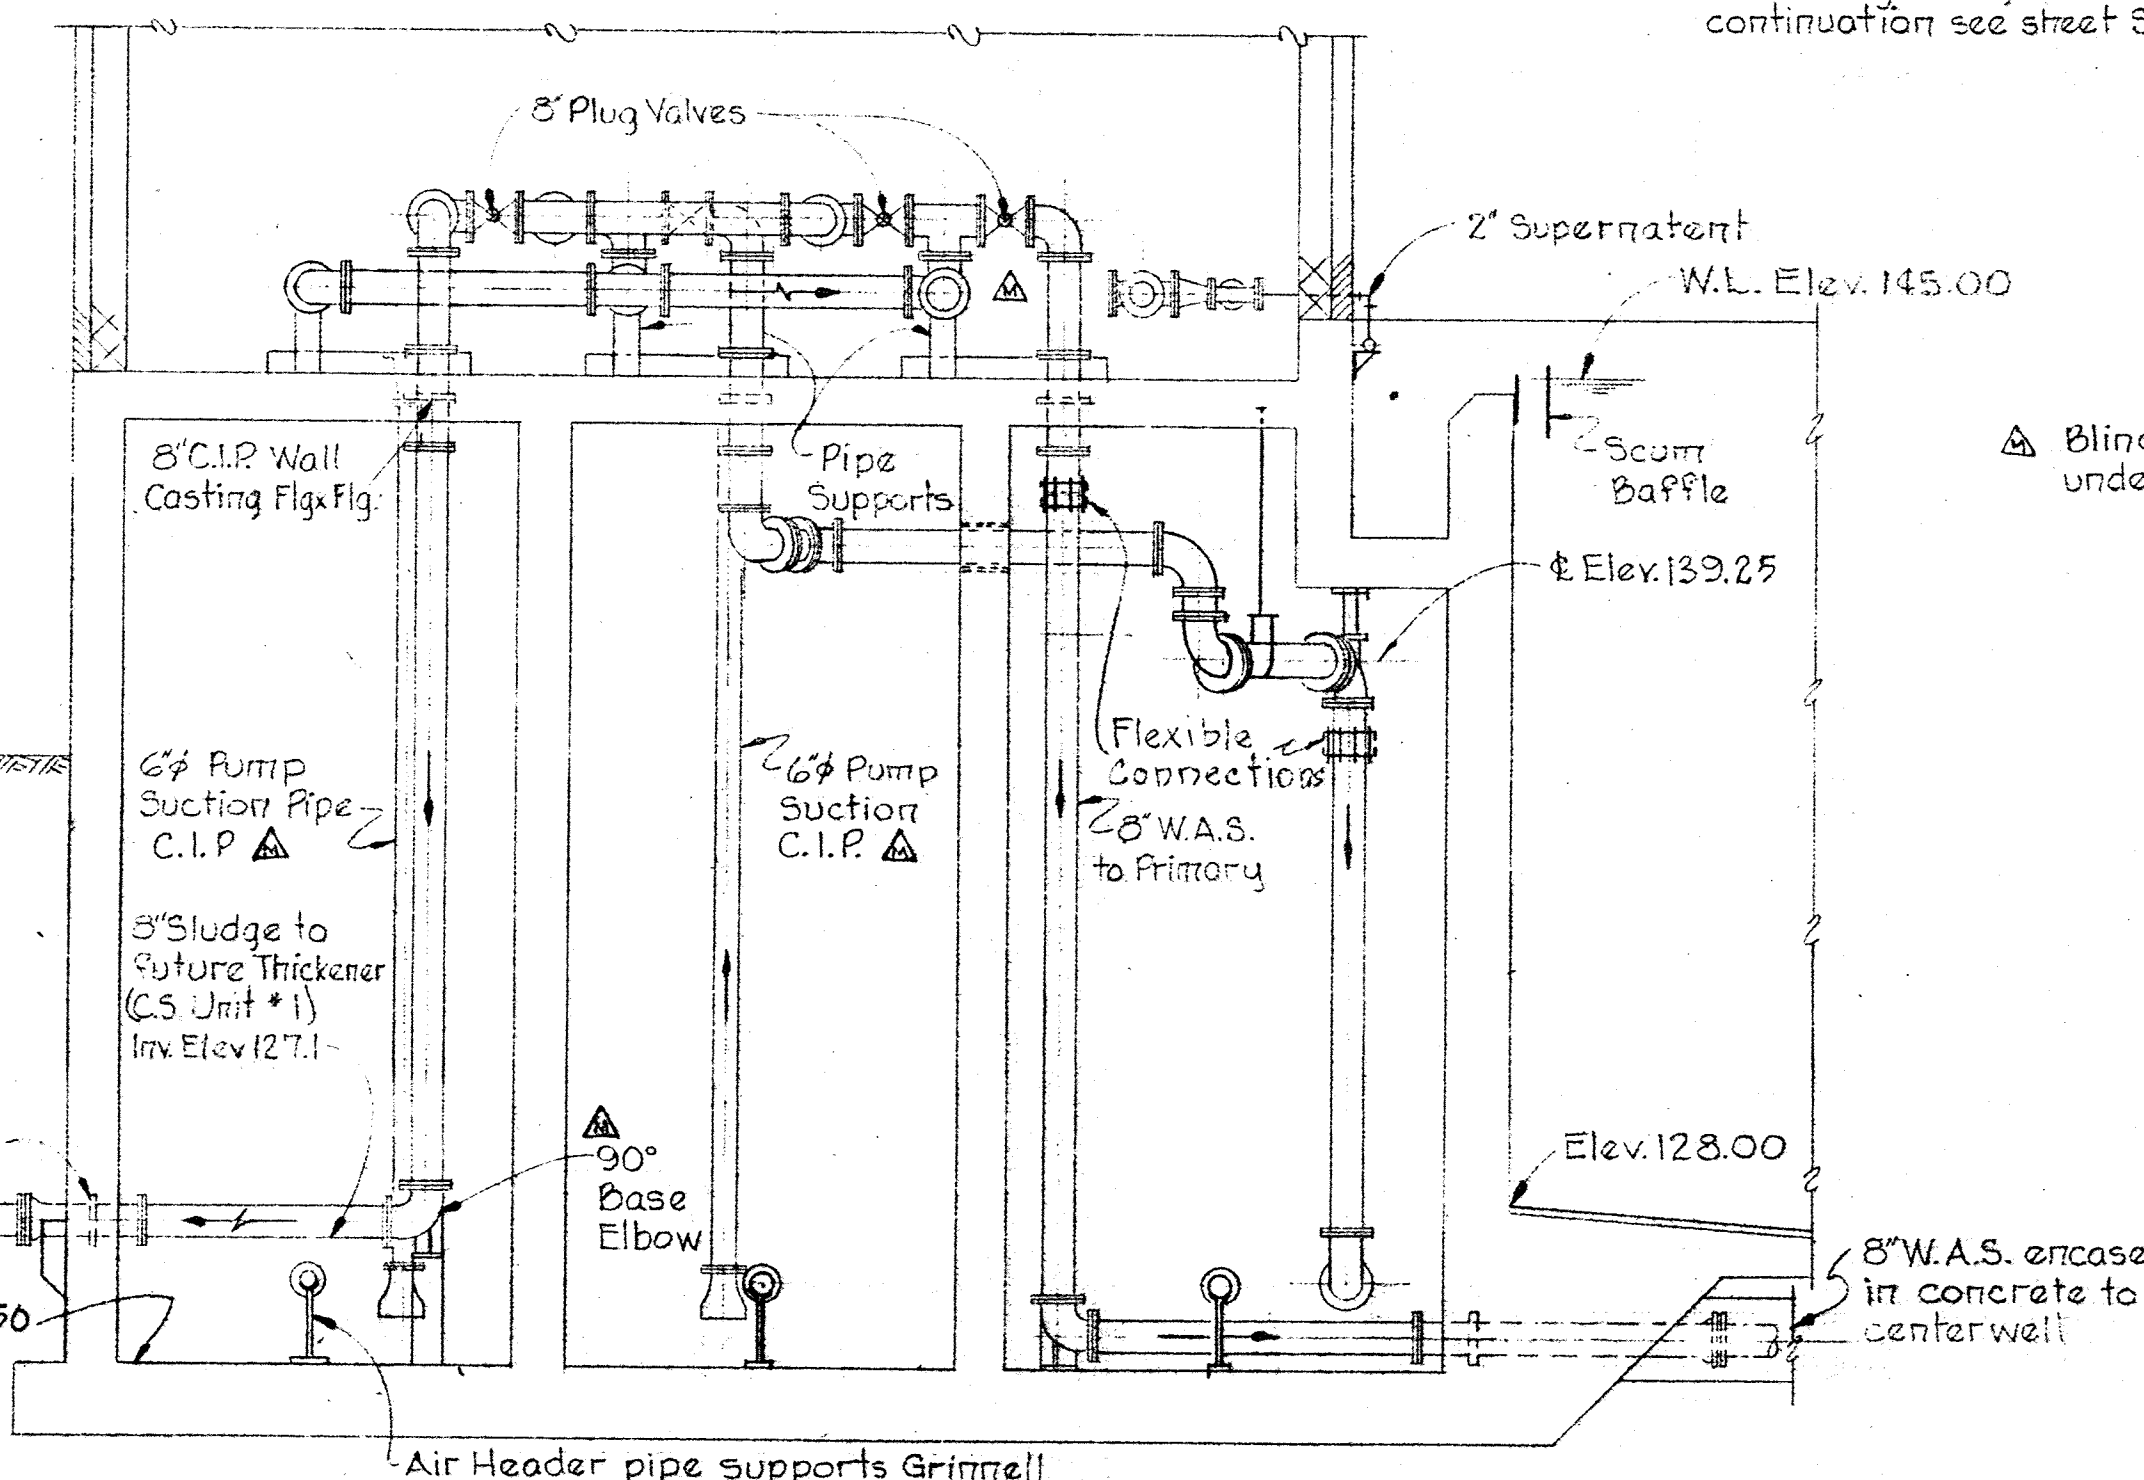

SECTION M-4B/M-3 & M-4  
Scale: 1/4" = 1'-0"

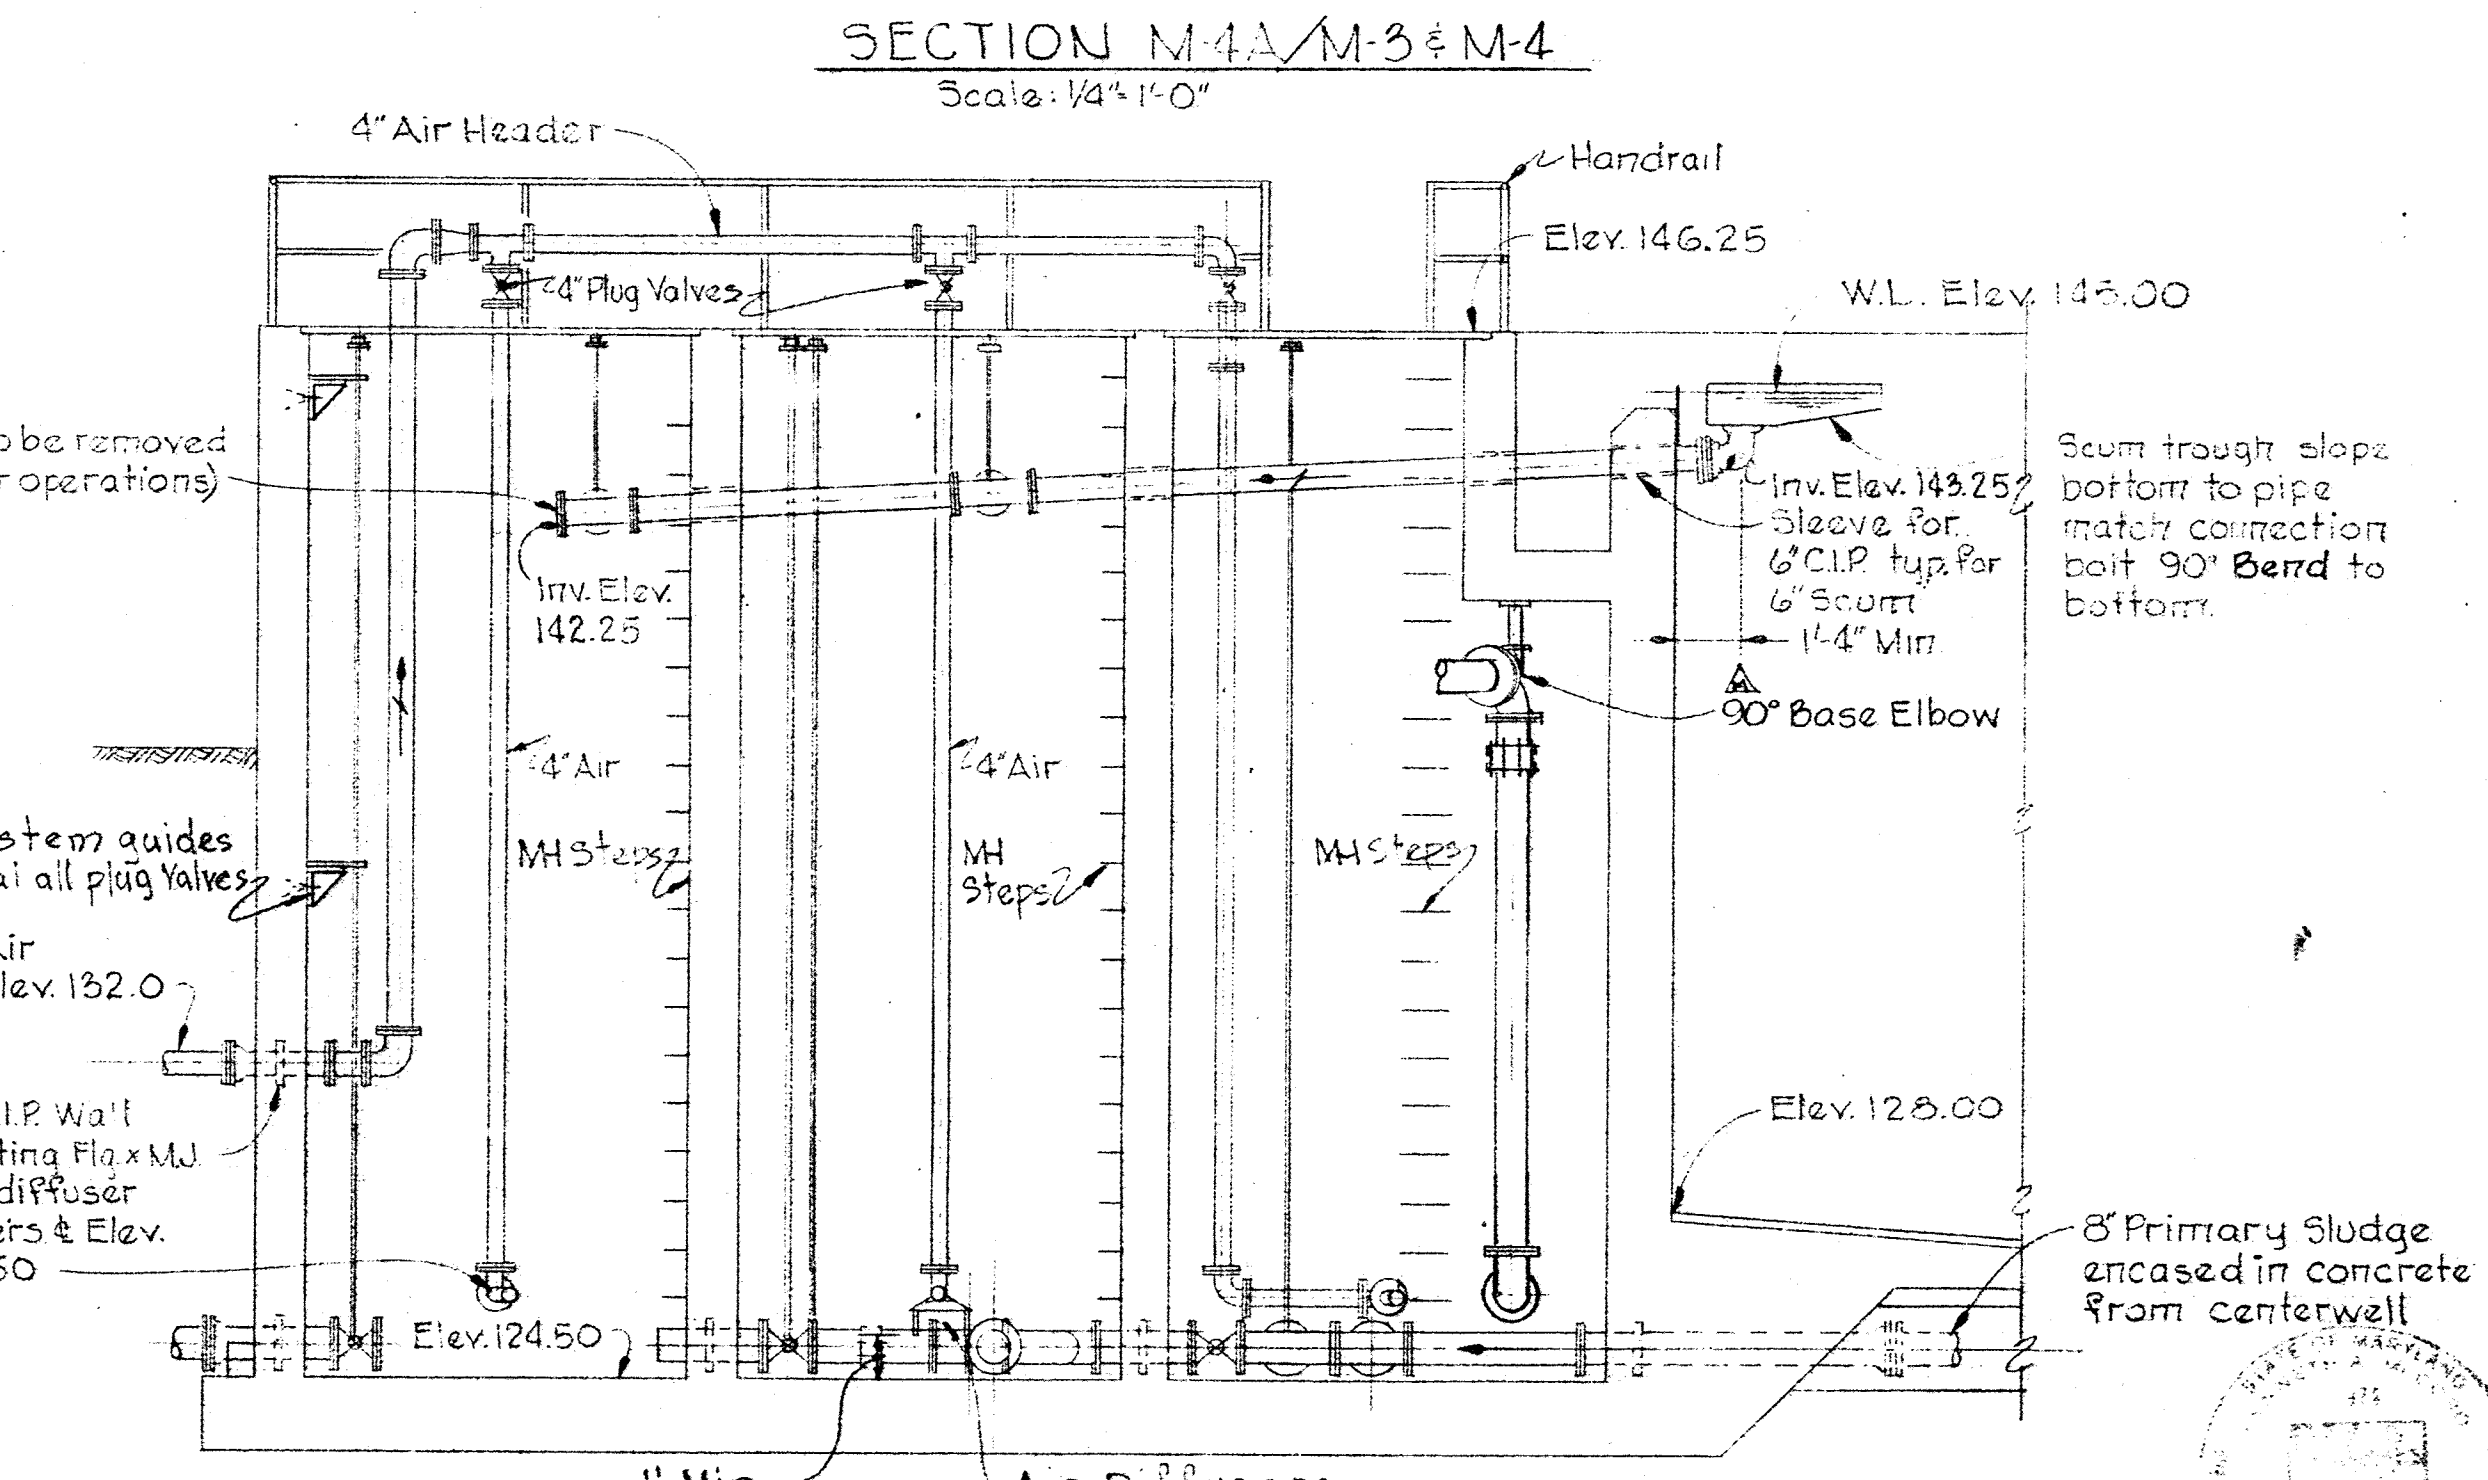

SECTION M-4A/M-3 & M-4  
Scale: 1/4" = 1'-0"

<p>WHITMAN, REQUARDT &amp; ASSOCIATES ENGINEERS 1304 ST. PAUL ST. BALTIMORE, MARYLAND</p>	<p>DEPARTMENT OF PUBLIC WORKS HOWARD COUNTY, MARYLAND 2/1/73 DATE W.O. Gilbert CHIEF - BUREAU OF ENGINEERING</p>	<p>CONTRACT NO. 525-S</p>	<p>SLUDGE OXIDATION BUILDING PLAN AND SECTIONS</p>	<p>SAVAGE WASTEWATER TREATMENT PLANT ADDITION NO. 3</p>	<p>DRAWING NO. 20 OF 28 SCALE AS SHOWN</p>
---	--	---------------------------	--	---	--




W.O. 6538-2

45 2011 1 2777 Construction Modification

SHEET M-4

**LEGEND**

- R.S.- Return Sludge
- W.A.S.- Waste Activated Sludge
- P.S.- Primary Sludge
- C.S.- Combined Sludge
- T.S.- Thickened Sludge
- O.S.- Oxidized Sludge
- S.S.- Supernatant Sludge

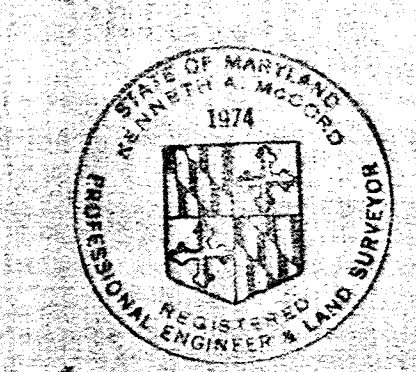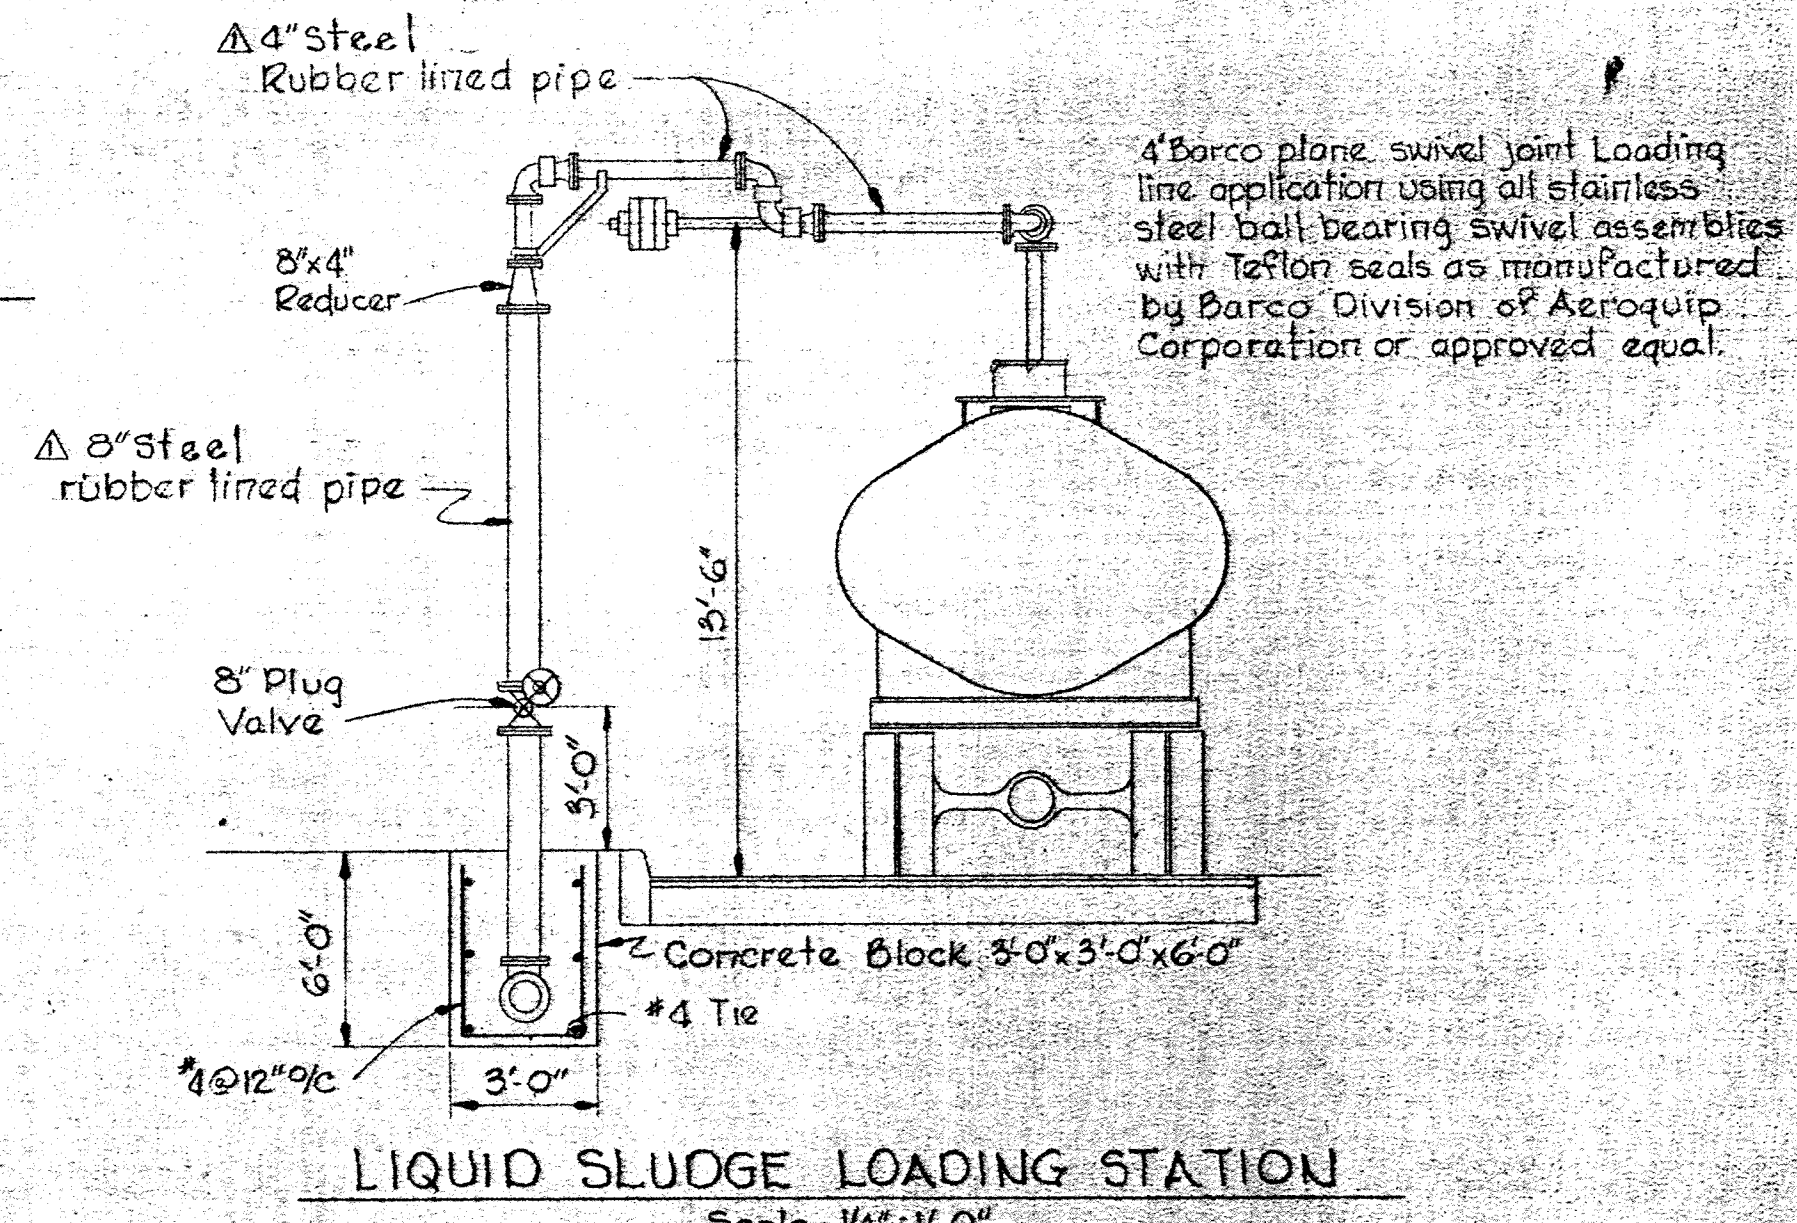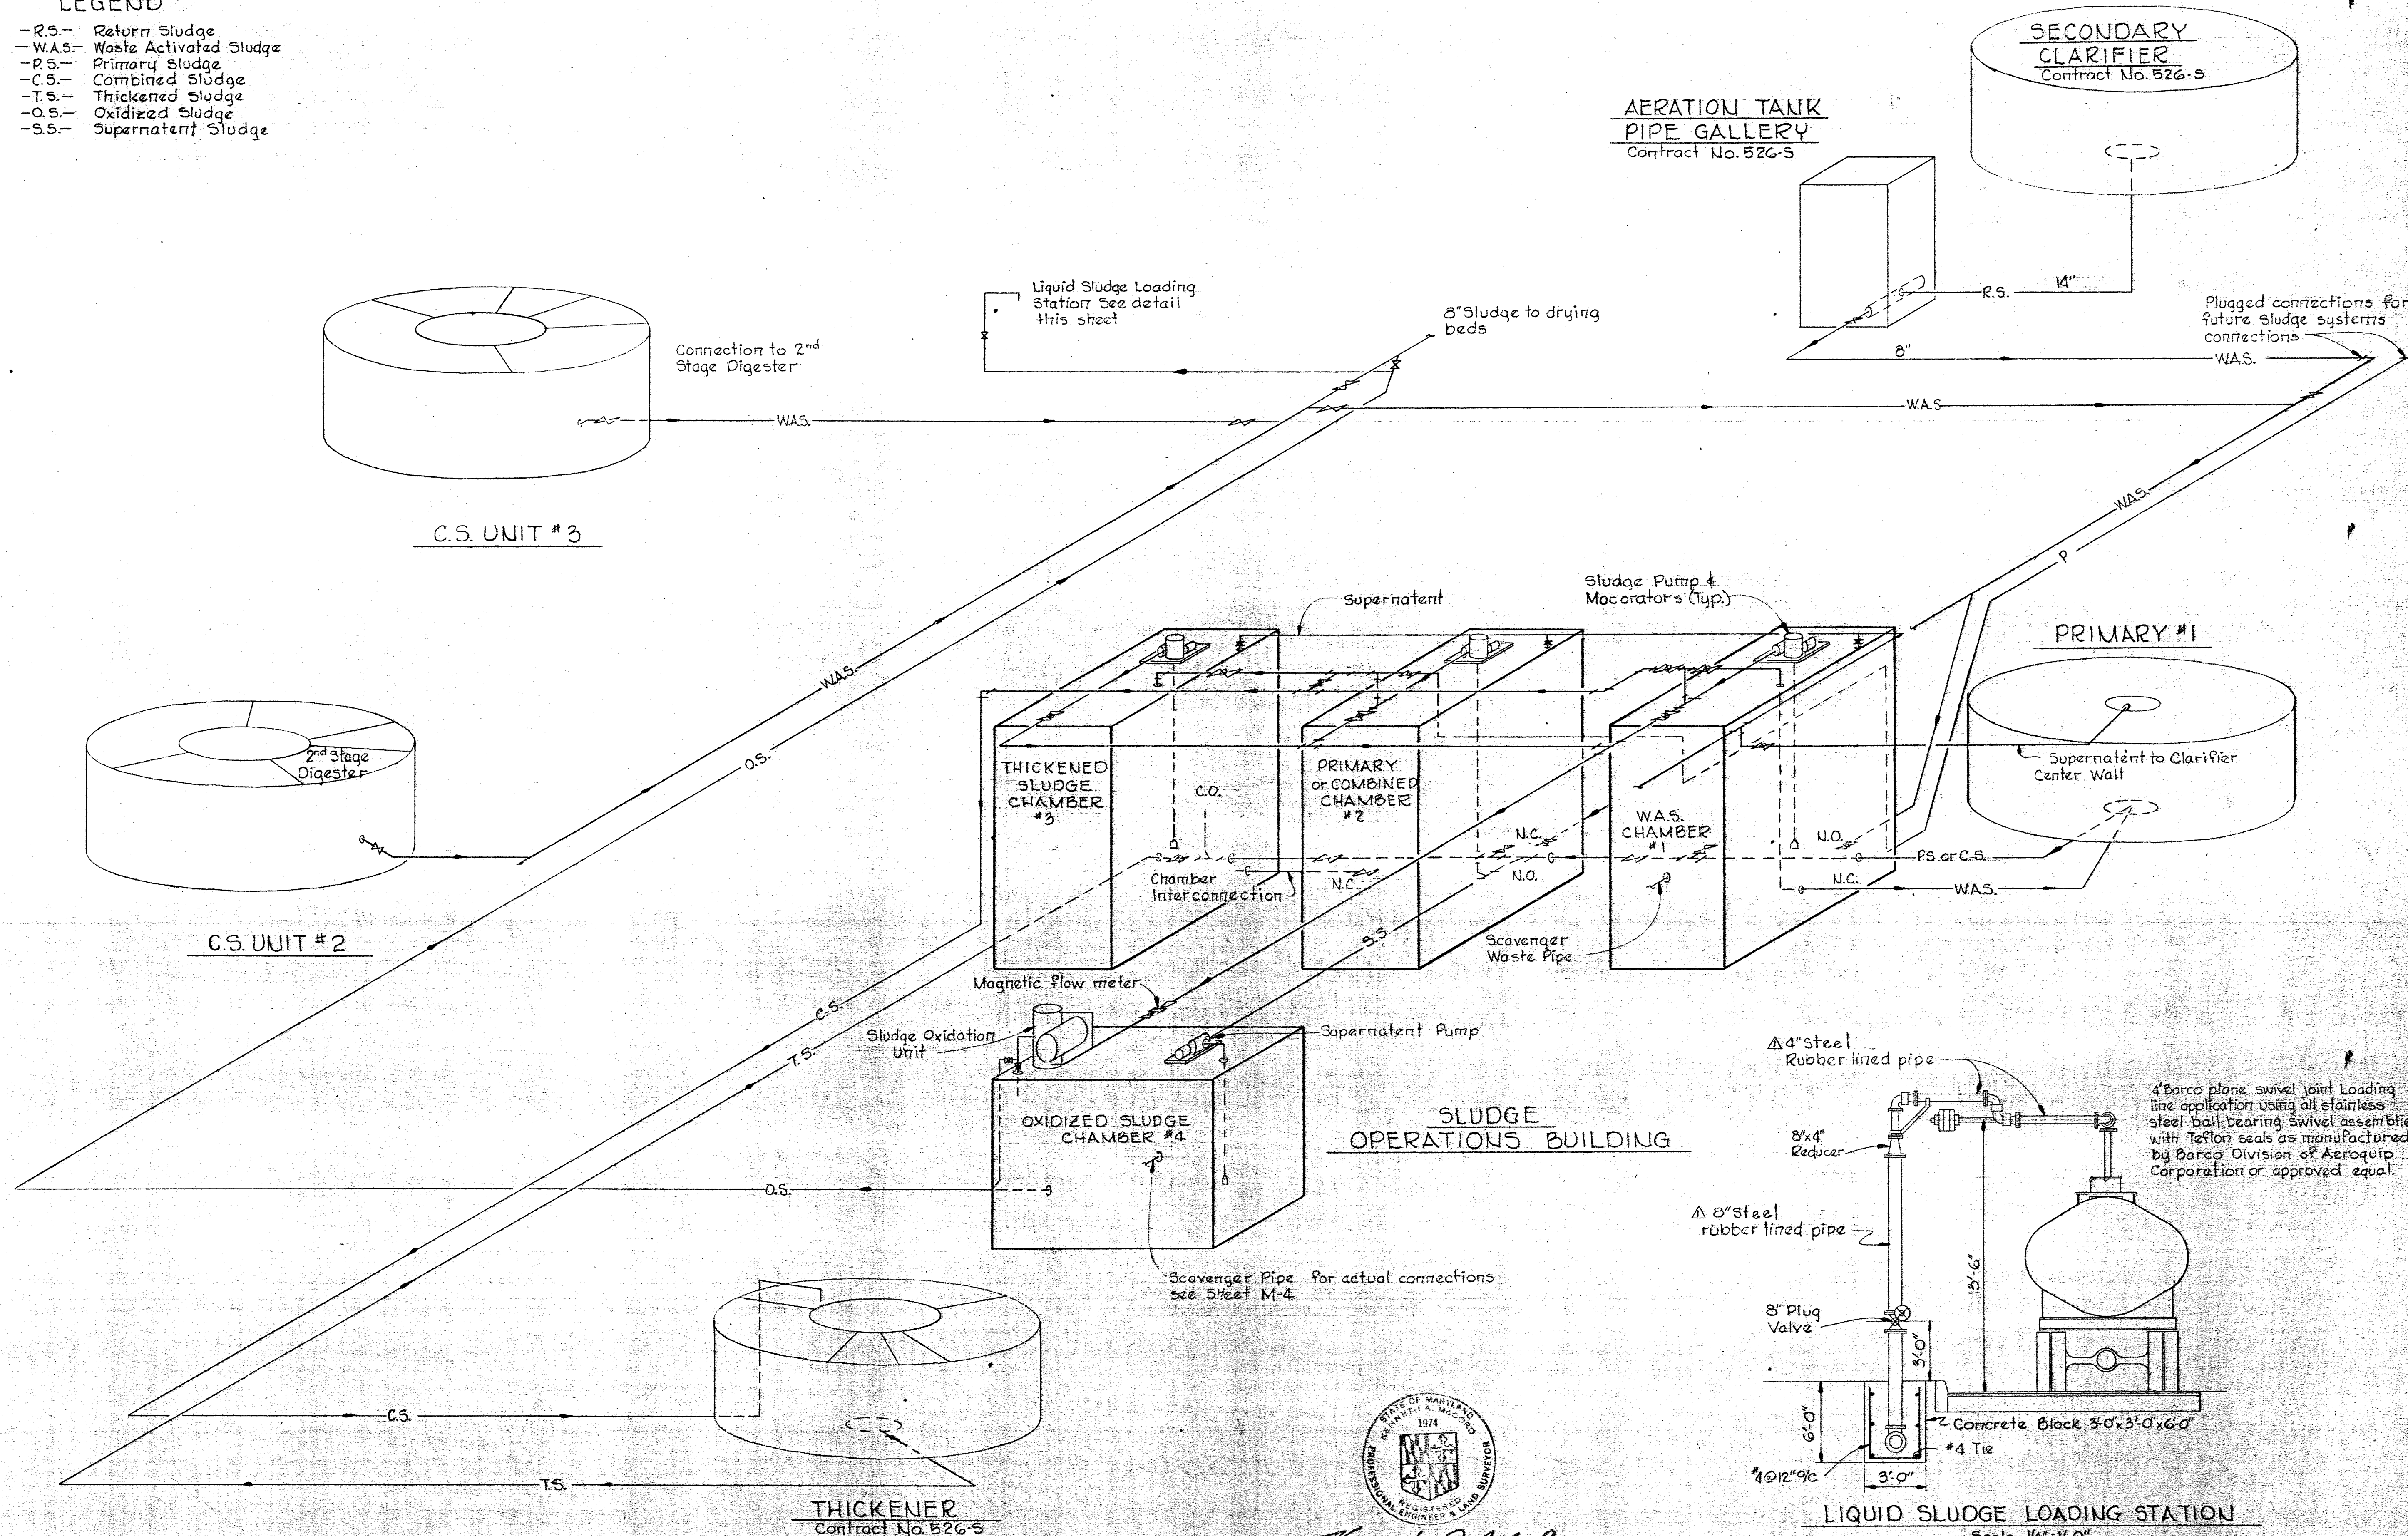


*Kenneth M. Mohr*

<p>WHITMAN, REQUARDT &amp; ASSOCIATES ENGINEERS 1304 ST. PAUL ST. BALTIMORE, MARYLAND</p>	<p>DEPARTMENT OF PUBLIC WORKS HOWARD COUNTY, MARYLAND DATE 2/1/73 <i>W.O. Gilbert</i> CHIEF - BUREAU OF ENGINEERING</p>	<p>CONTRACT NO. 525-S</p>	<p>SLUDGE PROCESS DIAGRAM</p>	<p>SAVAGE WASTEWATER TREATMENT PLANT ADDITION NO. 3</p>	<p>DRAWING NO. 21 OF 28 SCALE AS SHOWN SHEET M-5</p>
---	---	---------------------------	-------------------------------	---	--


W. O. 6538-2

Appendum Δ AS BUILT 4/16 1977


BRUNING 44510 14778

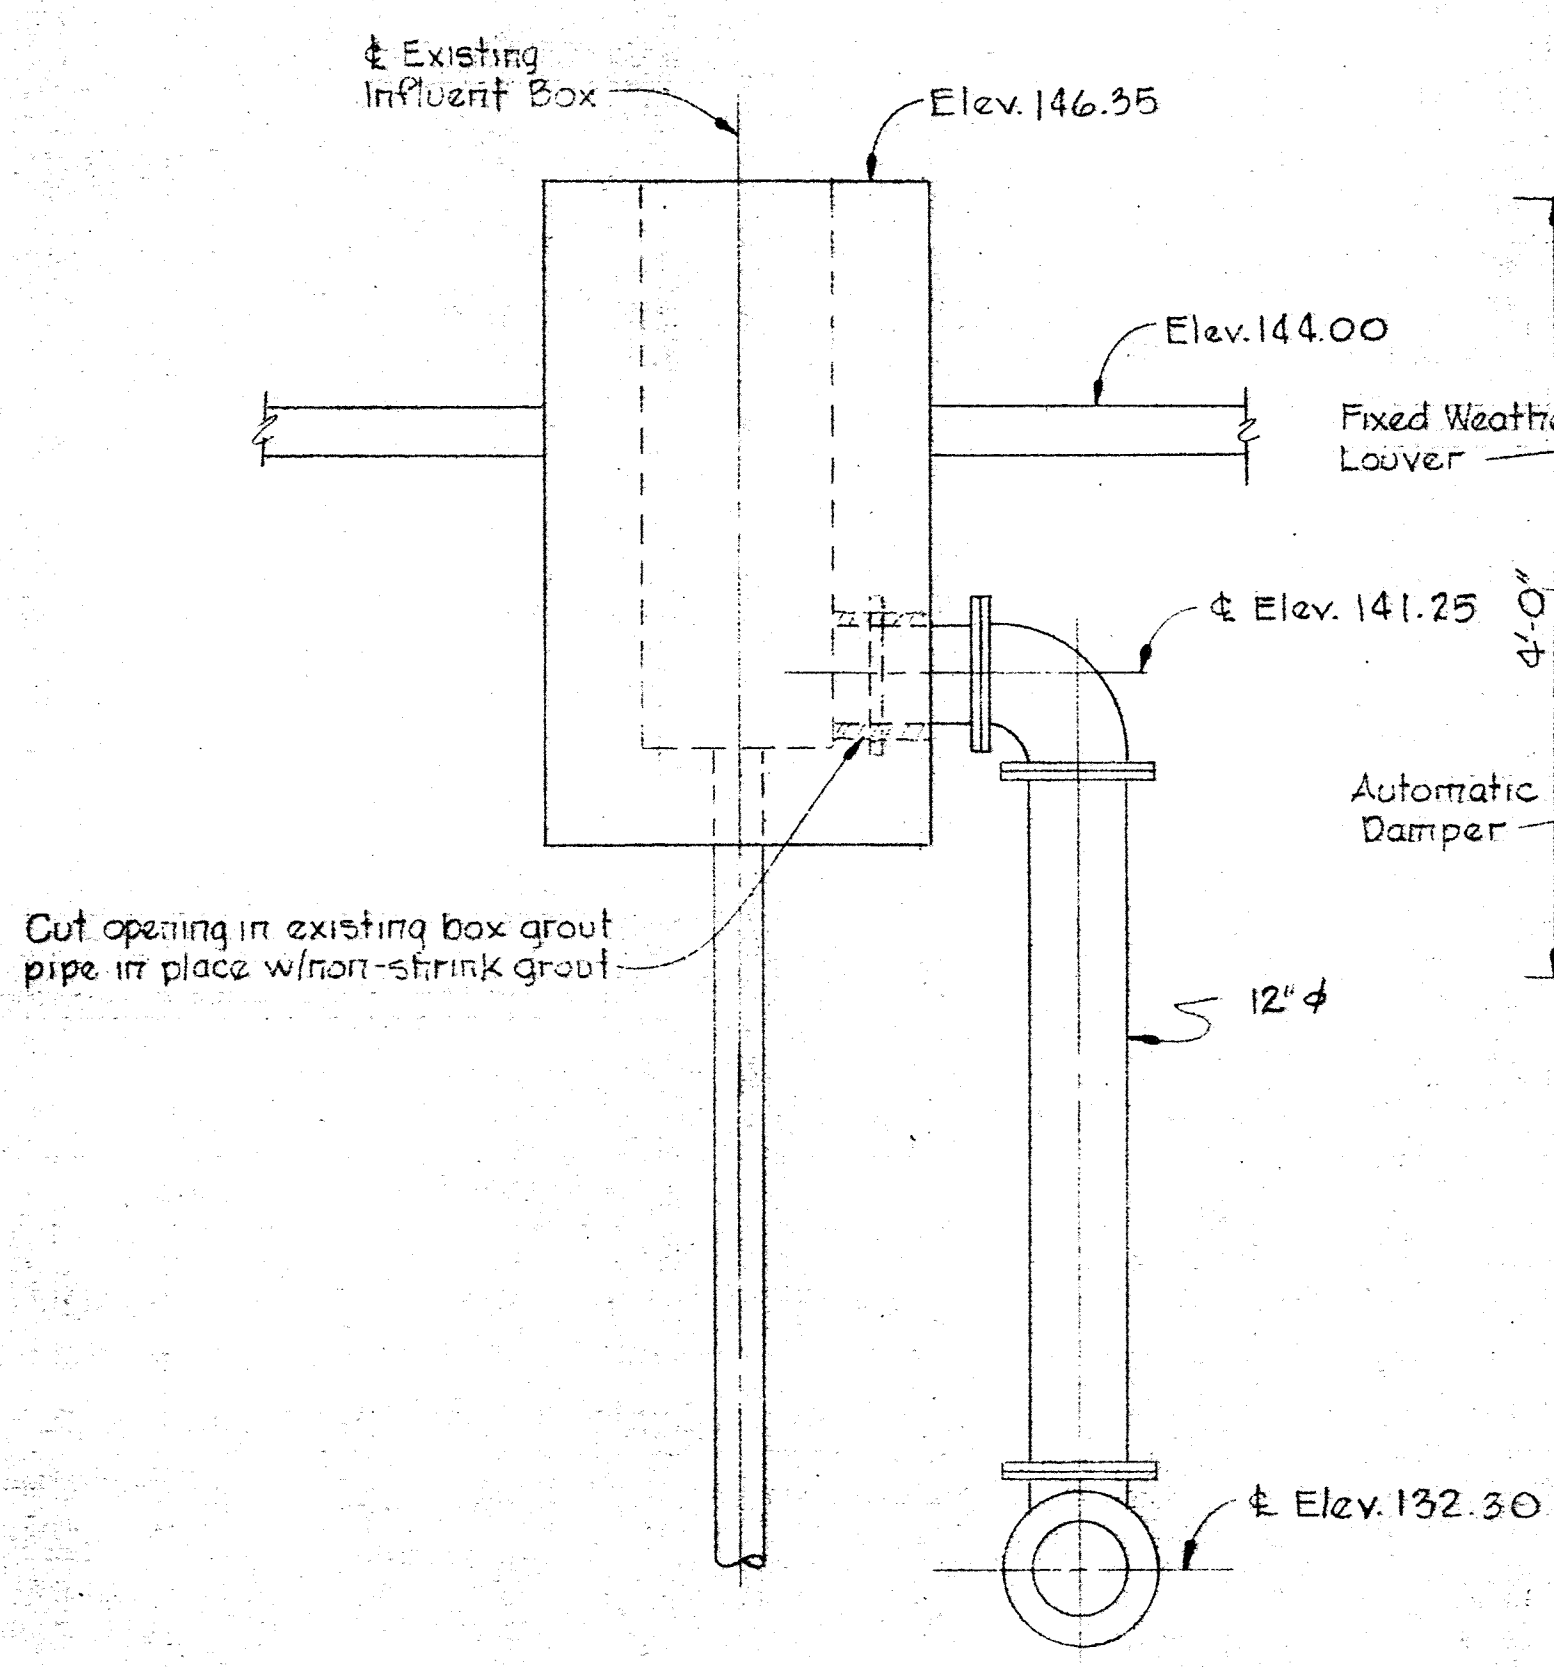


SECTION AT INFLUENT BOX TREATMENT UNIT NO. 1  
Scale: 1/2"=1'-0"

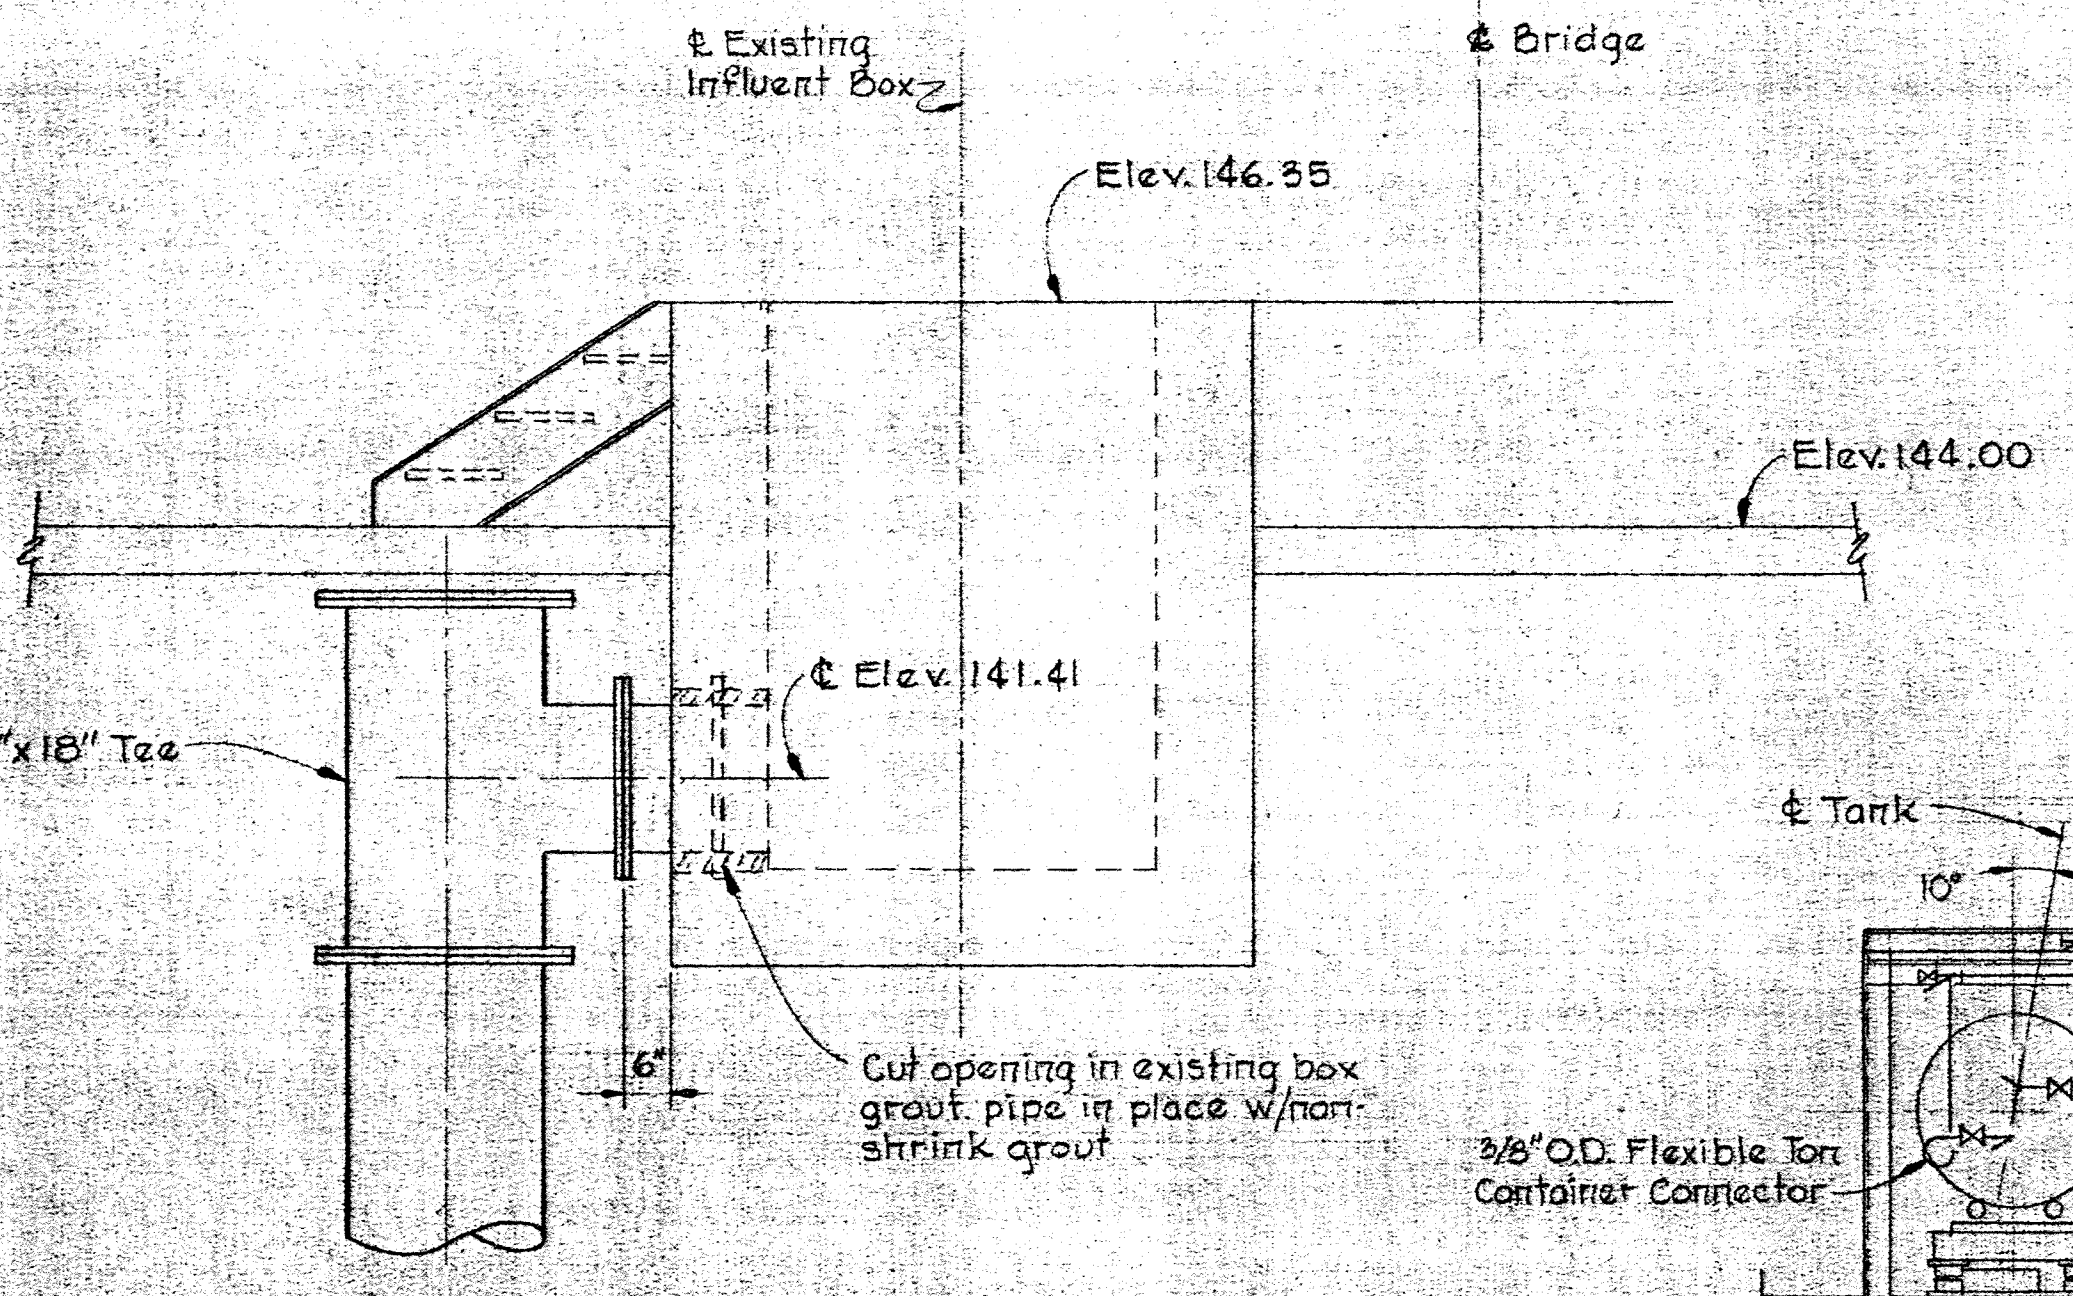

SECTION AT INFLUENT BOX TREATMENT UNIT NO. 3  
Scale: 1/2"=1'-0"

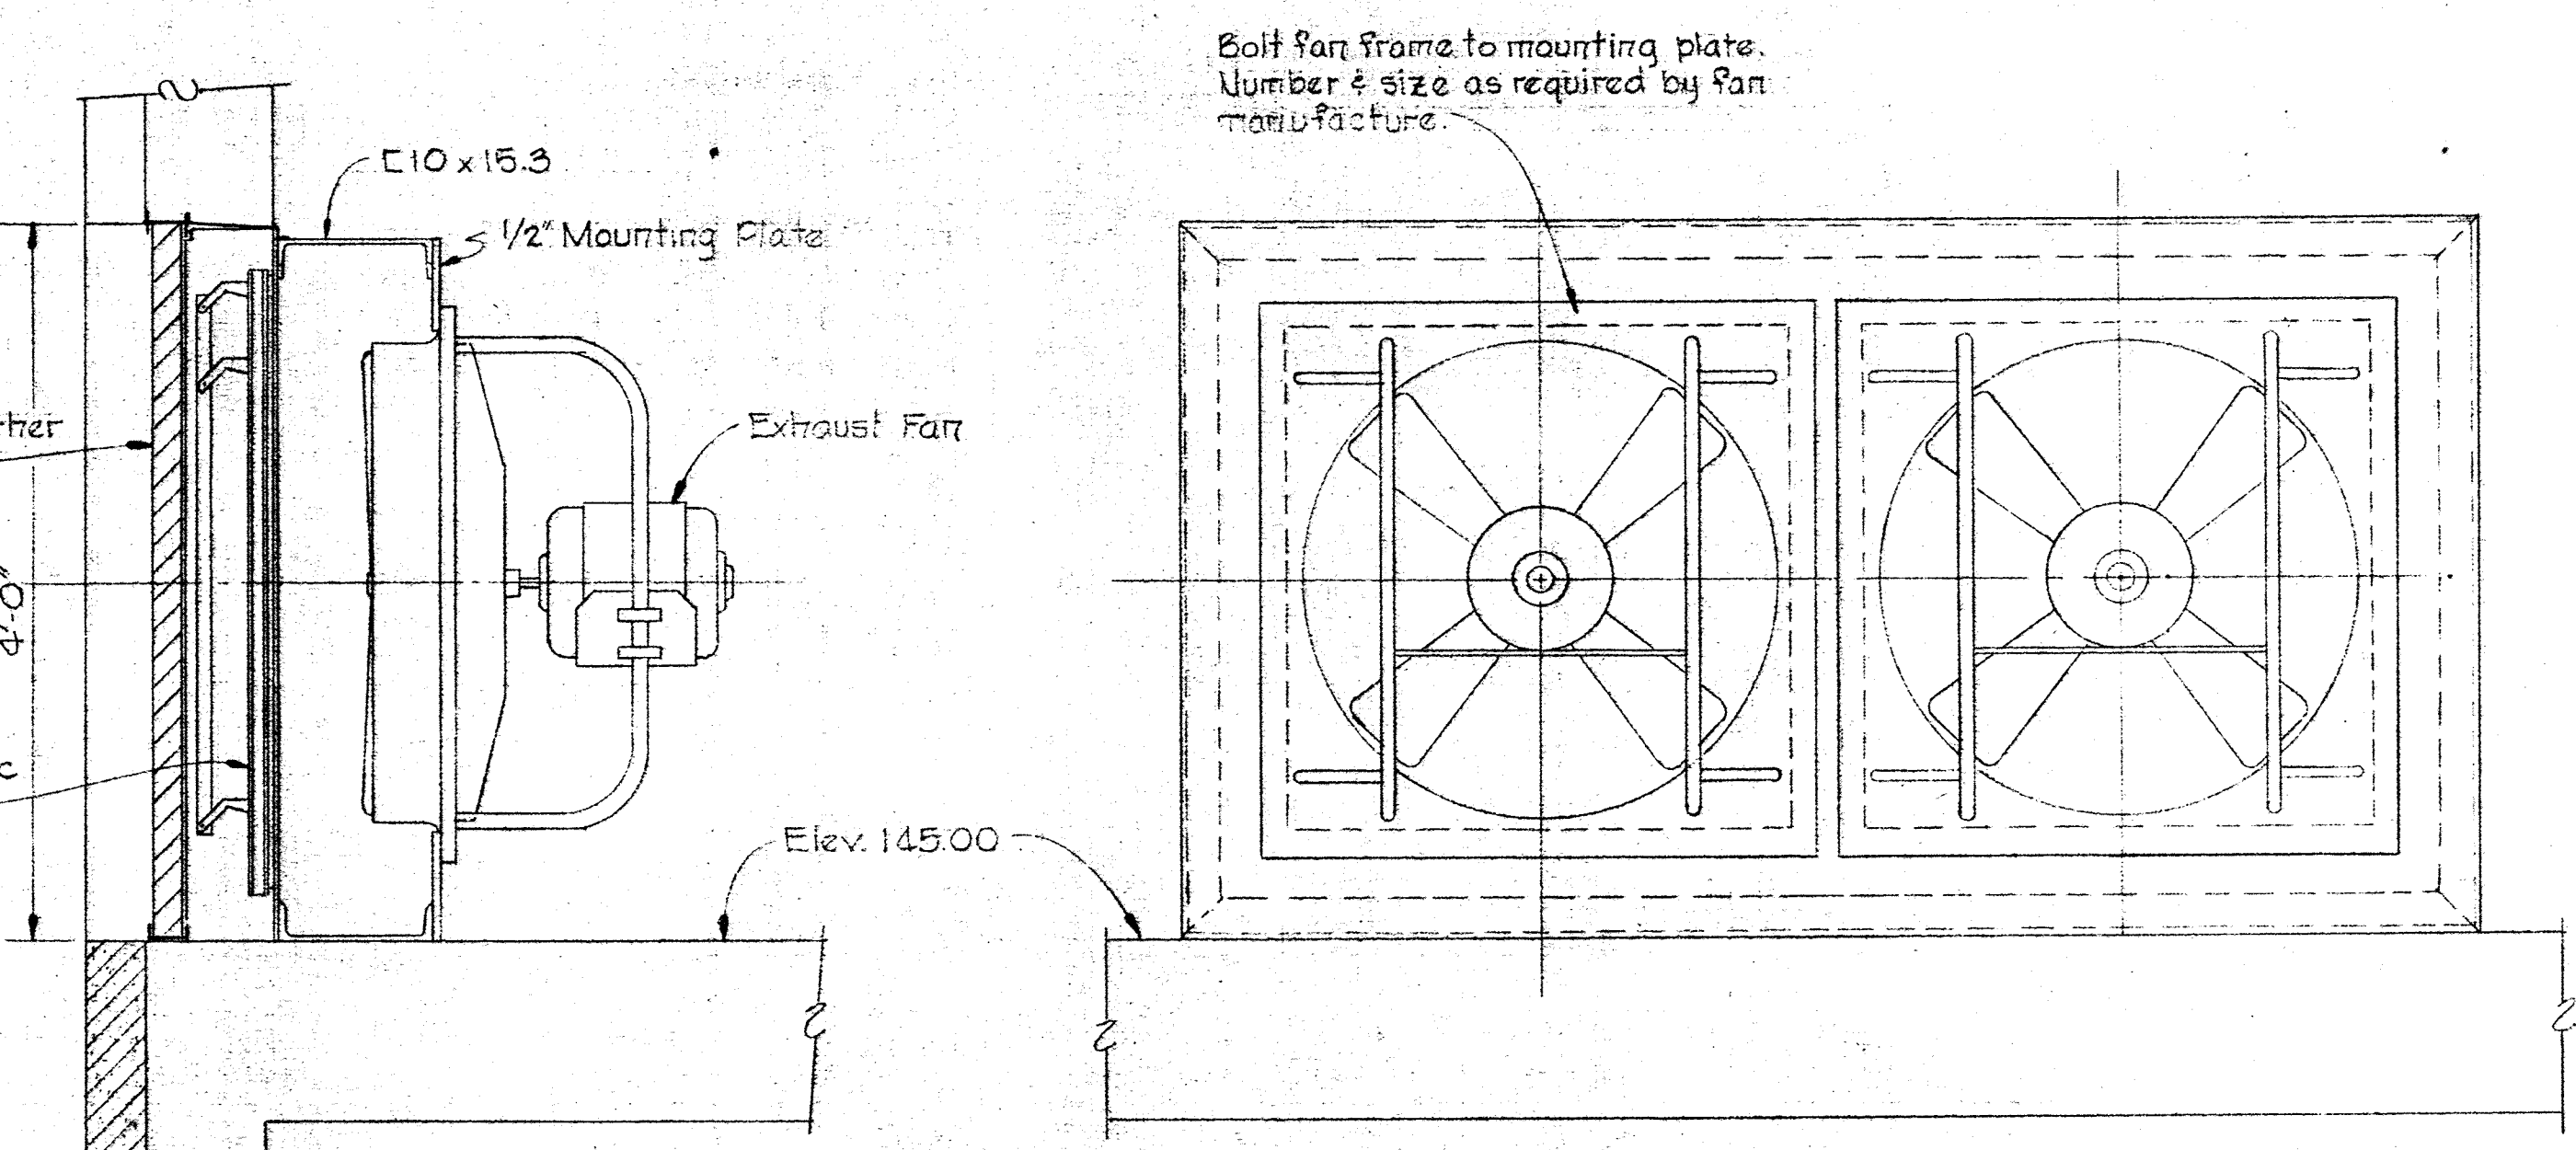


FAN DETAIL  
Scale: 1"=1'-0"

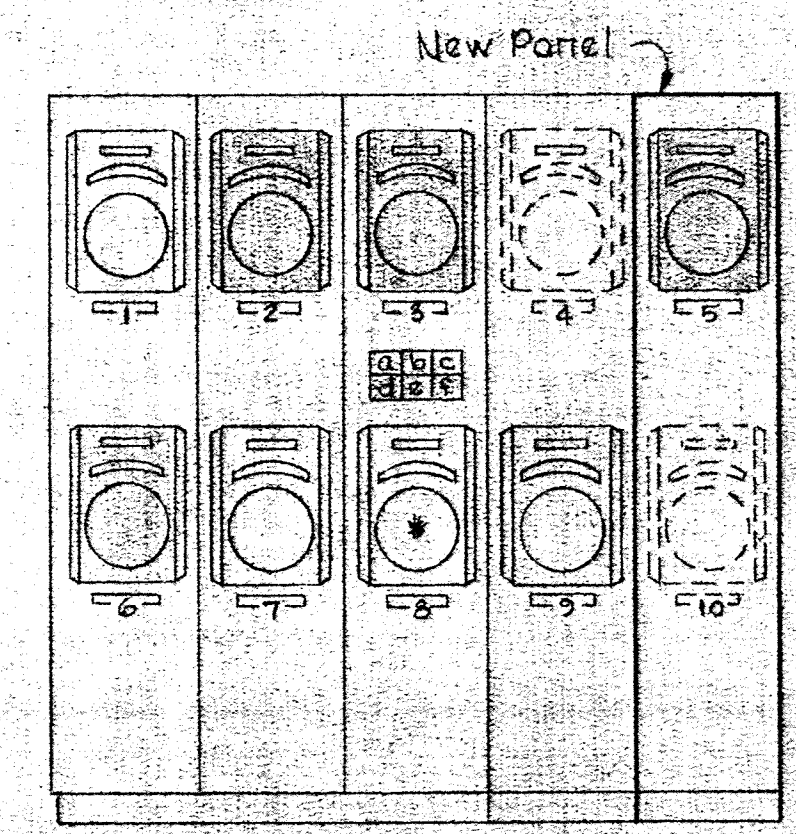

EXISTING PANELBOARD ELEVATION  
No Scale

- PANELBOARD LEGEND**
- 1 Sewage Effluent Flow - Treatment Unit C.S.#1
  - 2 Sewage Effluent Flow - Treatment Unit C.S.#2
  - 3 Sewage Effluent Flow - Treatment Unit C.S.#3
  - 526-3 4 Sewage Effluent Flow - Treatment Unit A.S.#3 (by others)
  - 5 Sewage Effluent - Total Flow
  - 6 Sewage Influent Flow - Primary No.1
  - 7 Return Sludge Flow - Treatment Unit C.S.#2
  - 8 Return Sludge Flow - Treatment Unit C.S.#3
  - 526-5 9 Return Sludge Flow - Treatment Unit A.S.#3 (by others)
  - 526-5 10 Plant Effluent - Chlorine Residual (by others)
  - a Collector Drive Trouble
  - b Blower Surge
  - c Wet Well Level & Control Air
  - d Sludge Oxidation
  - e Chlorine Leak
  - f Chlorine Weight
- \* Relocated  
 New Instrument or Alarm Panel

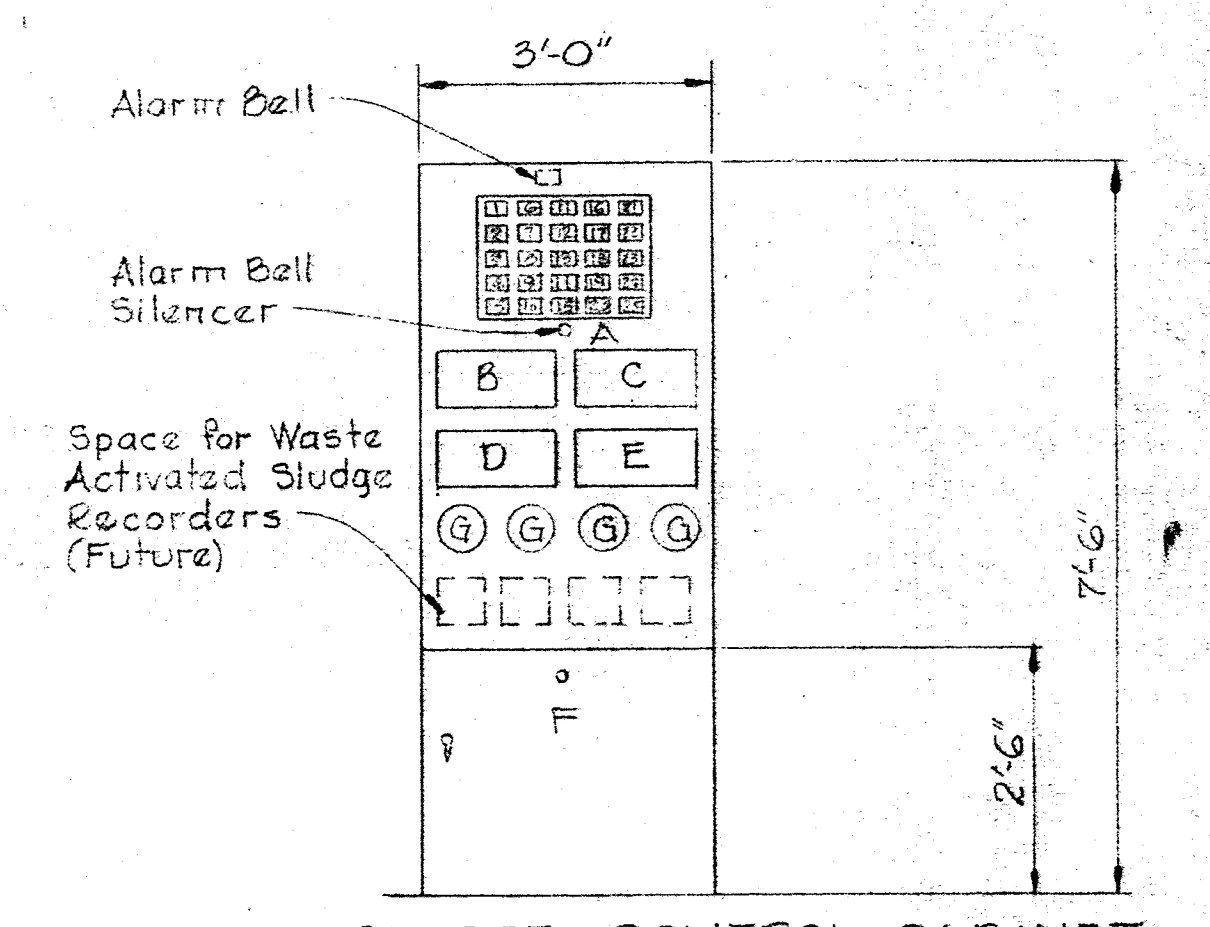

SLUDGE CONTROL CABINET  
Scale 1/2"=1'-0"

- SLUDGE CONTROL CABINET LEGEND**
- A-1 High Level Chamber #1
  - 2 Low Level Chamber #1
  - 3 High Density Chamber #1
  - 4 Low Density Chamber #1
  - 5 Secondary Clarifier Failure
  - 6 High Level Chamber #2
  - 7 Low Level Chamber #2
  - 8 High Density Chamber #2
  - 9 Low Density Chamber #2
  - 10 Spare
  - 11 High Level Chamber #3
  - 12 Low Level Chamber #3
  - 13 High Density Chamber #3
  - 14 Low Density Chamber #3
  - 15 Spare
  - 16 High Level Chamber #4
  - 17 Low Level Chamber #4
  - 18 Spare
  - 19 Sludge Pump & Macerator
  - 20 Low Air Pressure
  - 21 Oxidizer Failure
  - 22 Chlorine Low Scale Weight
  - 23 Chlorine Evaporator Low Temperature
  - 24 Chlorine Evaporator High Temperature
  - 25 Chlorine Leak
  - B Sludge Density Chamber #1 (WAS) (Recorder Console)
  - C Sludge Density Chamber #2 (Primary) (Recorder Console)
  - D Sludge Density Chamber #3 (Thickener) (Recorder Console)
  - E Oxidized Sludge Flow Recorder
  - F Bubbler Control Cabinet - 12 Pressure Switches, Purge Button and bubbler control accessories
  - G Level Gages - Sludge Chambers 1 thru 4


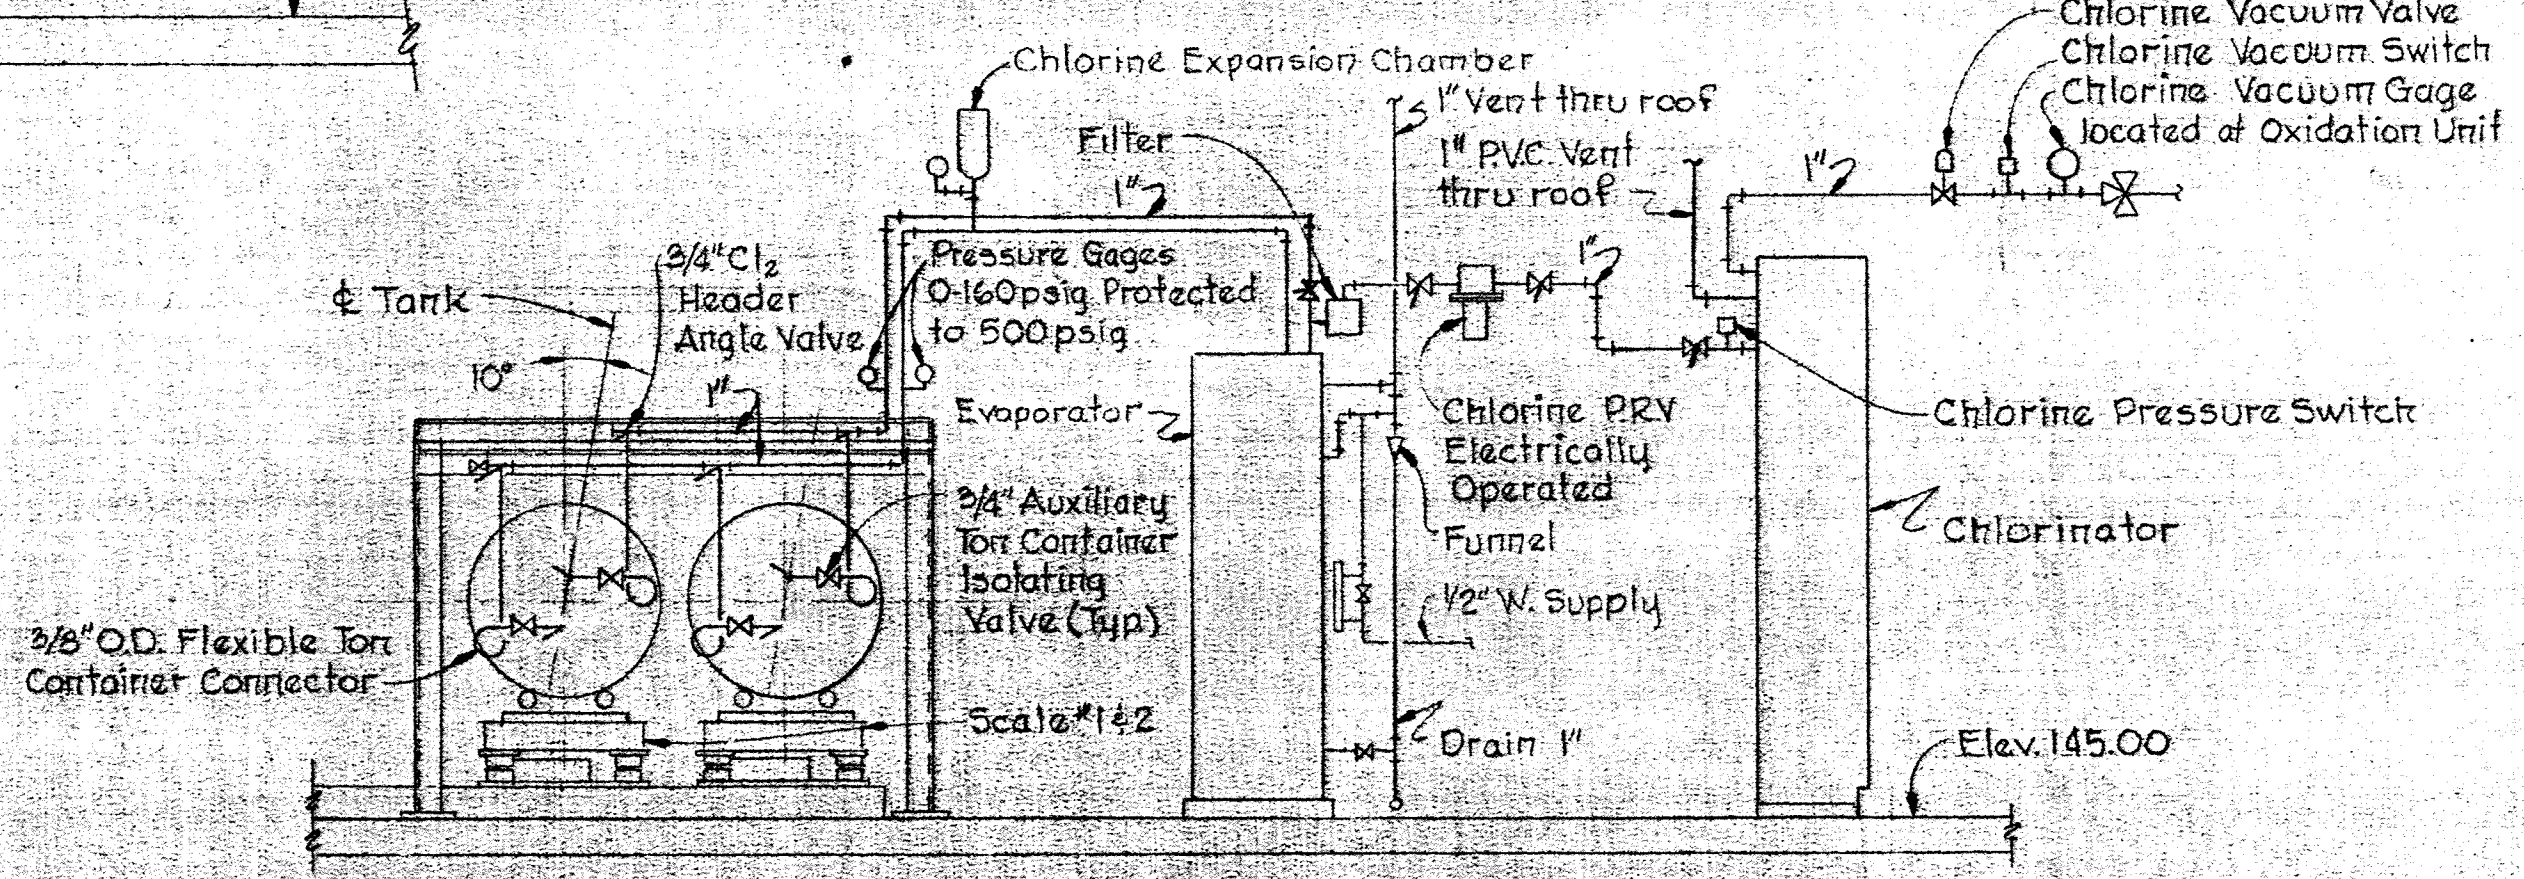


DIAGRAM - CHLORINE PIPING  
No Scale



DETAIL - CHLORINE EXPANSION CHAMBER  
Scale: 1"=1'-0"

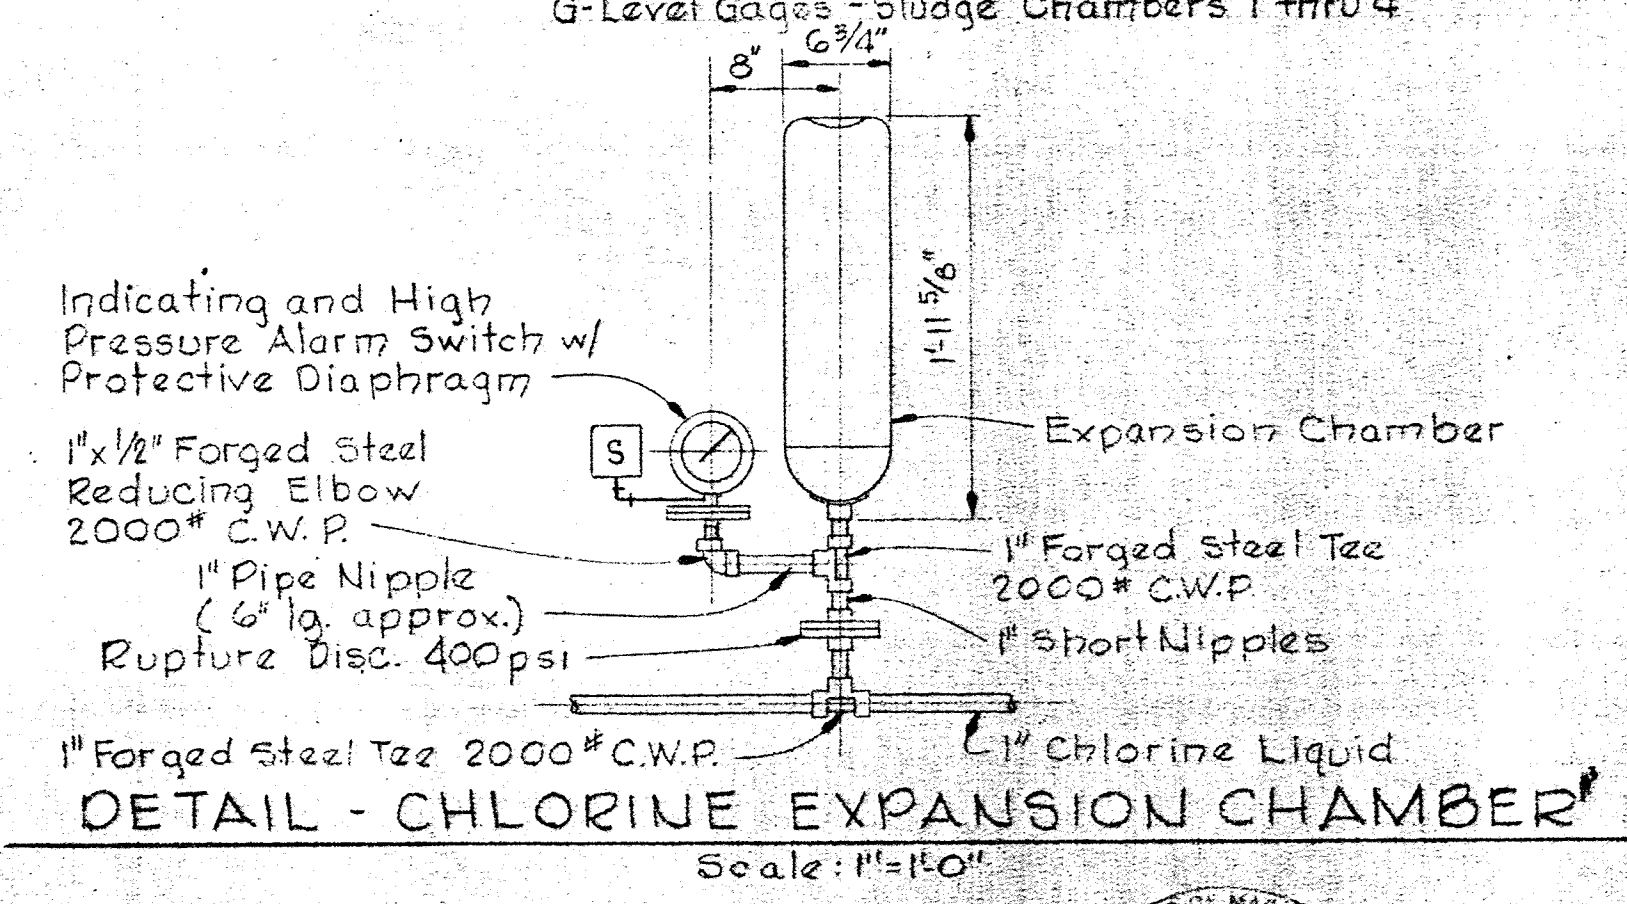


WHITMAN, REQUARDT & ASSOCIATES ENGINEERS 1304 ST. PAUL ST. BALTIMORE, MARYLAND	DEPARTMENT OF PUBLIC WORKS HOWARD COUNTY, MARYLAND W.O. Gilbert CHIEF - BUREAU OF ENGINEERING	CONTRACT NO. 525-S	MISCELLANEOUS DETAILS	SAVAGE WASTEWATER TREATMENT PLANT ADDITION NO. 3	DRAWING NO. 22 OF 28.	SCALE AS SHOWN
---	--	--------------------	-----------------------	---	--------------------------	----------------

W. 06538-2

AS BUILT  
 11/11/1977  
 SHEET M-6

NOTES

For General Electrical Notes & Electrical Legend See Sheet E-1

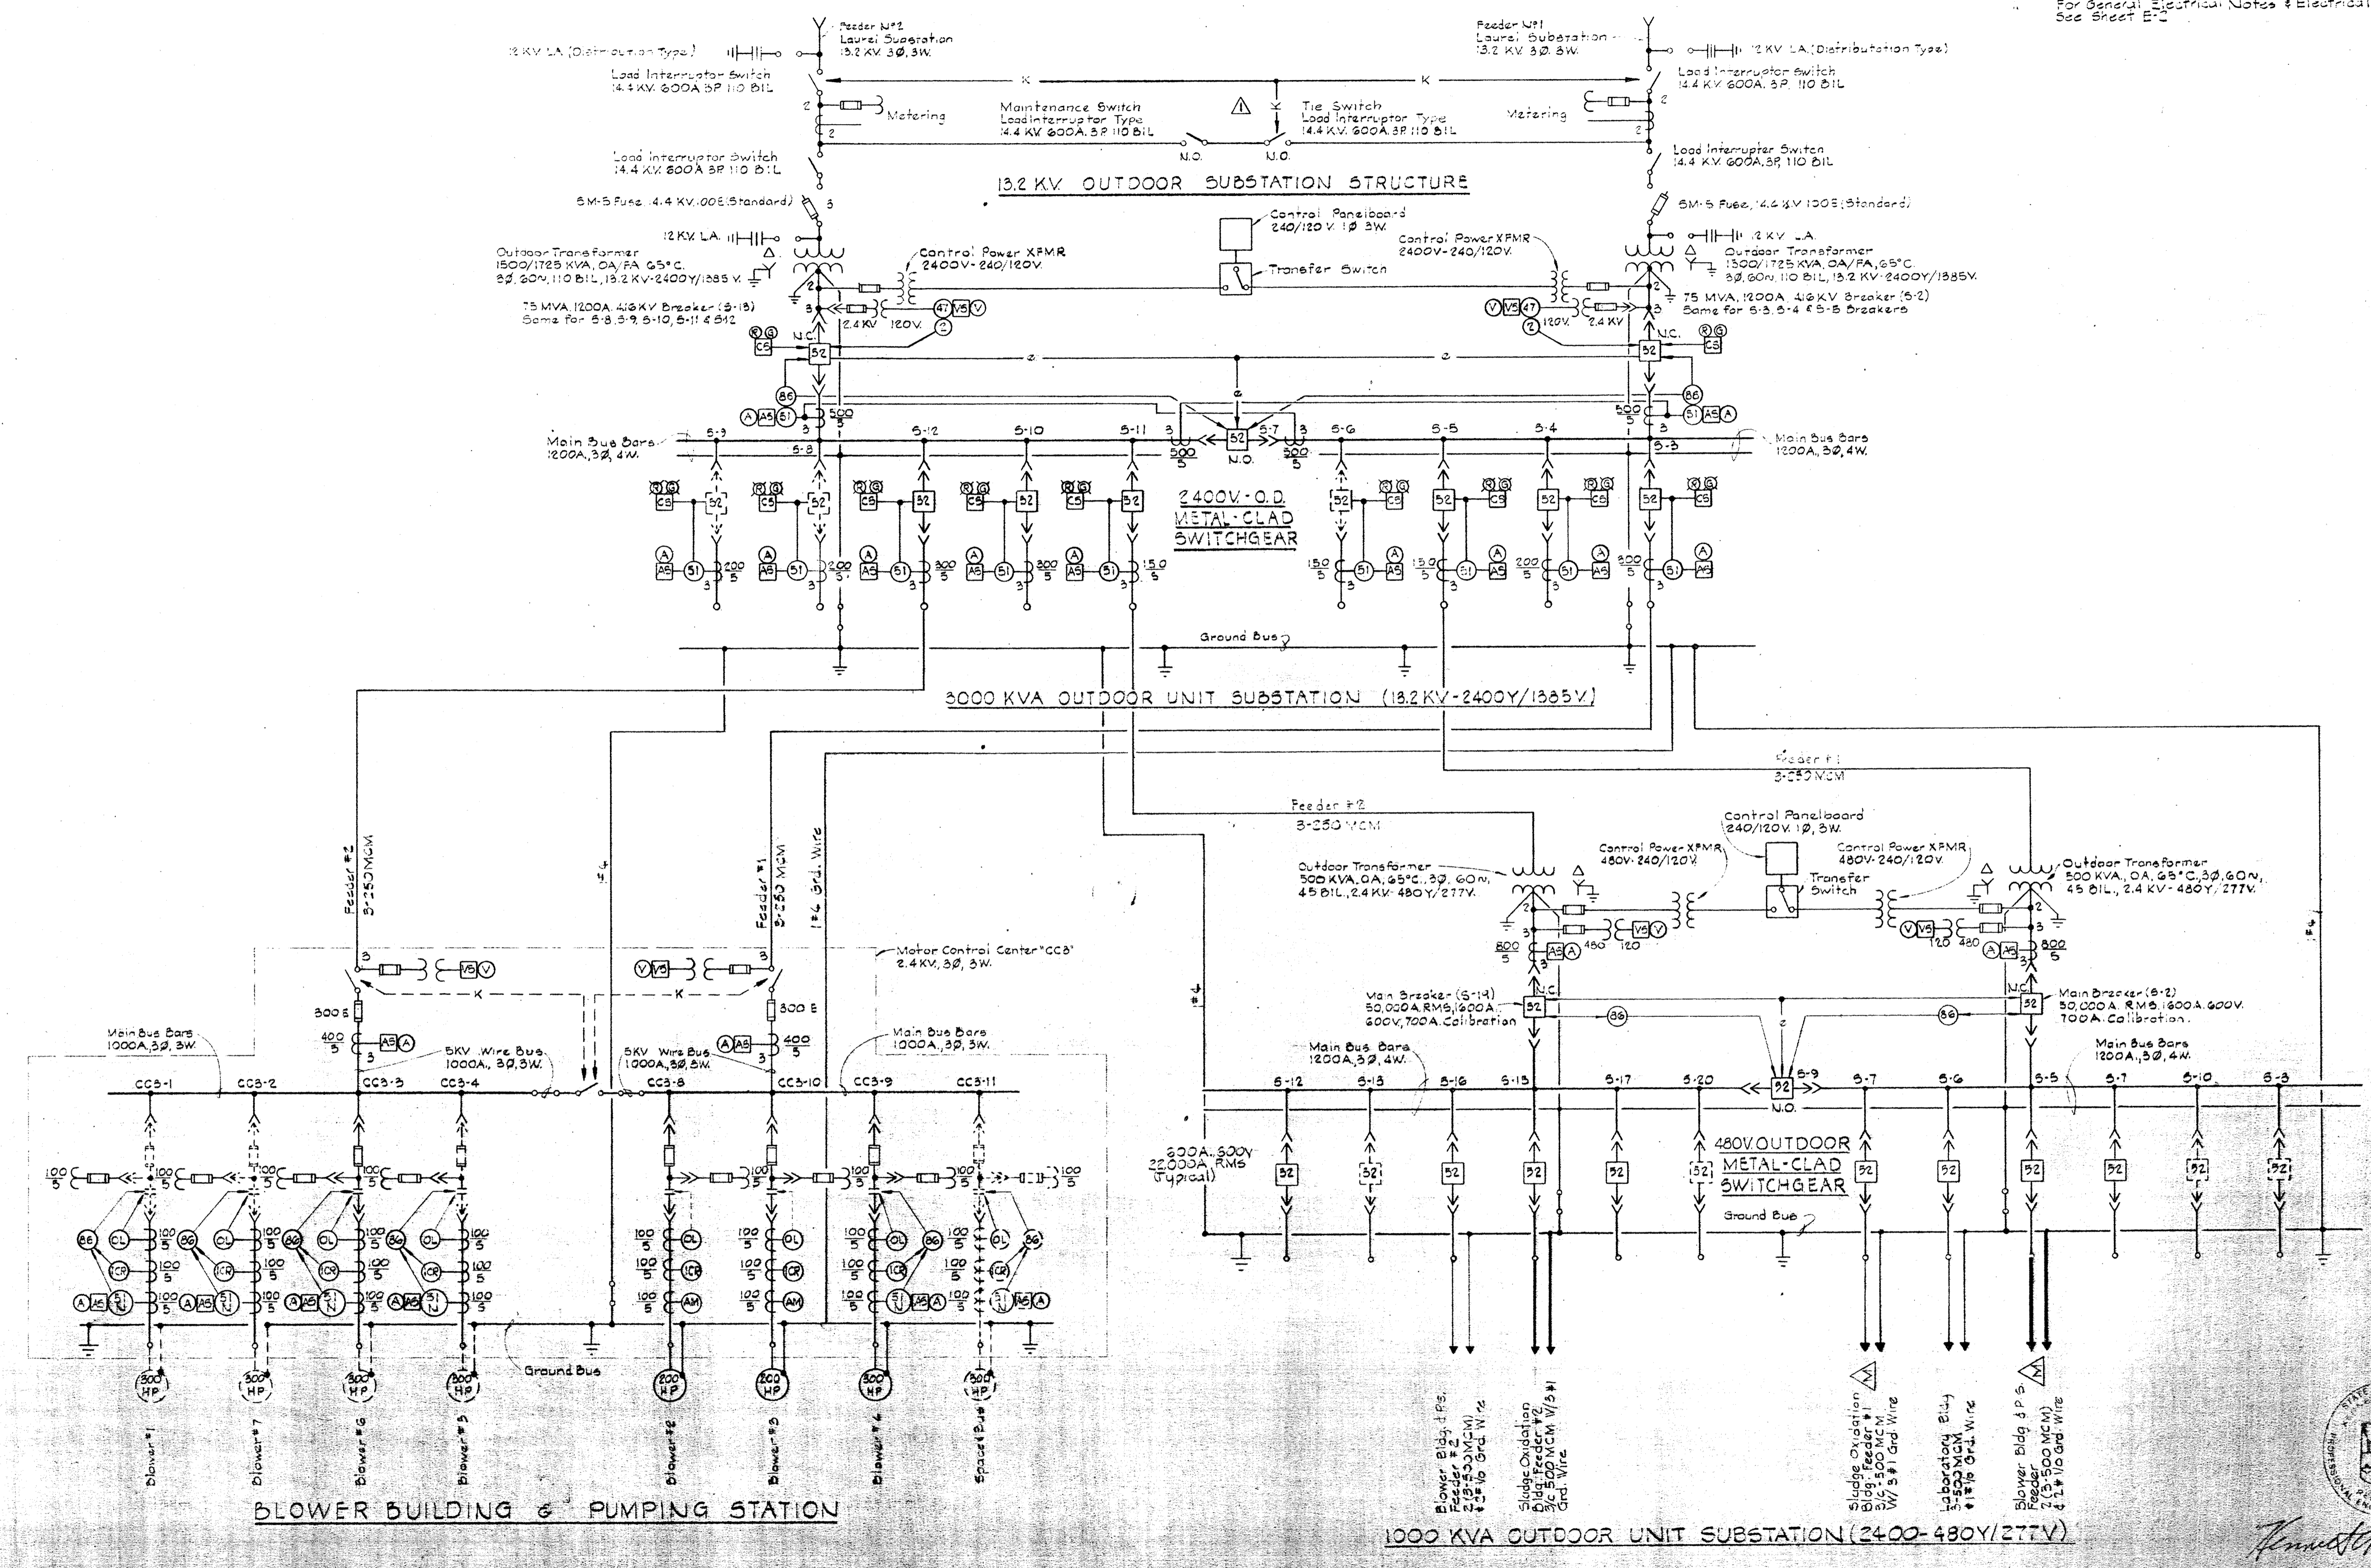

WHITMAN, REQUARDT & ASSOCIATES  
ENGINEERS  
1304 ST. PAUL ST.  
BALTIMORE, MARYLAND

DEPARTMENT OF PUBLIC WORKS  
HOWARD COUNTY, MARYLAND  
2/1/73  
DATE  
M. J. [Signature]  
CHIEF, BUREAU OF ENGINEERING

CONTRACT NO. 525-S

ONE LINE WIRING DIAGRAM

SAVAGE WASTEWATER  
TREATMENT PLANT ADDITION NO. 3

DRAWING  
NO. 23  
OF 28

SCALE  
AS  
SHOWN

W. O. 6538-2

Addendum  $\Delta$

*Handwritten signature*



DRAWING 44-510-14776

INTERIOR

- Outlet Incandescent-Ceiling-Recessed-Wall
Outlet Incandescent-Emergency-Ceiling-Wall
Outlet Clock-Single Face-Ceiling-Wall
Outlet Clock Double Face-Ceiling-Wall
Outlet Fluorescent-4 Foot
Outlet Fluorescent-4 Foot-With Kindorf Wiring Channel
Outlet Fluorescent-4 Foot-With Kindorf Support & Conduit
Outlet Fluorescent-2 Foot
Outlet Exit Light-Ceiling-Wall-With Or Without Directional Arrows
Outlet Mercury-Ceiling-Wall
Outlet Duplex Convenience
Outlet Special Purpose-Floor
Outlet 20A 250V Receptacle Polarized
Outlet 30A 250V Receptacle & Plug Polarized
Outlet Telephone Wall Desc-Extension
Outlet Intercommunication
Junction Box
Explosion proof-Weatherproof Where Indicated
Switch Single Pole Double Pole With Pilot Light
Switch Three Way Four Way
Switch Key Operated Door Operated
Switch Momentary Contact Remote Control
Contactor Number As Indicated
Thermostat Heating-Cooling-Freeze Stat
Aquastat
Unit Heater
Generator
Motor Constant Speed Variable Speed
Starter Manual Combination
Starter Magnetic (FVNR) Magnetic (FVR)
Starter Magnetic (FVNR-25 (Two Speed))
Disconnect Switch Fuses Unfused
Selector Switch Two Position
Secondary Motor Controls
Pull Box Size As Noted
Telemetering Transmitter
Lighting Panel
Power Panel
Telephone Or Signal Cabinet
Contactor Cabinet
Home Run To Panelboard Number Of Arrows Indicates Number Of Circuits Number Of Cross Lines Indicates Number Of Wires Where No Cross Lines Appear Two Conductors Are Implied
Conduit In Or On Ceiling Or Wall
Conduit In Or Under Floor
Conduit Telephone
Conduit Private Telephone
Conduit Fire Alarm
Conduit Communication
Conduit Emergency
Conduit Stub Up Stub Down
Conduit Seal
Disconnect Circuit Breaker
Outlet Incandescent Flood Light
Pushbutton Station One Two & Three Pushbutton Horn
Bell
Motor Control Center Wire & Cable Run Number
Switchgear Wire & Cable Run Number
Unit Substation Wire & Cable Run Number
Control Cable Number

UNDERGROUND

- Ductbank Number Of Ducts As Indicated
Existing Conduit Size As Indicated
Existing Direct Buried Cable Number & Size As Indicated
Direct Buried Cable Number & Size As Indicated
Conduit Size As Indicated

CIRCUIT BREAKER S.I.C. LEGEND

- 10 - 10,000 Amperes At Operating Voltage
14 - 14,000 Amperes At Operating Voltage
22 - 22,000 Amperes At Operating Voltage
30 - 30,000 Amperes At Operating Voltage
50 - 50,000 Amperes At Operating Voltage
60 - 60,000 Amperes At Operating Voltage
65 - 65,000 Amperes At Operating Voltage

LOCATION SYMBOLS FOR ELEMENTARY CONTROL DIAGRAMS

- Device located in respective Motor Control Center
Device located at respective unit
Device located at respective motor
Device located in Sludge Pump Control Cabinet
Device located outside Chlorine Room Doors
Device located at Oxidizer Unit
Device located at Sludge Operations Cont Cab
Device located in Existing Motor Control Center "CC2"

MOTOR CONTROL CENTERS & UNIT SUBSTATIONS AUXILIARY DESCRIPTION

- a - Red & Green Indicating Lights
b - Third Overload Relay
c - Running Time Meter
d - Hand Off Automatic Selector Switch
e - Start Stop Pushbutton Station
f - Key Interlock
g - 480-120V Control Transformer
h - Slow Fast Stop Pushbutton Station
j - Forward Reverse Stop Pushbutton Station
k - Open Close Control Switch
m - Hand Automatic Selector Switch
n - Summer Winter Selector Switch

ONE LINE/ELEMENTARY

- Molded Case Circuit Breaker
Oil Circuit Breaker
Selector Switch
Disconnecting Switch
Interrupter Switch
Selector Interrupter Switch
Knife Switch
Contacts-Normally Open
Contacts-Normally Closed
Current Transformer
Potential Transformer
Power Transformer
Ground
Resistor
Fuse
Pothead
Pushbutton
Pressure Switch
Float Switch
Flow Switch
Limit Switch
Thermostat
Disconnect Link
Lightning Arrestor
Incoming Line
Outgoing Line
Tie Line
Capacitor
Rectifier
Mechanical Interlock
Electrical Interlock
Key Interlock
Overcurrent Trip Thermal Type
Relay-Instantaneous Overcurrent
Relay Time Overcurrent
A.C. Power Circuit Breaker
Motor (Three Phase) Constant Speed Variable Speed
Starter Magnetic (FVNR) Magnetic (FVR)
Starter Magnetic (FVNR-25 (Two Speed))
Running Time Meter
Indicating Light Color As Indicated By Letter
Solenoid Motor (Single Phase)
Contactor Coil Starter Coil Number As Indicated
Ammeter-Ammeter Switch
Voltmeter-Voltmeter Switch
Wattmeter-Kilowatt Meter
Test Block-Test Switch
Recording-Recording Demand Meter
Relay-Number As Indicated
Instrument Switch-Control Switch
Ground Lamps
Power Factor Meter
Timer-Number As Indicated
Watt-Hour Meter-Watthour Meter
Phase Sequence Voltage Relay
Tripping Relay Lockout Type-Differential Relay
Automatic Transfer Switch
Electric Radiant Heaters
Contactor
Relay-Time Overcurrent w/instantaneous Trip
Ground Overcurrent Relay
Tripping Relay

- Demand Meter
Frequency Meter
Phase Meter
Position Indicator
Ground Sensing Relay
A.C. Power Circuit Breaker With Solid State Trip & Ground Device
Receptacle & Plug-Polarized
Horsepower Meter
Permissive Control Switch
Reverse-Phase, Or Phase-Balance Current Relay
Time Delay Relay
Voltage Unbalance Relay
Liquid or Gas Pressure Relay

GENERAL ELECTRICAL NOTES

- For PANELBOARD SCHEDULES, see Specifications, DETAILED ELECTRICAL REQUIREMENTS.
For explanation of Lighting Fixture Types shown on drawings see Specifications, DETAILED ELECTRICAL REQUIREMENTS.
Mounting heights for interior lighting fixtures shall be from finished floor to bottom of fixture, unless otherwise noted.
Mounting heights for lighting fixtures mounted on exterior walls of buildings shall be from finished floor to center line of recessed junction box, unless otherwise noted.
Verify all door swings before installing switch boxes.
Receptacles shall be mounted 2'-0" above finished floor, unless otherwise noted.
All Elementary Control Diagrams are shown in the de-energized position.
For Electrical Work on Primary Clarifier see Drawings S-4 & E-6.
For Control Cable Schedule see Drawing E-4.

EXTERIOR

- Mercury Area Light
Incandescent Area Light
Existing Pole
Pole Length & Class As Indicated
Pole With Down Guy & Anchor Length, Class & Lead As Indicated
Pole With Street Light Length & Class As Indicated
Primary Distribution Line KV-Number & size Of Wires As Indicated
Secondary Distribution Line-3P-Number & size Of Wires As Indicated
Service Drop-Number & Size Of Wires As Indicated
Weatherhead & Rack



Handwritten signature of the engineer.

WHITMAN, REQUARDT & ASSOCIATES ENGINEERS 1304 ST. PAUL ST. BALTIMORE, MARYLAND

DEPARTMENT OF PUBLIC WORKS HOWARD COUNTY, MARYLAND DATE: 1/11/73 CHIEF, BUREAU OF ENGINEERING

CONTRACT NO. 525-S

GENERAL ELECTRICAL NOTES AND ELECTRICAL LEGEND

SAVAGE WASTEWATER TREATMENT PLANT ADDITION NO. 3



DRAWING NO. 24 OF 28

SCALE AS SHOWN




**NOTES**


- For General Electrical Notes and Legends, see sheet E-2
- Switches are 3 Pole - 60A - 600V Non Fusable - Westinghouse Cat. # XU-362 w/ following nameplate: **WARNING DO NOT OPEN SWITCH WHEN PUMPING UNIT IS RUNNING.**
- Cable Reel & Hoist/Trolley Unit shall be connected up as oriented to help limit twisting stress on service cable to reel.

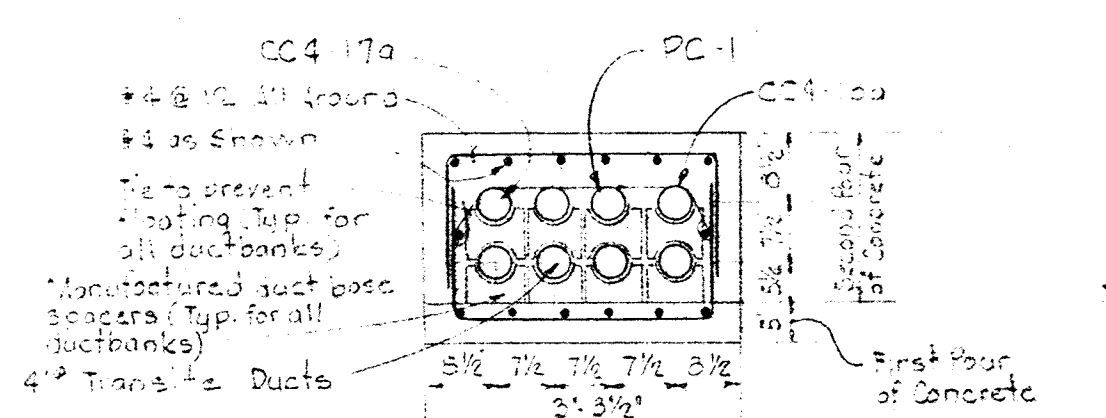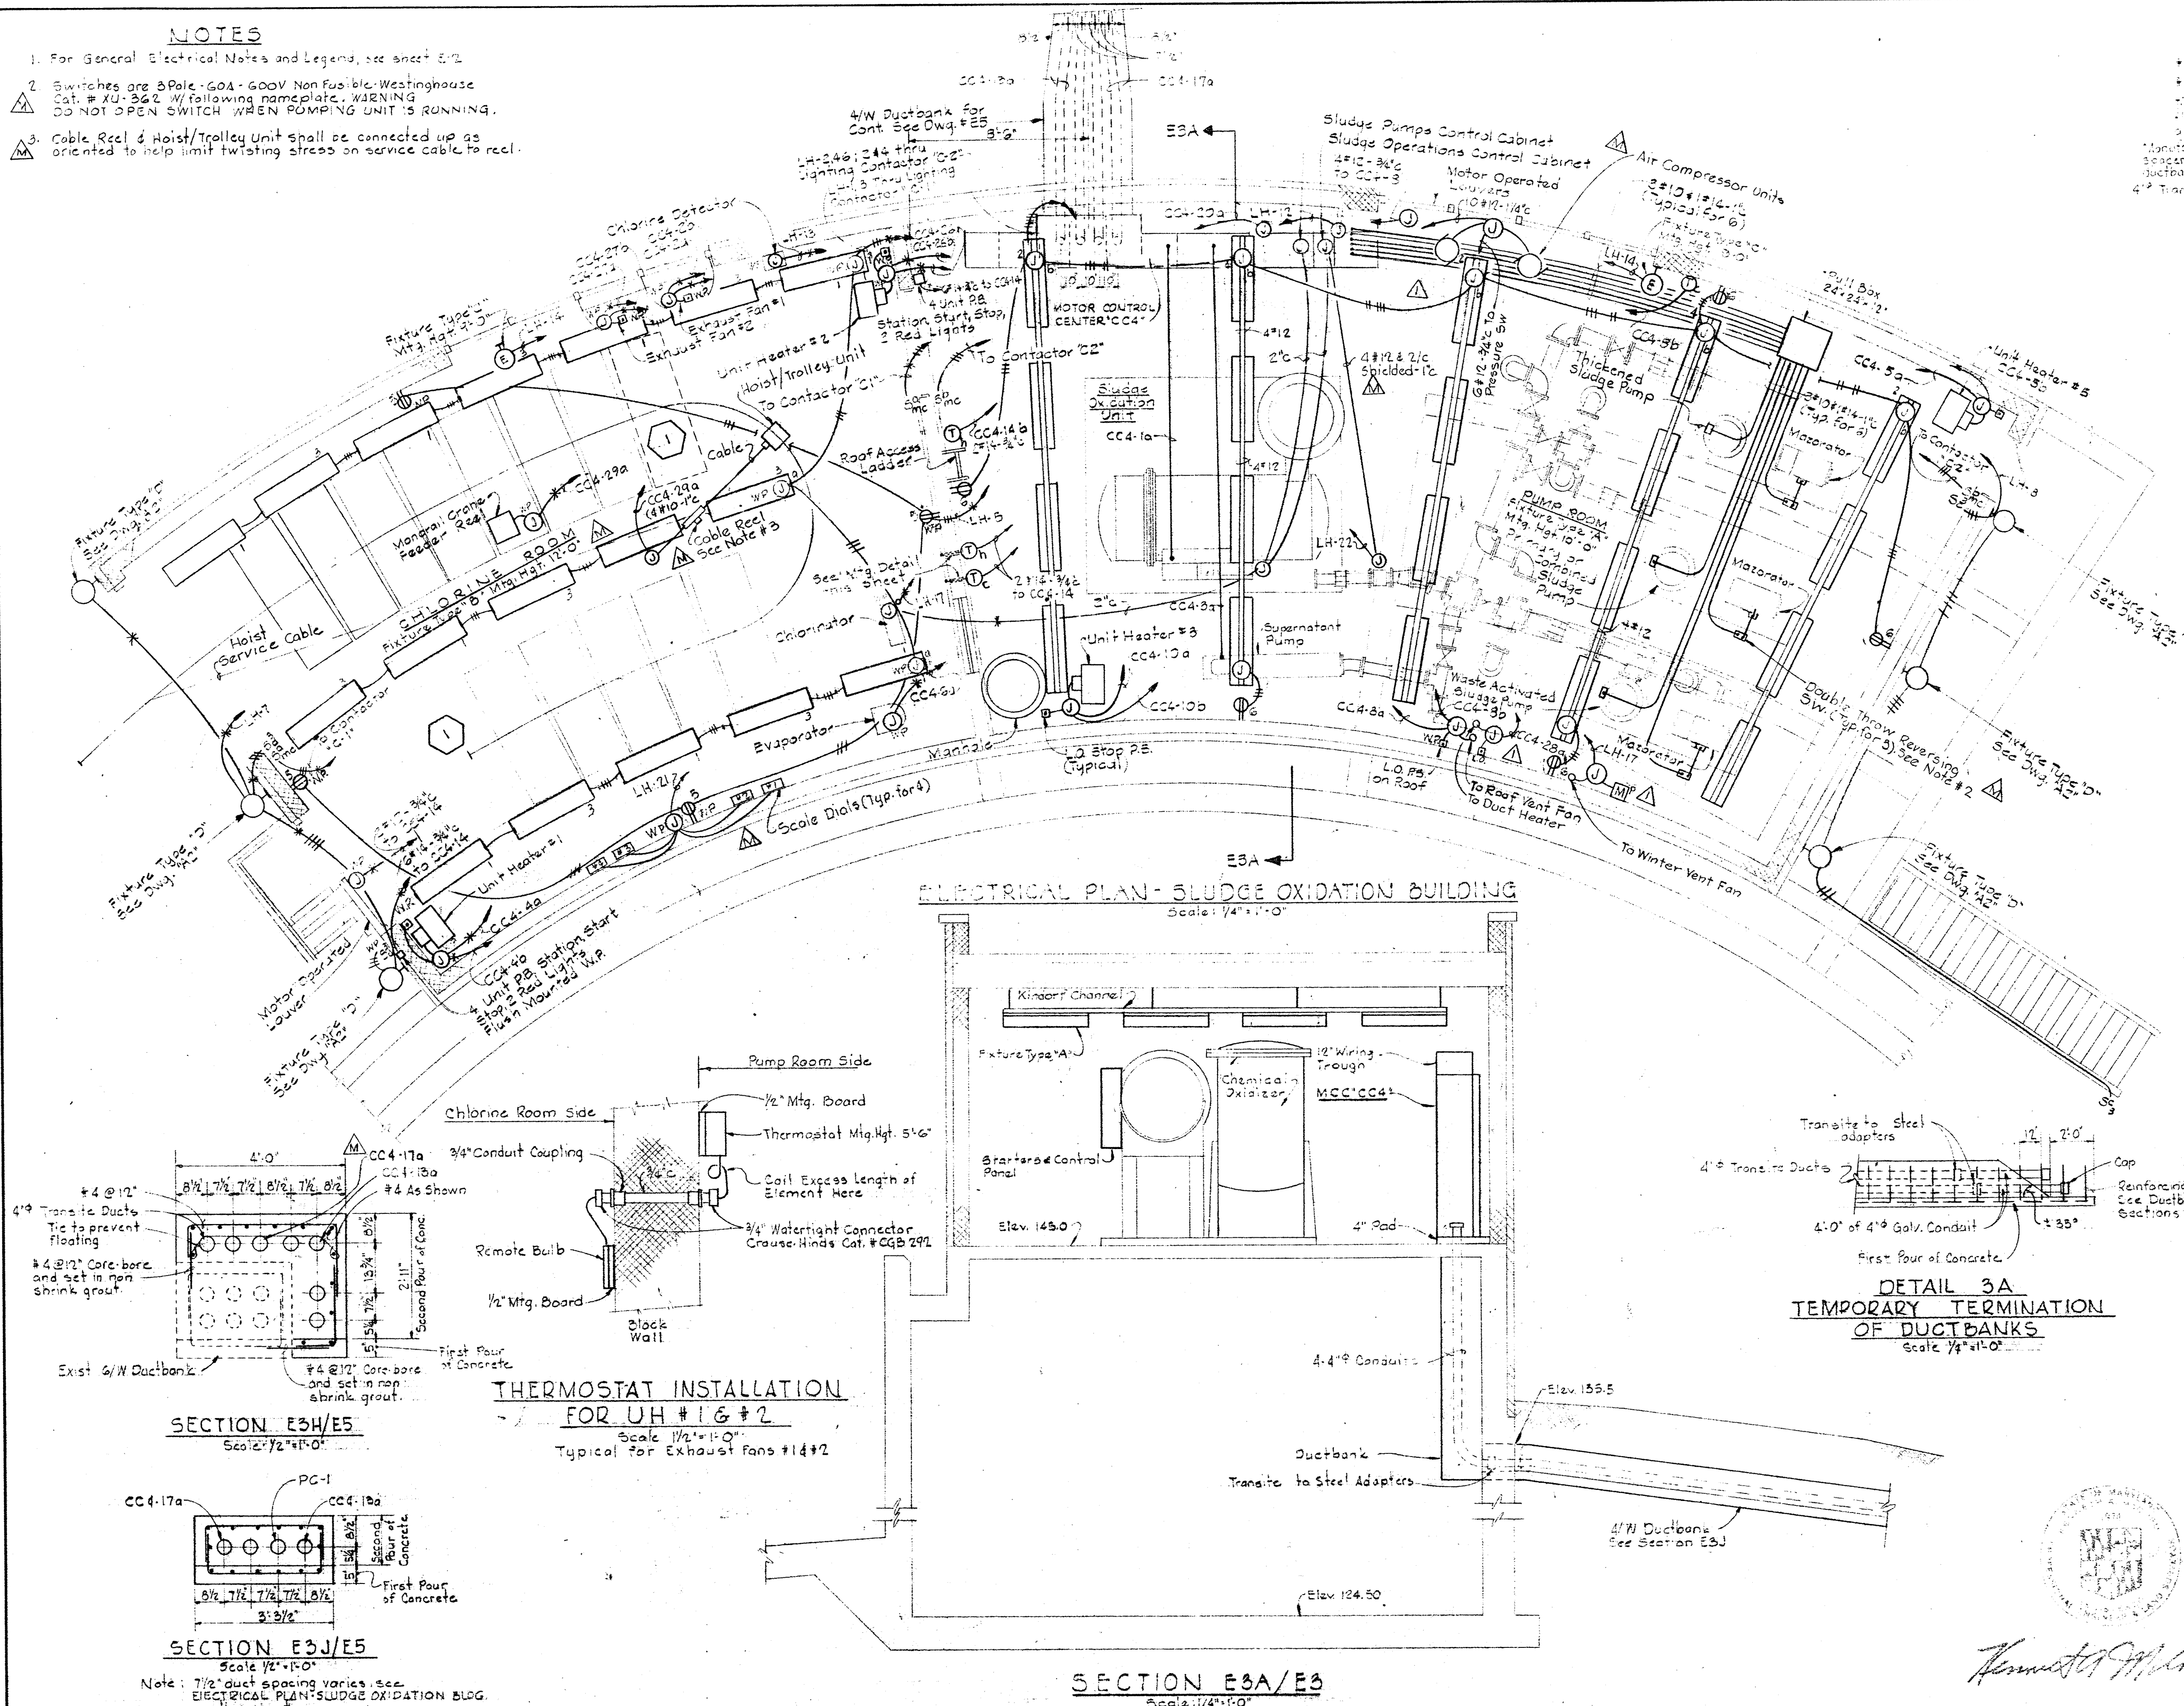


**SECTION E3B/E5**  
Scale: 1/2" = 1'-0"  
Typical for all ductbank sections

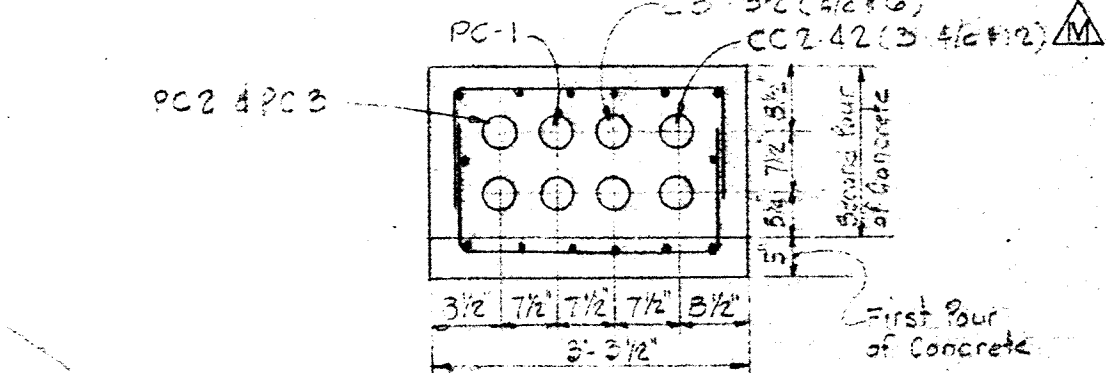


**SECTION E3C/E5**  
Scale: 1/2" = 1'-0"

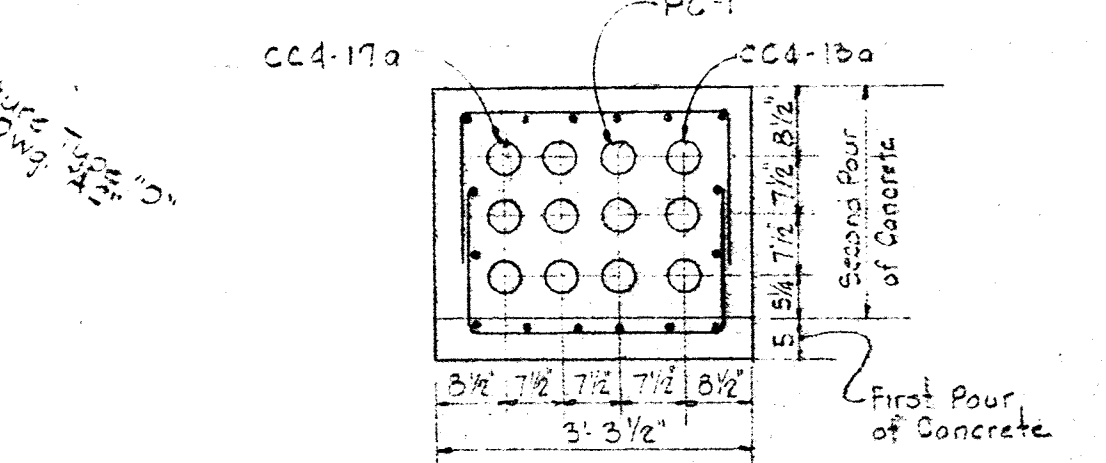


**SECTION E3D/E5**  
Scale: 1/2" = 1'-0"

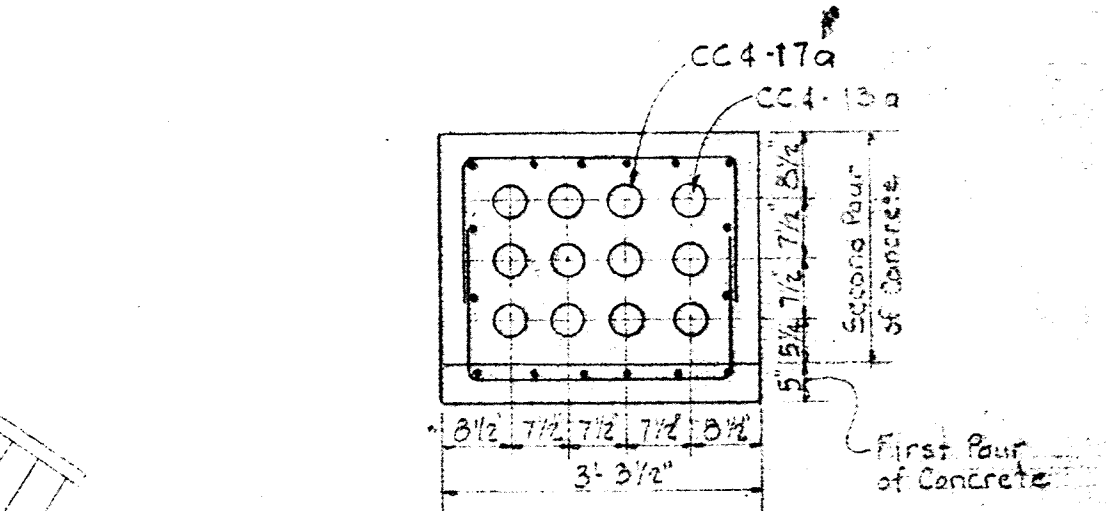


**SECTION E3E/E5**  
Scale: 1/2" = 1'-0"

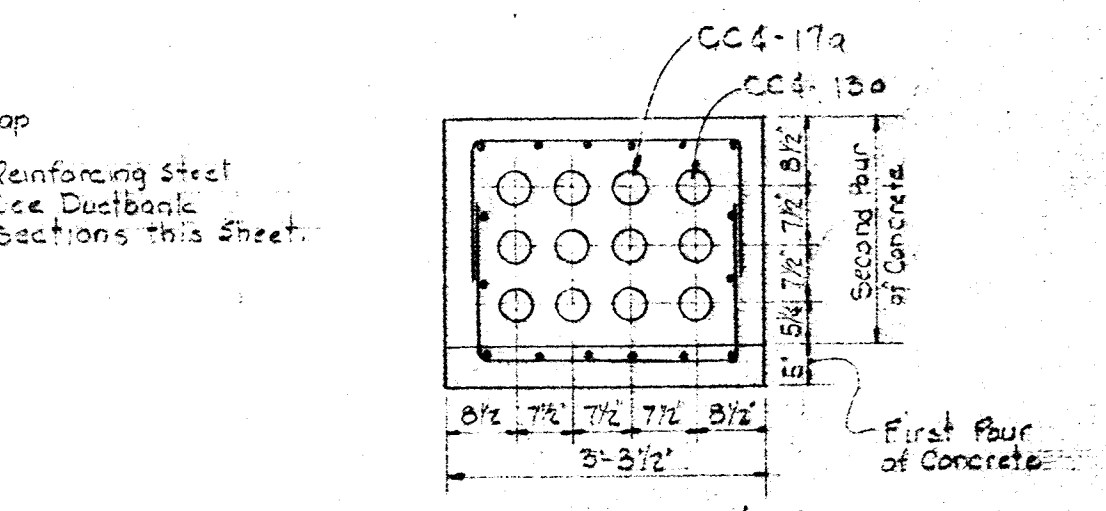


**SECTION E3F/E5**  
Scale: 1/2" = 1'-0"

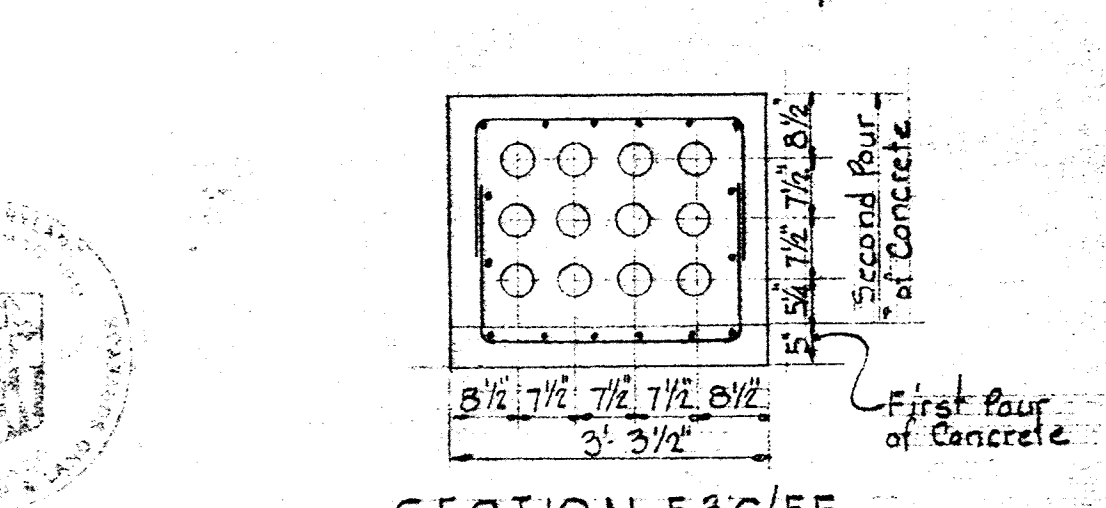


**SECTION E3G/E5**  
Scale: 1/2" = 1'-0"

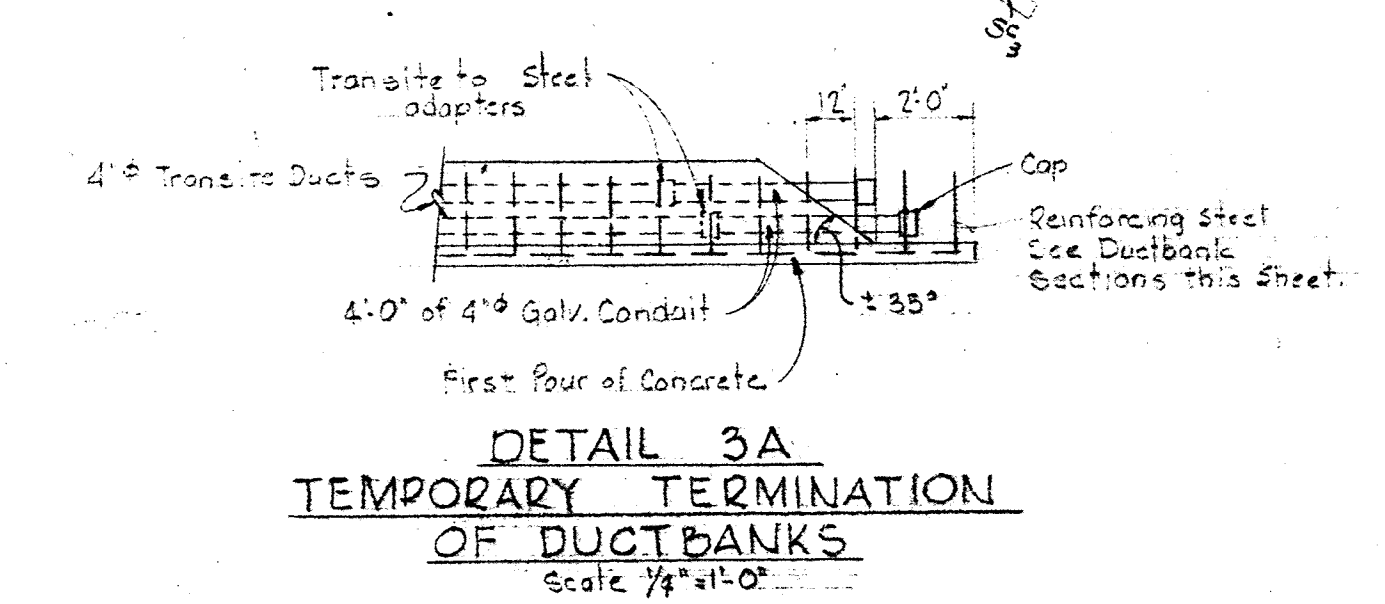


**DETAIL 3A**  
**TEMPORARY TERMINATION OF DUCTBANKS**  
Scale: 1/2" = 1'-0"

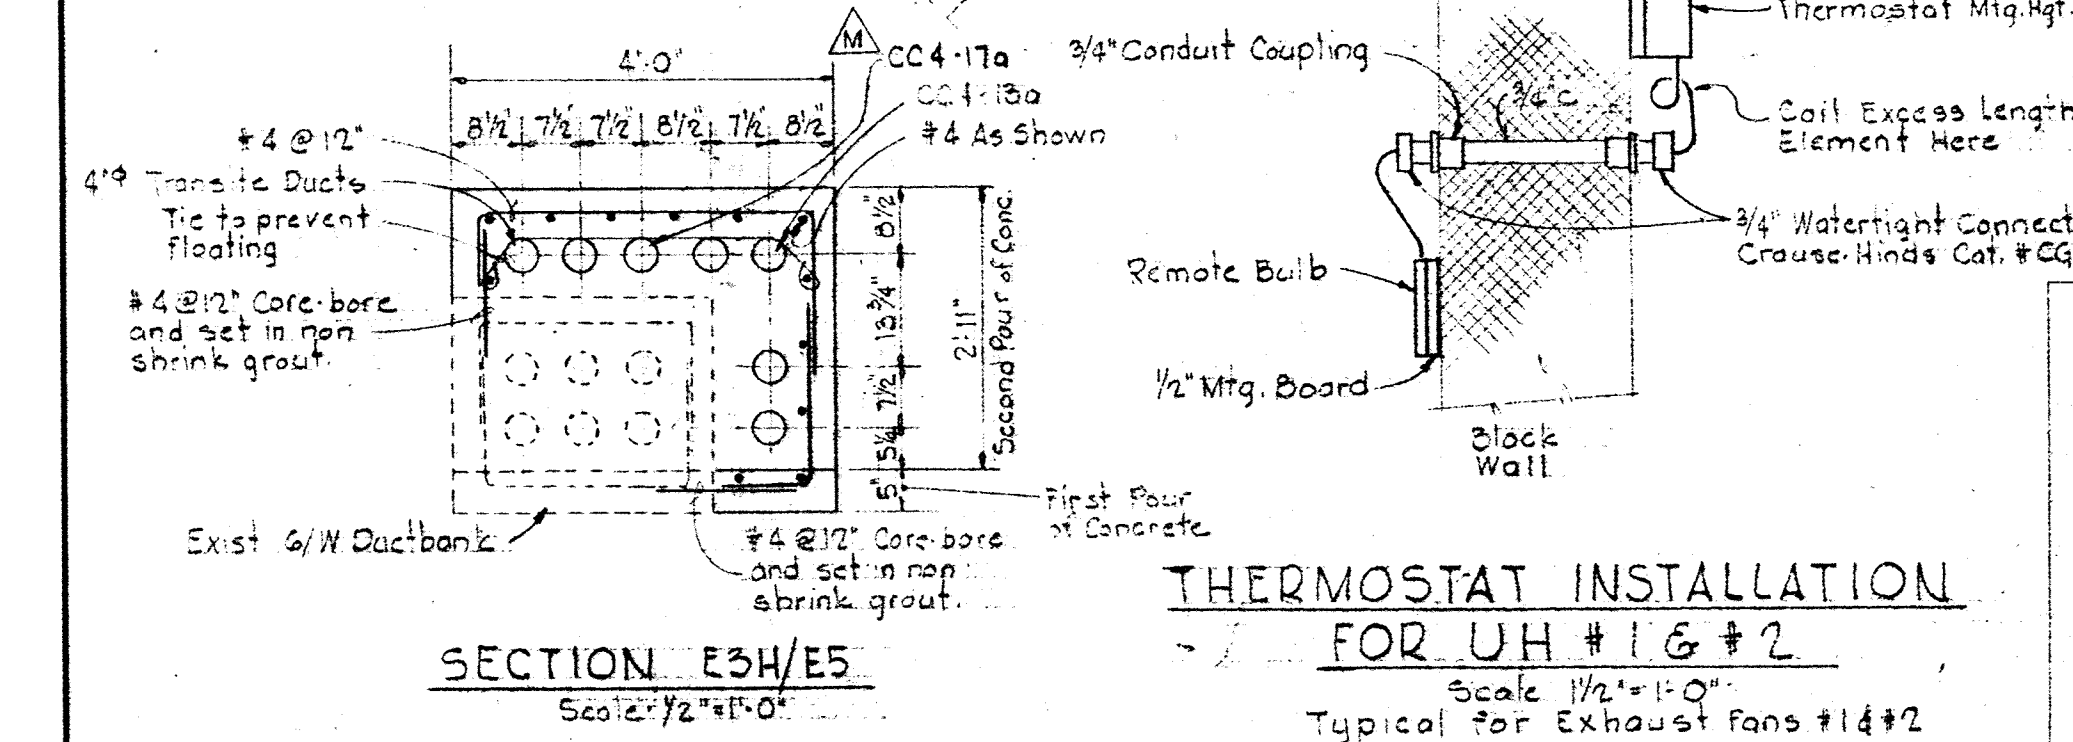

**THERMOSTAT INSTALLATION FOR UH #1 & #2**  
Scale: 1/2" = 1'-0"  
Typical for Exhaust fans #1 & #2

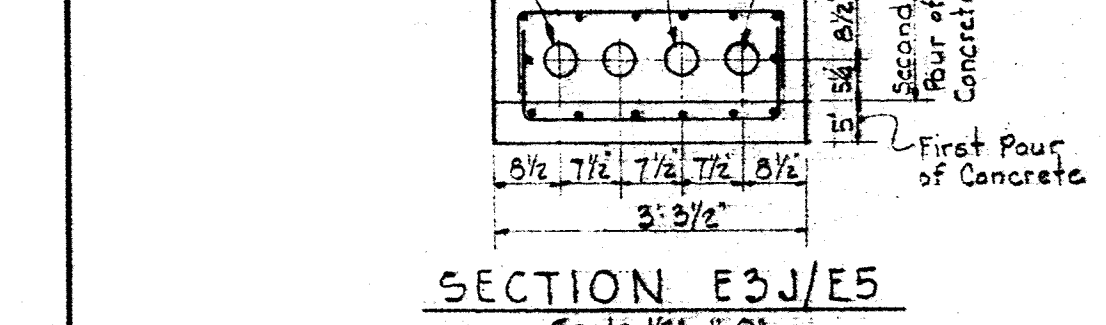

**SECTION E3H/E5**  
Scale: 1/2" = 1'-0"

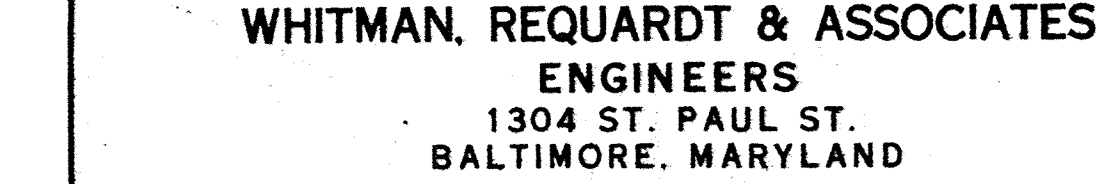

**SECTION E3J/E5**  
Scale: 1/2" = 1'-0"

Note: 1/2" duct spacing varies see ELECTRICAL PLAN - SLUDGE OXIDATION BLDG on this sheet.

WHITMAN, REQUARDT & ASSOCIATES ENGINEERS 1304 ST. PAUL ST. BALTIMORE, MARYLAND	DEPARTMENT OF PUBLIC WORKS HOWARD COUNTY, MARYLAND DATE: 2/1/73 W.O. 6538-2 CHIEF - BUREAU OF ENGINEERING	CONTRACT NO. 525-S	SLUDGE OXIDATION BUILDING	SAVAGE WASTEWATER TREATMENT PLANT ADDITION NO. 3	DRAWING NO. 25 OF 28	SCALE AS SHOWN
					SHEET E-3	


W. O. 6538-2 1 Change Order No. 4 2-19-74

*Handwritten signature and stamp*


Wire Trough

CC4-1	CC4-6	CC4-12	CC4-14	CC4-16	CC4-18	CC4-26
	CC4-7				CC4-19	CC4-27
CC4-2	CC4-8				CC4-20	CC4-28
CC4-3	CC4-9	CC4-13	CC4-15	CC4-17		CC4-29
	CC4-10				CC4-22	CC4-30
CC4-4					CC4-23	CC4-31
CC4-5	CC4-11	CC4-21	CC4-21	CC4-21	CC4-23	

MOTOR CONTROL CENTER "CC4"  
Scale: 1/2" = 1'-0"

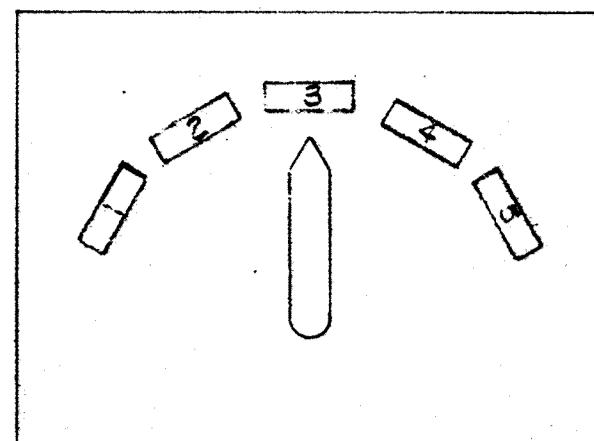

OXIDATION UNIT FEED PUMP & MAZORATOR SELECTOR SWITCH "S1"  
Note: Additional Contacts shall be provided as required by the Equipment Manufacturer

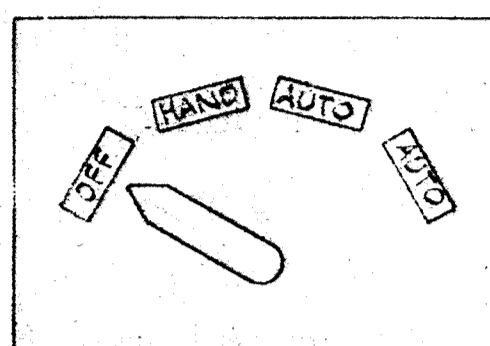

THICKENED SLUDGE PUMP & MAZORATOR SELECTOR SWITCH "S2"

Contacts	Positions	1	2	3	4	5
-1-1	1	X				
-1-2	2	X	X			
-1-3	3	X	X	X		
-1-4	4	X	X	X	X	
-1-5	5	X	X	X	X	X
-1-6						X
-1-7						X

Position	Nameplate
1	Thickened Sludge Pump & Mazorator - Primary or Combined Sludge Pump & Mazorator
2	Thickened Sludge Pump & Mazorator
3	Primary or Combined Sludge Pump & Mazorator
4	Waste Activated Sludge Pump & Mazorator
5	Primary or Combined Sludge Pump & Mazorator - Waste Activated Sludge Pump & Mazorator

Switch "S2" typical for:  
"S3" - Primary or Combined Sludge Pump & Mazorator  
"S4" - Waste Activated Sludge Pump & Mazorator


NOTES

For General Electrical Notes and Legend, see sheet E-2


Cable No.	FROM	TO	FOR	WIRE		CONDUIT RACEWAY
				NO.	SIZE TYPE	
PC-1	Sludge Operations Control Cabinet	Ex. Panelboard Lab. Bldg.	Alarms: Sludge Oxidation Unit Chlorine Gas Leak Chlorine Weight	10/c	1/2	See Drawings
PC-2	Valve Vault	Ex. Panelboard Lab. Bldg.	Primary Clarifier #1 Influent Flow Signal	2/c	Shield	See Drawings
PC-3	Valve Vault	Ex. Panelboard Lab. Bldg.	Control of Magnetic Flow Meter	4/c	1/2	See Drawings

MOTOR CONTROL CENTER SCHEDULE "CC4" - 480V - 3Ø - 3W - 60 Hz

UNIT NUMBER	NAMEPLATE DATA	DEVICE DESCRIPTION	HP or KVA	AUX. DESS.	BREAKER			RUN NUMBER	WIRE - POWER			WIRE - CONTROL			GRD. WIRE SIZE	CONDUIT SIZE	REMARKS
					FRAME	POLE	CALIB.		NO.	SIZE	TYPE	NO.	SIZE	TYPE			
CC4-1	Sludge Oxidizer Unit	Circuit Breaker	-	-	225	3	175	22	CC4-1a	3	#1/0	THW	-	-	#6	2"	
CC4-2	Exhaust Fan #1 Chlorine Room	Combination Starter Size 1, FVNR	1	a, b, c m.g.	100	3	15	14	CC4-2a CC4-2b	3	#12	THW	2	14	THW	#14	3/4"
CC4-3	Supernatant Pump	Combination Starter Size 1, FVNR	3	a, c, d, g	100	3	15	14	CC4-3a	3	#12	THW			THW	#14	1"
CC4-4	Unit Heater #1	Combination Contactor Size 1, FVNR	6	a, c, d, g	100	3	15	14	CC4-4a CC4-4b	3	#12	THW	4	14	THW	#14	3/4"
CC4-5	Unit Heater #5	Combination Contactor Size 1, FVNR	6	a, c, d, g	100	3	15	14	CC4-5a CC4-5b	3	#12	THW	4	14	THW	#14	3/4"
CC4-6	Evaporator	Combination Contactor Size 2, FVNR	15	a, c, d, g	100	3	30	14	CC4-6a	3	#10	THW			THW	#10	1"
CC4-7	Blank (Spare)	Combination Starter Size 2, FVNR	-	a, b, c, d, g	100	3	50	14									
CC4-8	Roof Vent Fan Pump Room	Combination Starter Size 1, FVNR	3	a, b, c, d, g	100	3	15	14	CC4-8a CC4-8b	3	#12	THW	2	14	THW	#14	3/4"
CC4-9a	Blank (Spare)	Circuit Breaker	-	-	100	3	20	14									
CC4-9b	15 KVA Transformer	Circuit Breaker	-	-	100	3	30	14									
CC4-10	Unit Heater #3	Combination Contactor Size 1, FVNR	7.5	a, c, d, g	100	3	15	14	CC4-10a CC4-10b	3	#12	THW	4	14	THW	#14	3/4"
CC4-11	Blank (Spare)	Combination Starter Size 1, FVNR	-	a, b, c, d, g	100	3	15	14									
CC4-12	Standard Nameplates	Ammeter, Voltmeter, SW, C.T.'s	-	See Specs	-	-	-	-									
CC4-13	Main Breaker Feeder #1	Power Circuit Breaker Drawout Type	-	See Specs	600	3	400	30	CC4-13a	3/4	500 MCM	RHW			W/ 3"	4"	
CC4-14	-	Control Relays	-	n	-	-	-	-									
CC4-15	Tie Breaker	Power Circuit Breaker Drawout Type	-	See Specs	600	3	400	30									
CC4-16	Standard Nameplates	Ammeter, Voltmeter, SW, C.T.'s	-	See Specs	-	-	-	-									
CC4-17	Main Breaker Feeder #2	Power Circuit Breaker Drawout Type	-	See Specs	600	3	400	30	CC4-17a	3/4	500 MCM	RHW			W/ 3"	4"	
CC4-18	Lighting Contactor "C1" Chlorine Room	Contactor, 1-2P, 30A	-	See Specs	-	-	-	-									
CC4-19	Lighting Contactor "C2" Pump Room	Contactor, 1-2P, 30A	-	See Specs	-	-	-	-									
CC4-20	Sludge Pumps Unit	Circuit Breaker	-	-	225	3	150	22	CC4-20a	3	2/0	THW			#4	3"	
CC4-21	-	Space for Incoming & Outgoing Cables	-	-	-	-	-	-									
CC4-22	Blank (Spare)	Combination Starter Size 2, FVNR	-	a, b, c, d, g	100	3	40	14									
CC4-23	Blank (Spare)	Combination Starter Size 1, FVNR	-	a, b, c, d, g	100	3	15	14									
CC4-24	Panelboard "LH" 20ØY/120 - 3Ø - 4W	Circuit Breaker Panelboard, See Specs	-	See Specs	-	-	-	-									
CC4-25	15 KVA Transformer 480V-20ØY/120, 3Ø, 4W	Transformer, 15 KVA, 480V-20ØY/120, 3Ø, 4W	15	See Specs	-	-	-	-									
CC4-26	Unit Heater #2	Combination Contactor Size 1, FVNR	7.5	a, c, d, g	100	3	15	14	CC4-26a CC4-26b	3	#12	THW	4	14	THW	#14	3/4"
CC4-27	Exhaust Fan #2 Chlorine Room	Combination Starter Size 1, FVNR	1	a, b, c, m, g	100	3	15	14	CC4-27a CC4-27b	3	#12	THW	2	14	THW	#14	3/4"
CC4-28	Duct Heater	Combination Contactor Size 2, FVNR	20	a, c, d, g	100	3	40	14	CC4-28a	3	#8	THW	6	14	THW	#10	1 1/2"
CC4-29a	Monorail Crane	Circuit Breaker	-	-	100	3	20	14	CC4-29a	3	#10	RHW			#12	1"	
CC4-29b	Blank (Spare)	Circuit Breaker	-	-	100	3	20	14									
CC4-30a	Blank (Spare)	Circuit Breaker	-	-	100	3	20	14									
CC4-30b	15 KVA Transformer	Circuit Breaker	-	-	100	3	30	14									
CC4-31	Transfer Switch	Automatic Transfer Switch AECO Bulletin 943	-	See Specs	-	-	-	-									

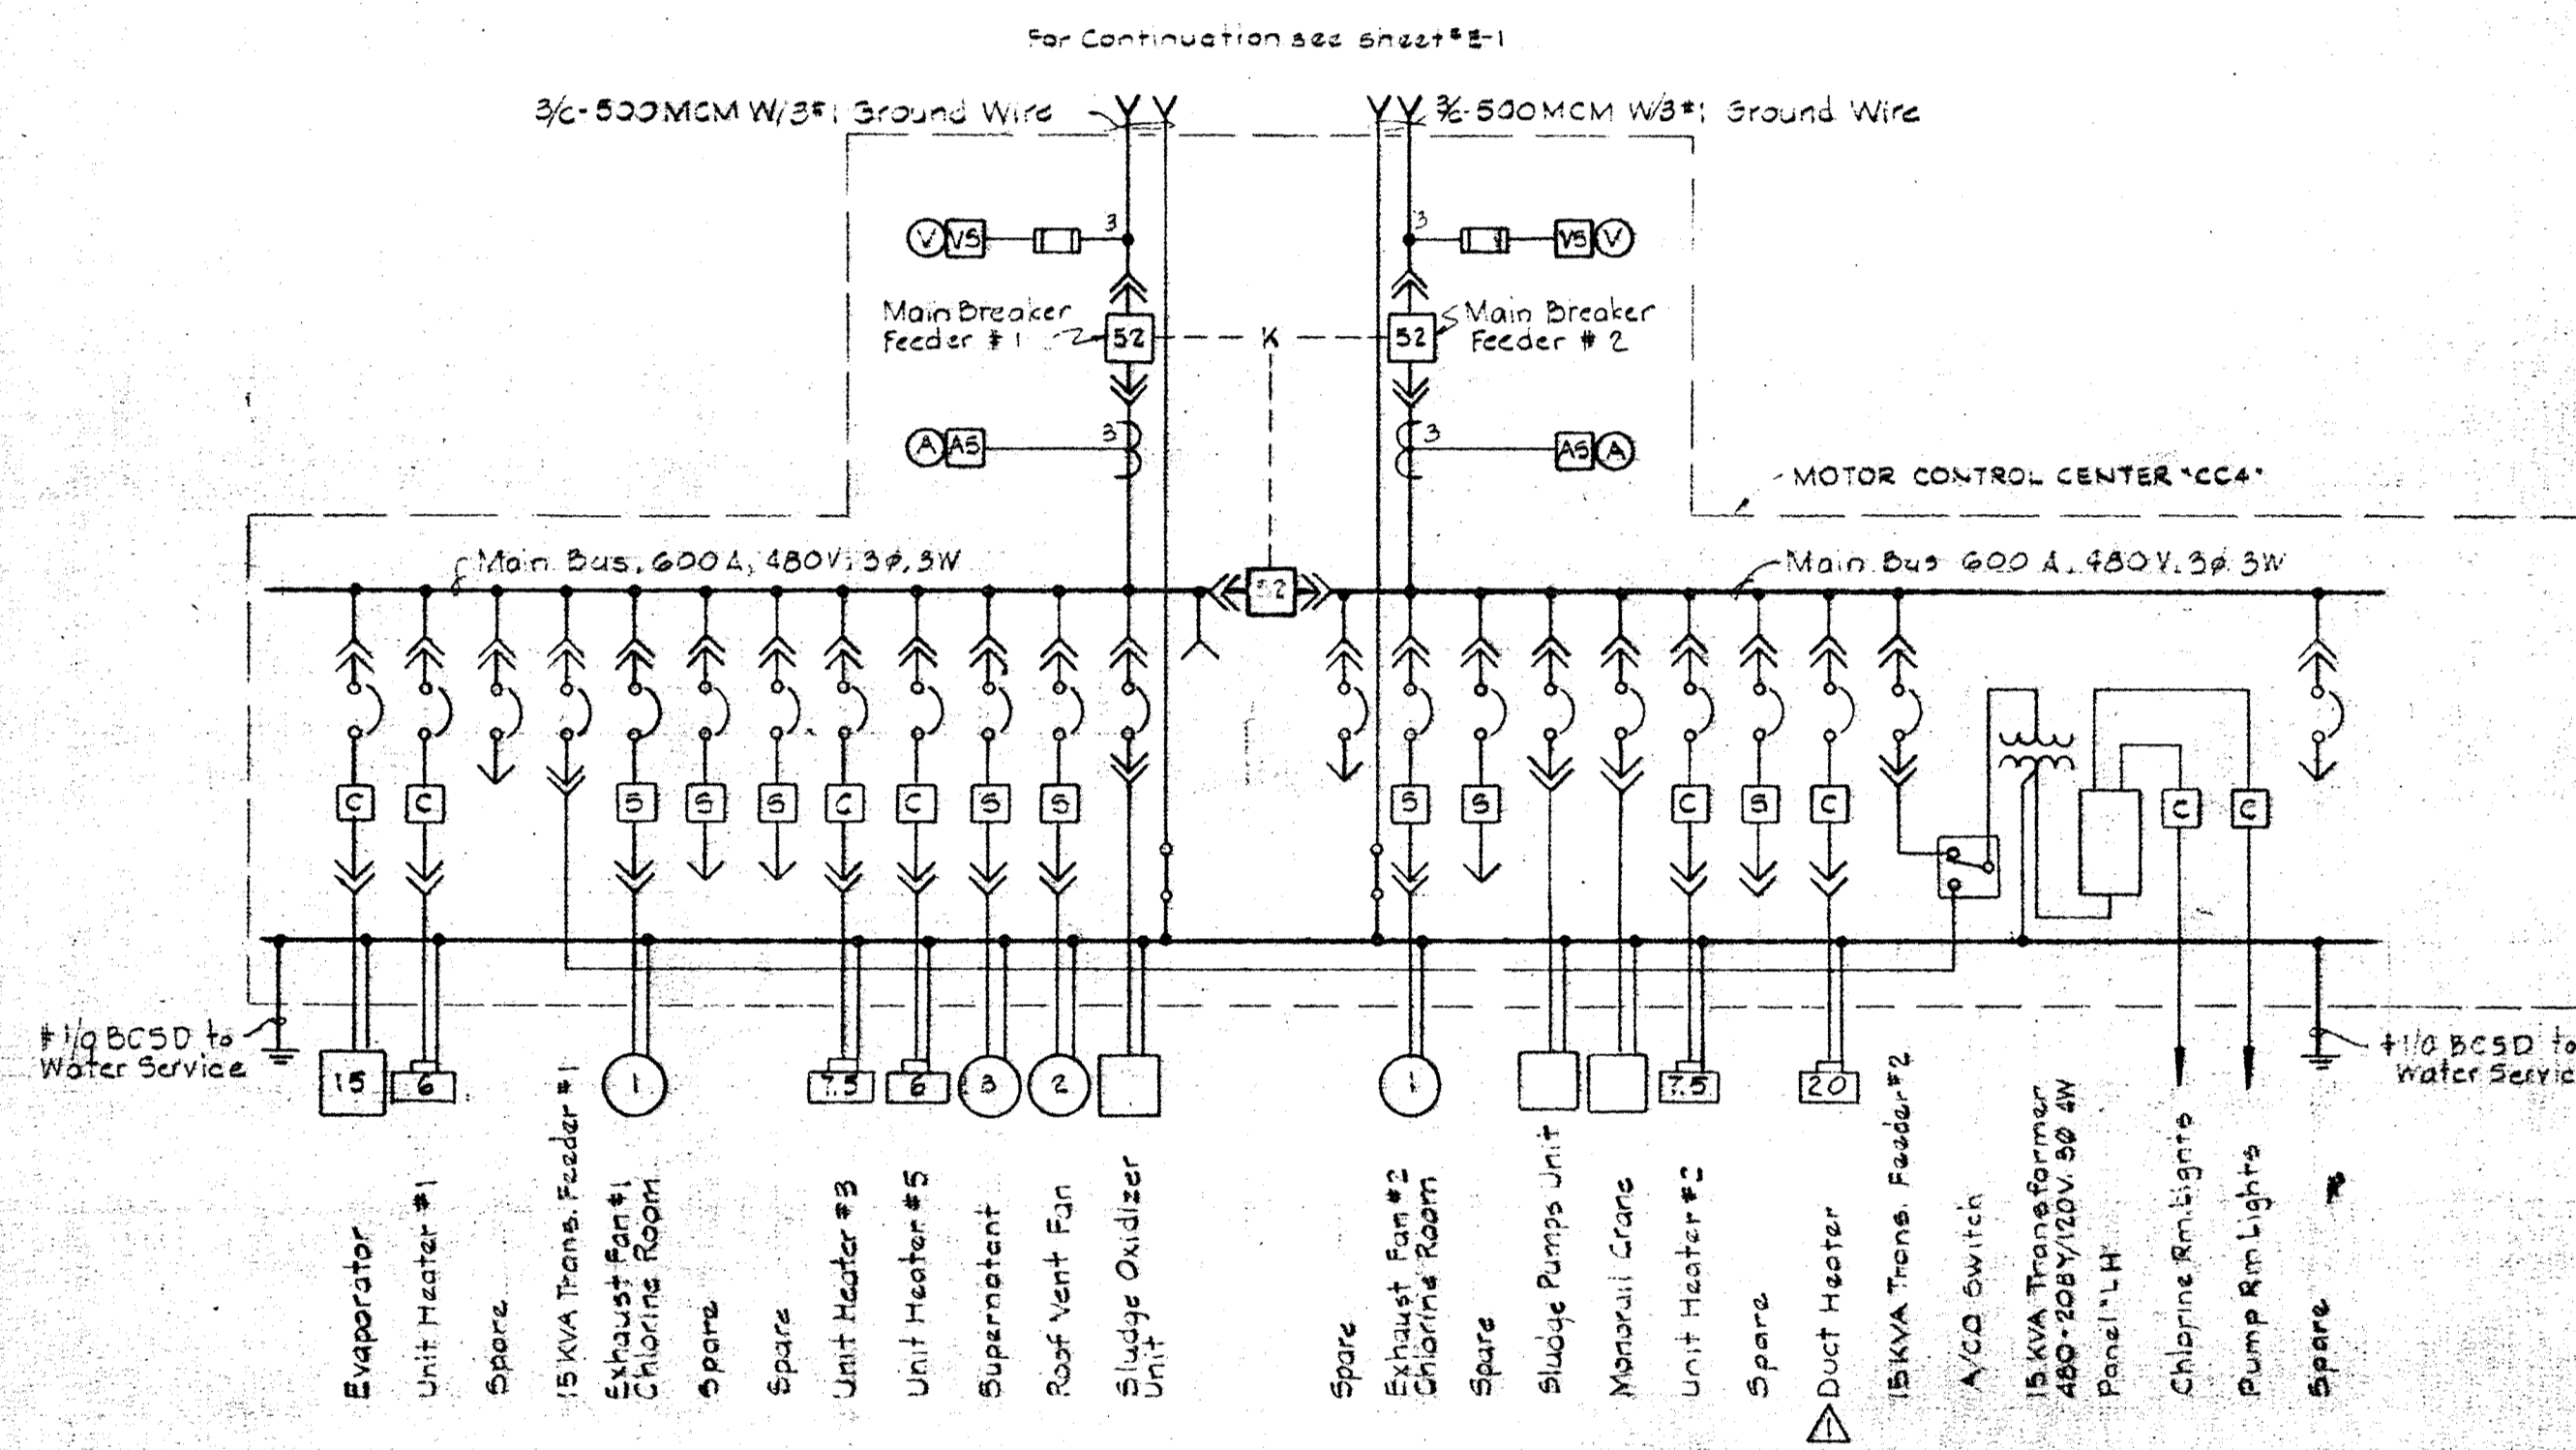

SLUDGE OXIDATION BUILDING  
No Scale

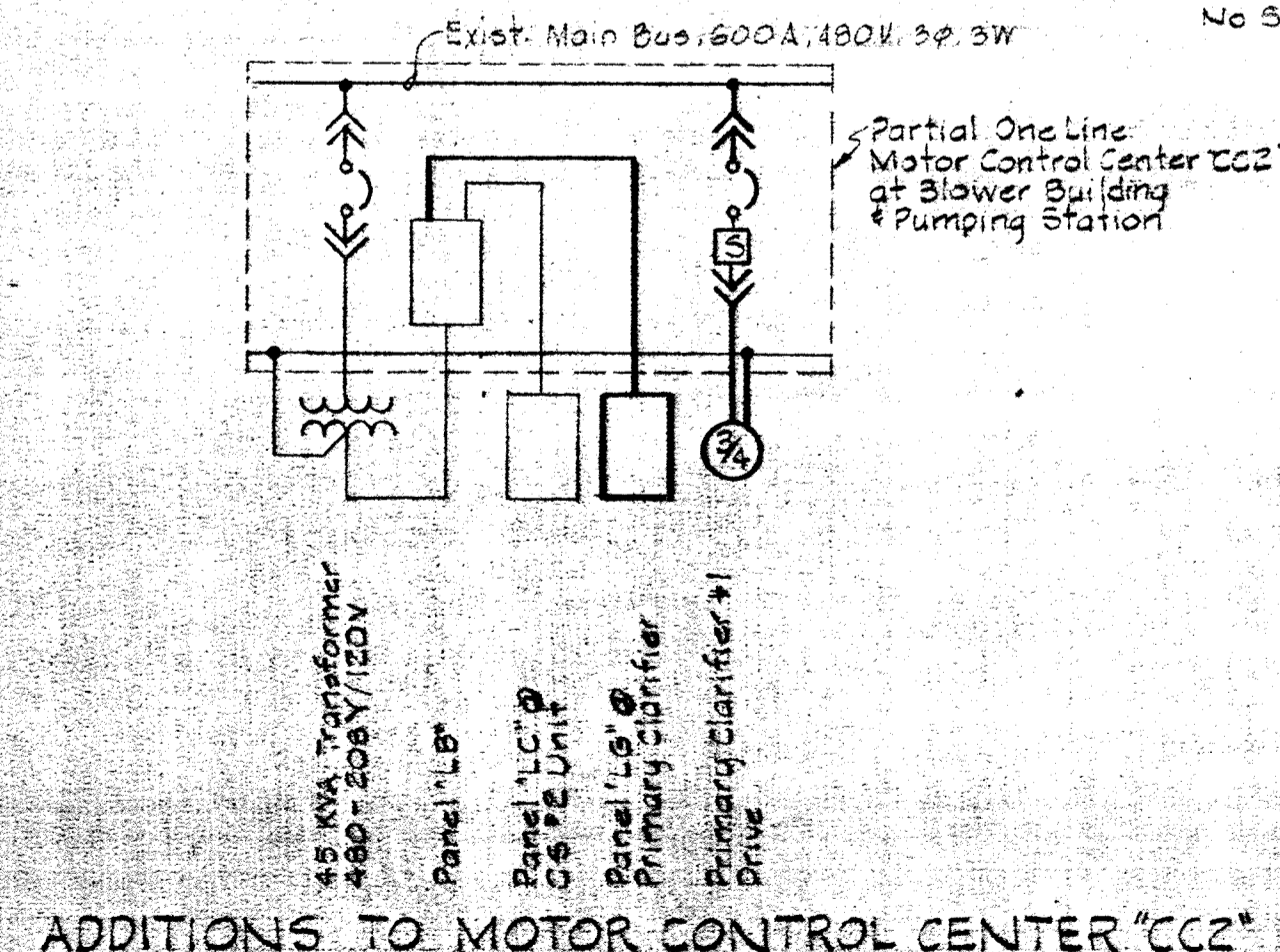

ADDITIONS TO MOTOR CONTROL CENTER "CC2"




Kenneth W. Wood

<b>WHITMAN, REQUARDT &amp; ASSOCIATES</b> ENGINEERS 1304 ST. PAUL ST. BALTIMORE, MARYLAND	DEPARTMENT OF PUBLIC WORKS HOWARD COUNTY, MARYLAND DATE: 7/1/73  CHIEF - BUREAU OF ENGINEERING	CONTRACT NO. 525-S	MOTOR CONTROL CENTER	SAVAGE WASTEWATER TREATMENT PLANT ADDITION NO. 3	DRAWING NO. 26	SCALE AS SHOWN
					OF 28	

W. O. 6538-2

Addendum


2" G. Top (Typical)

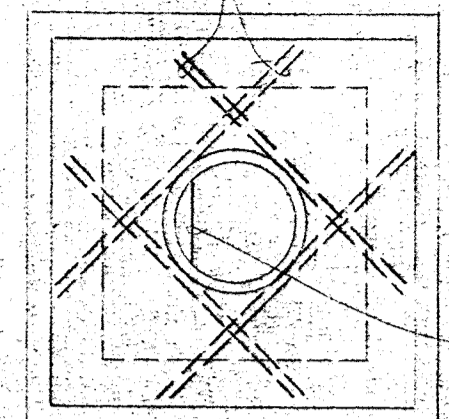

No. 6 Starting Ring  
2'-6" long typical for  
Manholes 4, 5, & 6

**MANHOLE PLAN**

(Typical for Manholes No. 4, 5 & 6)  
No Scale

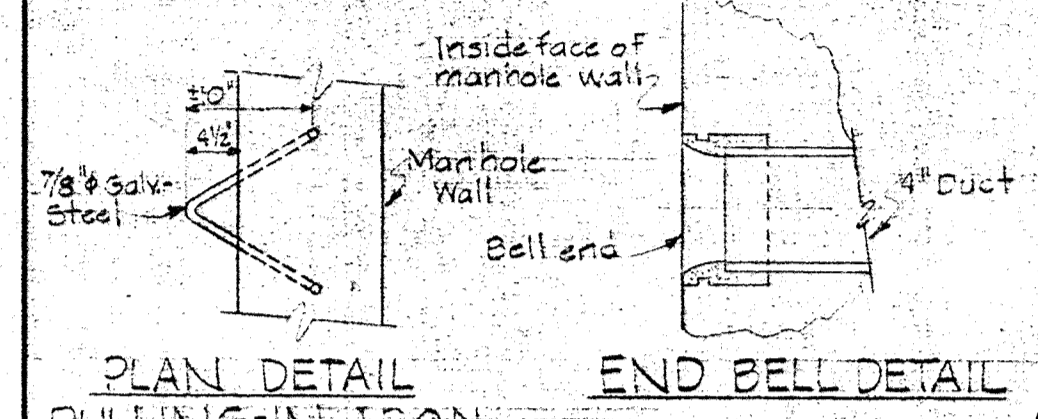


**PLAN DETAIL PULLING-IN IRON**



**ELEVATION DETAIL PULLING-IN IRON**

**MISCELLANEOUS MANHOLE DETAILS**  
No Scale


- NOTES**
1. For General Electrical Notes & Electrical Legend See Sheet E-2
  2. At Existing CS #2 & CS #3 disconnect existing float transmitter and connect new level transmitter as required by manufacturer.

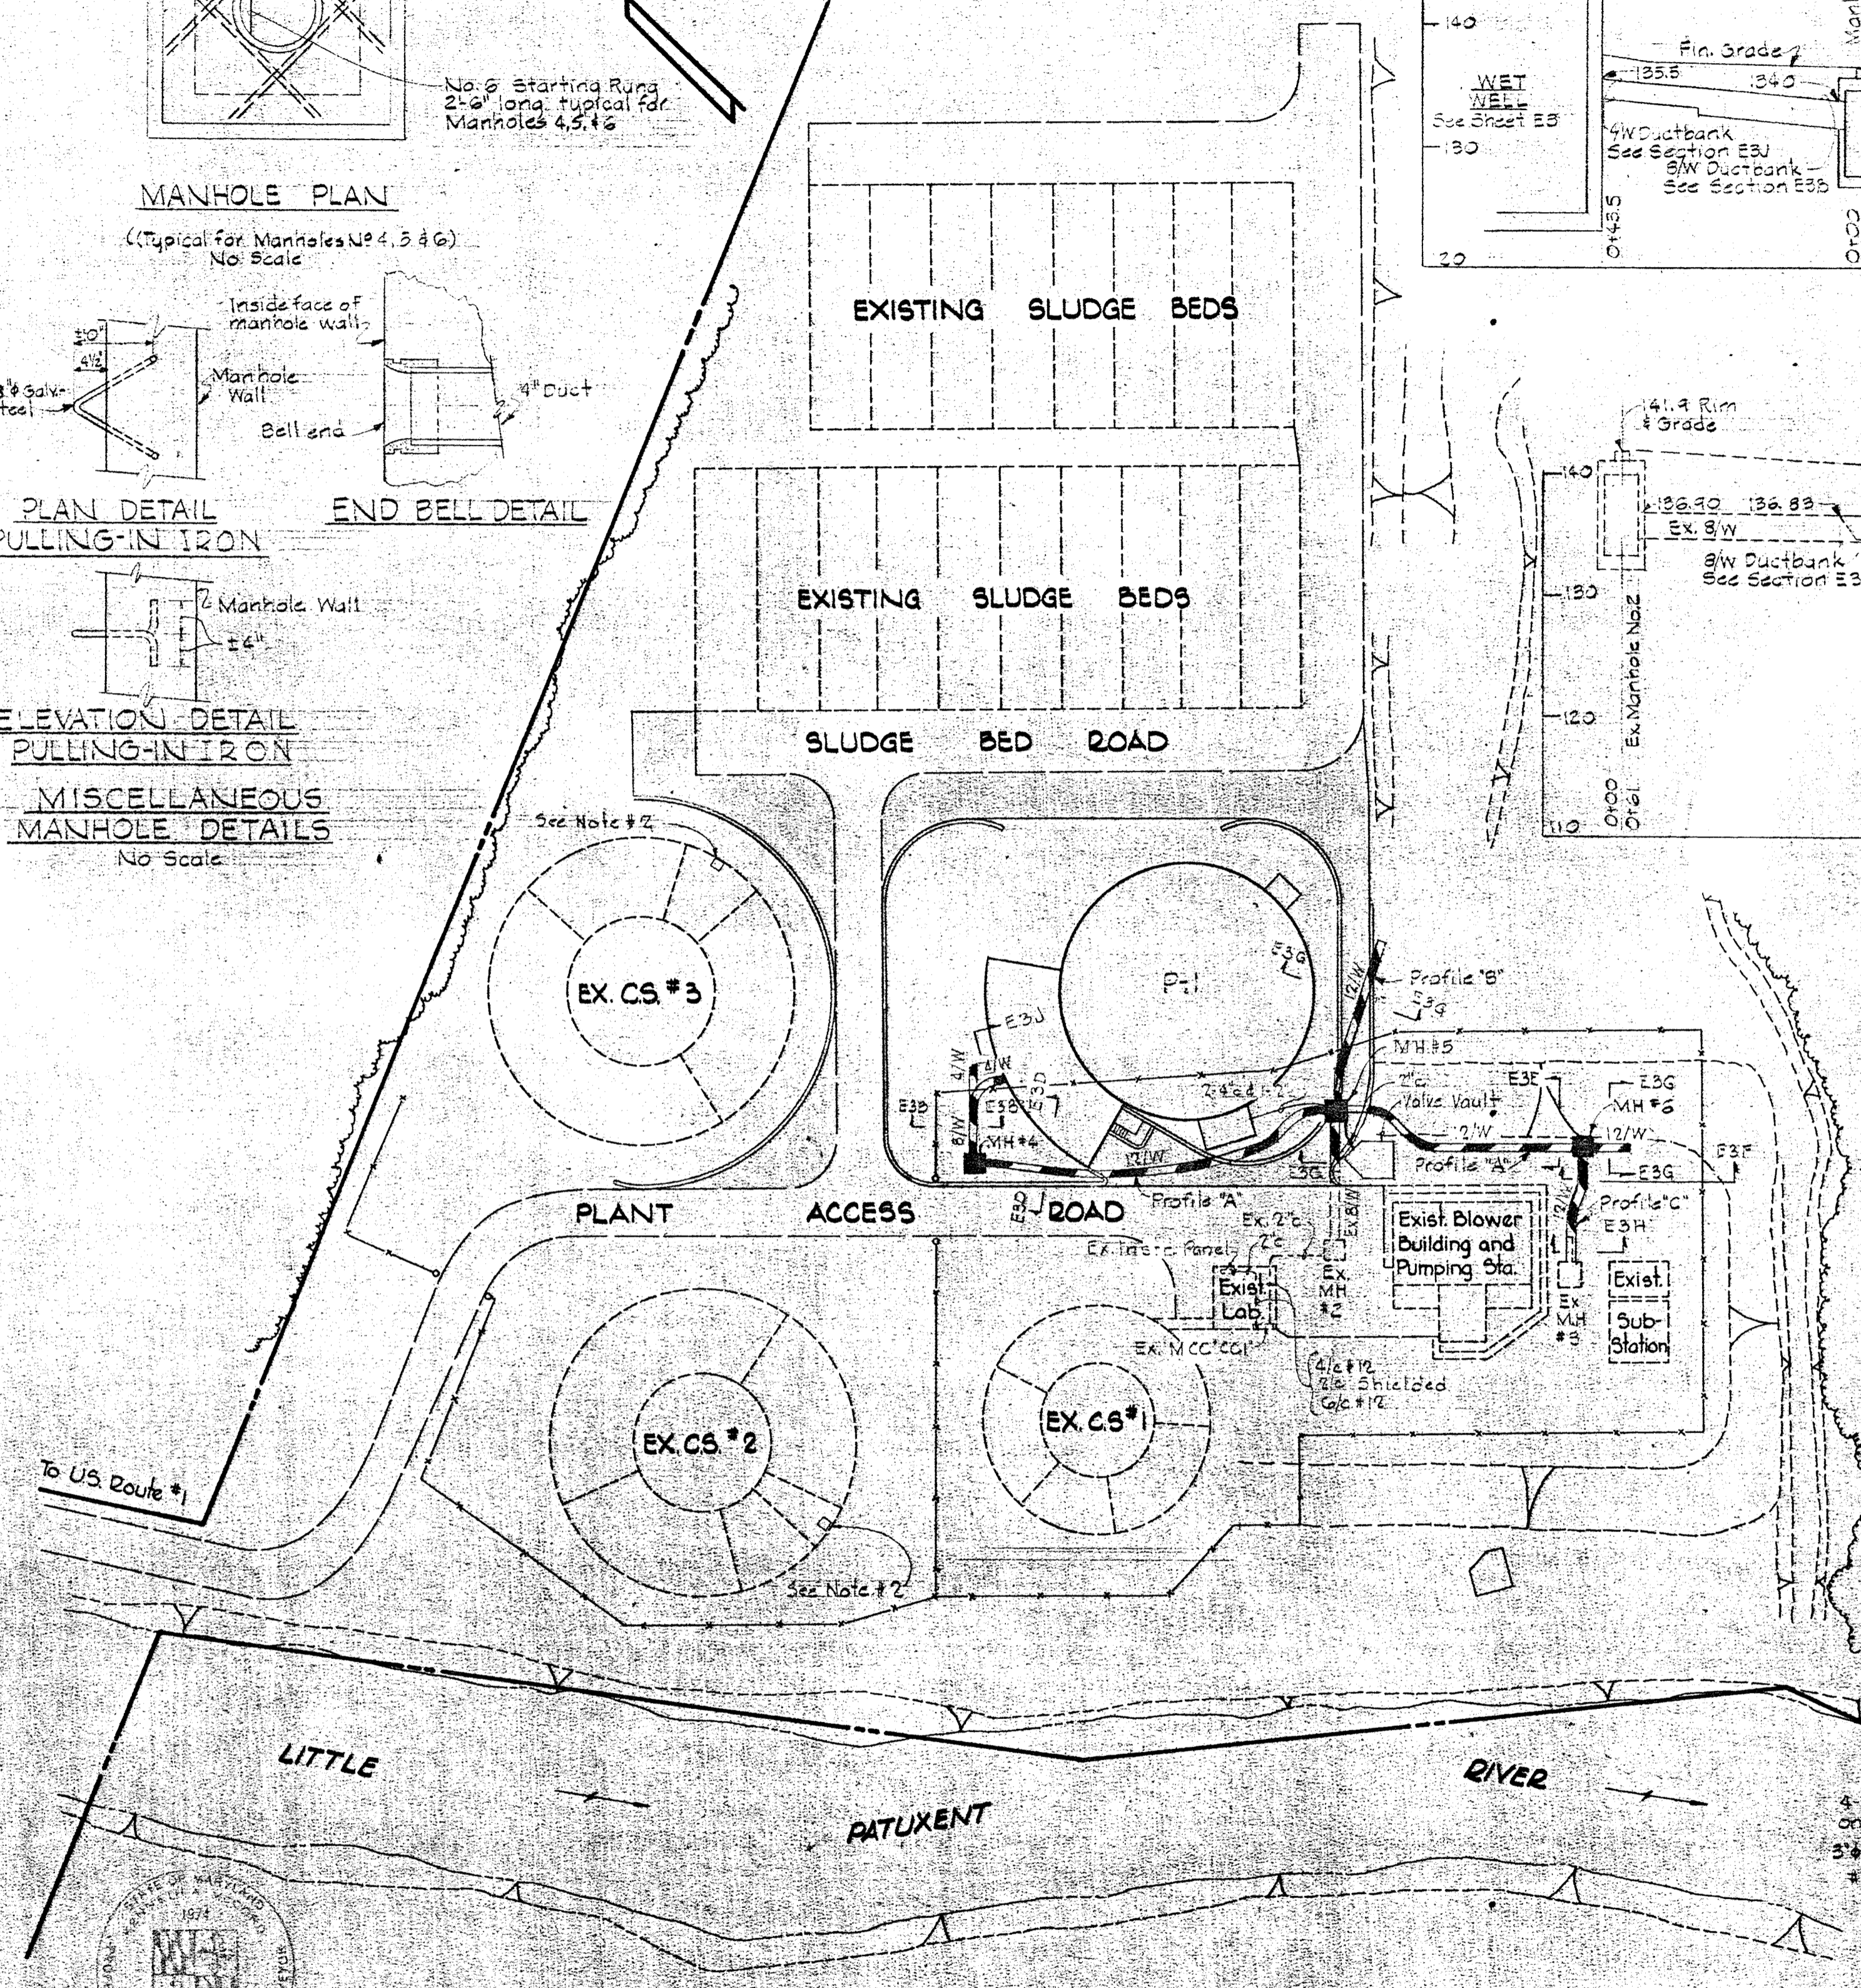

**SITE PLAN**


Scale: 1"=50'

Note: See Sheet C-6 for details of Utility layout

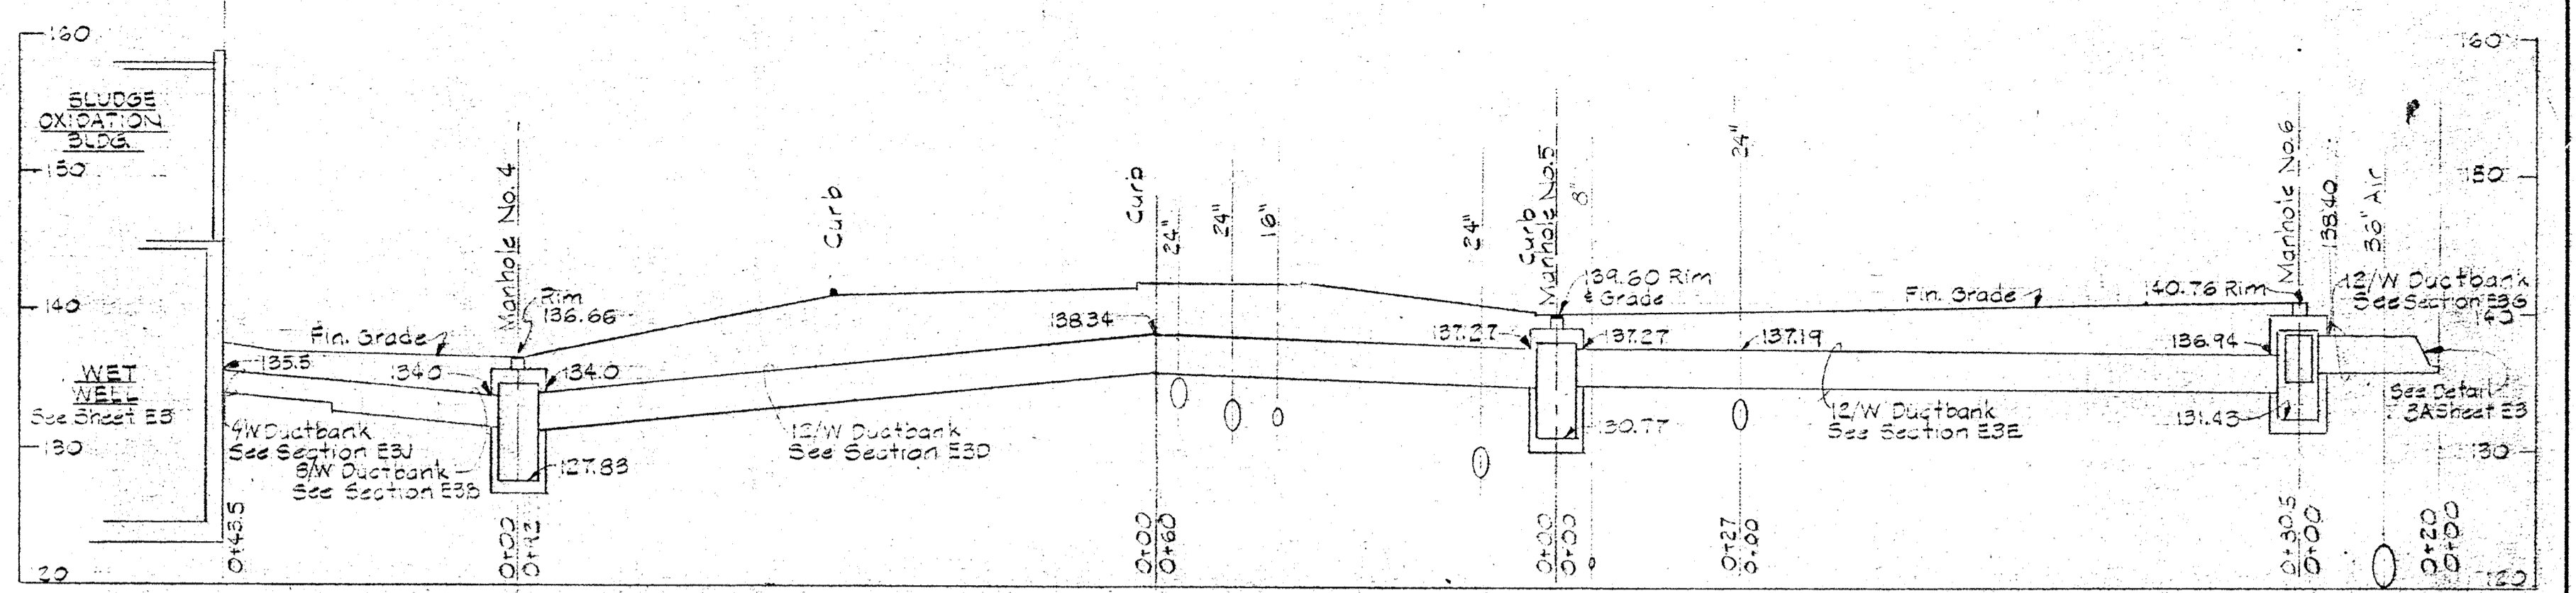


**PROFILE "A"**

Horiz.: 1"=20'-0"  
Vert.: 1"=10'-0"

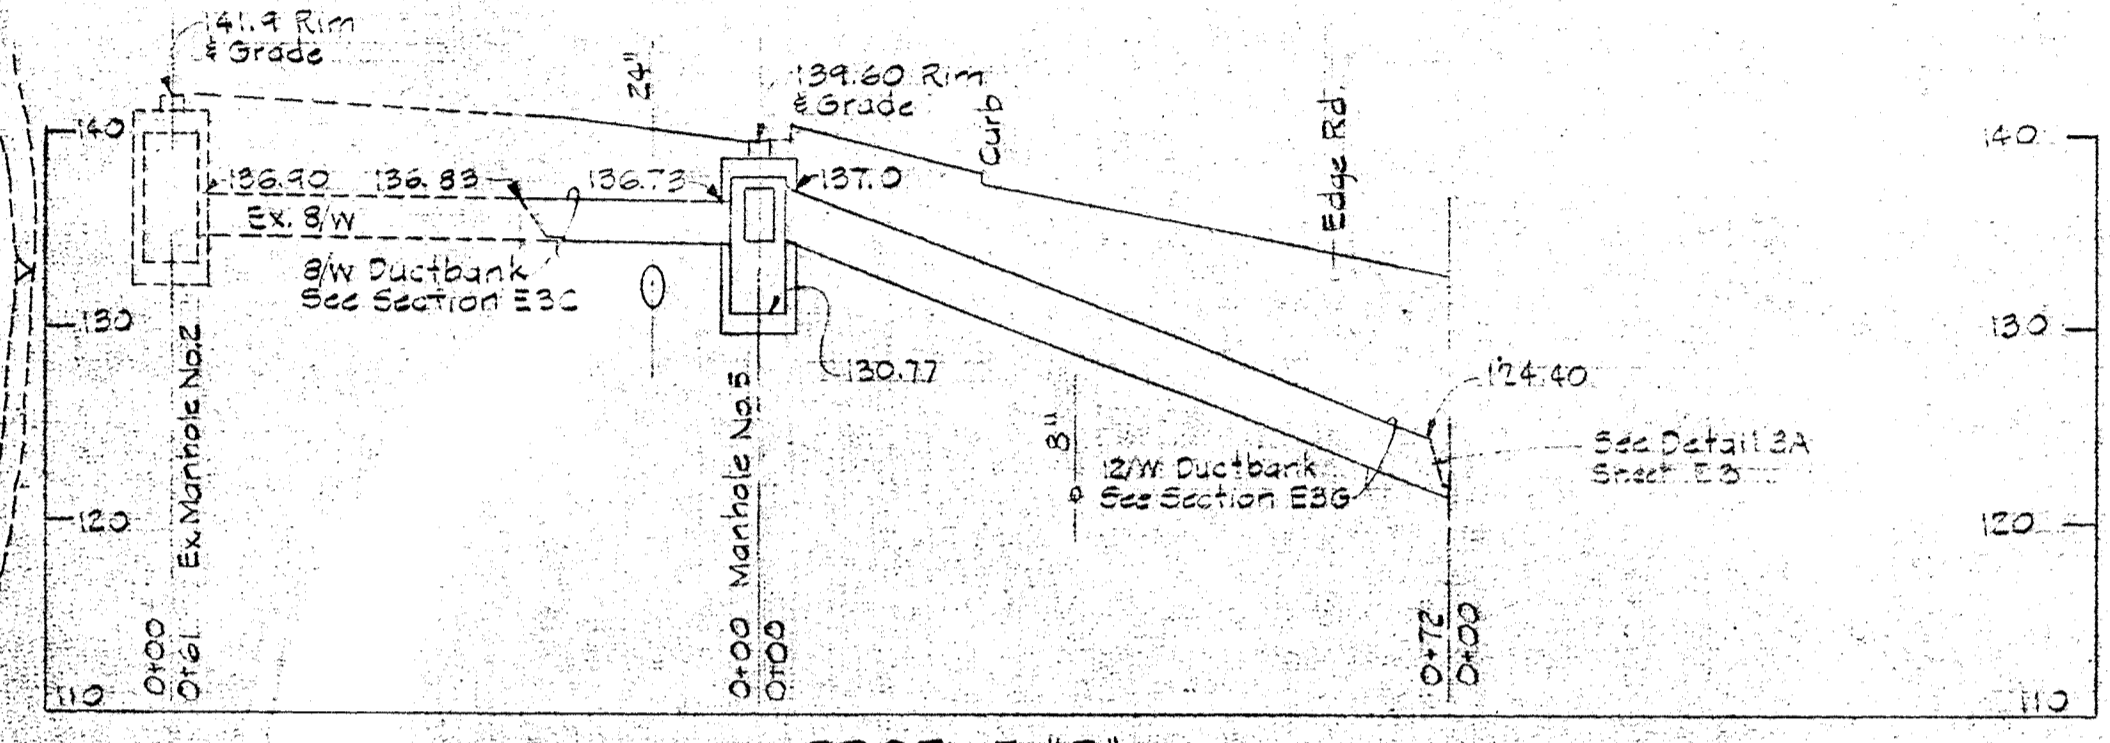


**PROFILE "B"**

Horiz.: 1"=20'-0"  
Vert.: 1"=10'-0"

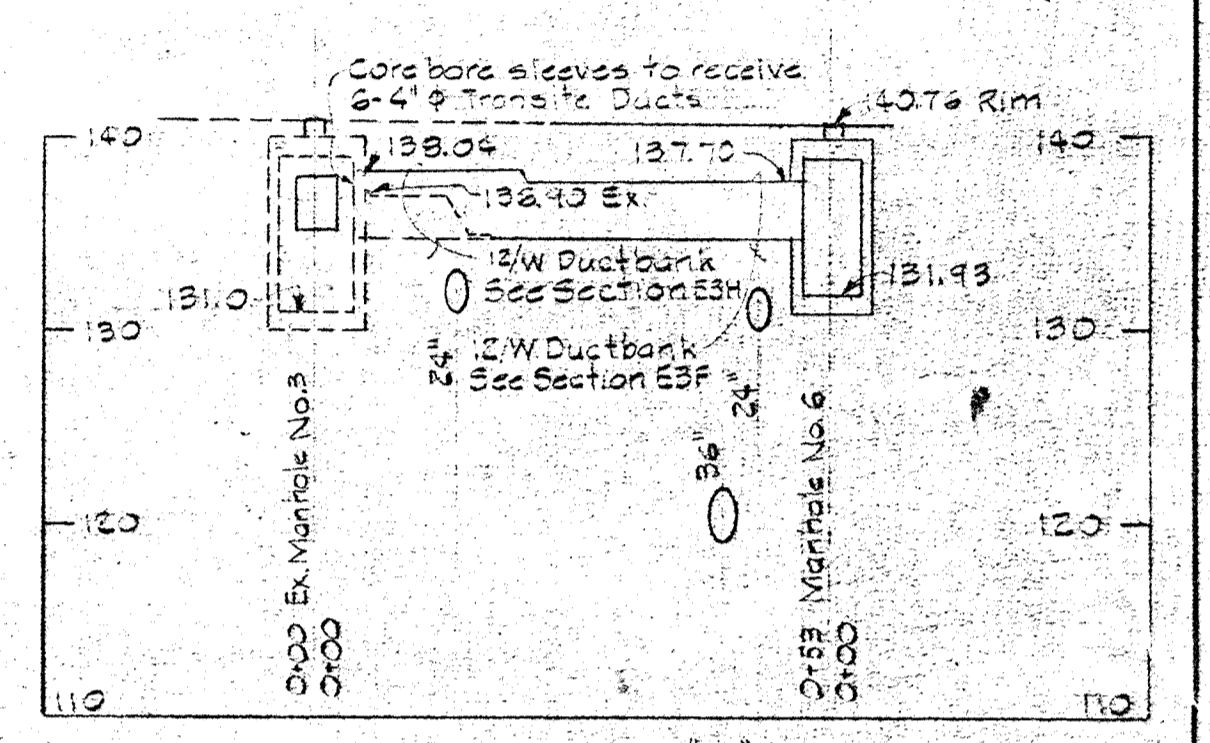

**PROFILE "C"**


Horiz.: 1"=20'-0"  
Vert.: 1"=10'-0"

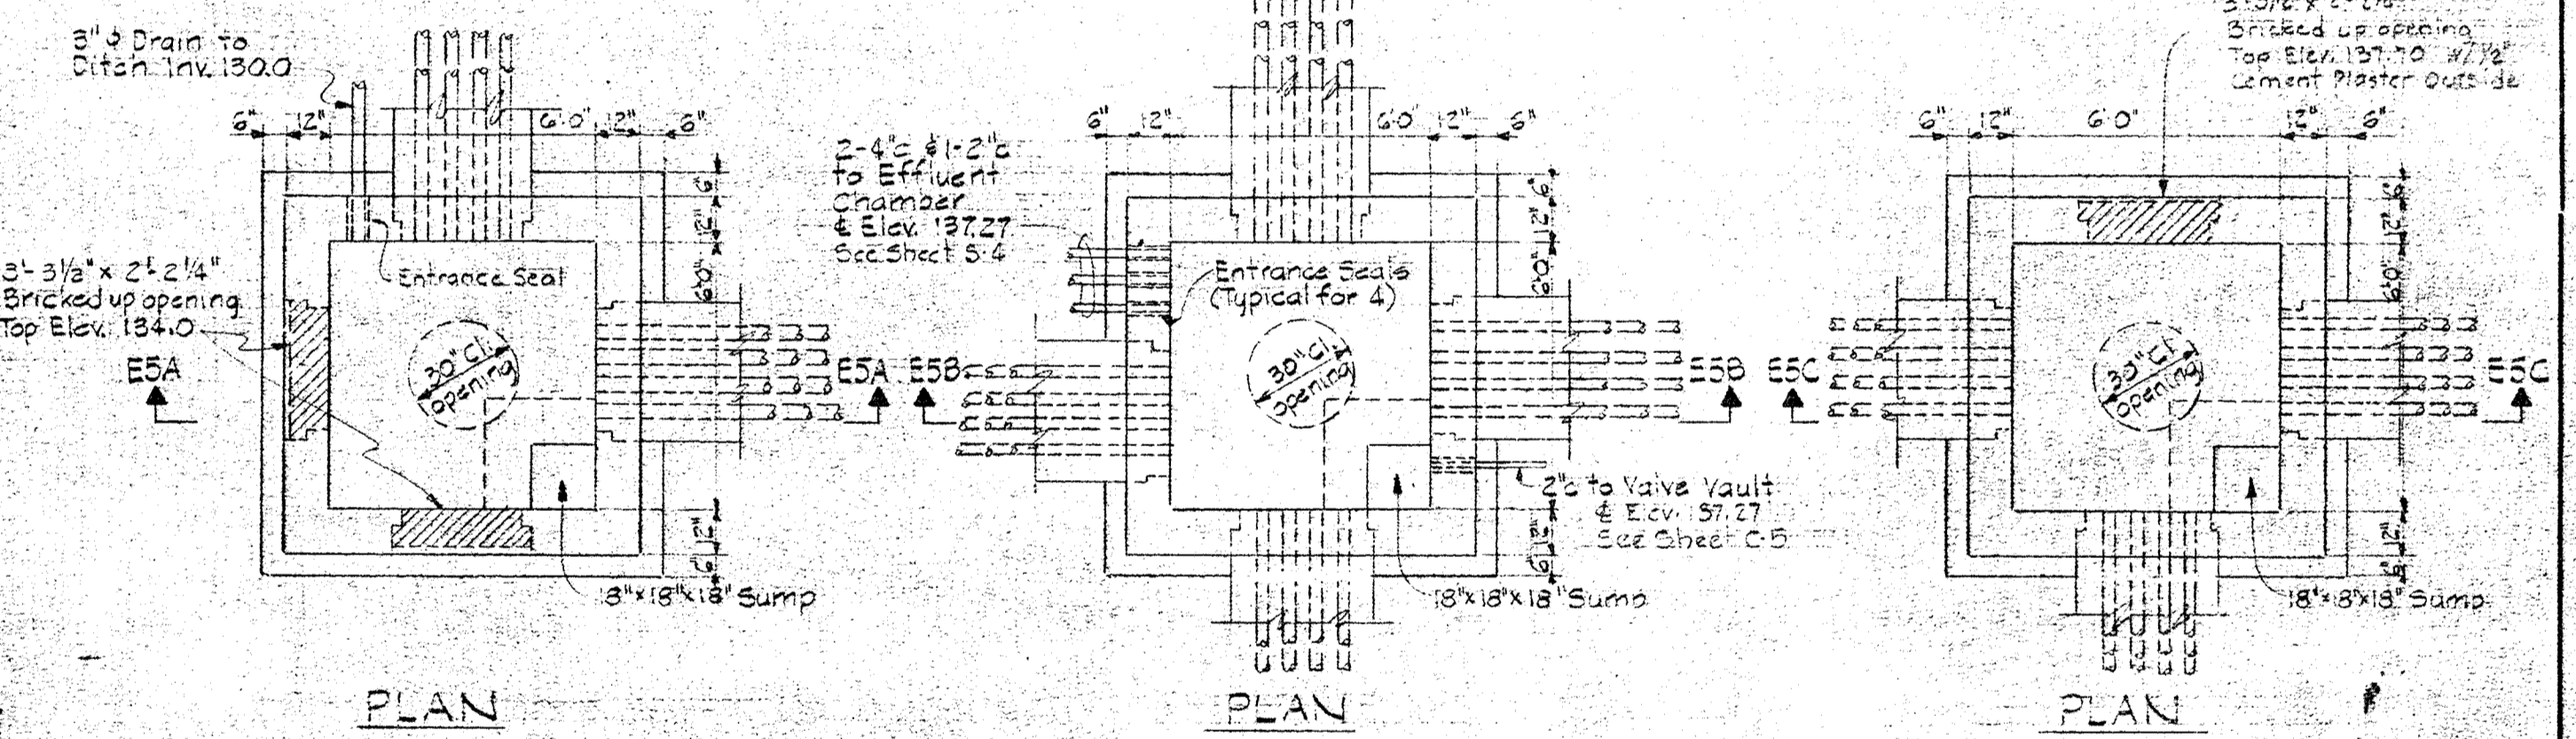

**PLAN**

**PLAN**


**PLAN**

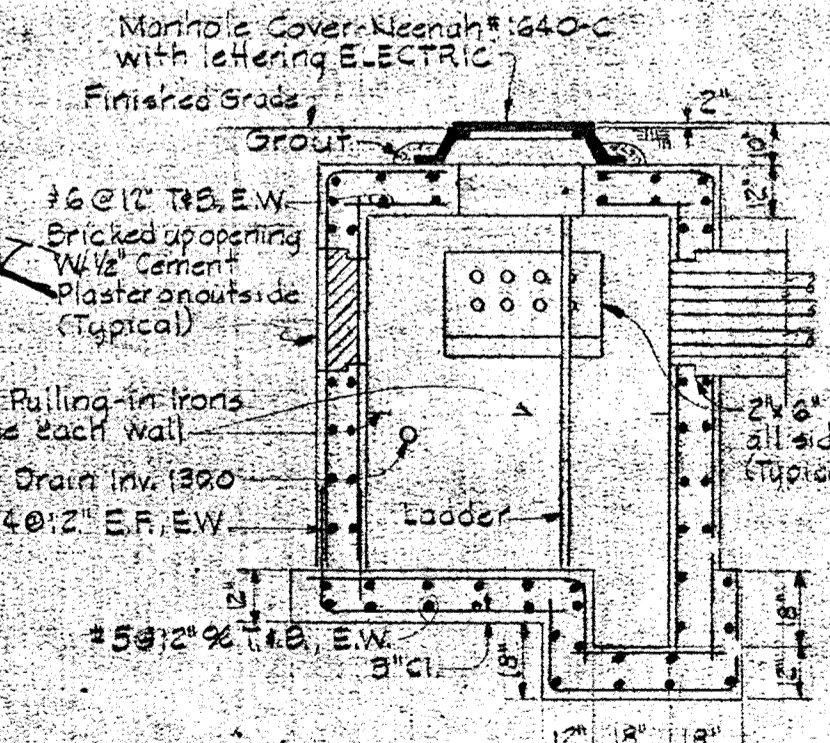

**SECTION E5A/E5**

MANHOLE No. 4


Scale: 1/4"=1'-0"

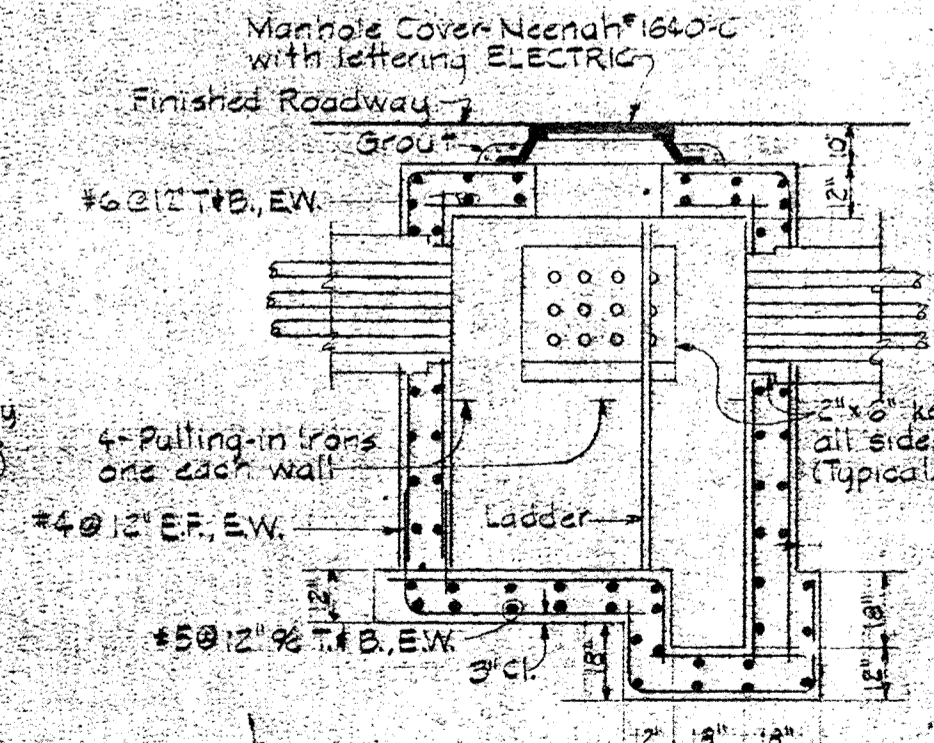

**SECTION E5B/E5**

MANHOLE No. 5

Scale: 1/4"=1'-0"

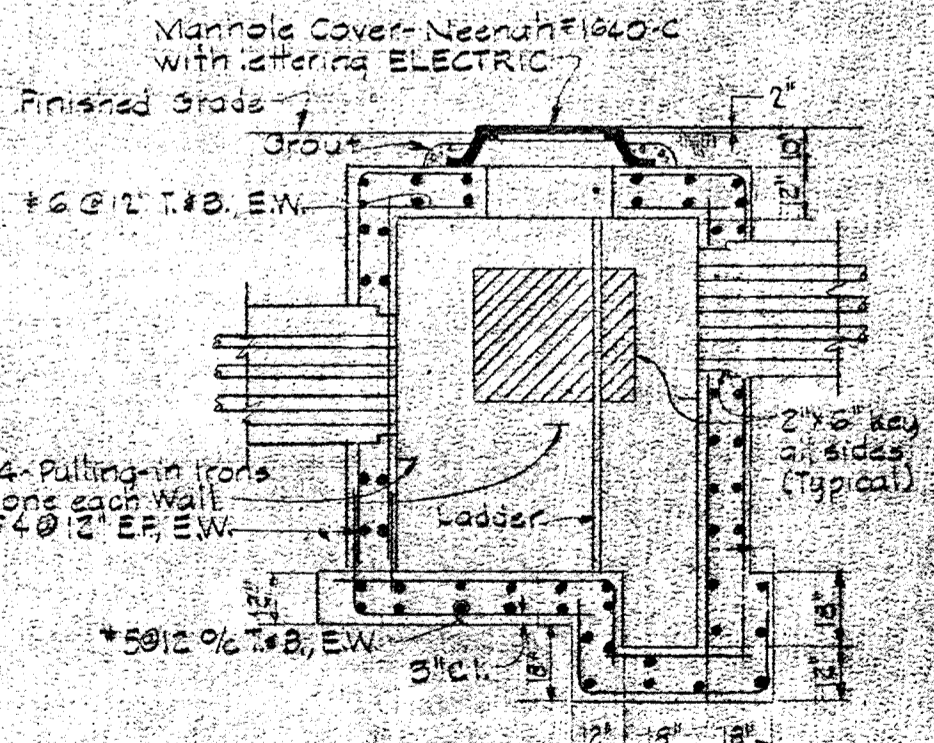

**SECTION E5C/E5**

MANHOLE No. 6

Scale: 1/4"=1'-0"

NOTE: For Depth of Manholes & Elev. of Ductbanks, See Profiles Above.

**WHITMAN, REQUARDT & ASSOCIATES**  
ENGINEERS  
1304 ST. PAUL ST.  
BALTIMORE, MARYLAND

**DEPARTMENT OF PUBLIC WORKS**  
HOWARD COUNTY, MARYLAND  
2/1/73  
DATE

**CONTRACT NO. 525-S**

**ELECTRICAL SITE PLAN**  
**AND MISCELLANEOUS DETAILS**






**SAVAGE WASTEWATER**  
**TREATMENT PLANT ADDITION NO. 3**

**DRAWING**  
**NO. 27**  
**OF 28**





**SCALE**  
**1"=50'**

W. O. 6538-2




**SHEET E-5**

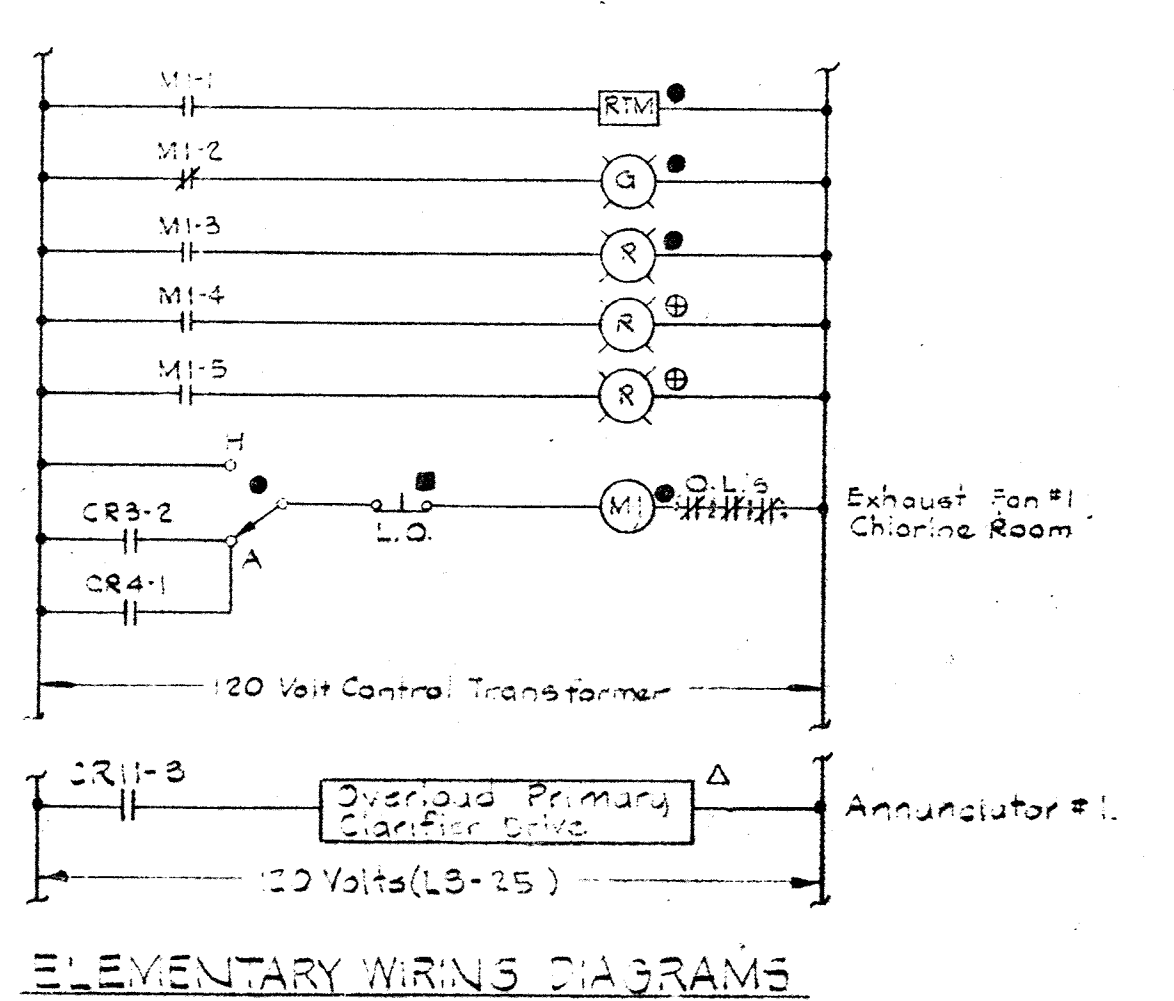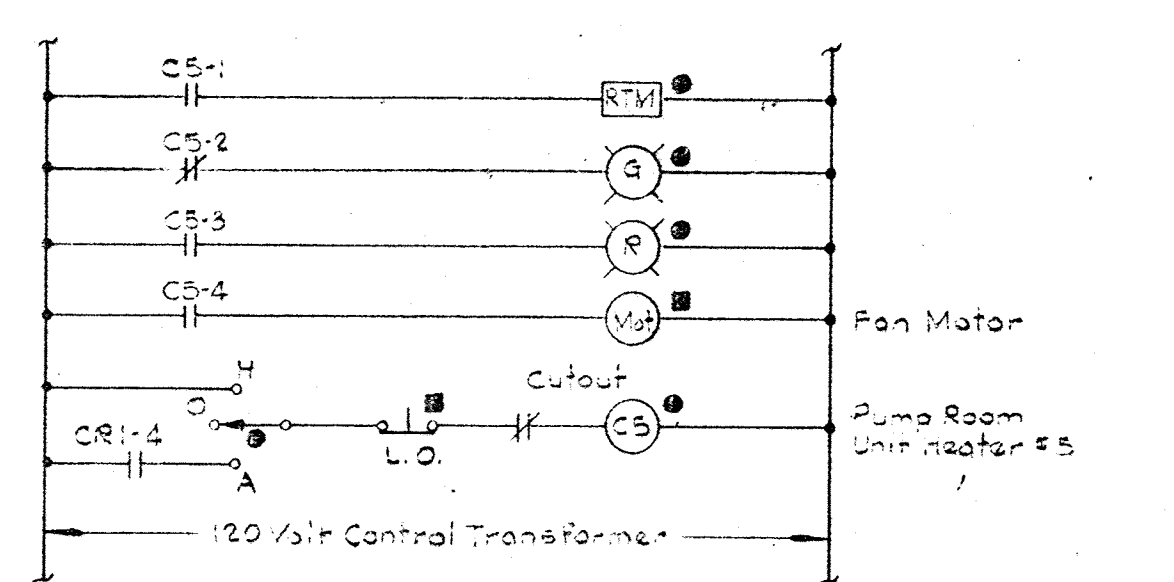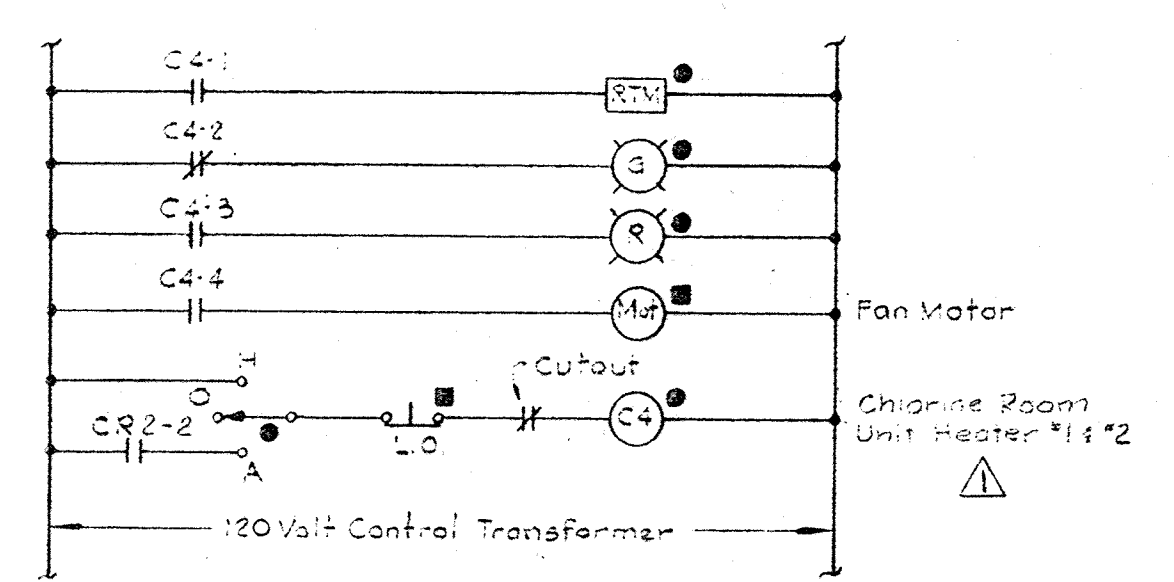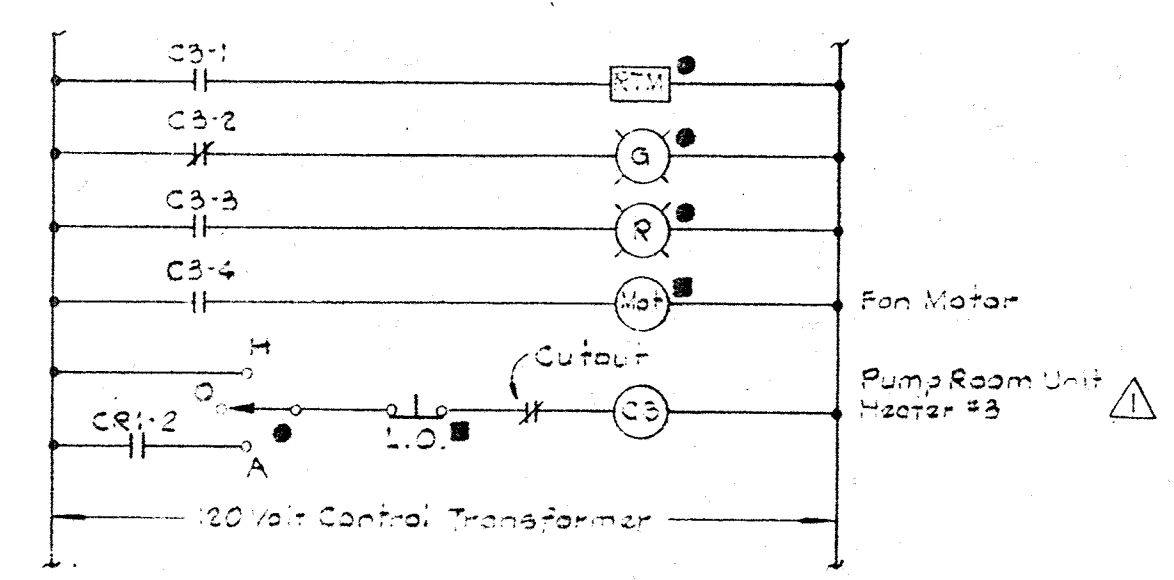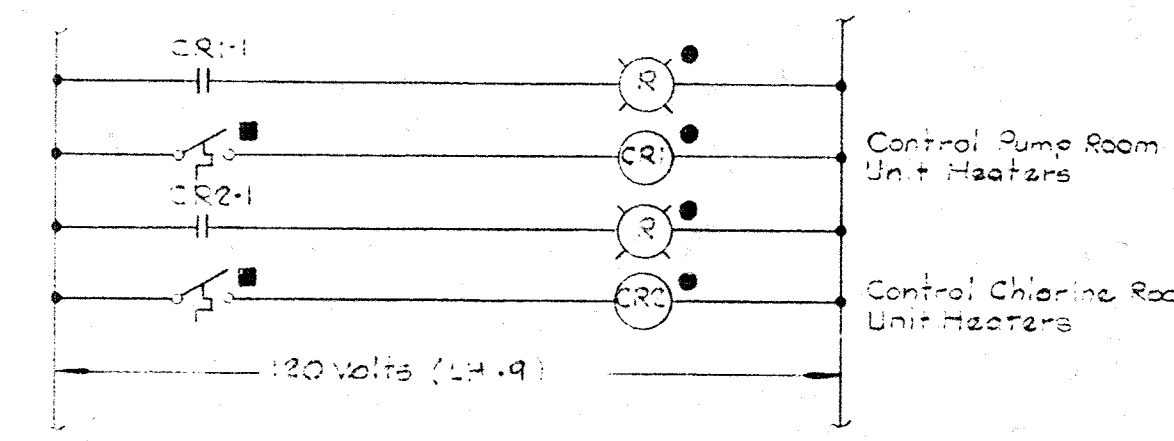




ELEMENTARY WIRING DIAGRAMS

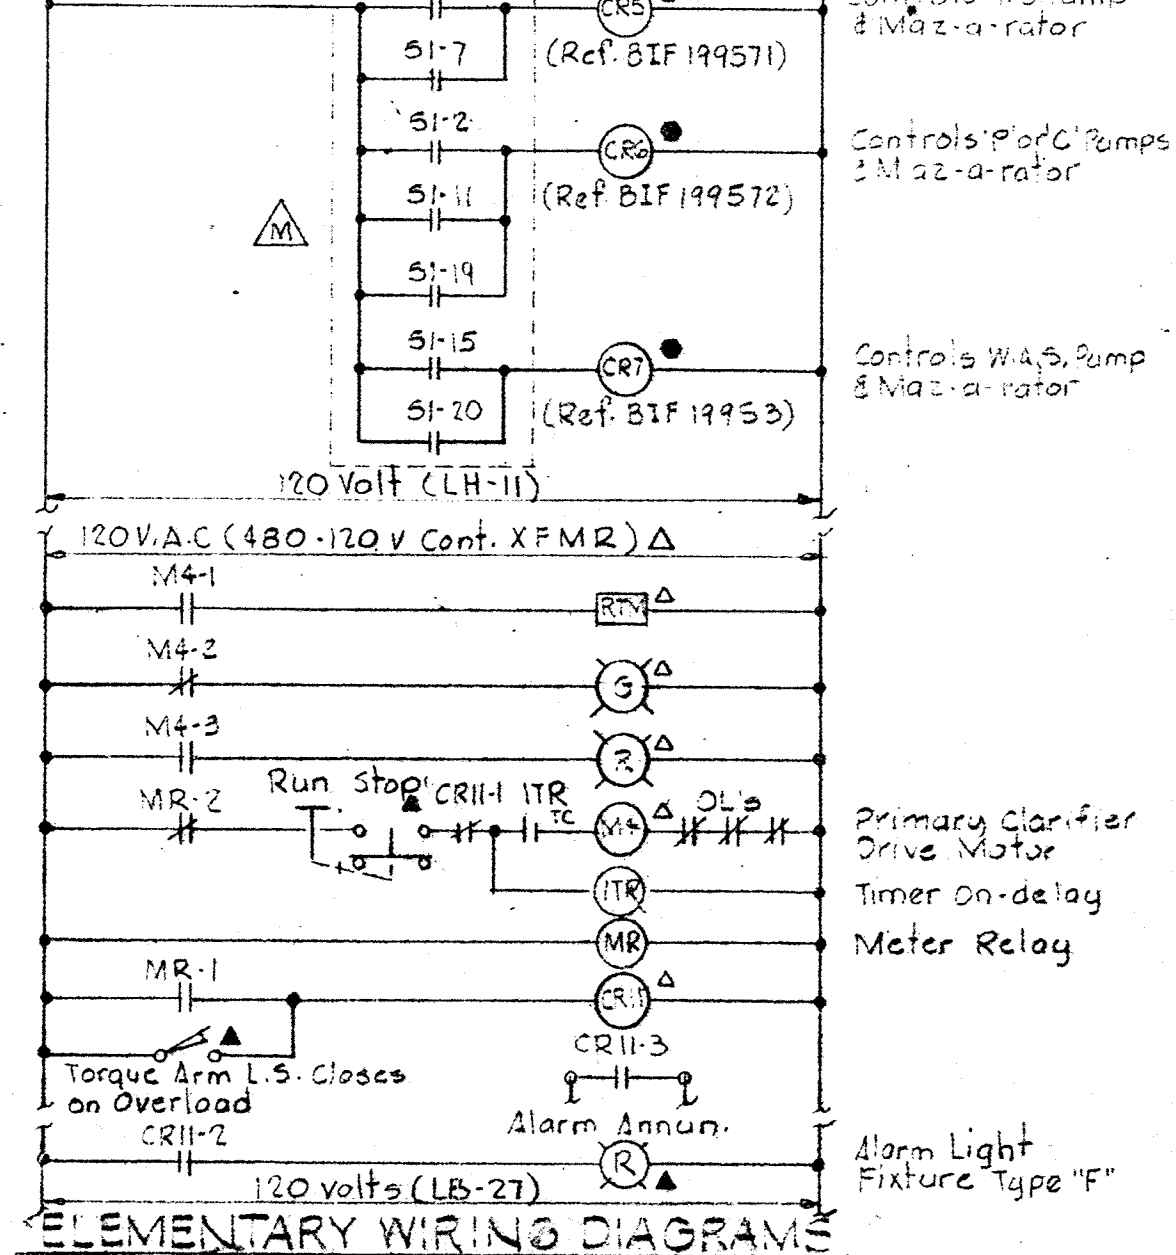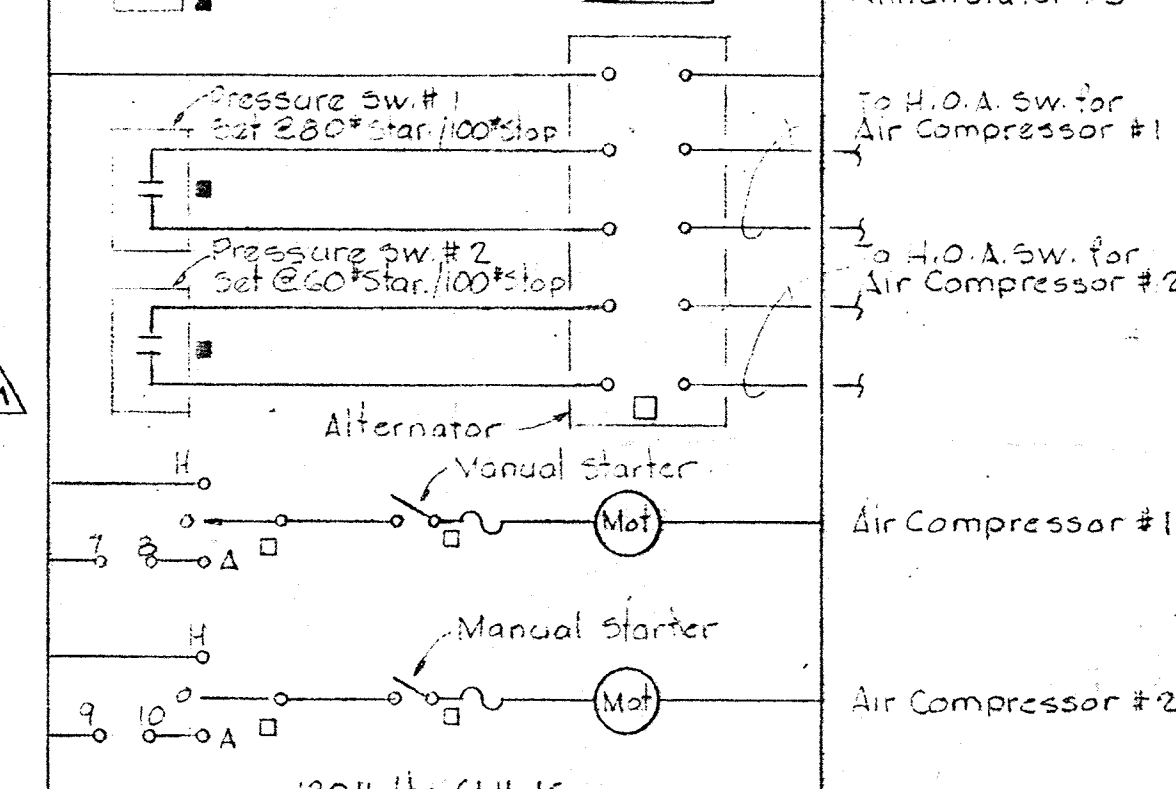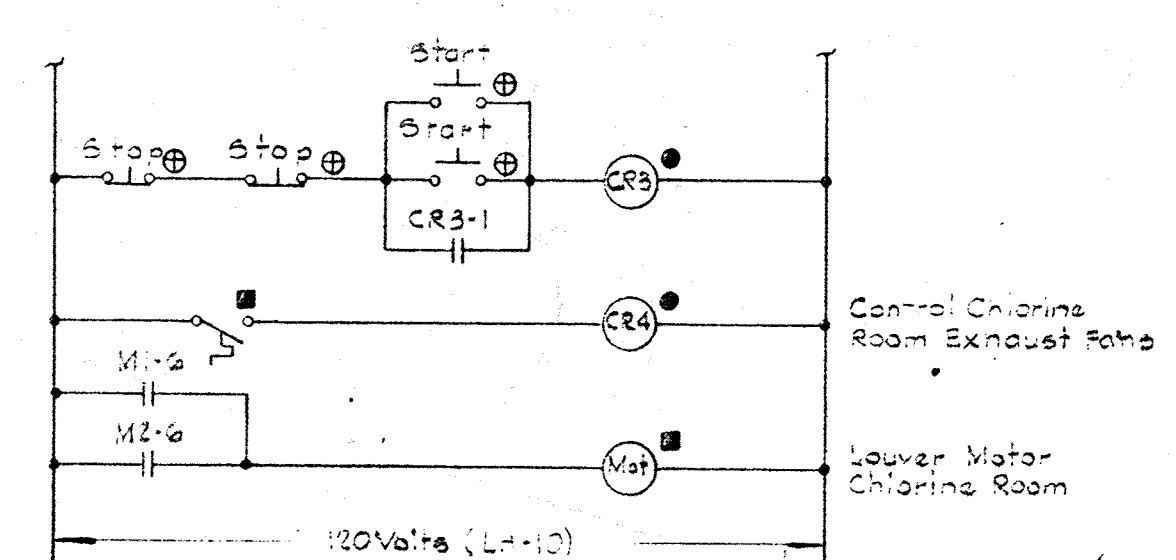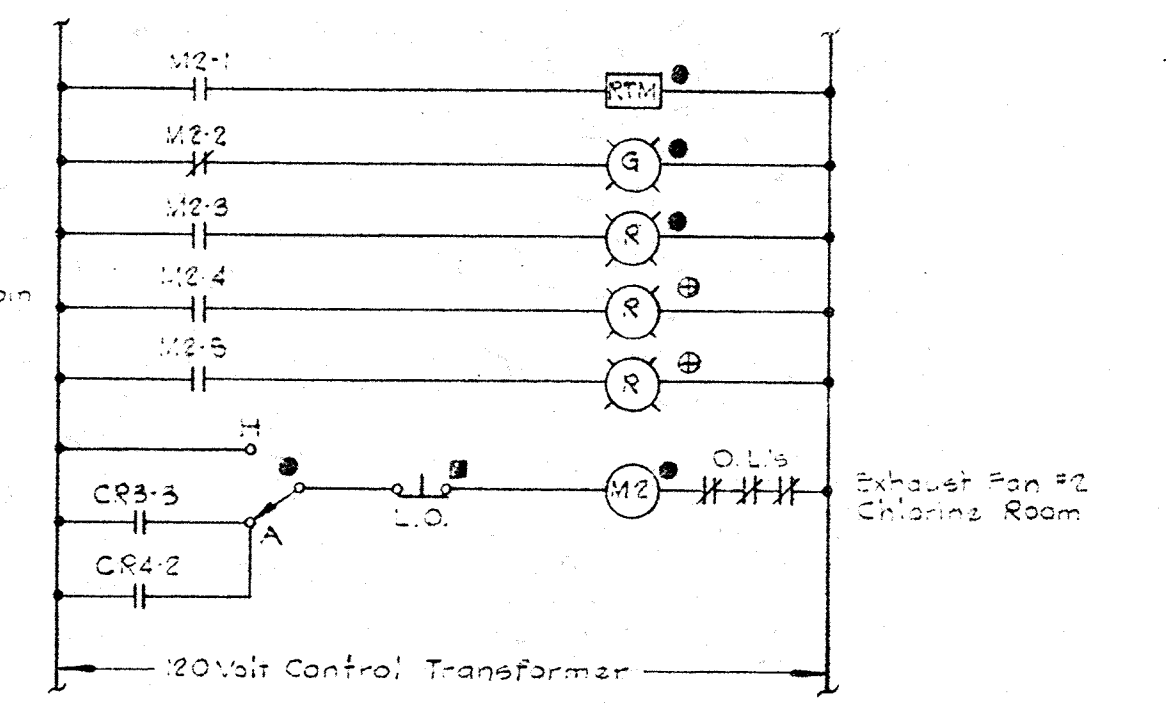

ELEMENTARY WIRING DIAGRAMS

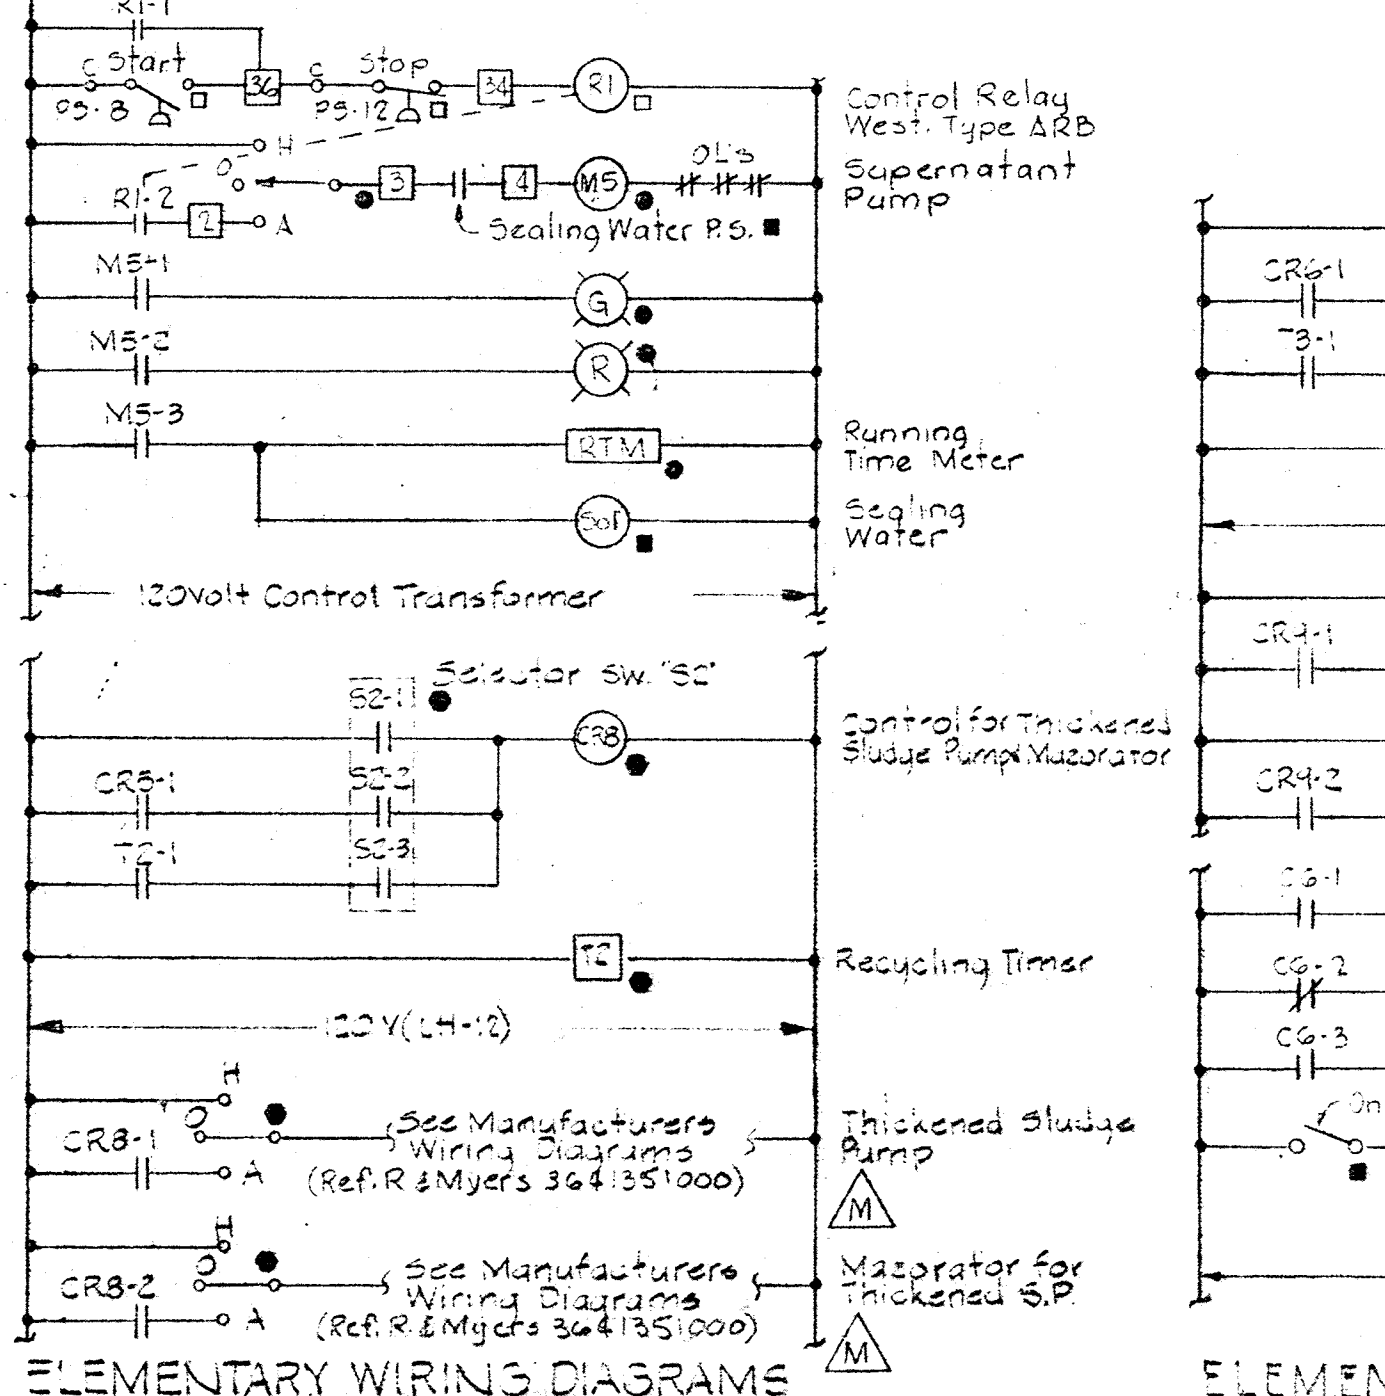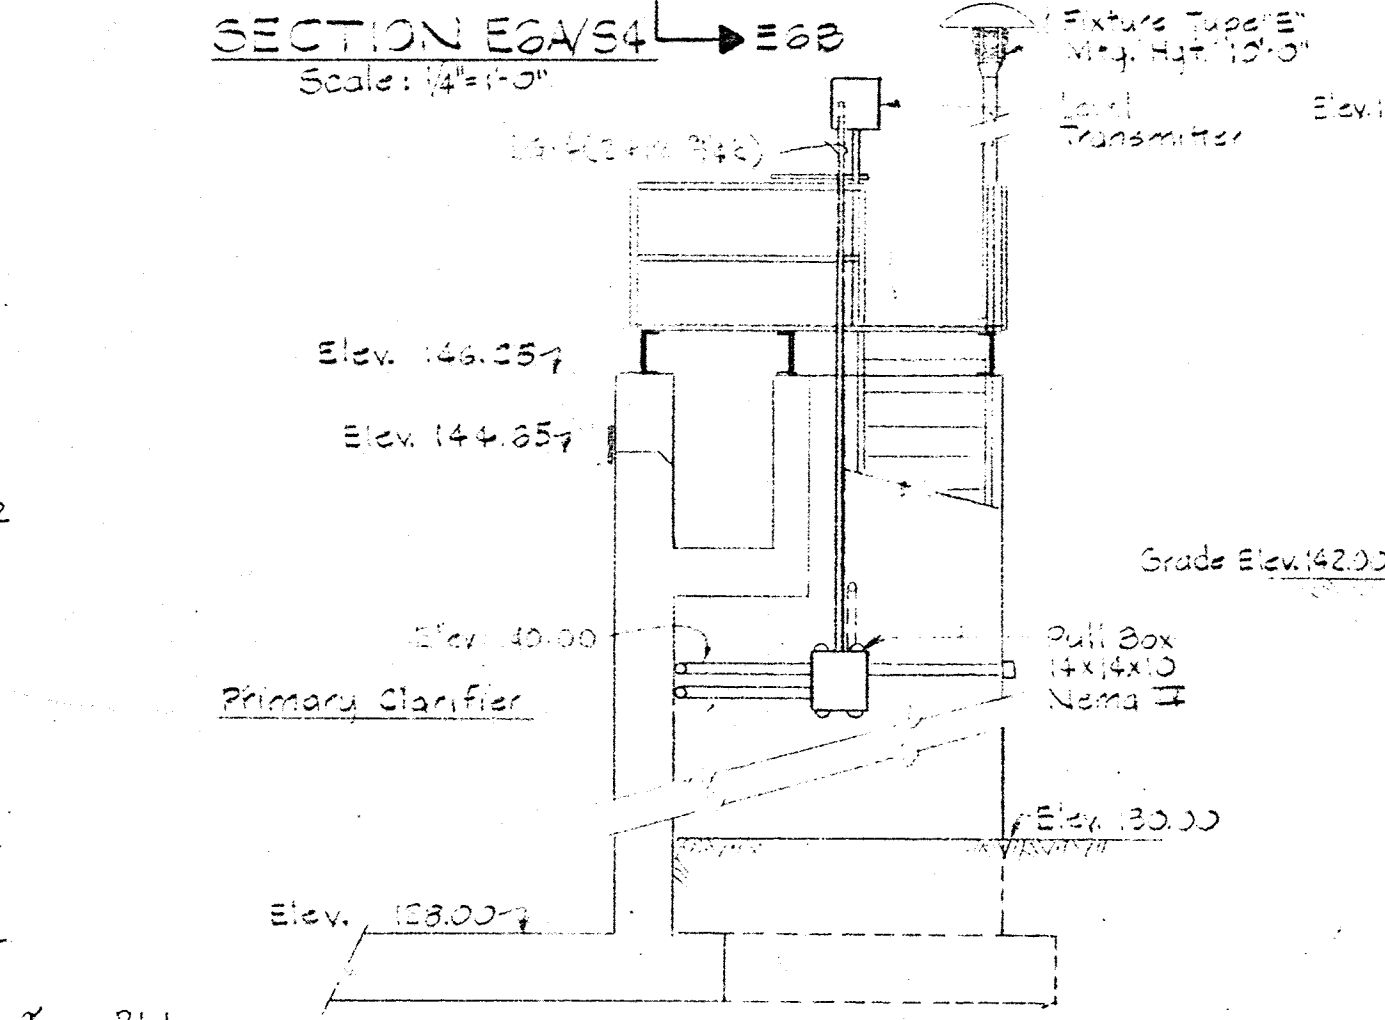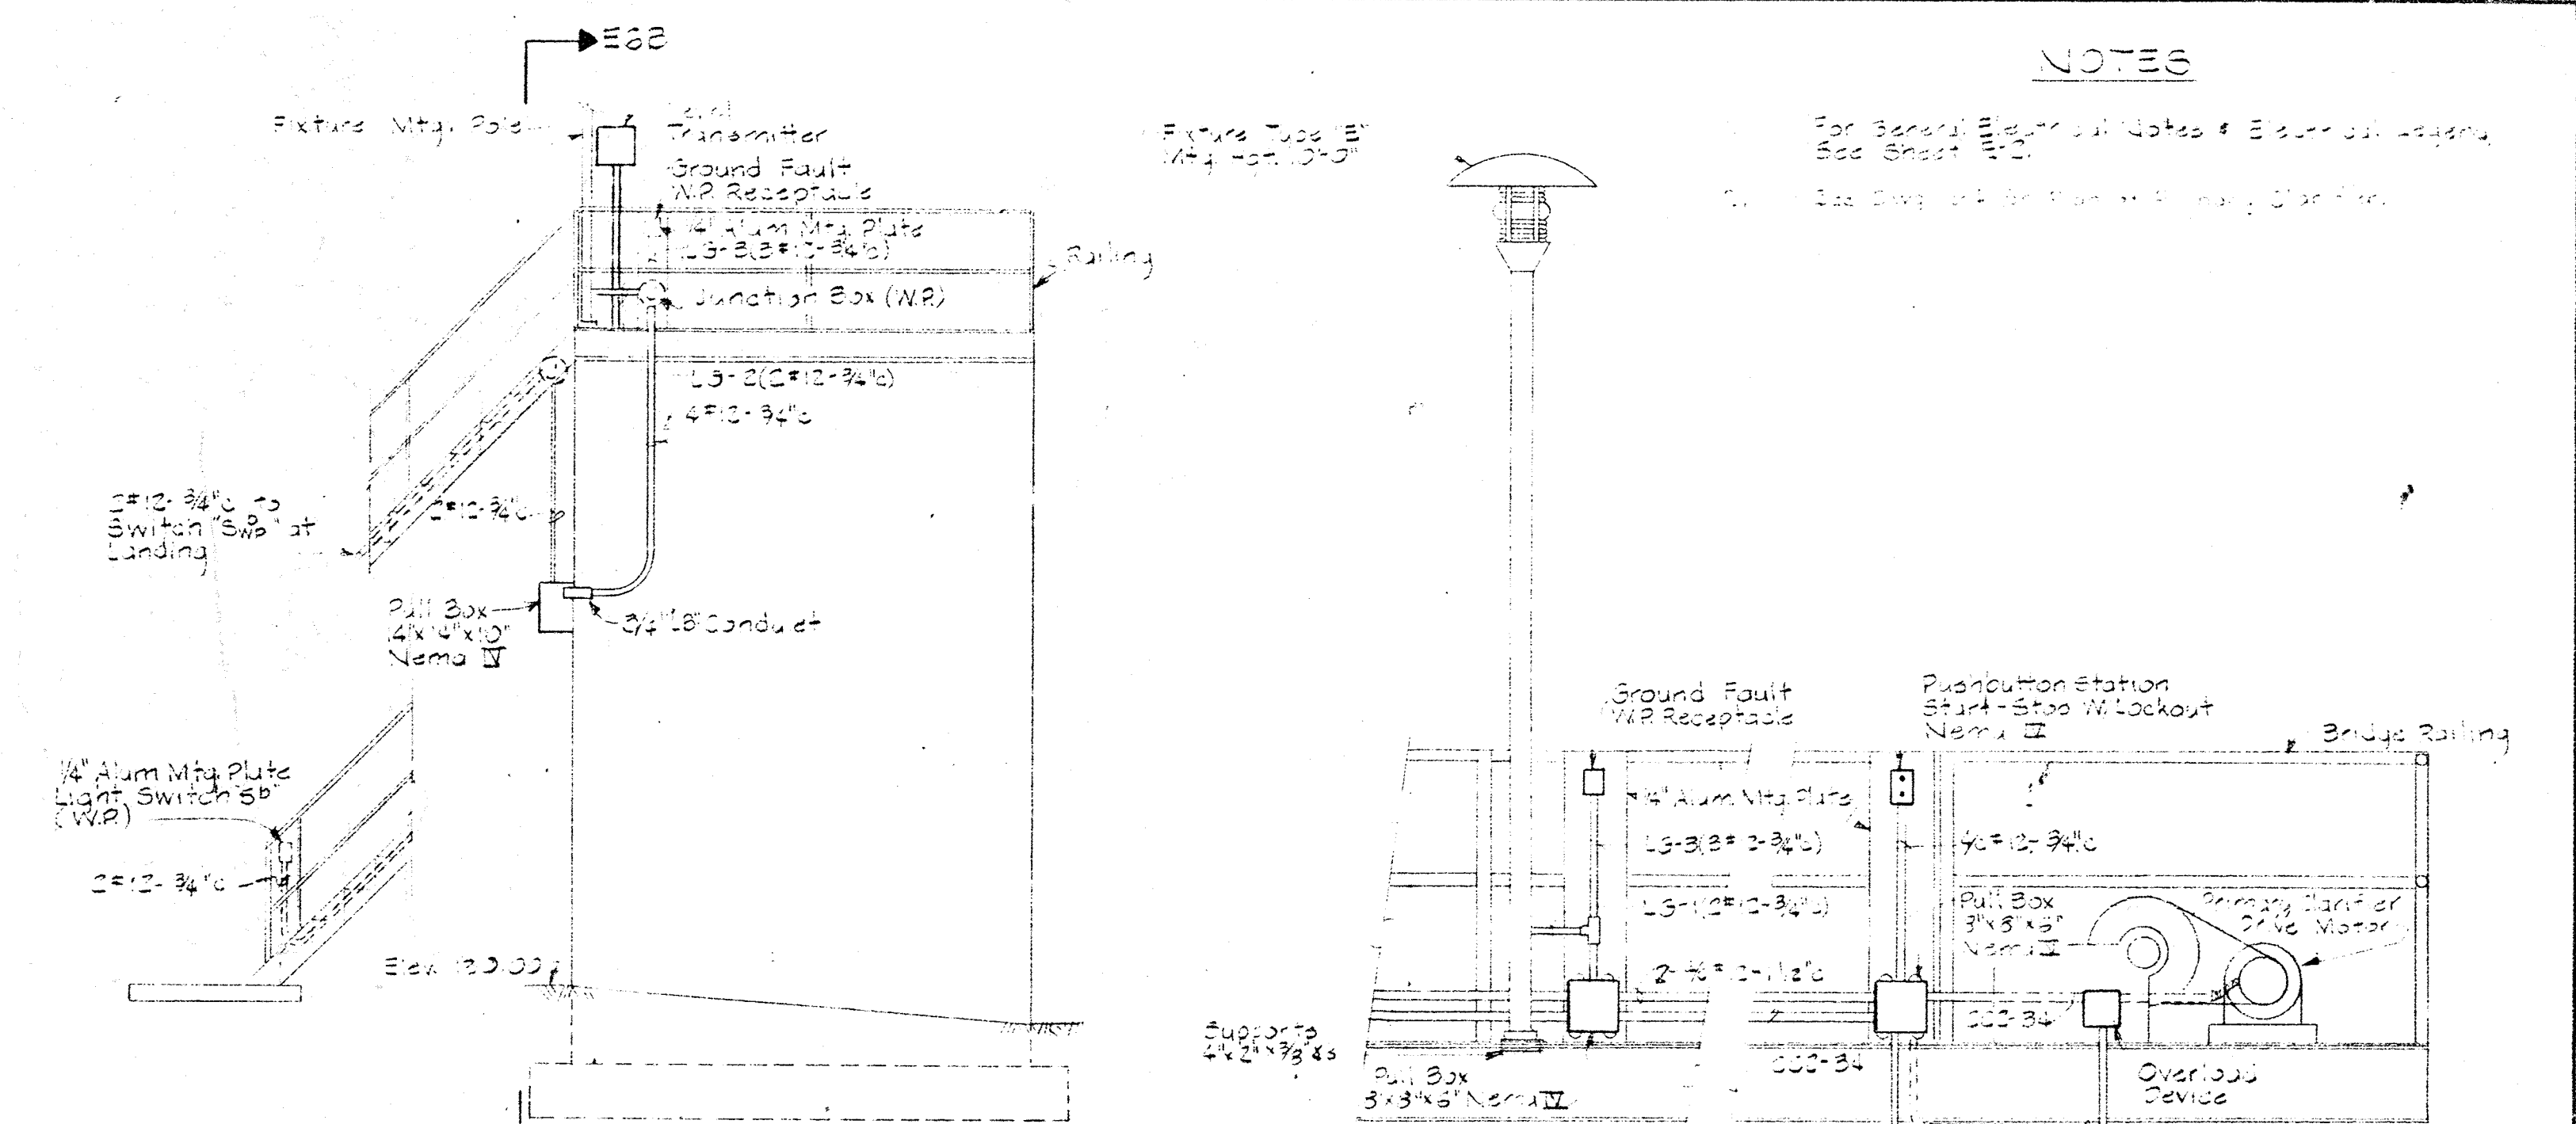

ELEMENTARY WIRING DIAGRAMS

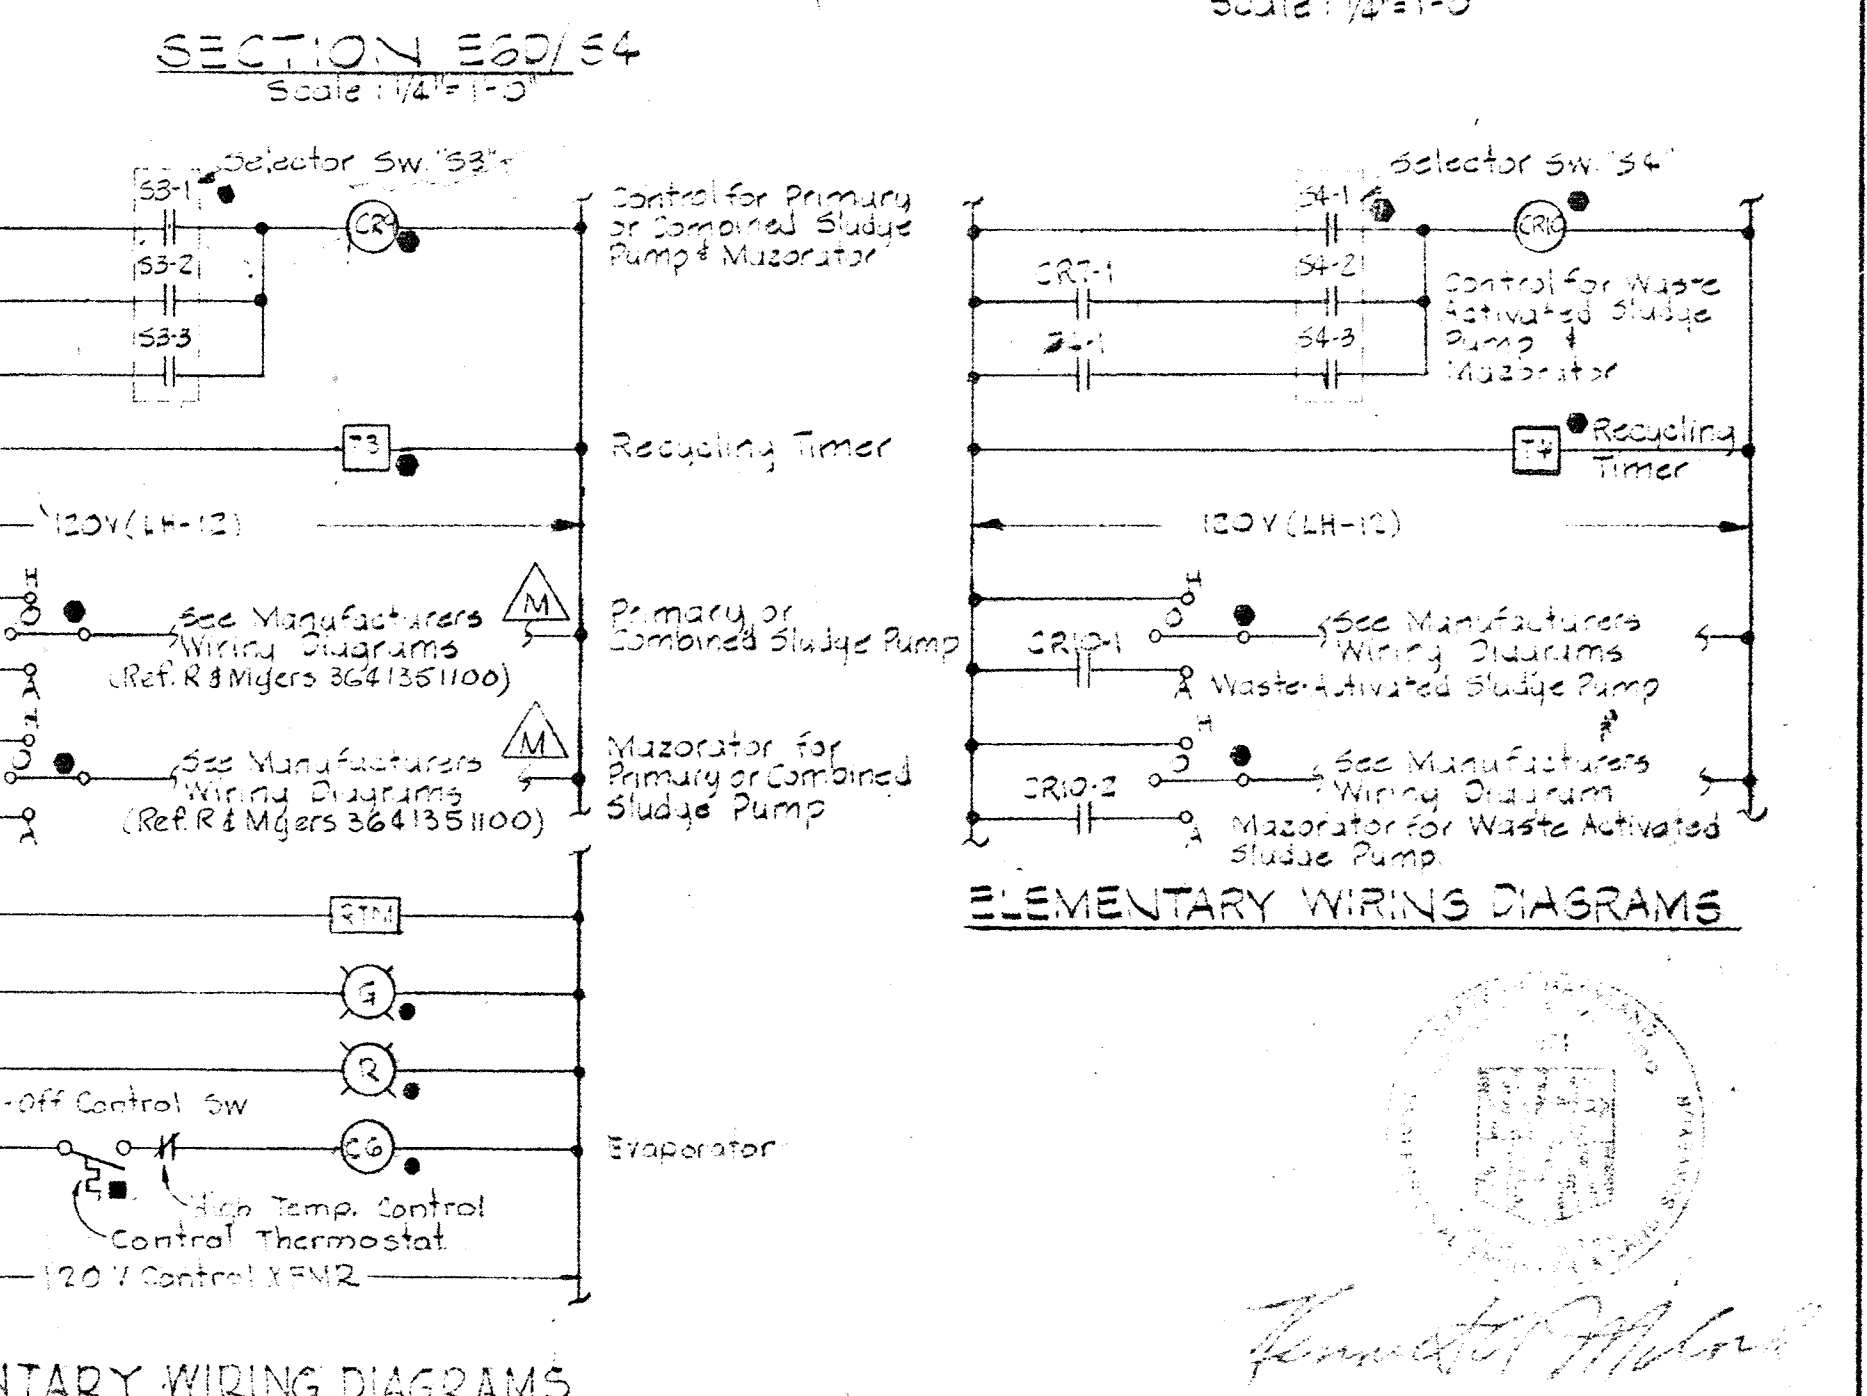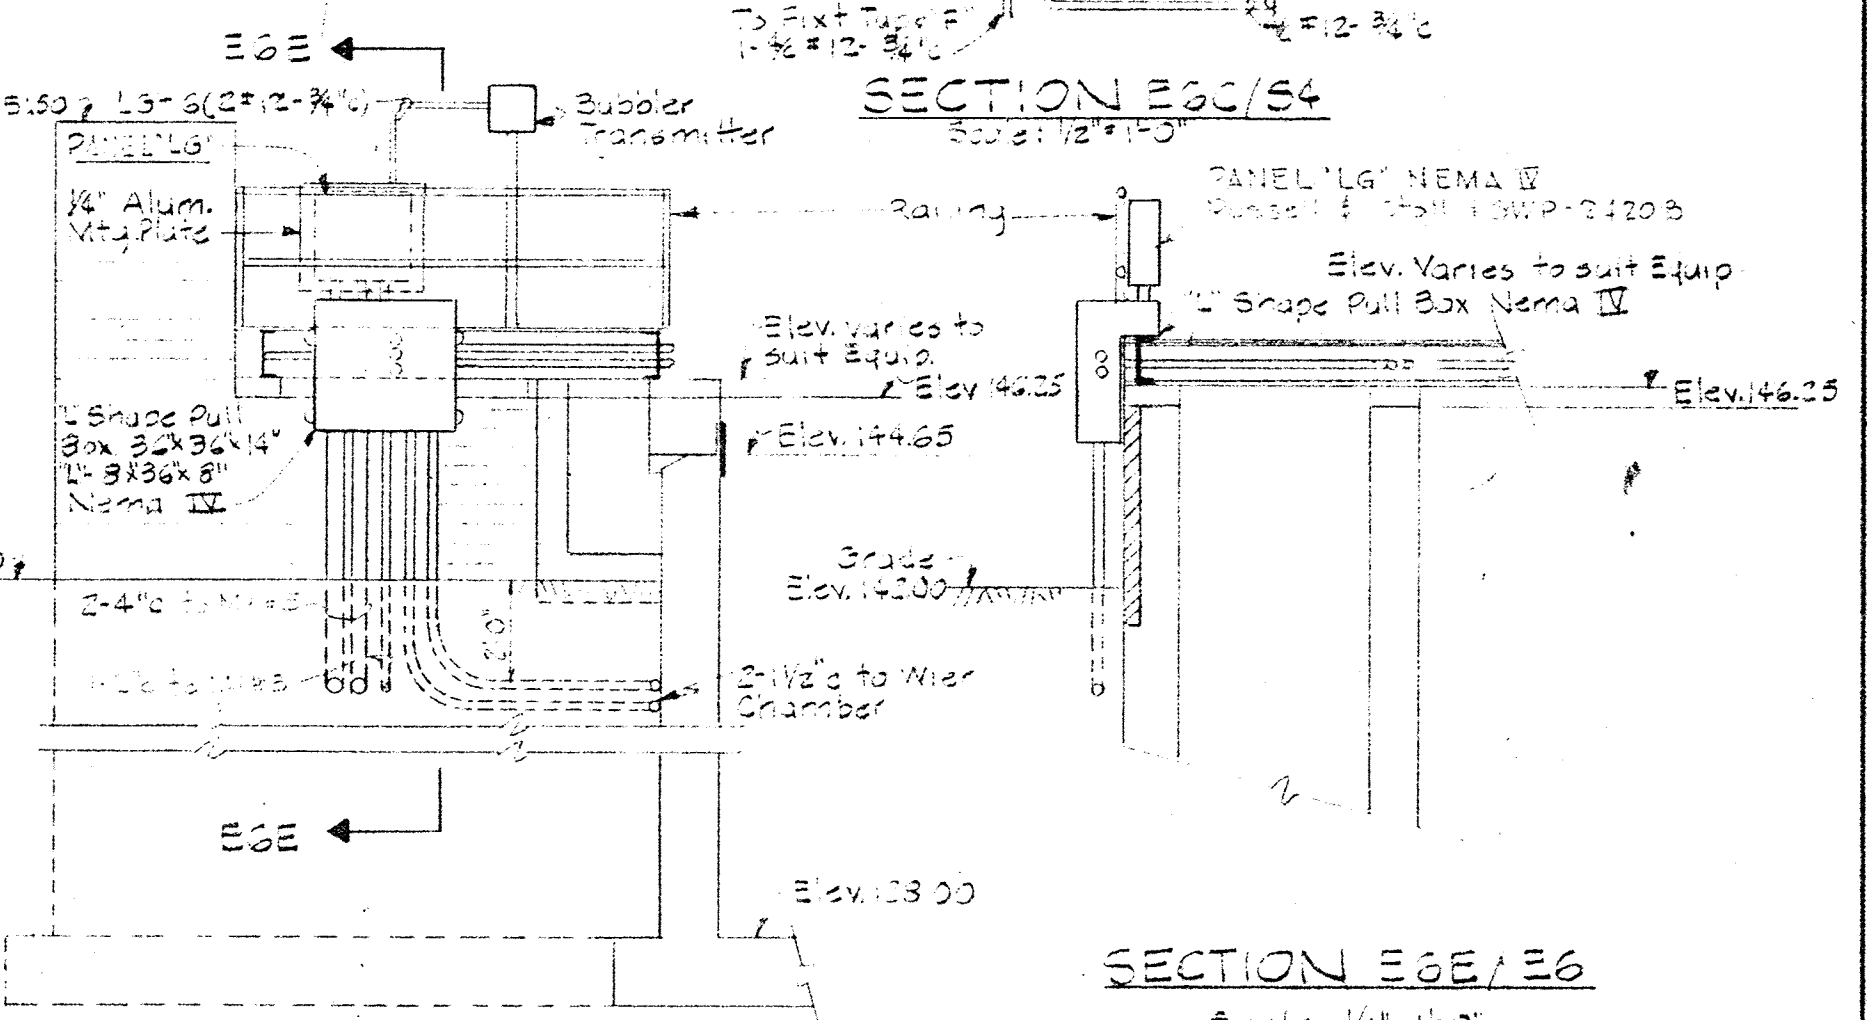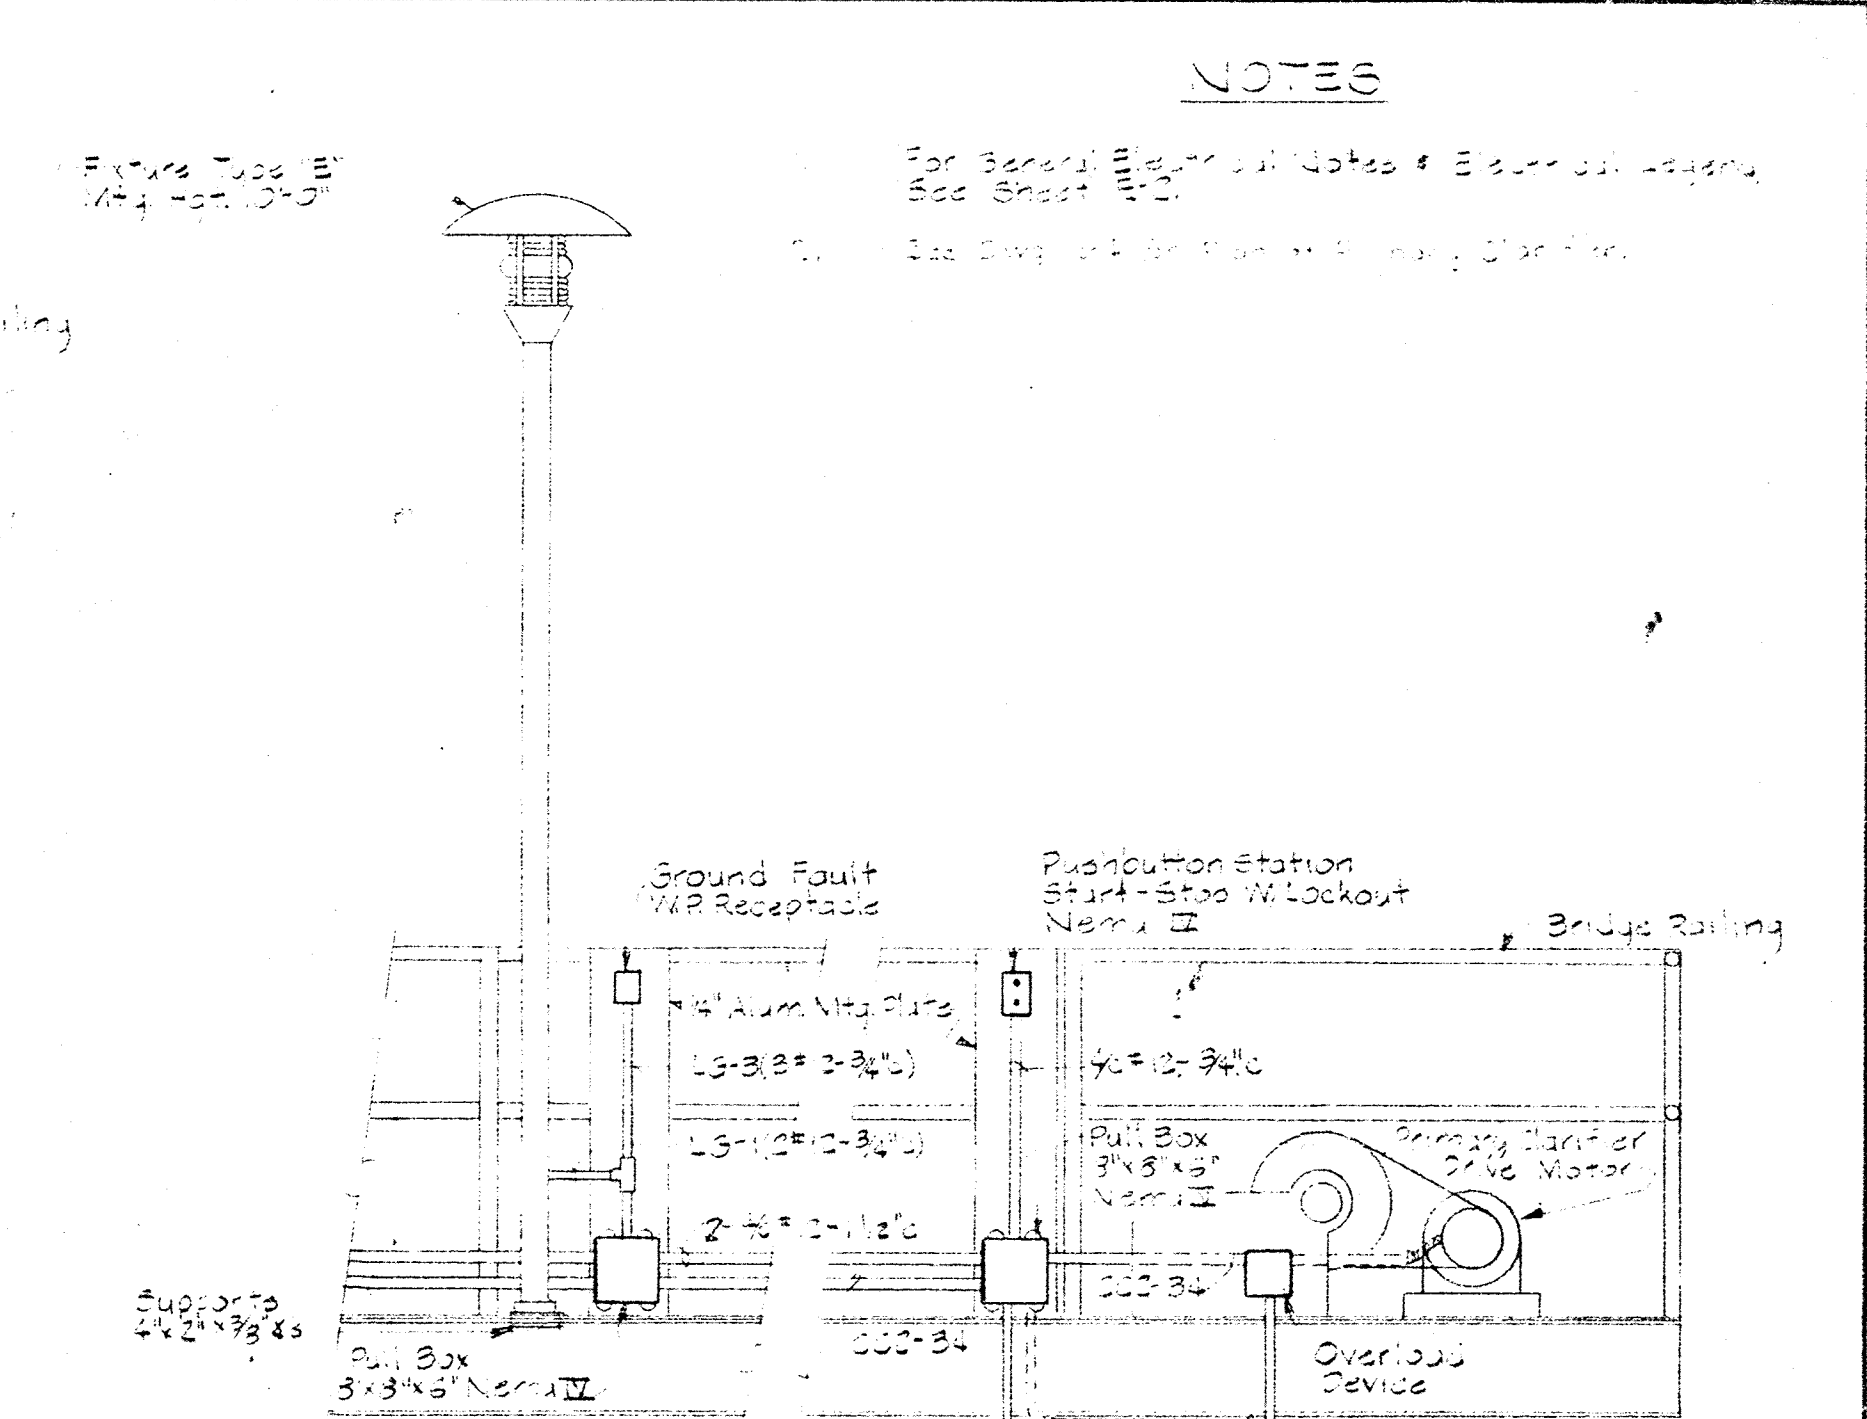

ELEMENTARY WIRING DIAGRAMS

NOTES  
For General Electrical Notes & Electrical Symbols See Sheet E-1  
See Shop List for Material Specifications

<p>WHITMAN, REQUARDT &amp; ASSOCIATES ENGINEERS 1304 ST. PAUL ST. BALTIMORE, MARYLAND</p>	<p>DEPARTMENT OF PUBLIC WORKS HOWARD COUNTY, MARYLAND 2/1/73 DATE</p>	<p>CONTRACT NO. 525-S</p>	<p>WIRING DIAGRAMS AND MISCELLANEOUS DETAILS</p>	<p>SAVAGE WASTEWATER TREATMENT PLANT ADDITION NO.3</p>	<p>DRAWING NO. 28 OF 28 SCALE AS SHOWN</p>
---	---	---------------------------	--	--	--

W. O. 6538-2

Addendum

SHEET E-6