

CAPITAL PROJECT S-4-6047
CONTRACT NO. 2720-S
MIDDLE PATUXENT INTERCEPTOR
LITTLE PATUXENT RIVER TO I-95
HOWARD COUNTY, MARYLAND
DEPARTMENT OF PUBLIC WORKS

QUANTITIES		
Item	Estimated	As-Built
12" Sewer	5 L.F.	3 L.F.
16" Sewer	150 L.F.	144 L.F.
24" Sewer	2280 L.F.	2,257 L.F.
27" Sewer	915 L.F.	608 L.F.
33" Sewer	1980 L.F.	1,942 L.F.
Manholes	260 V.F.	228 V.F.




- GENERAL NOTES**
- Approximate location of existing utilities is shown. The Contractor shall take all necessary precautions to protect existing utilities and to maintain uninterrupted service. Any damage incurred shall be repaired immediately to the satisfaction of the Engineer by the Contractor at the Contractor's expense.
 - The Contractor shall locate existing utilities a minimum of two weeks in advance of construction operations in vicinity of utilities. Cost shall be included in the unit price bid for excavation and backfill of sewer mains.
 - Contractor shall notify the following utilities or agencies at least (5) days before starting work shown on these plans:
Miss Utility 1-800-441-8355
State of Maryland - Department of Water Resources 301-267-5551
 - Clear all utilities by a minimum of 6". Clear all poles 2'-0" minimum, or tunnel as required. Cost for tunneling or bracing at poles shall be included in the unit price bid for excavation and backfill of sewer mains.
 - All pipe elevations shown are invert elevations.
 - All Manholes shall be 4'-0" inside diameter unless otherwise noted.
 - The Contractor shall provide a pipe joint in each sewer main within 2'-0" of the exterior manhole walls.
 - Watertight manhole frame and cover to be used where indicated on drawings [Standard Detail S-12 (RCR 63A)]. Where watertight manhole frame and cover is used, set top of frame 1'-6" above finished grade.
 - For details not shown on the Contract Drawings see Standard Details bound in the specifications.
 - Trees are to be protected from damage to the maximum extent.
 - Contractor shall remove trees, stumps and roots along line of excavation as directed by the Engineer. Payment for such removal shall be included in the unit price bid for excavation and backfill for sewer mains.
 - Horizontal and Vertical controls are based on the Maryland State Grid Coordinate System.

WS 20/5/21

As Built August 20, 1980

REV.	DATE	REMARKS

PURDUM & JESCHKE ENGINEERS 1023 N. CALVERT ST. BALTIMORE, MARYLAND	DEPARTMENT OF PUBLIC WORKS HOWARD COUNTY, MARYLAND <i>P.P. Rosen</i> DIRECTOR OF PUBLIC WORKS DATE 6-27-77	CONTRACT NO. 2720-S CAPITAL PROJECT NO. S-4-6047	LOCATION MAP OF SANITARY SEWERS	MIDDLE PATUXENT INTERCEPTOR ELECTION DISTRICT NO. 6 HOWARD COUNTY, MARYLAND	DRAWING NO. 1 OF 6	SCALE 1" = 600'	MAPS: 220-41,42 221-41,42
					Contract No. 2720-S Capital Project S-4-6047 Middle Patuxent Interceptor Little Patuxent River To Interstate 95	SEPTEMBER 5, 1975	

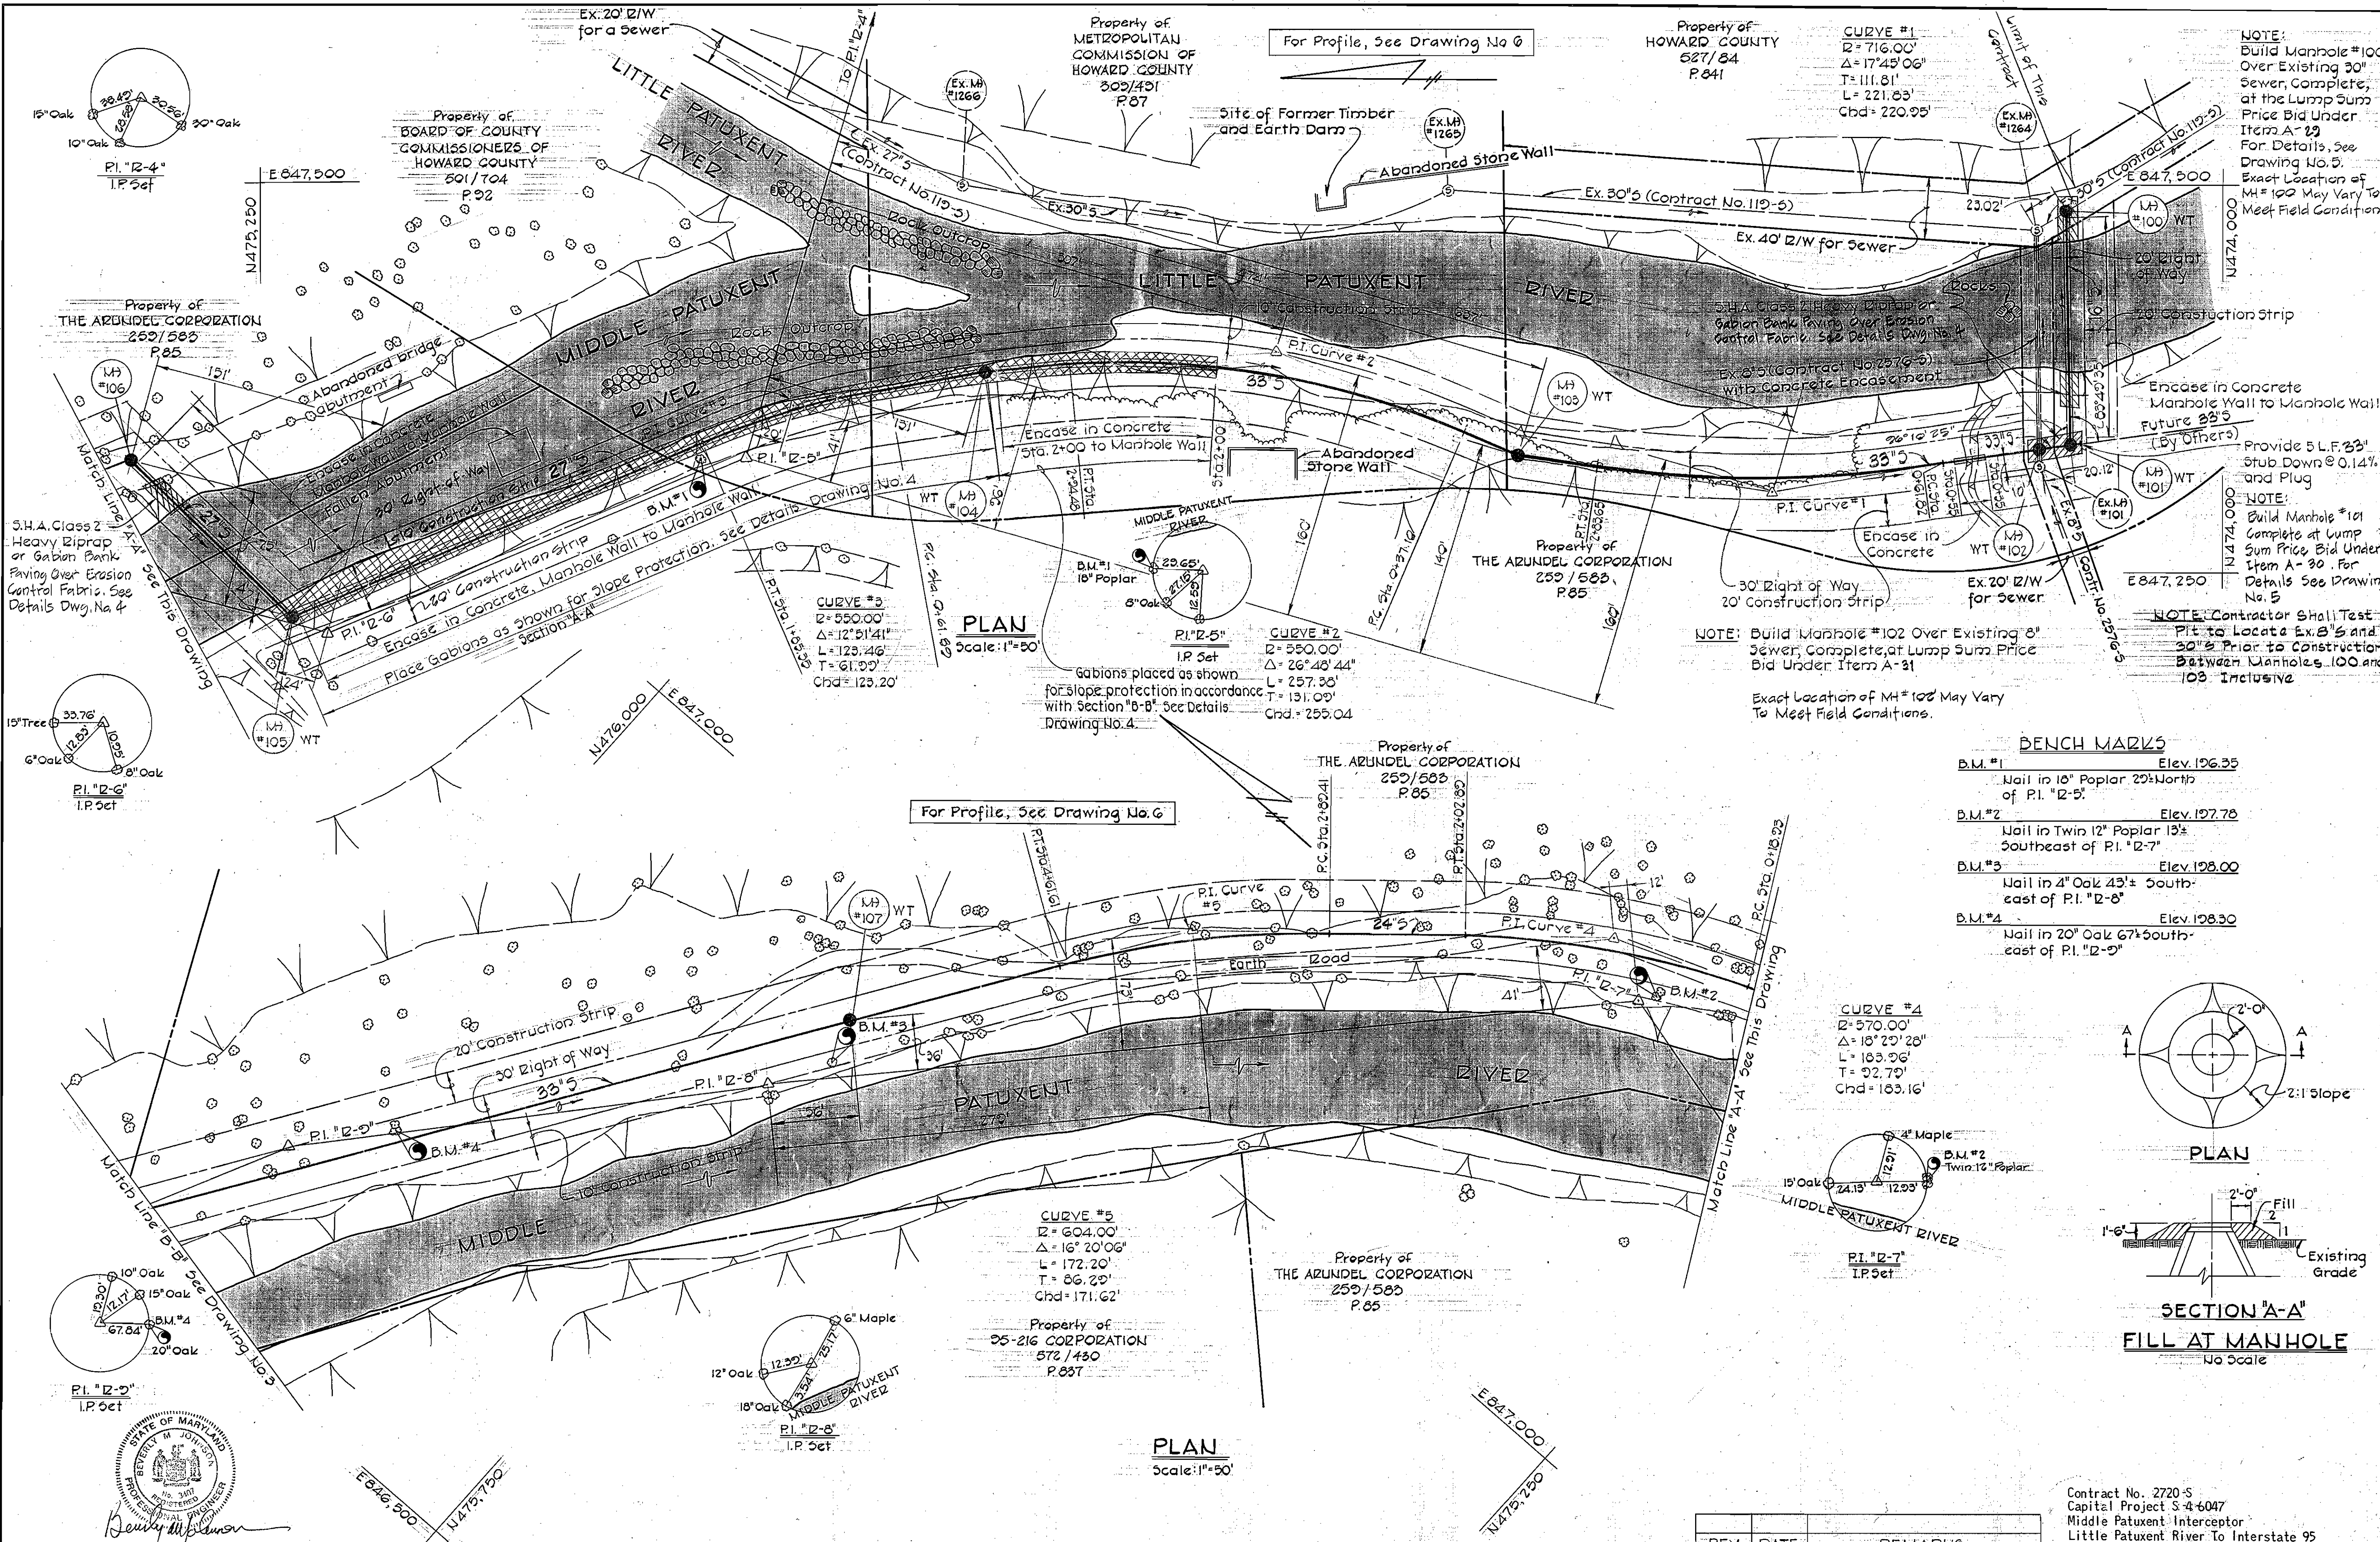



NOTE:
Build Manhole #100
Over Existing 30"
Sewer, Complete,
at the Lump Sum
Price Bid Under
Item A-29
For Details, See
Drawing No. 5.
Exact Location of
MH #100 May Vary To
Meet Field Conditions.

NOTE:
Build Manhole #101
Complete at Lump
Sum Price Bid Under
Item A-30. For
Details See Drawing
No. 5

NOTE: Contractor Shall Test
Pit to Locate Ex. S and
30' S Prior to Construction
Between Manholes 100 and
102 Inclusive

NOTE: Build Manhole #102 Over Existing 8"
Sewer, Complete, at Lump Sum Price
Bid Under Item A-31
Exact Location of MH #102 May Vary
To Meet Field Conditions.

- BENCH MARKS**
- B.M. #1 Elev. 126.35
Nail in 10" Poplar 20' North
of P.I. "D-5"
 - B.M. #2 Elev. 127.78
Nail in Twin 12" Poplar 13'
Southeast of P.I. "D-7"
 - B.M. #3 Elev. 128.00
Nail in 4" Oak 43'± South-
east of P.I. "D-8"
 - B.M. #4 Elev. 128.30
Nail in 20" Oak 67'± South-
east of P.I. "D-9"

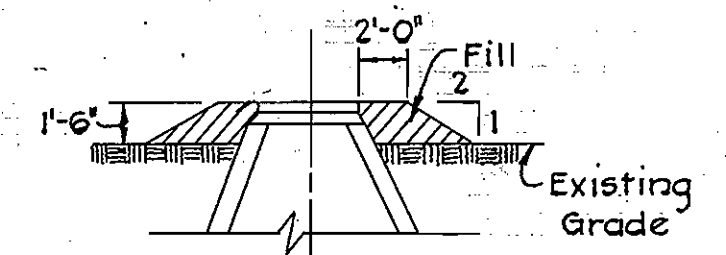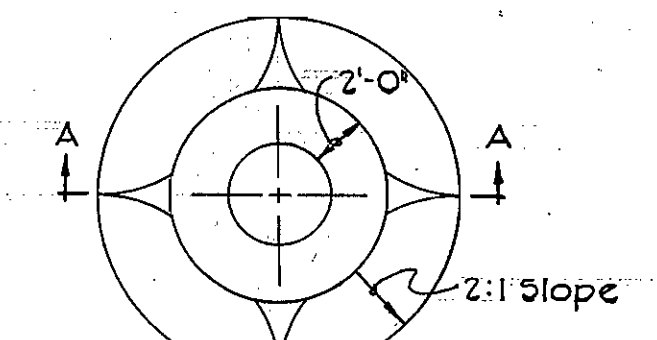


SECTION "A-A"
FILL AT MANHOLE
No Scale

CURVE #4
R = 570.00'
Δ = 18° 20' 28"
L = 183.96'
T = 32.79'
Chd = 183.16'

CURVE #5
R = 604.00'
Δ = 16° 20' 08"
L = 172.20'
T = 66.29'
Chd = 171.62'

PLAN
Scale: 1"=50'

PLAN
Scale: 1"=50'

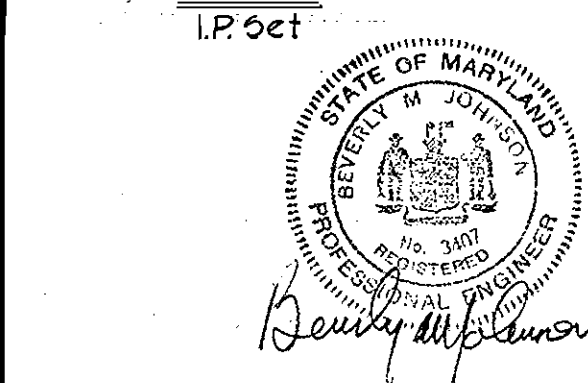

PURDUM & JESCHKE
ENGINEERS
1023 N. CALVERT ST.
BALTIMORE, MARYLAND

DEPARTMENT OF PUBLIC WORKS
HOWARD COUNTY, MARYLAND
6-27-77
DIRECTOR OF PUBLIC WORKS DATE

CONTRACT NO. 720-S
CAPITAL PROJECT NO. S-4 6047

PLAN
OF SANITARY SEWERS AND
DETAILS

MIDDLE PATUXENT INTERCEPTOR
ELECTION DISTRICT NO. 6
HOWARD COUNTY, MARYLAND

DRAWING SCALE
NO. 2 OF 6
AS SHOWN

REV.	DATE	REMARKS

WS 720 S/2

As Built August 20, 1980

CURVE #6
 R = 604.00'
 Δ = 27° 22' 52"
 L = 288.65'
 T = 147.13'
 Chd. = 205.91'

Property of
 HOWARD COUNTY
 351/199
 P.81

For Profile, See Drawing No. 6

BENCH MARKS
 B.M.#10 Elev. 220.22
 Nail in 12" Oak 42' ± South of
 P.I. "2-17"

PLAN
 Scale: 1" = 50'

REV.	DATE	REMARKS

Property of
 THE ARZUNDEL CORPORATION
 253/203
 P.10

Property of
 THE ARZUNDEL CORPORATION
 253/200
 P.12

For Profile, See Drawing No. 6

Connect to
 33' ± (Contr. No.
 2721-5) if Existing,
 Otherwise
 Place 33' stub
 up @ 0.12%
 and Plug

BENCH MARKS

B.M.#5 Elev. 199.65
 Nail in 30" Sycamore 42' ±
 Southeast of P.I. "2-10"

B.M.#6 Elev. 201.18
 Nail in 48" Sycamore 49' ±
 Northeast of P.I. "2-12"

B.M.#8 Elev. 203.62
 Nail in 24" Sycamore 18' ±
 East of P.I. "2-14"

B.M.#9 Elev. 206.35
 Nail in 18" Beech 41' ± West
 of P.I. "2-15"

B.M.#11 Elev. 217.64
 Nail in 12" Beech 12' ±
 Northeast of P.I. "2-18"

S.H.A. Class 2 Heavy
 Rip Rap or Gabion Bank
 Paving Over Erosion Control
 Fabric. See Detail Dwg. No. 4

WS 720 5/3

PURDUM & JESCHKE
 ENGINEERS
 1023 N. CALVERT ST.
 BALTIMORE, MARYLAND

DEPARTMENT OF PUBLIC WORKS
 HOWARD COUNTY, MARYLAND
 Director of Public Works DATE 6-28-77
 Chief Bureau of Engineering DATE 6-27-77

CONTRACT NO. 720-5
 CAPITAL PROJECT NO. S-4-6067

PLAN
 OF SANITARY SEWERS


MIDDLE PATUXENT INTERCEPTOR
 ELECTION DISTRICT NO. 6
 HOWARD COUNTY, MARYLAND

DRAWING NO. 3
 OF 6

SCALE 1" = 50'
 DESIGNED: JAM/JTA
 DRAFTED: ARZ
 CHECKED: TAF

NOTES:


1. The Excavated Opening shall Fit Closely the Outside Shape of the Liner Plates.
2. Where too much Ground is Removed, the Annular Space between Plates and Ground shall be Grouted Promptly or Temporarily Packed with Hay and Later Grouted.
3. Grout shall be Injected in Lower Holes First, Moving Up as the Back Space is Filled. Plugs shall be Installed in Holes after Filling at Each One.
4. Place Brick Bulkheads at Both Ends of Tunnel.

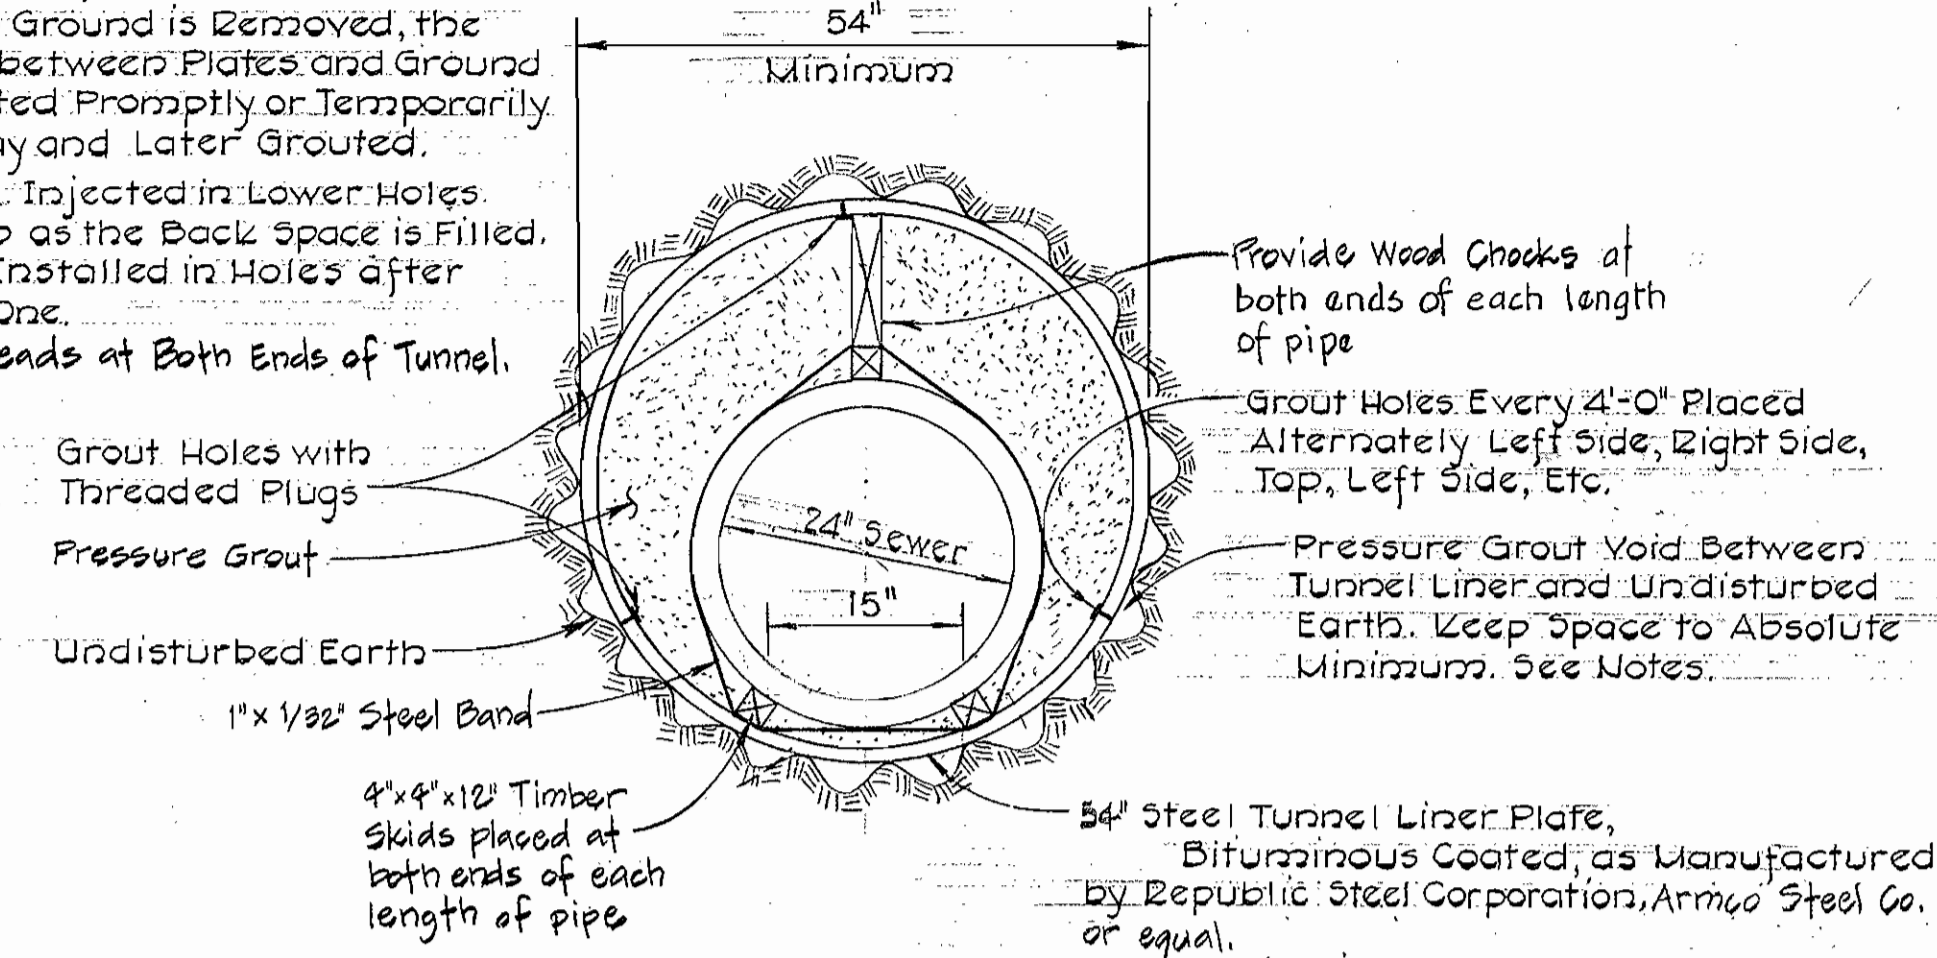

LINER PLATE DIMENSIONS	
MANUFACTURER	GAGE
REPUBLIC	12
ARMCO	14

TUNNEL DETAIL
Scale: 1/2" = 1'-0"


GABION STRUCTURE DATA	
Letter Code of Size	Approximate Length Width and Depth
C	12' x 3' x 3'
F	12' x 3' x 1'-6"

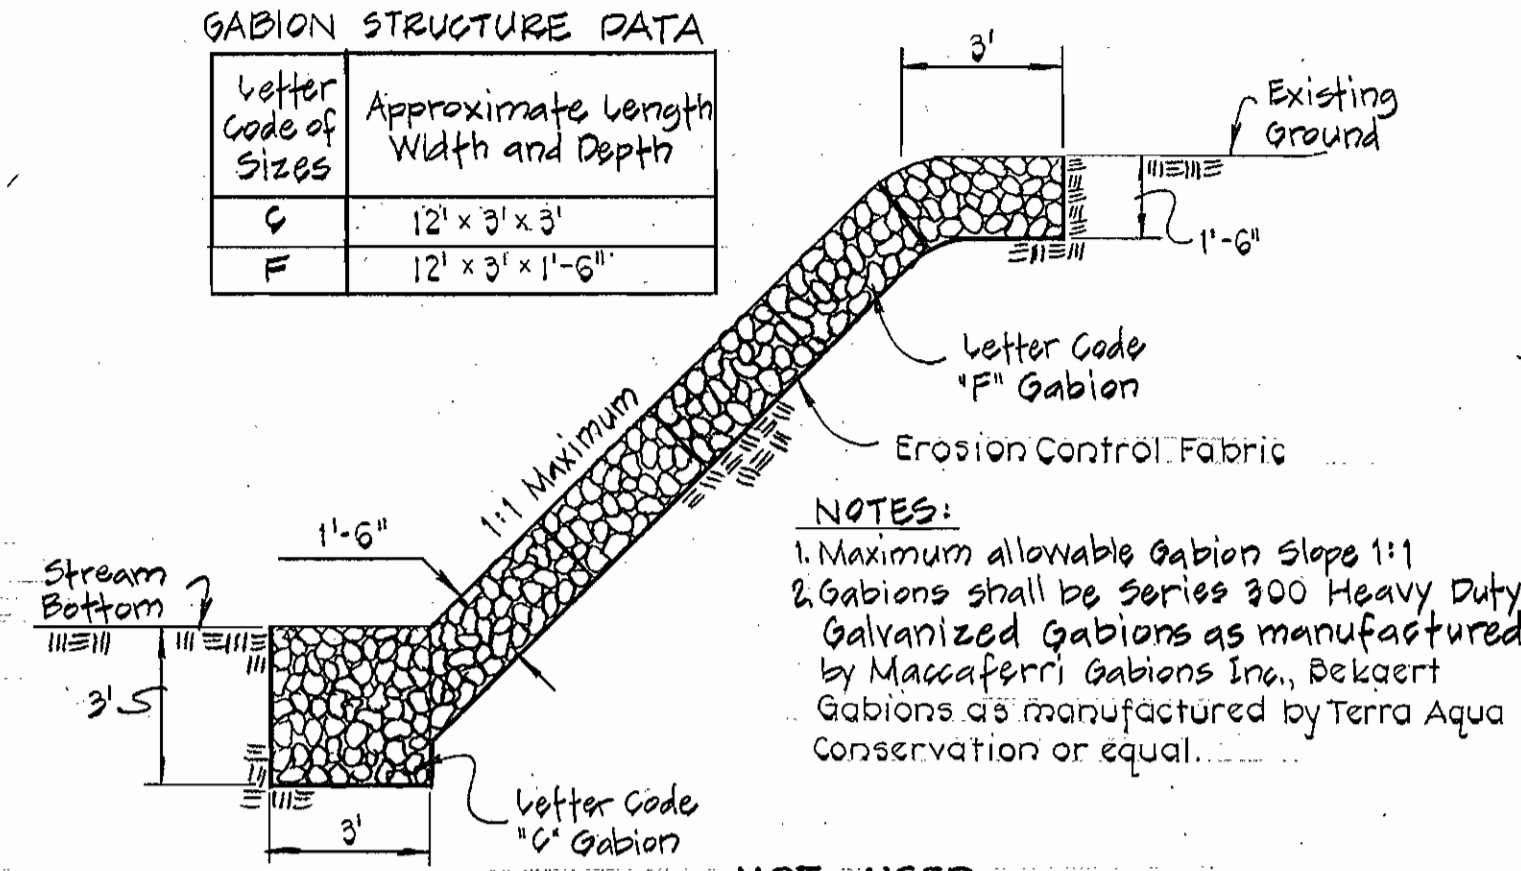

- NOTES:**
1. Maximum allowable Gabion Slope 1:1
 2. Gabions shall be Series 300 Heavy Duty Galvanized Gabions as manufactured by Maccaferri Gabions Inc., DeKaert Gabions as manufactured by Terra Aqua Conservation or equal.

GABION BANK PAVING AT PIPE CROSSINGS
No Scale

Rip-Rap to consist of dense rocks of random shapes and sizes, resistant to the action of air and water, and suitable for bank protection. All rocks shall weigh a minimum of 300 pounds.

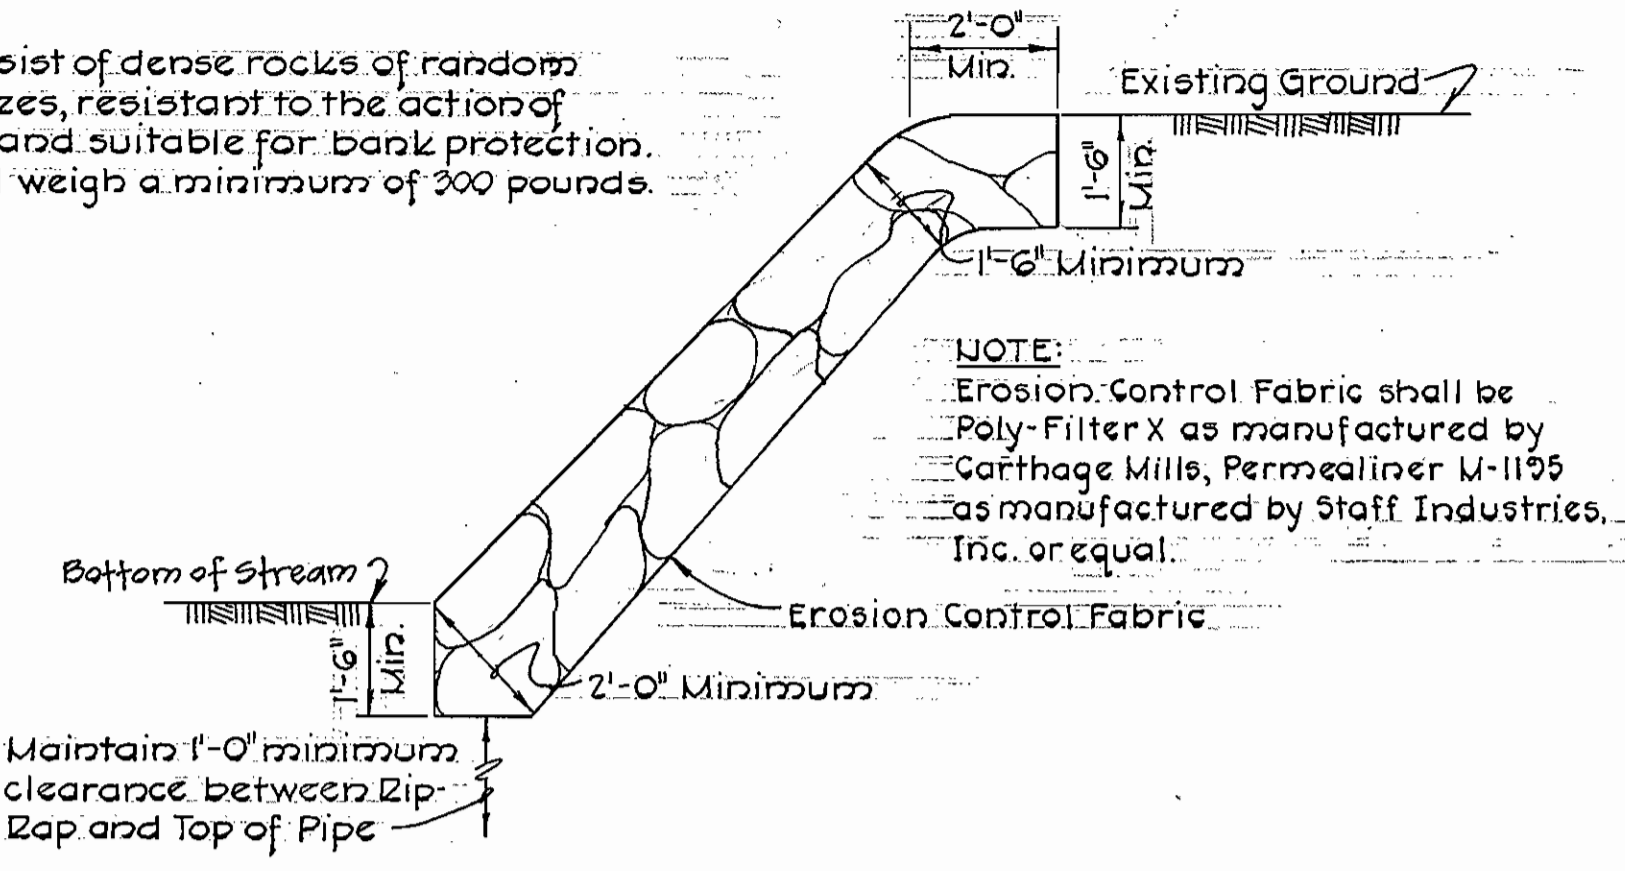


NOTE:
Erosion Control Fabric shall be Poly-Filter X as manufactured by Carthage Mills, Permealiner M-1195 as manufactured by Staff Industries, Inc. or equal.

S.H.A. CLASS 2 HEAVY RIP-RAP DETAIL
No Scale

GABION STRUCTURE DATA


Letter Code of Size	Approximate Length Width and Depth in Feet
A	6' x 3' x 3'
B	9' x 3' x 3'
C	12' x 3' x 3'
E	2' x 3' x 1'-6"
F	12' x 3' x 1'-6"

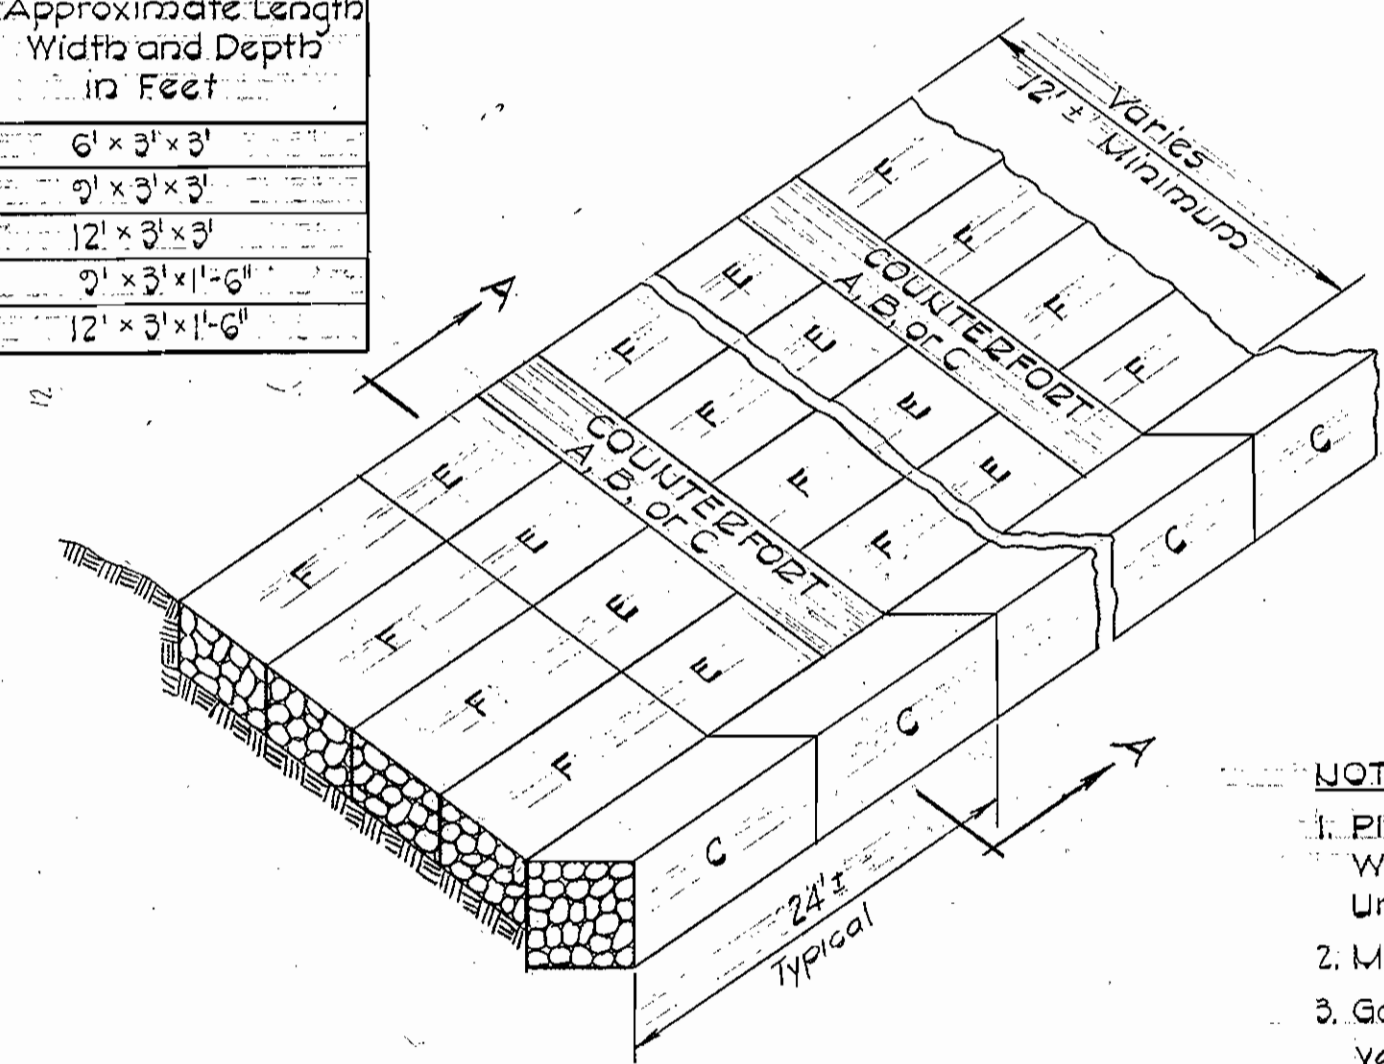

ISOMETRIC VIEW
No Scale


NOTES:

1. Place Counterfort Section Every 24' With Combinations of Type A, B, or C Gabion Units. As Required to Meet Existing Slope.
2. Maximum Allowable Gabion Slope 1:1
3. Gabions shall be Series 300 Heavy Duty Galvanized Gabions as manufactured by Maccaferri Gabions Inc., DeKaert Gabions as manufactured by Terra Aqua Conservation or equal.

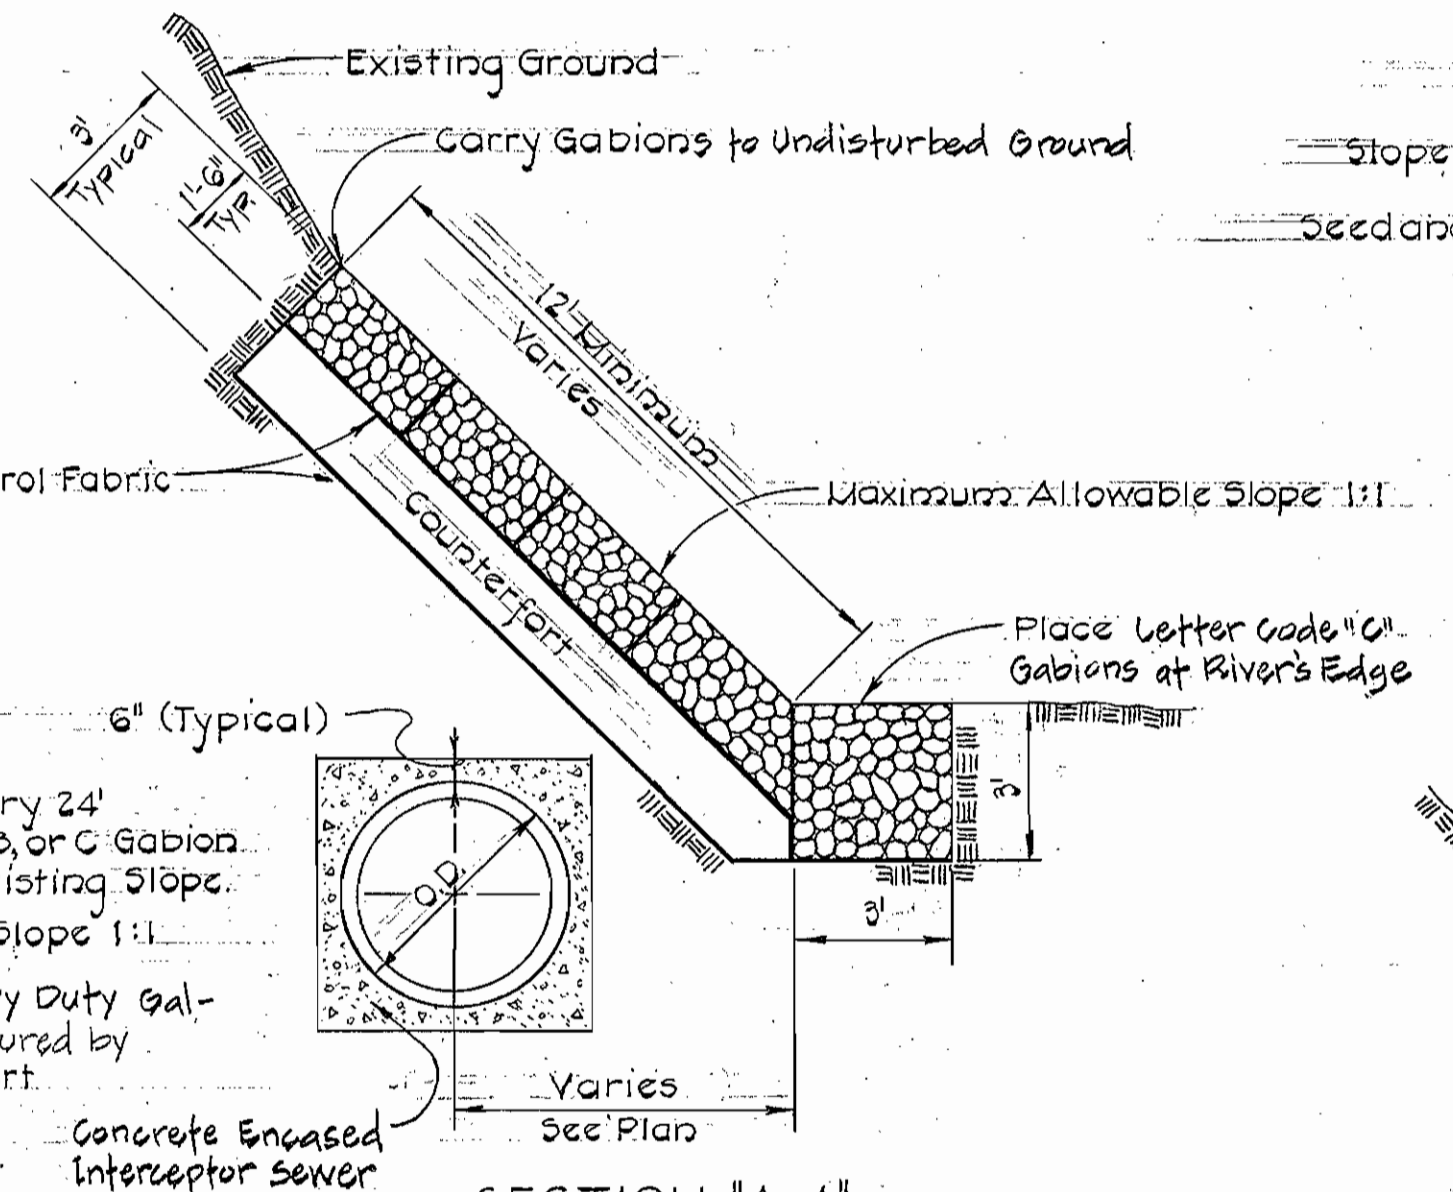


SECTION 'A-A'
Scale: 1/4" = 1'-0"

GABION SLOPE PROTECTION

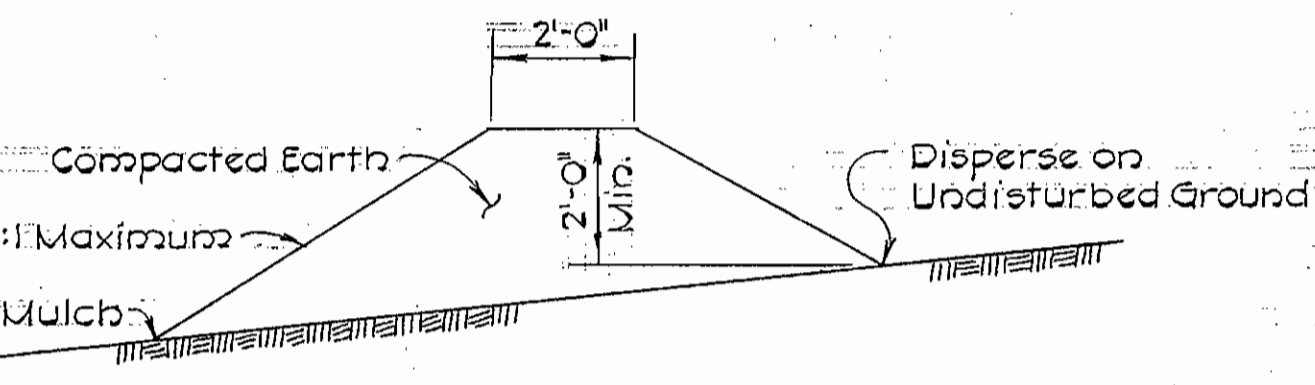

TEMPORARY EARTH DIVERSION BEAM
No Scale

Diversion Berms are required every 250 feet on continuous slopes of 4% or greater. The berms shall conform to the typical section shown hereon and shall be constructed across the construction areas immediately after the backfilling of the pipe trench and prior to placing stabilization in order to prevent erosion of the backfilled areas.

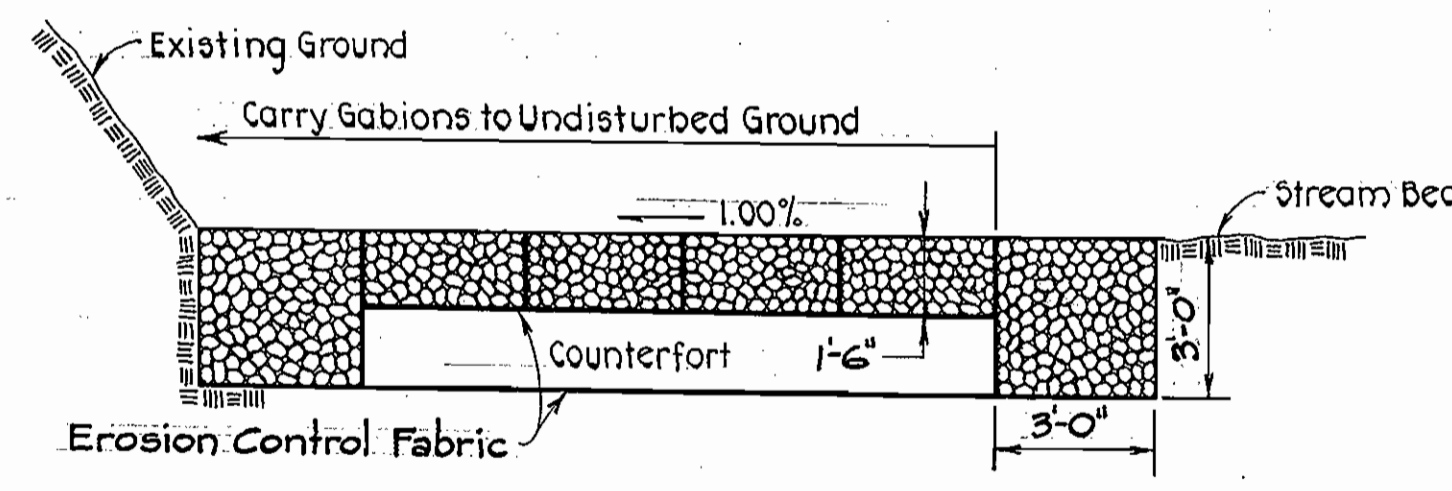

SECTION 'B-B'
Not to Scale



WS 720 S/4

PURDUM & JESCHKE
ENGINEERS
1023 N. CALVERT ST.
BALTIMORE, MARYLAND

DEPARTMENT OF PUBLIC WORKS
HOWARD COUNTY, MARYLAND
6-28-77
DIRECTOR OF PUBLIC WORKS DATE

CONTRACT NO. 720-S
CAPITAL PROJECT NO. S-4-6047

DETAILS

MIDDLE PATUXENT INTERCEPTOR
ELECTION DISTRICT NO. 6
HOWARD COUNTY, MARYLAND

DRAWING NO. 4 OF 6
SCALE AS SHOWN
DESIGNED: JMM/TA
DRAFTED: ARZ
CHECKED: TAF

REV.	DATE	REMARKS


Contract No. 2720-S
Capital Project S-4-6047
Middle Patuxent Interceptor
Little Patuxent River To Interstate 95

As Built August 20, 1980

WS 720 S/S

SUSPENSORY


SUSPENSORY

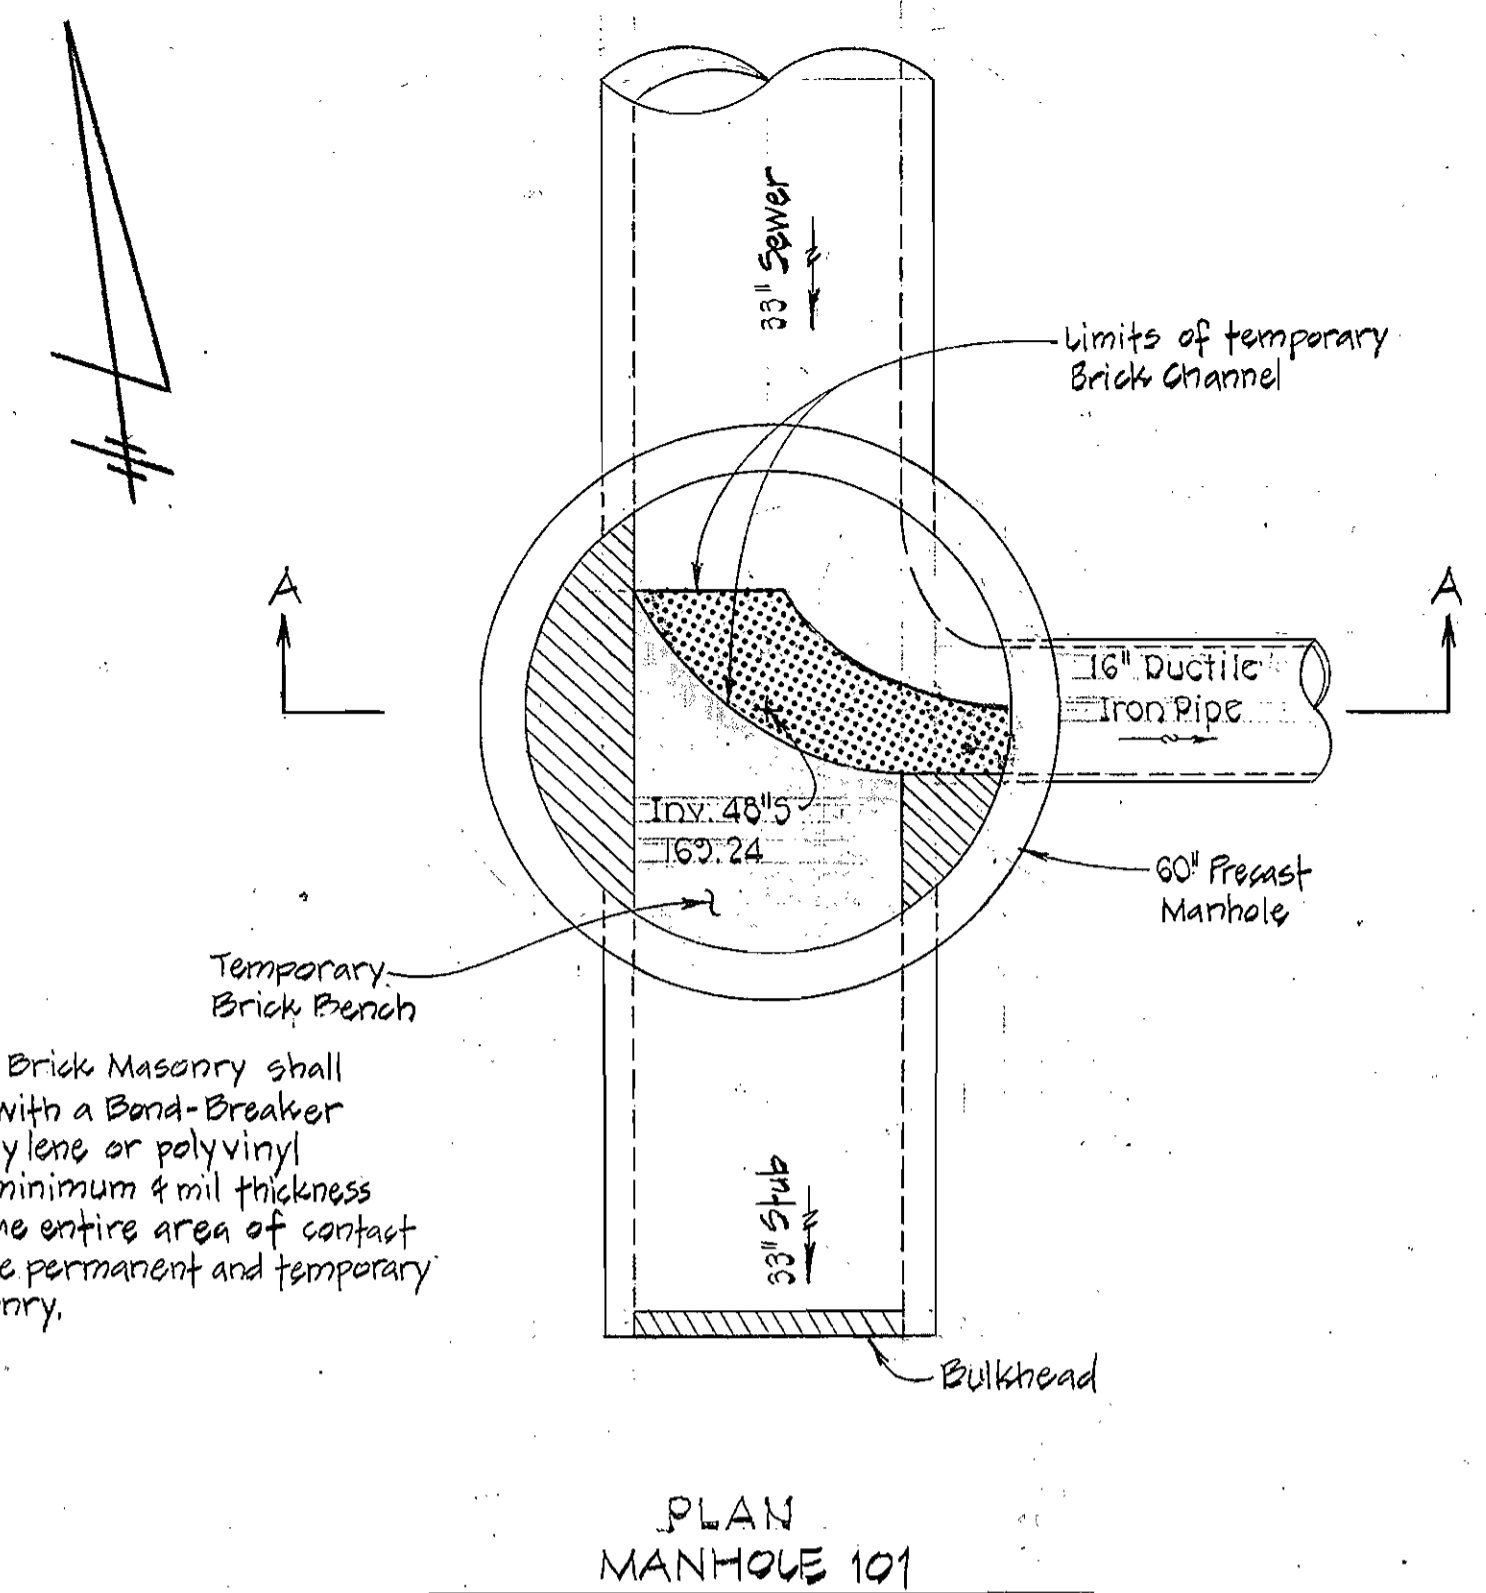


Note:
Temporary Brick Masonry shall be placed with a Bond-Breaker of polyethylene or polyvinyl chloride, minimum 4 mil thickness covering the entire area of contact between the permanent and temporary Brick Masonry.

Note:
Lump Sum Limits shall be manhole wall to manhole wall.

Contractor shall Provide Risers as Required and Watertight Frame and Cover in Accordance with Standard Detail S-5.

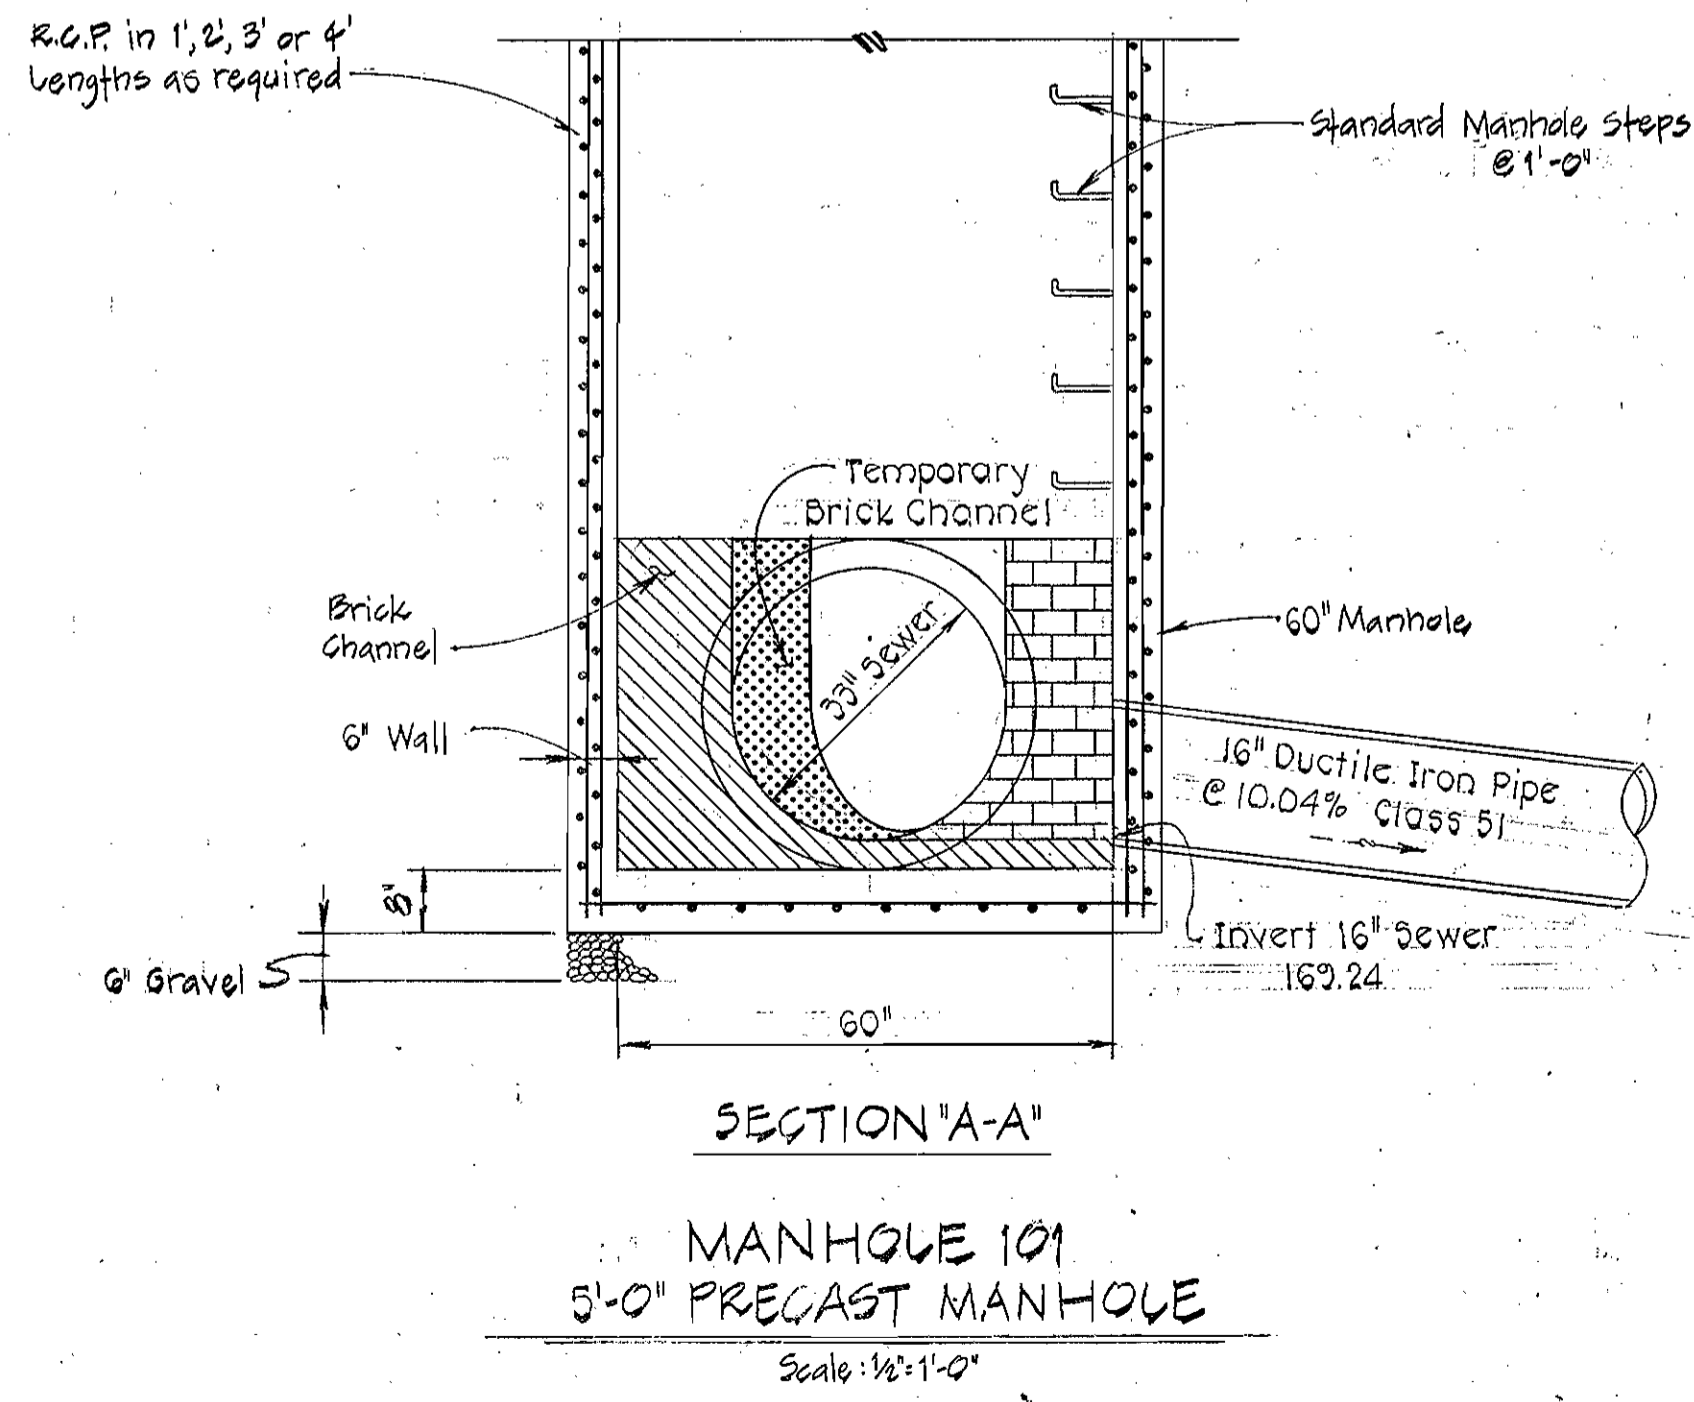

- Notes:
- Manhole Design shall conform to ASTM C 478 'Precast Reinforced Concrete Manhole Sections', latest Revision.
 - Reinforcing shall conform to ASTM A 185 and shall be provided in Bells and Spigots.
Area 60" Diameter = 0.17 in²/Vertical Ft.
 - All Concrete shall be 4000 p.s.i.
 - Pipe Openings shall be Provided as Required.
 - All Pipe Openings shall be sealed with Non-Shrink Grout Joint Filler.
 - Lift Pin Holes shall be provided in all Pieces for Handling.

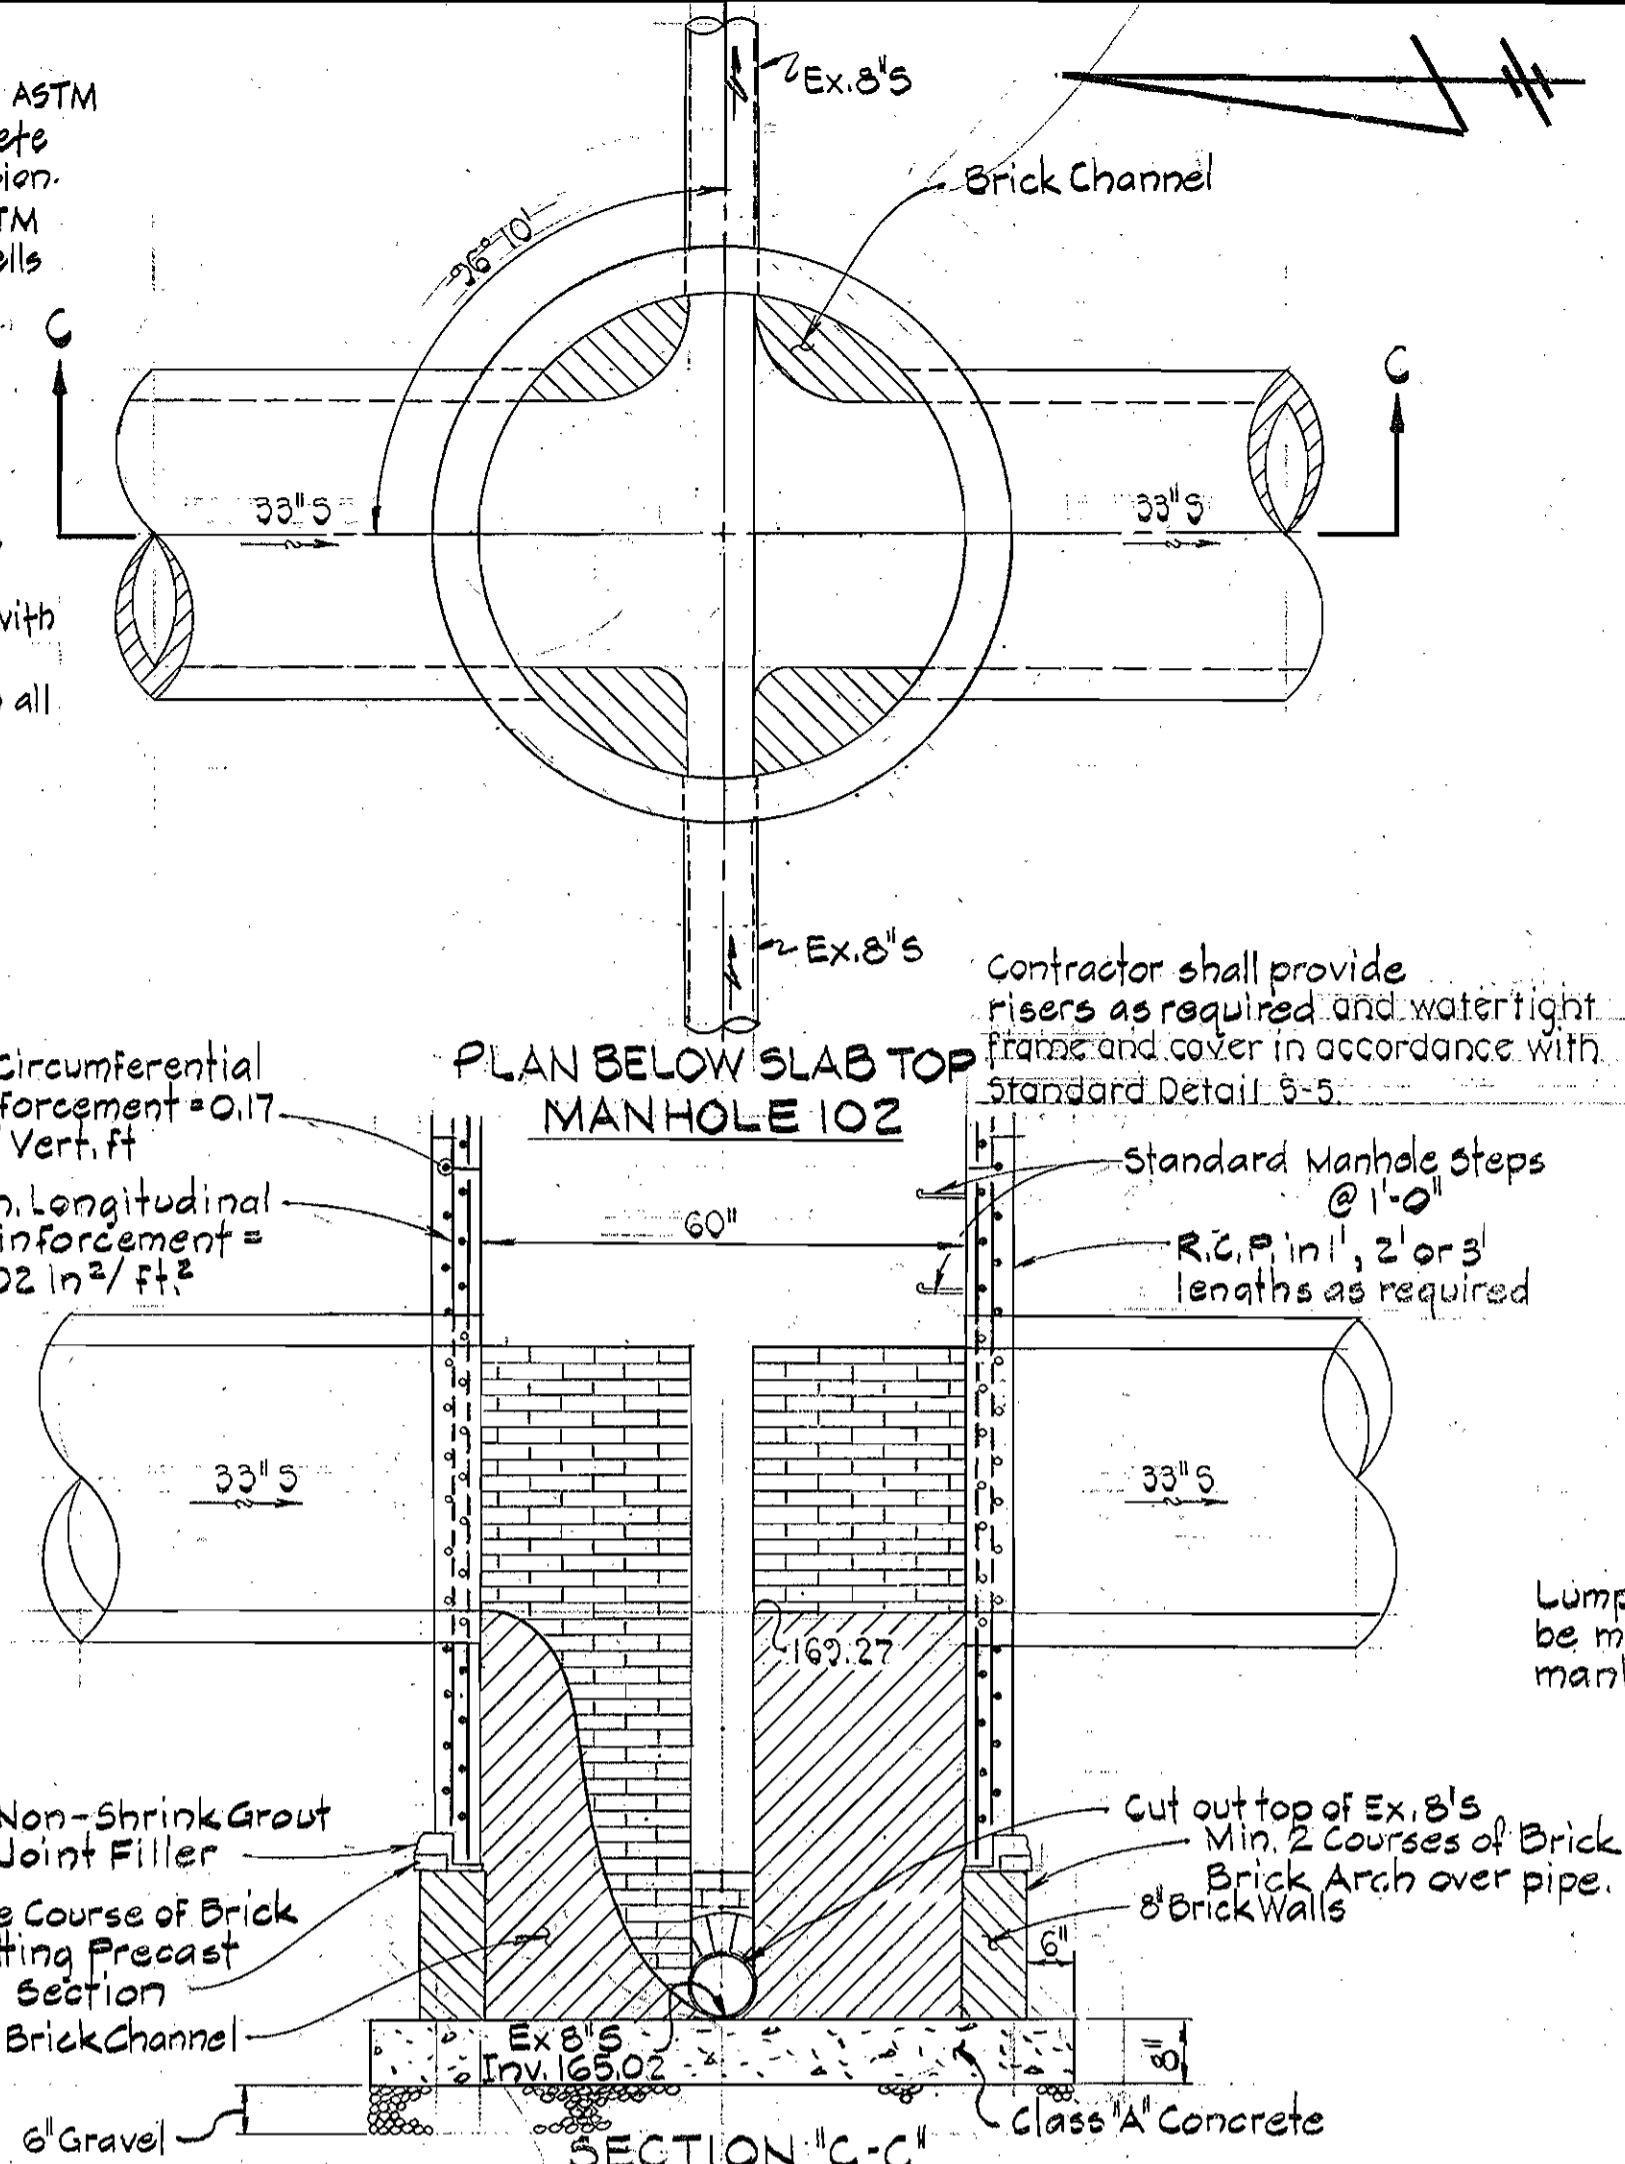


Non-Shrink Grout Joint Filler
Place One Course of Brick after Setting Precast Concrete Section
Brick Channel

Contractor shall provide risers as required and watertight frame and cover in accordance with Standard Detail S-5.

Min. Circumferential Reinforcement = 0.17 in²/Vert. Ft.
Min. Longitudinal Reinforcement = 0.02 in²/ft.²

MANHOLE 102-STANDARD PRECAST CONCRETE MH BUILT OVER EXISTING SEWER
Scale: 1/2"=1'-0"

Lump Sum Limits shall be manhole wall to manhole wall.

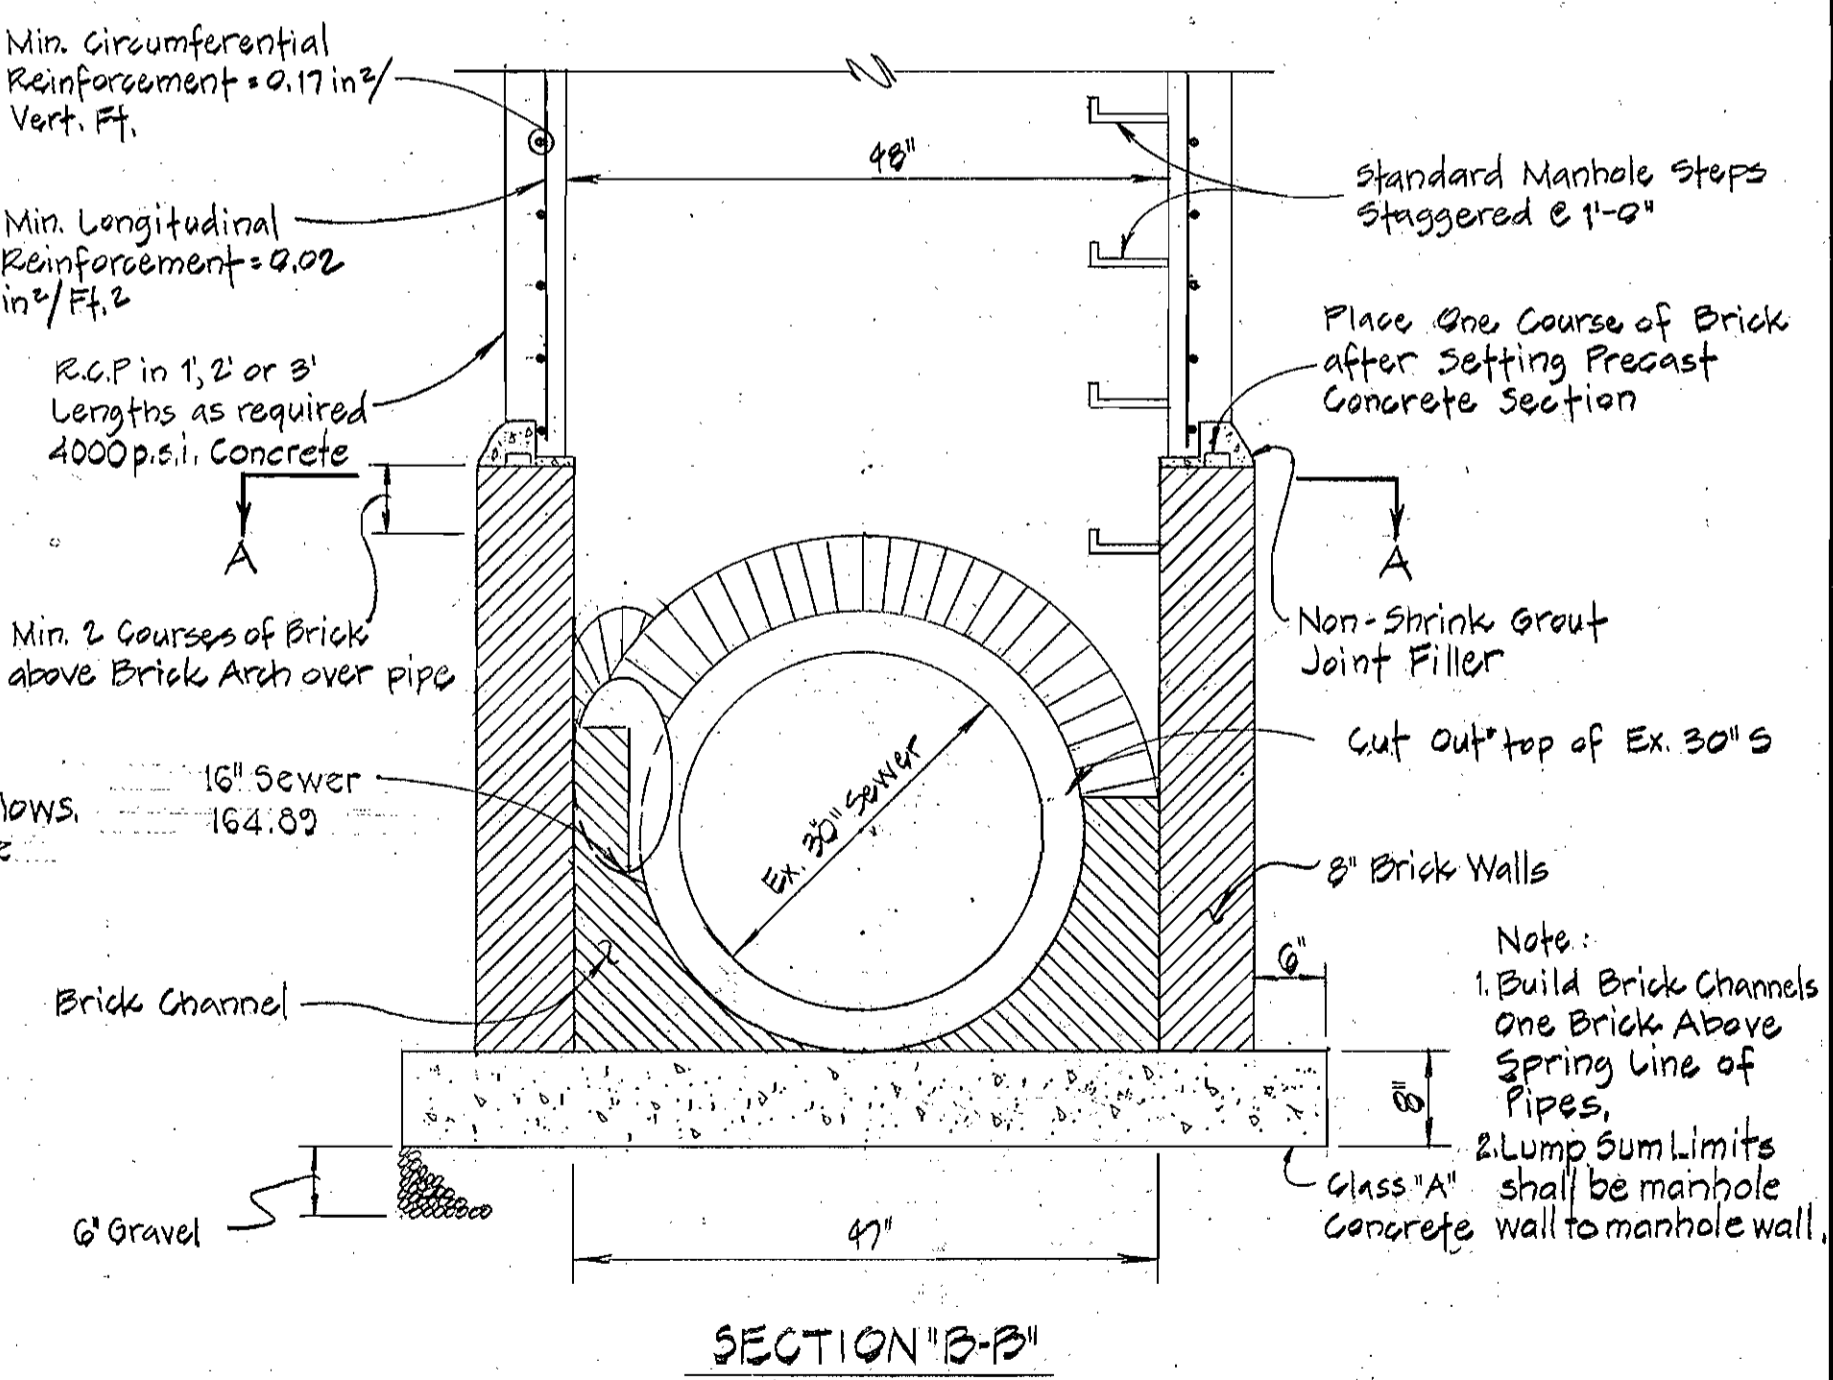

Contractor shall provide risers and Frame & Cover in accordance with Standard Detail S-5 or S-2.

Min. Circumferential Reinforcement = 0.17 in²/Vert. Ft.
Min. Longitudinal Reinforcement = 0.02 in²/ft.²
R.C.P. in 1', 2' or 3' Lengths as required 4000 p.s.i. Concrete
Min. 2 Courses of Brick above Brick Arch over pipe

MANHOLE 100 PRECAST CONCRETE MH BUILT OVER EXISTING SEWER
Scale: 3/4"=1'-0"

- Notes:
- Contractor shall thoroughly clean and apply a Bonding Agent to surfaces of the existing Sewers as directed in the Specifications.
 - Contractor shall take all necessary precautions to maintain continuous sewage flows.
 - Manholes 100, 101, and 102 may be built entirely of Brick.

Note:
1. Build Brick Channels One Brick Above Spring Line of Pipes.
2. Lump Sum Limits shall be manhole Concrete wall to manhole wall.

REV.	DATE	REMARKS

PURDUM & JESCHKE
ENGINEERS
1023 N. CALVERT ST.
BALTIMORE, MARYLAND

DEPARTMENT OF PUBLIC WORKS
HOWARD COUNTY, MARYLAND
Director of Public Works DATE 6-28-77
Chief-Bureau of Engineering DATE 6-27-77

CONTRACT NO. X720-S
CAPITAL PROJECT NO. S-4-8047

DETAILS

MIDDLE PATUXENT INTERCEPTOR
ELECTION DISTRICT NO. 6
HOWARD COUNTY, MARYLAND


DRAWING NO. 5 OF 6
SCALE AS SHOWN
DESIGNED: REP
DRAFTED: REC
CHECKED: TAF

As Built August 20, 1980


WS 720 S16

USE THE CITY

USE THE CITY

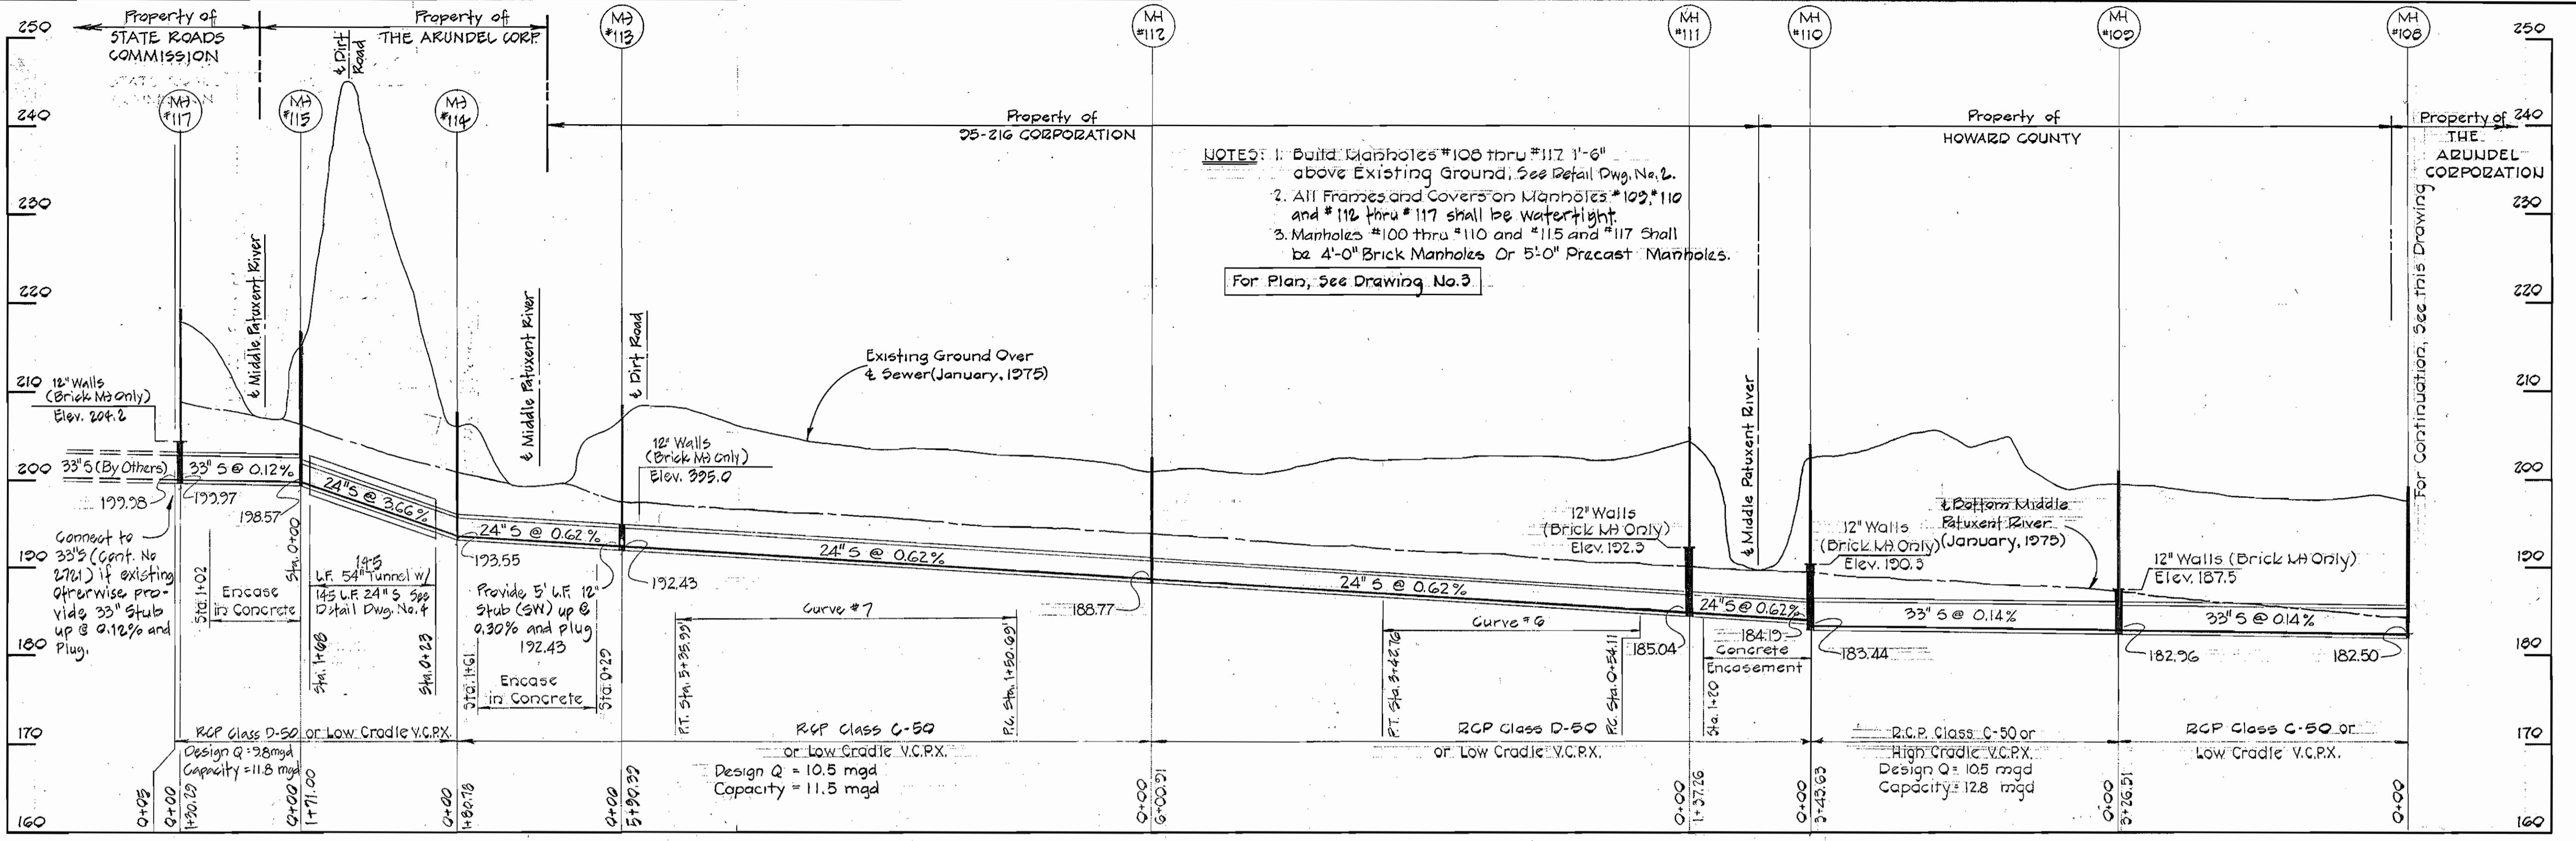

PROFILE
HORIZ: 1"=100'
VERT: 1"=10'

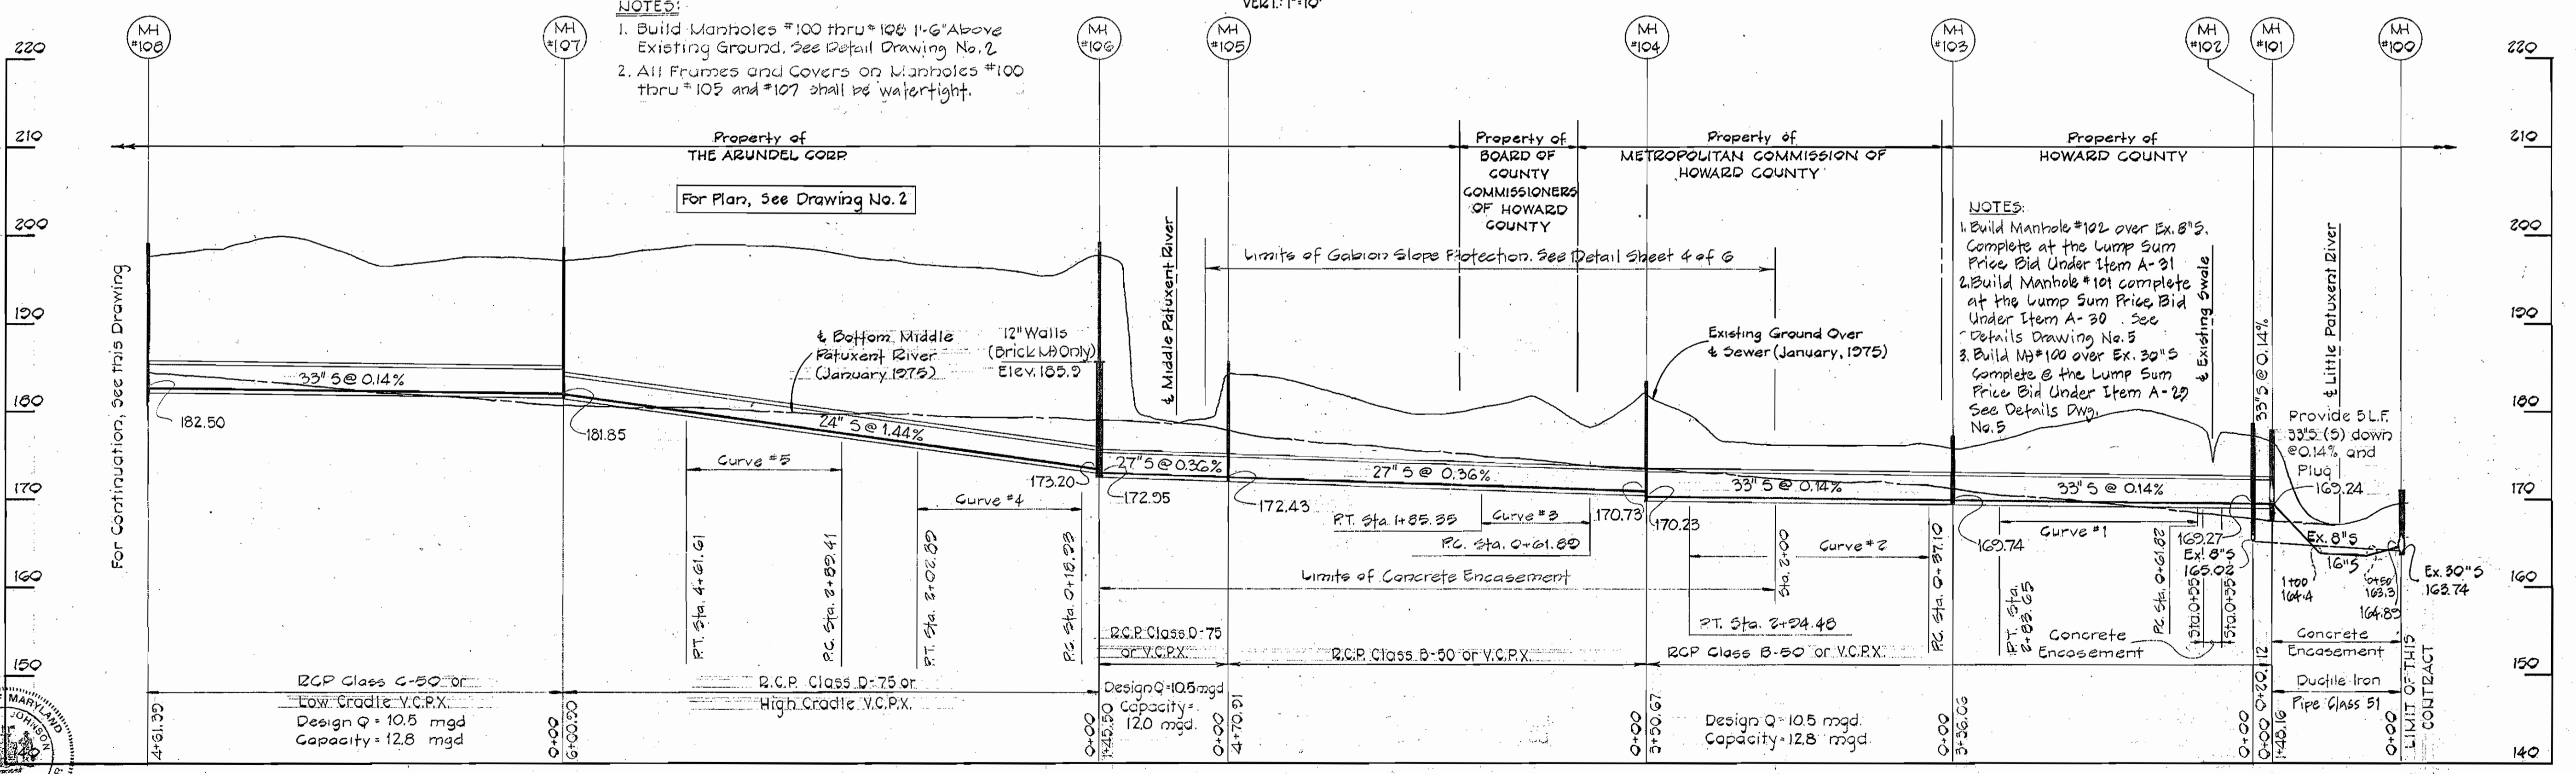

PROFILE
HORIZ: 1"=100'
VERT: 1"=10'

PURDUM & JESCHKE ENGINEERS
1023 N. CALVERT ST.
BALTIMORE, MARYLAND

DEPARTMENT OF PUBLIC WORKS
HOWARD COUNTY, MARYLAND
DIRECTOR OF PUBLIC WORKS DATE: 6-28-77
CHIEF BUREAU OF ENGINEERING DATE: 6-27-77

CONTRACT NO. X720-S
CAPITAL PROJECT NO. S-A 6047

PROFILES

MIDDLE PATUXENT INTERCEPTOR
ELECTION DISTRICT NO. 6
HOWARD COUNTY, MARYLAND

DRAWING NO. 6 OF 6
SCALE AS SHOWN
DESIGNED: JAM
DRAFTED: REC
CHECKED: TAF

Contract No. 2720-S
Capital Project S-4-6047
Middle Patuxent Interceptor
Little Patuxent River to Interstate 95