


QUANTITIES			
ITEMS	STD	AS-BUILT	MATERIAL / SUPPLIER
8\"/>			

TYPE OF BUILDINGS :	45 CLUSTER HOUSING UNITS
LIQUIDATION AREA :	FATAPSCO
NO. OF W.H.C. :	2
NO. OF S.H.C. :	N/A
WATER CODE :	402
SEWER CODE :	N/A

GENERAL NOTES

- APPROXIMATE LOCATION OF EXISTING MAINS ARE SHOWN. THE CONTRACTOR SHALL TAKE ALL NECESSARY PRECAUTIONS TO PROTECT EXISTING MAINS AND SERVICES AND MAINTAIN UNINTERRUPTED SUPPLY. ANY DAMAGE INCURRED SHALL BE REPAIRED IMMEDIATELY TO THE SATISFACTION OF THE ENGINEER, AT THE CONTRACTOR'S EXPENSE.
- ALL HORIZONTAL CONTROLS ARE BASED ON MARYLAND STATE COORDINATES.
- ALL VERTICAL CONTROLS ARE BASED ON U.S.G.S. DATUM.
- ALL PIPE ELEVATIONS SHOWN ARE INVERT ELEVATIONS.
- CLEAR ALL UTILITIES BY A MINIMUM OF 1'-0\"/>

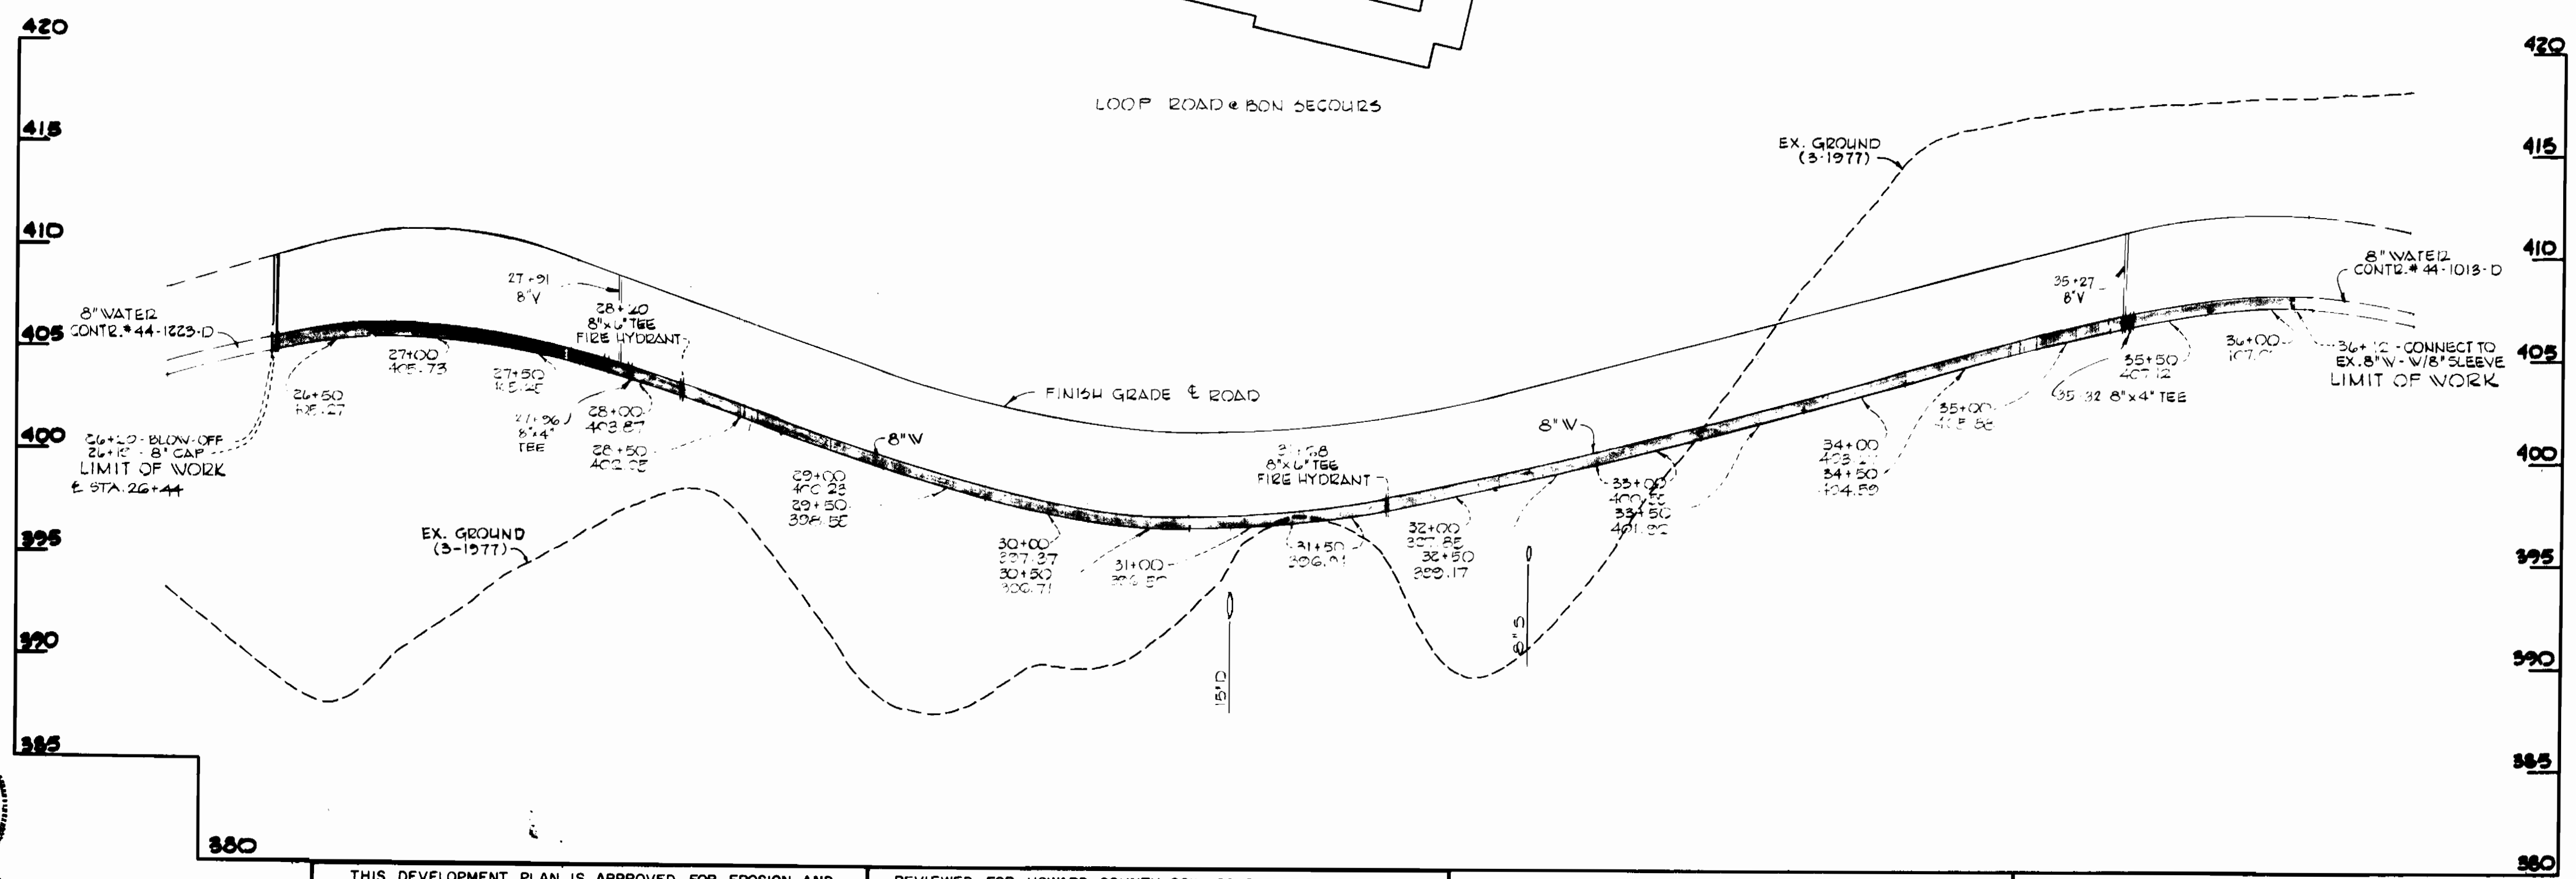

APPROVED: *Robert F. Bradley*
 ROBERT F. BRADLEY
 DATE: 4-30-84

THIS DEVELOPMENT PLAN IS APPROVED FOR EROSION AND SEDIMENT CONTROL BY THE HOWARD SOIL CONSERVATION DISTRICT AND MEETS TECHNICAL REQUIREMENTS.
 APPROVED: *Joseph K. Sennitt*
 HOWARD SOIL CONSERVATION DISTRICT
 DATE: 5/4/84

REVIEWED FOR HOWARD COUNTY SOIL CONSERVATION DISTRICT AND MEETS TECHNICAL REQUIREMENTS.
 APPROVED: *James McHale*
 U.S. SOIL CONSERVATION SERVICE
 DATE: 5/4/84

SEDIMENT CONTROL MEASURES FOR THIS CONTRACT WILL BE IMPLEMENTED IN ACCORDANCE WITH ARTICLE 15 OF THE STANDARD SPECIFICATIONS, AND SDP 82-75.

WATER MAIN PROFILE
 SCALE: HORIZ. 1\"/>

BENCH MARKS & LOCATIONS
 B.M. # 1 - EX. M.H. # 7176
 TOP OF RIM - ELEV. 400.85
 B.M. # 2 - EX. M.H. # 7177
 TOP OF RIM - ELEV. 411.68

CONTRACT NO. 44-1222-D
 BON SECOURS
 WATER MAIN EXTENSION
 HOWARD COUNTY, MD.

DEPARTMENT OF PUBLIC WORKS - HOWARD COUNTY MARYLAND
 APPROVED: *William F. Nunn*
 CHIEF BUREAU OF ENGINEERING
 DATE: 5-7-84
 APPROVED: *William F. Nunn*
 CHIEF - LAND DEVELOPMENT DIVISION
 DATE: 5-7-84

DAFT-McCUNE-WALKER, INC.
 530 E. JOPPA ROAD, TOWSON, MARYLAND 21204
 TELEPHONE (301) 296-3333

DES. #A.B.			
DRN. #A.T.	RA2	2	REVISE HYDRANT / METER LOCATIONS
CHK. #A.B.	RA2	1	RESTATION TIE INS PER MD HEALTH DEPT
DATE: 4/30/84	BY	NO.	REVISION

PLAN AND PROFILE OF WATER MAIN
 CONTRACT NO. 44-1222-D (PHASE 3)

BON SECOURS HOWARD COUNTY HEALTH PARK
 PARCEL B-1 PLAT 5385
 ELECTION DISTRICT ELLICOTT CITY NO. 2

DRAWING:	SCALE:
NO. 1	AS SHOWN
OF 1	

4. built 7/18/80