


**SEWER HOUSE CONNECTION TABLE**

LOTS	Inv@R	Min C	LOTS	Inv@R	Min C
210 211	287.0	280.2	269 270	274.4	277.8
212 213	285.1	288.3	271 272	275.0	278.3
214 215	283.0	286.2	273 274	275.4	278.8
216 217	280.9	284.1	275 276	276.2	279.7
218 219	278.0	281.2	277 278	277.6	281.2
220 221	277.7	280.9	279 280	278.2	281.7
222 223	277.5	280.7	281 282	279.1	282.3
224 225	277.3	280.5	283 284	280.9	284.1
226 227	281.3	284.8	285 286	284.2	287.4
228 229	283.9	287.2	287 288	286.5	289.7
230 231	286.4	289.7	289 290	288.8	292.0
232	287.6	290.9	291 292	292.4	295.6
			293 294	293.3	296.5
			295 296	294.0	297.4
233 234	293.3	296.7	297 298	294.5	298.3
235 236	291.5	294.9	299 300	293.5	296.8
237 238	288.9	292.3	301 302	293.0	296.4
239 240	289.0	288.4	303 304	291.3	294.8
241 242	282.3	285.6	305 306	289.1	292.5
243 244	279.7	282.9	307 308	285.8	289.2
245	277.0	280.2	309 310	283.5	286.9
246 247	276.8	280.1	311	281.8	285.2
248 249	275.2	278.5	312 313	276.4	279.8
250 251	273.5	276.7	314 315	275.4	278.8
252	271.7	274.9	316 317	274.5	277.9
253 254	272.0	275.2	318 319	273.5	276.9
255 256	272.2	275.4	320 321	273.8	277.1
257	272.4	275.6	322 323	277.8	281.2
258 259	272.9	276.2	324	281.7	285.0
260 261	273.3	276.6	325 326	289.1	288.4
262	273.5	276.8	327 328	287.6	290.9
263 264	273.3	276.6	329 330	291.0	294.3
265 266	273.5	276.8	331 332	293.5	296.7
267 268	273.9	277.5	333 334	293.8	297.0

TYPE OF BUILDING	Townhouses
Nº OF UNITS	125
Nº OF SHC's	125
Nº OF WHC's	125
DRAINAGE AREA	Potapasco W/WTP


**GENERAL NOTES**

- Approximate location of existing mains are shown. The contractor shall take all necessary precautions to protect existing mains and services and maintain uninterrupted supply. Any damage incurred shall be repaired immediately to the satisfaction of the Inspector, at the contractor's expense.
- All vertical controls are based on Maryland State Coordinates.
- All horizontal controls are based on U.S.G.S. Datum.
- All pipe elevations shown are invert elevations.
- Clear all utilities by a minimum of 6" clear all poles by 2'-0" minimum or tunnel as required. Any cost incurred to the contractor for tunneling or bracing at poles shall be included in unit prices bid for excavation and backfill.
- For details not shown on the drawings use Howard County Standard Details.
- For materials and construction methods use Howard County Standard Specifications & Ho. Co. Design Manual, Volume IV. The contractor shall have Volume IV on the job.
- Contractor shall locate existing utilities a minimum of two (2) weeks in advance of construction operations in the vicinity of proposed utilities at his own expense.
- Contractor shall notify the following utilities or agencies at least five (5) working days before starting work shown on these plans.
  - State Highway Administration - 531-5533
  - Baltimore Gas & Electric Company - Contractor Services - 850-4620
  - Baltimore Gas & Electric Company - Underground Damage Control - 859-9004
  - Baltimore Gas & Electric Company - Trouble Shooting - 298-9001
  - "Miss Utility" - 1-559-0100
  - Chesapeake & Potomac (C & P) Telephone Company - 1-800-257-7777
  - Colonial Pipeline Company - 795-1390
  - Bureau of Utilities Howard County - 992-2366
- Trees are to be protected from damage to maximum extent. Trees located within the construction strip are not to be removed or damaged by the contractor.
- Contractor shall remove trees, stumps, and roots along line of excavation as directed by the Inspector. Payment for such removal shall be included in the unit price bid for excavation and backfill.
- Place regulation "Men Working" and warning signs as required to comply with Maryland State Highway Administration Manual of Traffic Control for Highway Construction and Maintenance Operations.
- All water mains to be C.I.P. Class 52 unless otherwise noted.
- Top of all water mains to have a minimum of 3'-1/2' cover unless otherwise noted.
- Valves adjacent to tees shall be strapped to tees.
- Block all fittings with concrete.
- Bury line elevations on fire hydrants shall be set to the elevations shown on the drawings. All fire hydrants shall be strapped and buttressed with concrete in accordance with standard details. Soil around the fire hydrant to be compacted in accordance with Sections 1003 & 1008 of the Standard Specifications.
- All water house connections shall be for an inside meter setting.
- The contractor shall not operate any water main valves on the existing system.
- All sewer mains shall be C.S.P.X., V.C.P.X., P.V.C., or A.C.P. Class 2400 unless otherwise noted.
- The contractor shall provide a joint in all sewer mains within 2'-0" of exterior manhole wall.
- All manholes shall be 4'-0" inside diameter, unless otherwise noted.
- Water main and water house connection lines must have a minimum of one foot separation from the sanitary sewer and sewer house connections as they cross. Except at crossings, water and sewer lines shall have a minimum horizontal separation of 10'.
- All D.I.P. fittings shall be in accordance with AWWA specification C-153 Ductile Iron Compact Fittings, 3-inch through 12-inch for water and other liquids.
- WHC's to lots 233 thru 334 shall be 1".

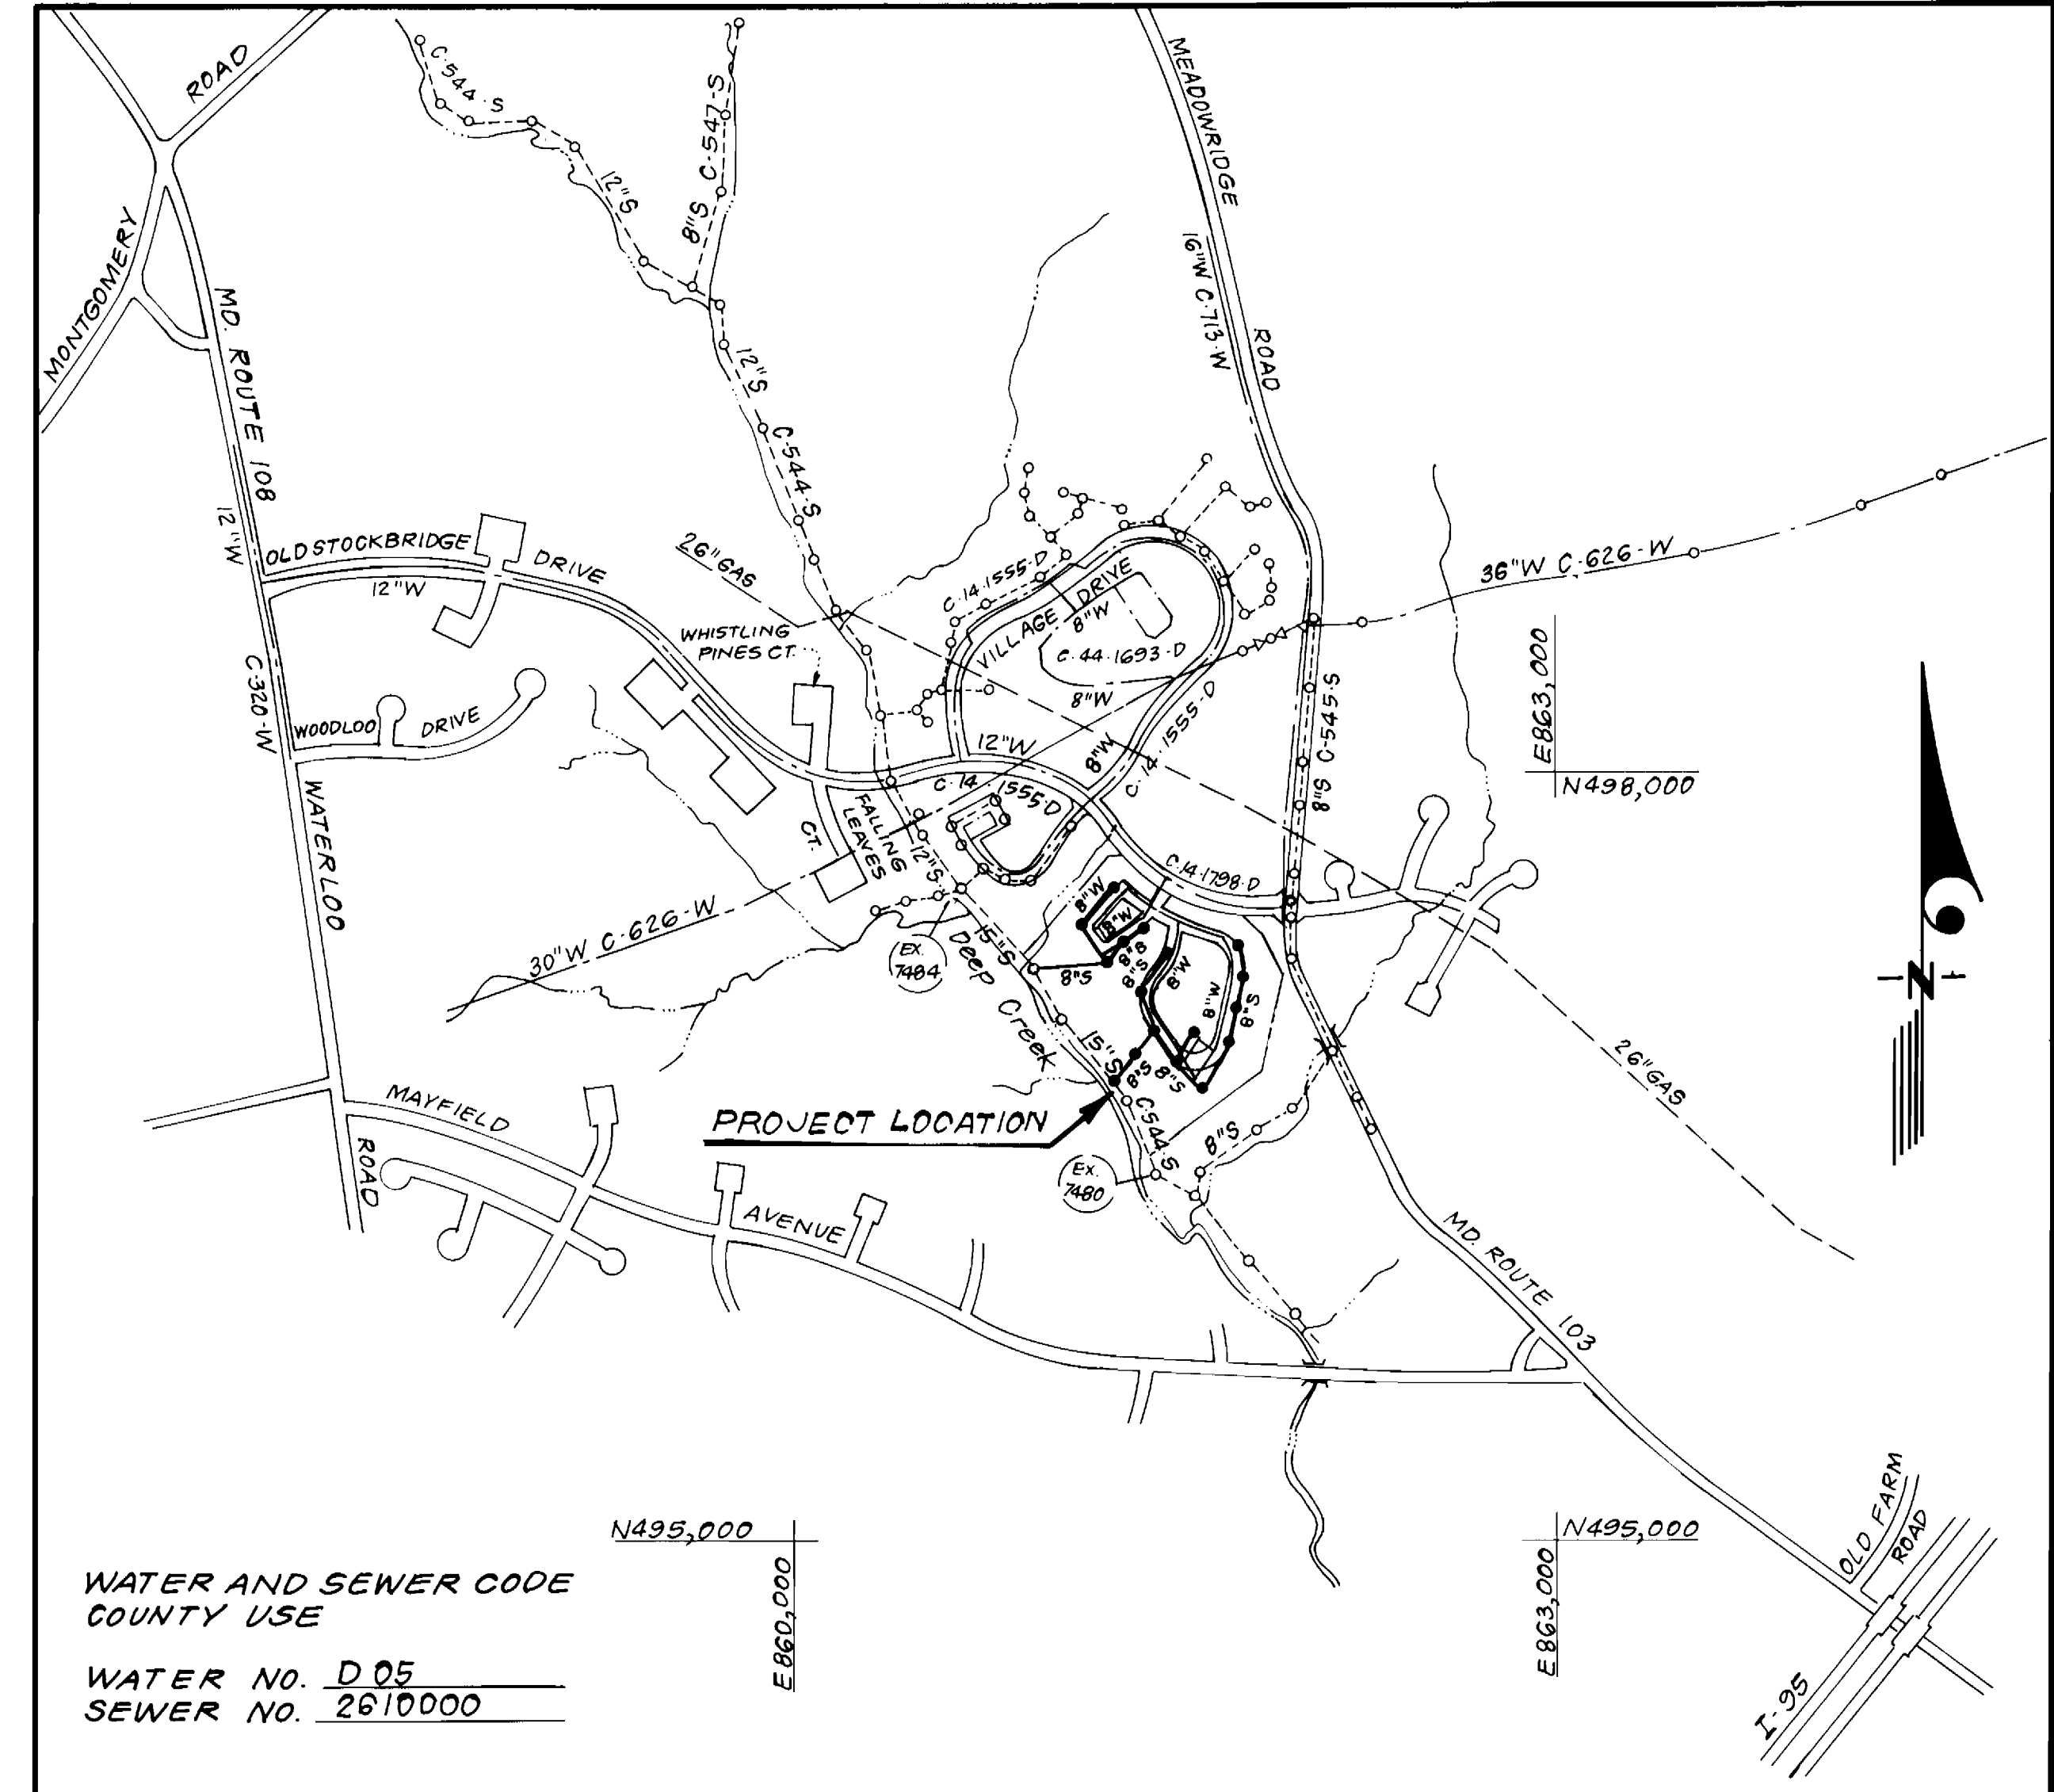

**VICINITY MAP**

WATER AND SEWER CODE COUNTY USE  
 WATER NO. D 05  
 SEWER NO. 2610000

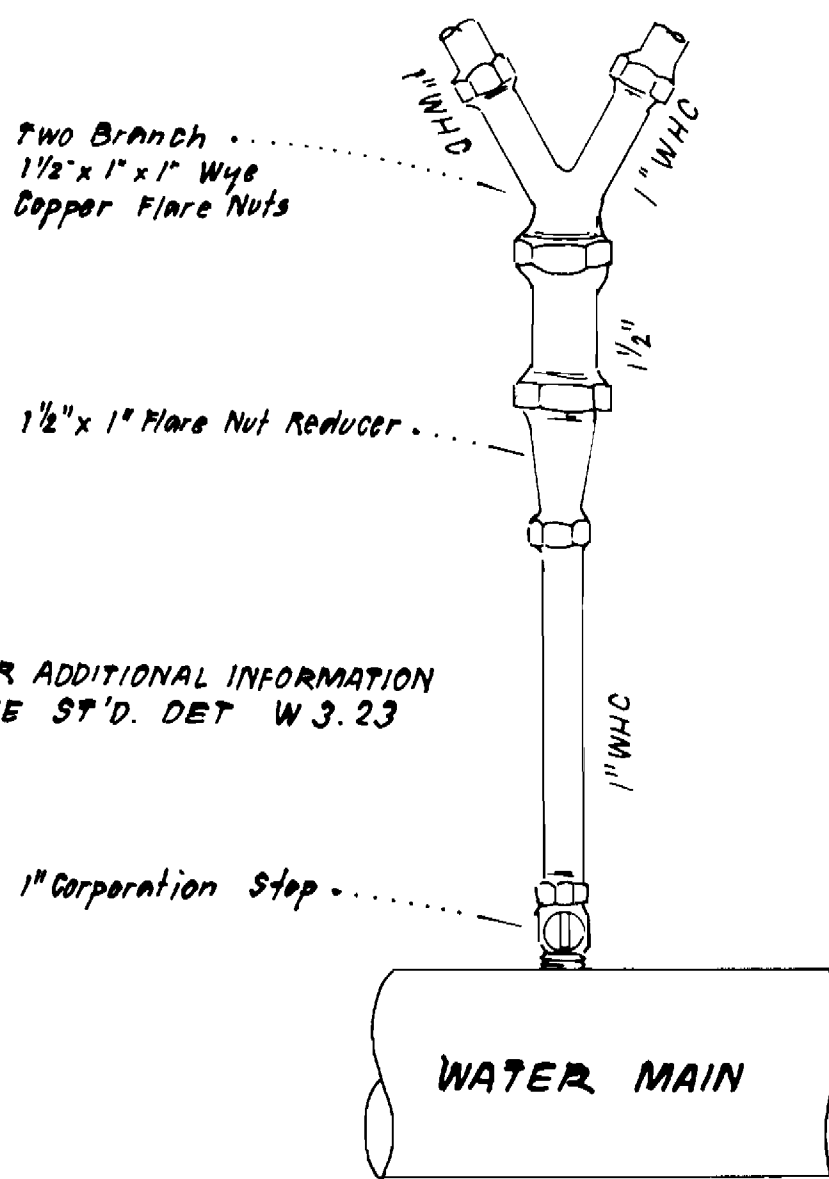

**SPECIAL DETAIL FOR DUAL BUILDING INSIDE METER SETTING**  
 NO SCALE

Sediment Control Measures will be implemented in accordance with Section 219 of the Specifications & with Road Construction Plan F-88-192; Drawing 54606 Sediment & Erosion Control.

REVIEWED FOR HOWARD SOIL CONSERVATION DISTRICT AND MEETS TECHNICAL REQUIREMENTS  
 SIGNATURE: *[Signature]* DATE: 11-14-88  
 U.S. SOIL CONSERVATION SERVICE

This Development Plan is approved for Soil Erosion and Sediment Control by the Howard Soil Conservation District.

APPROVED:  
 SIGNATURE: *[Signature]* DATE: 11/11/88  
 HOWARD S.C.D.


**CONTRACT NO. 14-1799-D**  
**WOODLAND VILLAGE**  
**SECTION 2 AREA 2, LOTS 210 THRU 341**  
**HOWARD COUNTY, MARYLAND**  
**DEPARTMENT OF PUBLIC WORKS**

QUANTITIES			
ITEM	EST'D	AS-BUILT	MATERIAL / SUPPLIER
8"W	2,117 L.F.	2069 L.F.	A&P Sewer & Water Supply, Atlantic States
6"W	552 L.F.		"
8"S	2,309 L.F.	2408 L.F.	" " " Certainteed "
6" SHC	2,210 L.F.	2229 L.F.	" " " " "
1" WHC	2,852 L.F.	2652 L.F.	" " " Cambridge Lea "
3/4" WHC	315 L.F.		"
F.H.	7 EA.	7 EA.	" " " Mueller Co. "
4'-0" Dia. MH	17 EA.	17 EA.	Atlantic Pipe Prods., Frames & Covers, E.A. Quinn Machine Shop
8" V	5 EA.	5 EA.	A&P Sewer & Water Prods., "Mueller"
6" V (654)	4 EA.	4 EA.	"

\* NOTE: AS-BUILTS ON SHEETS 2, 3, 4, 99, 100

DEPARTMENT OF PUBLIC WORKS HOWARD COUNTY, MARYLAND SIGNATURE: <i>[Signature]</i> DATE: 11-16-88 CHIEF, BUREAU OF ENGINEERING	CLARK-FINEPROCK & SACKETT ENGINEERS-PLANNERS-SURVEYORS 7135 MINSTREL WAY COLUMBIA, MD. 21045 Phone: Balt. (301) 381-7500 Wash. (301) 621-8100	DES: JTR DRN: VLM CHK: JTR DATE: 3-88	TITLE SHEET	WOODLAND VILLAGE SECTION 2 AREA 2, LOTS 210 THRU 341 1 <sup>ST</sup> ELECTION DISTRICT CONTRACT NO. 14-1799-D	SCALE 1"=600' SHEET 1 OF 4
---	---	--	-------------	--	-------------------------------------

A. BUI 2-14-92

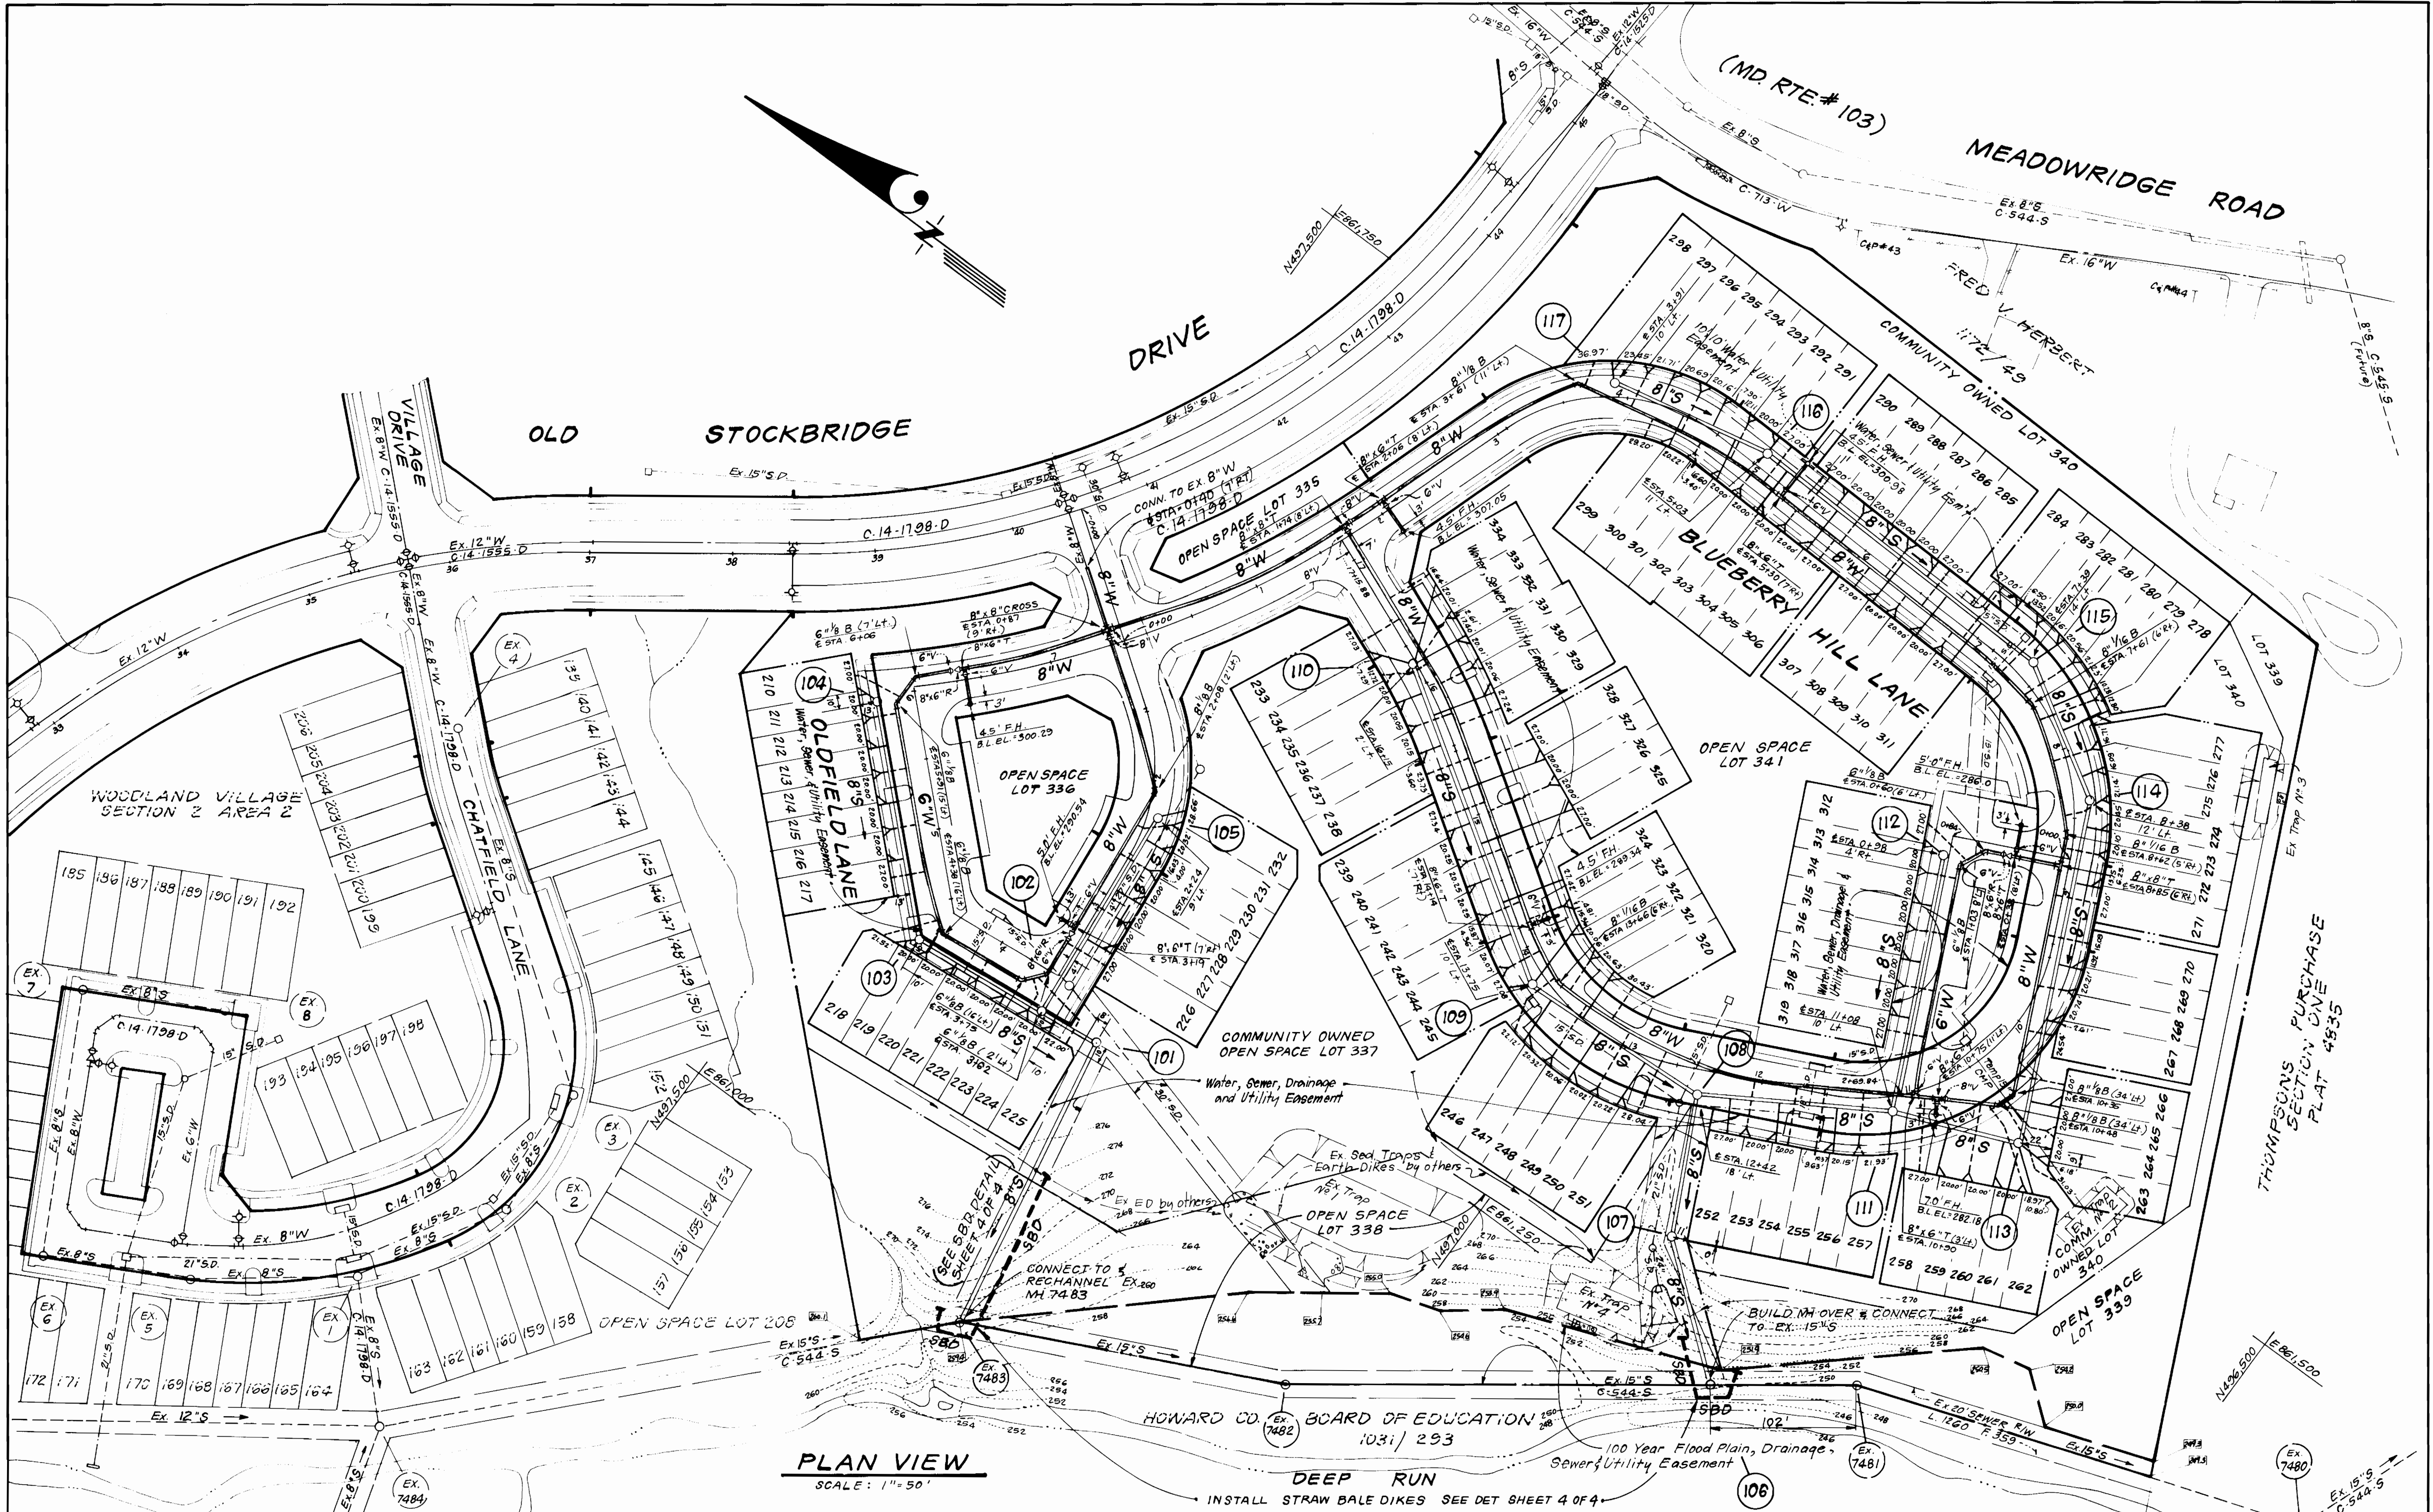

PLAN VIEW  
SCALE: 1" = 50'

DEPARTMENT OF PUBLIC WORKS  
HOWARD COUNTY, MARYLAND

11/10/88  
DIRECTOR OF PUBLIC WORKS DATE

11/16/88  
CHIEF, BUREAU OF ENGINEERING DATE

11/10/88  
CHIEF, BUREAU OF UTILITIES DATE

11/15/88  
CHIEF, LAND DEVELOPMENT DIV. DATE

CLARK · FINEPROCK & SACKETT, INC.  
ENGINEERS · PLANNERS · SURVEYORS

7135 MINSTREL WAY COLUMBIA MARYLAND 21045  
(301) 381-7500 BALTO. (301) 621-8100 WASH.



DES: JTR	JTR	1	Added 1" WHO to lot 334	1-24-92
DRN: VLM				
CHK: JTR				
DATE: 3-88	BY	NO.	REVISION	DATE

PLAN OF  
WATER & SEWER MAINS

600' SCALE MAP NO. 37 BLOCK NO.

WOODLAND VILLAGE  
SECTION 2 AREA 2, LOTS 210 THRU 341  
1<sup>ST</sup> ELECTION, DISTRICT  
CONTRACT NO. 14-1799-D


SCALE AS SHOWN  
SHEET 2 OF 4

Lot #	Distance	Type Conn.	Distance	Description	Lot #	Type Conn.	Distance	Description	Lot #	Type Conn.	Distance	Description	Lot #	Type Conn.	Distance	Description
210	WATER 30'			To MH-104	223	W	8'	To W.H.C.-224	236	W	44'	To MH-110	249	W	76'	To MH-108
	WATER 26'			To W.H.C.-211		W	20'	To MH-102		W	35'	To W.H.C.#237		W	60.5'	To STORM DRAIN MH
	SEWER 18'			To MH-104		S	34'	To S.H.C.-224		S	32'	To MH-110		S	75.5'	To MH-109
	SEWER 9'			To W.H.C.-210		S	6'	To S.H.C.-222		S	5'	To S.H.C.-235	250	W	72'	To MH-108
211	W 14'			To MH-104	224	W	8'	To MH-223	237	W	48'	To MH-110		W	56'	To S.D. MH
	W 6'			To W.H.C.-212		W	13'	To MH-102		W	5'	To W.H.C.#236		W	104'	To MH-109
	S 14'			To MH-104		S	13'	To MH-102		S	63'	To MH-110		S	41'	To S.D. MH
	S 14'			To W.H.C.-210		S	34'	To S.H.C.-223		S	6'	To S.H.C.-238	251	W	45.5'	To MH-108
212	W 17.5'			To MH-104	225	W	30'	To W.H.C.-224	238	W	77'	To MH-110		W	28'	To S.D. MH
	W 6'			To W.H.C.-211		W	29'	To MH-102		W	34'	To W.H.C.#236		W	109'	To MH-109
	S 27'			To MH-104		S	35'	To MH-101		S	6'	To S.H.C.-237		S	36'	To S.D. MH
	S 7'			To S.H.C.-213		S	6'	To S.H.C.-224		S	67.5'	To MH-110	252	W	44'	To MH-108
213	W 32'			To W.H.C.-212	226	W	55'	To MH-102	239	W	109'	To MH-110		W	53'	To S.D. MH
	W 6'			To W.H.C.-214		W	44'	To F.H.		W	98'	To 6" F.H. VALVE		S	42'	To S.D. MH
	S 7'			To S.H.C.-213		S	62'	To MH-101		S	92'	To F.H.		S	35'	To MH-108
	S 34'			To S.H.C.-214		S	36'	To S.D. MH		S	89'	To 6" F.H. VALVE	253	W	49'	To MH-108
214	W 6'			To W.H.C.-213	227	W	82'	To MH-102	240	W	68'	To 6" F.H. VALVE		W	58'	To S.D. MH
	W 32'			To W.H.C.-215		W	46'	To F.H.		W	73.5'	To F.H.		S	72'	To S.D. MH
	S 34'			To S.H.C.-213		S	40'	To S.D. MH		S	86'	To F.H.		S	62'	To MH-108
	S 7'			To S.H.C.-215		S	70'	To MH-101		S	83.5'	To 6" F.H. VALVE	254	W	73.5'	To MH-108
215	W 32'			To W.H.C.-214	228	W	88'	To MH-102	241	W	64.5'	To 6" F.H. VALVE		W	85'	To S.D. MH
	W 6'			To W.H.C.-216		W	87'	To MH-101		W	70'	To F.H.		S	77'	To S.D. MH
	S 34'			To S.H.C.-216		S	24'	To S.H.C.-227		S	60'	To F.H.		S	67'	To MH-108
	S 7'			To S.H.C.-214		S	7'	To S.H.C.-229		S	55'	To 6" F.H. VALVE	255	W	93.5'	To MH-108
216	W 6'			To W.H.C.-215	229	W	120'	To MH-101	242	W	40'	To 6" F.H. VALVE		W	105'	To S.D. MH
	W 30'			To W.H.C.-217		W	46'	To MH-105		W	49'	To F.H.		S	113'	To S.D. MH
	S 34'			To S.H.C.-215		S	33'	To S.H.C.-230		S	56'	To F.H.		S	101'	To MH-108
	S 7'			To S.H.C.-217		S	7'	To S.H.C.-228		S	51'	To 6" F.H. VALVE	256	W	38'	To MH-111
217	W 38'			To W.H.C.-218	230	W	35'	To MH-105	243	W	38'	To 6" F.H. VALVE		W	59'	To F.H.
	W 35'			To MH-103		W	79'	To F.H.		W	46.5'	To F.H.		S	37'	To INLET, & LID
	S 7'			To S.H.C.-216		S	7'	To S.H.C.-231		S	46'	To F.H.		S	49.5'	To MH-111
	S 58'			To MH-103		S	24.27'	To MH-105		S	38.5'	To 6" F.H. VALVE	257	W	37'	To MH-111
218	W 27'			To MH-103	231	W	102'	To F.H.	244	W	39.5'	To 6" F.H. VALVE		W	57'	To F.H.
	W 28'			To W.H.C.-219		W	19'	To MH-105		W	48'	To F.H.		S	67'	To INLET, & LID
	S 20'			To MH-103		S	7'	To S.H.C.-230		S	46'	To F.H.		S	30'	To MH-111
	S 15'			To S.H.C.-219		S	24'	To MH-105		S	39'	To 6" F.H. VALVE	258	W	46.5'	To MH-111
219	W 10'			To MH-103	232	W	20'	To MH-105	245	W	43'	To 6" F.H. VALVE		W	41.5'	To F.H.
	W 7'			To MH-220		W	110'	To F.H.		W	51'	To F.H.		S	55'	To MH-111
	S 10'			To MH-103		S	20'	To MH-105		S	57'	To F.H.		S	44'	To F.H.
	S 15'			To S.H.C.-218		S	8'	To W.H.C.-232		S	52'	To 6" F.H. VALVE	259	W	71'	To MH-111
220	W 15'			To MH-103	233	W	41'	To MH-110	246	W	77'	To 6" F.H. VALVE		W	52'	To F.H.
	W 7'			To W.H.C.-219		W	79'	To F.H.		W	83'	To F.H.		S	59'	To MH-111
	S 25'			To S.H.C.-219		S	30'	To MH-110		S	89'	To F.H.		S	45'	To F.H.
	S 6'			To S.H.C.-221		S	5'	To S.H.C.-234		S	41'	To 6" F.H. VALVE	260	W	75'	To MH-111
221	W 17'			To N.E. COR. INLET	234	W	22'	To MH-110	247	W	97'	To 6" F.H. VALVE		W	55'	To F.H.
	W 7'			To W.H.C.-222		W	99'	To F.H.		W	101.5'	To F.H.		S	90'	To MH-111
	S 32'			To S.H.C.-222		S	27.5'	To MH-110		S	90'	To F.H.		S	67'	To F.H.
	S 6'			To S.H.C.-220		S	5'	To S.H.C.-233		S	43'	To MH-109	261	W	108'	To MH-111
222	W 7'			To W.H.C.-221	235	W	23'	To MH-110	248	W	102'	To 6" F.H. VALVE		W	84'	To F.H.
	W 24'			To N.E. COR. INLET		W	104'	To F.H.		W	107'	To F.H.		S	93.5'	To MH-111
	S 6'			To S.H.C.-223		S	27.5'	To MH-110		S	70'	To MH-109		S	71'	To F.H.
	S 32'			To S.H.C.-221		S	5'	To S.H.C.-235		S	79.5'	To S.D. MH		S	62'	To F.H.

+ NOTE: FOR FIRST ±20' OFF OF WATER MAIN, 1" COPPER LINES FOR LOTS 263, 264, 265, ARE IN SAME TRENCH

DEPARTMENT OF PUBLIC WORKS HOWARD COUNTY, MARYLAND		DES: _____ DRN: _____ CHK: _____ DATE: _____		FIELD AS-BUILDS, WATER & SEWER REFER TO SHEET-2 OF PLANS		WOODLAND VILLAGE SECTION 2, AREA 2 LOTS 210 THRU 341 1 <sup>ST</sup> ELECTION DIST. CONTRACT NO. 14-1799-D		SCALE AS SHOWN
DIRECTOR OF PUBLIC WORKS _____ DATE _____ CHIEF, BUREAU OF ENGINEERING _____ DATE _____		BY NO. _____ REVISION _____ DATE _____		600' SCALE MAP NO. _____ BLOCK NO. _____		SHEET 2B OF _____		

LOT #	TYPE	CONN. DISTANCE	DESCRIPTION	LOT #	TYPE	CONN. DISTANCE	DESCRIPTION	LOT #	TYPE	CONN. DISTANCE	DESCRIPTION	LOT #	TYPE	CONN. DISTANCE	DESCRIPTION
275	W	14'	To MH-114	288	W	56'	To F.H.	301	W	51'	To MH-116	314	W	23'	To MH-112
	W	13'	To SHC-274		W	85'	To MH-116		W	80'	To F.H.	317	W	79'	To F.H.
	S	22'	To MH-114		S	69'	To F.H.		S	55'	To 6" F.H. VALVE	318	S	35'	To MH-112
276	S	72'	To F.H.	289	S	76'	To 6" F.H. VALVE	302	S	71'	To F.H.	315	S	88'	To F.H.
	W	79'	To MH-115		W	49'	To F.H.		W	37'	To MH-116		W	93'	To INLET, & LID
	W	35'	To MH-114		W	77'	To MH-116	303	W	56'	To F.H.	316	W	55'	To MH-112
	S	25'	To MH-114		S	35'	To F.H.		S	48'	To 6" F.H. VALVE		S	41'	To MH-112
277	S	73'	To F.H.	290	S	47'	To 6" F.H. VALVE	304	S	67'	To F.H.	319	S	93'	To F.H.
	W	40'	To MH-114		W	19'	To F.H.		W	36'	To MH-116	320	W	89.5'	To INLET, & LID
	W	73'	To MH-115		W	45'	To MH-116		W	52'	To F.H.		W	59.5'	To MH-112
	S	57'	To MH-114		S	29'	To F.H.		S	21'	To 6" F.H. VALVE	321	S	73'	To MH-112
278	S	98'	To F.H.	291	S	41.5'	To 6" F.H. VALVE	305	S	49'	To F.H.	317	S	80'	To INLET, & LID
	W	69'	To MH-114		W	15'	To F.H.		W	53'	To MH-116	318	W	93.5'	To MH-113
	W	57'	To MH-115		W	15'	To MH-116	306	W	50'	To F.H.	319	W	65'	To INLET, & LID
	S	65'	To MH-114		S	28'	To F.H.		S	19'	To 6" F.H. VALVE	320	W	79'	To MH-112
279	S	103'	To F.H.	292	S	43.5'	To 6" F.H. VALVE	307	S	48'	To F.H.	321	S	75'	To INLET, & LID
	W	74'	To MH-114		W	24'	To MH-116		W	58'	To MH-116	318	W	89'	To MH-113
	W	51'	To MH-115		W	45'	To F.H.	308	W	52'	To F.H.	319	W	63.5'	To INLET, & LID
	S	49'	To MH-115		S	33'	To F.H.		S	36'	To 6" F.H. VALVE	320	W	82'	To F.H.
280	S	80'	To MH-114	293	S	47'	To 6" F.H. VALVE	309	S	58'	To F.H.	321	S	58'	To INLET, & LID
	W	34'	To MH-115		W	29'	To MH-116	310	W	67'	To F.H.	322	W	57'	To MH-113
	W	97'	To MH-114		W	49'	To F.H.		W	82'	To MH-116	323	W	55.5'	To INLET, & LID
	S	43'	To MH-115		S	67'	To F.H.	311	S	41'	To 6" F.H. VALVE	324	S	79'	To F.H.
281	S	85'	To MH-114	294	S	74'	To 6" F.H. VALVE	312	S	62.5'	To F.H.	325	S	59'	To INLET, & LID
	W	32'	To MH-115		W	85'	To F.H.	313	W	91'	To F.H.	326	W	84'	To 6" F.H. VALVE
	W	102'	To MH-114		W	70'	To MH-117		W	112'	To MH-116	327	W	80'	To F.H.
	S	26'	To MH-115		S	72.5'	To F.H.	314	S	90.5'	To 6" F.H. VALVE	328	W	69'	To F.H.
282	S	5'	To S.H.C.-282	295	S	79'	To 6" F.H. VALVE	315	S	103'	To F.H.	329	S	62'	To MH-109
	W	30'	To MH-115		W	64'	To MH-117	316	W	109'	To MH-115	330	S	62'	To MH-109
	S	30'	To W.H.C.-281		W	5'	To W.H.C.-294	317	W	84'	To INLET	331	W	47'	To F.H.
	S	26'	To MH-115		S	109'	To F.H.	318	S	7.5'	To S.H.C.-307	332	W	26'	To F.H.
283	S	5'	To S.H.C.-281	296	S	47'	To MH-117	319	S	70'	To INLET, & LID	333	S	62'	To MH-110
	W	5'	To W.H.C.-282		W	27'	To MH-117	320	S	92'	To MH-115	334	S	43'	To F.H.
	S	35'	To MH-115		W	5'	To W.H.C.-297	321	S	48'	To INLET, & LID	335	W	OPEN SPACE	
	S	43'	To MH-115		S	114'	To F.H.	322	S	92'	To MH-115	336	W	OPEN SPACE	
284	S	5'	To S.H.C.-284	297	S	45'	To MH-117	323	S	48'	To INLET, & LID	337	W	OPEN SPACE	
	W	58'	To MH-115		W	5'	To W.H.C.-296	324	S	48'	To INLET, & LID	338	W	OPEN SPACE	
	W	27'	To W.H.C.-283		W	22'	To MH-117	325	W	71'	To MH-115	339	W	OPEN SPACE	
	S	47'	To MH-115		S	67'	To S.H.C.-299	326	W	43'	To INLET, & LID		W	21.5'	To F.H.
285	S	5'	To S.H.C.-283	298	S	17'	To MH-117	327	S	87'	To MH-115		S	25'	To F.H.
	W	86'	To MH-115		W	20'	To MH-117	328	S	45'	To INLET, & LID		S	54'	To MH-109
	W	125'	To F.H.		W	34'	To W.H.C.-297	329	W	65'	To MH-115		W	22.5'	To F.H.
	S	37'	To INLET, & LID		W	34'	To W.H.C.-297	330	W	37'	To INLET, & LID		W	30'	To 6" F.H. VALVE
286	S	5'	To S.H.C.-286	299	S	18.5'	To MH-117	331	S	59'	To MH-115		W	30'	To F.H.
	W	97'	To F.H.		S	70.5'	To S.H.C.-299	332	S	47'	To INLET, & LID		S	78'	To MH-109
	W	5'	To W.H.C.-287		W	48'	To MH-117	333	W	25.5'	To MH-112		W	73'	To F.H.
	S	42'	To INLET, & LID		W	87'	To MH-116	334	W	66'	To F.H.		W	78'	To 6" F.H. VALVE
	S	5'	To S.H.C.-285		S	93.5'	To 6" F.H. VALVE	335	S	15'	To MH-112		S	79'	To F.H.
287	S	91'	To F.H.	300	S	106'	To F.H.	336	S	68'	To F.H.		S	84'	To 6" F.H. VALVE
	W	6'	To W.H.C.-286		W	57'	To MH-116	337	W	20'	To MH-112		W	97'	To F.H.
	S	75'	To F.H.		W	72'	To MH-117	338	W	76.5'	To F.H.		W	100'	To 6" F.H. VALVE
	S	82'	To 6" F.H. VALVE		S	87'	To 6" F.H. VALVE	339	S	17'	To MH-112		S	83'	To F.H.
					S	98'	To F.H.		S	71'	To F.H.		S	89'	To 6" F.H. VALVE

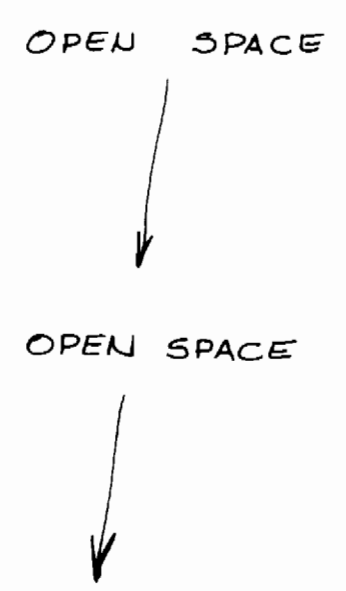

DEPARTMENT OF PUBLIC WORKS  
HOWARD COUNTY, MARYLAND

DIRECTOR OF PUBLIC WORKS DATE CHIEF, BUREAU OF ENGINEERING DATE





DES:			
DRN:			
CHK:			
DATE:	BY	NO.	REVISION

FIELD AS-BUILTS, S.H.C.'s & W.H.C.'s  
REFER TO SHEET-2 OF PLANS  
600' SCALE MAP NO. BLOCK NO.

WOODLAND VILLAGE  
SECTION-2, AREA-2 LOTS 210 - 341  
1<sup>ST</sup> ELECTION DISTRICT  
CONTRACT NO. 14-1799-D

SCALE AS SHOWN  
SHEET 2 OF 2

PROFILE SCALE  
HORIZONTAL 1" = 50'  
VERTICAL 1" = 5'

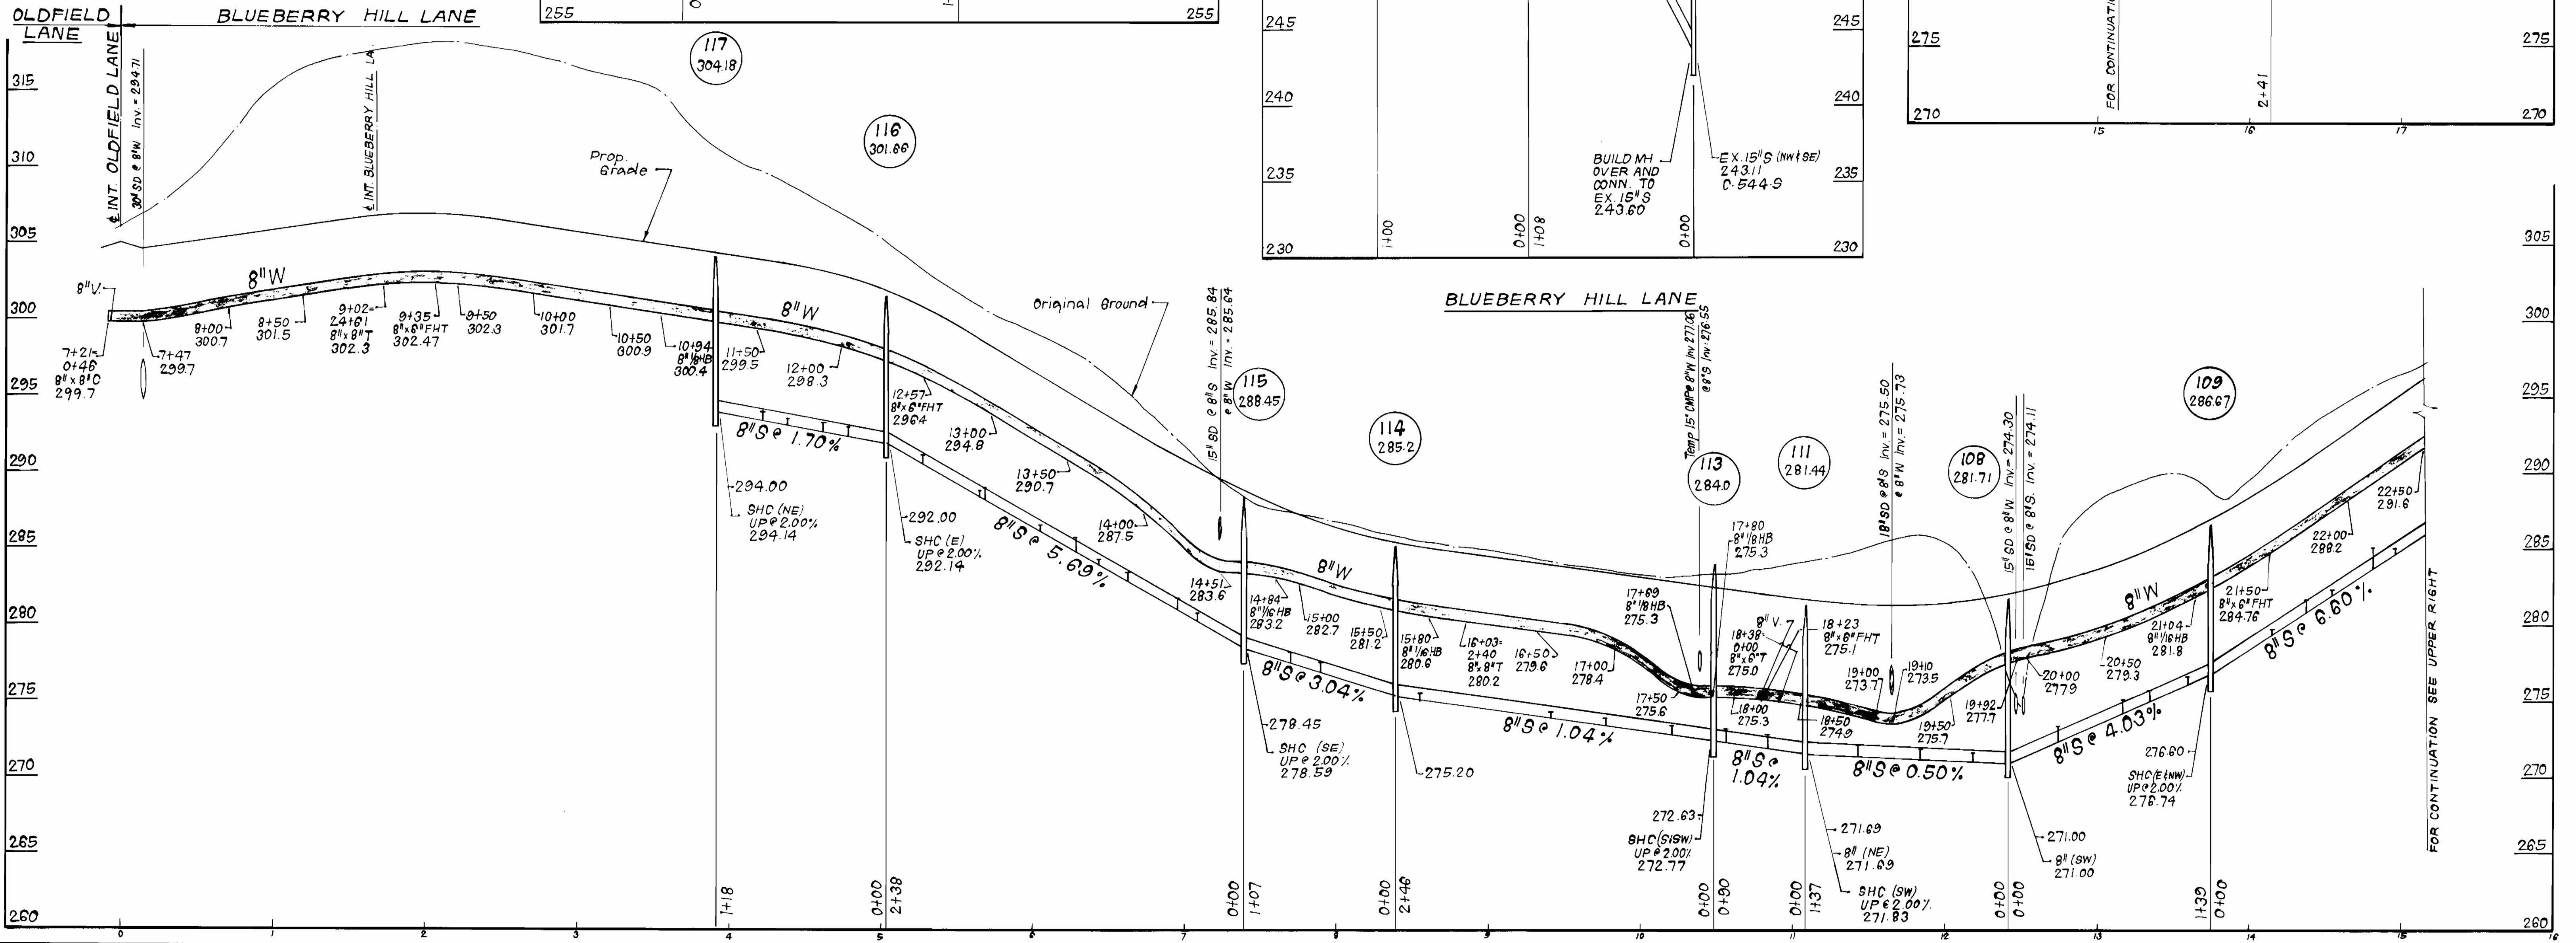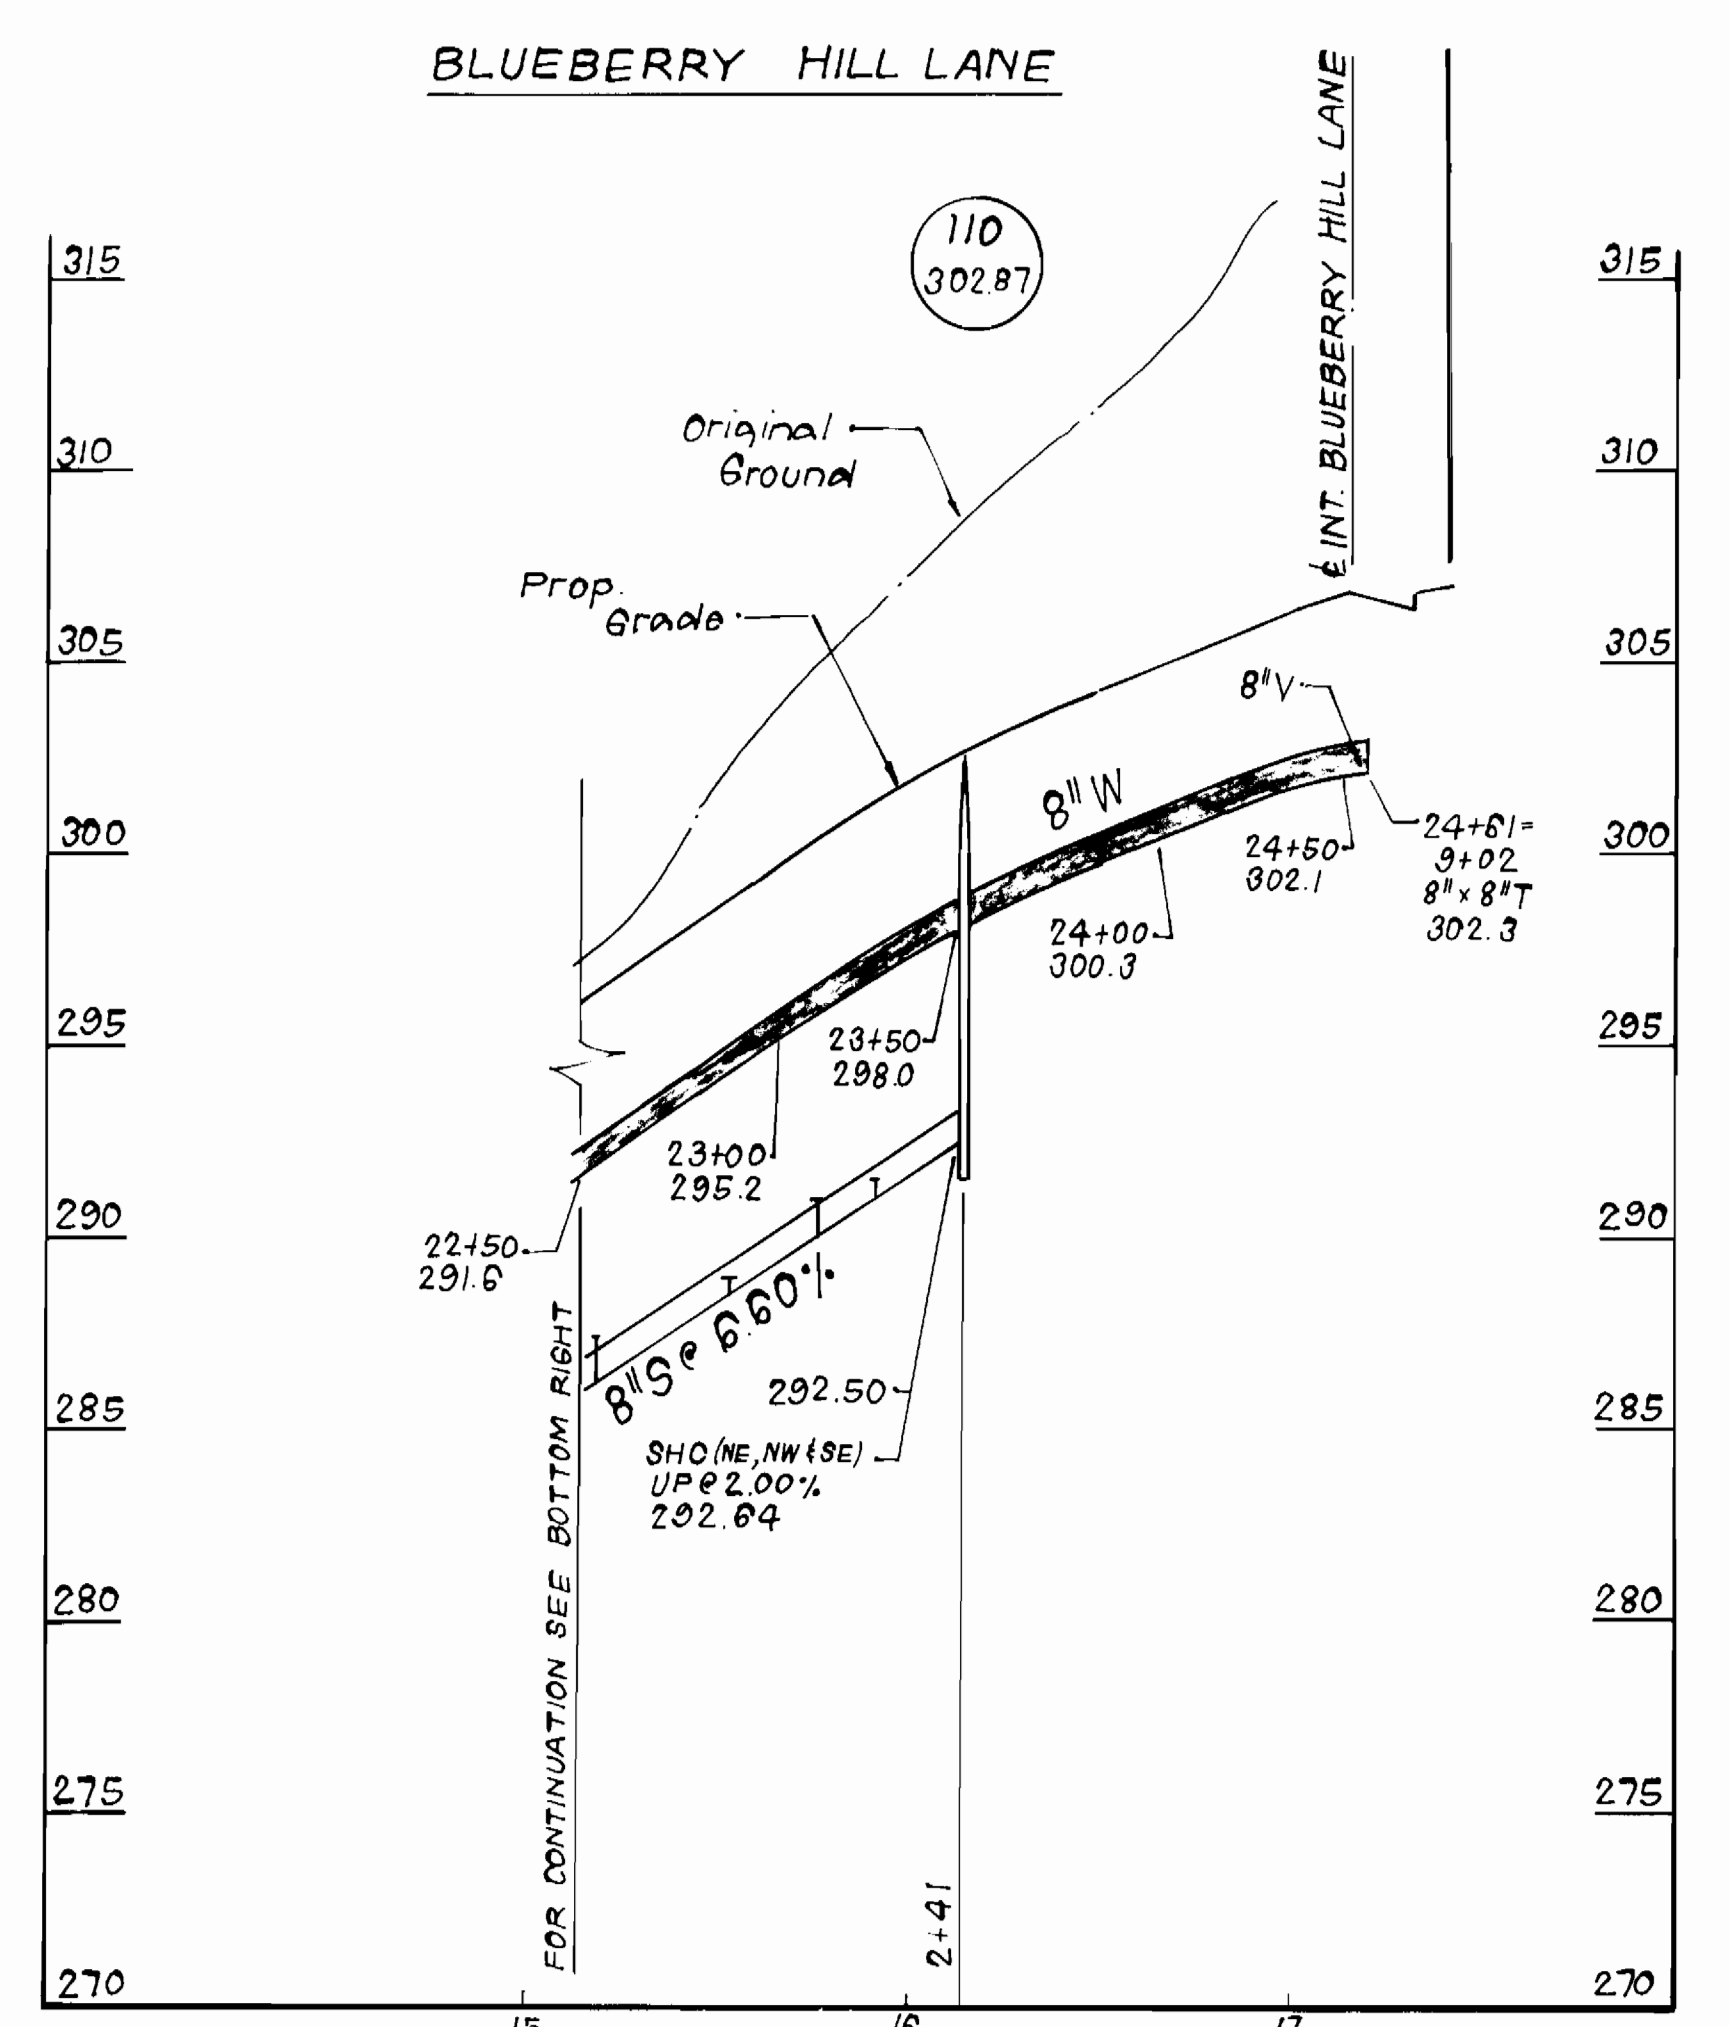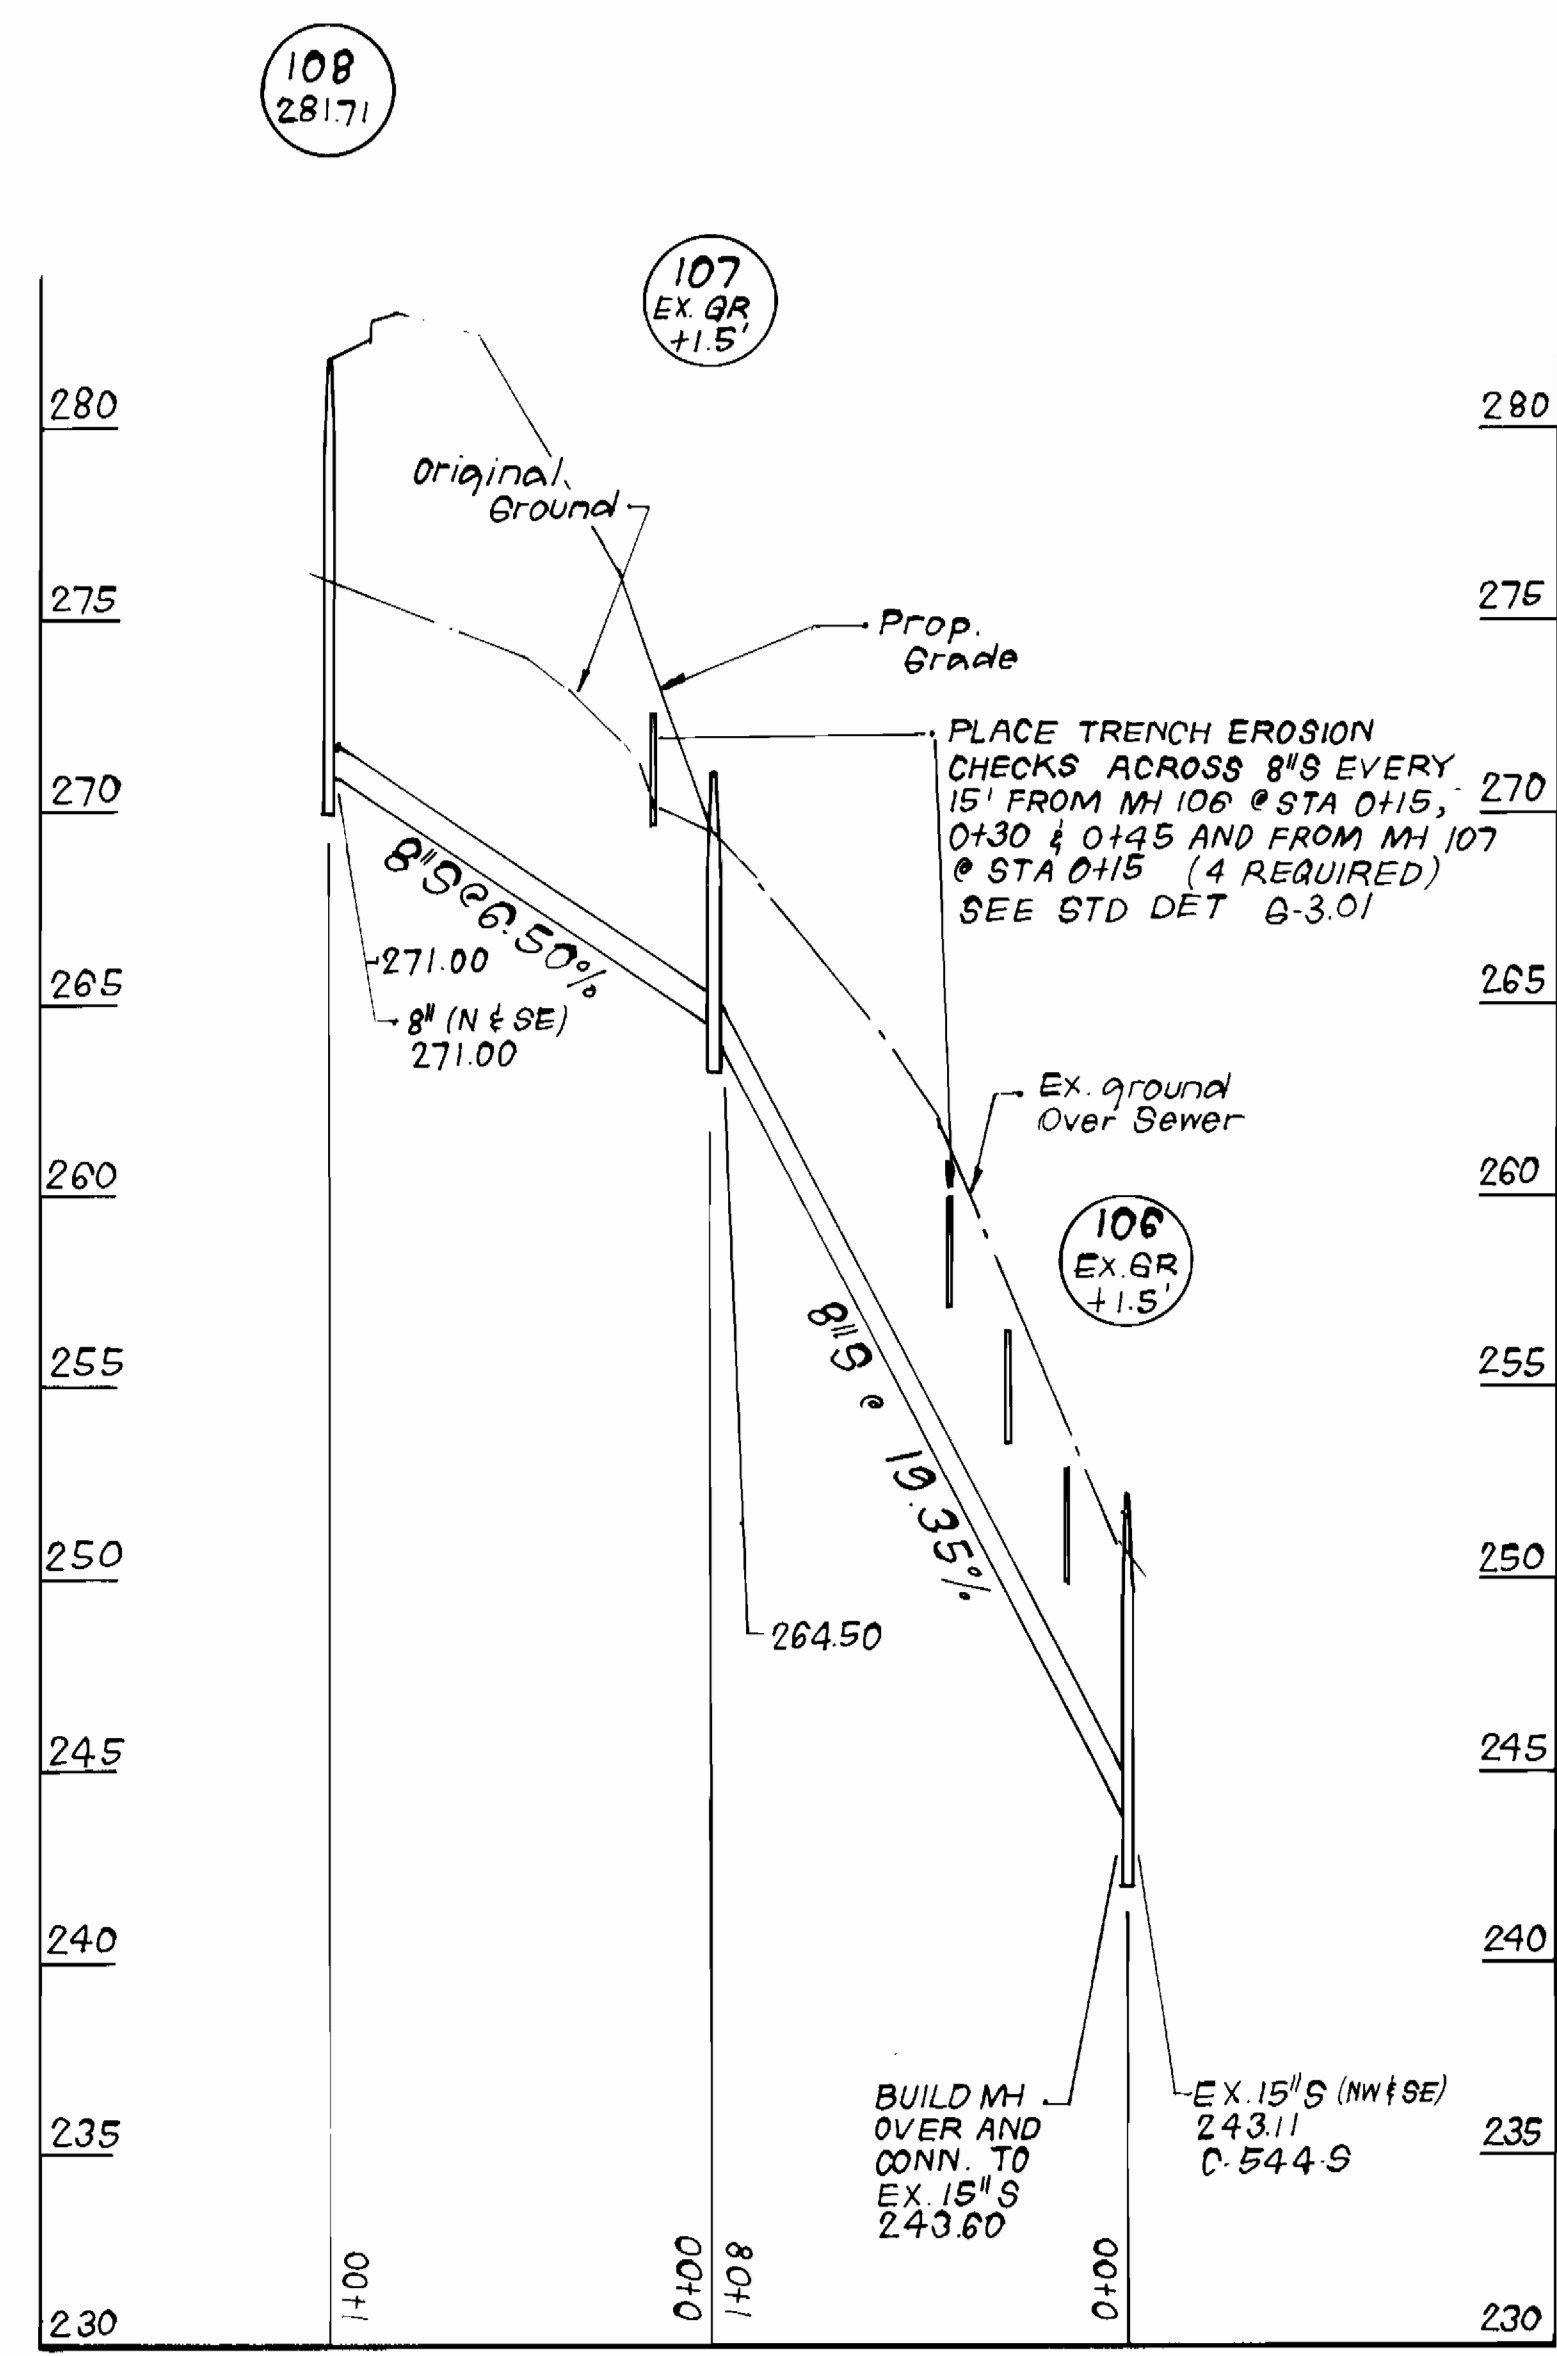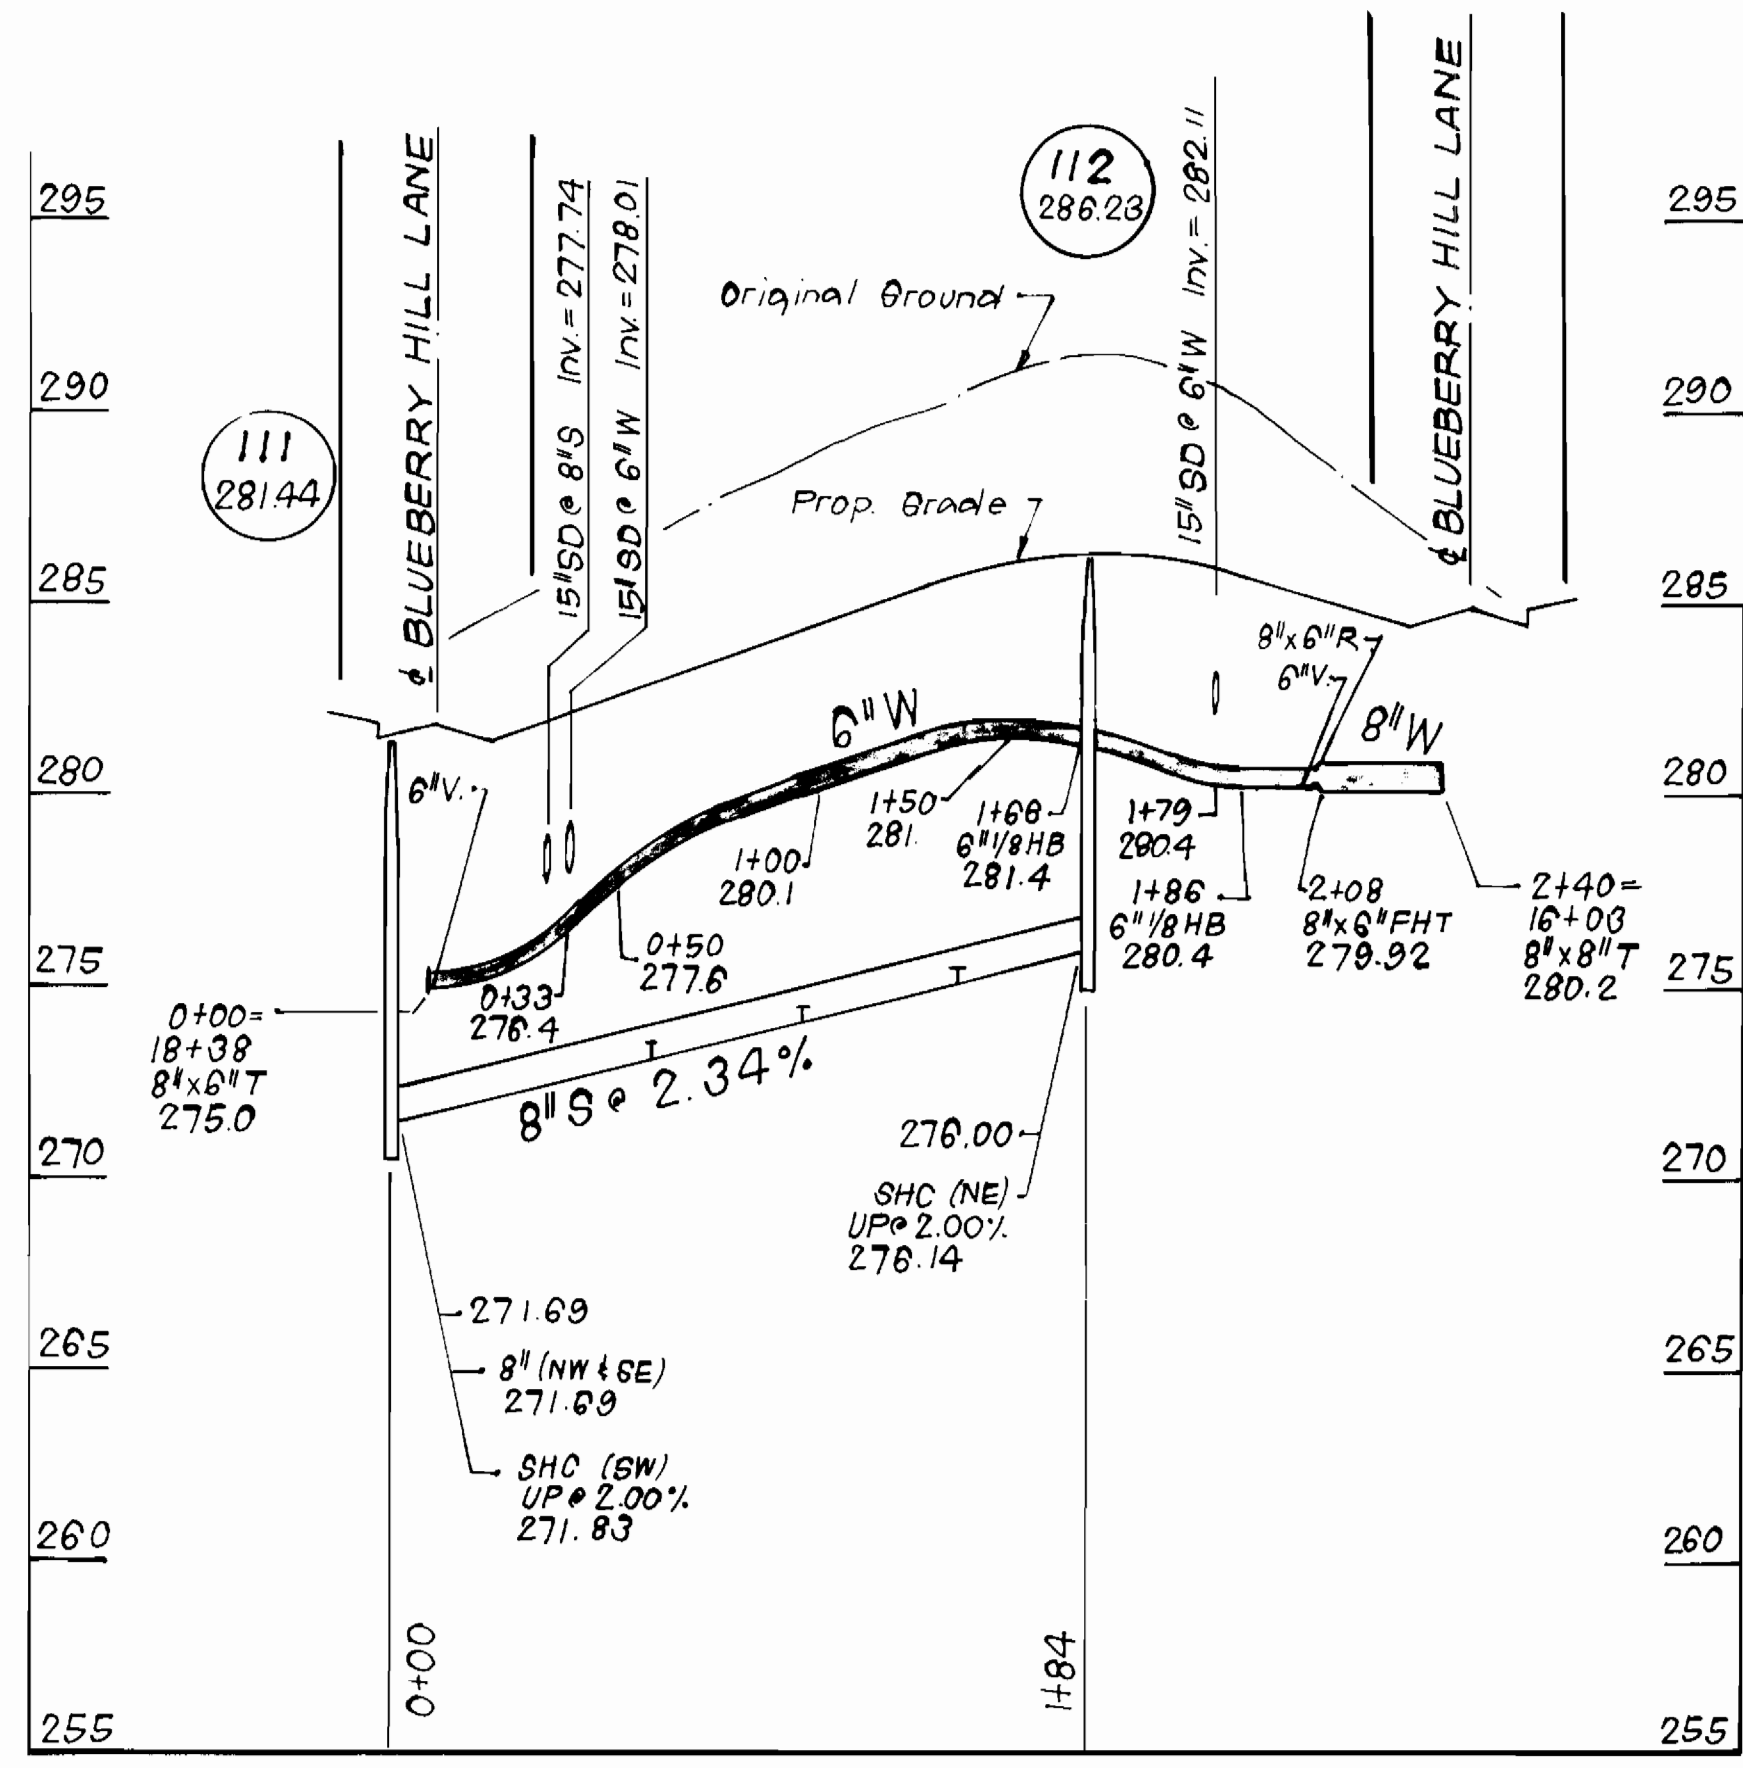

DEPARTMENT OF PUBLIC WORKS  
HOWARD COUNTY, MARYLAND

*James P. ...* 11-10-88  
DIRECTOR OF PUBLIC WORKS DATE

*Robert W. ...* 11-10-88  
CHIEF, BUREAU OF UTILITIES DATE

*Robert W. ...* 11-10-88  
CHIEF, LAND DEVELOPMENT DIV. DATE

**CFS** CLARK · FINEROCK & SACKETT, INC.  
ENGINEERS · PLANNERS · SURVEYORS

7135 MINSTREL WAY COLUMBIA MARYLAND 21045  
(301) 381-7500 BALTO. (301) 621-8100 WASH.



DES: JTR  
DRN: VLM  
CHK: JTR  
DATE: 3-88

BY NO. REVISION DATE

PROFILES OF  
WATER & SEWER MAINS

600' SCALE MAP NO. 37 BLOCK NO.


WOODLAND VILLAGE  
SECTION 2 AREA 2, LOTS 210 THRU 341  
1<sup>ST</sup> ELECTION DISTRICT  
CONTRACT NO. 14-1799-D

SCALE  
AS SHOWN


SHEET  
3 OF 4

**SEQUENCE OF CONSTRUCTION** (Outfall Sewers-Ex MH 7483 to MH1 & MH6 to MH7)


- | NO. | DESCRIPTION   | DAYS |
|-----|---|------|
| 1.  | Obtain grading permit   | 1    |
| 2.  | Clear and grade area and install sediment and erosion control devices                             | 4    |
| 3.  | Excavate and install 8" Sewer Pipe  | 4    |
| 4.  | Backfill trench and stabilize in accordance with standard details and specifications.             | 4    |
| 5.  | Remove sediment and erosion control devices and stabilize upon approval of S&E Control Inspector. | 7    |

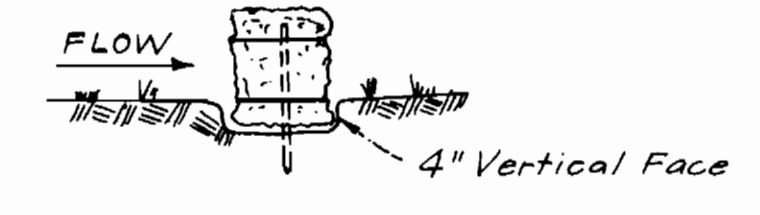



**BEDDING DETAIL**

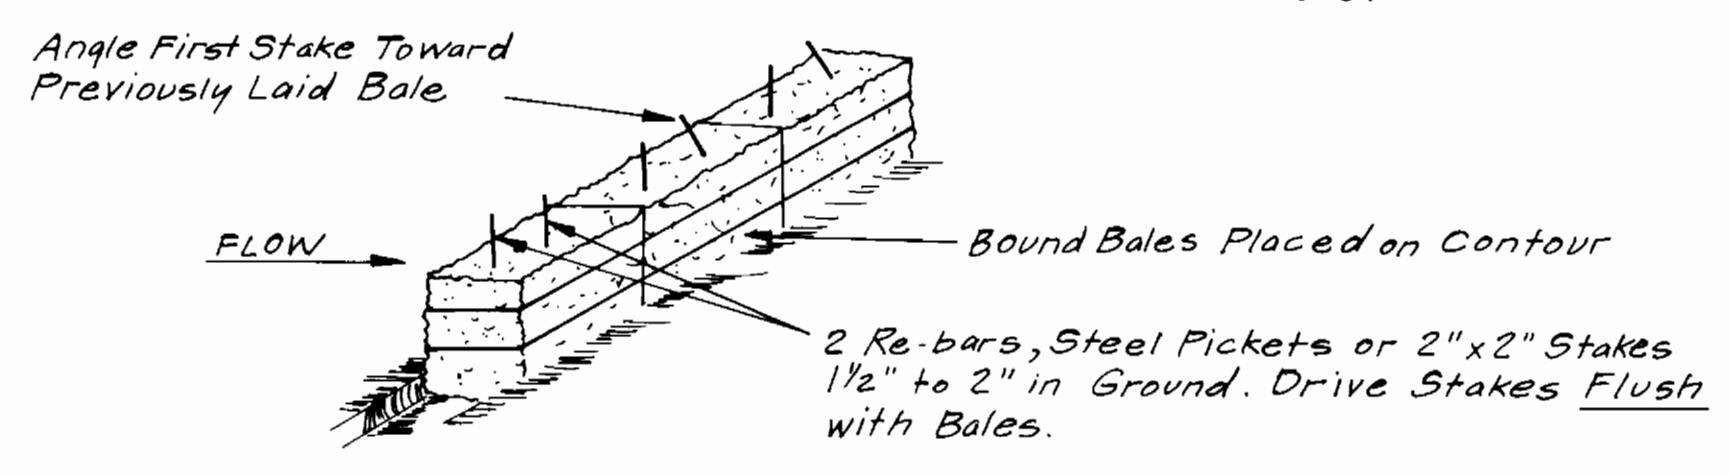

**ANCHORING DETAIL**  
**STRAW BALE DIKE**  
NO SCALE

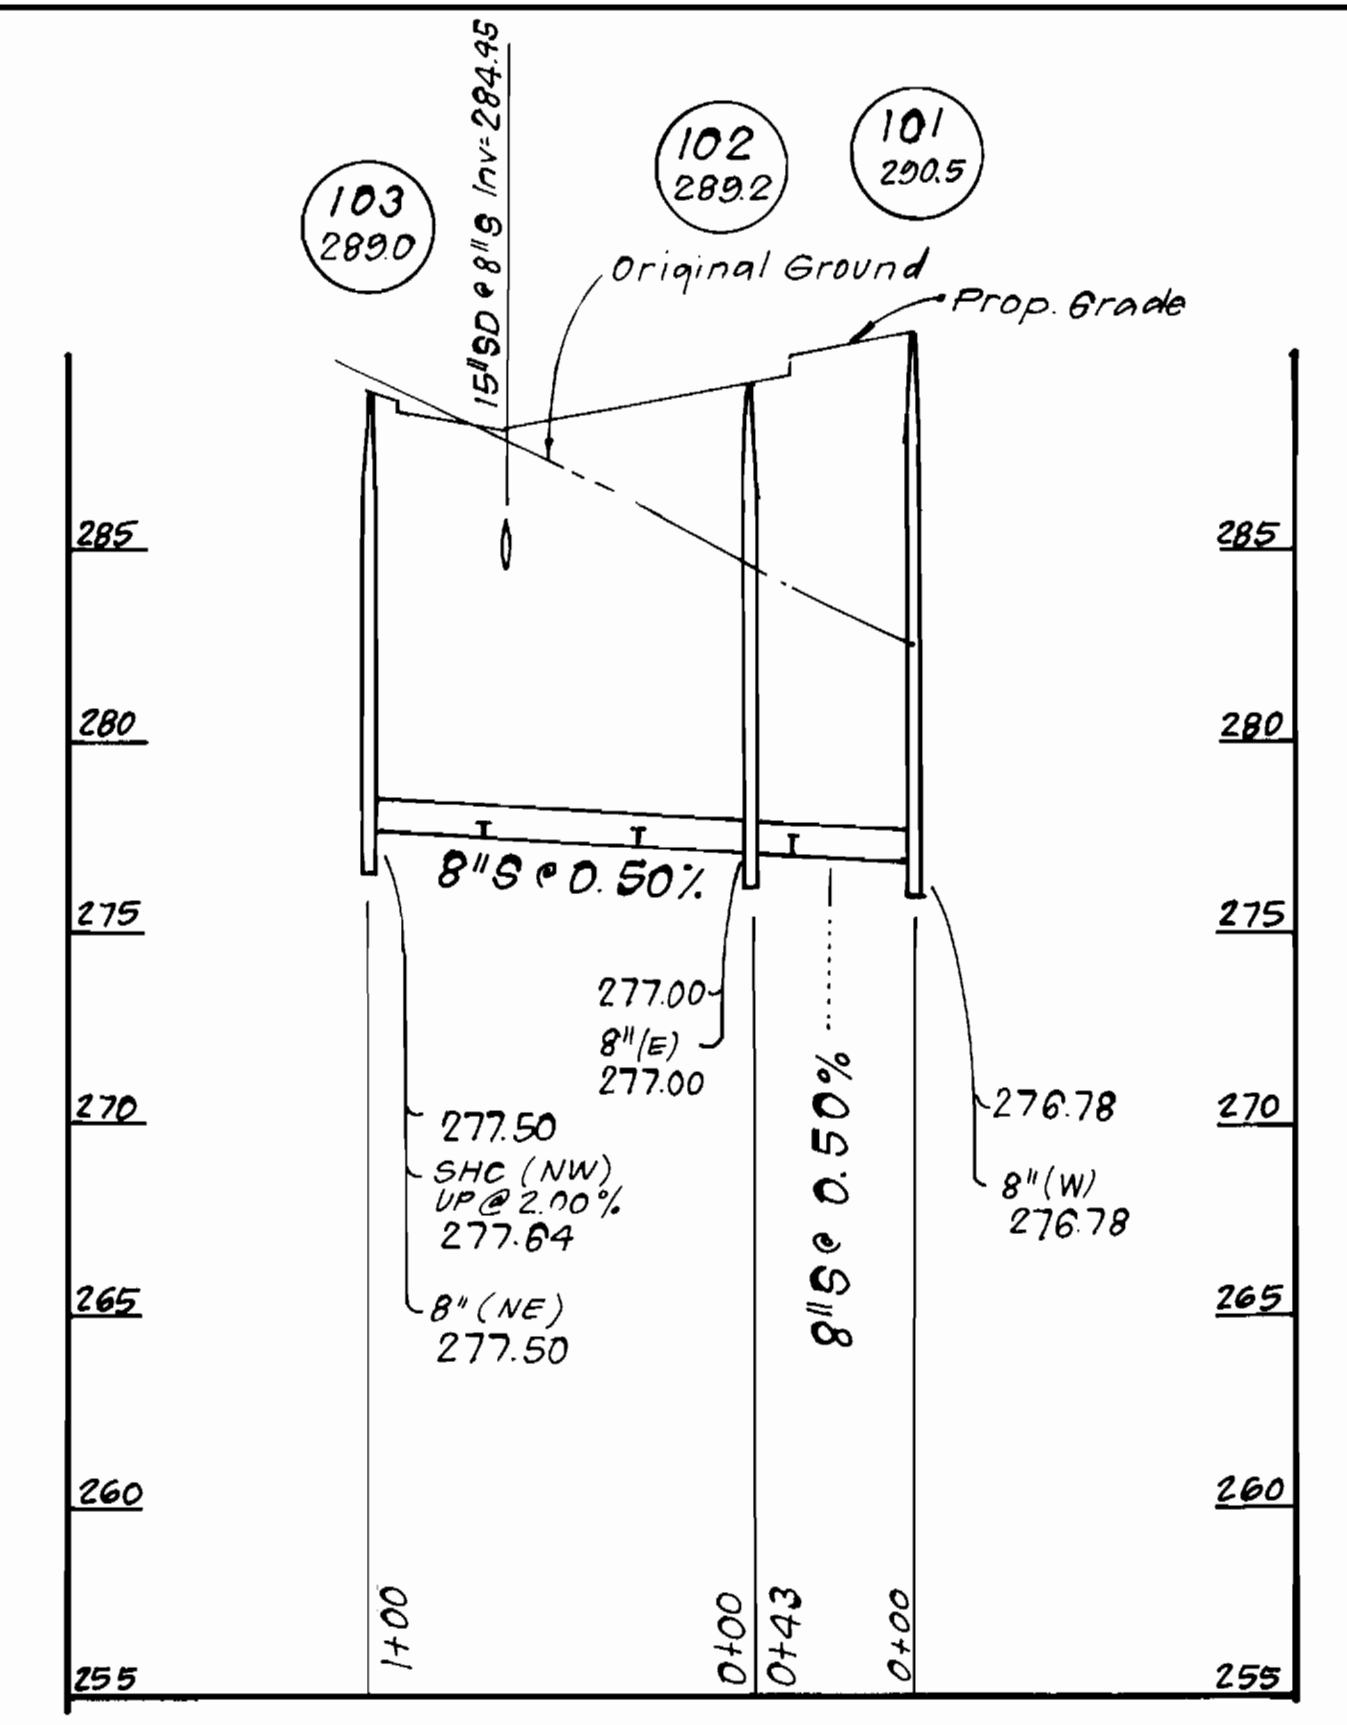

**PROFILE SCALE**  
HORZ. : 1" = 50'  
VERT. : 1" = 5'

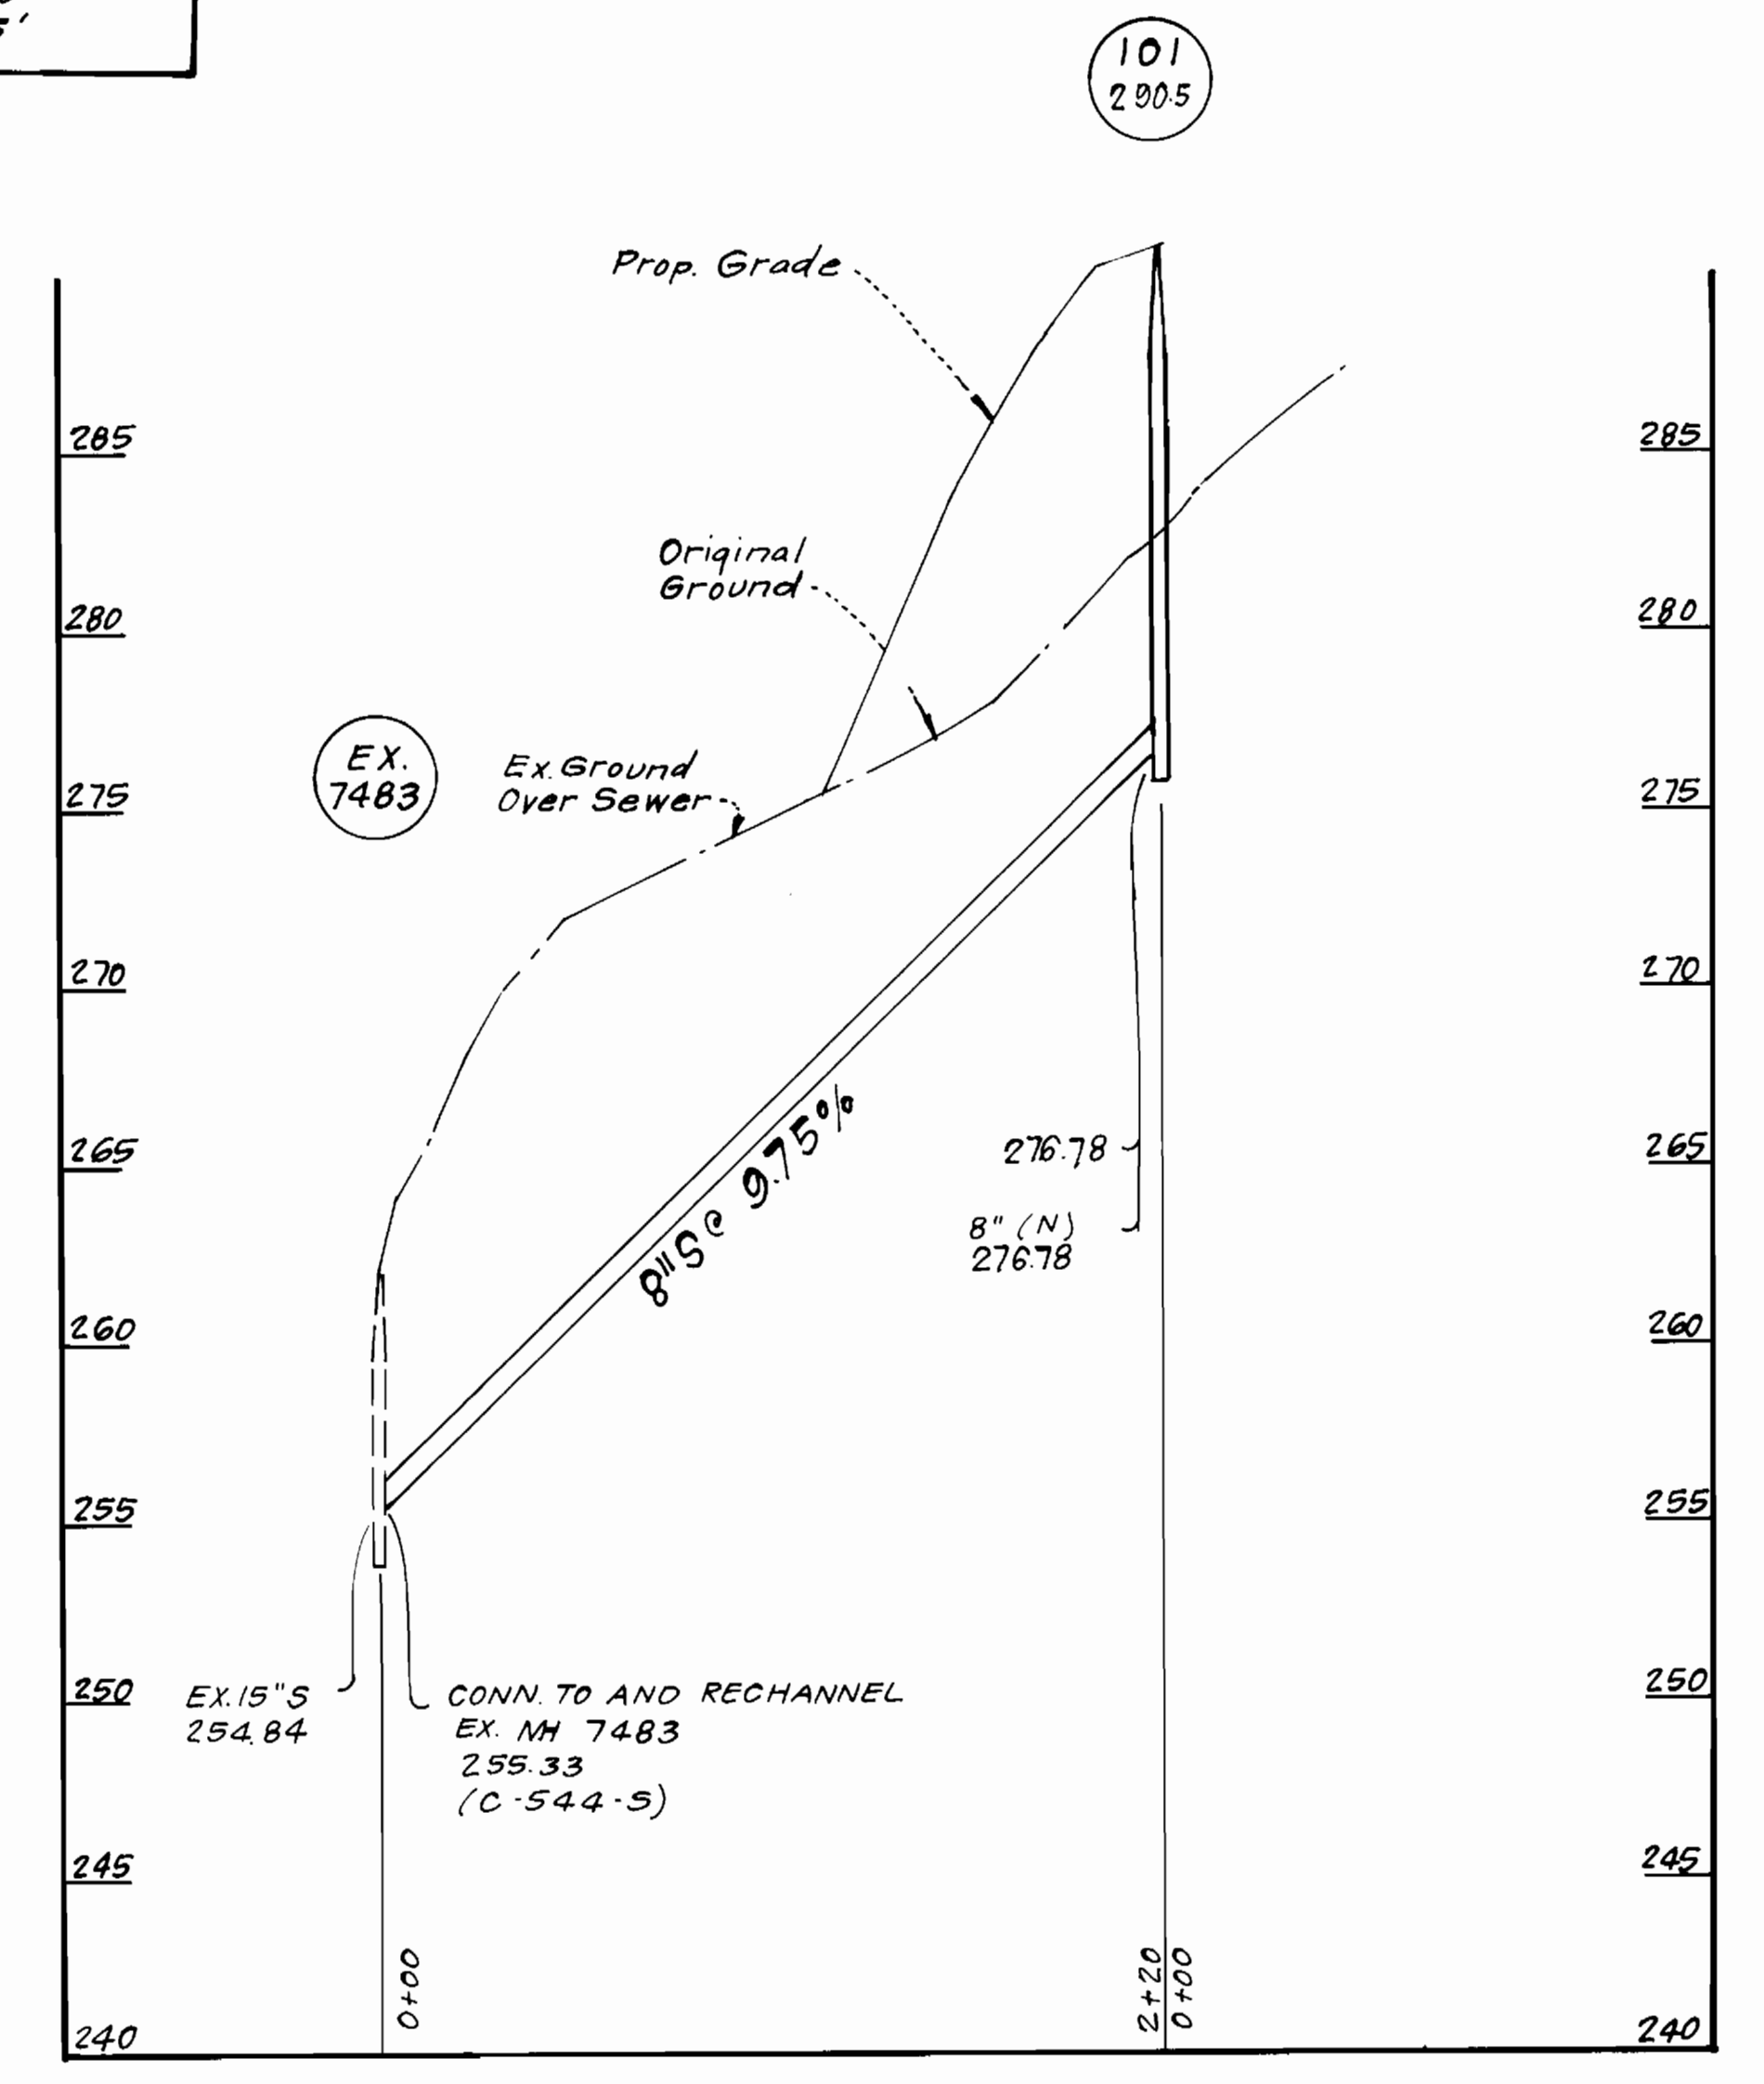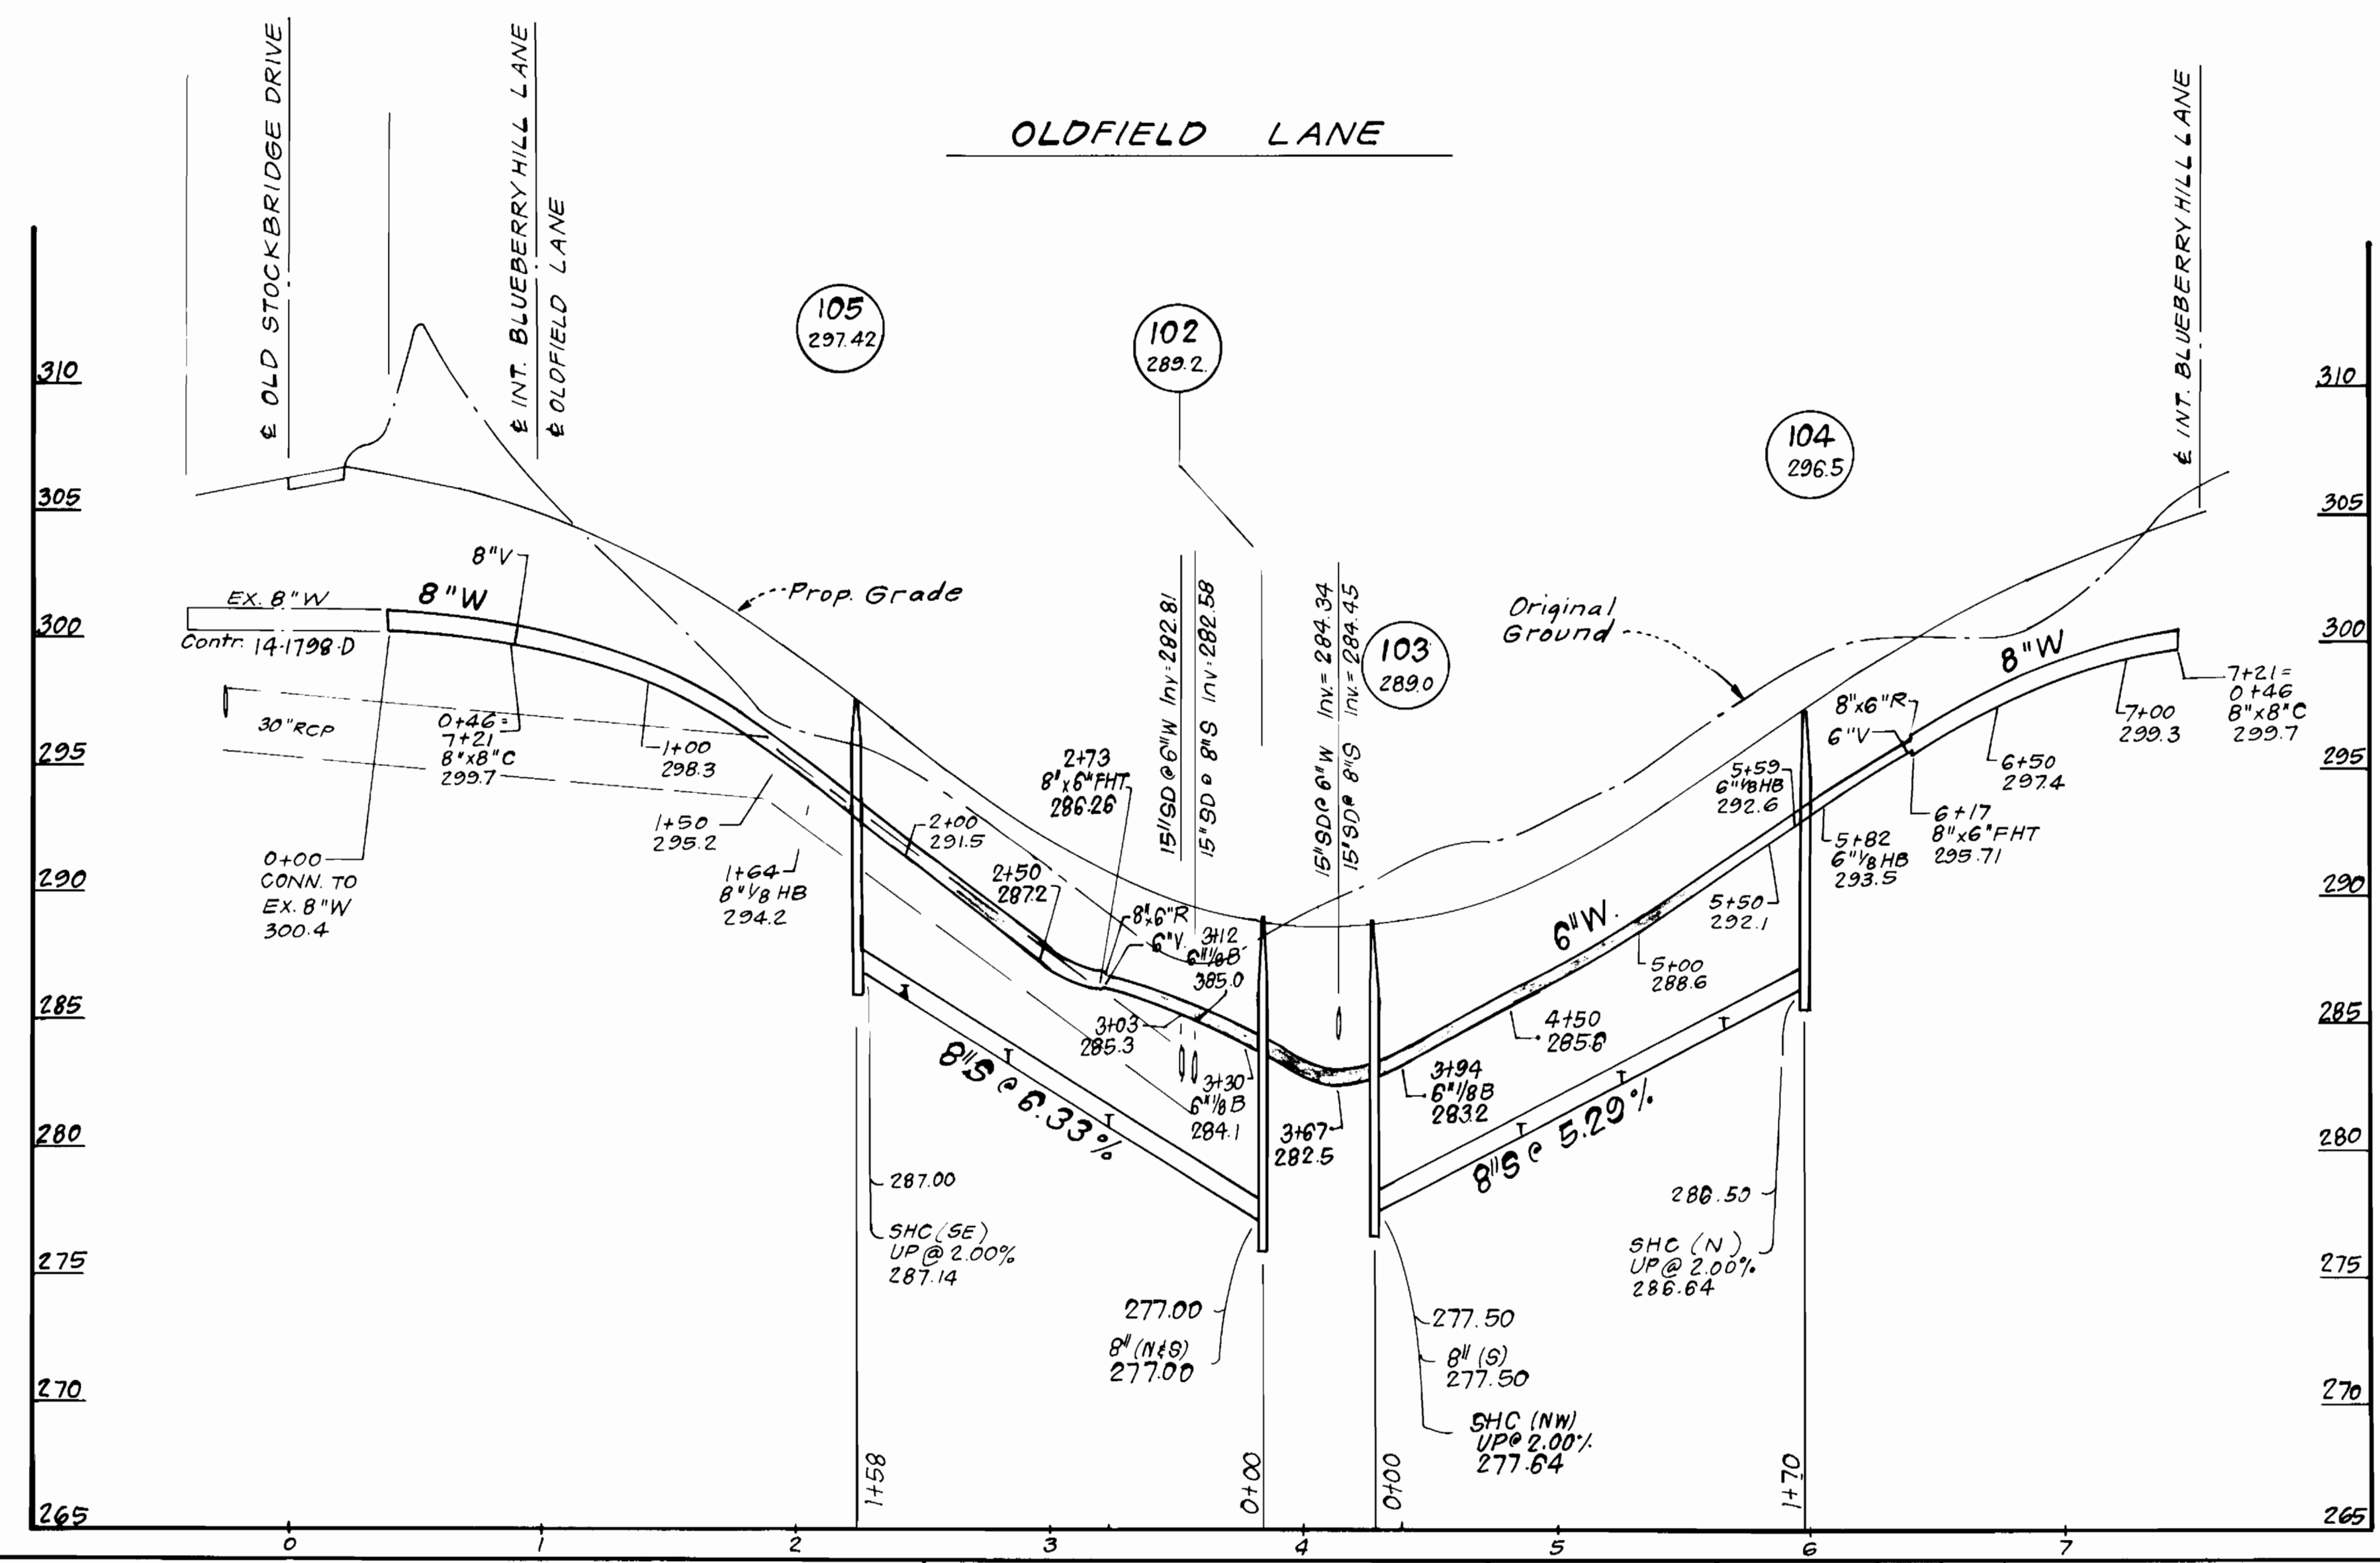

DEPARTMENT OF PUBLIC WORKS  
HOWARD COUNTY, MARYLAND

*James J. ...* 11/16/88  
DIRECTOR OF PUBLIC WORKS DATE

*Robert ...* 11-10-88  
CHIEF, BUREAU OF UTILITIES DATE

**CLARK · FINEFROCK & SACKETT, INC.**  
ENGINEERS · PLANNERS · SURVEYORS

7135 MINSTREL WAY COLUMBIA MARYLAND 21045  
(301) 381-7500 BALTO. (301) 621-8100 WASH.



DES: J. T. R.			
DRN: V. L. M.			
CHK: J. T. R.			
DATE: 3-88	BY	NO.	REVISION

PROFILES OF  
WATER & SEWER MAINS

600' SCALE MAP NO. 37 BLOCK NO.

WOODLAND VILLAGE  
SECTION 2 AREA 2, LOTS 210 THRU 34  
1ST ELECTION DISTRICT  
CONTRACT NO. 14-1799-D

SCALE  
AS SHOWN

SHEET  
4 OF 4