

VICINITY MAP
SCALE: 1" = 600'

- GENERAL NOTES**
- APPROXIMATE LOCATION OF EXISTING MAINS ARE SHOWN. THE CONTRACTOR SHALL TAKE ALL NECESSARY PRECAUTIONS TO PROTECT EXISTING MAINS AND SERVICES AND MAINTAIN UNINTERRUPTED SUPPLY. ANY DAMAGE INCURRED SHALL BE REPAIRED IMMEDIATELY TO THE SATISFACTION OF THE ENGINEER AT THE CONTRACTOR'S EXPENSE.
 - ALL HORIZONTAL CONTROLS ARE BASED ON MARYLAND STATE COORDINATES.
 - ALL VERTICAL CONTROLS ARE BASED ON U.S.G.C. DATA.
 - ALL PIPE ELEVATIONS SHOWN ARE INVERT ELEVATIONS.
 - CLEAR ALL UTILITIES BY A MINIMUM OF 6". CLEAR ALL POLES BY 2'-0" MINIMUM OR TUNNEL AS REQUIRED. THE OWNER HAS CONTACTED THE UTILITY COMPANY AND HAS MADE ARRANGEMENTS FOR BRACING OF POLES AS SHOWN ON THE DRAWINGS. IN THE EVENT THE CONTRACTOR'S WORK REQUIRES ADDITIONAL BRACING OF POLES, ANY COST INCURRED BY THE OWNER FOR THE BRACING OF ADDITIONAL POLES OR DAMAGES SHALL BE DEDUCTED FROM MONEY OWED TO THE CONTRACTOR. THE CONTRACTOR SHALL COORDINATE WITH THE UTILITY COMPANY TO SCHEDULE THE BRACING OF THE POLES.
 - FOR DETAILS NOT SHOWN ON THE DRAWINGS, AND FOR MATERIALS AND CONSTRUCTION METHODS, USE HOWARD COUNTY DESIGN MANUAL VOLUME IV, STANDARD SPECIFICATIONS AND DETAILS FOR CONSTRUCTION. THE CONTRACTOR SHALL HAVE A COPY OF VOLUME IV ON THE JOB.
 - WHERE TEST PITS HAVE BEEN MADE ON EXISTING UTILITIES, THEY ARE NOTED BY THE SYMBOL [Symbol] AT THE LOCATION OF THE TEST PIT. A NOTE OR NOTES CONTAINING THE RESULTS OF THE TEST PIT OR PITS IS INCLUDED ON THE DRAWINGS. EXISTING UTILITIES IN THE VICINITY OF THE PROPOSED WORK FOR WHICH TEST PITS HAVE BEEN DUG SHALL BE LOCATED BY THE CONTRACTOR TWO WEEKS IN ADVANCE OF CONSTRUCTION OPERATIONS AT THE CONTRACTOR'S EXPENSE.
 - CONTRACTOR SHALL NOTIFY THE FOLLOWING UTILITIES OR AGENCIES AT LEAST FIVE WORKING DAYS BEFORE STARTING WORK SHOWN ON THESE PLANS:
 - C&P..... 1-800-257-7777
 - STATE HIGHWAY ADMINISTRATION..... 531-5533
 - BALTIMORE GAS & ELECTRIC CO. CONTRACTOR SERVICES..... 850-4620
 - BALTIMORE GAS & ELECTRIC CO. UNDERGROUND DAMAGE CONTROL..... 859-3004
 - BALTIMORE GAS & ELECTRIC CO. TROUBLE SHOOTING..... 298-3001
 - MISS UTILITY..... 1-800-559-0100
 - COLONIAL PIPELINE CO..... 795-1390
 - BUREAU OF UTILITIES, HOWARD COUNTY DEPARTMENT OF PUBLIC WORKS..... 992-2366
 - TREES ARE TO BE PROTECTED FROM DAMAGE TO MAXIMUM EXTENT. TREES LOCATED WITHIN THE CONSTRUCTION STRIP ARE NOT TO BE REMOVED OR DAMAGED BY THE CONTRACTOR.
 - CONTRACTOR SHALL REMOVE TREES, STUMPS AND ROOTS ALONG LINE OF EXCAVATION AS DIRECTED BY THE ENGINEER. PAYMENT FOR SUCH REMOVAL SHALL BE INCLUDED IN THE UNIT PRICE BID FOR EXCAVATION AND BACKFILL.
 - PLACE REGULATION "MEN WORKING" AND WARNING SIGNS AS REQUIRED TO COMPLY WITH MARYLAND STATE HIGHWAY ADMINISTRATION MANUAL OF TRAFFIC CONTROL FOR HIGHWAY MAINTENANCE OPERATIONS.
 - ALL WATER MAINS TO BE D.I.P. UNLESS OTHERWISE NOTED.
 - TOP OF ALL WATER MAINS TO HAVE A MINIMUM OF 3'-6" COVER UNLESS OTHERWISE NOTED.
 - VALVES ADJACENT TO TEES SHALL BE STRAPPED TO TEES.
 - BLOCK ALL FITTINGS WITH CONCRETE.
 - BURY LINE ELEVATIONS ON FIRE HYDRANTS SHALL BE SET TO THE ELEVATIONS ON THE DRAWINGS. ALL FIRE HYDRANTS SHALL BE STRAPPED AND BUTTRESSED WITH CONCRETE IN ACCORDANCE WITH STANDARD DETAILS. SOIL AROUND THE FIRE HYDRANT TO BE COMPACTED IN ACCORDANCE WITH SECTIONS 1005 OF THE GENERAL REQUIREMENTS FOR WATER AND SEWER.
 - ALL WATER HOUSE CONNECTIONS SHALL BE FOR AN INSIDE METER SETTING.
 - THE CONTRACTOR SHALL NOT OPERATE ANY WATER MAIN VALVES ON THE EXISTING SYSTEM.
 - ALL D.I.P. FITTINGS SHALL BE IN ACCORDANCE WITH ANWA SPECIFICATION C-153 DUCTILE IRON COMPACT FITTINGS 3"-12" WATER AND OTHER LIQUIDS.
 - THE SERVICE CLAMPS ARE TO HAVE STAINLESS STEEL STRAPS.
 - ALL SEWER MAINS SHALL BE C.S.P.X., V.C.P.X., P.V.C. OR A.C.P. CLASS 2400 UNLESS OTHERWISE NOTED.
 - THE CONTRACTOR SHALL PROVIDE A JOINT IN ALL SEWER MAINS WITHIN 2'-0" OF EXTERIOR MANHOLE WALL.
 - ALL MANHOLES SHALL BE 4'-0" INSIDE DIAMETER UNLESS OTHERWISE NOTED.
 - MANHOLES SHOWN WITH 12" AND 16" WALLS ARE BRICK MANHOLES ONLY.
 - MANHOLES DESIGNATED M.T. IN PLAN AND PROFILE SHALL HAVE WATERTIGHT FRAME AND COVERS, STANDARD DETAIL 65.52 VOLUME IV WHERE WATERTIGHT MANHOLE IS USED, SET TOP OF FRAME 1'-6" ABOVE FINISHED GRADE.
 - HOUSE (S) WITH SYMBOL "C.N.S." INDICATES CELLAR CANNOT BE SERVED.
 - ALL WATER HOUSE CONNECTIONS SHALL HAVE A MINIMUM VERTICAL CLEARANCE OF 12" ABOVE ALL SANITARY SEWER CROSSINGS.
 - ALL SANITARY SEWER HOUSE CONNECTIONS SHALL HAVE A MINIMUM VERTICAL CLEARANCE OF 12" BELOW ALL WATER MAIN CROSSINGS.
 - PROFILE STATIONS SHALL BE ADJUSTED AS NECESSARY TO CONFORM TO PLAN DIMENSIONS.
 - NO PIPE SHALL BE LAID UNTIL LINES OF EXCAVATION HAVE BEEN BROUGHT TO SUBGRADE.

QUANTITIES

ITEM	QUANTITY	AS-BUILT	SUPPLIER
8" SEWER	1280 LF	1276 LF	J.M. Manufacturing Corp.
6" SHC	410 LF	459 LF	"
MANHOLES	8 Ea.	9	Atlantic Const. Co.
8" WATER	507 LF	505 LF	GRAFFIN Pipe Prod.
6" WATER	39 LF	38 LF	"
1" WHC	170 LF	166 LF	Howell Metals
3/4" WHC	178 LF	326 LF	"
FIRE HYDRANT 12" DR. 100 PSI	2 Ea.	2	Muller Co.
6" V. EXCL. F.H.V.	1 Ea.	1	"
EX. G.W. TO BE REPAIRED	126 LF	146 LF	GRAFFIN Pipe Prod.

HOWARD SOIL CONSERVATION DISTRICT:
REVIEWED FOR HOWARD SOIL CONSERVATION DISTRICT
AND MEETS TECHNICAL REQUIREMENTS





James M. H. Jr. 7/6/89
SOIL CONSERVATION SERVICE DATE

THIS PLAN IS APPROVED FOR SOIL EROSION AND SEDIMENT CONTROL BY THE HOWARD SOIL CONSERVATION DISTRICT.

Stephen J. ... 7/6/89
HOWARD SOIL CONSERVATION DISTRICT DATE

SEDIMENT CONTROL MEASURES FOR THIS CONTRACT WILL BE IMPLEMENTED IN ACCORDANCE WITH SECTION 219 OF THE HOWARD COUNTY STANDARD SPECIFICATIONS AND AS PER ROAD CONSTRUCTION PLANS #F-80-70

DEPARTMENT OF PUBLIC WORKS HOWARD COUNTY, MARYLAND <i>James M. H. Jr.</i> 7/10/89 DIRECTOR OF PUBLIC WORKS DATE <i>Michael A. ...</i> 6-30-89 CHIEF, BUREAU OF UTILITIES DATE		TRACY, SCHULTE & ASSOCIATES INC. planning engineering surveying 8480 Baltimore National Pike Suite 418 Ellicott City, Maryland 21043 <i>Tracy Schulte</i> CHIEF, LAND DEVELOPMENT DIVISION DATE		DES. DAM DRN. JH/DP/MM CHK. JKT DATE 11-11-89 BY NO. 6-26-89		PLAN OF WATER AND SEWER MAINS REVISIONS REVISED H.B. TO V.B. WALNUT ROAD CHANGED REDUCER 9/20		LINWOOD SECTION 5 ELECTION DISTRICT NO. 2 CONTRACT NO. 14-1857-D BLOCK NO. 1		SCALE AS SHOWN SHEET 1 OF 2
---	--	---	--	---	--	--	--	---	--	--------------------------------

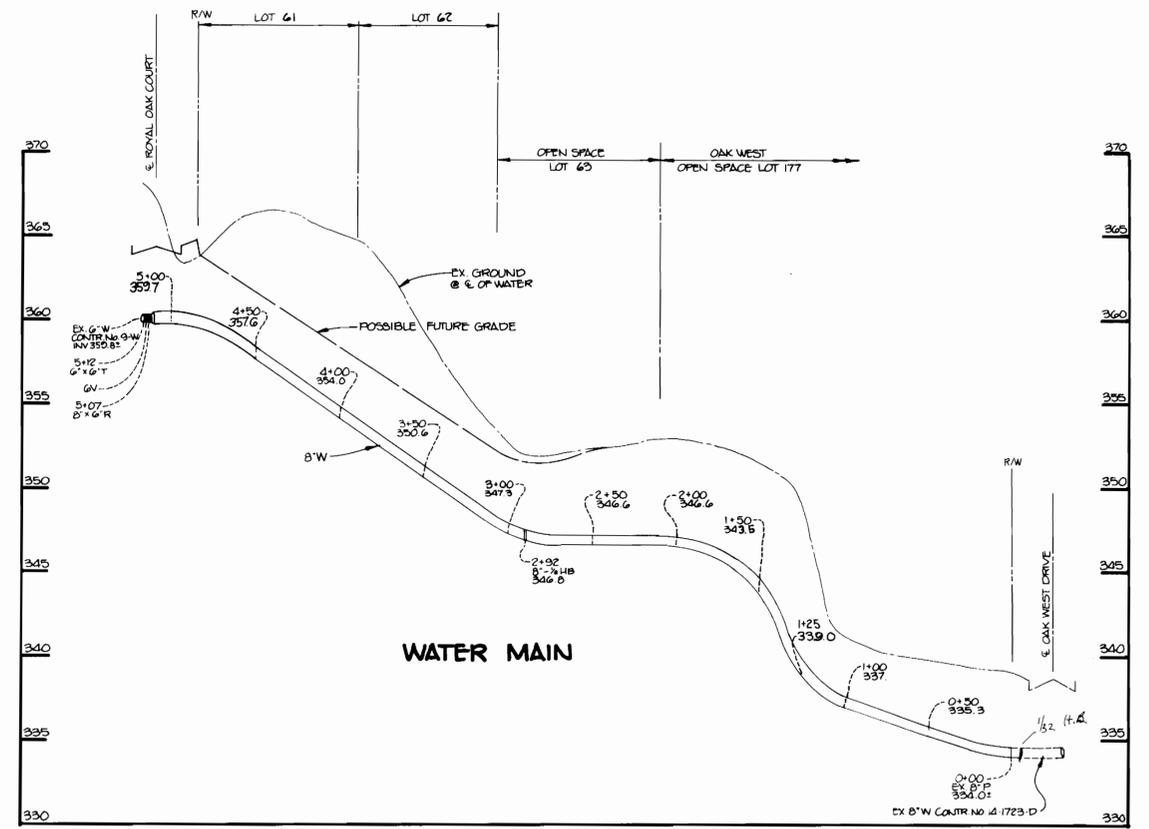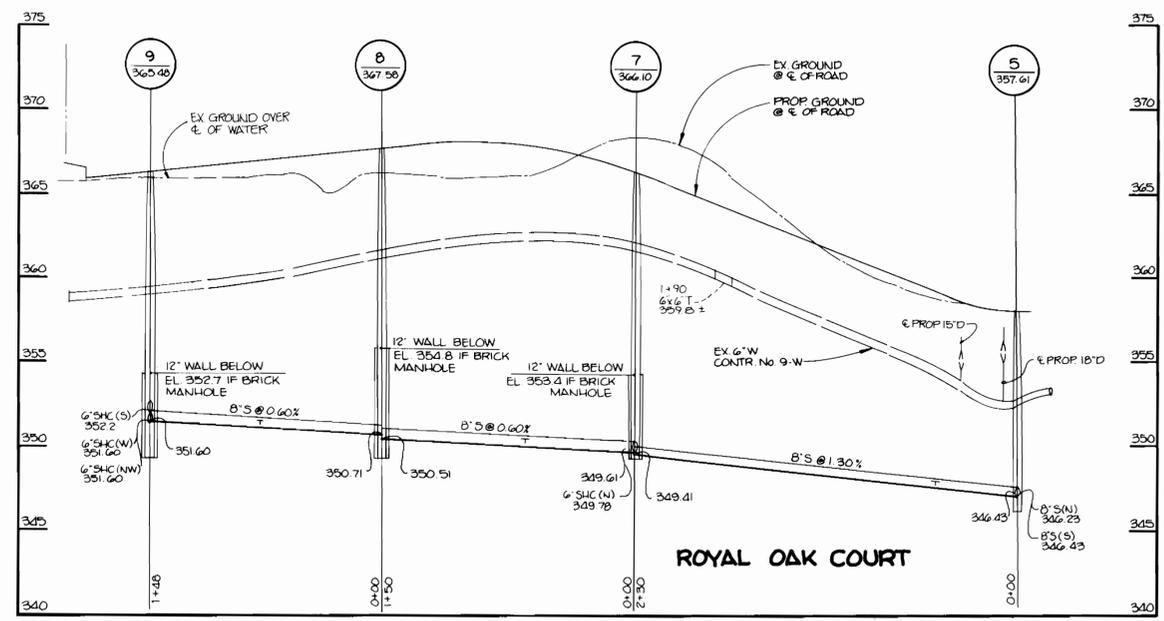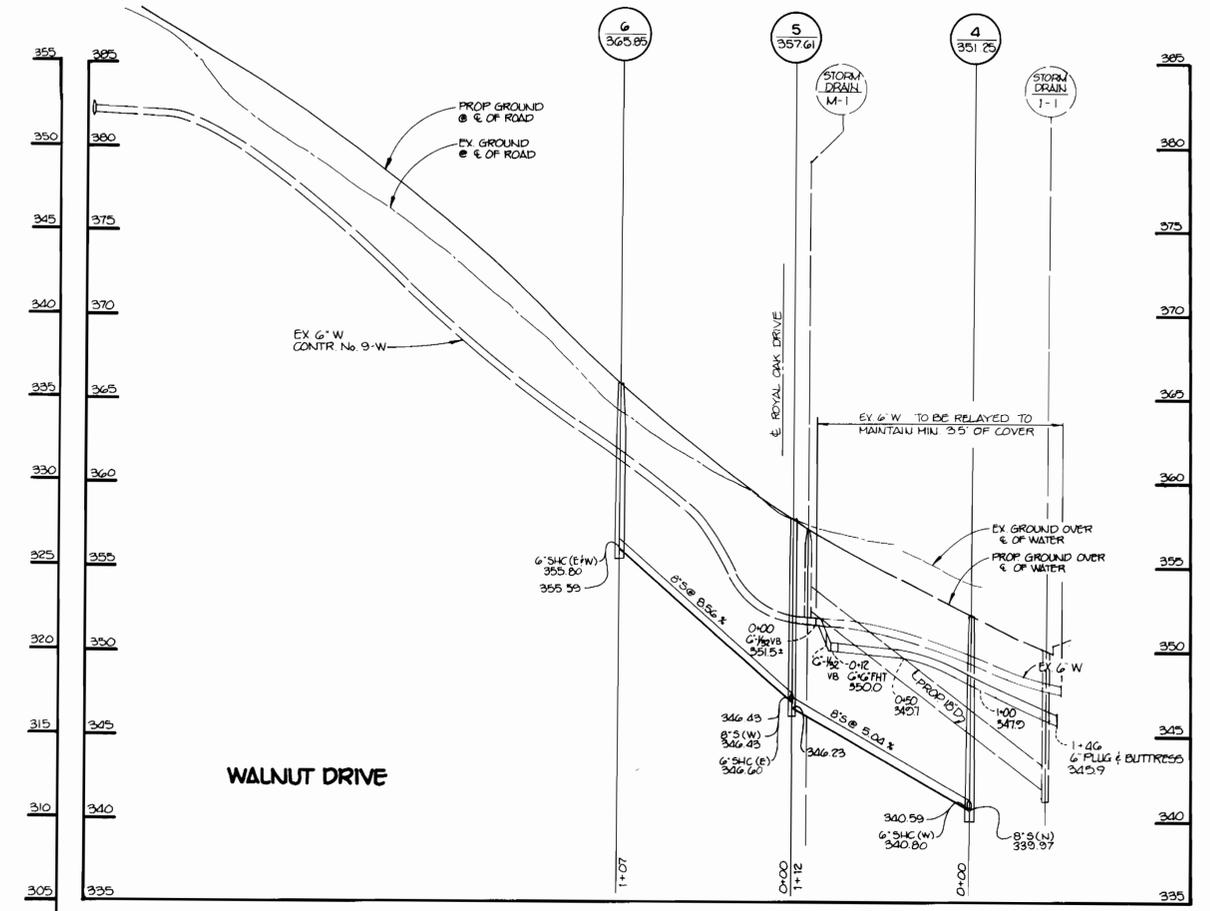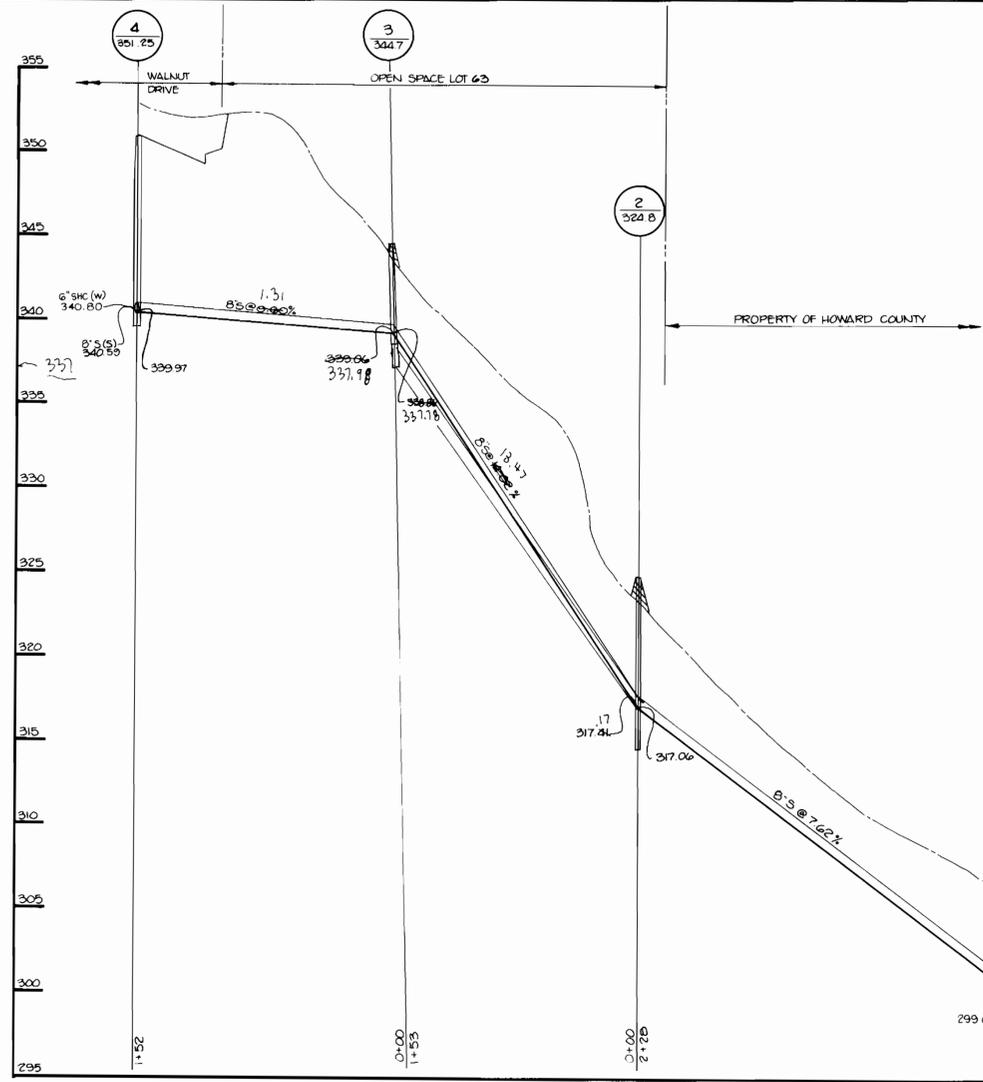

DEPARTMENT OF PUBLIC WORKS
HOWARD COUNTY, MARYLAND

James J. ... 7/10/89
DIRECTOR OF PUBLIC WORKS DATE

William S. ... 7/10/89
CHIEF BUREAU OF ENGINEERING DATE

Michael ... 7/10/89
CHIEF, BUREAU OF UTILITIES DATE

Paul ... 7/10/89
CHIEF, LAND DEVELOPMENT DIVISION DATE

TRACY, SCHULTE &
ASSOCIATES INC.

planning engineering surveying
8480 Baltimore National Pike Suite 418
Ellicott City, Maryland 21043



DES. DAM	
DRN. JH/MM	
CHK. JKT	
DATE 11/11/88	REVISIONS
6-26-89	

REVISED WATER LINE ELEVATIONS CHANGE H.B. TO V.B. WALNUT DR. 9/20

600' SCALE MAP NO. 25 BLOCK NO. 1

PROFILES

LINWOOD
SECTION 5
ELECTION DISTRICT NO. 2
CONTRACT NO. 14-1857-D

SCALE AS SHOWN

SHEET 2 OF 2

AS-BUILT 1/17/90