


Type of Buildings	Residential Townhouses
Number of Lots	45
Number of Water House Connections	44
Number of Sewer House Connections	41
Drainage Area	Little Patuxent

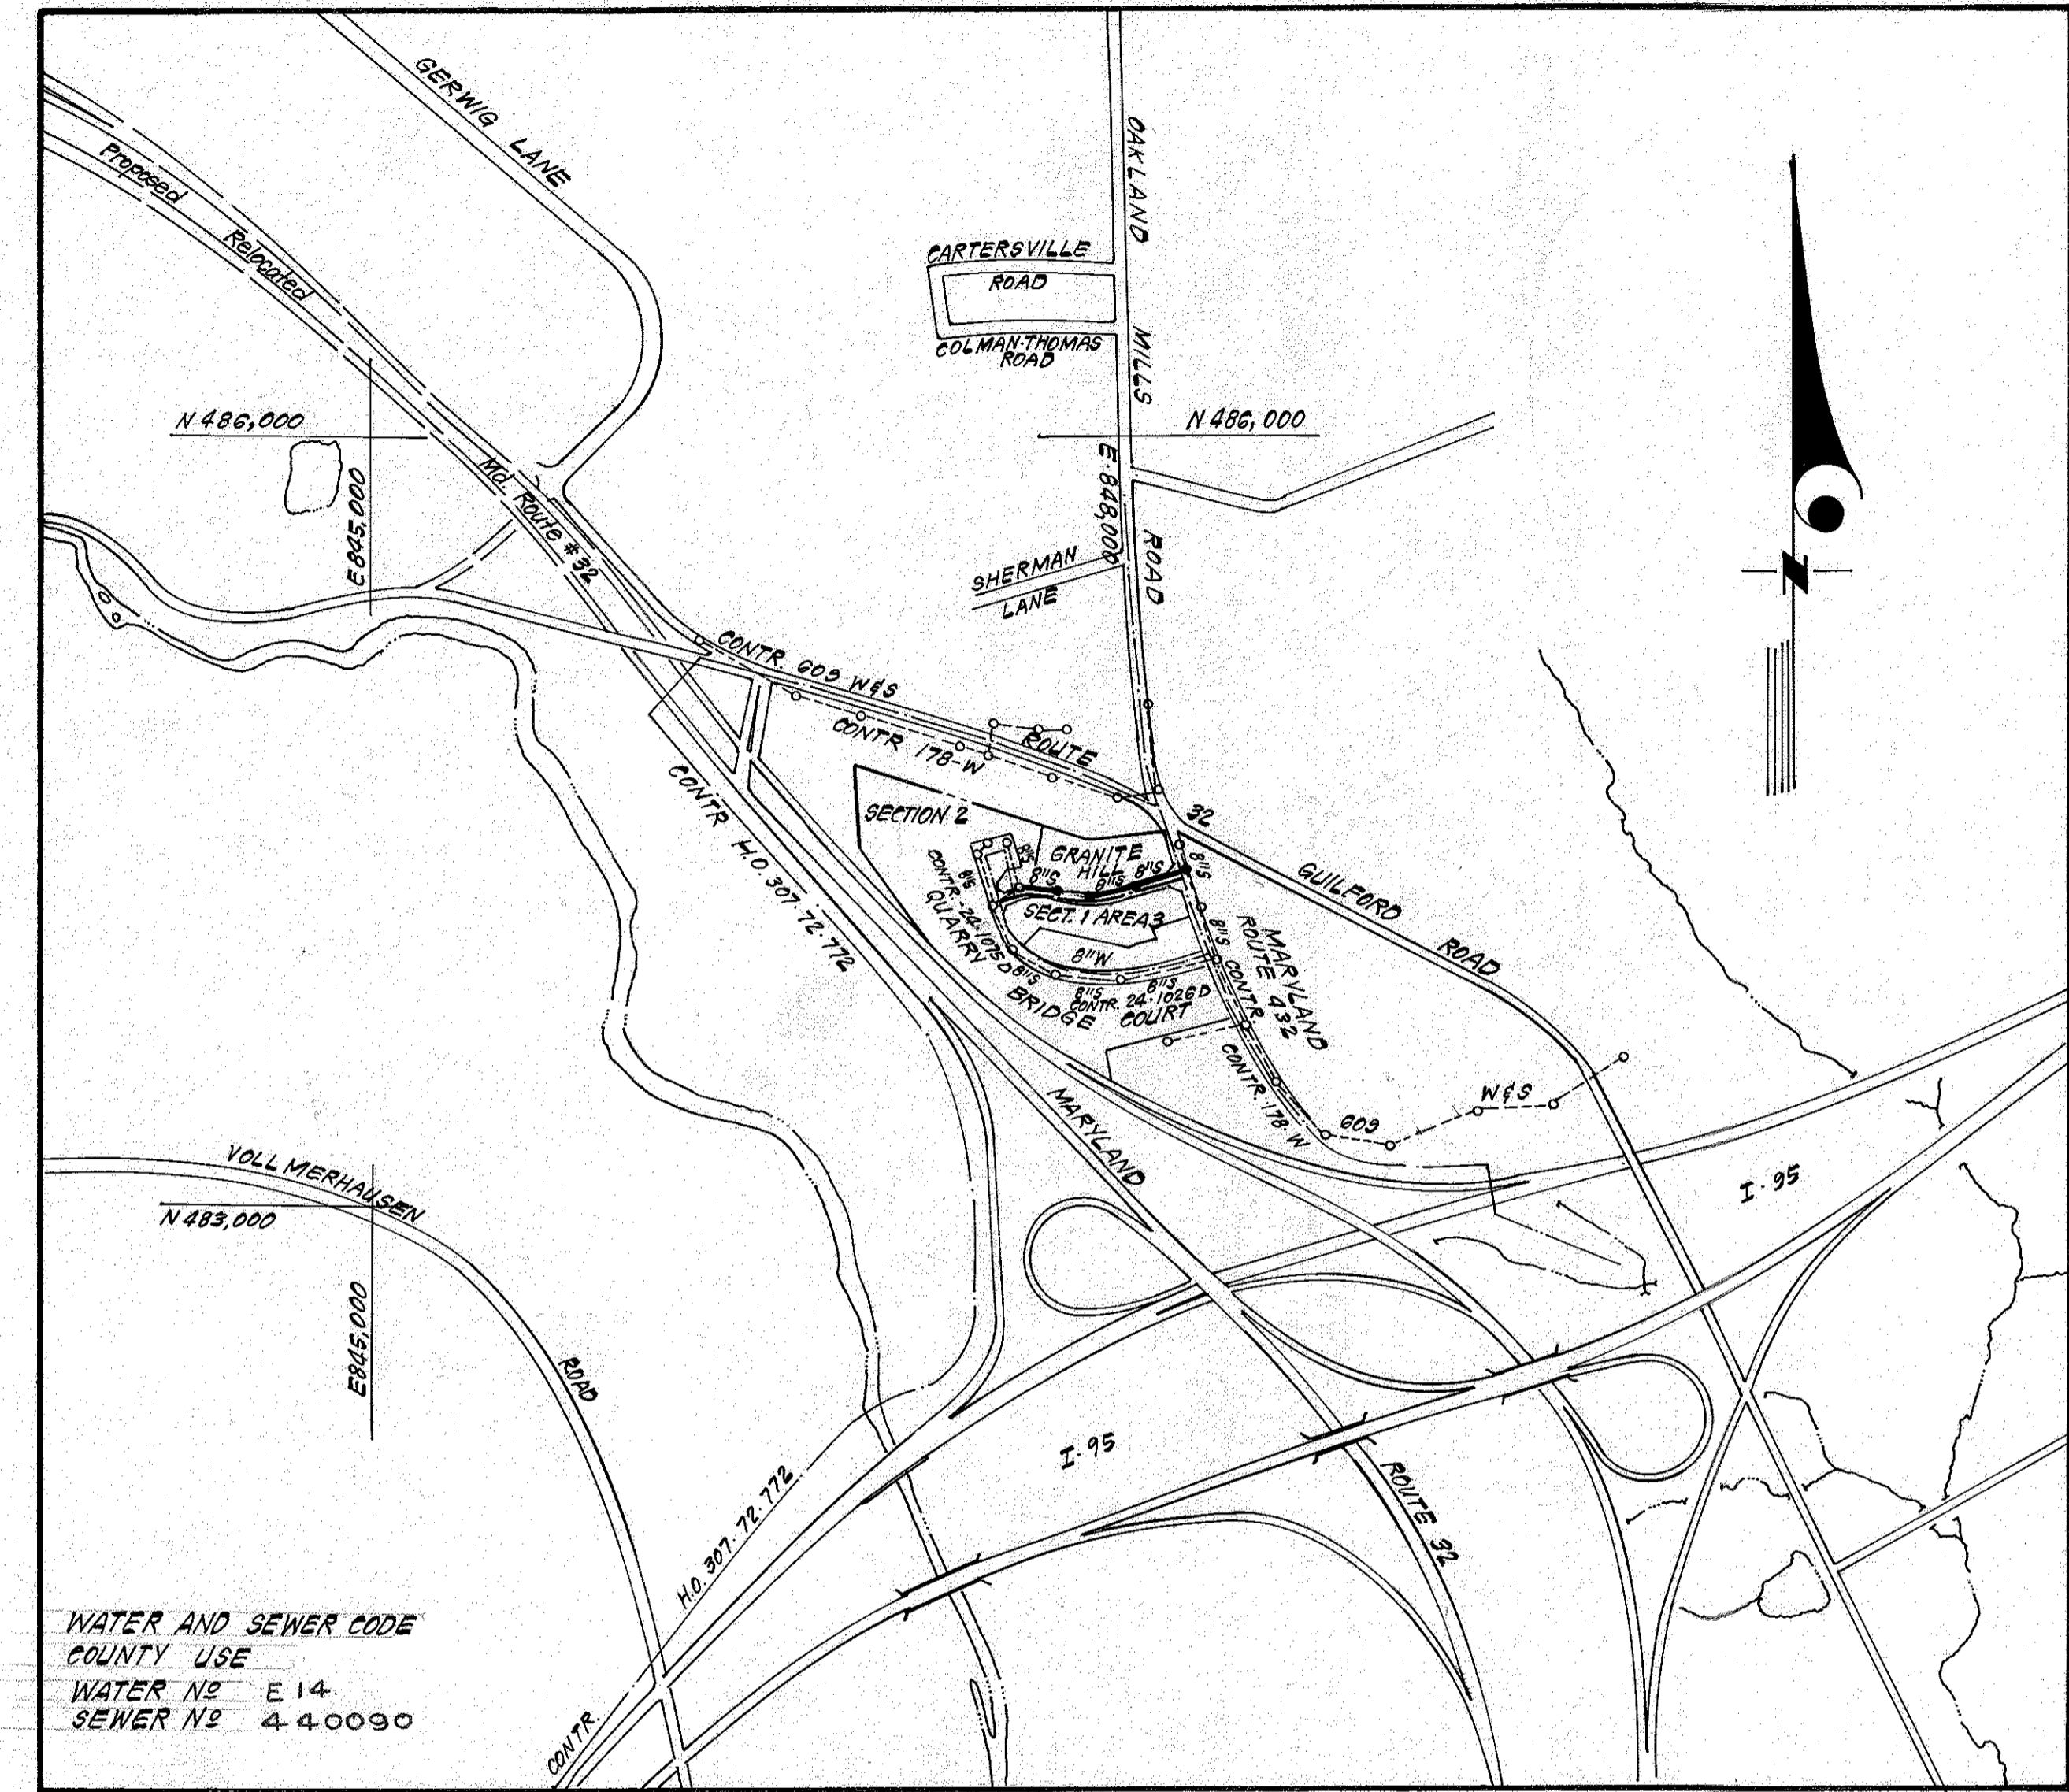

WATER AND SEWER CODE  
COUNTY USE  
WATER NO E 14  
SEWER NO 4 4 0090

VICINITY MAP  
Scale: 1" = 600'

GENERAL NOTES

1. Approximate location of existing mains are shown. The contractor shall take all necessary precautions to protect existing mains and services and maintain uninterrupted supply. Any damage incurred shall be repaired immediately to the satisfaction of the Inspector, at the contractor's expense.
2. All horizontal controls are based on Maryland State Coordinates.
3. All vertical controls are based on U.S.G.S. Datum.
4. All pipe elevations shown are invert elevations.
5. Clear all utilities by a minimum of 6" clear all poles by 2'-0" minimum or tunnel as required. Any cost incurred to the contractor for tunneling or bracing at poles shall be included in unit prices bid for excavation and backfill.
6. For details not shown on the drawings use Howard County Standard Details.
7. For materials and construction methods use Howard County Standard Specifications.
8. Contractor shall locate existing utilities a minimum of two (2) weeks in advance of construction operations in the vicinity of proposed utilities at his own expense.
9. Contractor shall notify the following utilities or agencies at least five (5) working days before starting work shown on these plans.
  - State Highway Administration - 531-5533
  - Baltimore Gas & Electric Company - Underground Electric Distribution Customer Service - 685-0123
  - Baltimore Gas & Electric Company - Underground Gas Distribution Customer Service - 685-0123
  - Engineering - Damage Control - 234-5621
  - "Miss Utility" - 1-559-0100
  - Chesapeake & Potomac (C & P) Telephone Company - 725-9976
  - American Telephone and Telegraph - Cable Location Division - 393-3553
  - Colonial Pipeline Company - 781-4641
  - Bureau of Utilities Howard County - 992-2366
10. Trees are to be protected from damage to maximum extent. Trees located within the construction strip are not to be removed or damaged by the contractor.
11. Contractor shall remove trees, stumps, and roots along line of excavation as directed by the Inspector. Payment for such removal shall be included in the unit price bid for excavation and backfill.
12. Place regulation "Men Working" and warning signs as required to comply with Maryland State Highway Administration Manual of Traffic Control for Highway Construction and Maintenance Operations.
13. All water mains to be C.I.P. or D.I.P. unless otherwise noted.
14. Top of all water mains to have a minimum of 3-1/2' cover unless otherwise noted.
15. Valves adjacent to tees shall be strapped to tees.
16. Block all fittings with concrete.
17. Bury line elevations on fire hydrants shall be set to the elevations shown on the drawings. All fire hydrants shall be strapped and buttressed with concrete in accordance with standard details. Soil around the fire hydrant to be compacted in accordance with Section 5-15 of the Standard Specifications.
18. All water house connections shall be for an inside meter setting.
19. The contractor shall not operate any water main valves on the existing system.
20. All sewer mains shall be C.S.P.X., V.C.P.X., P.V.C., or A.C.P. Class 2400 unless otherwise noted.
21. The contractor shall provide a joint in all sewer mains within 2'-0" of exterior manhole wall.
22. All manholes shall be 4'-0" inside diameter, unless otherwise noted.
23. Water main and water house connection lines must have a minimum of one foot separation from the sanitary sewer and sewer house connections as they cross. Except at crossings, water and sewer lines shall have a minimum horizontal separation of 10'.

Sediment Control Measures will be implemented in accordance with Article No. 15 of the Specifications & with Road Construction Plan F 83-20 ; Drawing , Sediment & Erosion Control.

REVIEWED FOR HOWARD SOIL CONSERVATION DISTRICT AND MEETS TECHNICAL REQUIREMENT.  
*James Kelly* 10-6-82  
SIGNATURE DATE  
U.S. SOIL CONSERVATION SERVICE  
This Development Plan is approved for Soil Erosion and Sediment Control by the Howard Soil Conservation District.  
APPROVED:  
*Howard S.C.D.* 10-5-82  
Howard S.C.D. DATE

CONTRACT NO. 24-1085 D W&S

GLEN OAKS  
HOWARD COUNTY, MARYLAND  
DEPARTMENT OF PUBLIC WORKS

QUANTITIES			
ITEM	BID	AS BUILT	MATERIAL / SUPPLIER
8" Water	660 LF	660 LF	D.I.P. / A:P
8" Sewer	543 LF	520 LF	V.C.P. / A:P
F.H.	2 EA	2 EA.	AMERICAN DARLING / A:P
12" x 8" T.S.W.	1 EA.	1 EA.	MUELLER CO. / A:P



*A. N. Cook*  
7-24-82

GLEN OAKS  
SECTION 1 AREA 3  
LOTS 1 THRU 47  
C. 24-1085-D

CLARK • FINEFROCK & SACKETT  
ENGINEERS • PLANNERS • SURVEYORS  
11315 LOCKWOOD DRIVE • SILVER SPRING, MARYLAND • (301) 593-3400

DEPARTMENT OF PUBLIC WORKS  
HOWARD COUNTY, MARYLAND  
*Joseph E. Newman* 10-7-82  
DIRECTOR OF PUBLIC WORKS DATE CHIEF, BUREAU OF ENGINEERING DATE  
*Robert M. Bevington* 10-7-82  
CHIEF, BUREAU OF UTILITIES DATE CHIEF, LAND DEVELOPMENT DIV. DATE


CONTRACT NO. 24-1085 D  
TITLE SHEET

GLEN OAKS  
SECTION 1 AREA 3  
6th ELECTION DISTRICT

DRAWING NO. 1 OF 2  
SCALE AS SHOWN

1085/1 WS

1085/2 WS

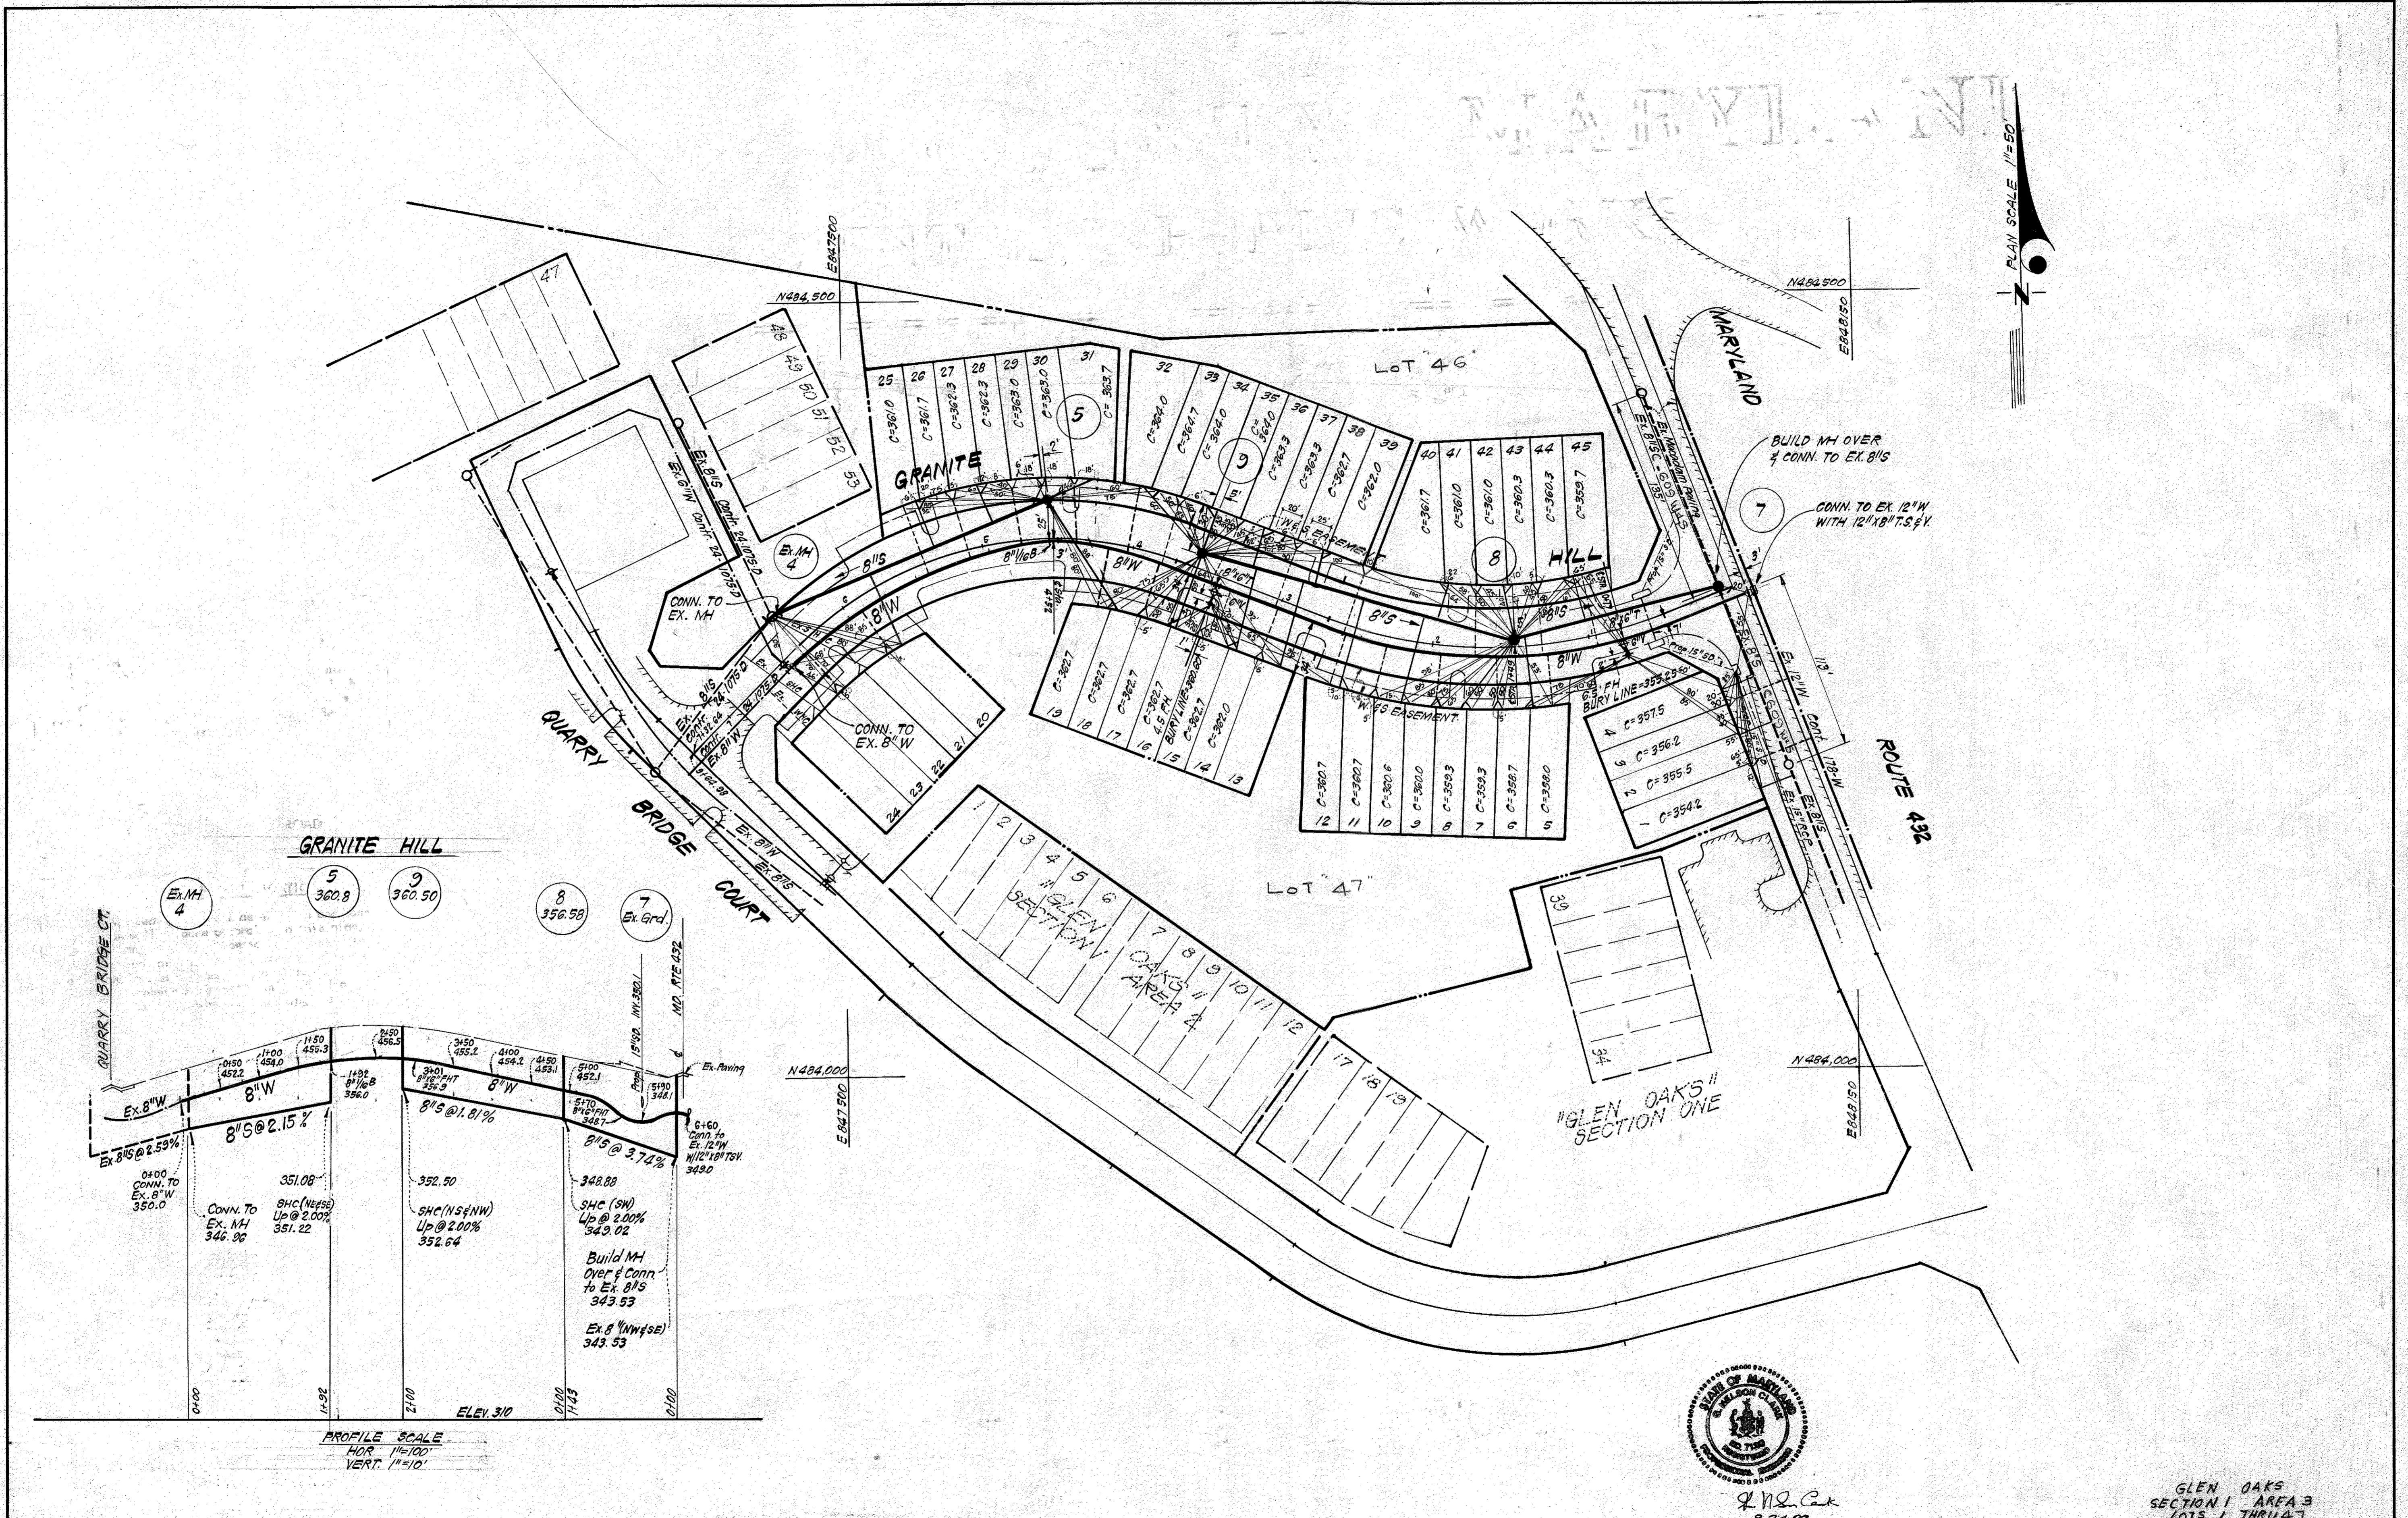

PLAN SCALE 1/4"=50'



J. H. Calk  
9-24-82

GLEN OAKS SECTION I AREA 3  
LOTS 1 THRU 47  
C 24-1085-D

<p>CLARK • FINEROCK &amp; SACKETT ENGINEERS • PLANNERS • SURVEYORS 11315 LOCKWOOD DRIVE • SILVER SPRING, MARYLAND • (301) 593-3400</p>	<p>DEPARTMENT OF PUBLIC WORKS HOWARD COUNTY, MARYLAND</p> <p><i>John E. Neuman</i> 10-7-82 <i>W. C. Brown</i> 10-7-82 DIRECTOR OF PUBLIC WORKS DATE CHIEF, BUREAU OF ENGINEERING DATE</p> <p><i>R. M. Bauman</i> 10-7-82 <i>W. C. Brown</i> CHIEF, BUREAU OF UTILITIES DATE CHIEF, LAND DEVELOPMENT DIV. DATE</p>		<p>CONTRACT NO. 24-1085 D</p>	<p>PLAN AND PROFILES OF WATER &amp; SEWER MAINS</p>	<p>GLEN OAKS SECTION I AREA 3 6th ELECTION DISTRICT</p>	<p>DRAWING NO. 2 OF 2</p>	<p>SCALE AS SHOWN</p>
	<p>AS-BUILT NOV. 26, 1982</p>						