






**EXISTING GREENFIELD ROAD  
WATER MAIN EXT.**

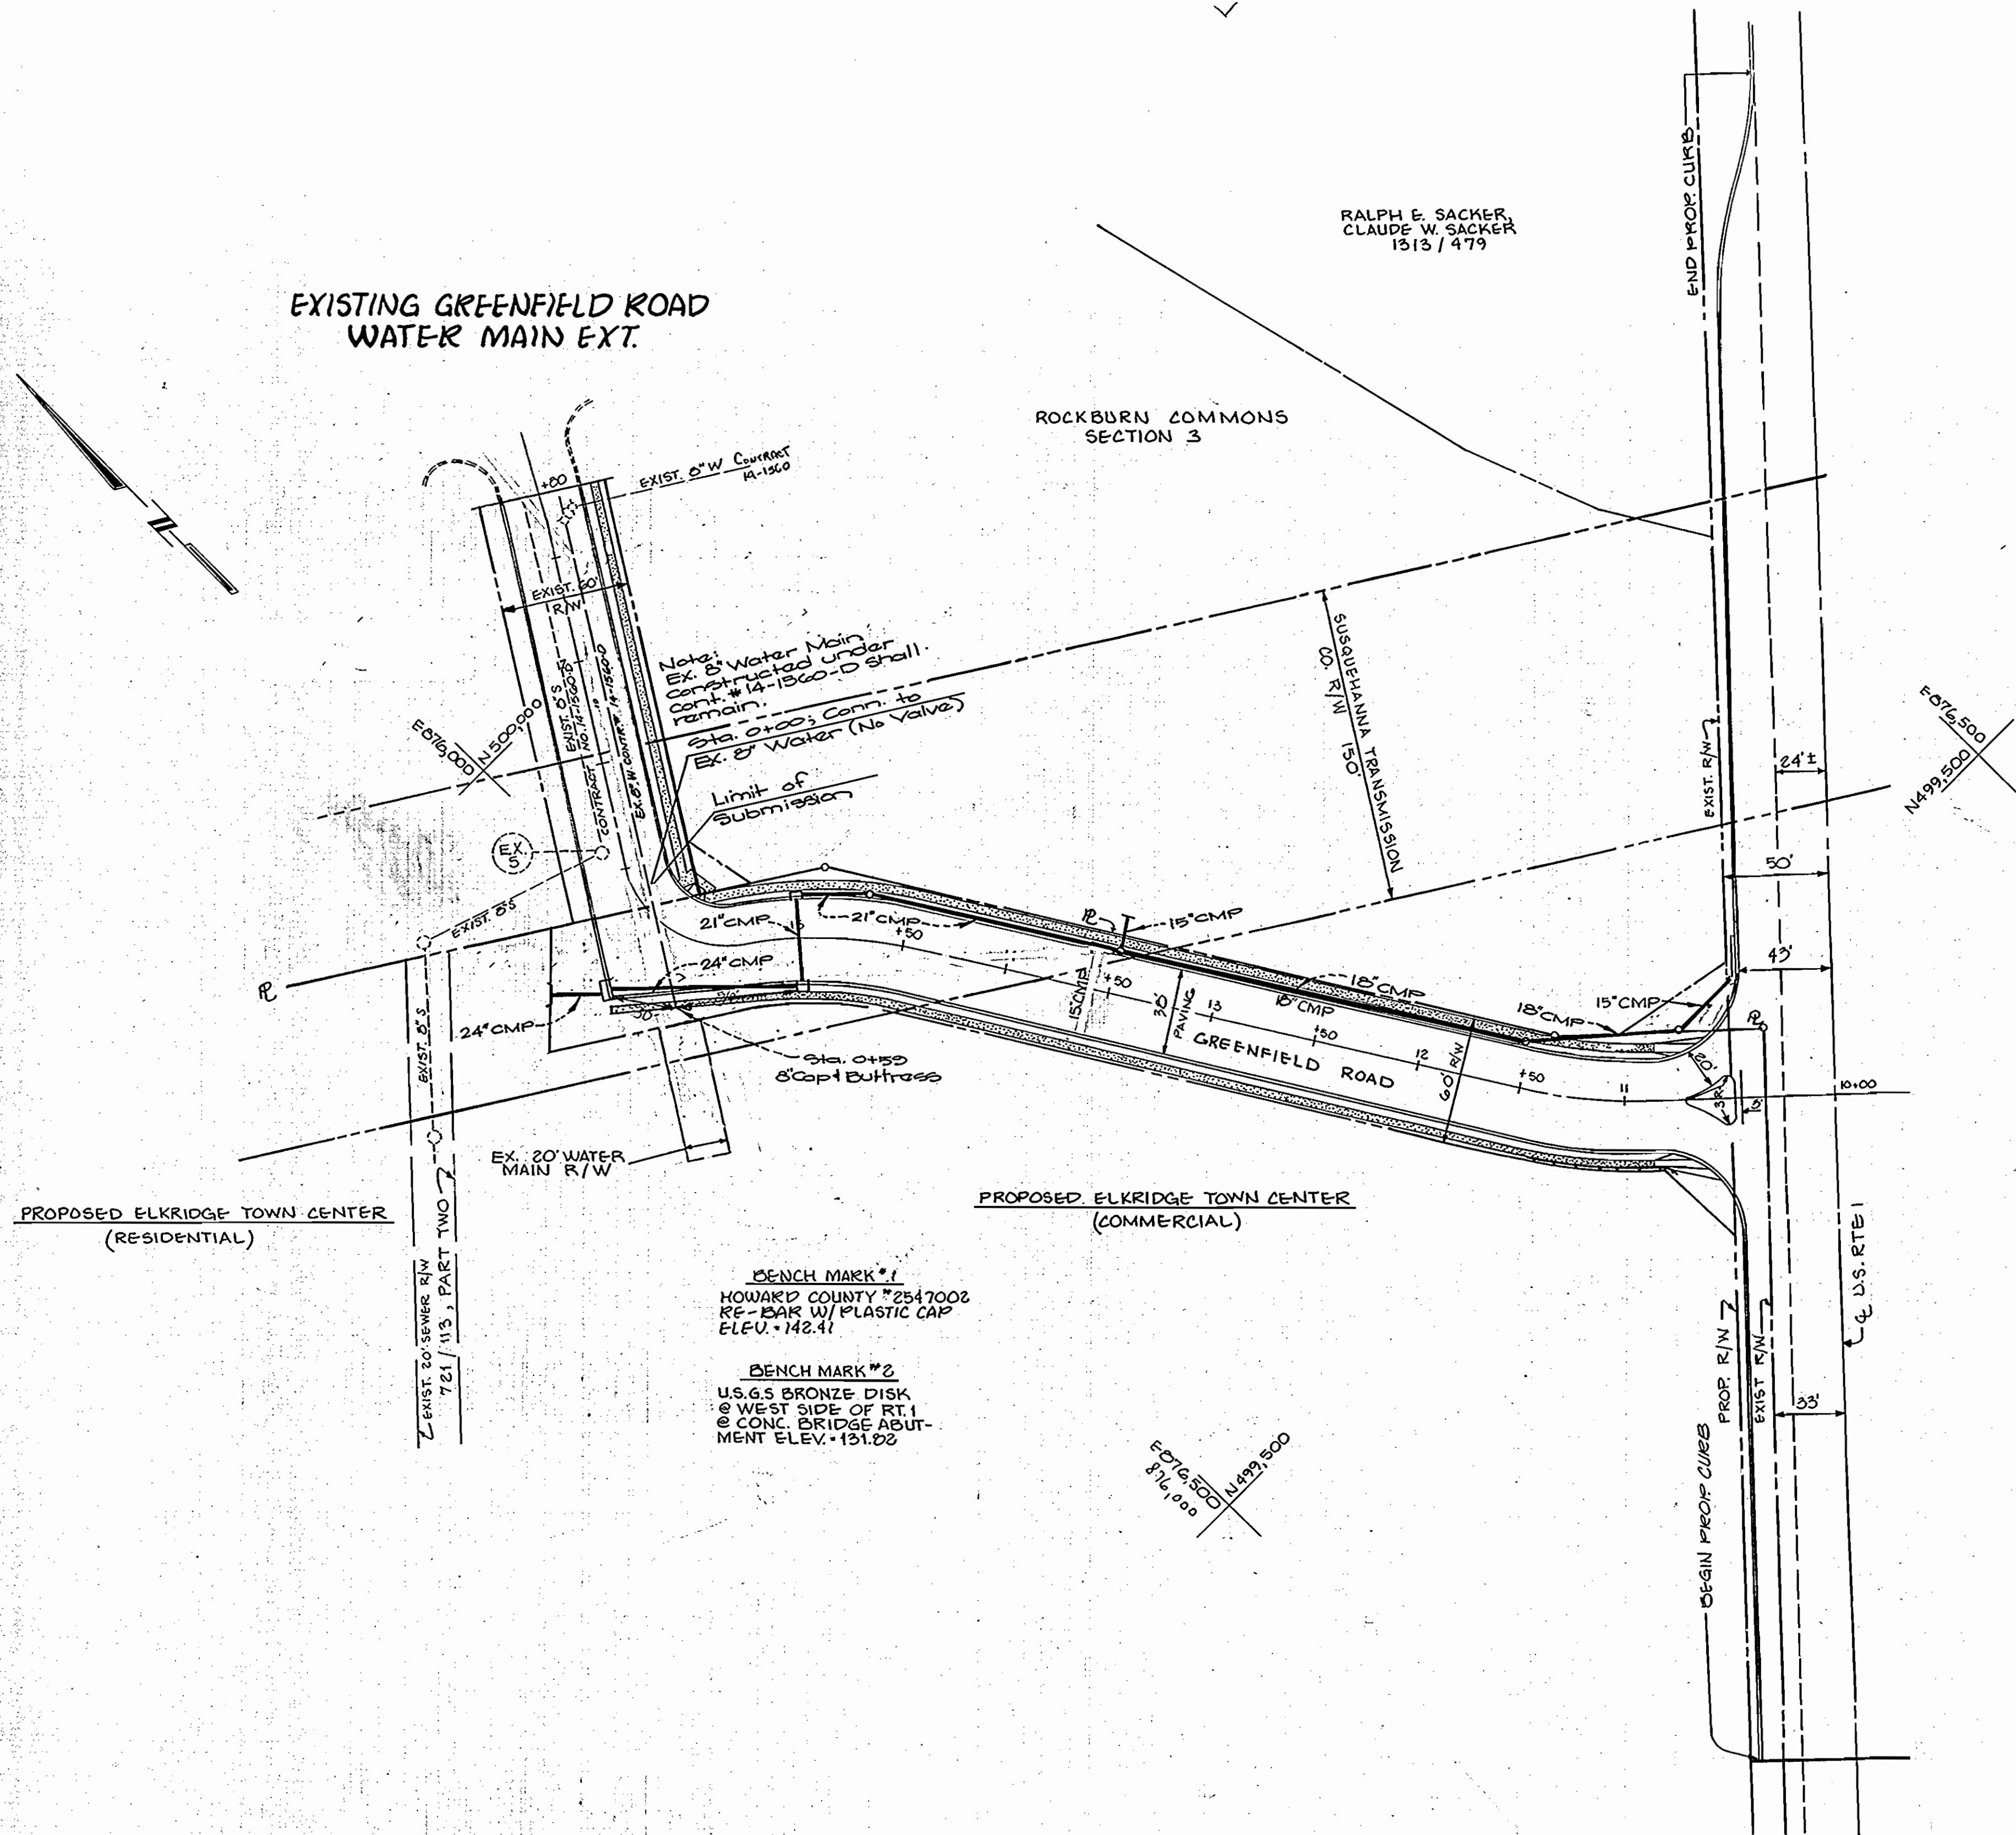


RALPH E. SACKER  
CLAUDE W. SACKER  
1313 / 479

ROCKBURN COMMONS  
SECTION 3

Notes:  
Ex. 8\"/>


BENCH MARK #1  
HOWARD COUNTY #2547002  
RE-3\"/>

BENCH MARK #2  
U.S.G.S BRONZE DISK  
@ WEST SIDE OF RT. 1  
@ CONC. BRIDGE ABUT-  
MENT ELEV. = 131.02

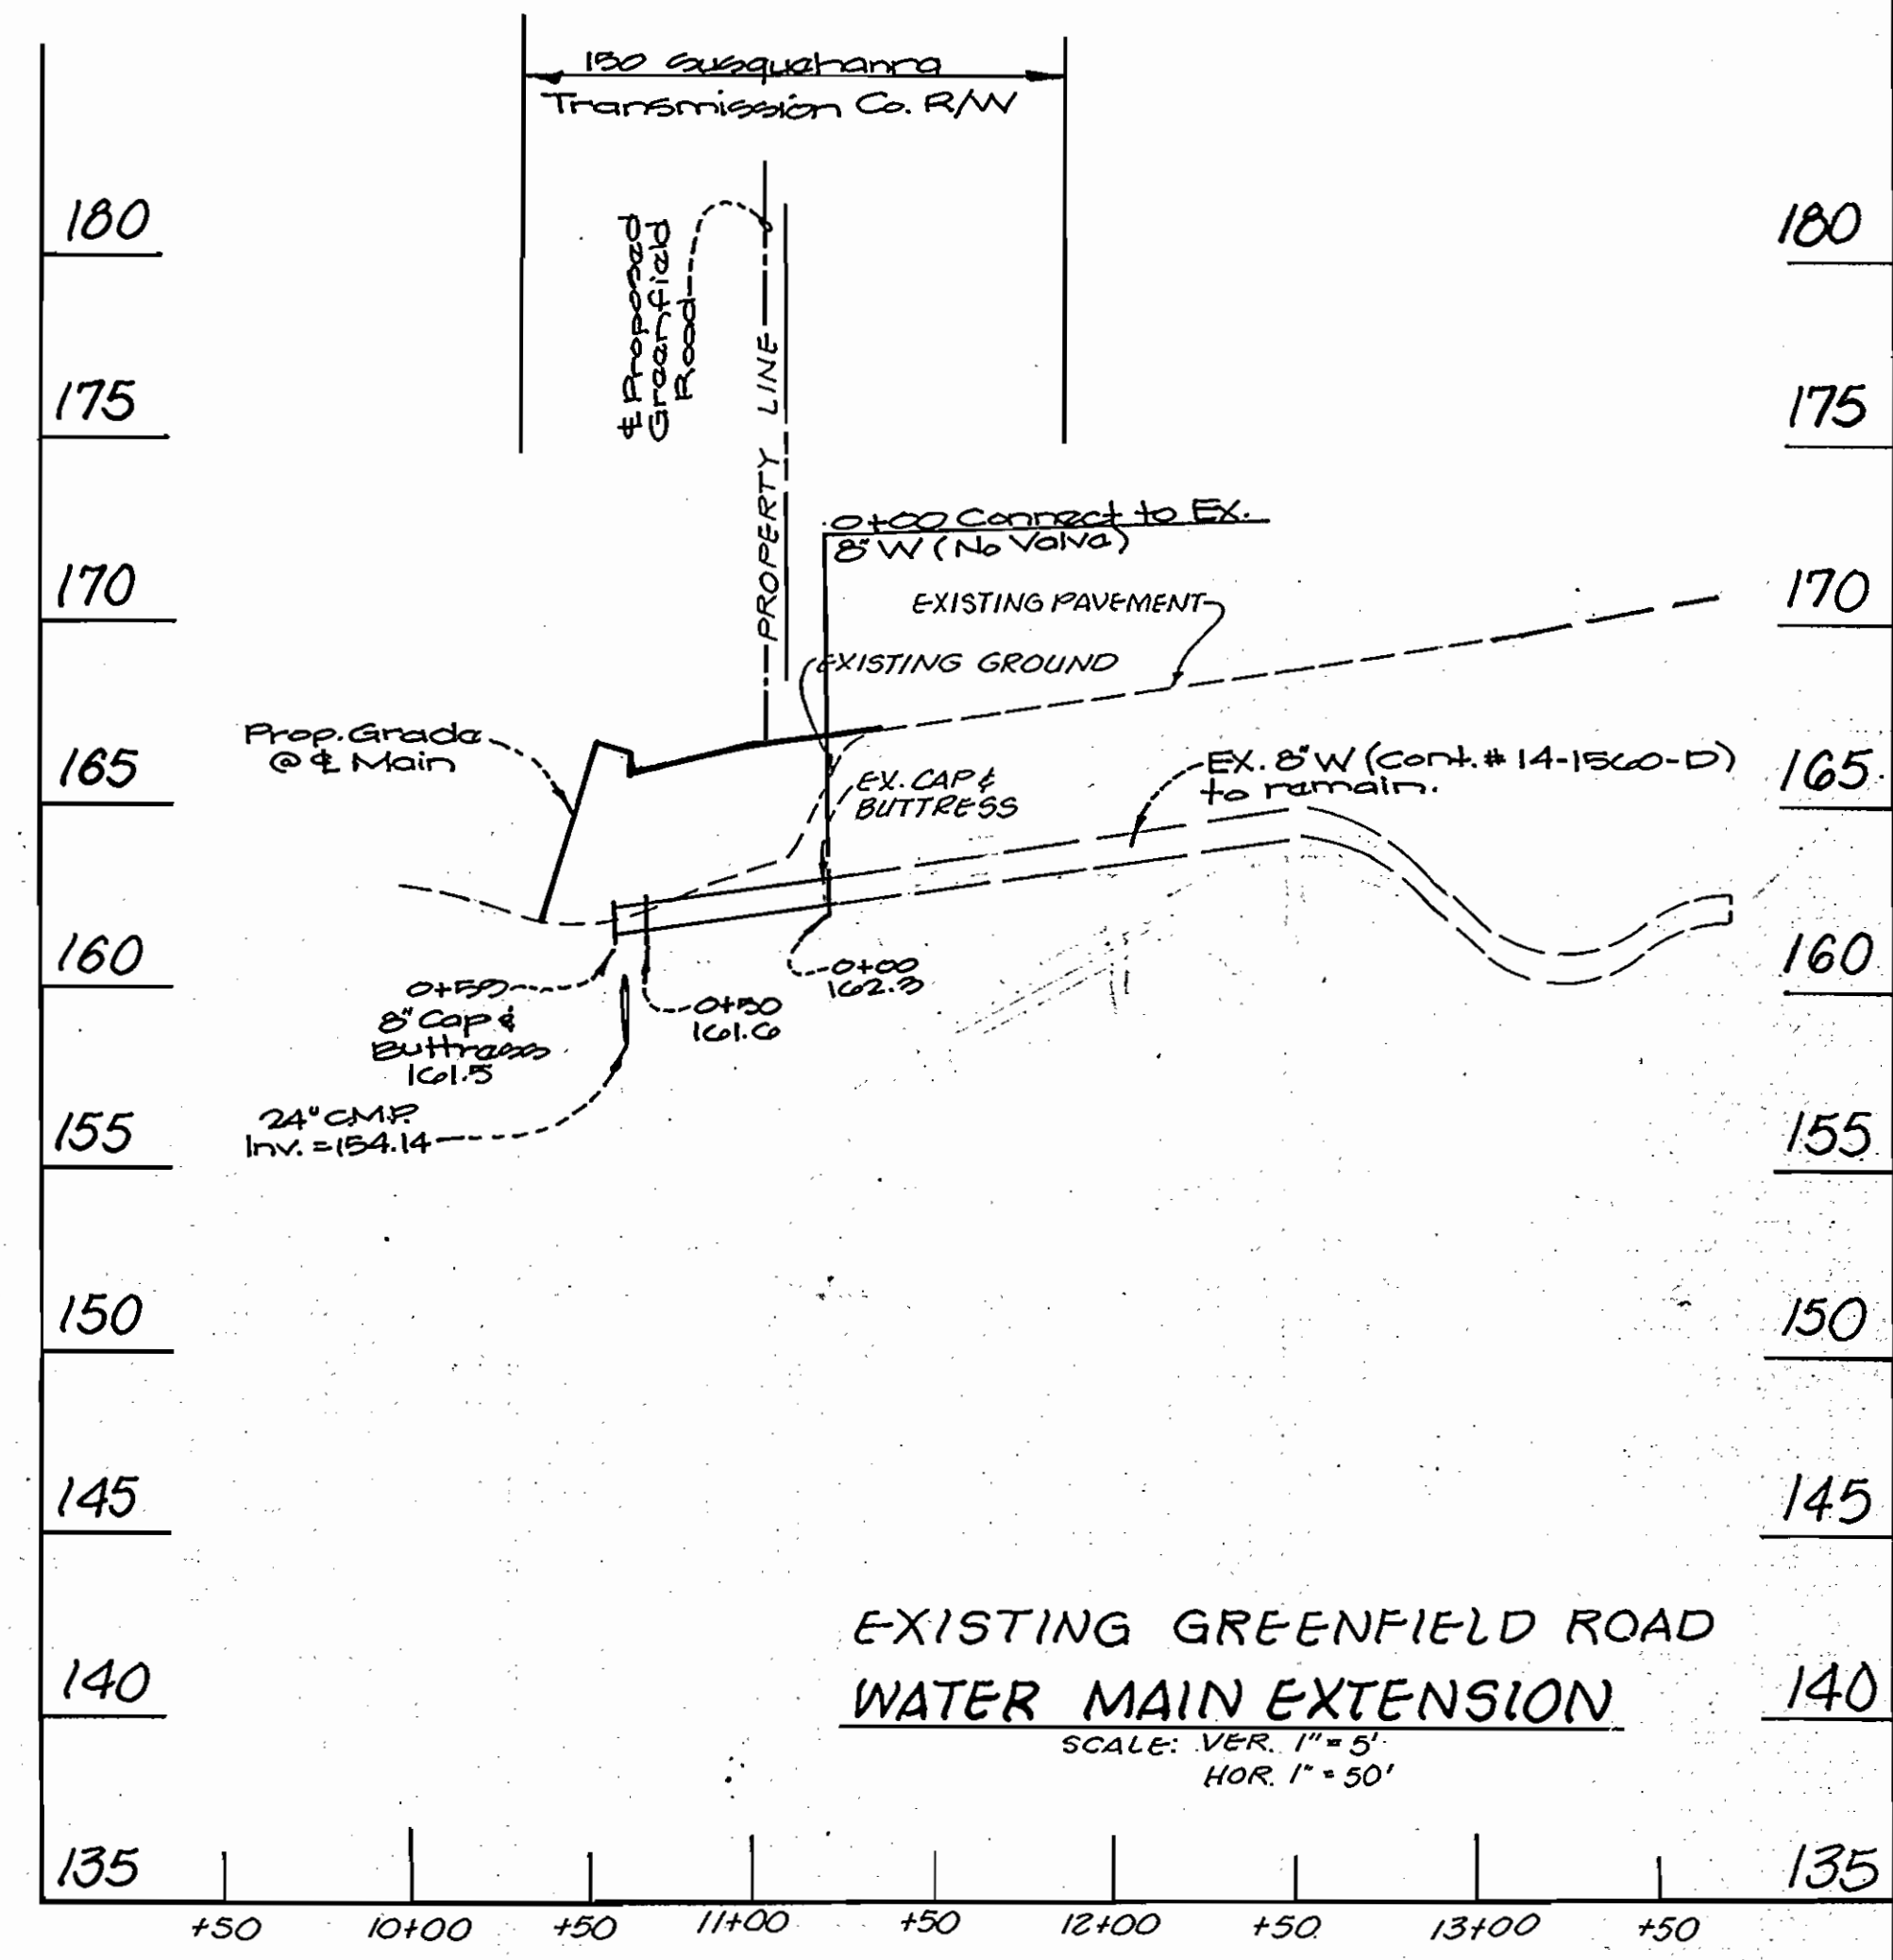

**EXISTING GREENFIELD ROAD  
WATER MAIN EXTENSION**

SCALE: VER. 1\"/>

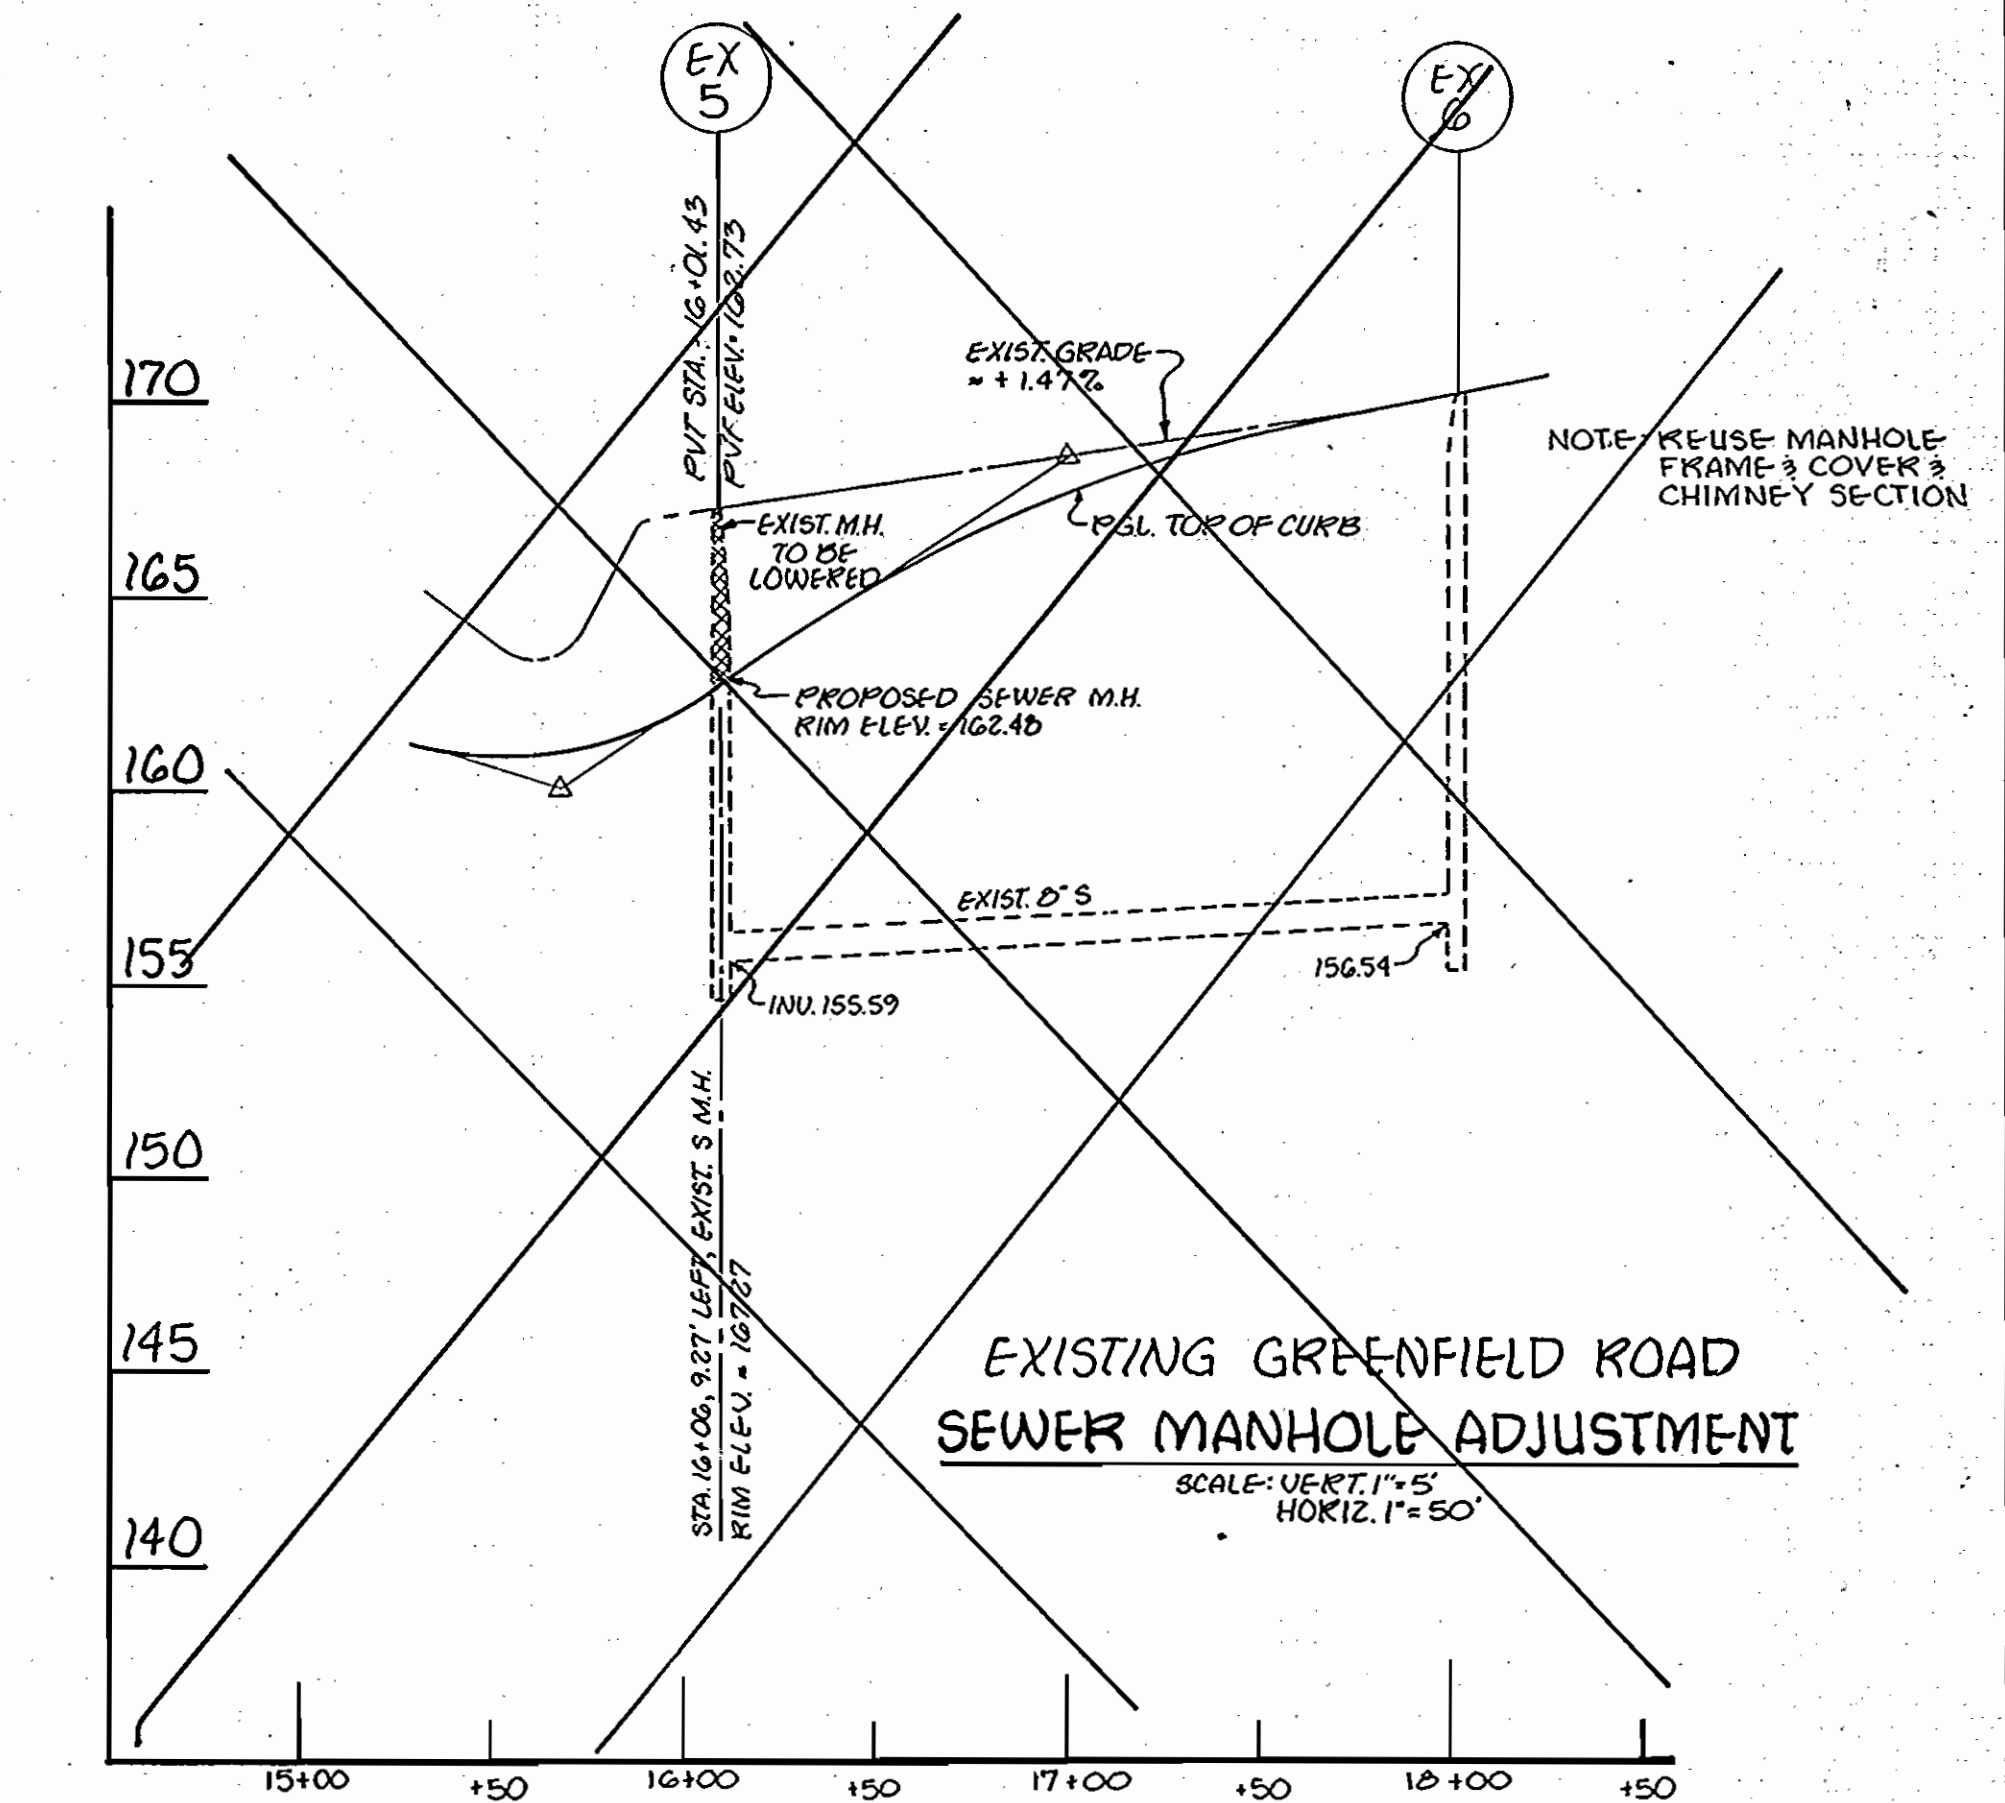

**EXISTING GREENFIELD ROAD  
SEWER MANHOLE ADJUSTMENT**

SCALE: VER. 1\"/>

APPROVED: HOWARD COUNTY DEPARTMENT OF PUBLIC WORKS  
 4/30/90  
 DATE  
 4/27/90  
 DATE  
 4/27/90  
 DATE  
 4/30/90  
 DATE

**GPI**  
 Greenman-Pedersen, Inc.  
 ENGINEERS/ARCHITECTS/PLANNERS  
 14504 GREENVIEW DRIVE, SUITE 100  
 LAUREL MD. 20708  
 (301) 470-2772 WASHINGTON  
 (301) 880-3055 BALTIMORE



DESIGNED: D.J.	BY NO.	REVISION	DATE
DRAWN: AJU	GAH 4	Revisions to reflect changes to F 30-02	10/29/91
CHECKED: PDH			
DATE: 4/20/90			

**WATER MAIN EXTENSION  
& SEWER LOWERING**

**ELKRIDGE TOWN CENTER**  
 GREENFIELD ROAD  
 CONTRACT NO. 44-3046-D  
 1ST ELECTION DISTRICT  
 HOWARD COUNTY, MARYLAND

AS-BUILT 12-10-91

SCALE:  
1\"/>
 SHEET  
NO. 2  
OF 2