


HOWARD COUNTY, MARYLAND

LITTLE PATUXENT WATER RECLAMATION PLANT

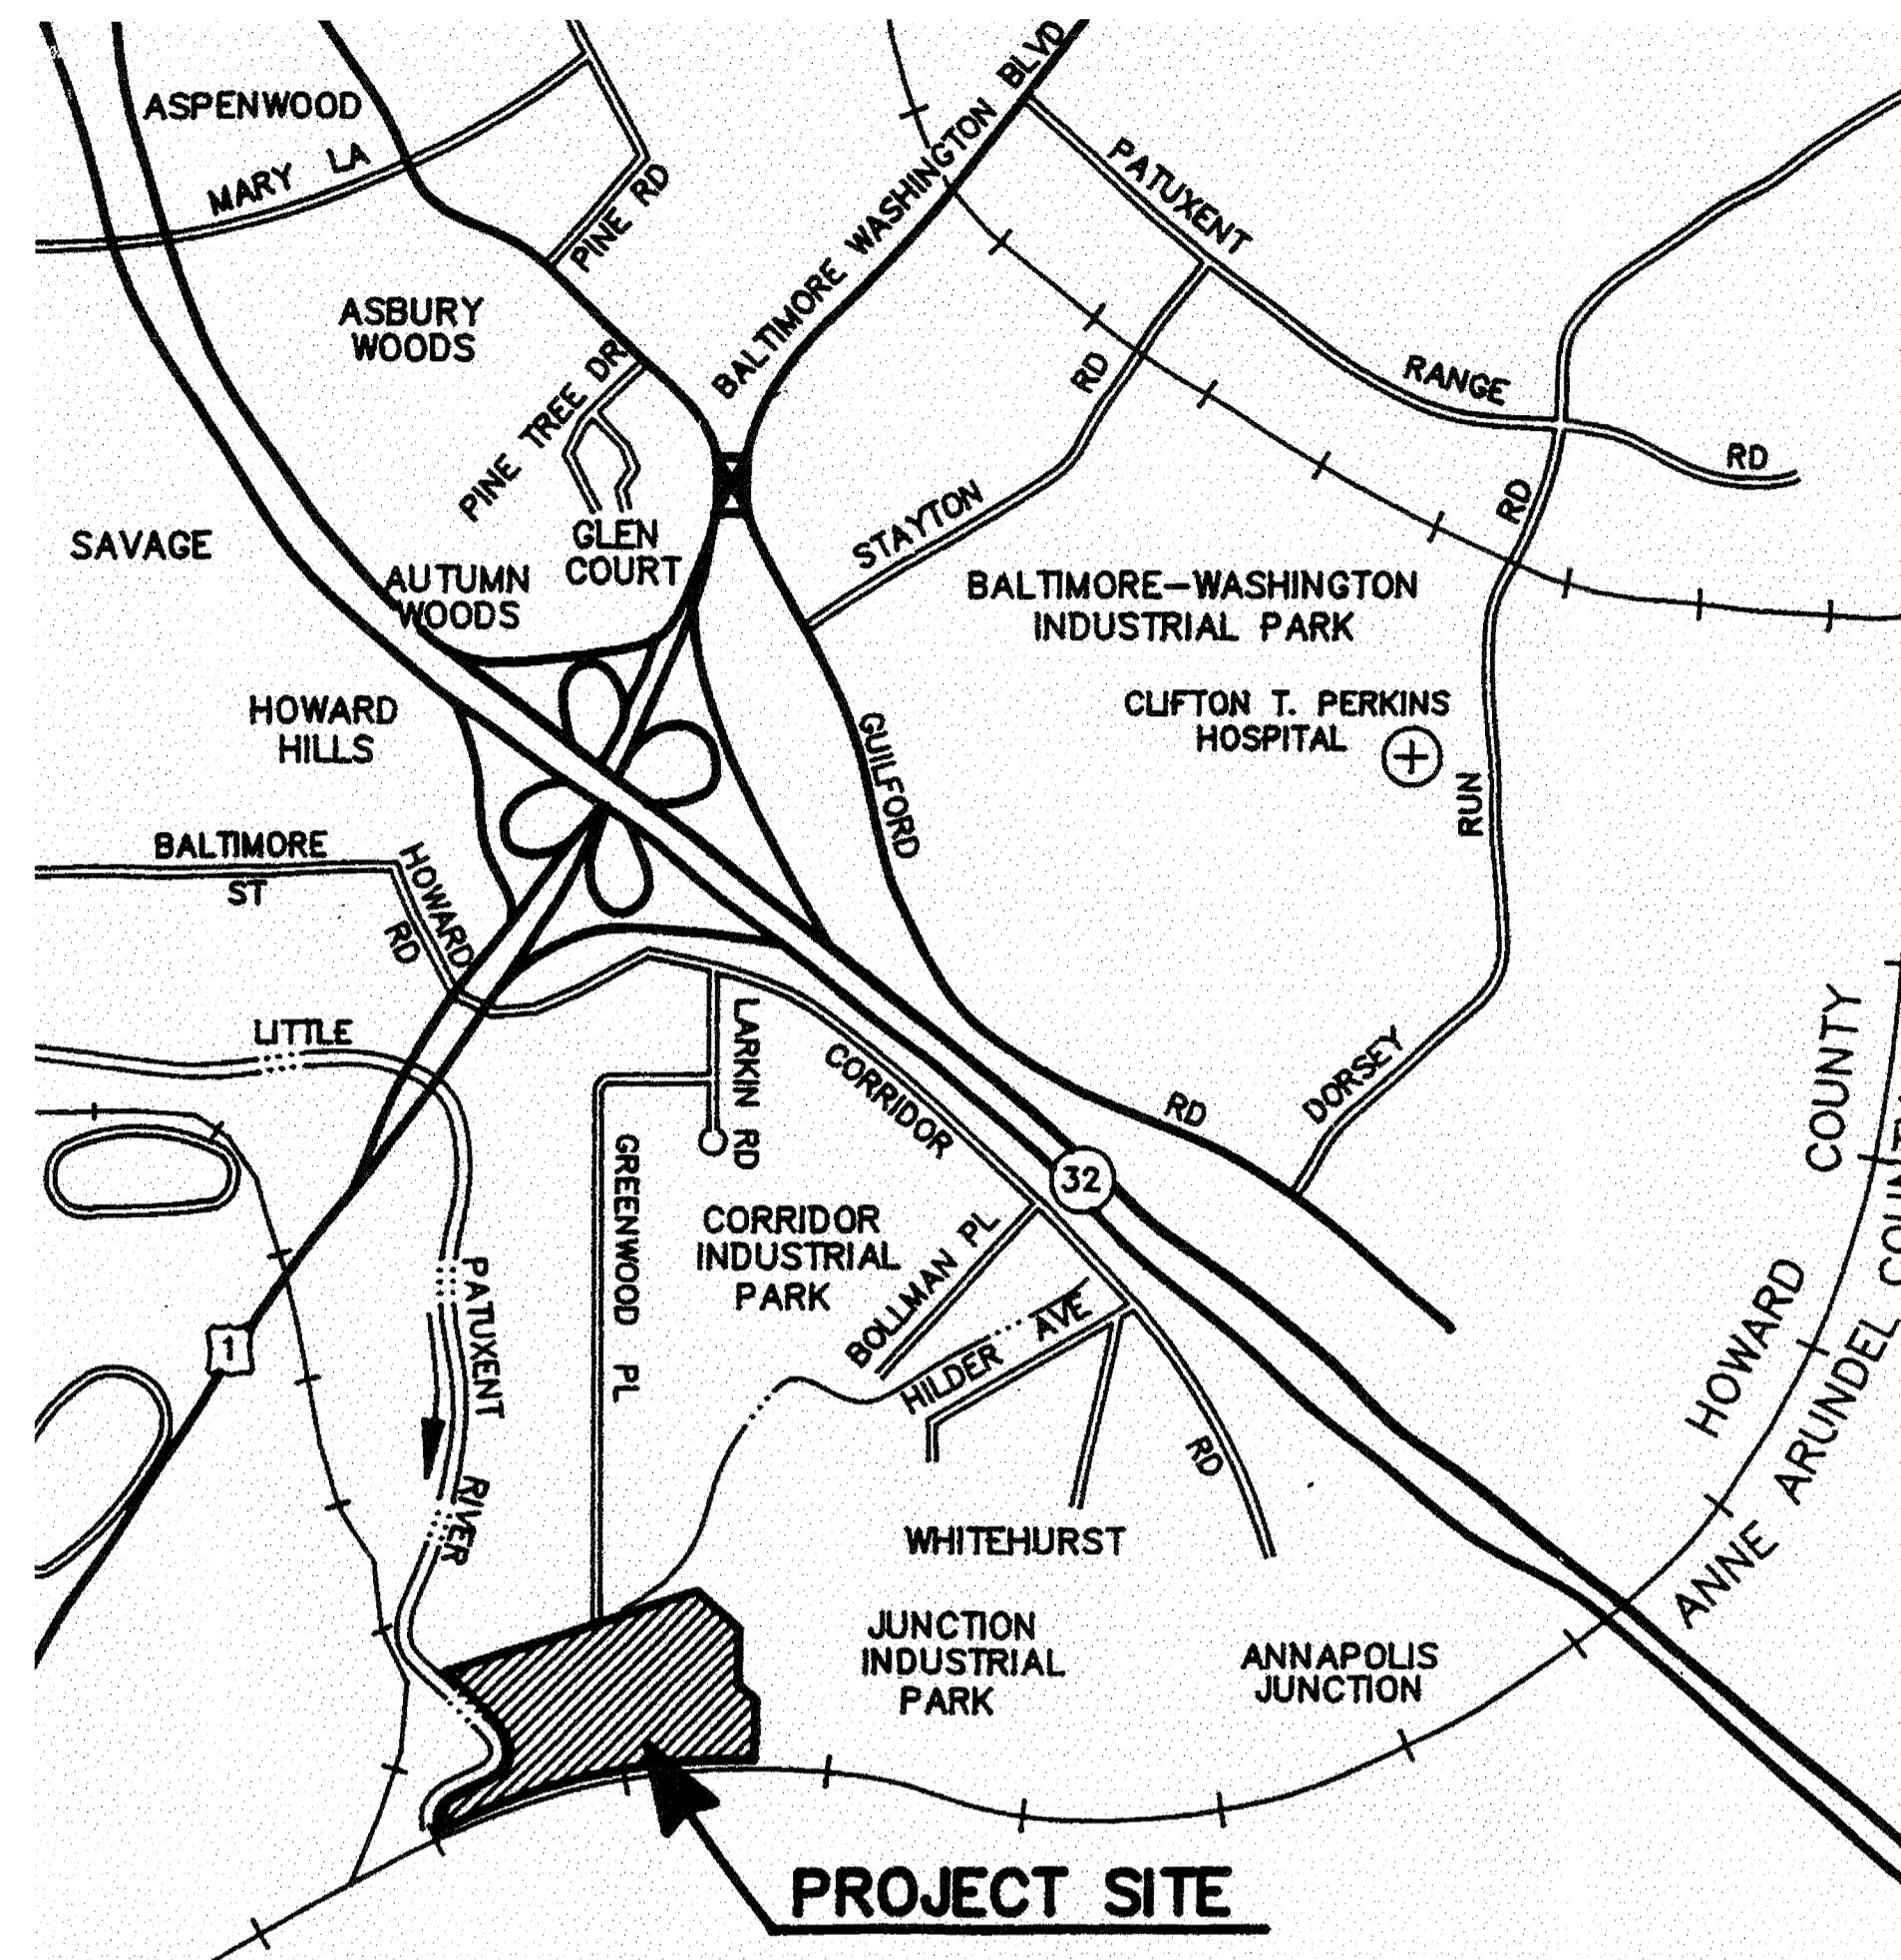

ADDITION NO. 6 LABORATORY RENOVATION

CAPITAL PROJECT NO. S-6205
CONTRACT NO. 20-3841

DEPARTMENT OF PUBLIC WORKS
HOWARD COUNTY, MARYLAND

_____ DIRECTOR OF PUBLIC WORKS	_____ DATE	_____ CHIEF, BUREAU OF ENGINEERING	_____ DATE
_____ CHIEF, BUREAU OF UTILITIES	_____ DATE	_____ CHIEF, WATER & SEWER DIVISION	_____ DATE

THIS DRAWING WAS
ORIGINALLY APPROVED
FOR CONSTRUCTION
AND SEALED BY
ROBERT J. RECTANUS, JR.
A REGISTERED
PROFESSIONAL ENGINEER
IN THE
STATE OF MARYLAND,
NO. 22927



BLACK & VEATCH LLP
Gaithersburg, Maryland

ASSOCIATE DESIGN FIRMS

STANTEC CONSULTING, LTD.
Surrey, British Columbia

BRYANT, BRYANT, & WILLIAMS
Washington, D. C.

A. MORTON THOMAS & ASSO., INC.
Rockville, Maryland

LACH ELECTRIC CORPORATION
Baltimore, Maryland

CONFORMED TO CONSTRUCTION RECORDS 11/03/03

SHEET
1 OF 28

L 1

LIST OF DRAWINGS

<u>SHEET NO.</u>	<u>DRAWING NO.</u>	<u>DRAWING TITLE</u>
<u>LAYOUT/OVERVIEW</u>		
1	L1	COVER SHEET/LOCATION MAP
2	L2	LIST OF DRAWINGS
3	L3	LEGEND AND DESIGNATIONS
4	L4	ABBREVIATIONS
5	L5	OVERALL SITE PLAN
<u>CIVIL/SITWORK</u>		
6	C1	SITE GRADING AND STAKING PLAN
<u>ARCHITECTURAL</u>		
7	A1	ADMINISTRATION BUILDING - LABORATORY DEMOLITION PLAN AND DETAILS
8	A2	ADMINISTRATION BUILDING - LABORATORY FLOOR PLAN
9	A3	ADMINISTRATION BUILDING - LAB - REFLECTED CEILING PLAN AND DETAILS
10	A4	ADMINISTRATION BUILDING - LABORATORY ARCHITECTURAL BUILDING SECTIONS
11	A5	ADMINISTRATION BUILDING - LABORATORY FURNITURE - EQUIPMENT SCHEDULE
12	A6	ADMINISTRATION BUILDING - LABORATORY WORK AREA ELEVATIONS
13	A7	ADMINISTRATION BUILDING - LABORATORY ROOF PLAN AND DETAILS
14	A8	ADMINISTRATION BUILDING - LOBBY DISPLAY PLAN, ELEVATIONS AND DETAILS
15	A9	ADMINISTRATION BUILDING - LABORATORY SAMPLE ENTRANCES ENLARGED PLAN AND DETAILS
16	A10	ADMINISTRATION BUILDING - LABORATORY MISCELLANEOUS DETAILS
<u>HVAC/PLUMBING</u>		
17	H1	ADMINISTRATION BUILDING - LEGEND AND ABBREVIATION
18	H2	ADMINISTRATION BUILDING - LABORATORY DEMOLITION PLAN
19	H3	ADMINISTRATION BUILDING - LABORATORY FLOOR PLAN, PARTIAL PLANS AND SECTION
20	H4	ADMINISTRATION BUILDING - LABORATORY DETAILS AND SCHEDULES
21	P1	ADMINISTRATION BUILDING - LABORATORY DEMOLITION PLAN
22	P2	ADMINISTRATION BUILDING - LABORATORY FLOOR PLAN
23	P3	ADMINISTRATION BUILDING - LABORATORY RISER DIAGRAMS, SCHEDULES AND DETAILS
<u>ELECTRICAL</u>		
24	E1	ADMINISTRATION BUILDING - LEGEND AND ABBREVIATIONS
25	E2	ADMINISTRATION BUILDING - LABORATORY EQUIPMENT ONE-LINE & SCHEMATIC DIAGRAMS
26	E3	ADMINISTRATION BUILDING - LABORATORY FLOOR PLAN - POWER PLAN
27	E4	ADMINISTRATION BUILDING - LABORATORY FLOOR PLAN - LIGHTING PLAN
28	E5	ADMINISTRATION BUILDING - LIGHTING FIXTURE AND PANELBOARD SCHEDULES

A
B
C
D
E
F

A
B
C
D
E
F

DEPARTMENT OF PUBLIC WORKS
HOWARD COUNTY, MARYLAND

CHIEF, BUREAU OF UTILITIES DATE



BLACK & VEATCH
Gaithersburg, Maryland

REG. PROF. ENGR. _____ DATE _____

THIS DRAWING WAS
ORIGINALLY APPROVED
FOR CONSTRUCTION
AND SEALED BY
ROBERT J. RECTANUS, JR.,
A REGISTERED
PROFESSIONAL ENGINEER
IN THE
STATE OF MARYLAND,
NO. 22927

DES: SLF							
DRN: SLF							
CHK:							
DATE:	11/03/03	CONFORMED TO CONSTRUCTION RECORDS		RHH	RJR	RJR	
	DATE	REVISIONS AND RECORD OF ISSUE	NO.	BY	CK	APP	

LAYOUT/OVERVIEW
CIVIL

LIST OF DRAWINGS

LITTLE PATUXENT WATER RECLAMATION PLANT
ADDITION NO. 6
LABORATORY RENOVATION

CAPITAL PROJECT S-6205
CONTRACT NO. 20-3841

HOWARD COUNTY, MARYLAND

SCALE
AS
SHOWN

SHEET
2 OF 28

L2

058472-5
FD58472A

GENERAL LEGEND

	SURFACED STREET, ROAD OR DRIVE		BUILDINGS, STRUCTURES
	SURFACED STREET, ROAD OR DRIVE WITH CURBS		STRUCTURES UNDERGROUND
	NON-SURFACED STREET, ROAD OR DRIVE		FUTURE BUILDINGS, STRUCTURES
	CONCRETE WALK		FENCE
	CATCH BASIN		FENCE, WOOD
	MANHOLE		RAILROAD, EACH TRACK
	DRAINAGE COURSE OR FLOW LINE		CENTERLINE
	EXISTING GROUND CONTOUR		HEDGE, BRUSH, SHRUBS, WOODS
	FINISH GRADE CONTOUR		SWAMP
	BANK OR SLOPE LINES		FIRE HYDRANT
	TEST HOLE AND NUMBER		YARD HYDRANT
	SURVEY LINE WITH PI, PT, OR POT		STREET LIGHT POLE
	CONCRETE ENCASMENT-PLAN		TRAFFIC SIGN
	CONCRETE REACTION BLOCKING AT BEND, PLUG OR TEE		STOPSIGN
	DRAINS OR CULVERTS		WATER OR GAS VALVE
	TUNNEL CASING - PLAN		WATER OR GAS METER
	TUNNEL CASING - PROFILE		TELEPHONE OR POWER POLE WITH GUY ANCHOR
	EXISTING		SECTION NUMBER OR DETAIL LETTER
	NEW		DRAWING NUMBER ON WHICH SECTION OR DETAIL APPEARS, OR WHERE SECTION IS CUT OR DETAIL IS NOTED
	WALL ELEVATION		AREA DESIGNATION
	NEW WATER LINE OR SEWER IN PROFILE		DOOR, WINDOW AND LOUVER SCHEDULE REFERENCE
	NON-CONNECTING PIPING		SCHEDULE NUMBER
	CONSTRUCTION EASEMENT LINE		ROOM NUMBER
	EASEMENT LINE		AREA DESIGNATION WITH CALLOUT
	RIGHT-OF-WAY LINE		EQUIPMENT REPRESENTATION WITH CALLOUT
	PROPERTY LINE		EXISTING FACILITY TO BE DEMOLISHED OR REMOVED
	PERMANENT EASEMENT LINE		
	TEMPORARY EASEMENT LINE		
	UTILITY EASEMENT LINE		
	SURVEY LINE SECTION LINE		
	WATER LINE		
	GAS LINE		
	TELEPHONE (UNDERGROUND)		
	ELECTRICAL (UNDERGROUND)		
	POWER OR TELEPHONE LINES (OVERHEAD)		

MATERIALS LEGEND

	EARTH OR GRADE		WOOD, SHEATHING, PANELING, DECKING, ETC.
	GRANULAR FILL (CRUSHED ROCK OR GRAVEL)		WOOD, STUDS, BEAMS, JOISTS, ETC.
	ROCK		RIPRAP
	NEW CONCRETE		CHECKERED PLATE
	EXISTING CONCRETE, PRECAST OR PRESTRESSED CONCRETE		STEEL (FOR 1" SCALE & LARGER)
	BRICK, FACE		STEEL OR ALUMINUM (FOR 3/4" SCALE & SMALLER)
	BRICK, COMMON		BAR GRATING (LINES IN DIRECTION OF SPAN)
	CONCRETE MASONRY UNITS (CMU)		ALUMINUM
	CUT STONE OR SAND FILL, GROUT, MORTAR, AND PLASTER		INSULATION (BATT)
	CAST STONE		INSULATION (RIGID)

PIPING SYSTEMS

	NEW PIPING		GAS, NATURAL
	UNDERGROUND PIPING		GRIT BASIN INFLUENT
	EXISTING PIPING		HEATING SYSTEM WATER RETURN
	FUTURE PIPING		HEATING SYSTEM WATER SUPPLY
	ALUMINUM SULFATE - (ALUM)		WATER, POTABLE HOT
	AUXILIARY PUMP STATION INFLUENT		HOT WATER CIRCULATING
	CHLORINE SOLUTION		INSTRUMENT AIR
	CONCENTRATED PRIMARY SCUM		INTERNAL RECYCLE
	DRAIN		LIME
	FIRE PROTECTION WATER SYSTEM		SODIUM HYDROXIDE
	FILTER BASIN INFLUENT		SODIUM HYPOCHLORITE
	FINAL CLARIFIER INFLUENT		PROCESS, NON-POTABLE
	FILTER EFFLUENT		WATER, NON-POTABLE HOT
	FLOW EQUALIZATION INFLUENT		
	FLOW EQUALIZATION EFFLUENT		
	FERMENTER SUPERNATANT		

PIPING ACCESSORIES LEGEND

	AUTOMATIC DRAIN TRAP		FLUME
	BLIND FLANGE		GAGE GLASS
	CALIBRATING COLUMN		HOSE CONNECTION
	CAP OR PLUG		HOSE REEL
	CENTRIFUGE		INJECTOR, EDUCTOR, BLENDER
	CLEANOUT		INLINE FILTER
	COMPRESSOR OR BLOWER		INSULATING NIPPLE
	CROSS		LEVEL SWITCH
	DIAPHRAGM SEAL		MIXER
	DIFFERENTIAL PRESSURE INDICATOR		OIL SEPARATOR
	DIFFERENTIAL PRESSURE SWITCH		ORIFICE PLATE
	DIFFUSER, CHANNEL		PIPE ANCHOR
	DIFFUSER, PIPE		PIPE GUIDE
	DRAIN OR BELL-UP		PITOT TUBE
	DRIP TRAP		PRESSURE GAUGE WITH SNUBBER
	DUPLEX STRAINER		PRESSURE SWITCH
	ELBOW		PRESSURE TRANSMITTER
	ELBOW TURNING DOWN		PUMP
	ELBOW TURNING UP		QUICK COUPLING
	EXPANSION COMPENSATOR		REDUCER
	EXPANSION TANK		ROTAMETER
	FLAME ARRESTER OR CHECK		RUPTURE DISK
	FLEXIBLE CONNECTOR		SAMPLE TAP
	FLEXIBLE HOSE OR TUBING		SCREEN
	FLOWMETER ELECTROMAGNETIC/ULTRASONIC		SEDIMENT TRAP/CONDENSATE ACCUMULATOR
	FLOW SWITCH		SET STOP METER
	FLOW TUBE		SIGHT GLASS

VALVE LEGEND

	PINCH VALVE		BACKWATER VALVE
	PLUG VALVE, ECCENTRIC		INLINE PRESSURE RELIEF VALVE
	PLUG VALVE, NON-ECCENTRIC		PRESSURE REGULATING VALVE
	BUTTERFLY VALVE		PRESSURE SUSTAINING OR MAINTAINING VALVE
	GATE VALVE		VACUUM BREAKER
	BALL VALVE		THERMAL SHUTOFF VALVE
	GLOBE VALVE		EXPLOSION RELIEF VALVE
	CHECK VALVE		HOSE FAUCET
	3 WAY VALVE		HOSE FAUCET W/VACUUM BREAKER
	4 WAY VALVE		HOSE VALVE W/HOSE NIPPLE
	ANGLE VALVE		BACKFLOW PREVENTER
	CHLORINE INSTITUTE VALVE		SAFETY RELIEF VALVE
	DIAPHRAGM VALVE		VACUUM RELIEF CHECK VALVE
	THROTTLING VALVE		

ACTUATOR LEGEND

	AIR, PNEUMATIC		SIGHT FLOW INDICATOR
	AIR/OIL TANDEM		SILENCER
	DIAPHRAGM		SLIDE GATE
	ELECTRIC, MOTORIZED		SLUICE GATE
	FLOAT		STATIC MIXER
	HYDRAULIC		STOP PLATE
	SOLENOID		STRAINER/BASKET
			SUCTION DIFFUSER
			SURGE CHAMBER
			TEE
			TEE LINE DOWN
			TEE LINE UP
			TEMPERATURE INDICATOR
			TEMPERATURE SENSING ELEMENT
			TEMPERATURE SWITCH
			TEMPERATURE TRANSMITTER
			THERMOMETER
			TRAP
			UNION
			VENT
			VENT - SCREENED
			VERTICAL MIXER
			WALL SLEEVE
			WATER HAMMER ARRESTOR
			WEIR
			WYE
			WYE STRAINER
			WYE STRAINER WITH BLOWOFF

EQUIPMENT DESIGNATION

AREA DESIGNATION

UNIT NUMBER

EQUIPMENT OR VALVE ABBREVIATION (SEE SPECIFICATIONS SECTION)

AREA DESIGNATION

LOCATION

3 WEST GALLERY

5 NORTH BASIN COMPLEX

6 EAST GALLERY

NOTE: SYMBOLS ON THIS SHEET WHICH ARE TO BE SHOWN AS EXISTING SHALL BE DELINEATED AS SCREENED (THOSE SYMBOLS WHICH ARE TO BE SHOWN AS NEW SHALL BE DELINEATED AS SOLID (HEAVY))

DEPARTMENT OF PUBLIC WORKS
HOWARD COUNTY, MARYLAND

CHIEF, BUREAU OF UTILITIES DATE

BLACK & VEATCH LLP
Gaithersburg, Maryland

REG. PROF. ENGR. DATE

THIS DRAWING WAS ORIGINALLY APPROVED FOR CONSTRUCTION AND SEALED BY ROBERT J. REICHTANUS, JR., A REGISTERED PROFESSIONAL ENGINEER IN THE STATE OF MARYLAND, NO. 22927

DES: FKA					
DRN: RLC					
CHK: WLK					
DATE:	11/03/03	CONFORMED TO CONSTRUCTION RECORDS		RHH	RJR
	DATE	REVISIONS AND RECORD OF ISSUE	NO.	BY	CK APP

LAYOUT/OVERVIEW
CIVIL

LEGEND AND DESIGNATIONS

LITTLE PATUXENT WATER RECLAMATION PLANT
ADDITION NO. 6
LABORATORY RENOVATION

CAPITAL PROJECT S-6205
CONTRACT NO. 20-3841

HOWARD COUNTY, MARYLAND


SCALE AS SHOWN

SHEET 3 OF 28

L3

ABBREVIATIONS

<p>A</p> <p>B</p> <p>C</p> <p>D</p> <p>E</p>	<p>ACID, AMBER INDICATING LIGHT, AMPERE</p> <p>ANCHOR BOLT</p> <p>ACID BATH SINK</p> <p>ALTERNATING CURRENT</p> <p>AIR CONDITIONER, (ING)</p> <p>ASBESTOS CEMENT PIPE</p> <p>ACOUSTIC, (AL)</p> <p>ACCESS DOOR, AREA DRAIN, AIR DAMPER, ANODE</p> <p>AMERICAN DISABILITY ACT</p> <p>ADDITIONAL</p> <p>ADHESIVE</p> <p>ADJUSTABLE, ADJACENT</p> <p>ADMINISTRATION</p> <p>AIR FLOW</p> <p>ABOVE FINISH FLOOR</p> <p>AHEAD</p> <p>AIR HANDLING UNIT</p> <p>ACTIVE LEAF</p> <p>ALTERNATE, (IVE)</p> <p>ALUMINUM</p> <p>AMMETER</p> <p>AMPERE</p> <p>ANAEROBIC</p> <p>ANDORIZED</p> <p>ACCESS PANEL</p> <p>APPROACH</p> <p>APPROXIMATE, (LY)</p> <p>ALARM RELAY</p> <p>ARCHITECTURAL</p> <p>AMMETER SWITCH</p> <p>ASSEMBLY</p> <p>AUTOMATIC</p> <p>AUXILIARY</p> <p>AUTOMATIC VALVE STATION</p> <p>AMERICAN WIRE GAGE</p> <p>ANOXIC</p> <p>BEAM</p> <p>BACK TO BACK</p> <p>BEARING AREA</p> <p>BALANCE</p> <p>BATTERY</p> <p>BEGIN CURVE</p> <p>BOARD</p> <p>BRICK EXPANSION JOINT</p> <p>BLIND FLANGE</p> <p>BUTTERFLY VALVE</p> <p>BRAKE HORSEPOWER</p> <p>BITUMINOUS</p> <p>BREAKER</p> <p>BUILDING</p> <p>BLOCK</p> <p>BENCHMARK</p> <p>BOTTOM OF FOOTING</p> <p>BOTTOM</p> <p>BACK PRESSURE</p> <p>BASEPLATE MARK NUMBER</p> <p>BEARING</p> <p>BRICK</p> <p>BOTH SIDES</p> <p>BELL AND SPIGOT</p> <p>BASEMENT</p> <p>BRITISH THERMAL UNIT</p> <p>BRITISH THERMAL UNIT-HOUR</p> <p>BELL-UP</p> <p>BUILT UP ROOFING</p> <p>BALL VALVE</p> <p>BEGIN VERTICAL CURVE</p> <p>COUNTER</p> <p>CENTER TO CENTER</p> <p>CATCH BASIN</p> <p>CEMENTITIOUS BACKER UNIT</p> <p>CEILING DIFFUSER</p> <p>CONTRACTION/EXPANSION JOINT</p> <p>CUBIC FEET PER MINUTE</p> <p>CUBIC FEET PER SECOND</p> <p>CURB AND GUTTER</p> <p>CHECKERED</p> <p>CAST IRON</p> <p>CAST IRON MANHOLE</p> <p>CAST IRON MANHOLE STEPS</p> <p>CAST IRON PIPE</p> <p>CAST IRON SOIL PIPE</p> <p>CONTROL JOINT</p> <p>CIRCUIT</p> <p>CLASS, CENTERLINE</p> <p>CEILING</p> <p>CLOSET</p> <p>CLEAR, (ANCE)</p> <p>CORRUGATED METAL PIPE</p> <p>CONCRETE MASONRY UNIT</p> <p>CLEAN OUT, COMPANY</p> <p>CHEMICAL OXYGEN DEMAND</p> <p>COLUMN</p> <p>COMBINATION</p> <p>COMBINED SEWER</p> <p>COMPRESSOR, (ED)</p> <p>CONCRETE</p> <p>CONNECTION</p> <p>CONSTRUCTION</p> <p>CONTINUOUS, CONTINUATION, CONTROL</p> <p>CONTRACTOR</p> <p>CORNER</p> <p>CORRIDOR, CORRUGATED</p> <p>CONTROL PANEL, CARPET</p> <p>COUPLING</p> <p>CONTROL POWER TRANSFORMER</p> <p>COURSES, (ING)</p> <p>CONTROL SWITCH, CONTROL STATION, CUP SINK</p> <p>COUNTERSUNK, (INK)</p> <p>CERAMIC TILE, CARPET TILE, CYCLE TIMER, CURRENT TRANSFORMER</p>	<p>CTR(S) CENTER(S)</p> <p>CU CUBIC</p> <p>CU YD CUBIC YARD</p> <p>CV CHECK VALVE</p> <p>CW COLD WATER</p> <p>CWR COLD WATER RETURN</p> <p>CWS COLD WATER SUPPLY</p> <p>D DOOR</p> <p>DBL DOUBLE</p> <p>DC DIRECT CURRENT</p> <p>DEG DEGREE</p> <p>DEPT DEPARTMENT</p> <p>DET DETAIL</p> <p>DF DRINKING FOUNTAIN</p> <p>DH DOOR HEIGHT</p> <p>DI DROP INLET, DUCTILE IRON</p> <p>DIA DIAMETER</p> <p>DIFF DIFFUSER</p> <p>DIM DIMENSION</p> <p>DIP DUCTILE IRON PIPE</p> <p>DISCH DISCHARGE</p> <p>DISP DISPENSER</p> <p>DIST DISTRIBUTION</p> <p>DIV DIVISION</p> <p>DL DEAD LOAD</p> <p>DM DAMPER MOTOR</p> <p>DMJ DOUBLE MECHANICAL JOINT</p> <p>DN DOWN</p> <p>DO DOOR OPENING, DISSOLVED OXYGEN</p> <p>DPDT DOUBLE POLE DOUBLE THROW</p> <p>DR DRAIN</p> <p>DS DOWNSPOUT</p> <p>DT DISTRIBUTION TRANSFORMER</p> <p>DV DRAIN VALVE</p> <p>DWG(S) DRAWING(S)</p> <p>DWL(S) DOWEL(S)</p> <p>E EAST, ELECTRICAL</p> <p>EA EACH</p> <p>EAT ENTERING AIR TEMPERATURE</p> <p>EC END CURVE</p> <p>ECC ECCENTRIC</p> <p>ECC RED ECCENTRIC REDUCER</p> <p>EEM EMERGENCY EYEWASH</p> <p>EF EACH FACE</p> <p>EFF EFFLUENT</p> <p>EJ EXPANSION JOINT</p> <p>EL ELEVATION</p> <p>ELBOW ELBOW</p> <p>ELEC ELECTRIC, (AL)</p> <p>ELEV ELEVATOR</p> <p>EMER EMERGENCY</p> <p>ENC ENCASEMENT</p> <p>ENCL ENCLOSURE</p> <p>ENT ENTRANCE</p> <p>EOL END OF LINE</p> <p>EPV ECCENTRIC PLUG VALVE</p> <p>EQ EQUAL</p> <p>EQUIP EQUIPMENT</p> <p>EW EACH WAY</p> <p>EMER EMERGENCY EYEWASH</p> <p>EMEF EACH WAY EACH FACE</p> <p>EXCH EXCHANGER</p> <p>EXH EXHAUST</p> <p>EX, EXIST EXISTING</p> <p>EXP EXPANSION, EXPOSED</p> <p>EXP JT EXPANSION JOINT</p> <p>EXT EXTENSION, EXTERIOR, EXTERNAL</p> <p>F FAN, FIBERGLASS</p> <p>F TO F FACE TO FACE</p> <p>FB FACE BRICK, FILTER BASIN</p> <p>FC FLEXIBLE CONNECTION, FLOW CONTROL, FINAL CLARIFIER</p> <p>FCA FLANGED COUPLING ADAPTER</p> <p>FDD FLOOR DRAIN</p> <p>FDN FOUNDATION</p> <p>FDPR FIRE DAMPER</p> <p>FE FIRE EXTINGUISHER, FLOW ELEMENT</p> <p>FEC FIRE EXTINGUISHER CABINET</p> <p>FF FACTORY FINISH</p> <p>FH FLAT HEAD, FIRE HYDRANT</p> <p>FHMS FLAT HEAD MACHINE SCREW</p> <p>FIG FIGURE</p> <p>FIN FINISH</p> <p>FIN GR FINISH GRADE</p> <p>FL FLOOR, FLOW LINE</p> <p>FLEX FLEXIBLE</p> <p>FLG FLANGE, FLASHING</p> <p>FM FORCE MAIN</p> <p>FO FUEL OIL</p> <p>FOB FLAT ON BOTTOM</p> <p>FOM FACE OF MASONRY</p> <p>FOS FACE OF STUDS</p> <p>FOT FLAT ON TOP</p> <p>FPM FEET PER MINUTE</p> <p>FRP FIBERGLASS REINFORCED PLASTIC</p> <p>FS FAR SIDE, FLOOR SLEEVE, FLOAT SWITCH, FLOOR SEALER</p> <p>FT FOOT</p> <p>FTG FOOTING</p> <p>FURN FURNISH, FURNISHED</p> <p>FV FLAP VALVE, FLOW CONTROL VALVE, PINCH VALVE</p> <p>FWD FORWARD</p> <p>G GAS</p> <p>GA GAUGE</p> <p>GAL GALLON</p> <p>GALV GALVANIZED</p> <p>GB GRID BASIN</p> <p>GC/MS GAS CHROMATOGRAPH/MASS SPECTROMETER</p> <p>GEN GENERAL, GENERATOR</p> <p>GLV GLOBE VALVE</p>	<p>GM GAS METER</p> <p>GPM GALLONS PER MINUTE</p> <p>GR GRADE</p> <p>GV GATE VALVE</p> <p>GWB GYPSUM WALLBOARD</p> <p>GYP GYPSUM</p> <p>H HIGH, HOUR, HYDROGEN</p> <p>HB HOSE BIBB</p> <p>HV HOLLOW CORE</p> <p>HDR HEADER</p> <p>HDRW HARDWARE</p> <p>HE HEAT EXCHANGER</p> <p>HEX HEXAGONAL</p> <p>HF HOSE FRUCCET</p> <p>HCT HEIGHT</p> <p>HH HANDHOLE</p> <p>HLS HIGH LEVEL SWITCH</p> <p>HMC HARNESSED MECHANICAL COUPLING</p> <p>HMD HOLLOW METAL DOOR</p> <p>HMJ HARNESSED MECHANICAL JOINT</p> <p>HORIZ HORIZONTAL</p> <p>HP HIGH POINT, HORSEPOWER</p> <p>HR HOUR, HANDRAIL</p> <p>HS HIGH STRENGTH</p> <p>HV HOSE VALVE</p> <p>HVAC HEATING, VENTILATING AND AIR CONDITIONING</p> <p>HW HOT WATER</p> <p>HWY HIGHWAY</p> <p>HYDRO HYDROPNEUMATIC</p> <p>I INDICATOR</p> <p>ID INSIDE DIAMETER</p> <p>IF INSIDE FACE</p> <p>I/I CURRENT TO CURRENT BOOSTER</p> <p>IN INCHES</p> <p>INC INCORPORATED</p> <p>INCL INCLUDING</p> <p>INCR INCREASE</p> <p>INST INSTRUMENT, (ATION)</p> <p>INSUL INSULATE, (ED), (ING)</p> <p>INT INTERIOR, INTERNAL</p> <p>INV INVERT</p> <p>IPS IRON PIPE SIZE</p> <p>IR INTERNAL RECYCLE</p> <p>JAN JANITOR</p> <p>JB JUNCTION BOX</p> <p>JF JOINT FILLER</p> <p>JT JOINT</p> <p>K KIPS</p> <p>KIT KITCHEN</p> <p>KO KNOCK OUT</p> <p>KS KITCHEN SINK</p> <p>KV KILOVOLT</p> <p>KVA KILOVOLT AMPERE</p> <p>KW KILOWATT</p> <p>KWH KILOWATT HOUR</p> <p>L LOUVER, ANGLE</p> <p>LAB LABORATORY</p> <p>LAM LAMINATE(D)</p> <p>LAT LEAVING AIR TEMPERATURE</p> <p>LAT LATERAL</p> <p>LAV LAVATORY</p> <p>LB(S) POUNDS</p> <p>LG LENGTH, LONG</p> <p>LH LEFT HAND</p> <p>LIN LINEAL, LINEAR</p> <p>LL LIVE LOAD</p> <p>LLH LONG LEG HORIZONTAL</p> <p>LLV LONG LEG VERTICAL</p> <p>LO LOUVER OPENING</p> <p>LS LABORATORY SINK, LEVEL SWITCH, LIMIT SWITCH</p> <p>LT LEFT, LAB TABLE</p> <p>MA MILLIAMPERE</p> <p>MACH MACHINE</p> <p>MAINT MAINTENANCE</p> <p>MAN MANUAL</p> <p>MAS MASONRY</p> <p>MATL MATERIAL</p> <p>MAX MAXIMUM</p> <p>MB MACHINE BOLT</p> <p>MC MECHANICAL COUPLING</p> <p>MCC MOTOR CONTROL CENTER</p> <p>MECH MECHANICAL</p> <p>MED MEDIUM</p> <p>MEZ MEZZANINE</p> <p>MFM MAGNETIC FLOWMETER</p> <p>MFR(S) MANUFACTURER(S)</p> <p>MG MILLION GALLONS</p> <p>MGD MILLION GALLONS PER DAY</p> <p>MG/L MILLIGRAMS PER LITER</p> <p>MH MANHOLE</p> <p>MIN MINIMUM, MINUTE</p> <p>MISC MISCELLANEOUS</p> <p>MJ MECHANICAL JOINT</p> <p>MJR MECHANICAL JOINT RETAINER GLAND</p> <p>MJTR MECHANICAL JOINT WITH TIE ROD</p> <p>MO MASONRY OPENING, MOTOR OPERATED</p> <p>MOD MODIFIED</p> <p>MP METERING PUMP</p> <p>MRO METAL ROOF DECK</p> <p>MS MACHINE SCREW</p> <p>MSL MEAN SEA LEVEL</p> <p>MT CERAMIC MOSAIC FLOOR TILE</p> <p>MTD MOUNTED</p> <p>MTL METAL</p> <p>MTR MOTOR</p> <p>MV MUD VALVE</p>	<p>N NORTH</p> <p>N/A NOT APPLICABLE</p> <p>NBC NAIL IN BOTTLE CAP</p> <p>NC NORMALLY CLOSED</p> <p>NEUT NEUTRAL</p> <p>NF NEAR FACE</p> <p>NO NORMALLY OPEN</p> <p>NO.(S) NUMBER(S)</p> <p>NOM NOMINAL</p> <p>NORM NORMAL</p> <p>NPT NATIONAL PIPE THREAD</p> <p>NPW NONPOTABLE WATER</p> <p>NSR NEAR SIDE</p> <p>NTS NOT TO SCALE</p> <p>OC ON CENTER, ODOR CONTROL</p> <p>OD OUTSIDE DIAMETER</p> <p>OF OUTSIDE FACE, OVERFLOW</p> <p>OH OVERHEAD</p> <p>OL OVERLOAD</p> <p>OP OPERATIONS</p> <p>OPER OPERATING</p> <p>OPNG OPENING</p> <p>OPP OPPOSITE</p> <p>OSL OUTSTANDING LEG</p> <p>OX OXIDE</p> <p>OZ OUNCE</p> <p>PC POINT OF CURVE, PRIMARY CLARIFIER</p> <p>PCC POINT OF COMPOUND CURVATURE</p> <p>PCCP PRESTRESSED CONCRETE CYLINDER PIPE</p> <p>PCP PIER CUTOFF POINT</p> <p>PCV PINCH VALVE</p> <p>PD PLAN DIMENSION</p> <p>PE PLAIN END</p> <p>PG PRESSURE GRADE</p> <p>PH PIPE HANGER, PENTHOUSE</p> <p>PI POINT OF INTERSECTION</p> <p>PIVC POINT OF INTERSECTION ON VERTICAL CURVE</p> <p>PL PLATE</p> <p>PLYWD PLYWOOD</p> <p>PNL(S) PANEL(S)</p> <p>POLY POLYMER</p> <p>POT POINT ON TANGENT</p> <p>PP POWER POLE</p> <p>PRI PRIMARY</p> <p>PR PAIR, PROCESS REACTOR</p> <p>PROJ PROJECTION</p> <p>PRS PRESSURE REDUCING STATION</p> <p>PRV POWER ROOF VENTILATOR, PRESSURE REDUCING VALVE</p> <p>PS PIPE SUPPORT</p> <p>PSF POUNDS PER SQUARE FOOT</p> <p>PSI POUNDS PER SQUARE INCH</p> <p>PT POINT, POINT OF TANGENCY</p> <p>PTD PAINT</p> <p>PV PLUG VALVE</p> <p>PVC POLYVINYL CHLORIDE, POINT ON VERTICAL CURVE</p> <p>PVCP POLYVINYL CHLORIDE PIPE</p> <p>PVMT PAVEMENT</p> <p>PW POTABLE WATER</p> <p>R RADIUS, RISER</p> <p>RAS RETURN ACTIVATED SLUDGE</p> <p>RCP REINFORCED CONCRETE PIPE</p> <p>RCCP REINFORCED CONCRETE CYLINDER PIPE</p> <p>RCHPEP REINFORCED CONCRETE HORIZONTAL ELLIPTICAL PIPE</p> <p>RD ROOF DRAIN, ROAD</p> <p>RDL ROOF DRAIN LEADER</p> <p>RECEP RECEPTION</p> <p>RECIRC RECIRCULATING</p> <p>RECP RECEPTACLE</p> <p>RED REDUCER, REDUCING</p> <p>REG REGULATOR, REGULATING</p> <p>REF REFERENCE</p> <p>REFR REFRIGERATION, REFRIGERATOR</p> <p>REINF REINFORCING</p> <p>REM REMOVABLE</p> <p>REQD REQUIRED</p> <p>RET RETURN</p> <p>REV REVISION, REVISED, REVERSED</p> <p>RFG ROOFING</p> <p>RG RETAINER GLAND</p> <p>RH ROOF HOOD, RIGHT HAND, ROUND HEAD, RED HEAD</p> <p>RHMS ROUND HEAD MACHINE SCREW</p> <p>RHWS ROUND HEAD WOOD SCREW</p> <p>RM ROOM</p> <p>RO ROUGH OPENING</p> <p>RPM REVOLUTIONS PER MINUTE</p> <p>RR RAILROAD</p> <p>RS RAW SLUDGE, RAW SEWAGE, ROLLED STEEL</p> <p>RT RIGHT</p> <p>RTG RATING</p> <p>RV REGULATING VALVE</p> <p>R/W RIGHT OF WAY</p> <p>S SOUTH, SPEAKER</p> <p>SAN SWR SANITARY SEWER</p> <p>SCM SCUM</p> <p>SCFM STANDARD CUBIC FEET PER MINUTE</p> <p>SCHED SCHEDULE</p> <p>SD STORM DRAIN, SOAP DISH</p> <p>SEC SECOND, SECONDARY</p> <p>SECT SECTION</p> <p>SER SK SERVICE SINK</p> <p>SG SLUICE GATE, SUPPLY GRILLE</p> <p>SH SHEET</p> <p>SHR SHOWER</p> <p>SHD SHOWER DOOR</p> <p>SIM SIMILAR</p>	<p>SKL SKYLIGHT</p> <p>SLG SLIDE GATE</p> <p>SM SHEET METAL</p> <p>SP SUMP PUMP</p> <p>SPA SPACING, SPACES</p> <p>SPEC(S) SPECIFICATION(S)</p> <p>SPLY SUPPLY</p> <p>SQ SQUARE</p> <p>SR SUPPLY REGISTER</p> <p>SS STAINLESS STEEL</p> <p>SS SANITARY SEWER</p> <p>SSK SERVICE SINK</p> <p>ST SELF TAPPING</p> <p>ST SWR STORM SEWER</p> <p>STA STATION</p> <p>STD STANDARD</p> <p>STL STEEL</p> <p>STOR STORAGE</p> <p>STR STRUCTURAL</p> <p>SUP SUPPLY</p> <p>SUSP SUSPENDED</p> <p>SV SHUTOFF VALVE</p> <p>SW SWITCH</p> <p>SWBD SWITCHBOARD</p> <p>SWGR SWITCHGEAR</p> <p>SWL SEAL WATER SOLENOID</p> <p>SYM SYMMETRICAL</p> <p>SYS SYSTEM</p> <p>T THERMOSTAT, TREAD, TOTALIZER</p> <p>T TRANSFORMER, TELEPHONE, TOP</p> <p>TAN TANGENT</p> <p>TB TERMINAL BOX</p> <p>T&B TOP AND BOTTOM</p> <p>TBE THREAD BOTH ENDS</p> <p>TBM TEMPORARY BENCHMARK</p> <p>TC TOWEL CABINET, TOP OF CURB</p> <p>TC TERMINAL CABINET</p> <p>TEL TELESCOPING</p> <p>TEMP TEMPERATURE, TEMPORARY</p> <p>TERM TERMINAL</p> <p>T&G TONGUE & GROOVE</p> <p>TH TEST HOLE</p> <p>THK THICK, THICKNESS</p> <p>THR THRESHOLD</p> <p>TI TOTALIZING INDICATOR, TEMPERATURE INDICATOR</p> <p>TIR TOTALIZING INDICATING RECORDER</p> <p>TOF TOP OF FOOTING</p> <p>TOM TOP OF MASONRY</p> <p>TOS TOP OF STEEL</p> <p>TP TWISTED PAIR COUPLE, TOWEL PIN</p> <p>TPD TONS PER DAY</p> <p>TRANS TRANSFORMER, TRANSMITTER, TRANSFER</p> <p>TS TEMPERATURE SWITCH</p> <p>TV TELEVISION</p> <p>TYP TYPICAL</p> <p>TW TILTING WEIR</p> <p>UDM ULTRASONIC DENSITY METER</p> <p>UGND UNDERGROUND</p> <p>UH UNIT HEATER</p> <p>UNIF UNIFORM</p> <p>UNO UNLESS NOTED OTHERWISE</p> <p>UR URINAL</p> <p>USGS UNITED STATES GEOLOGICAL SURVEY</p> <p>V VALVE, VOLT, VENT</p> <p>VAC VACUUM</p> <p>VAT VINYL ASBESTOS TILE</p> <p>VB VACUUM BREAKER</p> <p>VC VERTICAL CURVE, VICTAULIC COUPLING</p> <p>VCD VERTICAL CONTROL DAMPER</p> <p>VCP VITRIFIED CLAY PIPE</p> <p>VCT VINYL COMPOSITION TILE</p> <p>VERT VERTICAL</p> <p>VF VACUUM FILTER</p> <p>VIB VIBRATION</p> <p>VM VOLT METER</p> <p>VNR VENEER</p> <p>VV VENT VALVE</p> <p>W WEST, WIDE, WIDTH, WINDOW, WATT, WATER</p> <p>W/ WITH</p> <p>WAS WASTE ACTIVATED SLUDGE</p> <p>WB WALLBOARD</p> <p>WC WATER CLOSET</p> <p>WD WOOD, WIDTH</p> <p>WF WALL FITTING, WALL FABRIC</p> <p>WH WALL HYDRANT</p> <p>WL WATER LEVEL</p> <p>WM WATER METER, WATTMETER</p> <p>WO WINDOW OPENING</p> <p>W/O WITHOUT</p> <p>WOM WOMEN</p> <p>WP WATERPROOF, WORKING POINT</p> <p>WR WASTE RECEPTACLE</p> <p>WS WASTERSTOP</p> <p>WT WEIGHT, CERAMIC WALL TILE</p> <p>WW WETWELL</p> <p>WWF WELDED WIRE FABRIC</p> <p>X BY, TIMES</p> <p>YH YARD HYDRANT</p> <p>& AND</p> <p>@ AT</p> <p>€ CENTERLINE</p> <p>< DEFLECTION ANGLE</p> <p># NUMBER</p> <p>% PERCENT</p>
--	---	--	--	--	---

<p>DEPARTMENT OF PUBLIC WORKS HOWARD COUNTY, MARYLAND</p> <p>CHIEF, BUREAU OF UTILITIES DATE</p>	 <p>BLACK & VEATCH Gaithersburg, Maryland</p>	<p>THIS DRAWING WAS ORIGINALLY APPROVED FOR CONSTRUCTION AND SEALED BY ROBERT J. REICHAUS, JR. A REGISTERED PROFESSIONAL ENGINEER IN THE STATE OF MARYLAND, NO. 22927</p>	<p>DES: FKA</p> <p>DRN: RLC</p> <p>CHK: WLK</p> <p>DATE:</p>	<p>11/03/03</p>	<p>CONFORMED TO CONSTRUCTION RECORDS</p>	<p>RHH RJR RJR</p>	<p>LAYOUT/OVERVIEW CIVIL</p> <p>ABBREVIATIONS</p>	<p>LITTLE PATUXENT WATER RECLAMATION PLANT ADDITION NO. 6 LABORATORY RENOVATION</p> <p>CAPITAL PROJECT S-6205 CONTRACT NO. 20-3841</p> <p>HOWARD COUNTY, MARYLAND</p>	<p>SCALE AS SHOWN</p> <p>SHEET 4 OF 28</p> <p>L4</p>
--	---	---	--	-----------------	--	--------------------	---	---	--

D58472-5
F058472A

EXISTING LEGEND


- TREE
- TREE LINE
- TRAVERSE MARKER
- DROP INLET
- SIGN
- LIGHT POLE
- SANITARY MANHOLE
- WATER VALVE
- FIRE HYDRANT
- ELECTRIC MANHOLE
- TELEPHONE MANHOLE
- UTILITY POLE
- INDEX CONTOUR
- INTERMEDIATE CONTOUR
- PROPERTY LINE
- FENCE LINE
- UNDERGROUND PIPING 12" AND LARGER
- UNDERGROUND PIPING SMALLER THAN 12"
- RAILROAD TRACK
- TEST BORING

ABBREVIATIONS

- F FERMENTER
- FC FINAL CLARIFIER
- FEB FLOW EQUALIZATION BASIN
- PC PRIMARY CLARIFIER
- PR PROCESS REACTOR
- PS PRIMARY SUBSTATION

GENERAL NOTES:

1. ALL CONSTRUCTION SHALL BE IN ACCORDANCE WITH THE LATEST STANDARDS AND SPECIFICATIONS OF HOWARD COUNTY PLUS MSHA STANDARDS AND SPECIFICATIONS IF APPLICABLE.
2. THE CONTRACTOR SHALL NOTIFY THE DEPARTMENT OF PUBLIC WORKS/BUREAU OF ENGINEERING/CONSTRUCTION INSPECTION DIVISION AT (410) 313-1880 AT LEAST FIVE (5) WORKING DAYS PRIOR TO THE START OF WORK.
3. THE CONTRACTOR SHALL NOTIFY "MISS UTILITY" AT 1-800-257-7777 AT LEAST 48 HOURS PRIOR TO ANY EXCAVATION WORK BEING DONE.
4. ALL PLAN DIMENSIONS ARE TO FACE OF CURB UNLESS OTHERWISE NOTED.
5. THE EXISTING TOPOGRAPHY IS TAKEN FROM AERIAL SURVEY WITH MAXIMUM ONE FOOT CONTOUR INTERVALS PREPARED FOR AMT AND ASSOCIATES BY AIR SURVEY CORP., INC. DATED JUNE 1999.
6. THE COORDINATES SHOWN HEREON ARE BASED UPON THE HOWARD COUNTY GEODETIC CONTROL WHICH IS BASED UPON THE MARYLAND STATE PLANE COORDINATE SYSTEM. HOWARD COUNTY MONUMENT NOS. 47111 AND 47112N WERE USED FOR THIS PROJECT.
7. WATER IS PUBLIC (HO. CO. LITTLE PATUXENT WATER RECLAMATION PLANT).
8. SEWER IS PUBLIC (HO. CO. LITTLE PATUXENT WATER RECLAMATION PLANT).
9. EXISTING UTILITIES ARE BASED ON LITTLE PATUXENT WATER RECLAMATION PLANT AND MUST BE VERIFIED BY THE CONTRACTOR PRIOR TO START OF ANY DEMOLITION AND CONSTRUCTION.
10. FLOODPLAIN LIMITS FOR THIS PROJECT WERE TAKEN FROM HOWARD COUNTY STUDY DATED 1986.
11. THE ENTIRE LITTLE PATUXENT WASTEWATER TREATMENT PLANT SITE IS LOCATED IN THE 100 YEAR FLOODPLAIN, ELEV. 143.0.
12. OFFSITE DISPOSAL OF EXCESS MATERIAL WILL BE TO AN APPROVED SITE.
13. THE CONTRACTOR SHALL LOCATE AND PROTECT ALL EXISTING FACILITIES, STRUCTURES AND UTILITIES FROM DAMAGE UNLESS OTHERWISE SHOWN.
14. OMISSIONS/ADDITIONS OF UTILITIES FOUND DURING CONSTRUCTION ARE THE SOLE RESPONSIBILITY OF ANY CONTRACTOR ENGAGED IN CONSTRUCTION AT THIS SITE. THE ENGINEER SHALL BE NOTIFIED IMMEDIATELY OF ANY AND ALL UTILITY OMISSIONS/ADDITIONS.
15. IT SHALL BE THE RESPONSIBILITY OF THE CONTRACTOR TO REMOVE AND LEGALLY DISPOSE OF ANY AND ALL DEMOLISHED/DELETERIOUS MATERIALS.
16. EXISTING PAVEMENT SHALL BE SAWCUT PRIOR TO REMOVAL. ALL SAWCUT SHALL BE STRAIGHT, EVEN CUTS. JAGGED EDGES SHALL NOT BE PERMITTED. SAWCUT DEPTH SHALL EXTEND AT LEAST 2/3 TIMES THE THICKNESS OF THE EXISTING PAVEMENT THAT REMAINS IN PLACE.
17. POSITIVE DRAINAGE SHALL BE MAINTAINED AT ALL TIMES. PONDING OF WATER SHALL NOT BE PERMITTED. ALL PONDING WATER SHALL BE FILTERED THROUGH A PORTABLE SEDIMENT TRAP PRIOR TO DISCHARGE INTO THE PUBLIC STORM/SEWER SYSTEM.
18. SURFACED STREET AND PARKING AREAS SHALL BE MAINTAINED IN A CLEAN CONDITION, MUD AND DUST FREE AT ALL TIMES. ADEQUATE MEANS SHALL BE PROVIDED TO CLEAN TRUCKS AND EQUIPMENT.
19. CONTRACTOR SHALL HAND DIG TEST PITS AT ALL UTILITY CROSSINGS TO DETERMINE THEIR EXACT LOCATION, WELL IN ADVANCE OF ANY DEMOLITION/CONSTRUCTION.
20. ALL TIES TO EXISTING PAVEMENT/STRUCTURES AND CURB SHALL BE SMOOTH TRANSITIONS WITH NO ABRUPT CHANGES.
21. CONTRACTOR SHALL ADJUST ALL UTILITY FRAME AND COVERS TO MATCH NEW FINISHED GRADE.
22. THE SITE PLAN AND EROSION CONTROL PLAN ARE BASED ON THE SITE DEVELOPMENT PLAN (SDP) AMENDMENT DATED APRIL 10, 2000 AND SUBMITTED TO HOWARD COUNTY. THE SDP AMENDMENT IS INCLUDED IN THE CONTRACT BY REFERENCE. THE CONTRACTOR SHALL COMPLY WITH ALL REQUIREMENTS OF THE SDP AMENDMENT.

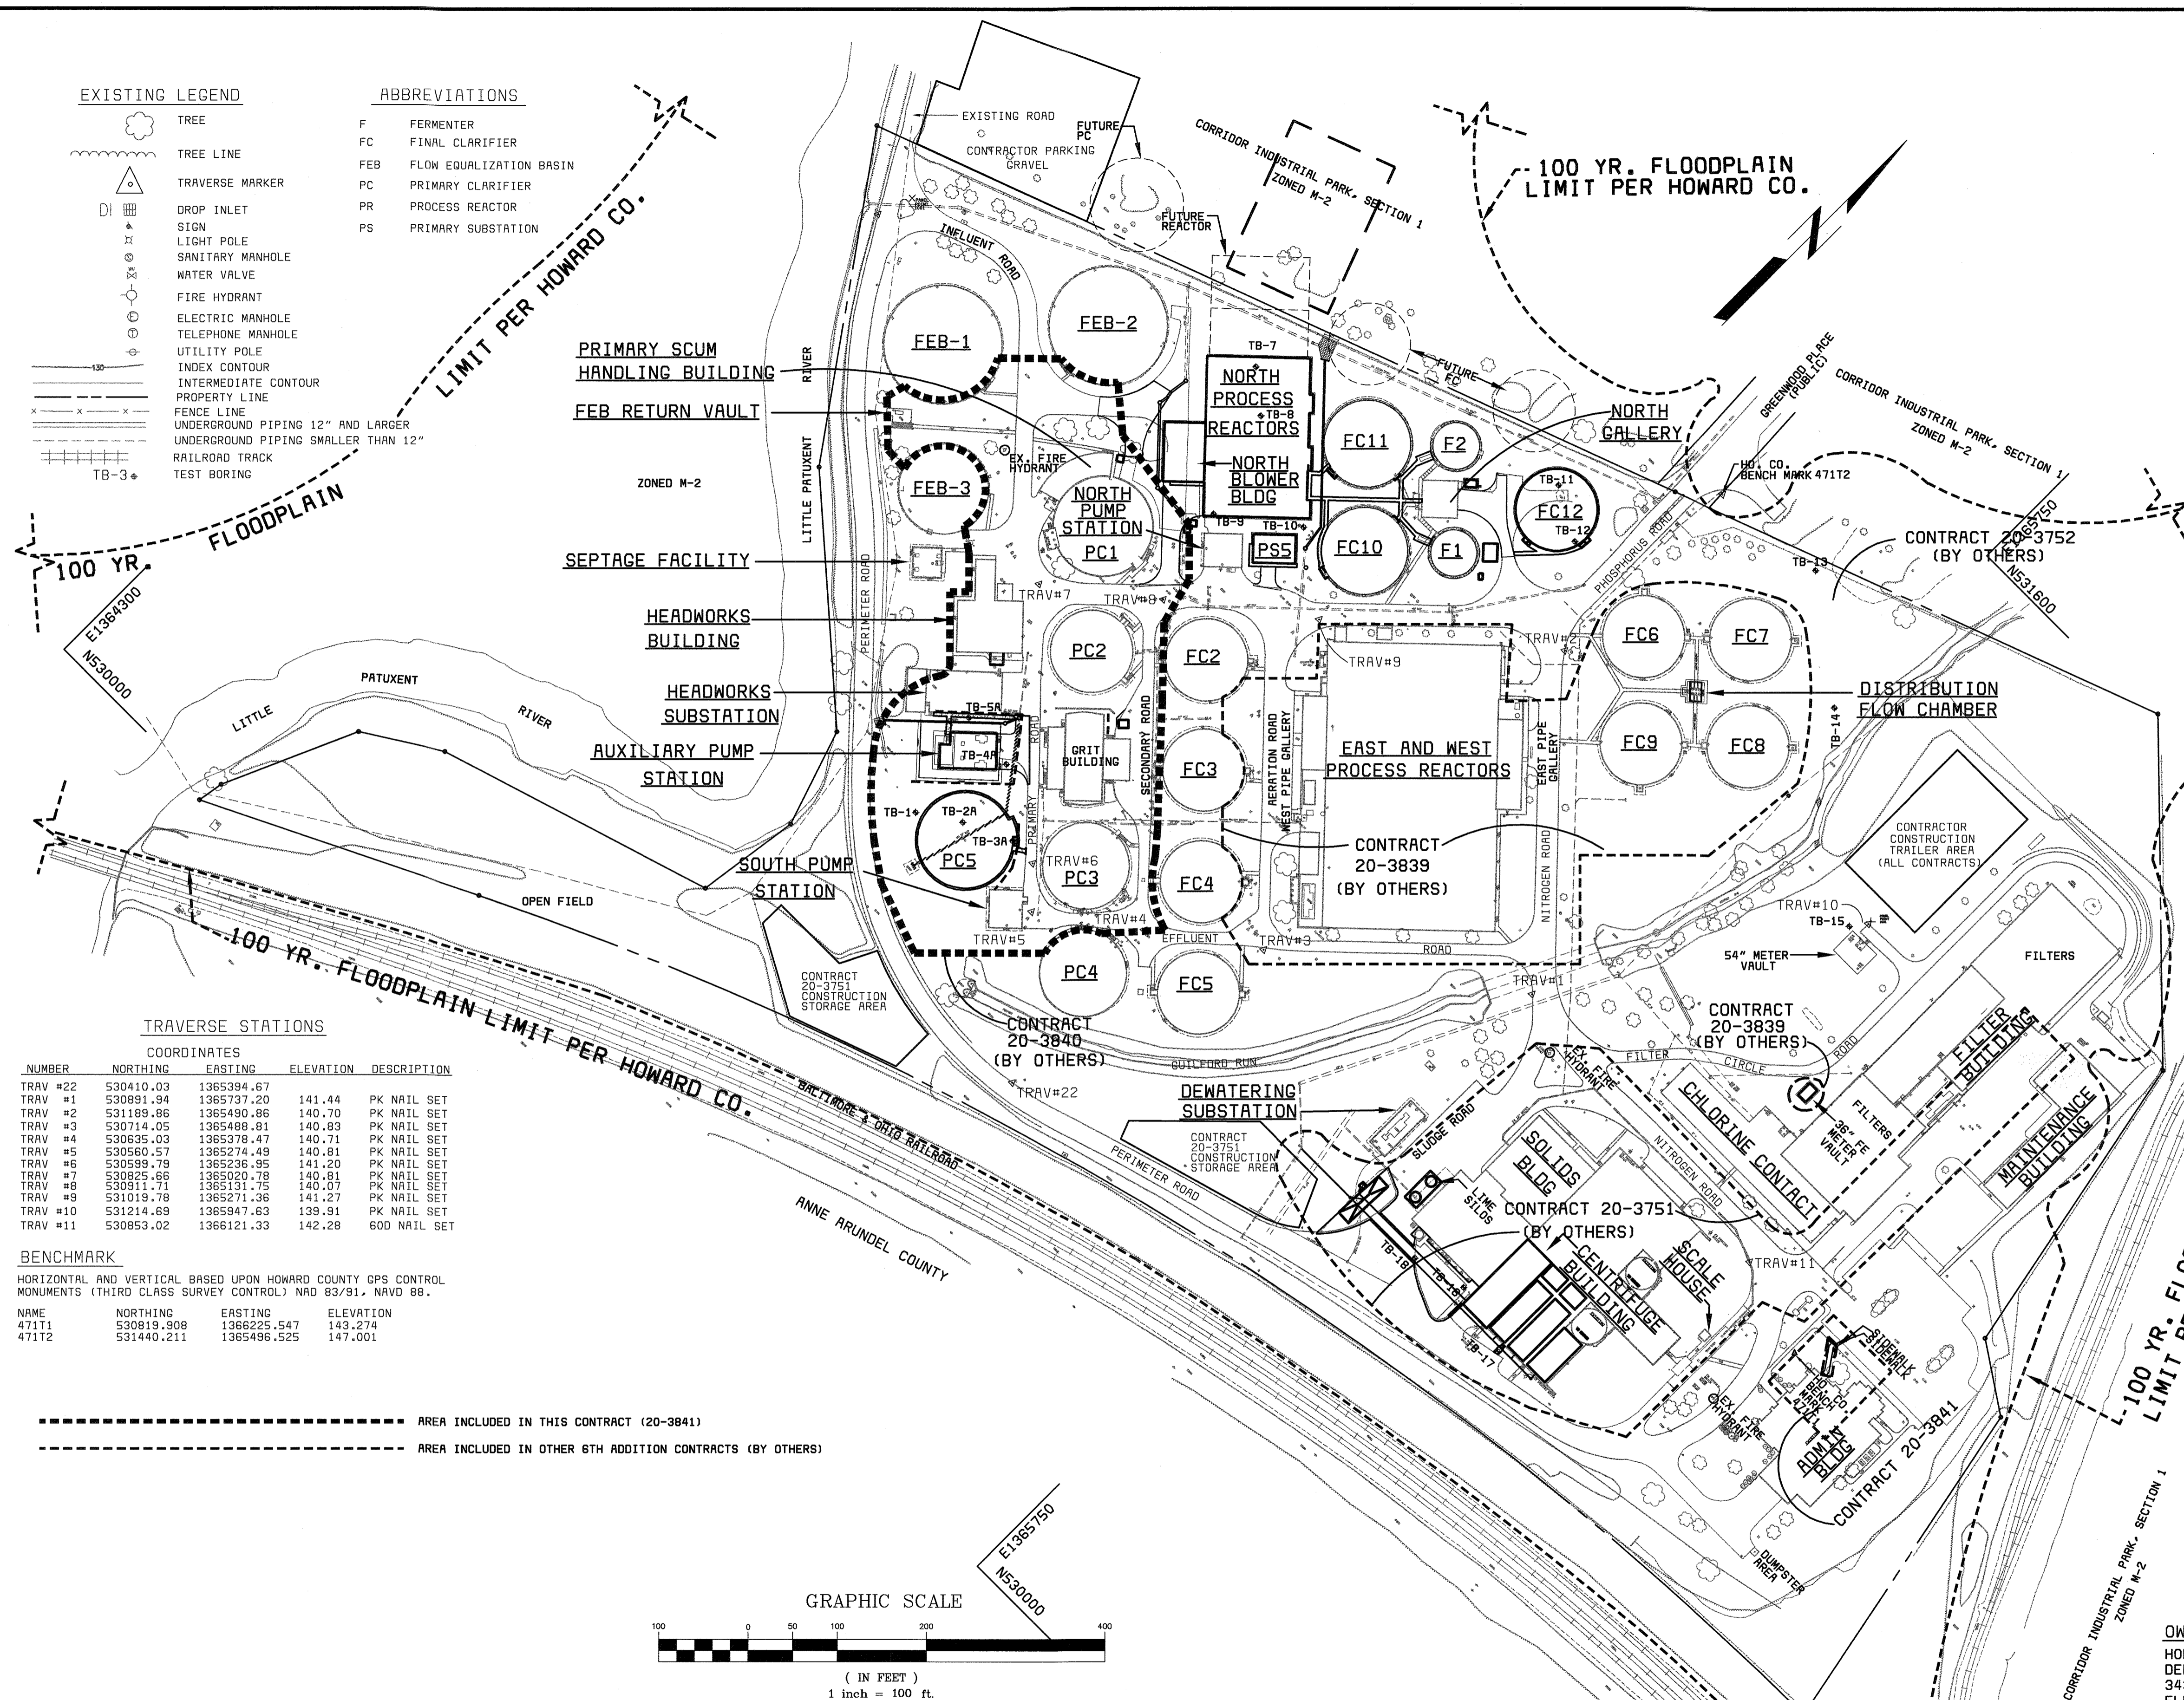


TRAVERSE STATIONS

NUMBER	NORTHING	EASTING	ELEVATION	DESCRIPTION
TRAV #22	530410.03	1365394.67		
TRAV #1	530891.94	1365737.20	141.44	PK NAIL SET
TRAV #2	531189.86	1365490.86	140.70	PK NAIL SET
TRAV #3	530714.05	1365488.81	140.83	PK NAIL SET
TRAV #4	530835.03	1365378.47	140.71	PK NAIL SET
TRAV #5	530560.57	1365274.49	140.81	PK NAIL SET
TRAV #6	530599.79	1365236.95	141.20	PK NAIL SET
TRAV #7	530825.66	1365020.78	140.81	PK NAIL SET
TRAV #8	530911.71	1365131.75	140.07	PK NAIL SET
TRAV #9	531019.78	1365271.36	141.27	PK NAIL SET
TRAV #10	531214.69	1365947.63	139.91	PK NAIL SET
TRAV #11	530853.02	1366121.33	142.28	60D NAIL SET

BENCHMARK

HORIZONTAL AND VERTICAL BASED UPON HOWARD COUNTY OPS CONTROL MONUMENTS (THIRD CLASS SURVEY CONTROL) NAD 83/91, NAVD 88.

NAME	NORTHING	EASTING	ELEVATION
47111	530819.908	1366225.547	143.274
47112	531440.211	1365496.525	147.001

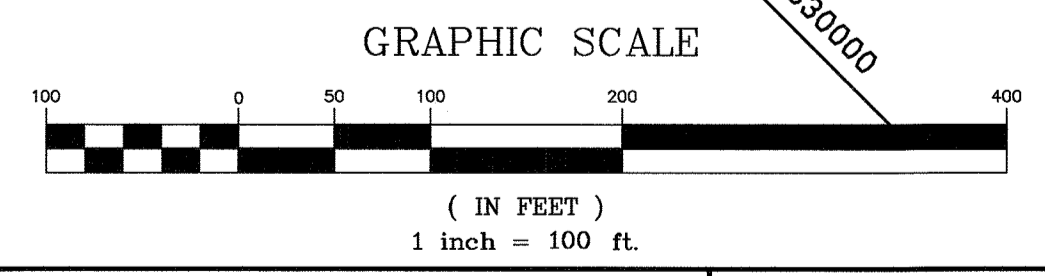

DEPARTMENT OF PUBLIC WORKS
HOWARD COUNTY, MARYLAND

CHIEF, BUREAU OF UTILITIES DATE

THIS DRAWING WAS ORIGINALLY APPROVED FOR CONSTRUCTION AND SEALED BY MICHAEL JOSEPH WIERCINSKI A REGISTERED PROFESSIONAL ENGINEER IN THE STATE OF MARYLAND, NO. 21816

DES: R ANCHORS					
DRN: R ANCHORS					
CHK: A REYES					
DATE: 10/01/01	DATE	REVISIONS AND RECORD OF ISSUE	NO.	BY	CHK APP

CIVIL

OVERALL SITE PLAN

OWNER/DEVELOPER
HOWARD COUNTY GOVERNMENT
DEPT. OF PUBLIC WORKS
3430 COURTHOUSE DRIVE
ELLCOTT CITY, MARYLAND 21043

LITTLE PATUXENT WATER RECLAMATION PLANT
ADDITION NO. 6
LABORATORY RENOVATION


CAPITAL PROJECT S-6205
CONTRACT NO. 20-3841

HOWARD COUNTY, MARYLAND


SCALE AS SHOWN

SHEET 5 OF 28

L5

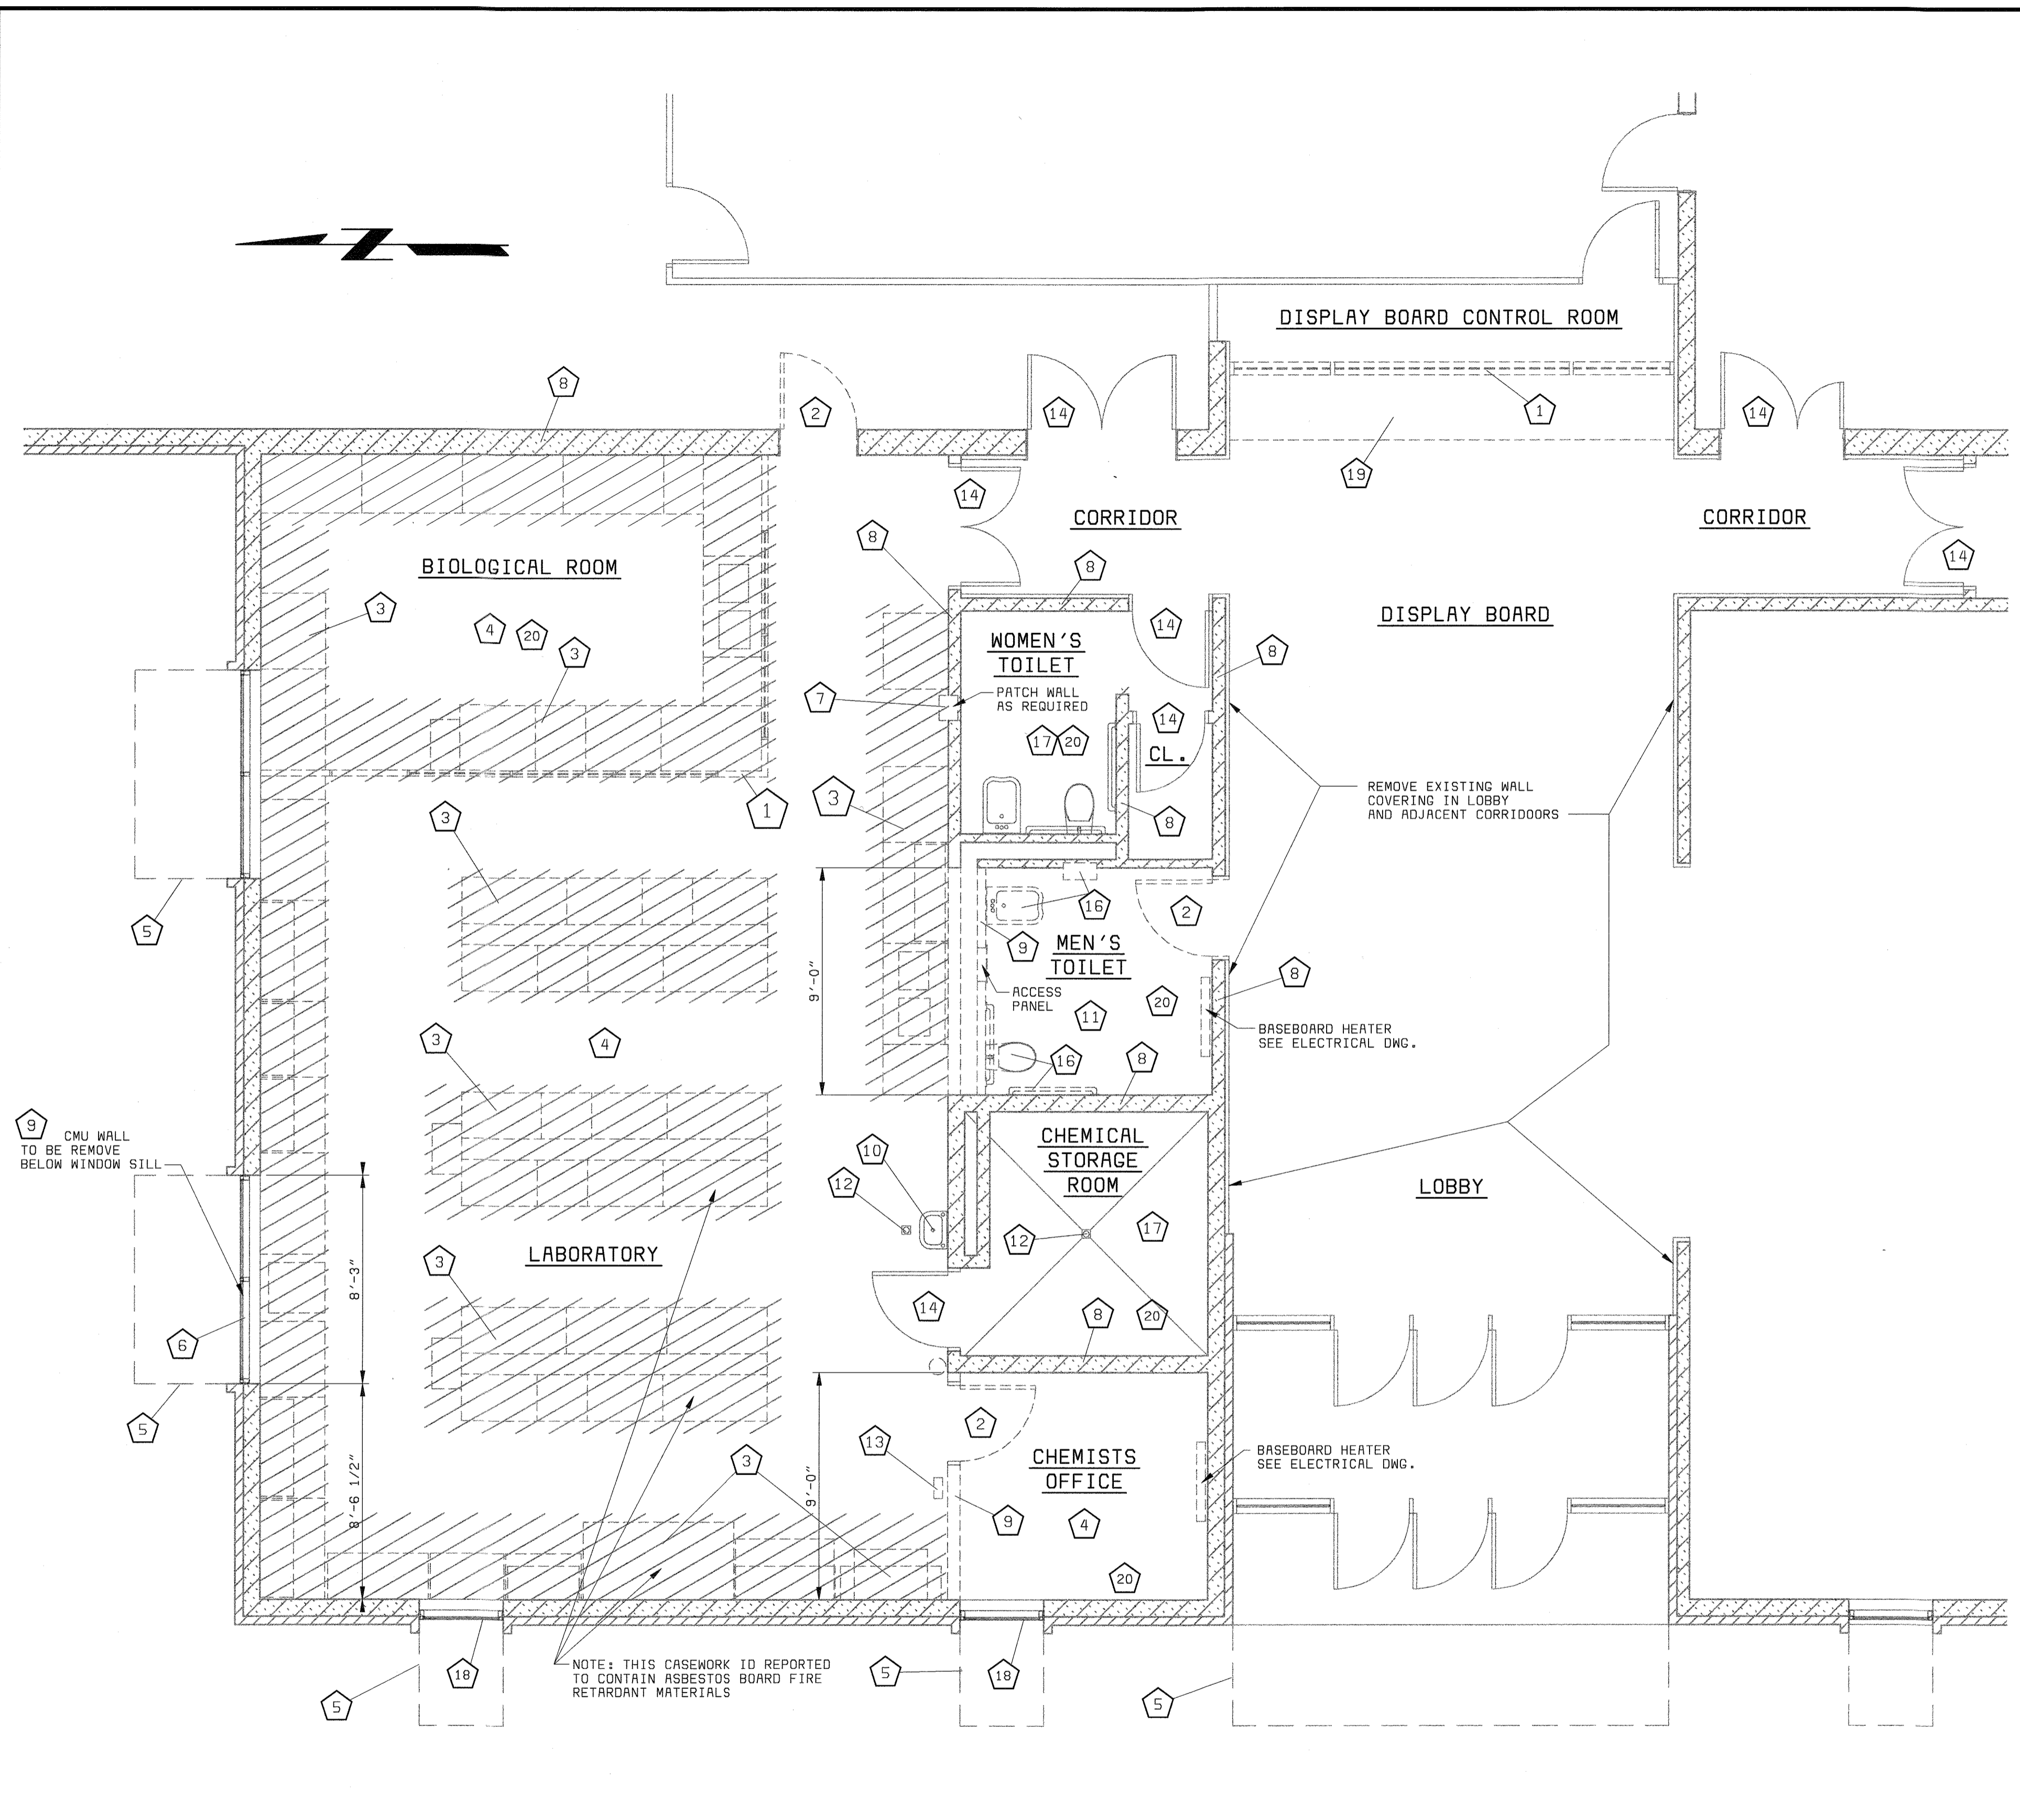

DEMOLITION PLAN - ELEV 145.00' 1/A1
1/4" = 1'-0"

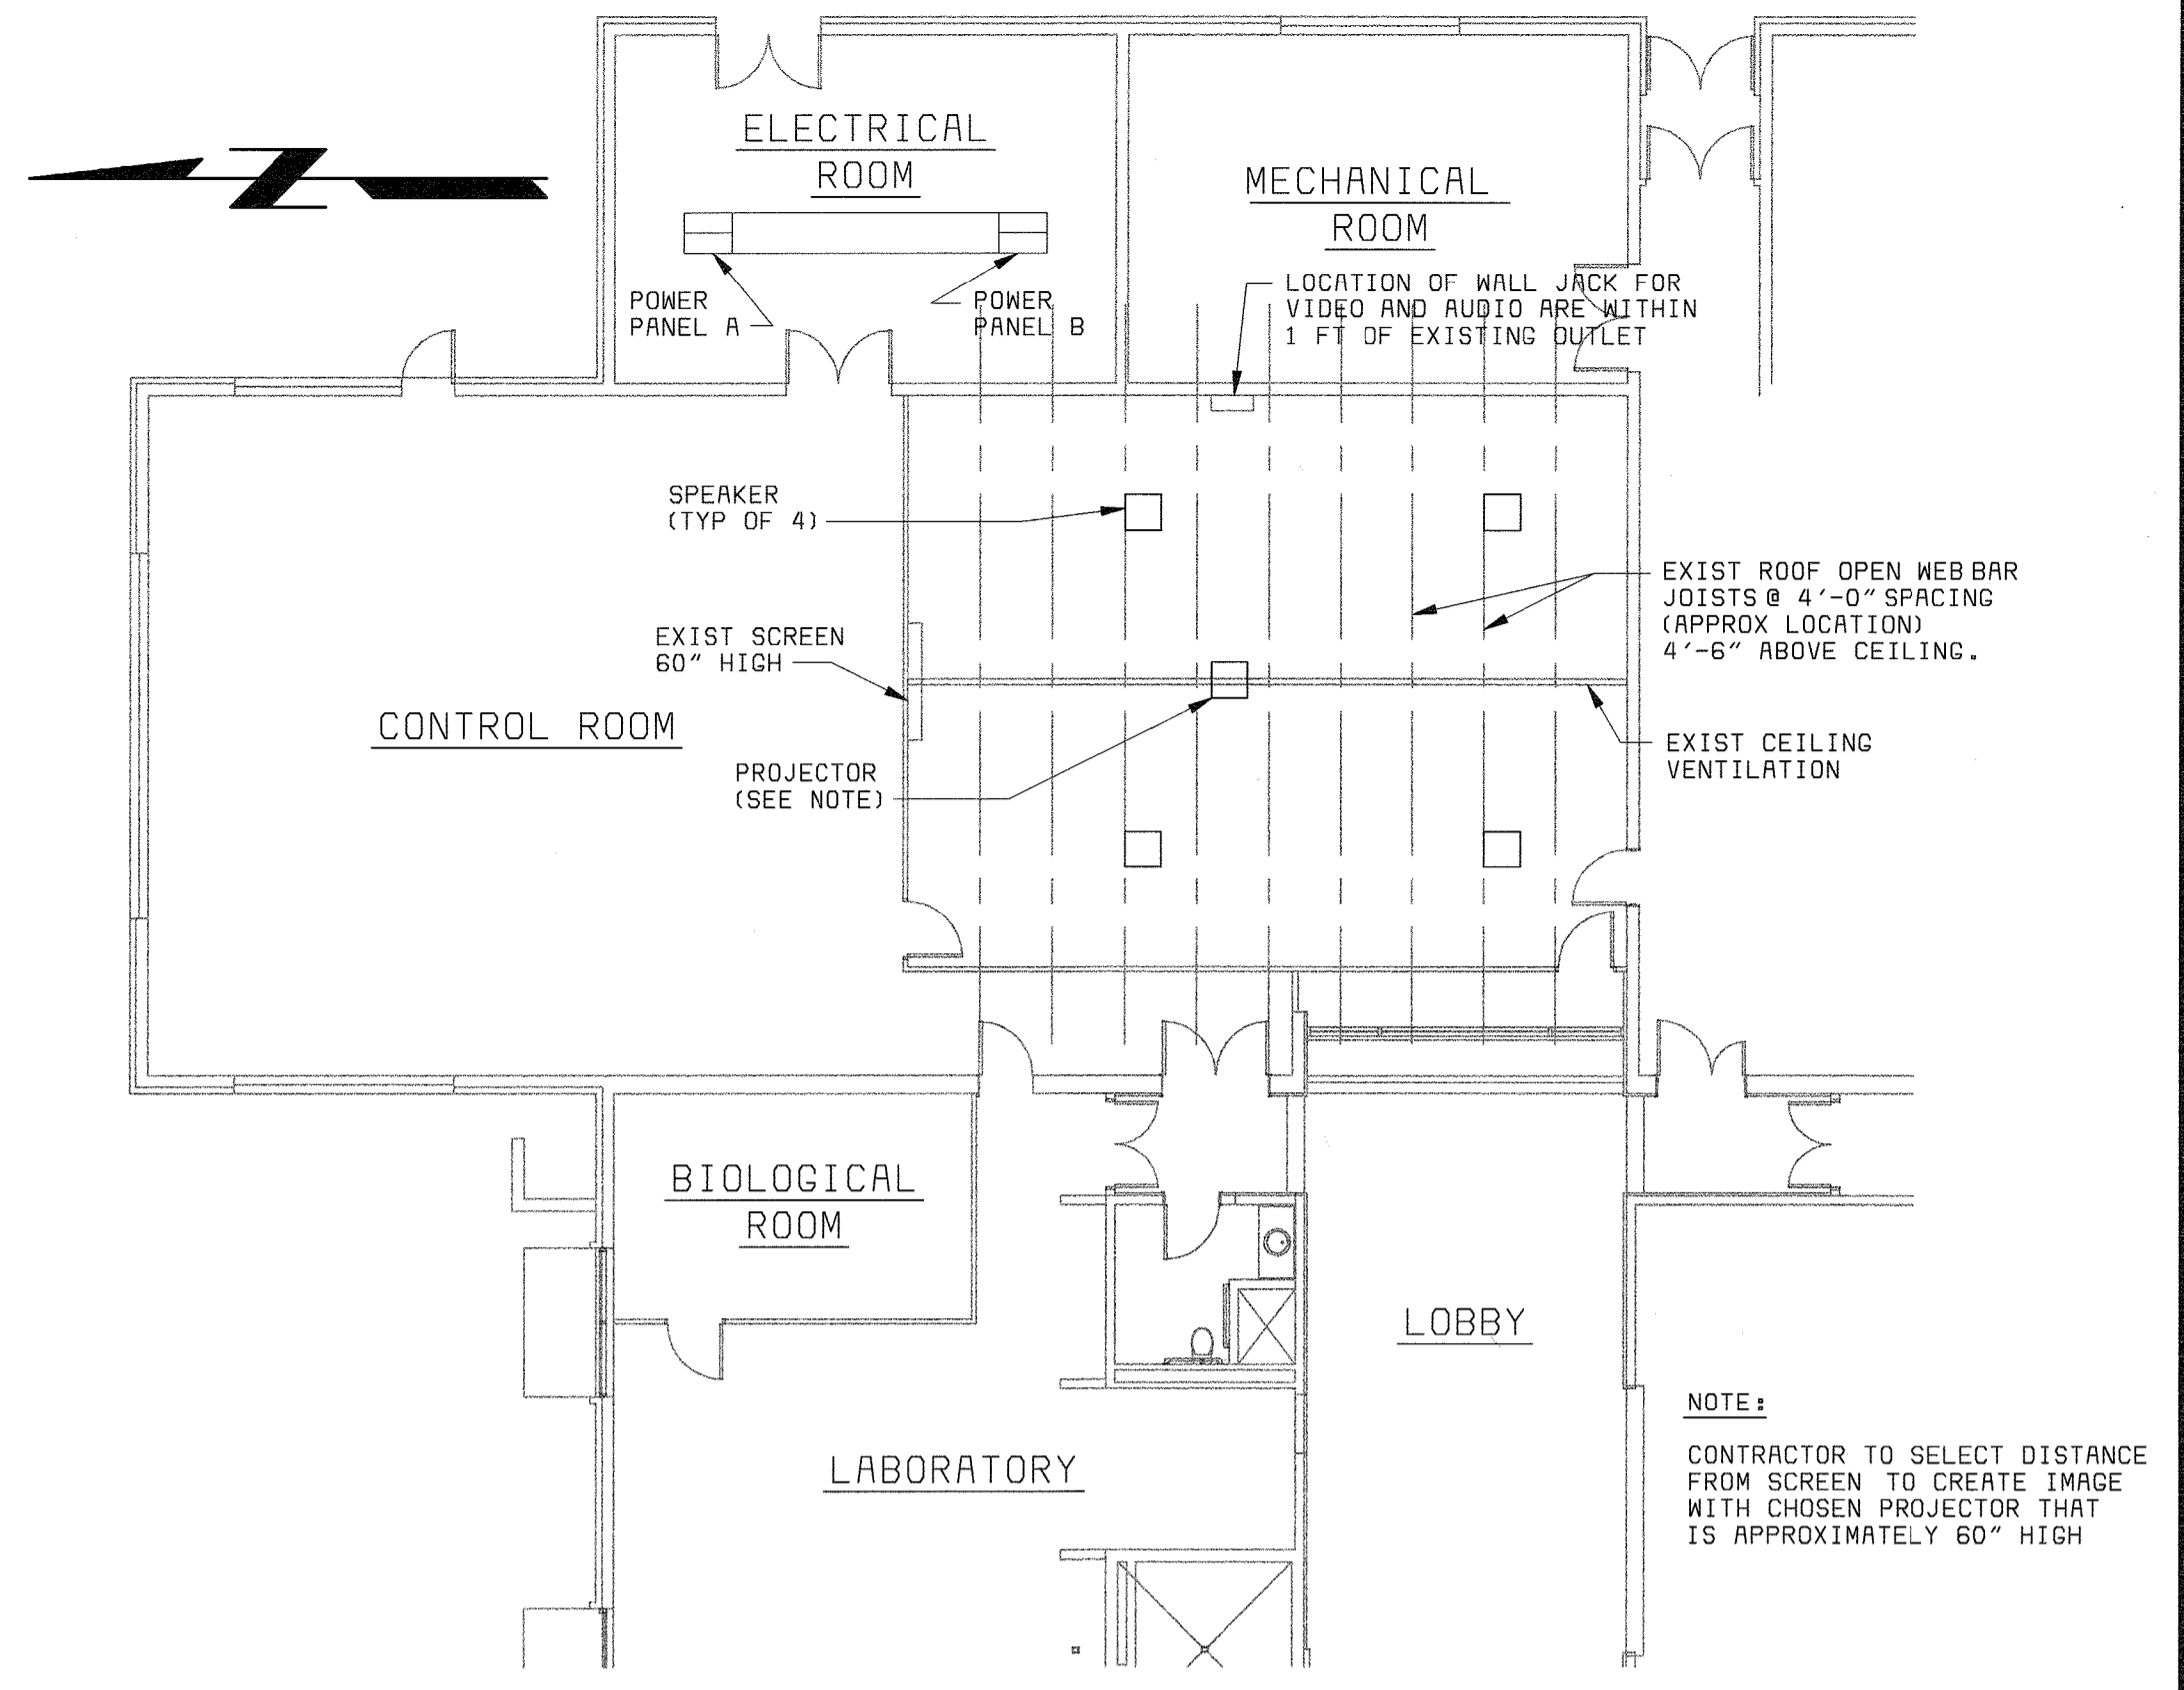



PLAN
3/32" = 1'-0"

LEGEND:

- TO REMOVE.
- EXISTING TO REMAIN.
- 1 REMOVE ALL PARTITIONS FROM SLAB TO UNDERSIDE OF ROOF DECK, INCLUDING WIRING AND OTHER CONCEALED ITEMS.
- 2 EXISTING DOOR TO BE REMOVED.
- 3 EXISTING CASEWORK TO BE REMOVED.
- 4 CEILING AND GRID TO BE REMOVED.
- 5 EXISTING CANOPY TO REMAIN
- 6 EXISTING WINDOW TO BE REMOVED.
- 7 REMOVE ELECTRIC WATER COOLER
- 8 CMU PARTITION TO REMAIN.
- 9 CMU PARTITION TO BE REMOVED.
- 10 EYE WASH TO REMAIN.
- 11 PLASTER CEILING TO BE REMOVED.
- 12 FLOOR DRAIN TO REMAIN
- 13 FIRE BLANKET TO BE TEMPORARILY REMOVED AND REINSTALL IN SAME LOCATION AFTER INSTALLATION OF CERAMIC TILE.
- 14 DOOR TO REMAIN.
- 15 NOT USED.
- 16 TOILET ACCESSORIES AND FIXTURES TO BE REMOVED.
- 17 P.C. PLASTER CEILING TO REMAIN.
- 18 EXISTING WINDOW TO REMAIN.
- 19 EXISTING DISPLAY BOARD TO BE REMOVED.
- 20 REMOVE EXISTING SEAMLESS FLOOR COATING, IF REQUIRED.
- 21 NOTE: SALVAGE EXISTING GLAZED C.M.U. TO BE REMOVED AND RE-USE FOR INFILL ON EAST SIDE OF THE WALL IN-FILL.

DEMOLITION NOTES:

1. FOR PANEL TO BE REMOVED SEE ELECTRICAL DRAWINGS.
2. FOR DUCTS AND DIFFUSERS TO BE REMOVED SEE MECHANICAL DRAWINGS.
3. FOR FLOOR DRAIN TO BE REMOVED SEE PLUMBING DRAWINGS.
4. FOR EXISTING EMERGENCY LIGHT AND SIGNAL TO BE REMOVED OR REUSED SEE ELECTRICAL DRAWINGS.
5. FOR PROPANE GAS PIPE TO BE REMOVED SEE MECHANICAL OR PLUMBING DRAWINGS.
6. REMOVE EXISTING FLOOR COATING IN LABORATORY, MEN'S TOILET AND CHEMISTS OFFICE.

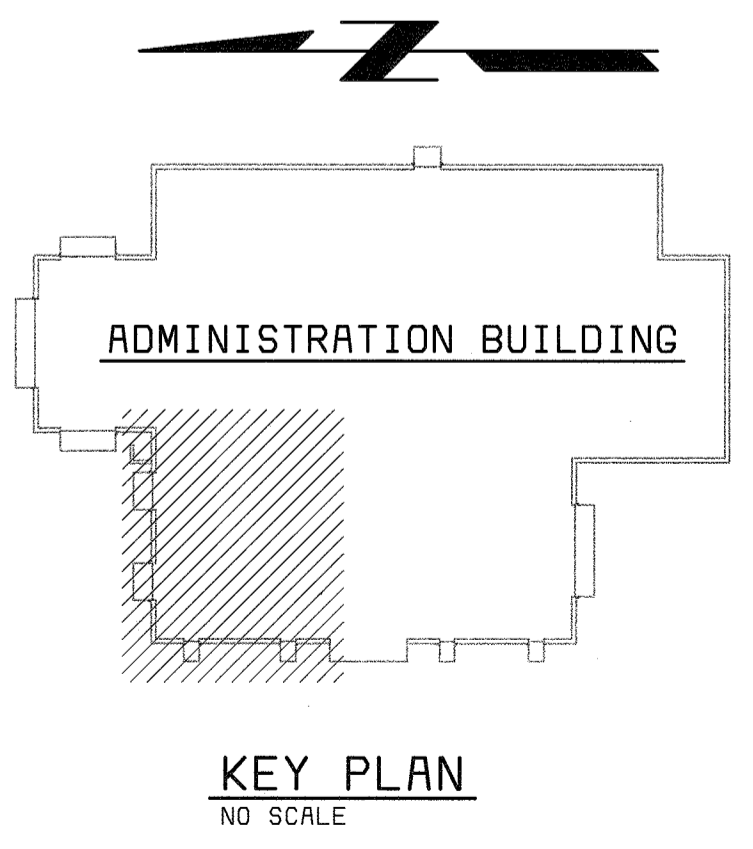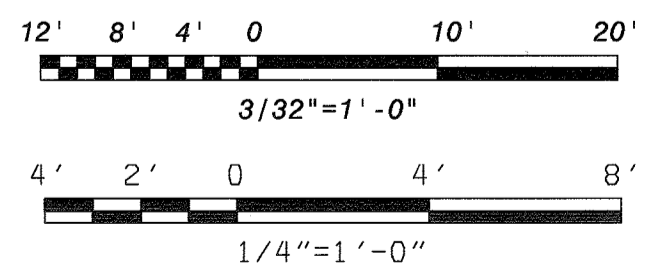

DEPARTMENT OF PUBLIC WORKS
HOWARD COUNTY, MARYLAND

bbw Architects • Designers • Planners
Bryant Bryant Williams, P.C.
4201 Connecticut Avenue N.W., Suite 500
Washington, D.C. 20008 (202) 241-2108

BLACK & VEATCH
Gaithersburg, Maryland
REG. PROF. ENGR. DATE




THIS DRAWING WAS
ORIGINALLY APPROVED
FOR CONSTRUCTION
AND SEALED BY
CHARLES J. BRYANT
A REGISTERED
ARCHITECT
IN THE
STATE OF MARYLAND,
NO. 1377-R

DES:	CH/JS				
DRN:	JS				
CHK:	CH	11/03/03	CONFORMED TO CONSTRUCTION RECORDS	RHH/RJR/RJR	
DATE:	08/00	11/26/02	ADDENDUM #2		
			REVISIONS AND RECORD OF ISSUE	NO. BY CK APP	

ARCHITECTURAL
**ADMINISTRATION BUILDING
LABORATORY
DEMOLITION PLAN AND DETAILS**

LITTLE PATUXENT WATER DEMOLITION PLANT
ADDITION NO. 6
LABORATORY RENOVATION
CAPITAL PROJECT S-6205
CONTRACT NO. 20-3841
HOWARD COUNTY, MARYLAND

SCALE AS SHOWN
SHEET 7 OF 28
A1

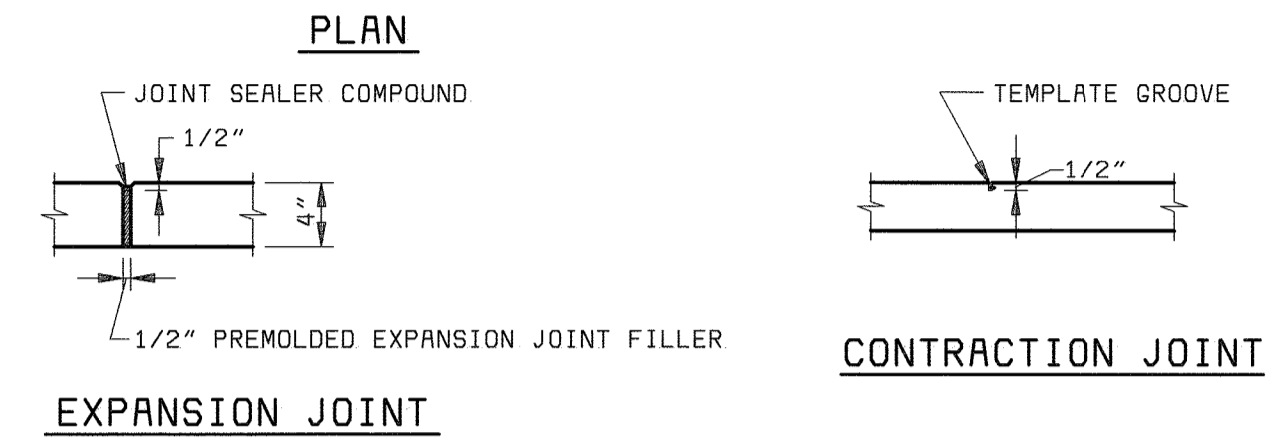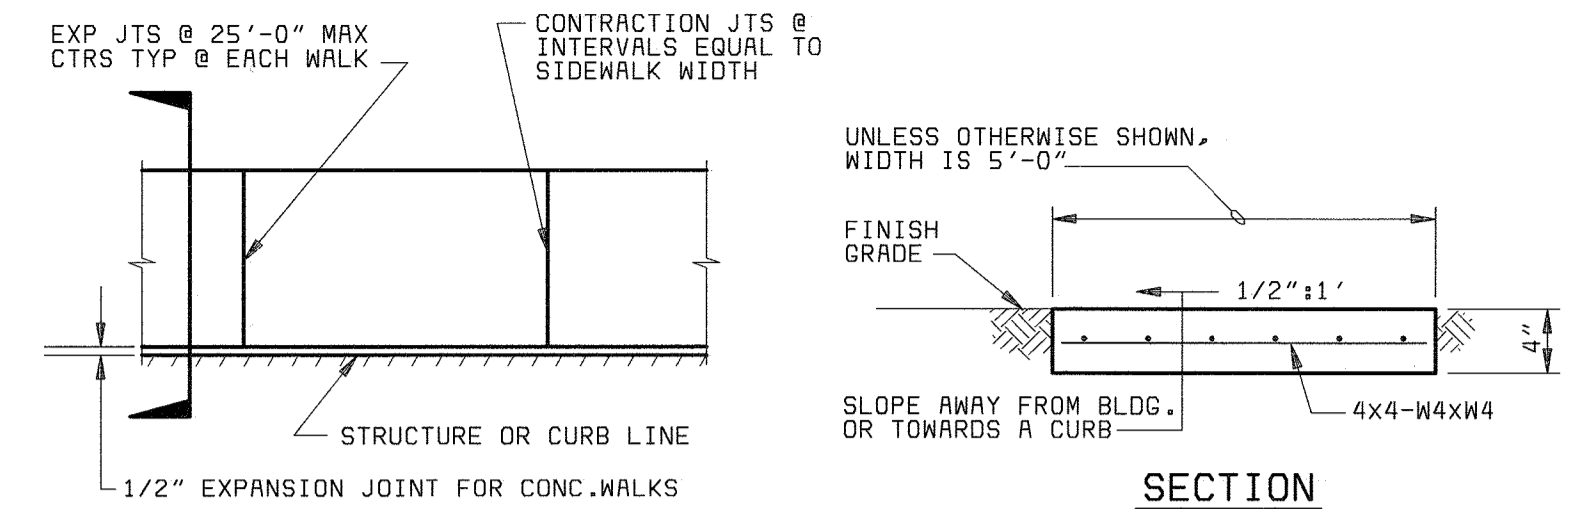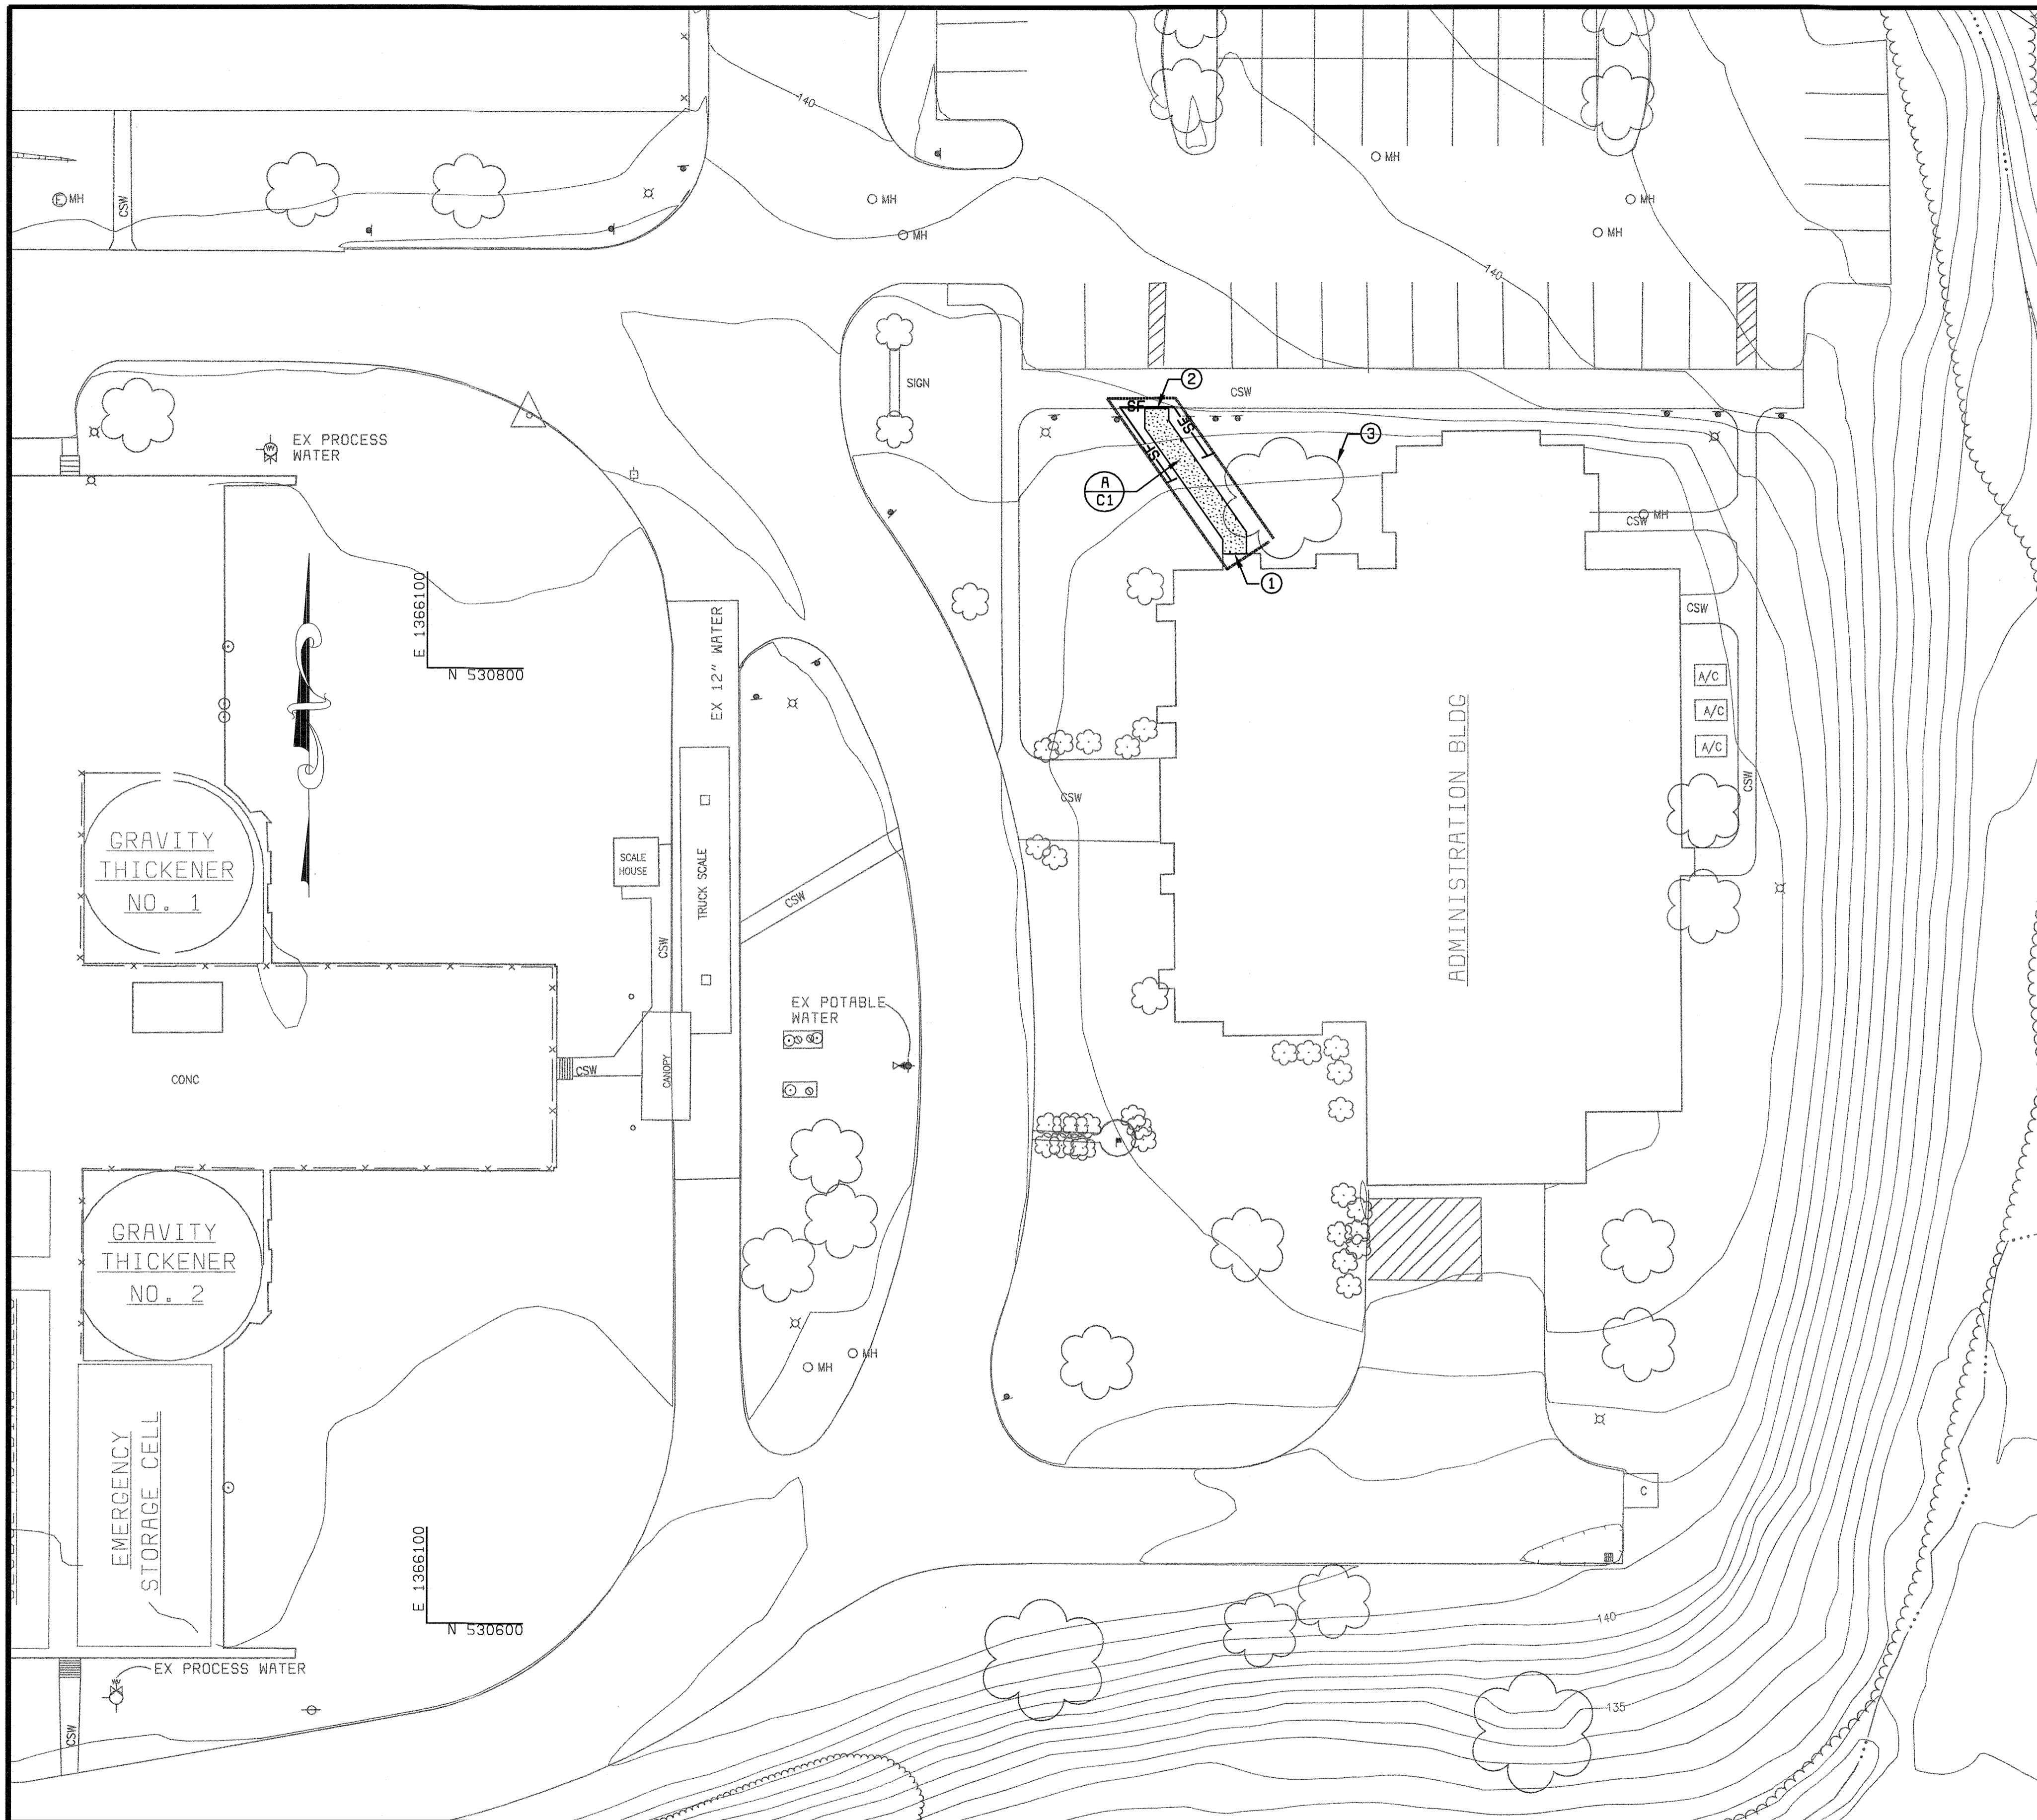

CONCRETE WALK DETAILS
NO SCALE

NOTES

1. INSTALL CONCRETE WALK UNDERNEATH EXISTING CANOPY. PROVIDE GRADING AS NECESSARY TO MATCH CONCRETE WALK ELEVATION TO EXISTING FINISHED FLOOR AT DOOR THRESHOLD, AS INDICATED ON DRAWING A9.
2. MATCH EXISTING SIDEWALK IN GRADE.
3. PROTECT EXISTING TREE FROM DAMAGE.

LEGEND

- PROPOSED CONCRETE SIDEWALK
- SF SILT FENCE
- LIMIT OF DISTURBANCE

DEPARTMENT OF PUBLIC WORKS
HOWARD COUNTY, MARYLAND
CHIEF, BUREAU OF UTILITIES DATE

AMT
A. MORTON THOMAS AND ASSOCIATES, INC.
CONSULTING ENGINEERS
12750 TWINBROOK PARKWAY, SUITE 200, ROCKVILLE MD 20852
TEL (301) 881-2566 FAX (301) 881-8814
E-MAIL JBYRNE@AMTENGINEERING.COM
AMT FILE # 98-154

BLACK & VEATCH LP
Gaithersburg, Maryland
REG. PROF. ENGR. DATE

THIS DRAWING WAS
ORIGINALLY APPROVED
FOR CONSTRUCTION
AND SEALED BY
MICHAEL JOSEPH NIERCINSKI
A REGISTERED
PROFESSIONAL ENGINEER
IN THE
STATE OF MARYLAND,
NO. 21816

DES: R ANCHORS					
DRN: R ANCHORS					
CHK: A REYES					
DATE: 10/01/01	DATE	REVISIONS AND RECORD OF ISSUE	NO.	BY	CK APP


CIVIL
SITE GRADING AND STAGING PLAN

LITTLE PATUXENT WATER RECLAMATION PLANT
ADDITION NO. 6
LABORATORY RENOVATION
CAPITAL PROJECT S-6205
CONTRACT NO. 20-3841
HOWARD COUNTY, MARYLAND


SCALE AS SHOWN
SHEET 6 OF 28
C-1

058472-5
FD56472A

GENERAL INSTRUMENT SYMBOLS

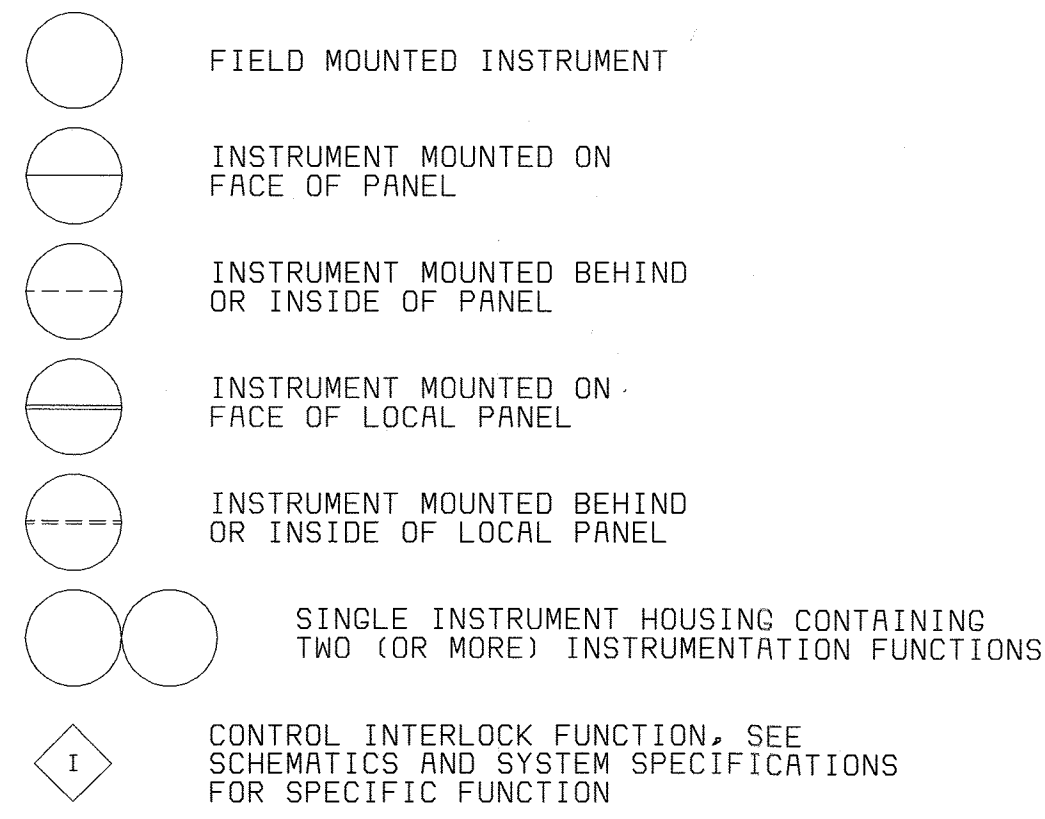

TAG NUMBERS AND ADDITIONAL DESIGNATIONS

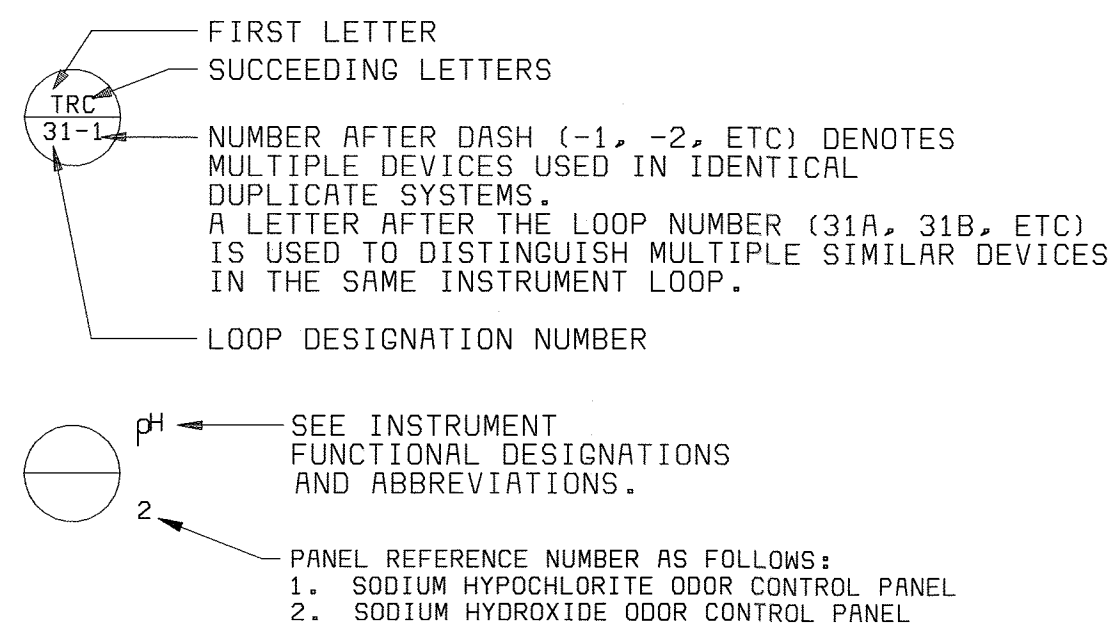


TAG NUMBERS MEANINGS OF IDENTIFICATION LETTERS

LETTER	FIRST LETTER		SUCCEEDING LETTERS		
	MEASURED OR INITIATING VARIABLE	MODIFIER	READOUT OR PASSIVE FUNCTION	OUTPUT FUNCTION	MODIFIER
A	ANALYSIS		ALARM		
B	BURNER, COMBUSTION		USER'S CHOICE	USER'S CHOICE	USER'S CHOICE
C	CONDUCTIVITY (ELECTRICAL)			CONTROL	
D	DENSITY (MASS) OR SPECIFIC GRAVITY	DIFFERENTIAL			
E	VOLTAGE (EMF)		PRIMARY ELEMENT		
F	FLOW RATE	RATIO (FRACTION)			
G	USER'S CHOICE		GLASS		
H	HAND (MANUALLY INITIATED)				HIGH
I	CURRENT (ELECTRICAL)		INDICATE		
J	POWER	SCAN			
K	TIME OR TIME-SCHEDULE	TIME RATE OF CHANGE		CONTROL STATION	
L	LEVEL		LIGHT (PILOT)		LOW
M	MOISTURE OR HUMIDITY	MOMENTARY			MIDDLE OR INTER-MEDIATE
N	USER'S CHOICE		USER'S CHOICE	USER'S CHOICE	USER'S CHOICE
O	USER'S CHOICE		ORIFICE (RESTRICTION)		
P	PRESSURE OR VACUUM		POINT (TEST CONNECTION)		
Q	QUANTITY	INTEGRATE OR TOTALIZE	INTEGRATE OR TOTALIZE		
R	RADIATION		RECORD OR PRINT		
S	SPEED OR FREQUENCY	SAFETY		SWITCH	
T	TEMPERATURE			TRANSMIT	
U	MULTIVARIABLE		MULTIFUNCTION	MULTIFUNCTION	MULTIFUNCTION
V	VIBRATION			VALVE, DAMPER, OR LOUVER	
W	WEIGHT OR FORCE		WELL		
X	UNCLASSIFIED		UNCLASSIFIED	UNCLASSIFIED	UNCLASSIFIED
Y	EVENT, STATE, OR PRESENCE			RELAY OR COMPUTE	
Z	POSITION, DIMENSION			DRIVE, ACTUATOR OR UNCLASSIFIED FINAL CONTROL ELEMENT	

DIGITAL SYSTEMS INTERFACE SYMBOLS

NOTE: REFER TO DETAILED SYSTEM SPECIFICATIONS FOR FUNCTIONAL DESCRIPTION. ALSO SEE I/O SCHEDULES FOR COMPLETE INPUT AND OUTPUT LISTINGS.

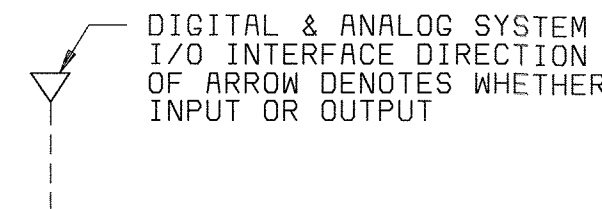

GENERAL NOTES

- IN GENERAL, THE P & ID SYMBOLS AND DEVICE IDENTIFICATIONS ARE BASED ON INSTRUMENT SOCIETY OF AMERICA, STANDARD PRACTICE ISA-SS-1 (1988). SOME MODIFICATIONS, ADDITIONS, AND ALTERATIONS HAVE BEEN MADE AS NEEDED TO ACCOMMODATE THE PROJECT REQUIREMENTS.
- ADDITIONAL CONTROL AND INTERLOCK REQUIREMENTS WHICH CAN BE MORE CLEARLY ILLUSTRATED ON SCHEMATIC DRAWINGS HAVE BEEN OMITTED FROM THE P & ID DRAWINGS. SOME PROCESS ITEMS, SUCH AS EQUIPMENT ISOLATION VALVES, BYPASS LINES, ETC., WHICH ARE NOT CRITICAL FOR AN UNDERSTANDING OF THE INSTRUMENTATION FUNCTIONS HAVE ALSO BEEN OMITTED.
- THIS IS A GENERAL LEGEND SHEET. SOME SYMBOLS AND ABBREVIATIONS MAY NOT BE UTILIZED ON THIS SPECIFIC PROJECT.
- PIPING AND EQUIPMENT LEGEND APPLIES TO P & ID SHEETS ONLY AND MAY DIFFER FROM LEGENDS FOR OTHER SHEETS.

GENERAL ABBREVIATIONS

AFD	AJUSTABLE FREQUENCY DRIVE	PCE	PRIMARY CLARIFIER EFFLUENT
A	AIR	PCI	PRIMARY CLARIFIER INFLUENT
AN	ANEROBIC ZONE	PRI	PRIMARY REACTOR INFLUENT
AX	ANOXIC ZONE	PR	PROCESS REACTOR
DB	DISTRIBUTION BOX	PS	PRIMARY SLUDGE
FBI	FLOCCULATION BASIN INFLUENT	RAS	RETURN ACTIVATED SLUDGE
FCI	FINAL CLARIFIER INFLUENT	RFS	RECYCLED FERMENTED SLUDGE
FSU	FERMENTER SUPERNATANT	WAS	WASTE ACTIVATED SLUDGE
FTS	FLOTATION THICKENED SLUDGE	WFS	WASTE FERMENTED SLUDGE
M	MOTOR, MIXER		
OX	OXIC		

FUNCTION DESIGNATIONS AND ABBREVIATIONS

INSTRUMENT DESIGNATIONS

K	GAIN OR ATTENUATE (INPUT:OUTPUT)
-K	GAIN AND REVERSE
Σ	ADD OR SUM (ADD AND SUBTRACT)
Δ	SUBTRACT (DIFFERENCE)
√	EXTRACT SQUARE ROOT
÷	DIVIDE
F(X)	CHARACTERIZE SIGNAL
>	HIGH-SELECT
<	LOW-SELECT
X	MULTIPLY
/	INTEGRATE (TIME INTEGRAL)
CH ₄	METHANE
CL ₂	CHLORINE RESIDUAL
CO ₂	CARBON DIOXIDE
DO	DISSOLVED OXYGEN
LEL	LOWER EXPLOSIVE LIMIT
MCC	MOTOR CONTROL CENTER
MLSS	MIXED LIQUOR SUSPENDED SOLIDS
O ₂	OXYGEN (PURITY)
pH	pH CELL
TURB	TURBIDITY

HAND SWITCH DESIGNATIONS


HOA	HAND-OFF-AUTO
LR	LOCAL REMOTE
OC	OPEN-CLOSE
OO	ON-OFF
LOR	LOCAL-OFF-REMOTE
OOA	ON-OFF-AUTO
OCR	OPEN-CLOSE-REMOTE
OOR	ON-OFF-REMOTE

POWER SUPPLY ABBREVIATIONS


AS	AIR SUPPLY
ES	ELECTRIC SUPPLY
GS	GAS SUPPLY
HS	HYDRAULIC SUPPLY
NS	NITROGEN SUPPLY
SS	STEAM SUPPLY
WS	WATER SUPPLY

AS POWER SUPPLY SOURCE LABEL. USED ONLY WHERE NECESSARY TO HELP CLARIFY AN INSTRUMENT OR SYSTEM FUNCTION.


LINE SYMBOLS

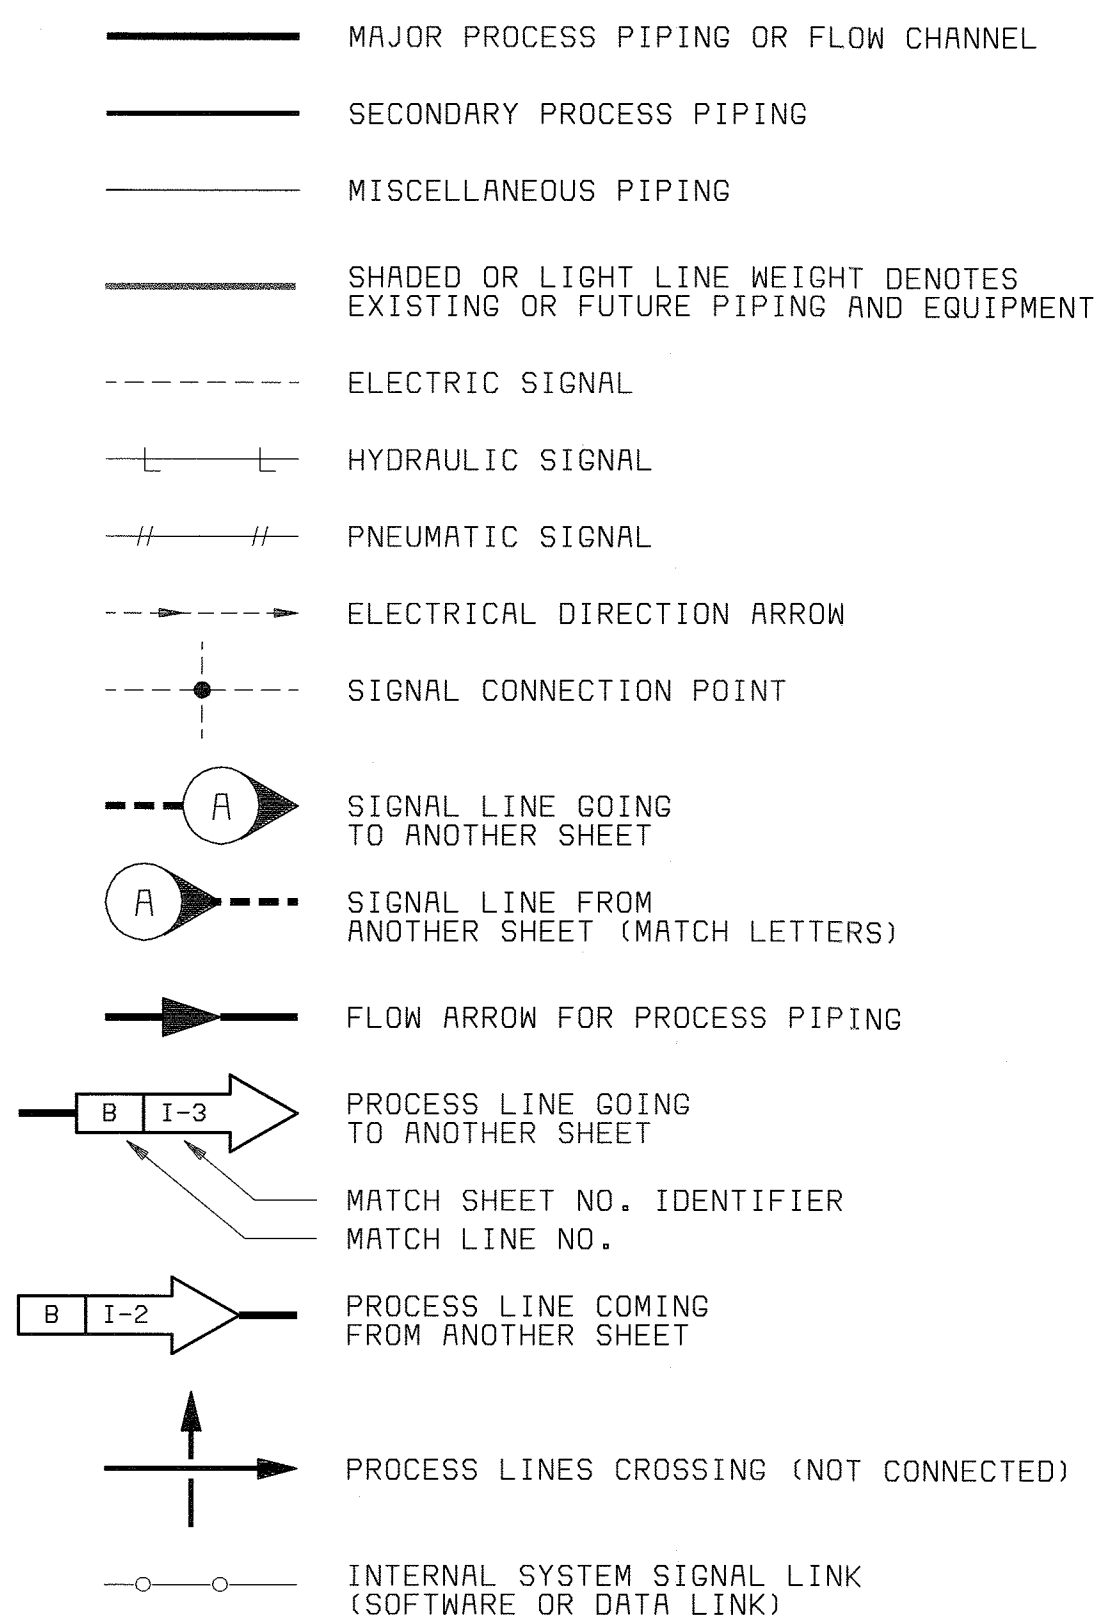

PROCESS DEVICE SYMBOLS

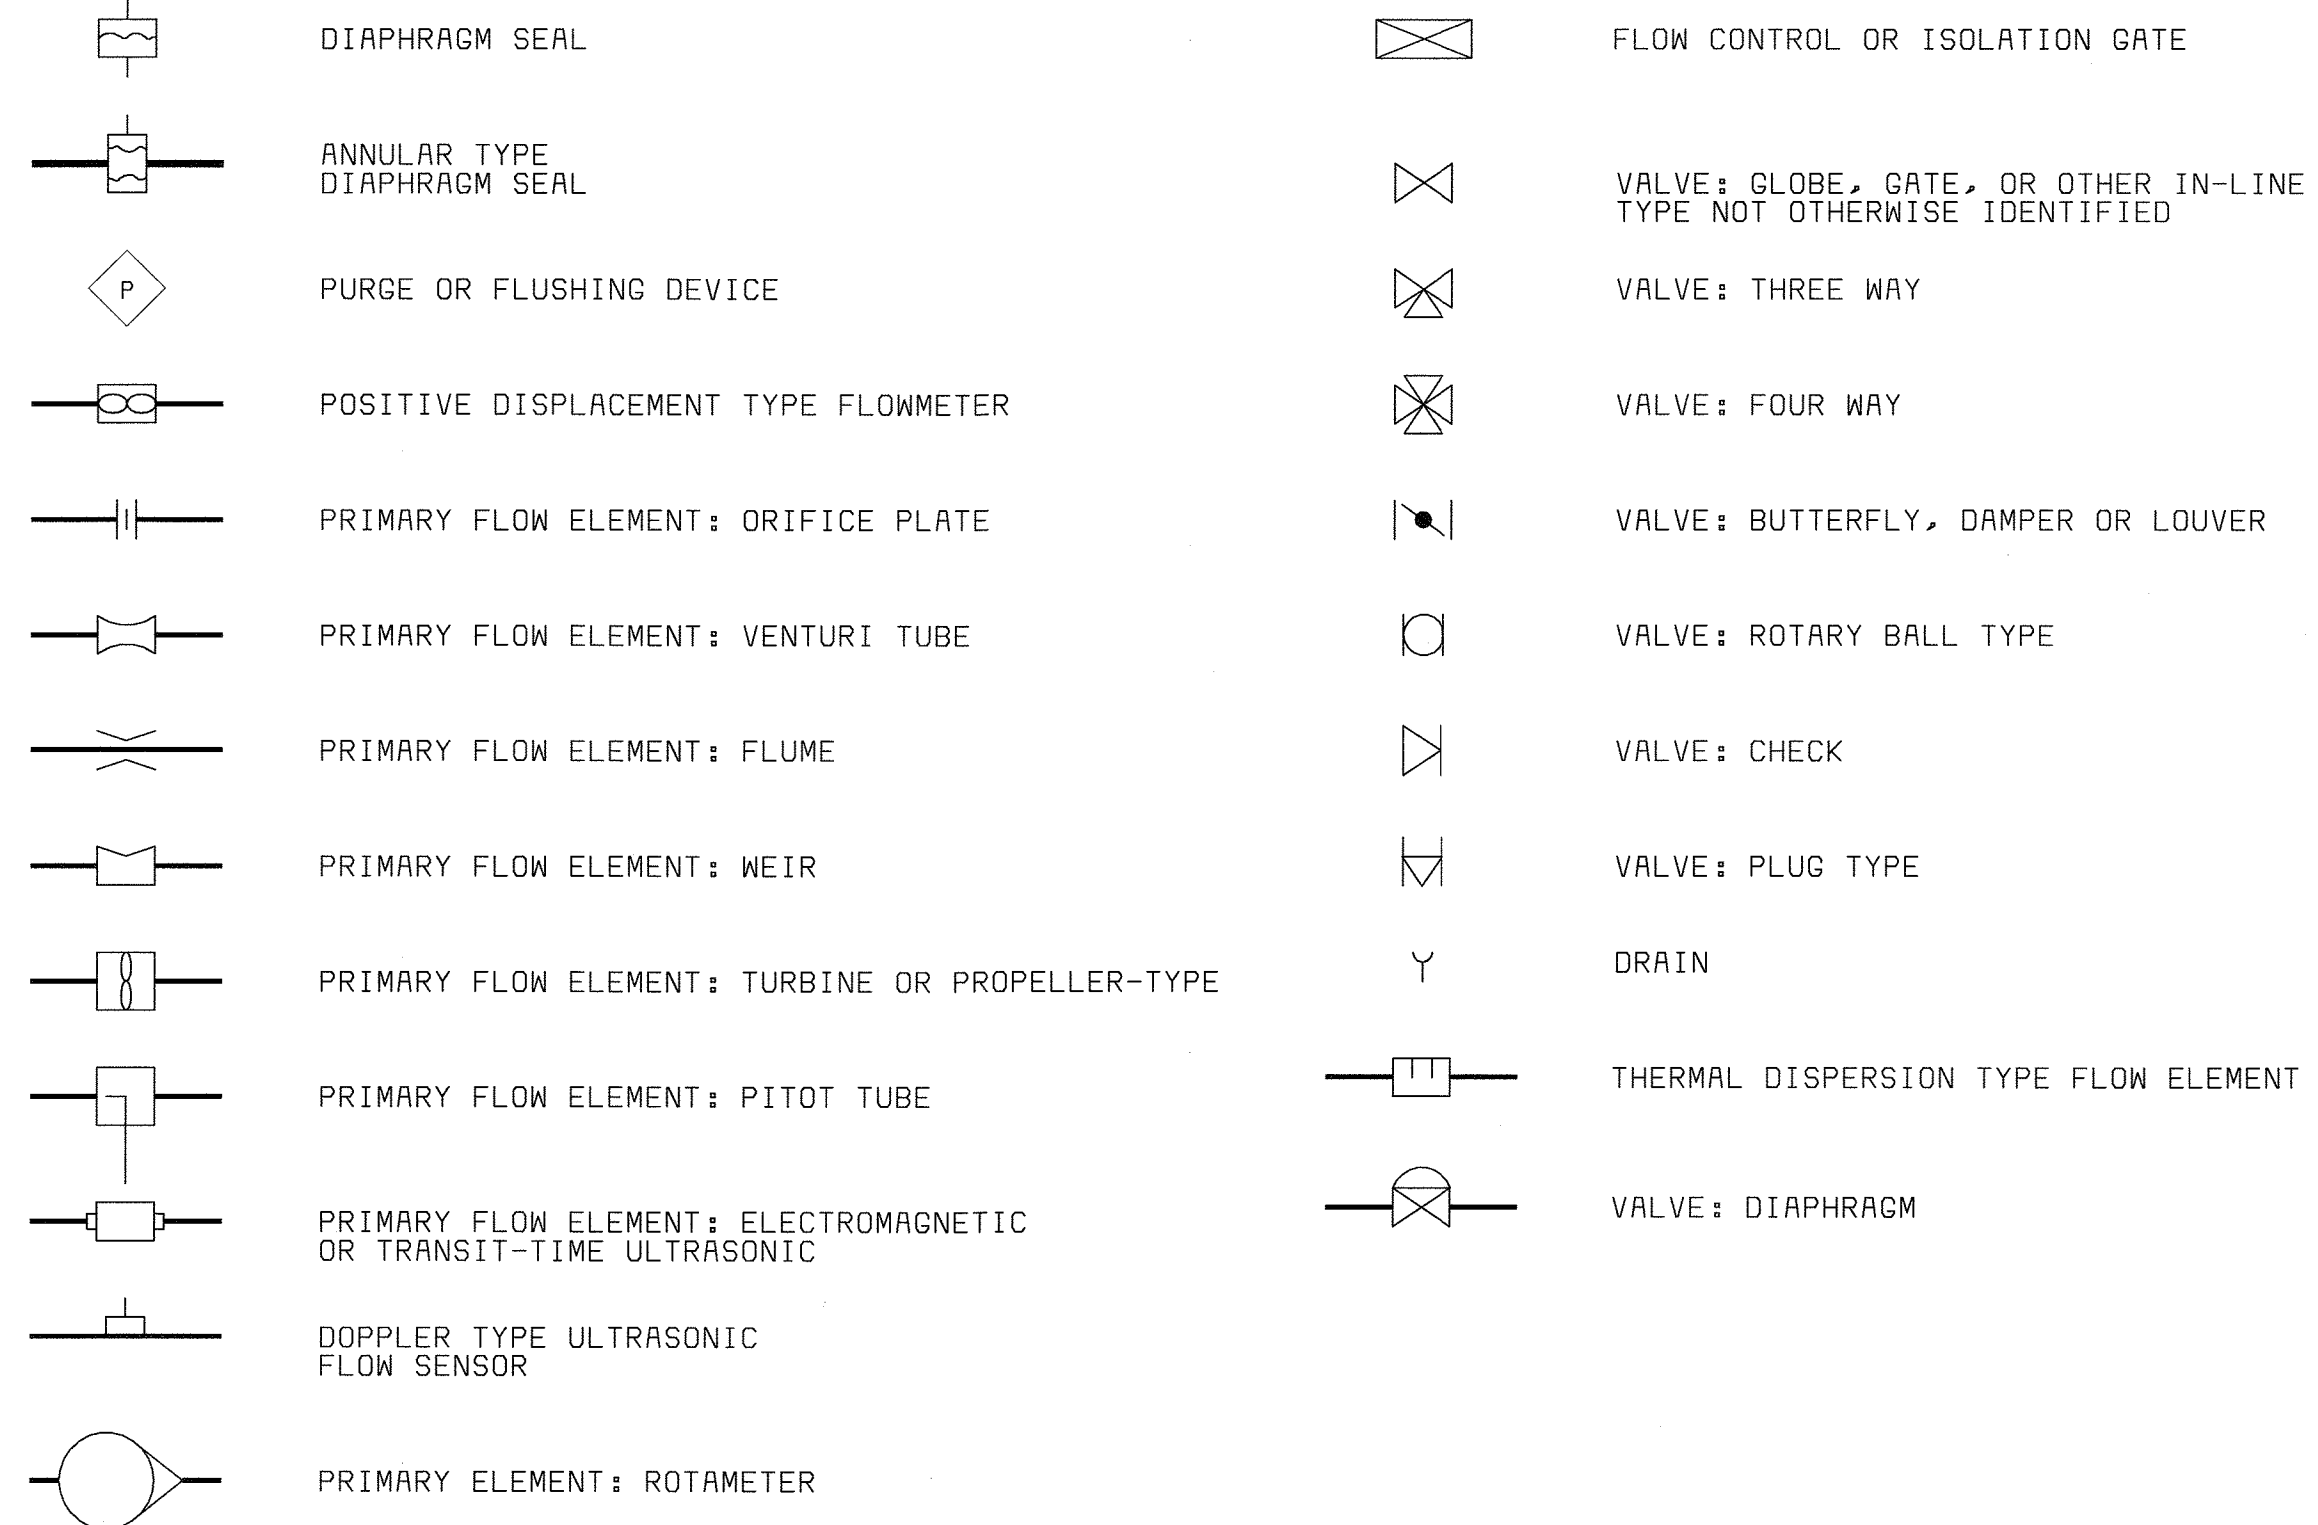

VALVE AND GATE ACTUATOR SYMBOLS

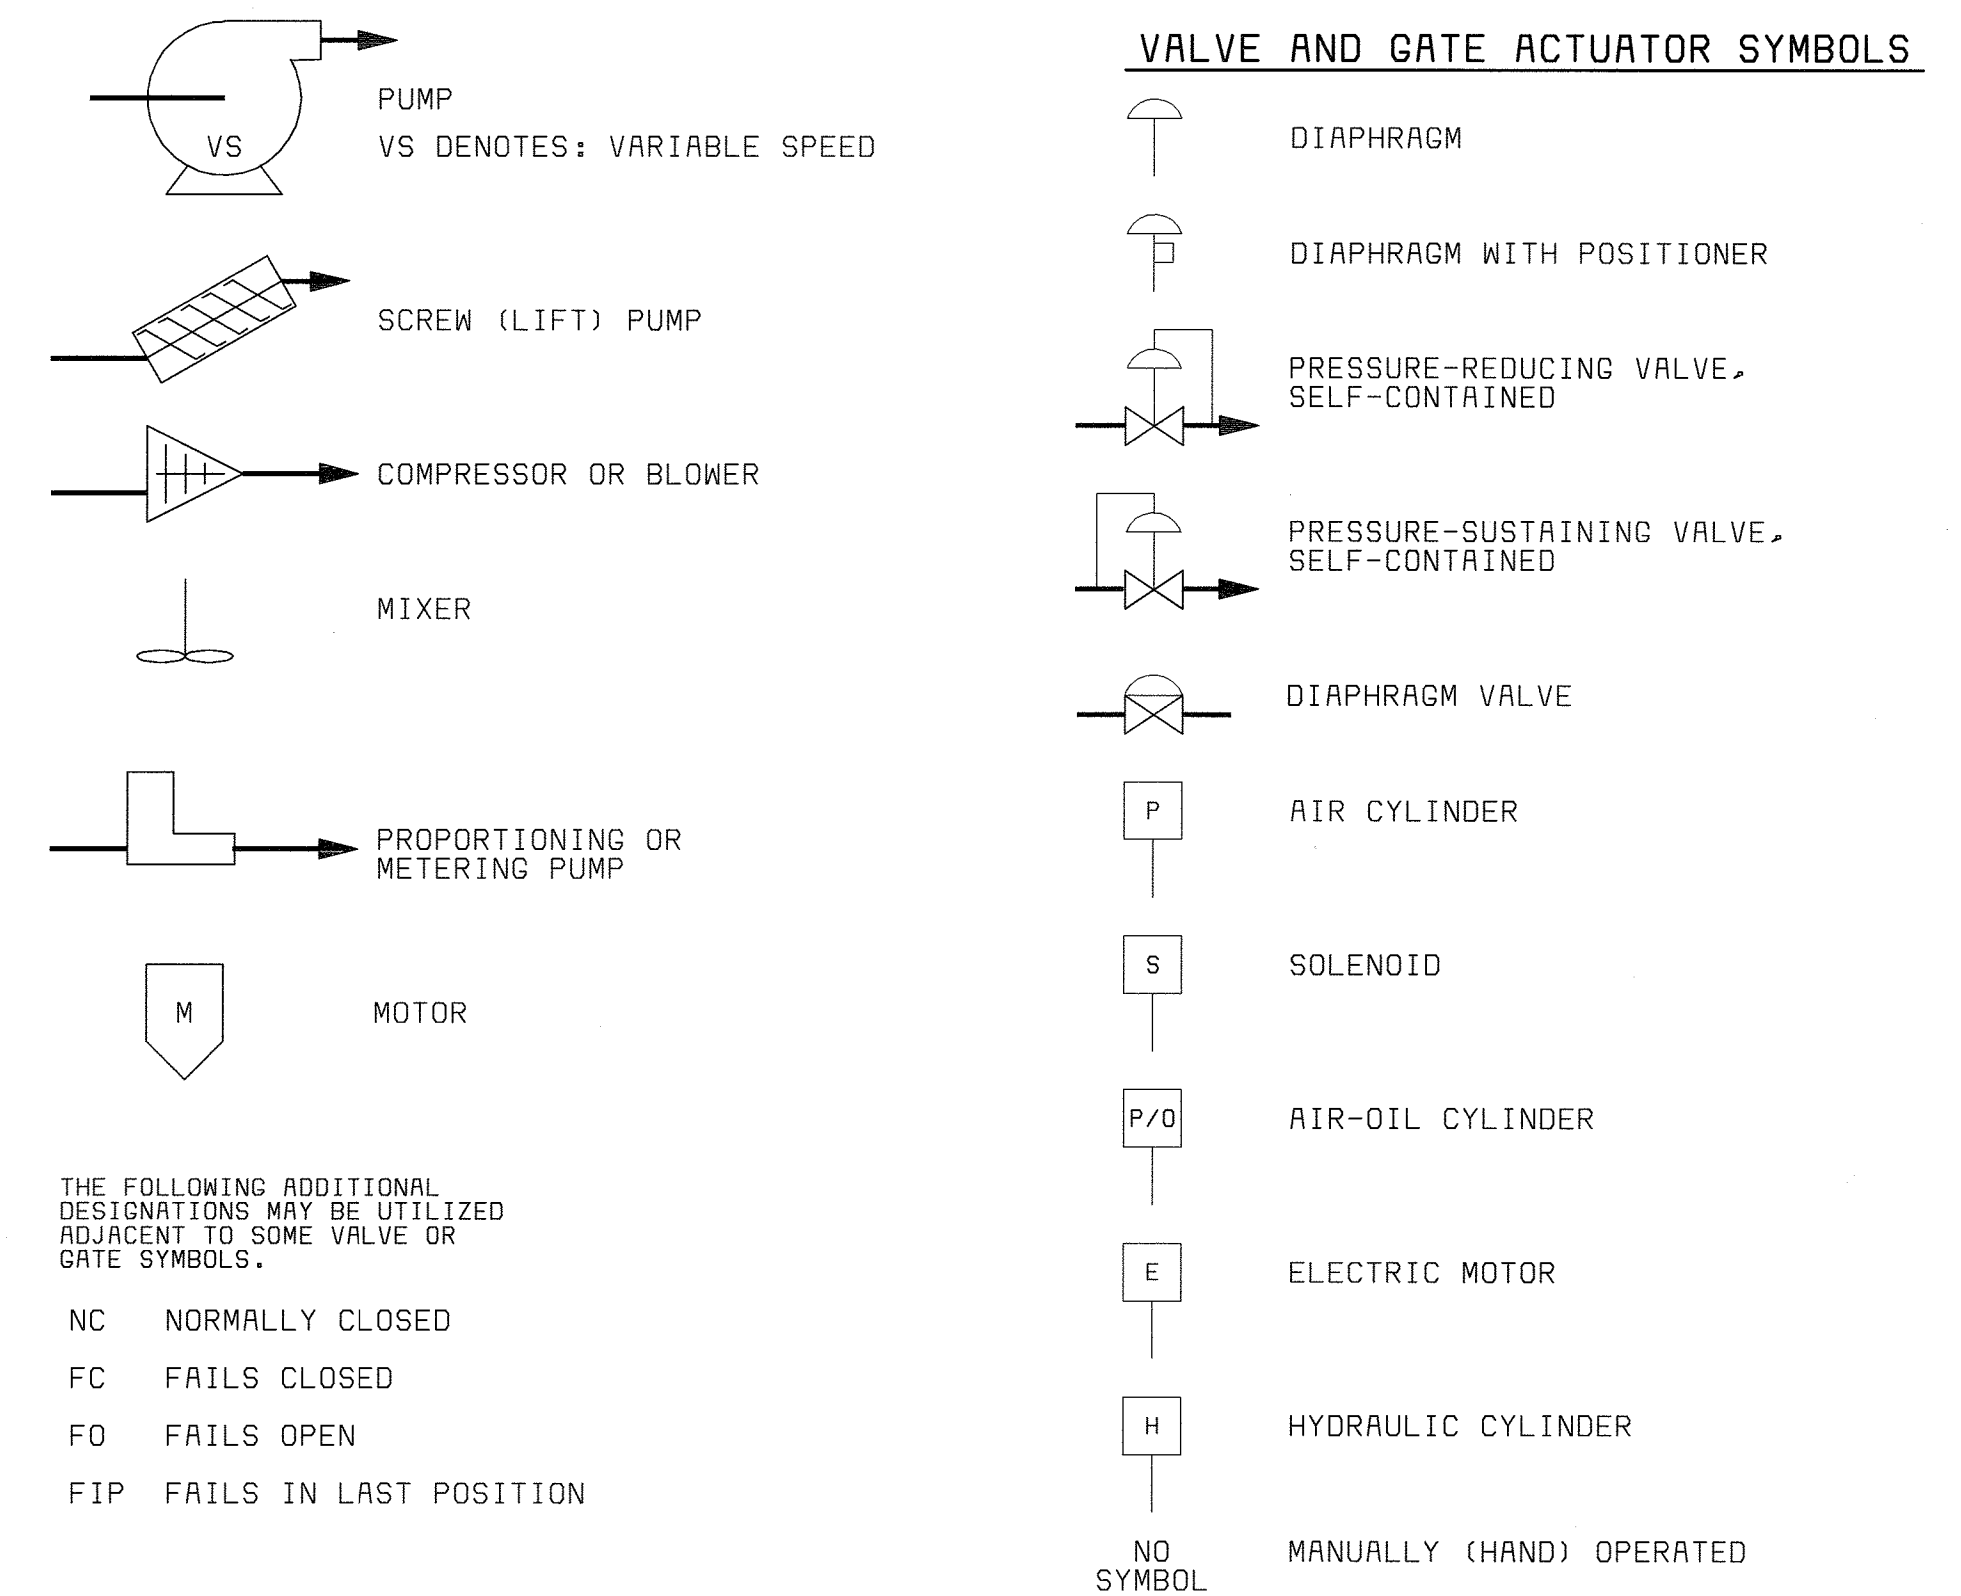

THE FOLLOWING ADDITIONAL DESIGNATIONS MAY BE UTILIZED REFERENT TO SOME VALVE OR GATE SYMBOLS:

NC	NORMALLY CLOSED
FC	FAILS CLOSED
FO	FAILS OPEN
FIP	FAILS IN LAST POSITION

DEPARTMENT OF PUBLIC WORKS
HOWARD COUNTY, MARYLAND
CHIEF, BUREAU OF UTILITIES DATE

BLACK & VEATCH
Gaithersburg, Maryland
REG. PROF. ENGR. DATE


THIS DRAWING WAS ORIGINALLY APPROVED FOR CONSTRUCTION AND SEALED BY DONALD R. STEVENS A REGISTERED PROFESSIONAL ENGINEER IN THE STATE OF MARYLAND, NO. 21876

DES: RSF					
DRN: TDR					
CHK: PWM					
DATE: 04/22/02	DATE	REVISIONS AND RECORD OF ISSUE	NO.	BY	CK APP
	7/22/05	CONFORMED TO CONSTRUCTION RECORDS		RHH	RJR

INSTRUMENTATION
P & ID
LEGEND & ABBREVIATIONS

LITTLE PATUXENT WATER RECLAMATION PLANT
ADDITION NO. 6
CONTROL SYSTEM EXPANSION
CAPITAL PROJECT S-6205
CONTRACT NO. 20-3842
HOWARD COUNTY, MARYLAND

SCALE AS SHOWN
SHEET 6 OF 39
I 1

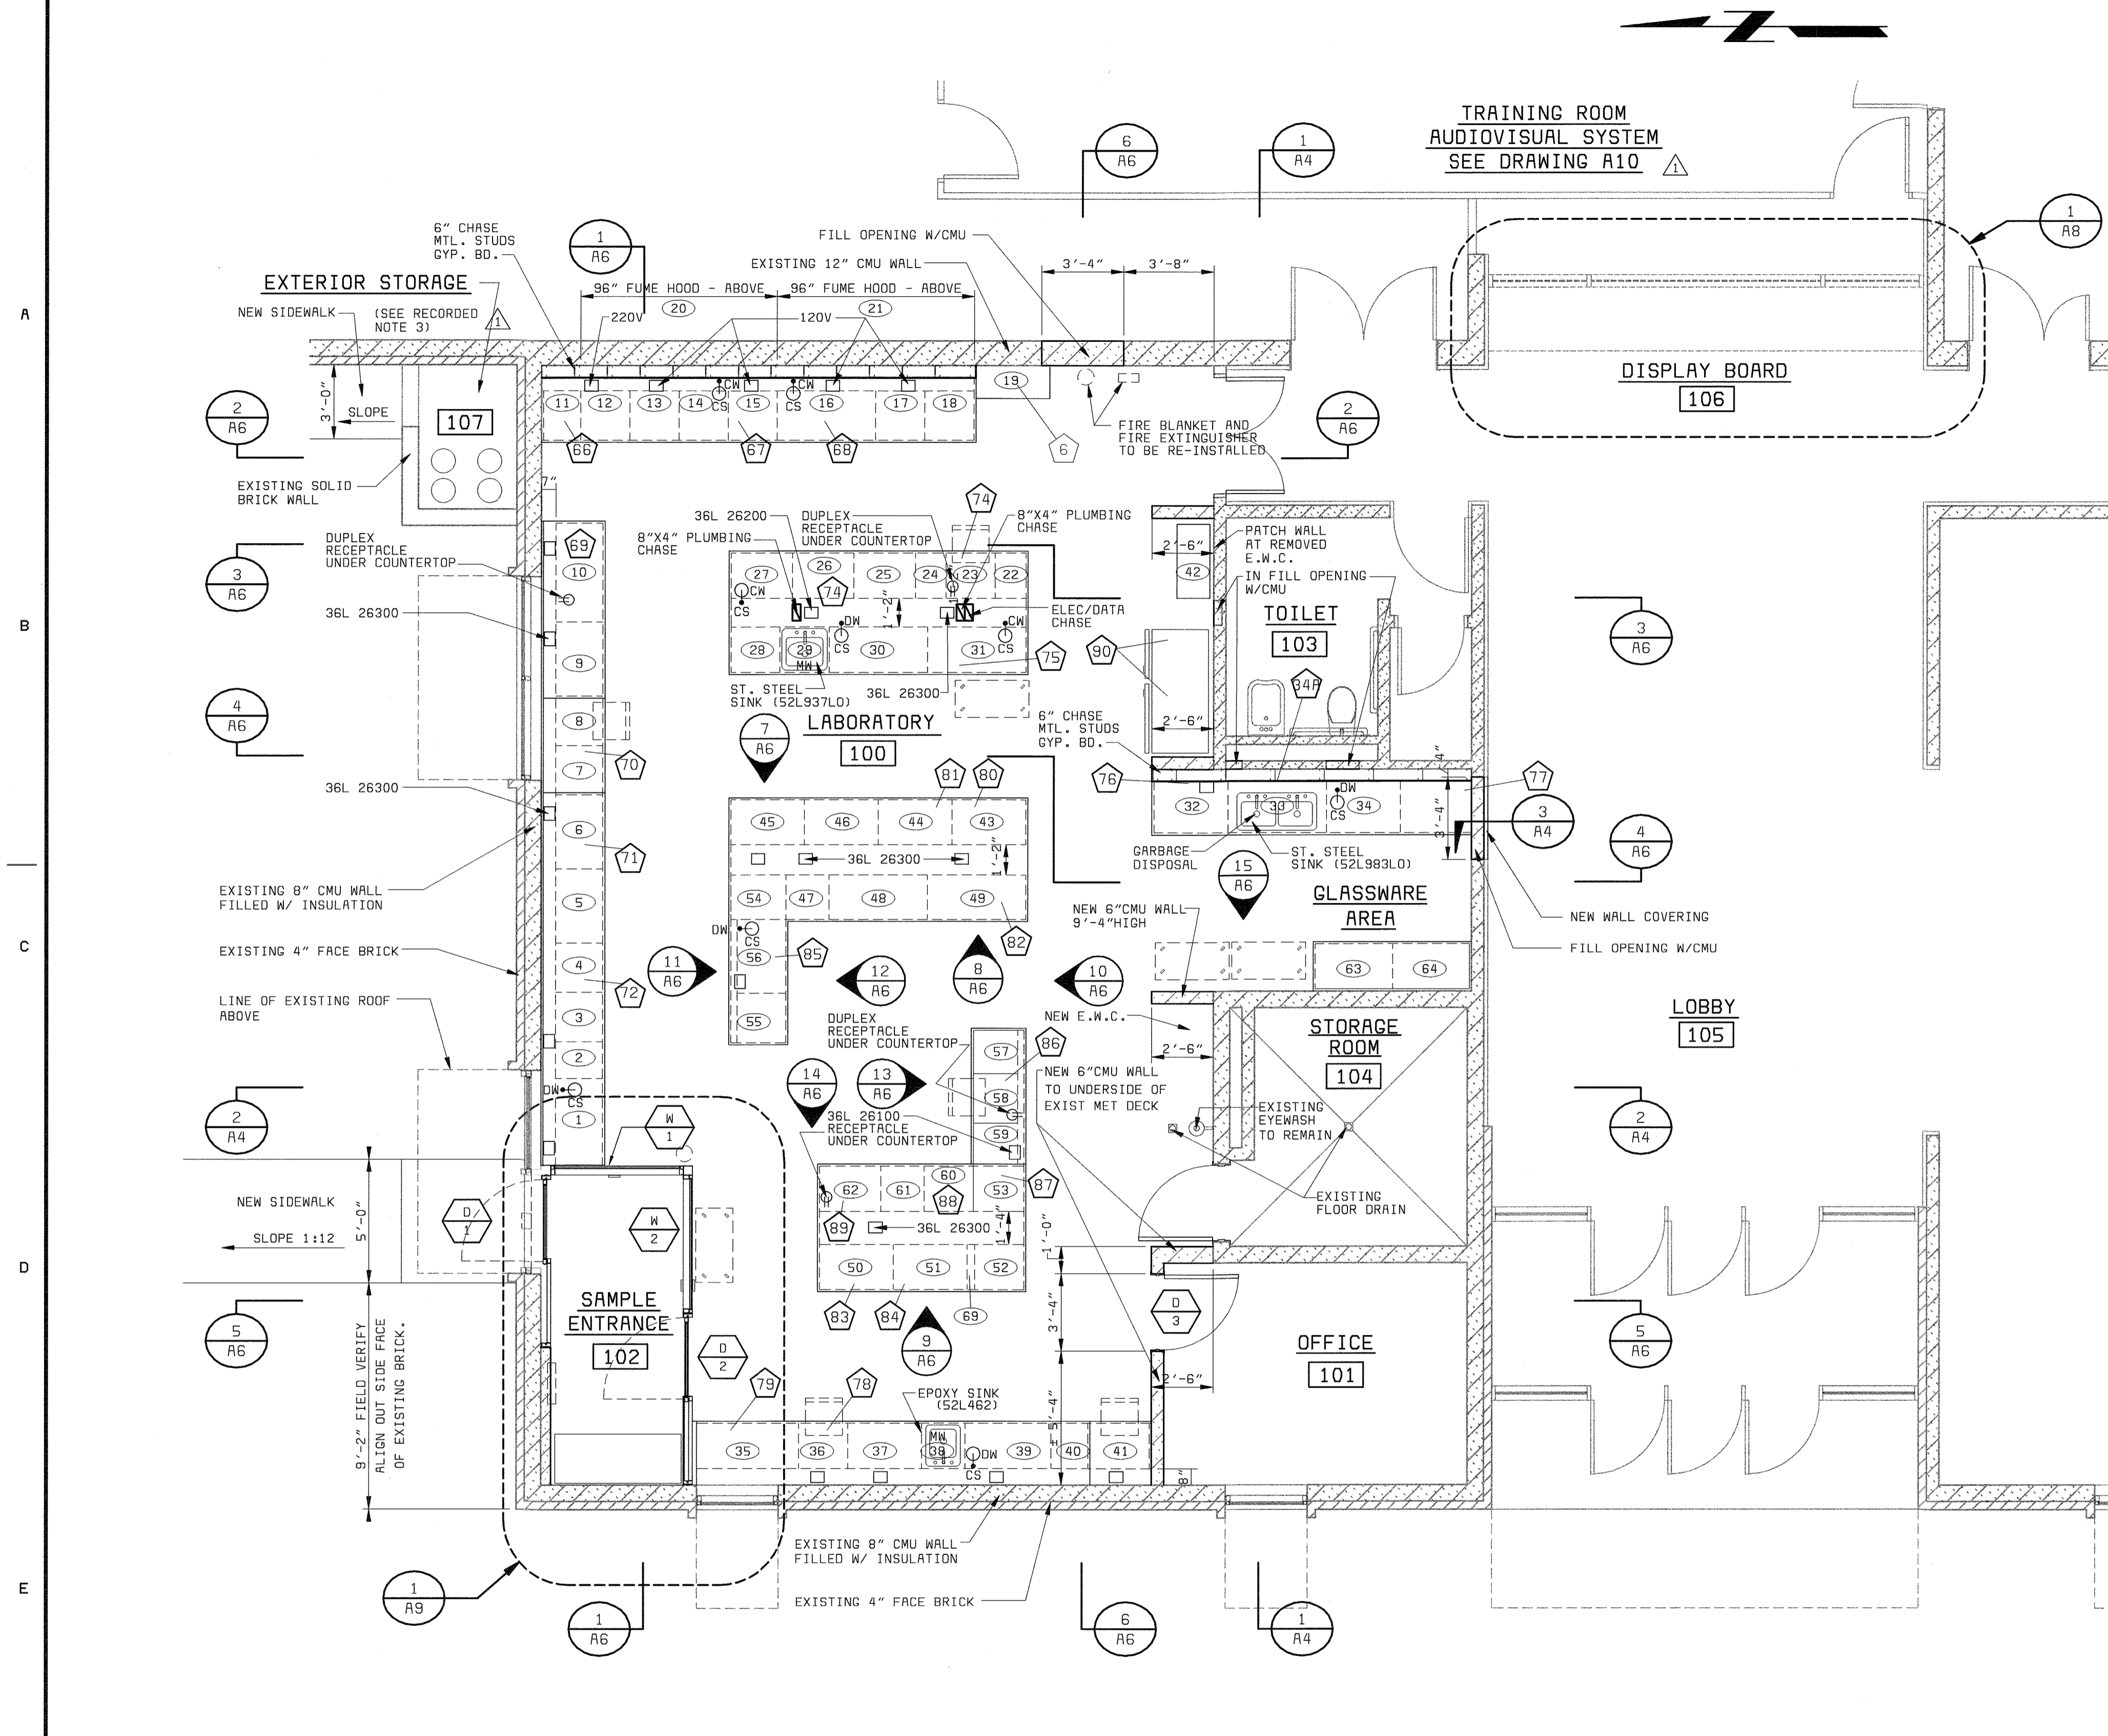

LABORATORY - FLOOR PLAN - EL. 145.00'
1/4" = 1'-0"

PLAN NOTES:

- FOR LABORATORY FURNITURE AND EQUIPMENT SCHEDULE SEE A-5.
- FOR NEW FLOOR DRAIN LOCATIONS SEE PLUMBING DRAWINGS.
- FOR WINDOW AND DOOR DETAILS SEE A-9.
- FOR REFLECTED CEILING PLAN SEE A-3.
- ALL INTERIOR PARTITION WALLS SHALL BE CONSTRUCTED FROM FINISH FLOOR TO UNDERSIDE OF CEILING UNLESS OTHERWISE NOTED.
- DIMENSIONS AT EXTERIOR WALL REFER TO INSIDE FACE OF GYPSUM BOARD OR CMU FINISH.
- + DIMENSIONS WHICH MAY BE ADJUSTED IF REQUIRED HOLD OTHER DIMENSIONS AS INDICATED.
- MAINTAIN EXISTING FIRE RATING AND ANY PENETRATION SHOULD BE SEALED AGAINST GAS MIGRATION.
- CHAIR SHOW ON PLANS ARE NOT IN CONTRACT.
- REMOVE AND REPLACE EXISTING VINYL WALL COVERING IN LOBBY AND ADJACENT CORRIDORS TO LIMIT OF DOORS WHICH ENCLOSE THE LOBBY/CORRIDOR AREAS.
- FOR WALL FINISHES REFERENCE TO BUILDING SECTIONS ON A4 (TYPICAL).
- PATCH OR REPLACE EXISTING GLAZED CMU BEHIND REMOVED HEATING UNIT TO MATCH SURROUNDING AREA.

LEGEND:

- NEW WALL
- EXISTING WALL
- CS= CUP SINK (FISHER 34L 132) 4" X 7" X 8" D.
- CW= COLD WATER (FISHER 32L 386)
- DW= DE-IONIZED WATER (FISHER 32L 513)
- MW= MIXED WATER (FISHER 32L 408)
- CUP SINK (CW OR DW)
- FUNCTIONAL DESCRIPTION
- EQUIPMENT / FURNITURE

ELECTRICAL LEGEND:



- RECEPTACLES: UNLESS OTHERWISE NOTED, ON COUNTERTOP, ARE FISHER 36L 26200, PEDESTAL OUTLETS (4 RECEPTACLES FACING ONE WAY)
- WHEN NOTED, 36L 26300 (4 RECEPTACLES ON EACH SIDE) OR 36L 26100 (2 RECEPTACLES ON EACH SIDE)

FUNCTIONAL DESCRIPTION LEGEND: ALSO REF. TO A5

- | | | |
|---|------------------------------------|----------------------|
| 66 MUFFLE FURNACE. | 76 WATER SYSTEM. | 86 PC. FOR TSS. |
| 67 CN DESTILLATION. | 77 DISHWASHER. | 87 METTLER BALANCE. |
| 68 TKN DIGESTION. | 78 BALANCE. | 88 CI. COLOR ANAL. |
| 69 CENTRIFUGE. | 79 DESSICATOR. | 89 B.O.D. INCUBATOR. |
| 70 PC. | 80 DESSICATOR FOR TSS | 90 REFRIGERATOR |
| 71 ATOMIC ABSORPTION. | 81 DESSICATOR FOR TS. | |
| 72 AUTOCLAVE. | 82 TS/TSS DRYING OVEN. | |
| 73 PC. | 83 WATER BATH FOR FECAL COLIFORMS. | |
| 74 NUTRIENT ANALYZER I W/ AUTOSAMPLER. | 84 INCUBATOR. | |
| 75 NUTRIENT ANALYZER II W/ AUTOSAMPLER. | 85 B.O.D. ANALYSIS | |

CONSTRUCTION RECORD NOTES

- ALL WALLS IN ROOMS 100, 101, 102, AND 103 ARE TO HAVE CERAMIC TILE. REGULAR BLOCK UNDER THE TILE IS ACCEPTABLE.
- CONTRACTOR DOES NOT NEED TO PROVIDE TWO HOUR FIRESTOPPING FOR PENETRATIONS FOR STORAGE ROOM 104.
- SIDEWALK DOES NOT NEED TO BE CONSTRUCTED.
- CHASE FOR LAB TABLE OUTSIDE STORAGE ROOM 102.
- THE ELECTRICAL SWITCHES LOCATED INSIDE AND OUTSIDE OF ROOM 102 SHOULD BE LOWERED TO THE NEXT COURSE DOWN. ALSO, THE LOCATION SHOULD BE COORDINATED WITH CABINETS AND COUNTERTOPS.
- REMOVE HEATING RADIATOR FROM TOILET. ROOM 107 WILL NOT BE RETILED.

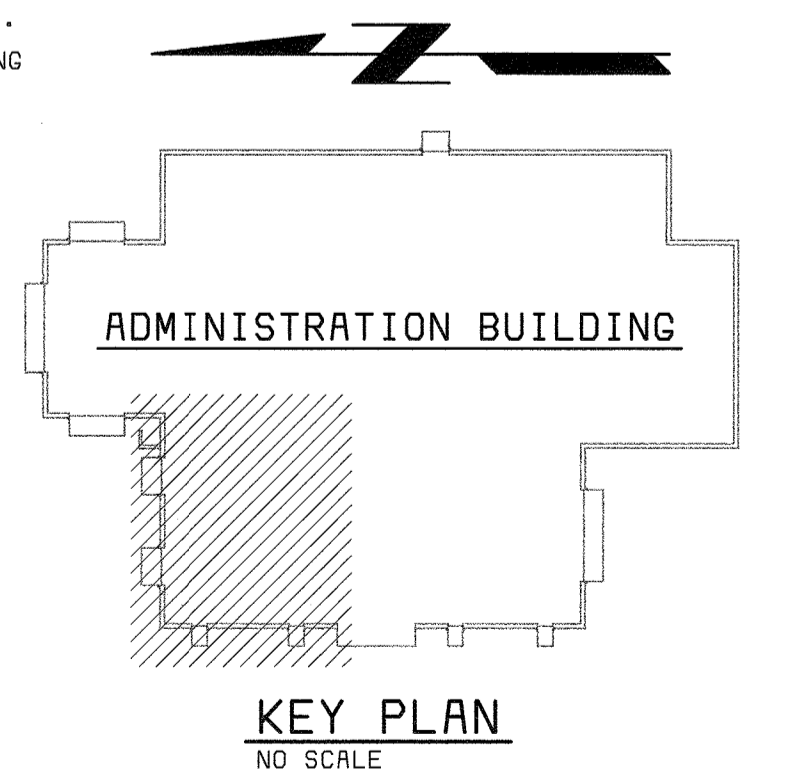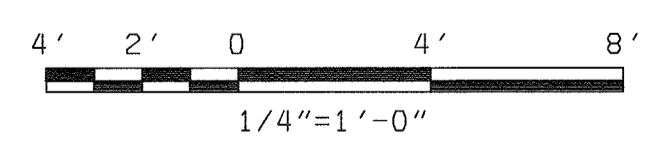

DEPARTMENT OF PUBLIC WORKS
HOWARD COUNTY, MARYLAND



BLACK & VEATCH
Gathersburg, Maryland


THIS DRAWING WAS
ORIGINALLY APPROVED
FOR CONSTRUCTION
AND SEALED BY
CHARLES I. BRYANT
A REGISTERED
ARCHITECT
IN THE
STATE OF MARYLAND,
NO. 1377-R

DES:	CH
DRN:	JS
CHK:	CH/JS
DATE:	08/00
11/03/03	CONFORMED TO CONSTRUCTION RECORDS
DATE	REVISIONS AND RECORD OF ISSUE
	NO. BY CK APP

ARCHITECTURAL
**ADMINISTRATION BUILDING
LABORATORY FLOOR PLAN**

LITTLE PATUXENT WATER RECLAMATION PLANT
ADDITION NO. 6
LABORATORY RENOVATION
CAPITAL PROJECT S-6205
CONTRACT NO. 20-3841
HOWARD COUNTY, MARYLAND

SCALE
AS
SHOWN
SHEET
8 OF 28
A2

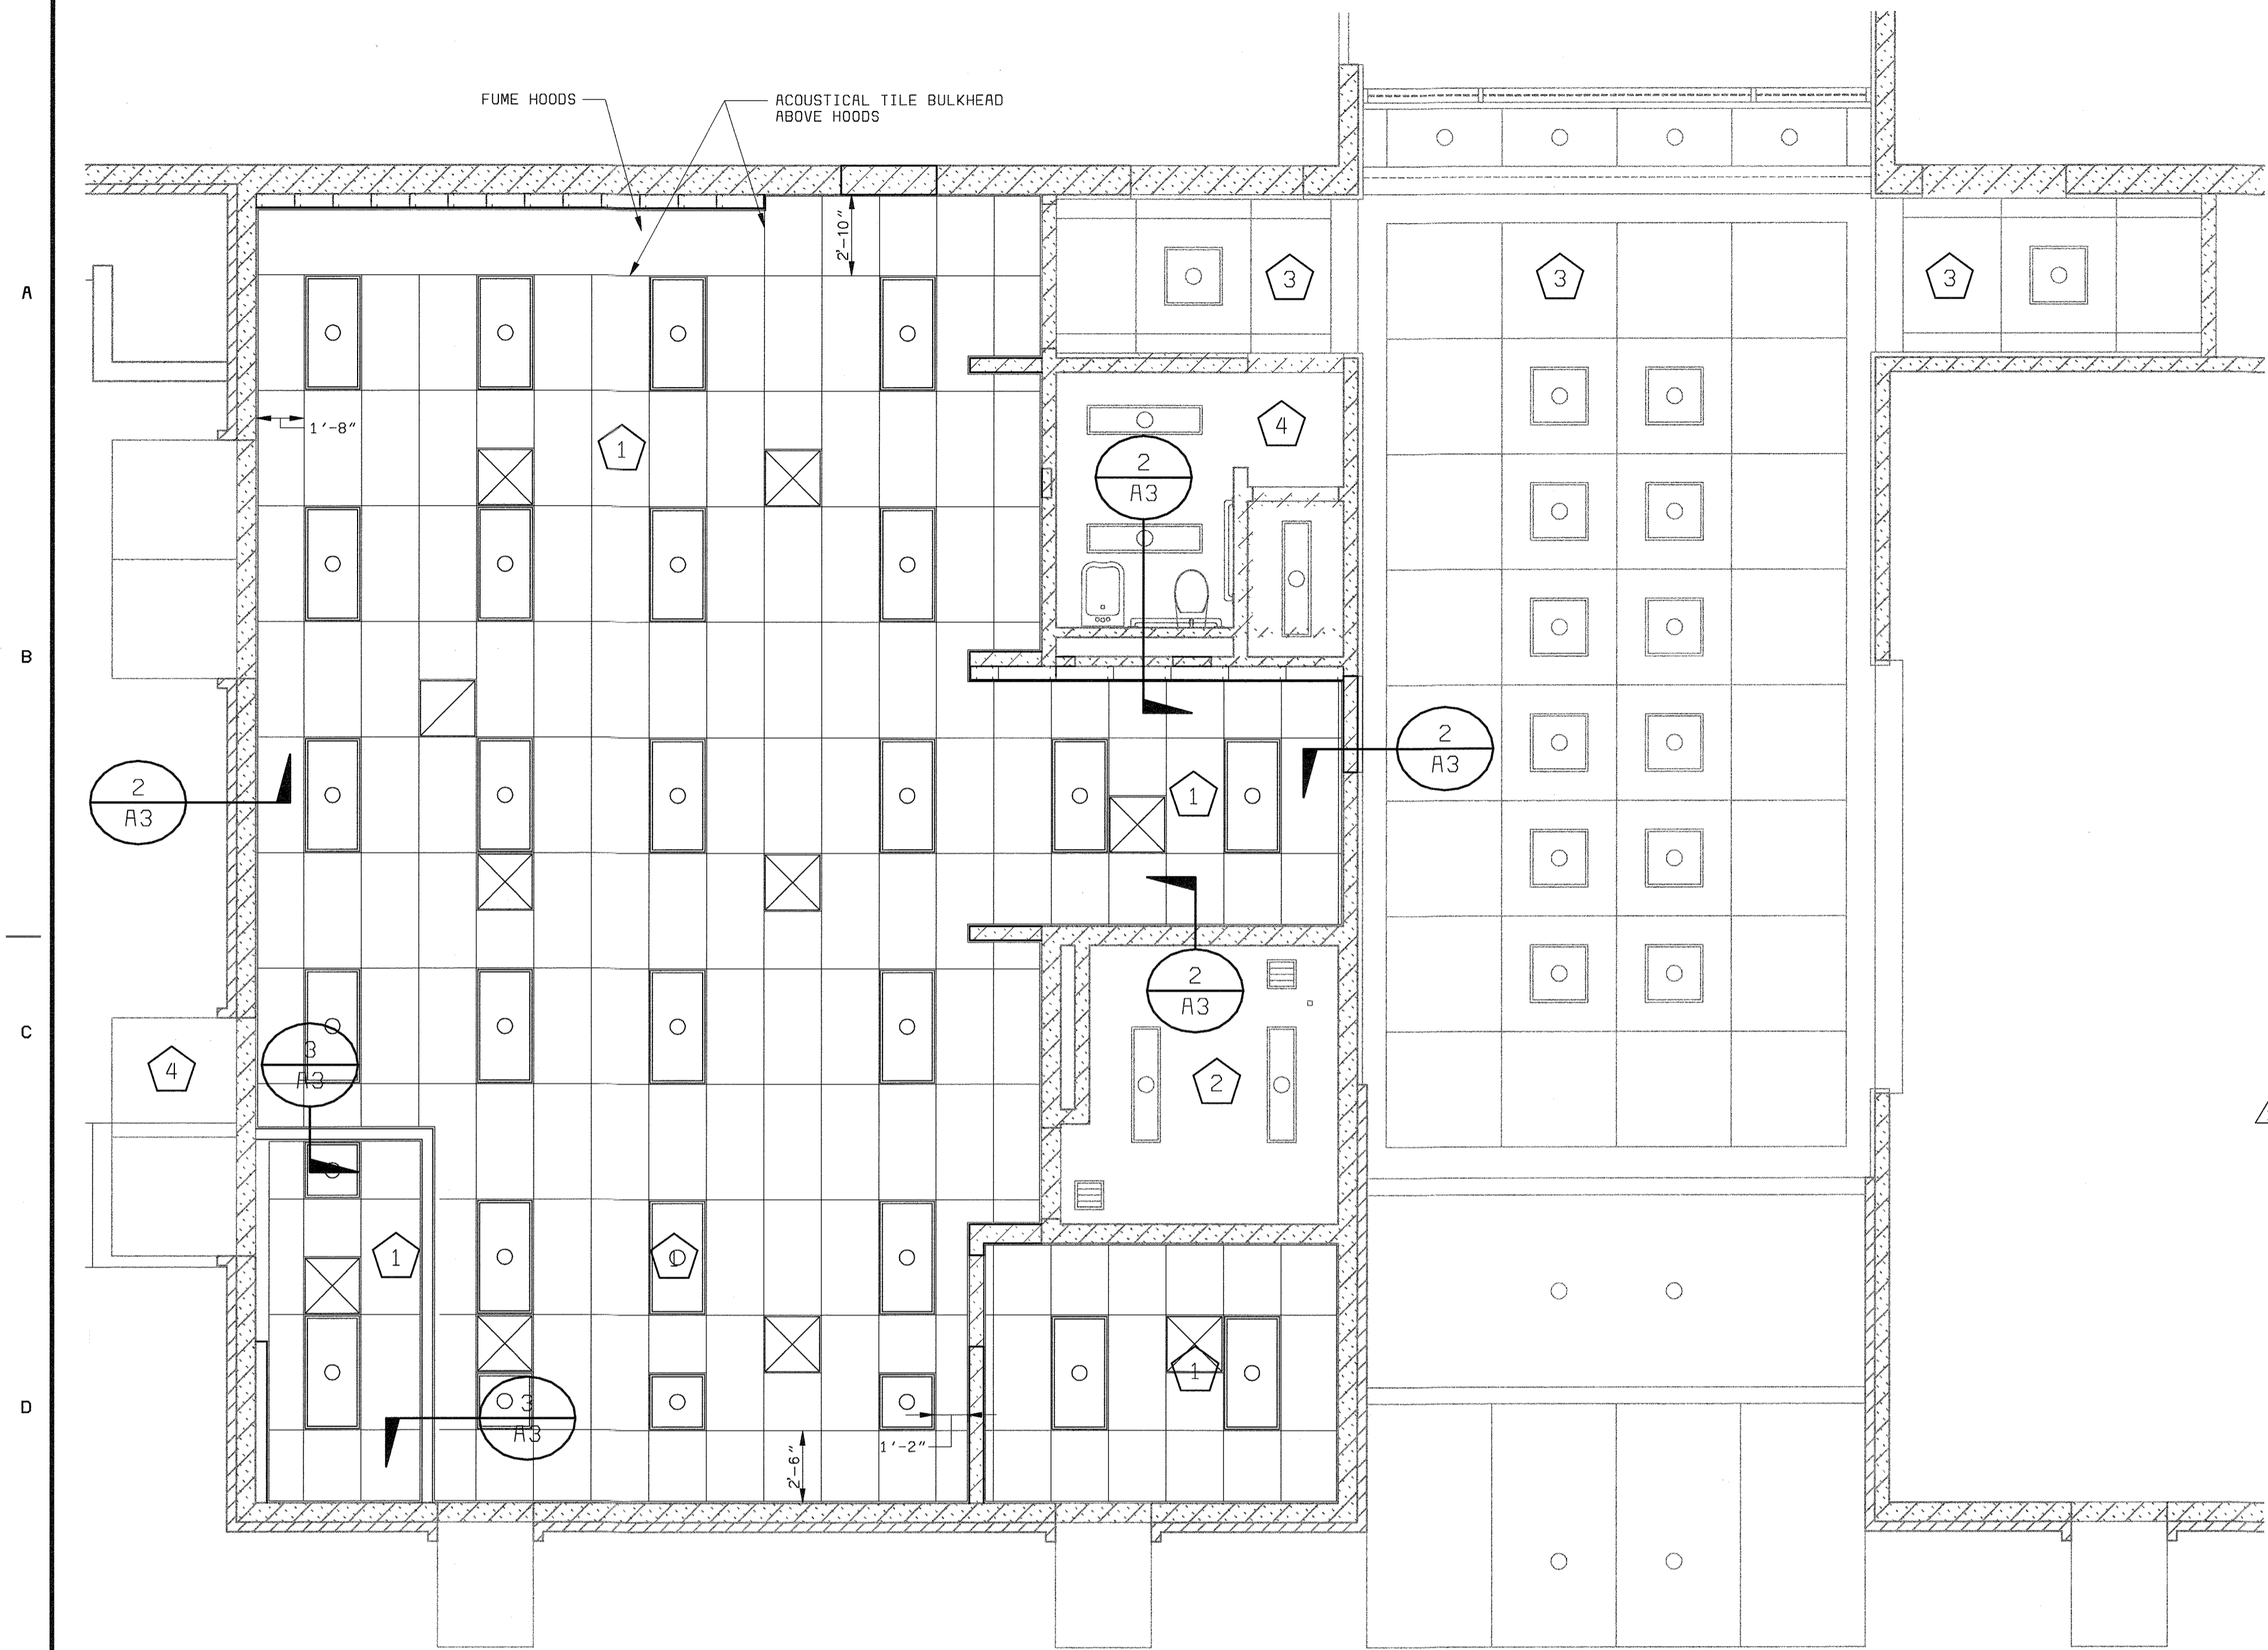


LEGEND:


- 1 2' X 4' NEW ACOUSTICAL CEILING PANELS.
- 2 NOT USED.
- 3 EXISTING ACOUSTICAL CEILING PANELS.
- 4 EXISTING P.C. PLASTER CEILING TO REMAIN.
- NEW 2' X 4' LIGHT FIXTURE
- NEW 1' X 4' LIGHT FIXTURE
- NEW 2' X 2' LIGHT FIXTURE
- EXISTING 2' X 4' LIGHT FIXTURE
- EXISTING 1' X 4' LIGHT FIXTURE
- EXISTING 2' X 2' LIGHT FIXTURE
- SPRINKLER
- RETURN SLOT DIFFUSER W/DESIGNATION
- SUPPLY SLOT DIFFUSER W/DESIGNATION
- ⊗ EXISTING AIR SUPPLY REGISTER
- ⊘ EXISTING AIR RETURN REGISTER
- EXISTING SPOT LIGHT FIXTURE

PLAN NOTES:


1. ACOUSTICAL CEILING 8'-0" ABOVE FIN. FLOOR - TO MATCH EXISTING.
2. FOR RETURN AND SUPPLY SLOT DIFFUSER LOCATIONS AND DIMENSION SEE H DRAWINGS.
3. FOR SPRINKLER SYSTEM SEE FIRE PROTECTION DRAWINGS.
4. ON THE EXISTING CONSTRUCTION TO REMAIN, REUSE THE LIGHT FIXTURES AND REPLACE IN ORIGINAL LOCATIONS.

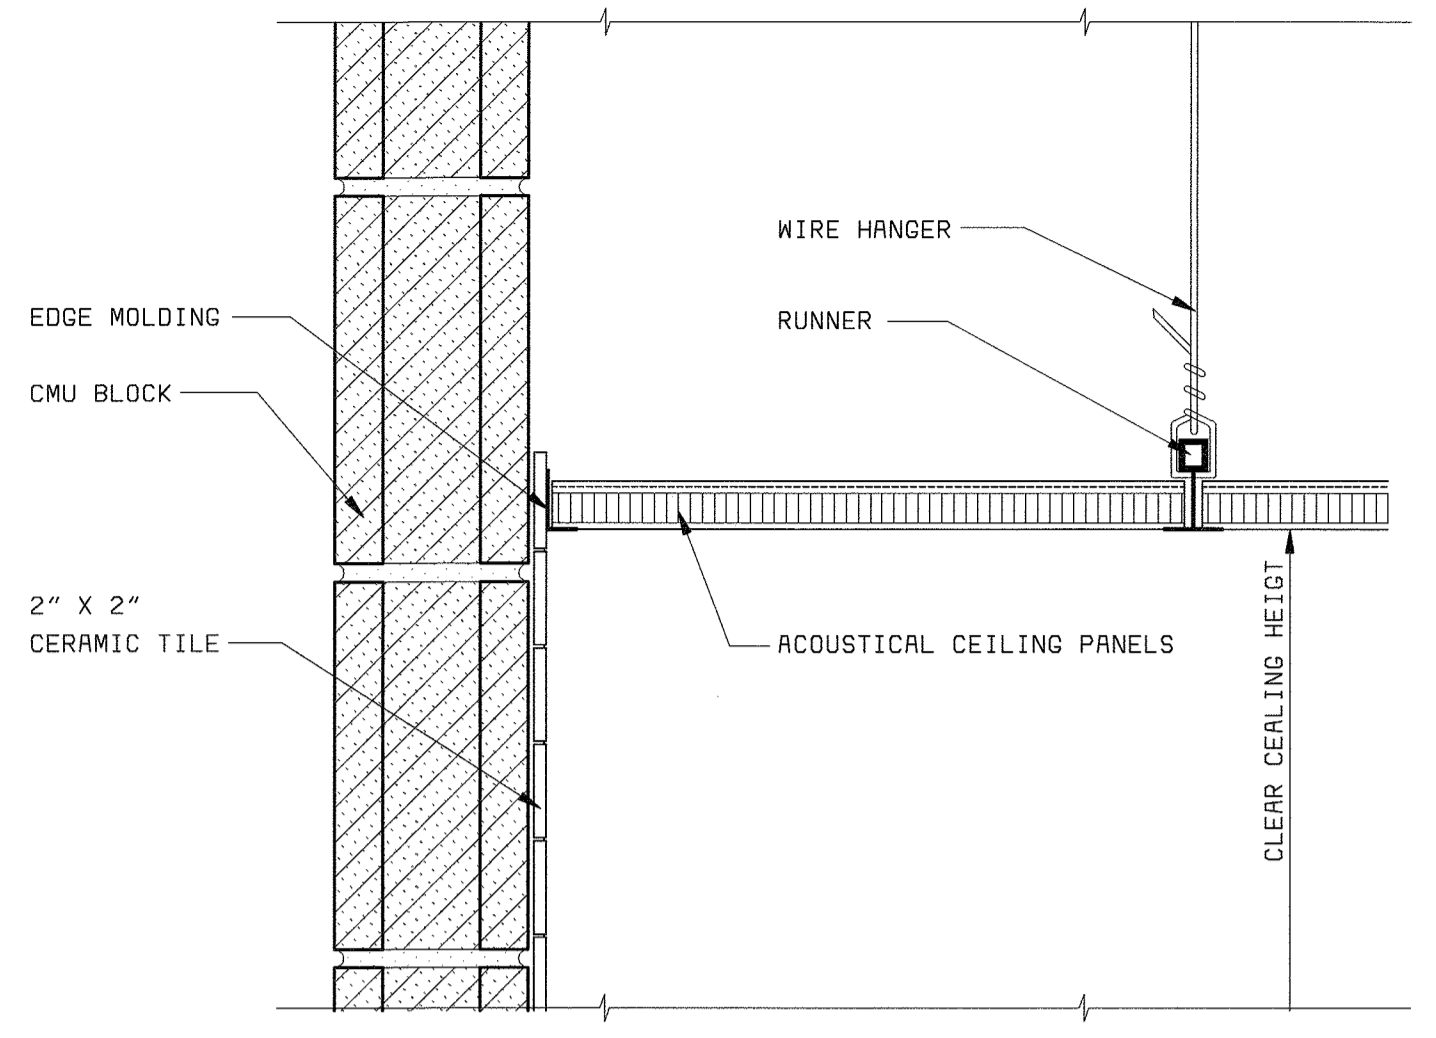


CEILING DETAIL 2
3" = 1'-0" (A3)

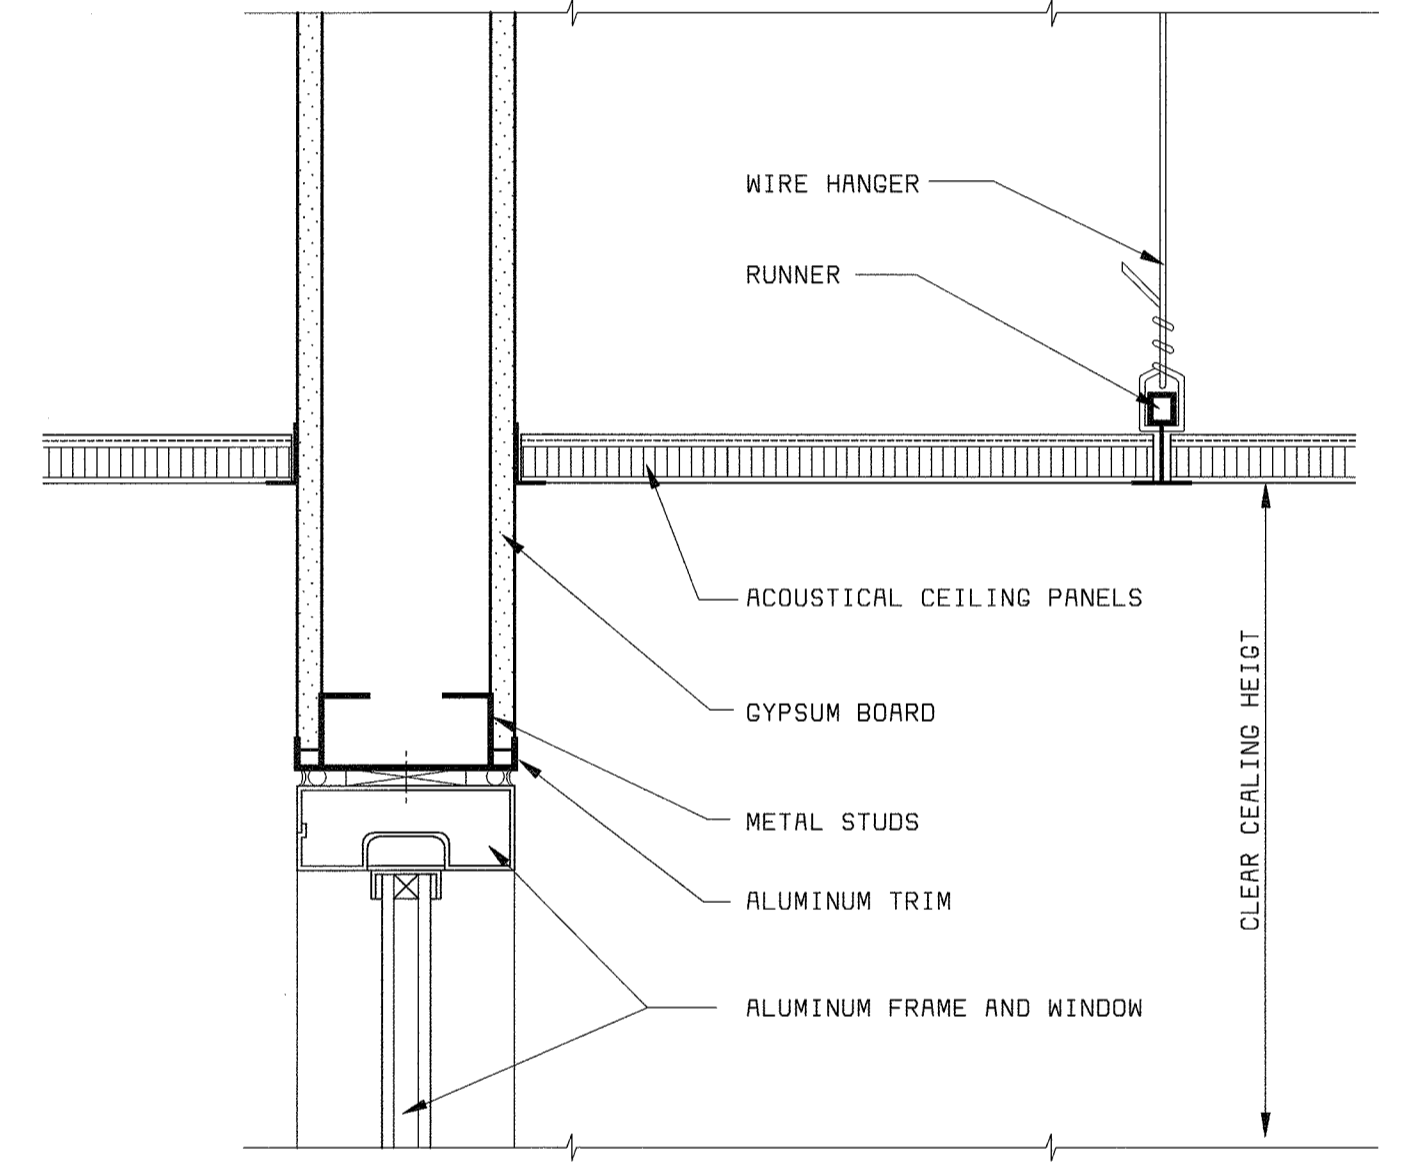

CEILING DETAIL 3
3" = 1'-0" (A3)

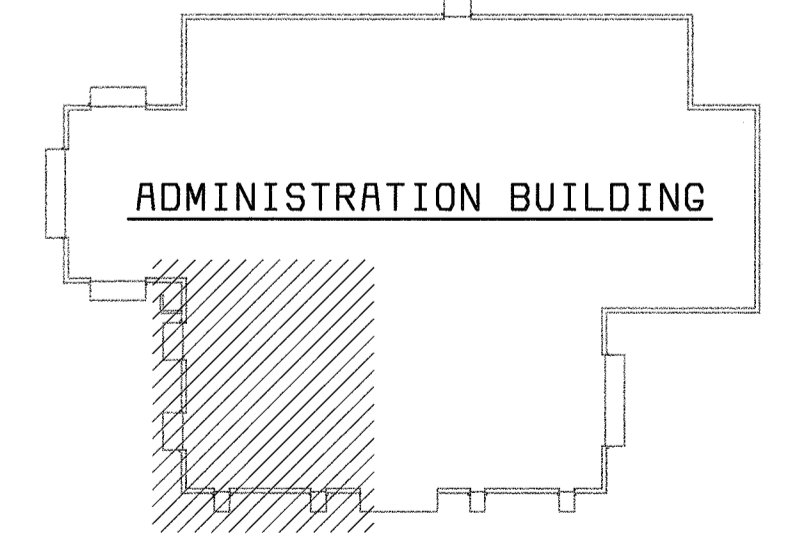


KEY PLAN
NO SCALE

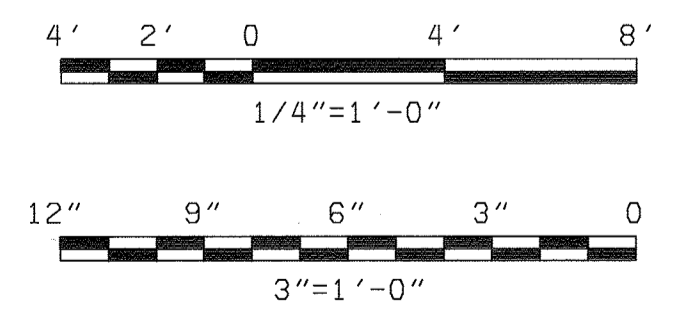


REFLECTED CEILING PLAN 1
1/4" = 1'-0" (A3)

<p>DEPARTMENT OF PUBLIC WORKS HOWARD COUNTY, MARYLAND</p> <p>bbw Architects • Designers • Planners Bryant Bryant Williams, P.C. 4201 Connecticut Avenue N.W., Suite 500 Washington, D.C. 20009 (202) 244-2100</p> <p>CHIEF, BUREAU OF UTILITIES DATE</p>	<p>BLACK & VEATCH LLP Gaithersburg, Maryland</p> <p>REG. PROF. ENGR. DATE</p>	<p>THIS DRAWING WAS ORIGINALLY APPROVED FOR CONSTRUCTION AND SEALED BY CHARLES I. BRYANT A REGISTERED ARCHITECT IN THE STATE OF MARYLAND, NO. 1377-R</p>	<p>DES: CH</p> <p>DRN: JS</p> <p>CHK: CH/JS</p> <p>DATE: 08/00</p>	<table border="1" style="width: 100%; border-collapse: collapse;"> <tr> <td style="width: 10%;"></td> <td style="width: 10%;"></td> <td style="width: 10%;"></td> <td style="width: 10%;"></td> <td style="width: 10%;"></td> <td style="width: 10%;"></td> <td style="width: 10%;"></td> <td style="width: 10%;"></td> <td style="width: 10%;"></td> <td style="width: 10%;"></td> </tr> <tr> <td>11/03/03</td> <td>CONFORMED TO CONSTRUCTION RECORDS</td> <td></td> <td></td> <td></td> <td></td> <td></td> <td></td> <td></td> <td></td> </tr> <tr> <td>DATE</td> <td>REVISIONS AND RECORD OF ISSUE</td> <td>NO.</td> <td>BY</td> <td>CK</td> <td>APP</td> <td></td> <td></td> <td></td> <td></td> </tr> </table>											11/03/03	CONFORMED TO CONSTRUCTION RECORDS									DATE	REVISIONS AND RECORD OF ISSUE	NO.	BY	CK	APP					<p>ARCHITECTURAL</p> <p>ADMINISTRATION BUILDING LAB - REFLECTED CEILING PLAN AND DETAILS</p>	<p>LITTLE PATUXENT WATER RECLAMATION PLANT ADDITION NO. 6 LABORATORY RENOVATION</p> <p>CAPITAL PROJECT S-6205 CONTRACT NO. 20-3841</p> <p>HOWARD COUNTY, MARYLAND</p>	<p>SCALE AS SHOWN</p> <p>SHEET 9 OF 28</p> <p>A3</p>
11/03/03	CONFORMED TO CONSTRUCTION RECORDS																																				
DATE	REVISIONS AND RECORD OF ISSUE	NO.	BY	CK	APP																																

05B472-5
FD58472A


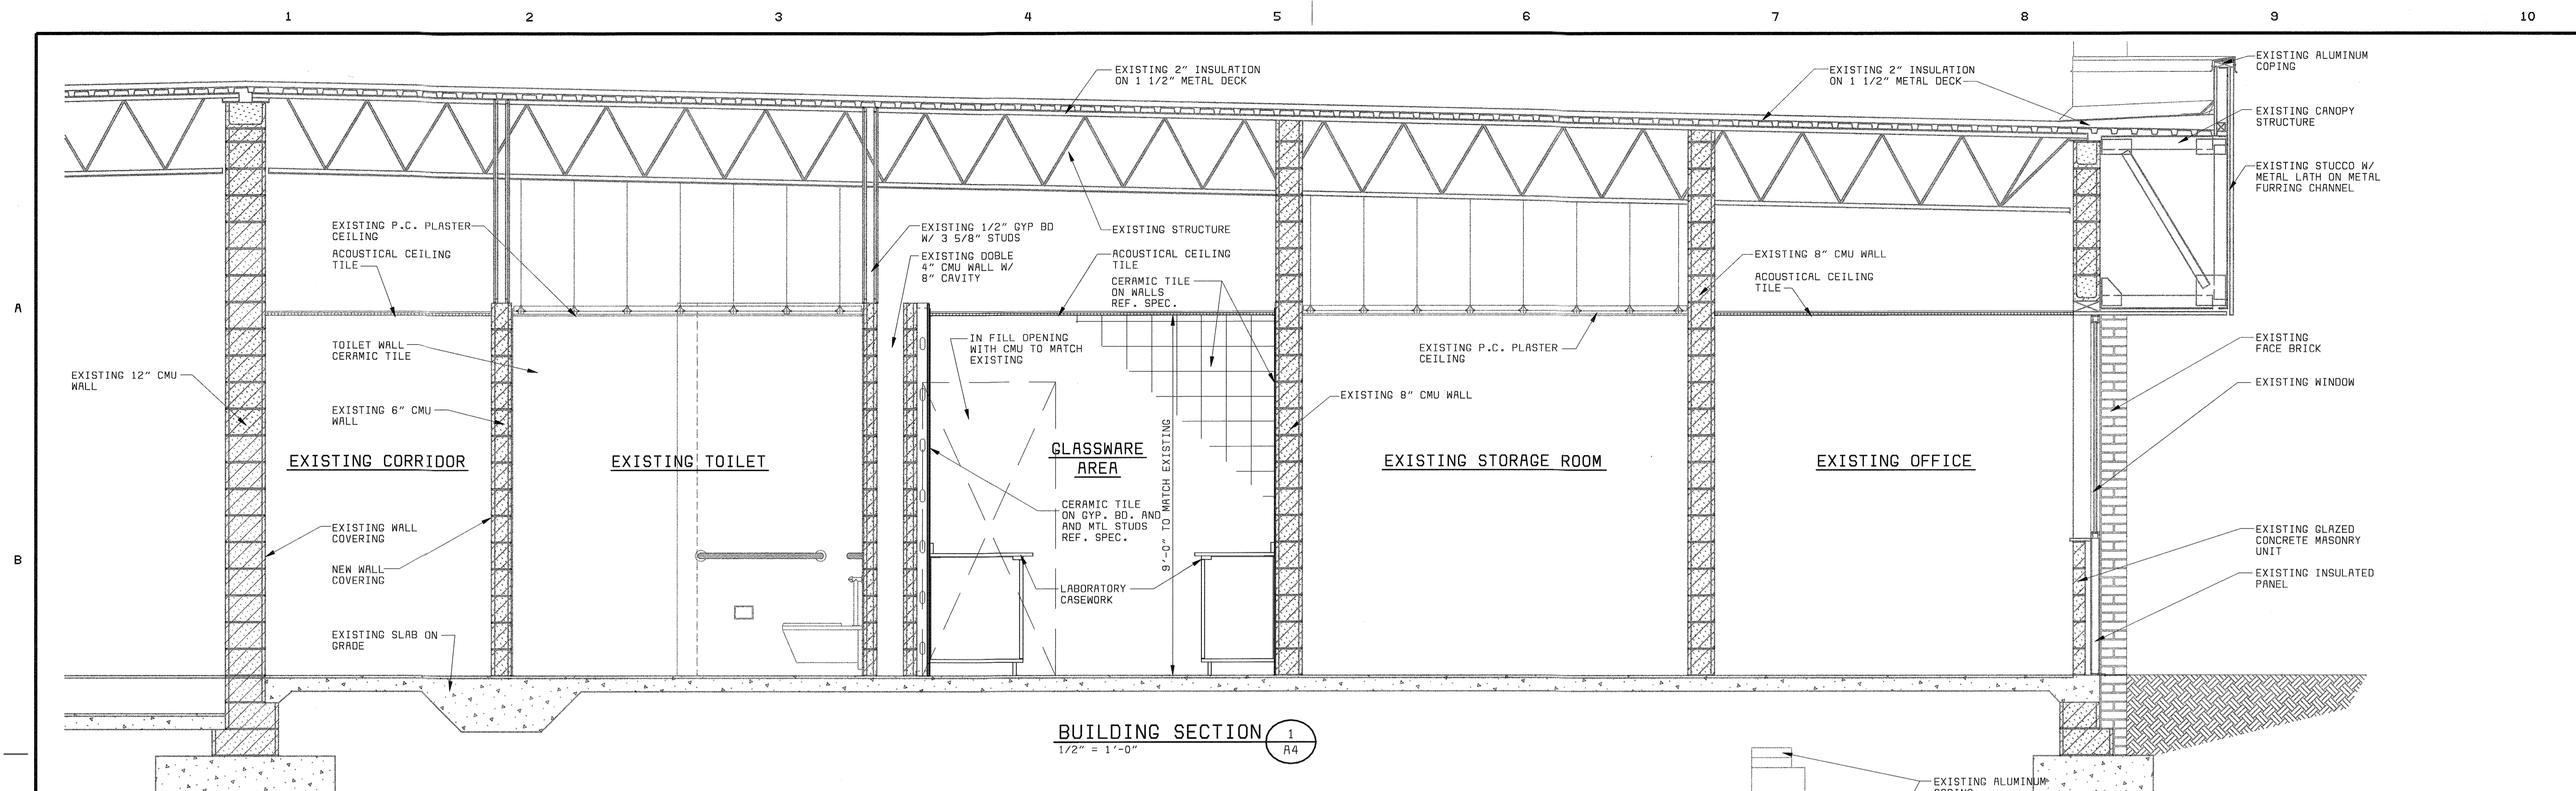


BUILDING SECTION 1
1/2" = 1'-0"

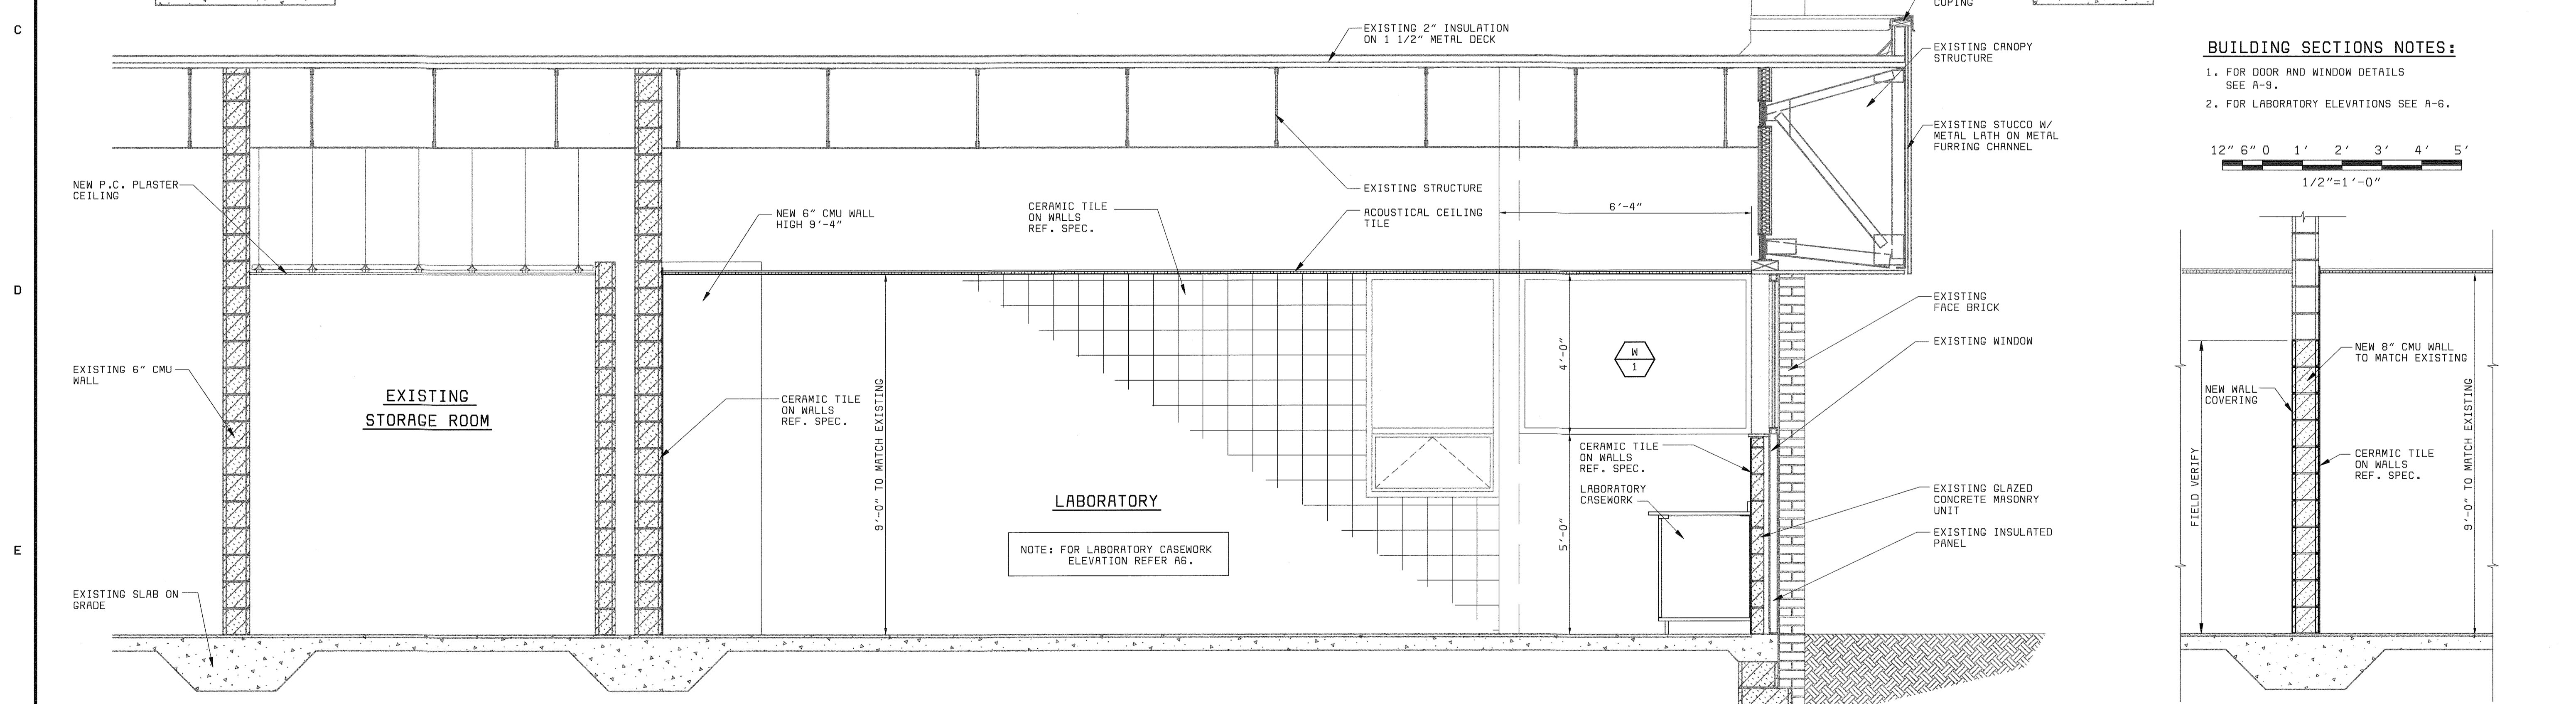

BUILDING SECTION 2
1/2" = 1'-0"

BUILDING SECTIONS NOTES:
 1. FOR DOOR AND WINDOW DETAILS SEE A-9.
 2. FOR LABORATORY ELEVATIONS SEE A-6.

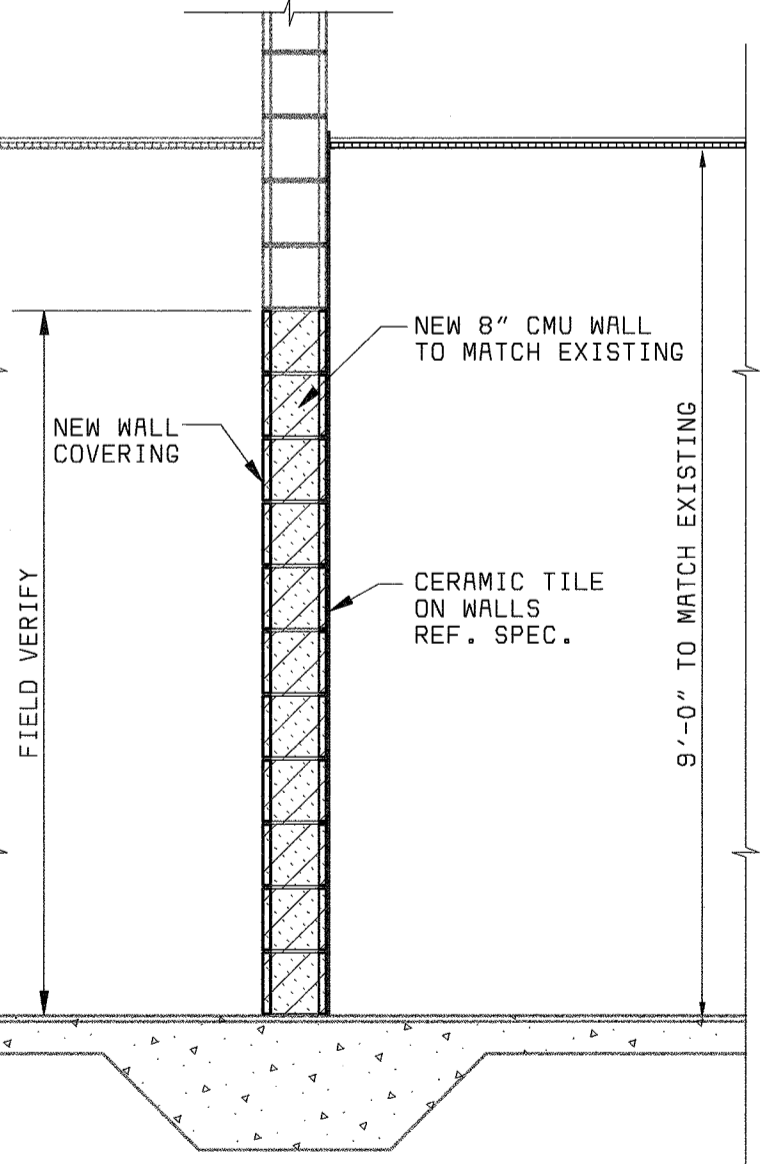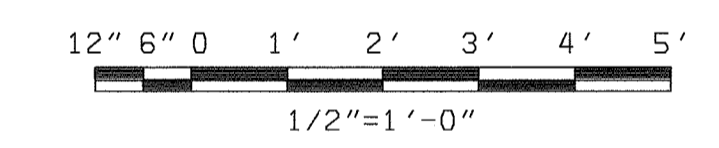

BUILDING SECTION 3
1/2" = 1'-0"

DEPARTMENT OF PUBLIC WORKS HOWARD COUNTY, MARYLAND bbw Architects • Designers • Planners Bryant Bryant Williams, P.C. 4201 Connecticut Avenue N.W., Suite 550 Washington, D.C., 20008 (202) 244-2108 CHIEF, BUREAU OF UTILITIES DATE	 BLACK & VEATCH Gaithersburg, Maryland REG. PROF. ENGR. DATE	THIS DRAWING WAS ORIGINALLY APPROVED FOR CONSTRUCTION AND SEALED BY CHARLES I. BRYANT A REGISTERED ARCHITECT IN THE STATE OF MARYLAND, NO. 1377-R	DES: CH/JS	ARCHITECTURAL ADMINISTRATION BUILDING LABORATORY ARCHITECTURAL BUILDING SECTIONS	LITTLE PATUXENT WATER RECLAMATION PLANT ADDITION NO. 6 LABORATORY RENOVATION CAPITAL PROJECT S-6205 CONTRACT NO. 20-3841 HOWARD COUNTY, MARYLAND	SCALE AS SHOWN
			DRN: JS			NO. BY CK APP
			CHK: CW			A4
			DATE: 08/00			
			11/03/03	CONFORMED TO CONSTRUCTION RECORDS		
				REVISIONS AND RECORD OF ISSUE		

LABORATORY FURNITURE AND EQUIPMENT SCHEDULE

LABORATORY FURNITURE AND EQUIPMENT SCHEDULE

NOTES:

EQUIP. No.	REFERENCE	MANUFACTURE AND MODEL No.	DESCRIPTION	DIMENSIONS	REMARKS
1	1/A-6 1	106S7320	DOOR CABINET - PULL OUT SHELVES	42" X 21-5/8" X 35-1/4"	WITH PULL-OUT SHELVES (2)
2	1/A-6 3	173S2320	DRAWER CABINET	18" X 21-5/8" X 35-1/4"	-
3	1/A-6 4	214S4320	CARBOY HOLDER	24" X 21-5/8" X 35-1/4"	-
4	1/A-6 5	501S2210	DRAWER FRAME	24" X 21-1/2"	SITTING TABLE
5	1/A-6 6	206S6320	DRAWER CABINET	36" X 21-5/8" X 35-1/4"	-
6	1/A-6 7	148S6320	COMBINATION CABINET	36" X 21-5/8" X 35-1/4"	WITH PULL-OUT SHELVES (2)
7	1/A-6 8	127S4220	COMBINATION CABINET W/PULL-BOARD	24" X 21-5/8" X 29-3/8"	WITH PULL-OUT SHELVES (2)
8	1/A-6 9	501S2210	DRAWER FRAME	24" X 21-1/2"	SITTING SPACE
9	1/A-6 10	180S6320	COMBINATION CABINET	36" X 21-5/8" X 35-1/4"	WITH PULL-OUT SHELVES (2)
10	1/A-6 11	181S8320	COMBINATION CABINET	48" X 21-5/8" X 35-1/4"	WITH PULL-OUT SHELVES (2)
11	2/A-6 1	137S2320	COMBINATION CABINET	18" X 21-5/8" X 35-1/4"	WITH PULL-OUT SHELVES (2)
12	2/A-6 2	950S8210	ACID STORAGE CABINET	24" X 21-5/8" X 35-1/4"	-
13	2/A-6 3	131S4320	COMBINATION CABINET	24" X 21-5/8" X 35-1/4"	WITH PULL-OUT SHELVES (2)
14	2/A-6 4	950S7410	FLAMMABLE LIQUID STORAGE CABINET	24" X 22" X 35-1/4"	-
15	2/A-6 5	131S4320	COMBINATION CABINET	24" X 21-5/8" X 35-1/4"	WITH PULL-OUT SHELVES (2)
16	2/A-6 6	121S8320	FUME HOOD CABINET	48" X 21-5/8" X 35-1/4"	WITH PULL-OUT SHELF (1)
17	2/A-6 7	950S8210	ACID STORAGE CABINET	24" X 21-5/8" X 35-1/4"	-
18	2/A-6 8	136S4320	COMBINATION CABINET	24" X 21-5/8" X 35-1/4"	WITH PULL-OUT SHELVES (2)
19	2/A-6 9	818S696M	TALL CASE	36" X 16" X 84"	-
20	2/A-6 10	54L600	FUME HOOD	96" X 31-1/4" X 54-1/4"	-
21	2/A-6 11	54L600	FUME HOOD	96" X 31-1/4" X 54-1/4"	-
22	3/A-6 1	131S1320	COMBINATION CABINET	15" X 21-5/8" X 35-1/4"	-
23	3/A-6 2	501S2210	DRAWER FRAME	24" X 21-1/2"	SITTING SPACE
24	3/A-6 3	164S1320	DRAWER CABINET	15" X 21-5/8" X 35-1/4"	-
25	3/A-6 4	100S5320	OPEN CABINET	30" X 21-5/8" X 35-1/4"	WITH 531S8250 EXTRA SHELF
26	3/A-6 5	203S5320	DRAWER CABINET	30" X 21-5/8" X 35-1/4"	-
27	3/A-6 6	206S5320	DRAWER CABINET	30" X 21-5/8" X 35-1/4"	-
28	4/A-6 1	164S4320	DRAWER CABINET	24" X 21-5/8" X 35-1/4"	-
29	4/A-6 2	112S4320	SINK CABINET	24" X 21-5/8" X 35-1/4"	-
30	4/A-6 3	182S8320	COMBINATION CABINET	48" X 21-5/8" X 35-1/4"	WITH PULL-OUT SHELVES (2)
31	4/A-6 4	182S8320	COMBINATION CABINET	48" X 21-5/8" X 35-1/4"	WITH PULL-OUT SHELVES (2)
32	4/A-6 5	115S6320	SINK CABINET	36" X 21-5/8" X 35-1/4"	-
33	4/A-6 6	115S3620	SINK CABINET	48" X 21-5/8" X 35-1/4"	-
34	4/A-6 7	115S6320	SINK CABINET	36" X 21-5/8" X 35-1/4"	-
34A	4/A-6	52L780	PEGBOARD	-	CONTRACTOR PURCHASE/CONTRACTOR INSTALL
34B	4/A-6	52L546	DRIP TROUGH FOR PEGBOARD	-	CONTRACTOR PURCHASE/CONTRACTOR INSTALL
35	5/A-6 1	148S8320	COMBINATION CABINET	48" X 21-5/8" X 35-1/4"	WITH PULL-OUT SHELVES (2)
36	5/A-6 2	501S2210	DRAWER FRAME	24" X 21-1/2"	SITTING SPACE
37	5/A-6 3	148S6320	COMBINATION CABINET	36" X 21-5/8" X 35-1/4"	WITH PULL-OUT SHELVES (2)
38	5/A-6 4	113S3320	SINK CABINET	21" X 21-5/8" X 35-1/4"	-
39	5/A-6 5	148S7320	COMBINATION CABINET	42" X 21-5/8" X 35-1/4"	WITH PULL-OUT SHELVES (2)
40	5/A-6 6	164S2320	DRAWER CABINET	18" X 21-5/8" X 35-1/4"	-
41	5/A-6 7	502S2200	DRAWER FRAME	30" X 21-1/2"	SITTING SPACE
42	6/A-6 1	818S696M	TALL CASE	36" X 16" X 84"	-
43	7/A-6 1	148S6320	COMBINATION CABINET	36" X 21-5/8" X 35-1/4"	WITH PULL-OUT SHELVES (2)
44	7/A-6 2	148S6320	COMBINATION CABINET	36" X 21-5/8" X 35-1/4"	WITH PULL-OUT SHELVES (2)
45	7/A-6 3	179S6320	COMBINATION CABINET	36" X 21-5/8" X 35-1/4"	WITH PULL-OUT SHELVES (2)

EQUIP. No.	REFERENCE	MANUFACTURE AND MODEL No.	DESCRIPTION	DIMENSIONS	REMARKS
46	7/A-6 4	501S2210	DRAWER FRAME	30" X 21-5/8" X 35-1/4"	SITTING SPACE
47	8/A-6 1	176S3320	DRAWER CABINET	21" X 21-5/8" X 35-1/4"	-
48	8/A-6 2	148S8320	COMBINATION CABINET	48" X 21-5/8" X 35-1/4"	WITH PULL-OUT SHELVES (2)
49	8/A-6 3	148S8320	COMBINATION CABINET	48" X 21-5/8" X 35-1/4"	WITH PULL-OUT SHELVES (2)
50	9/A-6 1	200S6320	DRAWER CABINET	36" X 21-5/8" X 35-1/4"	-
51	9/A-6 2	100S6320	BOOKSHELF CABINET	36" X 21-5/8" X 35-1/4"	-
52	9/A-6 3	136S4320	COMBINATION CABINET	24" X 21-5/8" X 35-1/4"	WITH PULL-OUT SHELVES (2)
53	10/A-6 1	303S3320	DOOR CABINET	21" X 21-5/8" X 35-1/4"	WITH PULL-OUT SHELVES (2)
54	11/A-6 1	303S3320	DOOR CABINET	21" X 21-5/8" X 35-1/4"	WITH PULL-OUT SHELVES (2)
55	12/A-6 1	127S4220	COMBINATION CABINET W/PULL-BOARD	24" X 21-5/8" X 29-3/8"	-
56	12/A-6 2	502S2210	DRAWER FRAME	42" X 21-1/2"	SITTING SPACE
57	13/A-6 1	130S3220	DRAWER CABINET	21" X 21-5/8" X 29-3/8"	-
58	13/A-6 2	501S2210	DRAWER FRAME	24" X 21-1/2"	SITTING SPACE
59	13/A-6 3	139S3220	DRAWER CABINET	21" X 21-5/8" X 29-3/8"	-
60	14/A-6 1	100S5320	OPEN CABINET	30" X 21-5/8" X 35-1/4"	-
61	14/A-6 2	136S3320	COMBINATION CABINET	21" X 21-5/8" X 35-1/4"	WITH PULL-OUT SHELVES (2)
62	14/A-6 3	-	OPEN SPACE	24"	FOR B.O.D. INCUBATOR
63	15/A-6 1	148S6320	COMBINATION CABINET	36" X 21-5/8" X 35-1/4"	WITH PULL-OUT SHELVES (2)
64	15/A-6 2	148S6320	COMBINATION CABINET	36" X 21-5/8" X 35-1/4"	WITH PULL-OUT SHELVES (2)
65	NOT USED				
66	1/A-2	NEY 525	EXISTING MUFFLE FURNACE.		OWNER WILL MOVE. CONTRACTOR TO RE-INSTALL (INCL. ATTACHMENT TO HOOD SYSTEM)
67	1/A-2	EXISTING	CN DISTILLATION.		OWNER REMOVE; OWNER RE-INSTALL
68	1/A-2	EXISTING	TKN DIGESTION.		OWNER REMOVE; OWNER RE-INSTALL
69	1/A-2	EXISTING	CENTRIFUGE.		OWNER REMOVE; OWNER RE-INSTALL
70	1/A-2	EXISTING	EXISTING PC.		OWNER REMOVE; OWNER RE-INSTALL
71	1/A-2	PERKIN/ELMER 3030	EXISTING ATOMIC ABSORPTION SPECTROPHOTOMETER		OWNER WILL MOVE OUT. CONTRACTOR TO RE-INSTALL WITH ALL CONNECTIONS (NEW)
72	1/A-2	MARKET FORGE	EXISTING AUTOCLAVE STERILMATIC STM-E		OWNER WILL MOVE OUT. CONTRACTOR TO RE-INSTALL WITH ALL EXHAUST PIPING AND OTHER CONNECTIONS (NEW)
73	1/A-2		EXISTING PC.		OWNER REMOVE; OWNER RE-INSTALL
74	1/A-2	NEW	NUTRIENT ANALYZER I W/ AUTOSAMPLER - OWNER PURCHASE		OWNER REMOVE; OWNER RE-INSTALL
75	1/A-2	NEW	NUTRIENT ANALYZER II W/ AUTOSAMPLER - OWNER PURCHASE		OWNER REMOVE; OWNER RE-INSTALL
76	1/A-2		WATER SYSTEM.		CONTRACTOR PURCHASE; CONTRACTOR INSTALL
77	1/A-2	MIELE G7783	GLASSWARE CLEANING APPARATUS (DISHWASHER)		CONTRACTOR PURCHASE; CONTRACTOR INSTALL
78	1/A-2	EXISTING	BALANCE.		OWNER REMOVE; OWNER RE-INSTALL
79	1/A-2	EXISTING	DESSICATOR.		OWNER REMOVE; OWNER RE-INSTALL
80	1/A-2	EXISTING	DESSICATOR FOR TSS		OWNER REMOVE; OWNER RE-INSTALL
81	1/A-2	EXISTING	DESSICATOR FOR TS.		OWNER REMOVE; OWNER RE-INSTALL
82	1/A-2	NEW	TS/TSS DRYING OVEN - OWNER PURCHASE		OWNER REMOVE; OWNER RE-INSTALL
83	1/A-2	NEW	WATER BATH FOR FECAL COLIFORMS - OWNER PURCHASE		OWNER REMOVE; OWNER RE-INSTALL
84	1/A-2	NEW	INCUBATOR - OWNER PURCHASE		OWNER REMOVE; OWNER RE-INSTALL
85	NOT USED				
86	1/A-2	EXISTING	PC. FOR TSS.		OWNER REMOVE; OWNER RE-INSTALL
87	1/A-2	EXISTING	METTLER BALANCE.		OWNER REMOVE; OWNER RE-INSTALL
88	1/A-2	EXISTING	CI. COLOR ANAL.		OWNER REMOVE; OWNER RE-INSTALL
89	1/A-2	97-990E	B.O.D. INCUBATOR (NEW)		CONTRACTOR PURCHASE; CONTRACTOR INSTALL
90	1/A-2	I4505SCA	REFRIGERATORS (NEW)		CONTRACTOR PURCHASE; CONTRACTOR INSTALL
91					
92					

1. UNLESS OTHERWISE NOTED, ALL ITEMS ARE PURCHASED NEW AND INSTALLED BY CONTRACTOR.
2. ALL ITEMS ARE FISHER HAMILTON REFERENCES UNLESS OTHERWISE NOTED.

DEPARTMENT OF PUBLIC WORKS
HOWARD COUNTY, MARYLAND



BLACK & VEATCH
Gathersburg, Maryland

THIS DRAWING WAS
ORIGINALLY APPROVED
FOR CONSTRUCTION
AND SEALED BY
CHARLES I. BRYANT
A REGISTERED
ARCHITECT
IN THE
STATE OF MARYLAND,
NO. 1377-R

DES: CH
DRN: JS
CHK: CH/JS
DATE: 08/00


11/03/03	CONFORMED TO CONSTRUCTION RECORDS	RHH	RJR	RJR
DATE	REVISIONS AND RECORD OF ISSUE	NO.	BY	CK APP

ARCHITECTURAL
ADMINISTRATION BUILDING
LABORATORY
FURNITURE - EQUIPMENT SCHEDULE


LITTLE PATUXENT WATER RECLAMATION PLANT
ADDITION NO. 6
LABORATORY RENOVATION
CAPITAL PROJECT S-6205
CONTRACT NO. 20-3841
HOWARD COUNTY, MARYLAND

SCALE
AS
SHOWN
SHEET
11 of 28
A5

058472-5
F058472A

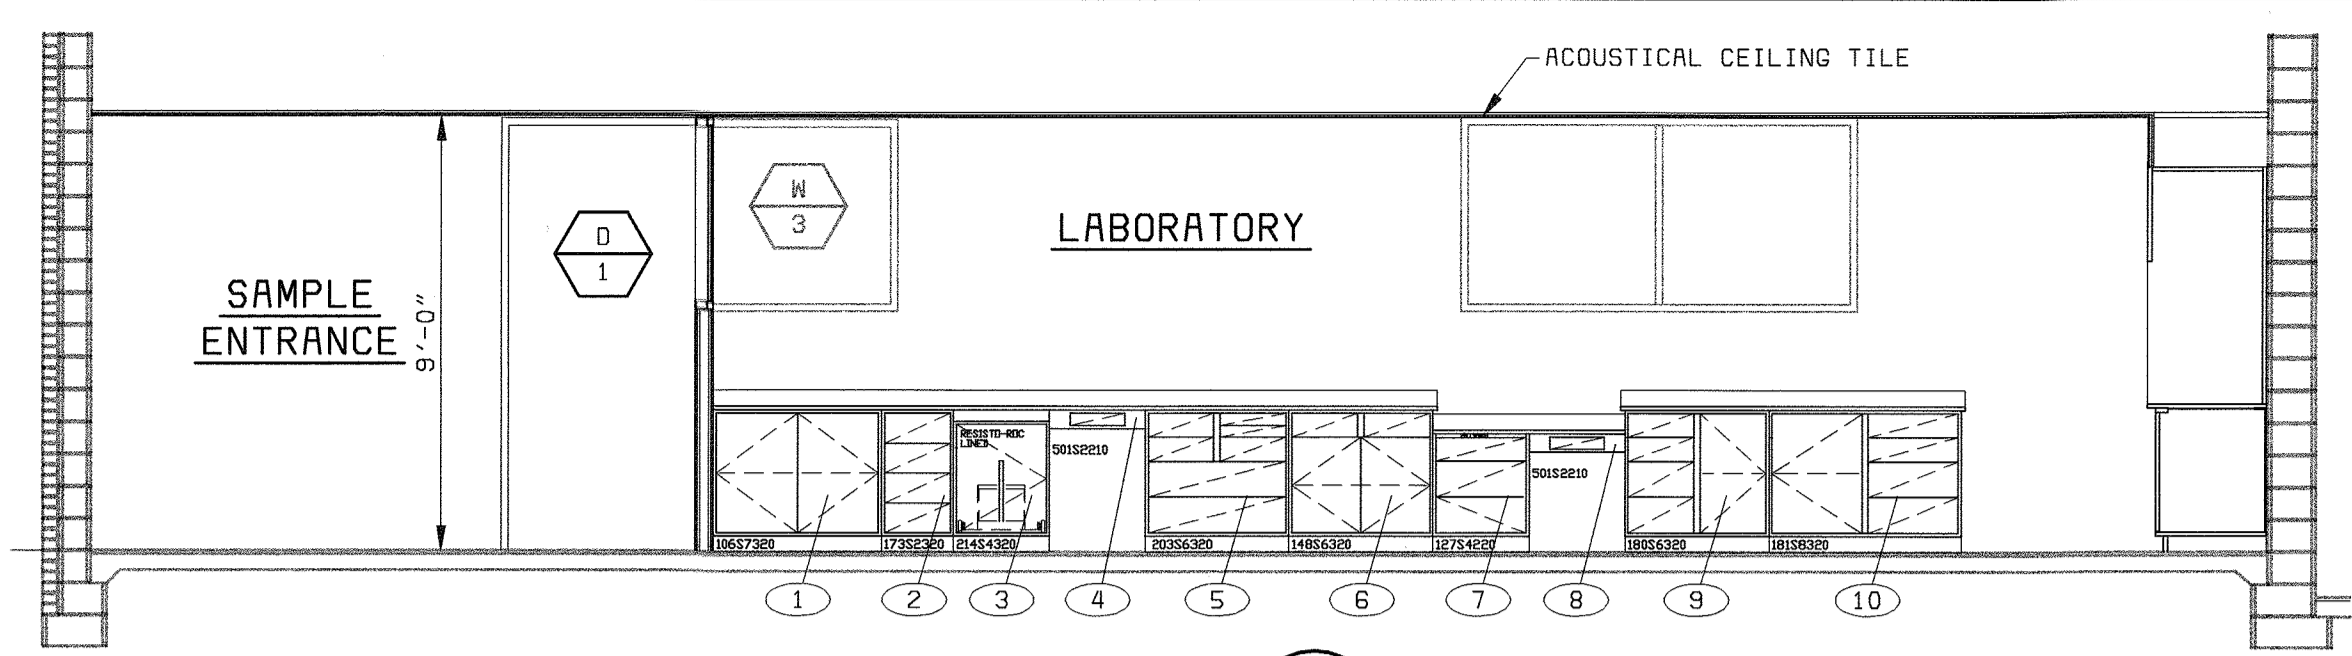


ELEVATION 1
1/4" = 1'-0" A-6

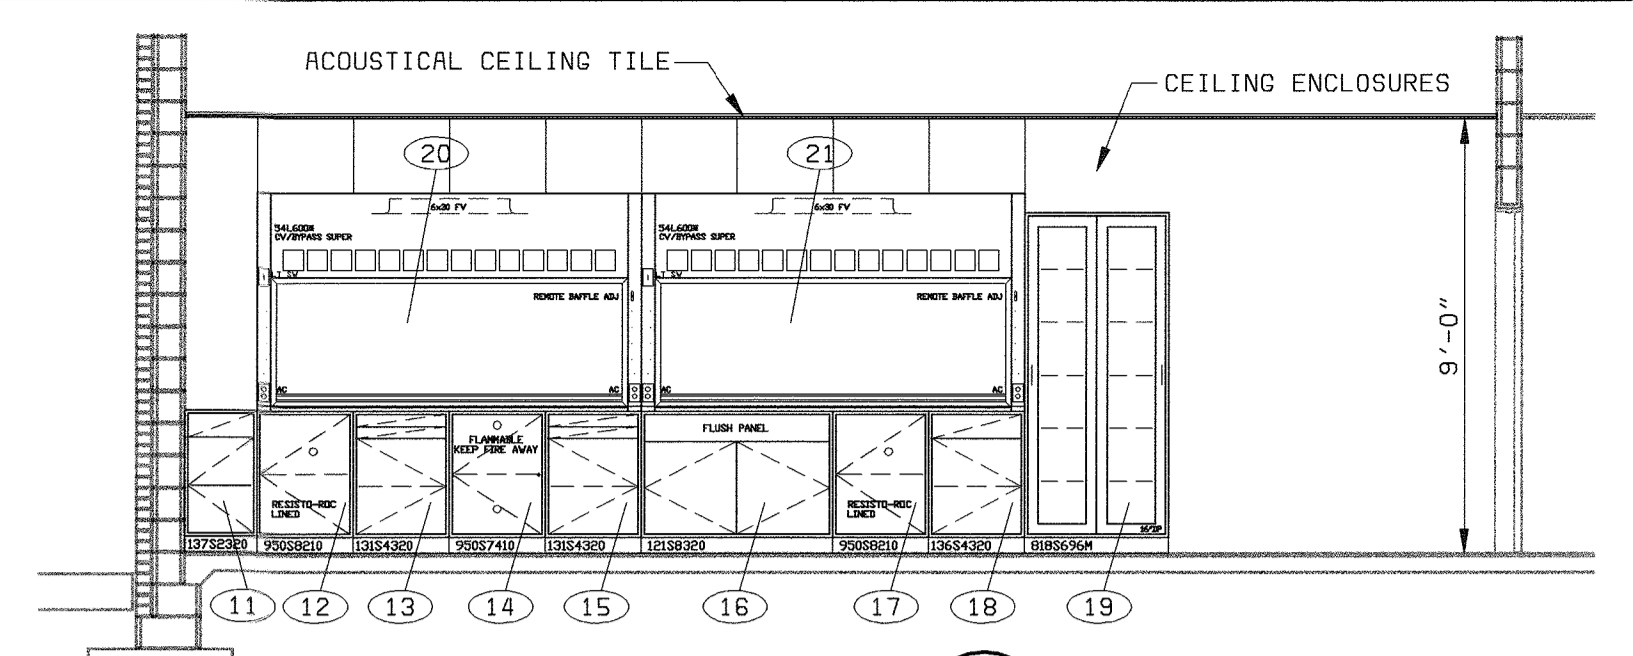


ELEVATION 2
1/4" = 1'-0" A-6


- ELEVATION NOTES:**
1. FOR FINISH, WINDOW AND DOOR SCHEDULE SEE A-7.
 2. FOR DOOR AND WINDOW DETAILS SEE A-7.
 3. FOR PARTITIONS TYPE SEE A-7.
 4. FOR LABORATORY CASEWORK SEE A-2
 5. FOR FURNITURE AND EQUIPMENT SCHEDULE SEE A-5.

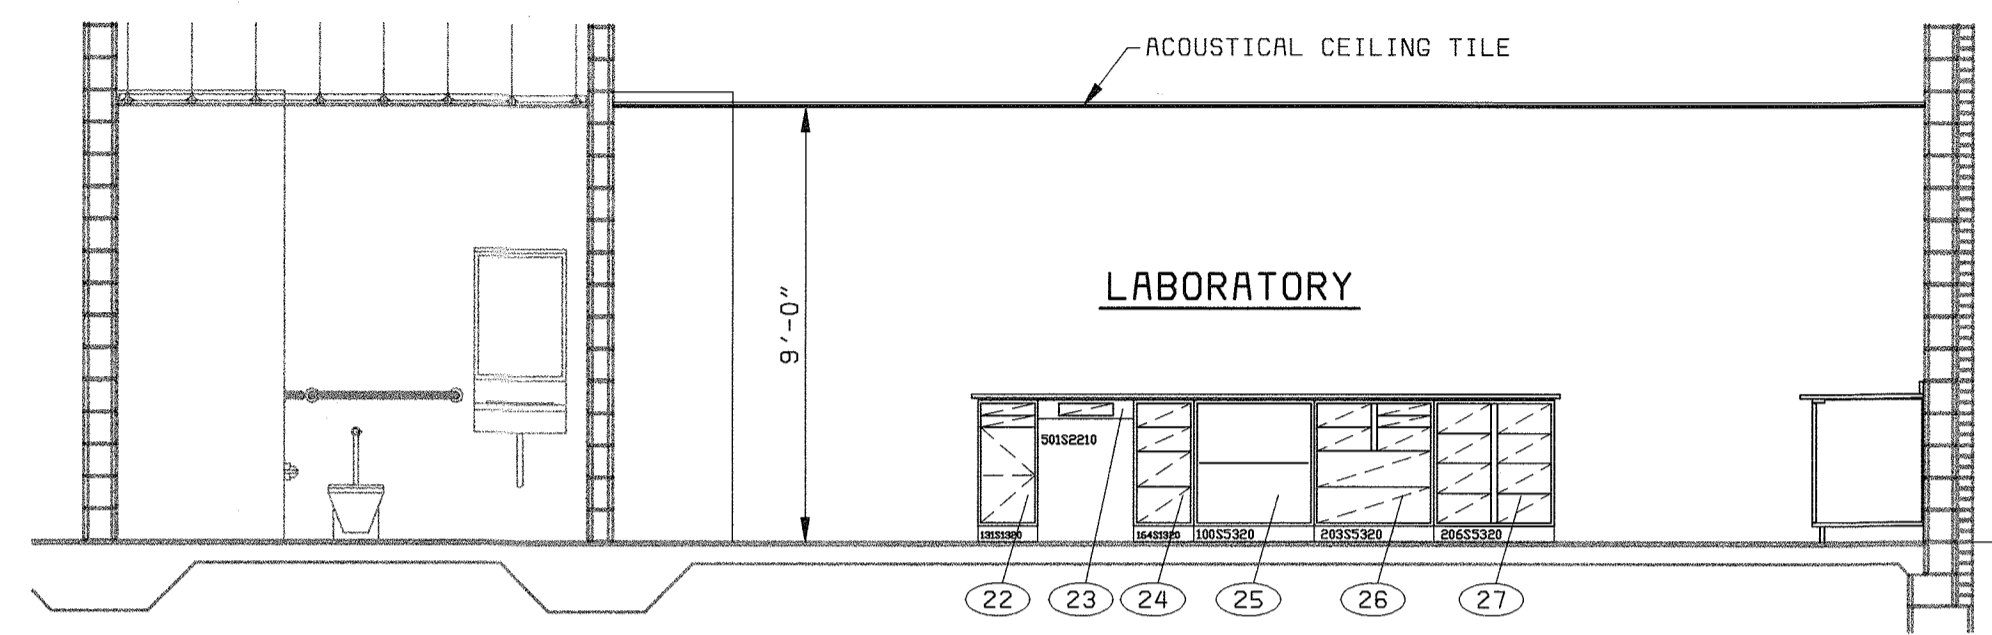


ELEVATION 3
1/4" = 1'-0" A-6

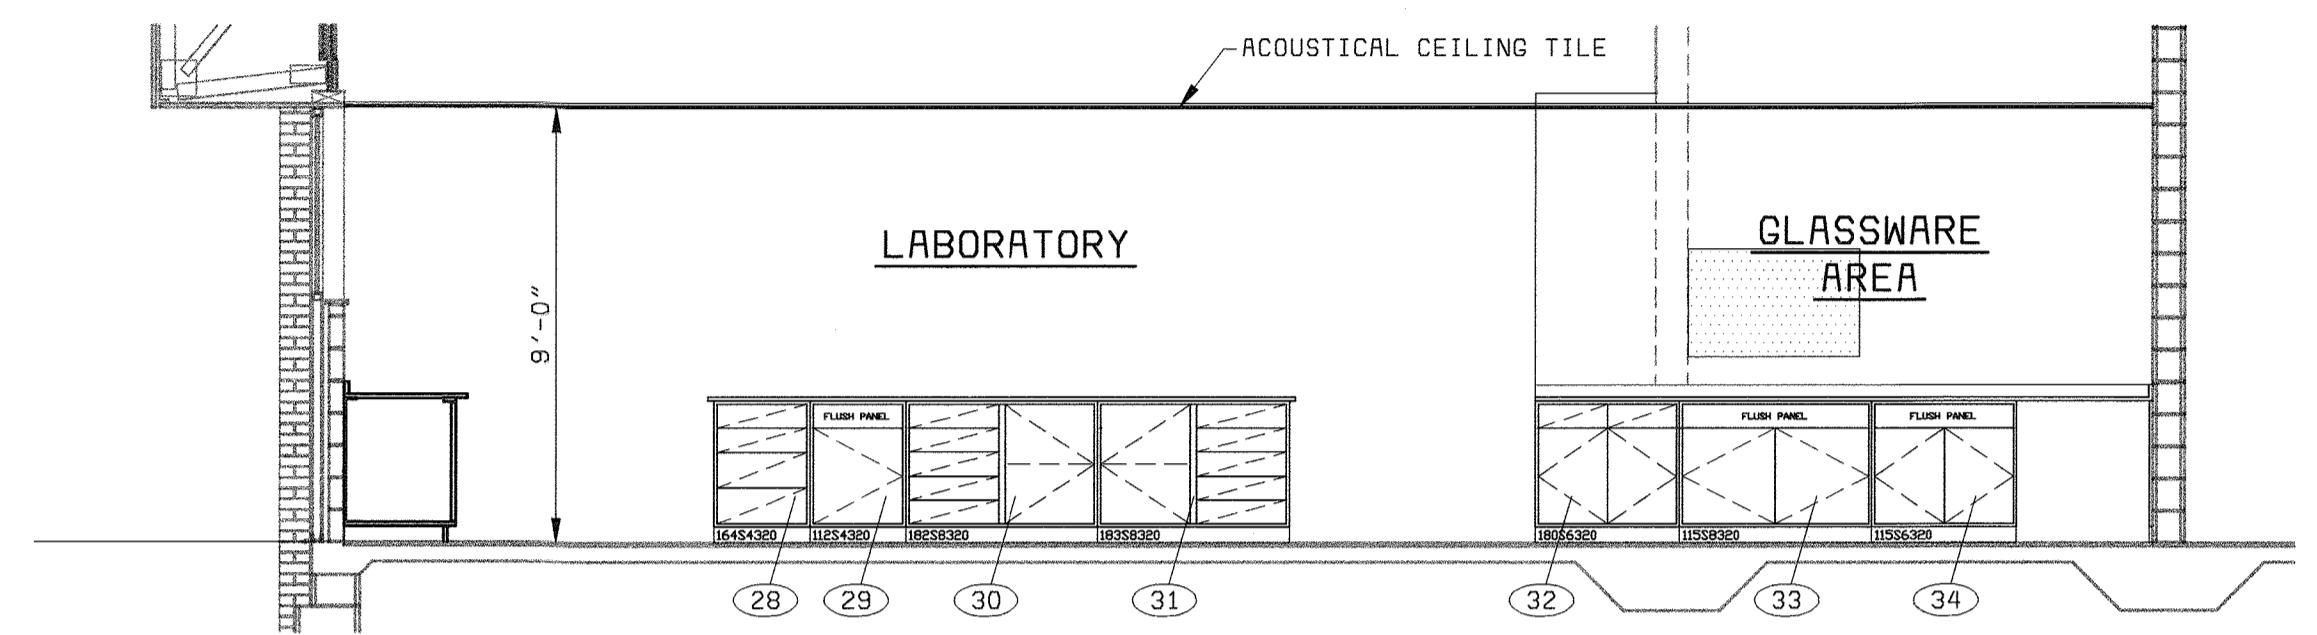


ELEVATION 4
1/4" = 1'-0" A-6

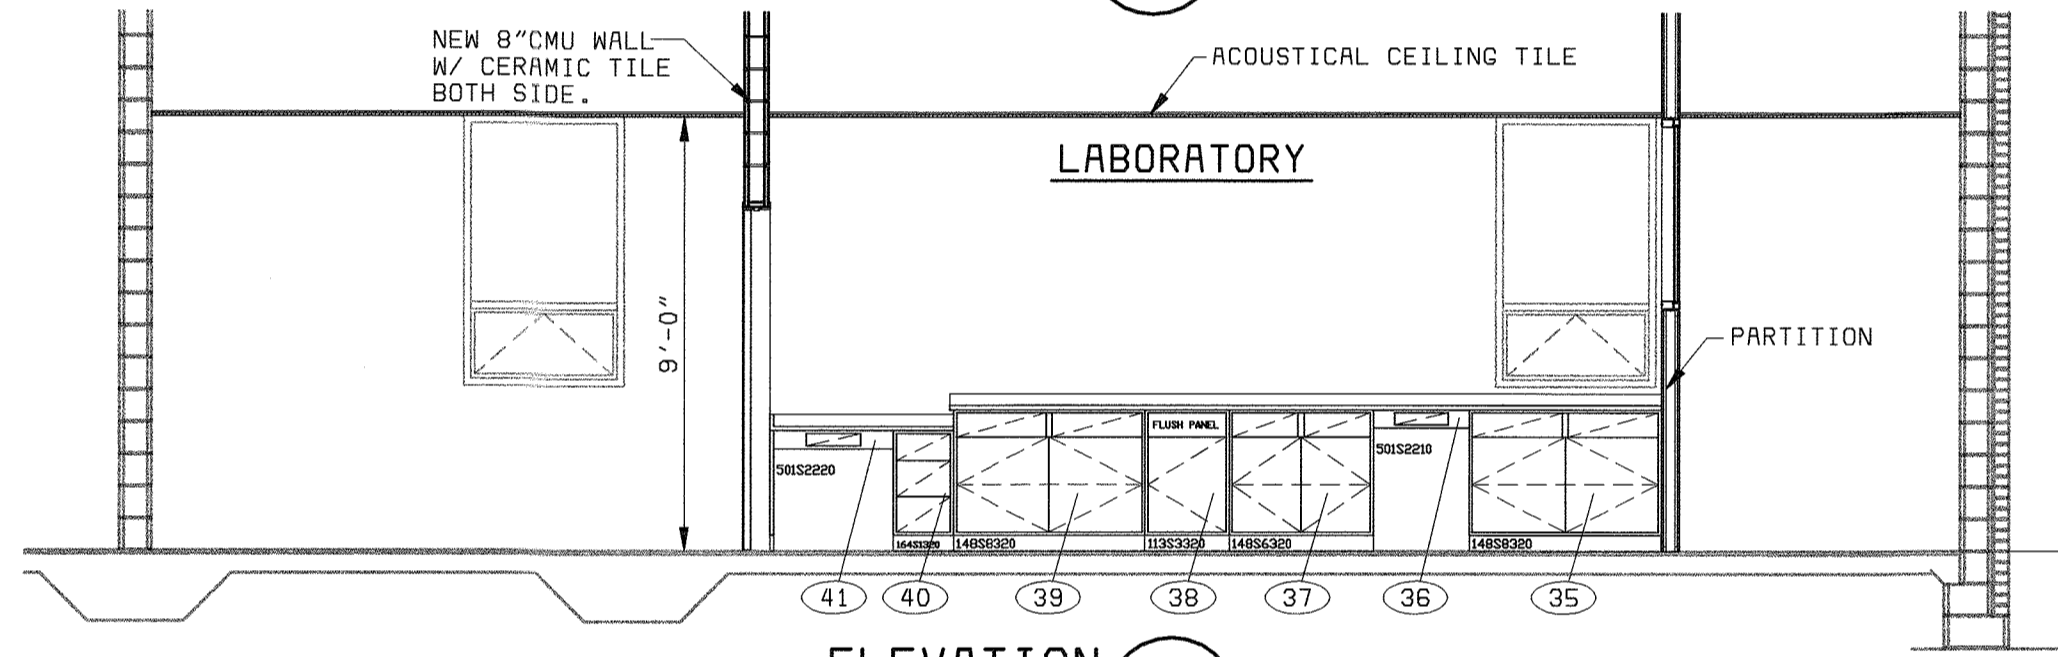


ELEVATION 5
1/4" = 1'-0" A-6

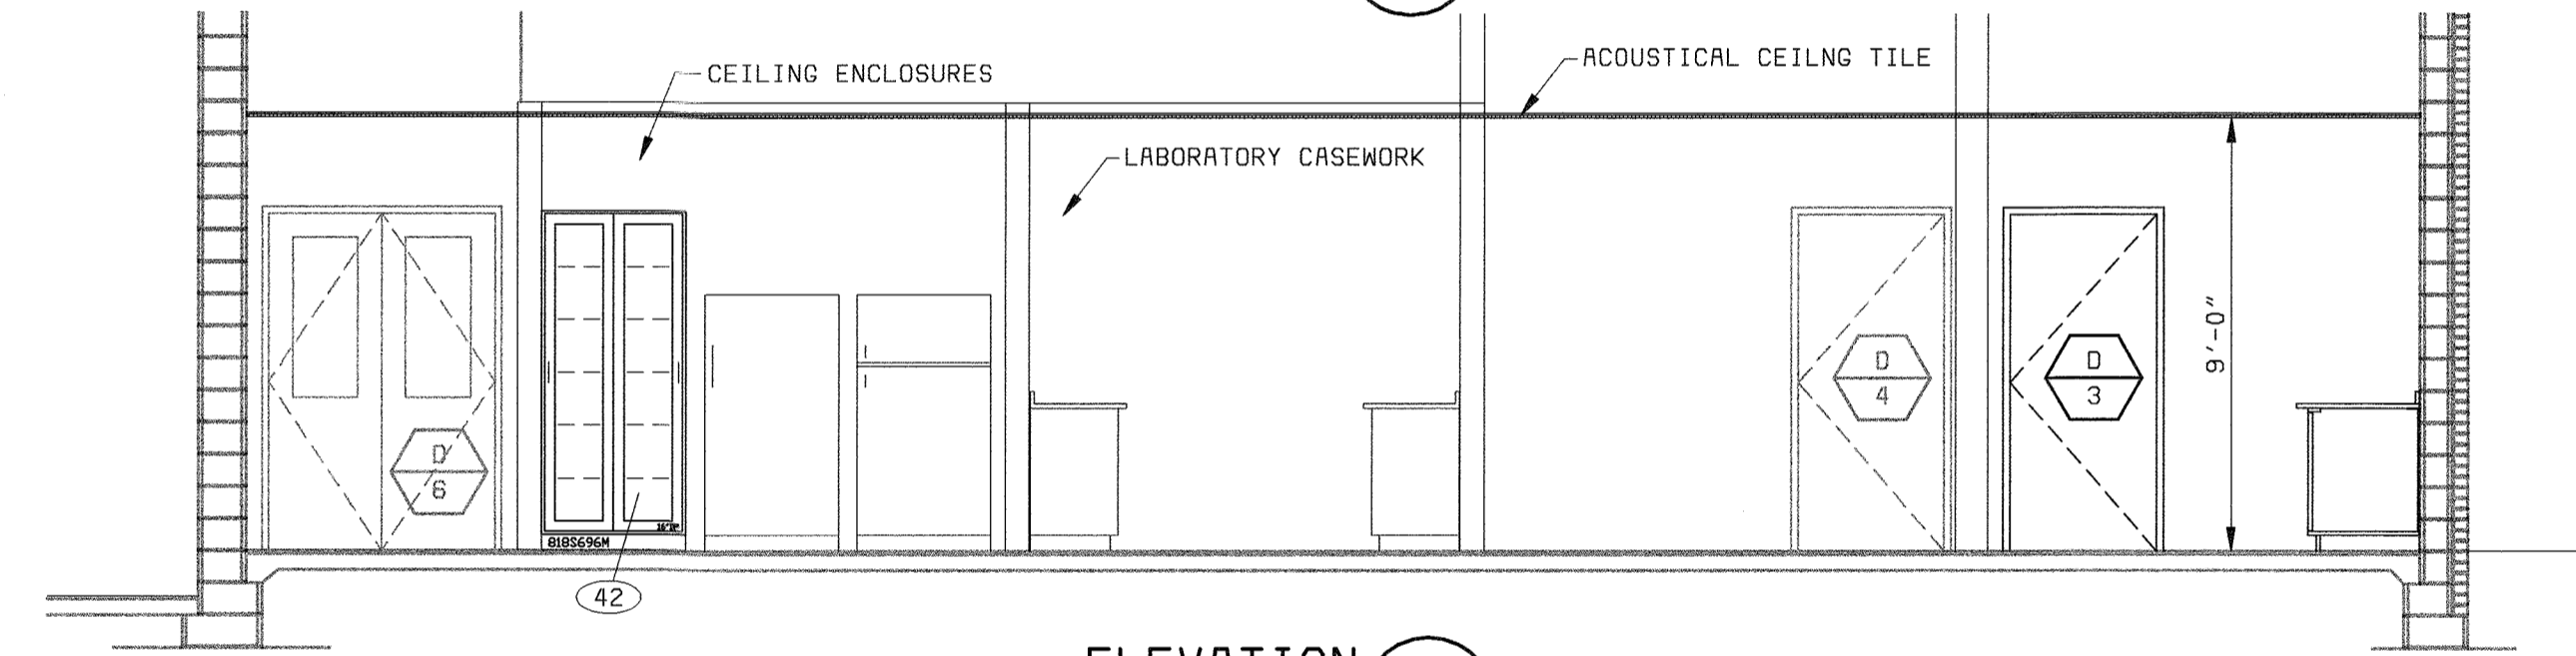


ELEVATION 6
1/4" = 1'-0" A-6

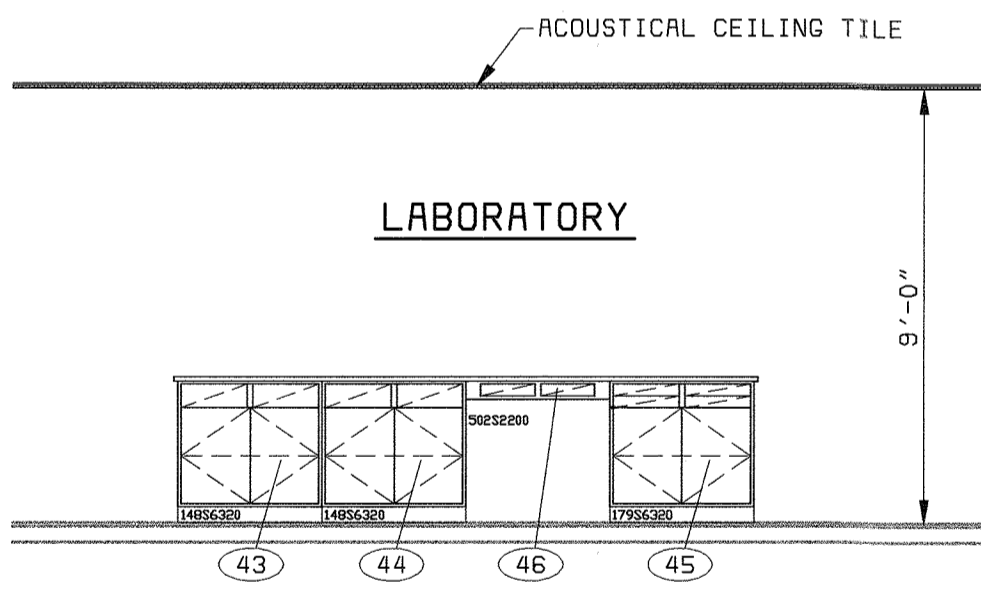


ELEVATION 7
1/4" = 1'-0" A-6

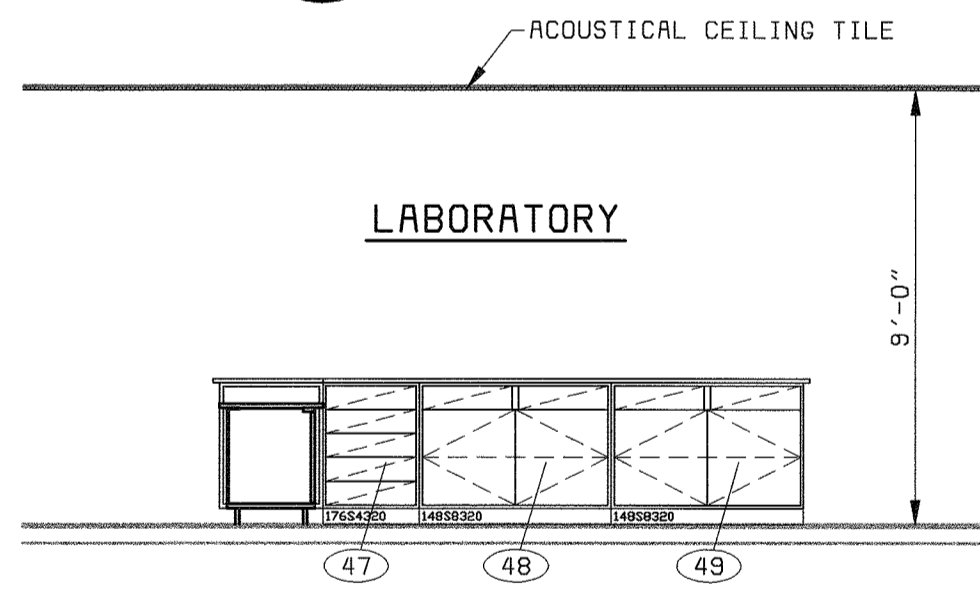


ELEVATION 8
1/4" = 1'-0" A-6

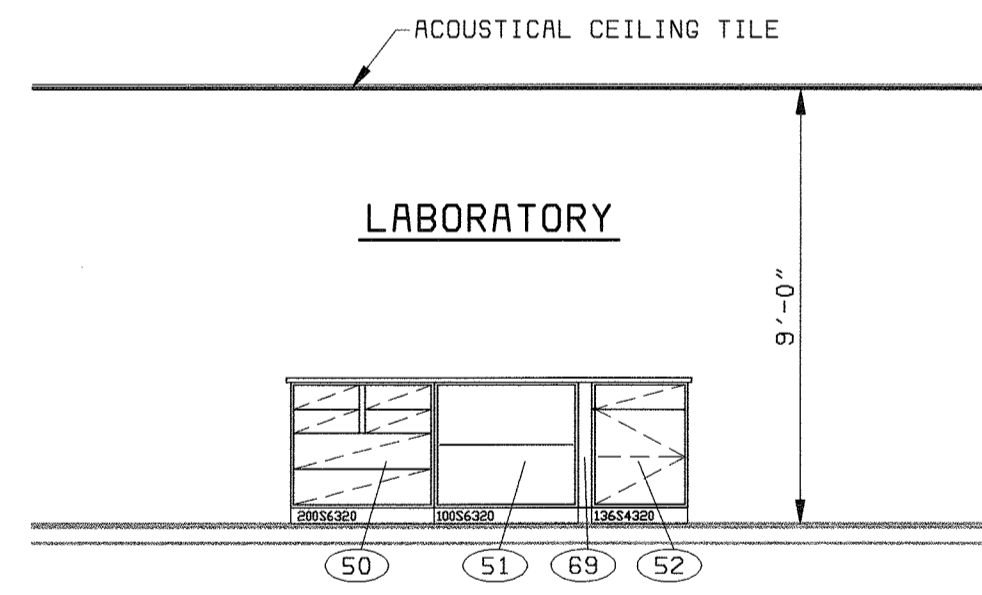


ELEVATION 9
1/4" = 1'-0" A-6

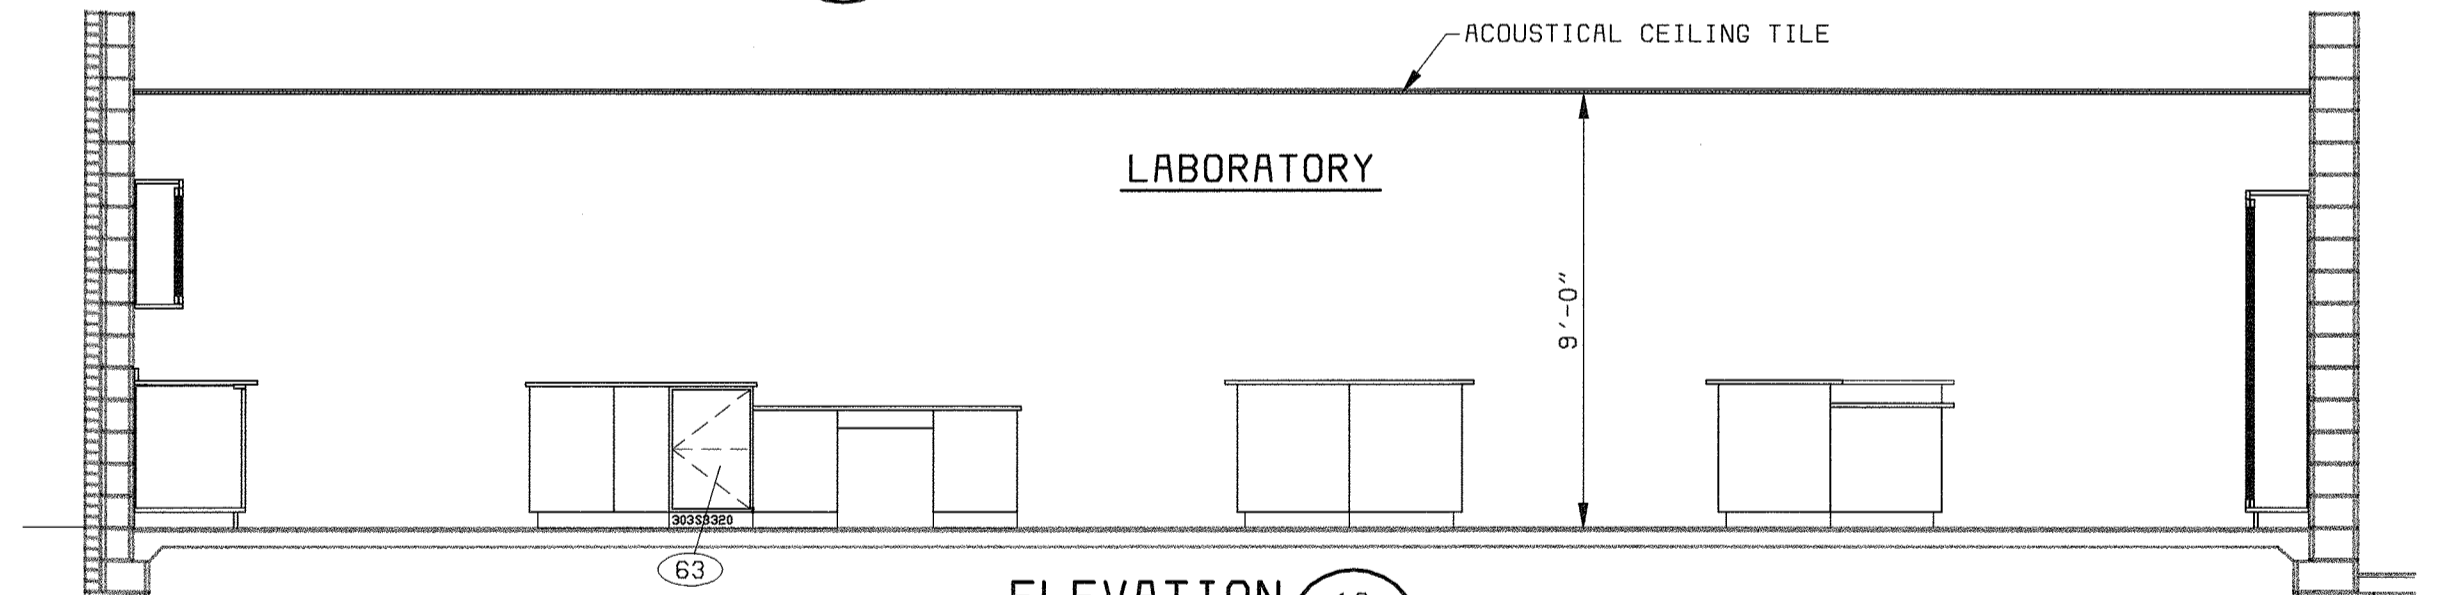


ELEVATION 10
1/4" = 1'-0" A-6

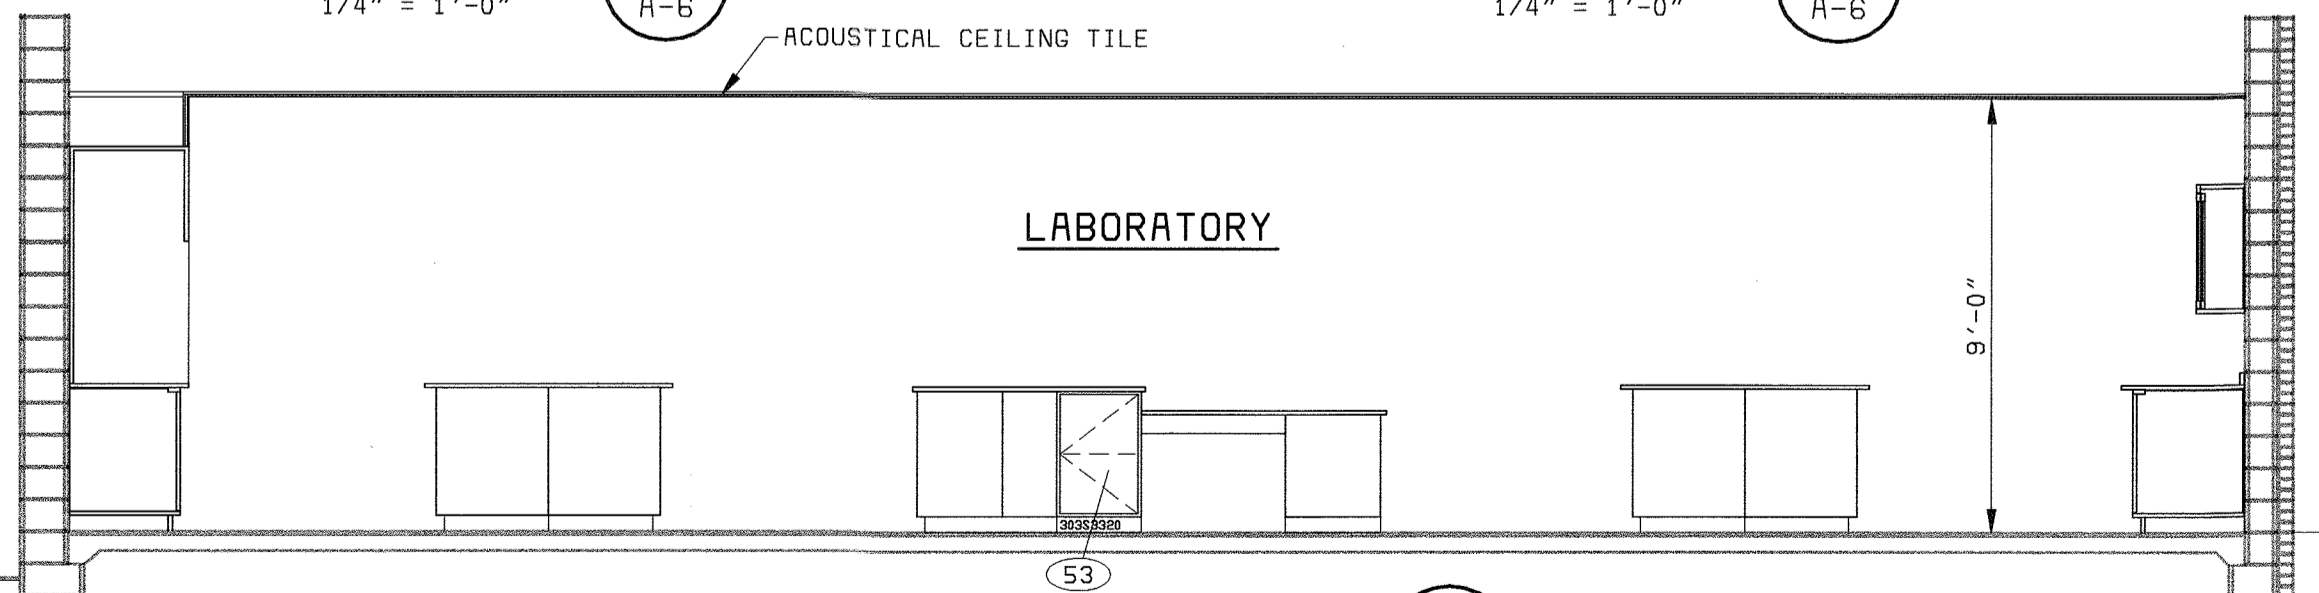


ELEVATION 11
1/4" = 1'-0" A-6

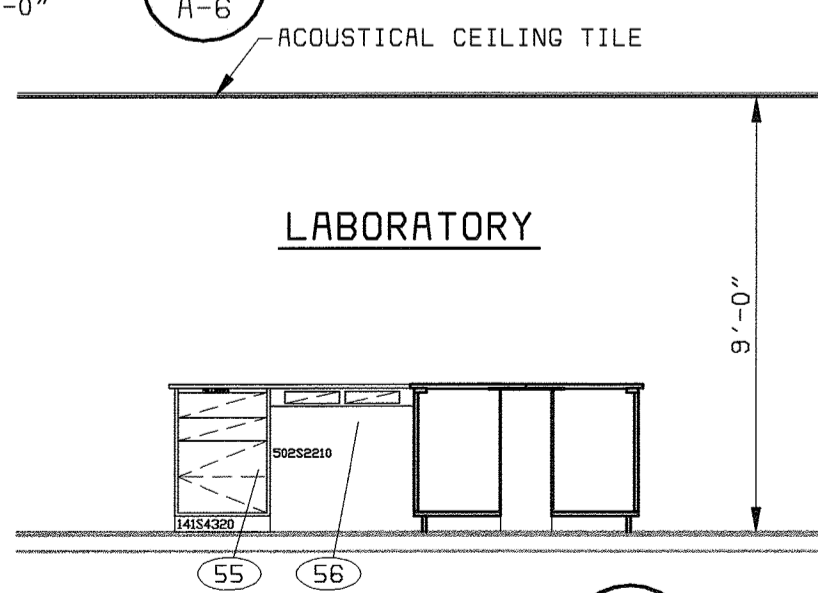


ELEVATION 12
1/4" = 1'-0" A-6

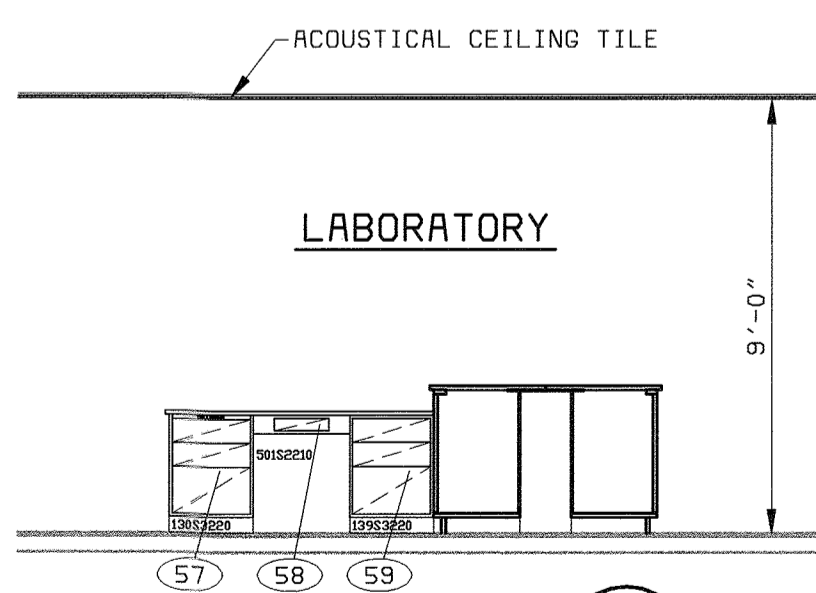

ELEVATION 13
1/4" = 1'-0" A-6

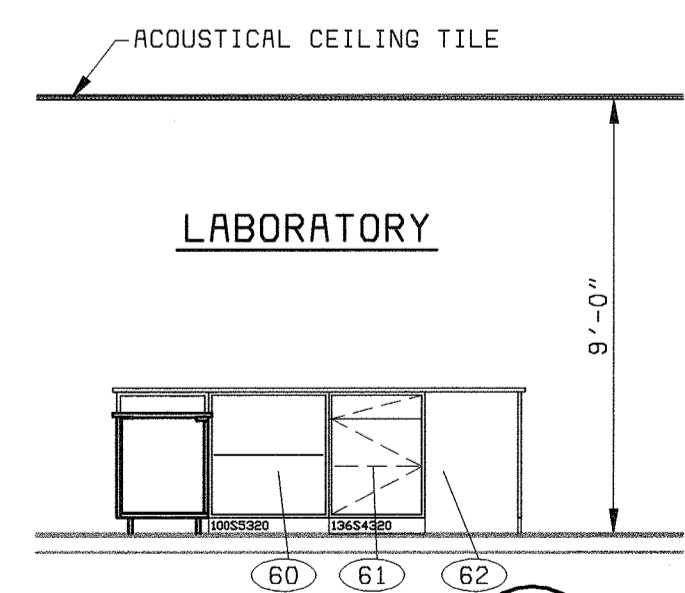


ELEVATION 14
1/4" = 1'-0" A-6

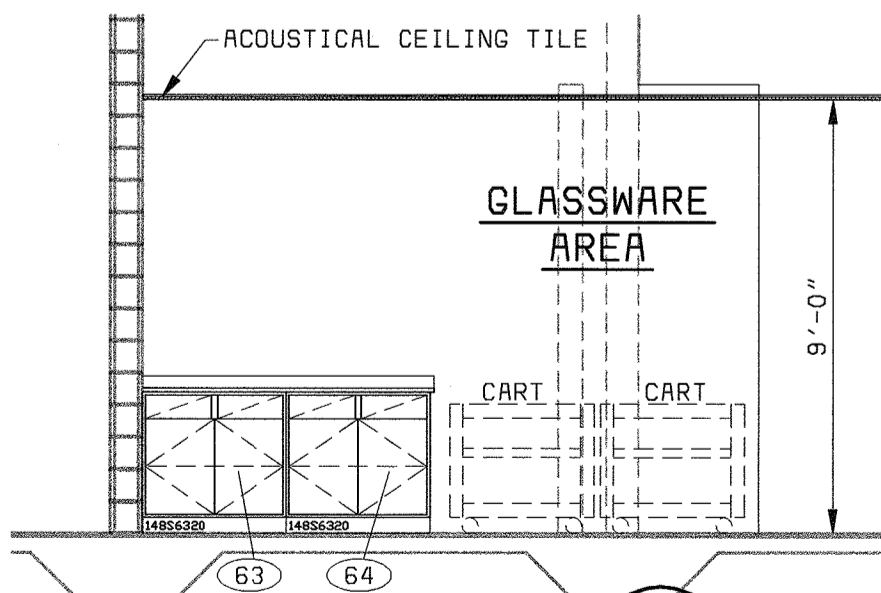

ELEVATION 15
1/4" = 1'-0" A-6

DEPARTMENT OF PUBLIC WORKS
HOWARD COUNTY, MARYLAND
CHIEF, BUREAU OF UTILITIES DATE

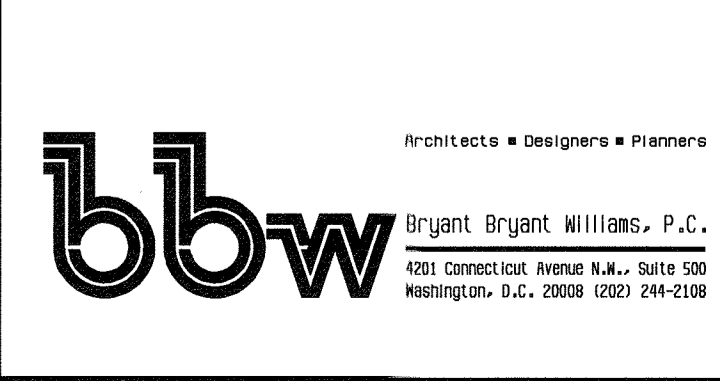

THIS DRAWING WAS
ORIGINALLY APPROVED
FOR CONSTRUCTION
AND SEALED BY
CHARLES T. BRYANT
A REGISTERED
ARCHITECT
IN THE
STATE OF MARYLAND,
NO. 1377-R

DES:	CH/JS				
DRN:	JS				
CHK:	CH				
DATE:	08/08	11/03/03	CONFORMED TO CONSTRUCTION RECORDS	RHH/RJR/RJR	
		DATE	REVISIONS AND RECORD OF ISSUE	NO.	BY


ARCHITECTURAL
ADMINISTRATION BUILDING
LABORATORY
WORK AREA ELEVATIONS

LITTLE PATUXENT WATER RECLAMATION PLANT
ADDITION NO. 6
LABORATORY RENOVATION
CAPITAL PROJECT S-6205
CONTRACT NO. 20-3841
HOWARD COUNTY, MARYLAND

SCALE
AS
SHOWN
SHEET
12 OF 28
A6


058472LS
F058472A

A
B
C
D
E
F

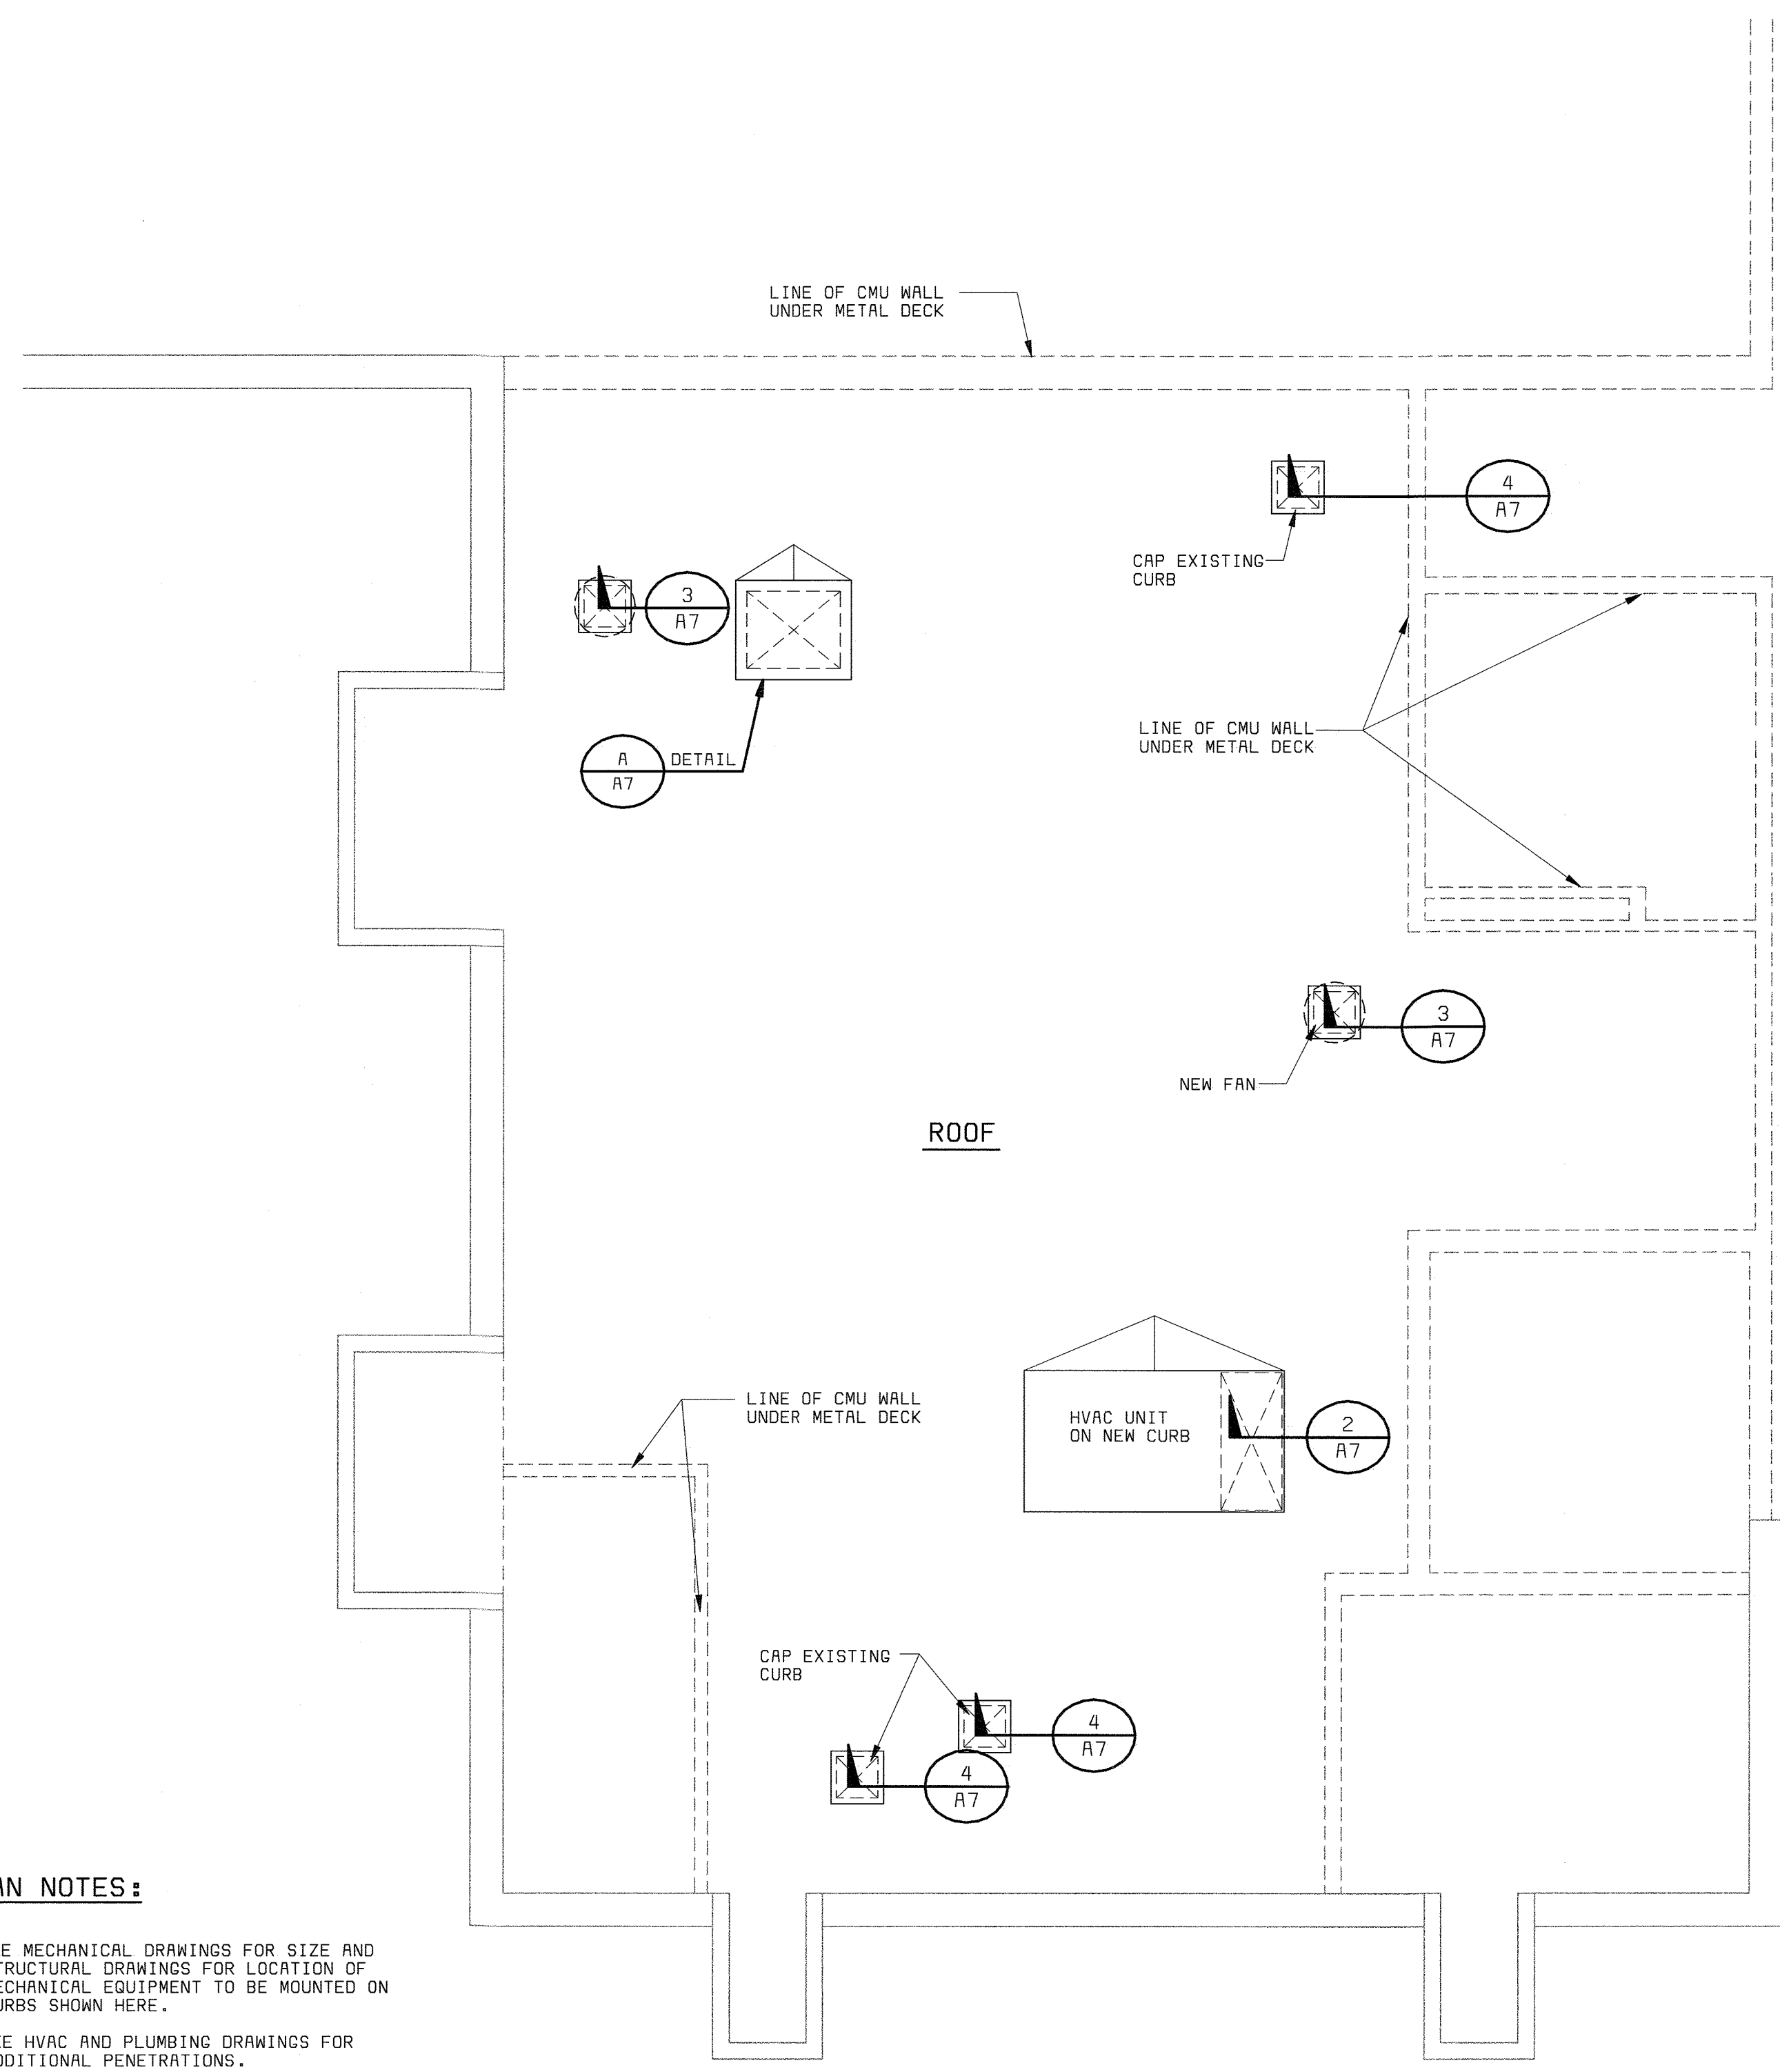


PLAN NOTES:


1. SEE MECHANICAL DRAWINGS FOR SIZE AND STRUCTURAL DRAWINGS FOR LOCATION OF MECHANICAL EQUIPMENT TO BE MOUNTED ON CURBS SHOWN HERE.
2. SEE HVAC AND PLUMBING DRAWINGS FOR ADDITIONAL PENETRATIONS.

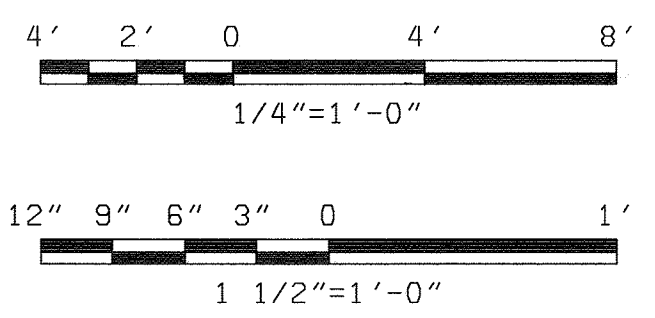


LABORATORY - ROOF PLAN
1/4" = 1'-0" (1 A7)

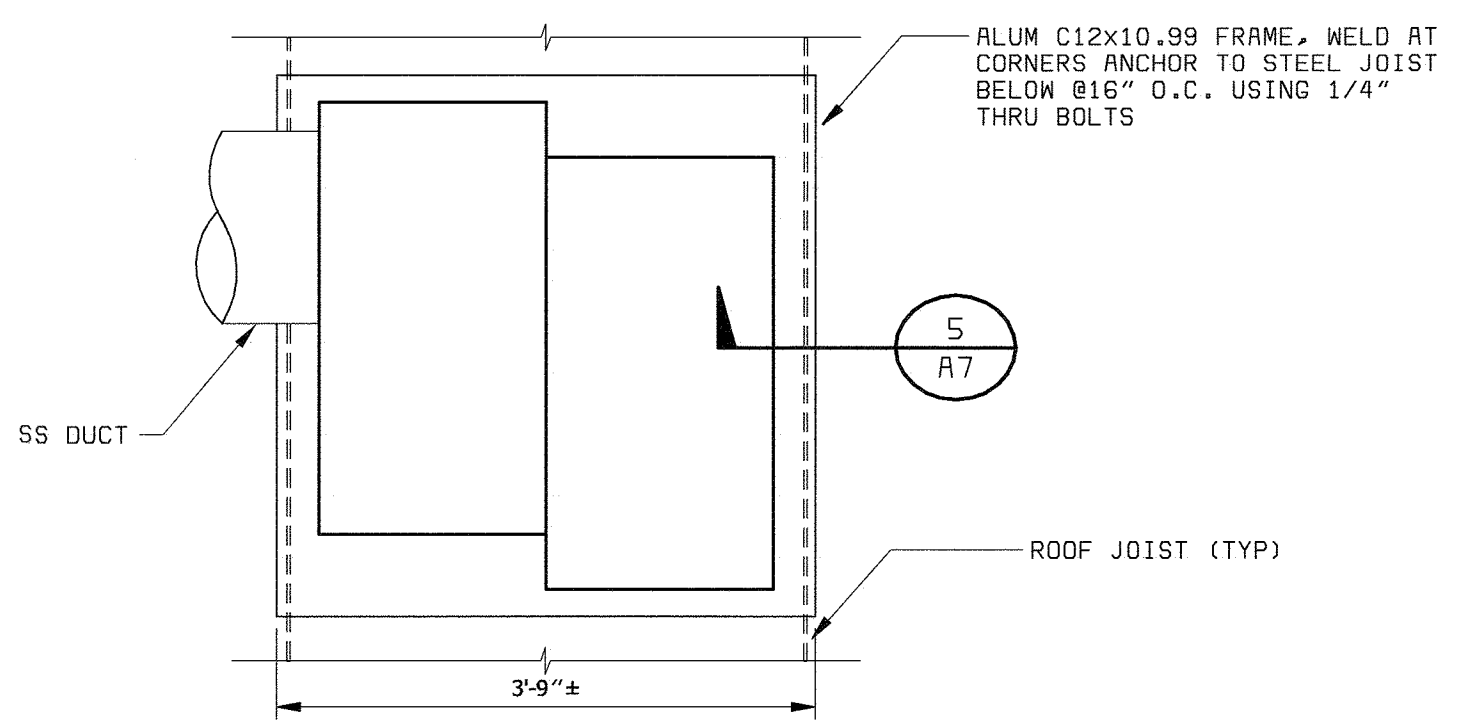


ROOF FAN PAD AND MOUNTING DETAIL
3/4" = 1'-0" (A7)

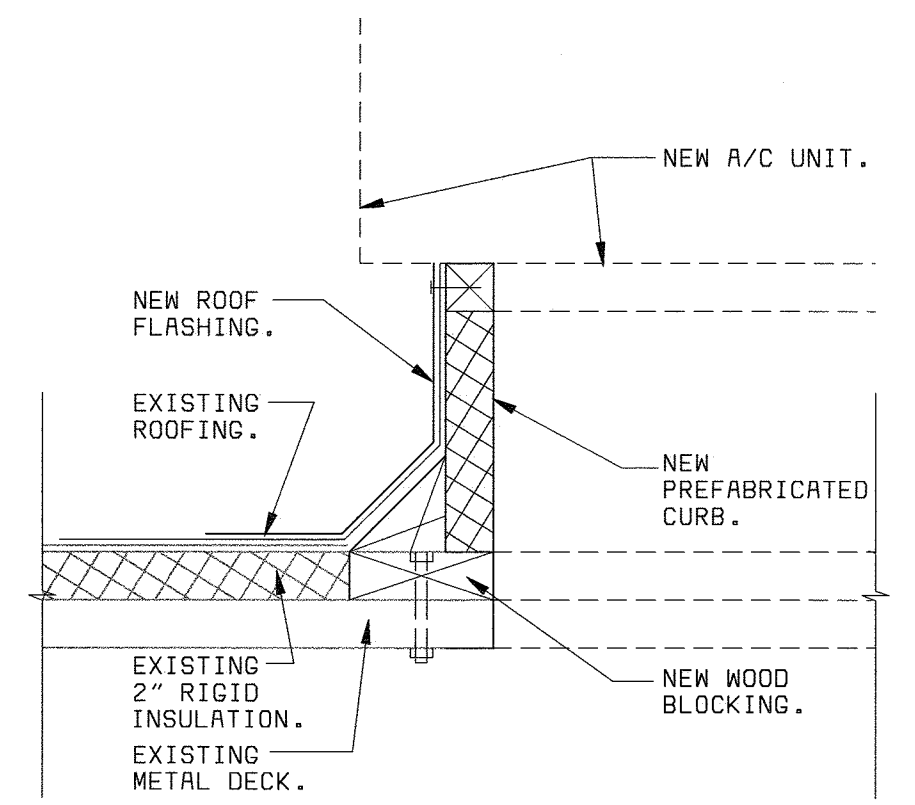


DETAIL 2
1 1/2" = 1'-0" (A7)

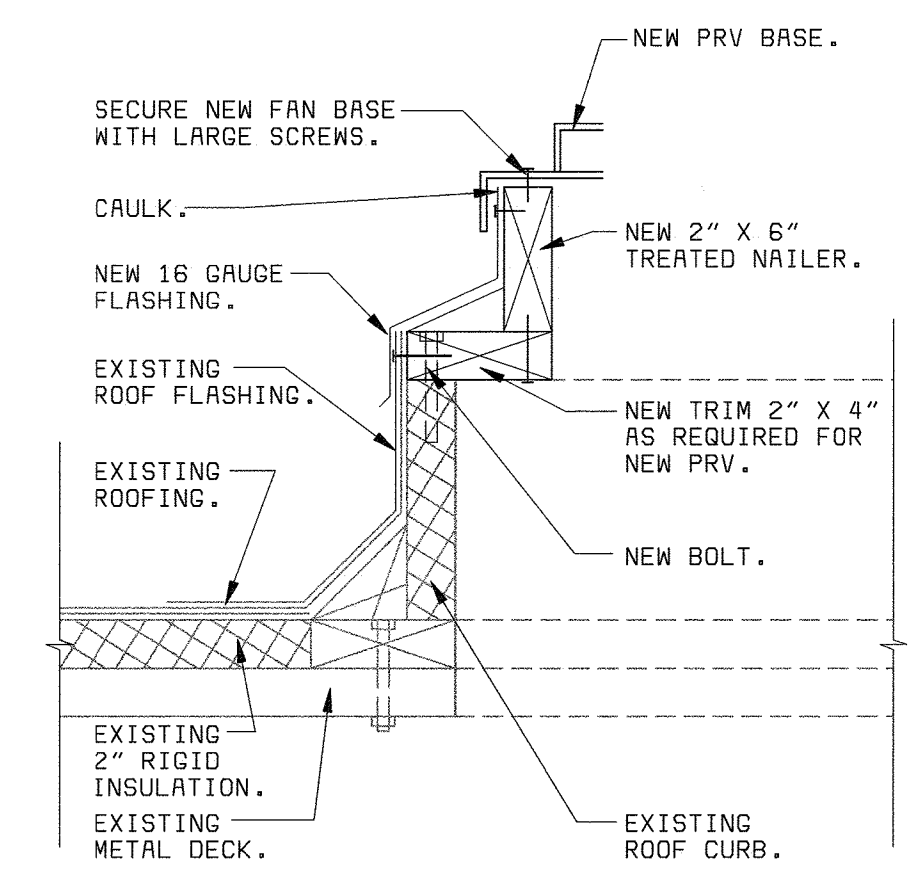


DETAIL 3
1 1/2" = 1'-0" (A7)

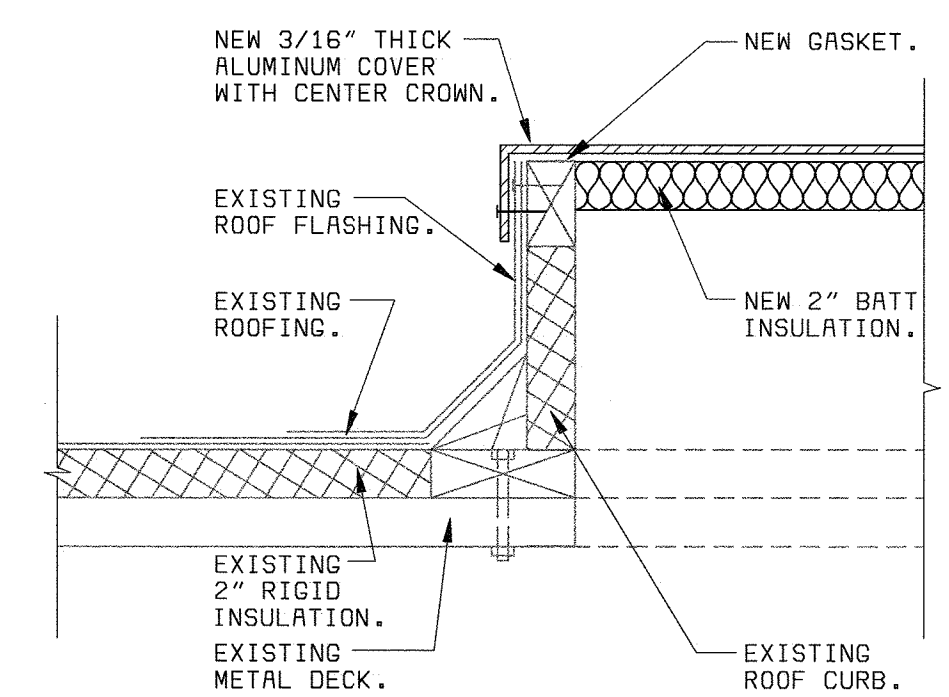

DETAIL 4
1 1/2" = 1'-0" (A7)

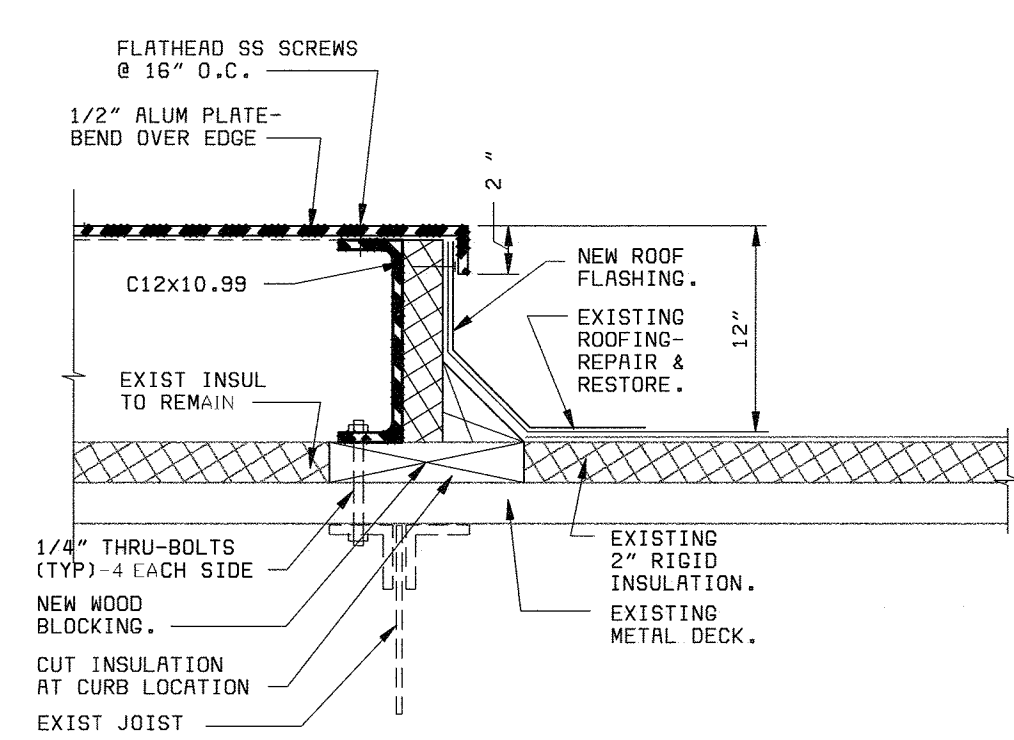

SECTION 5
1 1/2" = 1'-0" (A7)

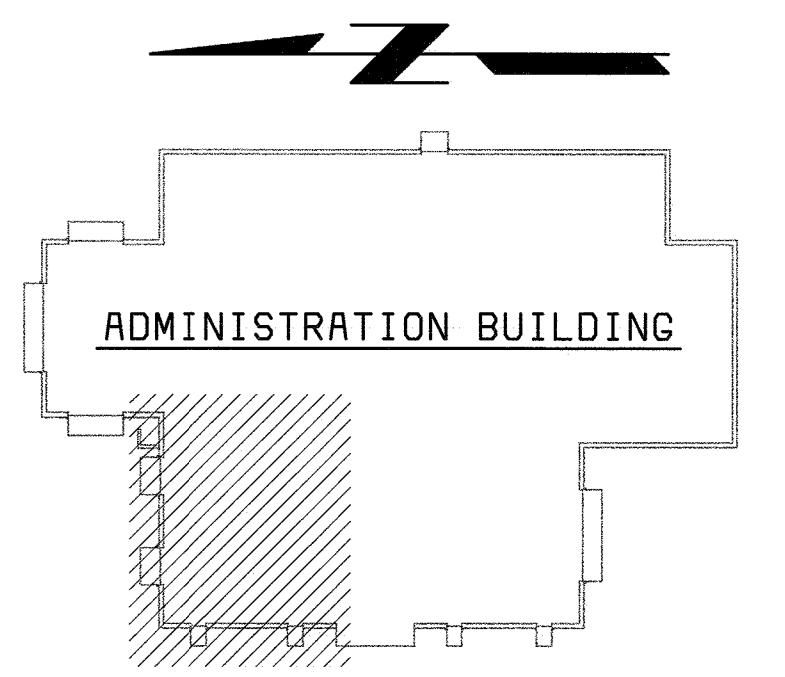

KEY PLAN
NO SCALE

DEPARTMENT OF PUBLIC WORKS
HOWARD COUNTY, MARYLAND
CHIEF, BUREAU OF UTILITIES DATE



BLACK & VEATCH
Gaithersburg, Maryland
REG. PROF. ENGR. DATE

THIS DRAWING WAS
ORIGINALLY APPROVED
FOR CONSTRUCTION
AND SEALED BY
CHARLES I. BRYANT
A REGISTERED
ARCHITECT
IN THE
STATE OF MARYLAND,
NO. 1377-R


DES:	CH						
DRN:	JS						
CHK:	CH/JS						
DATE:	08/00	11/03/03	CONFORMED TO CONSTRUCTION RECORDS				
			REVISIONS AND RECORD OF ISSUE				

ARCHITECTURAL
**ADMINISTRATION BUILDING
LABORATORY ROOF PLAN
AND DETAILS**


LITTLE PATUXENT WATER RECLAMATION PLANT
ADDITION NO. 6
LABORATORY RENOVATION
CAPITAL PROJECT S-6205
CONTRACT NO. 20-3841
HOWARD COUNTY, MARYLAND

SCALE
AS
SHOWN
SHEET
13 OF 28
A7


D58472-5
FD58472A

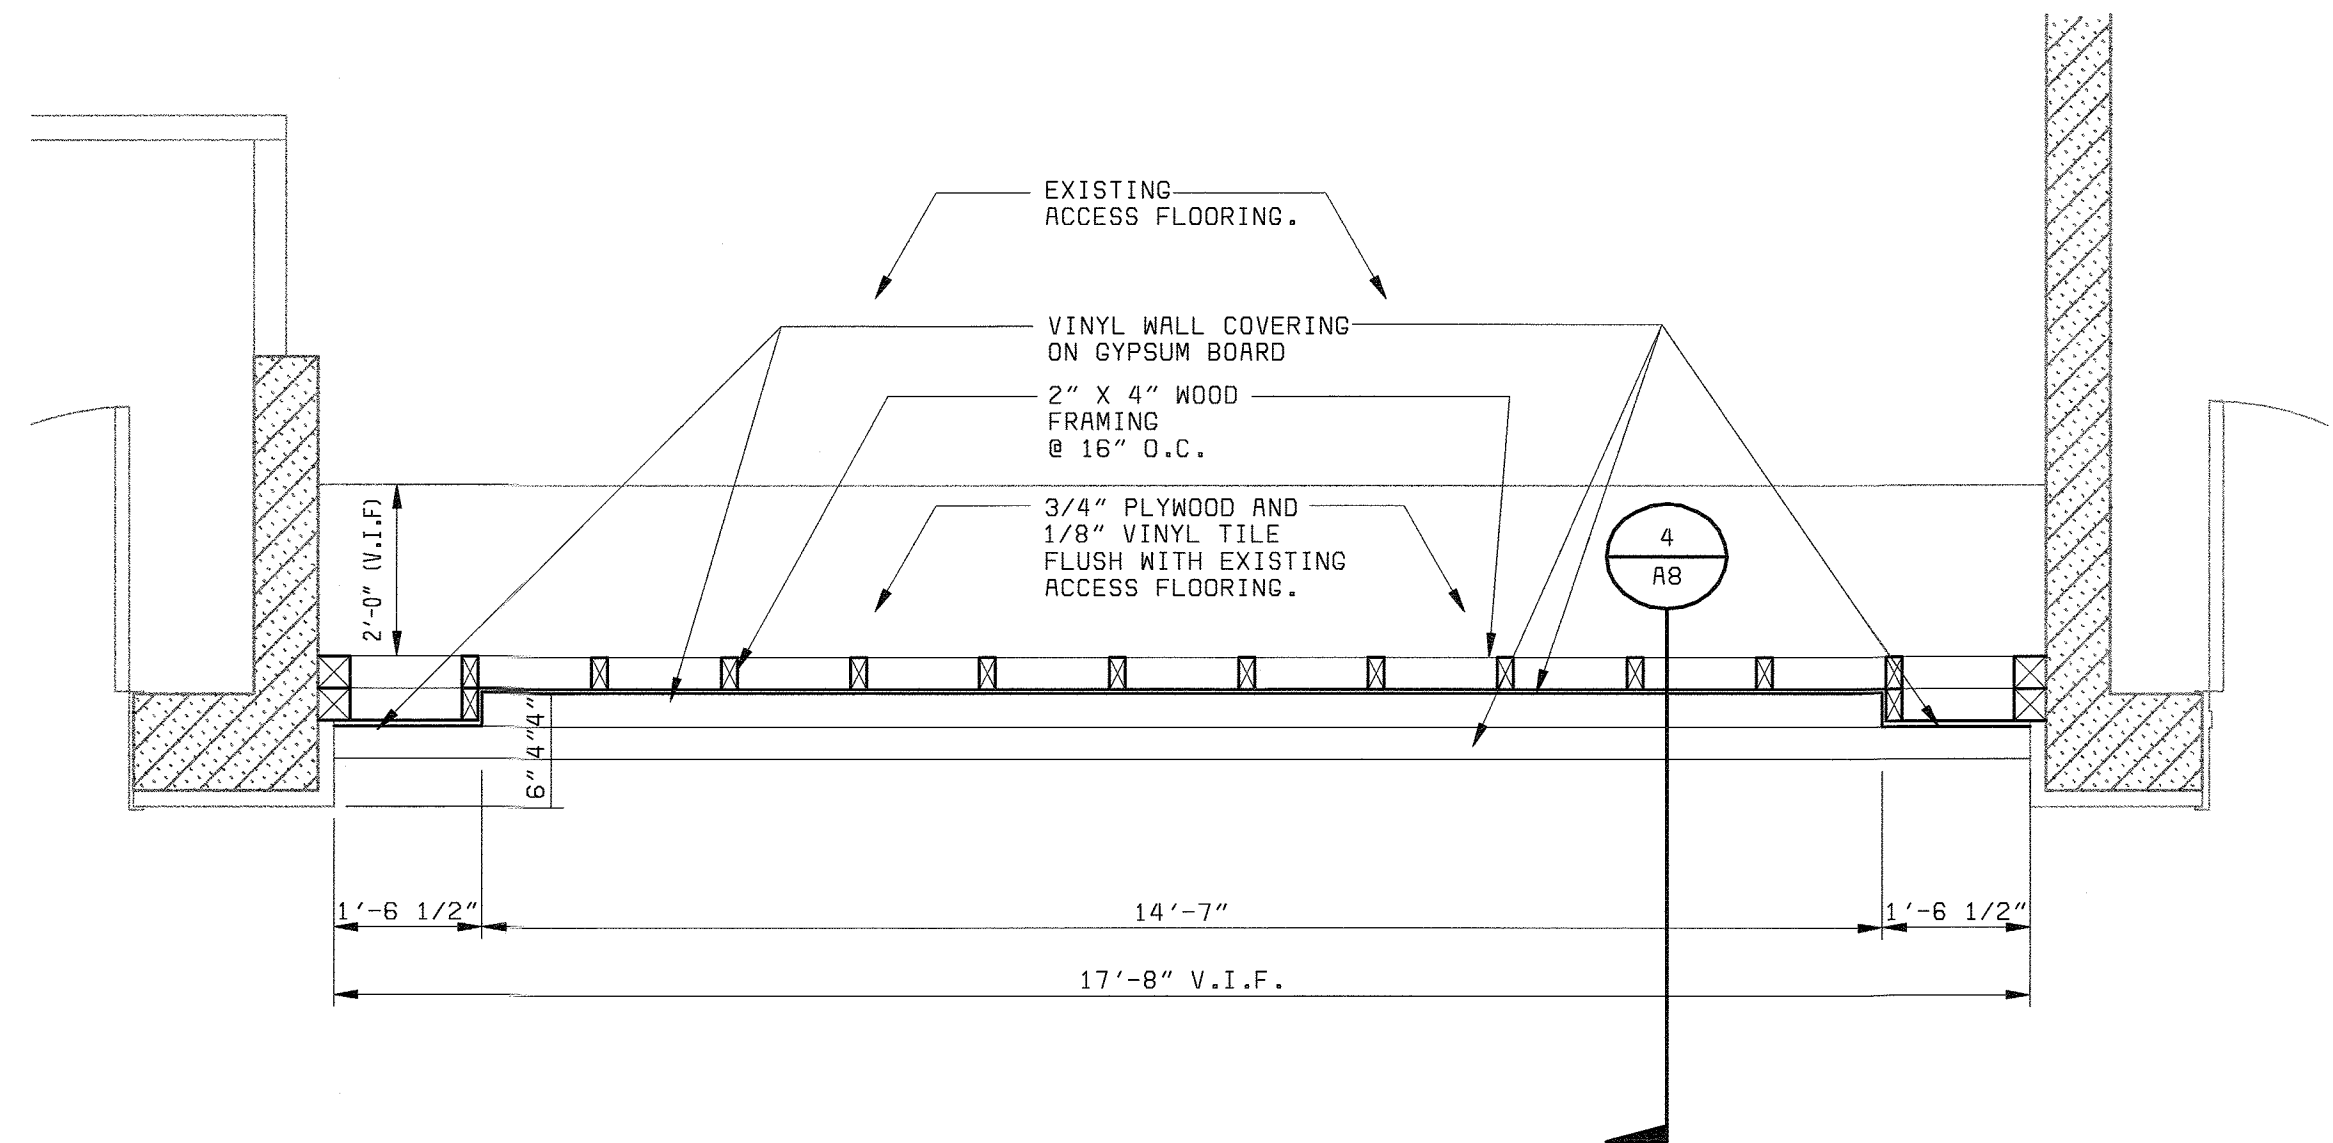


FLOOR PLAN 1
1/2" = 1'-0"

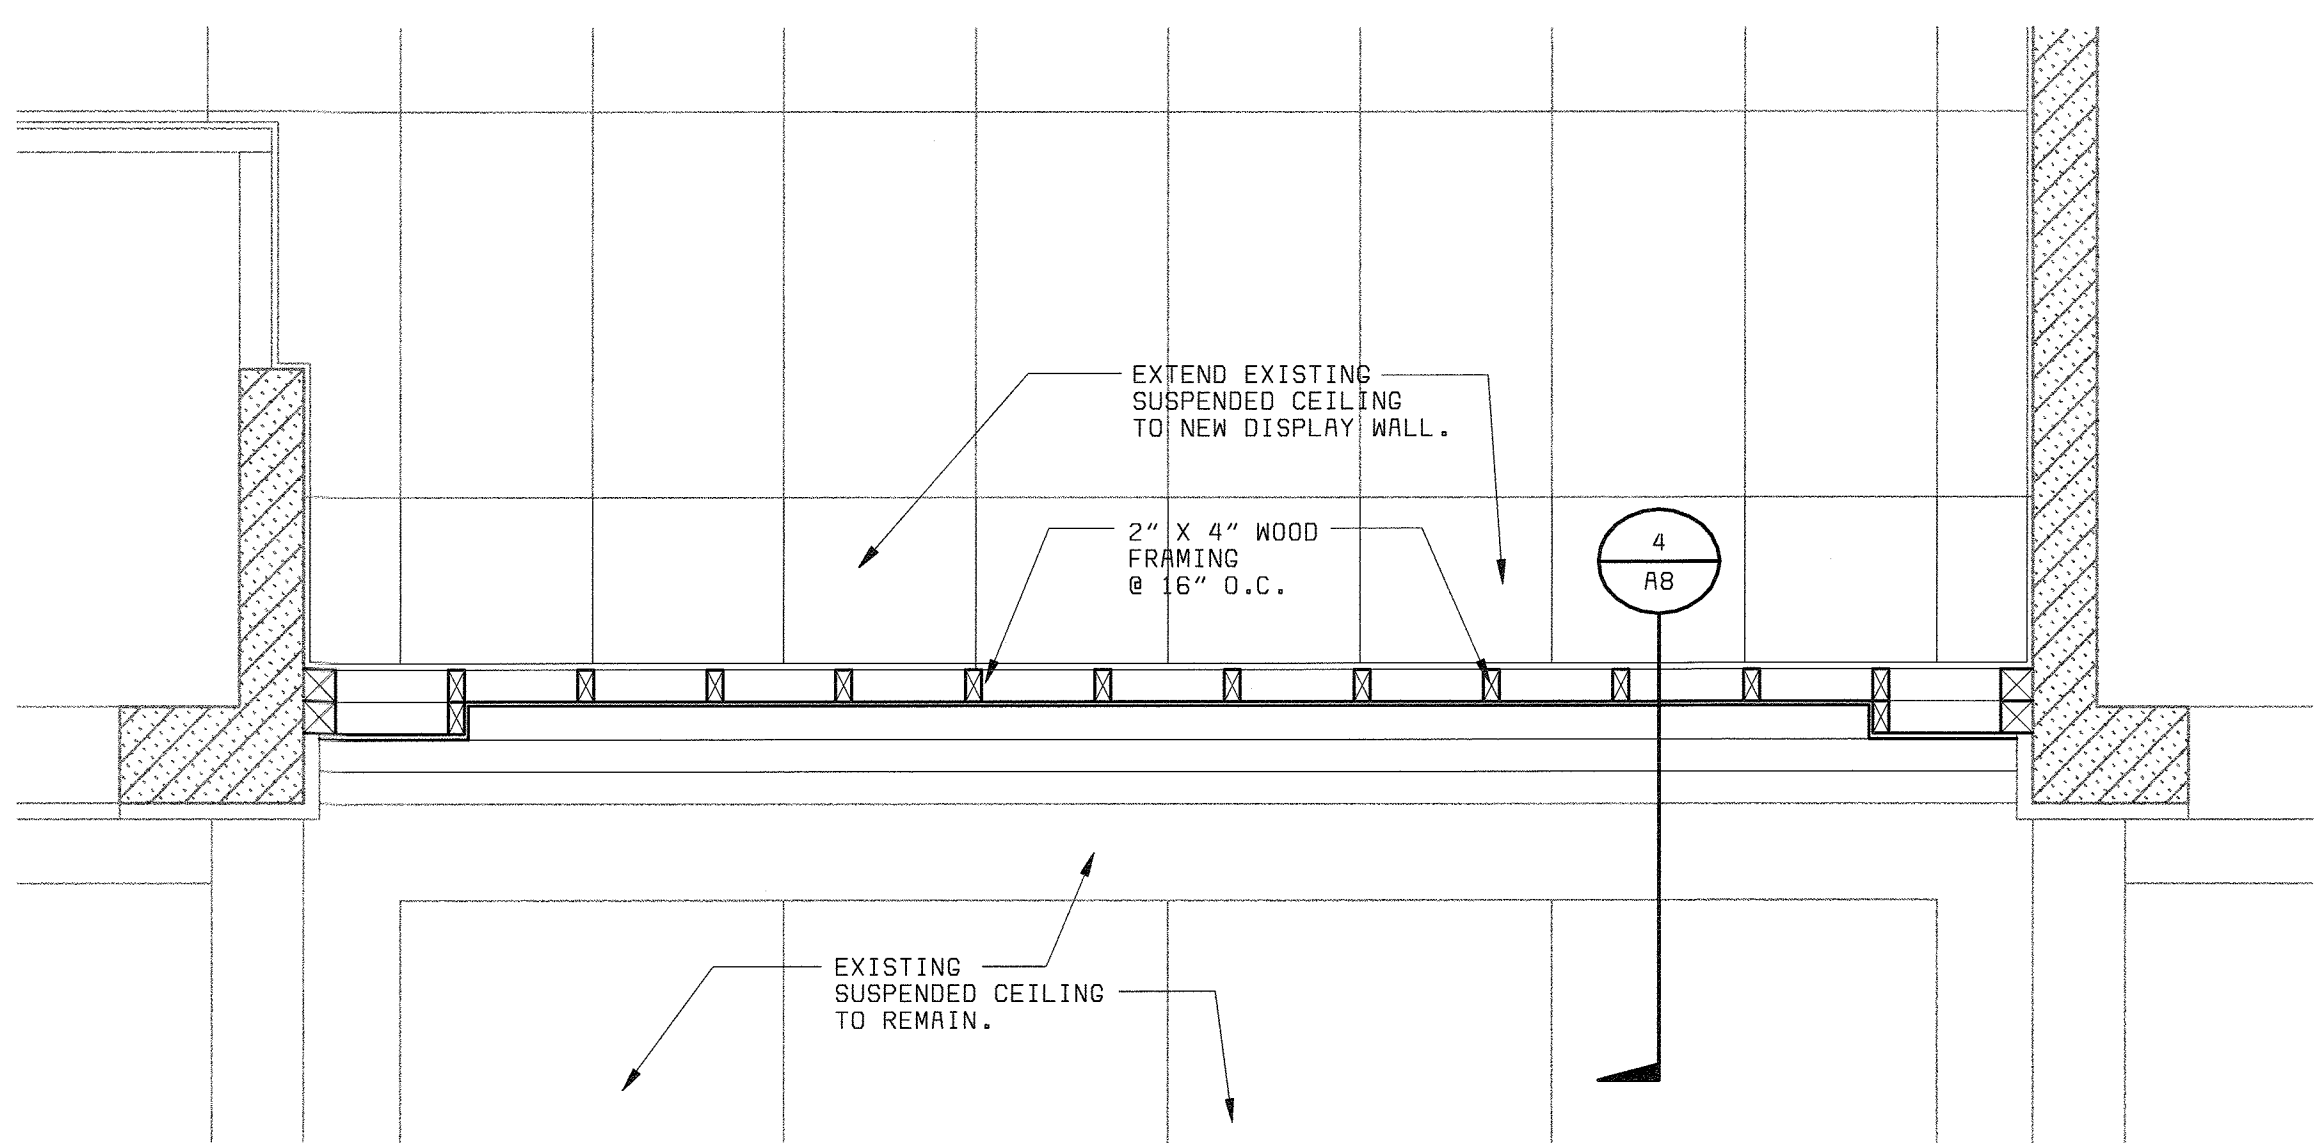

REFLECTED CEILING PLAN 2
1/2" = 1'-0"

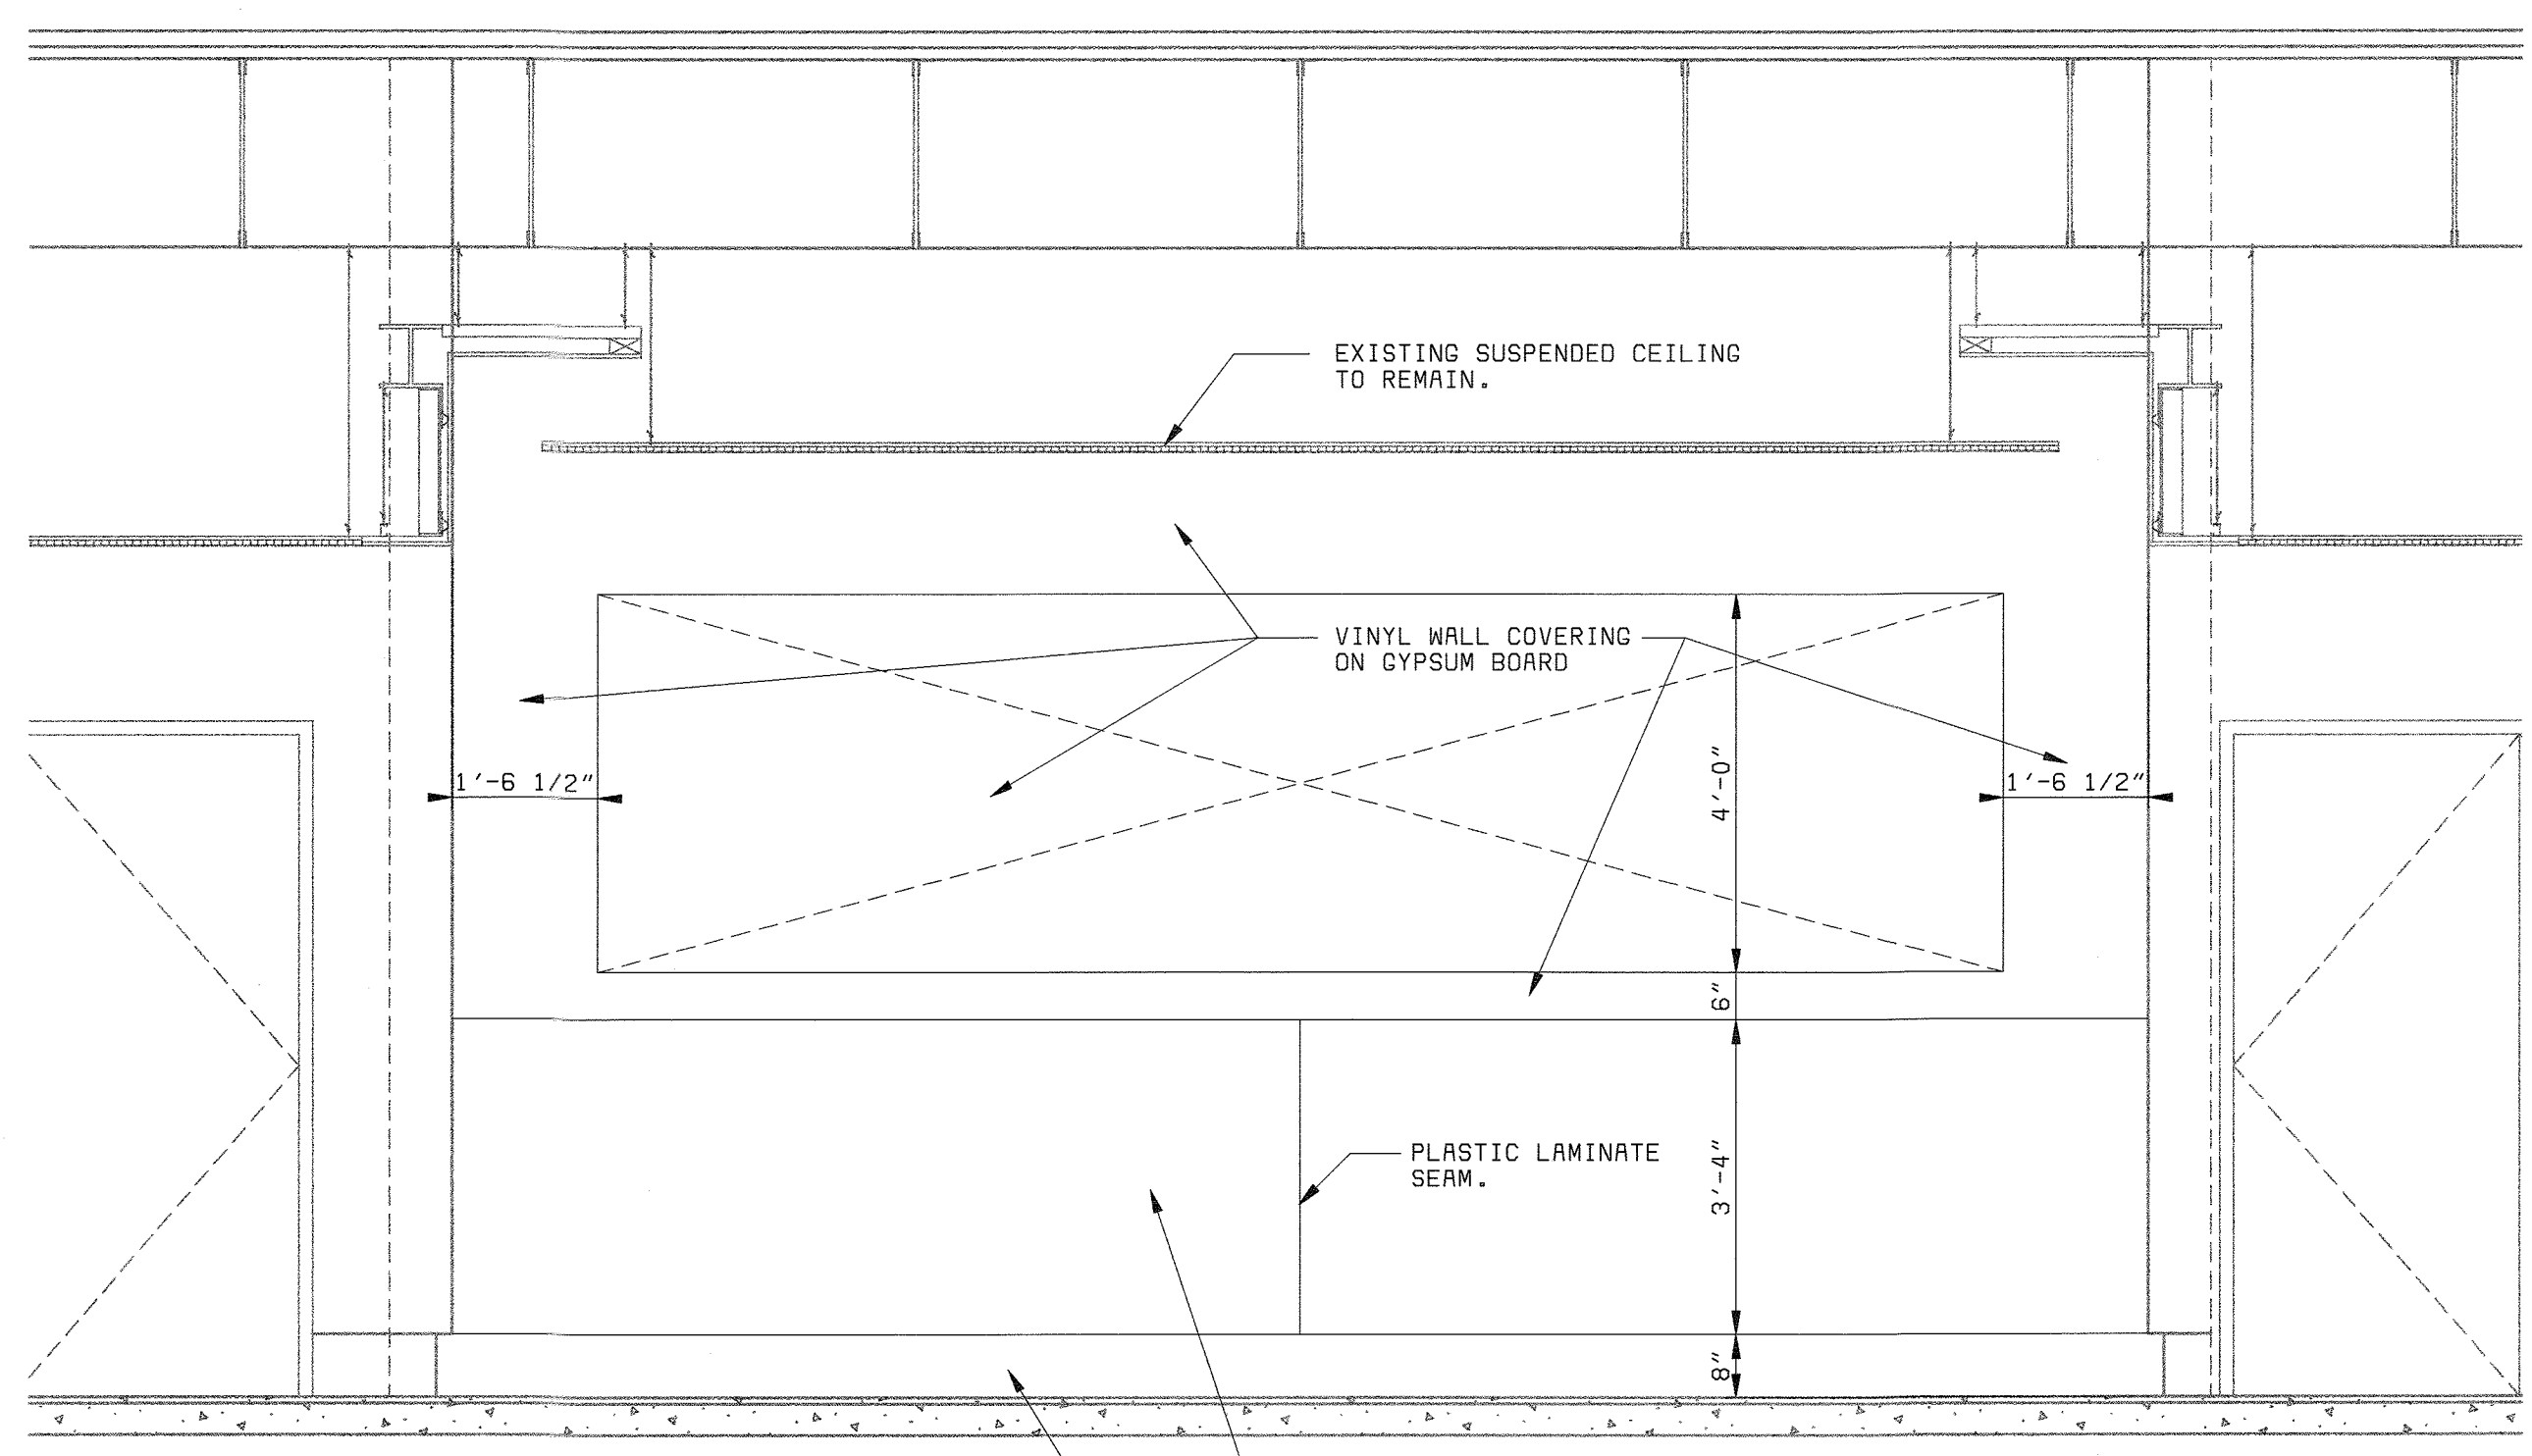


SECTION ELEVATION 3
1/2" = 1'-0"

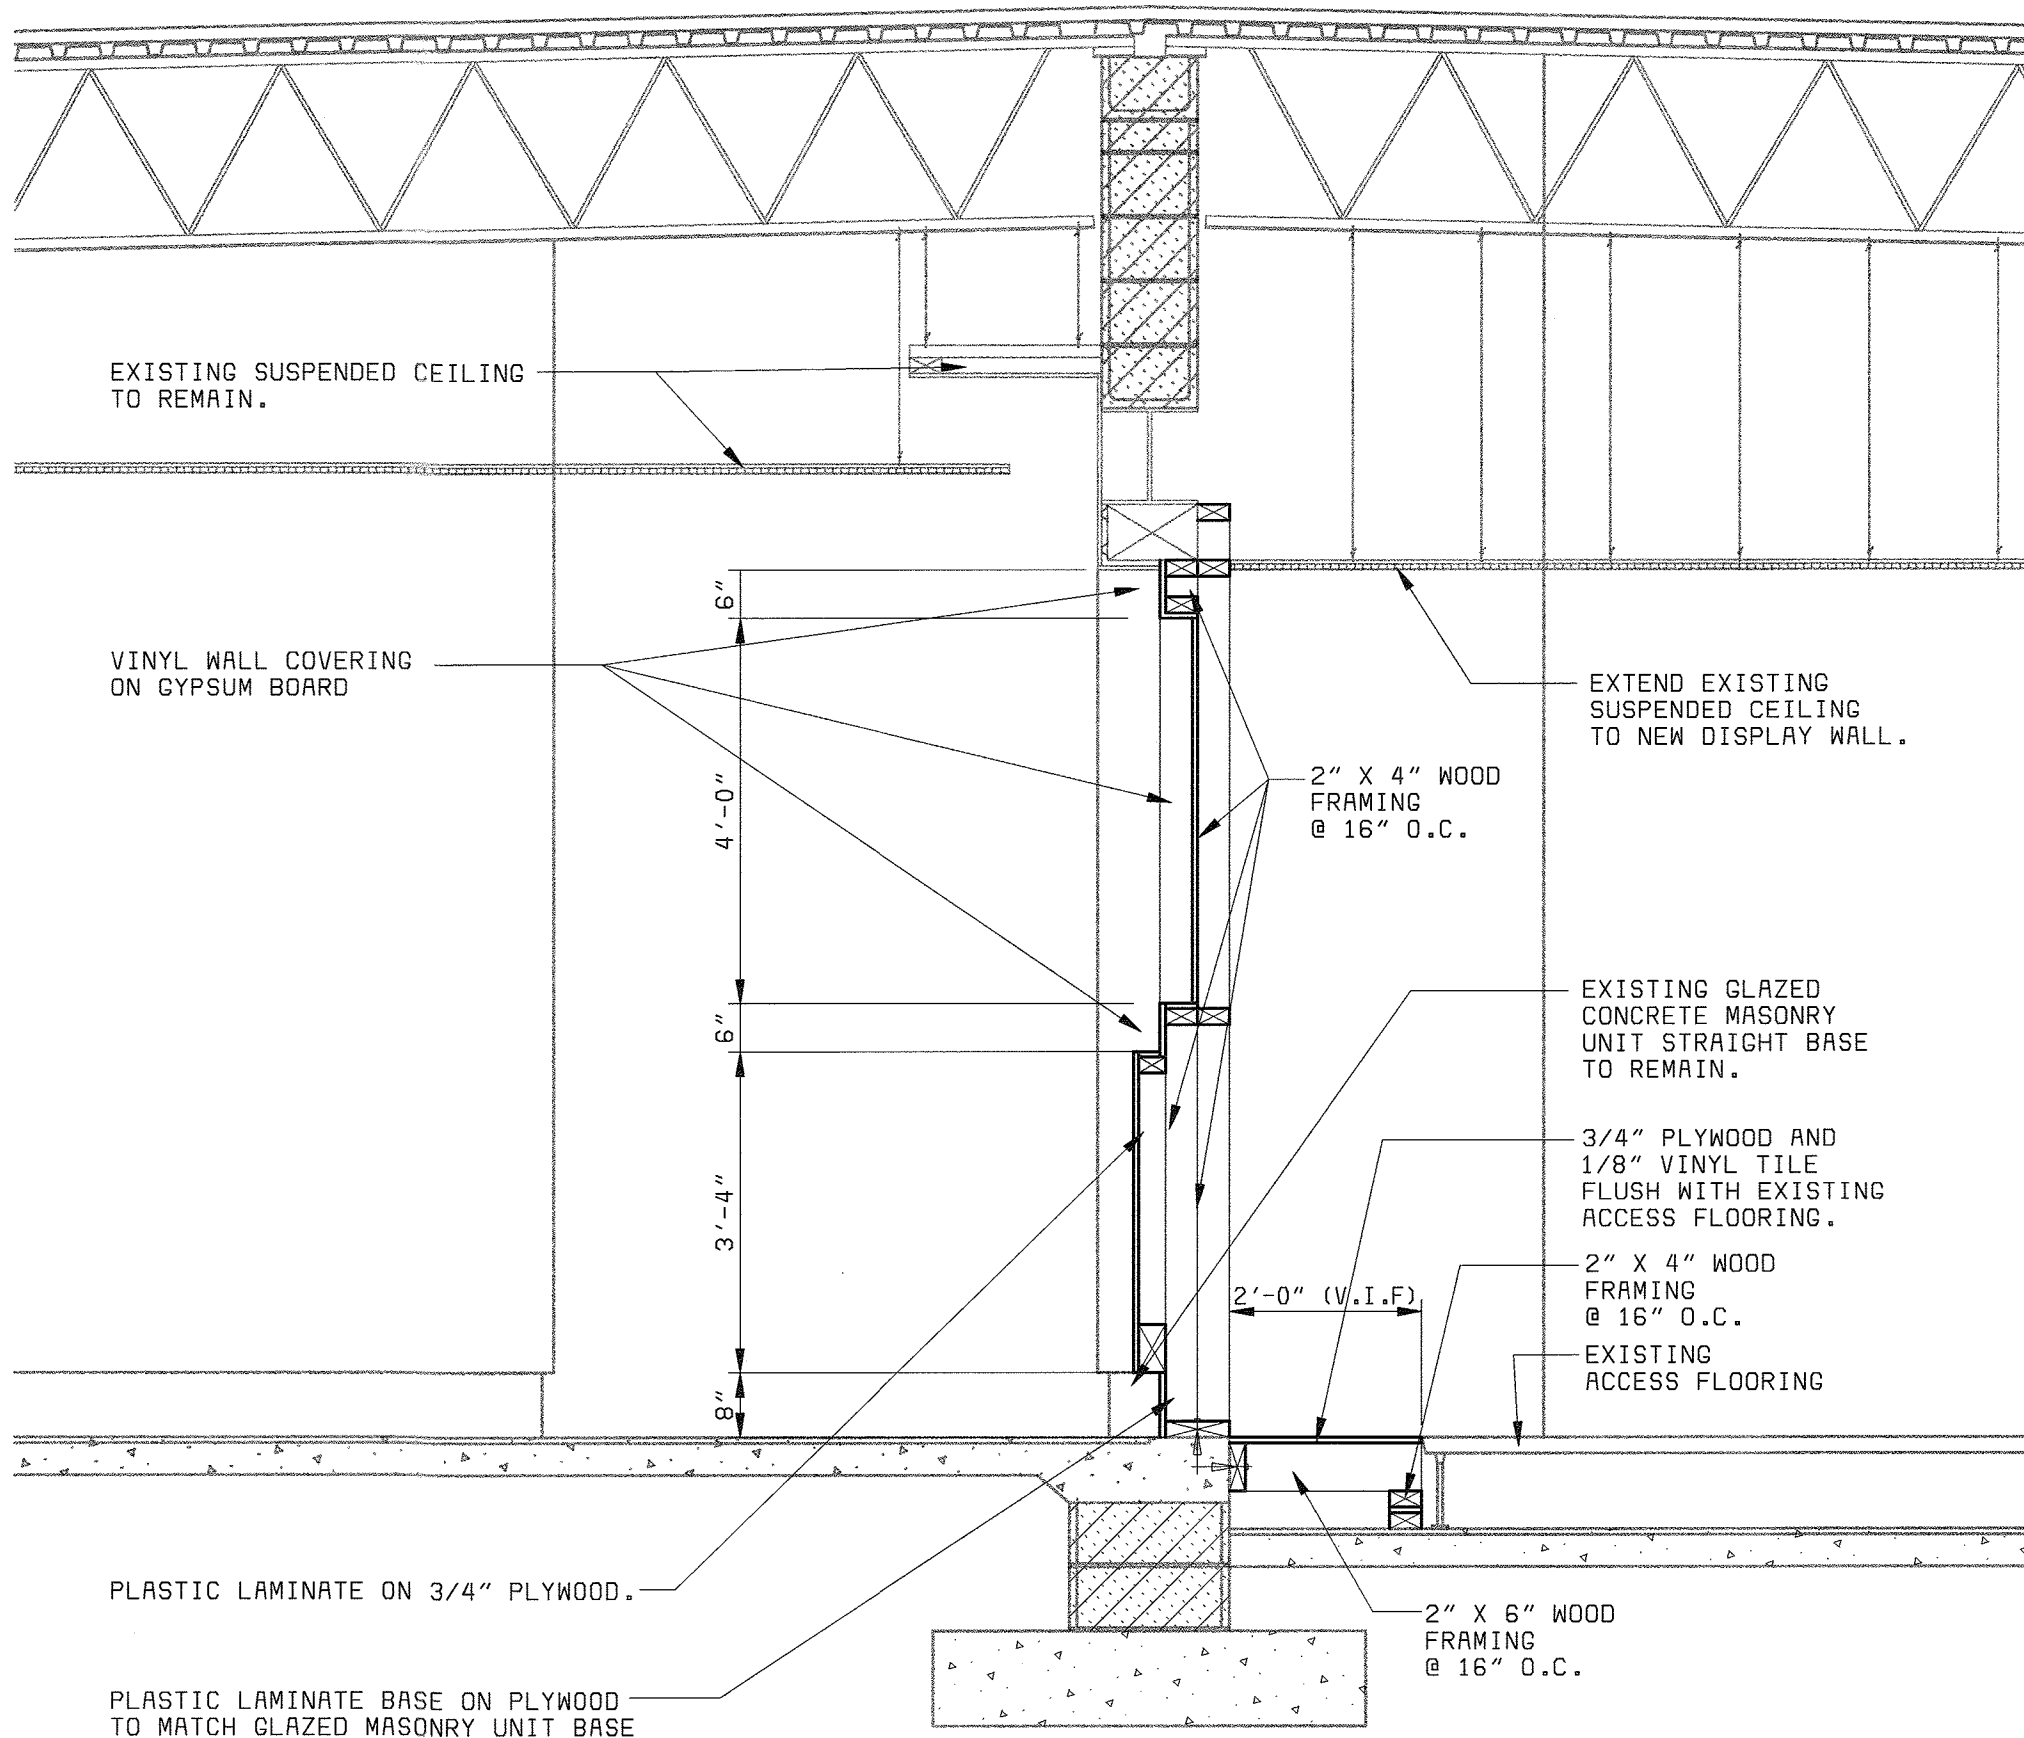


SECTION ELEVATION 4
1/2" = 1'-0"

DRAWING NOTES:

1. REMOVE AND SAVAGE EXISTING ALUMINUM LETTERS BELOW EXISTING DISPLAY BOARD.
2. THE QUALITY STANDARDS FOR THIS FINISH QUALITY WOODWORK WILL BE THE CONSTRUCTION BEING REMOVED (NOT INCLUDING THE WEAR AND TEAR), AND THE ARCHITECTURAL WOODWORK QUALITY STANDARDS OF THE AMERICAN WOODWORK INSTITUTE.

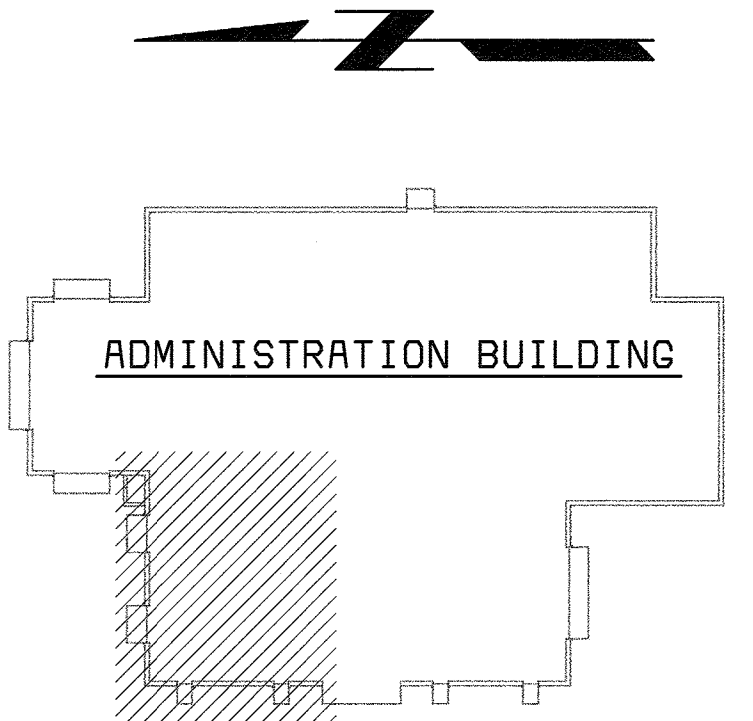

KEY PLAN
NO SCALE

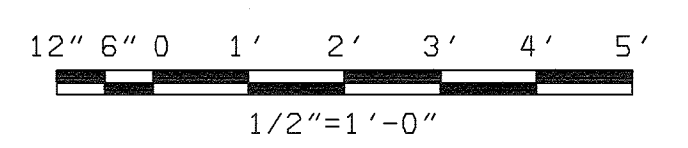

DEPARTMENT OF PUBLIC WORKS
HOWARD COUNTY, MARYLAND



BLACK & VEATCH LLP
Gaithersburg, Maryland



DES:	CH/JS				
DRN:	JS				
CHK:	CH				
DATE:	10/01	11/03/03	CONFORMED TO CONSTRUCTION RECORDS	RHH/RJR/RJR	
			REVISIONS AND RECORD OF ISSUE	NO.	BY

ARCHITECTURAL

**ADMINISTRATION BUILDING
LOBBY DISPLAY
PLAN, ELEVATION AND DETAILS**

**LITTLE PATUXENT WATER RECLAMATION PLANT
ADDITION NO. 6
LABORATORY RENOVATION**

CAPITAL PROJECT S-6205
CONTRACT NO. 20-3841


HOWARD COUNTY, MARYLAND

SCALE
AS
SHOWN


SHEET
14 OF 28

A8


D58472-LS
F058472A

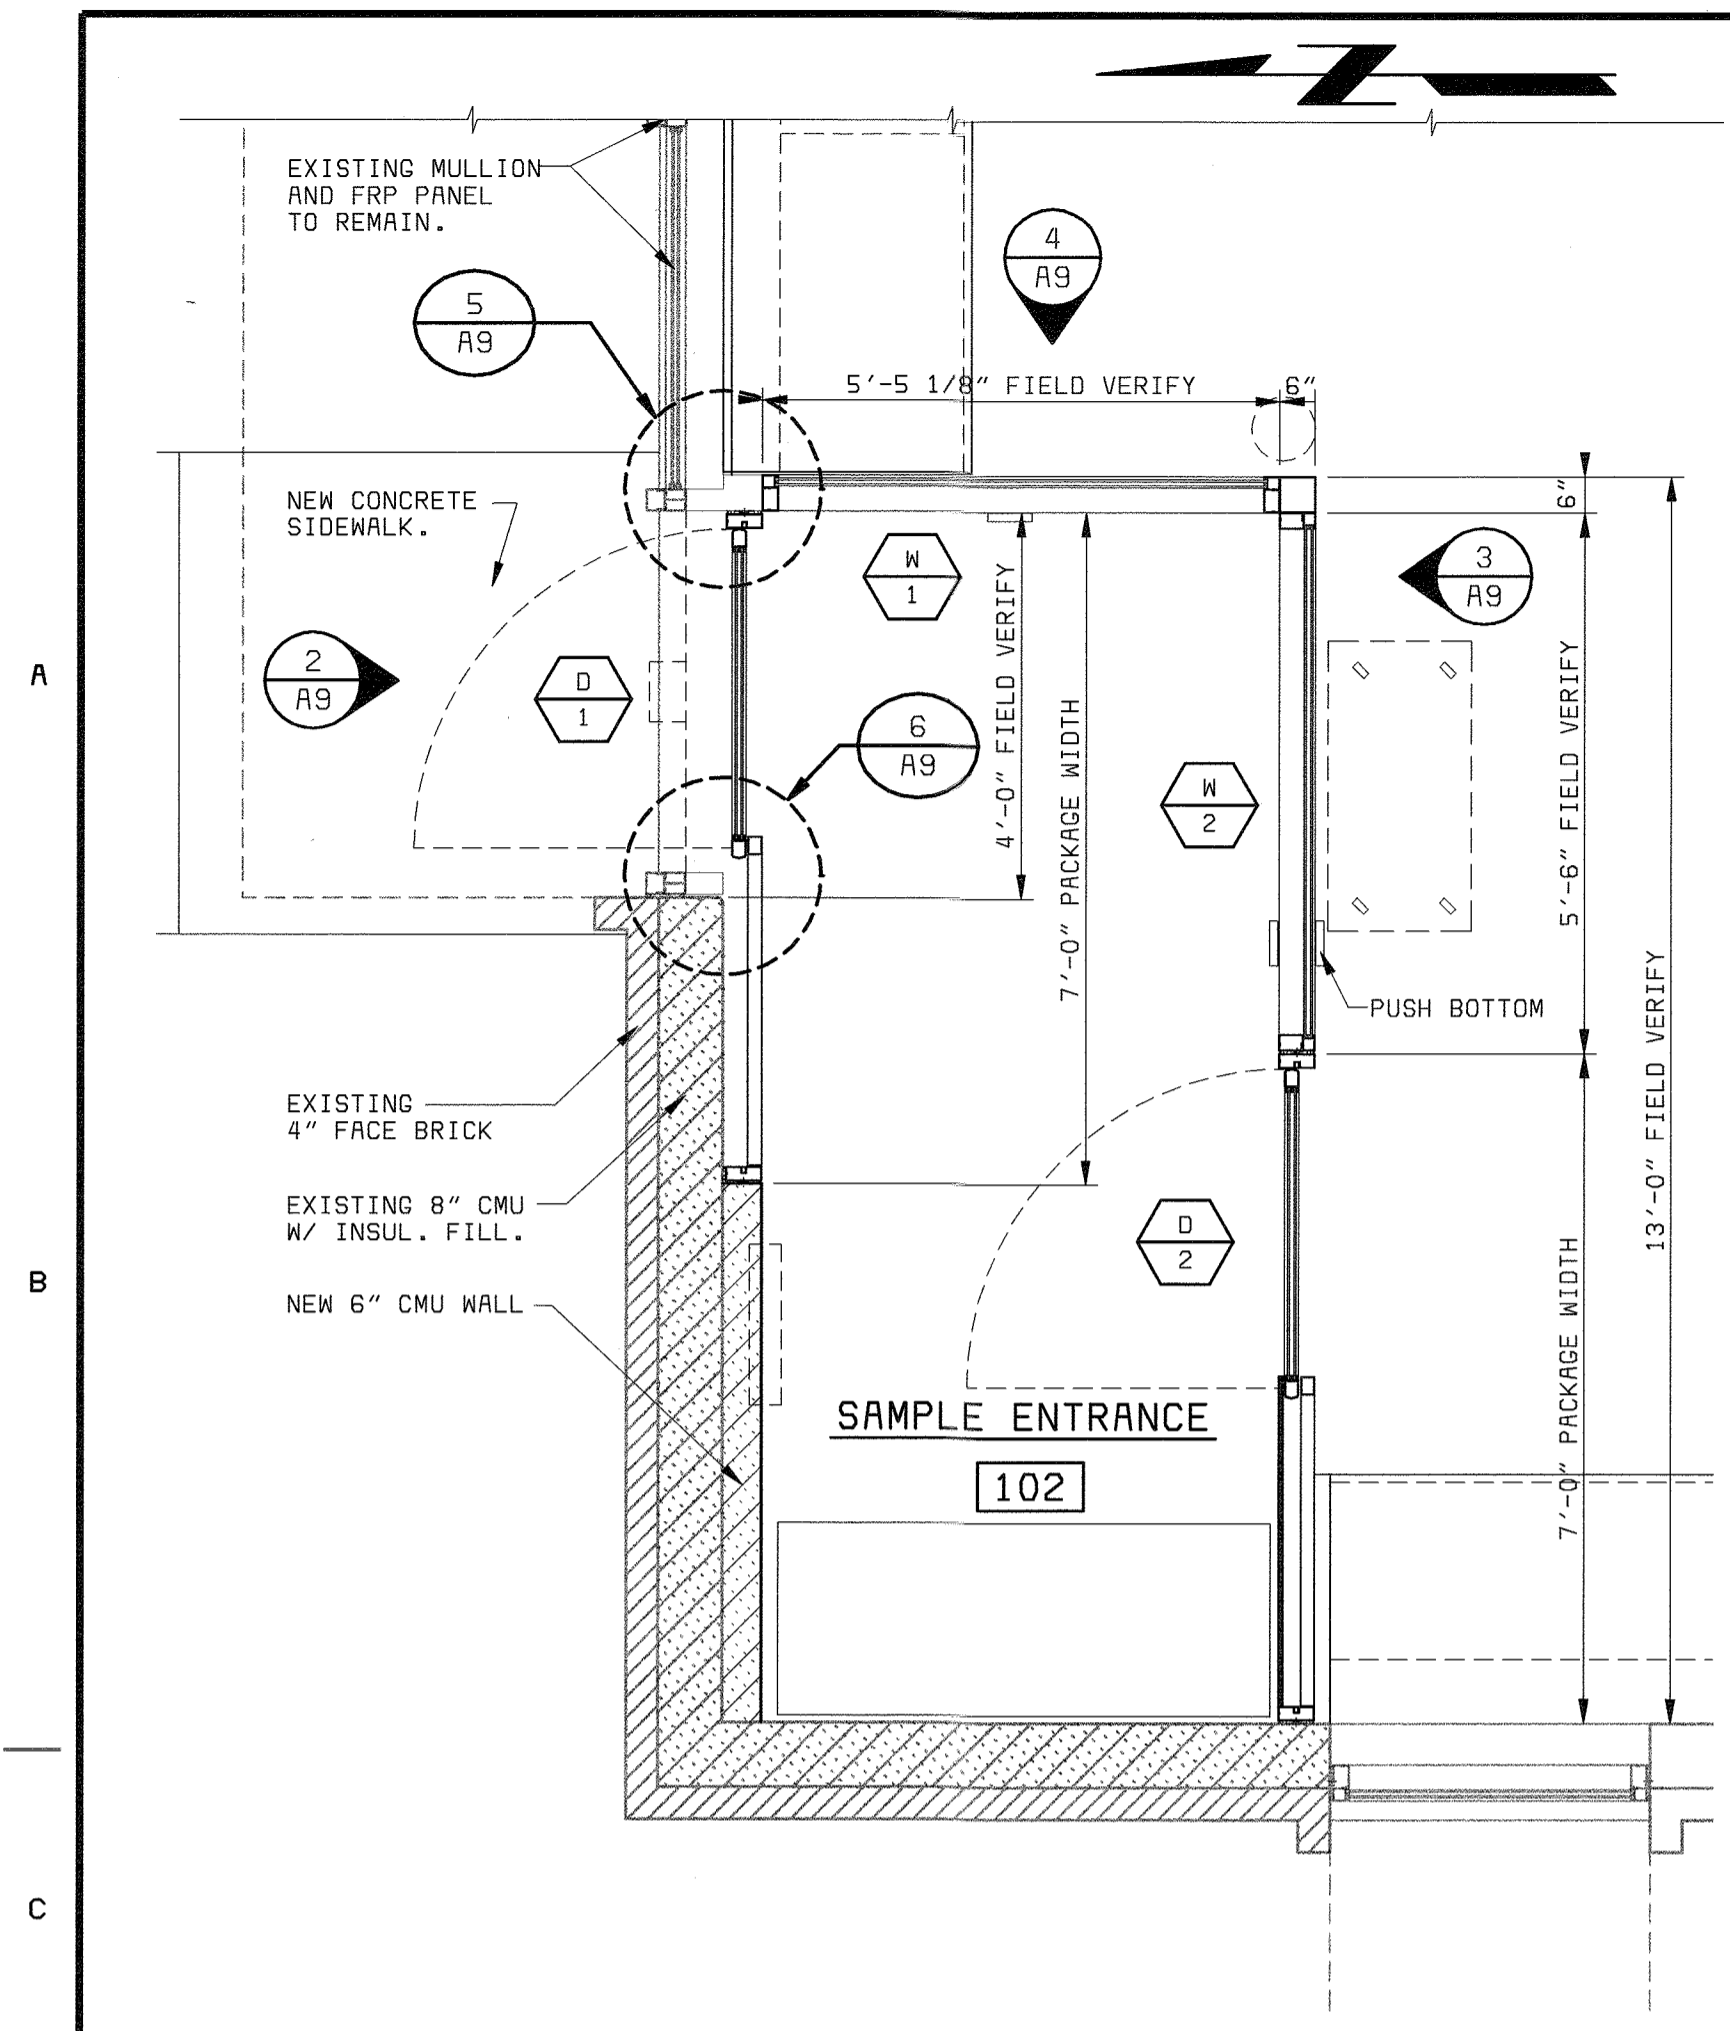


SAMPLE ENTRANCE DETAIL PLAN (1)
1/2" = 1'-0"

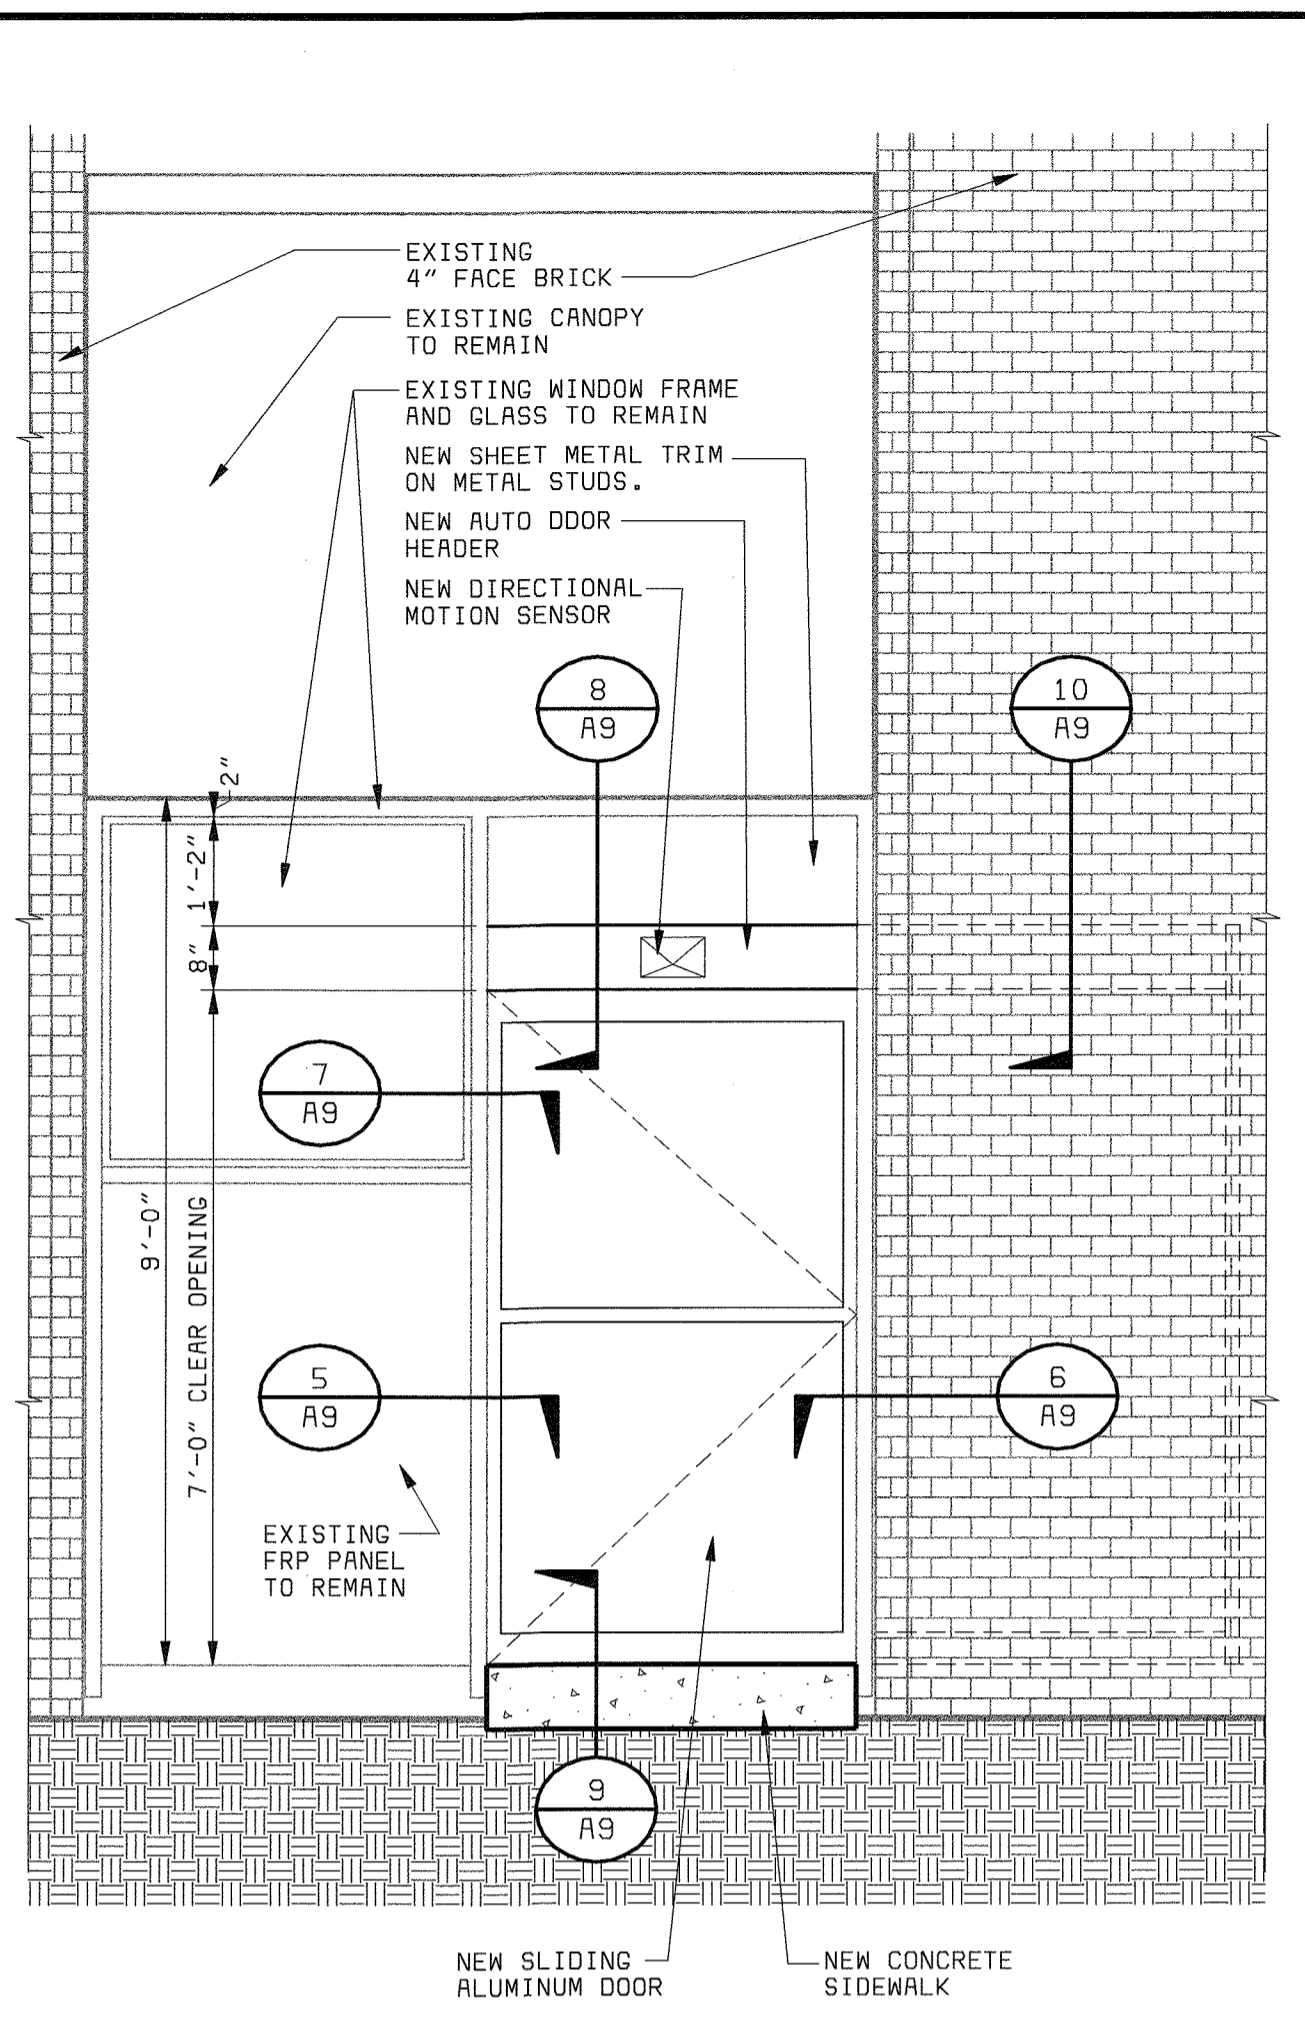


ELEVATION DETAIL (2)
1/2" = 1'-0"

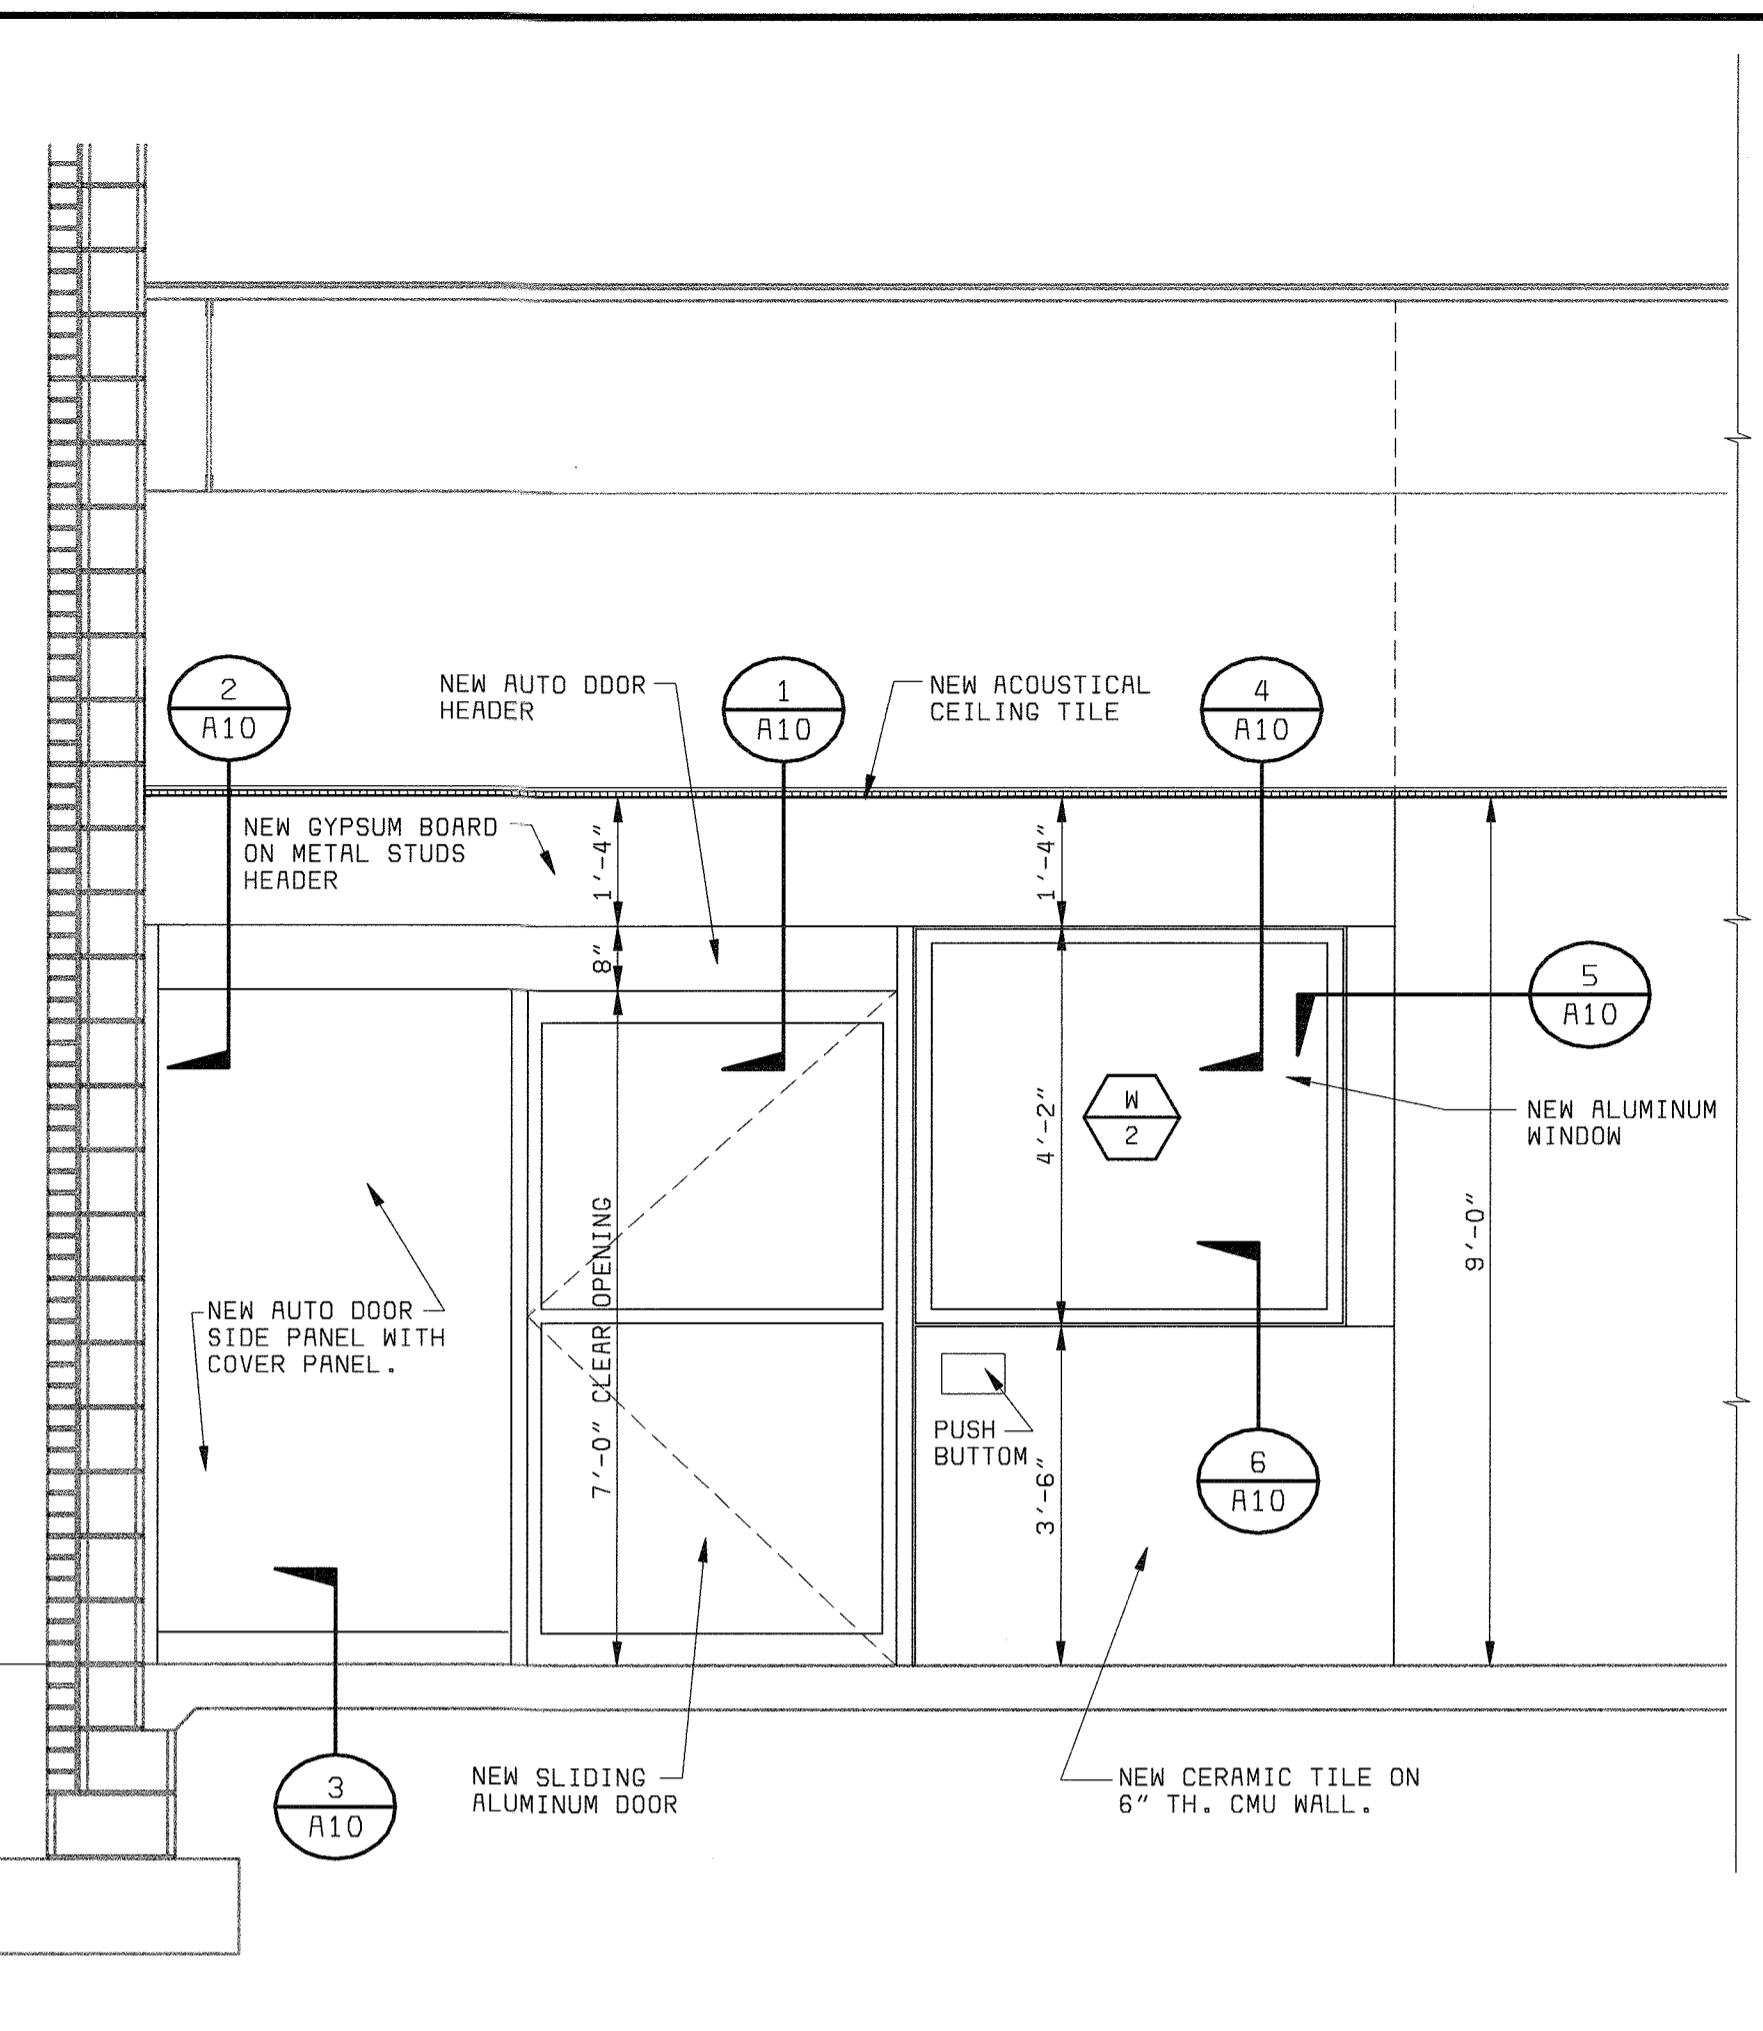

ELEVATION DETAIL (3)
1/2" = 1'-0"

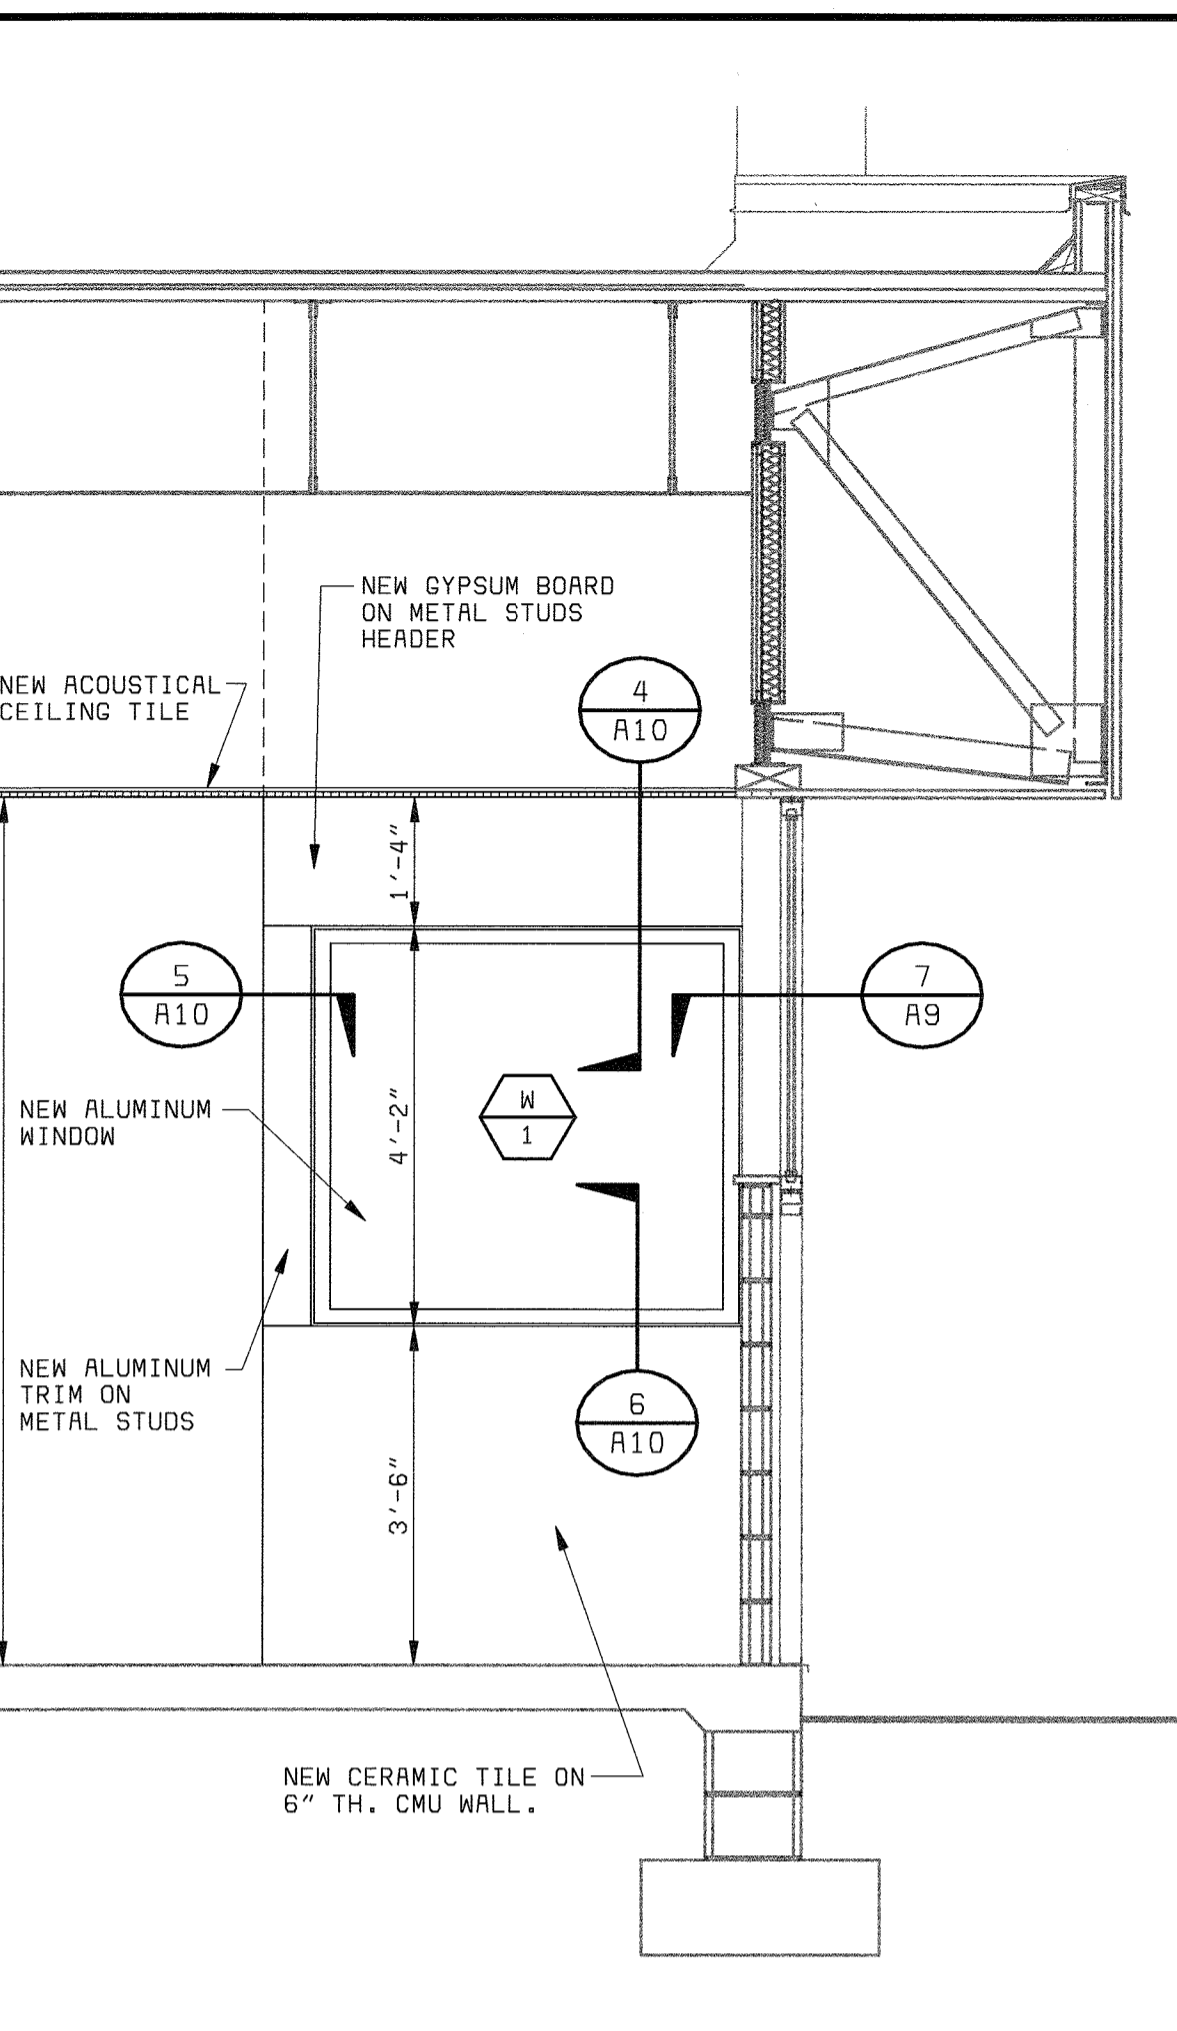


ELEVATION DETAIL (4)
1/2" = 1'-0"

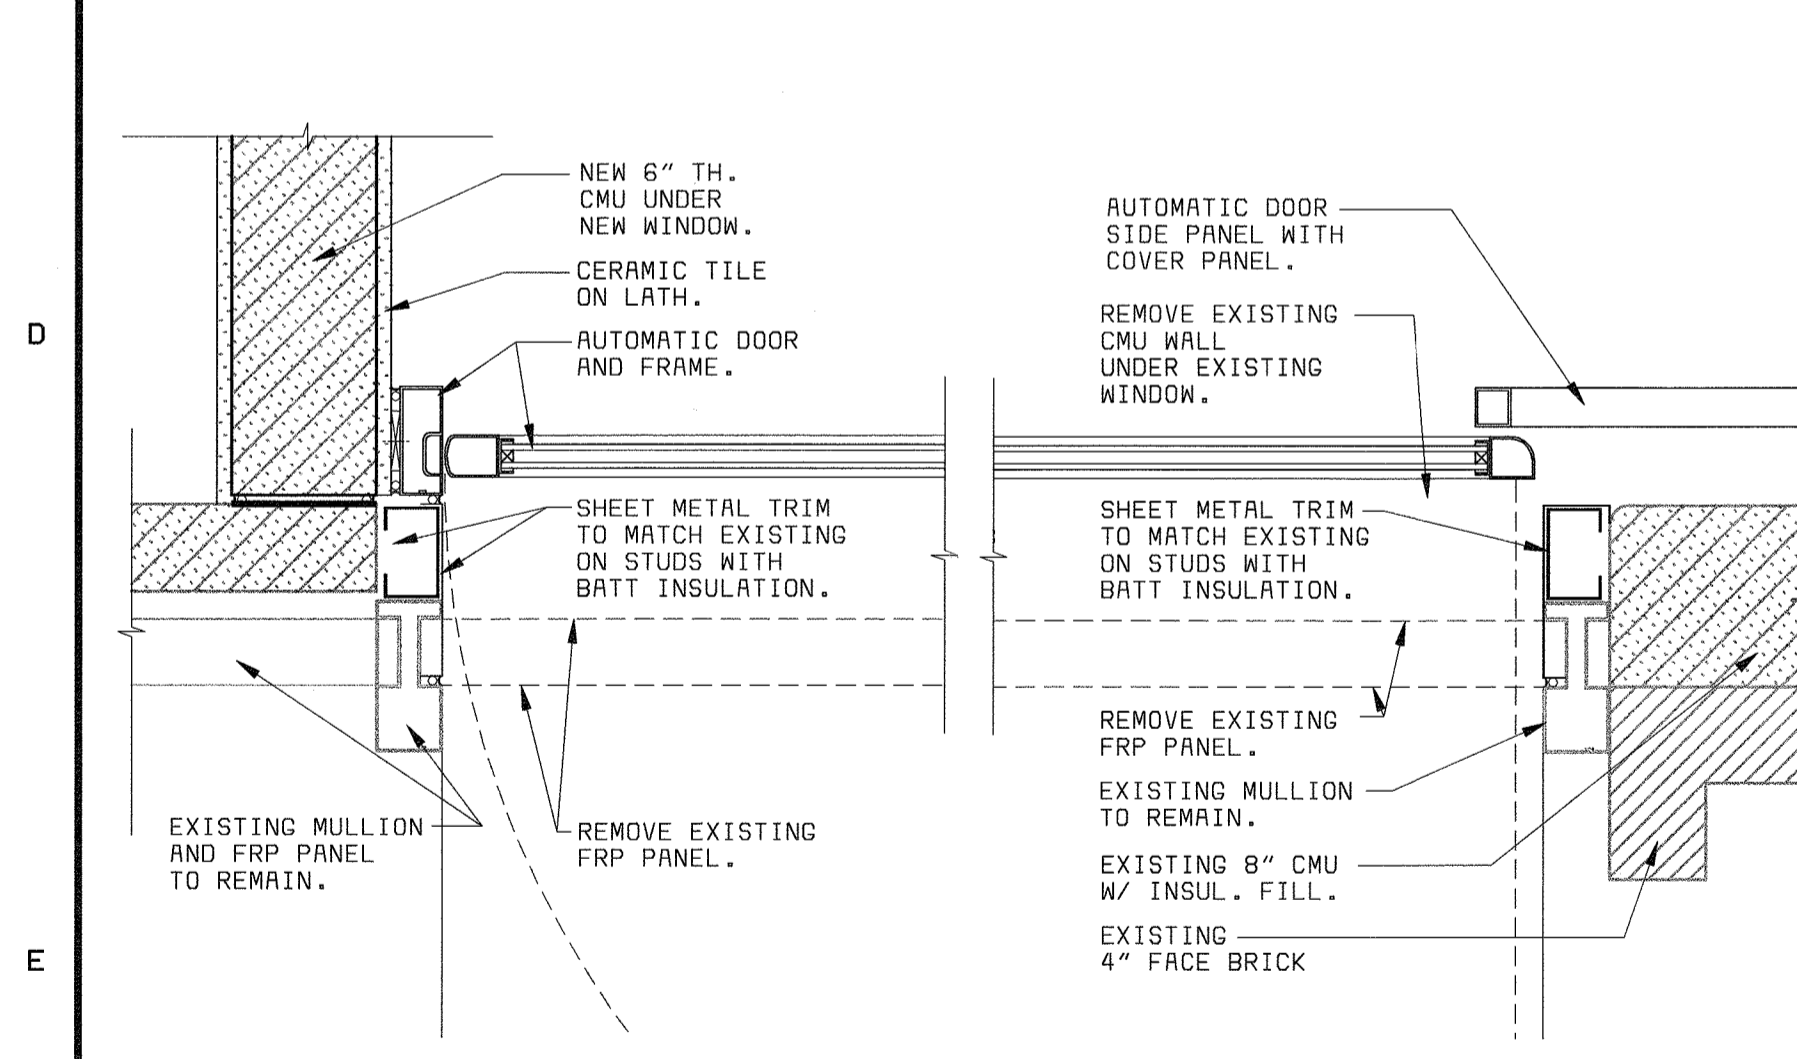


DETAIL (5)
1 1/2" = 1'-0"


DETAIL (6)
1 1/2" = 1'-0"

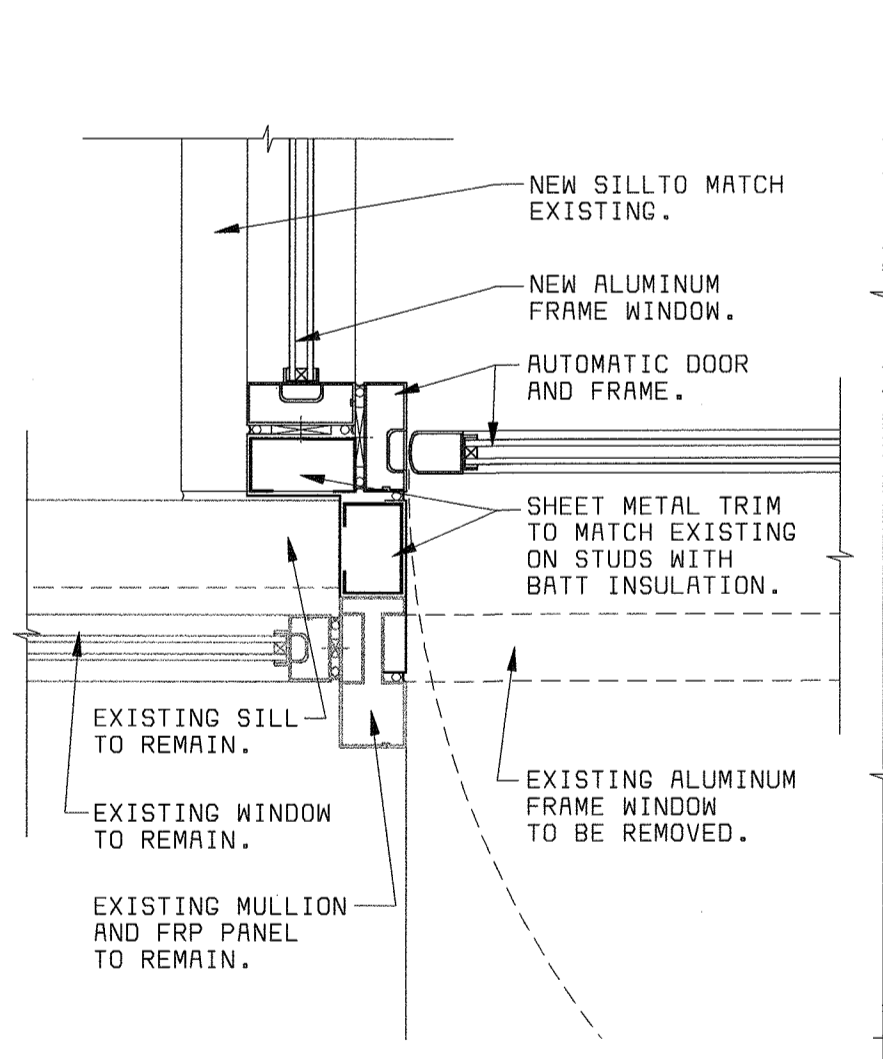


DETAIL (7)
1 1/2" = 1'-0"

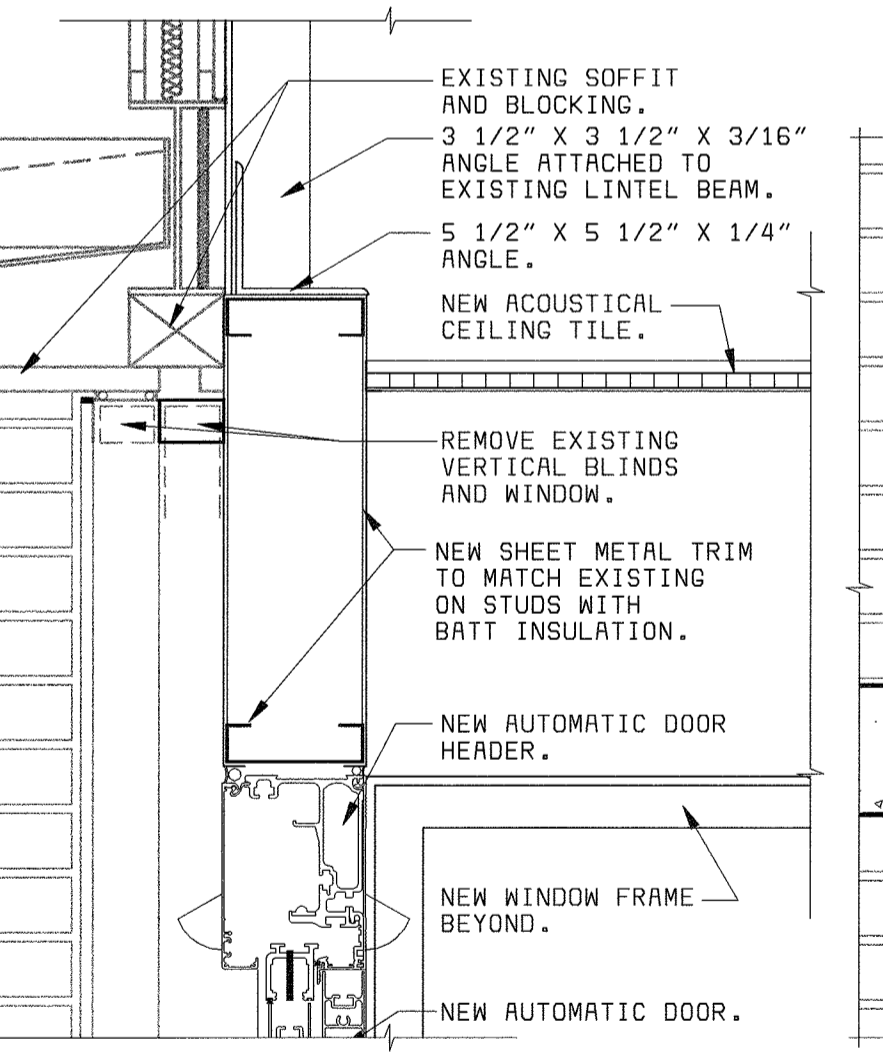



DETAIL (8)
1 1/2" = 1'-0"

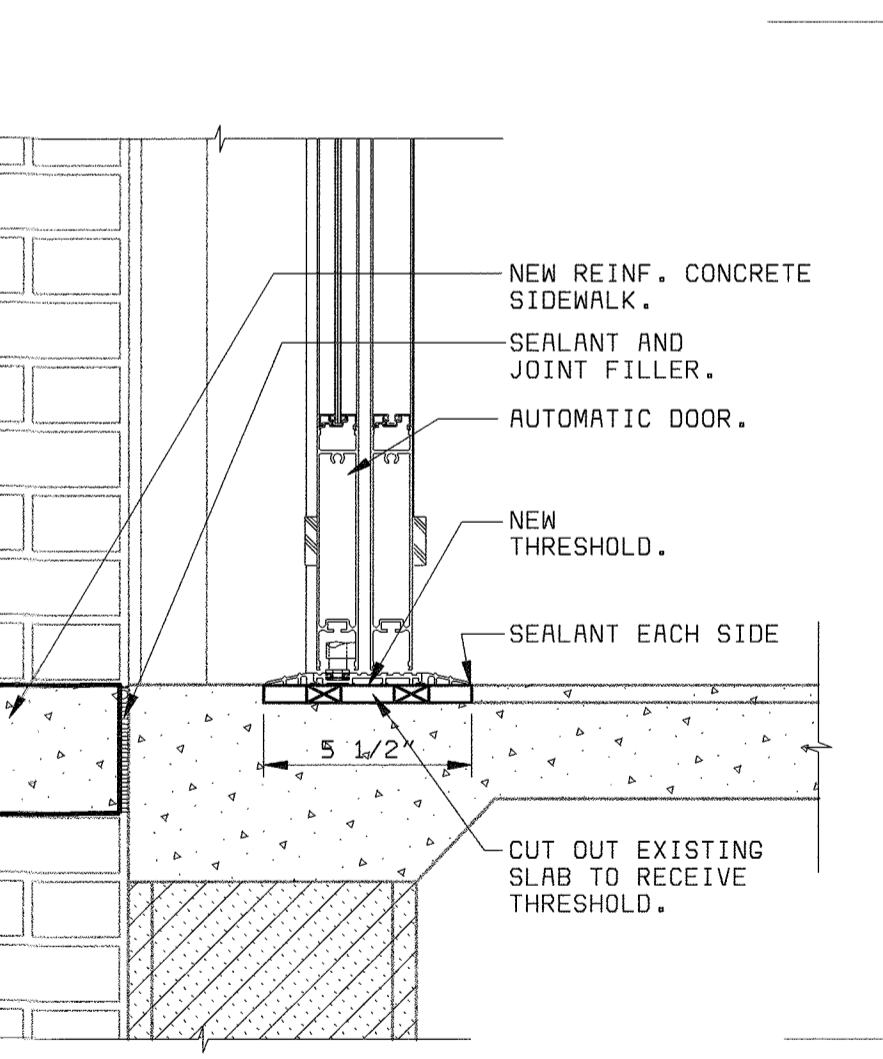

DETAIL (9)
1 1/2" = 1'-0"

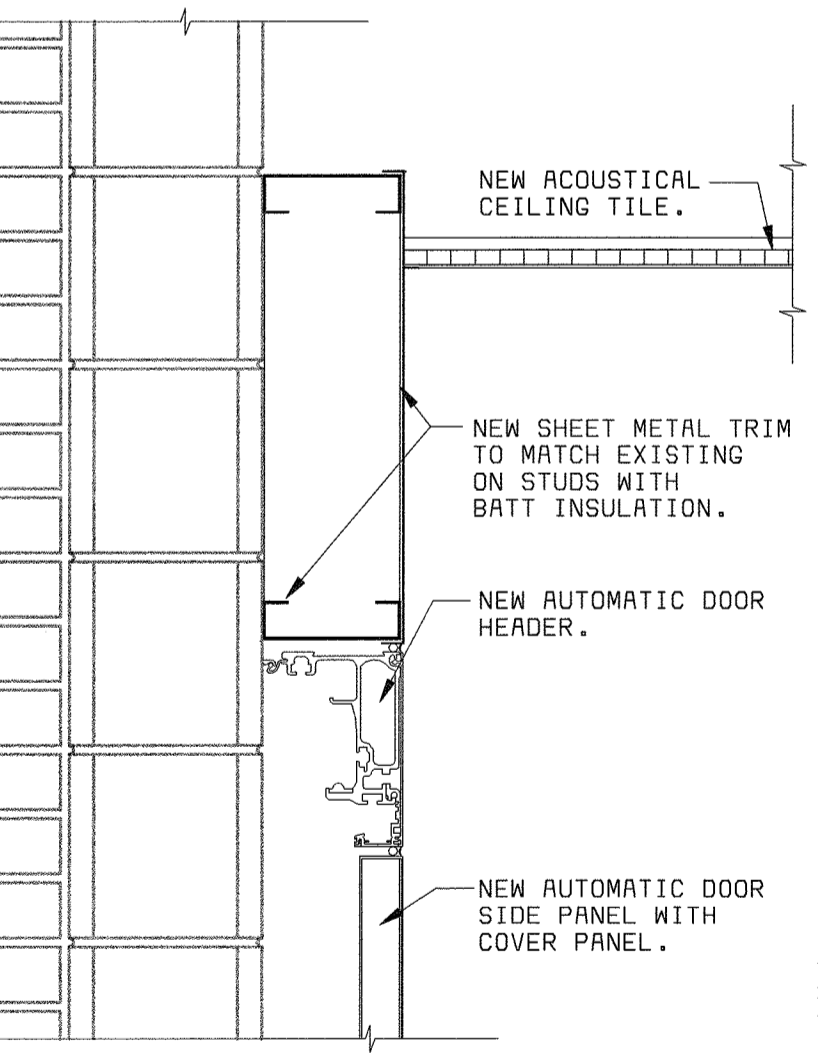

DETAIL (10)
1 1/2" = 1'-0"

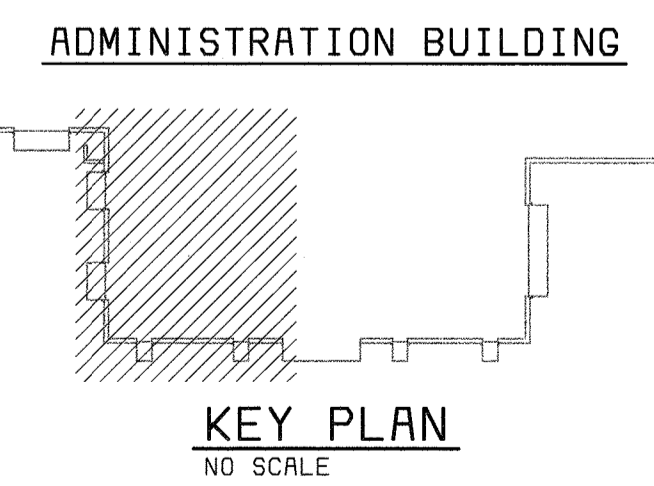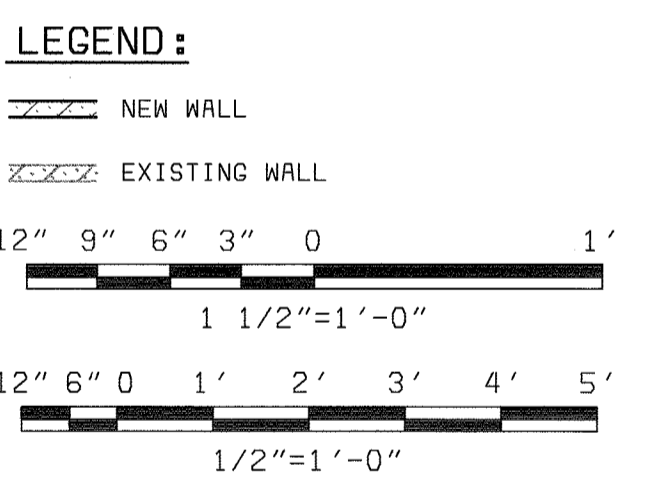

PLAN NOTES:
1. FOR FINISH, DOOR AND WINDOW SCHEDULES SEE A-7.
2. FOR REFLECTED CEILING PLAN SEE A-3.
3. MAINTAIN EXISTING FIRE RATING AND ANY PENETRATION SHOULD BE SEALED AGAINST GAS MIGRATION.

DEPARTMENT OF PUBLIC WORKS
HOWARD COUNTY, MARYLAND
CHIEF, BUREAU OF UTILITIES DATE

bbw Architects • Designers • Planners
Bryant Bryant Williams, P.C.
4201 Connecticut Avenue N.W., Suite 500
Washington, D.C. 20008 (202) 246-2108

BLACK & VEATCH LLP
Gaithersburg, Maryland
REG. PROF. ENGR. DATE


THIS DRAWING WAS
ORIGINALLY APPROVED
FOR CONSTRUCTION
AND SEALED BY
CHARLES T. BRYANT
A REGISTERED
ARCHITECT
IN THE
STATE OF MARYLAND,
NO. 1377-R

DES:	CH/JS				
DRN:	JS				
CHK:	CH				
DATE:	08/00	11/03/03	CONFORMED TO CONSTRUCTION RECORDS	RHH/RJR/RJR	
		DATE	REVISIONS AND RECORD OF ISSUE	NO.	BY CK APP


ARCHITECTURAL
**ADMINISTRATION BUILDING
LABORATORY SAMPLE ENTRANCE
ENLARGED PLAN AND DETAILS**

LITTLE PATUXENT WATER RECLAMATION PLANT
ADDITION NO. 6
LABORATORY RENOVATION
CAPITAL PROJECT S-6205
CONTRACT NO. 20-3841
HOWARD COUNTY, MARYLAND


SCALE
AS
SHOWN
SHEET
15 OF 28
A9

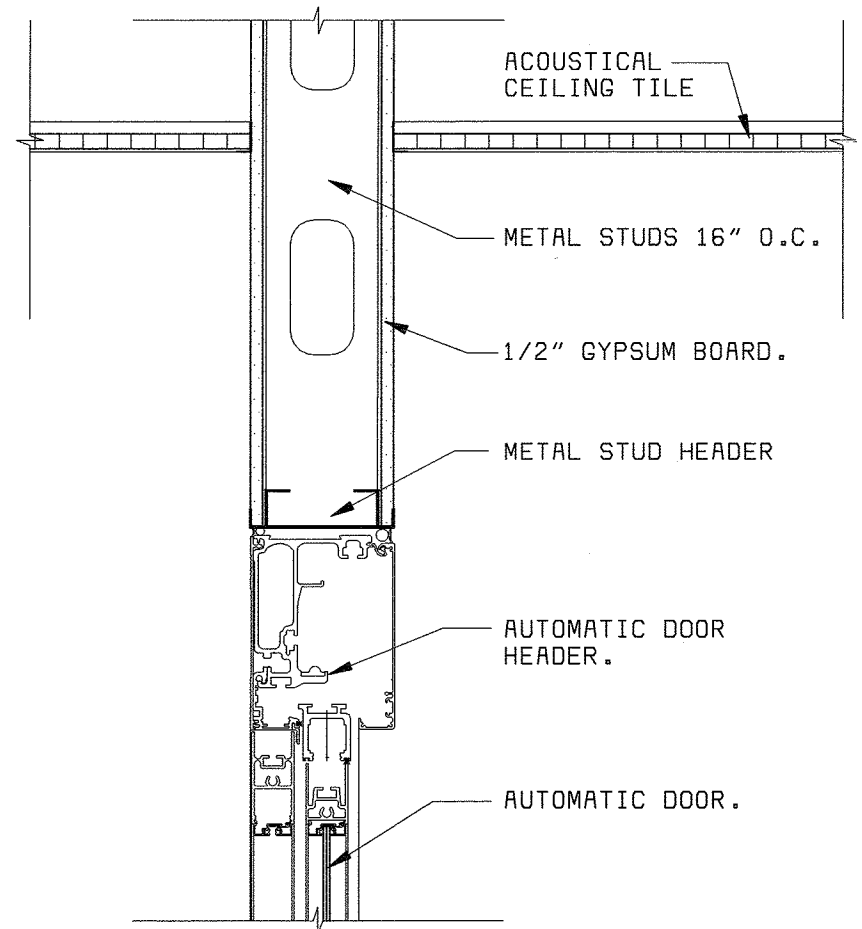


DETAIL 1
1 1/2" = 1'-0" A10

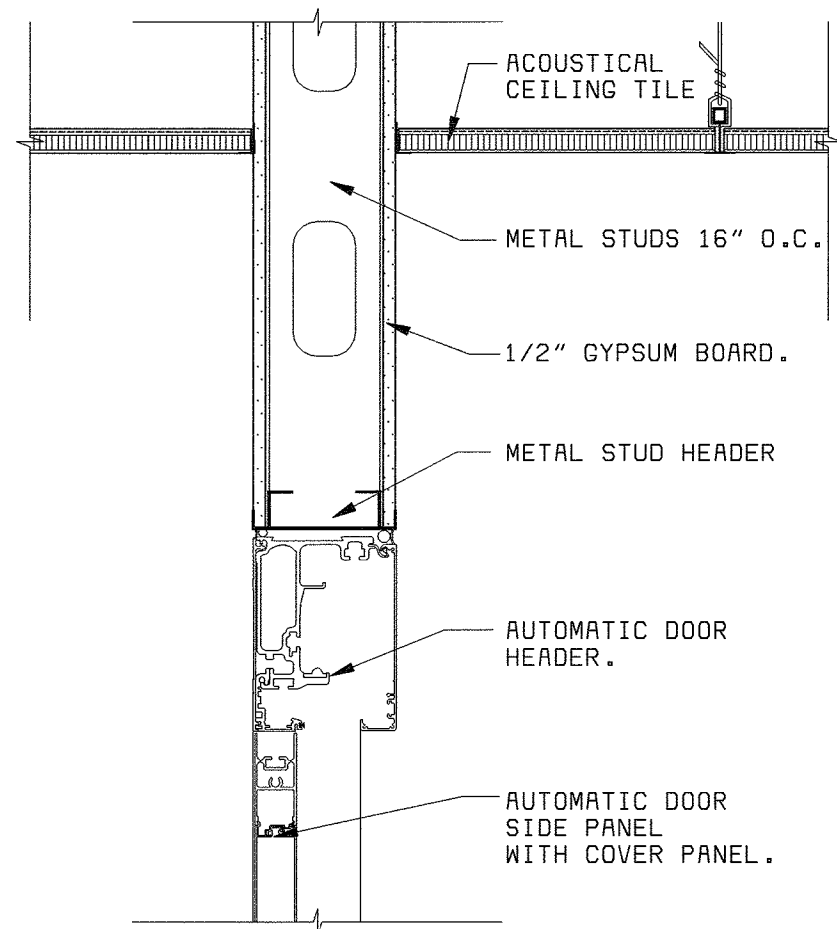


DETAIL 2
1 1/2" = 1'-0" A10

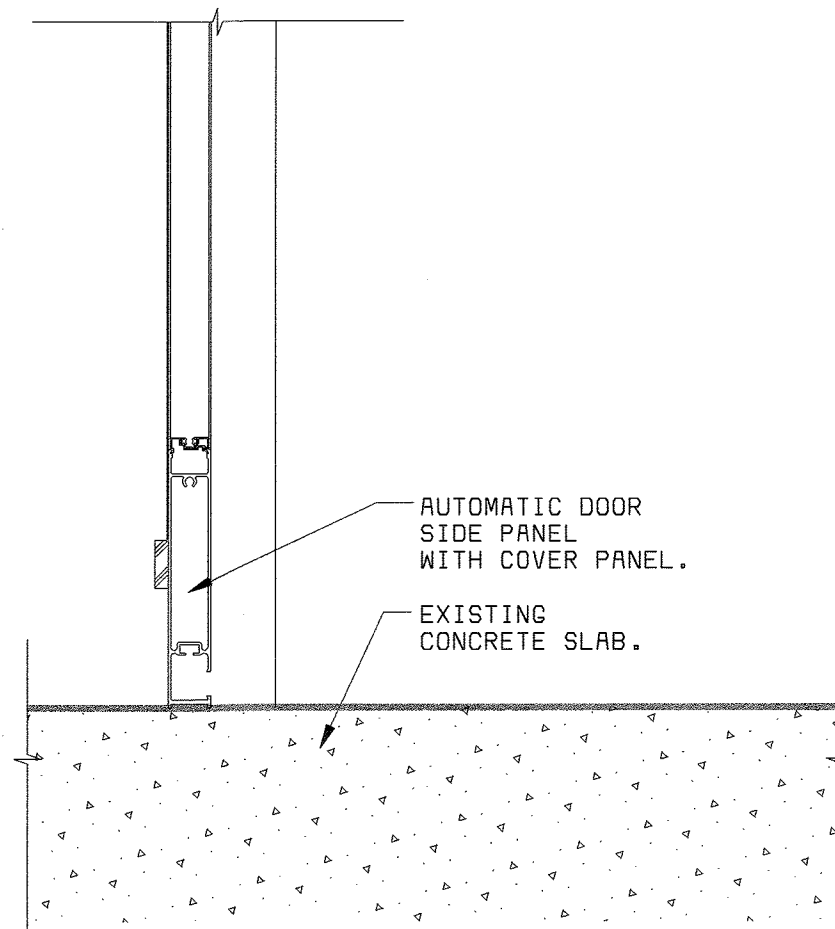


DETAIL 3
1 1/2" = 1'-0" A10

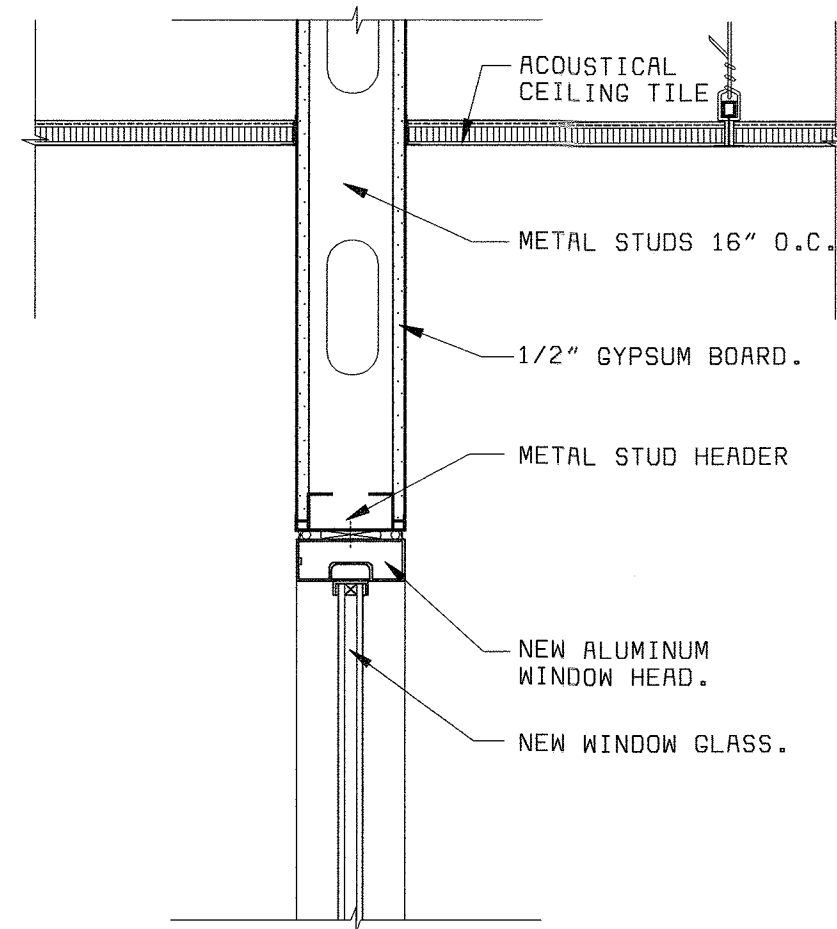


DETAIL 4
1 1/2" = 1'-0" A10

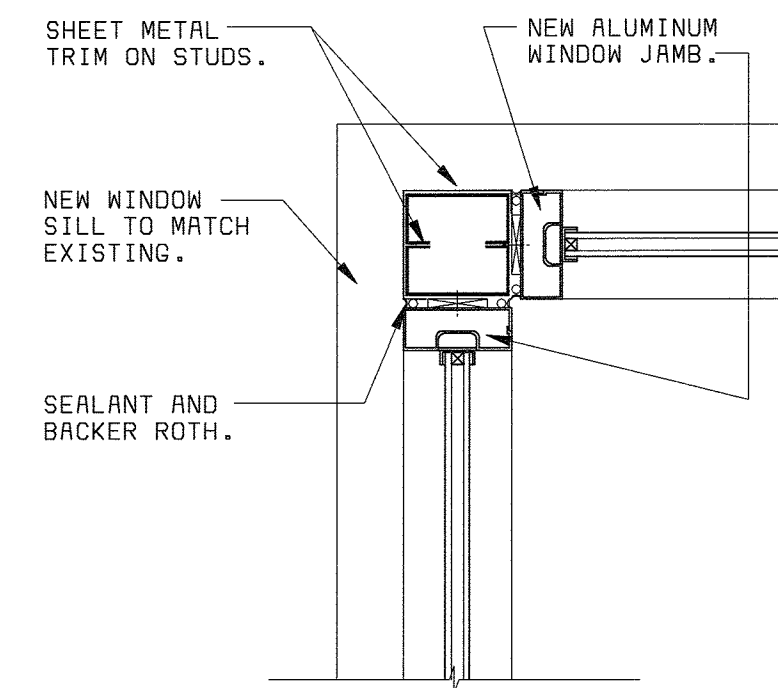

DETAIL 5
1 1/2" = 1'-0" A10


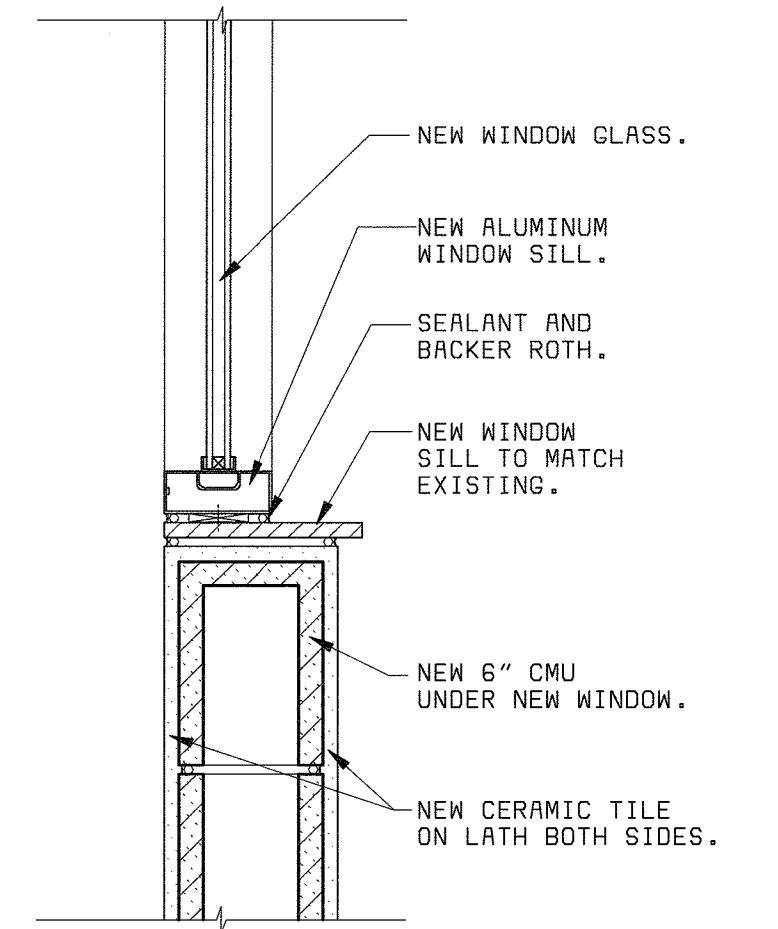


DETAIL 6
1 1/2" = 1'-0" A10

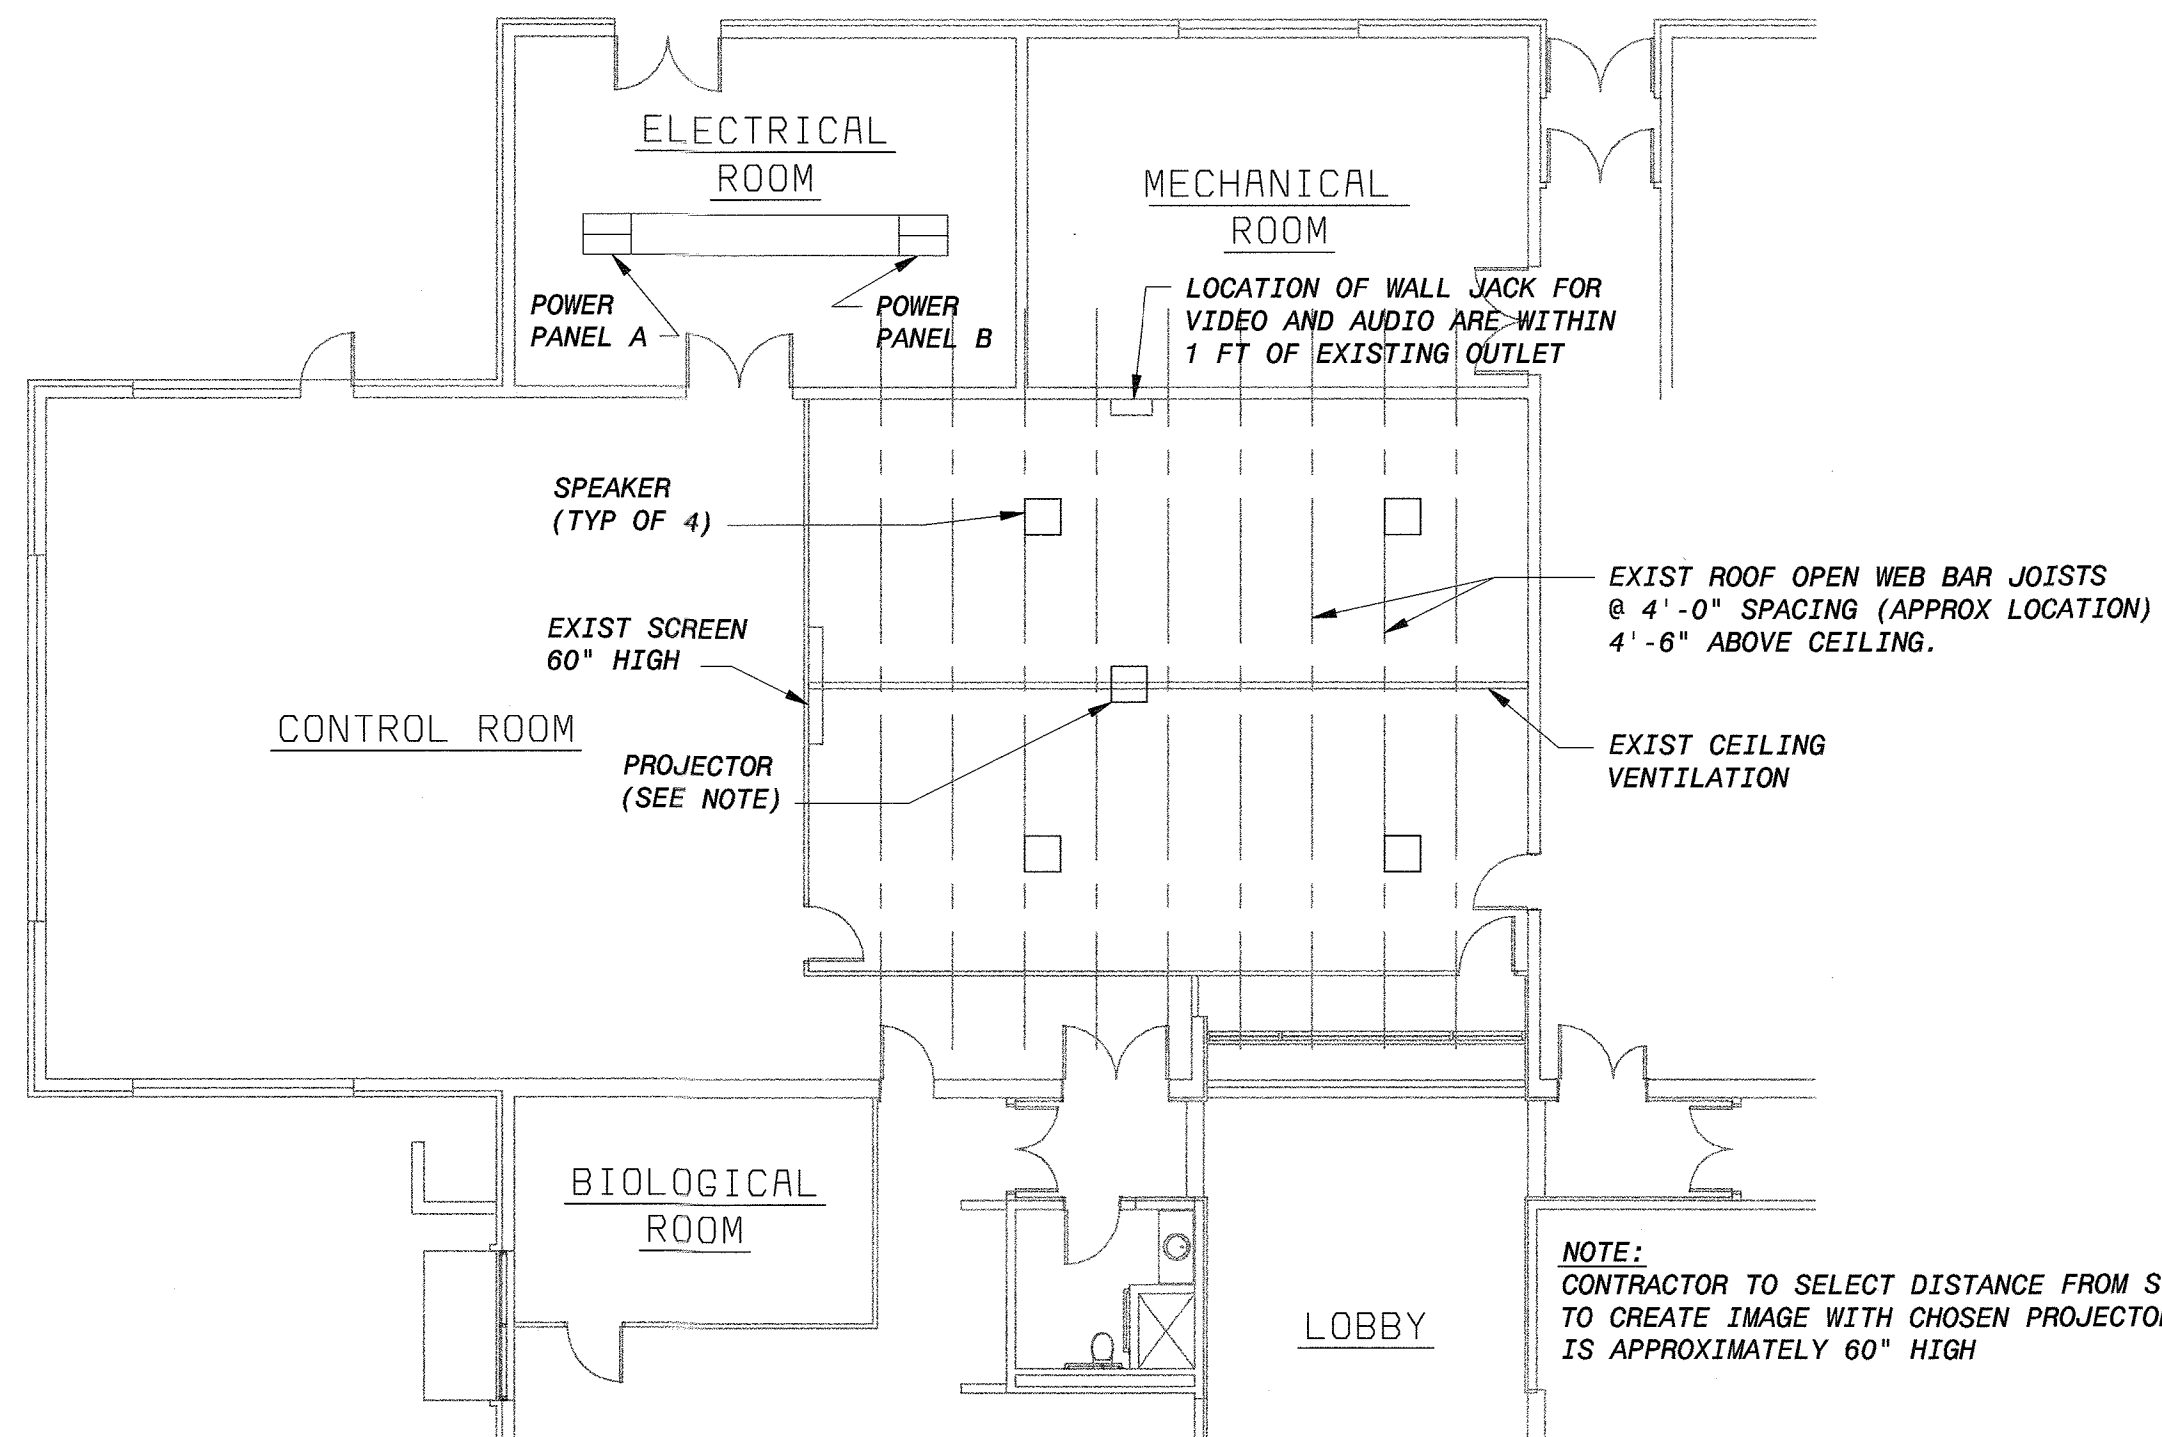

TRAINING ROOM AUDIOVISUAL SYSTEM
3/32" = 1'-0"

NOTE:
CONTRACTOR TO SELECT DISTANCE FROM SCREEN TO CREATE IMAGE WITH CHOSEN PROJECTOR THAT IS APPROXIMATELY 60" HIGH

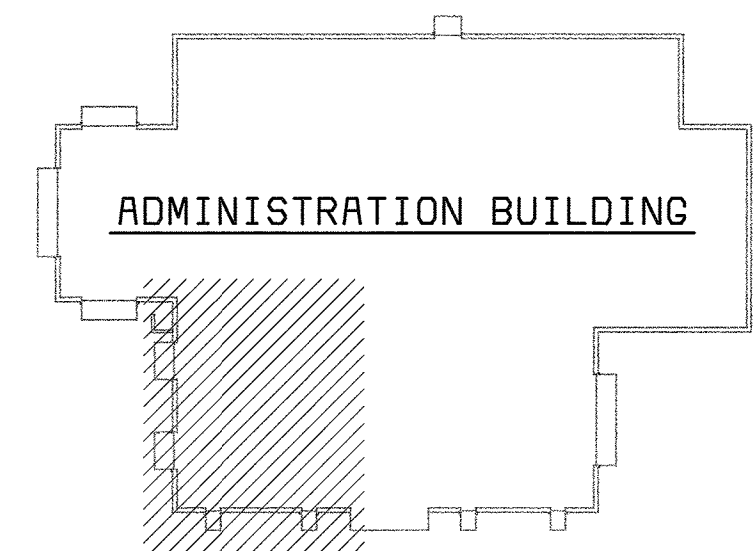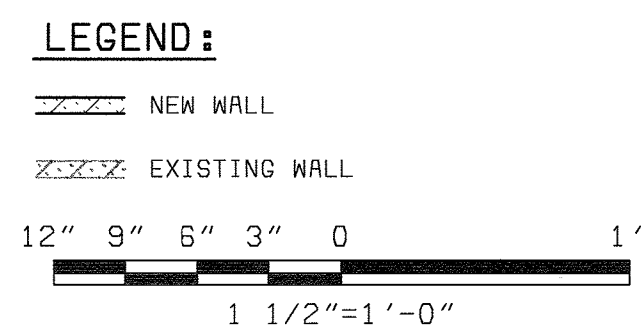

KEY PLAN
NO SCALE

- PLAN NOTES:**
- FOR FINISH, DOOR AND WINDOW SCHEDULES SEE A-7.
 - FOR REFLECTED CEILING PLAN SEE A-3.
 - MAINTAIN EXISTING FIRE RATING AND ANY PENETRATION SHOULD BE SEALED AGAINST GAS MIGRATION.

DEPARTMENT OF PUBLIC WORKS
HOWARD COUNTY, MARYLAND



THIS DRAWING WAS
ORIGINALLY APPROVED
FOR CONSTRUCTION
AND SEALED BY
CHARLES I. BRYANT
A REGISTERED
ARCHITECT
IN THE
STATE OF MARYLAND,
NO. 1377-R

DES:	CH/JS								
DRN:	JS								
CHK:	CH								
DATE:	01/01	11/03/03	CONFORMED TO CONSTRUCTION RECORDS						
		DATE	REVISIONS AND RECORD OF ISSUE						
				NO.	BY	CK	APP		

ARCHITECTURAL

ADMINISTRATION BUILDING
LABORATORY
MISCELLANEOUS DETAILS

LITTLE PATUXENT WATER RECLAMATION PLANT
ADDITION NO. 6
LABORATORY RENOVATION

CAPITAL PROJECT S-6205
CONTRACT NO. 20-3841

HOWARD COUNTY, MARYLAND

SCALE
AS
SHOWN

SHEET
16 OF 28

A10

058472-5
F058472A

ABBREVIATIONS

GENERAL MECHANICAL NOTES

Table of abbreviations for mechanical systems including HVAC, plumbing, and general building components.


Table of abbreviations for electrical and instrumentation systems.

- 1. THIS IS A GENERAL LEGEND AND ABBREVIATION SHEET FOR PLUMBING AND HVAC DRAWINGS. SOME ITEMS CONTAINED ON THIS SHEET MAY NOT BE USED ON THIS SPECIFIC PROJECT.

LEGEND

Legend table with columns for GENERAL, PIPE FITTINGS, VALVES, HVAC, and PLUMBING, each containing symbols and their descriptions.

AIR INLET AND OUTLET IDENTIFICATION

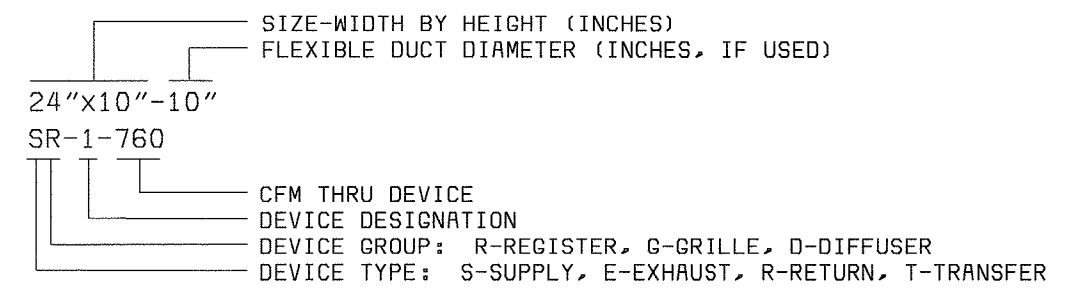

DEPARTMENT OF PUBLIC WORKS
HOWARD COUNTY, MARYLAND

Table with columns for DES, DRN, CHK, DATE and rows for GWP, JPC, JPC, LDW, JEP, MLP, 11/03/03, 10/03/01.

BLACK & VEATCH logo and contact information for Gaithersburg, Maryland, including a registered professional engineer seal.

Table with columns for DES, DRN, CHK, DATE and rows for GWP, JPC, JPC, LDW, JEP, MLP, 11/03/03, 10/03/01.

HVAC/PLUMBING
ADMINISTRATION BUILDING
LEGEND AND ABBREVIATIONS


LITTLE PATUXENT WATER RECLAMATION PLANT
ADDITION NO. 6
LABORATORY RENOVATION
CAPITAL PROJECT S-6205
CONTRACT NO. 20-3841
HOWARD COUNTY, MARYLAND

SCALE
AS
SHOWN
SHEET
17 OF 28
H1




PLAN NOTES:

- 1 REMOVE EXISTING 10 KW DUCT HEATER.
- 2 REMOVE EXISTING FUME HOOD EXHAUST FAN AND ALL ASSOCIATED DUCTS AND SUPPORTS LOCATED ABOVE CEILING.
- 3 REMOVE EXISTING RELIEF HOOD LOCATED ON ROOF. EXISTING ROOF CURB SHALL REMAIN.
- 4 REMOVE EXISTING FUME HOOD PRV LOCATED ON ROOF. EXISTING ROOF CURB SHALL REMAIN. REMOVE ASSOCIATED DUCTS.
- 5 REMOVE EXISTING EXHAUST PRV LOCATED ON ROOF. EXISTING ROOF CURB SHALL REMAIN. REMOVE ASSOCIATED DUCTWORK.
- 6 REMOVE EXISTING SUPPLY PRV LOCATED ON ROOF. REMOVE EXISTING ASSOCIATED DUCTWORK. EXISTING CURB SHALL REMAIN.
- 7 REMOVE AND RELOCATE EXISTING ATOMIC ABSORPTION EXHAUST HOOD AND FLEXIBLE DUCT.
- 8 REMOVE EXISTING ATOMIC ABSORPTION EXHAUST FAN LOCATED ABOVE CEILING. REMOVE ASSOCIATED DISCHARGE DUCT UP TO ROOF EXHAUST STACK. ROOF EXHAUST STACK SHALL REMAIN.
- 9 REMOVE EXISTING BASEBOARD ELECTRIC HEATER.

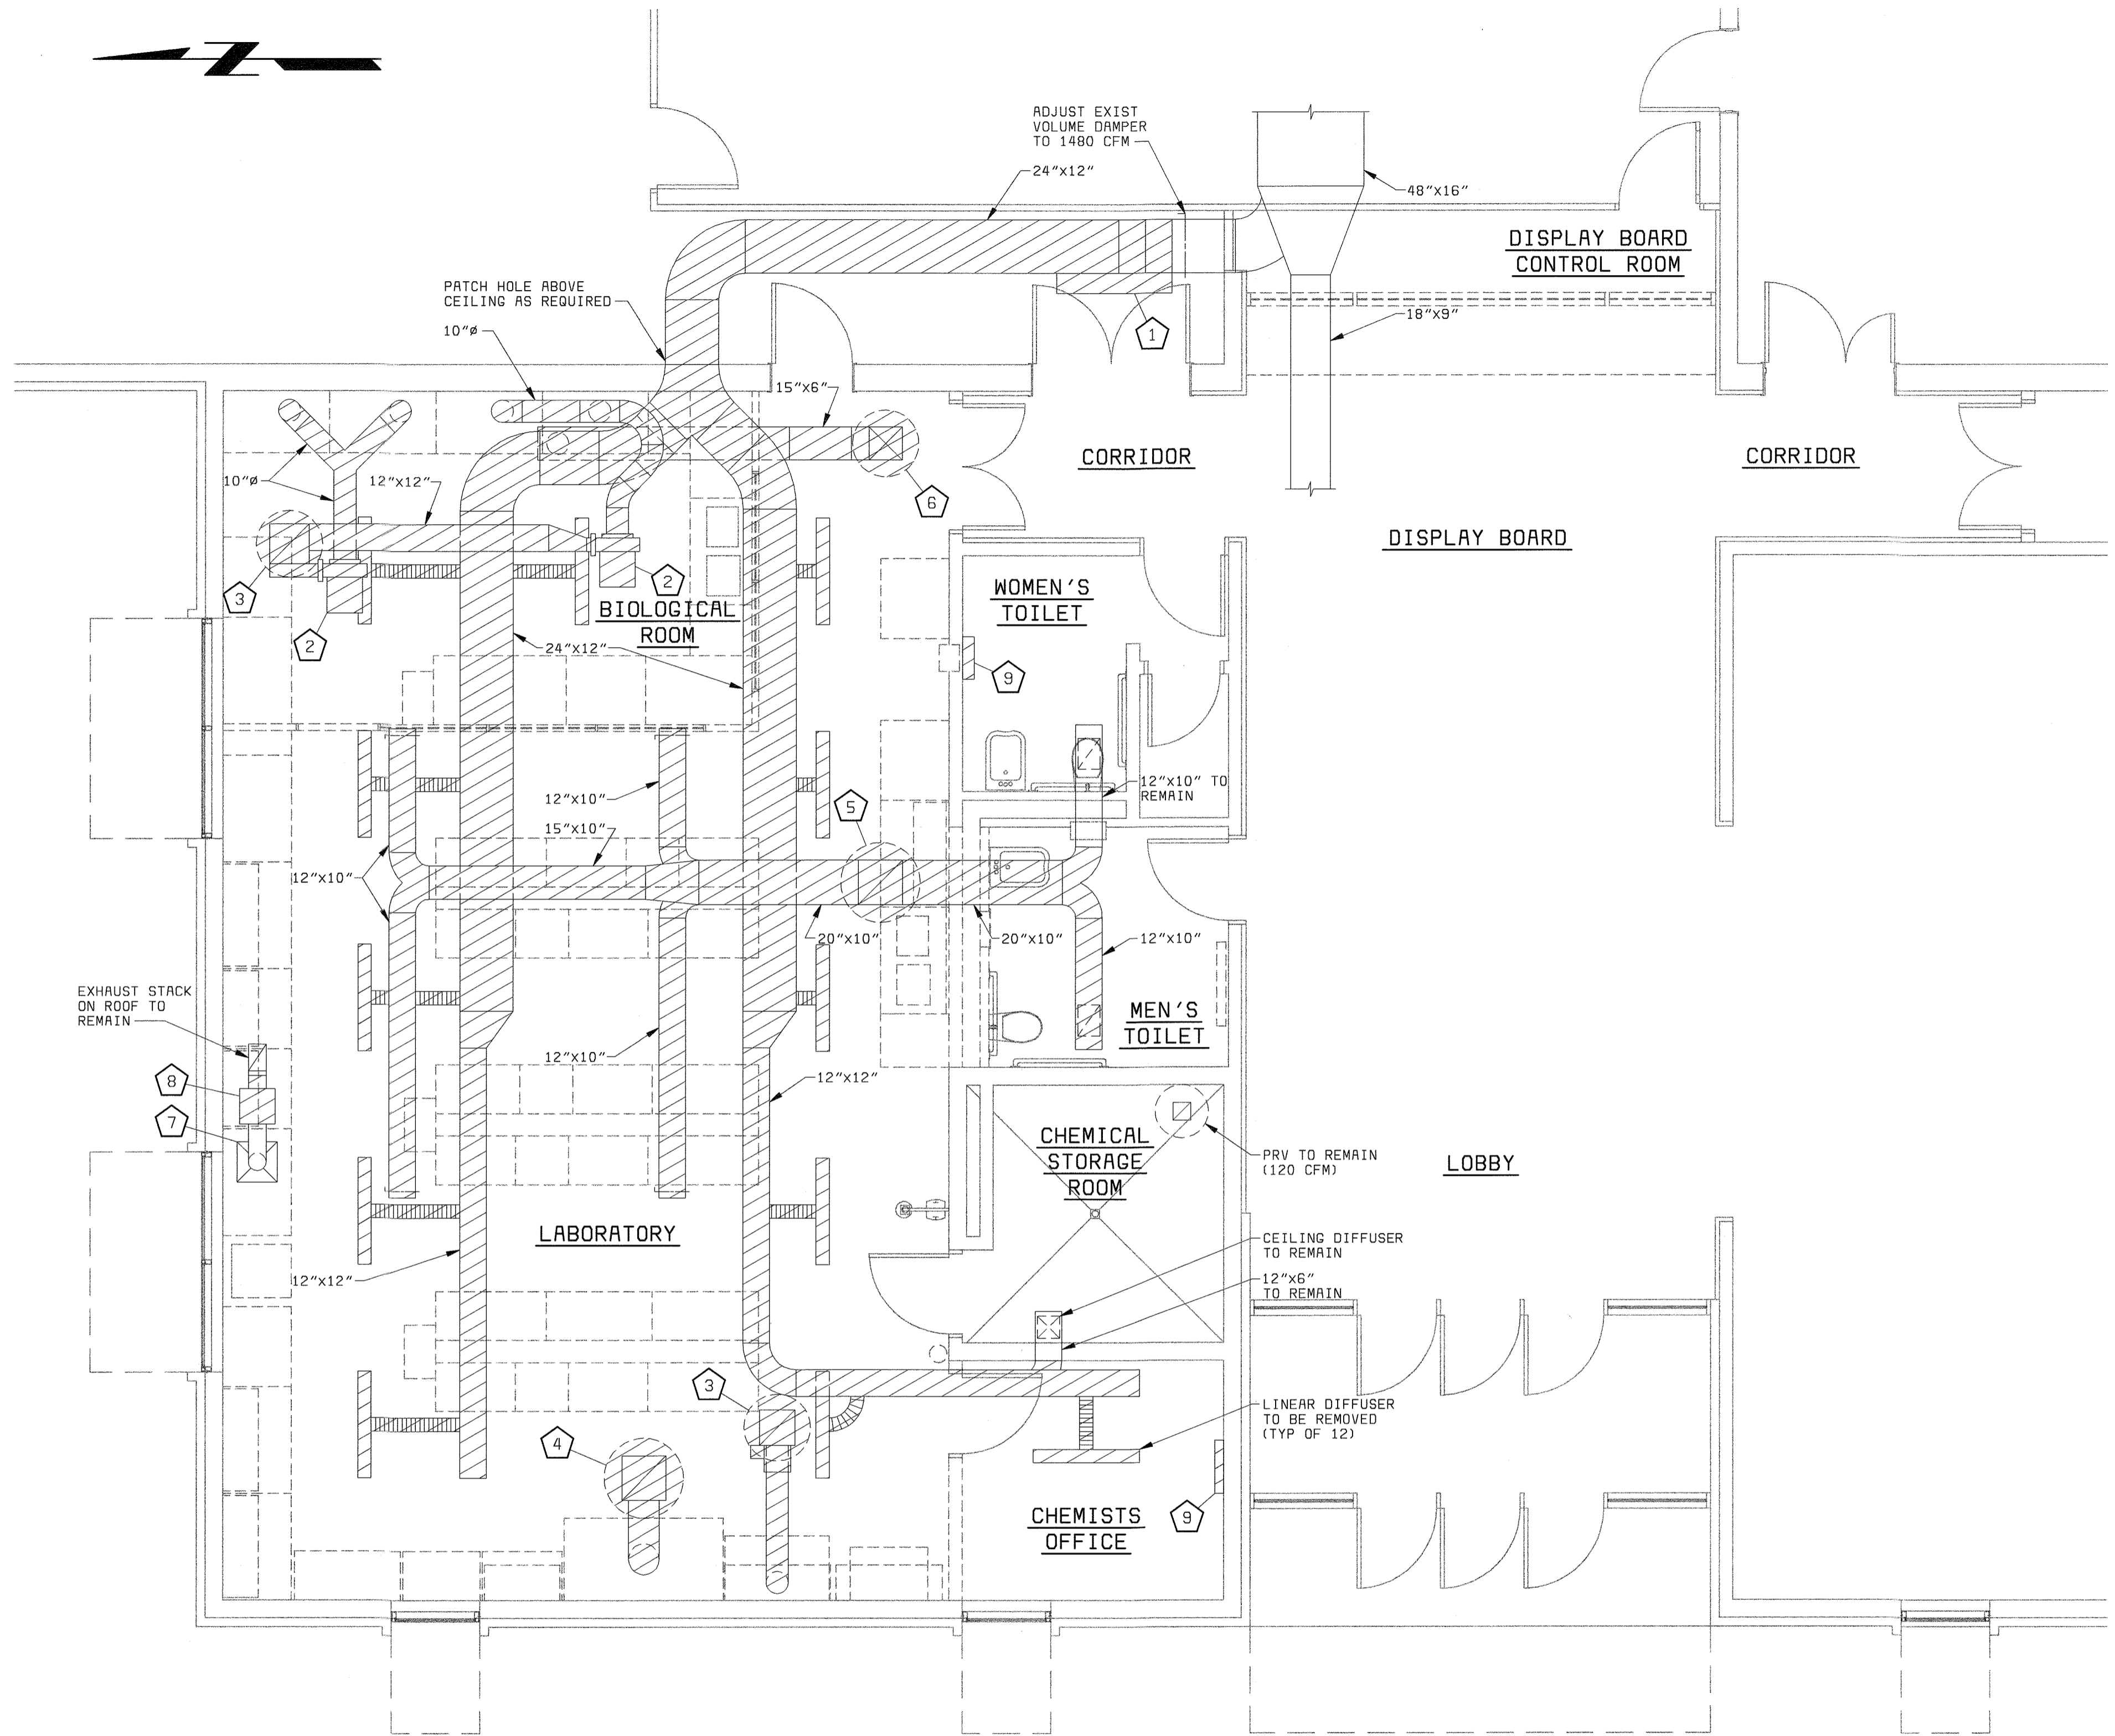

DEMOLITION PLAN - EL 145.00
1/4" = 1'-0"

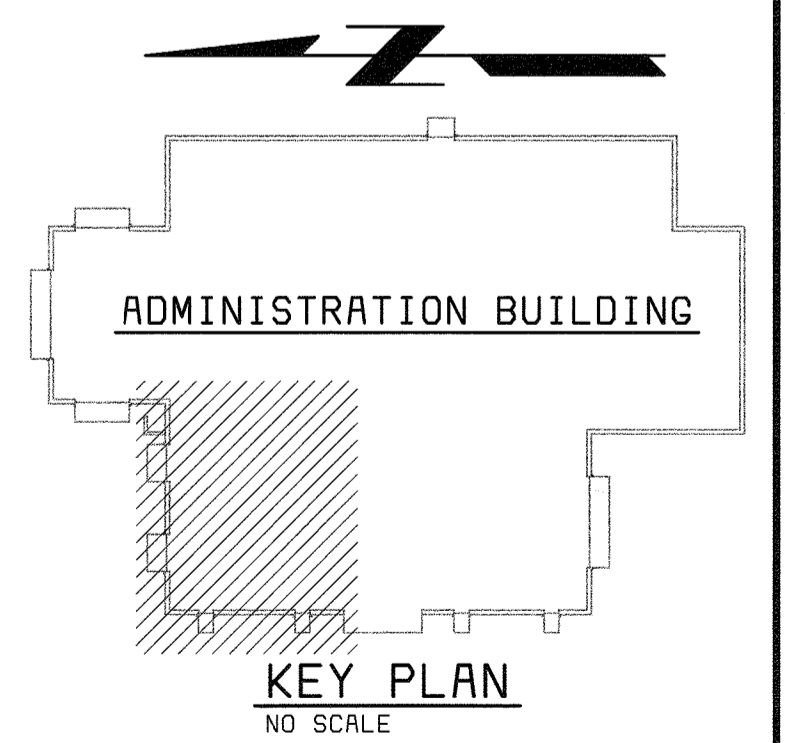

58472-112-ADM-H-T000003XF

58472-112-ADM-H-T000003XF

DEPARTMENT OF PUBLIC WORKS
HOWARD COUNTY, MARYLAND

CHIEF, BUREAU OF UTILITIES DATE

BLACK & VEATCH
Gaithersburg, Maryland

REG. PROF. ENGR. DATE

THIS DRAWING WAS
ORIGINALLY APPROVED
FOR CONSTRUCTION
AND SEALED BY
MARTIN L. PAPE
A REGISTERED
PROFESSIONAL ENGINEER
IN THE
STATE OF MARYLAND,
NO. 21992

DES: GWP,RWC					
DRN: BDL,LDW					
CHK: JEP					
DATE: 10/03/01	11/03/03	CONFORMED TO CONSTRUCTION RECORDS		RHH	RJR
	DATE	REVISIONS AND RECORD OF ISSUE	NO.	BY	CK APP

HVAC

**ADMINISTRATION BUILDING
LABORATORY
DEMOLITION PLAN**

LITTLE PATUXENT WATER RECLAMATION PLANT
ADDITION NO. 6
LABORATORY RENOVATION


CAPITAL PROJECT S-6205
CONTRACT NO. 20-3841

HOWARD COUNTY, MARYLAND


SCALE
AS
SHOWN

SHEET
18 OF 28


H2

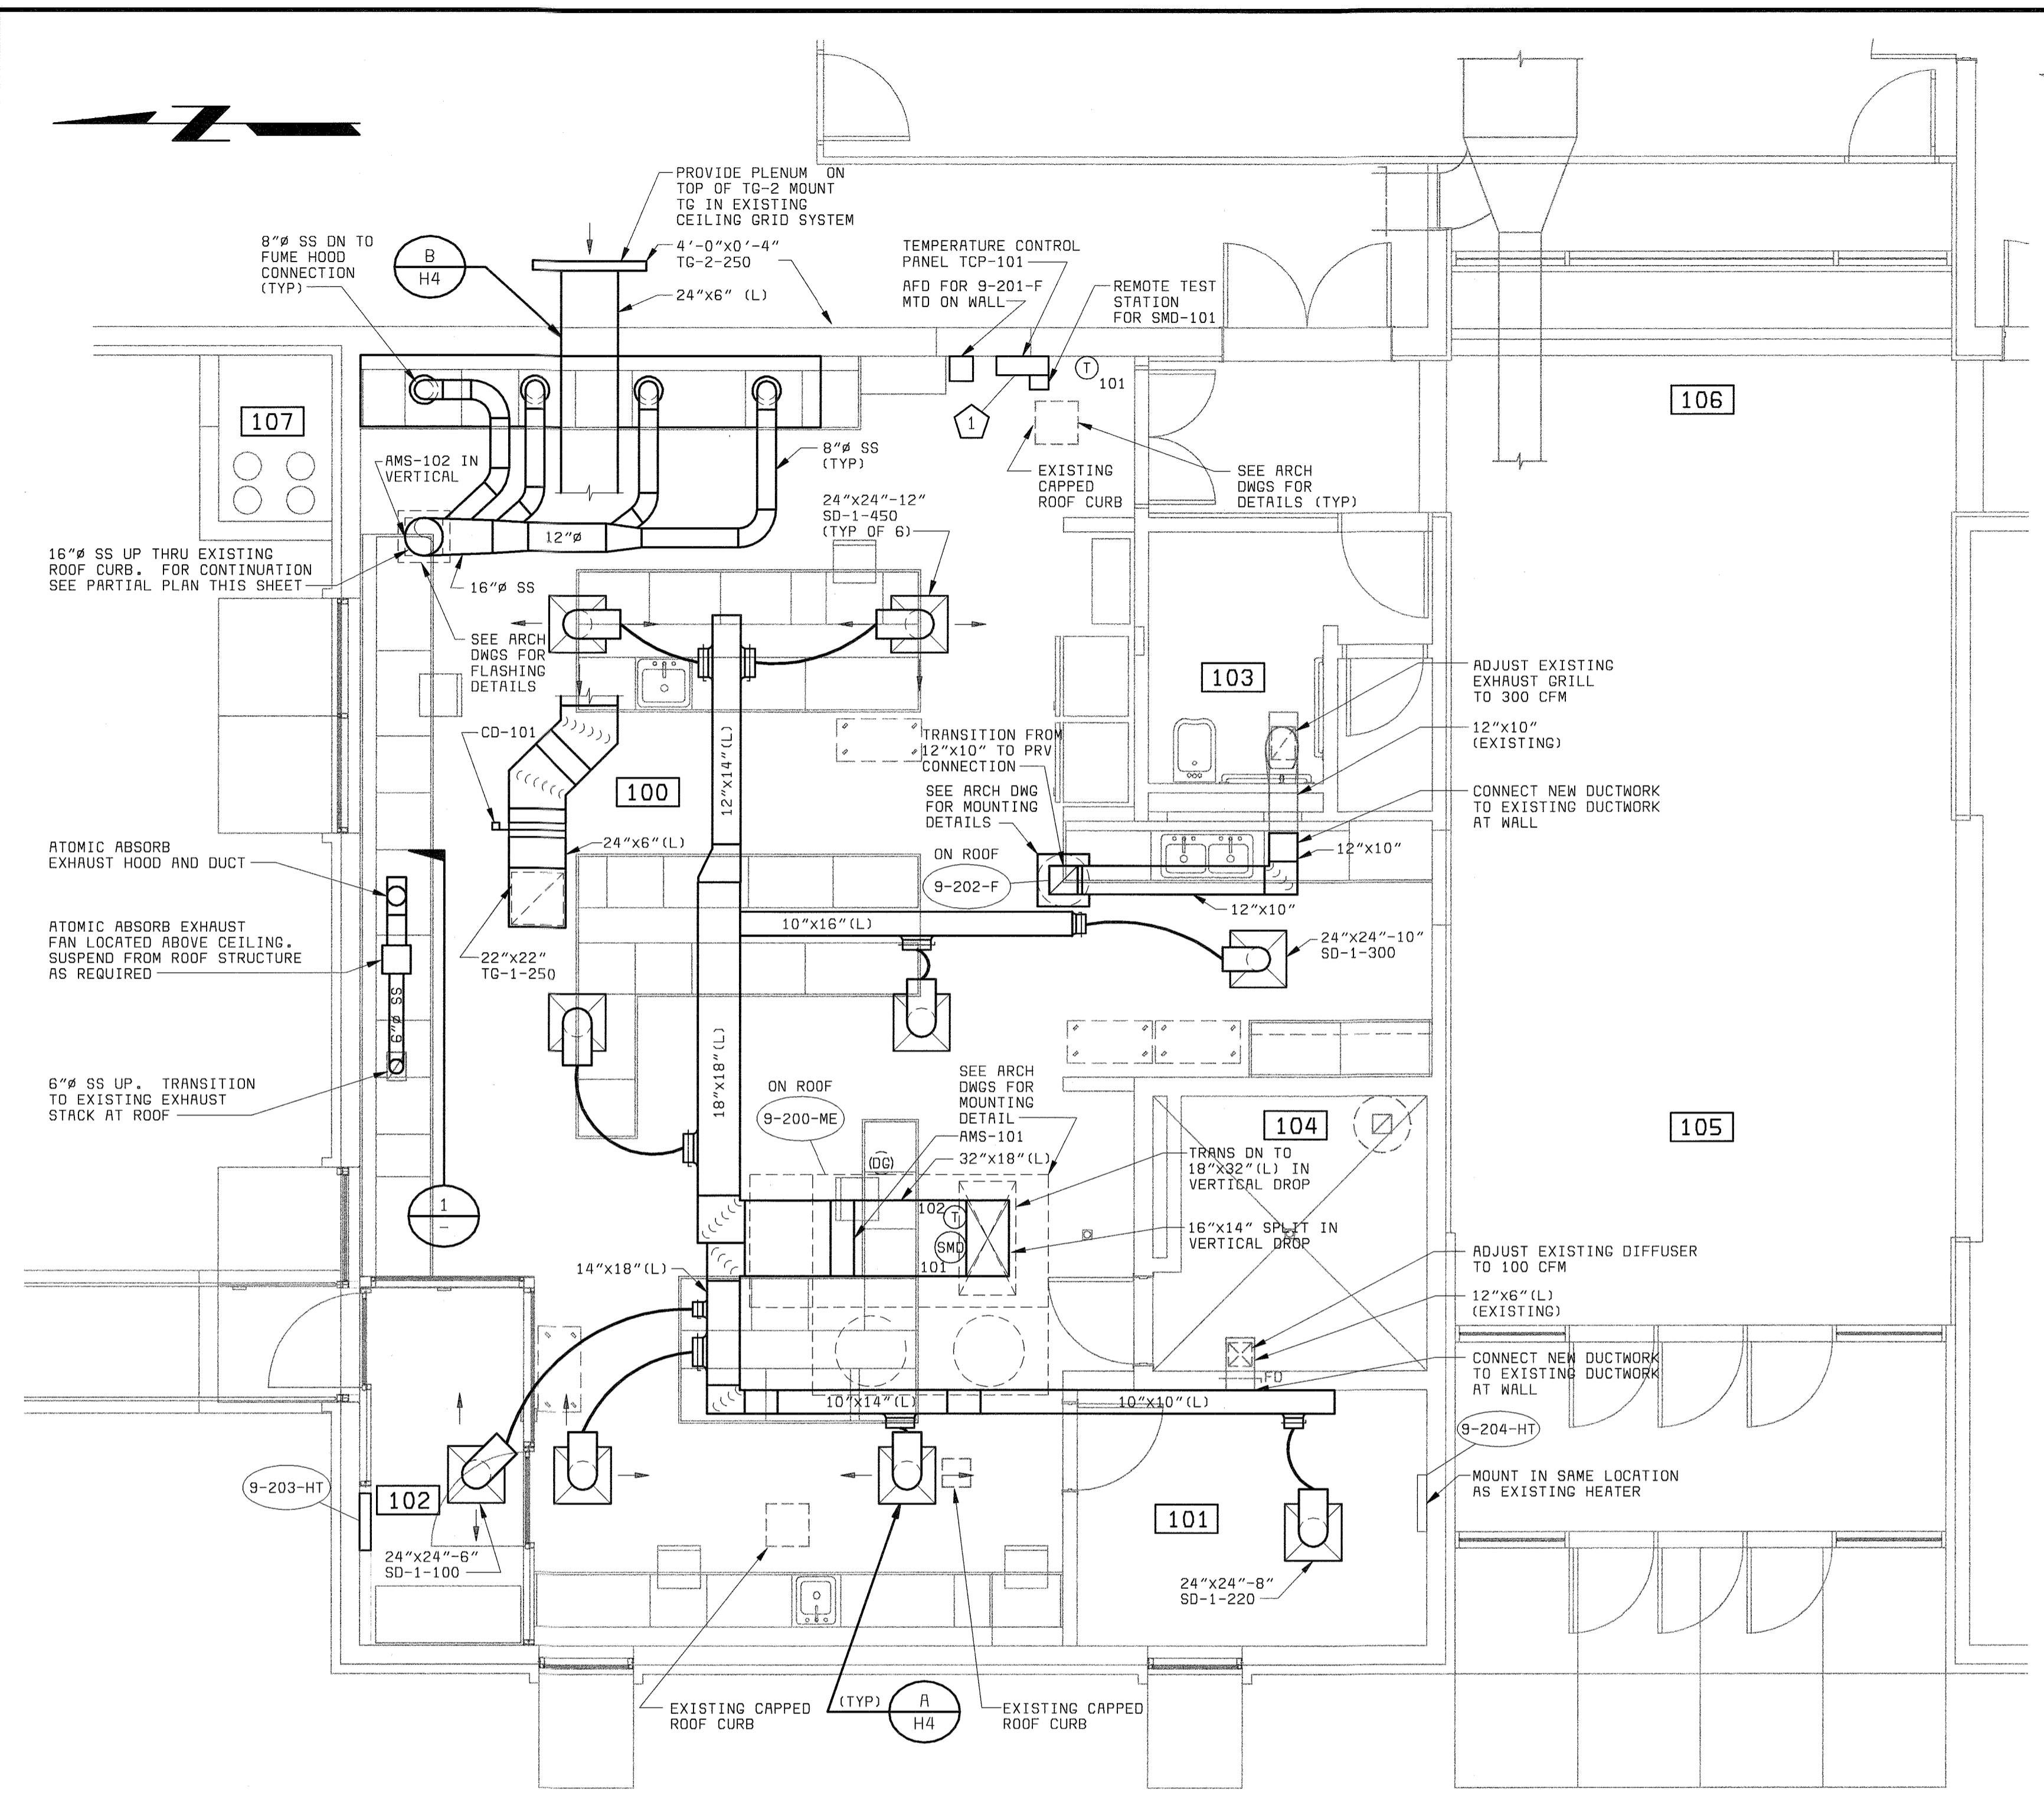


FLOOR PLAN - EL 145.00
1/4" = 1'-0"

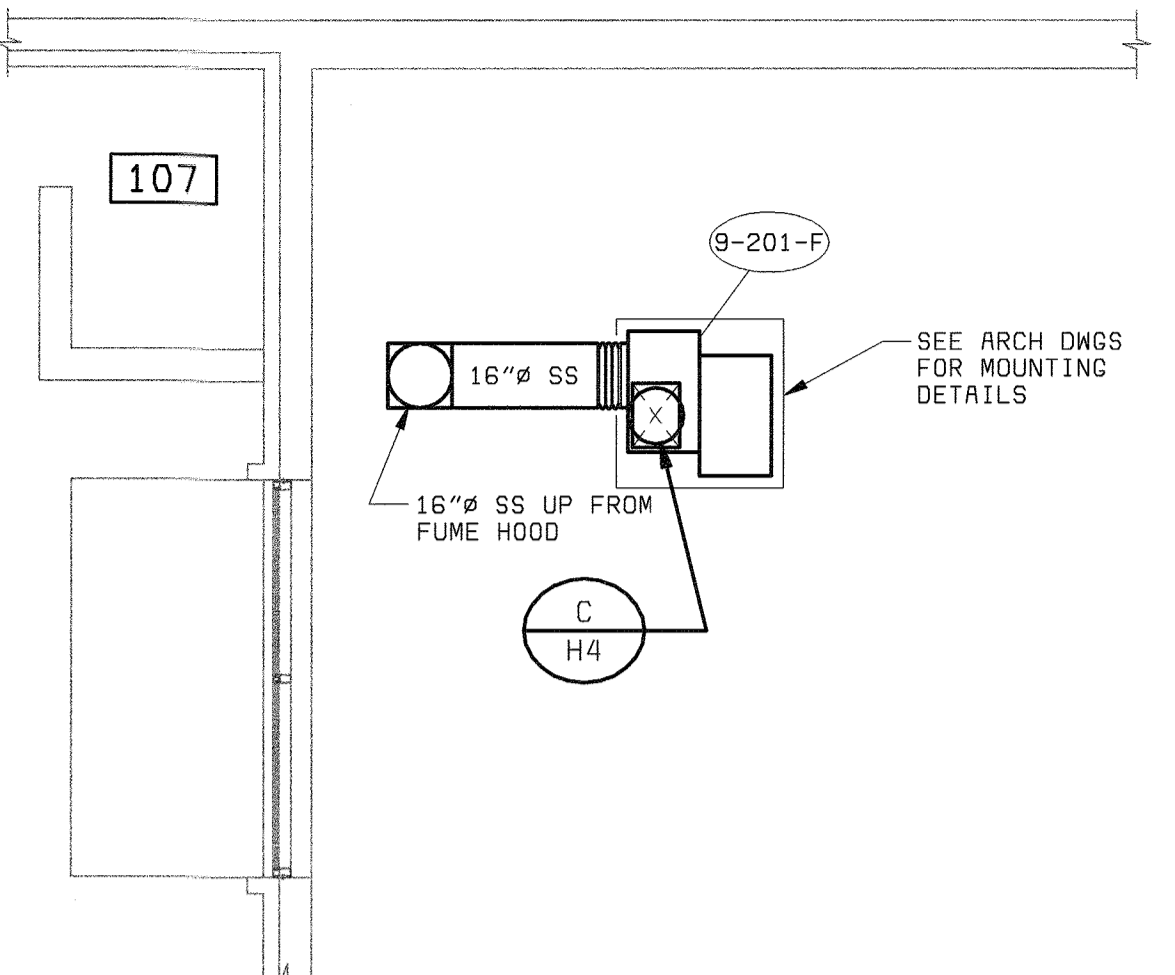

PARTIAL ROOF PLAN
1/4" = 1'-0"

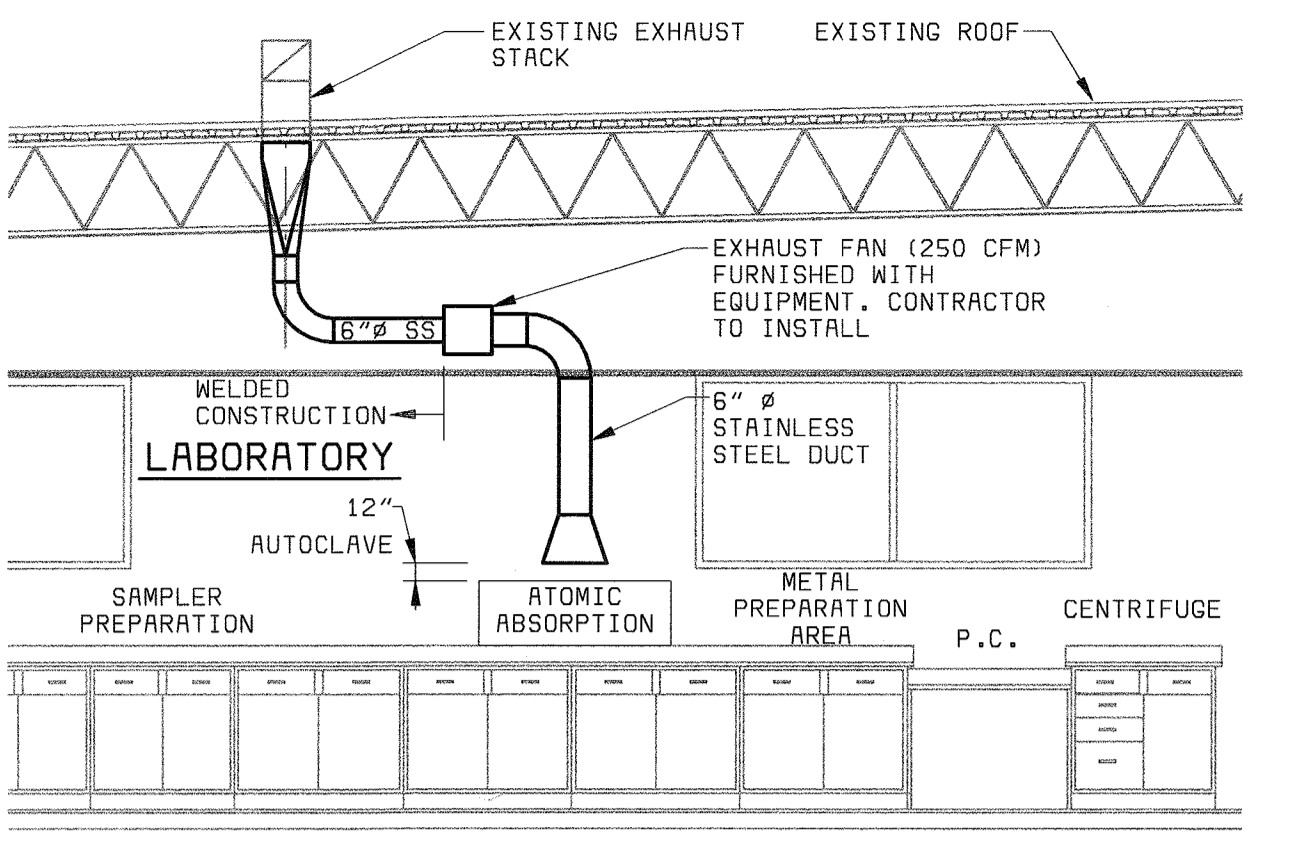


SECTION 1
1/4" = 1'-0"

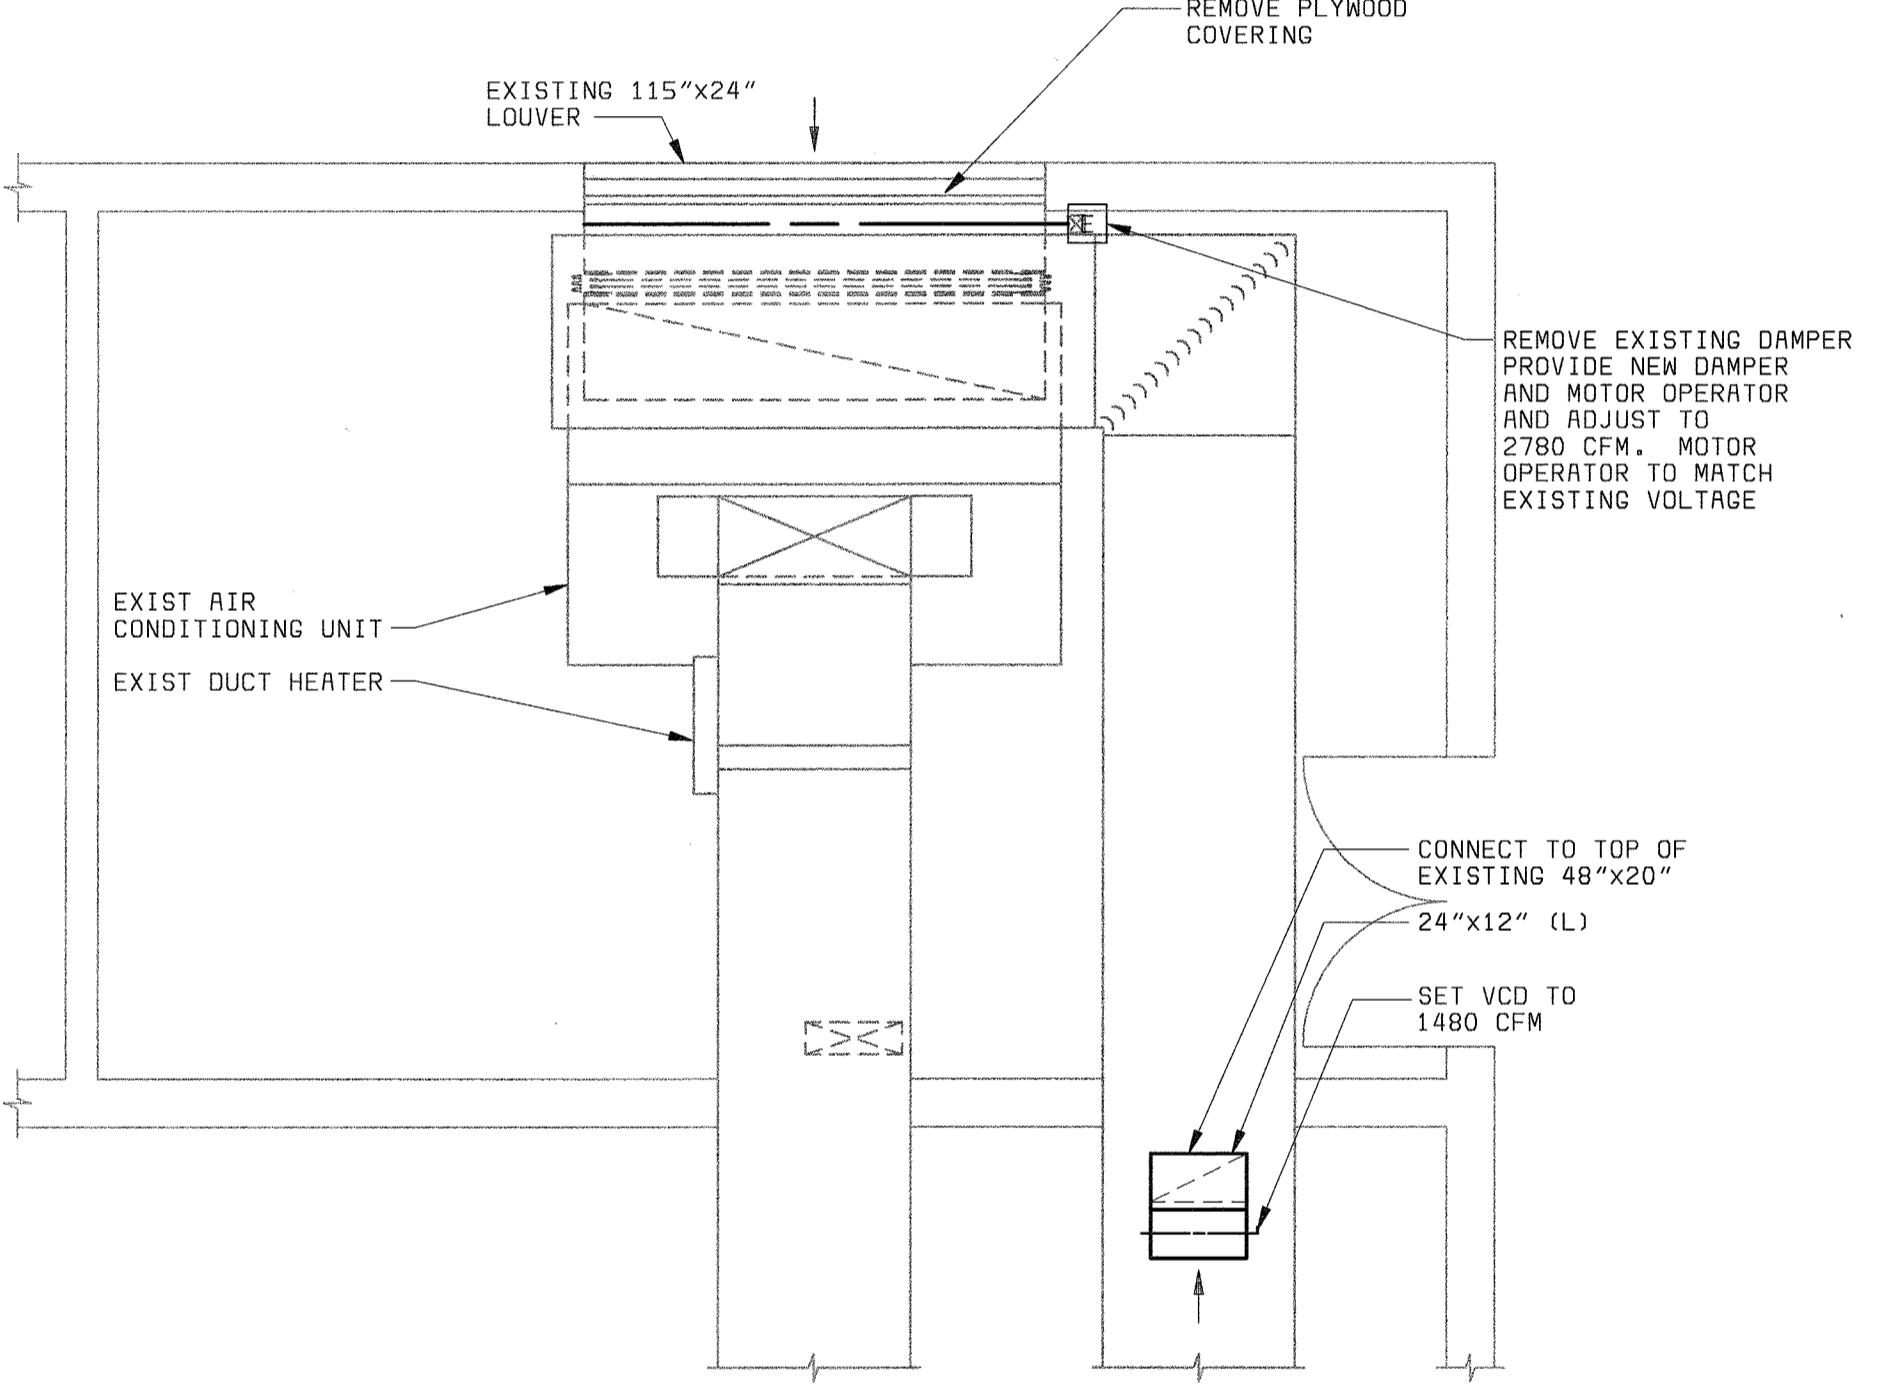

MECHANICAL ROOM PARTIAL PLAN
1/4" = 1'-0"

PLAN NOTES

- 1 FLOW INDICATOR FOR AMS-101 AND AMS-102 SHALL BE MOUNTED INSIDE OF TCP-101. TIME CLOCK SHALL BE MOUNTED INSIDE OF TCP-101 WITH OVERRIDE SWITCH MOUNTED ON FACE OF PANEL. REMOTE TEST STATION FOR SMD-101 SHALL BE MOUNTED ON FACE OF PANEL.

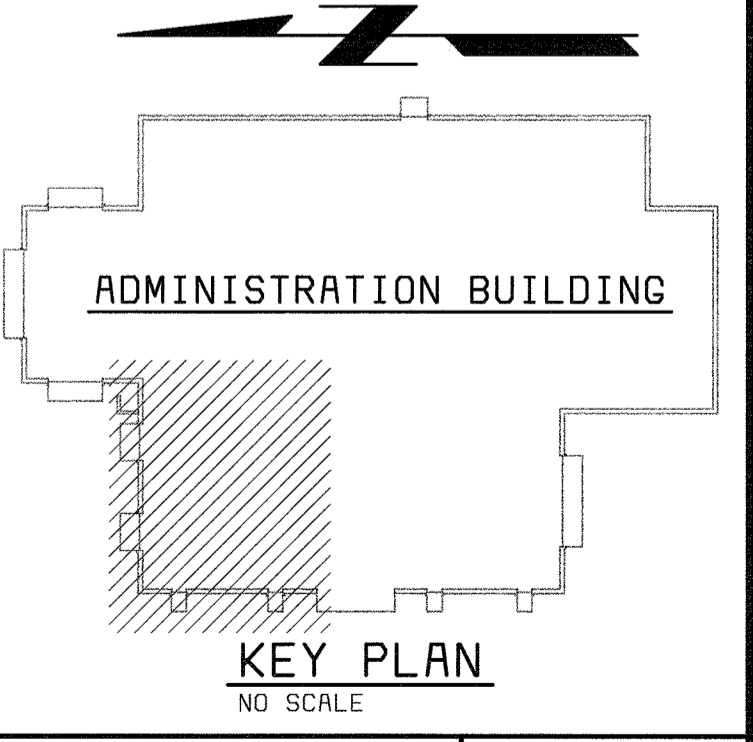

KEY PLAN
NO SCALE

58472-112-ADM-A-1000003XL
58472-104-ADM-H-1000003XQ

DEPARTMENT OF PUBLIC WORKS
HOWARD COUNTY, MARYLAND
CHIEF, BUREAU OF UTILITIES DATE

BLACK & VEATCH
Gathersburg, Maryland
REG. PROF. ENGR. DATE


THIS DRAWING WAS
ORIGINALLY APPROVED
FOR CONSTRUCTION
AND SEALED BY
MARTIN L. PAPE
A REGISTERED
PROFESSIONAL ENGINEER
IN THE
STATE OF MARYLAND,
NO. 21992

DES: GWP,RWC					
DRN: BDL,LDW					
CHK: JEP					
DATE: 10/03/01	DATE	REVISIONS AND RECORD OF ISSUE	NO.	BY	CK APP
	11/03/03	CONFORMED TO CONSTRUCTION RECORDS		RHH	RJR/RJR


HVAC
**ADMINISTRATION BUILDING
LABORATORY FLOOR PLAN,
PARTIAL PLANS AND SECTION**

**LITTLE PATUXENT WATER RECLAMATION PLANT
ADDITION NO. 6
LABORATORY RENOVATION**
CAPITAL PROJECT S-6205
CONTRACT NO. 20-3841
HOWARD COUNTY, MARYLAND


SCALE
AS
SHOWN
SHEET
19 OF 28
H3

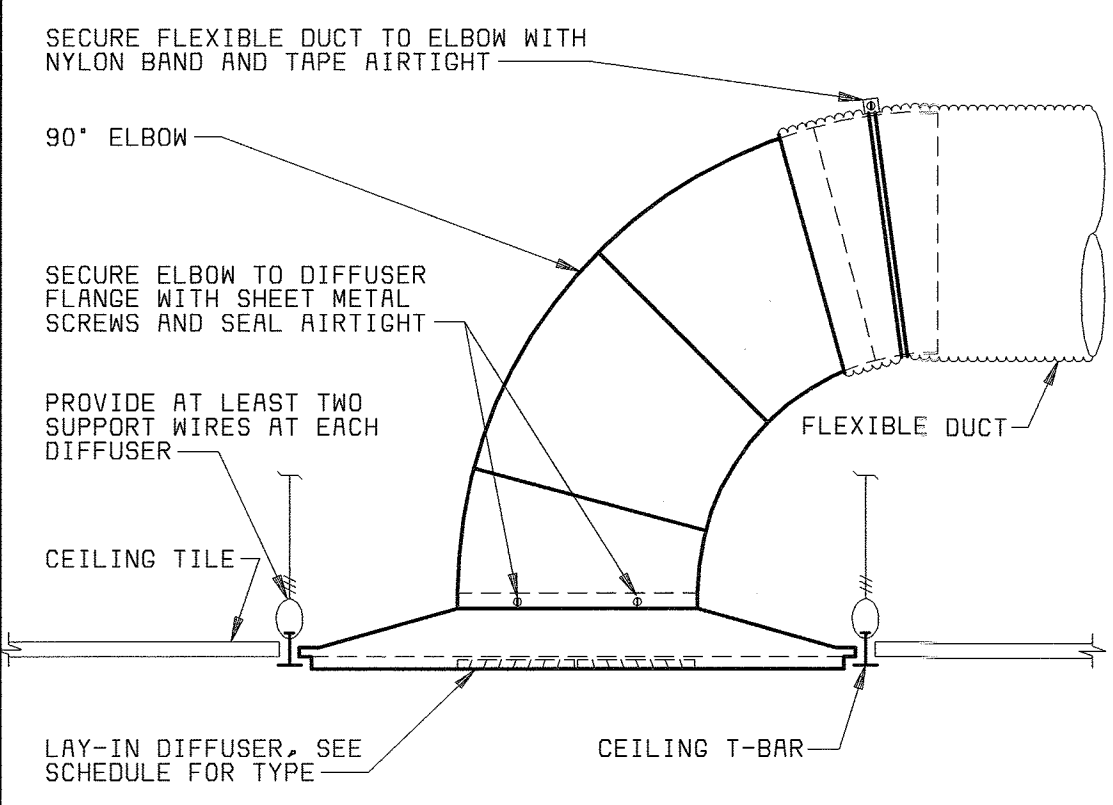


CEILING DIFFUSER (A) (H2)
NO SCALE

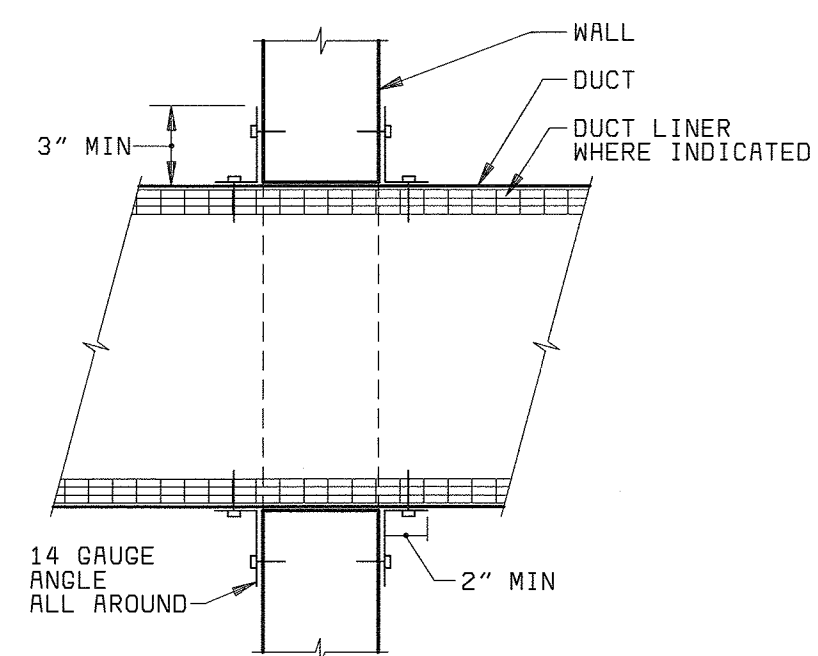


WALL PENETRATION (B) (H2)
NO SCALE

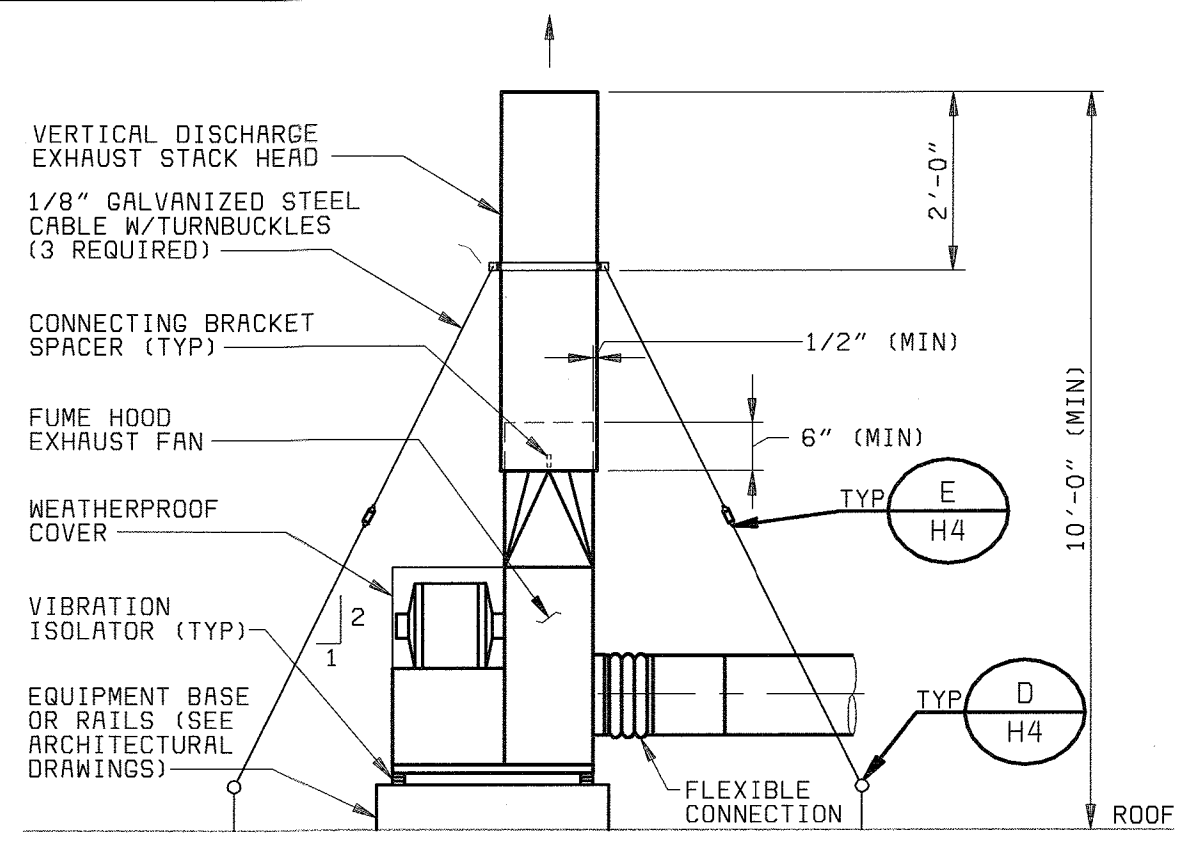

ROOF EXHAUST FAN (C) (H2)
NO SCALE

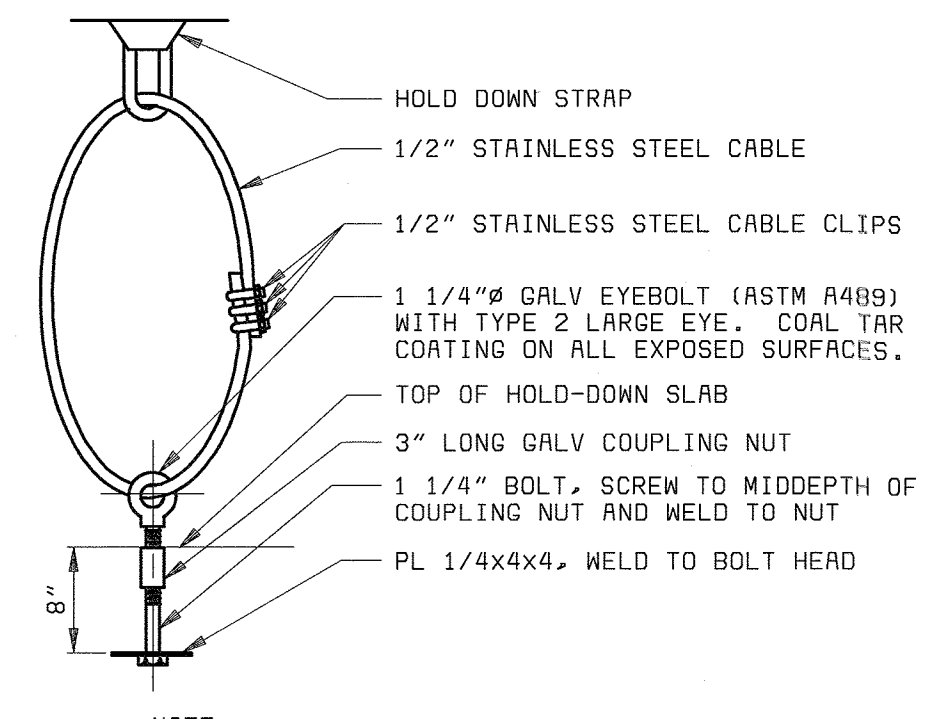

HOLD-DOWN DETAIL (D) (H4)
NO SCALE

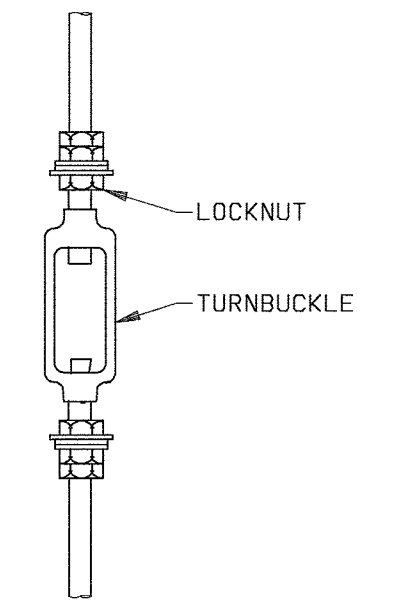

EQUIPMENT TURNBUCKLE (E) (H4)
NO SCALE

AIR DEVICE SCHEDULE

SYMBOL	MODEL	FRAME/BORDER	MATERIAL	FINISH	DAMPER TYPE	ACCESSORIES	REMARKS
SD-1	PAS-AA	LAY-IN	ALUMINUM	WHITE	OPPOSED		FLUSH FACE
TC-1	PAR-AA	LAY-IN	ALUMINUM	WHITE			FLUSH FACE
TG-2	CT-480	LAY-IN	ALUMINUM	WHITE			4'-0" LINEAR GRILLE

NOTES:
1. EQUIPMENT SCHEDULE MODEL NUMBERS BASED ON TITUS COMPANY
2. ALL DIFFUSER CORE STYLES ARE 4-WAY UNLESS OTHERWISE INDICATED ON THE PLANS

FAN SCHEDULE

UNIT NO	LOCATION	AIRFLOW (CFM)	ESP (IN WG)	MOTOR HP	POWER SUPPLY VOLTS/PHASE	MIN WHEEL DIA (IN)	WHEEL TYPE	DRIVE	APPROX WT (LBS)	REMARKS
9-201-F	LAB ROOF	3420	1.125	2	460/3	15	C	B	200	FUME HOOD EXHAUST FAN, 2D, 4, 5
9-202-F	LAB ROOF	300	0.375	1/6	115/1	8	C	D	40	REST ROOM EXHAUST FAN (PRV), 3

WHEEL TYPE NOTES: C - CENTRIFUGAL
P - PROPELLER

DRIVE NOTES: D - DIRECT
B - BELT

REMARKS:
1 - EXPLOSION-PROOF
2 - VIBRATION ISOLATOR A) RUBBER PAD B) RUBBER MOUNT C) RUBBER HANGER D) SPRING MOUNT E) SPRING HANGER F) RESTRAINED SPRING MOUNT
3 - BACKDRAFT DAMPER
4 - ARRANGEMENT 9, UPBLAST, CW
5 - ADJUSTABLE FREQUENCY DRIVE

HEATER SCHEDULE

UNIT NO	LOCATION	UNIT ORIENTATION	AIRFLOW (CFM)	AIR PD (IN WG)	OUTPUT CAPACITY		WATER FLOW (GPM)	WATER PD (FT)	MOTOR HP	POWER SUPPLY VOLTS/PHASE	APPROX WT (LBS)	REMARKS
					(BTUH)	(KW)						
9-203-HT	SAMPLE ENTRANCE	-	-	-	-	4.0	-	-	1/50	240/1	50	RECESSED WALL HTR
9-204-HT	OFFICE 101	-	-	-	-	0.5	-	-	-	120/1	-	BASE BOARD HEATER ELECTROMODE 8800 SERIES 27 INCHES LONG, BUILT IN T-STAT

UNIT ORIENTATION NOTES: H - HORIZONTAL DISCHARGE
V - VERTICAL DISCHARGE

NOTES:
ENTERING AIR TEMPERATURE - 72°F

PACKAGED AIR CONDITIONING UNIT SCHEDULE

UNIT NO	LOCATION	AIRFLOW (CFM)	ESP (IN WG)	INDOOR FAN MOTOR HP	POWER SUPPLY VOLTS/PHASE	MINIMUM CIRCUIT AMPACITY	COOLING				HEATING			OA (CFM)	APPROX WEIGHT (LBS)	REMARKS
							EAT (FDB)	CAPACITY (FWB)	SENSEIBLE	TOTAL	EAT (FDB)	CAPACITY (BTUH)	AUX CAPACITY (KW)			
9-200-ME	LAB ROOF	3420	0.375	3	460/3	106	91	75	126,100	220,100	13	273,200	-	3420	2000	

NOTES:
1. OUTDOOR COIL ENTERING AIR TEMPERATURE:
COOLING - 96°F
2. THE EQUIPMENT SHALL HAVE A MINIMUM EFFICIENCY AT THE ARI STANDARD RATING CONDITIONS OF NOT LESS THAN THE FOLLOWING:
>135,000 BTUH - 11.0 EER
3. THE FOLLOWING EQUIPMENT SHALL HAVE THE MINIMUM NUMBER OF CAPACITY STEP REDUCTIONS OR STAGES:
9-200-ME - 2 COOLING STEPS SCR CONTROL HEATING
4. UNIT SHALL HAVE BELT DRIVEN INDOOR FAN
5. UNIT SHALL BE PROVIDED WITH HOT GAS BYPASS AND LOW AMBIENT (0 F) CONTROLS.
6. UNIT SHALL BE PROVIDED WITH AN ADJUSTABLE FREQUENCY DRIVE

SEQUENCE OF OPERATIONS

THE PACKAGED AIR CONDITIONING UNIT (9-200-ME) SHALL HAVE TWO MODES OF OPERATION, OCCUPIED AND UNOCCUPIED. UNDER THE OCCUPIED MODE OF OPERATION, 9-200-ME SHALL OPERATE CONTINUOUSLY IN THE NORMAL COOLING OR HEATING MODE AND SHALL BE AT THE MAXIMUM AIRFLOW OF 3420 CFM. NORMAL COOLING AND HEATING SETPOINTS ARE 78 F AND 72 F RESPECTIVELY. THE LABORATORY FUME HOOD EXHAUST FAN (9-201-F) SHALL OPERATE CONTINUOUSLY AT THE NORMAL AIRFLOW RATE OF 3420 CFM. UNDER THE UNOCCUPIED MODE OF OPERATION, 9-200-ME SHALL OPERATE CONTINUOUSLY IN THE SETBACK COOLING OR HEATING MODE AND SHALL BE AT THE REDUCED AIRFLOW OF 1710 CFM (FIELD ADJUSTABLE). SETBACK COOLING AND HEATING SETPOINTS ARE 90 F AND 60 F RESPECTIVELY (FIELD ADJUSTABLE). THE LABORATORY FUME HOOD EXHAUST FAN (9-201-F) SHALL OPERATE CONTINUOUSLY AT THE REDUCED AIRFLOW RATE OF 1710 CFM (FIELD ADJUSTABLE).

THE ADJUSTABLE FREQUENCY DRIVES FOR 9-200-ME AND 9-201-F SHALL BE ADJUSTED TO THE INDICATED AIRFLOW RATES AND SHALL OPERATE AS INDICATED ABOVE. AIR FLOW MONITORING STATIONS AMS-101 AND AMS-102 SHALL BE USED TO ADJUST THE DRIVES TO THE PROPER AIRFLOW SETTINGS. AIRFLOW RATES SHALL BE INDICATED AT TCP-101.

A PROGRAM 7-DAY TIME CLOCK, WITH A MANUAL 2 HOUR OVERRIDE TIMER, SHALL BE PROVIDED IN THE TEMPERATURE CONTROL PANEL, TCP-101, TO SWITCH THE SYSTEM FROM OCCUPIED MODE TO UNOCCUPIED MODE OF OPERATION. A SPACE THERMOSTAT (T-101) SHALL BE PROVIDED WITH ADJUSTABLE SET POINTS AND BE ABLE TO HAVE SETBACK TEMPERATURE SETPOINTS. THE SYSTEM PROGRAM TIME CLOCK SHALL CONTROL THE SETTINGS OF THE SPACE THERMOSTAT (OCCUPIED AND UNOCCUPIED MODES OF OPERATION). WHEN THE UNOCCUPIED MODE IS OVERRIDDEN, THE SYSTEM SHALL RETURN TO THE OCCUPIED MODE OF OPERATION UNTILL THE PRESELECTED TIME PERIOD ELAPSES.

WHEN LOW LIMIT THERMOSTAT T-102 SENSES A TEMPERATURE BELOW ITS SET POINT OF 40 F, 9-200-ME SHALL BE DE-ENERGIZED AND FUME HOOD EXHAUST FAN (9-201-F) SHALL BE DE-ENERGIZED. WHEN SMOKE DETECTOR SMD-101 DETECTS SMOKE, 9-200-ME AND FUME HOOD EXHAUST FAN (9-201-F) SHALL DE-ENERGIZE AND AN INDICATING LIGHT ON THE SMOKE DETECTOR'S REMOTE TEST STATION SHALL ILLUMINATE.

THE REST ROOM EXHAUST FAN (9-202-F) SHALL BE INTERLOCKED WITH THE LIGHT SWITCH WHEN THE LIGHT SWITCH IS ON, THE FAN SHALL BE ENERGIZED.



THE WALL HEATER (9-203-HT) SHALL BE CONTROLLED BY A UNIT MOUNTED THERMOSTAT. WHEN THE THERMOSTAT SENSES A TEMPERATURE BELOW ITS SETTING OF 65 F, THE HEATER SHALL BE ENERGIZED.

THE BASE BOARD HEATER (9-204-HT) SHALL BE CONTROLLED BY A UNIT MOUNTED THERMOSTAT. WHEN THE THERMOSTAT SENSES A TEMPERATURE BELOW ITS SETTING OF 72 F, THE HEATER SHALL BE ENERGIZED.

THE ATOMIC ABSORPTION EXHAUST FAN AND TRANSFER CONTROL DAMPER (CD-101) SHALL BE INTERLOCKED WITH THE ATOMIC ABSORPTION UNIT. WHEN THE ATOMIC ABSORPTION UNIT IS IN OPERATION, THE EXHAUST FAN SHALL BE ENERGIZED AND THE CONTROL DAMPER (CD-101) SHALL BE ENERGIZED TO THE OPEN POSITION.

DEPARTMENT OF PUBLIC WORKS HOWARD COUNTY, MARYLAND CHIEF, BUREAU OF UTILITIES DATE	 BLACK & VEATCH Gaithersburg, Maryland REG. PROF. ENGR. DATE	THIS DRAWING WAS ORIGINALLY APPROVED FOR CONSTRUCTION AND SEALED BY MARTIN L. PAPE A REGISTERED PROFESSIONAL ENGINEER IN THE STATE OF MARYLAND, NO. 21992	DES: GWP,RWC							LITTLE PATUXENT WATER RECLAMATION PLANT ADDITION NO. 6 LABORATORY RENOVATION CAPITAL PROJECT S-6205 CONTRACT NO. 20-3841 HOWARD COUNTY, MARYLAND	SCALE AS SHOWN
			DRN: BDL,LDW								
			CHK: JEP								
			DATE: 10/03/01	DATE	CONFORMED TO CONSTRUCTION RECORDS		RHH/RJR/RJR				H4
					REVISIONS AND RECORD OF ISSUE		NO. BY CK APP				

058472-5
FD58472A

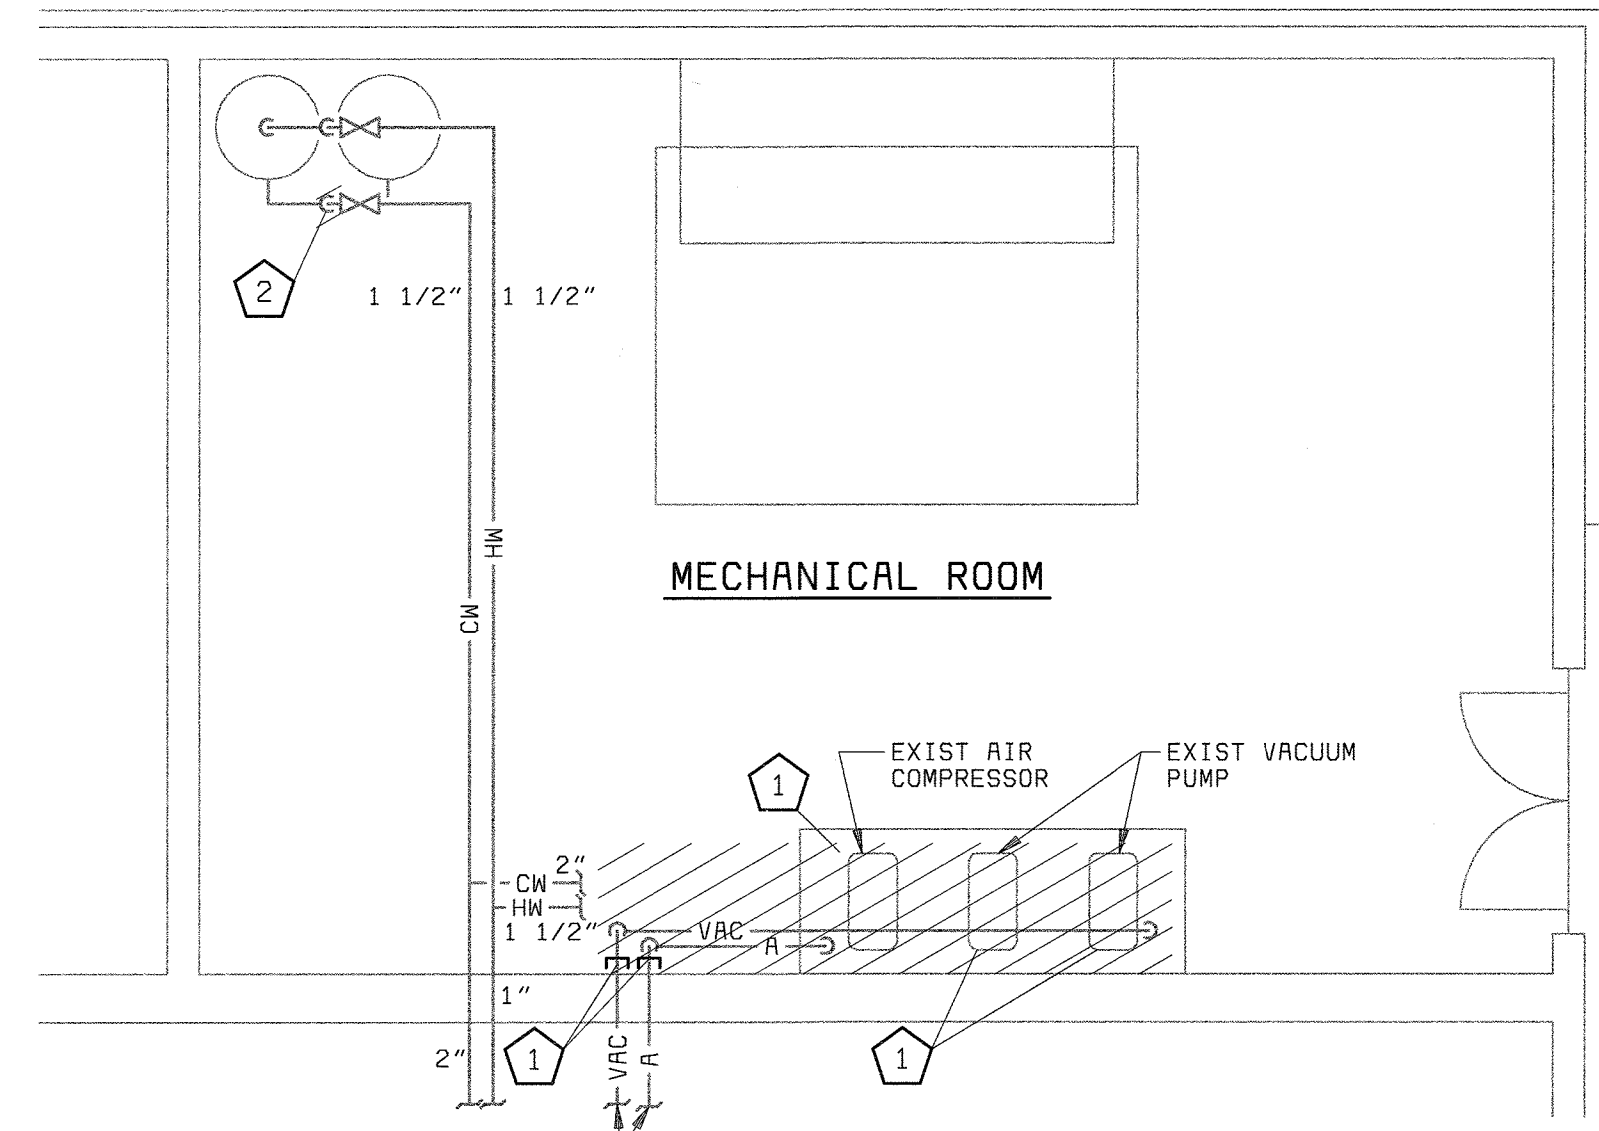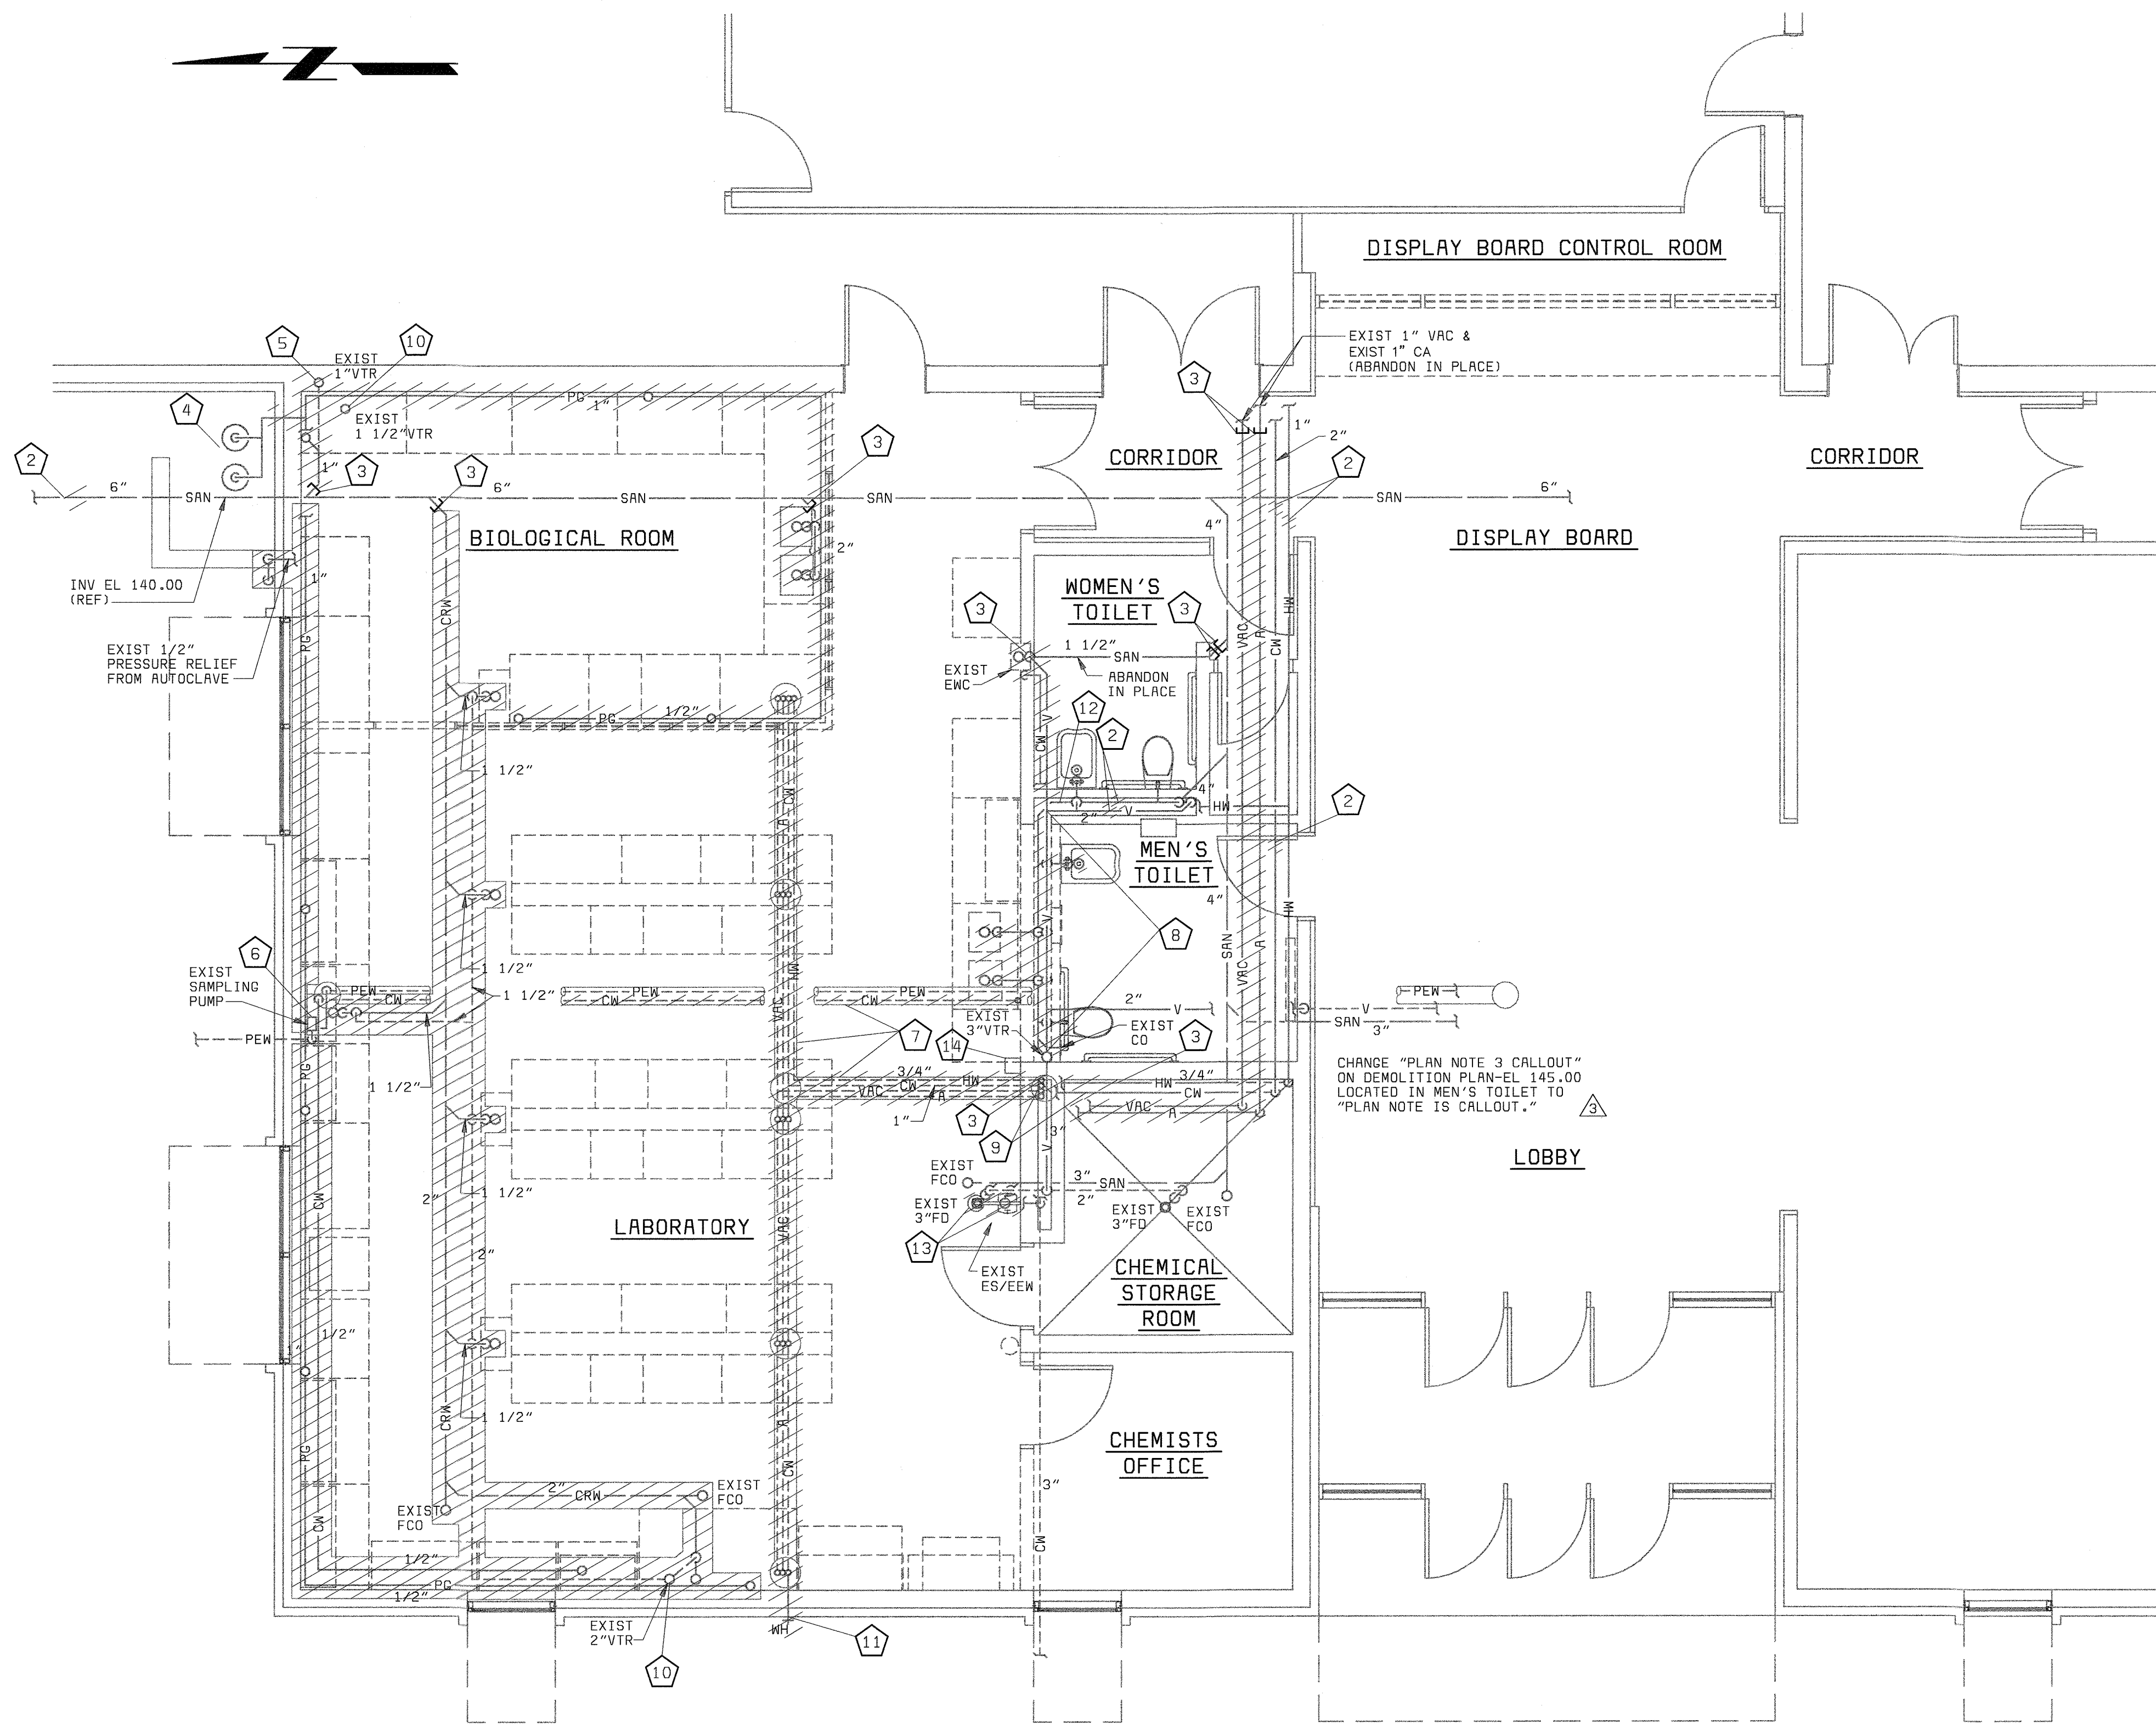


DEMOLITION PLAN - EL 145.00
1/4" = 1'-0"

PLAN NOTES:

- 1 CONTRACTOR SHALL REMOVE EXIST COMPRESSED AIR AND VACUUM PIPING FROM PUMPS AND COMPRESSOR TO WALL PENETRATIONS AND CAP. CONTRACTOR SHALL REMOVE EXISTING AIR COMPRESSOR AND VACUUM PUMPS.
- 2 CONTRACTOR SHALL MODIFY EXIST PIPING AS NECESSARY TO INSTALL NEW BRANCH PIPING.
- 3 CONTRACTOR SHALL REMOVE EXIST PIPING AND INSTALL CAP OR PLUG.
- 4 OWNER WILL REMOVE PROPANE TANKS AND ACCESSORIES.
- 5 CONTRACTOR SHALL REMOVE EXISTING VENT PIPING UP TO BOTTOM OF ROOF SLAB. CAP AND SEAL VENT PIPE ABOVE ROOF.
- 6 CONTRACTOR SHALL REMOVE EXISTING SAMPLING PUMP AS SHOWN IN DETAIL B, DRAWING P3.
- 7 CONTRACTOR SHALL CAP OR PLUG ALL EXISTING PIPING AT FLOOR LEVEL IN FLOOR CONDUIT EXCEPT FOR PEW PIPING. CONTRACTOR SHALL BLOWOUT ALL LINES TO ENSURE THAT NO WATER REMAINS IN PIPING BEFORE CAP OR PLUG IS INSTALLED.
- 8 CONTRACTOR SHALL MODIFY EXISTING VENT PIPING TO REMOVE UNUSED BRANCHES AND TO ROUTE ABOVE NEW CEILING.
- 9 CONTRACTOR SHALL REMOVE EXIST CW PIPING TO UNDERGROUND CONDUIT AND CAP OR PLUG AT BRANCH. CONTRACTOR SHALL MODIFY HEADER FOR NEW BRANCH CONNECTION TO NEW DEIONIZED WATER SYSTEM.
- 10 CONTRACTOR SHALL REMOVE EXISTING VENT PIPING UP THRU ROOF. NEW CRV PIPING THRU ROOF SHALL REUSE EXISTING ROOF PENETRATION. CONTRACTOR SHALL MODIFY AS NECESSARY.
- 11 CONTRACTOR SHALL REMOVE EXISTING WALL HYDRANT. EXISTING WALL PENETRATION SHALL BE MODIFIED AS NECESSARY TO ACCOMMODATE NEW WALL HYDRANT.
- 12 CONTRACTOR SHALL MODIFY EXISTING SANITARY DRAIN PIPING TO INSTALL NEW WALL CLEANOUT.
- 13 CONTRACTOR SHALL REMOVE EXISTING EMERGENCY SHOWER AND EMERGENCY EYEWASH.
- 14 CONTRACTOR SHALL REMOVE EXISTING DEIONIZED WATER E-PURE UNIT FOR RELOCATION TO GLASSWARE AREA.
- 15 CONTRACTOR SHALL REMOVE EXISTING HW PIPING TO UNDERGROUND CONDUIT AND MODIFY FOR CONNECTION TO NEW DEIONIZED WATER SYSTEM.

GENERAL NOTES:

- 1. CONTRACTOR SHALL FIELD VERIFY LOCATION OF ALL EXISTING PIPING AND EQUIPMENT SHOWN ON THIS DRAWING.
- 2. CONTRACTOR SHALL REMOVE ALL EXISTING LABORATORY PIPING NOT BEING REUSED SUBJECT TO OWNERS APPROVAL.

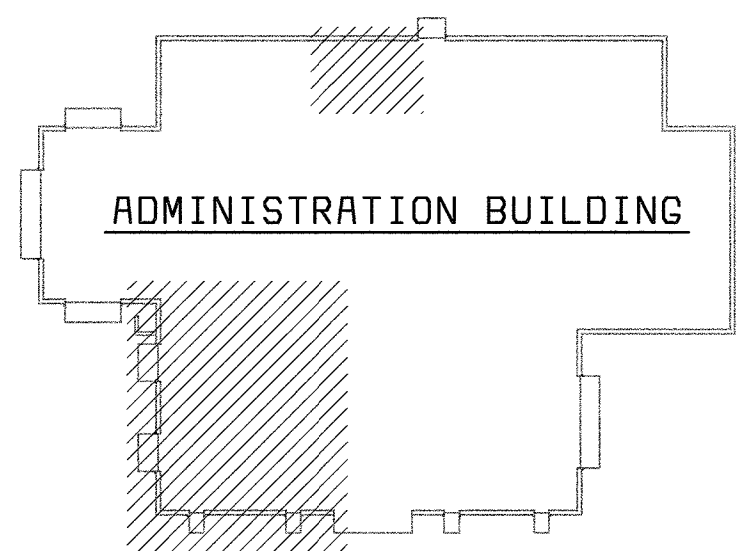


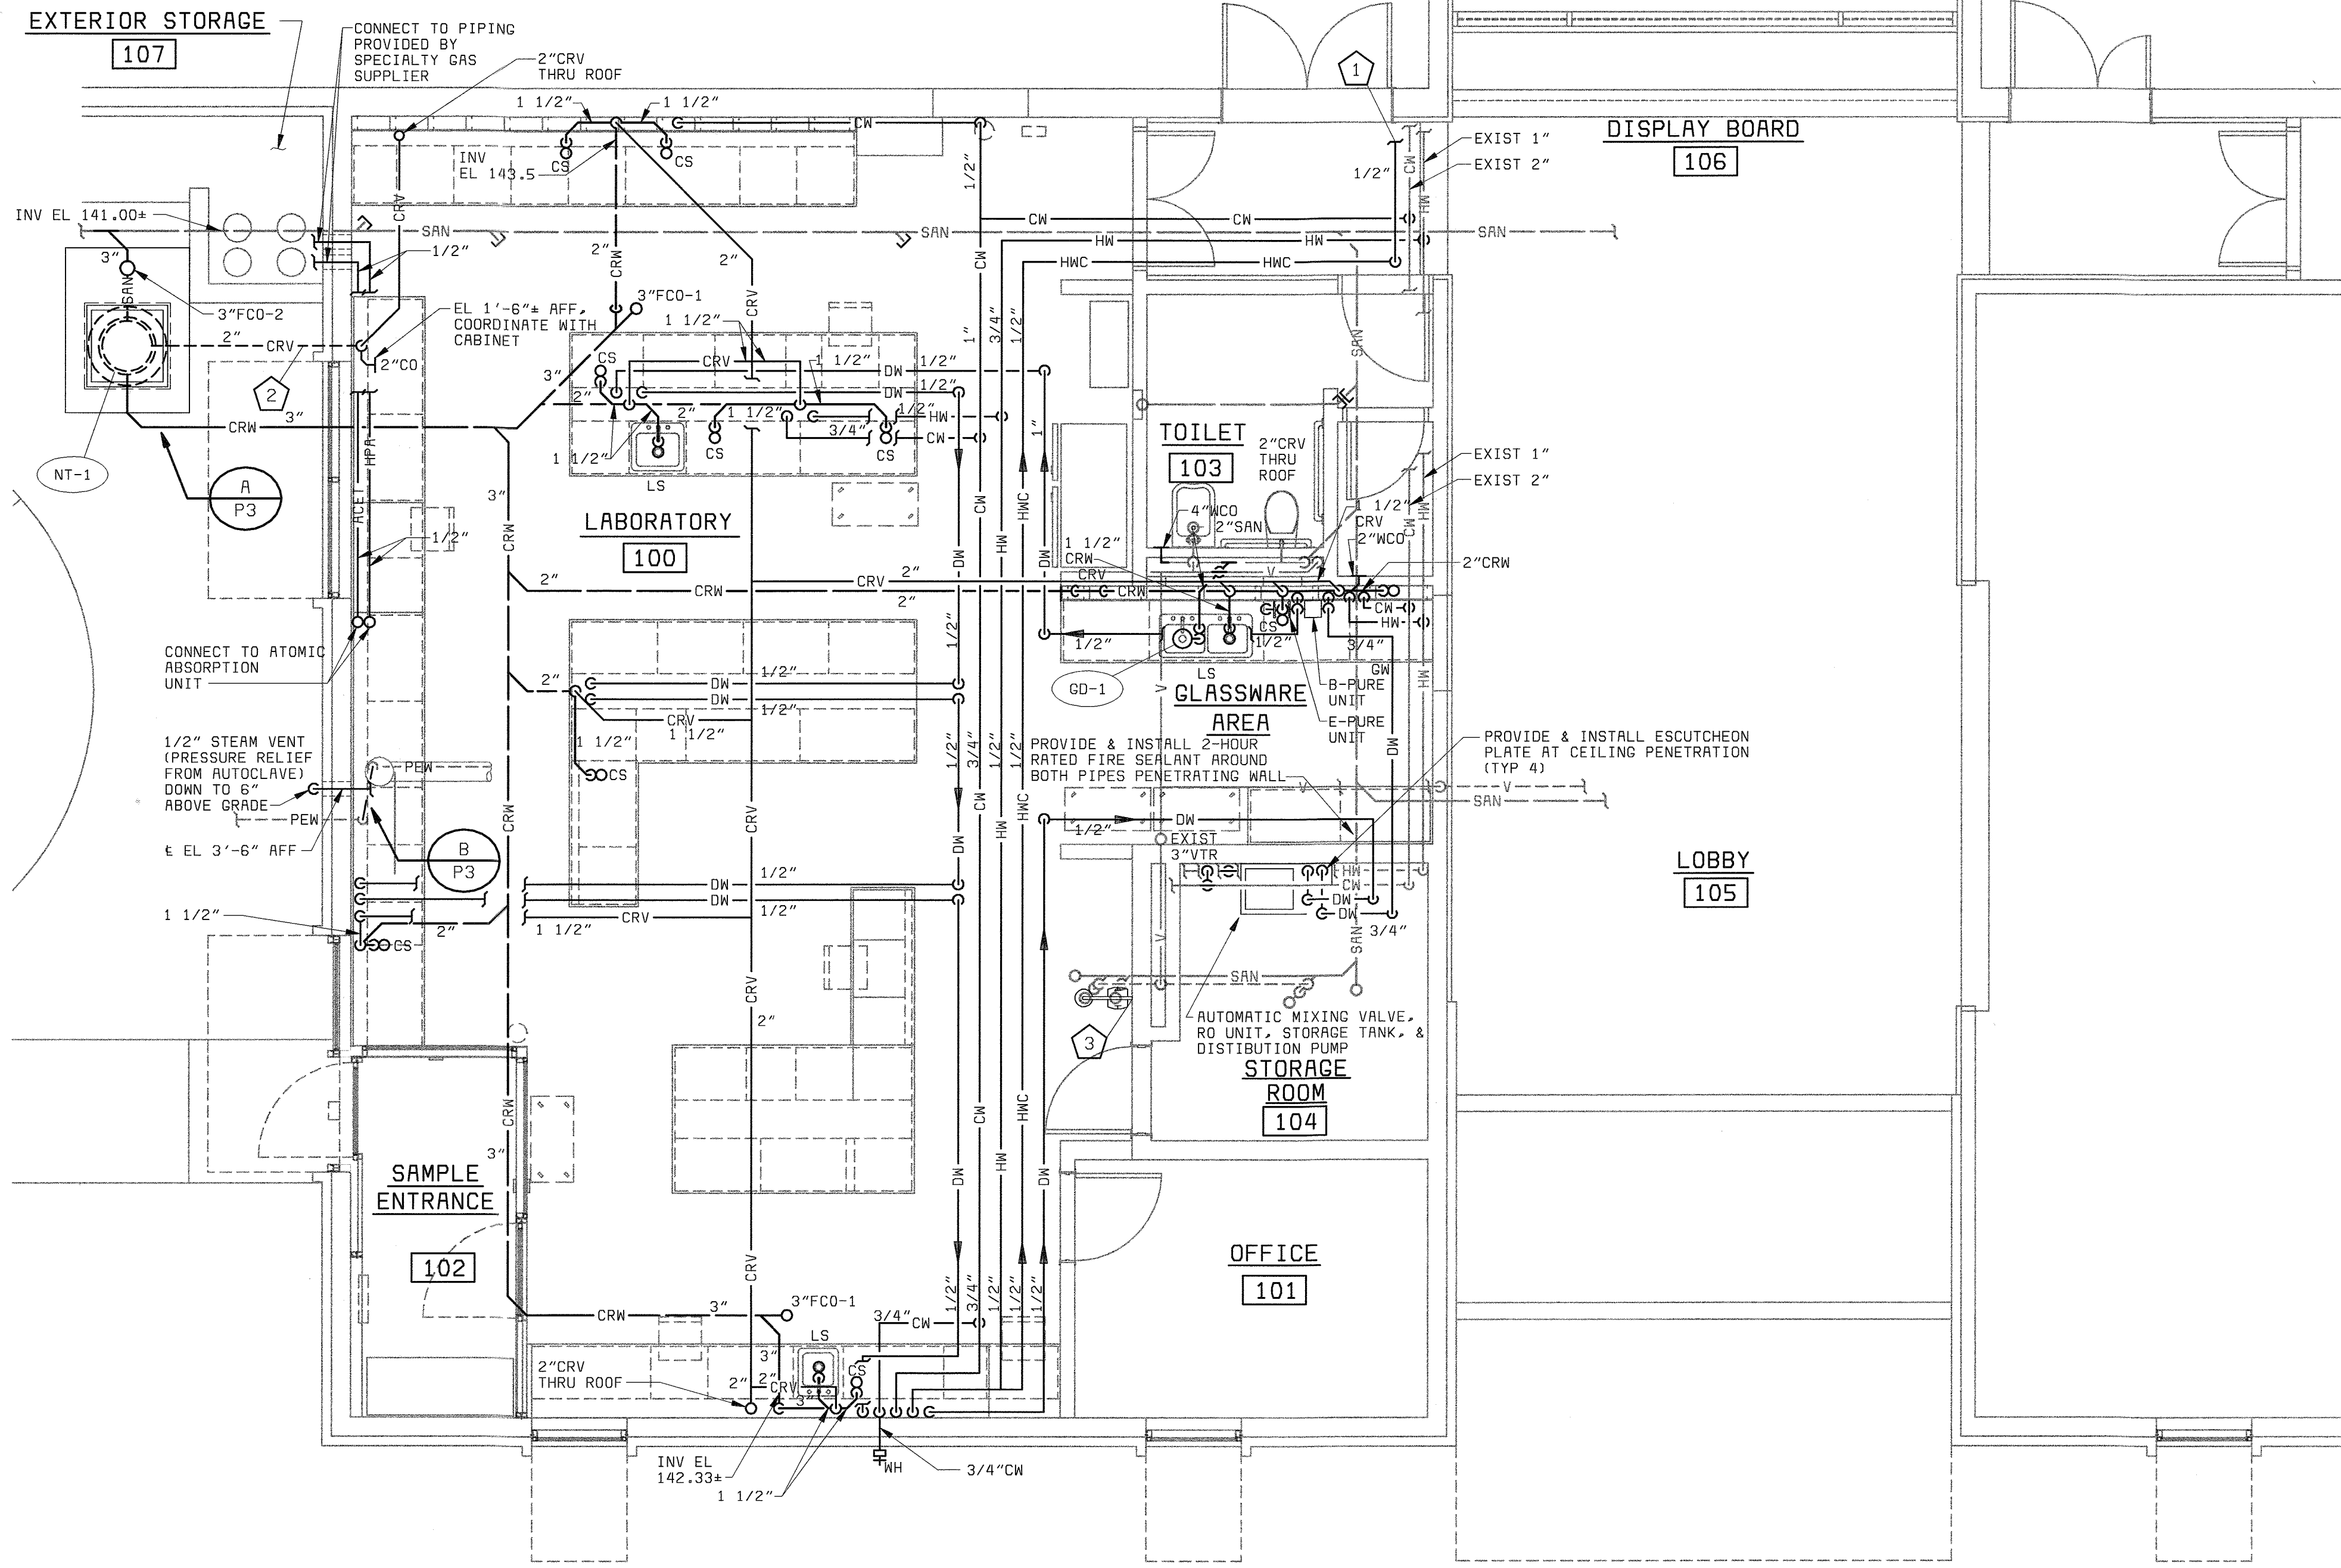
KEY PLAN
NO SCALE

DEMOLITION PLAN - EL 145.00
1/4" = 1'-0"


58472-112-ADM-A-T000003XF

58472-5
FD58472R

DEPARTMENT OF PUBLIC WORKS HOWARD COUNTY, MARYLAND  BLACK & VEATCH Gaithersburg, Maryland REG. PROF. ENGR. _____ DATE _____	THIS DRAWING WAS ORIGINALLY APPROVED FOR CONSTRUCTION AND SEALED BY MARTIN L. PAPE A REGISTERED PROFESSIONAL ENGINEER IN THE STATE OF MARYLAND, NO. 21992	DES: JPC						PLUMBING ADMINISTRATION BUILDING LABORATORY DEMOLITION PLAN	LITTLE PATUXENT WATER RECLAMATION PLANT ADDITION NO. 6 LABORATORY RENOVATION CAPITAL PROJECT S-6205 CONTRACT NO. 20-3841 HOWARD COUNTY, MARYLAND	SCALE AS SHOWN
		DRN: JPC	CHK: MLP	11/03/03	CONFORMED TO CONSTRUCTION RECORDS					
CHIEF, BUREAU OF UTILITIES DATE _____		DATE: 10/03/01	DATE	REVISIONS AND RECORD OF ISSUE						P1



FLOOR PLAN - EL 145.00
1/4" = 1'-0"

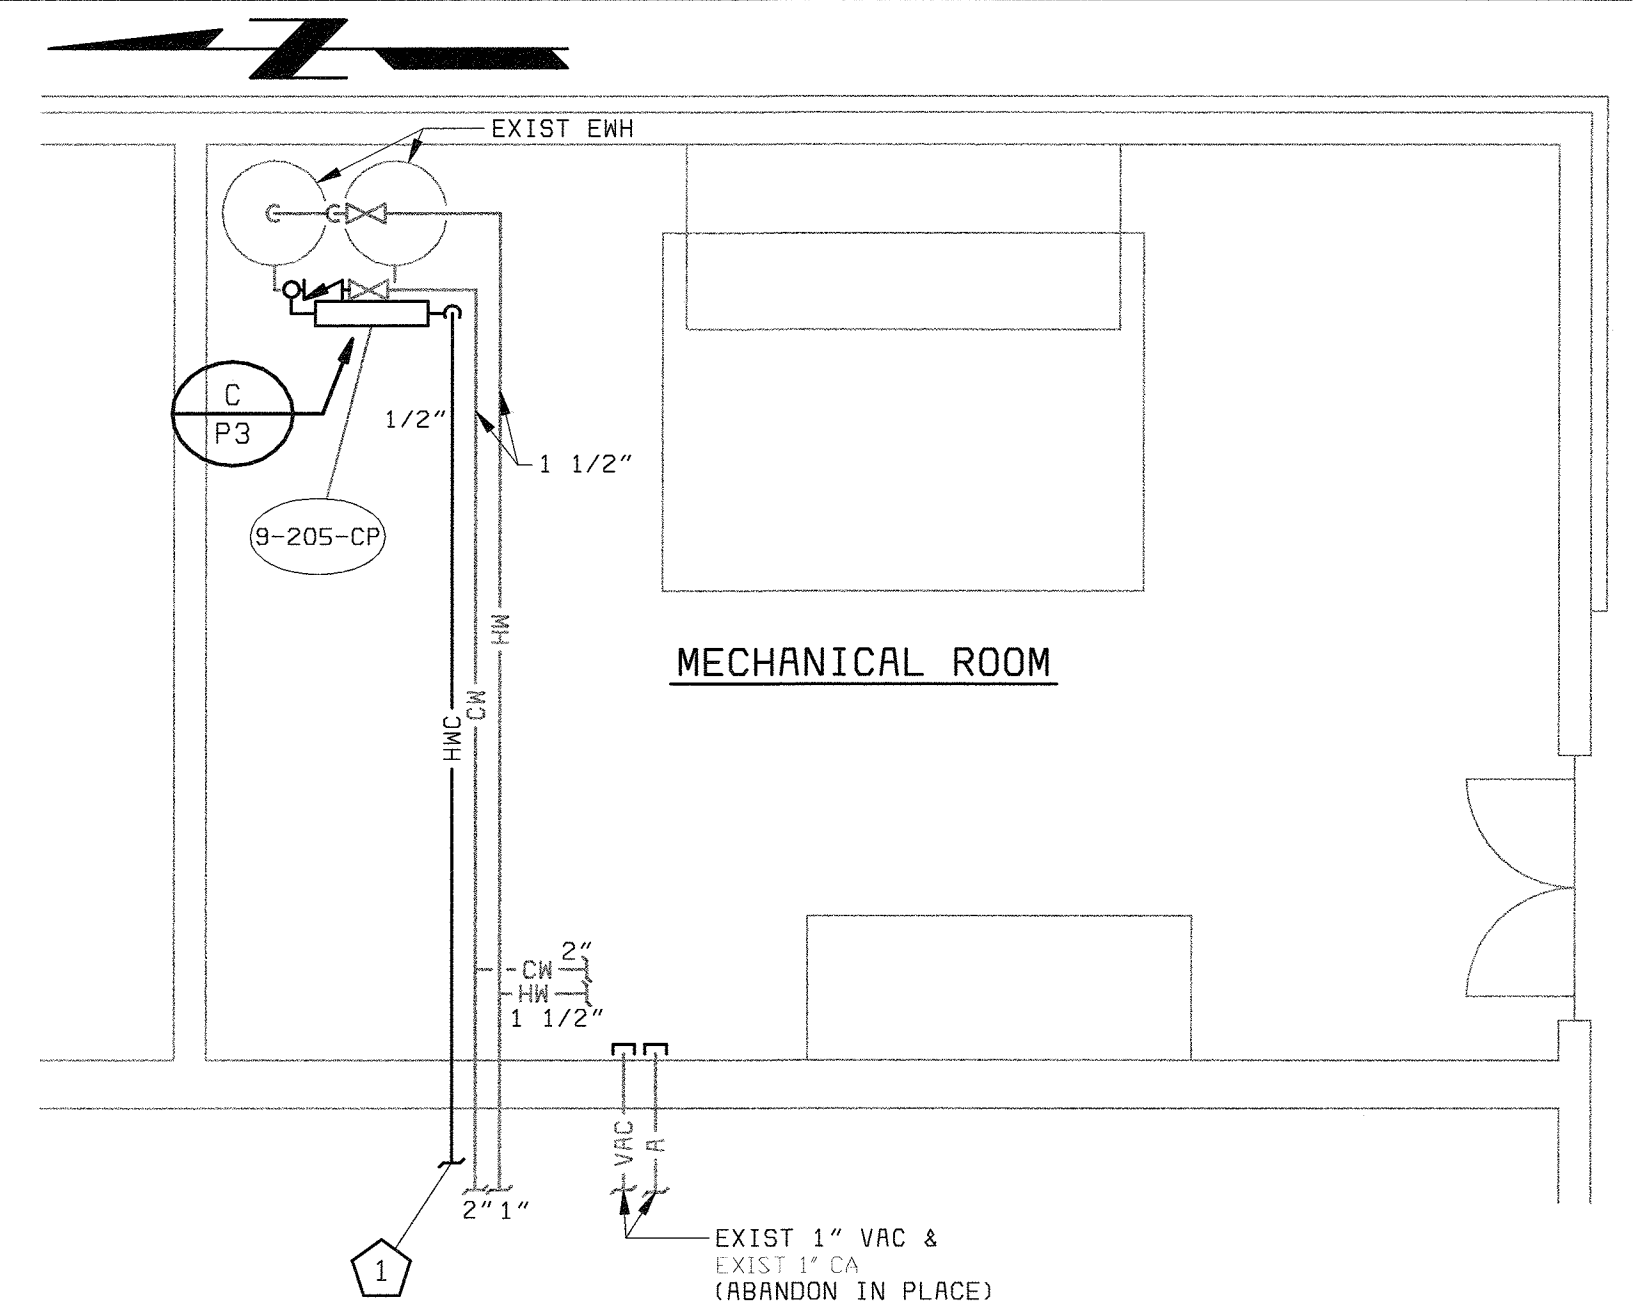


FLOOR PLAN - EL 145.00
1/4" = 1'-0"

PLAN NOTES:

- 1 CONTRACTOR SHALL FIELD ROUTE HOT WATER CIRCULATING PIPING FROM MECHANICAL ROOM TO LABORATORY. CONTRACTOR SHALL SUBMIT PIPE ROUTING PLAN TO ENGINEER FOR APPROVAL.
- 2 BELOW GRADE VENT PIPING SHALL BE SLOPED UPWARD AS MUCH AS POSSIBLE TOWARD THE BUILDING.
- 3 INSTALL NEW LAB EMERGENCY SHOWER AND NEW EMERGENCY EYEWASH. RECONNECT TO EXISTING WATER AND DRAIN CONNECTIONS.

GENERAL NOTES:

- 1. CONTRACTOR SHALL COORDINATE VENT AND WATER RISERS BELOW THE CEILING WITH PLUMBING CHASES SHOWN ON ARCHITECTURAL DRAWING A2.
- 2. SEE ARCHITECTURAL DRAWING A2 FOR TYPE OF WATER REQUIRED AT EACH SINK.

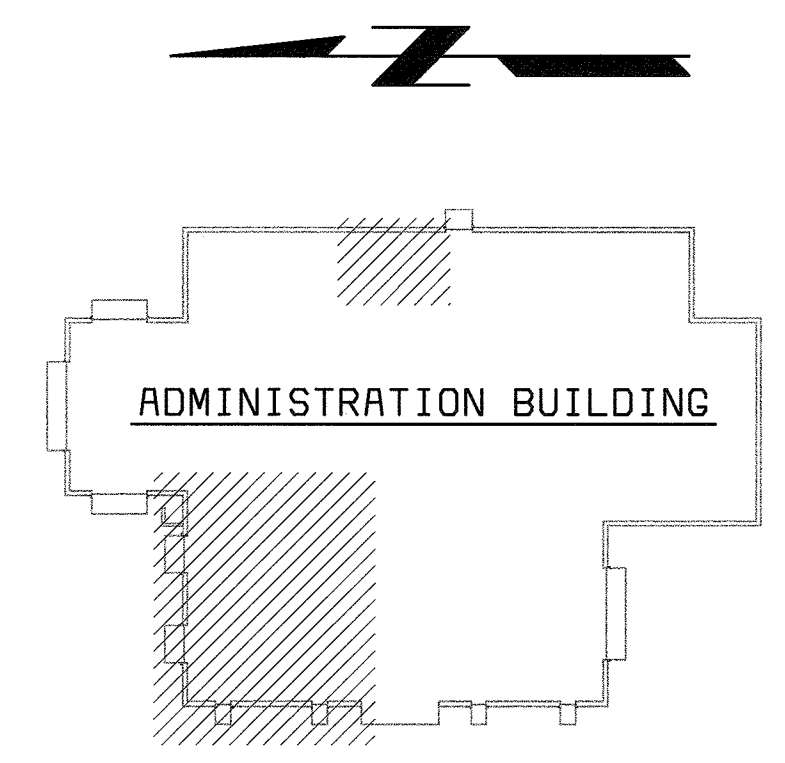

KEY PLAN
NO SCALE

58472-112-ADM-A-T000003XL

58472-5
FD58472A

DEPARTMENT OF PUBLIC WORKS
HOWARD COUNTY, MARYLAND

CHIEF, BUREAU OF UTILITIES DATE

BLACK & VEATCH
Gaithersburg, Maryland

REG. PROF. ENGR. _____ DATE _____

THIS DRAWING WAS
ORIGINALLY APPROVED
FOR CONSTRUCTION
AND SEALED BY
MARTIN L. PAPE
A REGISTERED
PROFESSIONAL ENGINEER
IN THE
STATE OF MARYLAND,
NO. 21992

DES: JPC					
DRN: JPC					
CHK: MLP					
DATE: 10/03/01	11/03/03	CONFORMED TO CONSTRUCTION RECORDS		RHH/RJR/RJR	
	DATE	REVISIONS AND RECORD OF ISSUE	NO.	BY	CK APP

PLUMBING

ADMINISTRATION BUILDING
LABORATORY
FLOOR PLAN

LITTLE PATUXENT WATER RECLAMATION PLANT
ADDITION NO. 6
LABORATORY RENOVATION


CAPITAL PROJECT S-6205
CONTRACT NO. 20-3841

HOWARD COUNTY, MARYLAND

SCALE
AS
SHOWN

SHEET
22 OF 28

P2

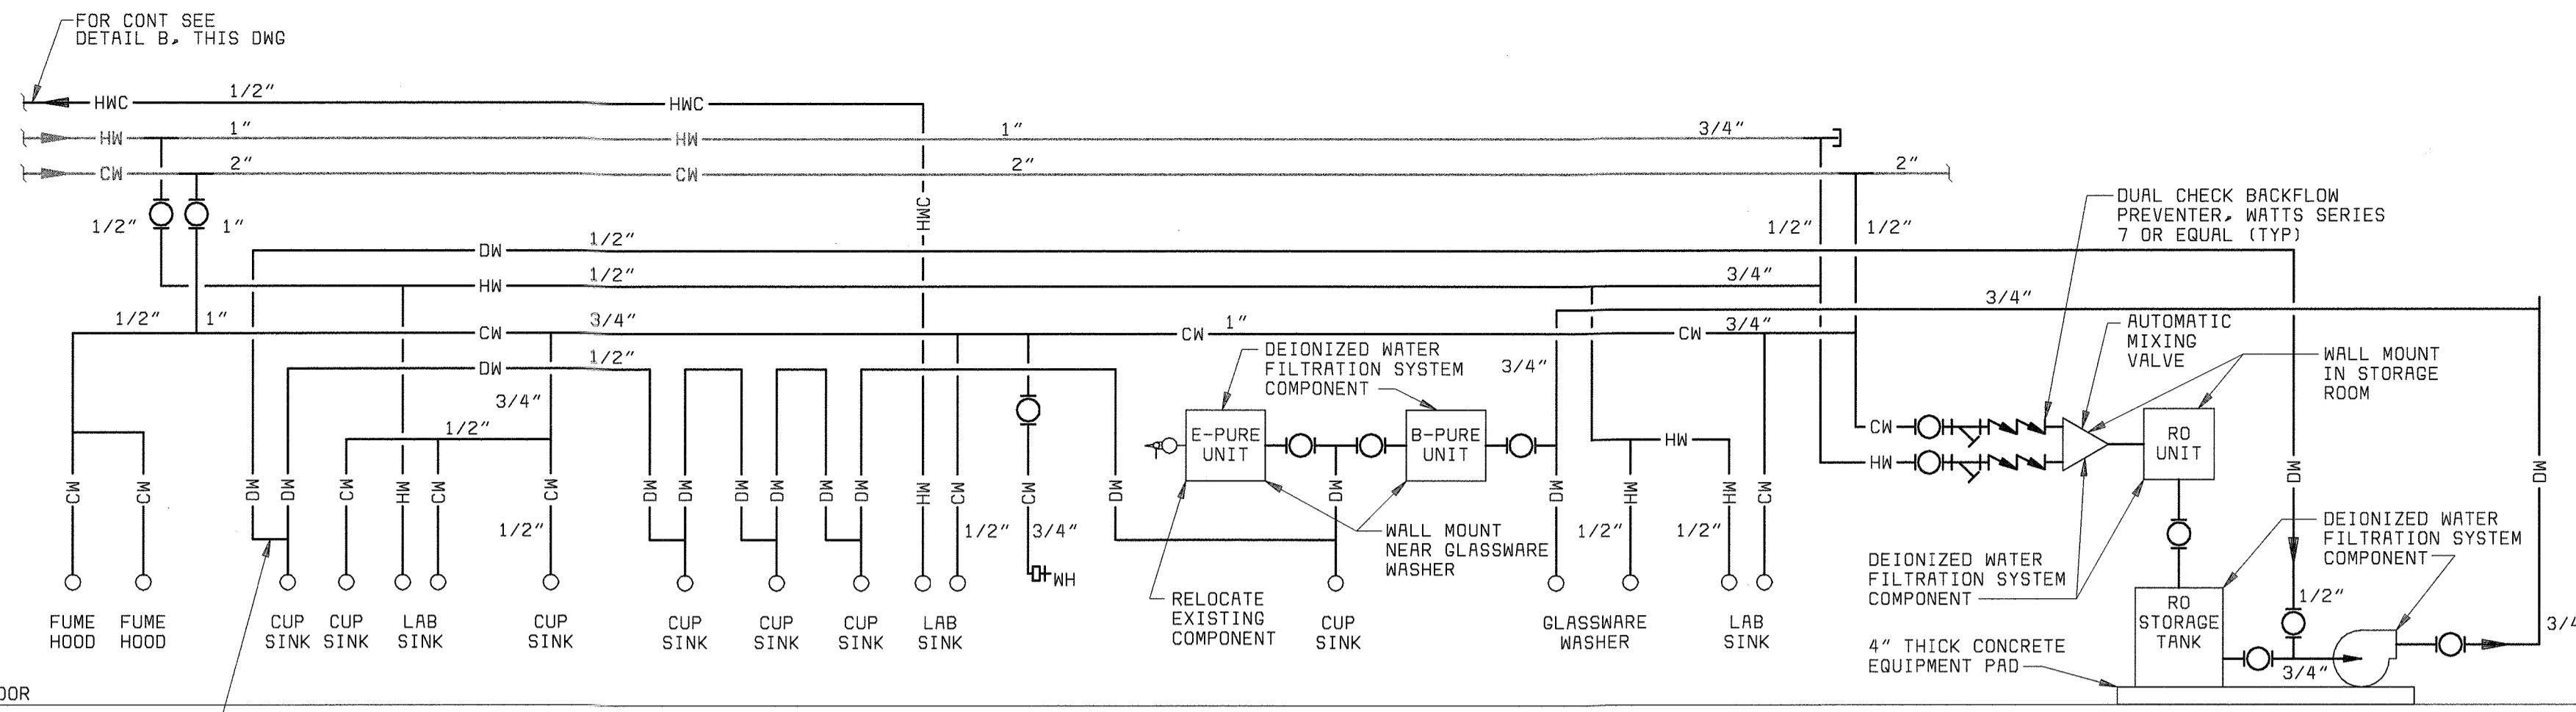

NOTE:
ALL PIPING SHALL BE 1/2" ID UNLESS OTHERWISE INDICATED.

LABORATORY WATER PIPING RISER DIAGRAM
NO SCALE

PLUMBING FIXTURE AND EQUIPMENT SCHEDULE


LABEL	DESCRIPTION	MANUFACTURER MODEL	REMARKS
NT-1	NEUTRALIZATION TANK, 55 GALLON, 3 INCH INLET AND OUTLET, 2 INCH VENT CONNECTION.	ORION STYLE 4	
FCO-1	CORROSION RESISTANT FLOOR CLEANOUT, POLYPROPYLENE BODY, NICKEL BRONZE COVER.	ORION FFCO-RD-NB SERIES	
FCO-2	HEAVY DUTY FLOOR CLEANOUT, SECURED ROUND ADJUSTABLE NICKEL BRONZE TOP.	SMITH 4100 SERIES	
ET-1	EXPANSION TANK, PIPELINE MOUNTED, 4.7 GALLON, PRECHARGE TO 80 PSIG.	AMTROL ST-12	
GD-1	FOOD WASTE DISPOSER, 1/2 HP, 120 VOLT, 1 PHASE.	IN-SINK-ERATOR 333/SS	
REMARKS: 1. FIXTURE AND INSTALLATION SHALL BE ADA COMPLIANT.			

PLUMBING PUMP SCHEDULE


UNIT NO	DESCRIPTION	MANUFACTURER MODEL	REMARKS
9-205-CP	IN-LINE HOT WATER CIRCULATING PUMP, 1 GPM, 5 FT HEAD, 120 VOLT, 1 PHASE, 60 HZ.	BELL & GOSSETT NBF-12	
REMARKS:			

PLUMBING FIXTURE CONNECTION SCHEDULE


SYMBOL	FIXTURE	WATER		SANITARY	
		HOT	COLD	WASTE	VENT
CS	CUP SINK	-	1/2"*	1 1/2"	1 1/2"
GW	GLASSWARE WASHER	1/2"	1/2"	1 1/2"	1 1/2"
LS	LAB SINK	1/2"	1/2"	1 1/2"	1 1/2"
REMARKS: 1. * - PROVIDE DW WATER WHERE INDICATED ON DRAWINGS.					

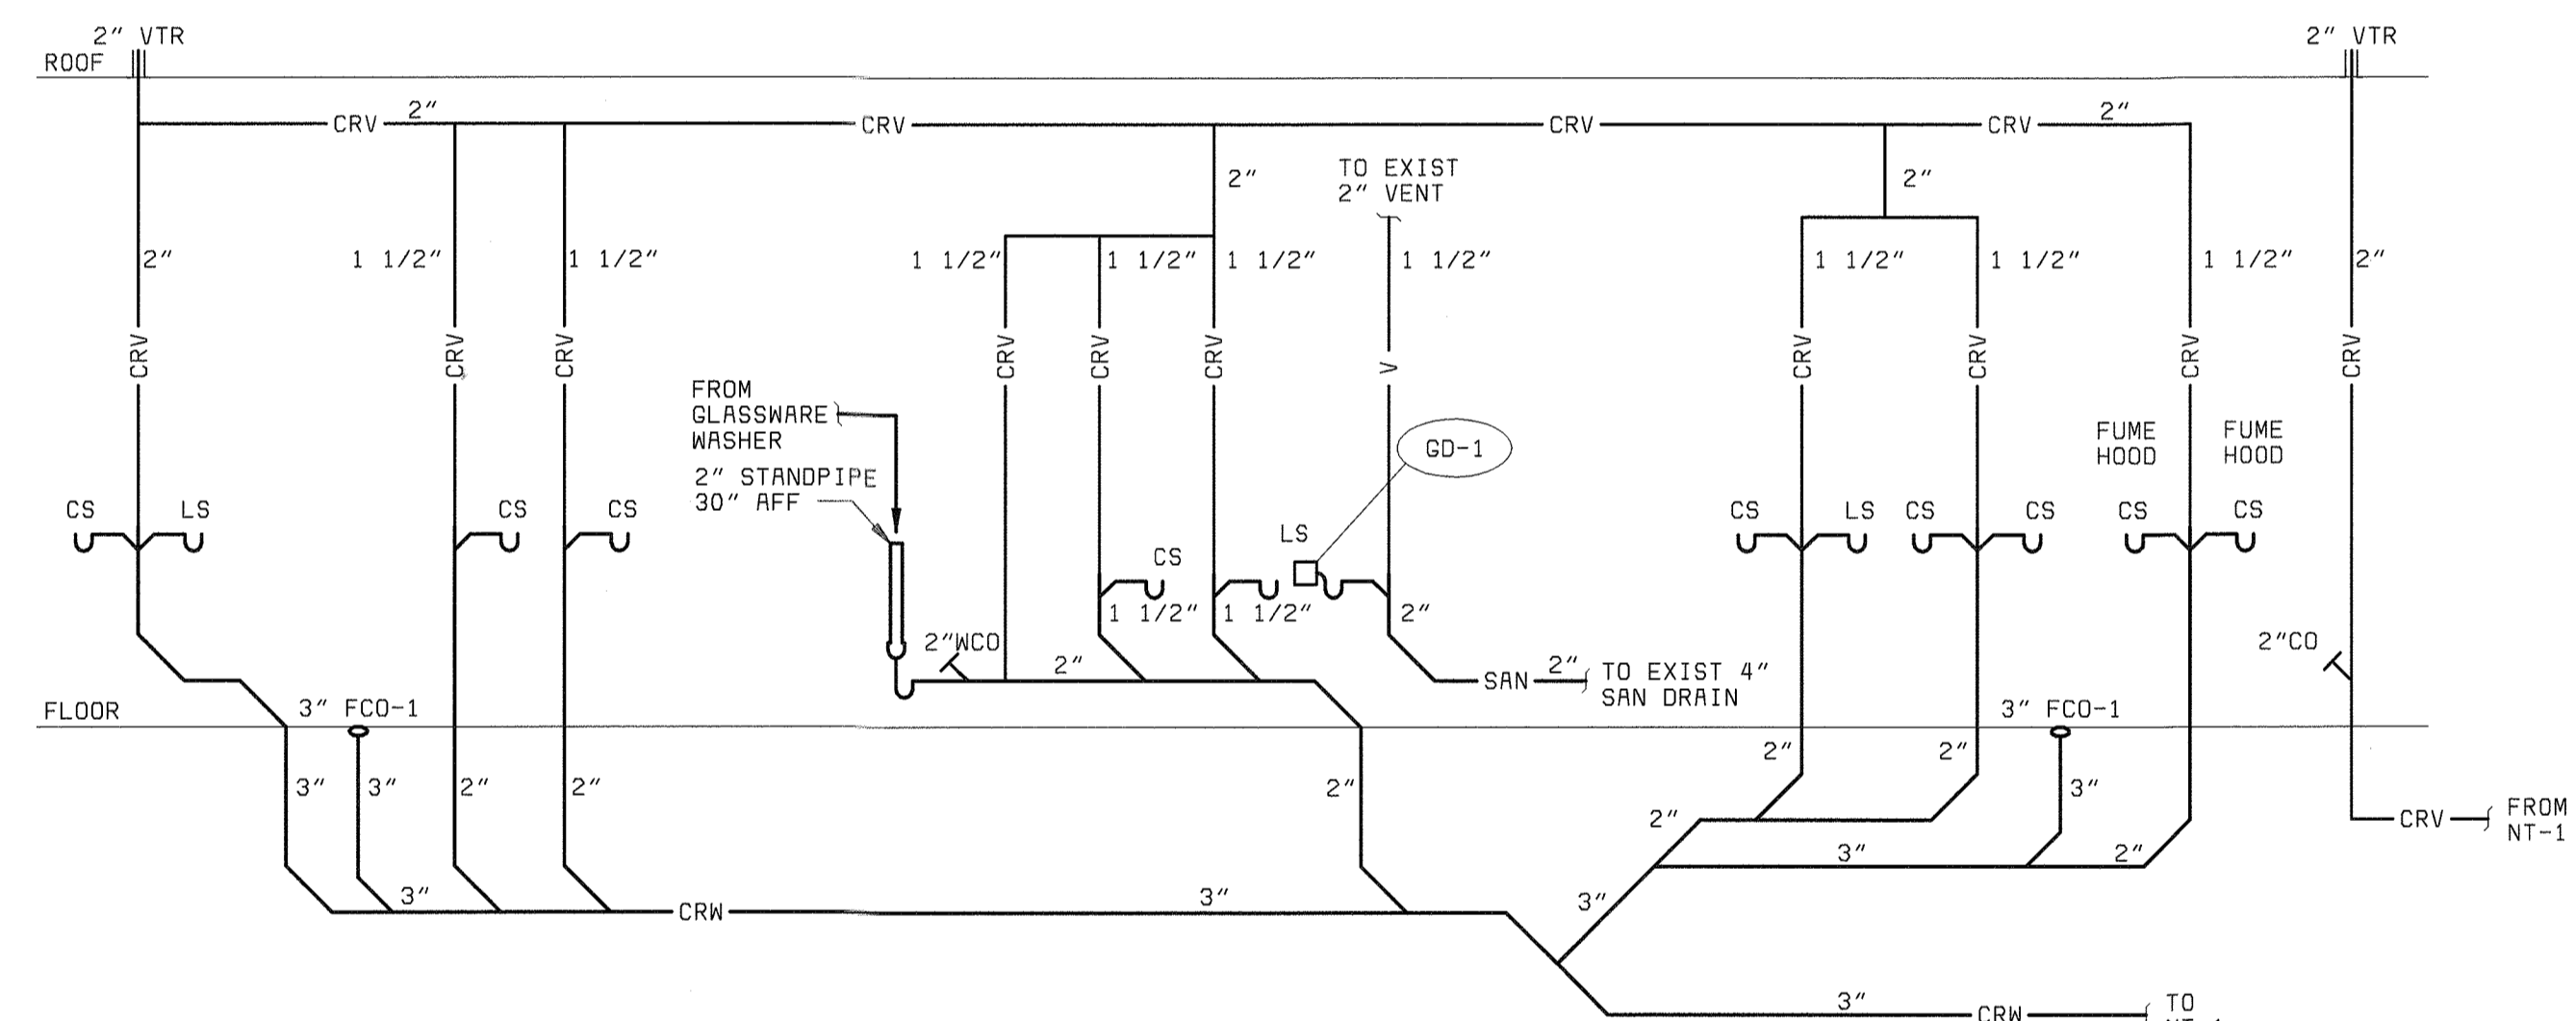


LABORATORY WASTE AND VENT RISER DIAGRAM
NO SCALE

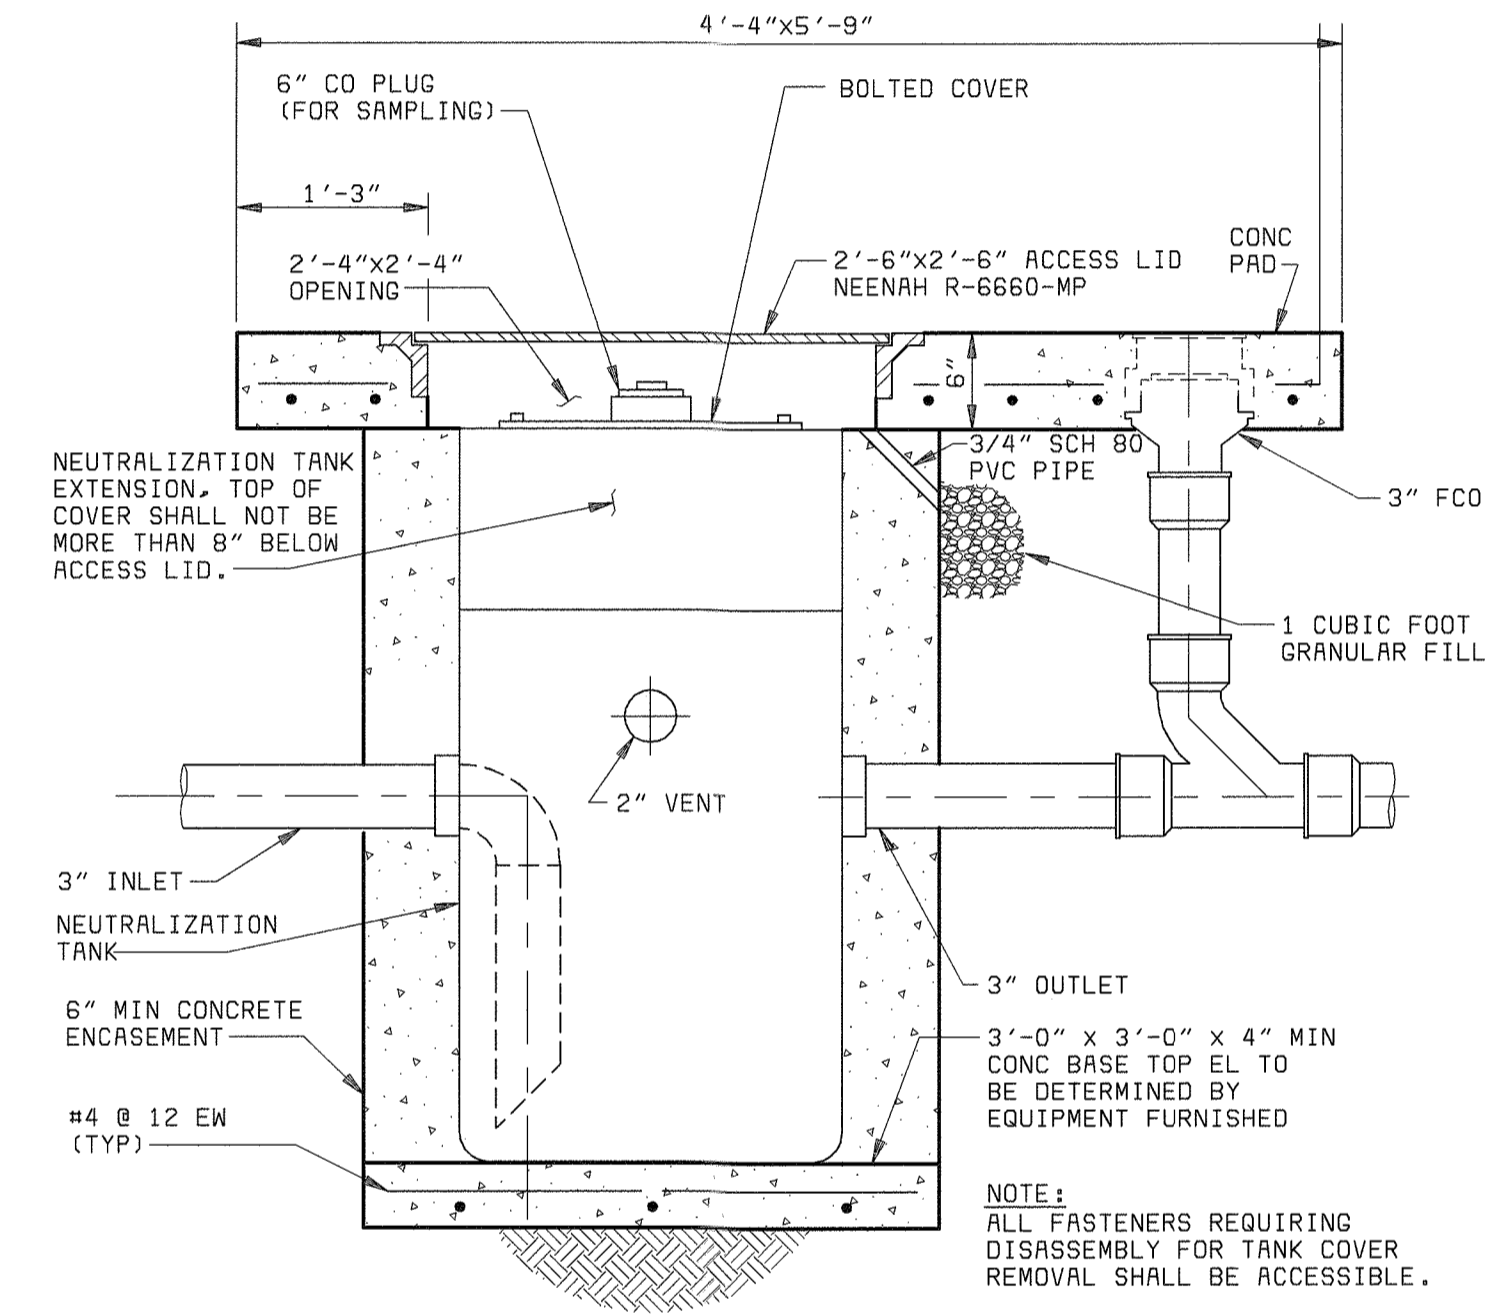


NEUTRALIZATION TANK DETAIL
NO SCALE

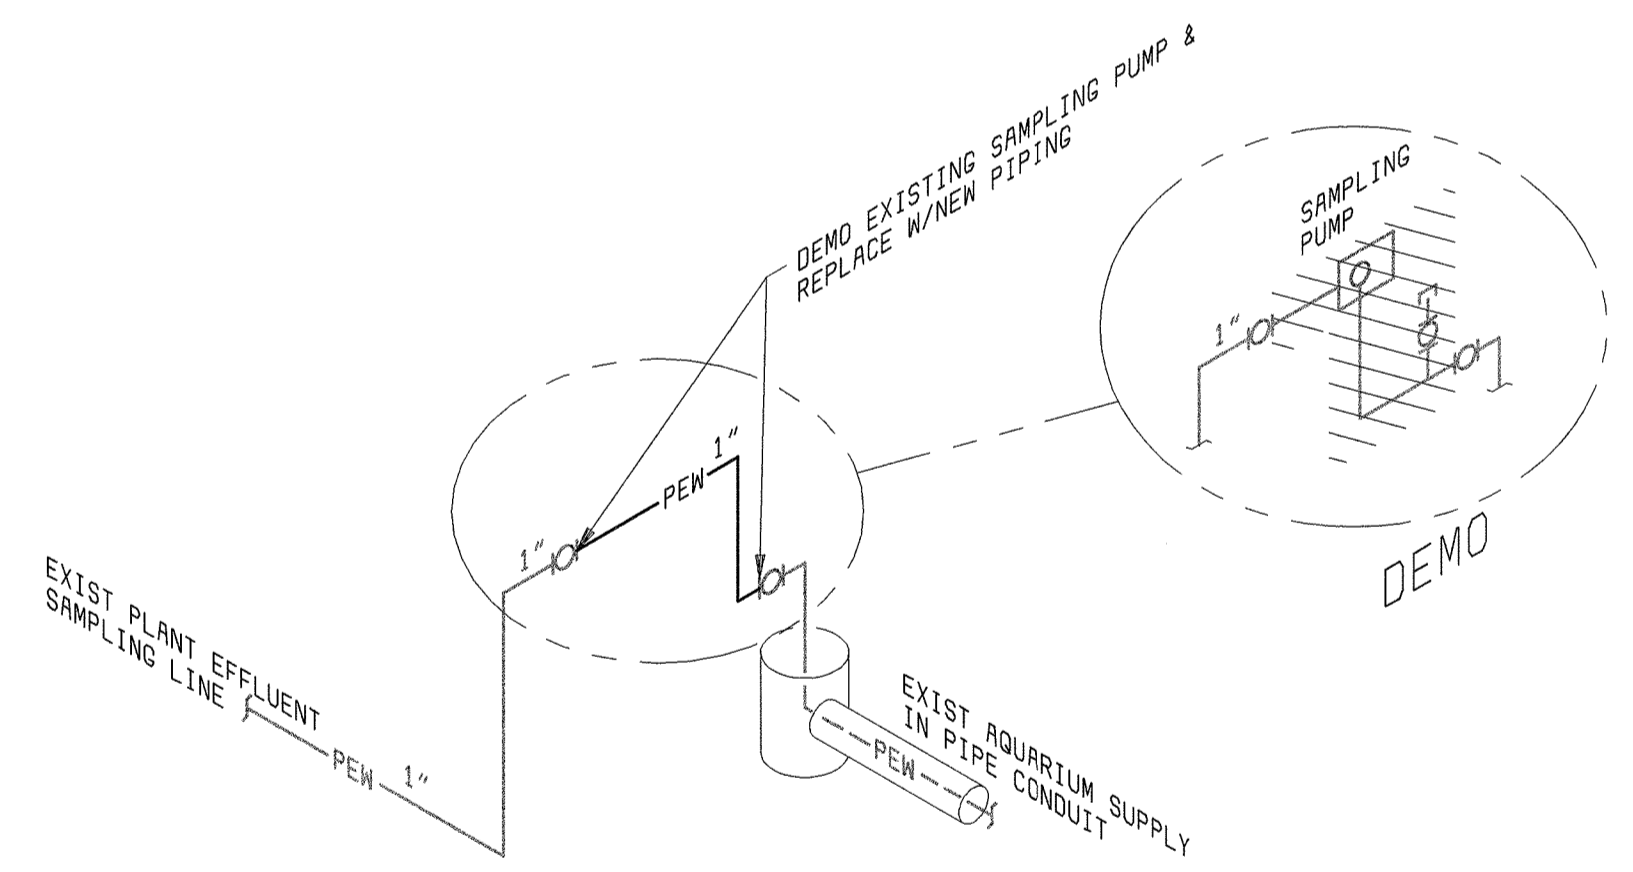

PLANT EFFLUENT PIPING DETAIL
NO SCALE

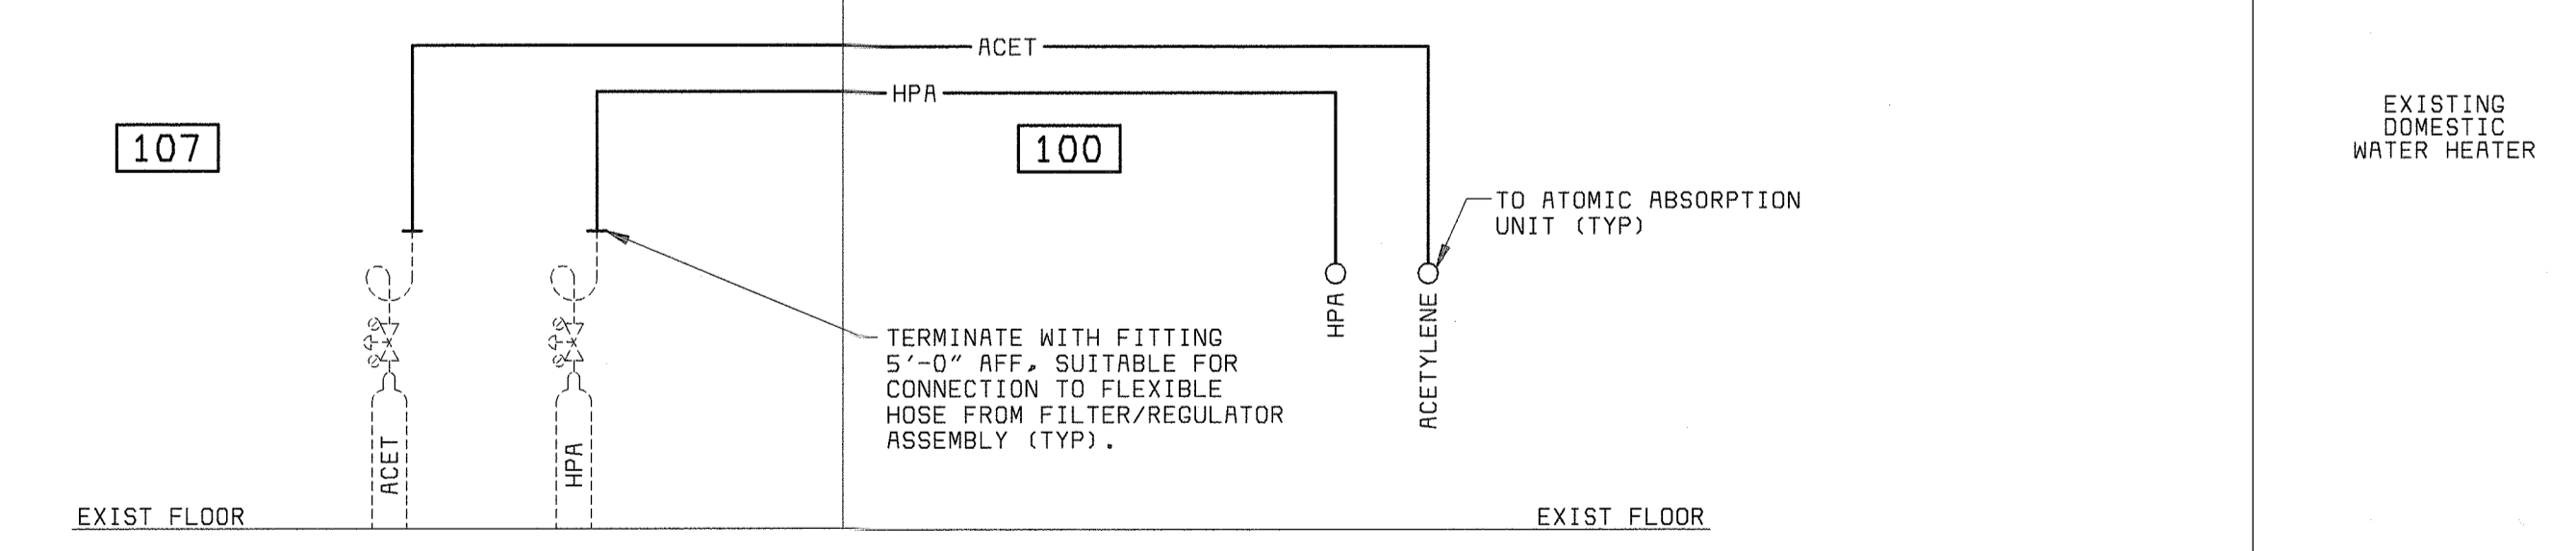

LABORATORY SPECIALTY GASES PIPING RISER DIAGRAM
NO SCALE

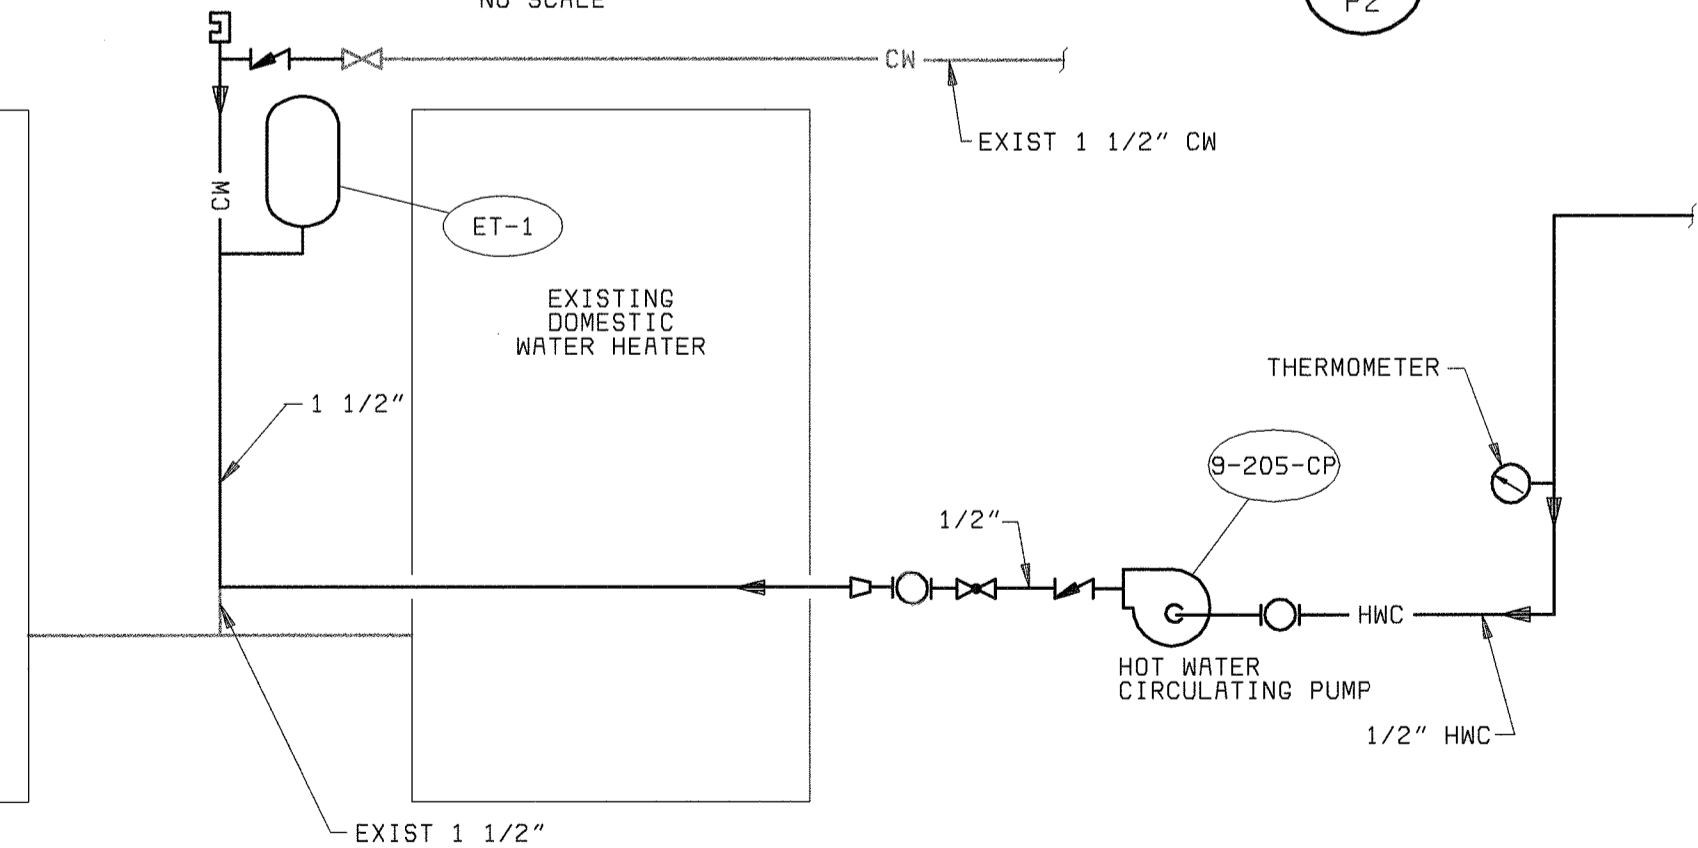


CIRCULATING HOT WATER PIPING SCHEMATIC
NO SCALE


- GENERAL NOTES:**
- CONTRACTOR SHALL FIELD VERIFY ALL EXISTING PIPING AND EQUIPMENT SHOWN ON THIS DRAWING.
 - CONTRACTOR SHALL FIELD VERIFY ROUTING AND PLACEMENT OF PIPING AND EQUIPMENT. FIELD ROUTE PIPING TO AVOID INTERFERENCES WITH OTHER PIPING, DUCTWORK, STRUCTURAL, ARCHITECTURAL AND ELECTRICAL ITEMS.

DEPARTMENT OF PUBLIC WORKS HOWARD COUNTY, MARYLAND CHIEF, BUREAU OF UTILITIES DATE	 BLACK & VEATCH Gaithersburg, Maryland REG. PROF. ENGR. DATE	THIS DRAWING WAS ORIGINALLY APPROVED FOR CONSTRUCTION AND SEALED BY MARTIN L. PAPE A REGISTERED PROFESSIONAL ENGINEER IN THE STATE OF MARYLAND, NO. 21992	DES: JPC					PLUMBING ADMINISTRATION BUILDING LABORATORY RISER DIAGRAMS, SCHEDULES & DETAILS	LITTLE PATUXENT WATER RECLAMATION PLANT ADDITION NO. 6 LABORATORY RENOVATION CAPITAL PROJECT S-6205 CONTRACT NO. 20-3841 HOWARD COUNTY, MARYLAND	SCALE AS SHOWN
			DRN: JPC	CHK: MLP	DATE: 10/03/01	11/03/03	CONFORMED TO CONSTRUCTION RECORDS			RHH/RJR/RJR

ONE-LINE DIAGRAM LEGEND

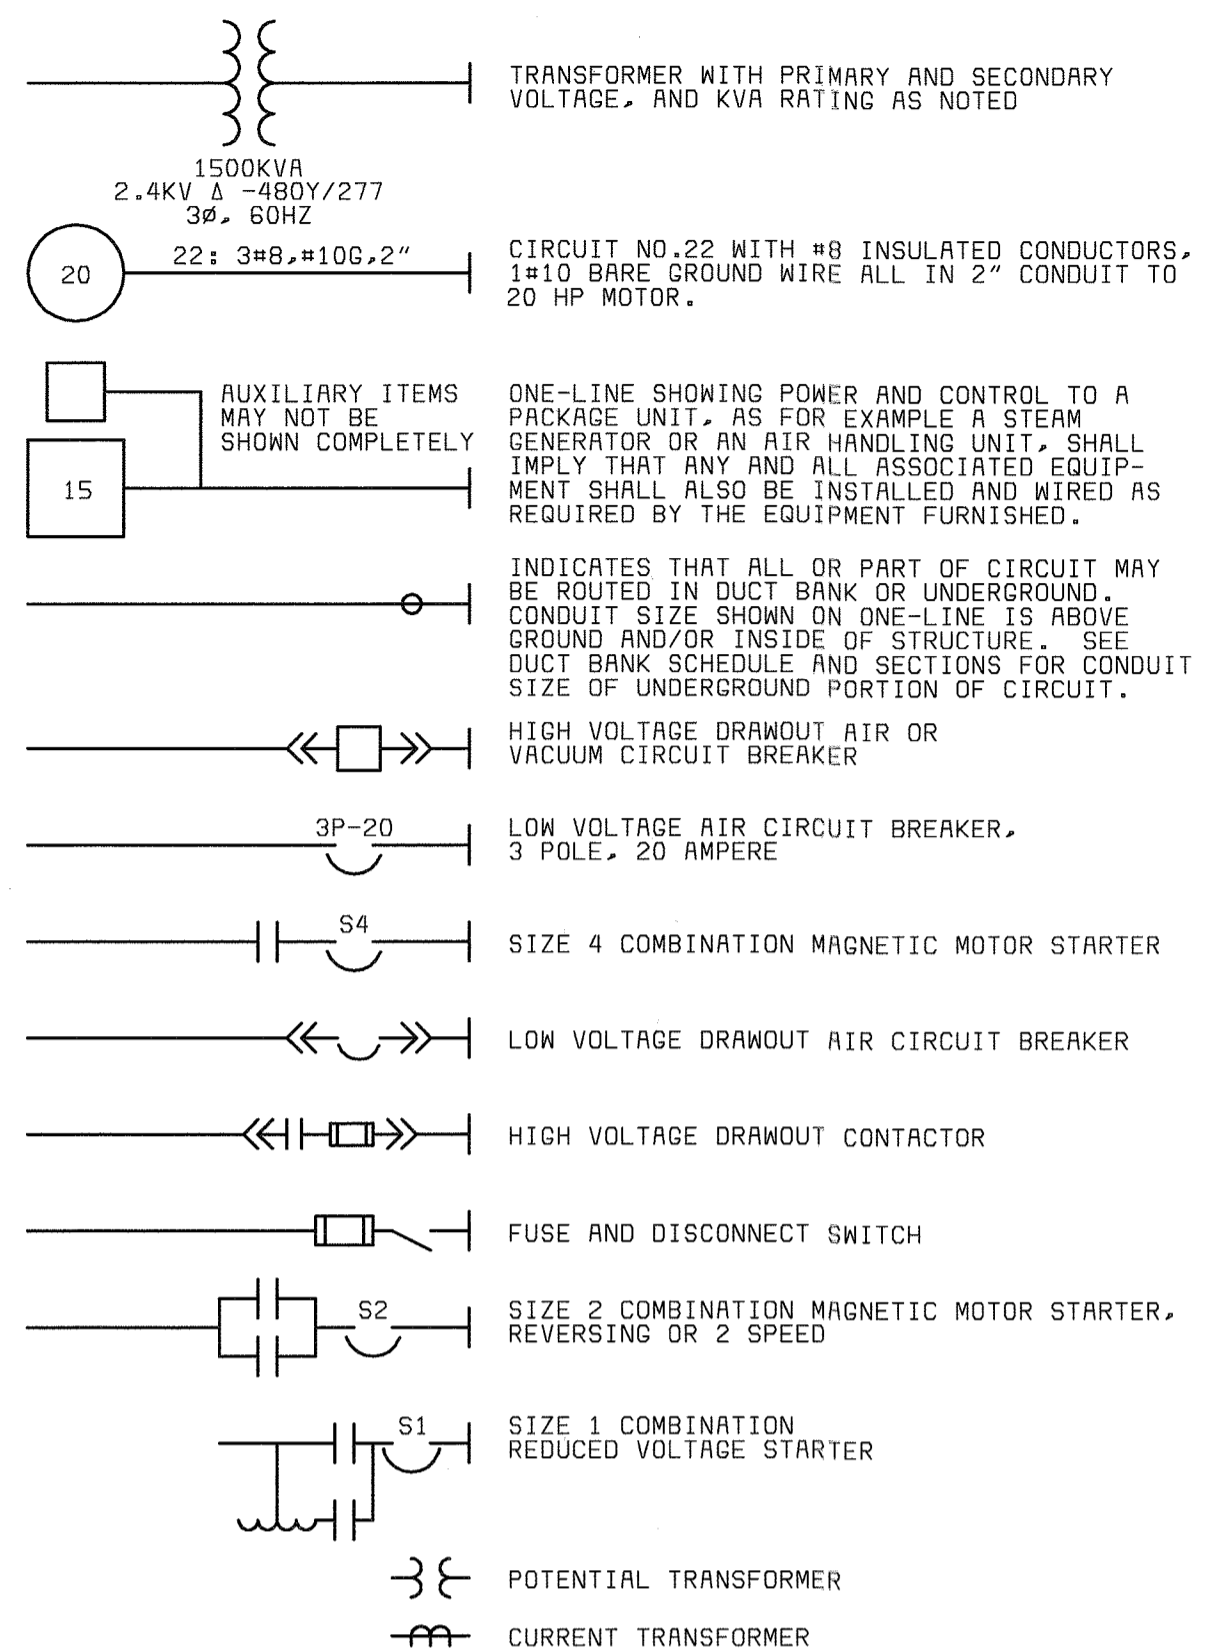


CONDUIT & WIRING INSTALLATION LEGEND

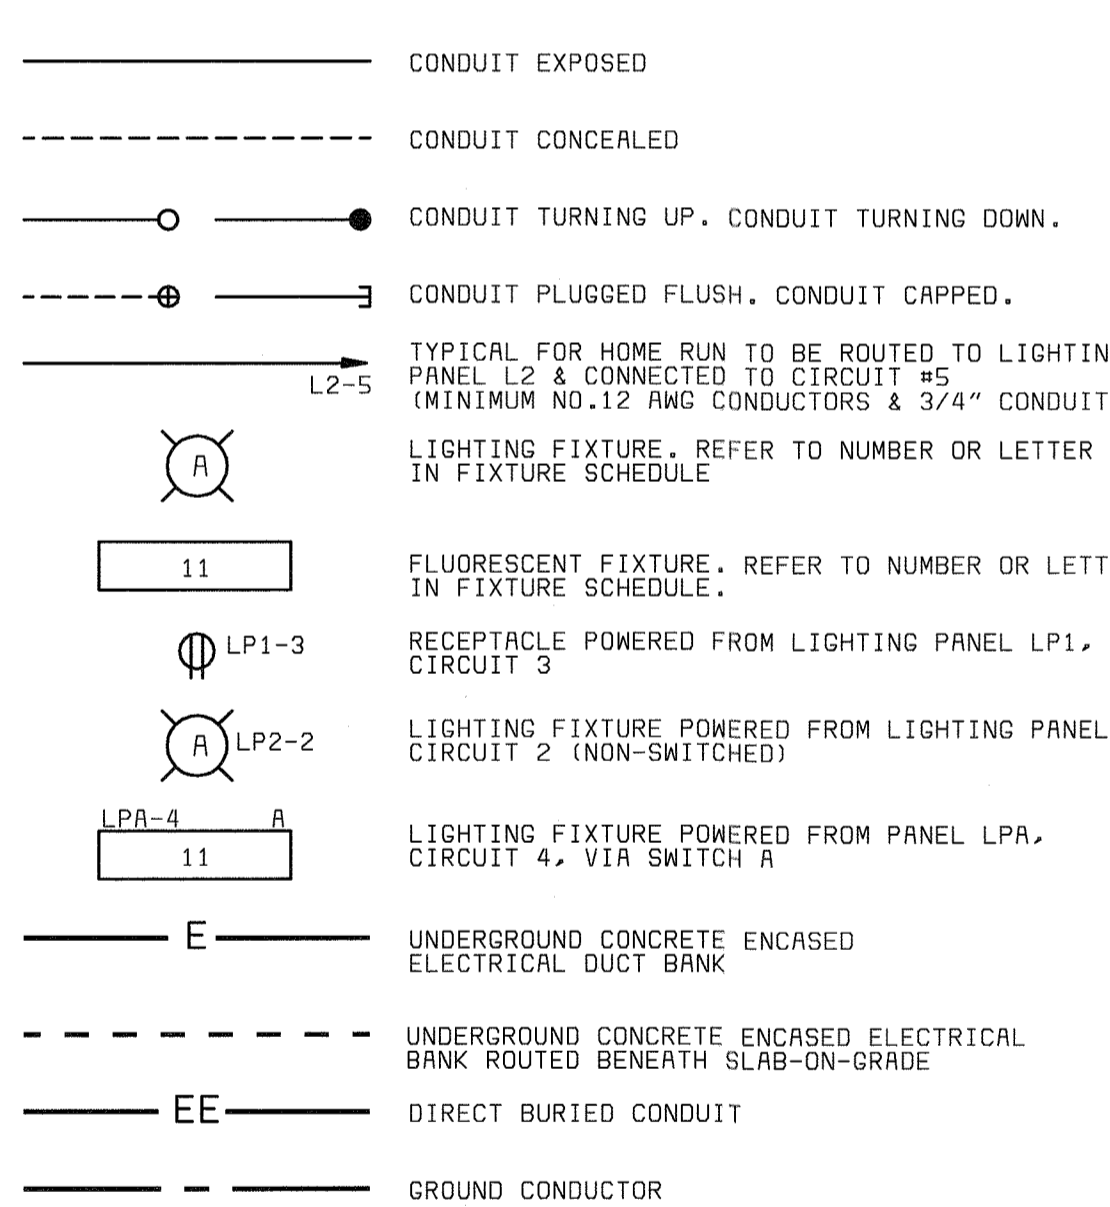


SWITCH & OUTLET SYMBOLS

S	SINGLE POLE SWITCH	SPL	SWITCH WITH PILOT LIGHT	⊕	DUPLEX RECEPTACLE 120 VOLT	⊕	120 VOLT DUPLEX RECEPTACLE (UPS)
S2	TWO POLE SWITCH	SKO	KEY OPERATED SWITCH	⊕	SIMPLEX RECEPTACLE	⊕	DUPLEX FLOOR OUTLET
S3	THREE-WAY SWITCH	SXP	EXPLOSION PROOF SWITCH	⊕	RANGE RECEPTACLE	⊕	TELEPHONE OUTLET
S4	FOUR-WAY SWITCH	SDM	DIMMER SWITCH	⊕	TWISTLOCK RECEPTACLE	⊕	TELEPHONE FLOOR OUTLET
SC1M	MOMENTARY SWITCH CONTROLLING CONTACTOR C1	S3A	THREE-WAY SWITCH CONTROLLING LIGHTS WITH "A" DESIGNATION	⊕	240V, 1Ø RECEPTACLE, TYPICAL AMPERE RATING NOTED	⊕	COAXIAL CABLE OUTLET
SWP	WEATHERPROOF SWITCH			⊕	480V, 3Ø WELDING RECEPTACLE, TYPICAL AMPERE RATING NOTED		


SCHEMATIC SYMBOLS

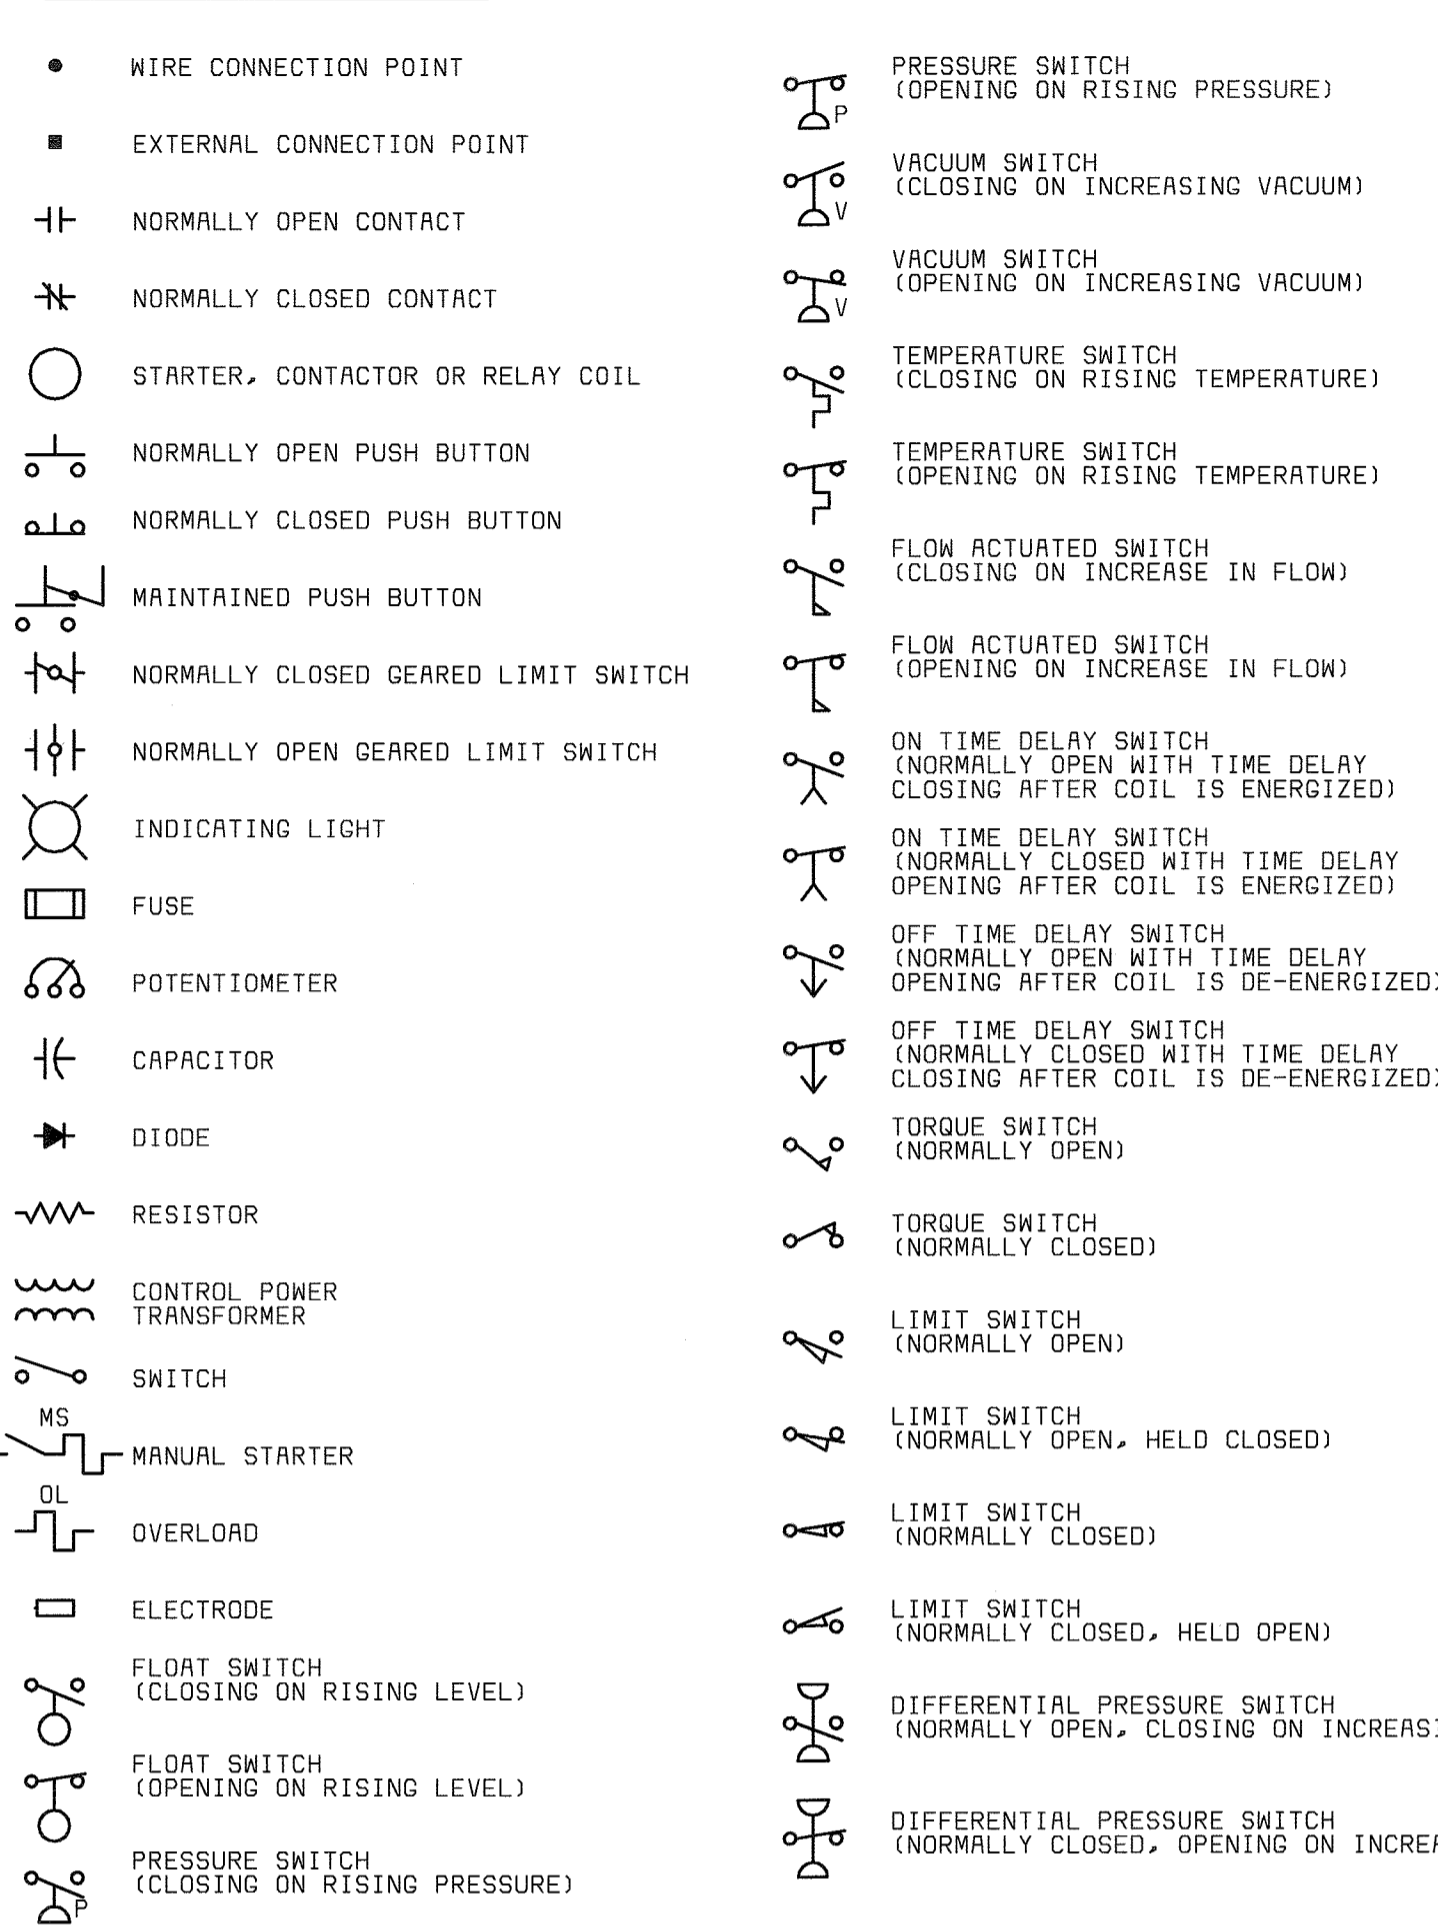

MISCELLANEOUS SYMBOLS

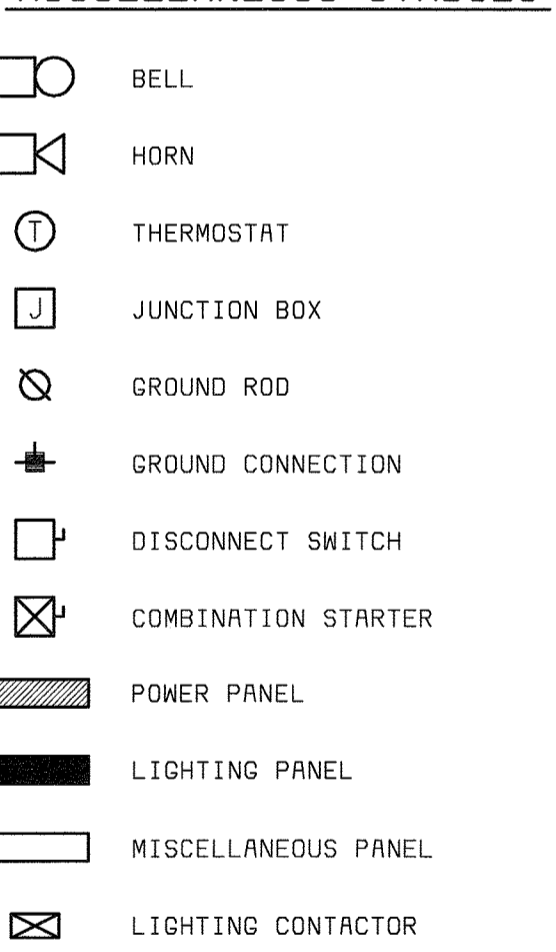

COMMUNICATION SYMBOLS

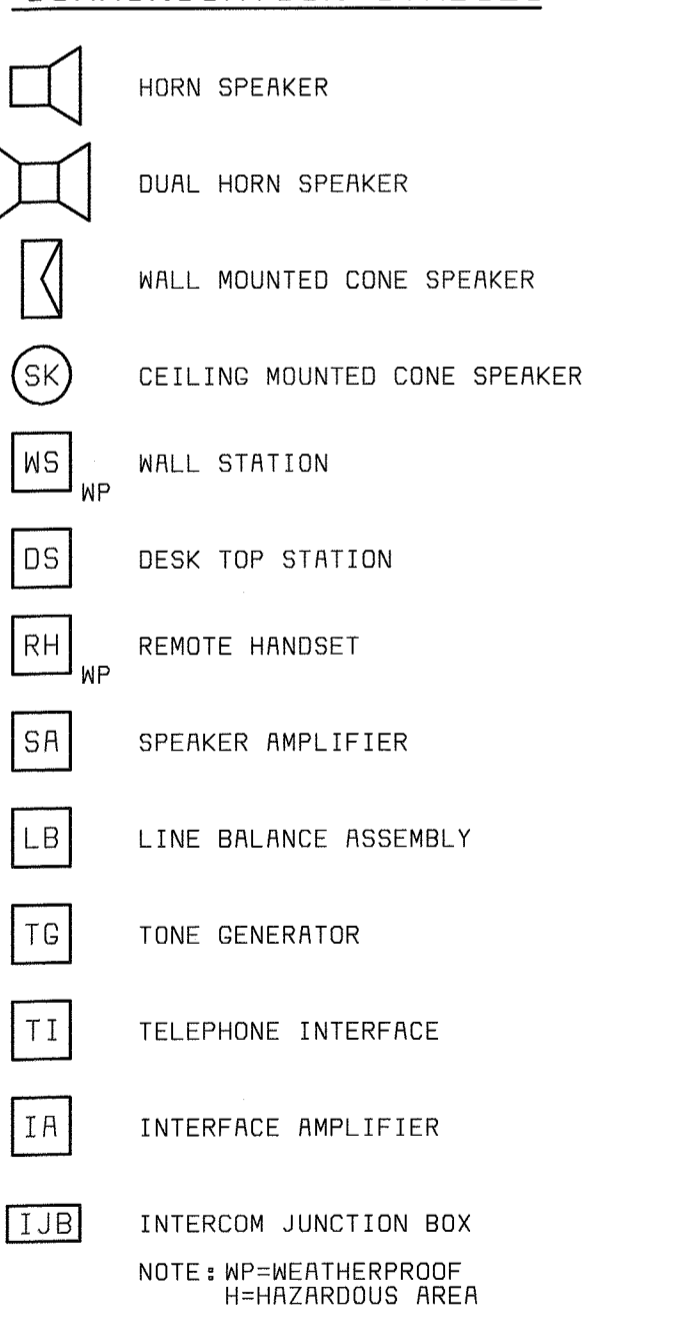

ABBREVIATIONS

A	AMBER, AMPERE, ALARM	M	MAGNETIC MOTOR STARTER
AC	ALTERNATING CURRENT	MA	MILLIAMPERE
ACB	AIR CIRCUIT BREAKER	MCB	MAIN CIRCUIT BREAKER
AF	AMPERE FRAME	MCC	MOTOR CONTROL CENTER
AFD	ADJUSTABLE FREQUENCY DRIVE	MCLU	MOTOR CONTROL LINEUP
AM	AMMETER	MCM	THOUSAND CIRCULAR MIL
ANN	ANNUNCIATOR	MD	MOISTURE DETECTOR
AR	ALARM RELAY	MFM	MAGNETIC FLOW METER
AS	AMMETER SWITCH	MFR	MANUFACTURER
AT	AMPERE TRIP	MH	MANHOLE OR MOUNTING HEIGHT
AWG	AMERICAN WIRE GAGE	MOV	MOTOR OPERATED VALVE
		MPR	MOTOR PROTECTION RELAY
BC	BATTERY CHARGER	MS	MANUAL MOTOR STARTER
BR	BRAKE	MSH	MOTOR SPACE HEATER
BT	BEARING TEMPERATURE	MV	MILLIVOLT
		MVA	MEGA VOLT AMPERE
C	CLOSE, COUNTER OR CONTACTOR	N	NEUTRAL
CAP	CAPACITOR	NC	NORMALLY CLOSED
CB	CIRCUIT BREAKER	NO	NORMALLY OPEN, NUMBER
CB"R"	CIRCUIT BREAKER AUXILIARY CONTACT (OPEN WHEN BREAKER IS OPEN OR TRIPPED)	O	OPEN
CB"R"	CIRCUIT BREAKER AUXILIARY CONTACT (CLOSED WHEN BREAKER IS CLOSED)	OCB	OIL CIRCUIT BREAKER
CD	CONTROL DAMPER	OL	OVERLOAD
CI	CELL INTERLOCK	OOA	ON-OFF-AUTO
CKT	CIRCUIT	OOR	ON-OFF-REMOTE
CL2	CHLORINE	P	PRIMARY
COS	CABLE OPERATED SWITCH	PCS	PLANT CONTROL SYSTEM
CP	CONTROL PANEL	PB	PUSH BUTTON OR PULL BOX
CPT	CONTROL POWER TRANSFORMER	PF	POWER FACTOR METER
CR	CURRENT OR CONTROL RELAY	PH	PHASE, CHEMICAL TERM
CS	CONTROL STATION	PLC	PROGRAMMABLE LOGIC CONTROLLER
CT	CYCLE TIMER OR CURRENT TRANSFORMER	PP	POWER PANEL
CTC	CYCLE TIMER CLUTCH	PRS	PROXIMITY SWITCH
CTM	CYCLE TIMER MOTOR	PS	PRESSURE SWITCH
2/C	2 CONDUCTOR	PT	POTENTIAL TRANSFORMER, PROGRAM TIMER
4/C	4" CONDUIT	2P	2 POLE
DC	DIRECT CURRENT	R	RED, RAISE, RELAY OR REVERSE
DI	DOOR INTERLOCK	RECP	RECEPTACLE
DM	DAMPER MOTOR OR DEMAND METER	RES	RESISTOR
DPDT	DOUBLE POLE DOUBLE THROW	RT	REPEATING TIMER
DPST	DOUBLE POLE SINGLE THROW	RTD	RESISTANCE TYPE TEMP DETECTOR
DPR	DIFFERENTIAL PRESSURE REGULATOR	RTU	REMOTE TERMINAL UNIT
DPS	DIFFERENTIAL PRESSURE SWITCH	RVSS	REDUSED VOLTAGE SOLID STATE STARTER
DS	DISCONNECT SWITCH	S2	SIZE 2 STARTER
DVLS	DISCHARGE VALVE LIMIT SWITCH	S2	SUPERVISORY CONTROL AND DATA ACQUISITION
E	ELECTRIC OPERATOR FOR CONTROL	SH	SPACE HEATER
EC	EMPTY CONDUIT	SN	SOLID NEUTRAL
EL	ELEVATION OR EMERGENCY LIGHT	SO	SOLENOID OILER
EMH	ELECTRICAL MANHOLE	SP	SINGLE POLE
ER	ELECTRODE RELAY	SPDT	SINGLE POLE DOUBLE THROW
ES	END SWITCH	SS	SINGLE POLE SINGLE THROW
ETM	ELAPSED TIME METER	SS	SELECTOR SWITCH
EX	EXISTING	SSS	SOLID STATE STARTER
F	FORWARD	SUPV	SUPERVISORY CONTROL
FD	FIRE DETECTOR	SV	SOLENOID VALVE
FS	FLOW SWITCH	SWB	SWITCHBOARD
G	GREEN OR GROUND	SWGR	SWITCHGEAR
GD	GROUND DETECTOR	T	THERMOSTAT, TIMER, OR TOTALIZER
GEN	GENERATOR	TACH	TACHOMETER
GFI	GROUND FAULT INTERRUPTER	TB	TERMINAL BLOCK
GLS	GEARED LIMIT SWITCH	TC	TIMER CLUTCH
#GB	#8 GROUND WIRE	TD	TIME DELAY RELAY
H	HIGH OR HUMIDISTAT	TEMP	TEMPERATURE
HC	HOT CIRCUIT	TM	TIMER MOTOR
HH	HANDHOLE	TQ	TORQUE
HMT	HIGH MOTOR TEMPERATURE	TS	TEMPERATURE SWITCH
HOA	HAND-OFF-AUTO	TTB	TELEPHONE TERMINAL BOX
HOR	HAND-OFF-REMOTE	UG	UNDERGROUND
HP	HORSEPOWER	UV	UNDER VOLTAGE
HWCO	HIGH WATER CUTOFF	UPS	UNINTERRUPTIBLE POWER SUPPLY
HZ	HERTZ (CYCLE)	V	VOLTS
I/O	INPUT/OUTPUT	VA	VOLT AMPERE
INST	INSTANTANEOUS	VAR	VARMETER
J	JUNCTION BOX	VLS	VALVE LIMIT SWITCH
JB	JUNCTION BOX	VM	VOLTMETER
K	KEY INTERLOCK	VPI	VALVE POSITION INDICATOR
KV	KILOVOLT	VS	VOLTMETER SWITCH
KVA	KILOVOLT AMPERE	W	WHITE OR WATTS
KVAR	KILOVAR	WH	WATT HOUR METER
KW	KILOWATT	WM	WATT METER
KWH	KILOWATT HOUR	WP	WEATHERPROOF
L	LOW, LEVEL	X	AUXILIARY RELAY
LA	LIGHTNING ARRESTER	XFMR	TRANSFORMER
LAN	LOCAL AREA NETWORK	XP	EXPLOSION PROOF
LC	LIGHTING CONTACTOR	Y	YELLOW
LOR	LOCAL-ON-OFF	Z	AUXILIARY RELAY
LP	LIGHTING PANEL	ZS	POSITION SWITCH
LS	LIMIT OR LEVEL SWITCH	ZSS	ZERO SPEED SWITCH
LWCO	LOW WATER CUTOFF		

1-1PR#16S	ONE, SINGLE PAIR, TWISTED, SHIELDED #16 CABLE
3-7/C#14	THREE, SINGLE, SEVEN CONDUCTOR #14 MULTICONDUCTOR CONTROL CABLES

AREA DESIGNATIONS

THE SPECIAL AREA DESIGNATION BOXES, AS DEFINED BELOW, ARE LOCATED ON THE PLAN DRAWINGS TO DEFINE ELECTRICAL INSTALLATION REQUIREMENTS. DESIGNATION BOXES ARE LOCATED WITHIN ROOM OR BELOW ROOM NUMBER. ALL INDOOR AREAS NOT INDICATED OTHERWISE ARE AREA TYPE I AND MINIMUM NEMA TYPE I ENCLOSURES.

AREA TYPE 1A	CORROSIVE CHEMICAL FEED AND STORAGE ROOMS. CONDUIT SYSTEM SHALL BE EXPOSED PVC RIGID NON-METALLIC CONDUIT WITH PVC FITTINGS, BOXES, AND ACCESSORIES.
AREA TYPE 4	INDOOR WET LOCATIONS SUCH AS VAULTS, HOSEDOWN AREAS, BASEMENTS, ETC. MINIMUM NEMA TYPE 4 ENCLOSURE FOR EQUIPMENT AND GASKETED FITTINGS IN A CONDUIT SYSTEM.
AREA TYPE 7A	CLASS I, DIVISION 1 AREA AS DEFINED BY NEC. ALL EQUIPMENT AND CONDUIT SYSTEMS SHALL BE RATED FOR USE IN THIS AREA.
AREA TYPE 7B	CLASS I, DIVISION 2, GROUP C AND D (METHANE, GASOLINE) AS DEFINED BY NEC. EQUIPMENT AND CONDUITS SYSTEMS SHALL BE RATED FOR USE IN THIS AREA.
AREA TYPE 12	INDOOR, DRY, DIRT AREA. REQUIRES MINIMUM NEMA TYPE 12 GASKETED ENCLOSURES FOR ALL EQUIPMENT AND GASKETED FITTINGS IN CONDUIT SYSTEMS.

GENERAL REQUIREMENTS

- THE CONTRACTOR SHALL BE RESPONSIBLE FOR ROUTING ALL CONDUITS NOT SHOWN ON THE PLANS. THIS SHALL INCLUDE ALL CONDUITS SHOWN ON THE ONE-LINES AND HOME-RUNS SHOWN ON THE PLAN DRAWINGS. CONDUITS SHALL BE ROUTED AS DEFINED IN THE SPECIFICATIONS.
- SPARE WIRES SHALL BE TAPED AND COILED.
- IF EQUIPMENT SUPPLIED BY MANUFACTURER HAS A LARGER LOAD THAN VALUE SHOWN, THE CABLE CONDUIT AND ELECTRICAL EQUIPMENT SHALL BE ENLARGED, AS REQUIRED, TO ACCOMMODATE THE HIGHER VALUE.
- THE CONTRACTOR SHALL BE RESPONSIBLE FOR FURNISHING PROPERLY SIZED STARTER OVERLOADS FOR EQUIPMENT FURNISHED.
- LIGHTING AND RECEPTACLE CIRCUITS DESIGNATED ON THE FLOOR PLANS ARE NOT SHOWN ON THE ONE-LINES. CONDUCTORS FOR LIGHTING, RECEPTACLES, AND MISCELLANEOUS 120VAC CIRCUITS SHALL BE MINIMUM NO. 12AWG. CONDUIT FOR LIGHTING, RECEPTACLES, AND MISCELLANEOUS 120VAC CIRCUITS SHALL BE MINIMUM 3/4".
- IN AREAS WHERE THERE ARE OVERHEAD BRIDGE CRANES, HOISTS, ETC., NO CONDUITS SHALL BE RUN OVERHEAD THAT WILL INTERFERE WITH THE OPERATION OF THE EQUIPMENT.

GENERAL NOTES

- SOLID LINES (————) INDICATE NEW WORK OR EQUIPMENT.
- SCREENED LINES (————) INDICATE EXISTING WORK OR EQUIPMENT.
- DASHED LINES (---) INDICATE FUTURE WORK OR EQUIPMENT.
- THIS IS A GENERAL LEGEND SHEET. SOME SYMBOLS AND ABBREVIATIONS MAY NOT BE UTILIZED ON THIS SPECIFIC PROJECT.
- INFORMATION RELATED TO CIRCUIT IDENTIFICATION, WIRE & CONDUIT SIZES, AND ROUTING, IS ON THE FOLLOWING DRAWING TYPES.
 - ONE-LINE DIAGRAMS SHOW CIRCUIT IDENTIFICATION, WIRE QUANTITY AND SIZES, AND CONDUIT SIZE WITHIN STRUCTURES. ONE-LINE DIAGRAMS ALSO INDICATE ORIGIN AND DESTINATION OF CIRCUITS, AND IDENTIFY CIRCUITS ROUTED UNDERGROUND.
 - FOR CIRCUITS WITHOUT UNDERGROUND PORTIONS, BUILDING FLOOR PLANS SHOW LOCATION OF EQUIPMENT FOR DETERMINING CIRCUIT LENGTH WITHIN THE STRUCTURE. FOR CIRCUITS WITH UNDERGROUND PORTIONS, ANTICIPATED PENETRATION OF UNDERGROUND CONDUITS ARE SHOWN ON STRUCTURE PLANS FOR DETERMINING THE LENGTH OF THE IN-STRUCTURE PORTIONS OF CIRCUITS. BUILDING FLOOR PLANS MAY ALSO SHOW HOME RUNS FOR LIGHTING, RECEPTACLE, AND OTHER MISCELLANEOUS EQUIPMENT CIRCUITS.
 - SITE PLANS INDICATE THE GENERAL ROUTING OF UNDERGROUND CONDUITS AND DUCT BANKS. CIRCUITS ROUTED IN UNDERGROUND CONDUITS OR DUCT BANKS ARE INDICATED IN DUCT BANK SECTIONS REFERENCED ON THE SITE PLAN.
 - DUCT BANK SECTIONS AND SCHEDULES IDENTIFY CONDUIT SIZE, CONDUIT MATERIAL, ARRANGEMENT OF THE UNDERGROUND CONDUITS, AND CIRCUITS ROUTED IN EACH UNDERGROUND CONDUIT.

DEPARTMENT OF PUBLIC WORKS
HOWARD COUNTY, MARYLAND
CHIEF, BUREAU OF UTILITIES DATE

BLACK & VEATCH
Gaithersburg, Maryland
REG. PROF. ENGR. DATE


THIS DRAWING WAS
ORIGINALLY APPROVED
FOR CONSTRUCTION
AND SEALED BY
DONALD A. STEVENS
A REGISTERED
PROFESSIONAL ENGINEER
IN THE
STATE OF MARYLAND.
NO. 21876

DES: MEP					
DRN: MEP					
CHK: CEC					
DATE: 10/03/01	DATE	REVISIONS AND RECORD OF ISSUE	NO.	BY	CK APP


ADMINISTRATION BUILDING
ELECTRICAL
LEGEND AND ABBREVIATIONS

LITTLE PATUXENT WATER RECLAMATION PLANT
ADDITION NO. 6
LABORATORY RENOVATION
CAPITAL PROJECT S-6205
CONTRACT NO. 20-3841
HOWARD COUNTY, MARYLAND


SCALE
AS
SHOWN
SHEET
24 OF 28
E1

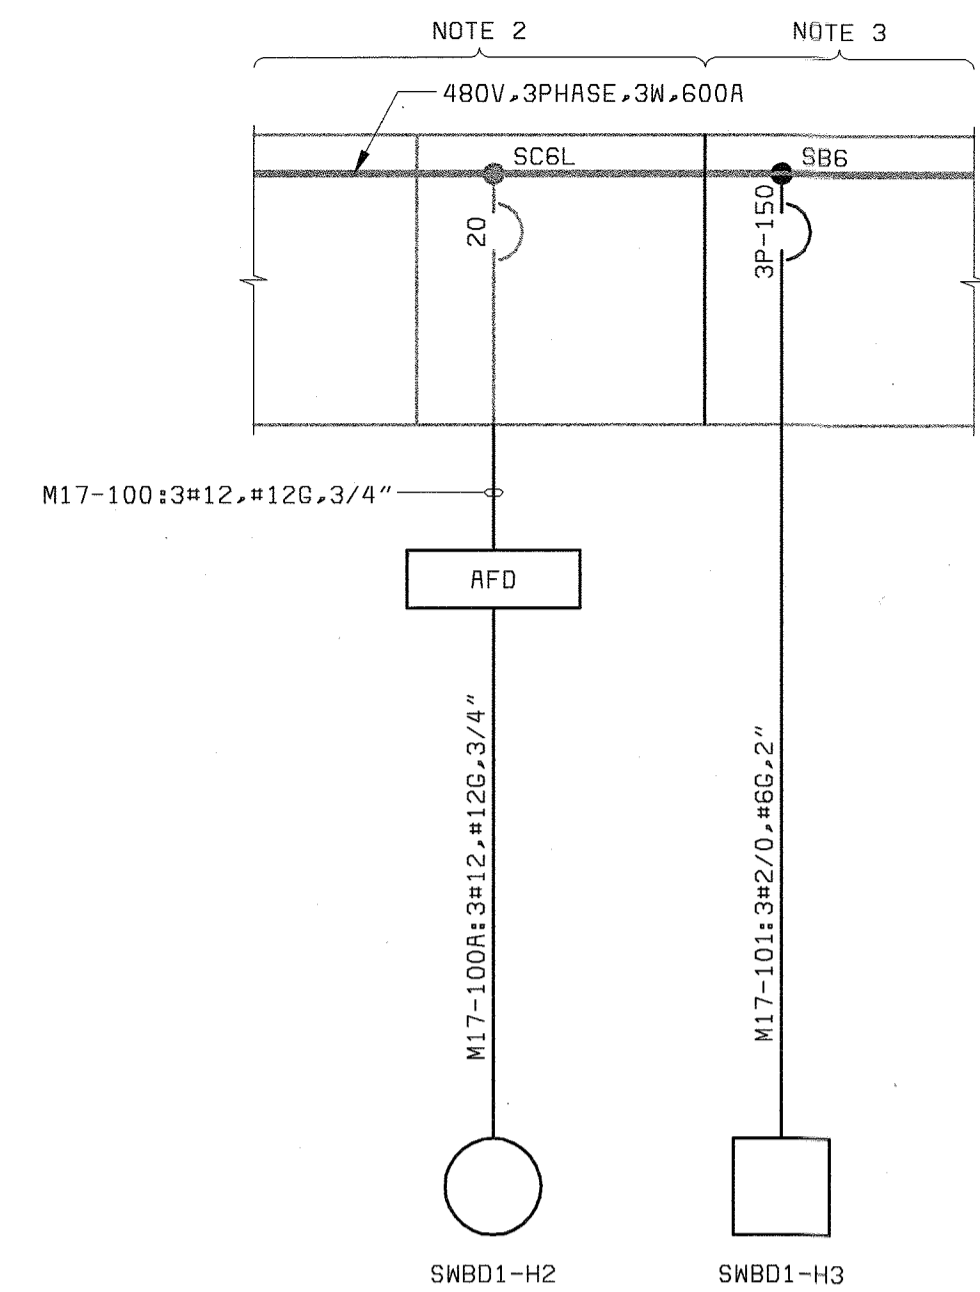

EXISTING SWBD1
PARTIAL ONE-LINE DIAGRAM
(ADMINISTRATION BUILDING ELECTRICAL ROOM)

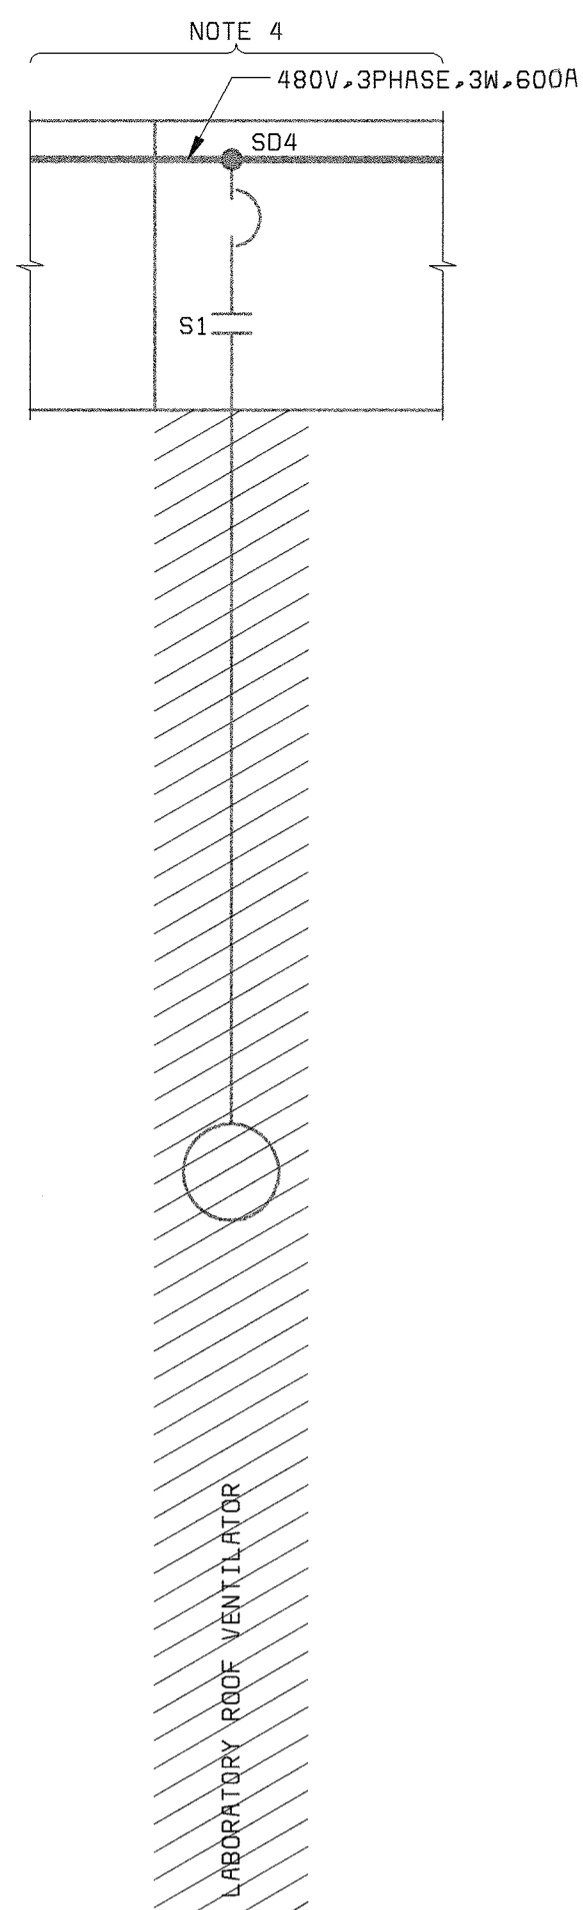

EXISTING MCC17
PARTIAL ONE-LINE DEMOLITION
(ADMINISTRATION BUILDING ELECTRICAL ROOM)

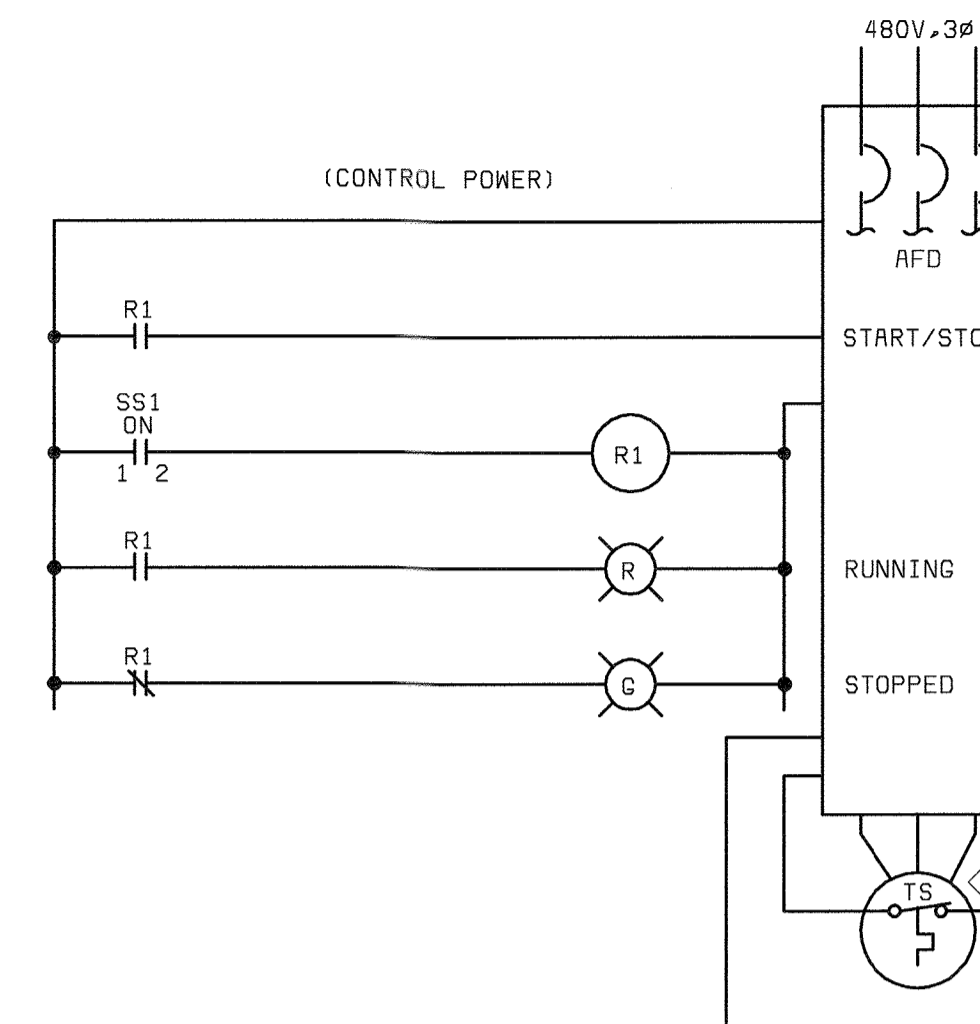


FUME HOOD EXHAUST FAN, 9-201-F
SCHEMATIC DIAGRAM

SWITCH DEVELOPMENT:

CONTACTS	POSITION	
	ON	OFF
1-2	X	

DEVICE LEGEND:

◇ AT DRIVEN EQUIPMENT

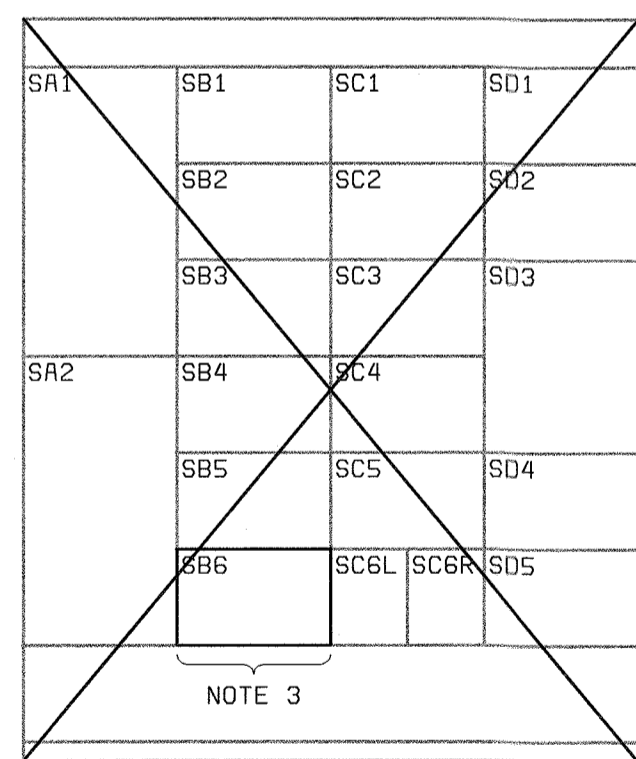

EXISTING MCC17 FRONT ELEVATION
NO SCALE

SWBD1

H1	J1	H1 SPARE	J1 SPARE
H2	J2	H2 FUME HOOD 20 AMP	J1 WATER HEATER 2 ADMIN. BLDG.
H3	J3	H3 ROOF TOP UNIT LAB 150 AMP	J3 AIR COND. UNIT ADMIN. BLDG.
H4	J4	H4 SPARE	J4 SPARE
H5	J5	H5 POWER TO MCC17 MAIN BREAKER 1	J5 POWER TO 167 KVA TRANS B
FILLER PLATE	J5		J6 SPARE

NOTES:

- SEE DRAWING E1 FOR ELECTRICAL LEGEND & ABBREVIATIONS AND GENERAL REQUIREMENTS.
- CONTRACTOR TO UTILIZE EXISTING BREAKERS AS INDICATED. EXISTING LINE-UP IS GE 7700 LINE CONTROL CENTER.
- CONTRACTOR SHALL REMOVE THE TWO 1/2-SPACE BREAKERS AND REPLACE WITH NEW BREAKER AS SHOWN.
- CONTRACTOR TO REMOVE EXISTING LOAD FEEDER AS SHOWN AND MAKE STARTER A SPARE.
- ALL NAMEPLATES SHALL BE CHANGED TO REPRESENT NEW/MODIFIED LOADS FOR THE WORK SHOWN HERE.

DEPARTMENT OF PUBLIC WORKS
HOWARD COUNTY, MARYLAND



THIS DRAWING WAS
ORIGINALLY APPROVED
FOR CONSTRUCTION
AND SEALED BY
DONALD R. STEVENS
A REGISTERED
PROFESSIONAL ENGINEER
IN THE
STATE OF MARYLAND,
NO. 21876

DES: GNS

DRN: MEP

CHK: CEC

DATE: 10/03/01

DATE	REVISIONS AND RECORD OF ISSUE	NO.	BY	CK	APP
11/03/03	CONFORMED TO CONSTRUCTION RECORDS		RHH	RJR	RJR

ADMINISTRATION BUILDING
ELECTRICAL

LABORATORY EQUIPMENT
ONE-LINE & SCHEMATIC DIAGRAMS

LITTLE PATUXENT WATER RECLAMATION PLANT
ADDITION NO. 6
LABORATORY RENOVATION

CAPITAL PROJECT S-6205
CONTRACT NO. 20-3841


HOWARD COUNTY, MARYLAND

SCALE
AS
SHOWN

SHEET
25 OF 28

E2

58472-5
FD58472A

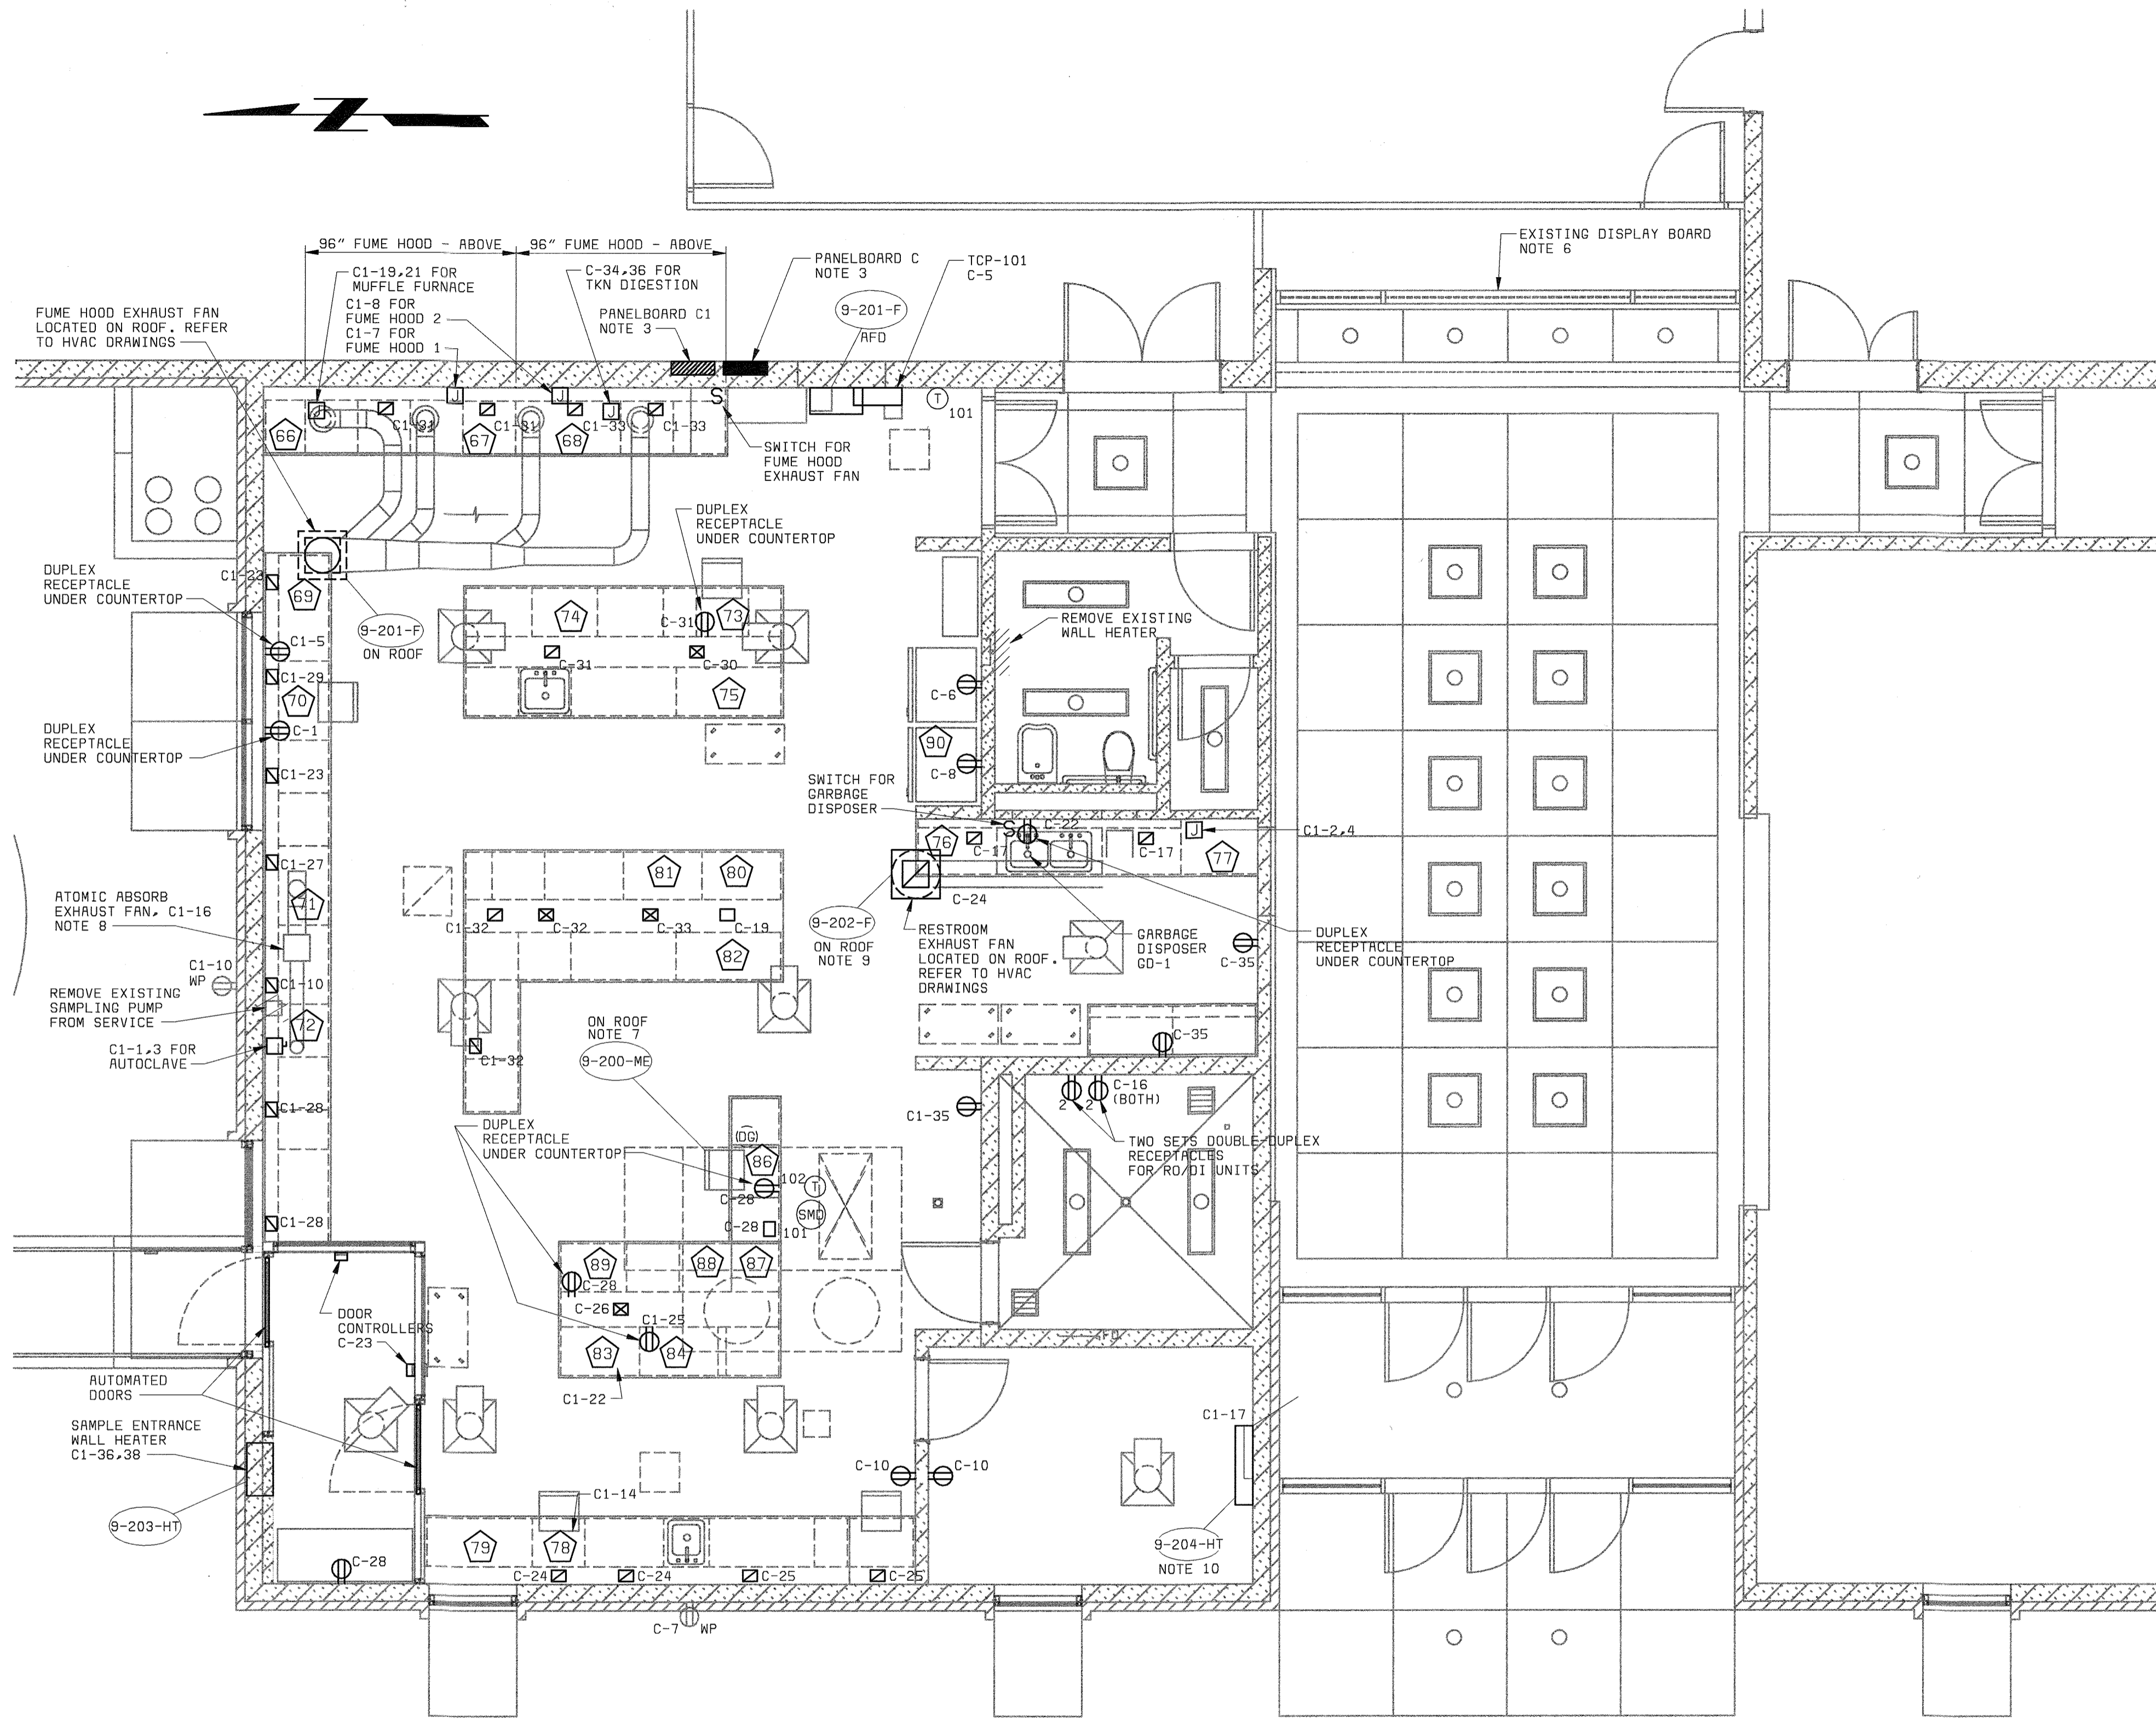


- ELECTRICAL LEGEND:**
- ☒ - RECEPTACLES: ON COUNTERTOP, FISHER HAMILTON MODEL 36L26300. PEDESTAL OUTLETS (4 RECEPTACLES ON EACH SIDE)
 - ☑ - RECEPTACLES: ON COUNTERTOP, FISHER HAMILTON MODEL 36L26200. PEDESTAL OUTLETS (4 RECEPTACLES ON ONE SIDE)
 - ☐ - RECEPTACLES: ON COUNTERTOP, FISHER HAMILTON MODEL 36L26100. PEDESTAL OUTLETS (2 RECEPTACLES ON EACH SIDE)
- NOTE: RECEPTACLES INDICATED ABOVE AND ON PLANS ARE PROVIDED WITH FURNITURE. ELECTRICAL CONTRACTOR TO PROVIDE POWER.

- EQUIPMENT LEGEND:**
- 66 RELOCATED MUFFLE FURNACE.
 - 67 CN DISTILLATION
 - 68 RELOCATED TKN DIGESTION.
 - 69 CENTRIFUGE.
 - 70 PC (COMPUTER 1)
 - 71 RELOCATED ATOMIC ABSORPTION.
 - 72 RELOCATED AUTOCLAVE.
 - 73 PC (COMPUTER 2)
 - 74 NUTRIENT ANALYZER I W/ AUTOSAMPLER.
 - 75 NUTRIENT ANALYZER II W/ AUTOSAMPLER.
 - 76 WATER SYSTEM.
 - 77 GLASSWASHER.
 - 78 BALANCE.
 - 79 DESSICATOR.
 - 80 DESSICATOR FOR TSS
 - 81 DESSICATOR FOR TS.
 - 82 TS/TSS DRYING OVEN.
 - 83 WATER BATH FOR FECAL COLIFORMS.
 - 84 INCUBATOR.
 - 85 NOT USED
 - 86 PC. FOR TSS.
 - 87 METTLER BALANCE.
 - 88 CI. COLOR ANAL.
 - 89 B.O.D INCUBATOR.
 - 90 REFRIGERATOR

- NOTES:**
1. SEE DRAWING E1 FOR ELECTRICAL LEGEND & ABBREVIATIONS AND GENERAL REQUIREMENTS.
 2. SEE PANELBOARD SCHEDULES ON DRAWING E5.
 3. EXISTING SUB-PANEL ASSEMBLIES FOR PANELS C AND C1 TO BE REPLACED WITH NEW SUB-PANELS.
 4. HOT WATER CIRCULATION PUMP 9-205-CP IS LOCATED IN EXISTING MECHANICAL ROOM. REFER TO DRAWING E5.
 5. EXISTING HEATERS AND OTHER EQUIPMENT ARE TO BE REMOVED FROM SERVICE. REFER TO ARCHITECTURAL, HVAC AND PLUMBING DEMOLITION DRAWINGS.
 6. EXISTING GRAPHIC DISPLAY BOARD SHALL BE REMOVED FROM SERVICE.
 7. A WEATHERPROOF (WP) CONVENIENCE RECEPTACLE SHALL BE INSTALLED ON THE ROOF IN THE VICINITY OF 9-200-ME (CIRCUIT C-27).
 8. NEW POWER CONDUCTORS SHALL BE INSTALLED FOR RELOCATED ATOMIC ABSORPTION FAN.
 9. CONTRACTOR SHALL PROVIDE SWITCH OR STARTER AS REQUIRED FOR THE LOADS, SUCH THAT EXHAUST FAN 9-202-F ON THE ROOF IS SWITCHED ON WHEN LIGHTS ARE TURNED ON IN THE RESTROOM.
 10. EXISTING WALL HEATER TO BE REMOVED AND REPLACED WITH NEW WALL HEATER 9-204-HT.
 11. ALL 120V & 240V POWER SUPPLY CIRCUITS SHALL BE 2#12, #12G IN 3/4" CONDUIT, EXCEPT THE GLASSWASHER, WHICH SHALL BE 2#8, #10G IN 3/4" CONDUIT.

- CONSTRUCTION RECORD NOTE:**
1. FOR LAB TABLE OUTSIDE STORAGE ROOM 102, A CHASE FOR ELECTRICAL CABLE AND POWER CONNECTION IS TO BE PROVIDED.

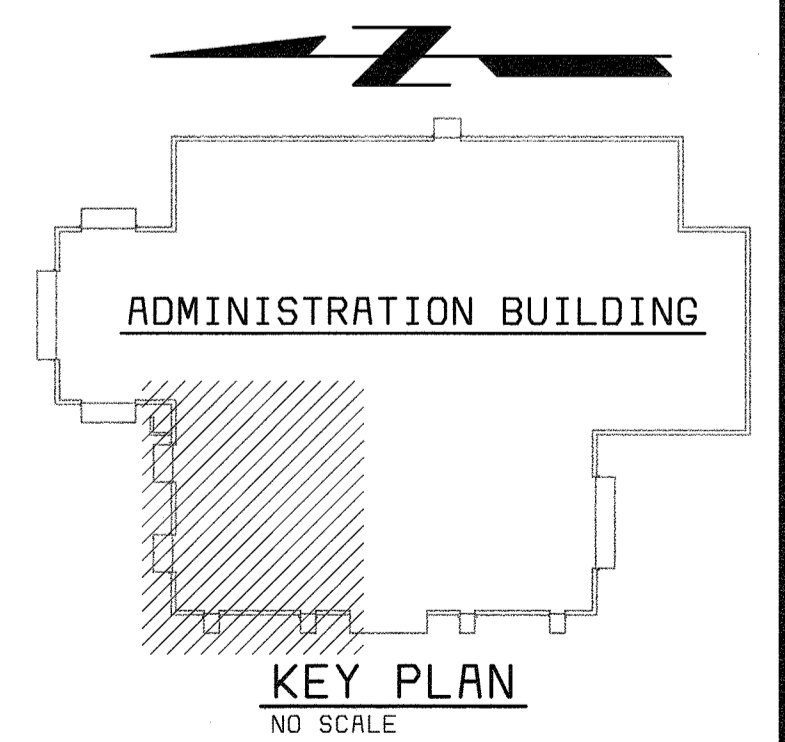


FLOOR PLAN - EL 145.00
1/4" = 1'-0"

58472-104-ADM-H-1000003X3
58472-112-ADM-A-1000003X1
58472-112-ADM-A-10000050P


D58472.5
FD58472A

DEPARTMENT OF PUBLIC WORKS HOWARD COUNTY, MARYLAND CHIEF, BUREAU OF UTILITIES DATE	 BLACK & VEATCH Gaithersburg, Maryland REG. PROF. ENGR. _____ DATE _____	THIS DRAWING WAS ORIGINALLY APPROVED FOR CONSTRUCTION AND SEALED BY DONALD R. STEVENS A REGISTERED PROFESSIONAL ENGINEER IN THE STATE OF MARYLAND, NO. 21976	DES: MEP DRN: MEP CHK: CEC DATE: 10/03/01	11/03/03 CONFORMED TO CONSTRUCTION RECORDS REVISIONS AND RECORD OF ISSUE	ADMINISTRATION BUILDING ELECTRICAL LABORATORY FLOOR PLAN POWER PLAN	LITTLE PATUXENT WATER RECLAMATION PLANT ADDITION NO. 6 LABORATORY RENOVATION CAPITAL PROJECT S-6205 CONTRACT NO. 20-3841 HOWARD COUNTY, MARYLAND	SCALE AS SHOWN SHEET 26 OF 28 E3
--	--	---	--	---	--	---	--

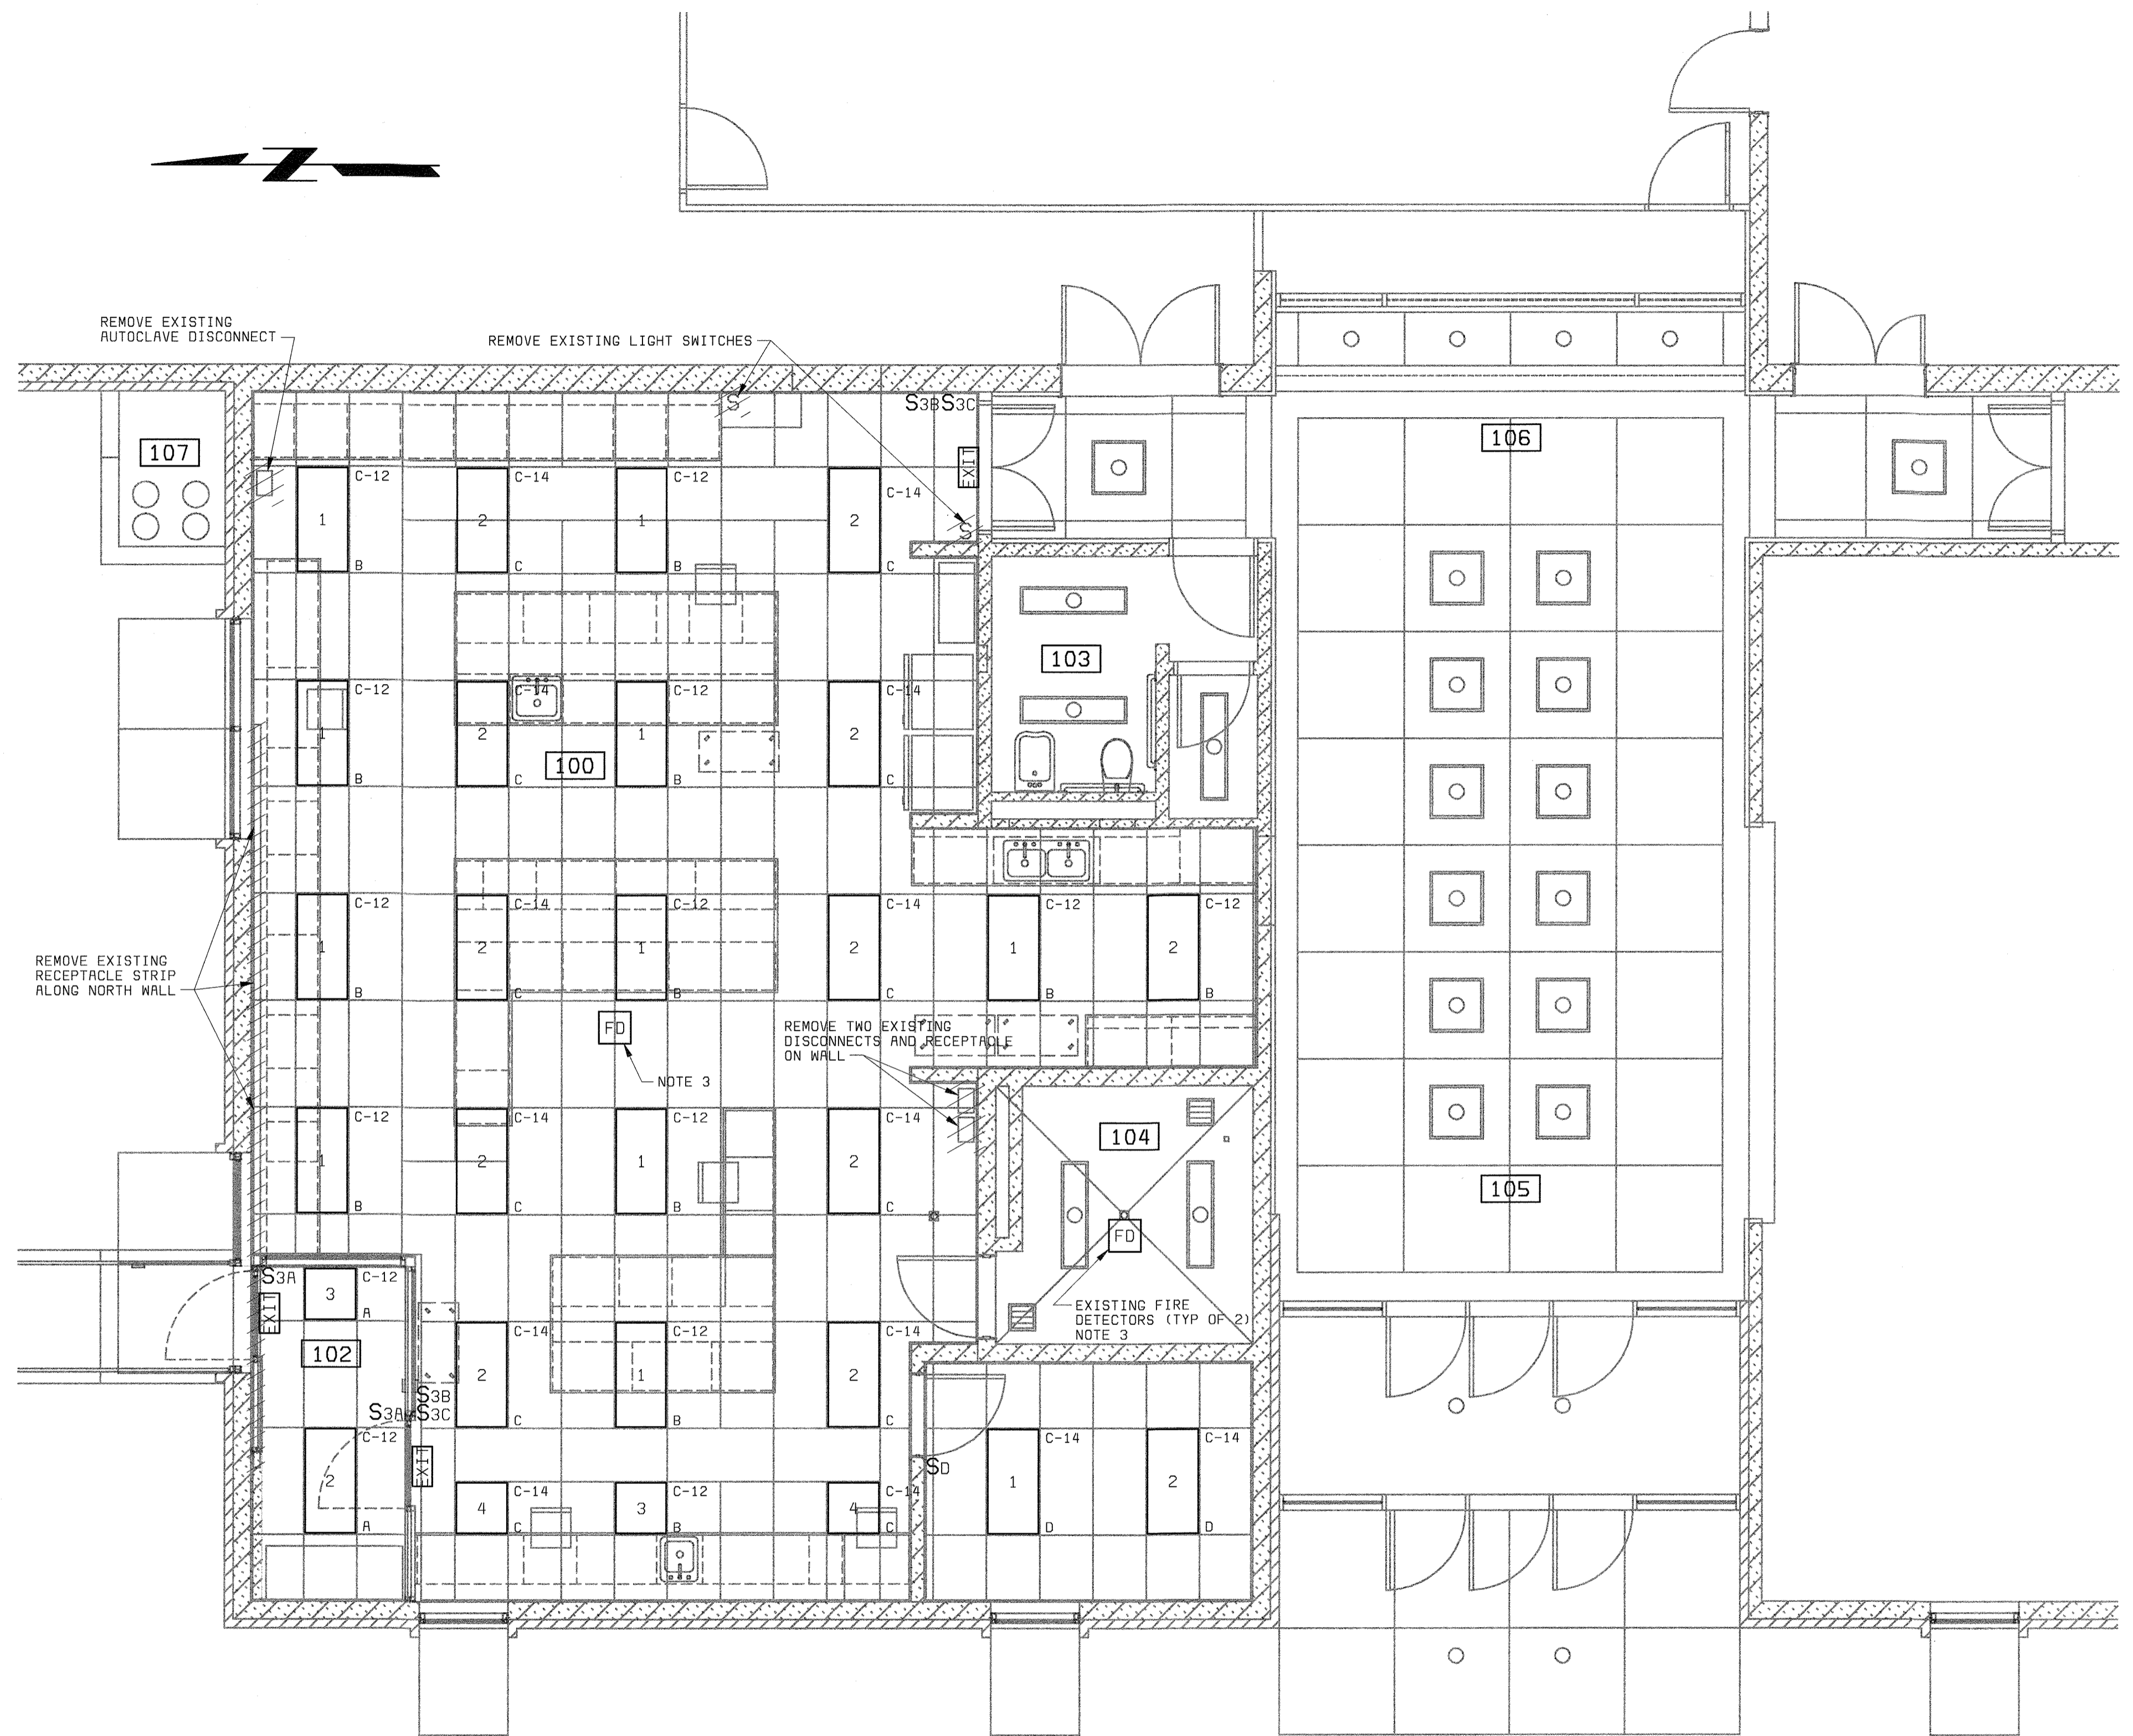

NOTES:

1. SEE DRAWING E1 FOR ELECTRICAL LEGEND & ABBREVIATIONS AND GENERAL REQUIREMENTS.
2. SEE LIGHTING FIXTURE AND PANELBOARD SCHEDULES ON DRAWING E5.
3. EXISTING LABORATORY FIRE DETECTION SYSTEM SHALL REMAIN IN PLACE. CONTRACTOR TO RE-INSTALL EXISTING FIRE DETECTORS.
4. EXISTING LIGHTING AND NUMEROUS RECEPTACLES IN FURNITURE SHALL BE REMOVED FROM SERVICE. REFER TO ARCHITECTURAL, HVAC AND PLUMBING DEMOLITION DRAWINGS.

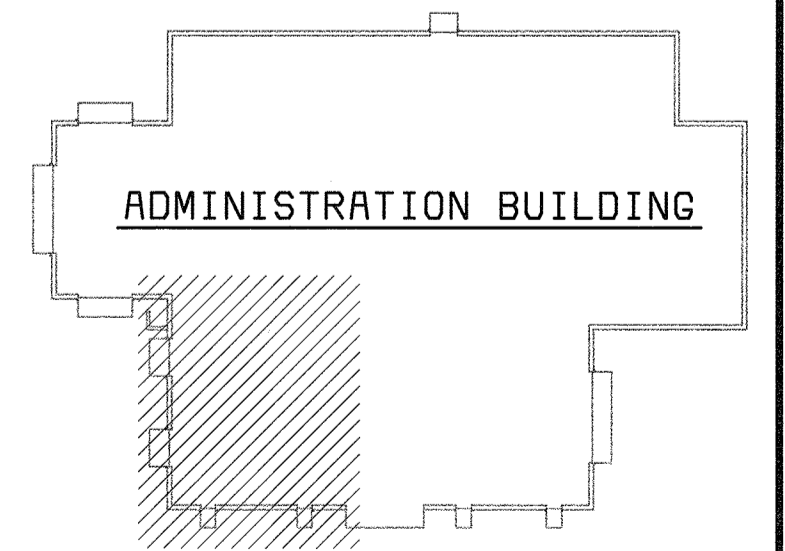

KEY PLAN
NO SCALE

FLOOR PLAN - EL 145.00
1/4" = 1'-0"

58472-104-ADM-H-1000003XJ
58472-112-ADM-A-1000003XL
58472-112-ADM-W-1000005OP

058472-5
FD58472R

DEPARTMENT OF PUBLIC WORKS
HOWARD COUNTY, MARYLAND

CHIEF, BUREAU OF UTILITIES DATE



BLACK & VEATCH
Gaithersburg, Maryland

REG. PROF. ENGR. _____ DATE _____

THIS DRAWING WAS
ORIGINALLY APPROVED
FOR CONSTRUCTION
AND SEALED BY
DONALD R. STEVENS
A REGISTERED
PROFESSIONAL ENGINEER
IN THE
STATE OF MARYLAND,
NO. 21876

DES: MEP					
DRN: MEP					
CHK: CEC					
DATE: 10/03/01	11/03/03	CONFORMED TO CONSTRUCTION RECORDS		RHH/RJR/RJR	
	DATE	REVISIONS AND RECORD OF ISSUE	NO.	BY	CK APP

ADMINISTRATION BUILDING
ELECTRICAL

LABORATORY FLOOR PLAN
LIGHTING PLAN

LITTLE PATUXENT WATER RECLAMATION PLANT
ADDITION NO. 6
LABORATORY RENOVATION

CAPITAL PROJECT S-6205
CONTRACT NO. 20-3841

HOWARD COUNTY, MARYLAND

SCALE
AS
SHOWN

SHEET
27 OF 28


E4

PANELBOARD: C1 (NOTE 2)		BUS: COPPER		MAINS: 3P-300A MAIN BREAKER	
SERVICE: 120/240V, 1Ø, 3W		RATING: 400A		LOCATION: CONTROL ROOM	
MOUNTING: SURFACE					
LOAD	P	BKR	CKT#	BKR	LOAD
AUTOCLAVE	2	20	1 2	30 2	GLASS WASHER
-	-	-	3 4	-	-
CENTRIFUGE	1	20	5 6	20 1	SPARE
FUME HOOD 1	1	20	7 8	20 1	FUME HOOD 2
RECEP - TRAINING ROOM FLOOR	1	20	9 10	20 1	RECEP - NORTH WALL INTERIOR/EXTERIOR
RECEP - TRAINING ROOM FLOOR	1	20	11 12	20 1	SPARE
SPARE	1	20	13 14	20 1	RECEP - BALANCE
SPARE	1	20	15 16	20 1	RECEP - A.A. FURNACE
CHEMIST OFFICE HEATER	1	20	17 18	20 1	SPARE
MUFFLE FURNACE	2	20	19 20	20 1	SPARE
-	-	-	21 22	20 1	WATER BATH
RECEP - NORTH LAB BENCH	1	20	23 24	20 1	RESTROOM EXHAUST FAN 9-202-F
* INCUBATOR	1	20	25 26	20 1	SPARE
RECEP - NORTH LAB BENCH	1	20	27 28	20 1	RECEP - NORTH LAB BENCH
RECEP - NORTH LAB BENCH	1	20	29 30	20 1	SPARE
RECEP - EAST LAB BENCH	1	20	31 32	20 1	RECEP - MIDDLE LAB TABLE
RECEP - EAST LAB BENCH	1	20	33 34	20 1	SPARE
RECEP - SOUTH LAB WALL NEAR STORAGE RM	1	20	35 36	20 2	SAMPLE ENTRANCE HEATER 9-203-HT
SPARE	1	20	37 38	-	-
SPARE	1	20	39 40	20 1	SPARE
SPARE	1	20	41 42	20 1	SPARE


PANELBOARD: C (NOTE 2)		BUS: COPPER		MAINS: 3P-175A MAIN BREAKER	
SERVICE: 120/240V, 1Ø, 3W		RATING: 400A		LOCATION: CONTROL ROOM	
MOUNTING: SURFACE					
LOAD	P	BKR	CKT#	BKR	LOAD
RECEP - NORTH WALL UNDER COUNTERTOP	1	20	1 2	20 1	EBH-10 LOBBY
EBH-8 LOBBY	1	20	3 4	20 1	SPARE
* TEMP. CONTROL PANEL TCP-101	1	20	5 6	20 1	RECEP - REFRIGERATOR & TOILET AREAS
RECEP - EXTERIOR WEST WALL	1	20	7 8	20 1	RECEP - REFRIGERATOR & LOBBY
SPARE	1	20	9 10	20 1	RECEP - CHEMIST OFFICE AREA
SPARE	1	20	11 12	20 1	LIGHTS - (ROWS 1,3,5,6) & ENTRANCE
SPARE	1	20	13 14	20 1	LIGHTS - LAB (ROWS 2,4) & OFFICE
SPARE	1	20	15 16	20 1	RECEP - STORAGE ROOM (RO/DI UNITS)
RECEP - GLASSWARE AREA	1	20	17 18	20 1	RECEP - COMPUTER
* RECEP - OVEN	1	20	19 20	20 1	RADIO CONTROL CONSOLE BATTERY CHARGER
SPARE	1	20	21 22	20 1	RECEP - GARBAGE DISPOSER GD-1
SAMPLE ENTRANCE AUTOMATED DOORS	1	20	23 24	20 1	RECEP - WEST WALL LAB
RECEP - WEST WALL LAB	1	20	25 26	20 1	RECEP - WEST LAB TABLE
RECEP - LAB ROOF (9-200-ME)	1	20	27 28	20 1	RECEP - WEST LAB AREA
FIRE ALARM RECEIVER PANEL	1	20	29 30	20 1	RECEP - EAST LAB TABLE
RECEP - EAST LAB TABLE	1	20	31 32	20 1	RECEP - MIDDLE LAB TABLE
RECEP - MIDDLE LAB TABLE	1	20	33 34	20 2	TKN DIGESTION
RECEP - GLASSWARE AREA	1	20	35 36	-	-
SPARE	1	20	37 38	20 1	SPARE
SPARE	1	20	39 40	20 1	SPARE
SPARE	1	20	41 42	20 1	SPARE

* DENOTES SERVICES THAT SHALL NOT BE GFCI PROTECTED (TYP OF 6). ALL OTHER CIRCUIT BREAKERS SHALL PROVIDE GFCI PROTECTION. ALL GFCI PROTECTED RECEPTACLES SHALL BE CLEARLY LABELED AS SUCH.

LIGHTING FIXTURE SCHEDULE				
SYMBOL	LAMP	MTG HGT	DESCRIPTION	MANUFACTURER
1	F32T8/SP35/RS 2850 LUMENS	RECESSED IN CEILING	2'x4' 4-LAMP FLUORESCENT TROFFER, FLUSH WHITE ALUMINUM FRAME DOOR, ELECTRONIC BALLAST, 120V	LITHONIA #2SP8G432FWA12125- 120GEB-1/4
2	F32T8/SP35/RS 2850 LUMENS	RECESSED IN CEILING	SAME AS FIXTURE NO. 2, EXCEPT WITH LITHONIA EMERGENCY BATTERY PACK PS1400-120V 60HZ, 120V	LITHONIA #2SP8G432FWA12125- 120GEB-1/4-EL14
3	F17T8/SP35/RS 1350 LUMENS	RECESSED IN CEILING	2'x2' 4-LAMP FLUORESCENT TROFFER, FLUSH WHITE ALUMINUM FRAME DOOR, ELECTRONIC BALLAST, 120V	LITHONIA #2SP8G417FWA12125- 120GEB-1/4
4	F17T8/SP35/RS 1350 LUMENS	RECESSED IN CEILING	SAME AS FIXTURE NO. 3, EXCEPT WITH LITHONIA EMERGENCY BATTERY PACK PS1400-120V 60HZ, 120V	LITHONIA #2SP8G417FWA12125- 120GEB-1/4-EL14
EXIT	SELF- LUMINOUS	UNIVERSAL MOUNT	SELF-LUMINOUS UNIVERSAL MOUNTED EXIT SIGN, WHITE HOUSING, SINGLE FACE, RED ACEPLATE, ALUMINUM ANODIZED FRAME, 20 YEAR LUMINOUS LIFE	LITHONIA #0SW1R20AA

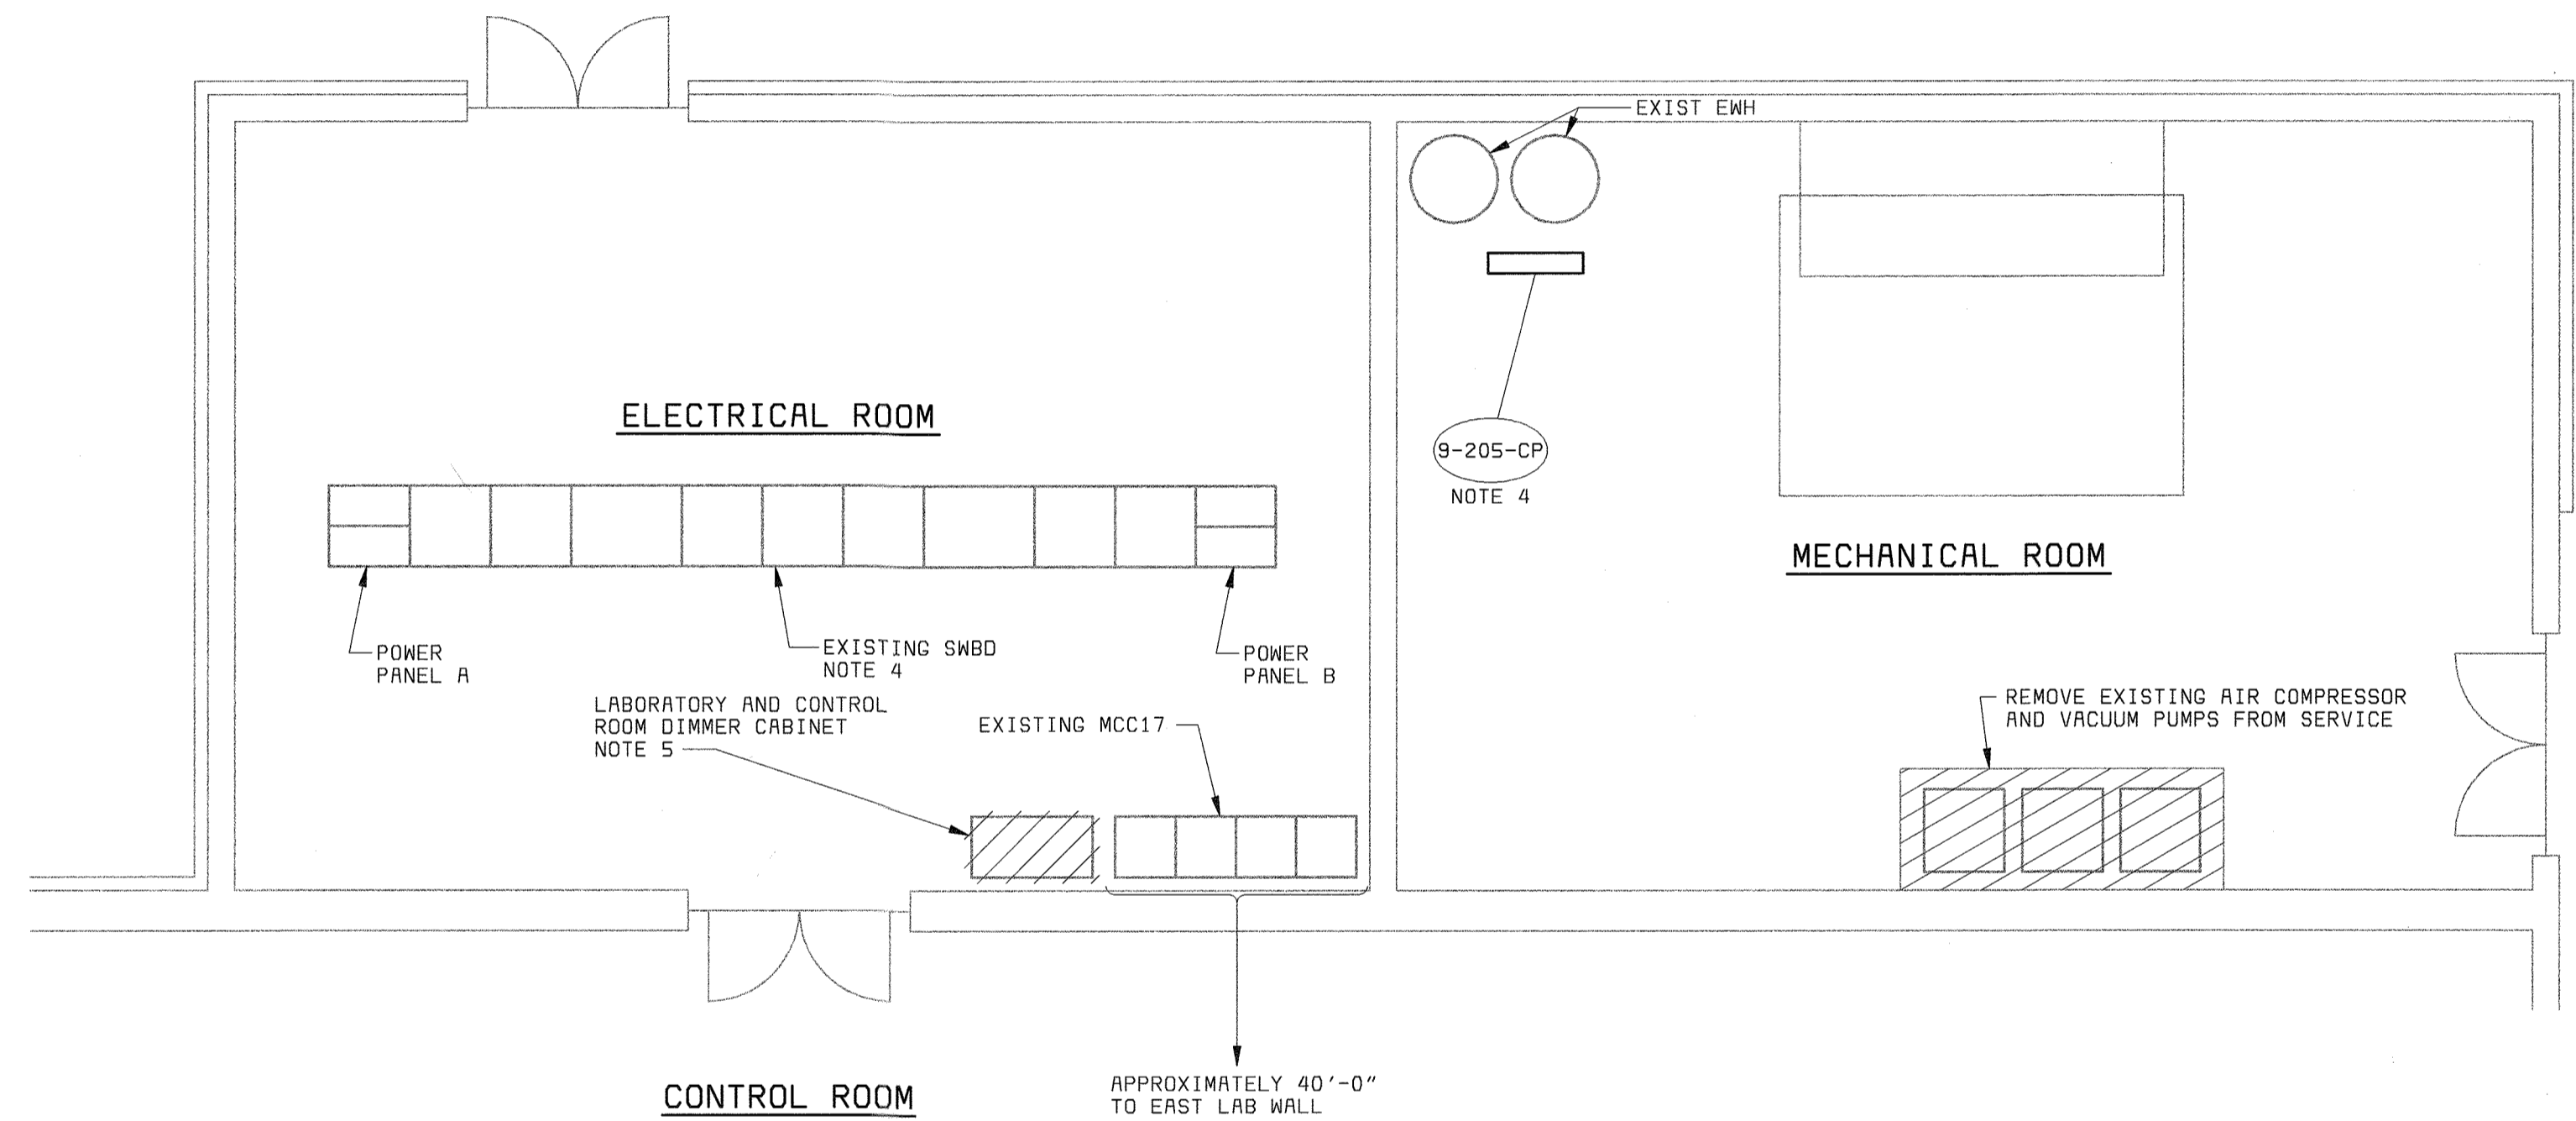

ELECTRICAL/MECHANICAL ROOM PLAN
1/4" = 1'-0"

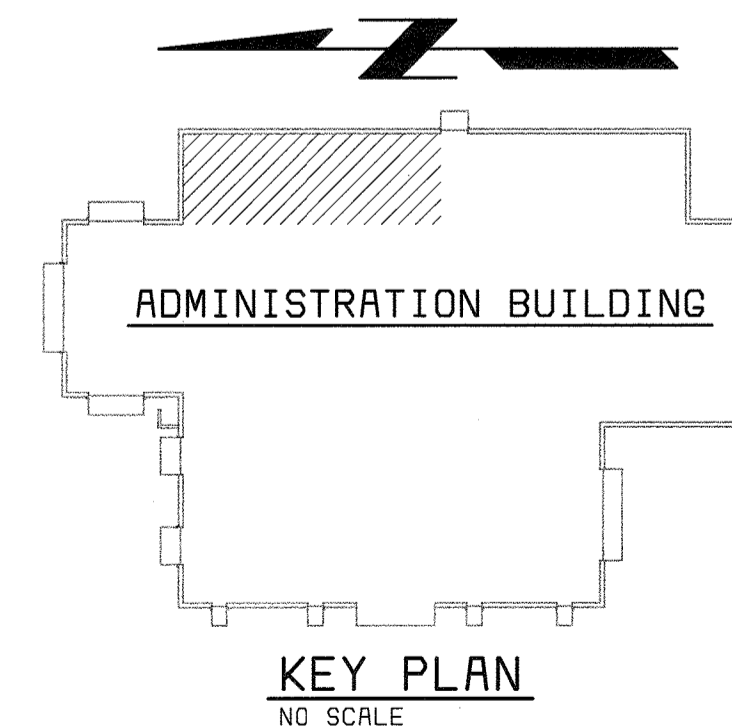

NOTES:

- SEE DRAWING E1 FOR ELECTRICAL LEGEND & ABBREVIATIONS AND GENERAL REQUIREMENTS.
- CONTRACTOR SHALL REMOVE AND REPLACE EXISTING PANELBOARD C & C1 SUB-PANEL ASSEMBLIES WITH NEW SUB-PANELS. CONTRACTOR SHALL RE-TERMINATE EXISTING MAIN FEEDER CABLES TO NEW PANEL ASSEMBLIES. ALL CIRCUIT BREAKERS SHALL BE NEW. EXISTING FLUSH MOUNTED PANELS ARE G.E. NAB TYPE AND ARE CURRENTLY USING G.E. TYPE TED CIRCUIT BREAKERS. CONTRACTOR SHALL CONFIRM.
- CONTRACTOR SHALL INCLUDE IN BID TIME FOR THE VERIFICATION AND RE-CONNECTION OF EXISTING CIRCUITS THAT ARE NOT BEING REMOVED (SHOWN WITH SCREENED TEXT ON PANELBOARD SCHEDULE). ALL NEW AND RECONNECTED CIRCUITS SHALL BE PROPERLY LABELED.
- CONTRACTOR SHALL POWER CIRCULATION PUMP FROM SPARE 120 VOLT CIRCUIT BREAKER IN ONE OF THE TWO EXISTING POWER PANELS (A OR B) LOCATED WITHIN EXISTING SWBD. CONTRACTOR SHALL FIELD DETERMINE/VERIFY.
- EXISTING LIGHT DIMMING BALLASTS AND PANEL ARE NO LONGER USED. CONTRACTOR SHALL REMOVE.

DEPARTMENT OF PUBLIC WORKS
HOWARD COUNTY, MARYLAND



REG. PROF. ENGR. DATE

DES: MEP									
DRN: MEP									
CHK: CEC									
DATE: 10/03/01	DATE	REVISIONS AND RECORD OF ISSUE	NO.	BY	CK	APP			

ADMINISTRATION BUILDING
ELECTRICAL

LIGHTING FIXTURE AND
PANELBOARD SCHEDULES

LITTLE PATUXENT WATER RECLAMATION PLANT
ADDITION NO. 6
LABORATORY RENOVATION

CAPITAL PROJECT S-6205
CONTRACT NO. 20-3841

HOWARD COUNTY, MARYLAND

SCALE
AS
SHOWN

SHEET
28 OF 28

E5