

QUANTITIES				
ITEM	ESTIMATED	AS-BUILT		
		QUANTITIES	TYPE	SUPPLIER
8" SEWER	5 L.F.	5 L.F.	PVC	
MANHOLES	1 EACH	1 EA.		
6" WATER	70 L.F.	70 L.F.	DIP	
8" WATER	3,925 L.F.	3,925 L.F.	DIP	
FIRE HYDRANTS	6 EACH	6 EA.		MUELLER
8" x 1/2" T.S. & V.	0			
8" x 1/2" TEE	1 EACH	7 EA.	DIP	
8" x 1/2" TEE	4 EACH	4 EA.	DIP	
6" VALVE	1 EACH	7 EA.	DIP	
8" VALVE	5 EACH	5 EA.	DIP	
8"-1/8" H.B.	2 EACH	2 EA.	DIP	
8"-1/8" H.B.	1 EACH			
8"-1/8" H.B.	1 EACH			
NAME OF UTILITY CONTRACTOR: GRAY AND SONS				
SURVEY & DRAFTING DIVISION AS-BUILT DATE: SEPTEMBER 2008				

WATER AND SEWER MAIN SEQUENCE OF CONSTRUCTION

- CONTRACTOR IS TO OBTAIN ALL NECESSARY PERMITS BEFORE BEGINNING CONSTRUCTION
 - A PRE-CONSTRUCTION MEETING MUST BE CONDUCTED BETWEEN PARTICIPANTS. NOTIFY THE SEDIMENT AND EROSION CONTROL INSPECTOR 48 HOURS PRIOR TO START OF CONSTRUCTION.
 - CALL MISS UTILITY TO LOCATE EXISTING WATER MAINS. CONTRACTOR IS RESPONSIBLE FOR DAMAGES.
 - INSTALL SILT FENCE AS INDICATED ON PLAN OR AS DIRECTED BY THE SEDIMENT AND EROSION CONTROL INSPECTOR. SELECT STOCKPILE AREAS WITHIN THE DRAINAGE DIVIDE OF SEDIMENT BASINS.
 - WITH APPROVAL OF THE SEDIMENT AND EROSION CONTROL INSPECTOR EXCAVATE TRENCH AND INSTALL WATER AND SEWER LINES. FOLLOW THE DIVISION 5.00 SPECIAL PROVISION PROCEDURES FOR CONTRACT NO. 44-3757-D.
 - WITH APPROVAL OF THE BUREAU OF UTILITIES INSPECTOR BACKFILL TRENCH TO FINISH GRADE AT AT SPECIFIED DENSITY AND RESTORE EARTH BERM.
 - NOTIFY SEDIMENT AND EROSION CONTROL INSPECTOR TO OBTAIN APPROVAL TO REMOVE SILT FENCE.
- NOTE: ESTIMATED TIME OF CONSTRUCTION FOR WATER AND SEWER LINES IS FIFTEEN (15) DAYS. THIS ESTIMATE MAY VARY DUE TO INCIDENT WEATHER.

DEVELOPER'S CERTIFICATION

"I HEREBY CERTIFY THAT ALL DEVELOPMENT AND CONSTRUCTION WILL BE DONE ACCORDING TO THIS PLAN OF DEVELOPMENT AND PLAN FOR EROSION AND SEDIMENT CONTROL AND THAT ALL RESPONSIBLE PERSONNEL INVOLVED IN THE CONSTRUCTION PROJECT WILL HAVE A CERTIFICATE OF ATTENDANCE AT A DEPARTMENT OF THE ENVIRONMENT APPROVED TRAINING PROGRAM FOR THE SEDIMENT AND EROSION BEFORE BEGINNING THE PROJECT. I ALSO AUTHORIZE PERIODIC ON-SITE INSPECTION BY THE HOWARD SOIL CONSERVATION DISTRICT OR THEIR AUTHORIZED AGENTS, AS ARE DEEMED NECESSARY."

Donna Trayer 4/27/00
SIGNATURE OF DEVELOPER DATE


ENGINEER'S CERTIFICATION

"I HEREBY CERTIFY THAT THIS PLAN FOR EROSION AND SEDIMENT CONTROL REPRESENTS A PRACTICAL AND WORKABLE PLAN BASED ON MY PERSONAL KNOWLEDGE OF THE SITE CONDITIONS AND THAT IT WAS PREPARED IN ACCORDANCE WITH THE REQUIREMENTS OF THE HOWARD SOIL CONSERVATION DISTRICT."

Michael J. Vay 6/19/2000
SIGNATURE OF ENGINEER DATE

BENCHMARK INFORMATION

B.M.#1 - HOWARD COUNTY MONUMENT NO. 4382	ELEV. = 209.58; DESCRIPTION: DESC
B.M.#2 - HOWARD COUNTY MONUMENT NO. 4386	ELEV. = 210.54; DESC: DESC

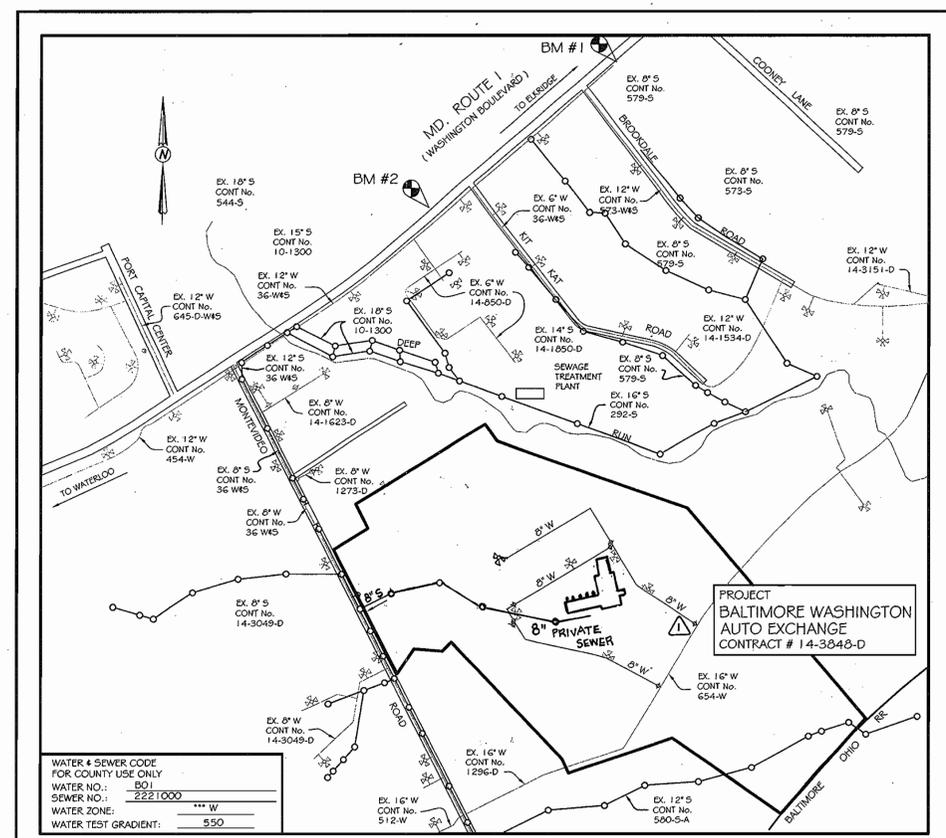

WATER & SEWER CODE FOR COUNTY USE ONLY
 WATER NO.: B01
 SEWER NO.: 222T000
 WATER ZONE: *** W
 WATER TEST GRADIENT: 550

TYPE OF BUILDING: COMMERCIAL VEHICLE AUCTION FACILITY
 NUMBER OF LOTS & PARCELS: 1
 NO. OF WATER HOUSE CONNECTIONS: 1
 NO. OF SEWER HOUSE CONNECTIONS: 1
 DRAINAGE AREA: WATERLOO
 TREATMENT PLANT: PATAPSCO WASTEWATER TREATMENT PLANT VIA THE ROUTE 108 PUMPING STATION

VICINITY MAP
 SCALE: 1"=600'

PLAN REFERENCE NUMBERS: F 99 - 44

GENERAL NOTES


- APPROPRIATE LOCATION OF EXISTING MAINS ARE SHOWN. THE CONTRACTOR SHALL TAKE ALL NECESSARY PRECAUTIONS TO PROTECT EXISTING MAINS AND SERVICES AND MAINTAIN UNINTERRUPTED SUPPLY. ANY DAMAGE INCURRED SHALL BE REPAIRED IMMEDIATELY TO THE SATISFACTION OF THE ENGINEER AT THE CONTRACTOR'S EXPENSE.
- ALL HORIZONTAL CONTROLS ARE BASED ON MARYLAND STATE COORDINATES.
- ALL VERTICAL CONTROLS ARE BASED ON U.S.G.S. DATUM.
- ALL PIPE ELEVATIONS ARE INVERT ELEVATIONS.
- CLEAR ALL UTILITIES BY A MINIMUM OF 6'. CLEAR ALL POLES BY 2'-0" MINIMUM OR TUNNEL AS REQUIRED. THE OWNER HAS CONTACTED THE UTILITY COMPANIES AND HAS MADE ARRANGEMENTS FOR BRACING OF POLES SHOWN ON THE DRAWINGS. IN THE EVENT THE CONTRACTOR'S WORK REQUIRES THE BRACING OF ADDITIONAL POLES, ANY COST INCURRED BY THE OWNER FOR BRACING OF ADDITIONAL POLES OR DAMAGES SHALL BE DEDUCTED FROM MONEY OWED TO THE CONTRACTOR. THE CONTRACTOR SHALL COORDINATE WITH THE UTILITY COMPANIES TO SCHEDULE THE BRACING OF POLES.
- FOR DETAILS NOT SHOWN ON THE DRAWINGS, AND FOR MATERIALS AND CONSTRUCTION METHODS, USE HOWARD COUNTY DESIGN MANUAL VOLUME IV, STANDARD SPECIFICATIONS AND DETAILS FOR CONSTRUCTION (LATEST EDITION). THE CONTRACTOR SHALL HAVE A COPY OF VOLUME IV ON THE JOB SITE.
- WHERE TEST FITS HAVE BEEN MADE ON EXISTING UTILITIES, THEY ARE NOTED BY THE SYMBOL AT THE LOCATION OF THE TEST FIT. A NOTE OR NOTES CONTAINING THE RESULTS OF THE TEST FIT OR FITS IS INCLUDED ON THE DRAWINGS. EXISTING UTILITIES IN THE VICINITY OF THE PROPOSED WORK FOR WHICH TEST FITS HAVE NOT BEEN DUG SHALL BE VERIFIED BY THE CONTRACTOR TO HIS OWN SATISFACTION. ANY DAMAGE TO EXISTING FACILITIES DUE TO THE CONTRACTOR'S NEGLIGENCE SHALL BE REPAIRED AT THE CONTRACTOR'S EXPENSE.
- CONTRACTOR SHALL NOTIFY THE FOLLOWING UTILITY COMPANIES OR AGENCIES AT LEAST FIVE (5) WORKING DAYS BEFORE STARTING WORK SHOWN ON THESE PLANS:
 STATE HIGHWAY ADMINISTRATION: 410-531-5533
 BALTIMORE GAS & ELECTRIC CO.: CONTRACTOR SERVICES: 410-850-4620
 BALTIMORE GAS & ELECTRIC CO.: UNDER GROUND DAMAGE CONTROL: 410-291-4607
 MISS UTILITY: 1-800-257-7777
 COLONIAL PIPELINE CO.: 1-410-549-4120
 BUREAU OF UTILITIES, HOWARD COUNTY DEPARTMENT OF PUBLIC WORKS: 410-313-4900
 BELL ATLANTIC: 1-800-446-5266
- TREES AND SHRUBS ARE TO BE PROTECTED FROM DAMAGE TO MAXIMUM EXTENT. TREES AND SHRUBS LOCATED WITHIN THE CONSTRUCTION STRIP ARE NOT TO BE REMOVED OR DAMAGED BY THE CONTRACTOR.
- CONTRACTOR SHALL REMOVE TREES, STUMPS AND ROOTS ALONG THE LINE OF EXCAVATION. PAYMENT FOR SUCH REMOVAL SHALL BE INCLUDED IN THE UNIT PRICE BID FOR CONSTRUCTION OF THE MAIN.
- THE CONTRACTOR SHALL NOTIFY THE BUREAU OF HIGHWAYS, HOWARD COUNTY, AT 410-313-2450 AT LEAST FIVE (5) WORKING DAYS BEFORE ANY OPEN CUT OF ANY COUNTY ROAD OR BORING/JACKING OPERATION IN COUNTY ROADS FOR LAYING WATER/SEWER MAINS OR HOUSE CONNECTIONS. THE APPROVAL OF THESE DRAWINGS WILL CONSTITUTE COMPLIANCE WITH DPW REQUIREMENTS PER SECTION 16.11-1 (a) OF THE HOWARD COUNTY CODE.

WATER NOTES

- ALL WATER MAINS TO BE D.I.P. CLASS 52 UNLESS OTHERWISE NOTED.
- TOPS OF ALL WATER MAINS TO HAVE A MINIMUM OF 5'-1/2" COVER UNLESS OTHERWISE NOTED.
- VALVES ADJACENT TO TREES SHALL BE STRAPPED TO TREES.
- ALL FITTINGS SHALL BE BUTTRESSED OR ANCHORED WITH CONCRETE IN ACCORDANCE WITH THE STANDARD DETAILS UNLESS OTHERWISE PROVIDED FOR ON THE DRAWINGS.
- FIRE HYDRANTS SHALL BE SET TO THE BURY LINE ELEVATIONS SHOWN ON THE DRAWINGS. ALL FIRE HYDRANTS SHALL BE RESTRAINED AN BUTTRESSED WITH CONCRETE IN ACCORDANCE WITH THE STANDARD DETAILS. SOIL AROUND THE FIRE HYDRANTS SHALL BE COMPACTED IN ACCORDANCE WITH SECTION 1000 AND 1005 OF THE STANDARD SPECIFICATIONS.
- THE CONTRACTOR SHALL NOT OPERATE ANY WATER MAIN VALVES ON THE EXISTING WATER SYSTEM.
- ALL WATER HOUSE CONNECTIONS SHALL BE FOR INSIDE METER SETTING UNLESS OTHERWISE NOTED ON PLANS OR IN THE SPECIFICATIONS.

SEWER NOTES


- ALL SEWER MAINS SHALL BE D.I.P. OR P.V.C. UNLESS OTHERWISE NOTED.
- ALL MANHOLES SHALL BE 4'-0" INSIDE DIAMETER UNLESS OTHERWISE NOTED.
- MANHOLES SHOWN WITH 12" AND 18" WALLS ARE FOR BRICK MANHOLES ONLY.
- MANHOLES DESIGNATED W.T. IN PLAN AND PROFILE SHALL HAVE WATERTIGHT FRAME AND COVERS, STANDARD DETAIL 65.52. WHERE WATERTIGHT FRAME AND COVER IS USED, SET TOP OF FRAME 1'-6" ABOVE FINISHED GRADE UNLESS OTHERWISE NOTED ON THE DRAWINGS.

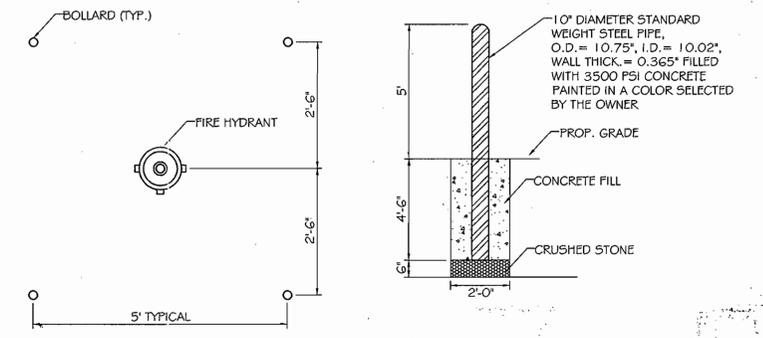

FIRE HYDRANT BOLLARD DETAIL
NOT TO SCALE


AS BUILT
DATE: SEPTEMBER 2008

CONTRACT No. 14-3848-D
BALTIMORE WASHINGTON
AUTO EXCHANGE
WATER AND SEWER MAIN EXTENSIONS
HOWARD COUNTY, MARYLAND

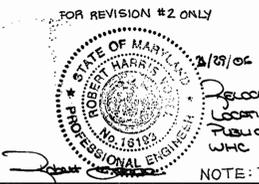

FOR REVISION #2 ONLY
 2/28/06
 Relocate Building to As-Built Location. Delete Portions of 8" Public Water Main. Reuse W.H.C. and Private Sewer Main.
 NOTE: THIS SET SUPERCEDES OLD SET.


DEPARTMENT OF PUBLIC WORKS HOWARD COUNTY, MARYLAND	DEPARTMENT OF PLANNING AND ZONING HOWARD COUNTY, MARYLAND	THAYER & ASSOCIATES, INC. 2868 CONSTELLATION WAY FINKSBURG, MARYLAND 21048 TEL/FAX: 410-840-8797	DESIGNED BY: M. J. K. DRAWN BY: C.A.D.D. CHECKED BY: M.J.K. DATE: MAY 2000	BY: [Signature]	TITLE SHEET	BALTIMORE WASHINGTON AUTO EXCHANGE CONTRACT NO. 14-3848-D FIRST ELECTION DISTRICT HOWARD COUNTY, MARYLAND	SCALE AS SHOWN SHEET 1 OF 9
---	--	--	---	-----------------	-------------	---	--------------------------------

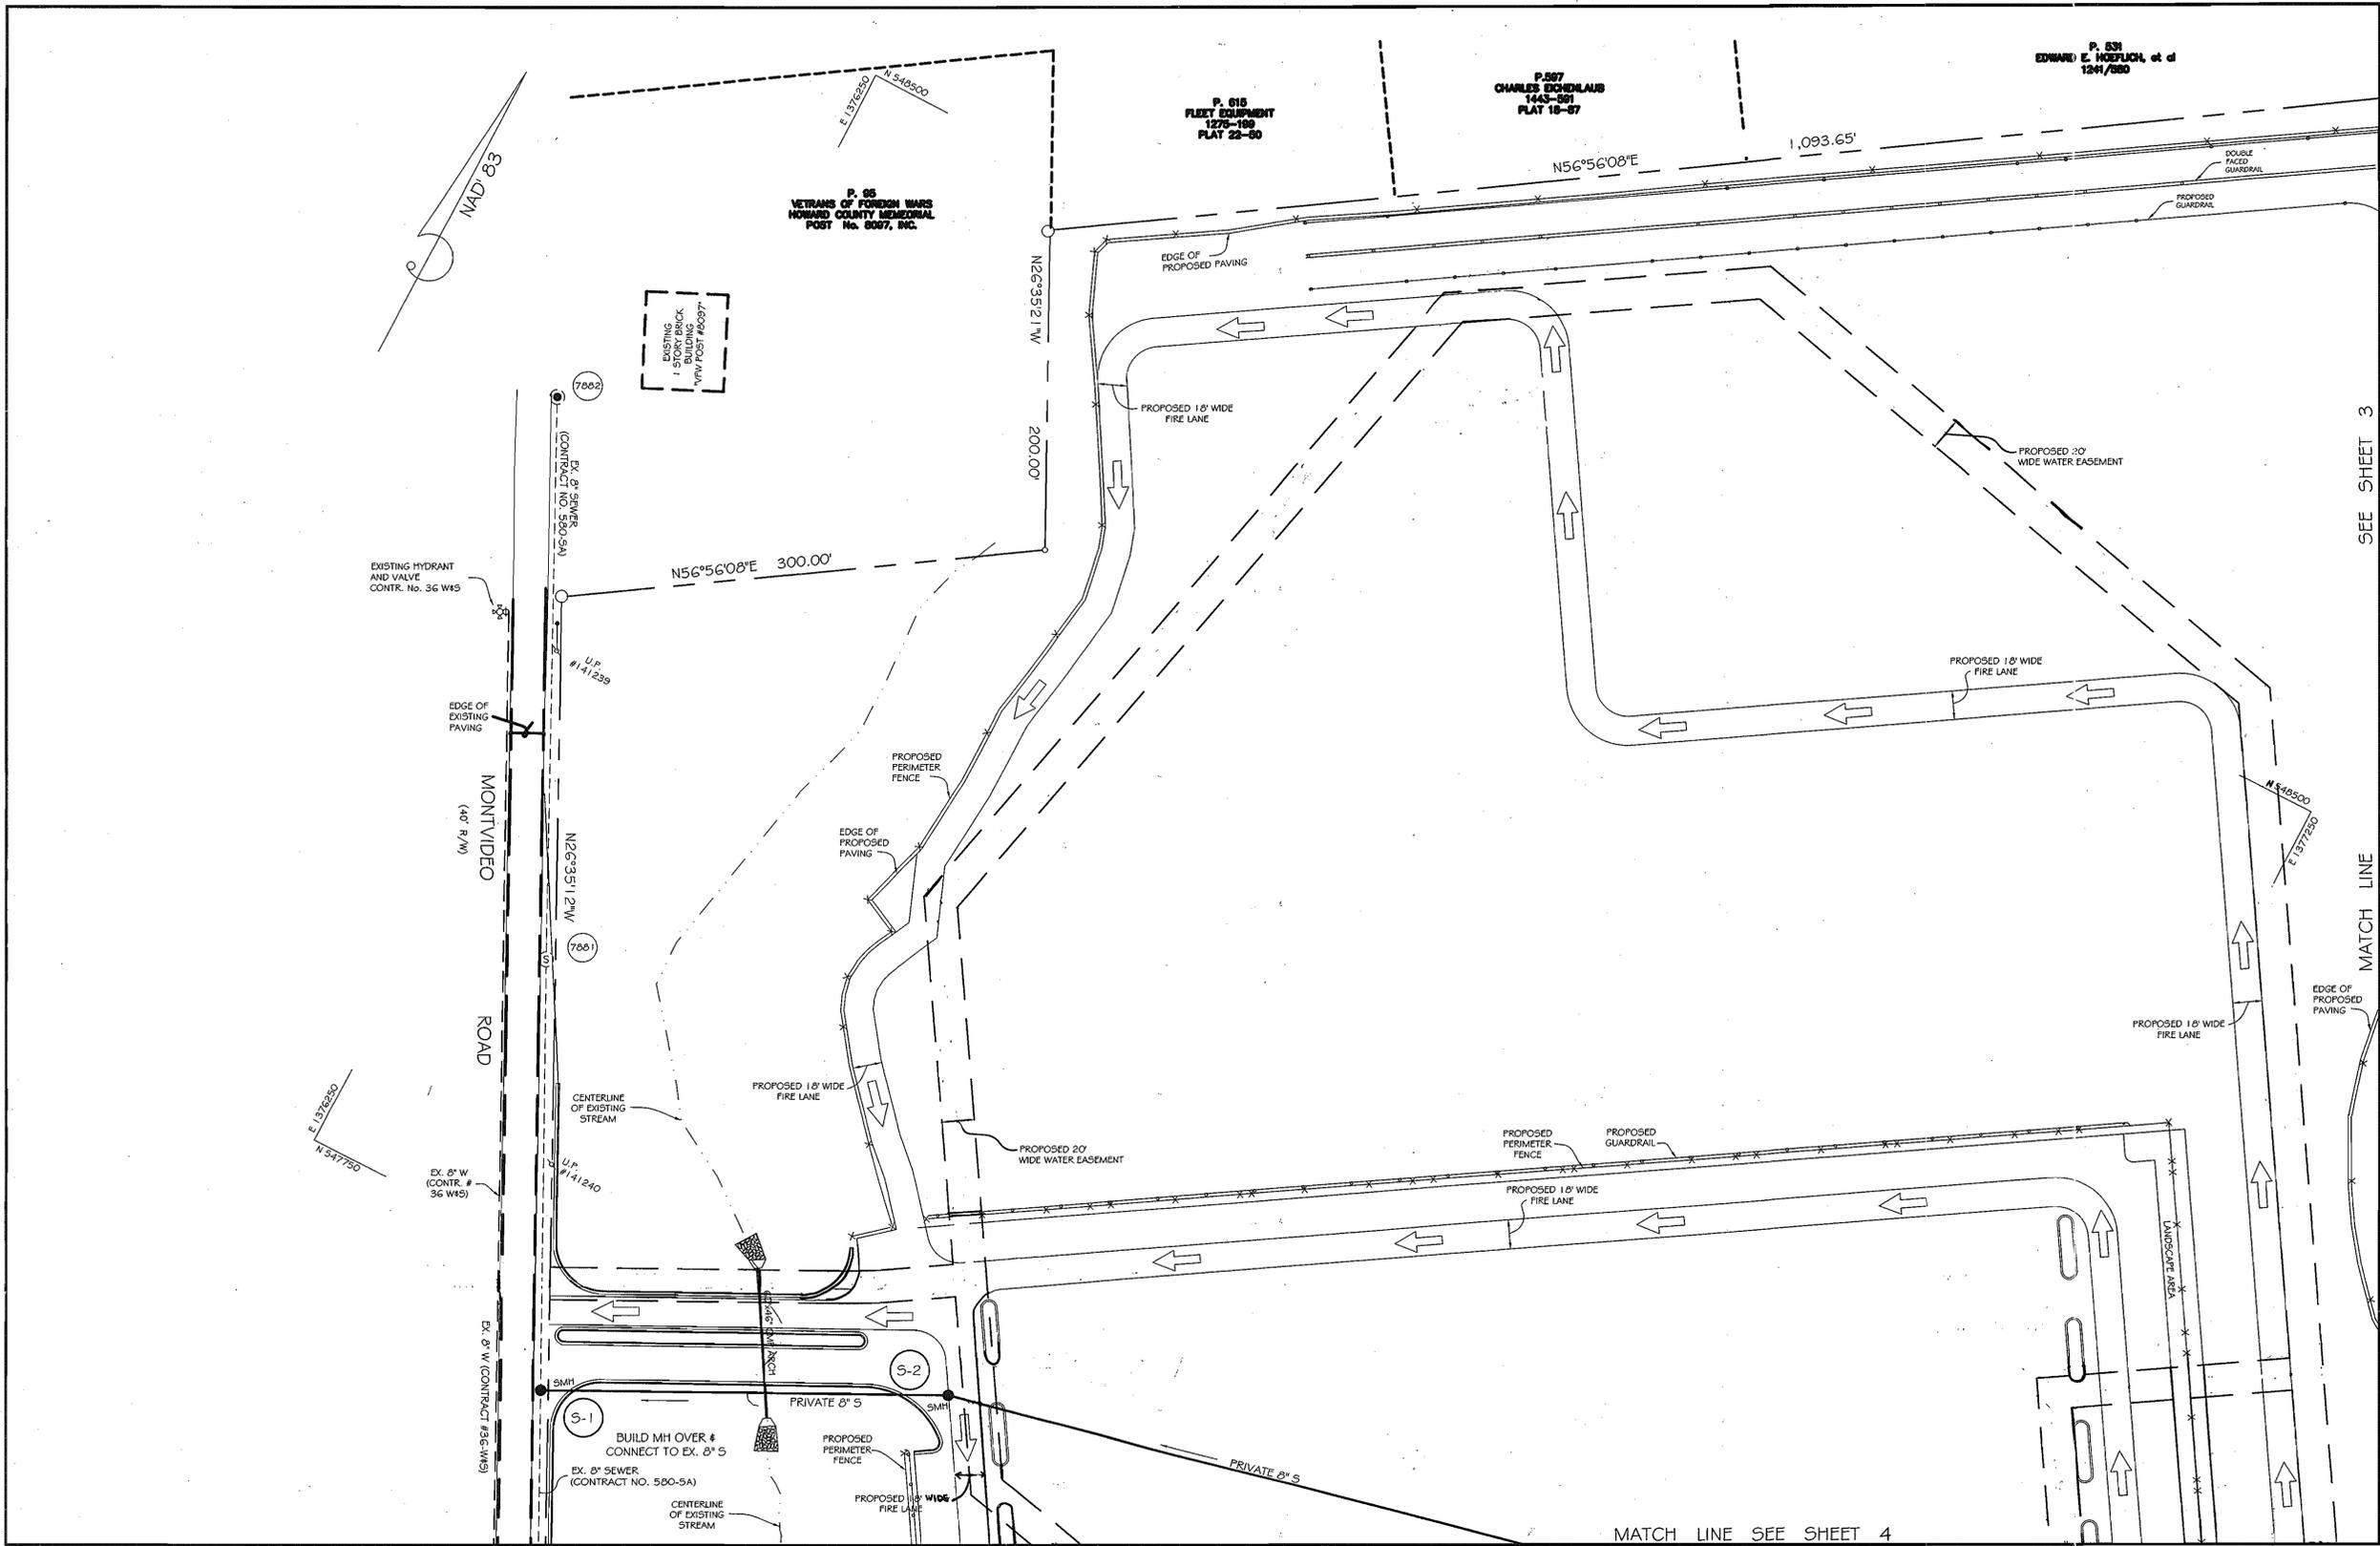

SEE SHEET 3

MATCH LINE

AS BUILT
DATE: SEPTEMBER 2008

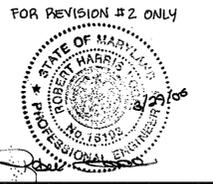

NOTE: THIS SET SUPERCEDES OLD SET

DEPARTMENT OF PUBLIC WORKS
HOWARD COUNTY, MARYLAND
Robert W. Berman
CHIEF, BUREAU OF UTILITIES
6-30-00
DATE

DEPARTMENT OF PLANNING AND ZONING
HOWARD COUNTY, MARYLAND
Michael J. Jay
CHIEF, DEVELOPMENT ENGINEERING DIVISION
7/14/00
DATE

THAYER & ASSOCIATES, INC.
2868 CONSTELLATION WAY
FINKSBURG, MARYLAND 21048
TEL/FAX: 410-840-8797




DESIGNED BY:	M. J. K.
DRAWN BY:	C.A.D.D.
CHECKED BY:	M.J.K.
DATE:	MAY 2000
BY:	NO.
NO.	REVISION
DATE:	3/16/06
DATE:	

PLAN SHEET
600' SCALE MAP NO. 43 BLOCK NO. 10
FILE NAME: BWAE WATSEW TITLE SHEET

BALTIMORE WASHINGTON AUTO EXCHANGE
CONTRACT NO. 14-3848-D
FIRST ELECTION DISTRICT
HOWARD COUNTY, MARYLAND

SCALE
1"=50'
SHEET
2 OF 9

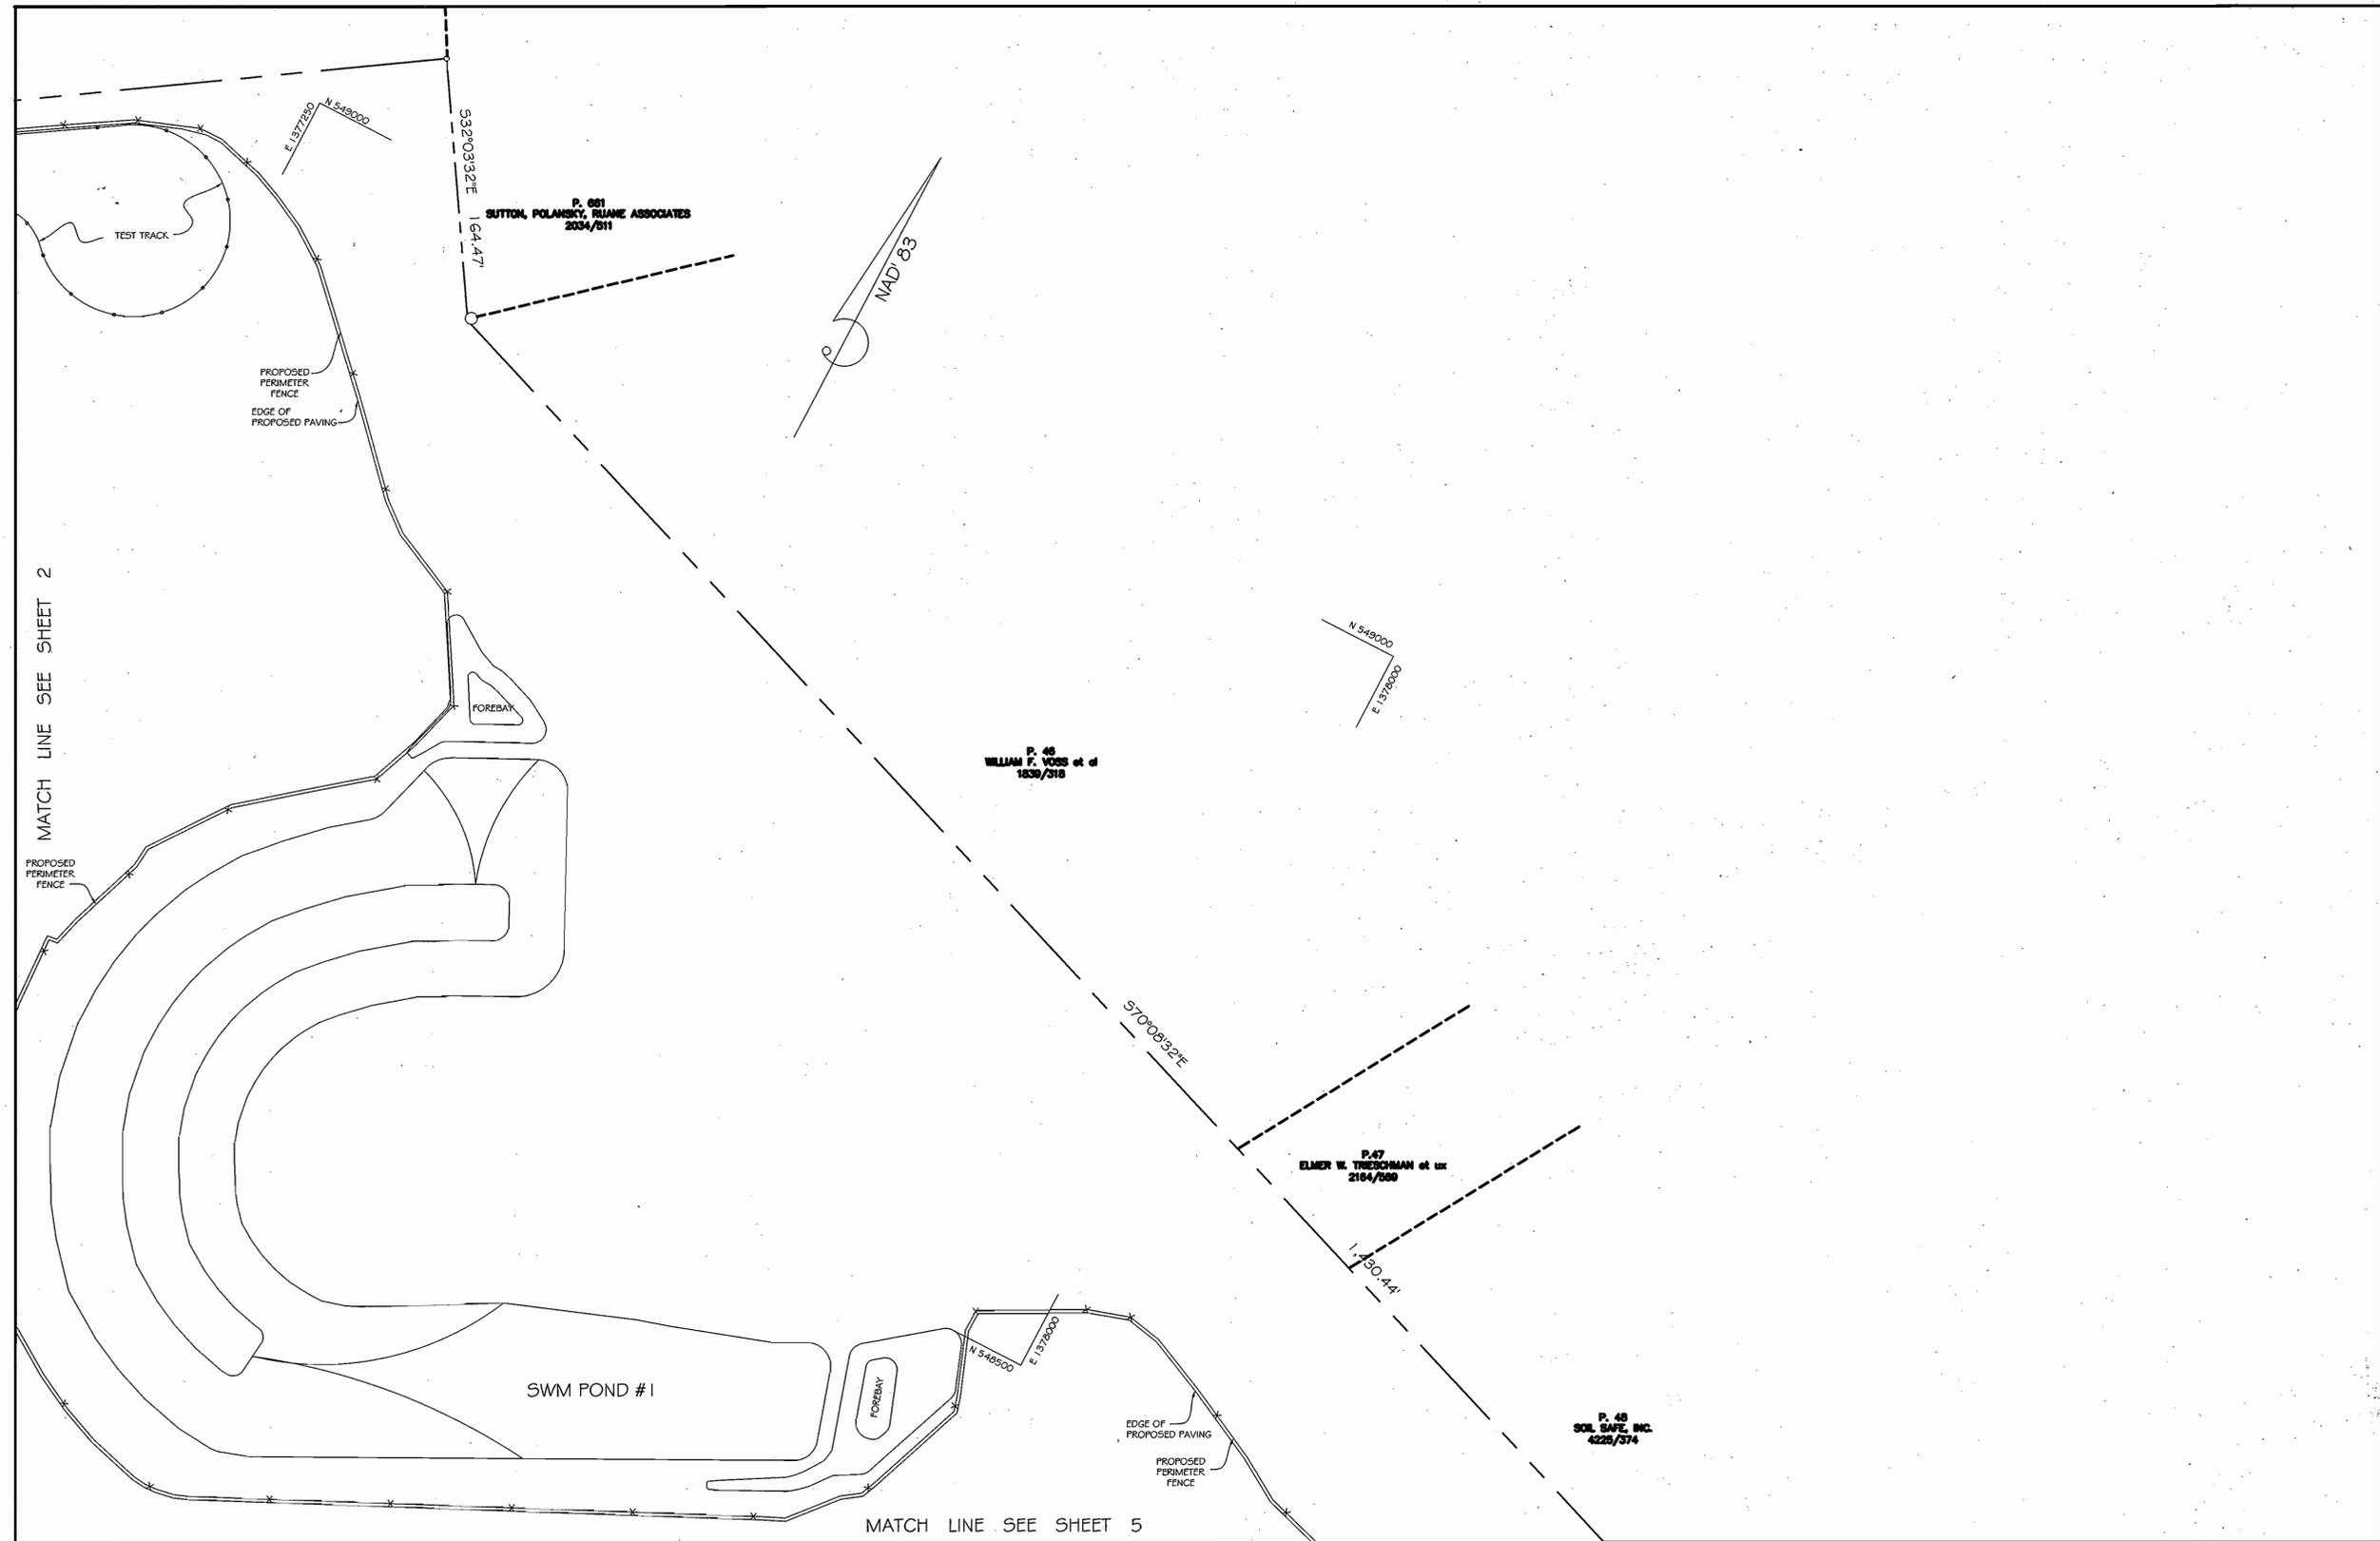

AS BUILT
DATE: SEPTEMBER 2008

NOTE: THIS SET SUPERCEDES OLD SET

DEPARTMENT OF PUBLIC WORKS
HOWARD COUNTY, MARYLAND

Robert Brown
CHIEF, BUREAU OF UTILITIES
6-30-00
DATE

DEPARTMENT OF PLANNING AND ZONING
HOWARD COUNTY, MARYLAND

Harold...
CHIEF, DEVELOPMENT ENGINEERING DIVISION
7/14/00
DATE

THAYER & ASSOCIATES, INC.
2868 CONSTELLATION WAY
FINKSBURG, MARYLAND 21048
TEL/FAX: 410-840-8797



DESIGNED BY:	M. J. K.		
DRAWN BY:	C.A.D.D.		
CHECKED BY:	M.J.K.		
DATE:	MAY 2000		
BY	NO.	REVISION	DATE

PLAN SHEET


600 SCALE MAP NO. 43 BLOCK NO. 10

FILE NAME: BWAE WATSEW TITLE SHEET


BALTIMORE WASHINGTON AUTO EXCHANGE
CONTRACT NO. 14-3848-D
FIRST ELECTION DISTRICT
HOWARD COUNTY, MARYLAND

SCALE
1"=50'

SHEET
3 of 9

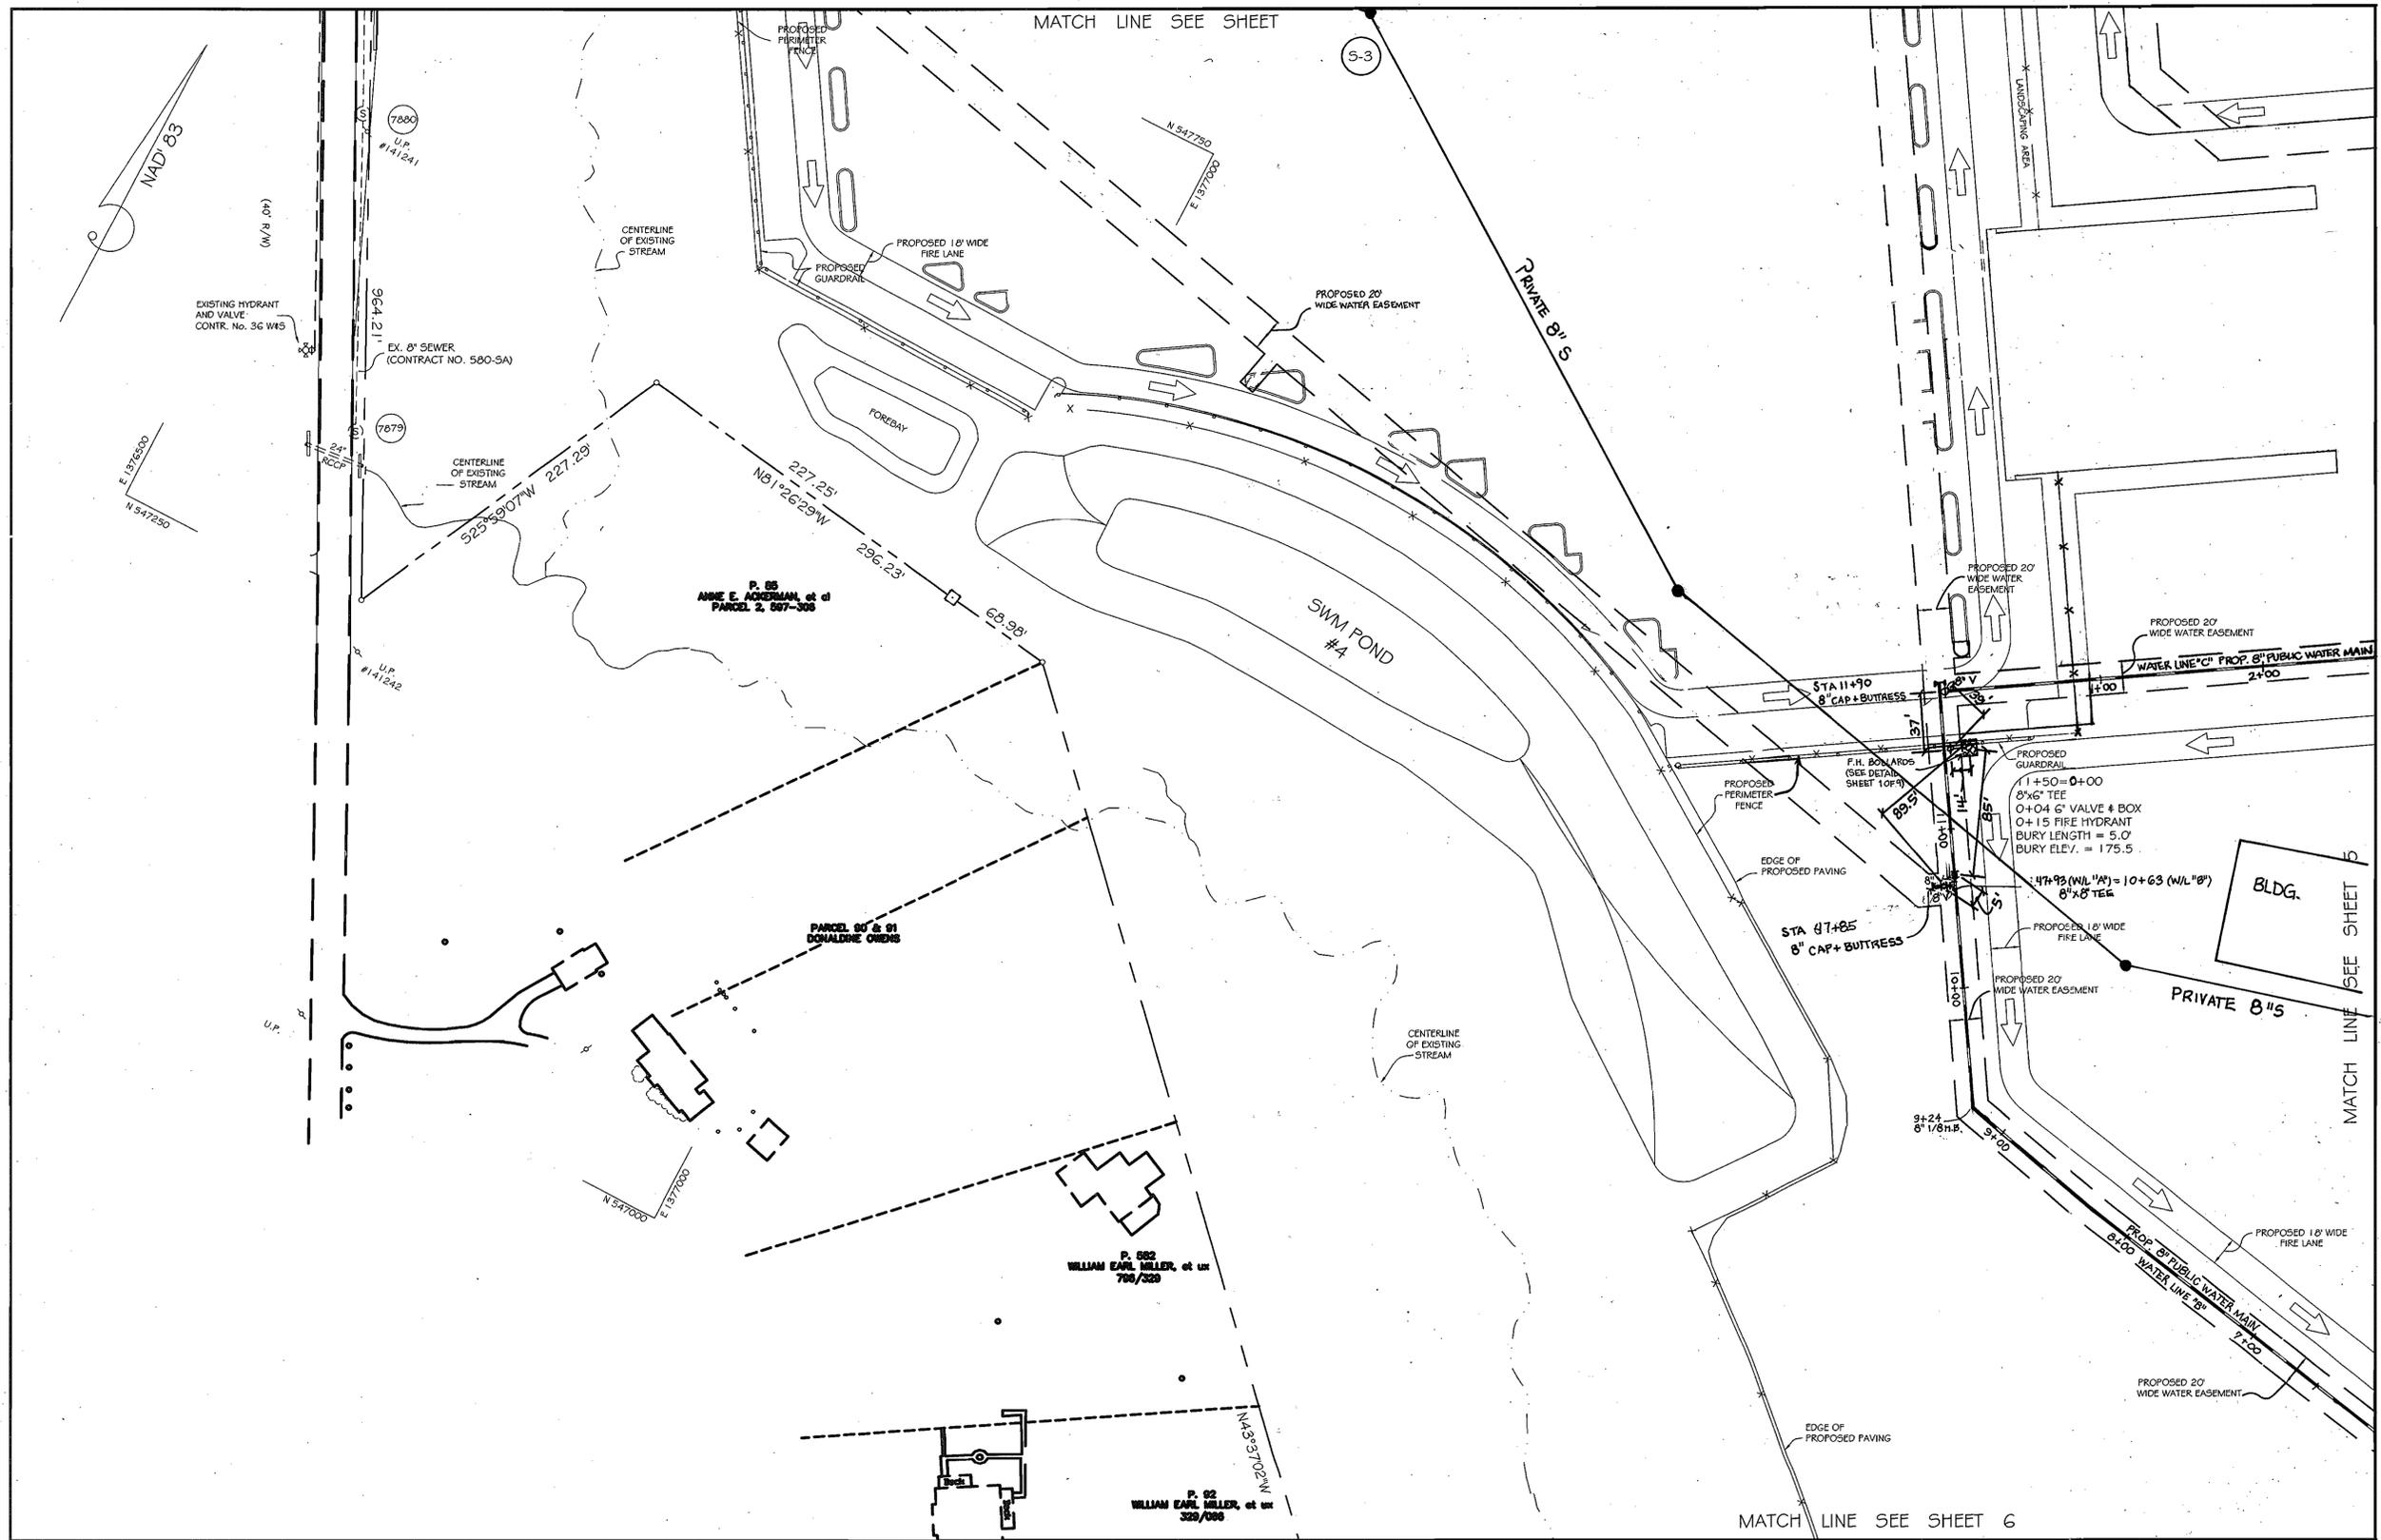

AS BUILT
DATE: SEPTEMBER 2008

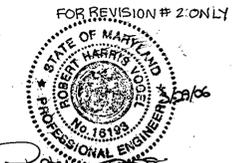

NOTE: THIS SET SUPERCEDES OLD SET

DEPARTMENT OF PUBLIC WORKS
HOWARD COUNTY, MARYLAND
DATE: 6-30-00

DEPARTMENT OF PLANNING AND ZONING
HOWARD COUNTY, MARYLAND
DATE: 7/14/00

THAYER & ASSOCIATES, INC.
2868 CONSTELLATION WAY
FINKSBURG, MARYLAND 21048
TEL/FAX: 410-840-8797




DESIGNED BY:	M. J. K.
DRAWN BY:	C.A.D.D.
CHECKED BY:	M.J.K.
DATE:	MAY 2000
BY:	NO.
NO.	2
REVISION:	RELOCATE BUILDING, DELETE 8" WATER
DATE:	3/16/04


PLAN SHEET
600' SCALE MAP NO. 43 BLOCK NO. 10
FILE NAME: BWAE WATSWA TITLE SHEET

BALTIMORE WASHINGTON AUTO EXCHANGE
CONTRACT NO. 14-3848-D
FIRST ELECTION DISTRICT
HOWARD COUNTY, MARYLAND

SCALE: 1"=50'
SHEET: 4 OF 9

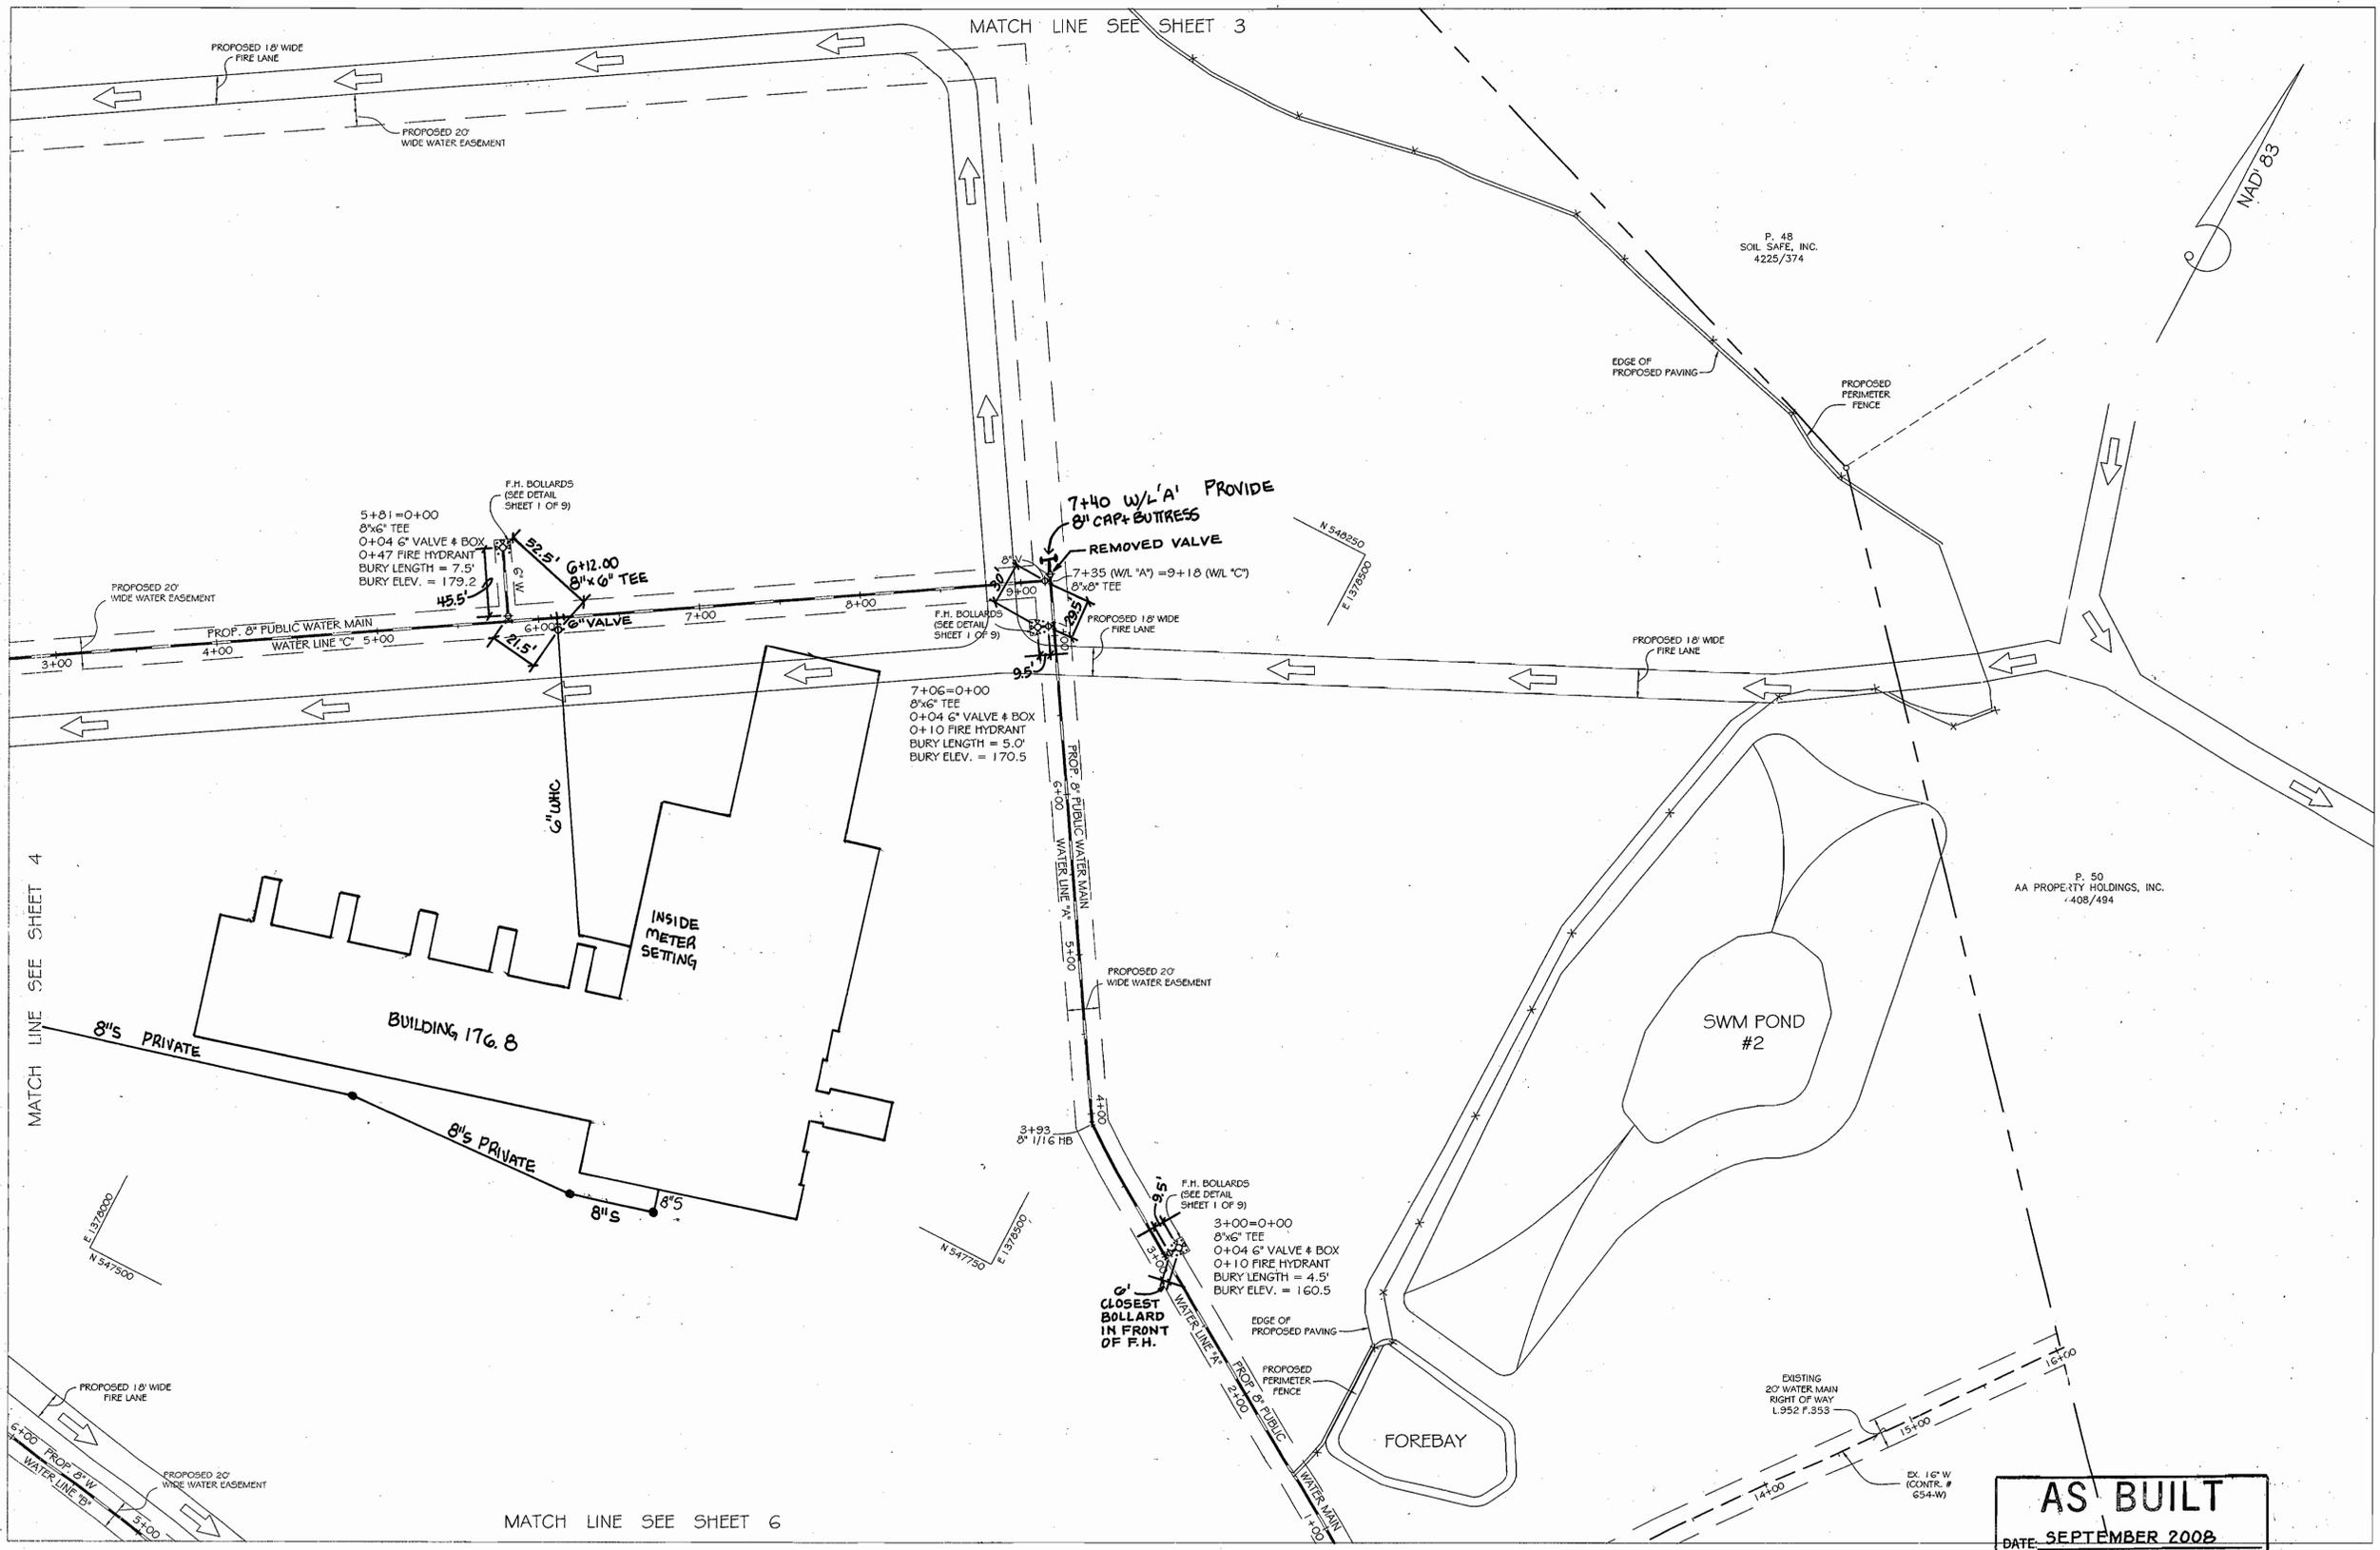

AS BUILT
DATE: SEPTEMBER 2008

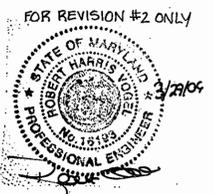

NOTE: THIS SET SUPERCEDES OLD SET

DEPARTMENT OF PUBLIC WORKS
HOWARD COUNTY, MARYLAND
6-30-00
CHIEF, BUREAU OF UTILITIES

DEPARTMENT OF PLANNING AND ZONING
HOWARD COUNTY, MARYLAND
7/14/08
CHIEF, DEVELOPMENT ENGINEERING DIVISION

THAYER & ASSOCIATES, INC.
2868 CONSTELLATION WAY
FINKSBURG, MARYLAND 21048
TEL/FAX: 410-840-8797




DESIGNED BY:	M. J. K.
DRAWN BY:	C.A.D.D.
CHECKED BY:	M.J.K.
DATE:	MAY 2000
BY NO.	RV 2
REVISION	RELOCATE BUILDING, DELETE 8" W
DATE	3/16/08

PLAN SHEET
600' SCALE MAP NO. 43 BLOCK NO. 10
FILE NAME: BWAE WATSEW TITLE SHEET

BALTIMORE WASHINGTON AUTO EXCHANGE
CONTRACT NO. 14-3848-D
FIRST ELECTION DISTRICT
HOWARD COUNTY, MARYLAND

SCALE 1"=50'
SHEET 5 OF 9

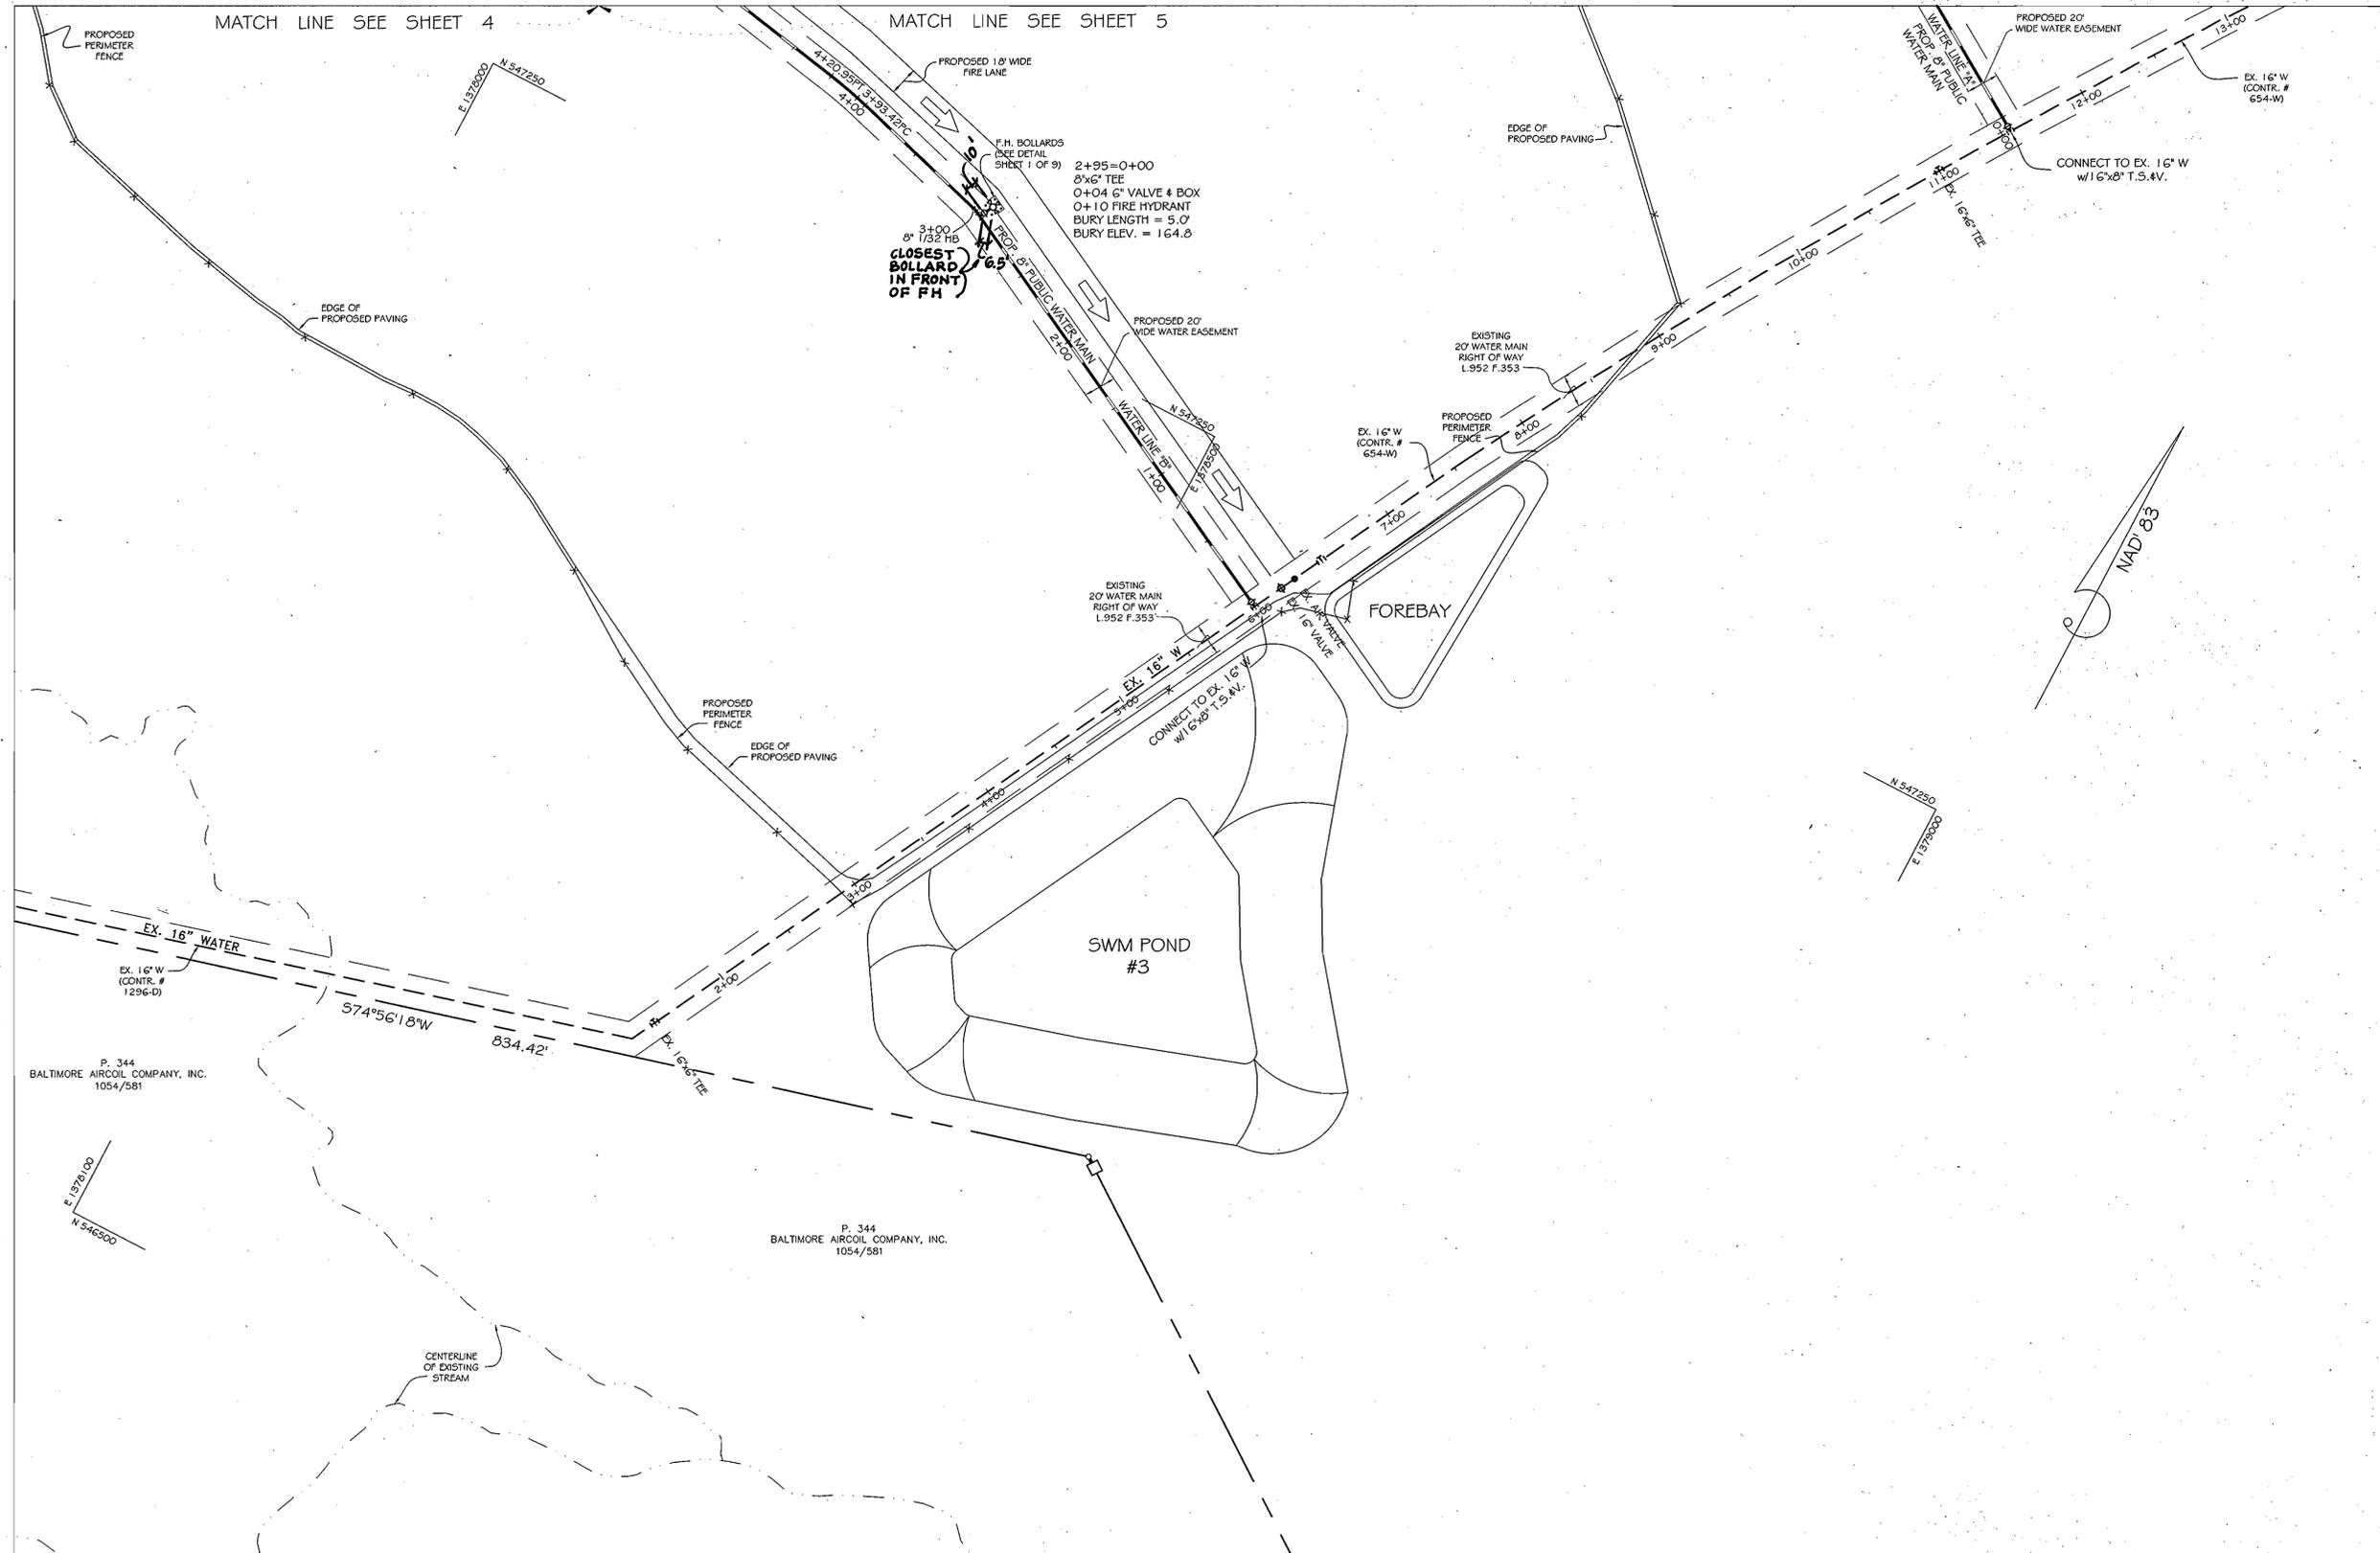

AS BUILT
DATE: SEPTEMBER 2008

NOTE: THIS SET SUPERCEDES OLD SET

DEPARTMENT OF PUBLIC WORKS
HOWARD COUNTY, MARYLAND

[Signature]
CHIEF, BUREAU OF UTILITIES

6-30-00
DATE

DEPARTMENT OF PLANNING AND ZONING
HOWARD COUNTY, MARYLAND

[Signature]
CHIEF, DEVELOPMENT ENGINEERING DIVISION

7/1/02
DATE

THAYER & ASSOCIATES, INC.
2868 CONSTELLATION WAY
FINKSBURG, MARYLAND 21048
TEL/FAX: 410-840-8797



DESIGNED BY:	M. J. K.	DATE:	MAY 2000
DRAWN BY:	C.A.D.D.	BY:	NO.
CHECKED BY:	M. J. K.	REVISION:	
DATE:	MAY 2000	DATE:	


PLAN SHEET

600' SCALE MAP NO. 43 BLOCK NO. 10
FILE NAME: BWAE WATSEW TITLE SHEET

**BALTIMORE WASHINGTON
AUTO EXCHANGE**
CONTRACT NO. 14-3848-D
FIRST ELECTION DISTRICT
HOWARD COUNTY, MARYLAND

SCALE
1"=50'

SHEET
6 OF 9

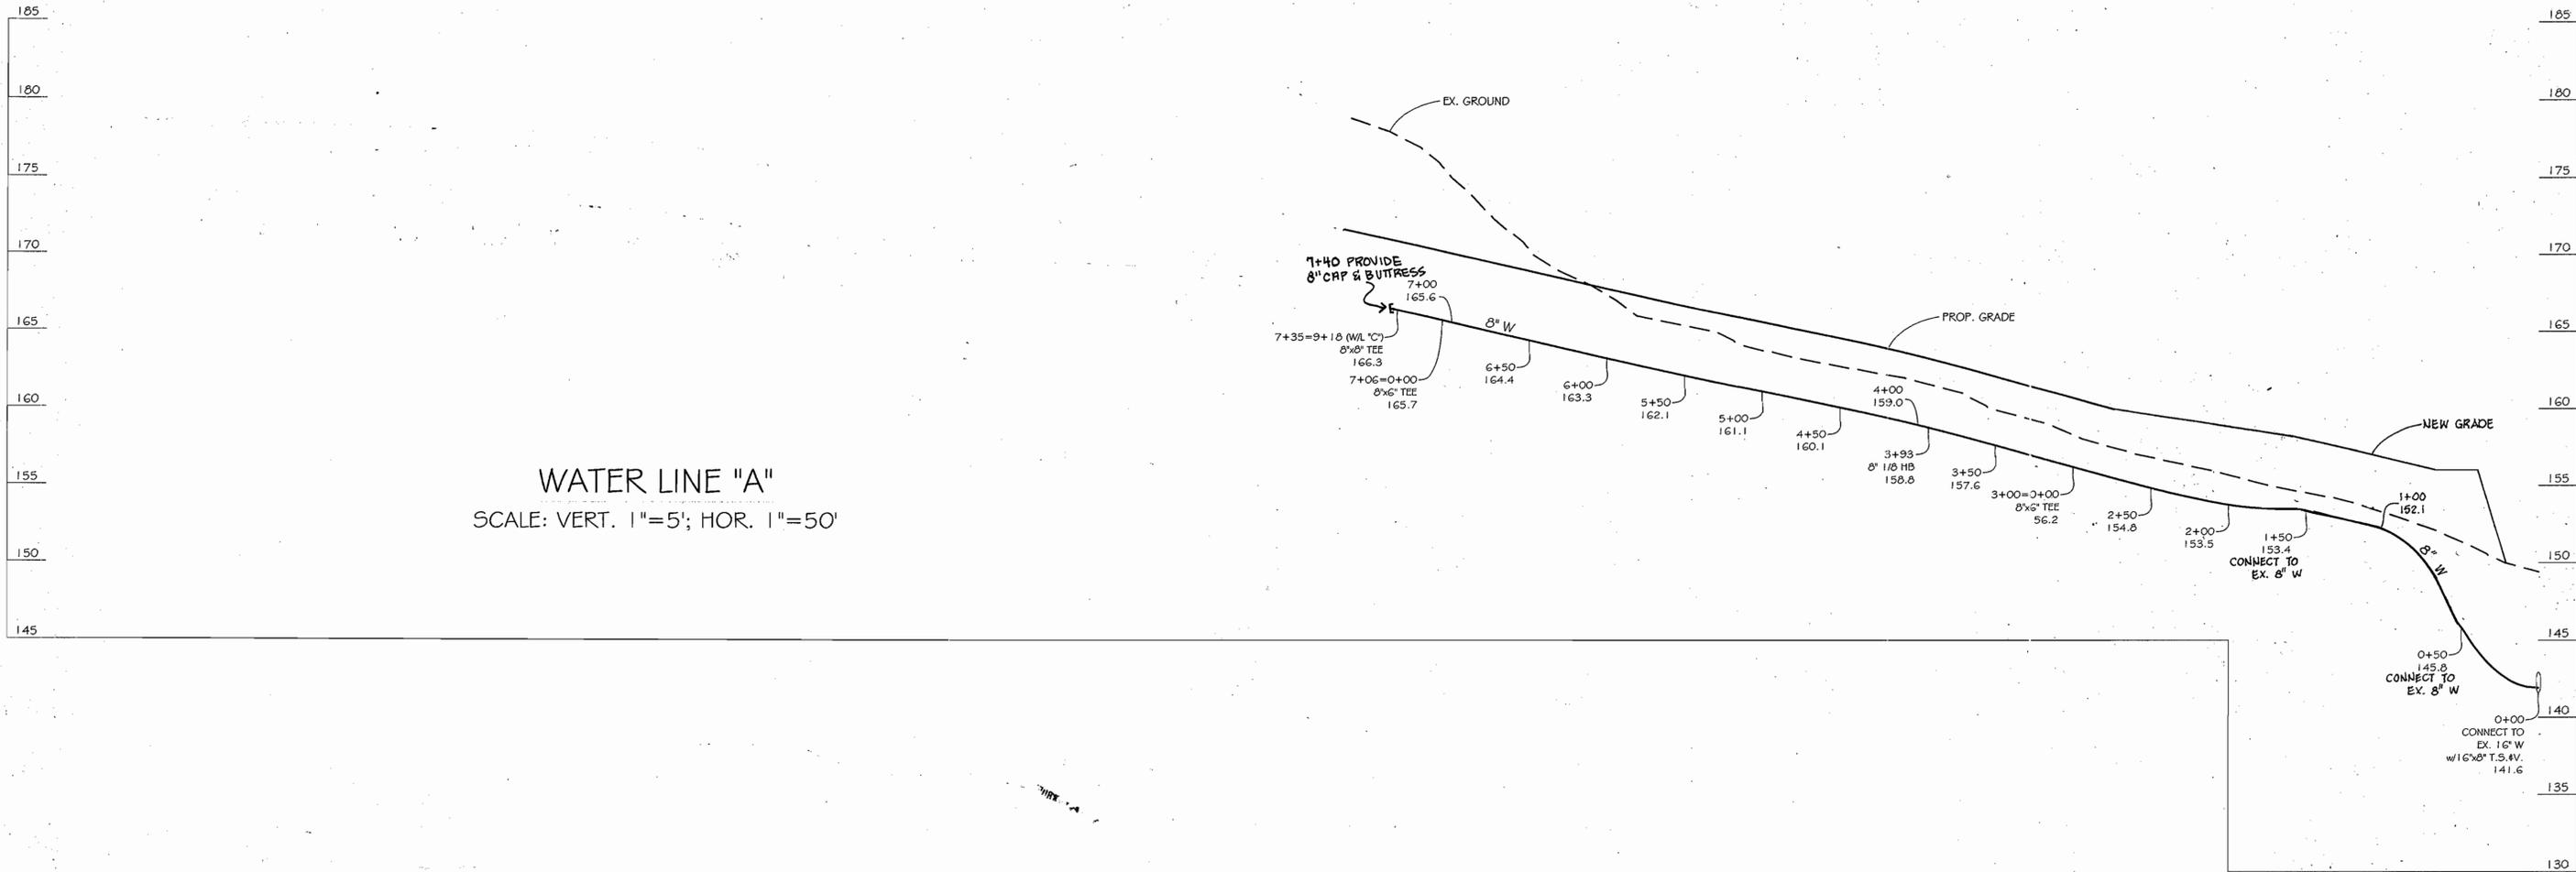

FOR REVISION #2 ONLY



AS BUILT
DATE: SEPTEMBER 2008

NOTE: THIS SET SUPERCEDES OLD SET

DEPARTMENT OF PUBLIC WORKS
HOWARD COUNTY, MARYLAND

DEPARTMENT OF PLANNING AND ZONING
HOWARD COUNTY, MARYLAND

THAYER & ASSOCIATES, INC.
2868 CONSTELLATION WAY
FINKSBURG, MARYLAND 21048
TEL/FAX: 410-840-8797



DESIGNED BY:	M. J. K.
DRAWN BY:	C.A.D.D.
CHECKED BY:	M.J.K.
DATE:	MAY 2000
BY:	NO.
NO.	NO.
REVISION	DATE
RV 2	RELOCATE BUILDING, REMOVE 8" W
GBT 1	VERTICALLY RELOCATED W/L "A" STA 0+50 TO 1+50

WATER PROFILES

600' SCALE MAP NO. 43 BLOCK NO. 10
FILE NAME: BWAE WATSEW TITLE SHEET

**BALTIMORE WASHINGTON
AUTO EXCHANGE**
CONTRACT NO. 14-3848-D
FIRST ELECTION DISTRICT
HOWARD COUNTY, MARYLAND


SCALE AS SHOWN
SHEET 7 OF 9

6-30-00
CHIEF, BUREAU OF UTILITIES


7/14/02
CHIEF, DEVELOPMENT ENGINEERING DIVISION



WATER LINE "A"
SCALE: VERT. 1"=5'; HOR. 1"=50'


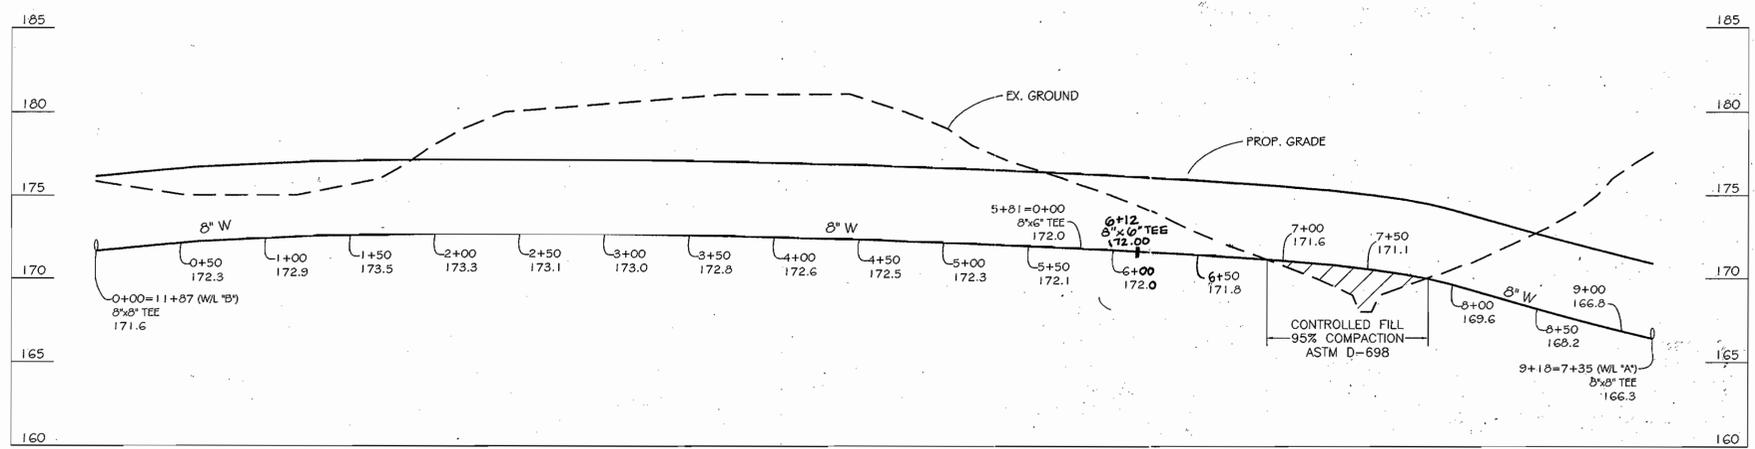


AS BUILT
DATE: SEPTEMBER 2008
WATER LINE "C"
SCALE: VERT. 1"=5'; HOR. 1"=50'

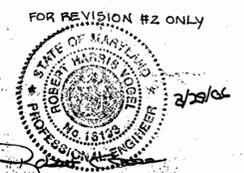


NOTE: THIS SET SUPERCEDES OLD SET

DEPARTMENT OF PUBLIC WORKS HOWARD COUNTY, MARYLAND <i>John J. ...</i> CHIEF, BUREAU OF UTILITIES 6-30-00 DATE	DEPARTMENT OF PLANNING AND ZONING HOWARD COUNTY, MARYLAND <i>Michael J. Kay</i> CHIEF, DEVELOPMENT ENGINEERING DIVISION 7/14/00 DATE	THAYER & ASSOCIATES, INC. 2868 CONSTELLATION WAY FINKSBURG, MARYLAND 21048 TEL/FAX: 410-840-8797	 MICHAEL J. KAY	DESIGNED BY: M. J. K. DRAWN BY: C.A.D.D. CHECKED BY: M.J.K. DATE: MAY 2000 BY: RV 2 NO. RELOCATE BUILDING, REMOVE 8" W DATE: 5/14/00	WATER PROFILES 600' SCALE MAP NO. 43 BLOCK NO. 10 FILE NAME: BWAE WATSEW TITLE SHEET	BALTIMORE WASHINGTON AUTO EXCHANGE CONTRACT NO. 14-3848-D FIRST ELECTION DISTRICT HOWARD COUNTY, MARYLAND SCALE AS SHOWN SHEET 8 OF 9
---	--	--	--------------------	---	--	---

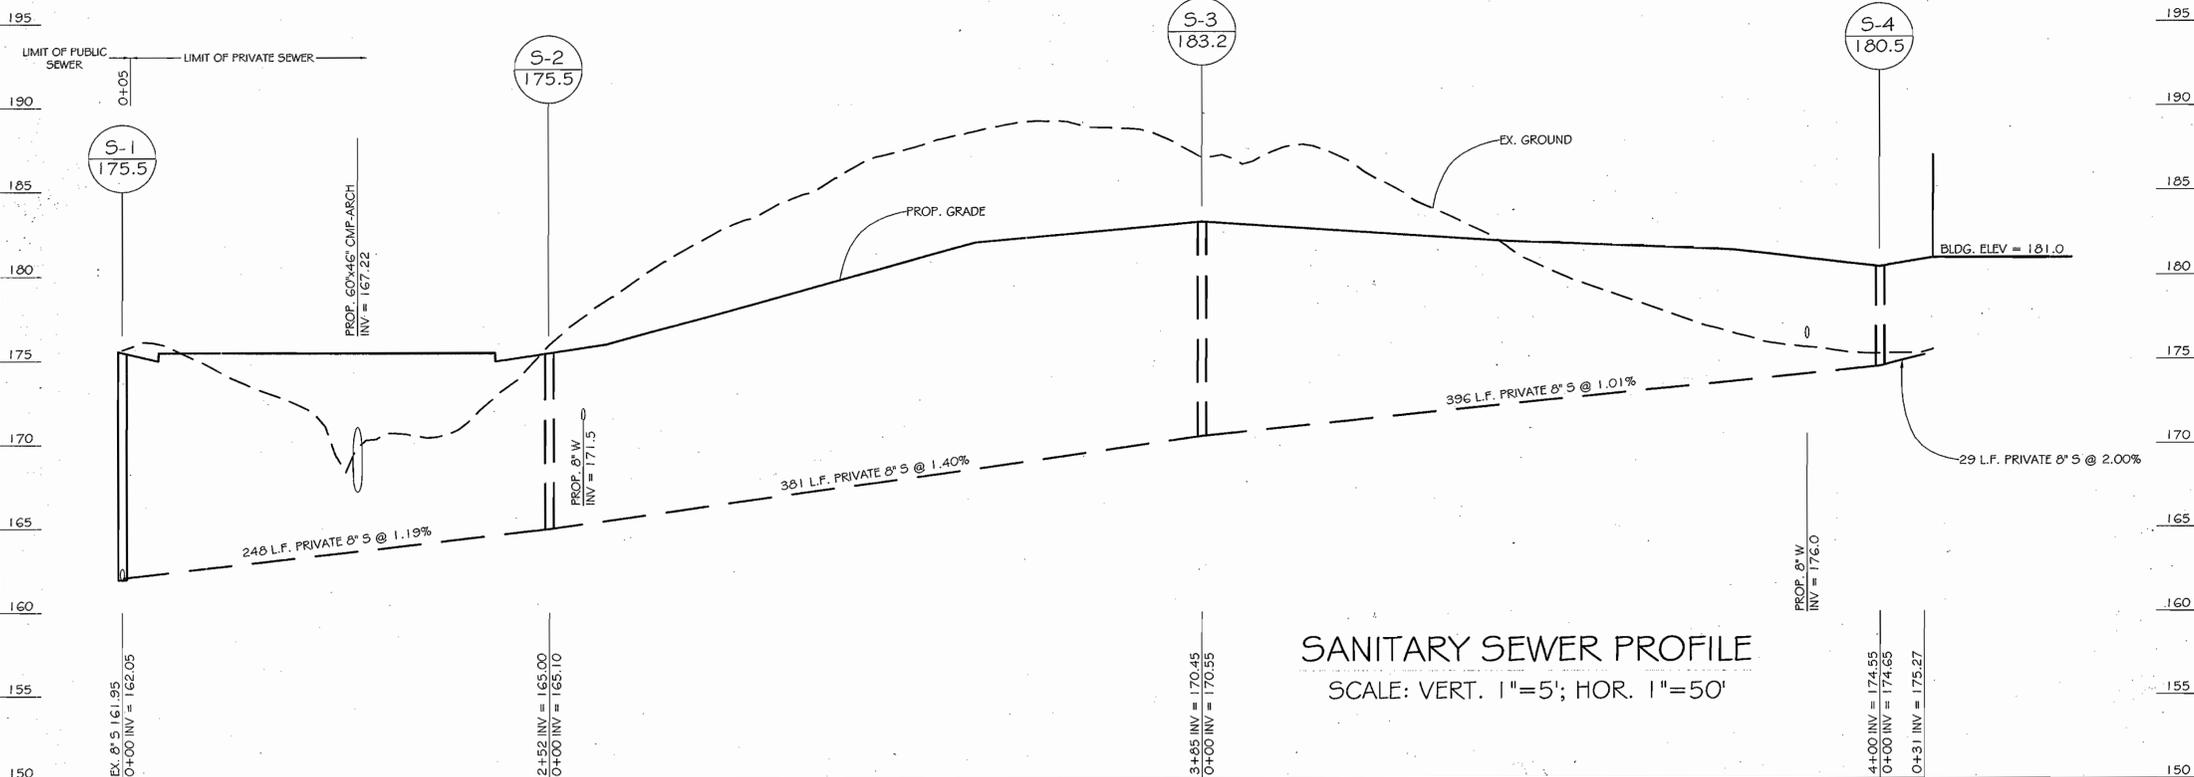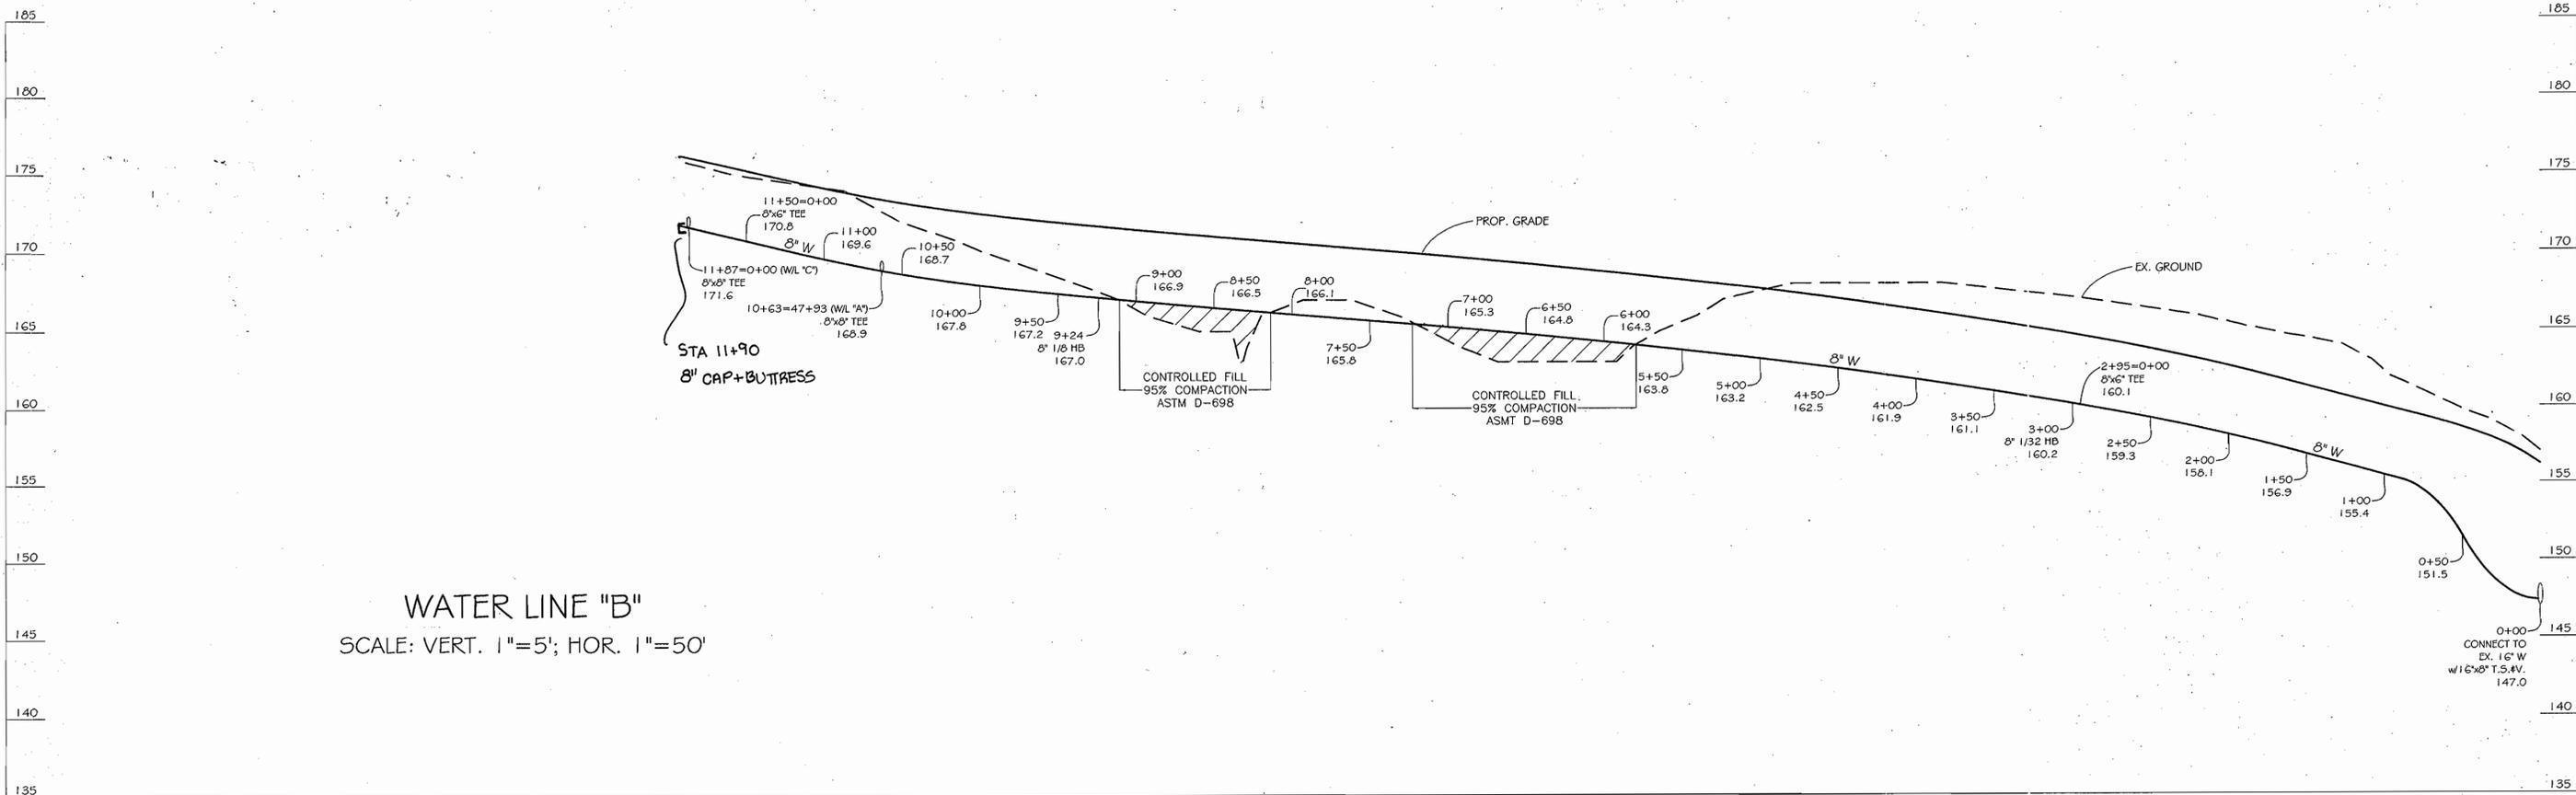

AS BUILT
DATE: SEPTEMBER 2008

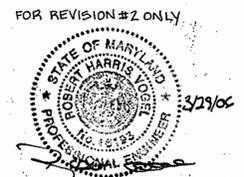

NOTE: THIS SET SUPERCEDES OLD SET

DEPARTMENT OF PUBLIC WORKS HOWARD COUNTY, MARYLAND DATE: 6-30-00 CHIEF, BUREAU OF UTILITIES	DEPARTMENT OF PLANNING AND ZONING HOWARD COUNTY, MARYLAND DATE: 7/14/00 CHIEF DEVELOPMENT ENGINEERING DIVISION	THAYER & ASSOCIATES, INC. 2868 CONSTELLATION WAY FINKSBURG, MARYLAND 21048 TEL/FAX: 410-840-8797	DESIGNED BY: M.J.K. DRAWN BY: C.A.D.D. CHECKED BY: M.J.K. DATE: MAY 2000 BY: NO.	REV 2 RELOCATE BUILDING, REMOVE 8" W DATE: 5/14/00	WATER AND SEWER PROFILES 600' SC/3" MAP NO. 43 BLOCK NO. 10 FILE NAME: BWAE WATSEW TITLE SHEET	BALTIMORE WASHINGTON AUTO EXCHANGE CONTRACT NO. 14-3848-D FIRST ELECTION DISTRICT HOWARD COUNTY, MARYLAND SCALE AS SHOWN SHEET 9 OF 9
--	---	--	--	---	--	---