
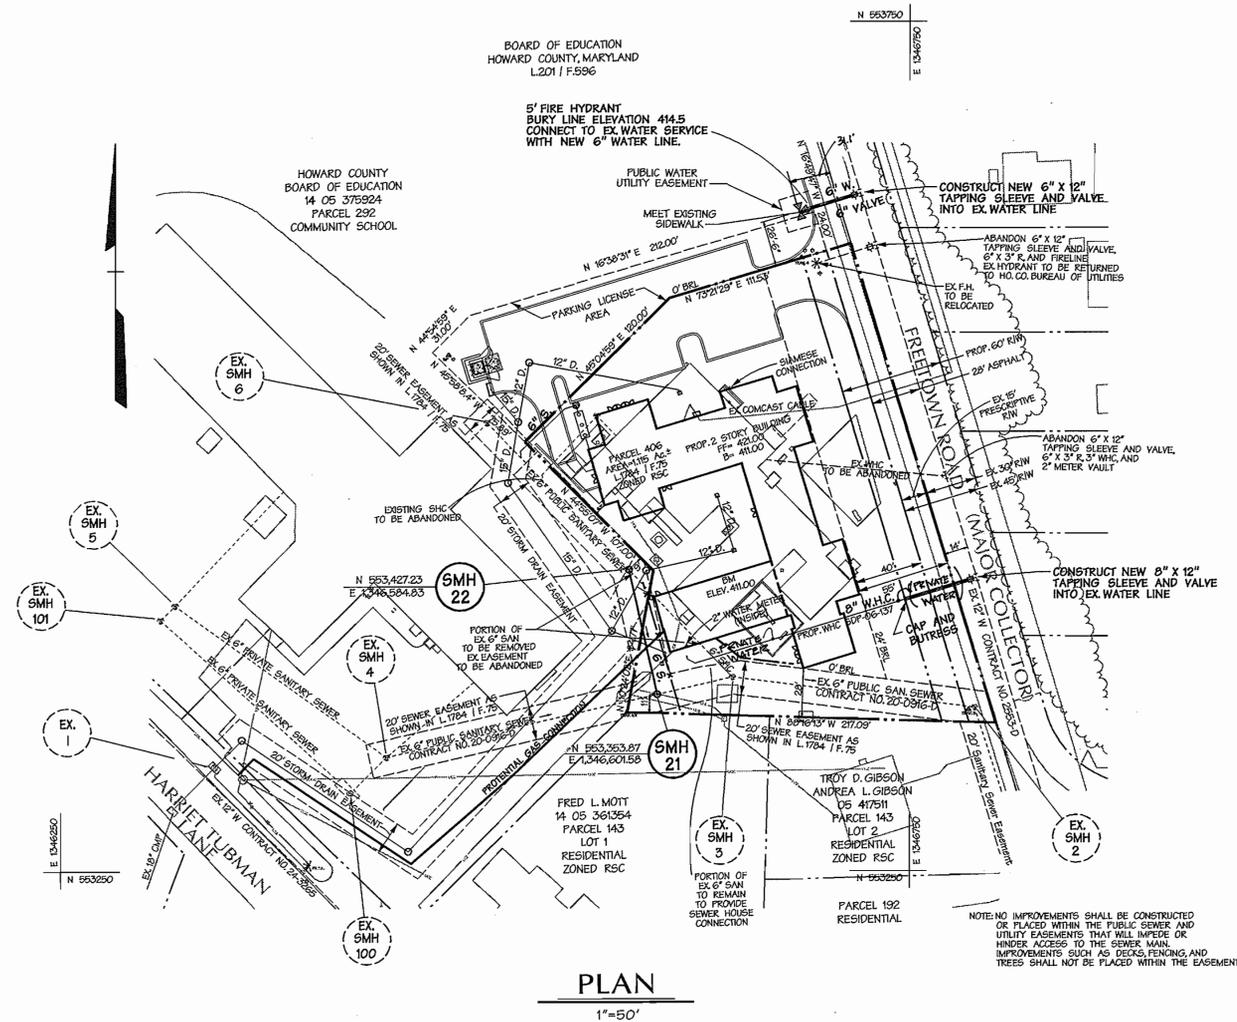


Structure	Waterline Station	Centerline Station/Coordinates
12" x 6" Tapping Tee & Valve	0+04	To Be Field Located

LEGEND

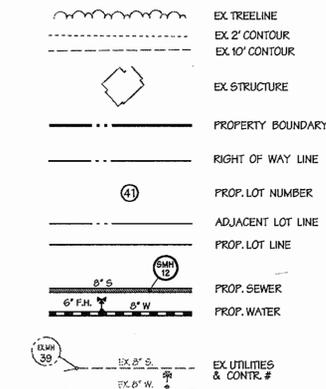

PLAN
1"=50'

NOTE: NO IMPROVEMENTS SHALL BE CONSTRUCTED OR PLACED WITHIN THE PUBLIC SEWER AND UTILITY EASEMENTS THAT WILL IMPEDE OR HINDER ACCESS TO THE SEWER MAIN. IMPROVEMENTS SUCH AS DECKS, FENCINGS, AND TREES SHALL NOT BE PLACED WITHIN THE EASEMENT.

OWNER / DEVELOPER:
HOWARD COUNTY
DEPARTMENT OF PUBLIC WORKS
3430 COURT HOUSE DRIVE
ELLCOTT CITY, MARYLAND 21043

Thu Dec 14 15:51:34 2006 02:00:00 PM S:\Projects\020006\020006.dwg

DEPARTMENT OF PUBLIC WORKS
HOWARD COUNTY, MARYLAND
Ruth B... 1-3-07
CHIEF - BUREAU OF UTILITIES - DATE

DEPARTMENT OF PLANNING & ZONING
HOWARD COUNTY, MARYLAND
[Signature] 1/10/07
CHIEF - DEVELOPMENT ENGINEERING DIVISION - DATE

DMW
Daft-McCune-Walker, Inc.
200 East Pennsylvania Avenue
Towson, Maryland 21286
(410) 296-3333
Fax 296-4705
A Team of Land Planners,
Landscape Architects,
Engineers, Surveyors &
Environmental Professionals




DESIGN BY:	CYS			
DRAWN BY:	GMO			
CHECKED BY:				
DATE:	11/21/06			
BY NO.	K01	1	ASBUILT DATA SHOWN	7/24/07
REVISION				

WATER & SEWER PLAN
600 SCALE MAP NO. 35 BLOCK NO. 24


**GRASSROOTS
CRISIS INTERVENTION CENTER
OF HOWARD COUNTY**
Election District No. 5 Howard County, Maryland
CONTRACT NO. 24-4414
TAX MAP 26 ZONED R-8C LOT/PARCEL # 406

SCALE:
1"=50'
SHEET
2 of 3

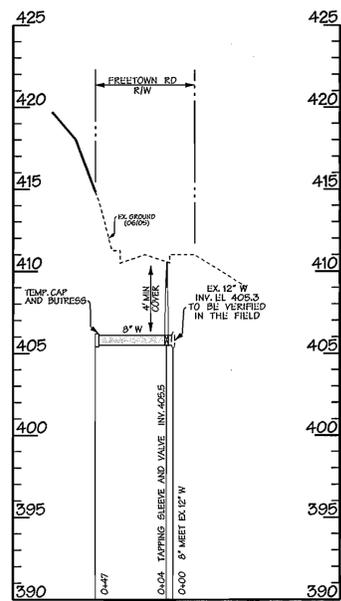


8" WATER CONNECTION

SCALE: HORIZ. 1"=50'
VERT. 1"=5'

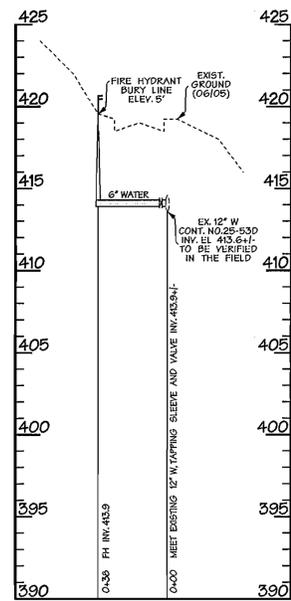

FIRE HYDRANT CONNECTION PROFILE

SCALE: HORIZ. 1"=50'
VERT. 1"=5'

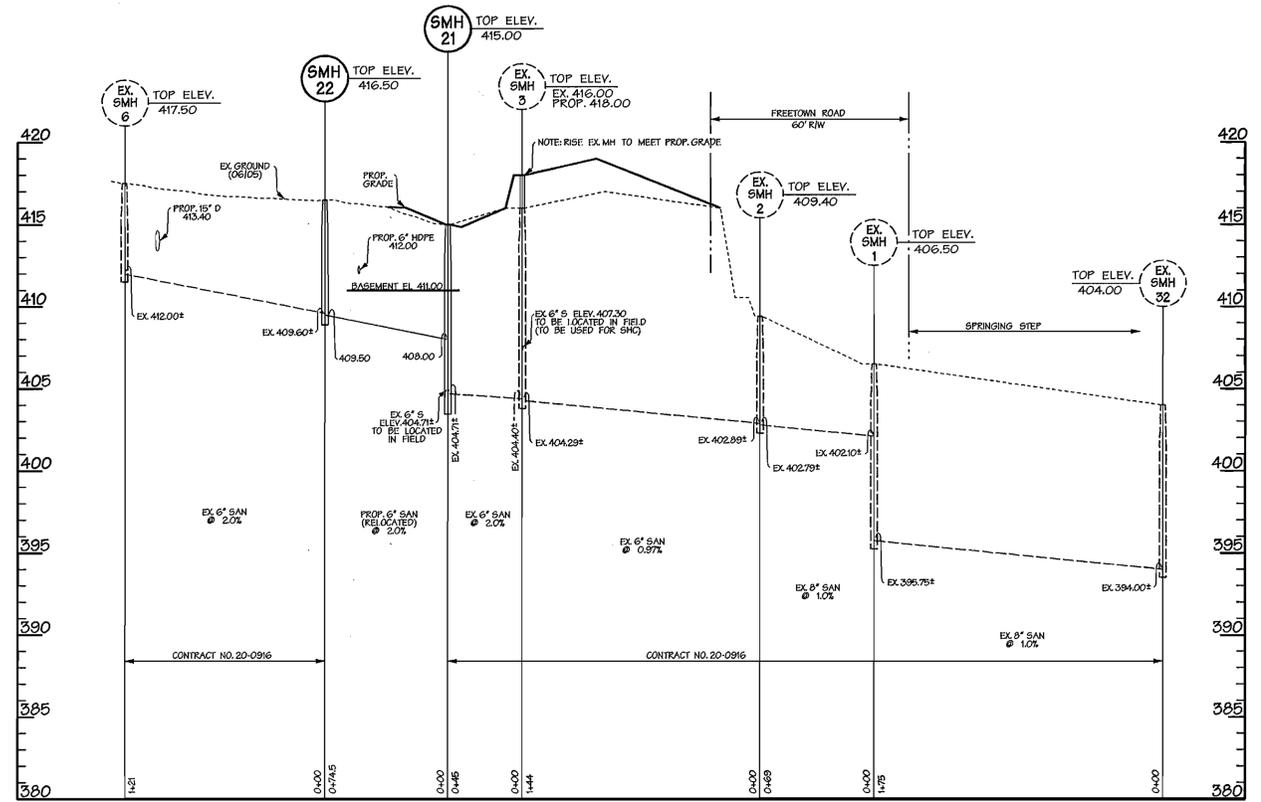

SANITARY PROFILE

SCALE: HORIZ. 1"=50'
VERT. 1"=5'

OWNER / DEVELOPER:
HOWARD COUNTY
DEPARTMENT OF PUBLIC WORKS
3430 COURT HOUSE DRIVE
ELLCOTT CITY, MARYLAND 21043

Mon Nov 20 10:52:42 2006 r:\02\0002\000RWS Plans\02\000RWS

DEPARTMENT OF PUBLIC WORKS
HOWARD COUNTY, MARYLAND

DEPARTMENT OF PLANNING & ZONING
HOWARD COUNTY, MARYLAND



200 East Pennsylvania Avenue
Towson, Maryland 21286
(410) 296-3333
Fax 296-4705



DESIGN BY:
CYS
DRAWN BY:
GMO
CHECKED BY:
G
DATE:
11/21/06

BY	NO.	REVISION	DATE

WATER & SEWER PROFILES

600 SCALE MAP NO. 35 BLOCK NO. 24

**GRASSROOTS
CRISIS INTERVENTION CENTER
OF HOWARD COUNTY**

Election District No. 5 Howard County, Maryland
CONTRACT NO. 24-4414

TAX MAP 35 ZONED R-5C

LOT/PARCEL # 406

SCALE:
As Shown

SHEET
3 of 3

SDP-06-137

Mon Nov 20 10:52:42 2006 r:\02\0002\000RWS Plans\02\000RWS