

TYPE OF BUILDING: RESIDENTIAL/COMMERCIAL  
 NUMBER OF PARCELS: N/A  
 WATER HOUSE CONNECTIONS: N/A  
 SEWER HOUSE CONNECTIONS: N/A  
 DRAINAGE AREA: LITTLE PATUXENT

VICINITY MAP  
 SCALE: 1" = 600'

INDEX OF SHEETS	
SHT. NO.	DESCRIPTION
1	TITLE SHEET
2	OVERALL PROFILE
3	GENERAL NOTES
4	PLAN AND PROFILE SHEET
5	PLAN AND PROFILE SHEET
6	PLAN AND PROFILE SHEET
7	PLAN AND PROFILE SHEET
8	PLAN AND PROFILE SHEET
9	MISCELLANEOUS DETAILS
10	MISCELLANEOUS DETAILS
11	MAINTENANCE OF TRAFFIC ACCESS ROAD PLAN
12	EROSION AND SEDIMENT CONTROL PLAN
13	EROSION AND SEDIMENT CONTROL PLAN
14	EROSION AND SEDIMENT CONTROL PLAN
15	EROSION AND SEDIMENT CONTROL PLAN
16	EROSION AND SEDIMENT CONTROL PLAN
17	EROSION AND SEDIMENT CONTROL NOTES & DETAILS
18	EROSION AND SEDIMENT CONTROL NOTES & DETAILS
19	EROSION AND SEDIMENT CONTROL NOTES & DETAILS
20	EROSION AND SEDIMENT CONTROL NOTES & DETAILS
21	JUNCTION CHAMBER 1001 PLAN, SECTIONS & DETAILS
22	JUNCTION CHAMBER 1002 PLAN, SECTIONS & DETAILS
23	JUNCTION CHAMBER 1003 PLAN, SECTIONS & DETAILS
24	JUNCTION CHAMBER 1001-1003 REINFORCEMENT DETAILS
25	JUNCTION CHAMBER 1001-1003 MISCELLANEOUS & REINFORCEMENT DETAILS & CAST IN PLACE CONCRETE NOTES
26	BY-PASS PLAN AND DETAILS & SUGGESTED SEQUENCE OF CONSTRUCTION

# LITTLE PATUXENT PARALLEL INTERCEPTOR SEWER CAPITAL PROJECT S-6175 CONTRACT NO. 20-4540 HOWARD COUNTY, MARYLAND

6' DOGHOUSE MANHOLE 3 EA.

**BILL OF MATERIALS**

ITEM	ESTIMATED QUANTITY	MATERIAL	AS-BUILT QUANTITY	SUPPLIER
12" SEWER	46.5 L.F.	PVC	55	
30" SEWER	158 L.F.	DIP CL 54 R.J.	158	
36" SEWER	4,286 L.F.	PVC-FRP	4,260	
42" SEWER	1,853 L.F.	PVC-FRP	1869	CROUSE ENG
42" Ø CASING	122 L.F.	STEEL	122	PITTSBURGH PIPE
48" Ø CASING	80 L.F.	STEEL	80	PITTSBURGH PIPE
4' MANHOLE	1 EA.	CONC/BRICK	1	ATLANTIC/ESP
5' MANHOLE	10 EA.	CONC/BRICK	10	ATLANTIC
6' MANHOLE	5 EA.	CONC/BRICK	5	ATLANTIC
8' MANHOLE	3 EA.	CONC/BRICK	3	ATLANTIC
4' ADDITIONAL MH	5 V.F.	CONC/BRICK	4.49	ATLANTIC
5' ADDITIONAL MH	64 V.F.	CONC/BRICK	64.14	ATLANTIC
6' ADDITIONAL MH	22 V.F.	CONC/BRICK	24.95	ATLANTIC
8' ADDITIONAL MH	20 V.F.	CONC/BRICK	19.51	ATLANTIC
JUNCTION CHAMBER	3 EA.	CONC/BRICK	3 EA.	AGGREGATE IN PLACE

NAME OF UTILITY CONTRACTOR :  
 CHECK BOX :  
 AS-BUILT DATE :

Sediment control measures for this contract will be implemented in accordance with Section 219 of the Specifications and as shown on these plans.  
 This plan is approved for soil erosion and sediment control by the Howard Soil Conservation District.  
*John P. Roberts* 6/3/10  
 HOWARD SOIL CONSERVATION DISTRICT DATE

BY THE DELVELOPER :  
 I/WE CERTIFY THAT ALL DEVELOPMENT AND CONSTRUCTION WILL BE DONE ACCORDING TO THIS PLAN, AND THAT ANY RESPONSIBLE PERSONNEL INVOLVED IN THE CONSTRUCTION PROJECT WILL HAVE A CERTIFICATE OF ATTENDANCE AT A DEPARTMENT OF THE ENVIRONMENT APPROVED TRAINING PROGRAM FOR THE CONTROL OF SEDIMENT AND EROSION BEFORE BEGINNING THE PROJECT. I ALSO AUTHORIZE PERIODIC ON-SITE INSPECTIONS BY THE HOWARD SOIL CONSERVATION DISTRICT.  
*Paul J. Simpson* 6/2/10  
 DEVELOPER DATE

BY THE ENGINEER :  
 I CERTIFY THAT THIS PLAN FOR EROSION AND SEDIMENT CONTROL REFERS TO A PRACTICAL AND WORKABLE PLAN BASED ON MY PERSONAL KNOWLEDGE OF THE SITE CONDITIONS AND THAT IT WAS PREPARED IN ACCORDANCE WITH THE REQUIREMENTS OF THE HOWARD SOIL CONSERVATION DISTRICT.  
*Thomas N. Dallapala* 6/2/10  
 ENGINEER DATE

PROFESSIONAL CERTIFICATION  
 I HEREBY CERTIFY THAT THESE DOCUMENTS WERE PREPARED OR APPROVED BY ME, AND THAT I AM A DULY LICENSED PROFESSIONAL ENGINEER UNDER THE LAWS OF THE STATE OF MARYLAND, LICENSE NO. 10966 EXPIRATION DATE: MAY 31, 2012  
*Thomas N. Dallapala* 6/2/10  
 THOMAS N. DALLAPALA DATE

DEPARTMENT OF PUBLIC WORKS  
 HOWARD COUNTY, MARYLAND  
*John P. Roberts* 6/2/10  
 DIRECTOR OF PUBLIC WORKS DATE  
*Paul J. Simpson* 6/2/10  
 CHIEF, BUREAU OF UTILITIES DATE  
*Paul J. Simpson* 6/2/10  
 CHIEF, UTILITY DESIGN DIVISION DATE


**Dewberry**  
 Dewberry & Davis LLC  
 3109 LORD BALTIMORE DRIVE  
 SUITE 110  
 BALTIMORE, MD 21244-2862  
 410.265.9500  
 FAX: 410.265.8875

DES:	LAL	SEE SHEETS 1, 2, 3, 5, 13 & 26 ADD MH 1006A	5/31/11
DRN:	CD	SEE SHEETS 2, 3, 5, 21, 22 & 23	7/20/11
CHK:	TND	REVISED CHANNELS & CROSS SECTIONS	5/12/12
		REV'D ELEVATIONS AND ADDED DIMS FOR SLUICE GATE OPERATIONS	07/11
DATE:	5.28.10		
BY:	NO.	REVISIONS	DATE

600' SCALE MAP NO. 37, 43  
 BLOCK NO. 5, 23  
 ELECTION DISTRICT NO. 5  
 HOWARD COUNTY, MARYLAND

AS-BUILTS  
 Jan. 17, 2013  
**LITTLE PATUXENT PARALLEL INTERCEPTOR**  
 CAPITAL PROJECT S-6175  
 CONTRACT NO. 20-4540  
**TITLE SHEET**  
 SCALE:  
 SHOWN  
 SHEET  
 1 OF 26

Plotted by: [unclear] on: 05/01/2010 at: 10:26am  
 Path: \\s:\projects\2010\2010-01-LPR-X-CONTR-SHEET-1.dwg  
 User: [unclear]  
 Date: 05/28/2010 at 10:26am  
 PLOT: [unclear]

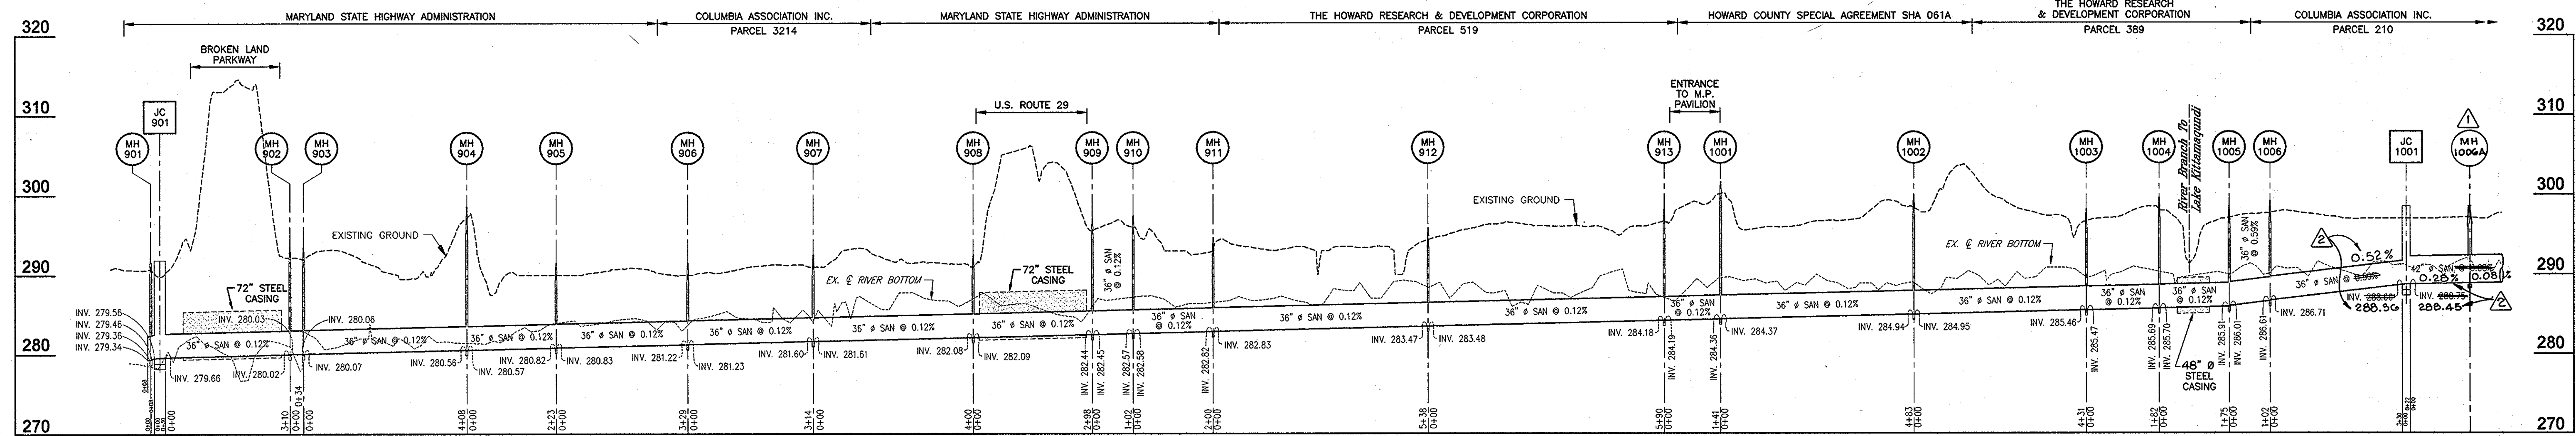


CONTRACT NO. 20-4539 (NOT IN CONTRACT)

CONTRACT NO. 20-4540

SEE SHEETS 4 to 8 FOR AS-BUILT INFORMATION

**PROFILE**

SCALE : HORIZ. 1" = 200'  
VERT. 1" = 10'

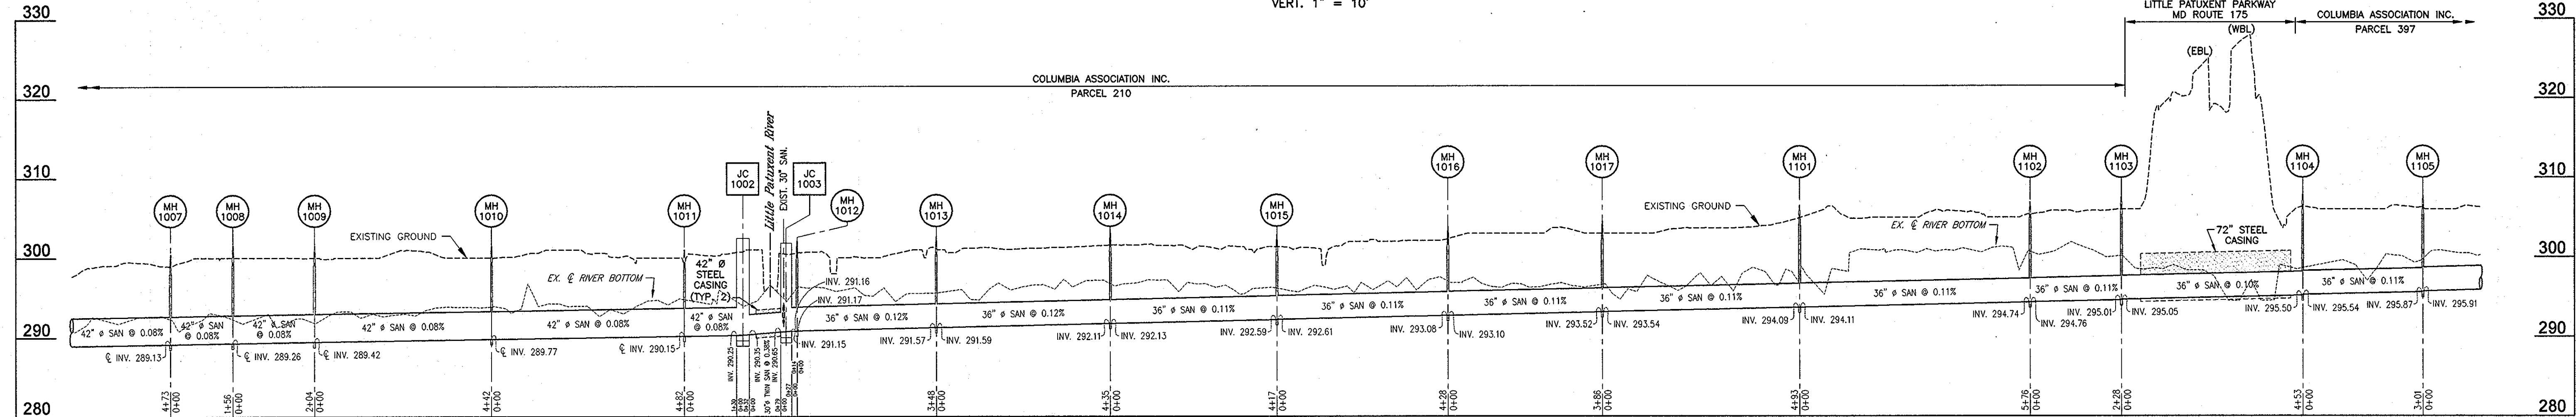


CONTRACT NO. 20-4540

CONTRACT NO. 20-4541 (NOT IN CONTRACT)

**PROFILE**

SCALE : HORIZ. 1" = 200'  
VERT. 1" = 10'

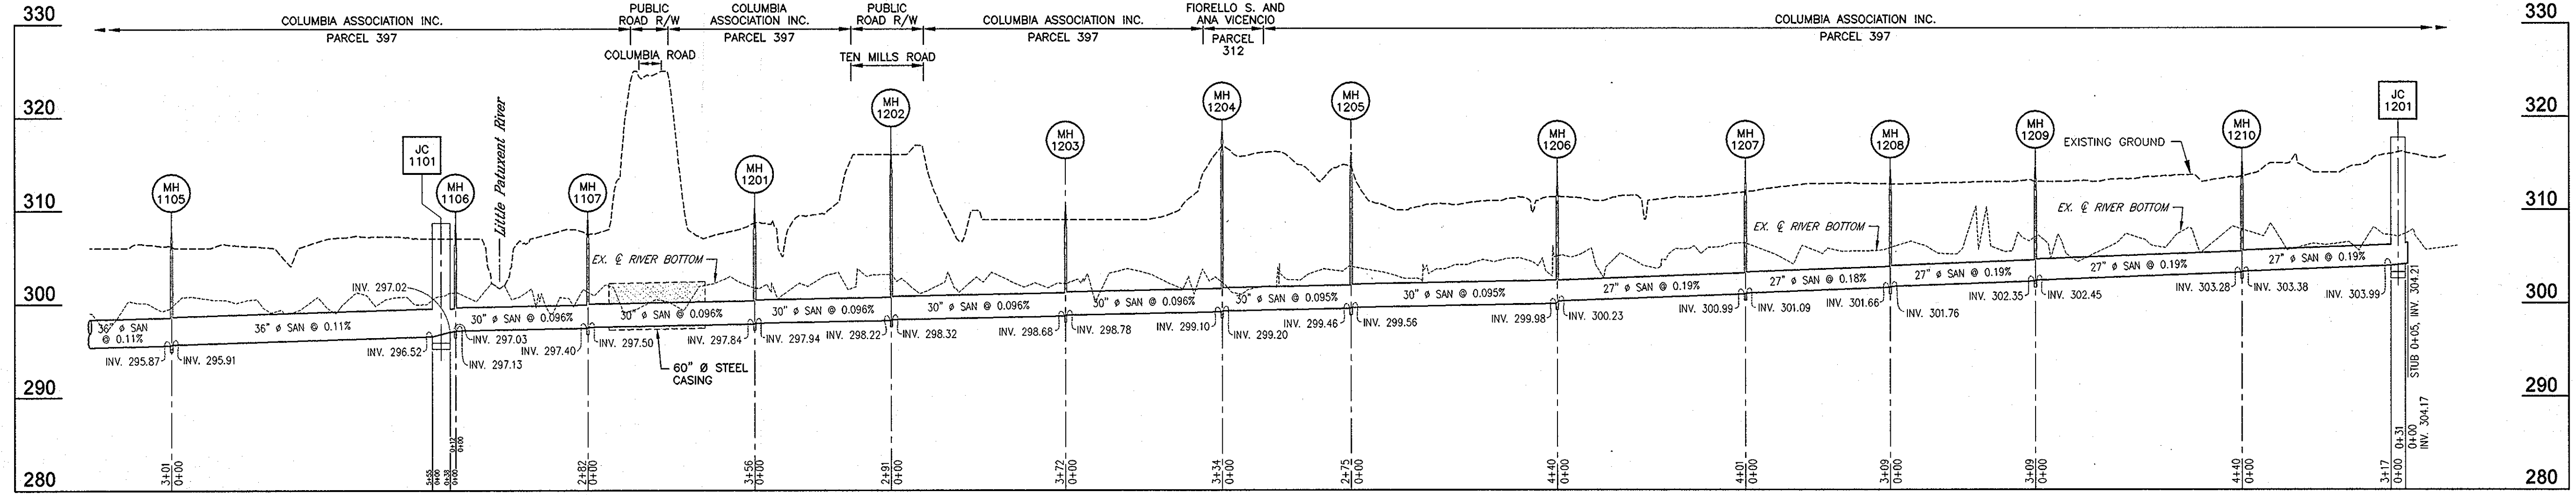

CONTRACT NO. 20-4541 (NOT IN CONTRACT)

CONTRACT NO. 20-4636 (NOT IN CONTRACT)

**PROFILE**

SCALE : HORIZ. 1" = 200'  
VERT. 1" = 10'

AS-BUILTS  
Jan. 17, 2013

DEPARTMENT OF PUBLIC WORKS  
HOWARD COUNTY, MARYLAND

**Dewberry**  
Dewberry & Davis LLC  
3108 LORD BALTIMORE DRIVE  
SUITE 110  
BALTIMORE, MD 21244-2862  
410.285.9500  
FAX: 410.285.8875



DES: LAL	LAL	ADD MH 1006A	5-31-11
DRN: CD	LAL	CHANGE ELEVATIONS @ JC-100J	7-20-11
CHK: TND			
DATE: 5.28.10	BY: NO.	REVISIONS	DATE

OVERALL PROFILE

LITTLE PATUXENT PARALLEL INTERCEPTOR  
CAPITAL PROJECT S-6175  
CONTRACT NO. 20-4540

SCALE: SHOWN

SHEET 2 OF 26

600' SCALE MAP NO. 37, 43 BLOCK NO. 5, 23


ELECTION DISTRICT NO. 5

HOWARD COUNTY, MARYLAND

Printed by: [Name] on: [Date] at: [Location]  
Title: [Title]  
Scale: [Scale]



FOR CONTINUATION SEE CONTRACT 20-4539, SHEET 6

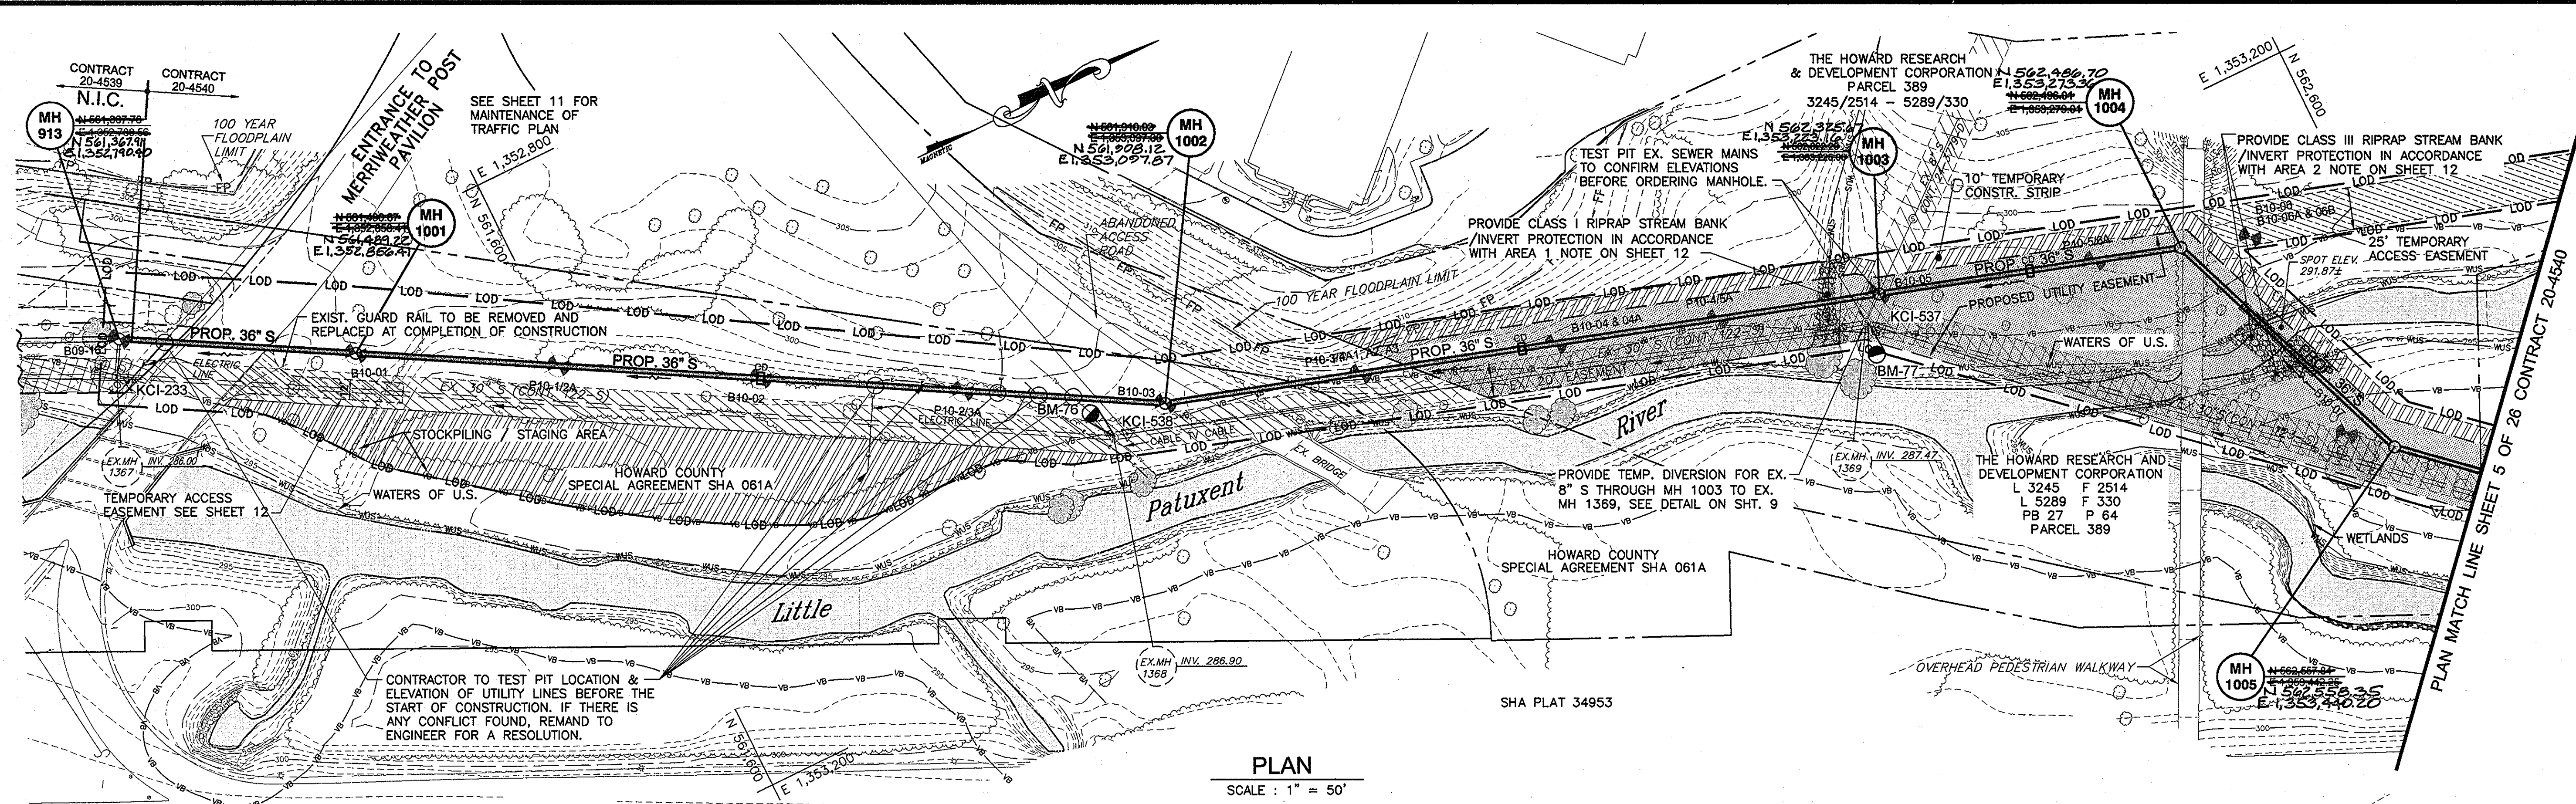

PLAN  
SCALE: 1" = 50'

U.S. ROUTE 29 (SOUTH)


NOTE:  
THE LOD IS COINCIDENT WITH THE PROPOSED UTILITY EASEMENT LINE AND SHOWN FIVE (5) FEET OUTSIDE THE ACTUAL LIMIT OF DISTURBANCE FOR CLARITY

NOTE:  
1. PRECONSTRUCTION CONTOURS SHALL BE RESTORED AFTER THE UTILITY HAS BEEN INSTALLED AND ALL EXCESS SPOIL SHALL BE REMOVED FROM SITE. THERE SHALL BE NO MOUNDING OR DISPOSING OF MATERIALS WITHIN THE LIMITS OF DISTURBANCE OR ANYWHERE ELSE ON SITE.  
2. SEE GENERAL NOTE 18 ON SHEET 3 OF 26.

BENCH MARK BM-76  
MANHOLE # 1368 ELEV. 297.87  
PUNCH HOLE ON MANHOLE RIM  
N 561,875 E 1,353,094


BENCH MARK BM-78  
MANHOLE # 1418 ELEV. 298.76  
PUNCH HOLE ON MANHOLE RIM  
N 562,621 E 1,353,519

BENCH MARK BM-77  
MANHOLE # 1369 ELEV. 298.61  
PUNCH HOLE ON MANHOLE RIM  
N 562,309 E 1,353,233

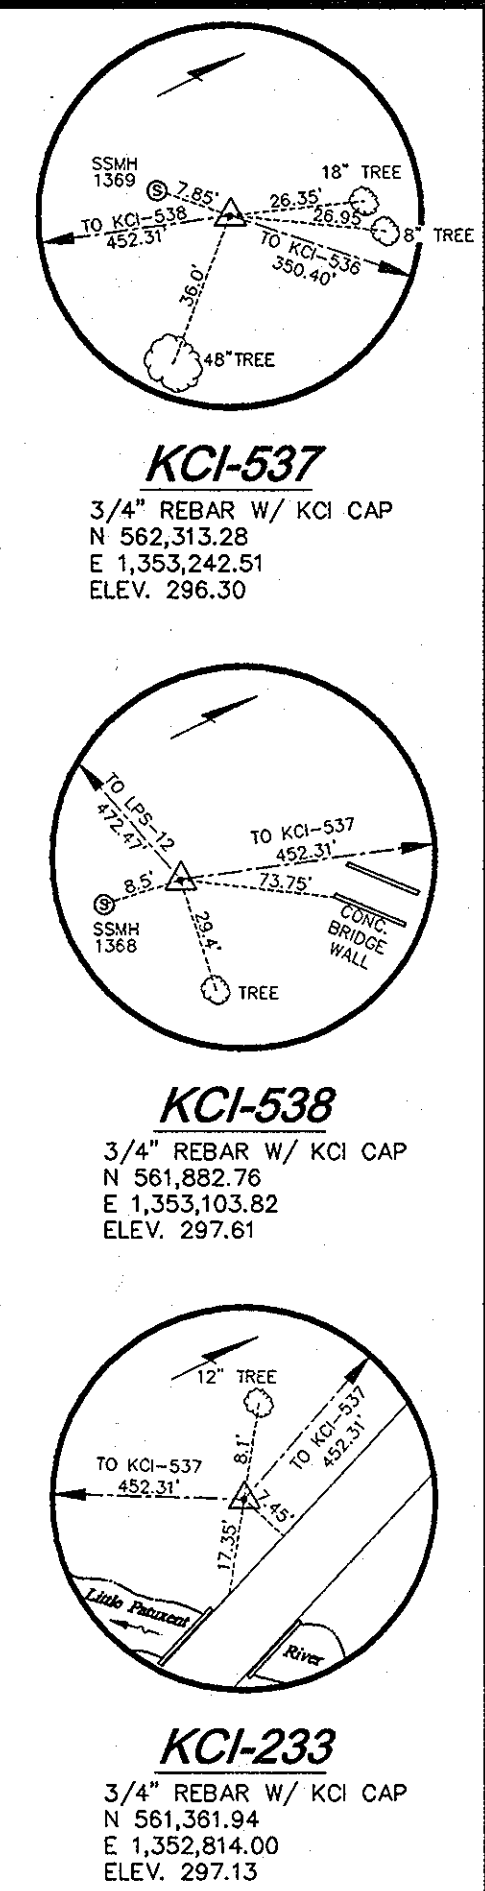

HOWARD COUNTY SPECIAL AGREEMENT SHA 061A

THE HOWARD RESEARCH & DEVELOPMENT CORPORATION

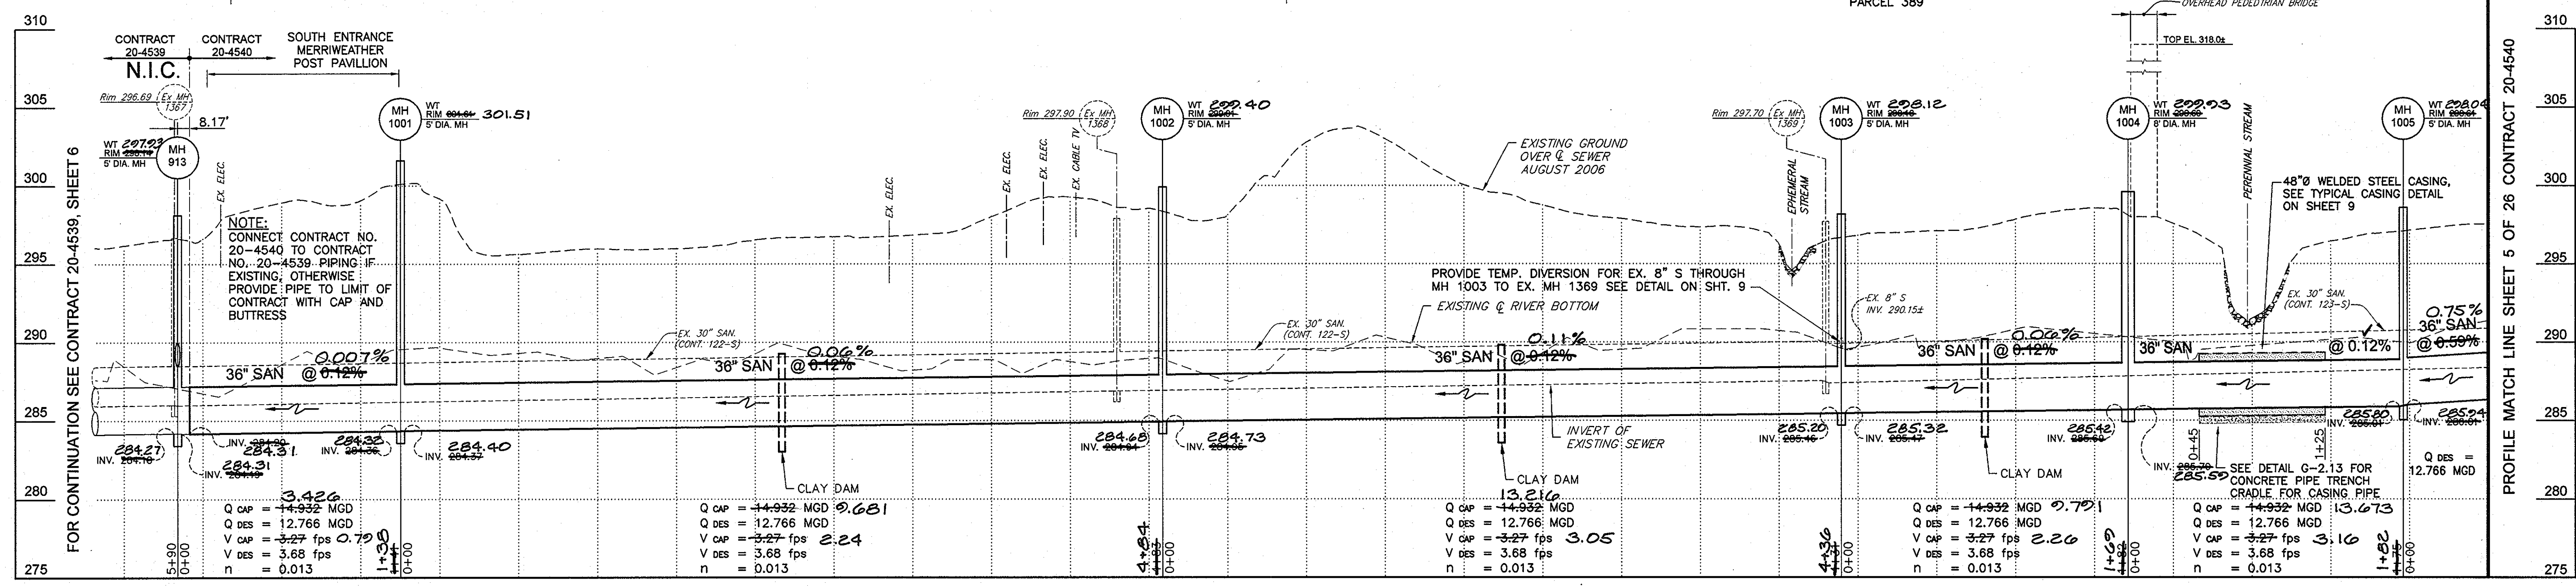

PROFILE  
SCALE: HORIZ. 1" = 50'  
VERT. 1" = 5'

AS-BUILT'S  
Jan. 17, 2013

DEPARTMENT OF PUBLIC WORKS  
HOWARD COUNTY, MARYLAND

Director of Public Works: *6/3/10*  
Date: *6/2/10*

Chief, Bureau of Engineering: *6/2/10*  
Date: *6/2/10*

Chief, Utility Design Division: *6/2/10*  
Date: *6/2/10*

**Dewberry**  
Dewberry & Davis LLC  
3106 LORD BALTIMORE DRIVE  
SUITE 110  
BALTIMORE, MD 21244-2662  
410.285.9500  
FAX: 410.285.8875



DES:	LAL				
DRN:	CD				
CHK:	TND				
DATE:	5.28.10	BY:	NO.	REVISIONS	DATE

PLAN AND PROFILE SHEET

600' SCALE MAP NO. 37, 43  
BLOCK NO. 5, 23


LITTLE PATUXENT PARALLEL INTERCEPTOR  
CAPITAL PROJECT S-6175  
CONTRACT NO. 20-4540  
ELECTION DISTRICT NO. 5  
HOWARD COUNTY, MARYLAND

SCALE:  
SHOWN


SHEET  
4 OF 26

**BENCH MARK BM-78**  
 MANHOLE # 1418 ELEV. 298.76  
 PUNCH HOLE ON MANHOLE RIM  
 N 562,621 E 1,353,519


**BENCH MARK BM-79**  
 MANHOLE # 1419 ELEV. 299.35  
 PUNCH HOLE ON MANHOLE RIM  
 N 563,166 E 1,353,747

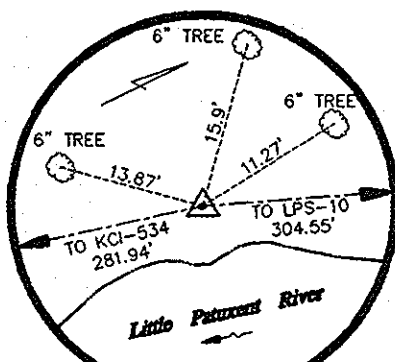


**KCI-533**  
 3/4" REBAR W/ KCI CAP  
 N 563,535.99 E 1,353,853.52  
 ELEV. 299.45

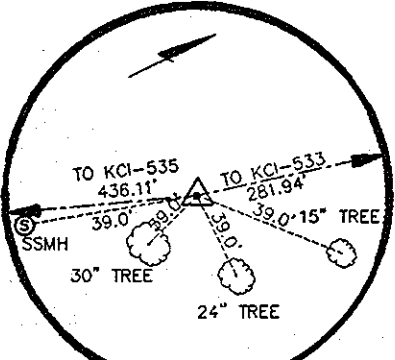

**KCI-534**  
 3/4" REBAR W/ KCI CAP  
 N 563,261.93 E 1,353,787.36  
 ELEV. 297.65

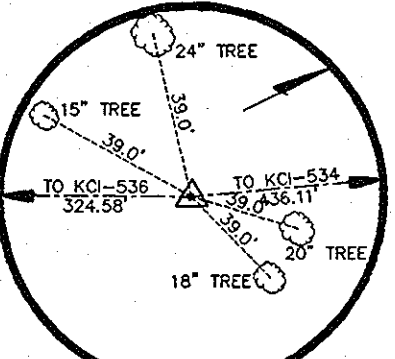

**KCI-535**  
 3/4" REBAR W/ KCI CAP  
 N 562,954.25 E 1,353,632.46  
 ELEV. 297.06

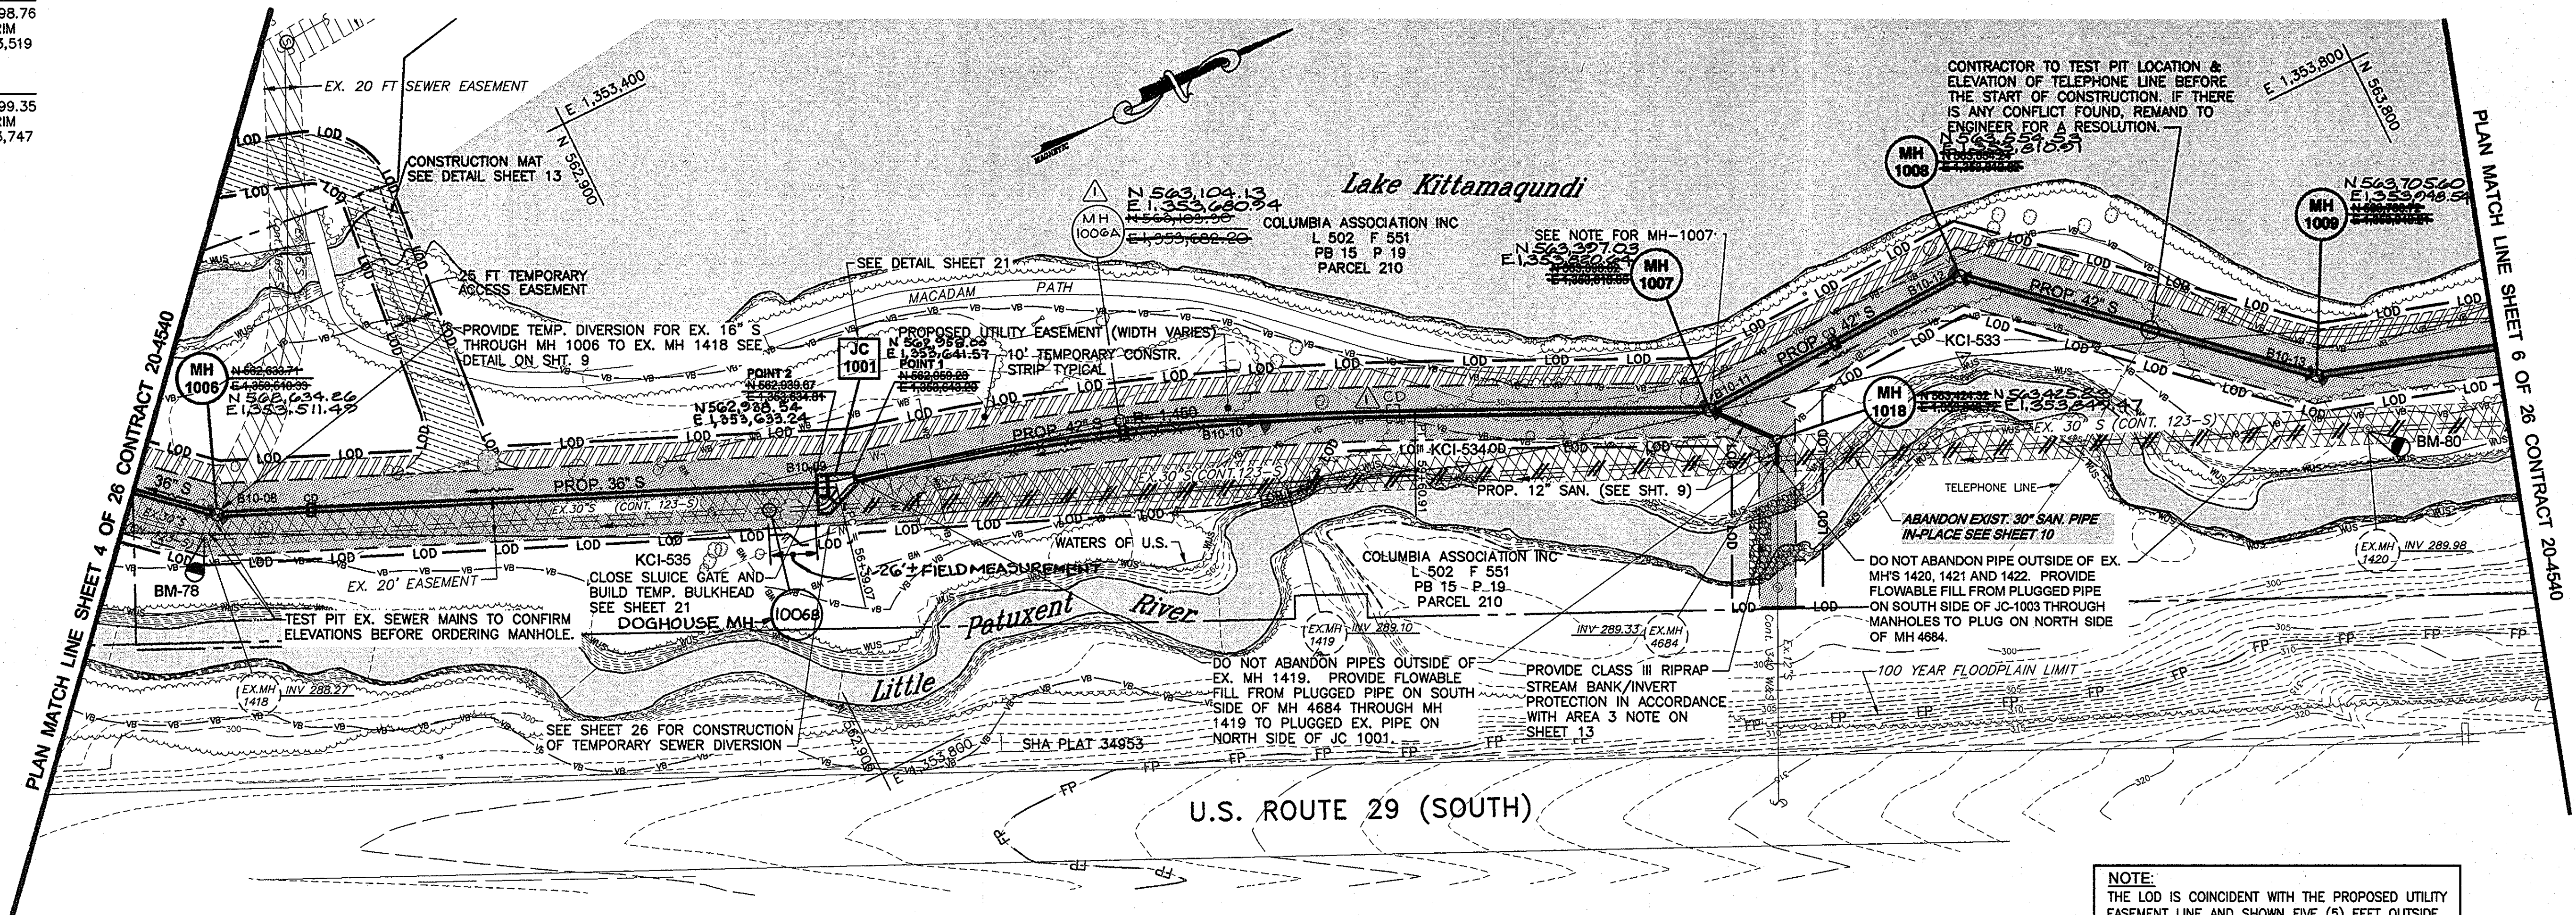


- NOTE:**
- PRECONSTRUCTION CONTOURS SHALL BE RESTORED AFTER THE UTILITY HAS BEEN INSTALLED AND ALL EXCESS SPOIL SHALL BE REMOVED FROM SITE. THERE SHALL BE NO MOUNDING OR DISPOSING OF MATERIALS WITHIN THE LIMITS OF DISTURBANCE OR ANYWHERE ELSE ON SITE.
  - SEE GENERAL NOTE 18 ON SHEET 3 OF 26.

**PLAN**  
 SCALE : 1" = 50'

**NOTE FOR MH-1007:**  
 MAINTAIN A MINIMUM OF 12" CLEARANCE BETWEEN THE OPENINGS FOR INCOMING 42" SEWER AND 12" SEWER TO MH-1007

**NOTE:**  
 THE LOD IS COINCIDENT WITH THE PROPOSED UTILITY EASEMENT LINE AND SHOWN FIVE (5) FEET OUTSIDE THE ACTUAL LIMIT OF DISTURBANCE FOR CLARITY

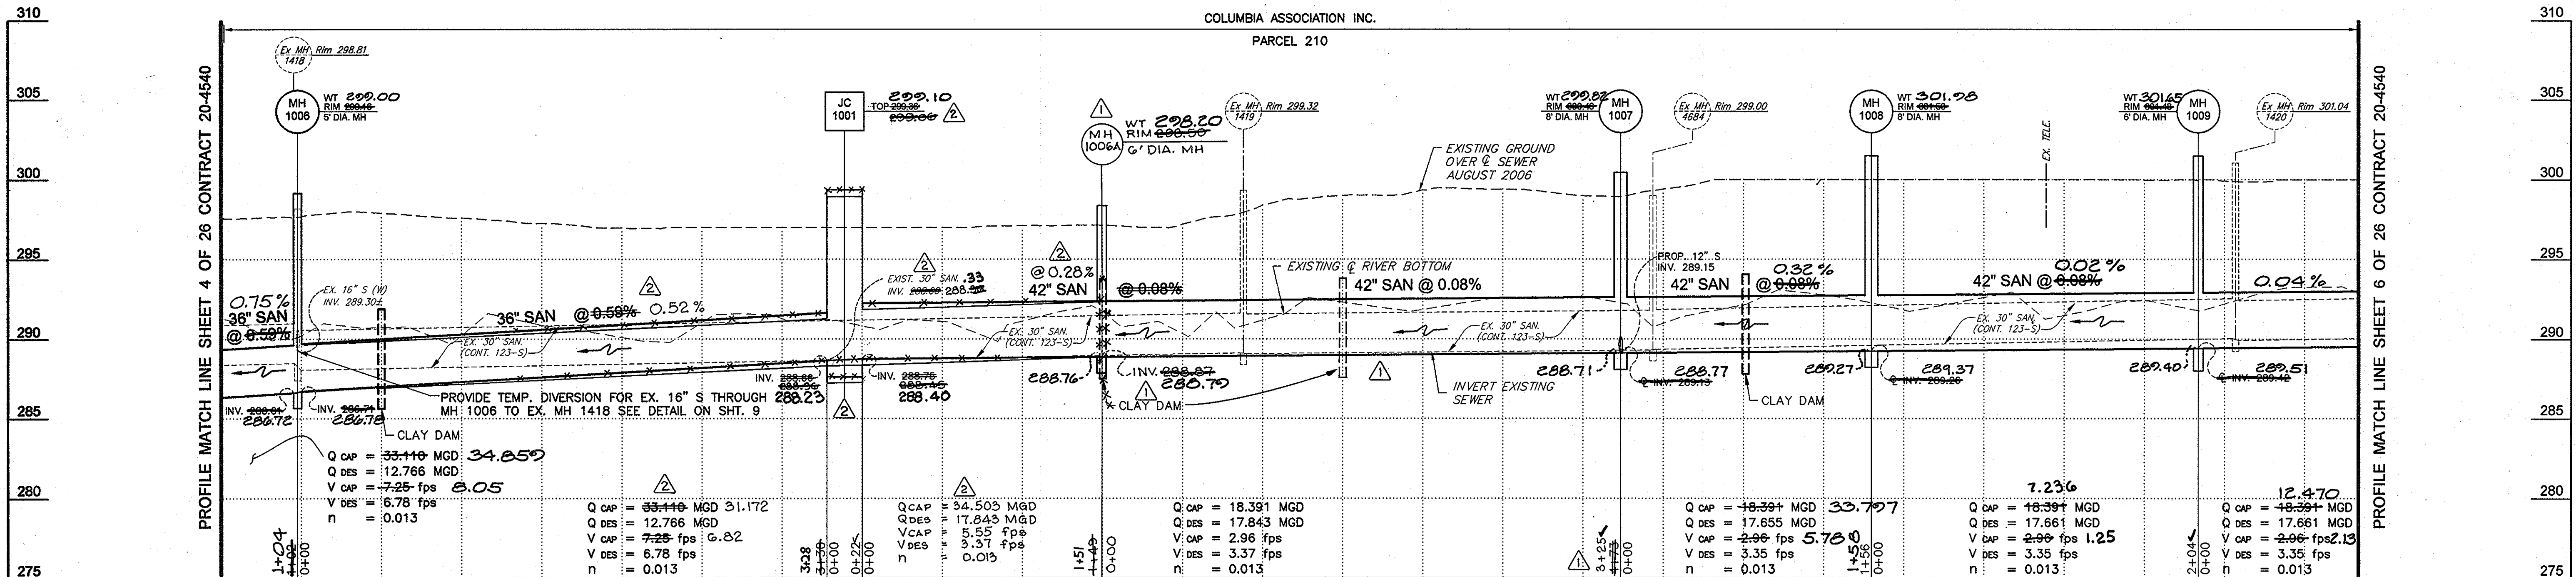

**PROFILE**  
 SCALE : HORIZ. 1" = 50'  
 VERT. 1" = 5'

**DEPARTMENT OF PUBLIC WORKS**  
 HOWARD COUNTY, MARYLAND

Director of Public Works: *Shane C. Clum* 6/2/10  
 Chief, Bureau of Utilities: *Shane C. Clum* 6/2/10

Chief, Bureau of Engineering: *Paul J. Spon* 6/2/10  
 Chief, Utility Design Division: *Paul J. Spon* 6/2/10

**Dewberry**  
 Dewberry & Davis LLC  
 3108 LORD BALTIMORE DRIVE  
 SUITE 110  
 BALTIMORE, MD 21244-2982  
 410.285.9500  
 FAX: 410.285.9875



DES: LAL	LAL	ADD MH 1006 A	5-31-11
DRN: CD	LAL	CHANGE ELEVATIONS AT JC-1001	7-20-11
CHK: TND			
DATE: 5.28.10	BY: NO.	REVISIONS	DATE

**PLAN AND PROFILE SHEET**


600' SCALE MAP NO. 37, 43  
 BLOCK NO. 5, 23

**LITTLE PATUXENT PARALLEL INTERCEPTOR**


CAPITAL PROJECT S-6175  
 CONTRACT NO. 20-4540

ELECTION DISTRICT NO. 5  
 HOWARD COUNTY, MARYLAND


SCALE: SHOWN  
 SHEET 5 OF 26

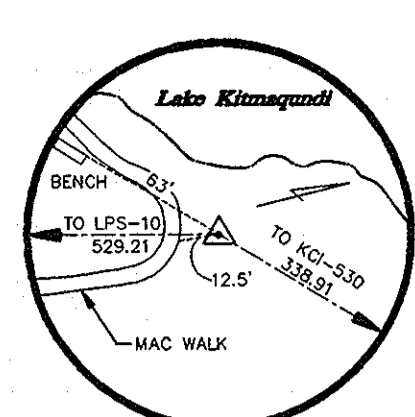


**LPS-09**  
3/4" REBAR & COLLAR  
N 564,332.70  
E 1,354,093.00  
ELEV. 300.77

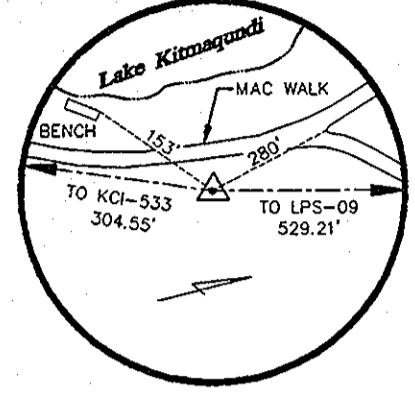

**LPS-10**  
3/4" REBAR & COLLAR  
N 563,818.87  
E 1,353,966.33  
ELEV. 300.96

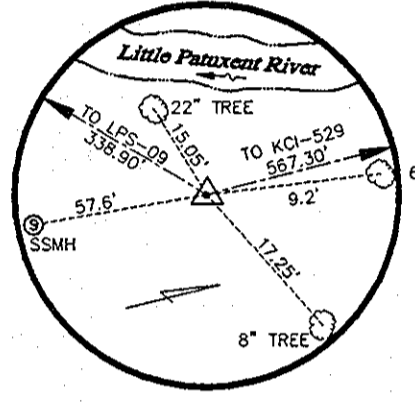

**KCI-530**  
3/4" REBAR & KCI CAP  
N 564,572.14  
E 1,354,332.84  
ELEV. 299.77

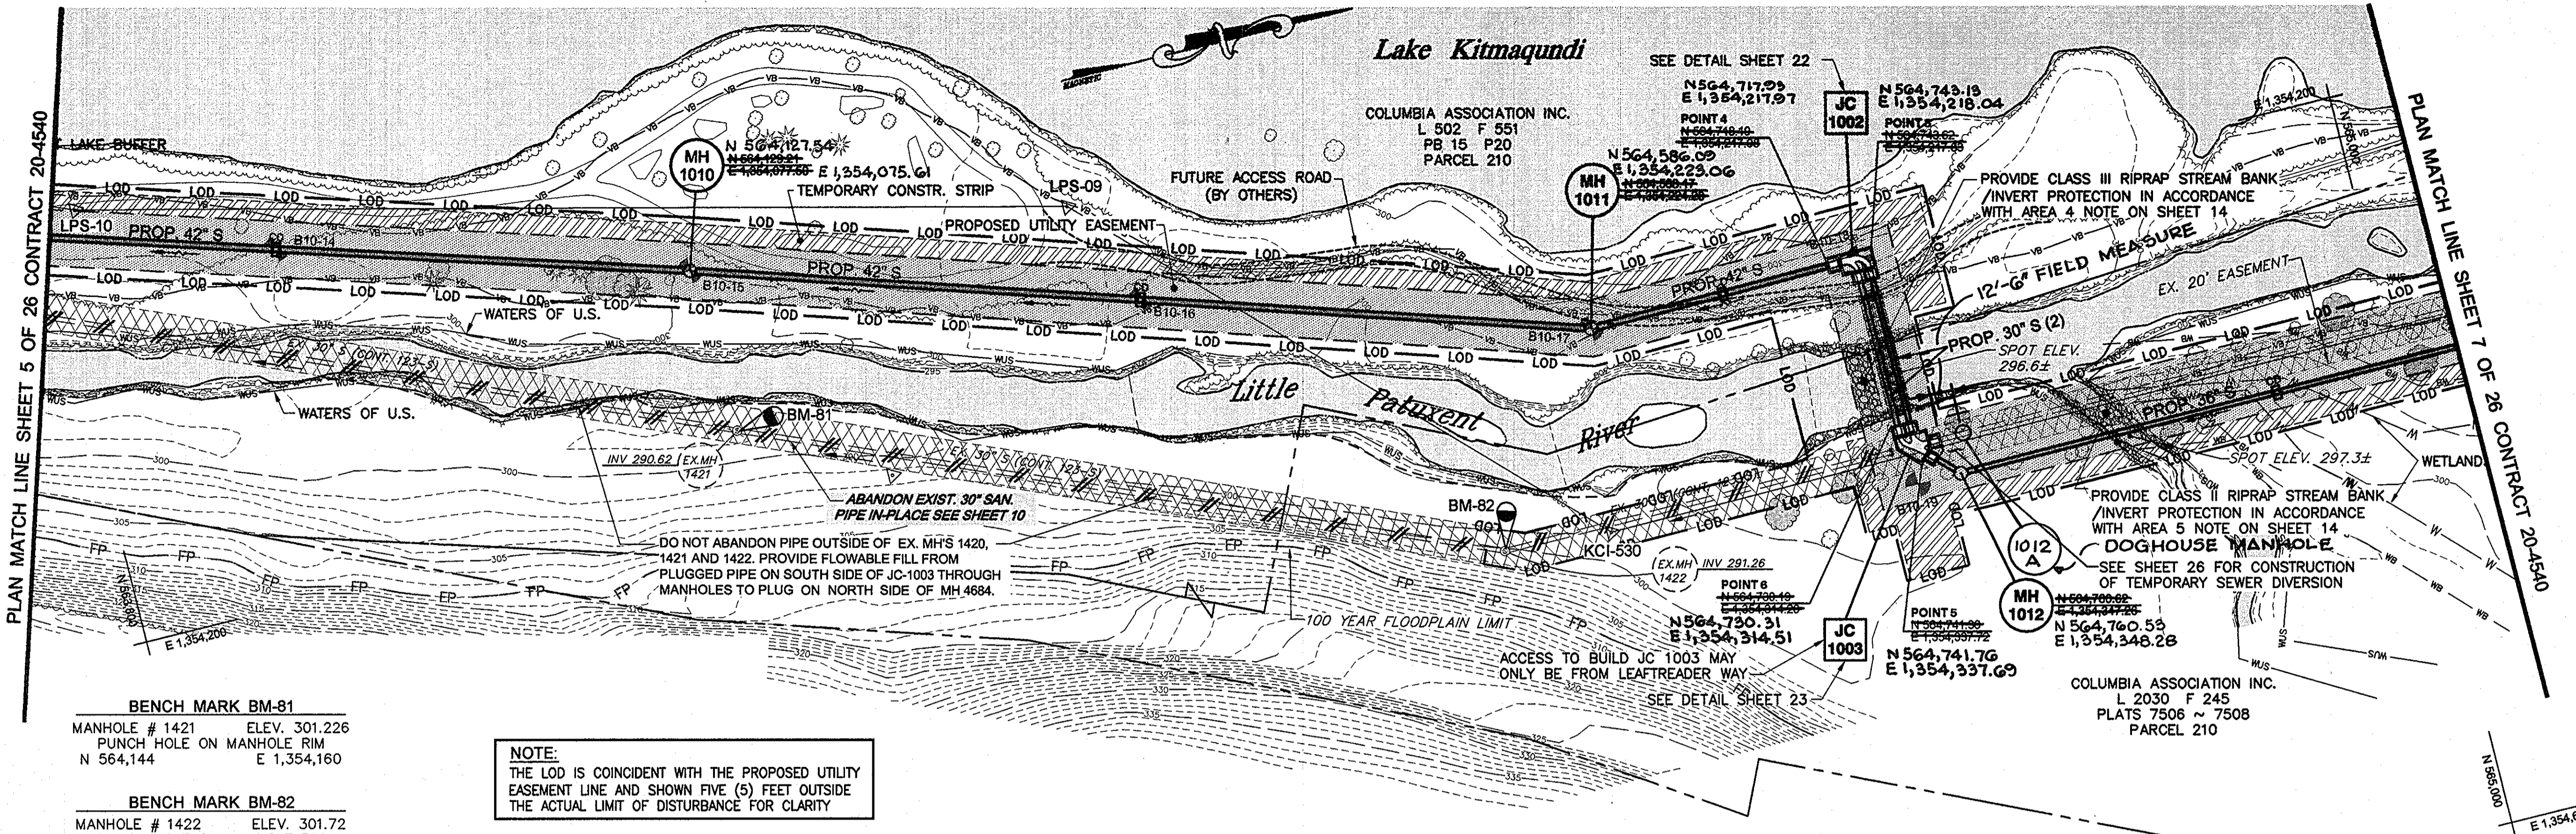


**BENCHMARK BM-81**  
MANHOLE # 1421 ELEV. 301.226  
PUNCH HOLE ON MANHOLE RIM  
N 564,144 E 1,354,160

**BENCHMARK BM-82**  
MANHOLE # 1422 ELEV. 301.72  
PUNCH HOLE ON MANHOLE RIM  
N 564,521 E 1,354,327

**NOTE:**  
THE LOD IS COINCIDENT WITH THE PROPOSED UTILITY EASEMENT LINE AND SHOWN FIVE (5) FEET OUTSIDE THE ACTUAL LIMIT OF DISTURBANCE FOR CLARITY

**PLAN**  
SCALE : 1" = 50'

**NOTE:**  
1. PRECONSTRUCTION CONTOURS SHALL BE RESTORED AFTER THE UTILITY HAS BEEN INSTALLED AND ALL EXCESS SPOIL SHALL BE REMOVED FROM SITE. THERE SHALL BE NO MOVING OR DISPOSING OF MATERIALS WITHIN THE LIMITS OF DISTURBANCE OR ANYWHERE ELSE ON SITE.  
2. SEE GENERAL NOTE 18 ON SHEET 3 OF 26.

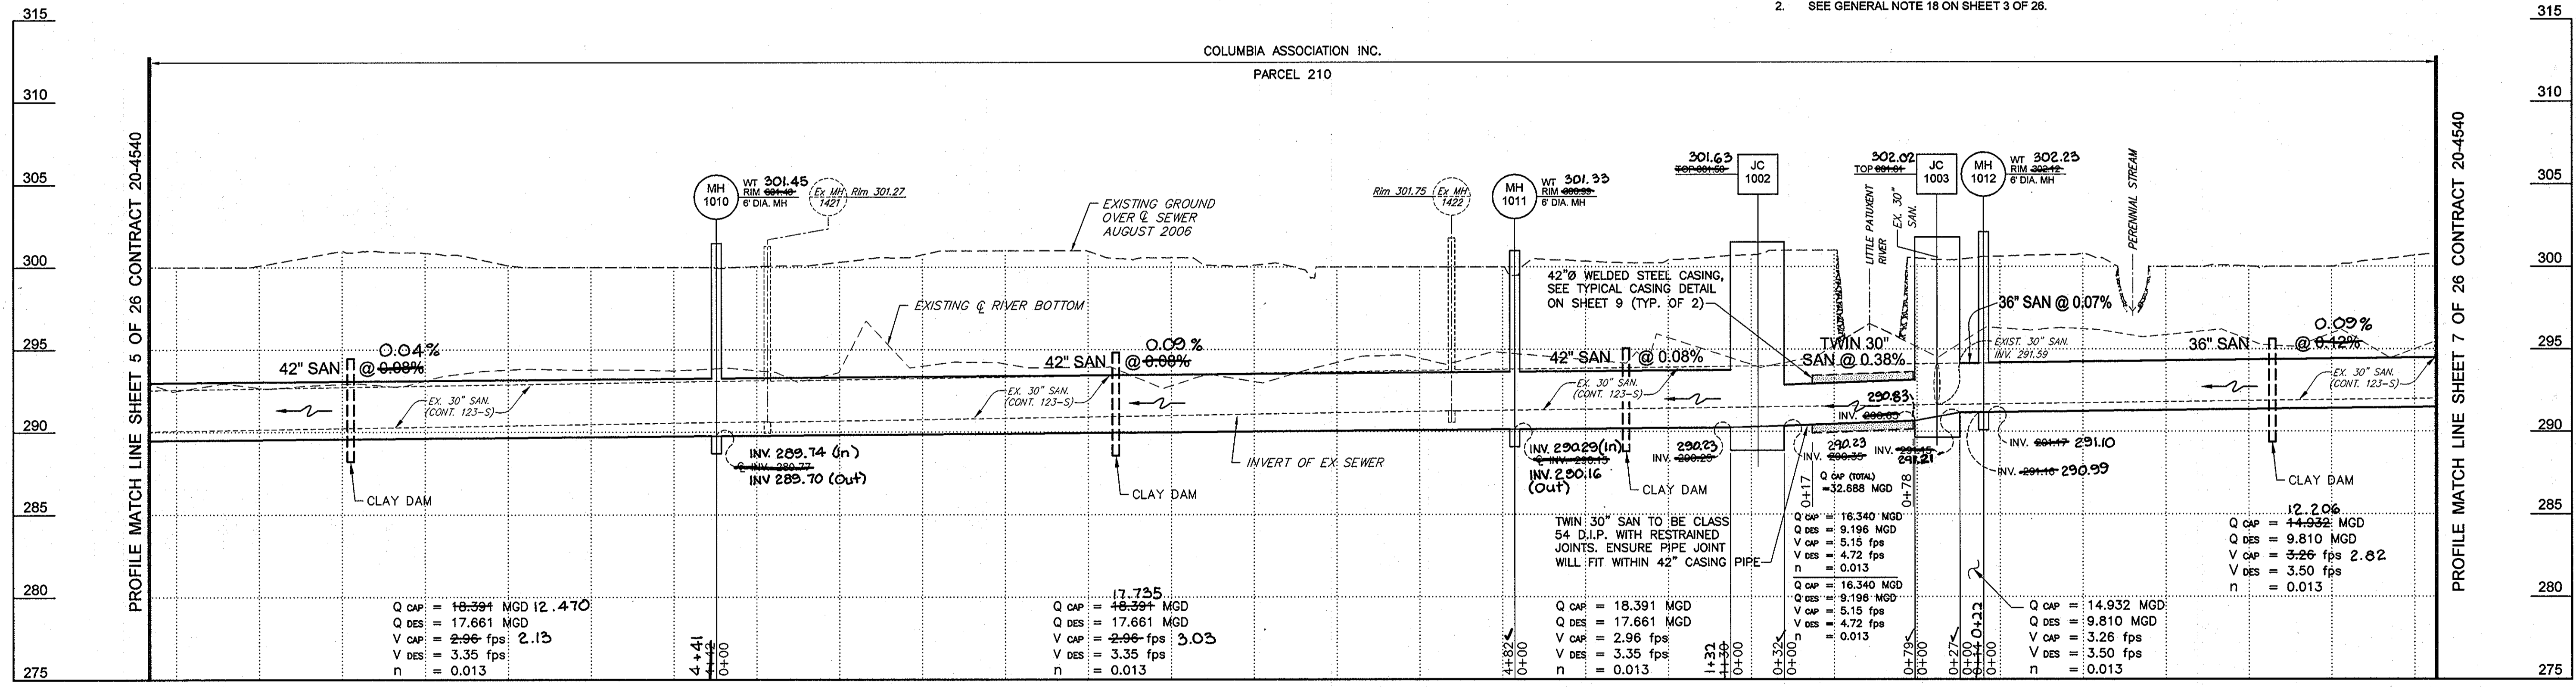

**PROFILE**  
SCALE : HORIZ. 1" = 50'  
VERT. 1" = 5'

AS-BUILTS  
Jan 17, 2013


**DEPARTMENT OF PUBLIC WORKS**  
HOWARD COUNTY, MARYLAND

Director of Public Works: *[Signature]* DATE: 6/2/10  
Chief, Bureau of Utilities: *[Signature]* DATE: 6/2/10

Chief, Bureau of Engineering: *[Signature]* DATE: 6/2/10  
Chief, Utility Design Division: *[Signature]* DATE: 6/2/10

**Dewberry**  
Dewberry & Davis LLC

3106 LORD BALTIMORE DRIVE  
SUITE 110  
BALTIMORE, MD 21244-2882  
410.285.9500  
FAX: 410.285.8875

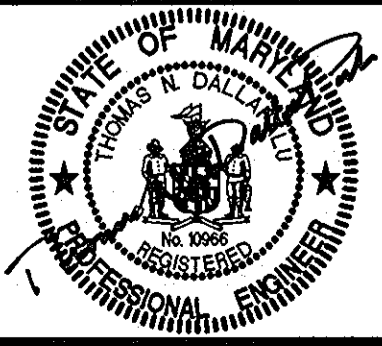

DES: LAL	
DRN: CD	
CHK: TND	
DATE: 5.28.10	
BY: NO.	REVISIONS
	DATE

**PLAN AND PROFILE SHEET**

600' SCALE MAP NO. 37, 43 BLOCK NO. 5, 23

**LITTLE PATUXENT PARALLEL INTERCEPTOR**

CAPITAL PROJECT S-6175  
CONTRACT NO. 20-4540


ELECTION DISTRICT NO. 5 HOWARD COUNTY, MARYLAND

SCALE: SHOWN


SHEET 6 OF 26

**BENCH MARK BM-83**  
 MANHOLE # 1423 ELEV. 301.21  
 "X" CUT ON MANHOLE RIM  
 N 565,102 E 1,354,326


**BENCH MARK BM-85**  
 MANHOLE # 1425 ELEV. 302.46  
 "X" CUT ON MANHOLE RIM  
 N 565,945 E 1,354,328

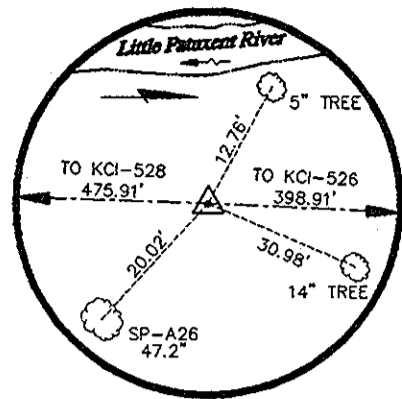


**KCI-527**  
 3/4" REBAR & KCI CAP  
 N 565,148.55  
 E 1,354,343.03  
 ELEV. 301.65

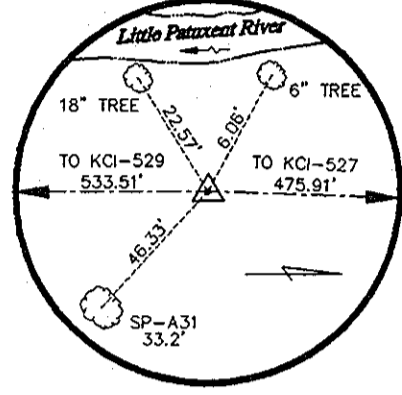

**KCI-528**  
 3/4" REBAR & KCI CAP  
 N 565,672.93  
 E 1,354,326.42  
 ELEV. 301.40

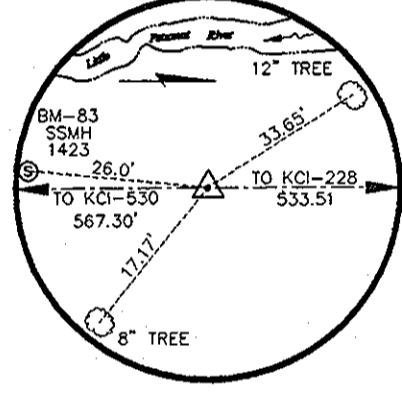


**KCI-529**  
 3/4" REBAR W/ KCI CAP  
 N 565,139.42  
 E 1,354,327.60  
 ELEV. 300.53

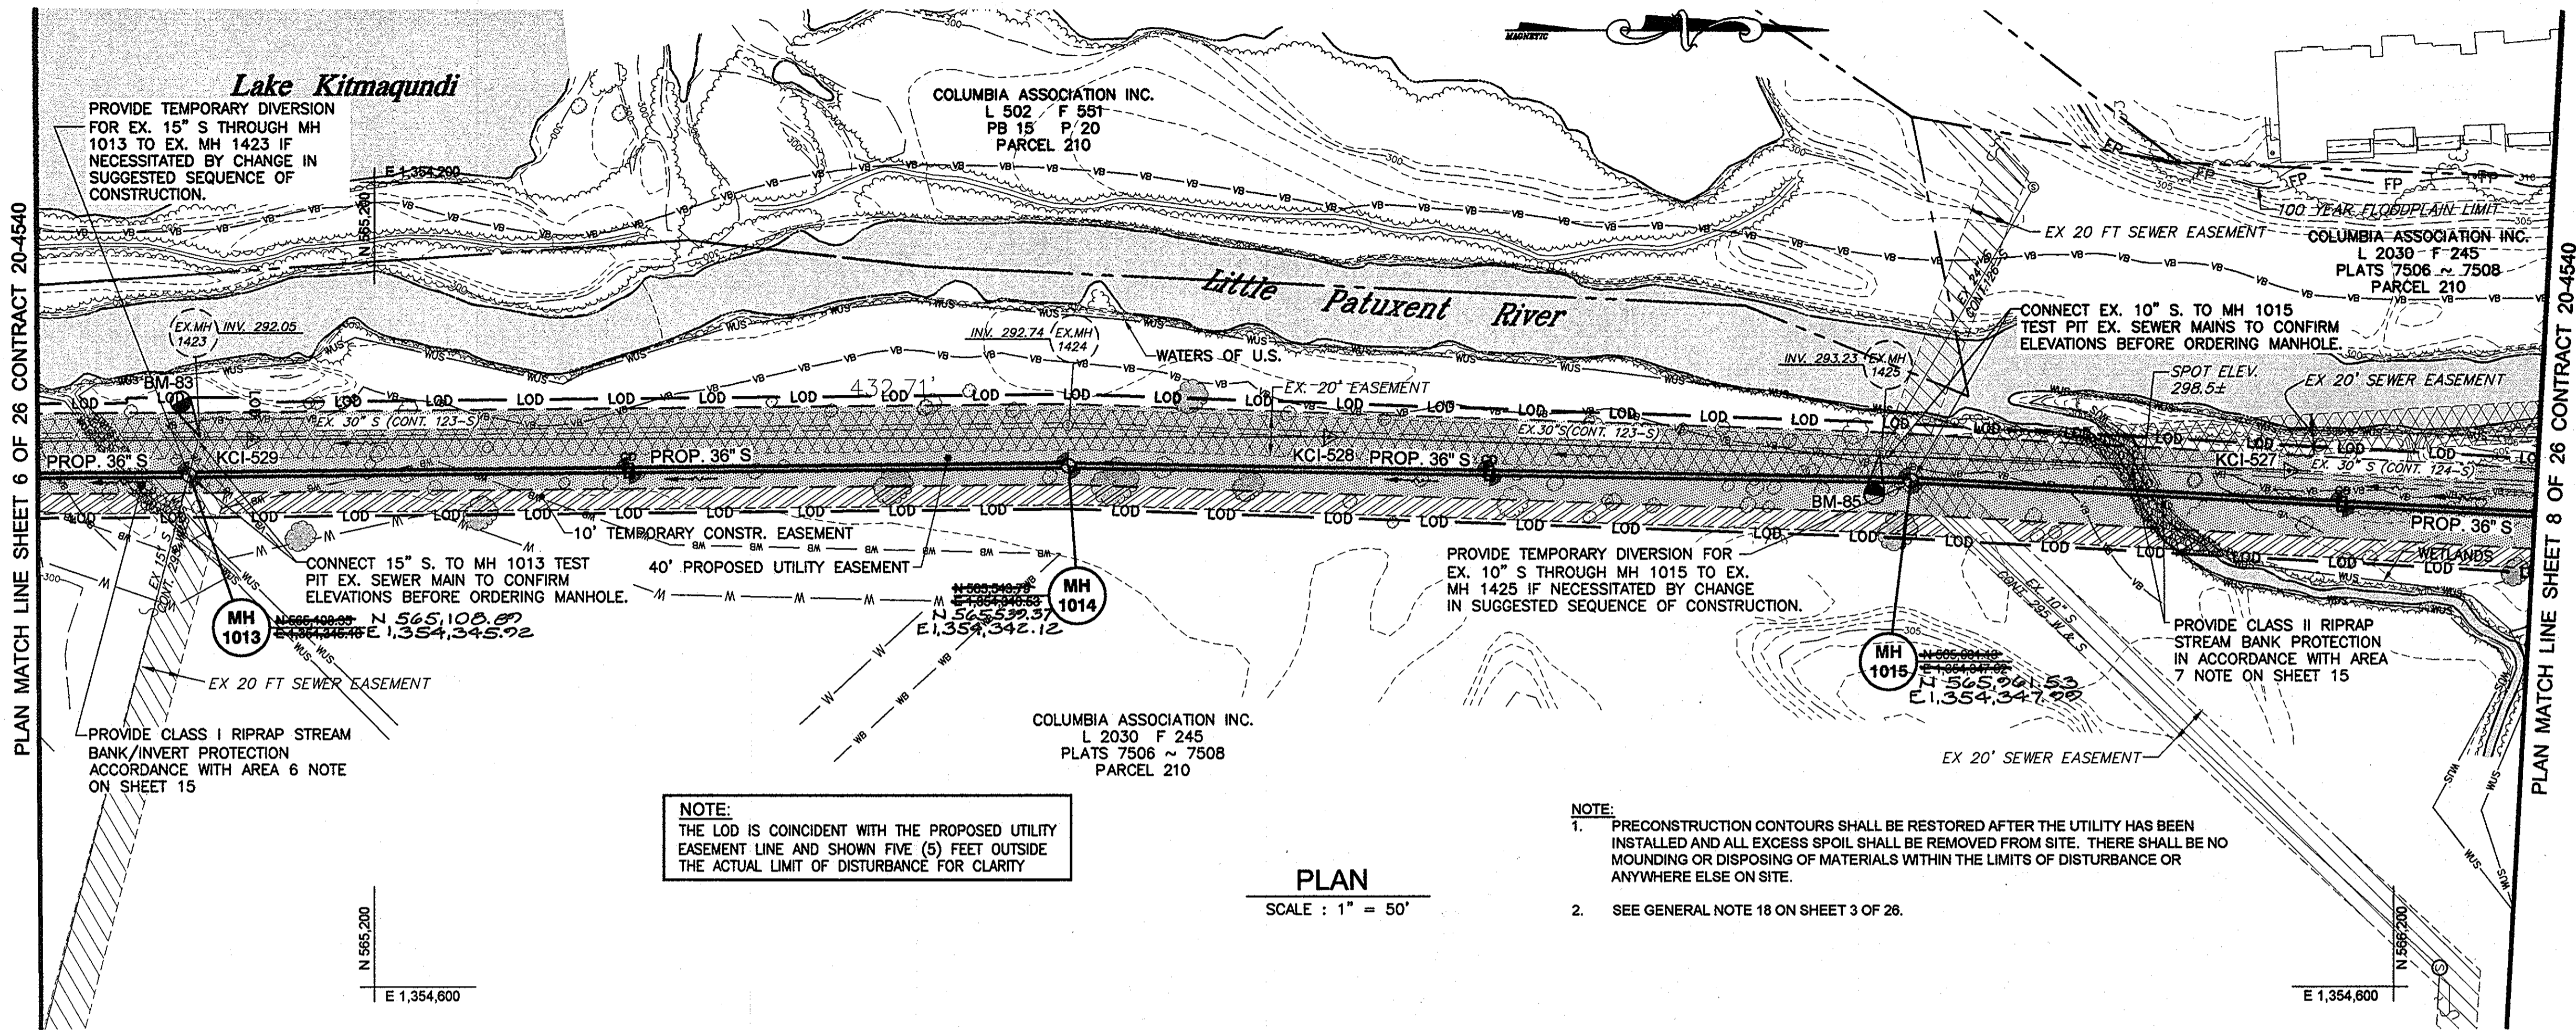

**NOTE:**  
 THE LOD IS COINCIDENT WITH THE PROPOSED UTILITY EASEMENT LINE AND SHOWN FIVE (5) FEET OUTSIDE THE ACTUAL LIMIT OF DISTURBANCE FOR CLARITY

**PLAN**  
 SCALE : 1" = 50'

**NOTE:**  
 1. PRECONSTRUCTION CONTOURS SHALL BE RESTORED AFTER THE UTILITY HAS BEEN INSTALLED AND ALL EXCESS SPOIL SHALL BE REMOVED FROM SITE. THERE SHALL BE NO MOUNDING OR DISPOSING OF MATERIALS WITHIN THE LIMITS OF DISTURBANCE OR ANYWHERE ELSE ON SITE.  
 2. SEE GENERAL NOTE 18 ON SHEET 3 OF 26.

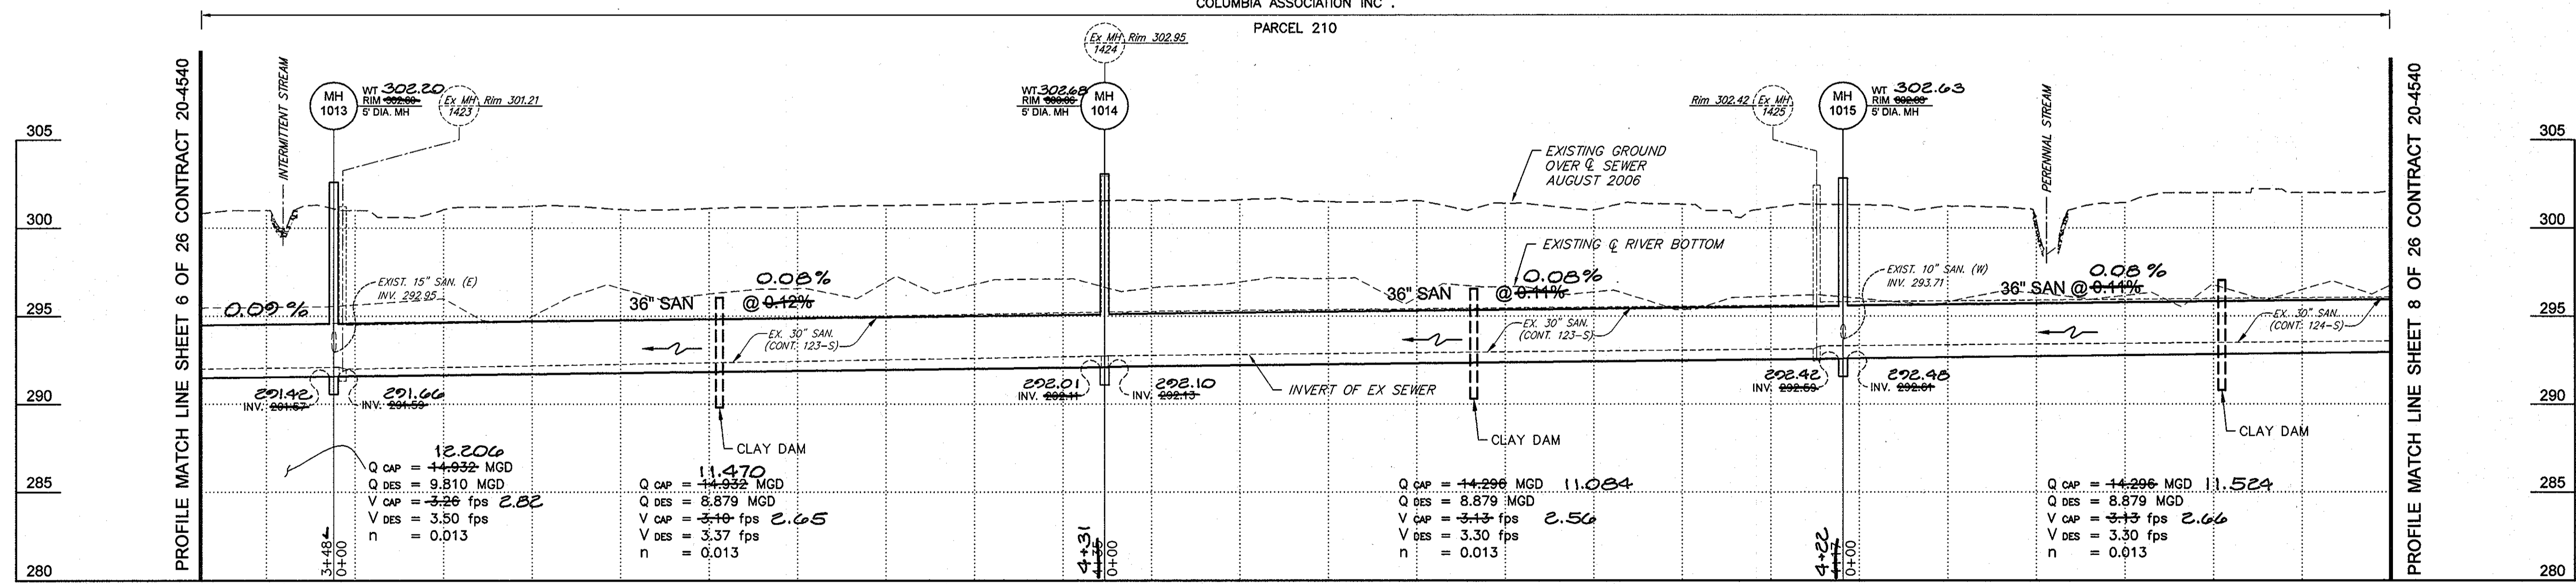

**PROFILE**  
 SCALE : HORIZ. 1" = 50'  
 VERT. 1" = 5'

**AS-BUILTS**  
 Jan 17, 2013

**DEPARTMENT OF PUBLIC WORKS**  
 HOWARD COUNTY, MARYLAND  
 Director of Public Works: [Signature] 6/13/10  
 Chief, Bureau of Engineering: [Signature] 6/13/10  
 Chief, Utility Design Division: [Signature] 6/13/10

**Dewberry**  
 Dewberry & Davis LLC  
 3106 LORD BALTIMORE DRIVE  
 SUITE 110  
 BALTIMORE, MD 21244-2962  
 410.285.9500  
 FAX: 410.285.8875



DES: LAL					
DRN: CD					
CHK: TND					
DATE: 5.28.10	BY: NO.	REVISIONS	DATE	600' SCALE MAP NO. 37, 43	BLOCK NO. 5, 23

**PLAN AND PROFILE SHEET**


**LITTLE PATUXENT PARALLEL INTERCEPTOR**  
 CAPITAL PROJECT S-6175  
 CONTRACT NO. 20-4540  
 ELECTION DISTRICT NO. 5  
 HOWARD COUNTY, MARYLAND

SCALE: SHOWN  
 SHEET 7 OF 26

Project: [unclear] Date: 01/26/10 4:06pm  
 Path: [unclear] X-PAN SHEET 6 of 9  
 User: [unclear] Section: [unclear] Section: [unclear] Section: [unclear]  
 User: [unclear] Date: 06/21/10 12:20pm  
 User: [unclear] Date: 06/21/10 12:20pm

**BENCH MARK BM-86**  
 MANHOLE # 1430 ELEV. 303.90  
 "X" CUT ON MANHOLE RIM  
 N 566,389 E 1,354,354


**BENCH MARK BM-88**  
 MANHOLE # 1432 ELEV. 305.22  
 "X" CUT ON MANHOLE RIM  
 N 567,269 E 1,354,450

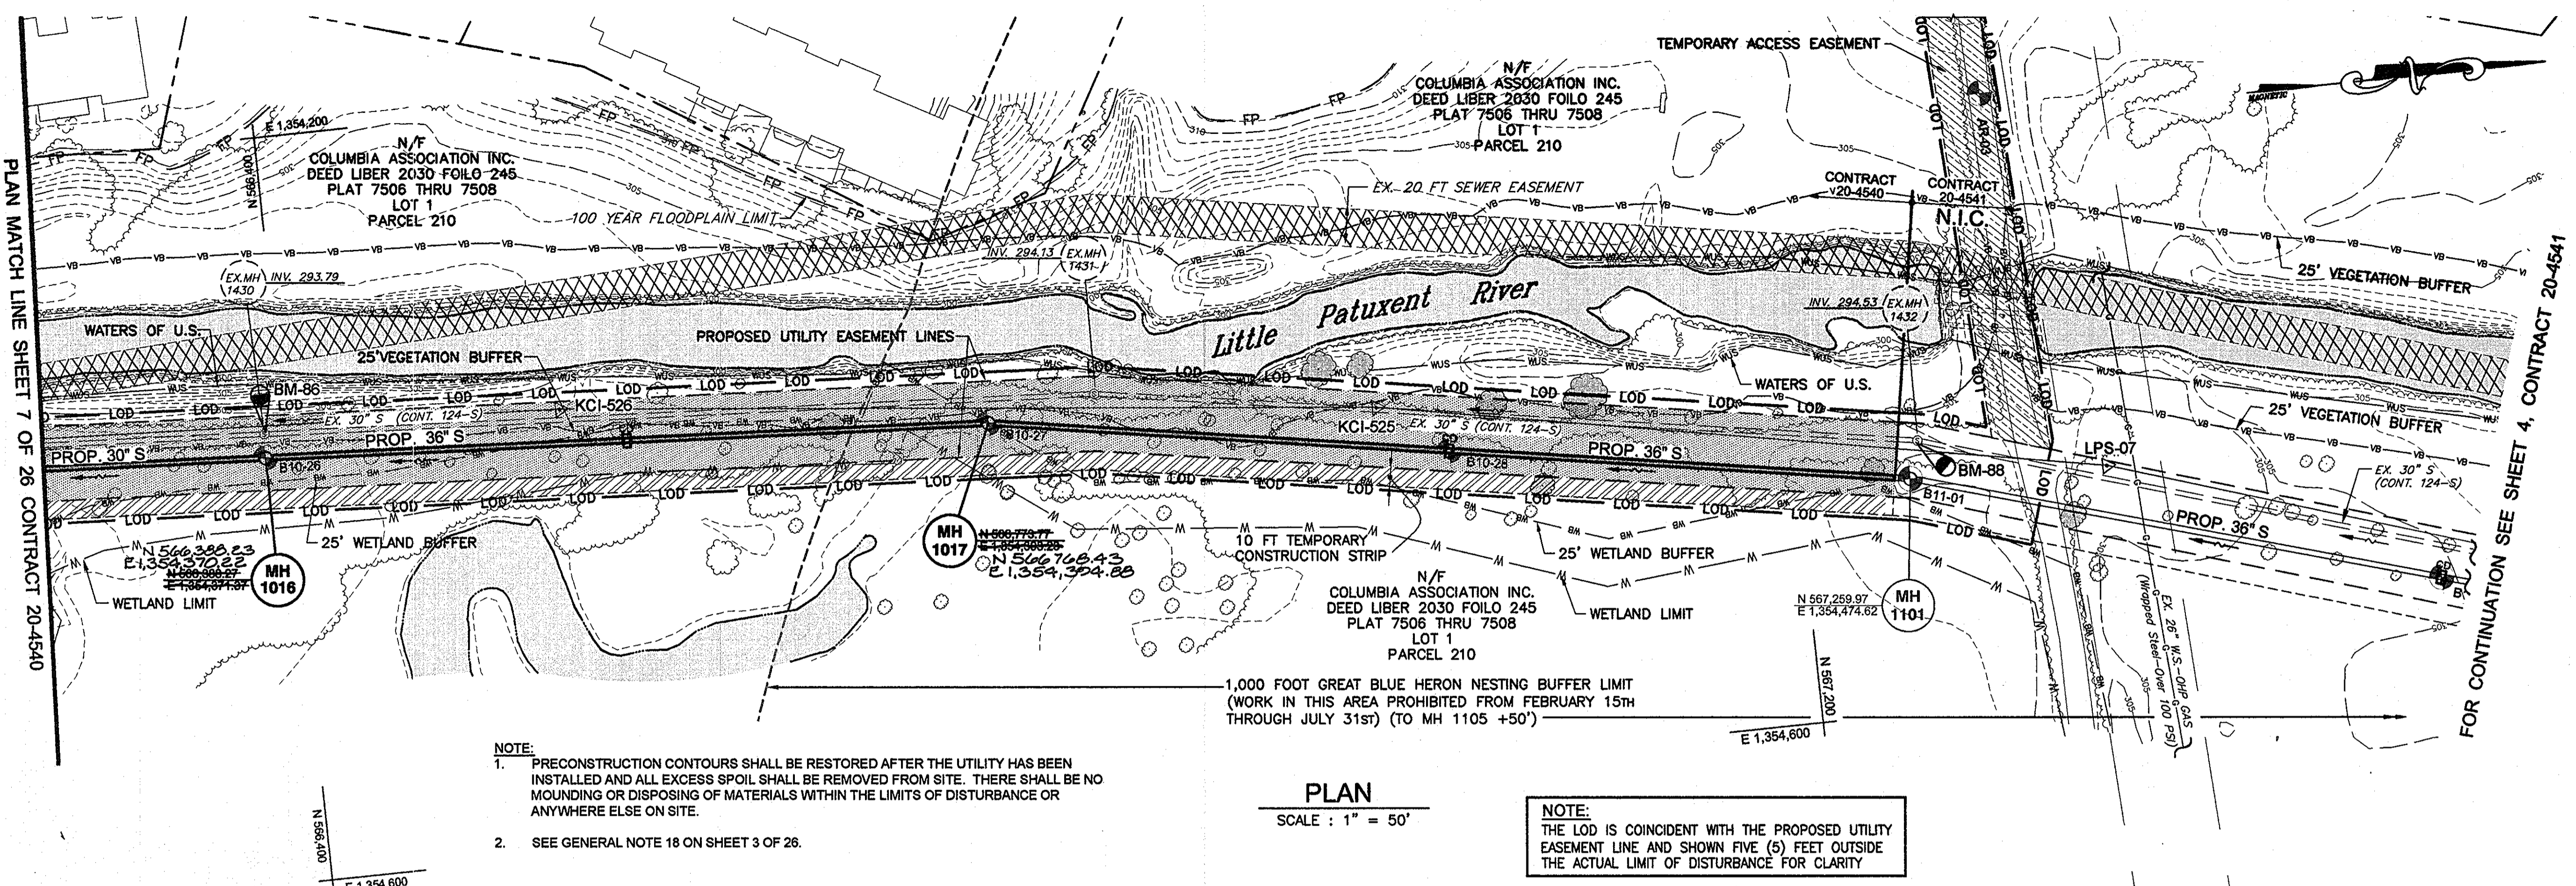


**NOTE:**  
 1. PRECONSTRUCTION CONTOURS SHALL BE RESTORED AFTER THE UTILITY HAS BEEN INSTALLED AND ALL EXCESS SPOIL SHALL BE REMOVED FROM SITE. THERE SHALL BE NO MOUNDING OR DISPOSING OF MATERIALS WITHIN THE LIMITS OF DISTURBANCE OR ANYWHERE ELSE ON SITE.  
 2. SEE GENERAL NOTE 18 ON SHEET 3 OF 26.

**PLAN**  
 SCALE : 1" = 50'


**NOTE:**  
 THE LOD IS COINCIDENT WITH THE PROPOSED UTILITY EASEMENT LINE AND SHOWN FIVE (5) FEET OUTSIDE THE ACTUAL LIMIT OF DISTURBANCE FOR CLARITY

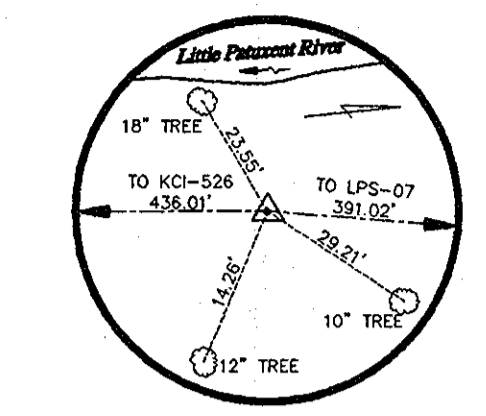


**KCI-525**  
 3/4" REBAR & KCI CAP  
 N 566,980.72  
 E 1,354,406.79  
 ELEV. 303.20

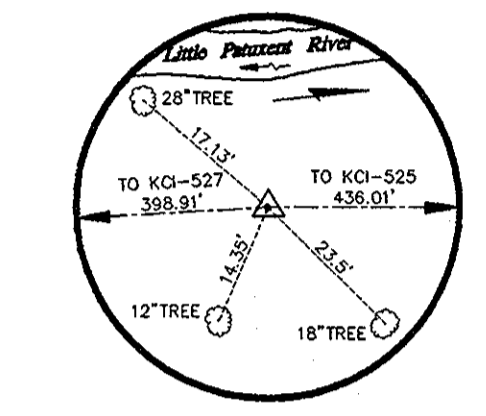

**KCI-526**  
 3/4" REBAR & KCI CAP  
 N 566,547.01  
 E 1,354,362.03  
 ELEV. 302.90

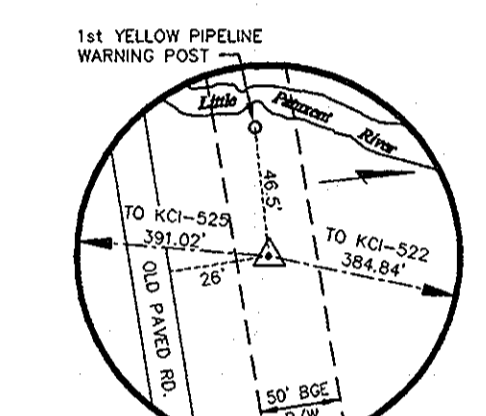


**LPS-07**  
 3/4" REBAR & RED CAP  
 N 567,365.08  
 E 1,354,478.65  
 ELEV. 305.91

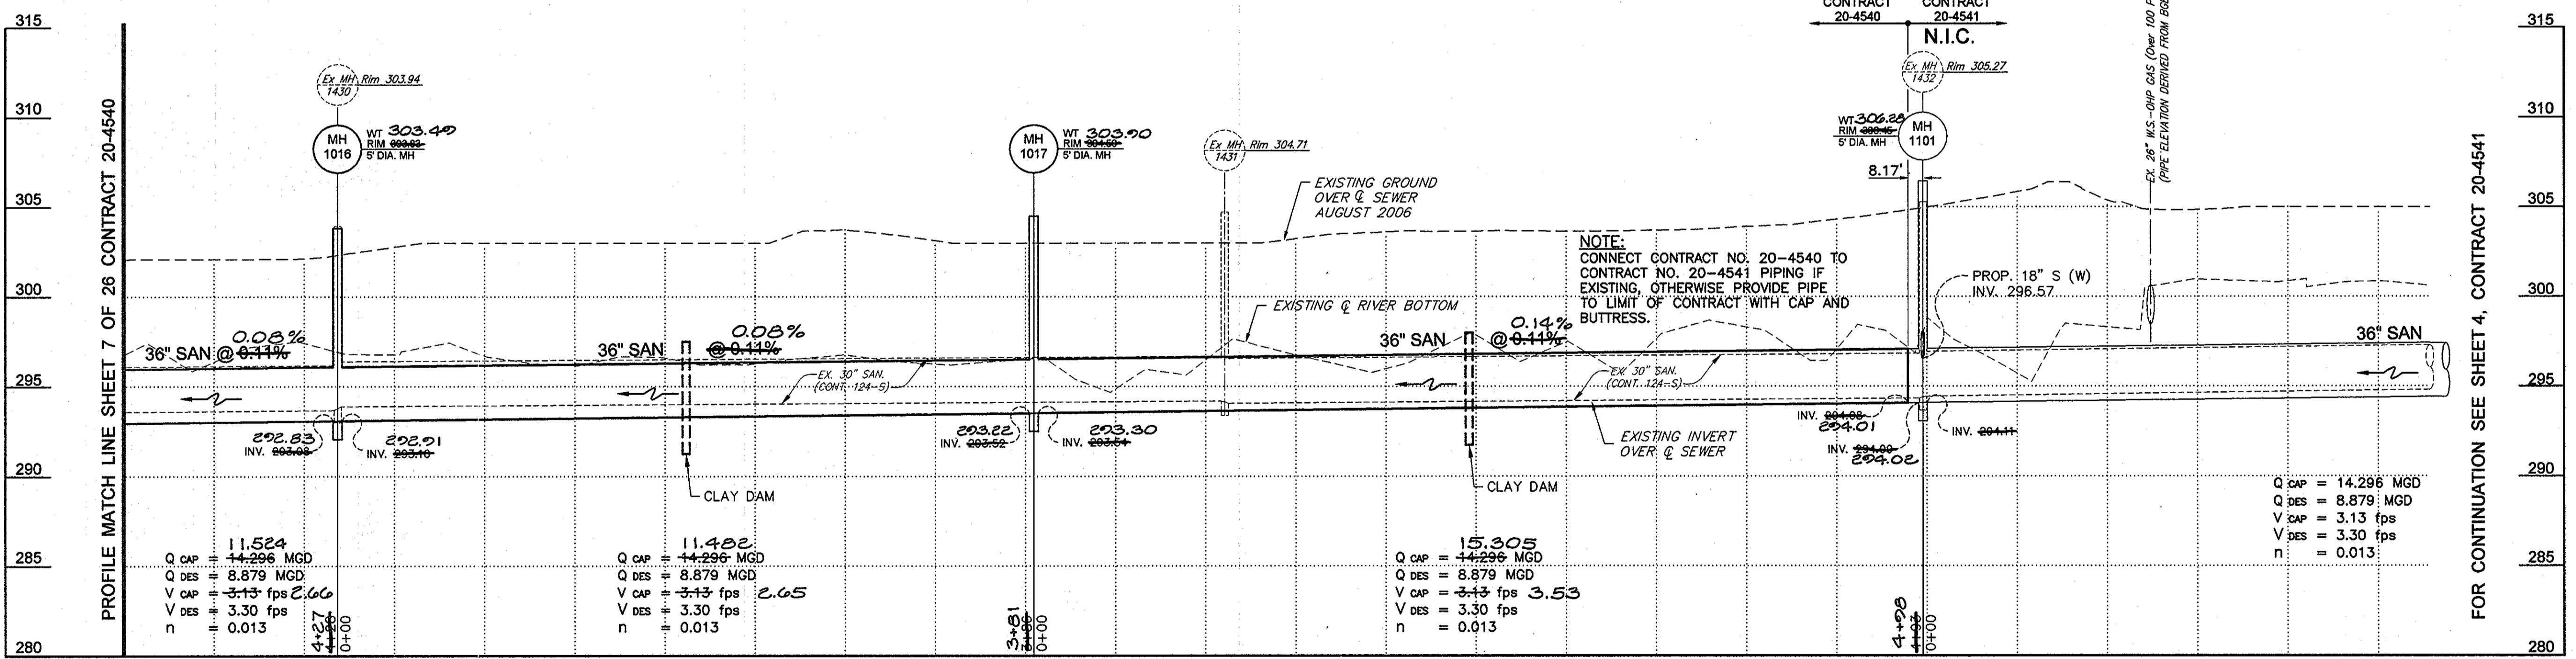

**PROFILE**  
 SCALE : HORIZ. 1" = 50'  
 VERT. 1" = 5'

**DEPARTMENT OF PUBLIC WORKS**  
 HOWARD COUNTY, MARYLAND

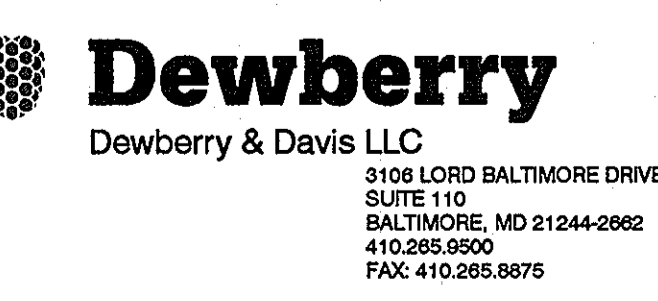

DES: LAL	BY	NO.	REVISIONS	DATE
DRN: CD				
CHK: TND				
DATE: 5.28.10				

**PLAN AND PROFILE SHEET**

600' SCALE MAP NO. 37, 43  
 BLOCK NO. 5, 23


**LITTLE PATUXENT PARALLEL INTERCEPTOR**

CAPITAL PROJECT S-6175  
 CONTRACT NO. 20-4540


ELECTION DISTRICT NO. 5  
 HOWARD COUNTY, MARYLAND

SCALE: SHOWN  
 SHEET 8 OF 26



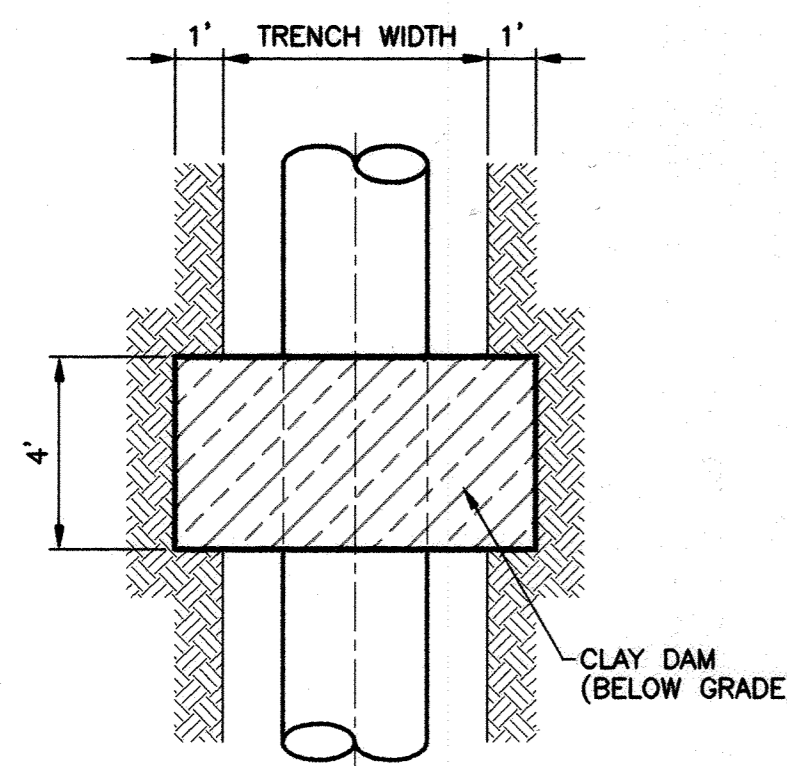

PLAN VIEW

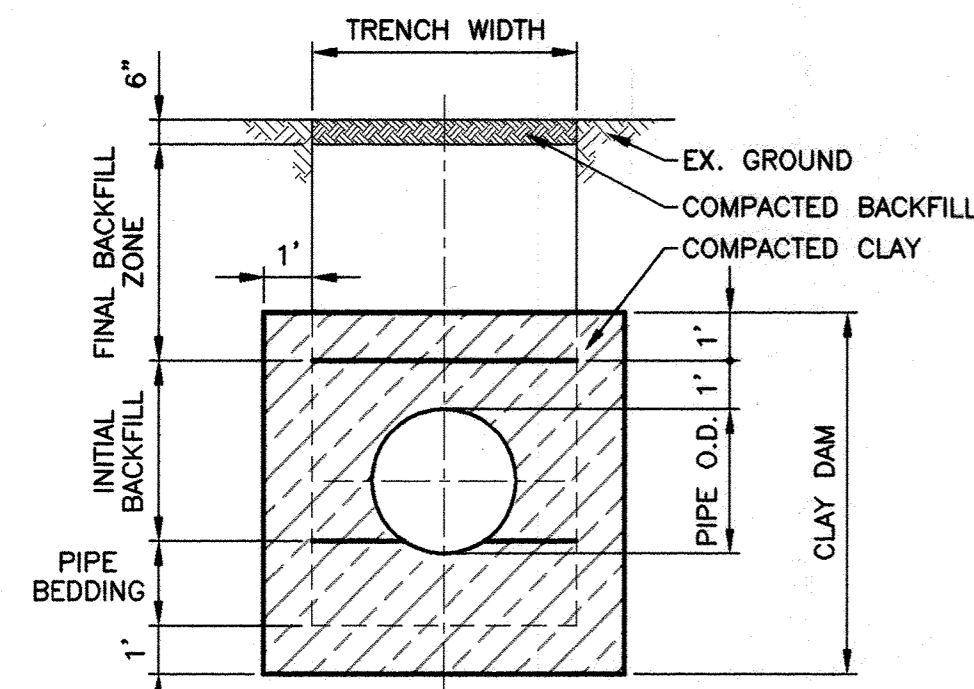


ELEVATION VIEW

CLAY DAM TYPICAL PIPE BEDDING DETAIL

NO SCALE

CLAY DAM NOTES:

1. CLAY DAM SHALL BE INSTALLED AT INTERVALS NO GREATER THAN 500 FEET AND AS SHOWN ON THE PLANS.
2. CLAY DAM LENGTH SHALL BE 4 FEET ALONG THE PIPE AXIS, AND SHALL BE PLACED FROM UNDERCUT SUBGRADE OR TRENCH SUBGRADE UP TO 1 FOOT OVER THE INITIAL BACKFILL.
3. PLACE CLAY DAM IN 6" LIFTS, USING CLAY MEETING THE REQUIREMENTS OF AASHTO M145 SOIL GROUPS A-6 OR A-7 AND COMPACT TO MIN. 92%.
4. NO STONE SHALL BE USED IN THE BOTTOM OF THE TRENCH OR IN THE FINAL BACKFILL ZONE ALONG THE LENGTH OF THE DAM.

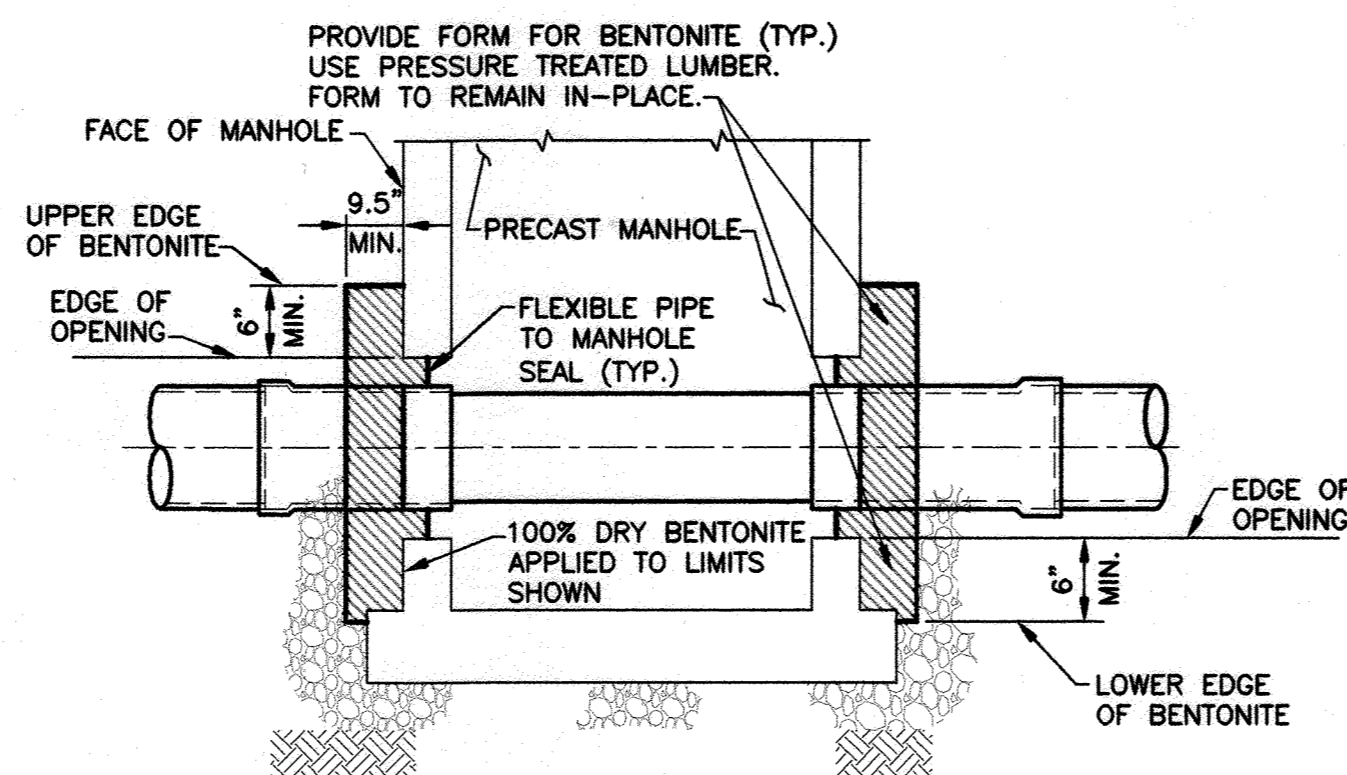




ELEVATION VIEW

PIPE TO MANHOLE & JUNCTION CHAMBER CONNECTION

NO SCALE

NOTES:

1. TEMPORARILY REMOVE EXISTING SANITARY SEWER AND RE-LAY PIPE THROUGH PRE-CAST OPENINGS IN PROPOSED MANHOLE AS NECESSARY, KEEPING A STRAIGHT ALIGNMENT.
2. SEAL PIPE TO MANHOLE OPENINGS WITH NON-SHRINK GROUT.
3. REMOVAL OF TEMPORARY DIVERSION THROUGH MANHOLE WILL BE BY OTHERS WHEN ALL DOWNSTREAM NEW SEWER IS PLACED IN-SERVICE.
4. ALL EXISTING SEWER PIPE INVERTS SHALL BE CHECKED BY TEST PIT PRIOR TO ORDERING MANHOLES.

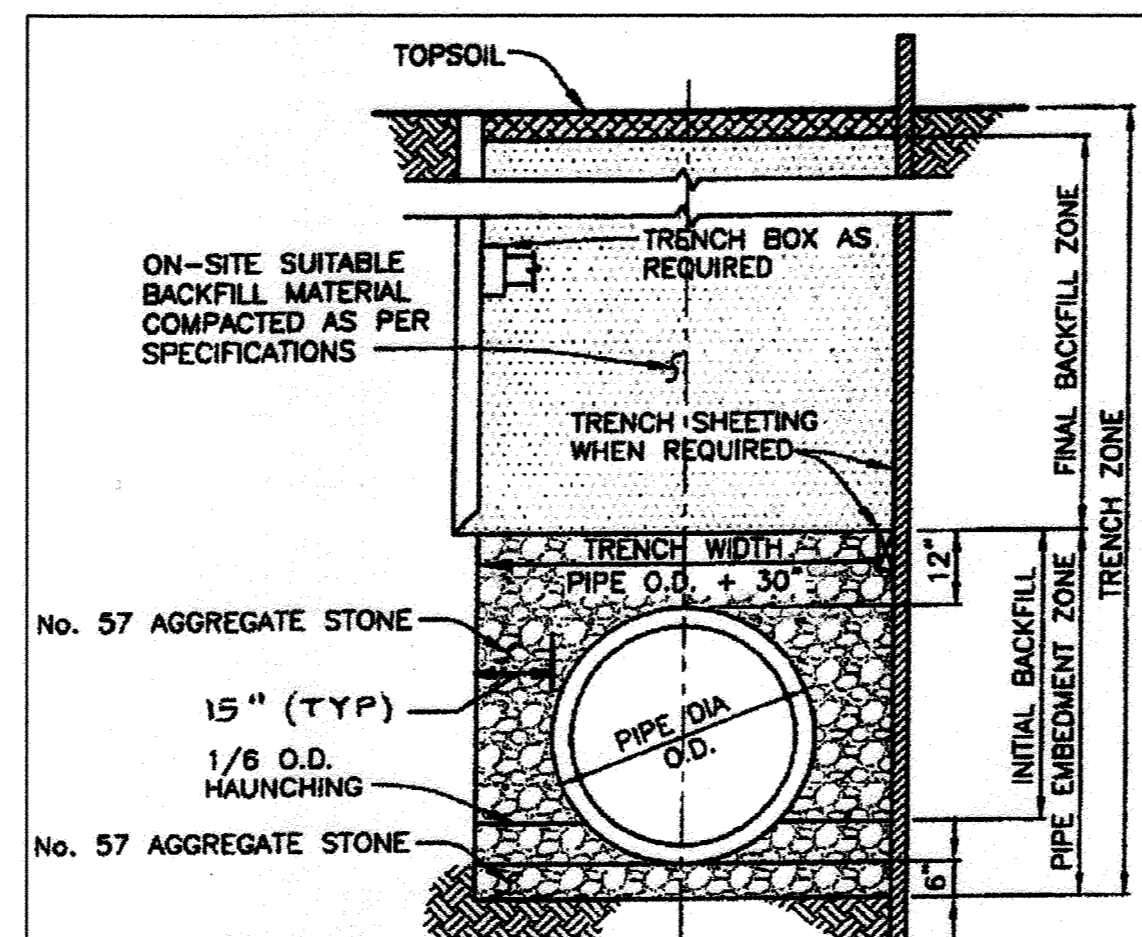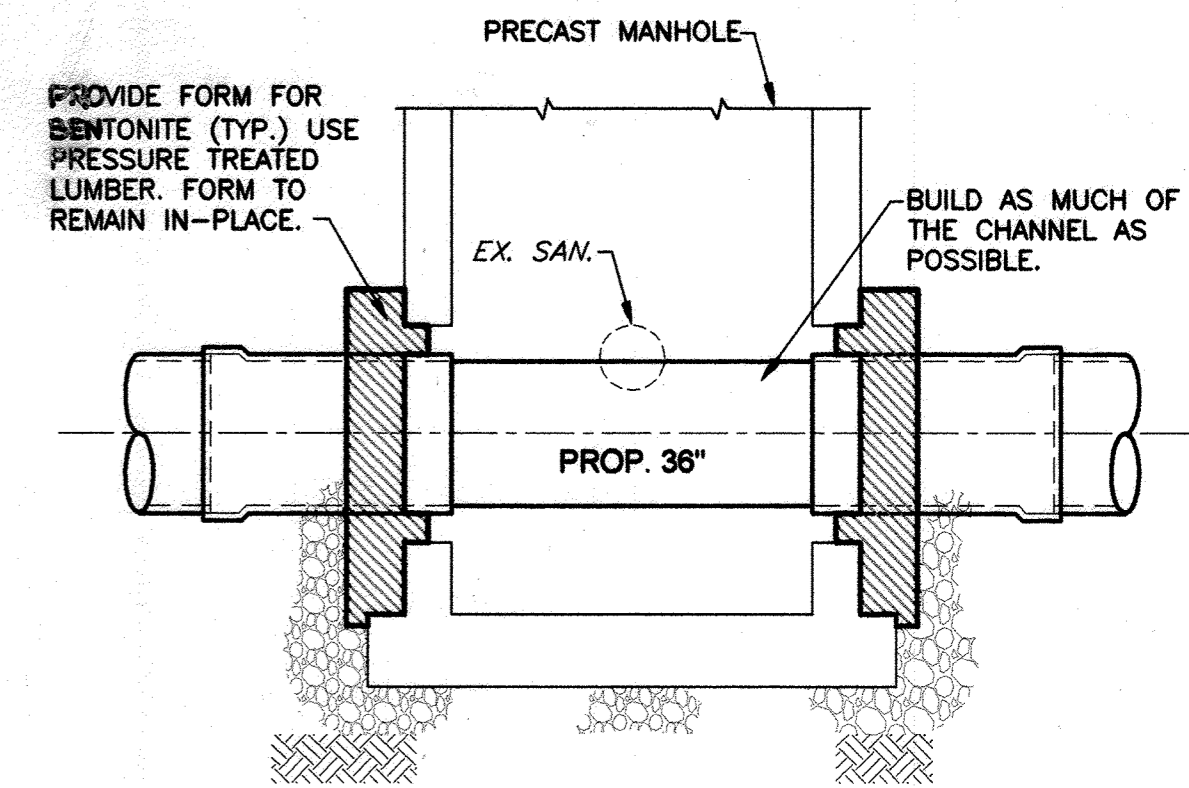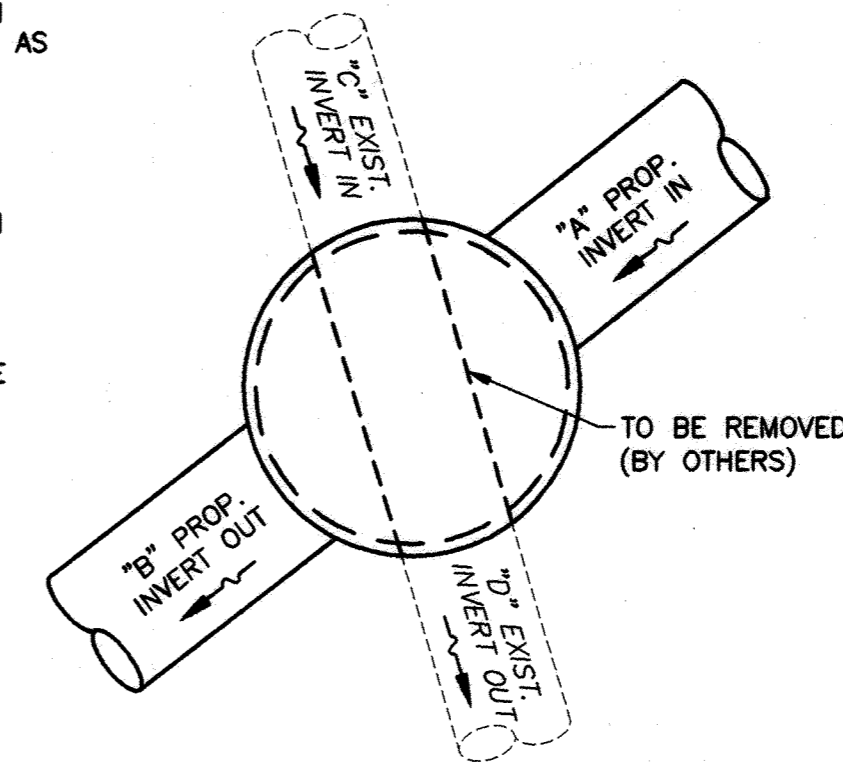


TRENCH DETAIL


NO SCALE

NOTES:

1. CONTRACTOR TO STRICTLY ADHERE TO SECTION 1000.03.05, "EXCAVATION AND SUBGRADE PREPARATION", OF THE STANDARD SPECIFICATIONS AND DETAILS OF CONSTRUCTION, VOLUME IV.
2. PRIOR TO PLACING INITIAL BACKFILL, CONTRACTOR SHALL PLACE A MAXIMUM 12-INCH LIFT OF No. 57 STONE FOR THE 1/6 O.D. HAUNCHING AREA ON EACH SIDE OF THE PIPE AND COMPACT THE STONE BY "SHOVEL SLICING" UNTIL STONE COMPLETELY FILLS ALL VOIDS ON THE UNDERSIDE OF THE PIPE.
3. TRENCH BACKFILL IN THE FINAL BACKFILL ZONE, FROM 12 INCHES ABOVE THE CROWN OF PIPE TO 6 INCHES BELOW THE FINAL GRADE, SHALL CONSIST OF ON-SITE SUITABLE BACKFILL MATERIAL AS MUCH AS PRACTICABLE AND MAY, BEGINNING AT A DEPTH 24 INCHES ABOVE THE CROWN OF PIPE, CONTAIN STONES NO LARGER THAN 12 INCHES IN ANY DIMENSION.

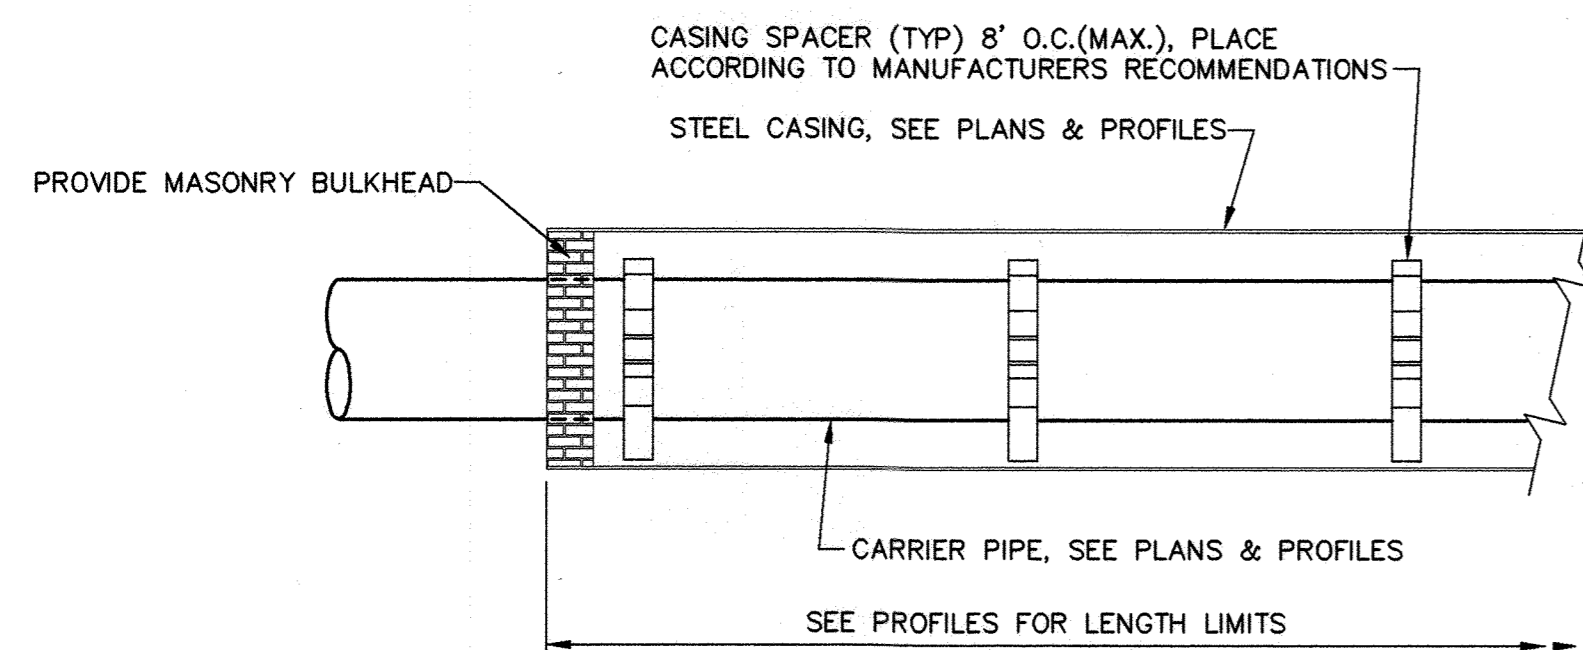

PROFILE VIEW

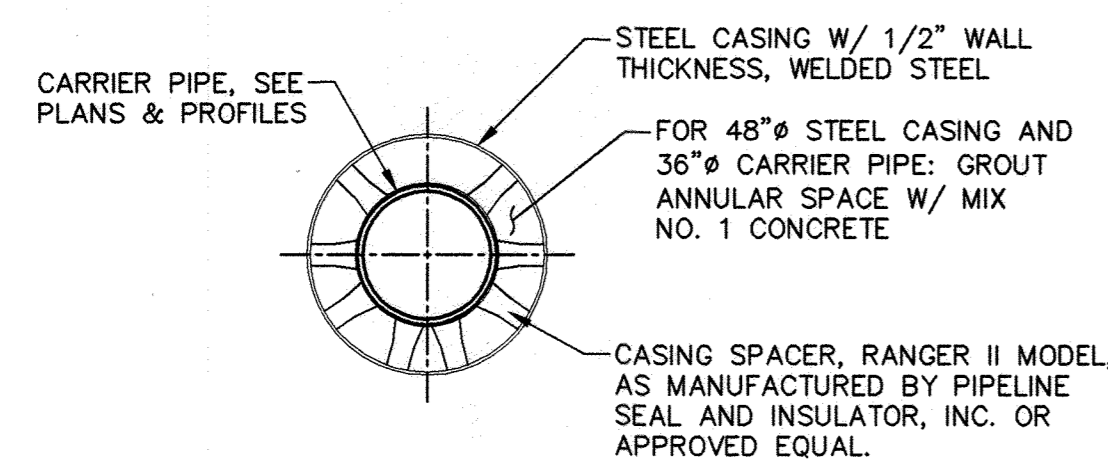

SECTION VIEW

TYPICAL CASING SPACER CONFIGURATION

NOT TO SCALE


TEMPORARY PIPE DIVERSION INVERT SCHEDULE											
MH-1003			MH-1006			MH-1013			MH-1015		
A	B	C	A	B	C	A	B	C	A	B	C
36"	36"	6"	36"	36"	16"	36"	36"	15"	36"	36"	10"
285.47	286.46	290.15	290.00	286.71	286.64	289.30	289.21	291.59	291.57	292.95	292.90
285.72	285.20			284.16	286.72			291.66	291.42		292.48

NOTES:

1. PROVIDE SEWAGE BY-PASS PUMPING TO SET NEW MANHOLES.
2. MH 1013 AND MH 1015 TEMPORARY PIPE DIVERSION ONLY NEEDED IF NECESSITATED BY CHANGE IN SUGGESTED SEQUENCE OF CONSTRUCTION.

TEMPORARY PIPE DIVERSION THROUGH PROPOSED MANHOLES

NOT TO SCALE

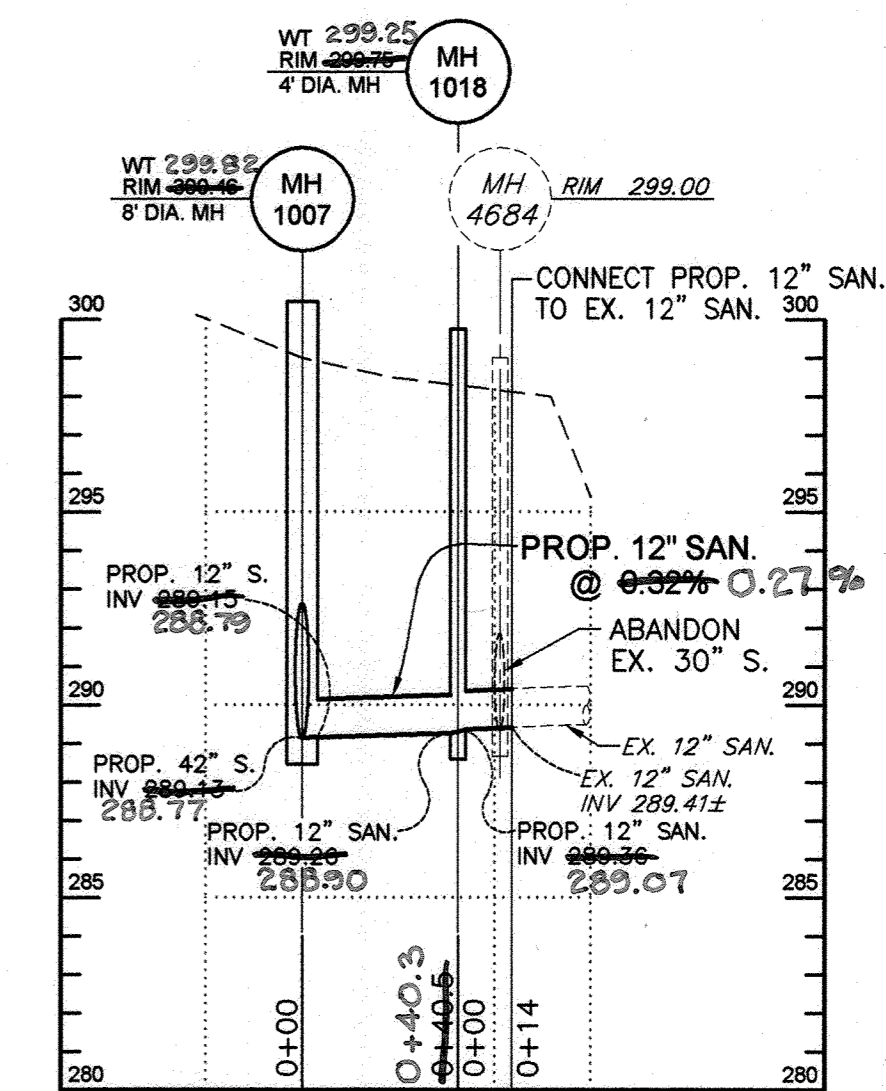

PROFILE

SCALE: HORIZ. 1"=50'  
VERT. 1"=5'

REFER TO SUGGESTED SEQUENCE OF CONSTRUCTION FOR WORK IN THIS AREA.


AS-BUILTS  
JUN 17 2010

DEPARTMENT OF PUBLIC WORKS  
HOWARD COUNTY, MARYLAND

DIRECTOR OF PUBLIC WORKS  
DATE 6/2/10  
CHIEF, BUREAU OF UTILITIES  
DATE 6/2/10

Dewberry  
Dewberry & Davis LLC

3106 LORD BALTIMORE DRIVE  
SUITE 110  
BALTIMORE, MD 21244-2882  
410.285.9500  
FAX: 410.285.8875

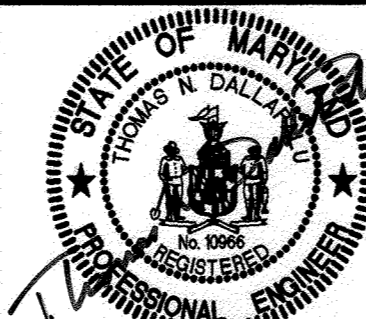

DES: LAL

DRN: CD

CHK: TND

DATE: 5.28.10

BY NO. REVISIONS

MISCELLANEOUS DETAILS

600' SCALE MAP NO. 37, 43 BLOCK NO. 5, 23

LITTLE PATUXENT PARALLEL INTERCEPTOR


CAPITAL PROJECT S-6175  
CONTRACT NO. 20-4540

ELECTION DISTRICT NO. 5

HOWARD COUNTY, MARYLAND

SCALE:  
SHOWN

SHEET  
9 OF 26

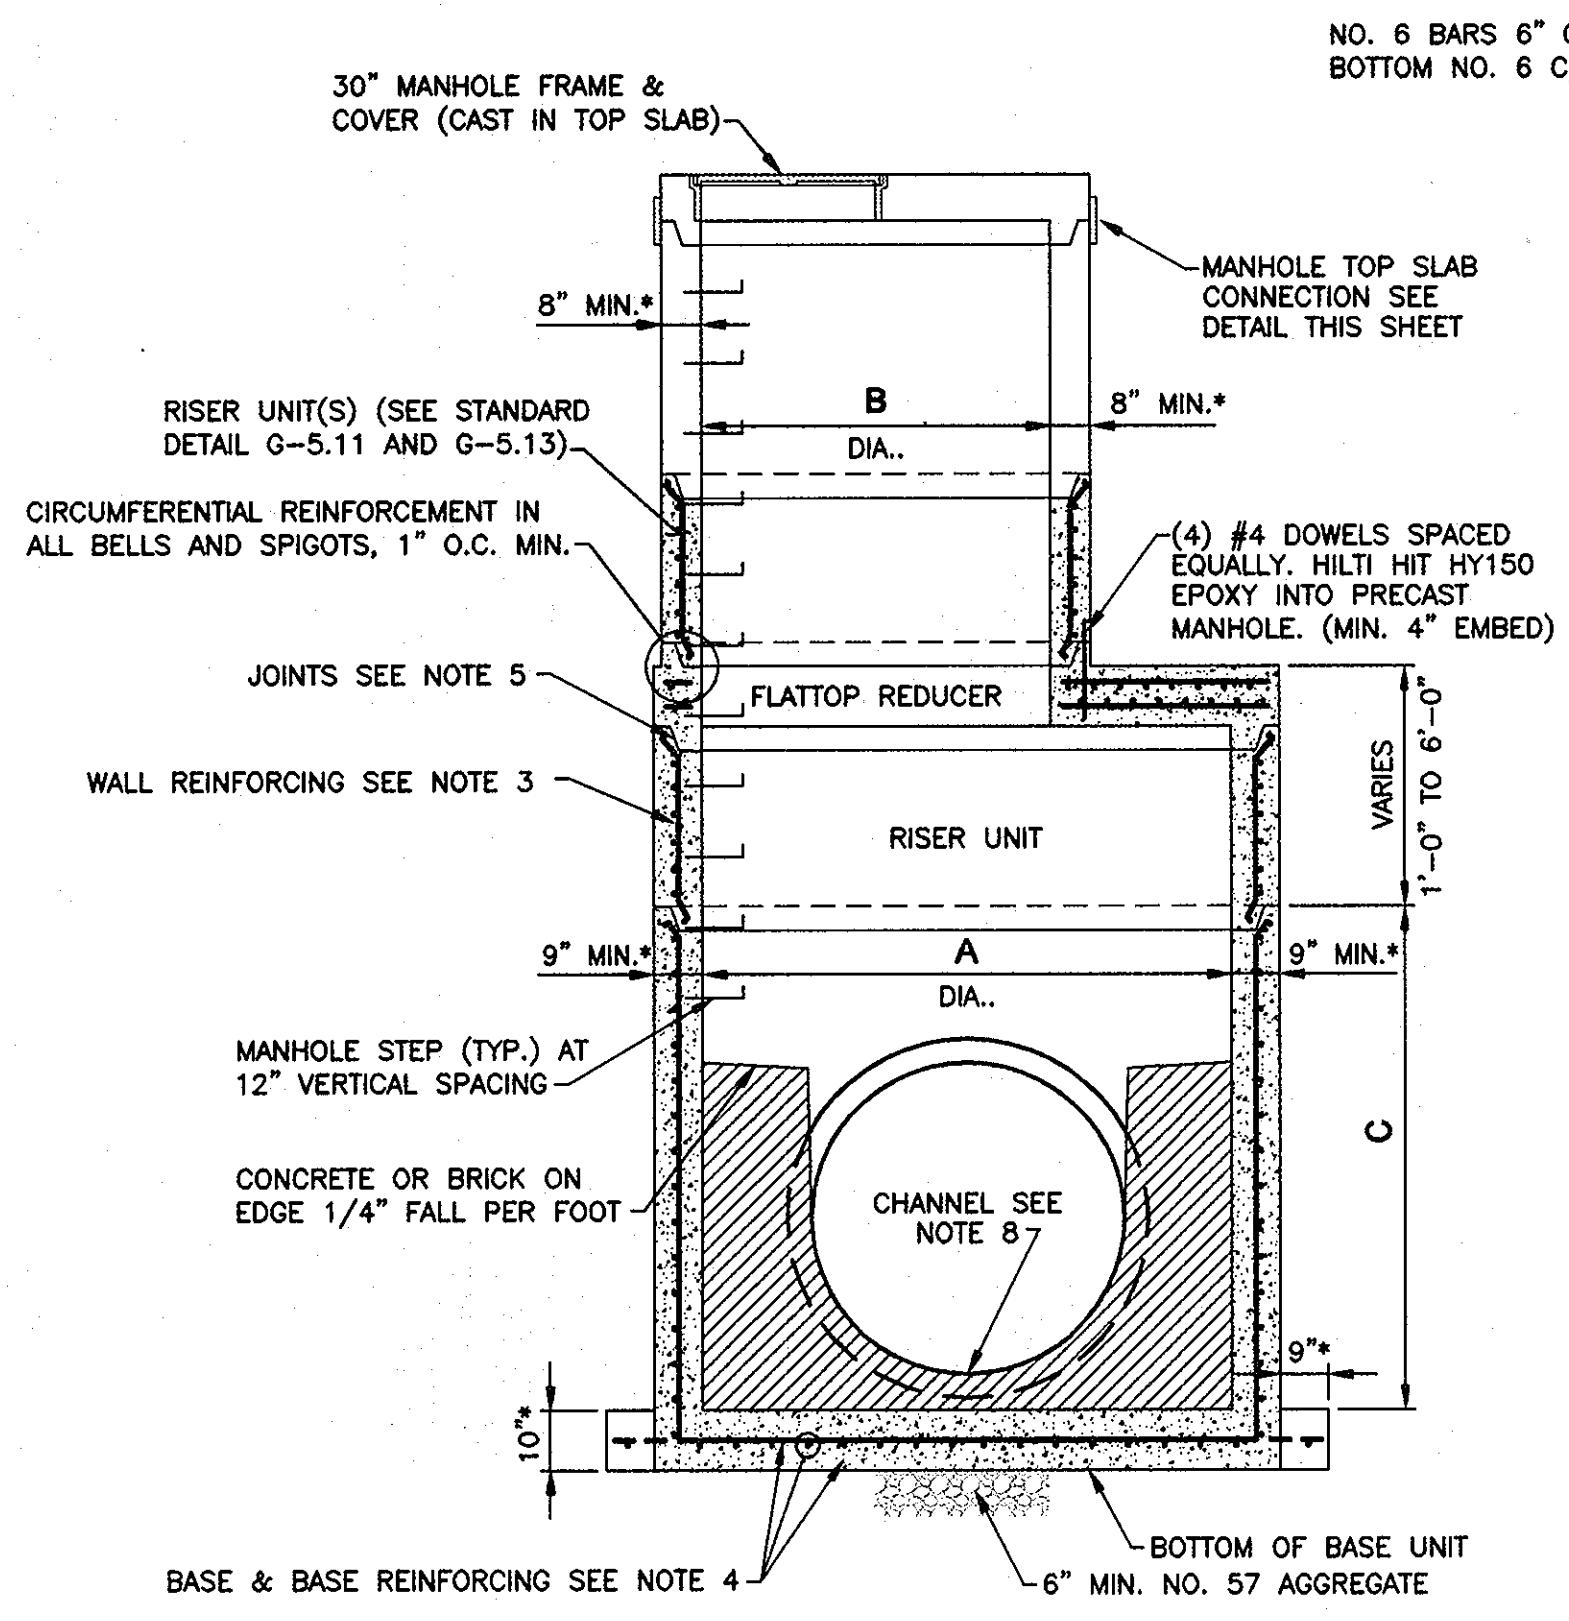


**ELEVATION VIEW**


\* DIMENSIONS TO BE CONFIRMED BY THE MANUFACTURER.  
**NOTE:**  
 "STANDARD DETAIL" REFERS TO DETAILS IN HOWARD COUNTY DESIGN MANUAL VOLUME IV, STANDARD SPECIFICATIONS AND DETAILS FOR CONSTRUCTION.

**6'-0" & 8'-0" DIAMETER PRECAST MANHOLE**  
 NO SCALE

6' AND 8' DIAMETER MANHOLE DIMENSION SCHEDULE								
MH DIA.	A	B	C	D*	E*	F*	G*	H*
6'	6'	4'	6'	7'-6"	2'-9"	2'-9"	5'-4"	1'-11"
8'	8'	5'	8'	9'-6"	3'-9"	3'-3"	6'-4"	1'-11"

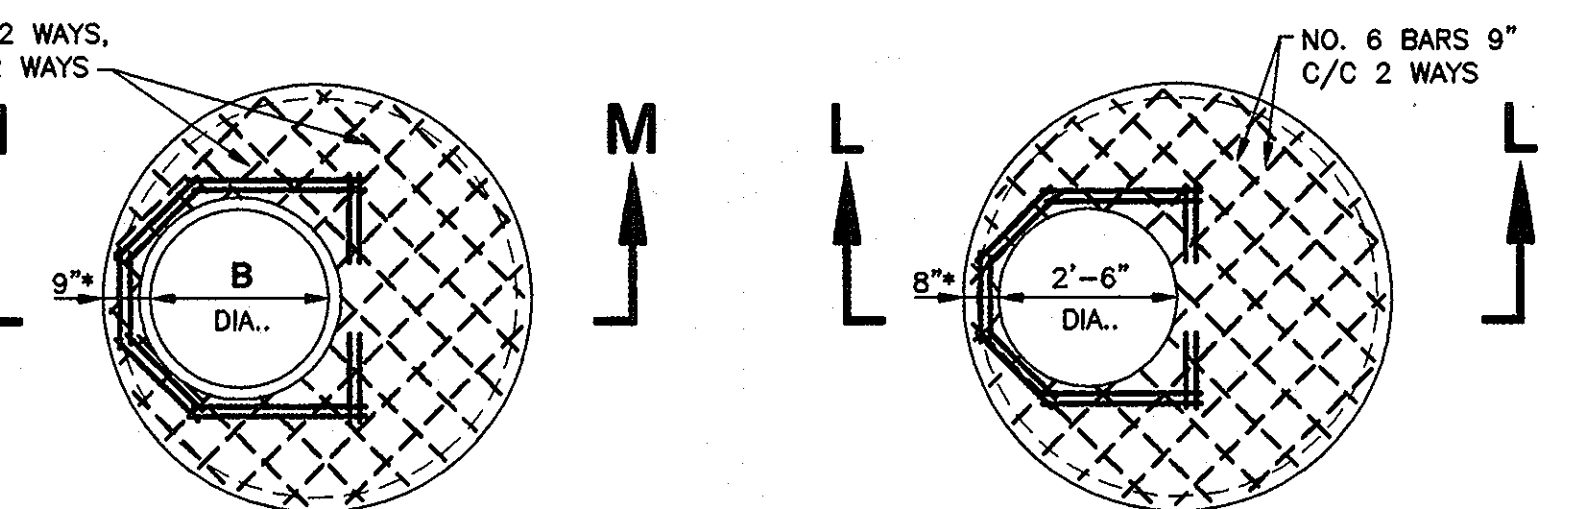


**MANHOLE FLAT TOP SLAB REDUCER PLAN**  
**MANHOLE FLAT TOP SLAB PLAN**

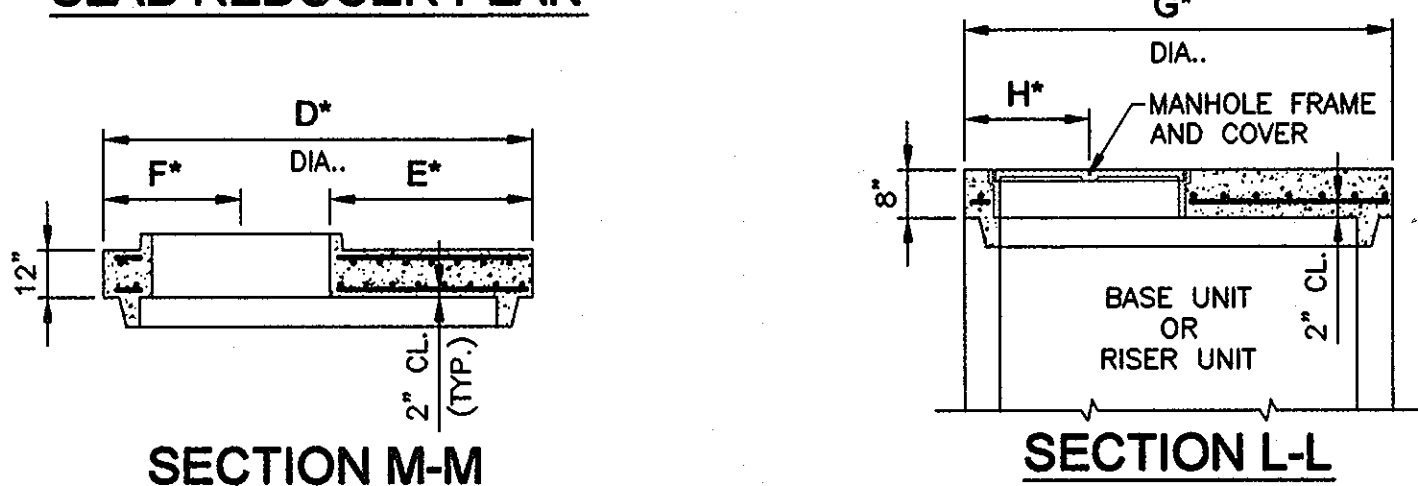

**SECTION M-M**  
**SECTION L-L**

- 6'-0" & 8'-0" DIAMETER MANHOLE NOTES:**
- MANHOLES SHALL BE CONSTRUCTED IN ACCORDANCE WITH ASTM C-478 AND THE GENERAL NOTES APPLICABLE TO PRECAST MANHOLES ON STANDARD DETAIL G-5.11.
  - CONCRETE SHALL BE MIX NO. 6 (4500 PSI).
  - WALL REINFORCEMENT FOR BASE AND RISER UNITS SHALL BE REINFORCEMENT BARS OR WELDED WIRE FABRIC WITH A MINIMUM AREA OF 0.28 IN<sup>2</sup>/FT FOR THE 72" DIAMETER MANHOLES AND 0.37 IN<sup>2</sup>/FT. FOR THE 96" DIAMETER MANHOLES, RESPECTIVELY. WELDED WIRE FABRIC SHALL CONFORM TO ASTM A-185 AND A-82. REINFORCEMENT BARS SHALL MEET ASTM A-615, GRADE 60.
  - BASE REINFORCEMENT TO BE REINFORCEMENT BARS OR WELDED WIRE FABRIC WITH A MINIMUM AREA OF 0.28 IN<sup>2</sup>/FT. FOR THE 72" DIAMETER MANHOLES AND 0.37 IN<sup>2</sup>/FT. FOR THE 96" DIAMETER MANHOLES, RESPECTIVELY. THE BASE SHALL BE MONOLITHIC WITH THE BASE UNIT OR JOINTED PER MANUFACTURER'S DESIGN.
  - THE MANUFACTURER SHALL FORM MALE AND FEMALE ENDS OF JOINTS USING THEIR OWN DESIGN. THE JOINTS SHALL BE SEALED BY THE CONTRACTOR AND MADE WATERTIGHT USING RUBBER O-RING GASKETS ASTM A-361 & C-443.
  - MINIMUM DISTANCE BETWEEN PIPE OPENINGS IN MANHOLE WALL SHALL BE 12 INCHES.
  - LIFT HOLES OR LIFT EYES SHALL BE PROVIDED IN EACH SECTION FOR HANDLING.
  - MIX NO. 6 PRECAST CONCRETE OR BRICK CHANNEL SHALL BE PROVIDED AND SHALL SLOPE TOWARD OUTLET AS DIRECTED BY THE ENGINEER.
  - NO MORE THAN ONE 1' HIGH RISER SECTION MAY BE USED PER MANHOLE.
  - MANHOLE INTERIOR LINER REQUIRED. REFER TO "SANITARY SEWER MANHOLES" SECTION OF THE SPECIAL PROVISIONS.


- 4'-0" DIAMETER MANHOLE NOTES:**
- MANHOLES SHALL BE CONSTRUCTED ACCORDING TO HOWARD COUNTY DESIGN MANUAL VOLUME IV STANDARD DETAILS G-5.11 AND G-5.12 EXCEPT THAT THE TOP RISER UNIT WILL BE CYLINDRICAL, NOT CONE SHAPED, WITH A 30" MANHOLE FRAME AND COVER CAST INTO A FLAT TOP SLAB WHICH HAS SAME CONFIGURATION, DIMENSIONS AND REINFORCEMENT AS THE TOP SLAB FOR THE 6'-0" DIAMETER MANHOLE SHOWN ON THIS SHEET.

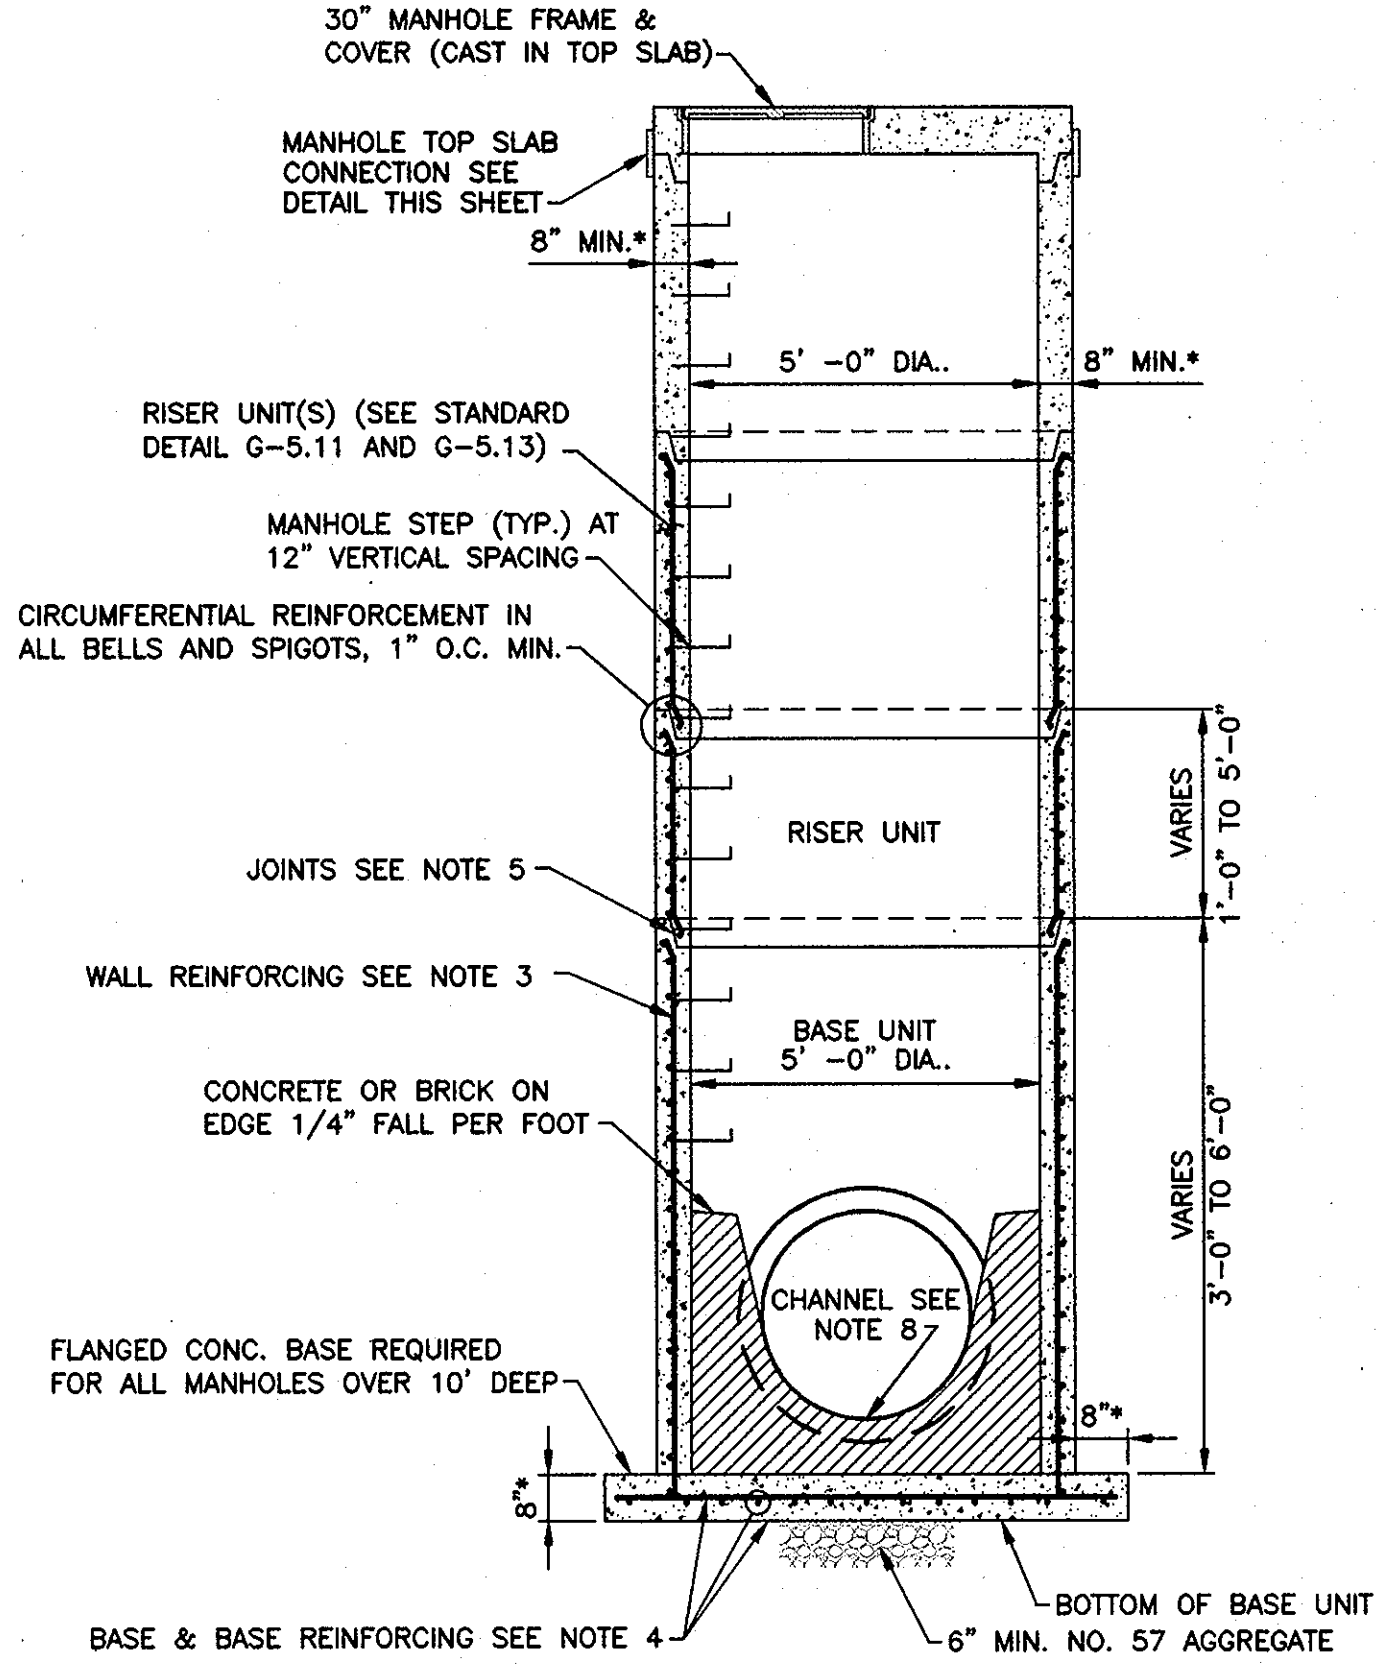


**ELEVATION VIEW**

\* DIMENSIONS TO BE CONFIRMED BY THE MANUFACTURER.  
**NOTE:**  
 "STANDARD DETAIL" REFERS TO DETAILS IN HOWARD COUNTY DESIGN MANUAL VOLUME IV, STANDARD SPECIFICATIONS AND DETAILS FOR CONSTRUCTION.

**5'-0" DIAMETER PRECAST MANHOLE**  
 NO SCALE

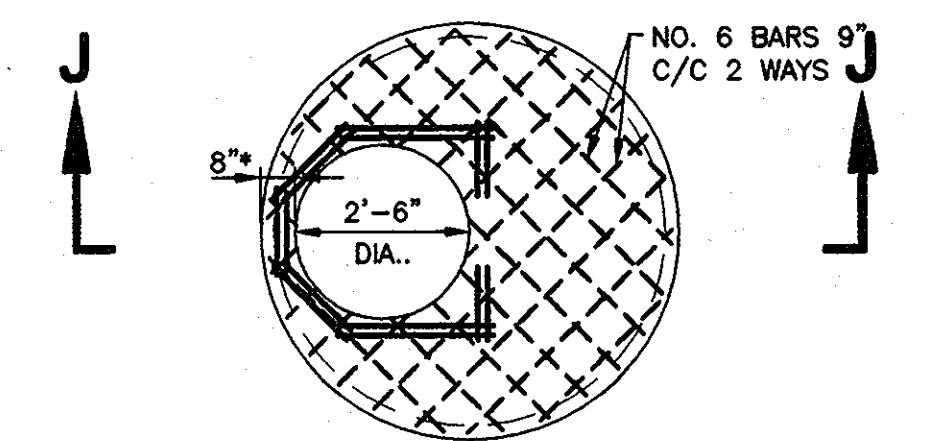


**5' Ø MANHOLE FLAT TOP SLAB PLAN**  
 (SHOWN WITHOUT FRAME & COVER)

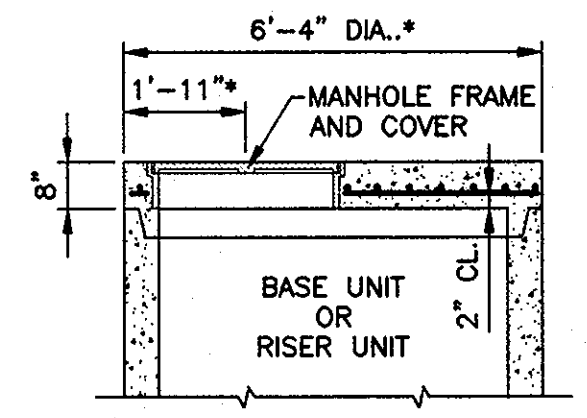


**SECTION J-J**


- 5'-0" DIAMETER MANHOLE NOTES:**
- MANHOLES SHALL BE CONSTRUCTED IN ACCORDANCE WITH ASTM C-478 AND THE GENERAL NOTES APPLICABLE TO PRECAST MANHOLES ON STANDARD DETAIL G-5.11.
  - CONCRETE SHALL BE MIX NO. 6 (4500 PSI).
  - WALL REINFORCEMENT FOR BASE AND RISER UNITS SHALL BE REINFORCEMENT BARS OR WELDED WIRE FABRIC WITH A MINIMUM AREA OF 0.23 IN<sup>2</sup>/FT. FOR THE 60" DIAMETER MANHOLES. WELDED WIRE FABRIC SHALL CONFORM TO ASTM A-185 AND A-82. REINFORCEMENT BARS SHALL MEET ASTM A-615, GRADE 60.
  - BASE REINFORCEMENT TO BE REINFORCEMENT BARS OR WELDED WIRE FABRIC WITH A MINIMUM AREA OF 0.23 IN<sup>2</sup>/FT. THE BASE SHALL BE MONOLITHIC WITH THE BASE UNIT OR JOINTED PER MANUFACTURER'S DESIGN.
  - THE MANUFACTURER SHALL FORM MALE AND FEMALE ENDS OF JOINTS USING THEIR OWN DESIGN. THE JOINTS SHALL BE SEALED BY THE CONTRACTOR AND MADE WATERTIGHT USING RUBBER O-RING GASKETS ASTM A-361 & C-443.
  - MINIMUM DISTANCE BETWEEN PIPE OPENINGS IN MANHOLE WALL SHALL BE 12 INCHES.
  - LIFT HOLES OR LIFT EYES SHALL BE PROVIDED IN EACH SECTION FOR HANDLING.
  - MIX NO. 6 PRECAST CONCRETE OR BRICK CHANNEL SHALL BE PROVIDED AND SHALL SLOPE TOWARD OUTLET AS DIRECTED BY THE ENGINEER.
  - NO MORE THAN ONE 1' HIGH RISER SECTION MAY BE USED PER MANHOLE.
  - MANHOLE INTERIOR LINER REQUIRED. REFER TO "SANITARY SEWER MANHOLES" SECTION OF THE SPECIAL PROVISIONS.

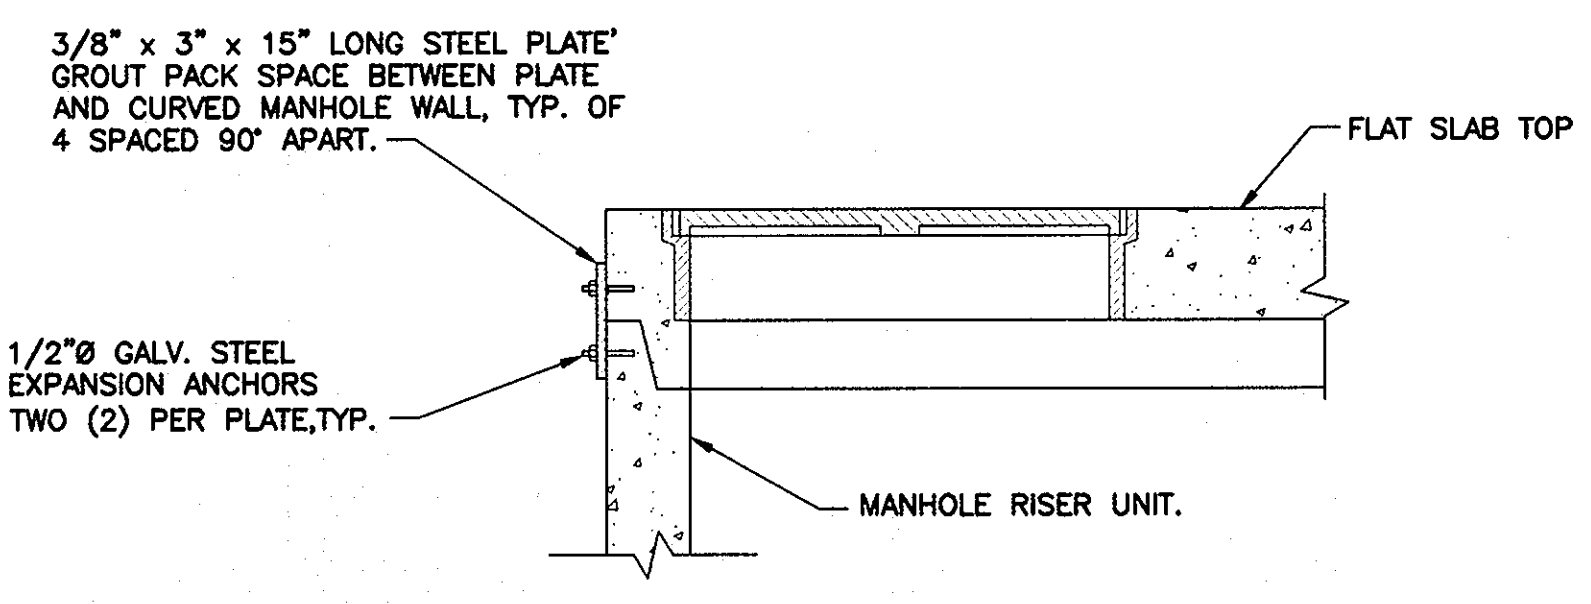

**MANHOLE SLAB TOP CONNECTION**  
 NO SCALE

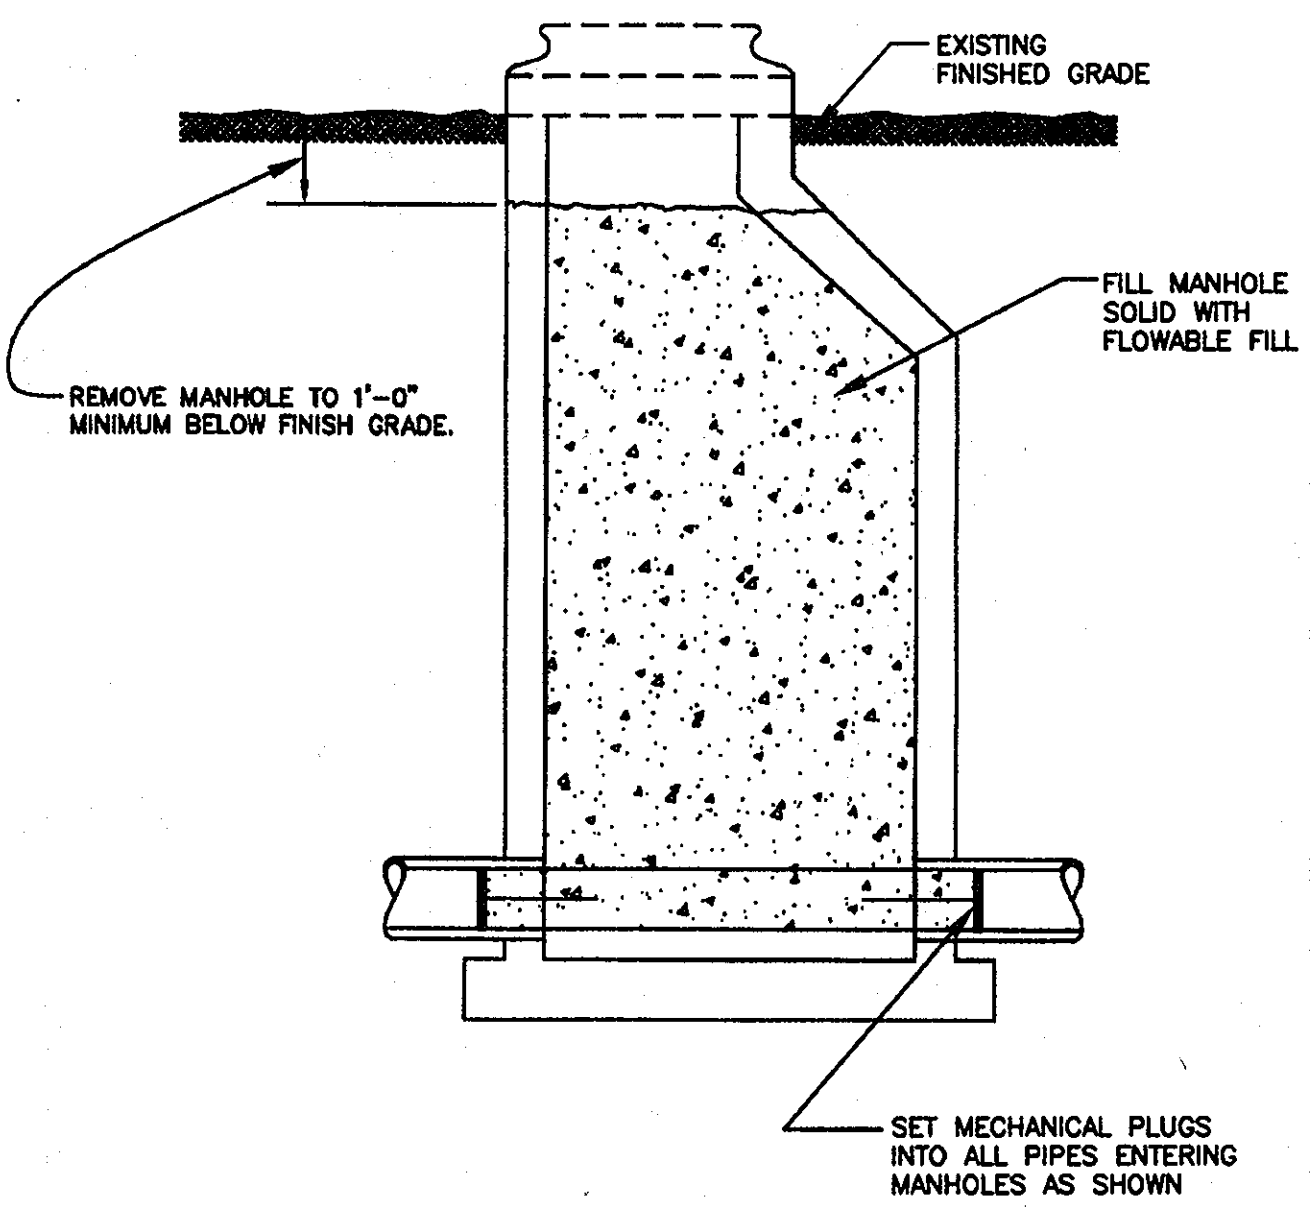

**COMPLETE MANHOLE ABANDONMENT**  
 NO SCALE

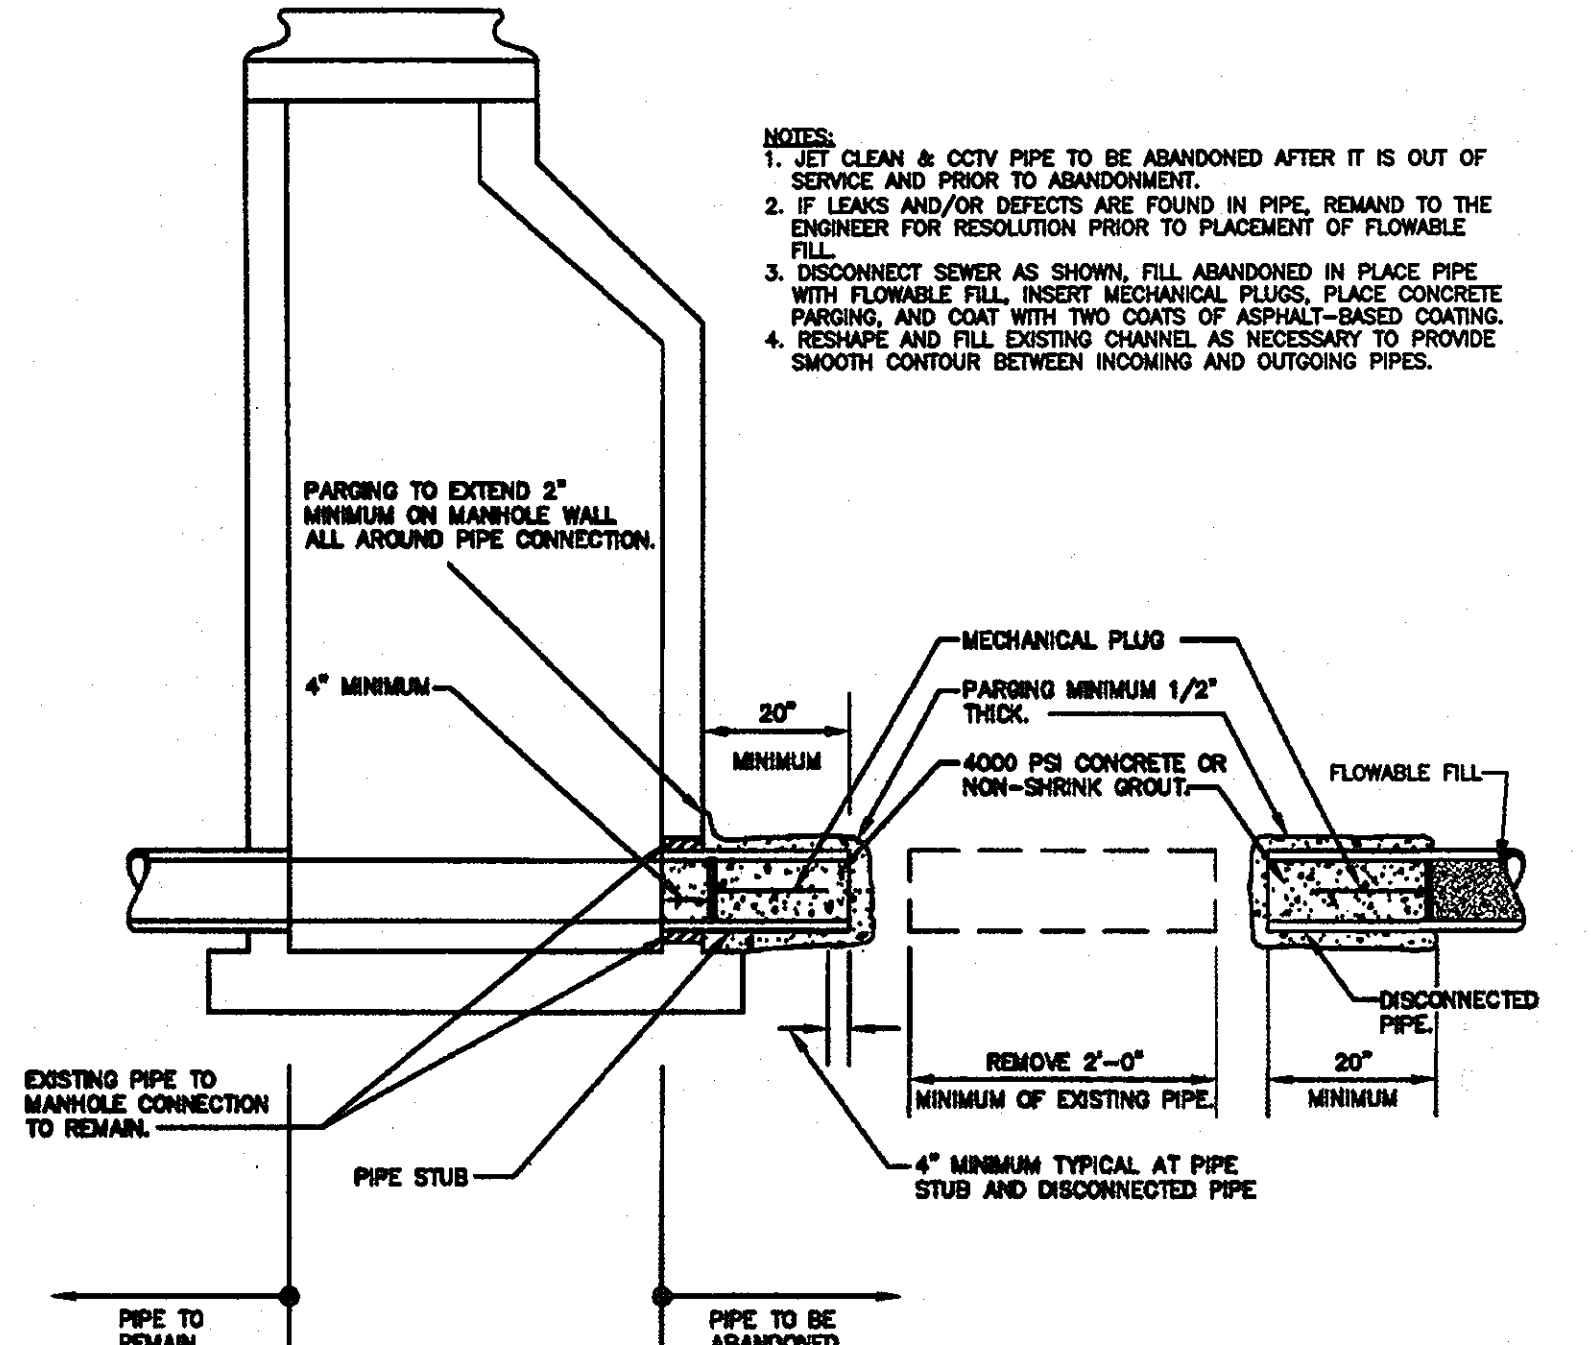

**ABANDONMENT OF PIPE AT MANHOLE & LEFT IN PLACE**  
 NO SCALE

**DEPARTMENT OF PUBLIC WORKS**  
 HOWARD COUNTY, MARYLAND

Director of Public Works: [Signature] DATE: 6/2/10  
 Chief, Bureau of Engineering: [Signature] DATE: 6/2/10  
 Chief, Utility Design Division: [Signature] DATE: 6/2/10

**Dewberry**  
 Dewberry & Davis LLC  
 3108 LORD BALTIMORE DRIVE  
 SUITE 110  
 BALTIMORE, MD 21244-2092  
 410.285.9500  
 FAX: 410.285.8875



DES: LAL			
DRN: CD			
CHK: TND			
DATE: 5.28.10	BY	NO.	REVISIONS

**MISCELLANEOUS DETAILS**




600' SCALE MAP NO. 37, 43  
 BLOCK NO. 5, 23

**LITTLE PATUXENT PARALLEL INTERCEPTOR**  
 CAPITAL PROJECT S-6175  
 CONTRACT NO. 20-4540

ELECTION DISTRICT NO. 5  
 HOWARD COUNTY, MARYLAND

SCALE: SHOWN  
 SHEET 10 OF 26

Printed by: [Company Name] Date: [Date] Job: [Job Name] Scale: [Scale] Project: [Project Name]

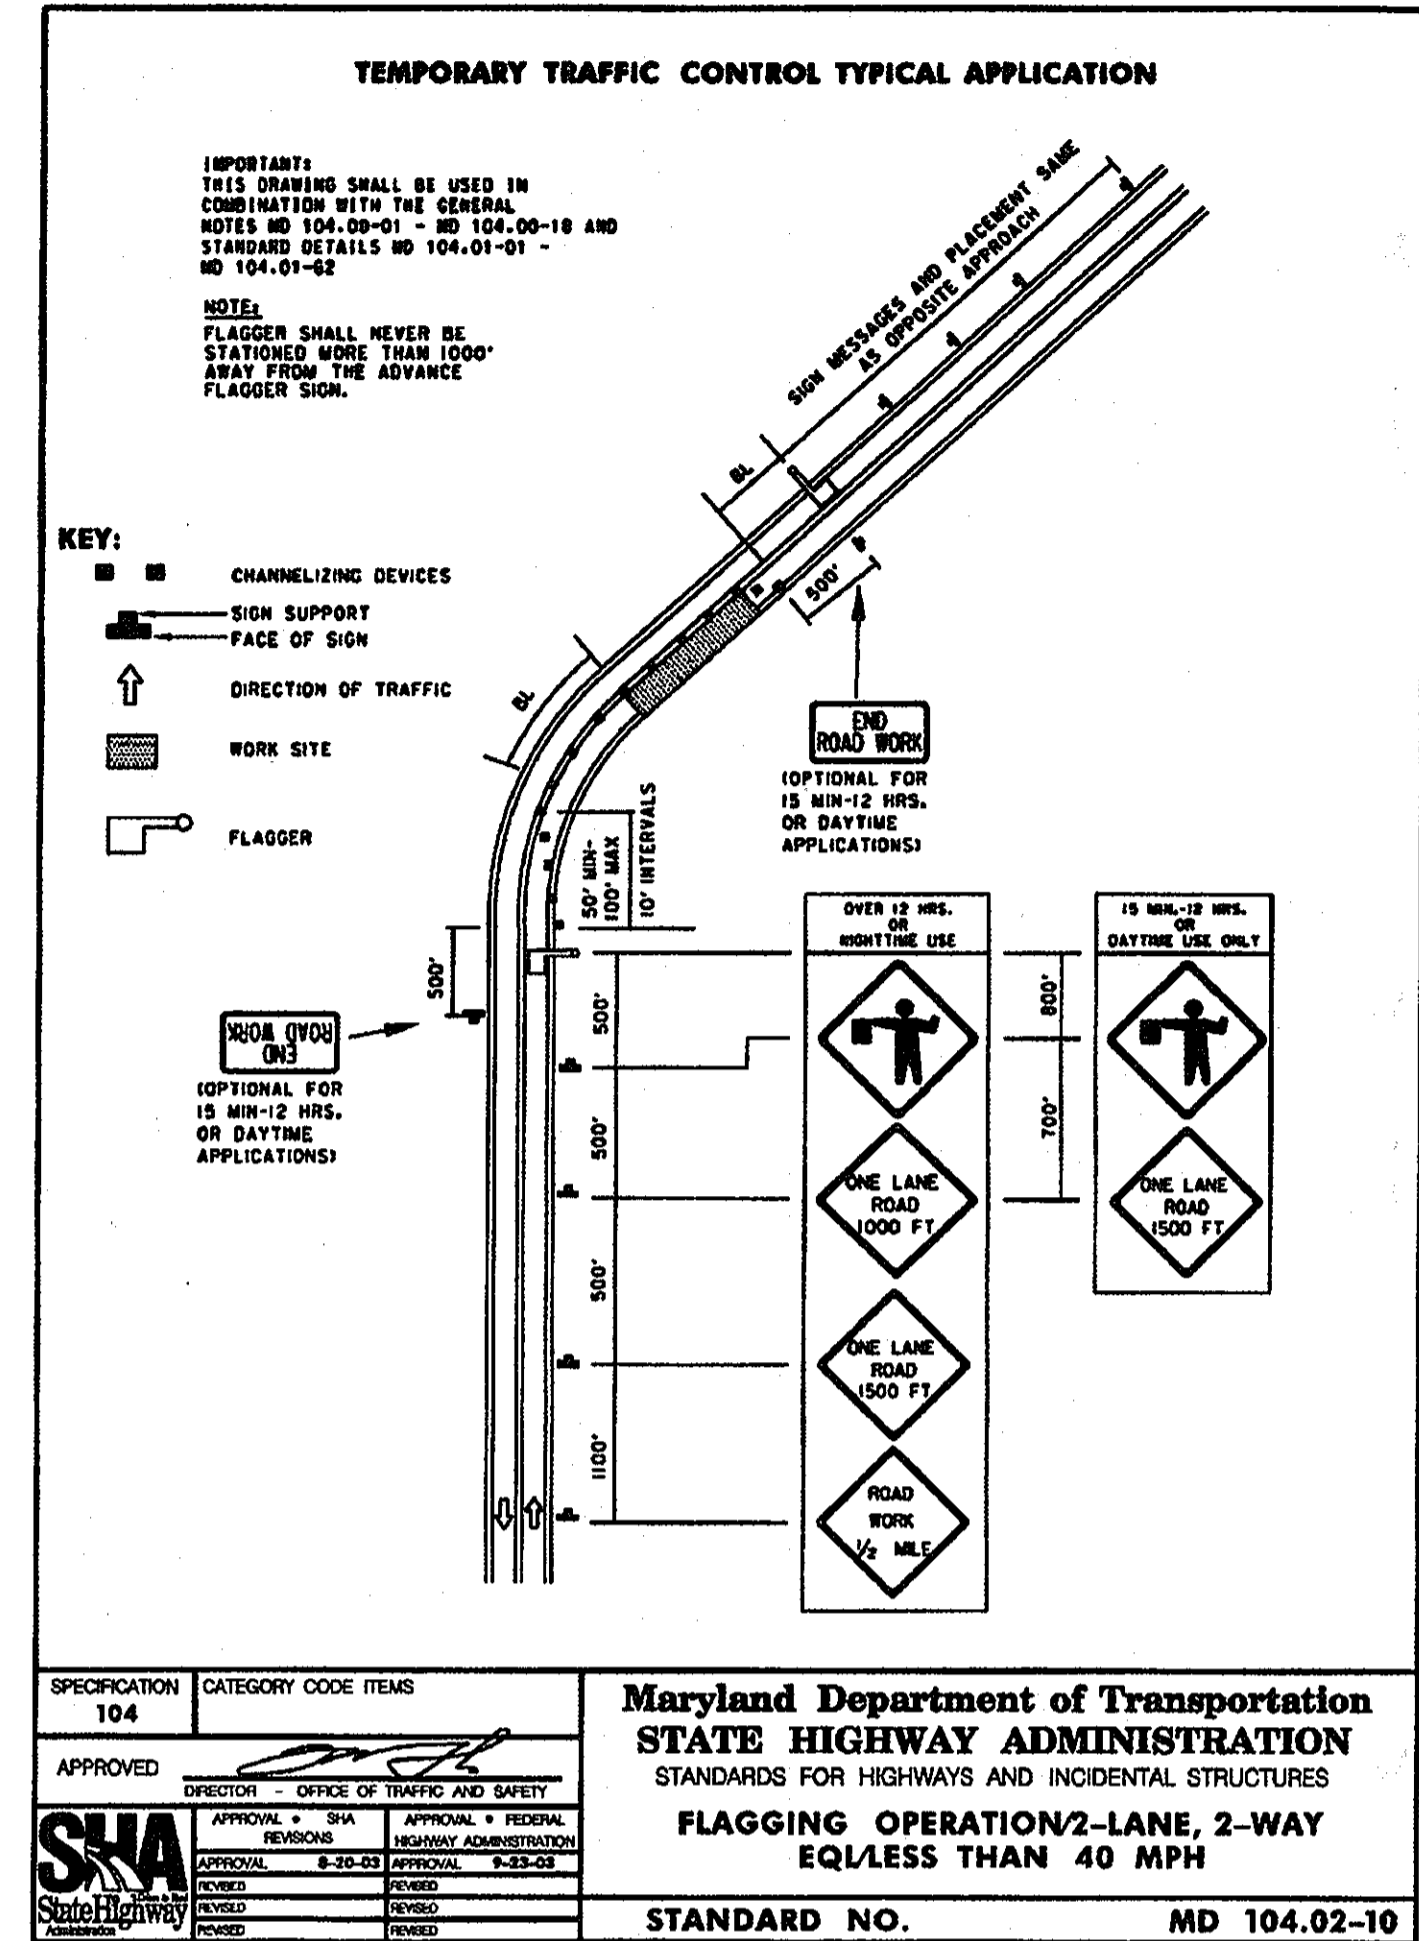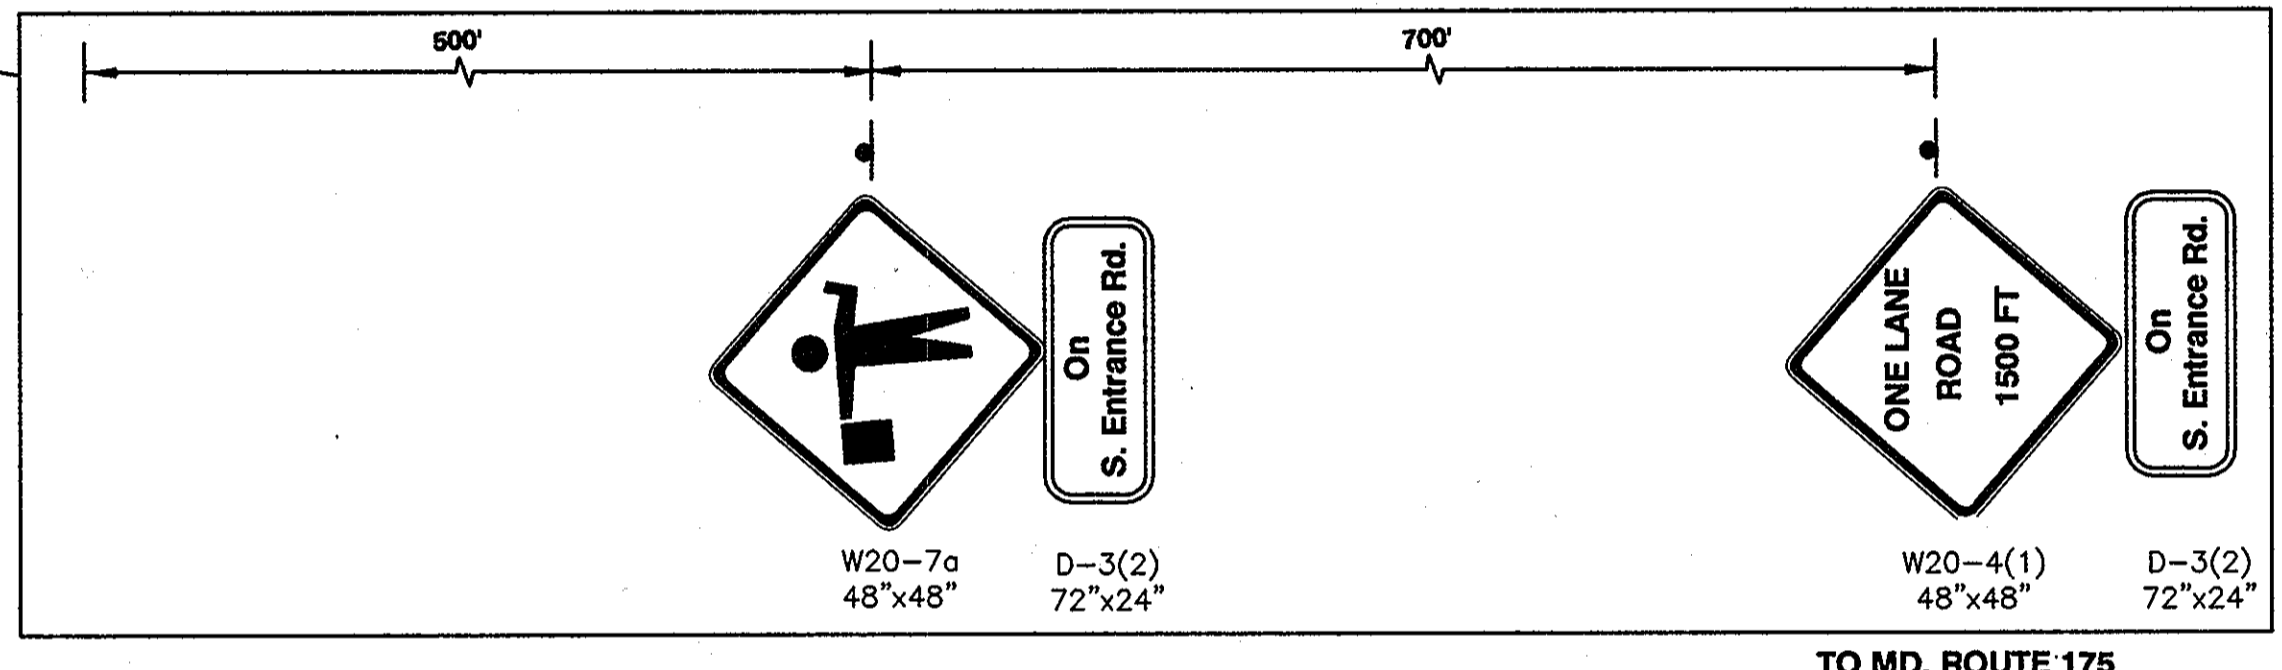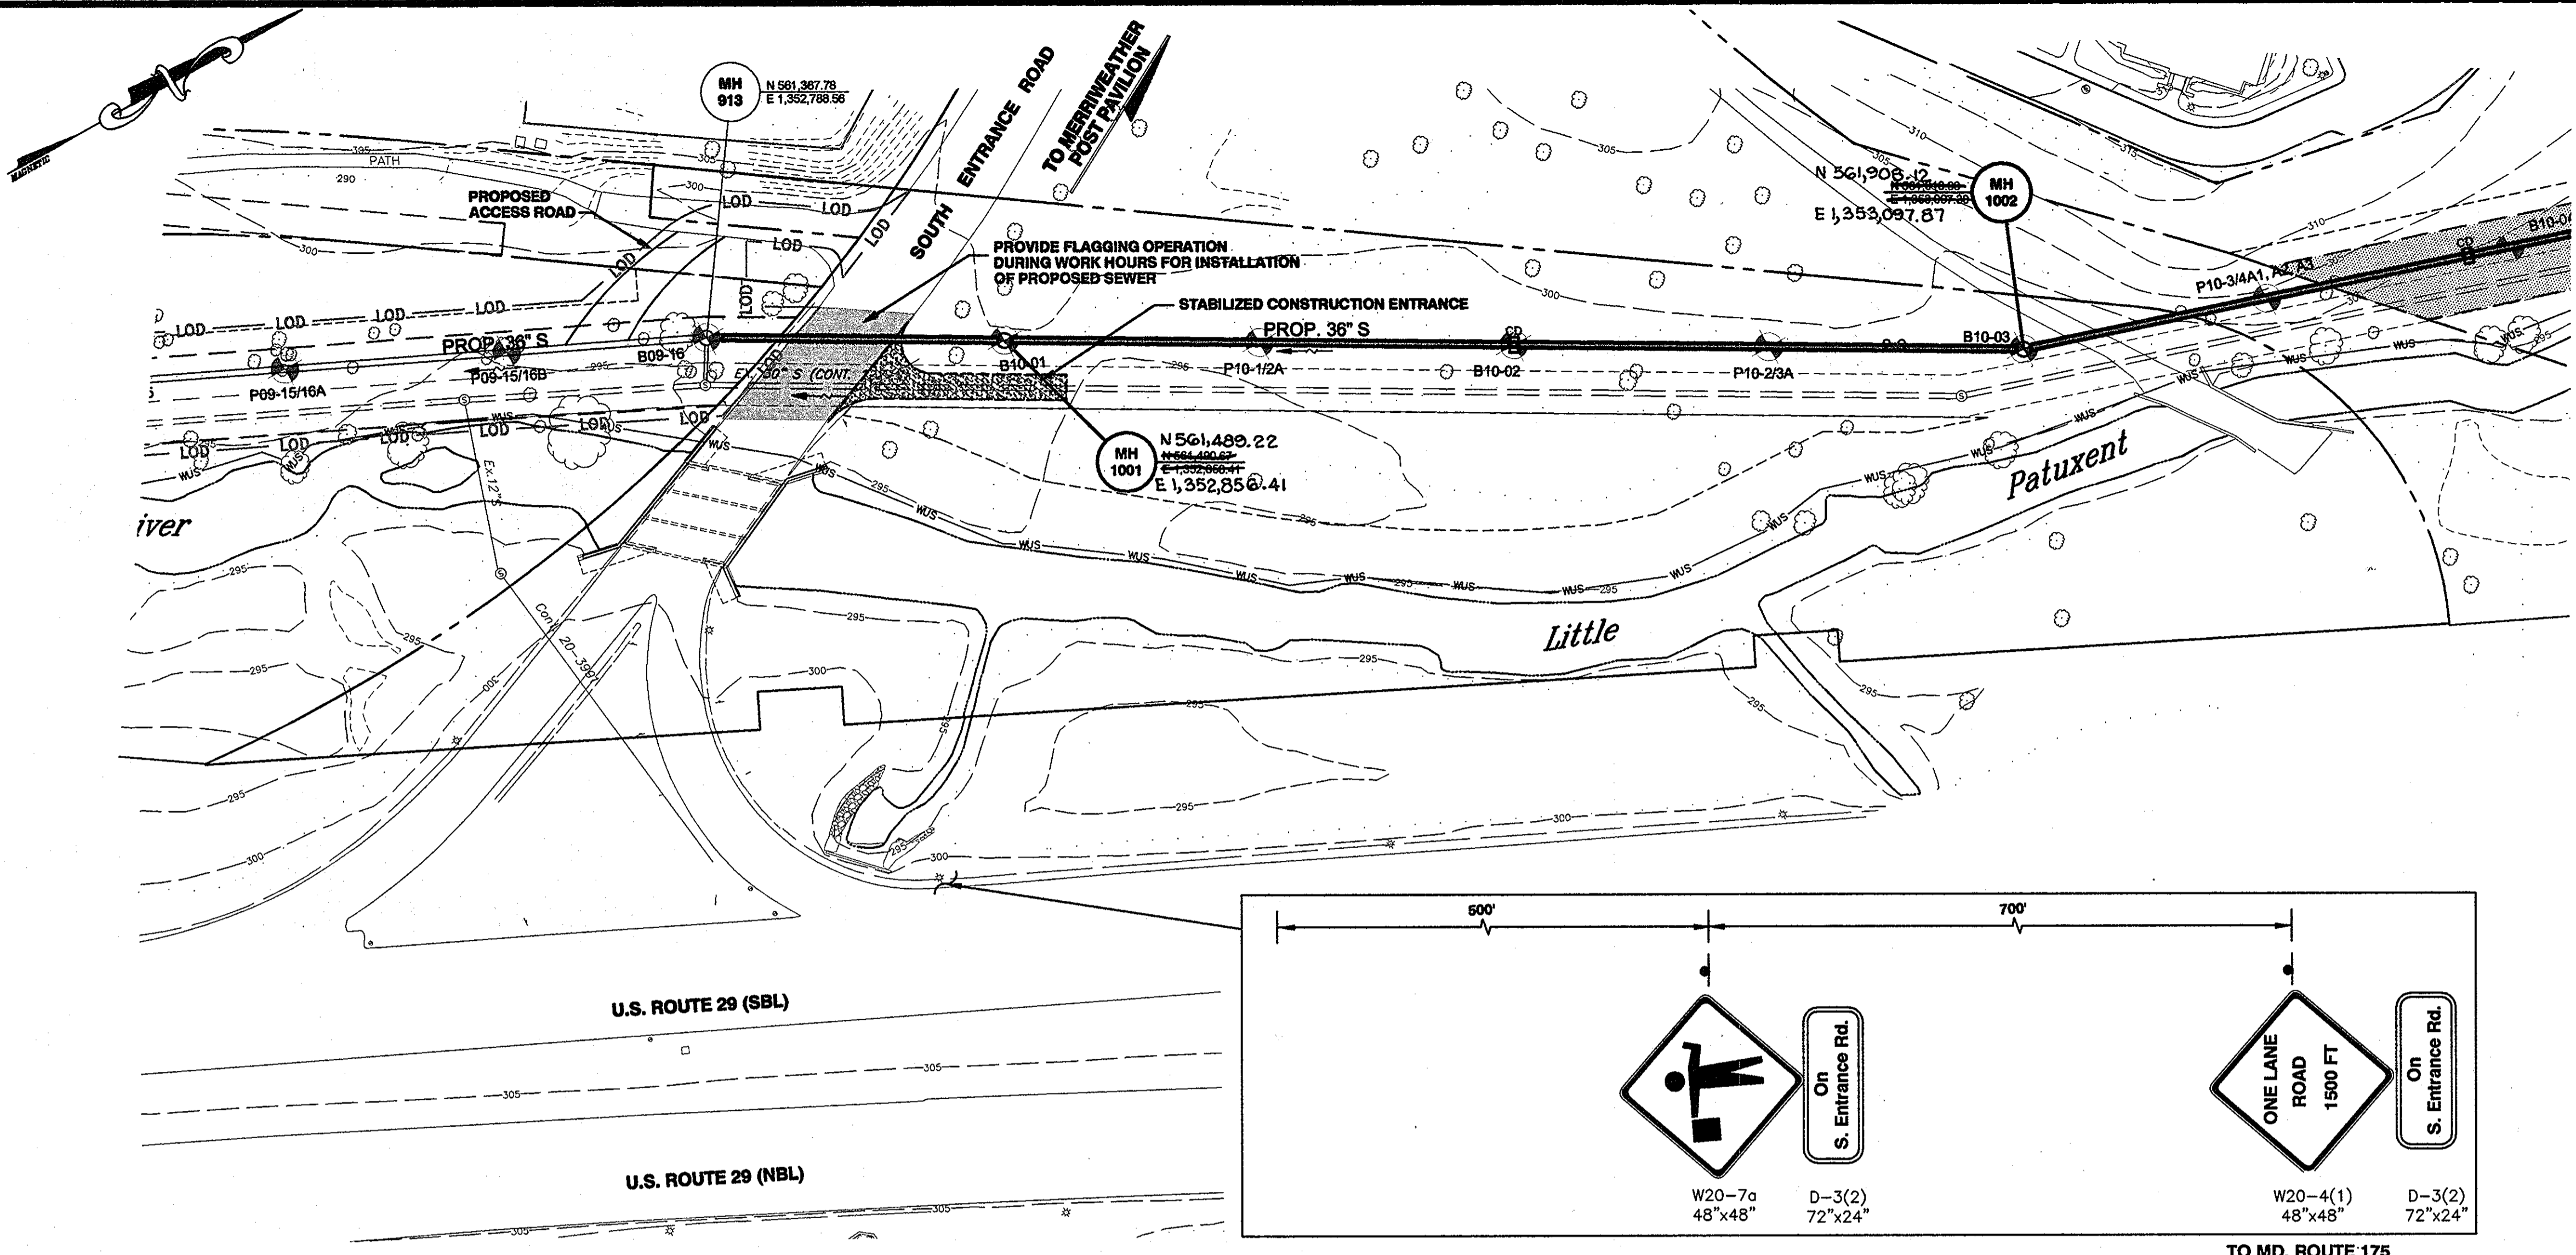

LEGEND:  
 WORK AREA

**GENERAL NOTES FOR TEMPORARY TRAFFIC CONTROL TYPICAL APPLICATIONS (TTCTA)**

1.0 INTRODUCTION

1.1 The General Notes (GN) supplement the Standard Details and the TTCTAs, and have been assembled to provide additional direction on the installation and application of traffic control devices shown in these standards. The GNs also provide additional guidelines and other useful information that will facilitate the installation of appropriate temporary traffic controls. Users of these standards shall also comply with provisions of FHWA's Manual on Uniform Traffic Control Devices (MUTCD) and SHA's Supplement to the MUTCD, Standard Specifications for Construction and Materials, and General Provisions for Construction Contracts.

1.2 The TTCTA show the minimum requirements necessary to plan for the safety of workers, motorists, pedestrians, and other system users throughout the temporary traffic control zone for various types of work activities. Typically, more traffic control devices are required for long-term stationary work activities than for short-term stationary work activities. Additional temporary traffic control devices may be necessary because of other traffic factors, such as the roadway's accident history, expected traffic backups, high truck traffic, roadway geometrics or characteristics, and other conditions that may adversely affect the flow of traffic. Users of these TTCTA should review the temporary traffic control setup once in place to ensure that traffic is traveling smoothly throughout the traffic control zone, driver expectancy is being met, and no other adjustments to the temporary traffic control devices are necessary. This review is to be repeated on a regular basis as noted elsewhere.

1.3 The TTCTA address a wide variety of different conditions; however, every situation could not be shown. Therefore, charts have been provided showing standard devices to be used for the proposed work zone activity and the placement of these devices for certain roadway conditions and work durations. The user is expected to combine the information from these charts into a workable traffic control plan.

1.4 In applying these standards and guidelines, questions about applications and interpretations should be referred to the State Highway Administration's Assistant District Engineer—Traffic, County Traffic Engineer, City Traffic Engineer, Public Works Engineer, or other responsible party, who has expertise in traffic engineering and has jurisdiction on the appropriate roadways. Such consultation may be required, for example, to determine the appropriate TTCTA for the work zone condition.

2.0 CHANNELIZING DEVICES

2.1 Taper Formulas:

$L = WS$  for speeds greater than ( $>$ ) 40 mph.  
 $L = WS^2/60$  for speeds equal to or less than ( $\leq$ ) 40 mph

Where: L = minimum length of taper (ft)  
 S = numerical value of prevailing travel speed or speed limit (MPH), whichever is higher, prior to work starting.  
 W = width of offset (ft)

2.2 Maximum spacing between channelizing devices:  
 Taper Channelization: equal in feet to the posted speed limit.  
 Tangent Channelization: equal in feet to twice the posted speed limit.

2.3 At horizontal or vertical curves, channelizing devices should be extended to a point where they are visible to approaching traffic. On two-lane, two-way roadways, a full taper length shall always be provided in advance of curves.

2.4 Drums, not cones, should always be used to form the taper on roadways having a prevailing travel speed greater than 40 MPH.

2.5 Storing channelizing devices within 30 feet of the edge of open section roadway or 15 feet of a closed section roadway along any roadway is prohibited without approval of the Engineer.

2.6 Type 3 object markers (VP-1) are required for barrier flare/tangent points.

2.7 The appropriate channelizing devices (including approved barrier) to separate opposing traffic shall be as shown on the plans or as directed by the Engineer.

2.8 On straight sections of roadway with full dimension center and/or lane lines, but without edge lines, channelizing drums shall be used to delineate the edge of the roadway, except at locations designated by the Engineer. Examples would include roadways with curbs, parking, bicycle lanes, or other markings. The channelizing drums may be spaced up to 500' apart where no undue hazards exist unless otherwise directed by the Engineer. On curves, these spacings shall be reduced to a value equal to the posted speed limit, unless otherwise directed by the Engineer.

2.9 For information on channelizing devices, refer to Standard Nos. MD 104.01-30B and MD 104.01-30C.

3.0 TRAFFIC CONTROL PLANS

3.1 Alternate traffic control plans may be presented to the County Traffic Engineer and/or SHA District Office for approval in conformance with Section 104.01 of the Standard Specifications for Construction and Materials.

3.2 All signs, channelizing devices, and other traffic control devices shall be in conformance with the latest edition of the MUTCD.

3.3 Access to all entrances, driveways, and side streets along S. Entrance Road shall be maintained at all times during work operations. The contractor shall provide advanced notice to business owners for work access entrances/driveways.

3.4 Work on S. Entrance Road shall be completed using a single lane closure with a flagging operation. Refer to Standard No. MD 104.02-10 and this plan for temporary lane closure and flagging operations. Maintain a minimum 10' lane width. Provide recessed steel plates over any open trenches at the end of each working day in order to open S. Entrance Road for 2-way traffic.

3.5 Storage of construction equipment and materials shall be located off the travel lanes at all times. The clear zone width for the work zone along S. Entrance Road is to be a minimum 16'.

3.6 Existing signs located within the work area shall either remain in place or be relocated/maintained as directed by the Engineer.

4.0 SEQUENCE OF CONSTRUCTION

4.1 Install Sediment and Erosion Control measures as indicated on the Sediment and Erosion Control Plans.

4.2 Install temporary traffic channelization devices and temporary signs as indicated on the details and this plan.

4.3 Construct proposed sewer main.

4.4 Construct full-depth patches on S. Entrance Road.

**DEPARTMENT OF PUBLIC WORKS**  
 HOWARD COUNTY, MARYLAND

Director: *[Signature]* 6/3/10  
 Chief, Bureau of Public Works

Chief, Bureau of Engineering: *[Signature]* 6/2/10  
 Chief, Utility Design Division

**Dewberry**  
 Dewberry & Davis LLC

3108 LORD BALTIMORE DRIVE  
 SUITE 110  
 BALTIMORE, MD 21244-2962  
 410.285.8200  
 FAX: 410.285.8875



DES: LAL	
DRN: CD	
CHK: TND	
DATE: 5.28.10	
BY: NO.	
REVISIONS	
DATE	

**MAINTENANCE OF TRAFFIC ACCESS ROAD PLAN**

600' SCALE MAP NO. 37, 43 BLOCK NO. 5, 23

**LITTLE PATUXENT PARALLEL INTERCEPTOR**  
 CAPITAL PROJECT S-6175  
 CONTRACT NO. 20-4540


ELECTION DISTRICT NO. 5 HOWARD COUNTY, MARYLAND

SCALE: SHOWN  
 SHEET 11 OF 26

**AS-BUILTS**  
**97% SUBMITTAL DATE 5-12-10**

Project: S-6175, Title: Little Patuxent Parallel Interceptor, Date: 5/28/10, Sheet: 11 of 26.

Project: C:\Users\j... Date: Jun 01, 2010 10:43:00 AM  
Title: ESC PLAN SHEET 12  
User: j...  
Scale: AS-BUILT  
Sheet: 12 OF 26  
Project Path: C:\Users\j...  
Drawing Path: C:\Users\j...  
Drawing Name: ESC PLAN SHEET 12  
Drawing Scale: AS-BUILT  
Drawing Sheet: 12 OF 26

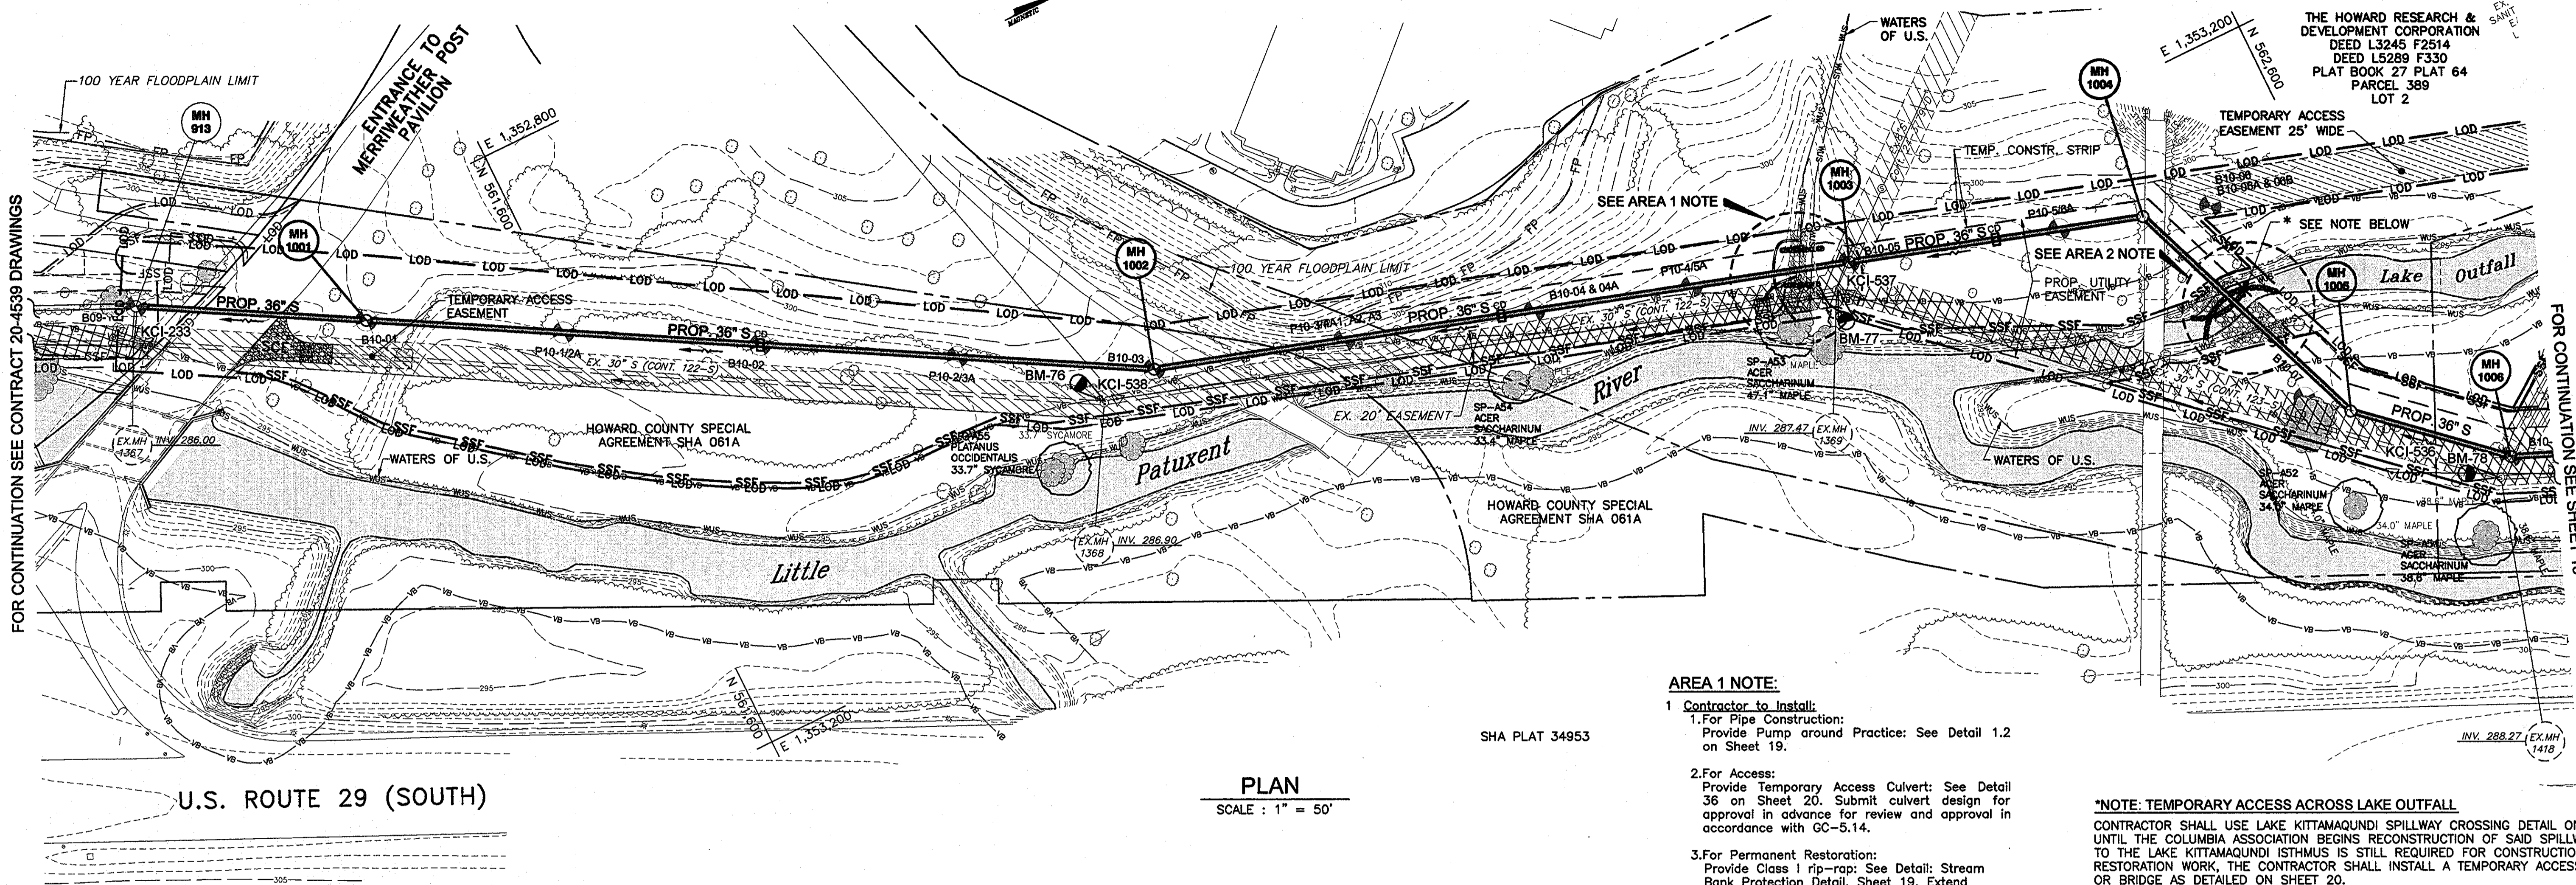

FOR CONTINUATION SEE CONTRACT 20-4539 DRAWINGS

FOR CONTINUATION SEE SHEET 13

THE HOWARD RESEARCH & DEVELOPMENT CORPORATION  
DEED L3245 F2514  
DEED L5289 F330  
PLAT BOOK 27 PLAT 64  
PARCEL 389  
LOT 2

SHA PLAT 34953

PLAN  
SCALE: 1" = 50'

AREA 1 NOTE:

- Contractor to Install:
  - For Pipe Construction: Provide Pump around Practice: See Detail 1.2 on Sheet 19.
  - For Access: Provide Temporary Access Culvert: See Detail 36 on Sheet 20. Submit culvert design for approval in advance for review and approval in accordance with GC-5.14.
  - For Permanent Restoration: Provide Class I rip-rap: See Detail: Stream Bank Protection Detail, Sheet 19. Extend rip-rap, Section C-C, through stream bottom.

AREA 2 NOTE:


- Contractor to Install:
  - For Pipe Construction: Provide Sandbag/Stone Diversion: See Detail 1.5 on Sheet 20.
  - For Access: Provide Temporary Access Culvert: (Detail 36) or Temporary Access Bridge (Detail 4.8) See Details on Sheet 20. Submit design for selected practice in advance for review and approval in accordance with GC-5.14.
  - For Permanent Restoration: Provide Class III rip-rap: See Detail: Stream Bank/Invert Protection, Sheet 19.

**NOTE: TEMPORARY ACCESS ACROSS LAKE OUTFALL**  
CONTRACTOR SHALL USE LAKE KITTAMAQUONDI SPILLWAY CROSSING DETAIL ON SHEET 13, UNTIL THE COLUMBIA ASSOCIATION BEGINS RECONSTRUCTION OF SAID SPILLWAY. IF ACCESS TO THE LAKE KITTAMAQUONDI ISTHMUS IS STILL REQUIRED FOR CONSTRUCTION OR RESTORATION WORK, THE CONTRACTOR SHALL INSTALL A TEMPORARY ACCESS CULVERT OR BRIDGE AS DETAILED ON SHEET 20.

**NOTE:**  
THE LOD IS COINCIDENT WITH THE PROPOSED UTILITY EASEMENT LINE AND SHOWN FIVE (5) FEET OUTSIDE THE ACTUAL LIMIT OF DISTURBANCE FOR CLARITY

- RESTORATION NOTES:**
- NON-TIDAL WETLANDS AND ASSOCIATED NON-TIDAL WETLAND BUFFERS WITHIN THE LIMITS OF DISTURBANCE (LOD) HAVE BEEN SHADED ON THIS PLAN FOR CLARITY. FOR WORKING IN THESE AREAS AND FOR RESTORING THEM ONCE THE SEWER INSTALLATION IS COMPLETE, THE CONTRACTOR SHALL ABIDE BY THE REQUIREMENTS OF THE "BEST MANAGEMENT PRACTICES FOR WORKING IN NON-TIDAL WETLANDS, WETLAND BUFFERS, WATERWAYS, AND 100-YEAR FLOODPLAIN" ON SHEET 18.
  - FOR GROUND PREPARATION, SOIL MODIFICATIONS, DISTURBED AREAS OUTSIDE OF THE WETLAND AND WETLAND BUFFER AREAS, SEE SHEET 17. THESE BASIC REQUIREMENTS ARE SUPPLEMENTED BY TECHNICAL SPECIFICATION SECTION 02260-"FINISH GRADING AND LANDSCAPING," IN THE SPECIFICATIONS, WHICH ADDRESS SPECIFIC SUB-GRADE PREPARATION AND FINISH GRADING REQUIREMENTS.
  - SHADING (SEE LEGEND THIS SHEET) DENOTES AREAS OF NON-TIDAL WETLANDS AND BUFFER WITHIN THE LOD

ESC LEGEND

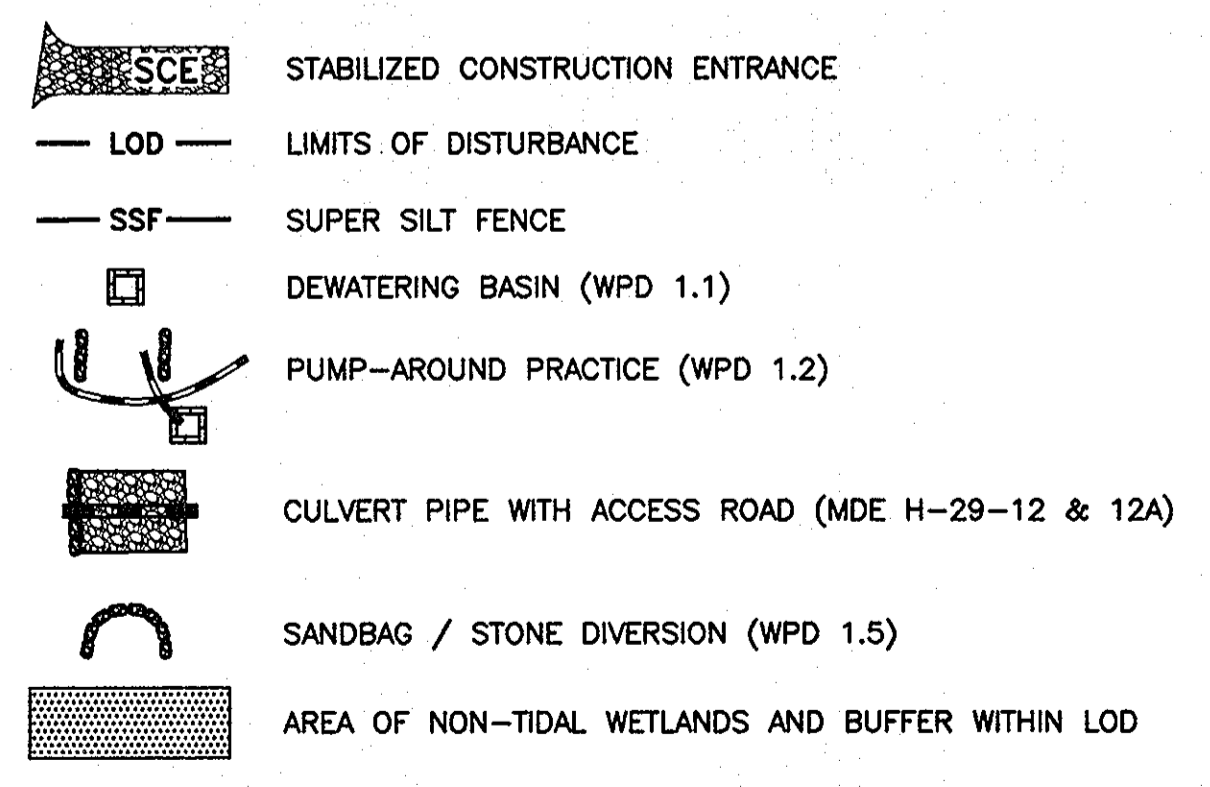

AS-BUILTS  
JUN 17 2010

ESC  
2 OF 10

DEPARTMENT OF PUBLIC WORKS  
HOWARD COUNTY, MARYLAND


*[Signature]* 6/3/10  
DIRECTOR OF PUBLIC WORKS DATE

*[Signature]* 6/2/10  
CHIEF, BUREAU OF UTILITIES DATE

*[Signature]* 6/2/10  
CHIEF, UTILITY DESIGN DIVISION DATE

*[Signature]* 6/2/10  
CHIEF, UTILITY DESIGN DIVISION DATE

**Dewberry**  
Dewberry & Davis LLC  
3108 LORD BALTIMORE DRIVE  
SUITE 110  
BALTIMORE, MD 21244-2662  
410.285.8500  
FAX: 410.285.8875

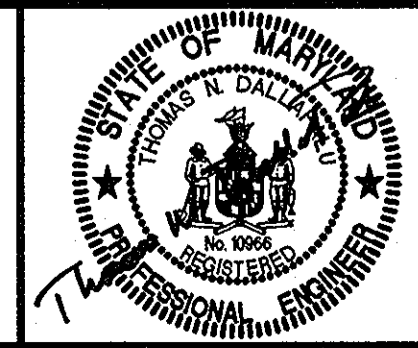

DES:	LAL
DRN:	CD
CHK:	TND
DATE:	5.28.10
BY:	NO.
NO.	
REVISIONS	
DATE	

**EROSION AND SEDIMENT CONTROL PLAN**

600' SCALE MAP NO. 37, 43 BLOCK NO. 5, 23


**LITTLE PATUXENT PARALLEL INTERCEPTOR**

CAPITAL PROJECT S-6175  
CONTRACT NO. 20-4540

ELECTION DISTRICT NO. 5 HOWARD COUNTY, MARYLAND

SCALE:  
SHOWN

SHEET  
12 OF 26




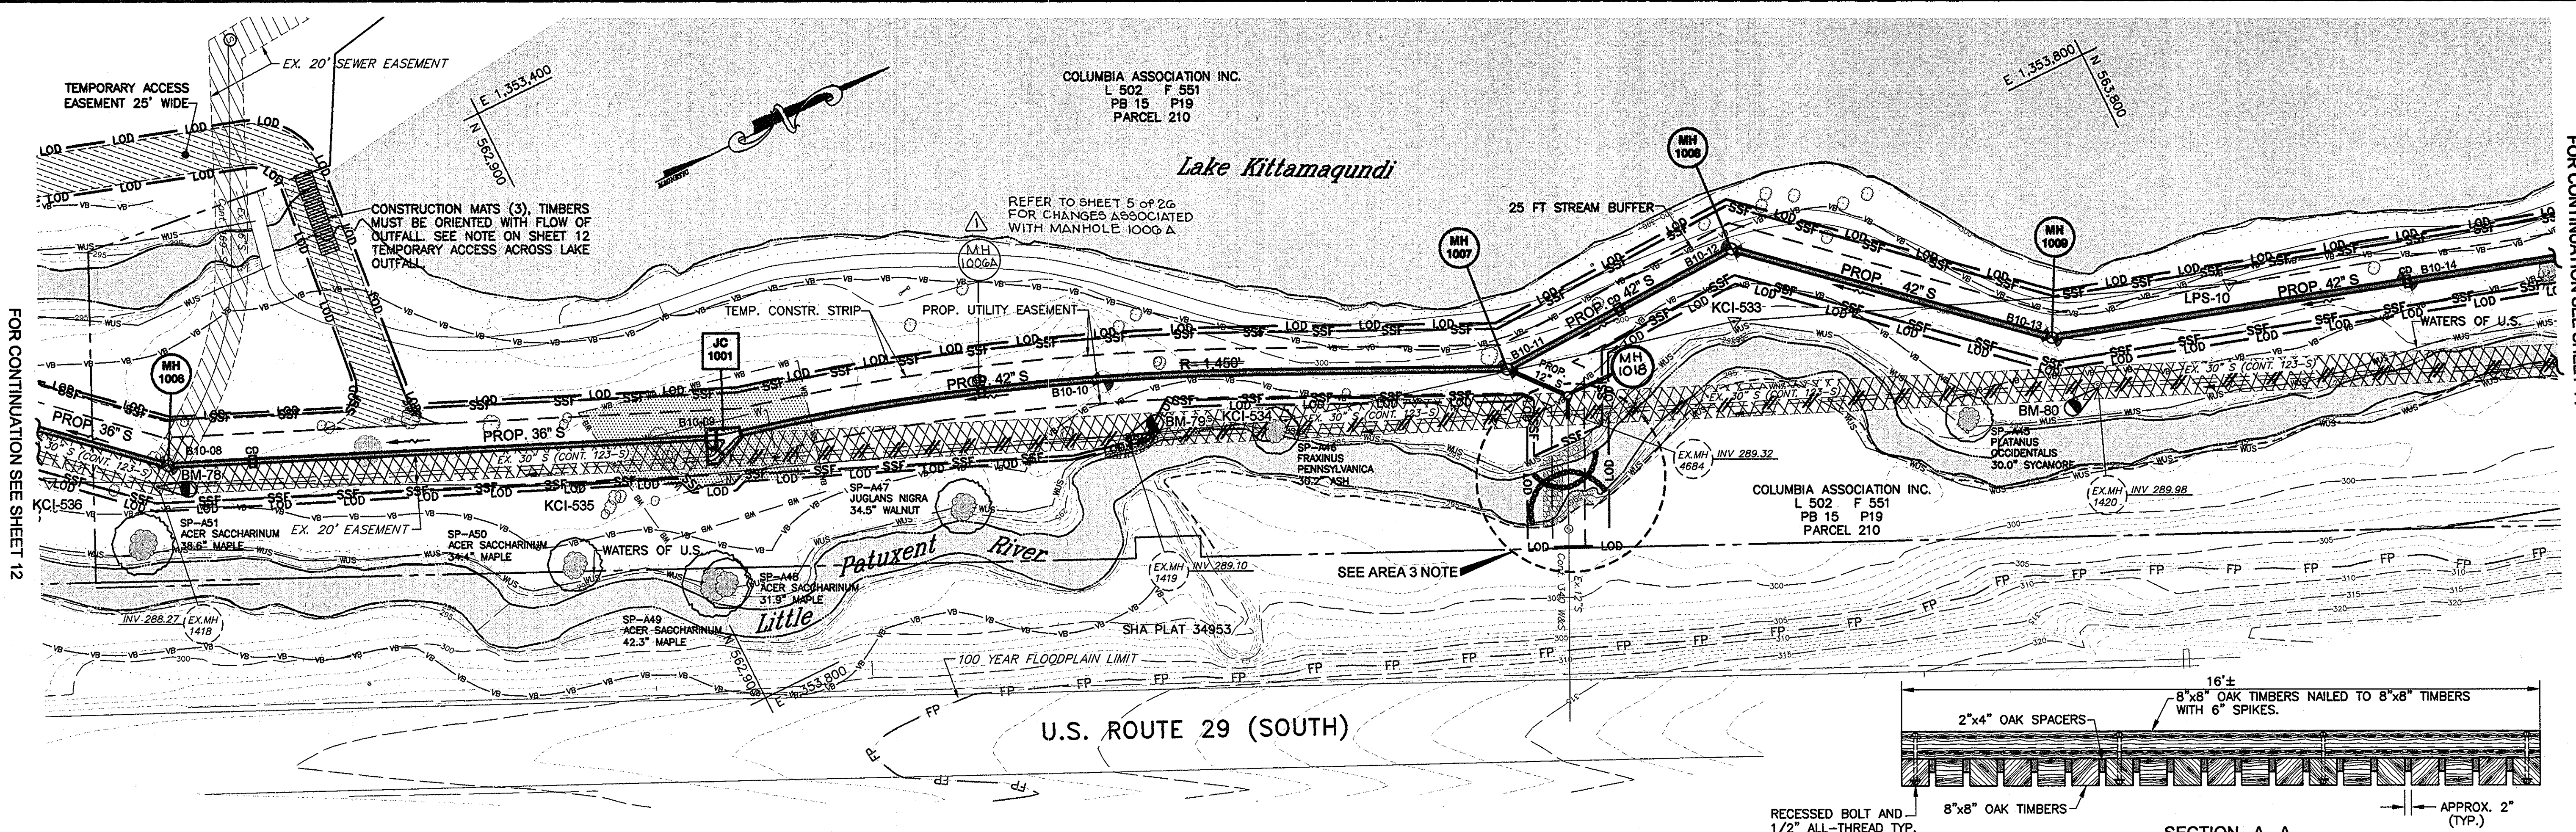


**PLAN**  
SCALE: 1" = 50'

**NOTE:**  
THE LOD IS COINCIDENT WITH THE PROPOSED UTILITY EASEMENT LINE AND SHOWN FIVE (5) FEET OUTSIDE THE ACTUAL LIMIT OF DISTURBANCE FOR CLARITY

- AREA 3 NOTE:**
- Contractor to Install:  
1. For Stream Bank/Invert Protection Installation:  
Provide Sandbag/Stone Diversion: See Detail 1.5 on Sheet 20.
  - For Access:  
Provide Temporary Access Culvert: (Detail 36) or Temporary Access Bridge (Detail 4.8.) See Details on Sheet 20. Submit design for selected practice in advance for review and approval in accordance with GC-5.14.
  - For Permanent Restoration:  
Provide Class III rip-rap: See Detail: Stream Bank/Invert Protection, Sheet 19.

- RESTORATION NOTES:**
- NON-TIDAL WETLANDS AND ASSOCIATED NON-TIDAL WETLAND BUFFERS WITHIN THE LIMITS OF DISTURBANCE (LOD) HAVE BEEN SHADED ON THIS PLAN FOR CLARITY. FOR WORKING IN THESE AREAS AND FOR RESTORING THEM ONCE THE SEWER INSTALLATION IS COMPLETE, THE CONTRACTOR SHALL ABIDE BY THE REQUIREMENTS OF THE "BEST MANAGEMENT PRACTICES FOR WORKING IN NON-TIDAL WETLANDS, WETLAND BUFFERS, WATERWAYS, AND 100-YEAR FLOODPLAIN" ON SHEET 18.
  - FOR GROUND PREPARATION, SOIL MODIFICATIONS, DISTURBED AREAS OUTSIDE OF THE WETLAND AND WETLAND BUFFER AREAS, REFER TO SHEET 17. THESE BASIC REQUIREMENTS ARE SUPPLEMENTED BY TECHNICAL SPECIFICATION, SECTION 02260 - "FINISH GRADING AND LANDSCAPING," IN THE SPECIFICATIONS, WHICH ADDRESS SPECIFIC SUB-GRADE PREPARATION AND FINISH GRADING REQUIREMENTS.
  - SHADING (SEE LEGEND THIS SHEET) DENOTES AREAS OF NON-TIDAL WETLANDS AND BUFFER WITHIN THE LOD

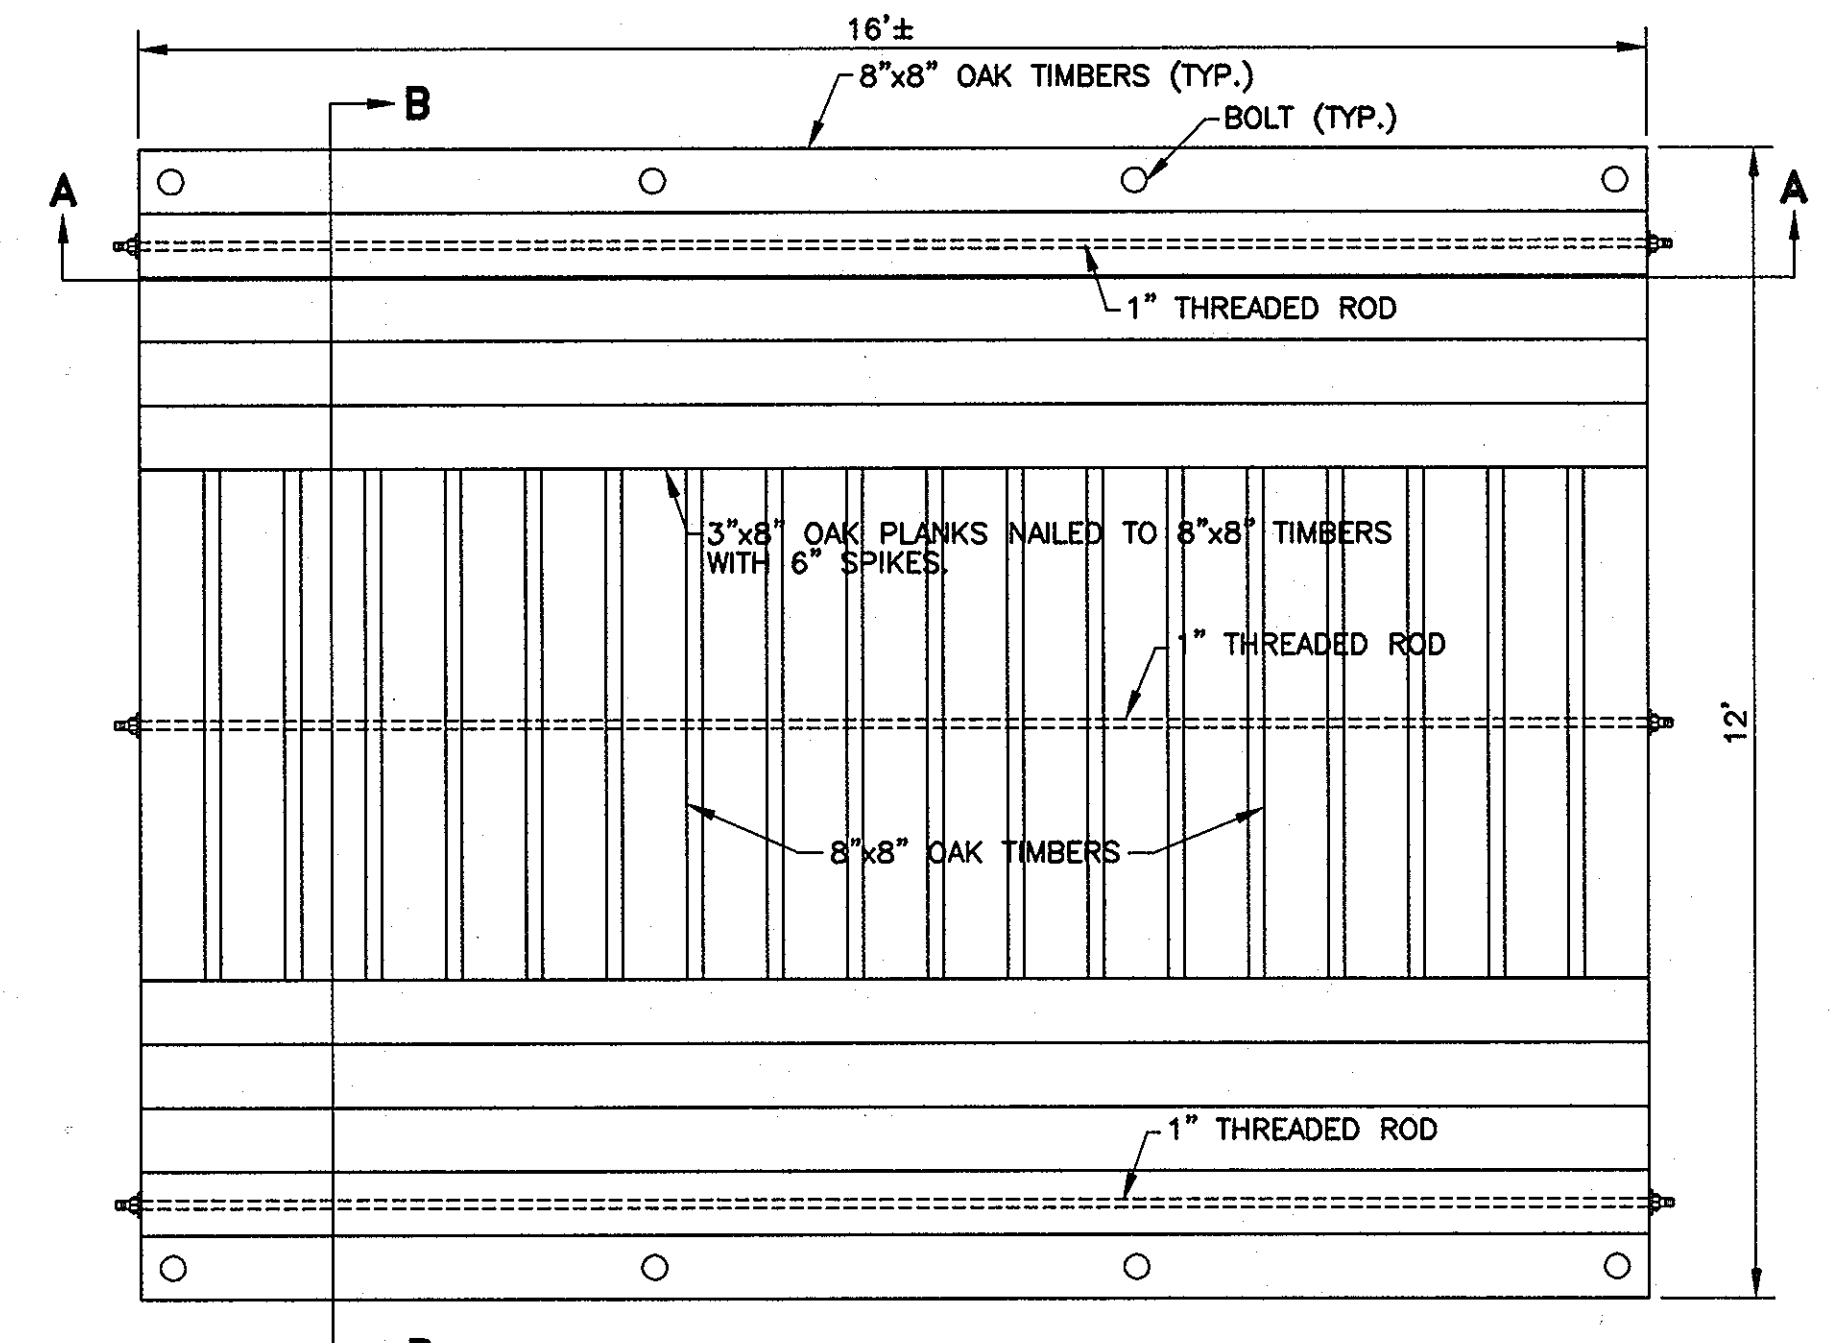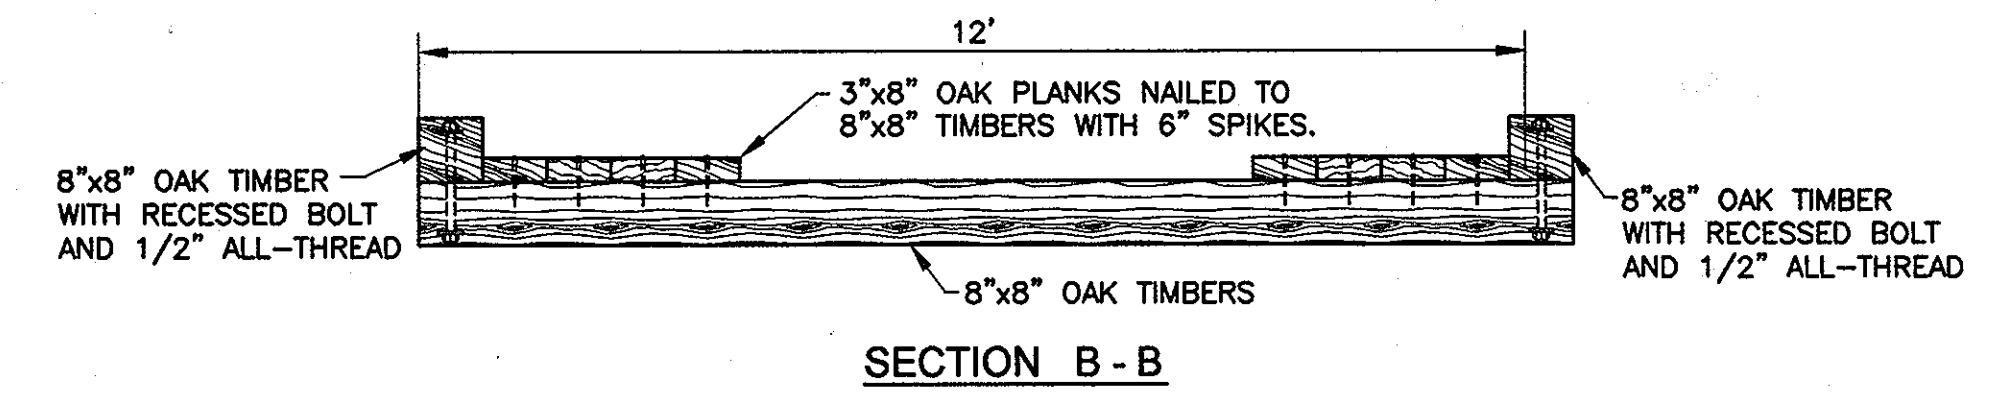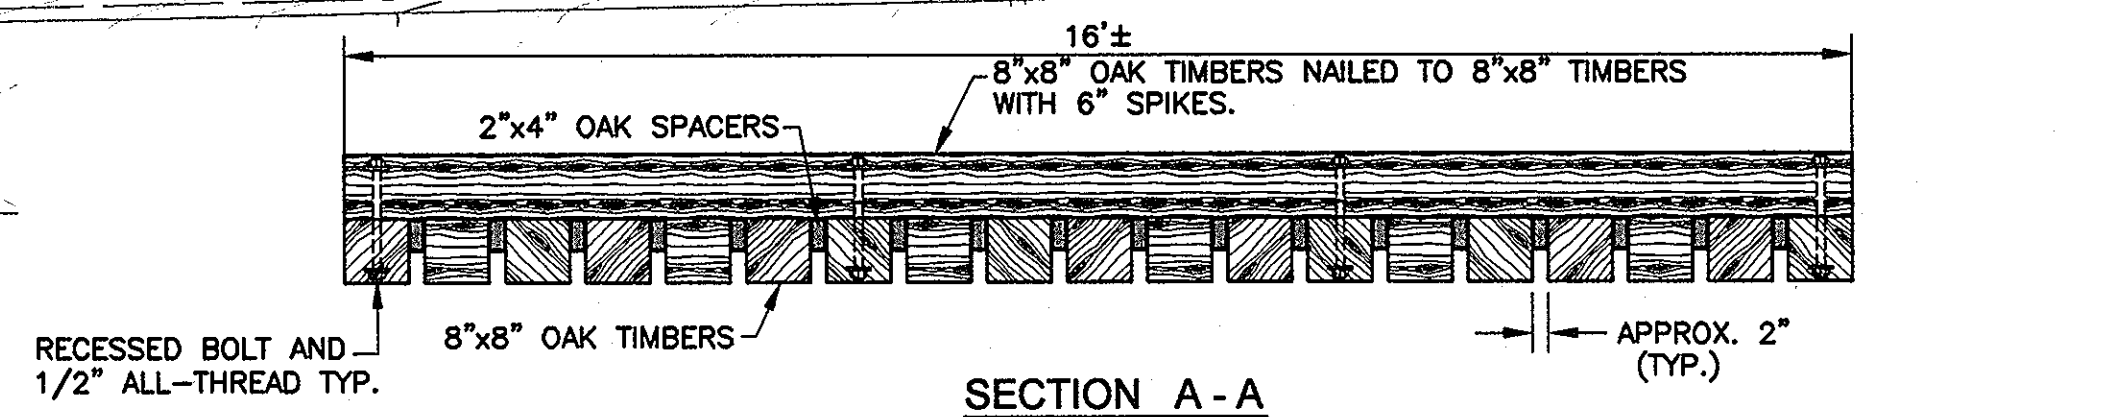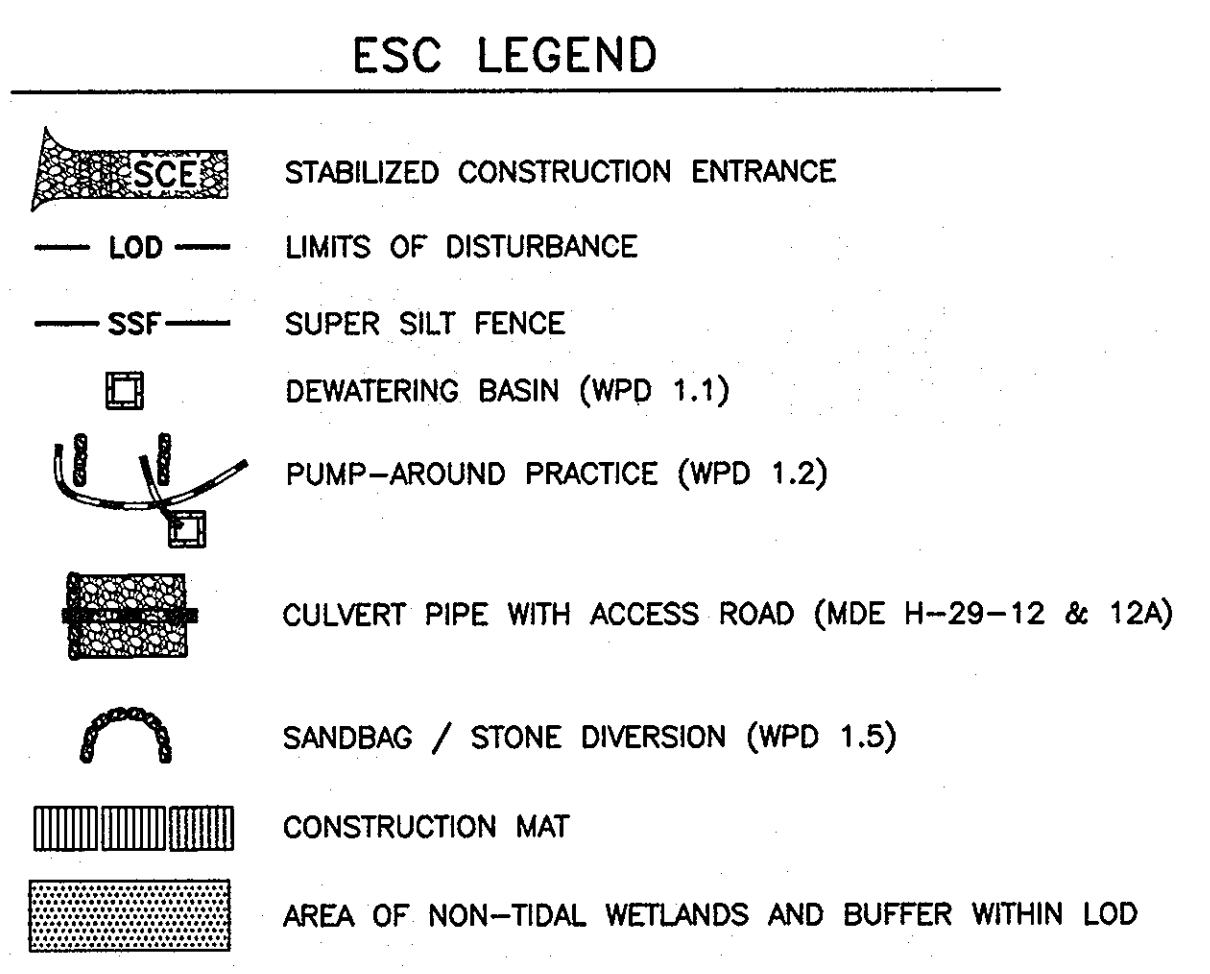

**CONSTRUCTION MAT**  
SCALE 1/2" = 1'  
(3 NEEDED)

**AS-BUILTS**  
JAN 17 2008

**ESC**  
3 OF 10

**DEPARTMENT OF PUBLIC WORKS**  
HOWARD COUNTY, MARYLAND

*Michael J. O'Brien* 6/13/10  
DIRECTOR OF PUBLIC WORKS DATE

*Paul J. Johnson* 6/2/10  
CHIEF, BUREAU OF ENGINEERING DATE

*John J. O'Brien* 6/2/10  
CHIEF, UTILITY DESIGN DIVISION DATE

**Dewberry**  
Dewberry & Davis LLC  
3108 LORD BALTIMORE DRIVE  
SUITE 110  
BALTIMORE, MD 21244-2662  
410.285.9500  
FAX: 410.285.8875



DES: LAL	LAL	ADD MH 1006A	5-31-11
DRN: CD			
CHK: TND			
DATE: 5.28.10	BY NO.	REVISIONS	DATE

**EROSION AND SEDIMENT CONTROL PLAN**

600' SCALE MAP NO. 37, 43 BLOCK NO. 5, 23

**LITTLE PATUXENT PARALLEL INTERCEPTOR**  
CAPITAL PROJECT S-6175  
CONTRACT NO. 20-4540


ELECTION DISTRICT NO. 5 HOWARD COUNTY, MARYLAND

SCALE: SHOWN

SHEET 13 OF 26

**AREA 4 NOTE:**

- 4 Contractor to Install:  
 1. For Pipe Construction:  
 Provide Sandbag/Stone Diversion: See Detail 1.5 Sheet 20.  
 2. For Permanent Restoration:  
 Provide Class III rip-rap: See Detail: Stream Bank/Invert Protection, Sheet 19.

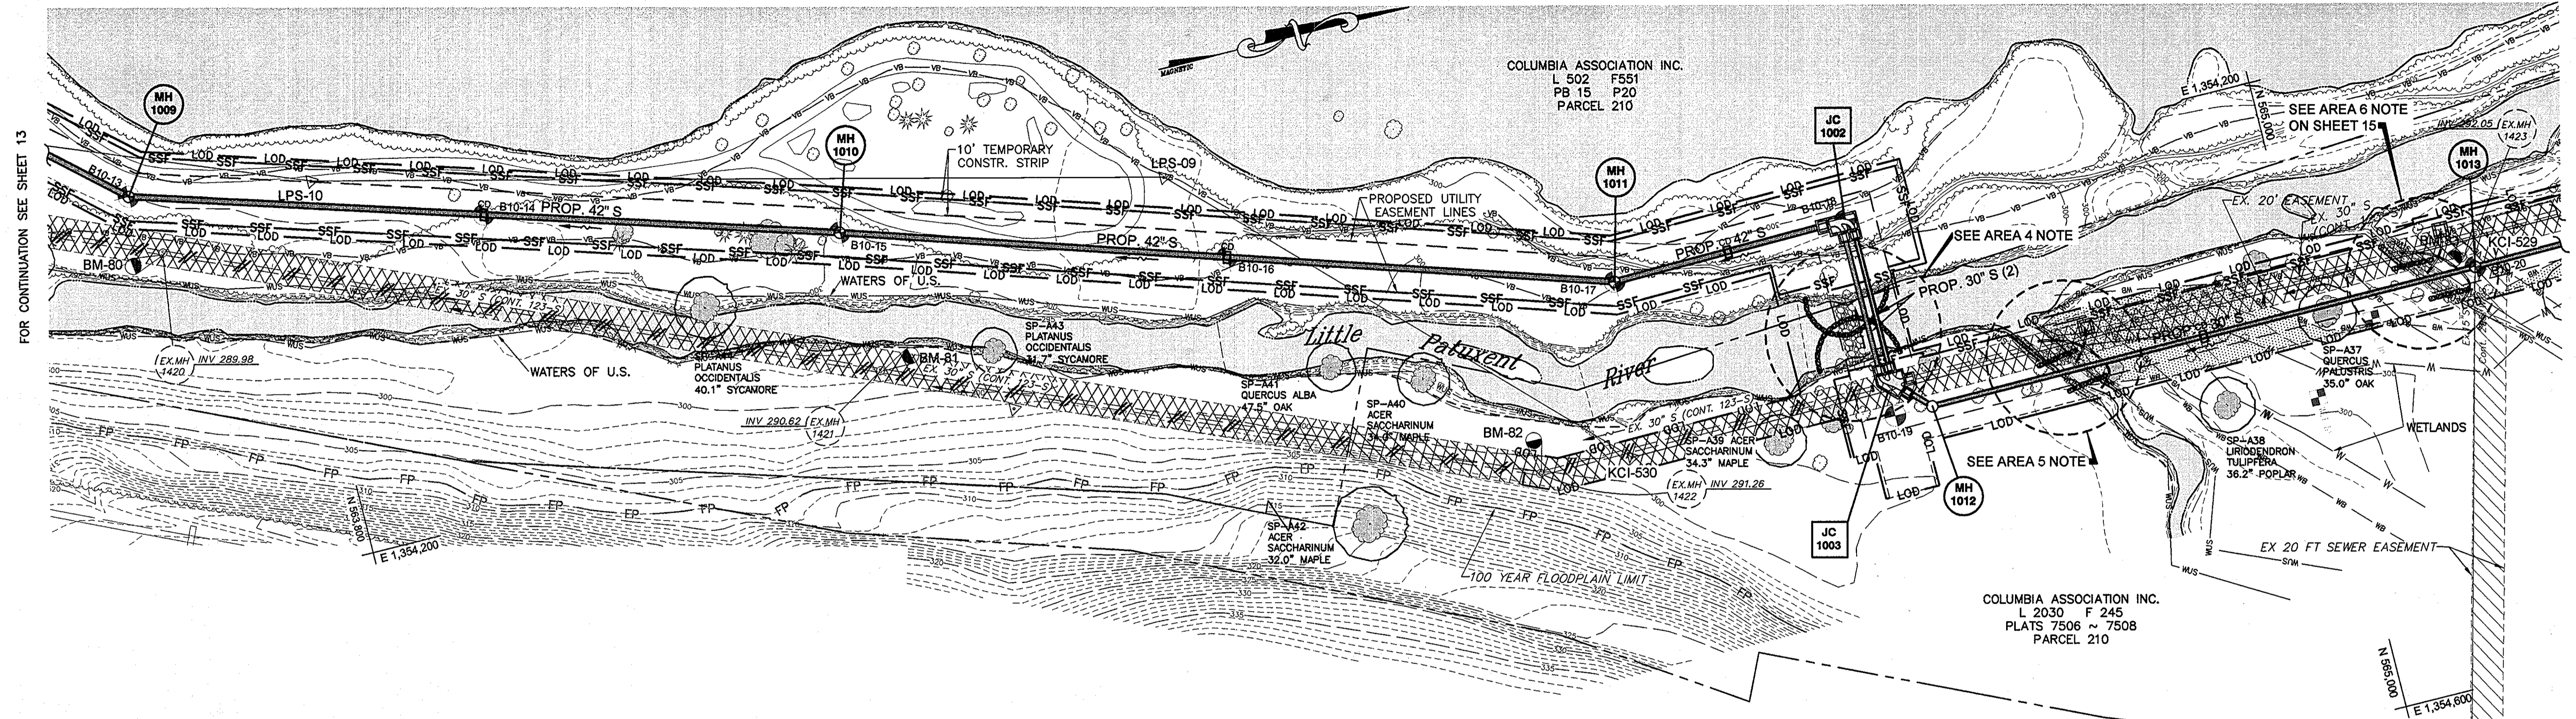

**PLAN**  
 SCALE : 1" = 50'

**NOTE:**  
 THE LOD IS COINCIDENT WITH THE PROPOSED UTILITY EASEMENT LINE AND SHOWN FIVE (5) FEET OUTSIDE THE ACTUAL LIMIT OF DISTURBANCE FOR CLARITY

**AREA 5 NOTE:**

- 5 Contractor to Install:  
 1. For Pipe Construction:  
 Provide Pump Around Practice: See Detail 1.2- Sheet 19.  
 2. For Access:  
 Provide Temporary Access Culvert: See Detail 36, Sheet 20.  
 Submit design for approval in advance for review and approval in accordance with GC-5.14.  
 3. For Permanent Restoration:  
 Provide Class II rip-rap: See Detail: Stream Bank/Invert Protection, Sheet 19.

**ESC LEGEND**

- STABILIZED CONSTRUCTION ENTRANCE
- LIMITS OF DISTURBANCE
- SUPER SILT FENCE
- DEWATERING BASIN (WPD 1.1)
- PUMP-AROUND PRACTICE (WPD 1.2)
- CULVERT PIPE WITH ACCESS ROAD (MDE H-29-12 & 12A)
- SANDBAG / STONE DIVERSION (WPD 1.5)
- AREA OF NON-TIDAL WETLANDS AND BUFFER WITHIN LOD

**RESTORATION NOTES:**

1. NON-TIDAL WETLANDS AND ASSOCIATED NON-TIDAL WETLAND BUFFERS WITHIN THE LIMITS OF DISTURBANCE (LOD) HAVE BEEN SHADED ON THIS PLAN FOR CLARITY. FOR WORKING IN THESE AREAS AND FOR RESTORING THEM ONCE THE SEWER INSTALLATION IS COMPLETE, THE CONTRACTOR SHALL ABIDE BY THE REQUIREMENTS OF THE "BEST MANAGEMENT PRACTICES FOR WORKING IN NON-TIDAL WETLANDS, WETLAND BUFFERS, WATERWAYS, AND 100-YEAR FLOODPLAIN" ON SHEET 18.
2. FOR GROUND PREPARATION, SOIL MODIFICATIONS, DISTURBED AREAS OUTSIDE OF THE WETLAND AND WETLAND BUFFER AREAS, REFER TO SHEET 17. THESE BASIC REQUIREMENTS ARE SUPPLEMENTED BY TECHNICAL SPECIFICATION, SECTION 02260-"FINISH GRADING AND LANDSCAPING," IN THE SPECIFICATIONS, WHICH ADDRESS SPECIFIC SUB-GRADE PREPARATION AND FINISH GRADING REQUIREMENTS.
3. SHADING (SEE LEGEND THIS SHEET) DENOTES AREAS OF NON-TIDAL WETLANDS AND BUFFER WITHIN THE LOD


**AS-BUILTS**  
 2010 07 2010

ESC  
 4 OF 10

**DEPARTMENT OF PUBLIC WORKS**  
 HOWARD COUNTY, MARYLAND

CHIEF, BUREAU OF UTILITIES  
 DATE: 6/2/10  
  
 CHIEF, UTILITY DESIGN DIVISION  
 DATE: 6/2/10

**Dewberry**  
 Dewberry & Davis LLC  
 3108 LORD BALTIMORE DRIVE  
 SUITE 110  
 BALTIMORE, MD 21244-2882  
 410.285.9500  
 FAX: 410.285.8875

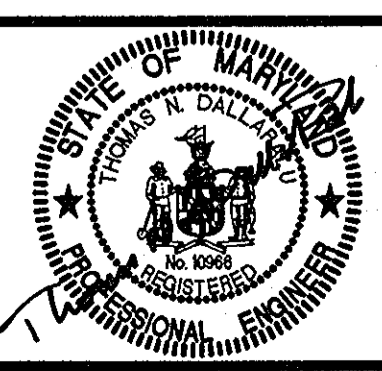

DES:	LAL				
DRN:	CD				
CHK:	TND				
DATE:	5.28.10	BY:	NO.	REVISIONS	DATE

**EROSION AND SEDIMENT CONTROL PLAN**

**LITTLE PATUXENT PARALLEL INTERCEPTOR**  
 CAPITAL PROJECT S-6175  
 CONTRACT NO. 20-4540

SCALE:  
 SHOWN  
 SHEET  
 14 OF 26


600' SCALE MAP NO. 37, 43 BLOCK NO. 5, 23 ELECTION DISTRICT NO. 5 HOWARD COUNTY, MARYLAND

**AREA 6 NOTE:**

- 6 Contractor to Install:
1. For Pipe Construction:  
Provide Pump Around Practice: See Detail 1.2-Sheet 19.
  2. For Access:  
Provide Temporary Access Culvert: See Detail 36, Sheet 20.  
Submit design for approval in advance for review and approval in accordance with GC-5.14.
  3. For Permanent Restoration:  
Provide Class I rip-rap: See Detail: Stream Bank Protection, Sheet 19. Extend rip-rap, Section C-C, through stream bottom.

**AREA 7 NOTE:**

- 7 Contractor to Install:
1. For Pipe Construction:  
Provide Pump Around Practice: See Detail 1.2, Sheet 19.
  2. For Access:  
Provide Temporary Access Culvert: See Detail 36, Sheet 20.  
Submit design for approval in advance for review and approval in accordance with GC-5.14.
  3. For Permanent Restoration:  
Provide Class II rip-rap: See Detail: Stream Bank Protection, Sheet 19. Extend rip-rap, Section C-C, through stream bottom.

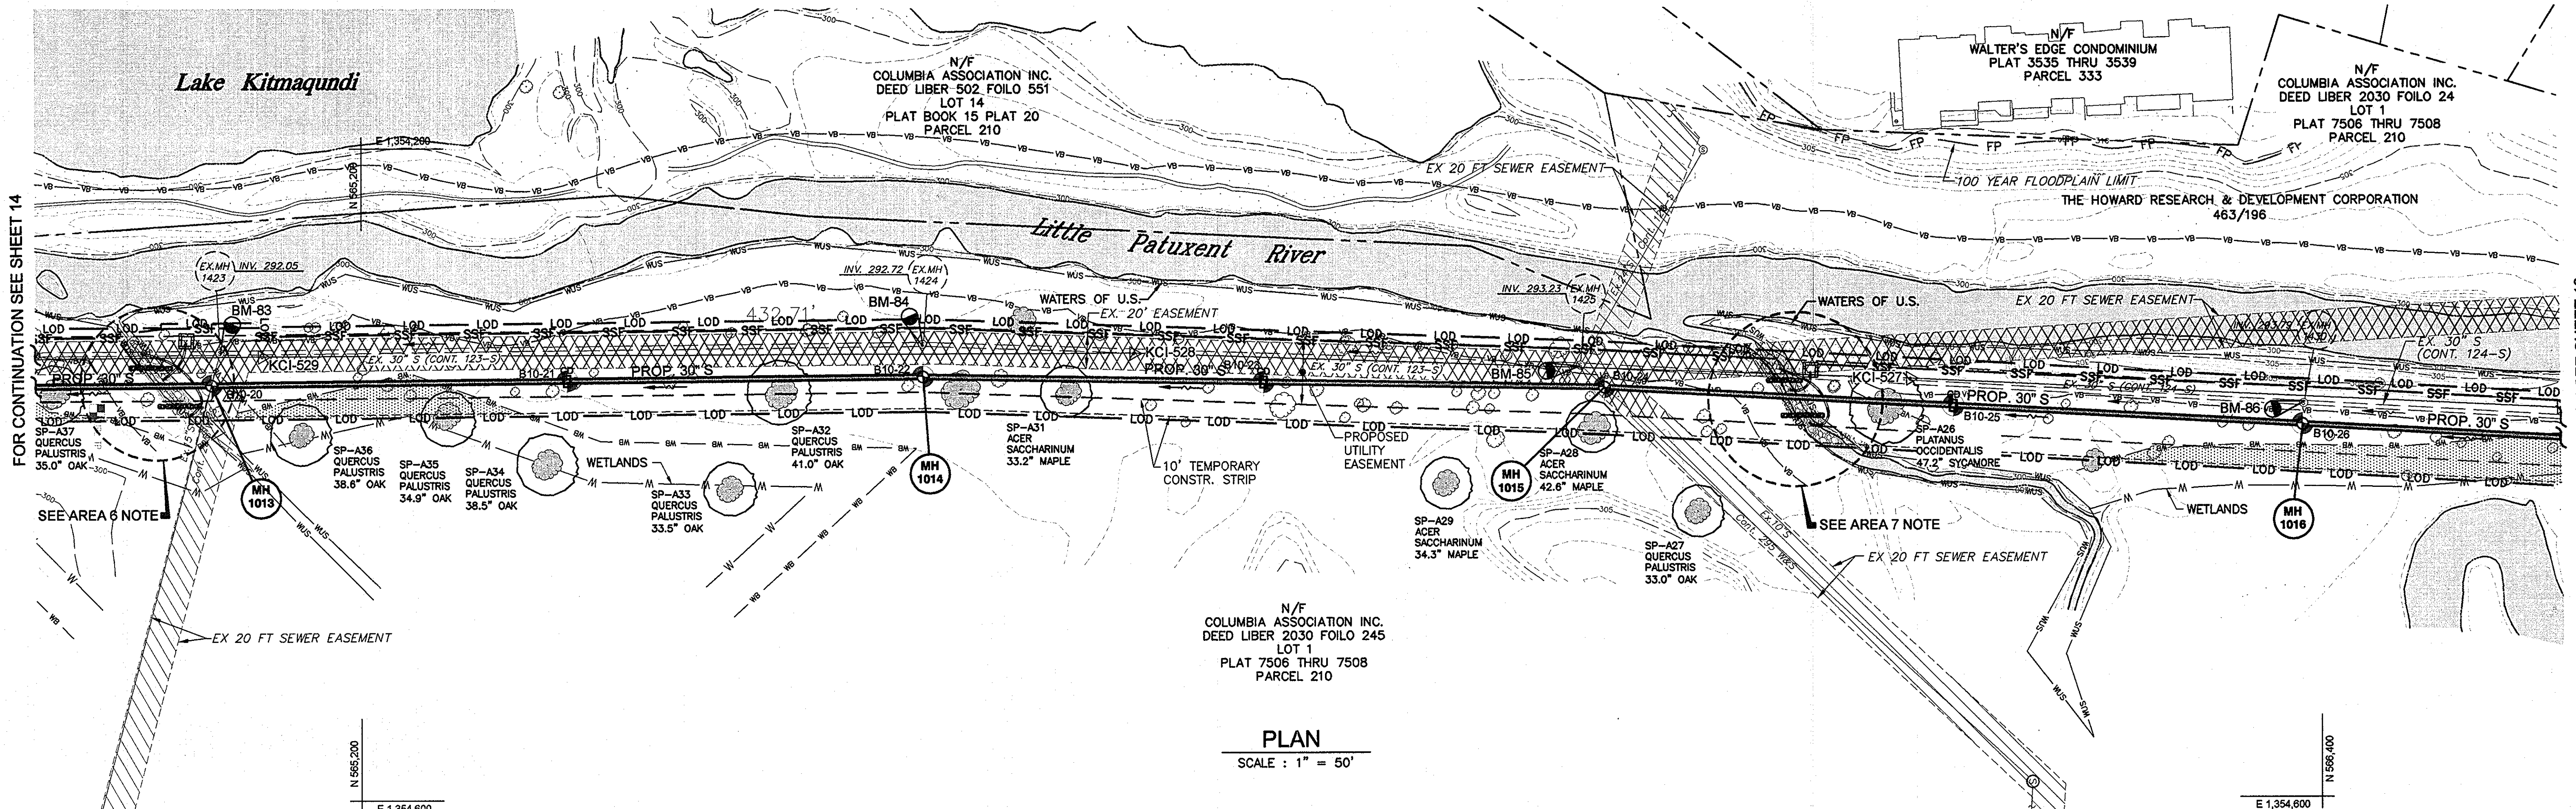

**PLAN**  
SCALE : 1" = 50'

**NOTE:**  
THE LOD IS COINCIDENT WITH THE PROPOSED UTILITY EASEMENT LINE AND SHOWN FIVE (5) FEET OUTSIDE THE ACTUAL LIMIT OF DISTURBANCE FOR CLARITY

**ESC LEGEND**

- SCE STABILIZED CONSTRUCTION ENTRANCE
- LOD LIMITS OF DISTURBANCE
- SSF SUPER SILT FENCE
- DEWATERING BASIN (WPD 1.1)
- PUMP-AROUND PRACTICE (WPD 1.2)
- CULVERT PIPE WITH ACCESS ROAD (MDE H-29-12 & 12A)
- SANDBAG / STONE DIVERSION (WPD 1.5)
- AREA OF NON-TIDAL WETLANDS AND BUFFER WITHIN LOD

**RESTORATION NOTES:**

1. NON-TIDAL WETLANDS AND ASSOCIATED NON-TIDAL WETLAND BUFFERS WITHIN THE LIMITS OF DISTURBANCE (LOD) HAVE BEEN SHADED ON THIS PLAN FOR CLARITY. FOR WORKING IN THESE AREAS AND FOR RESTORING THEM ONCE THE SEWER INSTALLATION IS COMPLETE, THE CONTRACTOR SHALL ABIDE BY THE REQUIREMENTS OF THE "BEST MANAGEMENT PRACTICES FOR WORKING IN NON-TIDAL WETLANDS, WETLAND BUFFERS, WATERWAYS, AND 100-YEAR FLOODPLAIN" ON SHEET 18.
2. FOR GROUND PREPARATION, SOIL MODIFICATIONS, DISTURBED AREAS OUTSIDE OF THE WETLAND AND WETLAND BUFFER AREAS, REFER TO SHEET 17. THESE BASIC REQUIREMENTS ARE SUPPLEMENTED BY TECHNICAL SPECIFICATION, SECTION 02260-"FINISH GRADING AND LANDSCAPING," IN THE SPECIFICATIONS, WHICH ADDRESS SPECIFIC SUB-GRADE PREPARATION AND FINISH GRADING REQUIREMENTS.
3. SHADING (SEE LEGEND THIS SHEET) DENOTES AREAS OF NON-TIDAL WETLANDS AND BUFFER WITHIN THE LOD

Plotted by: (name) on File Date: Jun 01, 2010 10:35am  
 Title: Little Patuxent Parallel Interceptor  
 User: (name)  
 Plot Location: (name)  
 Project: (name)  
 Sheet: (name)  
 Scale: (name)  
 Date: (name)

**DEPARTMENT OF PUBLIC WORKS**  
HOWARD COUNTY, MARYLAND

DATE 6/2/10  
CHIEF, BUREAU OF UTILITIES

DATE 6/2/10  
CHIEF, UTILITY DESIGN DIVISION

**Dewberry**  
Dewberry & Davis LLC

3108 LORD BALTIMORE DRIVE  
SUITE 110  
BALTIMORE, MD 21244-2962  
410.285.8500  
FAX: 410.285.8875



DES: LAL	
DRN: CD	
CHK: TND	
DATE: 5.28.10	
BY NO.	
REVISIONS	
DATE	

**EROSION AND SEDIMENT CONTROL PLAN**

600' SCALE MAP NO. 37, 43 BLOCK NO. 5, 23

**LITTLE PATUXENT PARALLEL INTERCEPTOR**  
CAPITAL PROJECT S-6175  
CONTRACT NO. 20-4540

ELECTION DISTRICT NO. 5 HOWARD COUNTY, MARYLAND


ESC  
5 OF 10

SCALE:  
SHOWN

SHEET  
15 OF 26

**AS-BUILTS**  
DATE 1/7/2011

Printed by: [unreadable] on: [unreadable] Date: [unreadable] 10:00:08 AM. Project: [unreadable] Interceptor: [unreadable] Sheet: [unreadable]

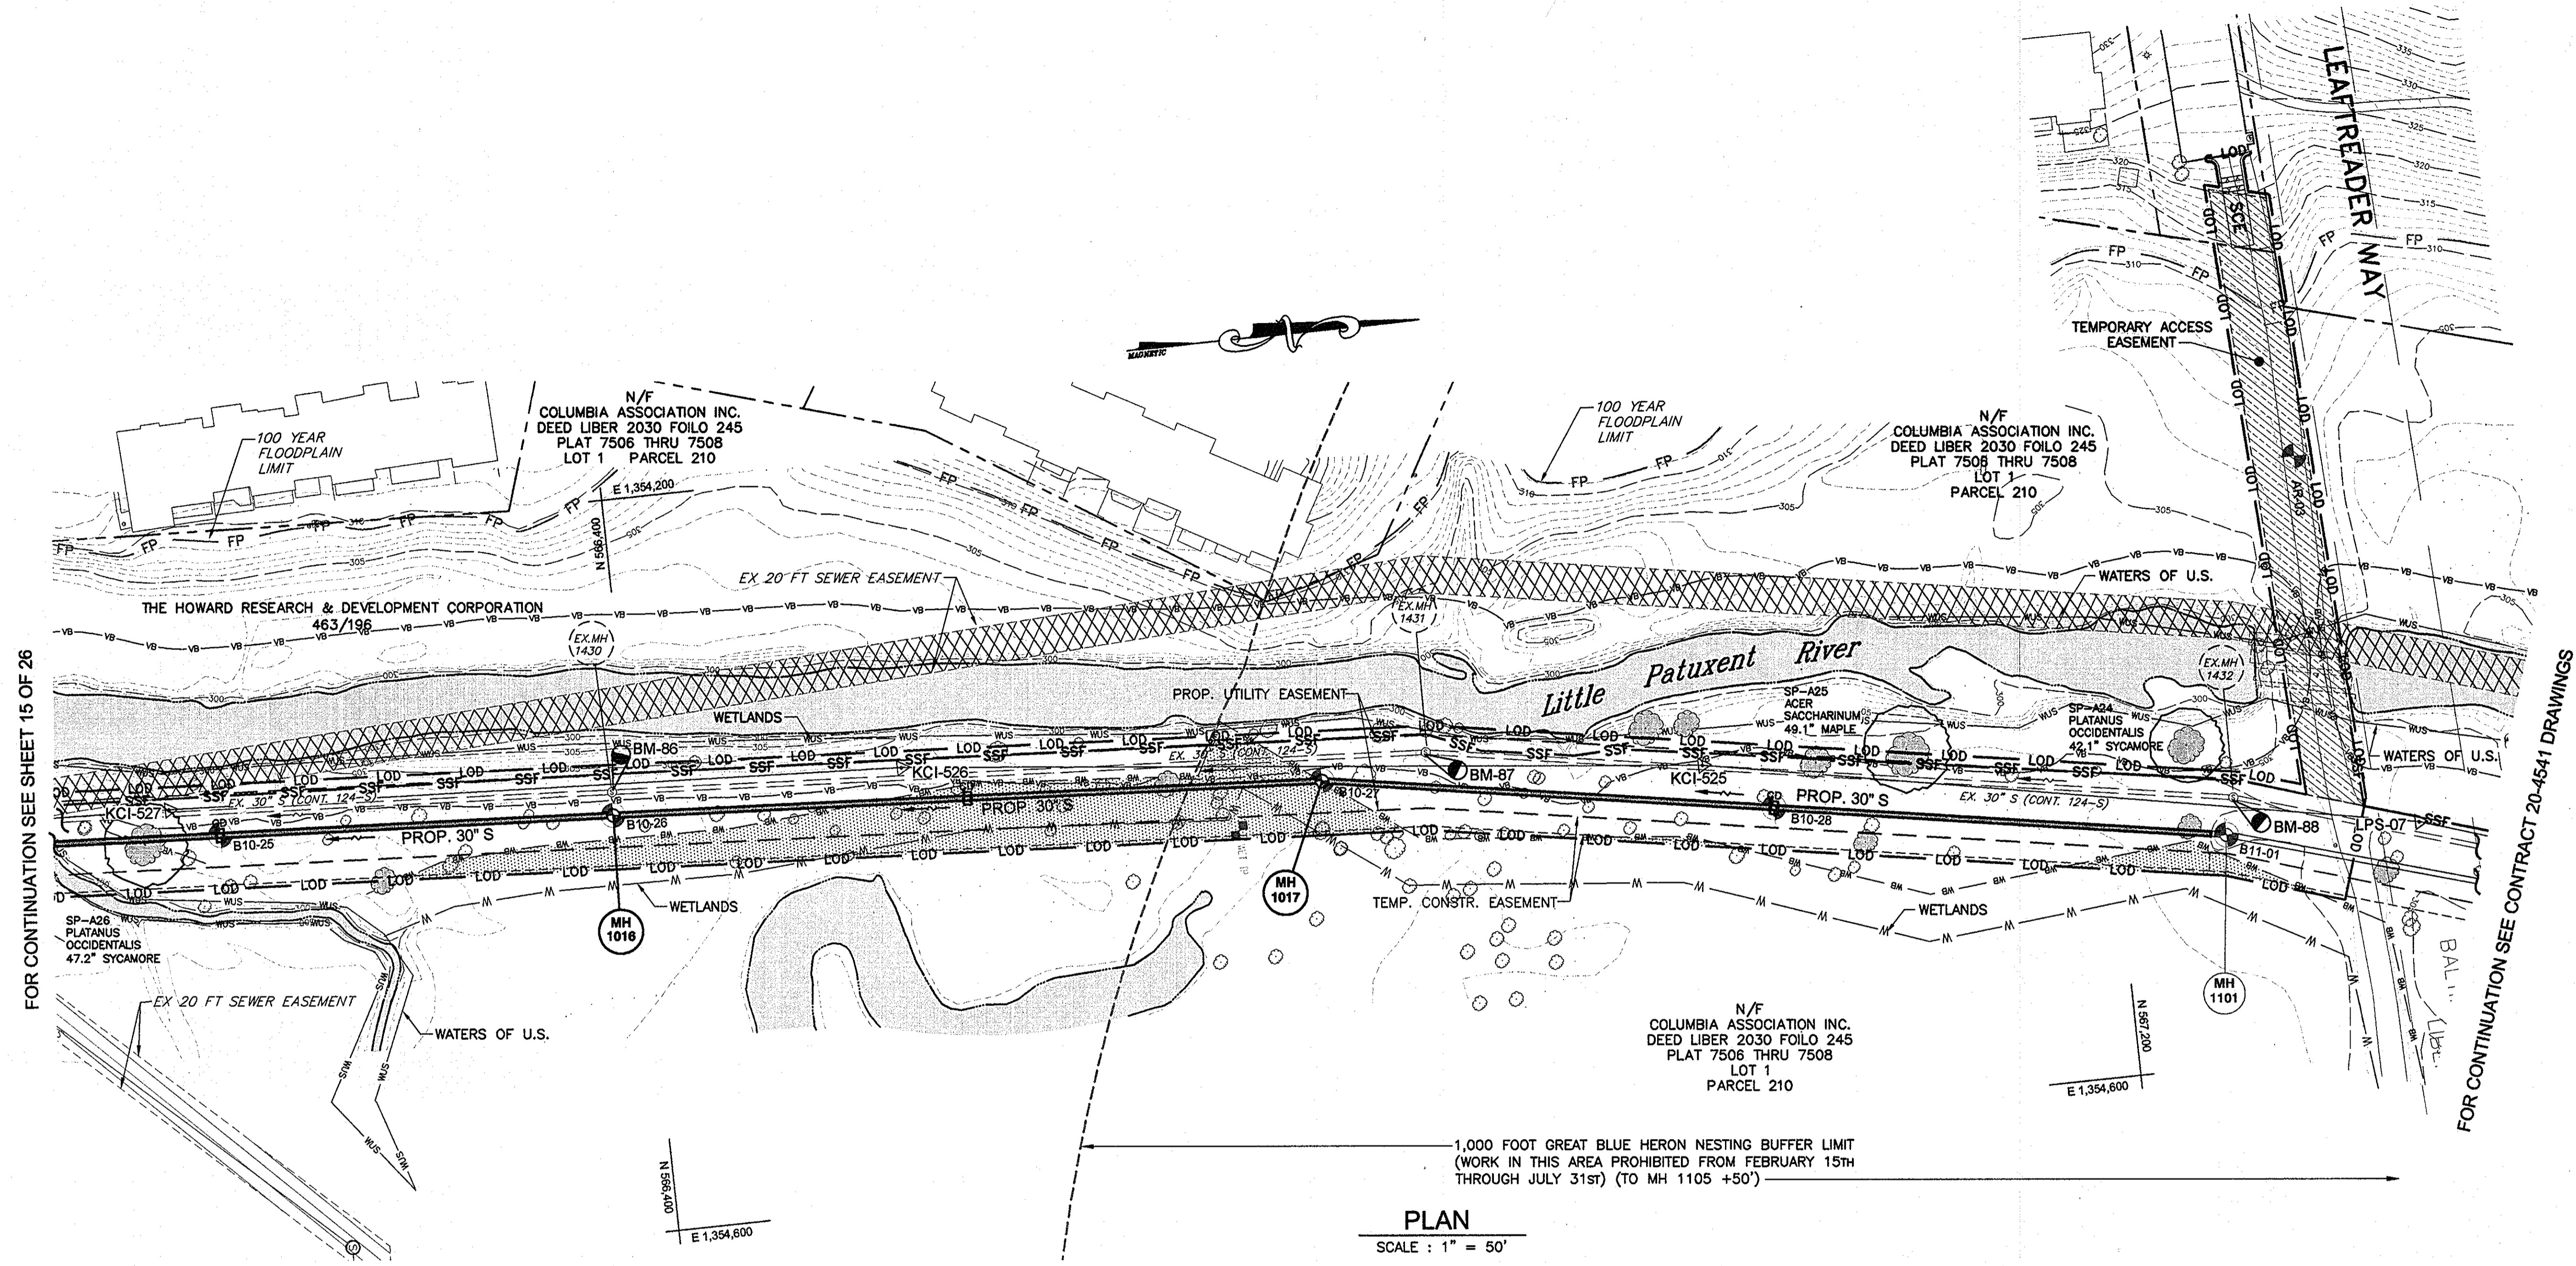

PLAN  
SCALE: 1" = 50'

**ESC LEGEND**

	STABILIZED CONSTRUCTION ENTRANCE
	LIMITS OF DISTURBANCE
	SUPER SILT FENCE
	DEWATERING BASIN (WPD 1.1)
	PUMP-AROUND PRACTICE (WPD 1.2)
	CULVERT PIPE WITH ACCESS ROAD (MDE H-29-12 & 12A)
	SANDBAG / STONE DIVERSION (WPD 1.5)
	AREA OF NON-TIDAL WETLANDS AND BUFFER WITHIN LOD

**NOTE:**  
THE LOD IS COINCIDENT WITH THE PROPOSED UTILITY EASEMENT LINE AND SHOWN FIVE (5) FEET OUTSIDE THE ACTUAL LIMIT OF DISTURBANCE FOR CLARITY

**RESTORATION NOTES:**  
1. NON-TIDAL WETLANDS AND ASSOCIATED NON-TIDAL WETLAND BUFFERS WITHIN THE LIMITS OF DISTURBANCE (LOD) HAVE BEEN SHADED ON THIS PLAN FOR CLARITY. FOR WORKING IN THESE AREAS AND FOR RESTORING THEM ONCE THE SEWER INSTALLATION IS COMPLETE, THE CONTRACTOR SHALL ABIDE BY THE REQUIREMENTS OF THE "BEST MANAGEMENT PRACTICES FOR WORKING IN NON-TIDAL WETLANDS, WETLAND BUFFERS, WATERWAYS, AND 100-YEAR FLOODPLAIN" ON SHEET 18.  
2. FOR GROUND PREPARATION, SOIL MODIFICATIONS, DISTURBED AREAS OUTSIDE OF THE WETLAND AND WETLAND BUFFER AREAS, REFER TO SHEET 17. THESE BASIC REQUIREMENTS ARE SUPPLEMENTED BY TECHNICAL SPECIFICATION, SECTION 02260-"FINISH GRADING AND LANDSCAPING," IN THE SPECIFICATIONS, WHICH ADDRESS SPECIFIC SUB-GRADE PREPARATION AND FINISH GRADING REQUIREMENTS.  
3. SHADING (SEE LEGEND THIS SHEET) DENOTES AREAS OF NON-TIDAL WETLANDS AND BUFFER WITHIN THE LOD

FOR CONTINUATION SEE CONTRACT 20-4541 DRAWINGS

**DEPARTMENT OF PUBLIC WORKS**  
HOWARD COUNTY, MARYLAND

Director of Public Works: [Signature] DATE: 6/3/10  
Chief, Bureau of Engineering: [Signature] DATE: 6/2/10  
Chief, Bureau of Utilities: [Signature] DATE: 6/2/10  
Chief, Utility Design Division: [Signature] DATE: 6/2/10

**Dewberry**  
Dewberry & Davis LLC  
3108 LORD BALTIMORE DRIVE  
SUITE 110  
BALTIMORE, MD 21244-2682  
410.285.9200  
410.285.8675



DES: LAL	
DRN: CD	
CHK: TND	
DATE: 5.28.10	
BY: NO.	
REVISIONS	
DATE	

**EROSION AND SEDIMENT CONTROL PLAN**

600' SCALE MAP NO. 37, 43 BLOCK NO. 5, 23

**LITTLE PATUXENT PARALLEL INTERCEPTOR**

CAPITAL PROJECT S-6175  
CONTRACT NO. 20-4540

ELECTION DISTRICT NO. 5 HOWARD COUNTY, MARYLAND

ESC 6 OF 10

SCALE: SHOWN

SHEET 16 OF 26

AS-BUILTS  
JUN 17 2010



STANDARDS AND SPECIFICATIONS FOR VEGETATIVE STABILIZATION

Section I - Vegetative Stabilization Methods and Materials

- A. Site Preparation
1. Install erosion and sediment control structures...
2. Perform all grading operations at right angles to the slope...
3. Schedule required soil tests to determine soil amendment composition...
B. Soil Amendments (Fertilizer and Lime Specifications)
1. Soil tests must be performed to determine the exact ratios and application rates...
2. Fertilizers shall be uniform in composition, free flowing and suitable for accurate application...
3. Lime materials shall be ground limestone (hydrated or burnt lime may be substituted)...
C. Seeded Protection
1. Temporary Seeding
a. Seedbed preparation shall consist of loosening soil to a depth of 3" to 5"...

- G. Mulching Seeded Areas - Mulch shall be applied to all seeded areas immediately after seeding.
1. If grading is completed outside of the seeding season, mulch alone shall be applied as prescribed...
2. When straw mulch is used, it shall be spread over all seeded areas at the rate of 2 tons/acre...
3. Wood cellulose fiber used as a mulch shall be applied at a net dry weight of 1,500 lbs. per acre...
H. Securing Straw Mulch (Mulch Anchoring)
1. A mulch anchoring tool is a tractor drawn implement designed to punch and anchor mulch into soil surface...
2. Wood Cellulose fiber may be used for anchoring straw. The fiber binder shall be applied at a net dry weight of 750 pounds/acre...
3. Application of liquid binders should be heavier at the edges where wind catches mulch...

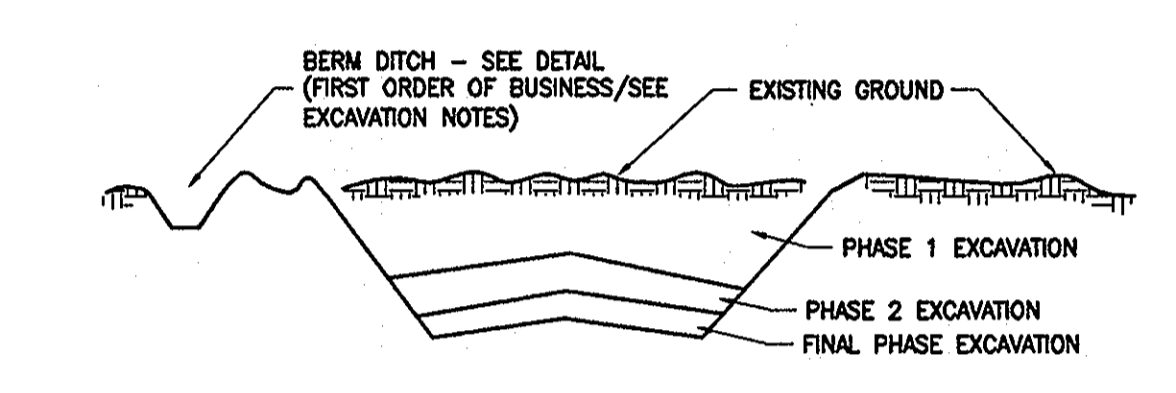


Figure 4 Incremental Stabilization - Cut

- J. Incremental Stabilization of Embankments - Fill Slopes
1. Embankments shall be constructed in lifts as prescribed on the plans.
2. Slopes shall be stabilized immediately when the vertical height of the multiple lifts reaches 15', or when the grading operation ceases as prescribed in the plans.
3. At the end of each day, temporary berms and pipe slope drains should be constructed along the top edge of the embankment to intercept surface runoff...
4. Construction sequence: Refer to Figure 5 (below)
a. Excavate and stabilize all temporary swales, side ditches, or berms that will be used to divert runoff around the fill. Construct Slope Silt Fence on low side of fill as shown in Figure 4, unless other methods shown on the plans address this area...
b. Place phase 1 embankment, dress and stabilize.
c. Place phase 2 embankment, dress and stabilize.
d. Place final phase embankment, dress and stabilize. Overseed previously seeded areas as necessary.

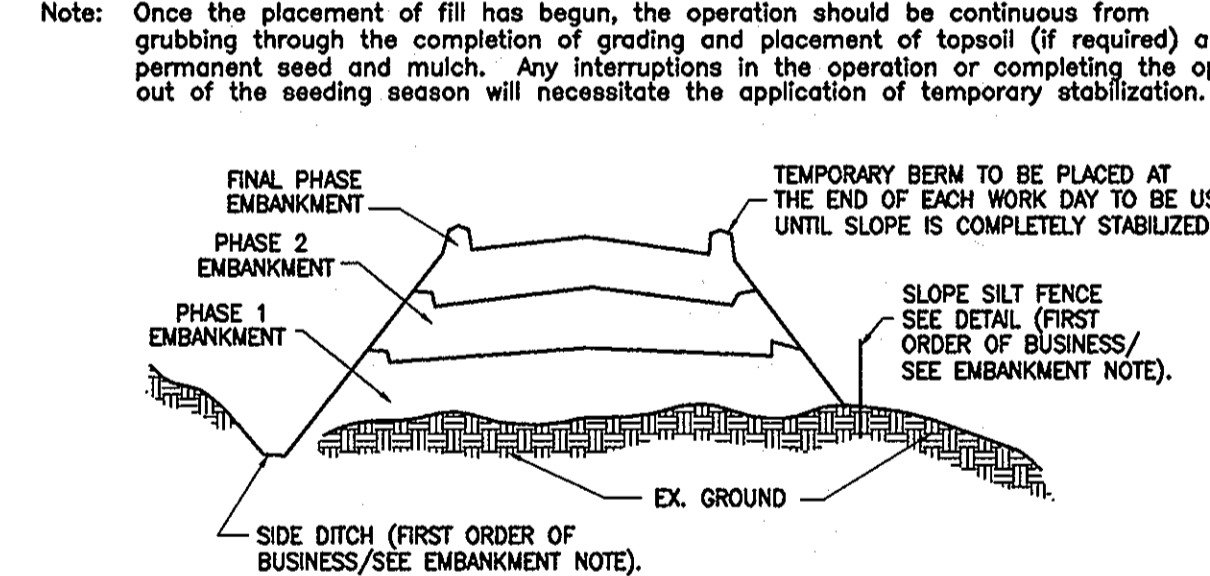


Figure 5 Incremental Stabilization - Embankment Fill Comply with MD 378 Specifications.

- Section II - Temporary Seeding
Vegetation - annual grass or grain used to provide cover on disturbed areas for up to 12 months. For longer duration of vegetative cover, Permanent Seeding is required.
A. Seed Mixtures - Temporary Seeding
1. Select one or more of the species or mixtures listed in Table 26 for the appropriate Plant Hardiness Zone (from Figure 5) and enter them in the Temporary Seeding Summary below, along with application rates, seeding dates and seeding depths. If this Summary is not put on the plans and completed, then Table 26 must be put on the plans.
2. For sites having soil tests performed, the rates shown on this table shall be deleted and the rates recommended by the testing agency shall be written in. Soil tests are not required for Temporary Seeding.

TEMPORARY SEEDING SUMMARY
SEED MIXTURE (HARDINESS ZONE 6b) FROM TABLE 26
Table with columns: NO., SPECIES, APPLICATION RATE (LB/AC), SEEDING DATES, SEEDING DEPTHS, FERTILIZER RATE (10-10-10), LIME RATE.

- Section III: Permanent Seeding
Seeding grass and legumes to establish ground cover for a minimum period of one year on disturbed areas generally receiving low maintenance.
A. Seed Mixtures - Permanent Seeding
1. Select one or more of the species or mixtures listed in Table 25 for the appropriate Plant Hardiness Zone (from Figure 5) and enter them in the Permanent Seed Summary below, along with application rates and seeding dates. Seeding depths can be estimated using Table 26. If this Summary is not put on the construction plans and completed, then Table 25 must be put on the plans. Additional planting specifications for exceptional sites such as shorelines, streambanks, or dunes or for special purposes such as wildlife or aesthetic treatment may be found in USDA-SCS Technical Field Office Guide, Section 342 - Critical Area Planting. For special lawn maintenance areas, see Section IV Sod and Turfgrass.
2. For sites having disturbed area over 5 acres, the rates shown on this table shall be deleted and the rates recommended by the soil testing agency shall be written in.
3. For areas receiving low maintenance, apply ureaform fertilizer (48-0-0) at 3 1/2 lbs/1000 sq. ft. (150 lbs/acre), in addition to the above soil amendments shown in the table below, to be performed at the time of seeding.

PERMANENT SEEDING SUMMARY
SEED MIXTURE (HARDINESS ZONE 6B) FROM TABLE 25
Table with columns: NO., SPECIES, APPLICATION RATE (LB/AC), SEEDING DATES, SEEDING DEPTHS, FERTILIZER RATE (N, P2O5, K2O), LIME RATE.

- Section IV - Sod: To provide quick cover on disturbed areas (2:1 grade or flatter).
A. General specifications
1. Class of turfgrass sod shall be Maryland or Virginia State Certified or Approved. Sod labels shall be made available to the job foreman and inspector.
2. Sod shall be machine cut at a uniform soil thickness of 3/4", plus or minus 1/4", at the time of cutting. Measurement for thickness shall exclude top growth and thatch. Individual pieces of sod shall be cut to the suppliers width and length. Maximum allowable deviation from standard widths and lengths shall be 5 percent. Broken pads and torn or uneven ends will not be acceptable.
3. Standing size sections of sod shall be strong enough to support their own weight and retain their size and shape when suspended vertically with a firm grasp on the upper 10 percent of the section.
4. Sod shall not be harvested or transplanted when moisture content (excessively dry or wet) may adversely affect its survival.
5. Sod shall be harvested, delivered, and installed within a period of 36 hours. Sod not transplanted within this period shall be approved by an agronomist or soil scientist prior to its installation.
B. Sod installation
1. During periods of excessively high temperature or in areas having dry subsoil, the subsoil shall be lightly irrigated immediately prior to laying the sod.
2. The first row of sod shall be laid in a straight line with subsequent rows placed parallel to and tightly wedged against each other. Lateral joints shall be staggered to promote more uniform growth and strength. Ensure that sod is not stretched or overlapped and that all joints are butted tight in order to prevent voids which would cause air drying of the roots.
3. Wherever possible, sod shall be laid with the long edges parallel to the contour and with staggering joints. Sod shall be rolled and tamped, pegged or otherwise secured to prevent slippage on slopes and to ensure solid contact between sod roots and the underlying soil surface.
4. Sod shall be watered immediately following rolling or tamping until the underside of the new sod pad and soil surface below the sod are thoroughly wet. The operations of laying, tamping and irrigating for any piece of sod shall be completed within eight hours.
C. Sod Maintenance
1. In the absence of adequate rainfall, watering shall be performed daily or as often as necessary during the first week and in sufficient quantities to maintain moist soil to a depth of 4". Watering should be done during the heat of the day to prevent wilting.
2. After the first week, sod watering is required as necessary to maintain adequate moisture content.
3. The first mowing of sod should not be attempted until the sod is firmly rooted. No more than 1/3 of the grass leaf shall be removed by the initial cutting or subsequent cuttings. Grass height shall be maintained between 2" and 3" unless otherwise specified.

- Section IV - Turfgrass Establishment
Areas where turfgrass may be desired include lawns, parks, playgrounds, and commercial sites which will receive a medium to high level of maintenance. Areas to receive seed shall be tilled by disking or other approved methods to a depth of 2 to 4 inches, leveled and raked to prepare a proper seedbed. Stones and debris over 1/2 inches in diameter shall be removed. The resulting seedbed shall be in such condition that future mowing of grasses will pose no difficulty.
Note: Choose certified material. Certified material is the best guarantee to cultivar purity. The certification program of the Maryland Department of Agriculture, Turf and Seed Section, provides a reliable means of consumer protection and assures a pure genetic line.

- A. Permanent Seeding
1. Kentucky Bluegrass - Full sun mixture - For use in areas that receive intensive management. Irrigation required in the areas of central Maryland and eastern shore. Recommended Certified Kentucky Bluegrass Cultivars Seeding Rate: 1.5 to 2.0 pounds/1000 square feet. A minimum of three bluegrass cultivars should be chosen ranging from a minimum of 10% to a maximum of 35% of the mixture by weight.
2. Kentucky Bluegrass/Perennial Rye - Full sun mixture - For use in full sun areas where rapid establishment is necessary and when turf will receive medium to intensive management. Certified Perennial Ryegrass Cultivars/Certified Kentucky Bluegrass Seeding rate: 2 pounds mixture/1000 square feet. A minimum of 3 Kentucky Bluegrass Cultivars must be chosen, with each cultivar ranging from 10% to 35% of the mixture by weight.
3. Tall Fescue/Kentucky Bluegrass - Full sun mixture - For use in drought prone areas and/or for areas receiving low to medium management in full sun to medium shade. Recommended mixture includes: certified Tall Fescue Cultivars 95-100%, certified Kentucky Bluegrass Cultivars 0-5%. Seeding rate: 5 to 8 lb/1000 sq. ft. One or more cultivars may be blended.
4. Kentucky Bluegrass/Fine Fescue - Shade Mixture - For use in areas with shade in Bluegrass lawns. For establishment in high quality, intensively managed turf area. Mixture includes: certified Kentucky Bluegrass Cultivars 30-40% and certified Fine Fescue and 50-70%. Seeding rate: 1 1/2 - 3 lbs/1000 square feet. A minimum of 3 Kentucky bluegrass cultivars must be chosen, with each cultivar ranging from a minimum of 10% to a maximum of 35% of the mixture by weight.
Note: Turfgrass varieties should be selected from those listed in the most current University of Maryland Publication, Agronomy Mimeo #77, 'Turfgrass Cultivar Recommendations for Maryland'.
B. Ideal times of seeding
Western MD: March 15 - June 1, August 1 - October 1 (Hardiness Zones - 5b, 6a)
Central MD: March 1 - May 15, August 15 - October 15 (Hardiness Zone - 6b)
Southern MD, Eastern Shore: March 1 - May 15, August 15 - October 15 (Hardiness Zones - 7a, 7b)
C. Irrigation
If soil moisture is deficient, supply new seedings with adequate water for plant growth (23/64" 0 1" every 3 to 4 days depending on soil texture) until they are firmly established. This is especially true when seedings are made late in the planting season, in abnormally dry or hot seasons, or on adverse sites.

- D. Repairs and Maintenance
Inspect all seeded areas for failures and make necessary repairs, replacements, and reseedings within the planting season.
1. Once the vegetation is established, the site shall have 95% ground cover to be considered adequately stabilized.
2. If the stand provides less than 40% ground coverage, reestablish following original lime, fertilizer, seedbed preparation and seeding recommendations.
3. If the stand provides between 40% and 94% ground coverage, overseeding and fertilizing half of the rates originally applied may be necessary.
4. Maintenance fertilizer rates for permanent seedings are shown in table 24. For lawns and other medium to high maintenance turfgrass areas, refer to the University of Maryland publication 'Lawn Care in Maryland' Bulletin No. 171.

SEDIMENT CONTROL GENERAL NOTES

- 1. A minimum of 48 hours notice must be given to Howard County Construction Inspection Division, Sediment Control Division prior to the start of any construction. 410-313-1855.
2. All vegetative and structural practices are to be installed according to the provisions of the plan and are to be in conformance with the most current Maryland Standards and Specifications for Soil Erosion and Sediment Control and revisions thereto.
3. Following initial soil disturbance or re-disturbance, permanent or temporary stabilization shall be completed within: a) 7 calendar days for all perimeter sediment control structures, dikes, perimeter slopes and all slopes greater than 3:1, b) 14 days as to all other disturbed or graded areas on the project site.
4. All disturbed areas must be stabilized within the time period specified above in accordance with the 1994 Maryland Standards and Specifications for Soil Erosion and Sediment Control for permanent stabilization (Sec. III), sod (Sec. III) temporary seeding (Sec. II) and mulching (Sec. I). Temporary stabilization with mulch alone can only be done when recommended seeding dates do not allow for proper germination and establishment of grasses.
5. All sediment control structures are to remain in place and are to be maintained in operative condition until permission for their removal has been obtained from the Howard County Sediment Control Inspector.
6. Site Analysis
Site is defined as areas involving any improvement.
Total Area of Site 9.43 Acres
Area Disturbed 9.43 Acres
Area to be paved .54 Sq. Yds.
Area to be Vegetatively Stabilized 45,600 Sq. Yds.
Total Cut 22,944 Cu. Yds.
Total Fill 22,944 Cu. Yds.
Offsite waste/borrow area location To be determined by contractor.
7. Any sediment control practices which is disturbed by grading activity for placement of utilities must be repaired on the same day of disturbance.
8. Additional sediment control must be provided, if deemed necessary by the Howard County Sediment Control Inspector.
9. On all sites with disturbed areas in excess of 2 acres, approval of the inspection agency shall be requested upon completion of installation of perimeter erosion and sediment controls, but before proceeding with any other earth disturbance or grading. Other building or grading inspection approvals may not be authorized until this initial approval by the inspection agency is made.
10. Trenches for the construction of utilities is limited to that which shall be back-filled and stabilized by the end of each work day.
11. Spoil from trench excavation shall be place on the uphill side of the excavation.
12. Site grading will begin only after all perimeter sediment control measures have been installed and are in a functioning condition.
13. Cut and fill quantities provided under site analysis do not represent bid quantities. These quantities do not distinguish between topsoil, structural fill or embankment material, nor do they reflect consideration of undercutting or removal of unsuitable material. The contractor shall familiarize himself with site conditions which may affect the work.

DEPARTMENT OF PUBLIC WORKS
HOWARD COUNTY, MARYLAND
DIRECTOR OF PUBLIC WORKS: DATE 6/2/10
CHIEF, BUREAU OF ENGINEERING: DATE 6/2/10
CHIEF OF UTILITIES: DATE 6/2/10
CHIEF, UTILITY DESIGN DIVISION: DATE W/D


Dewberry & Davis LLC
3106 LORD BALTIMORE DRIVE
SUITE 110
BALTIMORE, MD 21244-2692
410.285.9500
FAX: 410.285.9875

DES: LAL
DRN: CD
CHK: TND
DATE: 5.28.10




EROSION AND SEDIMENT CONTROL NOTES & DETAILS
REVISIONS: DATE: 600' SCALE MAP NO. 37, 43 BLOCK NO. 5, 23

LITTLE PATUXENT PARALLEL INTERCEPTOR
CAPITAL PROJECT S-6175
CONTRACT NO. 20-4540
ELECTION DISTRICT NO. 5
HOWARD COUNTY, MARYLAND

ESC 7 OF 10
SCALE: SHOWN
SHEET 17 OF 26

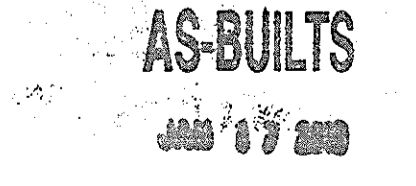

Printed by: (Gen) on Thu Date: Sat 01, 2010 - 4:29pm
User: F:\Projects\2010\000-Utility-Interceptors\2010-000-Utility-Interceptors\CADD\SECTION\_X1-17-18-C-UPR-1-E-02-UPRALS and NOTES SHEET17-18.dwg
Last Saved: May 28, 2010 - 11:43am
XREFS -> Projects\2010\000-Utility-Interceptors\2010-000-Utility-Interceptors\CADD\SECTION\_X1-17-18-C-UPR-X-1-Bottom.dwg

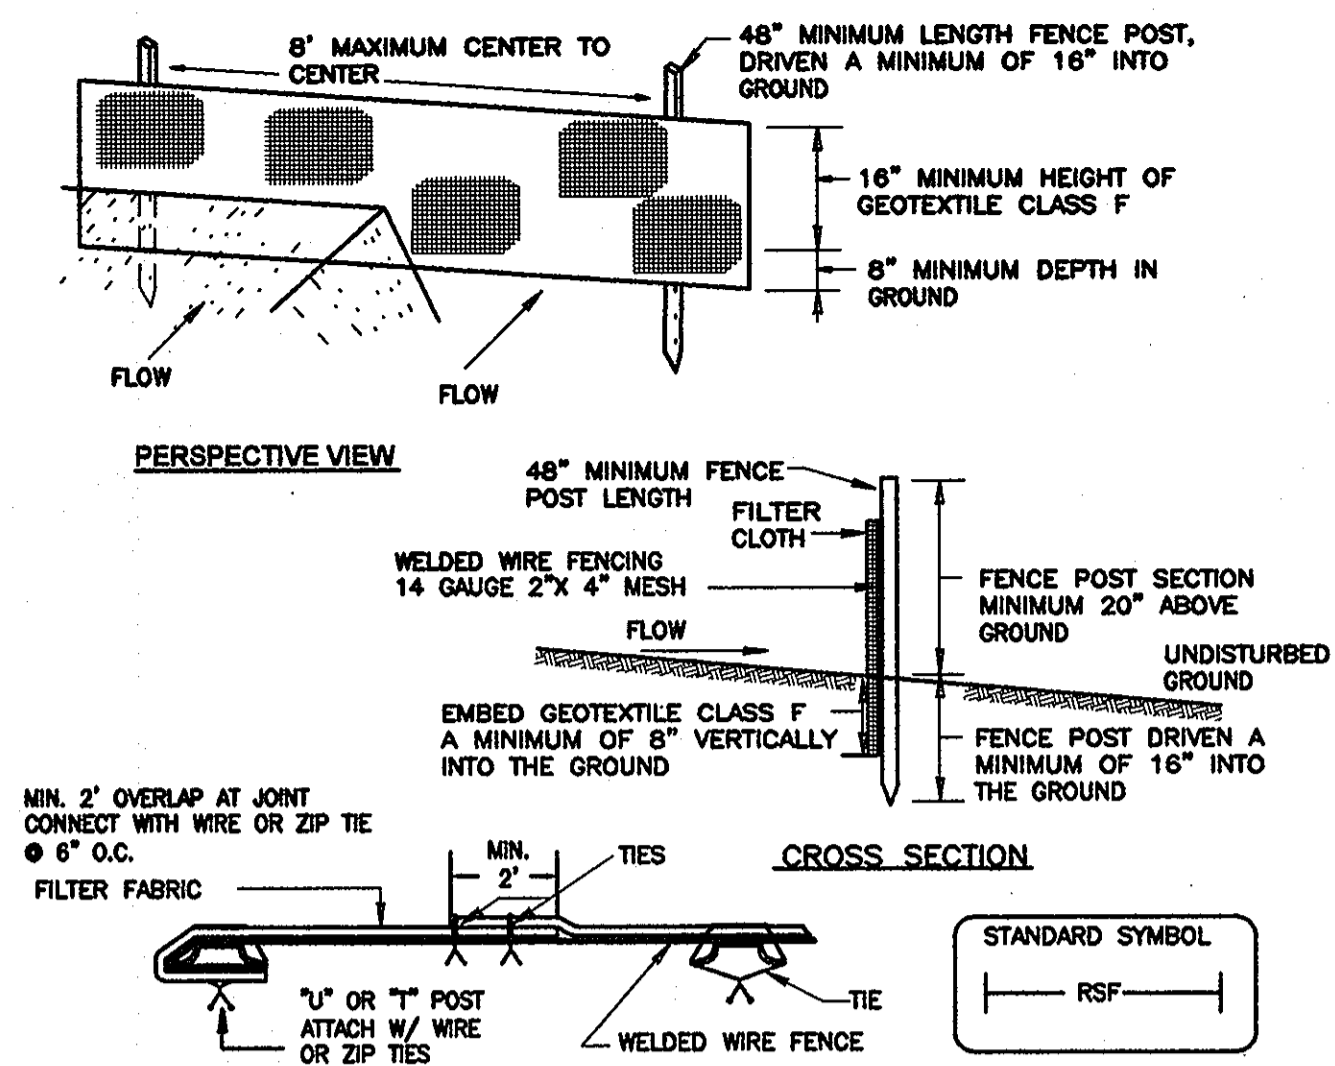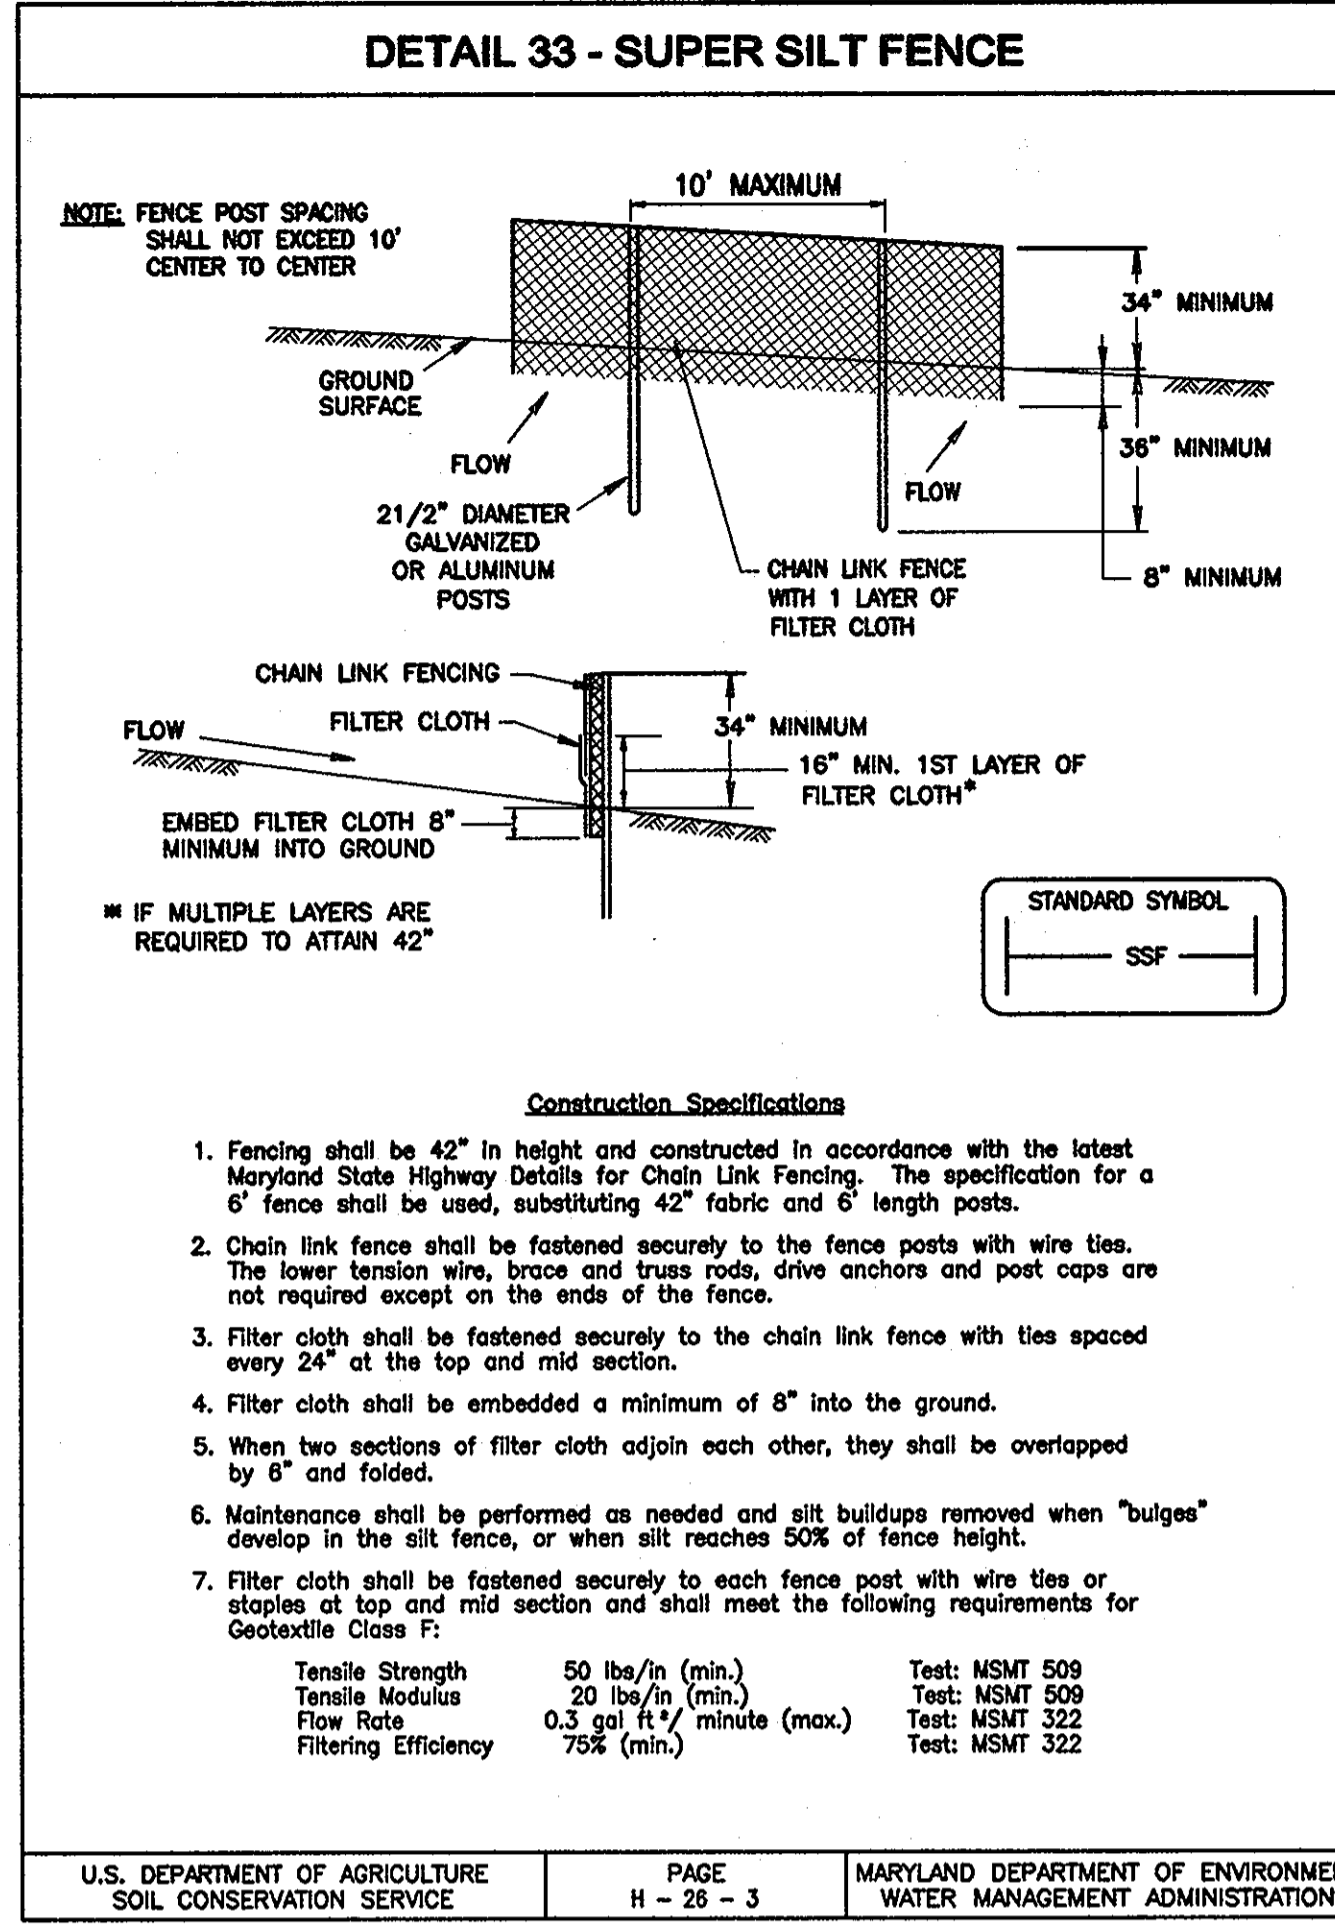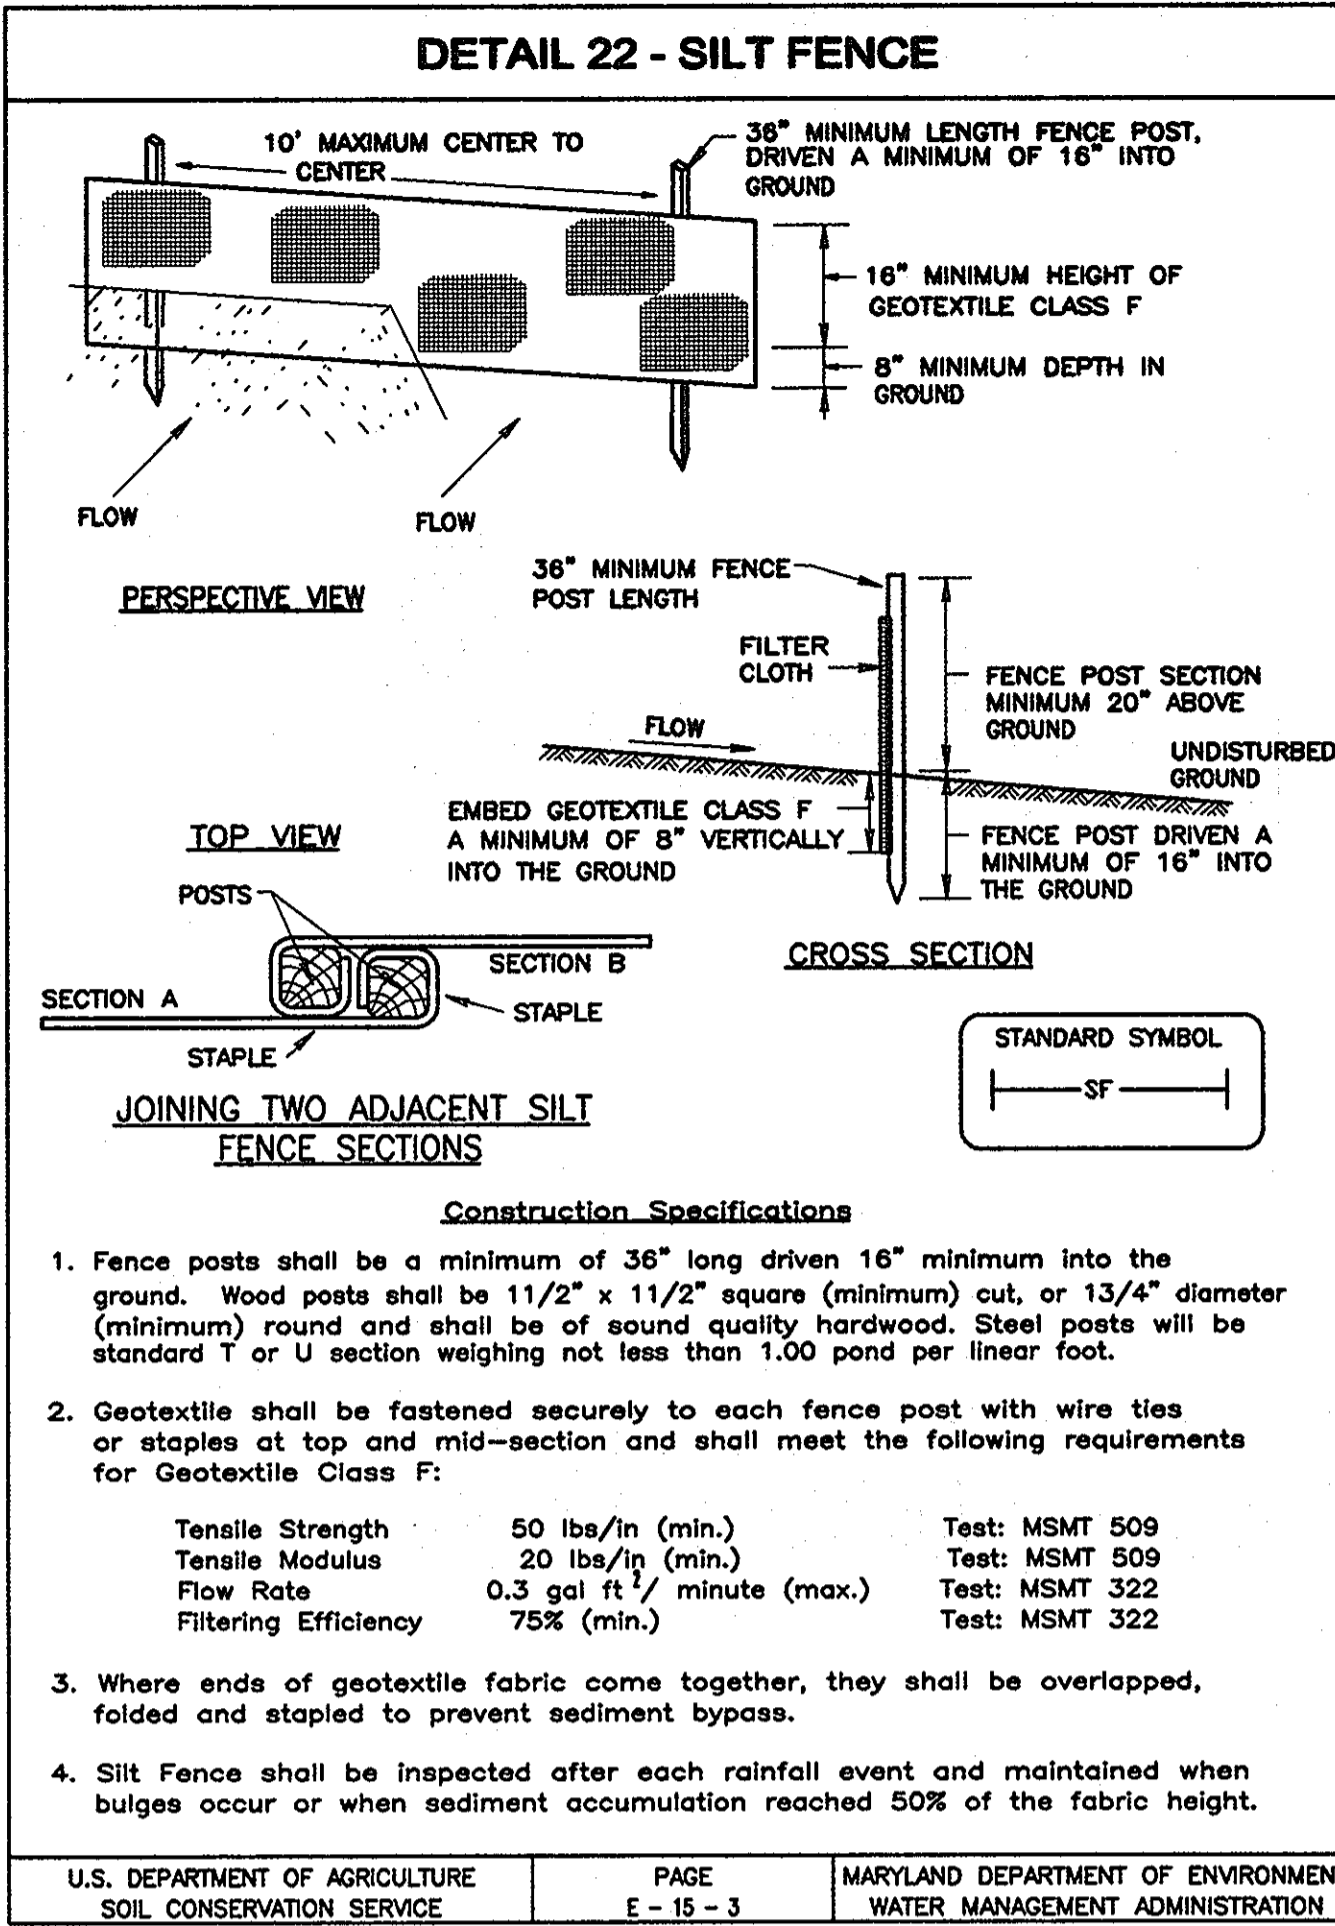

#### SILT FENCE

**Silt Fence Design Criteria**

Slope Steepness	(Maximum)	
	Slope Length	Silt Fence Length
Flatter than 50:1	unlimited	unlimited
50:1 to 10:1	125 feet	1,000 feet
10:1 to 5:1	100 feet	750 feet
5:1 to 3:1	60 feet	500 feet
3:1 to 2:1	40 feet	250 feet
2:1 and steeper	20 feet	125 feet

**Note:** In areas of less than 2% slope and sandy soils (USDA general classification system, soil Class A) maximum slope length and silt fence length will be unlimited. In these areas a silt fence may be the only perimeter control required.



U.S. DEPARTMENT OF AGRICULTURE SOIL CONSERVATION SERVICE	PAGE E - 15 - 3A	MARYLAND DEPARTMENT OF ENVIRONMENT WATER MANAGEMENT ADMINISTRATION
---	---------------------	---

#### SUPER SILT FENCE

**Design Criteria**

Slope	(Maximum)	
	Slope Steepness	Silt Fence Length
0 - 10%	0 - 10:1	Unlimited
10 - 20%	10:1 - 5:1	200 feet
20 - 33%	5:1 - 3:1	100 feet
33 - 50%	3:1 - 2:1	100 feet
50% +	2:1 +	50 feet

U.S. DEPARTMENT OF AGRICULTURE SOIL CONSERVATION SERVICE	PAGE H - 26 - 3A	MARYLAND DEPARTMENT OF ENVIRONMENT WATER MANAGEMENT ADMINISTRATION
---	---------------------	---

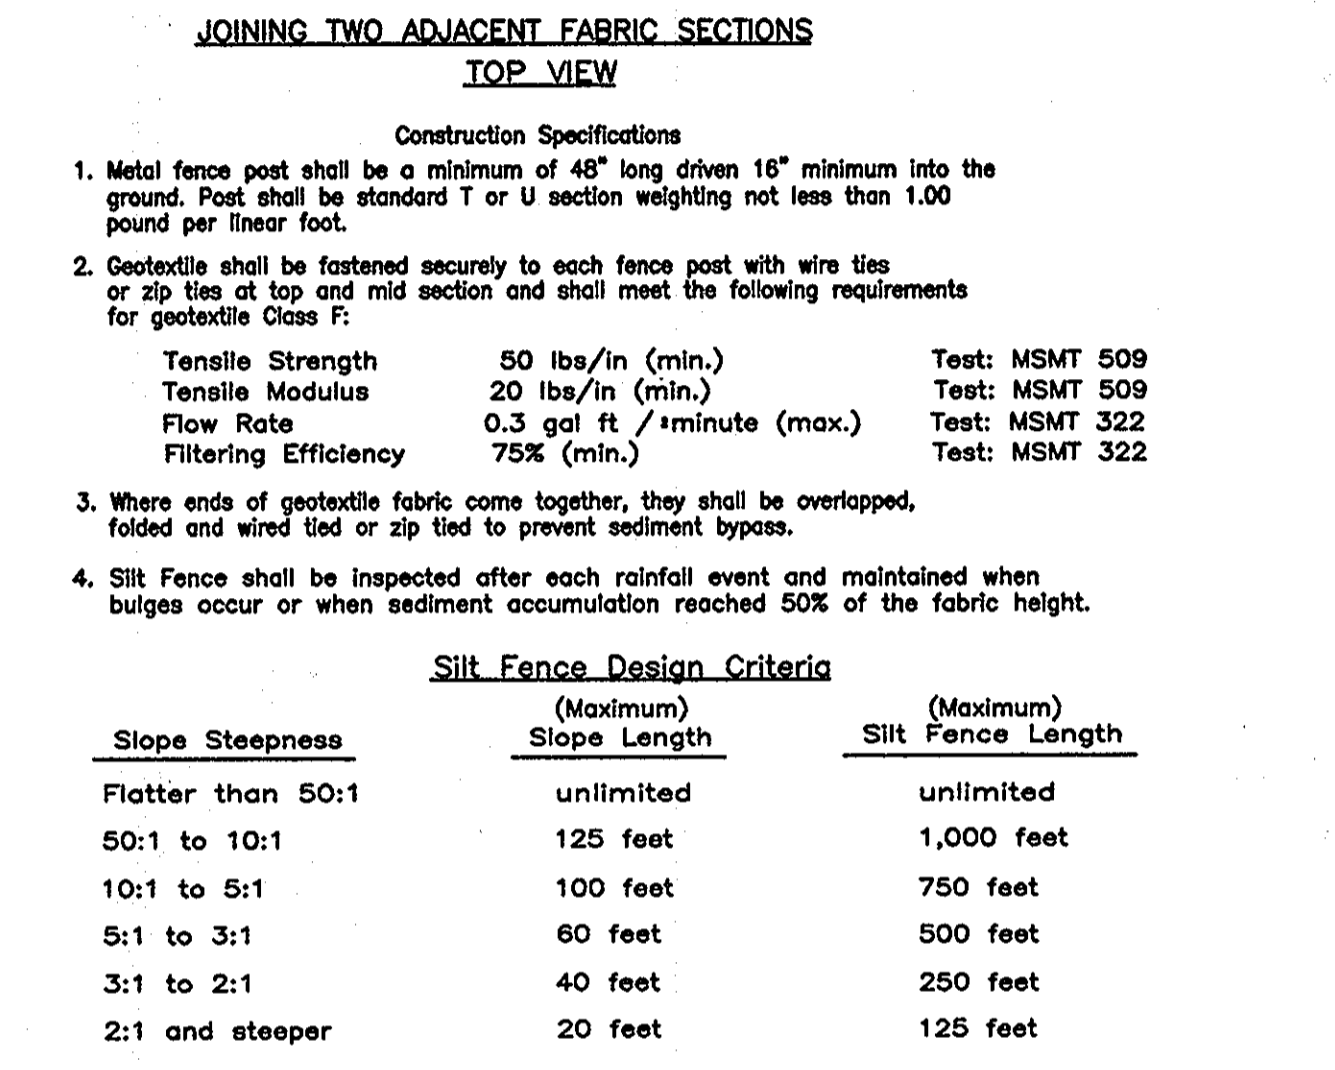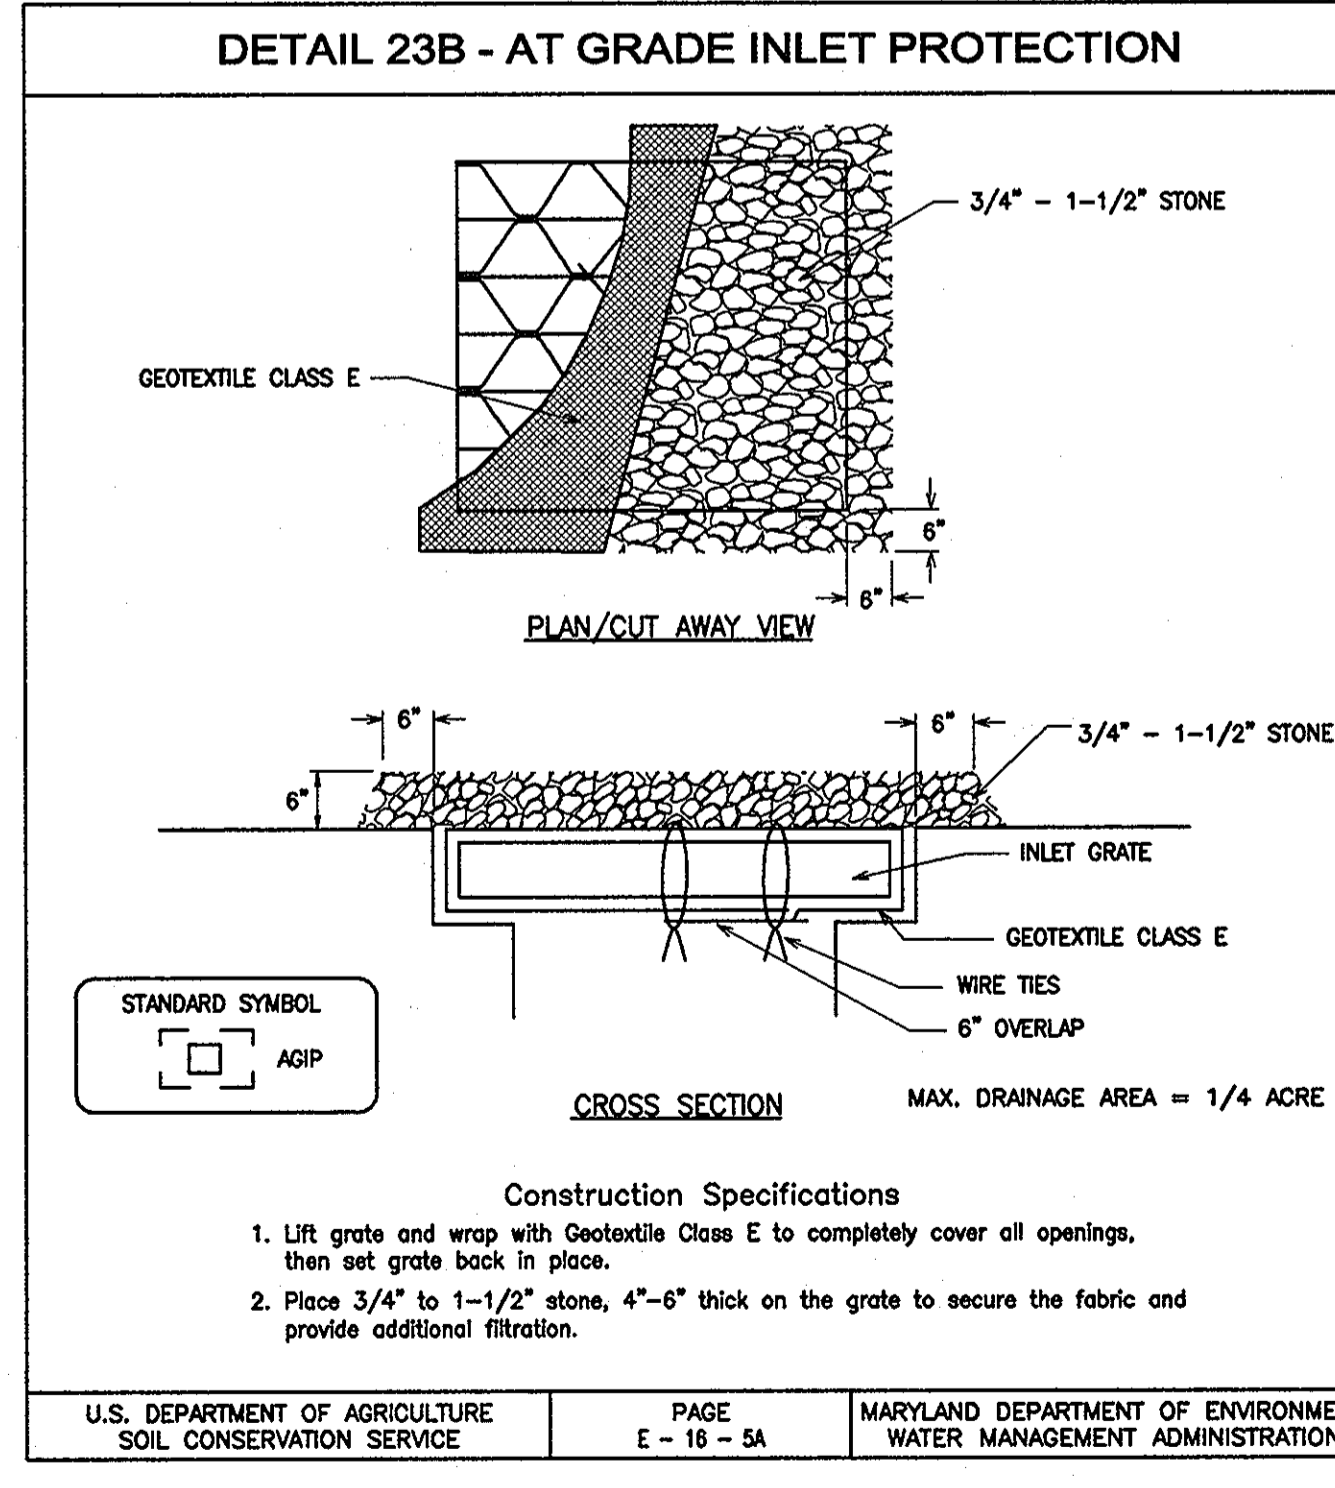

### PROJECT SEQUENCE OF CONSTRUCTION

- Notify Miss Utility (1-800-257-7777) at least 48 hours prior to beginning work.
- Notify Howard County Construction Inspection Division (1-410-313-3800) at least 48 hours prior to beginning work on-site and obtain grading permit.
- Clear and grub for sediment and erosion control measures or devices only. (7 days)
- Install all sediment and erosion control measures or devices including stabilized construction entrance(s). (10 days)
- Notify Howard County Construction Inspection Division upon completion of the installation work noted above. (1 day)
- With the approval of the Howard County Construction Inspection Division, clear and grub the remainder of the site and stabilize immediately. (21 days)
- Begin excavation and installation of utilities. Work shall be limited to that which can be backfilled and stabilized in one day per Standard Sediment Control Note No. 11. Stabilize work area at the end of each work day. (550 days)
- Connect to existing utilities where applicable. (7 days)
- With permission from the Sediment Control Inspector, remove stabilized construction entrance(s). (2 days)
- Stabilize all disturbed areas. (14 days)
- Following approval from the Howard County Construction Inspection Division Inspector, remove all remaining sediment control measures and stabilize any remaining areas. (7 days)

### BEST MANAGEMENT PRACTICES FOR WORKING IN NONTIDAL WETLANDS, WETLAND BUFFERS, WATERWAYS, AND 100-YEAR FLOODPLAIN

- No excess fill, construction material, or debris shall be stockpiled or stored in nontidal wetlands, nontidal wetland buffers, waterways, or the 100-year floodplain.
- Place materials in a location and manner which does not adversely impact surface or subsurface water flow into or out of nontidal wetlands, nontidal wetland buffers, waterways, or 100-year floodplain.
- Do not use excavated material as backfill if it contains waste metal products, unsightly debris, toxic material, or any other deleterious substance. If additional backfill is required, use clean material free of waste metal products, unsightly debris, toxic material, or any other deleterious substance.
- Place heavy equipment on mats or suitably operate the equipment to prevent damage to nontidal wetlands, nontidal wetland buffers, waterways, or the 100-year floodplain.
- Repair and maintain any serviceable structure or fill so there is no permanent loss of nontidal wetlands, nontidal wetland buffers, waterways, or permanent modification of the 100-year floodplain in excess of that lost under the originally authorized structure or fill.
- Rectify any nontidal wetlands, nontidal wetland buffers, waterways, or the 100-year floodplain temporarily impacted by any construction.
- All stabilization in the nontidal wetland and nontidal wetland buffer shall consist of the following species: Annual Ryegrass (*Lolium multiflorum*), Millet (*Setaria italica*), Barley (*Hordeum sp.*), Oats (*Avena sp.*), and/or Rye (*Secoale cereale*). These species will allow for stabilization of the site while also allowing for the voluntary revegetation of natural wetland species. Other non-persistent vegetation may be acceptable, but must be approved by the Nontidal Wetlands and Waterways Division. Kentucky 31 fescue shall not be utilized in wetland or buffer areas. The area should be seeded and mulched to reduce erosion after construction activities have been completed.
- After installation has been completed, make post-construction grades and elevations the same as the original grades and elevations in temporarily impacted areas.
- To protect aquatic species, in-stream work is prohibited as determined by classification of the stream:
  - Use 1 waters: in-stream work shall not be conducted during the period of March 1 through June 15, inclusive, during any year.
- Stormwater runoff from impervious surfaces shall be controlled to prevent the washing of debris into the waterway.
- Culverts shall be constructed and any riprap placed so as not to obstruct the movement of the aquatic species, unless the purpose of the activity is to impound water.

AS-BUILTS  
JUN 17 2010

ESC  
8 OF 10  
SCALE:  
SHOWN  
SHEET  
18 OF 26

DEPARTMENT OF PUBLIC WORKS  
HOWARD COUNTY, MARYLAND

6/3/10  
 DIRECTOR OF PUBLIC WORKS DATE  
 6/2/10  
 CHIEF, BUREAU OF UTILITIES DATE

**Dewberry**  
Dewberry & Davis LLC  
3106 LORD BALTIMORE DRIVE  
SUITE 110  
BALTIMORE, MD 21244-2092  
410.285.8500  
FAX: 410.285.8875



DES: LAL											
DRN: CD											
CHK: TND											
DATE: 5.28.10											
BY	NO.	REVISIONS	DATE								

600' SCALE MAP NO. 37, 43 BLOCK NO. 5, 23

EROSION AND SEDIMENT CONTROL NOTES & DETAILS

LITTLE PATUXENT PARALLEL INTERCEPTOR  
CAPITAL PROJECT S-6175  
CONTRACT NO. 20-4540

ELECTION DISTRICT NO. 5 HOWARD COUNTY, MARYLAND

Plotted by: (copy) on: 06/24/10 at: 01:20:10  
 Path: C:\Users\jason\AppData\Local\Temp\20100624\_11716-0-LPH\_X-ESC\_DETAILS\_and\_NOTES\_SHEET17-18.dwg  
 User: jason  
 Date: 06/24/10 at: 01:20:10  
 Plotter: HP DesignJet T1100 Series  
 PLOTTER: HP DesignJet T1100 Series  
 PLOTTER: HP DesignJet T1100 Series

MGWC 1.2: PUMP-AROUND PRACTICE

Temporary measure for dewatering in-channel construction sites

DESCRIPTION

The work should consist of installing a temporary pump around and supporting measures to divert flow around in-stream construction sites.

IMPLEMENTATION SEQUENCE


Sediment control measures, pump-around practice, and associated channel and bank construction should be completed in the following sequence (refer to Detail 1.2):

- 1. Construction activities including the installation of erosion and sediment control measures should not begin until all necessary easements and/or right-of-ways have been acquired. All existing utilities should be marked in the field prior to construction. The contractor is responsible for any damage to existing utilities that may result from construction and should repair the damage at his/her own expense to the county's or utility company's satisfaction.
2. The contractor should notify the Maryland Department of the Environment or WMA sediment control inspector at least 5 days before beginning construction. Additionally, the contractor should inform the local environmental protection and resource management inspection and enforcement division and the provider of local utilities a minimum of 48 hours before starting construction.
3. The contractor should conduct a pre-construction meeting on site with the WMA sediment control inspector, the county project manager, and the engineer to review limits of disturbance, erosion and sediment control requirements, and the sequence of construction. The contractor should stake out all limits of disturbance prior to the pre-construction meeting so they may be reviewed. The participants will also designate the contractor's staging areas and flag all trees within the limit of disturbance which will be removed for construction access. Trees should not be removed within the limit of disturbance without approval from the WMA or local authority.
4. Construction should not begin until all sediment and erosion control measures have been installed and approved by the engineer and the sediment control inspector. The contractor should stay within the limits of the disturbance as shown on the plans and minimize disturbance within the work area whenever possible.
5. Upon installation of all sediment control measures and approval by the sediment control inspector and the local environmental protection and resource management inspection and enforcement division, the contractor should begin work at the upstream section and proceed downstream beginning with the establishment of stabilized construction entrances. In some cases, work may begin downstream if appropriate. The sequence of construction must be followed unless the contractor gets written approval for deviations from the WMA or local authority. The contractor should only begin work in an area which can be completed by the end of the day including grading adjacent to the channel. At the end of each work day, the work area must be stabilized and the pump-around removed from the channel. Work should not be conducted in the channel during rain events.
6. Sandbag dikes should be situated at the upstream and downstream ends of the work area as shown on the plans, and stream flow should be pumped around and the work area. The pump should discharge onto a stable velocity dissipater made of riprap or sandbags.

MGWC 1.2: PUMP-AROUND PRACTICE

- 7. Water from the work area should be pumped to a sediment filtering measure such as a dewatering basin, sediment bag, or other approved source. The measure should be located such that the water drains back into the channel below the downstream sandbag dike.
8. Traversing a channel reach with equipment within the work area where no work is proposed should be avoided. If equipment has to traverse such a reach for access to another area, then timber mats or similar measures should be used to minimize disturbance to the channel. Temporary stream crossings should be used only when necessary and only where noted on the plans or specified. (See Section 4, Stream Crossings, Maryland Guidelines to Waterway Construction).
9. All stream restoration measures should be installed as indicated by the plans and all banks graded in accordance with the grading plans and typical cross-sections. All grading must be stabilized at the end of each day with seed and mulch or seed and matting as specified on the plans.
10. After an area is completed and stabilized, the clean water dike should be removed. After the first sediment flush, a new clean water dike should be established upstream from the old sediment dike. Finally, upon establishment of a new sediment dike below the old one, the old sediment dike should be removed.
11. A pump around must be installed on any tributary or storm drain outfall which contributes baseflow to the work area. This should be accomplished by locating a sandbag dike at the downstream end of the tributary or storm drain outfall and pumping the stream flow around the work area. This water should discharge onto the same velocity dissipater used for the main stem pump around.
12. If a tributary is to be restored, construction should take place on the tributary before work on the main stem reaches the tributary confluence. Construction in the tributary, including pump around practices, should follow the same sequence as for the main stem of the river or stream. When construction on the tributary is completed, work on the main stem should resume. Water from the tributary should continue to be pumped around the work area in the main stem.
13. The contractor is responsible for providing access to and maintaining all erosion and sediment control devices until the sediment control inspector approves their removal.
14. After construction, all disturbed areas should be regraded and revegetated as per the planting plan.

Maryland's Guidelines To Waterway Construction DETAIL 1.2: PUMP-AROUND PRACTICE

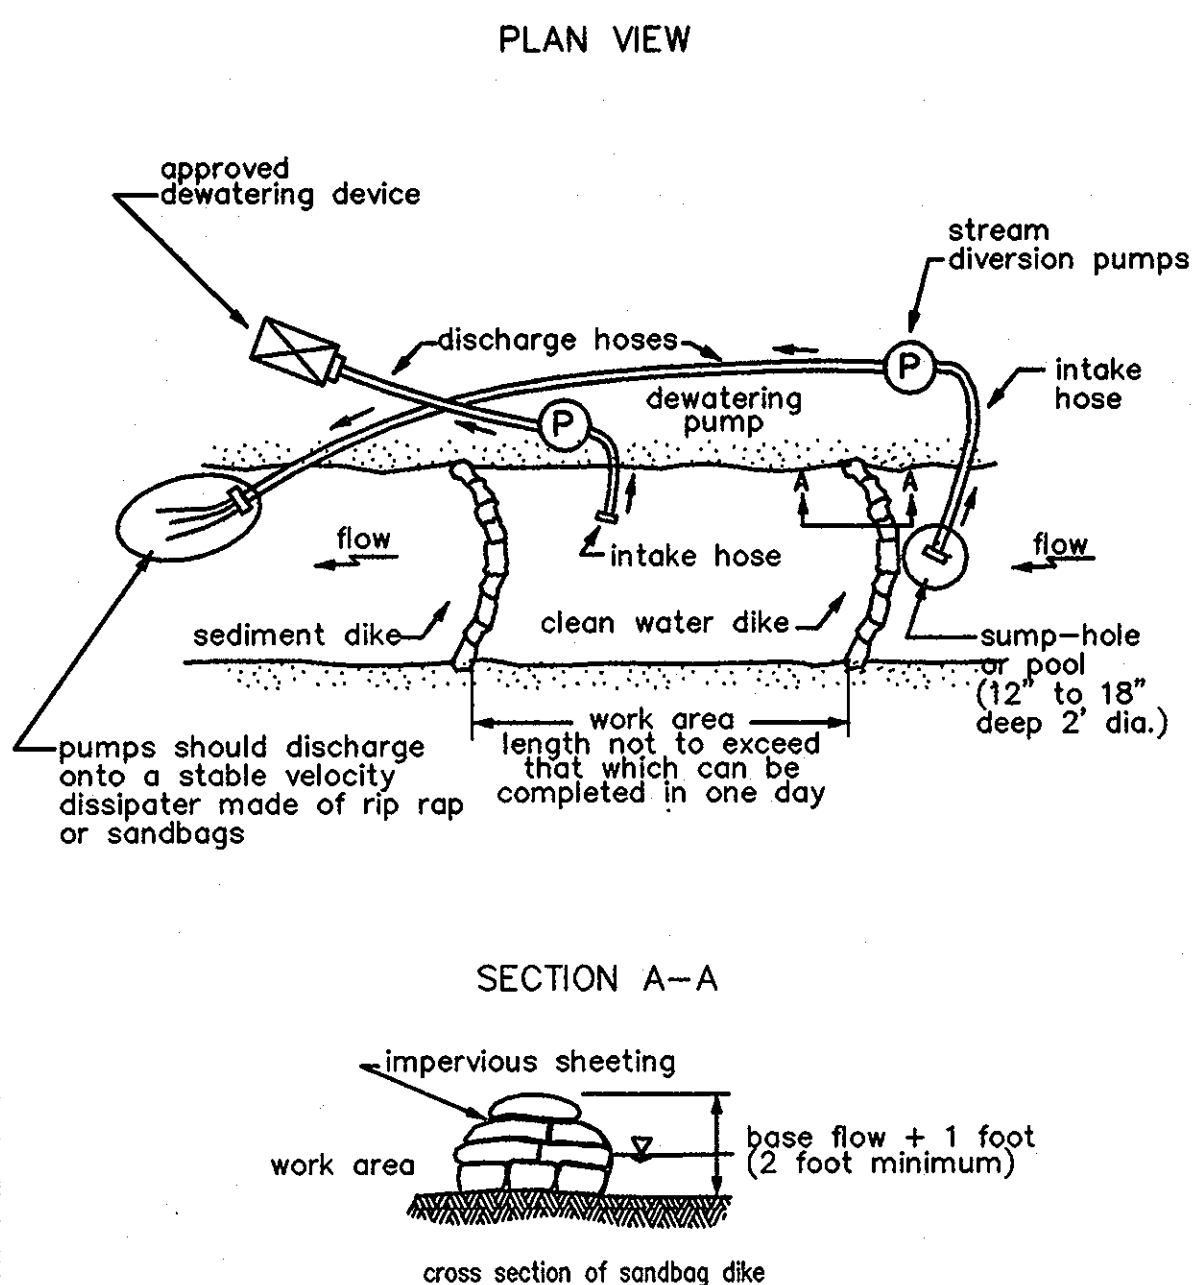

MGWC 1.1: DEWATERING BASINS

Temporary measure for filtering sediment-laden water

DESCRIPTION

The work should consist of installing dewatering basins jointly with channel diversion measures to filter sediment-laden water from in-stream construction sites before the water re-enters the downstream reach.

EFFECTIVE USES & LIMITATIONS

Undersized dewatering basins will not adequately filter sediment-laden water from the construction site.

MATERIAL SPECIFICATIONS

Materials for dewatering basins should meet the following requirements:



- Riprap: Riprap should be washed and have a diameter ranging from 4 to 6 inches (10 to 15 centimeters).
• Filter Cloth: Filter cloth should be a woven or non-woven fabric consisting only of continuous chain polymeric filaments or yarns of polyester. The fabric should be inert to commonly encountered chemicals, hydrocarbons, ultraviolet light, and mildew and should be not resistant.
• Straw Bales/Silt Fence: Straw bales should meet the criteria as specified in the 1994 Maryland Standards and Specifications for Soil Erosion and Sediment Control.

INSTALLATION GUIDELINES


Due to the danger of overtopping by events greater than the design flow, dewatering basins require a vegetative buffer strip to filter sediment-laden overflow. A 50-foot (15-meter) minimum grass-covered buffer width is required for slopes less than 20 degrees (1:2.7) when right-of-way is not limited. For slopes greater than 20 degrees, basins should have a 100-foot (30-meter) minimum buffer width when practical. All erosion and sediment control devices should be installed as the first order of business according to a plan approved by the Water Management Administration (WMA) or local authority. Dewatering basins should be constructed as follows (refer to Detail 1.1):

- 1. Excavated subsoil and topsoil should be stored separately and replaced in their natural order. Additionally, the excavated sediments should be prevented from entering the waterway by using sediment perimeter controls or other measures.
2. The dewatering basin should have a minimum depth of 3 feet (1 meter) where basin depth is measured from the top of the straw bales to the bottom of the excavation.
3. Once the dewatering basin becomes filled to one-half of the excavated depth, accumulated sediment should be removed and disposed of in an approved area outside the 100-year floodplain unless otherwise authorized by the WMA.
4. Sediment control devices should remain in place until all disturbed areas are stabilized and the inspecting authority approves their removal. All disturbed ground contours should be returned to their original condition unless otherwise approved by the WMA or local authority.

Maryland's Guidelines To Waterway Construction DETAIL 1.1: DEWATERING BASINS

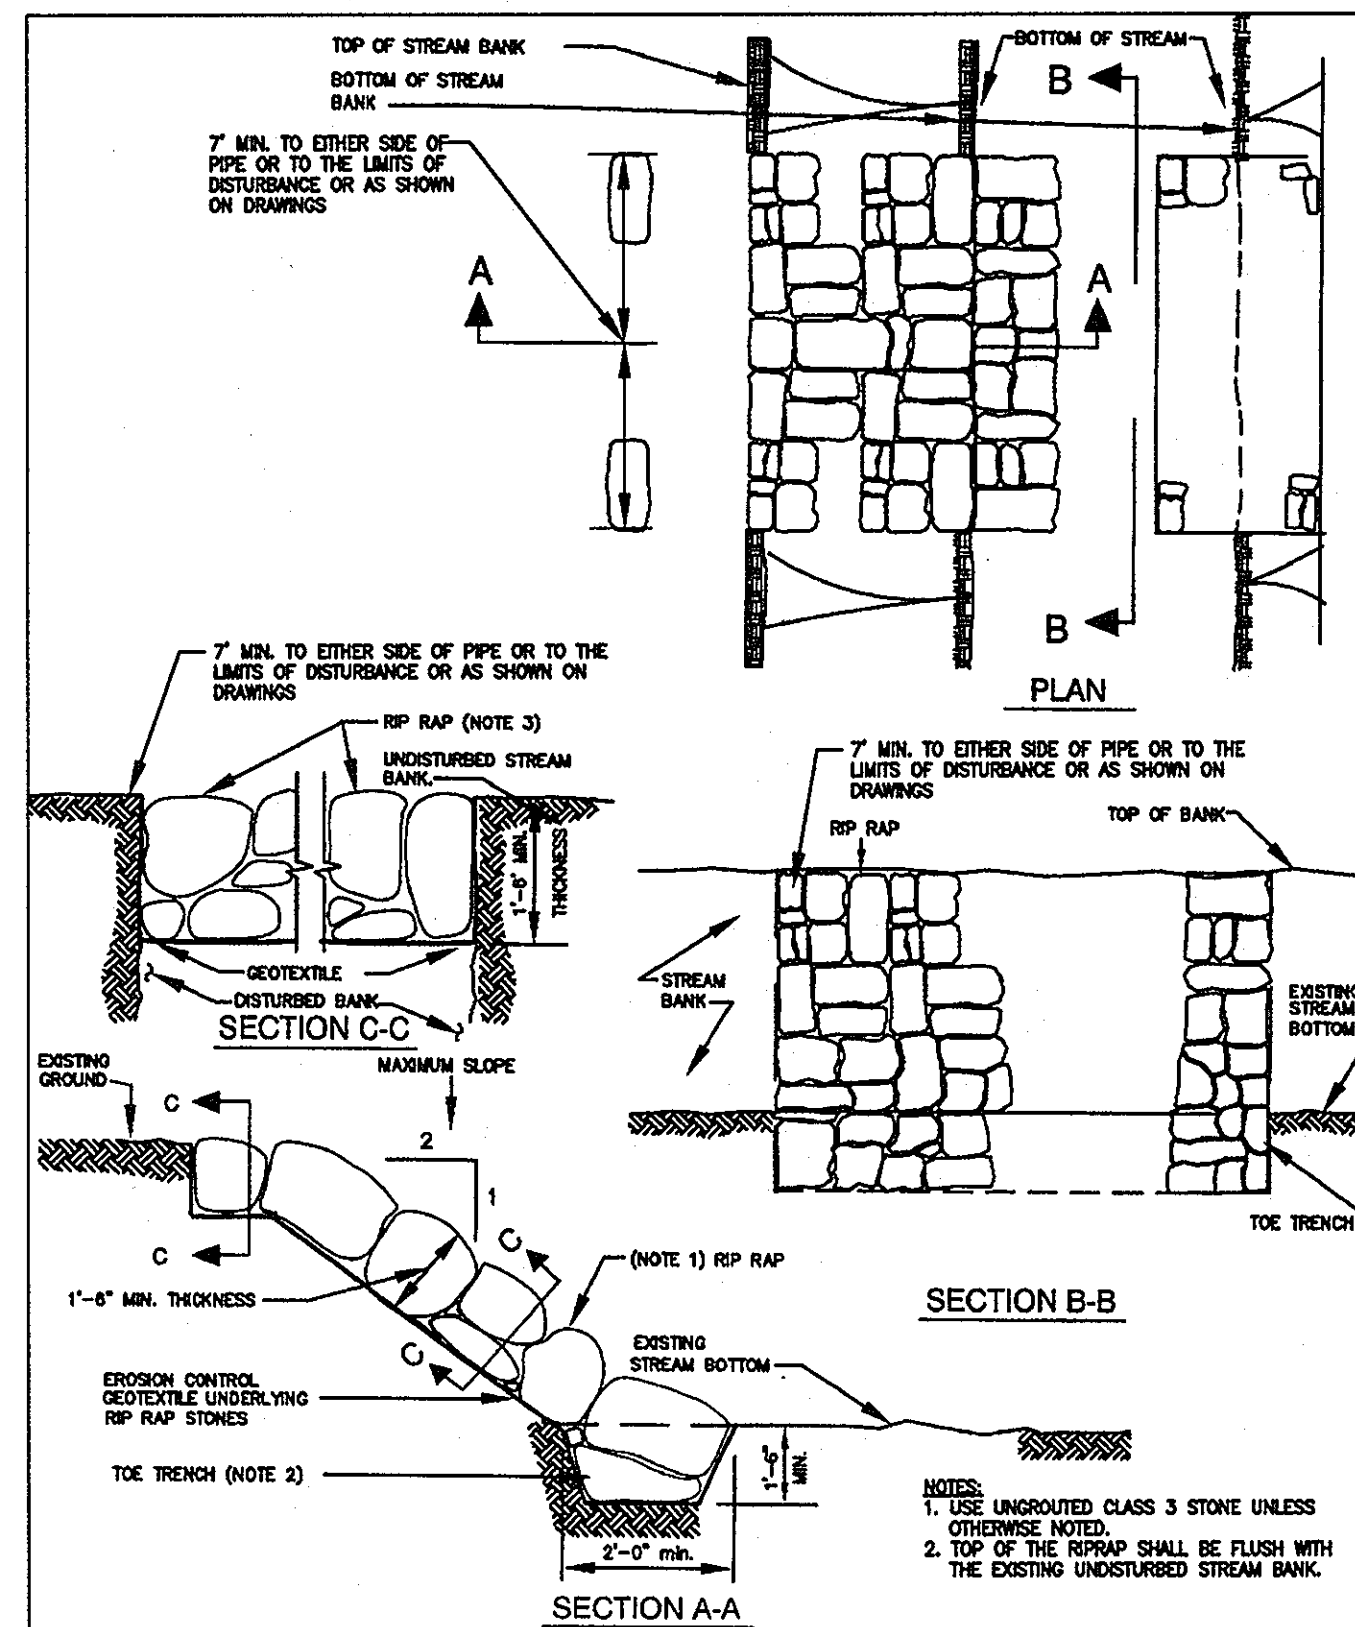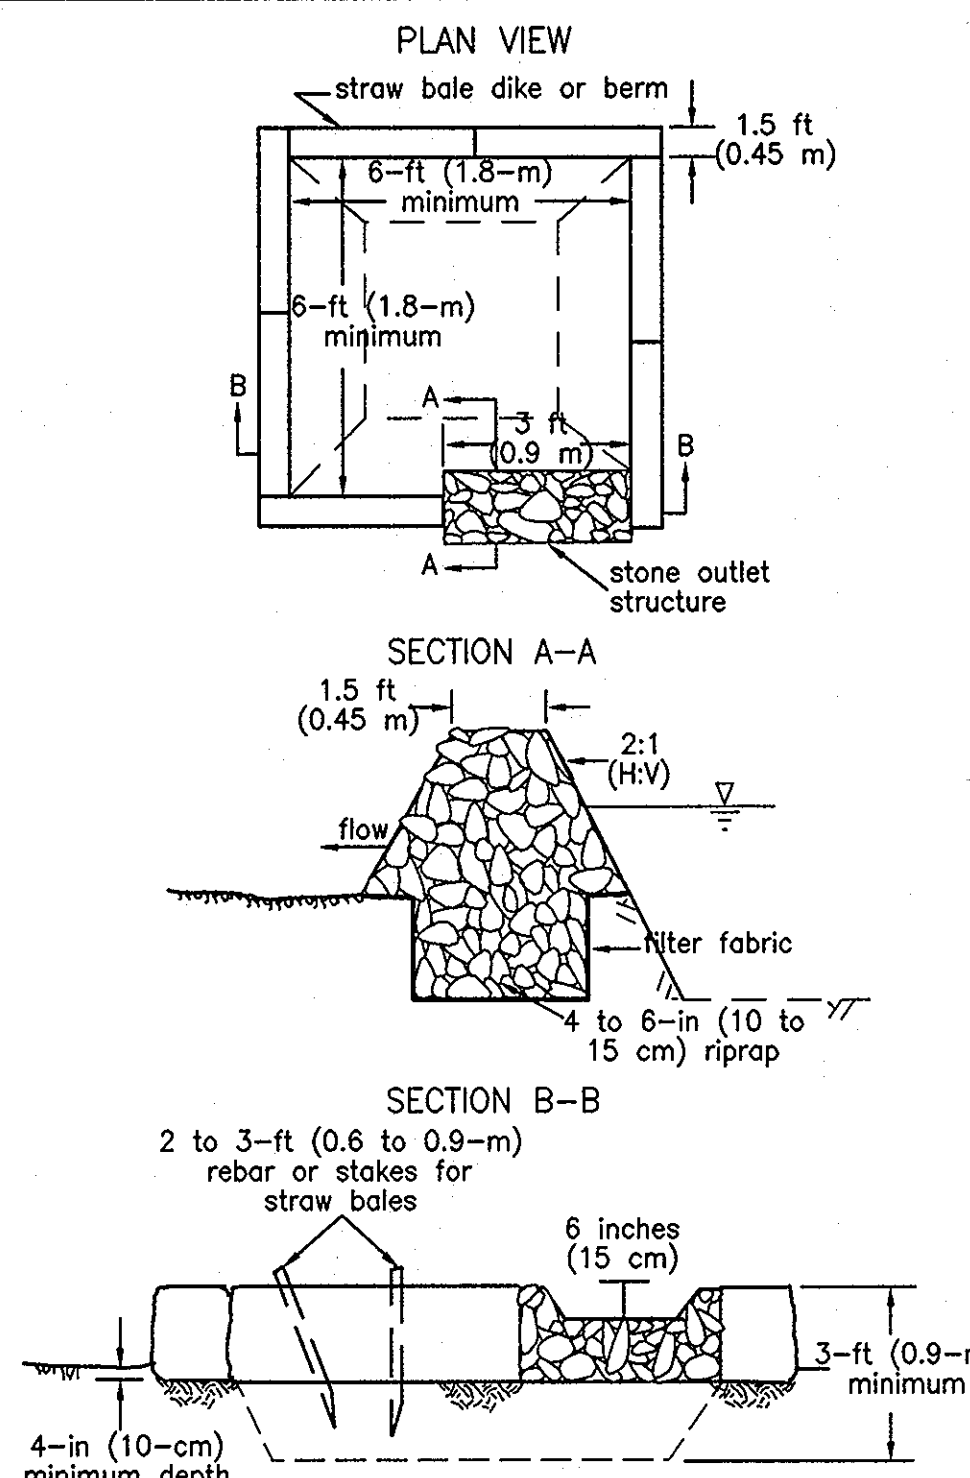

STREAM BANK PROTECTION NO SCALE

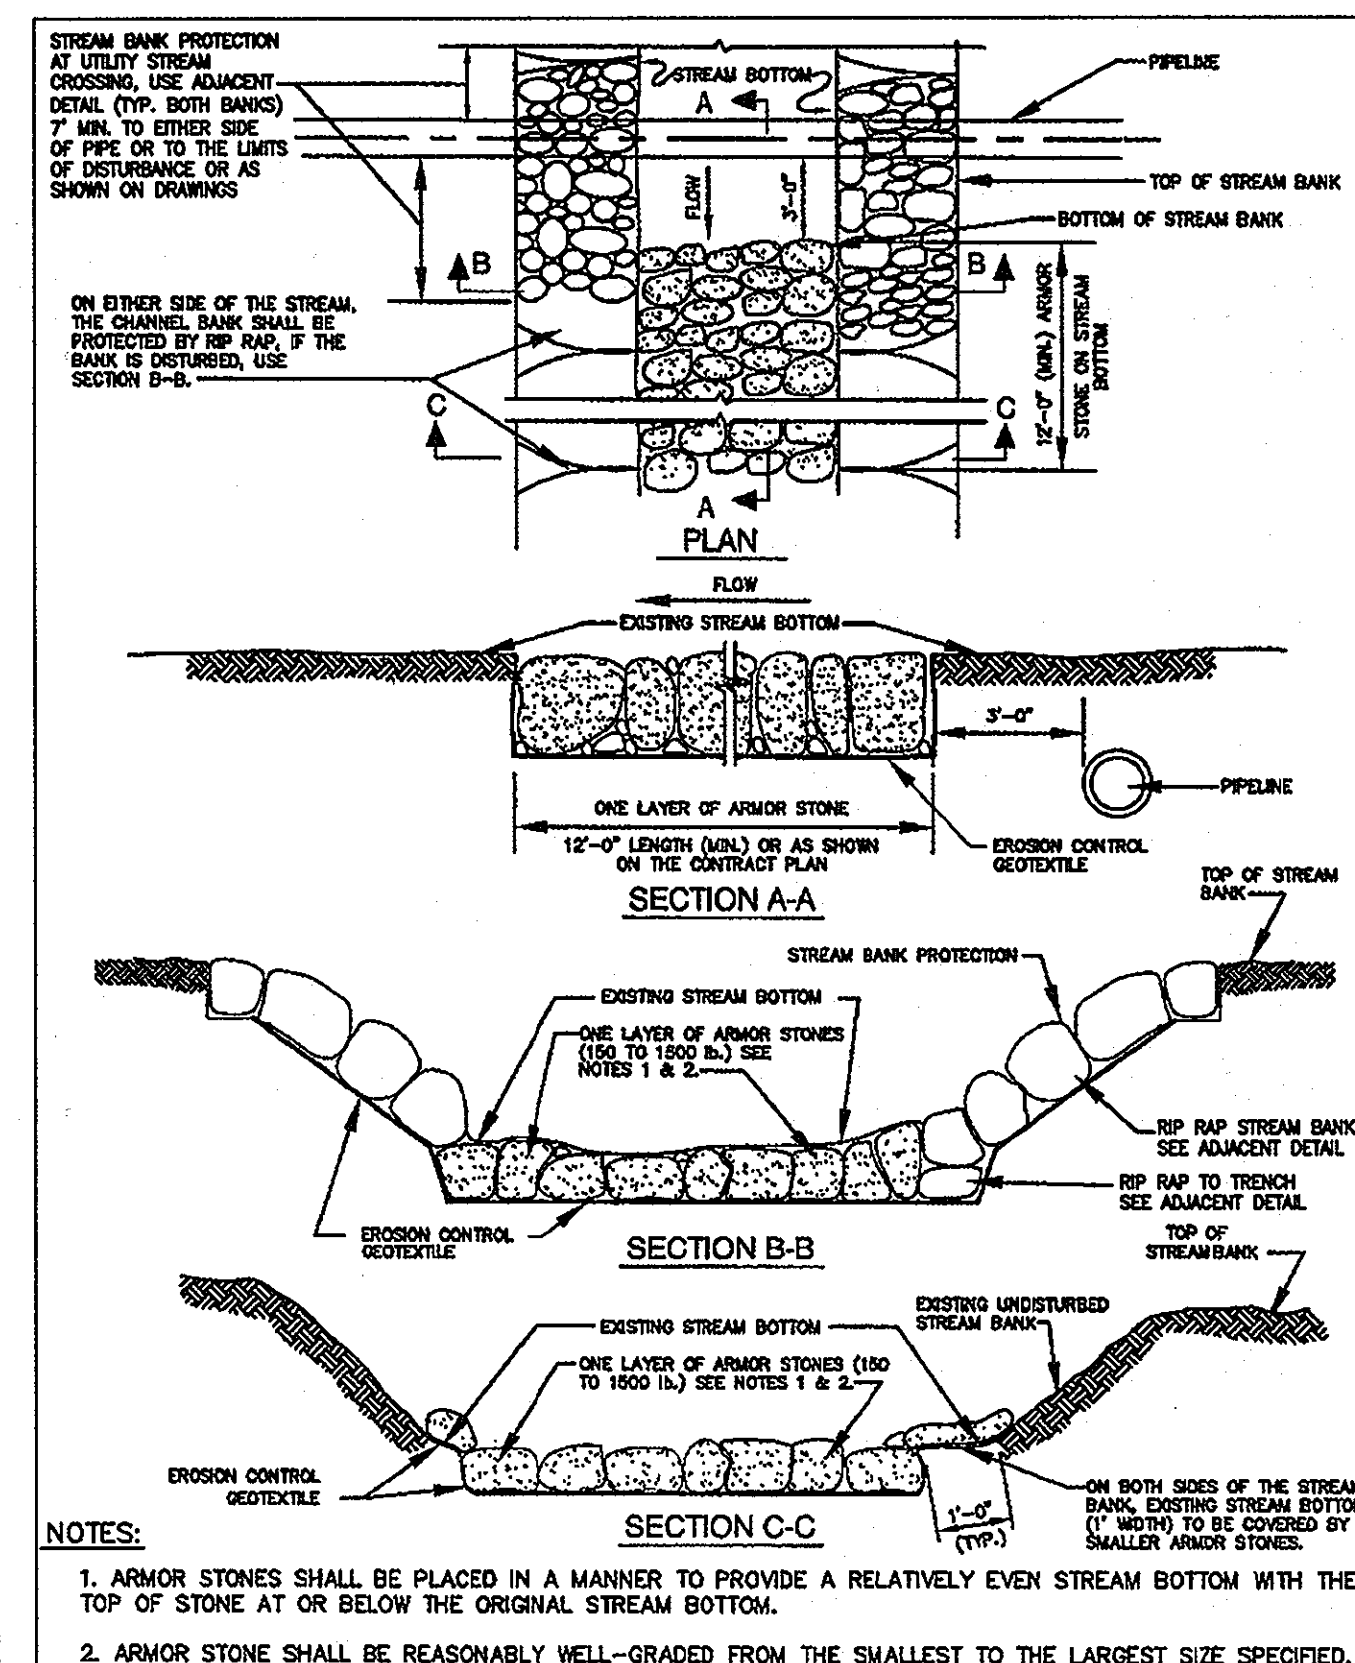

STREAM INVERT PROTECTION NO SCALE

DETAIL: STREAM BANK/ INVERT PROTECTION

AS-BUILTS JAN 17 2010

DEPARTMENT OF PUBLIC WORKS HOWARD COUNTY, MARYLAND. Includes signatures of Director of Public Works and Chief, Bureau of Engineering, dated 6/2/10.

Dewberry & Davis LLC logo and contact information: 3108 LORD BALTIMORE DRIVE SUITE 110 BALTIMORE, MD 21244-2682 410.285.9500 FAX 410.285.8875



Table with columns: DES: LAL, DRN: CD, CHK: TND, DATE: 5.28.10, BY: NO., REVISIONS, DATE.

EROSION AND SEDIMENT CONTROL NOTES & DETAILS. 600' SCALE MAP NO. 37, 43 BLOCK NO. 5, 23

LITTLE PATUXENT PARALLEL INTERCEPTOR CAPITAL PROJECT S-6175 CONTRACT NO. 20-4540 ELECTION DISTRICT NO. 5 HOWARD COUNTY, MARYLAND

ESC 9 OF 10 SCALE: SHOWN SHEET 19 OF 28

MGWC 1.5: SANDBAG/STONE CHANNEL DIVERSION

Temporary measure for dewatering in-channel construction sites

DESCRIPTION

The work should consist of installing sandbag or stone flow diversions for the purpose of erosion control when construction activities occur within the stream channel.

EFFECTIVE USES & LIMITATIONS

Diversions are used to isolate work areas from flow during the construction of in-stream projects. Diversions which have an insufficient flow capacity can fail and severely erode the disturbed channel section under construction.

MATERIAL SPECIFICATIONS

Materials for sandbag and stone stream diversions should meet the following requirements:

- Riprap: Riprap should be washed and have a minimum diameter of 6 inches (0.15 meters).
Sandbags: Sandbags should consist of materials which are resistant to ultra-violet radiation, tearing, and puncture and should be woven tightly enough to prevent leakage of the fill material (i.e., sand, fine gravel, etc.).
Sheeting: Sheeting should consist of polyethylene or other materials which are impervious and resistant to puncture and tearing.

INSTALLATION GUIDELINES

All erosion and sediment control devices, including dewatering basins, should be implemented as the first order of business according to a plan approved by the WMA or local authority.

Sandbag/stone diversions can be used independently or as components of other stream diversion techniques.

- The diversion structure should be installed from upstream to downstream.
The height of the sandbag/stone diversion should be a function of the duration of the project in the stream reach.
All excavated material should be deposited and stabilized in an approved area outside the 100-year floodplain unless otherwise authorized by the WMA.
Sediment-laden water from the construction area should be pumped to a dewatering basin.

MARYLAND DEPARTMENT OF THE ENVIRONMENT WATERWAY CONSTRUCTION GUIDELINES REVISED NOVEMBER 2000

PAGE 1.5 - 1


MGWC 1.5: SANDBAG/STONE CHANNEL DIVERSION

- Sheeting on the diversion should be positioned such that the upstream portion covers the downstream portion with at least a 18-inch (0.45 meters) overlap.
Sandbag or stone diversions should not obstruct more than 45% of the stream width.
Prior to removal of these temporary structures, any accumulated sediment should be removed, deposited and stabilized in an approved area outside the 100-year floodplain unless authorized by the WMA.
Sediment control devices are to remain in place until all disturbed areas are stabilized in accordance with an approved sediment and erosion control plan and the inspecting authority approves their removal.

MARYLAND DEPARTMENT OF THE ENVIRONMENT WATERWAY CONSTRUCTION GUIDELINES REVISED NOVEMBER 2000

PAGE 1.5 - 2

Maryland's Guidelines To Waterway Construction DETAIL 1.5: SANDBAG/STONE DIVERSION

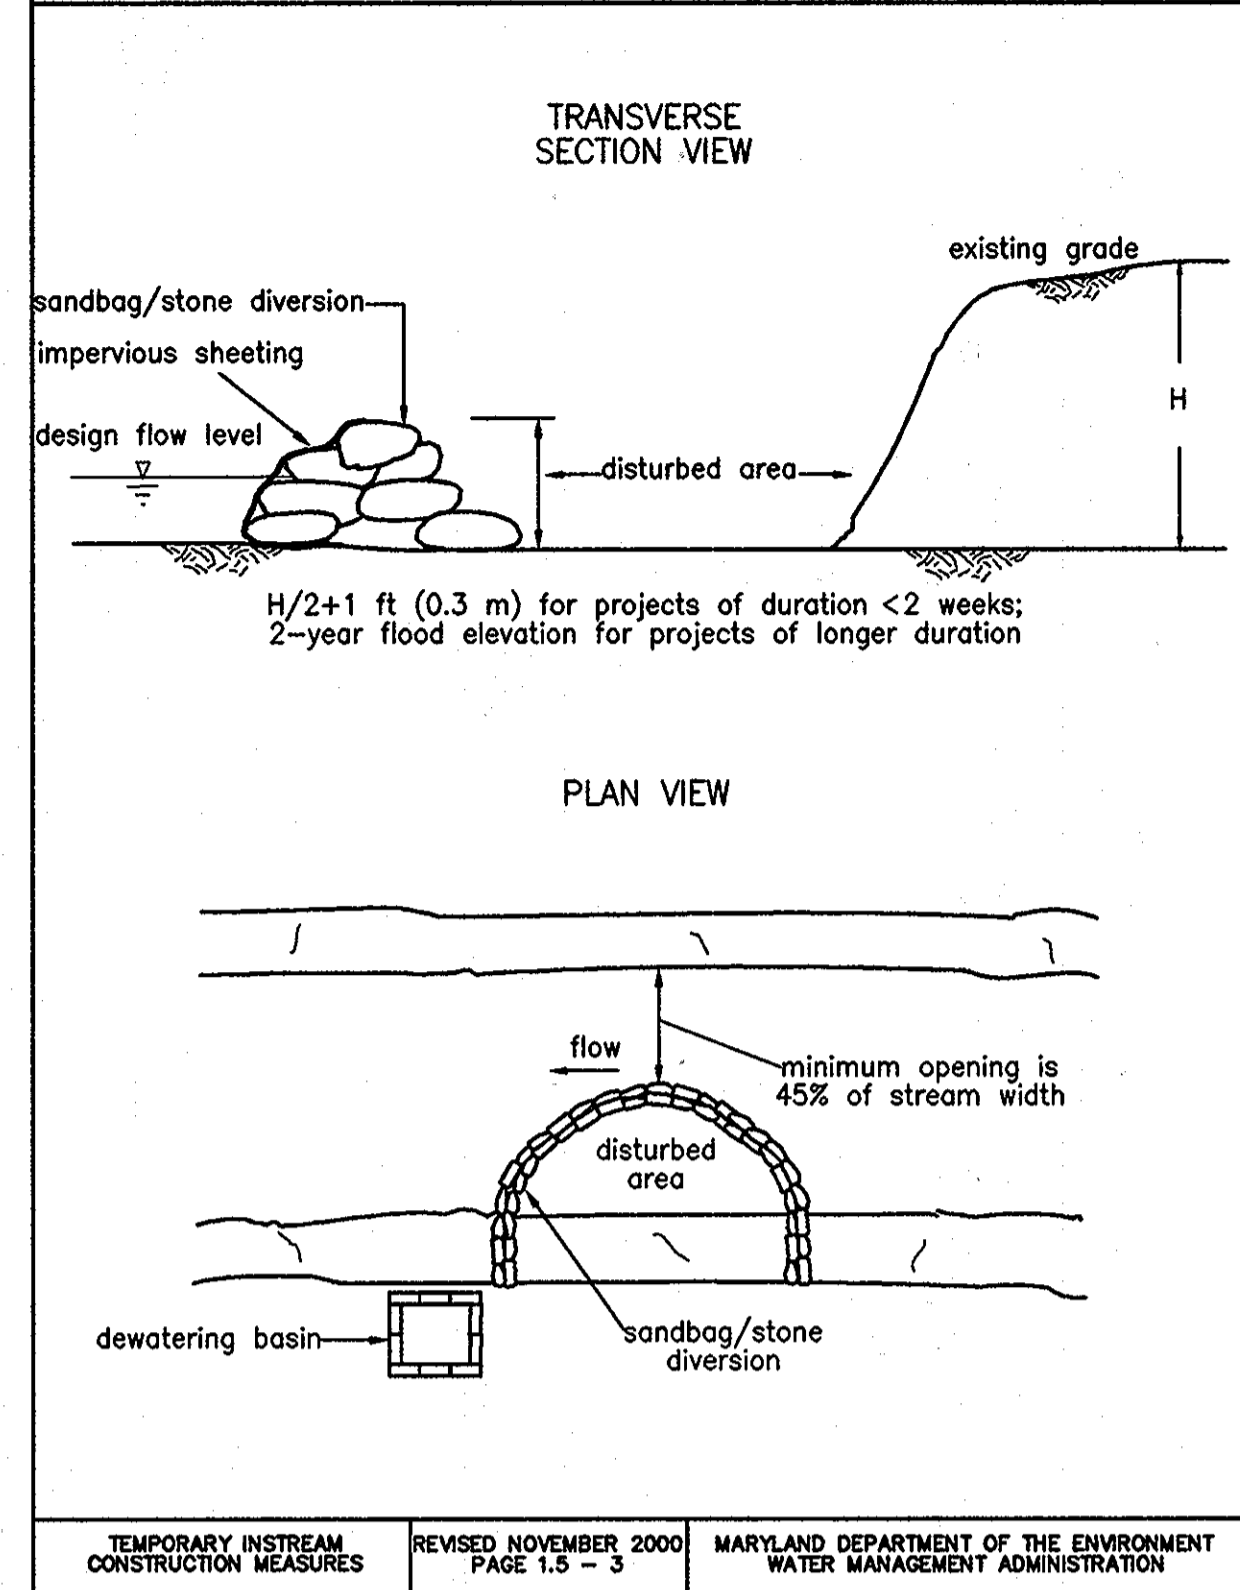

TEMPORARY INSTREAM CONSTRUCTION MEASURES REVISED NOVEMBER 2000 MARYLAND DEPARTMENT OF THE ENVIRONMENT WATER MANAGEMENT ADMINISTRATION

MGWC 4.8: TEMPORARY ACCESS BRIDGE

Temporary stream crossing intended for minimum corridor disturbance

DESCRIPTION

A temporary access bridge is a stream crossing made of wood, metal, or other materials designed to limit the amount of disturbance to the stream banks and bed.

EFFECTIVE USES & LIMITATIONS

Temporary access bridges are the preferred method of waterway crossing since they typically cause the least disturbance to the waterway bed and banks, pose the least chance for interference with fish migration, and can be quickly removed and reused.

MATERIAL SPECIFICATIONS

- Stringers: Stringers should either be logs, sawn timber, prestressed concrete beams, metal beams, or other approved materials.
Deck Materials: Deck materials should be of sufficient strength to support the anticipated load.

CONSTRUCTION SEQUENCE

All erosion and sediment control devices, including stream diversions, should be implemented as the first order of business according to a plan approved by the WMA or local authority.

- Abutments should be placed parallel to, and on, stable banks such that the structure is at or above bankfull depth to prevent the entrapment of floating materials and debris.
Temporary access bridges should be constructed to span the entire channel.
All decking members should be placed perpendicularly to the stringers, butted tightly, and securely fastened to the stringers.
Although run planks are optional, they may be necessary to properly distribute loads.
Curb or fenders may be installed along the outer sides of the deck to provide additional safety.
Bridges should be securely anchored at one end using steel cable or chain to prevent the bridge from floating downstream and possibly causing an obstruction to the flow.

MARYLAND DEPARTMENT OF THE ENVIRONMENT WATERWAY CONSTRUCTION GUIDELINES REVISED NOVEMBER 2000

PAGE 4.8 - 1


MGWC 4.8: TEMPORARY ACCESS BRIDGE

- All areas disturbed during installation should be stabilized within 14 calendar days in accordance with a revegetation plan approved by the WMA.
Periodic inspection should be performed by the user to ensure that the bridge, streambed, and stream banks are maintained and not damaged.
Maintenance should be performed as needed to ensure that the structure complies with all standards and specifications.
When the temporary bridge is no longer needed, all structures including abutments and other bridging materials should be removed within 14 calendar days.

MARYLAND DEPARTMENT OF THE ENVIRONMENT WATERWAY CONSTRUCTION GUIDELINES REVISED NOVEMBER 2000

PAGE 4.8 - 2

Maryland Guidelines to Waterway Construction DETAIL 4.8: TEMPORARY ACCESS BRIDGE

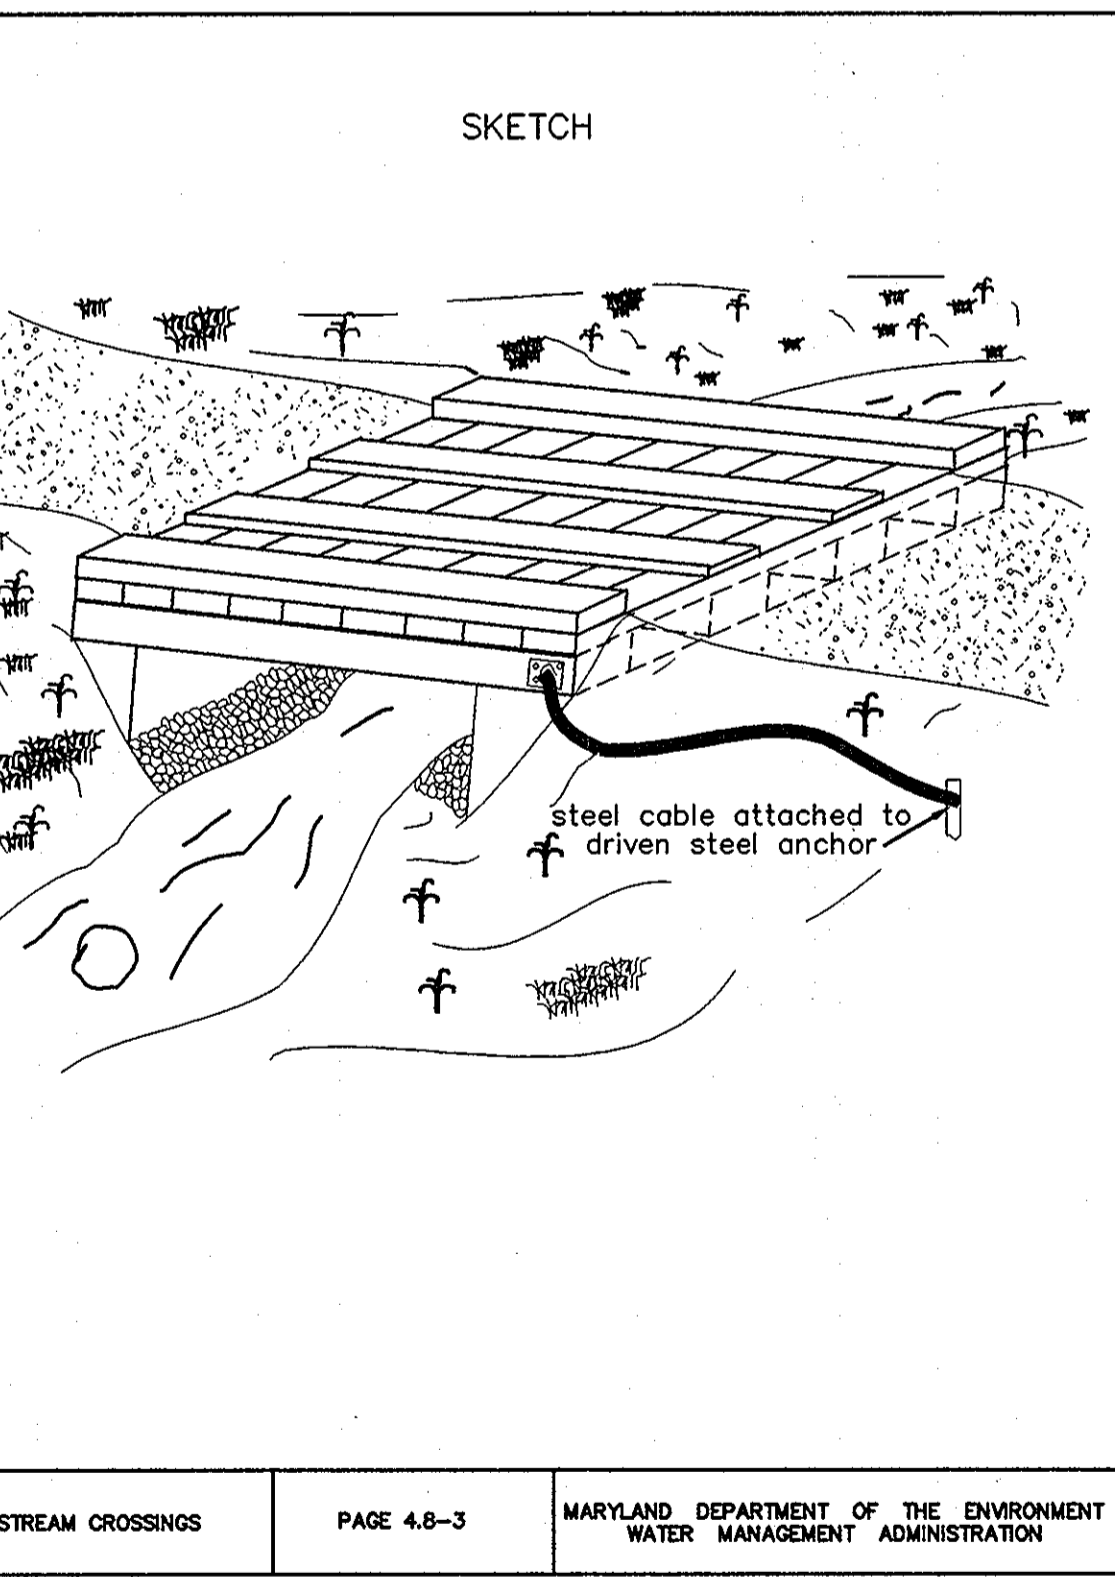


MARYLAND DEPARTMENT OF THE ENVIRONMENT WATER MANAGEMENT ADMINISTRATION

DETAIL 36 - TEMPORARY ACCESS CULVERT

TEMPORARY ACCESS CULVERT

Construction Specifications

- Restrictions - No construction or removal of a temporary access culvert will be permitted between October 1 through April 30 for Class III and Class IV Trout Waters or between March 1 through June 15 for non-trout waterways.
Culvert Strength - All culverts shall be strong enough to support their cross sectional area under maximum expected loads.
Culvert Size - The size of the culvert pipe shall be the largest pipe diameter that will fit into the existing channel without major excavation of the waterway channel or without major approach fills.
Culvert Length - The culvert(s) shall extend a minimum of one foot beyond the upstream and downstream toe to the aggregate placed around the culvert.
Filter Cloth - Filter cloth shall be placed on the streambed and streambanks prior to placement of the pipe culvert(s) and aggregate.
Culvert Placement - The invert elevation of the culvert shall be installed on the natural streambed grade to minimize interference with fish migration.
Culvert Protection - The culvert(s) shall be covered with a minimum of one foot of aggregate.
Stabilization - All areas disturbed during culvert installation shall be stabilized within 14 calendar days of the disturbance.

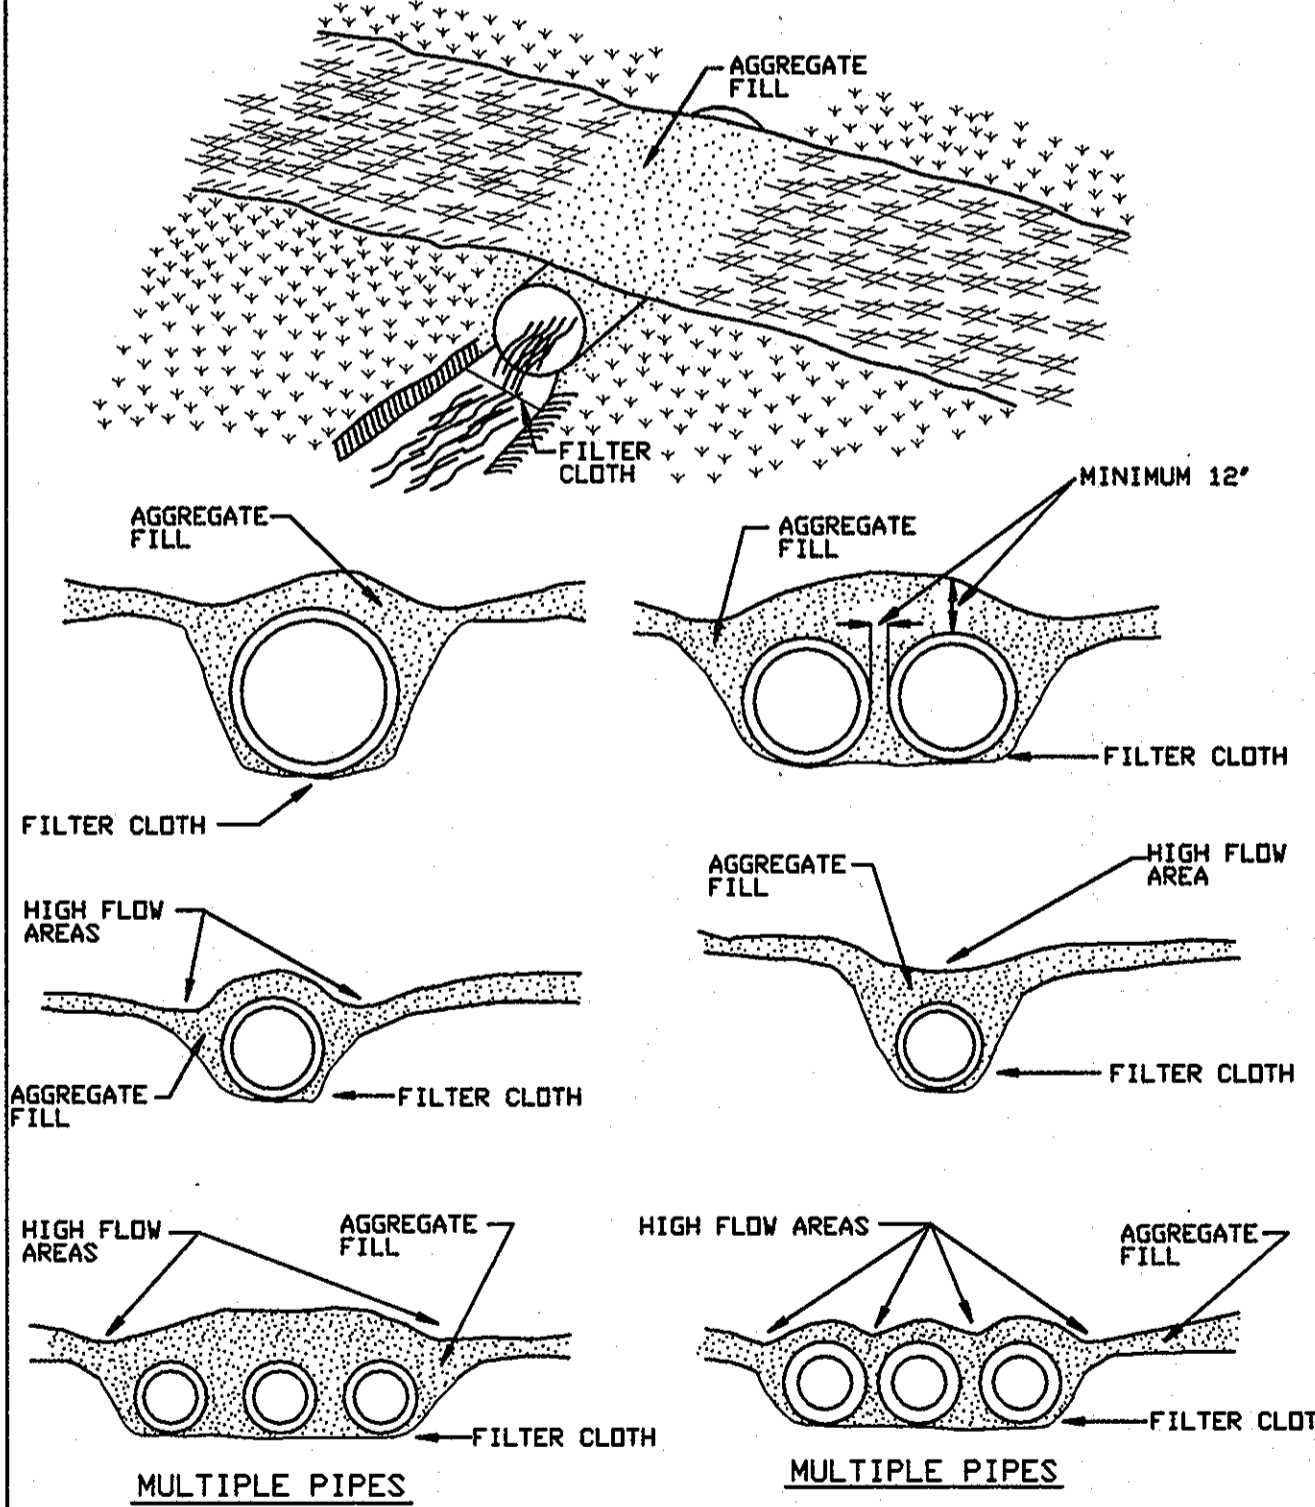

U.S. DEPARTMENT OF AGRICULTURE SOIL CONSERVATION SERVICE PAGE H - 29 - 12 MARYLAND DEPARTMENT OF ENVIRONMENT WATER MANAGEMENT ADMINISTRATION

U.S. DEPARTMENT OF AGRICULTURE SOIL CONSERVATION SERVICE PAGE H - 29 - 12A MARYLAND DEPARTMENT OF ENVIRONMENT WATER MANAGEMENT ADMINISTRATION

DEPARTMENT OF PUBLIC WORKS HOWARD COUNTY, MARYLAND

Handwritten signatures and dates for Director of Public Works, Chief, Bureau of Engineering, Chief, Utility Design Division, and Chief, Bureau of Utilities.

Dewberry Dewberry & Davis LLC

3108 LORD BALTIMORE DRIVE SUITE 110 BALTIMORE, MD 21244-2602



Table with columns: DES, DRN, CHK, DATE, BY, NO., REVISIONS, DATE. Includes handwritten values: DES: LAL, DRN: CD, CHK: TND, DATE: 5.28.10.

EROSION AND SEDIMENT CONTROL NOTES & DETAILS

600' SCALE MAP NO. 37, 43 BLOCK NO. 5, 23

LITTLE PATUXENT PARALLEL INTERCEPTOR

CAPITAL PROJECT S-6175 CONTRACT NO. 20-4540

ELECTION DISTRICT NO. 5

HOWARD COUNTY, MARYLAND



AS-BUILTS JAN 17 2008

ESC 10 OF 10

SCALE: SHOWN

SHEET 20 OF 28







Printed by (60610320) on Fri, 02 Jun 2010 7:22am... Job: Little Patuxent Parallel Interceptor (CAD) SECTION A11-19-20-10-1-P11 1:ESC DETAILS and NOTES SHEET 19-20-10

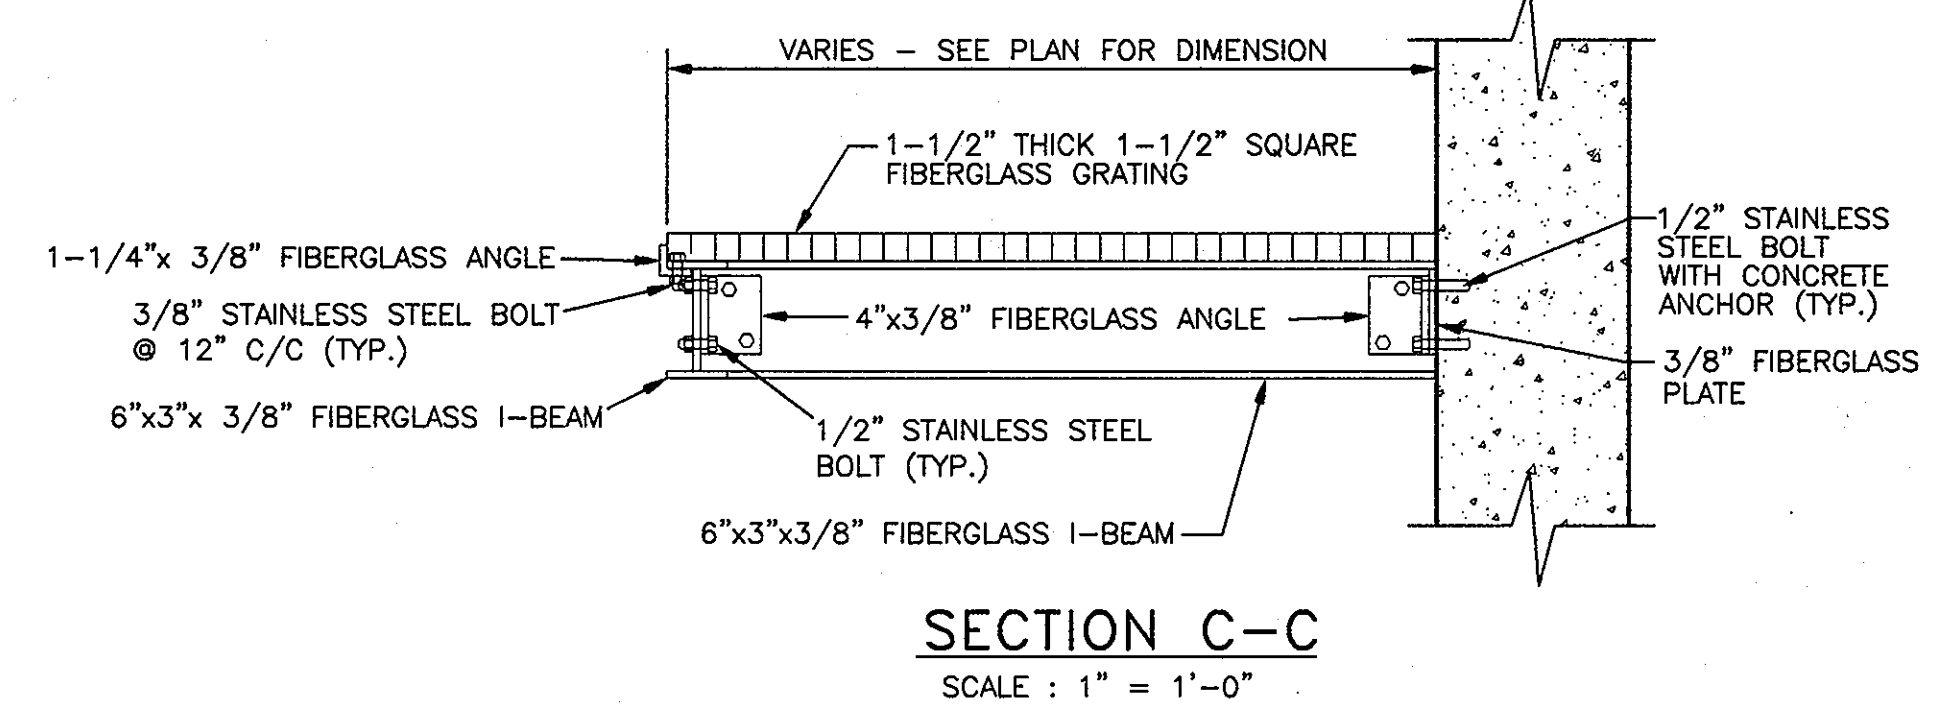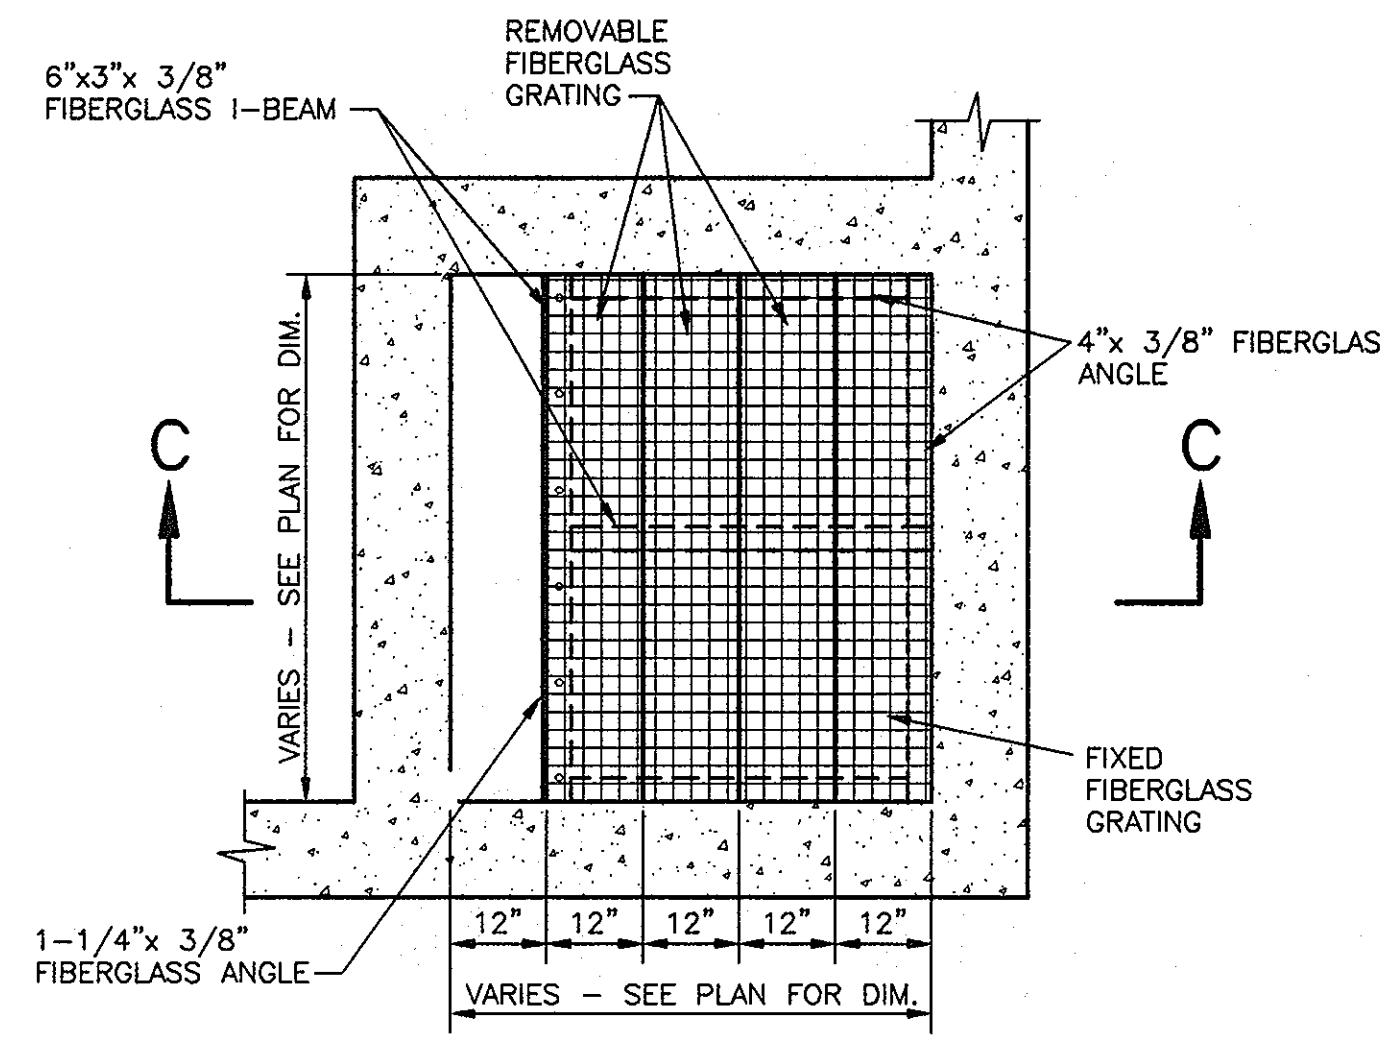

- NOTES:
1. SLUICE GATES SHALL BE FONTAINE SERIES 20 MODEL 202-WALL MOUNTED (COMPLETE WITH WALL THIMBLE) AND NON-RISING STEM (NRI) OR APPROVED EQUAL.
  2. A-LOK SINGLE CLAMP WATER STOPS SHALL BE USED AT PIPE ENTRY/EXIT POINTS OF THE DIVERSION STRUCTURE, AS INDICATED ON DRAWINGS.
  3. GROUND LEVEL POSITION INDICATOR SHALL BE A SEALED UNIT WITH A STAINLESS STEEL SEALED FLOOR BOX, KEY NUT OPERATOR AND POSITION INDICATOR SHALL BE GPI-S SERIES AS MANUFACTURED BY DYNATORQUE, INC. OR APPROVED EQUAL.
  4. SEWAGE SHALL NOT, UNDER ANY CIRCUMSTANCES, BE DISCHARGED TO THE NEW SEWER UNTIL WRITTEN PERMISSION IS PROVIDED BY THE COUNTY.
  5. POINTS S-1 AND S-2 SHALL BE CENTERED ON THE EXISTING 30 INCH DIAMETER SEWER. THE EXISTING SEWER LOCATION AND INVERTS SHALL BE VERIFIED BY THE CONTRACTOR PRIOR TO SEWER CONSTRUCTION. THE CONTRACTOR SHALL TEST PIT BOTH LOCATIONS AND VERIFY THE TOP & BOTTOM OF PIPE ELEVATIONS AND SHALL ALSO SURVEY THE INCOMING SEWER INVERT AT EX. MANHOLE 1418 & THE OUTGOING SEWER INVERT AT EX. MANHOLE 1419. THE CONTRACTOR SHALL IMMEDIATELY PROVIDE THIS INFORMATION TO THE ENGINEER AND NOTE ANY DISCREPANCIES. ALL INVERT ELEVATIONS ON THIS SHEET ARE SUBJECT TO THIS VERIFICATION BY TEST PIT.
  6. THE JUNCTION CHAMBER REQUIRES AN INTERIOR LINER & EXTERIOR WATERPROOFING IN ACCORDANCE WITH THE SPECIFICATIONS.
  7. ALL ALUMINUM SURFACES IN CONTACT WITH CONCRETE SHALL BE COATED WITH A BITUMINOUS/ASPHALTIC COMPOUND, MINIMUM 10 MIL. THICK.
  8. FOR STRUCTURAL DETAILS SEE SHEET 24.
  9. THE 6" DIAMETER OPENING WITH SEALED KEY NUT OPERATOR AND FLOOR BOX IN TOP SLAB IS OFFSET 6 INCHES FROM THE CENTERLINE OF THE 36" & 42" SLUICE GATES BELOW TO ALLOW FOR INSTALLATION OF THE GEARED LIFT.

CURVE STAKEOUT DATA		
POINT NO.	NORTH	EAST
PC-1	562,944.80	1,353,643.65
PI-1	562,946.89	1,353,644.55
PT-1	562,949.11	1,353,645.07
PC-2	562,933.60	1,353,652.73
PI-2	562,936.08	1,353,653.79
PT-2	562,938.58	1,353,652.79
PC-3	562,952.26	1,353,647.31
PI-3	562,954.61	1,353,646.37
PT-3	562,957.07	1,353,646.96

CURVE DATA				
CURVE NO.	RADIUS	TANGENT	LENGTH	Δ
1	26.29'	2.28'	4.54'	09°54'16"
2	6.50'	2.69'	5.10'	45°00'00"
3	8.00'	2.53'	4.90'	35°05'44"

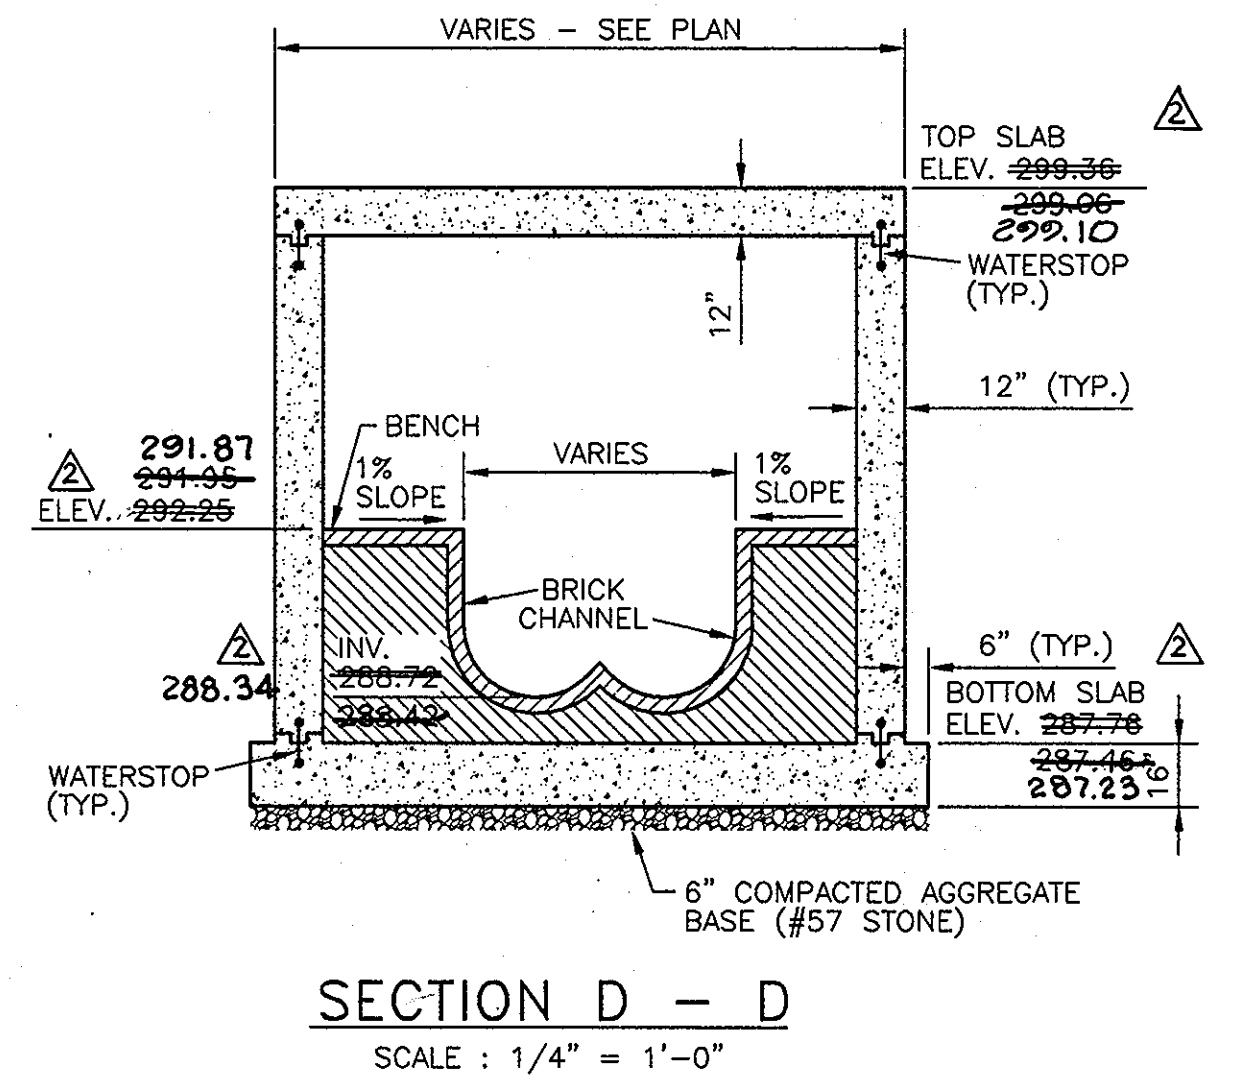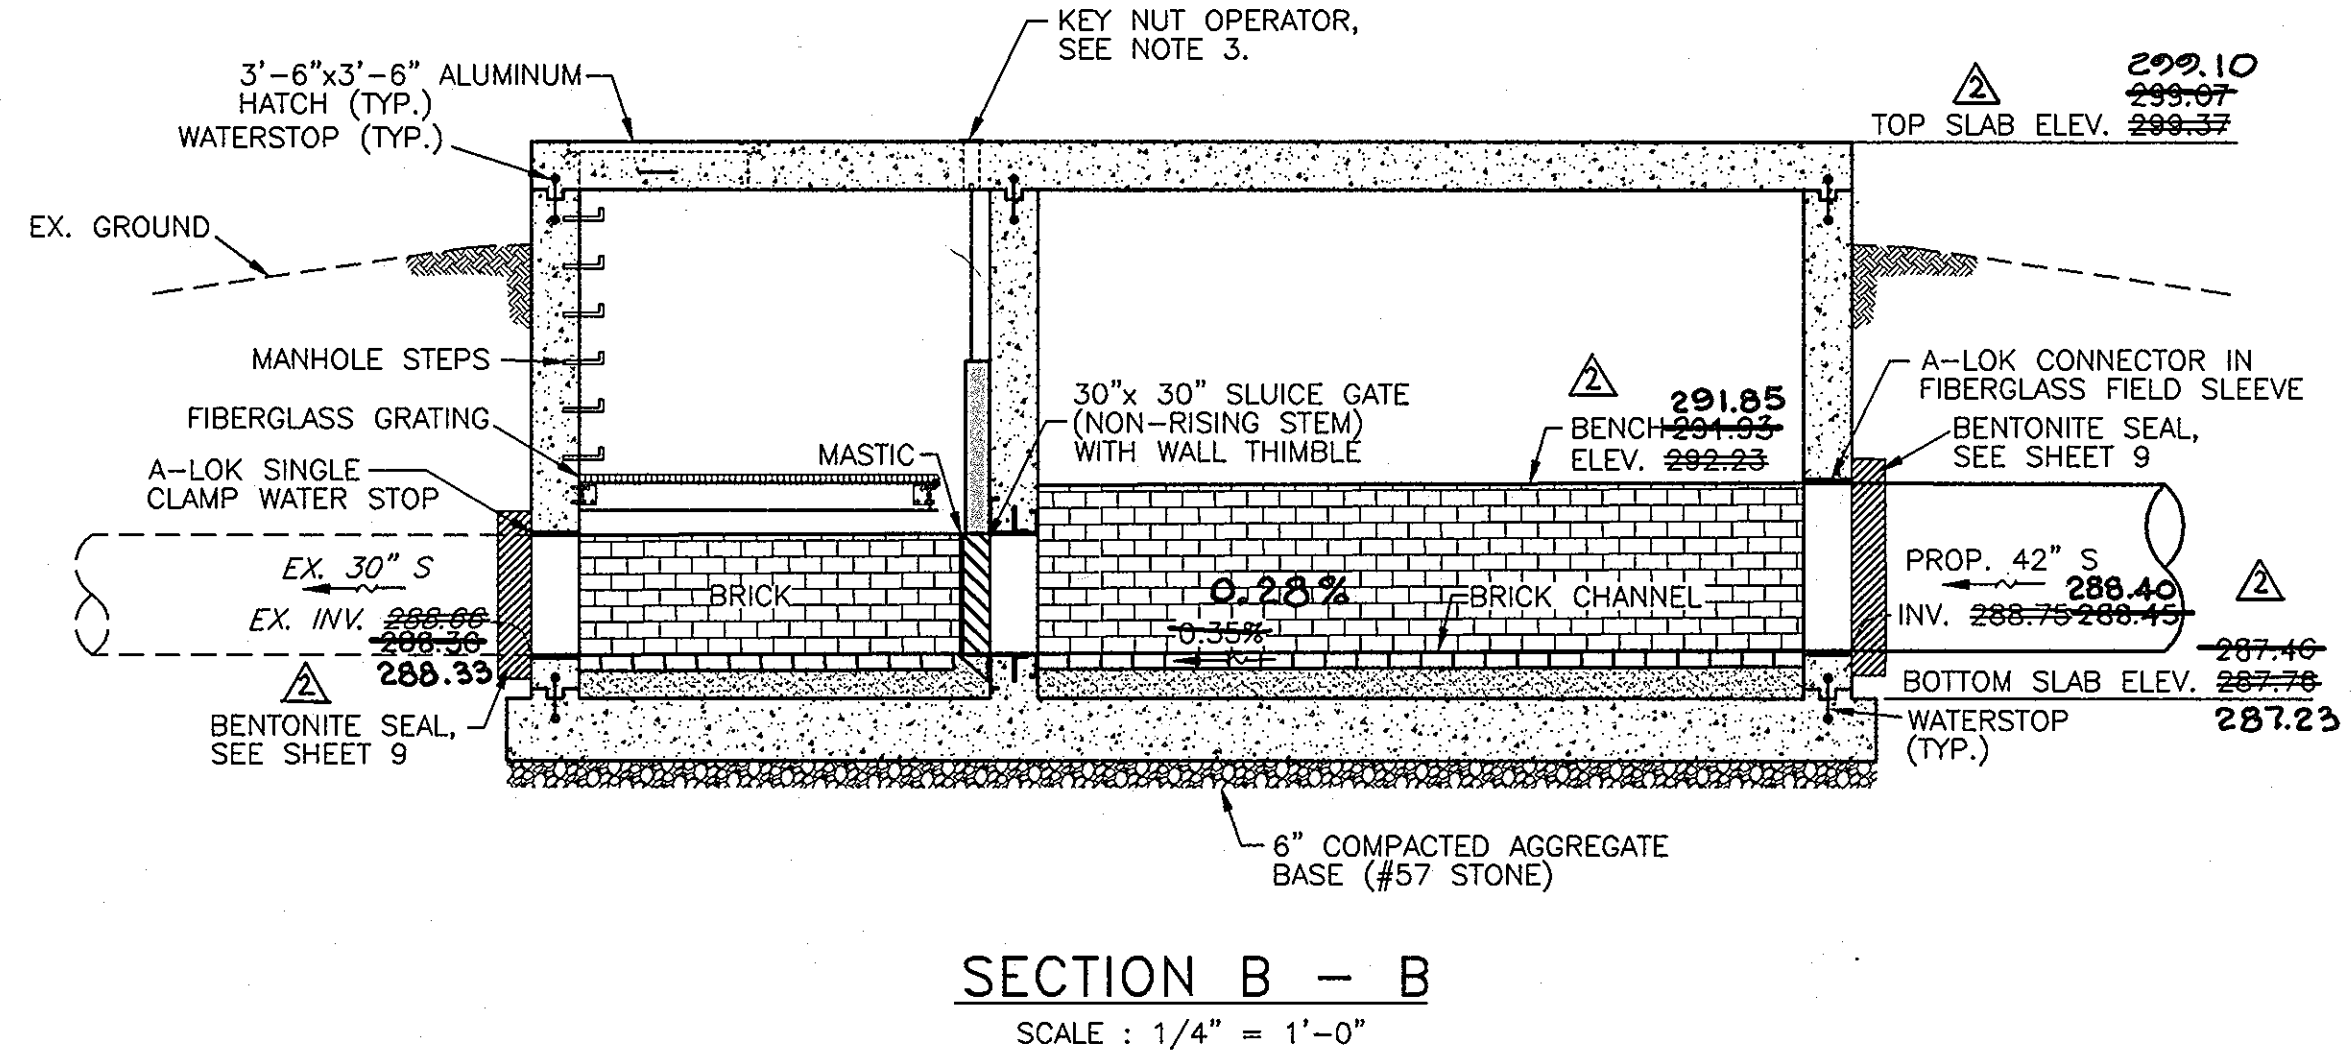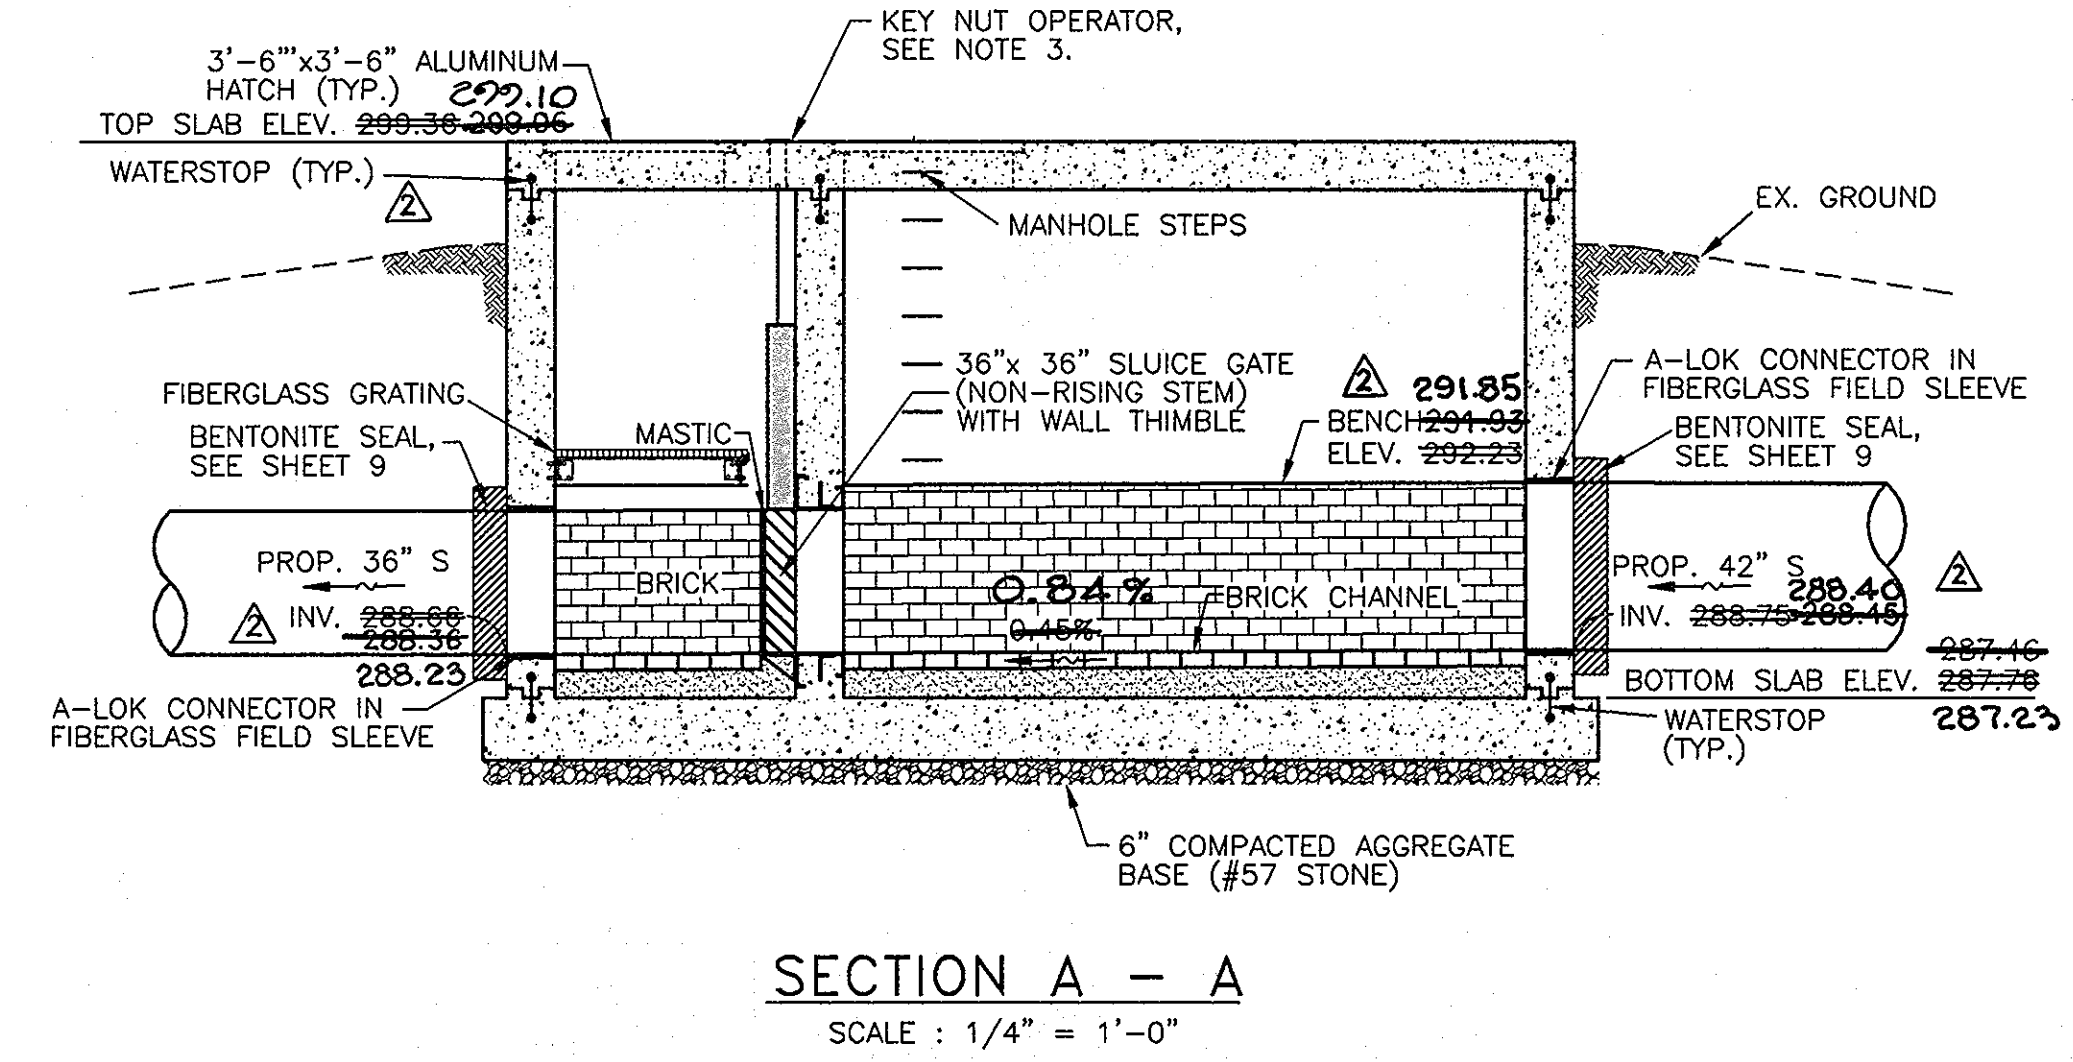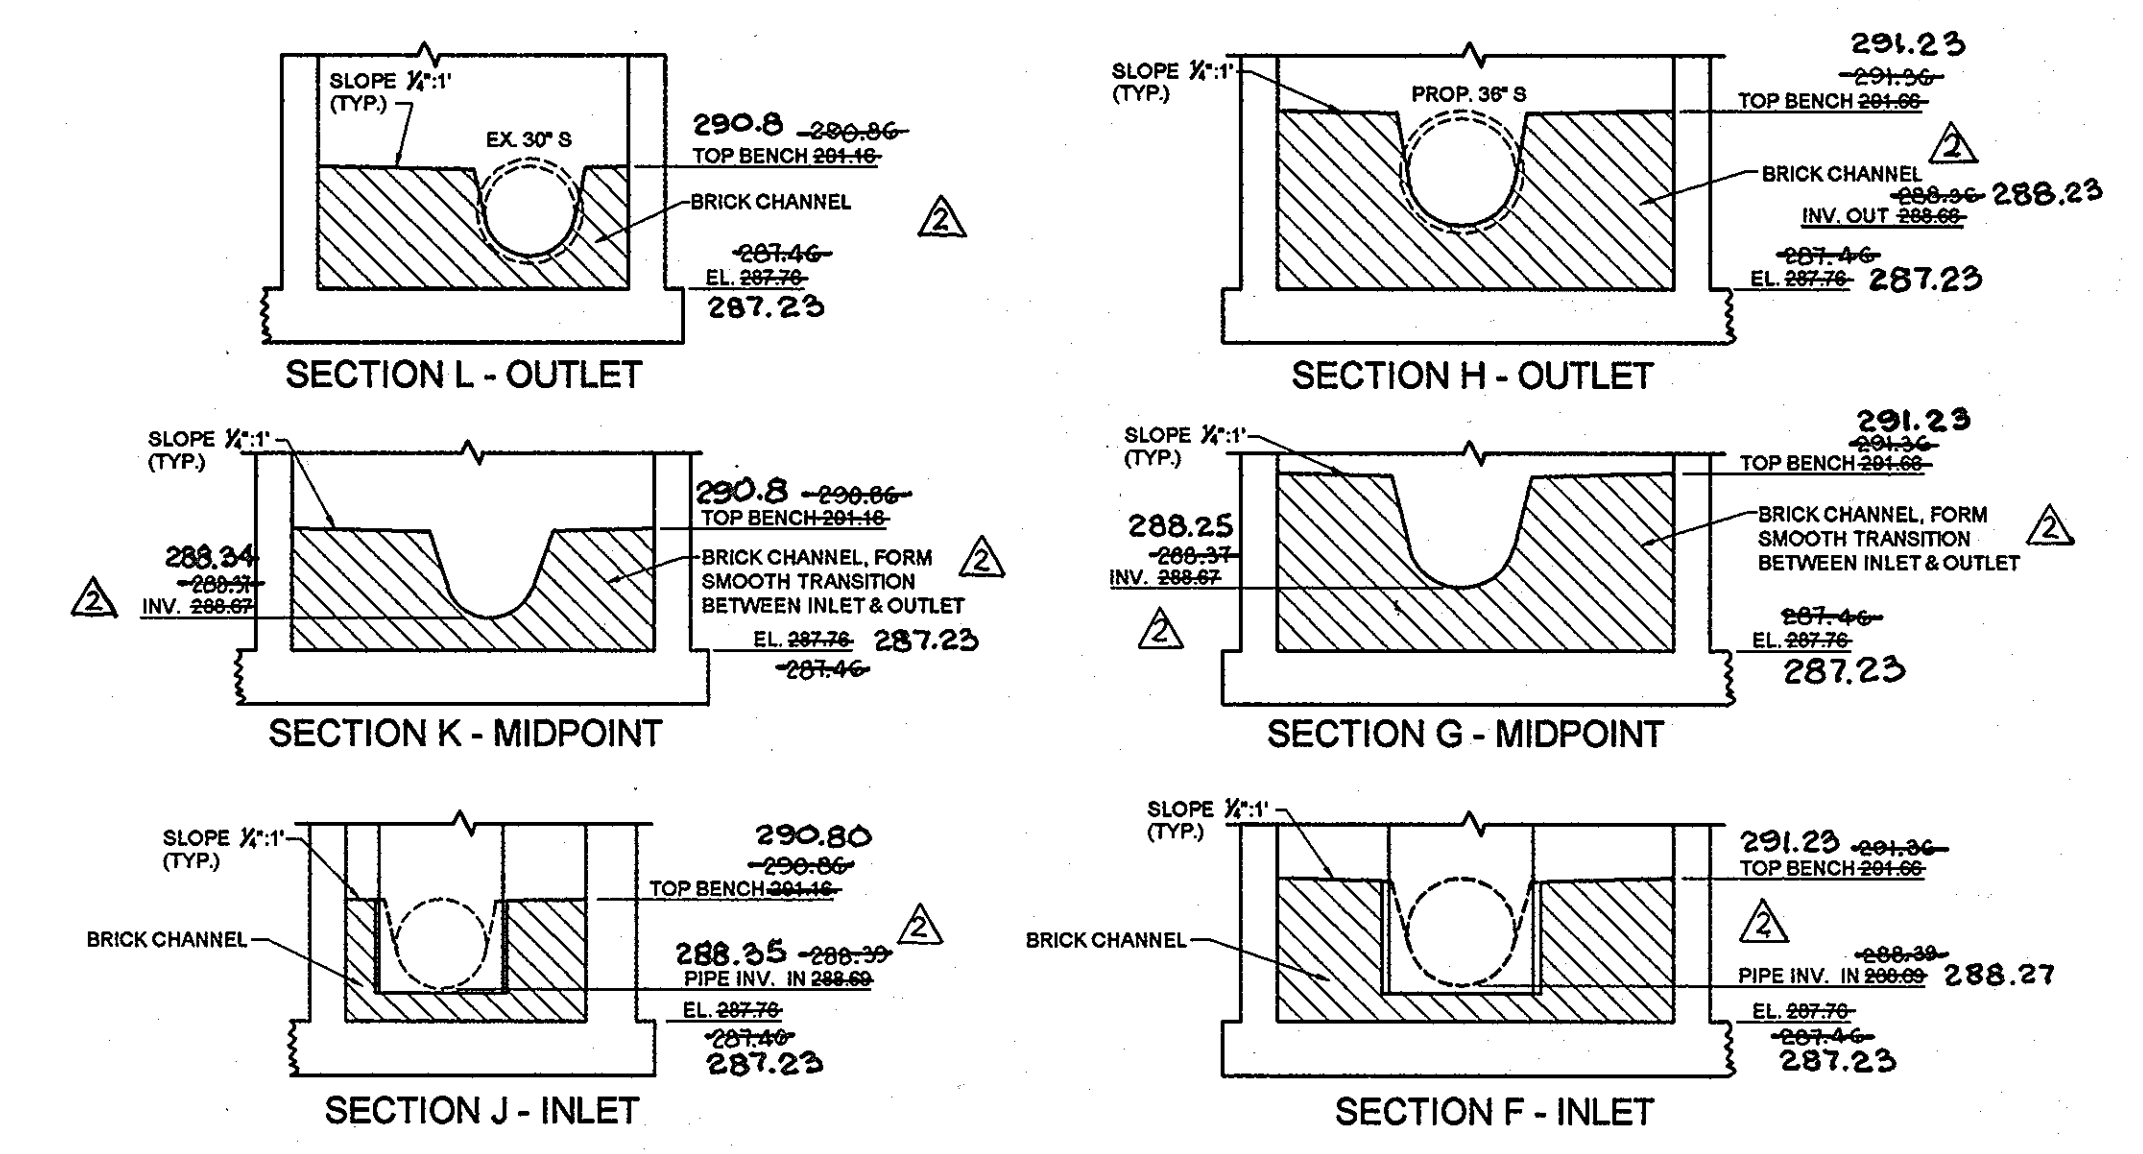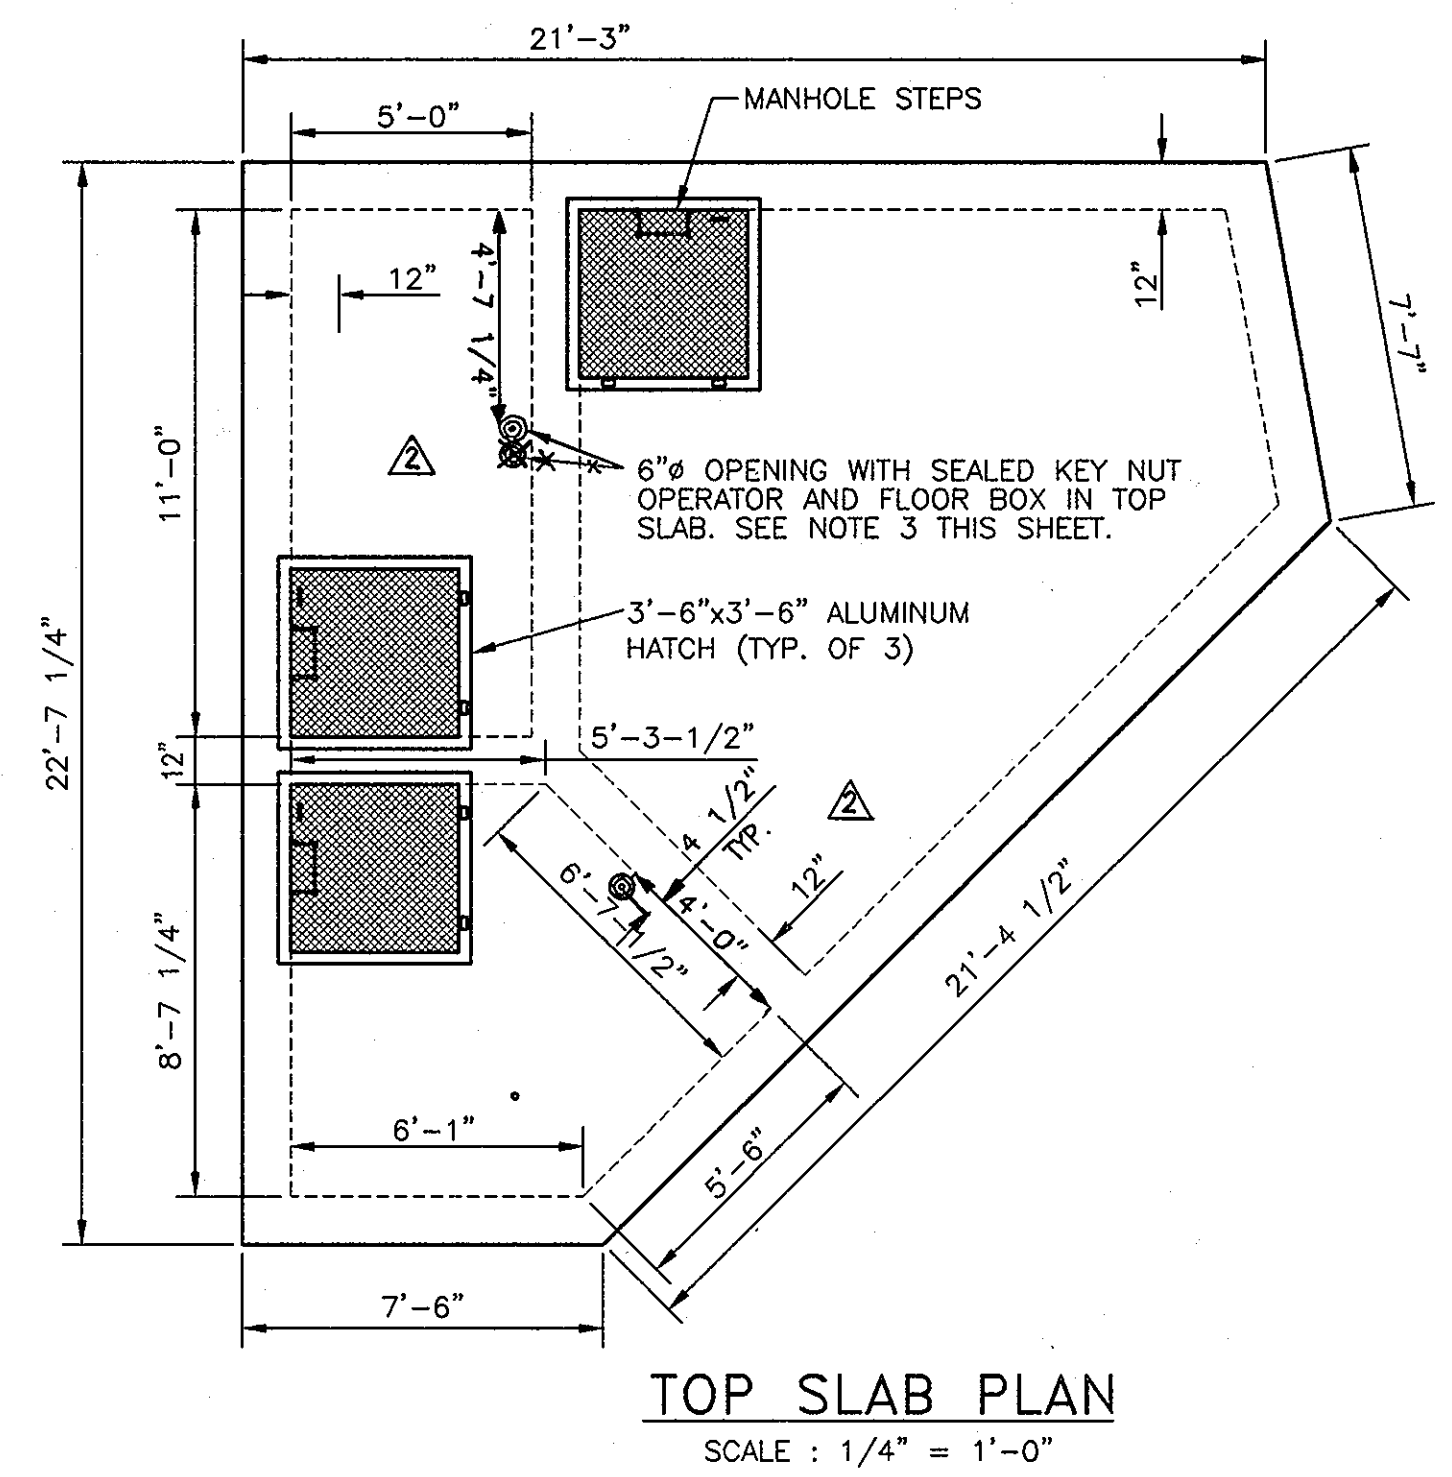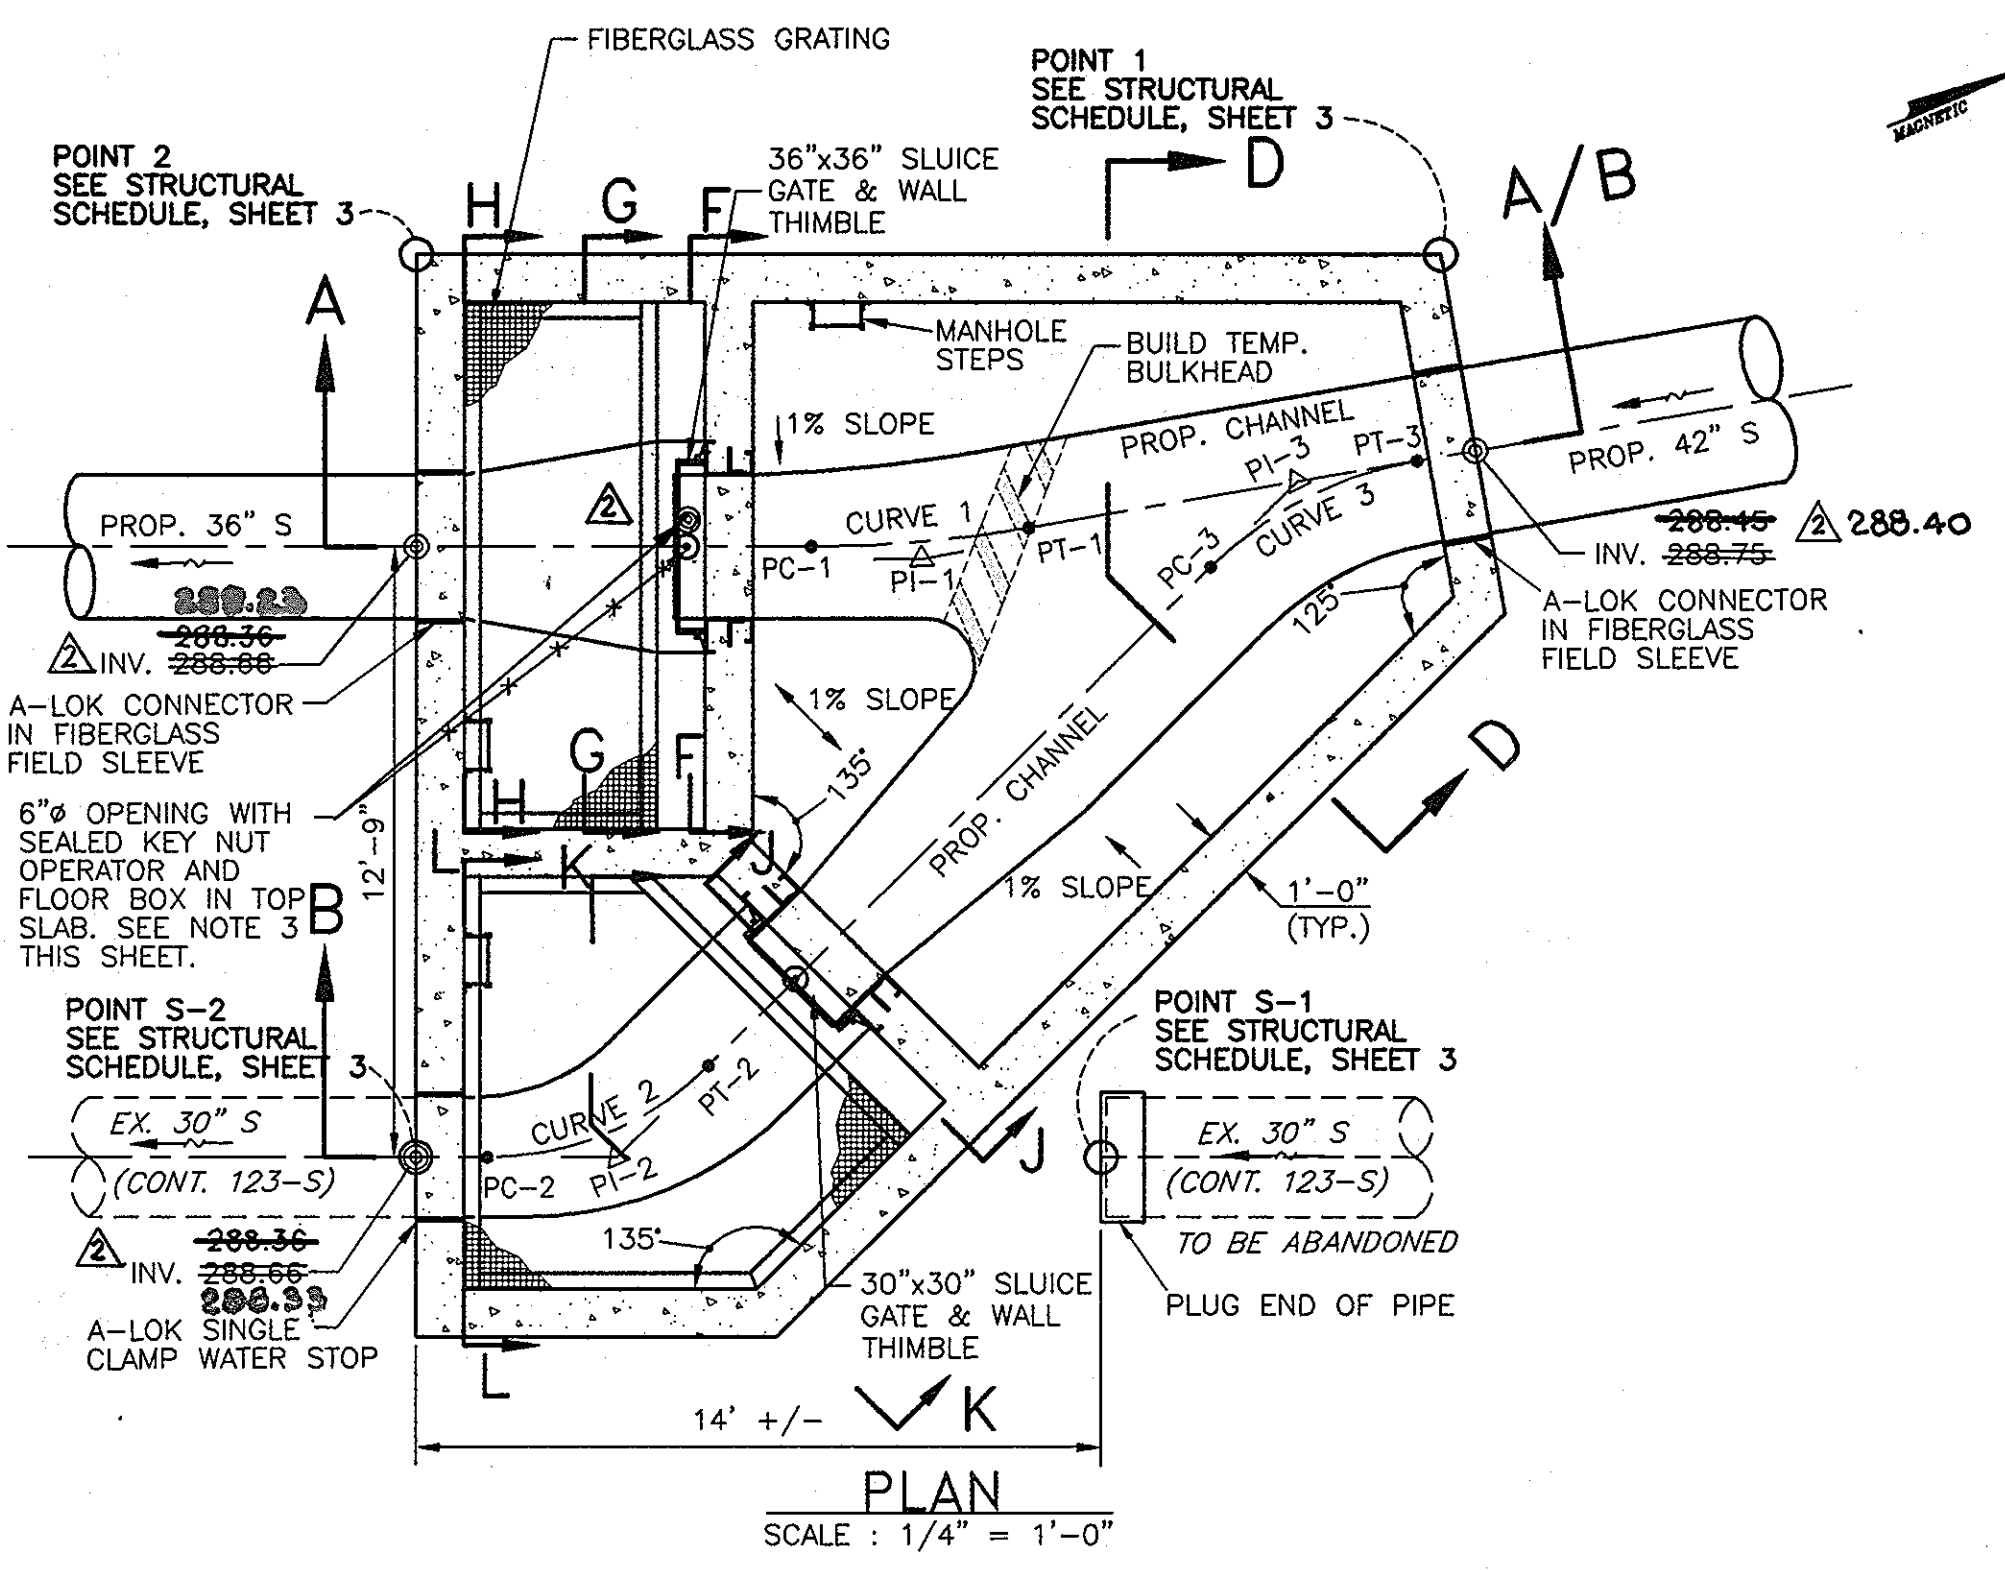

AS-BUILTS  
JAN 17 2012

DEPARTMENT OF PUBLIC WORKS  
HOWARD COUNTY, MARYLAND

Director of Public Works: *[Signature]* DATE: 6/2/10  
 Chief, Bureau of Engineering: *[Signature]* DATE: 6/1/10  
 Chief, Bureau of Utilities: *[Signature]* DATE: 6/1/10  
 Chief, Utility Design Division: *[Signature]* DATE: WD

**Dewberry**  
Dewberry & Davis LLC  
3108 LORD BALTIMORE DRIVE  
SUITE 110  
BALTIMORE, MD 21244-2882  
410.265.8500  
FAX: 410.265.8875



DES:	LAL			
DRN:	RLI			
CHK:	TND	LAL	REVISED ELEVATIONS AND ADDED DIMENSIONS FOR SLUICE GATE OPERATIONS	07/11
DATE:	5.28.10	BY:	NO.	REVISIONS



**JUNCTION CHAMBER 1001  
PLANS, SECTIONS, & DETAILS**

600' SCALE MAP NO. 37, 43  
BLOCK NO. 5, 23

**LITTLE PATUXENT PARALLEL INTERCEPTOR**  
CAPITAL PROJECT S-6175  
CONTRACT NO. 20-4540

ELECTION DISTRICT NO. 5  
HOWARD COUNTY, MARYLAND

SCALE: SHOWN  
SHEET 21 OF 26

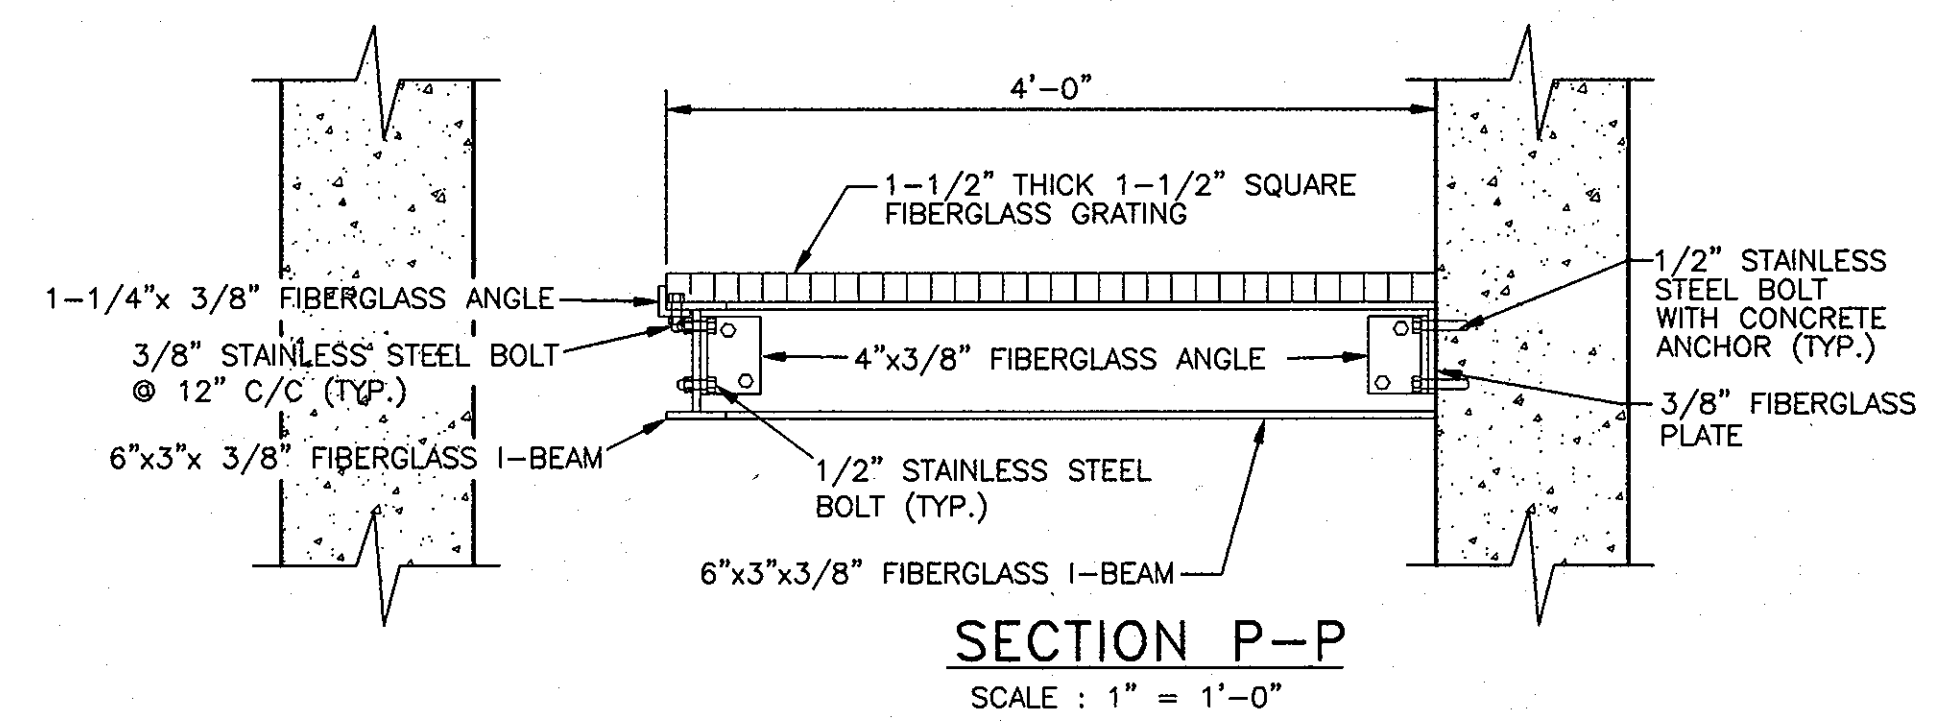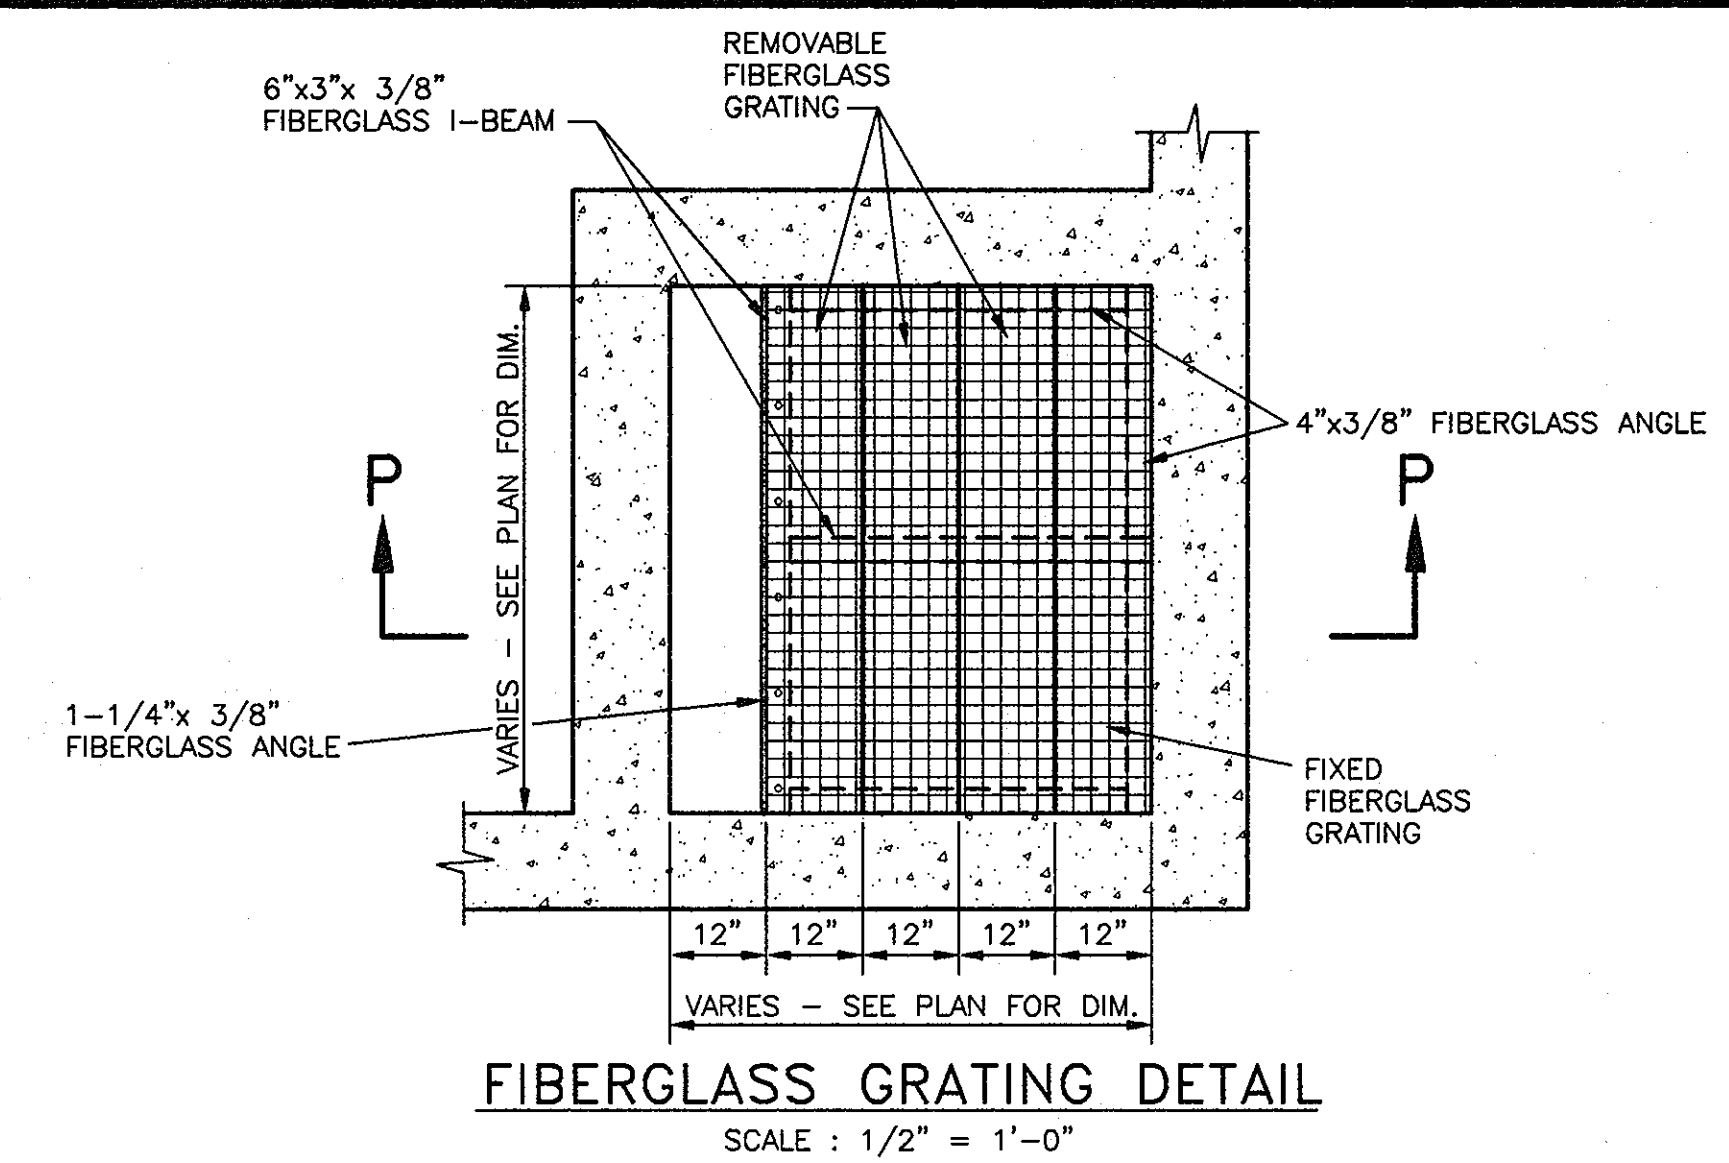







- NOTES:**
- SLUICE GATES SHALL BE FONTAINE SERIES 20 MODEL 202-WALL MOUNTED (COMPLETE WITH WALL THIMBLE) AND NON-RISING STEM (NRI) OR APPROVED EQUAL.
  - A-LOK SINGLE CLAMP WATER STOPS SHALL BE USED AT PIPE ENTRY/EXIT POINTS OF THE DIVERSION STRUCTURE, AS INDICATED ON DRAWINGS.
  - GROUND LEVEL POSITION INDICATOR SHALL BE A SEALED UNIT WITH A STAINLESS STEEL SEALED FLOOR BOX, KEY NUT OPERATOR AND POSITION INDICATOR SHALL BE GPI-S SERIES AS MANUFACTURED BY DYNATORQUE, INC. OR APPROVED EQUAL. SEWAGE SHALL NOT, UNDER ANY CIRCUMSTANCES, BE DISCHARGED TO THE NEW SEWER UNTIL WRITTEN PERMISSION IS PROVIDED BY THE COUNTY.
  - THE JUNCTION CHAMBER REQUIRES AN INTERIOR LINER & EXTERIOR WATERPROOFING IN ACCORDANCE WITH THE SPECIFICATIONS.
  - ALL ALUMINUM SURFACES IN CONTACT WITH CONCRETE SHALL BE COATED WITH A BITUMINOUS/ASPHALTIC COMPOUND, MINIMUM 10 MIL THICK.
  - FOR STRUCTURAL DETAILS SEE SHEET 24.
  - THE 6" DIAMETER OPENING WITH SEALED KEY NUT OPERATOR AND BOX IN TOP SLAB IS OFFSET 6 INCHES FROM THE CENTERLINE OF THE 36" & 42" SLUICE GATES BELOW TO ALLOW FOR INSTALLATION OF THE GEARED LIFT.

**CURVE DATA**

CURVE NO.	RADIUS	TANGENT	LENGTH	Δ
1	6.50'	6.56'	10.27'	90°31'50"
2	6.50'	6.56'	10.27'	90°31'50"

**CURVE STAKEOUT DATA**

POINT NO.	NORTH	EAST
PC-1	564,733.33	1,354,222.06
PI-1	564,739.89	1,354,221.96
PT-1	564,739.93	1,354,228.52
PC-2	564,726.83	1,354,222.16
PI-2	564,733.39	1,354,222.06
PT-2	564,733.43	1,354,228.62

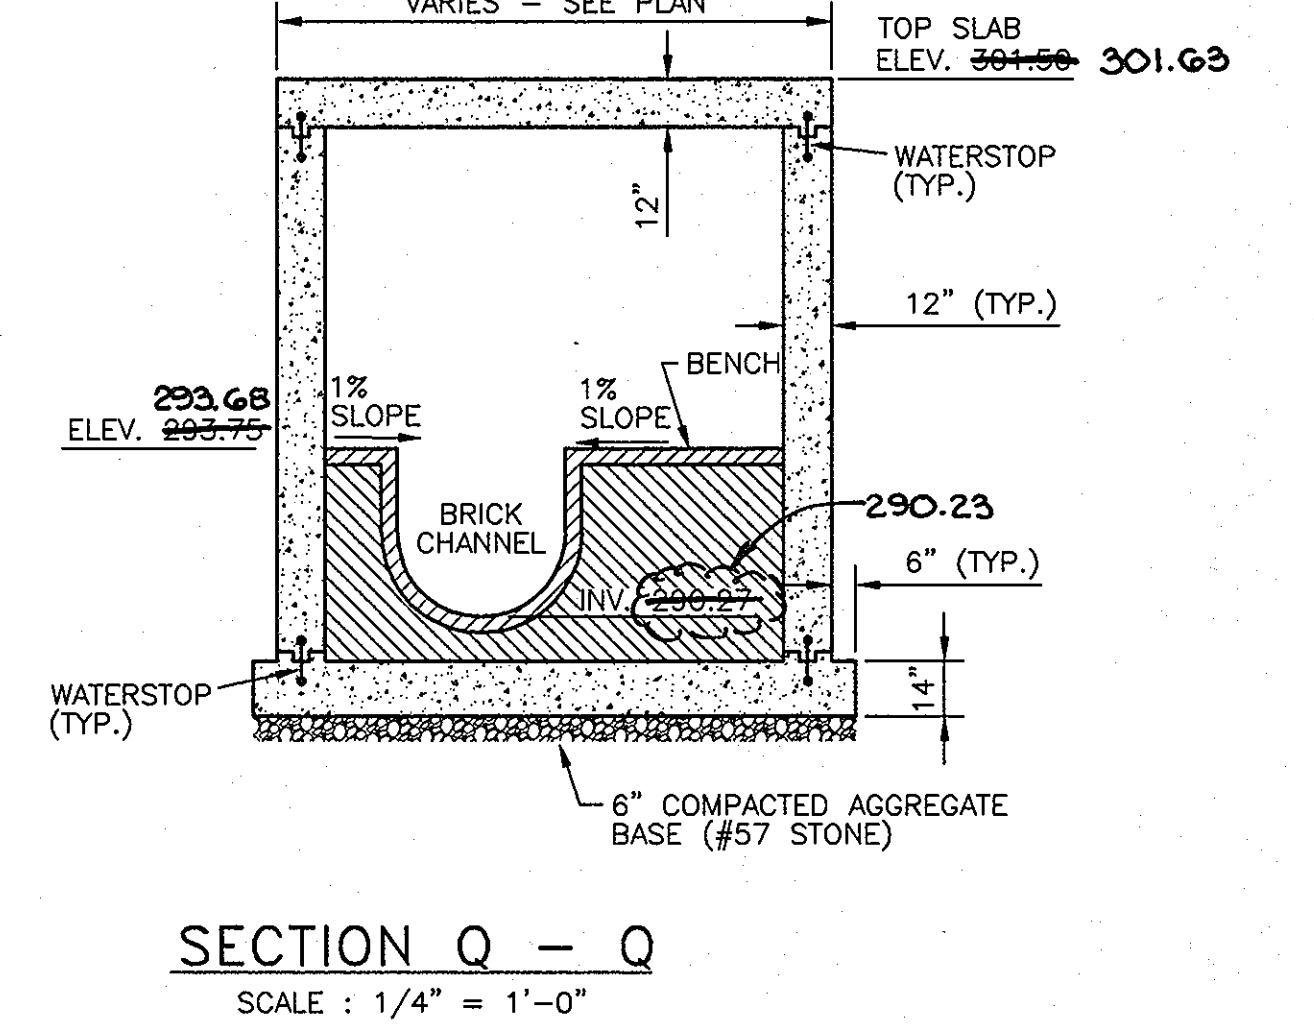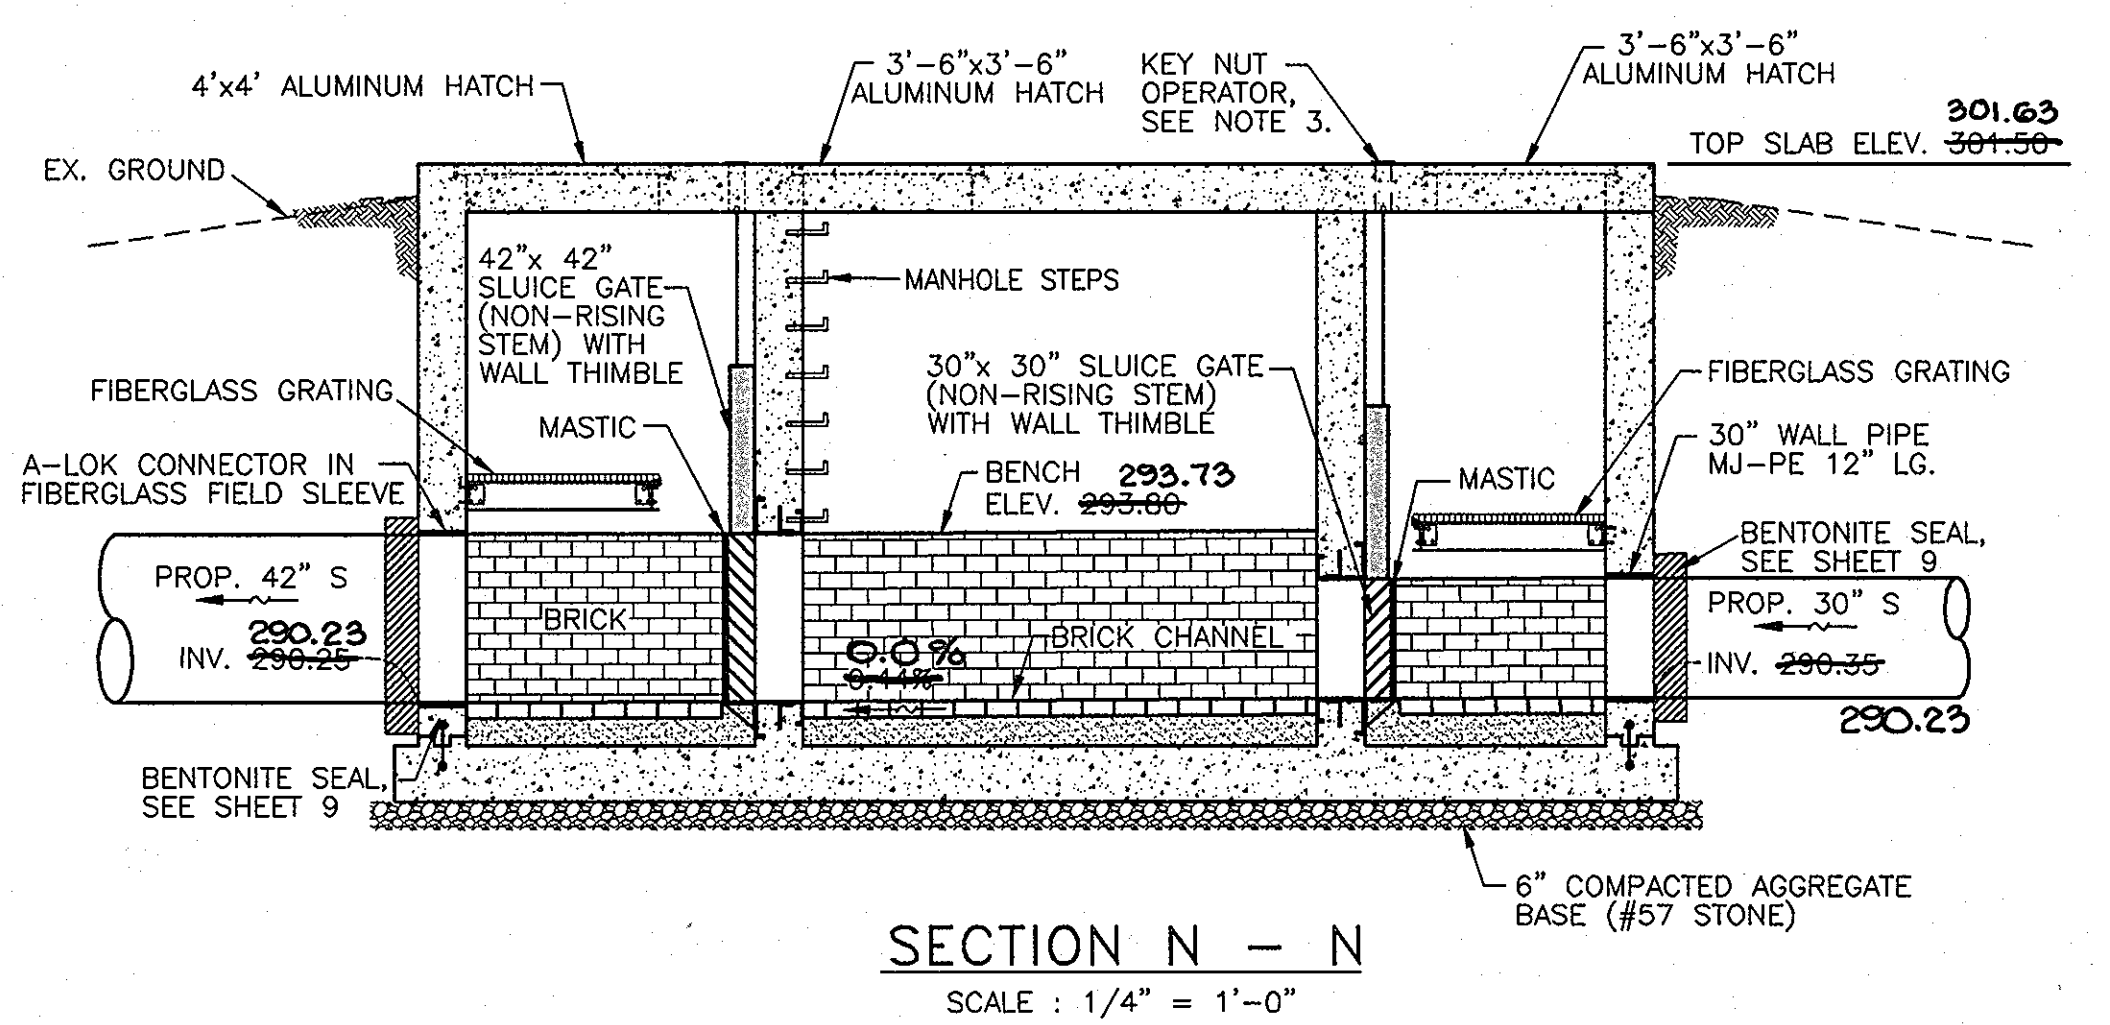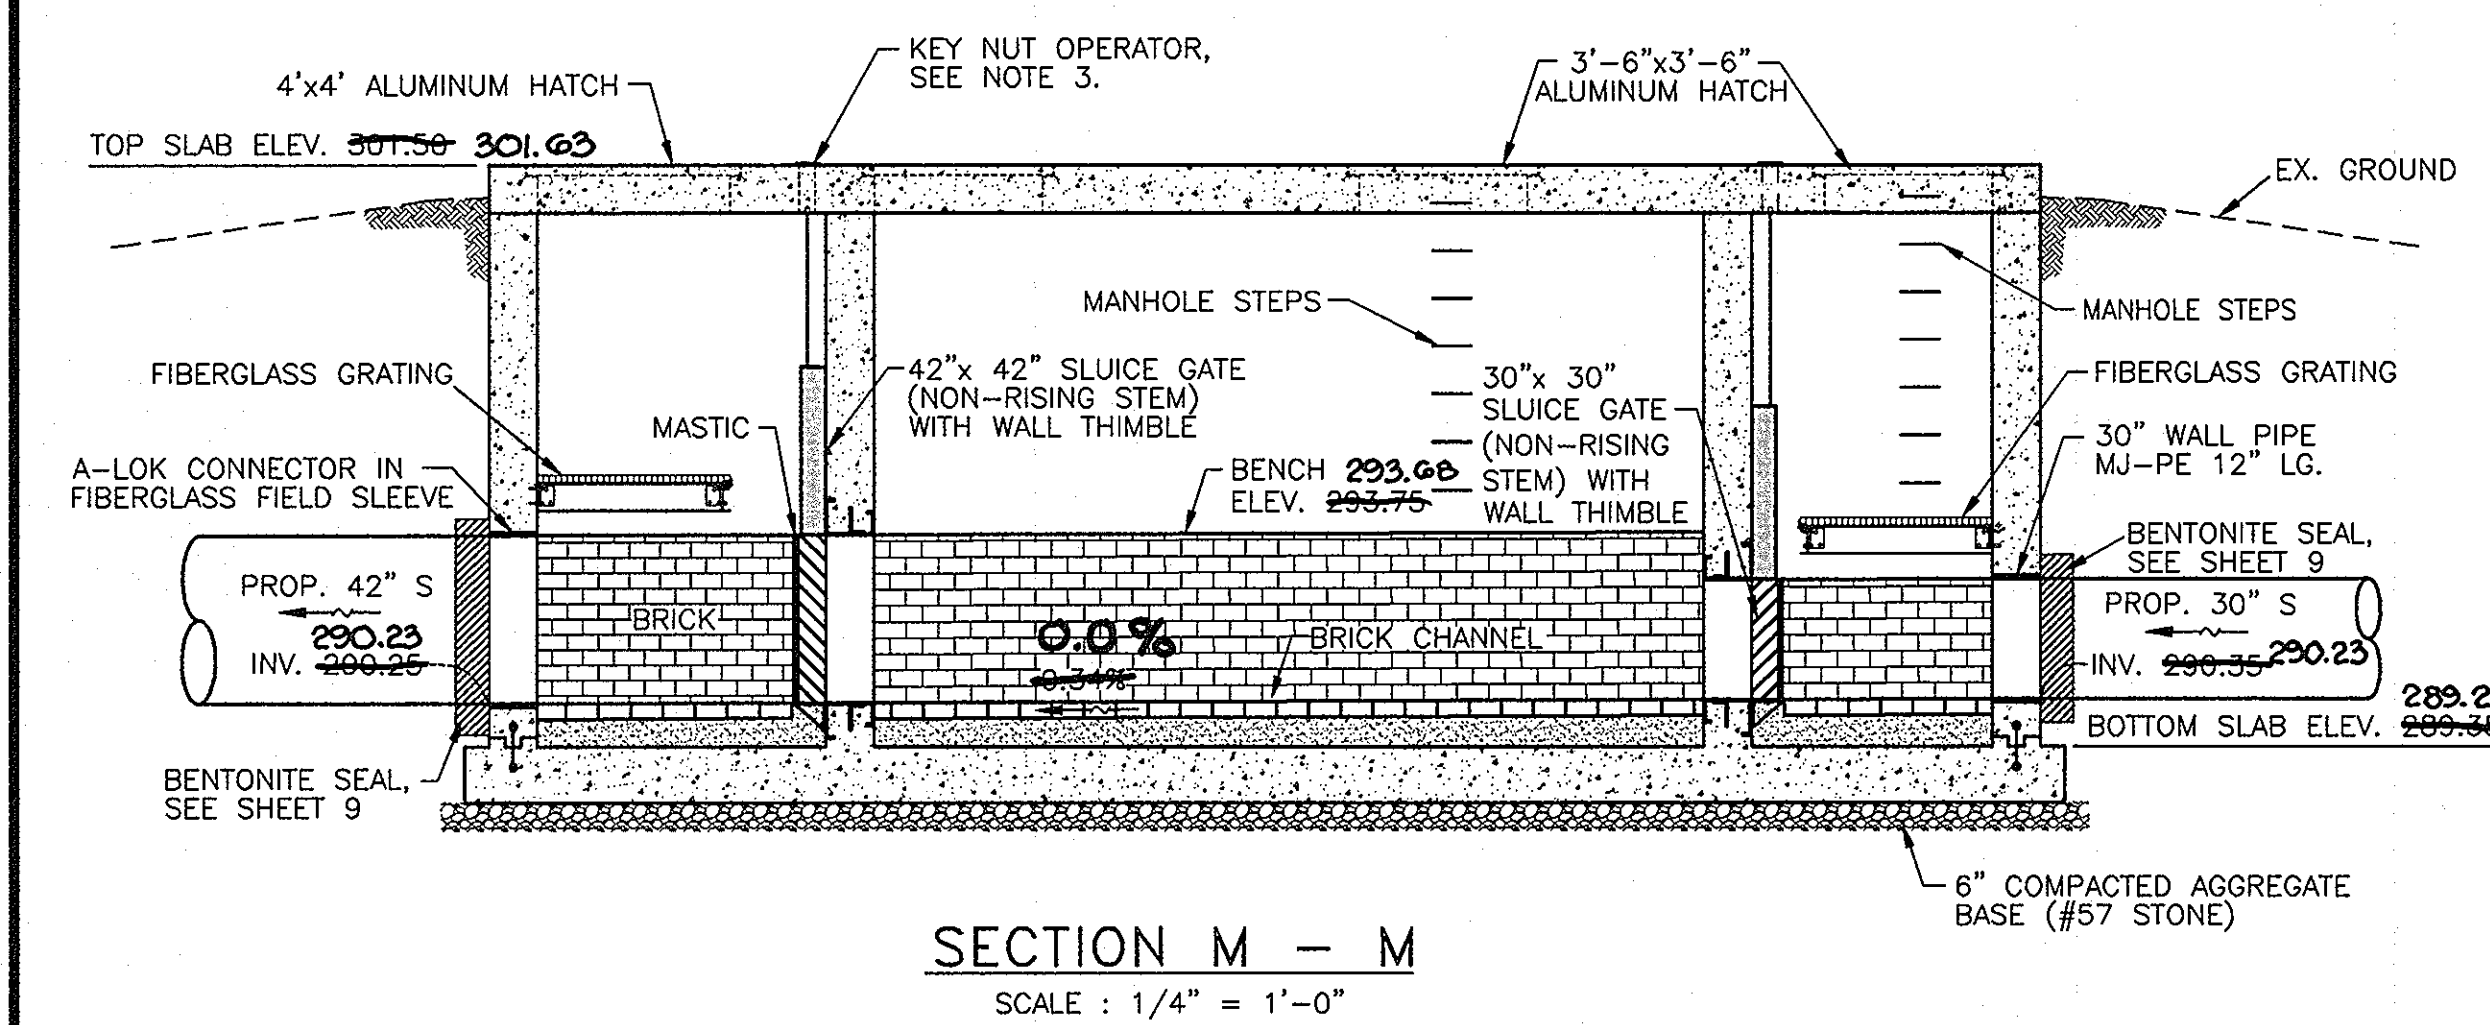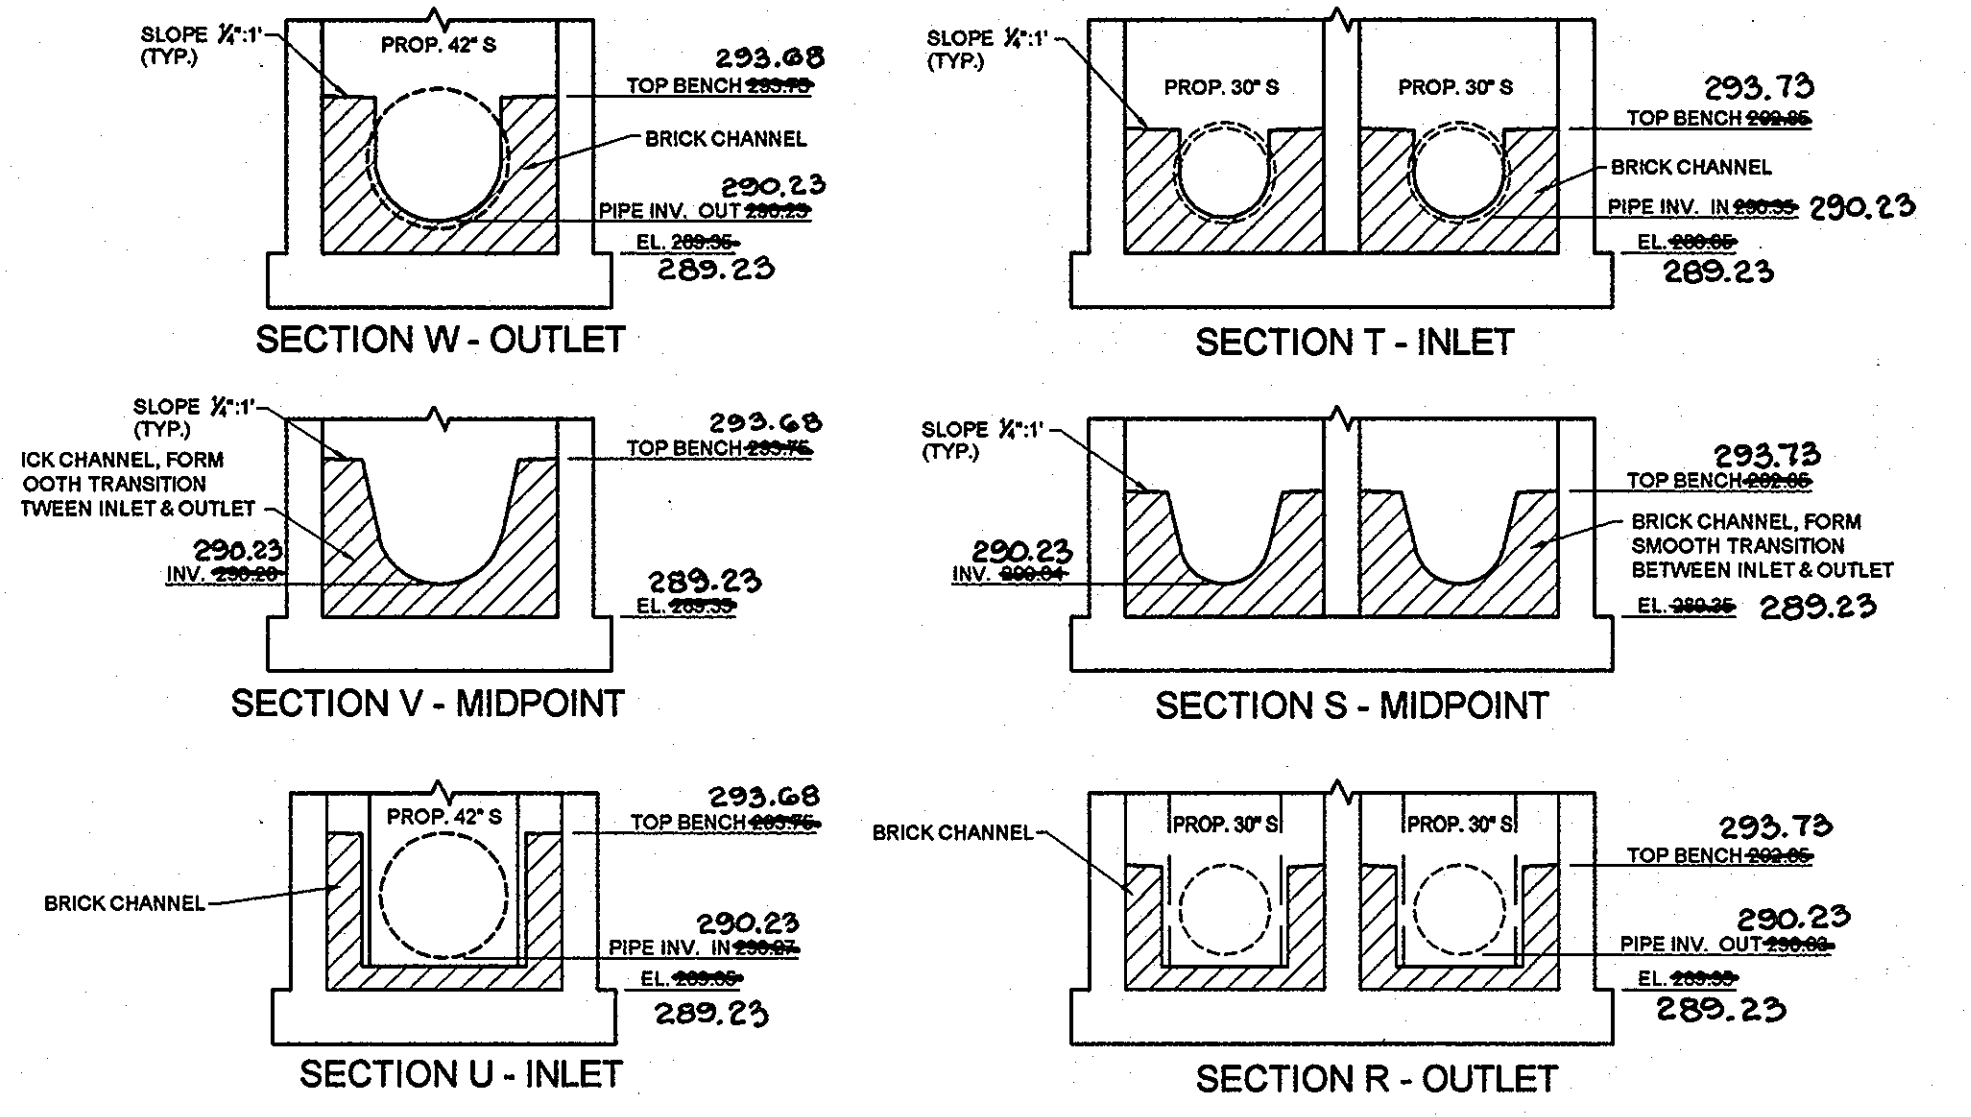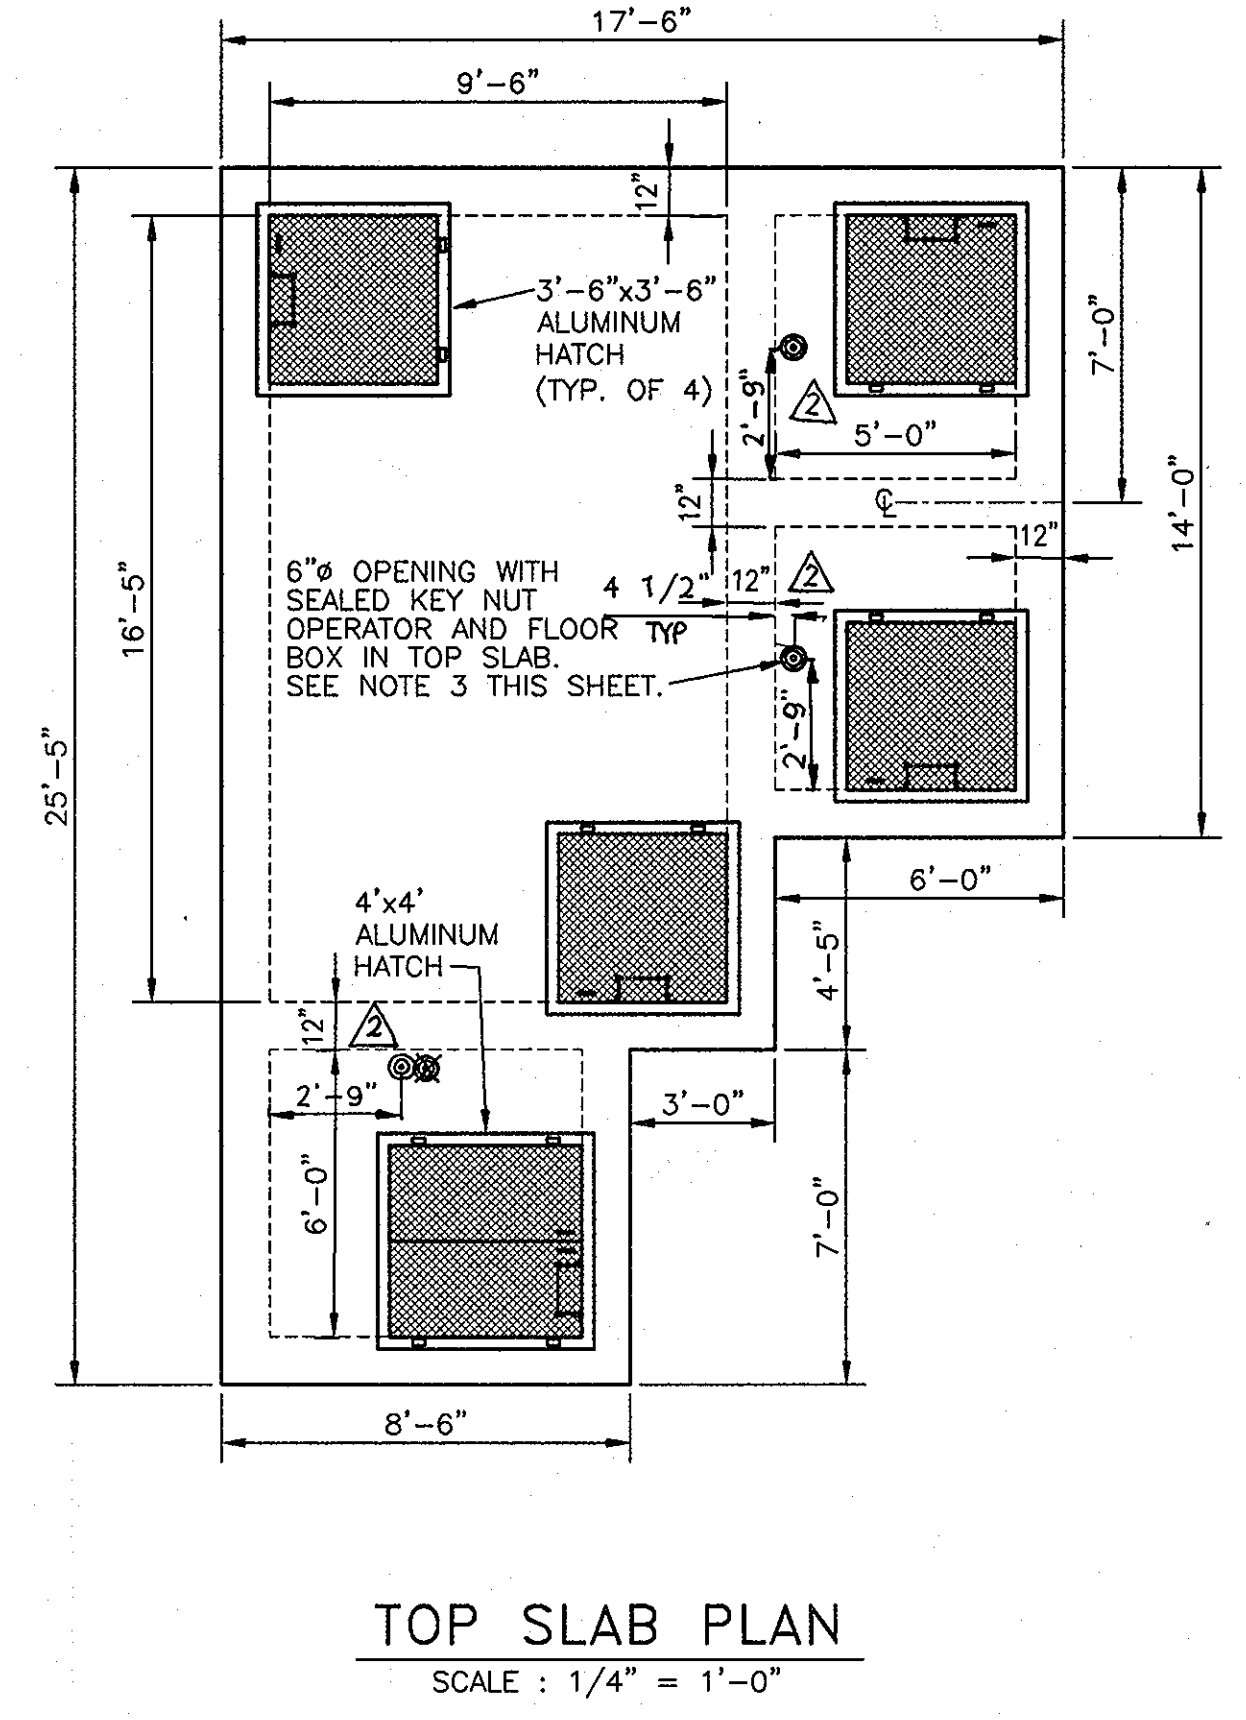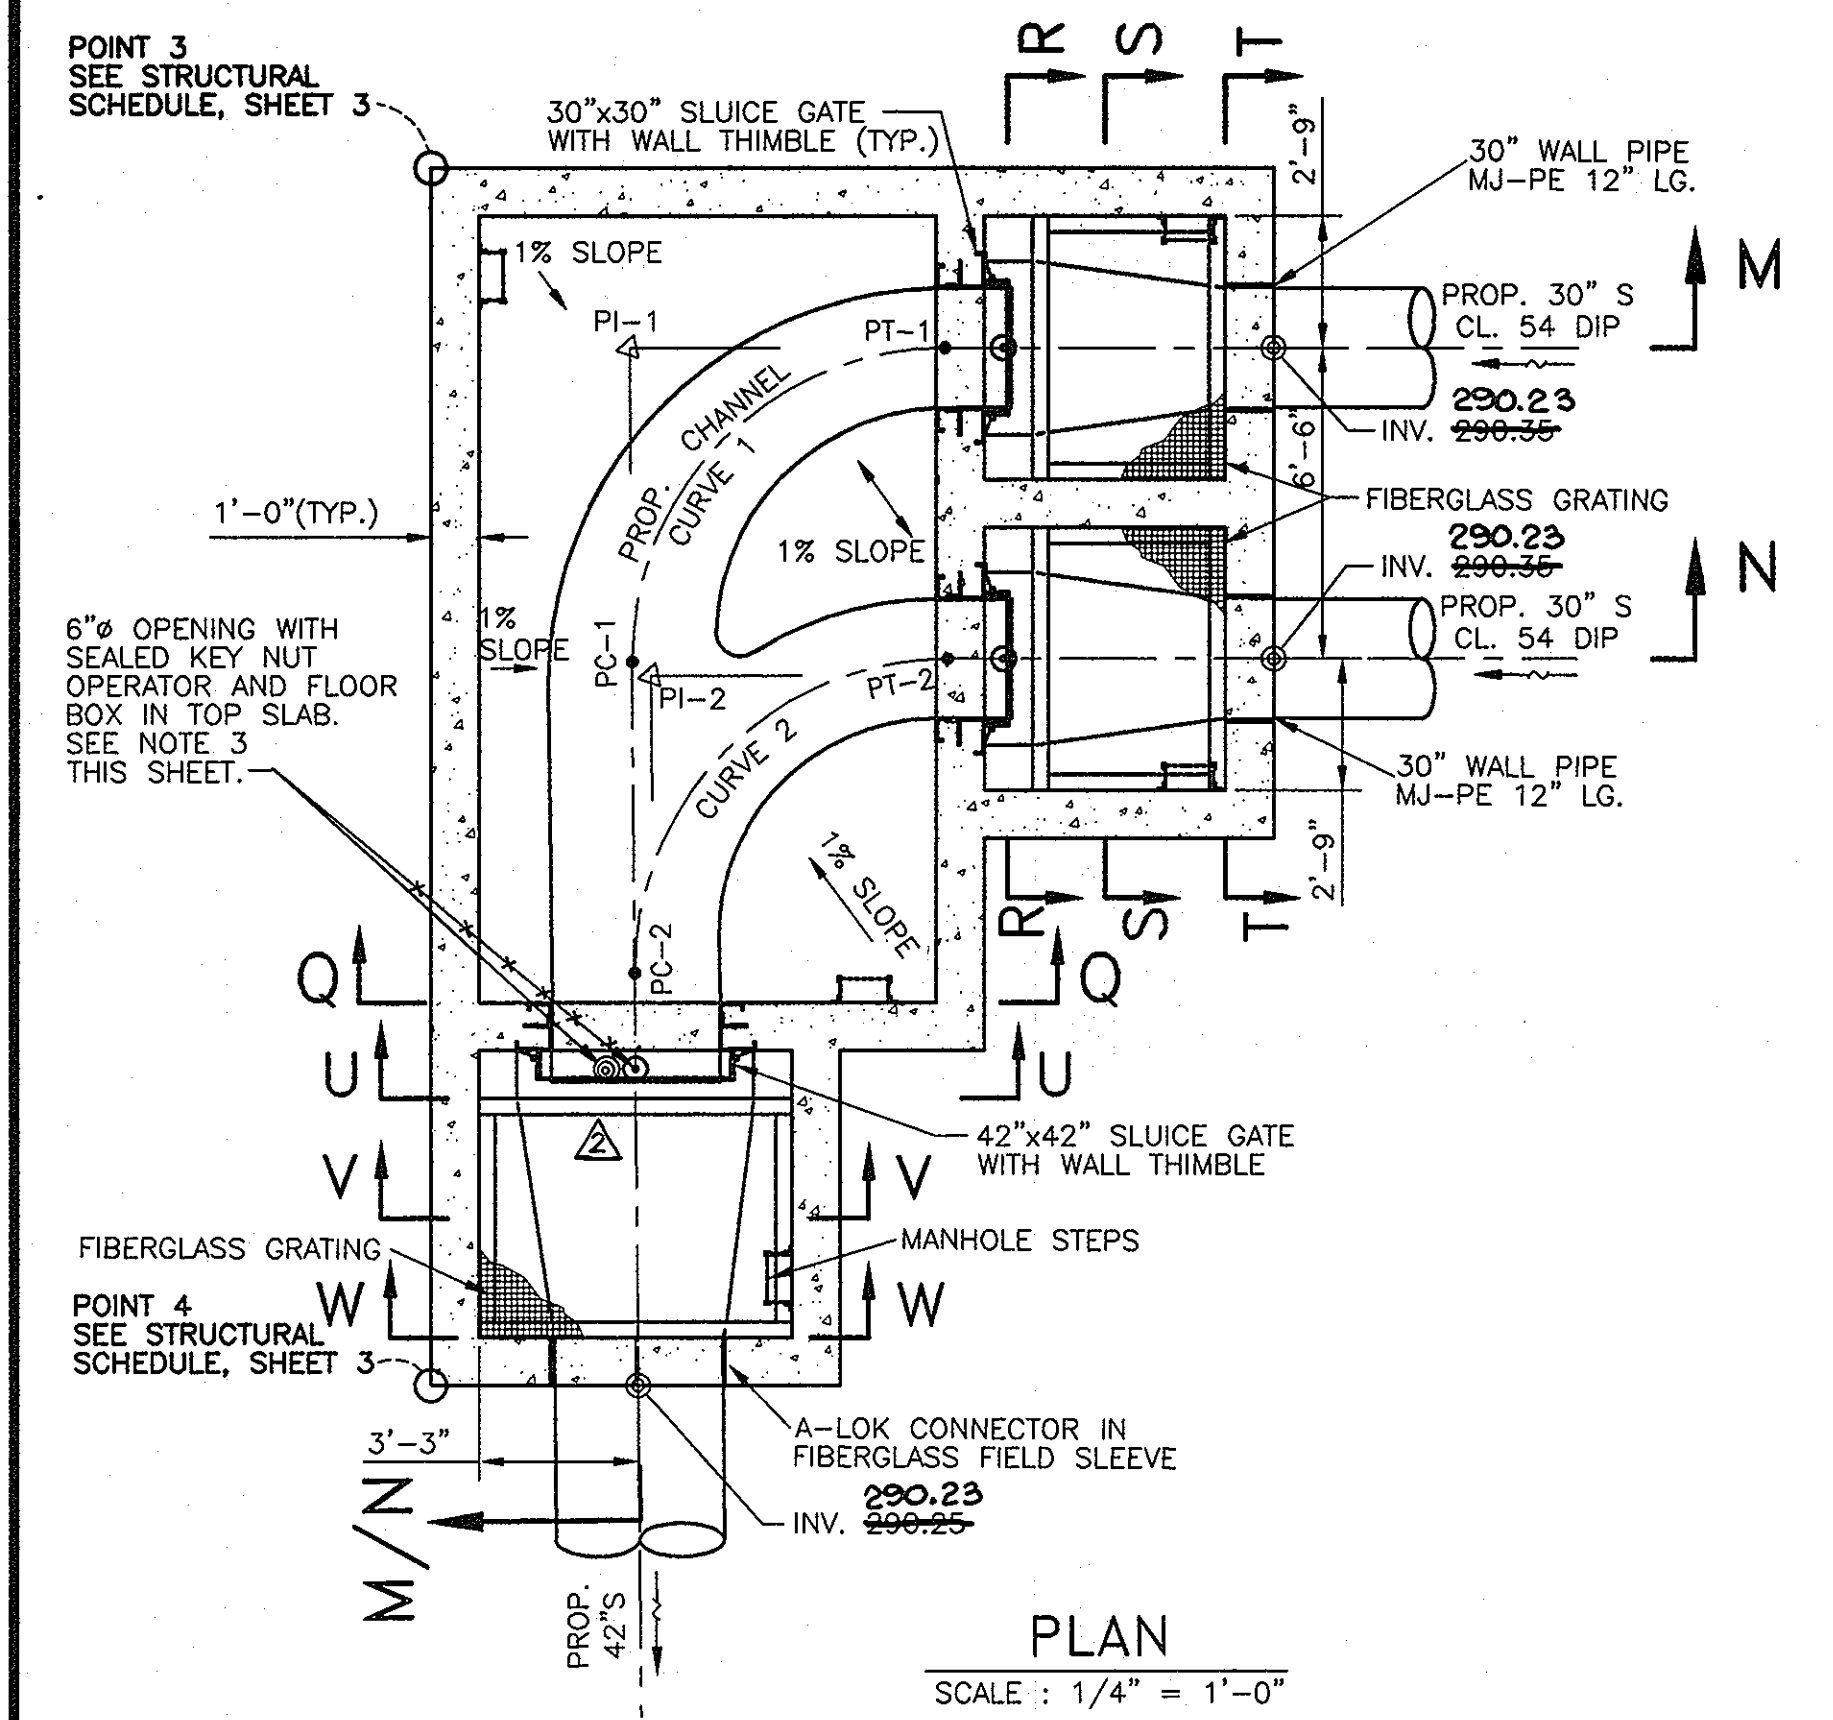

**DEPARTMENT OF PUBLIC WORKS**  
HOWARD COUNTY, MARYLAND

Director of Public Works: [Signature] 6/3/10  
 Chief, Bureau of Engineering: [Signature] 6/2/10  
 Chief, Bureau of Utilities: [Signature] 6/2/10  
 Chief, Utility Design Division: [Signature] 6/2/10

**Dewberry**  
Dewberry & Davis LLC  
3109 LORD BALTIMORE DRIVE  
SUITE 110  
BALTIMORE, MD 21244-2882  
410.285.8200  
FAX: 410.285.6875



DES: LAL  
 DRN: RLI  
 CHK: TND  
 DATE: 5.28.10

BY NO. REVISIONS DATE

LAL [Symbol] ADDED DIMENSIONS FOR SLUICE GATE OPERATIONS 07/11

**JUNCTION CHAMBER 1002**  
PLANS, SECTIONS, & DETAILS

600' SCALE MAP NO. 37, 43  
 BLOCK NO. 5, 23

**LITTLE PATUXENT PARALLEL INTERCEPTOR**  
CAPITAL PROJECT S-6175  
CONTRACT NO. 20-4540



ELECTION DISTRICT NO. 5  
 HOWARD COUNTY, MARYLAND

SCALE: SHOWN  
 SHEET 22 OF 28









**NOTES:**

1. SLUIZE GATES SHALL BE FONTAINE SERIES 20 MODEL 202-WALL MOUNTED (COMPLETE WITH WALL THIMBLE) AND NON-RISING STEM (NRI) OR APPROVED EQUAL.
2. A-LOK SINGLE CLAMP WATER STOPS SHALL BE USED AT PIPE ENTRY/EXIT POINTS OF THE DIVERSION STRUCTURE, AS INDICATED ON DRAWINGS.
3. GROUND LEVEL POSITION INDICATOR SHALL BE A SEALED UNIT WITH A STAINLESS STEEL SEALED FLOOR BOX. KEY NUT OPERATOR AND POSITION INDICATOR SHALL BE GPI-S SERIES AS MANUFACTURED BY DYNATORQUE, INC. OR APPROVED EQUAL.
4. SEWAGE SHALL NOT, UNDER ANY CIRCUMSTANCES, BE DISCHARGED TO THE NEW SEWER UNTIL WRITTEN PERMISSION IS PROVIDED BY THE COUNTY.
5. POINTS S-1 AND S-2 SHALL BE CENTERED ON THE EXISTING 30 INCH DIAMETER SEWER. THE EXISTING SEWER LOCATION AND INVERTS SHALL BE VERIFIED BY THE CONTRACTOR PRIOR TO SEWER CONSTRUCTION. THE CONTRACTOR SHALL TEST PIT BOTH LOCATIONS AND VERIFY THE TOP & BOTTOM OF PIPE ELEVATIONS AND SHALL ALSO SURVEY THE INCOMING SEWER INVERT AT EX. MANHOLE 1422 & THE OUTGOING SEWER INVERT AT EX. MANHOLE 1423. THE CONTRACTOR SHALL IMMEDIATELY PROVIDE THIS INFORMATION TO THE ENGINEER AND NOTE ANY DISCREPANCIES. ALL INVERT ELEVATIONS ON THIS SHEET ARE SUBJECT TO THIS VERIFICATION BY TEST PIT.
6. THE JUNCTION CHAMBER REQUIRES AN INTERIOR LINER & EXTERIOR WATERPROOFING IN ACCORDANCE WITH THE SPECIFICATIONS.
7. ALL ALUMINUM SURFACES IN CONTACT WITH CONCRETE SHALL BE COATED WITH A BITUMINOUS/ASPHALTIC COMPOUND, MINIMUM 10 MIL THICK.
8. FOR STRUCTURAL DETAILS SEE SHEET 24.
9. THE 6" DIAMETER OPENING WITH SEALED KEY NUT OPERATOR AND FLOOR BOX IN TOP SLAB IS OFFSET 6 INCHES FROM THE CENTERLINE OF THE 36" & 42" SLUIZE GATES BELOW TO ALLOW FOR INSTALLATION OF THE GEARED LIFT.

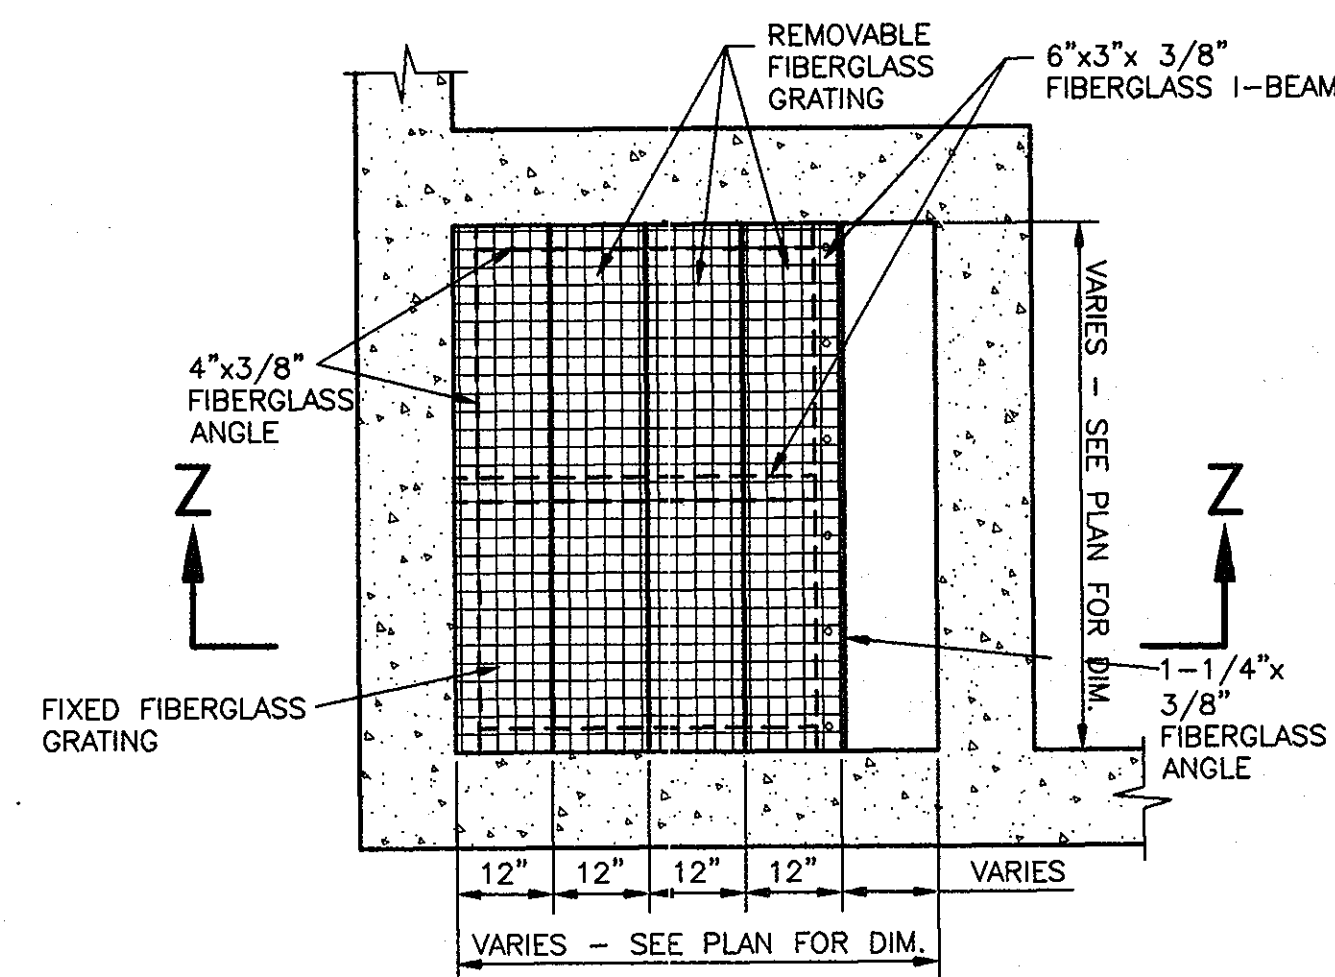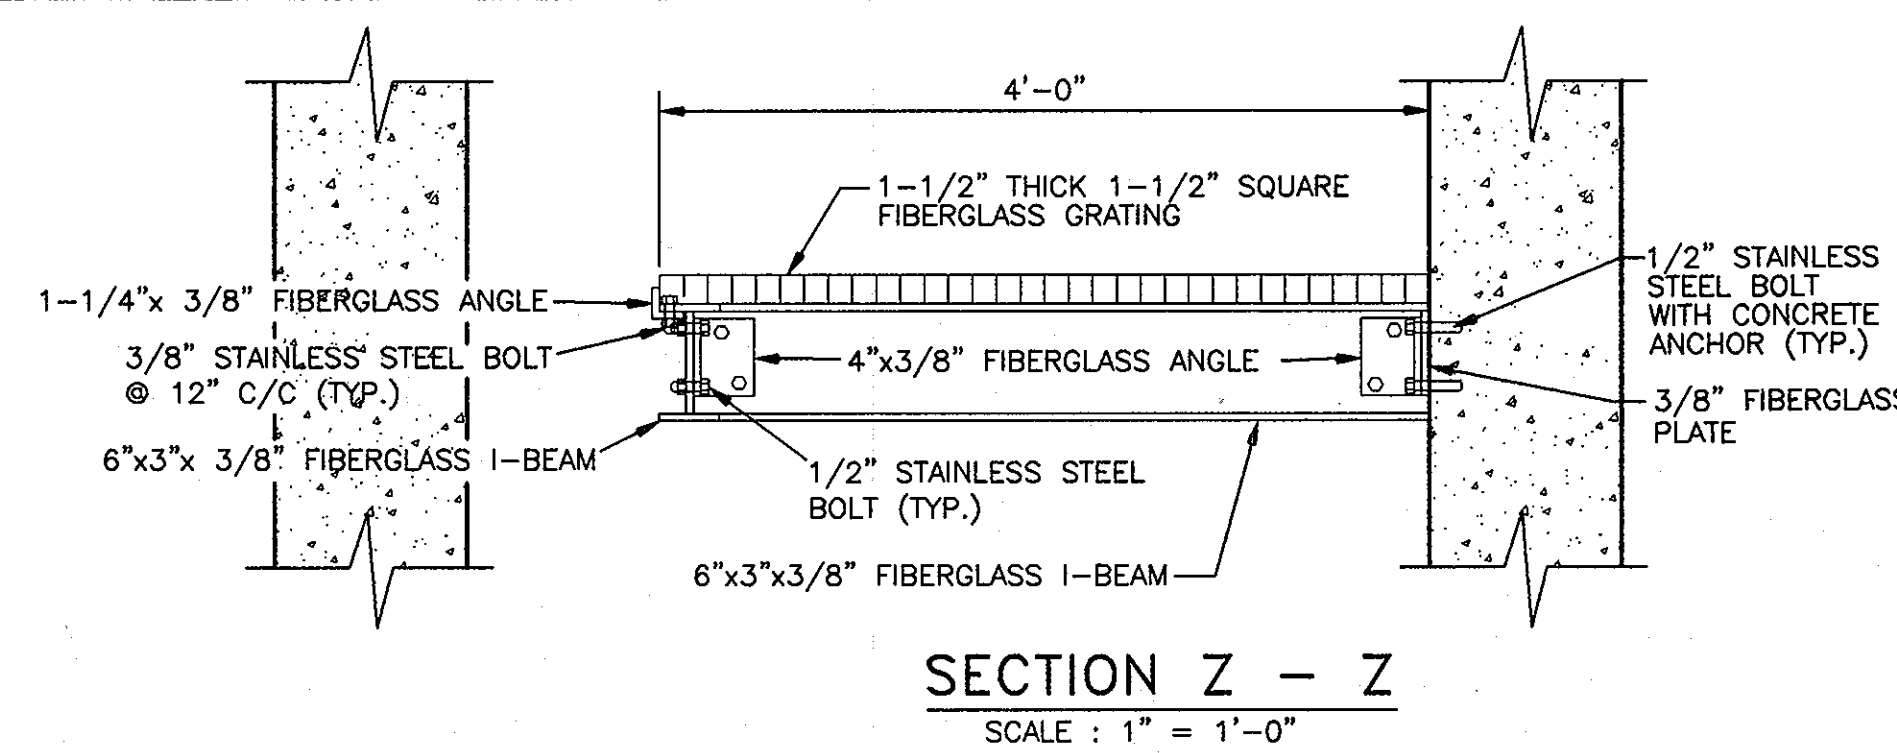

CURVE STAKEOUT DATA		
POINT NO.	NORTH	EAST
PC-1	564,740.49	1,354,320.90
PI-1	564,740.52	1,354,327.40
PT-1	564,747.02	1,354,327.37
PC-2	564,733.99	1,354,320.94
PI-2	564,734.01	1,354,324.79
PT-2	564,737.39	1,354,326.62
PC-3	564,737.39	1,354,326.62
PI-3	564,742.58	1,354,329.43
PT-3	564,746.78	1,354,333.58

CURVE DATA				
CURVE NO.	RADIUS	TANGENT	LENGTH	Δ
1	6.50'	6.50'	10.21'	90°00'00"
2	6.50'	3.84'	6.94'	61°11'28"
2	41.50'	5.90'	11.73'	16°11'28"

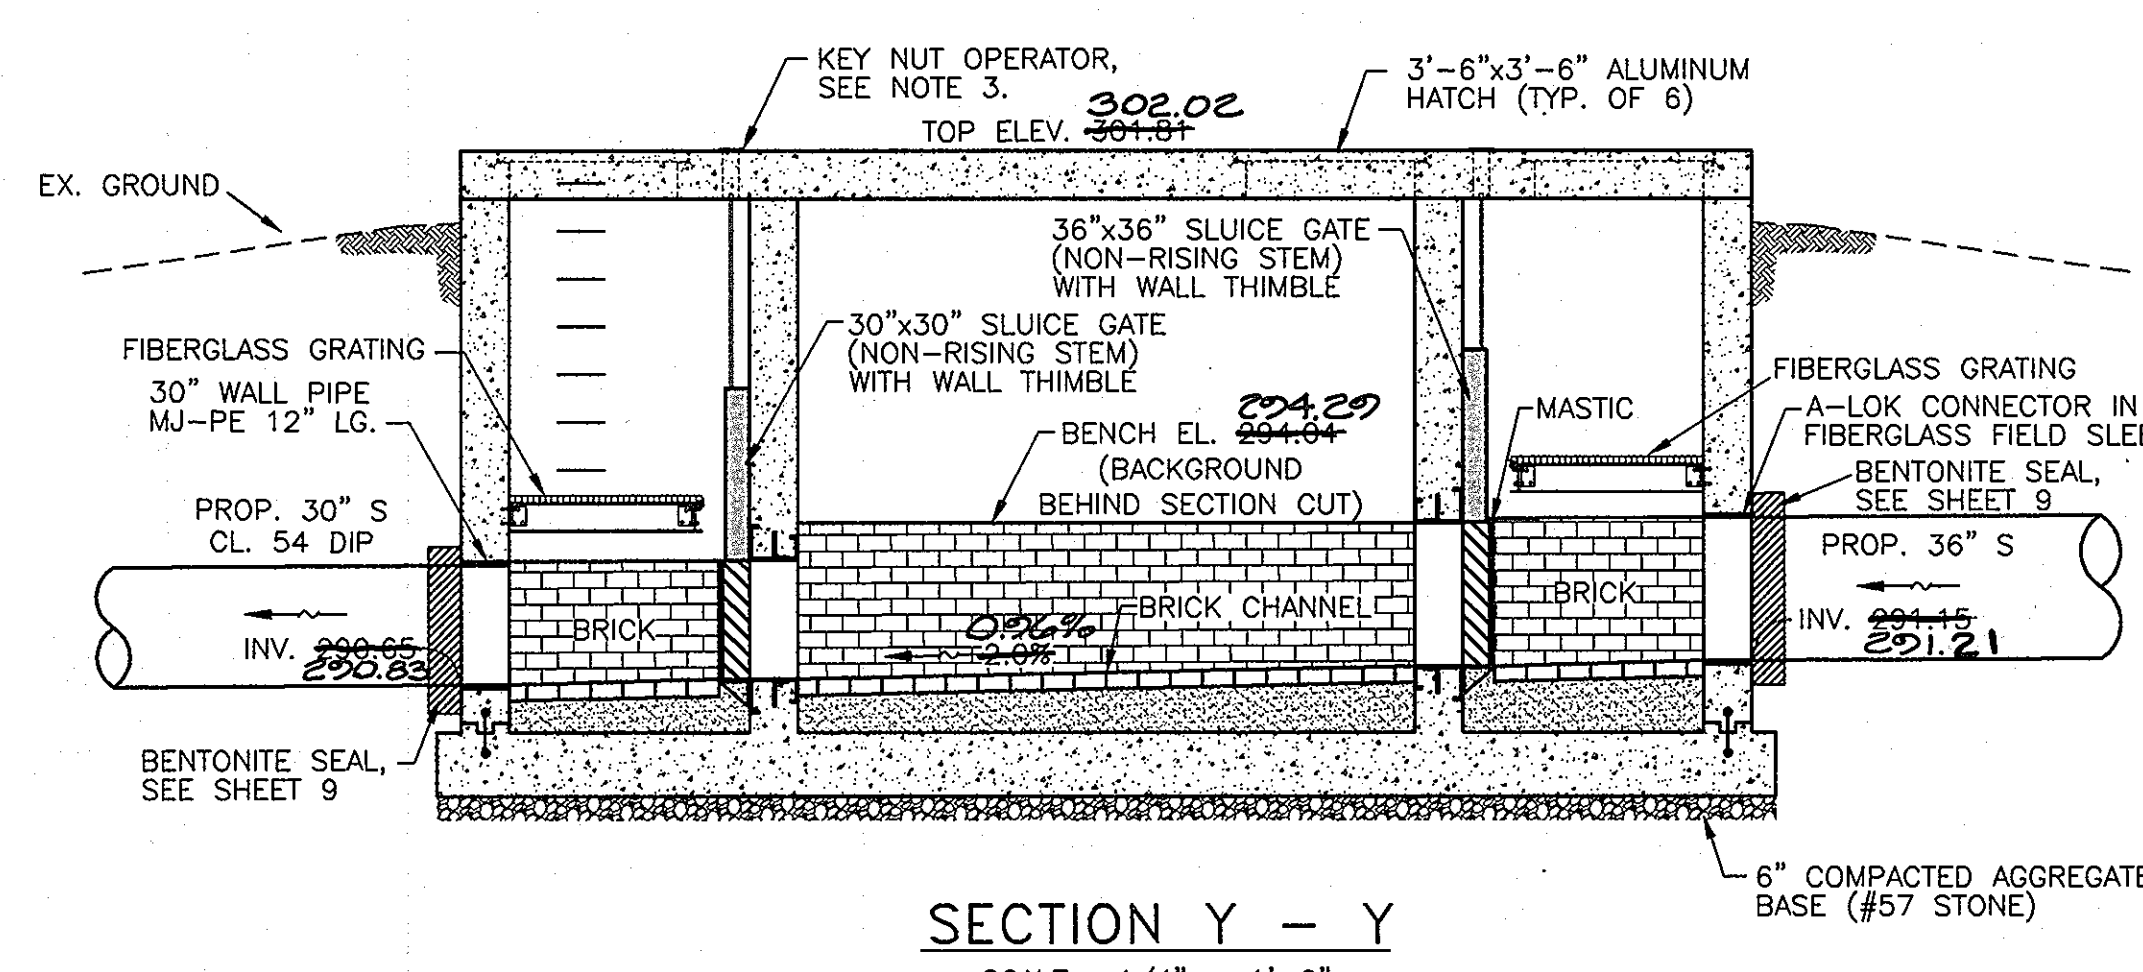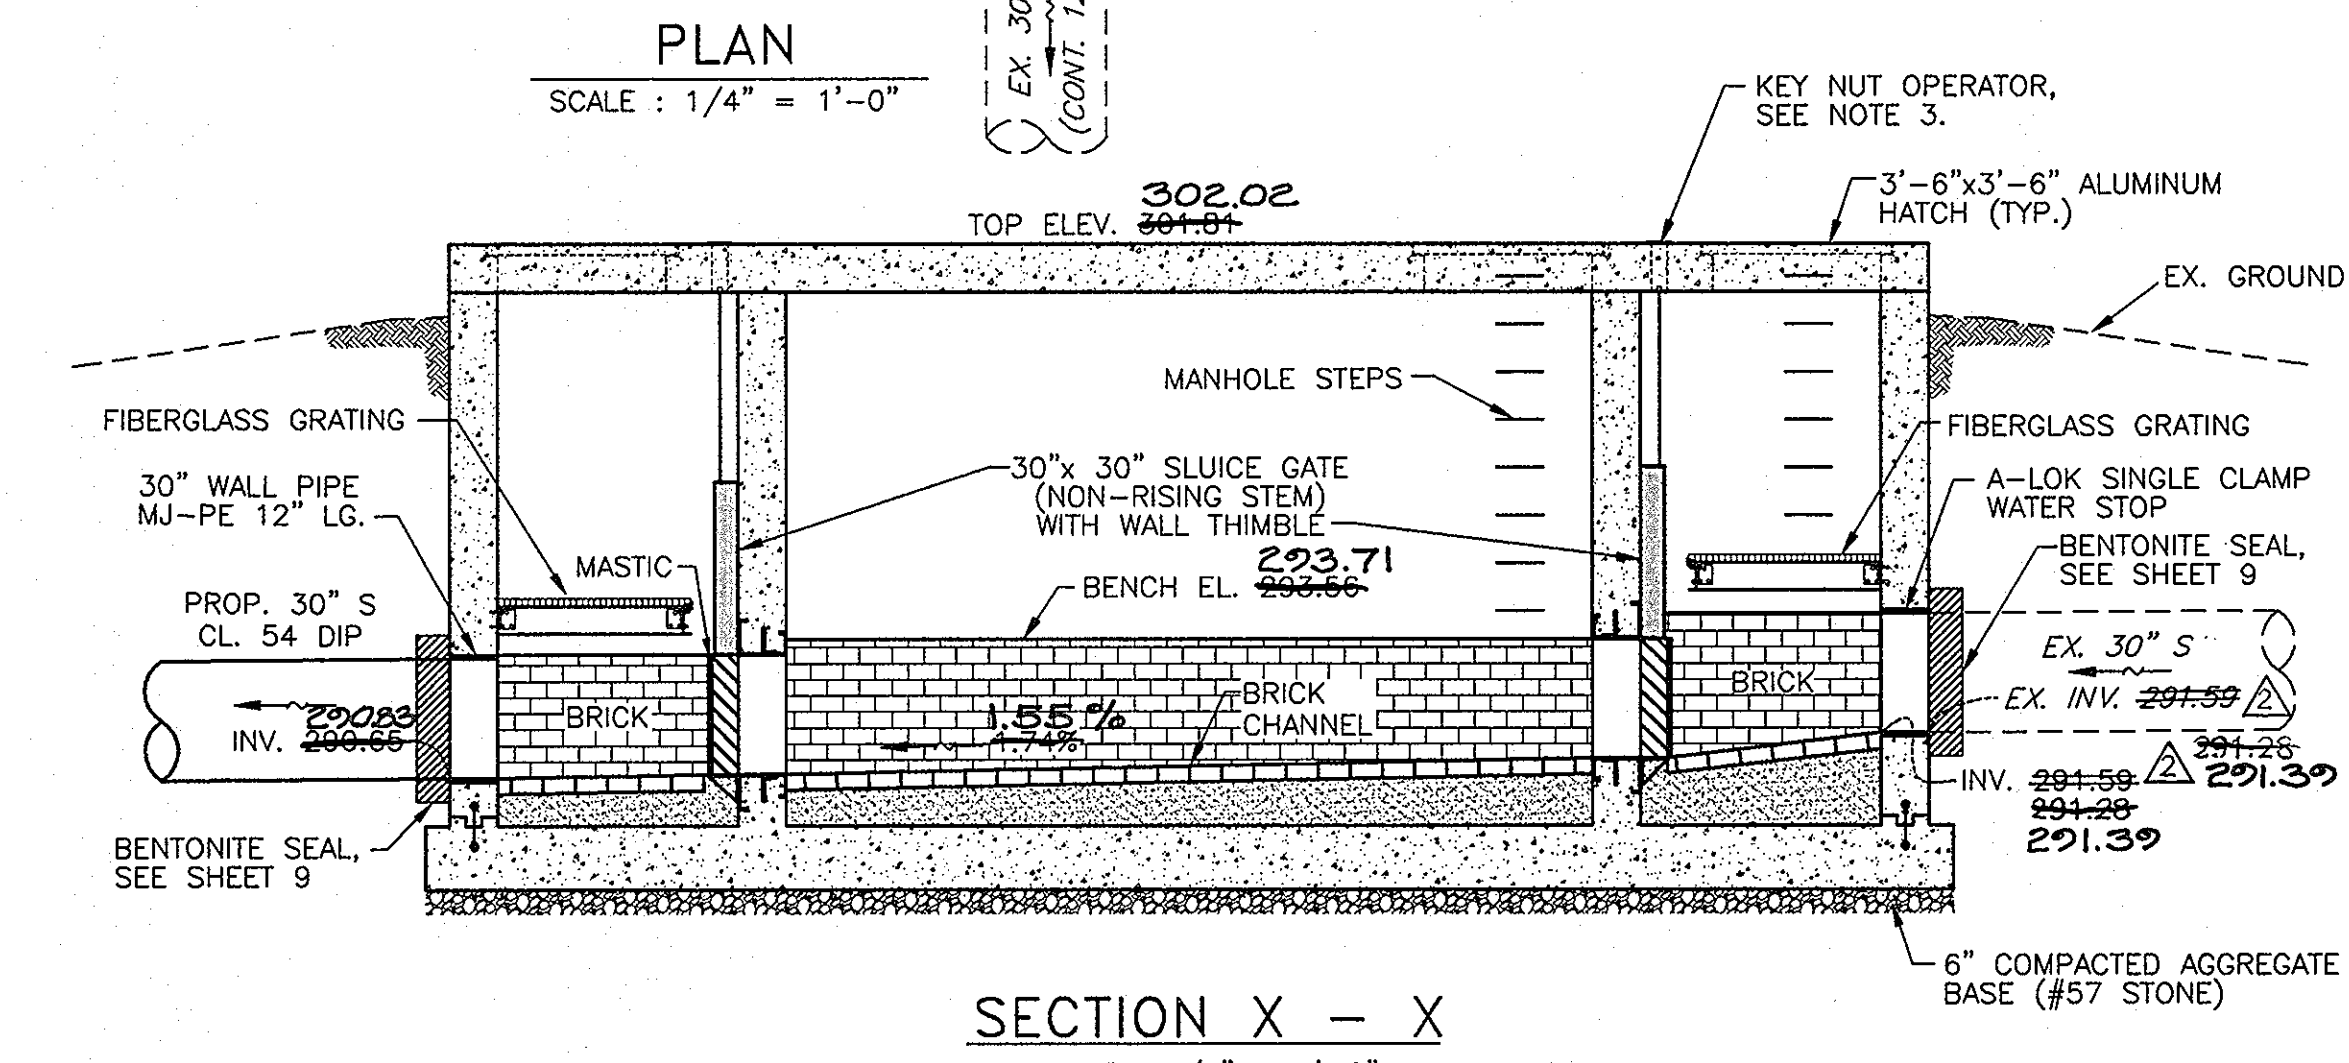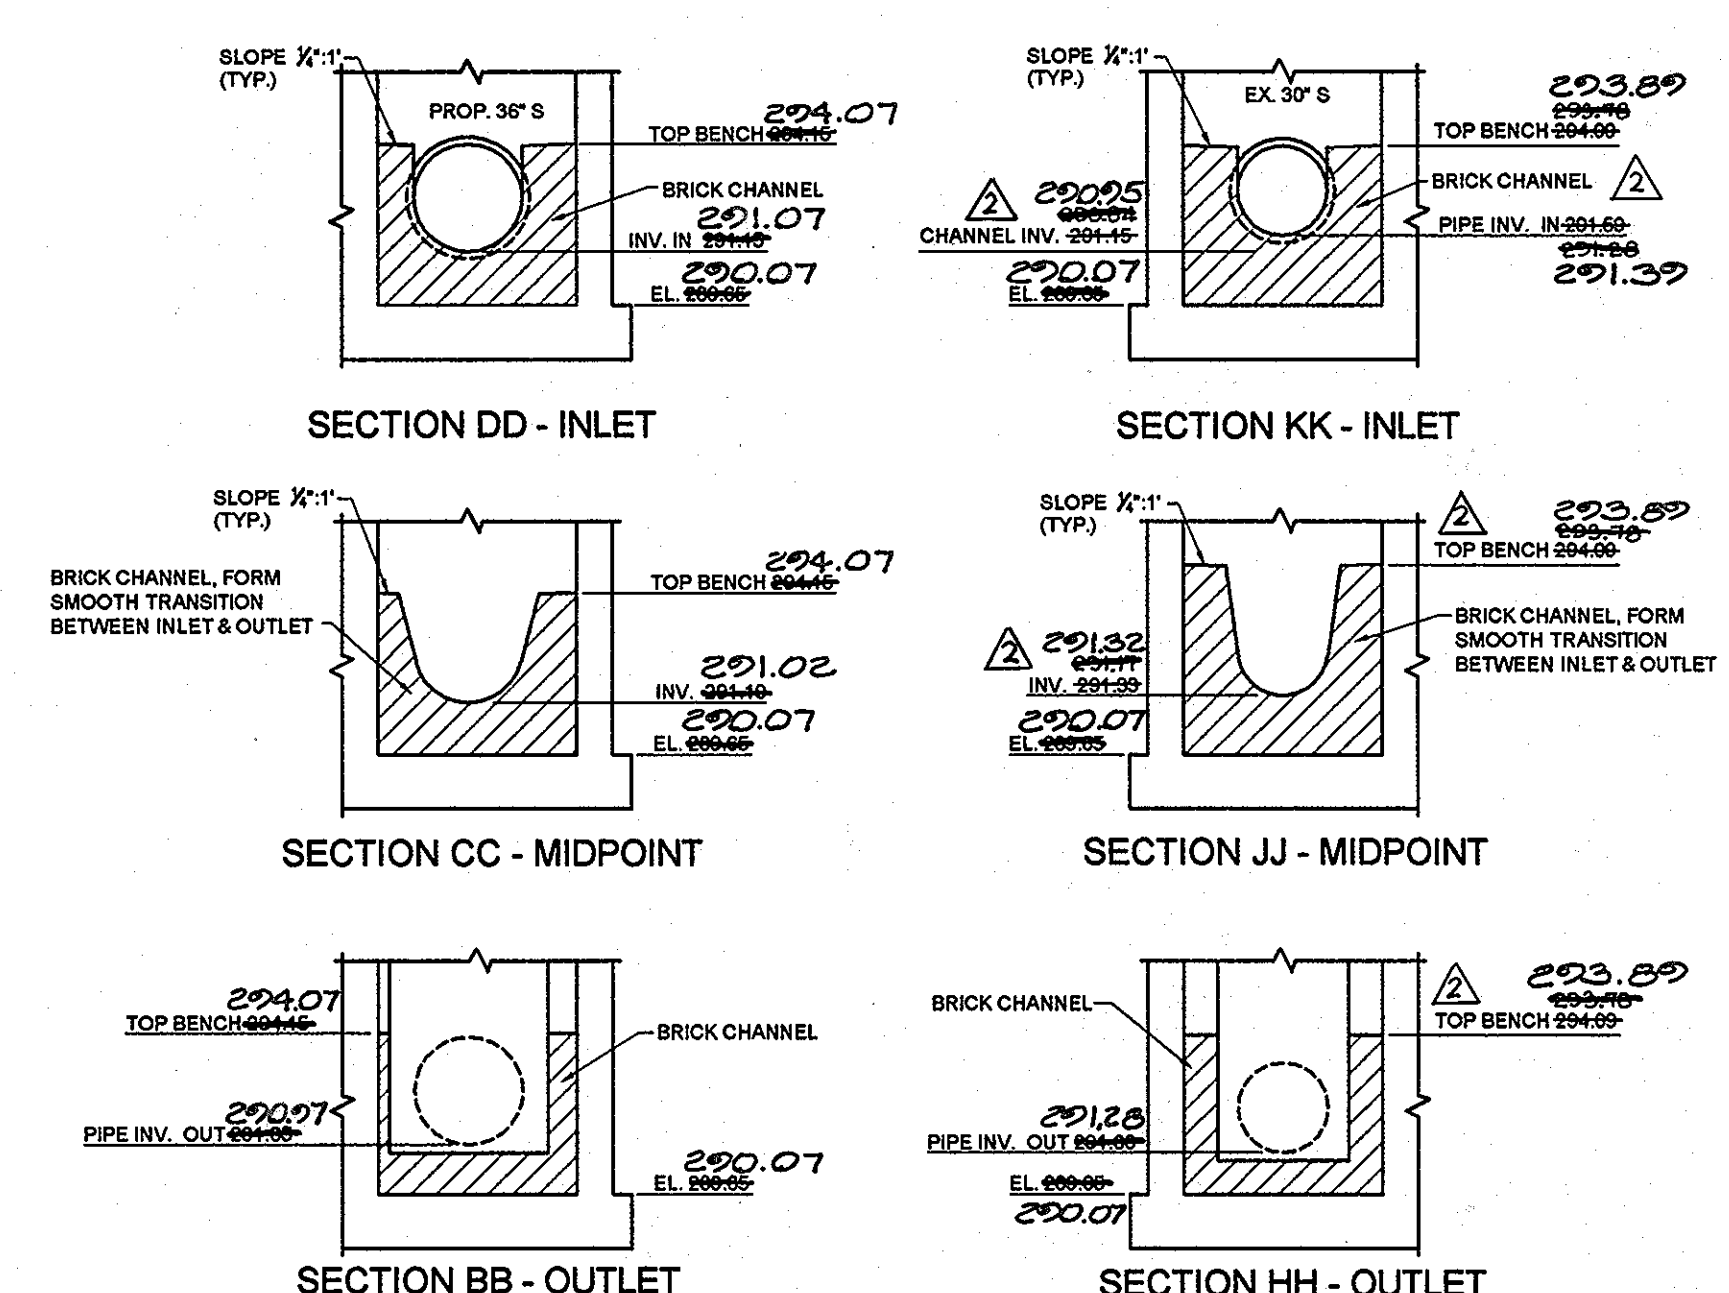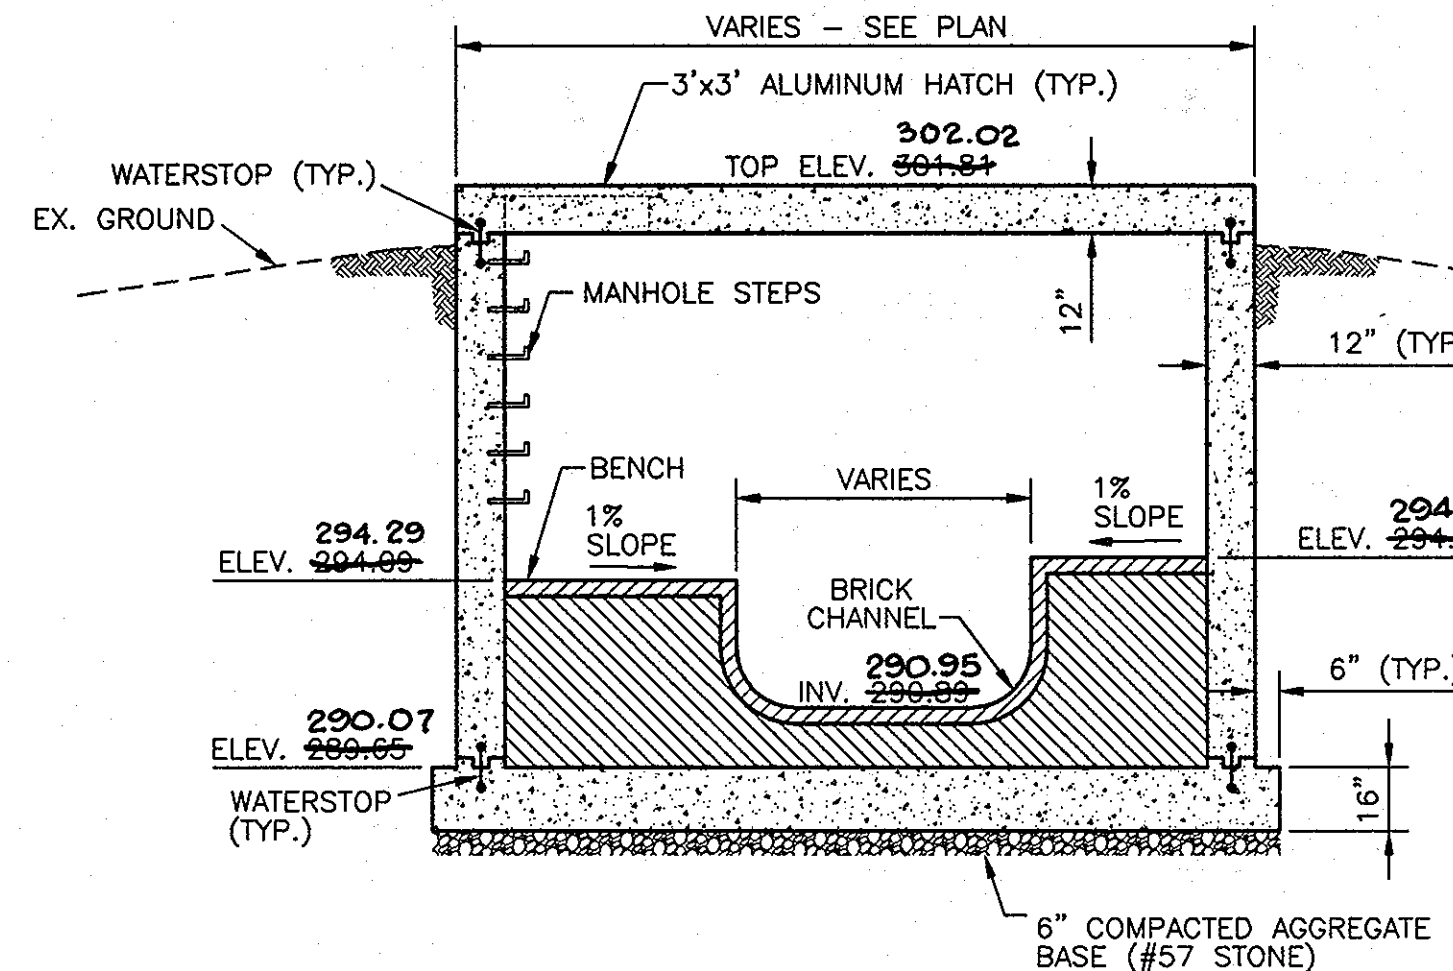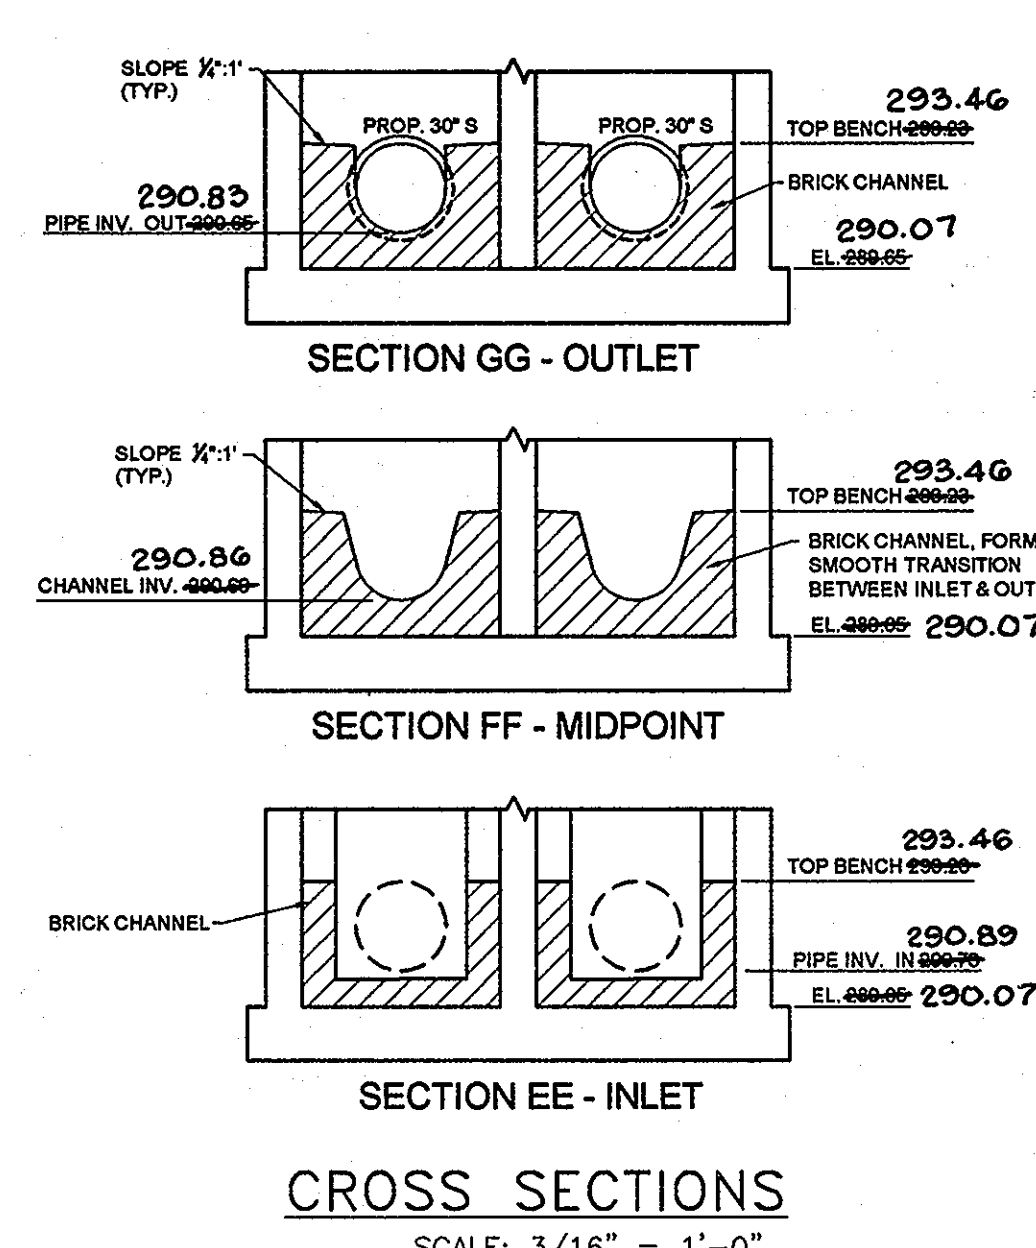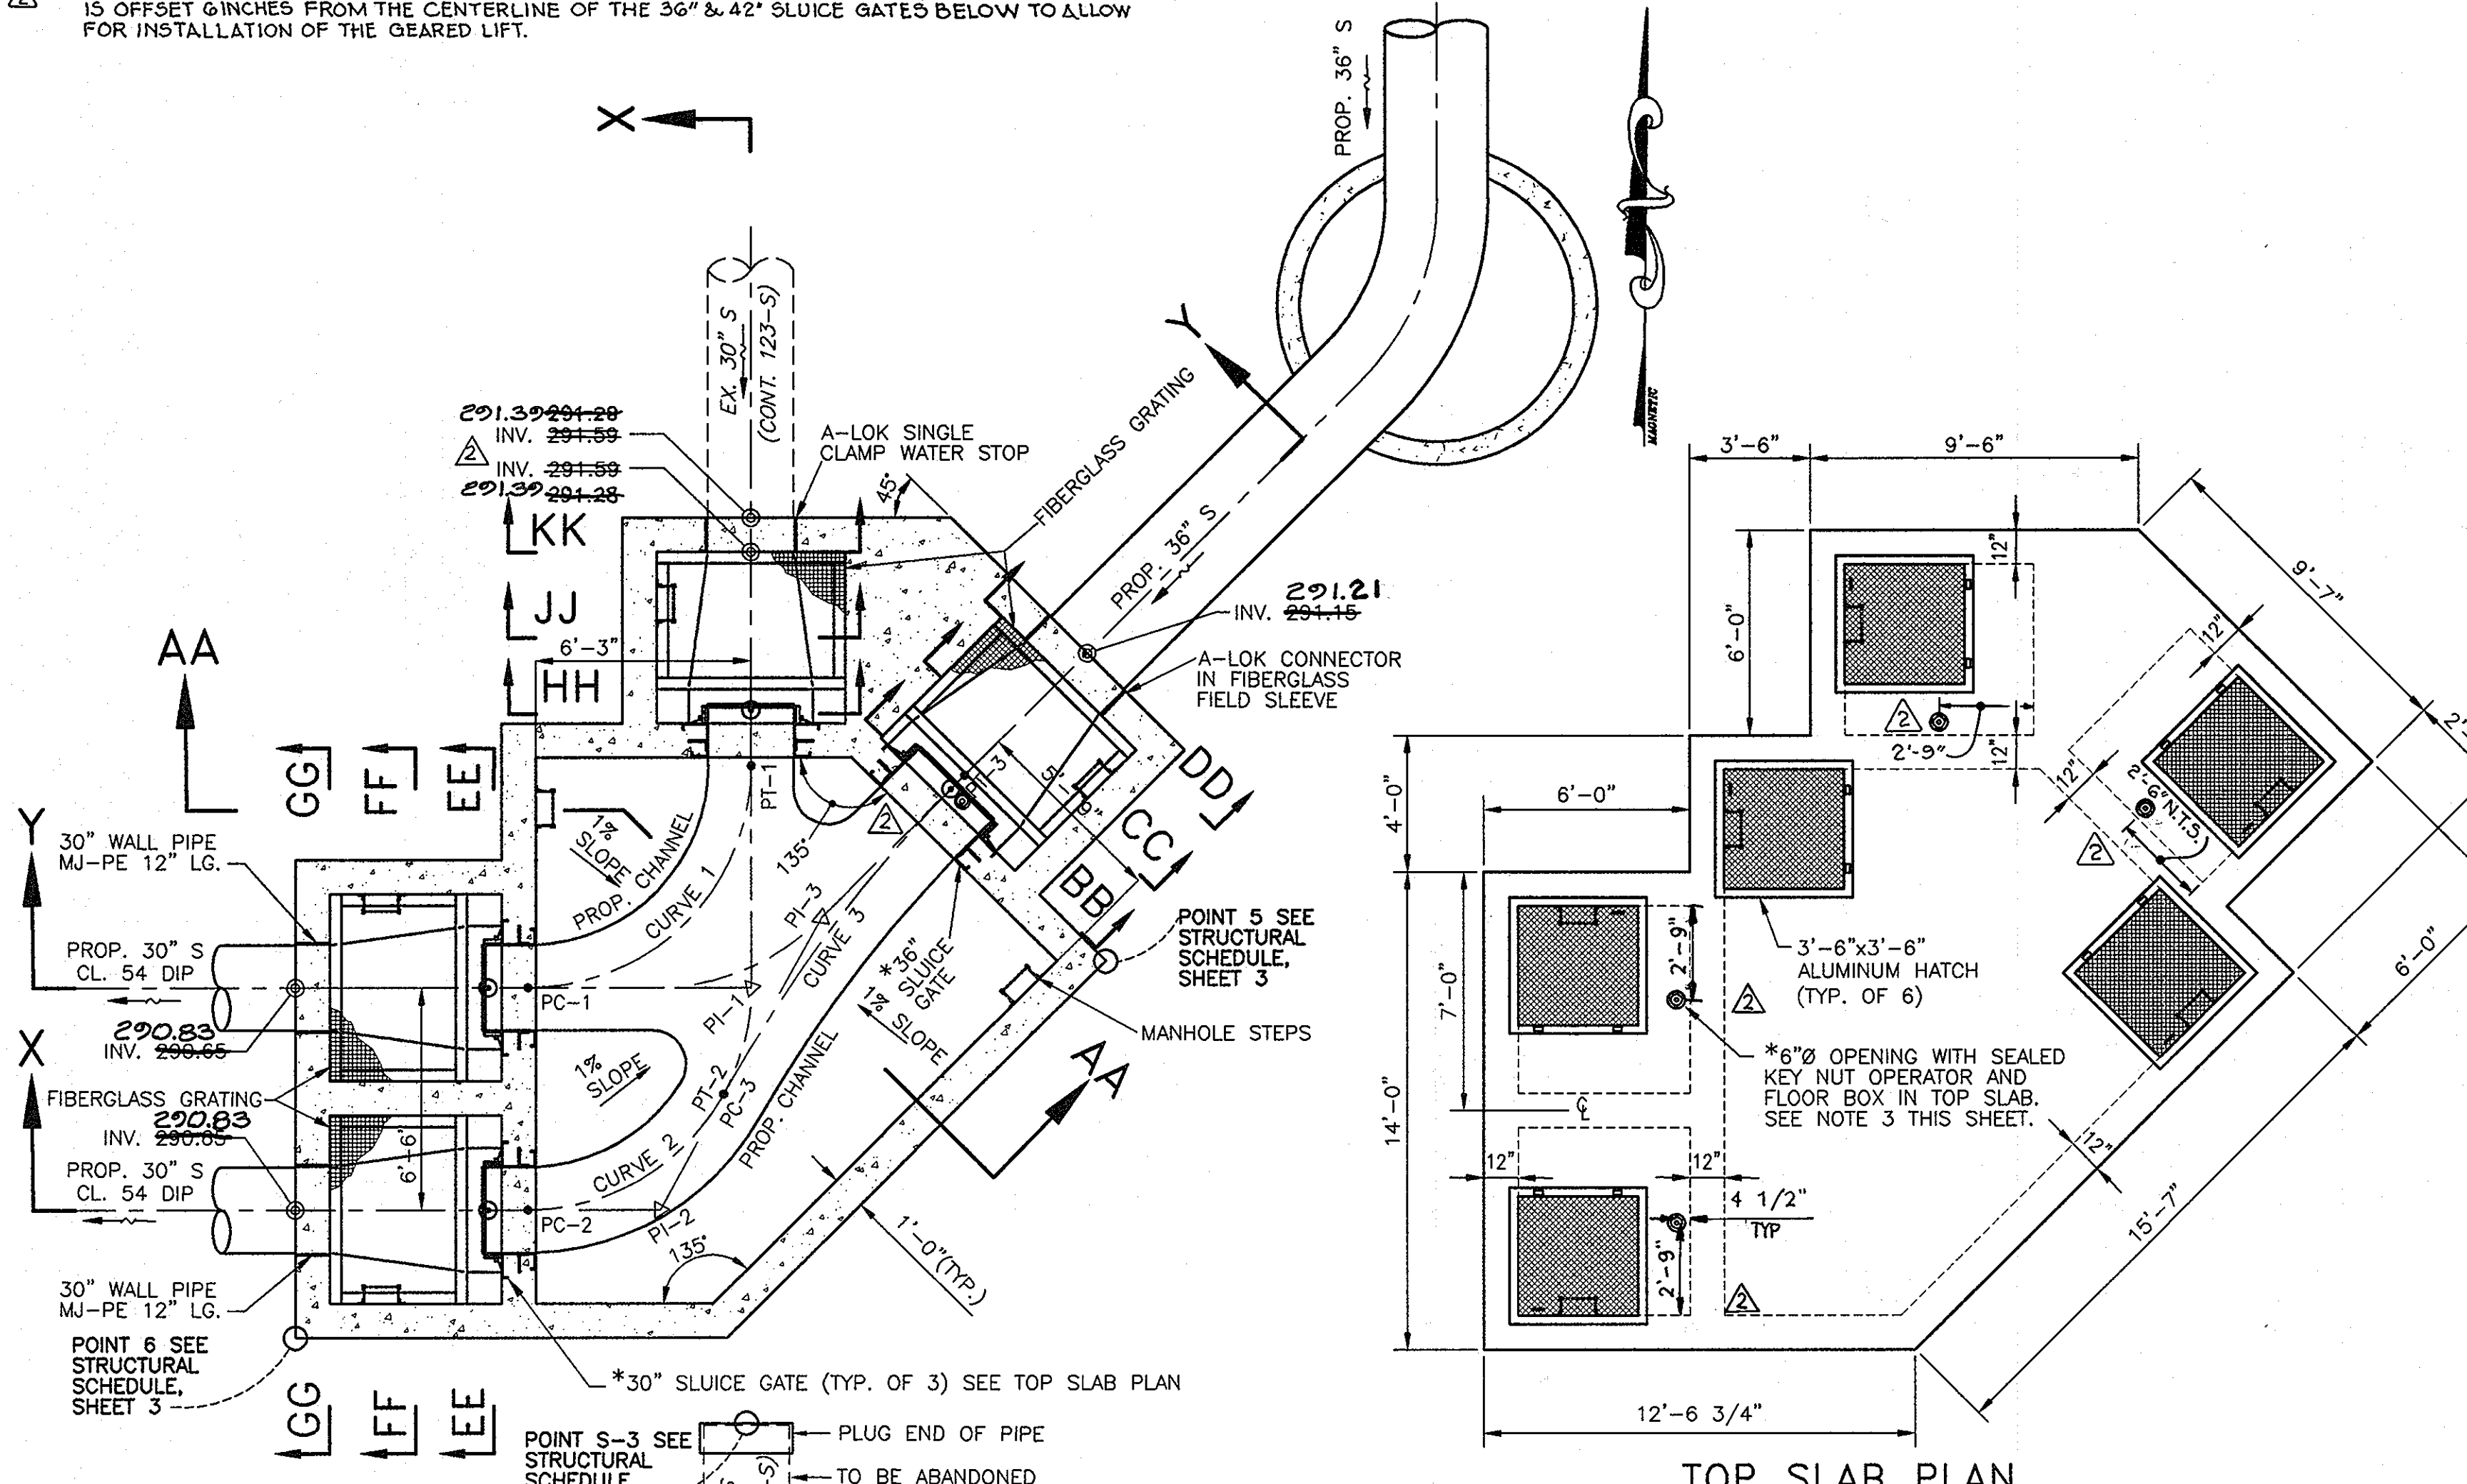


CROSS SECTIONS SCALE: 3/16" = 1'-0"

AS-BUILTS  
JUN 17 2010

**DEPARTMENT OF PUBLIC WORKS**  
HOWARD COUNTY, MARYLAND  
 Director: *Michael J. Preece* 6/2/10  
 Chief, Bureau of Engineering: *Robert J. Mason* 6/2/10  
 Chief, Bureau of Utilities: *Steve Cramer* 6/2/10  
 Chief, Utility Design Division: *Patricia A. ...* 6/2/10

**Dewberry**  
Dewberry & Davis LLC  
 3108 LORD BALTIMORE DRIVE  
 SUITE 110  
 BALTIMORE, MD 21244-2602  
 410.285.9500  
 FAX: 410.285.8875

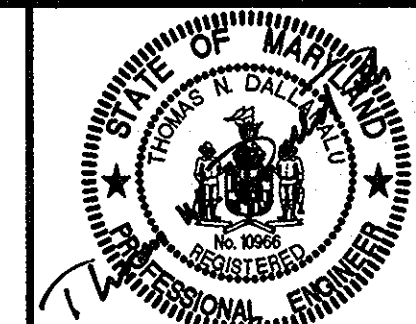

DES: LAL	
DRN: RLJ	
CHK: TND	LAL
DATE: 5.28.10	


REVISED ELEVATIONS AND ADDED DIMENSIONS FOR SLUIZE GATE OPERATIONS 07/11

**JUNCTION CHAMBER 1003**  
PLANS, SECTIONS, & DETAILS  
 600' SCALE MAP NO. 37, 43  
 BLOCK NO. 5, 23

**LITTLE PATUXENT PARALLEL INTERCEPTOR**  
 CAPITAL PROJECT S-6175  
 CONTRACT NO. 20-4540  
 ELECTION DISTRICT NO. 5  
 HOWARD COUNTY, MARYLAND


SCALE: SHOWN  
 SHEET 23 OF 26

Printed by: (solidworks) on 07/11/2010 at 10:47:27 AM  
 Plot Name: (solidworks) Junction Chamber Plans.dwg  
 User: (solidworks)  
 Plot Date: 07/11/2010  
 Plot Time: 10:47:27 AM  
 Plot Scale: 1:1  
 Plot Sheet: 23 of 26  
 Plot Path: (solidworks) Junction Chamber Plans.dwg

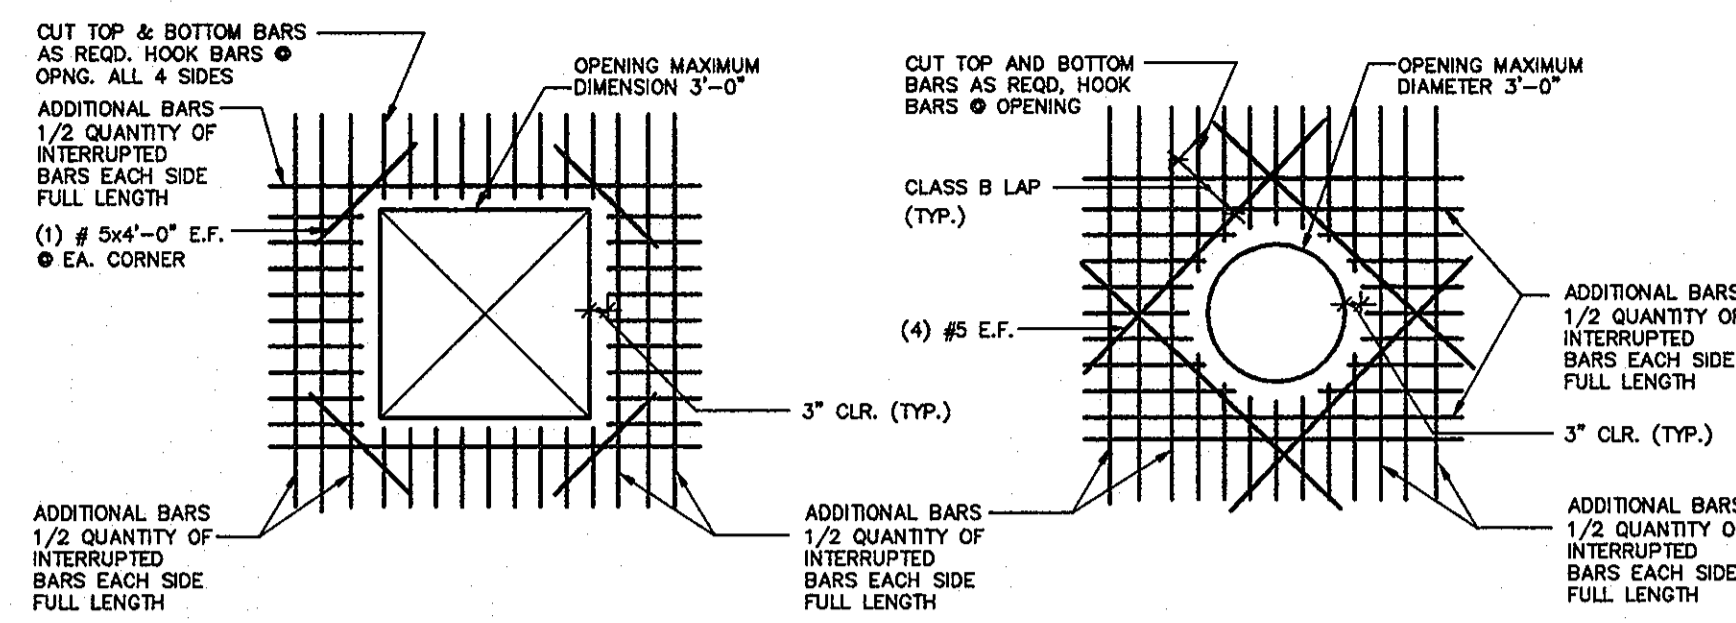


TYPICAL WALL OR SLAB OPENING DETAILS

SCALE : NTS

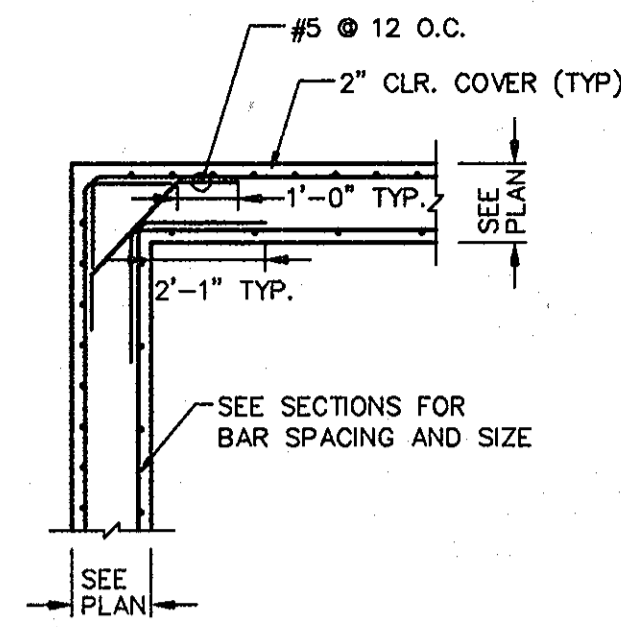


PLAN VIEW TYPICAL CORNER DETAIL

SCALE : NTS

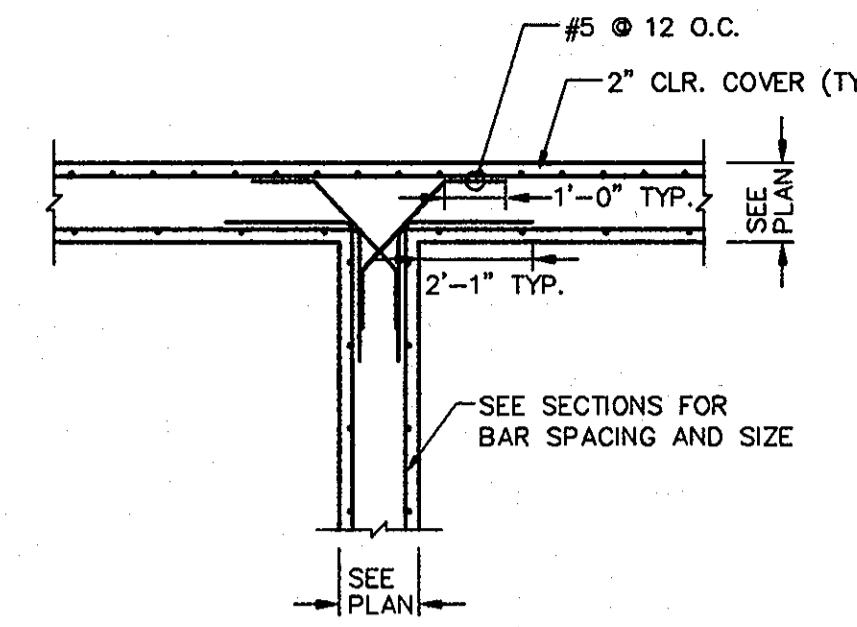

PLAN VIEW TYPICAL INTERSECTION DETAIL


SCALE : NTS

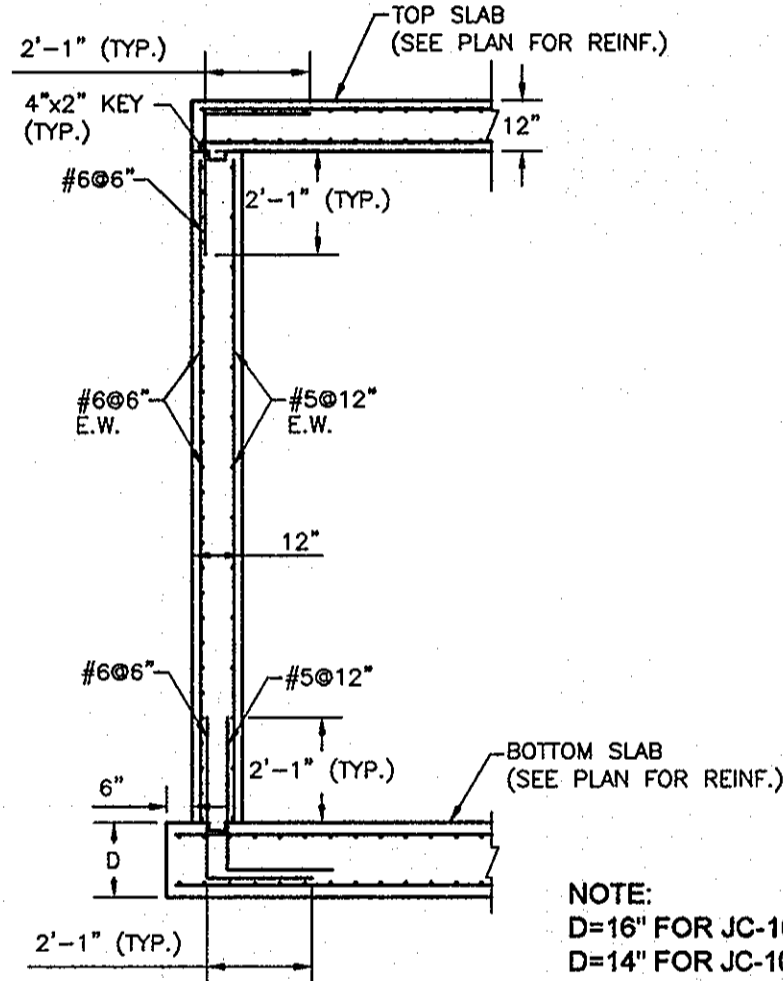

ELEVATION OUTER WALL TYPICAL SECTION


SCALE : NTS

NOTE: D=16\"/>

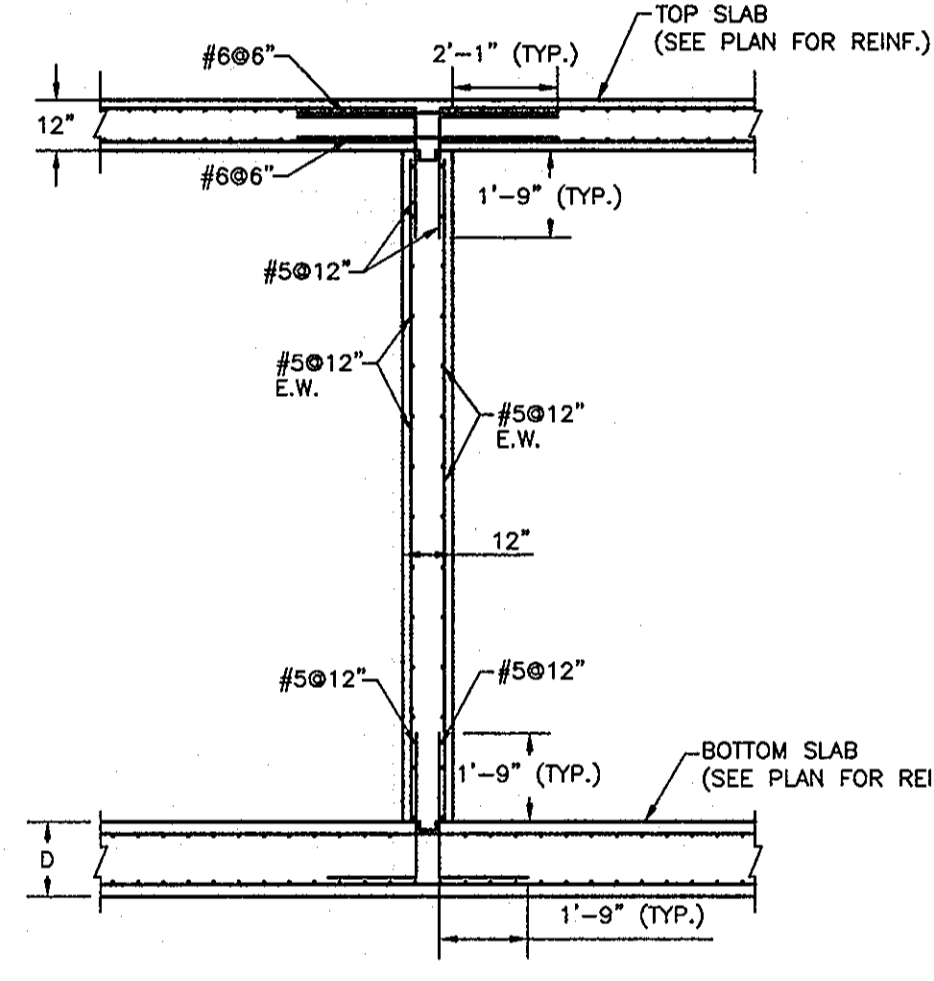

ELEVATION INNER WALL TYPICAL SECTION

SCALE : NTS

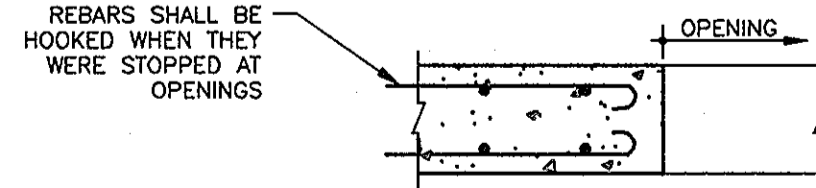

SECTION LL-LL

SCALE : NTS

DESIGN LOADS *	
DEAD LOADS - STRUCTURE	--- ACTUAL WEIGHT OF
WEIGHT OF SOIL P.C.F. DEAD LOAD	--- 100 P.C.F. TO RESIST UPLIFT 120
LIVE LOAD	--- IN AREAS NOT OCCUPIED BY EQUIPMENT OR SUBJECT TO TRUCK LOADING FLOOR - 100 P.S.F. EQUIPMENT - ACTUAL WEIGHT - 150 P.S.F. MINIMUM TRUCK - H20-44 AASHTO LOADING WALKWAYS - 100 P.S.F. STAIRWAY - 100 P.S.F. ROOF - 30 P.S.F.
SNOW LOAD	--- GROUND SNOW LOAD - 20 P.S.F.
WIND LOAD (EXPOSURE C)	--- BASIC WIND SPEED - 90 MPH
SEISMIC LOAD	--- DESIGN CATEGORY B
EARTH PRESSURES	--- LATERAL EARTH PRESSURES ARE BASED ON A FRICTION ANGLE OF 30°. BACKFILL MATERIAL SHALL NOT BE PLACED AGAINST FOUNDATION WALLS UNTIL THE UPPER BRACING COMPONENTS ARE IN PLACE FOR AT LEAST 7 DAYS.

**CAST IN PLACE CONCRETE NOTES**

ALL DIMENSIONS, LOCATIONS AND ELEVATIONS OF EXISTING STRUCTURES SHOWN ON THE CONTRACT DRAWINGS, SHALL BE VERIFIED IN THE FIELD BY THE CONTRACTOR. ALL DISCREPANCIES SHALL BE BROUGHT TO THE ATTENTION OF THE ENGINEER BEFORE PROCEEDING WITH THE WORK.  
THE SIZES AND LOCATIONS OF EQUIPMENT PADS AND PEDESTALS, AS WELL AS EQUIPMENT RELATED FLOOR AND SLAB OPENINGS, ARE DEPENDENT UPON THE ACTUAL EQUIPMENT FURNISHED. IT SHALL BE THE CONTRACTOR'S RESPONSIBILITY TO VERIFY AND COORDINATE ALL SUCH ITEMS. NO DIMENSIONS INDICATED ON THESE DRAWINGS SHALL BE ALTERED WITHOUT THE ENGINEER'S APPROVAL. ALL EQUIPMENT PADS AND OTHER EQUIPMENT SUPPORTS REQUIRED MAY NOT HAVE BEEN SHOWN ON THE STRUCTURAL DRAWINGS. REFER TO CIVIL, ARCHITECTURAL, MECHANICAL AND ELECTRICAL DRAWINGS FOR SIZES AND LOCATIONS OF SUCH PADS AND SUPPORTS.

FOR NOTES PERTAINING TO INDIVIDUAL STRUCTURES, SEE DRAWINGS FOR THOSE STRUCTURES.

**CODES**

\*INTERNATIONAL BUILDING CODE, 2006, INTERNATIONAL CODE COUNCIL  
AMERICAN INSTITUTE OF STEEL CONSTRUCTION, (AISC) "SPECIFICATION FOR STRUCTURAL STEEL BUILDINGS - ALLOWABLE STRESS DESIGN AND PLASTIC DESIGN" 1989  
AMERICAN CONCRETE INSTITUTE, (ACI-318-95) "BUILDING CODE REQUIREMENTS FOR REINFORCED CONCRETE"

**CONCRETE \***

ALL CONCRETE SHALL HAVE A MINIMUM COMPRESSIVE STRENGTH OF 4000 PSI AT 28 DAYS. REINFORCED CONCRETE SHALL BE DETAILLED AND CONSTRUCTED IN ACCORDANCE WITH THE AMERICAN CONCRETE INSTITUTE. (ACI 301-99) "SPECIFICATIONS FOR STRUCTURAL CONCRETE"  
ALL REINFORCEMENT SHALL CONFORM TO ASTM SPECIFICATION A615, DEFORMED, GRADE 60. WELDED WIRE FABRIC SHALL CONFORM TO ASTM SPECIFICATION A185.  
UNLESS OTHERWISE NOTED ON THE DRAWINGS, CONCRETE COVER FOR REINFORCEMENT SHALL BE AS FOLLOWS:

- A. UNIFORMED CONCRETE BOTTOM BARS IN FOOTINGS AND SLABS ON EARTH OR GRAVEL - 3"
- B. BEAMS, SLABS, COLUMNS AND WALLS, EXPOSED TO GROUND, WEATHER OR PROCESS LIQUID AFTER THE REMOVAL OF FORMS - 2"
- C. BEAMS, COLUMNS AND PIERS NOT EXPOSED TO WEATHER OR PROCESS LIQUID - 1 1/2"
- D. STRUCTURAL SLABS NOT EXPOSED TO GROUND, WEATHER, PROCESS LIQUID OR TRUCK TRAFFIC - 1"
- E. STRUCTURAL SLAB NOT EXPOSED TO GROUND, WEATHER OR PROCESS LIQUID, BUT SUBJECT TO TRUCK TRAFFIC:

TOP OF SLAB - 1 1/2"  
BOTTOM OF SLAB - 1"

ALL EXPOSED CONCRETE EDGES SHALL BE CHAMFERED 3/4" UNLESS OTHERWISE NOTED.

THE CONTRACTOR SHALL SUBMIT SHOP DETAILS OF REINFORCING STEEL BEFORE PROCEEDING WITH FABRICATION.

REINFORCING STEEL SHALL BE DETAILLED IN ACCORDANCE WITH THE AMERICAN CONCRETE INSTITUTE, (ACI 315) "DETAILS AND DETAILING OF CONCRETE REINFORCEMENT" AND (ACI SP-66) "ACI DETAILING MANUAL 1994".

ALL SPLICES FOR REINFORCING BARS NOT DIMENSIONED ON THE DRAWINGS SHALL BE DETAILLED AS TABULATED ON THIS DRAWING.

CONCRETE SLAB AND WALLS SHALL BE POURED BETWEEN INDICATED JOINTS, ALLOWING A MINIMUM PERIOD OF 3 DAYS TO ELAPSE BETWEEN ADJACENT POURS.

CONSTRUCTION JOINTS SHALL BE AS DETAILED ON THE DRAWINGS AND NO ADDITIONAL JOINTS SHALL BE USED, NOR ANY OMITTED, EXCEPT BY WRITTEN AUTHORIZATION OF THE ENGINEER. ADDITIONAL ENGINEER APPROVED CONSTRUCTION JOINTS SHALL NOT RESULT IN ADDITIONAL EXPENSE TO THE OWNER.

WATERSTOPS SHALL BE 3/8" THICK x 6" WIDE, PAUL MURPHY, FLAT DUMBBELL TYPE, AS NOTED ON THE DRAWINGS. SEE SPECIFICATIONS FOR OTHER REQUIREMENTS.

ANCHOR BOLTS AND EQUIPMENT PEDESTALS SHALL BE SIZED AND LOCATED AS REQUIRED TO SUIT EQUIPMENT FURNISHED.

SEE ARCHITECTURAL, CIVIL, MECHANICAL AND ELECTRICAL DRAWINGS FOR ALL EMBEDDED ITEMS SUCH AS SLEEVES, ANCHORS, ELECTRICAL CONDUITS, AND OPENINGS, WHICH MAY INTERFERE WITH CONCRETE CONSTRUCTION. ALL PIPING AND OTHER EMBEDDED ITEMS ARE NOT SHOWN ON STRUCTURAL DRAWINGS.

WHERE A BEAM FRAMES INTO A WALL, IF A CONSTRUCTION JOINT IS NOT INDICATED AT THE BOTTOM OF THE BEAM, A POCKET SHALL BE PROVIDED IN THE WALL FOR BEAM BEARING. THE DEPTH OF THE POCKET SHALL BE FULL THE THICKNESS OF THE WALL.

**FOUNDATION**

ALL FOUNDATIONS SHALL BE FOUND ON SOIL HAVING BEARING CAPACITY OF 3000 PSF (AS DETERMINED BY THE GEOTECHNICAL ENGINEER, EBA ENGINEERING, INC., MAY 2008) AT THE ELEVATIONS SHOWN ON THE STRUCTURAL DRAWINGS. WHERE FOUNDATIONS ARE FOUND ON FILL THE GEOTECHNICAL ENGINEER SHALL VERIFY ITS CAPACITY.

FOR MECHANICAL AND ELECTRICAL WORK TO BE INCORPORATED IN FOUNDATION WORK, SEE MECHANICAL AND ELECTRICAL DRAWINGS.

ALL EXCAVATIONS SHALL BE KEPT DRY. STANDING WATER SHALL NOT BE ALLOWED IN EXCAVATIONS. BEFORE PLACING ANY CONCRETE ON SUBGRADE, THE CONTRACTOR SHALL NOTIFY THE GEOTECHNICAL ENGINEER.

A STRUCTURAL SLAB SHALL BE USED WHEN UNCOMPACTED FILL EXCEEDS 8".

THE CONTRACTOR SHALL VERIFY THE BEARING CAPACITY OF THE BEARING SOILS IN THE FOOTING EXCAVATION PRIOR TO CASTING ANY FOOTINGS. WRITTEN VERIFICATION SHALL BE SUBMITTED TO THE ARCHITECT AND ENGINEER.

REFER TO THE SPECIFICATIONS AND SOILS REPORT (IF AVAILABLE) FOR THE SITE PREPARATION REQUIREMENTS.

**SHOP DRAWINGS**

THE GENERAL CONTRACTOR SHALL SUBMIT SHOP DRAWINGS FOR ALL STRUCTURAL ELEMENTS SHOWN ON THE CONTRACT DOCUMENTS FOR APPROVAL. THE STRUCTURAL ENGINEER WILL NOT BE RESPONSIBLE FOR THE STRUCTURAL CERTIFICATION AND DESIGN OF THE PROJECT IF THE GENERAL CONTRACTOR FAILS TO OBTAIN APPROVAL OF THE SHOP DRAWINGS. THE GENERAL CONTRACTOR SHALL INFORM THE STRUCTURAL ENGINEER IN WRITING CONCERNING DEVIATIONS AND/OR OMISSIONS FROM THE CONTRACT DOCUMENTS AT THE TIME OF SHOP DRAWING SUBMISSION. THE GENERAL CONTRACTOR SHALL STATE ON THE SHOP DRAWINGS THAT CONTRACT DOCUMENT REQUIREMENTS HAVE BEEN MET AND THAT ALL DIMENSIONS, CONDITIONS AND QUANTITIES HAVE BEEN REVIEWED AND VERIFIED AS SHOWN AND/OR CORRECTED ON THE SHOP DRAWINGS.

**MISCELLANEOUS ITEMS**

STRUCTURAL DRAWINGS SHALL BE USED IN CONJUNCTION WITH ARCHITECTURAL, MECHANICAL, ELECTRICAL AND PLUMBING DRAWINGS AND DRAWINGS OF OTHER TRADES. THE CONTRACTOR SHALL BE RESPONSIBLE FOR COORDINATING THE WORK OF ALL TRADES FOR THE STRUCTURAL WORK.

THE CONTRACTOR SHALL BE RESPONSIBLE FOR DESIGNING, FURNISHING, ERECTING, AND REMOVING ANY SHORING AND BRACING REQUIRED DURING CONSTRUCTION.

THE CONTRACTOR IS SOLELY RESPONSIBLE FOR ALL SAFETY REGULATIONS, PROGRAMS AND PRECAUTIONS RELATED TO ALL WORK ON THIS PROJECT.

THE CONTRACTOR IS SOLELY RESPONSIBLE FOR THE PROTECTION OF PERSONS AND PROPERTY EITHER ON OR ADJACENT TO THE PROJECT AND SHALL PROTECT SAME AGAINST INJURY, DAMAGE OR LOSS.

NO OPENINGS OR CHANGES IN SIZE, DIMENSION OR LOCATION SHALL BE MADE IN ANY STRUCTURAL ELEMENTS WITHOUT WRITTEN APPROVAL OF THE STRUCTURAL ENGINEER.

THE CONTRACTOR IS RESPONSIBLE FOR LIMITING THE AMOUNT OF CONSTRUCTION LOAD IMPOSED ON THE STRUCTURE. SUCH LOADS SHALL NOT EXCEED THE CAPACITY OF THE STRUCTURE AT ANY TIME.

THE STRUCTURE IS DESIGNED TO FUNCTION AS A UNIT UPON COMPLETION, AND ANY TEMPORARY BRACING OR SUPPORT REQUIRED TO ACCOMMODATE THE CONTRACTOR'S MEANS AND METHODS ARE THE RESPONSIBILITY OF THE CONTRACTOR.

CONTRACTOR SHALL VERIFY ALL EXISTING CONDITIONS PRIOR TO ORDERING MATERIALS OR PROCEEDING WITH NEW WORK IN AREAS AFFECTED BY EXISTING CONDITIONS. THE STRUCTURAL ENGINEER SHALL BE INFORMED IN WRITING OF CONFLICTS BETWEEN EXISTING AND PROPOSED NEW CONSTRUCTION.

CONTRACTOR IS RESPONSIBLE FOR COORDINATING ALL DIMENSIONS SHOWN ON THE CONTRACT DOCUMENTS. INCONSISTENCIES ON THE STRUCTURAL DRAWINGS OR BETWEEN THE STRUCTURAL DRAWINGS AND ANY OTHER CONTRACT, SHOP, FABRICATION, OR OTHER DRAWINGS OR INFORMATION SHALL BE BROUGHT TO THE ATTENTION OF THE STRUCTURAL ENGINEER PRIOR TO PROCEEDING WITH AFFECTED WORK.

AS-BUILT'S  
2008 12 28

DEPARTMENT OF PUBLIC WORKS  
HOWARD COUNTY, MARYLAND

*Michael J. ...* 6/3/10  
DIRECTOR OF PUBLIC WORKS  
CHIEF, BUREAU OF UTILITIES

*Robert P. ...* 6/2/10  
CHIEF, BUREAU OF ENGINEERING  
CHIEF, UTILITY DESIGN DIVISION

**Dewberry**  
Dewberry & Davis LLC  
3106 LORD BALTIMORE DRIVE  
SUITE 110  
BALTIMORE, MD 21244-2602  
410.285.9500  
FAX 410.285.8875



DES: LAL		
DRN: RLJ		
CHK: TND		
DATE: 5.28.10		

BY NO. REVISIONS DATE

JUNCTION CHAMBERS 1001-1003  
MISCELLANEOUS &  
REINFORCEMENT DETAILS &  
CAST IN PLACE CONCRETE NOTES

600' SCALE MAP NO. 37, 43      BLOCK NO. 5, 23


LITTLE PATUXENT PARALLEL INTERCEPTOR  
CAPITAL PROJECT S-6175  
CONTRACT NO. 20-4540

ELECTION DISTRICT NO. 5      HOWARD COUNTY, MARYLAND

SCALE: SHOWN  
SHEET 25 OF 28


Printed by: (c:\delve\20) on: 6/2/10 10:41:53 AM  
 Title: JUNCTION CHAMBERS 1001-1003 MISCELLANEOUS & REINFORCEMENT DETAILS & CAST IN PLACE CONCRETE NOTES  
 Plot Scale: 1:1  
 User: paulmurphy  
 Plot Device: HP DesignJet 2000-600  
 Scale: 1:1  
 Date: 6/2/10 10:41:53 AM



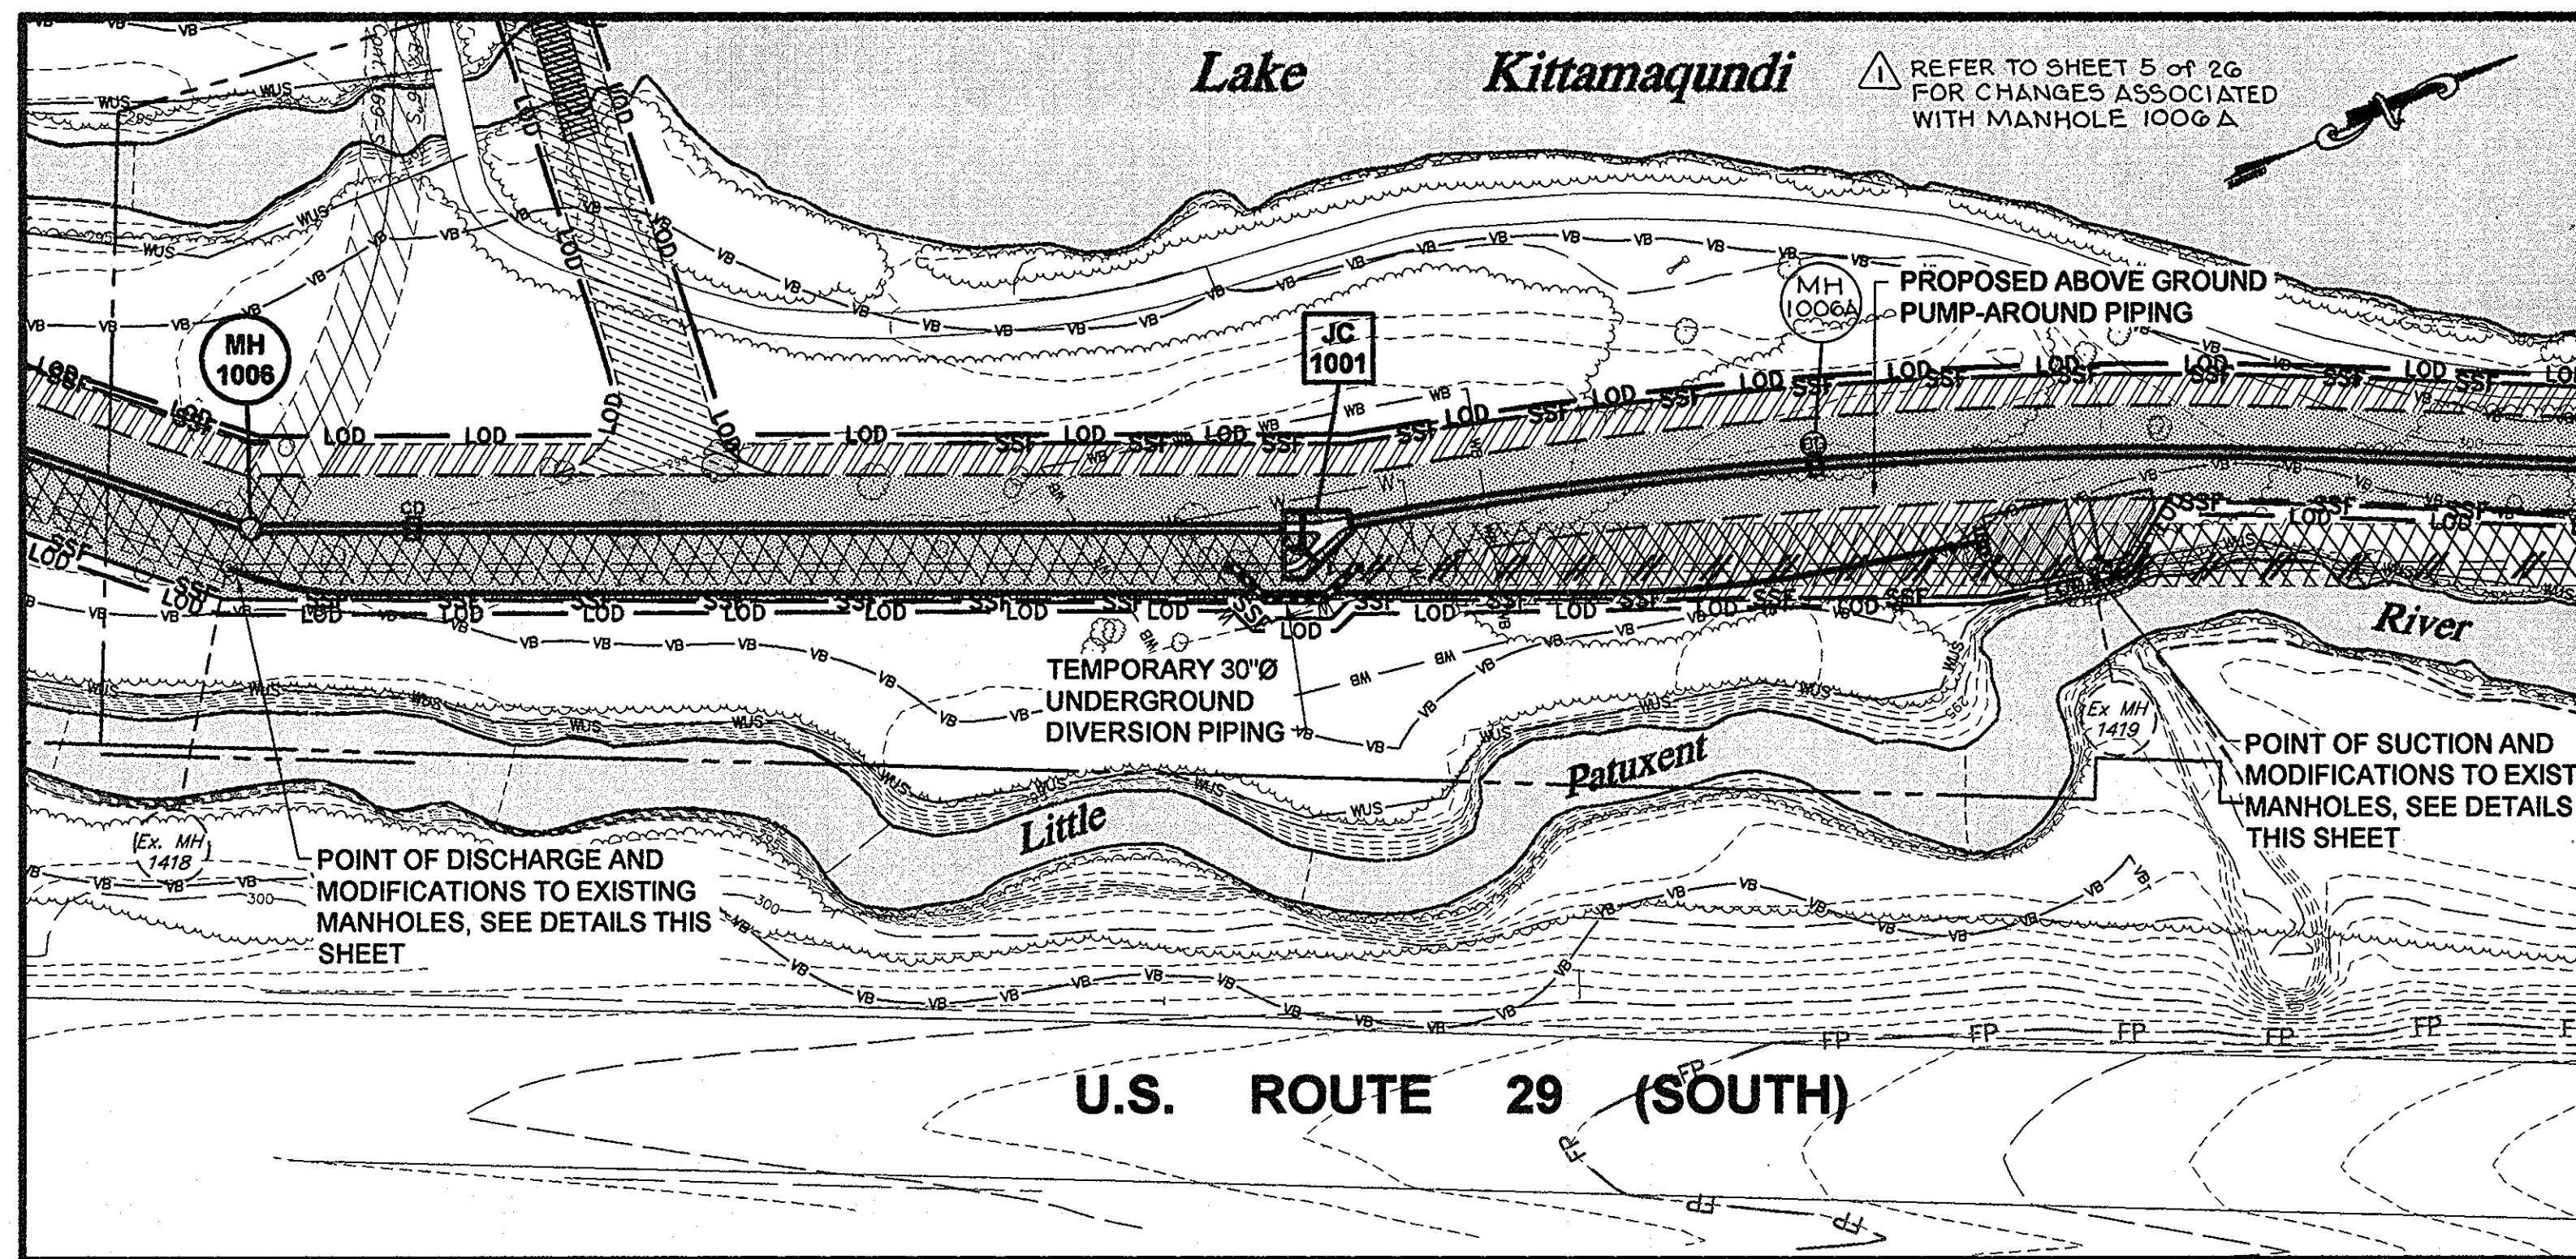

**BY-PASS PLAN AND CONSTRUCTION OF TEMPORARY UNDERGROUND DIVERSION**

SCALE: 1" = 50'

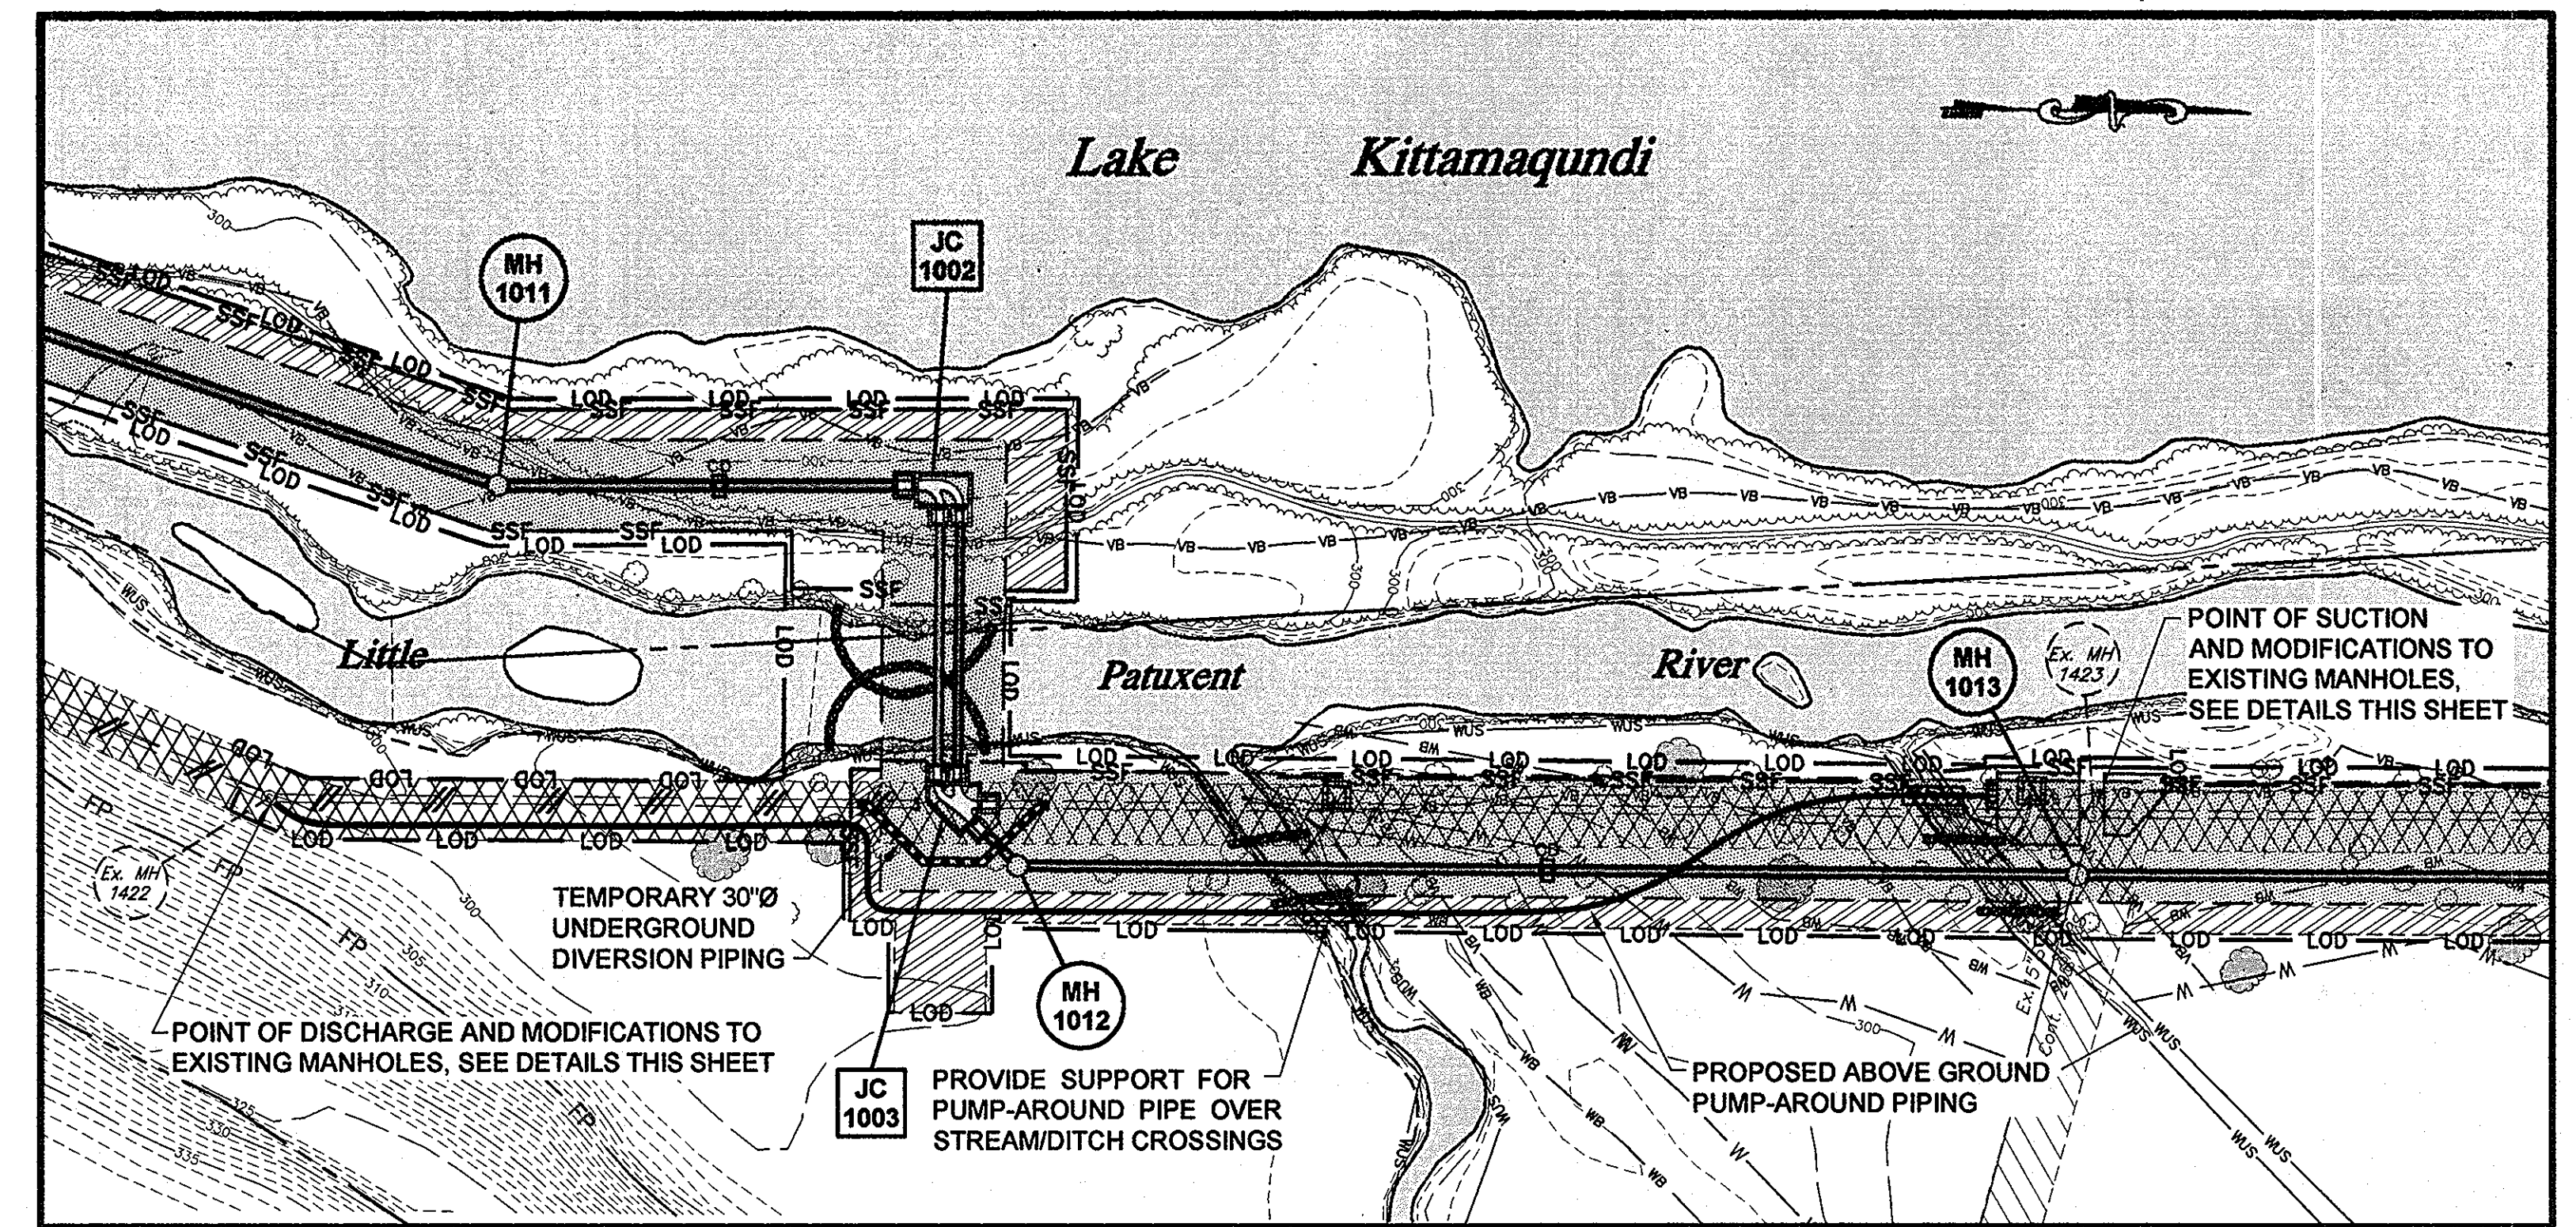

**BY-PASS PLAN AND CONSTRUCTION OF TEMPORARY UNDERGROUND DIVERSION**


SCALE: 1" = 50'

**SUGGESTED SEQUENCE OF CONSTRUCTION\***

- SEWAGE FLOWS MUST BE MAINTAINED @ ALL TIMES WITHOUT EXCEPTION.
- BUILD SEWER FROM MH 913 ± 5' TO MH 1008 ± 325'.
- INITIATE ABOVE GROUND BY-PASS PUMPING FOR CONSTRUCTION OF JUNCTION CHAMBER (JC) 1001 & CONSTRUCT TEMPORARY UNDERGROUND DIVERSION (TUD). DIVERT SEWAGE TO TUD. SUSPEND ABOVEGROUND BY-PASS OPERATIONS.
- BUILD JC 1001 & PROVIDE TEMPORARY BULKHEAD IN SW EXIT CHAMBER TO PREVENT SEWAGE FROM ENTERING NEW LINES.
- BUILD SEWER FROM JC 1001 TO JC 1002, THE TWIN 30-INCH RIVER CROSSING & THE 12" SEWER FROM MH 1007 TO MH 1018.
- INITIATE ABOVE GROUND BY-PASS PUMPING FOR CONSTRUCTION OF JUNCTION CHAMBER 1003 & CONSTRUCT TEMPORARY UNDERGROUND DIVERSION (TUD). DIVERT SEWAGE TO TUD. SUSPEND ABOVE GROUND BY-PASS OPERATIONS.
- BUILD JC 1003. PERFORM TESTING & IN-SERVICE INSPECTION OF THE COMPLETE NEW SYSTEM FROM JC 1001 TO JC 1003.
- INITIATE ABOVE GROUND BY-PASS PUMPING AT JC 1001 & JC 1003. WITH ABOVEGROUND BY-PASSES IN OPERATION:
  - CONSTRUCT CONNECTION BETWEEN JC 1001 & EXISTING DOWNSTREAM 30-INCH PIPE.
  - CONSTRUCT CONNECTION BETWEEN JC 1003 & EXISTING UPSTREAM 30-INCH PIPE & ALLOW SEWAGE TO PASS THROUGH THE NEW SEWER SYSTEM FROM JC 1003 TO JC 1001, EXITING VIA THE SE DISCHARGE CHAMBER. SUSPEND ABOVE GROUND BY-PASS PUMPING AROUND JC 1003 ONLY.
  - BEGIN OPERATION OF ADDITIONAL ABOVE GROUND BY-PASS TO DIVERT 12" SEWAGE FROM MH 4885 AROUND MH 4884 TO MH 1007. REMOVE & DISPOSE OF MH 4884, EXTEND 12" SEWER & CONNECT TO MH 1018. SUSPEND REMAINDER OF ABOVE GROUND BY-PASS PUMPING.
- BUILD SEWER FROM JC 1003 TO MH 1012 ± 3+43 TO INCLUDE FINAL TESTING & IN-SERVICE INSPECTION. BUILD MH 1013, MAKE CONNECTION AND ALLOW SEWAGE FROM LATERAL TO ENTER & PASS DOWNSTREAM INTO NEW 36-INCH SEWER.
- BUILD SEWER FROM MH 1013 TO MH 1014 ± 4+13 TO INCLUDE FINAL TESTING & IN-SERVICE INSPECTION. BUILD MH 1015, MAKE CONNECTION & ALLOW SEWAGE FROM LATERAL TO ENTER & PASS DOWNSTREAM INTO NEW 36-INCH SEWER.
- ABANDON EXISTING 30" SEWER AS PER THE CONTRACT DRAWINGS.


\*CONTRACTOR MAY SUBMIT REQUEST FOR ALTERNATIVE SEQUENCE OF CONSTRUCTION FOR APPROVAL IN ACCORDANCE WITH THE CONTRACT DOCUMENTS.

\*\*TEMPORARY UNDERGROUND DIVERSIONS MAY BE CONSTRUCTED IN ADVANCE OF ALL PIPE LAYING OPERATIONS WITHOUT REQUEST FOR ALTERNATIVE SEQUENCE OF CONSTRUCTION.

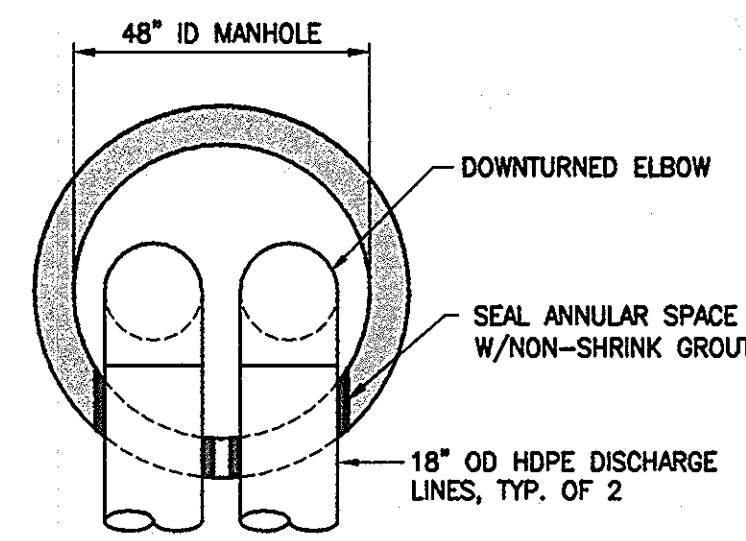


NOTE: HOLES IN MANHOLE WALL FOR DISCHARGE PIPES SHALL BE REPAIRED/PLUGGED WHEN WORK IS COMPLETE.

**POINT OF DISCHARGE**  
NOT TO SCALE

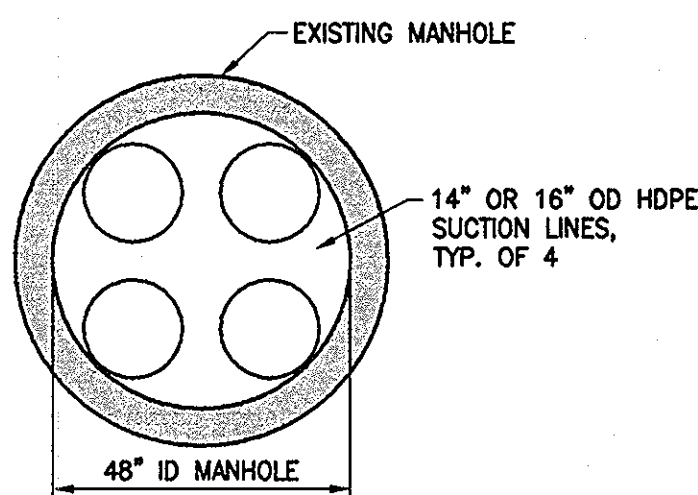


**POINT OF SUCTION**  
NOT TO SCALE

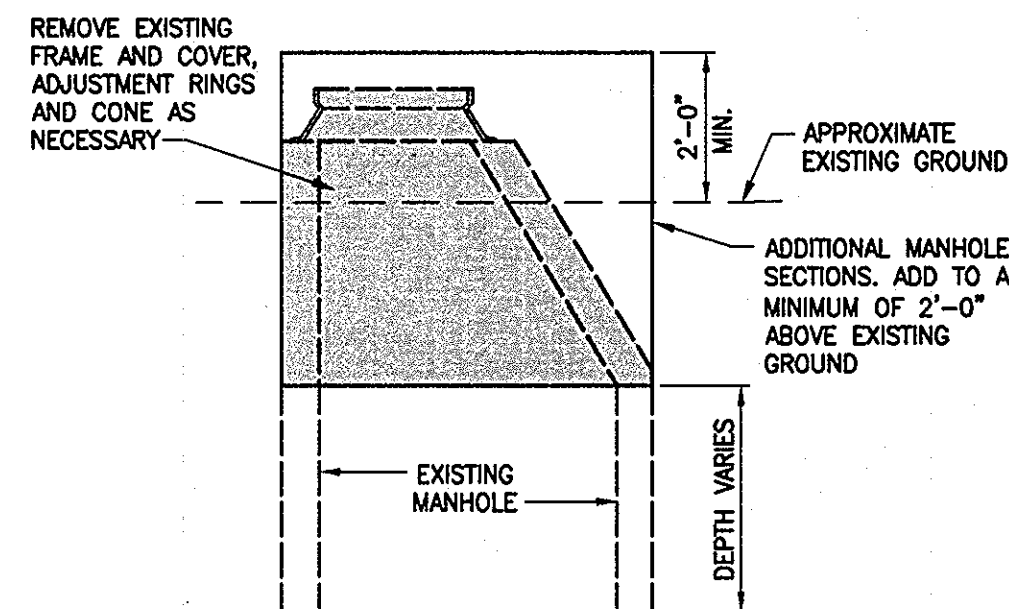

**MODIFICATIONS TO EXISTING MANHOLES 1418, 1419, 1422 & 1423**

NOT TO SCALE

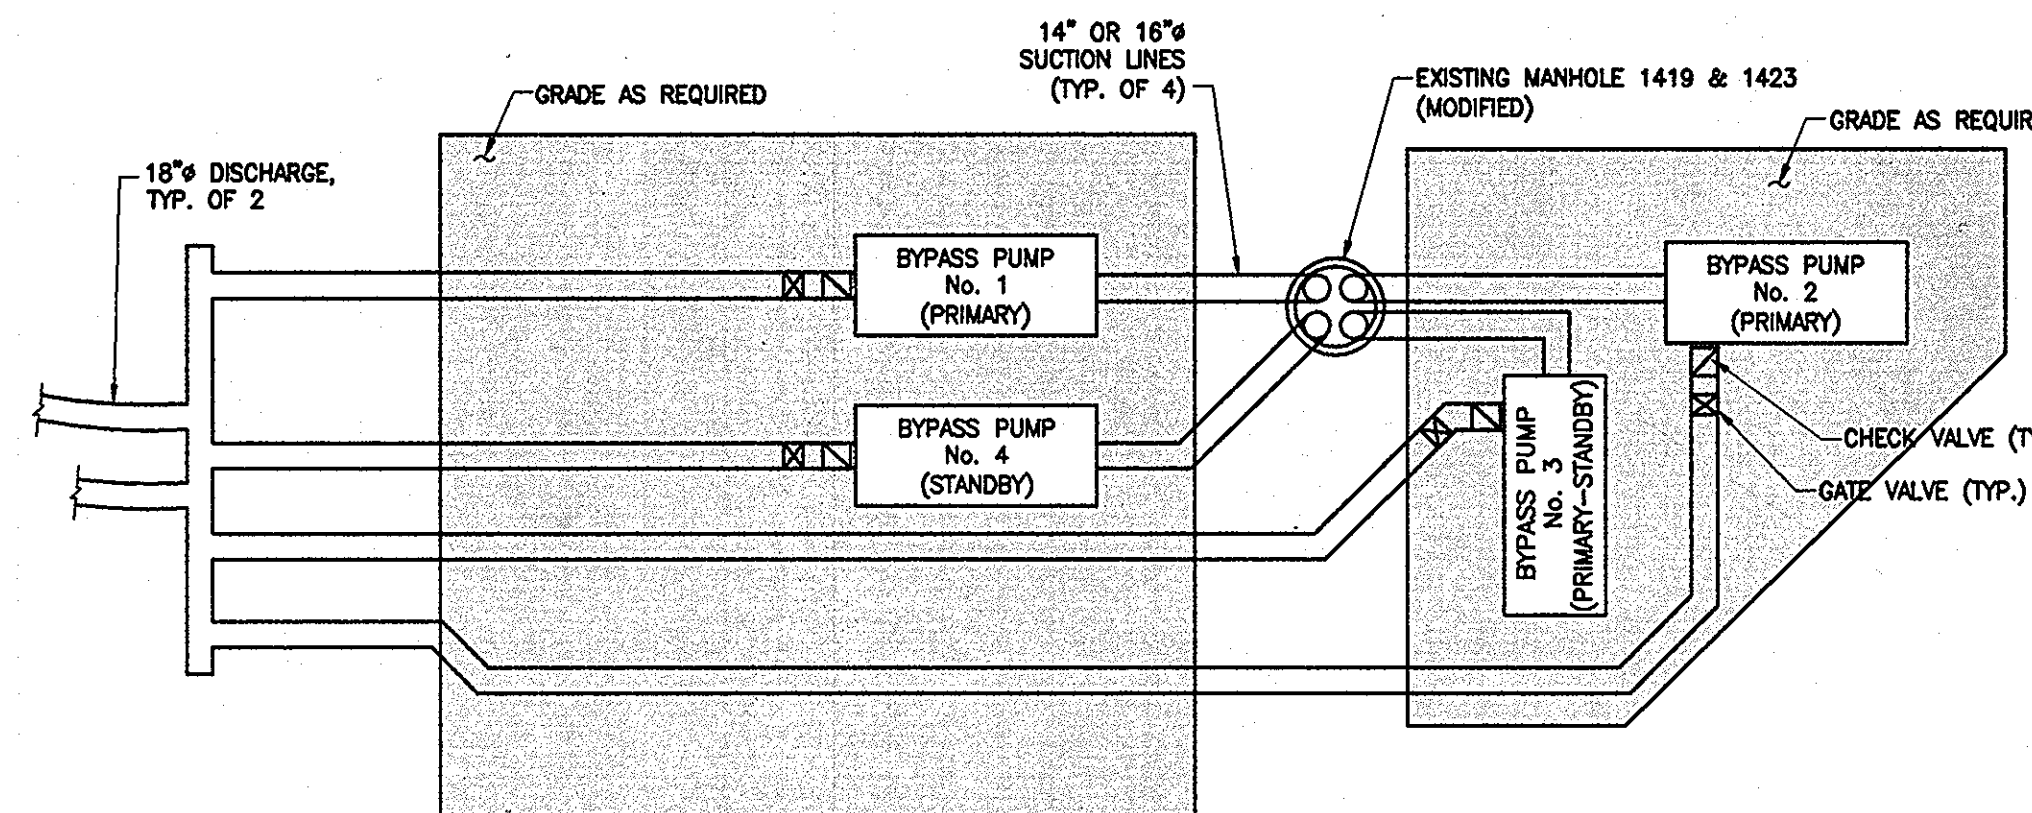


**BY-PASS PUMP SCHEMATIC LAYOUT**

NOT TO SCALE

**BY-PASS PUMP NOTES:**

- THE CONTRACTOR SHALL BE RESPONSIBLE FOR DESIGNING, FURNISHING, INSTALLING, OPERATING, AND MAINTAINING THE BYPASS SYSTEM, AS PER THE SPECIFICATIONS.
- THE CONTRACTOR SHALL SUBMIT SHOP DRAWINGS AND CALCULATIONS TO VERIFY DESIGN AND SIZING OF THE BYPASS SYSTEM.
- THE CONTRACTOR SHALL BE RESPONSIBLE, INCLUDING PAYMENT OF PENALTIES, FOR ANY VIOLATIONS AND SPILLAGE OF SEWAGE.
- EACH PUMP SHALL BE FITTED WITH AN INDIVIDUAL SUCTION PIPE. MANIFOLD SUCTION SHALL NOT BE ALLOWED.
- NO STORMWATER SHALL BE ALLOWED TO ENTER POINT OF SUCTION MANHOLE.
- STANDBY PUMP(S) SHALL BE CONNECTED AT ALL TIMES.
- PUMPS SHALL BE GODWIN DRI-PRIME MODEL DPC 300 (OR APPROVED EQUAL).
- PROTECTION FENCE SHALL BE INSTALLED ALONG NORTH SIDE OF PUMPS, SUCTION LINES AND DISCHARGE LINES AS A VISUAL BARRIER TO CONSTRUCTION TRAFFIC.

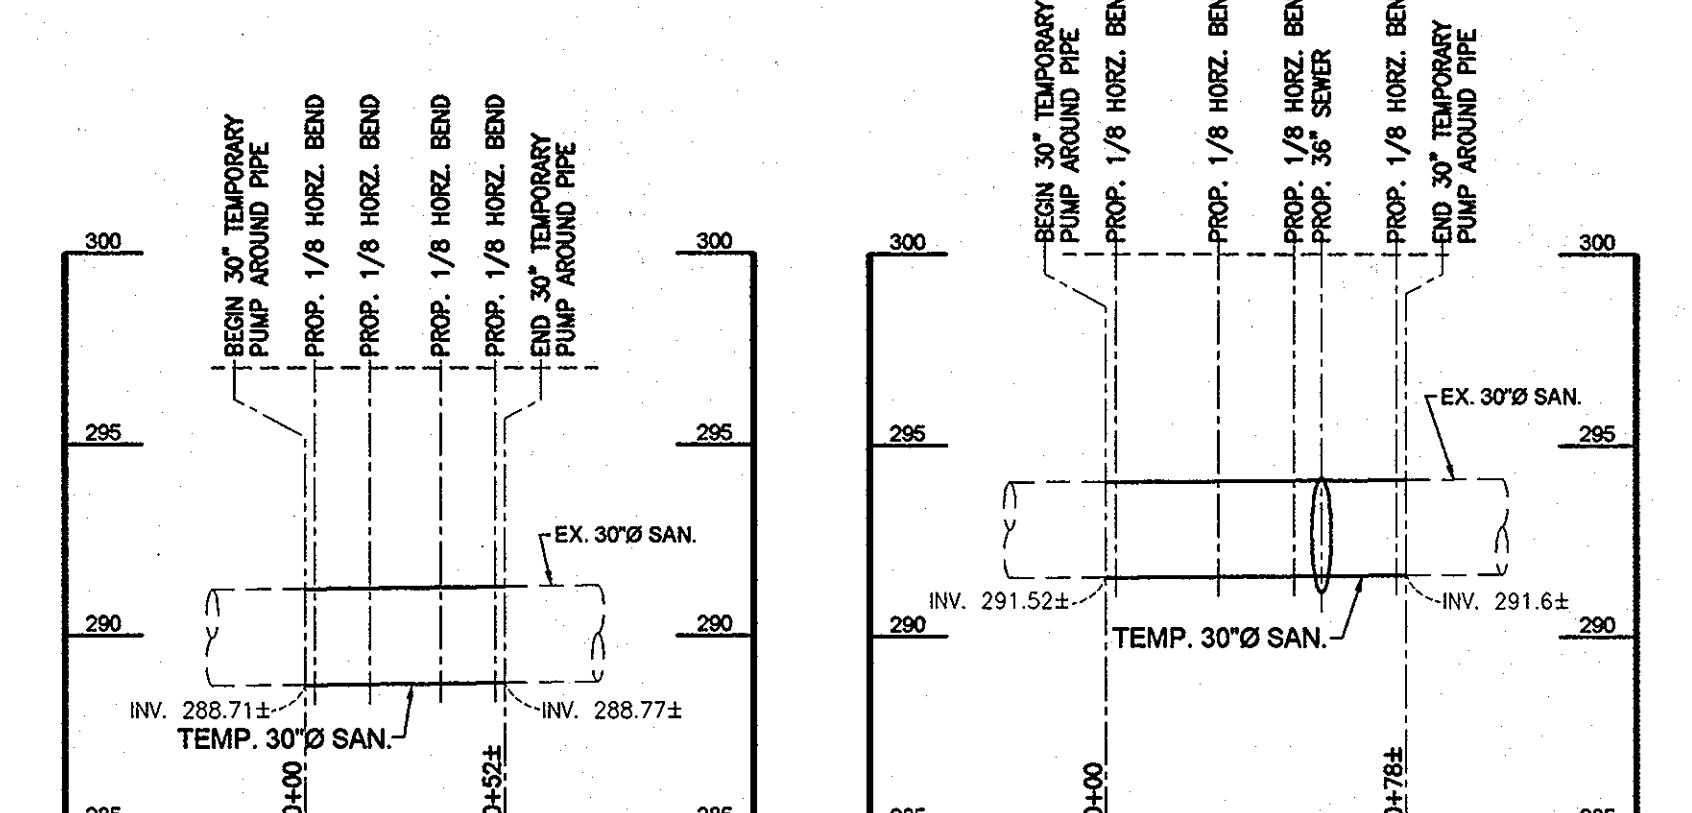

**JUNCTION CHAMBER 1001**


**JUNCTION CHAMBER 1003**

**TEMPORARY DIVERSION PIPE PROFILES**

SCALE: 1" = 50' H.  
1" = 5' V.

**TEMPORARY UNDERGROUND DIVERSIONS NOTES:**

- TEST PIT EXISTING SEWER TO VERIFY INVERT ELEVATIONS PRIOR TO SUBMISSION OF WORKING DRAWINGS.
- PROVIDE WORKING DRAWINGS OF DIVERSIONS FOR REVIEW IN ACCORDANCE WITH ARTICLE 21 OF SPECIAL PROVISIONS.
- REMOVE TEMPORARY PIPE DIVERSION FOR CONSTRUCTION OF JC-1003 AFTER EXISTING SEWER IS PUT IN SERVICE.

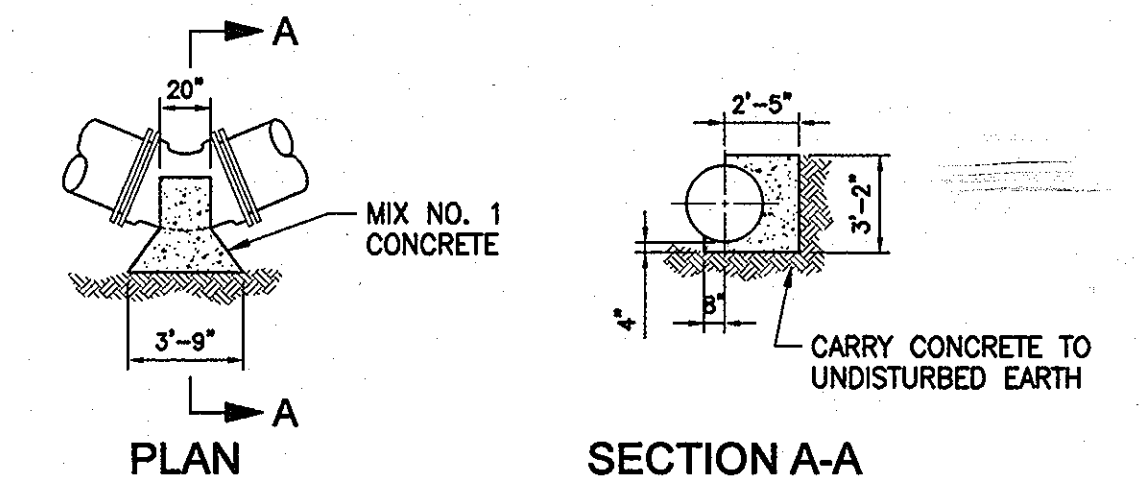

**BUTTRESS DETAIL FOR TEMPORARY 30" HORIZONTAL 1/8 BENDS**  
NOT TO SCALE

AS-BUILTS  
17

**DEPARTMENT OF PUBLIC WORKS**  
HOWARD COUNTY, MARYLAND

*Shane C. Carr* 6/2/10  
DIRECTOR OF PUBLIC WORKS DATE

*Paul J. Sporn* 6/2/10  
CHIEF, BUREAU OF ENGINEERING DATE

*Shane C. Carr* 6/2/10  
CHIEF, BUREAU OF UTILITIES DATE

*Paul J. Sporn* 6/2/10  
CHIEF, UTILITY DESIGN DIVISION DATE

**Dewberry**  
Dewberry & Davis LLC

3108 LORD BALTIMORE DRIVE  
SUITE 110  
BALTIMORE, MD 21244-2602  
410.285.9500  
FAX: 410.285.8875



DES: LAL	LAL	ADD MH 1006 A	5/31/11
DRN: CD			
CHK: TND			
DATE: 5.28.10	BY: NO.	REVISIONS	DATE

**BY-PASS PLAN AND DETAILS**

600' SCALE MAP NO. 37, 43  
BLOCK NO. 5, 23

**LITTLE PATUXENT PARALLEL INTERCEPTOR**

CAPITAL PROJECT S-6175  
CONTRACT NO. 20-4540

ELECTION DISTRICT NO. 5  
HOWARD COUNTY, MARYLAND

SCALE: SHOWN  
SHEET 26 OF 26