

TRAVERSE DATA				
TRAV. PT.	NORTHING	EASTING	ELEV.	DESCRIPTION
#3	590,565.33	1,365,830.97	330.44	REBAR AND CAP
#4	590,666.29	1,365,785.39	331.41	REBAR AND CAP
#5	590,562.36	1,365,583.52	333.64	REBAR AND CAP
#6	590,633.00	1,365,410.63	335.66	REBAR AND CAP
#7	590,762.61	1,365,279.88	337.01	REBAR AND CAP
#8	590,688.70	1,365,215.53	337.37	REBAR AND CAP
#9	590,565.32	1,365,171.97	356.62	REBAR AND CAP
#165 *SPUR*	590,763.04	1,365,579.27	334.34	REBAR AND CAP

SURVEY CONTROL

B.M. #1
 HOWARD CO. CONTROL PT. 24C2
 CONCRETE MONUMENT AT SURFACE
 NAD 83 (Adj. 1991): N 588,648.3230 E 1,366,038.1579
 NAVD 88: EL. 354.086

B.M. #2
 HOWARD CO. CONTROL PT. 25A2
 CONCRETE MONUMENT 5" BELOW GROUND WITH
 RAILROAD SPIKE 4" SOUTH
 NAD 83 (Adj. 1991): N 587,502.6869 E 1,366,556.3996
 NAVD 88: EL. 348.215

HOWARD COUNTY

DEPARTMENT OF PUBLIC WORKS


ELLCOTT CITY, MARYLAND 21043

QUANTITIES				
ITEM	UNIT	ESTIMATE	AS-BUILT	SUPPLIER
12" D.I.P. CLASS 54 SEWER MAIN	L.F.	496	545'	L/B WATER SERVICE
STD. 4'-0" PRECAST MANHOLE (HO. CO. STD. G-5.12)	EA.	2	2	ATLANTIC CONCRETE
STD. 4'-0" PRECAST DOGHOUSE WT MANHOLE (HO. CO. STD. G-5.14)	EA.	1	1	ATLANTIC CONCRETE
SEWER HOUSE CONNECTION	L.F.	50*	60'	L/B WATER SERVICE

* SEE NOTE 1 UNDER SEQUENCE OF CONSTRUCTION ON SHEET 7.

SEWER STAKEOUT TABLE		
ITEM	NORTHING	EASTING
MANHOLE #1 (HO. CO. STD. G-5.12)	590,643.01	1,365,639.19
MANHOLE #2 (HO. CO. STD. G-5.12)	590,766.25	1,365,415.41
MANHOLE #3 (HO. CO. STD. G-5.14)	590,746.94	1,365,320.87

NOTE: AFTER PLANS ARE APPROVED, ORIGINAL WATER AND SEWER CONTRACT 177-S MUST BE REDLINED TO REMOVE EXISTING SEWER AND REFERENCE THIS CONTRACT.

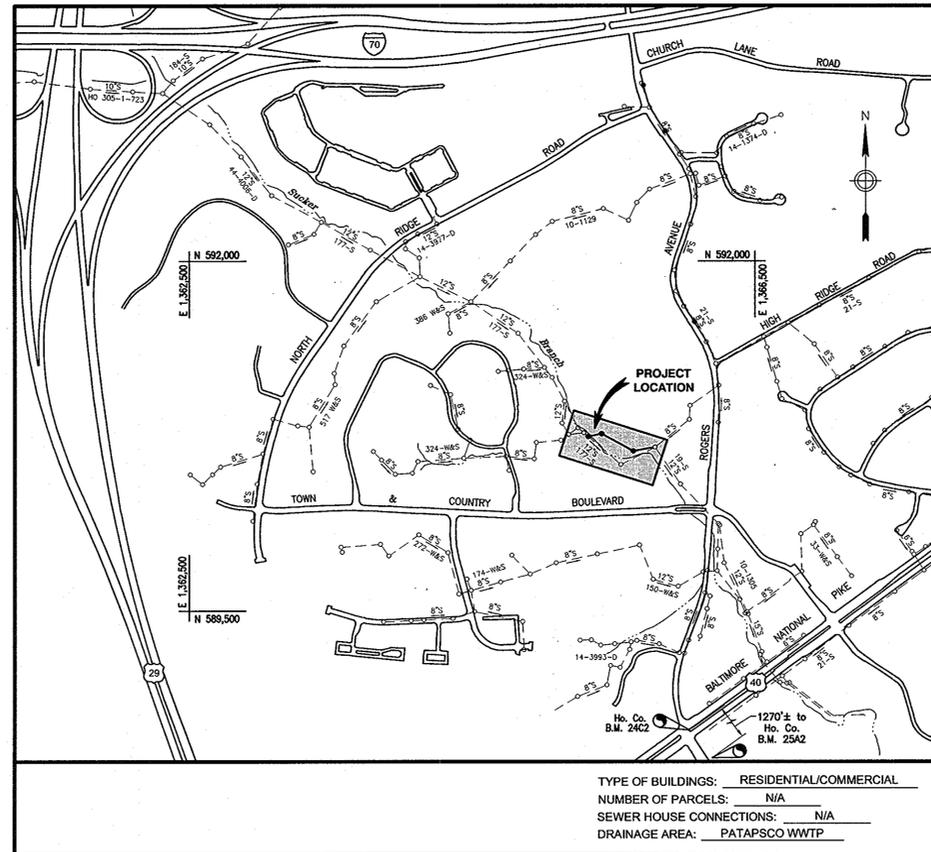

VICINITY MAP
 SCALE: 1" = 600'

SUCKER BRANCH

12-INCH SEWER MAIN REHABILITATION

CAPITAL PROJECT S-6268
 CONTRACT NO. 30-4582

INDEX OF SHEETS

SHEET NO.	DESCRIPTION
1	TITLE SHEET
2	SANITARY SEWER PLAN
3	SANITARY SEWER PROFILES
4	SEDIMENT AND EROSION CONTROL PLAN
5	SEDIMENT AND EROSION CONTROL NOTES
6	SEDIMENT AND EROSION CONTROL DETAILS
7	SEDIMENT AND EROSION CONTROL DETAILS

GENERAL NOTES

- Approximate locations of existing sanitary sewer are shown. The Contractor shall take all necessary precautions to protect existing mains and services and maintain uninterrupted service. Any damage incurred shall be repaired immediately to the satisfaction of the Engineer by the Contractor at the Contractor's expense.
- Topographic field surveys were performed in September 2007 by Dewberry & Davis LLC.
- Horizontal and Vertical Survey Controls:
 The coordinates shown on the drawings are based on Maryland State Reference System NAD 83/91 and NAVD 88 as projected by Howard County Geodetic Control Stations Howard Co. B.M. 24C2 and B.M. 25A2.
- All pipe elevations shown are invert elevations unless otherwise noted on the plans.
- Clear all utilities by a minimum of 12".
- For details not shown on the drawings, and for materials and construction methods, use Howard County Design Manual, Volume IV, Standard Specifications and Details for Construction (Latest Edition). The Contractor shall have a copy of Volume IV on the job.
- All existing utilities shall be test pitted/located as necessary and in advance of the proposed construction, in order to properly make all required utility crossings and/or connections. Any discrepancies or utility conflicts shall be immediately reported to the Engineer. Where test pits have been made on existing utilities, they are noted by the symbol at the location of the test pit. A note or notes containing the results of the test pit or pits is included on the drawings or specifications. Existing utilities in the vicinity of the proposed work for which test pits have not been dug shall be located by the Contractor two (2) weeks in advance of construction operations at his own expense.
- Contractor shall notify Miss Utility at 1-800-257-7777 at least five (5) working days before starting work shown on these plans.
- Trees and shrubs are to be protected from damage to the maximum extent. Trees and shrubs located within the construction strip noted by the symbol are to be protected in accordance with Howard County Volume IV Design Manual Standard Detail L-9.02.
- Contractor shall remove trees, stumps and roots along the line of excavation. Payment for such removal shall be included in the unit price bid for construction of the sanitary sewer.
- The approval of these drawings will constitute compliance with DPW requirements per Section 18.114(a) of the Howard County Code.
- The Contractor shall provide all necessary lines, grades and elevations, and cut sheets shall be prepared based on the lines and grades shown on the Contract drawings.

SEWER MAIN NOTES

- All 12-inch sewer mains shall be DIP, CL. 54 unless otherwise noted.
- 6-inch sewer house connections shall be DIP. Provide non-shear coupling by DFW (NDS) or equal for transition of existing pipe to DIP.
- Distances shown for the sewer main are along the centerline of the pipe from manhole to manhole.
- Elevations shown are to the invert of the sewer main.
- All manholes shall be 4'-0" inside diameter unless otherwise noted.
- Manholes designated as W.T. in Plan and Profile shall have water tight frames and covers, Standard Detail G5.52. Where water tight frame and cover is used, set top of frame 1'-6" above existing ground unless otherwise noted on drawings.

LEGEND

- TRAVERSE
- PROPERTY LINE
- DECIDUOUS TREE
- EVERGREEN TREE
- EX. CONTOUR
- EX. SAN. MANHOLE
- EX. SAN. SEWER MAIN
- PROP. SAN. MANHOLE
- PROP. SAN. SEWER MAIN
- WOODSLINE
- RIPRAP

PROFESSIONAL CERTIFICATION

I, THOMAS N. DALLAPALLU, HEREBY CERTIFY THAT THESE DOCUMENTS WERE PREPARED OR APPROVED BY ME, AND THAT I AM A DULY LICENSED PROFESSIONAL ENGINEER UNDER THE LAWS OF THE STATE OF MARYLAND, LICENSE NO. 10966 EXPIRATION DATE: MAY 31, 2012.

AS-BUILT 06-23-2011

EP-11-13

DEPARTMENT OF PUBLIC WORKS
 HOWARD COUNTY, MARYLAND

12/01/10
 DIRECTOR OF PUBLIC WORKS DATE

12/01/10
 CHIEF, BUREAU OF ENGINEERING DATE

12/01/10
 CHIEF, UTILITY DESIGN DIVISION DATE

Dewberry
 Dewberry & Davis LLC
 3106 LORD BALTIMORE DRIVE
 SUITE 110
 BALTIMORE, MD 21244-2662
 410.285.9500
 FAX: 410.285.8875



DES:	RJM				
DRN:	ARW				
CHK:	TND				
DATE:	DECEMBER 2010	RLI		AS-BUILT	6-23-11
		BY	NO.	REVISIONS	DATE

TITLE SHEET

600' SCALE MAP NO. 17

BLOCK NO. 24

SUCKER BRANCH
 12-INCH SEWER MAIN REHABILITATION
 CAPITAL PROJECT S-6268
 CONTRACT 30-4582


ELECTION DISTRICT NO. 2

HOWARD COUNTY, MARYLAND


SCALE: AS SHOWN

SHEET 1 OF 7

Produced by: (Auto) on: Plot Date: Dec 08, 2010 1:54pm
 Path: C:\Users\tdallapallu\AppData\Local\Temp\11549
 User: tdallapallu
 Plot Date: Dec 08, 2010 1:54pm
 User: tdallapallu
 Plot Date: Dec 08, 2010 1:54pm
 User: tdallapallu

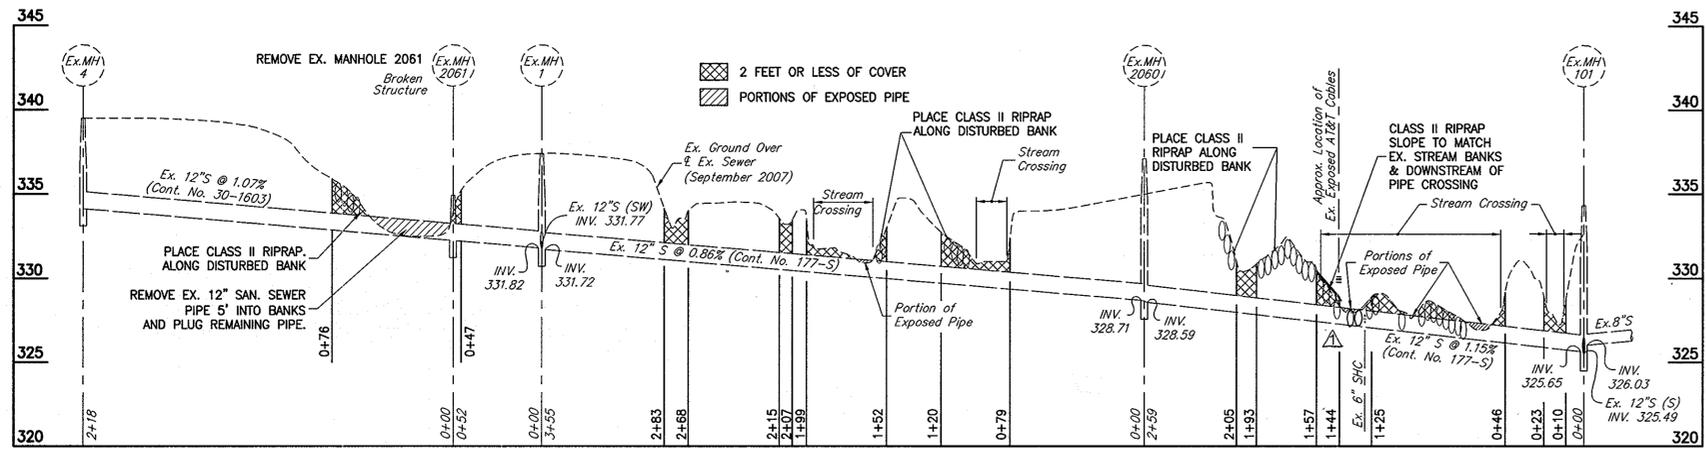


EXISTING SANITARY SEWER PROFILE
SCALE: 1"=50' HORIZ.
1"=5' VERT.

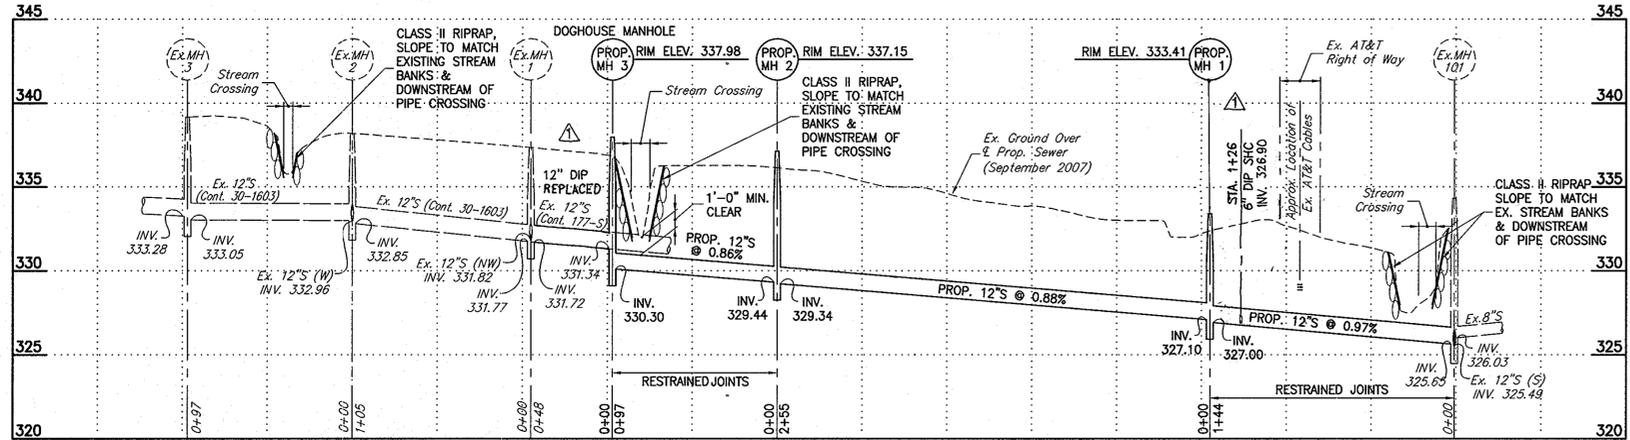


PROPOSED SANITARY SEWER PROFILE
SCALE: 1"=50' HORIZ.
1"=5' VERT.


NOTE: ALL STONE SHALL BE NATURALLY COLORED (NOT WHITE) AND SHALL BE APPROVED BY ENGINEER PRIOR TO INSTALLATION.

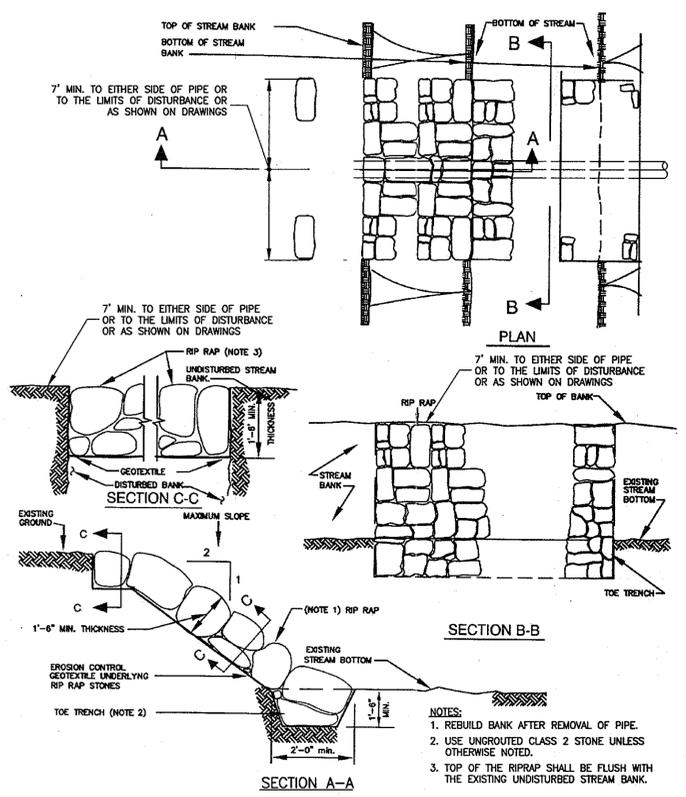


STREAM BANK PROTECTION AT ABANDONED PIPE LOCATIONS
NOT TO SCALE

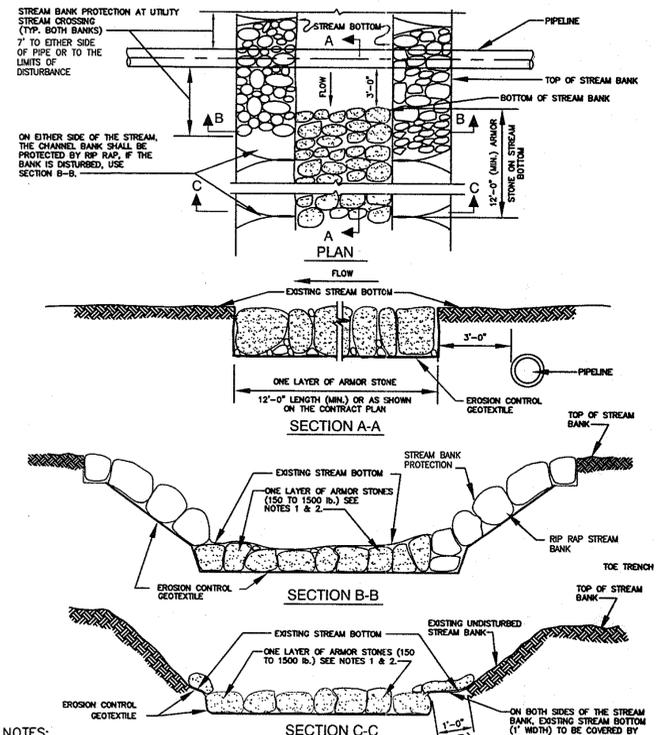

STREAM INVERT PROTECTION FOR SHALLOW UTILITY STREAM CROSSING
NOT TO SCALE

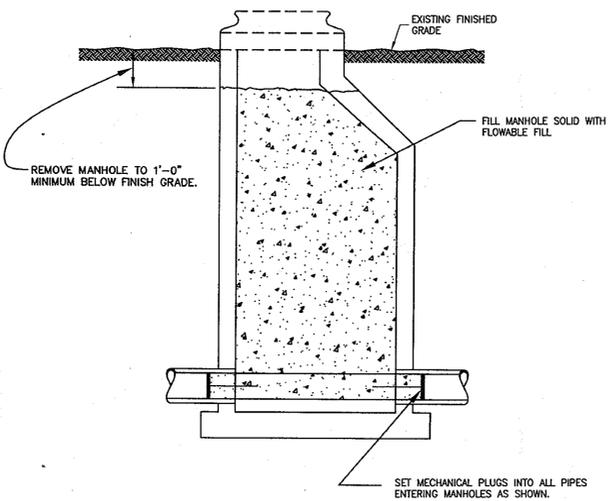

COMPLETE MANHOLE ABANDONMENT
NOT TO SCALE

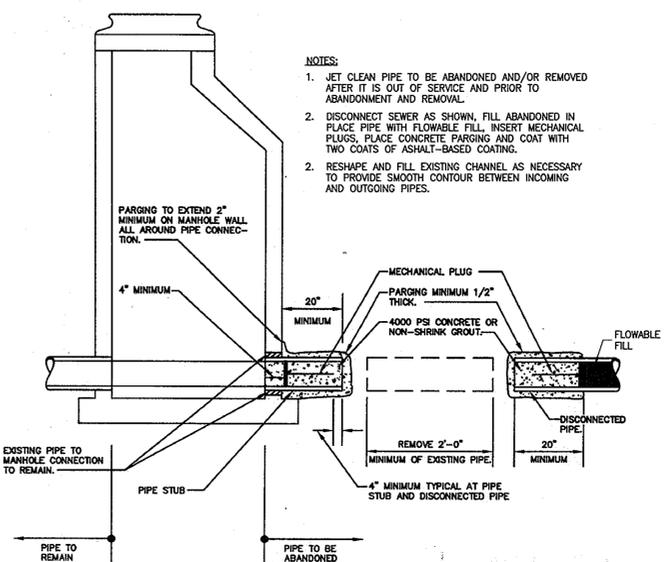

ABANDONMENT OF PIPE AT MANHOLE AND LEFT IN PLACE
NOT TO SCALE

PROFESSIONAL CERTIFICATION
I, THOMAS N. DALLAPALLI, HEREBY CERTIFY THAT THESE DOCUMENTS WERE PREPARED OR APPROVED BY ME, AND THAT I AM A DULY LICENSED PROFESSIONAL ENGINEER UNDER THE LAWS OF THE STATE OF MARYLAND, LICENSE NO. 10966 EXPIRATION DATE: MAY 31, 2012.

DEPARTMENT OF PUBLIC WORKS
HOWARD COUNTY, MARYLAND
THOMAS N. DALLAPALLI, Director of Public Works
RICHARD J. SEAMAN, Chief, Bureau of Engineering
SILVIA CLAY, Chief, Bureau of Utilities

Dewberry & Davis LLC
3106 LORD BALTIMORE DRIVE
SUITE 110
BALTIMORE, MD 21244-2662
410.265.9500
FAX: 410.265.8875

DES:	RJM
DRN:	ARW
CHK:	TND
DATE:	DECEMBER 2010
BY:	RLI
NO.:	AS-BUILT

SANITARY SEWER PROFILES AND DETAILS
AS-BUILTS 06-23-2011
600' SCALE MAP NO. 17
BLOCK NO. 24

SUCKER BRANCH
12-INCH SEWER MAIN REHABILITATION
CAPITAL PROJECT S-6268
CONTRACT 30-4582
ELECTION DISTRICT NO. 2
HOWARD COUNTY, MARYLAND

SCALE: AS SHOWN
SHEET 3 OF 7

STANDARDS AND SPECIFICATIONS FOR VEGETATIVE STABILIZATION

Section I - Vegetative Stabilization Methods and Materials

- A. Site Preparation
 - Install erosion and sediment control structures (either temporary or permanent) such as diversions, grade stabilization structures, berms, waterways, or sediment control basins.
 - Perform all grading operations at right angles to the slope. Final grading and shaping is not usually necessary for temporary seeding.
 - Schedule required soil tests to determine soil amendment composition and application rates for sites having disturbed area over 5 acres.
- B. Soil Amendments (Fertilizer and Lime Specifications)
 - Soil tests must be performed to determine the exact ratios and application rates for both lime and fertilizer on sites having disturbed areas over 5 acres. Soil analysis may be performed by the University of Maryland or a recognized commercial laboratory. Soil samples taken for engineering purposes may also be used for chemical analyses.
 - Fertilizers shall be uniform in composition, free flowing and suitable for accurate application by approved equipment. Manure may be substituted for fertilizer with prior approval from the appropriate approval authority. Fertilizers shall be delivered to the site fully labeled according to the applicable state fertilizer laws and shall bear the name, trade name or trademark and warranty of the producer.
 - Lime materials shall be ground limestone (hydrated or burnt lime may be substituted) which contains at least 50% total oxides (calcium oxide plus magnesium oxide). Limestone shall be ground to such fineness that at least 50% will pass through a #100 mesh sieve and 99-100% will pass through a #20 mesh sieve.
 - Incorporate lime and fertilizer into the top 3" - 5" of soil by disking or other suitable means.
- C. Seedbed Protection
 - Temporary Seeding
 - Seedbed preparation shall consist of loosening soil to a depth of 3" to 5" by means of suitable agricultural or construction equipment such as disc harrows or chisel plows or rippers mounted on construction equipment. After the soil is loosened it should not be rolled or dragged smooth but left in the roughened condition. Sloped areas (greater than 3:1) should be tracked leaving the surface in an irregular condition with ridges running parallel to the contour of the slope.
 - Apply fertilizer and lime as prescribed on the plans.
 - Incorporate lime and fertilizer into the top 3" - 5" of soil by disking or other suitable means.
 - Permanent Seeding
 - Minimum soil conditions required for permanent vegetative establishment:
 - Soil pH shall be between 6.0 and 7.0.
 - Soluble salts shall be less than 500 parts per million (ppm).
 - The soil shall contain less than 40% clay but enough fine grained material (>30% silt plus clay) to provide the capacity to hold a moderate amount of moisture. An exception is if loess or siltstone or siltstone is to be planted, then a sandy soil (<30% silt plus clay) would be acceptable.
 - Soil shall contain 1.5% minimum organic matter by weight.
 - Soil must contain sufficient pore space to permit adequate root penetration.
 - If these conditions cannot be met by soils on site, adding topsoil is required in accordance with Section 21 Standard and Specification for Topsoil.
 - Areas previously graded in conformance with the drawings shall be maintained in a true and even grade, then scarified or otherwise loosened to a depth of 3" - 5" to permit bonding of the topsoil to the surface area and to create horizontal erosion check slots to prevent topsoil from sliding down a slope.
 - Apply soil amendments as per soil tests or as included on the plans.
 - Mix soil amendments into the top 3" - 5" of topsoil by disking or other suitable means. Lawn areas should be raked to smooth the surface, remove large objects like stones and branches, and ready the area for seed application. Where site conditions will not permit normal seedbed preparation, loosen surface soil by dragging with a heavy chain or other equipment to roughen the surface. Steep slopes (steeper than 3:1) should be tracked by a dozer leaving the soil in an irregular condition with ridges running parallel to the contour of the slope. The top 1" - 3" of soil should be loose and friable. Seedbed loosening may not be necessary on newly disturbed areas.

G. Mulching Seeded Areas - Mulch shall be applied to all seeded areas immediately after seeding.

- If grading is completed outside of the seeding season, mulch alone shall be applied as prescribed in this section and maintained until the seeding season returns and seeding can be performed in accordance with these specifications.
- When straw mulch is used, it shall be spread over all seeded areas at the rate of 2 tons/acre. Mulch shall be applied to a uniform loose depth of between 1" and 2". Mulch applied shall achieve a uniform distribution and depth so that the soil surface is not exposed. If a mulch anchoring tool is to be used, the rate should be increased to 2.5 tons/acre.
- Wood cellulose fiber used as a mulch shall be applied at a net dry weight of 1,500 lbs. per acre. The wood cellulose fiber shall be mixed with water and the mixture shall contain a maximum of 50 lbs. of wood cellulose fiber per 100 gallons of water.
- Securing Straw Mulch (Mulch Anchoring): Mulch anchoring shall be performed immediately following mulch application to minimize loss by wind or water. This may be done by one of the following methods (listed by preference), depending upon size of area and erosion hazard:
 - A mulch anchoring tool is a tractor drawn implement designed to punch and anchor mulch into soil surface a minimum of two (2) inches. This practice is most effective on large areas, but is limited to flatter slopes where equipment can operate safely. If used on sloping land, this practice should be used on the contour if possible.
 - Wood Cellulose fiber may be used for anchoring straw. The fiber binder shall be applied at a net dry weight of 750 pounds/acre. The wood cellulose fiber shall be mixed with water and the mixture shall contain a maximum of 50 pounds of wood cellulose fiber per 100 gallons of water.
 - Application of liquid binders should be heavier at the edges where wind catches mulch, such as in valleys and on crests of banks. The remainder of area should be applied uniform after binder application. Synthetic binders - such as Acrylic DLR (Agra-Tack), DCA-70, Petrosol, Terra Tax II, Terra Tack AR or other approved equal may be used at rates recommended by the manufacturer to anchor mulch.
 - Lightweight plastic netting may be stapled over the mulch according to manufacturer's recommendations. Netting is usually available in rolls 4' to 15' feet wide and 300 to 3,000 feet long.

I. Incremental Stabilization - Cut Slopes

- All cut slopes shall be dressed, prepared, seeded and mulched as the work progresses. Slopes shall be excavated and stabilized in equal increments not to exceed 15'.
- Construction sequence (refer to Figure 4 below):
 - Excavate and stabilize all temporary swales, side ditches, or berms that will be used to convey runoff from the excavation.
 - Perform phase 1 excavation, dress and stabilize.
 - Perform phase 2 excavation, dress, and stabilize. Overseed phase 1 areas as necessary.
 - Perform final phase excavation, dress, and stabilize. Overseed previously seeded areas as necessary.

Note: Once excavation has begun, the operation should be continuous from grubbing through completion of grading and placement of topsoil (if required) and permanent seed and mulch. Any interruptions in the operation or completing the operation out of the season will necessitate the application of temporary stabilization.

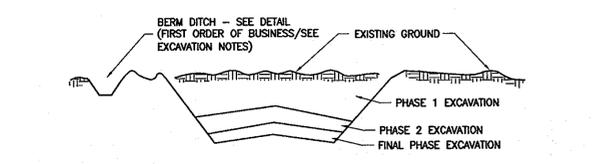


Figure 4 Incremental Stabilization - Cut

J. Incremental Stabilization of Embankments - Fill Slopes

- Embankments shall be constructed in lifts as prescribed on the plans.
- Slopes shall be stabilized immediately when the vertical height of the multiple lifts reaches 15', or when the grading operation ceases as prescribed in the plans.
- At the end of each day, temporary berms and pipe slope drains should be constructed along the top edge of the embankment to intercept surface runoff and convey it down the slope in a non-erotive manner to a sediment trapping device.
- Construction sequence: Refer to Figure 5 (below):
 - Excavate and stabilize all temporary swales, side ditches, or berms that will be used to divert runoff around the fill. Construct Slope Silt Fence on low side of fill as shown in Figure 4, unless other methods shown on the plans address this area.
 - Place phase 1 embankment, dress and stabilize.
 - Place phase 2 embankment, dress and stabilize.
 - Place final phase embankment, dress and stabilize. Overseed previously seeded areas as necessary.

Note: Once the placement of fill has begun, the operation should be continuous from grubbing through the completion of grading and placement of topsoil (if required) and permanent seed and mulch. Any interruptions in the operation or completing the operation out of the seeding season will necessitate the application of temporary stabilization.

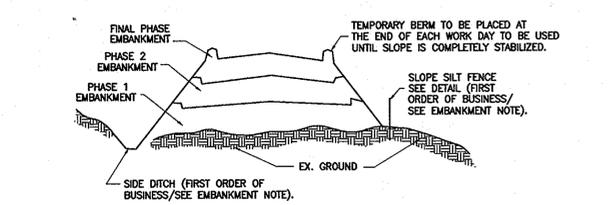


Figure 5 Incremental Stabilization - Embankment Fill
Comply with MD 378 Specifications.

Section II - Temporary Seeding

Vegetation - annual grass or grain used to provide cover on disturbed areas for up to 12 months. For longer duration of vegetative cover, Permanent Seeding is required.

A. Seed Mixtures - Temporary Seeding

- Select one or more of the species or mixtures listed in Table 26 for the appropriate Plant Hardiness Zone (from Figure 5) and enter them in the Temporary Seeding Summary below, along with application rates, seeding dates and seeding depths. If this Summary is not put on the plans and completed, then Table 26 must be put on the plans.
- For sites having soil tests performed, the rates shown on this table shall be deleted and the rates recommended by the testing agency shall be written in. Soil tests are not required for Temporary Seeding.

SEED MIXTURE (HARDINESS ZONE 6b)				FERTILIZER RATE (10-10-10)		LIME RATE
NO.	SPECIES	APPLICATION RATE (LB/AC)	SEEDING DATES	SEEDING DEPTHS		
	ANNUAL RYEGRASS	50 LB/AC	3/1 - 4/30 8/15 - 11/1	1/4" - 1/2"	600 LB/AC (15 LB / 1000 SF)	2 TONS/AC (100 LB / 1000 SF)
	MILLET	50 LB/AC	5/1 - 8/14	1/2"		

Section III: Permanent Seeding

Seeding grass and legumes to establish ground cover for a minimum period of one year on disturbed areas generally receiving low maintenance.

A. Seed Mixtures - Permanent Seeding

- Select one or more of the species or mixtures listed in Table 25 for the appropriate Plant Hardiness Zone (from Figure 5) and enter them in the Permanent Seed Summary below, along with application rates and seeding dates. Seeding depths can be estimated using Table 26. If this Summary is not put on the construction plans and completed, then Table 25 must be put on the plans. Additional planting specifications for exceptional sites such as shorelines, streambanks, or dunes or for special purposes such as wildlife or aesthetic treatment may be found in USDA-NRCS Technical Field Office Guide, Section 342 - Critical Area Planting. For special low maintenance areas, see Section IV Sod and V Turfgrass.
- For sites having disturbed area over 5 acres, the rates shown on this table shall be deleted and the rates recommended by the soil testing agency shall be written in.
- For areas receiving low maintenance, apply ureaform fertilizer (46-0-0) at 3 1/2 lbs/1000 sq. ft. (150 lbs/ac), in addition to the above soil amendments shown in the table below, to be performed at the time of seeding.

PERMANENT SEEDING SUMMARY

SEED MIXTURE (HARDINESS ZONE 6b)				FERTILIZER RATE (10-20-20)			LIME RATE
NO.	SPECIES	APPLICATION RATE (LB/AC)	SEEDING DATES	SEEDING DEPTHS	N	P205	K20
3	TALL FESCUE PERENNIAL RYE KY.BLUEGRASS	125 LB/AC 15 LB/AC 10 LB/AC	3/1 - 5/15 8/15 - 10/15	1/4" - 1/2"			
7	TALL FESCUE WEEPING LOVEGRASS SERICIA LESPEDEZA	110 LB/AC 3 LB/AC 20 LB/AC	3/1 - 10/15	1/4" - 1/2"	90 LB/AC (15 LB / 1000 SF)	175 LB/AC (4 LB / 1000 SF)	175 LB/AC (4 LB / 1000 SF)

Section IV - Sod: To provide quick cover on disturbed areas (2:1 grade or flatter).

A. General specifications

- Class of turfgrass sod shall be Maryland or Virginia State Certified or Approved. Sod labels shall be made available to the job foreman and inspector.
- Sod shall be machine cut at a uniform soil thickness of 3/4", plus or minus 1/4", at the time of cutting. Measurement for thickness shall exclude top growth and thatch. Individual pieces of sod shall be cut to the suppliers width and length. Maximum allowable deviation from standard widths and lengths shall be 5 percent. Broken pads and torn or uneven ends will not be acceptable.
- Standard size sections of sod shall be strong enough to support their own weight and retain their size and shape when suspended vertically with a firm grasp on the upper 10 percent of the section.
- Sod shall not be harvested or transported when moisture content (excessively dry or wet) may adversely affect its survival.
- Sod shall be harvested, delivered, and installed within a period of 36 hours. Sod not transported within this period shall be approved by an agronomist or soil scientist prior to its installation.
- Sod installation
 - During periods of excessively high temperature or in areas having dry subsoil, the subsoil shall be lightly irrigated immediately prior to laying the sod.
 - The first row of sod shall be laid in a straight line with subsequent rows placed parallel to and tightly wedged against each other. Lateral joints shall be staggered to promote more uniform growth and strength. Ensure that sod is not stretched or overlapped and that all joints are butted tight in order to prevent voids which would cause air drying of the roots.
 - Wherever possible, sod shall be laid with the long edges parallel to the contour and with staggering joints. Sod shall be rolled and tamped or otherwise secured to prevent slippage on slopes and to ensure solid contact between sod roots and the underlying soil surface.
 - Sod shall be watered immediately following rolling or tamping until the underside of the new sod pad and soil surface below the sod are thoroughly wet. The operations of laying, tamping and irrigating for any piece of sod shall be completed within eight hours.

C. Sod Maintenance

- In the absence of adequate rainfall, watering shall be performed daily or as often as necessary during the first week, in sufficient quantities to maintain moist soil to a depth of 4". Watering should be done during the heat of the day to prevent wilting.
- After the first week, sod watering is required as necessary to maintain adequate moisture content.
- The first mowing of sod should not be attempted until the sod is firmly rooted. No more than 1/3 of the grass leaf shall be removed by the initial cutting or subsequent cuttings. Grass height shall be maintained between 2" and 3" unless otherwise specified.

Section IV - Turfgrass Establishment

Areas where turfgrass may be desired include lawns, parks, playgrounds, and commercial sites which will receive a medium to high level of maintenance. Areas to receive seed shall be tilled by disking or other approved methods to a depth of 2 to 4 inches, leveled and raked to prepare a proper seedbed. Stones and debris over 1 1/2 inches in diameter shall be removed. The resulting seedbed shall be in such condition that future mowing of grasses will pose no difficulty.

Note: Choose certified material. Certified material is the best guarantee to cultivar purity. The certification program of the Maryland Department of Agriculture, Turf and Seed Section, provides a reliable means of consumer protection and assures a pure genetic line.

A. Permanent Seeding

- Kentucky Bluegrass - Full sun mixture - For use in areas that receive intensive management. Irrigation required in the areas of central Maryland and eastern shore. Recommended Certified Kentucky Bluegrass Cultivars Seeding Rate: 1.5 to 2.0 pounds/1000 square feet. A minimum of three bluegrass cultivars should be chosen ranging from a minimum of 10% to a maximum of 35% of the mixture by weight.
- Kentucky Bluegrass/Perennial Rye - Full sun mixture - For use in full sun areas where rapid establishment is necessary and when turf will receive medium to intensive management. Certified Perennial Ryegrass Cultivars/Certified Kentucky Bluegrass Cultivars must be chosen, with each cultivar ranging from 10% to 35% of the mixture by weight. Seeding rate: 2 pounds mixture/1000 square feet. A minimum of 3 Kentucky Bluegrass Cultivars must be chosen, with each cultivar ranging from 10% to 35% of the mixture by weight.
- Tall Fescue/Kentucky Bluegrass - Full sun mixture - For use in drought prone areas and/or for areas receiving low to medium management in full sun to medium shade. Recommended mixture includes: certified Tall Fescue Cultivars 95-100%, certified Kentucky Bluegrass Cultivars 0 - 5%. Seeding rate: 5 to 8 lb/1000 sf. One or more cultivars may be blended.
- Kentucky Bluegrass/Fine Fescue - Shade Mixture - For use in areas with shade in Bluegrass lawns. For establishment in high quality, intensively managed turf area. Mixture includes: certified Kentucky Bluegrass Cultivars 30-40% and certified Fine Fescue and 60-70%. Seeding rate: 1 1/2 - 3 lbs/1000 square feet. A minimum of 3 Kentucky bluegrass cultivars must be chosen, with each cultivar ranging from a minimum of 10% to a maximum of 35% of the mixture by weight.

Note: Turfgrass varieties should be selected from those listed in the most current University of Maryland Publication, Agronomy Mimeo #77, "Turfgrass Cultivar Recommendations for Maryland".

B. Ideal times of seeding

- Western MD: March 15 - June 1, August 1 - October 1 (Hardiness Zones - 5b, 6a)
- Central MD: March 1 - May 15, August 15 - October 15 (Hardiness Zone - 6b)
- Southern MD, Eastern Shore: March 1 - May 15, August 15 - October 15 (Hardiness Zones - 7a,7b)

C. Irrigation

If soil moisture is deficient, supply new seedlings with adequate water for plant growth (23/64" @ 1" every 3 to 4 days depending on soil tests) until they are firmly established. This is especially true when seedlings are made kits in the planting season, in abnormally dry or hot seasons, or on adverse sites.

D. Repairs and Maintenance

- Inspect all seeded areas for failures and make necessary repairs, replacements, and reseeding within the planting season.
- Once the vegetation is established, the site shall have 95% ground cover to be considered adequately stabilized.
- If the stand provides less than 40% ground coverage, reestablish following original firm, fertilizer, seedbed preparation and seeding recommendations.
- If the stand provides between 40% and 94% ground coverage, overseeding and fertilizing half of the rates originally applied may be necessary.
- Maintenance fertilizer rates for permanent seedings are shown in table 24. For lawns and other medium to high maintenance turfgrass areas, refer to the University of Maryland publication "Lawn Care n Maryland" Bulletin No. 171.

SEDIMENT CONTROL GENERAL NOTES

- A minimum of 48 hours notice must be given to Howard County Department of Inspections, Licenses and Permits, Sediment Control Division prior to the start of any construction. 410-313-1855.
- All vegetative and structural practices are to be installed according to the provisions of the plan and are to be in conformance with the most current Maryland Standards and Specifications for Soil Erosion and Sediment Control and revisions thereto.
- Following initial soil disturbance or re-disturbance, permanent or temporary stabilization shall be completed within: a) 7 calendar days for all perimeter sediment control structures, dikes, perimeter slopes and all slopes greater than 3:1, b) 14 days as to all other disturbed or graded areas on the project site.
- All disturbed areas must be stabilized within the time period specified above in accordance with the 1994 Maryland Standards and Specifications for Soil Erosion and Sediment Control for permanent seeding (Sec. 51), sod (Sec. 54) temporary seeding (Sec. 50) and mulching (Sec. 52). Temporary stabilization with mulch alone can only be done when recommended seeding dates do not allow for proper germination and establishment of grasses.
- All sediment control structures are to remain in place and are to be maintained in operative condition until permission for their removal has been obtained from the Howard County Sediment Control Inspector.
- Site Analysis

Total Area of Site	1.18 Acres
Area Disturbed	1.18 Acres
Area to be paved	0 Acres
Area to be Vegetatively Stabilized	1.18 Acres
Total Cut	670 Cu. Yds.
Total Fill	677 Cu. Yds.
Offsite waste/borrow area location	To be determined by contractor.
- Site is defined as areas involving any improvement.
- Any sediment control practices which is disturbed by grading activity for placement of utilities must be repaired on the same day of disturbance.
- Additional sediment control must be provided, if deemed necessary by the Howard County Sediment Control Inspector.
- On all sites with disturbed areas in excess of 2 acres, approval of the inspection agency shall be requested upon completion of installation of perimeter erosion and sediment controls, but before proceeding with any other earth disturbance or grading. Other building or grading inspection approvals may not be authorized until this initial approval by the inspection agency is made.
- Trenches for the construction of utilities is limited to three pipe lengths or that which shall be back-filled and stabilized by the end of each work day, whichever is shorter.
- Spoil from trench excavation shall be place on the uphill side of the excavation.

I/WE CERTIFY THAT ALL DEVELOPMENT AND CONSTRUCTION WILL BE DONE ACCORDING TO THIS PLAN, AND THAT ANY RESPONSIBLE PERSONNEL INVOLVED IN THE CONSTRUCTION PROJECT WILL HAVE A CERTIFICATE OF ATTENDANCE AT A DEPARTMENT OF THE ENVIRONMENT APPROVED TRAINING PROGRAM FOR THE CONTROL OF SEDIMENT AND EROSION BEFORE BEGINNING THE PROJECT. I ALSO AUTHORIZE PERIODIC ON-SITE INSPECTIONS BY THE HOWARD SOIL CONSERVATION DISTRICT.

Signature of Developer _____ Date _____

Print Name _____

I CERTIFY THAT THIS PLAN FOR EROSION AND SEDIMENT CONTROL REPRESENTS A PRACTICAL AND WORKABLE PLAN BASED ON MY PERSONAL KNOWLEDGE OF THE SITE CONDITIONS AND THAT IT WAS PREPARED IN ACCORDANCE WITH THE REQUIREMENTS OF THE HOWARD SOIL CONSERVATION DISTRICT

Signature of Engineer Thomas N. DallaPalà Date 12/9/10

Print Name _____

THIS DEVELOPMENT PLAN IS APPROVED FOR SOIL EROSION AND SEDIMENT CONTROL BY THE HOWARD SOIL CONSERVATION DISTRICT.

Signature of District Director John K. [Signature] Date 12/13/10

Howard Soil Conservation District

PROFESSIONAL CERTIFICATION
I, THOMAS N. DALLAPALA, HEREBY CERTIFY THAT THESE DOCUMENTS WERE PREPARED OR APPROVED BY ME, AND THAT I AM A DULY LICENSED PROFESSIONAL ENGINEER UNDER THE LAWS OF THE STATE OF MARYLAND, LICENSE NO. 10966 EXPIRATION DATE: MAY 31, 2012.

AS-BUILTS 06-23-2011

DEPARTMENT OF PUBLIC WORKS
HOWARD COUNTY, MARYLAND

12/10/10
12/10/10
12/10/10

DIRECTOR OF PUBLIC WORKS
CHIEF, BUREAU OF UTILITIES

12/9/10
12/9/10
12/9/10

CHIEF, BUREAU OF ENGINEERING
CHIEF, UTILITY DESIGN DIVISION

Dewberry & Davis LLC
3108 LORD BALTIMORE DRIVE
SUITE 110
BALTIMORE, MD 21244-2662
410.265.9500
FAX 410.265.8875

DES: RJM
DRN: ARW
CHK: TND
DATE: DECEMBER 2010

REVISIONS

NO.	DATE	DESCRIPTION
1	6-23-11	AS-BUILT

SEDIMENT AND EROSION CONTROL NOTES




60' SCALE MAP NO. 17
BLOCK NO. 24
ELECTION DISTRICT NO. 88

SUCKER BRANCH
12-INCH SEWER MAIN REHABILITATION
CAPITAL PROJECT S-6268
CONTRACT 30-4582

HOWARD COUNTY, MARYLAND

SCALE: NO SCALE
SHEET 5 OF 7

Prepared by: (Name) Job Post. Date: 09/01/2010 - 02:46am
 File-Location: C:\Users\j... \Documents\...
 Job-Number: 30-4582 - Notes
 Job-Name: 30-4582 - Notes
 Job-Title: 30-4582 - Notes
 Job-Date: 12/10/10
 Job-User: j...

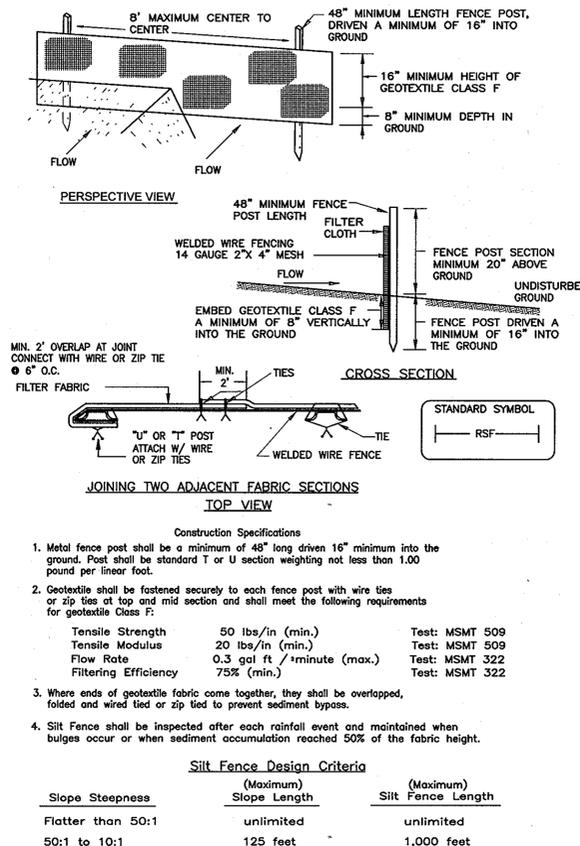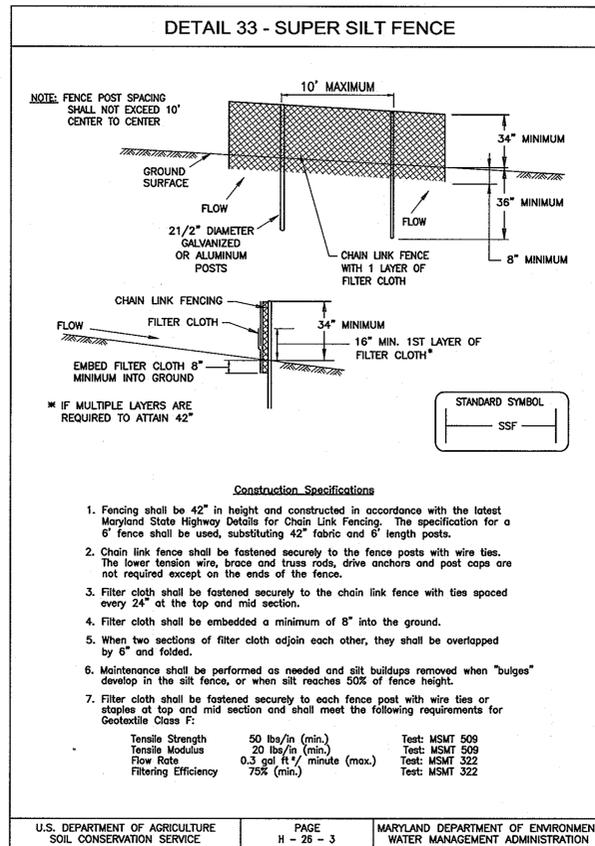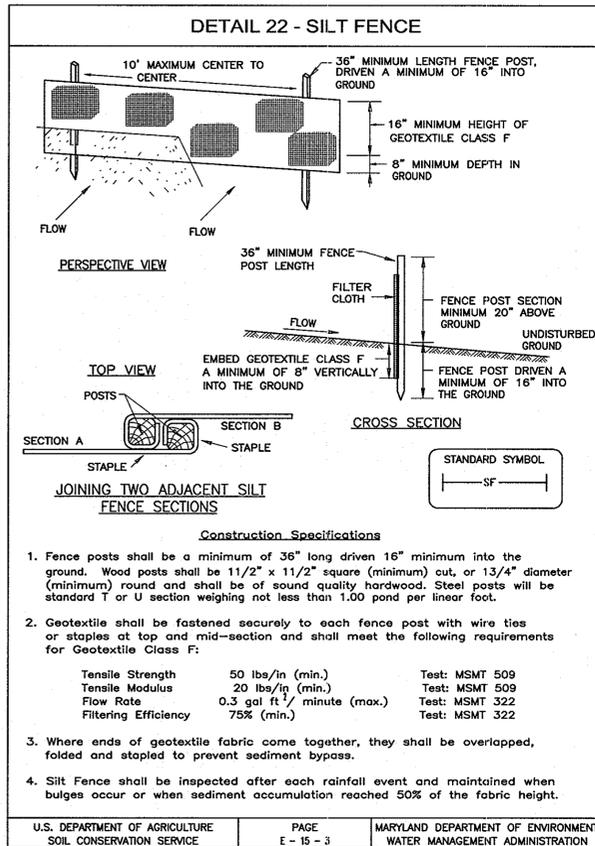

SILT FENCE

Slope Steepness	(Maximum) Slope Length	(Maximum) Silt Fence Length
Flatter than 50:1	unlimited	unlimited
50:1 to 10:1	125 feet	1,000 feet
10:1 to 5:1	100 feet	750 feet
5:1 to 3:1	60 feet	500 feet
3:1 to 2:1	40 feet	250 feet
2:1 and steeper	20 feet	125 feet

Note: In areas of less than 2% slope and sandy soils (USDA general classification system, soil Class A) maximum slope length and silt fence length will be unlimited. In these areas a silt fence may be the only perimeter control required.


U.S. DEPARTMENT OF AGRICULTURE SOIL CONSERVATION SERVICE	PAGE E - 15 - 3A	MARYLAND DEPARTMENT OF ENVIRONMENT WATER MANAGEMENT ADMINISTRATION
---	---------------------	---

SUPER SILT FENCE

Slope Steepness	(Maximum) Slope Length	(Maximum) Silt Fence Length
Flatter than 50:1	unlimited	unlimited
50:1 to 10:1	125 feet	1,000 feet
10:1 to 5:1	100 feet	750 feet
5:1 to 3:1	60 feet	500 feet
3:1 to 2:1	40 feet	250 feet
2:1 and steeper	20 feet	125 feet

Note: In areas of less than 2% slope and sandy soils (USDA general classification system, soil Class A) maximum slope length and silt fence length will be unlimited. In these areas a silt fence may be the only perimeter control required.

U.S. DEPARTMENT OF AGRICULTURE SOIL CONSERVATION SERVICE	PAGE H - 26 - 3A	MARYLAND DEPARTMENT OF ENVIRONMENT WATER MANAGEMENT ADMINISTRATION
---	---------------------	---

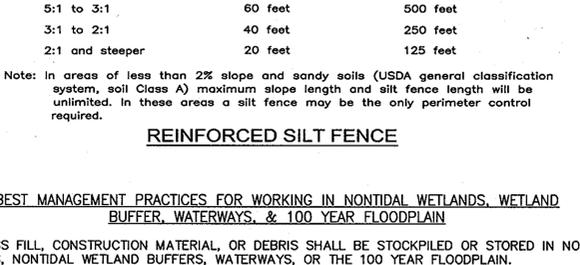

I/WE CERTIFY THAT ALL DEVELOPMENT AND CONSTRUCTION WILL BE DONE ACCORDING TO THIS PLAN, AND THAT ANY RESPONSIBLE PERSONNEL INVOLVED IN THE CONSTRUCTION PROJECT WILL HAVE A CERTIFICATE OF ATTENDANCE AT DEPARTMENT OF THE ENVIRONMENT APPROVED TRAINING PROGRAM FOR THE CONTROL OF SEDIMENT AND EROSION BEFORE BEGINNING THE PROJECT. I ALSO AUTHORIZE PERIODIC ON-SITE INSPECTIONS BY THE HOWARD SOIL CONSERVATION DISTRICT.

Signature of Developer _____ Date _____

Print Name _____

I CERTIFY THAT THIS PLAN FOR EROSION AND SEDIMENT CONTROL REPRESENTS A PRACTICAL AND WORKABLE PLAN BASED ON MY PERSONAL KNOWLEDGE OF THE SITE CONDITIONS AND THAT IT WAS PREPARED IN ACCORDANCE WITH THE REQUIREMENTS OF THE HOWARD SOIL CONSERVATION DISTRICT

Thomas H. Dally 12/9/10
Signature of Engineer Date

Thomas H. Dally
Print Name

THIS DEVELOPMENT PLAN IS APPROVED FOR SOIL EROSION AND SEDIMENT CONTROL BY THE HOWARD SOIL CONSERVATION DISTRICT.

John K. Minton 12/13/10
Howard Soil Conservation District Date



DEPARTMENT OF PUBLIC WORKS


HOWARD COUNTY, MARYLAND

John R. ... 12/10/10
DIRECTOR OF PUBLIC WORKS DATE

Shane C. ... 12/10/10
CHIEF, BUREAU OF UTILITIES DATE

Thomas N. Dally 12/10/10
CHIEF, BUREAU OF ENGINEERING DATE

John P. ... 12/10/10
CHIEF, UTILITY DESIGN DIVISION DATE

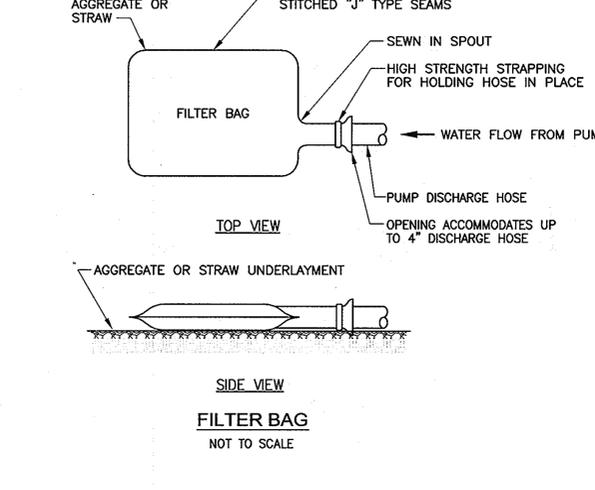

DEPARTMENT OF PUBLIC WORKS

HOWARD COUNTY, MARYLAND

John R. ... 12/10/10
DIRECTOR OF PUBLIC WORKS DATE

Shane C. ... 12/10/10
CHIEF, BUREAU OF UTILITIES DATE

Thomas N. Dally 12/10/10
CHIEF, BUREAU OF ENGINEERING DATE

John P. ... 12/10/10
CHIEF, UTILITY DESIGN DIVISION DATE

DES: RJM				
DRN: ARW				
CHK: TND				
DATE: DECEMBER 2010	RLI	AS-BUILT	8-23-11	
	BY NO.	REVISIONS	DATE	
			600' SCALE MAP NO. 17	BLOCK NO. 24

AS-BUILTS 06-23-2011

ESC 6 OF 7

SCALE: NO SCALE

SHEET 6 OF 7

STREAM RESTORATION
SEDIMENT AND EROSION
CONTROL DETAILS

SUCKER BRANCH
12-INCH SEWER MAIN REHABILITATION
CAPITAL PROJECT S-6268
CONTRACT 30-4582

ELECTION DISTRICT NO. 2 HOWARD COUNTY, MARYLAND

Plotted by: (jones) on Plot Date: Dec 08, 2010 - 11:09am
 Path: C:\Users\jones\Documents\2010\12\08\1109\1109.dwg
 Plot Scale: 1/8" = 1'-0"
 User: jones
 Plot Style: As-Plotted
 Color Table: Color
 Background: None
 Plot Device: HP DesignJet 5000 Series
 Plot Date: 12/08/2010 11:09:00 AM
 Plot Time: 11:09:00 AM
 Plot User: jones

