

ALPHA RIDGE LANDFILL WATER EXTENSION

HOWARD COUNTY, MARYLAND

DEPARTMENT OF PUBLIC WORKS

CAPITAL PROJECTS No. W-8288

CONTRACT NO. 14-4588

GENERAL NOTES

- APPROXIMATE LOCATIONS OF EXISTING MAINS ARE SHOWN. THE CONTRACTOR SHALL TAKE ALL NECESSARY PRECAUTIONS TO PROTECT EXISTING MAINS AND SERVICES AND MAINTAIN UNINTERRUPTED SERVICE. ANY DAMAGE INCURRED SHALL BE REPAIRED IMMEDIATELY TO THE SATISFACTION OF THE ENGINEER AT THE CONTRACTOR'S EXPENSE.
- TOPOGRAPHIC FIELD SURVEYS WERE PERFORMED IN APRIL & OCTOBER, 2007 BY KCI TECHNOLOGIES INC.
- HORIZONTAL AND VERTICAL SURVEY CONTROLS:
THE COORDINATES SHOWN ON THE DRAWINGS ARE BASED ON MARYLAND STATE REFERENCE SYSTEM NAD '83' 91 AS PROJECTED BY HOWARD COUNTY GEODETIC CONTROL STATION NO. ALPHA 3, BASE A, BASE F AND 16DA. ALL VERTICAL CONTROLS ARE BASED ON NAVD '88. VERTICAL CONTROLS PROVIDED ON THE DRAWINGS ARE REBAR WITH DISC AND CONC. COLUMN WITH DISC.
- ALL PIPE ELEVATIONS SHOWN ARE INVERT ELEVATIONS UNLESS OTHERWISE NOTED ON THE PLANS.
- CLEAR ALL UTILITIES BY A MINIMUM OF 12 INCHES. CLEAR ALL POLES BY 5'-0" MINIMUM OR TUNNEL AS REQUIRED UNLESS OTHERWISE NOTED. THE OWNER HAS CONTACTED THE UTILITY COMPANIES AND HAS MADE ARRANGEMENTS FOR BRACING OF POLES AS SHOWN ON THE DRAWINGS. IN THE EVENT THE CONTRACTOR'S WORK REQUIRES THE BRACING OF ADDITIONAL POLES, ANY COST INCURRED BY THE OWNER FOR THE BRACING OF ADDITIONAL POLES OR DAMAGES SHALL BE DEDUCTED FROM MONIES OWED THE CONTRACTOR. THE CONTRACTOR SHALL COORDINATE WITH UTILITY COMPANIES TO SCHEDULE THE BRACING OF THE POLES.
- FOR DETAILS NOT SHOWN ON THE DRAWING, AND FOR MATERIALS AND CONSTRUCTION METHODS, USE HOWARD COUNTY DESIGN MANUAL, VOLUME IV, STANDARD SPECIFICATIONS AND DETAILS FOR CONSTRUCTION (LATEST EDITION). THE CONTRACTOR SHALL HAVE A COPY OF VOLUME IV ON THE JOB.
- WHERE TEST PITS HAVE BEEN MADE ON EXISTING UTILITIES, THEY ARE NOTED BY THE SYMBOL AT THE LOCATION OF THE TEST PITS. A NOTE OR NOTES CONTAINING THE RESULTS OF THE TEST PIT OR PITS IS INCLUDED ON THE DRAWINGS. EXISTING UTILITIES IN THE VICINITY OF THE PROPOSED WORK FOR WHICH TEST PITS HAVE NOT BEEN DUG SHALL BE LOCATED BY THE CONTRACTOR TWO WEEKS IN ADVANCE OF CONSTRUCTION OPERATIONS AT HIS OWN EXPENSE.
- CONTRACTOR SHALL NOTIFY THE FOLLOWING UTILITY COMPANIES OR AGENCIES AT LEAST FIVE WORKING DAYS BEFORE STARTING WORK SHOWN ON THESE PLANS:


AT&T.....	1-800-252-1133
BGE (CONSTRUCTION SERVICES).....	410-850-4620
BGE (EMERGENCY).....	410-685-1400
BUREAU OF UTILITIES.....	410-313-4900
COLONIAL PIPELINE CO.....	410-795-1390
MISS UTILITY.....	1-800-257-7777
STATE HIGHWAY ADMINISTRATION.....	410-531-5533
VERIZON.....	1-800-743-0033 / 410-224-9210
TRANSCON.....	410-984-3442
- TREES AND SHRUBS ARE TO BE PROTECTED FROM DAMAGE TO THE MAXIMUM EXTENT. TREES AND SHRUBS LOCATED WITHIN THE CONSTRUCTION STRIP ARE NOT TO BE REMOVED OR DAMAGED BY THE CONTRACTOR.
- THE CONTRACTOR SHALL REMOVE TREES, STUMPS AND ROOTS ALONG THE LINE OF EXCAVATION. PAYMENT FOR SUCH REMOVAL SHALL BE INCLUDED IN THE UNIT PRICE BID FOR CONSTRUCTION OF THE MAIN.
- THE CONTRACTOR SHALL NOTIFY THE BUREAU OF HIGHWAYS, HOWARD COUNTY, AT (410)313-7450 AT LEAST FIVE WORKING DAYS BEFORE ANY OPEN CUTTING OR BORING / JACKING OF ANY COUNTY ROADS FOR LAYING WATER / SEWER MAINS OR HOUSE CONNECTIONS. THE APPROVAL OF THESE DRAWINGS WILL CONSTITUTE COMPLIANCE WITH DPW REQUIREMENTS PER SECTION 18.114(d) OF THE HOWARD COUNTY CODE.

WATER GENERAL NOTES

- ALL DUCTILE IRON PIPES TO BE USED ON THE PUBLIC WATER SYSTEM SHALL BE CLASS 54. DUCTILE IRON FITTINGS SHALL MEET THE REQUIREMENTS OF THE HOWARD COUNTY DESIGN MANUAL VOLUME IV-STANDARD SPECIFICATIONS AND DETAILS FOR CONSTRUCTION AND SHALL BE EXTERIOR EPOXY COATED IN ACCORDANCE WITH AWWA C116.
- TOPS OF ALL WATER MAINS SHALL HAVE A MINIMUM OF 3'-6" OF COVER UNLESS OTHERWISE NOTED
- VALVES ADJACENT TO TEES SHALL BE STRAPPED TO TEES.
- ALL FITTINGS SHALL BE BUTTRESSED OR ANCHORED WITH CONCRETE IN ACCORDANCE WITH THE STANDARD DETAILS UNLESS OTHERWISE PROVIDED FOR ON THE DRAWINGS.
- FIRE HYDRANTS SHALL BE SET TO BURY LINE ELEVATIONS SHOWN ON THE DRAWINGS. ALL FIRE HYDRANTS SHALL BE INSTALLED IN ACCORDANCE WITH STANDARD DETAILS. THE SOIL AROUND THE FIRE HYDRANT SHALL BE COMPACTED IN ACCORDANCE WITH SECTION 1000 AND SECTION 1005 OF THE STANDARD SPECIFICATIONS.
- THE CONTRACTOR SHALL NOT OPERATE ANY WATER MAIN VALVES ON THE EXISTING WATER SYSTEM.
- WATER MAINS SHALL BE FILLED WITH WATER AND BROUGHT TO 150 PSI FOR 2 HOURS, VARYING 5 PSI. SEE HOWARD COUNTY DESIGN MANUAL.

SUGGESTED SEQUENCE OF CONSTRUCTION FOR WATER

- CONSTRUCT NEW 8" DIP WATER MAIN AND ASSOCIATED APPURTENANCES FROM STA. 0+00 TO STA. 11+55. RESTRAIN JOINTS AS SHOWN ON THE DRAWING (SEE SHEET 2 OF 3).
- TEST THE NEW WATER MAIN PER HOWARD COUNTY STAND SPECIFICATIONS.
- CONNECT NEW 8" DIP WATER MAIN TO EX. 8" WATER MAIN WITH NEW 8"x8" CROSS AT STA. 11+22. COORDINATE TEMPORARY SHUTDOWN WITH ALPHA RIDGE LANDFILL FOR CONNECTION.
- RESTORE AREA.

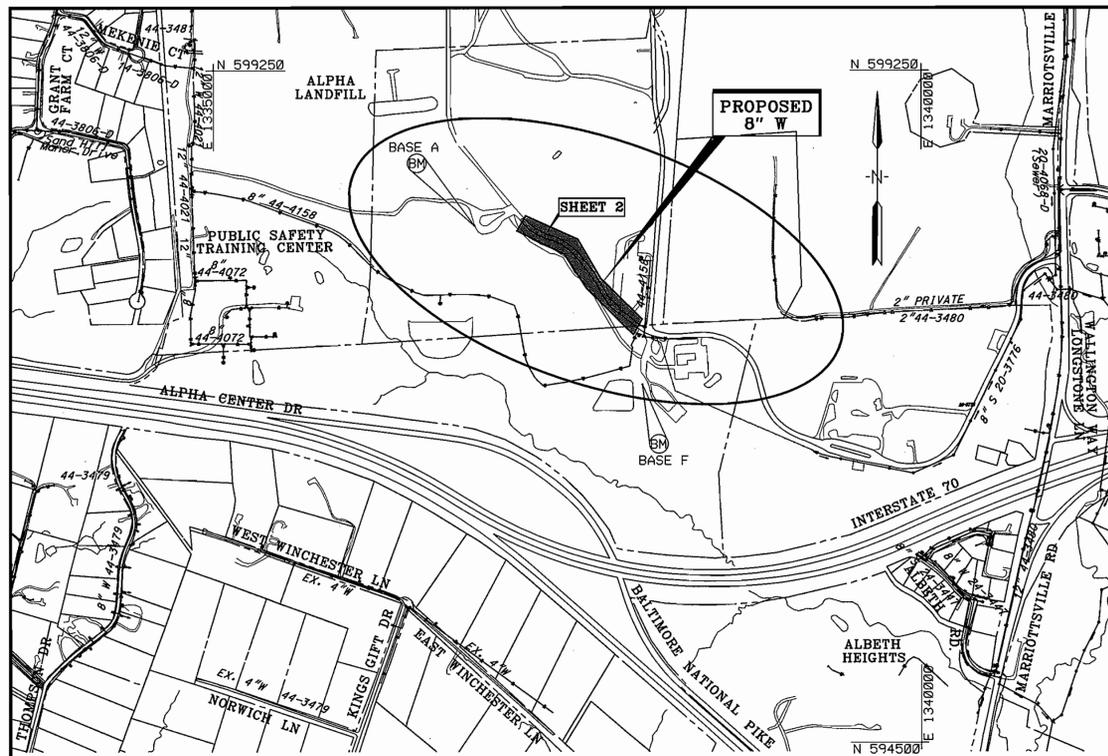

LOCATION MAP

SCALE: 1" = 600'

HORIZONTAL AND VERTICAL CONTROL BASED ON MARYLAND NAD83(91) (HORIZONTAL) AND NAVD88 (VERTICAL) DATUM. HOWARD COUNTY GEODETIC SURVEY CONTROL NUMBERS:

NO. BASE A	NO. BASE F
N 598156.23	N 597030.50
E 1336841.78	E 1338031.40
ELEV. 564.87	ELEV. 512.93

INDEX OF SHEETS

SHEET No.	DESCRIPTION
1.....	TITLE SHEET
2.....	8" WATER LINE PLAN AND PROFILE
3.....	EROSION AND SEDIMENT CONTROL NOTES AND DETAILS

QUANTITIES

ITEM	UNIT	ESTIMATE	AS-BUILT	MATERIAL SUPPLIER
8" WATER	L.F.	1157	1151	BRS/GRIFFIN PIPE
8" RSGV	EACH	4	4	BRS/MUELLER CO.
NAME OF UTILITY CONTRACTOR: W.F. WILSON & SONS, INC.				
FIRE HYDRANT & VALVE	EACH	1	1	BRS/MUELLER CO.

RESTORATION SCHEDULE

LOCATION	DISTANCE (FT.)	TYPE
UNPAVED PRIVATE ROAD (SH. 2 OF 3)	17	GRAVEL
PAVED PRIVATE ROAD (SH. 2 OF 3)	44	ASPHALT
WL STA. 0+00 TO STA. 11+57	1157	MULCH & SEEDING

TYPE OF BUILDING:	N/A
NUMBER OF PARCELS:	N/A
DRAINAGE AREA:	LITTLE PATUXENT
PRESSURE ZONE:	730'
WATER TEST GRADIENT	1000'

LEGEND

- TRAVERSE POINT
- WATER MAIN
- FIRE HYDRANT
- VALVE
- LIMIT OF DISTURBANCE
- WATER HOUSE CONNECTION
- SEWER HOUSE CONNECTION
- TEST PIT LOCATION
- BORING LOCATION
- DECIDUOUS TREE
- CONIFEROUS TREE
- EXISTING FIRE HYDRANT
- EXISTING VALVE
- EXISTING WATER MAIN
- EXISTING GAS MAIN
- EXISTING OVERHEAD ELECTRIC
- EXISTING UNDERGROUND ELECTRIC
- EXISTING SEWER MAIN
- EXISTING MANHOLE
- WATERS OF THE U.S.
- WETLAND
- WETLAND BUFFER

AS-BUILT

DATE: 1/6/09



PROFESSIONAL CERTIFICATION. I HEREBY CERTIFY THAT THESE DOCUMENTS WERE PREPARED OR APPROVED BY ME, AND THAT I AM A DULY LICENSED PROFESSIONAL ENGINEER UNDER THE LAWS OF THE STATE OF MARYLAND, LICENSE NO.: 28911 EXPIRATION DATE: 1/11/10

PLOTTED: 10:31 AM on Wednesday, August 06, 2008
FILE: W:\2008\14-4588\14-4588-25.dwg
PLOT: W:\2008\14-4588\14-4588-25.dwg

DEPARTMENT OF PUBLIC WORKS
HOWARD COUNTY, MARYLAND

[Signature] 8/15/08
DIRECTOR OF PUBLIC WORKS DATE

[Signature] 8/15/08
CHIEF, BUREAU OF ENGINEERING DATE

[Signature] 8/15/08
CHIEF, BUREAU OF UTILITIES DATE

[Signature] 8/15/08
CHIEF, UTILITY DESIGN DIVISION DATE

ENGINEERS
PLANNERS
SCIENTISTS
CONSTRUCTION MANAGERS

KCI
TECHNOLOGIES

10 NORTH PARK DRIVE
HUNT VALLEY, MD 21030
PHONE: (410) 316-7800
FAX: (410) 316-7817
WWW.KCI.COM

DES: CLO					
DRN: CK					
CHK: TWW					
DATE: DEC. 2007	LFN		AS BUILT - DBW 1/6/09		
BY	NO.		REVISION	DATE	600' SCALE MAP NO. 16 BLOCK NO. 9 & 10

TITLE SHEET

ALPHA RIDGE LANDFILL
WATER EXTENSION

CAPITAL PROJECTS No. W-8288
CONTRACT NO. 14-4588


ELECTION DISTRICT NO.3 HOWARD COUNTY, MARYLAND

SCALE AS SHOWN
SHEET 1 OF 3

HOWARD COUNTY GVMT.
TAX MAP 16, PARCEL 220
LIBER 856, FOLIO 337
LIBER 891, FOLIO 314
65 AC.

PROPERTY OF HOWARD COUNTY
GOVERNMENT


HOWARD COUNTY GVMT.
TAX MAP 16, PARCEL 253
LIBER 856, FOLIO 337
LIBER 891, FOLIO 314
38 AC.

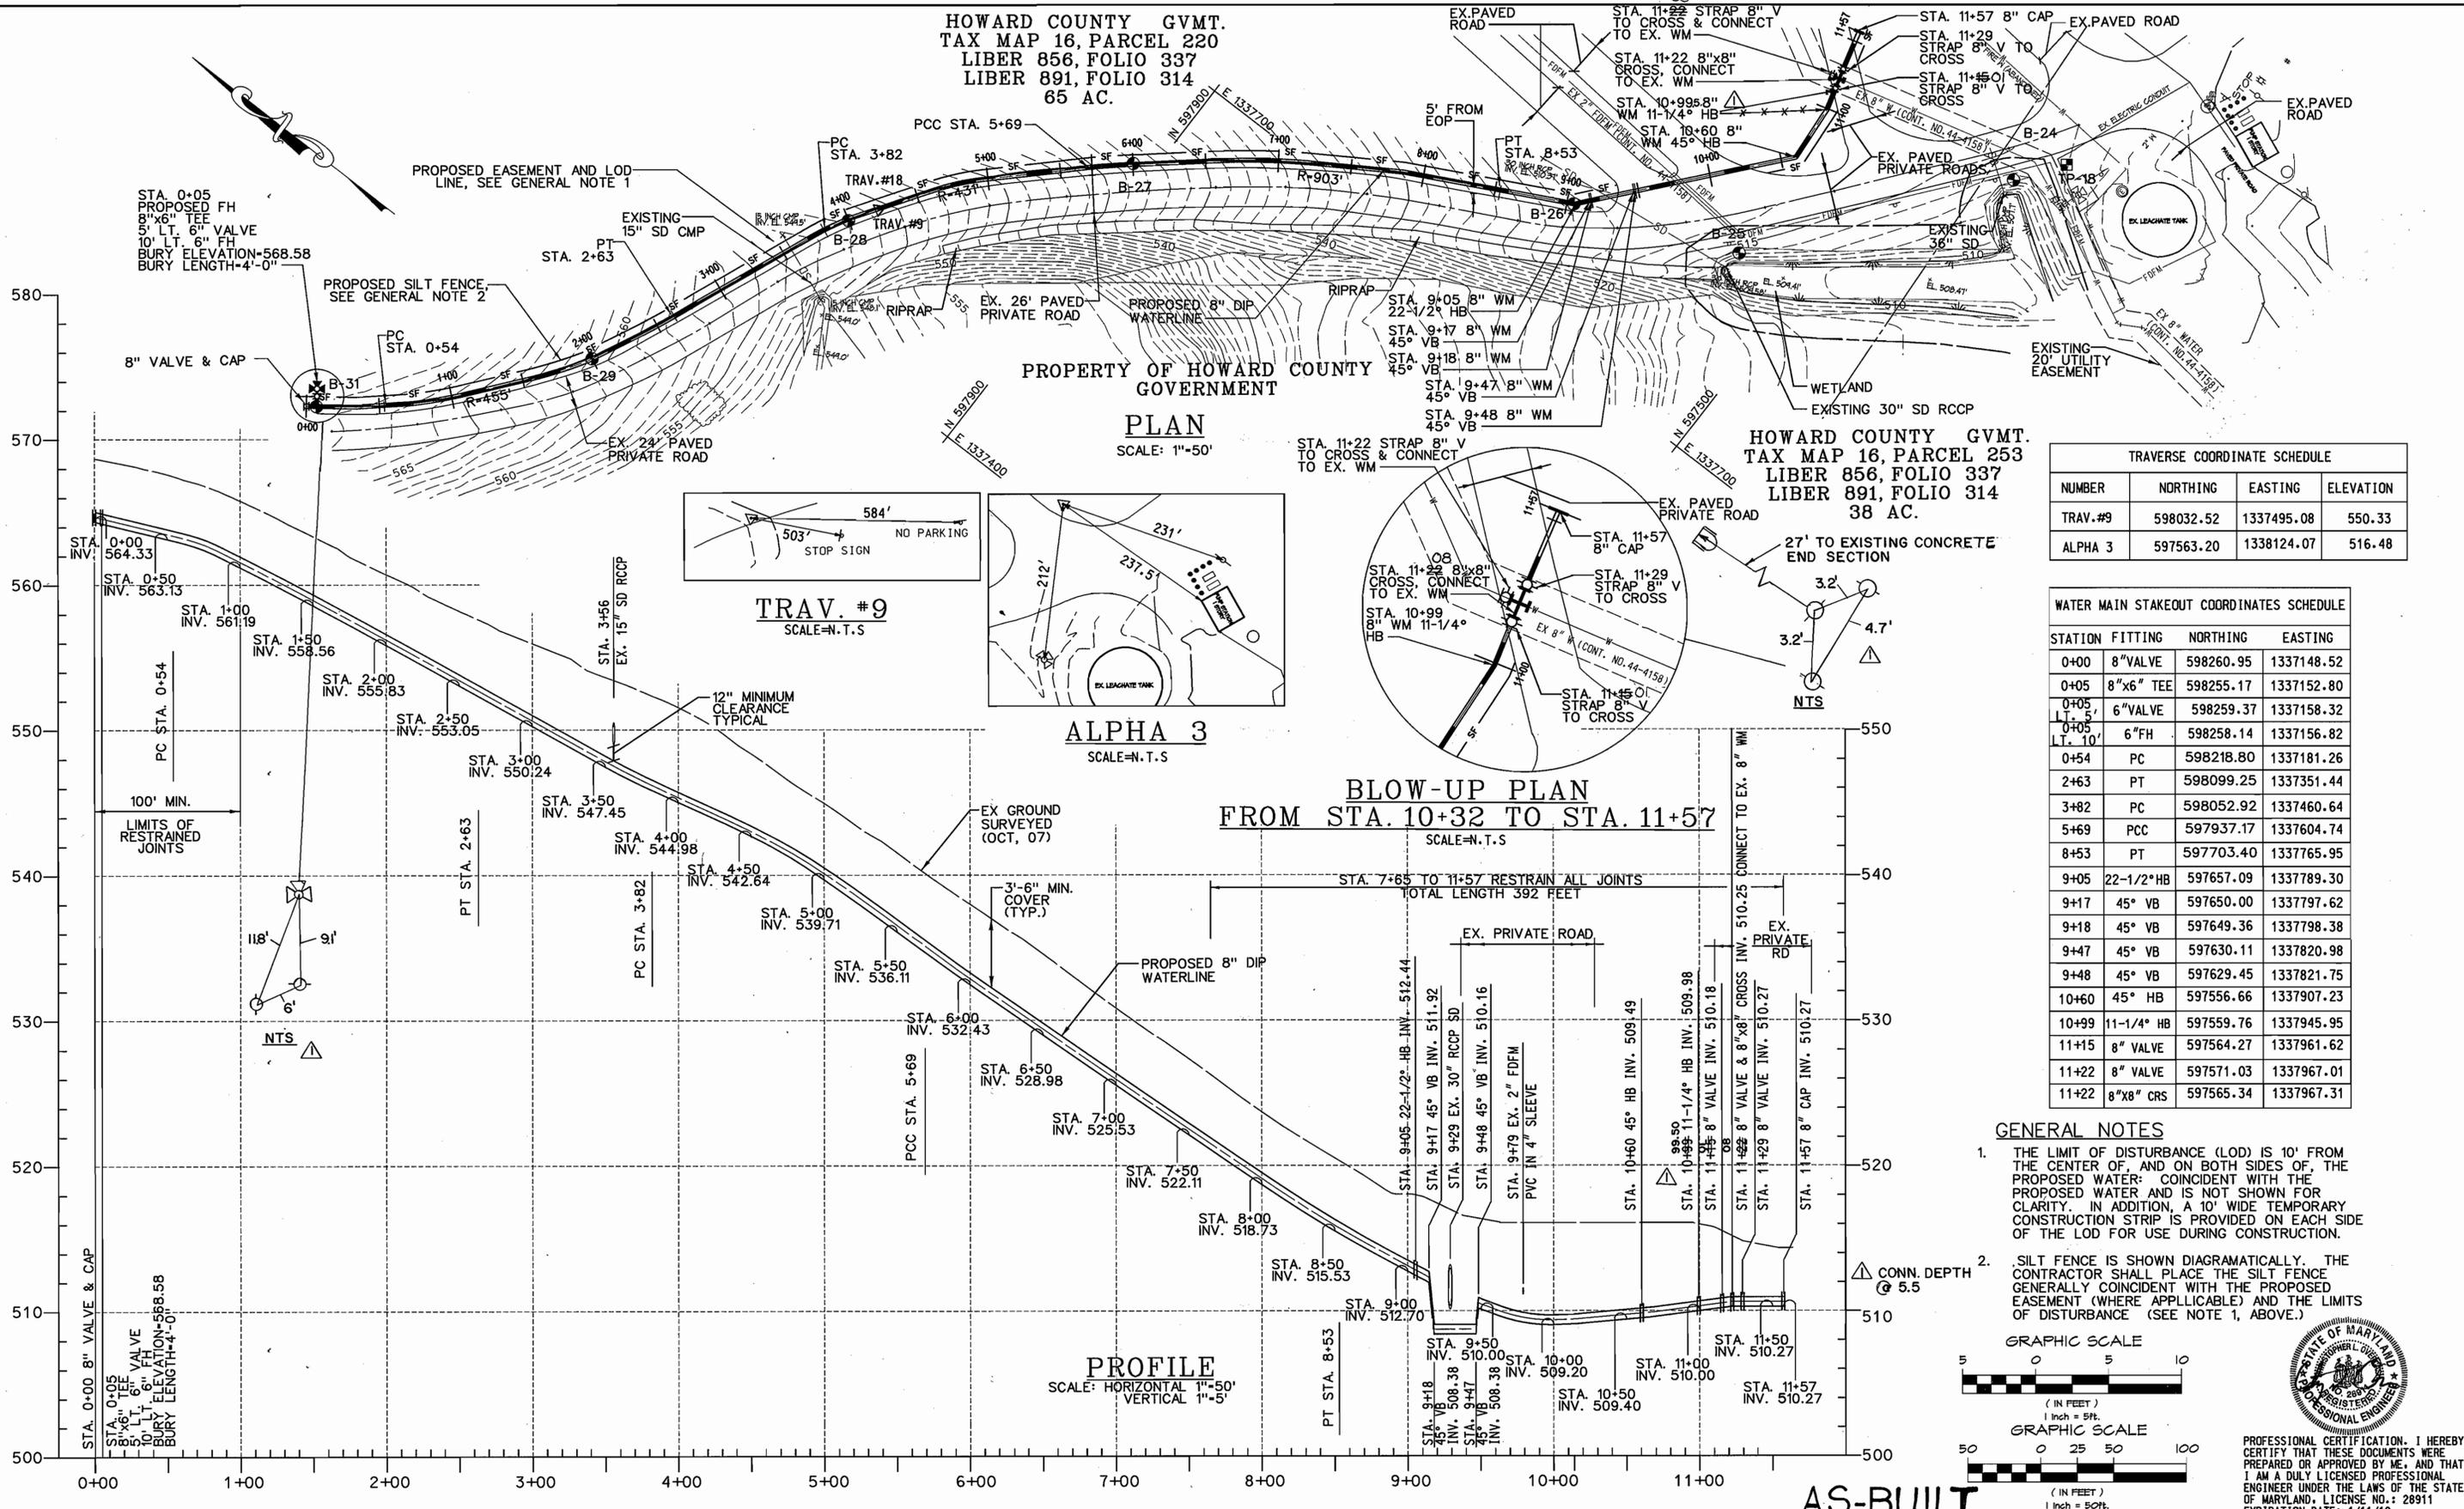

TRAVERSE COORDINATE SCHEDULE			
NUMBER	NORTHING	EASTING	ELEVATION
TRAV.#9	598032.52	1337495.08	550.33
ALPHA 3	597563.20	1338124.07	516.48

WATER MAIN STAKEOUT COORDINATES SCHEDULE			
STATION	FITTING	NORTHING	EASTING
0+00	8" VALVE	598260.95	1337148.52
0+05	8"x6" TEE	598255.17	1337152.80
0+05	6" VALVE	598259.37	1337158.32
0+05	6" FH	598258.14	1337156.82
0+54	PC	598218.80	1337181.26
2+63	PT	598099.25	1337351.44
3+82	PC	598052.92	1337460.64
5+69	PCC	597937.17	1337604.74
8+53	PT	597703.40	1337765.95
9+05	22-1/2" HB	597657.09	1337789.30
9+17	45° VB	597650.00	1337797.62
9+18	45° VB	597649.36	1337798.38
9+47	45° VB	597630.11	1337820.98
9+48	45° VB	597629.45	1337821.75
10+60	45° HB	597556.66	1337907.23
10+99	11-1/4" HB	597559.76	1337945.95
11+15	8" VALVE	597564.27	1337961.62
11+22	8" VALVE	597571.03	1337967.01
11+22	8"x8" CRS	597565.34	1337967.31

- GENERAL NOTES**
- THE LIMIT OF DISTURBANCE (LOD) IS 10' FROM THE CENTER OF, AND ON BOTH SIDES OF, THE PROPOSED WATER. COINCIDENT WITH THE PROPOSED WATER AND IS NOT SHOWN FOR CLARITY. IN ADDITION, A 10' WIDE TEMPORARY CONSTRUCTION STRIP IS PROVIDED ON EACH SIDE OF THE LOD FOR USE DURING CONSTRUCTION.
 - SILT FENCE IS SHOWN DIAGRAMMATICALLY. THE CONTRACTOR SHALL PLACE THE SILT FENCE GENERALLY COINCIDENT WITH THE PROPOSED EASEMENT (WHERE APPLICABLE) AND THE LIMITS OF DISTURBANCE (SEE NOTE 1, ABOVE.)

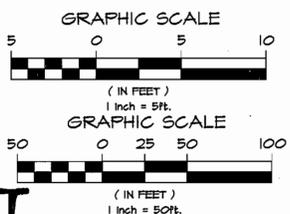

PROFESSIONAL CERTIFICATION. I HEREBY CERTIFY THAT THESE DOCUMENTS WERE PREPARED OR APPROVED BY ME, AND THAT I AM A DULY LICENSED PROFESSIONAL ENGINEER UNDER THE LAWS OF THE STATE OF MARYLAND. LICENSE NO.: 28911 EXPIRATION DATE: 1/11/10

DEPARTMENT OF PUBLIC WORKS
HOWARD COUNTY, MARYLAND

Raymond A. Skaloe
DIRECTOR OF PUBLIC WORKS
DATE: 8/15/08

Paul J. Johnson
CHIEF, BUREAU OF ENGINEERING
DATE: 8/15/08

Sharon Chan
CHIEF, BUREAU OF UTILITIES
DATE: 8/15/08

Clayton
CHIEF, UTILITY DESIGN DIVISION
DATE: 8/15/08

ENGINEERS
PLANNERS
SCIENTISTS
CONSTRUCTION MANAGERS

KCI
TECHNOLOGIES

10 NORTH PARK DRIVE
HUNT VALLEY, MD 21030
PHONE: (410) 316-7800
FAX: (410) 316-7817
WWW.KCI.COM

DES:	CLO		
DRN:	CK		
CHK:	TW		
DATE:	DEC. 2007		
BY:	NO.		
REVISION:			
DATE:			

8" WATER LINE
PLAN AND PROFILE






600' SCALE MAP NO. 16 BLOCK NO. 9 & 10

**ALPHA RIDGE LANDFILL
WATER EXTENSION**

CAPITAL PROJECTS No. W-8288
CONTRACT NO. 14-4588
ELECTION DISTRICT NO.3 HOWARD COUNTY, MARYLAND

SCALE AS SHOWN
SHEET 2 OF 3

PLOTTED: 10/22/08 BY: J. Frick, August 08, 2008
 BY: Jason Wolfe, Division 002, Environmental/Engineering
 FILE: M:\2008\010\3464_25\Drawings\W-C-02-04-3464-25.dwg

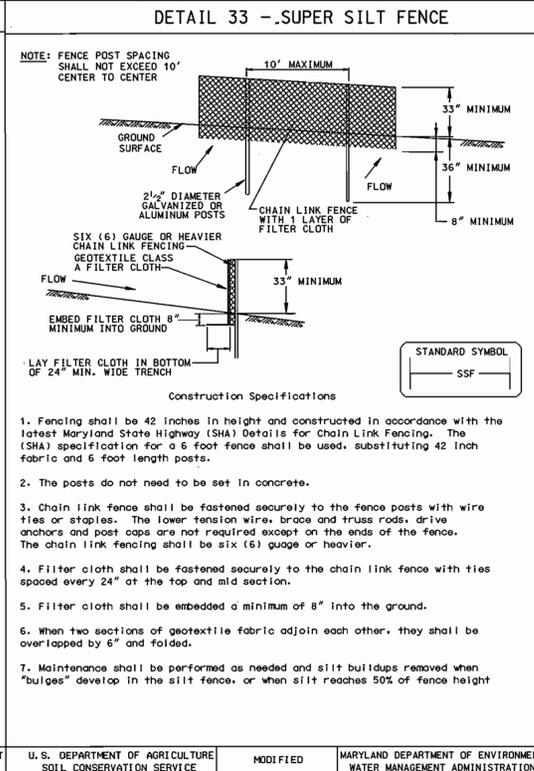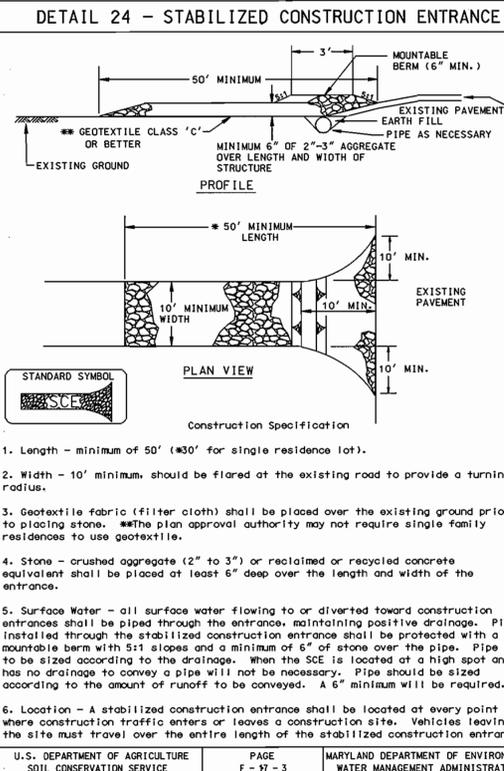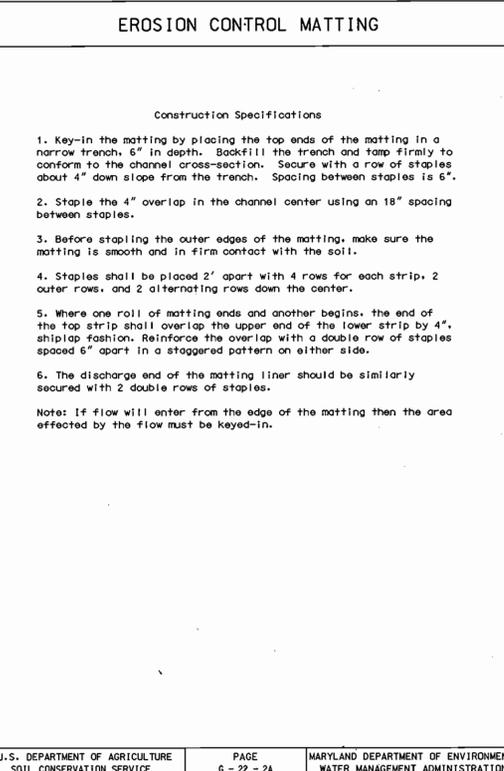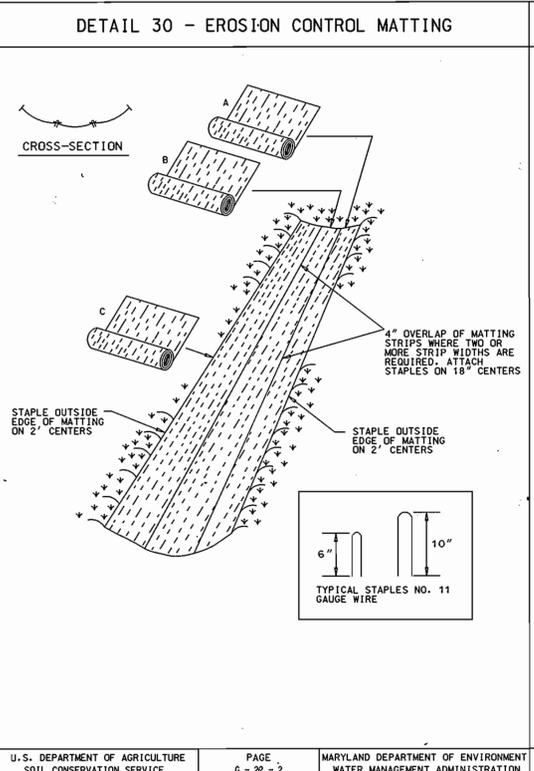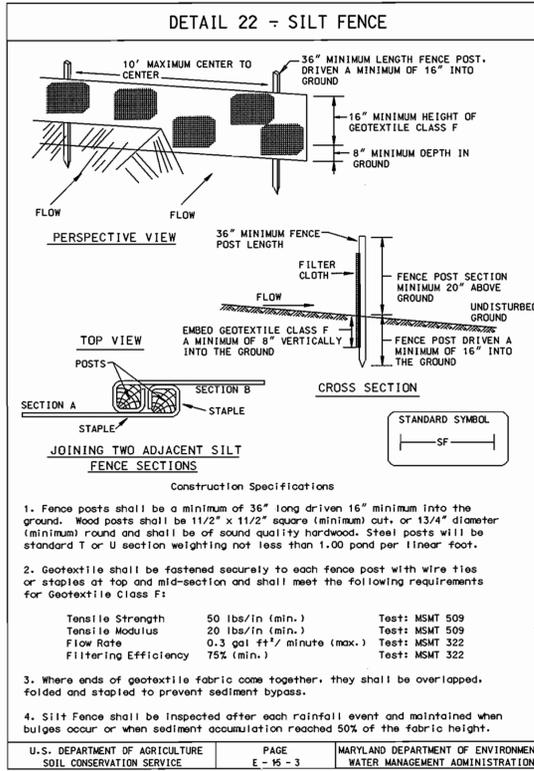

PERMANENT SEEDING NOTES

APPLY TO GRADED OR CLEARED AREAS NOT SUBJECT TO IMMEDIATE FURTHER DISTURBANCE WHERE A PERMANENT LONG-LIVED VEGETATIVE COVER IS NEEDED.

SEEDING PREPARATION: LOOSEN UPPER THREE INCHES OF SOIL BY RAKING, DISKING OR OTHER ACCEPTABLE MEANS BEFORE SEEDING, IF NOT PREVIOUSLY LOOSENED.

SOIL AMENDMENTS: IN LIEU OF SOIL TEST RECOMMENDATIONS, USE ONE OF THE FOLLOWING SCHEDULES:

- 1) PREFERRED -** APPLY 2 TONS PER ACRES DOLOMITIC LIMESTONE (92 LBS/1000 SQ FT.) AND 600 LBS PER ACRE 10-10-10 FERTILIZER (14 LBS/1000 SQ FT.) BEFORE SEEDING. HARROW OR DISK INTO UPPER THREE INCHES OF SOIL AT TIME OF SEEDING. APPLY 400 LBS PER ACRE 30-0-0 UREAFORM FERTILIZER (9 LBS/1000 SQ FT.).
- 2) ACCEPTABLE -** APPLY 2 TONS PER ACRE DOLOMITIC LIMESTONE (92 LBS/1000 SQ FT.) AND 1000 LBS PER ACRE 10-10-10 FERTILIZER (23 LBS/1000 SQ FT.) BEFORE SEEDING. HARROW OR DISK INTO UPPER THREE INCHES OF SOIL.

SEEDING: FOR THE PERIODS MARCH 1 THRU APRIL 30, AND AUGUST 1 THRU OCTOBER 15, SEED WITH 60 LBS PER ACRE (1.4 LBS/1000 SQ FT.) OF KENTUCKY 31 TALL FESCUE. FOR THE PERIOD MAY 1 THRU JULY 31, SEED WITH 60 LBS KENTUCKY 31 TALL FESCUE PER ACRE AND 2 LBS PER ACRE (.05 LBS/1000 SQ FT.) OF WEEPING LOVEGRASS. DURING THE PERIOD OF OCTOBER 16 THRU FEBRUARY 29, PROTECT SITE BY: OPTION (1) 2 TONS PER ACRE OF WELL ANCHORED STRAW MULCH AND SEED AS SOON AS POSSIBLE IN THE SPRING. OPTION (2) USE SOD. OPTION (3) SEED WITH 60 LBS/ACRE KENTUCKY 31 TALL FESCUE AND MULCH WITH 2 TONS/ACRE WELL ANCHORED STRAW.

MULCHING: APPLY 1-1/2 TO 2 TONS PER ACRE (70 TO 90 LBS/1000 SQ FT.) OF UNDRITTED SMALL GRAIN STRAW IMMEDIATELY AFTER SEEDING. ANCHOR MULCH IMMEDIATELY AFTER APPLICATION USING MULCH ANCHORING TOOL OR 218 GALLONS PER ACRE (5 GAL/1000 SQ FT.) OF EMULSIFIED ASPHALT ON FLAT AREAS. ON SLOPES 8 FEET OR HIGHER, USE 348 GALLONS PER ACRE (8 GAL/1000 SQ FT.) FOR ANCHORING.

MAINTENANCE: INSPECT ALL SEEDING AREAS AND MAKE NEEDED REPAIRS, REPLACEMENTS AND RESEEDINGS.

TEMPORARY SEEDING NOTES

APPLY TO GRADED OR CLEARED AREAS LIKELY TO BE REDISTURBED WHERE A SHORT-TERM VEGETATIVE COVER IS NEEDED.


SEEDING PREPARATION: LOOSEN UPPER THREE INCHES OF SOIL BY RAKING, DISKING OR OTHER ACCEPTABLE MEANS BEFORE SEEDING, IF NOT PREVIOUSLY LOOSENED.

SOIL AMENDMENTS: - APPLY 600 LBS PER ACRE 10-10-10 FERTILIZER (14 LBS/1000 SQ FT.).

SEEDING: - FOR PERIODS MARCH 1 THRU APRIL 30 AND FROM AUGUST 15 THRU OCTOBER 15, SEED WITH 2-1/2 BUSHEL PER ACRE OF ANNUAL RYE (3.2 LBS/1000 SQ FT.). FOR THE PERIOD MAY 1 THRU AUGUST 14, SEED WITH 3 LBS PER ACRE OF WEEPING LOVEGRASS (.07 LBS/1000 SQ FT.). FOR THE PERIOD NOVEMBER 16 THRU FEBRUARY 29, PROTECT SITE BY APPLYING 2 TONS PER ACRE OF WELL ANCHORED STRAW MULCH AND SEED AS SOON AS POSSIBLE IN THE SPRING, OR USE SOD.

MULCHING: - APPLY 1-1/2 TO 2 TONS PER ACRE (70 TO 90 LBS/1000 SQ FT.) OF UNDRITTED SMALL GRAIN STRAW IMMEDIATELY AFTER SEEDING. ANCHOR MULCH IMMEDIATELY AFTER APPLICATION USING MULCH ANCHORING TOOL OR 218 GAL PER ACRE (5 GAL/1000 SQ FT.) OF EMULSIFIED ASPHALT ON FLAT AREAS. ON SLOPES 8 FT OR HIGHER, USE 348 GAL PER ACRE (8 GAL/1000 SQ FT.) FOR ANCHORING.

REFER TO THE 1994 MARYLAND STANDARDS AND SPECIFICATIONS FOR SOIL EROSION AND SEDIMENT CONTROL FOR RATE AND METHODS NOT COVERED.

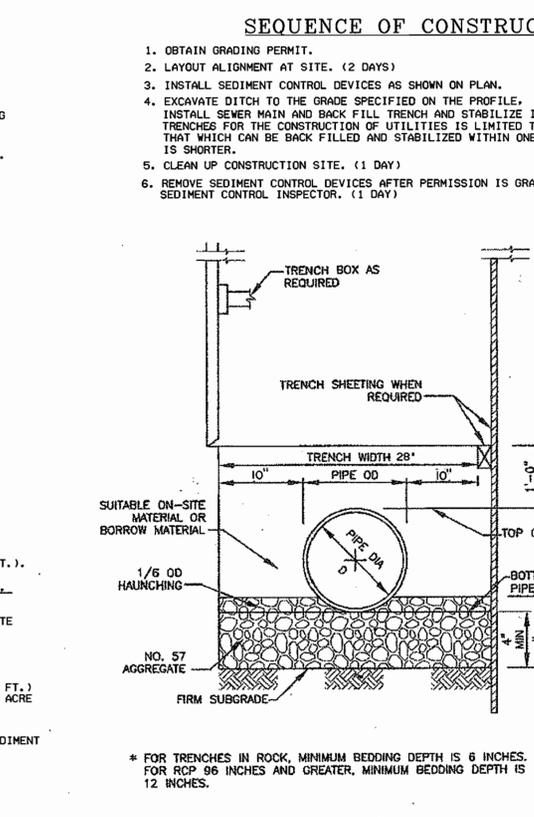

STANDARD SEDIMENT CONTROL NOTES

- A MINIMUM OF 48 HOURS NOTICE MUST BE GIVEN TO THE HOWARD COUNTY DEPARTMENT OF INSPECTIONS, LICENSES AND PERMITS, SEDIMENT CONTROL DIVISION PRIOR TO THE START OF ANY CONSTRUCTION, (313-1855).
- ALL VEGETATIVE AND STRUCTURAL PRACTICES ARE TO BE INSTALLED ACCORDING TO THE PROVISIONS OF THIS PLAN AND ARE TO BE IN CONFORMANCE WITH THE MOST CURRENT "MARYLAND STANDARDS AND SPECIFICATIONS FOR SOIL EROSION AND SEDIMENT CONTROL", AND REVISIONS THERETO.
- FOLLOWING INITIAL SOIL DISTURBANCE OR REDISTURBANCE, PERMANENT OR TEMPORARY STABILIZATION SHALL BE COMPLETED WITHIN:
 - 7 CALENDER DAYS FOR ALL PERIMETER SEDIMENT CONTROL STRUCTURES, DIKES, PERIMETER SLOPES AND ALL SLOPES GREATER THAN 3:1.
 - 14 DAYS AS TO ALL OTHER DISTURBED OR GRADED AREAS ON THE PROJECT SITE.
- ALL SEDIMENT TRAPS/BASINS SHOWN MUST BE FENCED AND WARNING SIGNS POSTED AROUND THEIR PERIMETER IN ACCORDANCE WITH VOL. 1, CHAPTER 12, OF THE HOWARD COUNTY DESIGN MANUAL, STORM DRAINAGE.
- ALL DISTURBED AREAS MUST BE STABILIZED WITHIN THE TIME PERIOD SPECIFIED ABOVE IN ACCORDANCE WITH THE 1994 MARYLAND STANDARDS AND SPECIFICATIONS FOR SOIL EROSION AND SEDIMENT CONTROL (SEC. 020.0) FOR PERMANENT SEEDINGS, SOD, TEMPORARY SEEDING AND MULCHING. TEMPORARY STABILIZATION WITH MULCH ALONE CAN ONLY BE DONE WHEN RECOMMENDED SEEDING DATES DO NOT ALLOW FOR PROPER GERMINATION AND ESTABLISHMENT OF GRASSES.
- ALL SEDIMENT CONTROL STRUCTURES ARE TO REMAIN IN PLACE AND ARE TO BE MAINTAINED IN OPERATIVE CONDITION UNTIL PERMISSION FOR THEIR REMOVAL HAS BEEN OBTAINED FROM THE HOWARD COUNTY SEDIMENT CONTROL INSPECTOR.
- SITE ANALYSIS:**

TOTAL AREA OF SITE	0.6 ACRES	
AREA DISTURBED	0.5 ACRES	
AREA TO BE ROOFED OR PAVED	N/A	ACRES
AREA TO BE VEGETATIVELY STABILIZED	N/A	ACRES
TOTAL CUT	N/A	CU. YDS.
TOTAL FILL	N/A	CU. YDS.
OFFSITE WASTE/BORROW AREA LOCATION	N/A	
- ANY SEDIMENT CONTROL PRACTICE WHICH IS DISTURBED BY GRADING ACTIVITY FOR PLACEMENT OF UTILITIES MUST BE REPAIRED ON THE SAME DAY OF THE DISTURBANCE.
- ADDITIONAL SEDIMENT CONTROLS MUST BE PROVIDED, IF DEEMED NECESSARY BY THE HOWARD COUNTY SEDIMENT CONTROL INSPECTOR.
- ON ALL SITES WITH DISTURBED AREAS IN EXCESS OF 2 ACRES, APPROVAL OF THE INSPECTION AGENCY SHALL BE REQUESTED UPON COMPLETION OF INSTALLATION OF PERIMETER EROSION AND SEDIMENT CONTROLS, BUT BEFORE PROCEEDING WITH ANY OTHER EARTH DISTURBANCE OR GRADING. OTHER BUILDING OR GRADING INSPECTION APPROVALS MAY NOT BE AUTHORIZED UNTIL THIS INITIAL APPROVAL BY THE INSPECTION AGENCY IS MADE.
- TRENCHES FOR THE CONSTRUCTION OF UTILITIES IS LIMITED TO THREE (3) PIPE LENGTHS OR THAT WHICH CAN BE BACK FILLED AND STABILIZED WITHIN ONE WORKING DAY, WHICHEVER IS SHORTER.
- CONTRACTOR SHALL PLACE EXCAVATED MATERIALS ON UPHILL SIDE OF TRENCH AND PLACE SILT FENCE ON DOWNHILL SIDE OF TRENCH.

BEST MANAGEMENT PRACTICE (BMP) NOTES

- NO EXCESS FILL, CONSTRUCTION MATERIAL, OR DEBRIS SHALL BE STOCKPILED OR STORED IN NONTIDAL WETLANDS, NONTIDAL WETLAND BUFFERS, WATERWAYS, OR THE 100 YEAR FLOODPLAIN.
- PLACE MATERIALS IN A LOCATION AND MANNER WHICH DOES NOT ADVERSELY IMPACT SURFACE WATER FLOW INTO OR OUT OF NONTIDAL WETLANDS, NONTIDAL WETLAND BUFFERS, WATERWAYS, OR THE 100 YEAR FLOODPLAIN.
- DO NOT USE THE EXCAVATED MATERIAL AS BACKFILL IF IT CONTAINS WASTE METAL PRODUCTS, UNSIGHTLY DEBRIS, TOXIC MATERIAL, OR ANY OTHER DELETERIOUS SUBSTANCE. IF ADDITIONAL BACKFILL IS REQUIRED USE CLEAN MATERIAL FREE OF WASTE METAL PRODUCTS, UNSIGHTLY DEBRIS, TOXIC MATERIAL, OR ANY OTHER DELETERIOUS SUBSTANCE.
- PLACE HEAVY EQUIPMENT ON MATS OR SUITABLY OPERATE THE EQUIPMENT TO PREVENT DAMAGE TO NONTIDAL WETLANDS, NONTIDAL WETLANDS BUFFERS, WATERWAYS, OR THE 100 YEAR FLOODPLAIN.
- REPAIR AND MAINTAIN ANY SERVICEABLE STRUCTURE OR FILL SO THERE IS NO PERMANENT MODIFICATION OF THE 100 YEAR FLOODPLAIN IN EXCESS OF THAT LOST UNDER THE ORIGINALLY AUTHORIZED STRUCTURE OR FILL.
- RECTIFY ANY NONTIDAL WETLANDS, WETLAND BUFFERS, WATERWAYS, OR 100 YEAR FLOODPLAIN TEMPORARILY IMPACTED BY ANY CONSTRUCTION.
- ALL STABILIZATION IN THE NONTIDAL WETLAND AND NONTIDAL WETLAND BUFFER SHALL CONSIST OF THE FOLLOWING SPECIES: ANNUAL RYEGRASS (LOLIUM MULTIFLORUM), MILLET (SETARIA ITALICA), BABY BLUE CRABGRASS (HORDEUM SP.), AND/OR RYE (SECALE CEREALE). THESE SPECIES WILL ALLOW FOR THE STABILIZATION OF THE SITE WHILE ALSO ALLOWING FOR THE VOLUNTARY REVEGETATION OF NATURAL WETLAND SPECIES. OTHER NON-PERSISTENT VEGETATION MAY BE ACCEPTABLE, BUT MUST BE APPROVED BY THE NONTIDAL WETLANDS AND WATERWAYS DIVISION. KENTUCKY 31 FESCUE SHALL NOT BE UTILIZED IN WETLAND OR BUFFER AREAS. THE AREA SHOULD BE SEEDING AND MULCHED TO REDUCE EROSION AFTER CONSTRUCTION ACTIVITIES HAVE BEEN COMPLETED.
- AFTER INSTALLATION HAS BEEN COMPLETED, MAKE POST CONSTRUCTION GRADES AND ELEVATIONS THE SAME AS THE ORIGINAL GRADES AND ELEVATIONS IN TEMPORARILY IMPACTED AREAS.
- TO PROTECT AQUATIC SPECIES, IN-STREAM WORK IS PROHIBITED AS DETERMINED BY THE CLASSIFICATION OF THE STREAM.

USE 1/2 WATERS IN STREAM WORK SHALL NOT BE CONDUCTED DURING THE PERIOD MARCH 1 THROUGH JUNE 15, INCLUSIVE, DURING ANY YEAR.
- STORMWATER RUNOFF FROM IMPERVIOUS SURFACES SHALL BE CONTROLLED TO PREVENT THE WASHING OF DEBRIS INTO THE WATERWAYS.
- CULVERTS SHALL BE CONSTRUCTED AND ANY RIPRAP PLACED SO AS NOT TO OBSTRUCT THE MOVEMENT OF AQUATIC SPECIES, UNLESS THE PURPOSE OF THE ACTIVITY IS TO IMPOUND WATER.

DEVELOPER'S CERTIFICATION

I, *Paul D. Jensen*, 8/15/08
BUREAU OF ENGINEERING
DEPARTMENT OF PUBLIC WORKS

ENGINEER'S CERTIFICATION

I, *Christopher L. Overcash, P.E.*, 8/16/08
DATE
KCI TECHNOLOGIES, INC.
10 NORTH PARK DRIVE
HUNT VALLEY, MD 21038

AS-BUILT
DATE 1/6/09

U.S. DEPARTMENT OF AGRICULTURE SOIL CONSERVATION SERVICE PAGE H-17-3 MARYLAND DEPARTMENT OF ENVIRONMENT WATER MANAGEMENT ADMINISTRATION

NOTE: SCE TO BE INSTALLED AT THE DIRECTION OF THE SOIL CONSERVATION INSPECTOR.

DEPARTMENT OF PUBLIC WORKS
HOWARD COUNTY, MARYLAND

Paul D. Jensen 8/15/08
DATE
CHIEF, BUREAU OF ENGINEERING

John K. Robertson 8/15/08
DATE
CHIEF, UTILITY DESIGN DIVISION

ENGINEERS
PLANNERS
SCIENTISTS
CONSTRUCTION MANAGERS

KCI TECHNOLOGIES

10 North Park Drive
Hunt Valley, MD 21038
Phone: (410) 316-7800
Fax: (410) 316-7817
www.kci.com

DES: CLO
DRN: CK
CHK: TWW

DATE: DEC. 2007

BY NO. AS BUILT-DBW 11/09

REVISION

EROSION AND
SEDIMENT CONTROL
NOTES AND DETAILS

600' SCALE MAP NO. 16 BLOCK NO. 9 & 10

ALPHA RIDGE LANDFILL
WATER EXTENSION

CAPITAL PROJECTS No. W-8288
CONTRACT NO. 14-4588

ELECTION DISTRICT NO.3 HOWARD COUNTY, MARYLAND

SCALE AS SHOWN
SHEET 3 OF 3

PLOTTED: 09/23/08 AM 10:35 Wednesday, August 06, 2008
By: Jordan Work Division 0102 Environmental Engineering
FILE: M:\2008\0102\3464\25\Drawings\W-C-03-04\3464-25SEED.dwg