
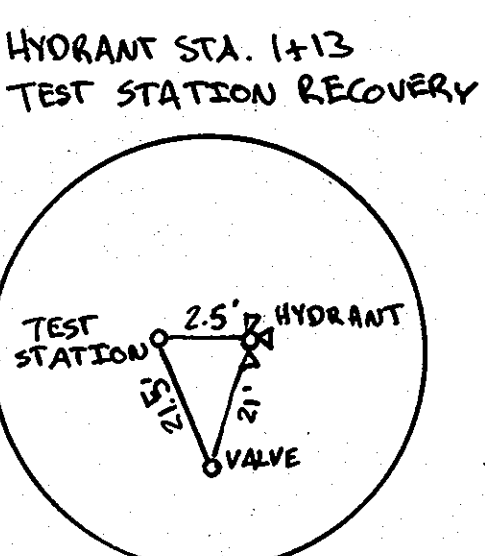


PLAN VIEW  
SCALE: 1" = 50'


WATER METER FOR ALL BUILDINGS SHALL BE AN INSIDE METER SETTING.

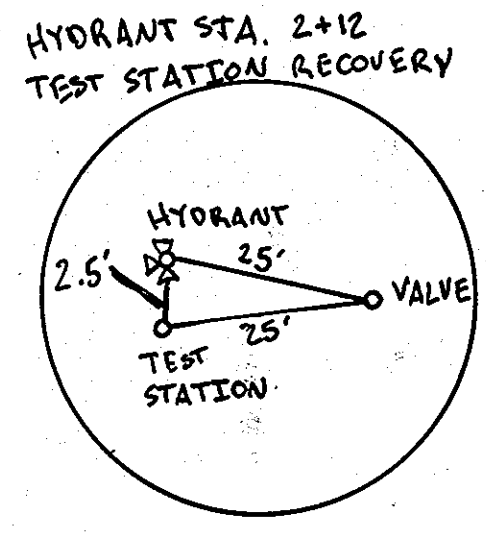

DEPARTMENT OF PUBLIC WORKS  
HOWARD COUNTY, MARYLAND

DEPARTMENT OF PLANNING AND ZONING  
HOWARD COUNTY, MARYLAND

**BENCHMARK**  
ENGINEERS & LAND SURVEYORS & PLANNERS  
**ENGINEERING, INC.**  
8400 BALTIMORE NATIONAL PIKE A SUITE 418 A ELICOTT CITY, MARYLAND 21043  
(P) 410-485-8105 (F) 410-485-6644  
80 THOMAS JOHNSON DRIVE & FREDERICK, MARYLAND 21702  
(P) 301-371-3050 (F) 301-371-3056  
WWW.BE-CMLENGINEERING.COM


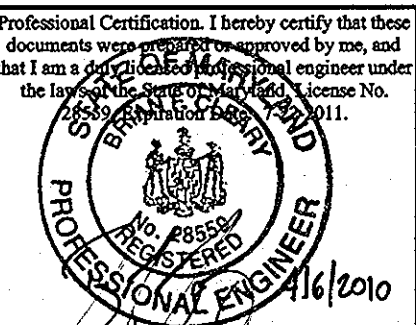


DESIGN: DBT	BEI 5	REVISE WHO'S FROM G TO A FOR BLDGS A1, A2, A3, A4, A5, A6 AND ACT. REVISE SIZES TO BE A1	2-27-2012
DRAFT: JMC/DBT	BEI 4	REVISE UNLOCATIONS BIPS: A1, A2, A3, A4, A5, A6 & D2	11-2-11
CHK: --	BEI 3	REVISE WATER MAIN TO PVC FROM D.I.P.	8-24-2011
	BEI 2	SHOW REVISED LOCATIONS OF EX. F.M.'S IN RESORT ROAD	5-4-2011
	BEI 1	REVISE LOCATIONS OF B' PRIVATE FIRE, BLDG ENTRANCE, KNOX BOX FOR BLDG B (HARRIS TEETER) ADD OF SMC IN BEAR OF HARRIS TEETER. REVISE BURST LENGTH TELY G FIVE BLDG AT	4-14-2011
DATE: 04/2010	KCI 6	AS-SHOWN	7-17-2012
BY NO.		REVISIONS	DATE

PLAN VIEW  
PUBLIC WATER MAINS

TOWN SQUARE AT TURF VALLEY  
PARCEL 'J' AND OPEN SPACE LOT 3 OF  
TURF VALLEY PROFESSIONAL BUILDINGS  
CONTRACT NO. 44-4653-D

SCALE:  
AS SHOWN  
SHEET NO.  
2 OF 4

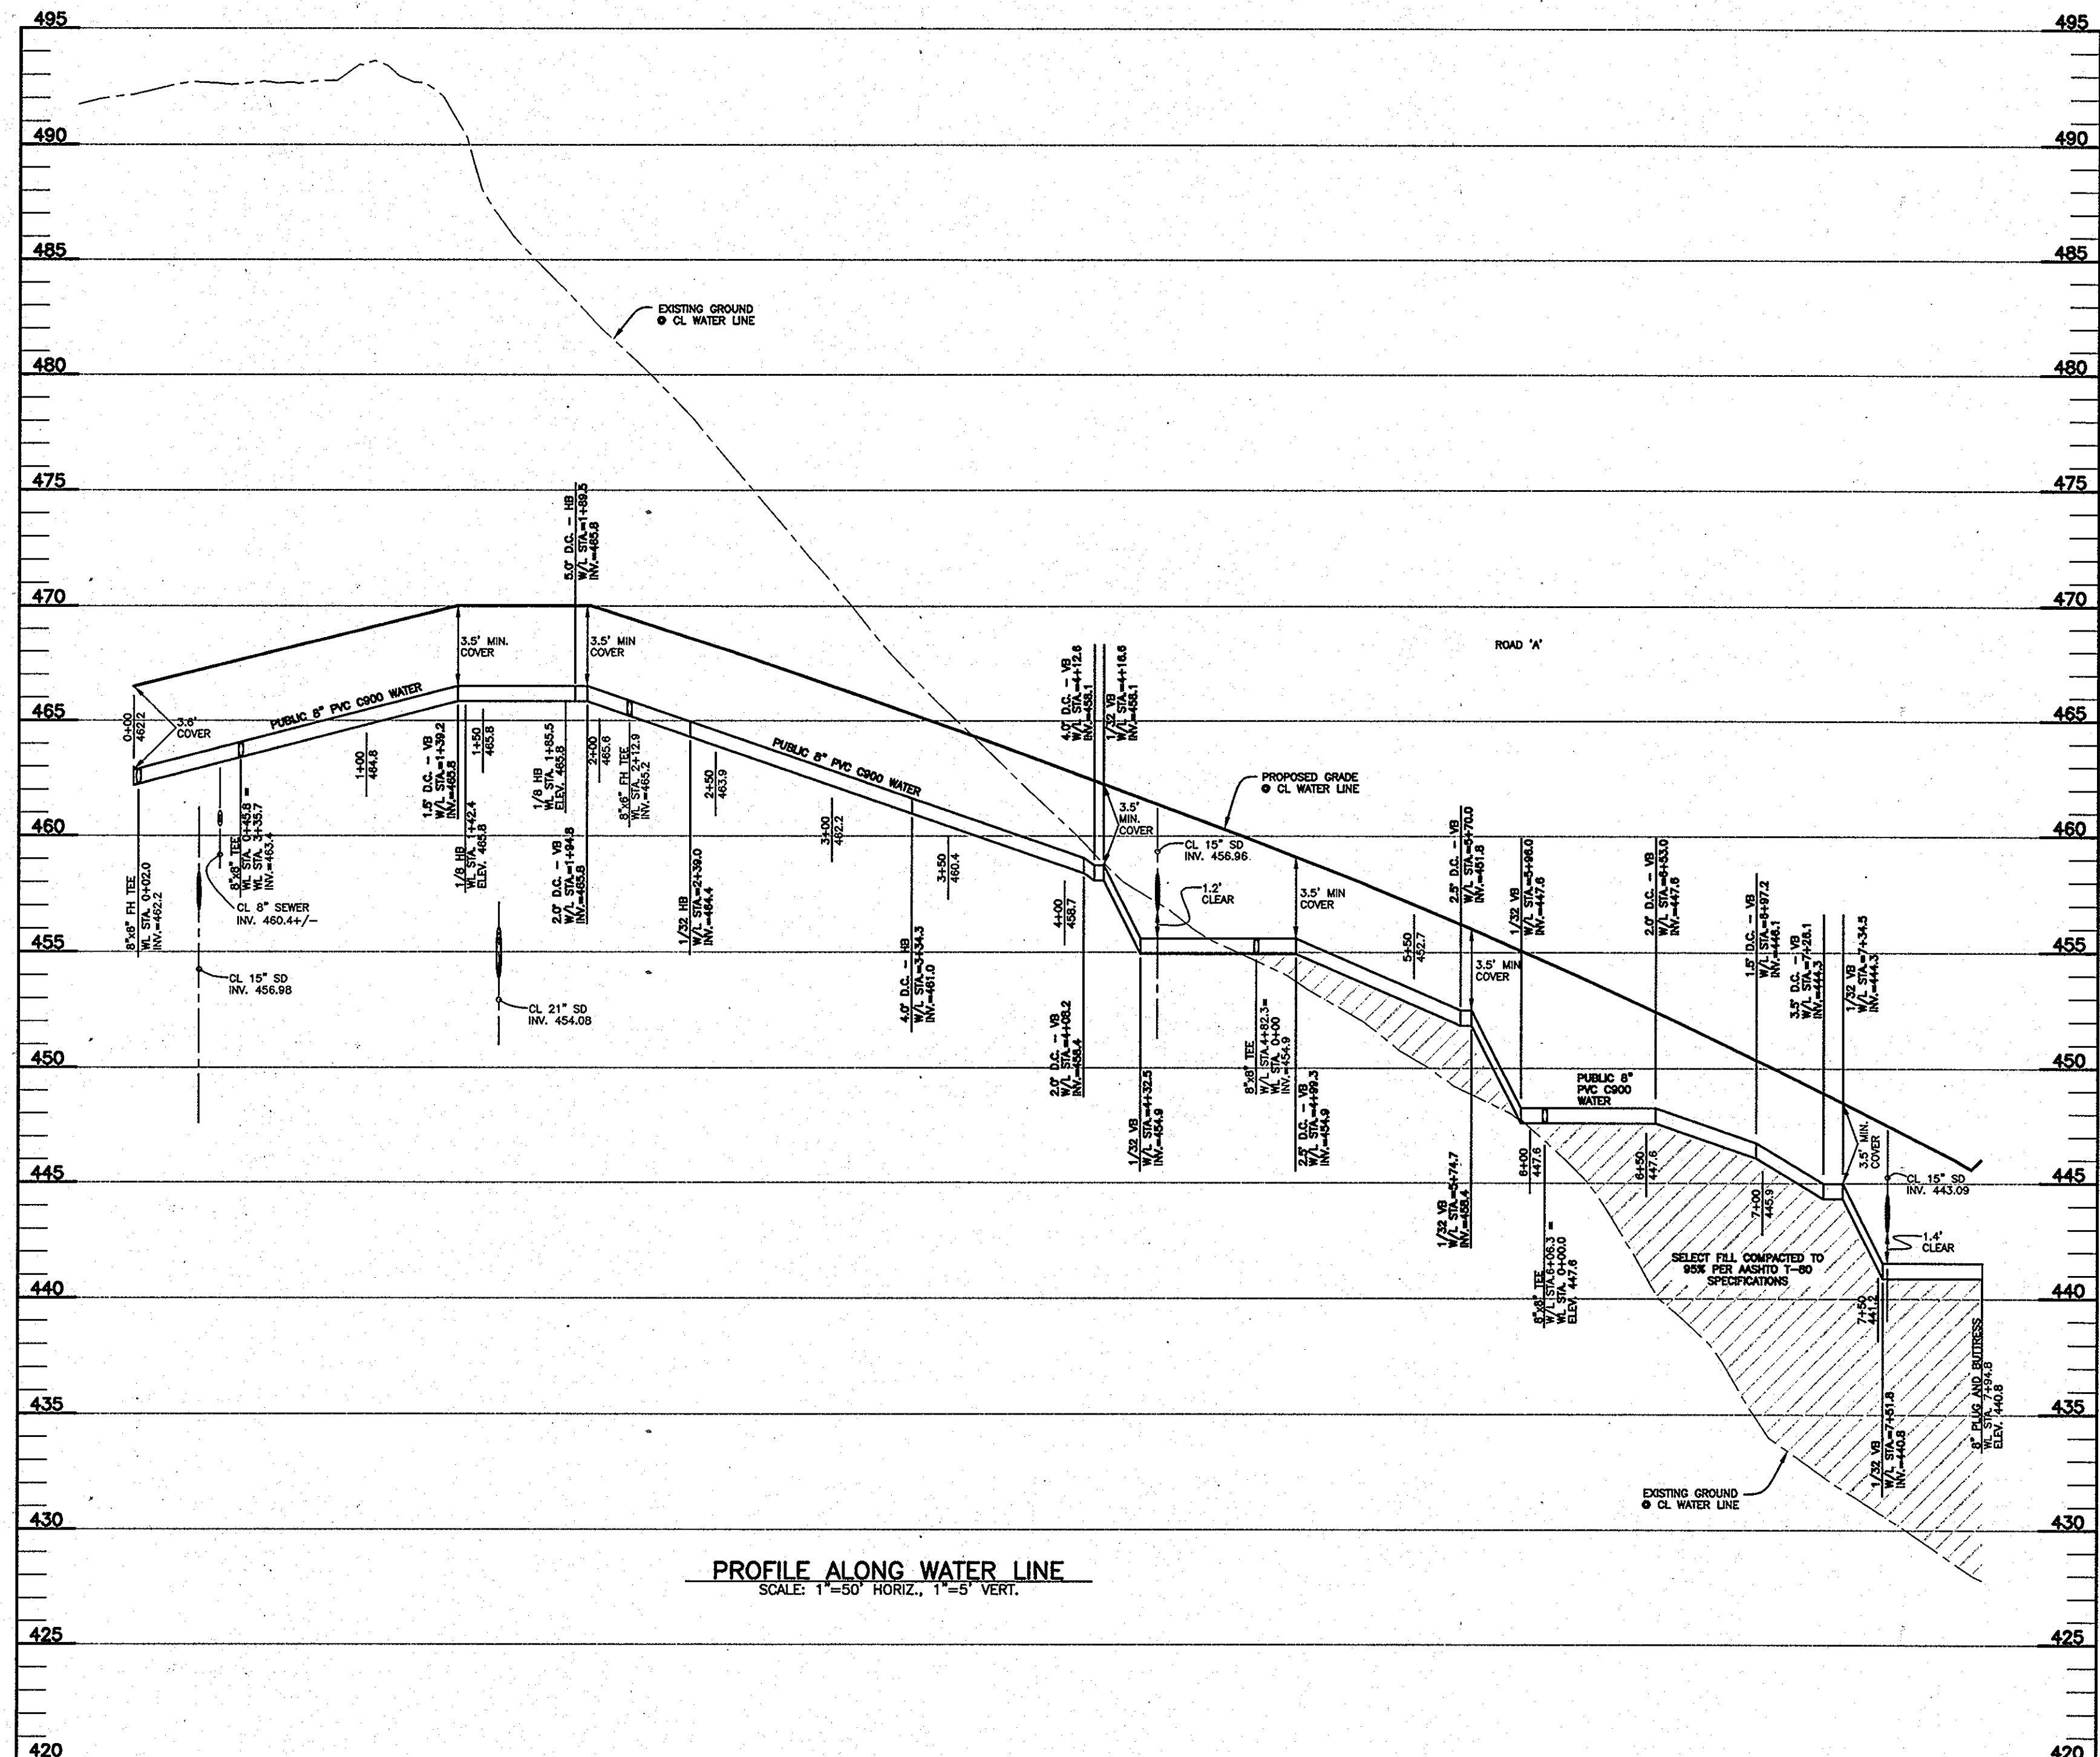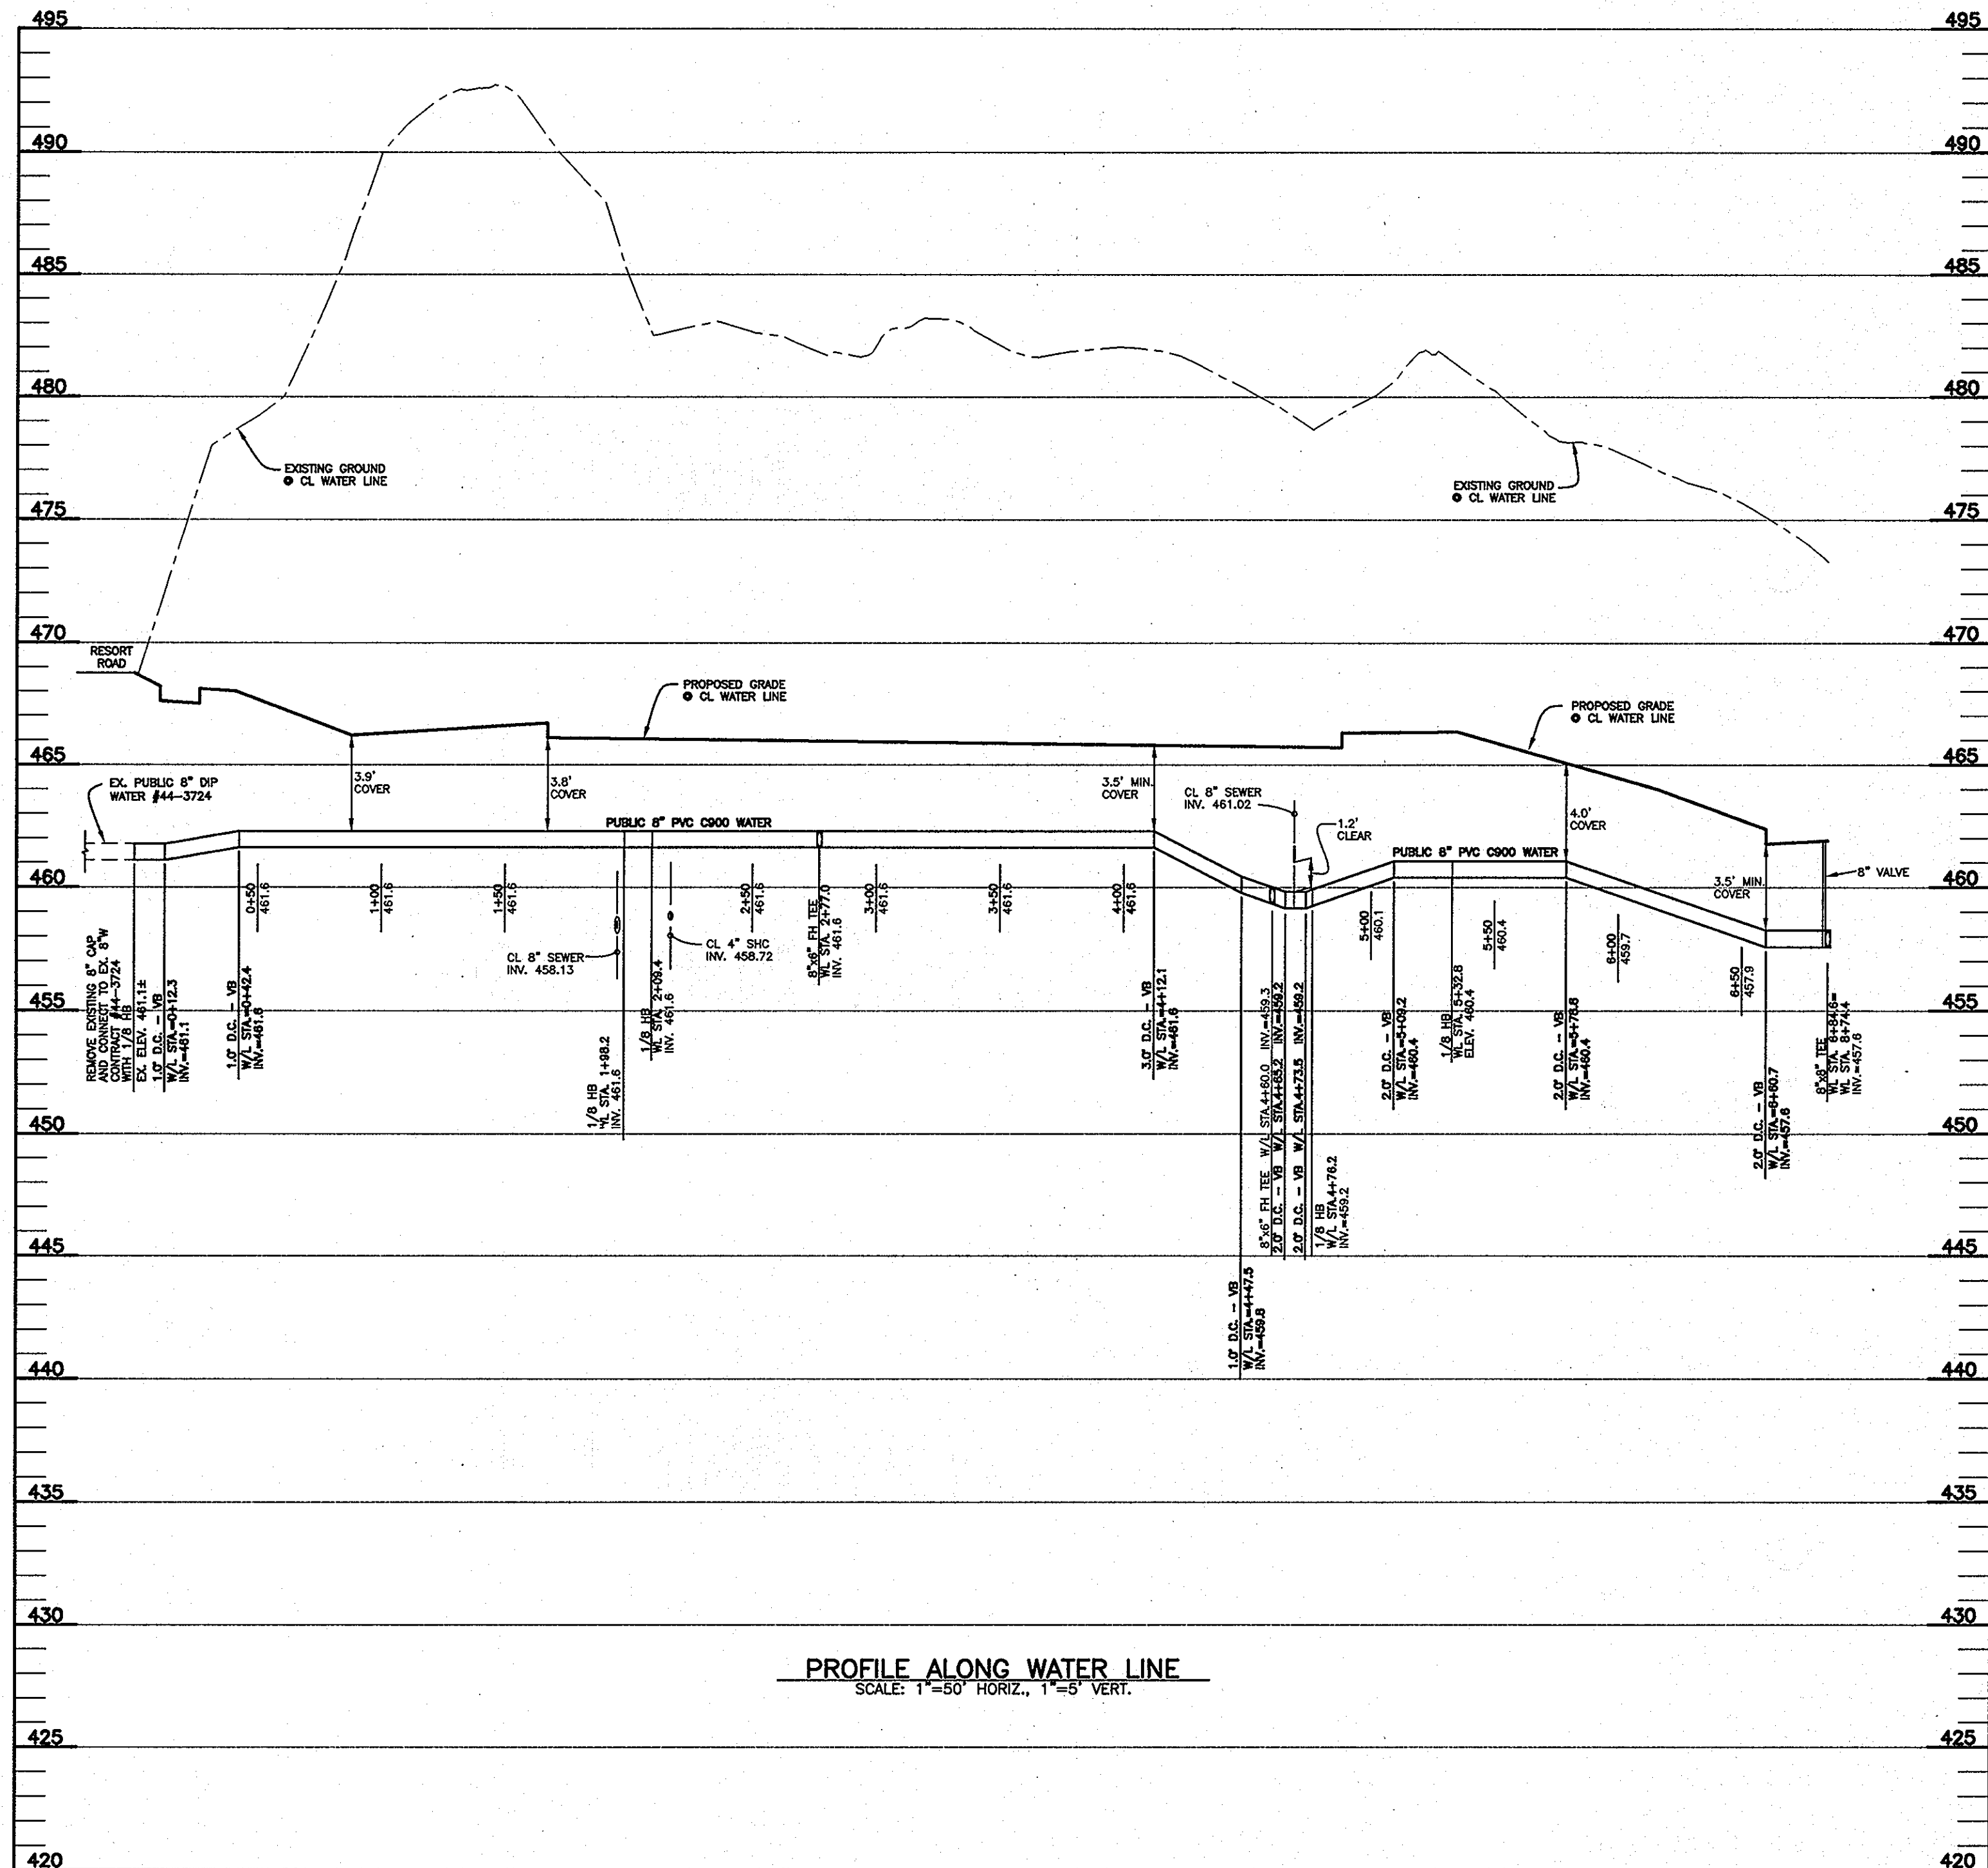

THE PURPOSE OF THIS REPLACEMENT SHEET IS TO REVISE THE WATER MAIN MATERIAL FROM D.I.P. TO PVC C900 DR-18


DEPARTMENT OF PUBLIC WORKS  
HOWARD COUNTY, MARYLAND

*John C. ...* 9/2/11  
CHIEF, BUREAU OF UTILITIES DATE

DEPARTMENT OF PLANNING AND ZONING  
HOWARD COUNTY, MARYLAND

*...* 9/2/11  
CHIEF, DEVELOPMENT ENGINEERING DIVISION DATE

**BENCHMARK**  
ENGINEERS & LAND SURVEYORS & PLANNERS  
**ENGINEERING, INC.**  
8480 BALTIMORE NATIONAL PIKE SUITE 418 & ELLIOTT CITY, MARYLAND 21043  
(P) 410-455-0105 (F) 410-455-0644  
60 THOMAS JOHNSON DRIVE & FREDERICK, MARYLAND 21702  
(P) 301-371-3505 (F) 301-371-3506  
WWW.BE-ONLINEENGINEERING.COM

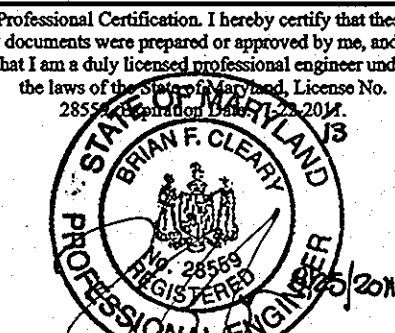

DESIGN:	MCR/DBT		
DRAFT:	JMC/DBT		
CHK:	--	BE1 2	REVISE WATER TO BE PVC C100 DE-18
DATE:	08/2011	BE1 1	ADD 8" x 8" TEE AT STA. 4182.10. REVISE WATER FROM 4180 TO 1480
BY:	NO.		



**REVISED PROFILES OF PUBLIC WATER MAINS**

600 SCALE MAP: 16 BLOCK: 16 200 SCALE MAP: 146

**TOWN SQUARE AT TURF VALLEY**  
PARCEL 'J' AND OPEN SPACE LOT 3 OF  
TURF VALLEY PROFESSIONAL BUILDINGS  
**CONTRACT NO. 44-4653-D**

SCALE:  
AS SHOWN

SHEET NO.  
3 OF 4

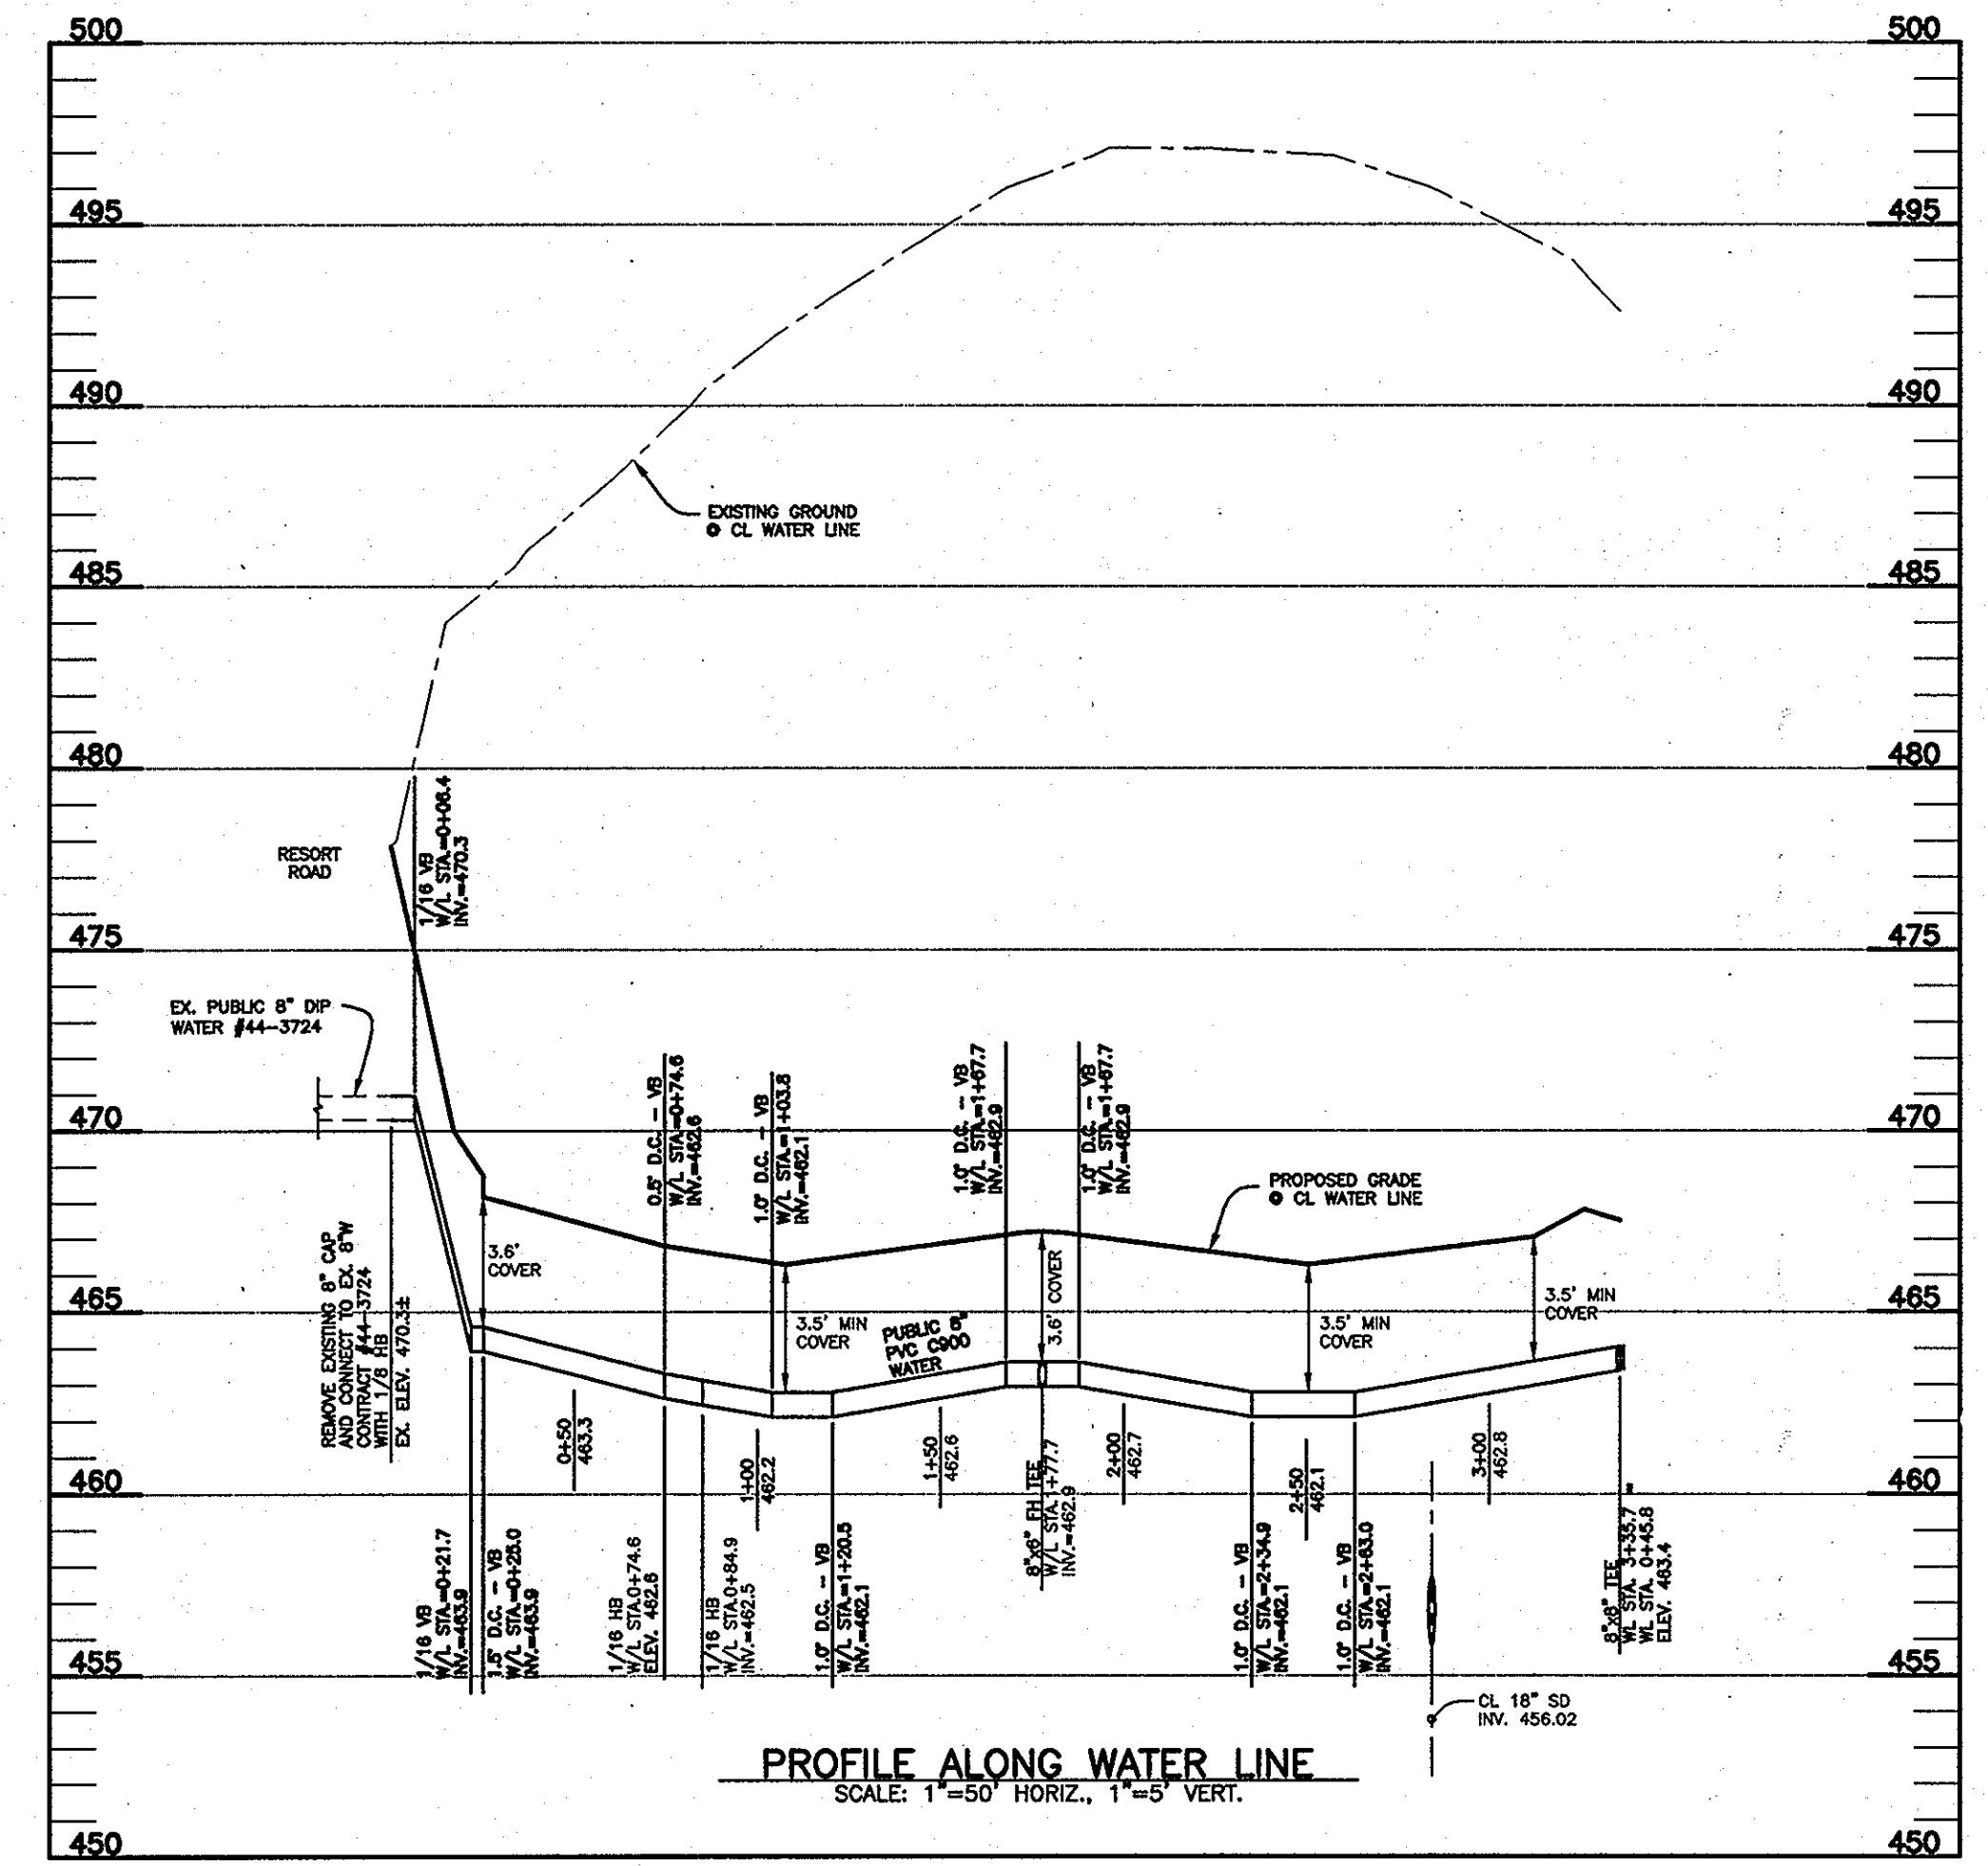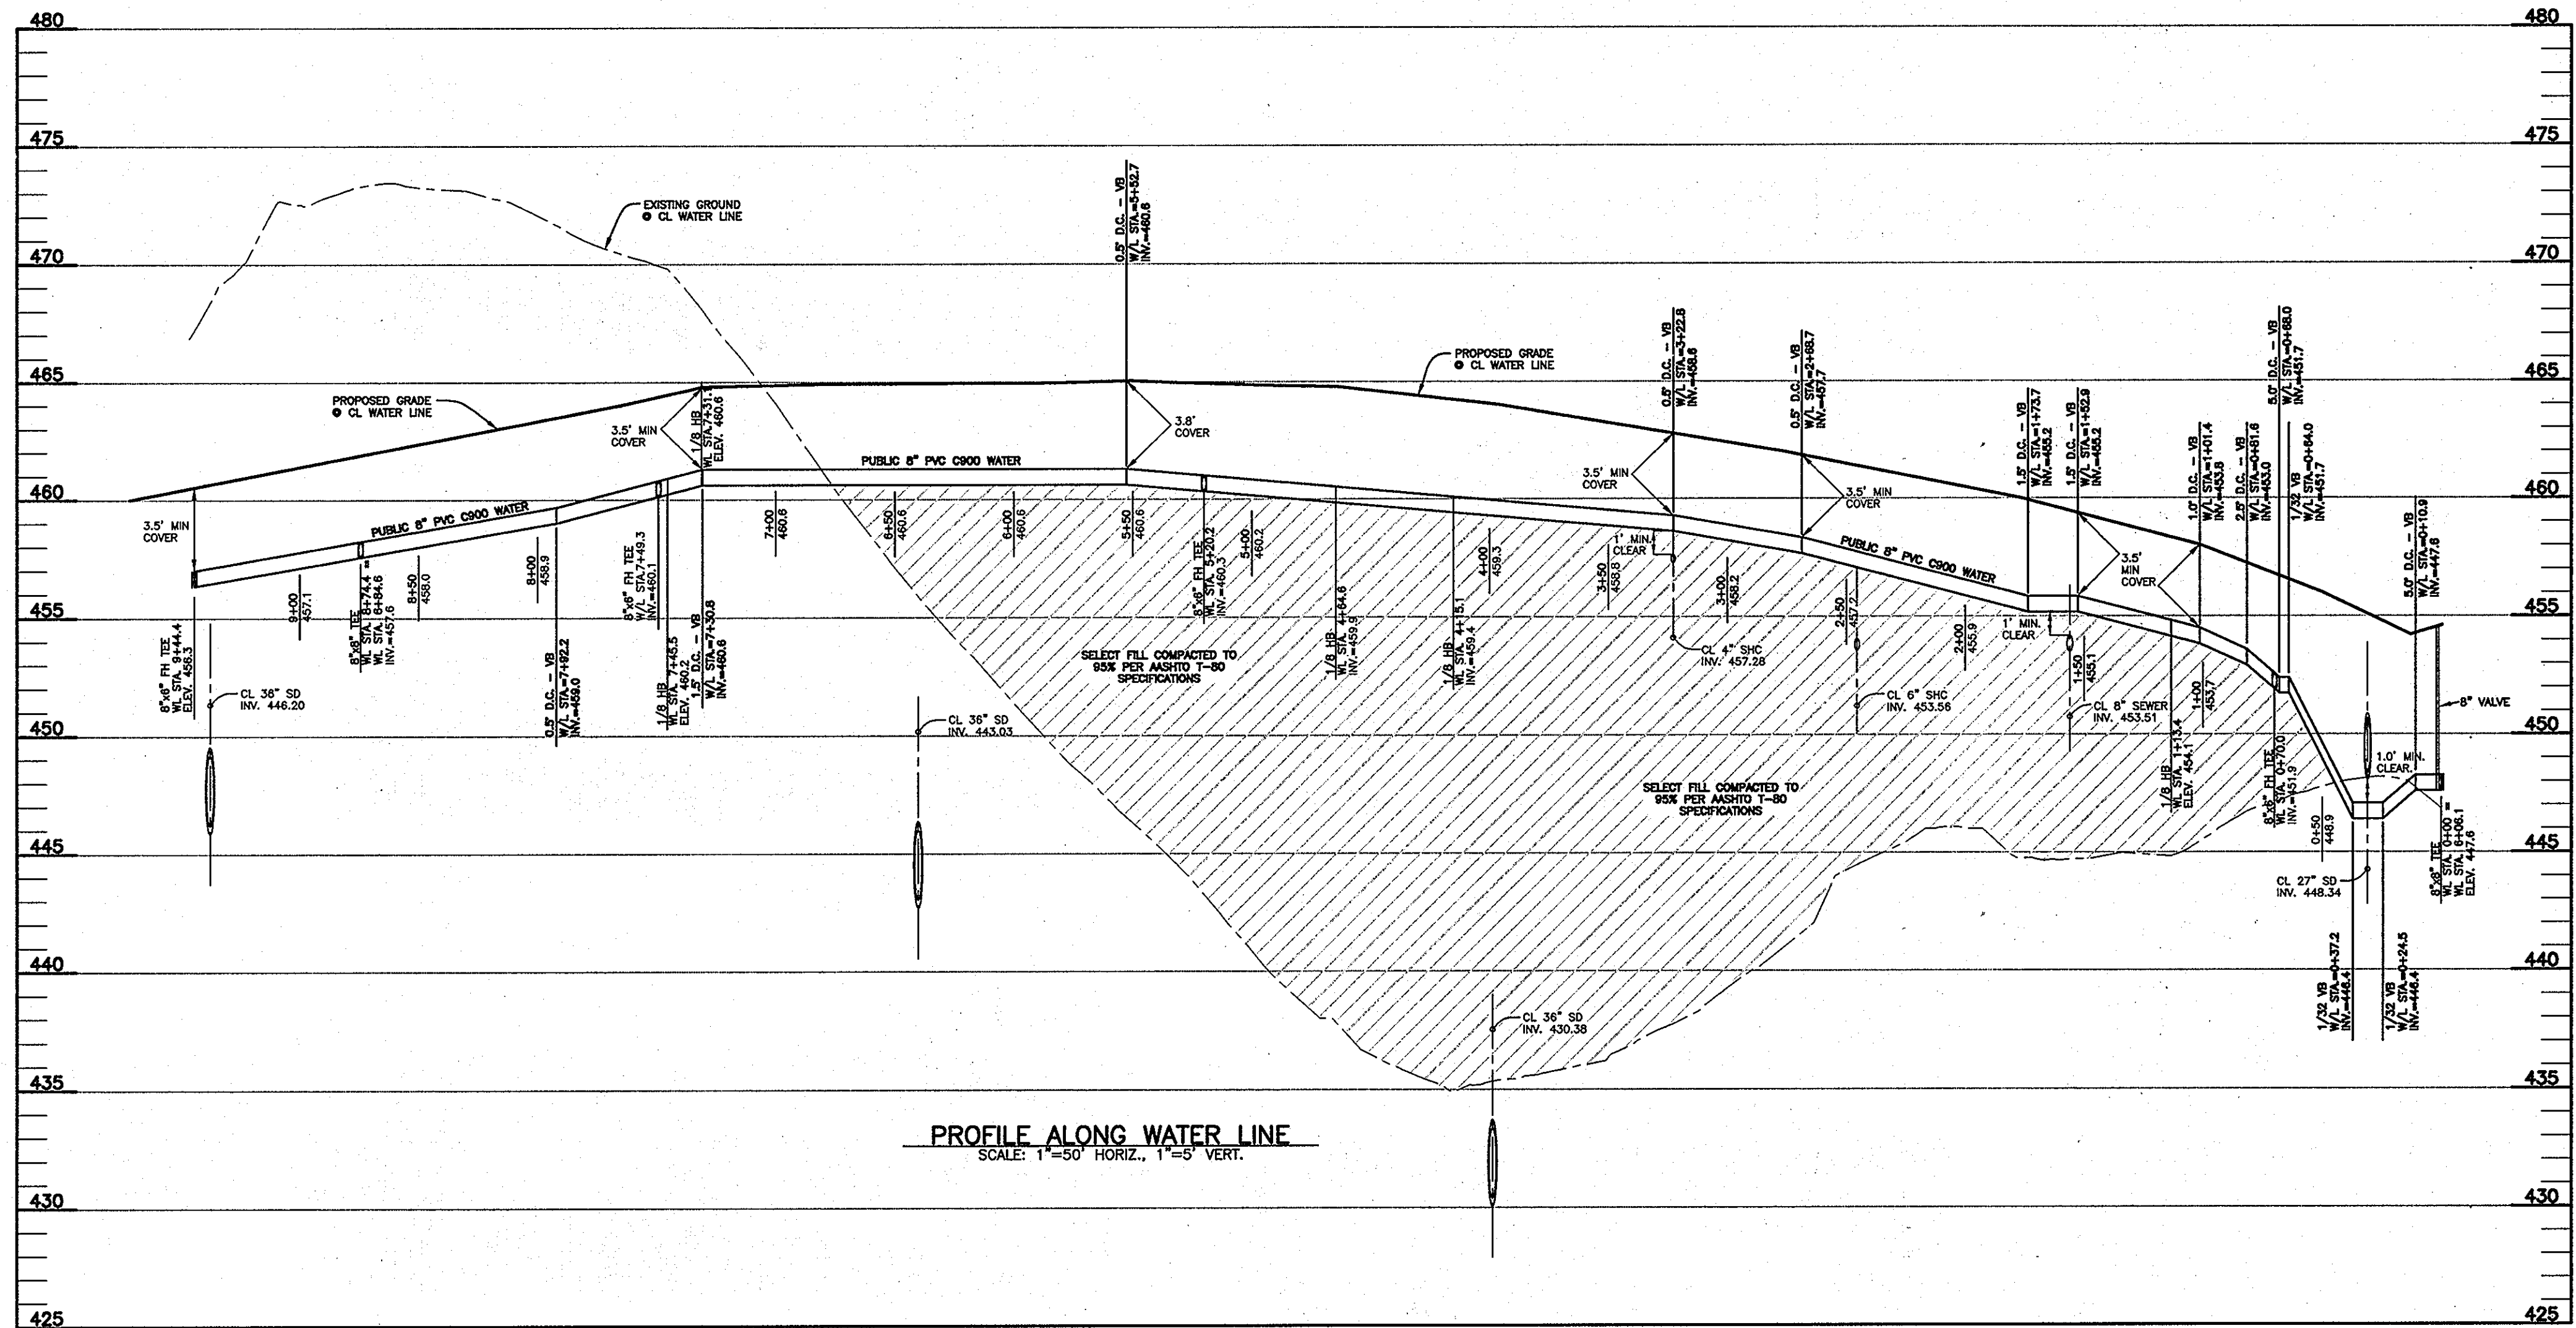

THE PURPOSE OF THIS REPLACEMENT SHEET IS TO REVISE THE WATER MAIN MATERIAL FROM D.I.P. TO PVC C900 DR-18.

DEPARTMENT OF PUBLIC WORKS  
HOWARD COUNTY, MARYLAND


*Steve C. Kern* 9/2/11  
CHIEF, BUREAU OF UTILITIES

DEPARTMENT OF PLANNING AND ZONING  
HOWARD COUNTY, MARYLAND

*John J. ...* 9/2/11  
CHIEF, DEVELOPMENT ENGINEERING DIVISION

**BENCHMARK**  
ENGINEERS & LAND SURVEYORS & PLANNERS  
**ENGINEERING, INC.**

8480 BALTIMORE NATIONAL PIKE SUITE 418 A ELIJAH CITY, MARYLAND 21043  
(P) 410-465-8105 (F) 410-465-8944  
80 THOMAS JOHNSON DRIVE A FREDERICK, MARYLAND 21702  
(P) 301-371-3555 (F) 301-371-3556  
WWW.BE-CVAENGINEERING.COM

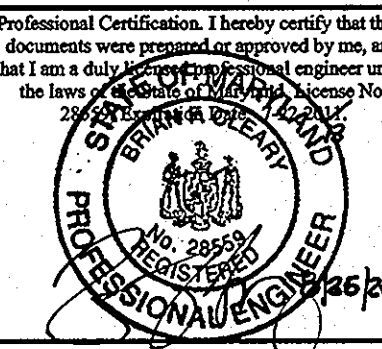

DESIGN: MCR/DBT			
DRAFT: JMC/DBT			
CHK: --	BE1	1	REVISE WATER TO BE PVC C900 DR-18
DATE: 08/2011	BE1	1	REVISE WATER FROM STA. 2450 TO 2452.7
			REVISE WATER AT 27\"/>
			DATE: 4-14-2011
	BY	NO.	REVISIONS

**REVISED PROFILES OF PUBLIC WATER MAINS**

600 SCALE MAP: 16 BLOCK: 16 200 SCALE MAP: 146

**TOWN SQUARE AT TURF VALLEY**  
PARCEL 'J' AND OPEN SPACE LOT 3 OF  
TURF VALLEY PROFESSIONAL BUILDINGS  
**CONTRACT NO. 44 4653-D**

SCALE:  
AS SHOWN

SHEET NO.  
4 OF 4