



QUANTITY TABLE

ITEMS	QUANTITIES ESTIMATED	QUANTITIES		MANUFACTURER/SUPPLIER
		QUANTITIES	TYPE	
STANDARD MH (HO. CO. STD.G-5.12)	2 EACH			
8" SEWER MAIN	190 LF			
4" SHC	75 L.F.			
# 4" SHC	3 EACH			
8" WATER MAIN (PVC C-900, DR-18)	235 LF			
1 1/2" WATER HOUSE CONNECTION	42 LF			
# 1 1/2" WHC	3 EACH			
8"x12" T. S. & V	1 EACH			
8" CAP & BUTTRESS	1 EACH			
NAME OF UTILITY CONTRACTOR:				
SURVEY AND DRAFTING DIVISION AS-BUILT DATE				

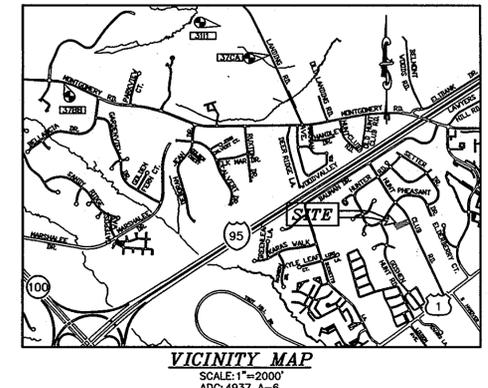

GENERAL NOTES

- APPROXIMATE LOCATIONS OF EXISTING MAINS ARE SHOWN. THE CONTRACTOR SHALL TAKE ALL NECESSARY PRECAUTIONS TO PROTECT EXISTING MAINS AND SERVICES AND MAINTAIN UNINTERRUPTED SERVICE. ANY DAMAGE INCURRED SHALL BE REPAIRED IMMEDIATELY TO THE SATISFACTION OF THE ENGINEER AT THE CONTRACTOR'S EXPENSE.
- TOPOGRAPHY SHOWN HEREON IS BASED ON A FIELD RUN SURVEY PERFORMED ON OR ABOUT AUGUST 2012 BY MILDENBERG, BOENDER ASSOCIATES.
- HORIZONTAL AND VERTICAL SURVEY CONTROLS: THE COORDINATES SHOWN ON THE DRAWINGS ARE BASED ON MARYLAND STATE REFERENCE SYSTEM NAD '83/91 AS PROJECTED BY HOWARD COUNTY GEODETIC CONTROL STATIONS NO. 311 AND NO. 37CA. ALL VERTICAL CONTROLS ARE BASED ON NAVD '88. VERTICAL CONTROLS PROVIDED ON THE DRAWINGS ARE HO.CO. GEODETIC CONTROL STA. 3111 AND 37CA.
- ALL PIPE ELEVATIONS SHOWN ARE INVERT ELEVATIONS UNLESS OTHERWISE NOTED ON THE PLANS.
- CLEAR ALL UTILITIES BY A MINIMUM OF 12 INCHES. CLEAR ALL POLES BY 5'-0" MINIMUM OR TUNNEL AS REQUIRED UNLESS OTHERWISE NOTED. THE OWNER HAS CONTACTED THE UTILITY COMPANIES AND HAS MADE ARRANGEMENTS FOR BRACING OF POLES AS SHOWN ON THE DRAWINGS. IN THE EVENT THE CONTRACTOR'S WORK REQUIRES THE BRACING OF ADDITIONAL POLES, ANY COST INCURRED BY THE OWNER FOR THE BRACING OF ADDITIONAL POLES OR DAMAGES SHALL BE DEDUCTED FROM MONIES OWED THE CONTRACTOR. THE CONTRACTOR SHALL COORDINATE WITH THE UTILITY COMPANIES TO SCHEDULE THE BRACING OF THE POLES.
- FOR DETAILS NOT SHOWN ON THE DRAWING, AND FOR MATERIALS AND CONSTRUCTION METHODS, USE HOWARD COUNTY DESIGN MANUAL, VOLUME IV, STANDARD SPECIFICATIONS AND DETAILS FOR CONSTRUCTION (LATEST EDITION). THE CONTRACTOR SHALL HAVE A COPY OF VOLUME IV ON THE JOB.
- WHERE TEST PITS HAVE BEEN MADE ON EXISTING UTILITIES, THEY ARE NOTED BY THE SYMBOL AT THE LOCATIONS OF THE TEST PITS. A NOTE OR NOTES CONTAINING THE RESULTS OF THE TEST PIT OR PITS IS INCLUDED ON THE DRAWINGS. EXISTING UTILITIES IN THE VICINITY OF THE PROPOSED WORK FOR WHICH TEST PITS HAVE NOT BEEN DUG SHALL BE LOCATED BY THE CONTRACTOR TWO WEEKS IN ADVANCE OF CONSTRUCTION OPERATIONS AT HIS OWN EXPENSE.
- THE CONTRACTOR SHALL NOTIFY THE FOLLOWING UTILITY COMPANIES OR AGENCIES AT LEAST FIVE WORKING DAYS BEFORE STARTING WORK SHOWN ON THESE PLANS:
 - AT&T.....1-800-252-1133
 - BGE(CONTRACTOR SERVICES).....410-637-8713
 - BGE(EMERGENCY).....410-685-0123
 - BUREAU OF UTILITIES.....410-313-4900
 - COLONIAL PIPELINE CO.....410-795-1390
 - STATE HIGHWAY ADMINISTRATION.....410-531-5533
 - VERIZON.....1-800-743-0033/410-224-9210
 - MISS UTILITY.....1-800-257-7777
- TREES AND SHRUBS ARE TO BE PROTECTED FROM DAMAGE TO THE MAXIMUM EXTENT. TREES AND SHRUBS LOCATED WITHIN THE CONSTRUCTION STRIP ARE NOT TO BE REMOVED OR DAMAGED BY THE CONTRACTOR.
- THE CONTRACTOR SHALL REMOVE TREES, STUMPS AND ROOTS ALONG THE LINE OF EXCAVATION. PAYMENT FOR SUCH REMOVAL SHALL BE INCLUDED IN THE UNIT PRICE BID FOR CONSTRUCTION OF THE MAIN.
- THE CONTRACTOR SHALL NOTIFY THE BUREAU OF HIGHWAYS, HOWARD COUNTY, AT (410)313-7450 AT LEAST FIVE WORKING DAYS BEFORE OPEN CUTTING OR BORING/JACKING OF ANY COUNTY ROAD FOR LAYING WATER/SEWER MAINS OR HOUSE CONNECTIONS. THE APPROVAL OF THESE DRAWINGS WILL CONSTITUTE COMPLIANCE WITH DPW REQUIREMENTS PER SECTION 18.114(a) OF THE HOWARD COUNTY CODE.

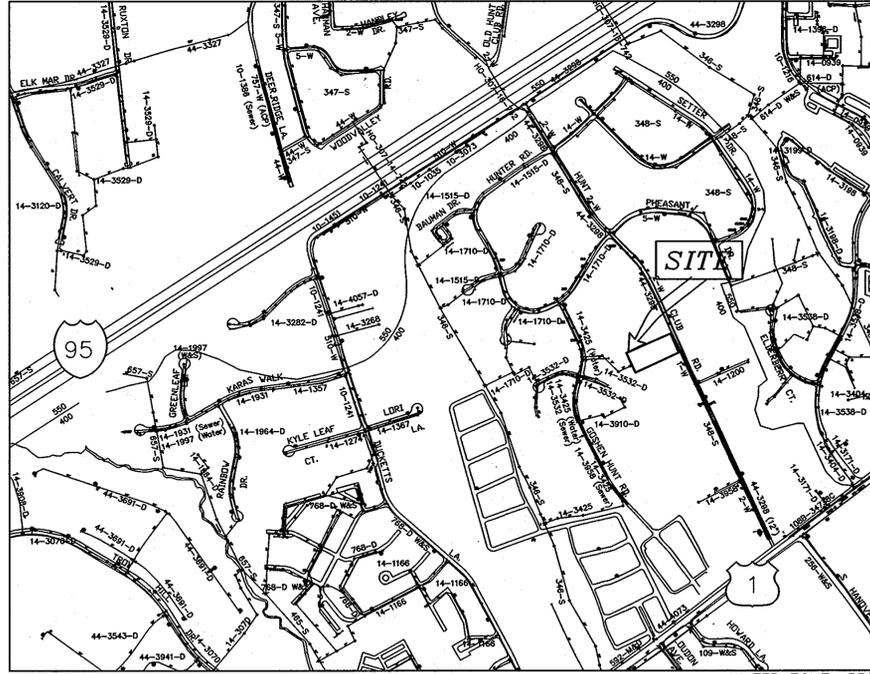

LOCATION MAP

SCALE: 1" = 600'

TYPE OF BUILDING	RESIDENTIAL
No. OF UNITS	4
No. OF WATER HOUSE CONNECTION	3
No. OF SEWER HOUSE CONNECTIONS	3
DRAINAGE AREA	PATAPSCO
TREATMENT PLANT	PATAPSCO

BM#1	BM#2
N 559,900.34	N 560,043.15
E 1,385,849.83	E 1,386,196.81
EL. 192.71	EL. 214.81

INDEX OF DRAWINGS

NO.	DESCRIPTION
1	TITLE SHEET
2	PRELIMINARY WATER AND SEWER PLAN AND PROFILES

EROSION AND SEDIMENT CONTROL FOR THIS CONTRACT IS PROVIDED UNDER : F-13-061

LEGEND

- EXISTING SEWER MAIN AND MANHOLE
- EXISTING WATER MAIN AND VALVE
- EXISTING FIRE HYDRANT
- PROPOSED SEWER MAIN
- PROPOSED SEWER HOUSE CONNECTION
- PROPOSED SEWER MANHOLE
- PROPOSED WATER MAIN
- PROPOSED WATER HOUSE CONNECTION
- PROPOSED FIRE HYDRANT

PROPERTY OWNER

HARMONY BUILDERS
4228 COLUMBIA ROAD
ELLCOTT CITY, MARYLAND 21042
(410)465-7200

I/WE CERTIFY THAT ALL DEVELOPMENT AND CONSTRUCTION WILL BE DONE ACCORDING TO THIS PLAN, AND THAT ANY RESPONSIBLE PERSONNEL INVOLVED IN THE CONSTRUCTION PROJECT WILL HAVE A CERTIFICATE OF ATTENDANCE AT A DEPARTMENT OF THE ENVIRONMENT APPROVED TRAINING PROGRAM FOR THE CONTROL OF SEDIMENT AND EROSION BEFORE BEGINNING THE PROJECT. I ALSO AUTHORIZE PERIODIC ON-SITE INSPECTION BY THE HOWARD SOIL CONSERVATION DISTRICT.

DEVELOPER'S SIGNATURE
SCOTT GODWIN
DEVELOPER'S NAME
08/19/13
DATE

I HEREBY CERTIFY THAT THIS PLAN FOR EROSION AND SEDIMENT CONTROL REPRESENTS A PRACTICAL AND WORKABLE PLAN BASED ON MY PERSONAL KNOWLEDGE OF THE SITE CONDITIONS AND THAT IT WAS PREPARED IN ACCORDANCE WITH THE REQUIREMENTS OF THE HOWARD SOIL CONSERVATION DISTRICT.

ENGINEER'S SIGNATURE
JEFFREY SLOMAN P.E.
ENGINEER'S NAME
8/16/13
DATE

THIS DEVELOPMENT PLAN IS APPROVED FOR SOIL EROSION AND SEDIMENT CONTROL BY THE SOIL CONSERVATION DISTRICT.

HOWARD SCD
9/16/13
DATE

PLAN REFERENCE NUMBERS:
ECP 13-015, F-13-061

I HEREBY CERTIFY THAT THESE DOCUMENTS WERE PREPARED OR APPROVED BY ME AND THAT I AM A DULY LICENSED PROFESSIONAL ENGINEER UNDER THE LAWS OF THE STATE OF MARYLAND, LICENSE NO. 40091, EXP DATE 2/13/15

JEFFREY SLOMAN P.E.
8/16/13
DATE

CONTRACT NO.: 14-4799-D
LOCKE PROPERTY
LOTS 1 THRU 4
WATER AND SEWER MAIN EXTENSION
HOWARD COUNTY, MARYLAND
DEPARTMENT OF PUBLIC WORKS

- WATER**
- ALL WATER MAINS SHALL BE PVC (C-900), DR-18 UNLESS OTHERWISE NOTED.
 - TOPS OF ALL WATER MAINS SHALL HAVE A MINIMUM OF 3' - 6" OF COVER UNLESS OTHERWISE NOTED.
 - VALVES ADJACENT TO TEES SHALL BE STRAPPED TO TEES.
 - ALL FITTINGS SHALL BE BUTTRESSED OR ANCHORED WITH CONCRETE IN ACCORDANCE WITH STANDARD DETAILS UNLESS OTHERWISE PROVIDED FOR ON THE DRAWINGS.
 - FIRE HYDRANTS SHALL BE SET TO THE BURY LINE ELEVATIONS SHOWN ON THE DRAWINGS. ALL FIRE HYDRANTS SHALL BE INSTALLED IN ACCORDANCE WITH STANDARD DETAILS. THE SOIL AROUND THE FIRE HYDRANT SHALL BE COMPACTED IN ACCORDANCE WITH SECTION 1000 AND SECTION 1005 OF THE STANDARD SPECIFICATIONS. THE CONTRACTOR SHALL NOT OPERATE ANY WATER MAIN VALVES ON THE EXISTING WATER SYSTEM.
 - TRACER WIRE AND CONTINUITY TEST STATIONS SHALL BE INSTALLED ON ALL DIP AND PVC WATER MAINS IN ACCORDANCE WITH THE HOWARD COUNTY DESIGN MANUAL.
 - FOR PVC WATER MAINS, ALL RECORDS FOR THE QUALITY CONTROL AND QUALIFICATION TEST REQUIREMENTS NOTED IN SECTION 5.1 OF THE AWWA STANDARD C900 FOR PVC PRESSURE PIPE SHALL BE SUBMITTED WITH THE PIPE MATERIAL CERTIFICATIONS OR SHOP DRAWINGS PRIOR TO APPROVAL OF THE MATERIAL FOR USE. THE TEST RECORDS SHALL BE FOR THE PIPE TO BE INSTALLED UNDER THIS CONTRACT. ALL PVC PIPE SHALL CONTAIN MARKINGS TO ALLOW CROSS-REFERENCING OF THE PIPE SUPPLIED TO THE TEST RECORDS RECEIVED.
 - UNLESS OTHERWISE NOTED ON THE PLANS OR IN THE SPECIFICATIONS, SEVENTEEN (17) POND SACRIFICIAL ANODES SHALL BE INSTALLED ON ALL VALVES AND METALLIC FITTINGS USED WITH PVC WATER MAINS IN ACCORDANCE WITH VOLUME IV, STANDARD SPECIFICATIONS AND DETAILS FOR CONSTRUCTION. MAGNESIUM ANODES SHALL BE INSTALLED ON ALL VALVES AND DUCTILE IRON FITTINGS INCLUDING RESTRAINTS AND HARNESSES. ZINC ANODES SHALL BE INSTALLED ON ALL STAINLESS STEEL FITTINGS AND SADDLES USED WITH PVC MAINS. ALL "T" USED WITH PVC MAINS SHALL BE DUCTILE IRON.
 - ALL NEW WATER MAIN JOINTS ARE TO BE RESTRAINED.
 - FOR A MINIMUM 1.5" WHC FOR SINGLE FAMILY DWELLINGS OUTSIDE METER SETTINGS FOR 1' METERS SHALL BE USED.
- SEWER**
- ALL SEWER MAINS SHALL BE P.V.C. UNLESS OTHERWISE NOTED.
 - ALL MANHOLES SHALL BE 4'-0" INSIDE DIAMETER UNLESS OTHERWISE NOTED.
 - FORCE MAINS SHALL BE D.I.P. ONLY.
 - MANHOLES SHOWN WITH 12" AND 16" WALLS ARE FOR BRICK MANHOLES ONLY.
 - MANHOLES DESIGNATED W.T. IN PLAN AND PROFILE SHALL HAVE WATERTIGHT FRAME AND COVER, STANDARD DETAIL G5.52. WHERE WATERTIGHT MANHOLE FRAMES AND COVERS ARE USED, SET TOP OF FRAME 1'-6" ABOVE FINISHED GRADE UNLESS OTHERWISE NOTED ON THE DRAWINGS.
 - HOUSE(S) WITH THE SYMBOL "C.N.S." INDICATED THAT THE CELLAR CANNOT BE SERVED.

DEPARTMENT OF PUBLIC WORKS
HOWARD COUNTY, MARYLAND

CHIEF, BUREAU OF UTILITIES
8/16/13
DATE

DEPARTMENT OF PLANNING & ZONING
HOWARD COUNTY, MARYLAND

CHIEF, DEVELOPMENT ENGINEERING DIVISION
9-12-13
DATE

MILDENBERG, BOENDER & ASSOC., INC.
Engineers Planners Surveyors
6800 Deerpath Road, Suite 150, Ellicott City, Maryland 21075
(410) 897-0286 Fax (410) 897-0288 Fax




engineering	MMM				
illustration	MMM				
approval	JLS				
project	12-015				
date	AUG. 2013	BY	NO.	REVISION	DATE

TITLE SHEET


600' SCALE MAP NO. 38 BLOCK NO. 7

LOCKE PROPERTY
LOTS: 1 THRU 4
CONTRACT NO. 14-4799-D
FIRST ELECTION DISTRICT
HOWARD COUNTY


H: 12-015 LOCKE PROPERTY.DWG 12-015-W-S.DWG

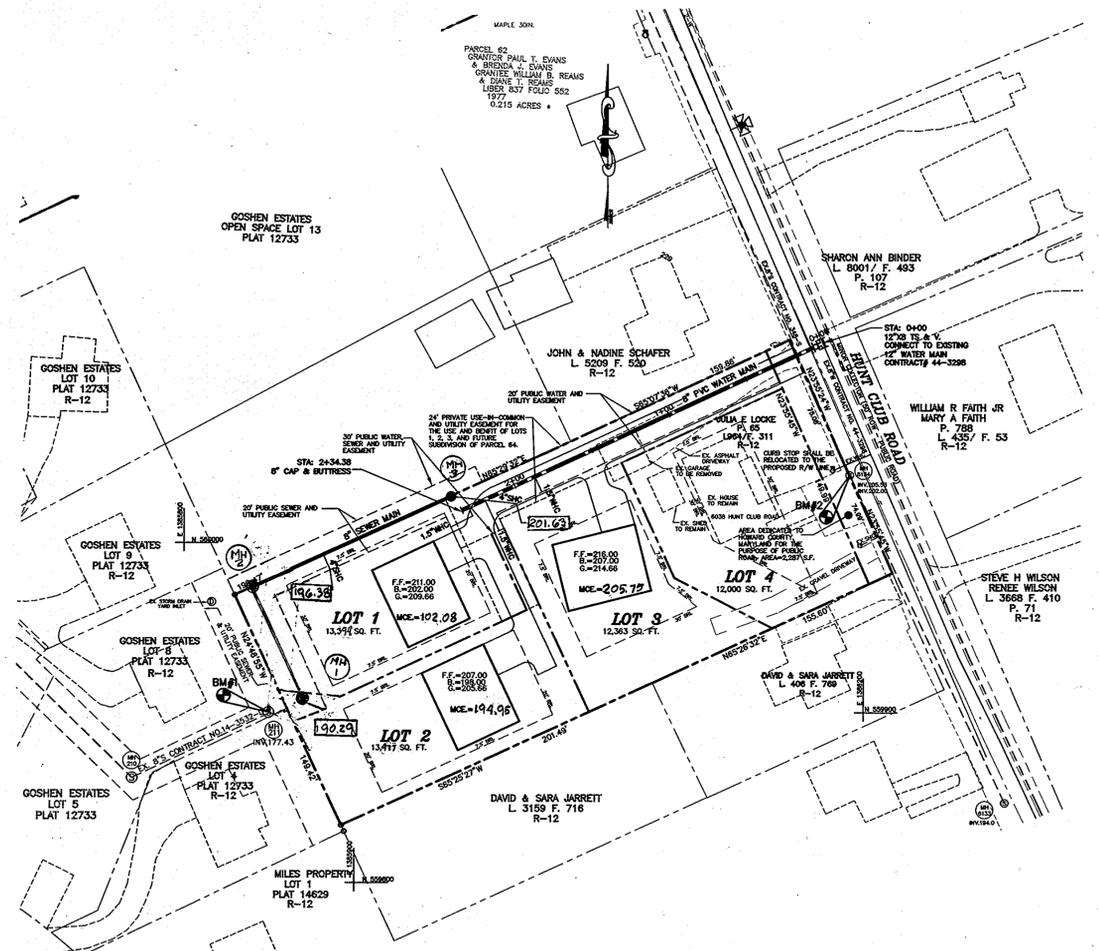

PLAN VIEW
SCALE 1" = 50'

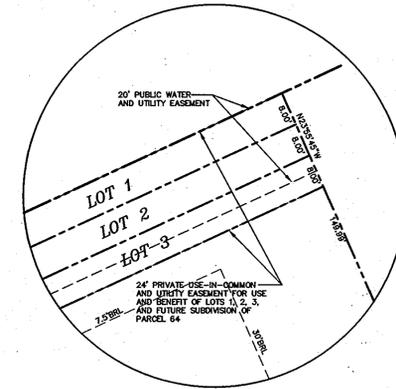


FRONTAGE DETAIL
SCALE 1" = 20'

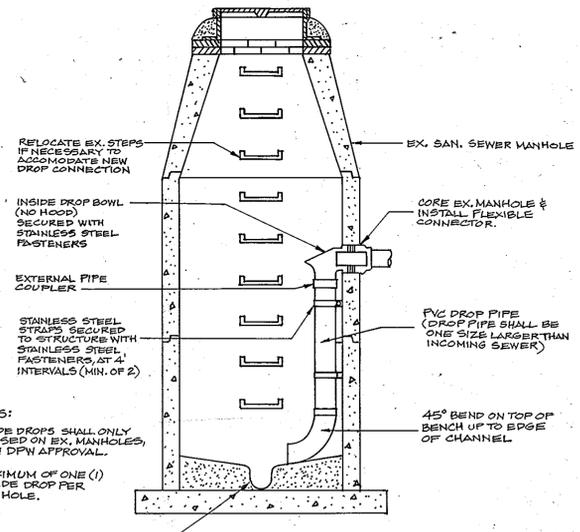


DETAIL 5-1.33
INSIDE DROP-EXISTING MANHOLE
NOT TO SCALE

- NOTES:
- INSIDE DROPS SHALL ONLY BE USED ON EX. MANHOLES, WITH DFW APPROVAL.
 - MAXIMUM OF ONE (1) INSIDE DROP PER MANHOLE.

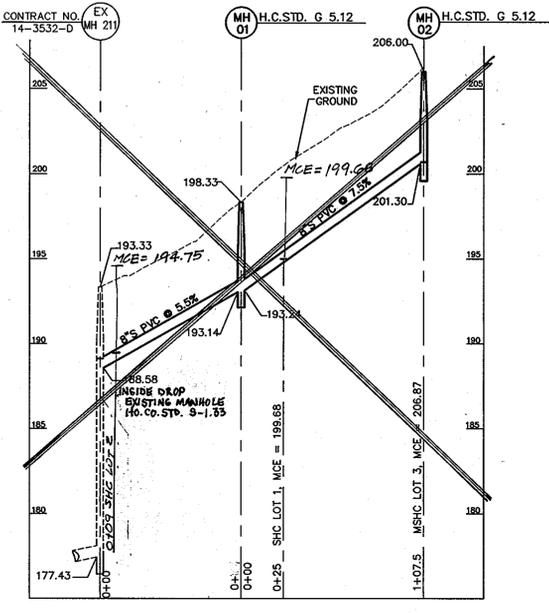

SEWER PROFILE
SCALE: HOR. 1" = 50'
VER. 1" = 5'

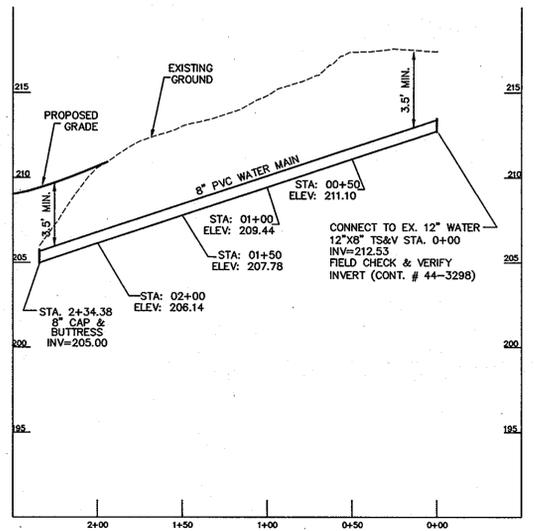

WATER PROFILE
SCALE: HOR. 1" = 50'
VER. 1" = 5'

8" WATER MAIN TABULATION CHART

APPURTENANCE	LOCATION (NORTHING & EASTING)
12"x8" TS & V	N 560,117.54 E 1,386,176.14
8" CAP AND BUTTRESS	N 560,018.95 E 1,385,963.50

MANHOLE LOCATION CHART

MH #	LOCATION (NORTHING & EASTING)
MH 01	N 559,909.07 E 1,385,808.73
MH 02	N 559,973.55 E 1,385,338.96
MH 03	N 560,027.20 E 1,385,957.17

SEWER HOUSE CONNECTION TABLE


LOT #	% SLOPE	INV. @ 8'S	INV. @ R.O.W.	MCE
1	2%	196.18	196.38	201.08
2	2%	196.05	196.25	194.95
3	2%	200.85	201.05	205.75

WATER HOUSE CONNECTION AS-BUILT LOCATION TABLE

LOT	ADDRESS	LOCATION DIMENSION 1	LOCATION DIMENSION 2
1	HUNT CLUB ROAD		
2	HUNT CLUB ROAD		
3	HUNT CLUB ROAD		
4	HUNT CLUB ROAD		

SEWER HOUSE CONNECTION AS-BUILT LOCATION TABLE

LOT	ADDRESS	LOCATION DIMENSION 1	LOCATION DIMENSION 2
1	HUNT CLUB ROAD		
2	HUNT CLUB ROAD		
3	HUNT CLUB ROAD		
4	HUNT CLUB ROAD		

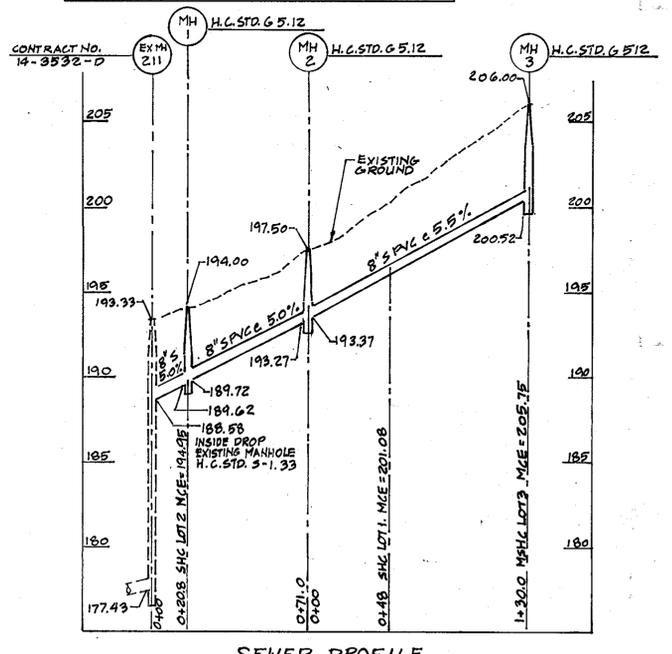

SEWER PROFILE
SCALE: HOR. 1" = 50'
VER. 1" = 5'

I HEREBY CERTIFY THAT THESE DOCUMENTS WERE PREPARED OR APPROVED BY ME AND THAT I AM A DULY LICENSED PROFESSIONAL ENGINEER UNDER THE LAWS OF THE STATE OF MARYLAND, LICENSE NO. 40091, EXP DATE 2/13/15

Jeffrey S. Sloman 8/16/13
JEFFREY S. SLOMAN P.E. DATE

DEPARTMENT OF PUBLIC WORKS
HOWARD COUNTY, MARYLAND

Steve Green
CHIEF, BUREAU OF UTILITIES

DEPARTMENT OF PLANNING & ZONING
HOWARD COUNTY, MARYLAND

Chad Edwards 9-12-13
CHIEF, DEVELOPMENT ENGINEERING DIVISION

MILDENBERG, BOENDER & ASSOC., INC.
Engineers Planners Surveyors
6800 Deerpath Road, Suite 150, Elkridge, Maryland 21075
(410) 937-0286 Cell (410) 937-0288 Fax



engineering	illustration	approval	project	date	BY	NO.	REVISION	DATE
MMM	MMM	MBA	12-015	AUG. 2013				
		MBA					REV. SEWER ALIGNMENT, REV. PROFILE & MCE	FEB. 14
		MBA					REPLACED DROP 'B' CONNECTION WITH INSIDE DROP CONNECTION TO EX. MANHOLE, REPLICATE SHC FOR LOT 1.	OCT. 13
		MBA					REV. MCE FOR LOT 1, CORRECT AREA OF LOTS 1 & 2	

WATER AND SEWER PLAN AND PROFILES

600' SCALE MAP NO. 38 BLOCK NO. 7

LOCKE PROPERTY
LOTS: 1-4,
CONTRACT NO. 14-4799-D
FIRST ELECTION DISTRICT
HOWARD COUNTY