



QUANTITIES				
ITEM	ESTIMATED	AS-BUILT		SUPPLIER
		QUANTITIES	TYPE	
8" SDR-35	634 L.F.	611 L.F.	SDR-35	NORTH AMERICAN
4" SDR-35	40 L.F.	35 L.F.	SDR-35	JIM EAGLE
MANHOLES	5 EACH	5 EA	CONCRETE	BACK RIVER
CLEAN-OUT	4 EACH	4 EA	CONCRETE	BACK RIVER
3" L.P.S.: PVC	478 L.F.	220 L.F.		
2" LATERAL: PVC	1,864 L.F.	1,047 L.F.		
DRAINFIELD TRENCH	2,084 L.F.	2,084 L.F.		
3,000 GAL. SETTLING TANK	2 EACH	2 EA		BACK RIVER
3,000 GAL. PUMP TANK	1 EACH	1 EA		BACK RIVER
ELECTRICAL CONTROLS & TELEMETRY CONTROL / MAINTENANCE BUILDING	1 EACH			
8" ISOLATION GATE VALVE	1 EACH			

NAME OF UTILITY CONTRACTOR: HTI CONTRACTORS & HYDRO TERRA GROUP  
SURVEY & DRAFTING DIVISION AS-BUILT DATE:

**BENCHMARK INFORMATION**

B.M.#1 - HOWARD COUNTY CONTROL STATION #22A - HORIZONTAL - (NAD '83)  
LOCATED ALONG ROUTE 32, APPROX. 2.3' OFF EDGE OF PAVING, APPROX. .45 MILES EAST OF PFEFFERKORN ROAD AND APPROX. .25 MILES WEST OF WEST IVORY ROAD  
N 587,502.739  
E 1,317,898.020  
ELEVATION = 568.926 - VERTICAL - (NAVD '86)

B.M.#2 - HOWARD COUNTY CONTROL STATION #22AC - HORIZONTAL - (NAD '83)  
LOCATED ALONG THE ROUND ABOUT AT PFEFFERKORN ROAD & BUENTWOOD ROAD, ALONG THE NORTH/EAST SIDE OF THE ROUND ABOUT, APPROX. 4' OFF EDGE OF PAVING AND 7' NORTH OF A YIELD TRAFFIC SIGN  
N 585,110.892  
E 1,315,756.722  
ELEVATION = 643.880 - VERTICAL - (NAVD '86)

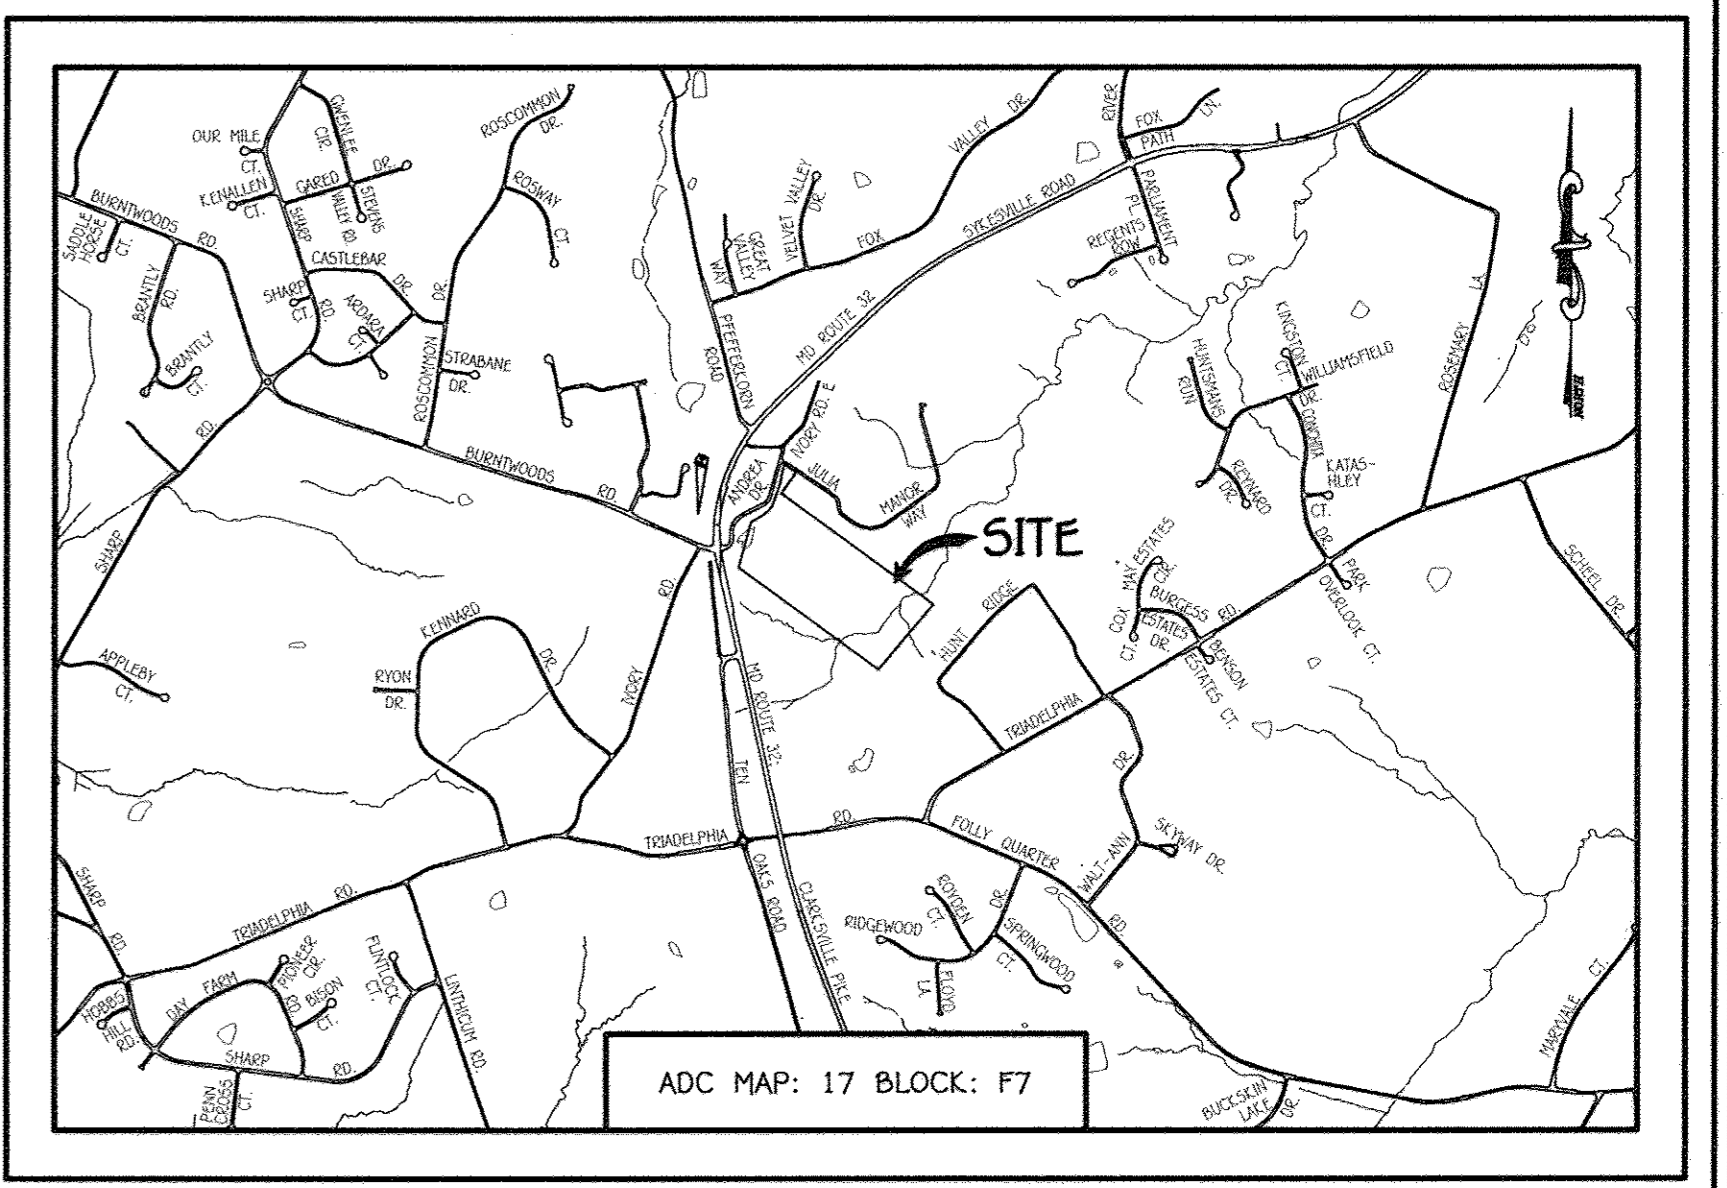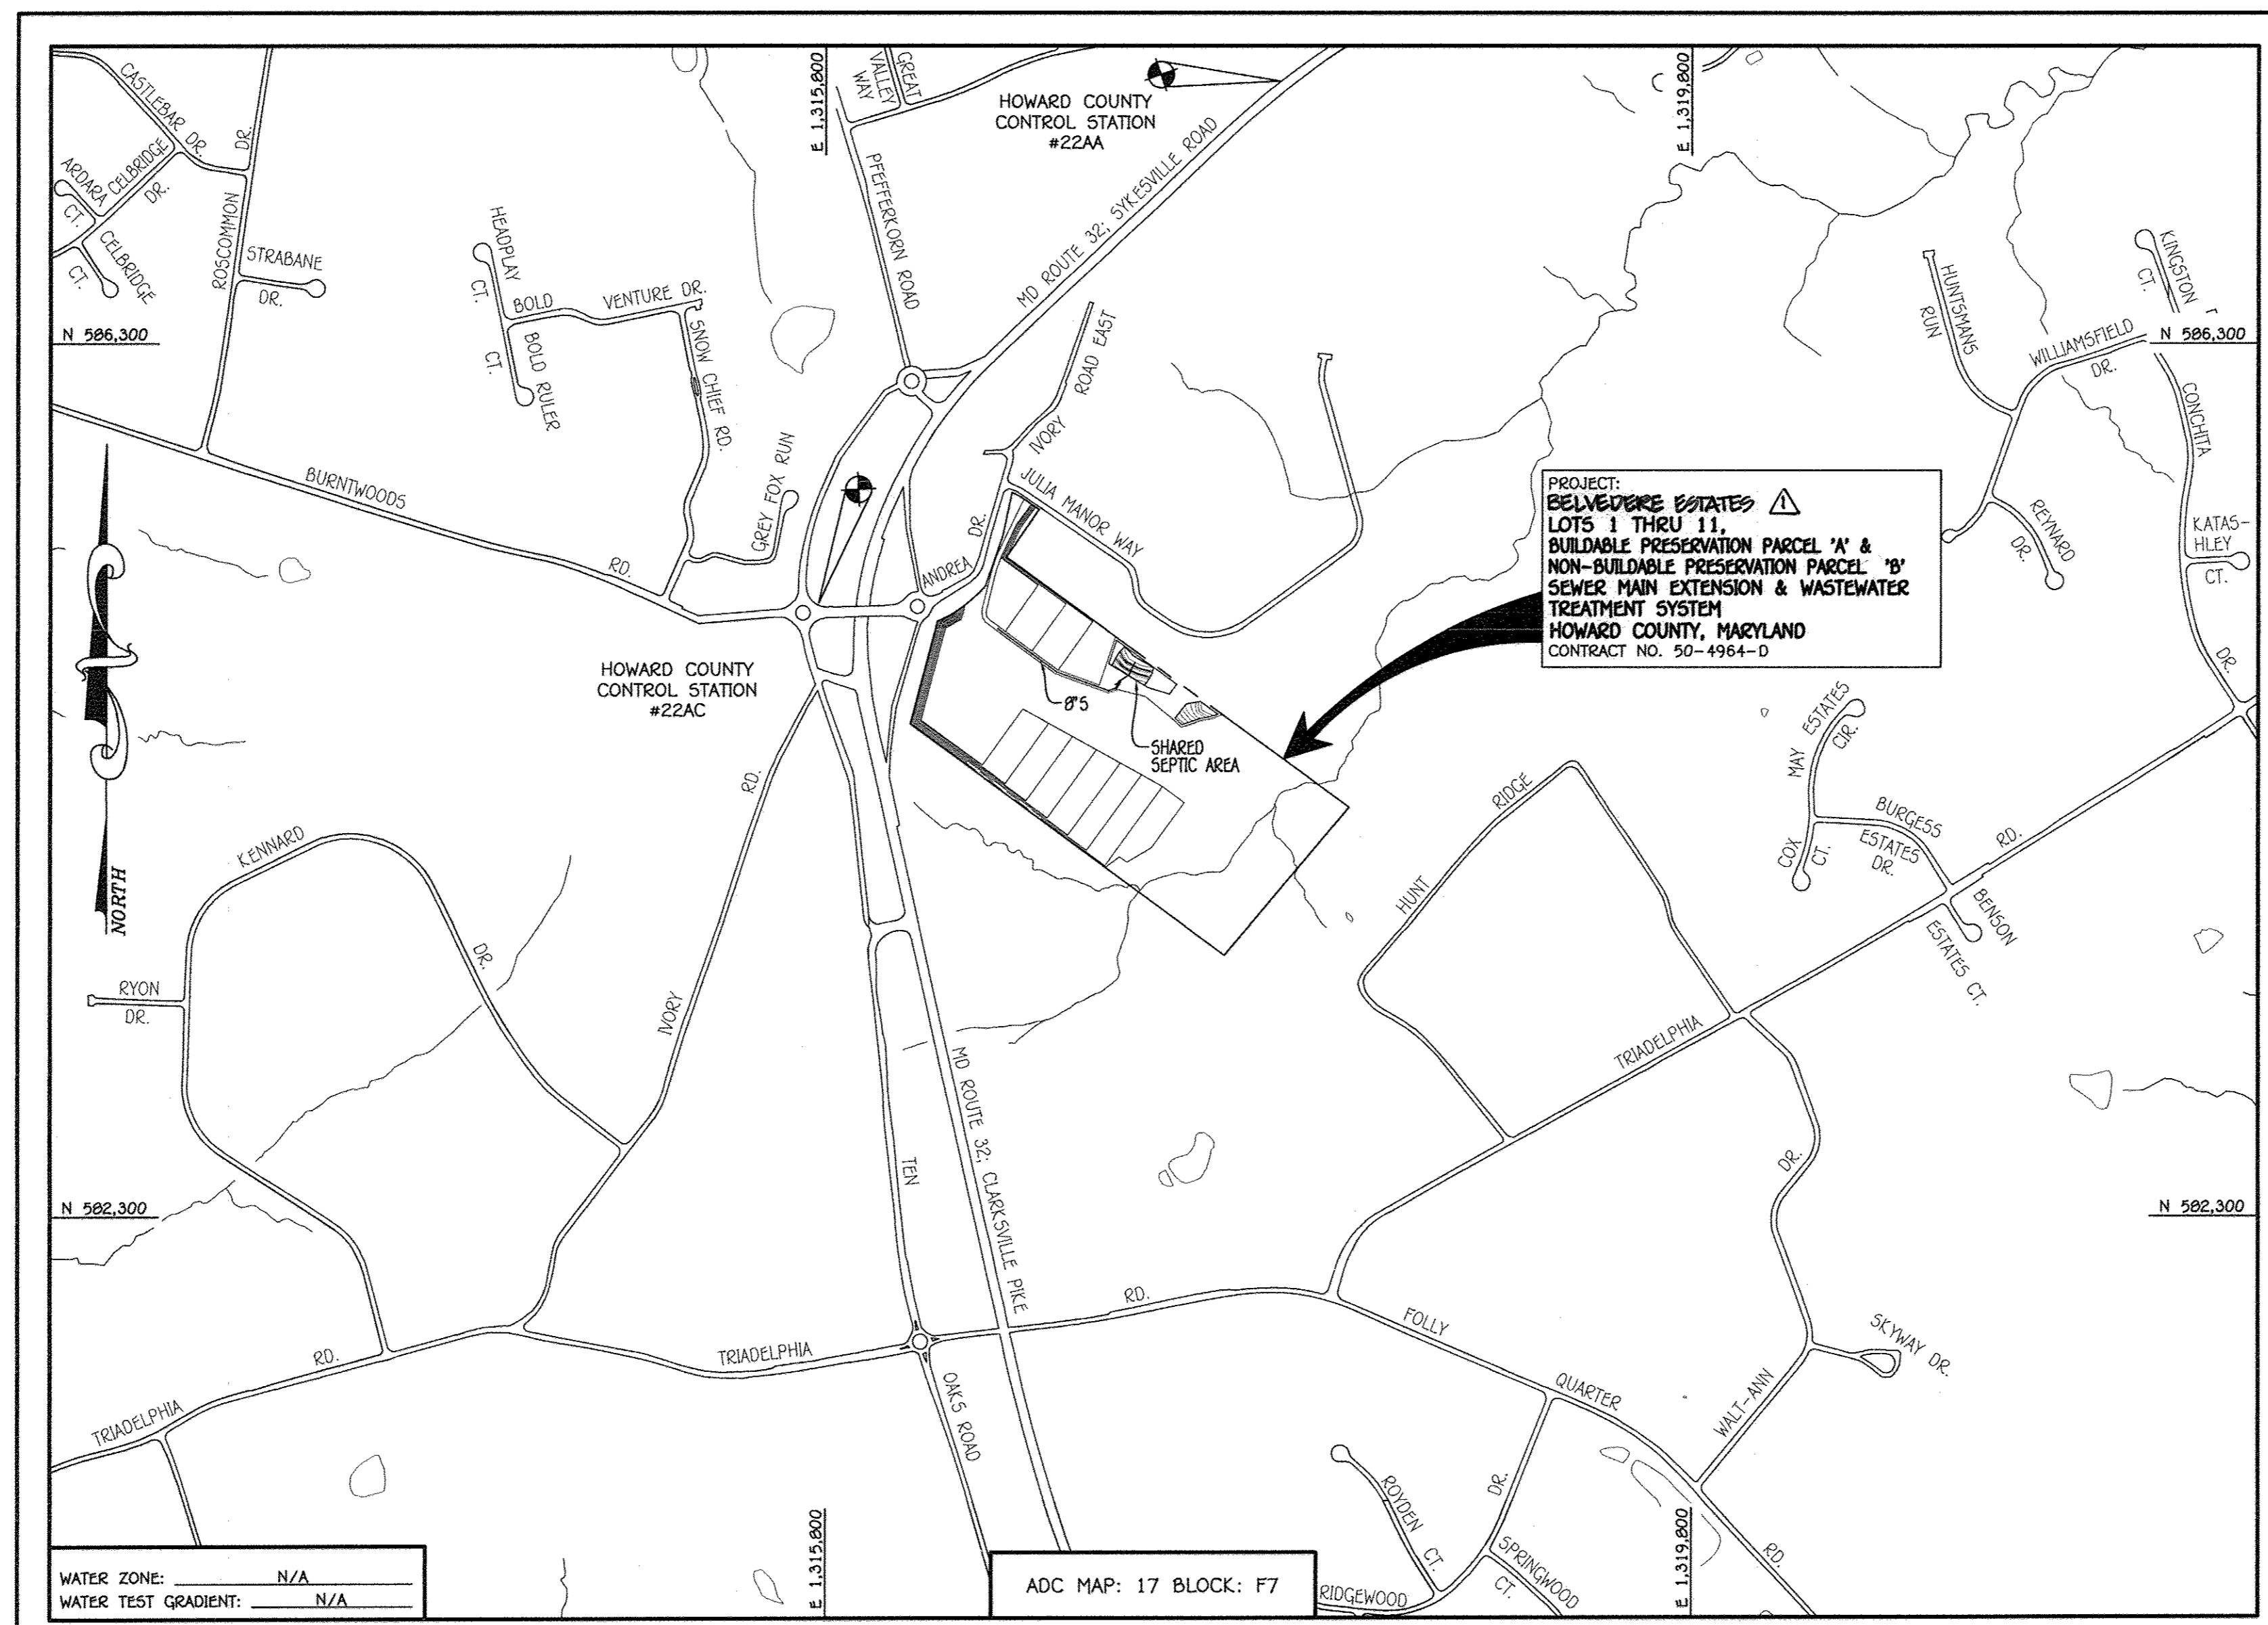

- GENERAL NOTES**  
SCALE: 1" = 2000'
- PART A**
- APPROXIMATE LOCATIONS OF EXISTING MAINS ARE SHOWN. THE CONTRACTOR SHALL TAKE ALL NECESSARY PRECAUTIONS TO PROTECT EXISTING MAINS AND SERVICES AND MAINTAIN UNINTERRUPTED SERVICE. ANY DAMAGE INCURRED SHALL BE REPAIRED IMMEDIATELY TO THE SATISFACTION OF THE ENGINEER AT THE CONTRACTOR'S EXPENSE.
  - TOPOGRAPHIC FIELD SURVEYS WERE PERFORMED ON OR ABOUT JUNE, 2009 BY FISHER, COLLINS & CARTER, INC.
  - HORIZONTAL AND VERTICAL SURVEY CONTROLS:  
THE COORDINATES SHOWN ON THE DRAWINGS ARE BASED ON MARYLAND STATE REFERENCE SYSTEM NAD '83/91' AS PROJECTED BY HOWARD COUNTY GEODETIC CONTROL STATIONS NO. 22A & NO. 22AC.  
ALL VERTICAL CONTROLS ARE BASED ON NAVD '86 VERTICAL CONTROLS PROVIDED ON THE DRAWINGS.
  - ALL PIPE ELEVATIONS SHOWN ARE INVERT ELEVATIONS UNLESS OTHERWISE NOTED ON THE PLANS.
  - CLEAR ALL UTILITIES BY A MINIMUM OF 12 INCHES. CLEAR ALL POLES BY 5'-0" MINIMUM OR TUNNEL AS REQUIRED UNLESS OTHERWISE NOTED. THE OWNER HAS CONTACTED THE UTILITY COMPANIES AND HAS MADE ARRANGEMENTS FOR BRACING OF POLES AS SHOWN ON THE DRAWINGS. IN THE EVENT THE CONTRACTOR'S WORK REQUIRES BRACING OF ADDITIONAL POLES, ANY COST INCURRED BY THE OWNER FOR THE BRACING OF THE ADDITIONAL POLES OR DAMAGES SHALL BE DEDUCTED FROM MONIES OWED THE CONTRACTOR. THE CONTRACTOR SHALL COORDINATE WITH THE UTILITY COMPANIES TO SCHEDULE THE BRACING OF THE POLES.
  - FOR DETAILS NOT SHOWN ON THE DRAWINGS AND FOR MATERIALS AND CONSTRUCTION METHODS, USE HOWARD COUNTY DESIGN MANUAL, VOLUME IV, STANDARD SPECIFICATIONS AND DETAILS FOR CONSTRUCTION (LATEST EDITION). THE CONTRACTOR SHALL HAVE A COPY OF VOLUME IV ON THE JOB SITE.
  - WHERE TEST PITS HAVE BEEN MADE ON EXISTING UTILITIES, THEY ARE NOTED BY THE SYMBOL AT THE LOCATIONS OF THE TEST PITS. A NOTE OR NOTES CONTAINING THE RESULTS OF THE TEST PIT OR PITS IS INCLUDED ON THE DRAWINGS. EXISTING UTILITIES IN THE VICINITY OF THE PROPOSED WORK FOR WHICH TEST PITS HAVE NOT BEEN DUG SHALL BE LOCATED BY THE CONTRACTOR TWO WEEKS IN ADVANCE OF CONSTRUCTION OPERATIONS AT HIS OWN EXPENSE.
  - THE CONTRACTOR SHALL NOTIFY THE FOLLOWING UTILITY COMPANIES OR AGENCIES AT LEAST FIVE WORKING DAYS BEFORE STARTING WORK SHOWN ON THESE PLANS:  
AT&T ..... 1-800-252-1133  
BGE (CONTRACTOR SERVICES) ..... 410-637-8713  
BGE (EMERGENCY) ..... 410-689-0153  
BUREAU OF UTILITIES ..... 410-313-4900  
COLONIAL PIPELINE CO ..... 410-795-1390  
M&S UTILITY ..... 1-800-257-7777  
STATE HIGHWAY ADMINISTRATION ..... 410-531-5533  
VERIZON ..... 1-800-743-0033 / 410-224-9210
- 9** TREES AND SHRUBS ARE TO BE PROTECTED FROM DAMAGE TO THE MAXIMUM EXTENT. TREES AND SHRUBS LOCATED WITHIN THE CONSTRUCTION STRIP ARE NOT TO BE REMOVED OR DAMAGED BY THE CONTRACTOR.
- 10** CONTRACTOR SHALL REMOVE TREES, STUMPS AND ROOTS ALONG THE LINE OF EXCAVATION. PAYMENT FOR SUCH REMOVAL SHALL BE INCLUDED IN THE UNIT PRICE BID FOR THE CONSTRUCTION OF THE MAIN.
- 11** THE CONTRACTOR SHALL NOTIFY THE BUREAU OF HIGHWAYS, HOWARD COUNTY, AT (410)-313-7450 AT LEAST FIVE WORKING DAYS BEFORE OPEN CUTTING OR BORING/JACKING OF ANY COUNTY ROAD FOR LAYING WATER/SEWER MAINS OR HOUSE CONNECTIONS. THE APPROVAL OF THESE DRAWINGS WILL CONSTITUTE COMPLIANCE WITH DPW REQUIREMENTS PER SECTION 18.114(a) OF THE HOWARD COUNTY CODE.
- PART B: WATER MAIN GENERAL NOTES**
- WATER SERVICE TO ALL BUILDABLE LOTS SHALL BE PROVIDED BY INDIVIDUAL PRIVATE ON-SITE WELLS.
- PART C: SEWER MAIN GENERAL NOTES**
- ALL SEWER MAINS SHALL BE D.I.P. OR P.V.C. UNLESS OTHERWISE NOTED.
  - ALL MANHOLES SHALL BE 4'-0" INSIDE DIAMETER UNLESS OTHERWISE NOTED.
  - FORCE MAINS SHALL BE D.I.P. ONLY.
  - MANHOLES SHOWN WITH 12" AND 16" WALLS ARE FOR BRICK MANHOLES ONLY.
  - MANHOLES DESIGNATED W.T. IN PLAN AND PROFILE SHALL HAVE WATERTIGHT FRAME AND COVER, STANDARD DETAIL C5-52. WHERE WATERTIGHT MANHOLE FRAMES AND COVERS ARE USED, SET TOP OF FRAME 1'-6" ABOVE FINISHED GRADE UNLESS OTHERWISE NOTED ON THE DRAWINGS.
  - HOUSE(S) WITH THE SYMBOL "C.N.S." INDICATES THAT CELLAR CANNOT BE SERVED.
  - LOTS 5 THRU 11 SHALL HAVE PRIVATE ON-SITE SEWAGE DISPOSAL SYSTEMS.
- NOTE:** THE WASTEWATER TREATMENT FACILITY & SHARED SEWAGE SYSTEM IS DESIGNED BASED ON THE FOLLOWING PARAMETERS:  
TOTAL NUMBER OF DWELLINGS CONNECTED TO THE SYSTEM: 4  
NUMBER OF BEDROOMS PER DWELLING: 5  
TOTAL NUMBER OF BEDROOMS: 4 DWELLINGS X 5 BEDROOMS PER DWELLING = 20 BEDROOMS  
DAILY DESIGN FLOW = 150 gpd per BEDROOM  
TOTAL DAILY DESIGN FLOW = 150 gpd per BEDROOM X 20 BEDROOMS = 3,000 GALLONS PER DAY

TYPE OF BUILDING: RESIDENTIAL - SINGLE FAMILY DETACHED DWELLINGS		LOCATION MAP	
NUMBER OF LOTS:	11	SCALE: 1" = 600'	
NO. OF WATER HOUSE CONNECTIONS:	N/A	PLAN REFERENCE NUMBERS: SP-10-004 F-16-065 (RECORD PLAT)	
NO. OF SEWER HOUSE CONNECTIONS:	4		
SEWER SHED:	N/A		
TREATMENT PLANT:	SHARED CENTRAL TREATMENT FACILITY & SHARED SEPTIC DISPOSAL FACILITY ON NON-BUILDABLE PRESERVATION PARCEL 'C'		

CONTRACT NO. 50-4964-D

**△ BELVEDERE ESTATES**

LOTS 1 THRU 11, BUILDABLE PRESERVATION PARCEL 'A' AND NON-BUILDABLE PRESERVATION PARCEL 'B' △

SEWER MAIN EXTENSION & WASTEWATER TREATMENT SYSTEM

HOWARD COUNTY, MARYLAND

**DEVELOPER'S CERTIFICATION**

I/WE HEREBY CERTIFY THAT ALL DEVELOPMENT AND CONSTRUCTION WILL BE DONE ACCORDING TO THIS PLAN OF DEVELOPMENT AND PLAN FOR EROSION AND SEDIMENT CONTROL AND THAT ALL RESPONSIBLE PERSONNEL INVOLVED IN THE CONSTRUCTION PROJECT WILL HAVE A CERTIFICATE OF ATTENDANCE AT THE DEPARTMENT OF THE ENVIRONMENT APPROVED TRAINING PROGRAM FOR THE CONTROL OF SEDIMENT AND EROSION BEFORE BEGINNING THE PROJECT. I ALSO AUTHORIZE PERIODIC ON-SITE INSPECTION BY THE HOWARD SOIL CONSERVATION DISTRICT OR THEIR AUTHORIZED AGENTS, AS ARE DEEMED NECESSARY.

*Paul W. Keidel; FOR:*  
**MR. GEORGE BOARMAN** 1/18/17  
SIGNATURE OF DEVELOPER DATE

**ENGINEER'S CERTIFICATION**

I HEREBY CERTIFY THAT THIS PLAN FOR EROSION AND SEDIMENT CONTROL REPRESENTS A PRACTICAL AND WORKABLE PLAN BASED ON MY PERSONAL KNOWLEDGE OF THE SITE CONDITIONS AND THAT IT WAS PREPARED IN ACCORDANCE WITH THE REQUIREMENTS OF THE HOWARD SOIL CONSERVATION DISTRICT.

*Paul W. Keidel* 1/18/17  
SIGNATURE OF ENGINEER DATE

SEDIMENT CONTROL MEASURES FOR THIS CONTRACT WILL BE IMPLEMENTED IN ACCORDANCE WITH SECTION 306 OF THE HOWARD COUNTY DESIGN MANUAL, VOLUME IV: STANDARD SPECIFICATIONS AND DETAILS FOR CONSTRUCTION AND AS SHOWN ON THE ROAD CONSTRUCTION PLAN, F-16-065.

*Paul W. Keidel; FOR:*  
**MR. GEORGE BOARMAN** 1/18/17  
SIGNATURE OF DEVELOPER DATE

LEGEND	
---	EX. WATER MAIN
---	EX. SEWER MAIN
○	EX. SEWER MANHOLE
---	EX. SEWER, WATER & UTILITY EASEMENT
---	EX. FIRE HYDRANT
○	EX. VALVE
---	PROP. WATER MAIN
---	PROP. SEWER MAIN
○	PROP. SEWER MANHOLE
---	PROP. SEWER, WATER & UTILITY EASEMENT
---	PROP. WHC
---	PROP. SHC
---	PROP. FIRE HYDRANT
○	PROP. VALVE

F-16-065

THIS DEVELOPMENT IS APPROVED FOR EROSION AND SEDIMENT CONTROL BY HOWARD SOIL CONSERVATION DISTRICT.

APPROVED: *John R. Robertson* 2/8/17  
HOWARD SOIL CONSERVATION DISTRICT DATE

APPROVED FOR PRIVATE WATER AND SHARED SEWAGE DISPOSAL FOR LOTS 1-4.

*Michael J. Davis* 2/17/17  
HOWARD COUNTY HEALTH OFFICER DATE


**OWNER** △  
BOKEMAN PROPERTY INVESTMENT, LLC  
12166 MARYLAND ROUTE 216  
FULTON, MARYLAND 20759  
PHONE: (301) 725-4704

**DEVELOPER**  
BELVEDERE ESTATES DEVELOPMENT CORPORATION  
13402 CLARKSVILLE PIKE  
HIGHLAND, MARYLAND 20777  
PHONE: (410) 707-1976

SCALE: 1" = 50'

CONTRACT NO. 50-4964-D  
BELVEDERE ESTATES  
LOTS 1 THRU 11, BUILDABLE PRESERVATION PARCEL 'A' AND NON-BUILDABLE PRESERVATION PARCEL 'B'  
SEWER MAIN EXTENSION & WASTEWATER TREATMENT SYSTEM  
HOWARD COUNTY, MARYLAND

DEPARTMENT OF PUBLIC WORKS HOWARD COUNTY, MARYLAND <i>John R. Robertson</i> 1/25/17 CHIEF, BUREAU OF UTILITIES DATE	DEPARTMENT OF PLANNING AND ZONING HOWARD COUNTY, MARYLAND <i>Al Chohan</i> 2-22-17 CHIEF, DEVELOPMENT ENGINEERING DIVISION DATE	I HEREBY CERTIFY THAT THESE DOCUMENTS WERE PREPARED OR APPROVED BY ME, AND THAT I AM A DULY LICENSED PROFESSIONAL ENGINEER UNDER THE LAWS OF THE STATE OF MARYLAND. LICENSE NO. 12043 EXPIRATION DATE 5/7/16/18. <b>FISHER, COLLINS &amp; CARTER, INC.</b> CIVIL ENGINEERING CONSULTANTS & LAND SURVEYORS CENTRAL SQUARE OFFICE PARK - 10272 BALTIMORE NATIONAL PIKE BLIHOOT CITY, MARYLAND 21042 (410) 461 - 2959 <i>Paul W. Keidel</i> PAUL W. KEIDEL	DESIGNED BY: B.C.R. DRAWN BY: B.C.R. CHECKED BY: P.W.K. DATE: JANUARY, 2017 BY: NO.	SEWER MAIN EXTENSION & WASTEWATER TREATMENT SYSTEM TITLE SHEET 600' SCALE MAP NO. 22 BLOCK NO. 8 F.C.C. WORK ORDER NO. 71160 FILE NAME: SEWER MAIN EXTENSION PLAN	REVISION: 7/17/17 REVISED TITLE BLOCK WITH NEW PROPERTY INFORMATION & REVISIONS SUBMITTED TO DEPARTMENT OF PUBLIC WORKS	SCALE AS SHOWN SHEET 1 OF 7
--	--	---	---	---	---	--------------------------------

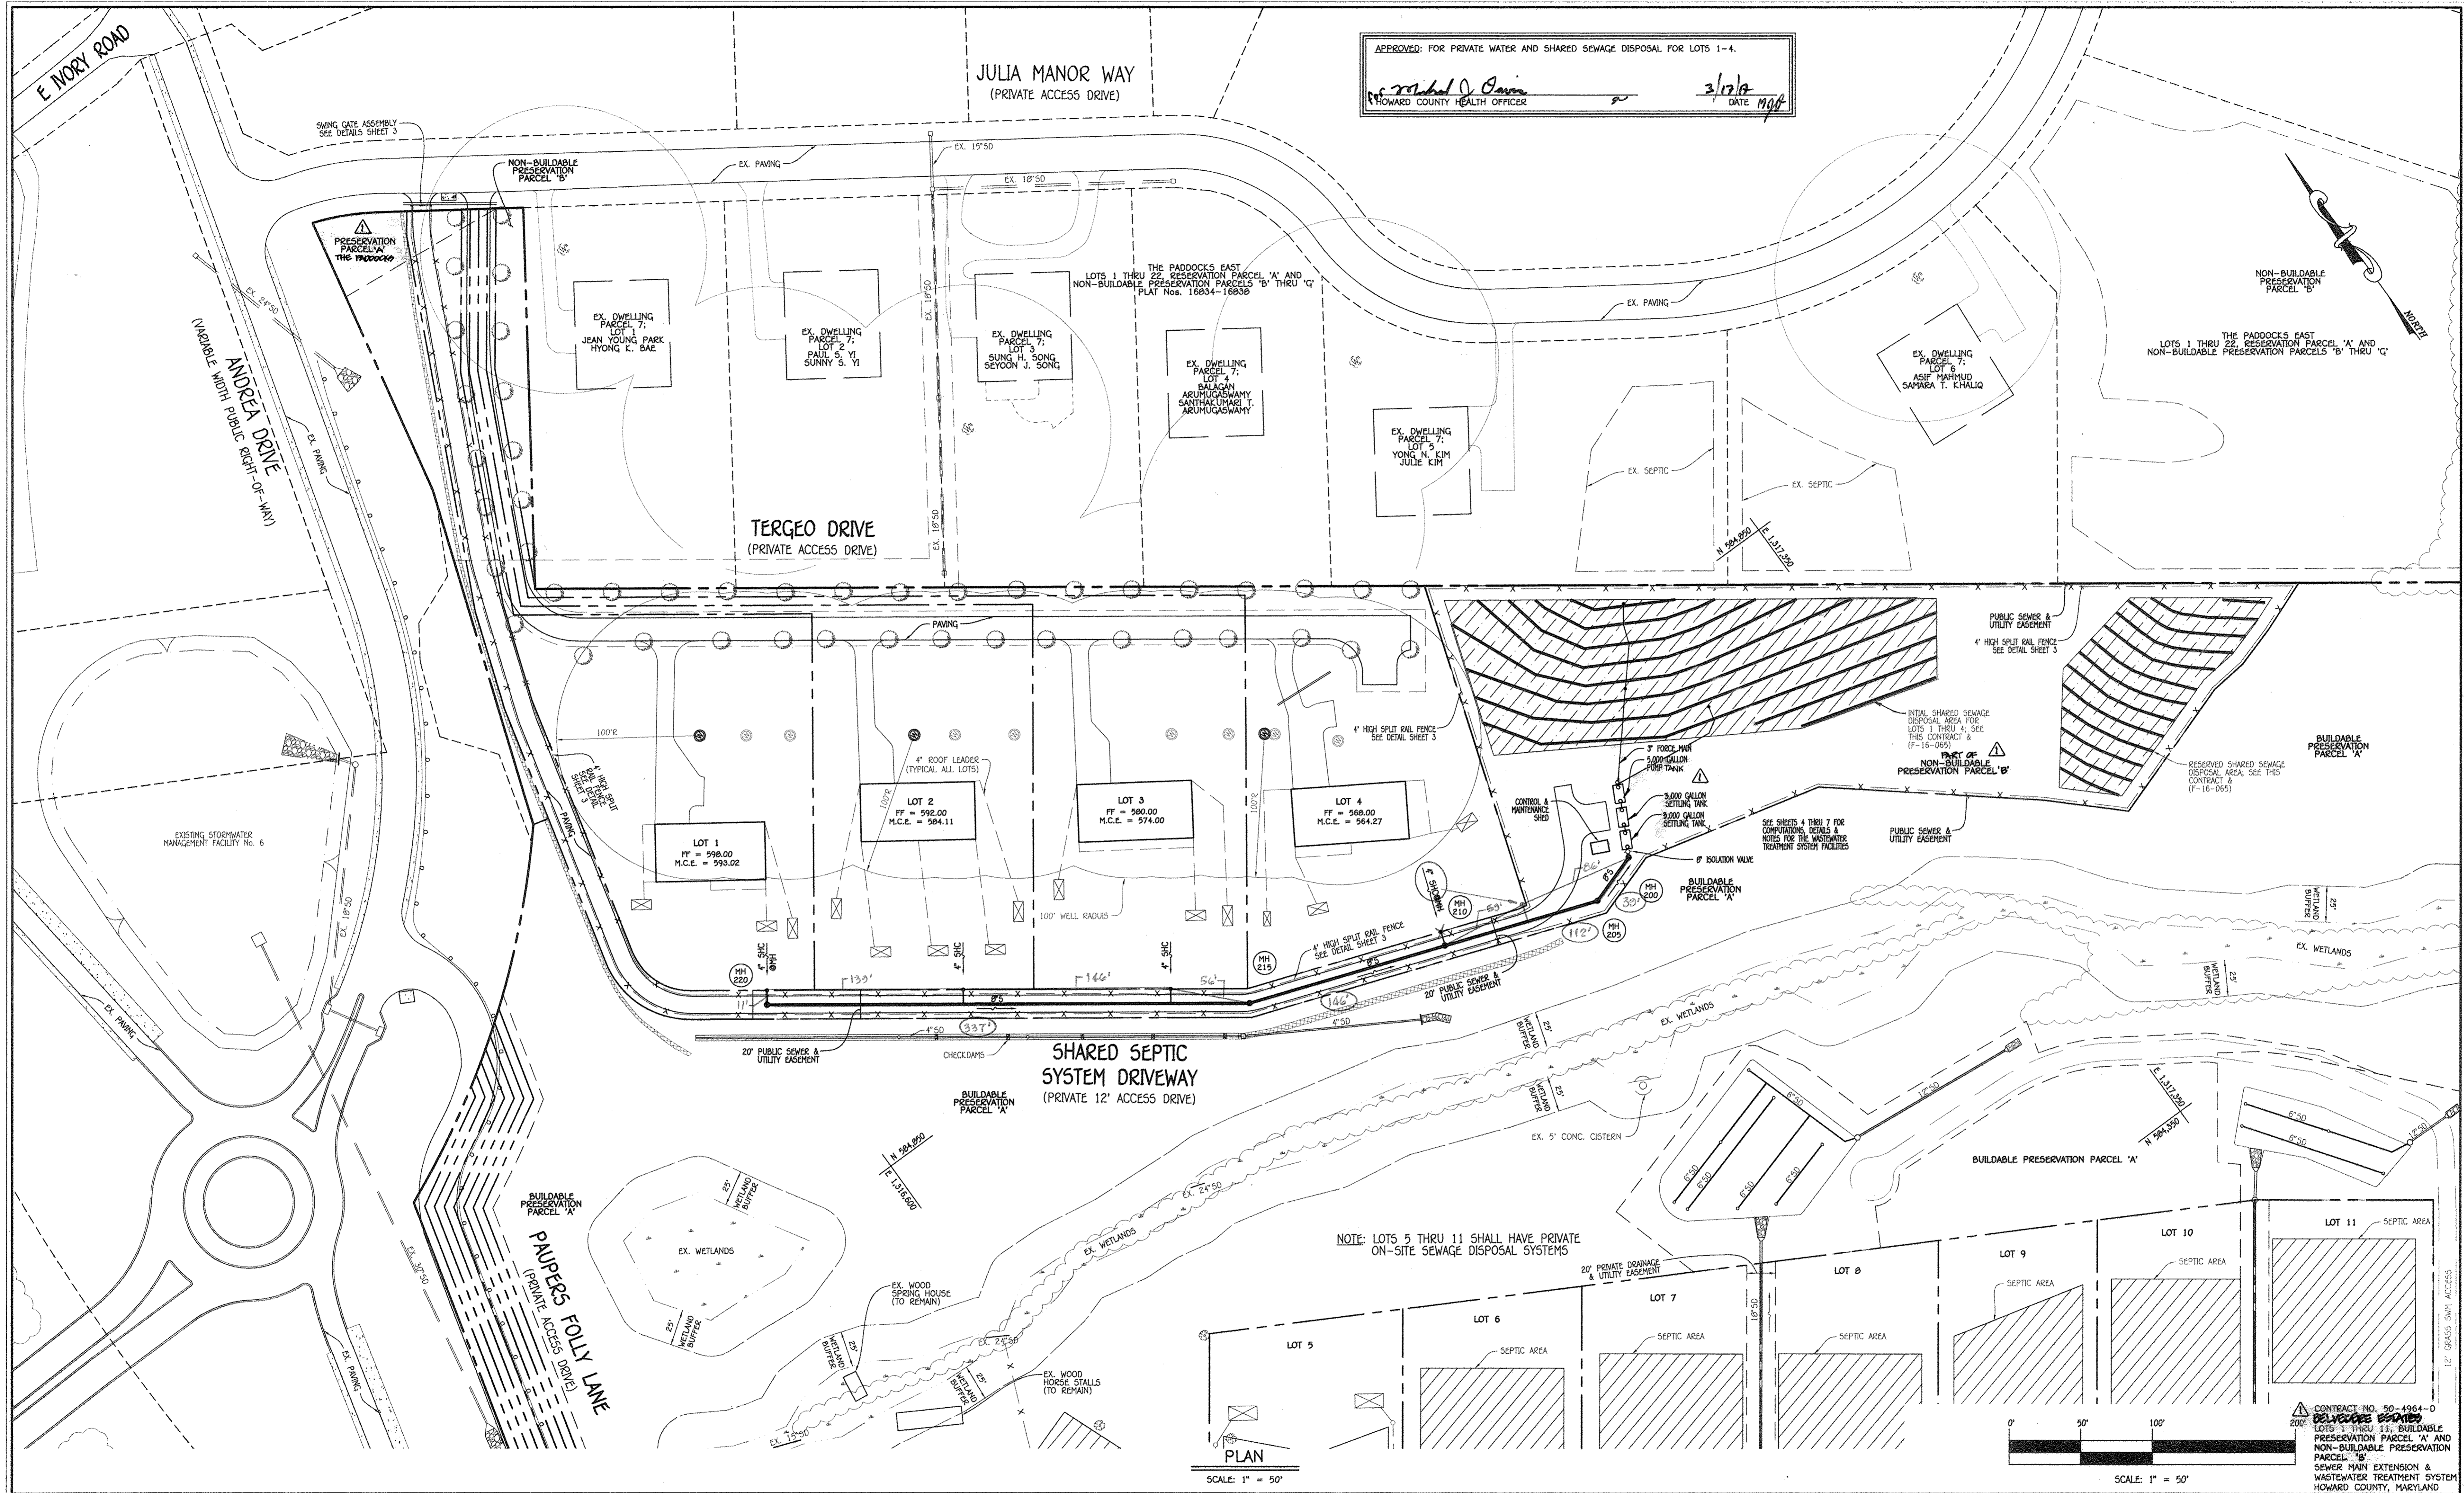

APPROVED FOR PRIVATE WATER AND SHARED SEWAGE DISPOSAL FOR LOTS 1-4.  
*Rachel O. Davis*  
 HOWARD COUNTY HEALTH OFFICER  
 3/13/17  
 DATE MGD

SHARED SEPTIC SYSTEM DRIVEWAY  
 (PRIVATE 12' ACCESS DRIVE)

NOTE: LOTS 5 THRU 11 SHALL HAVE PRIVATE ON-SITE SEWAGE DISPOSAL SYSTEMS

PLAN  
 SCALE: 1" = 50'


DEPARTMENT OF PUBLIC WORKS  
 HOWARD COUNTY, MARYLAND  
 CHIEF, BUREAU OF UTILITIES

DEPARTMENT OF PLANNING AND ZONING  
 HOWARD COUNTY, MARYLAND  
 CHIEF, DEVELOPMENT ENGINEERING DIVISION

DATE: 2-27-17

I HEREBY CERTIFY THAT THESE DOCUMENTS WERE PREPARED OR APPROVED BY ME, AND THAT I AM A DULY LICENSED PROFESSIONAL ENGINEER UNDER THE LAWS OF THE STATE OF MARYLAND.  
 LICENSE NO. 12043 EXPIRATION DATE 5/16/18.

**FISHER, COLLINS & CARTER, INC.**  
 CIVIL ENGINEERING CONSULTANTS & LAND SURVEYORS  
 CENTRAL SQUARE OFFICE PARK - 10232 BALTIMORE NATIONAL PIKE  
 ELICOTT CITY, MARYLAND 21042  
 (410) 461-2995

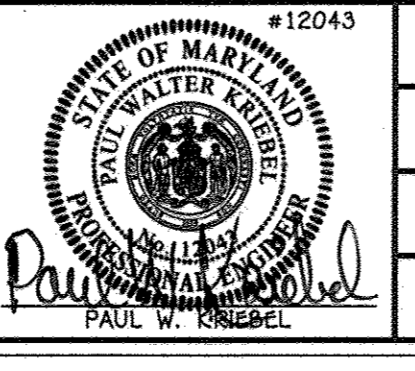

DESIGNED BY: B.C.R.  
 DRAWN BY: B.C.R.  
 CHECKED BY: P.W.K.  
 DATE: JANUARY, 2017

REVISIONS:

NO.	REVISION	DATE
1	REVISED THIS BLOCK WITH NEW PROPERTY INFORMATION & REVISED SETBACKS (TANKS FROM 2,000 GALLON TO 3,000 GALLON)	7/17/17


SEWER MAIN EXTENSION & WASTEWATER TREATMENT SYSTEM PLAN

600' SCALE MAP NO. 22 BLOCK NO. B  
 F.C.C. WORK ORDER NO. 71180  
 FILE NAME: SEWER MAIN EXTENSION PLAN

**BELVEDERE ESTATES**  
 LOTS 1 THRU 11.  
 BUILDABLE PRESERVATION PARCEL 'A' AND NON-BUILDABLE PRESERVATION PARCEL 'B'  
 SEWER MAIN EXTENSION & WASTEWATER TREATMENT SYSTEM  
 CONTRACT NO. 50-4964-D  
 THIRD ELECTION DISTRICT  
 HOWARD COUNTY, MARYLAND

SCALE AS SHOWN  
 SHEET 2 OF 7

K:\SDS\PROJ\1160\_Beamman\_Property\Utility\Sewer\_Contract\_Plan\Final\Sewer\_Contract\_Plan.dwg

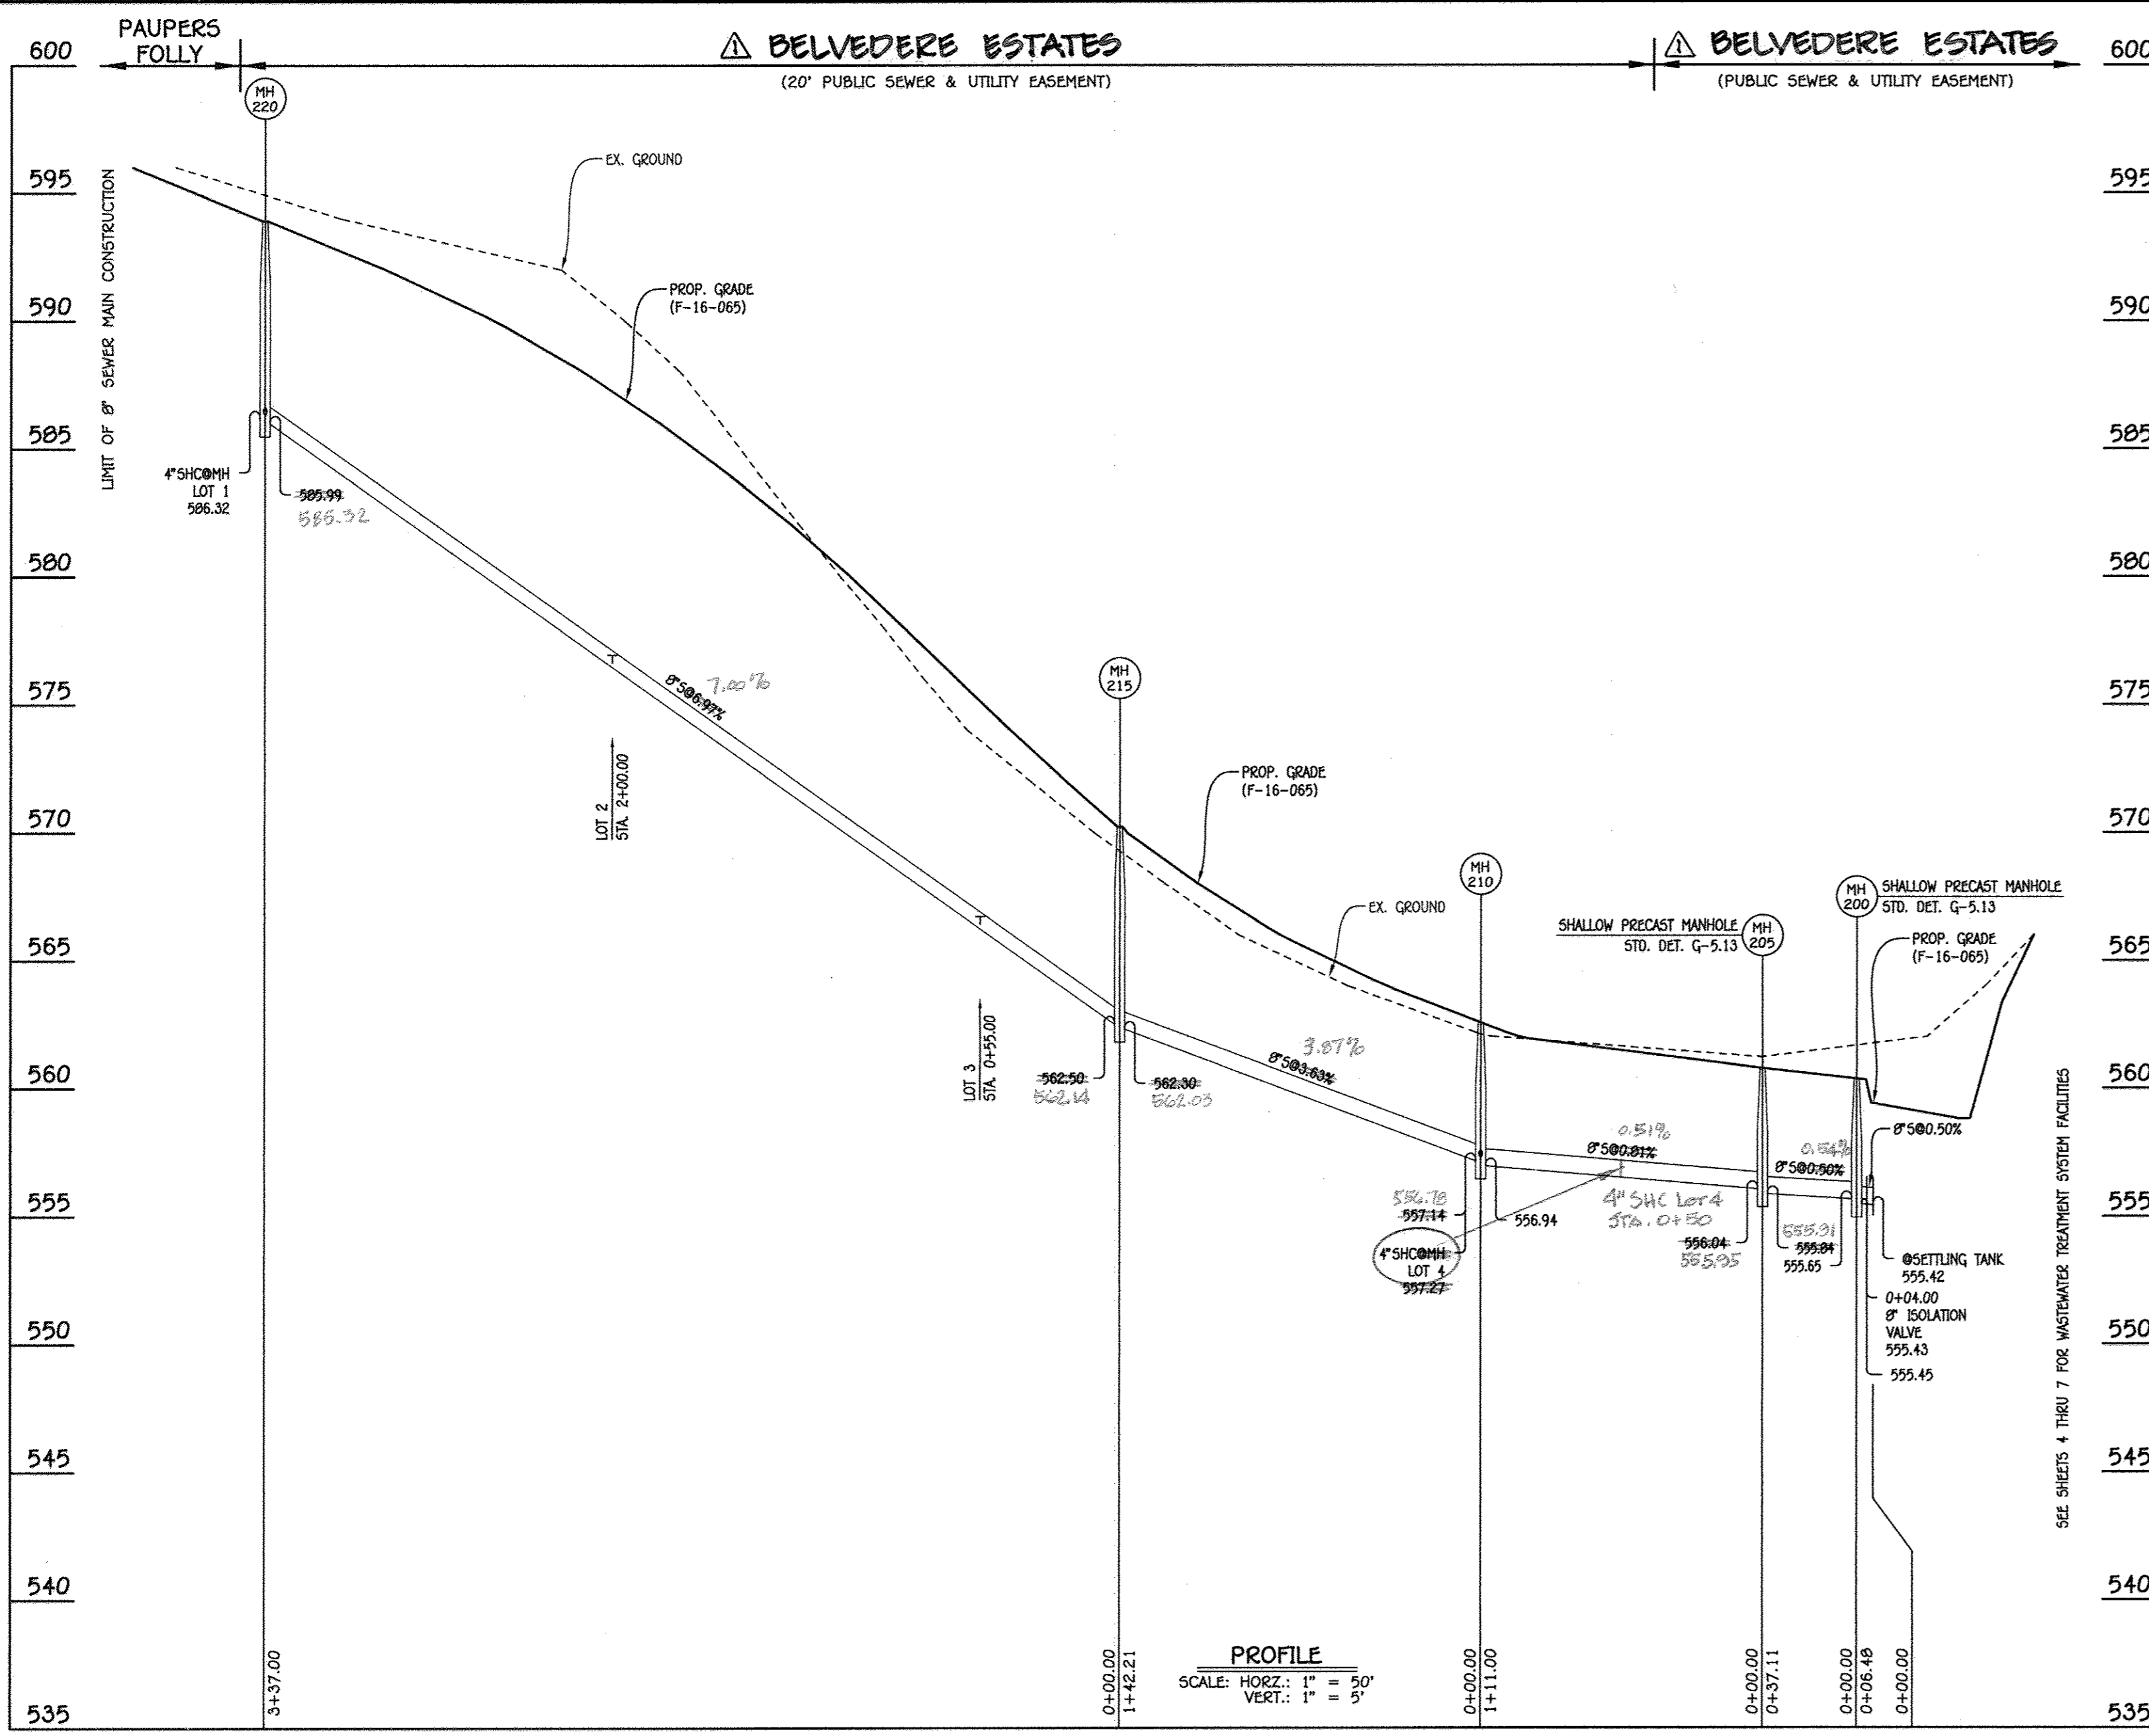

### MANHOLE TABULATION CHART

NO.	NORTHING	EASTING	RIM ELEVATION
200	584719.70	1317142.78	560.35
205	584708.23	1317107.48	560.77
210	584745.79	1317003.03	562.56
215	584793.92	1316869.21	570.23
220	584991.59	1316996.27	593.91

NOTE: SET MH RIMS FLUSH W/PROPOSED GRADE.


### SEWER HOUSE CONNECTION CHART

STATION	LOT	ELEVATION AT MAIN	ELEVATION AT EASEMENT	M.C.E.	B.E.	F.F.
MH 205 TO MH 210						
0+55 RT.	4	557.27	557.47	564.27	0	568.00
MH 215 TO MH 220						
0+55 RT.	3	566.50	566.70	574.00	0	580.00
2+00 RT.	2	576.61	576.81	584.11	0	592.00
0+MH 220 RT.	1	586.32	586.52	593.02	0	598.00

### SEWER HOUSE CONNECTION AS-BUILT LOCATION TABLE


LOT NUMBER	ADDRESS	LOCATION DIMENSION 1	LOCATION DIMENSION 2
1		MH 220 11'	SUC LOT 2 139'
2		SUC LOT 1 139'	SUC LOT 3 146'
3		SUC LOT 2 146'	MH 215 56'
4		MH 200 86'	MH 210 55'

**8" SEWER MAIN: LOTS 1 THRU 4; TO WASTEWATER TREATMENT SYSTEM FACILITIES**

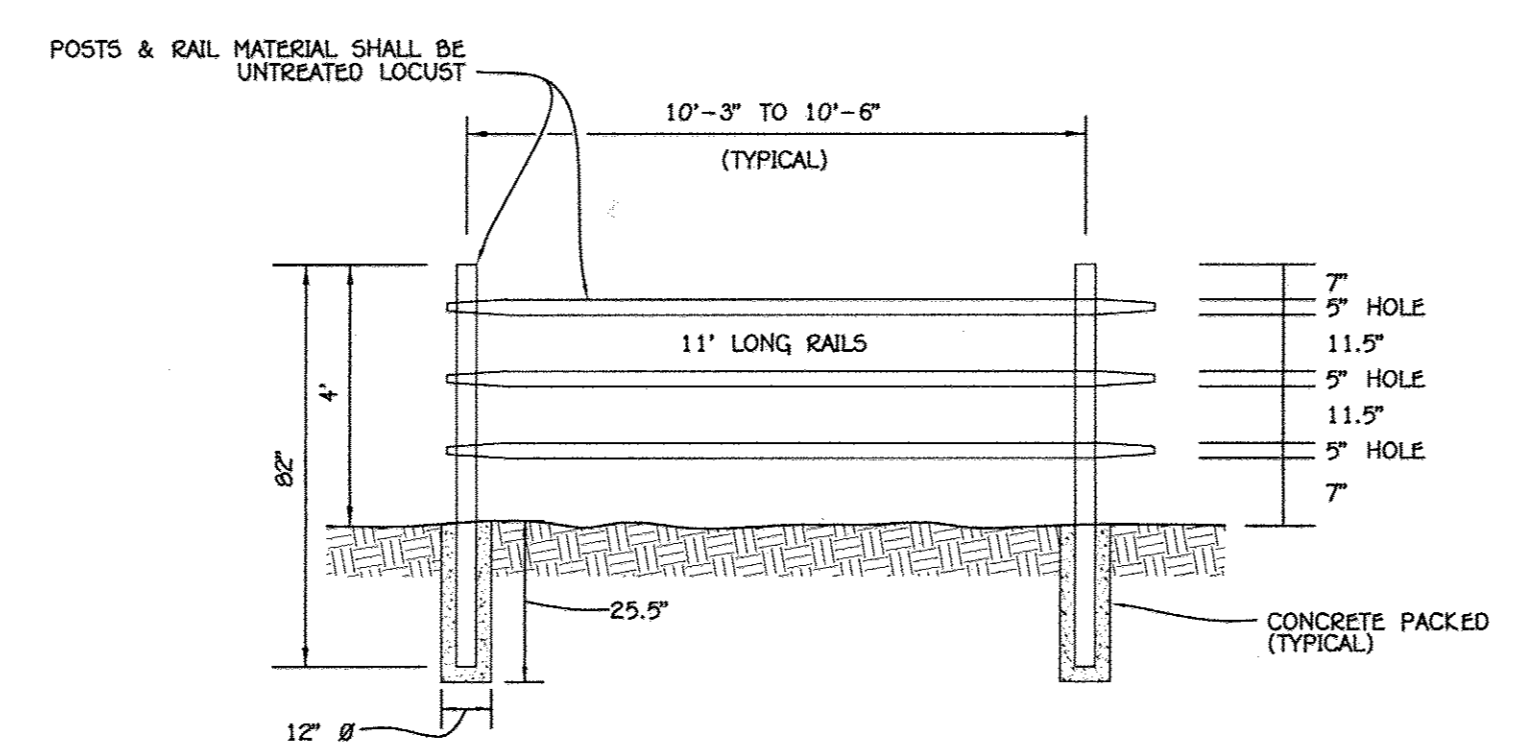


**DETAIL: SPLIT RAIL FENCE**  
NO SCALE

NOTE: SEE SHEET 2 FOR PLAN LOCATION

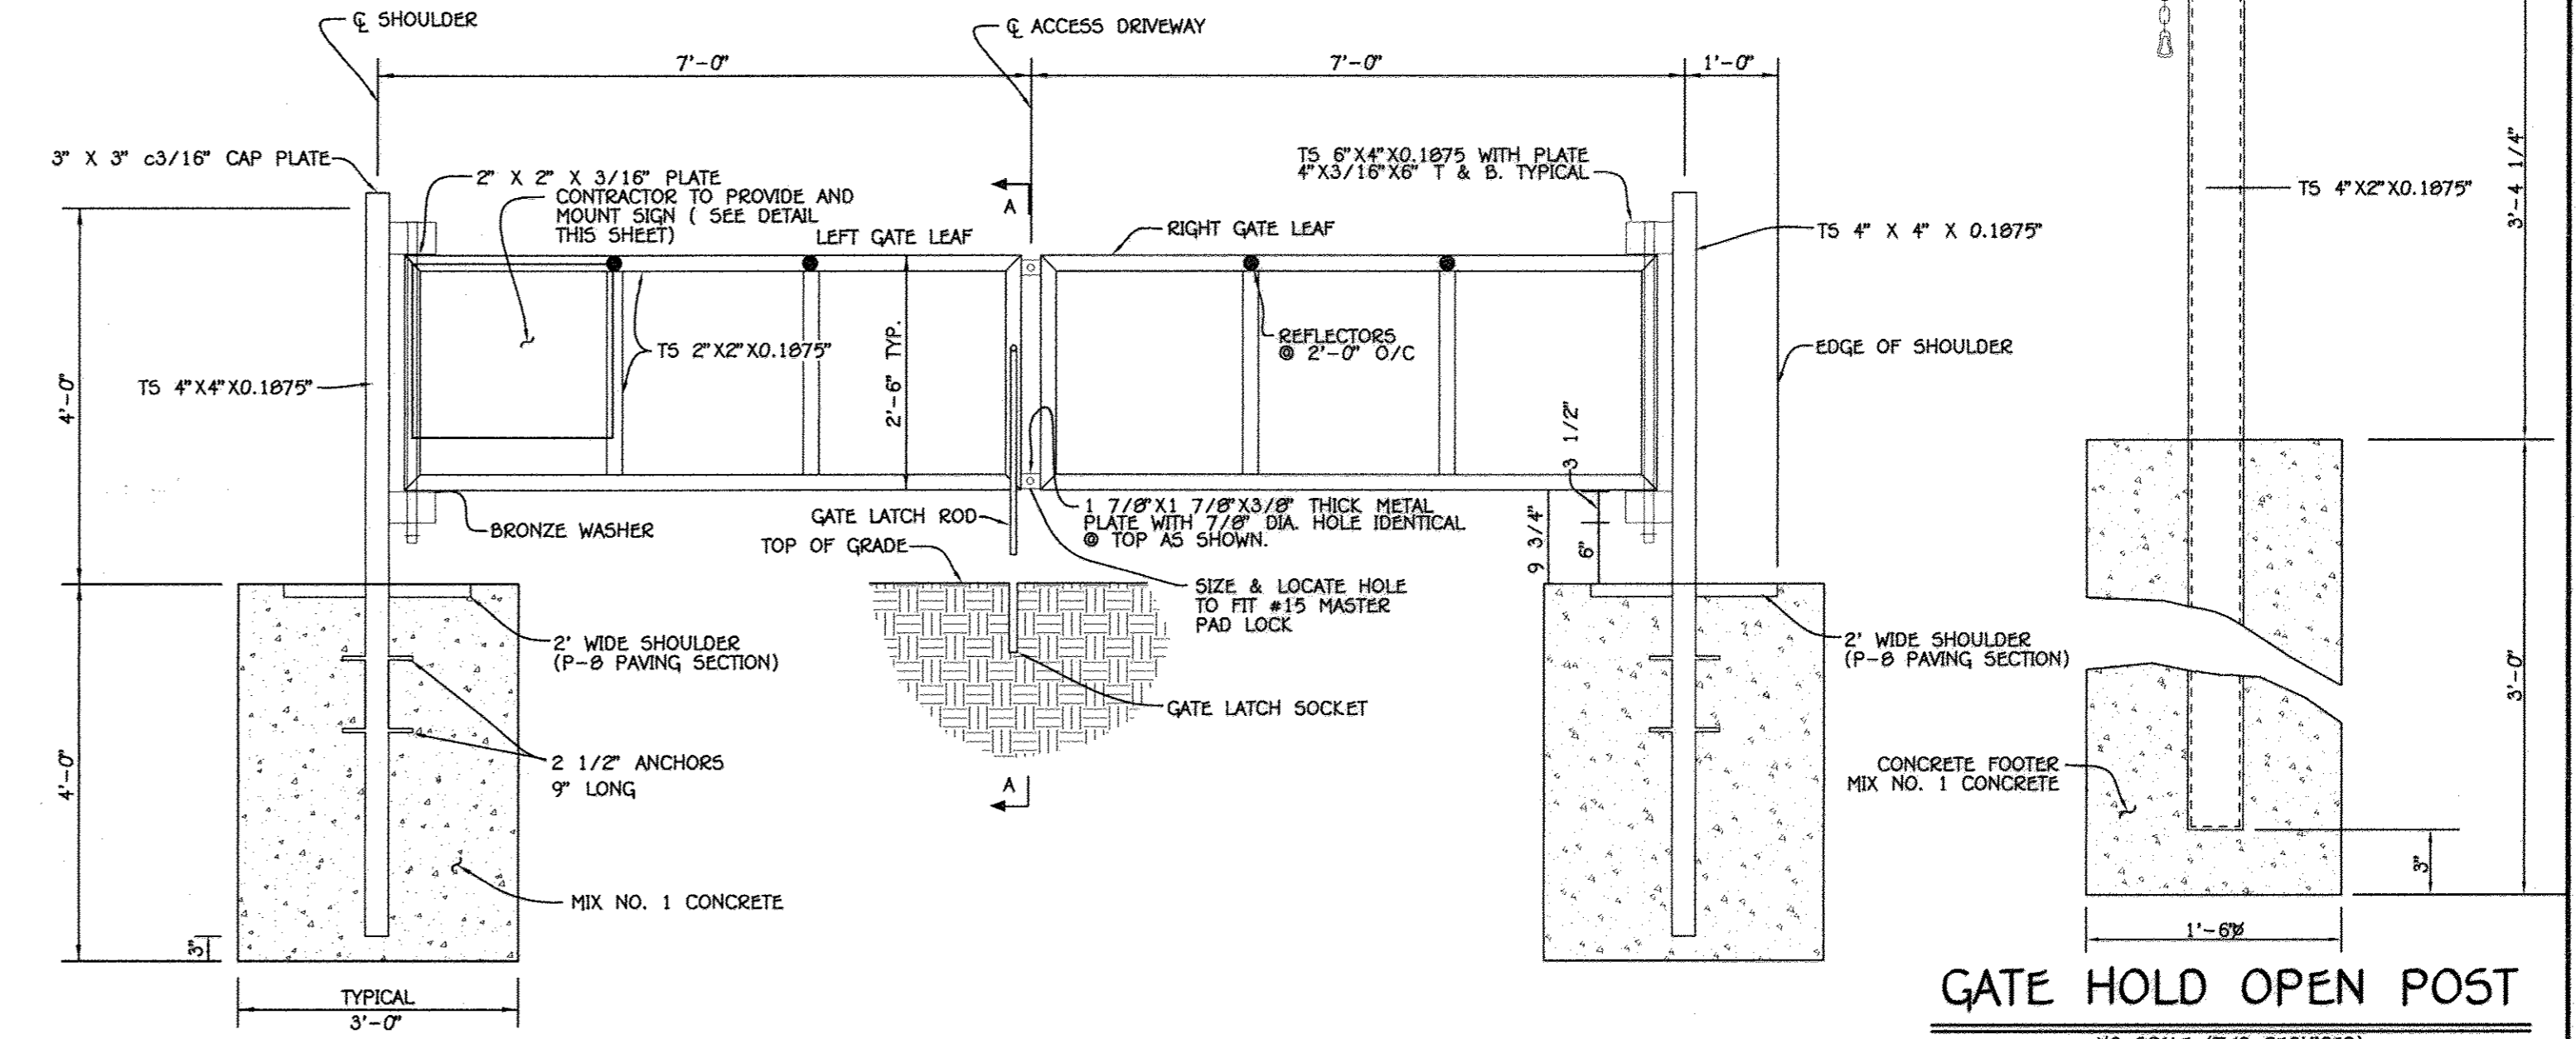

**SWING GATE ASSEMBLY**  
NO SCALE

NOTE: SEE SHEET 2 FOR PLAN LOCATION

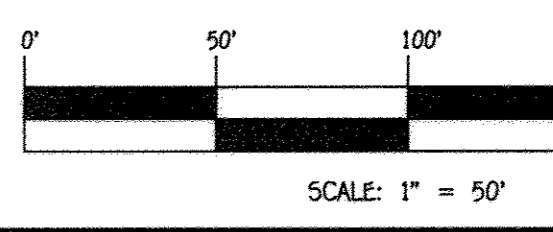


**GATE HOLD OPEN POST**  
NO SCALE (TWO REQUIRED)

APPROVED FOR PRIVATE WATER AND SHARED SEWAGE DISPOSAL FOR LOTS 1-4.  
*Howard County Health Officer*  
 DATE: 3/13/17

DEPARTMENT OF PUBLIC WORKS  
 HOWARD COUNTY, MARYLAND  
 DATE: 2-27-17

DEPARTMENT OF PLANNING AND ZONING  
 HOWARD COUNTY, MARYLAND  
 DATE: 2-27-17

I HEREBY CERTIFY THAT THESE DOCUMENTS WERE PREPARED OR APPROVED BY ME, AND THAT I AM A DULY LICENSED PROFESSIONAL ENGINEER UNDER THE LAWS OF THE STATE OF MARYLAND.  
**FISHER, COLLINS & CARTER, INC.**  
 CIVIL ENGINEERING CONSULTANTS & LAND SURVEYORS  
 12272 BALDORNE NATIONAL Pkwy.  
 GAITHERSBURG, MARYLAND 20878  
 (410) 481-2995

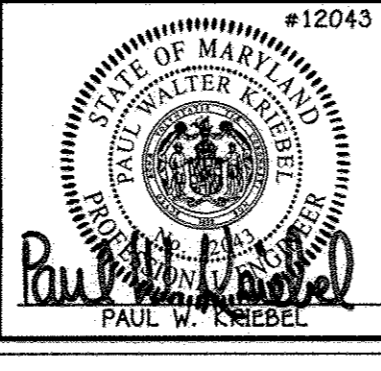

DESIGNED BY: B.C.R.  
 DRAWN BY: B.C.R.  
 CHECKED BY: P.W.K.  
 DATE: JANUARY, 2017  
 REVISION: 1/17/17

SEWER MAIN EXTENSION & WASTEWATER TREATMENT SYSTEM PROFILE & CHARTS SWING GATE ASSEMBLY DETAIL & SPLIT RAIL FENCE DETAIL  
 600' SCALE MAP NO. 22 BLOCK NO. B  
 F.C.C. WORK ORDER NO. 71150  
 FILE NAME: SEWER MAIN EXTENSION PLAN

**BELVEDERE ESTATES**  
 LOTS 1 THRU 11, BUILDABLE PRESERVATION PARCEL 'A' AND NON-BUILDABLE PRESERVATION PARCEL 'B'  
 SEWER MAIN EXTENSION & WASTEWATER TREATMENT SYSTEM  
 CONTRACT NO. 50-4964-D  
 THIRD ELECTION DISTRICT  
 HOWARD COUNTY, MARYLAND  
 SCALE AS SHOWN  
 SHEET 3 OF 7

<b>Use Projections</b>	
Houses served by on-site system	4
Bedrooms per house	5
Total Bedrooms	20
Total design flow at 150 gpd/bedroom (gpd)	3,000
ADF (gpd)	1,500
Settling tank volume required (gal)	6,000
<b>Notes</b>	
calculated values in <i>italics</i>	
ADF = average daily flow	
unit rates from Howard County Well and Septic memo Nov 2014	


**USE PROJECTIONS**

QUANTITIES			
ITEMS	QUANTITIES ESTIMATED	AS-BUILT	
		QUANTITIES	MANUFACTURER/SUPPLIER
3W x 3H DRAINFIELD TRENCHES	2,084 L.F.		
3" PVC FORCE MAIN	478 L.F.		
2" PVC LATERAL	1,864 L.F.		
2,000 GALLON SETTLING TANK(S)	2		
5,000 GALLON PUMP TANK	1		
DRAINFIELD DOSING PUMPS	3		
8' x 12' CONTROL SHED	1		


NAME OF UTILITY CONTRACTOR: \_\_\_\_\_

SURVEY AND DRAFTING DIV. CHECKBOX: \_\_\_\_\_ AS-BUILT DATE: \_\_\_\_\_

**SYMBOLS**


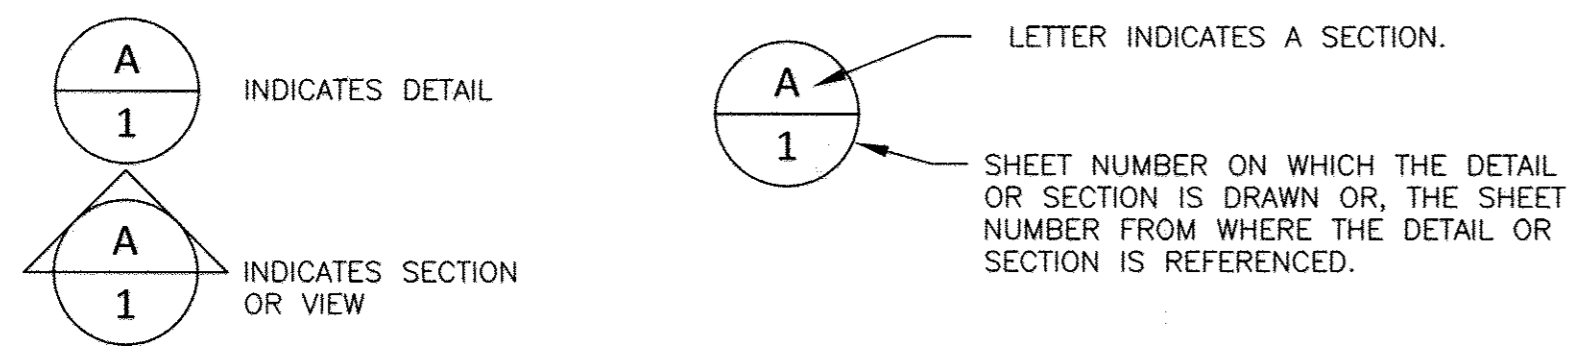


line symbol	description
WW	wastewater
TW	treated water
AA	aeration air
V	vent (to atmosphere)
PE	polyethylene
E	electric power wire
PVC	sch 40 polyvinyl chloride
DWV	drain waste vent polyvinyl chloride
ECPVC	polyvinyl chloride electrical conduit

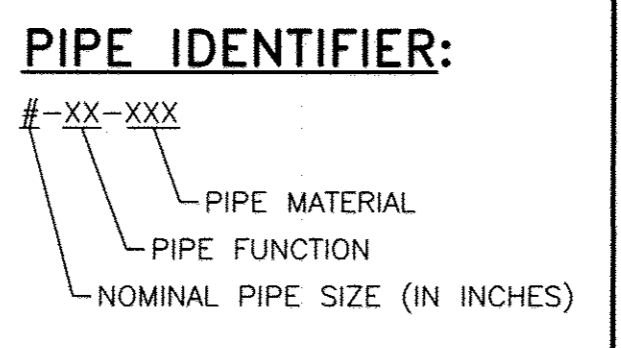

P&ID Key Notes					
part symbol	component	nominal size	notes	material	#
ST1-2	top-seam settling tank	3,000 gal	(2) 24" dia PE manholes	concrete	2
PT	pumping tank	4700 gal	(2) 24" dia PE manholes	concrete	1
P1-3	dose pumps - Goulds WE20H	230 vac	sewage pump		3
T1-T9	treatment trenches	length varies	3' wide, 1' gravel		9

**WWTS SCHEMATIC KEY**

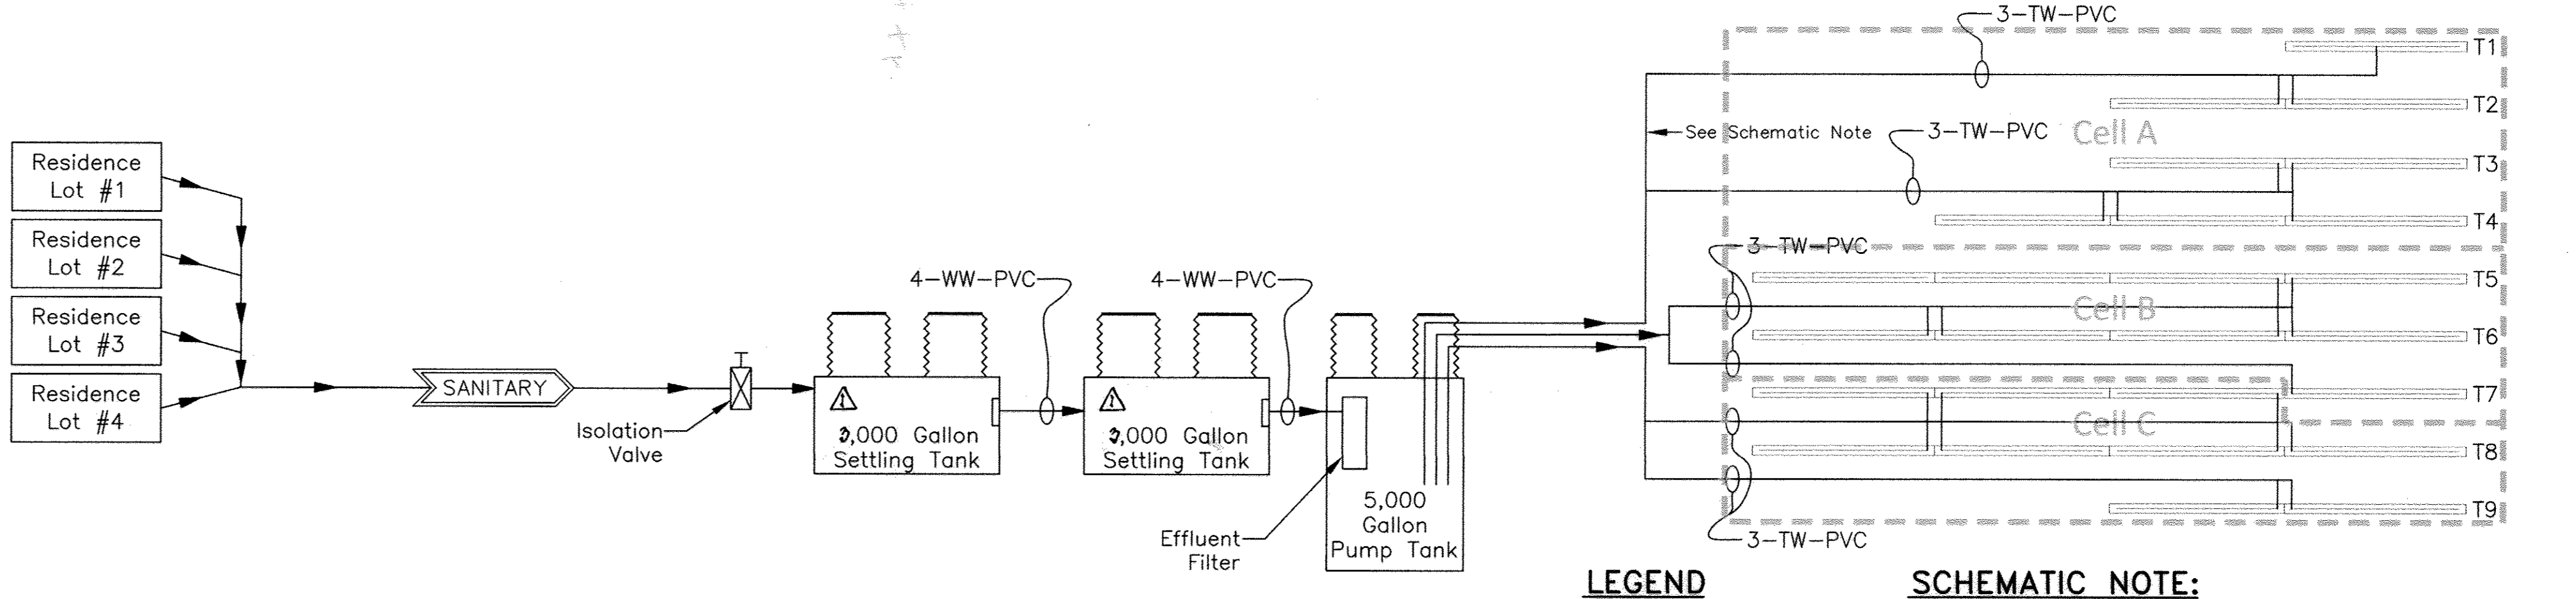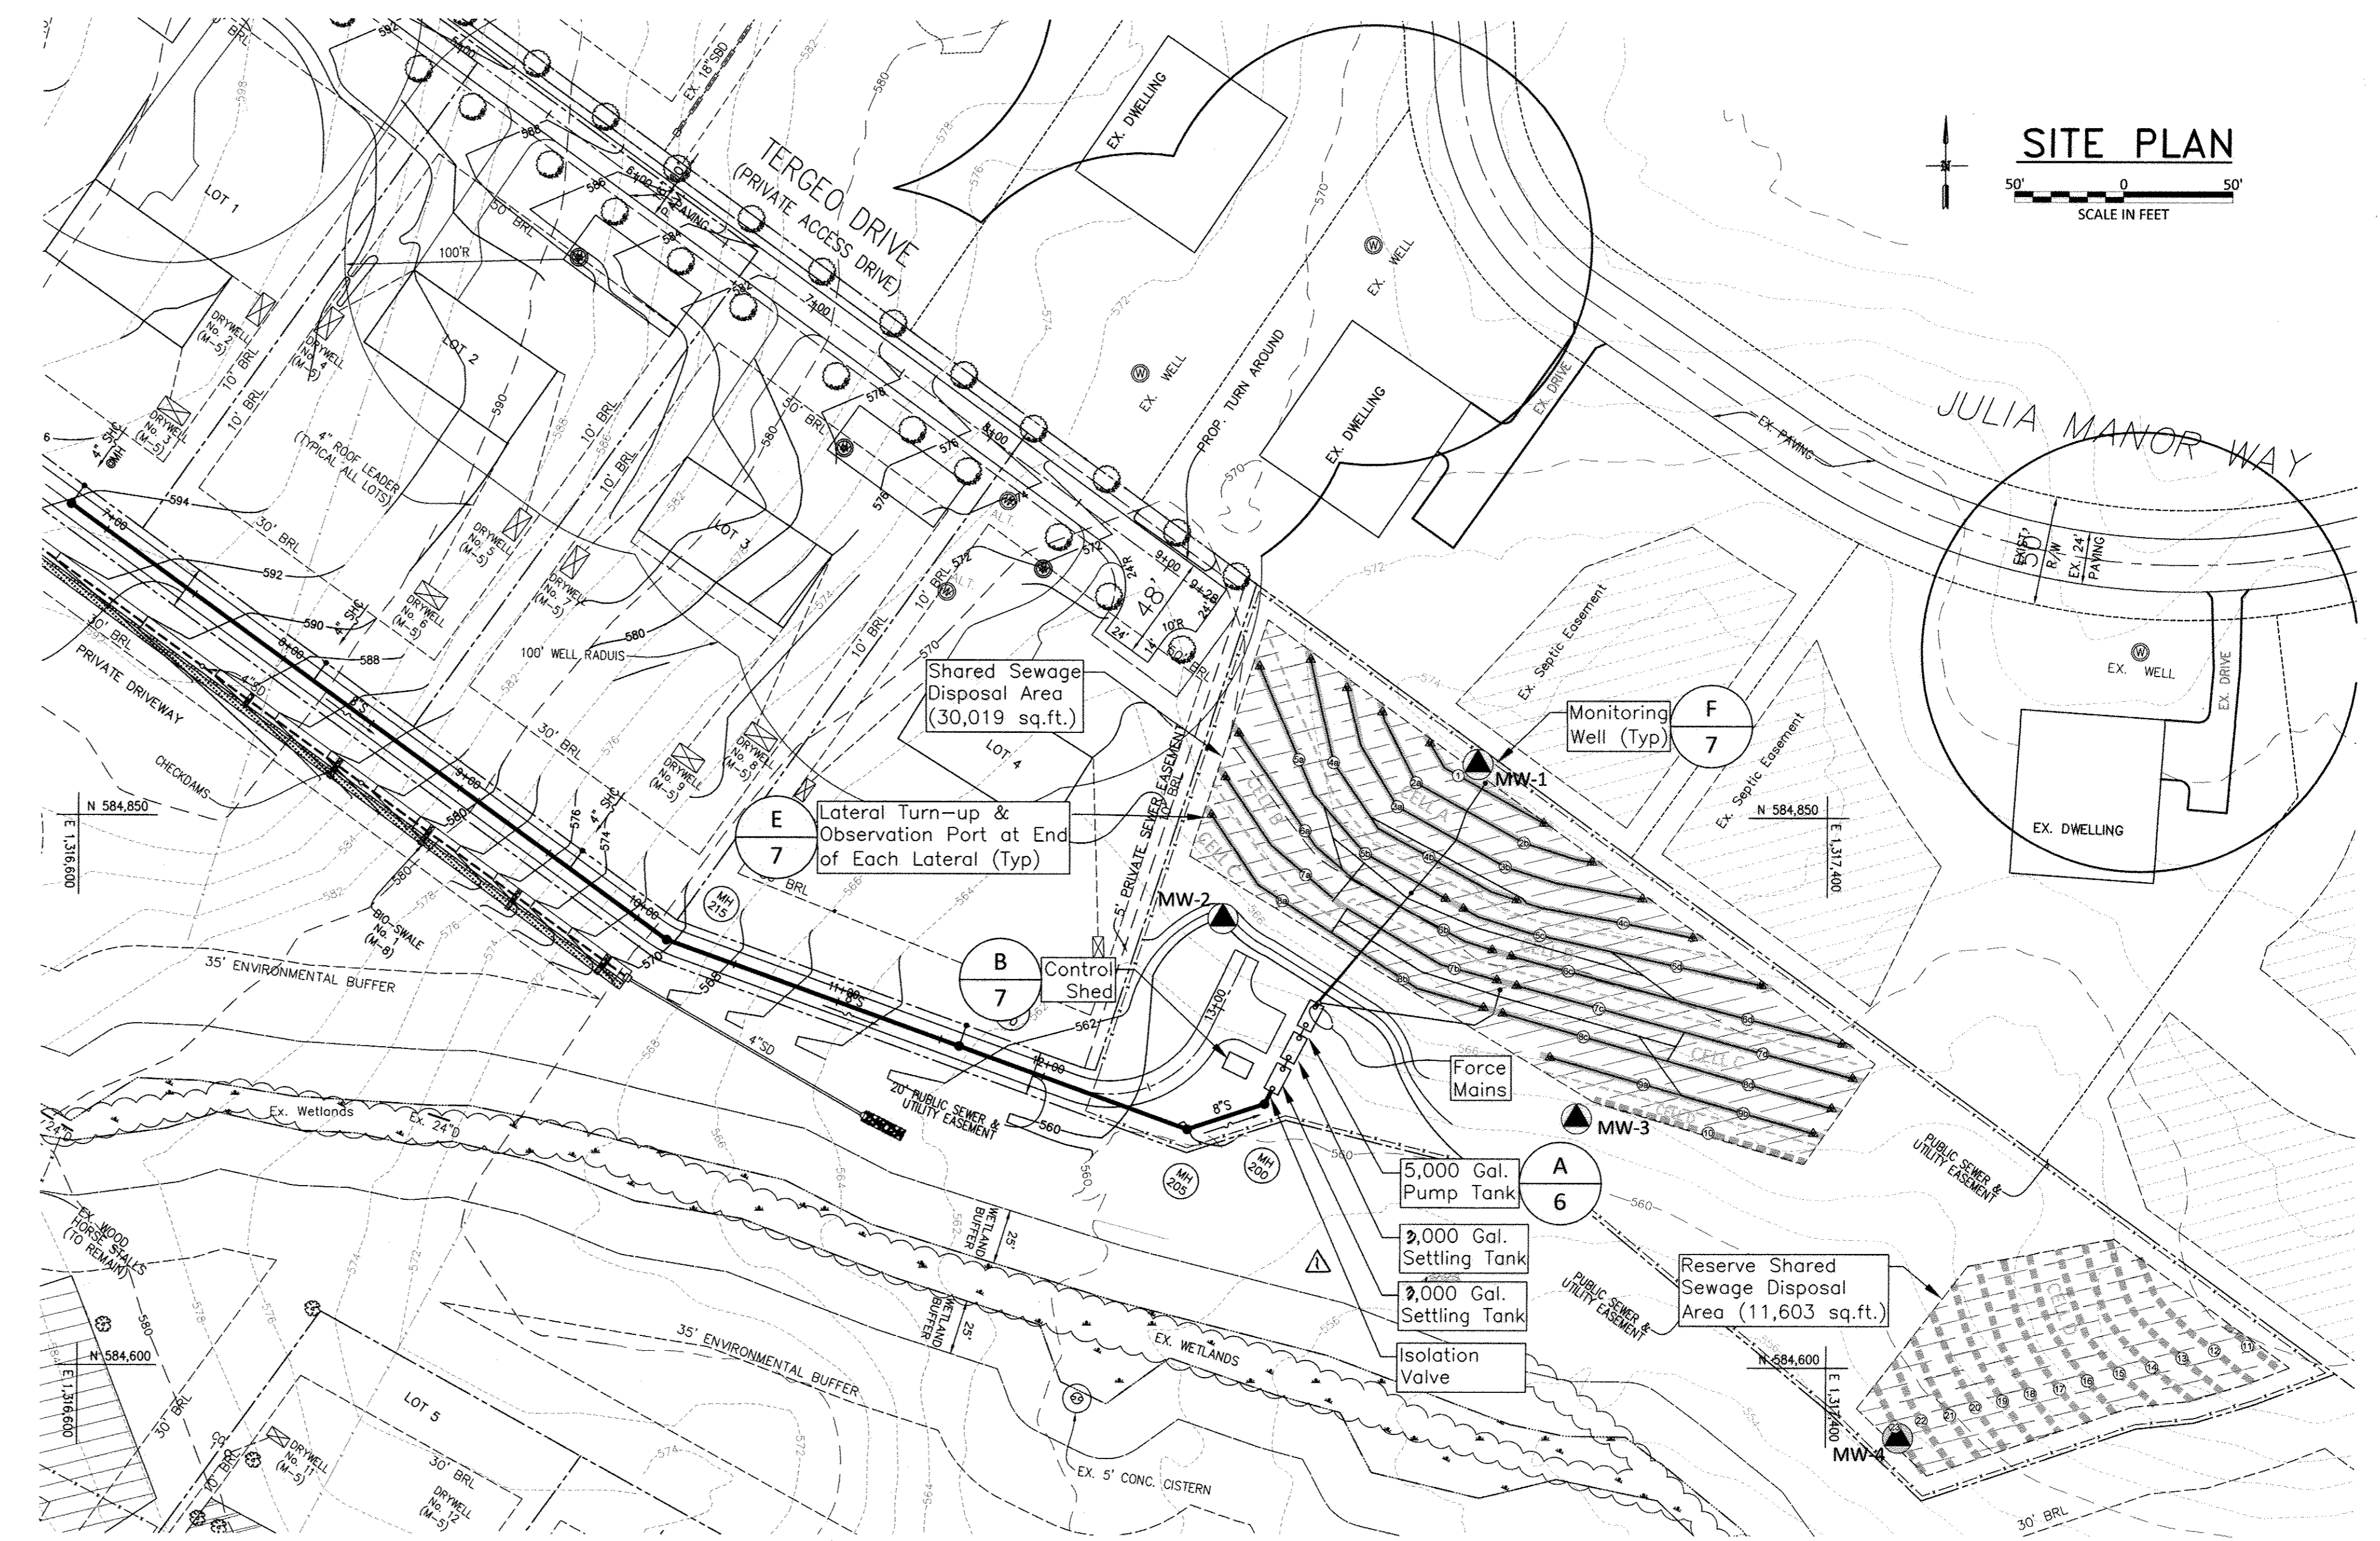

**LEGEND**

Control Valve

Flow Arrow

To or From Outside Project Limits

**SCHEMATIC NOTE:**

ALL DISTRIBUTION/MANIFOLD PIPING IS IDENTIFIED AS 3-TW-PVC. LATERAL PIPING WITHIN TRENCHES IS 2-TW-PVC. SEE DETAIL SHEET FOR MORE INFORMATION.

APPROVED: FOR PRIVATE WATER AND SHARED SEWAGE FOR LOTS 1-4

*For Michael O. Davis* 3/17/17 DATE

HOWARD COUNTY HEALTH OFFICER

DEPARTMENT OF PUBLIC WORKS  
HOWARD COUNTY, MARYLAND

DEPARTMENT OF PLANNING AND ZONING  
HOWARD COUNTY, MARYLAND

1160 Business Parkway South  
Suite E  
Westminster, Maryland 21157

Hydro-Terra Group

Hydro-Terra Group

1160 Business Parkway South  
Suite E  
Westminster, Maryland 21157

(410) 861-5376 (phone)  
(410) 861-5467 (fax)

I HEREBY CERTIFY THAT THESE DOCUMENTS WERE PREPARED OR APPROVED BY ME, AND THAT I AM A DULY LICENSED PROFESSIONAL ENGINEER UNDER THE LAWS OF THE STATE OF MARYLAND. LICENSE NO. 7203 EXPIRATION DATE IS 4/22/17.

Hydro-Terra Group

1160 Business Parkway South  
Suite E  
Westminster, Maryland 21157

(410) 861-5376 (phone)  
(410) 861-5467 (fax)

DESIGNED BY: M.D.S.

DRAWN BY: M.D.S.

CHECKED BY: M.J.M.

DATE: January, 2017

REVISION

1-17-2017

7/17/17

SEWER MAIN EXTENSION & WASTEWATER TREATMENT SYSTEM SITE PLAN & PFD

600' SCALE MAP NO. 22 BLOCK NO. 8

F.C.C. WORK ORDER NO. 71160

FILE NAME: SEWER MAIN EXTENSION PLAN

**BELVEDERE ESTATES**

LOTS 1 THRU 11, BUILDABLE PRESERVATION PARCEL 'A' AND NON-BUILDABLE PRESERVATION PARCEL 'B'

SEWER MAIN EXTENSION & WASTEWATER TREATMENT SYSTEM

CONTRACT NO. 50-4964-D  
THIRD ELECTION DISTRICT  
HOWARD COUNTY, MARYLAND

SCALE AS SHOWN

SHEET 4 OF 7

**Trench Design: 200% capacity with 66/66/66 low pressure distribution system**

Trench	existing ground elevation (feet msl)	perc ID's	sidewall top elevation (feet msl)	perc rates (minutes per inch)	trench bottom elevation (feet msl)	trench length (feet)	application rate (gpd/sqft)	capacity (gpd, L*W*Appr/CF)
<b>Primary Capacity (200%)</b>								
1	573.5	P-26	567.5	5	566.5	75	0.8	217
2	573.0	P-25, P-26	567.0	5	566.0	135	0.8	390
3	572.5	P-25, P-27	566.5	5	565.5	190	0.8	548
4	572.0	P-25, P-27, P-33	566.0	<30	565.0	250	0.8	721
5	571.0	P-33	565.0	24	564.0	300	0.8	865
6	570.0	P-32, P-33, P-34, P-28	564.0	<30	563.0	330	0.8	952
7	569.0	P-32, P-48, P-34, P-28	563.0	<15	562.0	336	0.8	968
8	567.5	P-32, P-48, P-34, P-28	561.5	<15	560.5	330	0.8	950
9	566.0	P-29, P-30	560.0	<30	559.0	135	0.8	389
<b>Reserve Capacity (100%)</b>								
10	570.0	P-36	564.0	8	563.0	100	0.8	288
11	569.0	P-35	563.0	4	562.0	30	0.8	88
12	569.0	P-35	563.0	4	562.0	78	0.8	226
13	568.5	P-35, P-43	562.5	<15	561.5	89	0.8	256
14	568.0	P-43	562.0		561.0	89	0.8	256
15	567.5	P-43	561.5	12	560.5	86	0.8	248
16	566.5	P-46, P-42, P-42A	560.5		559.5	83	0.8	239
17	565.5	P-46, P-42, P-42A	559.5	<30	558.5	85	0.8	245
18	564.5	P-46, P-42, P-42A	558.5		557.5	86	0.8	248
19	563.0	P-46, P-42, P-42A	557.0		556.0	80	0.8	230
20	561.5	P-47	555.5	21	554.5	71	0.8	206
21	560.0	P-47	554.0		553.0	63	0.8	183
22	559.0	P-47, P-41	553.0	<30	552.0	55	0.8	158
23	557.5	P-47, P-41	551.5	<30	550.5	45	0.8	130

Trench width (ft) = 3.0      300% total capacity (gpd) = 9,000  
Sidewall Height (ft) = 1.0      100% capacity (gpd) = 3,000  
Trench bottom depth (ft) = 7.0      primary capacity (gpd) = 6,000  
reserve capacity (gpd) = 3,000

**Notes:**  
calculated values in italics  
gpd = gallons per day  
NA = not available  
msl = mean sea level in feet  
laterals in each cell are same elevation


**TRENCHFIELD DESIGN**

**Distribution Design**


Cell	Trench	Lateral	lateral elevation (feet msl)	depth of lateral (ft)	depth of gravel below lateral (ft)	trench segment length (feet)	# holes - each lateral	perforation spacing (feet)	lateral length (feet)	perforation diameter (inches)	perforation flow (gpm)	lateral flow (gpm)	lateral dose rate (gpm/foot of trench)	max. lateral friction loss (feet)	max. lateral friction loss (psi)	cell dose flow (gpm)	lateral dose velocity (fpm)
<b>A</b>																	
1	a	567.5	4.0	3.0	38	4	9.43	33.0	9/32	1.62	6.5	0.172	0.03	0.01		0.6	
2	a	567.0	3.5	3.5	67	7	9.57	62.2	9/32	1.62	11.3	0.169	0.18	0.08		1.1	
3	a	566.5	4.0	4.0	95	10	9.52	90.4	9/32	1.62	16.2	0.170	0.51	0.22		1.5	111.7
4	a	566.0	4.5	4.5	84	9	9.33	79.3	9/32	1.62	14.6	0.174	0.37	0.16		1.4	
5	a	565.0	3.0	3.0	75	8	9.38	70.3	9/32	1.62	13.0	0.173	0.26	0.11		1.2	
6	a	564.0	4.0	4.0	83	9	9.22	78.4	9/32	1.62	14.6	0.176	0.36	0.16		1.4	
7	a	563.0	2.0	5.0	84	9	9.33	79.3	9/32	1.62	14.6	0.174	0.37	0.16		1.4	
<b>B</b>																	
1	a	567.0	4.0	4.0	83	9	9.22	78.4	9/32	1.62	14.6	0.176	0.36	0.16		1.4	
2	a	567.0	4.0	4.0	83	9	9.22	78.4	9/32	1.62	14.6	0.176	0.36	0.16		1.4	
3	a	567.0	4.0	4.0	83	9	9.22	78.4	9/32	1.62	14.6	0.176	0.36	0.16		1.4	
<b>C</b>																	
1	a	564.5	4.0	4.0	83	9	9.17	77.9	9/32	1.62	14.6	0.177	0.36	0.16		1.4	
2	a	564.5	4.0	4.0	83	9	9.17	77.9	9/32	1.62	14.6	0.177	0.36	0.16		1.4	
3	a	564.5	4.0	4.0	83	9	9.17	77.9	9/32	1.62	14.6	0.177	0.36	0.16		1.4	
4	a	564.5	5.5	5.5	67	7	9.57	62.2	9/32	1.62	11.3	0.169	0.18	0.08		1.1	
5	a	564.0	1.5	5.5	67	7	9.57	62.2	9/32	1.62	11.3	0.169	0.18	0.08		1.1	

**Notes:**  
calculated values in italics      friction C factor for plastic pipe= 140  
gpm = gallons per minute      lateral inside diameter (2" PVC pipe, in) = 2.07  
msl = mean sea level in feet      design distal head (feet) = 3.0  
All laterals within a cell are set at the same elevation.  
laterals end 1/2 hole spacing from end of trench

**DISTRIBUTION DESIGN**

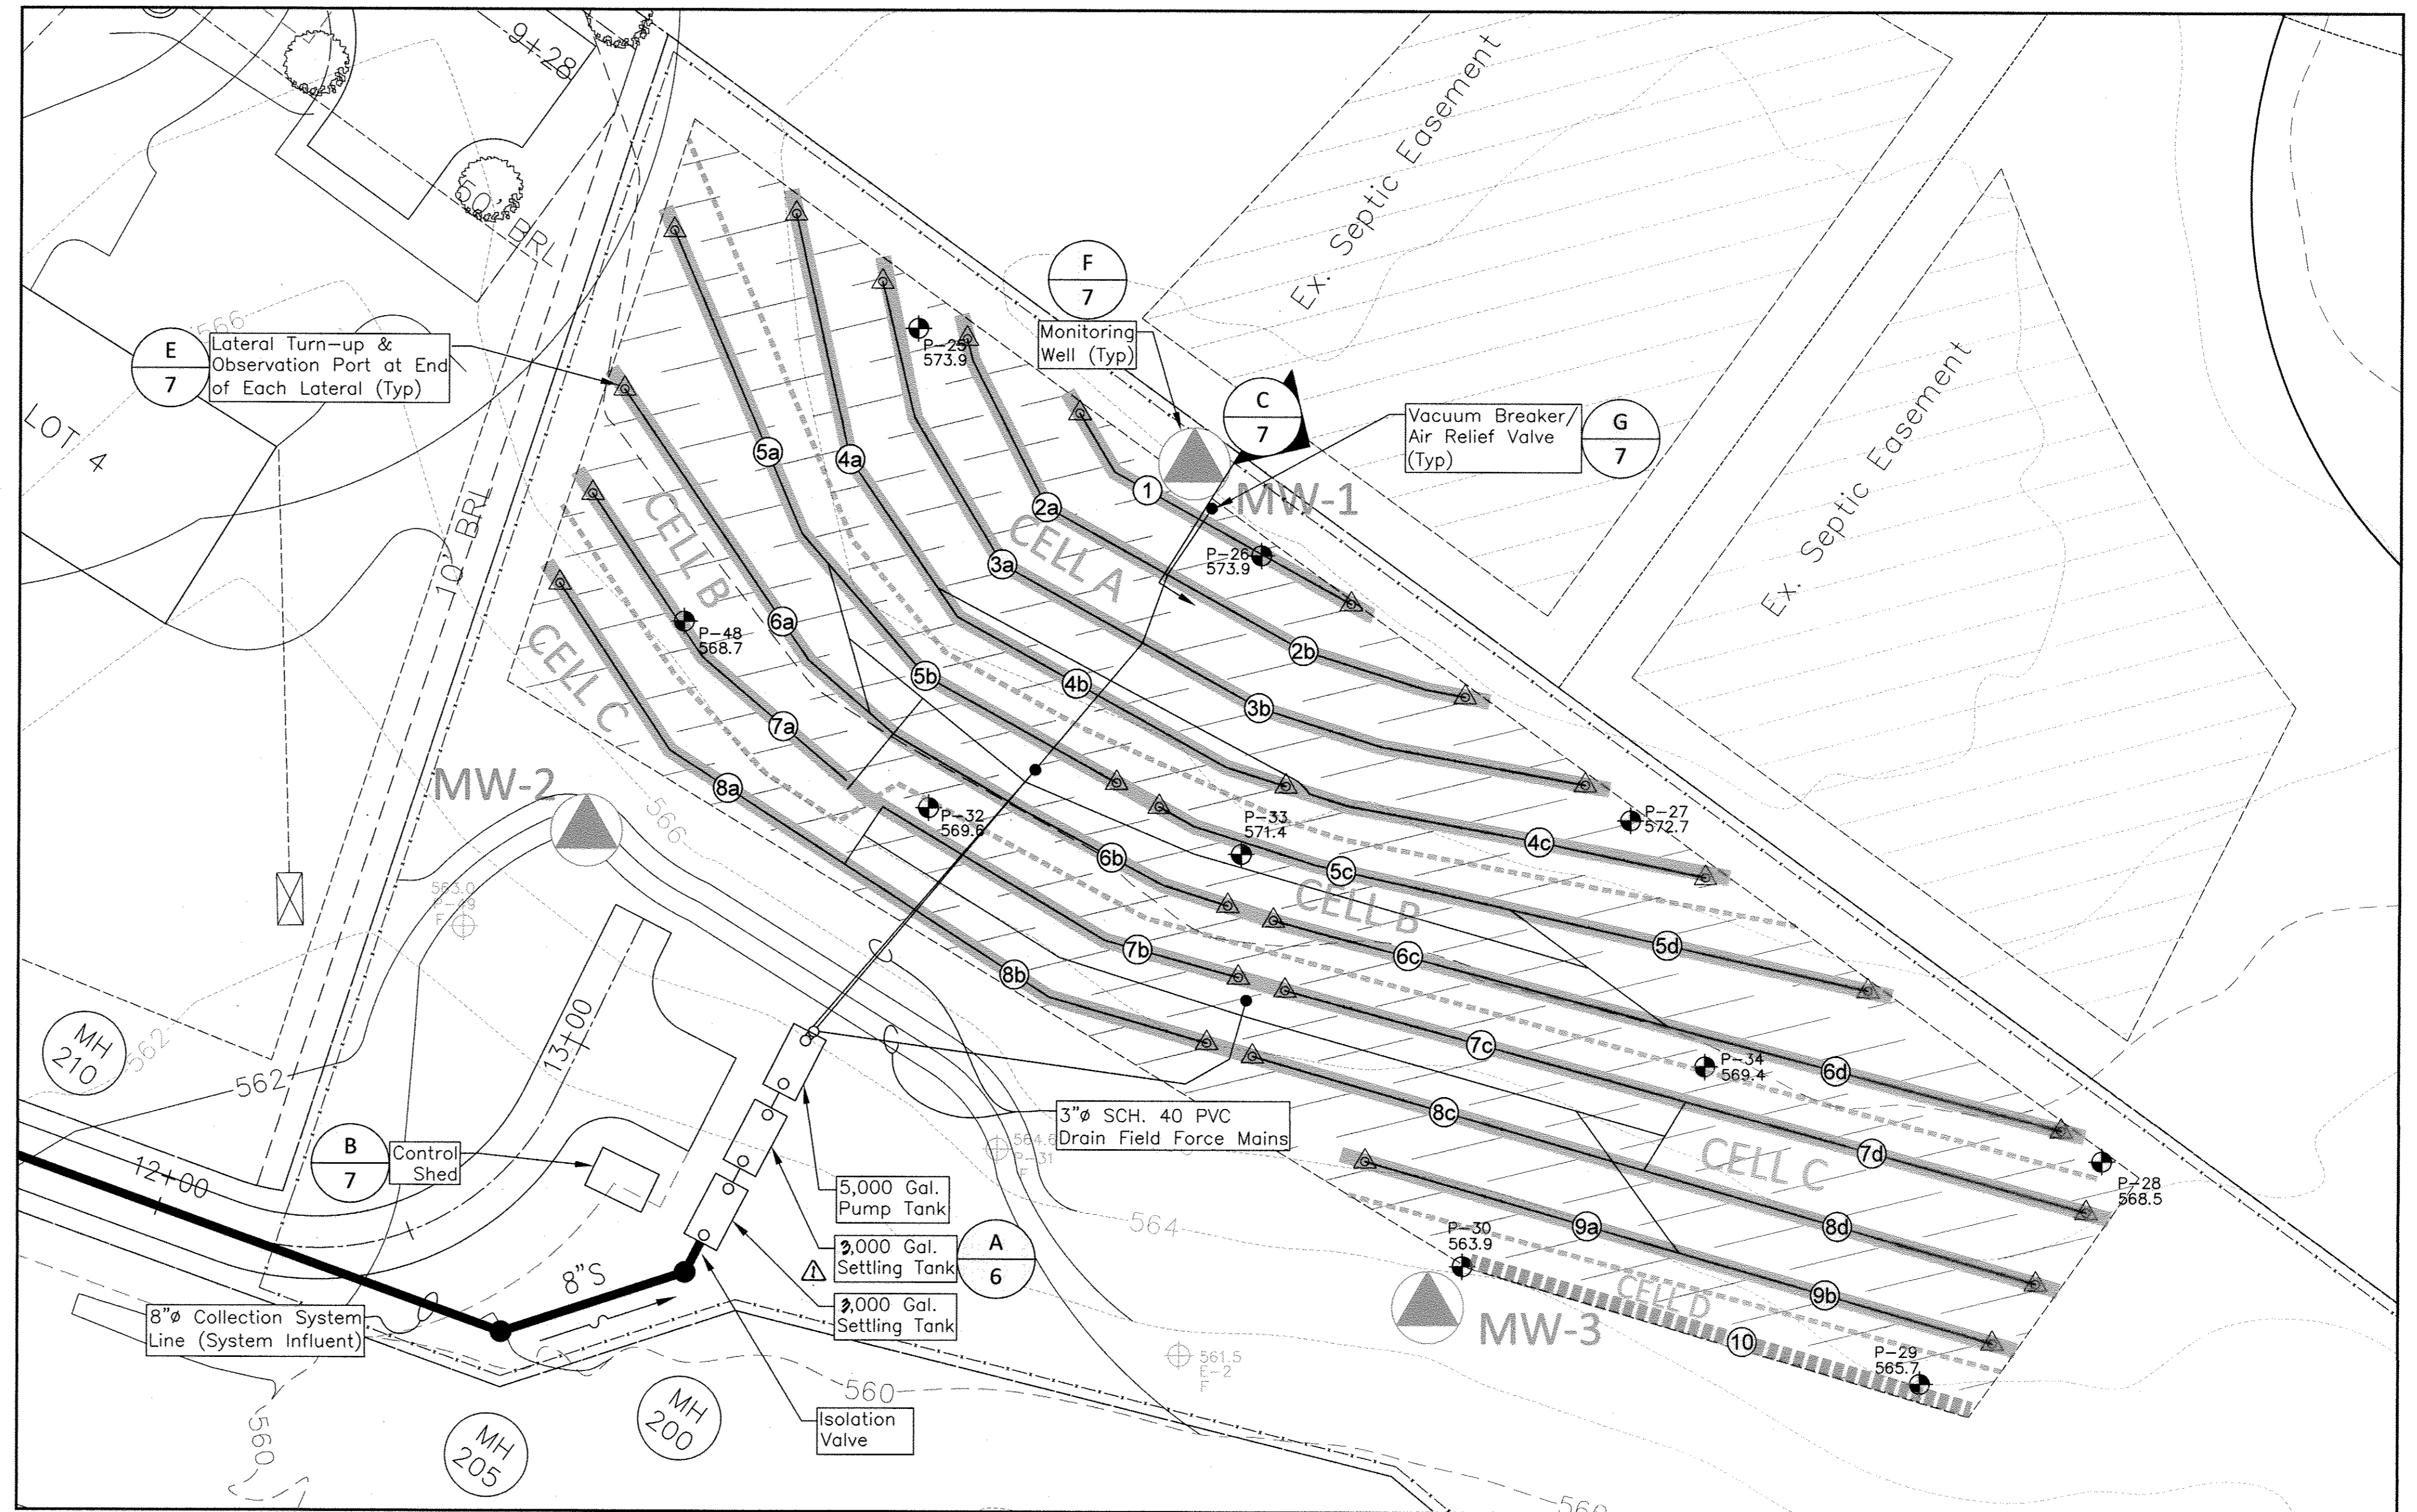

**DRAINFIELD PLAN**

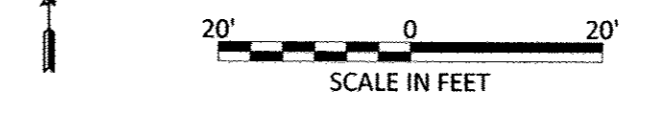

**PERC TEST RESULTS**

Test #	Limiting Zone				Elevation (feet msl)	Top of Treatment Zone	Bottom of Treatment Zone
	Depth (feet)	Total Depth (feet)	Perc Rate (min/inch)	Max Sidewall Depth (feet)		Zone (feet)	Zone (feet)
P-25	4.0	13.1	5	5.1	572.9	568.9	563.8
P-26	5.0	13.5	18	4.5	573.9	568.9	564.4
P-27	4.5	13.5	11	5.0	572.7	568.2	563.2
P-28	4.0	12.5	3	4.5	568.5	564.5	560.0
P-29	5.0	13.0	7	4.0	565.7	560.7	556.7
P-30	5.0	12.5	28	3.5	563.9	558.9	555.4
P-32	3.0	12.0	13	5.0	569.6	566.6	561.6
P-33	4.0	14.0	24	6.0	571.4	567.4	561.4
P-34	7.0	12.5	6	1.5	571.4	564.4	562.9
P-48	3.2	13.0	3	5.8	568.7	565.5	559.7
P-35	3.0	12.0	4	5.0	567.9	564.9	559.9
P-36	4.0	12.0	8	4.0	569.4	565.4	561.4
P-41	3.0	12.5	25	5.5	557.0	554.0	548.5
P-42	4.0	12.5	7	4.5	564.8	560.8	556.3
P-42A	5.5	13.0	11	3.5	564.5	559.0	555.5
P-43	3.5	14.0	12	6.5	568.4	564.9	558.4
P-46	3.0	13.0	13	6.0	564.5	561.5	555.5
P-47	3.3	13.0	21	5.7	559.2	555.9	550.2

**Notes:**  
1. Observation Port shall be located between the last and second to last perforation of each lateral.  
2. Vacuum breaker/air relief valve shall be located at highest point of each cell.

APPROVED: FOR PRIVATE WATER AND SHARED SEWAGE FOR LOTS 1-4  
for Richard C. Davis 3/17/17  
HOWARD COUNTY HEALTH/OFFICER DATE

Richard C. Davis  
CHIEF, BUREAU OF UTILITIES DATE

DEPARTMENT OF PLANNING AND ZONING  
HOWARD COUNTY, MARYLAND

Charles R. Crocken  
CHIEF, DEVELOPMENT ENGINEERING DIVISION DATE

I HEREBY CERTIFY THAT THESE DOCUMENTS WERE PREPARED OR APPROVED BY ME, AND THAT I AM A DULY LICENSED PROFESSIONAL ENGINEER UNDER THE LAWS OF THE STATE OF MARYLAND. LICENSE NO. 7803 EXPIRATION DATE IS 4/22/17.

Charles R. Crocken  
HYDRO-TERRA GROUP  
1106 Business Parkway South  
Suite E  
Westminster, Maryland 21157  
(410) 861-5376 (phone)  
(410) 861-5487 (fax)


D.M.S.  
DRAWN BY: M.D.S.  
CHECKED BY: M.J.M.  
DATE: January, 2017

600' SCALE MAP NO. 22 BLOCK NO. 8  
F.C.C. WORK ORDER NO. 71160  
FILE NAME: SEWER MAIN EXTENSION PLAN

SEWER MAIN EXTENSION & WASTEWATER TREATMENT SYSTEM ENLARGED DRAINFIELD PLAN


BEWEDERE ESTATES  
LOTS 1 THRU 11,  
BUILDABLE PRESERVATION PARCEL 'A' AND  
NON-BUILDABLE PRESERVATION PARCEL 'B'  
SEWER MAIN EXTENSION & WASTEWATER TREATMENT SYSTEM  
CONTRACT NO. 50-4964-D  
THIRD ELECTION DISTRICT  
HOWARD COUNTY, MARYLAND

SCALE AS SHOWN  
SHEET 5 OF 7

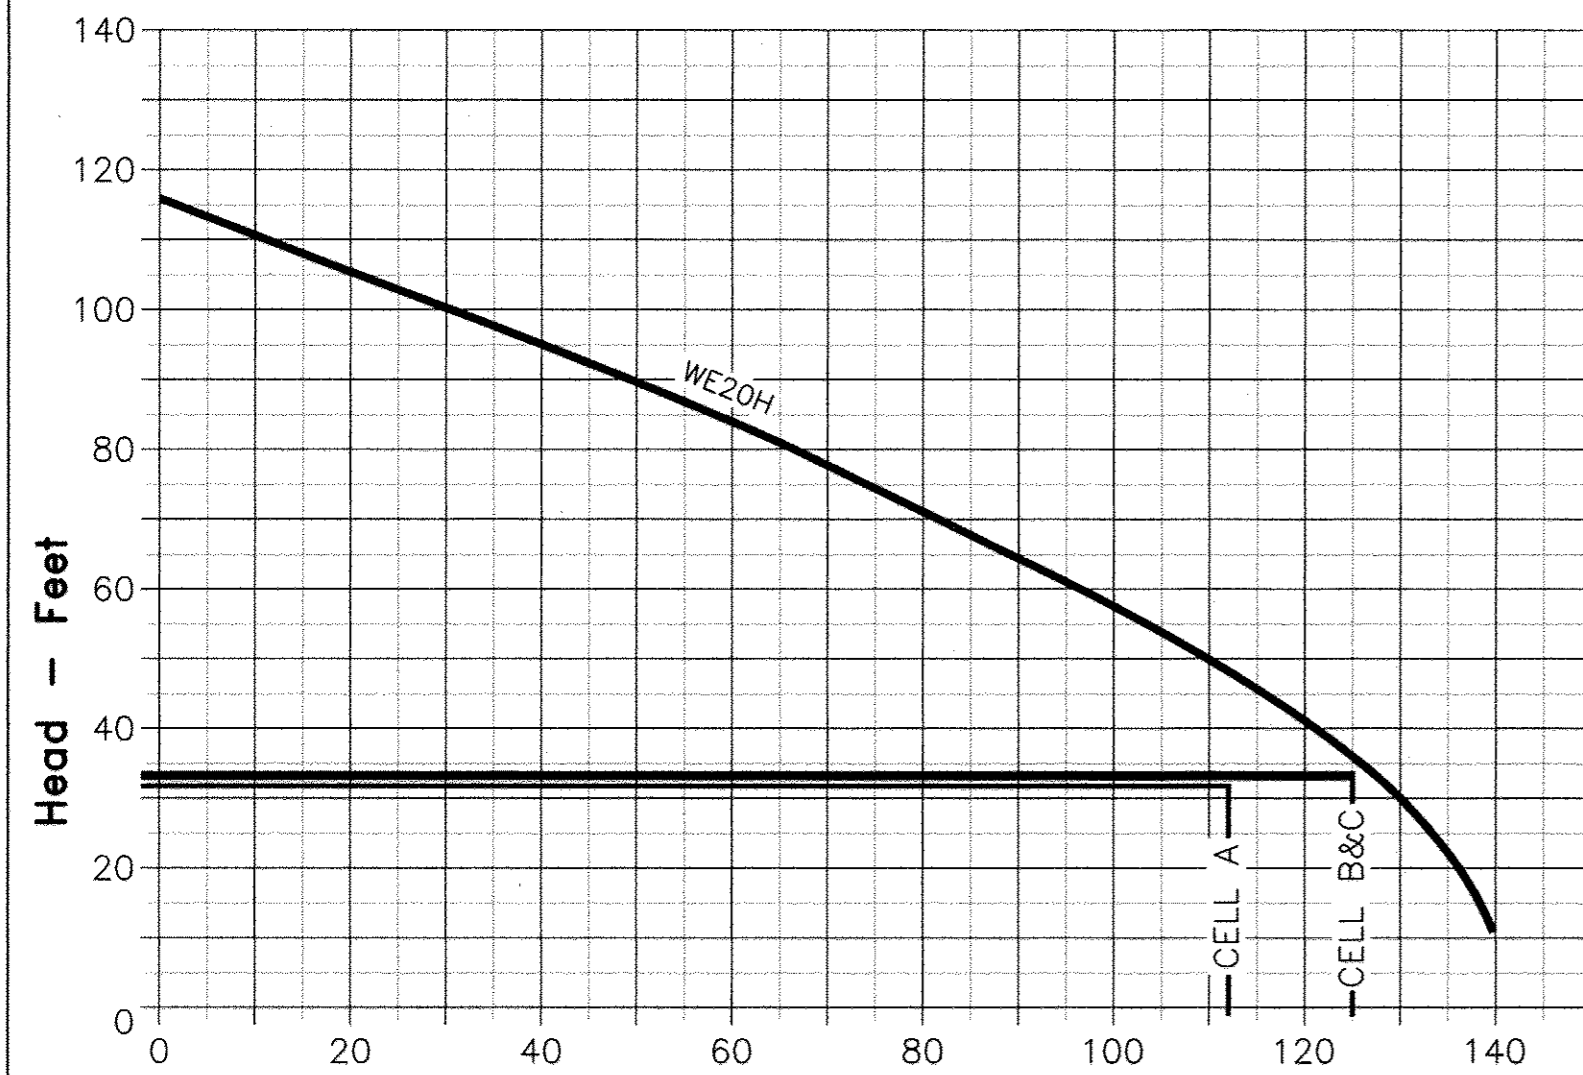



Flow - GPM  
**DOSE PUMP CURVE(S)**  
GOULDS WE20H

**DIMENSIONS**  
(All dimensions are in inches. Do not use for construction purposes.)

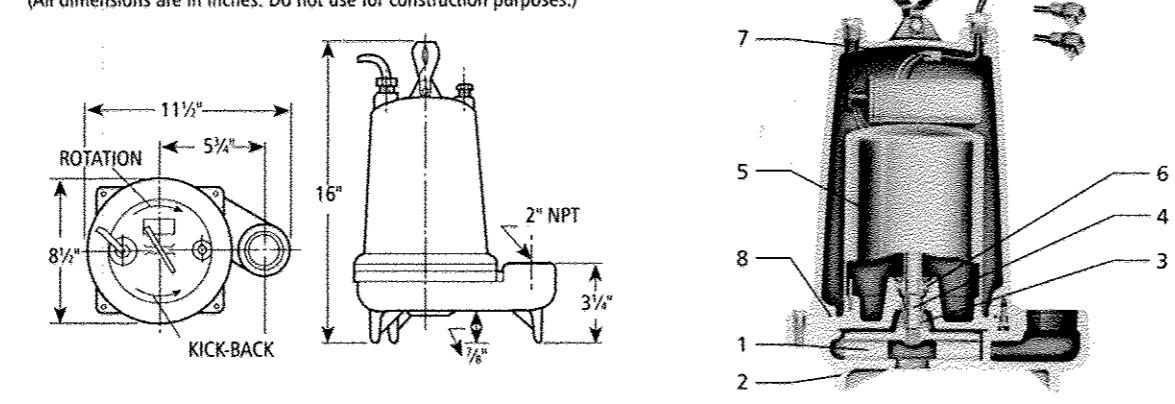

Item No.	Description
1	Impeller
2	Casing
3	Mechanical Seal
4	Motor Shaft
5	Motor
6	Ball Bearings
7	Power Cable
8	Casing O-Ring

H  
6  
**DOSE PUMP**  
GOULDS WE20H

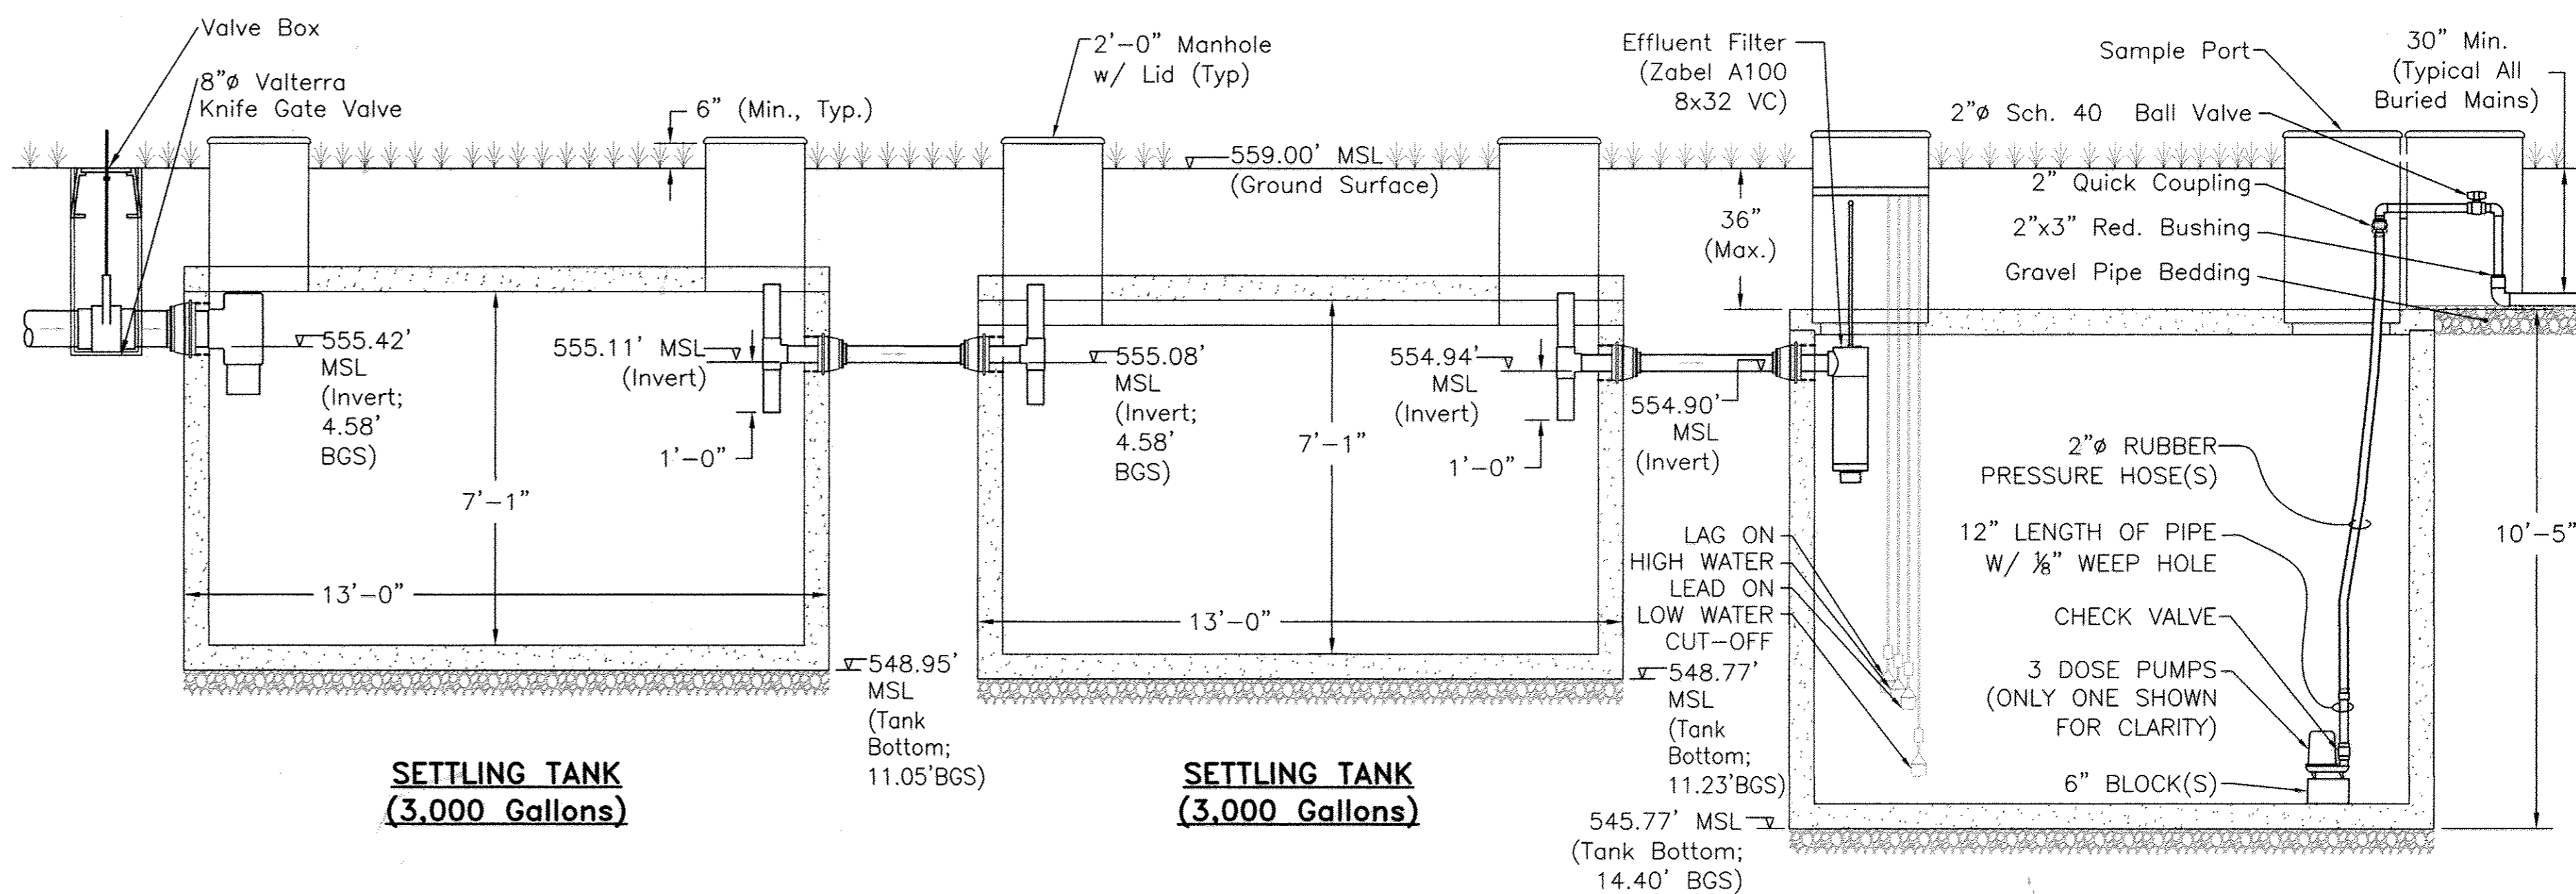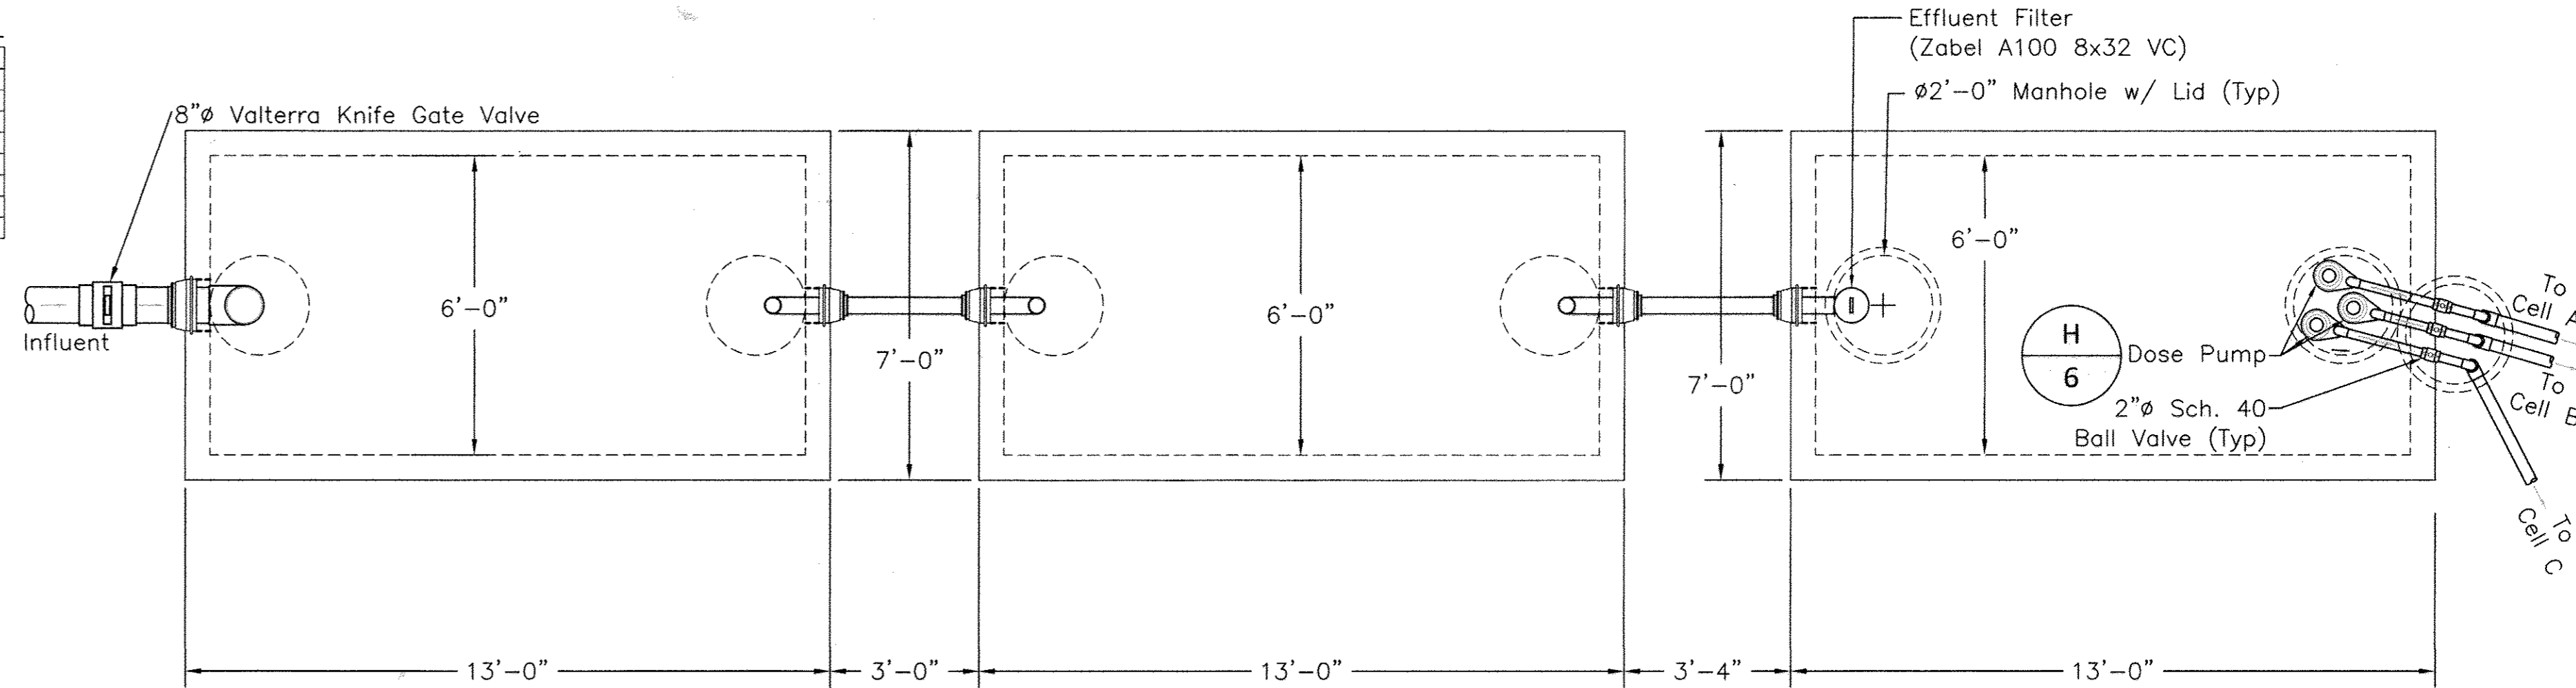

**SETTLING TANK**  
(3,000 Gallons)

**SETTLING TANK**  
(3,000 Gallons)

**5,000 GALLON**  
**PUMP TANK**


**TREATMENT SYSTEM**  
SCALE: 3/8" = 1'-0"

**Triplex Control Panel**

Three phase, triplex alternating pump control with intrinsically safe circuits. The Model 324 control panel is designed for applications requiring intrinsically safe float circuits or other circuit extensions. This panel will alternately control two 208/240/480 VAC three phase pumps. The alternating action equalizes pump wear. In addition to the alternating pump control, this system provides override control should either pump fail. If an alarm condition occurs, an additional alarm switch activates the audiovisual alarm system. Common applications include pump chambers, lift stations, or other installations classified as hazardous locations requiring intrinsically safe circuits.

**PANEL COMPONENTS**

- Enclosure measures 16 x 14 x 6 inches (40.64 x 35.56 x 15.24 cm) NEMA 4X (ultraviolet stabilized thermoplastic with removable mounting feet for outdoor or indoor use).
- Intrinsically Safe Module limits the amount of energy to switches preventing ignition of flammable gases.
- Intrinsically Safe Partition isolates intrinsically safe wiring.
- Motor Protective Switches provide adjustable overload, branch circuit protection and pump disconnect.
- IEC Motor Contactors control pumps by switching electrical lines.
- HOA Switches for manual pump control (mounted on circuit board).
- Multi-Tap Transformer (208/240/480 VAC primary) provides 120V control/alarm voltage or 600VAC primary transformer.
- Alternating Circuit Board provides pump control and alternation of pumps (U.S. Patent # 5,309,352).
- Green Pump Run Indicator Lights (mounted on circuit board).
- Control/Alarm Fuse (mounted on circuit board).
- Float Status Indicator Lights (mounted on circuit board).
- Input Power Terminal Block
- Ground Lugs
- Control/Alarm Power Indicator Light (mounted on circuit board).
- Control ON/OFF Switch (mounted on circuit board).

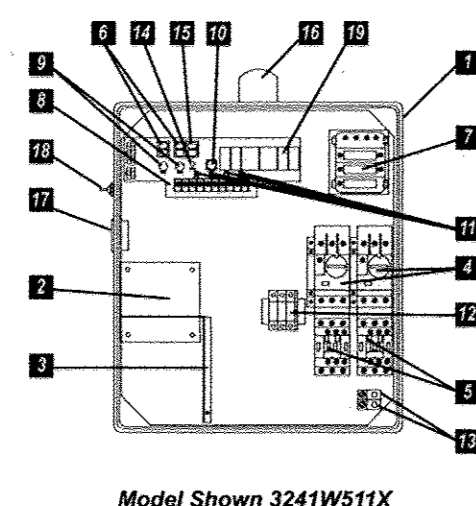

Model Shown 3241W511X

**FEATURES**

- Industrial control panel is UL Listed relating to hazardous locations with intrinsically safe circuit extensions
- Dual safety certification for the United States and Canada
- Standard package includes three 20' SJE MillAmpMaster™ control switches
- Complete with step-by-step installation instructions
- Five-year limited warranty



SEE BACKSIDE FOR COMPLETE LISTING OF AVAILABLE OPTIONS.  
SEE PRICE BOOK FOR LIST PRICE.

Design Input	Calculations
setting tank capacity (gallons per inch)	maximum daily flow (MDF) (gpd) 3,000
normal setting tank fluid level (inches)	average daily flow (ADF) (gpd) 1,500
	settling tank volume required (gal) 6,000
	normal settling tank capacity (gal) 6,104

Static hydraulic profile (with invert elevations)		
ST1 influent invert elev. (feet msl)	555.42	*2'-4" gravity sewer bury
ST2 influent invert elev. (feet msl)	555.08	
pump tank bottom elev. (feet msl)	545.77	
dose pump elev. (feet msl)	546.77	*Pump suction is 6" above tank bottom

Cell A lateral elev. (feet msl)	567.50	Cell A in-service lift for dose pump (feet)	20.7
Cell B lateral elev. (feet msl)	567.00	Cell B in-service lift for dose pump (feet)	20.2
Cell C lateral elev. (feet msl)	564.50	Cell C in-service lift for dose pump (feet)	17.7

Pumping and Dosing		
cell A flow (gpm)	112	force main velocity (feet/second) 4.8
Cell A force main length (feet)	137	Cell A force main friction loss (feet) 6.7
Cell A minor loss equivalent length (feet)	61.2	Cell A max. total dynamic head (feet) 30.9
		Cell A main volume (gal) 53
		Cell A total lateral volume (gal) 113.6
		Cell A dose vol. @ main + 5x lateral (gal) 621

cell B flow (gpm)	125	force main velocity (feet/second) 5.4
Cell B force main length (feet)	156	Cell B force main friction loss (feet) 9.0
Cell B minor loss equivalent length (feet)	61.2	Cell B max. total dynamic head (feet) 32.6
		Cell B main volume (gal) 60
		Cell B total lateral volume (gal) 124.8
		Cell B dose vol. @ main + 5x lateral (gal) 684

cell C flow (gpm)	125	force main velocity (feet/second) 5.4
Cell C force main length (feet)	185	Cell C force main friction loss (feet) 10.2
Cell C minor loss equivalent length (feet)	61.2	Cell C max. total dynamic head (feet) 31.3
		Cell C main volume (gal) 71
		Cell A total lateral volume (gal) 124.8
		Cell C dose vol. @ main + 5x lateral (gal) 695

Dose Tank Capacity	
dose tank diameter (inches)	144
dose tank width (inches)	72
dose tank height to invert (inches)	104
# cells in service	3
timer override height (inches)	38
high water alarm height (inches)	36
timer enable height (inches)	34
low water cutoff height (inches)	18
triplex effluent pumps (Goulds)	WE20H
Triplex control panel (SJE Rhombus)	
tank height above invert (inches)	9

Notes  
gpd = gallons per day  
gpm = gallons per minute  
msl = mean sea level in feet  
calculated values in italics  
set floats based on weight +/- 3"  
triplex control panel shall have individual hand/off/auto switches for each dose pump  
two cells shall always be in service, with one cell resting

**Notes**

- All inspection, viewing and pump out ports shall be secured to prevent accidental or unauthorized access.
- No more than 3 FT of fill shall be placed anywhere over tank lid(s).
- Tank measurements and elevations are based on septic tanks and pump chambers as manufactured by Gillespie Precast, LLC (1-800-638-6884); equal manufacturer may be accepted with shop drawing submittal and engineer approval.
- Dose Pump control panel shall have event counters and elapsed time meters.
- Minimum force main bury depth shall be 2'-6" (30") to top of pipe and shall maintain a positive or zero slope in the direction of flow.
- All tanks shall be tested for water tightness prior to service.
- All tanks shall be set upon 6"-8" of gravel bedding.
- Pump control system shall automatically notify the county remotely in the event of a pump failure or high water alarm. Remote Notification shall be routinely tested as part of regular O&M.

**CONTROL PANEL SPECIFICATION**

**DESIGN INPUT**

APPROVED: FOR PRIVATE WATER AND SHARED SEWAGE FOR LOTS 1-4

HOWARD COUNTY HEALTH OFFICER  
DATE: 7/28/2017

DEPARTMENT OF PUBLIC WORKS  
HOWARD COUNTY, MARYLAND  
DATE: 7/27/17

DEPARTMENT OF PLANNING AND ZONING  
HOWARD COUNTY, MARYLAND  
DATE: 7/31/17

I HEREBY CERTIFY THAT THESE DOCUMENTS WERE PREPARED OR APPROVED BY ME, AND THAT I AM A DULY LICENSED PROFESSIONAL ENGINEER UNDER THE LAWS OF THE STATE OF MARYLAND.  
LICENSE NO. 7803 EXPIRATION DATE IS 4/22/19.  
Hydro-Terra Group  
1106 Business Parkway South  
Suite E  
Westminster, Maryland 21157  
DATE: 7/13/2017  
CHARLES R. CROCKEN


DESIGNED BY: M.D.S.  
DRAWN BY: M.D.S.  
CHECKED BY: M.J.M.  
DATE: 5/3/17  
BY NO. REVISION

SEWER MAIN EXTENSION & WASTEWATER TREATMENT SYSTEM  
DETAILS SHEET 1  
600' SCALE MAP NO. 22 BLOCK NO. 8  
F.C.C. WORK ORDER NO. 71160  
FILE NAME: SEWER MAIN EXTENSION PLAN



**REPLACEMENT SHEET**

BELVEDERE ESTATES  
LOTS 1 THRU 11,  
BUILDABLE PRESERVATION PARCEL 'A' AND  
NON-BUILDABLE PRESERVATION PARCEL 'B'  
SEWER MAIN EXTENSION & WASTEWATER TREATMENT SYSTEM  
CONTRACT NO. 50-4964-D  
THIRD ELECTION DISTRICT  
HOWARD COUNTY, MARYLAND  
SCALE AS SHOWN  
SHEET 6 OF 7

CONTRACT NO. 50-4964-D  
BELVEDERE ESTATES  
LOTS 1 THRU 11, BUILDABLE PRESERVATION PARCEL 'A' AND NON-BUILDABLE PRESERVATION PARCELS 'B' SEWER MAIN EXTENSION & WASTEWATER TREATMENT SYSTEM HOWARD COUNTY, MARYLAND

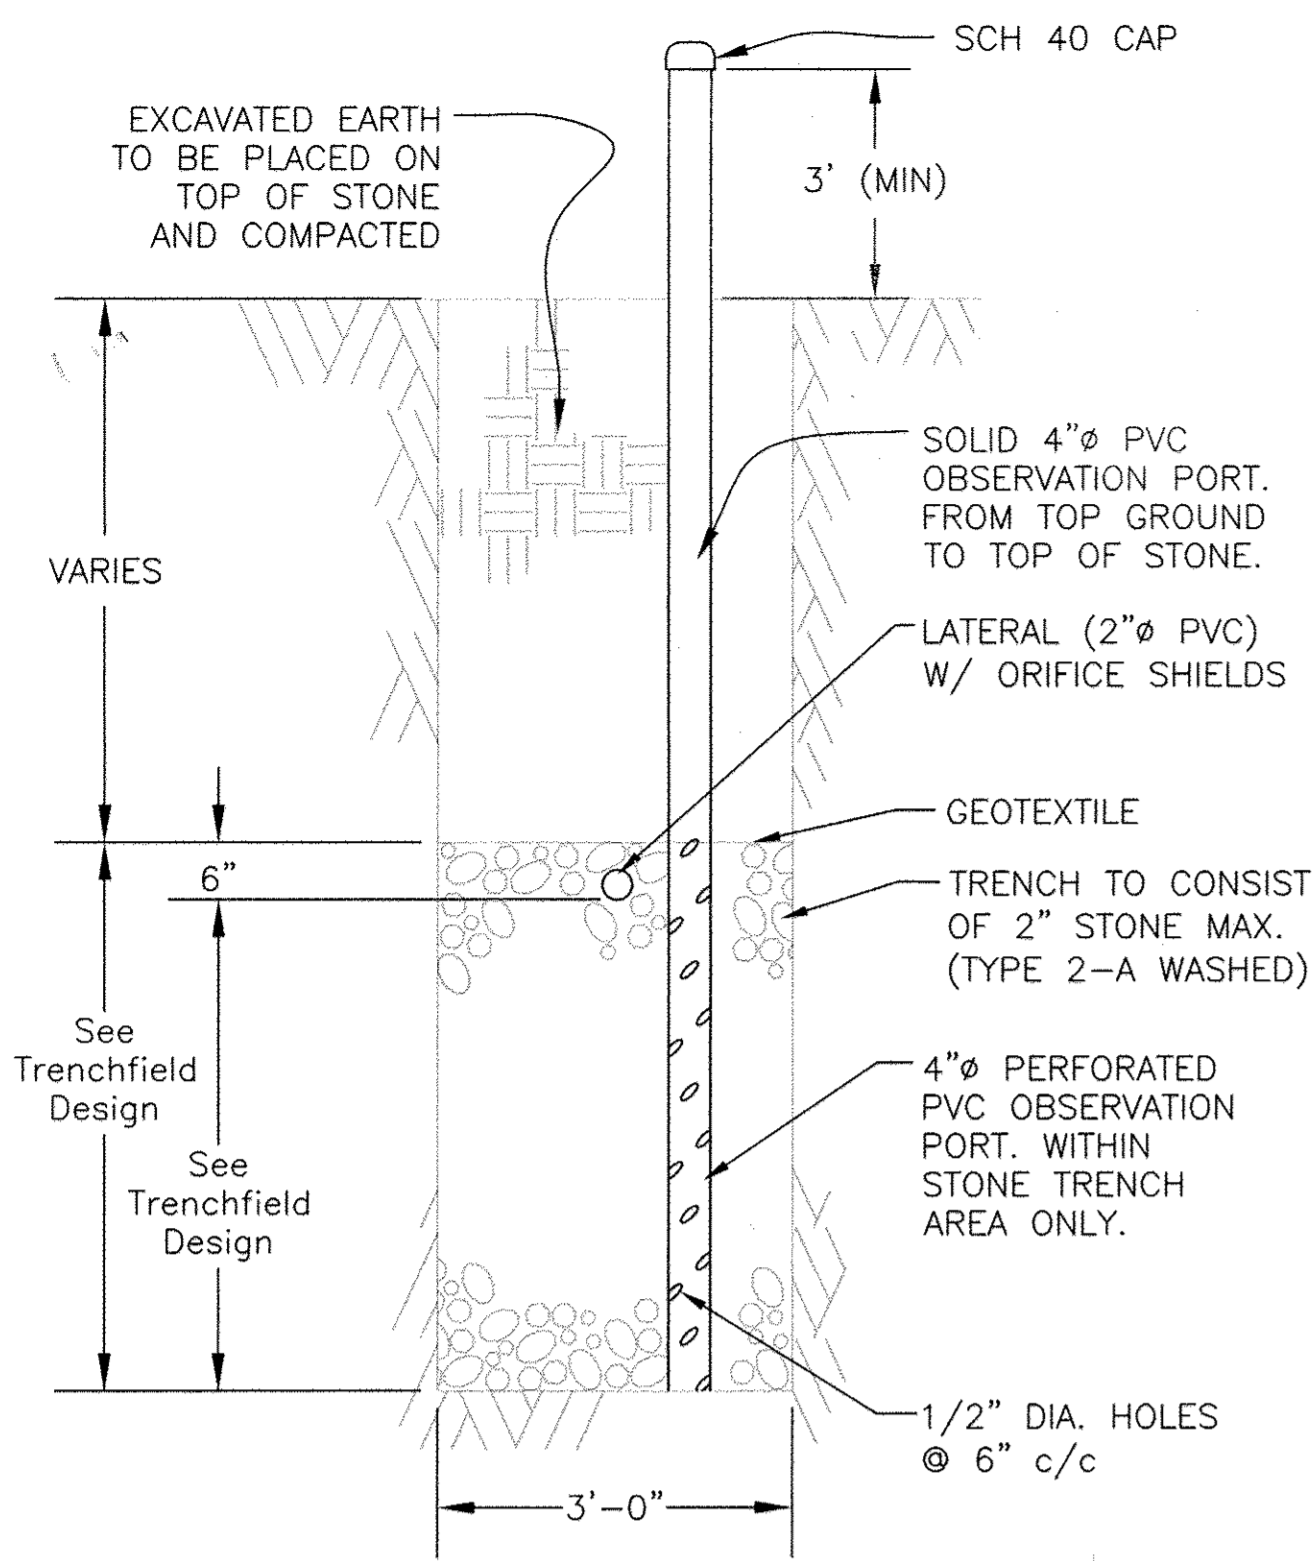


**TYPICAL OBSERVATION PORT** (E 5)  
NOT TO SCALE

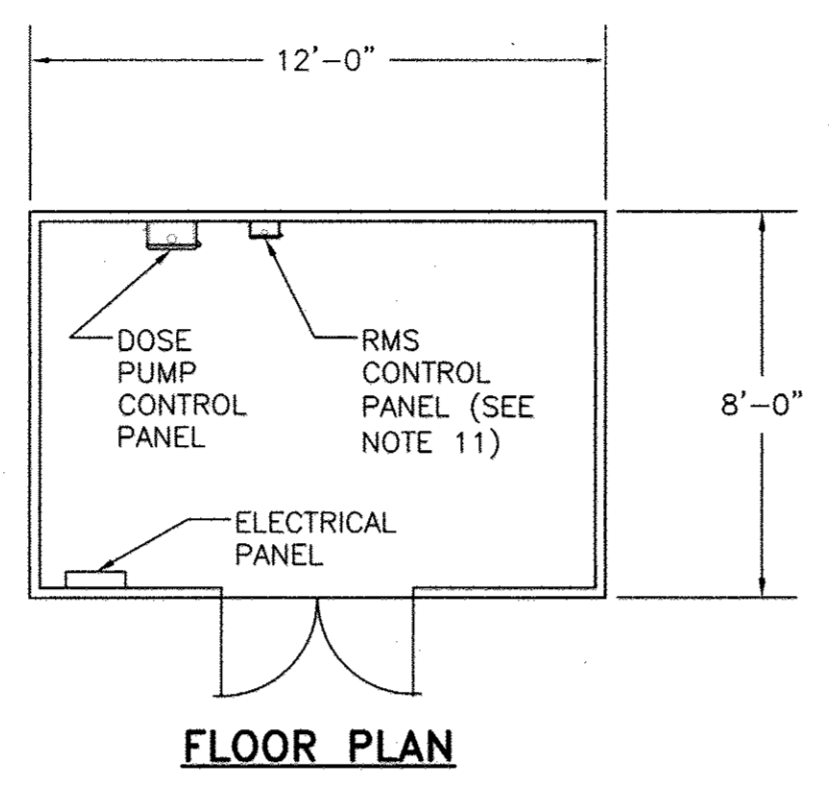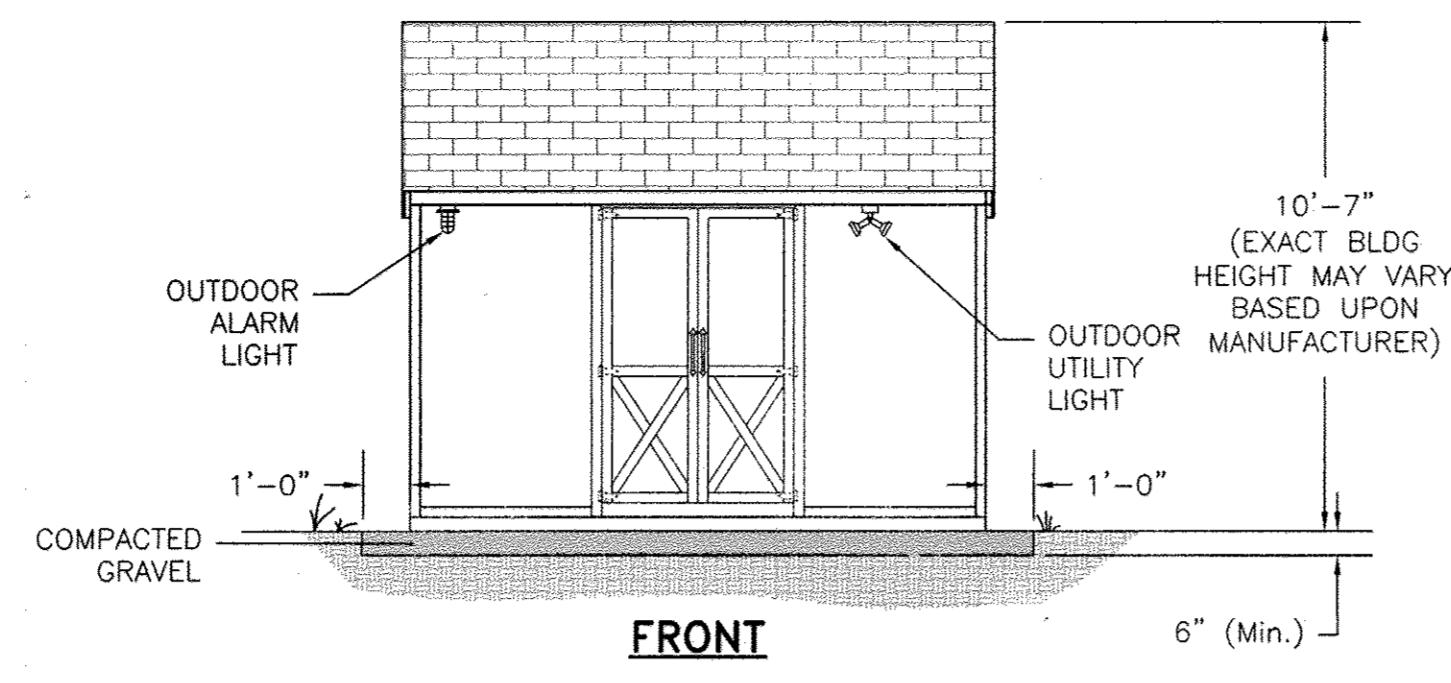


**CONTROL SHED** (B 4, B 5)  
1/4" = 1'-0"

- UTILITY SHED NOTES:**
- UTILITY STORAGE BUILDING SHALL BE PROVIDED AT PUMP STATION WITH CONTROL PANEL MOUNTED INSIDE.
  - BUILDING SHALL BE RIDGE CABINET COMPANY HIGH WALL BARN STYLE STORAGE BUILDING. 8' X 12', VINYL SIDED WITH 8" SIDE WALLS AND NO WINDOWS, WITH ONE DOUBLE DOOR ON END OF BUILDING. BUILDING SHALL HAVE 10" RIDGE VENT, 4"X4" PRESSURE TREATED SKIDS, 2"X4" FLOOR JOISTS (16" ON CENTER), 5/8" PLYWOOD FLOOR SHEATHING, 2"X4" VENT, ALL WALLS TO BE PLATED AT BOTTOM AND DOUBLE PLATED AT THE TOP, 1/2" ROOF SHEATHING, 240 POUND ASPHALT 20 YEAR SHINGLES, DOORS AND FRAME TO BE REINFORCED, DOOR HINGES MUST BE "T" TYPE OR STRAP TYPE, 3 HINGES PER DOOR SIDE (PIANO HINGES ARE NOT ACCEPTABLE), LOCKS ARE TO BE KEYED ALIKE WITH BAUER CH751 LOCK.
  - VINYL SIDING SHALL BE ALMOND COLOR AND SHINGLES SHALL BE BROWN COLOR.
  - A RED ALARM BEACON SHALL BE MOUNTED ON THE OUTSIDE OF THE BUILDING.
  - BUILDING SHALL BE PLACED ON TOP OF 6" (MIN.) CR6 COMPACTED STONE.
  - GRADING TO BE LEVEL AND COMPACTED PRIOR TO PLACEMENT OF BUILDING.
  - FIELD PLACEMENT OF PANELS, PIPING, BLOWERS, AND TANKS SHALL BE APPROVED BY SITE ENGINEER.
  - ALL PIPING AND CONDUIT PENETRATIONS SHALL BE THROUGH THE FLOOR OF THE BUILDING AND SHALL BE SEALED WITH SPRAY FOAM INSULATION.
  - BUILDING SHALL HAVE A 230 VAC LOAD CENTER WITH APPROPRIATE CIRCUIT BREAKERS.
  - BUILDING SHALL HAVE AT LEAST 3 DOUBLE-DUPLEX CONVENIENCE OUTLETS, A CEILING LIGHT, OUTDOOR FLOODLIGHTS, AND AN OUTDOOR ALARM LIGHT.
  - A REMOTE MONITORING SYSTEM (RMS) SHALL BE INSTALLED THAT SHALL REMOTELY NOTIFY THE COUNTY IN THE EVENT OF A PUMP FAILURE OR A HIGH WATER ALARM. THE RMS SHALL BE COMPATIBLE WITH THE COUNTY'S EXISTING REMOTE MONITORING NETWORK AND INFRASTRUCTURE. RMS ALERT SYSTEM TESTING SHALL BE PART OF REGULAR O&M.

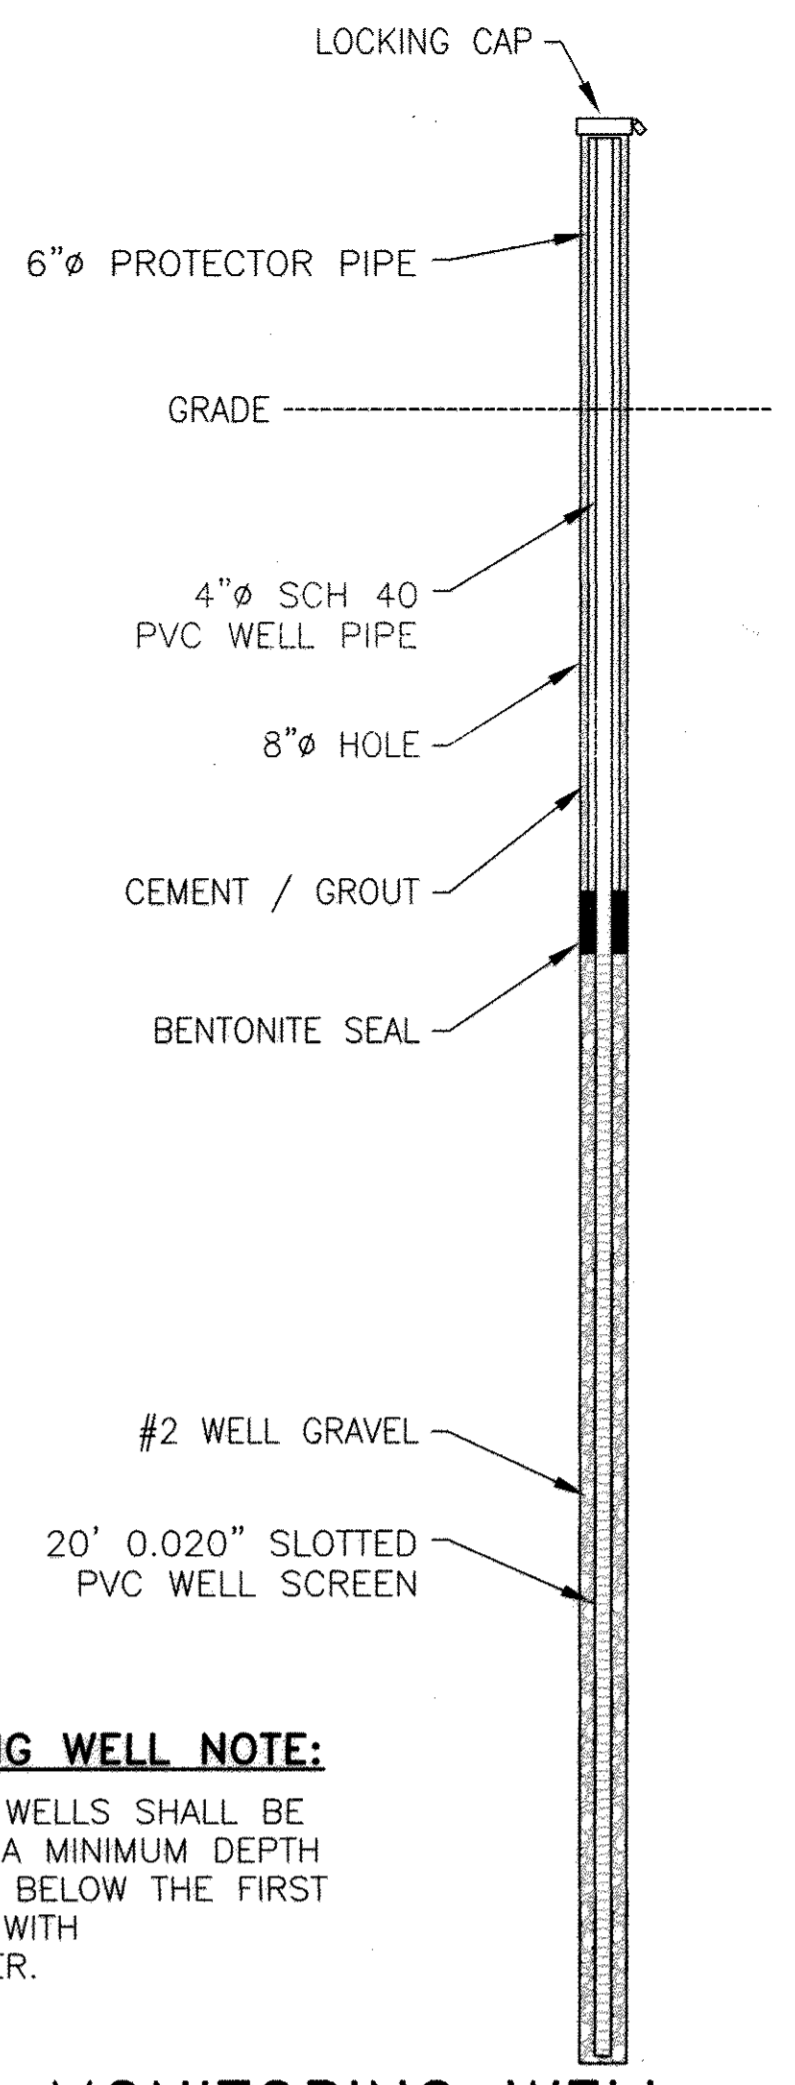


**MONITORING WELL NOTE:**  
MONITORING WELLS SHALL BE DRILLED TO A MINIMUM DEPTH OF 15 FEET BELOW THE FIRST ENCOUNTER WITH GROUNDWATER.

**MONITORING WELL** (F 4, F 5)  
NOT TO SCALE

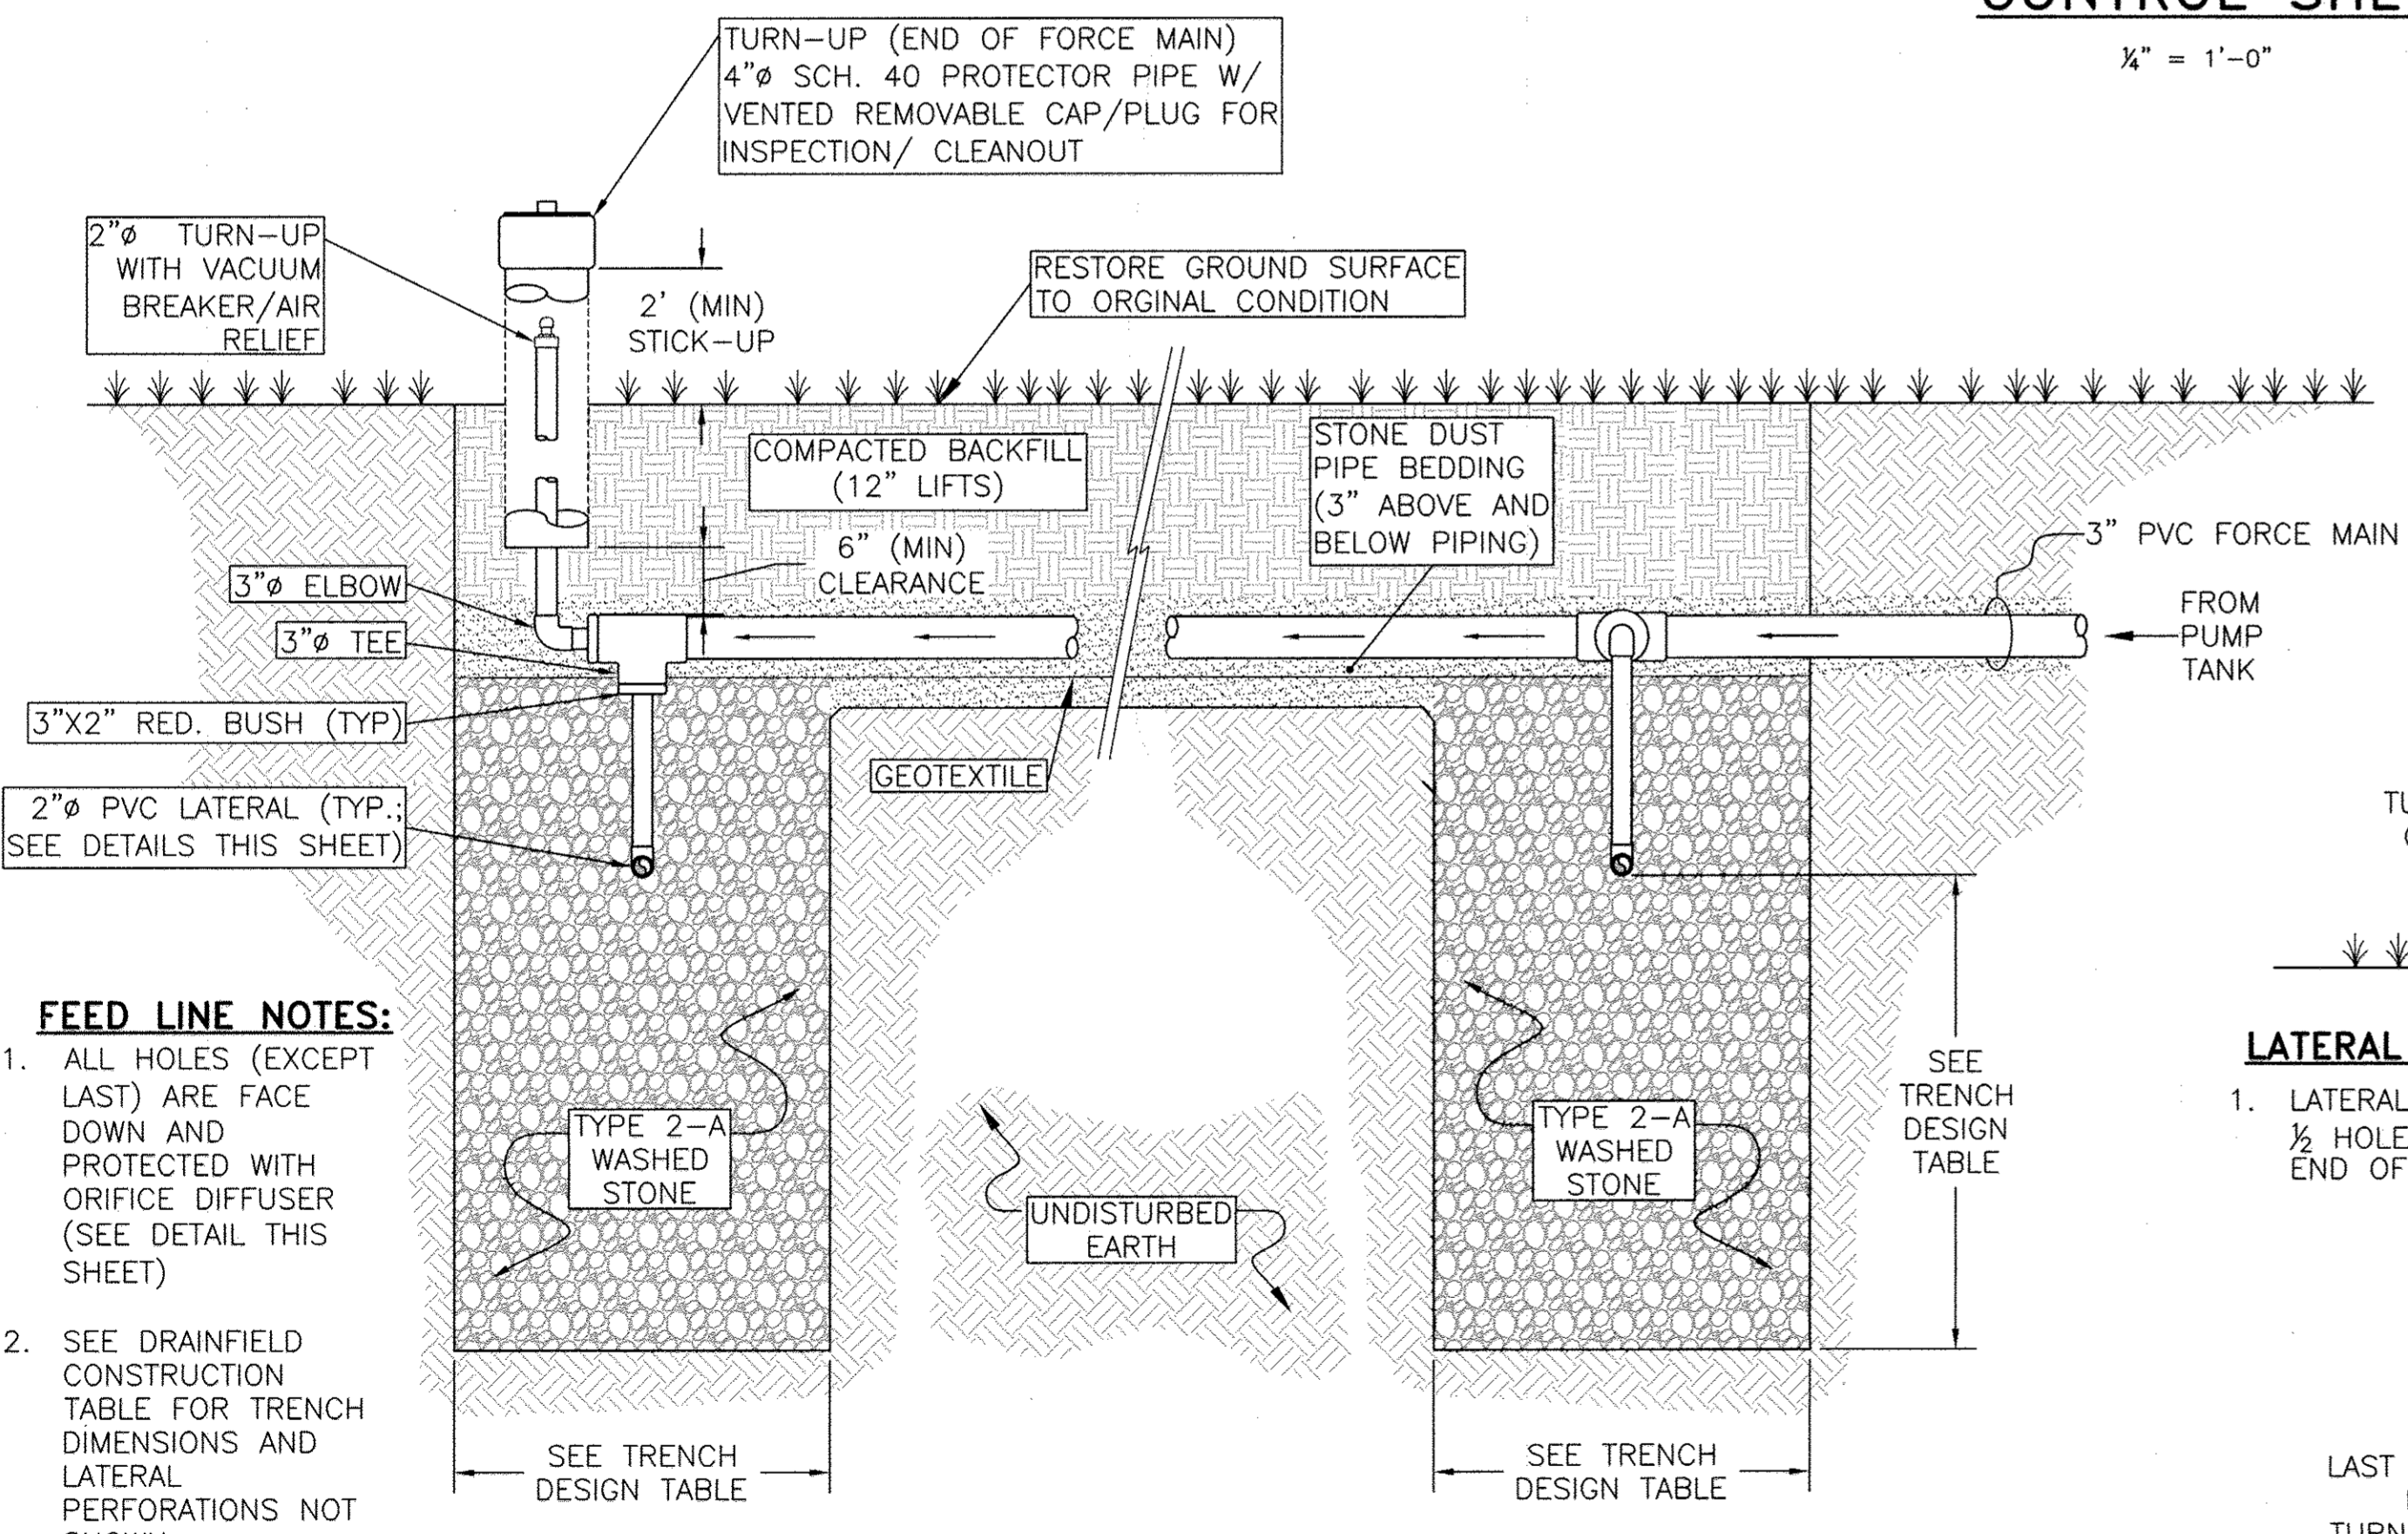


- FEED LINE NOTES:**
- ALL HOLES (EXCEPT LAST) ARE FACE DOWN AND PROTECTED WITH ORIFICE DIFFUSER (SEE DETAIL THIS SHEET)
  - SEE DRAINFIELD CONSTRUCTION TABLE FOR TRENCH DIMENSIONS AND LATERAL PERFORATIONS NOT SHOWN.

**FEED LINE/DEEP TRENCH DETAIL (TYP)** (C 5)  
NOT TO SCALE

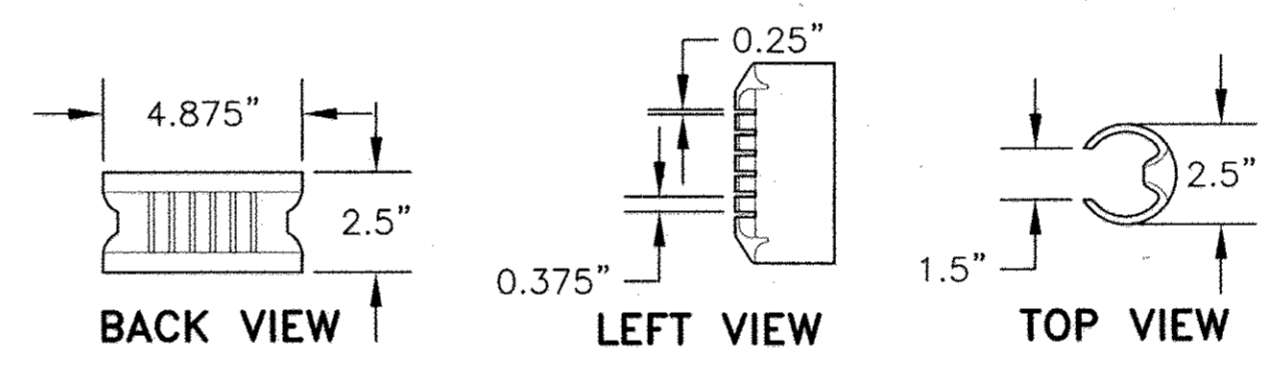


**SIM TECH ORIFICE SHIELD 2" (STF-106-2.0)**  
NOT TO SCALE

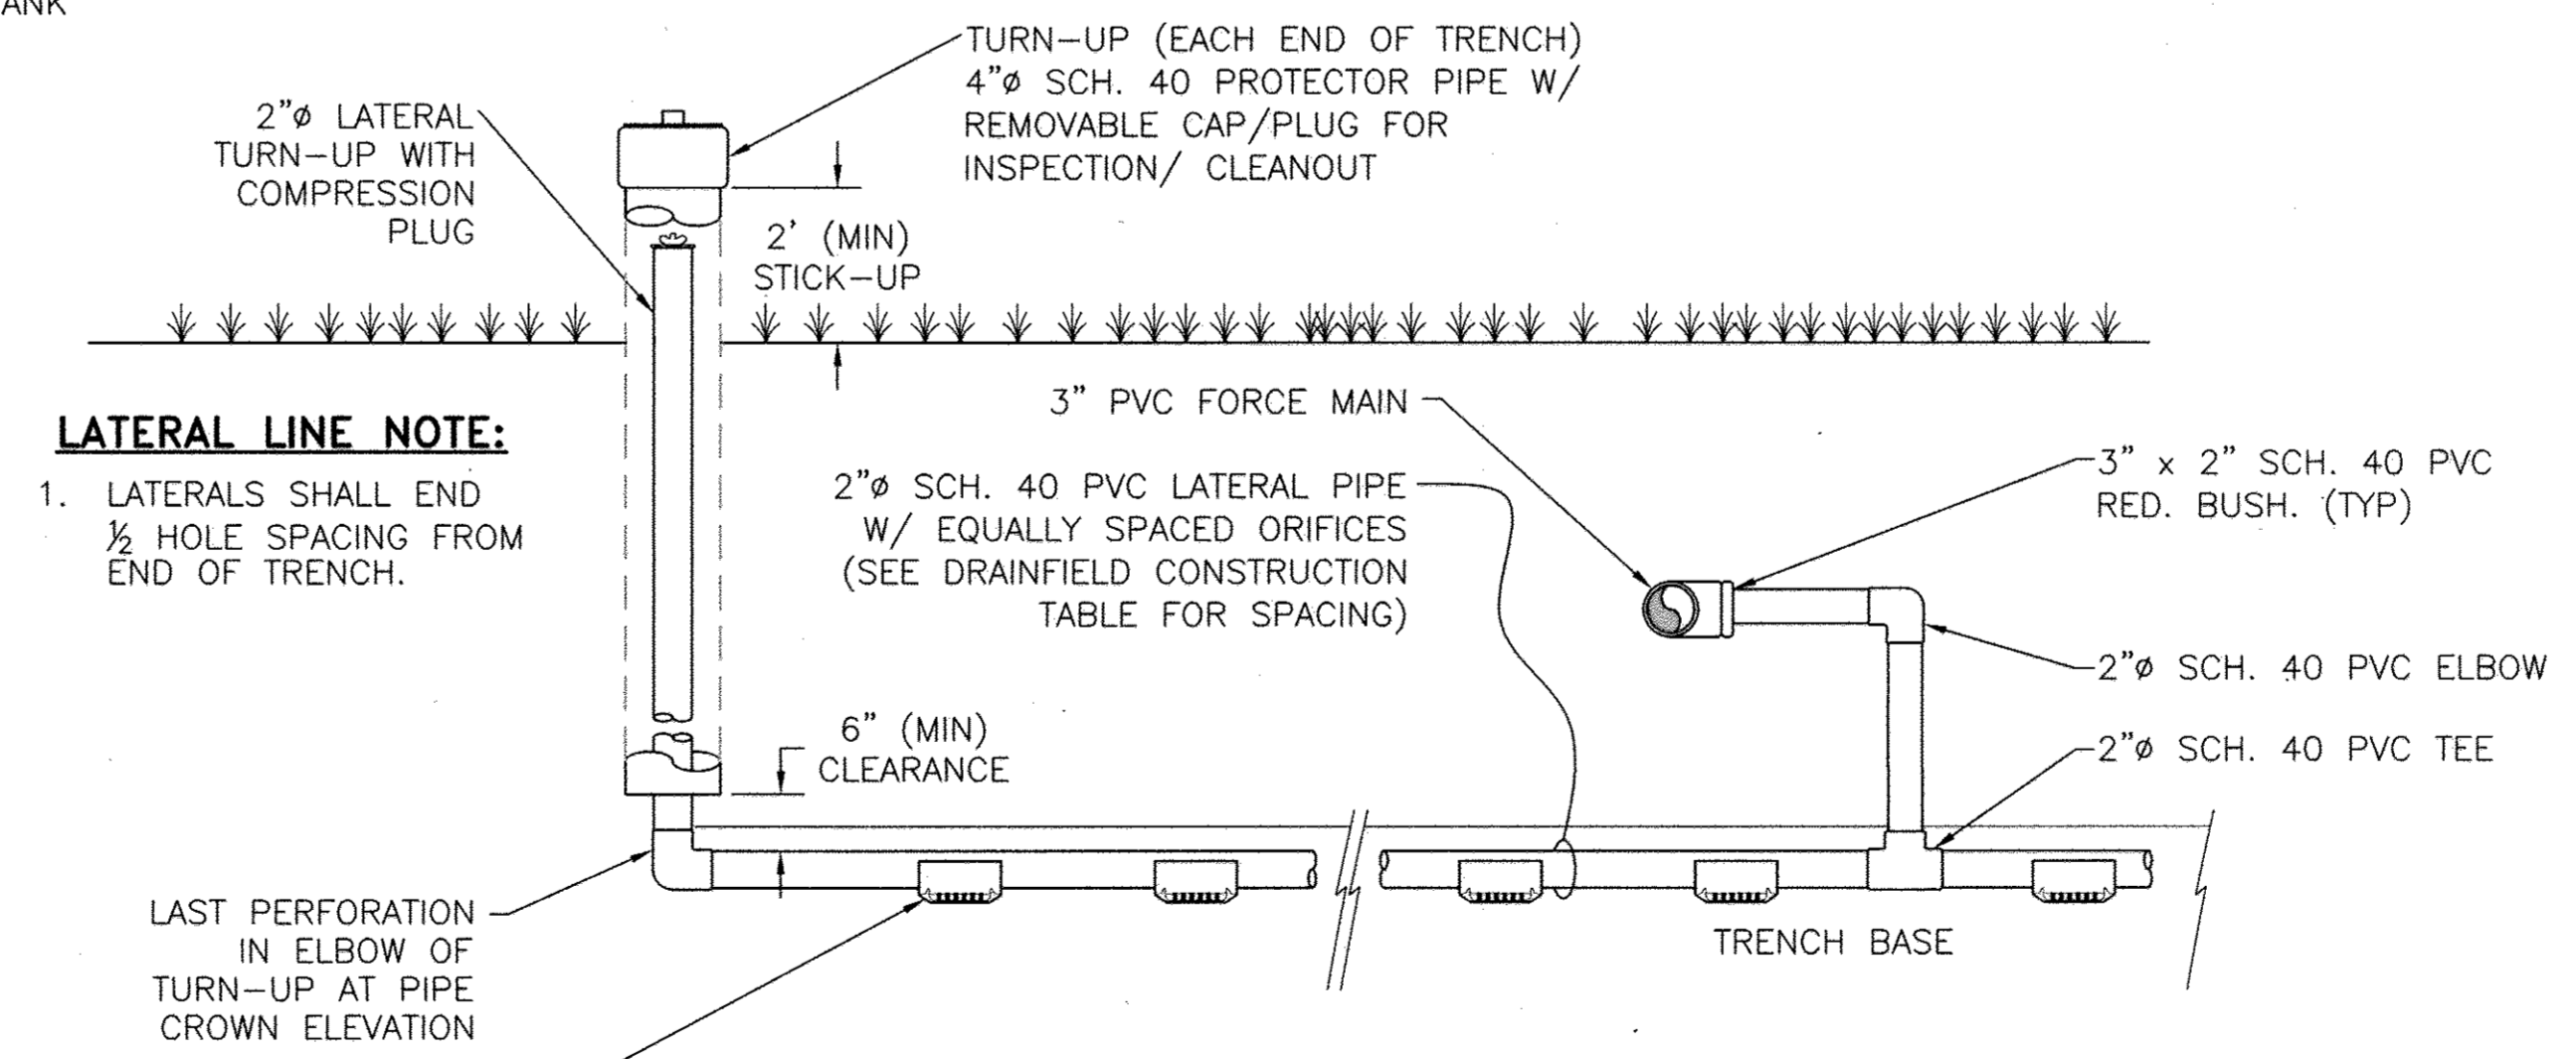

- LATERAL LINE NOTE:**
- LATERALS SHALL END 1/2 HOLE SPACING FROM END OF TRENCH.

**DISTRIBUTION LATERAL DETAIL** (D 7)  
NOT TO SCALE

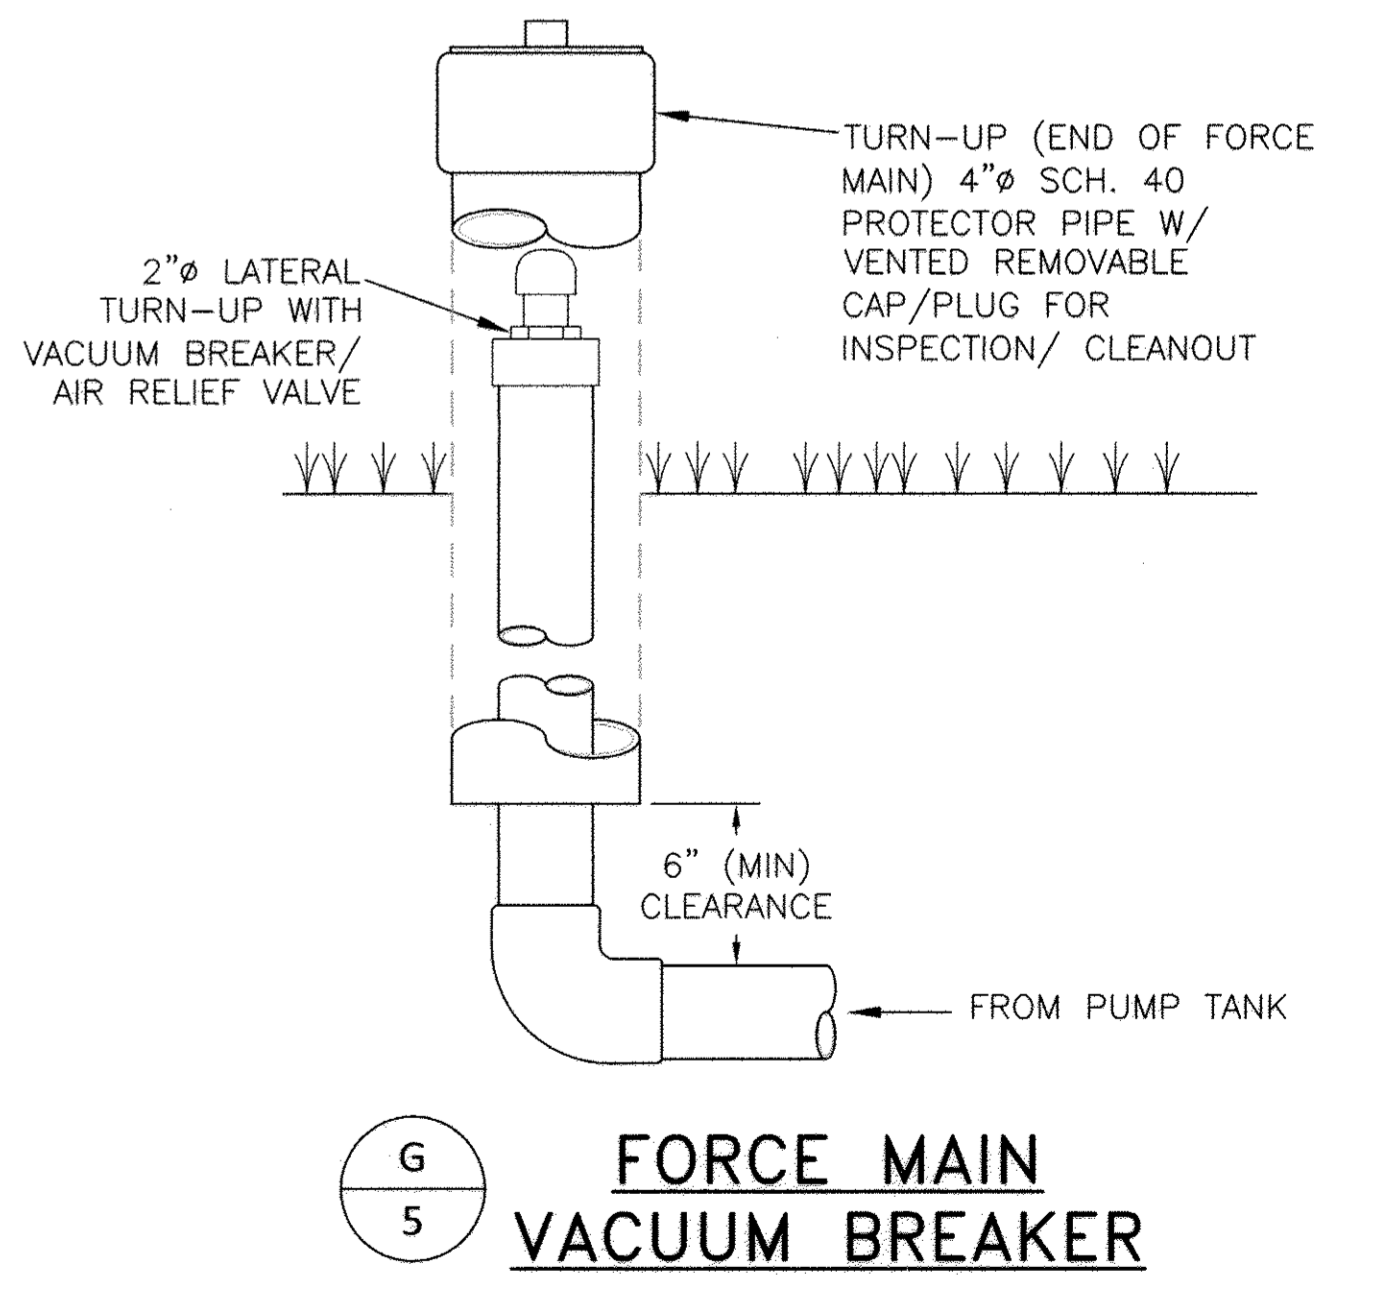

**FORCE MAIN VACUUM BREAKER** (G 5)

APPROVED: FOR PRIVATE WATER AND SHARED SEWAGE FOR LOTS 1-4  
DATE: 3/12/17  
HOWARD COUNTY HEALTH OFFICER

DEPARTMENT OF PUBLIC WORKS  
HOWARD COUNTY, MARYLAND  
DATE: 1/25/17

DEPARTMENT OF PLANNING AND ZONING  
HOWARD COUNTY, MARYLAND  
DATE: 2-22-17

I HEREBY CERTIFY THAT THESE DOCUMENTS WERE PREPARED OR APPROVED BY ME, AND THAT I AM A DULY LICENSED PROFESSIONAL ENGINEER UNDER THE LAWS OF THE STATE OF MARYLAND.  
LICENSE NO. 7803 EXPIRATION DATE IS 4/22/17.  
Hydro-Terra Group  
1108 Business Parkway South  
Suite E  
Westminster, Maryland 21157  
(410) 861-5376 (phone)  
(410) 861-5467 (fax)

1-17-2017  
CHARLES R. CROCKEN

M.D.S.	
DRAWN BY:	M.D.S.
CHECKED BY:	M.J.M.
DATE:	January, 2017
BY:	NO.

SEWER MAIN EXTENSION & WASTEWATER TREATMENT SYSTEM DETAILS SHEET 2	
600' SCALE MAP NO. 22	BLOCK NO. 8
F.C.C. WORK ORDER NO. 71160	
DATE: 7/17/17	FILE NAME: SEWER MAIN EXTENSION PLAN

**BELVEDERE ESTATES**  
LOTS 1 THRU 11, BUILDABLE PRESERVATION PARCEL 'A' AND NON-BUILDABLE PRESERVATION PARCEL 'B'  
SEWER MAIN EXTENSION & WASTEWATER TREATMENT SYSTEM  
CONTRACT NO. 50-4964-D  
THIRD ELECTION DISTRICT  
HOWARD COUNTY, MARYLAND  
SCALE AS SHOWN  
SHEET 7 OF 7