
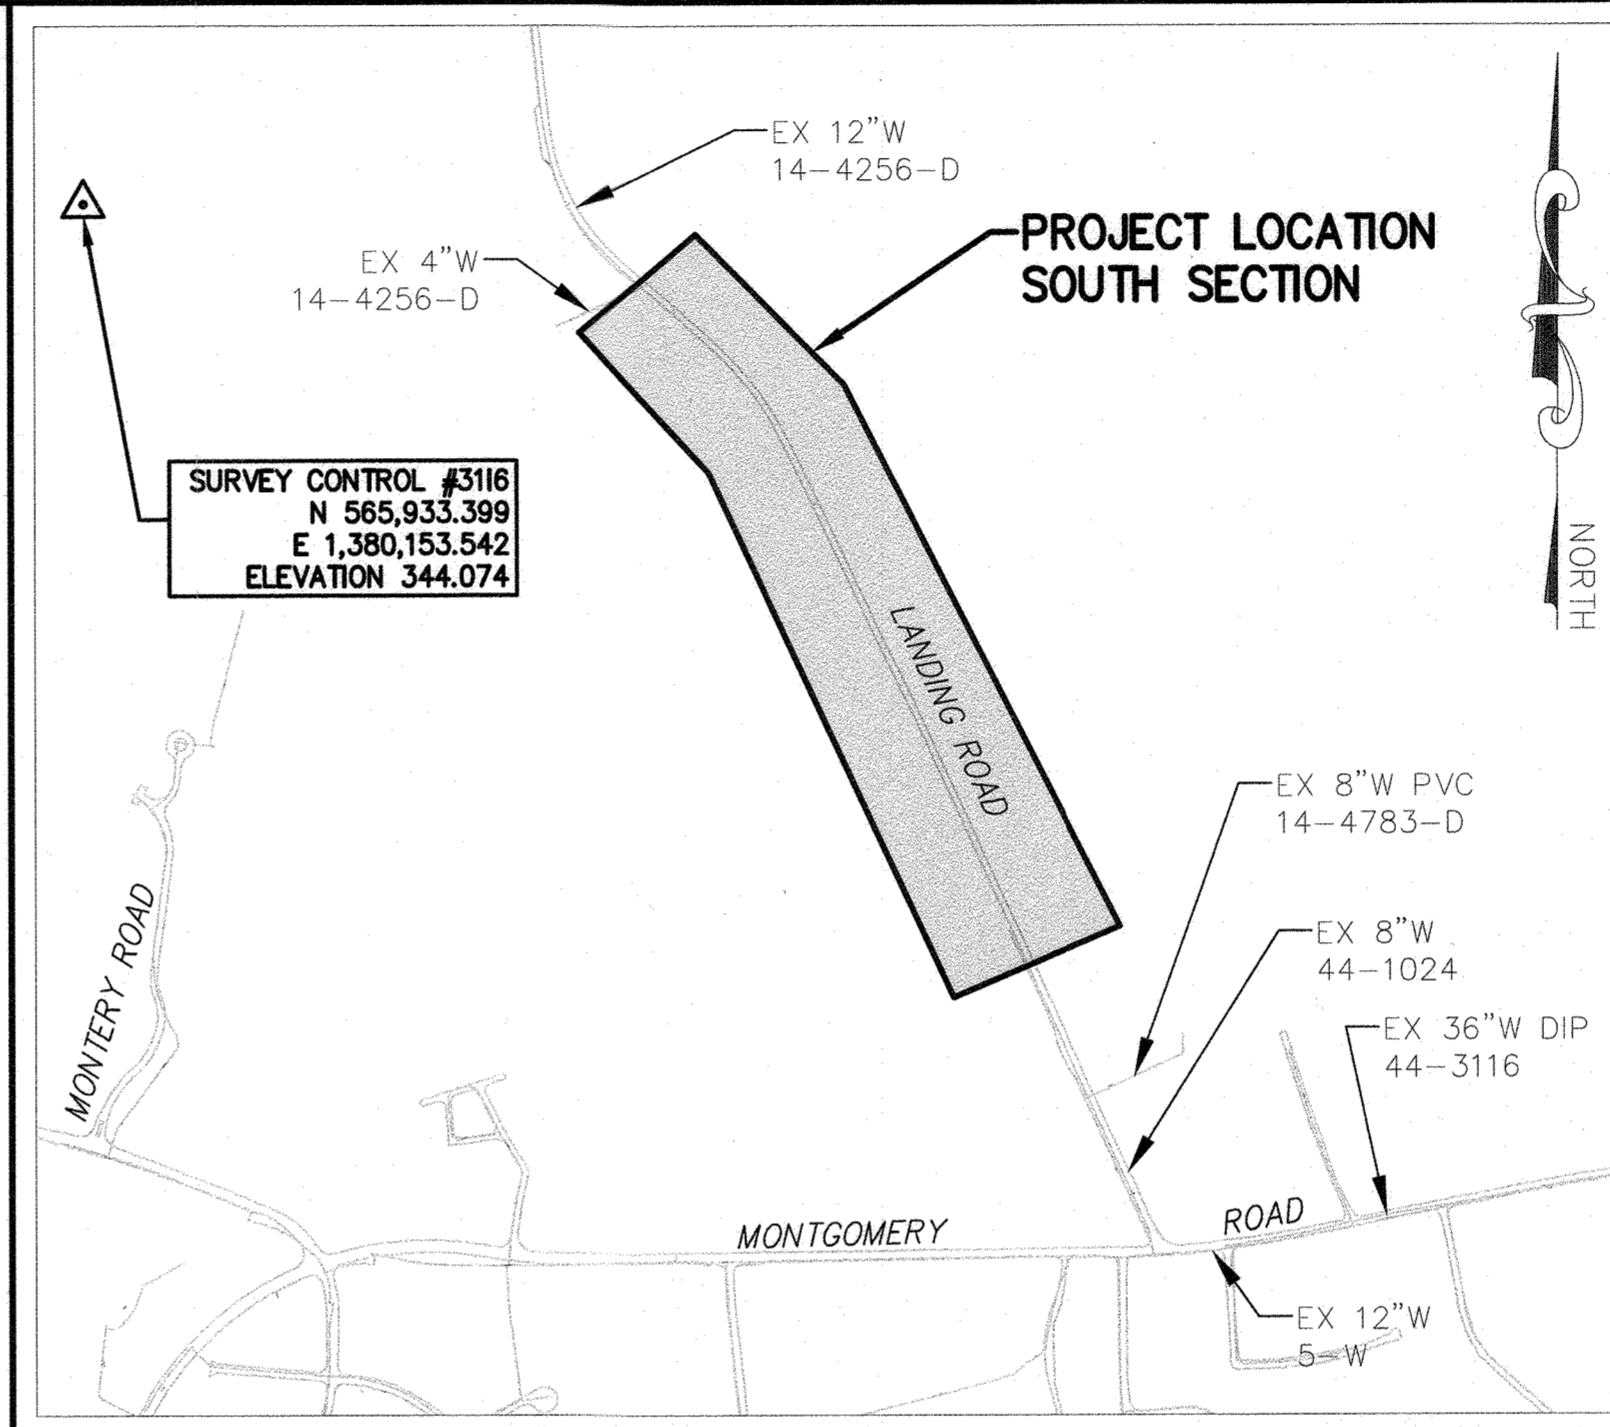
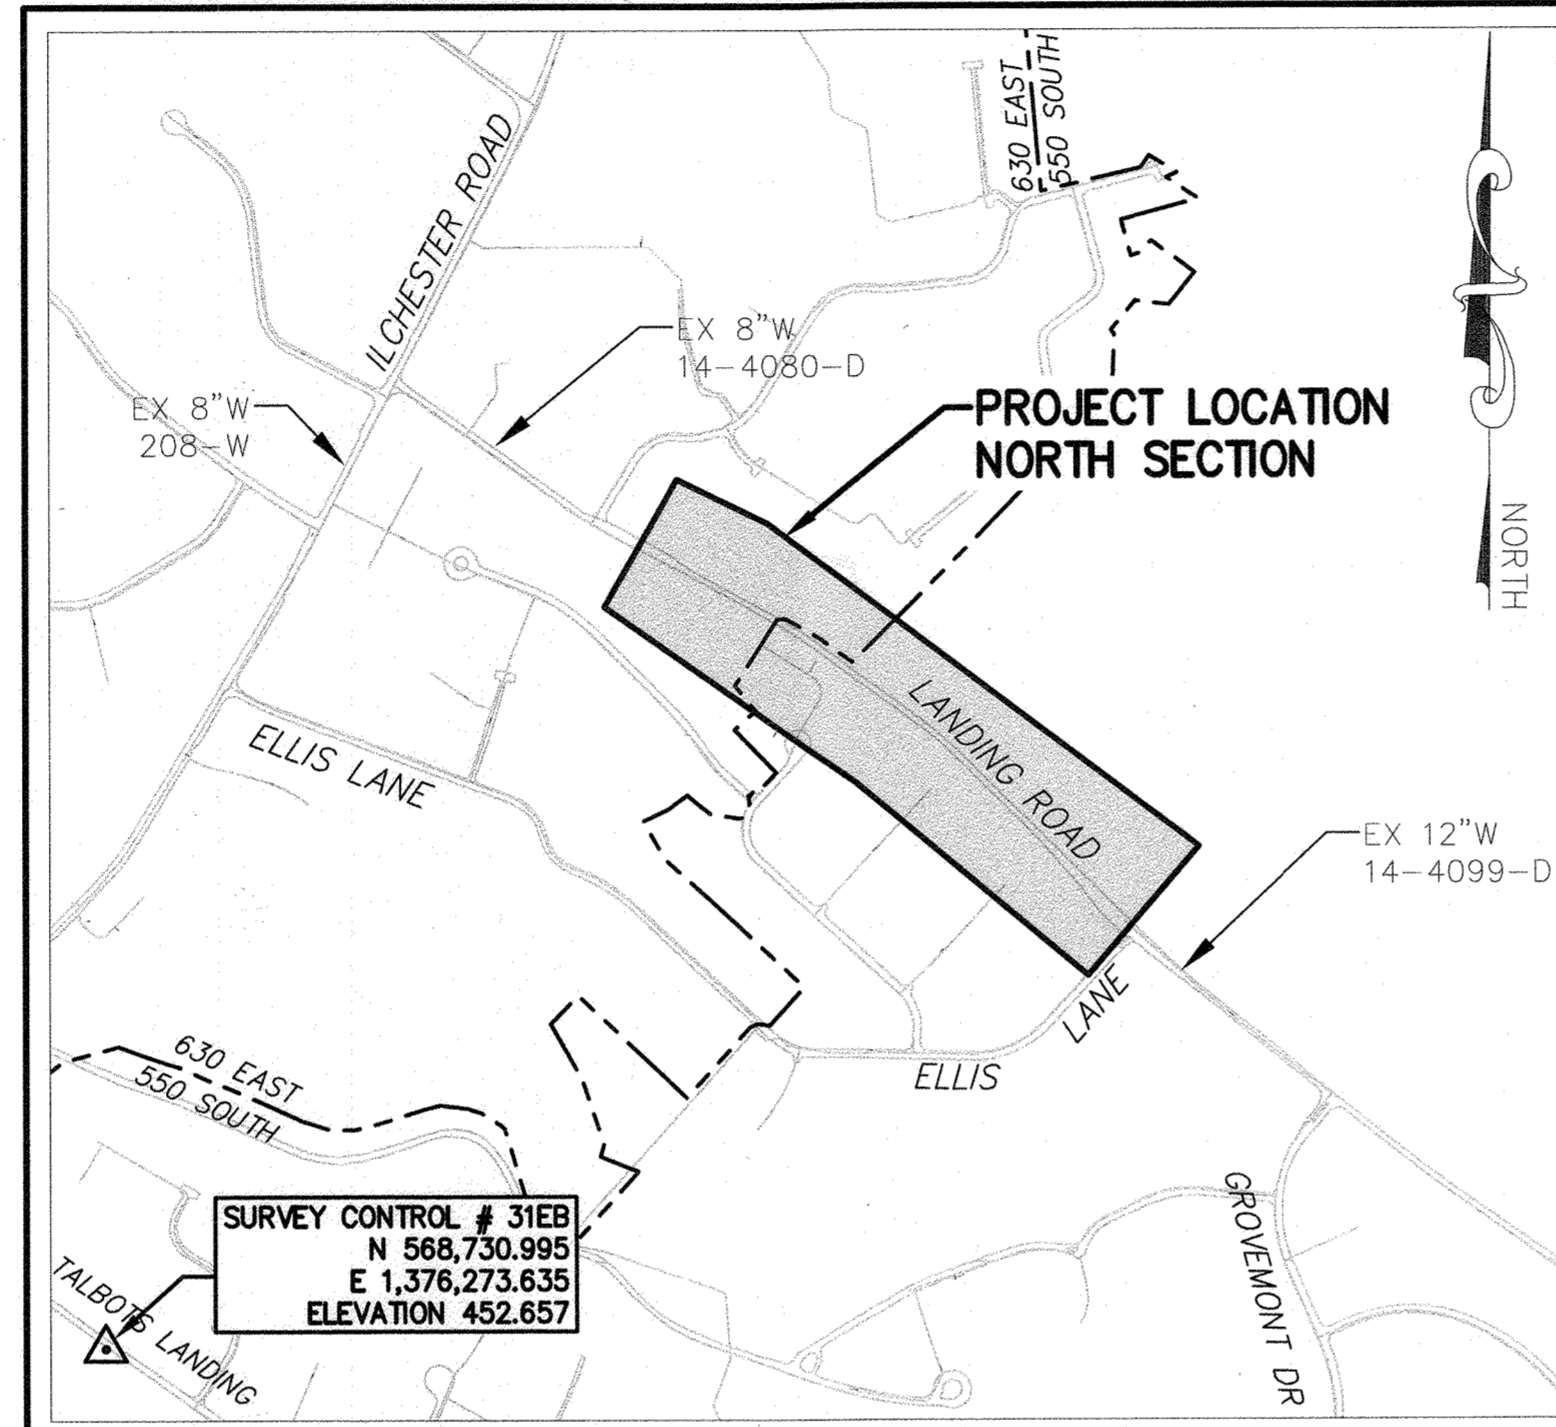


WATER NOTES:

- 1. ALL PROPOSED WATER MAINS SHALL BE POLYVINYL CHLORIDE (PVC) PRESSURE CLASS DR-14 IN ACCORDANCE WITH ANSI/AWWA C900, WITH DUCTILE IRON (DI) FITTINGS.
2. ALL HYDRANTS, MAINLINE GATE VALVES, WATER SERVICE VALVES AND PIPING, AND SIMILAR APPURTENANCES (FOR BOTH PERMANENT AND TEMPORARY INSTALLATIONS) SHALL BE RATED FOR A MINIMUM OPERATING PRESSURE OF 305 PSI.
3. TOPS OF ALL WATER MAINS SHALL HAVE A MINIMUM OF 3'-6" OF COVER UNLESS OTHERWISE NOTED.
4. VALVES ADJACENT TO TEES SHALL BE STRAPPED TO TEES.
5. ALL FITTINGS SHALL BE BUTTRESSED OR ANCHORED WITH CONCRETE IN ACCORDANCE WITH STANDARD DETAILS UNLESS RESTRAINED JOINTS ARE INSTALLED AS SPECIFIED ON THE DRAWINGS.
6. FIRE HYDRANTS SHALL BE SET TO THE BURY LINE ELEVATIONS SHOWN ON THE DRAWINGS. ALL FIRE HYDRANTS SHALL BE INSTALLED IN ACCORDANCE WITH STANDARD DETAILS. THE SOIL AROUND THE FIRE HYDRANT SHALL BE COMPACTED IN ACCORDANCE WITH SECTION 1000 AND SECTION 1005 OF THE STANDARD SPECIFICATIONS.
7. THE CONTRACTOR SHALL NOT OPERATE ANY WATER MAIN VALVES ON THE EXISTING WATER SYSTEM.
8. ALL TIE-INS TO EXISTING WATER MAINS SHALL BE COORDINATED WITH THE HOWARD COUNTY BUREAU OF UTILITIES AT LEAST 10 WORKING DAYS PRIOR TO SCHEDULING THE WORK.
9. SALVAGEABLE VALVES AND APPURTENANCES TO BE REMOVED SHALL BE DELIVERED TO THE HOWARD COUNTY DEPARTMENT OF PUBLIC WORKS - BUREAU OF UTILITIES, AS DIRECTED BY THE ENGINEER OR THE COUNTY.
10. IN ACCORDANCE WITH THE 10 STATE STANDARD REQUIREMENTS, WHERE PROPOSED WATER MAIN CROSSES EXISTING OR PROPOSED SEWER, THE WATER MAINS SHALL BE INSTALLED WITH MINIMUM 18-INCHES VERTICAL CLEARANCE (BETWEEN THE OUTSIDE OF THE WATER MAIN AND THE OUTSIDE OF THE SEWER). ALL CROSSINGS OF THE NEW WATER MAIN WITH EXISTING SANITARY OR STORM SEWER PIPING SHALL BE ACCOMPLISHED BY CENTERING A FULL LENGTH OF THE NEW WATER MAIN PIPING AT THE CROSSING TO MAXIMIZE THE DISTANCE OF ANY WATER MAIN JOINT FROM THE CROSSING.
11. NO WATER SHALL BE DISCHARGED FROM THE EXISTING WATER MAIN TO THE ENVIRONMENT, WITHOUT FIRST DECHLORINATING. THE CONTRACTOR SHALL SUBMIT THE DECHLORINATION METHOD TO THE ENGINEER FOR REVIEW.
12. TRACER WIRES AND CONTINUITY TEST STATIONS SHALL BE INSTALLED ON ALL DIP AND PVC WATER MAINS IN ACCORDANCE WITH THE HOWARD COUNTY DESIGN MANUAL.
13. FOR PVC WATER MAINS, ALL RECORDS FOR THE QUALITY CONTROL AND QUALIFICATION TEST REQUIREMENTS NOTED IN SECTION 5.1 OF THE AWWA STANDARD C900 FOR PVC PRESSURE PIPE SHALL BE SUBMITTED WITH THE PIPE MATERIAL CERTIFICATIONS OR SHOP DRAWINGS PRIOR TO APPROVAL OF THE MATERIAL FOR USE. THE TEST RECORDS SHALL BE FOR THE PIPE TO BE INSTALLED UNDER THIS CONTRACT. ALL PVC PIPE SHALL CONTAIN MARKINGS TO ALLOW CROSS REFERENCING OF THE PIPE SUPPLIED TO THE TEST RECORDS RECEIVED.
14. UNLESS OTHERWISE NOTED ON THE PLANS OR IN THE SPECIFICATIONS, SACRIFICIAL ANODES SHALL BE INSTALLED ON ALL VALVES AND METALLIC FITTINGS USED WITH PVC WATER MAINS IN ACCORDANCE WITH VOLUME IV, STANDARD SPECIFICATIONS AND DETAILS FOR CONSTRUCTION. SEVENTEEN (17) POUND MAGNESIUM ANODES SHALL BE INSTALLED ON ALL VALVES AND DUCTILE IRON FITTINGS INCLUDING RESTRAINTS AND HARNESSSES. TWELVE (12) POUND ZINC ANODES SHALL BE INSTALLED ON ALL STAINLESS STEEL FITTINGS AND SADDLES USED WITH PVC MAINS. ALL "TEES" USED WITH PVC MAINS SHALL BE DUCTILE IRON.
15. PROPER ASSEMBLY OF GASKETED PVC PIPE JOINTS: THE MANUFACTURER'S INSERTION LINE OF GASKETED PVC PIPE JOINTS INDICATES THE MAXIMUM DEPTH OF INSERTION OF THE SPIGOT INTO THE BELL. AFTER ASSEMBLY OF THE JOINT, THE INSERTION LINE SHALL REMAIN VISIBLE. DUAL INSERTION LINES ON GASKETED PVC PIPE INDICATE THE MAXIMUM AND MINIMUM DEPTH OF INSERTION OF THE SPIGOT INTO THE BELL. THE CONTRACTOR SHALL NOT OVER INSERT OR OVER HOME THE SPIGOT INTO THE BELL OF PVC PIPE.
16. ALL CHANGES IN HORIZONTAL OR VERTICAL DIRECTION OF PVC WATER PIPE SHALL BE MADE WITH STANDARD BENDS, 5-DEGREE SWEEPS OR HIGH DEFLECTION (HD) COUPLINGS. NO BENDING OF THE PIPE OR DEFLECTING OF PVC PIPE JOINTS IS PERMITTED. WHERE HIGH DEFLECTION COUPLINGS OR 5-DEGREE SWEEPS ARE TO BE INSTALLED, THE CONTRACTOR SHALL PROVIDE ONE FULL PIPE LENGTH (20-FOOT LONG) ON EITHER SIDE OF THE HIGH DEFLECTION COUPLING OR 5-DEGREE SWEEP. THE CONTRACTOR SHALL USE A VIBRATORY PLATE COMPACTOR OR OTHER APPROVED MEANS TO THOROUGHLY COMPACT THE #57 STONE ON BOTH SIDES OF THE HIGH DEFLECTION COUPLING OR 5-DEGREE SWEEP, TAKING CARE NOT TO USE COMPACTION EQUIPMENT DIRECTLY OVER THE FITTING.
17. PVC HIGH DEFLECTION COUPLINGS SHALL BE LIMITED TO A TOTAL DEFLECTION OF 3-DEGREES (1-1/2 DEGREE ON EITHER END OF THE COUPLING), SHALL BE RATED FOR A MINIMUM 235 PSI MEETING THE REQUIREMENTS OF AWWA C900, SHALL HAVE A MINIMUM LAY LENGTH OF 9-INCHES AND SHALL HAVE CENTER STOPS. PVC HIGH DEFLECTION COUPLINGS SHALL BE CERTAINTED PVC HIGH DEFLECTION (HD) STOP COUPLINGS OR EQUAL. FIVE DEGREE SWEEPS SHALL BE BELL BY SPIGOT, RATED FOR A MINIMUM 235 PSI, DR-18, MEETING THE REQUIREMENTS OF ANSI/AWWA C900 AND SHALL BE MULTI FITTINGS (IPEX) BLUE BRUTE DR-18 OR EQUAL.
18. WITHIN THE LIMITS OF RESTRAINED JOINTS, RESTRAINED COUPLINGS SHALL BE USED IN LIEU OF HIGH DEFLECTION COUPLINGS. RESTRAINED COUPLINGS SHALL BE LIMITED TO A TOTAL DEFLECTION OF 3-DEGREES (1-1/2 DEGREE ON EITHER END OF THE COUPLING), THE PIPE SHALL BE INSERTED AN EQUAL DEPTH ON BOTH SIDES OF THE COUPLING. THE CONTRACTOR SHALL PROVIDE CORROSION PROTECTION AS PER STANDARD DETAILS AND AS SHOWN IN THESE DRAWINGS. RESTRAINED COUPLINGS SHALL BE RATED FOR A MINIMUM 305 PSI, DR-14, MEETING THE REQUIREMENTS OF ANSI/AWWA C900 AND SHALL BE SERIES 3800 MEGA-COUPLING, AS MANUFACTURED BY EBAA IRON, INC. OR APPROVED EQUAL.

LANDING ROAD WATER MAIN LOOP
HOWARD COUNTY
DEPARTMENT OF PUBLIC WORKS
CAPITAL PROJECT NO. W8305
CONTRACT NO. 44-5059
MDE 201960115/19-NT-3014

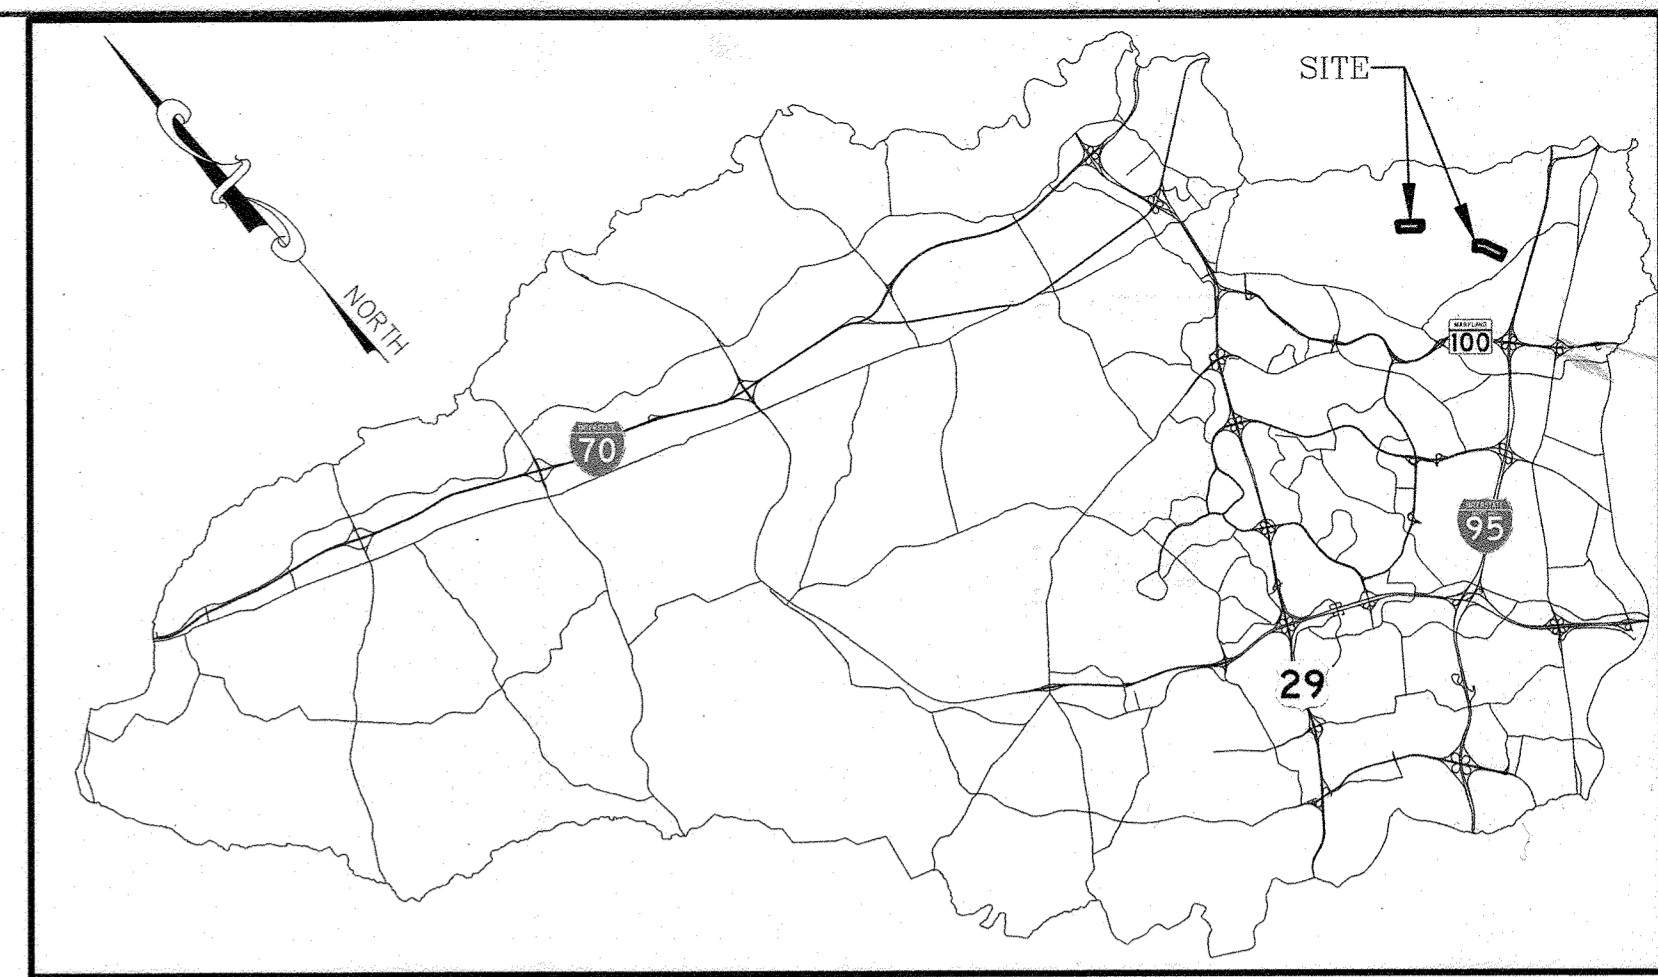

WATER ZONE: 550 SOUTH, 630 EAST
TEST GRADIENT: 800 FT (630 EAST ZONE)
805 FT (550 SOUTH ZONE)
TYPE OF BUILDINGS: N/A
NUMBER OF PARCELS: N/A
NO. OF WATER CONNECTIONS: 20
NO. OF SEWER CONNECTIONS: N/A
DRAINAGE AREA: PATAPSCO

VICINITY MAP
SCALE: 1" = 600'

HOWARD COUNTY GEODETIC SURVEY CONTROL POINTS table with columns for Station#, East, North, and Elevation.

INDEX OF DRAWINGS

Table with columns for SHEET NO., DRAWING NO., and DESCRIPTION, listing various drawing sheets from 01 to 18.

PURPOSE STATEMENT:

CONTRACT NO. 44-5059 WILL COMPLETE THE WATER MAIN LOOP ALONG LANDING ROAD, CONNECTING THE WATER SYSTEM BETWEEN ILCHESTER ROAD (630 EAST ZONE) AND MONTGOMERY ROAD (550 ZONE). THIS PROJECT IS REQUIRED UNDER THE HOWARD COUNTY MASTER PLAN FOR WATER AND SEWERAGE AND IS NEEDED TO PROVIDE ADEQUATE DOMESTIC WATER SUPPLY AND FIRE PROTECTION, AS WELL AS PROVIDING AN EMERGENCY CONNECTION BETWEEN THE 630 EAST AND 550 ZONES. THE PROJECT WILL ALSO PROVIDE ACCESS TO PUBLIC WATER FOR APPROXIMATELY EIGHTEEN (18) EXISTING PROPERTIES AND ONE (1) NEW DEVELOPMENT WHICH DO NOT CURRENTLY HAVE ACCESS TO PUBLIC WATER SERVICE.

OWNER/DEVELOPER CERTIFICATION:

I/WE HEREBY CERTIFY THAT ANY CLEARING, GRADING, CONSTRUCTION, OR DEVELOPMENT WILL BE DONE IN ACCORDANCE WITH THE EROSION AND SEDIMENT CONTROL PLAN INCLUDING INSPECTING AND MAINTAINING CONTROLS, AND THAT THE RESPONSIBLE PERSONNEL INVOLVED IN THE CONSTRUCTION PROJECT WILL HAVE A CERTIFICATE OF TRAINING AT A DEPARTMENT OF THE ENVIRONMENT (MDE) APPROVED TRAINING PROGRAM FOR THE CONTROL OF EROSION AND SEDIMENT PRIOR TO BEGINNING THE PROJECT. I CERTIFY RIGHT-OF-ENTRY FOR PERIODIC ON-SITE EVALUATION BY HOWARD COUNTY, THE HOWARD SOIL CONSERVATION DISTRICT AND/OR MDE.

HSCD: EP-19-27

HOWARD SOIL CONSERVATION DISTRICT CERTIFICATION:

THIS PLAN IS APPROVED FOR SOIL EROSION AND SEDIMENT CONTROL BY THE HOWARD SOIL CONSERVATION DISTRICT (HSCD).

ENGINEER'S CERTIFICATION:

I HEREBY CERTIFY THAT THIS PLAN HAS BEEN DESIGNED IN ACCORDANCE WITH CURRENT MARYLAND EROSION AND SEDIMENT CONTROL LAWS, REGULATIONS, AND STANDARDS, THAT IT REPRESENTS A PRACTICAL AND WORKABLE PLAN BASED ON MY PERSONAL KNOWLEDGE OF THE SITE, AND THAT IT WAS PREPARED IN ACCORDANCE WITH THE REQUIREMENTS OF THE HOWARD SOIL CONSERVATION DISTRICT.

Signature of Zachary C. Knight, Project Manager, dated 4/26/2019.

Signature of Howard Soil Conservation District, dated 4/6/19.


Signature of Engineer, dated 04/25/2019.

AS-BUILT MAY 2020

DEPARTMENT OF PUBLIC WORKS HOWARD COUNTY, MARYLAND. Signatures of Director of Public Works and Chief, Bureau of Utilities, dated 5/3/19 and 5-2-19.

RK&K logo and address: P: 410.728.2900, 700 East Pratt Street, Suite 500 | Baltimore, MD 21202.

PROFESSIONAL CERTIFICATION: I HEREBY CERTIFY THAT THESE DOCUMENTS WERE PREPARED OR APPROVED BY ME, AND THAT I AM A DULY LICENSED PROFESSIONAL ENGINEER UNDER THE LAWS OF THE STATE OF MARYLAND. LICENSE NO. 20566. EXPIRATION DATE: 03/06/2020.

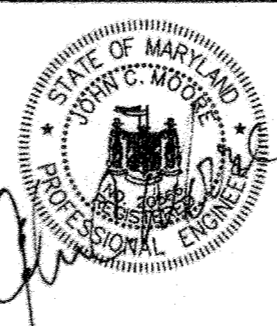

Revision table with columns for DES., BY, NO., REVISION, and DATE.

TITLE SHEET, GENERAL NOTES, AND INDEX OF DRAWINGS

600' SCALE MAP NO. 31, 37 BLOCK NO. 5, 6, 10, 11, 17, 18, 24

PROJECT NO. W8305 CONTRACT NO. 44-5059. LANDING ROAD WATER MAIN LOOP. SHEET NO. 01 OF 18.

R:\01\01\2012\12154_1\002\LANDING RD.dwg Apr 17, 2019 - 2:29pm ENV:CTB Plot Scale 1=1 Plot By: bgrass Tab: G-02

ABBREVIATIONS

ABAN	ABANDONED
ADA	AMERICANS WITH DISABILITIES ACT
ADJ	ADJUSTABLE, ADJACENT
ALT	ALTERNATE, ALTERNATIVE
APPROX	APPROXIMATE
ASTM	AMERICAN SOCIETY FOR TESTING AND MATERIALS
AVE	AVENUE
BGE	BALTIMORE GAS AND ELECTRIC
BLDG	BUILDING
BLK	BLOCK
BLKG	BLOCKING
BLT(S)	BOLT(S)
BM	BENCHMARK
CC	CORROSION CONTROL
CFM	CUBIC FEET PER MINUTE
C&G	CURB AND GUTTER
CI	CAST IRON
CIP	CAST IRON PIPE
CL	CLASS, CLEARANCE, CENTER LINE
CLR	CLEAR, CLEARANCE
CO	CLEAN OUT
COMB	COMBINATION
CONC	CONCRETE
COND	CONDUIT
CONN	CONNECTION
CONST	CONSTRUCTION
CONT	CONTINUOUS, CONTINUATION, CONTROL
COV	COVER
CP	CATHODIC PROTECTION
CPLG	COUPLING
CTV	CABLE TELEVISION
DEG	DEGREE
DEPT	DEPARTMENT
DET	DETAIL
DI	DROP INLET, DUCTILE IRON
DIA	DIAMETER
DIM	DIMENSION
DIP	DUCTILE IRON PIPE
DIV	DIVISION
DN	DOWN
DOT	DEPARTMENT OF TRANSPORTATION
DR	DRAIN
DTL	DETAIL
DV	DIVISION VALVE
DWG(S)	DRAWING(S)
E	EAST, ELECTRIC
EA	EACH
EBOX	ELECTRICAL BOX
EL	ELEVATION
ELEC	ELECTRIC
ELEV	ELEVATION
EOP	EDGE OF PAVEMENT
EQ	EQUAL
EQUIP	EQUIPMENT
EX	EXISTING
EXT	EXTENSION, EXTERIOR, EXTERNAL
FH	FIRE HYDRANT
FLEX	FLEXIBLE
FLG	FLANGE
FM	FORCE MAIN, FLOW METER
FO	FIBER OPTIC
FP	FLOOD PLAIN
FT	FEET, FOOT
G	GAS
GAB	GRADED AGGREGATE BASE
GALV	GALVANIZED
GPM	GALLONS PER MINUTE
GR	GRADE
GV	GATE VALVE, GRAVITY VENTILATOR
HB	HORIZONTAL BEND
HC	HOWARD COUNTY
HD	HIGH DEFLECTION
HMA	HOT MIX ASPHALT
HORIZ	HORIZONTAL
HR	HOUR
HWY	HIGHWAY
ID	INSIDE DIAMETER
IN	INCH, INCHES
INC	INCORPORATED
INCL	INCLUDING
INL	INLET
INSUL	INSULATE, INSULATION, INSULATING
INV	INVERT
JT	JOINT

ABBREVIATIONS (CONT'D)

L	LENGTH
LB(S)	POUND(S)
LF	LINEAR FEET
LG	LENGTH, LONG
LOC	LIMIT OF CONTRACT
LOD	LIMIT OF DISTURBANCE
LP	LOW POINT, LIGHT POLE
LT	LEFT
MAX	MAXIMUM
M.B.	MAILBOX
MDSHA	MARYLAND STATE HIGHWAY ADMINISTRATION
MECH	MECHANICAL
MED	MEDIUM
MFR(S)	MANUFACTURER(S)
MG	MILLION GALLONS
MGD	MILLION GALLONS PER DAY
MH	MANHOLE
MIN	MINIMUM, MINUTE
MISC	MISCELLANEOUS
MJ	MECHANICAL JOINT
MPH	MILES PER HOUR
N	NORTH
NA	NOT APPLICABLE
N.I.C	NOT IN CONTRACT
NO.(S)	NUMBER(S)
NPT	NATIONAL PIPE THREAD
NTS	NOT TO SCALE
OD	OUTSIDE DIAMETER
OH	OVERHEAD
OPP	OPPOSITE, OPPOSING
PAV	PAVEMENT
PE	PLAIN END
PK	PK NAIL
PL	PLATE
PROP	PROPOSED
PSI	POUNDS PER SQUARE INCH
PT	POINT
PVC	POLYVINYL CHLORIDE
R	RADIUS, RISER, RIM ELEVATION
RCP	REINFORCED CONCRETE PIPE
RD	ROAD
REF	REFERENCE
REQD	REQUIRED
REV	REVISION, REVISED
ROW	RIGHT-OF-WAY
R/W	RIGHT-OF-WAY
RT	RIGHT
S	SOUTH, SEWER
SAN	SANITARY
SB	SOIL BORING
SD	STORM DRAIN
SECT	SECTION
SF	SILT FENCE
SHC	SANITARY SEWER HOUSE CONNECTION
SPEC(S)	SPECIFICATION(S)
SQ	SQUARE
SS	STAINLESS STEEL, SANITARY SEWER
STA	STATION
STD	STANDARD
SYS	SYSTEM
T	TOP
TBD	TO BE DETERMINED
TEL	TELEPHONE
TEMP	TEMPERATURE, TEMPORARY
TH	TEST HOLE
TOP	TOP (OF PIPE) ELEVATION
TP	TEST PIT
TRAV	TRAVERSE
TYP	TYPICAL
UFGS	UNIFIED FACILITIES GUIDE SPECIFICATIONS
USGS	UNITED STATES GEOLOGICAL SURVEY
V	VALVE, VERTICAL
VB	VERTICAL BEND
VCP	VITRIFIED CLAY PIPE
VERT	VERTICAL
W	WEST, WIDTH, WATER
W/	WITH
WHC	WATER HOUSE CONNECTION
WM	WATER METER
W/O	WITHOUT
WSS	WATER SUPPLY SERVICE
WV	WATER VALVE

ABBREVIATIONS (CONT'D)

X	BY, TIMES
&	AND
@	AT
#	NUMBER
%	PERCENT

LEGEND

SANITARY SEWER	
SANITARY SEWERS 12" AND OVER	
SANITARY SEWER FORCE MAIN	
WATER	
STORM DRAIN	
STORM DRAIN INLET	
OVERHEAD ELECTRIC	
UNDERGROUND ELECTRIC	
UNDERGROUND TELEPHONE	
UNDERGROUND CABLE	
GAS	
PROPERTY LINE	
UTILITY EASEMENT	
MINOR CONTOURS	
MAJOR CONTOURS	
100-YEAR FLOODPLAIN	
WETLAND BOUNDARY	
25' WETLAND BUFFER	
STREAM BUFFER	
WATERS OF THE US	
FENCE	
GUARDRAIL	
RAILROAD TRACKS	
TREE LINE OR WOODS	
WATER FIRE HYDRANT	
WATER VALVE	
GAS METER	
ELECTRIC POLE GUY	
ELECTRIC POLE	
UTILITY MARKER	
SIGN	
MAILBOX	
SANITARY SEWER MANHOLE	
STORM DRAIN MANHOLE	
BORING	
TRAVERSE LOCATION	
TEST HOLE LOCATION	
WATER MAIN	
WATER VALVE	
WATER FIRE HYDRANT	
WATER HOUSE CONNECTION	

PROPOSED

QUANTITIES			
ITEM	ESTIMATED QUANTITY	AS-BUILT	SUPPLIER
12" C900 PVC DR-14 PIPE	4162	LF	
8" C900 PVC DR-14 PIPE	25	LF	
12" GATE VALVE	5	EA	
8" GATE VALVE	2	EA	
12" DIVISION VALVE	1	EA	
6" FIRE HYDRANT ASSEMBLY	7	EA	
12" - 11.25" (1/32) ELBOW	4	EA	
8" - 45" (1/8) ELBOW	3	EA	
12" - 5" SWEEP	3	EA	
12" HD COUPLING	17	EA	
12" RESTRAINED COUPLING	15	EA	
12" X 8" REDUCER	2	EA	
1" COPPER PIPE	211	LF	
1.5" COPPER PIPE	72	LF	
3/4" METER SETTING & VAULT	18	EA	
1" METER SETTING & VAULT	1	EA	
TWIN 1" METER SETTING & VAULT	1	EA	
12"X8" TEE	1	EA	
12" X 6" FH TEE	7	EA	
12" DI MJ SOLID SLEEVE	2	EA	
8" DI MJ SOLID SLEEVE	3	EA	
12"X12" DI OFFSET	1	EA	


FITTING SCHEDULE - LANDING ROAD (NORTH SECTION)			
STATION	FITTING	NORTHING	EASTING
0+00	8" DI SOLID SLEEVE	571,157.1666	1,378,062.3571
0+05	8" VALVE	571,154.8578	1,378,066.8451
0+10	8" DI 45' HB	571,152.6077	1,378,071.2563
0+23	12"X8" REDUCER	571,156.5965	1,378,083.6146
0+36.50	12" DI 45' HB	571,160.7538	1,378,096.4959
3+64.50	12" VALVE	571,000.3552	1,378,382.5760
4+91.40	12"X6" FH TEE	570,929.5812	1,378,487.8213
5+28.20	12" VALVE	570,908.6107	1,378,518.0918
5+33.12	12"X8" TEE	570,905.8596	1,378,522.1670
9+80.70	12" VALVE	570,637.2148	1,378,879.9651
9+85.70	12"X6" FH TEE	570,633.9132	1,378,883.6566
14+60.85	12" VALVE	570,303.9649	1,379,225.5446
14+65.75	12"X6" FH TEE	570,300.5279	1,379,229.0438
18+25	12" DI SOLID SLEEVE	570,049.7632	1,379,462.7015

FITTING SCHEDULE - LANDING ROAD (SOUTH SECTION)			
STATION	FITTING	NORTHING	EASTING
-0+51	12"X6" FH TEE	565,705.0798	1,381,868.5104
0+00	12" DI SOLID SLEEVE	565,671.5868	1,381,906.7404
5+95	12" VALVE	565,244.0938	1,382,314.9072
6+00	12"X6" FH TEE	565,239.7947	1,382,317.4549
12+25	12"X6" FH TEE	564,767.2793	1,382,545.9990
17+45	12" VALVE	564,208.2654	1,382,814.1211
17+50	12"X6" FH TEE	564,203.7075	1,382,816.1780
23+38	12"X8" REDUCER	563,702.1312	1,383,042.1312
23+45.33	8" DI 45' HB	563,682.3264	1,383,050.7495
23+54.42	8" DI 45' HB	563,673.8151	1,383,047.6223
23+58.46	8" VALVE	563,670.3467	1,383,050.0354
23+63	8" DI SOLID SLEEVE	563,665.6127	1,383,051.7063


AS-BUILT MAY 2020

DEPARTMENT OF PUBLIC WORKS HOWARD COUNTY, MARYLAND DIRECTOR OF PUBLIC WORKS CHIEF, BUREAU OF UTILITIES	 P: 410.728.2900 700 East Pratt Street, Suite 500 Baltimore, MD 21202 Engineers Construction Managers Planners Scientists www.rkk.com Responsive People Creative Solutions	PROFESSIONAL CERTIFICATION: I HEREBY CERTIFY THAT THESE DOCUMENTS WERE PREPARED OR APPROVED BY ME, AND THAT I AM A DULY LICENSED PROFESSIONAL ENGINEER UNDER THE LAWS OF THE STATE OF MARYLAND. LICENSE NO. 20566. EXPIRATION DATE: 09/06/2020.		DES: REG/WJG	BY: NO.	REVISION	DATE	LEGEND, ABBREVIATIONS, AND FITTING SCHEDULES	PROJECT NO. W8305 CONTRACT NO. 44-5059 LANDING ROAD WATER MAIN LOOP	SCALE
				DRN: RAD/REG	CHK: JCM/NKS	SIGN DATE: 04/25/20	600' SCALE MAP NO. 31, 37			BLOCK NO. 5, 6, 10, 11, 17, 18, 24


RK&K\Projects\2019\12154_H06280A\Task 12 - Landing Road W8305\CAD\Plans\3-pgh-100-LANDING RD.dwg Apr 17, 2019 - 2:30pm ENV.CTB Plot Scale 1=1 Plot By: bgruss Tab: G-03

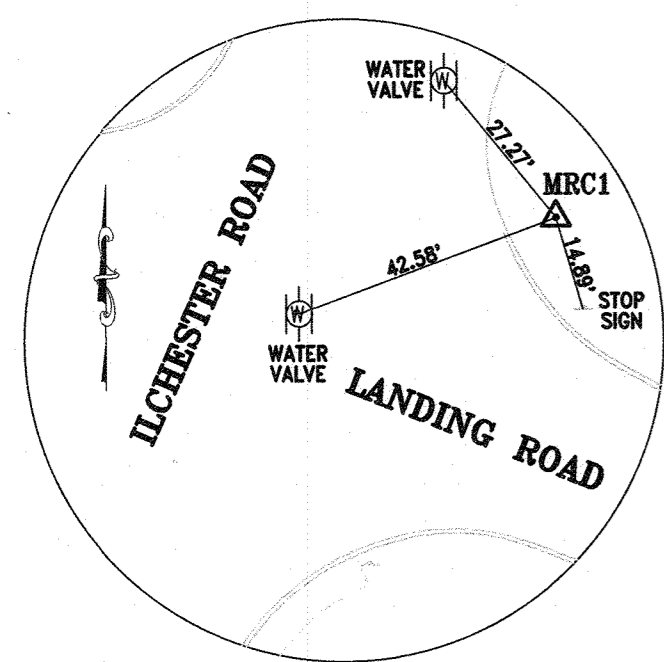


MRC1
 NORTHING = 571713.7912
 EASTING = 1377203.3801
 ELEVATION = 469.730

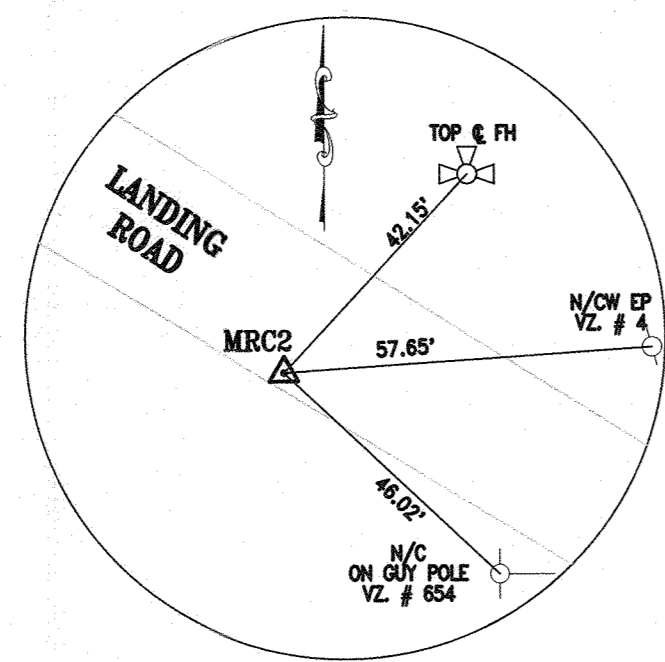


MRC2
 NORTHING = 571429.8382
 EASTING = 1377594.2172
 ELEVATION = 427.630

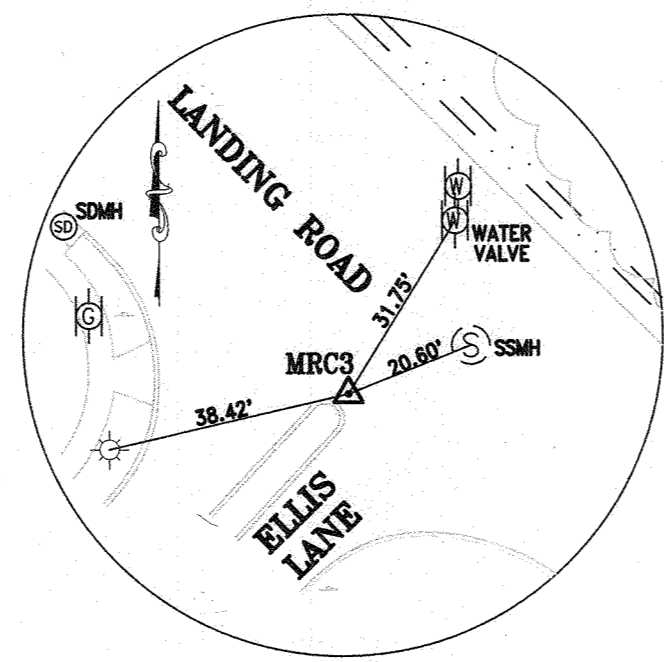


MRC3
 NORTHING = 570012.5431
 EASTING = 1379473.0648
 ELEVATION = 347.600

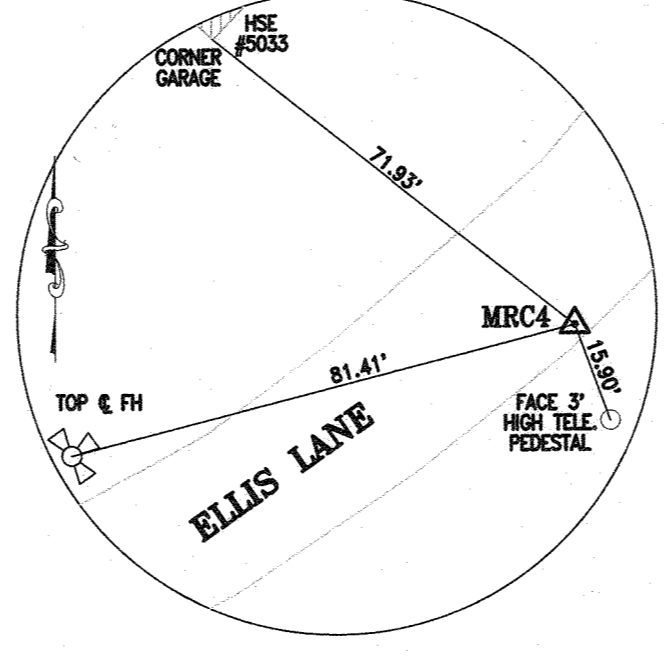


MRC4
 NORTHING = 569714.1666
 EASTING = 1379206.4987
 ELEVATION = 373.740

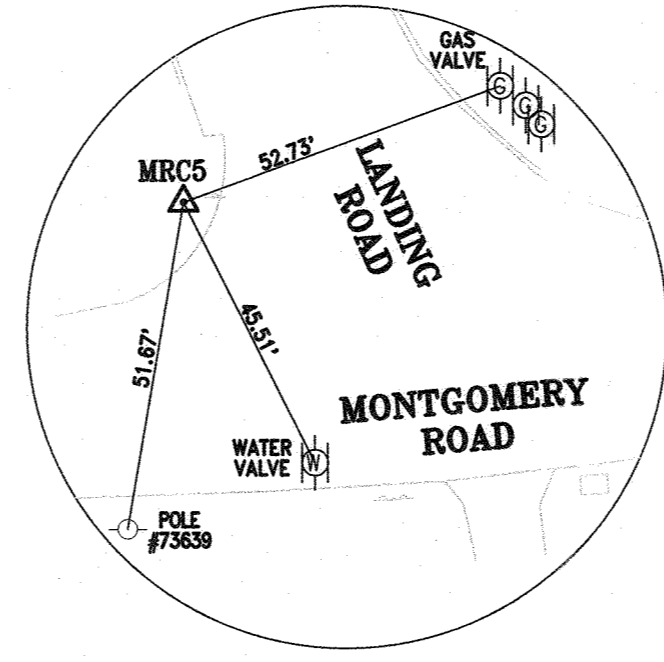


MRC5
 NORTHING = 562699.2042
 EASTING = 1383477.2989
 ELEVATION = 257.200

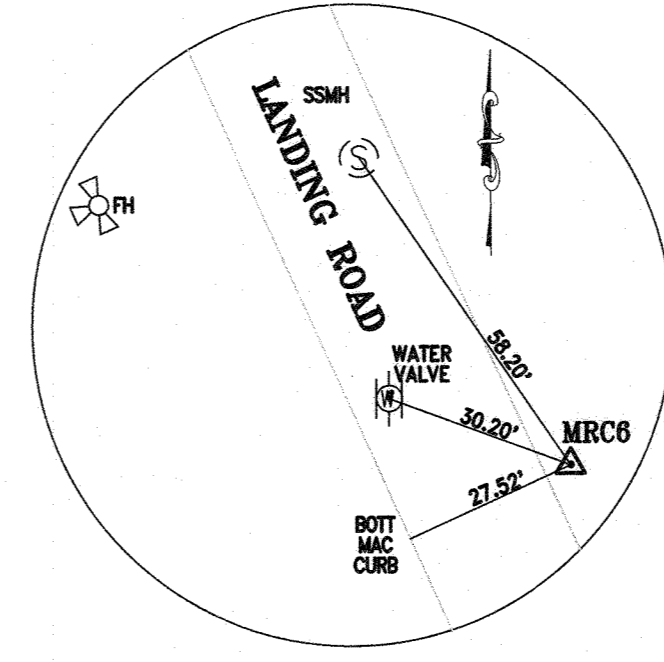


MRC6
 NORTHING = 563140.7191
 EASTING = 1383319.1746
 ELEVATION = 237.770

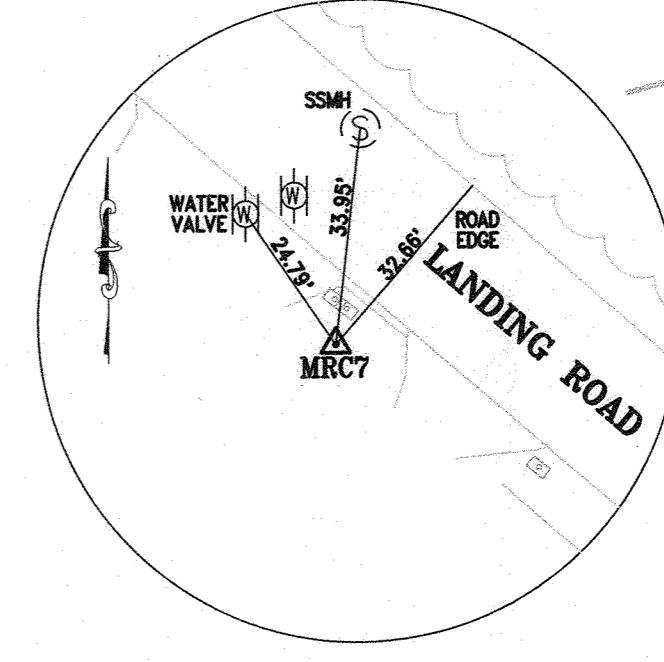


MRC7
 NORTHING = 571429.8382
 EASTING = 1377594.2172
 ELEVATION = 427.630

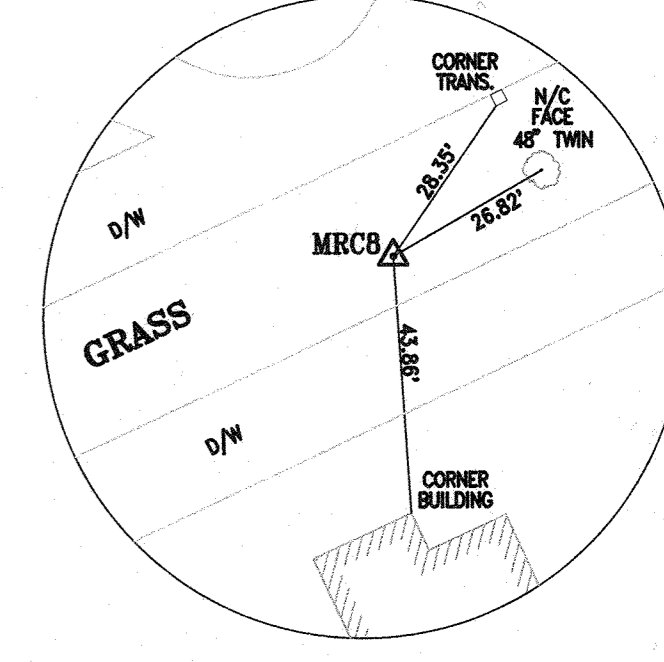


MRC8
 NORTHING = 565540.0663
 EASTING = 1381685.0388
 ELEVATION = 302.070

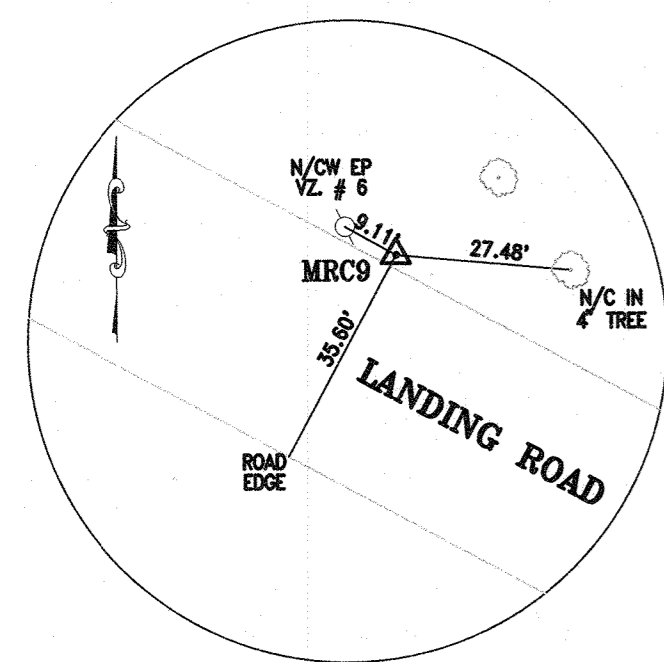


MRC9
 NORTHING = 571269.9229
 EASTING = 1377923.2405
 ELEVATION = 421.400

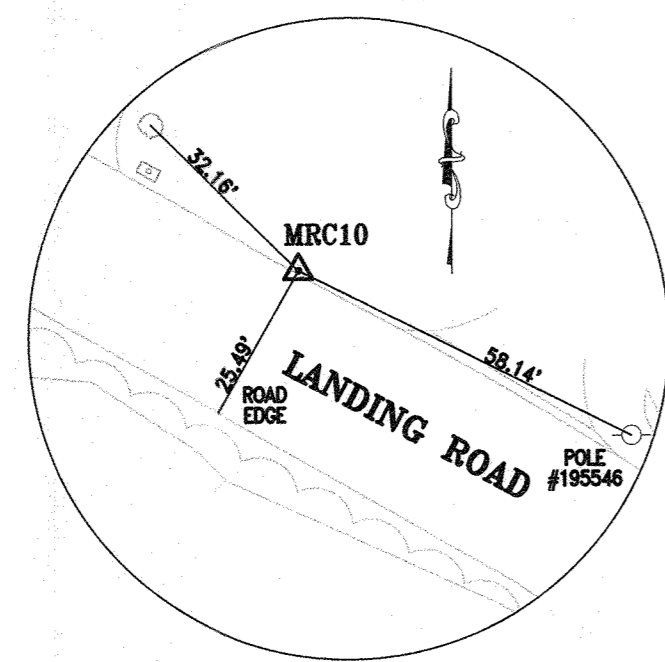


MRC10
 NORTHING = 571037.2337
 EASTING = 1378333.8951
 ELEVATION = 395.940

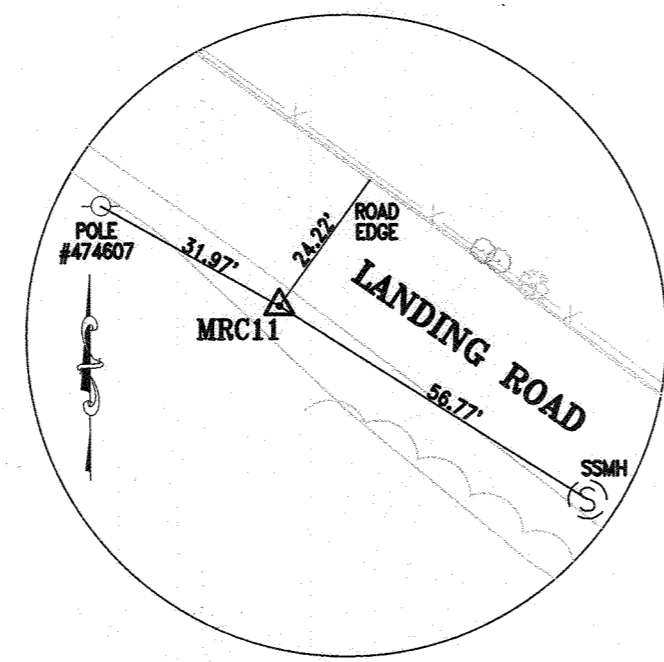


MRC11
 NORTHING = 570695.2547
 EASTING = 1378780.9986
 ELEVATION = 387.330

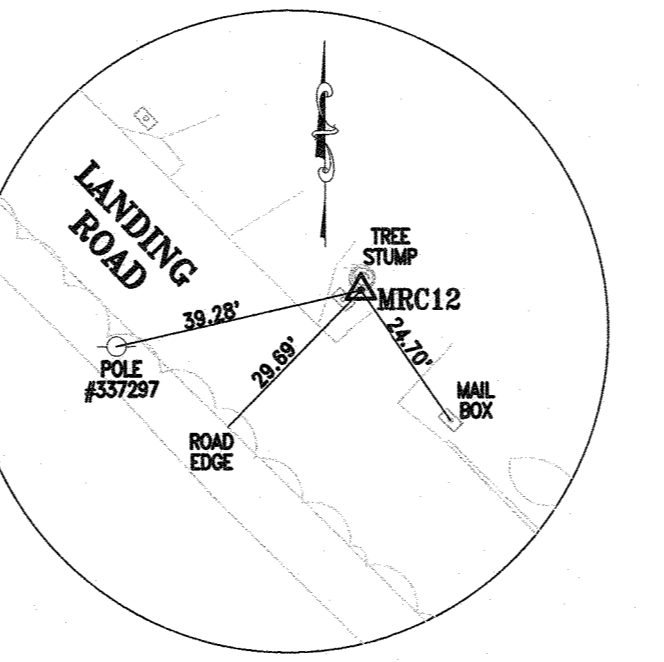


MRC12
 NORTHING = 570489.6337
 EASTING = 1379056.8485
 ELEVATION = 370.230

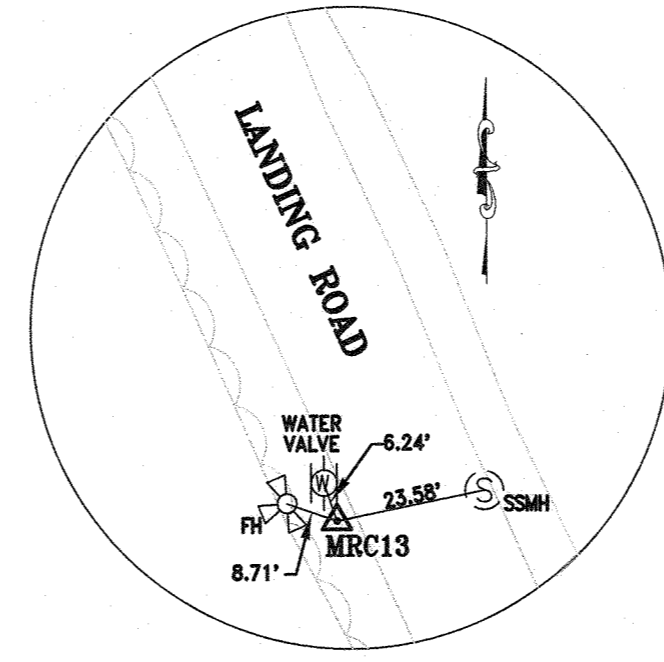


MRC13
 NORTHING = 563656.8579
 EASTING = 1383054.0141
 ELEVATION = 251.650

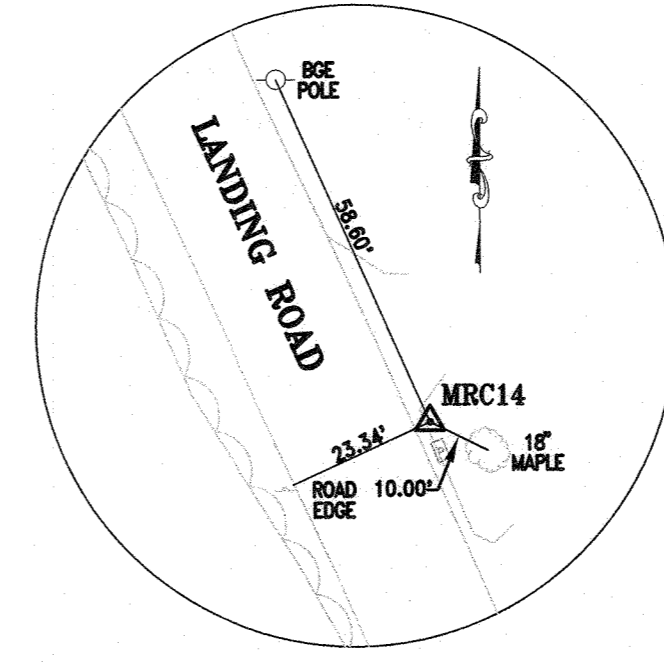


MRC14
 NORTHING = 564124.0750
 EASTING = 1382872.0608
 ELEVATION = 244.330

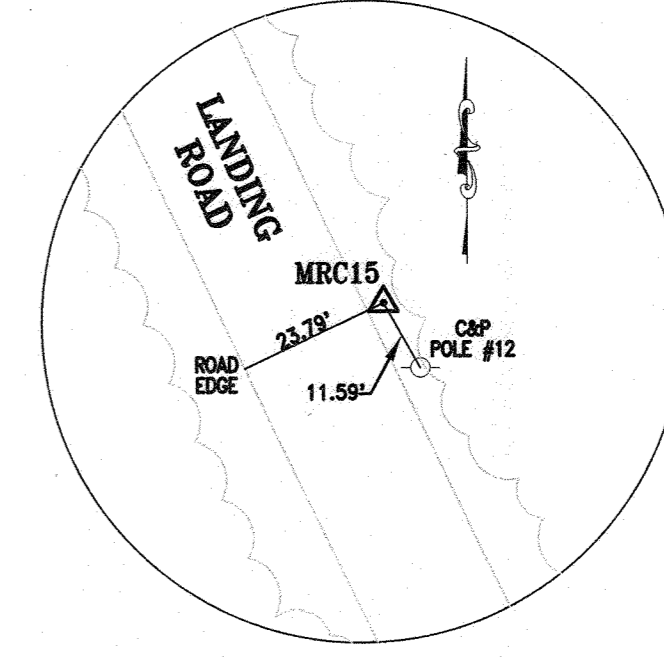


MRC15
 NORTHING = 564647.9438
 EASTING = 1382622.6564
 ELEVATION = 274.560

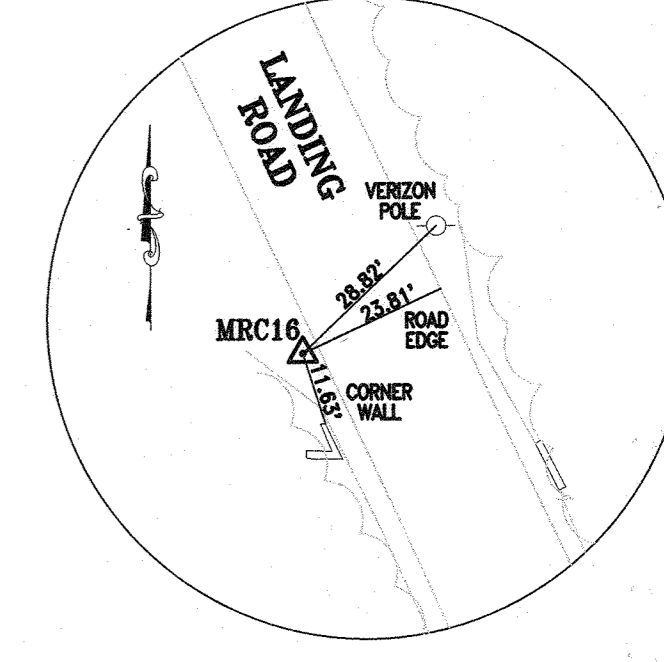


MRC16
 NORTHING = 564858.2150
 EASTING = 1382494.5181
 ELEVATION = 286.990

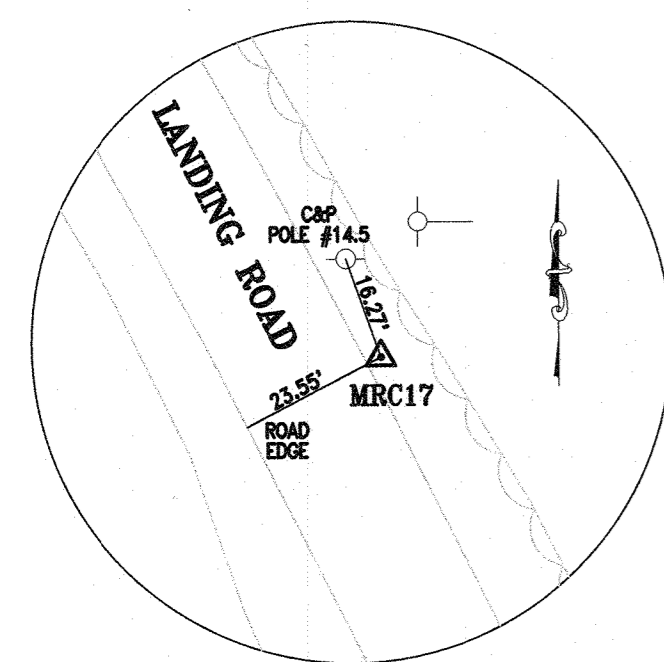

MRC17
 NORTHING = 565208.4395
 EASTING = 1382355.3259
 ELEVATION = 305.000

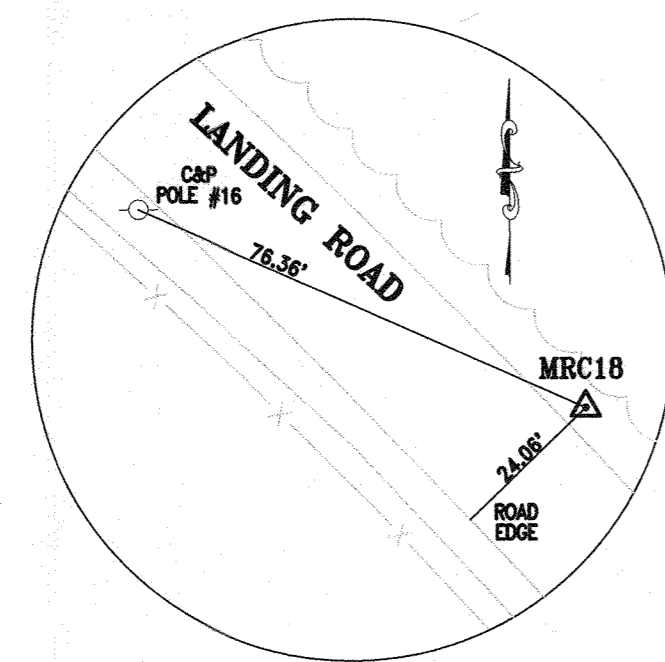

MRC18
 NORTHING = 565447.2171
 EASTING = 1382187.5897
 ELEVATION = 297.510

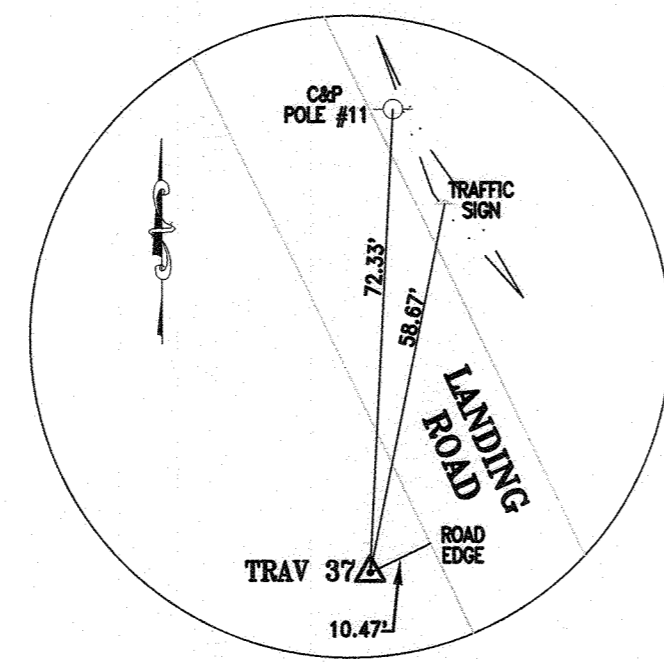

TRAY 37
 NORTHING = 564321.5212
 EASTING = 1382742.8353
 ELEVATION = 256.894

AS-BUILT MAY 2020 G-03

DEPARTMENT OF PUBLIC WORKS
 HOWARD COUNTY, MARYLAND
 Director of Public Works: *[Signature]* 5/3/19
 Chief, Bureau of Engineering: *[Signature]* 4/25/19
 Chief, Bureau of Utilities: *[Signature]* 5-2-19
 Chief, Utility Design Division: *[Signature]* 4/25/19

RK&K
 P: 410.728.2900
 700 East Pratt Street, Suite 500 | Baltimore, MD 21202
 Engineers | Construction Managers | Planners | Scientists
 www.rkk.com
 Responsive People | Creative Solutions

PROFESSIONAL CERTIFICATION:
 I HEREBY CERTIFY THAT THESE DOCUMENTS WERE PREPARED OR APPROVED BY ME, AND THAT I AM A DULY LICENSED PROFESSIONAL ENGINEER UNDER THE LAWS OF THE STATE OF MARYLAND.
 LICENSE NO. 20586
 EXPIRATION DATE: 09/06/2020




DES:	BY:	NO.:	REVISION:	DATE:
REG/WJG				
DRN:				
RAD/REG				
CHK:				
JCM/NKS				
SIGN DATE:				
CA/25/19				

SURVEY CONTROL AND STAKEOUT
 600' SCALE MAP NO. 31, 37 BLOCK NO. 5, 6, 10, 11, 17, 18, 24

PROJECT NO. W8305
 CONTRACT NO. 44-5059
 LANDING ROAD WATER MAIN LOOP
 ELECTION DISTRICT NO. 7
 HOWARD COUNTY, MARYLAND

SCALE: AS SHOWN
 SHEET NO.: 03 OF 18

RKK212515 - \\baldwin\2012\2012\12154_160680A\Task_12 - Landing Road W8305\CADD\Plan\1-10T-LANDING RD.dwg Apr 17, 2019 - 2:31pm ENVC/B Plot Scale: 1"=150' Plot By: bgrays Tab: C-01

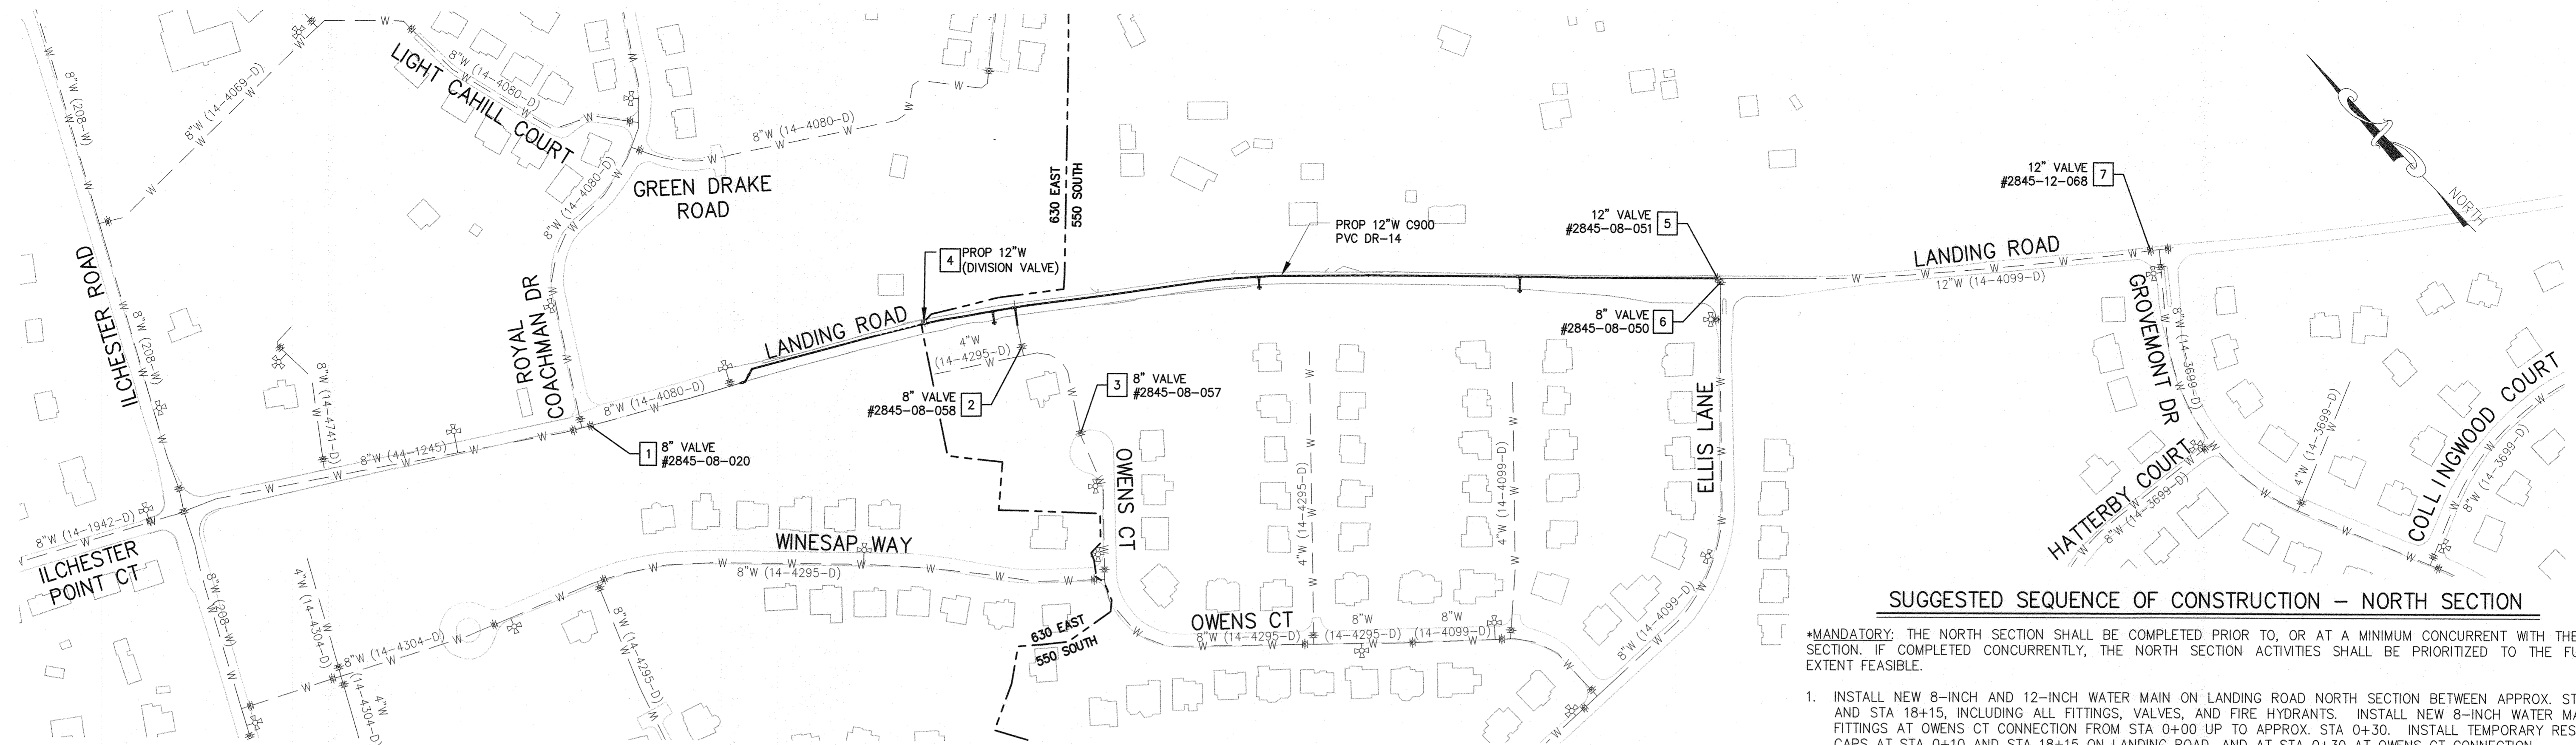


SHUTOFF PLAN - NORTH SECTION
SCALE: 1" = 150'

SEQUENCE OF CONSTRUCTION - GENERAL NOTES

1. THE SUGGESTED SEQUENCE OF CONSTRUCTION DOES NOT INCLUDE CONCURRENT SEDIMENT AND EROSION CONTROL MEASURES, AND MAINTENANCE OF TRAFFIC ACTIVITIES, WHICH SHALL ALSO BE FOLLOWED AS DESCRIBED IN THE CONTRACT DOCUMENTS.
2. THE CONTRACTOR SHALL VERIFY THAT THE EXISTING WATER MAINS AND VALVES ARE ADEQUATELY RESTRAINED PRIOR TO REMOVAL OF EXISTING WATER MAIN AT THE CONNECTION LOCATIONS. THE CONTRACTOR SHALL PROVIDE TEMPORARY THRUST BLOCKING ON THE EXISTING AND NEW WATER MAINS AS NEEDED TO COMPLETE CONNECTION TO THE NEW WATER MAIN AT NO ADDITIONAL COST TO THE COUNTY.
3. THE CONTRACTOR SHALL NOTIFY ALL PROPERTY OWNERS AFFECTED BY THE PROPOSED WATER SHUTDOWN. WRITTEN SHUTDOWN NOTICES SHALL BE PROVIDED A MINIMUM 48 HOURS IN ADVANCE OF A SHUTDOWN, DELIVERED TO EACH PROPERTY AND BUILDING WITH WATER SERVICE AFFECTED BY THE SHUTDOWN. ALL WATER SHUTDOWNS MUST BE LIMITED TO MAXIMUM OF EIGHT (8) HOURS AND SHALL BE PERFORMED DURING A LOW WATER DEMAND PERIOD IN CONSULTATION WITH THE COUNTY PERSONNEL AND IMPACTED PROPERTY OWNERS. SEE WATER NOTE 8, REGARDING COORDINATING WITH COUNTY BUREAU OF UTILITIES FOR SHUTDOWNS, TIE-INS, OR OTHER REQUIRED WATER SYSTEM OPERATIONAL NEED.

SUGGESTED SEQUENCE OF CONSTRUCTION - NORTH SECTION

- *MANDATORY: THE NORTH SECTION SHALL BE COMPLETED PRIOR TO, OR AT A MINIMUM CONCURRENT WITH THE SOUTH SECTION. IF COMPLETED CONCURRENTLY, THE NORTH SECTION ACTIVITIES SHALL BE PRIORITIZED TO THE FURTHEST EXTENT FEASIBLE.
1. INSTALL NEW 8-INCH AND 12-INCH WATER MAIN ON LANDING ROAD NORTH SECTION BETWEEN APPROX. STA 0+10 AND STA 18+15, INCLUDING ALL FITTINGS, VALVES, AND FIRE HYDRANTS. INSTALL NEW 8-INCH WATER MAIN AND FITTINGS AT OWENS CT CONNECTION FROM STA 0+00 UP TO APPROX. STA 0+30. INSTALL TEMPORARY RESTRAINED CAPS AT STA 0+10 AND STA 18+15 ON LANDING ROAD, AND AT STA 0+30 AT OWENS CT CONNECTION.
 2. COMPLETE HYDROSTATIC AND LEAKAGE TESTS. FLUSH AND DISINFECT NEWLY INSTALLED WATER MAIN AND FITTINGS, AS REQUIRED.
 3. THE CONTRACTOR SHALL MAKE SURE TO KEEP THE NEWLY INSTALLED 12-INCH DIVISION VALVE 4, AT STA 2+73.80 IN THE CLOSED POSITION BEFORE COMPLETING THE TIE-INS.
 4. CLOSE VALVE 1. REMOVE RESTRAINED CAP AND BUTTRESS AND COMPLETE TIE-IN OF NEW 12-INCH WATER MAIN AT STA 0+00 ON LANDING ROAD. OPEN VALVE 1.
 5. CLOSE VALVES 2, AND 3. REMOVE TEMPORARY RESTRAINED CAPS AND COMPLETE TIE-IN OF NEW 8-INCH WATER MAIN AT STA 0+37 AT OWENS CT CONNECTION. OPEN VALVE 3; KEEP VALVE 2 CLOSED.
 6. CLOSE VALVES 5, 6, AND 7. REMOVE TEMPORARY RESTRAINED CAP AND COMPLETE TIE-IN OF NEW 12-INCH WATER MAIN AT STA 18+25. OPEN VALVES 2, 5, 6, AND 7.

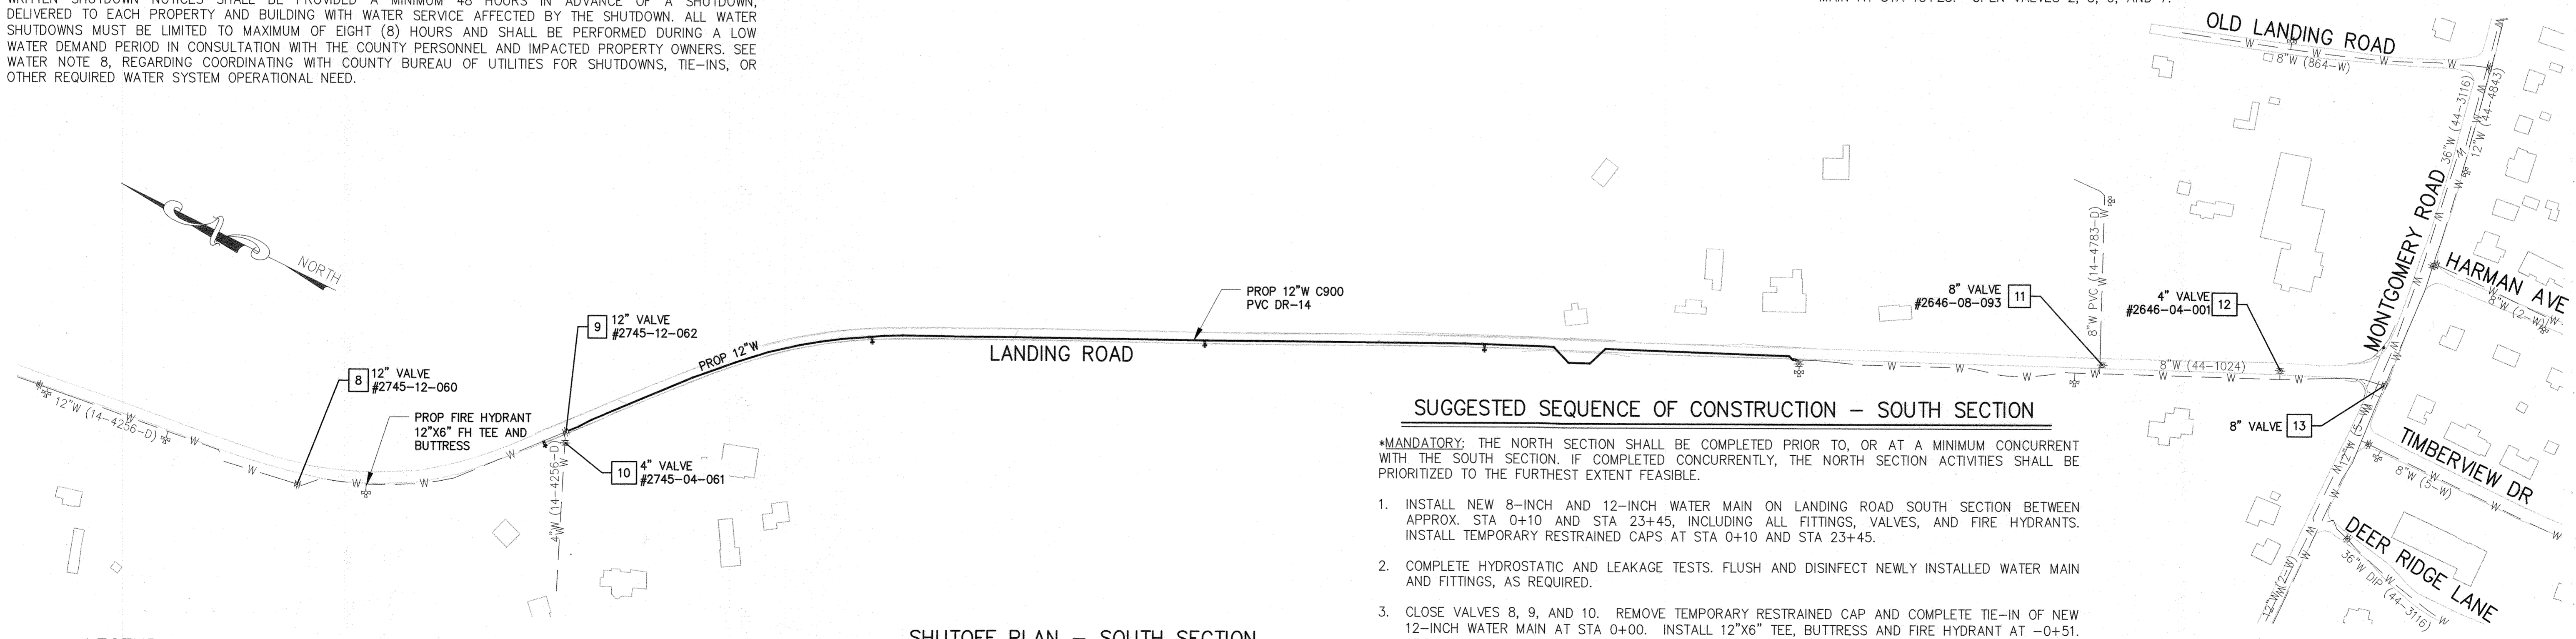

SHUTOFF PLAN - SOUTH SECTION
SCALE: 1" = 150'

SUGGESTED SEQUENCE OF CONSTRUCTION - SOUTH SECTION


- *MANDATORY: THE NORTH SECTION SHALL BE COMPLETED PRIOR TO, OR AT A MINIMUM CONCURRENT WITH THE SOUTH SECTION. IF COMPLETED CONCURRENTLY, THE NORTH SECTION ACTIVITIES SHALL BE PRIORITIZED TO THE FURTHEST EXTENT FEASIBLE.
1. INSTALL NEW 8-INCH AND 12-INCH WATER MAIN ON LANDING ROAD SOUTH SECTION BETWEEN APPROX. STA 0+10 AND STA 23+45, INCLUDING ALL FITTINGS, VALVES, AND FIRE HYDRANTS. INSTALL TEMPORARY RESTRAINED CAPS AT STA 0+10 AND STA 23+45.
 2. COMPLETE HYDROSTATIC AND LEAKAGE TESTS. FLUSH AND DISINFECT NEWLY INSTALLED WATER MAIN AND FITTINGS, AS REQUIRED.
 3. CLOSE VALVES 8, 9, AND 10. REMOVE TEMPORARY RESTRAINED CAP AND COMPLETE TIE-IN OF NEW 12-INCH WATER MAIN AT STA 0+00. INSTALL 12"X6" TEE, BUTTRESS AND FIRE HYDRANT AT -0+51. OPEN VALVES 8 AND 10; KEEP VALVE 8 CLOSED.
 4. CLOSE VALVES 11, 12, AND 13. REMOVE TEMPORARY RESTRAINED CAP AND COMPLETE TIE-IN OF NEW 12-INCH WATER MAIN AT STA 23+63. OPEN VALVES 9, 11, 12, AND 13. RESTORE THE AREA.

LEGEND
--- WATER PRESSURE ZONE BOUNDARY

AS-BUILT MAY 2020


DEPARTMENT OF PUBLIC WORKS HOWARD COUNTY, MARYLAND				PROFESSIONAL CERTIFICATION: I HEREBY CERTIFY THAT THESE DOCUMENTS WERE PREPARED OR APPROVED BY ME, AND THAT I AM A DULY LICENSED PROFESSIONAL ENGINEER UNDER THE LAWS OF THE STATE OF MARYLAND. LICENSE NO. 20566 EXPIRATION DATE: 09/06/2020		DES: REG/WJG DRN: RAD/REG CHK: JCM/NKS SIGN DATE: 04/25/19		PROJECT NO. W8305 CONTRACT NO. 44-5059		SCALE AS SHOWN	
DIRECTOR OF PUBLIC WORKS <i>[Signature]</i> DATE: 5-2-19	CHIEF, BUREAU OF ENGINEERING <i>[Signature]</i> DATE: 4/29/19	CHIEF, BUREAU OF UTILITIES <i>[Signature]</i> DATE: 4/29/19	CHIEF, UTILITY DESIGN DIVISION <i>[Signature]</i> DATE: 4/29/19	P: 410.728.2900 700 East Pratt Street, Suite 500 Baltimore, MD 21202 Engineers Construction Managers Planners Scientists www.rkk.com Responsive People Creative Solutions		WATER SHUTOFF PLAN AND SEQUENCE OF CONSTRUCTION		LANDING ROAD WATER MAIN LOOP		SHEET NO. 04 OF 18	
600' SCALE MAP NO. 31, 37 BLOCK NO. 5, 6, 10, 11, 17, 18, 24 ELECTION DISTRICT NO. 7 HOWARD COUNTY, MARYLAND						1"=150'		C-01			

RKK21 S75 - \\bairv01\2012\2012\1215_HCC080A\Task 12 - Landing Road W8305 CADD\Plans As-Built\VE-BUT-PO2-LANDING RD.dwg Aug 13, 2020 - 3:41pm ENW/CIB Plot Scale 1=1 Plot By: pme/hundur Tab: C-02

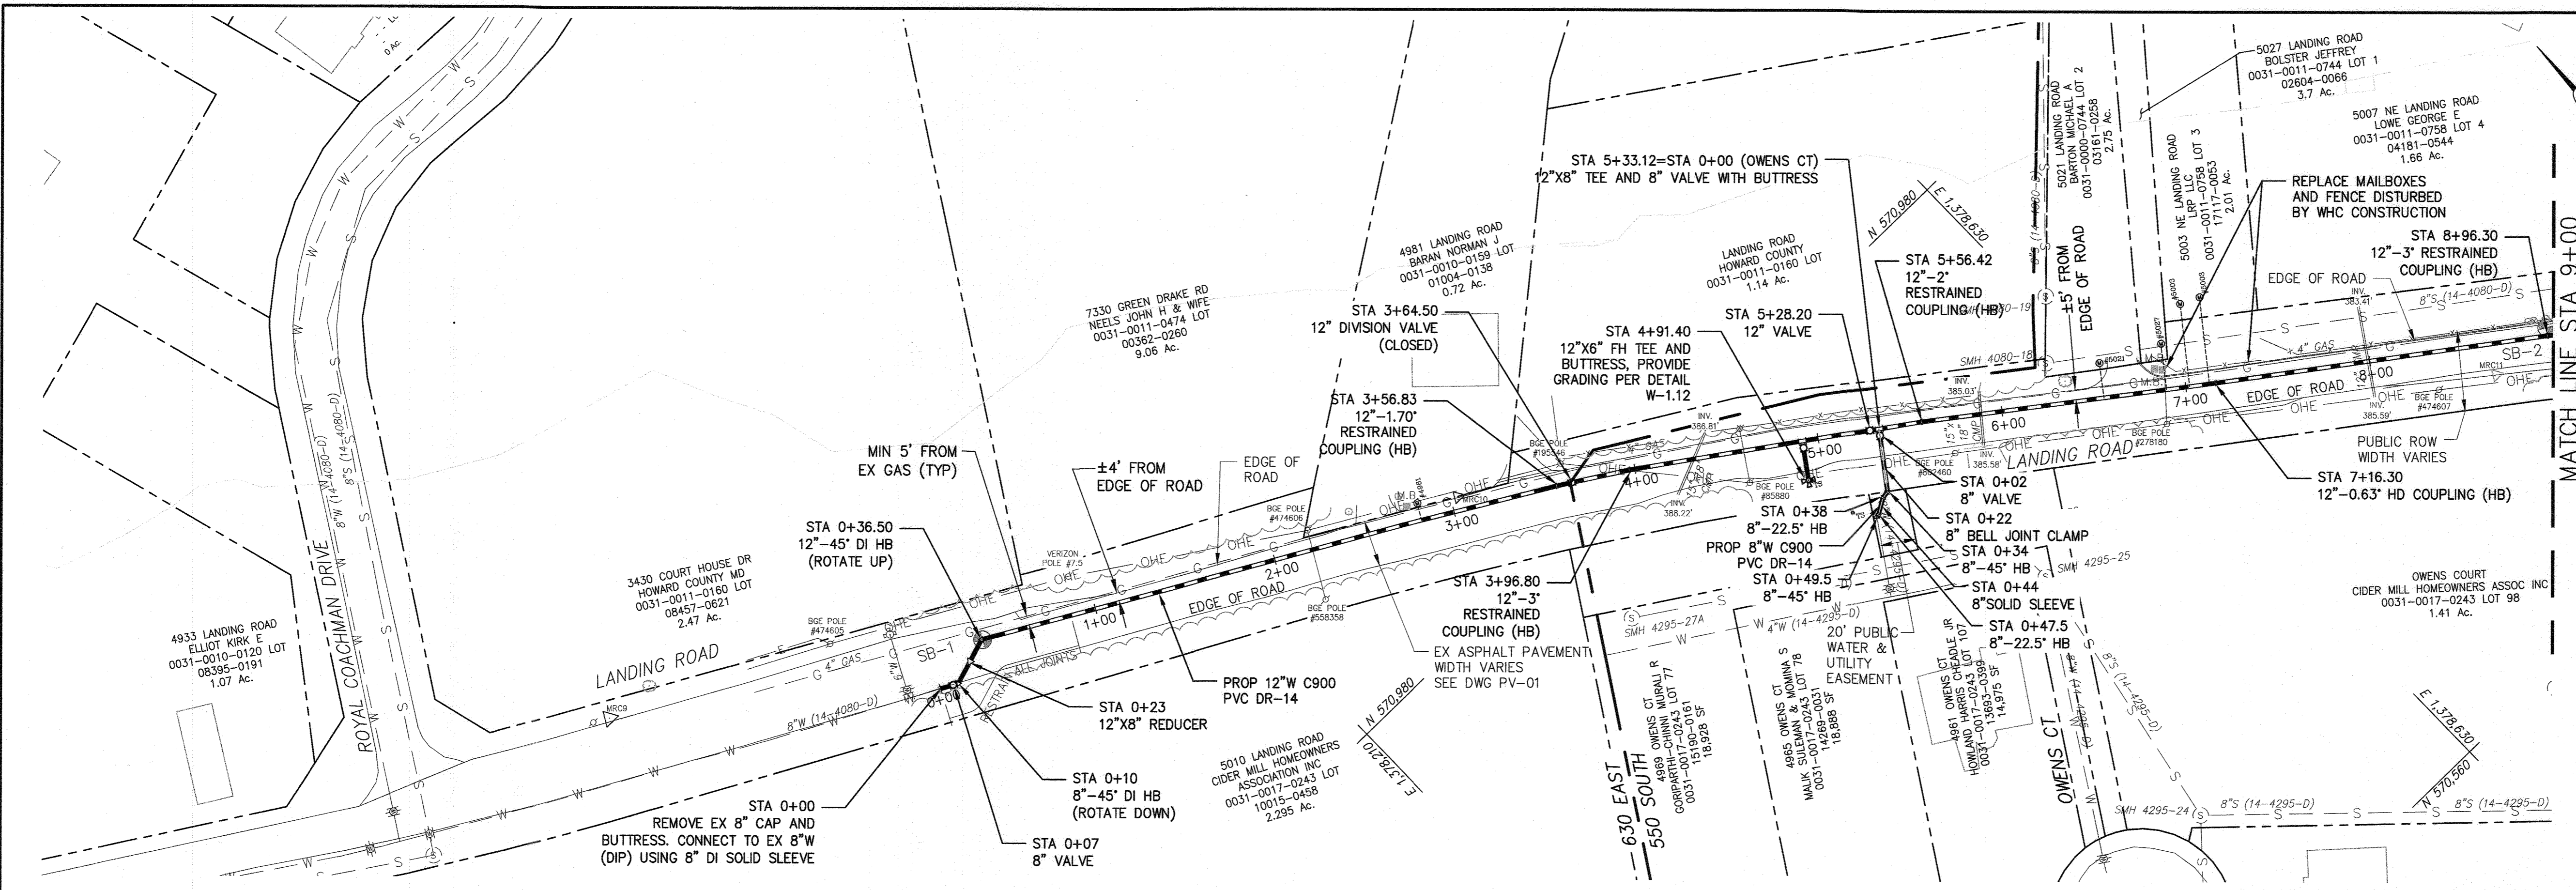

PLAN - LANDING ROAD NORTH SECTION

SCALE: 1" = 50'

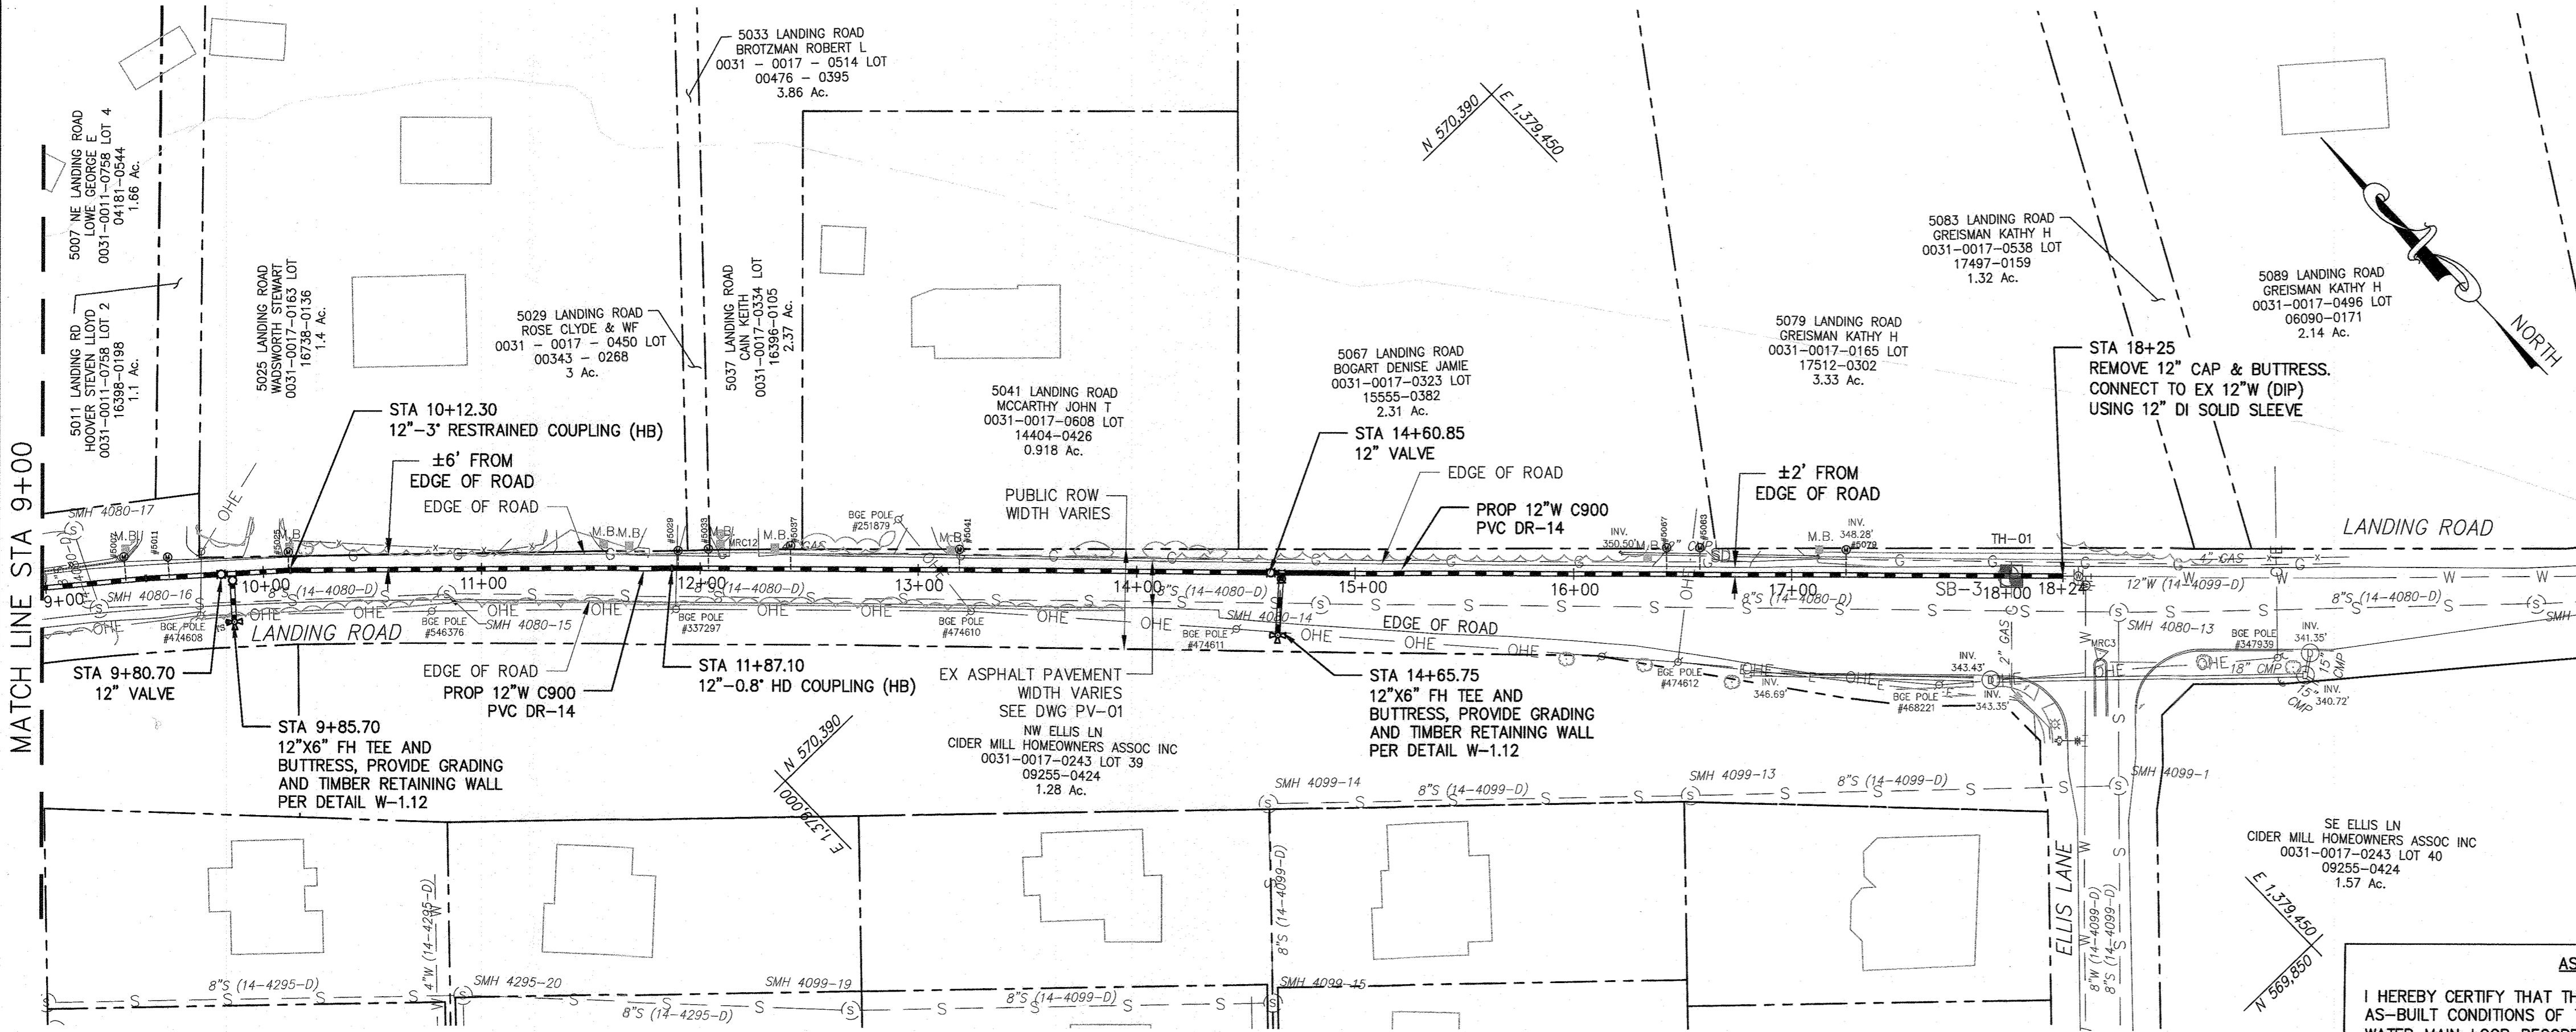

PLAN - LANDING ROAD NORTH SECTION

SCALE: 1" = 50'


SOIL BORINGS				
BORING #	NORTHING	EASTING	ELEV.	PAVEMENT THICKNESS
SB-01	571,160.79	1,378,096.42	410.54	7"
SB-02	570,695.13	1,378,817.35	387.11	6"
SB-03	570,066.97	1,379,466.99	347.82	6"

UTILITY TEST HOLE					
TEST HOLE #	NORTHING	EASTING	TOP OF UTILITY	SURFACE ELEV.	DESCRIPTION
TH-01	570,066.15	1,379,468.34	344.81	347.76	GAS

NEW WATER HOUSE CONNECTIONS									
APPROX STATION	SERVICE ADDRESS	SERVICE SIZE	METER SIZE	METER TYPE (SINGLE/TWIN)	LENGTH OF WHC (LF)	TYPE OF SERVICE	NORTHING	EASTING	STD DETAIL
2+82	4981 LANDING RD	1"	3/4"	SINGLE	7'	RESIDENTIAL	571,041.7516	1,378,311.0846	
6+55	5021 LANDING RD	1"	3/4"	SINGLE	17'	RESIDENTIAL	570,833.3821	1,378,620.8140	W-3.27
6+95	5027 LANDING RD	1"	3/4"	SINGLE	15'	RESIDENTIAL	570,828.6708	1,378,653.9479	
7+02	5003 LANDING RD	1.5"	1"	TWIN	43'	RESIDENTIAL	570,805.6321	1,378,658.0959	W-3.32
7+13	5003 LANDING RD	1.5"	1"	SINGLE	45'	RESIDENTIAL	570,799.2326	1,378,666.6924	W-3.28
9+37	5007 LANDING RD	1"	3/4"	SINGLE	9'	RESIDENTIAL	570,665.6170	1,378,846.8382	
9+57	5011 LANDING RD	1"	3/4"	SINGLE	7'	RESIDENTIAL	570,652.8448	1,378,862.0128	
10+10	5025 LANDING RD	1"	3/4"	SINGLE	5'	RESIDENTIAL	570,622.8646	1,378,906.6423	
11+90	5029 LANDING RD	1"	3/4"	SINGLE	6'	RESIDENTIAL	570,499.6567	1,379,037.8529	
12+04	5033 LANDING RD	1"	3/4"	SINGLE	7'	RESIDENTIAL	570,484.0953	1,379,042.2150	W-3.27
12+42	5037 LANDING RD	1"	3/4"	SINGLE	7'	RESIDENTIAL	570,457.7144	1,379,069.0646	
13+20	5041 LANDING RD	1"	3/4"	SINGLE	8'	RESIDENTIAL	570,409.6611	1,379,131.8094	
16+42	5067 LANDING RD	1"	3/4"	SINGLE	10'	RESIDENTIAL	570,185.3618	1,379,363.9718	
16+58	5063 LANDING RD	1"	3/4"	SINGLE	10'	RESIDENTIAL	570,174.7831	1,379,374.8589	
17+25	5079 LANDING RD	1"	3/4"	SINGLE	10'	RESIDENTIAL	570,119.2382	1,379,414.2468	

RESTRAINED LENGTHS - LANDING RD			
STATION (FROM)	STATION (TO)	SIZE	JOINTS TO BE RESTRAINED
0+00	0+23	8"	ALL JOINTS
0+23	0+91	12"	ALL JOINTS
2+42	6+50	12"	ALL JOINTS
8+58	11+03	12"	ALL JOINTS
13+38	15+83	12"	ALL JOINTS

AS-BUILT DRAWINGS:
 I HEREBY CERTIFY THAT THIS PLAN HAS BEEN REVISED TO REFLECT THE AS-BUILT CONDITIONS OF THE CAPITAL PROJECT W8305, LANDING ROAD WATER MAIN LOOP RECORDED BY HOWARD COUNTY'S CONTRACTOR AND INSPECTOR.
 [Signature] 35329 8/20/20
 Engineer's Signature - Registration Number Date

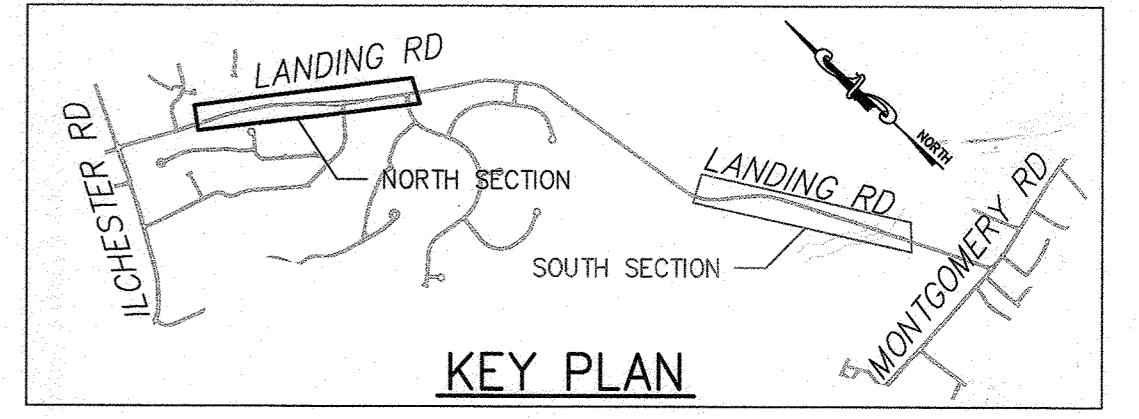

AS-BUILT MAY 2020

DEPARTMENT OF PUBLIC WORKS
 HOWARD COUNTY, MARYLAND
 [Signature] 11/4/2020 [Signature] 9/6/20
 DIRECTOR OF PUBLIC WORKS DATE CHIEF, BUREAU OF ENGINEERING DATE
 [Signature] 11-4-2020 [Signature] 9/6/2020
 CHIEF, BUREAU OF UTILITIES DATE CHIEF, UTILITY DESIGN DIVISION DATE


RK&K
 P: 410.728.2900
 700 East Pratt Street, Suite 500 | Baltimore, MD 21202
 Engineers | Construction Managers | Planners | Scientists
 www.rk.com
 Responsive People | Creative Solutions

PROFESSIONAL CERTIFICATION:
 I HEREBY CERTIFY THAT THESE DOCUMENTS WERE PREPARED OR APPROVED BY ME, AND THAT I AM A DULY LICENSED PROFESSIONAL ENGINEER UNDER THE LAWS OF THE STATE OF MARYLAND,
 LICENSE NO. 35329,
 EXPIRATION DATE: 01/14/2022


DES:	BY:	NO.:	REVISION:	DATE:
REG/WJC	RKK	1	AS-BUILT REPLACEMENT SHEET	5/2020
DRN:				
CHK:				
JCM/NKS				
DATE:				
8/20/20				

600' SCALE MAP NO. 31, 37 BLOCK NO. 5, 6, 10, 11, 17, 18, 24 ELECTION DISTRICT NO. 7 HOWARD COUNTY, MARYLAND

PROJECT NO. W8305
 CONTRACT NO. 44-5059
 WATER PLAN - NORTH SECTION
 (STA 0+00 TO STA 18+25)
 LANDING ROAD WATER MAIN LOOP
 SCALE: AS SHOWN
 SHEET NO. 05 OF 18

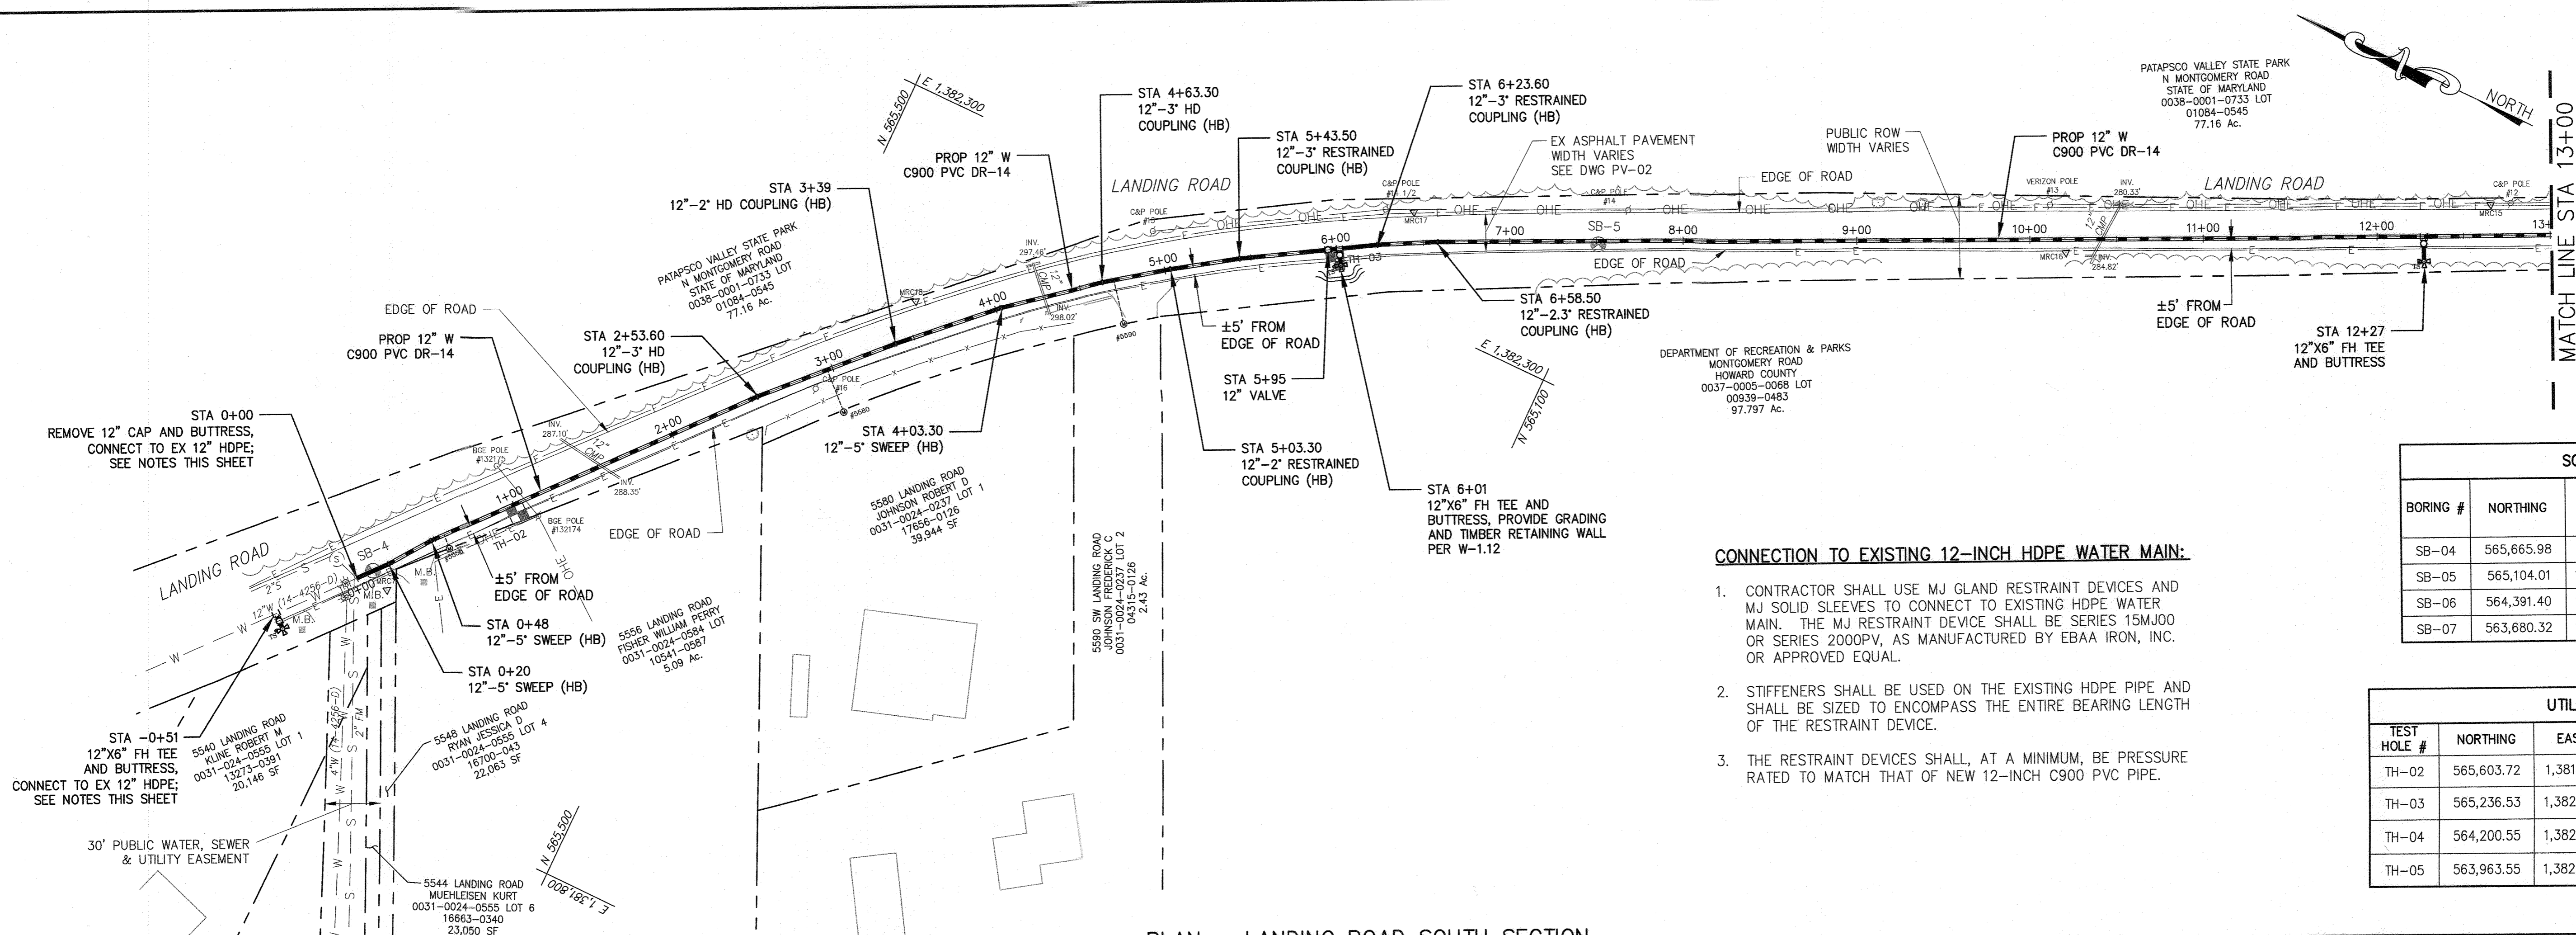

PLAN - LANDING ROAD SOUTH SECTION
SCALE: 1" = 50'

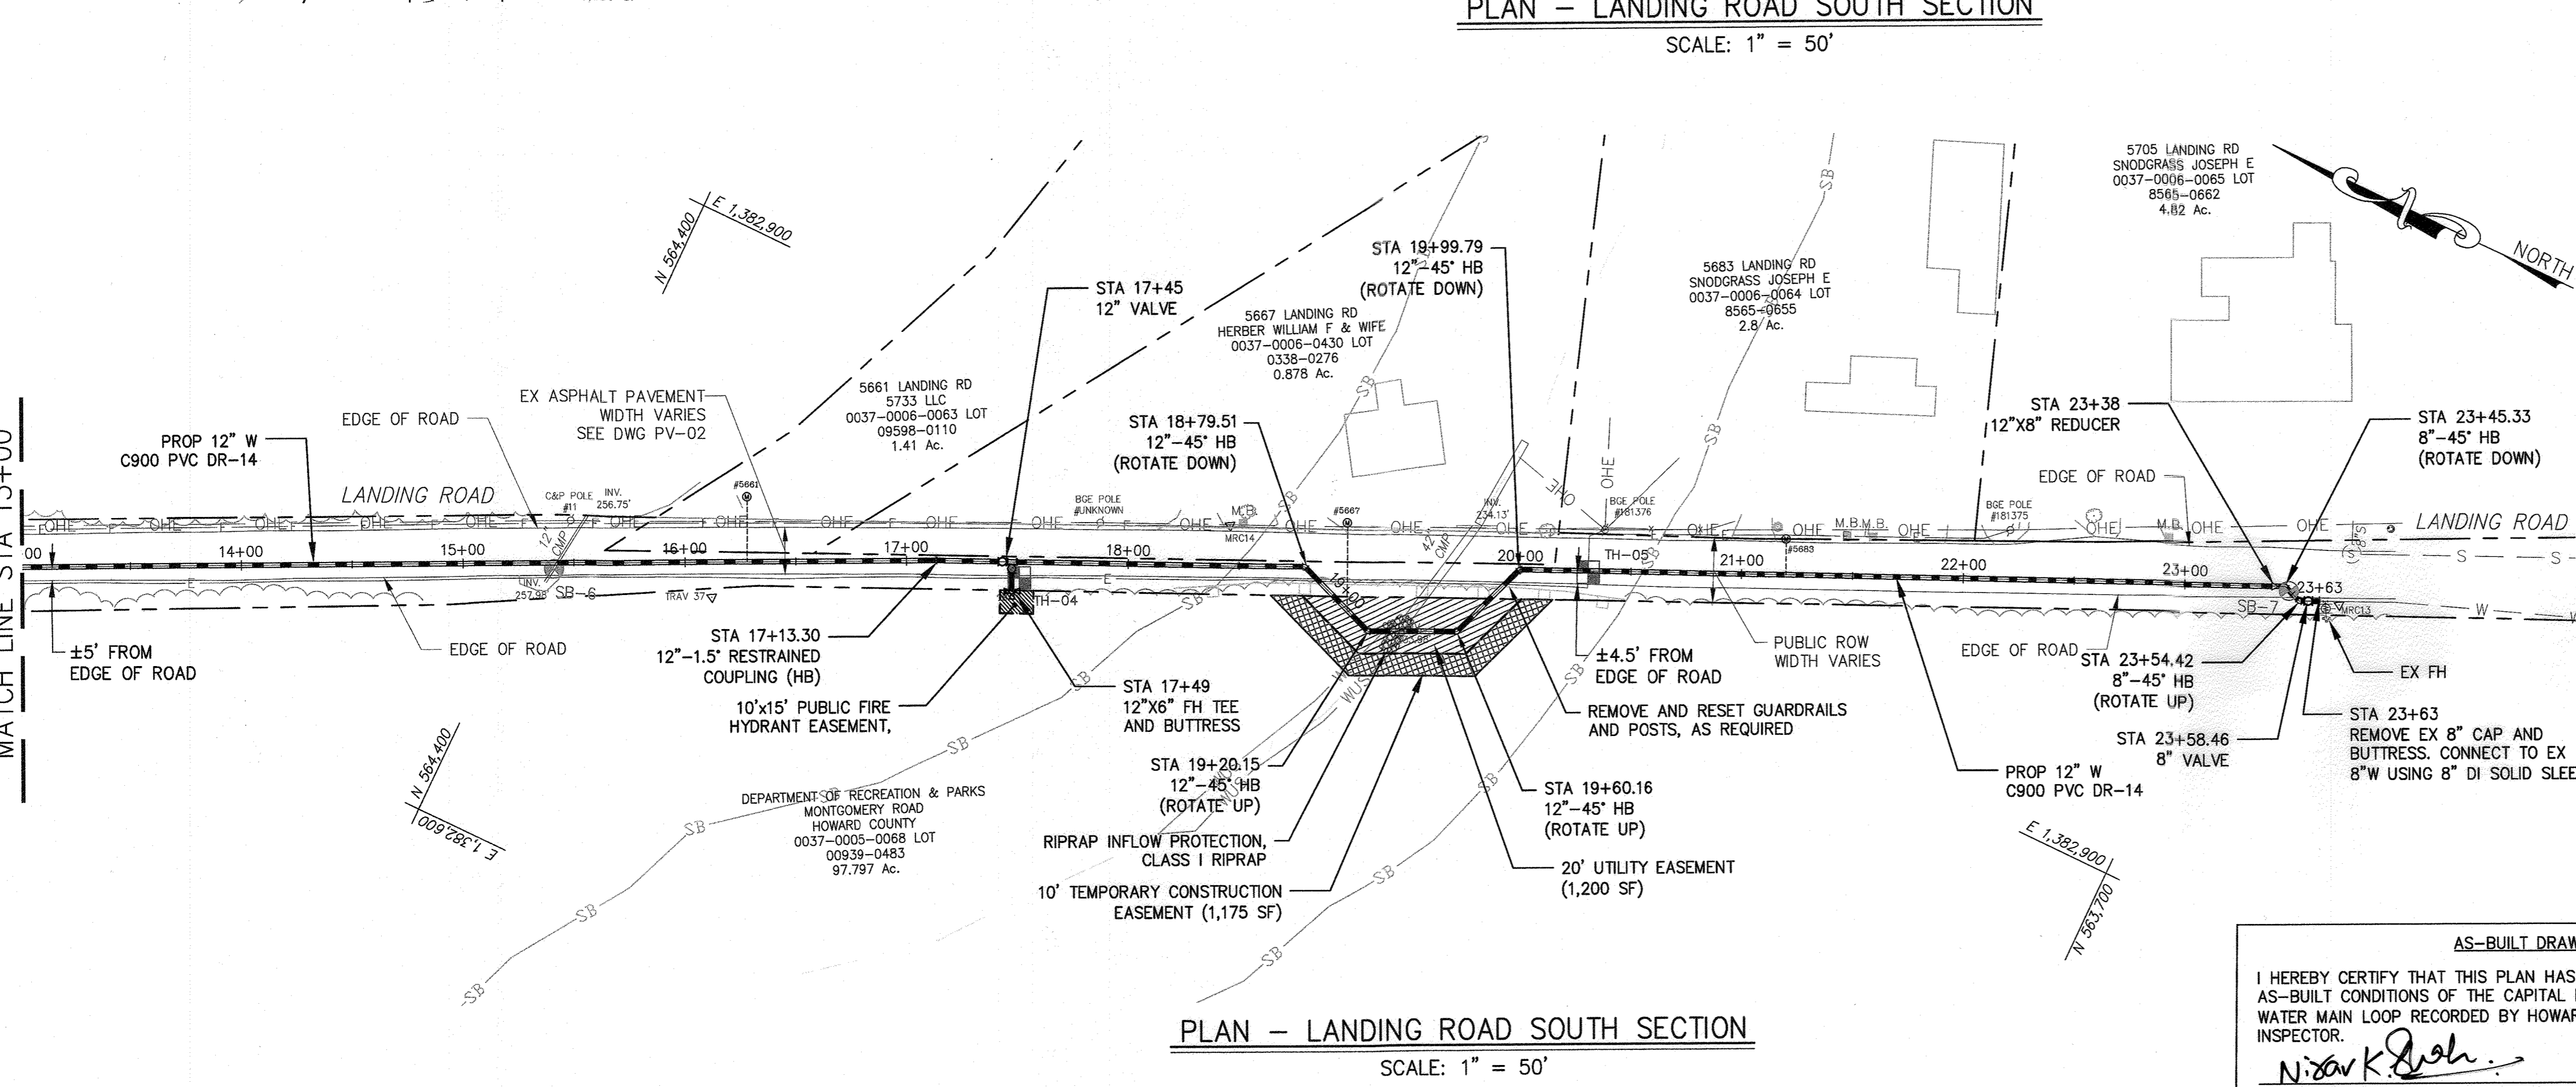

PLAN - LANDING ROAD SOUTH SECTION
SCALE: 1" = 50'

AS-BUILT DRAWINGS:
I HEREBY CERTIFY THAT THIS PLAN HAS BEEN REVISED TO REFLECT THE AS-BUILT CONDITIONS OF THE CAPITAL PROJECT W8305, LANDING ROAD WATER MAIN LOOP RECORDED BY HOWARD COUNTY'S CONTRACTOR AND INSPECTOR.
N. [Signature] 35329 8/20/20
Engineer's Signature - Registration Number Date

AS-BUILT MAY 2020

SOIL BORINGS

BORING #	NORTHING	EASTING	ELEV.	PAVEMENT THICKNESS
SB-04	565,665.98	1,381,914.04	285.82	6.5"
SB-05	565,104.01	1,382,384.00	301.80	8.5"
SB-06	564,391.40	1,382,723.39	260.19	8"
SB-07	563,680.32	1,383,049.65	253.28	8"

- CONNECTION TO EXISTING 12-INCH HDPE WATER MAIN:
- CONTRACTOR SHALL USE MJ GLAND RESTRAINT DEVICES AND MJ SOLID SLEEVES TO CONNECT TO EXISTING HDPE WATER MAIN. THE MJ RESTRAINT DEVICE SHALL BE SERIES 15MJ00 OR SERIES 2000PV, AS MANUFACTURED BY EBAA IRON, INC. OR APPROVED EQUAL.
 - STIFFENERS SHALL BE USED ON THE EXISTING HDPE PIPE AND SHALL BE SIZED TO ENCOMPASS THE ENTIRE BEARING LENGTH OF THE RESTRAINT DEVICE.
 - THE RESTRAINT DEVICES SHALL, AT A MINIMUM, BE PRESSURE RATED TO MATCH THAT OF NEW 12-INCH C900 PVC PIPE.

UTILITY TEST HOLE



TEST HOLE #	NORTHING	EASTING	TOP OF UTILITY	SURFACE ELEV.	DESCRIPTION
TH-02	565,603.72	1,381,980.01	285.36	288.44	(3) 1.5" ELECTRIC
TH-03	565,236.53	1,382,312.04	301.77	305.18	(3) 1.5" ELECTRIC
TH-04	564,200.55	1,382,312.04	246.09	249.38	(3) 1.5" ELECTRIC
TH-05	563,963.55	1,382,925.20	241.17	244.82	(3) 1.5" ELECTRIC

NEW WATER HOUSE CONNECTIONS

APPROX STATION	SERVICE ADDRESS	SERVICE SIZE	METER SIZE	METER TYPE (SINGLE/TWIN)	PROP LENGTH OF WHC (LF)	TYPE OF SERVICE	NORTHING	EASTING	STD DETAIL
0+55	5556 LANDING RD	1"	3/4"	SINGLE	6'	RESIDENTIAL	565,631.3323	1,381,943.9782	W-3.27
2+98	5580 LANDING RD	1"	3/4"	SINGLE	23'	RESIDENTIAL	565,456.4618	1,382,115.6737	
4+70	5590 LANDING RD	1"	3/4"	SINGLE	24'	RESIDENTIAL	565,332.9086	1,382,226.4400	
16+28	5661 LANDING RD	1"	3/4"	SINGLE	25'	RESIDENTIAL	564,313.9996	1,382,764.4200	
19+07	5667 LANDING RD	1"	3/4"	SINGLE	35'	RESIDENTIAL	564,060.2126	1,382,860.3520	
21+20	5683 LANDING RD	1"	3/4"	SINGLE	14'	RESIDENTIAL	563,894.6184	1,382,973.3596	

RESTRAINED LENGTHS - LANDING RD

STATION (FROM)	STATION (TO)	SIZE	JOINTS TO BE RESTRAINED
0+00	1+25	12"	ALL JOINTS
4+72	7+17	12"	ALL JOINTS
11+95	12+55	12"	ALL JOINTS
16+23	20+51	12"	ALL JOINTS
22+50	23+38	12"	ALL JOINTS
23+38	23+63	8"	ALL JOINTS

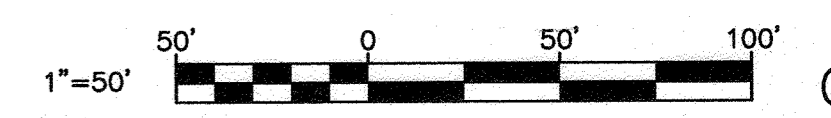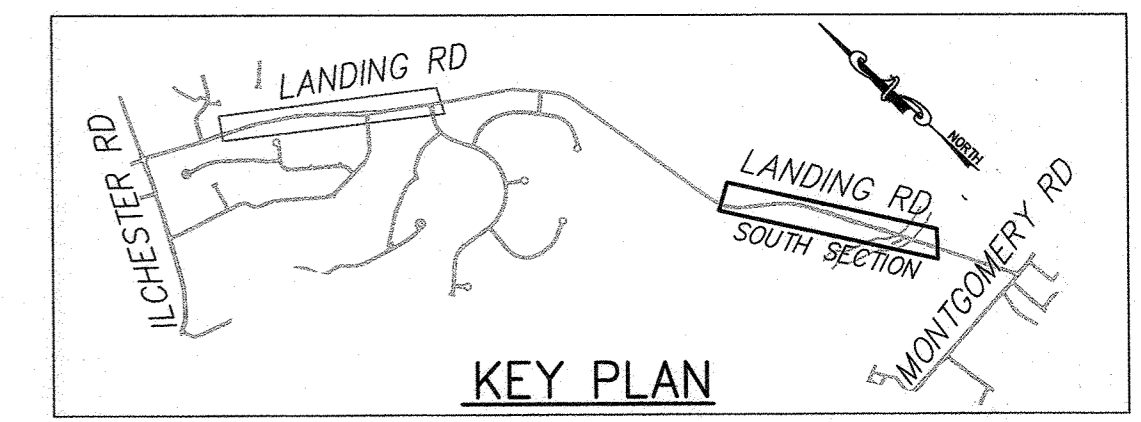


R02121515 - \\sawyer\1\2012\02\12164-Jacobs\A\Task 12 - Landing Road W8305\CADD\Drawings\12164-003-LANDING RD.dwg Aug 13, 2020 - 3:42pm ENW/CTB Plot Scale 1=1 Plot By: pmj/mjander Tab: C-03

DEPARTMENT OF PUBLIC WORKS
HOWARD COUNTY, MARYLAND

11/4/2020
11-4-2020

RK&K
P: 410.728.2900
700 East Pratt Street, Suite 500 | Baltimore, MD 21202
Engineers | Construction Managers | Planners | Scientists
www.rkandk.com
Responsive People | Creative Solutions

PROFESSIONAL CERTIFICATION:
I HEREBY CERTIFY THAT THESE DOCUMENTS WERE PREPARED OR APPROVED BY ME, AND THAT I AM A DULY LICENSED PROFESSIONAL ENGINEER UNDER THE LAWS OF THE STATE OF MARYLAND, LICENSE NO. 35329, EXPIRATION DATE: 01/14/2022.

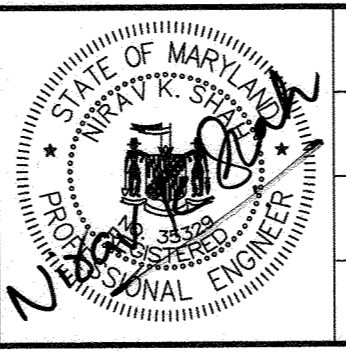

DES:	BY:	NO.:	REVISION:	DATE:
REG/WJG	RKK	AS-BUILT REPLACEMENT SHEET		5/2020
DRN: RAD/REG				
CHK: JCM/NKS				
SIGN DATE: 8/20/20				

WATER PLAN - SOUTH SECTION
(STA 0+00 TO STA 23+63)

600' SCALE MAP NO. 31, 37 BLOCK NO. 5, 6, 10, 11, 17, 18, 24

PROJECT NO. W8305
CONTRACT NO. 44-5059


LANDING ROAD WATER MAIN LOOP

ELECTION DISTRICT NO. 7

HOWARD COUNTY, MARYLAND


SCALE: AS SHOWN
SHEET NO. 06 OF 18

06/21/2019 10:21:25 AM \\s01\proj\2019\12154_1000\00A\Task 12 - Landing Road W8305\CAD\Plans\7-p\15-P004-LANDING RD.dwg Apr 17, 2019 - 2:35pm ENV:CTB Plot Scale 1"=1' Plot By: bgyross Tab: C-04

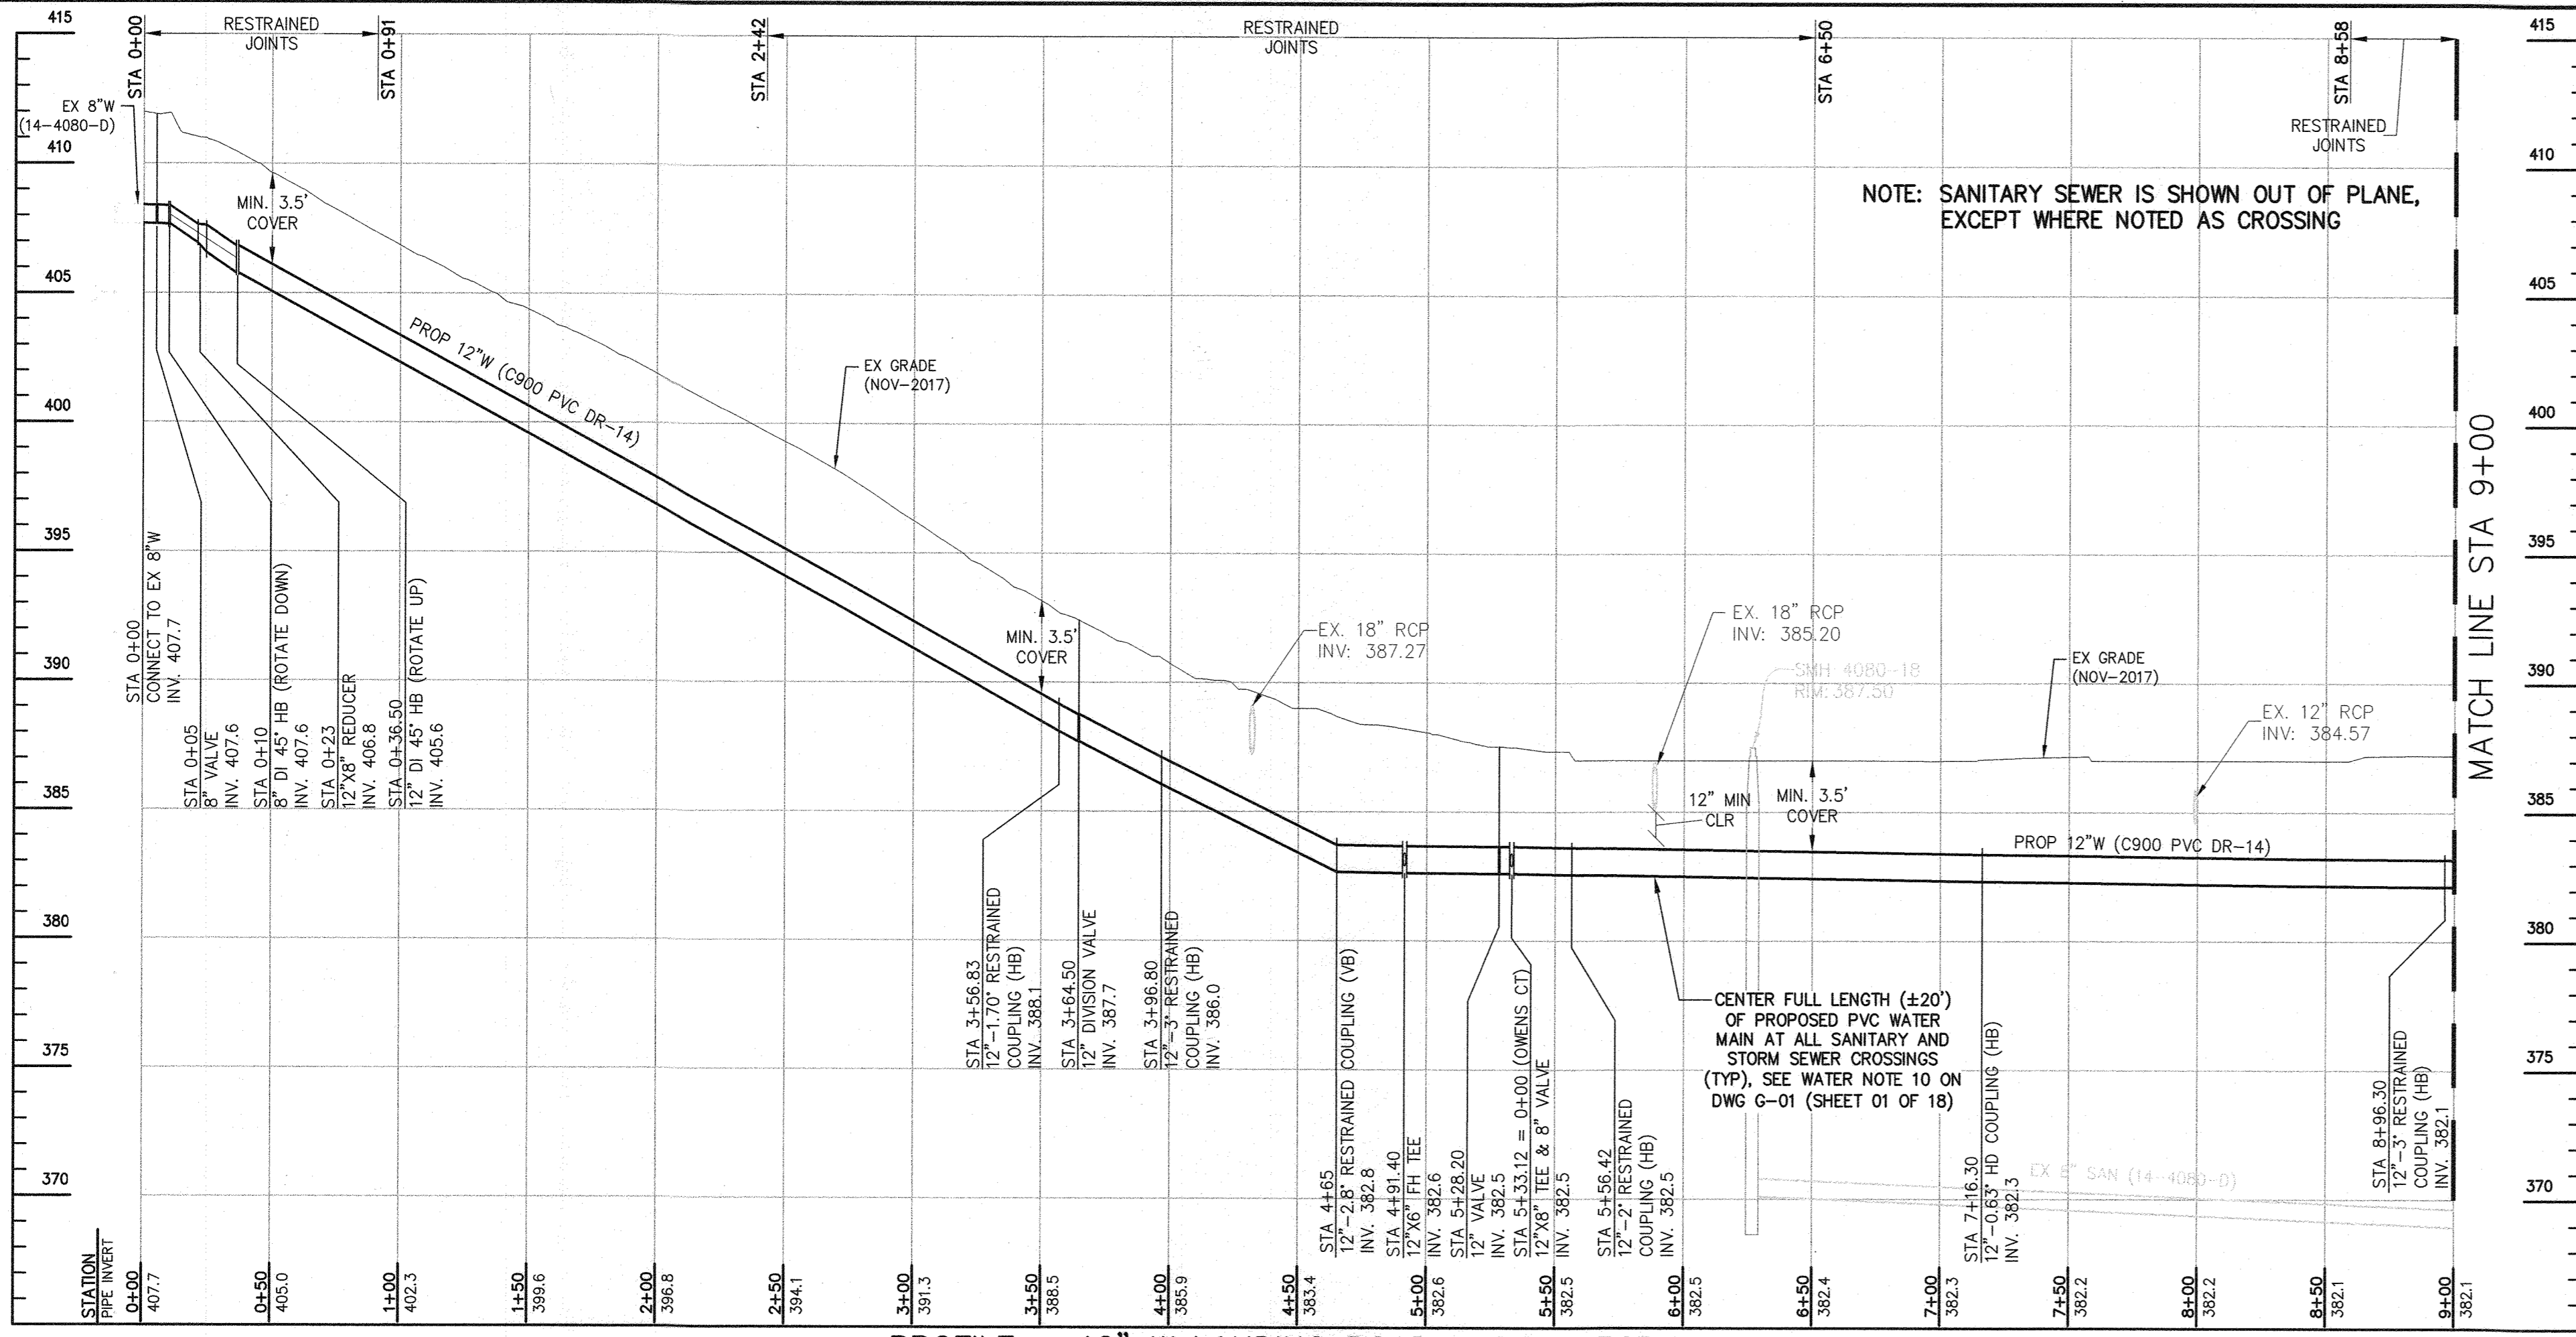


PROFILE - 12" W LANDING ROAD NORTH SECTION

SCALE: 1" = 50' HORIZ.
1" = 5' VERT.

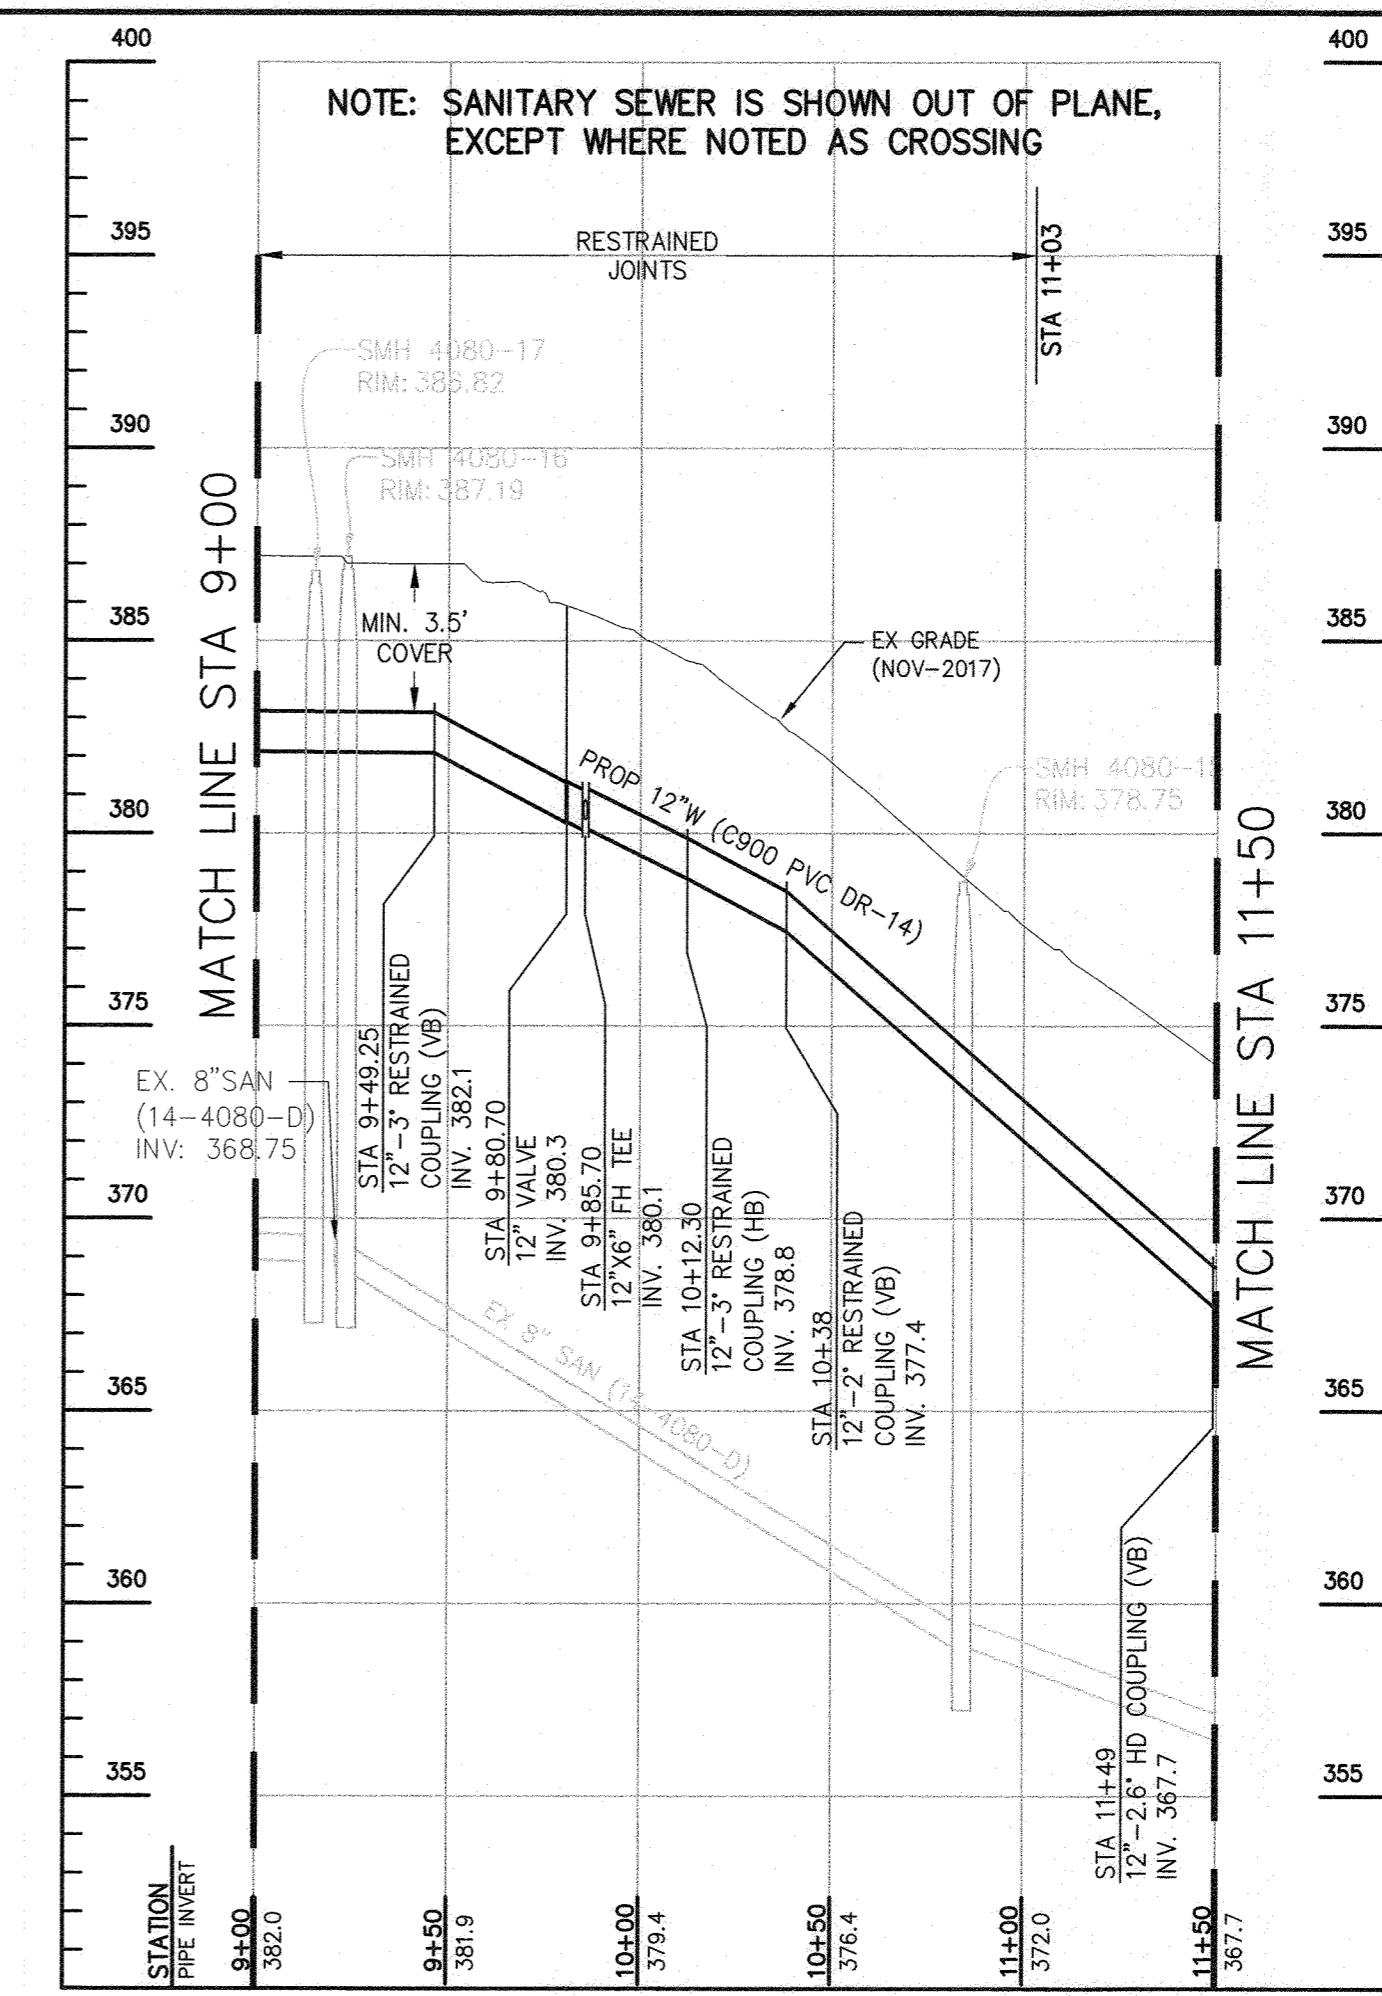


PROFILE - 12" W LANDING ROAD NORTH SECTION

SCALE: 1" = 50' HORIZ.
1" = 5' VERT.

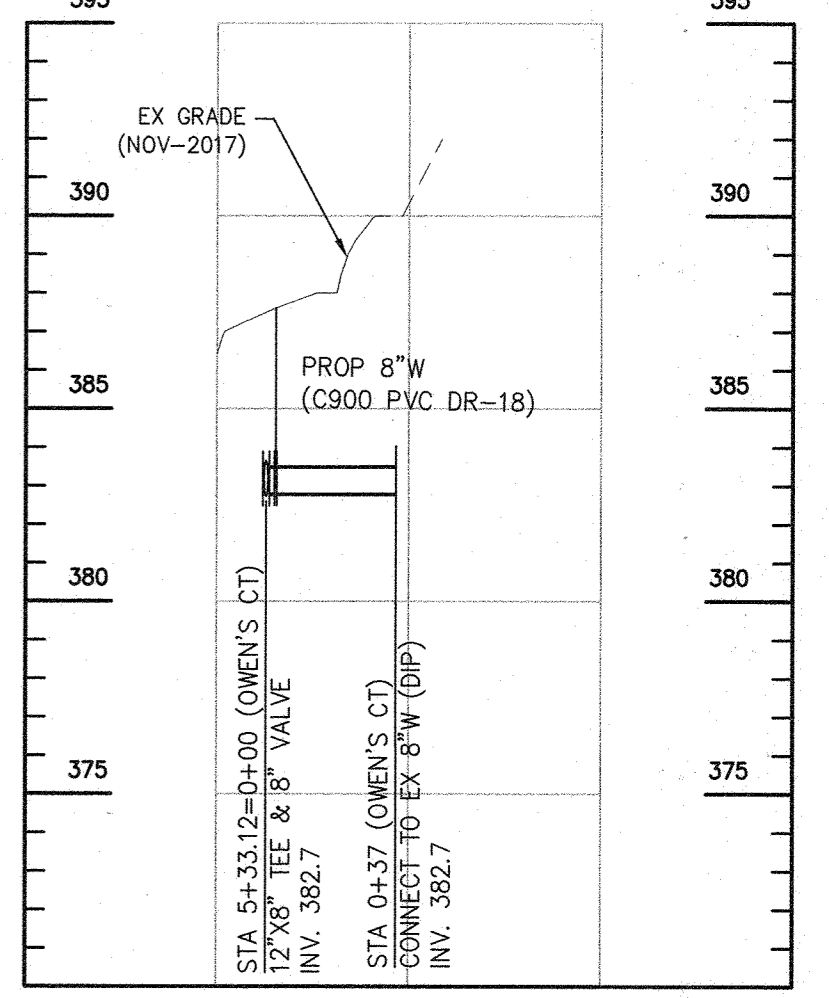


PROFILE - 8" W OWENS CT

SCALE: 1" = 50' HORIZ.
1" = 5' VERT.

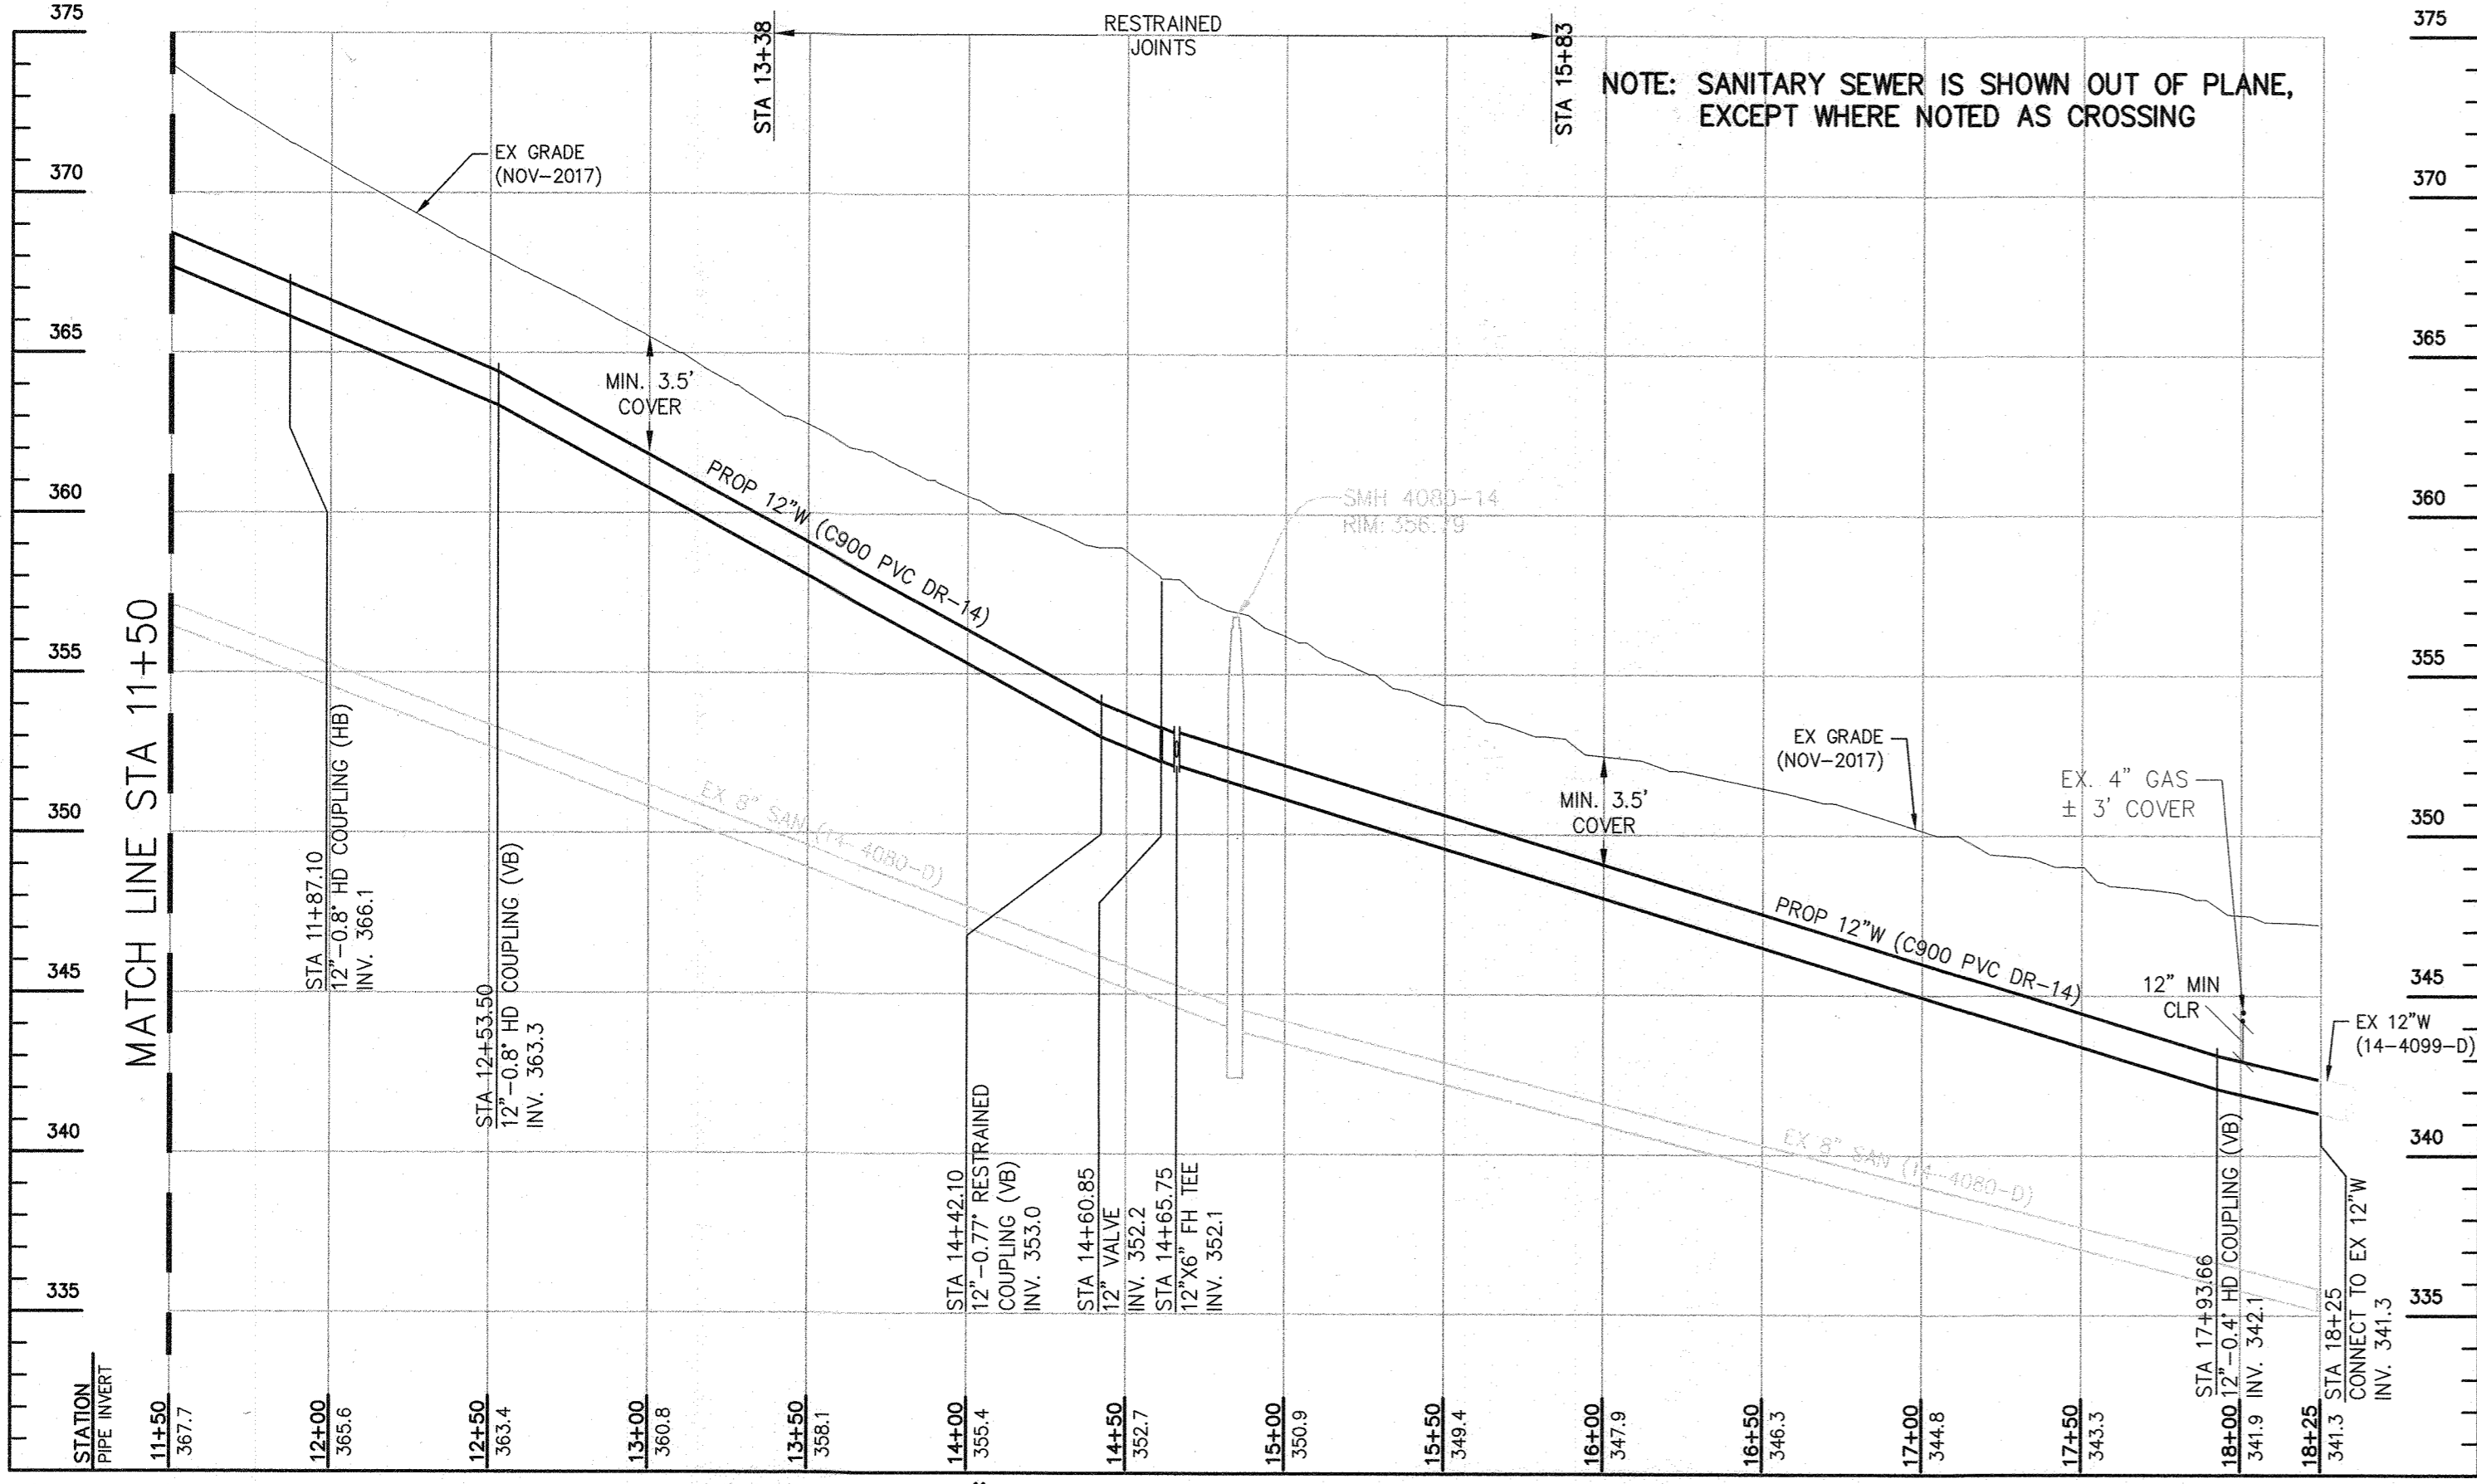


PROFILE - 12" W LANDING ROAD NORTH SECTION

SCALE: 1" = 50' HORIZ.
1" = 5' VERT.

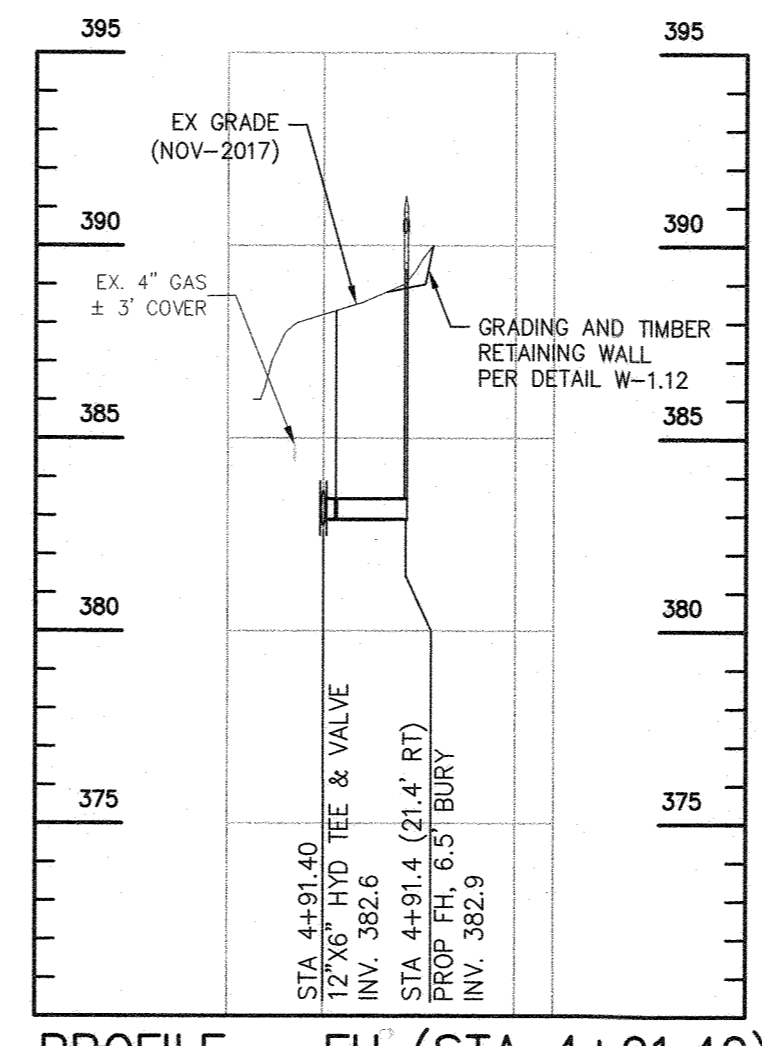


PROFILE - FH (STA 4+91.40)

SCALE: 1" = 50' HORIZ.
1" = 5' VERT.

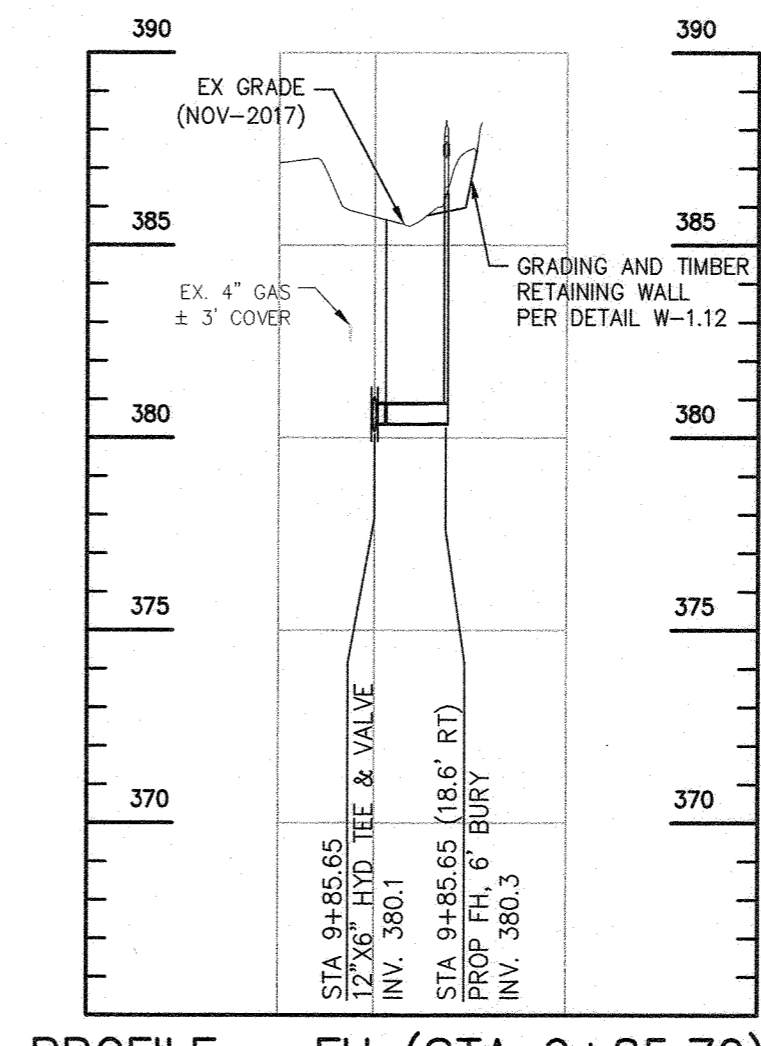


PROFILE - FH (STA 9+85.70)

SCALE: 1" = 50' HORIZ.
1" = 5' VERT.

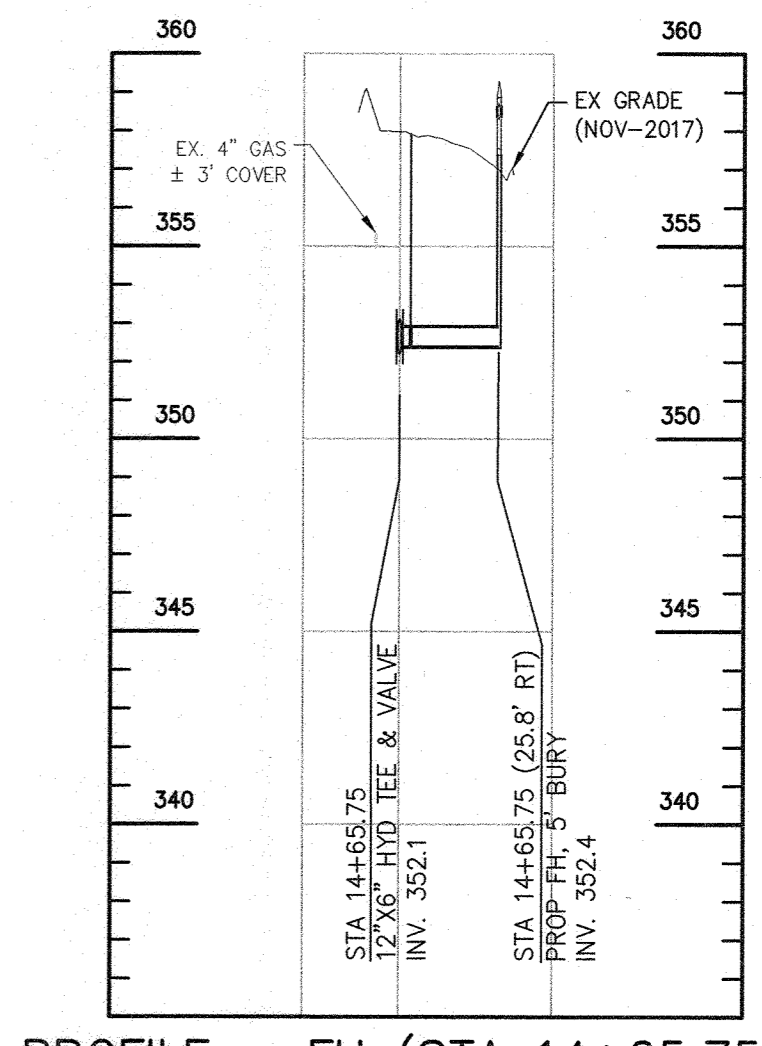

PROFILE - FH (STA 14+65.75)

SCALE: 1" = 50' HORIZ.
1" = 5' VERT.

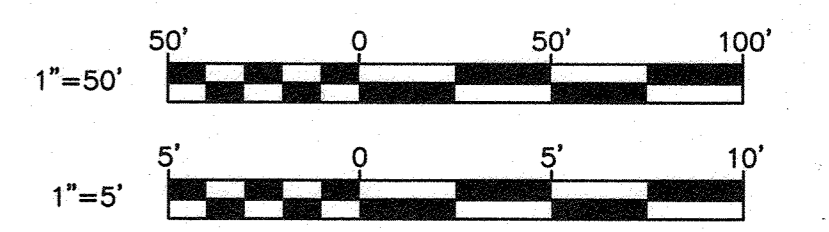

AS-BUILT MAY 2020

DEPARTMENT OF PUBLIC WORKS
 HOWARD COUNTY, MARYLAND
 [Signature] 5/19
 DIRECTOR OF PUBLIC WORKS DATE
 [Signature] 5-2-19
 CHIEF, UTILITY DESIGN DIVISION DATE

RK&K
 P: 410.728.2900
 700 East Pratt Street, Suite 500 | Baltimore, MD 21202
 Engineers | Construction Managers | Planners | Scientists
 www.rk&k.com
 Responsive People | Creative Solutions

PROFESSIONAL CERTIFICATION:
 I HEREBY CERTIFY THAT THESE DOCUMENTS WERE PREPARED OR APPROVED BY ME, AND THAT I AM A DULY LICENSED PROFESSIONAL ENGINEER UNDER THE LAWS OF THE STATE OF MARYLAND.
 LICENSE NO. 20566
 EXPIRATION DATE: 09/06/2020


DES:	BY:	NO.:	REVISION:	DATE:
REG/WJG				
RAD/REG				
JCM/NKS				
SIGN/DATE:				
04/25/19				

WATER PROFILE - NORTH SECTION
 (STA 0+00 TO STA 18+25)
 600' SCALE MAP NO. 31, 37 BLOCK NO. 5, 6, 10, 11, 17, 18, 24

PROJECT NO. W8305
 CONTRACT NO. 44-5059
 LANDING ROAD WATER MAIN LOOP
 ELECTION DISTRICT NO. 7
 HOWARD COUNTY, MARYLAND


SCALE AS SHOWN
 SHEET NO. 07 OF 18

R021\SYS - \\\nasr01\0202\2012\12154_Hoc60A\Task 12 - Landing Road W8305\CADD\Plans\p\UT-F005_LANDING RD.dwg Apr 17, 2019 - 2:37pm ENV:CTB Plot Scale 1"=1' Plot By: bgross Tab: C-05

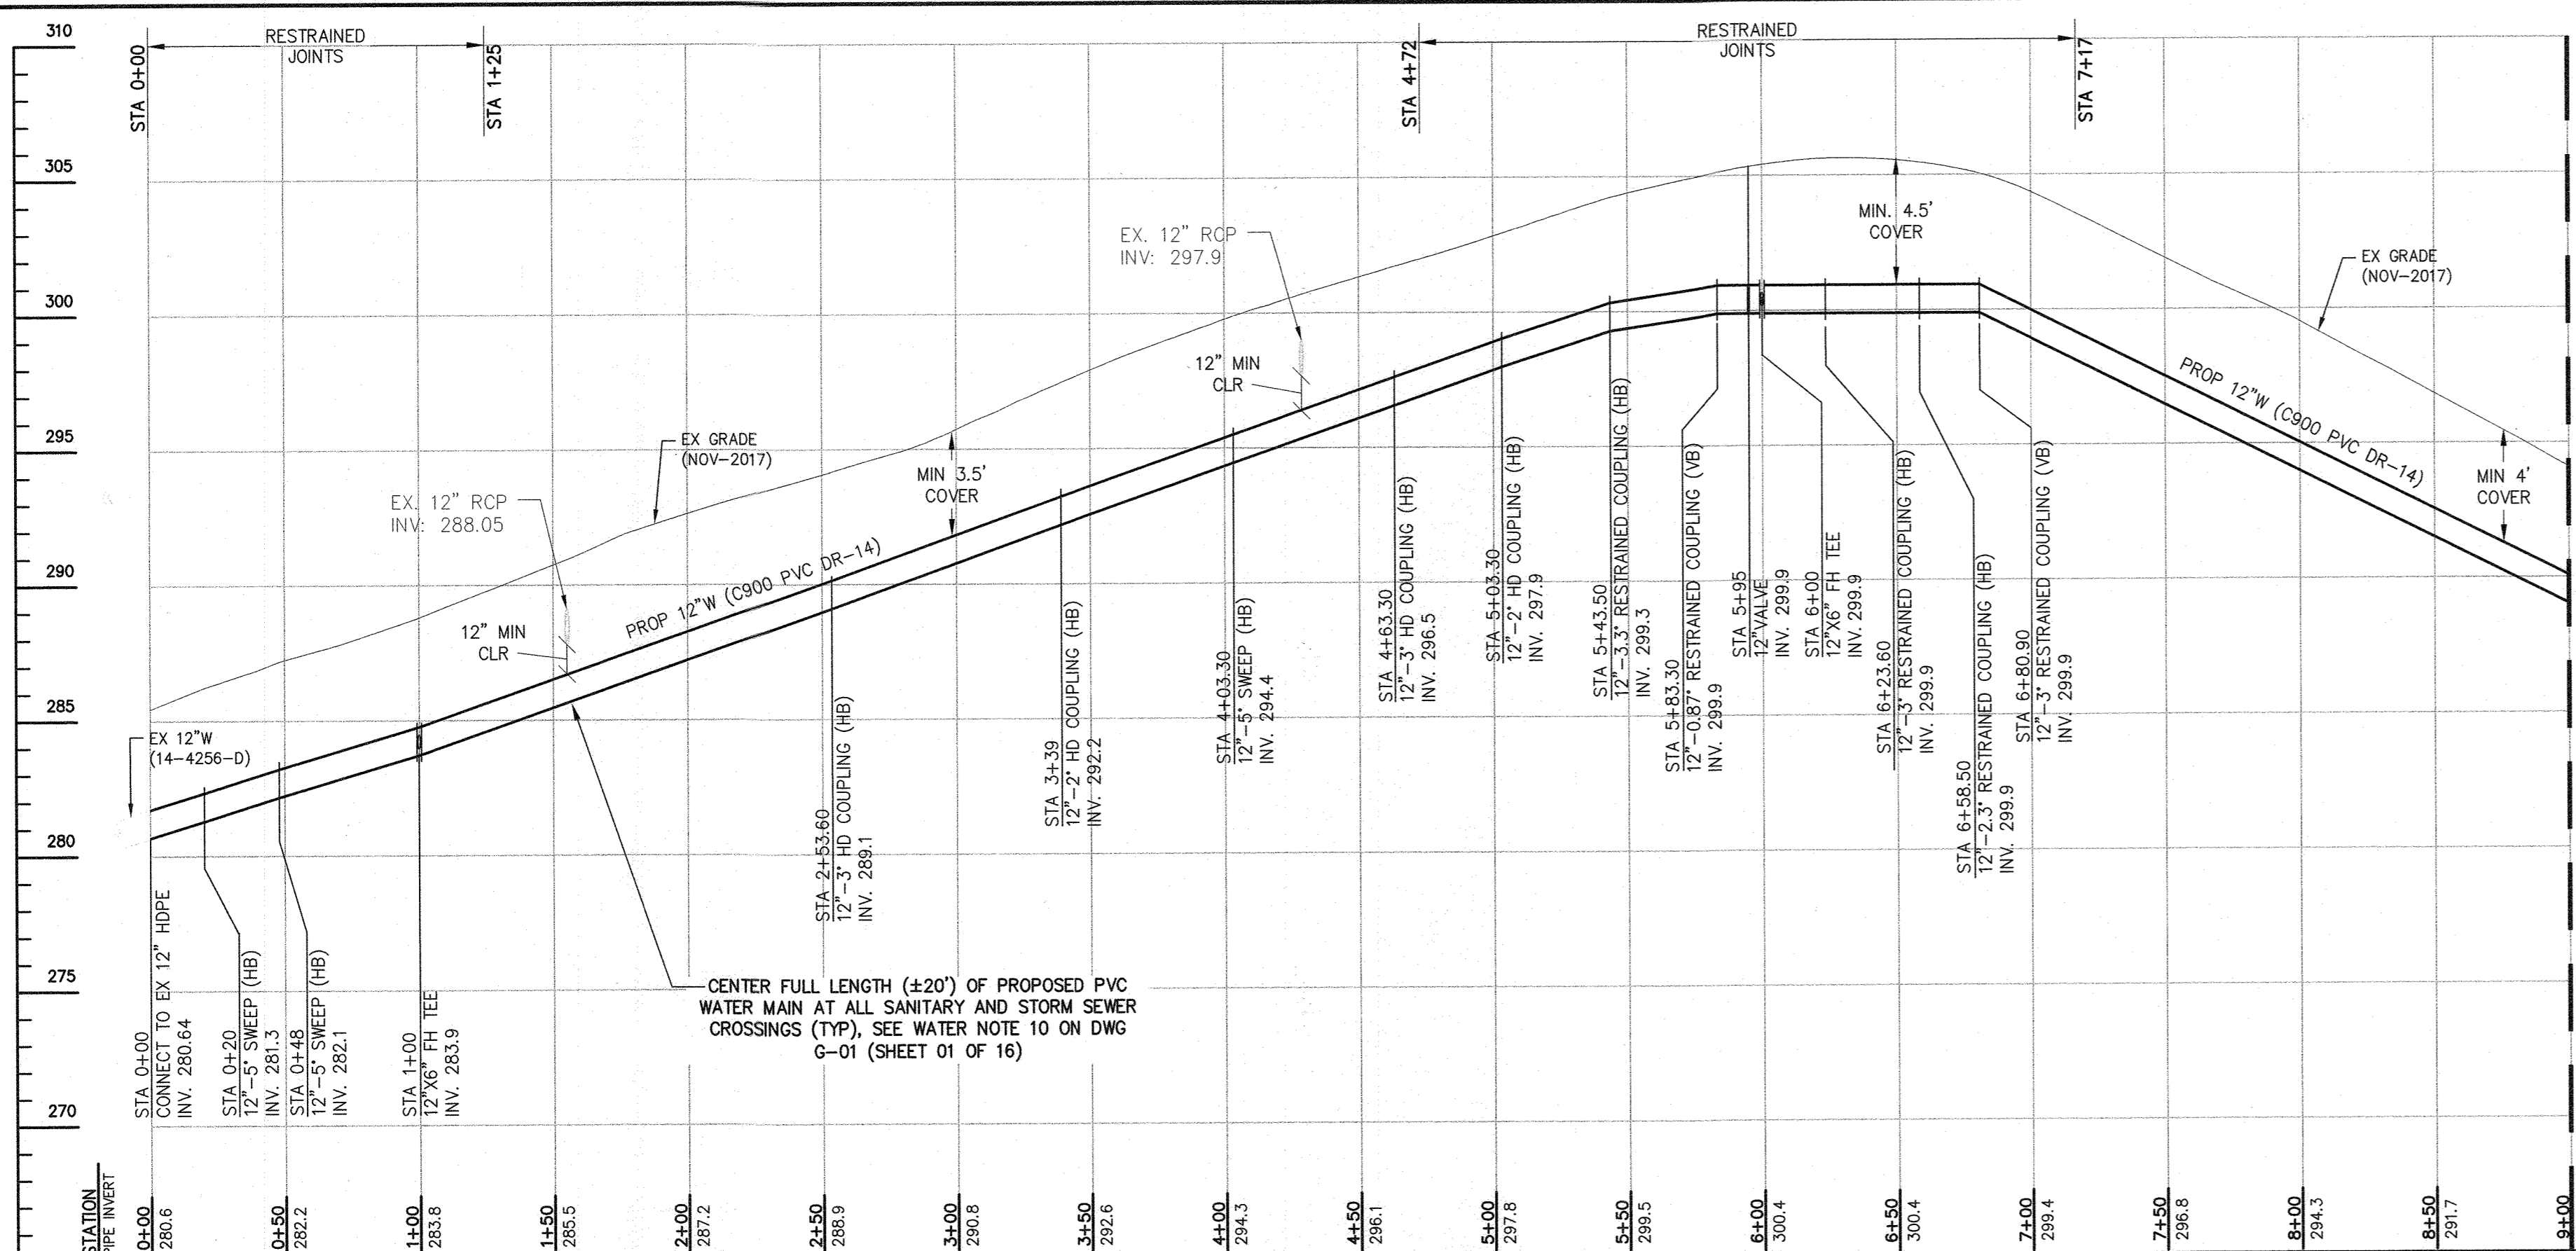


PROFILE - 12" W LANDING ROAD SOUTH SECTION

SCALE: 1" = 50' HORIZ.
1" = 5' VERT.

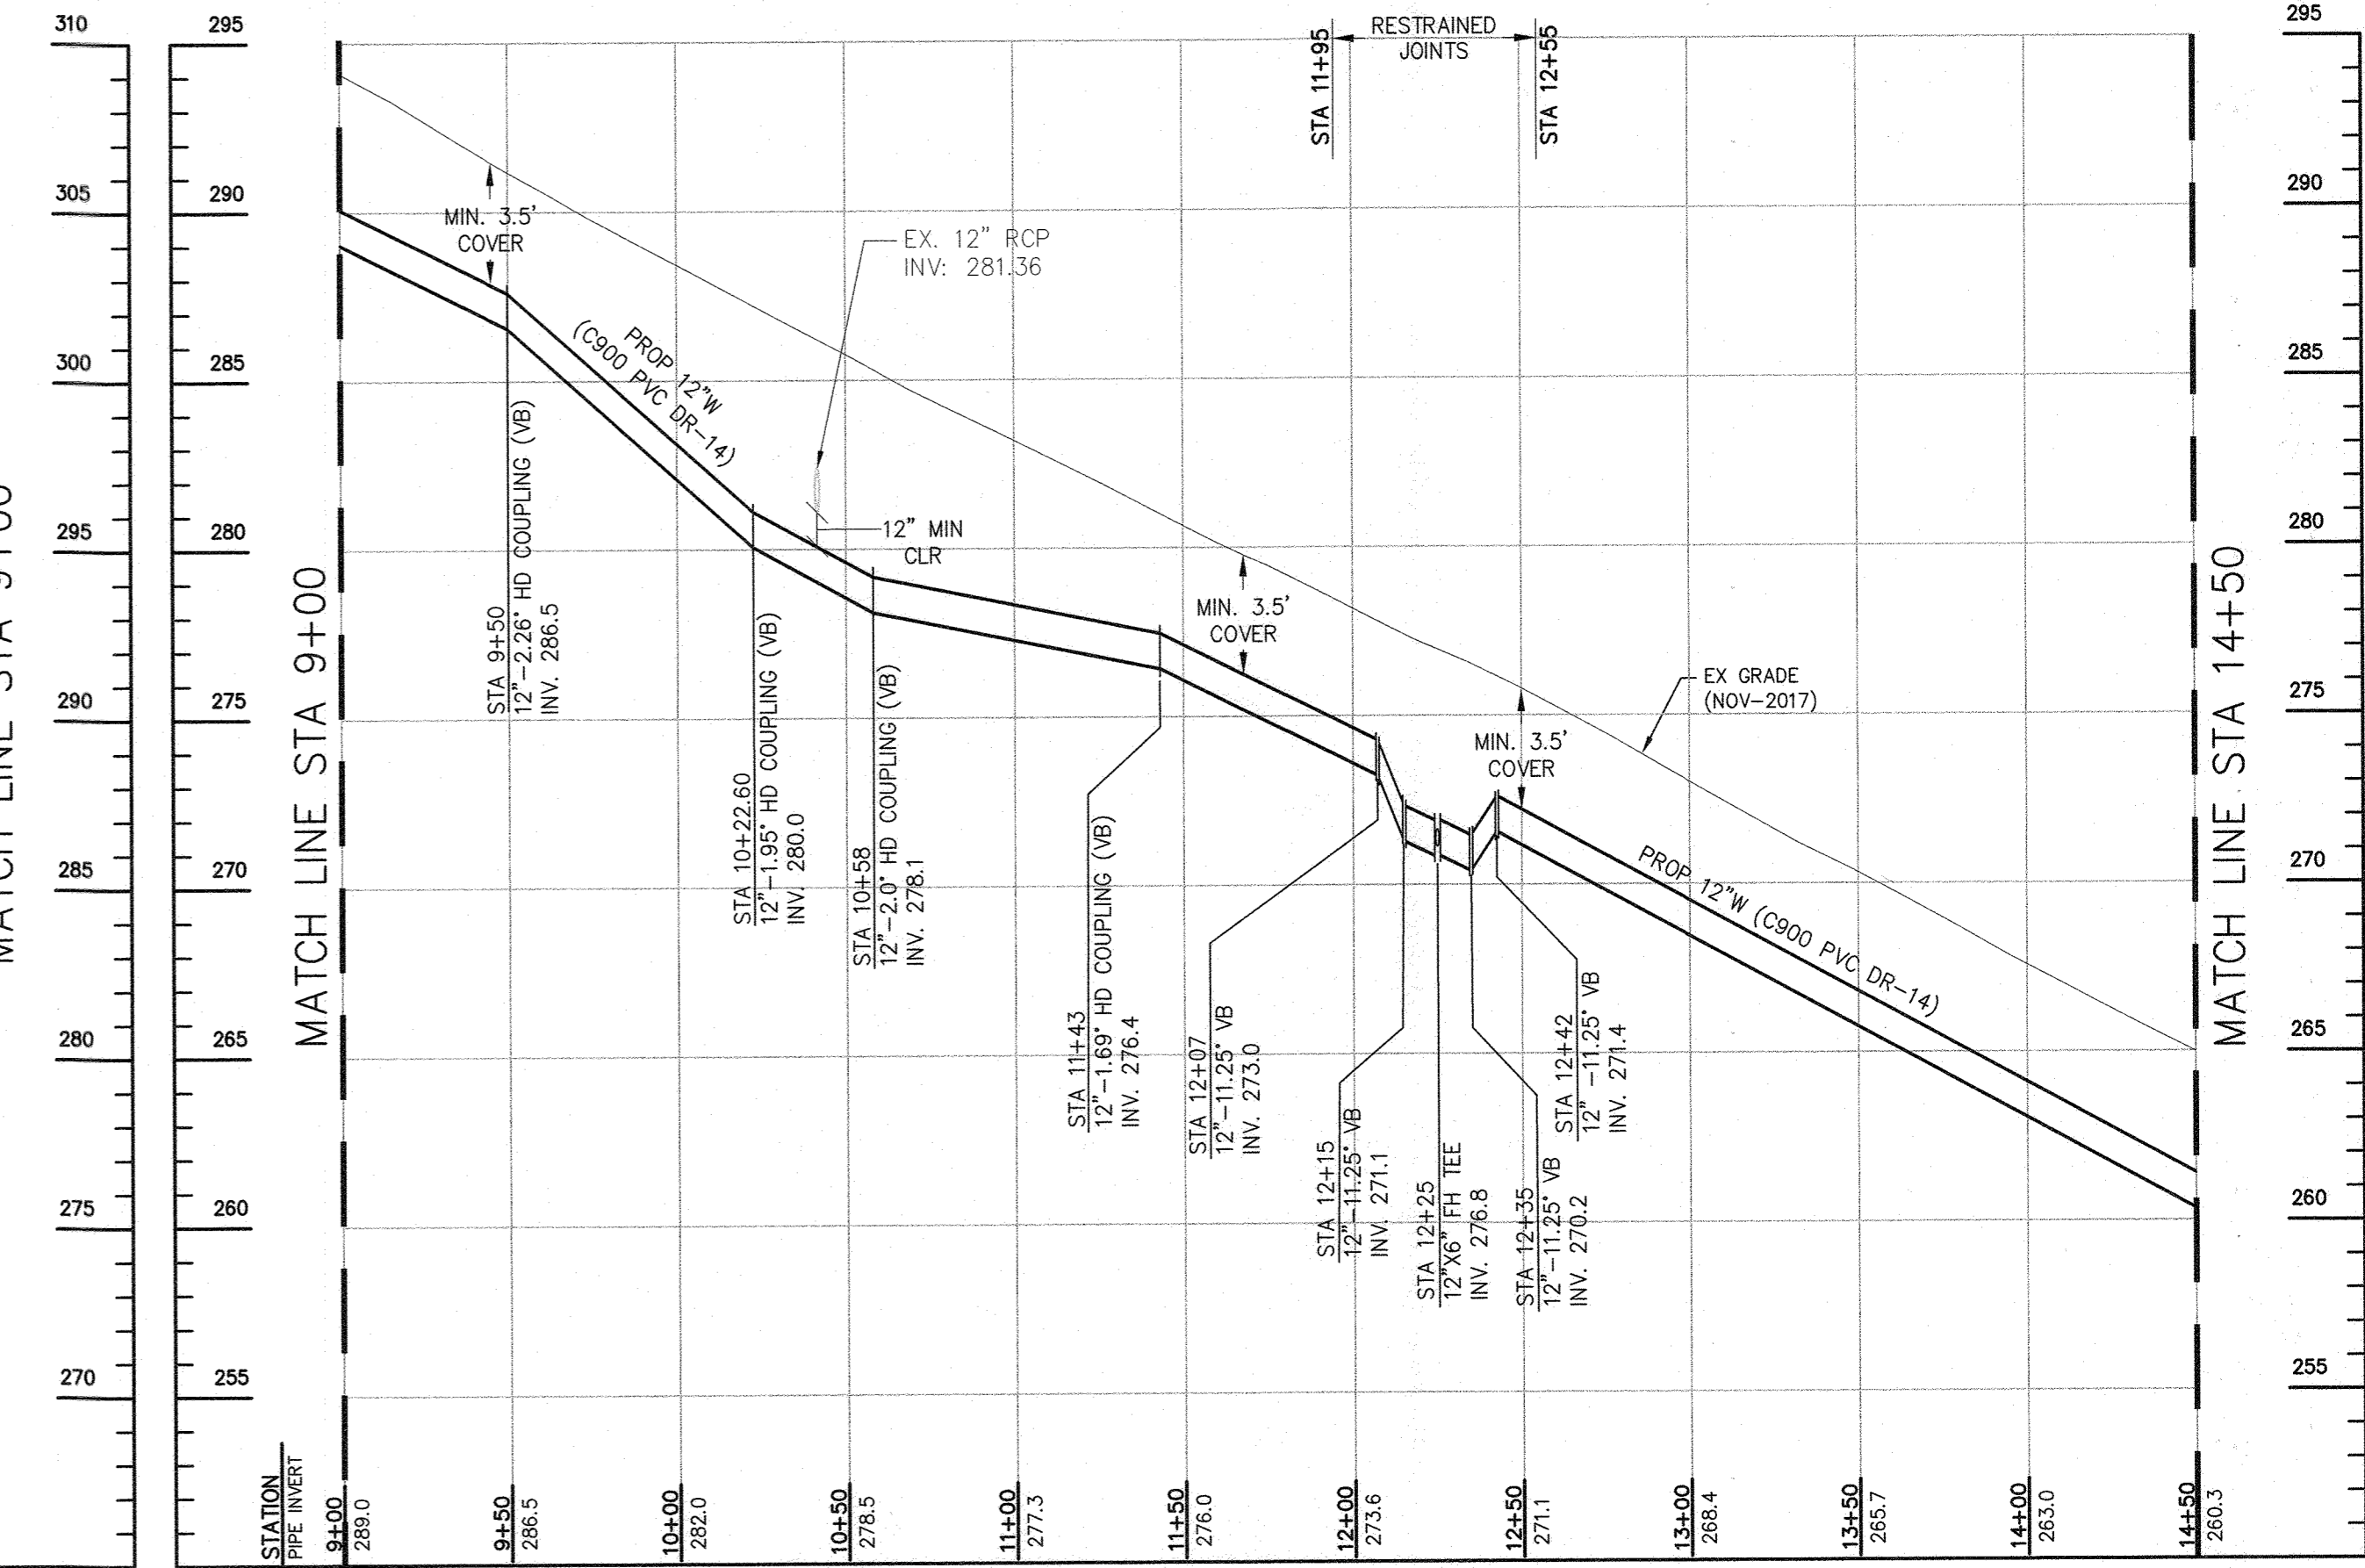


PROFILE - 12" W LANDING ROAD SOUTH SECTION

SCALE: 1" = 50' HORIZ.
1" = 5' VERT.

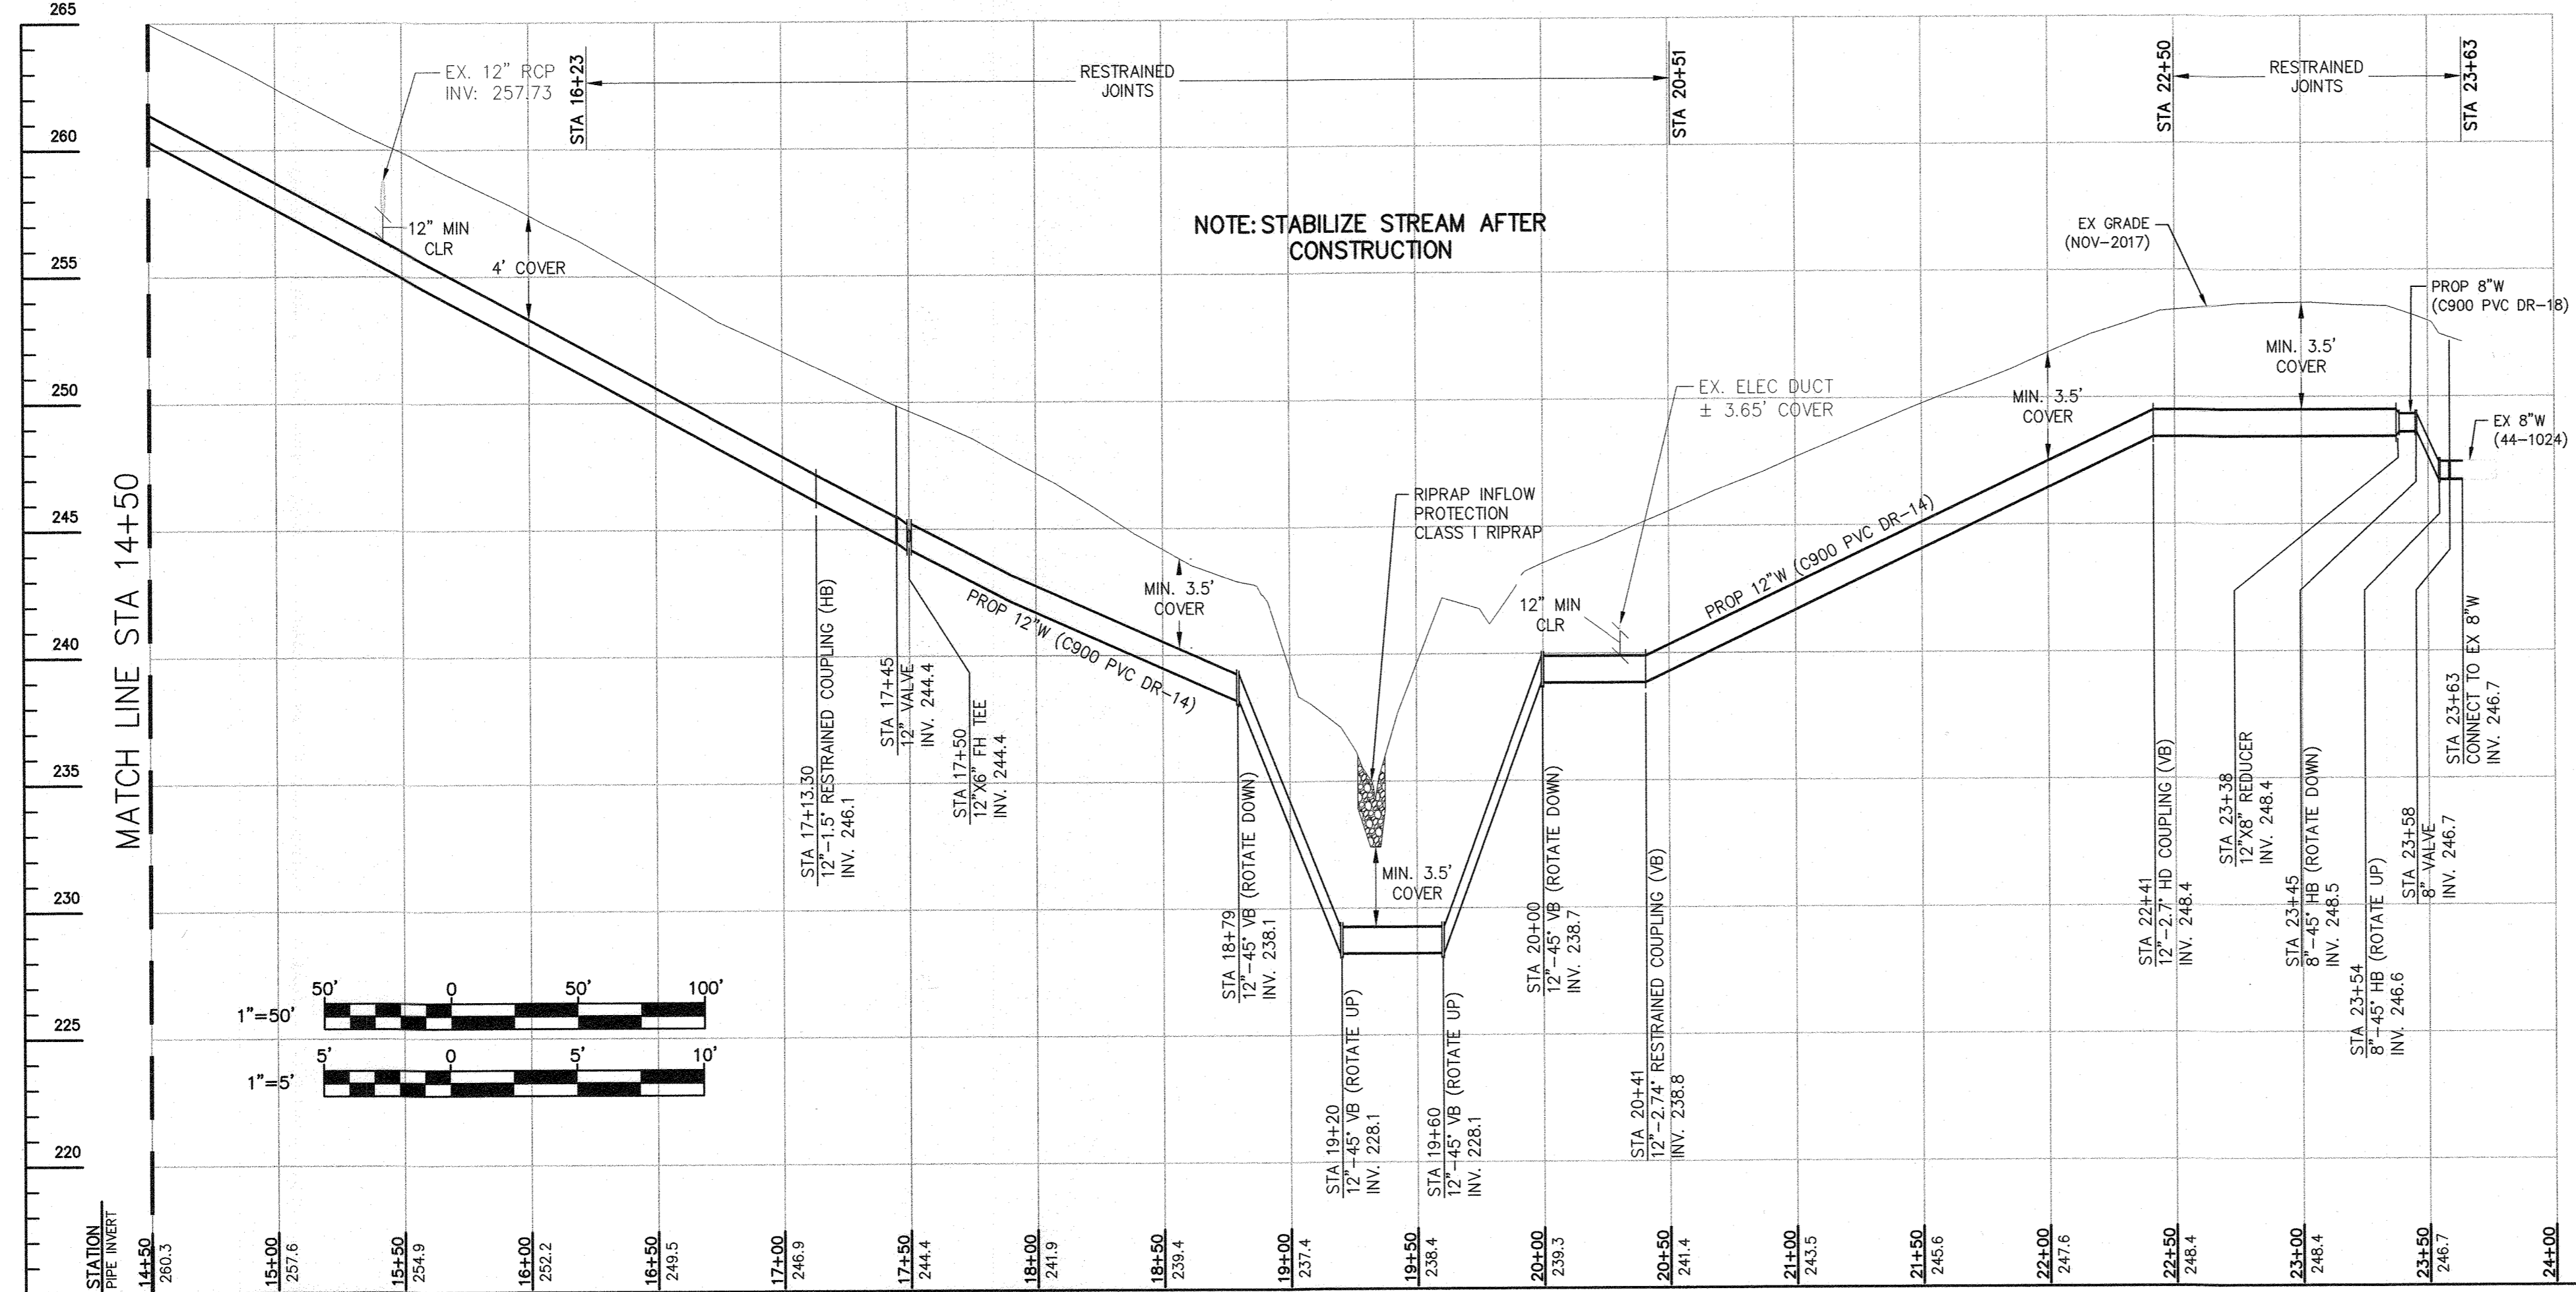


PROFILE - 12" W LANDING ROAD SOUTH SECTION

SCALE: 1" = 50' HORIZ.
1" = 5' VERT.

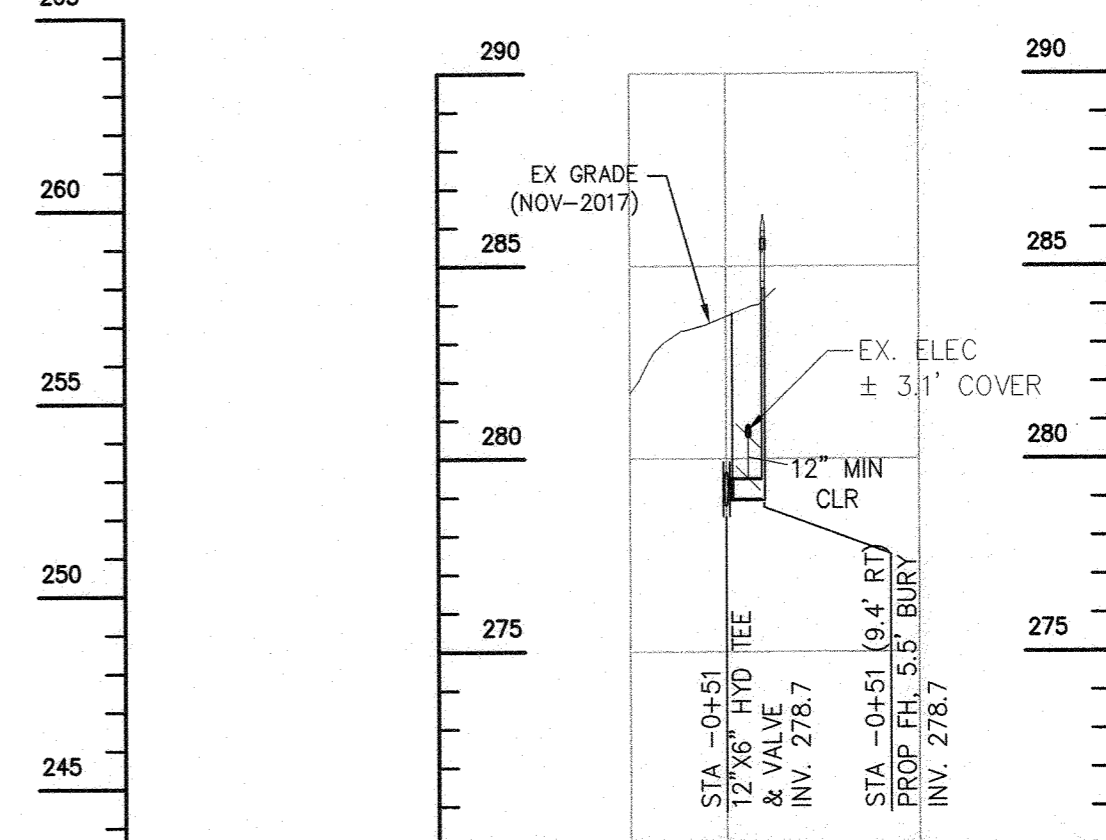


PROFILE - FH (STA 1+00)

SCALE: 1" = 50' HORIZ.
1" = 5' VERT.

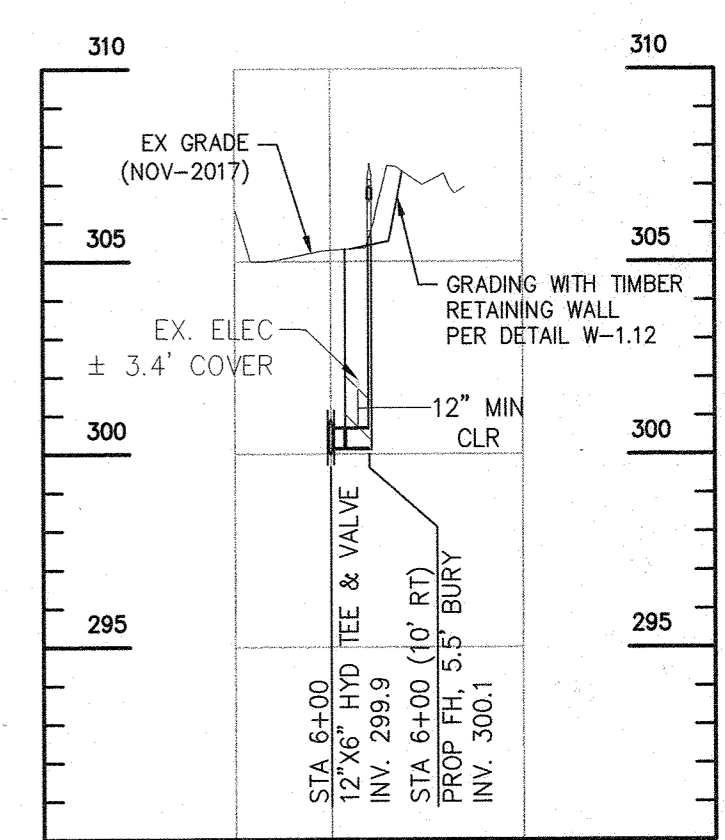


PROFILE - FH (STA 6+00)

SCALE: 1" = 50' HORIZ.
1" = 5' VERT.

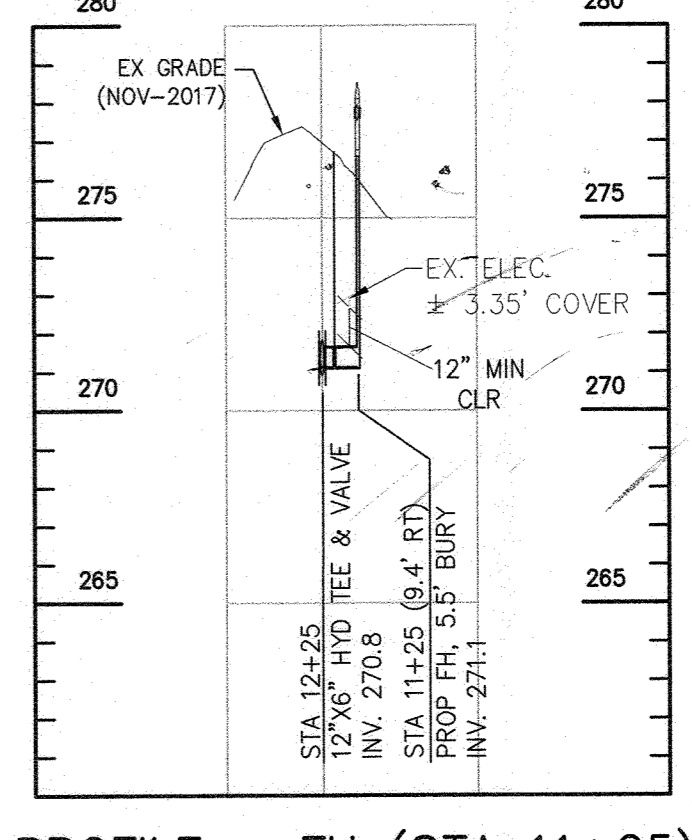

PROFILE - FH (STA 11+25)

SCALE: 1" = 50' HORIZ.
1" = 5' VERT.

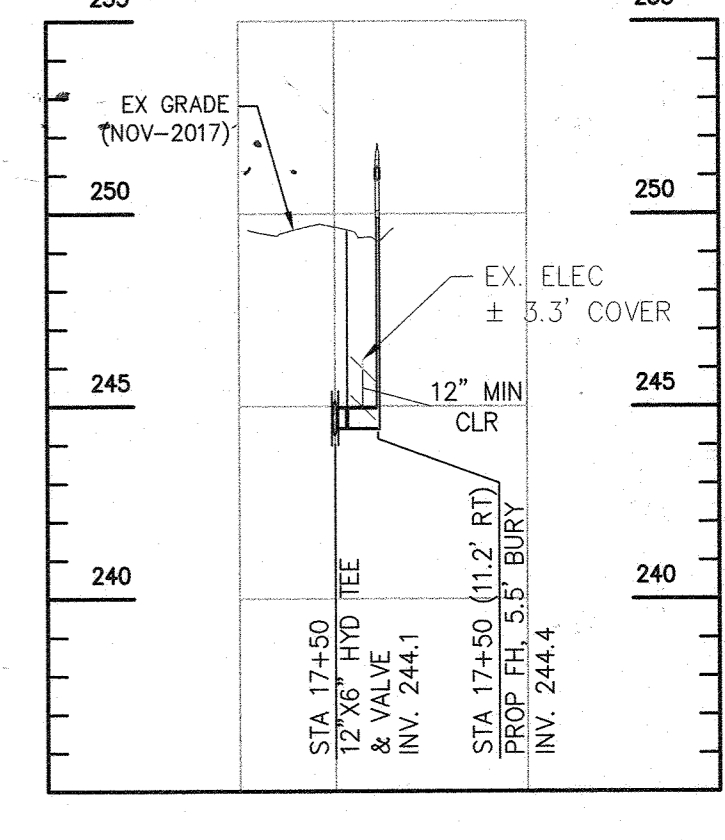

PROFILE - FH (STA 17+50)


SCALE: 1" = 50' HORIZ.
1" = 5' VERT.

AS-BUILT MAY 2020

DEPARTMENT OF PUBLIC WORKS
 HOWARD COUNTY, MARYLAND
 Director: *Michael J. ...* 5/19/19
 Chief, Bureau of Engineering: *Thomas E. ...* 4/25/19
 Chief, Bureau of Utilities: *...* 5-2-19
 Chief, Utility Design Division: *...* 4/19/19

RK&K
 P: 410.728.2900
 700 East Pratt Street, Suite 500 | Baltimore, MD 21202
 Engineers | Construction Managers | Planners | Scientists
 www.rkk.com
 Responsive People | Creative Solutions





PROFESSIONAL CERTIFICATION:
 I HEREBY CERTIFY THAT THESE
 DOCUMENTS WERE PREPARED OR
 APPROVED BY ME, AND THAT I
 AM A DULY LICENSED
 PROFESSIONAL ENGINEER UNDER
 THE LAWS OF THE STATE OF
 MARYLAND.
 LICENSE NO. 20566
 EXPIRATION DATE: 09/06/2020

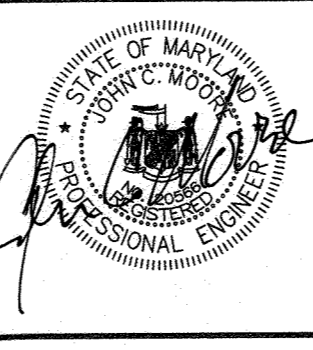






DES.	BY	NO.	REVISION	DATE
REG/WJG				
DRN:				
RAD/REG				
CHK:				
JCM/NKS				
SIGN DATE:				
04/25/19				

WATER PROFILE - SOUTH SECTION
 (STA 0+00 TO STA 23+63)
 600' SCALE MAP NO. 31, 37 BLOCK NO. 5, 6, 10, 11, 17, 18, 24

PROJECT NO. W8305
 CONTRACT NO. 44-5059
 LANDING ROAD WATER MAIN LOOP
 ELECTION DISTRICT NO. 7
 HOWARD COUNTY, MARYLAND
 SCALE: AS SHOWN
 SHEET NO. 08 OF 18
 C-05

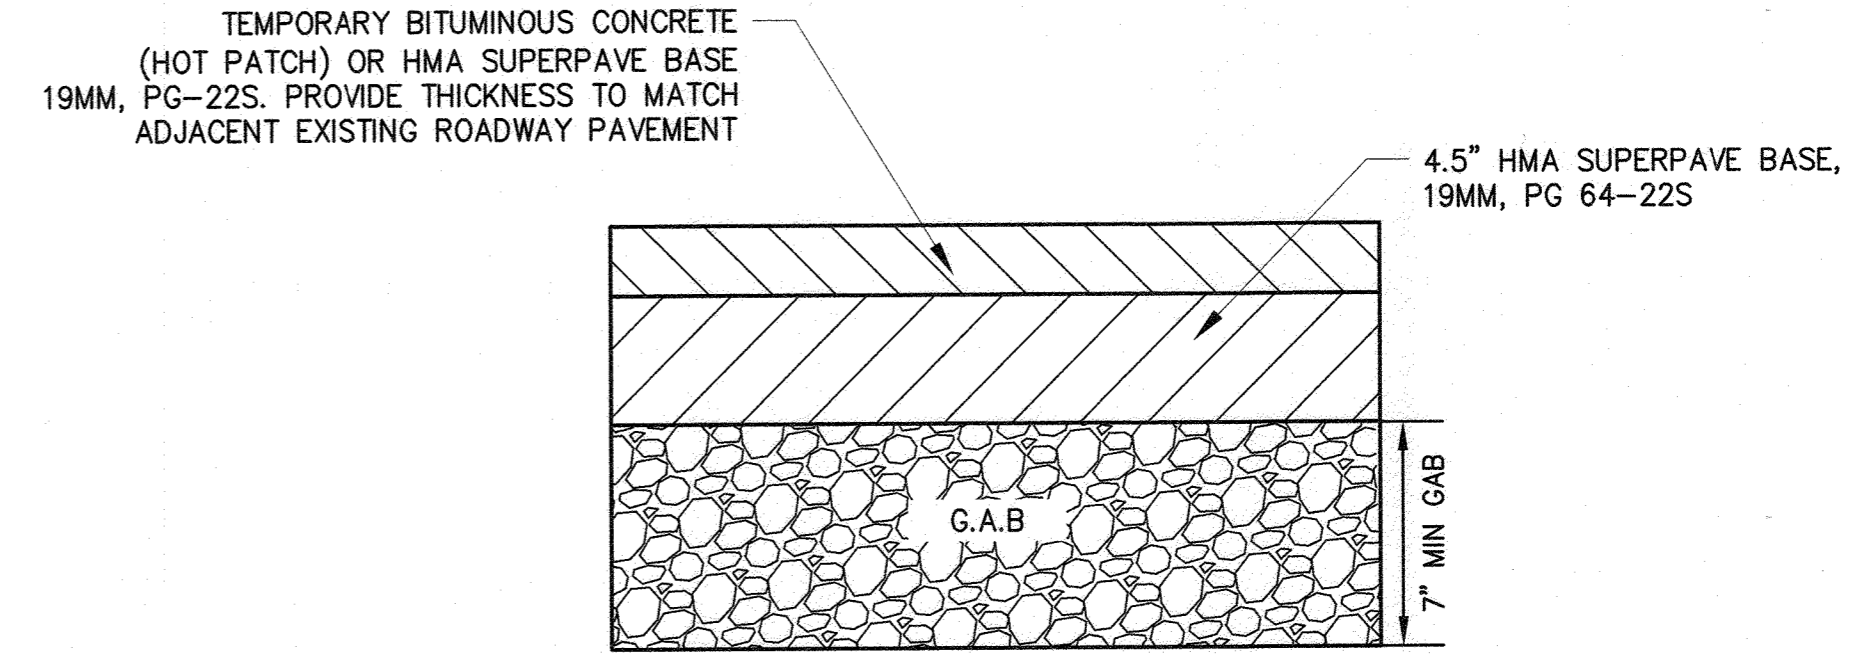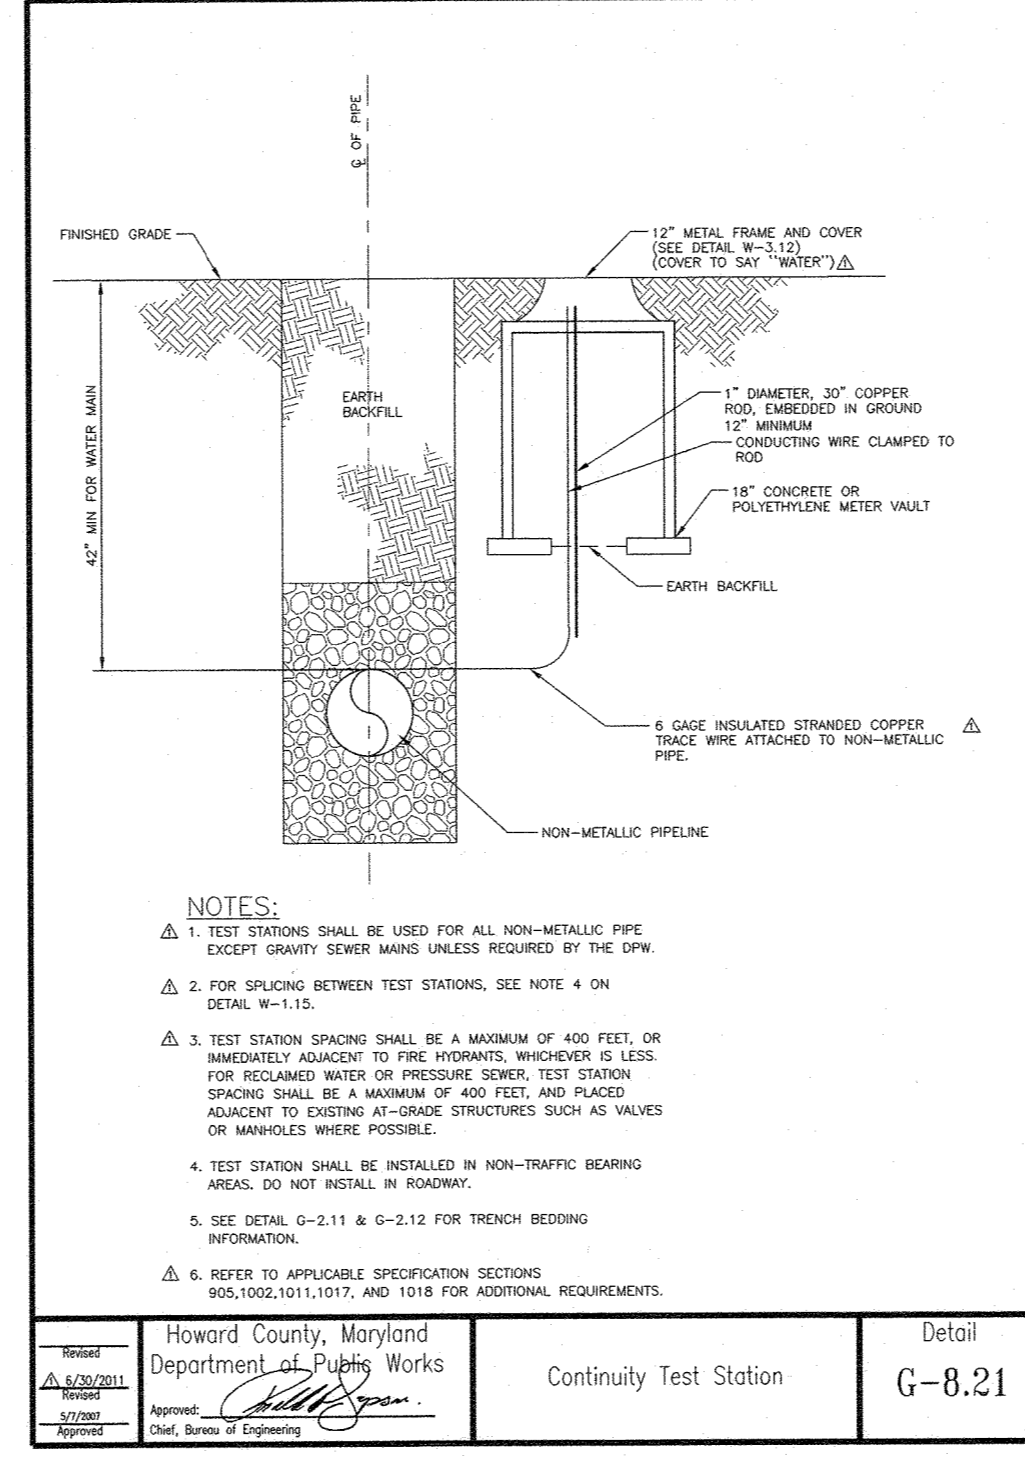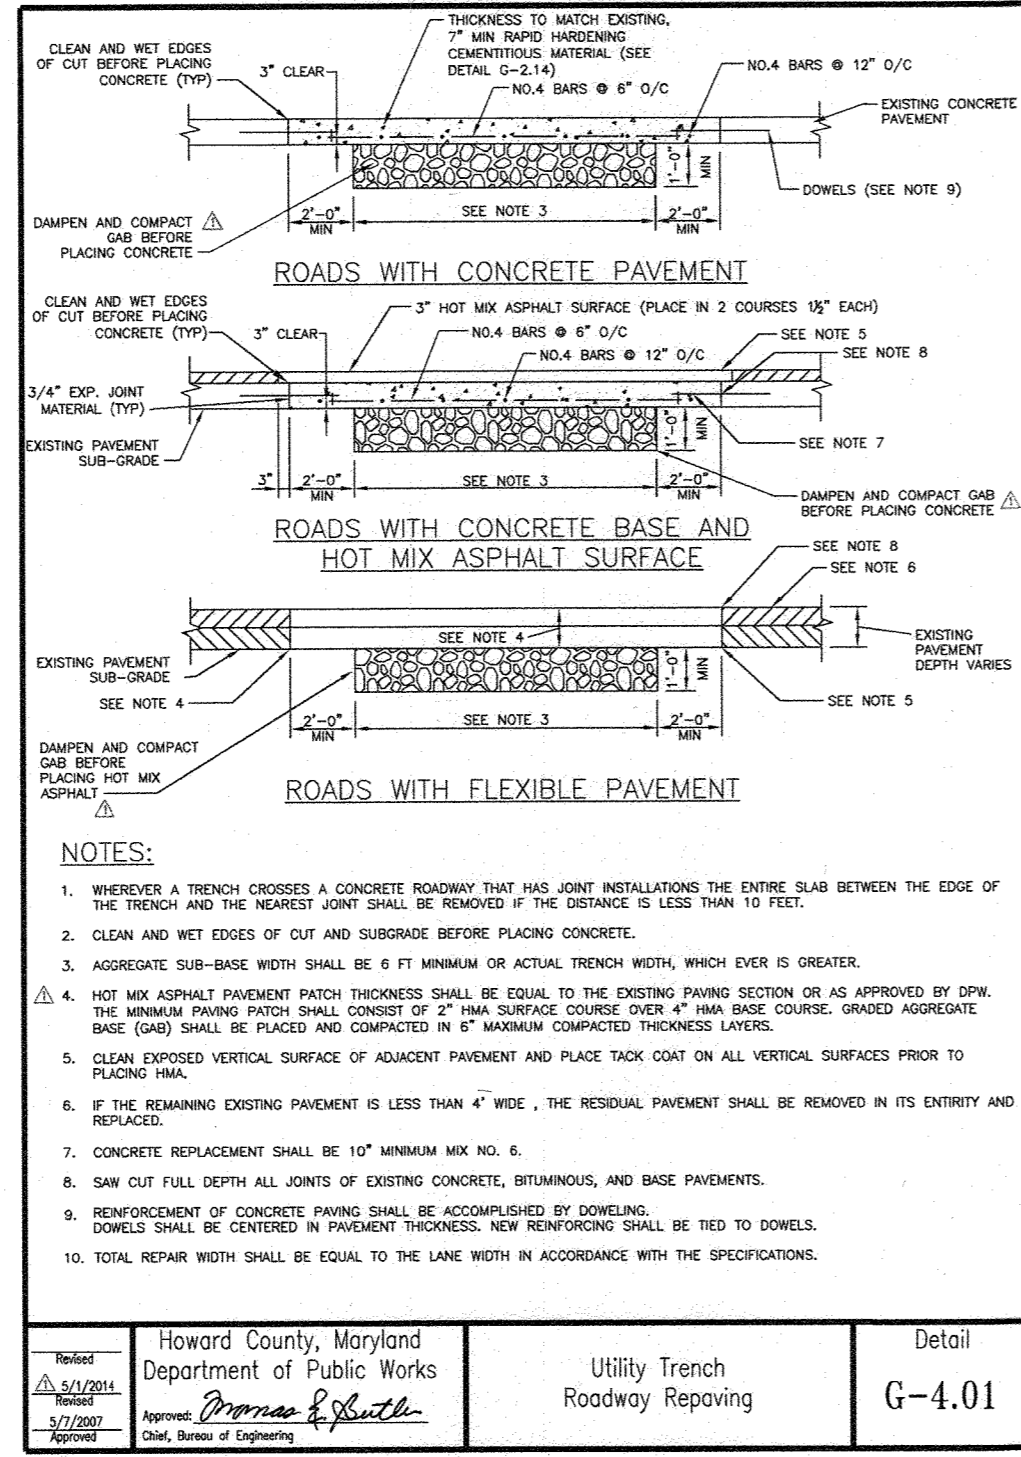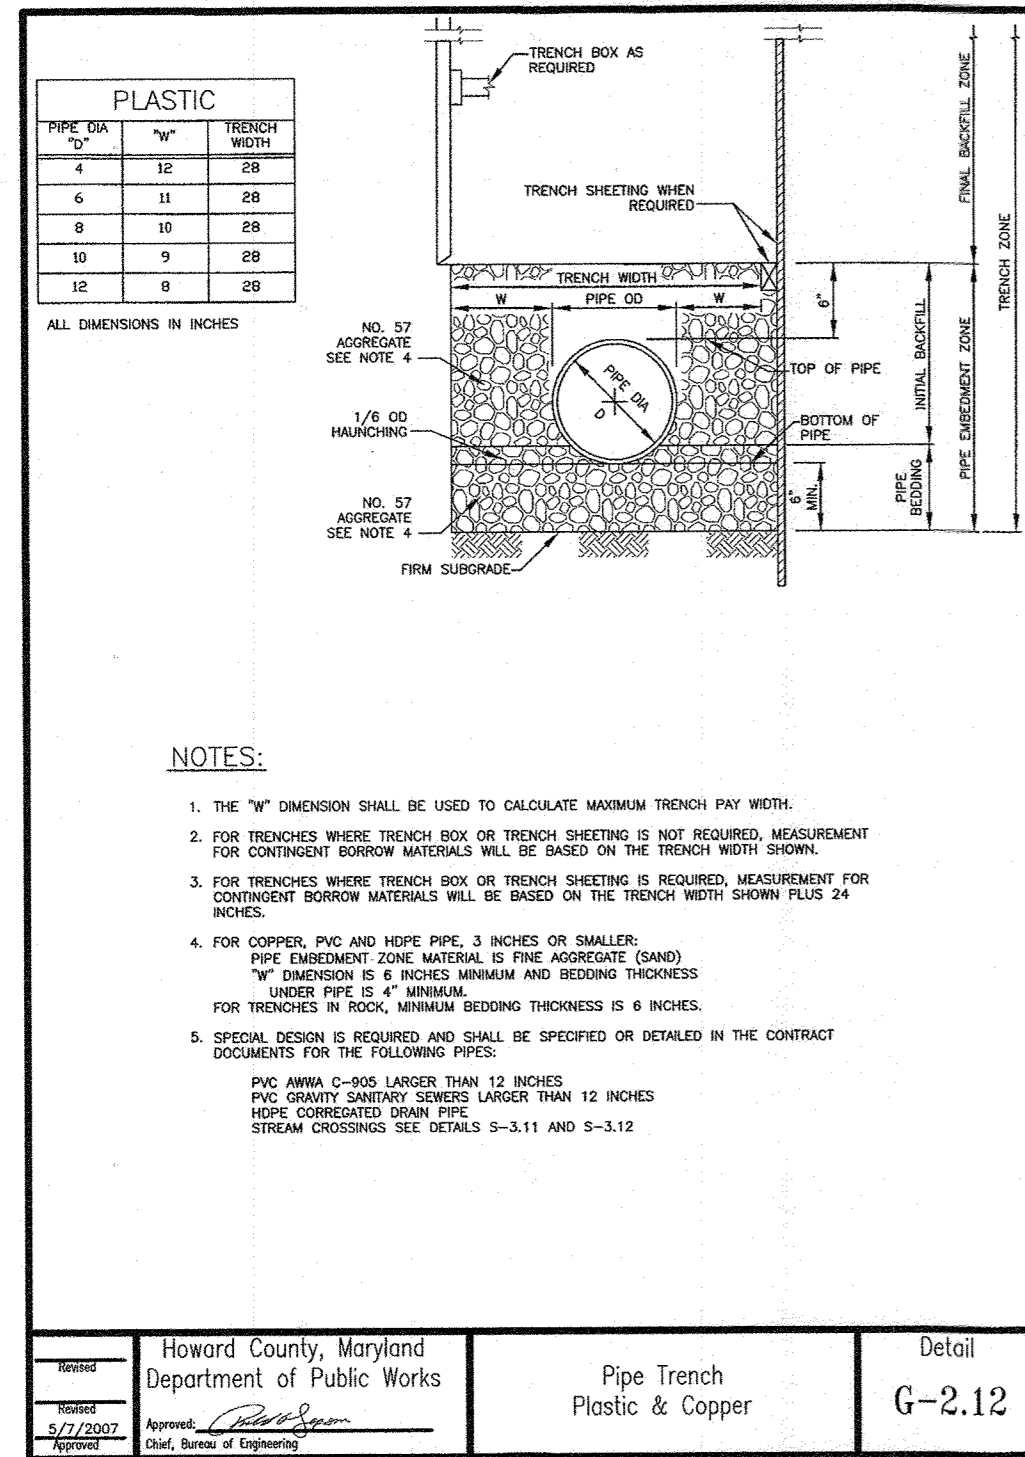

TEMPORARY UTILITY TRENCH PAVING RESTORATION
 SCALE: NTS
 FOR TRENCH DETAIL REFER TO HOWARD COUNTY STANDARD DETAIL G-2.12 AND G-4.01






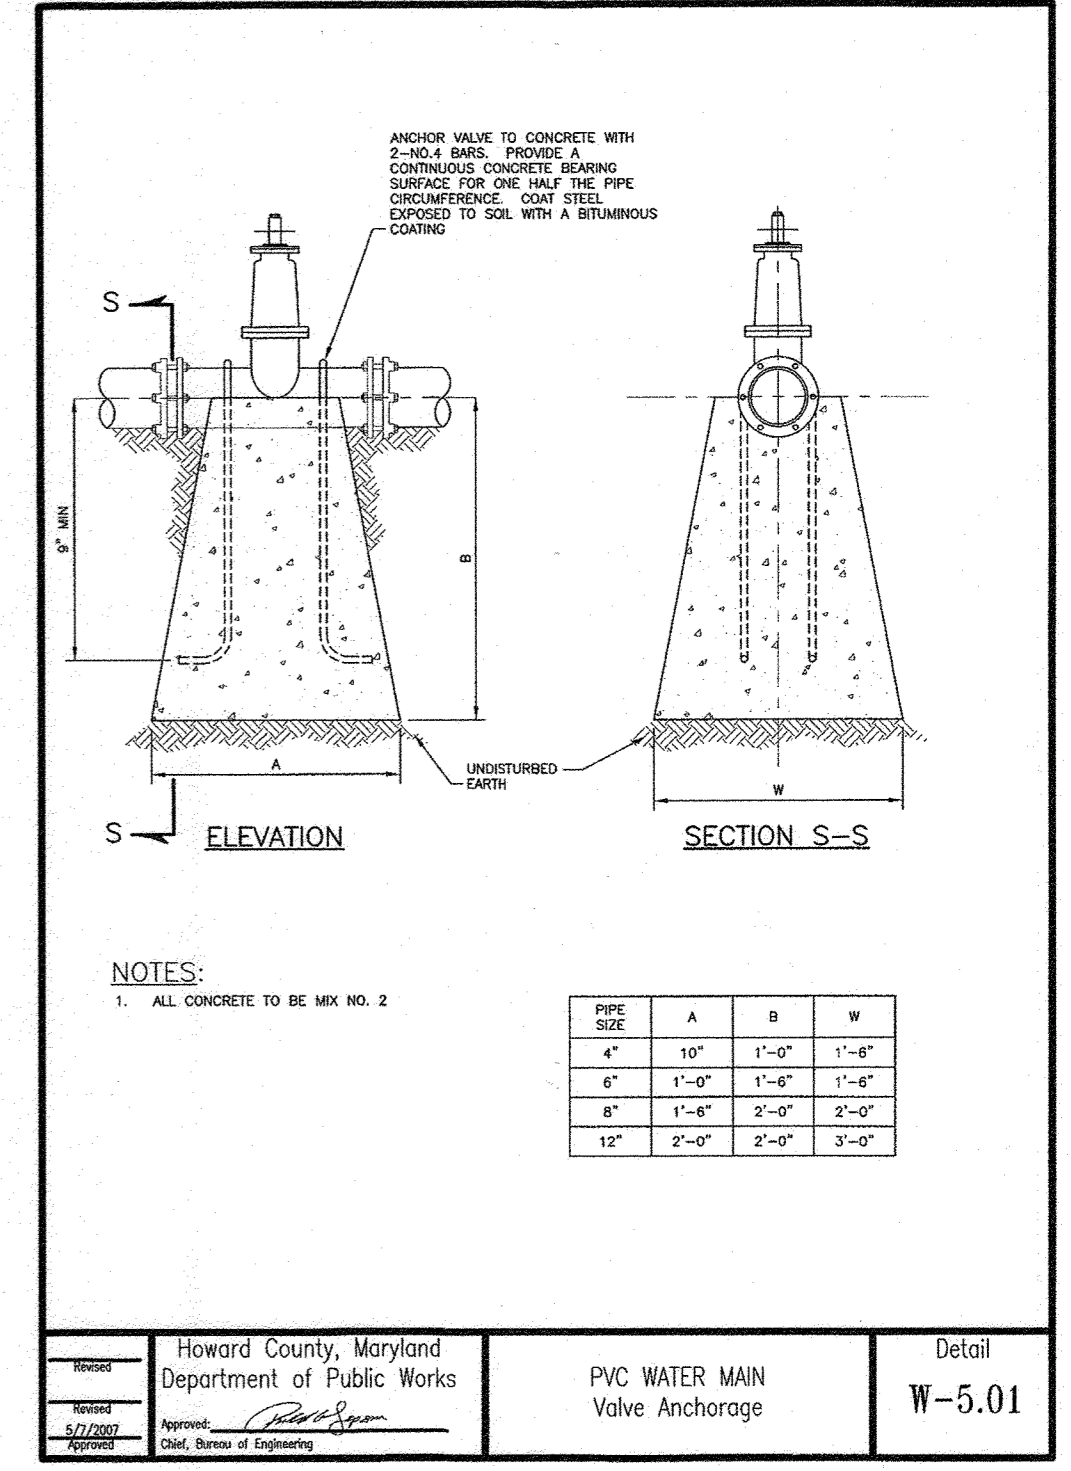
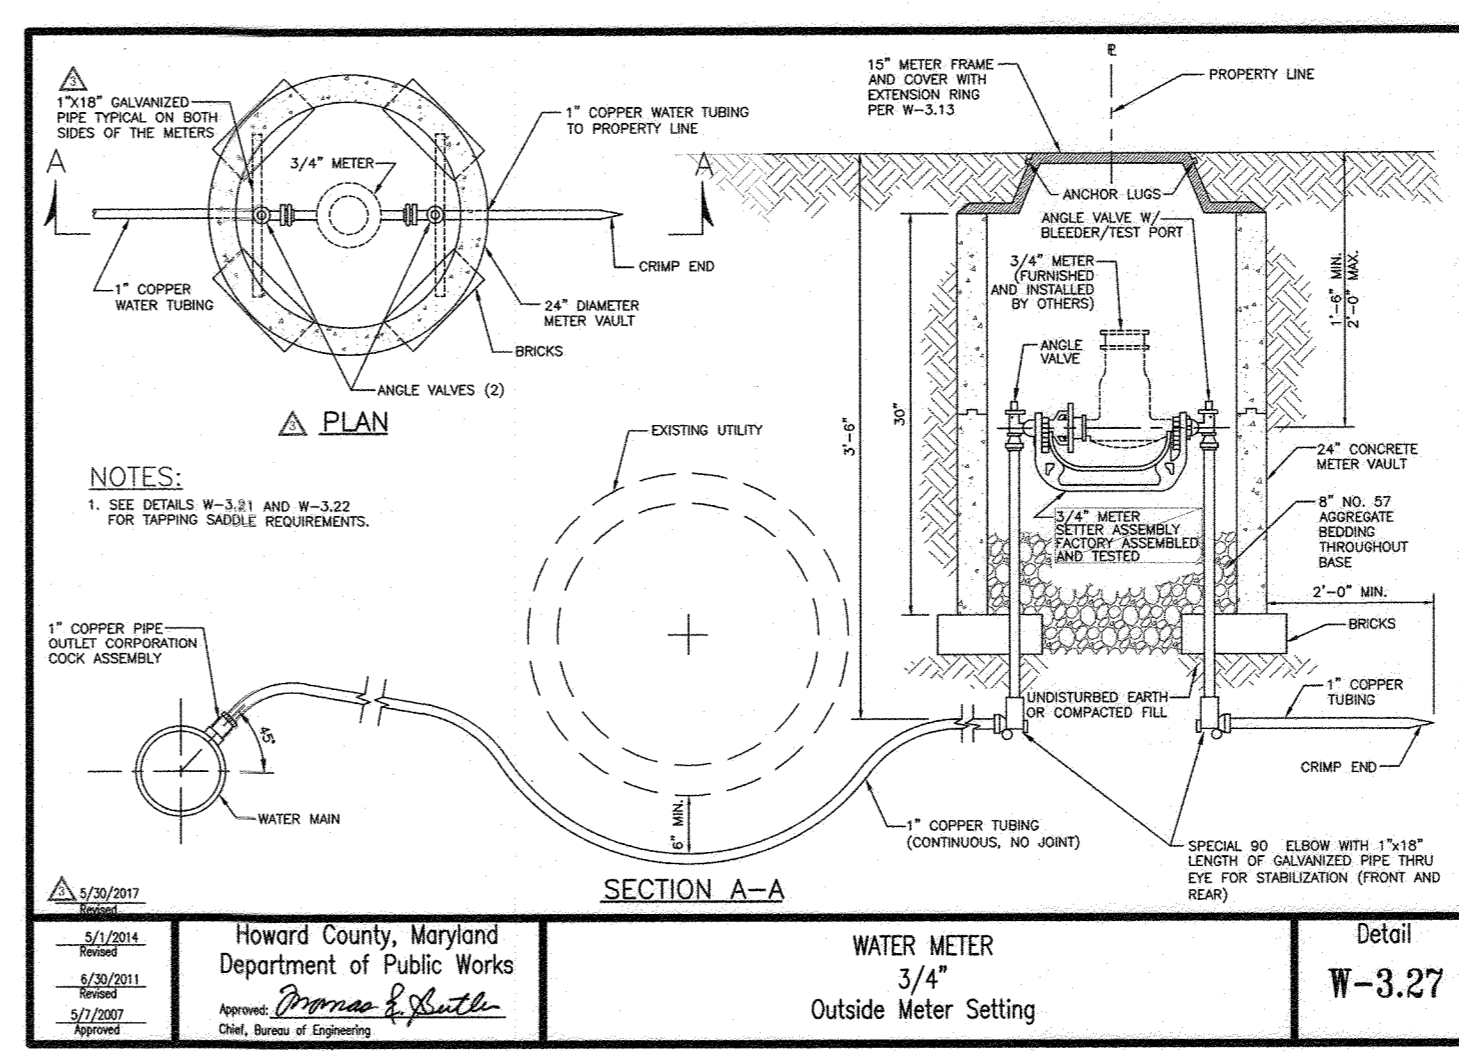
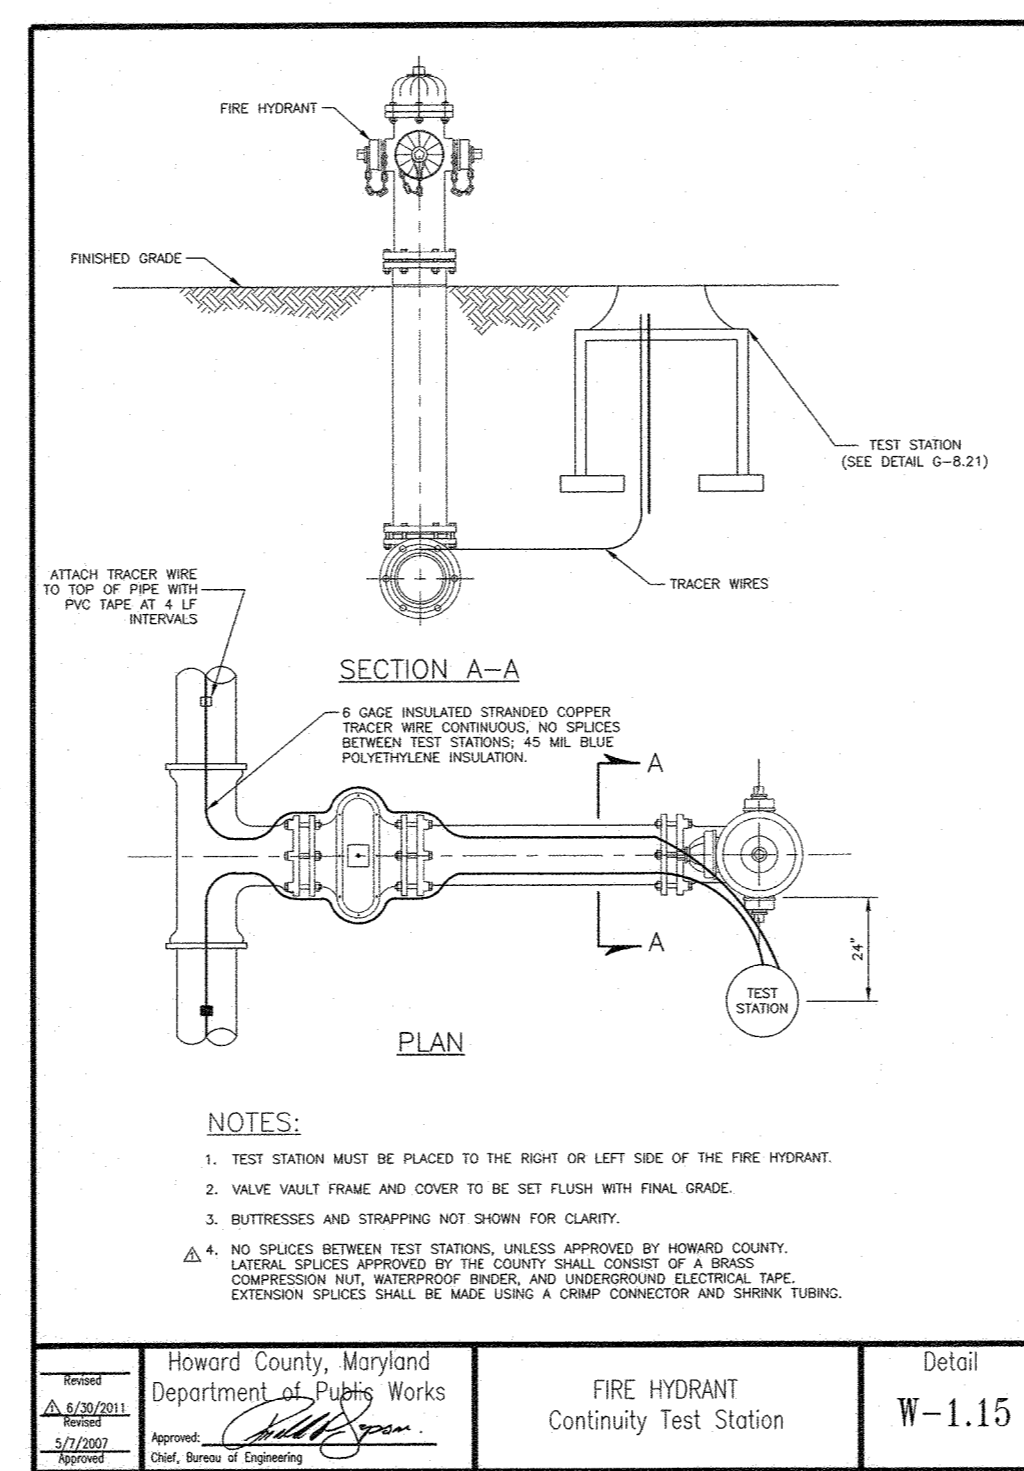
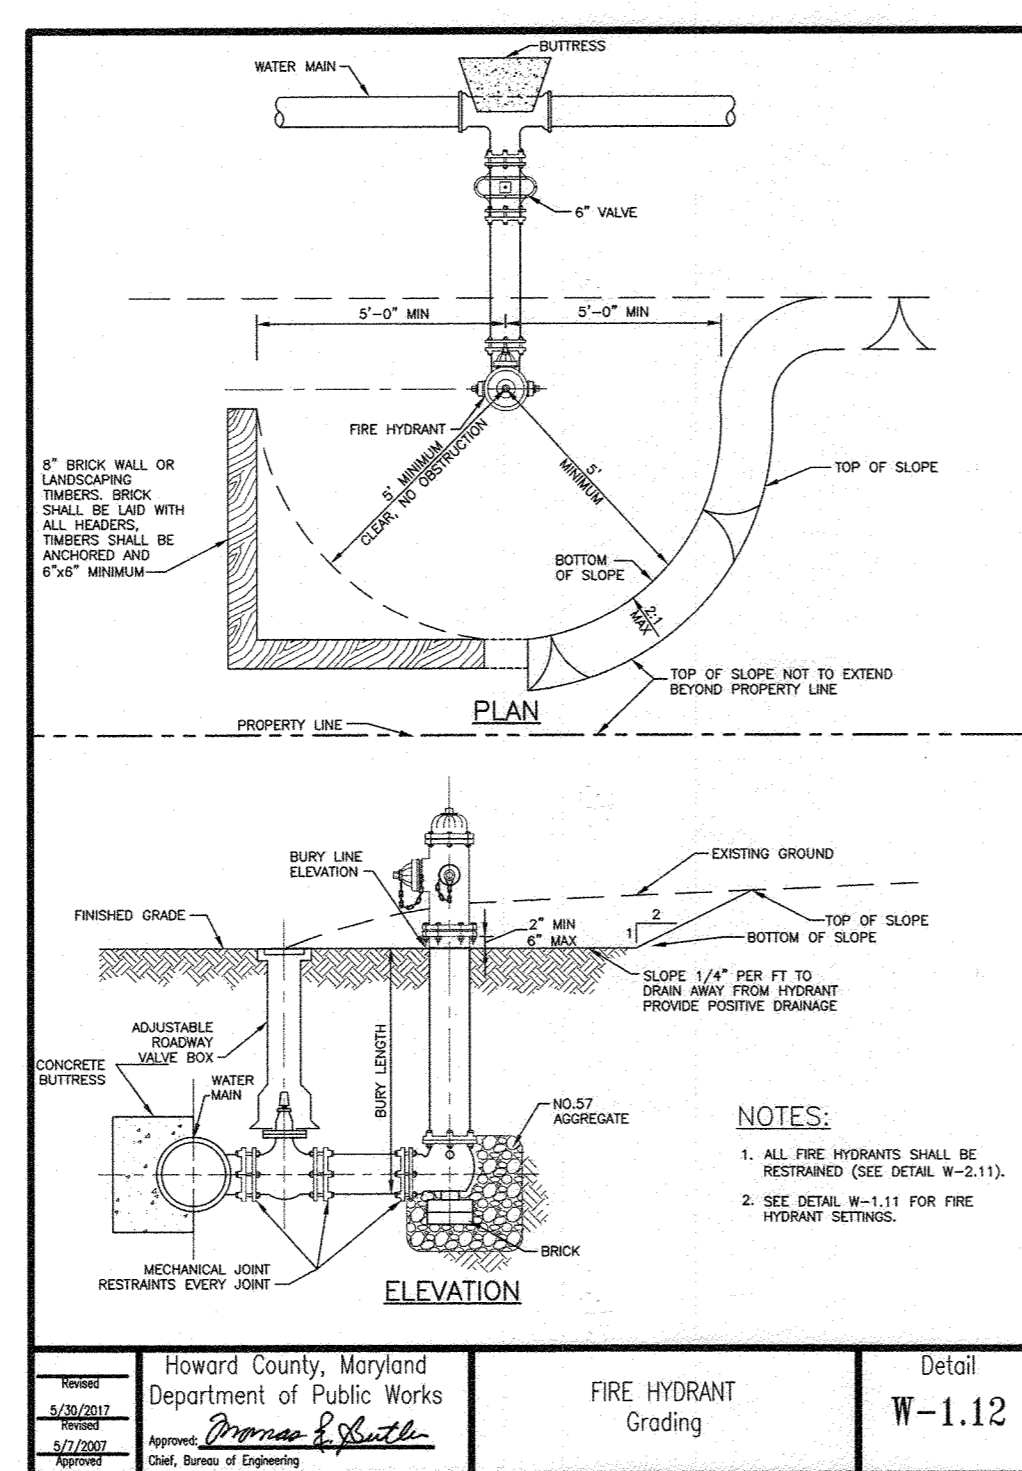
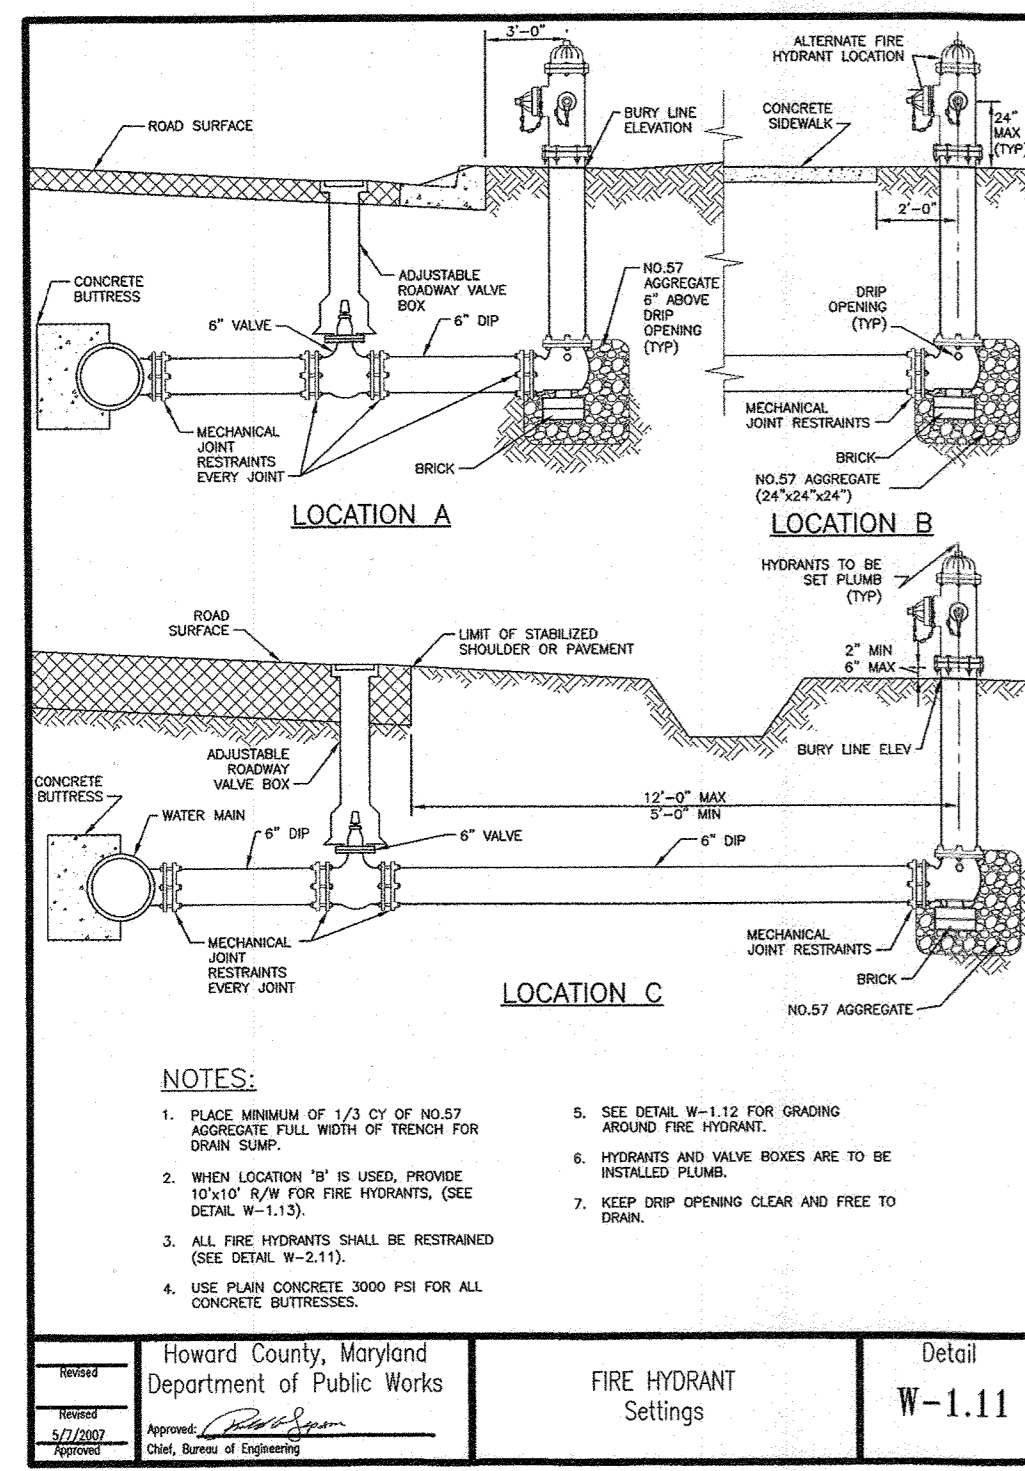


W:\01\2012\12154_H6C80A\Task 12 - Landing Road W8305\CADD\Plans\9-p\1-D001_LANDING RD.dwg Apr 17, 2019 - 2:39pm ENV:CTB Plot Scale 1=1 Plot By: bgress Tab:C-06

AS-BUILT MAY 2020 C-06

DEPARTMENT OF PUBLIC WORKS HOWARD COUNTY, MARYLAND Director of Public Works: <i>Mark D. Lucia</i> 5/19/19 Chief, Bureau of Engineering: <i>Thomas B. Buttle</i> 5/19/19 Chief, Bureau of Utilities: <i>Chris Long</i> 5-2-19 Chief, Utility Design Division: <i>Chris Long</i> 4/29/19		RK&K P: 410.728.2900 700 East Pratt Street, Suite 500 Baltimore, MD 21202 Engineers Construction Managers Planners Scientists www.rkk.com Responsive People Creative Solutions	PROFESSIONAL CERTIFICATION: I HEREBY CERTIFY THAT THESE DOCUMENTS WERE PREPARED OR APPROVED BY ME, AND THAT I AM A DULY LICENSED PROFESSIONAL ENGINEER UNDER THE LAWS OF THE STATE OF MARYLAND, LICENSE NO. 20586, EXPIRATION DATE: 09/08/2020.	DES: REG/WJG DRN: RAD/REG CHK: JCM/NKS SIGN/DATE: 6/25/19	BY NO. REVISION DATE	WATER AND MISCELLANEOUS DETAILS 600' SCALE MAP NO. 31, 37 BLOCK NO. 5, 6, 10, 11, 17, 18, 24	PROJECT NO. W8305 CONTRACT NO. 44-5059 LANDING ROAD WATER MAIN LOOP ELECTION DISTRICT NO. 7 HOWARD COUNTY, MARYLAND	SCALE: AS SHOWN SHEET NO. 09 OF 18
---	--	--	--	--	----------------------	---	---	---------------------------------------

2021/05/12 12:54:36 PM 12154-146080A Task 12 - Landing Road W8305 (CAD) Plans \D-pc-0001_LANDING RD.dwg Apr 17, 2019 - 2:38pm EN/CTB Plot Scale 1=1 Plot By: bgress Tab: CP-01

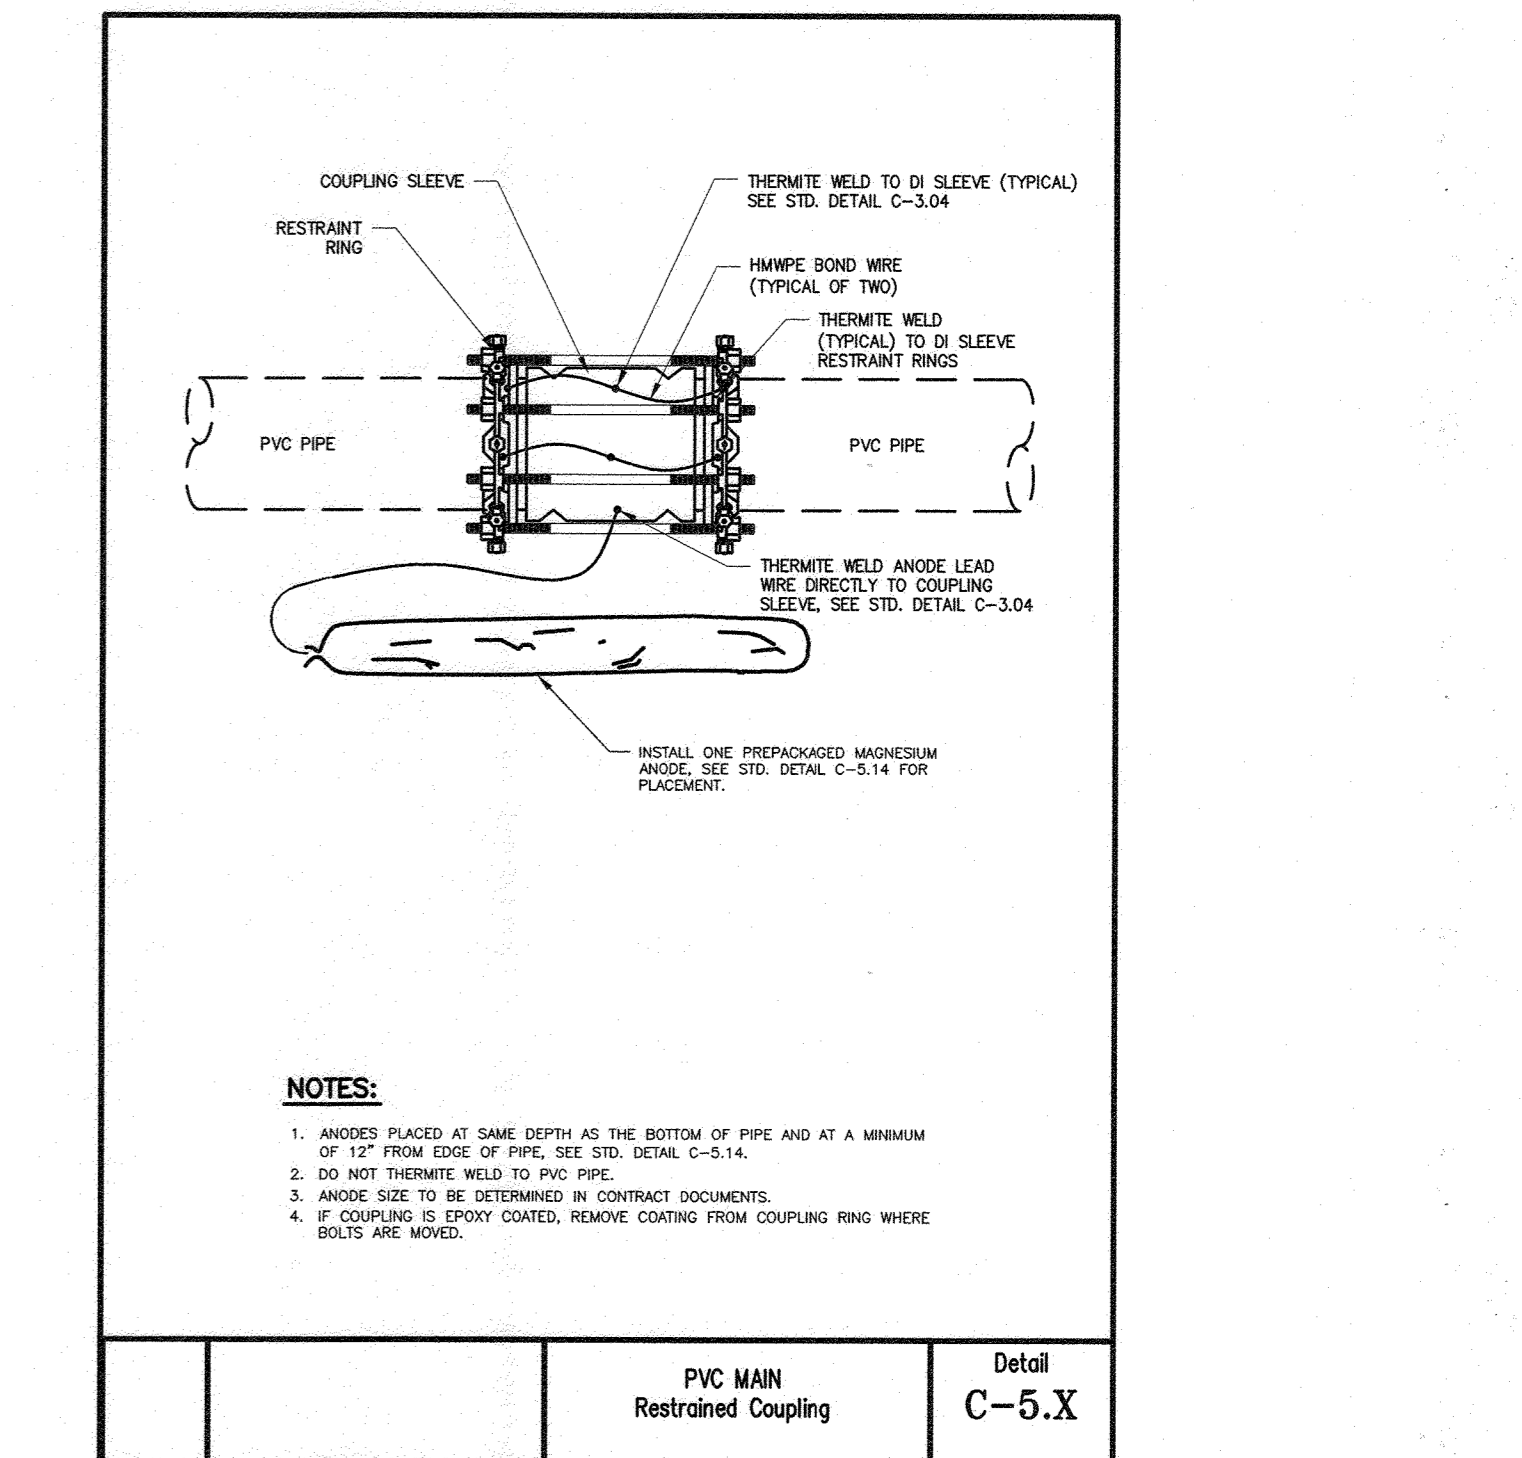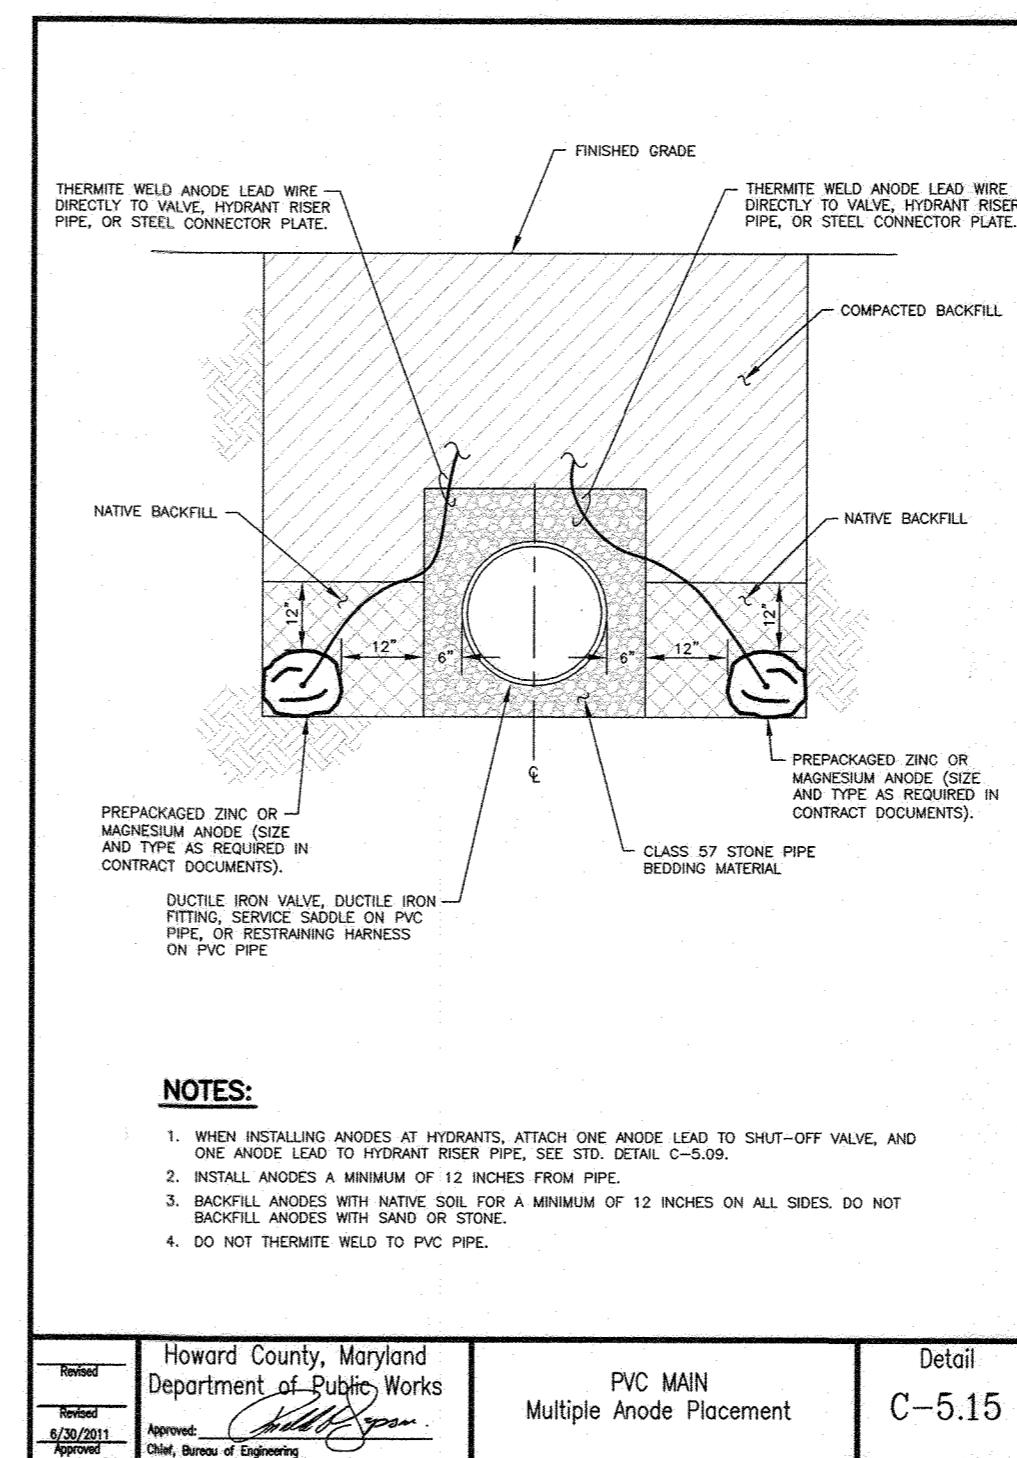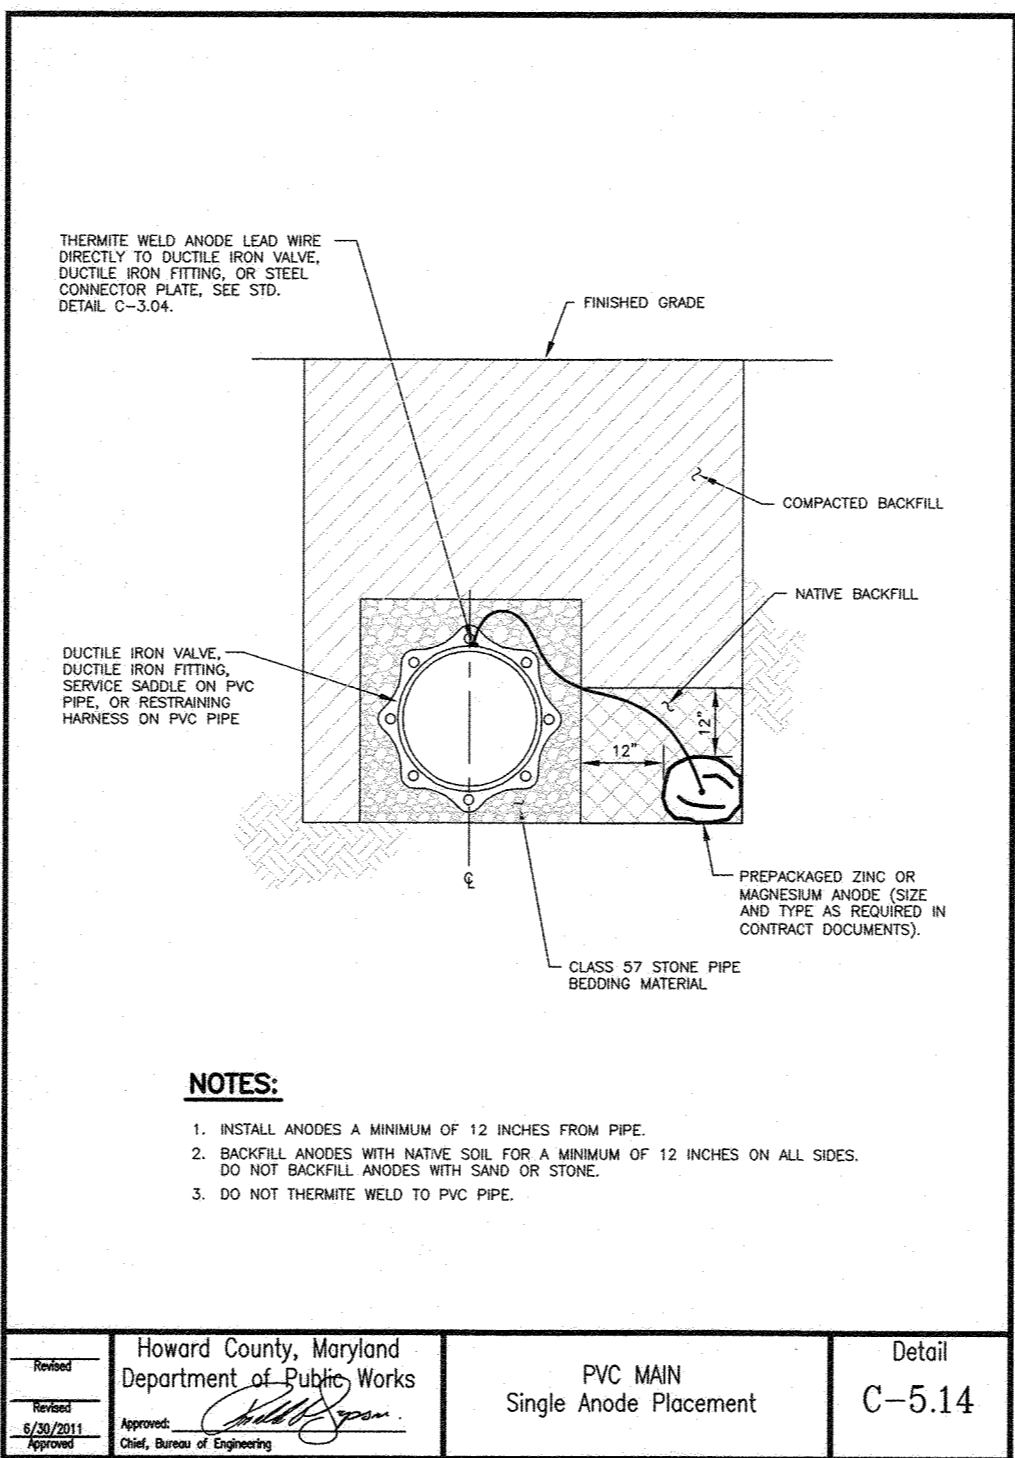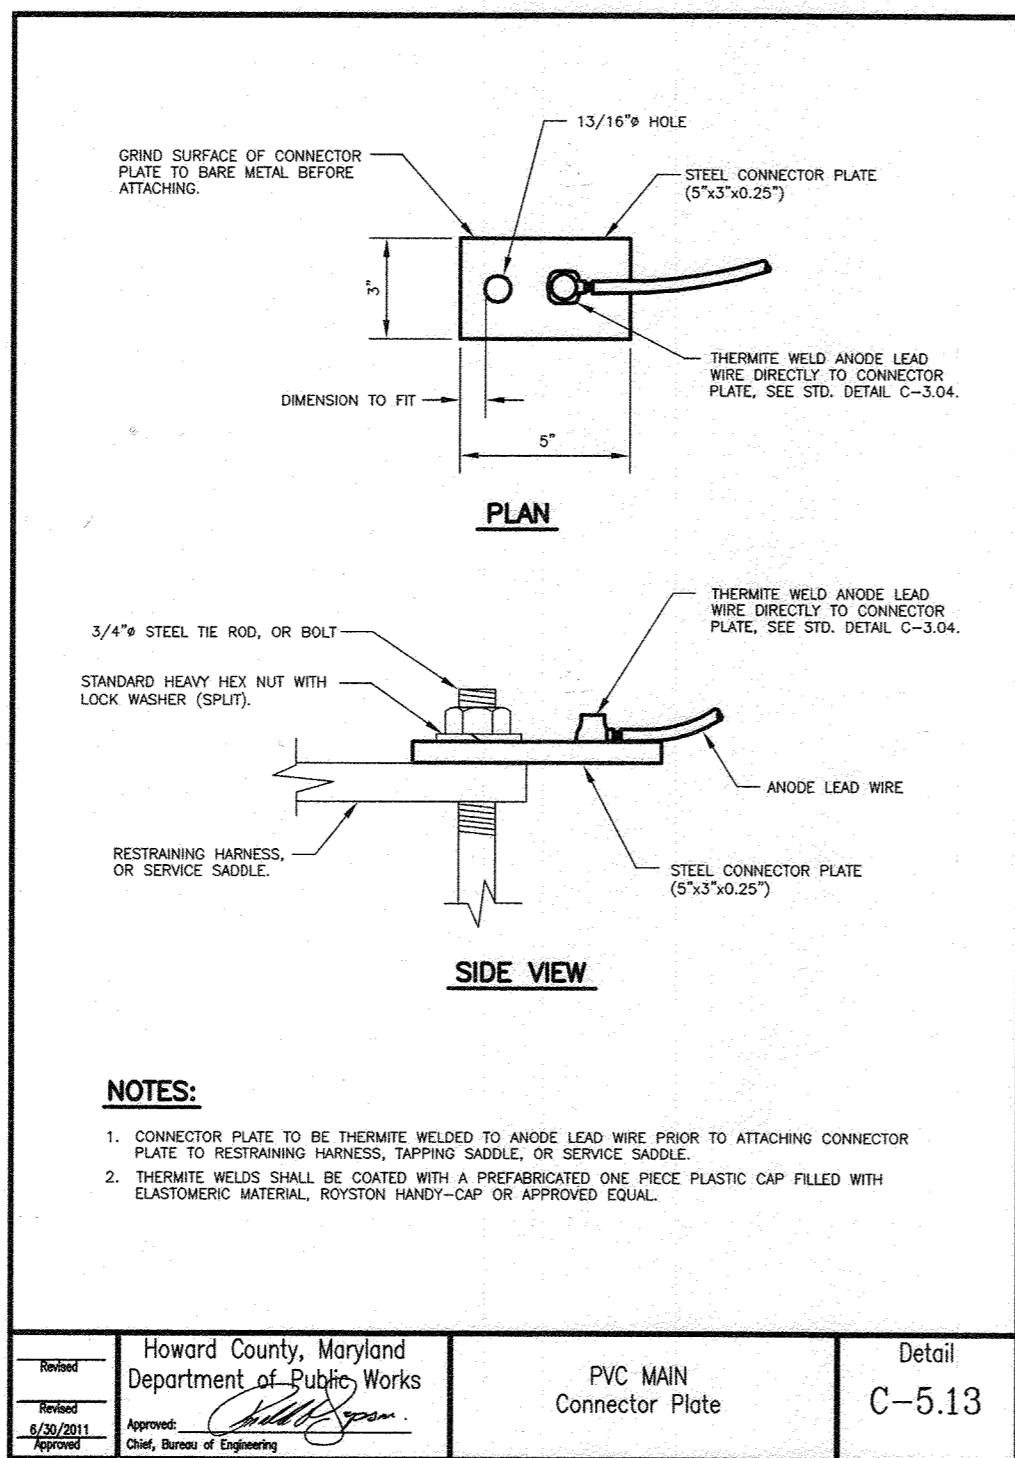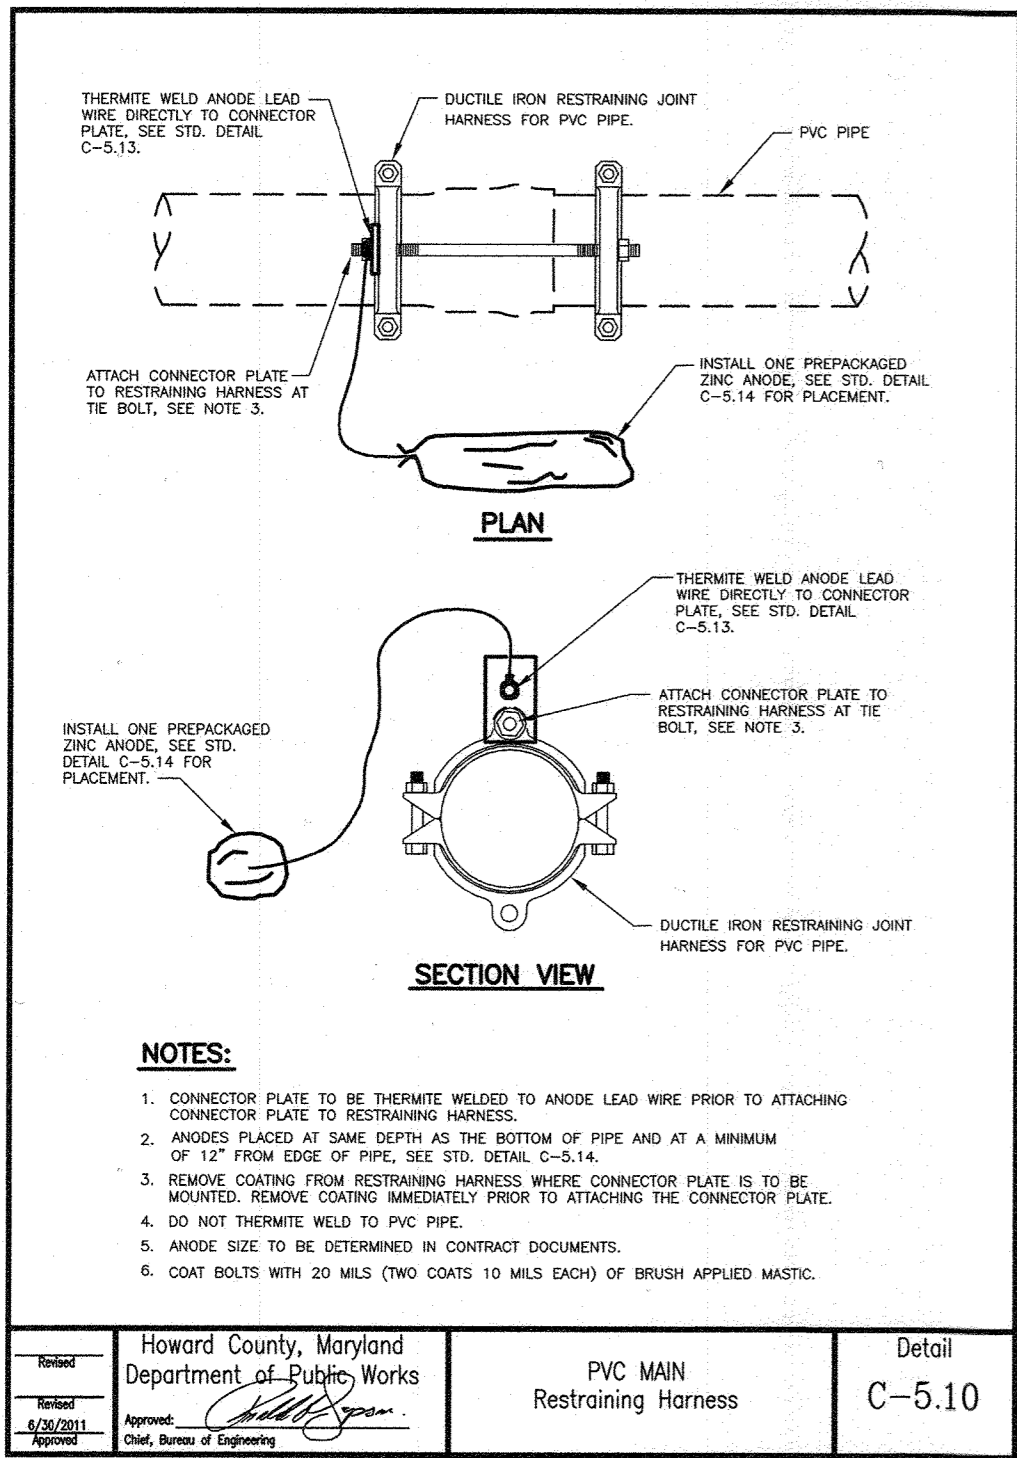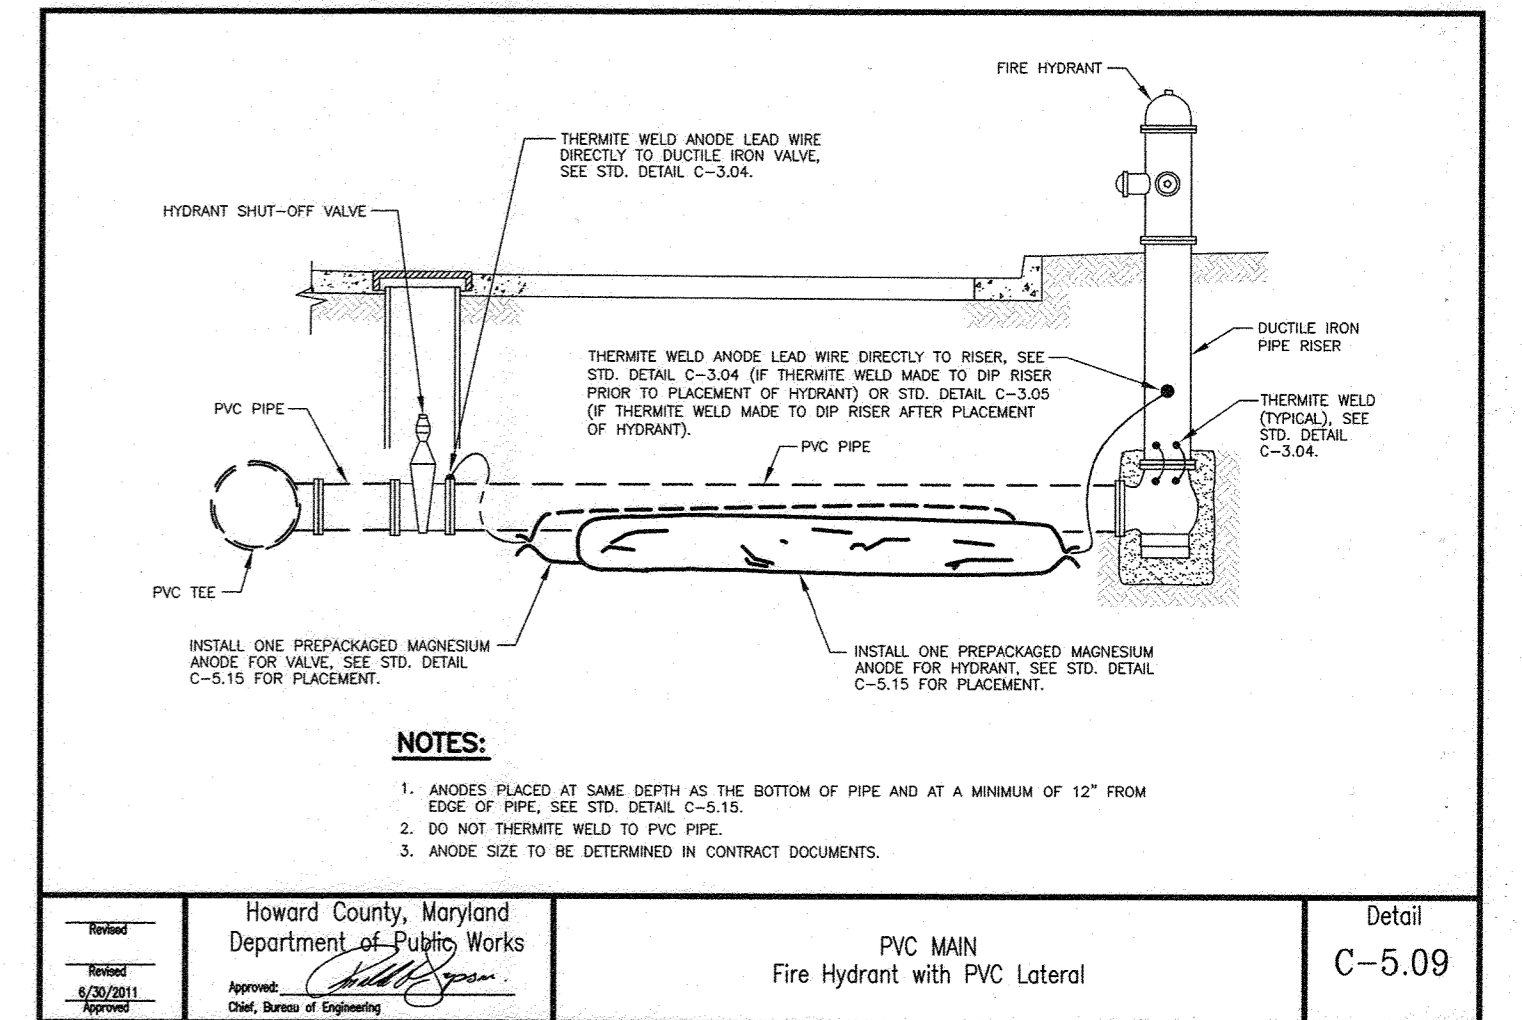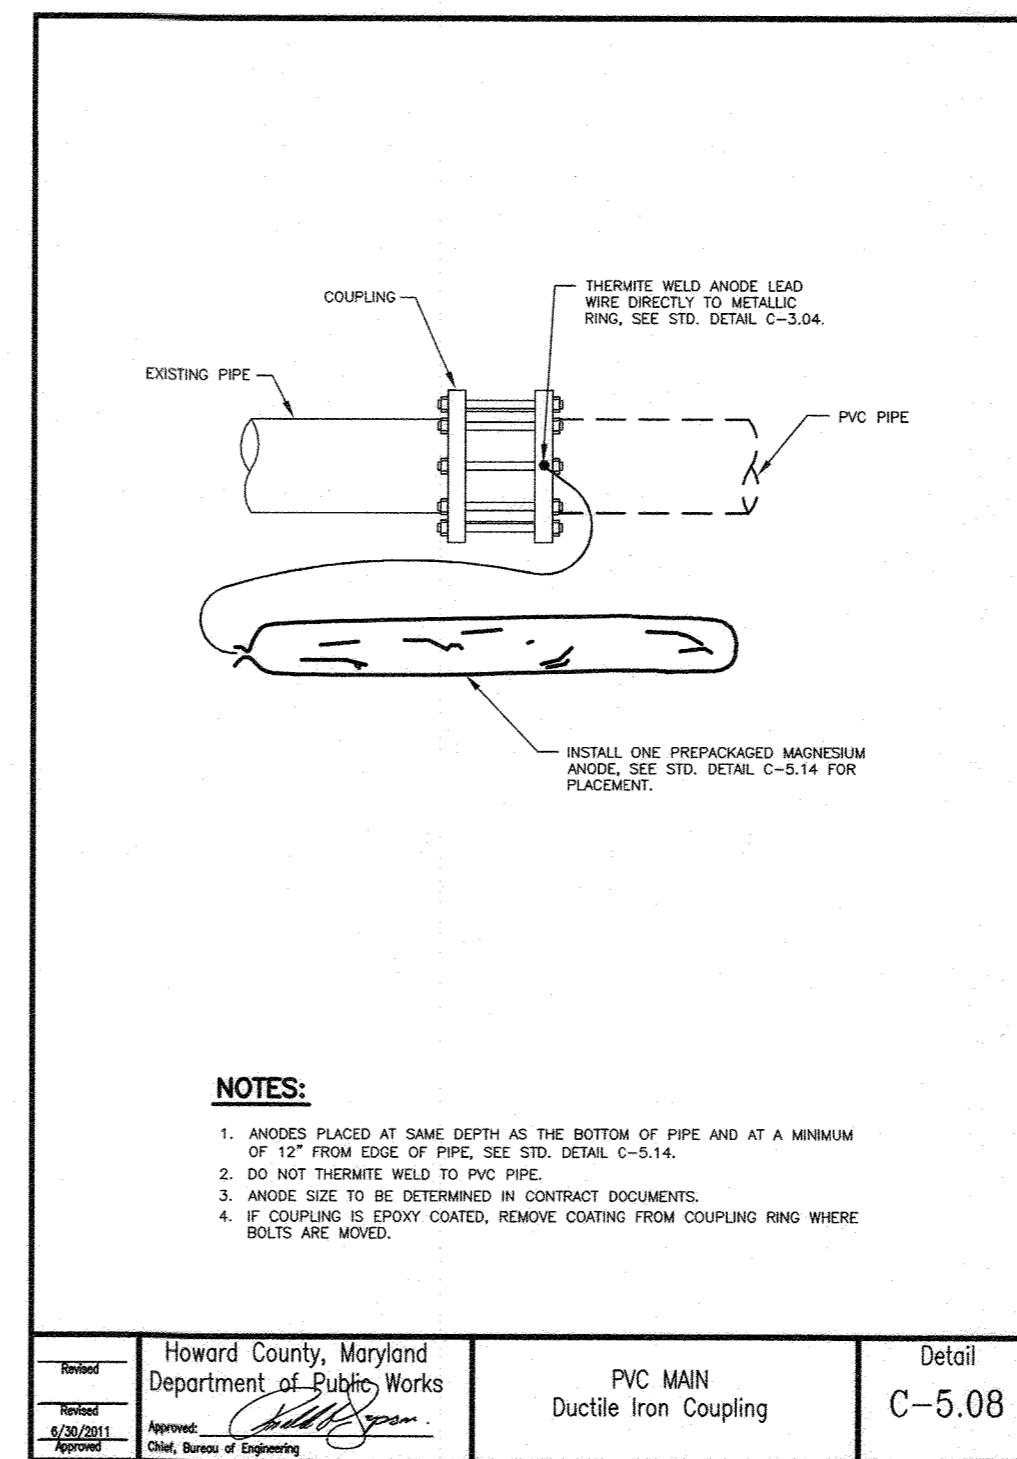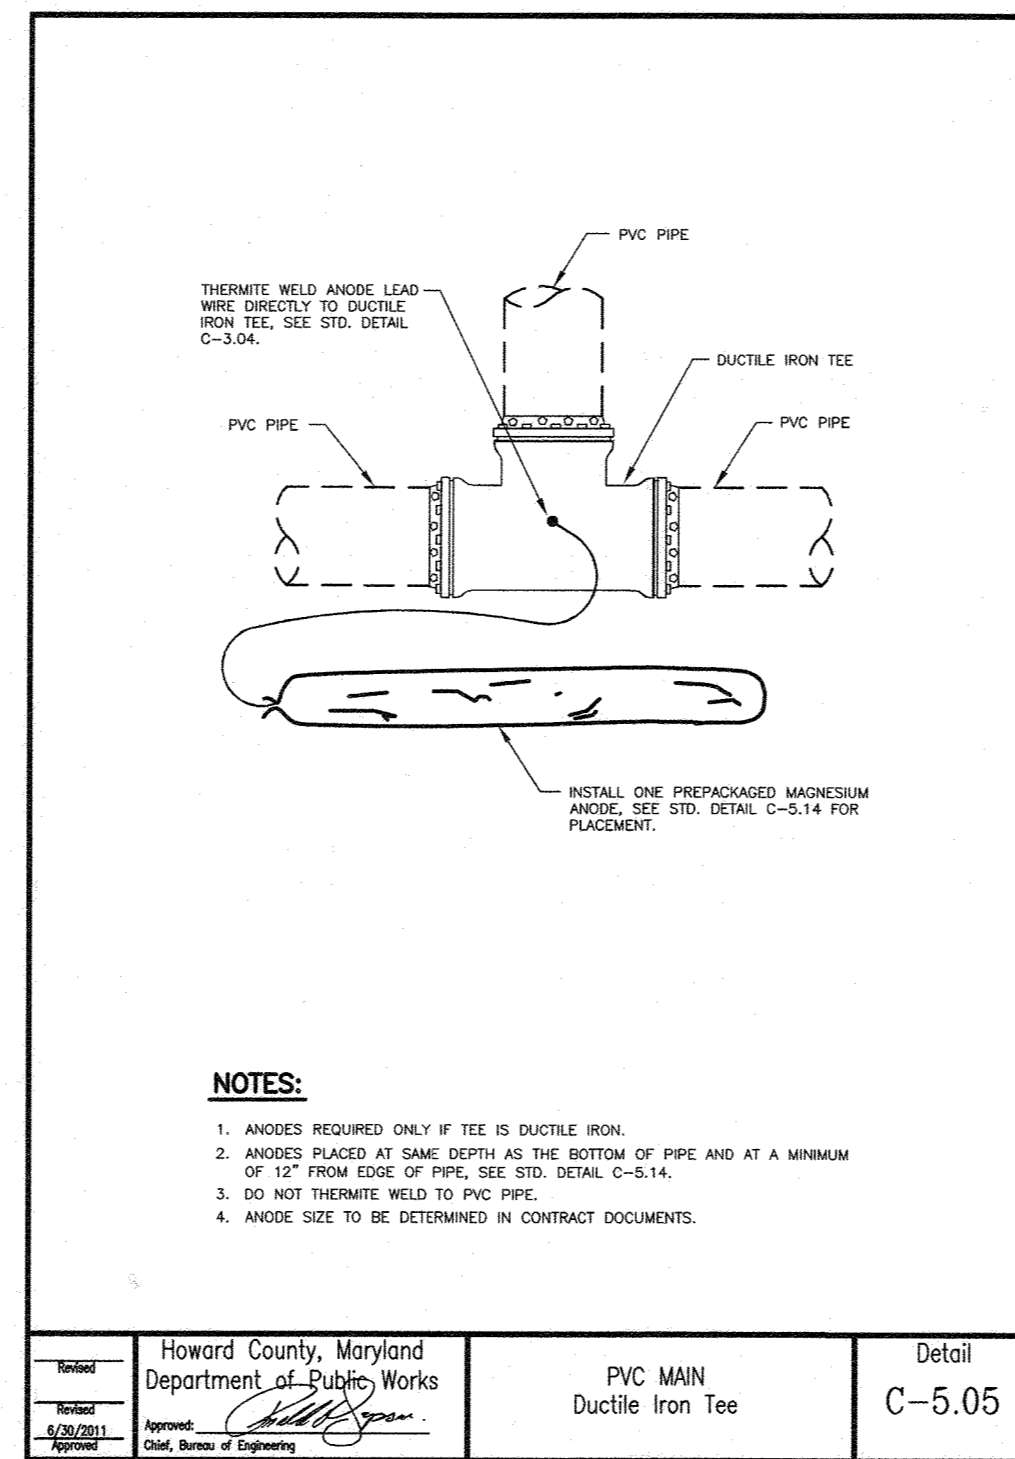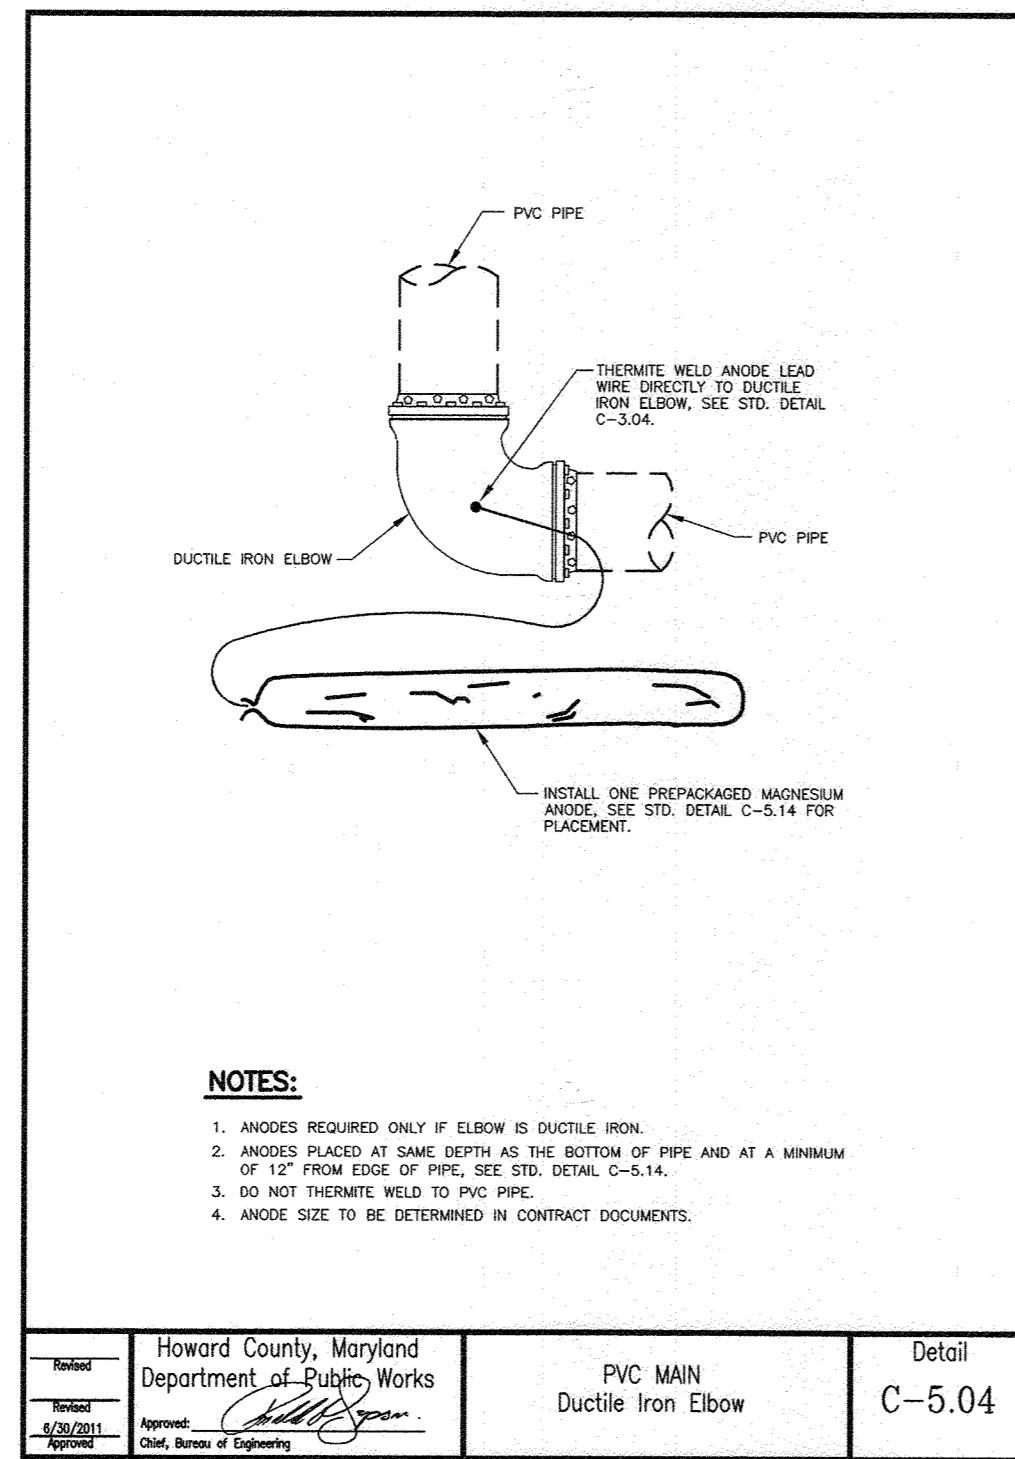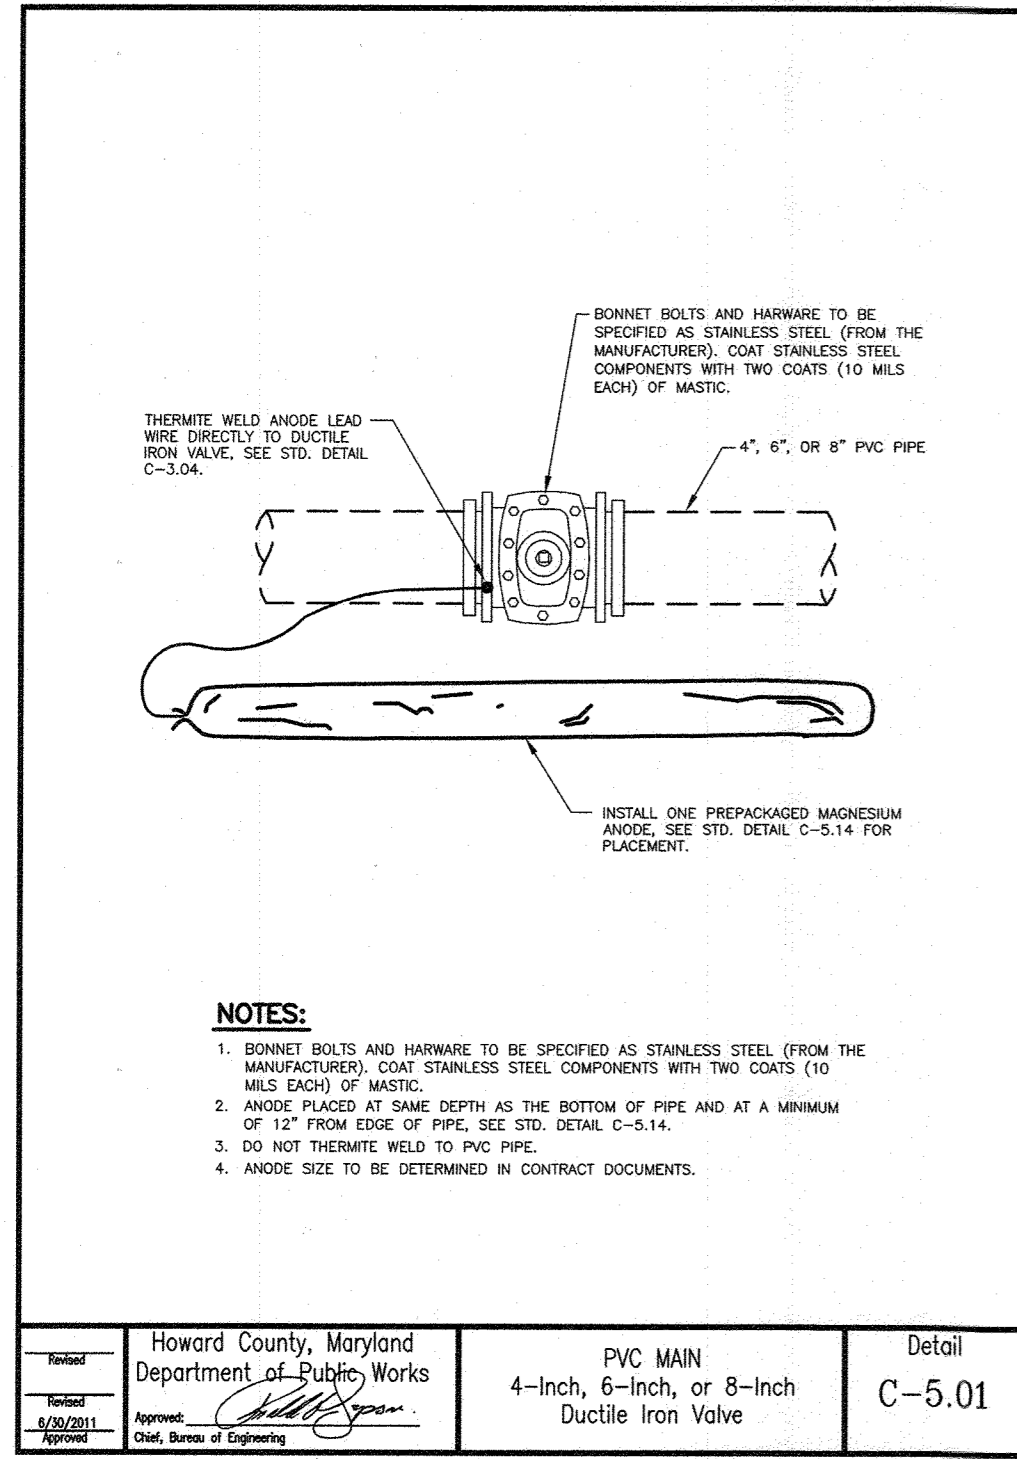

DEPARTMENT OF PUBLIC WORKS
 HOWARD COUNTY, MARYLAND
 Director of Public Works: *Michael D. Price* 5/13/19
 Chief, Bureau of Engineering: *Dennis E. Swell* 4/29/19
 Chief, Bureau of Utilities: *Bob Taylor* 5-2-19
 Chief, Utility Design Division: *[Signature]* 4/29/19

RK&K
 P: 410.728.2900
 700 East Pratt Street, Suite 500 | Baltimore, MD 21202
 Engineers | Construction Managers | Planners | Scientists
 www.rkk.com
 Responsive People | Creative Solutions

PROFESSIONAL CERTIFICATION:
 I HEREBY CERTIFY THAT THESE DOCUMENTS WERE PREPARED OR APPROVED BY ME, AND THAT I AM A DULY LICENSED PROFESSIONAL ENGINEER UNDER THE LAWS OF THE STATE OF MARYLAND, LICENSE NO. 20566, EXPIRATION DATE: 09/06/2020.



DES:	BY:	NO.	REVISION	DATE
REG/WJG				
DRN:				
RAD/REG				
CHK:				
JCM/NKS				
SIGNATURE:				
04/25/19				



CORROSION CONTROL DETAILS
 600' SCALE MAP NO. 31, 37 BLOCK NO. 5, 6, 10, 11, 17, 18, 24

AS-BUILT MAY 2020

PROJECT NO. W8305
 CONTRACT NO. 44-5059
LANDING ROAD WATER MAIN LOOP
 ELECTION DISTRICT NO. 7 HOWARD COUNTY, MARYLAND

CP-01
 SCALE AS SHOWN
 SHEET NO. 10 OF 18

R:\21\GIS\GIS\2012\12154_Hoc080A\Task 12 - Landing Road W8305\CAD\Plans\11-pMT-001_LANDING RD.dwg Apr 17, 2019 - 2:39pm
 ENV\CTB Plot Scale = 1 Plot By: bgress Tab:M-01

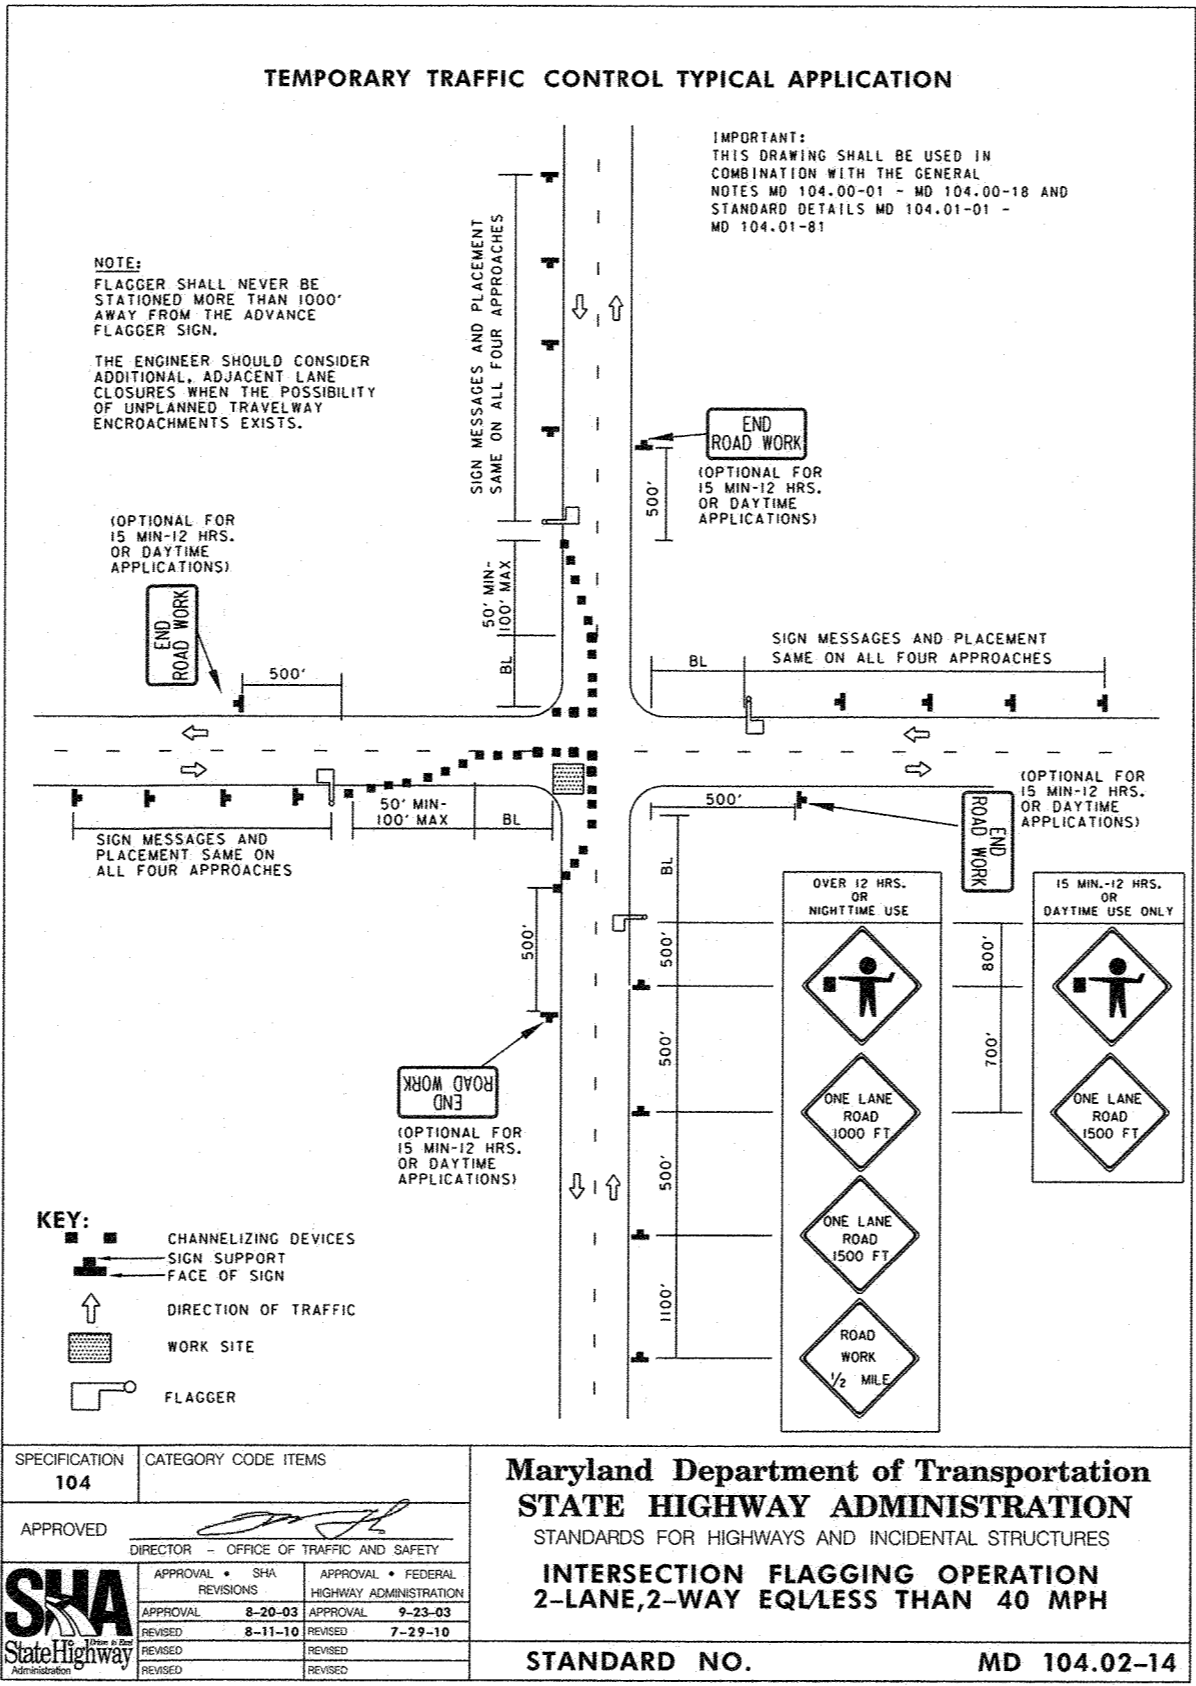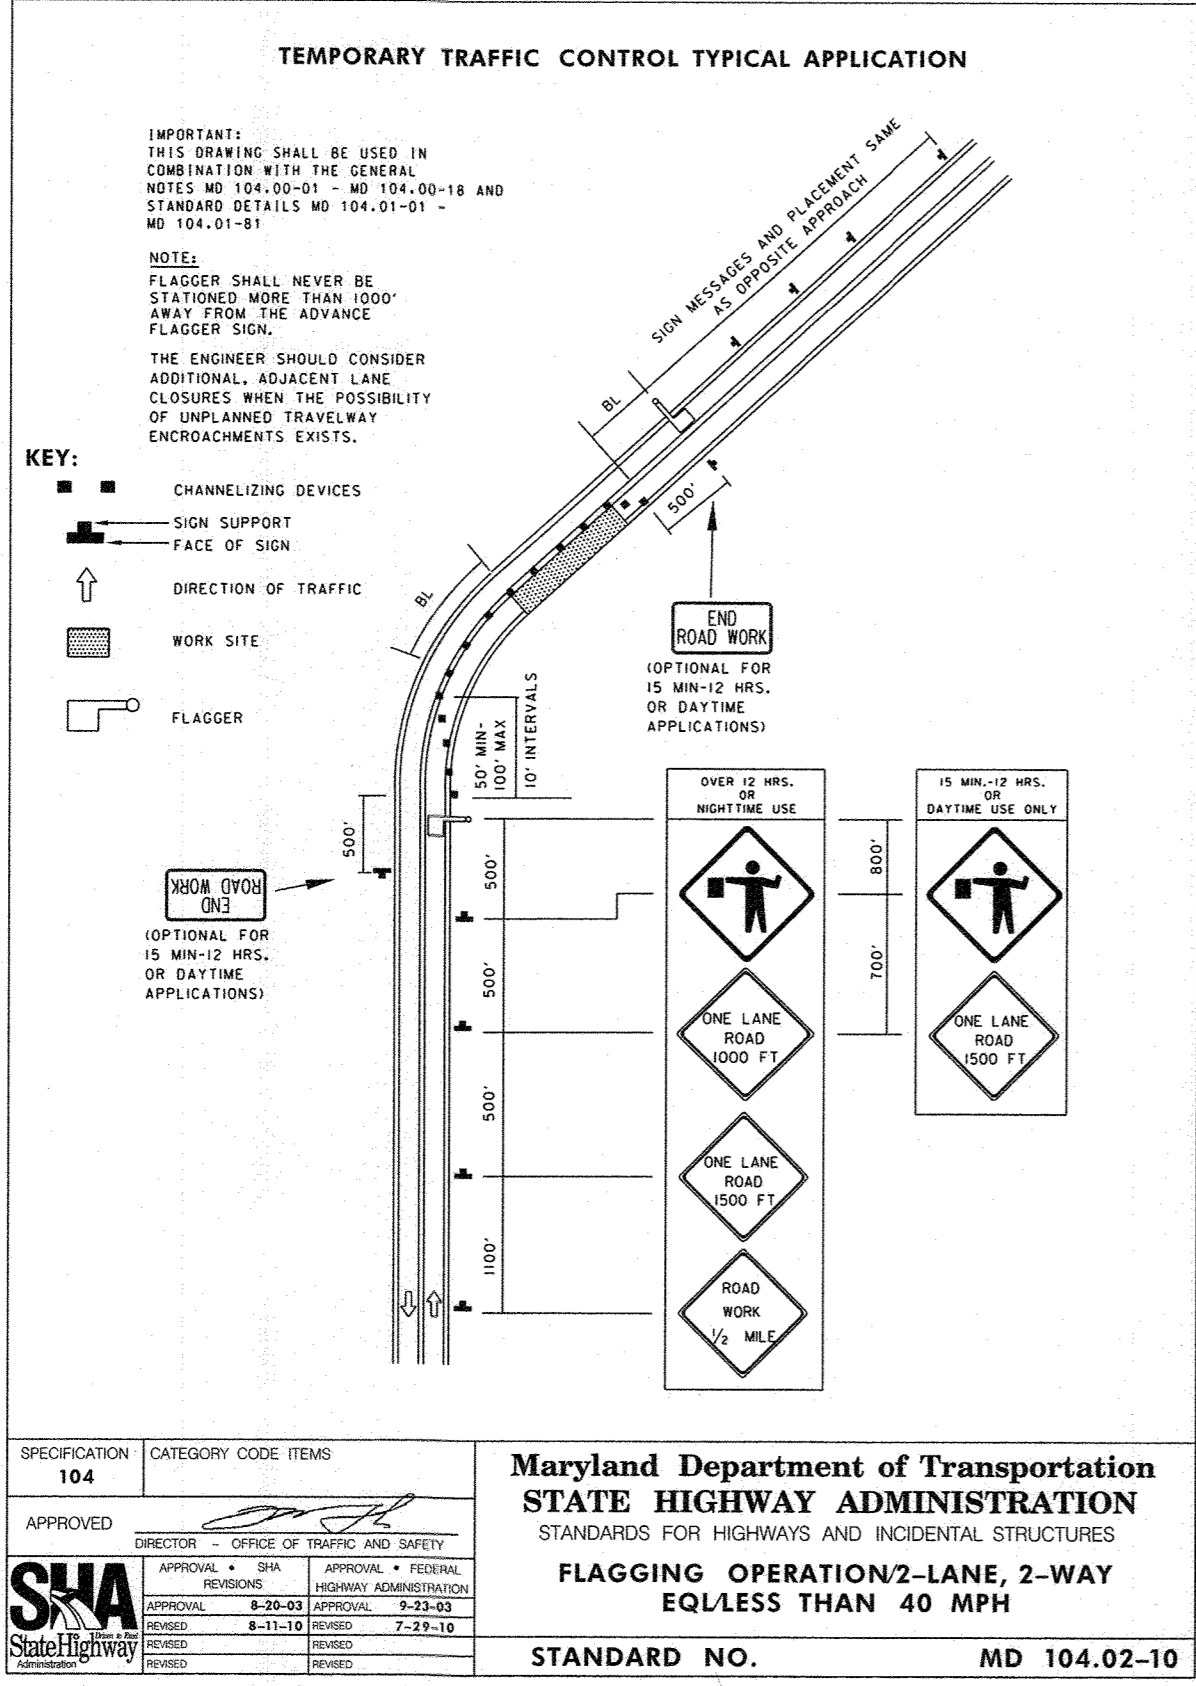

TRAFFIC CONTROL PLAN – GENERAL NOTES

- HOWARD COUNTY TRAFFIC SHALL BE NOTIFIED AT LEAST 3 DAYS PRIOR TO BEGINNING ANY WORK IN ORDER TO SCHEDULE A FIELD INSPECTION OF TRAFFIC CONTROL DEVICES. CONTACT THE TRAFFIC DIVISION AT (410) 313-2430.
- ALL CONSTRUCTION AND MATERIALS FOR THE TRAFFIC CONTROL DEVICES SHALL BE IN ACCORDANCE WITH THE STANDARDS CONTAINED IN THE LATEST EDITION OF THE STATE OF MARYLAND MANUAL ON UNIFORM TRAFFIC CONTROL DEVICES.
- TRAVEL LANES SHALL BE A MINIMUM OF TEN FEET IN WIDTH. WHEN ONLY ONE LANE IS OPEN, FLAGGERS AND THE APPROPRIATE SIGNING SHALL BE PROVIDED. THE ROADWAY SHALL BE REOPENED TO TWO WAY TRAFFIC AT THE END OF EACH WORK SHIFT.
- REFLECTORIZED CHANNELIZING DEVICES SHALL BE USED AT NIGHT ALONG THE CONSTRUCTION AREA.
- THE CONTRACTOR SHALL BACKFILL THE TRENCH IMMEDIATELY AFTER THE INSTALLATION OF A SECTION OF PIPE. IF STEEL PLATES ARE TO BE USED, APPROPRIATE SIGNING WILL BE REQUIRED. STEEL PLATES MUST BE PINNED. STEEL PLATES ON ALL COUNTY ROADWAYS MUST BE RECESSED, AS MUST ALL STEEL PLATES TO BE PLACED FOR MORE THAN 24 HOURS BETWEEN DECEMBER 1st AND MARCH 15th. THE CONTRACTOR SHALL NOT LEAVE AN OPEN TRENCH UNATTENDED.
- THE CONTRACTOR SHALL INSTALL W8-8(4) "STEEL PLATES" SIGN (IN ACCORDANCE WITH LATEST EDITION OF MDT SHA'S STANDARD SIGN BOOK) FOR EACH DIRECTION OF TRAFFIC APPROACHING THE STEEL PLATES, APPROXIMATELY 500 FEET IN ADVANCE OF THE STEEL PLATES.
- ALL TEMPORARY SIGNS THAT DO NOT APPLY WHEN ROAD IS OPEN SHALL BE COVERED OR REMOVED, OR TURNED AWAY.
- CHANNELIZING DEVICES AND TEMPORARY STRIPING SHALL BE REMOVED AS SOON AS PRACTICAL.
- ALL TRAFFIC CONTROL DEVICES SHALL BE KEPT IN THEIR PROPER POSITION AT ALL TIMES AND SHALL BE REPAIRED, REPLACED OR CLEANED AS NECESSARY TO PRESERVE THEIR APPEARANCE AND CONTINUITY.
- ALL CONSTRUCTION SIGNING SHALL BE IN ACCORDANCE WITH THE TYPICAL SIGN PLACEMENT SHOWN ON THESE PLANS AND SHALL NOT OBSTRUCT EXISTING TRAFFIC CONTROL DEVICES.
- ANY CHANGES TO THE TCP SHALL BE SUBMITTED TO THE TRAFFIC ENGINEERING DIVISION FOR REVIEW AND APPROVAL. REQUESTS FOR DETOURS AND ROAD CLOSURES SHALL BE SUBMITTED TO THE TRAFFIC DIVISION AT 410-313-2430 5 DAYS IN ADVANCE WITH A DETOUR PLAN FOR APPROVAL.
- CONSTRUCTION & WORKER'S VEHICLES SHALL NOT BE PARKED IN A MANNER THAT WILL IMPEDE TRAFFIC OR IMPAIR SIGHT DISTANCE. THESE VEHICLES SHOULD BE PARKED OFF-STREET ON THE CONSTRUCTION SITE OR ON A SIDE STREET NOT UNDER CONSTRUCTION.
- FLAGGERS SHALL BE CERTIFIED FLAGGER AND SHALL HAVE THEIR CERTIFIED FLAGGER CARD WITH THEM AT ALL TIMES DURING FLAGGING OPERATIONS.
- CONTRACTOR'S TRAFFIC MANAGER MUST HAVE A MDSA TEMPORARY TRAFFIC CONTROL MANAGER'S TRAINING COURSE CARD.
- THE HOWARD COUNTY PUBLIC SCHOOL SYSTEM, 410-313-6278, SHALL BE ADVISED OF WORK ACTIVITIES WHICH MAY AFFECT BUS ROUTE TIMING AS EARLY AS PRACTICAL.
- PORTABLE VARIABLE MESSAGE SIGNS (PVMS), SHALL BE PLACED 10 DAYS PRIOR TO ROAD WORK. CONTACT THE TRAFFIC DIVISION FOR LOCATION AND MESSAGES ON THE PVMS.

DEPARTMENT OF PUBLIC WORKS HOWARD COUNTY, MARYLAND	
DIRECTOR OF PUBLIC WORKS <i>(Signature)</i> DATE: 5-2-19	CHIEF OF ENGINEERING <i>(Signature)</i> DATE: 4/25/19
CHIEF OF UTILITIES <i>(Signature)</i> DATE:	CHIEF OF UTILITY DESIGN DIVISION <i>(Signature)</i> DATE:

RK&K
 P: 410.728.2900
 700 East Pratt Street, Suite 500 | Baltimore, MD 21202
 Engineers | Construction Managers | Planners | Scientists
 www.rk.com
 Responsive People | Creative Solutions

PROFESSIONAL CERTIFICATION:
 I HEREBY CERTIFY THAT THESE DOCUMENTS WERE PREPARED OR APPROVED BY ME, AND THAT I AM A DULY LICENSED PROFESSIONAL ENGINEER UNDER THE LAWS OF THE STATE OF MARYLAND, LICENSE NO. 20566, EXPIRATION DATE: 09/06/2020.

(Signature)
(Stamp)

DES:	REG/WJG	BY	NO.	REVISION		DATE
DRN:	RAD/REG					
CHK:	JCM/NKS					
SIGN DATE:	04/25/19					

MAINTENANCE OF TRAFFIC NOTES AND DETAILS

600' SCALE MAP NO. 31, 37 BLOCK NO. 5, 6, 10, 11, 17, 18, 24

AS-BUILT MAY 2020


PROJECT NO. W8305
 CONTRACT NO. 44-5059

LANDING ROAD WATER MAIN LOOP

ELECTION DISTRICT NO. 7
 HOWARD COUNTY, MARYLAND

MT-01
 SCALE AS SHOWN
 SHEET NO. 11 OF 18


Rk217357 1/23/2012 12154_H6C880A\Task 12 - Landing Road W8305 CAD\PIR12-SP1-F001_LANDING RD.dwg Apr 17, 2019 - 2:40pm ENV/CTB Plot Scale 1" = 1' Plot By: bgrues Tab: P4-01

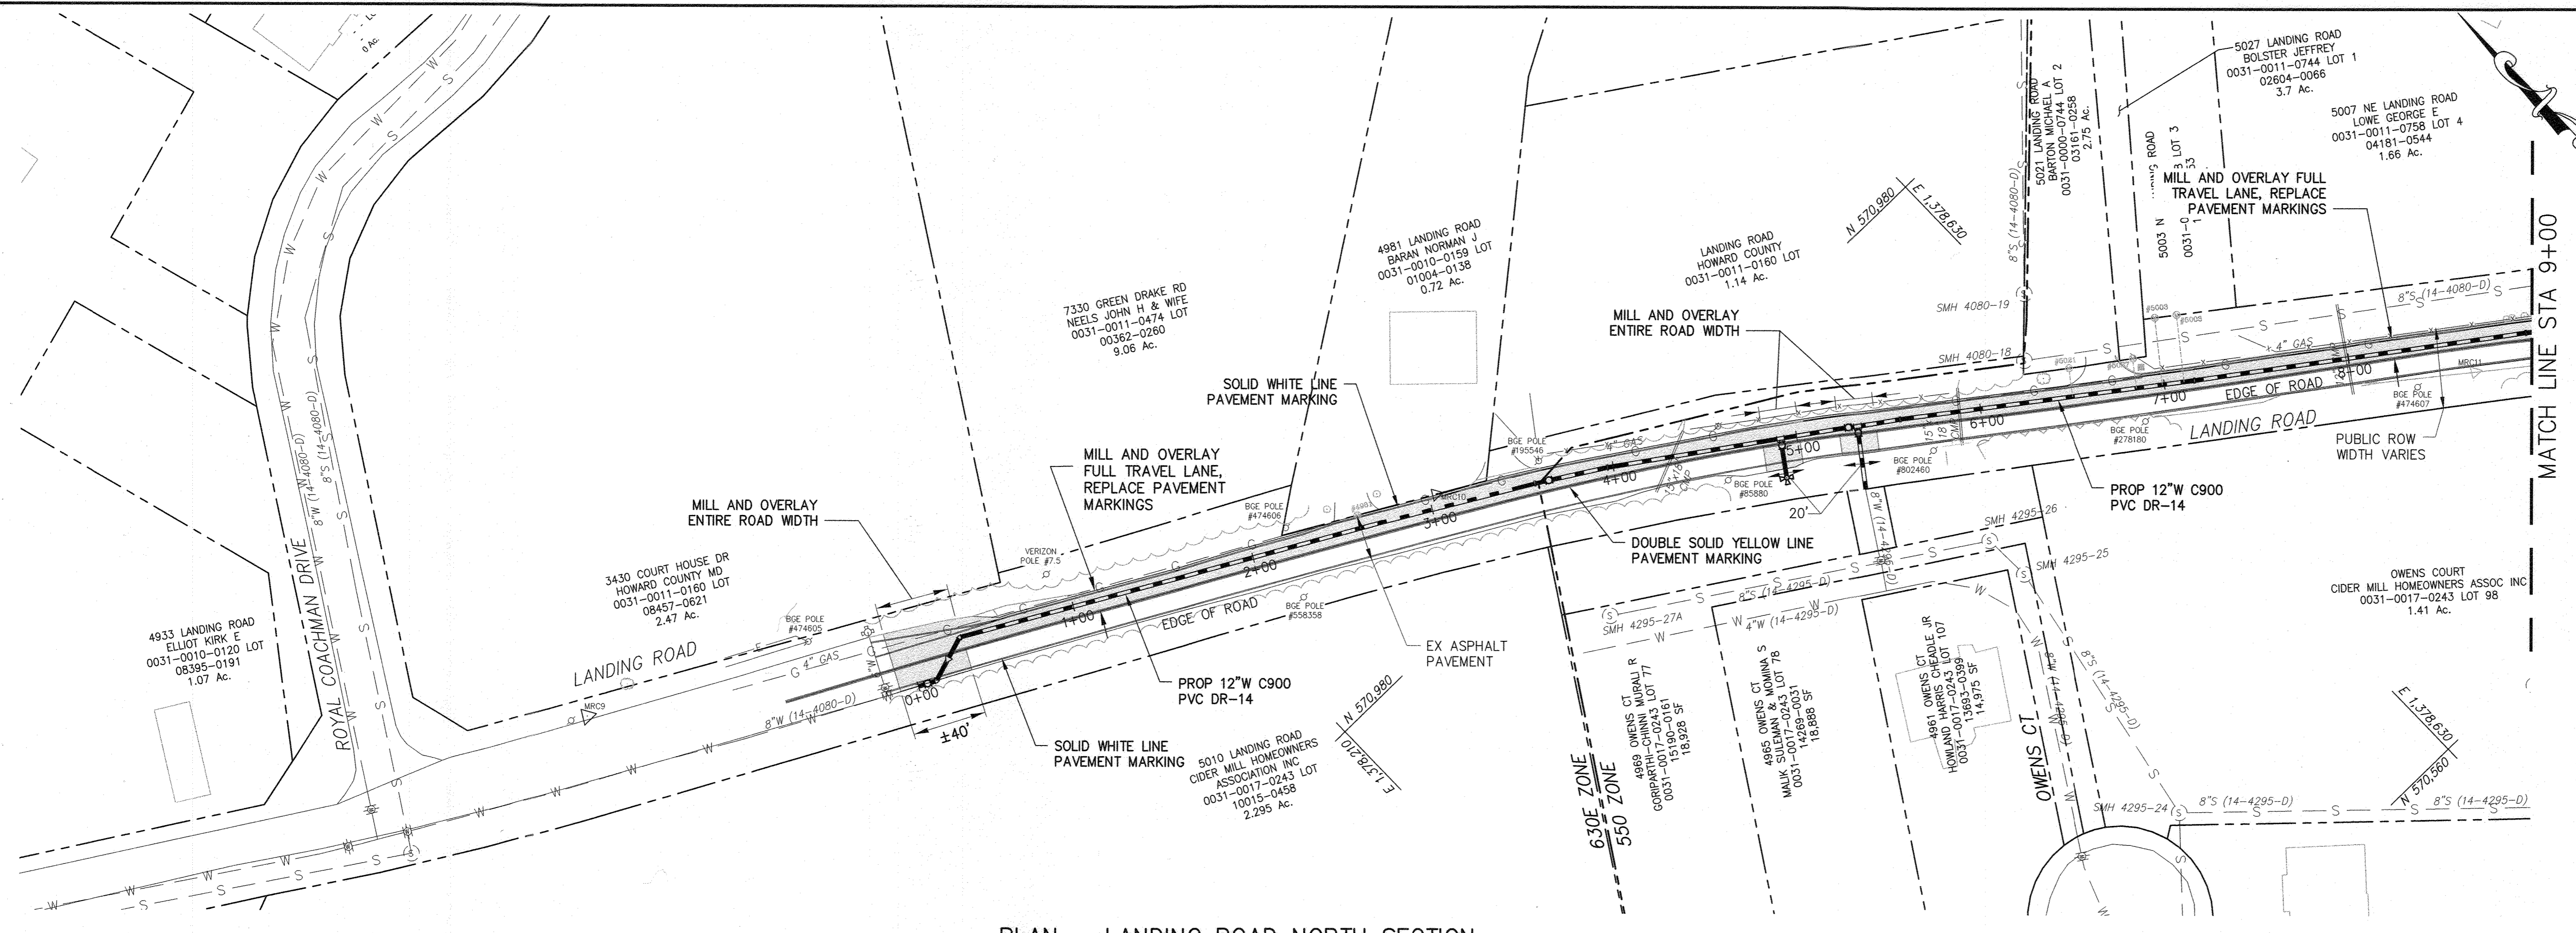

PLAN - LANDING ROAD NORTH SECTION
SCALE: 1" = 50'


LIMITS OF PAVEMENT REPAIR
(PROVIDE 2" MILL AND
OVERLAY OUTSIDE OF THE
WATER MAIN TRENCH REPAIR)

- NOTES:
- PAVEMENT REPAIR:
REFER TO THE LATEST EDITION HOWARD COUNTY STANDARD SPECIFICATION SECTION 504 - ASPHALT PAVEMENT, STANDARD DETAILS G-4.01 UTILITY TRENCH ROADWAY REPAIRING AND R-2.01 PAVING SECTION P-4, CBR 5 TO <7.
 - PAVEMENT MARKINGS:
ALL EXISTING PAVEMENT MARKINGS SHALL REMAIN IN PLACE OR SHALL BE IMMEDIATELY REPLACED IN KIND. REFER TO THE LATEST EDITION HOWARD COUNTY STANDARD SPECIFICATION SECTION 549 PAVEMENT MARKINGS, STANDARD DETAILS T-7.01 TYPICAL INTERSECTION PAVEMENT MARKING LAYOUT AND T-7.03 SIGNING AND MARKING DETAILS.

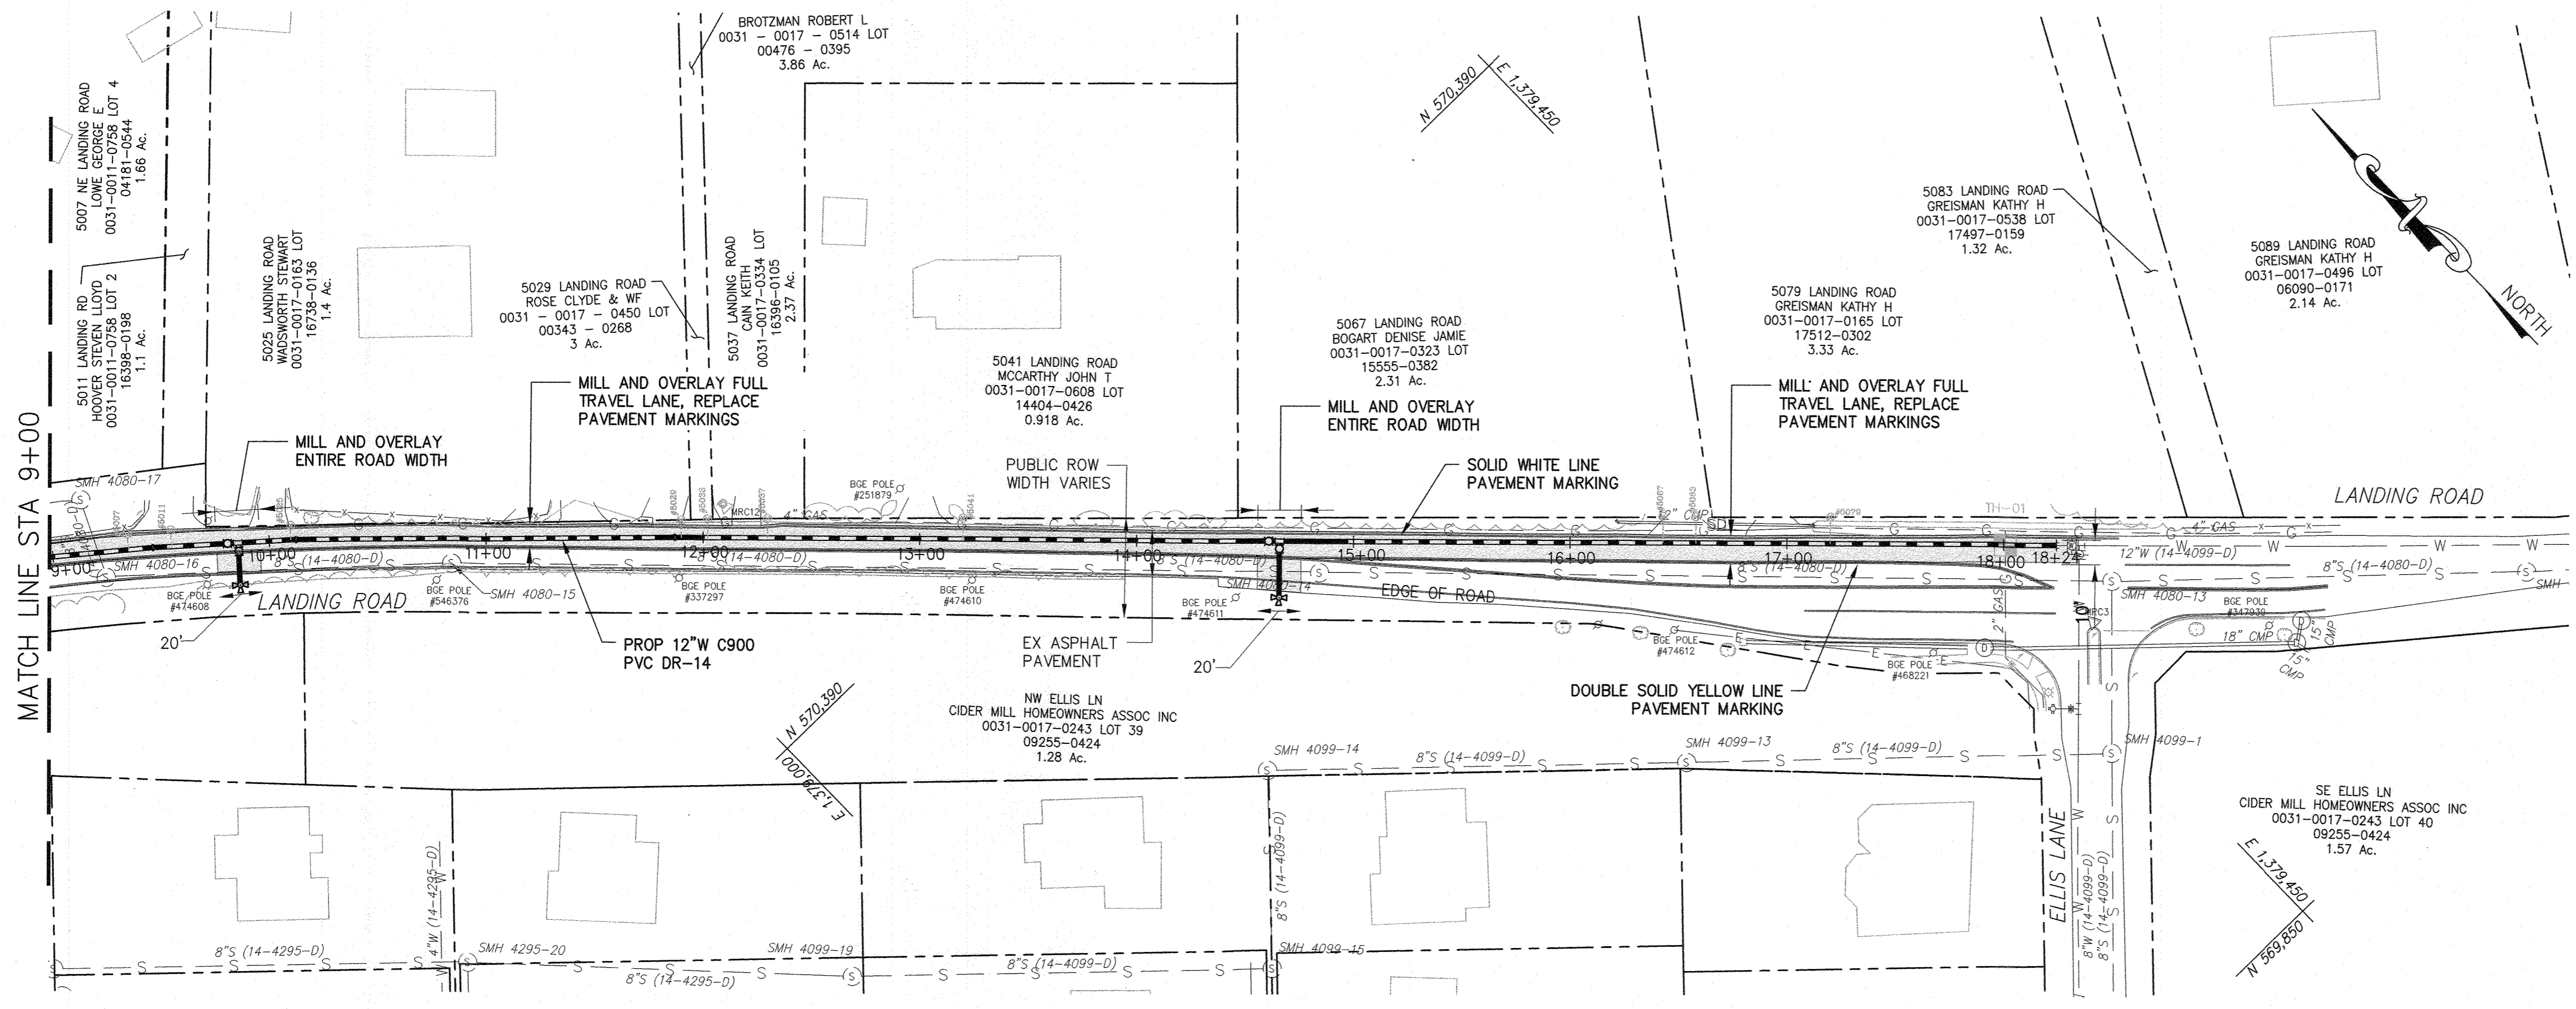

PLAN - LANDING ROAD NORTH SECTION
SCALE: 1" = 50'

AS-BUILT MAY 2020

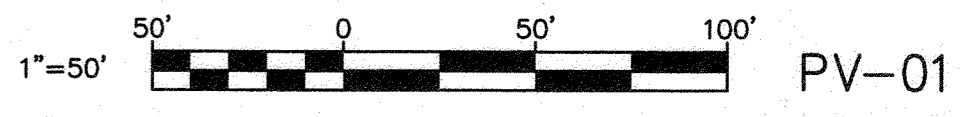

DEPARTMENT OF PUBLIC WORKS
HOWARD COUNTY, MARYLAND

Muhammad Khan 5/21/19
DIRECTOR OF PUBLIC WORKS DATE


Thomas E. Buttle 5/29/19
CHIEF, BUREAU OF ENGINEERING DATE

Tom Starnes 5-2-19
CHIEF, BUREAU OF UTILITIES DATE

[Signature] 4/29/19
CHIEF, UTILITY DESIGN DIVISION DATE

RK&K
P-410.728.2900
700 East Pratt Street, Suite 500 | Baltimore, MD 21202
Engineers | Construction Managers | Planners | Scientists
www.rk&k.com
Responsive People | Creative Solutions

PROFESSIONAL CERTIFICATION:
I HEREBY CERTIFY THAT THESE
DOCUMENTS WERE PREPARED OR
APPROVED BY ME, AND THAT I
AM A DULY LICENSED
PROFESSIONAL ENGINEER UNDER
THE LAWS OF THE STATE OF
MARYLAND,
LICENSE NO. 20566,
EXPIRATION DATE: 09/06/2020.

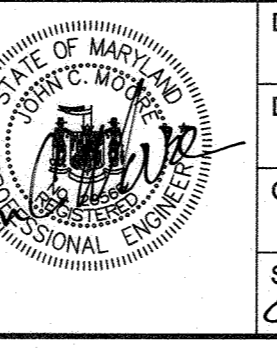

DES:	BY:	NO.	REVISION	DATE
REG/WJG				
DRN: RAD/REG				
CHK: JCM/NKS				
SIGN DATE: 04/25/19				

PAVING PLAN - NORTH SECTION
(STA 0+00 TO STA 18+25)

600' SCALE MAP NO. 31, 37 BLOCK NO. 5, 6, 10, 11, 17, 18, 24 ELECTION DISTRICT NO. 7

PROJECT NO. W8305
CONTRACT NO. 44-5059

LANDING ROAD WATER MAIN LOOP


HOWARD COUNTY, MARYLAND

PV-01

SCALE
AS SHOWN

SHEET NO.
12 OF 18


RKT21515 - 1 - 10/12/2012\2012\12154_HG0280A\Task 12 - Landing Road W8305\CADD\Plans\13-pv-PV-02-LANDING RD.dwg Apr 17, 2019 - 2:41pm Plot Scale = 1" = 50' EN/CTB Plot By: bgress Tab: PV-02

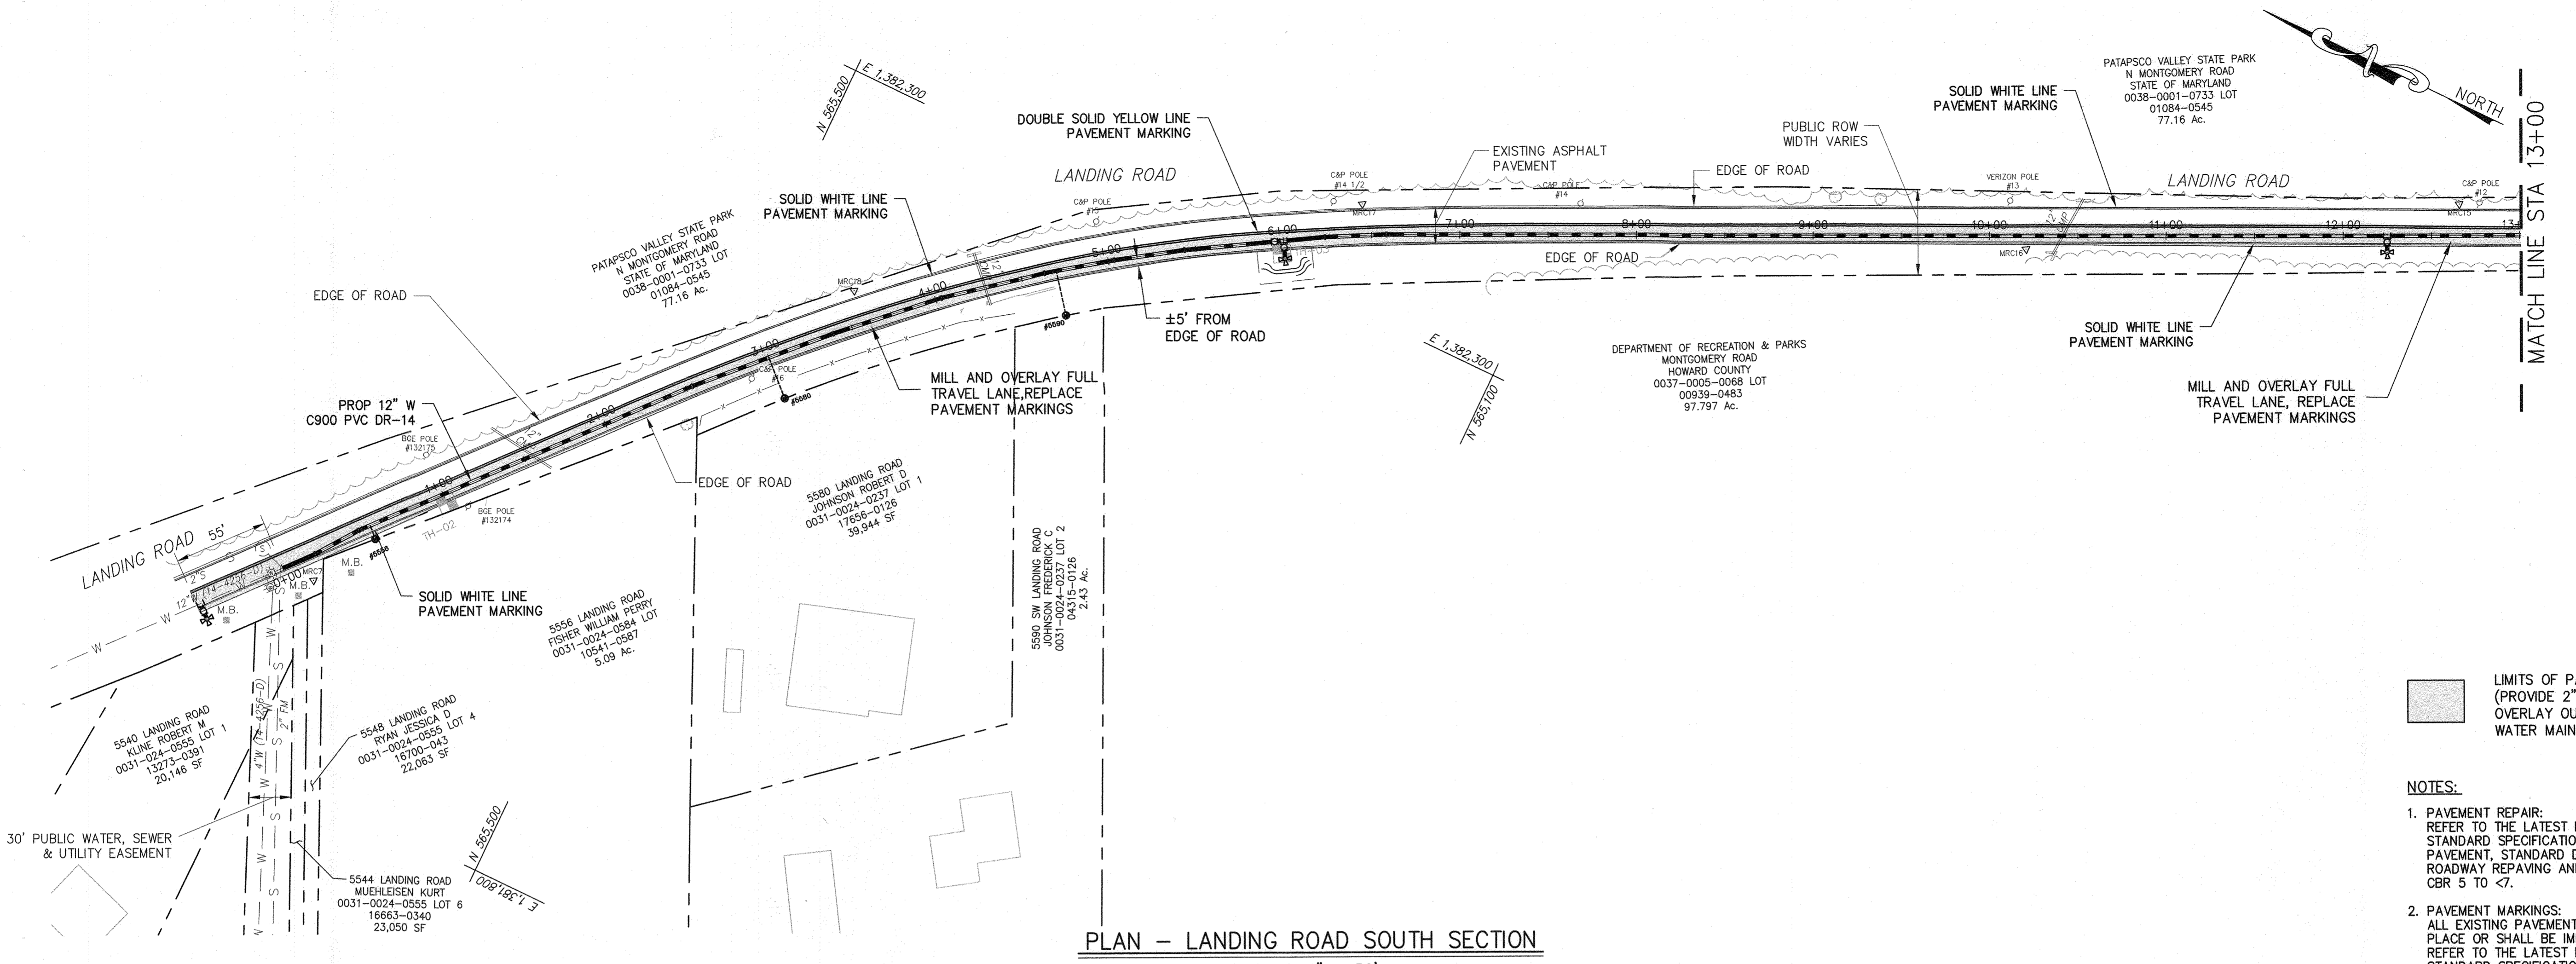


PLAN - LANDING ROAD SOUTH SECTION
SCALE: 1" = 50'

LIMITS OF PAVEMENT REPAIR
 (PROVIDE 2" MILL AND
 OVERLAY OUTSIDE OF THE
 WATER MAIN TRENCH REPAIR)

- NOTES:
- PAVEMENT REPAIR: REFER TO THE LATEST EDITION HOWARD COUNTY STANDARD SPECIFICATION SECTION 504 - ASPHALT PAVEMENT, STANDARD DETAILS G-4.01 UTILITY TRENCH ROADWAY REPAIR AND R-2.01 PAVING SECTION P-4, CBR 5 TO <.
 - PAVEMENT MARKINGS: ALL EXISTING PAVEMENT MARKINGS SHALL REMAIN IN PLACE OR SHALL BE IMMEDIATELY REPLACED IN KIND. REFER TO THE LATEST EDITION HOWARD COUNTY STANDARD SPECIFICATION SECTION 549 PAVEMENT MARKINGS, STANDARD DETAILS T-7.01 TYPICAL INTERSECTION PAVEMENT MARKING LAYOUT AND T-7.03 SIGNING AND MARKING DETAILS.

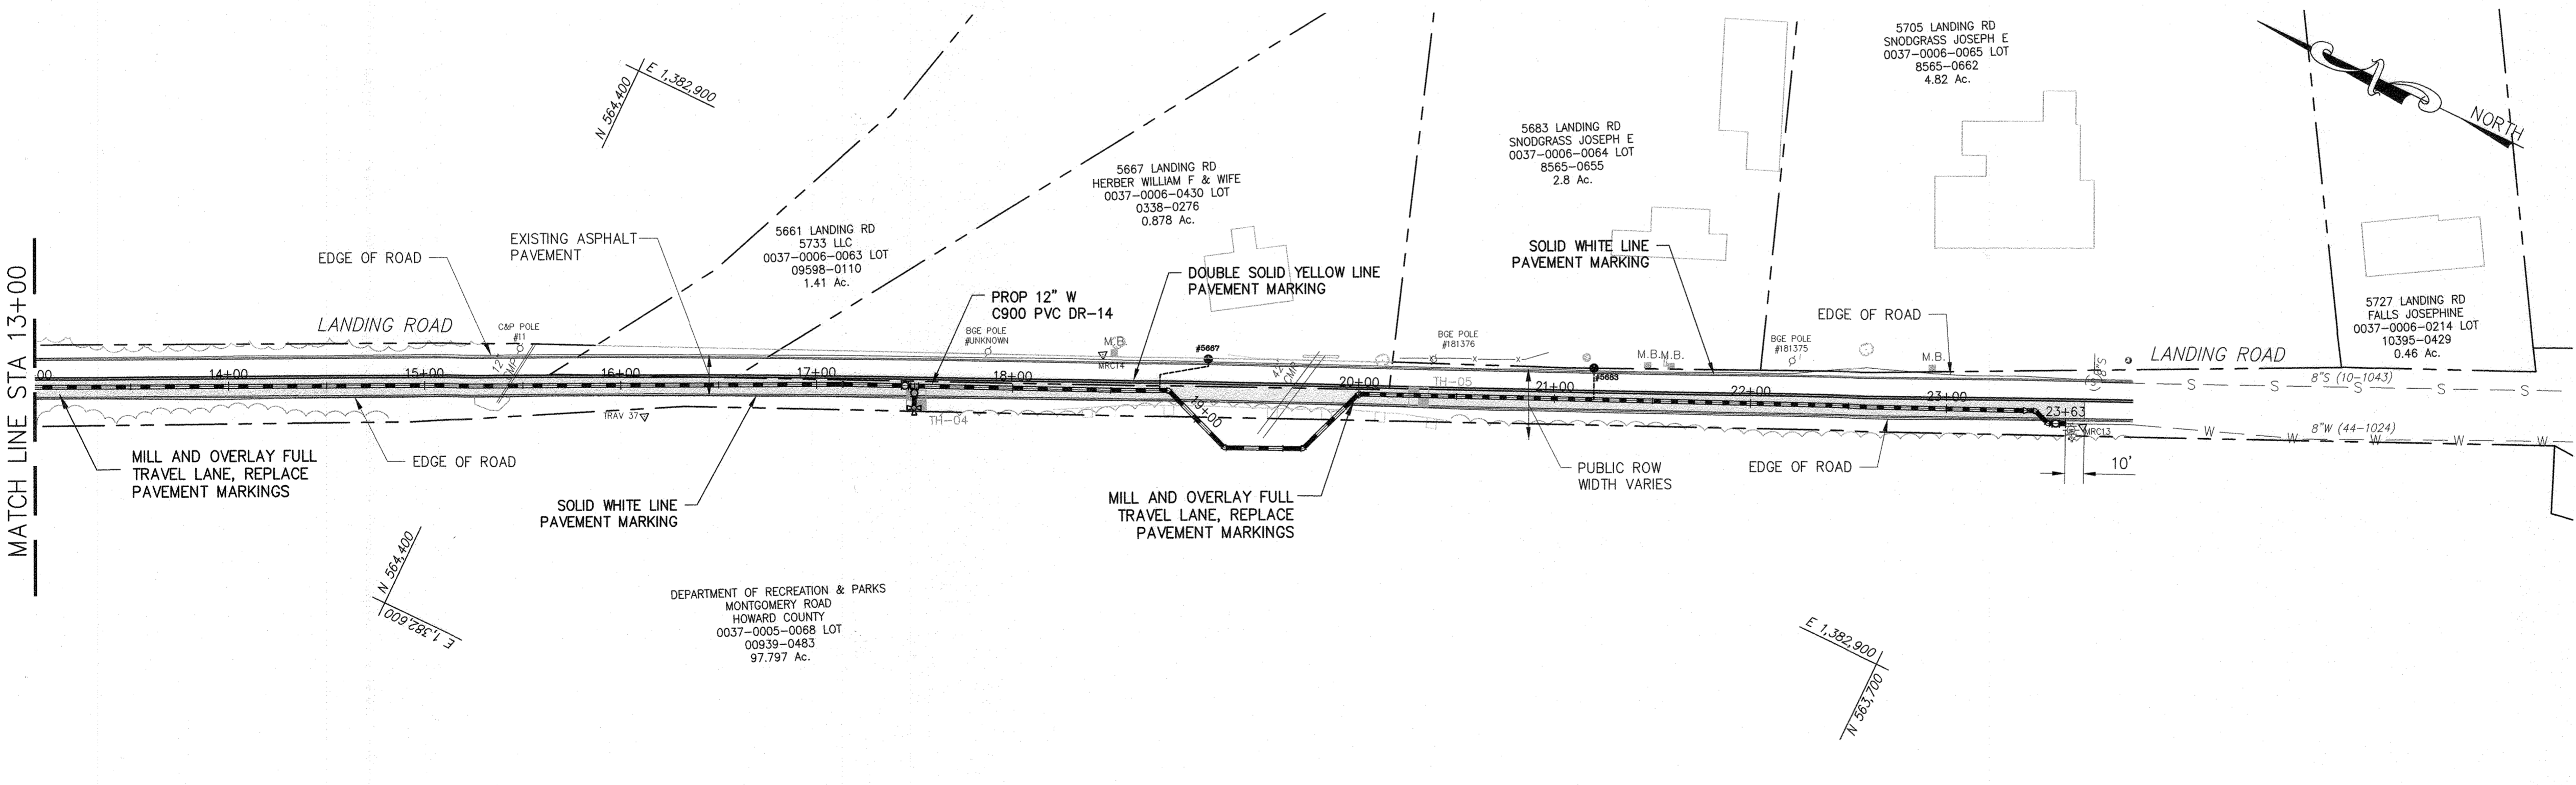

PLAN - LANDING ROAD SOUTH SECTION
SCALE: 1" = 50'

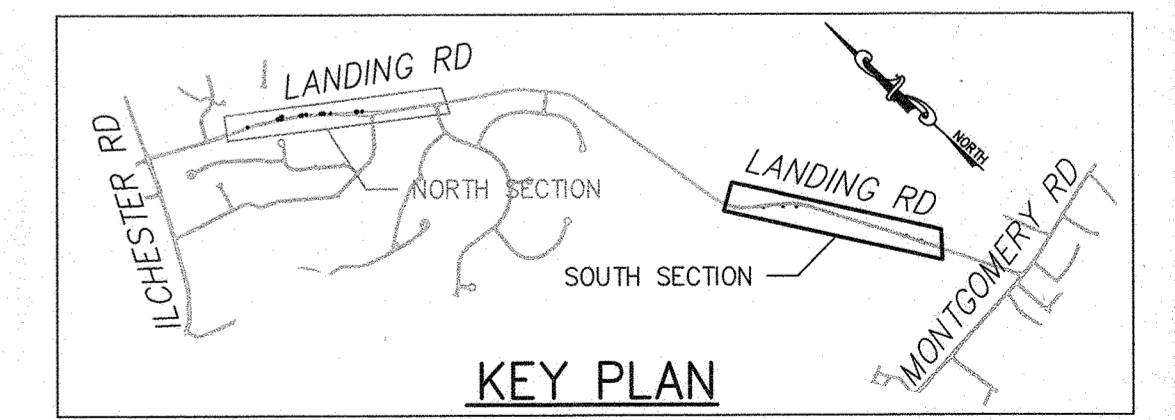

AS-BUILT MAY 2020


1"=50' 0 50' 100' PV-02

DEPARTMENT OF PUBLIC WORKS
 HOWARD COUNTY, MARYLAND

Director of Public Works: *M. J. Jones* 5/31/19
 Chief, Bureau of Engineering: *Thomas B. Sullivan* 4/29/19
 Chief, Bureau of Utilities: *Chris Kelly* 5-2-19
 Chief, Utility Design Division: *U. [Signature]* 4/29/19

RK&K
 P: 410.728.2900
 700 East Pratt Street, Suite 500 | Baltimore, MD 21202
 Engineers | Construction Managers | Planners | Scientists
 www.rkk.com
 Responsive People | Creative Solutions

PROFESSIONAL CERTIFICATION:
 I HEREBY CERTIFY THAT THESE
 DOCUMENTS WERE PREPARED OR
 APPROVED BY ME, AND THAT I
 AM A DULY LICENSED
 PROFESSIONAL ENGINEER UNDER
 THE LAWS OF THE STATE OF
 MARYLAND,
 LICENSE NO. 20566,
 EXPIRATION DATE: 09/06/2020.

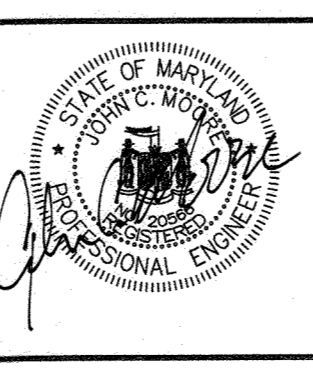


DES:	BY:	NO.:	REVISION:	DATE:
REG/WJG				
DRN:				
RAD/REG				
CHK:				
JCM/NKS				
SIGN DATE:				
04/25/19				

PAVING PLAN - SOUTH SECTION
 (STA 0+00 TO STA 23+63)

600' SCALE MAP NO. 31, 37 BLOCK NO. 5, 6, 10, 11, 17, 18, 24

PROJECT NO. W8305
 CONTRACT NO. 44-5059
 LANDING ROAD WATER MAIN LOOP
 ELECTION DISTRICT NO. 7
 HOWARD COUNTY, MARYLAND

SCALE
 AS SHOWN
 SHEET NO.
 13 OF 18

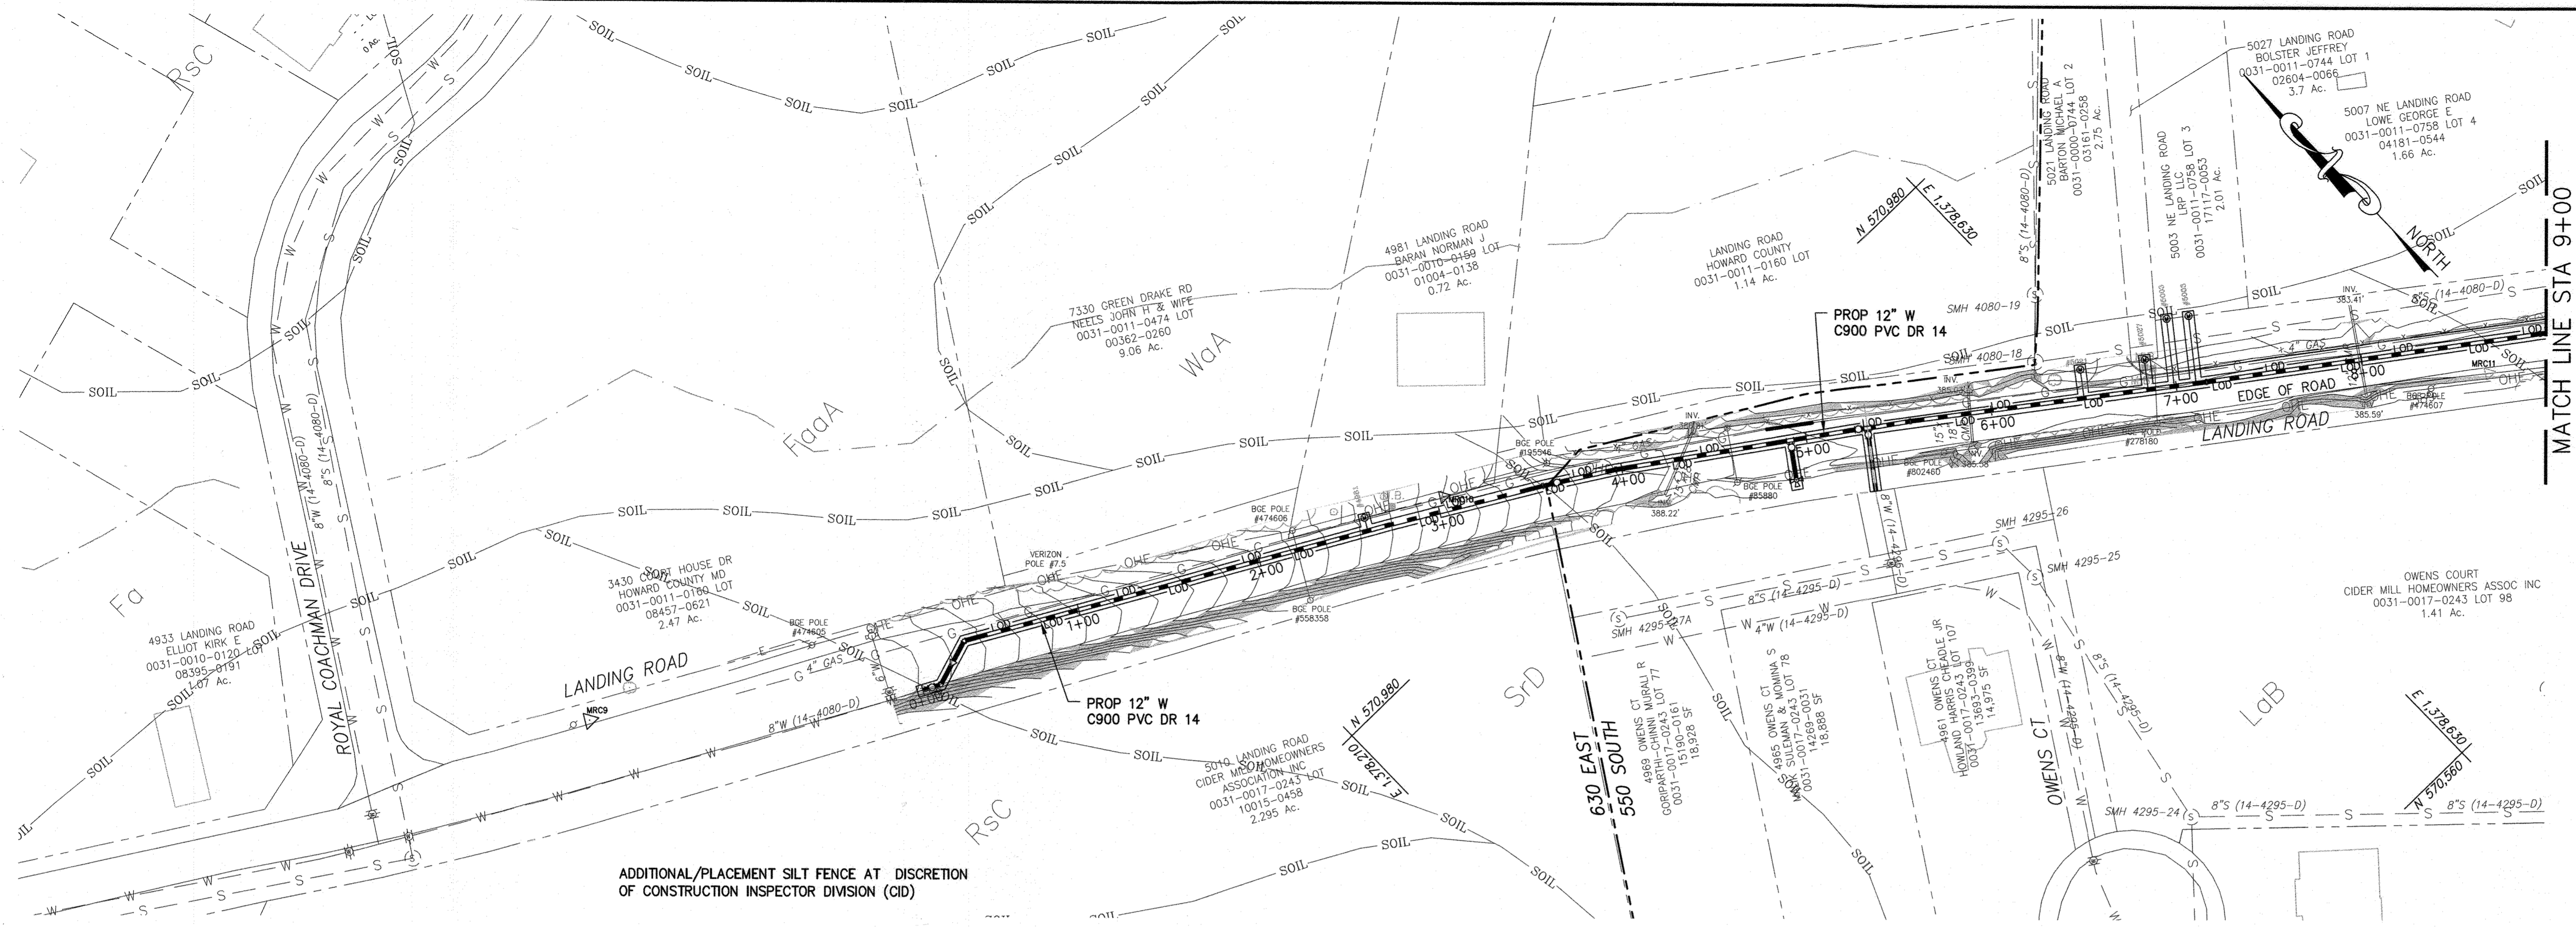


PLAN - LANDING ROAD NORTH SECTION
SCALE: 1" = 50'

- SOIL NOTES**
- SOIL DATA IS BASED ON THE WEB SOIL SURVEY WEBSITE BY THE USDA NATURAL RESOURCES CONSERVATION SERVICE:
 FaaA FALLSINGTON SANDY LOAMS, 0 TO 2 PERCENT SLOPES, Kw=0.24
 GdD GLADSTONE-LEGORE COMPLEX, STONY, 15 TO 25 PERCENT SLOPES Kw=0.28
 LaB LEGORE SILT LOAM, 3 TO 8 PERCENT SLOPES Kw=0.64
 LaC LEGORE SILT LOAM, 8 TO 15 PERCENT SLOPES, Kw=0.64
 RbC RUSSETT FINE SANDY LOAM, 5 TO 10 PERCENT SLOPES, Kw=0.43
 SrD SASSAFRAS AND CROOM SOILS, 10 TO 15 PERCENT SLOPES, Kw=0.37
 WaA WATCHUNG SILT LOAM, 0 TO 3 PERCENT SLOPES, Kw=0.43
 - TOP SOIL SHALL BE PROVIDED IN ACCORDANCE WITH THE LATEST EDITION OF THE SHA STANDARD SPECIFICATIONS OF CONSTRUCTION AND MATERIALS. SECTION 920 - LANDSCAPING MATERIALS.

- UTILITY TRENCH SEDIMENT CONTROL PROCEDURES**
- EXCAVATE TRENCH MATERIAL SHALL BE PLACED ON THE HIGH SIDE OF THE TRENCH.
 - IMMEDIATELY FOLLOWING PIPE INSTALLATION THE TRENCH SHALL BE BACKFILLED, COMPACTED AND STABILIZED AT THE END OF EACH WORKING DAY. SEE HSCD NOTE #9 ON DWG. ES-03 (SHT 16 OF 18).
 - TEMPORARY STEEL PLATES SHALL BE PLACED ON ANY DISTURBED AREA DAILY.


- STANDARD STABILIZATION NOTE**
- FOLLOWING INITIAL SOIL DISTURBANCE OR RE-DISTURBANCE, PERMANENT OR TEMPORARY STABILIZATION MUST BE COMPLETED WITHIN:
- THREE (3) CALENDAR DAYS AS TO THE SURFACE OF ALL PERIMETER DIKES, SWALES, DITCHES, PERIMETER SLOPES, AND ALL SLOPES STEEPER THAN THREE (3) HORIZONTAL TO ONE (1) VERTICAL (3:1); AND
 - SEVEN (7) CALENDAR DAYS AS TO ALL OTHER DISTURBED OR GRADED AREAS ON THE PROJECT SITE NOT UNDER ACTIVE GRADING.

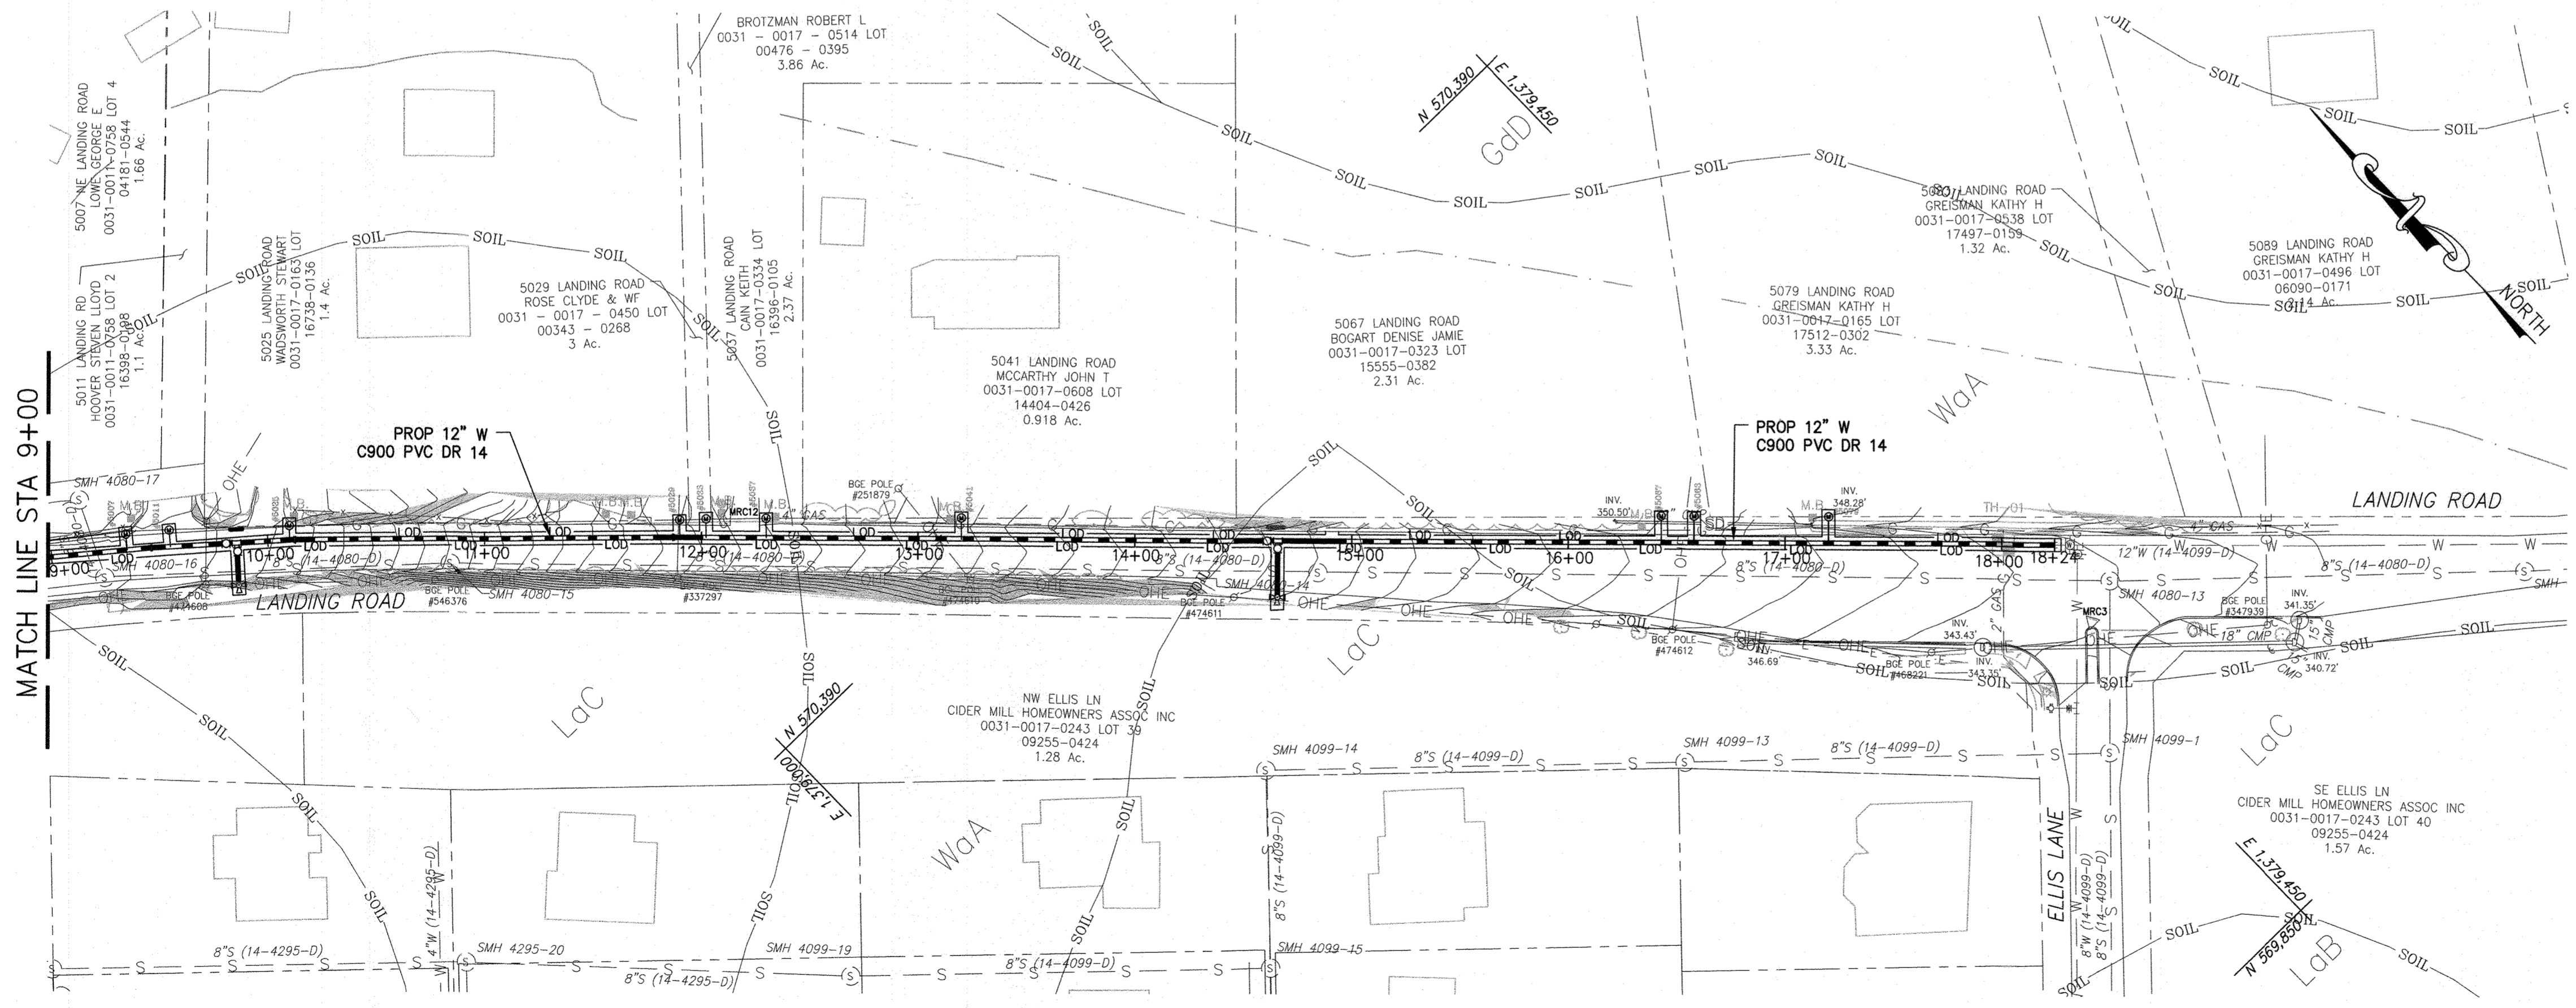


PLAN - LANDING ROAD NORTH SECTION
SCALE: 1" = 50'

**SEQUENCE OF CONSTRUCTION
NORTH SECTION**

- A PRECONSTRUCTION MEETING MUST OCCUR WITH THE HOWARD COUNTY DEPARTMENT OF PUBLIC WORKS, CONSTRUCTION INSPECTION DIVISION (CID), 410-313-1855 AFTER THE FUTURE LOD AND PROTECTED AREAS ARE MARKED CLEARLY IN THE FIELD. A MINIMUM OF 48 HOURS NOTICE TO CID MUST BE GIVEN AT THE FOLLOWING STAGES:
 - PRIOR TO THE START OF EACH DISTURBANCE
 - UPON COMPLETION OF THE INSTALLATION OF PERIMETER EROSION AND SEDIMENT CONTROLS, BUT BEFORE PROCEEDING WITH ANY OTHER EARTH DISTURBANCE OR GRADING
 - PRIOR TO THE START OF ANOTHER PHASE OF CONSTRUCTION OR OPENING OF ANOTHER GRADING UNIT,
 - PRIOR TO THE REMOVAL OR MODIFICATION OF SEDIMENT CONTROL PRACTICES.
- INSTALL PERIMETER CONTROLS AS NECESSARY.... ONE (1) DAY
- CONTACT CID PER 1.b ABOVE.
- COMPLETE WATER MAIN CONSTRUCTION.... FIFTEEN (25) DAYS
- COMPLETE TIE-INS TO EXISTING WATER MAINS.... THREE (3) DAYS
- RESTORE PAVING AND SURROUNDING AREAS.... FIVE (5) DAYS
- ONCE THE PROJECT SITE IS STABILIZED AND CONTROLS CAN BE REMOVED, CONTACT CID PER 1.d ABOVE.
- REMOVE ANY REMAINING SEDIMENT CONTROLS AND STABILIZE AREAS DISTURBED BY REMOVAL OF SEDIMENT CONTROLS.... ONE (1) DAY

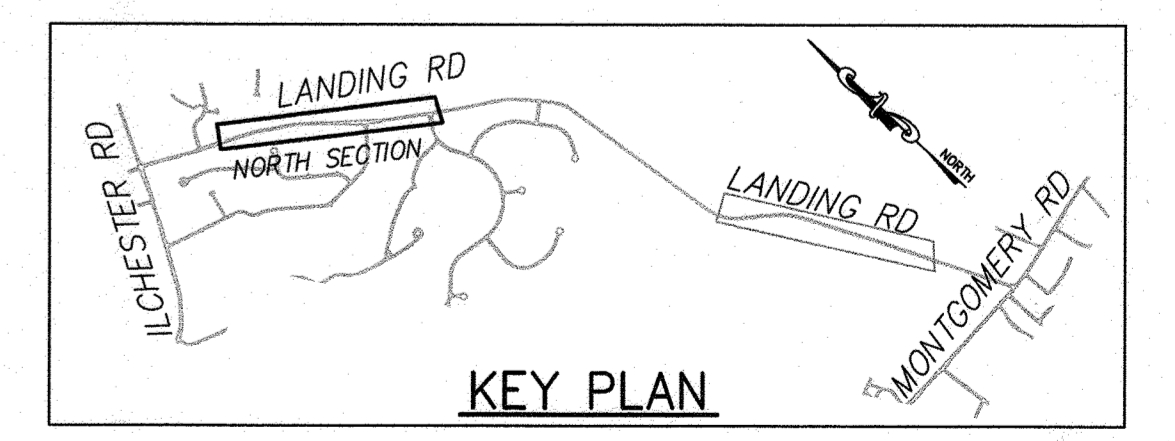

AS-BUILT MAY 2020

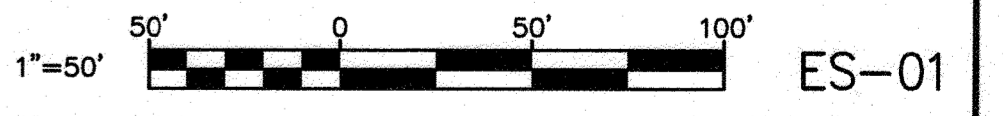

MDE PERMIT #201960115/19-NT-3014

DEPARTMENT OF PUBLIC WORKS
HOWARD COUNTY, MARYLAND

Michael J. ... 5/2/19
DIRECTOR OF PUBLIC WORKS DATE

Thomas P. ... 4/29/19
CHIEF, BUREAU OF ENGINEERING DATE

... 5-2-19
CHIEF, BUREAU OF UTILITIES DATE

... 4/29/19
CHIEF, UTILITY DESIGN DIVISION DATE

RK&K

P: 410.728.2900
700 East Pratt Street, Suite 500 | Baltimore, MD 21202
Engineers | Construction Managers | Planners | Scientists
www.rk.com
Responsive People | Creative Solutions

PROFESSIONAL CERTIFICATION:
I HEREBY CERTIFY THAT THESE DOCUMENTS WERE PREPARED OR APPROVED BY ME, AND THAT I AM A DULY LICENSED PROFESSIONAL ENGINEER UNDER THE LAWS OF THE STATE OF MARYLAND.
LICENSE NO. 20566
EXPIRATION DATE: 09/06/2020.



DES:	BY:	NO.	REVISION	DATE
REG/WJG				
DRN:				
RAD/REG				
CHK:				
JCM/NKS				
SIGN DATE:				
04/25/19				


EROSION AND SEDIMENT CONTROL
PLAN - NORTH SECTION

PROJECT NO. W8305
CONTRACT NO. 44-5059

LANDING ROAD WATER MAIN LOOP

SCALE
AS SHOWN

SHEET NO.
14 OF 18

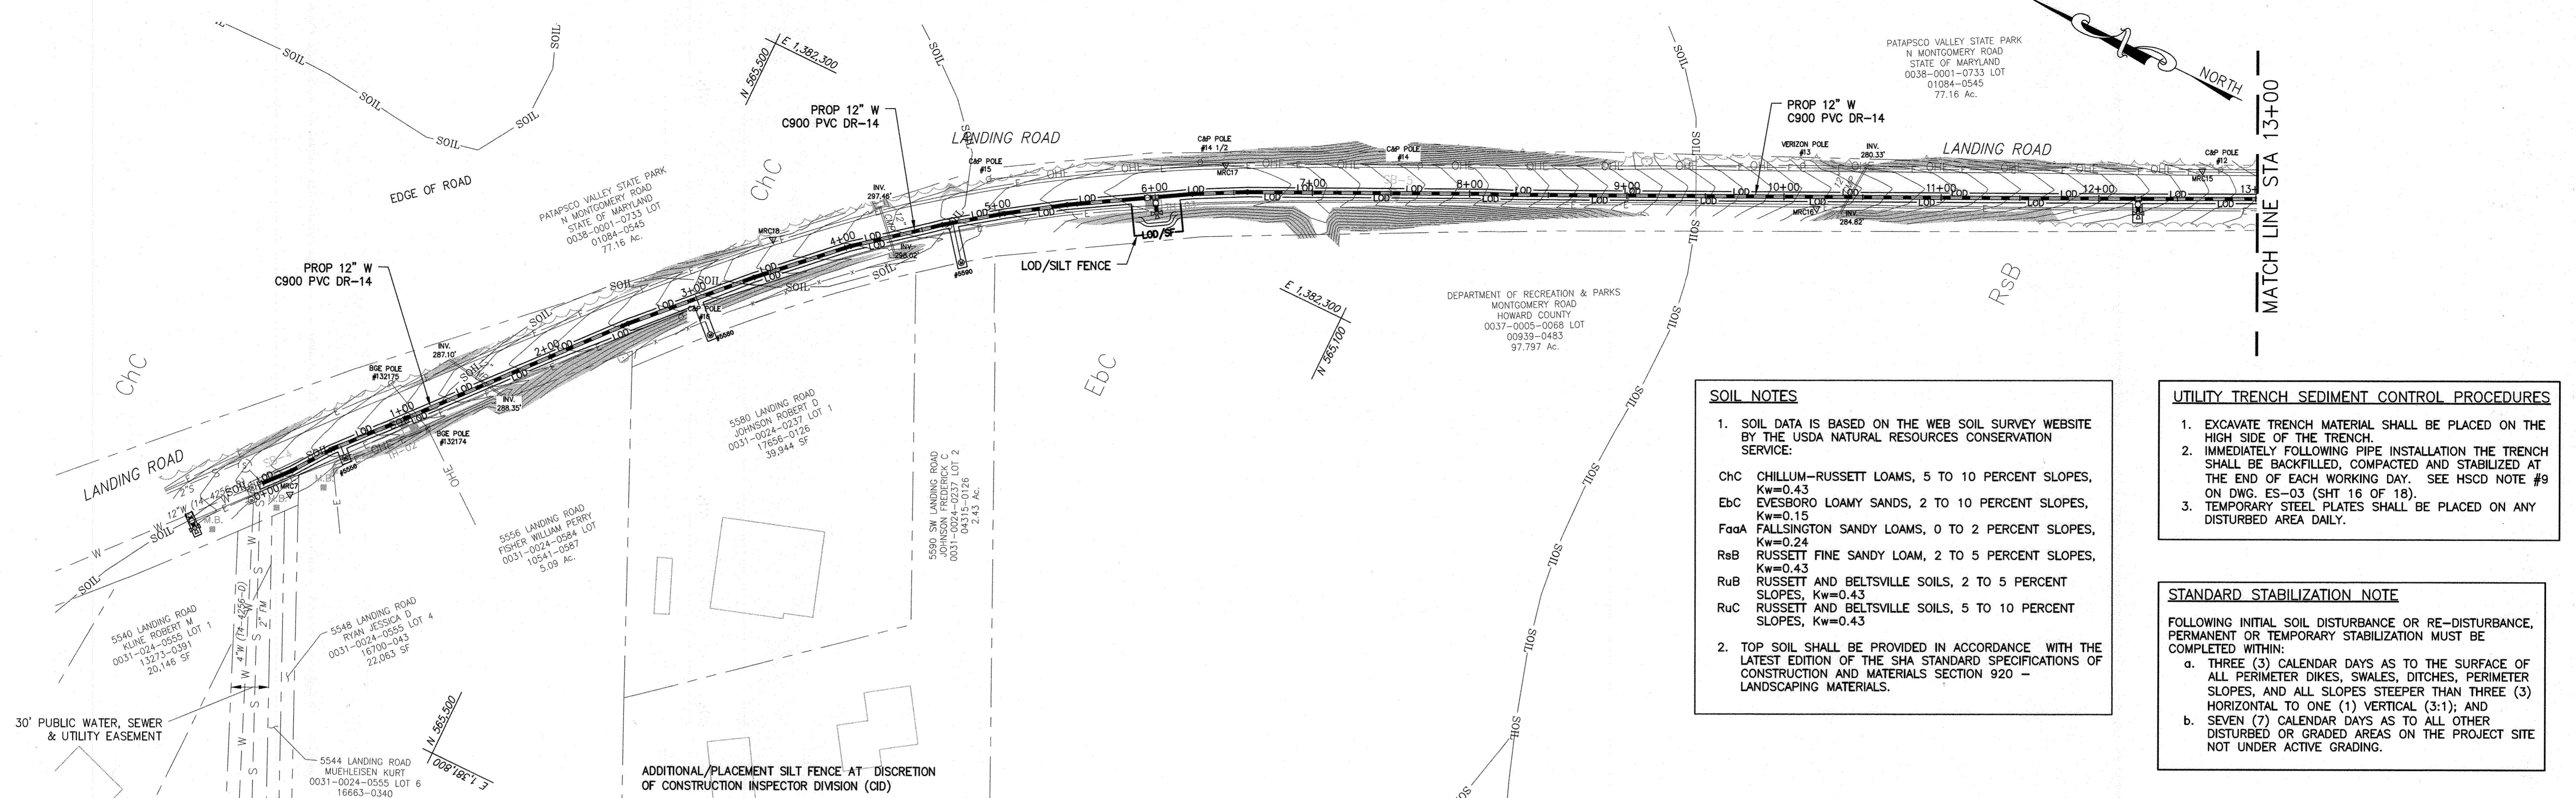

PLAN - LANDING ROAD SOUTH SECTION
SCALE: 1" = 50'

SOIL NOTES

- SOIL DATA IS BASED ON THE WEB SOIL SURVEY WEBSITE BY THE USDA NATURAL RESOURCES CONSERVATION SERVICE:
 - Chc CHILLUM-RUSSETT LOAMS, 5 TO 10 PERCENT SLOPES, Kw=0.43
 - Ebc EVESBORO LOAMY SANDS, 2 TO 10 PERCENT SLOPES, Kw=0.15
 - FaaA FALLSINGTON SANDY LOAMS, 0 TO 2 PERCENT SLOPES, Kw=0.24
 - Rsb RUSSETT FINE SANDY LOAM, 2 TO 5 PERCENT SLOPES, Kw=0.43
 - Rub RUSSETT AND BELTSVILLE SOILS, 2 TO 5 PERCENT SLOPES, Kw=0.43
 - Ruc RUSSETT AND BELTSVILLE SOILS, 5 TO 10 PERCENT SLOPES, Kw=0.43
- TOP SOIL SHALL BE PROVIDED IN ACCORDANCE WITH THE LATEST EDITION OF THE SHA STANDARD SPECIFICATIONS OF CONSTRUCTION AND MATERIALS SECTION 920 - LANDSCAPING MATERIALS.


UTILITY TRENCH SEDIMENT CONTROL PROCEDURES

- EXCAVATE TRENCH MATERIAL SHALL BE PLACED ON THE HIGH SIDE OF THE TRENCH.
- IMMEDIATELY FOLLOWING PIPE INSTALLATION THE TRENCH SHALL BE BACKFILLED, COMPACTED AND STABILIZED AT THE END OF EACH WORKING DAY. SEE HSCD NOTE #9 ON DWG. ES-03 (SHT 16 OF 18).
- TEMPORARY STEEL PLATES SHALL BE PLACED ON ANY DISTURBED AREA DAILY.

STANDARD STABILIZATION NOTE

FOLLOWING INITIAL SOIL DISTURBANCE OR RE-DISTURBANCE, PERMANENT OR TEMPORARY STABILIZATION MUST BE COMPLETED WITHIN:


- THREE (3) CALENDAR DAYS AS TO THE SURFACE OF ALL PERIMETER DIKES, SWALES, DITCHES, PERIMETER SLOPES, AND ALL SLOPES STEEPER THAN THREE (3) HORIZONTAL TO ONE (1) VERTICAL (3:1); AND
- SEVEN (7) CALENDAR DAYS AS TO ALL OTHER DISTURBED OR GRADED AREAS ON THE PROJECT SITE NOT UNDER ACTIVE GRADING.

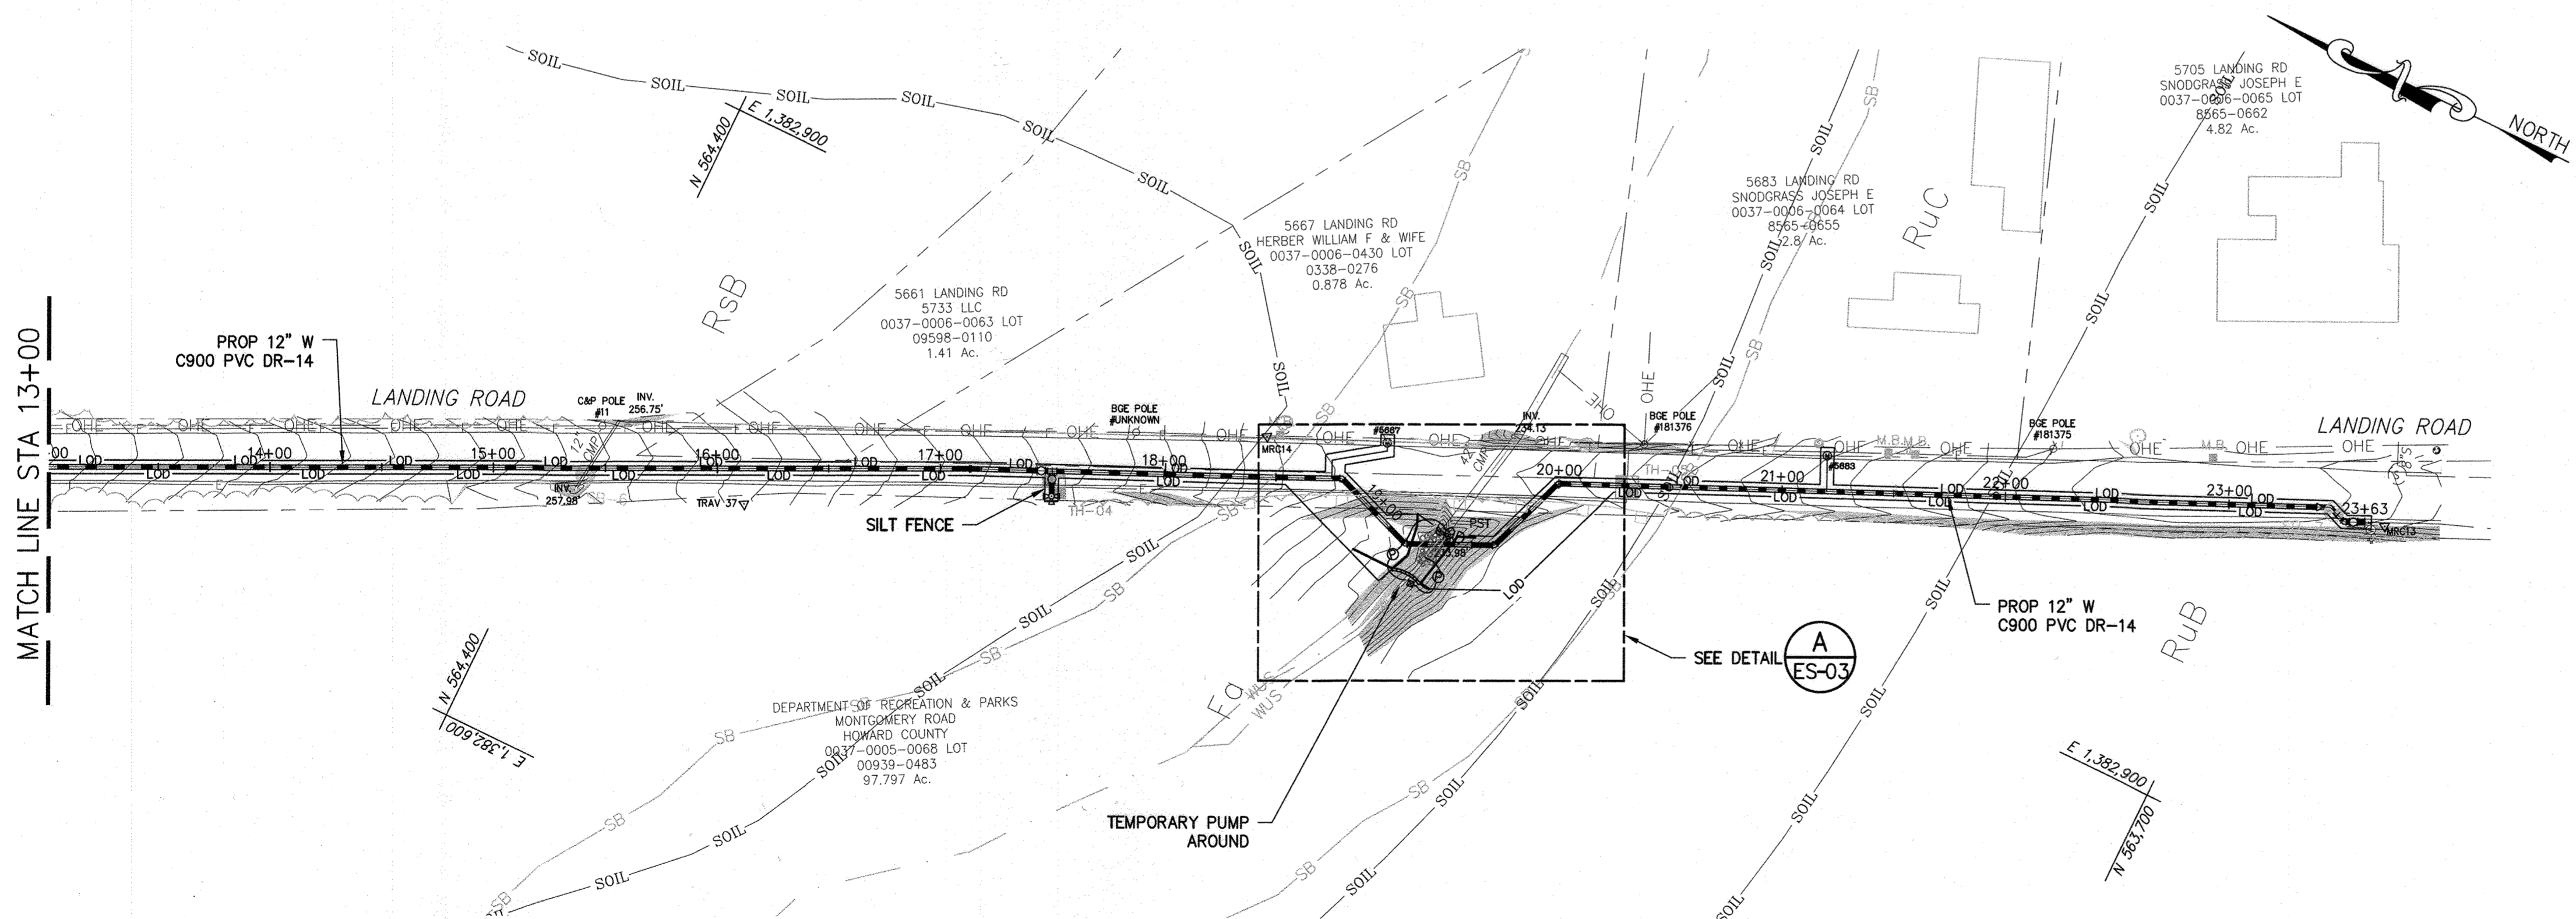

PLAN - LANDING ROAD SOUTH SECTION
SCALE: 1" = 50'

SEQUENCE OF CONSTRUCTION SOUTH SECTION

- A PRECONSTRUCTION MEETING MUST OCCUR WITH THE HOWARD COUNTY DEPARTMENT OF PUBLIC WORKS, CONSTRUCTION INSPECTION DIVISION (CID), 410-313-1855 AFTER THE FUTURE LOD AND PROTECTED AREAS ARE MARKED CLEARLY IN THE FIELD. A MINIMUM OF 48 HOURS NOTICE TO CID MUST BE GIVEN AT THE FOLLOWING STAGES:
 - PRIOR TO THE START OF EACH DISTURBANCE
 - UPON COMPLETION OF THE INSTALLATION OF PERIMETER EROSION AND SEDIMENT CONTROLS, BUT BEFORE PROCEEDING WITH ANY OTHER EARTH DISTURBANCE OR GRADING
 - PRIOR TO THE START OF ANOTHER PHASE OF CONSTRUCTION OR OPENING OF ANOTHER GRADING UNIT,
 - PRIOR TO THE REMOVAL OR MODIFICATION OF SEDIMENT CONTROL PRACTICES.
- INSTALL PERIMETER CONTROLS AS NECESSARY.... ONE (1) DAY
- CONTACT CID PER 1.b ABOVE.
- COMPLETE WATER MAIN CONSTRUCTION.... TWENTY (35) DAYS
 - INSTALL TEMPORARY PUMP AROUND, MGWC 1.2, AT STA 19+50 DURING IN-STREAM CONSTRUCTION. SANDBAGS TO BE REMOVED AND STREAM FLOW RESTORED AT THE END OF EVERY WORK DAY.
- COMPLETE TIE-INS TO EXISTING WATER MAINS.... TWO (2) DAYS
- RESTORE PAVING AND SURROUNDING AREAS.... FIVE (5) DAYS
- ONCE THE PROJECT SITE IS STABILIZED AND CONTROLS CAN BE REMOVED, CONTACT CID PER 1.d ABOVE.
- REMOVE ANY REMAINING SEDIMENT CONTROLS AND STABILIZE AREAS DISTURBED BY REMOVAL OF SEDIMENT CONTROLS.... ONE (1) DAY

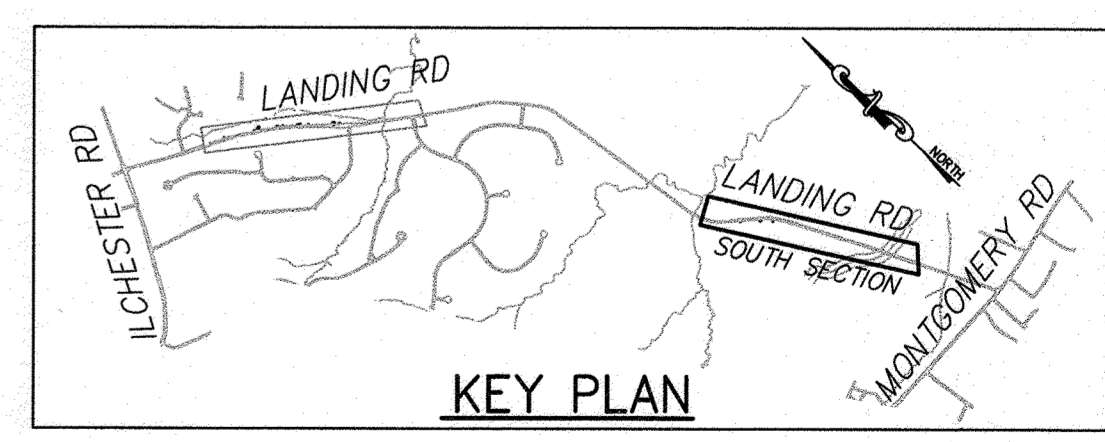

AS-BUILT MAY 2020

1"=50' 0 50' 100' ES-02

MDE PERMIT #201960115/19-NT-3014

DEPARTMENT OF PUBLIC WORKS
HOWARD COUNTY, MARYLAND

M. D. ... 5/1/19
DIRECTOR OF PUBLIC WORKS DATE

D. ... 4/29/19
CHIEF, BUREAU OF ENGINEERING DATE

C. ... 5-2-19
CHIEF, BUREAU OF UTILITIES DATE

D. ... 4/29/19
CHIEF, UTILITY DESIGN DIVISION DATE

RK&K

P: 410.728.2900
700 East Pratt Street, Suite 500 | Baltimore, MD 21202
Engineers | Construction Managers | Planners | Scientists
www.rk.com
Responsive People | Creative Solutions

PROFESSIONAL CERTIFICATION:
I HEREBY CERTIFY THAT THESE DOCUMENTS WERE PREPARED OR APPROVED BY ME, AND THAT I AM A DULY LICENSED PROFESSIONAL ENGINEER UNDER THE LAWS OF THE STATE OF MARYLAND.
LICENSE NO. 20566
EXPIRATION DATE: 09/06/2020

DES:	BY:	NO.:	REVISION:	DATE:
REG/WJG				
RAD/REG				
CHK:				
JCM/NKS				
SIGN DATE:				
04/25/19				

EROSION AND SEDIMENT CONTROL
PLAN - SOUTH SECTION

PROJECT NO. W8305
CONTRACT NO. 44-5059
LANDING ROAD WATER MAIN LOOP

SCALE
AS SHOWN
SHEET NO.
15 OF 18

600' SCALE MAP NO. 31, 37 BLOCK NO. 5, 6, 10, 11, 17, 18, 24 ELECTION DISTRICT NO. 7 HOWARD COUNTY, MARYLAND

R2121519 1/2012/2012/12154_JacobDA\Task 12 - Landing Road W8305 CADD\Plans\19-pes-P002-LANDING RD.dwg Apr 22, 2019 - 12:01pm ENV/CIB Plot Scale 1=1 Plot By: bgrasso Tab: ES-02

HOWARD SOIL CONSERVATION DISTRICT (HSCD) STANDARD SEDIMENT CONTROL NOTES

1. A PRECONSTRUCTION MEETING MUST OCCUR WITH THE HOWARD COUNTY DEPARTMENT OF PUBLIC WORKS, CONSTRUCTION INSPECTION DIVISION (CID), 410-313-1855 AFTER THE FUTURE LOD AND PROTECTED AREAS ARE MARKED CLEARLY IN THE FIELD. A MINIMUM OF 48 HOURS NOTICE TO CID MUST BE GIVEN AT THE FOLLOWING STAGES:
 - PRIOR TO THE START OF EACH DISTURBANCE
 - UPON COMPLETION OF THE INSTALLATION OF PERIMETER EROSION AND SEDIMENT CONTROLS, BUT BEFORE PROCEEDING WITH ANY OTHER EARTH DISTURBANCE OR GRADING
 - PRIOR TO THE START OF ANOTHER PHASE OF CONSTRUCTION OR OPENING OF ANOTHER GRADING UNIT,
 - PRIOR TO THE REMOVAL OR MODIFICATION OF SEDIMENT CONTROL PRACTICES.

OTHER BUILDING OR GRADING INSPECTION APPROVALS MAY NOT BE AUTHORIZED UNTIL THIS INITIAL APPROVAL BY THE INSPECTION AGENCY IS MADE. OTHER RELATED STATE AND FEDERAL PERMITS SHALL BE REFERENCED, TO ENSURE COORDINATION AND TO AVOID CONFLICTS WITH THIS PLAN.

2. ALL VEGETATIVE AND STRUCTURAL PRACTICES ARE TO BE INSTALLED ACCORDING TO THE PROVISIONS OF THIS PLAN AND ARE TO BE IN CONFORMANCE WITH THE MOST CURRENT MARYLAND STANDARDS AND SPECIFICATIONS FOR SOIL EROSION AND SEDIMENT CONTROL AND REVISIONS THERETO.
3. FOLLOWING INITIAL SOIL DISTURBANCE OR RE-DISTURBANCE, PERMANENT OR TEMPORARY STABILIZATION SHALL BE COMPLETED WITHIN: A) 3 CALENDAR DAYS FOR ALL PERIMETER SEDIMENT CONTROL STRUCTURES, DIKES, PERIMETER SLOPES AND ALL SLOPES GREATER THAN 3:1, B) 7 DAYS AS TO ALL OTHER DISTURBED OR GRADED AREAS ON THE PROJECT SITE.
4. ALL DISTURBED AREAS MUST BE STABILIZED WITHIN THE TIME PERIOD SPECIFIED ABOVE IN ACCORDANCE WITH THE 2011 MARYLAND STANDARDS AND SPECIFICATIONS FOR SOIL EROSION AND SEDIMENT CONTROL FOR PERMANENT SEEDING (SEC. B-4-5), TEMPORARY SEEDING (SEC. B-4-4) AND MULCHING (SEC. B-4-3). TEMPORARY STABILIZATION WITH MULCH ALONE CAN ONLY BE APPLIED BETWEEN THE FALL AND SPRING SEEDING DATES IF THE GROUND IS FROZEN. INCREMENTAL STABILIZATION (SEC. B-4-1) SPECIFICATIONS SHALL BE ENFORCED IN AREAS WITH > 15' OF CUT AND/OR FILL. STOCKPILES (SEC. B-4-8) IN EXCESS OF 20 FT. MUST BE BENCHED WITH STABLE OUTLET. ALL CONCENTRATED FLOW, STEEP SLOPE, AND HIGHLY ERODIBLE AREAS SHALL RECEIVE SOIL STABILIZATION MATTING (SEC. B-4-6).

5. ALL SEDIMENT CONTROL STRUCTURES ARE TO REMAIN IN PLACE AND ARE TO BE MAINTAINED IN OPERATIVE CONDITION UNTIL PERMISSION FOR THEIR REMOVAL HAS BEEN OBTAINED FROM THE HOWARD COUNTY SEDIMENT CONTROL INSPECTOR.

6. SITE ANALYSIS:
 TOTAL AREA OF SITE: 5.70 ACRES (LINEAR PUBLIC UTILITY PROJECT WITHIN LANDING ROAD)
 AREA DISTURBED: 0.72 ACRES
 AREA TO BE ROOFED OR PAVED: 1.12 ACRES
 AREA TO BE VEGETATIVELY STABILIZED: 0.14 ACRES (MINOR SHOULDER WORK)
 TOTAL CUT: 3,700 CU. YDS. (ALL TRENCH EXCAVATION FOR 12" AND 8" WATER)
 TOTAL FILL: 3,700 CU. YDS.
 OFFSITE WASTE/BORROW AREA LOCATION: . . . TO BE DETERMINED BY CONTRACTOR, SITE SHALL HAVE AN ACTIVE GRADING PERMIT

7. ANY SEDIMENT CONTROL PRACTICE WHICH IS DISTURBED BY GRADING ACTIVITY FOR PLACEMENT OF UTILITIES MUST BE REPAIRED ON THE SAME DAY OF DISTURBANCE.

8. ADDITIONAL SEDIMENT CONTROL MUST BE PROVIDED, IF DEEMED NECESSARY BY THE HOWARD COUNTY SEDIMENT CONTROL INSPECTOR. THE SITE AND ALL CONTROLS SHALL BE INSPECTED BY THE CONTRACTOR WEEKLY; AND THE NEXT DAY AFTER EACH RAIN EVENT. A WRITTEN REPORT BY THE CONTRACTOR, MADE AVAILABLE UPON REQUEST, IS PART OF EVERY INSPECTION AND SHOULD INCLUDE:
 - INSPECTION DATE
 - INSPECTION TYPE (ROUTINE, PRE-STORM EVENT, DURING RAIN EVENT)
 - NAME AND TITLE OF INSPECTOR
 - WEATHER INFORMATION (CURRENT CONDITIONS AS WELL AS TIME AND AMOUNT OF LAST RECORDED PRECIPITATION)
 - BRIEF DESCRIPTION OF PROJECT'S STATUS (E.G., PERCENT COMPLETE) AND/OR CURRENT ACTIVITIES
 - EVIDENCE OF SEDIMENT DISCHARGES
 - IDENTIFICATION OF SEDIMENT CONTROLS THAT REQUIRE MAINTENANCE
 - IDENTIFICATION OF MISSING OR IMPROPERLY INSTALLED SEDIMENT CONTROLS
 - COMPLIANCE STATUS REGARDING THE SEQUENCE OF CONSTRUCTION AND STABILIZATION REQUIREMENTS
 - PHOTOGRAPHS
 - MONITORING/SAMPLING
 - MAINTENANCE AND/OR CORRECTIVE ACTION PERFORMED
 - OTHER INSPECTION ITEMS AS REQUIRED BY THE GENERAL PERMIT FOR STORM ASSOCIATED WITH CONSTRUCTION ACTIVITIES (NPDES, MDE).

9. TRENCHES FOR THE CONSTRUCTION OF UTILITIES IS LIMITED TO THREE PIPE LENGTHS OR THAT WHICH SHALL BE BACK-FILLED AND STABILIZED BY THE END OF EACH WORK DAY, WHICHEVER IS SHORTER.

10. ANY MAJOR CHANGES OR REVISIONS ON THE PLAN OR SEQUENCE OF CONSTRUCTION MUST BE REVIEWED AND APPROVED BY THE HSCD PRIOR TO PROCEEDING WITH CONSTRUCTION. MINOR REVISIONS MAY ALLOWED BY THE CID PER LIST OF HSCD-APPROVED FIELD CHANGES.

11. DISTURBANCE SHALL NOT OCCUR OUTSIDE THE LOD. A PROJECT IS TO BE SEQUENCED SO THAT GRADING ACTIVITIES BEGIN ON ONE GRADING UNIT (MAXIMUM ACREAGE OF 20 AC. PER GRADING UNIT) AT A TIME. WORK MAY PROCEED TO A SUBSEQUENT GRADING UNIT WHEN AT LEAST 50 PERCENT OF THE DISTURBED AREA IN THE PRECEDING GRADING UNIT HAS BEEN STABILIZED AND APPROVED BY THE CID. UNLESS OTHERWISE SPECIFIED AND APPROVED BY THE CID, NO MORE THAN 30 ACRES CUMULATIVELY MAY BE DISTURBED AT A GIVEN TIME.

12. WASH WATER FROM ANY EQUIPMENT, VEHICLES, WHEELS, PAVEMENT, AND OTHER SOURCES MUST BE TREATED IN A SEDIMENT BASIN OR OTHER APPROVED WASHOUT STRUCTURE.

13. TOPSOIL SHALL BE STOCKPILED AND PRESERVED ON-SITE FOR REDISTRIBUTION ONTO FINAL GRADE.

14. ALL SILT FENCE AND SUPER SILT FENCE SHALL BE PLACED ON-THE-CONTOUR, AND BE IMBRICATED AT 25' MINIMUM INTERVALS, WITH LOWER ENDS CURLED UPHILL BY 2' IN ELEVATION.

15. STREAM CHANNELS MUST NOT BE DISTURBED DURING THE FOLLOWING RESTRICTED TIME PERIODS (INCLUSIVE):
 - USE I AND II MARCH 1 – JUNE 15
 - USE III AND IIIB OCTOBER 1 – APRIL 30
 - USE IV MARCH 1 – MAY 31

16. A COPY OF THIS PLAN, THE 2011 MARYLAND STANDARDS AND SPECIFICATIONS FOR SOIL EROSION AND SEDIMENT CONTROL, AND ASSOCIATED PERMITS SHALL BE ON-SITE AND AVAILABLE WHEN THE SITE IS ACTIVE.

MDE PERMIT #201960115/19-NT-3014

DEPARTMENT OF PUBLIC WORKS
HOWARD COUNTY, MARYLAND

M. J. [Signature] 5/19/19
DIRECTOR OF PUBLIC WORKS DATE

Thomas J. Sully 4/19/19
CHIEF, BUREAU OF ENGINEERING DATE

[Signature] 5-2-19
CHIEF, BUREAU OF UTILITIES DATE

[Signature] 4/19/19
CHIEF, UTILITY DESIGN DIVISION DATE

RK&K
P: 410.728.2900
700 East Pratt Street, Suite 500 | Baltimore, MD 21202
Engineers | Construction Managers | Planners | Scientists
www.rkk.com
Responsive People | Creative Solutions

PROFESSIONAL CERTIFICATION:
I HEREBY CERTIFY THAT THESE DOCUMENTS WERE PREPARED OR APPROVED BY ME, AND THAT I AM A DULY LICENSED PROFESSIONAL ENGINEER UNDER THE LAWS OF THE STATE OF MARYLAND, LICENSE NO. 20566, EXPIRATION DATE: 09/06/2020.

[Signature]
PROFESSIONAL ENGINEER

DES:	BY	NO.	REVISION	DATE
REG/WJG				
DRN: RAD/REG				
CHK: JCM/NKS				
SIGN DATE: 04/25/19				

EROSION AND SEDIMENT CONTROL NOTES

600' SCALE MAP NO. 31, 37 BLOCK NO. 5, 6, 10, 11, 17, 18, 24

PROJECT NO. W8305
CONTRACT NO. 44-5059

LANDING ROAD WATER MAIN LOOP

ELECTION DISTRICT NO. 7 HOWARD COUNTY, MARYLAND

SCALE AS SHOWN SHEET NO. 16 OF 18

SUPPLEMENTAL EROSION AND SEDIMENT CONTROL NOTES

1. STAGING AND STOCKPILING:
NO STAGING OR STOCKPILE AREAS ALLOWED ON-SITE.
2. STABILIZED CONSTRUCTION ENTRANCE (SCE) AND EQUIPMENT CLEANING AREA (ECA):
THERE ARE NO SCEs INCLUDED IN THIS PROJECT. PROVIDE AN EQUIPMENT CLEANING AREA (ECA) DURING CONSTRUCTION, AS DIRECTED BY THE ENGINEER. REFER TO ECA DETAIL ON DRAWING ES-05 (SHEET 18 OF 18). REMOVE ACCUMULATED STONE AND SEDIMENT PRIOR TO DISMANTLING THE ECA.

3. COORDINATION WITH MAINTENANCE OF TRAFFIC PLAN:
THE SEDIMENT AND EROSION CONTROL SEQUENCES SHALL BE COORDINATED WITH THE MAINTENANCE OF TRAFFIC PLANS TO MAINTAIN CONTINUITY OF THE PRACTICES DURING ALL PHASES OF THE PROPOSED WORK. CONCURRENT CONSTRUCTION WITHIN THE VARIOUS PHASES MAY BE UNDERTAKEN IN ACCORDANCE WITH THE MAINTENANCE OF TRAFFIC PLAN. APPROPRIATE EROSION AND SEDIMENT CONTROL MEASURES SHALL BE IN PLACE PRIOR TO BEGINNING CONCURRENT WORK. SEDIMENT AND EROSION CONTROL MEASURES SHALL BE REMOVED UPON COMPLETION OF THEIR INTENDED FUNCTION. PERMANENT STABILIZATION OF CONTRIBUTORY DRAINAGE AREA AND PRIOR APPROVAL FROM THE SEDIMENT CONTROL INSPECTOR. SEDIMENT AND EROSION CONTROL MEASURES NECESSARY FOR SUBSEQUENT PHASE OF THE WORK SHALL BE MAINTAINED AS REQUIRED BY THE STANDARDS AND SPECIFICATIONS.

4. DEWATERING
ANY EFFLUENT FROM DEWATERING FOUNDATIONS, TRENCHES AND OTHER DISTURBED AREAS MUST BE TREATED BY AN APPROVED SEDIMENT CONTROL DEVICE BEFORE BEING DISCHARGED. CONTRACTOR TO USE PORTABLE SEDIMENT TANKS.

5. SEQUENCE OF CONSTRUCTION
THE SEQUENCE OF CONSTRUCTION INCLUDED IN THESE PLANS IS APPROVED BY HOWARD COUNTY. THIS SEQUENCE OF CONSTRUCTION MAY BE MODIFIED BY THE CONTRACTOR. HOWEVER, THE CONTRACTOR MUST OBTAIN HOWARD COUNTY APPROVAL FOR ANY MODIFICATIONS PRIOR TO IMPLEMENTING A REVISED SEQUENCE OF CONSTRUCTION IN THE FIELD.

NO DISTURBED AREAS SHALL BE LEFT UNSTABILIZED OVERNIGHT, UNLESS RUNOFF IS DIRECTED TO AN APPROVED SEDIMENT CONTROL DEVICE.

6. CONTRACTOR SHALL REMOVE SPOILS TO A SITE WITH AN APPROVED SEDIMENT AND EROSION CONTROL PERMIT.

LEGEND

ROADWAY RIGHT OF WAY AND PROPERTY LINE: _____

LIMIT OF DISTURBANCE: --- LOD --- LOD --- LOD ---

SILT FENCE: — SF — SF —

STEEP SLOPES (>25%): [SHADING]

PROPOSED

WATER MAIN: ————

WATER VALVE: [Symbol]

WATER FIRE HYDRANT: [Symbol]

WATER HOUSE CONNECTION: - - - - (M)

EXISTING

WATER: --- W --- W --- W --- W ---

UNDERGROUND ELECTRIC: — E — E — E —

UNDERGROUND TELEPHONE: — T — T —

MINOR CONTOURS: - - - - 492 - - - -

MAJOR CONTOURS: - - - - 490 - - - -

WATER FIRE HYDRANT: [Symbol]


WATER VALVE: [Symbol]

STREAM CENTERLINE: ————

STREAM BUFFER: — SB — SB —

WATERS OF THE US: - - - - WUS - - - -

TREE LINE OR WOODS GUARDRAIL: [Symbol]

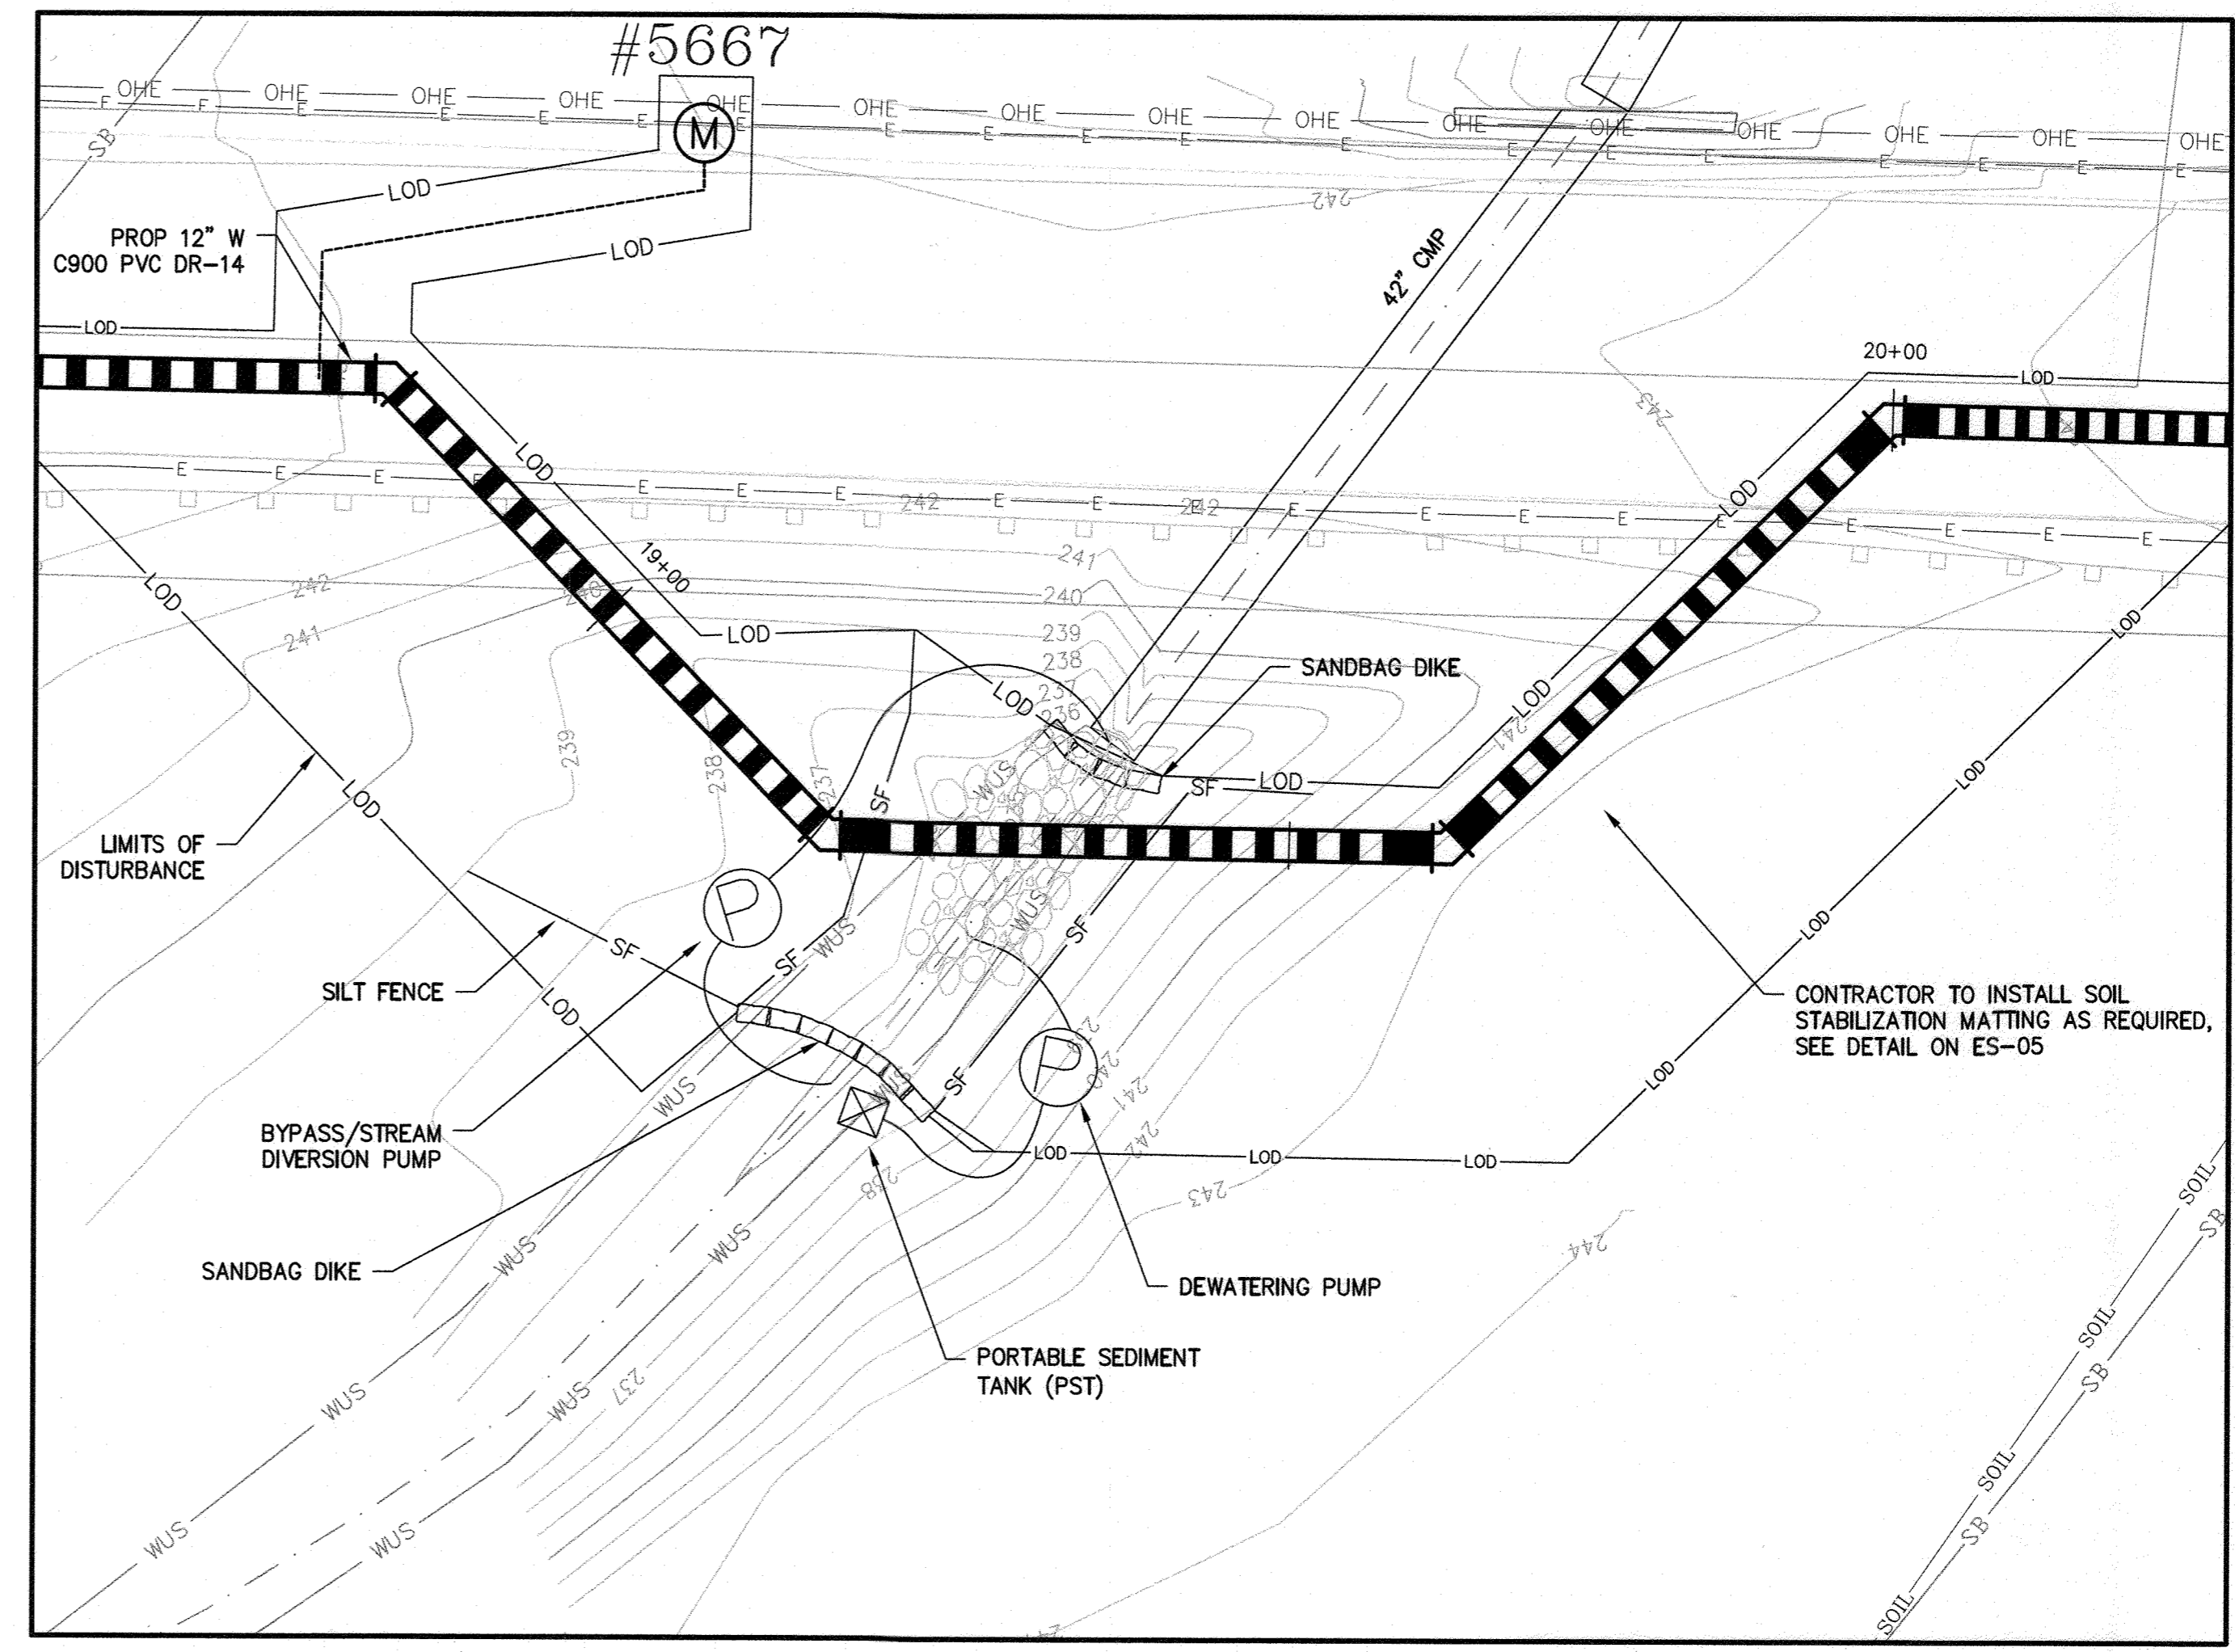

- TEMPORARY PUMP AROUND NOTES:**
1. THE CONTRACTOR SHALL CLOSE SILT FENCE ONTO SANDBAG ENDS. ENDS TO BE CURLED UPHILL.
 2. THE CONTRACTOR SHALL INCLUDE 3-DAY CLEAR (NO PRECIPITATION) NWS FORECAST, AND PERMISSION FROM INSPECTOR, BEFORE ANY DISTURBANCE WITHIN STREAM.
 3. THE PUMP CAPACITY FOR TEMPORARY BYPASS/DIVERSION PUMPS SHALL BE MINIMUM 25.8 GPM, BASED ON ONE CFS/SQ. MILE OF DRAINAGE AREA.

AS-BUILT MAY 2020

TEMPORARY PUMP AROUND DETAIL

SCALE: 1" = 10'



ENVGDB Plot Scale 1=1 Plot By: bprgos Take: ES-03

ENVGDB Plot Scale 1=1 Plot By: bprgos Take: ES-03

R2K2\SYS - \baldm01\2019\2019\2154_H06080A\Task 12 - Landing Road W8305_CADD\Plans\18-PES-0003_LANDING RD.dwg Apr 19, 2019 1:07pm Plot Scale 1=1 Plot By: pmjmundor Tab: ES-05

MGWC 1.2: PUMP-AROUND PRACTICE

Temporary measure for dewatering in-channel construction sites

DESCRIPTION

The work should consist of installing a temporary pump around and supporting measures to divert flow around in-stream construction sites.

IMPLEMENTATION SEQUENCE

Sediment control measures, pump-around practices, and associated channel and bank construction should be completed in the following sequence (refer to Detail 1.2):

1. Construction activities including the installation of erosion and sediment control measures should not begin until all necessary easements and/or right-of-ways have been acquired. All existing utilities should be marked in the field prior to construction. The contractor is responsible for any damage to existing utilities that may result from construction and should repair the damage at his/her own expense to the county's or utility company's satisfaction.
2. The contractor should notify the Maryland Department of the Environment or WMA sediment control inspector at least 5 days before beginning construction. Additionally, the contractor should inform the local environmental protection and resource management inspection and enforcement division and the provider of local utilities a minimum of 48 hours before starting construction.
3. The contractor should conduct a pre-construction meeting on site with the WMA sediment control inspector, the county project manager, and the engineer to review limits of disturbance, erosion and sediment control requirements, and the sequence of construction. The contractor should state out all limits of disturbance prior to the pre-construction meeting so they may be reviewed. The participants will also designate the contractor's staging areas and flag all trees within the limit of disturbance which will be removed for construction access. Trees should not be removed within the limit of disturbance without approval from the WMA or local authority.
4. Construction should not begin until all sediment and erosion control measures have been installed and approved by the engineer and the sediment control inspector. The contractor should stay within the limits of the disturbance as shown on the plans and minimize disturbance within the work area whenever possible.
5. Upon installation of all sediment control measures and approval by the sediment control inspector and the local environmental protection and resource management inspection and enforcement division, the contractor should begin work at the upstream section and proceed downstream beginning with the establishment of stabilized construction entrances. In some cases, work may begin downstream if appropriate. The sequence of construction must be followed unless the contractor gets written approval for deviations from the WMA or local authority. The contractor should only begin work in an area which can be completed by the end of the day including grading adjacent to the channel. At the end of each work day, the work area must be stabilized and the pump around removed from the channel. Work should not be conducted in the channel during rain events.
6. Sandbag dikes should be situated at the upstream and downstream ends of the work area as shown on the plans, and stream flow should be pumped around the work area. The pump should discharge onto a stable velocity dissipator made of riprap or sandbags.

TEMPORARY INSTREAM CONSTRUCTION MEASURES MARYLAND DEPARTMENT OF THE ENVIRONMENT
NATURAL RESOURCES CONSERVATION SERVICE WATERWAY CONSTRUCTION GUIDELINES
REVISION NOVEMBER 2000
 PAGE 1.2-1

MGWC 1.2: PUMP-AROUND PRACTICE

7. Water from the work area should be pumped to a sediment filtering measure such as a dewatering basin, sediment bag, or other approved source. The measure should be located such that the water drains back into the channel below the downstream sandbag dike.
8. Traversing a channel reach with equipment within the work area where no work is proposed should be avoided. If equipment has to traverse such a reach for access to another area, then timber mats or similar measures should be used to minimize disturbance to the channel. Temporary stream crossings should be used only when necessary and only where noted on the plans or specified. (See Section 4, Stream Crossings, Maryland Guidelines to Waterway Construction).
9. All stream restoration measures should be installed as indicated by the plans and all banks graded in accordance with the grading plans and typical cross-sections. All grading must be stabilized at the end of each day with seed and mulch or seed and mulch as specified on the plans.
10. After an area is completed and stabilized, the clean water dike should be removed. After the first sediment flush, a new clean water dike should be established upstream from the old sediment dike. Finally, upon establishment of a new sediment dike below the old one, the old sediment dike should be removed.
11. A pump around must be installed on any tributary or storm drain outfall which contributes baseflow to the work area. This should be accomplished by locating a sandbag dike at the downstream end of the tributary or storm drain outfall and pumping the stream flow around the work area. This water should discharge onto the same velocity dissipator used for the main stem pump around.
12. If a tributary is to be restored, construction should take place on the tributary before work on the main stem reaches the tributary confluence. Construction in the tributary, including pump around practices, should follow the same sequence as for the main stem of the river or stream. When construction on the tributary is completed, work on the main stem should resume. Water from the tributary should continue to be pumped around the work area in the main stem.
13. The contractor is responsible for providing access to and maintaining all erosion and sediment control devices until the sediment control inspector approves their removal.
14. After construction, all disturbed areas should be regraded and revegetated as per the planting plan.

TEMPORARY INSTREAM CONSTRUCTION MEASURES MARYLAND DEPARTMENT OF THE ENVIRONMENT
NATURAL RESOURCES CONSERVATION SERVICE WATERWAY CONSTRUCTION GUIDELINES
REVISION NOVEMBER 2000
 PAGE 1.2-2

Maryland's Guidelines To Waterway Construction DETAIL 1.2: PUMP-AROUND PRACTICE

PLAN VIEW

SECTION A-A

TEMPORARY INSTREAM CONSTRUCTION MEASURES REVISION NOVEMBER 2000 MARYLAND DEPARTMENT OF THE ENVIRONMENT
PAGE 1.2-3 WATER MANAGEMENT ADMINISTRATION

U-SHAPED EQUIPMENT CLEANING AREA

NOTES:

1. SLOPE TO MEET DETAIL E-2 AND CONSTRUCTION SPECIFICATIONS THEREOF.
2. ECA TO BE PLACED AT LOWEST END OF LOT AND CLEANED DAILY.
3. IMMEDIATELY REMOVE STONE AND/OR SEDIMENT SPILLED, DROPPED, OR TRACKED ONTO ADJACENT ROADWAY BY VACUUMING, SCRAPING, AND/OR SWEEPING.
4. C.D. MAY WAIVE INSTALLATION OF ECA WHERE INSPECTOR ACCEPTS SAME-DAY STABILIZATION WITH SEED/SSM OR SO2.

DETAIL E-1 SILT FENCE

STANDARD SYMBOL:

CROSS SECTION

MARYLAND STANDARDS AND SPECIFICATIONS FOR SOIL EROSION AND SEDIMENT CONTROL
U.S. DEPARTMENT OF AGRICULTURE MARYLAND DEPARTMENT OF ENVIRONMENT
NATURAL RESOURCES CONSERVATION SERVICE 2011 WATER MANAGEMENT ADMINISTRATION

DETAIL E-1 SILT FENCE

STANDARD SYMBOL:

CONSTRUCTION SPECIFICATIONS

1. USE WOOD POSTS 1 1/4 x 1 1/4 x 3/4 INCH (MINIMUM) SQUARE CUT OF SOUND QUALITY HARDWOOD, AS AN ALTERNATIVE TO WOODEN POST USE STANDARD "T" OR "U" SECTION STEEL POSTS WEIGHING NOT LESS THAN 1 POUND PER LINEAR FOOT.
2. USE 36 INCH MINIMUM POSTS DRIVEN 18 INCH MINIMUM INTO GROUND NO MORE THAN 6 FEET APART.
3. USE WOVEN SILT FILM GEOTEXTILE AS SPECIFIED IN SECTION H-1 MATERIALS AND FASTEN GEOTEXTILE SECURELY TO UPSLOPE SIDE OF FENCE POSTS WITH WIRE TIES OR STAPLES AT TOP AND MID-SECTION.
4. PROVIDE MANUFACTURER CERTIFICATION TO THE AUTHORIZED REPRESENTATIVE OF THE INSPECTION/ENFORCEMENT AUTHORITY SHOWING THAT THE GEOTEXTILE USED MEETS THE REQUIREMENTS IN SECTION H-1 MATERIALS.
5. EMBED GEOTEXTILE A MINIMUM OF 8 INCHES VERTICALLY INTO THE GROUND, BACKFILL AND COMPACT THE SOIL ON BOTH SIDES OF FABRIC.
6. WHERE TWO SECTIONS OF GEOTEXTILE ADJOIN: OVERLAP, TWIST, AND STAPLE TO POST IN ACCORDANCE WITH THIS DETAIL.
7. EXTEND BOTH ENDS OF THE SILT FENCE A MINIMUM OF FIVE HORIZONTAL FEET UPSLOPE AT 45 DEGREES TO THE MAIN FENCE ALIGNMENT TO PREVENT RUNOFF FROM GOING AROUND THE ENDS OF THE SILT FENCE.
8. REMOVE ACCUMULATED SEDIMENT AND DEBRIS WHEN BULGES DEVELOP IN SILT FENCE OR WHEN SEDIMENT REACHES 25% OF FENCE HEIGHT. REPLACE GEOTEXTILE IF TORN, IF UNDERMINING OCCURS, REINSTALL FENCE.

MARYLAND STANDARDS AND SPECIFICATIONS FOR SOIL EROSION AND SEDIMENT CONTROL
U.S. DEPARTMENT OF AGRICULTURE 2011 MARYLAND DEPARTMENT OF ENVIRONMENT
NATURAL RESOURCES CONSERVATION SERVICE WATER MANAGEMENT ADMINISTRATION

DETAIL F-3 PORTABLE SEDIMENT TANK

STANDARD SYMBOL:

CONSTRUCTION SPECIFICATIONS

1. PROVIDE 1 CUBIC FOOT OF STORAGE FOR EACH GALLON PER MINUTE OF PUMP CAPACITY. REQUIRED STORAGE VOLUME MAY BE ATTAINED BY PLACEMENT OF TANKS IN PARALLEL WITH INFLOW EVENLY DISTRIBUTED AMONG TANKS. OVERLAPPING OF TANKS IS NOT PERMITTED.
2. USE 60 INCH CORRUGATED METAL OR PLASTIC PIPE WITH 1 INCH DIAMETER PERFORATIONS, 6 INCHES IN CENTER FOR THE INNER PIPE LINE PIPE WITH NONWOVEN GEOTEXTILE, AS SPECIFIED IN SECTION H-1 MATERIALS, SANDWICHED BETWEEN, AND ATTACHED TO, 1/2 INCH HARDWARE CLOTH.
3. OVERLAP GEOTEXTILE 8 INCHES MINIMUM AT VERTICAL SEAM AND AT THE BOTTOM PLATE.
4. ANCHOR GEOTEXTILE AT BOTTOM OF TANK WITH 4 INCHES OF 2 TO 3 INCH CLEAN STONE OR EQUIVALENT RECYCLED CONCRETE.
5. USE 72 INCH CORRUGATED METAL OR PLASTIC OUTER PIPE WITH PERMANENT OUTFLOW PIPE WITH INVERT LOWER THAN INFLOW PIPE.
6. INFLOW PIPE MUST DISCHARGE INTO INNER PIPE AND BE REMOVABLE.
7. PLACE TANK ON LEVEL SURFACE AND DISCHARGE TO A STABLE AREA AT A NONEROSIVE RATE.
8. A PORTABLE SEDIMENT TANK REQUIRES FREQUENT MAINTENANCE. REMOVE ACCUMULATED SEDIMENT FROM INNER PIPE WHEN IT REACHES TWO FEET IN DEPTH. IF SYSTEM CLOGS, PULL OUT INNER PIPE, REMOVE ACCUMULATED SEDIMENT, AND REPLACE GEOTEXTILE. KEEP POINT OF DISCHARGE FREE OF EROSION.

MARYLAND STANDARDS AND SPECIFICATIONS FOR SOIL EROSION AND SEDIMENT CONTROL
U.S. DEPARTMENT OF AGRICULTURE 2011 MARYLAND DEPARTMENT OF ENVIRONMENT
NATURAL RESOURCES CONSERVATION SERVICE WATER MANAGEMENT ADMINISTRATION

DETAIL B-4-6-D PERMANENT SOIL STABILIZATION MATTING SLOPE APPLICATION

STANDARD SYMBOL:

CONSTRUCTION SPECIFICATIONS


1. USE MATTING THAT HAS A DESIGN VALUE FOR SHEAR STRESS EQUAL TO OR HIGHER THAN THE SHEAR STRESS OBSERVED ON APPROVED PLANS.
2. USE PERMANENT SOIL STABILIZATION MATTING MADE OF OPEN WEAVE SYNTHETIC, NON-DEGRADABLE FIBERS OR ELEMENTS OF UNIFORM THICKNESS AND DISTRIBUTION THROUGHOUT. CHEMICALLY TREATED IN THE MAT MUST BE NON-LEACHING AND NON-TOXIC TO VEGETATION AND SEED GERMINATION AND NON-AOBIOUS TO THE SOIL. IF PRESENT, NETTING MUST BE EXTENSIVELY PERFORATED WITH A MAXIMUM OPENING OF 2.0 INCHES AND SUFFICIENTLY SPACED OR SEWN ON 2 INCH CENTERS ALONG LONGITUDINAL AXIS OF THE MATERIAL TO PREVENT SEPARATION OF THE NET FROM THE FIBERS.
3. SECURE MATTING USING STEEL STAPLES OR WOOD STAPLES. STAPLES MUST BE "U" OR "T" SHAPED STEEL WIRE HAVING A MINIMUM GAUGE OF NO. 11 AND NO. 8 RESPECTIVELY. "U" SHAPED STAPLES MUST AVERAGE 1 TO 1 1/2 INCHES WIDE AND BE A MINIMUM OF 6 INCHES LONG. SHAPED STAPLES MUST HAVE A MINIMUM 8 INCH MAIN LEG, A MINIMUM 1 INCH SECONDARY LEG, AND MINIMUM 4 INCH HEAD. STAPLES MUST BE ROUGH-SAWN HARDWOOD, 12 TO 24 INCHES IN LENGTH, 1/2 INCH IN CROSS SECTION, AND WEDGE SHAPE AT THE BOTTOM.
4. PERFORM FINAL GRADING, TOPSOIL APPLICATION, SEEDBED PREPARATION, AND PERMANENT SEEDING IN ACCORDANCE WITH SPECIFICATIONS. PLACE MATTING WITHIN 48 HOURS OF COMPLETING SEEDING OPERATIONS, UNLESS END OF WORKDAY STABILIZATION IS SPECIFIED ON THE APPROVED EROSION AND SEDIMENT CONTROL PLAN.
5. UNROLL MATTING DOWN SLOPE. LAY MATTING SMOOTHLY AND FIRMLY UPON THE SEEDBED SURFACE. AVOID STRETCHING THE MATTING.
6. OVERLAP OR ABUT EDGES OF MATTING ROLLS PER MANUFACTURER RECOMMENDATIONS. OVERLAP ROLL ENDS BY 8 INCHES (MINIMUM), WITH THE UPSLOPE MAT OVERLAPPING ON TOP OF THE DOWNSLOPE MAT.
7. KEY IN THE TOP OF SLOPE END OF MAT 6 INCHES (MINIMUM) BY DIGGING A TRENCH, PLACING THE MATTING ROLL END IN THE TRENCH, STAPLING THE MAT IN PLACE, REPLACING THE EXCAVATED MATERIAL, AND TAMING TO SECURE THE MAT END IN THE KEY.
8. STAPLE/STAKE MAT IN A STAGGERED PATTERN ON 4 FOOT (MAXIMUM) CENTERS THROUGHOUT AND 2 FOOT (MAXIMUM) CENTERS ALONG SEAMS, JOINTS, AND ROLL ENDS.
9. IF SPECIFIED BY THE DESIGNER OR MANUFACTURER AND DEPENDING ON THE TYPE OF MAT BEING INSTALLED, ONCE THE MATTING IS KEYED AND STAPLED IN PLACE, FILL THE MAT Voids WITH TOP SOIL OR GRANULAR MATERIAL AND LIGHTLY COMPACT OR ROLL TO MAXIMIZE SOIL/MAT CONTACT WITHOUT CRUSHING MAT.
10. ESTABLISH AND MAINTAIN VEGETATION SO THAT REQUIREMENTS FOR ADEQUATE VEGETATIVE ESTABLISHMENT ARE CONTINUOUSLY MET IN ACCORDANCE WITH SECTION B-4 VEGETATIVE STABILIZATION.

MARYLAND STANDARDS AND SPECIFICATIONS FOR SOIL EROSION AND SEDIMENT CONTROL
U.S. DEPARTMENT OF AGRICULTURE 2011 MARYLAND DEPARTMENT OF ENVIRONMENT
NATURAL RESOURCES CONSERVATION SERVICE WATER MANAGEMENT ADMINISTRATION

DEPARTMENT OF PUBLIC WORKS
 HOWARD COUNTY, MARYLAND
 Director of Public Works: *Mark D. ...* 5/3/19
 Chief, Bureau of Utilities: *...* 5-2-19
 Chief, Bureau of Engineering: *James E. ...* 4/29/19
 Chief, Utility Design Division: *...* 4/29/19

RK&K
 P: 410.728.2900
 700 East Pratt Street, Suite 500 | Baltimore, MD 21202
 Engineers | Construction Managers | Planners | Scientists
 www.rkk.com
 Responsive People | Creative Solutions

PROFESSIONAL CERTIFICATION:
 I HEREBY CERTIFY THAT THESE DOCUMENTS WERE PREPARED OR APPROVED BY ME, AND THAT I AM A DULY LICENSED PROFESSIONAL ENGINEER UNDER THE LAWS OF THE STATE OF MARYLAND, LICENSE NO. 20586, EXPIRATION DATE: 09/06/2020.

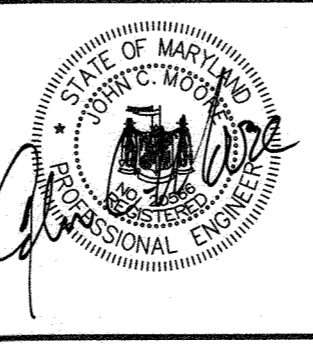

DES.	BY	NO.	REVISION	DATE
REG/WJG				
DRN:				
RAD/REG				
CHK:				
JCM/NKS				
SIGN DATE:				
04/25/19				

EROSION AND SEDIMENT CONTROL
 DETAILS
 600' SCALE MAP NO. 31, 37 BLOCK NO. 5, 6, 10, 11, 17, 18, 24

AS-BUILT MAY 2020

PROJECT NO. W8305
 CONTRACT NO. 44-5059
 LANDING ROAD WATER MAIN LOOP
 ELECTION DISTRICT NO. 7
 HOWARD COUNTY, MARYLAND

SCALE: AS SHOWN
 SHEET NO. 18 OF 18