KINGS MEADE, SECTION 1, LOT 81 SWM POND REPAIRS PROJECT

HOWARD COUNTY, MARYLAND STORMWATER MANAGEMENT DIVISION CAPITAL PROJECT D-1159

GENERAL NOTES

- 1. ALL CONSTRUCTION SHALL BE IN ACCORDANCE WITH THE LATEST STANDARDS AND SPECIFICATIONS OF HOWARD COUNTY AND MSHA STANDARDS AND SPECIFICATIONS, IF APPLICABLE.
- 2. THE CONTRACTOR SHALL NOTIFY THE DEPARTMENT OF PUBLIC WORKS BUREAU OF ENGINEERING/CONSTRUCTION INSPECTION DIVISION AT (410) 313-1880 AT LEAST FIVE (5) WORKING DAYS PRIOR TO ANY EXCAVATION WORK
- 3. THE CONTRACTOR SHALL NOTIFY "MISS UTILITY" AT 1-800-257-7777 AT LEAST 5 DAYS PRIOR TO ANY EXCAVATION WORK BEING DONE
- GEODETIC CONTROL, WHICH IS BASED UPON THE MARYLAND STATE PLANE COORDINATE SYSTEM. BENCHMARKS SHOWN HEREON WERE PROVIDED BY HOWARD COUNTY SURVEY DIVISION AND AB CONSULTANTS.
- EXISTING UTILITIES ARE BASED ON FIELD SURVEYS AND AVAILABLE RECORD
- THE WETLAND DELINEATION FOR THIS PROJECT WAS PERFORMED BY KCI TECHNOLOGIES, INC. IN AUGUST 2006.
- 7. TOPOGRAPHIC SURVEY OF THE SITE WAS PERFORMED BY AB CONSULTANTS, INC. IN AUGUST 2006.
- 8. A JOINT PERMIT APPLICATION HAS BEEN SUBMITTED TO THE MARYLAND DEPARTMENT OF THE ENVIRONMENT FOR THIS PROJECT. (TRACKING NUMBER
- 9. NO TRAFFIC STUDY IS REQUIRED FOR THIS PROJECT.
- 10. OBSTRUCTIONS SHOWN ON THIS DRAWING ARE FOR THE CONVENIENCE OF THE CONTRACTOR ONLY AND KCITECHNOLOGIES, INC. DOES NOT WARRANT OR GUARANTEE THE CORRECTNESS OR COMPLETENESS OF THE INFORMATION GIVEN. THE CONTRACTOR MUST VERIFY SUCH INFORMATION TO HIS OWN SATISFACTION.
- 11. SHOULD THE CONTRACTOR DISCOVER ANY DISCREPANCIES BETWEEN THE PLANS AND THE FIELD CONDITIONS, THE ENGINEER SHALL BE NOTIFIED IMMEDIATELY TO RESOLVE THE SITUATION. SHOULD THE CONTRACTOR MAKE FIELD CORRECTIONS OR ADJUSTMENTS WITHOUT NOTIFYING THE ENGINEER, THE CONTRACTOR ASSUMES ALL RESPONSIBILITY FOR THOSE CHANGES.
- 12. THE CONTRACTOR SHALL TAKE ALL NECESSARY PRECAUTIONS TO PROTECT THE EXISTING UTILITIES AND MAINTAIN UNINTERRUPTED SERVICE. ANY DAMAGE INCURRED DUE TO THE CONTRACTOR'S OPERATION SHALL BE REPAIRED IMMEDIATELY.
- 13. EXISTING GROUND AND/OR VEGETATION DISTURBED BY THE PROPOSED WORK SHALL BE RESTORED TO PRE-CONSTRUCTION CONDITION OR BETTER BY CONCLUSION OF THE PROJECT ..
- 14. THE PROPOSED PROJECT IS LOCATED OFF WILLOW BROOK WAY. 15. THIS UNNAMED TRIBUTARY OF THE LITTLE PATUXENT RIVER IS A USE 1 STREAM. IN-STREAM CONSTRUCTION IS PROHIBITED FOR THE PERIOD OF MARCH 1 TO JUNE 15, INCLUSIVE OF ANY YEAR

LEGEND

EX. TREES EXIST. MAJOR CONTOUR EXIST. MINOR CONTOUR --346PROP. CONTOURS PROP. CONTOURS REMOVABLE PUMPING STATION SILT BAG FILTERING DEVICE INTAKE & DISCHARGE HOSES

SANDBAG DAM SILT FENCE —— SSF — SUPER SILT FENCE ORANGE SAFETY FENCE —— LOD — LIMIT OF DISTURBANCE

STABILIZED CONSTRUCTION ENTERANCE

AS- BUILT CERTIFICATION HEREBY CERTIFY THAT THE FACILITY SHOWN ON THIS PLAN WAS CONSTRUCTED AS SHOWN ON THE "AS BUILT" PLATS AND MEETS THE APPROVED PLANS AND SPECIFICATIONS. 5-4-07 THESE PLANS HAVE BEEN REVIEWED FOR THE HOWARD SOIL CONSERVATION DISTRICT AND MEET THE TECHNICAL REQUIREMENTS FOR SMALL POND CONSTRUCTION, SOIL EROSION AND SEDIMENT CONTROL.

USDA - NATURAL RESOURCES CONSERVATION SERVICE THESE PLANS FOR SMALL POND CONSTRUCTION, SOIL EROSION AND SEDIMENT CONTROL, MEET THE REQUIREMENTS OF THE HOWARD SOIL CONSENTATION DISTRICT.

ENGINEER'S CERTIFICATE ACCORDANCE WITH THE REQUIREMENTS OF THE HOWARD SOIL CONSERVATION DISTRICT. I HAVE NOTIFIED THE "I/WE CERTIFY THAT ALL DEVELOPMENT AND/OR CONSTRUCTION WILL BE DONE ACCORDING TO THESE PLANS, AND THAT ANY RESPONSIBLE PERSONNEL INVOLVED IN THE CONSTRUCTION PROJECT WILL HAVE A CERTIFICATE OF ATTENDANCE AT A DEPARTMENT OF THE ENVIRONMENT APPROVED TRAINING PROGRAM FOR THE CONTROL OF SEDIMENT AND EROSION BEFORE BEGINNING THE PROJECT. I SHALL ENGAGE A REGISTERED PROFESSIONAL ENGINEER TO SUPERVISE POND CONSTRUCTION AND PROVIDE THE HOWARD SOIL CONSERVATION DISTRICT WITH AN "AS-BUILT" PLAN OF THE POND WITHIN 30 DAYS OF COMPLETION. I ALSO AUTHORIZE PERIODIC ON-SITE INSPECTIONS BY THE HOWARD SOIL CONSERVATION DISTRICT." SIGNATURE OF DEVELOPER (PRINT NAME BELOW SIGNATURE)

HOWARD COUNTY SURVEY CONTROL								
DESIGNATION	NORTHING	EASTING	ELEVATION					
42 R1	547820.238	1351171.590	375.85					
42 R2	546946.800	1352118.566	331.52					

AS-BUILT MAY 2007

AS SHOWN 1/5/07 01-043223.17 CAPITAL PROJECT NO.: CONSTRUCTION ISSUE:

TITLE

SHEET

 ∞

KINGS MEASWM

EP-07-07

NOT TO SCALE

SHEET NO.: 1 OF 6

SEDIMENT CONTROL NOTES & DETAILS SITE ANALYSIS DATA CHART TOTAL PROJECT AREA: 0.39 ACRES. DISTURBED AREA: 0.39 ACRES (16,782 SF). PROPOSED USE FOR THE SITE: RETROFIT EXISTING STORMWATER FACILITY 4. ORIGINAL POND CONSTRUCTION PERFORMED UNDER KINGS MEADE. SECTION 1 (F-85-203).

INDEX OF SHEETS

DESCRIPTION

TITLE SHEET

STORMWATER MANAGEMENT PLAN

SWM RETROFIT NOTES & DETAILS

SWM RETROFIT NOTES & DETAILS

SEDIMENT AND EROSION CONTROL PLAN

SHEE


"ICERTIFY THAT THIS PLAN FOR POND CONSTRUCTION, EROSION AND SEDIMENT CONTROL REPRESENTS A PRACTICAL AND WORKABLE PLAN BASED ON MY PERSONAL KNOWLEDGE OF THE SITE CONDITIONS. THIS PLAN WAS PREPARED IN DEVELOPER THAT HE/SHE MUST ENGAGE A REGISTERED PROFESSIONAL ENGINEER TO SUPERVISE POND CONSTRUCTION AND PROVIDE THE HOWARD SOIL CONSERVATION DISTRICT WITH AN "AS-BUILT" PLAN OF THE POND WITHIN 30 DAYS OF COMPLETION."


SIGNATURE OF ENGINEER (PRINT NAME BELOW SIGNATURE)


DATE

Howard E. Saltzman

CONTRACTOR SHALL ENSURE THAT SANITARY MANHOLE IS NOT DAMAGED BY CONSTRUCION EQUIPMENT OR DURING PLACEMENT CONSTRUCTION SPECIFICATIONS (Maryland Code 378 Pond - January 2000) OF RIPRAP Materials - (Aluminum Pipe) - This pipe and its appurtenances shall conform to the requirements TREE LINEof AASHTO Specification M-196 or M-211 with watertight coupling bands or flanges. Aluminum These specifications are appropriate to all ponds within the scope of the Standard for practice MD-378. Pipe, when used with flowable fill or when soil and/or water conditions warrant for increased All references to ASTM and AASHTO specifications apply to the most recent version. durability, shall be fully bituminous coated per requirements of AASHTO Specification M-190 Type A. Aluminum surfaces that are to be in contact with concrete shall be painted with one coat of zinc chromate primer or two coats of asphalt. Hot dip galvanized bolts may be used for EMERGENCY SPILLWAY_ connections. The pH of the surrounding soils shall be between 4 and 9. ELEV. 317.30 Areas designated for borrow areas, embankment, and structural works shall be cleared, grubbed and stripped of topsoil. All trees, vegetation, roots and other objectionable material shall be removed. Channel Coupling bands, anti-seep collars, end sections, etc., must be composed of the same material banks and sharp breaks shall be sloped to no steeper than 1:1. All trees shall be cleared and grubbed and coatings as the pipe. Metals must be insulated from dissimilar materials with use of rubber or within 15 feet of the toe of the embankment. plastic insulating materials at least 24 mils in thick-ness. UTILITY ESMT Areas to be covered by the reservoir will be cleared of all trees, brush, logs, fences, rubbish and other Connections - All connections with pipes must be completely watertight. The drain pipe or barrel objectionable material unless otherwise designated on the plans. Trees, brush, and stumps shall be cut connection to the riser shall be welded all around when the pipe and riser are metal. Anti-seep approximately level with the ground surface. For dry stormwater management ponds, a minimum of a 25collars shall be connected to the pipe in such a manner as to be completely watertight. Dimple foot radius around the inlet structure shall be cleared. bands are not considered to be watertight. All cleared and grubbed material shall be disposed of outside and below the limits of the dam and -CLASS II RIPRAP All connections shall use a rubber or neoprene gasket when joining pipe sections. The end of reservoir as directed by the owner or his representative. When specified, a sufficient quantity of topsoil each pipe shall be re-rolled an adequate number of corrugations to accommodate the bandwidth. will be stockpiled in a suitable location for use on the embankment and other designated areas. The following type connections are acceptable for pipes less than 24 inches in diameter: flanges on both ends of the pipe with a circular 3/8 inch closed cell neoprene gasket, pre-punched to the flange bolt circle, sandwiched between adjacent flanges; a 12- inch wide standard lap type band with 12- inch wide by 3/8-inch thick closed cell circular neoprene gasket; and a 12-inch wide VEGETATION ZONE Material - The fill material shall be taken from approved designated borrow areas. It shall be free of roots, hugger type band with o-ring gaskets having a minimum diameter of 1/2 inch greater than the stumps, wood, rubbish, stones greater than 6", frozen or other objectionable materials. Fill material for the corrugation depth. Pipes 24 inches in diameter and larger shall be connected by a 24 inch long center of the embankment, and cut off trench shall conform to Unified Soil Classification GC, SC, CH, or annular corrugated band using a minimum of 4 (four) rods and lugs, 2 on each connecting pipe CL and must have at least 30% passing the #200 sieve. Consideration may be given to the use of other end. A 24-inch wide by 3/8-inch thick closed cell circular neoprene gasket will be installed with 12 materials in the embankment if designed by a geotechnical engineer. Such special designs must have inches on the end of each pipe. Flanged joints with 3/8 inch closed cell gaskets the full width of construction supervised by a geotechnical engineer. Materials used in the outer shell of the embankment the flange is also acceptable. Helically corrugated pipe shall have either continuously welded must have the capability to support vegetation of the quality required to prevent erosion of the seams or have lock seams with internal caulking or a neoprene bead. POPL 5. Bedding - The pipe shall be firmly and uniformly bedded throughout its entire length. Where rock Placement - Areas on which fill is to be placed shall be scarified prior to placement of fill. Fill materials or soft, spongy or other unstable soil is encountered, all such material shall be removed and shall be placed in maximum 8 inch thick (before compaction) layers which are to be continuous over the replaced with suitable earth compacted to provide adequate support. entire length of the fill. The most permeable borrow material shall be placed in the downstream portions of the embankment. The principal spillway must be installed concurrently with fill placement and not Backfilling shall conform to "Structure Backfill". excavated into the embankment. 7. Other details (anti-seep collars, valves, etc.) shall be as shown on the drawings. Compaction - The movement of the hauling and spreading equipment over the fill shall be controlled so BARREL that the entire surface of each lift shall be traversed by not less than one tread track of heavy equipment Reinforced Concrete Pipe - All of the following criteria shall apply for reinforced concrete pipe: or compaction shall be achieved by a minimum of four complete passes of a sheepsfoot, rubber tired or vibratory roller. Fill material shall contain sufficient moisture such that the required degree of compaction Materials - Reinforced concrete pipe shall have bell and spigot joints with rubber gaskets and will be obtained with the equipment used. The fill material shall contain sufficient moisture so that if shall equal or exceed ASTM C-361 formed into a ball it will not crumble, yet not be so wet that water can be squeezed out. Bedding - Reinforced concrete pipe conduits shall be laid in a concrete bedding/cradle for their When required by the reviewing agency the minimum required density shall not be less than 95% of entire length. This bed-ding/cradle shall consist of high slump concrete placed under the pipe and maximum dry density with a moisture content within ±2% of the optimum. Each layer of fill shall be up the sides of the pipe at least 50% of its out-side diameter with a minimum thickness of 6 compacted as necessary to obtain that density, and is to be certified by the Engineer at the time of inches. Where a concrete cradle is not needed for structural reasons, flowable fill may be used as construction. All compaction is to be determined by AASHTO Method T-99 (Standard Proctor). described in the "Structure Backfill" section of this standard. Gravel bedding is not permitted. Cut Off Trench - The cutoff trench shall be excavated into impervious material along or parallel to the Laying pipe - Bell and spigot pipe shall be placed with the bell end upstream. Joints shall be centerline of the embankment as shown on the plans. The bottom width of the trench shall be governed made in accordance with recommendations of the manufacturer of the material. After the joints by the equipment used for excavation, with the minimum width being four feet. The depth shall be at least are sealed for the entire line, the bedding shall be placed so that all spaces under the pipe are four feet below existing grade or as shown on the plans. The side slopes of the trench shall be 1 to 1 or filled. Care shall be exercised to prevent any deviation from the original line and grade of the GRASS flatter. The backfill shall be compacted with construction equipment, rollers, or hand tampers to assure pipe. The first joint must be located within 4 feet from the riser. maximum density and minimum permeability. Backfilling shall conform to "Structure Backfill". Embankment Core - The core shall be parallel to the centerline of the embankment as shown on the plans. The top width of the core shall be a minimum of four feet. The height shall extend up to at least the Other details (anti-seep collars, valves, etc.) shall be as shown on the drawings. 10 year water elevation or as shown on the plans. The side slopes shall be 1 to 1 or flatter. The core shall be compacted with construction equipment, rollers, or hand tampers to assure maximum density and Plastic Pipe - The following criteria shall apply for plastic pipe: minimum permeability. In addition, the core shall be placed concurrently with the outer shell of the Materials - PVC pipe shall be PVC-1120 or PVC-1220 conforming to ASTM D-1785 or ASTM D-2241. Corrugated High Density Polyethylene (HDPE) pipe, couplings and fittings shall conform to the following: 4" - 10" inch pipe shall meet the requirements of AASHTO M252 Type S, and 12" through 24" inch shall meet the requirements of AASHTO M294 Type S. Backfill adjacent to pipes or structures shall be of the type and quality conforming to that specified for the EL=314.96' GARD adjoining fill material. The fill shall be placed in horizontal layers not to exceed four inches in thickness 2. Joints and connections to anti-seep collars shall be completely watertight. and compacted by hand tampers or other manually directed compaction equipment. The material needs to fill completely all spaces under and adjacent to the pipe. At no time during the backfilling operation 3. Bedding -The pipe shall be firmly and uniformly bedded throughout its entire length. Where shall driven equipment be allowed to operate closer than four feet, measured horizontally, to any part of a rock or soft, spongy or other unstable soil is encountered, all such material shall be removed and structure. Under no circumstances shall equipment be driven over any part of a concrete structure or replaced with suitable earth compacted to provide adequate support. pipe, unless there is a compacted fill of 24" or greater over the structure or pipe. Backfilling shall conform to "Structure Backfill". Structure backfill may be flowable fill meeting the requirements of Maryland Department of Section 313 as modified. The mixture shall have a 100-200 psi; 28 day unconfined compressive strength. The flowable fill shall have a minimum pH of 4.0 and a minimum resistivity of 2,000 ohm-cm. Material Drainage Diaphragms - When a drainage diaphragm is used, a registered professional engineer will shall be placed such that a minimum of 6" (measured perpendicular to the outside of the pipe) of flowable supervise the design and construction inspection. fill shall be under (bedding), over and, on the sides of the pipe. It only needs to extend up to the spring TREE LINE line for rigid conduits. Average slump of the fill shall be 7" to assure flowability of the material. Adequate measures shall be taken (sand bags, etc.) to prevent floating the pipe. When using flowable fill, all metal pipe shall be bituminous coated. Any adjoining soil fill shall be placed in horizontal layers not to exceed Concrete shall meet the requirements of Maryland Department of Transportation, State Highway four inches in thickness and compacted by hand tampers or other manually directed compaction Administration Standard Specifications for Construction and Materials, Section 414, Mix No. 3. ∞ equipment. The material shall completely fill all voids adjacent to the flowable fill zone. At no time during the backfilling operation shall driven equipment be allowed to operate closer than four feet, measured Rock Riprap horizontally, to any part of a structure. Under no circumstances shall equipment be driven over any part of a structure or pipe unless there is a compacted fill of 24" or greater over the structure or pipe. Backfill Rock riprap shall meet the requirements of Maryland Department of Transportation, State Highway material outside the structural backfill (flowable fill) zone shall be of the type and quality conforming to Administration Standard Specifications for Construction and Materials, Section 311. Geofestile shall be that specified for the core of the embankment or other embankment materials. placed under all riprap and shall meet the requirements of Maryland Department of Transportation, State KINGS MEADE, SECTION 1, SWM POND REPAIRS PROJECT Highway Administration Standard Specifications for Construction and Materials, Section 921.09, Class C. **Pipe Conduits** Care of Water during Construction All pipes shall be circular in cross section. All work on permanent structures shall be carried out in areas free from water. The Con-tractor shall Corrugated Metal Pipe - All of the following criteria shall apply for corrugated metal pipe: construct and maintain all temporary dikes, levees, cofferdams, drainage channels, and stream diversions -100-YEAR WSEL necessary to protect the areas to be occupied by the permanent works. The contractor shall also furnish. in-stall, operate, and maintain all necessary pumping and other equipment required for removal of water from various parts of the work and for maintaining the excavations, foundation, and other parts of the minimum coating thickness of 0.01 inch (10 mil) on both sides of the pipe. This pipe and its appurtenances shall conform to the requirements of AASHTO Specifications M-245 & M-246 with work free from water as required or directed by the engineer for constructing each part of the work. After vatertight coupling bands or flanges. having served their purpose, all temporary protective works shall be removed or leveled and graded to the extent required to prevent obstruction in any degree whatsoever of the flow of water to the spillway or Materials - (Aluminum Coated Steel Pipe) - This pipe and its appurtenances shall conform to the outlet works and so as not to interfere in any way with the operation or maintenance of the structure. requirements of AASHTO Specification M-274 with watertight coupling bands or flanges. Stream diversions shall be maintained until the full flow can be passed through the permanent works. The Aluminum Coated Steel Pipe, when used with flowable fill or when soil and/or water conditions removal of water from the required excavation and the foundation shall be accomplished in a manner and warrant the need for increased durability, shall be fully bituminous coated per requirements of to the extent that will maintain stability of the excavated slopes and bottom required excavations and will AASHTO Specification M-190 Type A. Any aluminum coating damaged or otherwise removed allow satisfactory performance of all construction operations. During the placing and compacting of shall be replaced with cold applied bituminous coating com-pound. Aluminum surfaces that are to material in required excavations, the water level at the locations being refilled shall be maintained below be in contact with concrete shall be painted with one coat of zinc chromate primer or two coats of the bottom of the excavation at such locations which may require draining the water sumps from which the water shall be pumped. LONGITUDINAL _ REINFORCEMENT -MASTIC JOINT SEALER PEAK DISCHARGES All borrow areas shall be graded to provide proper drainage and left in a sightly condition. All exposed surfaces of the embankment, spillway, spoil and borrow areas, and berms shall be stabilized by seeding, liming, fertilizing and mulching in accordance with the Natural Resources Conservation Service Standards PRE-CONSTRUCTION | POST-CONSTRUCTION | Q(cfs) | WSEL(ft) | Q(cfs) | WSEL(ft) and Specifications for Critical Area Planting (MD-342) or as shown on the accompanying drawings. 2.5 313.82 3.0 313.79 313.89 2-YR 4.0 315.08 4.5 5.0 315.10 317,17 STORMWATER Construction operations will be carried out in such a manner that erosion will be controlled and water and PLAN VIEW air pollution minimized. State and local laws concerning pollution abatement will be followed. Construction 42.9 317.28 45.5 317.24 MANAGEMENT SCALE: 1" - 20' plans shall detail erosion and sediment control measures 100-YR | 135.5 | 318.67 145.2 318.38 3**18.33** PLAN AS-BUILT REINFORCEMENT OPERATION, MAINTENANCE AND INSPECTION 1"= 20" TRAV PT 2 BARREL JOINT SEAL DETAIL AS - BUILT Inspection of the pond(s) shown hereon shall be performed at least annually, in 1/5/07 MAY 2007 accordance with the checklist and requirements contained within USDA, NRCS THESE PLANS HAVE BEEN REVIEWED FOR THE HOWARD SOIL CONSERVATION DISTRICT AND MEET THE TECHNICAL REQUIREMENTS FOR SMALL POND CONSTRUCTION, SOIL EROSION AND SEDIMENT CONTROL. 01-043223.17 "Standards And Specifications For Ponds" (MD-378). The pond owner(s) and any APITAL PROJECT NO.: D-1159 ERMIT ISSUE: heirs, successors, or assigns shall be responsible for the safety of the pond and the USDA - NATURAL RESOURCES CONSERVATION SERVICE continued operation, surveillance, inspection, and maintenance thereof. The pond CONSTRUCTION ISSUE: owner(s) shall promptly notify the Soil Conservation District of any unusual THESE PLANS FOR SMALL POND CONSTRUCTION, SOIL EROSION AND SEDIMENT CONTROL, MEET THE REQUIREMENTS OF THE HOWARD SOIL CONSERVATION DISTRICT. observations that may be indications of distress such as excessive seepage, turbid seepage, sliding, or slumping. EP-07-07 SHEET NO .: 2 OF 6

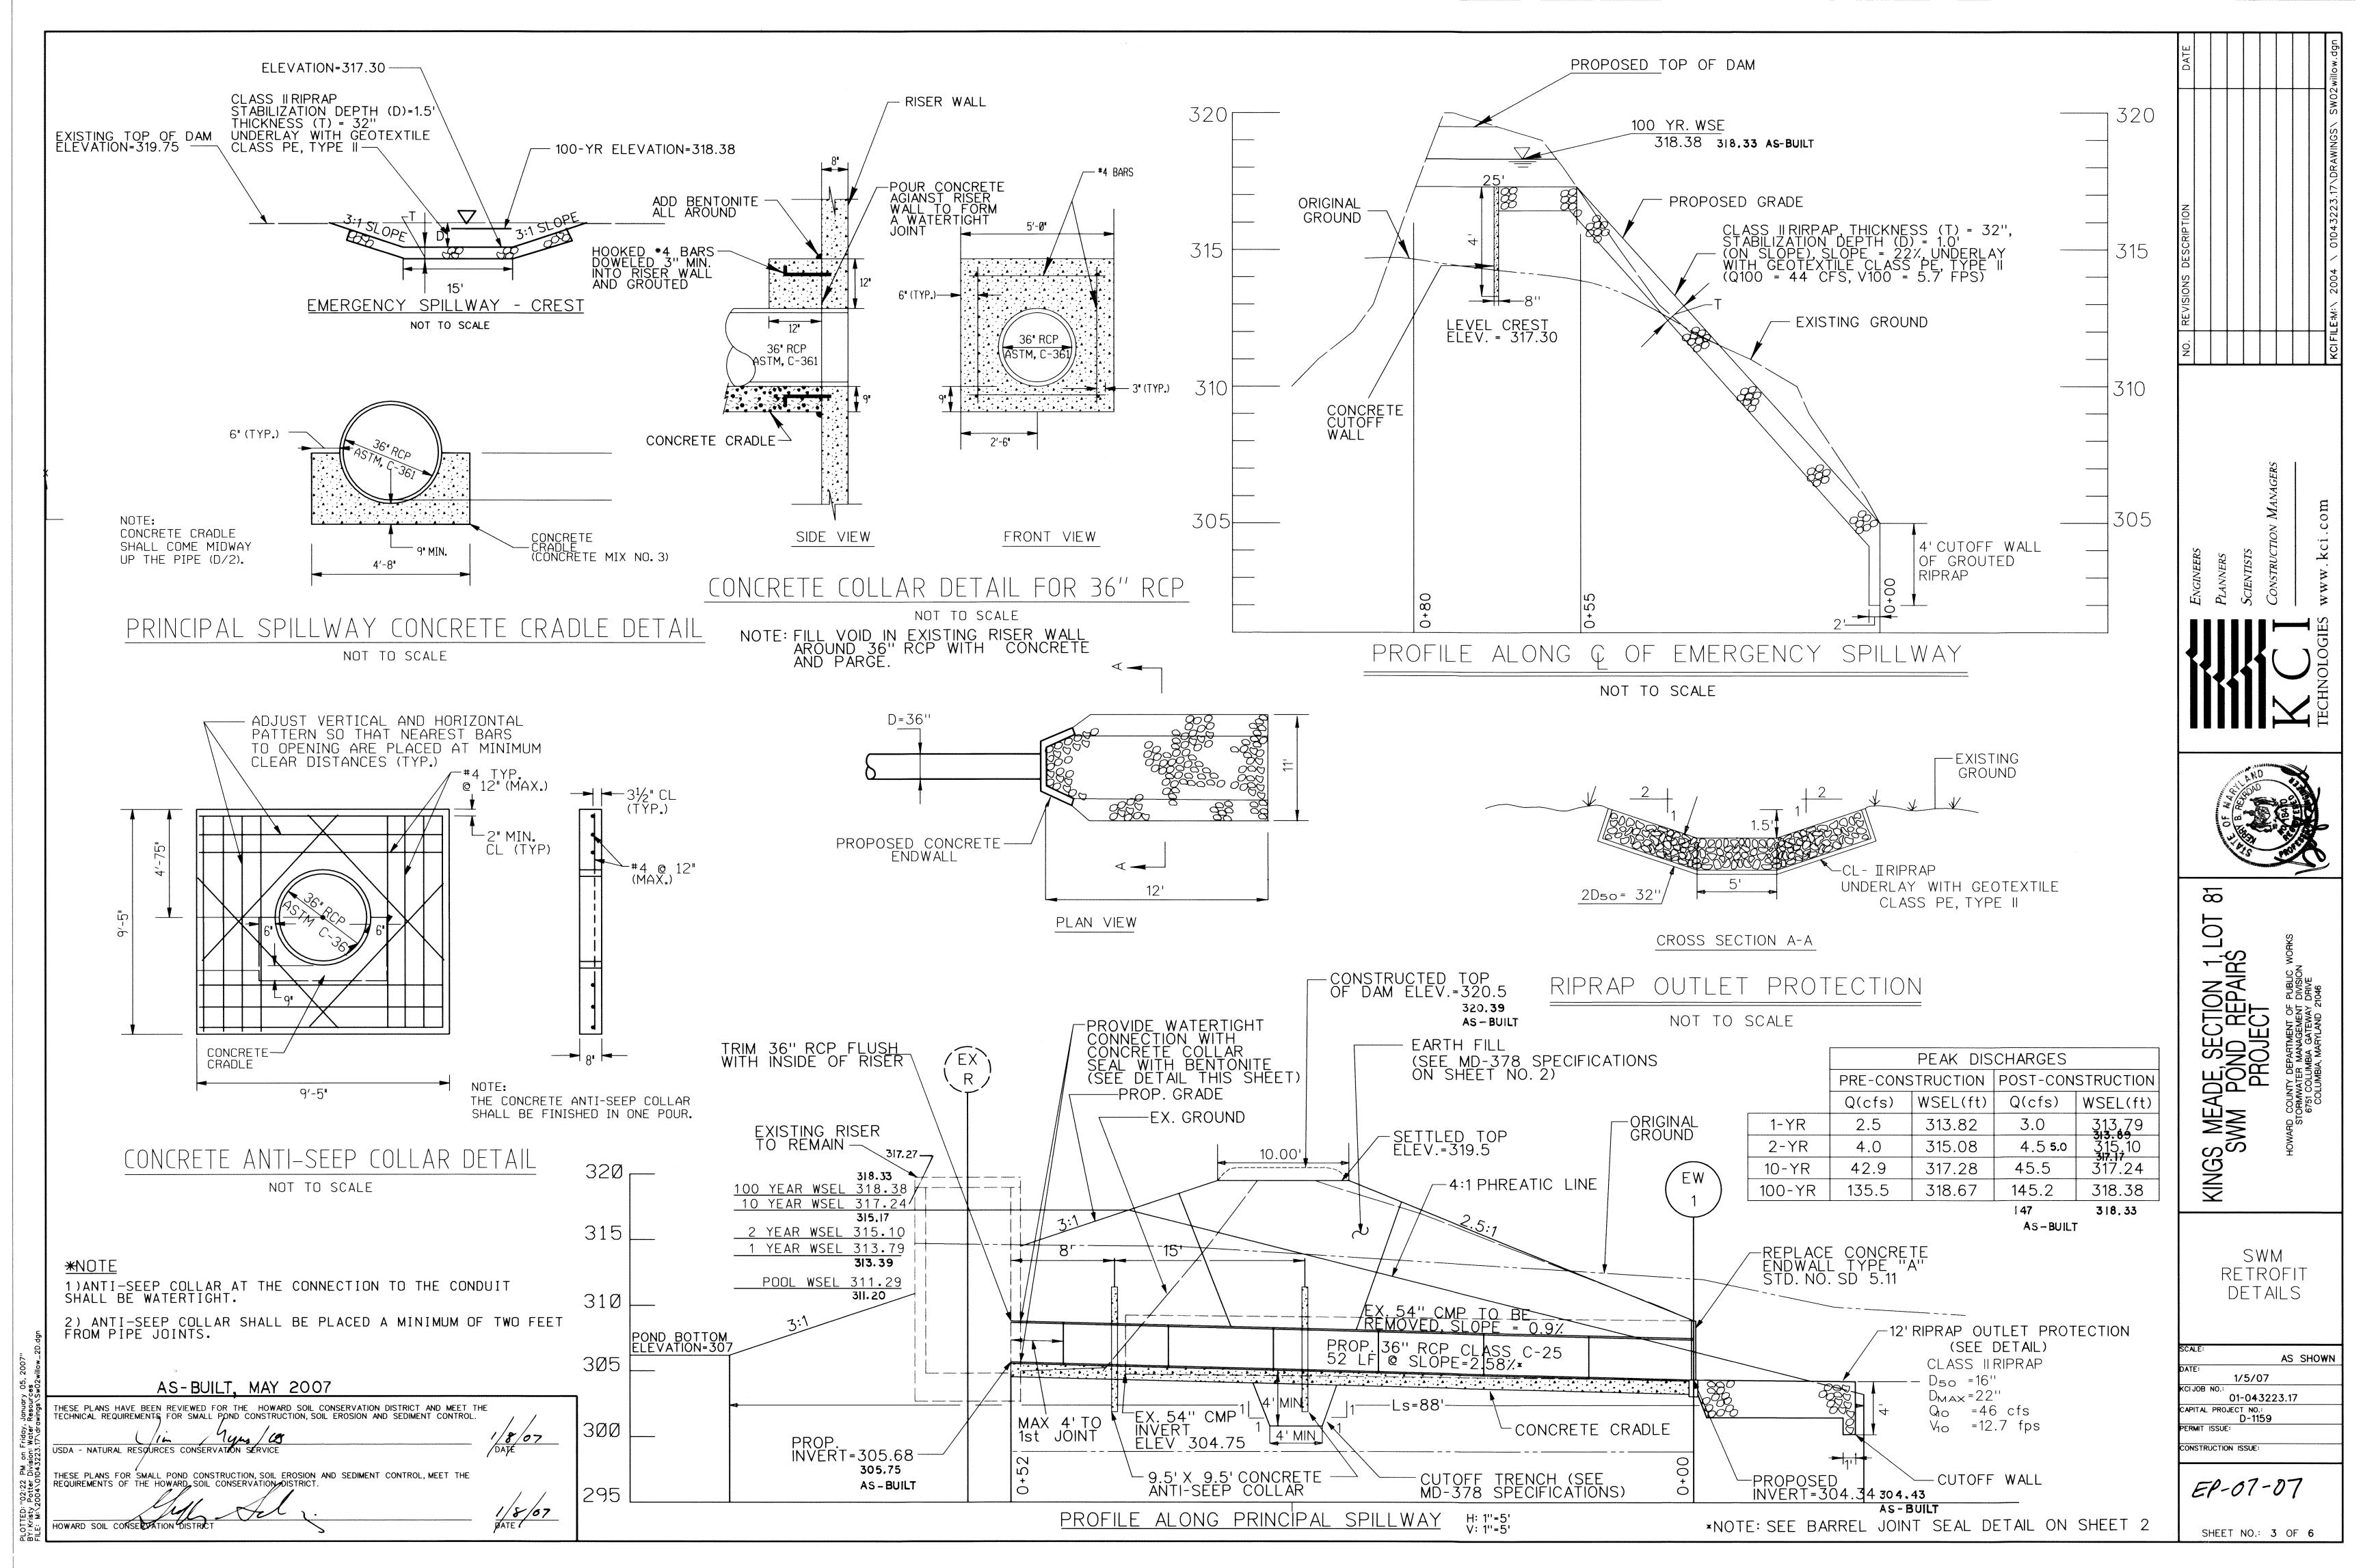

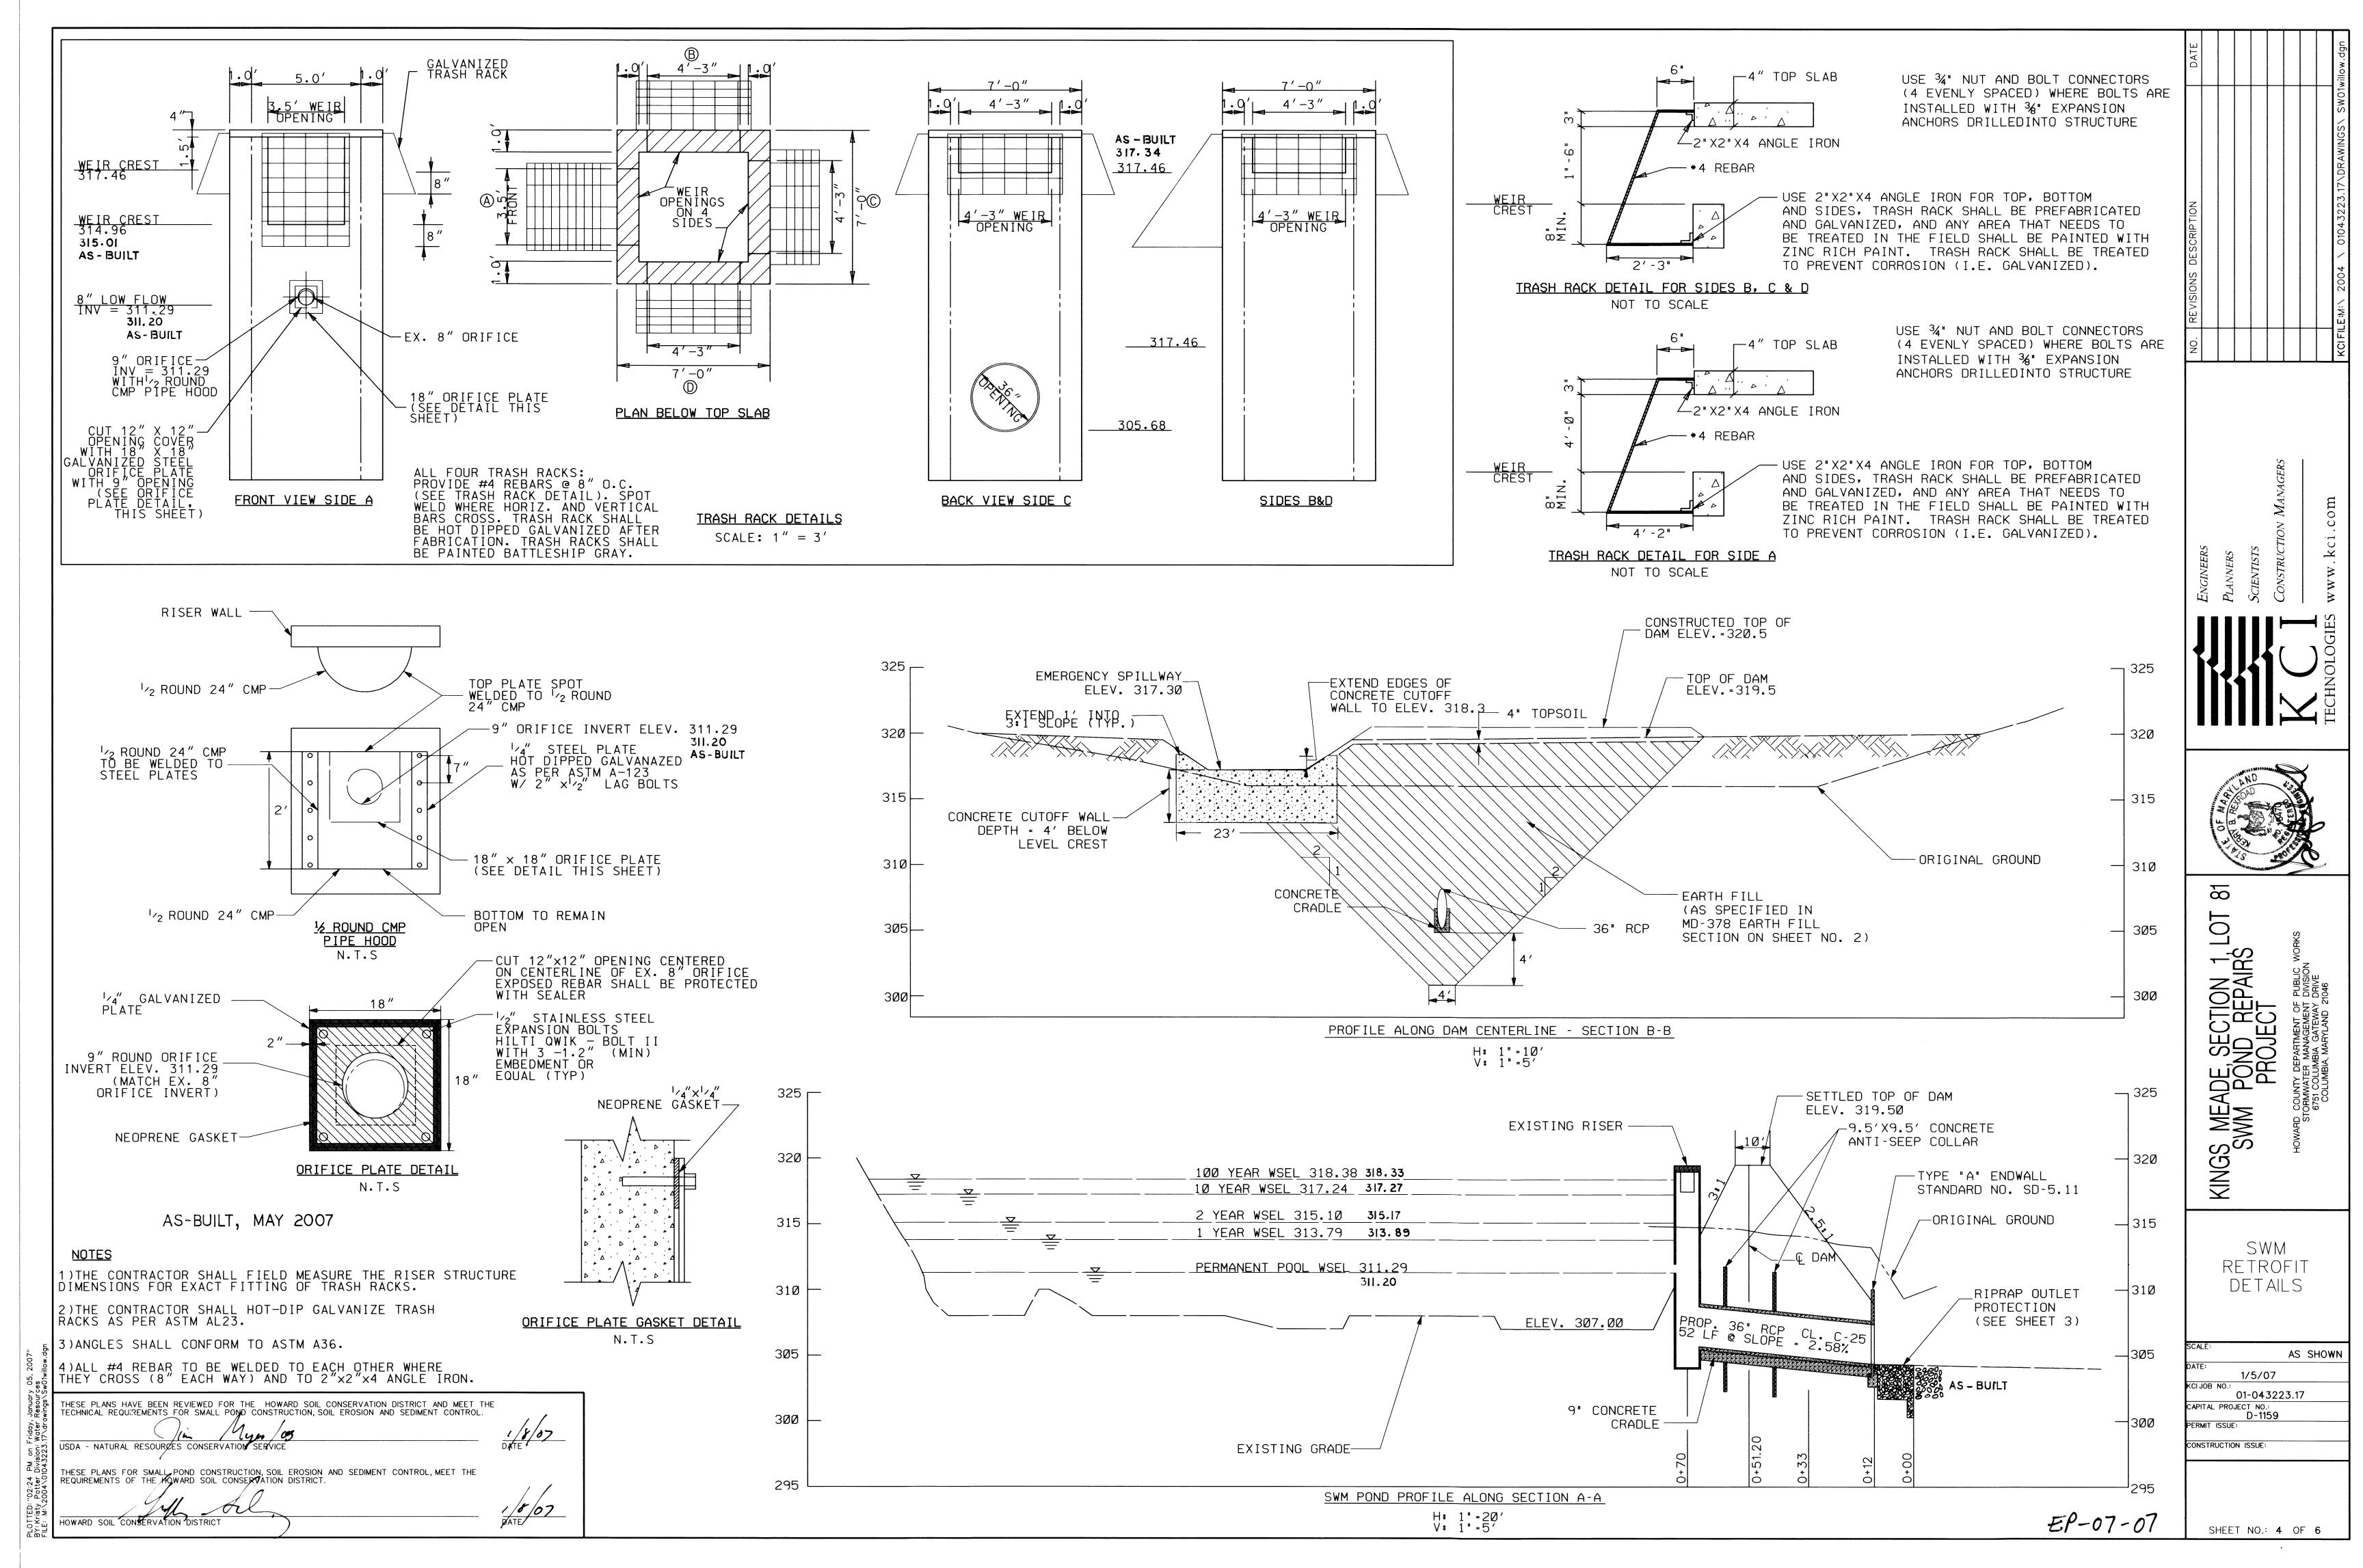

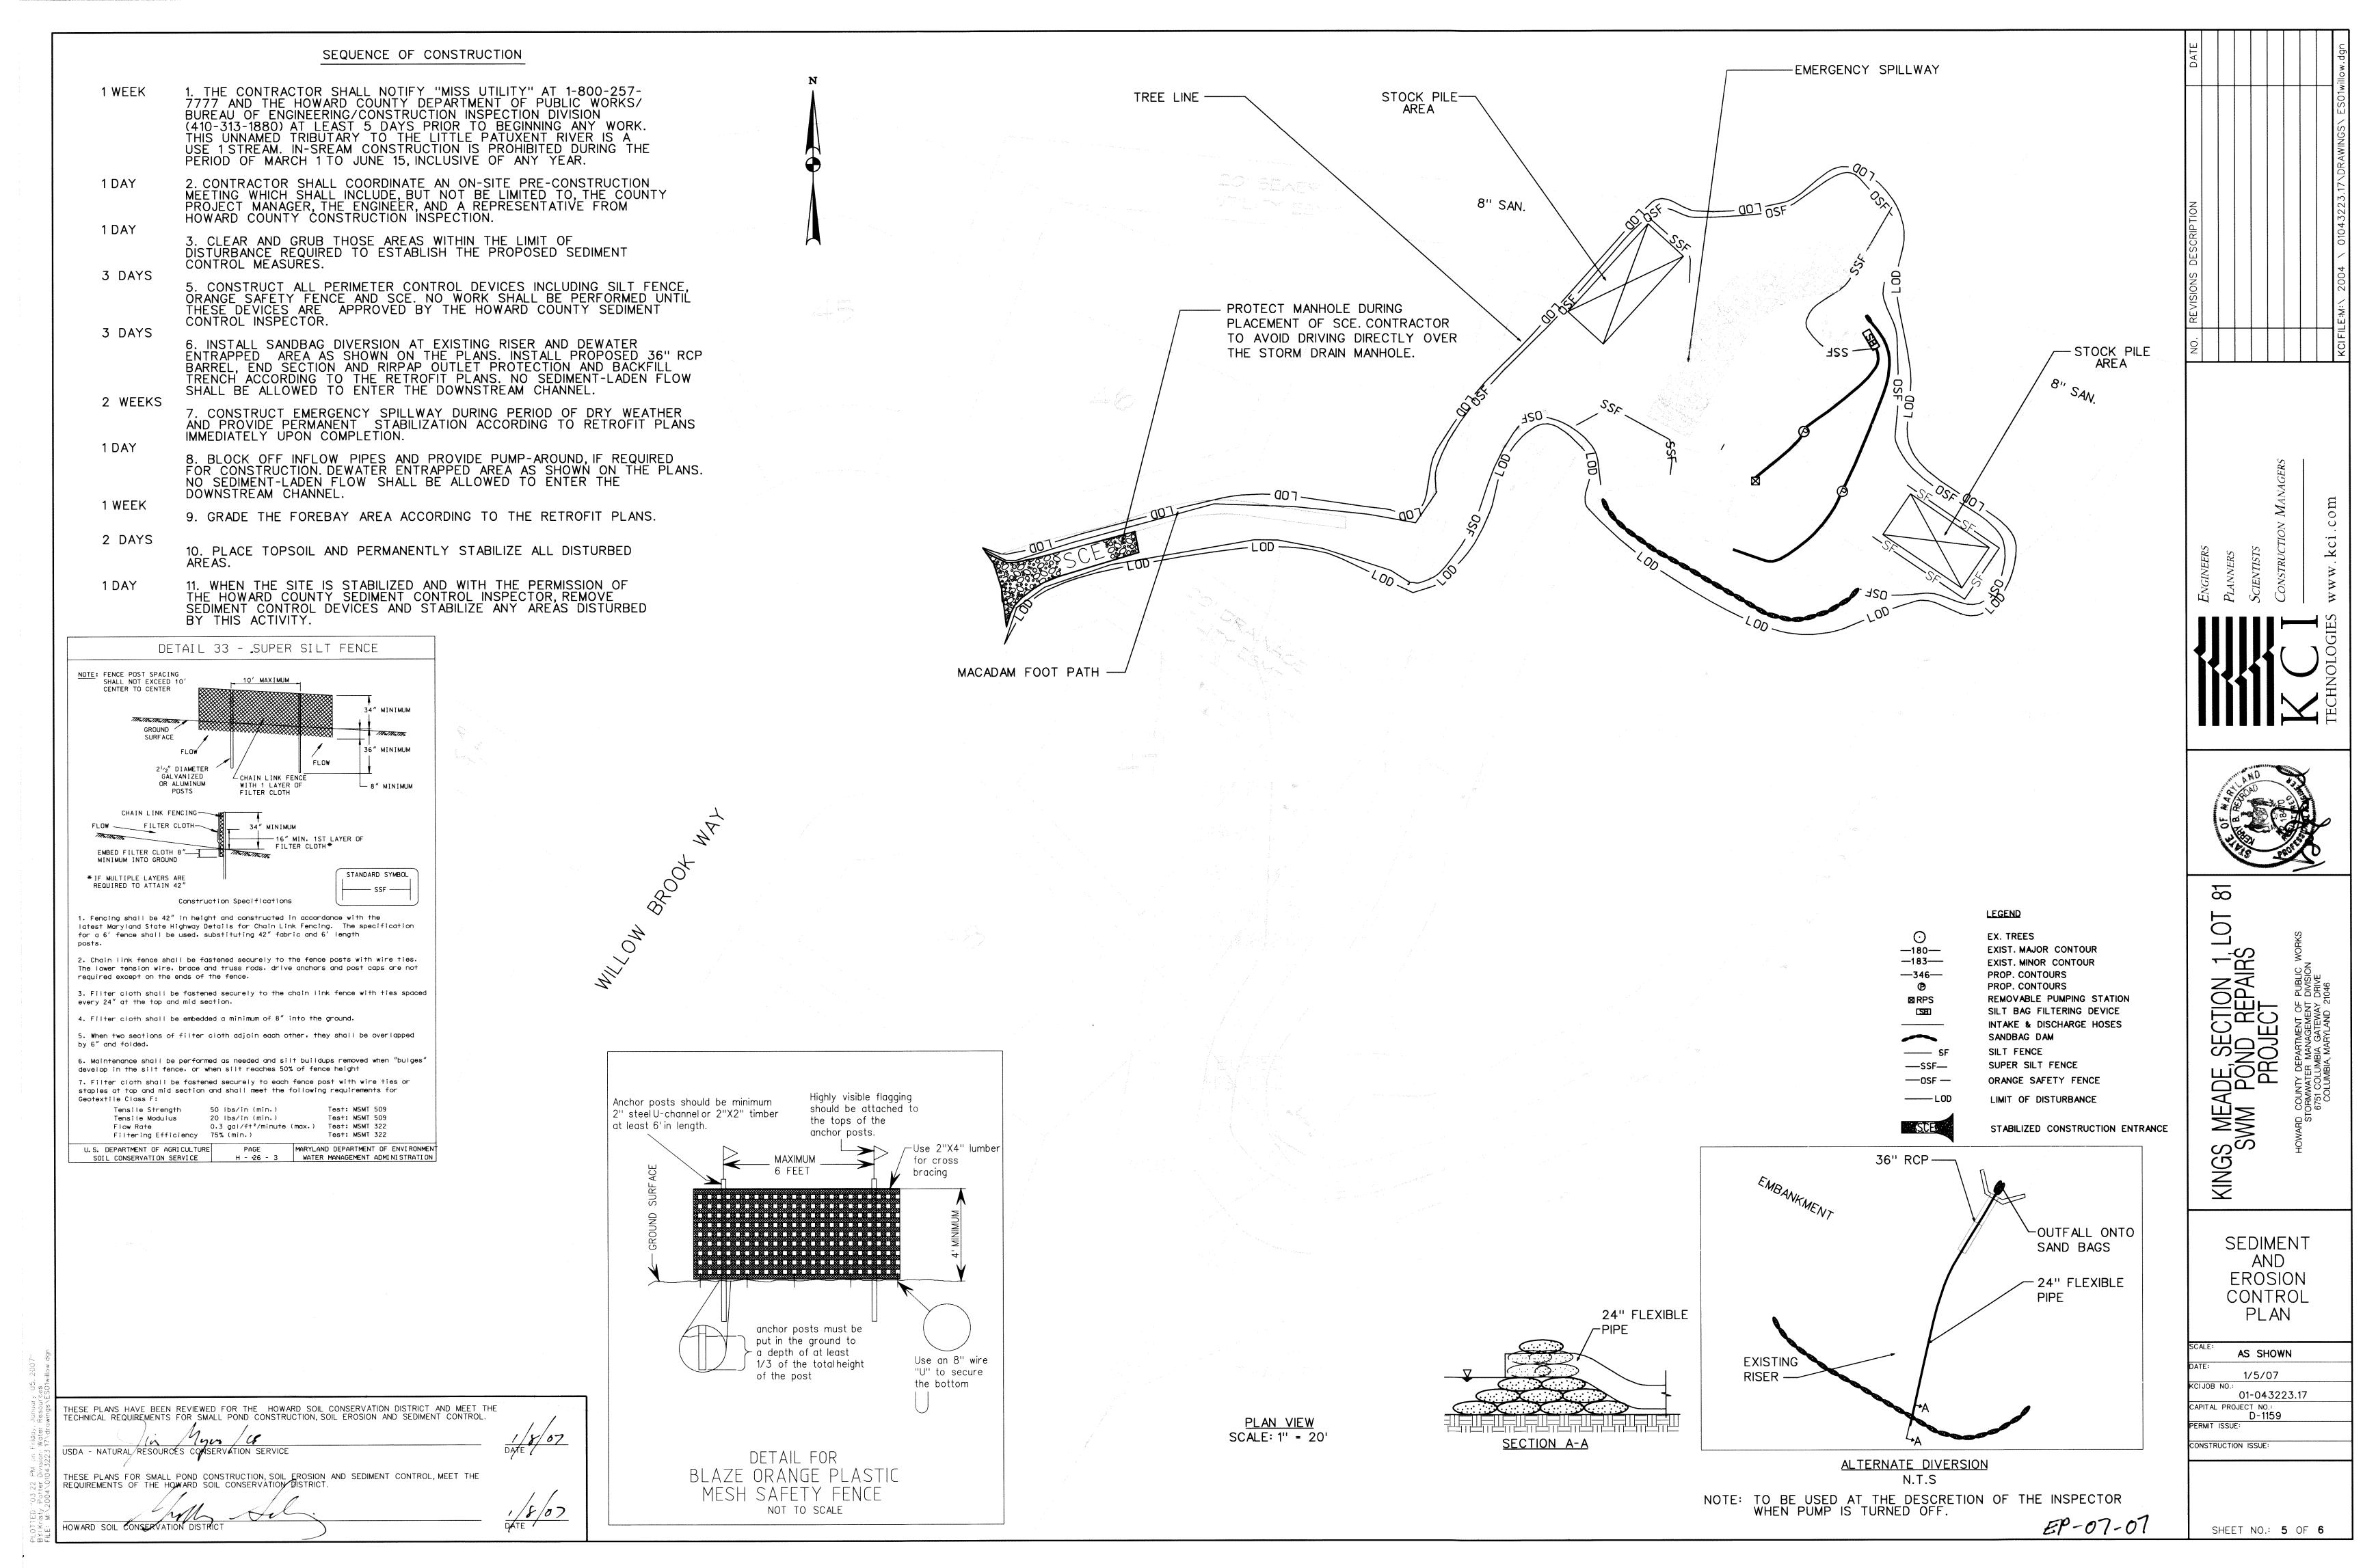

2. Width - 10' minimum, should be flared at the existing road to provide a turning

3. Geotextile fabric (filter cloth) shall be placed over the existing ground prior to placing stone. **The plan approval authority may not require single family

4. Stone - crushed aggregate (2" to 3") or reclaimed or recycled concrete equivalent shall be placed at least 6" deep over the length and width of the

5. Surface Water - all surface water flowing to or diverted toward construction entrances shall be piped through the entrance, maintaining positive drainage. Pipe installed through the stabilized construction entrance shall be protected with a mountable berm with 5:1 slopes and a minimum of 6" of stone over the pipe. Pipe has to be sized according to the drainage. When the SCE is located at a high spot and has no drainage to convey a pipe will not be necessary. Pipe should be sized

6. Location - A stabilized construction entrance shall be located at every point where construction traffic enters or leaves a construction site. Vehicles leaving

according to the amount of runoff to be conveyed. A 6" minimum will be required the site must travel over the entire length of the stabilized construction entrance MARYLAND DEPARTMENT OF ENVIRONMENT U.S. DEPARTMENT OF AGRICULTURE SOIL CONSERVATION SERVICE WATER MANAGEMENT ADMINISTRATION SOIL CONSERVATION SERVICE

5" MINIMUM LENGTH FENCE POST 10' MAXIMUM CENTER TO DRIVEN A MINIMUM OF 16" INTO PERSPECTIVE VIEW POST LENGTH - FENCE POST SECTION MINIMUM 20" ABOVE FLOW GROUND EMBED GEOTEXTILE CLASS F A MINIMUM OF 8" VERTICALLY FENCE POST DRIVEN A INTO THE GROUND MINIMUM OF 16" INTO CROSS SECTION SECTION I STANDARD SYMBOL ------SF ------JOINING TWO ADJACENT SILT FENCE SECTIONS . Fence posts shall be a minimum of 36" long driven 16" minimum into the ground. Wood posts shall be $1\frac{1}{2}$ " x $1\frac{1}{2}$ " square (minimum) cut, or $1\frac{3}{4}$ " diameter (minimum) round and shall be of sound quality hardwood. Steel posts will be standard T or U section weighting not less than 1.00 pond per linear foot

DETAIL 22, - SILT FENCE

2. Geotextile shall be fastened securely to each fence post with wire ties or staples at top and mid-section and shall meet the following requirements for Geotextile Class I Tensile Strenath 50 lbs/in (min.) Test: MSMT 509 Tensile Modulus 20 lbs/in (min.) Test: MSMT 509

0.3 galft / minute (max.) Test: MSMT 322

Test: MSMT 32 Where ends of geotextile fabric come together, they shall be overlapped folded and stapled to prevent sediment bypas

75% (min.) 2

Flow Rate

Filtering Efficiency


bulges occur or when sediment accumulation reached 50% of the fabric heigh

DETAIL 1.2: PUMP-AROUND PRACTICE NOTE: THIS MEASURE MUST BE LOCATED WHERE IT WILL BE READILY ACCESSIBLE TO ALLOW FOR IT'S PRACTICLE USE. ----HOOK AND CHAIN FOR REMOVAL PLAN VIEW Perforated (removable STANDARD SYMBO 12" - 36" pipe wrapped w/ 1/2" hardware cloth and Geotextile dewatering device 0 0 0 0 DISCHARGE HOSES - ANTICIPATED WATER 0000 SURFACE ELEV 20000 20000 DEWATERING PUMP 20000 0000 0000 <u>(0000</u> CLEAN GRAVEL 0 0 0 0 VAXVAVAVAVAVAVA\V 0000 CLEAN WATER DIKE SEDIMENT DIKE 0 0 0 0 0000 work area 0 0 0 0 length not to exceed 8 11 11 18 PUMPS SHOULD DISCHARGE that which can be ONTO A STABLE VELOCITY completed in one day DISSIPATOR MADE OF RIP RAP 0 0 0 OR SANDBAGS HARDWARE CLOTH WEIGHT AS NECESSARY O PREVENT FLOATATION TO PREVENT FLOATATION F BOTTON PLATE FOR EACH OF CENTER PIPE SECTION A-A ELEVATION Construction Specifications l. The outer pipe should be 48" dia. or shall, in any case, be at least 4" greater n diameter than the center pipe. The outer pipe shall be wrapped with ½" hardw cloth to prevent backfill material from entering the perforations. After installing the outer pipe, backfill around outer pipe with 2" aggregate CROSS SECTION OF SANDBAG DIKE 3. The inside stand pipe (center pipe) should be constructed by perforating a corrugated or PVC pipe between 12" and 36" in diameter. The perforations shall be 1/2" X 6" slits or 1" diameter holes 6" on center. The center pipe shall be wrapped with 1/2" hardware cloth first, then wrapped again with Geotextile Class E

MARYLAND DEPARTMENT OF ENVIRONMENT

DETAIL 20A - REMOVABLE PUMPING STATION

STABILIZED AREA DISCHARGE HOSE STABILIZED AREA INTAKE HOSE-

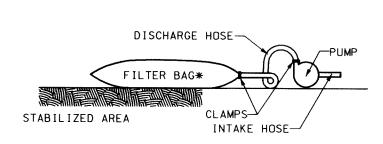

* NON-WOVEN GEOTEXTILE FILTER BAG WHICH RETAINS ALL SEDIMENT PARTICLES LARGER THAN 150 MICRONS.

NOTES: 1. PLACE FILTER BAGS ON STABLE OR WELL VEGETATED AREAS WHICH ARE FLATTER THAN 5% AND WILL NOT ERODE WHEN SUBJECTED TO

2. CLAMP PUMP DISCHARGE HOSES SECURELY INTO FILTER BAGS.

3. LIMIT PUMPING RATE TO 1/2 THE MANUFACTURER'S MAXIMUM PUMPING RATE.

4. WHEN SEDIMENTS FILL $^{1}\!\!\!\!/_2$ THE VOLUME OF A FILTER BAG, IMMEDIATELY REMOVE THAT BAG FROM SERVICE. PROPERLY DISPOSE OF SPENT BAGS WITH THEIR SEDIMENTS.

FILTER BAG SPECIFICATIONS

- 1. FILTER BAG SHALL BE MADE OF NON-WOVEN GEOTEXTILE WITH A MINIMUM SURFACE AREA OF 225 SQUARE FEET PER
- 2. ALL STRUCTURAL SEAMS SHALL BE SEWN WITH A DOUBLE STITCH USING A DOUBLE NEEDLE MACHINE WITH HIGH STRENGTH THREAD. SEAM STRENGTH SHALL WITHSTAND 100
- LB/IN USING ASTM D-4884 TEST METHOD. 3. FILTER BAG SHALL HAVE A NOZZLE LARGE ENOUGH TO ACCOMMODATE A FOUR(4) INCH DIAMETER PUMP DISCHARGE
- 4. NOZZLE SHALL BE SEALED TIGHTLY AROUND THE PUMP DISCHARGE HOSE WITH A STRAP OR SIMILAR DEVICE TO

PREVENT UNFIL TERED WATER FROM ESCAPING

- 5. FILTER BAG SHALL BE PLACED ON A LEVEL OR GENTLY SLOPING (5% MAXIMUM) AREA
- 6. FILTER BAG SHALL BE PLACED UPON A BASE OF STRAW BALES OR THREE (3) INCHES OF CLEAN STONE TO PROMOTE DEWATERING THROUGH BOTTOM SURFACE OF THE FILTER
- 7. PUMPING RATES SHALL BE CONTROLLED TO PREVENT. EXCESSIVE PRESSURE WITHIN THE FILTER BAG. AS THE BAG BECOMES FILLED WITH SEDIMENT THE PUMPING RATE SHALL BE REDUCED
- 8. THE FILTER BAG SHALL BE DEWATERED, REMOVED AND DISPOSED OF UPON COMPLETION OF PUMPING OPERATIONS OR AFTER IT HAS REACHED CAPACITY, WHICHEVER OCCURS FIRST. THE DEWATERED SEDIMENT FROM THE BAG SHALL BE

SPREAD IN AN UPLAND AREA AND STABILIZED WITHIN 24

9. THE GEOTEXTILE FABRIC SHALL MEET THE FOLLOWING MINIMUM REQUIREMENTS WITH PROPERTIES DETERMINED IN ACCORDANCE WITH THE FOLLOWING PROCEDURES:

WEIGHT 10 OZ/YD ASTM D-3776 GRAB TENSILE 210 LBS. ASTM D-4632 PUNCTURE 150 LBS. ASTM D-4833 FLOW RATE 70 GAL/MIN/FT2 ASTM D-4491 PERMITIVITY (SEC) ASTM D-4991 **UV RESISTANCE** ASTM D-4355 APPARENT OPENING SIZE (AOS) 40-80

ASTM D-4751

0

SECTION ND REPAIF SOJECT

om

MGWC 1.2: PUMP-AROUND PRACTICE TEMPORARY MEASURE FOR DEWATERING IN CHANNEL CONSTRUCTION SITES

THE WORK SHOULD CONSIST OF INSTALLING A TEMPORARY PUMP AROUND AND SUPPORTING MEASURES TO DIVERT FLOW AROUND IN-STREAM CONSTRUCTION SITES

IMPLEMENTATION SEQUENCE

SEDIMENT CONTROL MEASURES, PUMP-AROUND PRACTICES, AND ASSOCIATED CHANNEL AND BANK CONSTRUCTION SHOULD BE COMPLETED IN THE FOLLOWING SEQUENCE (REFER TO DETAIL 1.2)

CONSTRUCTION ACTIVITIES INCLUDING THE INSTALLATION OF EROSION AND SEDIMENT CONTROL MEASURES SHOULD NOT BEGIN UNTIL ALL NECESSARY EASEMENTS AND/OR RIGHT-OF-WAYS HAVE BEEN ACQUIRED. ALL EXISTING UTILITIES SHOULD BI MARKED IN THE FIELD PRIOR TO CONSTRUCTION. THE CONTRACTOR IS RESPONSIBLE FOR ANY DAMAGE TO EXISTING UTILITIES THAT MAY RESULT FROM CONSTRUCTION AND SHOULD REPAIR THE DAMAGE AT HIS/HER OWN EXPENSE TO THE COUNTY'S OF

THE CONTRACTOR SHOULD NOTIFY THE MARYLAND DEPARTMENT OF THE ENVIRONMENT OR WMA SEDIMENT CONTROL INSPECTOR AT LEAST 5 DAYS BEFORE BEGINNING CONSTRUCTION. ADDITIONALLY, THE CONTRACTOR SHOULD INFORM THE LOCAL ENVIRONMENTAL PROTECTION AND RESOURCE MANAGEMENT INSPECTION AND ENFORCEMENT DIVISION AND THE PROVIDER OF LOCAL UTILITIES A MINIMUM OF 48 HOURS BEFORE STARTING CONSTRUCTION

THE CONTRACTOR SHOULD CONDUCT A PRE-CONSTRUCTION MEETING ON SITE WITH THE WMA SEDIMENT CONTROL INSPECTOR, THE COUNTY PROJECT MANAGER, AND THE ENGINEER TO REVIEW LIMITS OF DISTURBANCE, EROSION AND SEDIMENT CONTROL REQUIREMENTS. AND THE SEQUENCE OF CONSTRUCTION. THE CONTRACTOR SHOULD STAKE OUT ALL LIMITS OF DISTURBANCE PRIOR TO THE PRE-CONSTRUCTION MEETING SO THEY MAY BE REVIEWED. THE PARTICIPANTS WILL ALSO ESIGNATE THE CONTRACTOR'S STAGING AREAS AND FLAG ALL TREES WITHIN THE LIMIT OF DISTURBANCE. WHICH WILL F REMOVED FOR CONSTRUCTION ACCESS. TREES SHOULD NOT BE REMOVED WITHIN THE LIMIT OF DISTURBANCE WITHOUT APPROVAL FROM THE WMA OR LOCAL AUTHORITY.

CONSTRUCTION SHOULD NOT BEGIN UNTIL ALL SEDIMENT AND EROSION CONTROL MEASURES HAVE BEEN INSTALLED AND APPROVED BY THE ENGINEER AND THE SEDIMENT CONTROL INSPECTOR. THE CONTRACTOR SHOULD STAY WITHIN THE LIMITS OF HE DISTURBANCE AS SHOWN ON THE PLANS AND MINIMIZE DISTURBANCE WITHIN THE WORK AREA WHENEVER POSSIBLE.

UPON INSTALLATION OF ALL SEDIMENT CONTROL MEASURES AND APPROVAL BY THE SEDIMENT CONTROL INSPECTOR AND THE LOCAL ENVIRONMENTAL PROTECTION AND RESOURCE MANAGEMENT INSPECTION AND ENFORCEMENT DIVISION. THE CONTRACTOR SHOULD BEGIN WORK AT THE UPSTREAM SECTION AND PROCEED DOWNSTREAM BEGINNING WITH THE STABLISHMENT OF STABILIZED CONSTRUCTION ENTRANCES. IN SOME CASES, WORK MAY BEGIN DOWNSTREAM IF APPROPRIATE. THE SEOUENCE OF CONSTRUCTION MUST BE FOLLOWED UNLESS THE CONTRACTOR GETS WRITTEN APPROVAL FOR DEVIATIONS FROM THE WMA OR LOCAL AUTHORITY. THE CONTRACTOR SHOULD ONLY BEGIN WORK IN AN AREA WHICH CAN BE COMPLETED BY THE END OF THE DAY INCLUDING GRADING ADJACENT TO THE CHANNEL. AT THE END OF EACH WORKDAY, THE WORK AREA MUST BE STABILIZED AND THE PUMP AROUND REMOVED FROM THE CHANNEL. WORK SHOULD NOT BE CONDUCTED IN THE

SANDBAG DIKES SHOULD BE SITUATED AT THE UPSTREAM AND DOWNSTREAM ENDS OF THE WORK AREA AS SHOWN ON THI LANS, AND STREAM FLOW SHOULD BE PUMPED AROUND THE WORK AREA. THE PUMP SHOULD DISCHARGE ONTO A STABLE ELOCITY DISSIPATER MADE OF RIPRAP OR SANDBAGS.

WATER FROM THE WORK AREA SHOULD BE PUMPED TO A SEDIMENT FILTERING MEASURE SUCH AS A DEWATERING BASIN EDIMENT BAG, OR OTHER APPROVED SOURCE. THE MEASURE SHOULD BE LOCATED SUCH THAT THE WATER DRAINS BACK INTO HE CHANNEL BELOW THE DOWNSTREAM SANDBAG DIKE.

TRAVERSING A CHANNEL REACH WITH EQUIPMENT WITHIN THE WORK AREA WHERE NO WORK IS PROPOSED SHOULD BE AVOIDED. IF EQUIPMENT HAS TO TRAVERSE SUCH A REACH FOR ACCESS TO ANOTHER AREA, THEN TIMBER MATS OR SIMILAR MEASURES SHOULD BE USED TO MINIMIZE DISTURBANCE TO THE CHANNEL. TEMPORARY STREAM CROSSINGS SHOULD BE USED ONLY WHEN NECESSARY AND ONLY WHERE NOTED ON THE PLANS OR SPECIFIED. (SEE SECTION 4, STREAM CROSSINGS, MARYLAND

ALL STREAM RESTORATION MEASURES SHOULD BE INSTALLED AS INDICATED BY THE PLANS AND ALL BANKS GRADED IN ACCORDANCE WITH THE GRADING PLANS AND TYPICAL CROSS-SECTIONS. ALL GRADING MUST BE STABILIZED AT THE END OF ACH DAY WITH SEED AND MULCH OR SEED AND MATTING AS SPECIFIED ON THE PLANS.

AFTER AN AREA IS COMPLETED AND STABILIZED, THE CLEAN WATER DIKE SHOULD BE REMOVED. AFTER THE FIRST SEDIMENT FLUSH, A NEW CLEAN WATER DIKE SHOULD BE ESTABLISHED UPSTREAM FROM THE OLD SEDIMENT DIKE. FINALLY UPON ESTABLISHMENT OF A NEW SEDIMENT DIKE BELOW THE OLD ONE, THE OLD SEDIMENT DIKE SHOULD BE REMOVED.

A PUMP AROUND MUST BE INSTALLED ON ANY TRIBUTARY OR STORM DRAIN OUTFALL, WHICH CONTRIBUTES BASEFLOW TO THE WORK AREA. THIS SHOULD BE ACCOMPLISHED BY LOCATING A SANDBAG DIKE AT THE DOWNSTREAM END OF THE TRIBUTARY OR STORM DRAIN OUTFALL AND PUMPING THE STREAM FLOW AROUND THE WORK AREA. THIS WATER SHOULD DISCHARGE ONTO THE SAME VELOCITY DISSIPATER USED FOR THE MAIN STEM PUMP AROUND. IF A TRIBUTARY IS TO BE RESTORED, CONSTRUCTION SHOULD TAKE PLACE ON THE TRIBUTARY BEFORE WORK ON THE MAIN

STEAM REACHES THE TRIBUTARY CONFLUENCE. CONSTRUCTION IN THE TRIBUTARY, INCLUDING PUMP AROUND PRACTICES. SHOULD FOLLOW THE SAME SEQUENCE AS FOR THE MAIN STEM OF THE RIVER OR STREAM. WHEN CONSTRUCTION ON THE TRIBUTARY IS COMPLETED, WORK ON THE MAIN STEM SHOULD RESUME. WATER FROM THE TRIBUTARY SHOULD CONTINUE TO BE PUMPED AROUND THE WORK AREA IN THE MAIN STEM.

THE CONTRACTOR IS RESPONSIBLE FOR PROVIDING ACCESS TO AND MAINTAINING ALL EROSION AND SEDIMENT CONTROL DEVICES UNTIL THE SEDIMENT CONTROL INSPECTOR APPROVES THEIR REMOVAL.

4. AFTER CONSTRUCTION, ALL DISTURBED AREAS SHOULD BE REGRADED AND REVEGETATED AS PER THE PLANTING PLAN.

TEMPORARY VEGATATIVE STABILIZATION

SEEDBED PREPARATION

WATER MANAGEMENT ADMINISTRATION

LOOSEN UPPER THREE INCHES BY DISCING, RAKING OR OTHER ACCEPTABLE MEANS. B) SOIL AMENDMENTS:

APPLY 600 LBS PER ACRE OF 10-10-10 FERTILIZER AND TWO TONS PER ACRE OF LIME

FOR PERIODS OF MARCH I TO APRIL 30 AND AUGUST 15 TO NOVEMBER 15, SEED WITH 2.5 BU PER ACRE OF CEREAL RYE PLUS 30 LBS PER ACRE OF TALL FESCUE OR 5 LBS PER ACRE OF REDTOP OR 20 LBS PEI

MARYLAND DEPARTMENT OF ENVIRONMENT U.S. DEPARTMENT OF AGRICULTURE

SOIL CONSERVATION SERVICE

OR PERIOD OF MAY I TO AUGUST 14, SEED WITH 3 LBS PER ACRE OF WEEPING LOVEGRASS OR 40 LB MULCHING SPECIFICATIONS:

MULCH SHALL BE APPLIED TO ALL SEEDED AREAS IMMEDIATELY AFTER SEEDING APPLY 2 TONS PER ACRE OF STRAW OVER ALL SEEDED AREAS. IF A MULCH ANCHORING TOOL IS TO BE USED. THE RATE SHALL BE INCREASED TO 2.5 TONS PER ACRES **

MULCH ANCHORING SHALL BE PERFORMED IMMEDIATELY FOLLOWING MULCH APPLICATION TO MINIMIZE LOSS BY WIND AND WATER. THE TYPE OF MULCH ANCHORING USED MUST COMPLY WITE THE 1994 MARYLAND STANDARD AND SPECIFICATIONS.

IF OTHER SEED MIXES ARE TO BE SUBSTITUTED, THEY MUST COMPLY WITH THE 1994 MARYLAND TANDARD AND SPECIFICTAIONS, CHAPTER 20, TABLE 25. IF A DIFFERENT TYPE OF MULCH IS TO BE USED, IT MUST COMPLY WITH THE 1994 MARYLAND TANDARD AND SPECIFICTION, CHAPTER 20. ERMANENT VEGATATIVE STABILIZATION

LL DISTURBED AREAS, WHICH ARE NOT TO BE PAVED, SHALL BE PERMANENTLY STABILIZED AS

OOSEN UPPER THREE INCHES BY RAKING, DISCING, OR OTHER ACCEPTABLE MEANS AFTER SPREADING

PPLY 500 LBS PER ACRE OF 10-10-10 FERTILIZER AND TWO TONS PER ACRE OF LIME.

OR PERIODS OF MARCH I TO MAY 15 AND AUGUST 15 TO OCTOBER 15, SEED WITH 125 LBS PER ACRE OF ALL FESCUE, 15 LBS PER ACRE OF PERENNIAL RYEGRASS, AND 10 LBS OF KENTUCKY BLUEGRASS.

OR PERIOD OF MAY 16 TO AUGUST 14, SEED WITH 110 LBS PER ACRE OF TALL FESCUE AND 3 LBS PER CRE OF WEEPING LOVEGRASS OR PERIOD OF OCTOBER 16 TO FEBRUARY 28, PROTECT SITE BY: PTIONS - 1) 2 TONS PER ACRE OF WELL ANCHORED STRAW MULCH AND SEED AS SOON AS POSSIBLE IN

HE SPRING, 2) USE SOD, OR 3) SEED WITH 60 LBS PER ACRE OF TALL FESCUE AND MULCH WITH 2 TONS ER ACRE OF WELL ANCHORED STRAW. IOTE: FOR QUICK COVER WITH TALL FESCUE, ADD 2 LBS OF SMALL GRAIN PER 1,000 SQ. FT. D) MULCHING SPECIFICATIONS

MULCH SHALL BE APPLIED TO ALL SEEDED AREAS IMMEDIATELY AFTER SEEDING. APPLY 2 TONS PER ACRE OF STRAW OVER ALL SEEDED AREAS. IF A MULCH ANCHORING TOOL IS TO BE USED, THE RATE SHALL BE INCREASED TO 2.5 TONS PER ACRES.** MULCH ANCHORING SHALL BE PERFORMED IMMEDIATELY FOLLOWING MULCH APPLICATION TO MINIMIZE LOSS BY WIND AND WATER. THE TYPE OF MULCH ANCHORING USED MUST COMPLY WITH THE 1994 MARYLAND STANDARD AND SPECIFICATIONS.

* IF OTHER SEED MIXES ARE TO BE SUBSTITUTED, THEY MUST COMPLY WITH THE 1994 MARYLAND STANDARD AND SPECIFICTAIONS, CHAPTER 20, TABLE 25. ** IF A DIFFERENT TYPE OF MULCH IS TO BE USED, IT MUST COMPLY WITH THE 1994 MARYLAND STANDARD AND SPECIFICTION, CHAPTER 20.

HOWARD COUNTY CONSERVATION DISTRIC STANDARD SEDIMENT CONTROL NOTES

CONSTRUCTION MEASURES

REVISED NOVEMBER 2**006**

A MINIMUM OF 48 HOURS NOTICE MUST BE GIVEN TO THE HOWARD COUNTY DEPARTMENT OF INSPECTIONS, LICENSES AND PERMITS, SEDIMENT CONTROL DIVISION PRIOR TO THE START OF ANY CONSTRUCTION (313-1855).

ALL VEGETATIVE AND STRUCTURAL PRACTICES ARE TO BE INSTALLED ACCORDING TO THE PROVISIONS OF THIS PLAN AND ARE TO BE CONFORMANCE WITH THE MOST CURRENT MARYLAND STANDARDS AND SPECIFICATION FOR SOIL EROSION AND SEDIMENT CONTROL AND REVISIONS

FOLLOWING INITIAL SOIL DISTURBANCE OR RE-DISTURBANCE, PERMANENT ORTEMPORARY STABILIZATION SHALL BE COMPLETED WITHIN: A) 7 CALENDAR DAYS FOR ALL PERIMETER SEDIMENT CONTROL STRUCTURES, DIKES, PERIMETER SLOPES AND ALL SLOPES GREATER THAN 3:1, B) 14 DAYS AS TO ALL OTHER DISTURBED OR GRADED AREAS ON THE PROJECT SITI

ALL SEDIMENT TRAPS/BASINS SHOWN MUST BE FENCED AND WARNING SIGN POSTED AROUND THEIR PERIMETER IN ACCORDANCE WITH VOL. 1, CHAPTER 12 OF THE HOWARD COUNTY DESIGN MANUAL, STORM DRAINAGE.

ALL DISTURBED AREAS MUST BE STABILIZED WITHIN THE TIME PERIOD SPECIFIED ABOVE IN ACCORDANCE WITH THE 1994 MARYLAND STANDARDS AND SPECIFICATION FOR SOIL EROSION AND SEDIMENT CONTROL FOR PERMANENT SEEDING (SEC. 51), SOD (SEC. 54), TEMPORARY SEEDING (SEC. 50) AND MULCHING SEC. 52). TEMPORARY STABILIZATION WITH MULCH ALONE CAN ONLY BE DONE WHEN RECOMMENDED SEEDING DATES DO NOT ALLOW FOR PROPER GERMINATION AND ESTABLISHMENT OF GRASSES

ALL SEDIMENT CONTROL STRUCTURES ARE TO REMAIN IN PLACE AND ARE TO BE MAINTAINED IN OPERATIVE CONDITION UNTIL PERMISSION FOR THEIR REMOVAL HAS BEEN OBTAINED FROM THE HOWARD COUNTY SEDIMENT CONTROL

SITE ANALYSIS:

TOTAL AREA OF SITE 0 44 ACRES AREA DISTURBED 0.44 ACRES AREA TO BE ROOFED OR PAVED 0 ACRES AREA TO BE VEGETATIVELY STABILIZED 0.34 ACRES

TOTAL CUT 766 CU. YDS. TOTAL FILL 1,243 CU. YDS. OFFSITE WASTE/BORROW AREA LOCATION TO BE DETERMINED*

ANY SEDIMENT CONTROL PRACTICE WHICH IS DISTURBED BY GRADING ACTIVITY FOR PLACEMENT OF UTILITIES MUST BE REPAIRED ON THE SAME DAY OF DISTURBANCE.

ADDITIONAL SEDIMENT CONTROL MUST BE PROVIDED, IF DEEMED NECESSARY BY THE HOWARD COUNTY SEDIMENT CONTROL INSPECTOR.

ON ALL SITES WITH DISTURBED AREAS IN EXCESS OF 2 ACRES, APPROVAL OF THE INSPECTION AGENCY SHALL BE REQUESTED UPON COMPLETION OF INSTALLATION OF PERIMETER EROSION AND SEDIMENT CONTROLS, BUT BEFORE PROCEEDING WITH ANY OTHER EARTH DISTURBANCE OR GRADING. OTHER BUILDING OR GRADING INSPECTION APPROVALS MAY NOT BE AUTHORIZED UNTIL THIS INITIAL APPROVAL BY THE INSPECTION AGENCY IS MADE.

TRENCHES FOR THE CONSTRUCTION OF UTILITIES IS LIMITED TO THREE PIPE LENGTHS OR THAT WHICH SHALL BE BACK-FILLED AND STABILIZED BY THE END OF EACH WORK DAY, WHICHEVER IS SHORTER

*OFFSITE WASTE/BORROW SITE SHALL HAVE AN APPROVED SEDIMENT CONTROL PLAN

21.0 STANDARD AND SPECIFICATIONS FOR TOPSOIL

DEFINITION

BAG DISCHARGES.

PLACEMENT OF TOPSOIL OVER A PREPARED SUBSOIL PRIOR TOSTABLISHMENT OF PERMANENT VEGETATION.

PURPOSE

PROVIDE A SUITABLE SOIL MEDIUM FOR VEGETATIVE GROWTH. SOILS OF CONCERN HAVE LOW MOISTURE CONTENT, LOW NUTRIENT LEVELS, LOW PH, MATERIALS TOXIC TO PLANTS, AND/OR UNACCEPTABLE SOIL GRADATION.

ONDITIONS WHERE PRACTICE APPLIES

DIVERSION PUMPS

intake

sump-hole

(12" to 18" deep

or pool

2' dia.)

MARYLAND DEPARTMENT OF THE ENVIRONMENT

WATER MANAGEMENT ADMINISTRAT

THIS PRACTICE IS LIMITED TO AREAS HAVING 2:1 OR FLATTER SLOPES

- THE TEXTURE OF THE EXPOSED SUBSOIL/PARENT MATERIAL IS NOT ADEQUATE TO PRODUCE VEGETATIVE GROWTH.
- THE SOIL MATERIAL IS SO SHALLOW THAT THE ROOTING ZONE IS NOT DEEP ENOUGH TO SUPPORT PLANTS OR FURNISH CONTINUING SUPPLIES OF
- MOISTURE AND PLANT NUTRIENTS. THE ORIGINAL SOIL TO BE VEGETATED CONTAINS MATERIAL TOXIC TO PLANT GROWTH.
- THE SOIL IS SO ACIDIC THAT TREATMENT WITH LIMESTONE IS NOT FEASIBLE.
- FOR THE PURPOSE OF THESE STANDARD SPECIFICATIONS, AREAS HAVING SLOPES STEEPER THAN 2:1 REQUIRE SPECIAL CONSIDERATION AND DESIGN FOR ADEQUATE STABILIZATION. AREAS HAVING SLOPES STEEPER THAN 2:1 SHALL HAVE THE APPROPRIATE STABILIZATION SHOWN ON THE PLANS.

ONSTRUCTION AND MATERIAL SPECIFICATIONS

TOPSOIL SALVAGED FROM THE EXISTING SITE MAY BE USED PROVIDED THAT IT MEETS THE STANDARDS AS SET FORTH IN THESE SPECIFICATIONS, TYPICALLY, THE DEPTH OF TOPSOIL TO BE SALVAGED FOR A GIVEN SOIL TYPE CAN BE FOUND IN THE REPRESENTATIVE SOIL PROFILE SECTION IN THE SOIL SURVEY PUBLISHED BY USDA-SCS IN COOPERATION WITH MARYLAND AGRICULTURAL EXPERIMENTAL STATION.

TOPSOIL SPECIFICATIONS - SOIL TO BE USED AS TOPSOIL MUST MEET THE FOLLOWING:

- TOPSOIL SHALL BE A LOAM, SANDY LOAM, CLAY LOAM, SILT LOAM, SANDY CLAY LOAM, LOAMY SAND. OTHER SOILS MAY BE USED IF RECOMMENDED BY AN AGRONOMIST OR SOIL SCIENTIST AND APPROVED BY THE APPROPRIATE APPROVAL AUTHORITY. REGARDLESS, TOPSOIL SHALL NOT BE A MIXUTRE OF CONTRASTING TEXTURED SUBSOILS AND SHALL CONTAIN LESS THAN 5% BY VOLUME OF CINDERS. STONES, SLAG, COARSE FRAGMENTS, GRAVEL. STICKS. ROOTS, TRASH, OR OTHER MATERIALS LARGER THAN 1 1/2" IN DIAMETER.
- TOPSOIL MUST BE FREE OF PLANTS OR PLANT PARTS SUCH A BERMUDA GRASS. QUACKGRASS, JOHNSONGRASS, NUTSEDGE, POISON IVY, THISTLE, OR OTHERS AS
- WHERE THE SUBSOIL IS EITHER HIGHLY ACIDIC OR COMPOSED OF HEAVY CLAYS. GROUND LIMESTONE SHALL BE SPREAD AT THE RATE OF 4-8 TONS/ACRE (200-400 POUNDS PER 1,000 SQUARE FEET) PRIOR TO THE PLACEMENT OF TOPSOIL. LIME SHALL BE DISTURBED CONJUNCTION WITH TILLAGE OPERATIONS AS DESCRIBED IN THE FOLLOWING PROCEDURES

II. FOR SITES HAVING DISTURBED AREAS UNDER 5 ACRES

i. PLACE TOPSOIL (IF REQUIRED) AND APPLY SOIL AMENDMENTS AS SPECIFIED IN 20.0 VEGETATIVE STABILIZATION - SECTION I -VEGETATIVE STABILIZATION METHODS AND MATERIALS.

V. FOR SITES HAVING DISTURBED AREAS OVER 5 ACRES:

- i. ON SOIL MEETING TOPSOIL SPECIFICATIONS, OBTAIN TEST RESULTS DICTATING FERTILIZER AND LIME AMENDMENTS REQUIRED TO BRING THE SOIL INTO COMPLIANCE WITH THE FOLLOWING:
- a. PH FOR TOPSOIL SHALL BE BETWEEN 6.0 AND 7.5. IF THE TESTED SOIL DEMONSTRATES A PH OF LESS THAN 6.0, SUFFICIENT LIME SHALL BE PRESCRIBED TO RAISE THE PH TO 6.5 OR HIGHER.
- b. ORGANIC CONTENT OF TOPSOIL SHALL BE NOT LESS THAN 1.5 PERCENT BY
- c. TOPSOIL HAVING SOLUBLE SALT CONTENT GREATER THAN 500 PARTS PER MILLION SHALL NOT BE USED.
- d. NO SOD OR SEED SHALL BE PLACED ON SOIL WHICH HAS BEEN TREATED WITH SOIL STERILANTS OR CHEMICALS USED FOR WEED CONTROL UNTIL SUFFICIENT TIME AS ELAPSED (14 DAYS MIN.) TO PERMIT DISSIPATION OF PHYTO-TOXIC MATERIALS.

NOTE: TOPSOIL SUBSTITUTES OR AMENDMENTS, AS RECOMMENDED BY A QUALIFIED AGRONOMIST OR SOIL SCIENTIST AND APPROVED BY THE APPROPRIAT APPROVAL AUTHORITY, MAY BE USED IN LIEU OF NATURAL TOPSOIL.

ii. PLACE TOPSOIL (IF REQUIRED) AND APPLY SOIL AMENDMENTS AS SPECIFIED IN 20.0 VEGETATIVE STABILIZATION - SECTION Í -

. TOPSOIL APPLICATION

- i. WHEN TOPSOILING, MAINTAIN NEEDED EROSION AND SEDIMENT CONTROL PRACTICES SUCH AS DIVERSIONS, GRADE STABILIZATION STRUCTURES, EARTH DIKES, SLOPE SILT FENCE AND SEDIMENT TRAPS AND BASINS.
- ii. GRADES ON THE AREAS TO BE TOPSOILED, WHICH HAVE BEEN PREVIOUSLY ESTABLISHED, SHALL BE MAINTAINED, ALBEIT 4" - 8" HIGHER IN ELEVATION.
- iii. TOPSOIL SHALL BE UNIFORMLY DISTRIBUTED IN A 4" 8" LAYER AND LIGHTLY COMPACTED TO A MINIMUM THICKNESS OF 4". SPREADING SHALL BE PERFORMED IN SUCH A MANNER THAT SODDING OR SEEDING CAN PROCEED WITH A MINMUM OF ADDITIONAL SOIL PREPARATION AND TILLAGE. ANY IRREGULARITIES IN THE SURFACE RESULTING FROM TOPSOILING OR OTHER OPERATIONS SHALL BE WATER POCKETS.
- iv. TOPSOIL SHALL NOT BE PLACED WHILE THE TOPSOIL OR SUBSOIL IS IN A FROZEN OR MUDDY CONDITION, WHEN THE SUBSOIL IS EXCESSIVELY WET OR IN A CONDITION THAT MY OTHERWISE BE DETRIMENTAL TO PROPER GRADING AND SEEDBED PREPARATION. CORRECTED IN ORDER TO PREVENT THE FORMATION OF DEPRESSIONS OR

TEMPORARY SEEDING SUMMARY

SEED MIXTURE (HARDINESS ZONE 6B) FROM TABLE 26					FERTILIZER RATE	LIME
NO.	SPECIES	APPLICATION RATE (LB/AC)	SEEDING DATES	SEEDING DEPTHS	(10-10-10)	RATE
1	RYE	140	3/1-4/30 8/15-11/15	1-2 INCH	600 LB/AC (15 LB/1000 SF)	2 tons/ac (100 LB/
2	RYE PLUS FOXTAIL MILLET	150	3/1-4/30 5/1-8/14 8/15-11/15	1 INCH		1000 SF)

USDA - NATURAL RESOURCES CONSERVATION SERVICE THIS DEVELOPMENT IS APPROVED FOR SOIL EROSION AND SEDIMENT CONTROL BY THE HOWARD SOIL CONSERVATION DISTRICT.

PERMANENT SEEDING SUMMARY

SEED MIXTURE (HARDINESS ZONE 6B) FERTILIZER RATE FROM TABLE 25 (10-20-20)						LIME	
NO. SPECIES	APPLICATION RATE (LB/AC)	SEEDING DATES	SEED ING DEPTHS	N	P205	K20	
TALL FESCUE (85%) 1 PERENNIAL RYEGRASS (10%) KENTUCKY BLUEGRASS (5%)	125 15 10	3/1-5/15 8/15-10/15	1-2 INCH	90 LB/AC	175 lb/ac	175 lb/ac (4.0 LB/	2 tons/ac (100 LB/
2 KENTUCKY BLUEGRASS (50%) HARD FESCUE (40%) RED TOP (10%)	150	3/1-5/15 8/15-10/15	1-2 I NCH	1000 SF)	1000 SF)	1000 SF)	1000 SF)

SHEET NO.: 6 OF 6

01-043223.17

CAPITAL PROJECT NO.

CONSTRUCTION ISSUE: