


# LONGVIEW DRIVE STREAM STABILIZATION

## CAPITAL PROJECT # D-1175

### GENERAL NOTES

- ALL CONSTRUCTION SHALL BE IN ACCORDANCE WITH THE LATEST STANDARDS AND SPECIFICATIONS OF HOWARD COUNTY PLUS MSHA STANDARDS AND SPECIFICATIONS IF APPLICABLE.
- THE EXISTING INFORMATION SHOWN ON THESE PLANS WAS TAKEN FROM THE BEST AVAILABLE SOURCES AND SHALL BE VERIFIED BEFORE STARTING CONSTRUCTION. HOWARD COUNTY DOES NOT GUARANTEE THE COMPLETENESS OR THE CORRECTNESS OF THE SHOWN INFORMATION.
- THE CONTRACTOR IS SOLELY RESPONSIBLE FOR CONSTRUCTION MEANS, METHODS, TECHNIQUES, SEQUENCES, PROCEDURES, AND SAFETY PRECAUTIONS AND PROGRAMS.
- THE CONTRACTOR SHALL NOTIFY THE DEPARTMENT OF PUBLIC WORKS/BUREAU OF ENGINEERING/CONSTRUCTION INSPECTION DIVISION AT (410) 313-1880 AT LEAST FIVE (5) DAYS PRIOR TO THE START OF WORK.
- THE CONTRACTOR SHALL NOTIFY "MISS UTILITY" AT 1-800-257-7777 AT LEAST FIVE (5) WORKING DAYS PRIOR TO ANY EXCAVATION WORK BEING DONE.
- PRIOR TO BEGINNING ANY CONSTRUCTION ACTIVITIES, PHOTOGRAPHS OF THE PROPOSED WORK AREA AND ACCESS SHALL BE TAKEN.
- TRAFFIC CONTROL DEVICES, MARKINGS AND SIGNING FOR LONGVIEW DRIVE AND US 40 SHALL BE IN ACCORDANCE WITH THE LATEST EDITION OF THE MANUAL OF UNIFORM TRAFFIC CONTROL DEVICES (MUTCD). ALL STREET AND REGULATORY SIGNS SHALL BE IN PLACE PRIOR TO THE START OF WORK.
- A JOINT PERMIT APPLICATION HAS BEEN SUBMITTED AND APPROVED BY THE MARYLAND DEPARTMENT OF THE ENVIRONMENT FOR THIS PROJECT (HO SWM/PLUMTREE BRANCH STABILIZATION) 2017-61314. PROJECT IMPACTS INCLUDE WORK IN A USE IV-P STREAM. UNDER THIS PERMIT, IN-STREAM WORK IS PROHIBITED FROM MARCH 1 TO MAY 31, INCLUSIVE OF ANY YEAR.
- THE EXISTING TOPOGRAPHY WAS TAKEN FROM FIELD RUN SURVEY WITH ONE FOOT CONTOUR INTERVALS PREPARED BY AB CONSULTANTS, INC. IN DECEMBER 2016.
- THE COORDINATES SHOWN HEREON ARE BASED UPON THE HOWARD COUNTY GEODETIC CONTROL, WHICH IS BASED UPON THE MARYLAND STATE PLANE COORDINATE SYSTEM. HOWARD COUNTY MONUMENT NOS. 24BS, 24BB, AND 24BF WERE USED FOR THIS PROJECT.
- WATER IS PUBLIC.
- SEWER IS PUBLIC.
- 100-YEAR FLOODPLAIN ELEVATION IS SHOWN ON THE PLANS. THERE ARE FEMA MAPPED FLOODPLAINS WITHIN THE PROJECT LIMITS.
- PLUMTREE BRANCH IS NOT A TIER II WATER. AS A TRIBUTARY WITHIN THE LITTLE PATUXENT WATERSHED, THE STREAM IS AN IMPAIRED WATERWAY WITH THE FOLLOWING TMDL'S:
  - TSS - GIS ID: G1118, REPORT: LITTLE PATUXENT RIVER SEDIMENT
- TEMPORARY STAGING AND/OR STOCKPIILING OF ERODIBLE MATERIALS (E.G. EXCAVATED MATERIAL) WITHIN THE 100-YEAR FLOODPLAIN DESIGNATED ON THE PLANS SHALL BE LIMITED TO THE AMOUNT OF MATERIAL THE CONTRACTOR CAN PLACE AND/OR HAUL OFF IN A SINGLE DAY. THE CONTRACTOR SHALL MONITOR THE WEATHER FORECAST AND ADJUST STOCKPILE/STAGING OPERATIONS ACCORDINGLY TO MINIMIZE THE LOSS OF MATERIAL OR OTHER ADVERSE IMPACTS.
- THE CONTRACTOR SHALL NOT STORE EQUIPMENT, MATERIALS, AND/OR SUPPLIES BEYOND THE LIMIT OF DISTURBANCE SHOWN ON THE PLANS.
- EXISTING UTILITIES ARE BASED ON AVAILABLE RECORDS. THE CONTRACTOR MUST VERIFY INFORMATION TO HIS/HER SATISFACTION.
- NO WETLANDS ARE LOCATED WITHIN THE PROJECT LIMITS.
- NO TRAFFIC STUDY IS REQUIRED FOR THIS PROJECT.
- THERE ARE NO BURIAL GROUNDS OR CEMETERY SITES LOCATED ON THE PROJECT SITE.
- THERE IS ONE EXISTING FOREST CONSERVATION EASEMENT LOCATED WITHIN PARCEL 810. 2,029 SF OF THIS FOREST CONSERVATION EASEMENT WILL BE DISTURBED. ALL FOREST CONSERVATION EASEMENT AREAS WILL BE REPLANTED IN COORDINATION WITH THE DEPARTMENT OF RECREATION AND PARKS.
- THE CONTRACTOR SHALL TAKE ALL NECESSARY PRECAUTIONS TO PROTECT THE EXISTING UTILITIES AND MAINTAIN UNINTERRUPTED SERVICE. ANY DAMAGE INCURRED DUE TO THE CONTRACTOR'S OPERATION SHALL BE REPAIRED IMMEDIATELY AT THE CONTRACTOR'S EXPENSE. ALL UTILITIES SHALL HAVE A CLEARANCE BY A MINIMUM OF 6 INCHES VERTICALLY AND A MINIMUM OF 5 FEET HORIZONTALLY.
- THE CONTRACTOR SHALL EXERCISE CARE IN ALL ACTIVITIES INVOLVING EITHER CUT AND FILL OR GRADING IN THE VICINITY OF TREES THAT ARE TO REMAIN. ALL EARTH CUTS AND ACTIVITIES IN THE VICINITY OF TREES TO REMAIN SHALL BE MADE IN A MANNER THAT DOES NOT DISTURB THE CRITICAL ROOT ZONE WITHIN THE DRIPLINE OF THE TREE. PROTECTIVE ORANGE FENCING SHALL BE INSTALLED AROUND THE PERIMETER OF THE CRITICAL ROOT ZONE PRIOR TO CONSTRUCTION. THE LOCATION OF THE PROTECTIVE ORANGE FENCING SHALL BE APPROVED BY THE ENGINEER OR HIS/HER REPRESENTATIVE PRIOR TO CONSTRUCTION.
- UPON COMPLETION OF THE WORK, BUT PRIOR TO DE-MOBILIZATION, THE CONTRACTOR SHALL REMOVE ALL REMNANTS OF CONSTRUCTION MATERIALS FROM THE SITE. THE CONTRACTOR SHALL RESTORE ALL DISTURBED AREAS TO A CONDITION EQUAL OR BETTER THAN THE PRE-CONSTRUCTION CONDITIONS.
- BIOHABITATS SHALL CERTIFY IN WRITTEN LETTER THAT THE CONSTRUCTION ACTIVITIES HAVE BEEN COMPLETED IN ACCORDANCE TO THESE PLANS.
- TEMPORARY DISTURBANCE WITHIN THE 100' PERENNIAL STREAM BUFFER, STREAM CHANNEL, AND 100-YR FLOODPLAIN ARE NECESSARY FOR CONSTRUCTION OF THE STREAM RESTORATION PROJECT IN ACCORDANCE WITH SECTION 16.116(C) OF THE SUBDIVISION AND LAND DEVELOPMENT REGULATION.

### VICINITY MAP

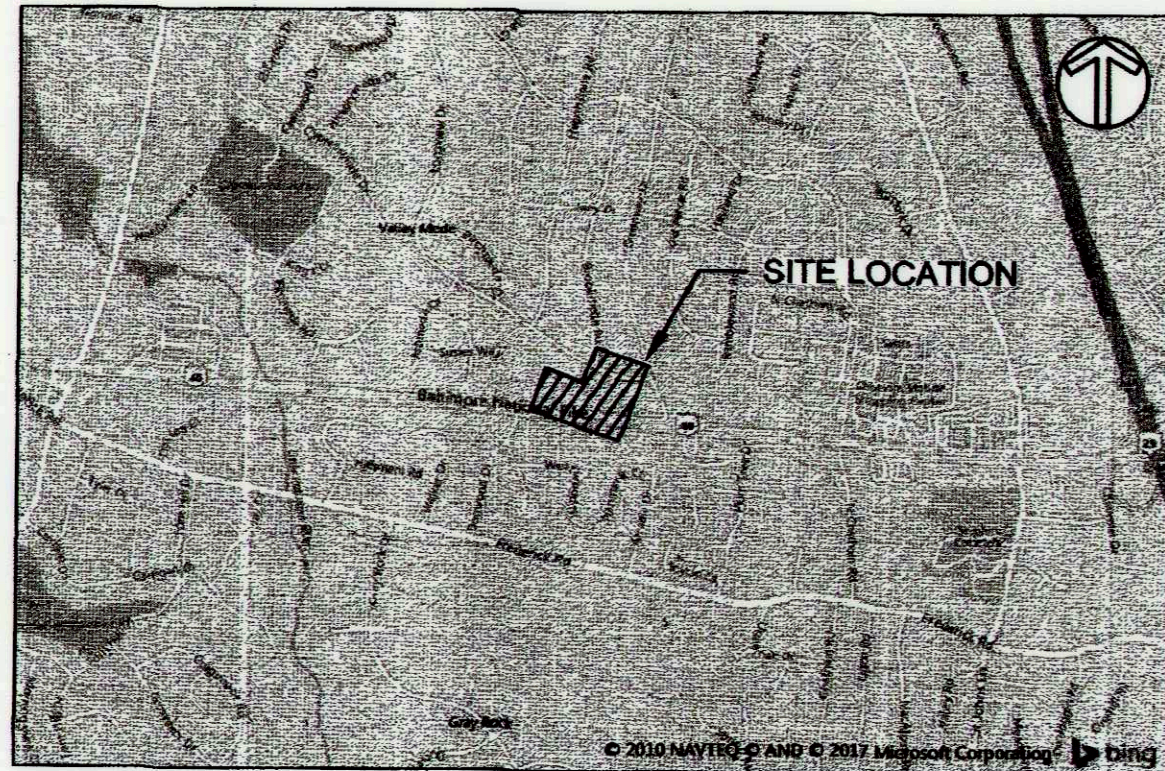

ADC MAP COORDINATES:  
MAP: 11 LETTER: K NUMBER: 7  
0 1000 2000

### SHEET LIST TABLE

| Sheet # | Sheet Title                        |          |
|---------|------------------------------------|----------|
| 1       | TITLE SHEET                        | AS-BUILT |
| 2       | EXISTING CONDITIONS                |          |
| 3       | EXISTING CONDITIONS                |          |
| 4       | PROPOSED CONDITIONS                | AS-BUILT |
| 5       | PROPOSED CONDITIONS                | AS-BUILT |
| 6       | PROFILE AND CROSS SECTION          |          |
| 7       | DETAILS                            |          |
| 8       | DETAILS                            |          |
| 9       | EROSION & SEDIMENT CONTROL PLAN    |          |
| 10      | EROSION & SEDIMENT CONTROL PLAN    |          |
| 11      | EROSION & SEDIMENT CONTROL DETAILS |          |
| 12      | EROSION & SEDIMENT CONTROL DETAILS |          |
| 13      | EROSION & SEDIMENT CONTROL DETAILS |          |
| 14      | EROSION & SEDIMENT CONTROL DETAILS |          |
| 15      | EROSION & SEDIMENT CONTROL DETAILS |          |
| 16      | PLANTING PLAN                      |          |
| 17      | PLANTING PLAN                      |          |
| 18      | PLANTING DETAILS                   |          |

DESIGN NARRATIVE:  
LONGVIEW STREAM STABILIZATION DESIGN WAS COMPLETED WITH THE FOLLOWING IN MIND:

- SITE ANALYSIS DATA:
- TOTAL PROJECT AREA = 0.94 AC
  - WETLAND TOTAL AREA = 0.00 AC
  - WETLAND BUFFER TOTAL AREA = 0.00 AC
  - FLOODPLAIN AREA = 0.85 AC
  - FOREST AREA = 0.30 AC
  - STEEP SLOPES AREA = 0.22 AC
  - ERODIBLE SOILS AREA = 0.26 AC
  - DISTURBED AREA = 0.94 AC
  - PROPOSED SITE USE = FLOODPLAIN FOREST
  - PROPOSED IMPERVIOUS AREA = 0.00 AC

- STREAM STABILIZATION IS PROPOSED WITHIN THE LIMITS OF THE EXISTING CHANNEL TO ENHANCE STREAM FUNCTIONALITY AND REDUCE STREAM BED AND BANK EROSION. MAJOR IMPACTS TO TREES WERE AVOIDED AND MINIMIZED TO THE EXTENT POSSIBLE.
- ALL PROPOSED GRADING MAINTAINS NATURAL FLOW PATTERNS OF THE SURROUNDING FLOODPLAIN FLOWING INTO PLUMTREE BRANCH, WHILE PLUMTREE BRANCH CONTINUES TO FLOW AND DISCHARGE INTO THE LITTLE PATUXENT RIVER.
- NO CHANGES IN IMPERVIOUS COVER OR NON-IMPERVIOUS AREAS ARE PROPOSED.
- EROSION AND SEDIMENT CONTROLS ARE PROPOSED TO PROPERLY CONTROL ALL SEDIMENT LADEN RUNOFF FROM THE CONSTRUCTION SITE AND PROTECT ALL DOWNSTREAM BODIES OF WATER IN ACCORDANCE WITH THE 2011 MARYLAND STANDARDS AND SPECIFICATIONS FOR SOIL EROSION AND SEDIMENT CONTROL. SWM IS NOT REQUIRED FOR THIS STREAM STABILIZATION PROJECT.
- NO ESD PRACTICES ARE BEING IMPLEMENTED AS THERE IS NO IMPERVIOUS AREA REQUIRING TREATMENT ON SITE.
- ALL EXISTING TREE LINES WILL BE REESTABLISHED WITH NATIVE VEGETATION.

### LEGEND

| EXISTING  | PROPOSED                             |
|---|--------------------------------------|
| --- MAJOR CONTOUR   | --- 425 MAJOR CONTOUR                |
| - - - MINOR CONTOUR   | --- 424 MINOR CONTOUR                |
| - - - GIS 2' CONTOURS   | - - - - - STREAM CENTERLINE          |
| SS SANITARY SEWER   | --- 100YR PROP 100-YR FLOODPLAIN     |
| SD STORM DRAIN  | --- BOULDER TOE                      |
| W WATER SUPPLY  | --- COIR FIBER LOG PLUG              |
| OHE OVERHEAD ELECTRIC   | --- COBBLE RIFFLE GRADE CONTROL      |
| UGE UNDERGROUND ELECTRIC  | X X PROPOSED FENCE                   |
| G GAS SUPPLY  | --- PROPOSED GUARDRAIL               |
| 100YR EX 100-YR FEMA FLOODPLAIN                                       | --- LOD LIMIT OF DISTURBANCE         |
| --- TREELINE  | --- LOW LIMIT OF ACCESS              |
| --- GIS PROPERTY LINE   | --- SF SILT FENCE                    |
| --- SURVEYED PROPERTY LINE  | --- SSF SUPER SILT FENCE             |
| --- EASEMENT LINE   | --- TREE REMOVAL                     |
| FCE GIS FOREST CONSERVATION EASEMENT                                  | --- TREE SAVE                        |
| --- GUARDRAIL   | --- STAGING AND STOCKPIILING AREA    |
| --- BUILDINGS (GIS)   | --- MULCH ACCESS ROAD                |
| --- ROADS AND DRIVEWAYS (GIS)   | --- SOIL STABILIZATION MATTING       |
| SB 75' STREAM BUFFER  | --- HARDWOOD MATTING                 |
| GbC SOIL BOUNDARIES   | --- STABILIZED CONSTRUCTION ENTRANCE |
| UaF HIGHLY ERODIBLE SOILS (15% - 19.99% OR Kw > 0.35 WITH SLOPE > 5%) | --- FILTER BAG                       |
| --- STEEP SLOPES (20% OR GREATER SLOPES)                              | --- PUMP AROUND LOCATION             |
| --- TREE  | --- FLOW DIVERSION PIPE              |
| --- TREE > 30" DBH WITH CRITICAL ROOT ZONE                            | --- SAND BAG DIKES                   |
| --- TRAVERSE POINT  | --- MOUNTABLE BERM                   |
| --- MAILBOX   |                                      |
| --- FIRE HYDRANT  |                                      |
| --- UTILITY POLE  |                                      |
| --- SEWER MANHOLE   |                                      |
| --- GUY WIRE  |                                      |
| --- CMP CORRUGATED METAL PIPE   |                                      |

### AS-BUILT LEGEND

| Map Unit Symbol | Map Unit Name  | K-Factor (Average Soil) | Hydro. Pattern | Hydrologic Soil Group | Highly Erodible | Drainage Class          |
|-----------------|--|-------------------------|----------------|-----------------------|-----------------|-------------------------|
| GbB             | Gladstone loam, 3 to 5 percent slopes                        | 0.20                    | Non-Hydric     | A                     | NO              | Well Drained            |
| GbC             | Gladstone loam, 8 to 15 percent slopes                       | 0.20                    | Non-Hydric     | A                     | NO              | Well Drained            |
| GfB             | Gladstone-Urban land complex, 0 to 8 percent slopes          | 0.20                    | Non-Hydric     | A                     | NO              | Well Drained            |
| GfC             | Gladstone-Urban land complex, 8 to 15 percent slopes         | 0.20                    | Non-Hydric     | A                     | N/A             | Well Drained            |
| GhB             | Glenelg-Urban land complex, 0 to 8 percent slopes            | 0.20                    | Non-Hydric     | B                     | N/A             | Well Drained            |
| Gub             | Glenelg-Urban land-Urban land complex, 0 to 8 percent slopes | 0.37                    | Non-Hydric     | C                     | YES             | Moderately Well Drained |
| Ha              | Hillboro-Codonus silt loams, 0 to 3 percent slopes           | 0.37                    | Hydric         | B/D                   | NO              | Poorly Drained          |
| UaF             | Urban land, High way 0 to 85 percent slopes                  | N/A                     | Hydric         | D                     | N/A             | N/A                     |


This development plan is approved for soil erosion and sediment control by the HOWARD SOIL CONSERVATION DISTRICT  
 Date: 1/2/18  
 Howard SCD

DEPARTMENT OF PUBLIC WORKS, HOWARD CO, MD

Director, Department of Public Works  
 Date: 12-21-17

Chief, Bureau of Environmental Services  
 Date: 12/19/17

Chief, Stormwater Management Division  
 Date: 12/14/17

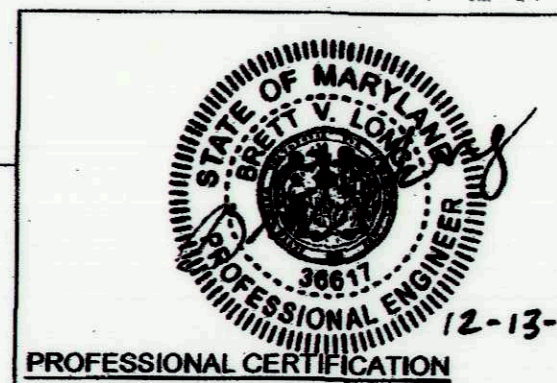

ENGINEER'S CERTIFICATE  
 I CERTIFY THAT THIS PLAN FOR SEDIMENT AND EROSION CONTROL REPRESENTS A PRACTICAL AND WORKABLE PLAN BASED ON MY PERSONAL KNOWLEDGE OF THE SITE CONDITIONS AND THAT IT WAS PREPARED IN ACCORDANCE WITH THE REQUIREMENTS OF THE HOWARD SOIL CONSERVATION DISTRICT.  
 Signature: Brett Long  
 Date: 12-13-2017

DEVELOPERS CERTIFICATE  
 I HEREBY CERTIFY THAT THESE DOCUMENTS WERE PREPARED OR APPROVED BY ME, AND THAT I AM A DULY LICENSED PROFESSIONAL ENGINEER UNDER THE LAWS OF THE STATE OF MARYLAND.  
 License #: 36617  
 Expiration Date: 6/3/2018

DEVELOPERS CERTIFICATE  
 I HEREBY CERTIFY THAT ALL DEVELOPMENT AND CONSTRUCTION WILL BE DONE ACCORDING TO THIS PLAN FOR SEDIMENT AND EROSION CONTROL, AND THAT ALL RESPONSIBLE PERSONNEL INVOLVED IN THE CONSTRUCTION PROJECT WILL HAVE A CERTIFICATE OF ATTENDANCE AT A DEPARTMENT OF THE ENVIRONMENT APPROVED TRAINING PROGRAM FOR THE CONTROL OF SEDIMENT AND EROSION BEFORE THE BEGINNING OF THE PROJECT. I ALSO AUTHORIZE PERIODIC ON-SITE INSPECTION BY THE HOWARD SOIL CONSERVATION DISTRICT.  
 Signature: James M. Brown  
 Date: 1/3/18

CLIENT  
 HOWARD COUNTY DPW  
 BUREAU OF ENVIRONMENTAL SERVICES  
 STORMWATER MANAGEMENT DIVISION  
 6751 GATEWAY DRIVE, SUITE 514  
 COLUMBIA, MD 21046  
 PHONE: (410) 313-6413

DATE ISSUES / REVISIONS  
 AS BUILT CERTIFICATION  
 I HEREBY CERTIFY, BY MY SEAL, THAT TO THE BEST OF MY KNOWLEDGE AND BELIEF THE FACILITIES SHOWN ON THIS PLAN WERE CONSTRUCTED AS SHOWN ON THIS "AS-BUILT" PLAN MEET THE APPROVED PLANS AND SPECIFICATIONS.  
 Signature: Brett Long  
 Date: 10-9-2018

Biohabitats  
 The Stables Building 2081 Clipper Park Road  
 Baltimore, MD 21211 / ph: 410.554.0156  
 fx: 410.554.0168 / www.biohabitats.com  
 Restore the Earth & Inspire Ecological Stewardship

### LONGVIEW DRIVE STREAM STABILIZATION

SITE ADDRESS: 9509 LONGVIEW DR, ELICOTT CITY, MD  
 ZONING: R-20, R-6D TAX MAP/GRID/PARCEL: 002400030040  
 ELECTION DISTRICT: 02 OPEN LOT N/A  
 WAIVER PETITION WP-18-022

### TITLE SHEET

PROJECT NO.: 13005.50 SCALE: NTS  
 SEAL: RW/KT CHECK: MDT/MWT  
 DWG. NO.: 1 OF 18  
 Date: 12-13-2017

MATCHLINE - SHEET 3

**CLIENT**  
 HOWARD COUNTY DPW  
 BUREAU OF ENVIRONMENTAL SERVICES  
 STORMWATER MANAGEMENT DIVISION  
 6751 GATEWAY DRIVE, SUITE 514  
 COLUMBIA, MD 21046  
 PHONE: (410) 313-6413

DATE ISSUES / REVISIONS



**Biohabitats**  
 The Stables Building 2081 Clipper Park Road  
 Baltimore, MD 21211 / ph: 410.554.0156  
 fx: 410.554.0168 / www.biohabitats.com  
 Restore the Earth & Inspire Ecological Stewardship

**LONGVIEW DRIVE  
 STREAM  
 STABILIZATION**

SITE ADDRESS: 6608 LONGVIEW DR, ELLICOTT CITY, MD  
 ZONING: R-20, R-ED TAX MAP GRID/PARCEL: 0024/0003/0640  
 ELECTION DISTRICT: 02 OPEN LOT N/A  
 WAIVER PETITION WP-18-022

**EXISTING  
 CONDITIONS**


PROJECT NO. 13005.50 SCALE: 1" = 20'  
 SEAL: RW/KT CHECK: MDT/MWT  
 DWG NO.:

STATE OF MARYLAND  
 BRETT V. TORRES  
 PROFESSIONAL ENGINEER  
 36611  
 12-13-2017

**2 OF 18**

TRAVERSE TABLE

| POINT | NORTHING  | EASTING    | ELEVATION |
|-------|-----------|------------|-----------|
| 1     | 586933.85 | 1357436.12 | 370.30    |
| 2     | 587105.39 | 1357380.04 | 362.69    |
| 3     | 587347.83 | 1357395.91 | 368.96    |
| 100   | 586832.01 | 1357441.76 | 370.88    |
| 101   | 586949.92 | 1357250.55 | 373.17    |
| 102   | 587465.41 | 1357384.47 | 368.63    |

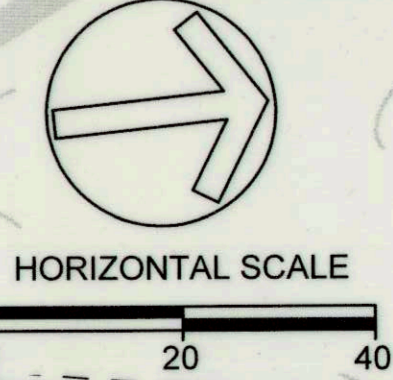

NOTE: GEOMETRY TABLES FOR ALIGNMENT LOCATED ON SHEET 4


DEPARTMENT OF PUBLIC WORKS, HOWARD COUNTY, MD  
 [Signature]  
 CHIEF, BUREAU OF ENVIRONMENTAL SERVICES  
 DATE: 12/19/17

| Line Table: Alignments |        |               |
|------------------------|--------|---------------|
| Line #                 | Length | Direction     |
| L1                     | 11.6   | S00° 03' 50"W |
| L2                     | 33.3   | S12° 15' 26"E |
| L3                     | 18.9   | S04° 29' 45"E |
| L4                     | 17.3   | S06° 06' 45"W |
| L5                     | 9.0    | S21° 47' 58"W |
| L6                     | 10.0   | S22° 37' 58"W |
| L7                     | 4.5    | S27° 37' 57"W |
| L8                     | 29.1   | S14° 55' 19"W |
| L9                     | 4.1    | S10° 14' 56"E |
| L10                    | 10.0   | S02° 26' 29"E |
| L11                    | 40.7   | S05° 55' 24"E |
| L12                    | 35.8   | S16° 58' 30"E |
| L13                    | 13.9   | S37° 36' 40"E |
| L14                    | 24.3   | S21° 40' 46"E |
| L15                    | 10.0   | S20° 00' 57"E |

| Line Table: Alignments |        |               |
|------------------------|--------|---------------|
| Line #                 | Length | Direction     |
| L16                    | 28.9   | S28° 58' 22"E |
| L17                    | 29.0   | S26° 56' 21"E |
| L18                    | 17.8   | S01° 59' 08"E |
| L19                    | 30.7   | S35° 01' 09"E |
| L20                    | 33.5   | S15° 32' 16"E |
| L21                    | 11.8   | S23° 16' 07"E |

**CLIENT**  
HOWARD COUNTY DPW  
BUREAU OF ENVIRONMENTAL SERVICES  
STORMWATER MANAGEMENT DIVISION  
6751 GATEWAY DRIVE, SUITE 514  
COLUMBIA, MD 21046  
PHONE: (410) 313-6413

DATE ISSUES / REVISIONS

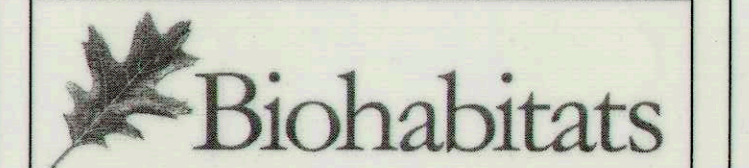


The Stables Building 2081 Clipper Park Road  
Baltimore, MD 21211 / ph: 410.554.0156  
fx: 410.554.0168 / www.biohabitats.com  
*Restore the Earth & Inspire Ecological Stewardship*

## LONGVIEW DRIVE STREAM STABILIZATION


SITE ADDRESS: 9509 LONGVIEW DR, ELLICOTT CITY, MD  
ZONING: R-20, P.FED TAX MAP: GRID 3 PARCEL: 0024/0003/0640  
ELECTION DISTRICT: 02 OPEN LOT: N/A  
WAIVER PETITION WP-18-022

### EXISTING CONDITIONS

PROJECT NO.: 13005.50 SCALE: 1" = 20'  
SEAL: BY: RW/KT CHECK: MDT/MWT  
DWG NO.:

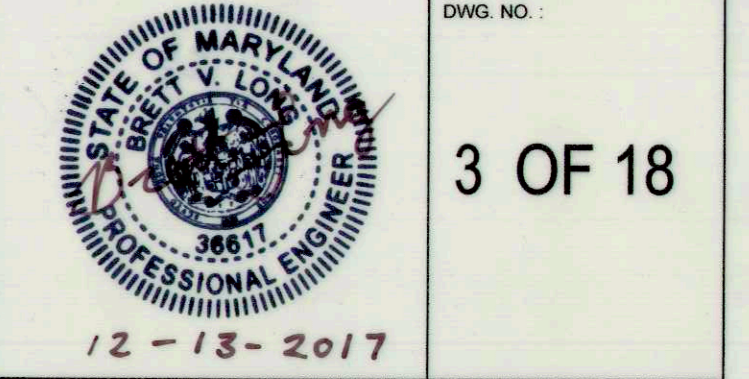

**BRETT V. LONG**  
PROFESSIONAL ENGINEER  
12-13-2017

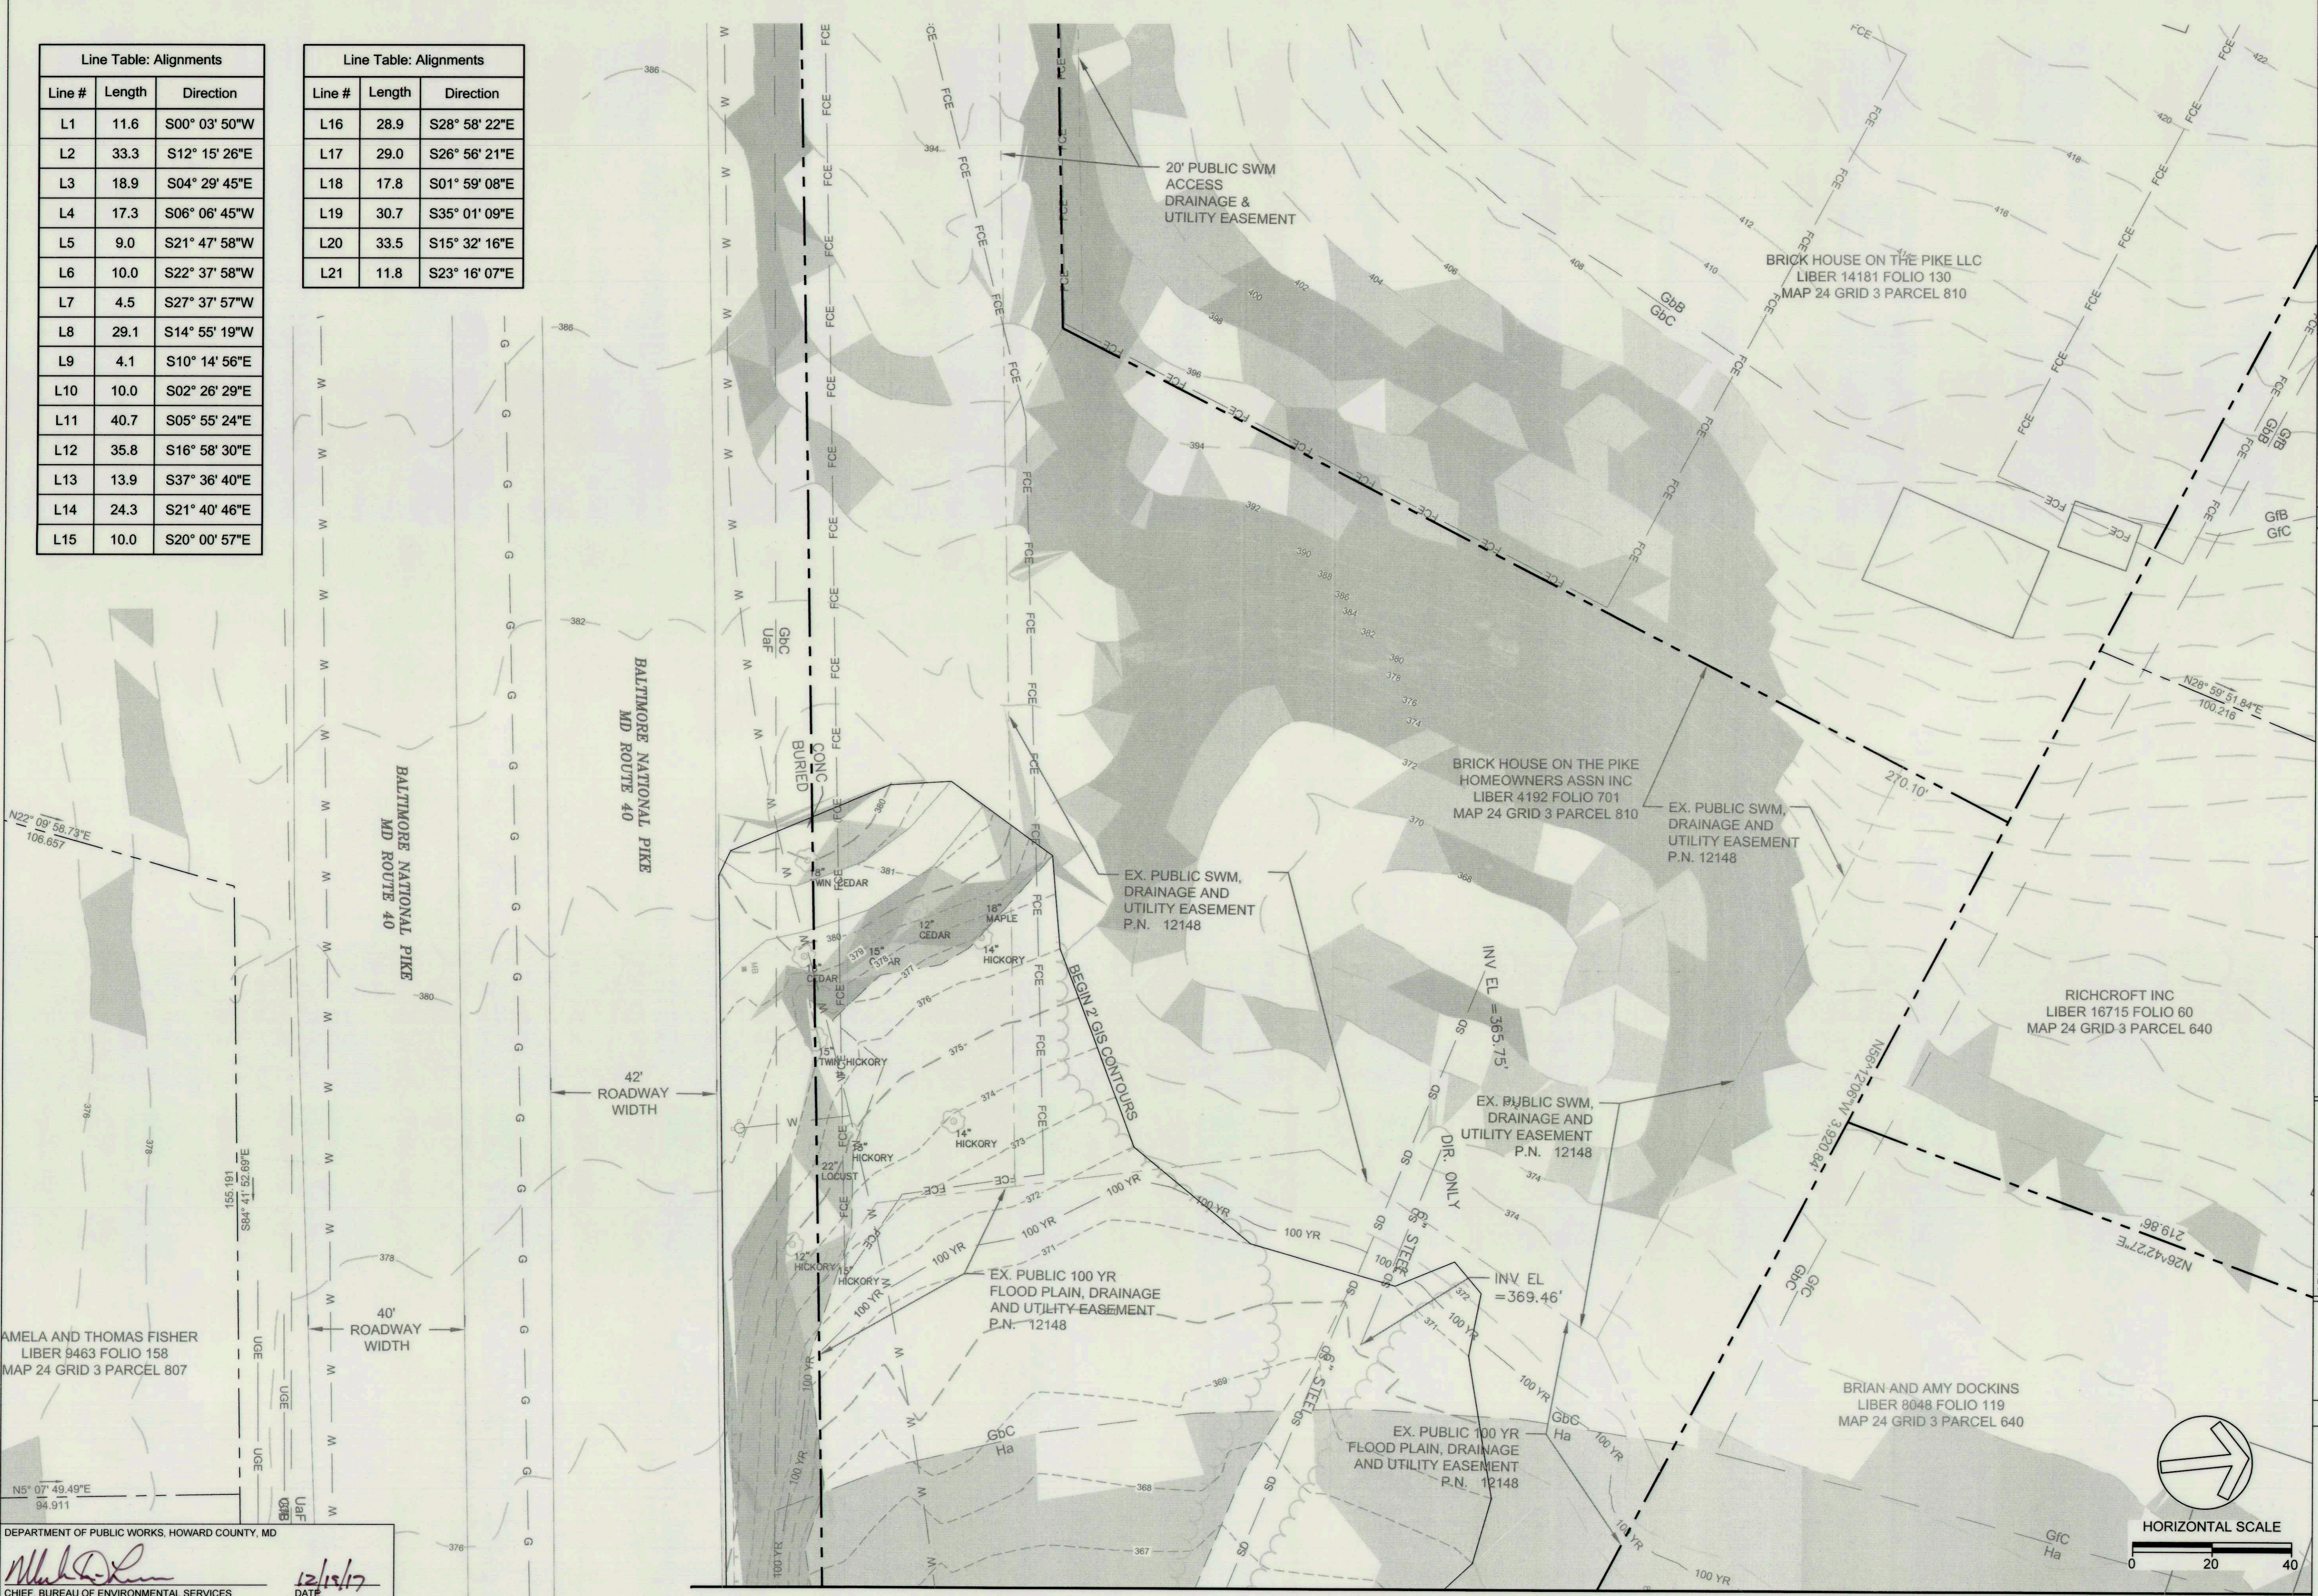


AMELA AND THOMAS FISHER  
LIBER 9463 FOLIO 158  
MAP 24 GRID 3 PARCEL 807

DEPARTMENT OF PUBLIC WORKS, HOWARD COUNTY, MD  
*[Signature]*  
CHIEF, BUREAU OF ENVIRONMENTAL SERVICES  
DATE: 12/15/17

### MATCHLINE - SHEET 2

MATCHLINE - SHEET 5

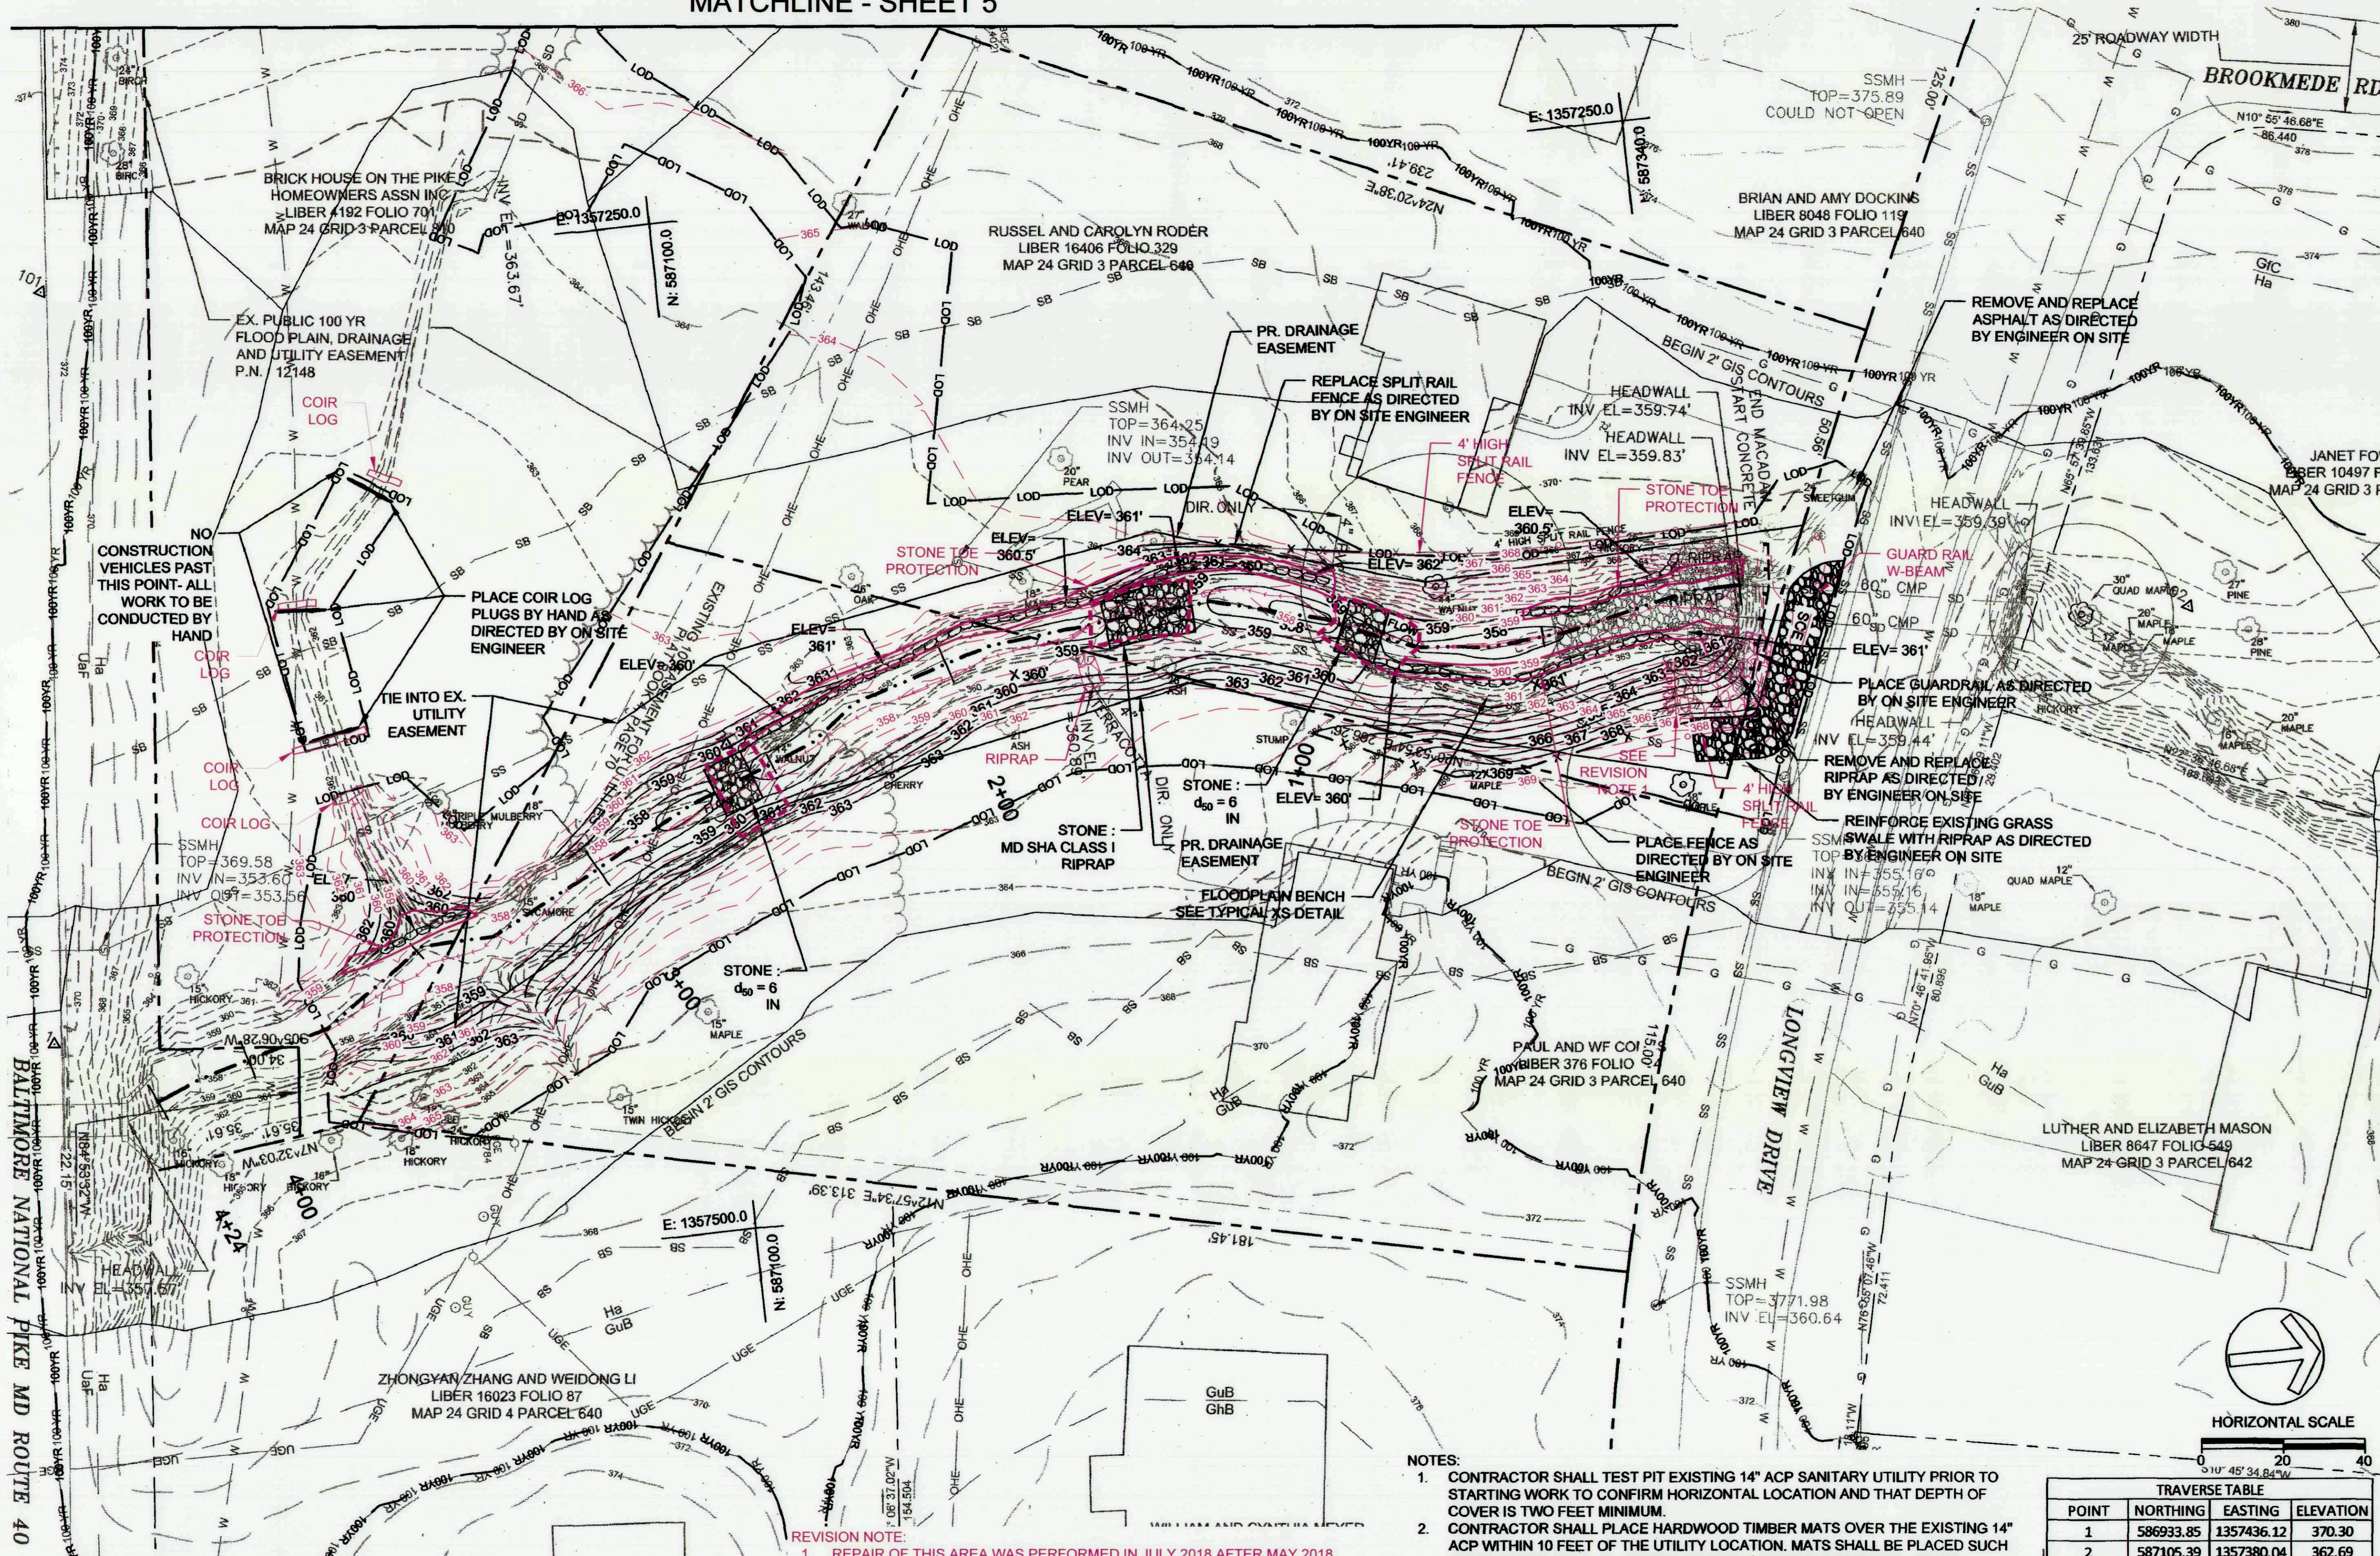

**CLIENT**  
 HOWARD COUNTY DPW  
 BUREAU OF ENVIRONMENTAL SERVICES  
 STORMWATER MANAGEMENT DIVISION  
 6751 GATEWAY DRIVE, SUITE 514  
 COLUMBIA, MD 21046  
 PHONE: (410) 313-6413

DATE ISSUES / REVISIONS



10-9-2018

AS BUILT CERTIFICATION  
 I HEREBY CERTIFY, BY MY SEAL, THAT TO THE BEST OF MY KNOWLEDGE AND BELIEF THE FACILITIES SHOWN ON THIS "AS-BUILT" PLAN MEET THE APPROVED PLANS AND SPECIFICATIONS.

Brett Jung 10-9-2018  
 NAME DATE

**Biohabitats**  
 The Stables Building 2081 Clipper Park Road  
 Baltimore, MD 21211 / ph: 410.554.0156  
 fx: 410.554.0168 / www.biohabitats.com  
 Restore the Earth & Inspire Ecological Stewardship


**LONGVIEW DRIVE  
 STREAM  
 STABILIZATION**

SITE ADDRESS: 9500 LONGVIEW DR, ELLICOTT CITY, MD  
 ZONING: R-20, R-ED TAX MAP/GRID/PARCEL: 0024100030640  
 ELECTION DISTRICT: 02 OPEN LOT NA  
 WAIVER PETITION WP-19-022

**PROPOSED  
 CONDITIONS**

PROJECT NO.: 13005.50 SCALE: 1" = 20'  
 SEAL: BY: RW/KT CHECK: MDT/MVW  
 DWG. NO.:

Professional Engineer seal for Brett Jung, State of Maryland, License No. 38617.  
 12-13-2017

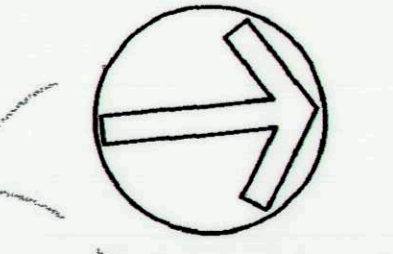


**TRAVERSE TABLE**

| POINT | NORTHING  | EASTING    | ELEVATION |
|-------|-----------|------------|-----------|
| 1     | 586933.85 | 1357436.12 | 370.30    |
| 2     | 587105.39 | 1357380.04 | 362.69    |
| 3     | 587347.83 | 1357395.91 | 368.96    |
| 100   | 586832.01 | 1357441.76 | 370.88    |
| 101   | 586949.92 | 1357250.55 | 373.17    |
| 102   | 587465.41 | 1357384.47 | 368.63    |

- NOTES:**
- CONTRACTOR SHALL TEST PIT EXISTING 14" ACP SANITARY UTILITY PRIOR TO STARTING WORK TO CONFIRM HORIZONTAL LOCATION AND THAT DEPTH OF COVER IS TWO FEET MINIMUM.
  - CONTRACTOR SHALL PLACE HARDWOOD TIMBER MATS OVER THE EXISTING 14" ACP WITHIN 10 FEET OF THE UTILITY LOCATION. MATS SHALL BE PLACED SUCH THAT NO MAT JOINT IS LOCATED DIRECTLY OVER THE EXISTING UTILITY.
  - SUPPLEMENT EXISTING OUTFALL PROTECTION ALONG STREAM BED WITH CLASS I RIPRAP AS DIRECTED TO RESTORE TO A FUNCTIONING CONDITION. ADEQUATE PROTECTION SHALL EXTEND A MINIMUM OF 55' DOWNSTREAM OF THE LONGVIEW DRIVE CULVERT.

**REVISION NOTE:**  
 1. REPAIR OF THIS AREA WAS PERFORMED IN JULY 2018 AFTER MAY 2018 FLOODING DEVASTATED THE PROJECT AREA. DESIGN FOR REPAIRS WAS DEVELOPED COLLABORATIVELY BY THE CONTRACTOR, HOWARD COUNTY, AND BIOHABITATS. SURFACE REPAIRS ARE CAPTURED IN THIS AS-BUILT.

DEPARTMENT OF PUBLIC WORKS, HOWARD COUNTY, MD  
 12/19/17  
 CHIEF, BUREAU OF ENVIRONMENTAL SERVICES

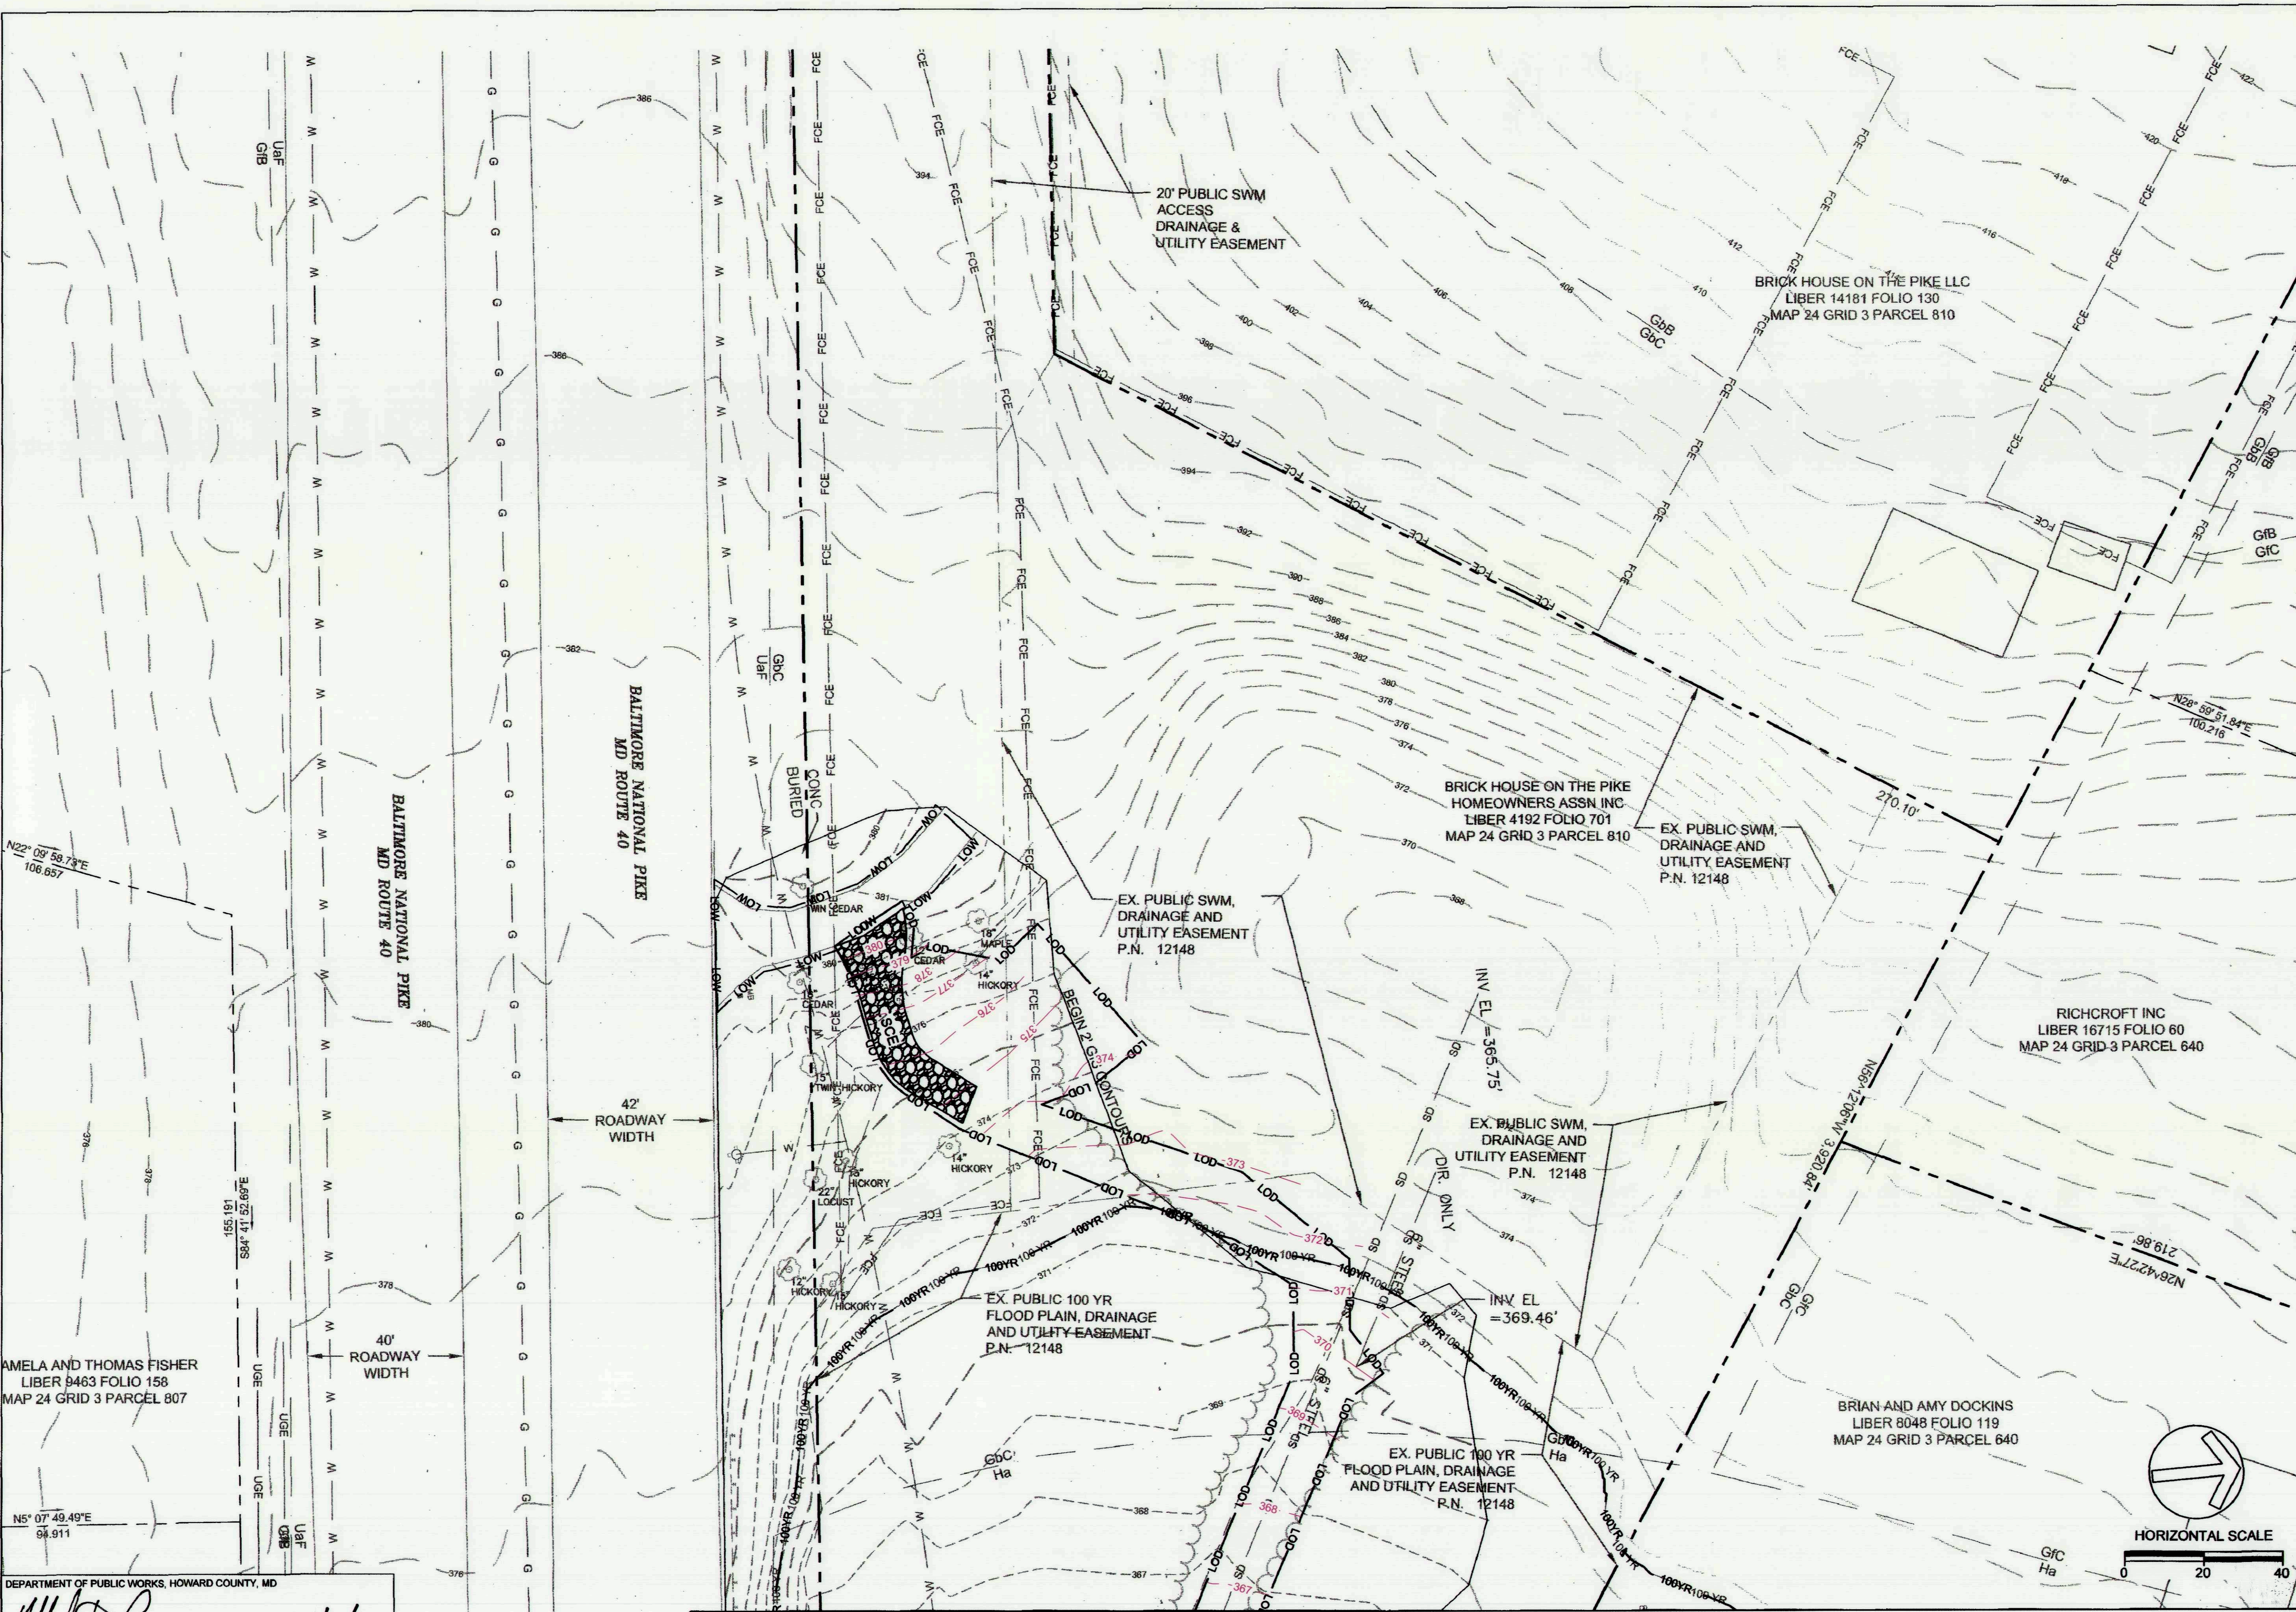

**CLIENT**  
 HOWARD COUNTY DPW  
 BUREAU OF ENVIRONMENTAL SERVICES  
 STORMWATER MANAGEMENT DIVISION  
 6751 GATEWAY DRIVE, SUITE 514  
 COLUMBIA, MD 21046  
 PHONE: (410) 313-6413

DATE ISSUES / REVISIONS

STATE OF MARYLAND  
 SHEET V. LONG  
 36611  
 PROFESSIONAL ENGINEER  
 10-9-2018

AS BUILT CERTIFICATION  
 I HEREBY CERTIFY, BY MY SEAL, THAT TO THE BEST OF MY KNOWLEDGE AND BELIEF THE FACILITIES SHOWN ON THIS PLAN WERE CONSTRUCTED AS SHOWN ON THIS "AS-BUILT" PLAN MEET THE APPROVED PLANS AND SPECIFICATIONS.

*Brett Long* 10-9-2018  
 NAME DATE

**Biohabitats**  
 The Stables Building 2081 Clipper Park Road  
 Baltimore, MD 21211 / ph: 410.554.0156  
 fx: 410.554.0168 / www.biohabitats.com  
 Restore the Earth & Inspire Ecological Stewardship

**LONGVIEW DRIVE  
 STREAM  
 STABILIZATION**

SITE ADDRESS: 6599 LONGVIEW DR, ELLICOTT CITY, MD  
 ZONING: R-20, R-ED TAX MAP GRID/PARCEL: 0024/0003/0040  
 ELECTION DISTRICT: 02 OPEN LOT N/A  
 VARNER PETITION WF-18-022

**PROPOSED  
 CONDITIONS**

PROJECT NO.: 13005.50 SCALE: 1" = 20'  
 SEAL: BY: RW/KT CHECK: MDT/MWT  
 DWG. NO.: 5 OF 18  
 STATE OF MARYLAND  
 SHEET V. LONG  
 36611  
 PROFESSIONAL ENGINEER  
 12-13-2017


AMELA AND THOMAS FISHER  
 LIBER 9463 FOLIO 158  
 MAP 24 GRID 3 PARCEL 807

DEPARTMENT OF PUBLIC WORKS, HOWARD COUNTY, MD  
*[Signature]*  
 CHIEF, BUREAU OF ENVIRONMENTAL SERVICES  
 DATE: 12/19/17



MATCHLINE - SHEET 4

HOWARD COUNTY DPW  
 BUREAU OF ENVIRONMENTAL SERVICES  
 STORMWATER MANAGEMENT DIVISION  
 6751 GATEWAY DRIVE, SUITE 514  
 COLUMBIA, MD 21046  
 PHONE: (410) 313-6413

PROFILE VIEW OF PLUMTREE BRANCH

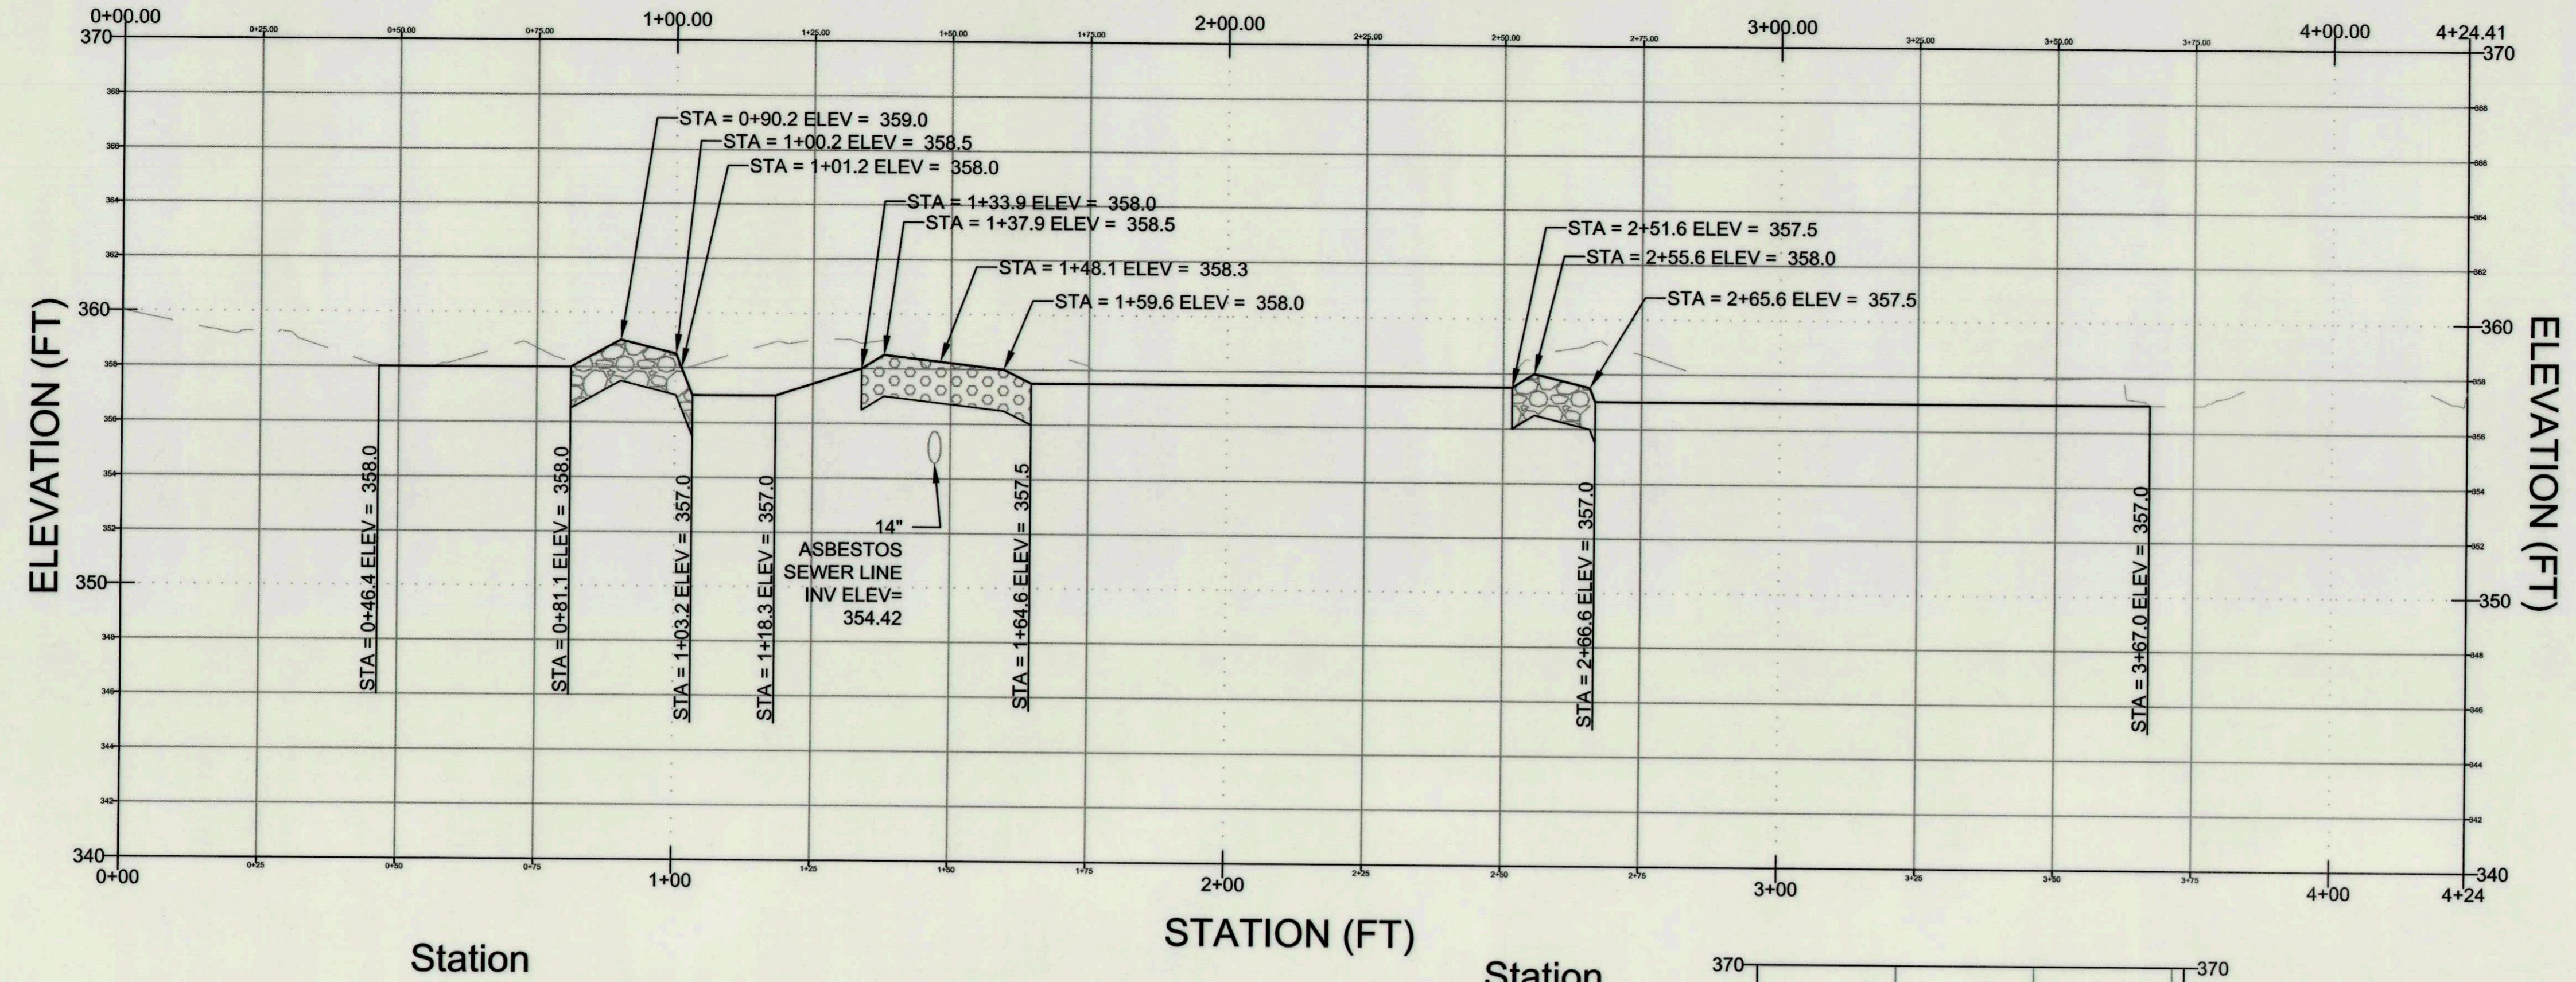


Station  
 PROFILE VIEW OF SEWER  
 Station

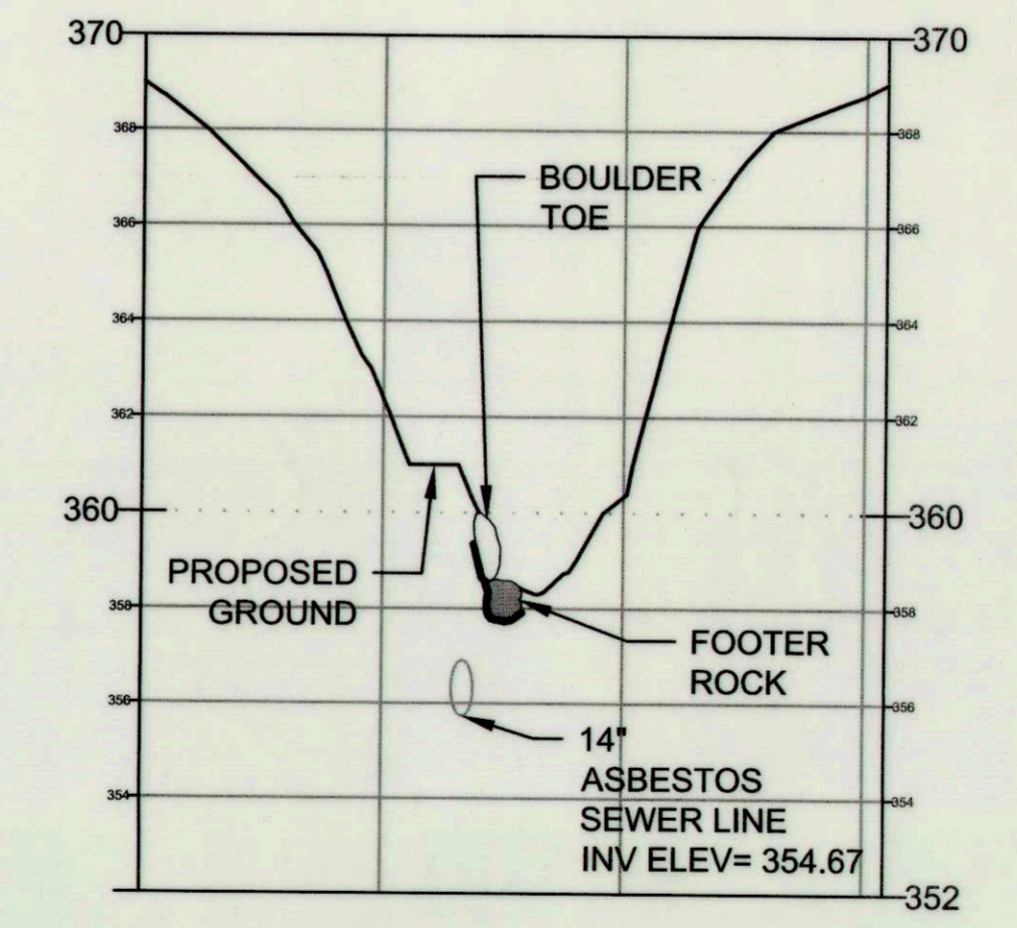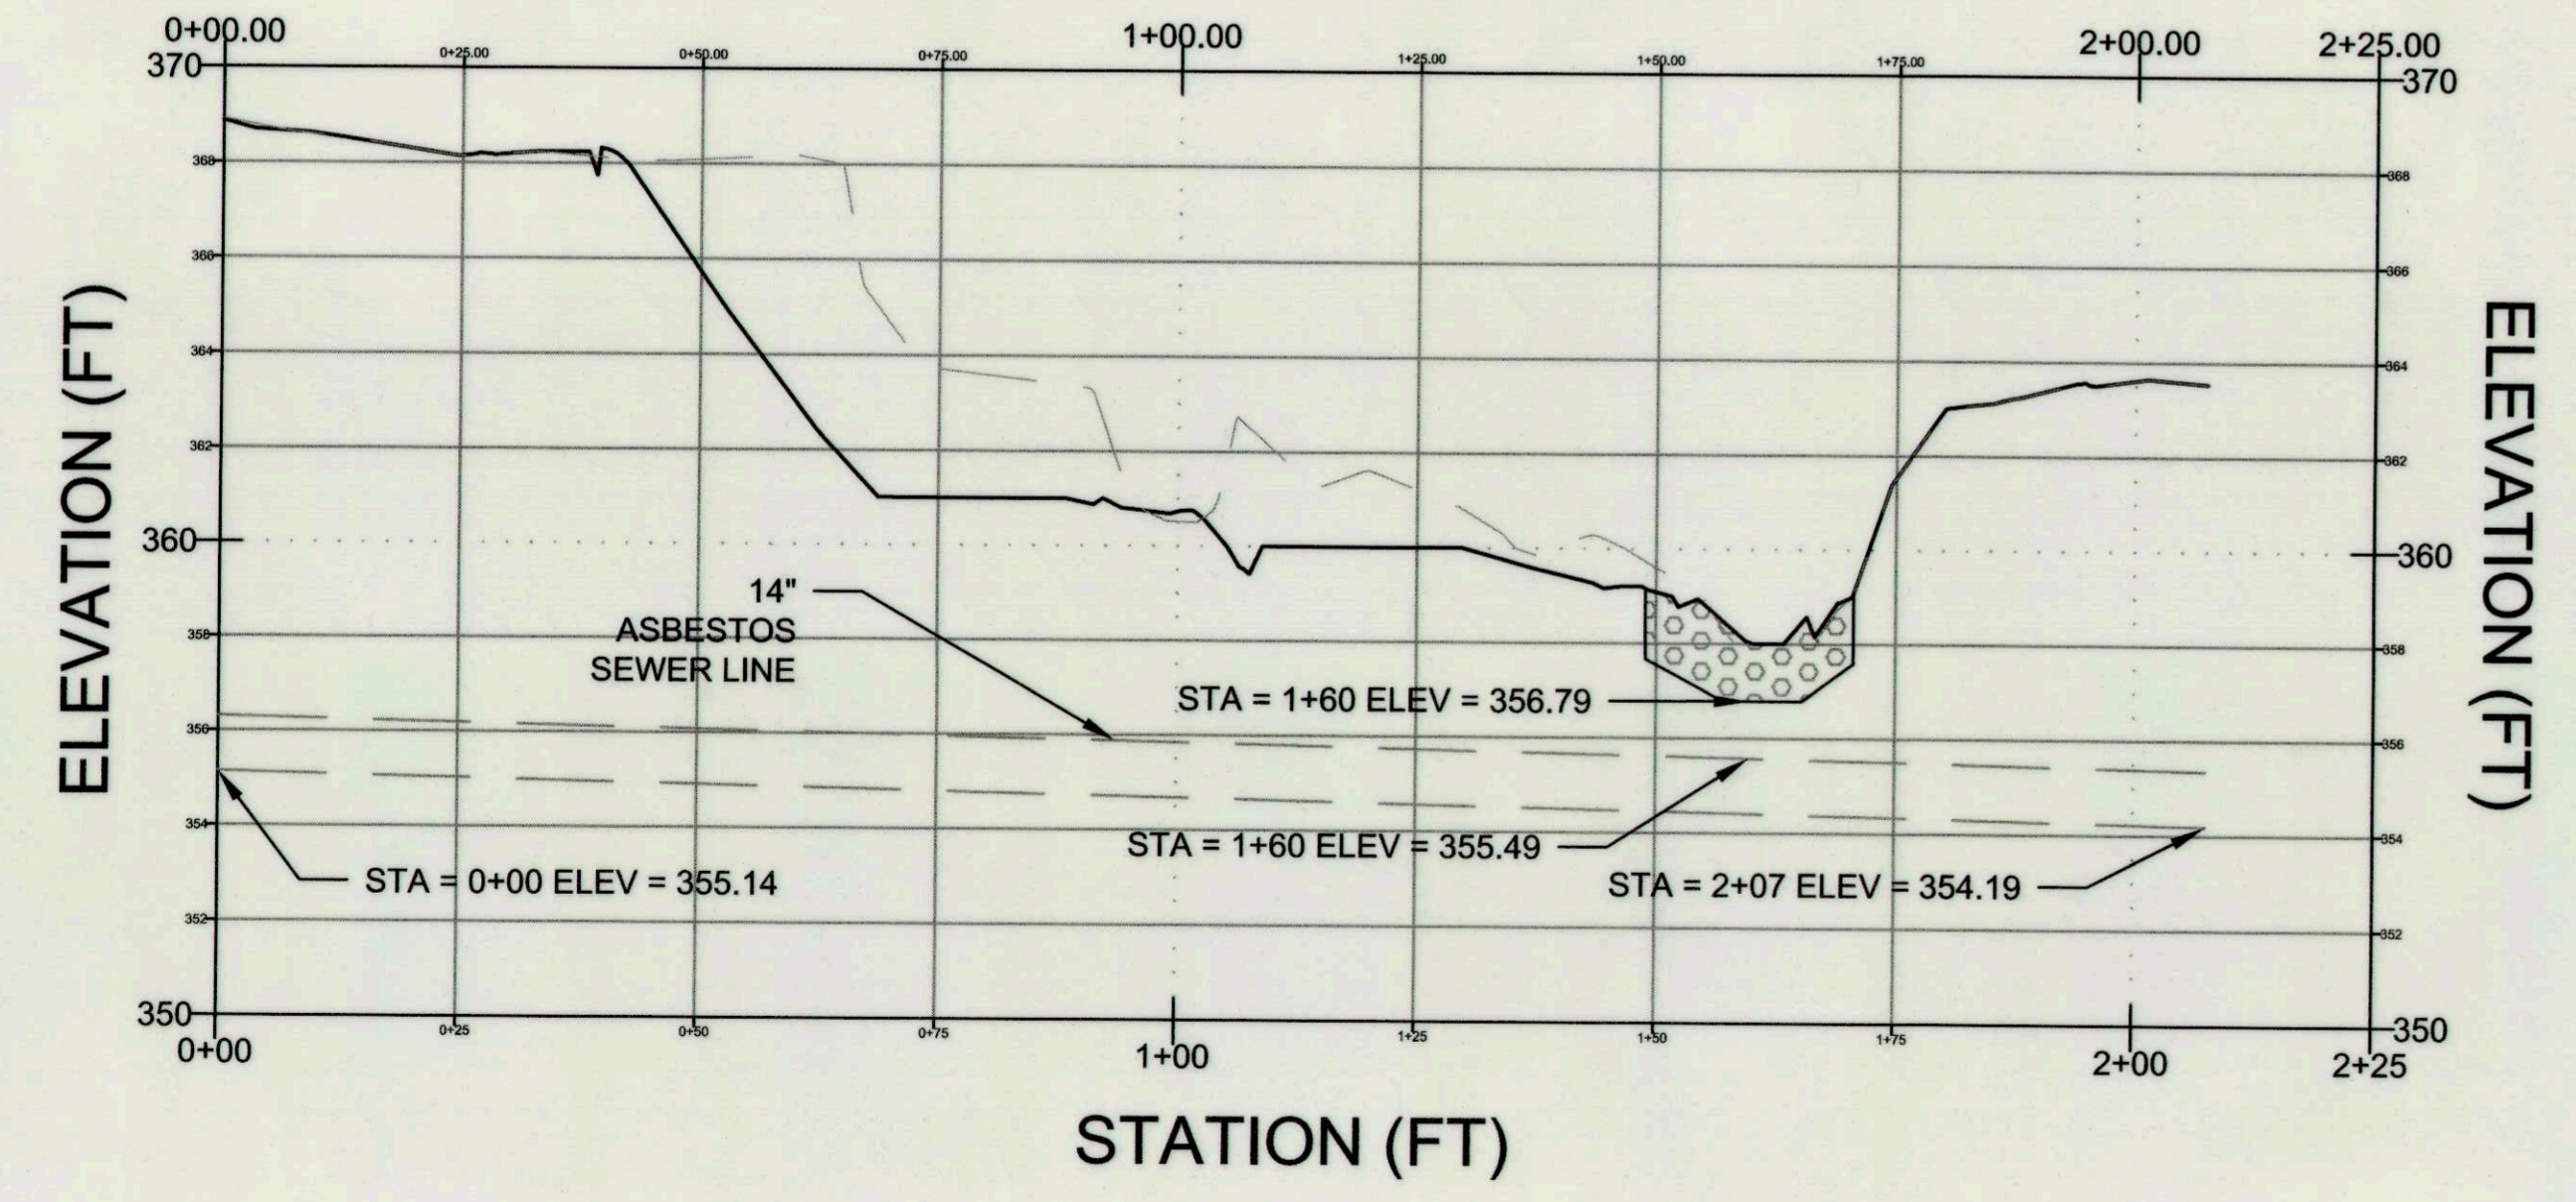

SEWER CROSS-SECTION WITH BOULDER TOE PROTECTION  
 PROFILE STA 0+83.5  
 REFER TO SHEET 7 FOR DETAIL

VERT: 1" = 4'  
 HOR: 1" = 20'

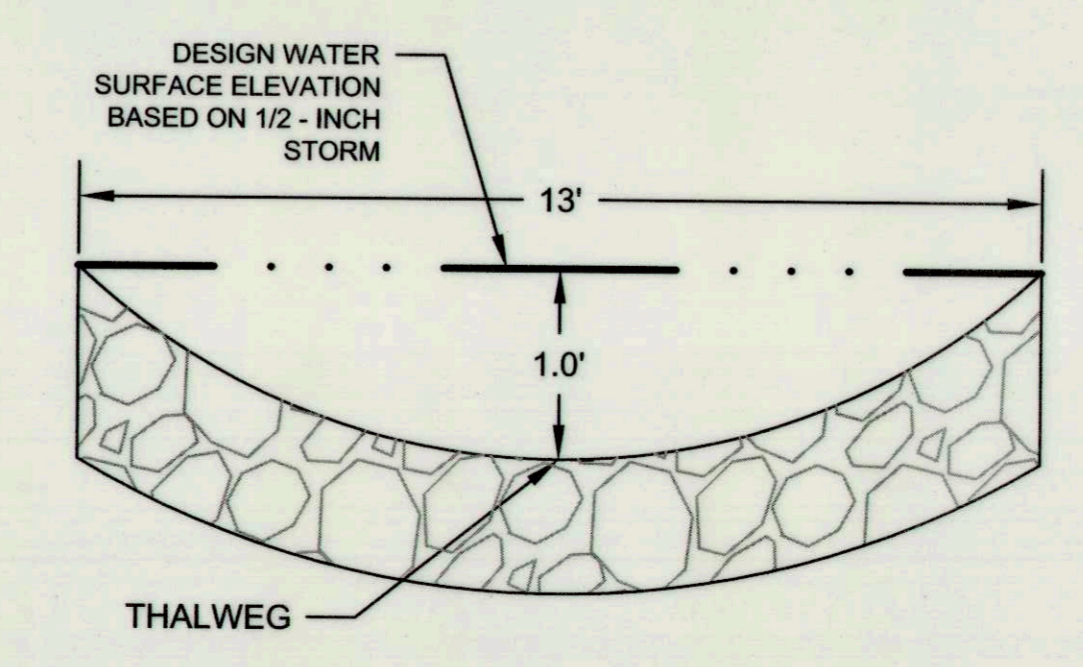

COBBLE RIFFLE GRADE CONTROL CROSS-SECTIONS  
 PROFILE STA 0+90.2, 1+37.9; 2+55.6

PROFILE LEGEND

- EXISTING GRADE
- PROPOSED GRADE
- 14" ASBESTOS SEWER LINE
- COBBLE RIFFLE GRADE CONTROL
- MD SHA CLASS I RIPRAP GRADE CONTROL

DEPARTMENT OF PUBLIC WORKS, HOWARD COUNTY, MD  
  
 CHIEF, BUREAU OF ENVIRONMENTAL SERVICES  
 DATE 12/19/17


The Stables Building 2081 Clipper Park Road  
 Baltimore, MD 21211 / ph: 410.554.0156  
 fx: 410.554.0168 / www.biohabitats.com  
 Restore the Earth & Inspire Ecological Stewardship

LONGVIEW DRIVE  
 STREAM  
 STABILIZATION

SITE ADDRESS: 9509 LONGVIEW DR, ELLICOTT CITY, MD  
 ZONING: R-20, R-ED TAX MAP GRID/PARCEL: 0024/0003/0640  
 ELECTION DISTRICT: 02 OPEN LOT N/A  
 WAIVER PETITION WP-18-022


TITLE  
 PROFILE AND  
 CROSS SECTION

PROJECT NO.: 13005.50 SCALE: NTS  
 SEAL: BY: RW/KT CHECK: MDT/MWT  
 DWG NO.:

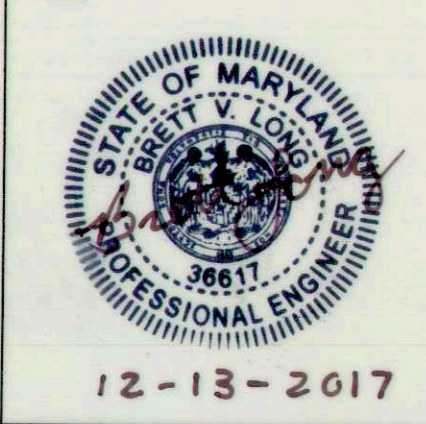


HOWARD COUNTY DPW  
BUREAU OF ENVIRONMENTAL SERVICES  
STORMWATER MANAGEMENT DIVISION  
6751 GATEWAY DRIVE, SUITE 514  
COLUMBIA, MD 21046  
PHONE: (410) 313-6413

DATE ISSUES / REVISIONS

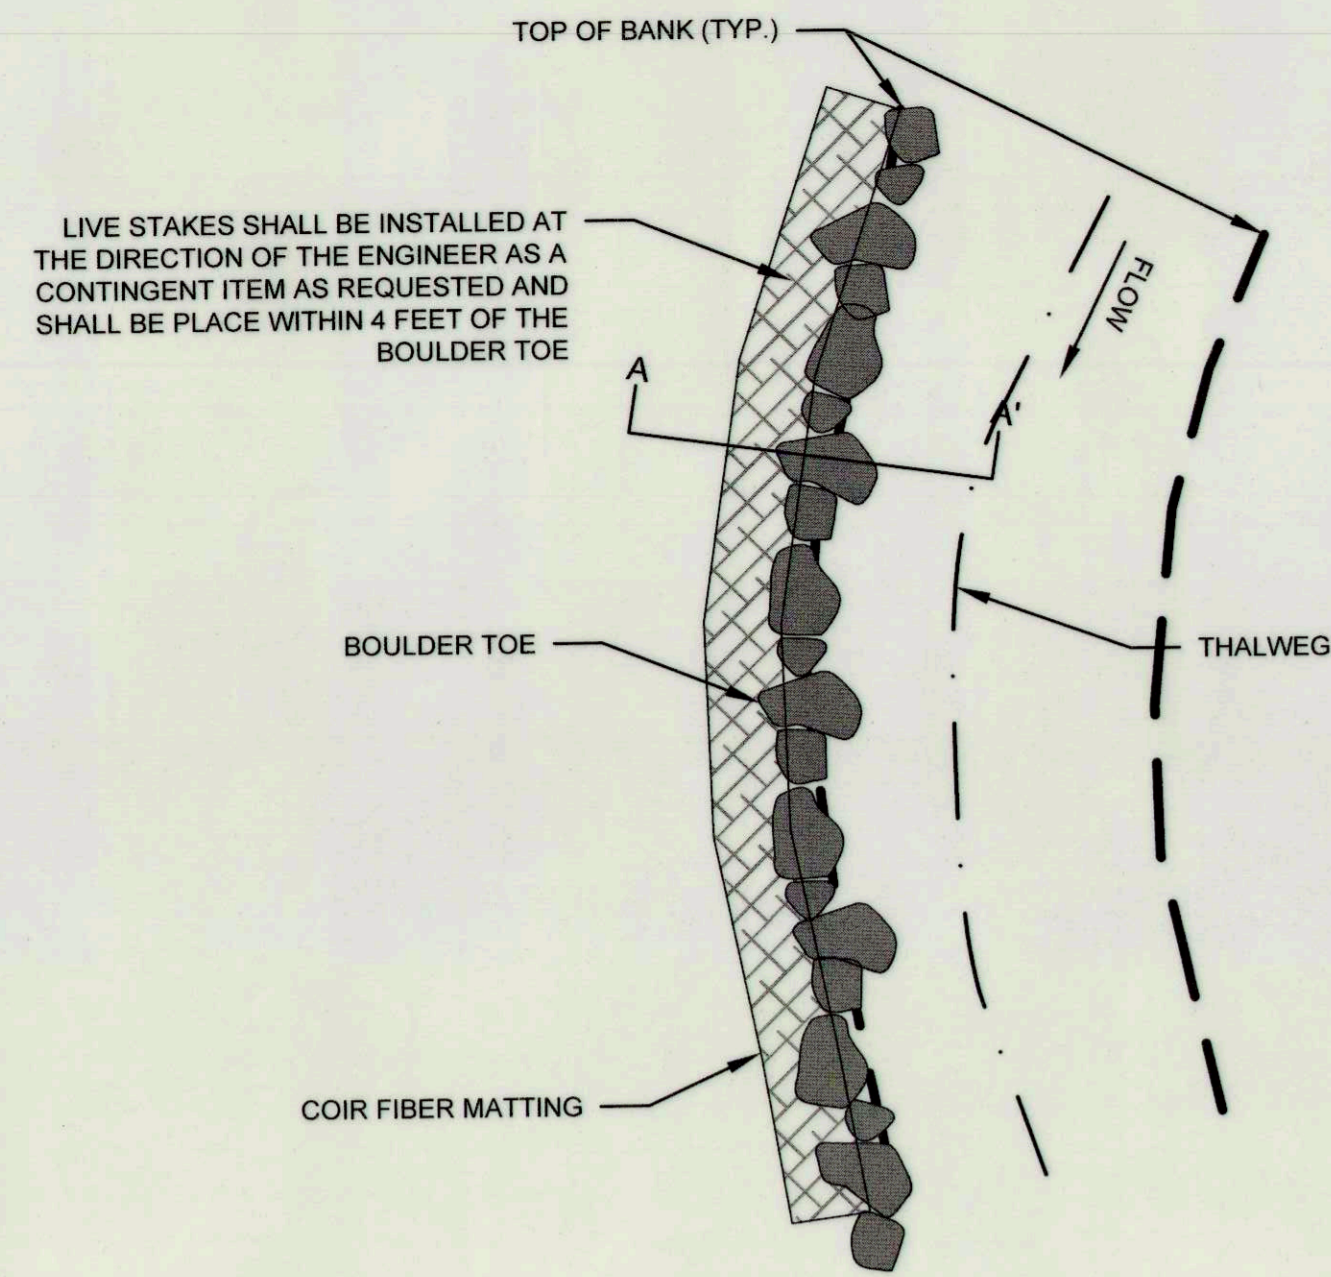


BOULDER TOE PROTECTION  
PLAN - TYPICAL

NOT TO SCALE

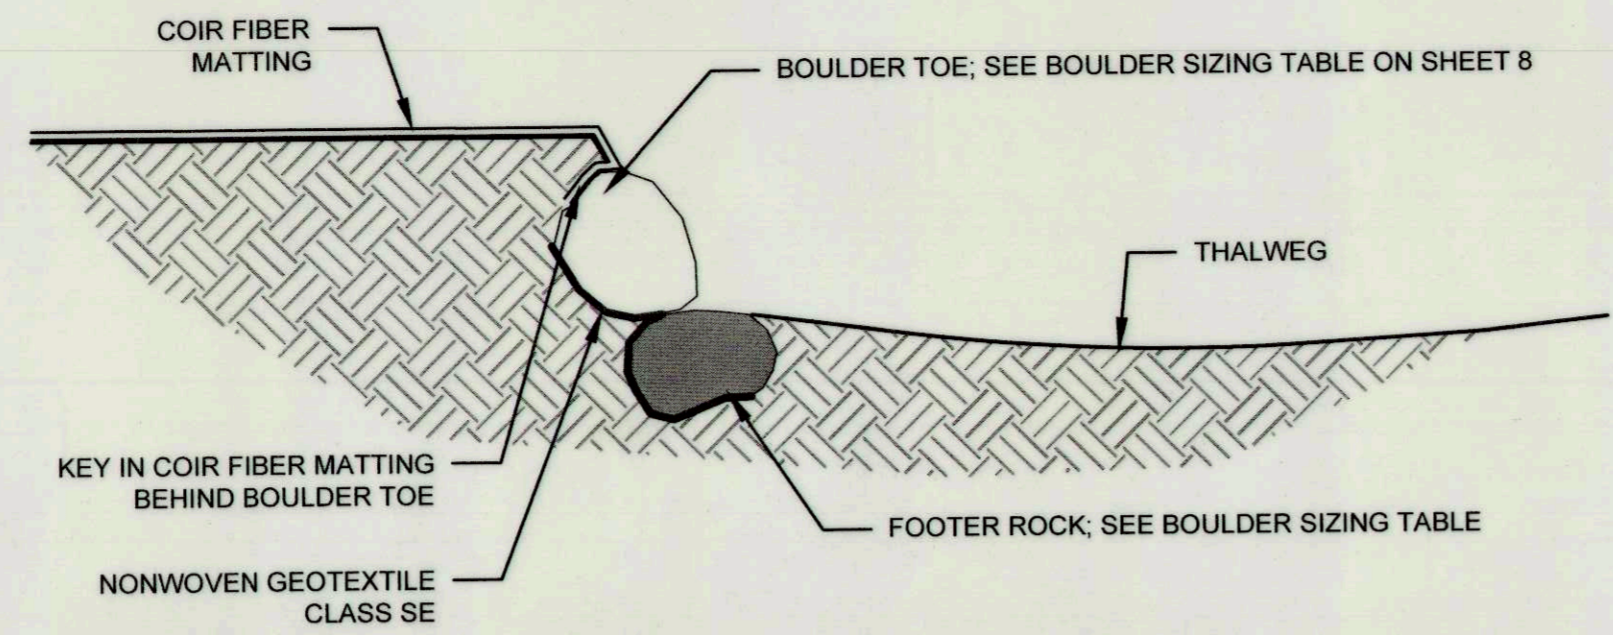

BOULDER TOE PROTECTION  
SECTION A-A'


NOT TO SCALE

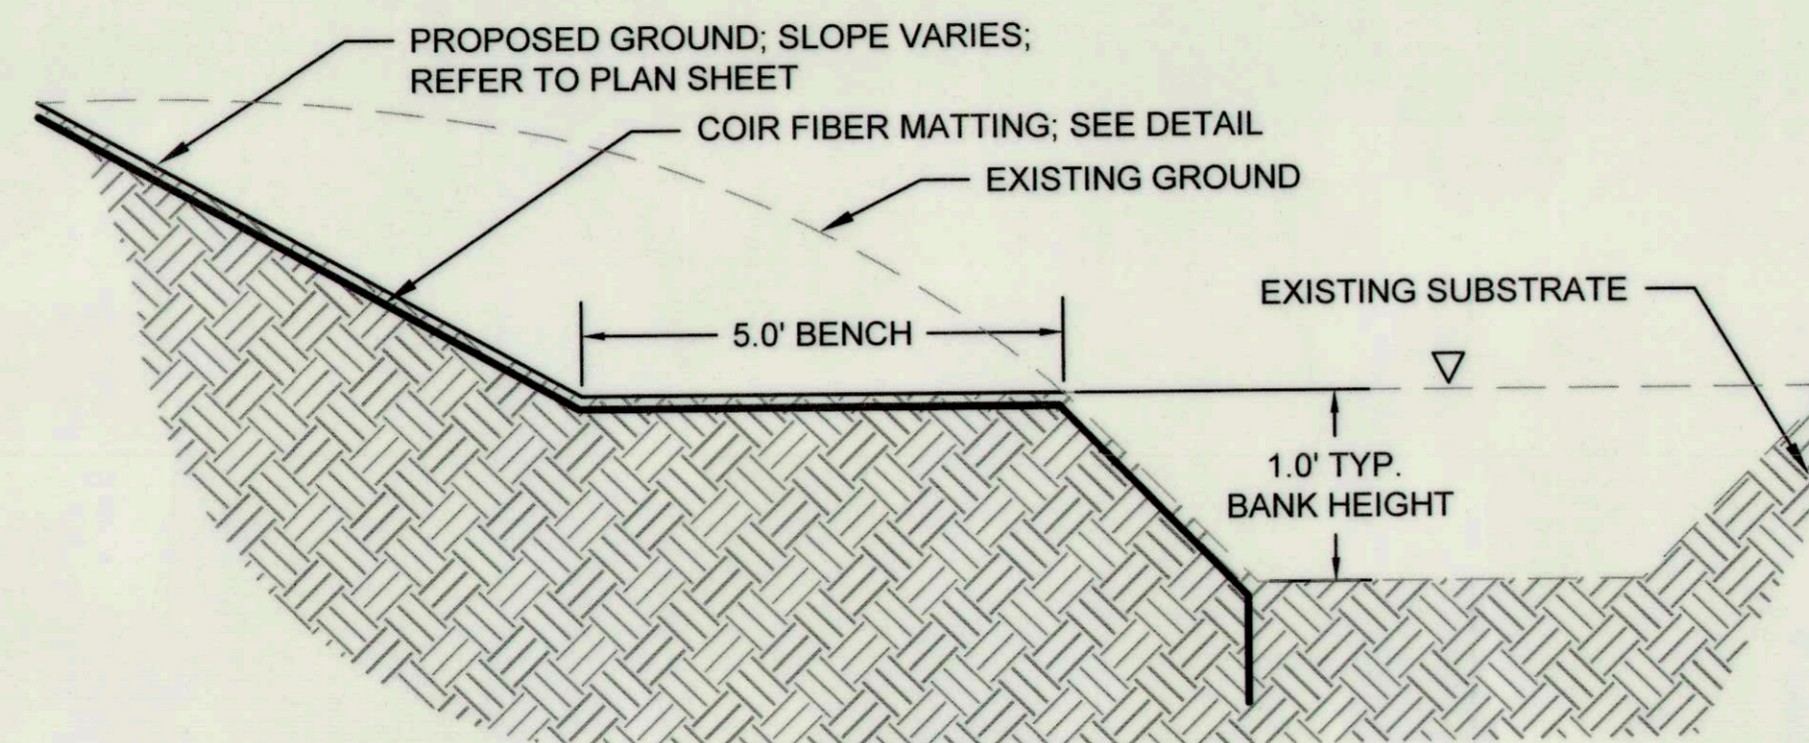

TYPICAL BANK HEIGHT- CROSS SECTION

STA 0+15.9 LT TO 2+36.3 LT

NOT TO SCALE

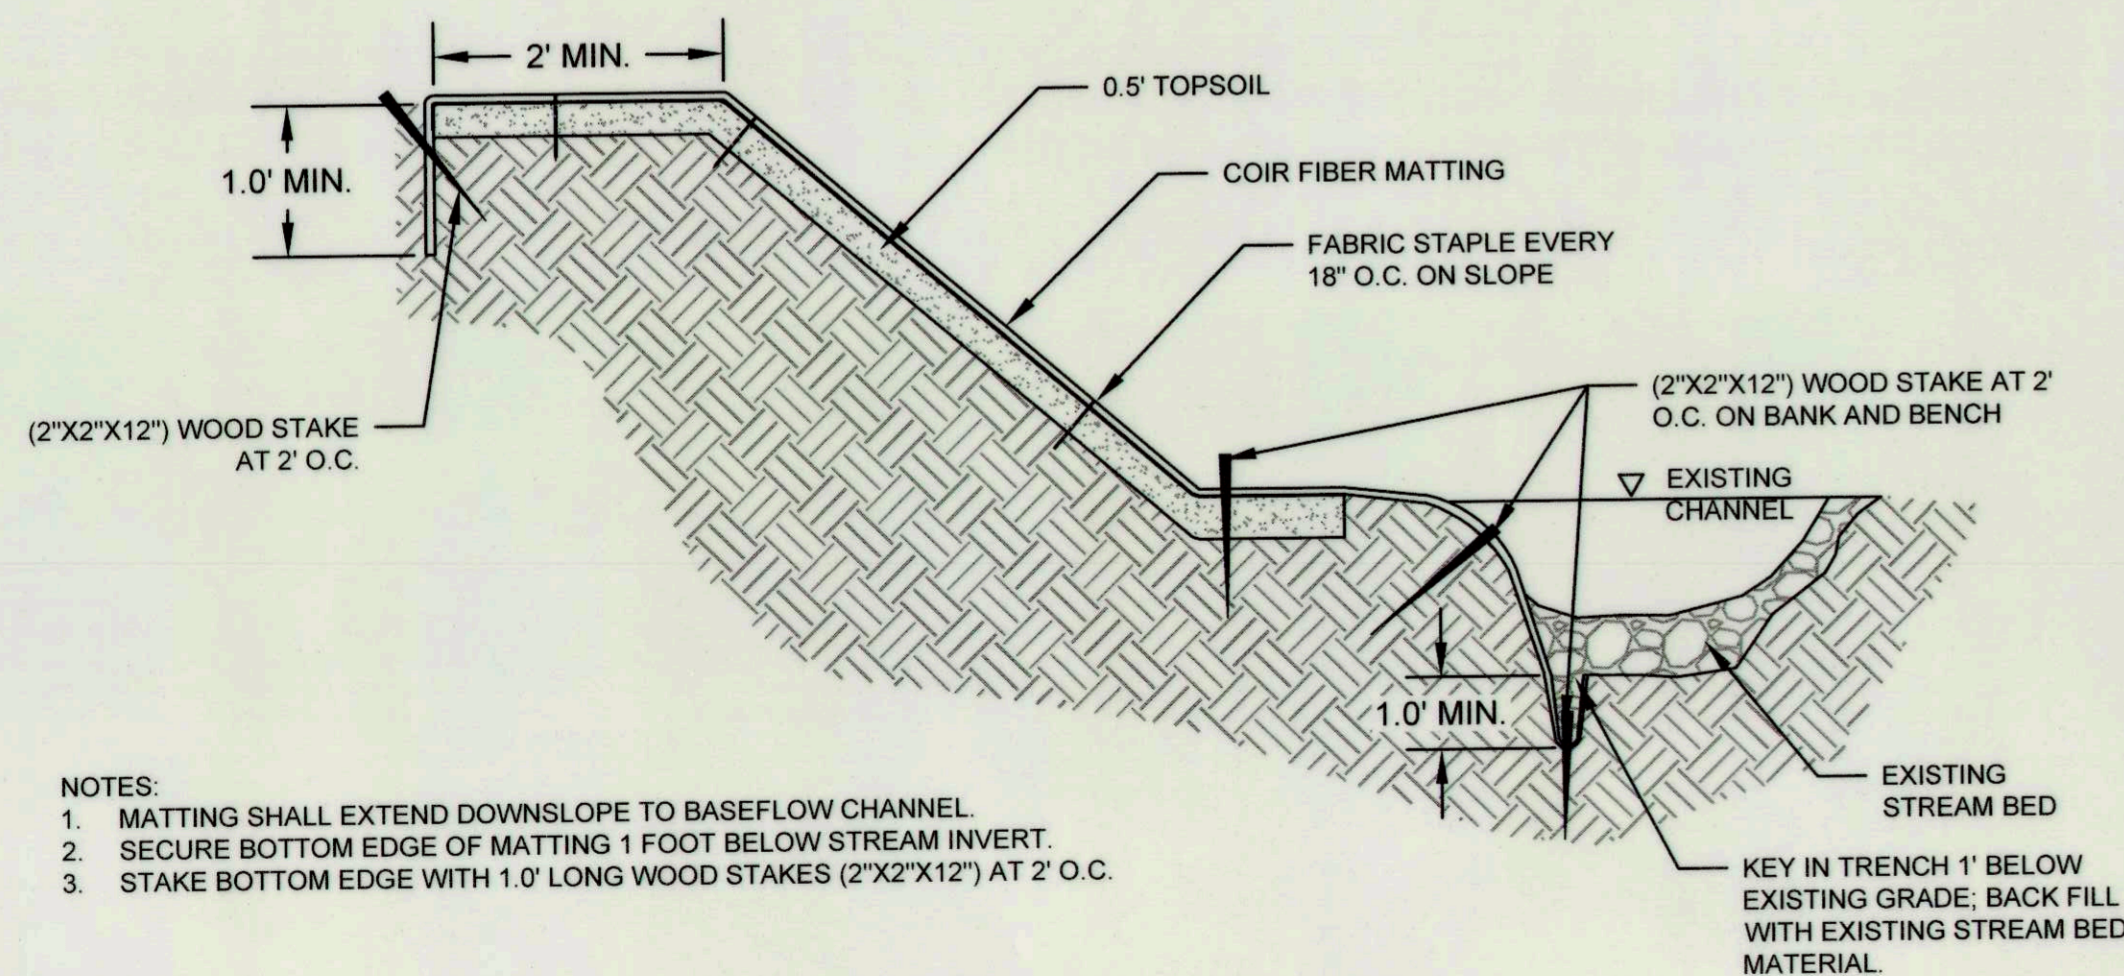


- NOTES:
- MATting SHALL EXTEND DOWNSLOPE TO BASEFLOW CHANNEL.
  - SECURE BOTTOM EDGE OF MATting 1 FOOT BELOW STREAM INVERT.
  - STAKE BOTTOM EDGE WITH 1.0' LONG WOOD STAKES (2"X2"X12") AT 2' O.C.

NOTE: COIR FIBER MATting SHALL BE ROLLED LENGTH WISE ALONG EACH STREAM BANK EXTENDING FROM TOE OF SLOPE TO A MINIMUM OF TWO FEET PAST THE TOP OF SLOPE UPON COMPLETION OF GRADING AND APPLICATION OF HERBACEOUS PERMANENT SEEDING. IF MORE THAN ONE ROLL IS REQUIRED, MID-BANK OVERLAP SHOULD BE A MINIMUM OF ONE FOOT AND SECURELY FASTENED WITH STAPLES. MATting CAN BE INSTALLED INCREMENTALLY AS CONSTRUCTION PROGRESSES, PER THE SEQUENCE OF CONSTRUCTION.


COIR FIBER MATting - TYPICAL SLOPE CROSS SECTION

NOT TO SCALE

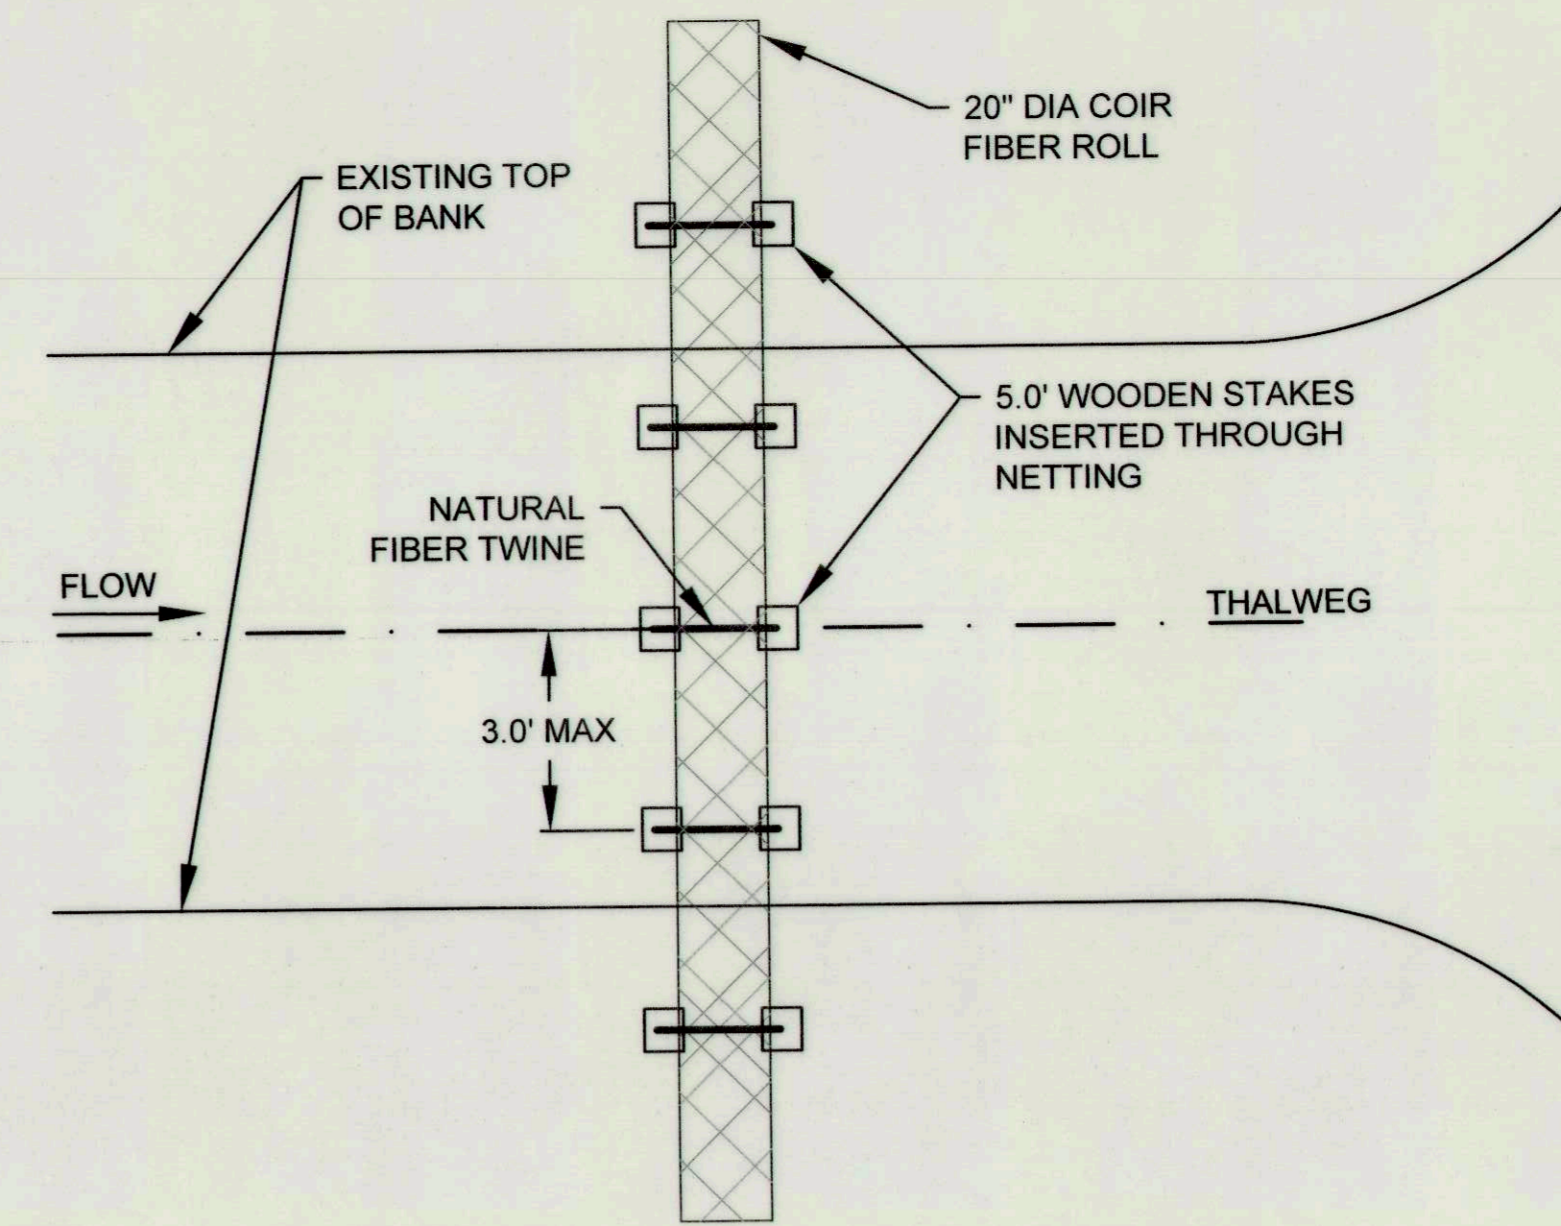

COIR FIBER LOG PLUG  
PLAN VIEW - TYPICAL


NOT TO SCALE

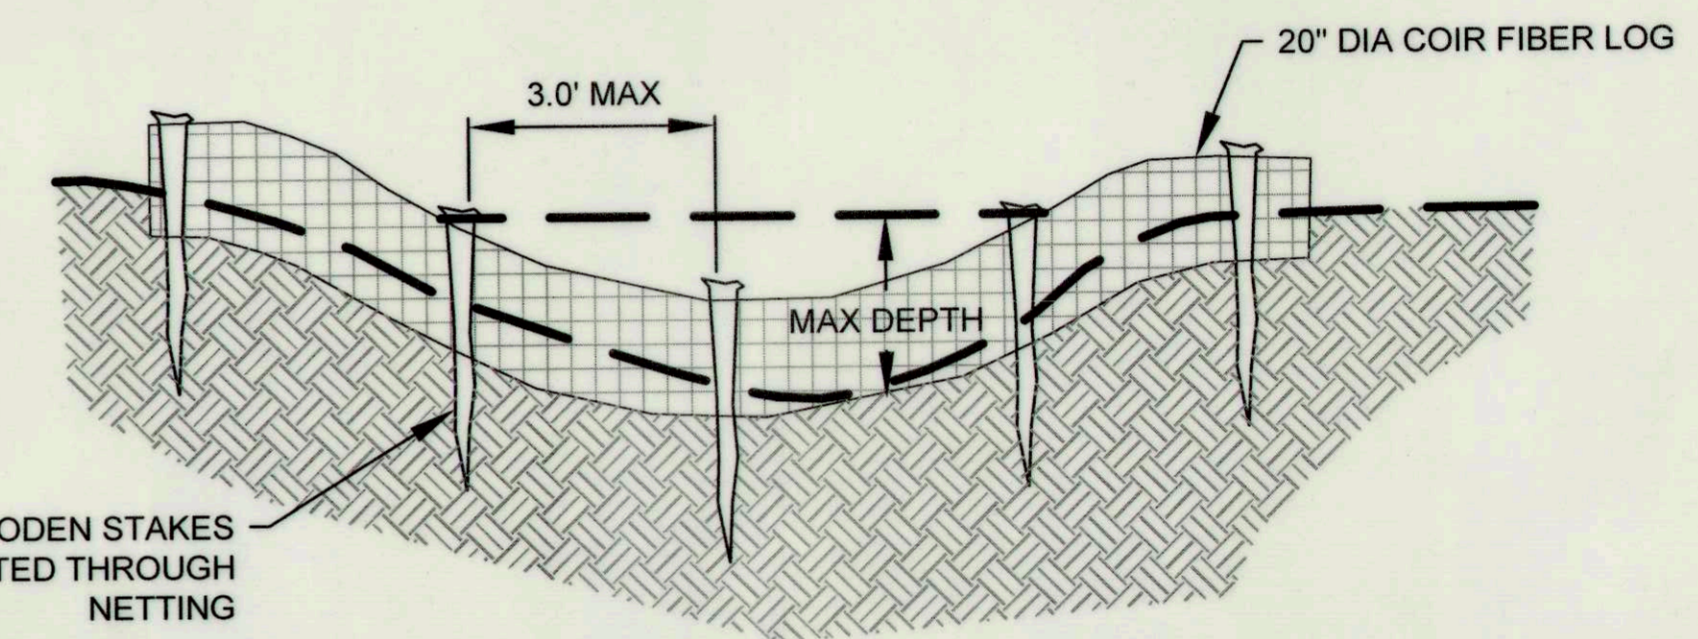

- NOTES:
- TOP OF PLUG SHALL BE AT LEAST 1/2 BUT NOT GREATER THAN 3/4 OF MAX DEPTH OF CHANNEL.
  - THE CONTRACTOR SHALL BE REQUIRED TO ADD ADDITIONAL STAKES AS NEEDED TO ENSURE STABILITY OF THE COIR LOG. THE CONTRACTOR MAY ALSO BE REQUIRED TO VARY THE ORIENTATION OF THE STAKE IN ORDER TO IMPROVE STABILITY AND/OR EASE OF INSTALLATION.


COIR FIBER LOG PLUG  
CROSS SECTION- TYPICAL

NOT TO SCALE

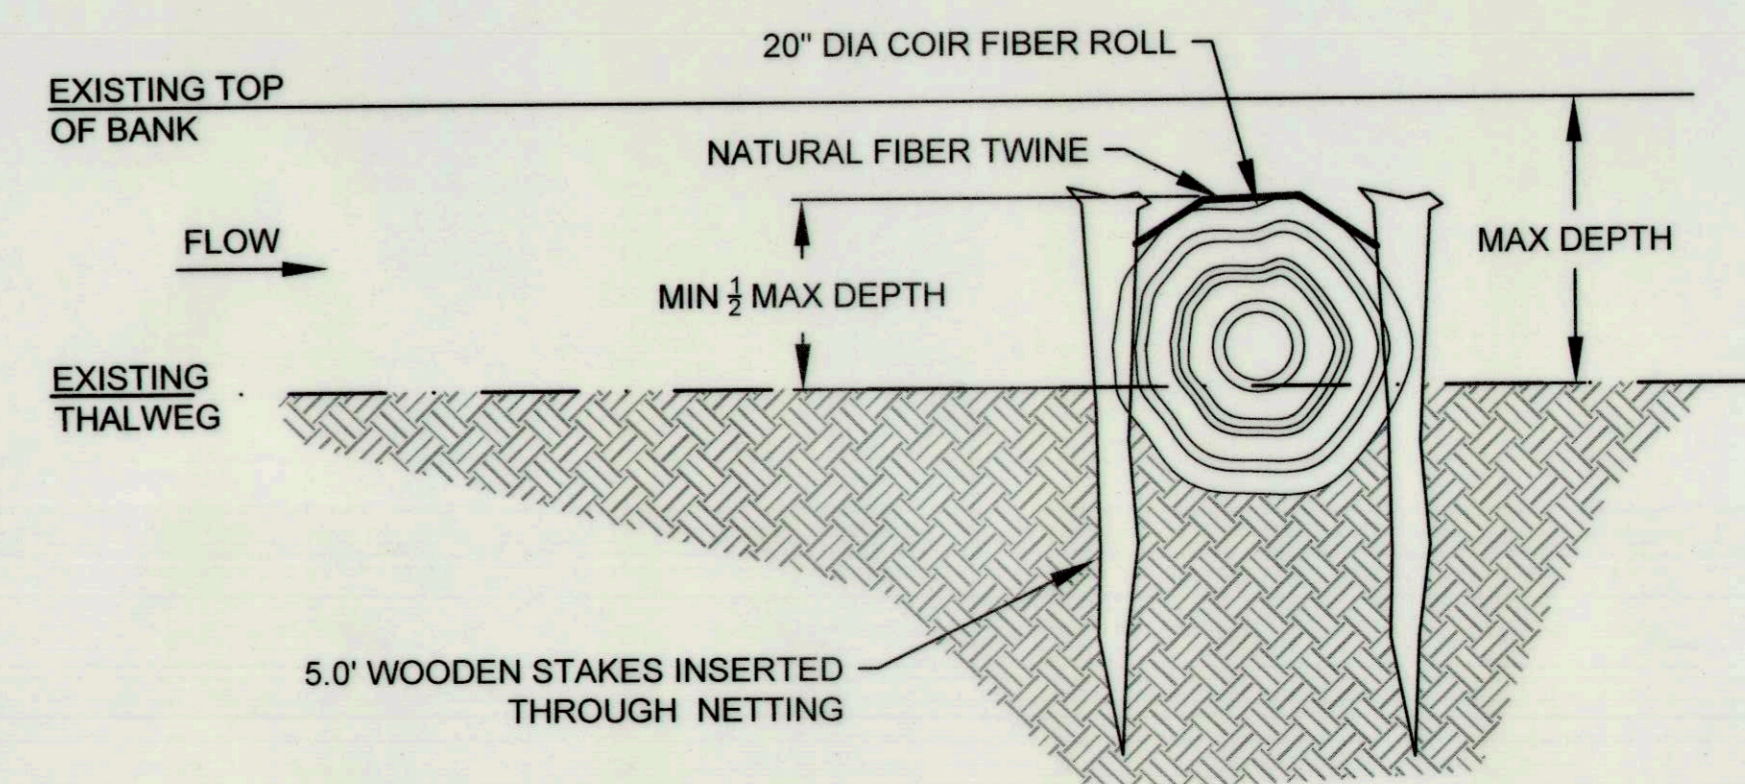

COIR FIBER LOG PLUG  
PROFILE VIEW- TYPICAL

NOT TO SCALE

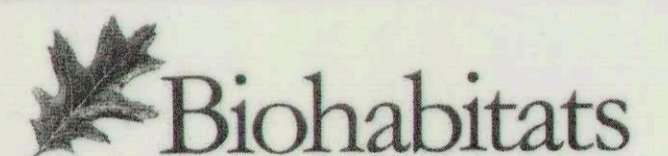

The Stables Building 2081 Clipper Park Road  
Baltimore, MD 21211 / ph: 410.554.0156  
fx: 410.554.0168 / www.biohabitats.com

Restore the Earth & Inspire Ecological Stewardship

LONGVIEW DRIVE  
STREAM  
STABILIZATION

SITE ADDRESS: 9509 LONGVIEW DR, ELLICOTT CITY, MD  
ZONING: R-20, R-ED TAX MAP/GRID/PARCEL: 0024/0003/0840  
ELECTION DISTRICT: 02 OPEN LOT N/A  
WAIVER PETITION WP-18-022

TITLE:

DETAILS


PROJECT NO.: 13005.50

SCALE: NTS

SEAL:

BY: RW/KT CHECK: MDT/MWT


DWG. NO.:

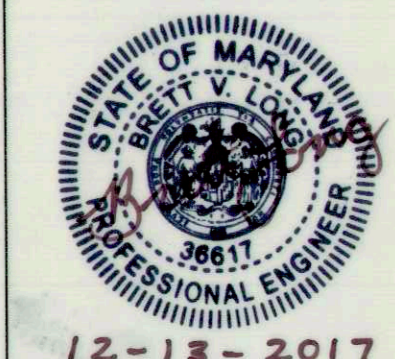

This development plan is approved for soil erosion and sediment control by the HOWARD SOIL CONSERVATION DISTRICT  
1/2/18  
Howard SCD


DEPARTMENT OF PUBLIC WORKS, HOWARD COUNTY, MD  
12/19/17  
CHIEF, BUREAU OF ENVIRONMENTAL SERVICES

HOWARD COUNTY DPW  
 BUREAU OF ENVIRONMENTAL SERVICES  
 STORMWATER MANAGEMENT DIVISION  
 6751 GATEWAY DRIVE, SUITE 514  
 COLUMBIA, MD 21046  
 PHONE: (410) 313-6413

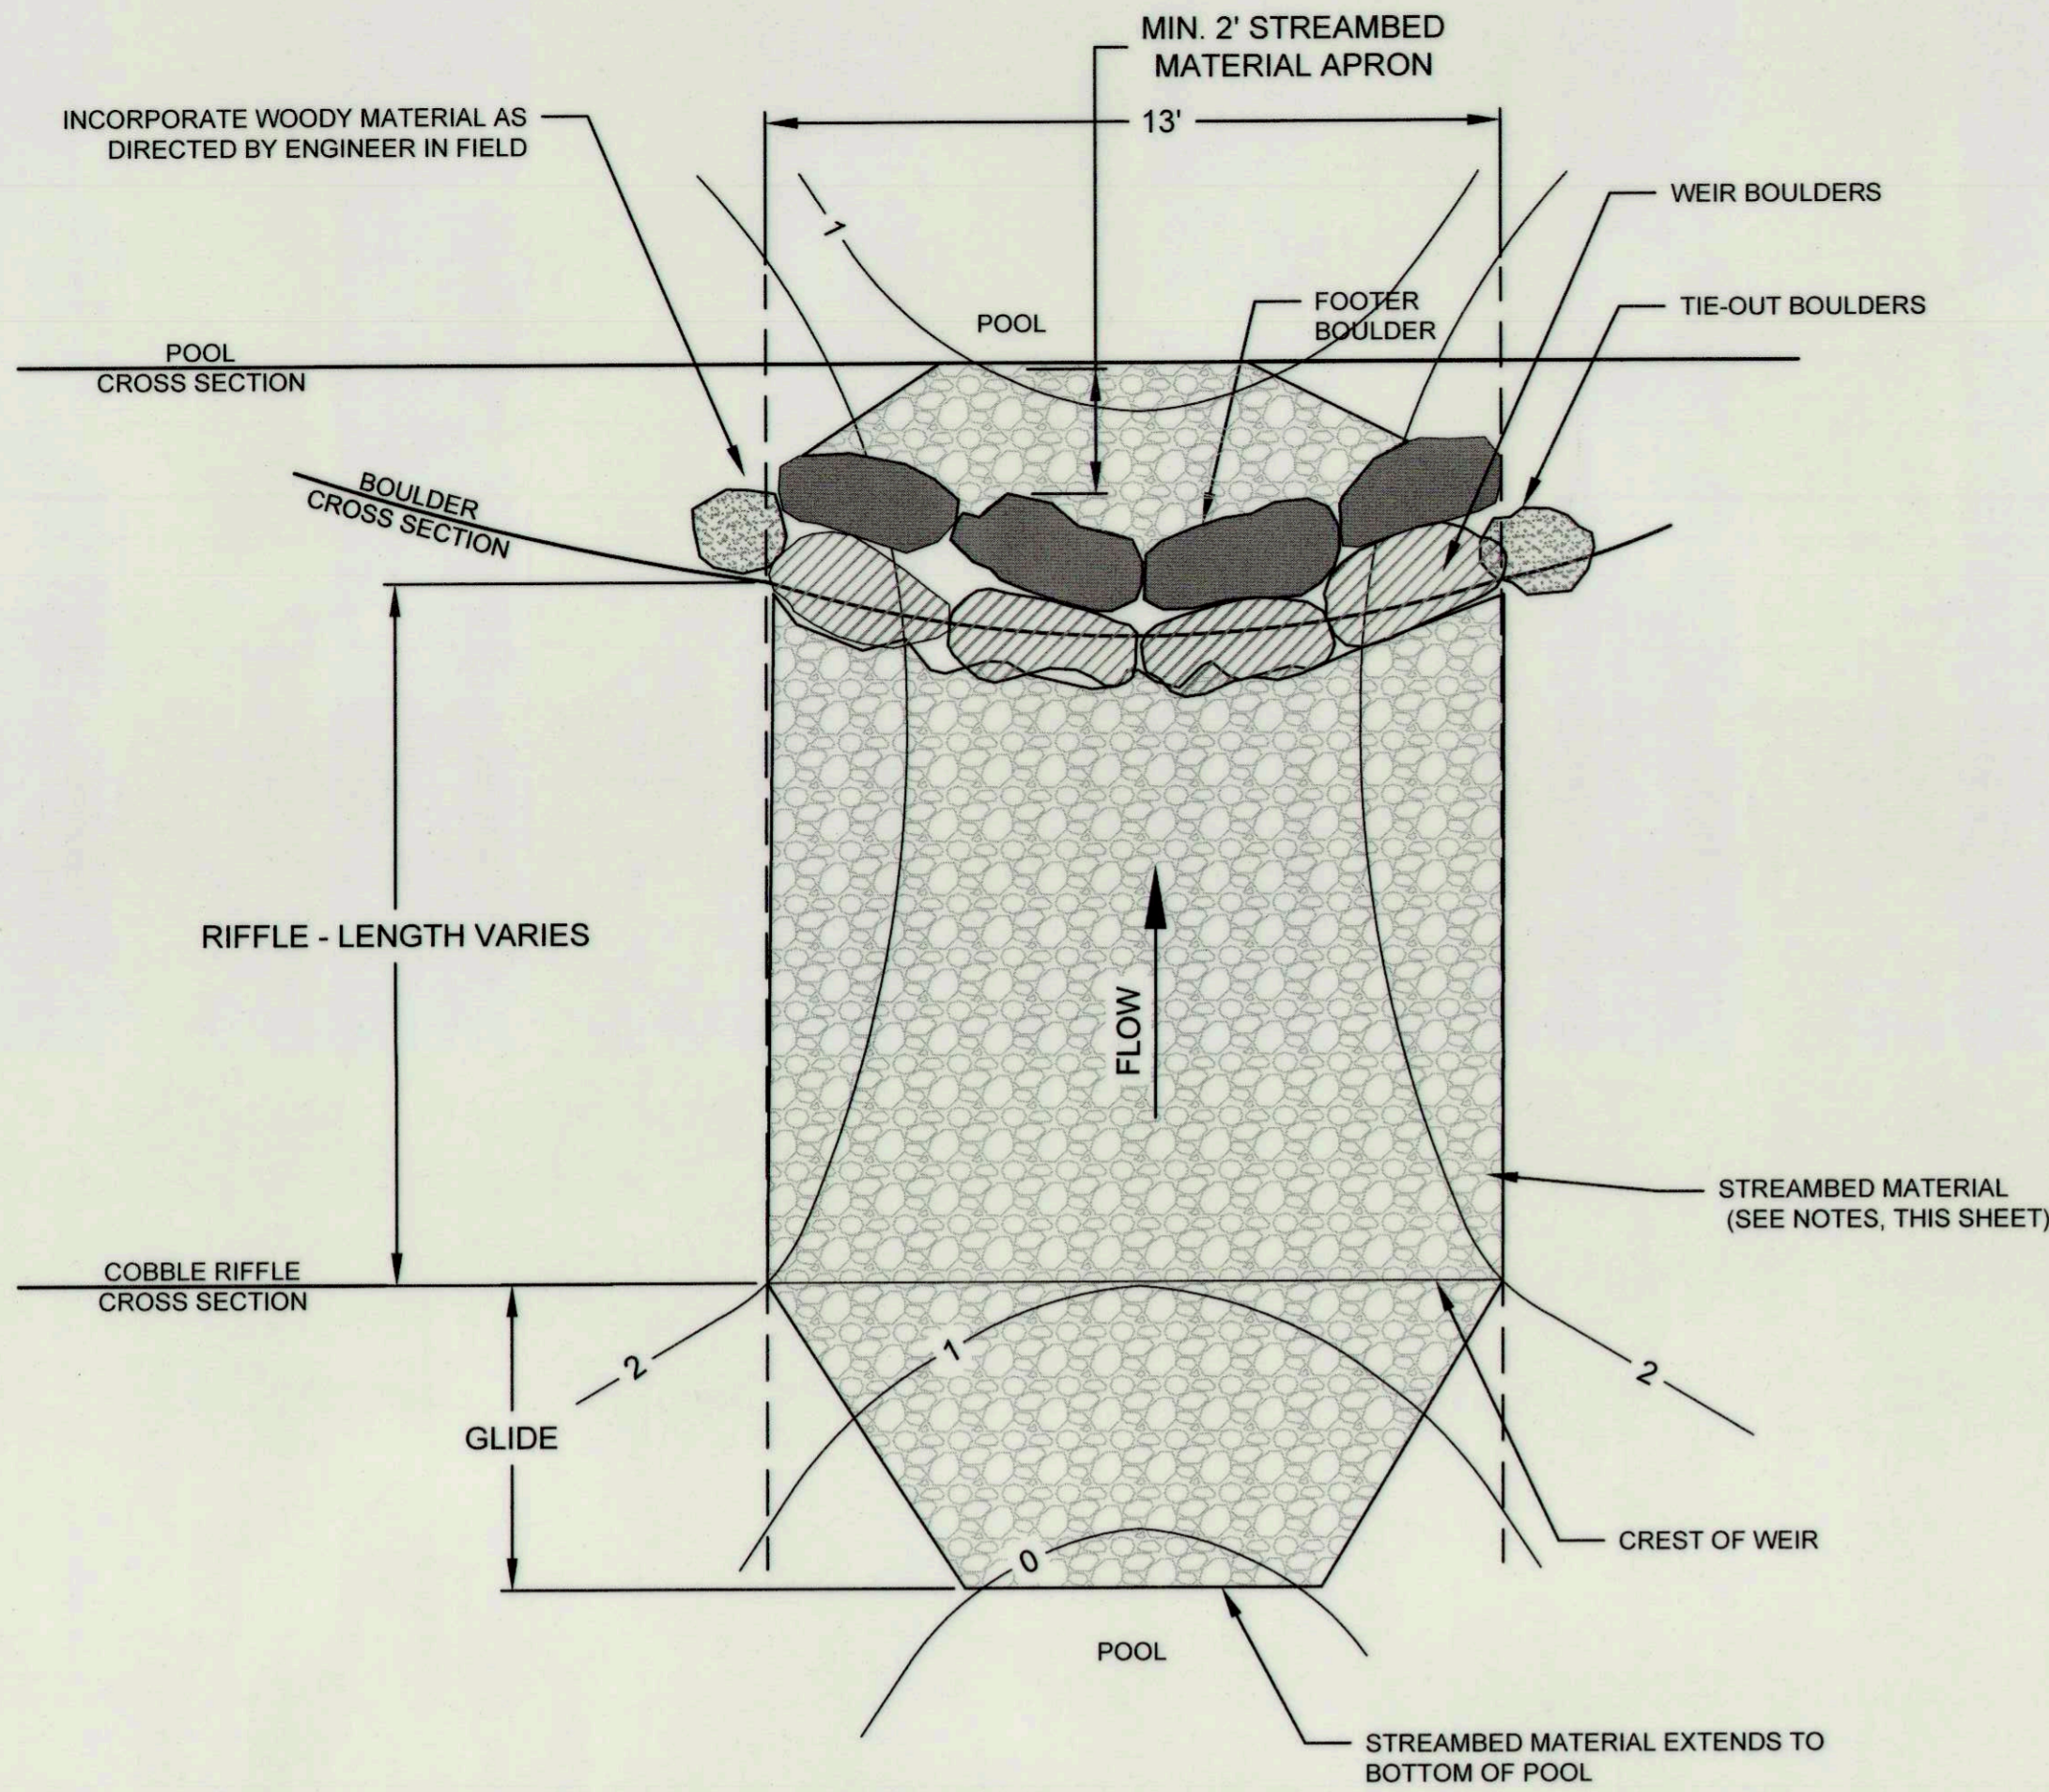

| CUMULATIVE % FINER | STREAMBED MATERIAL RIFFLES | GRAVEL ALL REACHES |
|--------------------|----------------------------|--------------------|
|                    | SIZE (IN)                  | SIZE (IN)          |
| 10                 | 2.6                        | 1/4                |
| 15                 | 3.0                        | N/A                |
| 30                 | 4.3                        | 1/2                |
| 50                 | 6.0                        | 1                  |
| 85                 | 8.5                        | 2                  |
| 100                | 9.6                        | 3                  |

| CUMULATIVE % FINER | COBBLE SIZE (IN) |
|--------------------|------------------|
| 3-20               | No. 200          |
| 20-50              | No. 40           |
| 35-70              | No. 10           |
| 60-100             | 1/2 in           |
| 85-100             | 1 in             |
| 100                | 2 1/2 in         |

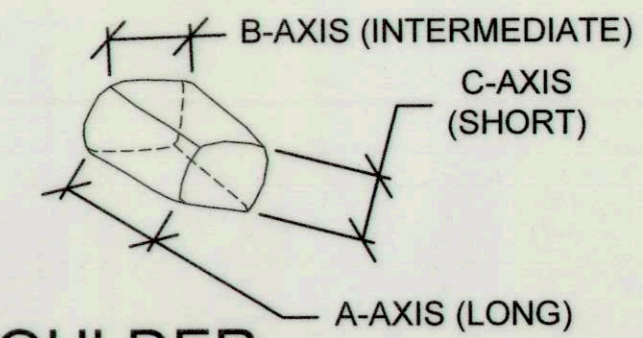

**BOULDER BOULDER AXIS** NOT TO SCALE


| BOULDER TYPE | A-AXIS | B-AXIS | C-AXIS |
|--------------|--------|--------|--------|
| WEIR         | 1-2    | 1-2    | 1-2    |
| FOOTER       | 1-2    | 1-2    | 1-2    |
| TIE-OUT      | 1-2    | 1-2    | 1-2    |
| TOE          | 1-2    | 1-2    | 1-2    |

**RIFFLE NOTES:**

1. TIE-OUT BOULDER SHALL EXTEND A MIN. OF ONE BOULDER LENGTH INTO EXISTING BANK. WHERE THIS CONFLICTS WITH EXISTING TREE ROOTS OR BEDROCK, TIE-OUT BOULDER MAY BE ELIMINATED OR ADJUSTED AT DIRECTION OF OWNER.
2. SEE TYPICAL SECTIONS FOR DEPTH AND WIDTH AT BOULDER CROSS SECTION.
3. STREAMBED MATERIAL DEPTH VARIES BETWEEN MAINSTEM AND TRIBUTARY. SEE PROFILE.
4. APRON MATERIAL SHALL CONSIST OF STREAMBED MATERIAL OF THE SAME GRADATION AS THE RIFFLE.
5. GRAVEL MATERIAL SHALL BE MIXED, WORKED IN, OR WASHED INTO THE STREAMBED MATERIAL TO THE SATISFACTION OF THE ENGINEER. THE QUANTITY OF GRAVEL MATERIAL REQUIRED MAY BE UP TO 25% OF THE VOLUME OF STREAMBED MATERIAL.
6. SUITABLE GRAVEL MATERIAL HARVESTED ON-SITE SHALL BE USED PRIOR TO IMPORTING GRAVEL.
7. GRANULAR FILTER MATERIAL IS A SUITABLE SUBSTITUTION FOR GRAVEL MATERIAL.
8. NUMBER OF BOULDERS VARIES DEPENDING ON TYPICAL SECTIONS AND BOULDER DIMENSIONS.
9. ALL BOULDER RIFFLES SHALL USE CLASS 2 RIPRAP AS STREAM BED MATERIAL.

**COBBLE RIFFLE GRADE CONTROL PLAN VIEW**

NOT TO SCALE

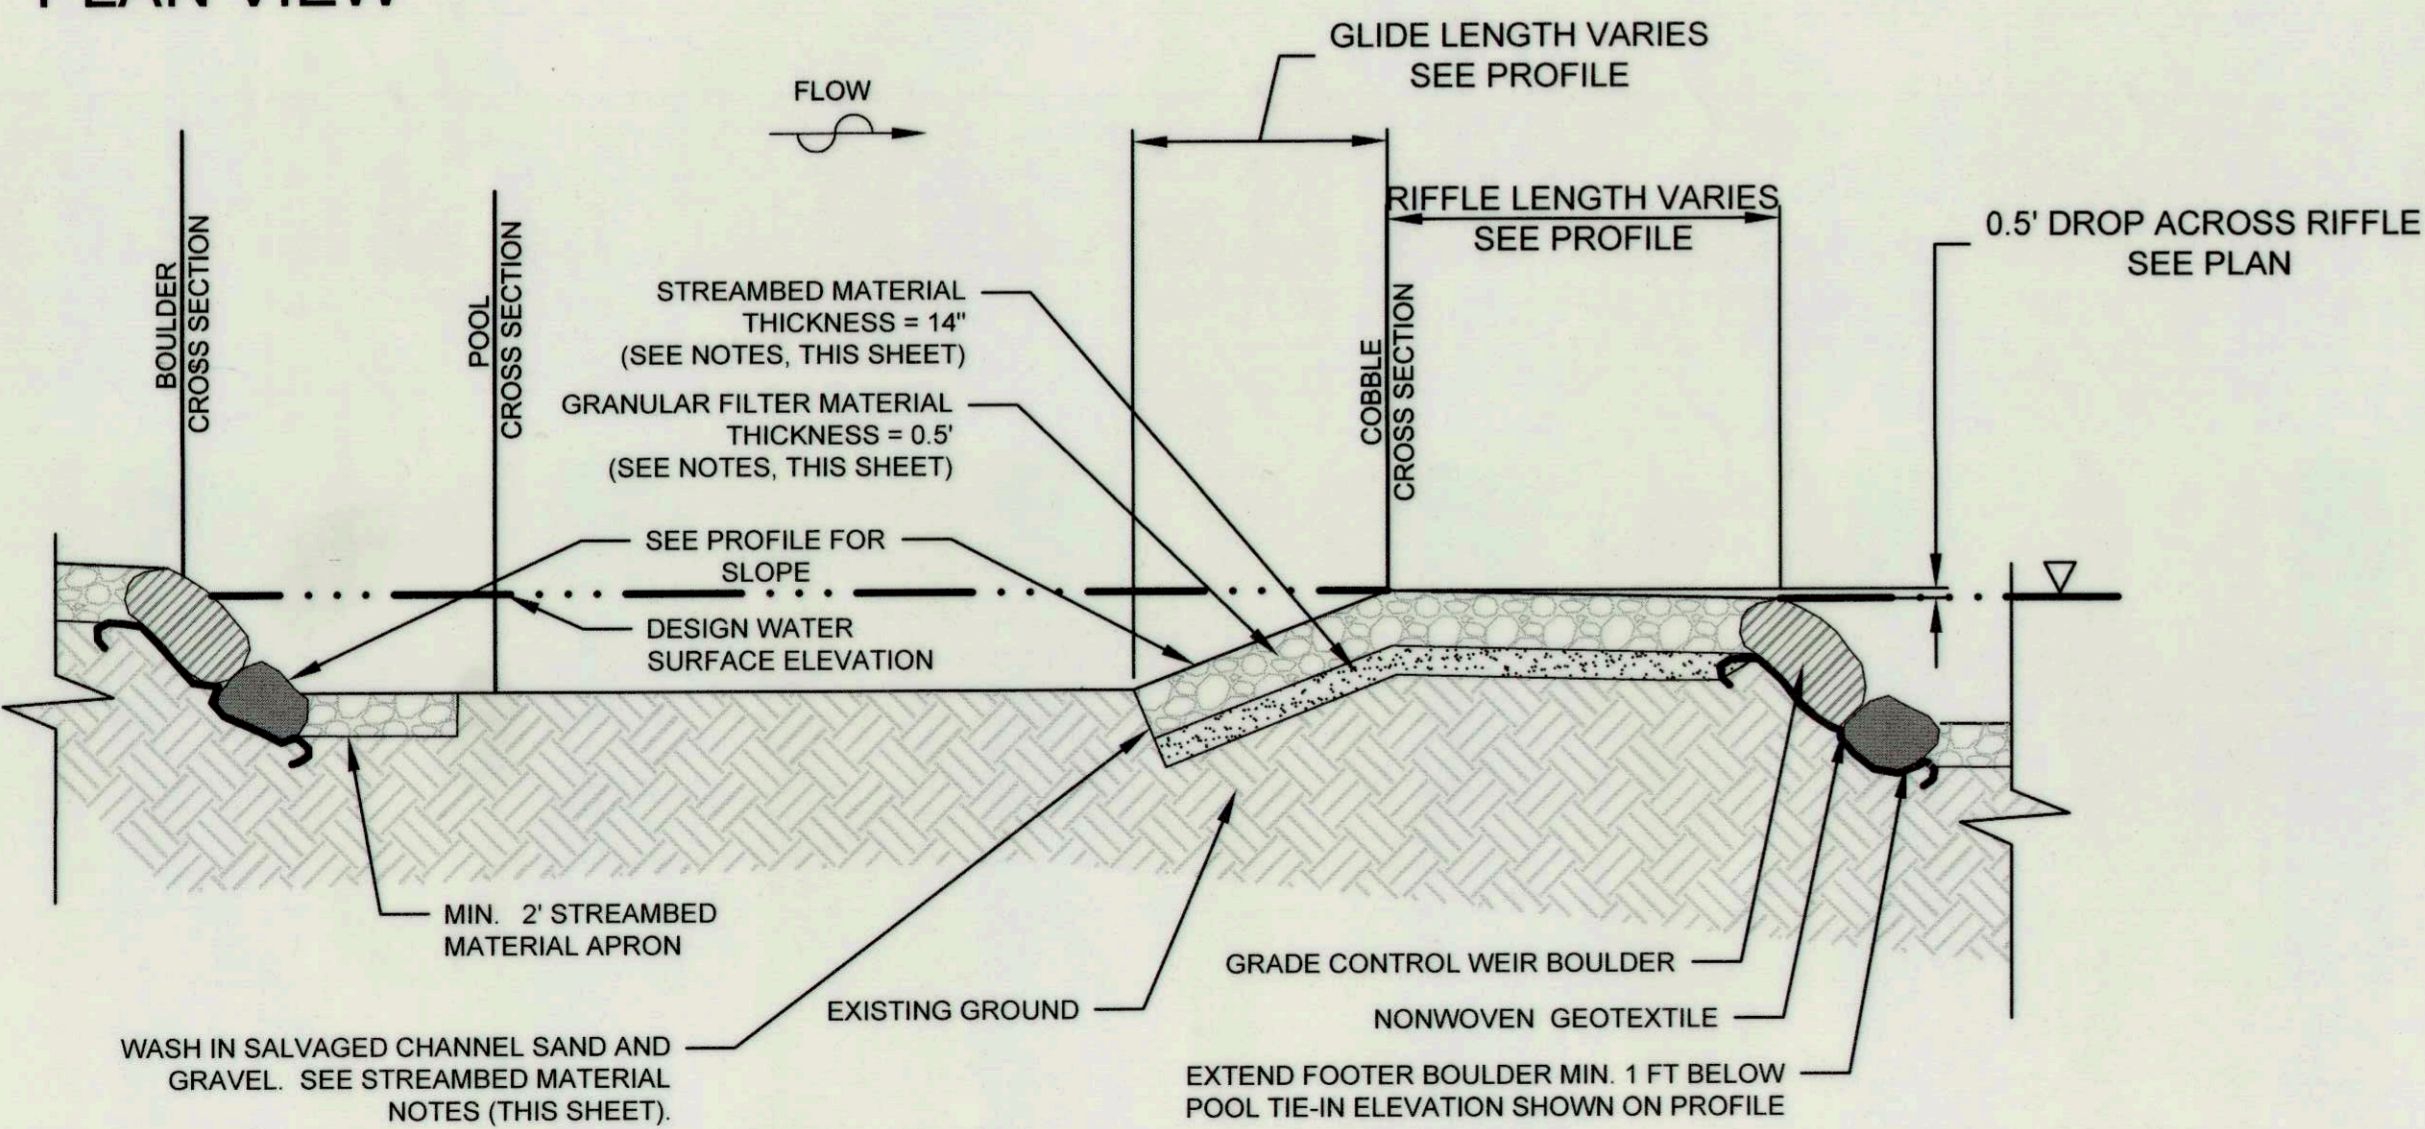


**COBBLE RIFFLE GRADE CONTROL NOTES:**

1. ALL COBBLE RIFFLE GRADE CONTROL STRUCTURES SHALL BE CONSTRUCTED FROM DOWNSTREAM TO UPSTREAM
2. REFER TO STREAMBED MATERIAL NOTES FOR DIRECTIONS FOR HOW RIFFLE GRADE CONTROL MATERIAL SHALL BE PLACED.
3. CONTRACTOR AND ENGINEER SHALL WALK SITE TO IDENTIFY SUITABLE MATERIAL FOR ALL COBBLE RIFFLE GRADE CONTROLS.
4. CONTRACTOR SHALL EXHAUST SUITABLE MATERIALS FROM ON-SITE EXCAVATION PRIOR TO IMPORTING NEW COBBLE RIFFLE GRADE CONTROL MATERIALS.
5. ENGINEER WILL APPROVE ALL ON-SITE MATERIAL.
6. ALL COBBLE RIFFLE GRADE CONTROL MATERIAL MUST BE CLEAN AND FREE FROM TRASH.
7. INCORPORATE LARGE WOODY DEBRIS IN POOLS AS DIRECTED BY ENGINEER IN FIELD.
8. WHERE EXISTING CHANNEL INVERT IS AT OR HIGHER THAN FINISHED GRADE, FILL IS NOT NEEDED.


**COBBLE RIFFLE GRADE CONTROL PROFILE**

NOT TO SCALE

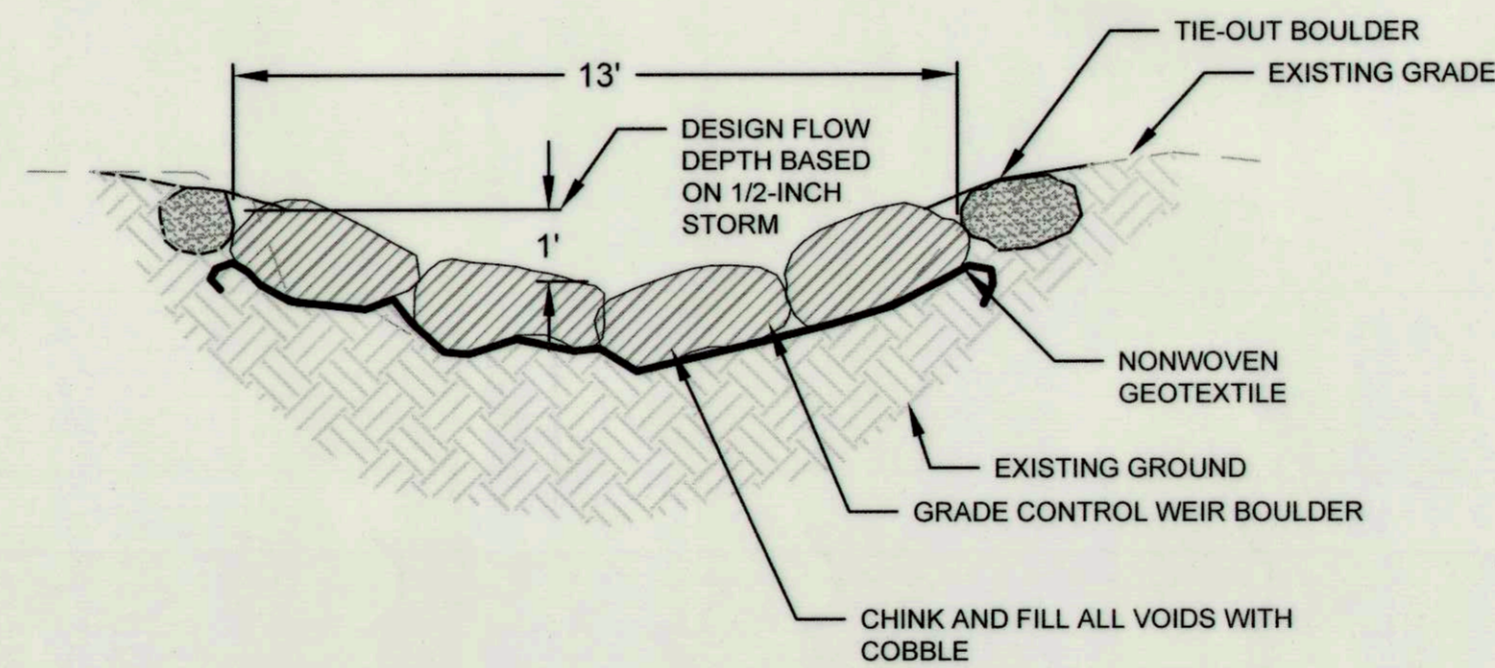

**COBBLE RIFFLE GRADE CONTROL BOULDER CROSS SECTION**

NOT TO SCALE

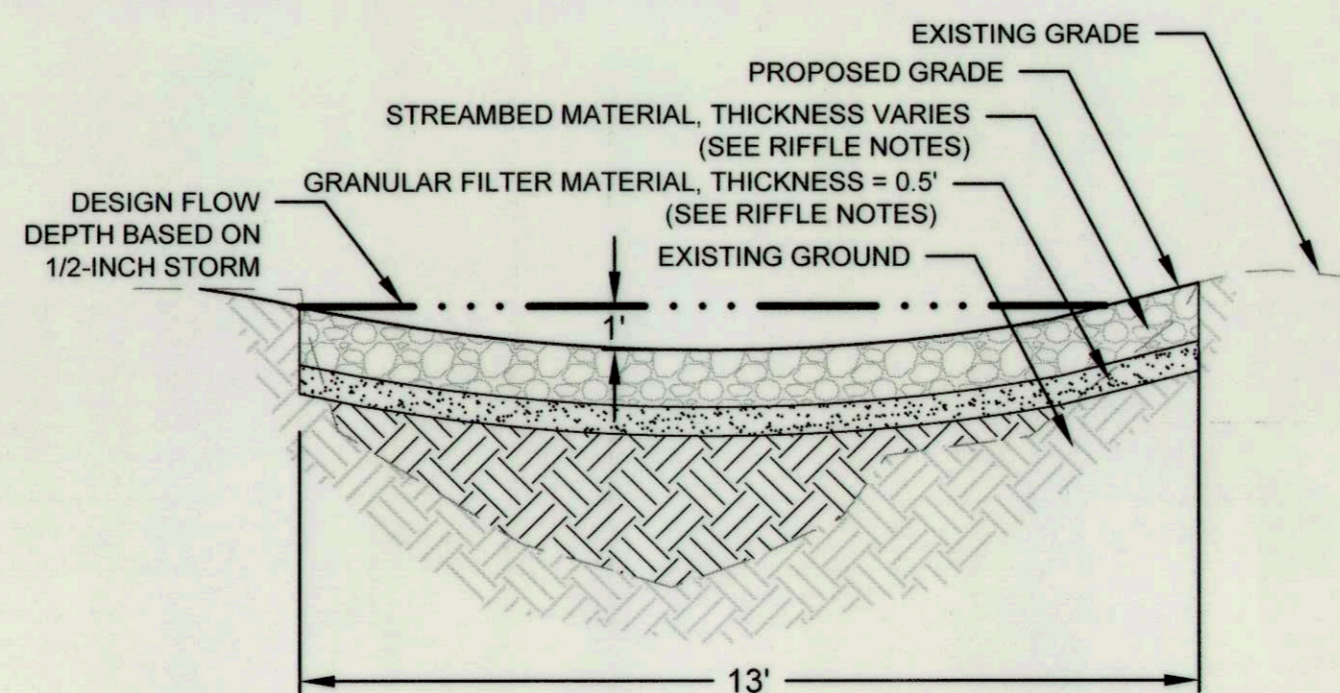


**STREAMBED MATERIAL NOTES:**

1. PLACE COBBLE IN A LIFT WITH THICKNESS EQUAL TO THE LARGEST STONE IN GRADATION. DO NOT DROP STONES FROM A HEIGHT GREATER THAN 2 FEET ABOVE THE FINISHED SUBGRADE.
2. PLACE SAND AND GRAVEL ON TOP OF EACH LIFT OF THE FRAMEWORK GRADATION AND USE PRESSURIZED WATER TO WASH THE FINES INTO THE VOIDS IN THE STONE LAYER. APPLY WATER SUFFICIENT TO ASSURE THAT ALL VOID SPACES ARE FILLED.
3. REMOVE ANY EXCESS SAND AND GRAVEL PRIOR TO PLACING THE NEXT LIFT OF COBBLE TO ASSURE COBBLE-TO-COBBLE CONTACT AND THAT THE SUBSEQUENT LIFT DOES NOT REST ON SAND AND GRAVEL.
4. PLACE THE NEXT LIFT AS DESCRIBED ABOVE UNTIL THE FINISH GRADE HAS BEEN REACHED.
5. ALL SAND AND GRAVEL SHALL BE APPROVED BY ENGINEER. SHOULD SUITABLE MATERIAL NOT BE AVAILABLE ON SITE, FURNISHED MATERIAL MEETING SPECIFICATIONS FOR GRANULAR FILL MAY BE USED AS APPROVED BY ENGINEER.

**COBBLE RIFFLE GRADE CONTROL COBBLE RIFFLE CROSS SECTION**

NOT TO SCALE

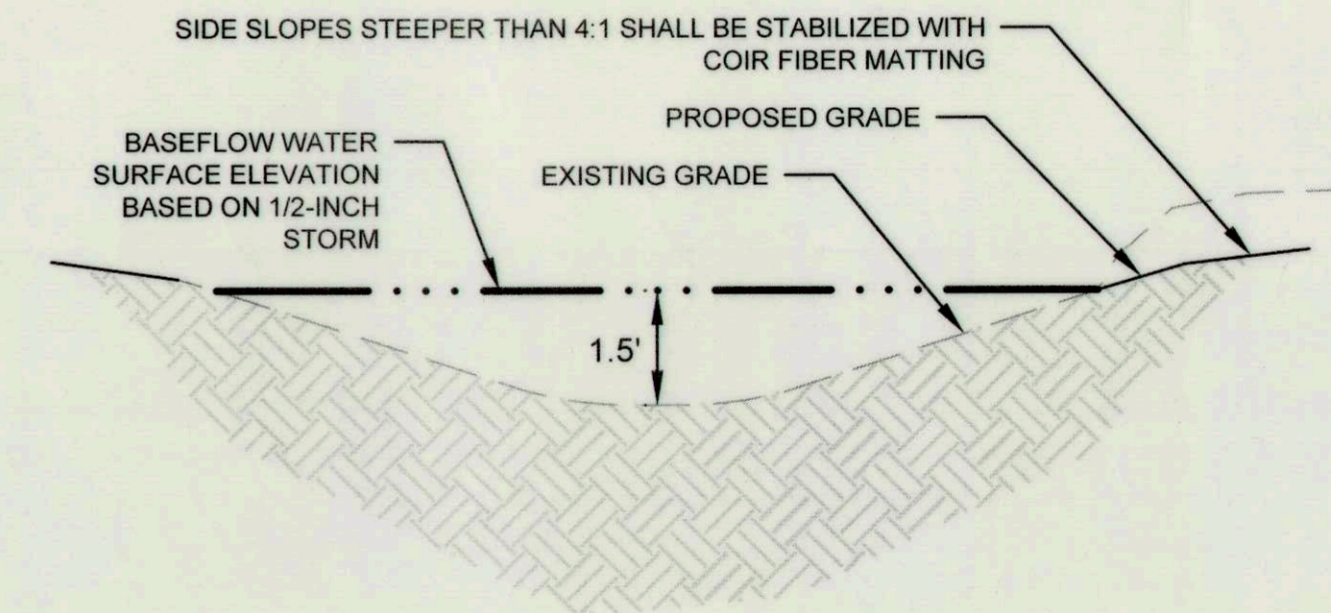

**COBBLE RIFFLE GRADE CONTROL POOL CROSS SECTION**

NOT TO SCALE

**FILL MATERIAL NOTES IF REQUIRED:**

1. FILL MATERIAL SHALL BE SUITABLE MATERIAL FROM ON-SITE EXCAVATIONS FIRST, THEN FROM OTHER SOURCES.
2. THE MATERIAL SHALL BE CLEAN EARTH.
3. THE MATERIAL SHALL BE FREE FROM VEGETABLE MATTER, ORGANIC MATERIAL, SLUDGE, GRIT, TRASH, DEBRIS, MUCK, SWAMP MUCK, ROOTS, ROOT MATS, LOGS, STUMPS, TREE STUMPS, BRUSH, FROZEN MATERIAL OR OTHER DELETERIOUS SUBSTANCES.

This development plan is approved for soil erosion and sediment control by the HOWARD SOIL CONSERVATION DISTRICT

Howard SCD 1/2/18  
Date

DEPARTMENT OF PUBLIC WORKS, HOWARD COUNTY, MD

*Michael J. ...* 12/19/17  
DATE  
 CHIEF, BUREAU OF ENVIRONMENTAL SERVICES

DATE ISSUES / REVISIONS

The Stables Building 2081 Clipper Park Road  
 Baltimore, MD 21211 / ph: 410.554.0156  
 fx: 410.554.0168 / www.biohabitats.com  
 Restore the Earth & Inspire Ecological Stewardship

**LONGVIEW DRIVE STREAM STABILIZATION**

SITE ADDRESS: 9509 LONGVIEW DR. ELLICOTT CITY, MD  
 ZONING: R-20, R-ED TAX MAP/GRID/PARCEL: 0024/0003/0640  
 ELECTION DISTRICT: 02 OPEN LOT NO.

TITLE:

**DETAILS**

PROJECT NO.: 13005.50

SCALE: NTS

SEAL:


BY: RW/KT CHECK: MDT/MWT

DWG. NO.:





HOWARD COUNTY DPW  
 BUREAU OF ENVIRONMENTAL SERVICES  
 STORMWATER MANAGEMENT DIVISION  
 6751 GATEWAY DRIVE, SUITE 514  
 COLUMBIA, MD 21046  
 PHONE: (410) 313-6413

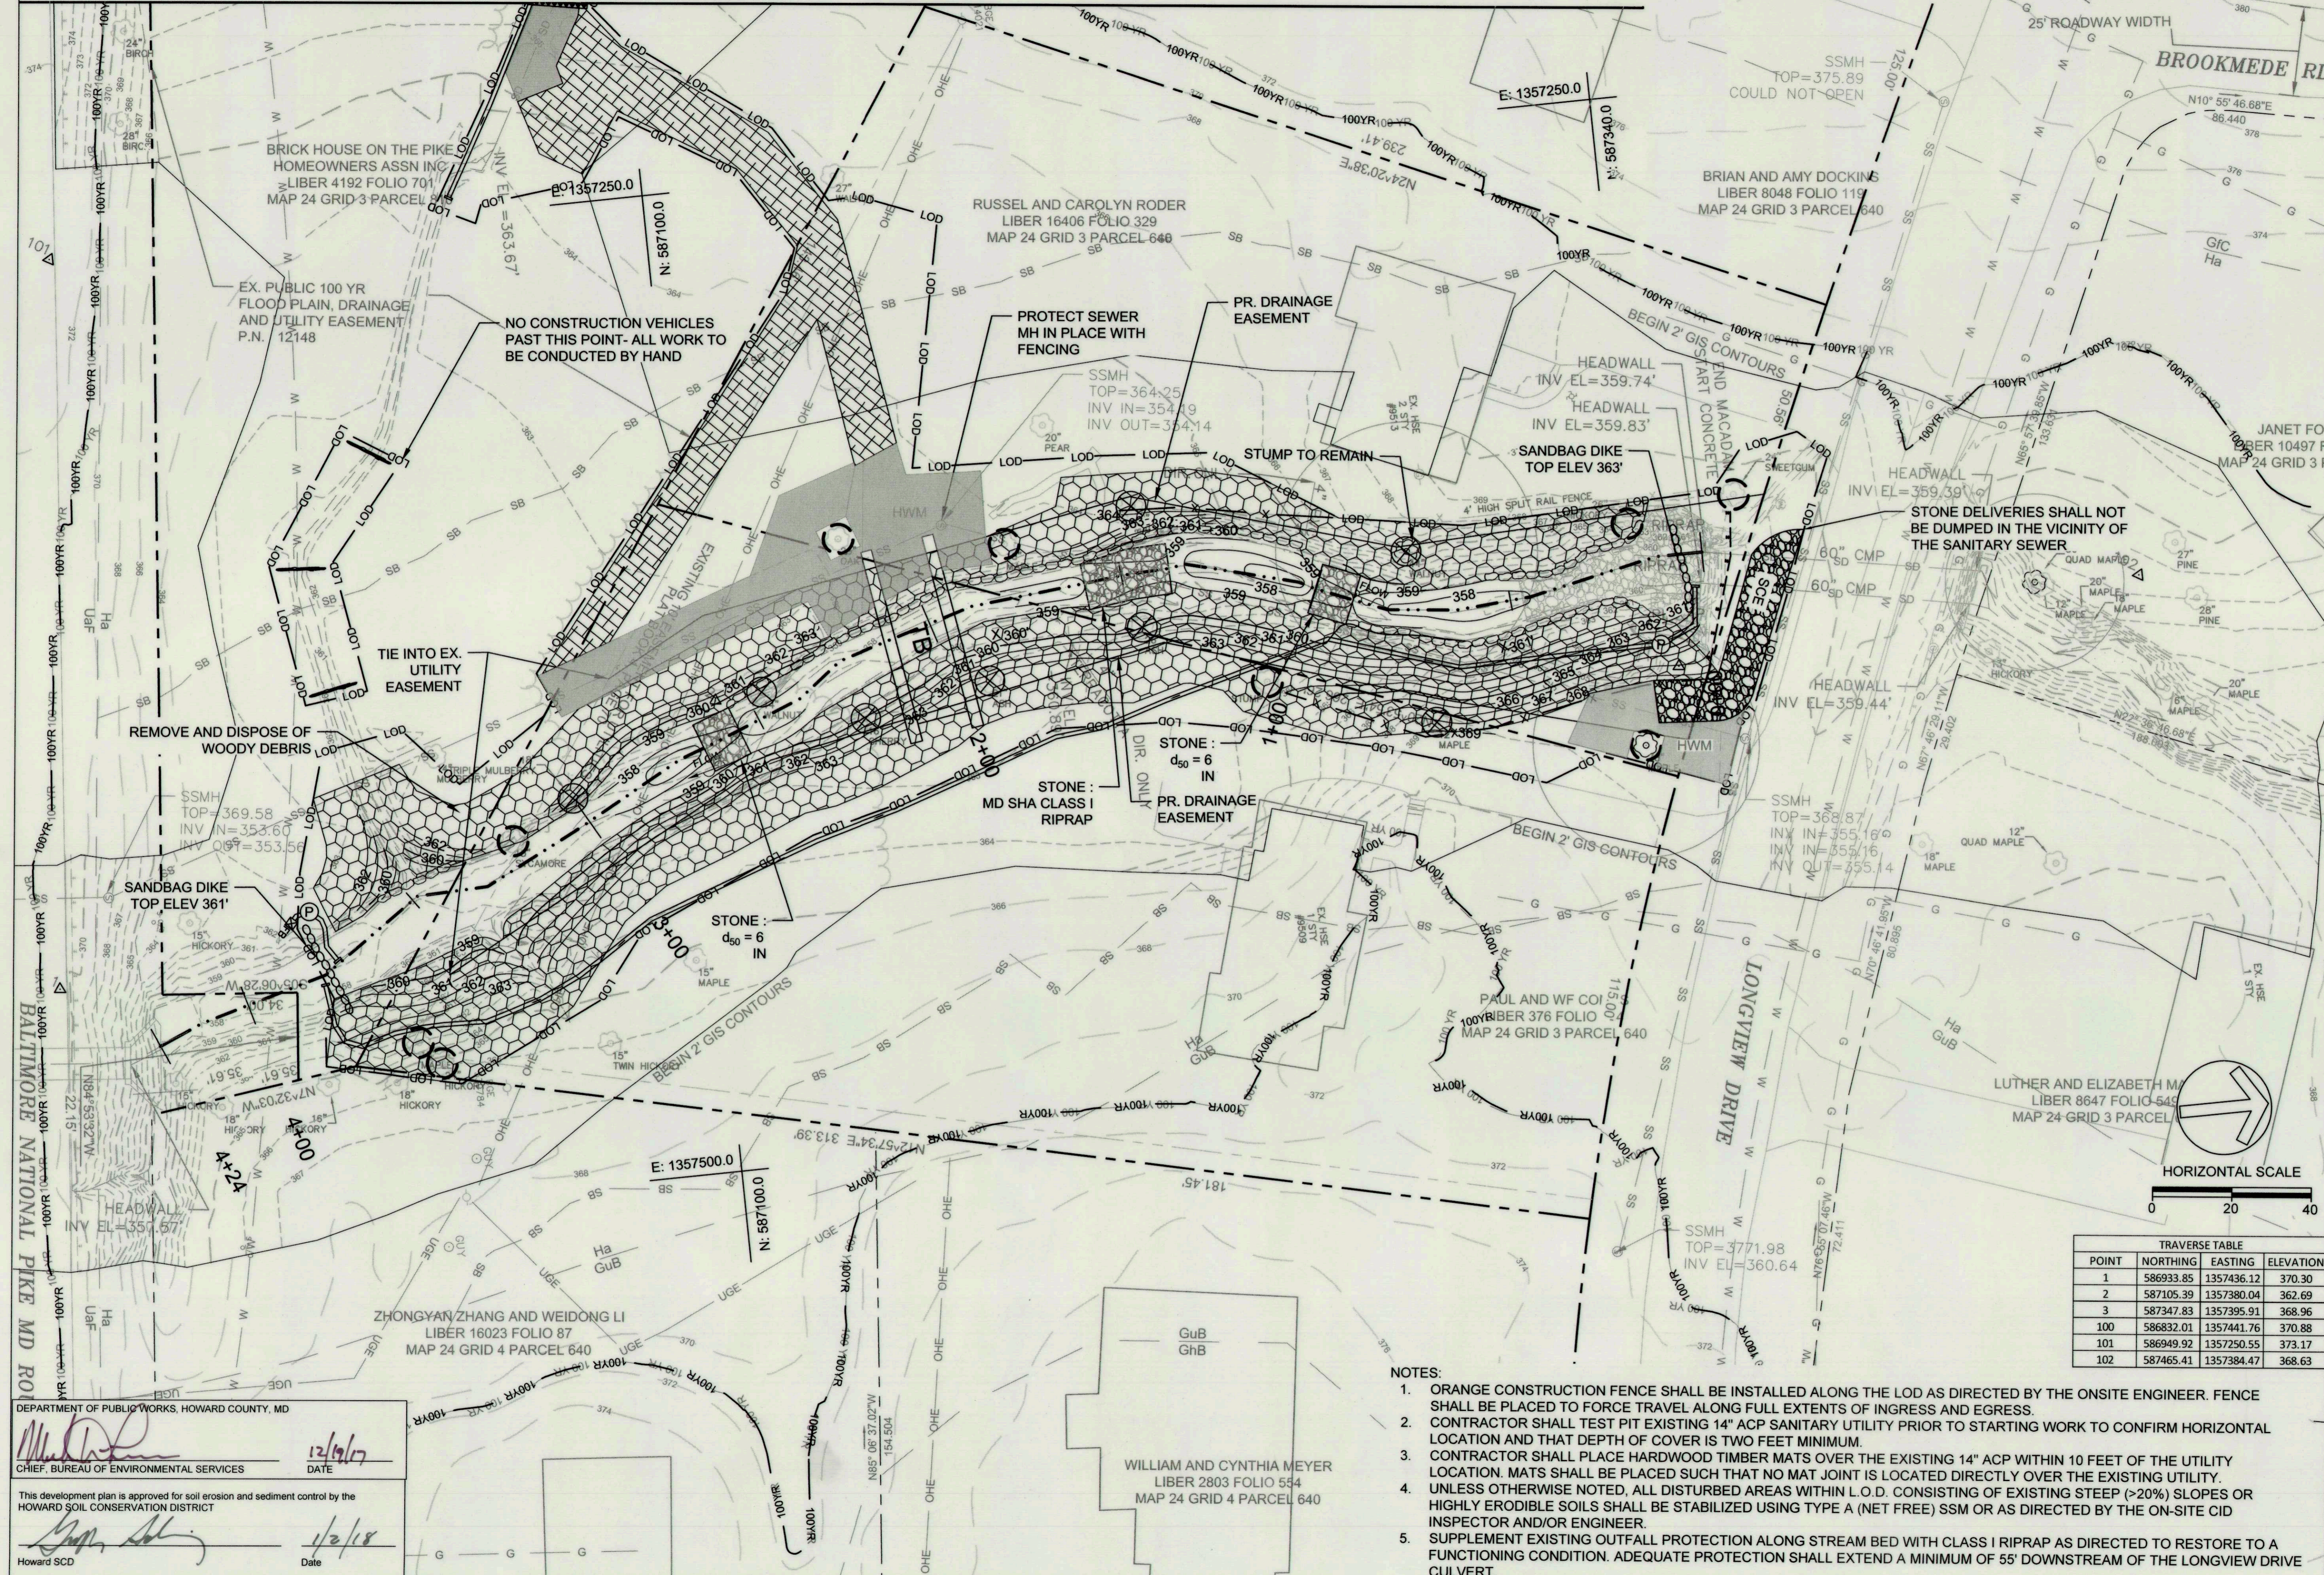

| DATE | ISSUES / REVISIONS |
|------|--------------------|
|      |                    |

**Biohabitats**  
 The Stables Building 2081 Clipper Park Road  
 Baltimore, MD 21211 / ph: 410.554.0156  
 fx: 410.554.0168 / www.biohabitats.com  
 Restore the Earth & Inspire Ecological Stewardship

**LONGVIEW DRIVE  
 STREAM  
 STABILIZATION**

SITE ADDRESS: 9509 LONGVIEW DR, ELLICOTT CITY, MD  
 ZONING: R-20, R-ED TAX MAP/GRID/PARCEL: 0024/0003/0640  
 ELECTION DISTRICT: 02 OPEN LOT N/A  
 WAIVER PETITION WP-18-022

**EROSION &  
 SEDIMENT  
 CONTROL PLAN**

PROJECT NO.: 13005.50 SCALE: 1" = 20'  
 SEAL: BY: RW/KT CHECK: MDT/MWT  
 DWG. NO.: 9 OF 18  
 STATE OF MARYLAND PROFESSIONAL ENGINEER 36617  
 12-13-2017

TRAVERSE TABLE

| POINT | NORTHING  | EASTING    | ELEVATION |
|-------|-----------|------------|-----------|
| 1     | 586933.85 | 1357436.12 | 370.30    |
| 2     | 587105.39 | 1357380.04 | 362.69    |
| 3     | 587347.83 | 1357395.91 | 368.96    |
| 100   | 586832.01 | 1357441.76 | 370.88    |
| 101   | 586949.92 | 1357250.55 | 373.17    |
| 102   | 587465.41 | 1357384.47 | 368.63    |


- NOTES:
- ORANGE CONSTRUCTION FENCE SHALL BE INSTALLED ALONG THE LOD AS DIRECTED BY THE ONSITE ENGINEER. FENCE SHALL BE PLACED TO FORCE TRAVEL ALONG FULL EXTENTS OF INGRESS AND EGRESS.
  - CONTRACTOR SHALL TEST PIT EXISTING 14" ACP SANITARY UTILITY PRIOR TO STARTING WORK TO CONFIRM HORIZONTAL LOCATION AND THAT DEPTH OF COVER IS TWO FEET MINIMUM.
  - CONTRACTOR SHALL PLACE HARDWOOD TIMBER MATS OVER THE EXISTING 14" ACP WITHIN 10 FEET OF THE UTILITY LOCATION. MATS SHALL BE PLACED SUCH THAT NO MAT JOINT IS LOCATED DIRECTLY OVER THE EXISTING UTILITY. UNLESS OTHERWISE NOTED, ALL DISTURBED AREAS WITHIN L.O.D. CONSISTING OF EXISTING STEEP (>20%) SLOPES OR HIGHLY ERODIBLE SOILS SHALL BE STABILIZED USING TYPE A (NET FREE) SSM OR AS DIRECTED BY THE ON-SITE CID INSPECTOR AND/OR ENGINEER.
  - SUPPLEMENT EXISTING OUTFALL PROTECTION ALONG STREAM BED WITH CLASS I RIPRAP AS DIRECTED TO RESTORE TO A FUNCTIONING CONDITION. ADEQUATE PROTECTION SHALL EXTEND A MINIMUM OF 55' DOWNSTREAM OF THE LONGVIEW DRIVE CULVERT.

DEPARTMENT OF PUBLIC WORKS, HOWARD COUNTY, MD  
 Chief, Bureau of Environmental Services  
 12/9/17  
 DATE  
 This development plan is approved for soil erosion and sediment control by the HOWARD SOIL CONSERVATION DISTRICT  
 1/2/18  
 Date  
 Howard SCD

**CLIENT**

HOWARD COUNTY DPW  
 BUREAU OF ENVIRONMENTAL SERVICES  
 STORMWATER MANAGEMENT DIVISION  
 6751 GATEWAY DRIVE, SUITE 514  
 COLUMBIA, MD 21046  
 PHONE: (410) 313-6413

DATE ISSUES / REVISIONS

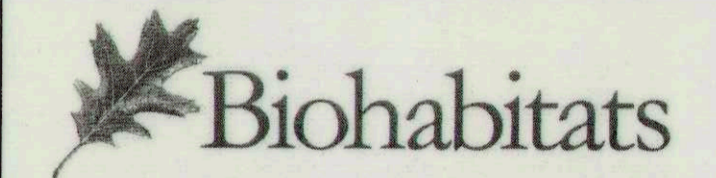

The Stables Building 2081 Clipper Park Road  
 Baltimore, MD 21211 / ph: 410.554.0156  
 fx: 410.554.0168 / www.biohabitats.com  
 Restore the Earth & Inspire Ecological Stewardship

**LONGVIEW DRIVE  
 STREAM  
 STABILIZATION**

SITE ADDRESS: 9509 LONGVIEW DR, ELLICOTT CITY, MD  
 ZONING: R-20, R-ED TAX MAP/GRID/PARCEL: 002410003/0640  
 ELECTION DISTRICT: 02 OPEN LOT N/A  
 WAIVER PETITION WP-18-022

**EROSION &  
 SEDIMENT  
 CONTROL PLAN**

PROJECT NO.: 13005.50 SCALE: 1" = 20'

SEAL: BY: RW/KT CHECK: MDT/MWT  
 DWG. NO.:



10 OF 18

12-13-2017



**MATCHLINE - SHEET 9**

- NOTE:**
1. ORANGE CONSTRUCTION FENCE SHALL BE INSTALLED ALONG THE LOD AS DIRECTED BY THE ONSITE ENGINEER. FENCE SHALL BE PLACED TO FORCE TRAVEL ALONG FULL EXTENTS OF INGRESS AND EGRESS.
  2. UNLESS OTHERWISE NOTED, ALL DISTURBED AREAS WITHIN L.O.D. CONSISTING OF EXISTING STEEP (>20%) SLOPES OR HIGHLY ERODIBLE SOILS SHALL BE STABILIZED USING TYPE A (NET FREE) SSM OR AS DIRECTED BY THE ON-SITE CID INSPECTOR AND/OR ENGINEER.



DEPARTMENT OF PUBLIC WORKS, HOWARD COUNTY, MD

*Mark D. P... 12/18/17*  
 CHIEF, BUREAU OF ENVIRONMENTAL SERVICES DATE

This development plan is approved for soil erosion and sediment control by the HOWARD SOIL CONSERVATION DISTRICT


*Y... 1/2/18*  
 Howard SCD Date

**DETAIL H-4-1 TEMPORARY ACCESS BRIDGE**

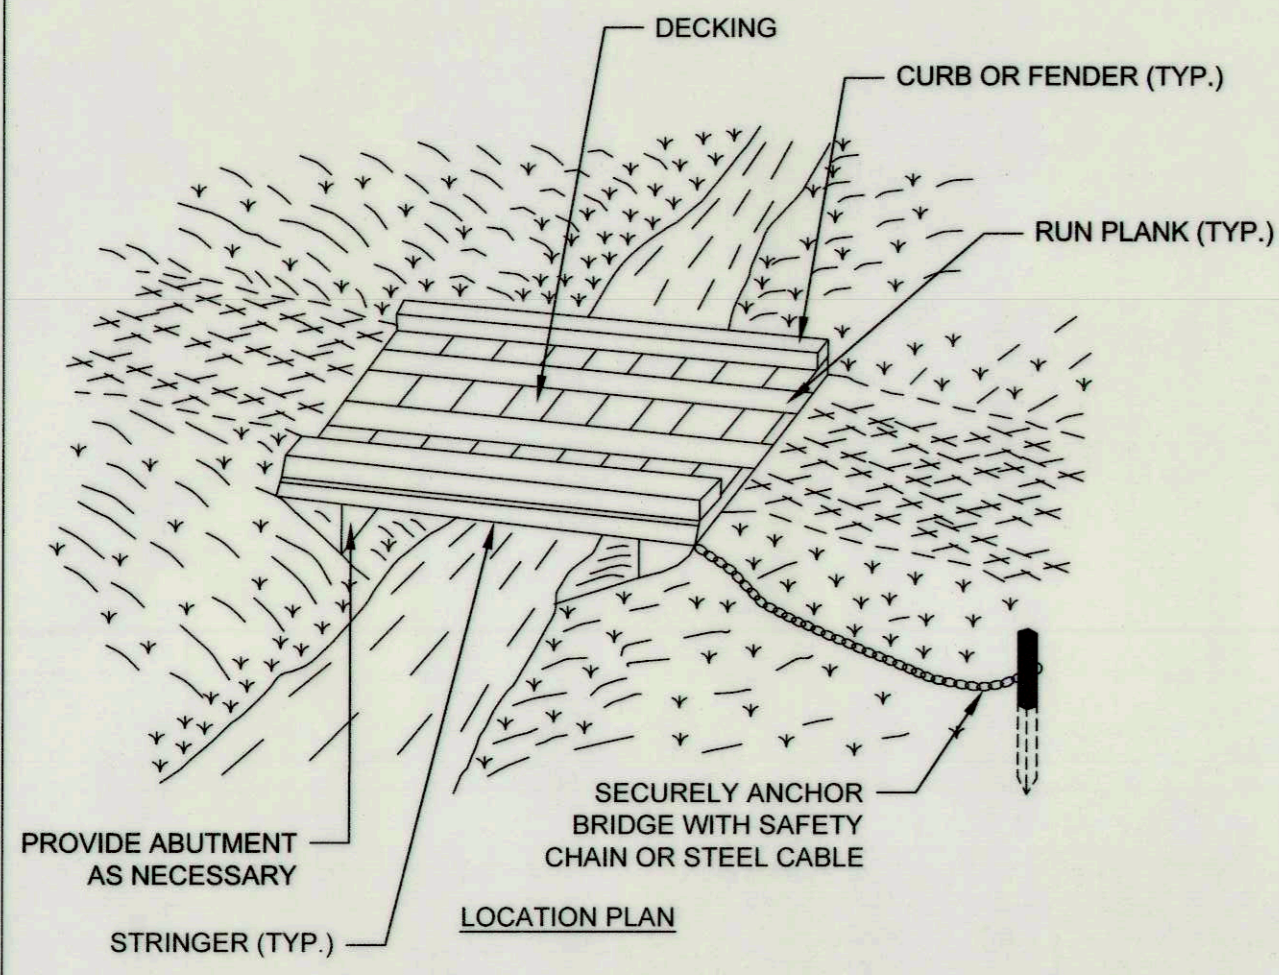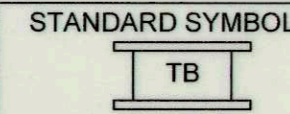

NOTE: TIME OF YEAR RESTRICTIONS DO NOT APPLY TO THE CONSTRUCTION OR REMOVAL OF A TEMPORARY ACCESS BRIDGE UNLESS THERE IS DISTURBANCE TO THE STREAM CHANNEL.



**DETAIL H-4-1 TEMPORARY ACCESS BRIDGE**

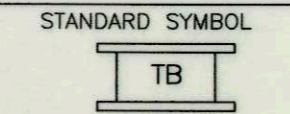

**CONSTRUCTION SPECIFICATIONS**

1. CONSTRUCT TEMPORARY BRIDGE STRUCTURE AT OR ABOVE THE BANK ELEVATION TO PREVENT IMPACTS FROM FLOATING MATERIALS AND DEBRIS.
2. PLACE ABUTMENTS PARALLEL TO, AND ON, STABLE BANKS.
3. CONSTRUCT BRIDGE TO SPAN ENTIRE CHANNEL UNLESS OTHERWISE INDICATED ON APPROVED PLAN.
4. USE STRINGERS CONSISTING OF LOGS, SAWN TIMBER, PRESTRESSED CONCRETE BEAMS, METAL BEAMS, OR OTHER APPROVED MATERIALS.
5. SELECT DECKING MATERIALS TO PROVIDE SUFFICIENT STRENGTH TO SUPPORT THE ANTICIPATED LOAD. PLACE ALL DECKING MEMBERS PERPENDICULAR TO THE STRINGERS, BUTT TIGHTLY, AND SECURELY FASTEN. DECKING MATERIALS MUST BE BUTTED TIGHTLY TO PREVENT ANY SOIL MATERIAL TRACKED ONTO THE BRIDGE FROM FALLING INTO THE WATERWAY BELOW.
6. SECURELY FASTEN OPTIONAL RUN PLANKING FOR THE LENGTH OF THE SPAN. PROVIDE A RUN PLANK FOR EACH TRACK OF THE EQUIPMENT WHEELS, ALTHOUGH RUN PLANKS ARE OPTIONAL. THEY MAY BE NECESSARY TO PROPERLY DISTRIBUTE LOADS.
7. INSTALL CURBS THE ENTIRE LENGTH OF THE OUTER SIDES OF THE DECK TO PREVENT SEDIMENT FROM ENTERING THE STREAM CHANNEL.
8. ANCHOR BRIDGE SECURELY AT ONLY ONE END USING STEEL CABLE OR CHAIN. ANCHORING AT ONLY ONE END WILL PREVENT CHANNEL OBSTRUCTION IN THE EVENT THAT FLOODWATERS FLOAT THE BRIDGE. ACCEPTABLE ANCHORS ARE LARGE TREES, LARGE BOULDERS, OR DRIVEN STEEL POSTS. ANCHOR MUST BE SUFFICIENT TO PREVENT THE BRIDGE FROM FLOATING DOWNSTREAM.
9. AREAS DISTURBED DURING BRIDGE INSTALLATION AND/OR REMOVAL MUST NOT BE LEFT UNSTABILIZED OVERNIGHT UNLESS THE RUNOFF IS DIRECTED TO AN APPROVED SEDIMENT CONTROL DEVICE.
10. STABILIZE APPROACH TO BRIDGE AND KEEP FREE OF EROSION. CLEAN SEDIMENT FROM DECKING AND CURBS DAILY BY SCRAPING, SWEEPING, AND/OR VACUUMING. ENSURE THAT DECKING AND CURBS REMAIN TIGHTLY BUTTED WITHOUT GAPS. REMOVE DEBRIS TRAPPED BY BRIDGE. MAINTAIN AREAS ADJACENT TO CROSSING TO CONTINUOUSLY MEET REQUIREMENTS FOR ADEQUATE VEGETATIVE ESTABLISHMENT IN ACCORDANCE WITH SECTION B-4 VEGETATIVE STABILIZATION.
11. AFTER THE TEMPORARY CROSSING IS NO LONGER NEEDED, REMOVE IT WITHIN 14 CALENDAR DAYS. IF SUBJECT TO THE USE DESIGNATION CLOSURE, REMOVE AT THE END OF CLOSURE PERIOD. PROTECT STREAM BANKS DURING BRIDGE REMOVAL AND STABILIZE ALL DISTURBED AREAS WITH EROSION CONTROL MATTING. ACCOMPLISH REMOVAL OF THE BRIDGE AND CLEAN UP OF THE AREA WITHOUT CONSTRUCTION EQUIPMENT WORKING IN THE WATERWAY CHANNEL. STORE ALL REMOVED MATERIALS IN AN APPROVED STAGING AREA.



**DETAIL B-1 STABILIZED CONSTRUCTION ENTRANCE**

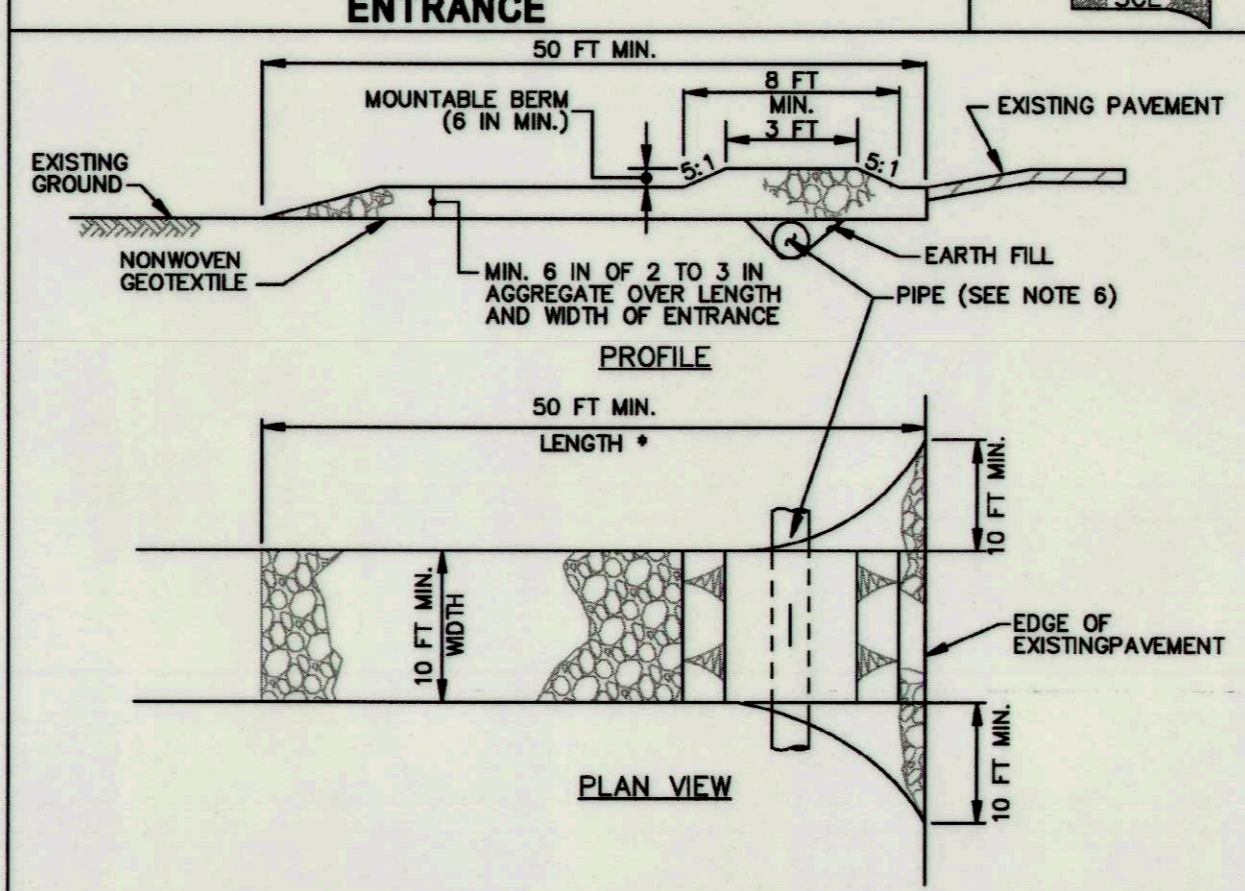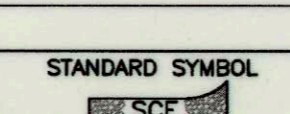

**CONSTRUCTION SPECIFICATIONS**

1. PLACE STABILIZED CONSTRUCTION ENTRANCE IN ACCORDANCE WITH THE APPROVED PLAN. VEHICLES MUST TRAVEL OVER THE ENTIRE LENGTH OF THE SCE. USE MINIMUM LENGTH OF 50 FEET (30 FEET FOR SINGLE RESIDENCE LOT). USE MINIMUM WIDTH OF 10 FEET. FLARE SCE 10 FEET MINIMUM AT THE EXISTING ROAD TO PROVIDE A TURNING RADIUS.
2. PIPE ALL SURFACE WATER FLOWING TO OR DIVERTED TOWARD THE SCE UNDER THE ENTRANCE. MAINTAIN POSITIVE DRAINAGE. PROTECT PIPE INSTALLED THROUGH THE SCE WITH A MOUNTABLE BERM WITH 5:1 SLOPES AND A MINIMUM OF 12 INCHES OF STONE OVER THE PIPE. PROVIDE PIPE AS SPECIFIED ON APPROVED PLAN. WHEN THE SCE IS LOCATED AT A HIGH SPOT AND HAS NO DRAINAGE TO CONVEY, A PIPE IS NOT NECESSARY. A MOUNTABLE BERM IS REQUIRED WHEN SCE IS NOT LOCATED AT A HIGH SPOT.
3. PREPARE SUBGRADE AND PLACE NONWOVEN GEOTEXTILE, AS SPECIFIED IN SECTION H-1 MATERIALS.
4. PLACE CRUSHED AGGREGATE (2 TO 3 INCHES IN SIZE) OR EQUIVALENT RECYCLED CONCRETE (WITHOUT REBAR) AT LEAST 6 INCHES DEEP OVER THE LENGTH AND WIDTH OF THE SCE.
5. MAINTAIN ENTRANCE IN A CONDITION THAT MINIMIZES TRACKING OF SEDIMENT. ADD STONE OR MAKE OTHER REPAIRS AS CONDITIONS DEMAND TO MAINTAIN CLEAN SURFACE, MOUNTABLE BERM, AND SPECIFIED DIMENSIONS. IMMEDIATELY REMOVE STONE AND/OR SEDIMENT SPILLED, DROPPED, OR TRACKED ONTO ADJACENT ROADWAY BY VACUUMING, SCRAPING, AND/OR SWEEPING. WASHING ROADWAY TO REMOVE MUD TRACKED ONTO PAVEMENT IS NOT ACCEPTABLE UNLESS WASH WATER IS DIRECTED TO AN APPROVED SEDIMENT CONTROL PRACTICE.



**DETAIL E-3 SUPER SILT FENCE**

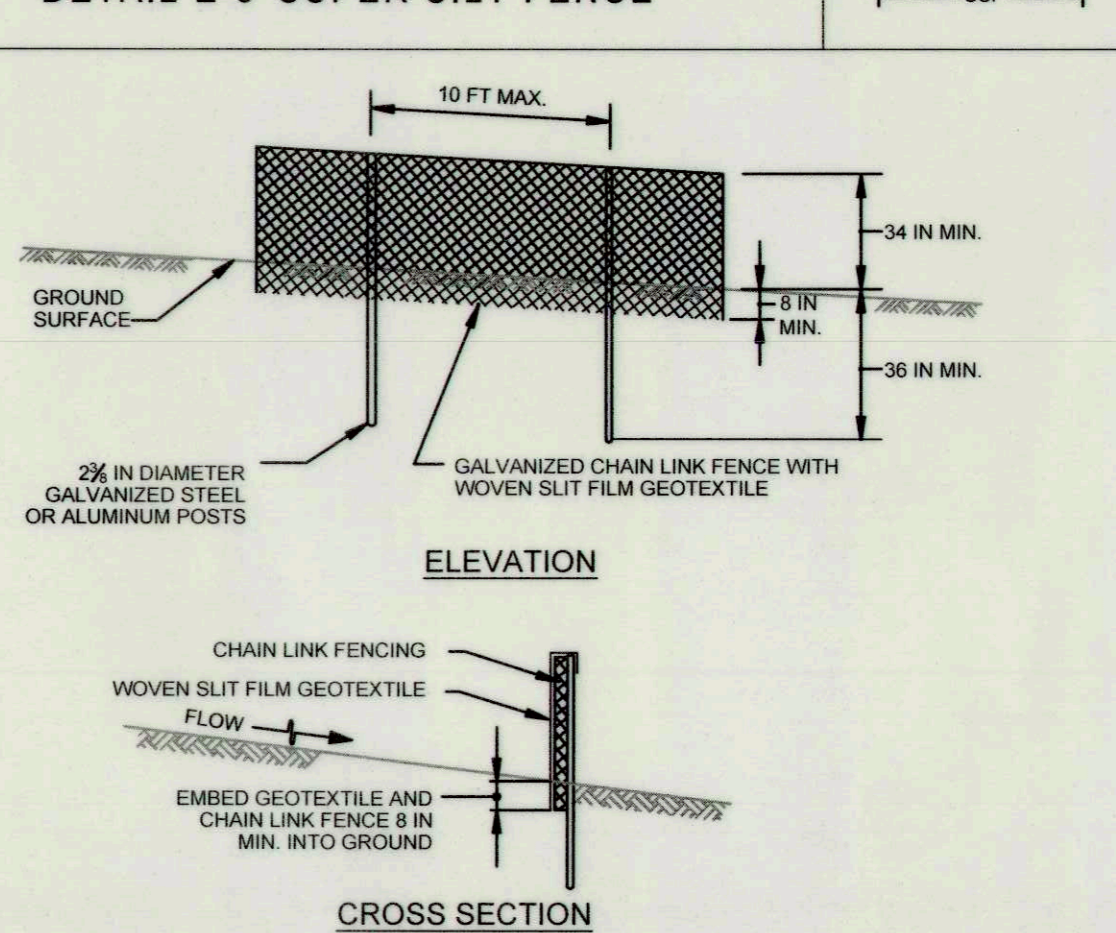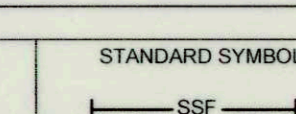

**CONSTRUCTION SPECIFICATIONS**

1. INSTALL 2 1/2 INCH DIAMETER GALVANIZED STEEL POSTS OF 0.085 INCH WALL THICKNESS AND SIX FOOT LENGTH SPACED NO FURTHER THAN 10 FEET APART. DRIVE THE POSTS A MINIMUM OF 36 INCHES INTO THE GROUND.
2. FASTEN 9 GAUGE OR HEAVIER GALVANIZED CHAIN LINK FENCE (2 1/2 INCH MAXIMUM OPENING) 42 INCHES IN HEIGHT SECURELY TO THE FENCE POSTS WITH WIRE TIES OR HUG RINGS.
3. FASTEN WOVEN SLIT FILM GEOTEXTILE AS SPECIFIED IN SECTION H-1 MATERIALS. SECURELY TO THE UPSLOPE SIDE OF CHAIN LINK FENCE WITH TIES SPACED EVERY 24 INCHES AT THE TOP AND MID SECTION. EMBED GEOTEXTILE AND CHAIN LINK FENCE A MINIMUM OF 3 INCHES INTO THE GROUND.
4. WHERE ENDS OF THE GEOTEXTILE COME TOGETHER, THE ENDS SHALL BE OVERLAPPED BY 6 INCHES, FOLDED, AND STAPLED TO PREVENT SEDIMENT BY PASS.
5. EXTEND BOTH ENDS OF THE SUPER SILT FENCE A MINIMUM OF FIVE HORIZONTAL FEET UPSLOPE AT 45 DEGREES TO THE MAIN FENCE ALIGNMENT TO PREVENT RUNOFF FROM GOING AROUND THE ENDS OF THE SUPER SILT FENCE.
6. PROVIDE MANUFACTURER CERTIFICATION TO THE INSPECTION/ENFORCEMENT AUTHORITY SHOWING THAT GEOTEXTILE USED MEETS THE REQUIREMENTS IN SECTION H-1 MATERIALS.
7. REMOVE ACCUMULATED SEDIMENT AND DEBRIS WHEN BULGES DEVELOP IN FENCE OR WHEN SEDIMENT REACHES 25% OF FENCE HEIGHT. REPLACE GEOTEXTILE IF TORN. IF UNDERMINING OCCURS, REINSTALL CHAIN LINK FENCING AND GEOTEXTILE.



**DETAIL F-4 FILTER BAG**

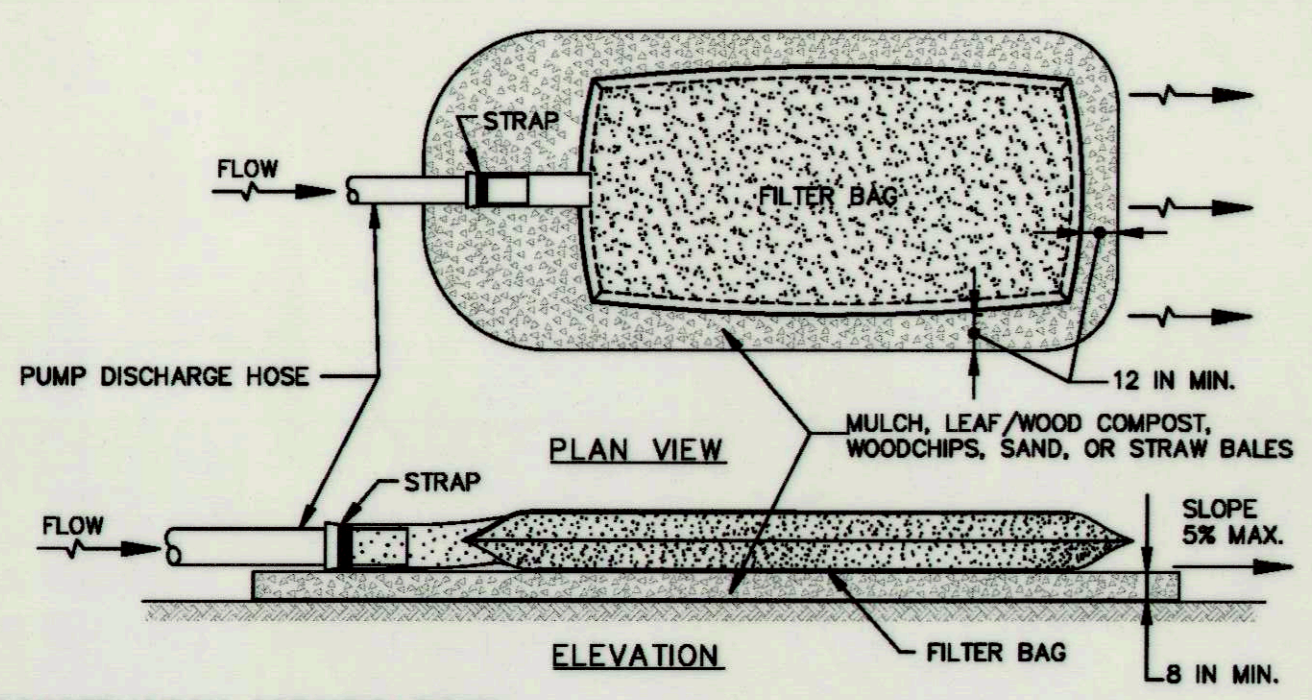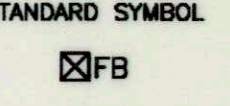

**CONSTRUCTION SPECIFICATIONS**


1. TIGHTLY SEAL SLEEVE AROUND THE PUMP DISCHARGE HOSE WITH A STRAP OR SIMILAR DEVICE.
  2. PLACE FILTER BAG ON SUITABLE BASE (E.G., MULCH, LEAF/WOOD COMPOST, WOODCHIPS, SAND, OR STRAW BALES) LOCATED ON A LEVEL OR 5% MAXIMUM SLOPING SURFACE. DISCHARGE TO A STABILIZED AREA. EXTEND BASE A MINIMUM OF 12 INCHES FROM EDGES OF BAG.
  3. CONTROL PUMPING RATE TO PREVENT EXCESSIVE PRESSURE WITHIN THE FILTER BAG IN ACCORDANCE WITH THE MANUFACTURER RECOMMENDATIONS. AS THE BAG FILLS WITH SEDIMENT, REDUCE PUMPING RATE.
  4. REMOVE AND PROPERLY DISPOSE OF FILTER BAG UPON COMPLETION OF PUMPING OPERATIONS OR AFTER BAG HAS REACHED CAPACITY, WHICHEVER OCCURS FIRST. SPREAD THE DEWATERED SEDIMENT FROM THE BAG IN AN APPROVED UPLAND AREA AND STABILIZE WITH SEED AND MULCH BY THE END OF THE WORK DAY. RESTORE THE SURFACE AREA BENEATH THE BAG TO ORIGINAL CONDITION UPON REMOVAL OF THE DEVICE.
  5. USE NONWOVEN GEOTEXTILE WITH DOUBLE STITCHED SEAMS USING HIGH STRENGTH THREAD. SIZE SLEEVE TO ACCOMMODATE A MAXIMUM 4 INCH DIAMETER PUMP DISCHARGE HOSE. THE BAG MUST BE MANUFACTURED FROM A NONWOVEN GEOTEXTILE THAT MEETS OR EXCEEDS MINIMUM AVERAGE ROLL VALUES (MARV) FOR THE FOLLOWING:
- |                                   |                            |             |
|-----------------------------------|----------------------------|-------------|
| GRAB TENSILE                      | 250 LB                     | ASTM D-4632 |
| PUNCTURE                          | 150 LB                     | ASTM D-4833 |
| FLOW RATE                         | 70 GAL/MIN/FT <sup>2</sup> | ASTM D-4491 |
| PERMITTIVITY (SEC <sup>-1</sup> ) | 1.2 SEC <sup>-1</sup>      | ASTM D-4491 |
| UV RESISTANCE                     | 70% STRENGTH @ 500 HOURS   | ASTM D-4355 |
| APPARENT OPENING SIZE (AOS)       | 0.15-0.18 MM               | ASTM D-4751 |
| SEAM STRENGTH                     | 90%                        | ASTM D-4632 |
6. REPLACE FILTER BAG IF BAG CLOGS OR HAS RIPS, TEARS, OR PUNCTURES. DURING OPERATION KEEP CONNECTION BETWEEN PUMP HOSE AND FILTER BAG WATER TIGHT. REPLACE BEDDING IF IT BECOMES DISPLACED.

**DETAIL C-8 MOUNTABLE BERM**

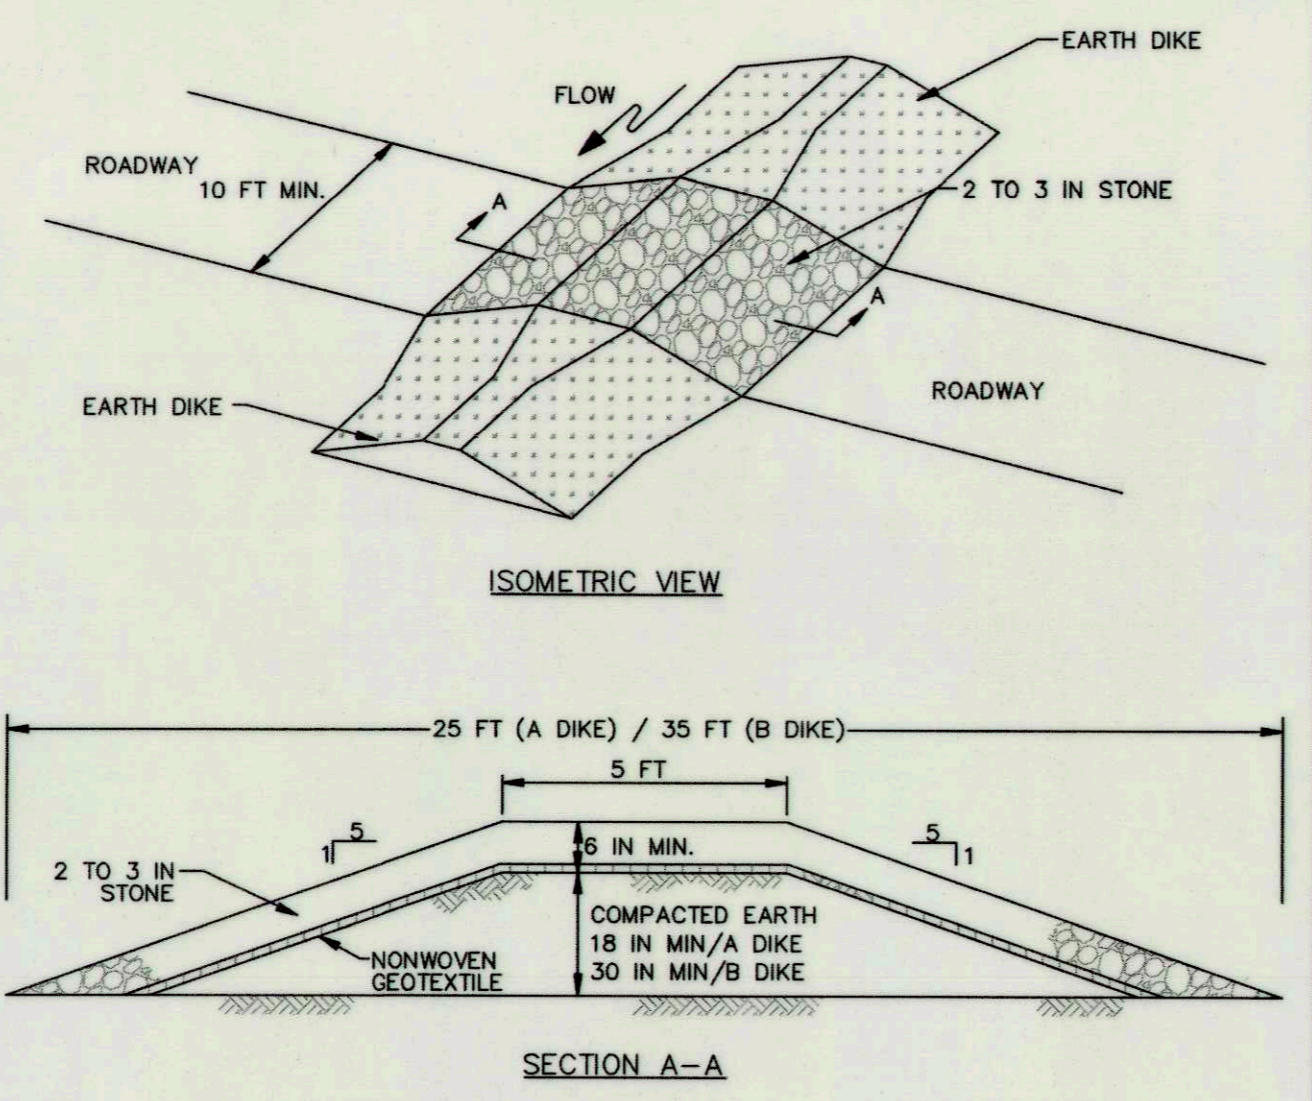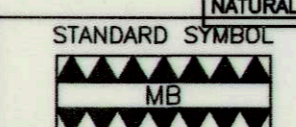


**CONSTRUCTION SPECIFICATIONS**

1. USE MINIMUM WIDTH OF 10 FEET TO ALLOW FOR VEHICULAR PASSAGE.
2. PLACE NONWOVEN GEOTEXTILE, AS SPECIFIED IN SECTION H-1 MATERIALS, OVER THE EARTH MOUND PRIOR TO PLACING STONE.
3. PLACE 2 TO 3 INCH STONE OR EQUIVALENT RECYCLED CONCRETE AT LEAST 6 INCHES DEEP OVER THE LENGTH AND WIDTH OF THE MOUNTABLE BERM.
4. MAINTAIN LINE, GRADE, AND CROSS SECTION. ADD STONE OR MAKE OTHER REPAIRS AS CONDITIONS DEMAND TO MAINTAIN SPECIFIED DIMENSIONS. REMOVE ACCUMULATED SEDIMENT AND DEBRIS. MAINTAIN POSITIVE DRAINAGE.

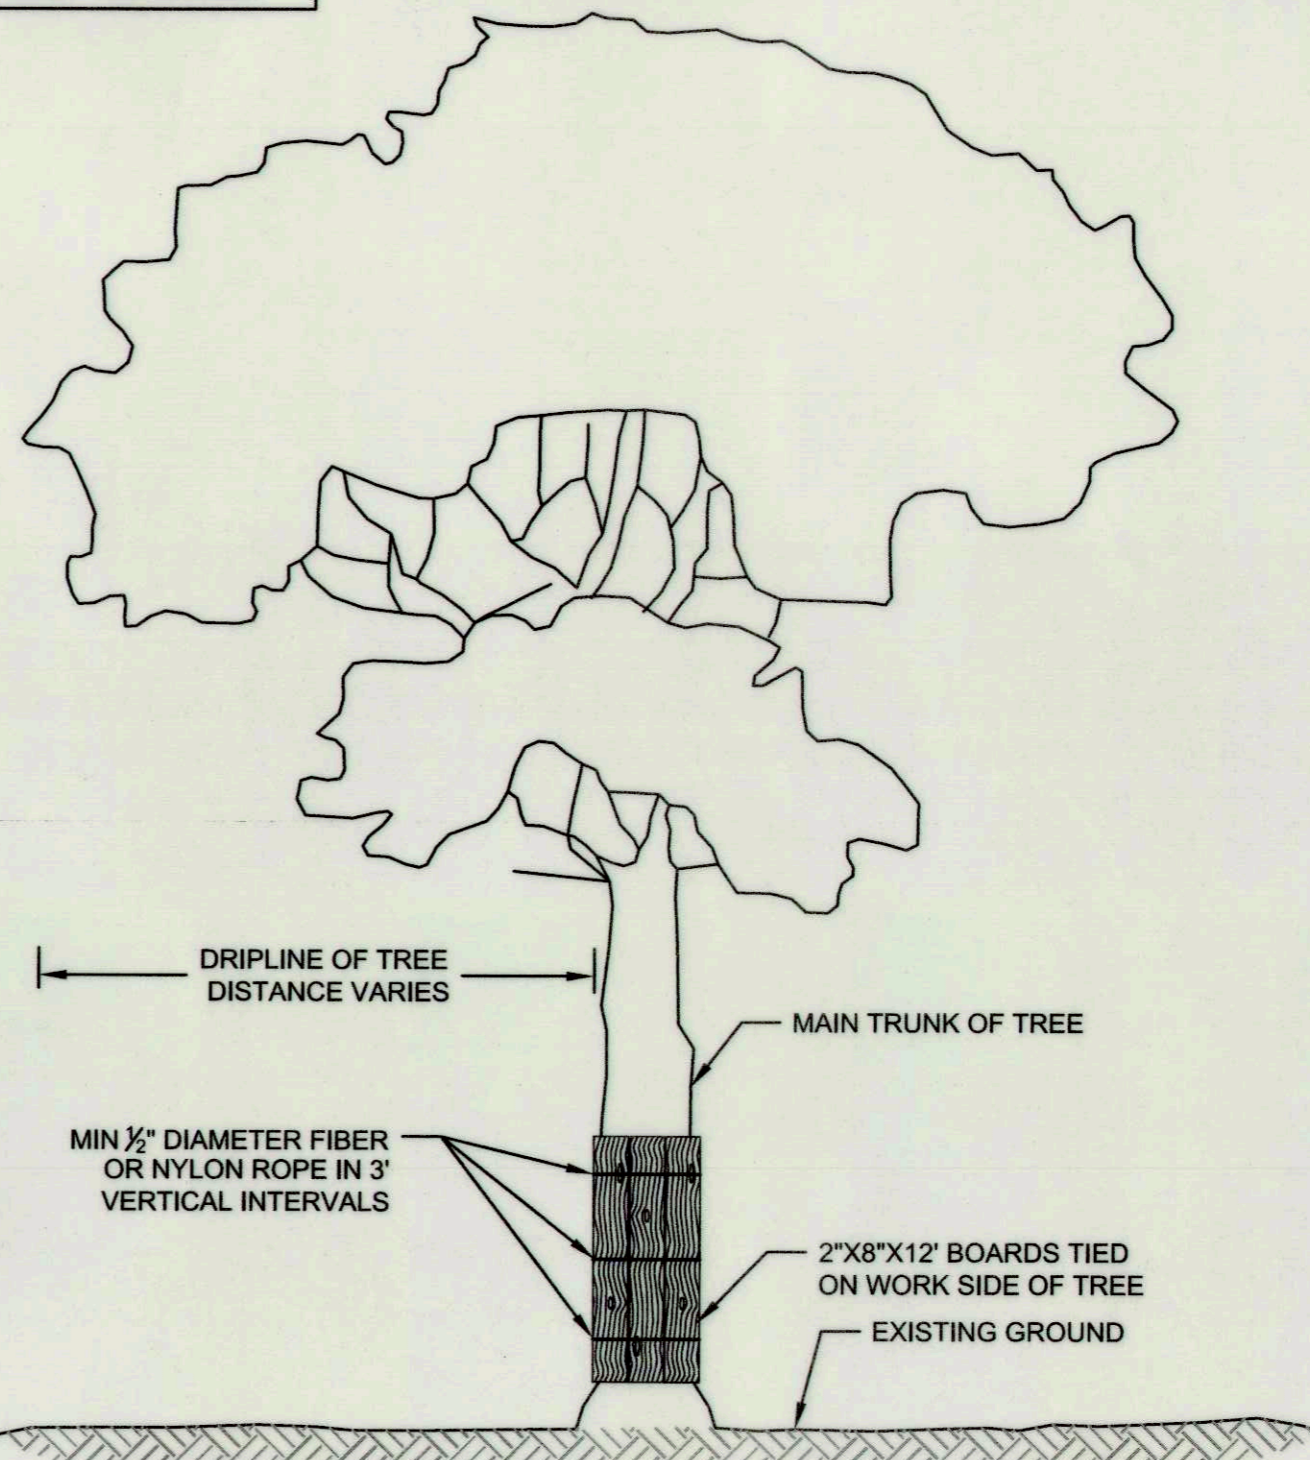

- NOTES:
1. TIE SUFFICIENT 2"x8"x12" BOARDS AROUND MAIN TRUNK OF TREE WITH 1/2" DIAMETER ROPE (FIBER OR NYLON) TO PROTECT ALL AREAS EXPOSED TO CONSTRUCTION.
  2. INSTALL WIRE EYE BOLTS WITH MINIMUM INNER DIAMETER OF 3/8" AND MINIMUM LENGTH OF 4" FIRMLY IN EACH PLANK WHERE FIBER OR NYLON ROPES CROSS OVER PLANKS.
  3. WHERE SIGNIFICANT TREE BRANCHES EXIST WHICH PREVENT PLANK INSTALLATION, PLANKING SHALL EXTEND TO THE ELEVATION OF THE LOWEST BRANCH.

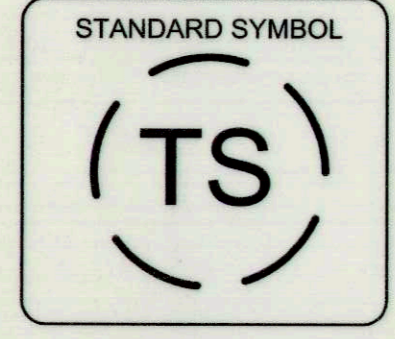

**CLIENT**

HOWARD COUNTY DPW  
BUREAU OF ENVIRONMENTAL SERVICES  
STORMWATER MANAGEMENT DIVISION  
6751 GATEWAY DRIVE, SUITE 514  
COLUMBIA, MD 21046  
PHONE: (410) 313-6413

| DATE | ISSUES / REVISIONS |
|------|--------------------|
|      |                    |

**Biohabitats**  
The Stables Building 2081 Clipper Park Road  
Baltimore, MD 21211 / ph: 410.554.0156  
fx: 410.554.0168 / www.biohabitats.com  
Restore the Earth & Inspire Ecological Stewardship

**LONGVIEW DRIVE STREAM STABILIZATION**

SITE ADDRESS: 9659 LONGVIEW DR. ELLICOTT CITY, MD  
ZONING: R-20, R-ED TAX MAP/GRID/PARCEL: 0024/0003/0640  
ELECTION DISTRICT: 02 OPEN LOT N/A  
WAIVER PETITION WP-18-022

**EROSION & SEDIMENT CONTROL DETAILS**

PROJECT NO.: 13005.50 SCALE: NTS  
SEAL: RW/KT CHECK: MDT/MWT  
DWG. NO.: 11 OF 18  
12-15-2017

MARYLAND STANDARDS AND SPECIFICATIONS FOR SOIL EROSION AND SEDIMENT CONTROL  
U.S. DEPARTMENT OF AGRICULTURE NATURAL RESOURCES CONSERVATION SERVICE 2011 MARYLAND DEPARTMENT OF ENVIRONMENT WATER MANAGEMENT ADMINISTRATION

MARYLAND STANDARDS AND SPECIFICATIONS FOR SOIL EROSION AND SEDIMENT CONTROL  
U.S. DEPARTMENT OF AGRICULTURE NATURAL RESOURCES CONSERVATION SERVICE 2011 MARYLAND DEPARTMENT OF ENVIRONMENT WATER MANAGEMENT ADMINISTRATION

This development plan is approved for soil erosion and sediment control by the HOWARD SOIL CONSERVATION DISTRICT

Howard SCD Date: 1/2/18

DEPARTMENT OF PUBLIC WORKS, HOWARD COUNTY, MD  
CHIEF, BUREAU OF ENVIRONMENTAL SERVICES DATE: 1/15/17

Temporary measure for dewatering in-channel construction sites

**DESCRIPTION**

The work should consist of installing a temporary pump around and supporting measures to divert flow around in-stream construction sites.



**IMPLEMENTATION SEQUENCE**

Sediment control measures, pump-around practices, and associated channel and bank construction should be completed in the following sequence (refer to Detail 1.2):

1. Construction activities including the installation of erosion and sediment control measures should not begin until all necessary easements and/or right-of-ways have been acquired. All existing utilities should be marked in the field prior to construction. The contractor is responsible for any damage to existing utilities that may result from construction and should repair the damage at his/her own expense to the county's or utility company's satisfaction.
2. The contractor should notify the Maryland Department of the Environment or WMA sediment control inspector at least 5 days before beginning construction. Additionally, the contractor should inform the local environmental protection and resource management inspection and enforcement division and the provider of local utilities a minimum of 48 hours before starting construction.
3. The contractor should conduct a pre-construction meeting on site with the WMA sediment control inspector, the county project manager, and the engineer to review limits of disturbance, erosion and sediment control requirements, and the sequence of construction. The contractor should stake out all limits of disturbance prior to the pre-construction meeting so they may be reviewed. The participants will also designate the contractor's staging areas and flag all trees within the limit of disturbance which will be removed for construction access. Trees should not be removed within the limit of disturbance without approval from the WMA or local authority.
4. Construction should not begin until all sediment and erosion control measures have been installed and approved by the engineer and the sediment control inspector. The contractor should stay within the limits of the disturbance as shown on the plans and minimize disturbance within the work area whenever possible.
5. Upon installation of all sediment control measures and approval by the sediment control inspector and the local environmental protection and resource management inspection and enforcement division, the contractor should begin work at the upstream section and proceed downstream beginning with the establishment of stabilized construction entrances. In some cases, work may begin downstream if appropriate. The sequence of construction must be followed unless the contractor gets written approval for deviations from the WMA or local authority. The contractor should only begin work in an area which can be completed by the end of the day including grading adjacent to the channel. At the end of each work day, the work area must be stabilized and the pump around removed from the channel. Work should not be conducted in the channel during rain events.
6. Sandbag dikes should be situated at the upstream and downstream ends of the work area as shown on the plans, and stream flow should be pumped around the work area. The pump should discharge onto a stable velocity dissipater made of riprap or sandbags.

7. Water from the work area should be pumped to a sediment filtering measure such as a dewatering basin, sediment bag, or other approved source. The measure should be located such that the water drains back into the channel below the downstream sandbag dike.
8. Traversing a channel reach with equipment within the work area where no work is proposed should be avoided. If equipment has to traverse such a reach for access to another area, then timber mats or similar measures should be used to minimize disturbance to the channel. Temporary stream crossings should be used only when necessary and only where noted on the plans or specified. (See Section 4, Stream Crossings, Maryland Guidelines to Waterway Construction).
9. All stream restoration measures should be installed as indicated by the plans and all banks graded in accordance with the grading plans and typical cross-sections. All grading must be stabilized at the end of each day with seed and mulch or seed and matting as specified on the plans.
10. After an area is completed and stabilized, the clean water dike should be removed. After the first sediment flush, a new clean water dike should be established upstream from the old sediment dike. Finally, upon establishment of a new sediment dike below the old one, the old sediment dike should be removed.
11. A pump around must be installed on any tributary or storm drain outfall which contributes baseflow to the work area. This should be accomplished by locating a sandbag dike at the downstream end of the tributary or storm drain outfall and pumping the stream flow around the work area. This water should discharge onto the same velocity dissipater used for the main stem pump around.
12. If a tributary is to be restored, construction should take place on the tributary before work on the main stem reaches the tributary confluence. Construction in the tributary, including pump around practices, should follow the same sequence as for the main stem of the river or stream. When construction on the tributary is completed, work on the main stem should resume. Water from the tributary should continue to be pumped around the work area in the main stem.
13. The contractor is responsible for providing access to and maintaining all erosion and sediment control devices until the sediment control inspector approves their removal.
14. After construction, all disturbed areas should be regraded and revegetated as per the planting plan.

Maryland's Guidelines To Waterway Construction  
DETAIL 1.2: PUMP-AROUND PRACTICE

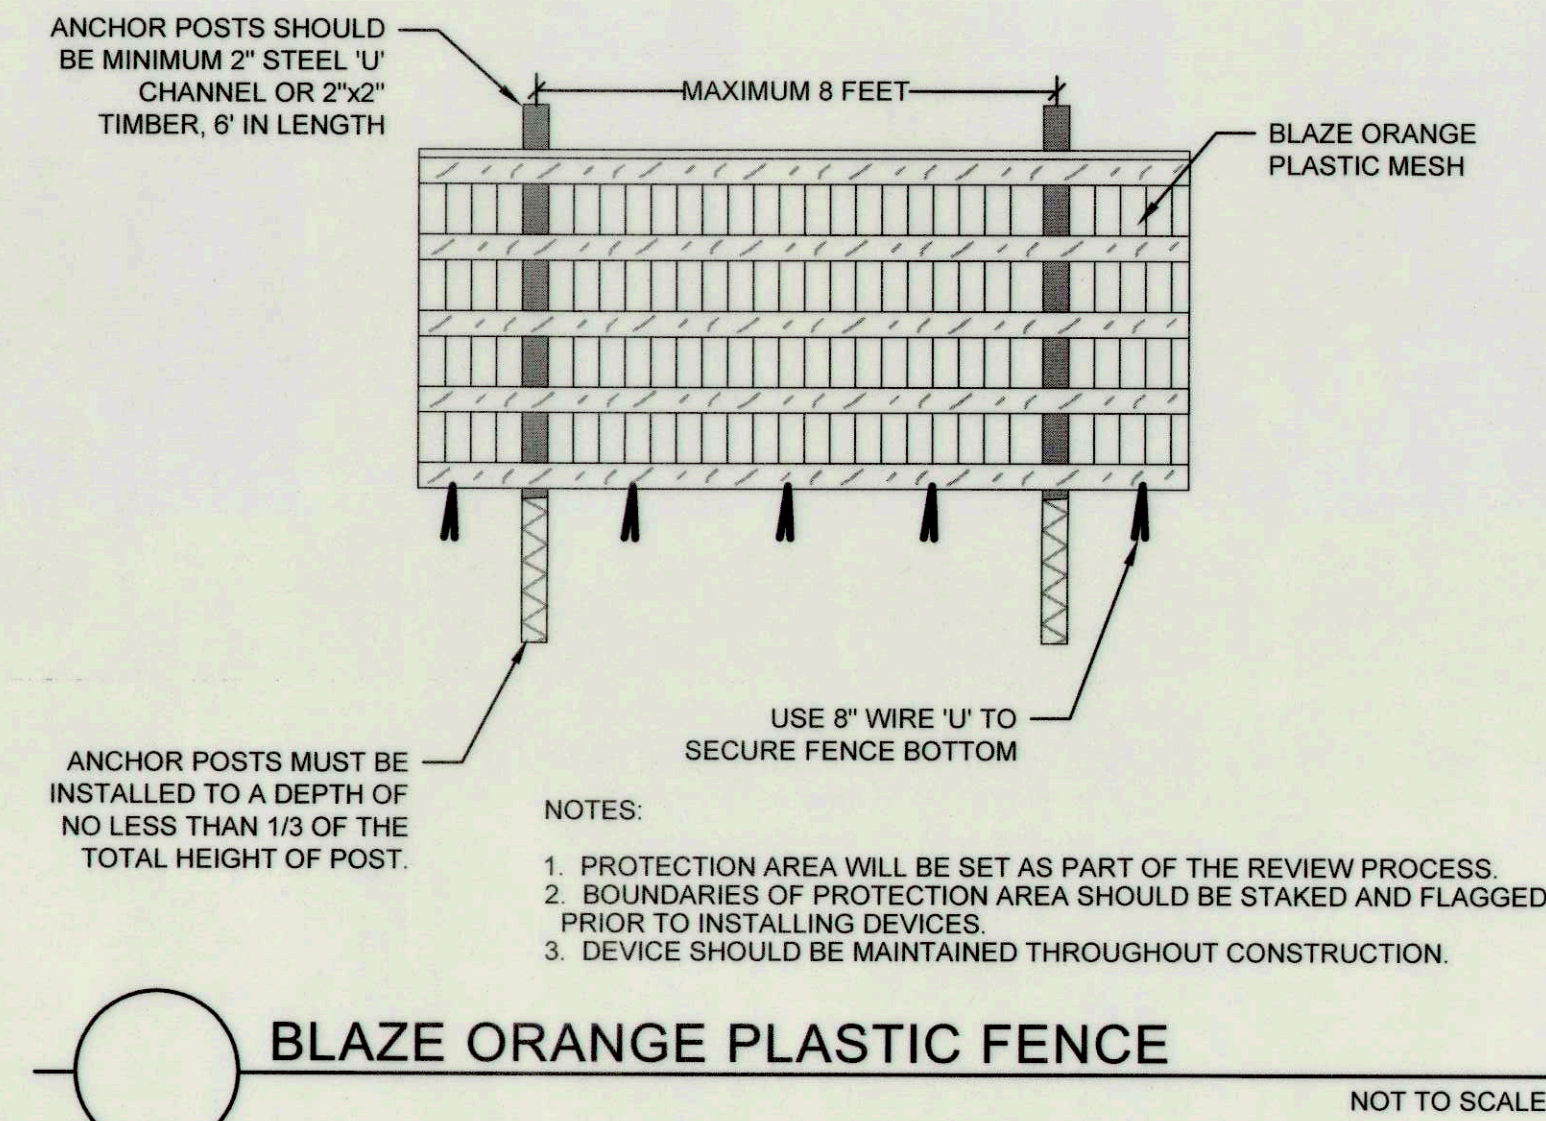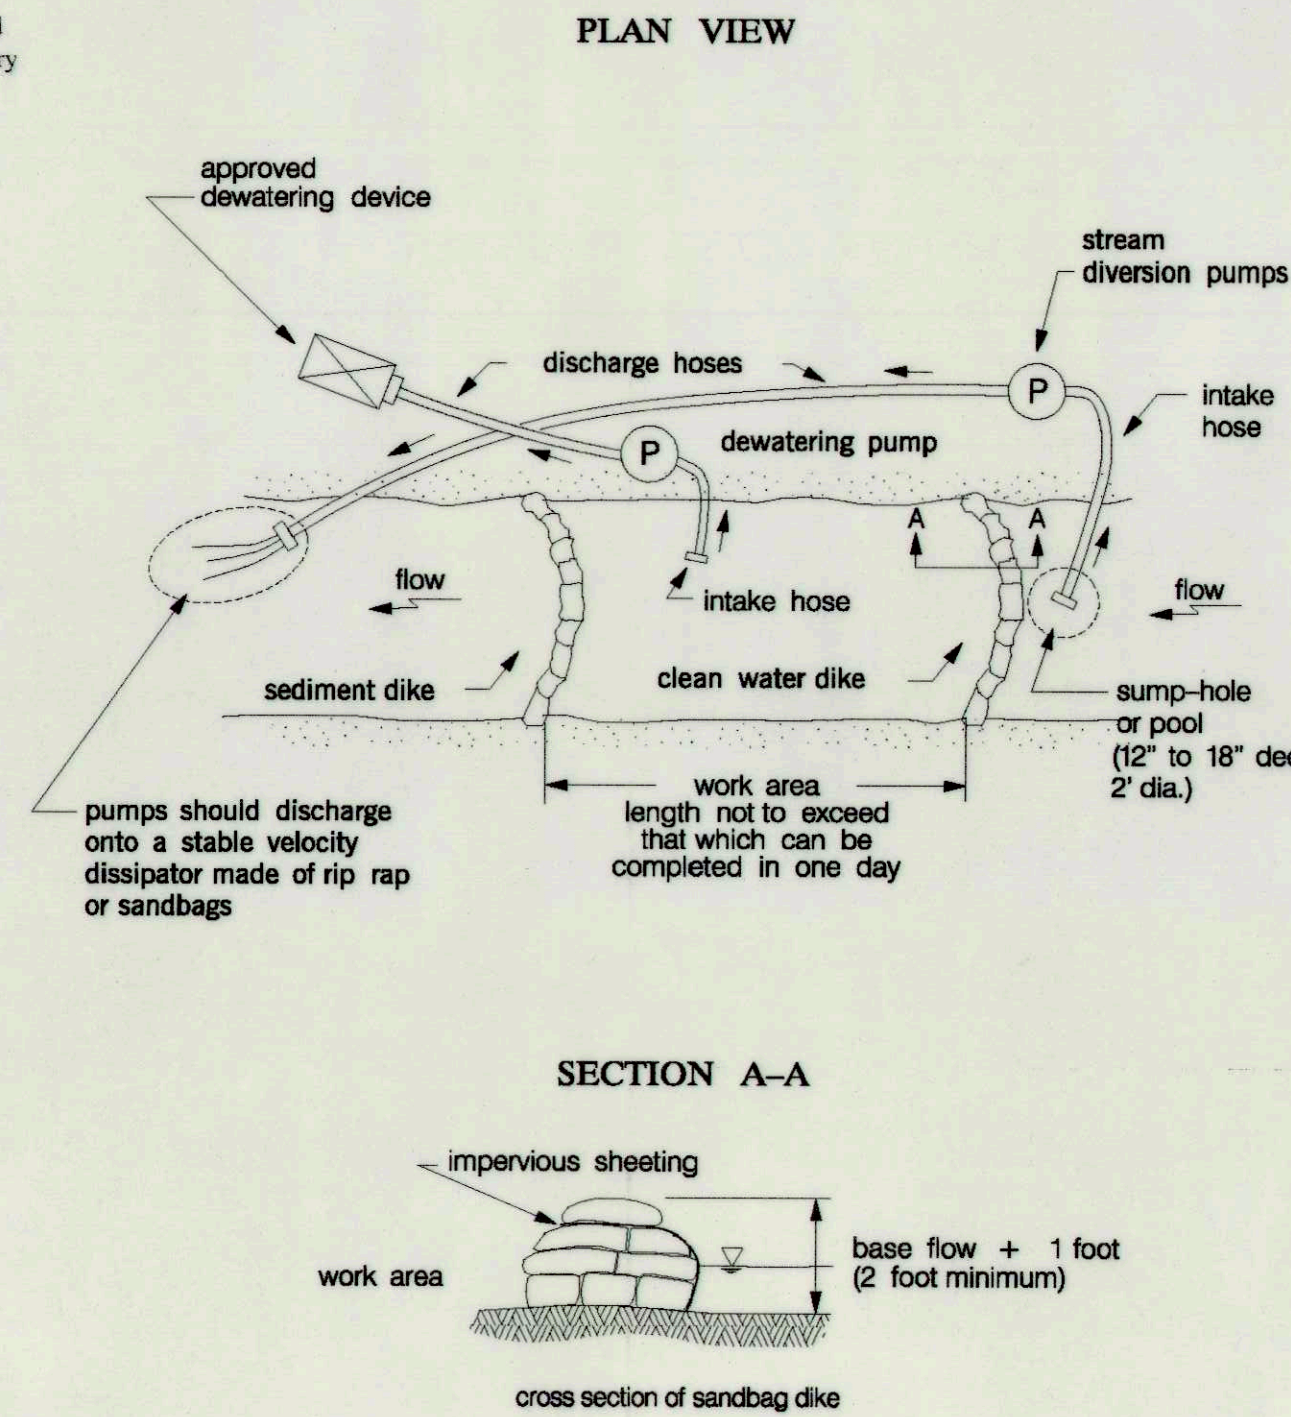

BLAZE ORANGE PLASTIC FENCE



NOT TO SCALE

CLIENT

HOWARD COUNTY DPW  
BUREAU OF ENVIRONMENTAL SERVICES  
STORMWATER MANAGEMENT DIVISION  
6751 GATEWAY DRIVE, SUITE 514  
COLUMBIA, MD 21046  
PHONE: (410) 313-6413

DATE ISSUES / REVISIONS



1. PROTECTION AREA WILL BE SET AS PART OF THE REVIEW PROCESS.
2. BOUNDARIES OF PROTECTION AREA SHOULD BE STAKED AND FLAGGED PRIOR TO INSTALLING DEVICES.
3. DEVICE SHOULD BE MAINTAINED THROUGHOUT CONSTRUCTION.

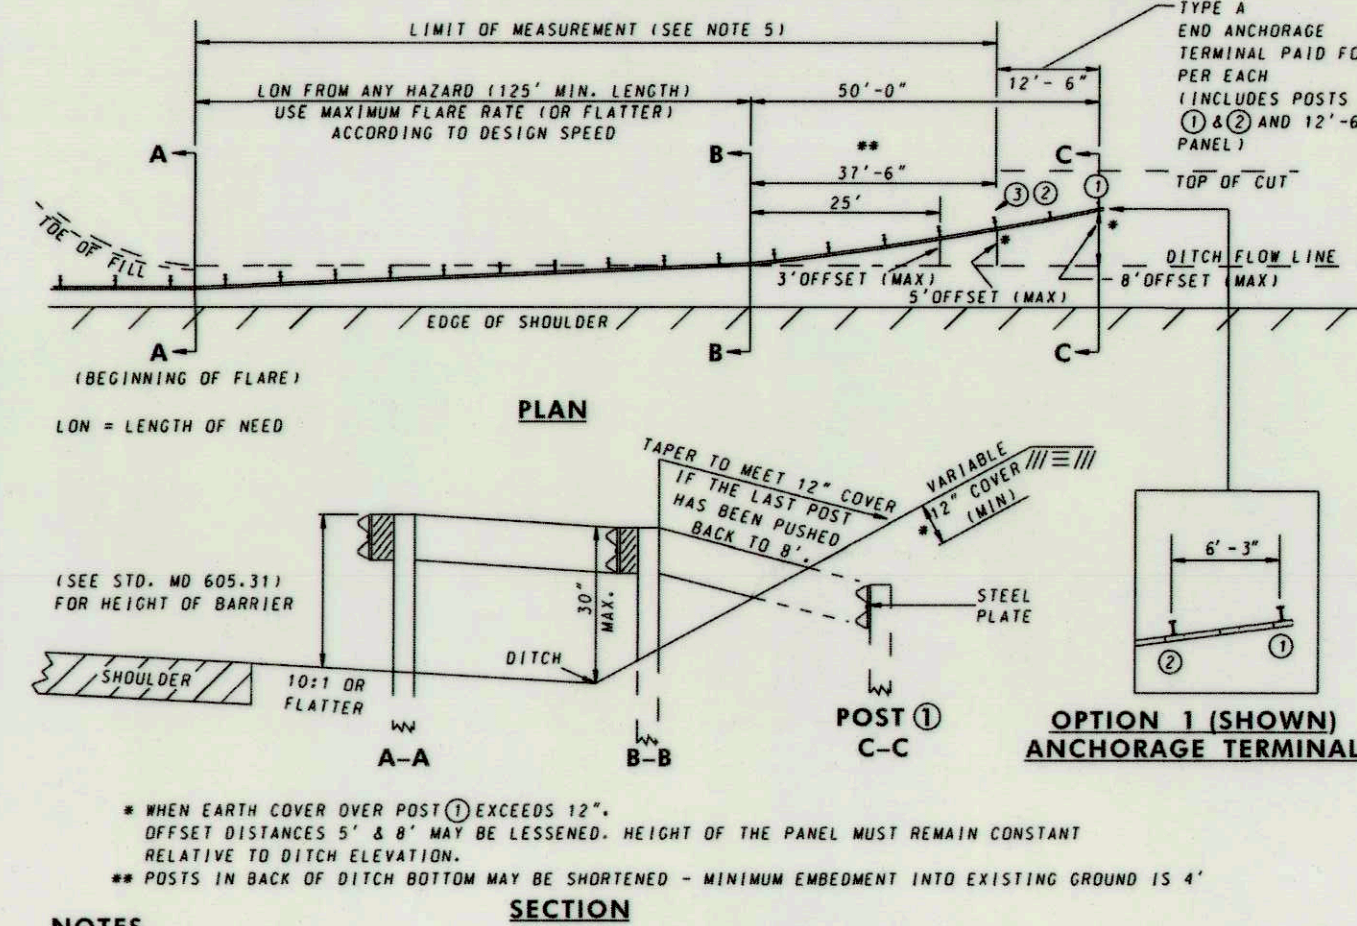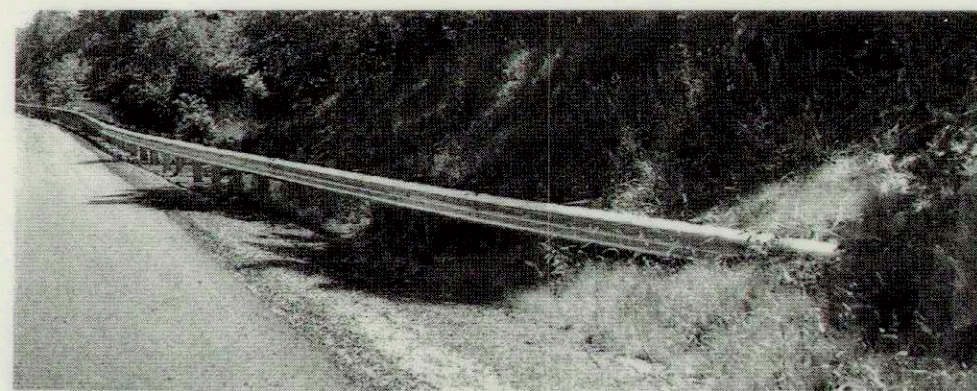

- NOTES:**
1. ALL POSTS SHALL BE 6' IN LENGTH. POSTS 1 AND 2 SHALL BE 4'-0" IN LENGTH.
  2. THE SLOPE BACK FILL MATERIAL SHALL BE COMPACTED FIRMLY TO THE ESTABLISHED SLOPE AND STABILIZED AS DIRECTED BY THE ENGINEER.
  3. THE CONTRACTOR HAS THE OPTION TO CONSTRUCT THE END ANCHORAGE TERMINAL USING ONE OF THE TWO OPTIONS.  
OPTION 1 - 4" STEEL POSTS (SEE STD. MD 605.01-02)  
OPTION 2 - CONCRETE ANCHOR BLOCKS (SEE STD. MD 605.01-03)
  4. LOW SPEED INSTALLATIONS REQUIRES 50 FEET (MINIMUM) "LON".
  5. PAID FOR PER LINEAR FOOT OF "TRAFFIC BARRIER W BEAM USING 6 FOOT POST." THE "END ANCHORAGE TERMINAL FOR TYPE A END TREATMENT EITHER OPTION." PAID FOR PER EACH.
  6. FOR ALTERNATIVE OFFSET BLOCKS SEE STD. MD 605.21 NOTE 5.

|               |                       |   |
|---------------|-----------------------|---|
| SPECIFICATION | 605                   | CATEGORY CODE ITEMS                       |
| APPROVED      | <i>Kate G. McCall</i> | DIRECTOR - OFFICE OF HIGHWAY DEVELOPMENT  |
| APPROVAL      | SHA                   | APPROVAL - FEDERAL HIGHWAY ADMINISTRATION |
| APPROVAL      | 11-10-99              | APPROVAL - 7-2-99                         |
| REVISION      | 5-29-07               | REVISION - 5-2-07                         |
| REVISION      |                       | REVISION                                  |
| REVISION      |                       | REVISION                                  |

Maryland Department of Transportation  
STATE HIGHWAY ADMINISTRATION  
STANDARDS FOR HIGHWAYS AND INCIDENTAL STRUCTURES  
TRAFFIC BARRIER W BEAM WITH  
TYPE A END ANCHORAGE  
(SINGLE RAIL)  
STANDARD NO. MD 605.01

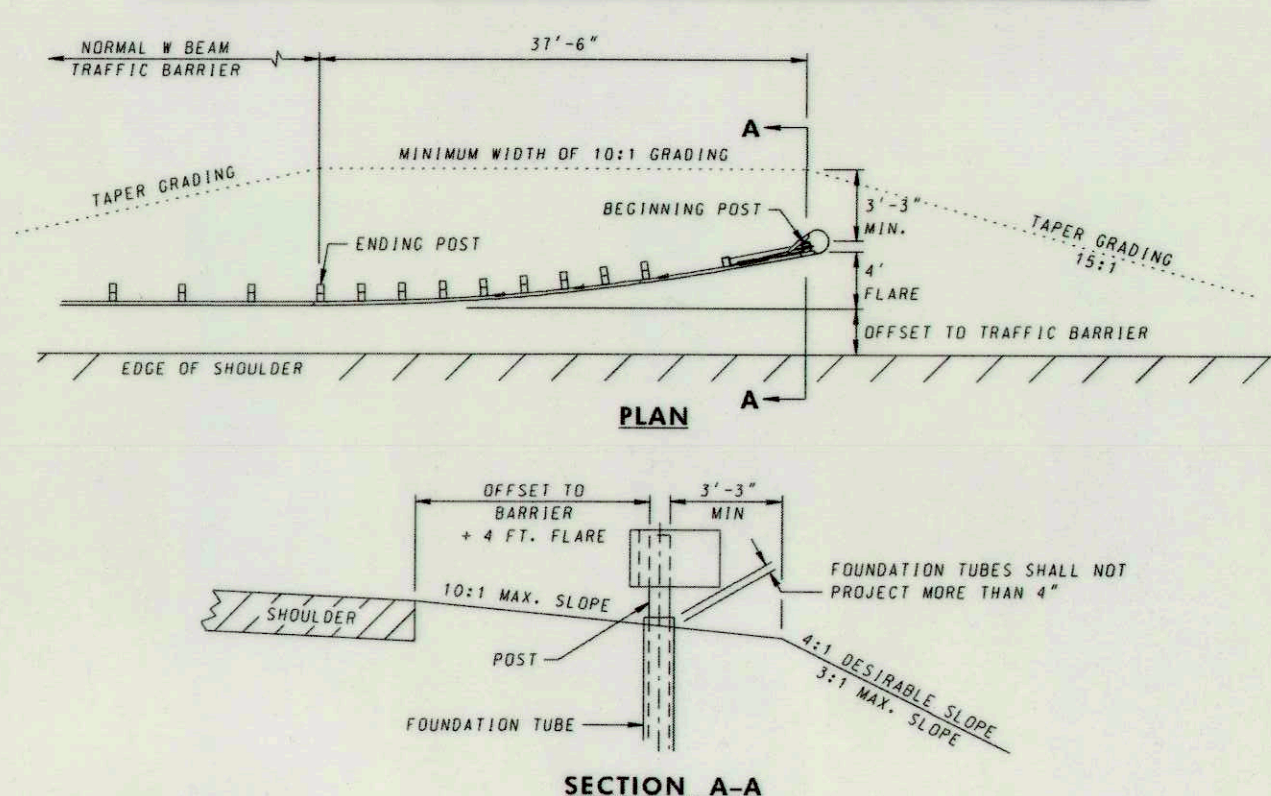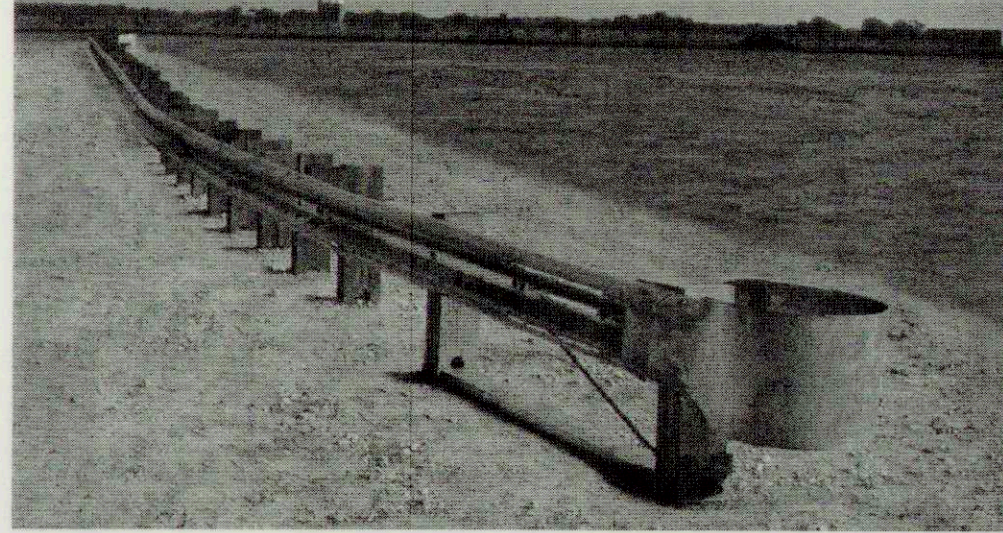


- NOTES:** APPLICABLE TO ALL TYPE B TERMINALS
1. 6:1 MAX GRADING IS ALLOWABLE WHEN THE BARRIER IS LOCATED 12 FT. OR MORE FROM THE OUTSIDE EDGE OF SHOULDER.
  2. END TREATMENT DELINEATION SHALL BE PLACED IN ACCORDANCE WITH STD. MD 605.02-01
  3. 4" FLARE REQUIRED
  4. TYPE B TERMINAL SHALL ONLY BE USED WHEN THE GRADING AS SHOWN AND THE REQUIRED LENGTH OF NEED IS PROVIDED.

|               |                       |   |
|---------------|-----------------------|---|
| SPECIFICATION | 605                   | CATEGORY CODE ITEMS                       |
| APPROVED      | <i>Kate G. McCall</i> | DIRECTOR - OFFICE OF HIGHWAY DEVELOPMENT  |
| APPROVAL      | SHA                   | APPROVAL - FEDERAL HIGHWAY ADMINISTRATION |
| APPROVAL      | 11-10-99              | APPROVAL - 7-2-99                         |
| REVISION      | 12-17-12              | REVISION - 12-17-12                       |
| REVISION      |                       | REVISION                                  |
| REVISION      |                       | REVISION                                  |


Maryland Department of Transportation  
STATE HIGHWAY ADMINISTRATION  
STANDARDS FOR HIGHWAYS AND INCIDENTAL STRUCTURES  
TYPE B TRAFFIC BARRIER END TREATMENT  
STANDARD NO. MD 605.02

TEMPORARY INSTREAM CONSTRUCTION MEASURES  
REVISED NOVEMBER 2000  
PAGE 12 - 3  
MARYLAND DEPARTMENT OF THE ENVIRONMENT  
WATER MANAGEMENT ADMINISTRATION

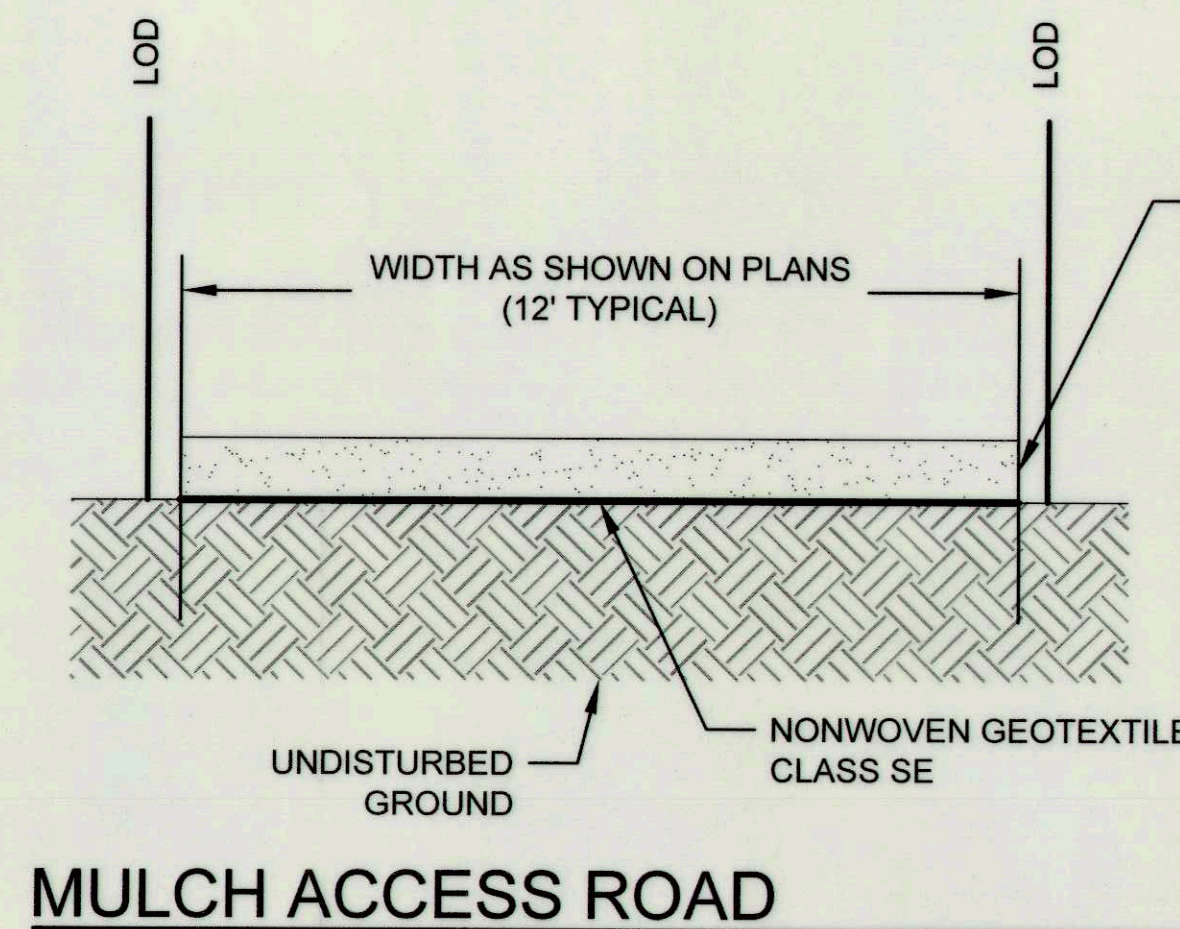

MULCH ACCESS ROAD

NOT TO SCALE

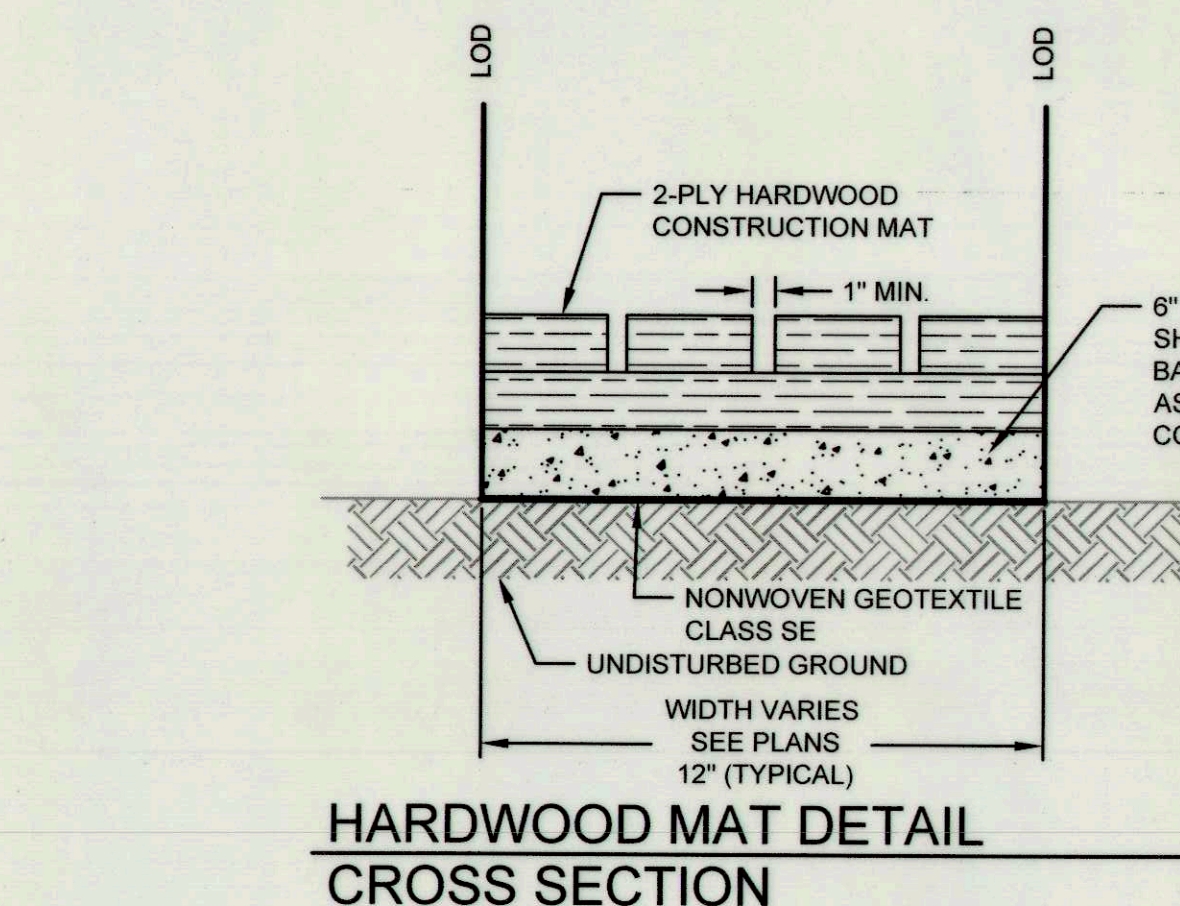

HARDWOOD MAT DETAIL  
CROSS SECTION

NOT TO SCALE

This development plan is approved for soil erosion and sediment control by the HOWARD SOIL CONSERVATION DISTRICT  
*Sheldon Johnson*  
Howard SCD

DEPARTMENT OF PUBLIC WORKS, HOWARD COUNTY, MD  
*Michael...*  
CHIEF, BUREAU OF ENVIRONMENTAL SERVICES

Biohabitats  
The Stables Building 2081 Clipper Park Road  
Baltimore, MD 21211 / ph: 410.554.0156  
fx: 410.554.0168 / www.biohabitats.com  
Restore the Earth & Inspire Ecological Stewardship


LONGVIEW DRIVE  
STREAM  
STABILIZATION

SITE ADDRESS: 9509 LONGVIEW DR. ELLICOTT CITY, MD  
ZONING: R-20, R-ED TAX MAP/GRID/PARCEL: 0024/0003/0640  
ELECTION DISTRICT: 02 OPEN LOT N/A  
WAIVER PETITION WP-18-022

EROSION &  
SEDIMENT  
CONTROL DETAILS

PROJECT NO.: 13005.50 SCALE: NTS

SEAL: BY: RW/KT CHECK: MDT/MWT  
DWS NO.:

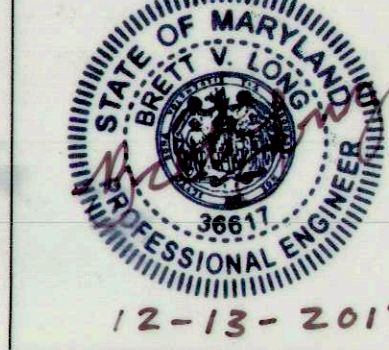

**CLIENT**

HOWARD COUNTY DPW  
 BUREAU OF ENVIRONMENTAL SERVICES  
 STORMWATER MANAGEMENT DIVISION  
 6751 GATEWAY DRIVE, SUITE 514  
 COLUMBIA, MD 21046  
 PHONE: (410) 313-6413

**DATE ISSUES / REVISIONS**

| DATE | ISSUES / REVISIONS |
|------|--------------------|
|      |                    |




**LONGVIEW DRIVE  
 STREAM  
 STABILIZATION**

SITE ADDRESS: 6509 LONGVIEW DR, ELLICOTT CITY, MD  
 ZONING: R-30, R-ED TAX MAP/PARCEL: 002410003/0640  
 ELECTION DISTRICT: 02 OPEN LOT WA  
 WAIVER PETITION WP-18-022

**EROSION &  
 SEDIMENT  
 CONTROL DETAILS**

PROJECT NO.: 13005.50 SCALE: 1" = 20'  
 SEAL: BY: RW/KT CHECK: MDT/MWT  
 DWG. NO.:

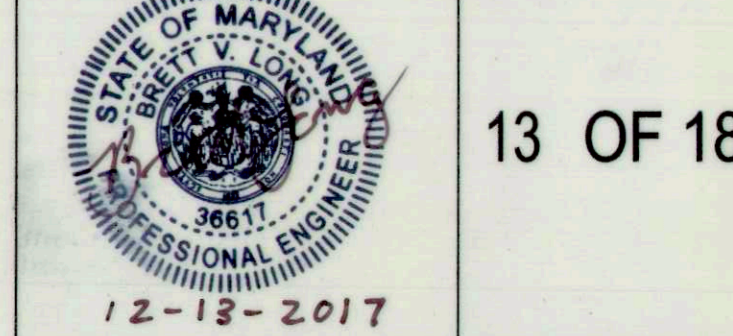

**B-4-8 STANDARDS AND SPECIFICATIONS**

**FOR STOCKPILE AREA**

**Definition**

A mound or pile of soil protected by appropriately designed erosion and sediment control measures.

**Purpose**

To provide a designated location for the temporary storage of soil that controls the potential for erosion, sedimentation, and changes to drainage patterns.

**Conditions Where Practice Applies**

Stockpile areas are utilized when it is necessary to salvage and store soil for later use.

**Criteria**

- The stockpile location and all related sediment control practices must be clearly indicated on the erosion and sediment control plan.
- The footprint of the stockpile must be sized to accommodate the anticipated volume of material and based on a side slope ratio no steeper than 2:1. Benching must be provided in accordance with Section B-3 Land Grading.
- Runoff from the stockpile area must drain to a suitable sediment control practice.
- Access the stockpile area from the upgrade side.
- Clear water runoff into the stockpile area must be minimized by use of a diversion device such as an earth dike, temporary swale or diversion fence. Provisions must be made for discharging concentrated flow in a non-erosive manner.
- Where runoff concentrates along the toe of the stockpile fill, an appropriate erosion/sediment control practice must be used to intercept the discharge.
- Stockpiles must be stabilized in accordance with the 3/7 day stabilization requirement as well as Standard B-4-1 Incremental Stabilization and Standard B-4-4 Temporary Stabilization.
- If the stockpile is located on an impervious surface, a liner should be provided below the stockpile to facilitate cleanup. Stockpiles containing contaminated material must be covered with impermeable sheeting.

**Maintenance**

The stockpile area must continuously meet the requirements for Adequate Vegetative Establishment in accordance with Section B-4 Vegetative Stabilization. Side slopes must be maintained at no steeper than a 2:1 ratio. The stockpile area must be kept free of erosion. If the vertical height of a stockpile exceeds 20 feet for 2:1 slopes, 30 feet for 3:1 slopes, or 40 feet for 4:1 slopes, benching must be provided in accordance with Section B-3 Land Grading.

Velocity (v) measures the rate of flow through a defined area and is calculated as:

$$v = \frac{1.486R^{2/3}S^{1/2}}{n}$$

where:  
 v = velocity (ft/sec)  
 n = Manning's roughness coefficient  
 R = hydraulic radius (ft)  
 S = channel slope (ft/ft)

- Use Table B.7 to assist in selecting the appropriate soil stabilization matting for slope applications based on the slope, the slope length, and the soil-erodibility K factor.

**Table B.7: Soil Stabilization on Slopes**

| Slope   | 20:1 or Flatter (<=5%) |              | <20:1 to 4:1 (>5 - 25%) |              | <4:1 to 3:1 (>25 - 33%) |              | <3:1 to 2.5:1 (>33 - 40%) |              | <2.5:1 to 2:1** (>40 - 50%) |              |
|---|------------------------|--------------|-------------------------|--------------|-------------------------|--------------|---------------------------|--------------|-----------------------------|--------------|
|   | 0-30                   | 30-60/60-120 | 0-30                    | 30-60/60-120 | 0-30                    | 30-60/60-120 | 0-30                      | 30-60/60-120 | 0-30                        | 30-60/60-120 |
| Slope Length (feet)*                                    |                        |              |                         |              |                         |              |                           |              |                             |              |
| Straw Mulch/Wood Cellulose Fiber                        |                        |              | for K ≤ 0.35***         |              |                         |              |                           |              |                             |              |
| Temporary Matting with Design Shear Stress ≥ 1.5 lb/sf  |                        |              |                         |              |                         |              |                           |              |                             |              |
| Temporary Matting with Design Shear Stress ≥ 1.75 lb/sf |                        |              |                         |              |                         |              |                           |              |                             |              |
| Temporary Matting with Design Shear Stress ≥ 2.0 lb/sf  |                        |              |                         |              |                         |              |                           |              |                             |              |
| Temporary Matting with Design Shear Stress ≥ 2.25 lb/sf |                        |              |                         |              |                         |              |                           |              |                             |              |

Effective range for all K values unless otherwise specified

- \* Slope length includes contributing flow length.
- \*\* Slopes steeper than 2:1 must be engineered.
- \*\*\* Soil having a K value less than or equal to 0.35 can be stabilized effectively with straw mulch or wood cellulose fiber when located on slopes steeper than 5%. Soil stabilization matting is required on all slopes steeper than 5% that have soil with a K factor greater than 0.35. K factor ratings are published in the NRCS Soil Survey <http://websoilsurvey.nrcs.usda.gov/app>. During construction or reclamation, the soil-erodibility K value should represent the upper 6 inches of the final fill material re-spread as the last lift. Only the effects of rock fragments within the soil profile are considered in the estimation of the K value. Do not adjust K values to account for rocks on the soil surface or increases in soil organic matter related to management activities.

**Maintenance**

Vegetation must be established and maintained so that the requirements for Adequate Vegetative Establishment are continuously met in accordance with Section B-4 Vegetative Stabilization.

**2. Application**

- Apply mulch to all seeded areas immediately after seeding.
  - When straw mulch is used, spread it over all seeded areas at the rate of 2 tons per acre to a uniform loose depth of 1 to 2 inches. Apply mulch to achieve a uniform distribution and depth so that the soil surface is not exposed. When using a mulch anchoring tool, increase the application rate to 2.5 tons per acre.
  - Wood cellulose fiber used as mulch must be applied at a net dry weight of 1500 pounds per acre. Mix the wood cellulose fiber with water to attain a mixture with a maximum of 50 pounds of wood cellulose fiber per 100 gallons of water.
- 3. Anchoring**
- Perform mulch anchoring immediately following application of mulch to minimize loss by wind or water. This may be done by one of the following methods (listed by preference), depending upon the size of the area and erosion hazard:
    - A mulch anchoring tool is a tractor drawn implement designed to punch and anchor mulch into the soil surface a minimum of 2 inches. This practice is most effective on large areas, but is limited to flatter slopes where equipment can operate safely. If used on sloping land, this practice should follow the contour.
    - Wood cellulose fiber may be used for anchoring straw. Apply the fiber binder at a net dry weight of 750 pounds per acre. Mix the wood cellulose fiber with water at a maximum of 50 pounds of wood cellulose fiber per 100 gallons of water.
    - Synthetic binders such as Acrylic DLR (Agro-Tack), DCA-70, Peto-seal, Terra Tax II, Terra Tack AR or other approved equal may be used. Follow application rates as specified by the manufacturer. Application of liquid binders needs to be heavier at the edges where wind catches mulch, such as in valleys and on crests of banks. **Use of asphalt binders is strictly prohibited.**
    - Lightweight plastic netting may be stapled over the mulch according to manufacturer recommendations. Netting is usually available in rolls 4 to 15 feet wide and 300 to 3,000 feet long.

**B-4-6 STANDARDS AND SPECIFICATIONS**

**FOR SOIL STABILIZATION MATTING**

**Definition**

Material used to temporarily or permanently stabilize channels or steep slopes until groundcover is established.

**Purpose**

To protect the soils until vegetation is established.

**Conditions Where Practice Applies**

On newly seeded surfaces to prevent the applied seed from washing out; in channels and on steep slopes where the flow has erosive velocities or conveys clear water; on temporary swales, earth dikes, and perimeter dike swales as required by the respective design standard; and, on stream banks where moving water is likely to wash out new vegetative plantings.

**Design Criteria**

- The soil stabilization matting that is used must withstand the flow velocities and shear stresses determined for the area, based on the 2-year, 24-hour frequency storm for temporary applications and the 10-year, 24-hour frequency storm for permanent applications. Designate on the plan the type of soil stabilization matting using the standard symbol and include the calculated shear stress for the respective treatment area.
- Matting is required on permanent channels where the runoff velocity exceeds two and half feet per second (2.5 fps) or the shear stress exceeds two pounds per square foot (2 lbs/ft<sup>2</sup>). On temporary channels discharging to a sediment trapping practice, provide matting where the runoff velocity exceeds four feet per second (4 fps).
- Temporary soil stabilization matting is made with degradable (lasts 6 months minimum), natural, or manmade fibers of uniform thickness and distribution of fibers throughout and is smolder resistant. The maximum permissible velocity for temporary matting is 6 feet per second.
- Permanent soil stabilization matting is an open weave, synthetic material consisting of non-degradable fibers or elements of uniform thickness and distribution of weave throughout. The maximum permissible velocity for permanent matting is 8.5 feet per second.
- Calculate channel velocity and shear stress using the following procedure:

Shear Stress (τ) is a measure of the force of moving water against the substrate and is calculated as:

$$\tau = \gamma \cdot R \cdot S_w$$

where:  
 τ = shear stress (lb/ft<sup>2</sup>)  
 γ = weight density of water (62.4 lb/ft<sup>3</sup>)  
 R = average water depth (hydraulic radius) (ft)  
 S<sub>w</sub> = water surface slope (ft/ft)

**B-4-3 STANDARDS AND SPECIFICATIONS**

**FOR SEEDING AND MULCHING**

**Definition**

The application of seed and mulch to establish vegetative cover.

**Purpose**

To protect disturbed soils from erosion during and at the end of construction.

**Conditions Where Practice Applies**

To the surface of all perimeter controls, slopes, and any disturbed area not under active grading.

**Criteria**

- A. Seeding**
- Specifications**
    - All seed must meet the requirements of the Maryland State Seed Law. All seed must be subject to re-testing by a recognized seed laboratory. All seed used must have been tested within the 6 months immediately preceding the date of sowing such material on any project. Refer to Table B.4 regarding the quality of seed. Seed tags must be available upon request to the inspector to verify type of seed and seeding rate.
    - Mulch alone may be applied between the fall and spring seeding dates only if the ground is frozen. The appropriate seeding mixture must be applied when the ground thaws.
    - Inoculants: The inoculant for treating legume seed in the seed mixtures must be a pure culture of nitrogen fixing bacteria prepared specifically for the species. Inoculants must not be used later than the date indicated on the container. Add fresh inoculants as directed on the package. Use four times the recommended rate when hydroseeding. Note: It is very important to keep inoculant as cool as possible until used. Temperatures above 75 to 80 degrees Fahrenheit can weaken bacteria and make the inoculant less effective.
    - Sod or seed must not be placed on soil which has been treated with soil sterilants or chemicals used for weed control until sufficient time has elapsed (14 days min.) to permit dissipation of phyto-toxic materials.
  - Application**
    - Dry Seeding: This includes use of conventional drop or broadcast spreaders.
      - Incorporate seed into the subsoil at the rates prescribed on Temporary Seeding Table B.1, Permanent Seeding Table B.3, or site-specific seeding summaries.
      - Apply seed in two directions, perpendicular to each other. Apply half the seeding rate in each direction. Roll the seeded area with a weighted roller to provide good seed to soil contact.

B.15

**B-4-1 STANDARDS AND SPECIFICATIONS**

**FOR INCREMENTAL STABILIZATION**

**Definition**

Establishment of vegetative cover on cut and fill slopes.

**Purpose**

To provide timely vegetative cover on cut and fill slopes as work progresses.


**Conditions Where Practice Applies**

Any cut or fill slope greater than 15 feet in height. This practice also applies to stockpiles.

**Criteria**

- A. Incremental Stabilization - Cut Slopes**
- Excavate and stabilize cut slopes in increments not to exceed 15 feet in height. Prepare seedbed and apply seed and mulch on all cut slopes as the work progresses.
  - Construction sequence example (Refer to Figure B.1):
    - Construct and stabilize all temporary swales or dikes that will be used to convey runoff around the excavation.
    - Perform Phase 1 excavation, prepare seedbed, and stabilize.
    - Perform Phase 2 excavation, prepare seedbed, and stabilize. Overseed Phase 1 areas as necessary.
    - Perform final phase excavation, prepare seedbed, and stabilize. Overseed previously seeded areas as necessary.

**Note:** Once excavation has begun the operation should be continuous from grubbing through the completion of grading and placement of topsoil (if required) and permanent seed and mulch. Any interruptions in the operation or completing the operation out of the seeding season will necessitate the application of temporary stabilization.

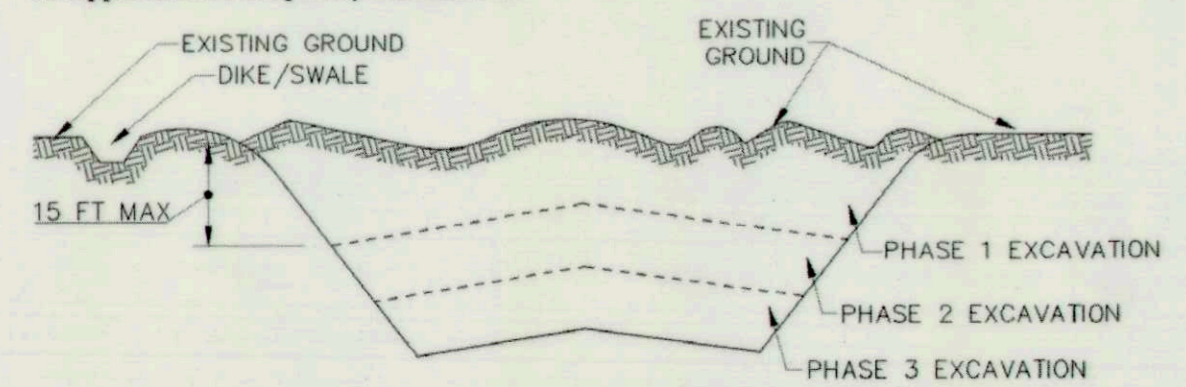

**Figure B.1: Incremental Stabilization - Cut**

B.10

**B. Mulching**


- Drill or Cultipacker Seeding: Mechanized seeders that apply and cover seed with soil.
    - Cultipacking seeders are required to bury the seed in such a fashion as to provide at least 1/4 inch of soil covering. Seedbed must be firm after planting.
    - Apply seed in two directions, perpendicular to each other. Apply half the seeding rate in each direction.
  - Hydroseeding: Apply seed uniformly with hydroseeder (slurry includes seed and fertilizer).
    - If fertilizer is being applied at the time of seeding, the application rates should not exceed the following: nitrogen, 100 pounds per acre total of soluble nitrogen; P<sub>2</sub>O<sub>5</sub> (phosphorous), 200 pounds per acre; K<sub>2</sub>O (potassium), 200 pounds per acre.
    - Lime: Use only ground agricultural limestone (up to 3 tons per acre may be applied by hydroseeding). Normally, not more than 2 tons are applied by hydroseeding at any one time. Do not use burnt or hydrated lime when hydroseeding.
    - Mix seed and fertilizer on site and seed immediately and without interruption.
    - When hydroseeding do not incorporate seed into the soil.
- 1. Mulch Materials (in order of preference)**
- Straw consisting of thoroughly threshed wheat, rye, oat, or barley and reasonably bright in color. Straw is to be free of noxious weed seeds as specified in the Maryland Seed Law and not musty, moldy, caked, decayed, or excessively dusty. **Note: Use only sterile straw mulch in areas where one species of grass is desired.**
  - Wood Cellulose Fiber Mulch (WCFM) consisting of specially prepared wood cellulose processed into a uniform fibrous physical state.
    - WCFM is to be dyed green or contain a green dye in the package that will provide an appropriate color to facilitate visual inspection of the uniformly spread slurry.
    - WCFM, including dye, must contain no germination or growth inhibiting factors.
    - WCFM materials are to be manufactured and processed in such a manner that the wood cellulose fiber mulch will remain in uniform suspension in water under agitation and will blend with seed, fertilizer and other additives to form a homogeneous slurry. The mulch material must form a blotter-like ground cover, on application, having moisture absorption and percolation properties and must cover and hold grass seed in contact with the soil without inhibiting the growth of the grass seedlings.
    - WCFM material must not contain elements or compounds at concentration levels that will be phyto-toxic.
    - WCFM must conform to the following physical requirements: fiber length of approximately 10 millimeters, diameter approximately 1 millimeter, pH range of 4.0 to 8.5, ash content of 1.6 percent maximum and water holding capacity of 90 percent minimum.

B.16

**B. Incremental Stabilization - Fill Slopes**

- Construct and stabilize fill slopes in increments not to exceed 15 feet in height. Prepare seedbed and apply seed and mulch on all slopes as the work progresses.
- Stabilize slopes immediately when the vertical height of a lift reaches 15 feet, or when the grading operation ceases as prescribed in the plans.
- At the end of each day, install temporary water conveyance practice(s), as necessary, to intercept surface runoff and convey it down the slope in a non-erosive manner.
- Construction sequence example (Refer to Figure B.2):
  - Construct and stabilize all temporary swales or dikes that will be used to divert runoff around the fill. Construct silt fence on low side of fill unless other methods shown on the plans address this area.
  - At the end of each day, install temporary water conveyance practice(s), as necessary, to intercept surface runoff and convey it down the slope in a non-erosive manner.
  - Place Phase 1 fill, prepare seedbed, and stabilize.
  - Place Phase 2 fill, prepare seedbed, and stabilize.
  - Place final phase fill, prepare seedbed, and stabilize. Overseed previously seeded areas as necessary.

**Note:** Once the placement of fill has begun the operation should be continuous from grubbing through the completion of grading and placement of topsoil (if required) and permanent seed and mulch. Any interruptions in the operation or completing the operation out of the seeding season will necessitate the application of temporary stabilization.

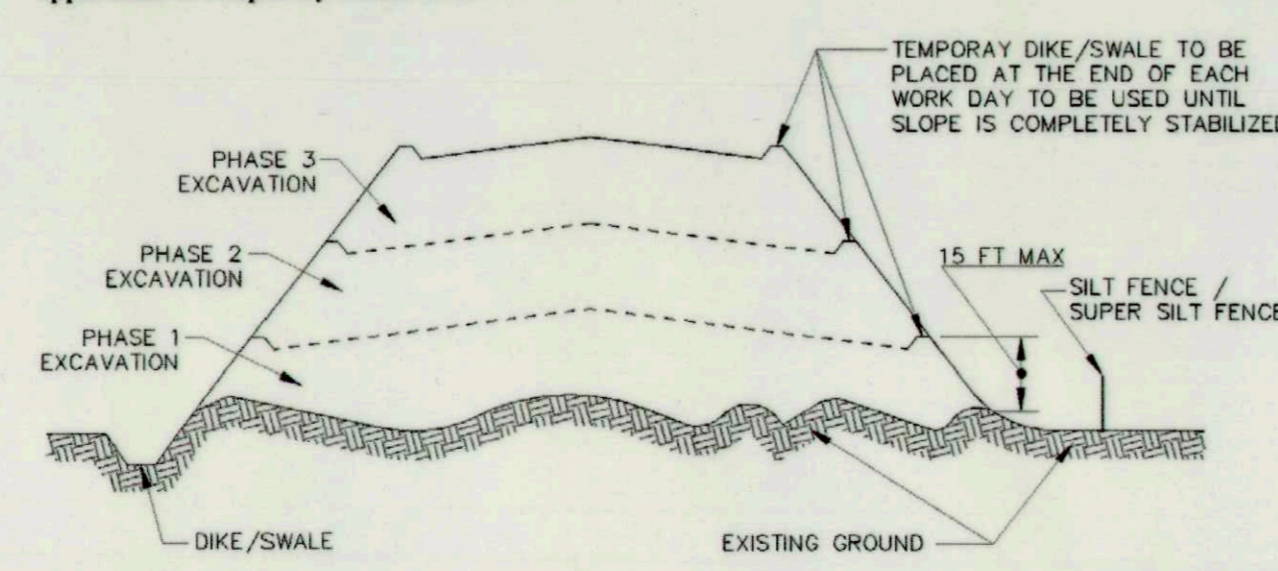

**Figure B.2: Incremental Stabilization - Fill**

B.11

B.17

B.36

B.43

B.37

This development plan is approved for soil erosion and sediment control by the HOWARD SOIL CONSERVATION DISTRICT  
 [Signature]  
 Howard SCD  
 Date: 1/2/18

DEPARTMENT OF PUBLIC WORKS, HOWARD COUNTY, MD  
 [Signature]  
 CHIEF, BUREAU OF ENVIRONMENTAL SERVICES  
 DATE: 12/19/17

**B-4.2 STANDARDS AND SPECIFICATIONS**

**FOR**

**SOIL PREPARATION, TOPSOILING, AND SOIL AMENDMENTS**

**Definition**

The process of preparing the soils to sustain adequate vegetative stabilization.

**Purpose**

To provide a suitable soil medium for vegetative growth.

**Conditions Where Practice Applies**

Where vegetative stabilization is to be established.

**Criteria**

- A. Soil Preparation
  - 1. Temporary Stabilization
    - a. Seedbed preparation consists of loosening soil to a depth of 3 to 5 inches by means of suitable agricultural or construction equipment, such as disc harrows or chisel plows or rippers mounted on construction equipment. After the soil is loosened, it must not be rolled or dragged smooth but left in the roughened condition. Slopes 3:1 or flatter are to be tracked with ridges running parallel to the contour of the slope.
    - b. Apply fertilizer and lime as prescribed on the plans.
    - c. Incorporate lime and fertilizer into the top 3 to 5 inches of soil by disking or other suitable means.
  - 2. Permanent Stabilization
    - a. A soil test is required for any earth disturbance of 5 acres or more. The minimum soil conditions required for permanent vegetative establishment are:
      - i. Soil pH between 6.0 and 7.0.
      - ii. Soluble salts less than 500 parts per million (ppm).
      - iii. Soil contains less than 40 percent clay but enough fine grained material (greater than 30 percent silt plus clay) to provide the capacity to hold a moderate amount of moisture. An exception: if lovegrass will be planted, then a sandy soil (less than 30 percent silt plus clay) would be acceptable.
      - iv. Soil contains 1.5 percent minimum organic matter by weight.
      - v. Soil contains sufficient pore space to permit adequate root penetration.
    - b. Application of amendments or topsoil is required if on-site soils do not meet the above conditions.
    - c. Graded areas must be maintained in a true and even grade as specified on the approved plan, then scarified or otherwise loosened to a depth of 3 to 5 inches.

B.12

- B. Topsoiling
  - 1. Topsoil is placed over prepared subsoil prior to establishment of permanent vegetation. The purpose is to provide a suitable soil medium for vegetative growth. Soils of concern have low moisture content, low nutrient levels, low pH, materials toxic to plants, and/or unacceptable soil gradation.
  - 2. Topsoil salvaged from an existing site may be used provided it meets the standards as set forth in these specifications. Typically, the depth of topsoil to be salvaged for a given soil type can be found in the representative soil profile section in the Soil Survey published by USDA-NRCS.
  - 3. Topsoiling is limited to areas having 2:1 or flatter slopes where:
    - a. The texture of the exposed subsoil/parent material is not adequate to produce vegetative growth.
    - b. The soil material is so shallow that the rooting zone is not deep enough to support plants or furnish continuing supplies of moisture and plant nutrients.
    - c. The original soil to be vegetated contains material toxic to plant growth.
    - d. The soil is so acidic that treatment with limestone is not feasible.
  - 4. Areas having slopes steeper than 2:1 require special consideration and design.
  - 5. Topsoil Specifications: Soil to be used as topsoil must meet the following criteria:
    - a. Topsoil must be a loam, sandy loam, clay loam, silt loam, sandy clay loam, or loamy sand. Other soils may be used if recommended by an agronomist or soil scientist and approved by the appropriate approval authority. Topsoil must not be a mixture of contrasting textured subsoils and must contain less than 5 percent by volume of cinders, stones, slag, coarse fragments, gravel, sticks, roots, trash, or other materials larger than 1½ inches in diameter.
    - b. Topsoil must be free of noxious plants or plant parts such as Bermuda grass, quack grass, Johnson grass, nut sedge, poison ivy, thistle, or others as specified.
    - c. Topsoil substitutes or amendments, as recommended by a qualified agronomist or soil scientist and approved by the appropriate approval authority, may be used in lieu of natural topsoil.
  - 6. Topsoil Application
    - a. Erosion and sediment control practices must be maintained when applying topsoil.
    - b. Uniformly distribute topsoil in a 5 to 8 inch layer and lightly compact to a minimum thickness of 4 inches. Spreading is to be performed in such a manner that sodding or seeding can proceed with a minimum of additional soil preparation and tillage. Any irregularities in the surface resulting from topsoiling or other operations must be corrected in order to prevent the formation of depressions or water pockets.
    - c. Topsoil must not be placed if the topsoil or subsoil is in a frozen or muddy condition, when the subsoil is excessively wet or in a condition that may otherwise be detrimental to proper grading.

B.13

This development plan is approved for soil erosion and sediment control by the HOWARD SOIL CONSERVATION DISTRICT

*[Signature]*  
Howard SCD  
Date: 1/2/18

DEPARTMENT OF PUBLIC WORKS, HOWARD COUNTY, MD  
*[Signature]*  
CHIEF, BUREAU OF ENVIRONMENTAL SERVICES  
DATE: 12/15/17

and seedbed preparation.

C. Soil Amendments (Fertilizer and Lime Specifications)

- 1. Soil tests must be performed to determine the exact ratios and application rates for both lime and fertilizer on sites having disturbed areas of 5 acres or more. Soil analysis may be performed by a recognized private or commercial laboratory. Soil samples taken for engineering purposes may also be used for chemical analyses.
- 2. Fertilizers must be uniform in composition, free flowing and suitable for accurate application by appropriate equipment. Manure may be substituted for fertilizer with prior approval from the appropriate approval authority. Fertilizers must all be delivered to the site fully labeled according to the applicable laws and must bear the name, trade name or trademark and warranty of the producer.
- 3. Lime materials must be ground limestone (hydrated or burnt lime may be substituted except when hydroseeding) which contains at least 50 percent total oxides (calcium oxide plus magnesium oxide). Limestone must be ground to such fineness that at least 50 percent will pass through a #100 mesh sieve and 98 to 100 percent will pass through a #20 mesh sieve.
- 4. Lime and fertilizer are to be evenly distributed and incorporated into the top 3 to 5 inches of soil by disking or other suitable means.
- 5. Where the subsoil is either highly acidic or composed of heavy clays, spread ground limestone at the rate of 4 to 8 tons/acre (200-400 pounds per 1,000 square feet) prior to the placement of topsoil.

**B-4.5 STANDARDS AND SPECIFICATIONS**

**FOR**

**PERMANENT STABILIZATION**

**Definition**

To stabilize disturbed soils with permanent vegetation.

**Purpose**

To use long-lived perennial grasses and legumes to establish permanent ground cover on disturbed soils.

**Conditions Where Practice Applies**

Exposed soils where ground cover is needed for 6 months or more.

**Criteria**

- A. Seed Mixtures
    - 1. General Use
      - a. Select one or more of the species or mixtures listed in Table B.3 for the appropriate Plant Hardiness Zone (from Figure B.3) and based on the site condition or purpose found on Table B.2. Enter selected mixture(s), application rates, and seeding dates in the Permanent Seeding Summary. The Summary is to be placed on the plan.
      - b. Additional planting specifications for exceptional sites such as shorelines, stream banks, or dunes or for special purposes such as wildlife or aesthetic treatment may be found in USDA-NRCS Technical Field Office Guide, Section 342 - Critical Area Planting.
      - c. For sites having disturbed area over 5 acres, use and show the rates recommended by the soil testing agency.
      - d. For areas receiving low maintenance, apply urea form fertilizer (46-0-0) at 3 ½ pounds per 1000 square feet (150 pounds per acre) at time of seeding in addition to the soil amendments shown in the Permanent Seeding Summary.
    - 2. Turfgrass Mixtures
      - a. Areas where turfgrass may be desired include lawns, parks, playgrounds, and commercial sites which will receive a medium to high level of maintenance.
      - b. Select one or more of the species or mixtures listed below based on the site conditions or purpose. Enter selected mixture(s), application rates, and seeding dates in the Permanent Seeding Summary. The summary is to be placed on the plan.
        - i. Kentucky Bluegrass: Full Sun Mixture: For use in areas that receive intensive management. Irrigation required in the areas of central Maryland and Eastern Shore. Recommended Certified Kentucky Bluegrass Cultivars Seeding Rate: 1.5 to 2.0 pounds per 1000 square feet. Choose a minimum of three Kentucky bluegrass cultivars with each ranging from 10 to 35 percent of the total mixture by weight.
        - ii. Kentucky Bluegrass/Perennial Rye: Full Sun Mixture: For use in full sun areas where rapid establishment is necessary and when turf will receive medium to intensive management. Certified Perennial Ryegrass Cultivars/Certified Kentucky Bluegrass Seeding Rate: 2 pounds mixture per 1000 square feet. Choose a minimum of three Kentucky bluegrass cultivars with each ranging from 10 to 35 percent of the total mixture by weight.
        - iii. Tall Fescue/Kentucky Bluegrass: Full Sun Mixture: For use in drought prone areas and/or for areas receiving low to medium management in full sun to medium shade. Recommended mixture includes; Certified Tall Fescue Cultivars 95 to 100 percent, Certified Kentucky Bluegrass Cultivars 0 to 5 percent. Seeding Rate: 5 to 8 pounds per 1000 square feet. One or more cultivars may be blended.
        - iv. Kentucky Bluegrass/Fine Fescue: Shade Mixture: For use in areas with shade in Bluegrass lawns. For establishment in high quality, intensively managed turf area. Mixture includes; Certified Kentucky Bluegrass Cultivars 30 to 40 percent and Certified Fine Fescue and 60 to 70 percent. Seeding Rate: 1½ to 3 pounds per 1000 square feet.
- Notes:**  
**Select turfgrass varieties from those listed in the most current University of Maryland Publication, Agronomy Memo #77, "Turfgrass Cultivar Recommendations for Maryland"**
- Choose certified material. Certified material is the best guarantee of cultivar purity. 1 certification program of the Maryland Department of Agriculture, Turf and Seed Select provides a reliable means of consumer protection and assures a pure genetic line**
- c. Ideal Times of Seeding for Turf Grass Mixtures
    - Western MD: March 15 to June 1, August 1 to October 1 (Hardiness Zones: 5b, 6a)
    - Central MD: March 1 to May 15, August 15 to October 15 (Hardiness Zone: 6b)
    - Southern MD, Eastern Shore: March 1 to May 15, August 15 to October 15 (Hardiness Zones: 7a, 7b)
  - d. Till areas to receive seed by disking or other approved methods to a depth of 2 to 4 inches, level and rake the areas to prepare a proper seedbed. Remove stones and debris over 1½ inches in diameter. The resulting seedbed must be in such condition that future mowing of grasses will pose no difficulty.
  - e. If soil moisture is deficient, supply new seedlings with adequate water for plant growth (½ to 1 inch every 3 to 4 days depending on soil texture) until they are firmly established. This is especially true when seedlings are made late in the planting season, in abnormally dry or hot seasons, or on adverse sites.

**Permanent Seeding Summary**

| No. | Species             | Application Rate (lb/acre) | Hardiness Zone (from Figure B.3): <b>6b</b> |                                 | Seeding Depths | Fertilizer Rate (10-20-20)          |                               |                         | Lime Rate                 |
|-----|---------------------|----------------------------|---|---------------------------------|----------------|-------------------------------------|-------------------------------|-------------------------|---------------------------|
|     |                     |                            | Seeding Dates                               | Seeding Dates                   |                | N                                   | P <sub>2</sub> O <sub>5</sub> | K <sub>2</sub> O        |                           |
| 4   | DEERTONGUE          | 15                         | 3/1-5/15, 5/16-8/15, 8/15-10/15             | 3/1-5/15, 5/16-8/15, 8/15-10/15 | ¼- ½ in        | 45 pounds per acre (1.0 lb/1000 sf) | 90 lb/ac (2 lb/1000 sf)       | 90 lb/ac (2 lb/1000 sf) | 2 tons/ac (90 lb/1000 sf) |
|     | CREeping RED FESCUE | 20                         | 3/1-5/15, 5/16-8/15, 8/15-10/15             | 3/1-5/15, 5/16-8/15, 8/15-10/15 | ¼- ½ in        |                                     |                               |                         |                           |
|     | VIRGINIA WILD RYE   | 5                          | 3/1-5/15, 5/16-8/15, 8/15-10/15             | 3/1-5/15, 5/16-8/15, 8/15-10/15 | ¼- ½ in        |                                     |                               |                         |                           |

B. Sod: To provide quick cover on disturbed areas (2.1 grade or flatter).

1. General Specifications

- a. Class of turfgrass sod must be Maryland State Certified. Sod labels must be made available to the job foreman and inspector.
- b. Sod must be machine cut at a uniform soil thickness of ¾ inch, plus or minus ¼ inch, at the time of cutting. Measurement for thickness must exclude top growth and thatch. Broken pads and torn or uneven ends will not be acceptable.
- c. Standard size sections of sod must be strong enough to support their own weight and retain their size and shape when suspended vertically with a firm grasp on the upper 10 percent of the section.
- d. Sod must not be harvested or transplanted when moisture content (excessively dry or wet) may adversely affect its survival.
- e. Sod must be harvested, delivered, and installed within a period of 36 hours. Sod not transplanted within this period must be approved by an agronomist or soil scientist prior to its installation.

2. Sod Installation

- a. During periods of excessively high temperature or in areas having dry subsoil, lightly irrigate the subsoil immediately prior to laying the sod.
- b. Lay the first row of sod in a straight line with subsequent rows placed parallel to it and tightly wedged against each other. Stagger lateral joints to promote more uniform growth and strength. Ensure that sod is not stretched or overlapped and that all joints are butted tight in order to prevent voids which would cause air drying of the roots.
- c. Wherever possible, lay sod with the long edges parallel to the contour and with staggering joints. Roll and tamp, peg or otherwise secure the sod to prevent slippage on slopes. Ensure solid contact exists between sod roots and the underlying soil surface.
- d. Water the sod immediately following rolling and tamping until the underside of the new sod pad and soil surface below the sod are thoroughly wet. Complete the operations of laying, tamping and irrigating for any piece of sod within eight hours.

3. Sod Maintenance

- a. In the absence of adequate rainfall, water daily during the first week or as often and sufficiently as necessary to maintain moist soil to a depth of 4 inches. Water sod during the heat of the day to prevent wilting.
- b. After the first week, sod watering is required as necessary to maintain adequate moisture content.
- c. Do not mow until the sod is firmly rooted. No more than ¼ of the grass leaf must be removed by the initial cutting or subsequent cuttings. Maintain a grass height of at least 3 inches unless otherwise specified.

**B-4.4 STANDARDS AND SPECIFICATIONS**

**FOR**

**TEMPORARY STABILIZATION**

**Definition**

To stabilize disturbed soils with vegetation for up to 6 months.

**Purpose**

To use fast growing vegetation that provides cover on disturbed soils.

**Conditions Where Practice Applies**

Exposed soils where ground cover is needed for a period of 6 months or less. For longer duration of time, permanent stabilization practices are required.

**Criteria**

- 1. Select one or more of the species or seed mixtures listed in Table B.1 for the appropriate Plant Hardiness Zone (from Figure B.3), and enter them in the Temporary Seeding Summary below along with application rates, seeding dates and seeding depths. If this Summary is not put on the plan and completed, then Table B.1 plus fertilizer and lime rates must be put on the plan.
- 2. For sites having soil tests performed, use and show the recommended rates by the testing agency. Soil tests are not required for Temporary Seeding.
- 3. When stabilization is required outside of a seeding season, apply seed and mulch or straw mulch alone as prescribed in Section B-4.3.A.1.b and maintain until the next seeding season.

**Temporary Seeding Summary**

| No. | Species         | Application Rate (lb/acre) | Hardiness Zone (from Figure B.3): <b>6b</b> |               | Seeding Depths | Fertilizer Rate (10-20-20) | Lime Rate                 |
|-----|-----------------|----------------------------|---|---------------|----------------|----------------------------|---------------------------|
|     |                 |                            | Seeding Dates                               | Seeding Dates |                |                            |                           |
|     | ANNUAL RYEGRASS | 40                         | 5/1-5/15                                    | 8/1-10/15     | 0.5 in         | 436 lb/ac (10 lb/1000 sf)  | 2 tons/ac (90 lb/1000 sf) |
|     | FOXTAIL MILLET  | 30                         | 5/16-7/31                                   |               | 0.5 in         |                            |                           |

**B-4 STANDARDS AND SPECIFICATIONS**

**FOR**

**VEGETATIVE STABILIZATION**

**Definition**

Using vegetation as cover to protect exposed soil from erosion.

**Purpose**

To promote the establishment of vegetation on exposed soil.

**Conditions Where Practice Applies**

On all disturbed areas not stabilized by other methods. This specification is divided into sections on incremental stabilization, soil preparation, soil amendments and topsoiling; seeding and mulching; temporary stabilization; and permanent stabilization.

**Effects on Water Quality and Quantity**

Stabilization practices are used to promote the establishment of vegetation on exposed soil. When soil is stabilized with vegetation, the soil is less likely to erode and more likely to allow infiltration of rainfall, thereby reducing sediment loads and runoff to downstream areas.

Planting vegetation in disturbed areas will have an effect on the water budget, especially on volumes and rates of runoff, infiltration, evaporation, transpiration, percolation, and groundwater recharge. Over time, vegetation will increase organic matter content and improve the water holding capacity of the soil and subsequent plant growth.

Vegetation will help reduce the movement of sediment, nutrients, and other chemicals carried by runoff to receiving waters. Plants will also help protect groundwater supplies by assimilating those substances present within the root zone.

**Sediment control practices must remain in place during grading, seedbed preparation, seeding, mulching, and vegetative establishment.**

**Adequate Vegetative Establishment**

Inspect seeded areas for vegetative establishment and make necessary repairs, replacements, and reseedings within the planting season.

- 1. Adequate vegetative stabilization requires 95 percent groundcover.
- 2. If an area has less than 40 percent groundcover, restabilize following the original recommendations for lime, fertilizer, seedbed preparation, and seeding.
- 3. If an area has between 40 and 94 percent groundcover, over-seed and fertilize using half of the rates originally specified.
- 4. Maintenance fertilizer rates for permanent seeding are shown in Table B.6.

B.9

**DETAIL B-4-6-A TEMPORARY SOIL STABILIZATION MATTING CHANNEL APPLICATION**

STANDARD SYMBOL  
TSSMC - \* lb/ft<sup>2</sup>  
(\* INCLUDE SHEAR STRESS)

**CONSTRUCTION SPECIFICATIONS ISOMETRIC VIEW**

- USE MATTING THAT HAS A DESIGN VALUE FOR SHEAR STRESS EQUAL TO OR HIGHER THAN THE SHEAR STRESS DESIGNATED ON APPROVED PLANS.
- USE TEMPORARY SOIL STABILIZATION MATTING MADE OF DEGRADABLE (LASTS 6 MONTHS MINIMUM) NATURAL OR MAN-MADE FIBERS (MOSTLY ORGANIC). MAT MUST HAVE UNIFORM THICKNESS AND DISTRIBUTION OF FIBERS THROUGHOUT AND BE SMOOTHER RESISTANT. CHEMICALS USED IN THE MAT MUST BE NON-LEACHING AND NON-TOXIC TO VEGETATION AND SEED GERMINATION AND NON-INJURIOUS TO THE SKIN. IF PRESENT, NETTING MUST BE EXTRUDED PLASTIC WITH A MAXIMUM MESH OPENING OF 2x2 INCHES AND SUFFICIENTLY BONDED OR SEWN ON 2 INCH CENTERS ALONG LONGITUDINAL AXIS OF THE MATERIAL TO PREVENT SEPARATION OF THE NET FROM THE PARENT MATERIAL.
- SECURE MATTING USING STEEL STAPLES, WOOD STAKES, OR BIODEGRADABLE EQUIVALENT. STAPLES MUST BE "U" OR "T" SHAPED STEEL WIRE HAVING A MINIMUM GAUGE OF NO. 11 AND NO. 8 RESPECTIVELY. "U" SHAPED STAPLES MUST AVERAGE 1 TO 1½ INCHES WIDE AND BE A MINIMUM OF 6 INCHES LONG. "T" SHAPED STAPLES MUST HAVE A MINIMUM 8 INCH MAIN LEG, A MINIMUM 1 INCH SECONDARY LEG, AND A MINIMUM 4 INCH HEAD. WOOD STAKES MUST BE ROUGH-SAWN HARDWOOD, 12 TO 24 INCHES IN LENGTH, 1x3 INCH IN CROSS SECTION, AND WEDGE SHAPED AT THE BOTTOM.
- PERFORM FINAL GRADING, TOPSOIL APPLICATION, SEEDBED PREPARATION, AND PERMANENT SEEDING IN ACCORDANCE WITH SPECIFICATIONS. PLACE MATTING WITHIN 48 HOURS OF COMPLETING SEEDING OPERATIONS UNLESS END OF WORKDAY STABILIZATION IS SPECIFIED ON THE APPROVED EROSION AND SEDIMENT CONTROL PLAN.
- UNROLL MATTING IN DIRECTION OF WATER FLOW, CENTERING THE FIRST ROLL ON THE CHANNEL CENTERLINE. WORK FROM CENTER OF CHANNEL OUTWARD WHEN PLACING ROLLS. LAY MAT SMOOTHLY AND FIRMLY ON THE SEEDED SURFACE. AVOID STRETCHING THE MATTING.
- KEY-IN UPSTREAM END OF EACH MAT ROLL BY DIGGING A 6 INCH (MINIMUM) TRENCH AT THE UPSTREAM END OF THE MATTING, PLACING THE ROLL END IN THE TRENCH, STAPLING THE MAT IN PLACE, REPLACING THE EXCAVATED MATERIAL, AND TAMPING TO SECURE THE MAT END.
- OVERLAP OR ABUT THE ROLL EDGES PER MANUFACTURER RECOMMENDATIONS. OVERLAP ROLL ENDS BY 6 INCHES (MINIMUM), WITH THE UPSTREAM MAT OVERLAPPING ON TOP OF THE NEXT DOWNSTREAM MAT.
- STAPLE/STAKE MAT IN A STAGGERED PATTERN ON 4 FOOT (MAXIMUM) CENTERS THROUGHOUT AND 2 FOOT (MAXIMUM) CENTERS ALONG SEAMS, JOINTS, AND ROLL ENDS.
- ESTABLISH AND MAINTAIN VEGETATION SO THAT REQUIREMENTS FOR ADEQUATE VEGETATIVE ESTABLISHMENT ARE CONTINUOUSLY MET IN ACCORDANCE WITH SECTION B-4 VEGETATIVE STABILIZATION.

MARYLAND STANDARDS AND SPECIFICATIONS FOR SOIL EROSION AND SEDIMENT CONTROL

U.S. DEPARTMENT OF AGRICULTURE NATURAL RESOURCES CONSERVATION SERVICE 2011 MARYLAND DEPARTMENT OF ENVIRONMENT WATER MANAGEMENT ADMINISTRATION

**CLIENT**

HOWARD COUNTY DPW  
BUREAU OF ENVIRONMENTAL SERVICES  
STORMWATER MANAGEMENT DIVISION  
6751 GATEWAY DRIVE, SUITE 514  
COLUMBIA, MD 21046  
PHONE: (410) 313-6413

**DATE ISSUES / REVISIONS**

The Stables Building 2081 Clipper Park Road  
Baltimore, MD 21211 / ph: 410.554.0156  
fx: 410.554.0168 / www.biohabitats.com  
*Restore the Earth & Inspire Ecological Stewardship*


**LONGVIEW DRIVE STREAM STABILIZATION**

SITE ADDRESS: 9509 LONGVIEW DR, ELLICOTT CITY, MD  
ZONING: R-20 R-ED TAX MAP GRID/PARCEL: 0624/0003/0540  
ELECTION DISTRICT: 02 OPEN LOT: N/A  
WAIVER PETITION: WP-18-022

**EROSION & SEDIMENT CONTROL DETAILS**

PROJECT NO.: 13005.50 SCALE: NTS

SEAL: BY: RW/KT CHECK: MDT/MWT  
DWG. NO.:

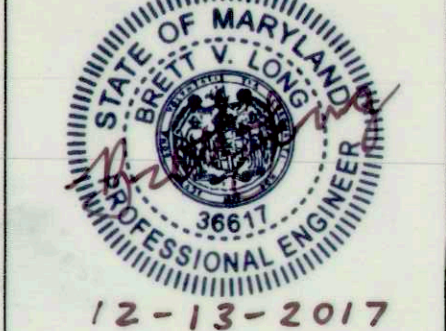

14 OF 18

**SEQUENCE OF CONSTRUCTION**

**EROSION AND SEDIMENT CONTROL SETUP - 1.5 WEEKS**

- SEVEN DAYS PRIOR TO THE COMMENCEMENT OF MOBILIZATION ACTIVITIES, THE CONTRACTOR SHALL NOTIFY THE MARYLAND STATE HIGHWAY DISTRICT OFFICE OF THEIR SCHEDULED START DATE.
  - THE CONTRACTOR SHALL STAKE OUT THE LIMITS OF DISTURBANCE AS SHOWN ON THE GRADING PLAN. THE CONTRACTOR MUST OBTAIN A GRADING PERMIT. STREAM CHANNEL MUST NOT BE DISTURBED DURING MARCH 1 TO MAY 31. (1 DAY) THIS PROJECT IS SUBJECT TO THE FOLLOWING APPROVALS:
    - U.S. ARMY CORPS OF ENGINEERS NONTIDAL WETLANDS AND WATERWAYS PERMIT #TBD
    - MDE NONTIDAL WETLANDS AND WATERWAYS PERMIT AI #156538, TRACKING #201761314
    - OBTAIN GRADING PERMIT FROM DILP
  - THE CONTRACTOR SHALL CONDUCT A PRE-CONSTRUCTION MEETING ONSITE WITH SEDIMENT CONTROL INSPECTOR AND THE ENGINEER TO REVIEW THE LIMITS OF DISTURBANCE, STRUCTURE STAKEOUT, EROSION AND SEDIMENT CONTROL REQUIREMENTS, AND THE SEQUENCE OF CONSTRUCTION. THE PARTICIPANTS WILL ALSO VERIFY THE LOCATION OF THE TEMPORARY STOCKPILE AREA AND ANY NECESSARY STAGING AREA, AND FLAG ANY TREES WITHIN THE LIMITS OF DISTURBANCE WHICH WILL BE REMOVED FOR CONSTRUCTION ACCESS AND GRADING. (1 DAY)
  - THE CONTRACTOR SHALL INSTALL THE STABILIZED CONSTRUCTION ENTRANCE AND BLAZE ORANGE FENCE AND TREE PROTECTION AREAS AND PLANKING AS SHOWN ON THE GRADING PLANS OR AS DIRECTED BY THE ENGINEER. (1 DAY)
  - THE CONTRACTOR SHALL ESTABLISH THE TEMPORARY STOCKPILE AREA IN THE LOCATION INDICATED ON THE GRADING PLAN (NOTE: INSTALL SUPER SILT FENCE AROUND THE PERIMETER OF THE STOCKPILE AREA AS SHOWN). (1 DAY)
  - INSTALL REMAINING PERIMETER EROSION AND SEDIMENT CONTROL DEVICES AS SHOWN ON THE PLANS. (1 DAY)
  - CLEAR CORRIDOR AS REQUIRED TO INSTALL THE MULCH ACCESS ROAD IN THE LOCATION DEPICTED ON THE PLANS. CARE SHOULD BE TAKEN TO MINIMIZE ANY UNNECESSARY DISTURBANCE TO EXISTING VEGETATION AND ROOT ZONES. INSTALL MULCH ACCESS ROAD AND STABILIZE DISTURBED AREAS WITH MULCH AS WORK PROGRESSES. (3 DAYS)
  - INSTALL PUMP AROUND DIVERSIONS. (1 DAY)  
STA 0+00 TO 4+24 (2 WEEKS)
- NOTE: A THREE DAY DRY WEATHER PERIOD PER THE NOAA FORECAST IS REQUIRED PRIOR TO INITIATING WORK.
- CONSTRUCTION SHALL NOT BEGIN UNTIL ALL SEDIMENT AND EROSION CONTROL MEASURES HAVE BEEN INSTALLED AND APPROVED BY THE HOWARD COUNTY DEPARTMENT OF PUBLIC WORKS, CONSTRUCTION INSPECTION DIVISION INSPECTOR. CLEAR LIMITS OF DISTURBANCE AS REQUIRED. WORK SHALL PROGRESS IN AN UPSTREAM DIRECTION FROM STA 4+24 TO STA 2+00 AND IN A DOWNSTREAM DIRECTION FROM STA 0+00 TO 2+00. BOTH WORK AREAS MAY BE CONSTRUCTED CONCURRENTLY OR SEPARATELY AS APPROVED BY THE SEDIMENT CONTROL INSPECTOR. GRADING SHALL BE LIMITED TO THE AREA THAT CAN BE STABILIZED IN A SINGLE WORK DAY. INSTALL IN-STREAM STRUCTURES (COBBLE RIFFLES AND BOULDER TOE) AND COIR MATTING AS WORK PROGRESSES DAILY. (1 WEEK)
  - STABILIZE REMAINDER OF WORK AREA. (1 DAY)
  - WITH THE APPROVAL OF THE SEDIMENT CONTROL INSPECTOR AND THE ENGINEER REMOVE ALL SEDIMENT AND EROSION CONTROL MEASURES. THE CONTRACTOR SHALL TAKE CARE TO REMOVE ALL EXCESS CONSTRUCTION DEBRIS AND TRASH GENERATED FROM CONSTRUCTION ACTIVITIES FROM THE SITE. (1 DAY)
  - PLANT SITE ACCORDING TO PLANTING PLAN IN APPROPRIATE PLANTING SEASON. (3 DAYS)

**HOWARD SOIL CONSERVATION DISTRICT STANDARD (HSCD)**

**SEDIMENT CONTROL NOTES**

- A PRE-CONSTRUCTION MEETING MUST OCCUR WITH THE HOWARD COUNTY DEPARTMENT OF PUBLIC WORKS, CONSTRUCTION INSPECTION DIVISION (CID), 410-313-1855 AFTER THE FUTURE LOD AND PROTECTED AREAS ARE MARKED CLEARLY IN THE FIELD. A MINIMUM OF 48 HOUR NOTICE TO CID MUST BE GIVEN AT THE FOLLOWING STAGES:
    - PRIOR TO THE START OF EARTH DISTURBANCE,
    - UPON COMPLETION OF THE INSTALLATION OF PERIMETER EROSION AND SEDIMENT CONTROLS, BUT BEFORE PROCEEDING WITH ANY OTHER EARTH DISTURBANCE OR GRADING,
    - PRIOR TO THE START OF ANOTHER PHASE OF CONSTRUCTION OR OPENING OF ANOTHER GRADING UNIT,
    - PRIOR TO THE REMOVAL OR MODIFICATION OF SEDIMENT CONTROL PRACTICES.
- OTHER BUILDING OR GRADING INSPECTION APPROVALS MAY NOT BE AUTHORIZED UNTIL THIS INITIAL APPROVAL BY THE INSPECTION AGENCY IS MADE. OTHER RELATED STATE AND FEDERAL PERMITS SHALL BE REFERENCED, TO ENSURE COORDINATION AND TO AVOID CONFLICTS WITH THIS PLAN.
- ALL VEGETATIVE AND STRUCTURAL PRACTICES ARE TO BE INSTALLED ACCORDING TO THE PROVISIONS OF THIS PLAN AND ARE TO BE IN CONFORMANCE WITH THE 2011 MARYLAND STANDARDS AND SPECIFICATIONS FOR SOIL EROSION AND SEDIMENT CONTROL, AND REVISIONS THERETO.
  - FOLLOWING INITIAL SOIL DISTURBANCE OR RE-DISTURBANCE, PERMANENT OR TEMPORARY STABILIZATION IS REQUIRED WITHIN THREE (3) CALENDAR DAYS AS TO THE SURFACE OF ALL PERIMETER CONTROLS, DIKES, SWALES, DITCHES, PERIMETER SLOPES, AND ALL SLOPES STEEPER THAN 3 HORIZONTAL TO 1 VERTICAL (3:1); AND SEVEN (7) CALENDAR DAYS AS TO ALL OTHER DISTURBED AREAS ON THE PROJECT SITE EXCEPT FOR THOSE AREAS UNDER ACTIVE GRADING.
  - ALL DISTURBED AREAS MUST BE STABILIZED WITHIN THE TIME PERIOD SPECIFIED ABOVE IN ACCORDANCE WITH THE 2011 MARYLAND STANDARDS AND SPECIFICATIONS FOR SOIL EROSION AND SEDIMENT CONTROL FOR TOPSOIL (SEC. B-4-2), PERMANENT SEEDING (SEC. B-4-5), TEMPORARY SEEDING (SEC. B-4-4) AND MULCHING (SEC. B-4-3). TEMPORARY STABILIZATION WITH MULCH ALONE CAN ONLY BE APPLIED BETWEEN THE FALL AND SPRING SEEDING DATES IF THE GROUND IS FROZEN. INCREMENTAL STABILIZATION (SEC. B-4-1) SPECIFICATIONS SHALL BE ENFORCED IN AREAS WITH >15' OF CUT AND/OR FILL. STOCKPILES (SEC. B-4-8) IN EXCESS OF 20 FT. MUST BE BENCHED WITH STABLE STABILIZATION MATTING (SEC. B-4-6).
  - ALL SEDIMENT CONTROL STRUCTURES ARE TO REMAIN IN PLACE, AND ARE TO BE MAINTAINED IN OPERATIVE CONDITION UNTIL PERMISSION FOR THEIR REMOVAL HAS BEEN OBTAINED FROM THE CID.
  - SITE ANALYSIS:
 

|                                     |   |
|-------------------------------------|---|
| TOTAL AREA OF SITE:                 | 0.94 ACRES  |
| AREA DISTURBED:                     | 0.94 ACRES  |
| AREA TO BE ROOFED OR PAVED:         | 0.00 ACRES  |
| AREA TO BE VEGETATIVELY STABILIZED: | 0.80 ACRES  |
| TOTAL CUT:                          | 375 CU. YDS.  |
| TOTAL FILL:                         | 105 CU. YDS.  |
| OFFSITE WASTE/BORROW AREA LOCATION: | TBD AS APPROVED BY CID; SITE MUST HAVE AN ACTIVE GRADING PERMIT |
  - ANY SEDIMENT CONTROL PRACTICE WHICH IS DISTURBED BY GRADING ACTIVITY FOR PLACEMENT OF UTILITIES MUST BE REPAIRED ON THE SAME DAY OF DISTURBANCE.
  - ADDITIONAL SEDIMENT CONTROL MUST BE PROVIDED, IF DEEMED NECESSARY BY THE CID. THE SITE AND ALL CONTROLS SHALL BE INSPECTED BY THE CONTRACTOR WEEKLY; AND THE NEXT DAY AFTER EACH RAIN EVENT. A WRITTEN REPORT BY THE CONTRACTOR, MADE AVAILABLE UPON REQUEST, IS PART OF EVERY INSPECTION AND SHOULD INCLUDE:
    - INSPECTION DATE
    - INSPECTION TYPE (ROUTINE, PRE-STORM EVENT, DURING RAIN EVENT)
    - NAME AND TITLE OF INSPECTOR
    - WEATHER INFORMATION (CURRENT CONDITIONS AS WELL AS TIME AND AMOUNT OF LAST RECORDED PRECIPITATION)
    - BRIEF DESCRIPTION OF PROJECT'S STATUS (E.G., PERCENT COMPLETE) AND/OR CURRENT ACTIVITIES
    - EVIDENCE OF SEDIMENT DISCHARGES
    - IDENTIFICATION OF PLAN DEFICIENCIES
    - IDENTIFICATION OF SEDIMENT CONTROLS THAT REQUIRE MAINTENANCE
    - IDENTIFICATION OF MISSING OR IMPROPERLY INSTALLED SEDIMENT CONTROLS
    - COMPLIANCE STATUS REGARDING THE SEQUENCE OF CONSTRUCTION AND STABILIZATION REQUIREMENTS
    - PHOTOGRAPHS
    - MONITORING/SAMPLING
    - MAINTENANCE AND/OR CORRECTIVE ACTION PERFORMED
    - OTHER INSPECTION ITEMS AS REQUIRED BY THE GENERAL PERMIT FOR STORMWATER ASSOCIATED WITH CONSTRUCTION ACTIVITIES (NPDES, MDE).
  - TRENCHES FOR THE CONSTRUCTION OF UTILITIES IS LIMITED TO THREE PIPE LENGTHS OR THAT WHICH CAN AND SHALL BE BACK-FILLED AND STABILIZED BY THE END OF EACH WORKDAY, WHICHEVER IS SHORTER.
  - ANY MAJOR CHANGES OR REVISIONS TO THE PLAN OR SEQUENCE OF CONSTRUCTION MUST BE REVIEWED AND APPROVED BY THE HSCD PRIOR TO PROCEEDING WITH CONSTRUCTION. MINOR REVISIONS MAY ALLOWED BY THE CID PER THE LIST OF HSCD-APPROVED FIELD CHANGES.
  - DISTURBANCE SHALL NOT OCCUR OUTSIDE THE L.O.D. A PROJECT IS TO BE SEQUENCED SO THAT GRADING ACTIVITIES BEGIN ON ONE GRADING UNIT (MAXIMUM ACREAGE OF 20 AC. PER GRADING UNIT) AT A TIME. WORK MAY PROCEED TO A SUBSEQUENT GRADING UNIT WHEN AT LEAST 50 PERCENT OF THE DISTURBED AREA IN THE PRECEDING GRADING UNIT HAS BEEN STABILIZED AND APPROVED BY THE CID. UNLESS OTHERWISE SPECIFIED AND APPROVED BY THE CID, NO MORE THAN 30 ACRES CUMULATIVELY MAY BE DISTURBED AT A GIVEN TIME.
  - WASH WATER FROM ANY EQUIPMENT, VEHICLES, WHEELS, PAVEMENT, AND OTHER SOURCES MUST BE TREATED IN A SEDIMENT BASIN OR OTHER APPROVED WASHOUT STRUCTURE.
  - TOPSOIL SHALL BE STOCKPILED AND PRESERVED ON-SITE FOR REDISTRIBUTION ONTO FINAL GRADE.
  - ALL SILT FENCE AND SUPER SILT FENCE SHALL BE PLACED ON-THE-CONTOUR, AND BE IMBRICATED AT 25' MINIMUM INTERVALS, WITH LOWER ENDS CURLED UPHILL BY 2' IN ELEVATION.
  - STREAM CHANNELS MUST NOT BE DISTURBED DURING THE FOLLOWING RESTRICTED TIME PERIODS (INCLUSIVE):
    - USE I AND IP MARCH 1 - JUNE 15
    - USE III AND IIIIP OCTOBER 1 - APRIL 30
    - USE IV MARCH 1 - MAY 31
  - A COPY OF THIS PLAN, THE 2011 MARYLAND STANDARDS AND SPECIFICATIONS FOR SOIL EROSION AND SEDIMENT CONTROL, AND ASSOCIATED PERMITS SHALL BE ON-SITE AND AVAILABLE WHEN THE SITE IS ACTIVE.


**SEDIMENT CONTROL NOTES**

- NOTE: CONDUCT A PRE-CONSTRUCTION MEETING. NOTIFY THE DEPARTMENT OF PUBLIC WORKS, BUREAU OF ENGINEERING/CONSTRUCTION INSPECTION DIVISION AT LEAST 48 HOURS BEFORE COMMENCING WORK AT (410) 313-1855. WORK MAY NOT COMMENCE UNTIL THE PERMITTEE OR THE RESPONSIBLE ENGINEER HAVE MET ON SITE WITH THE SEDIMENT AND EROSION CONTROL INSPECTOR TO REVIEW THE APPROVED PLANS.
- A MINIMUM OF 48 HOURS NOTICE MUST BE GIVEN TO THE HOWARD COUNTY DEPARTMENT OF INSPECTIONS, LICENCES AND PERMITS, SEDIMENT CONTROL DIVISION PRIOR TO THE START OF ANY CONSTRUCTION (313-1855).
- THE CONTRACTOR SHALL NOTIFY "MISS-UTILITY" AT 1-800-257-7777 AT LEAST 48 HOURS PRIOR TO ANY EXCAVATION WORK BEING DONE.
- ALL VEGETATIVE AND STRUCTURAL PRACTICES ARE TO BE INSTALLED ACCORDING TO THE PROVISIONS OF THIS PLAN AND ARE TO BE IN CONFORMANCE WITH THE MOST CURRENT MARYLAND STANDARDS AND SPECIFICATIONS FOR SOIL EROSION AND SEDIMENT CONTROL AND REVISIONS THERETO.
- CONSTRUCTION ACTIVITIES INCLUDING THE INSTALLATION OF EROSION AND SEDIMENT CONTROL MEASURES SHALL NOT BEGIN UNTIL ALL REQUIRED EASEMENTS AND RIGHT-OF-WAYS HAVE BEEN OBTAINED.
- CONSTRUCTION SHALL NOT BEGIN UNTIL ALL SEDIMENT AND EROSION CONTROL MEASURES HAVE BEEN INSTALLED AND APPROVED BY THE ENGINEER AND THE SEDIMENT CONTROL INSPECTOR. THE HOWARD COUNTY DEPARTMENT OF PUBLIC WORKS, CONSTRUCTION INSPECTION DIVISION INSPECTOR SHALL BE NOTIFIED UPON COMPLETION OF CONTROL INSTALLATION FOR EACH PHASE OF CONSTRUCTION.
- THE CONTRACTOR SHALL STAY WITHIN THE LIMIT OF DISTURBANCE AS SHOWN ON THE PLANS AND MINIMIZE DISTURBANCE WITHIN THE WORKING AREA WHEREVER POSSIBLE. NO TREES SHALL BE REMOVED WITHIN THE LIMIT OF DISTURBANCE WITHOUT APPROVAL FROM THE ENGINEER.
- THE CONSTRUCTION SEQUENCE MUST BE FOLLOWED UNLESS THE CONTRACTOR GETS WRITTEN APPROVAL FROM THE HOWARD SOIL CONSERVATION DISTRICT OR THE SEDIMENT CONTROL INSPECTOR.
- FOR ALL ASPECTS OF CONSTRUCTION FOLLOWING INITIAL SOIL DISTURBANCE OR RE-DISTURBANCE, PERMANENT OR TEMPORARY STABILIZATION MUST BE COMPLETED WITHIN:
  - THREE (3) CALENDAR DAYS AS TO THE SURFACE OF ALL PERIMETER DIKES, SWALES, DITCHES, PERIMETER SLOPES, AND ALL SLOPES STEEPER THAN 3 HORIZONTAL TO 1 VERTICAL (3:1); AND SEVEN (7) CALENDAR DAYS AS TO ALL OTHER DISTURBED OR GRADED AREAS ON THE PROJECT SITE NOT UNDER ACTIVE GRADING.
  - ANY SEDIMENT CONTROL PRACTICE THAT IS DISTURBED BY GRADING ACTIVITY FOR PLACEMENT OF UTILITIES MUST BE REPAIRED ON THE SAME DAY OF DISTURBANCE.
- ADDITIONAL SEDIMENT CONTROL MUST BE PROVIDED, IF DEEMED NECESSARY BY THE HOWARD COUNTY SEDIMENT CONTROL INSPECTOR.
- TRENCHES FOR THE CONSTRUCTION OF UTILITIES IS LIMITED TO THREE PIPE LENGTHS OR THAT WHICH SHALL BE BACK-FILLED AND STABILIZED BY THE END OF EACH WORK DAY, WHICHEVER IS SHORTER.

**CLIENT**

HOWARD COUNTY DPW  
BUREAU OF ENVIRONMENTAL SERVICES  
STORMWATER MANAGEMENT DIVISION  
6751 GATEWAY DRIVE, SUITE 514  
COLUMBIA, MD 21046  
PHONE: (410) 313-6413

| DATE | ISSUES / REVISIONS |
|------|--------------------|
|------|--------------------|

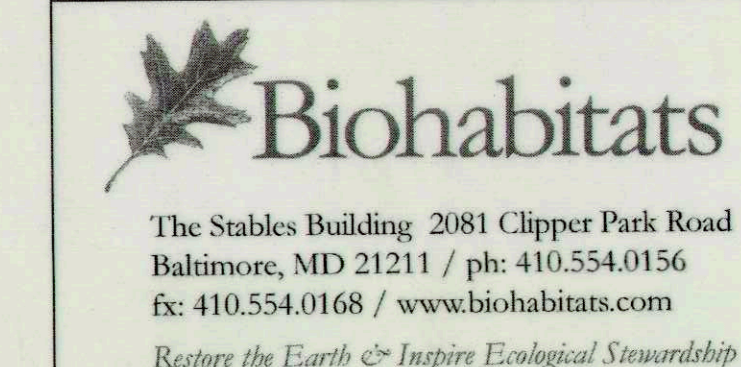


**LONGVIEW DRIVE  
STREAM  
STABILIZATION**

SITE ADDRESS: 6909 LONGVIEW DR, ELLICOTT CITY, MD  
ZONING: R-20, R-ED TAX MAP/GRID/PARCEL: 0024/0003/0640  
ELECTION DISTRICT: 02 OPEN LOT N/A  
WAIVER PETITION WP-18-022

**EROSION &  
SEDIMENT  
CONTROL DETAILS**

|              |          |           |         |
|--------------|----------|-----------|---------|
| PROJECT NO.: | 13005.50 | SCALE:    | NTS     |
| SEAL:        |          | BY:       | RW/KT   |
|              |          | CHECK:    | MDT/MWT |
|              |          | DWG. NO.: |         |

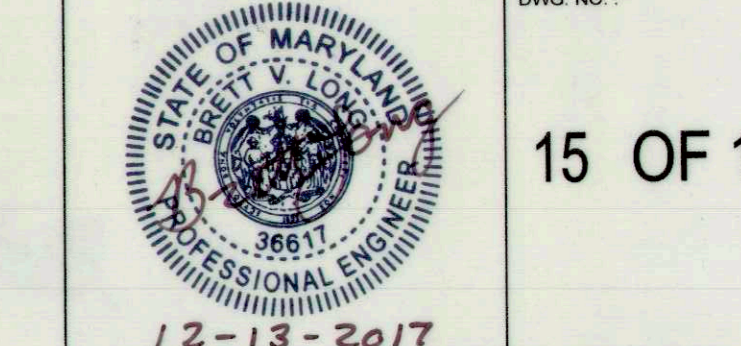

15 OF 18

This development plan is approved for soil erosion and sediment control by the HOWARD SOIL CONSERVATION DISTRICT  
*[Signature]*  
Howard SCD

DEPARTMENT OF PUBLIC WORKS, HOWARD COUNTY, MD  
*[Signature]*  
CHIEF, BUREAU OF ENVIRONMENTAL SERVICES  
DATE: 12/19/17

MATCHLINE - SHEET 17



**CLIENT**  
 HOWARD COUNTY DPW  
 BUREAU OF ENVIRONMENTAL SERVICES  
 STORMWATER MANAGEMENT DIVISION  
 6751 GATEWAY DRIVE, SUITE 514  
 COLUMBIA, MD 21046  
 PHONE: (410) 313-6413

DATE ISSUES / REVISIONS

**Biohabitats**  
 The Stables Building 2081 Clipper Park Road  
 Baltimore, MD 21211 / ph: 410.554.0156  
 fx: 410.554.0168 / www.biohabitats.com  
 Restore the Earth & Inspire Ecological Stewardship


**LONGVIEW DRIVE  
 STREAM  
 STABILIZATION**

TRAVERSE TABLE

| POINT | NORTHING  | EASTING    | ELEVATION |
|-------|-----------|------------|-----------|
| 1     | 586933.85 | 1357436.12 | 370.30    |
| 2     | 587105.39 | 1357380.04 | 362.69    |
| 3     | 587347.83 | 1357395.91 | 368.96    |
| 100   | 586832.01 | 1357441.76 | 370.88    |
| 101   | 586949.92 | 1357250.55 | 373.17    |
| 102   | 587465.41 | 1357384.47 | 368.63    |

**PLANTING LEGEND**

- PLANTING ZONE 1  
RIPARIAN PIEDMONT FOREST
- PLANTING ZONE 2  
FLOODPLAIN BENCH
- PLANTING ZONE 3  
TURFGRASS

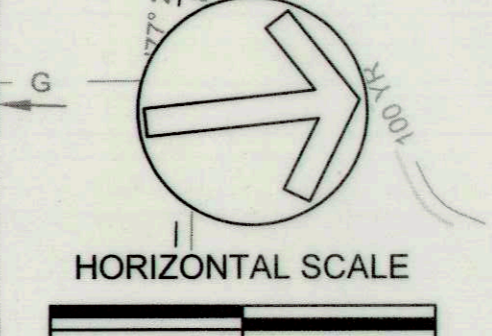


DEPARTMENT OF PUBLIC WORKS, HOWARD COUNTY, MD  
 [Signature]  
 CHIEF, BUREAU OF ENVIRONMENTAL SERVICES  
 DATE 12/14/17

SITE ADDRESS: 9509 LONGVIEW DR, ELLICOTT CITY, MD  
 ZONING: R-20, R-ED TAX MAP/GRID/PARCEL: 0024/0003/0640  
 ELECTION DISTRICT: 02 OPEN LOT N/A  
 WAIVER PETITION WP-18-022

**PLANTING PLAN**

PROJECT NO.: 13005.50 SCALE: 1" = 20'  
 SEAL BY: RW/KT CHECK: MDT/MWT  
 DWG. NO.:

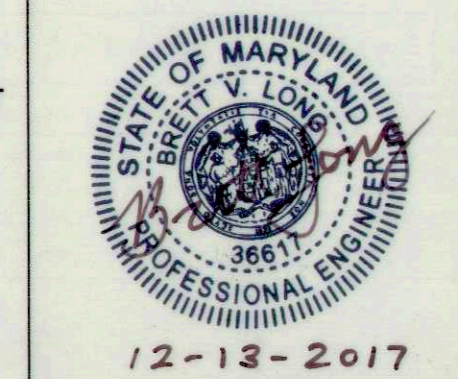




CLIENT

HOWARD COUNTY DPW  
 BUREAU OF ENVIRONMENTAL SERVICES  
 STORMWATER MANAGEMENT DIVISION  
 6751 GATEWAY DRIVE, SUITE 514  
 COLUMBIA, MD 21046  
 PHONE: (410) 313-6413

DATE ISSUES / REVISIONS

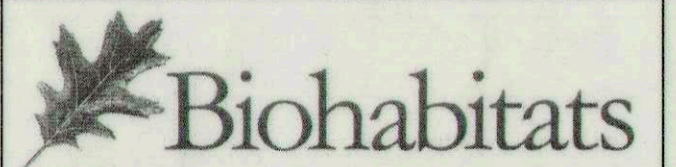

The Stables Building 2081 Clipper Park Road  
 Baltimore, MD 21211 / ph: 410.554.0156  
 fx: 410.554.0168 / www.biohabitats.com  
 Restore the Earth & Inspire Ecological Stewardship


LONGVIEW DRIVE  
 STREAM  
 STABILIZATION

SITE ADDRESS: 9509 LONGVIEW DR. ELLICOTT CITY, MD  
 ZONING: R-20, R-ED TAX MAP GRID/PARCEL: 0024/0003/00640  
 ELECTION DISTRICT: 02 OPEN LOT N/A  
 WAIVER PETITION WP-18-022

PLANTING PLAN

PROJECT NO.: 13005.50 SCALE: 1" = 20'

SEAL: BY: RW/KT CHECK: MDT/MWT  
 DWG. NO.:

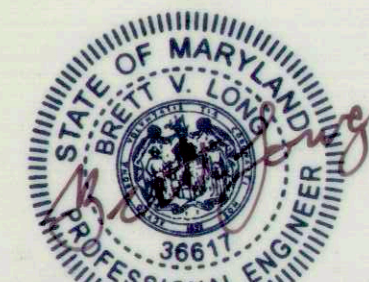

17 OF 18

12-13-2017



AMELA AND THOMAS FISHER  
 LIBER 9463 FOLIO 158  
 MAP 24 GRID 3 PARCEL 807

N5° 07' 49.49"E  
 94.911

DEPARTMENT OF PUBLIC WORKS, HOWARD COUNTY, MD  
 Chief, Bureau of Environmental Services  
 DATE: 12/19/17

MATCHLINE - SHEET 16

**CLIENT**

HOWARD COUNTY DPW  
BUREAU OF ENVIRONMENTAL SERVICES  
STORMWATER MANAGEMENT DIVISION  
6751 GATEWAY DRIVE, SUITE 514  
COLUMBIA, MD 21046  
PHONE: (410) 313-6413

DATE ISSUES / REVISIONS




The Stables Building 2081 Clipper Park Road  
Baltimore, MD 21211 / ph: 410.554.0156  
fx: 410.554.0168 / www.biohabitats.com  
Restore the Earth • Inspire Ecological Stewardship

**LONGVIEW DRIVE  
STREAM  
STABILIZATION**

SITE ADDRESS: 9509 LONGVIEW DR, ELLICOTT CITY, MD  
ZONING: R-33, R-ED TAX MAP/PARCEL: 0024/0003/00640  
ELECTION DISTRICT: 02 OPEN LOT N/A  
WAIVER PETITION WP-18-022

**PLANTING DETAILS**

|              |          |           |         |
|--------------|----------|-----------|---------|
| PROJECT NO.: | 13005.50 | SCALE:    | NTS     |
| SEAL:        |          | BY:       | RW/KT   |
|              |          | CHECK:    | MDT/MWT |
|              |          | DWG. NO.: |         |

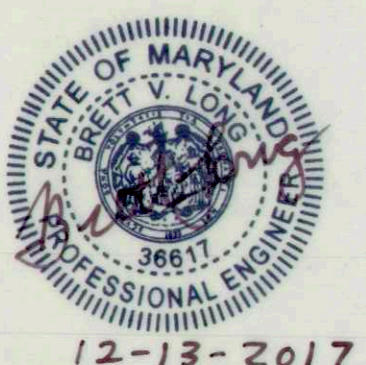

**PLANT COMPOSITION SCHEDULE**  
**Zone 1 - Riparian Forest** Size (acres): 0.35

| Overall Minimum Spacing (ft.) | Quantity per acre | Frequency (%) | Species Quantity | Vegetation Strata/Species Name    | Common Name         | Unit              | Spacing Type | Height        | Individual Minimum Spacing (ft.) |
|-------------------------------|-------------------|---------------|------------------|-----------------------------------|---------------------|-------------------|--------------|---------------|----------------------------------|
| 20                            | 109               |               |                  | <b>TREES*</b>                     |                     |                   |              |               |                                  |
|                               |                   | 20            | 8                | <i>Acer rubrum</i>                | Red maple           | CON (#10-15)      | Random       | 6 ft. min.    | 44                               |
|                               |                   | 5             | 2                | <i>Betula nigra</i>               | River birch         | CON (#10-15)      | Random       | 6 ft. min.    | 87                               |
|                               |                   | 10            | 4                | <i>Nyssa sylvatica</i>            | Black gum           | CON (#10-15)      | Random       | 6 ft. min.    | 62                               |
|                               |                   | 10            | 4                | <i>Platanus occidentalis</i>      | Sycamore            | CON (#10-15)      | Random       | 6 ft. min.    | 62                               |
|                               |                   | 15            | 6                | <i>Quercus alba</i>               | White oak           | CON (#10-15)      | Random       | 6 ft. min.    | 50                               |
|                               |                   | 15            | 6                | <i>Cornus florida</i>             | Flowering dogwood   | CON (#10-15)      | Random       | 5 ft. min.    | 50                               |
|                               |                   | 10            | 4                | <i>Sassafras albidum</i>          | Sassafras           | CON (#10-15)      | Random       | 5 ft. min.    | 62                               |
|                               |                   | 15            | 6                | <i>Cercis canadensis</i>          | Eastern redbud      | CON (#10-15)      | Random       | 5 ft. min.    | 50                               |
|                               |                   | 100           | 40               | = total                           |                     |                   |              |               |                                  |
| 13.4                          | 243               |               |                  | <b>SHRUBS</b>                     |                     |                   |              |               |                                  |
|                               |                   | 25            | 21               | <i>Amelanchier arborea</i>        | Common Serviceberry | CON (#2)          | Random       | 3 - 4 ft (#2) | 27                               |
|                               |                   | 25            | 21               | <i>Ilex verticillata</i>          | Winterberry         | CON (#2)          | Random       | 3 - 4 ft (#2) | 27                               |
|                               |                   | 30            | 26               | <i>Lindera benzoin</i>            | Spicebush           | CON (#2)          | Random       | 3 - 4 ft (#2) | 24                               |
|                               |                   | 20            | 17               | <i>Viburnum dentatum</i>          | Southern arrowwood  | CON (#2)          | Random       | 3 - 4 ft (#2) | 30                               |
|                               |                   | 100           | 85               | = total                           |                     |                   |              |               |                                  |
| N/A                           | 70                |               |                  | <b>NATIVE SEED</b>                |                     |                   |              |               |                                  |
|                               |                   | 15            | 0.37             | <i>Asclepias syriaca</i>          | Common milkweed     | LB of P.L.S. 76 % | SEED         | N/A           | N/A                              |
|                               |                   | 15            | 0.37             | <i>Chasmanthium latifolium</i>    | River oats          | LB of P.L.S. 76 % | SEED         | N/A           | N/A                              |
|                               |                   | 12            | 0.29             | <i>Dichanthelium clandestinum</i> | Deer tongue         | LB of P.L.S. 76 % | SEED         | N/A           | N/A                              |
|                               |                   | 12            | 0.29             | <i>Elymus riparius</i>            | Riverbank wild rye  | LB of P.L.S. 76 % | SEED         | N/A           | N/A                              |
|                               |                   | 12            | 0.29             | <i>Elymus virginicus</i>          | Virginia wild rye   | LB of P.L.S. 76 % | SEED         | N/A           | N/A                              |
|                               |                   | 12            | 0.29             | <i>Eutrochium fistulosum</i>      | Joe-pye weed        | LB of P.L.S. 76 % | SEED         | N/A           | N/A                              |
|                               |                   | 10            | 0.25             | <i>Lolium multiflorum</i>         | Annual rye          | LB of P.L.S. 76 % | SEED         | N/A           | N/A                              |
|                               |                   | 12            | 0.29             | <i>Monarda fistulosa</i>          | Wild bergamot       | LB of P.L.S. 76 % | SEED         | N/A           | N/A                              |
|                               |                   | 100           | 2.45             | = total                           |                     |                   |              |               |                                  |

CON=container, P.L.S.=pure live seed  
\* No trees are to be planted within 15' on either side of the sanitary sewer and overhead utility lines

**PLANT COMPOSITION SCHEDULE**  
**Zone 2 - Floodplain Bench** Size (acres): 0.03

| Overall Minimum Spacing (ft.) | Quantity per acre | Frequency (%) | Species Quantity | Vegetation Strata/Species Name        | Common Name        | Unit              | Spacing Type | Height        | Individual Minimum Spacing (ft.) |
|-------------------------------|-------------------|---------------|------------------|---------------------------------------|--------------------|-------------------|--------------|---------------|----------------------------------|
| 6                             | 1210              |               |                  | <b>SHRUBS</b>                         |                    |                   |              |               |                                  |
|                               |                   | 25            | 9                | <i>Alnus semilata</i>                 | Smooth alder       | CON (#2)          | Random       | 3 - 4 ft (#2) | 12                               |
|                               |                   | 20            | 7                | <i>Ilex verticillata</i>              | Winterberry        | CON (#2)          | Random       | 3 - 4 ft (#2) | 14                               |
|                               |                   | 15            | 6                | <i>Lindera benzoin</i>                | Spicebush          | CON (#2)          | Random       | 3 - 4 ft (#2) | 15                               |
|                               |                   | 20            | 7                | <i>Sambucus nigra var. canadensis</i> | Elderberry         | CON (#2)          | Random       | 3 - 4 ft (#2) | 14                               |
|                               |                   | 20            | 7                | <i>Viburnum acerifolium</i>           | Mapleleaf viburnum | CON (#2)          | Random       | 3 - 4 ft (#2) | 14                               |
|                               |                   | 100           | 36               | = total                               |                    |                   |              |               |                                  |
| N/A                           | 70                |               |                  | <b>NATIVE SEED</b>                    |                    |                   |              |               |                                  |
|                               |                   | 15            | 0.03             | <i>Elymus riparius</i>                | Riverbank wild rye | LB of P.L.S. 76 % | SEED         | N/A           | N/A                              |
|                               |                   | 25            | 0.05             | <i>Dichanthelium clandestinum</i>     | Deer tongue grass  | LB of P.L.S. 76 % | SEED         | N/A           | N/A                              |
|                               |                   | 10            | 0.02             | <i>Eupatorium fistulosum</i>          | Joe-pye weed       | LB of P.L.S. 76 % | SEED         | N/A           | N/A                              |
|                               |                   | 5             | 0.01             | <i>Lobelia cardinalis</i>             | Cardinal flower    | LB of P.L.S. 76 % | SEED         | N/A           | N/A                              |
|                               |                   | 10            | 0.02             | <i>Onoclea sensibilis</i>             | Sensitive fern     | LB of P.L.S. 76 % | SEED         | N/A           | N/A                              |
|                               |                   | 10            | 0.02             | <i>Osmunda regalis</i>                | Royal fern         | LB of P.L.S. 76 % | SEED         | N/A           | N/A                              |
|                               |                   | 15            | 0.03             | <i>Saururus cernuus</i>               | Lizards tail       | LB of P.L.S. 76 % | SEED         | N/A           | N/A                              |
|                               |                   | 10            | 0.02             | <i>Woodwardia areolata</i>            | Netted chainfern   | LB of P.L.S. 76 % | SEED         | N/A           | N/A                              |
|                               |                   | 100           | 0.21             | = total                               |                    |                   |              |               |                                  |

CON=container, P.L.S.=pure live seed

**PLANT COMPOSITION SCHEDULE**  
**ZONE 3 - TURF GRASS** Size (acres): 0.39

| Overall Minimum Spacing (ft.) | Quantity per acre | Frequency (%) | Species Quantity | Vegetation Strata/Species Name | Common Name   | Unit              | Spacing Type | Size | Individual Minimum Spacing (ft.) |
|-------------------------------|-------------------|---------------|------------------|--------------------------------|---------------|-------------------|--------------|------|----------------------------------|
| N/A                           | 40                |               |                  | <b>NATIVE SEED</b>             |               |                   |              |      |                                  |
|                               |                   | 25            | 3.9              | <i>Agrostis alba</i>           | Red top       | LB of P.L.S. 76 % | SEED         | N/A  | N/A                              |
|                               |                   | 30            | 4.7              | <i>Festuca ovina</i>           | Sheeps fescue | LB of P.L.S. 76 % | SEED         | N/A  | N/A                              |
|                               |                   | 45            | 7                | <i>Festuca rubra</i>           | Red fescue    | LB of P.L.S. 76 % | SEED         | N/A  | N/A                              |
|                               |                   | 100           | 15.6             | = total                        |               |                   |              |      |                                  |

CON=container

**PLANT COMPOSITION SCHEDULE: REFER TO PLANTING SHEETS 32-35**  
**ZONE 4 - LANDSCAPE TREES** Size (acres): n/a


| Overall Minimum Spacing (ft.) | Species Quantity | ID | Vegetation Strata/Species Name | Common Name               | Unit | Form        | Size    | Individual Minimum Spacing (ft.) |
|-------------------------------|------------------|----|--------------------------------|---------------------------|------|-------------|---------|----------------------------------|
| N/A                           |                  |    | <b>OVERSTORY TREES</b>         |                           |      |             |         |                                  |
|                               | 1                | BN | <i>Betula nigra</i>            | River birch               | B&B  | Clump Form  | 2" cal. | Per Plan                         |
|                               | 3                | AR | <i>Acer rubrum</i>             | Red Maple (October Glory) | B&B  | Single Stem | 4" cal. | Per Plan                         |
|                               | 6                | CC | <i>Cercis canadensis</i>       | Redbud                    | B&B  | Single Stem | 2" cal. | Per Plan                         |
|                               | 2                | QA | <i>Quercus alba</i>            | White oak                 | B&B  | Single Stem | 4" cal. | Per Plan                         |
|                               | 12               |    | = total                        |                           |      |             |         |                                  |

B&B= Balled & Burlapped

**PLANT COMPOSITION SCHEDULE**  
**ZONE 5 - LIVE STAKES** Size (acres): 0.027


| Individual Plant Minimum Spacing (ft.) | Quantity per AC | Frequency (%) | Species Quantity | Vegetation Strata/Species Name       | Common Name        | Unit        | Spacing Type | Size (ft.) | Overall Minimum Species Spacing (ft.)* |
|--|-----------------|---------------|------------------|--------------------------------------|--------------------|-------------|--------------|------------|--|
| 1                                      | 43560           | LF            |                  | <b>SHRUBS - LIVE BRANCH LAYERING</b> |                    |             |              |            |  |
|  |                 | 25            | 294              | <i>Cornus amomum</i>                 | Silky dogwood      | live branch | N/A          | 3          | N/A                                    |
|  |                 | 25            | 294              | <i>Cornus sericea</i>                | Redosier dogwood   | live branch | N/A          | 3          | N/A                                    |
|  |                 | 15            | 176.4            | <i>Salix discolor</i>                | Pussy willow       | live branch | N/A          | 3          | N/A                                    |
|  |                 | 15            | 176.4            | <i>Salix exigua ssp. Interior</i>    | Sandbar willow     | live branch | N/A          | 3          | N/A                                    |
|  |                 | 10            | 117.6            | <i>Salix sericea</i>                 | Silky willow       | live branch | N/A          | 3          | N/A                                    |
|  |                 | 10            | 117.6            | <i>Viburnum dentatum</i>             | Arrowleaf viburnum | live branch | N/A          | 3          | N/A                                    |
|  |                 | 100           | 1176             | = total                              |                    |             |              |            |  |

\*Live Stakes are a contingent item and shall be installed at the direction of the engineer

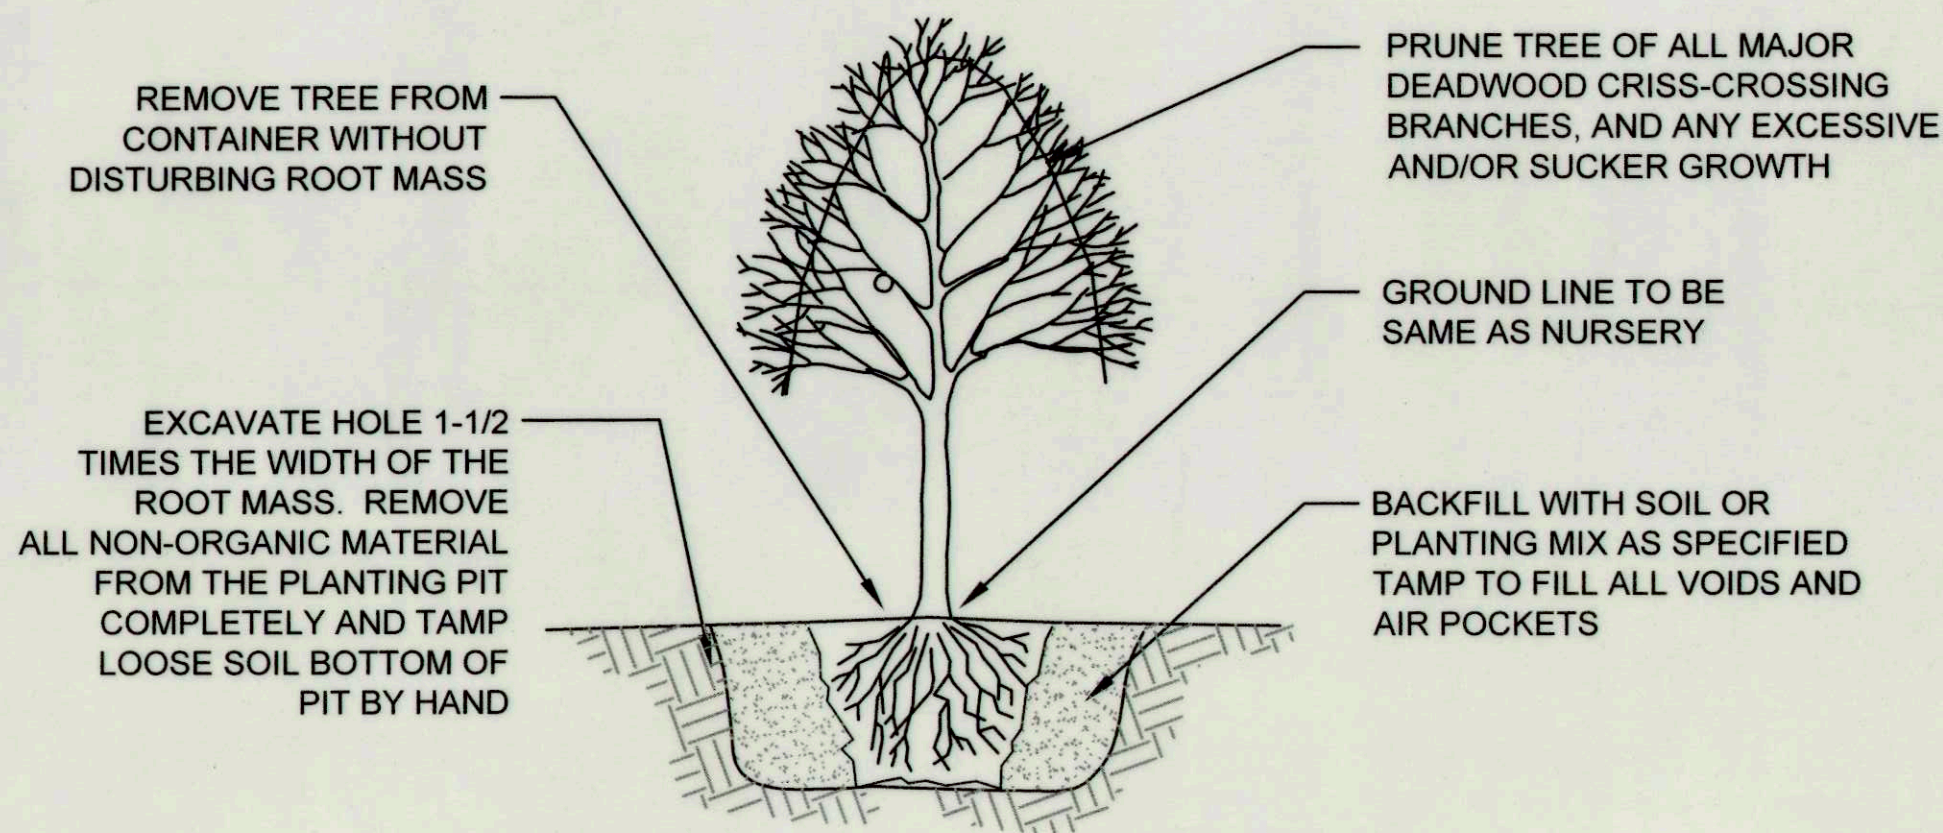


**TREE PLANTING - CONTAINER GROWN**

NOT TO SCALE

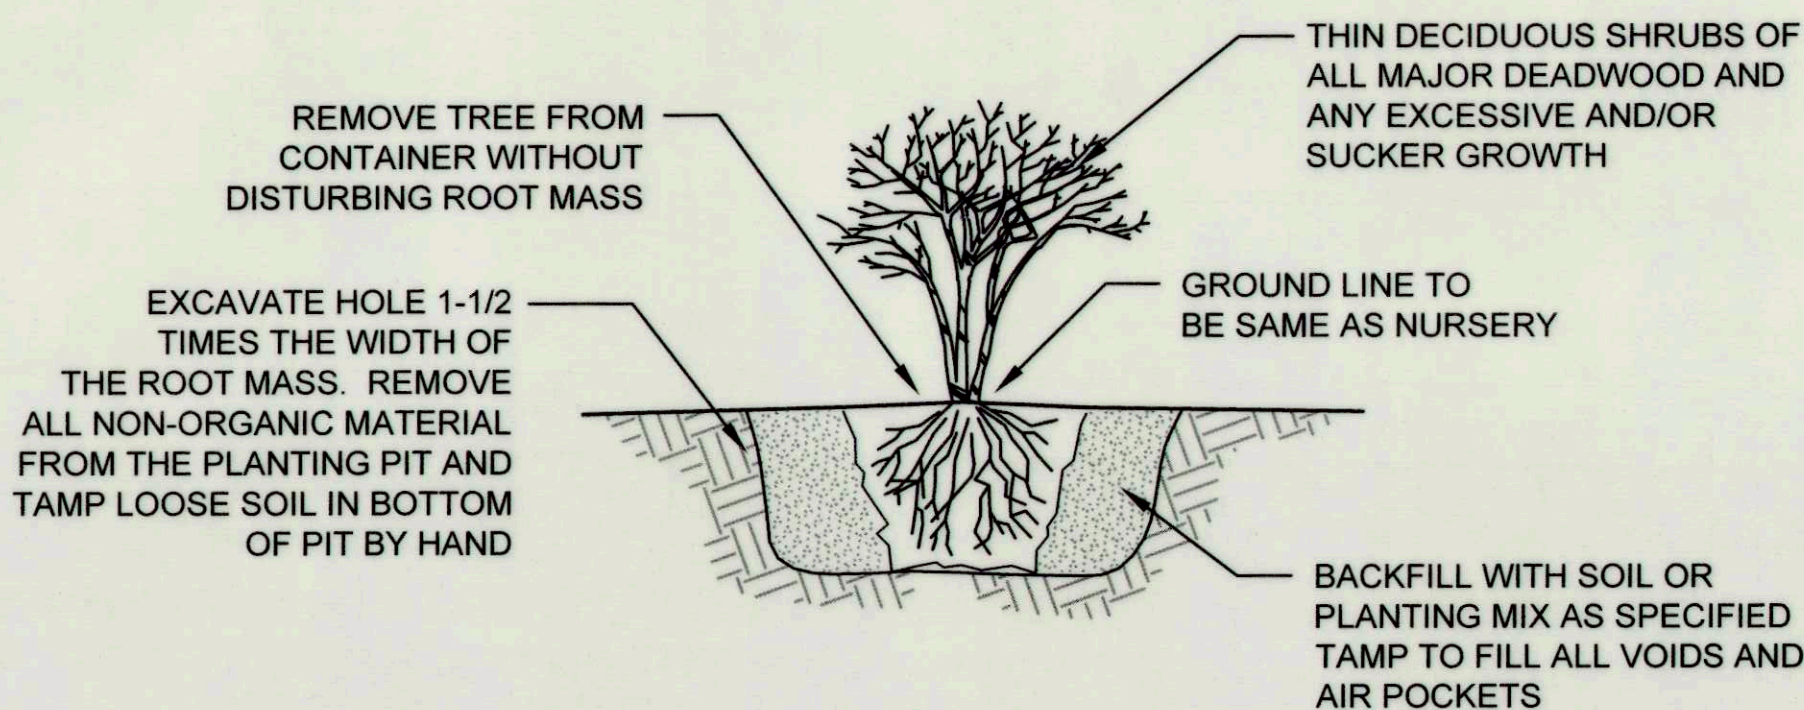

**SHRUB PLANTING - CONTAINER GROWN**

NOT TO SCALE

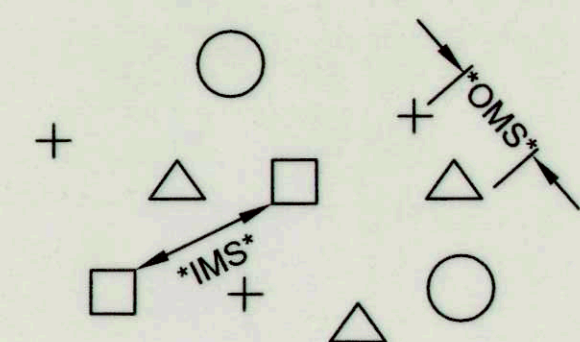

OMS- AN OVERALL MINIMUM SPACING DISTANCE "OMS" IS ASSIGNED TO THE PLANTING CONFIGURATION \*SEE PLANT SCHEDULE\*  
IMS- AN INDIVIDUAL MINIMUM SPACING DISTANCES "IMS" IS ASSIGNED TO EACH INDIVIDUAL SPECIES \*SEE PLANT SCHEDULE\*

**PLANT SPACING - RANDOM**

NOTE: EACH SYMBOL INDICATES A DIFFERENT SPECIES

**PLAN VIEW**

NOT TO SCALE

DEPARTMENT OF PUBLIC WORKS, HOWARD COUNTY, MD  
[Signature]  
CHIEF, BUREAU OF ENVIRONMENTAL SERVICES  
DATE: 12/14/17