




- LEGEND**
- BOLLARD
 - ✱ LIGHT
 - PAINT STRIPE
 - CURB
 - STORM DRAIN INLET
 - ⊙ TEST PIT LOCATED BY MATRICCIANI CO.
 - ⊙ FIRE HYDRANT

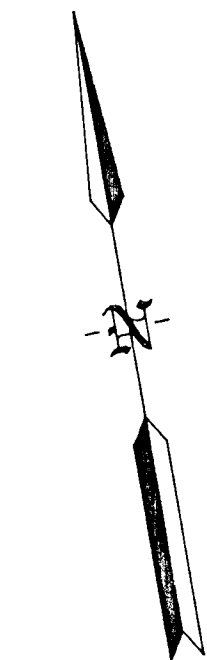

856400
522000

I, Warren Sorg, certify that this Topographic Survey Plat is the actual record of the electronic data collection topographic survey performed by me or by personnel under my direct supervision. This plat is the original and final graphic representation of the field survey performed on or about July 7, 1993. The instrument used in this survey was a Wild T1000 theodolite (3" accuracy) and Wild GRE-3 data collector. This Topographic Survey plat meets the requisite accuracy as specified for this project by Howard County, Department of Public Works.

Warren W. Sorg 1/6/93
Warren W. Sorg
MD Reg. No. 10858

DATE	REVISION

AS BUILT SURVEY

ELLCOTT CITY PARKING LOT
ELLCOTT CITY
HOWARD COUNTY, MARYLAND
CAPITAL PROJECT No. D1102

PROJ. MGR.	DRAWING NO. 91150.01	SCALE 1"=20'	DATE 7/15/93	SHEET NO. 1 OF 1
DESIGN	GREENMAN-PEDERSEN, INC. ENGINEERS/ARCHITECTS/PLANNERS			
DRAWN	14504 GREENVIEW DRIVE, SUITE 100, LAUREL, MD. 20709			
CHECKED	WASH. (301) 470-2772 BALT. (410) 880-3055			

154