

SHEET INDEX	
1	PLAN OF DAVIS AVENUE STORMWATER MANAGEMENT
2	PROFILES AND DETAILS
3	SEDIMENT CONTROL PLAN
4	SEDIMENT CONTROL NOTES AND DETAILS
5	PLANTING PLAN

STORMWATER MANAGEMENT DESIGN SUMMARY - SWMF #1				
DRAINAGE AREA: 32.9 acres				
DESIGN STORM (YR.)	FACILITY INFLOW (C.F.S.)	FACILITY DISCHARGE (C.F.S.)	WATER SURFACE ELEVATION (FT.)	STORAGE VOLUME (AC. FT.)
1	38.0	6.6	188.42	1.481
2	52.2	30.2	188.69	1.604
10	97.7	97.3	189.12	1.800
100	165.8	164.0	189.38	1.918

NOTE: THE STORMWATER MANAGEMENT FACILITY IS A DETENTION FACILITY AND IS TO BE OWNED AND MAINTAINED BY HOWARD COUNTY.


OPERATION, MAINTENANCE AND INSPECTION
 HOWARD COUNTY WILL OWN, OPERATE, MAINTAIN THE STORMWATER MANAGEMENT FACILITY. INSPECTION OF THE POND BY SHOWN HEREON SHALL BE PERFORMED AT LEAST ANNUALLY. IN ACCORDANCE WITH THE CHECKLIST AND REQUIREMENTS CONTAINED WITHIN USDA, SOCS "STANDARDS AND SPECIFICATIONS FOR PONDS" (10-378) HOWARD COUNTY DEPARTMENT OF PUBLIC WORKS AND ANY HEIRS, SUCCESSORS OR ASSIGNS SHALL BE RESPONSIBLE FOR THE SAFETY OF THE ROAD AND THE CONTINUED OPERATION, SURVEILLANCE, INSPECTION, AND MAINTENANCE THEREOF. HOWARD COUNTY DEPARTMENT OF PUBLIC WORKS SHALL PROMPTLY NOTIFY THE SOIL CONSERVATION DISTRICT OF ANY UNUSUAL OBSERVATIONS THAT MAY BE INDICATIONS OF DISTRESS SUCH AS EXCESSIVE SEEPAGE, TURBID SEEPAGE, SLIDING, OR SLUMPING.

S.W.M. FACILITY EMBANKMENT & DATA	
STATIONS	BEARINGS
① CL STA 0+00, N 525,502.58 E 1,359,510.70	① - N 12°36'32" E, 4.73'
② CL STA 0+04.73	② - R=10.00', L=10.50'
③ CL STA 0+15.23	③ - S 44°13'07" E, 76.54'
④ CL STA 0+91.77	④ - S 80°44'34" N, 39.62'
⑤ CL STA 1+27.38	⑤ - R=95.00', L=15.53'
⑥ CL STA 1+42.42	⑥ - N 63°18'54" E, 52.35'
⑦ CL STA 1+75.25	

NOTE: CONTRACTOR TO MAINTAIN THROUGH TRAFFIC TO ALL BUSINESSES DURING CONSTRUCTION.


BENCHMARKS

BM1 N 525,643.91 E 1,359,624.32 EL=189.95
 RIEMER MUEGGE & ASSOC., INC CONTROL STATION NUMBER 100, PIN WITH YELLOW CAP.
 BM2 N 525,518.09 E 1,359,541.62 EL=187.48
 RIEMER MUEGGE & ASSOC., INC CONTROL STATION NUMBER 101, PARKER KALON NAIL WITH SHINER.
 HOWARD COUNTY SURVEY CONTROL STATION 508A
 N 527,561.67 E 1,359,772.59 EL=249.40
 HOWARD COUNTY SURVEY CONTROL STATION 508S
 N 524,999.36 E 1,357,925.68 EL=178.15

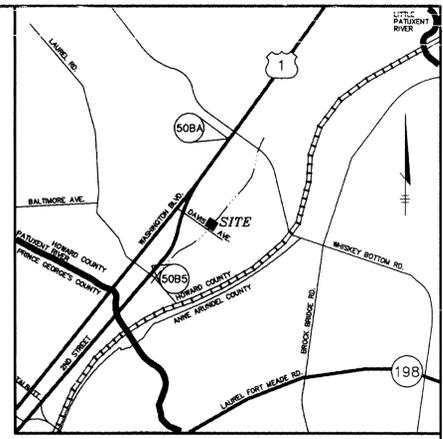

GENERAL NOTES

- ALL CONSTRUCTION SHALL BE IN ACCORDANCE WITH THE LATEST STANDARDS AND SPECIFICATIONS OF HOWARD COUNTY PLUS MEHA STANDARDS AND SPECIFICATIONS, IF APPLICABLE.
- THE CONTRACTOR SHALL NOTIFY THE DEPARTMENT OF PUBLIC WORKS/BUREAU OF ENGINEERING/CONSTRUCTION INSPECTOR DIVISION AT (410) 313-1800 AT LEAST FIVE (5) WORKING DAYS PRIOR TO THE START OF WORK.
- THE CONTRACTOR SHALL NOTIFY "MISS UTILITY" AT 1-800-257-7777 AT LEAST 48 HOURS PRIOR TO ANY EXCAVATION WORK BEING DONE.
- TRAFFIC CONTROL DEVICES, MARKINGS, AND SIGNING SHALL BE IN ACCORDANCE WITH THE LATEST EDITION OF THE MANUAL ON UNIFORM TRAFFIC CONTROL DEVICES (MUTCD). ALL STREET AND REGULATORY SIGNS SHALL BE IN PLACE PRIOR TO THE PLACEMENT OF AN ASPHALT.
- THE EXISTING TOPOGRAPHY IS TAKEN FROM AN APRIL, 1997, FIELD SURVEY WITH MAXIMUM TWO FOOT CONTOUR INTERVALS PREPARED BY RIEMER MUEGGE & ASSOCIATES, INC.
- THE COORDINATES SHOWN HEREON ARE BASED UPON THE HOWARD COUNTY GEODETIC CONTROL WHICH IS BASED UPON THE MARYLAND STATE PLANE COORDINATE SYSTEM. HOWARD COUNTY MONUMENT NOS. 508A AND 508S WERE USED FOR THIS PROJECT.
- APPROXIMATE LOCATION OF EXISTING UTILITIES ARE SHOWN. THE CONTRACTOR SHALL TAKE ALL NECESSARY PRECAUTIONS TO PROTECT THE EXISTING UTILITIES AND MAINTAIN UNINTERRUPTED SERVICE. ANY DAMAGE INCURRED DUE TO CONTRACTOR'S OPERATION SHALL BE REPAIRED IMMEDIATELY AT THE CONTRACTOR'S EXPENSE. EXISTING UTILITIES ARE SHOWN BASED ON THE BEST AVAILABLE INFORMATION.
- A TRAFFIC STUDY IS NOT REQUIRED FOR THIS PROJECT.
- A NOISE STUDY IS NOT REQUIRED FOR THIS PROJECT.
- A GEOTECHNICAL STUDY WAS PREPARED BY HILLES-GARNES, INC DATED MAY, 1997.
- A BOUNDARY SURVEY HAS NOT BEEN PREPARED FOR THIS PROJECT.
- SUBJECT PROPERTY ZONED M-2.
- ALL ELEVATIONS SHOWN ARE BASED ON THE U.S.C. AND G.S. MEAN SEA LEVEL DATUM, 1929. HORIZONTAL ELEVATIONS ARE BASED ON N.A.D. 83.
- THE CONTRACTOR SHALL TEST PIT EXISTING UTILITIES AT LEAST FIVE (5) DAYS BEFORE STARTING WORK ON THESE DRAWINGS.
- CONTRACTOR IS SOLELY RESPONSIBLE FOR CONSTRUCTION MEANS, METHODS, TECHNIQUES, SEQUENCES, PROCEDURES, AND SAFETY PRECAUTIONS AND PROGRAMS.
- PIPE SHALL NOT BE INSTALLED BY THE CONTRACTOR UNTIL THE LENGTH CALLED FOR AT EACH STATION HAS BEEN APPROVED BY THE ENGINEER IN THE FIELD.
- NO PIPE SHALL BE LAID UNTIL LINES OF EXCAVATION HAVE BEEN BROUGHT WITHIN 6" OF FINISHED GRADE.
- SEDIMENT AND EXCAVATED MATERIAL SHALL BE HAULED OFF-SITE AND DISPOSED AT AN APPROVED SOIL DISPOSAL AREA WITH AN APPROVED SEDIMENT CONTROL PLAN.
- ALL INLETS SHALL BE CONSTRUCTED IN ACCORDANCE WITH HOWARD COUNTY STANDARDS.
- ALL PIPE ELEVATIONS SHOWN ARE INVERT ELEVATIONS.
- STORM DRAIN TRENCHES WITHIN ROAD RIGHT OF WAY SHALL BE BACKFILLED AND COMPACTED IN ACCORDANCE WITH THE HOWARD COUNTY DESIGN MANUAL, VOLUME IV, I.E., STANDARD SPECIFICATIONS AND DETAILS FOR CONSTRUCTION, LATEST AMENDMENTS.
- THIS PROJECT HAS BEEN APPROVED BY THE MARYLAND DEPARTMENT OF THE ENVIRONMENT UNDER #91-NI-0666, TRACKING #1491165131.
- ALL FILL AREAS WITHIN ROADWAY AND UNDER STRUCTURES TO BE COMPACTED TO A MINIMUM OF 95% COMPACTION OF AASHTO T100.
- CONTRACTOR TO GRADE AROUND THE TOP OF THE PROPOSED INLETS IN ORDER TO PROVIDE POSITIVE DRAINAGE TO THE INLETS. LINING SHALL BE AS SHOWN ON THE PLANS OR AS DIRECTED BY THE ENGINEER.
- TREES AND SHRUBS ARE TO BE PROTECTED FROM DAMAGE TO MAXIMUM EXTENT.
- CLEAR ALL UTILITIES BY A MINIMUM OF 12". CLEAR ALL POLES BY 2'-0" MINIMUM OR TUNNEL AS REQUIRED. THE CONTRACTOR SHALL COORDINATE WITH THE UTILITY COMPANIES TO SCHEDULE THE BRACING OF THE POLES, AT THE CONTRACTORS EXPENSE.
- PROPERTY INFORMATION HAS BEEN OBTAINED FROM THE BEST AVAILABLE SOURCE, AND CANNOT BE WARRANTED TO BE COMPLETE AND ACCURATE.
- CONTRACTOR SHALL INSTALL A WATERTIGHT JOINT BETWEEN CONCRETE WALL AND 12" CONCRETE PIPE USING A WATER STOP (#5-30) AS MANUFACTURED BY PRESS SEAL GASKET CORPORATION OR APPROVED EQUIVALENT.
- THE CONTRACTOR SHALL VIDEO TAPE THE SITE, INCLUDING DAVIS AVENUE, BEFORE AND IMMEDIATELY AFTER CONSTRUCTION. TAPE SHALL BE AT LEAST 5 MIN. LONG FOR EACH SESSION AND TAPE SHALL BE GIVEN TO COUNTY INSPECTOR. TAPE SHALL SHOW SITE DETAIL AND BE OF GOOD QUALITY.
- EXISTING MANHOLES T771, T776 AND SH11 HAVE NOT BEEN FIELD LOCATED.
- CONTRACTOR SHALL PLACE 4" TOPSOIL OVER DISTURBED AREAS TO BE VEGETATED. REVISE EXISTING TOPSOIL WHERE POSSIBLE.

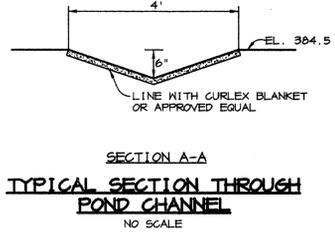

OWNER/DEVELOPER
 HOWARD COUNTY DEPARTMENT OF PUBLIC WORKS
 DIVISION OF STORMWATER MANAGEMENT
 6751 COLUMBIA GATEWAY DRIVE
 COLUMBIA, MARYLAND 21046

BY THE DEVELOPER:
 I/WE CERTIFY THAT ALL DEVELOPMENT AND CONSTRUCTION WILL BE DONE ACCORDING TO THIS PLAN, AND THAT ANY RESPONSIBLE PERSONNEL INVOLVED IN THE CONSTRUCTION PROJECT WILL HAVE A CERTIFICATE OF ATTENDANCE AT A DEPARTMENT OF THE ENVIRONMENT APPROVED TRAINING PROGRAM FOR THE CONTROL OF SEDIMENT AND EROSION BEFORE BEGINNING THE PROJECT. I SHALL ENGAGE A REGISTERED PROFESSIONAL ENGINEER TO SUPERVISE POND CONSTRUCTION AND PROVIDE THE HOWARD SOIL CONSERVATION DISTRICT WITH AN "AS-BUILT" PLAN OF THE POND WITHIN 30 DAYS OF COMPLETION. I ALSO AUTHORIZE PERIODIC ON-SITE INSPECTIONS BY THE HOWARD SOIL CONSERVATION DISTRICT.
John J. O'Hara 1/27/98
 DEVELOPER DATE

BY THE ENGINEER:
 I CERTIFY THAT THIS PLAN FOR POND CONSTRUCTION, EROSION AND SEDIMENT CONTROL REPRESENTS A PRACTICAL AND WORKABLE PLAN BASED ON MY PERSONAL KNOWLEDGE OF THE SITE CONDITIONS. THIS PLAN WAS PREPARED IN ACCORDANCE WITH THE REQUIREMENTS OF THE HOWARD SOIL CONSERVATION DISTRICT. I HAVE NOTIFIED THE DEVELOPER THAT HE/SHE MUST ENGAGE A REGISTERED PROFESSIONAL ENGINEER TO SUPERVISE POND CONSTRUCTION AND PROVIDE THE HOWARD SOIL CONSERVATION DISTRICT WITH AN "AS-BUILT" PLAN OF THE POND WITHIN 30 DAYS OF COMPLETION.
Donald E. Hicks 1/27/98
 ENGINEER DATE

THESE PLANS HAVE BEEN REVIEWED FOR THE HOWARD SOIL CONSERVATION DISTRICT AND MEET THE TECHNICAL REQUIREMENTS FOR SMALL POND CONSTRUCTION, SOIL EROSION AND SEDIMENT CONTROL.
Cammy Simmons 1/27/98
 NATURAL RESOURCES CONSERVATION DATE
 THESE PLANS FOR SMALL POND CONSTRUCTION, SOIL EROSION AND SEDIMENT CONTROL MEET THE REQUIREMENTS OF THE HOWARD SOIL CONSERVATION DISTRICT.
Rudolph J. ... 1/27/98
 HOWARD SOIL CONSERVATION DISTRICT DATE

AS-BUILT CERTIFICATION
 I HEREBY CERTIFY THAT THE FACILITY SHOWN ON THIS PLAN HAS BEEN CONSTRUCTED IN ACCORDANCE WITH THE "AS-BUILT" PLANS AND MEETS THE APPROVED PLANS AND SPECIFICATIONS.
Donald E. Hicks, P.E. 1/27/98
 DONALD E. HICKS, P.E. DATE 1/27/98
 I CERTIFY MEANS TO STATE OR DECLARE A PROFESSIONAL OPINION BASED UPON ON-SITE INSPECTIONS AND MATERIAL TESTS WHICH ARE CONDUCTED DURING CONSTRUCTION. THE ON-SITE INSPECTIONS AND MATERIAL TESTS ARE THOSE INSPECTIONS AND TESTS DEEMED SUFFICIENT AND APPROPRIATE BY COMMONLY ACCEPTED ENGINEERING STANDARDS. CERTIFY DOES NOT MEAN OR IMPLY A GUARANTEE BY THE ENGINEER NOR DOES AN ENGINEER'S CERTIFICATION RELIEVE ANY OTHER PARTY FROM MEETING REQUIREMENTS IMPOSED BY CONTRACT, EMPLOYMENT, OR OTHER MEANS, INCLUDING MEETING COMMONLY ACCEPTED INDUSTRY PRACTICES.

DEPARTMENT OF PUBLIC WORKS
 HOWARD COUNTY, MARYLAND
John J. O'Hara 1/27/98
 DIRECTOR OF PUBLIC WORKS DATE
Andrew M. ... 1-30-98
 CHIEF, BUREAU OF HIGHWAYS DATE

























RIEMER MUEGGE & ASSOCIATES, INC.
 ENGINEERING & ENVIRONMENTAL SERVICES • PLANNING • SURVEYING
 8810 Centre Park Drive, Columbia, Maryland 21045
 tel 410.997.8900 fax 410.997.5282
 FILE: 97085/SDF1

ARTHUR E. MUEGGE #8107

DES:	AAP				
DRN:	BLW				
CHK:	AAP				
DATE:	1/21/98	BAC	REVISED SWMF PER AS BUILT REDLINES	12.30.98	
BY	NO.	REVISION		DATE	

PLAN OF DAVIS AVENUE
 STORMWATER MANAGEMENT
 600' SCALE MAP NO. 50 BLOCK NO. 4.10




DAVIS AVENUE
 STORMWATER MANAGEMENT
 6th ELECTION DISTRICT
 HOWARD COUNTY, MARYLAND
 CAPITAL PROJECT NO. D-1112
 SCALE 1"=30'
 SHEET 1 OF 5

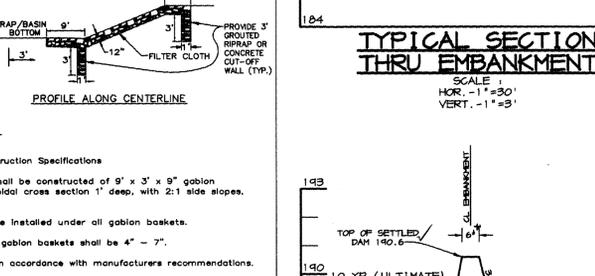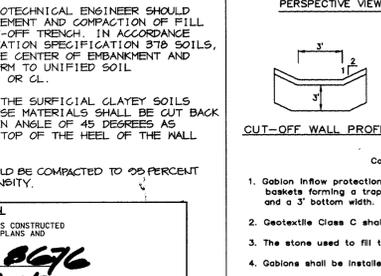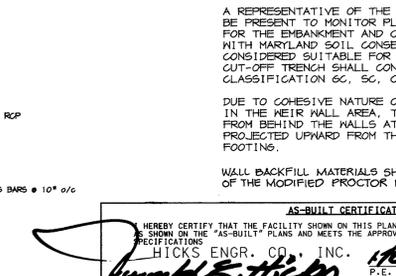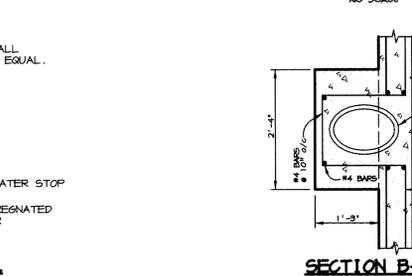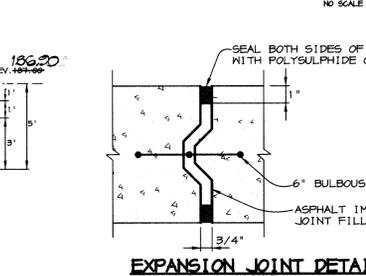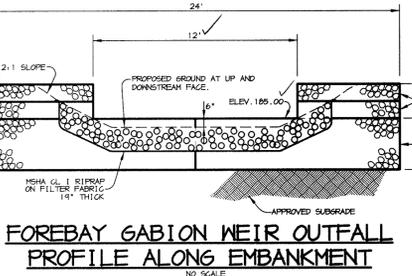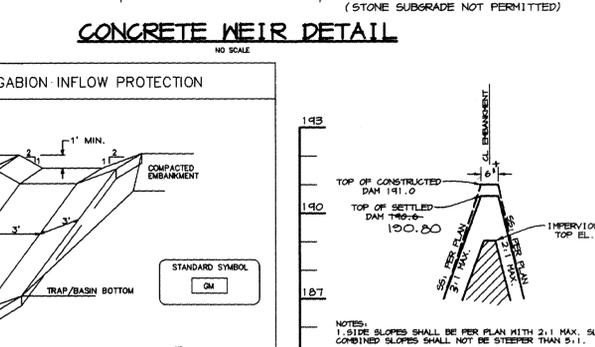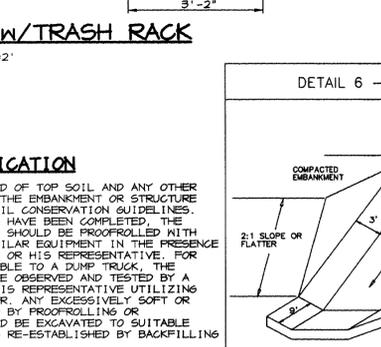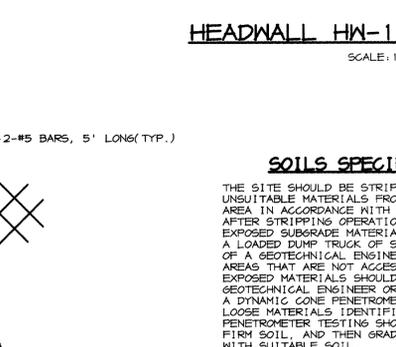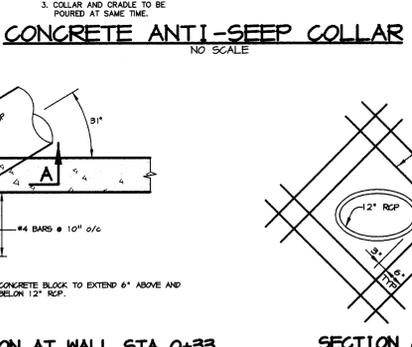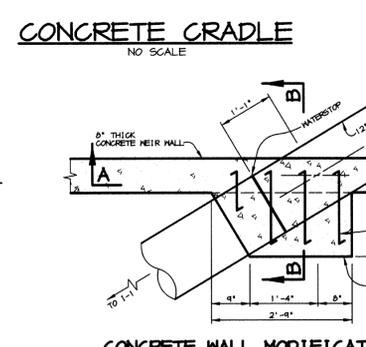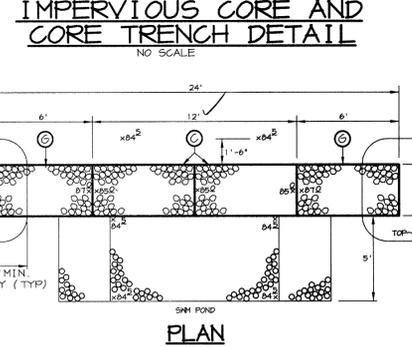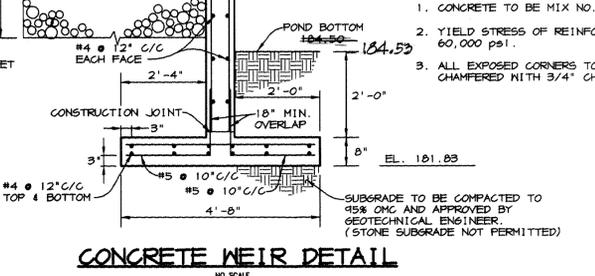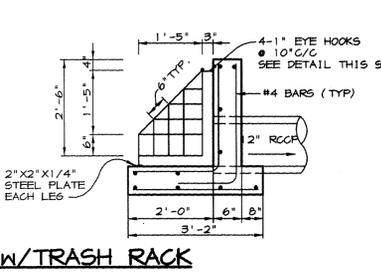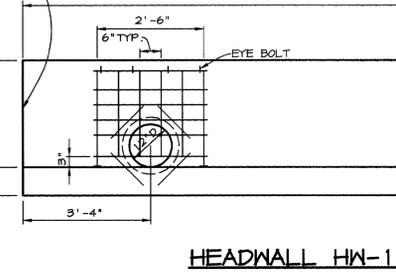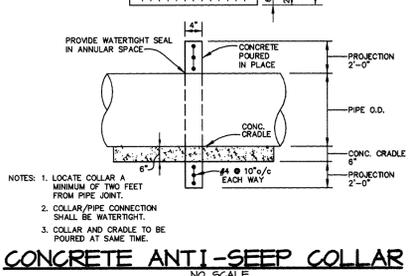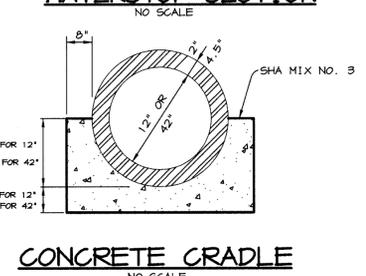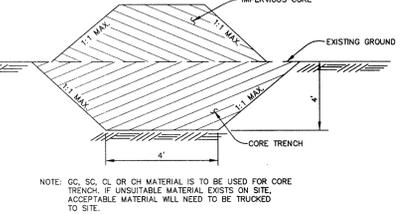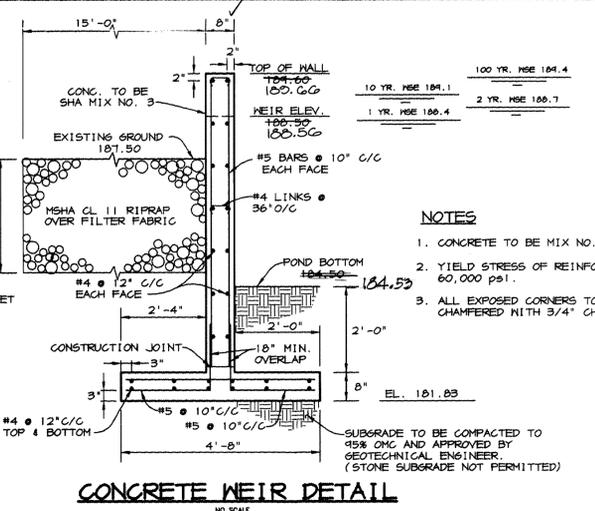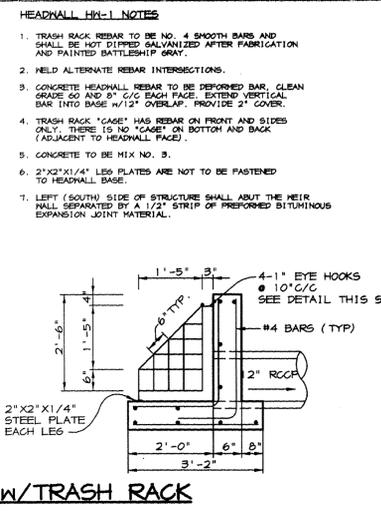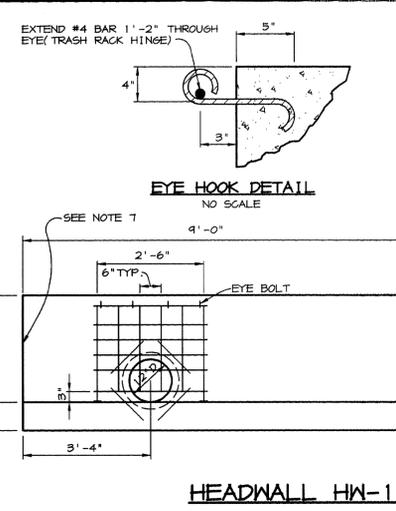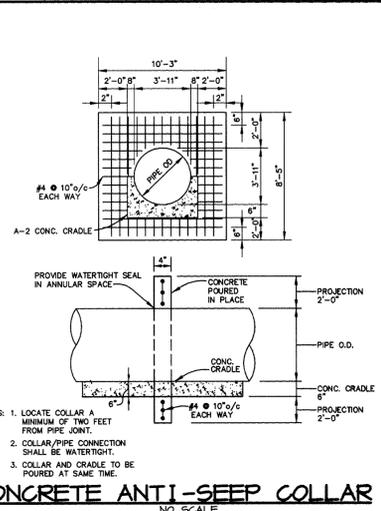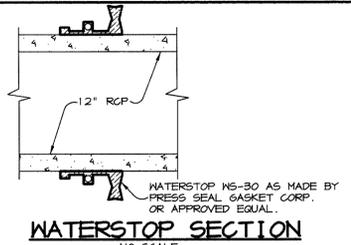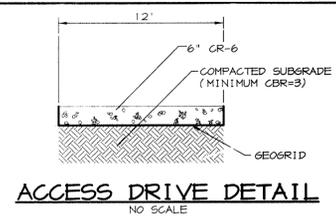

GABION SCHEDULE





LETTER DESIGNATION	NO. OF GABIONS	GABION DIMENSIONS
C	2	12' x 3' x 3'
D	4	6' x 3' x 1'

NOTES:
 1. GABIONS SHALL BE PVC COATED.
 2. OUTFALL RIPRAP SHALL EXTEND UP TO ELEV. 86.0

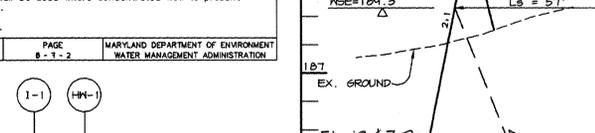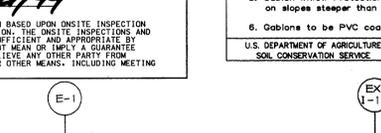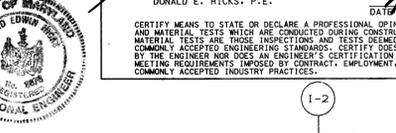

STRUCTURE SCHEDULE

STRUCTURE	TYPE	LOCATION	INV. IN	INV. OUT	ELEV.	REMARKS
I-1	D INLET	N 525,562.31 E 1,259,500.44	184.37	184.12	187.01	HOCO STD. DETAIL SD 4.11 THROAT @ N.E. & S.E. SIDE
I-2	D INLET	N 525,603.00 E 1,359,464.54	-	186.37	188.33	HOCO STD. DETAIL SD 4.11 THROAT @ N.W. SIDE
E-1	END SECTION	N 525,591.43 E 1,359,557.08	-	-	184.21	HOCO STD. DETAIL SD 5.51
HN-1		N 525,556.13 E 1,359,531.91	-	-	184.32	SEE DETAIL THIS SHEET

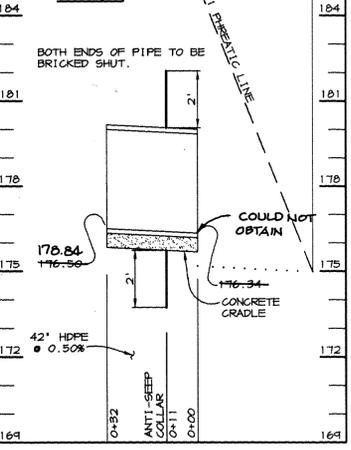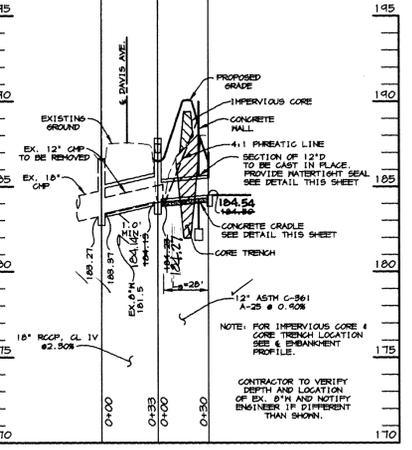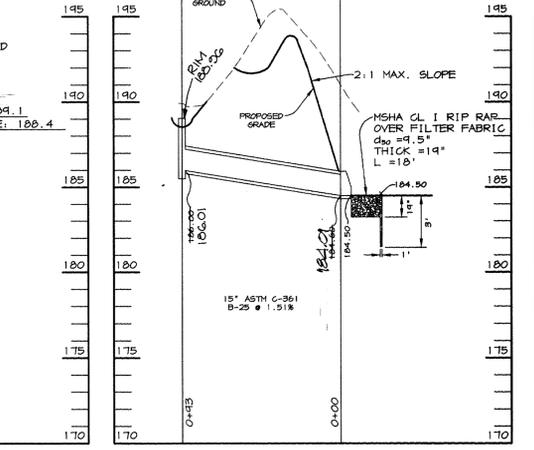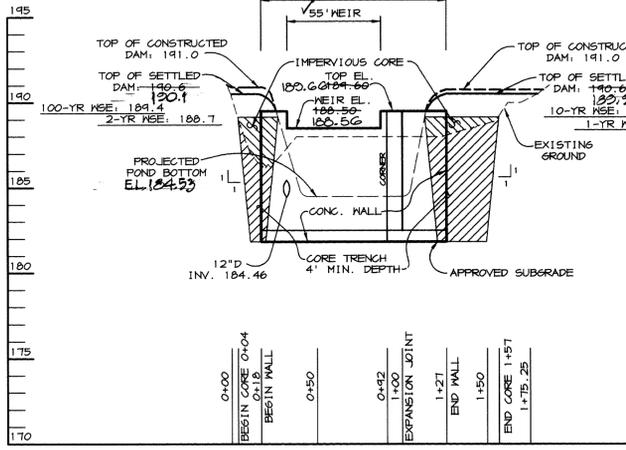

BY THE DEVELOPER:
 I/WE CERTIFY THAT ALL DEVELOPMENT AND CONSTRUCTION WILL BE DONE ACCORDING TO THIS PLAN, AND THAT ANY RESPONSIBLE PERSONNEL INVOLVED IN THE CONSTRUCTION PROGRAM WILL HAVE A CERTIFICATE OF ATTENDANCE AT A DEPARTMENT OF THE ENVIRONMENT APPROVED TRAINING PROGRAM FOR THE CONTROL OF SEDIMENT AND EROSION BEFORE BEGINNING THE PROJECT. I SHALL ENGAGE A REGISTERED PROFESSIONAL ENGINEER TO SUPERVISE POND CONSTRUCTION AND PROVIDE THE HOWARD SOIL CONSERVATION DISTRICT WITH AN "AS-BUILT" PLAN OF THE POND WITHIN 30 DAYS OF COMPLETION. I ALSO AUTHORIZE PERIODIC ON-SITE INSPECTIONS BY THE HOWARD SOIL CONSERVATION DISTRICT.

DEVELOPER: *John J. O'Hara* DATE: 12/7/98

BY THE ENGINEER:
 THESE PLANS HAVE BEEN REVIEWED FOR THE HOWARD SOIL CONSERVATION DISTRICT AND MEET THE TECHNICAL REQUIREMENTS FOR SMALL POND CONSTRUCTION, SOIL EROSION AND SEDIMENT CONTROL, AND NATURAL RESOURCES CONSERVATION.

ENGINEER: *Arthur E. Muegge* DATE: 12/7/98



DEPARTMENT OF PUBLIC WORKS
 HOWARD COUNTY, MARYLAND

DATE: 1/29/98
 DATE: 1/27/98

RIEMER MUEGGE & ASSOCIATES, INC.
 ENGINEERING & ENVIRONMENTAL SERVICES • PLANNING • SURVEYING

8818 Centre Park Drive, Columbia, Maryland 21045
 tel 410.997.8900 fax 410.997.9262
 FILE: 9705/SDP3



DES: AAP
 DRN: BLW
 CHK: AAP
 DATE: 1/21/98

PROFILES AND DETAILS

DATE: 12-30-98
 REVISION: REVISE PER AS-BUILT RED LINES

DAVIS AVENUE
 STORMWATER MANAGEMENT
 6TH ELECTION DISTRICT
 HOWARD COUNTY, MARYLAND
 CAPITAL PROJECT No. D-1112

SCALE: AS SHOWN
 SHEET: 2 OF 5

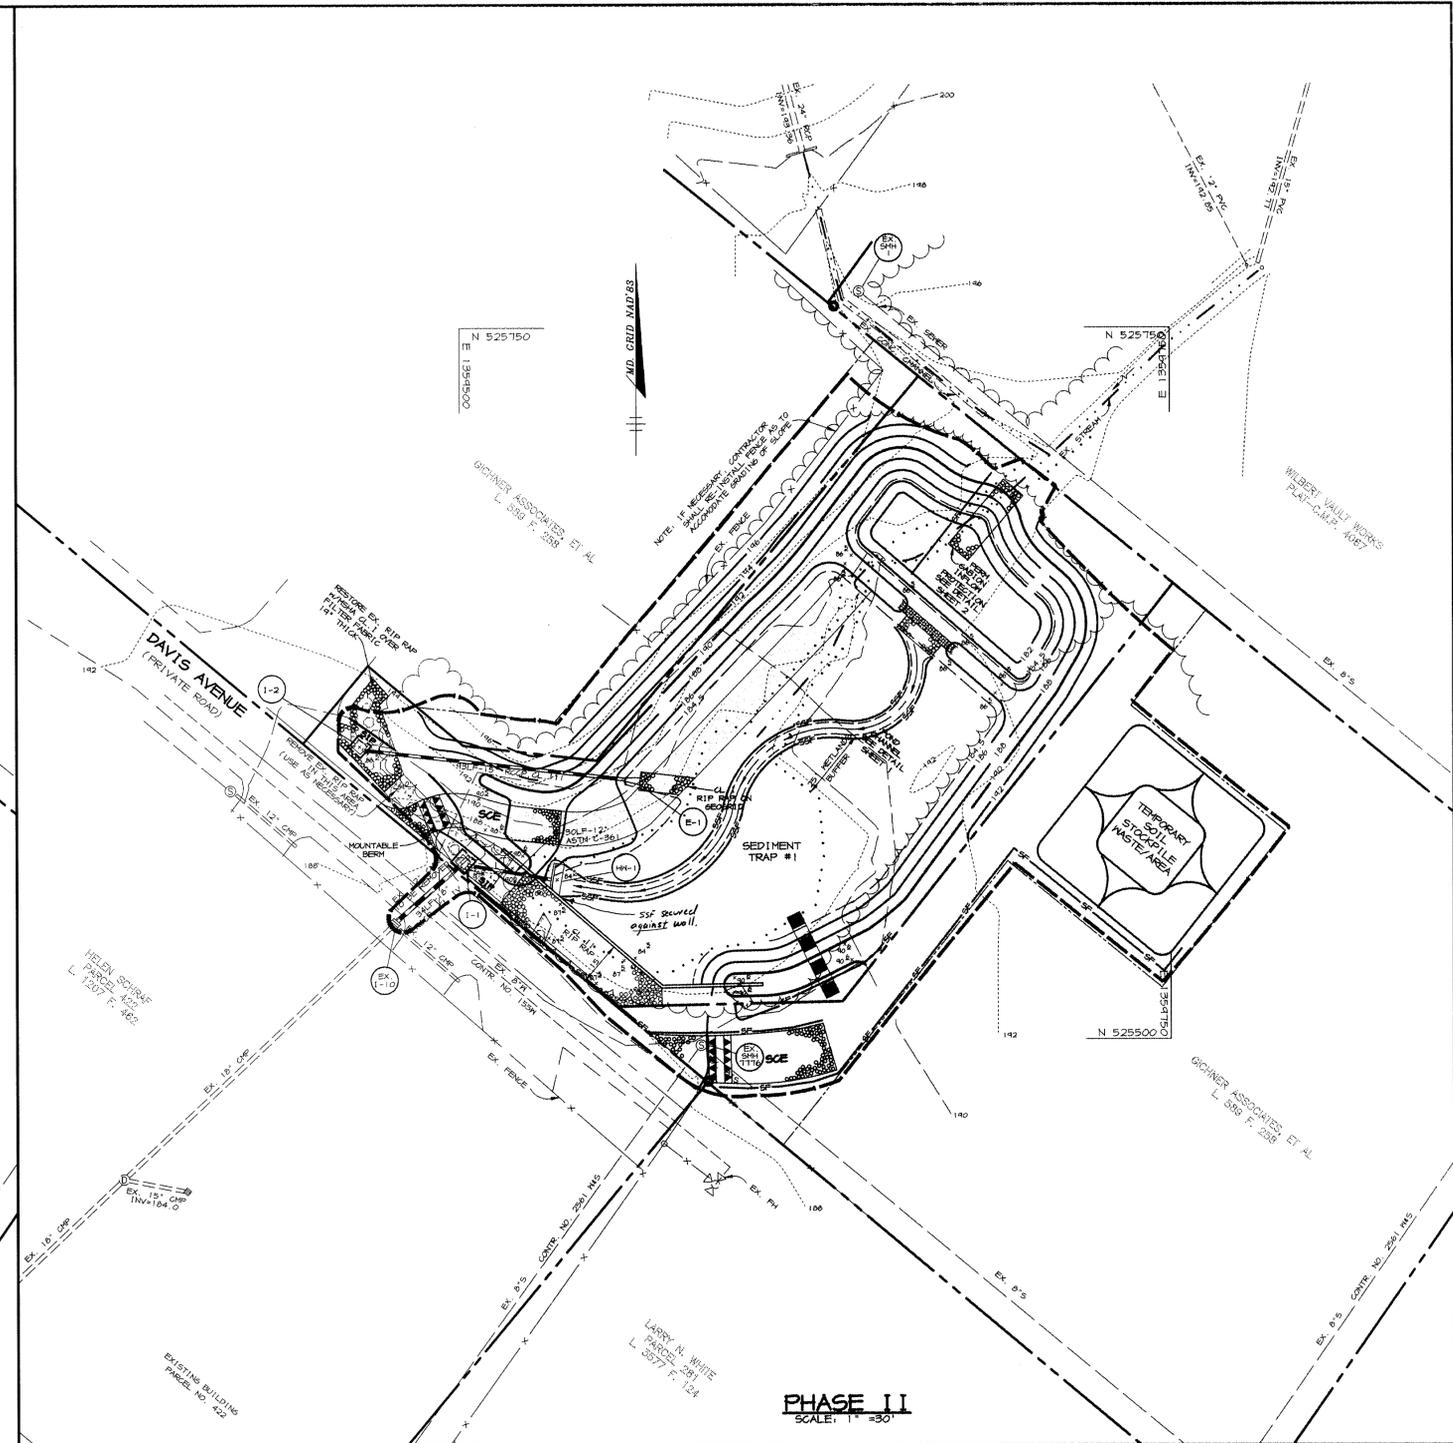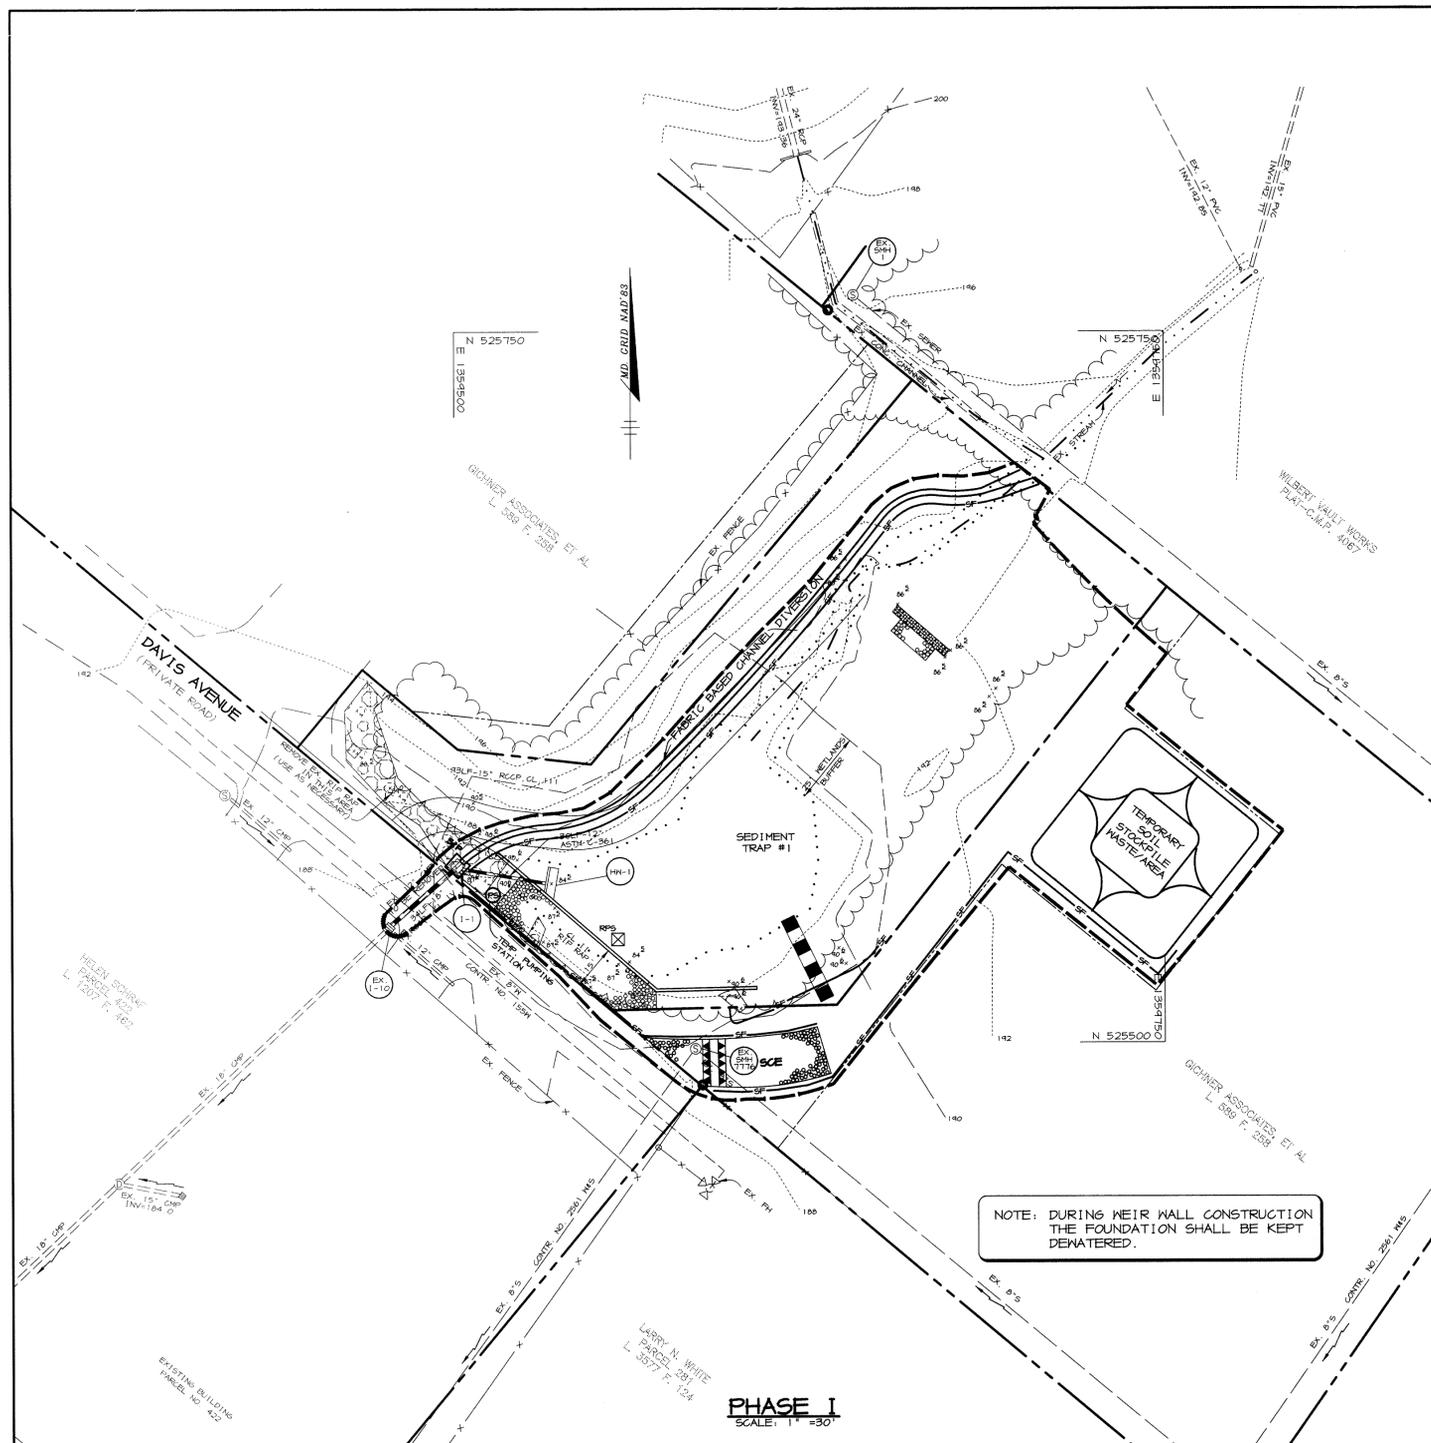

BY THE DEVELOPER:
 I/WE CERTIFY THAT ALL DEVELOPMENT AND CONSTRUCTION WILL BE DONE ACCORDING TO THIS PLAN, AND THAT ANY RESPONSIBLE PERSONNEL INVOLVED IN THE CONSTRUCTION PROJECT WILL HAVE A CERTIFICATE OF ATTENDANCE AT A DEPARTMENT OF THE ENVIRONMENT APPROVED TRAINING PROGRAM FOR THE CONTROL OF SEDIMENT AND EROSION BEFORE BEGINNING THE PROJECT. I SHALL ENGAGE A REGISTERED PROFESSIONAL ENGINEER TO SUPERVISE POND CONSTRUCTION AND PROVIDE THE HOWARD SOIL CONSERVATION DISTRICT WITH AN "AS-BUILT" PLAN OF THE POND WITHIN 30 DAYS OF COMPLETION. I ALSO AUTHORIZE PERIODIC ON-SITE INSPECTIONS BY THE HOWARD SOIL CONSERVATION DISTRICT.

DEVELOPER: *John J. O'Hara* DATE: 1/27/98

BY THE ENGINEER:
 I CERTIFY THAT THIS PLAN FOR POND CONSTRUCTION, EROSION AND SEDIMENT CONTROL REPRESENTS A PRACTICAL AND WORKABLE PLAN BASED ON MY PERSONAL KNOWLEDGE OF THE SITE CONDITIONS. THIS PLAN WAS PREPARED IN ACCORDANCE WITH THE REQUIREMENTS OF THE HOWARD SOIL CONSERVATION DISTRICT. I HAVE NOTIFIED THE DEVELOPER THAT HE/SHE MUST ENGAGE A REGISTERED PROFESSIONAL ENGINEER TO SUPERVISE POND CONSTRUCTION AND PROVIDE THE HOWARD SOIL CONSERVATION DISTRICT WITH AN "AS-BUILT" PLAN OF THE POND WITHIN 30 DAYS OF COMPLETION.

ENGINEER: *Robert E. Sathyan* DATE: 1-27-98


THESE PLANS HAVE BEEN REVIEWED FOR THE HOWARD SOIL CONSERVATION DISTRICT AND MEET THE TECHNICAL REQUIREMENTS FOR SMALL POND CONSTRUCTION, SOIL EROSION AND SEDIMENT CONTROL.

Carol Simmons for 6/23/98 DATE

THESE PLANS FOR SMALL POND CONSTRUCTION, SOIL EROSION AND SEDIMENT CONTROL MEET THE REQUIREMENTS OF THE HOWARD SOIL CONSERVATION DISTRICT.

Robert E. Sathyan for 6/23/98 DATE

FABRIC BASED CHANNEL DIVERSION
 TYPICAL SECTION
 NO SCALE

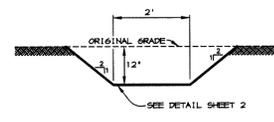

- LEGEND**
- STABILIZED CONSTRUCTION ENTRANCE
 - SILT FENCE
 - LIMIT OF DISTURBANCE
 - STANDARD INLET PROTECTION
 - REMOVABLE PUMPING STATION
 - TEMPORARY PUMPING (ESTIMATED PUMP SIZE = 2 HP)

**THIS SHEET FOR
 SEDIMENT CONTROL ONLY**

- SEQUENCE OF CONSTRUCTION**
1. Obtain grading permit.
 2. Install perimeter controls (silt fence, stabilized construction entrance, fabric based channel diversion).
 3. With permission of SEC Inspector, install concrete wall, 12" low flow structure and 42" pipe.
 4. Using a pump to pass stream water over work area, or during a dry weather forecast, install inlet I-1, rebuild existing I-10 and inlet protection, replace existing 12" GWP with 18" RCP, and connect 12" low flow to I-1.
 5. Excavate east side of pond, stabilize banks, install riprap at concrete wall outfall, construct and stabilize meandering channel thru pond.
 6. Using a pump to pass stream water over work area, or during a dry weather forecast, install gabion inflow protection, east portion of forbay and forbay outfall.
 7. Install silt fence on both sides of pond channel, install inlet protection on inlet I-1 and divert stream to forbay. Obtain permission from SEC Inspector to proceed.
 8. Grade west side of pond and forbay. Install S.G.E.
 9. Install inlet I-2 to E-1, on riprap outfall.
 10. Fine grade and stabilize area per planting plan.
 11. With permission of SEC Inspector, remove sediment controls and stabilize area disturbed by this process.

DEPARTMENT OF PUBLIC WORKS
 HOWARD COUNTY, MARYLAND

James J. Shaw 1/29/98 DATE
 DIRECTOR OF PUBLIC WORKS

John J. O'Hara 1/27/98 DATE
 CHIEF, BUREAU OF WASTE MANAGEMENT

Robert E. Sathyan 1/27/98 DATE
 CHIEF, STORMWATER MANAGEMENT DIVISION

RIEMER MUEGGE & ASSOCIATES, INC.
 ENGINEERING • ENVIRONMENTAL SERVICES • PLANNING • SURVEYING
 8818 Centre Park Drive, Columbia, Maryland 21045
 tel 410.997.8900 fax 410.997.9282
 FILE: 97085/SDP2



PES:	AAP				
DRN:	BLN				
CHK:	AAP				
DATE:	1/21/98	BY	NO.	REVISION	

SEDIMENT CONTROL PLANS

DATE: 600' SCALE MAP NO. 50 BLOCK NO. 4.10

**DAVIS AVENUE
 STORMWATER MANAGEMENT**
 6th ELECTION DISTRICT
 HOWARD COUNTY, MARYLAND
 CAPITAL PROJECT No. D-1112

SCALE
 1"=30'
 SHEET
 3 OF 5

MD-370 STANDARDS AND SPECIFICATIONS

SPECIFICATIONS
These specifications are appropriate to all ponds within the scope of the Standard for Practice MD-370. All references to ASTM and AASHTO specifications apply to the most recent version.

SITE PREPARATION
Areas designated for borrow areas, embankment, and structural works shall be cleared, grubbed and stripped of all trees, vegetation, roots and other objectionable material shall be removed. Channel banks and sharp breaks shall be sloped to no steeper than 1:1.

Areas to be covered by the reservoir will be cleared of all trees, brush, logs, fences, rubbish and other objectionable material unless otherwise designated on the plans. Trees, brush and stumps shall be cut approximately level with the ground surface. For dry streamer management ponds, a minimum of a 50 foot radius around the inlet structure shall be cleared.

All cleared and grubbed material shall be disposed of outside and below the limits of the dam and reservoir as directed by the owner or his representative. When specified, a sufficient quantity of topsoil will be stockpiled in a suitable location for use on the embankment and other designated areas.

EARTH FILL
Material - The fill material shall be taken from approved designated borrow areas. It shall be free of roots, stumps, wood, rubbish, stones greater than 6" frozen or other objectionable material. Fill material for the center of the embankment and cut of trench shall conform to Unified Soil Classification of SC, SH, or SL. Consideration may be given to the use of other materials in the embankment if design and construction are supervised by a geotechnical engineer.

Placement - Areas on which fill is to be placed shall be scarified prior to placement of fill. Fill materials shall be placed in maximum 8-inch thick (before compaction) layers which one to be continuous over the entire length of the fill. The most permeable borrow material shall be placed in the downstroke portions of the embankment. The principal spillway must be installed concurrently with fill placement and not excavated into the embankment.

Compaction - The movement of the hauling and spreading equipment over the fill shall be controlled so that the entire surface of each lift shall be traversed by not less than one tread track of the equipment or compaction shall be achieved by a minimum of four complete passes of a sheepsfoot, rubber tire or vibratory roller. Consideration may be given to the use of other methods if the required degree of compaction will be obtained with the equipment used. The fill material shall contain sufficient moisture so that if formed into a ball it will crumble but not so wet that water can be squeezed out.

When a minimum required density is specified, it shall not be less than 98% of maximum dry density with a moisture content within +/- 2% of the optimum. Each layer of fill shall be compacted as necessary to obtain that density, and is to be certified by the Engineer at the time of construction. All compaction to be determined by ASTM Method T-99.

EROSION AND SEDIMENT CONTROL
Construction operations will be carried out in such a manner that erosion will be controlled and water and air pollution minimized. State and local laws concerning pollution abatement will be followed. Construction plans shall show the location and extent of all erosion control measures to be employed during the construction process.

Refer to the 1984 MARYLAND STANDARDS AND SPECIFICATIONS FOR SOIL EROSION AND SEDIMENT CONTROL for rate and methods not covered.

The back fill shall be compacted with construction equipment, rollers, or hand tampers to assure maximum density and minimum permeability.

STRUCTURE BACKFILL
Backfill adjacent to pipes or structures shall be of the type and quality conforming to that specified for the adjacent fill material. The fill shall be placed in horizontal layers not to exceed four inches in thickness and compacted by hand tampers or other manually directed compaction equipment. The material needs to fill completely around and adjacent to the pipe. At no time during the backfilling operation shall driven equipment be allowed to operate closer than four feet, measured horizontally, to any part of a structure. Under no circumstances shall equipment be driven over any part of a concrete structure or pipe, unless there is a compacted fill of 24" or greater over the structure or pipe.

PIPE CONDUITS
All pipes shall be circular in cross section.

Reinforced Concrete Pipe - All of the following criteria shall apply for reinforced concrete pipe:
1. Materials - Reinforced concrete pipe shall have bell and spigot joints with rubber gaskets and shall equal or exceed ASTM Designation C-561.

Bedding - All reinforced concrete pipe conduits shall be laid in a concrete bedding for their entire length. This bedding shall consist of high slump concrete placed under the pipe and up the side of the pipe at least 10" to 12" outside diameter with a minimum thickness of 3 inches, or as shown on the drawings.

Laying pipe - Bell and spigot pipe shall be placed with the bell end upstream. Joints shall be made in accordance with recommendations of the manufacturer of the material. After the joints are sealed for the entire length, the bedding shall be placed so that all spigot pipe are completely filled. Care shall be exercised to prevent any deviation from the original line and grade of the pipe. The first joint must be located within 2 feet from the riser.

Backfilling shall conform to Structure Backfill.

Other details (anti-seep collars, valves, etc.) shall be as shown on the drawings.

Polyvinyl Chloride (PVC) pipe - All of the following criteria shall apply for polyvinyl chloride (PVC) pipe:
1. Materials - PVC pipe shall be PVC-1120 or PVC-1220 conforming to ASTM D-1785 or ASTM D-2241.

Joints and connections to anti-seep collars shall be completely watertight.

Bedding - The pipe shall be firmly and uniformly bedded throughout its entire length. Where rock or soft, spongy or other unstable soil is encountered, all such material shall be removed and replaced with suitable earth appropriate to provide adequate support.

Backfilling shall conform to Structure Backfill.

Other details (anti-seep collars, valves, etc.) shall be as shown on the drawings.

CONCRETE
Concrete shall meet the requirements of Maryland Department of Transportation, State Highway Administration Standard Specifications for Construction and Materials, Section 608, Mix No. 3.

ROCK RIPRAP
Rock riprap shall meet the requirements of Maryland Department of Transportation State Highway Administration Standard Specifications for Construction and Materials, Section 608, Mix No. 3.

The riprap shall be placed to the required thickness in one operation. The rock shall be delivered and placed in a manner that will insure the riprap in place shall be reasonably homogeneous with the larger rocks uniformly distributed and firmly in contact one to another with the smaller rocks filling the voids between the larger rocks. Filter cloth shall be placed under all riprap and shall meet the requirements of Maryland Department of Transportation, State Highway Administration Standard Specifications for Construction and Materials, Section 414.12.

CARE OF WATER DURING CONSTRUCTION
All work on permanent structures shall be carried out in areas free from water. The contractor shall construct and maintain all temporary dikes, levees, cofferdams, drainage channels, and stream diversions necessary to protect the areas to be occupied by the permanent works. The contractor shall also furnish, install, operate, and maintain all necessary pumping and other equipment required for removal of water from the various parts of the work and for maintaining the excavations, foundation, and other parts of the work free from water as required or directed by the engineer for constructing each part of the work. After having served their purpose, all temporary protective works shall be removed or leveled and graded to the extent required to prevent disturbance in any degree whatsoever of the flow of water to the spillway or outlet works and so as not to interfere in any way with the operation or maintenance of the structure. Stream diversions shall be maintained until the full flow can be passed through the permanent works. The removal of water from the required excavation and the foundation shall be accomplished in a manner and to the extent that will maintain stability of the excavated slopes and bottom of required excavations and will allow satisfactory performance of all construction operations. During the placing and compacting of material in required excavations, the water level of the locations being refilled shall be maintained below the bottom of the excavation at all locations which may require draining the water to pumps from which the water shall be pumped.

STABILIZATION
All borrow areas shall be graded to provide proper drainage and left in a slightly condition. All exposed surfaces of the embankment, spillway, spill and borrow areas, and berms shall be stabilized by seeding, liming, fertilizing and mulching to the satisfaction of the Maryland Soil Conservation Service Standards and Specifications for Critical Area Planting (MD-342) or as shown on the accompanying drawings.

EROSION AND SEDIMENT CONTROL
Construction operations will be carried out in such a manner that erosion will be controlled and water and air pollution minimized. State and local laws concerning pollution abatement will be followed. Construction plans shall show the location and extent of all erosion control measures to be employed during the construction process.

Refer to the 1984 MARYLAND STANDARDS AND SPECIFICATIONS FOR SOIL EROSION AND SEDIMENT CONTROL for rate and methods not covered.

TEMPORARY SEEDING NOTES
Apply to graded or cleared areas likely to be redisturbed where a short-term vegetative cover is needed.

Seeding Preparation - Loosen upper three inches of soil by raking, disking or other acceptable means before seeding, if not previously loosened.

Soil Amendments - Apply 600 lbs. per acre 10-10-10 fertilizer (14 lbs. per 1000 sq. ft.).

Seeding - For periods March 1 thru April 30 and from August 15 thru November 15, seed with 2-1/2 bushels of annual ryegrass (3.2 lbs. per 1000 sq. ft.). For the period May 1 thru August 14, seed with 3 lbs. per acre of creeping lovegrass (2.07 lbs. per 1000 sq. ft.). For the period November 16 thru February 26, protect site by applying 2 tons per acre of well-anchored mulch and seed as soon as possible in the spring, or use sod.

Mulching - Apply 1-1/2 to 2 tons per acre (70 to 90 lbs. per 1000 sq. ft.) of unrotted small grain straw immediately after seeding. Anchor mulch immediately after application using mulch anchoring tool or 2 lb. gal. per 1000 sq. ft. of emulsified asphalt on flat areas. On slopes, 8 ft. or higher, use 341 gal. per acre (8 gal. per 1000 sq. ft.) for anchoring.

Refer to the 1988 MARYLAND STANDARDS AND SPECIFICATIONS FOR SOIL EROSION AND SEDIMENT CONTROL for rate and methods not covered.

PERMANENT SEEDING NOTES
Apply to graded or cleared areas not subject to immediate further disturbance where a permanent long-lived vegetative cover is needed.

Seeding Preparation - Loosen upper three inches of soil by raking, disking or other acceptable means before seeding, if not previously loosened.

Soil Amendments - In lieu of soil test recommendations, use one of the following schedules:
1. Preferred - Apply 2 tons per acre dolomitic limestone (42 lbs. per 1000 sq. ft.) and 600 lbs. per acre 10-10-10 fertilizer (14 lbs. per 1000 sq. ft.) before seeding. Harrow or disc into the soil. At time of seeding, apply 400 lbs. per acre 30-0-0 ureaform fertilizer (4 lbs. per 1000 sq. ft.).
2. Acceptable - Apply 2 tons per acre dolomitic limestone (42 lbs. per 1000 sq. ft.) and 1000 lbs. per acre 10-10-10 fertilizer (28 lbs. per 1000 sq. ft.) before seeding. Harrow or disc into upper three inches of soil.

Seeding - For the period March 1 thru April 30 and from August 15 thru October 15, seed with 60 lbs. per acre (1.4 lbs. per 1000 sq. ft.) of Kentucky 31 Tall Fescue per acre and 2 lbs. per acre (0.05 lbs. per 1000 sq. ft.) of creeping lovegrass. During the period October 16 thru February 26, protect site by one of the following options:
1) 2 tons per acre of well-anchored mulch straw and seed as soon as possible in the spring.
2) Use sod.
3) Seed with 60 lbs. per acre Kentucky 31 Tall Fescue and mulch with 2 tons per acre well-anchored straw.

Mulching - Apply 1-1/2 to 2 tons per acre (70 to 90 lbs. per 1000 sq. ft.) of unrotted small grain straw immediately after seeding. Anchor mulch immediately after application using mulch anchoring tool or 2 lb. gal. per 1000 sq. ft. of emulsified asphalt on flat areas. On slopes, 8 ft. or higher, use 341 gal. per acre (8 gal. per 1000 sq. ft.) for anchoring.

Maintenance - Inspect all seeded areas and make needed repairs, replacements and reseedings.

21.0 STANDARD AND SPECIFICATIONS FOR TOPSOIL
Definition
Placement of topsoil over a prepared subsoil prior to establishment of permanent vegetation.

Purpose
To provide a suitable soil medium for vegetative growth. Soils of concern have low moisture content, low nutrient level, low pH, excessive salinity, and/or unacceptable soil gradation.

Conditions Where Practice Applies
1. This practice is limited to areas having 2:1 or flatter slopes where:
a. The texture of the exposed subsoil/parent material is not adequate to produce vegetative growth.
b. The soil nutrient level is not adequate to support plants or furnish continuing supplies of moisture and plant nutrients.
c. The original soil to be vegetated contains material toxic to plant growth.
d. The soil is so acidic that treatment with limestone is not feasible.

2. For the purpose of these standards and specifications, areas having slopes steeper than 2:1 require special construction design and stabilization methods. Areas having slopes steeper than 2:1 shall have the appropriate stabilization shown on the plans.

Construction and Material Specifications
1. Topsoil salvaged from the existing site may be used provided that it meets the standards set forth in these specifications. Topsoil shall be salvaged for a given site only if it can be found in the representative soil profile section in the Soil Survey published by USDA-SSS in cooperation with Maryland Agricultural Experiment Station.

2. Topsoil Specifications - Soil to be used as topsoil must meet the following:
I. Topsoil shall be a loam, sandy loam, clay loam, silt loam, sandy clay loam, loamy sand. Other soils may be used if recommended by an agronomist or soil scientist and approved by the appropriate approval authority. Regardless, topsoil shall not be a mixture of contrasting textures and shall contain less than 10% of any one of the following: gravel, cinders, slag, coarse fragments, gravel, sticks, roots, trash, or other material larger than 1 1/2" in diameter.
II. Topsoil must be free of plants or plant parts such as bamboo grass, quackgrass, Johnsongrass, nutgrass, poison ivy, thistle, or others as specified.
III. Where subsoil is either highly acidic or composed of heavy clay, ground limestone shall be spread at the rate of 4.0 tons/acre (300-400 pounds per 1,000 square feet) prior to the placement of topsoil. Lime shall be distributed uniformly over designated areas and worked into the subsoil to a depth of 12" below the top of the topsoil.

3. For sites having disturbed areas under 5 acres:
I. Place topsoil (if required) and apply soil amendments as specified in 20.0 Vegetative Stabilization - Section I - Vegetative Stabilization Methods and Materials.
II. For sites having disturbed areas over 5 acres:
I. On soil meeting Topsoil specifications, obtain test results dictating fertilizer and lime amendments required to bring the soil into compliance with the following:
a. pH for topsoil shall be between 6.0 and 7.5. If the tested soil demonstrates a pH of less than 6.0, sufficient lime shall be applied to bring the pH to 6.0.
b. Organic content of topsoil shall not be less than 1.5 percent by weight.
c. Topsoil having soluble salt content greater than 2 parts per million (ppm) shall not be used.
d. Topsoil having soluble salt content greater than 2 parts per million (ppm) shall not be used. Chemicals used for weed control until sufficient time has elapsed (14 days min.) to permit disposal of phytotoxic materials.

Note: Topsoil substitutes to amendments, as recommended by a qualified agronomist or soil scientist and approved by the appropriate approval authority may be used in lieu of natural topsoil.

4. Place topsoil (if required) and apply soil amendments as specified in 20.0 Vegetative Stabilization - Section I - Vegetative Stabilization Methods and Materials.

V. Topsoil Application
1. When topsoiling, maintain needed erosion and sediment control practices such as diversions, grass seedings, silt fences, earth dikes, slope silt fences and sediment traps and basins.
2. Grades on the areas to be topsoiled, which have been previously established, shall be maintained, albeit 4" - 8" higher in elevation.
3. Topsoil shall be uniformly distributed in a 4" - 8" layer and lightly compacted to a minimum thickness of 4". Spreading shall be performed in such a manner that seeding or sodding can proceed with a minimum of additional soil preparation and silt fence or silt trap installation in the surface resulting from topsoiling or other operations shall be avoided in order to prevent the formation of depressions or water pockets.
4. Topsoil shall not be placed while the topsoil or subsoil is in a frozen or muddy condition, when the subsoil is excessively wet or in a condition that may otherwise be detrimental to proper grading and seedbed preparation.

VI. Alternative for Permanent Seeding - Instead of applying the full amounts of lime and commercial fertilizer, composted sludge and amendments may be applied as specified below:
1. Composted sludge material for use as a soil conditioner for sites having disturbed areas over 5 acres shall be tested to prescribe amendments and for site having disturbed areas over 5 acres shall conform to the following requirements:
a. Composted sludge shall be supplied by, or originate from, a person or persons that are permitted (at the time of acquisition of the compost) by the Maryland Department of the Environment under COMA 26.06.
b. Composted sludge shall contain at least 1 percent nitrogen, 1.5 percent phosphorus, and 0.2 percent potassium and have a pH of 7.0 to 9.0. If compost does not meet these requirements, the appropriate constituents must be added to meet the requirements prior to use.
c. Composted sludge shall be applied at a rate of 1,000 square feet per acre.
d. Composted sludge shall be amended with a potassium fertilizer applied at the rate of 4 lbs./1,000 square feet, and 1/2 the normal lime application rate.

References: Guideline Specifications, Soil Preparation and Seeding, MDVA, Pub. #1, Cooperative Extension Service, University of Maryland and Virginia Polytechnic Institutes, Revised 1978.

SEDIMENT CONTROL NOTES
1. A MINIMUM OF 48 HOURS NOTICE MUST BE GIVEN TO THE HOWARD COUNTY DEPARTMENT OF INSPECTIONS AND PERMITS PRIOR TO THE START OF ANY CONSTRUCTION (318-10299).
2. ALL VEGETATIVE AND STRUCTURAL PRACTICES ARE TO BE INSTALLED ACCORDING TO THE PROVISIONS OF THIS PLAN AND ARE TO BE IN CONFORMANCE WITH THE MARYLAND STANDARDS AND SPECIFICATIONS FOR SOIL AND EROSION CONTROL, AND REVISIONS THEREON.
3. FOLLOWING INITIAL SOIL DISTURBANCE OR REDISTURBANCE, PERMANENT OR TEMPORARY STABILIZATION SHALL BE COMPLETED WITHIN A) CALENDAR DATES FOR ALL PERMETER SEDIMENT CONTROL STRUCTURES, DIKES, PERMETER SLOPES AND ALL SLOPES AND ALL SLOPES GREATER THAN 3:1, B) 14 DAYS AFTER OTHER DISTURBED OR GRADED AREAS ON THE PROJECT SITE.
4. ALL SEDIMENT TRAPS/BASINS SHOWN MUST BE FENCED AND MARKING SIGNS POSTED AROUND THE PERIMETER IN ACCORDANCE WITH VOL. 1, CHAPTER 12, OF THE HOWARD COUNTY DESIGN MANUAL, STORM DRAINAGE.
5. ALL DISTURBED AREAS MUST BE STABILIZED WITHIN THE TIME PERIOD SPECIFIED ABOVE IN ACCORDANCE WITH THE 1984 MARYLAND STANDARDS AND SPECIFICATIONS FOR SOIL AND EROSION CONTROL FOR PERMANENT SEEDINGS (SEC. 31), SOD (SEC. 34), TEMPORARY SEEDING (SEC. 30) AND MULCHING (SEC. 32). TEMPORARY STABILIZATION WITH MULCH ALONE CAN ONLY BE DONE WHEN REGENERATED SEEDING DATES DO NOT ALLOW FOR PROPER GERMINATION AND ESTABLISHMENT OF GRASSES.
6. ALL SEDIMENT CONTROL STRUCTURES ARE TO REMAIN IN PLACE AND ARE TO BE MAINTAINED IN OPERATIVE CONDITION UNTIL PERMISSION FOR THEIR REMOVAL HAS BEEN OBTAINED FROM THE HOWARD COUNTY SEDIMENT CONTROL INSPECTOR.
7. SITE ANALYSIS:
TOTAL AREA OF SITE AREA DISTURBED: 0.64 ACRES
AREA TO BE ROOFED OR PAVED: 0.48 ACRES
AREA TO BE VEGETATIVELY STABILIZED: 0.48 ACRES
TOTAL CUT: 39.60 CUBIC YARDS
TOTAL FILL: 19.00 CUBIC YARDS
WASTE/BORROW AREA: 0.08 ACRES
REMAINDER OF EARTHWORK PERFORMED UNDER 6P-48-23.
8. ANY SEDIMENT CONTROL PRACTICE WHICH IS DISTURBED BY GRADING ACTIVITY FOR PLACEMENT OF UTILITIES MUST BE REPAIRED ON THE SAME DAY OF DISTURBANCE.
9. ADDITIONAL SEDIMENT CONTROLS MUST BE PROVIDED, IF DEEMED NECESSARY BY THE HOWARD COUNTY SEDIMENT CONTROL INSPECTOR.
10. SITE GRADING WILL BEGIN ONLY AFTER ALL PERMETER SEDIMENT CONTROL MEASURES HAVE BEEN INSTALLED AND ARE IN A FUNCTIONING CONDITION.
11. CUT AND FILL QUANTITIES PROVIDED UNDER SITE ANALYSIS DO NOT REPRESENT BID QUANTITIES. THESE QUANTITIES DO NOT DISTINGUISH BETWEEN TOPSOIL, STRUCTURAL FILL OR EMBANKMENT MATERIAL, NOR DO THEY REFLECT CONSIDERATION OF REMOVAL OF UNSUITABLE MATERIAL. THE CONTRACTOR SHALL FAMILIARIZE HIMSELF WITH SITE CONDITIONS WHICH MAY AFFECT THE WORK.
12. ON ALL SITES WITH DISTURBED AREAS IN EXCESS OF 2 AC., APPROVAL OF THE INSPECTION AGENCY SHALL BE REQUESTED UPON COMPLETION OF INSTALLATION OF PERMETER EROSION AND SEDIMENT CONTROLS, BUT BEFORE PROCEEDING WITH ANY OTHER EARTH DISTURBANCE OR GRADING. OTHER BUILDING OR GRADING INSPECTION APPROVALS MAY NOT BE AUTHORIZED UNTIL THIS INITIAL APPROVAL BY THE INSPECTION AGENCY IS MADE.
13. BORROW SITE TO BE PRE-APPROVED BY THE SEDIMENT CONTROL INSPECTOR, OR IN CASE OF EXCESS MATERIAL, AN APPROVED SEDIMENT CONTROL PLAN WILL BE NEEDED TO DEPOSIT EXCESS OFF-SITE.

BY THE DEVELOPER:
I/WE CERTIFY THAT ALL DEVELOPMENT AND CONSTRUCTION WILL BE DONE ACCORDING TO THIS PLAN, AND THAT ANY RESPONSIBLE PERSONNEL INVOLVED IN THE CONSTRUCTION PROJECT WILL HAVE A CERTIFICATE OF ATTENDANCE AT A DEPARTMENT OF THE ENVIRONMENT APPROVED TRAINING PROGRAM FOR THE CONTROL OF SEDIMENT AND EROSION BEFORE BEGINNING THE PROJECT. I SHALL ENGAGE A REGISTERED PROFESSIONAL ENGINEER TO SUPERVISE POND CONSTRUCTION AND PROVIDE THE HOWARD COUNTY CONSERVATION DISTRICT WITH AN "AS-BUILT" PLAN OF THE POND WITHIN 30 DAYS OF COMPLETION. I ALSO AUTHORIZE PERIODIC INSPECTIONS BY THE HOWARD COUNTY CONSERVATION DISTRICT.

John J. Howe 1/27/98
DEVELOPER DATE

BY THE ENGINEER:
I CERTIFY THAT THIS PLAN FOR POND CONSTRUCTION, EROSION AND SEDIMENT CONTROL, REPRESENTS A PRACTICAL AND WORKABLE PLAN BASED ON MY PERSONAL KNOWLEDGE OF THE SITE CONDITIONS. THIS PLAN WAS PREPARED IN ACCORDANCE WITH THE REQUIREMENTS OF THE HOWARD COUNTY CONSERVATION DISTRICT. I HAVE NOTIFIED THE DEVELOPER THAT HE/SHE MUST ENGAGE A REGISTERED PROFESSIONAL ENGINEER TO SUPERVISE POND CONSTRUCTION AND PROVIDE THE HOWARD COUNTY CONSERVATION DISTRICT WITH AN "AS-BUILT" PLAN OF THE POND WITHIN 30 DAYS OF COMPLETION.

Andrew M. Rauwolf 1-30-98
ENGINEER DATE

THESE PLANS HAVE BEEN REVIEWED FOR THE HOWARD COUNTY CONSERVATION DISTRICT AND MEET THE TECHNICAL REQUIREMENTS FOR SMALL POND CONSTRUCTION, SOIL EROSION AND SEDIMENT CONTROL.
David Stearns /es 4/23/98
NATURAL RESOURCES CONSERVATION DATE

THESE PLANS FOR SMALL POND CONSTRUCTION, SOIL EROSION AND SEDIMENT CONTROL MEET THE REQUIREMENTS OF THE HOWARD COUNTY CONSERVATION DISTRICT.
Robert E. Eckhart /es 4/23/98
HOWARD COUNTY CONSERVATION DISTRICT DATE

DEPARTMENT OF PUBLIC WORKS
HOWARD COUNTY, MARYLAND

1/27/98
DATE

1-30-98
DATE

1-27-98
DATE

1-27-98
DATE

DEPARTMENT OF PUBLIC WORKS
HOWARD COUNTY, MARYLAND

1/27/98
DATE

1-30-98
DATE

1-27-98
DATE

DEPARTMENT OF PUBLIC WORKS
HOWARD COUNTY, MARYLAND

1/27/98
DATE

1-30-98
DATE

1-27-98
DATE

DEPARTMENT OF PUBLIC WORKS
HOWARD COUNTY, MARYLAND

1/27/98
DATE

1-30-98
DATE

1-27-98
DATE

DEPARTMENT OF PUBLIC WORKS
HOWARD COUNTY, MARYLAND

1/27/98
DATE

1-30-98
DATE










1-27-98
DATE

REIMER MUEGGE & ASSOCIATES, INC.
ENGINEERING & ENVIRONMENTAL SERVICES & PLANNING & SURVEYING
8818 Centex Park Drive, Columbia, Maryland 21045
tel 410.997.8800 fax 410.997.5282
FAX: 97085/SDPS

ARTHUR E. MUEGGE #8107


DES: AAP
DRN: BLN
CHK: AAP
DATE: 1/21/98

BY NO. REVISION

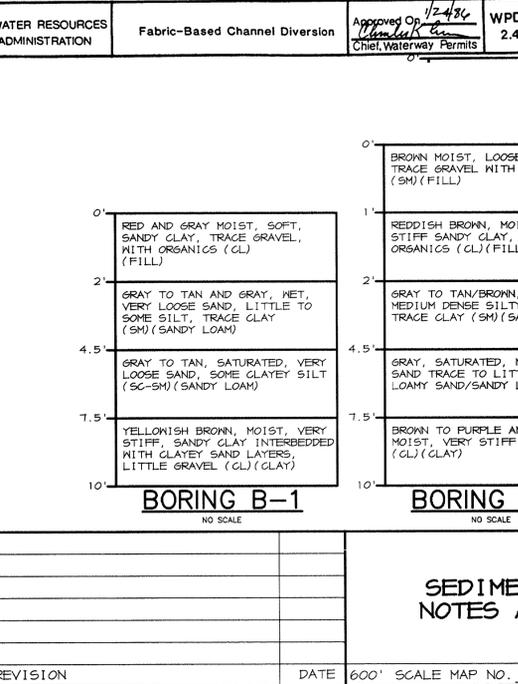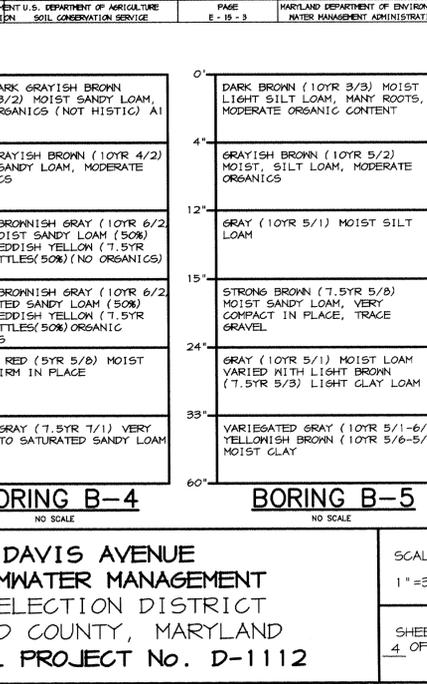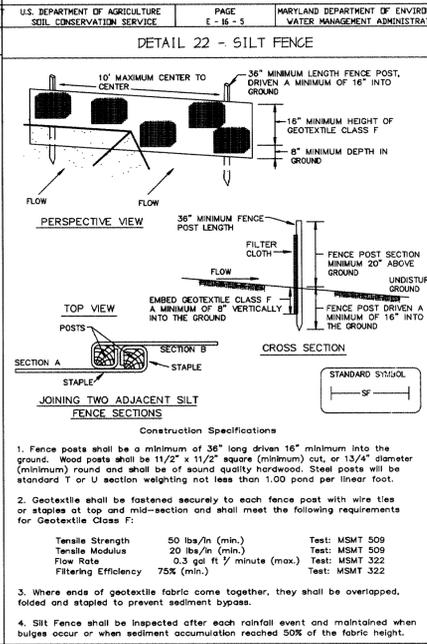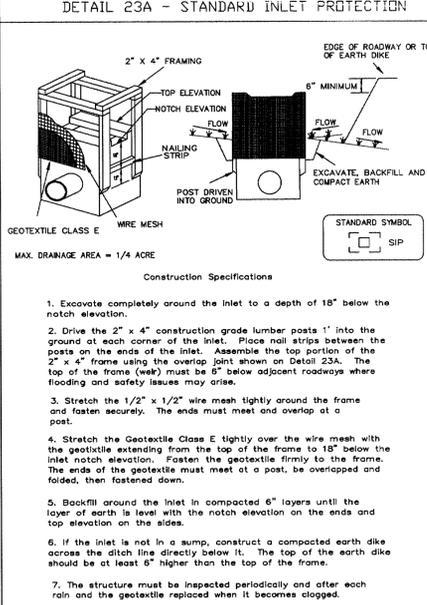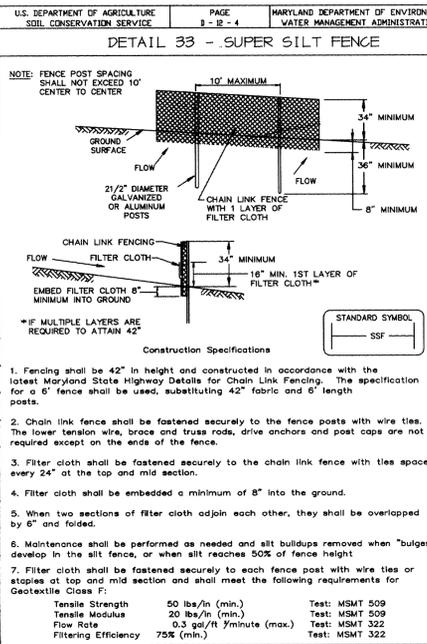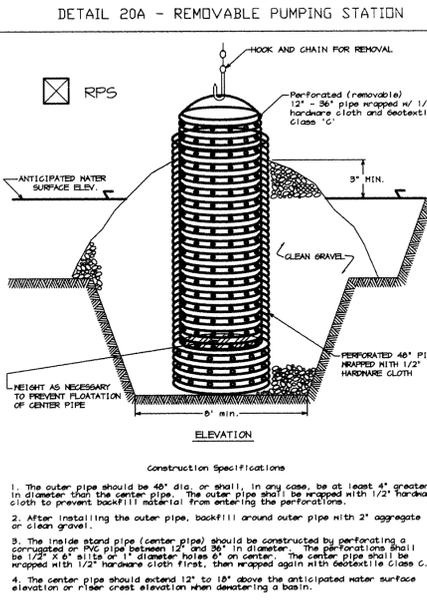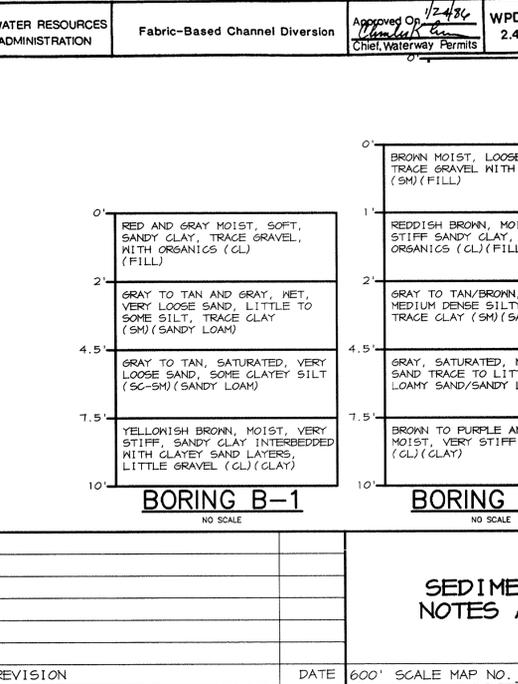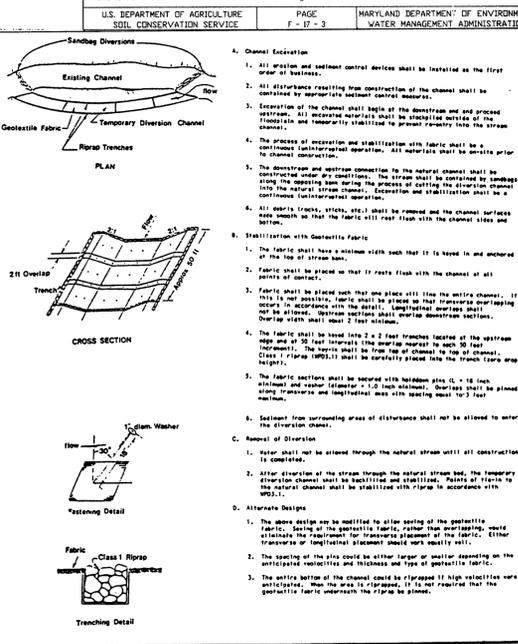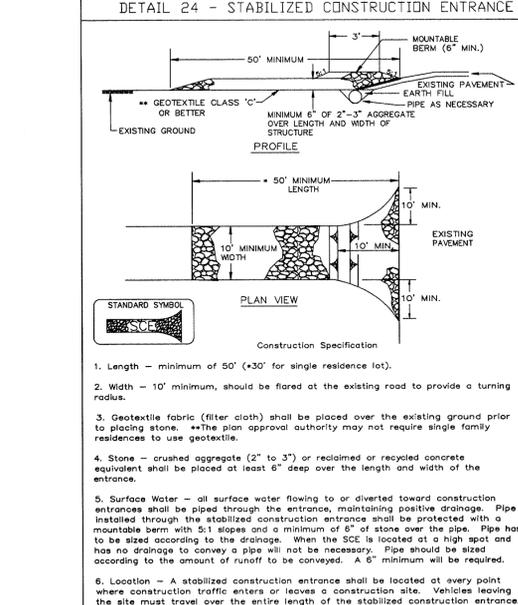


SEDIMENT CONTROL NOTES AND DETAILS

SCALE MAP NO. 50 BLOCK NO. 4.10

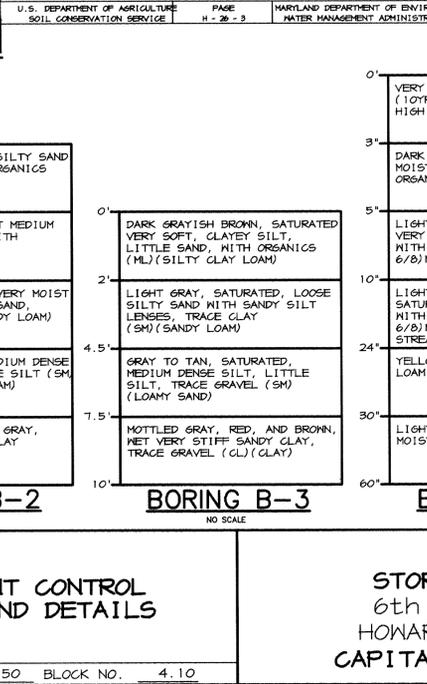

SEDIMENT CONTROL NOTES AND DETAILS

SCALE MAP NO. 50 BLOCK NO. 4.10

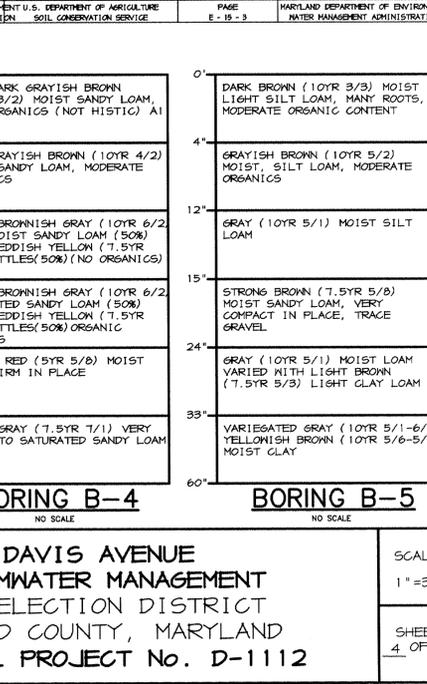


**STORMWATER MANAGEMENT FACILITY
PLANTING SPECIFICATIONS**

1. PLANT SPECIES REQUIRED ARE NORMALLY UNAVAILABLE FROM STANDARD LANDSCAPE NURSERY SOURCES. THE CONTRACTOR MUST MAKE ARRANGEMENTS WITH COMPETENT WETLANDS RESTORATION SPECIALISTS TO INSURE A SUPPLY OF THE REQUIRED MATERIAL.
2. THE CONTRACTOR AND/OR THEIR SUBCONTRACTOR SHOULD BE AWARE OF THE SITE DESIGN CONDITIONS AND SHOULD TAKE ALL PRUDENT STEPS TO INSURE THAT THE PLANT MATERIAL SPECIFIED ON THE PLANS IS PROPERLY ACCLIMATED. IF THE PLANT MATERIAL IS AVAILABLE FROM SOURCES WHERE WETLAND CONDITIONS ARE DUPLICATED AT THE NURSERY, THE CONTRACTOR SHOULD FAVOR THESE SOURCES AS THE SUPPLIER.
3. IT IS RECOMMENDED THAT PLANTING BE COMPLETED EARLY IN THE SPRING.
4. PLANT LIVE STAKES 1' (ONE FOOT) INTO GABION MATTRESS ON EACH SIDE AND 15' (FIFTEEN FEET) FROM OUTER EDGE OF MATTRESS IN DIAMOND PATTERN (2' O.C.).

**STORMWATER MANAGEMENT FACILITY
PLANTING SCHEDULE**

SYMBOL	QTY.	SPECIES	SIZE	SPACING	INDICATOR
	979	LEERSIA ORYZOIDES RICE CUTGRASS	1 3/4" P.P.	1' O.C.	OBL
	91	SAURUS CERNUUS LIZARDS TAIL	1 QT. POT	4' O.C.	OBL
	244	EUPATORIUM PURPUREUM JOE PYE WEED	1 QT. POT	3' O.C.	FACH
	202	PANICUM VIRGATUM SWITCHGRASS	1 QT. POT	4' O.C.	FAC
	171	SALIX PURPUREA STREAMCO WILLOW (LIVE STAKES) SEE NOTE 4 ABOVE	3' LENGTH	2' O.C.	OBL

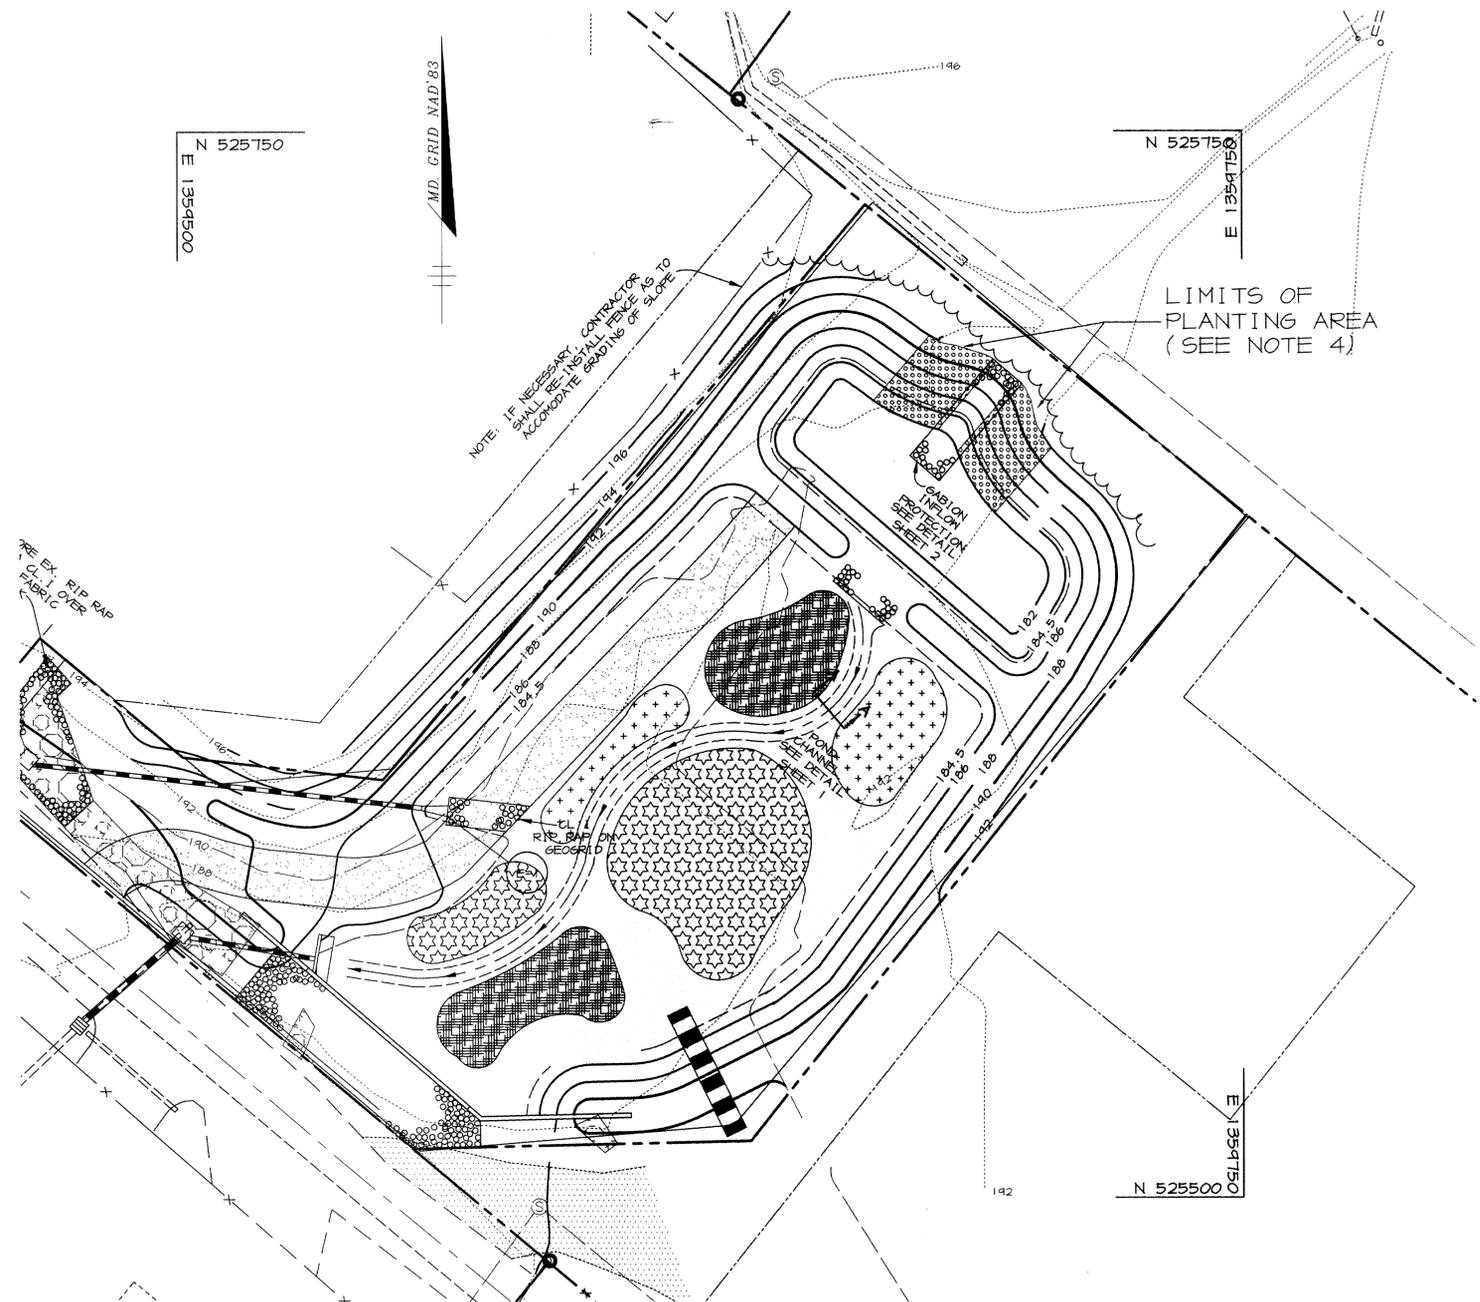

THIS PLAN FOR PLANTING PURPOSES ONLY.

<p>DEPARTMENT OF PUBLIC WORKS HOWARD COUNTY, MARYLAND</p> <p><i>James J. ...</i> 1/29/98 DIRECTOR OF PUBLIC WORKS DATE</p> <p><i>Howard E. ...</i> 1/27/98 CHIEF, BUREAU OF WASTE MANAGEMENT DATE</p> <p><i>Howard E. ...</i> 1/27/98 CHIEF, STORMWATER MANAGEMENT DIVISION DATE</p>	<p>RIEMER MUEGGE & ASSOCIATES, INC. ENGINEERING • ENVIRONMENTAL SERVICES • PLANNING • SURVEYING 8818 Centre Park Drive, Columbia, Maryland 21045 tel 410.997.8900 fax 410.997.9282</p>	 <p>ARTHUR E. MUEGGE #8707</p>	<table border="1"> <tr> <td>DES:</td> <td>KEH</td> <td></td> <td></td> <td></td> </tr> <tr> <td>DRN:</td> <td>KEH</td> <td></td> <td></td> <td></td> </tr> <tr> <td>CHK:</td> <td>AAP</td> <td></td> <td></td> <td></td> </tr> <tr> <td>DATE:</td> <td>1/21/98</td> <td>BY</td> <td>NO.</td> <td>REVISION</td> </tr> </table>	DES:	KEH				DRN:	KEH				CHK:	AAP				DATE:	1/21/98	BY	NO.	REVISION	<p>STORMWATER MANAGEMENT FACILITY PLANTING PLAN</p> <p>DATE 600' SCALE MAP No. 50 BLOCK No. 4.10</p>	<p>DAVIS AVENUE STORMWATER MANAGEMENT 6th ELECTION DISTRICT HOWARD COUNTY, MARYLAND CAPITAL PROJECT No. D-1112</p>	<p>SCALE 1" = 20'</p> <p>SHEET 5 OF 5</p>
DES:	KEH																									
DRN:	KEH																									
CHK:	AAP																									
DATE:	1/21/98	BY	NO.	REVISION																						