

# HOWARD COUNTY, MARYLAND DEPARTMENT OF PUBLIC WORKS PINE TREE ROAD & GLEN COURT DRAINAGE AND ROADWAY IMPROVEMENTS

## HOWARD COUNTY CAPITAL PROJECT D-1140 PHASE 1 (PH.1) CONSTRUCTION

### GENERAL NOTES

- This contract shall be constructed under provisions of the Maryland Department of Transportation, State Highway Administration (S.H.A.) "Standard Specifications for Construction and Materials," dated January 2001, including all revisions thereof and additions thereto, except where noted otherwise; the Special Provisions included in the invitation for bids book; the Administration Book of Standards for Highways and Incidental Structures; as well as the latest Howard County Design Manual Standards and Specifications & Details for Construction dated 2006 and revisions thereof and additions thereto.
- The Contractor shall notify the Department of Public Works/Bureau of Engineering/Construction Inspection Division at (410) 313-1870 at least five (5) working days prior to the start of work.
- The Contractor shall notify "Miss Utility" at 1-800-257-7777 at least forty-eight (48) hours prior to any excavation work. The Contractor shall contact the following utilities at least 5 days prior to beginning any work under this contract. For additional information and requirements with respect to utilities, see Special Provisions.  
BGE Gas Division (410) 291-5834  
BGE Electric Division (410) 855-6958  
Verizon (410) 224-9980  
Comcast (410) 497-0232
- Project Background: Location: Savage, Maryland  
Tax Map: 47  
Election District: 6
- Traffic control devices, markings, and signing shall be in accordance with the latest edition of the Manual on Uniform Traffic Control Devices (MUTCD).
- Any damage caused by the Contractor to existing public right-of-way, existing paving, existing curb and gutter, existing utilities, etc. shall be corrected at the Contractor's expense.
- The existing utilities shown hereon are located from the best information available, but no guarantee is made to their accuracy. The approximate location of existing utilities are shown for the Contractor's information and convenience. The Contractor shall locate existing utilities to his/her own satisfaction and well in advance of any construction activities. Additionally, the Contractor shall take all necessary precautions to protect all existing utilities and maintain uninterrupted service.
- Horizontal and vertical datums based on to the Maryland State Plane Coordinate System NAD 83 and NAVD 88 and is referenced to Howard County Survey Control Monuments: 47F5 N 535,985.0356 E 1,365,653.5044 Elev. 235.045 & 48AB N 538,384.4557 E 1,366,415.8225 Elev. 225.702
- Clearing shall be limited to the "Limit of Disturbance" as shown on the sediment and erosion control plan. Grading shall be done in such a manner as to provide positive drainage. Contractor shall seed and mulch all disturbed areas except as otherwise directed.
- The contractor shall take extreme caution not to disturb the existing vegetation outside the limits of disturbance. Soil stabilization shall conform to "Maryland Standards and Specifications for Soil Erosion and Sediment Control," dated 1994, published jointly by Water Management Administration, Soil Conservation Service, and State Soil Conservation Committee.
- All fill areas shall be compacted to a minimum of 95% of the maximum dry density as determined and verified in accordance with AASHTO T-180.
- This drawing is based on a field ran topographic survey performed by Associated Engineering Services, Inc. (AESI) 34 West Franklin St, Hagerstown, Maryland 21740 on or about October 2006 and May 2008.
- All sign posts used for traffic control signs installed in the County Right-of-Way shall be mounted on a 2" galvanized steel, perforated, square tube post (14 gauge) inserted into a 2-1/2" galvanized steel, perforated, square tube steve (12 gauge) - 3' long. A galvanized steel pole cap shall be mounted on top of each post.
- A staging and stockpile area will be determined by the contractor and approved by the Howard County Engineer.
- There are numerous residential sump pump outlet pipes present within the area of this project. The contractor shall walk the project with the engineer to note the exact location of these pipes and make allowances to provide positive drainage from them to the proposed curb and gutter flow line.

### MAINTENANCE OF TRAFFIC (MOT)

- All work shall be done in accordance with MD SHA Standard Detail MD 104.02-10, MD 104.00-14(13.0) Pavement Edge Drop Off, and MD 104.06-11. Refer to Sheet 14A for additional information.
- Contractor to maintain a minimum 10' travel lane at all times. Refer to section for MOT for storm drain construction along Pine Tree Road (see sheet 14) for additional information. Also refer to Sheet 14A.
- Throughout the period of construction, traffic will be maintained by implementing standard traffic control work zone typical plans in accordance with the latest plans and manuals of the Maryland State Highway Administration. The contractor will be required to adhere to The Manual of Uniform Traffic Control Devices (2009 edition and all revisions). All open trenches shall be plated and construction barriers shall be removed during non-working hours (4:00pm-9:00am). The contractor is required to maintain access to all driveways at all times for the duration of the project. If the contractor is unable to reconstruct existing driveway aprons after curb installation, contractor shall provide graded aggregate backfill behind curb to maintain use of driveways. All items not listed in the itemized schedule of prices, required for maintaining traffic, including but not limited to signing, barriers, drums, temporary aggregate and pavement, shall be included in the lump sum unit bid price for maintenance of traffic.

### FOREST CONSERVATION NOTES

- This project is exempt from Forest Conservation requirements. For the encroachment along the Howe Property, 8614 Pine Tree Road for the installation of the storm drain system the linear project exemption is applicable because it is a single lot clearing less than 20,000 square feet of forest.
- For the Open Space beyond the ES-1 outfall, the Forest Conservation obligations have already been met under F-95-15 for the Winterbook Subdivision.


**CONSTRUCTION ASBUILT CERTIFICATION**  
I hereby certify the as-built information shown hereon (in red) is correct to the best of my knowledge and belief and that is the result of a field run survey performed under my direct supervision in accordance with the laws regulating land surveys in the State of Maryland.  
*Wayne F. Aubertin* 1-5-15  
Wayne F. Aubertin, Prof. L.S. Maryland Reg. #21330 Exp. 01/07/17  
Snider & Associates, Land Surveyors  
20270 Goldenrod Lane, Suite 110  
Germantown, MD 20876 Ph. 301-948-5100 Fax 301-948-1286

PLAN LOCATION OF TEST PIT

NOTE:  
ROADWAY BORING AND TEST PIT LOG SUMMARY SHEETS  
ARE INCLUDED IN THE INFORMATION FOR BID (IFB) BOOK.

### INDEX OF DRAWINGS

SHEET NO.	TITLE
1	TITLE SHEET
2	TYPICAL ROADWAY SECTIONS AND DETAILS
3	TRAVERSE CONTROL POINT LOCATIONS
4	GEOMETRIC LAYOUT
5-6	ROADWAY PLANS
7	FLOW LINE CONTROL POINT LOCATION PLAN AND DETAILS
8-9	STORM DRAIN PROFILES
10	STORM DRAIN PROFILES, DRAINAGE PIPE STRUCTURE SCHEDULE AND INLET CURB AND GUTTER TRANSITION TABLE
11-12	EROSION AND SEDIMENT CONTROL PLAN
13-14	EROSION AND SEDIMENT CONTROL NOTES AND DETAILS
14A	MAINTENANCE OF TRAFFIC DETAILS

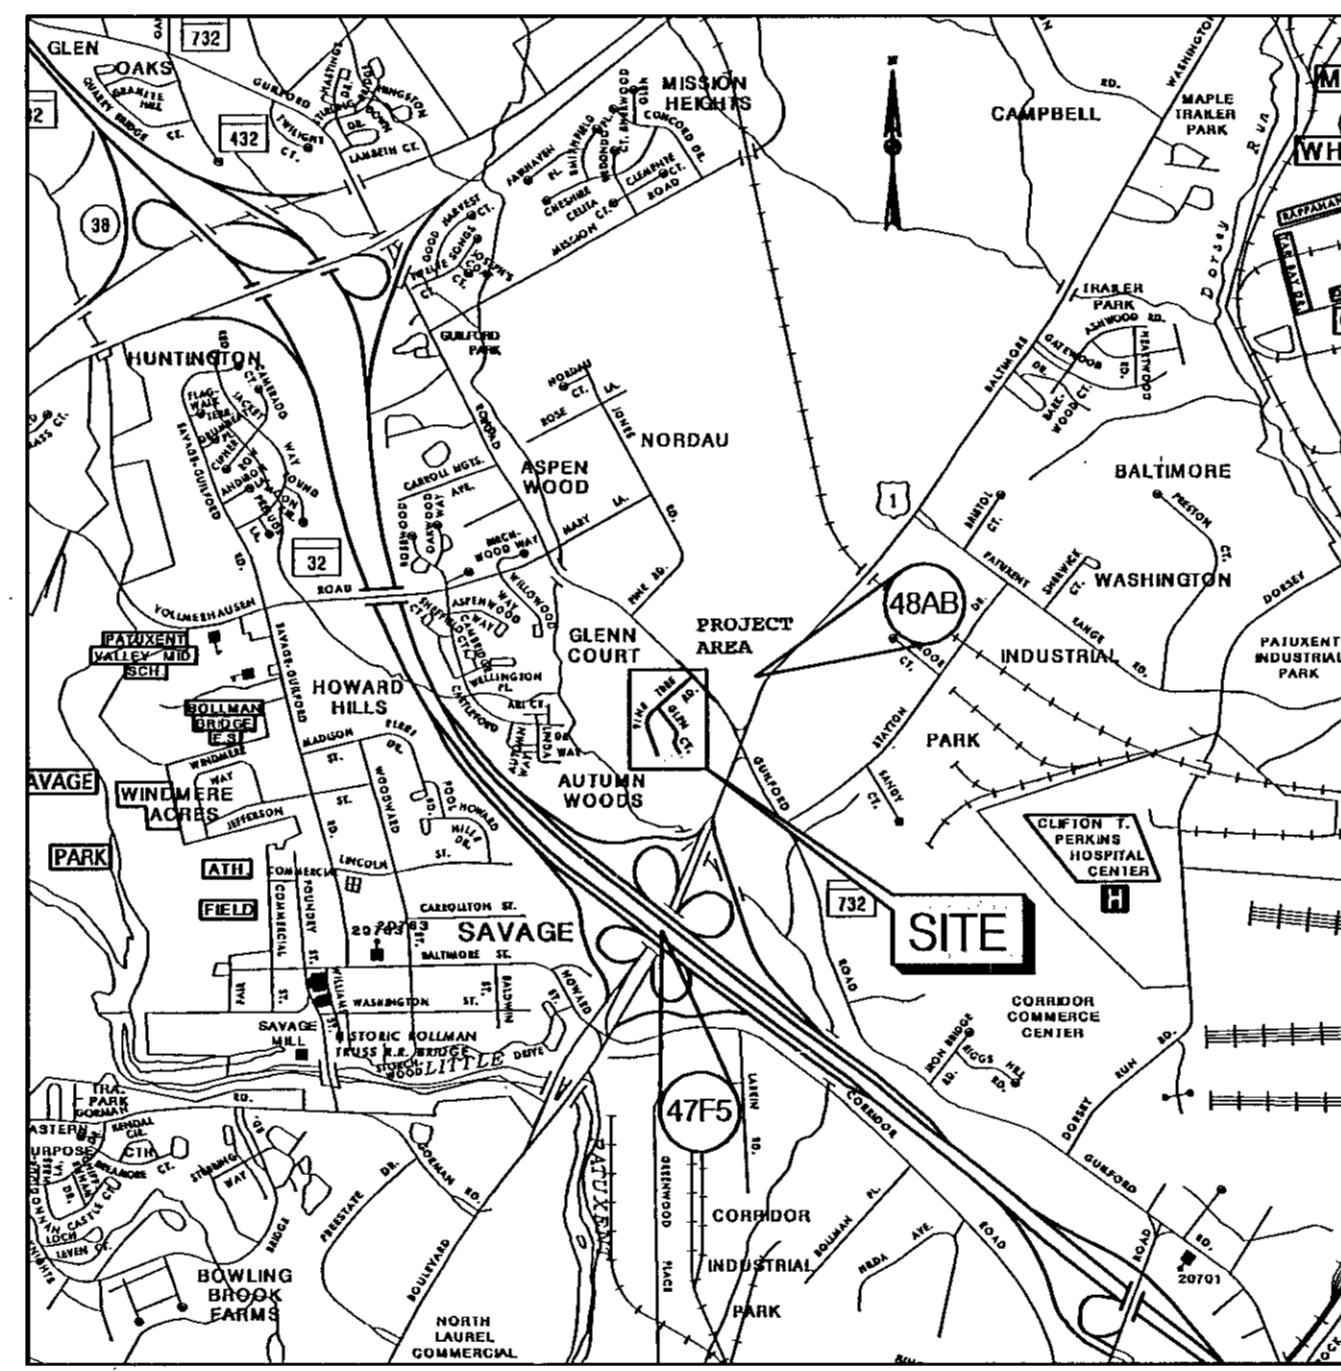

LOCATION MAP  
SCALE: 1" = 2000'

*Charles S. Nolan* 5/22/12  
CHARLES S. NOLAN, P.E. DATE


"PROFESSIONAL CERTIFICATION. I HEREBY CERTIFY THESE DOCUMENTS ARE PREPARED OR APPROVED BY ME, AND THAT I AM A DULY LICENSED PROFESSIONAL ENGINEER UNDER THE LAWS OF THE STATE OF MARYLAND, LICENSE NO. 15212, EXPIRATION DATE: 12/24/2014."

OWNER / DEVELOPER CERTIFICATION	
"I/We certify that all development and/or construction will be done according to these plans, and that any responsible personnel involved in the construction project will have a Certificate of Attendance at a Department of the Environment Approved Training Program for the Control of Sediment and Erosion before beginning project. I also authorize periodic on-site inspections by the Howard Soil Conservation District."	
<i>Steve Sharon</i> Signature of Owner/Developer	5/21/12 Date
Print name below signature	
ENGINEER CERTIFICATION	
"I certify that this plan for erosion and sediment control represents a practical and workable plan based on my personal knowledge of the site conditions. This Plan was prepared in accordance with the requirements of the Howard Soil Conservation District."	
<i>Charles S. Nolan</i> Signature of Engineer	5/22/12 Date
Charles S. Nolan	
These plans are approved for soil erosion and sediment control by the Howard Soil Conservation District.	
<i>John K. Blanton</i> Howard S.C.D.	5/22/12 Date
EP-11-004	


DEPARTMENT OF PUBLIC WORKS HOWARD COUNTY, MARYLAND <i>John K. Blanton</i> 5/22/12 DIRECTOR OF PUBLIC WORKS DATE <i>Steve Sharon</i> 5-30-12 CHIEF, BUREAU OF HIGHWAYS DATE	NOLAN Associates, Inc. Engineers - Civil/Structural/Inspections 4785 Dorsey Hall Drive Suite 124 Ellicott City, Maryland 21042 Phone: (410) 995-3851 Fax: (410) 995-1363	DES: GWF/JW DRN: JRW CHK: GWF DATE: APRIL 2012	TITLE SHEET	PINE TREE ROAD/GLEN COURT DRAINAGE AND ROADWAY IMPROVEMENTS, PH. 1 CAPITAL PROJECT D-1140 ELECTION DISTRICT NO. 6 HOWARD COUNTY, MARYLAND	SCALE: AS SHOWN SHEET 1 OF 14A
---	---	---	-------------	---	---

AS BUILT




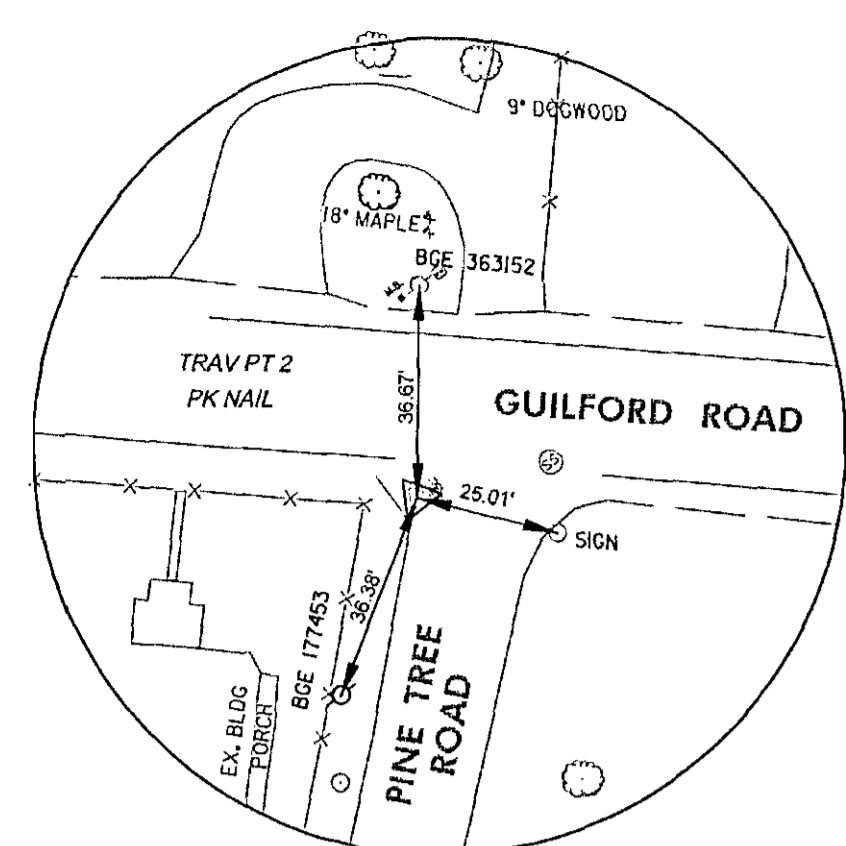


**TRAVERSE PT 2**  
 N 538842.0527  
 E 1365851.7894  
 ELEV. 225.86  
 NOT TO SCALE

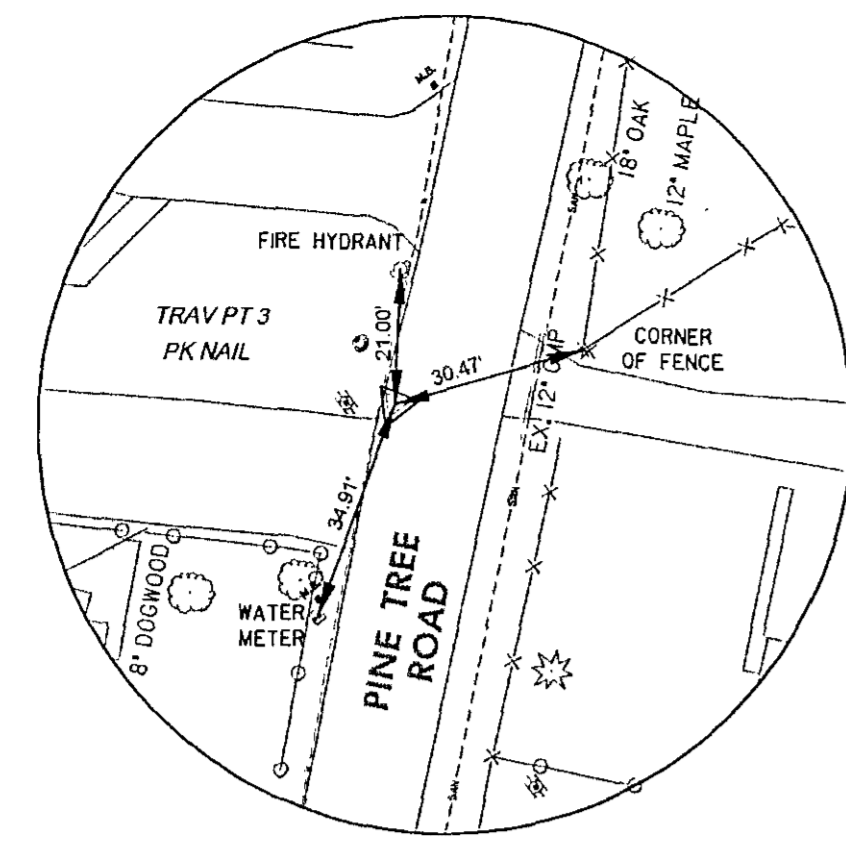


**TRAVERSE PT 3**  
 N 538630.6174  
 E 1365603.2565  
 ELEV. 217.95  
 NOT TO SCALE

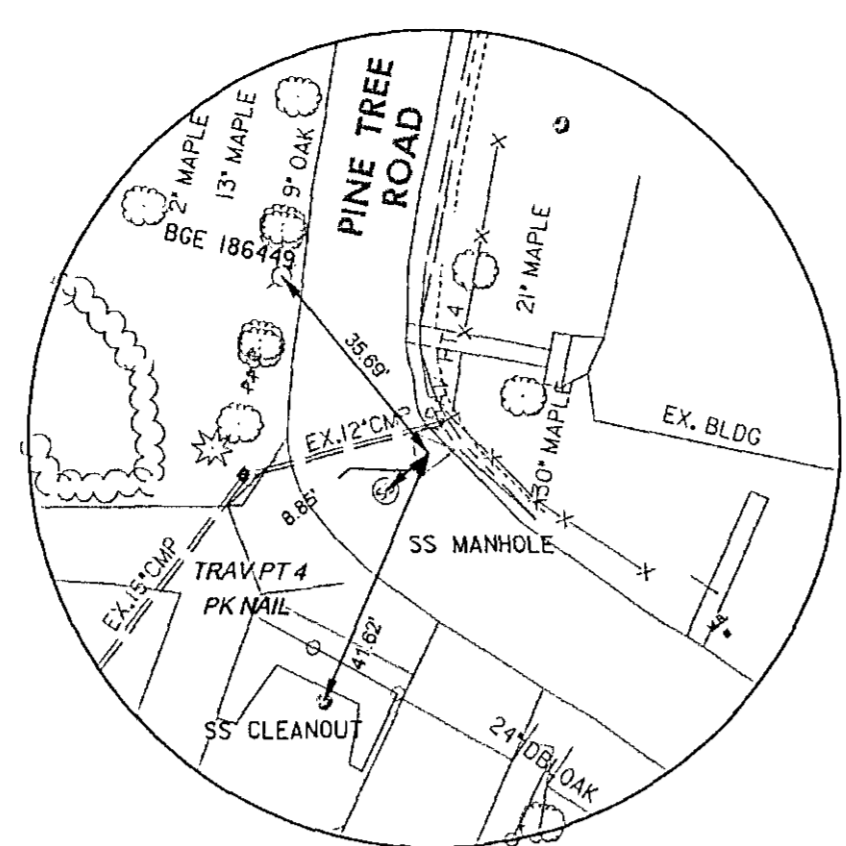


**TRAVERSE PT 4**  
 N 538411.4500  
 E 1365385.5394  
 ELEV. 213.71  
 NOT TO SCALE

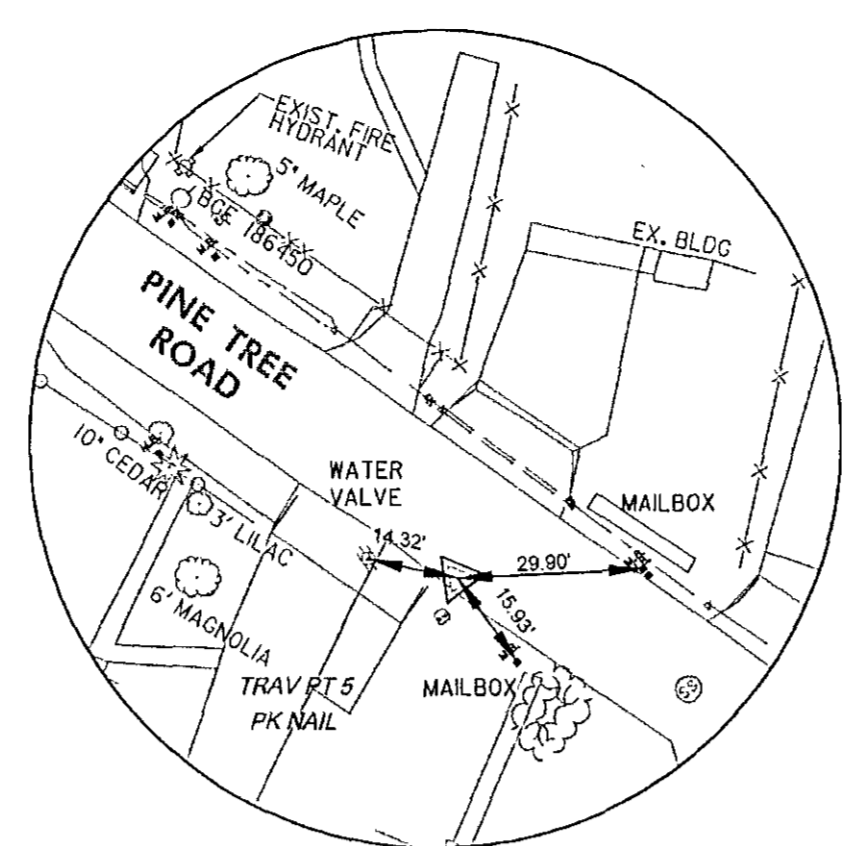


**TRAVERSE PT 5**  
 N 538173.8211  
 E 1365440.4791  
 ELEV. 210.53  
 NOT TO SCALE

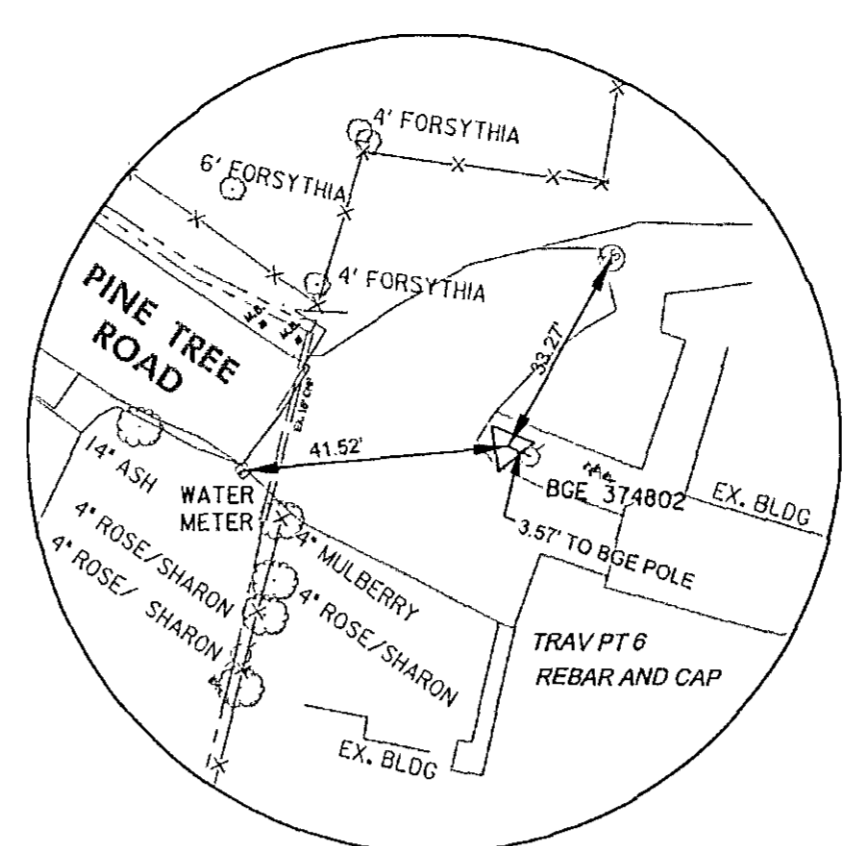


**TRAVERSE PT 6**  
 N 538043.8483  
 E 1365506.7161  
 ELEV. 208.77  
 NOT TO SCALE

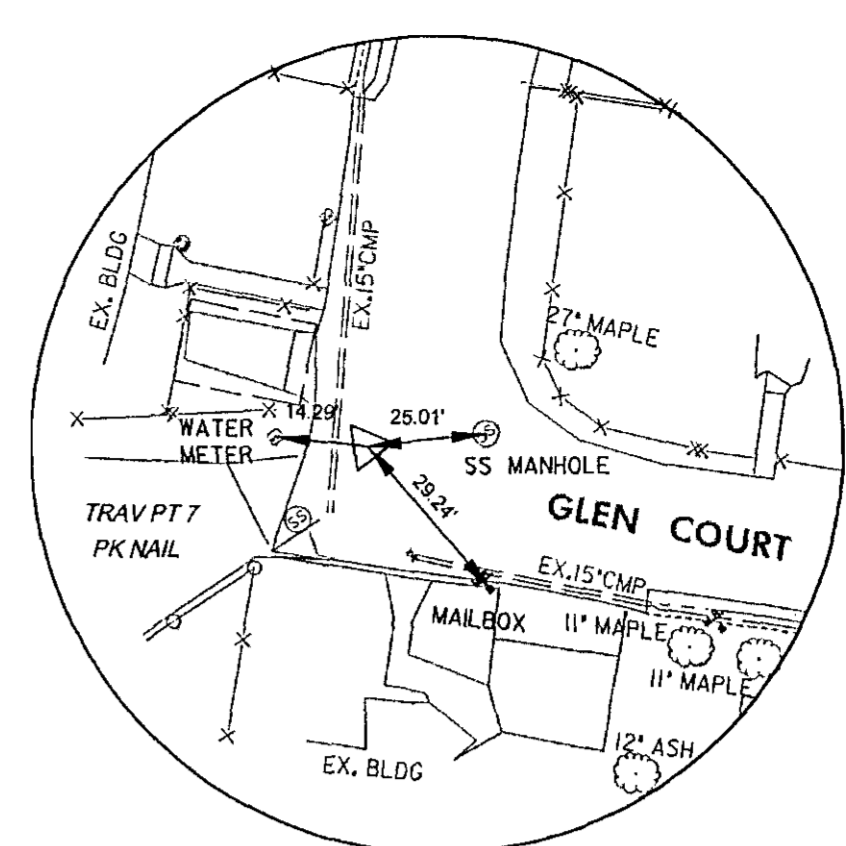


**TRAVERSE PT 7**  
 N 538145.7721  
 E 1365649.9951  
 ELEV. 211.10  
 NOT TO SCALE

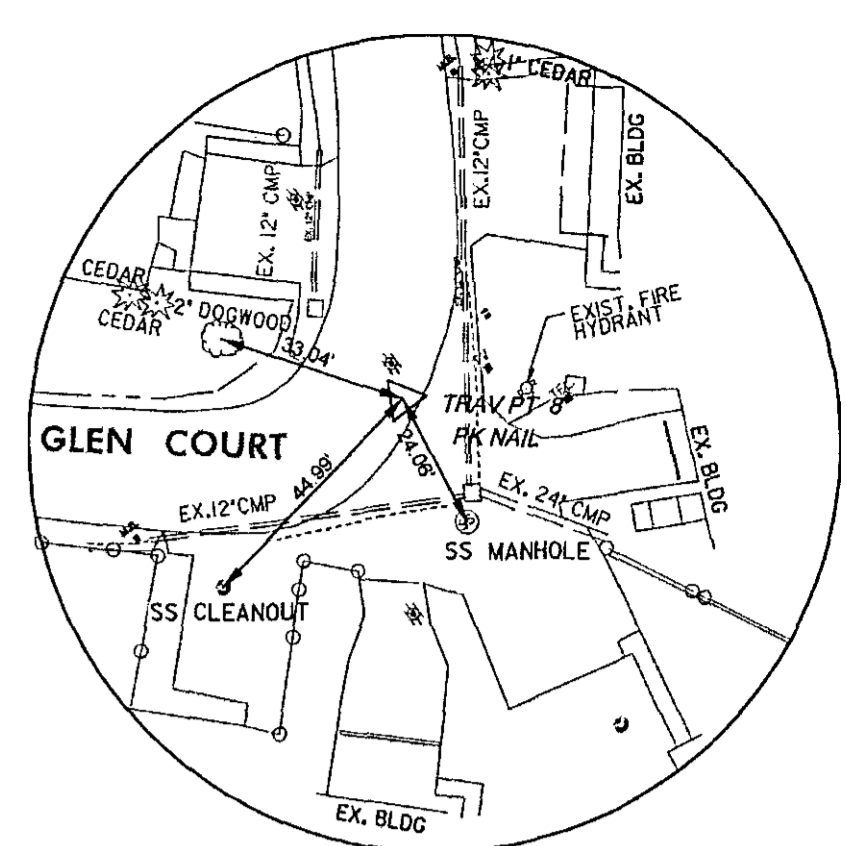


**TRAVERSE PT 8**  
 N 537942.9412  
 E 1365865.8135  
 ELEV. 199.62  
 NOT TO SCALE

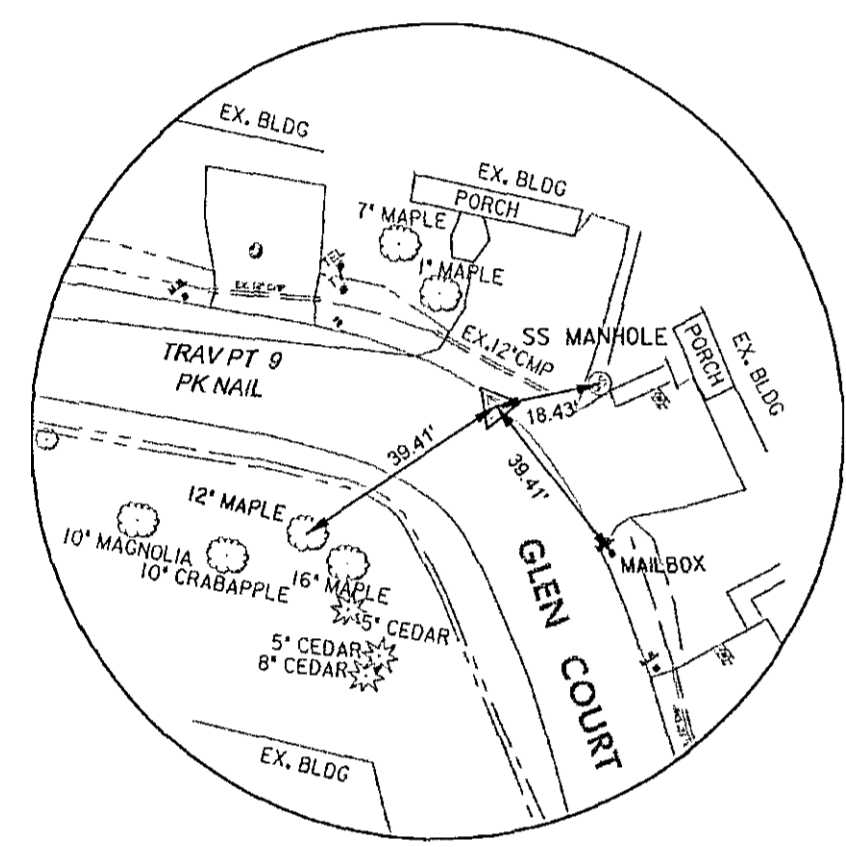


**TRAVERSE PT 9**  
 N 538099.5661  
 E 1365943.6905  
 ELEV. 204.72  
 NOT TO SCALE

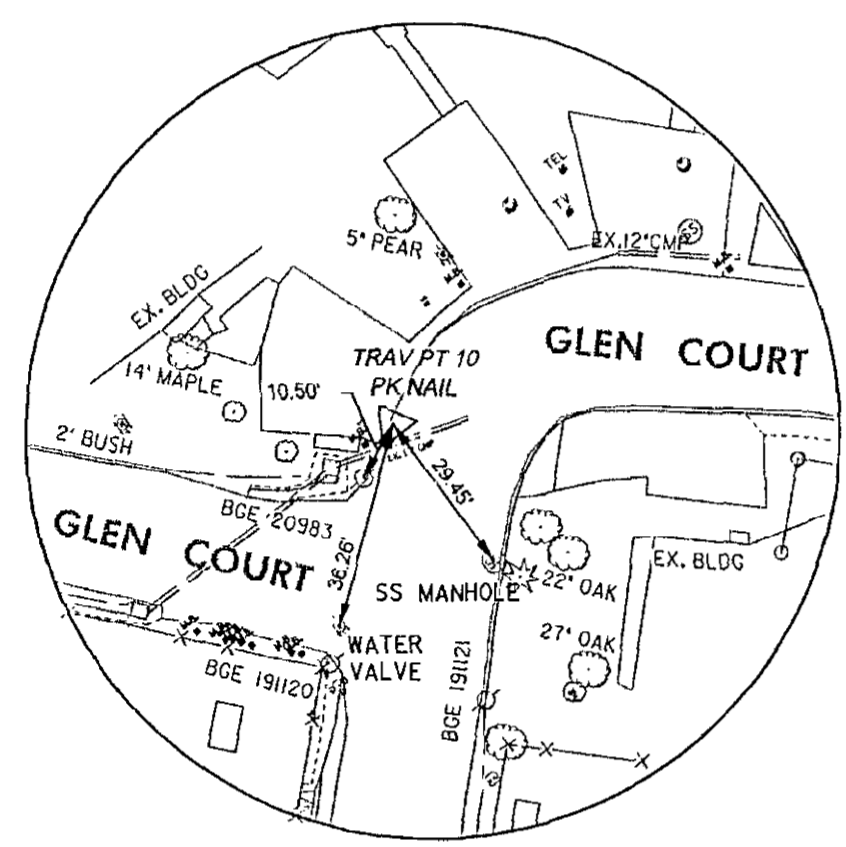


**TRAVERSE PT 10**  
 N 538256.8225  
 E 1365762.7583  
 ELEV. 212.29  
 NOT TO SCALE

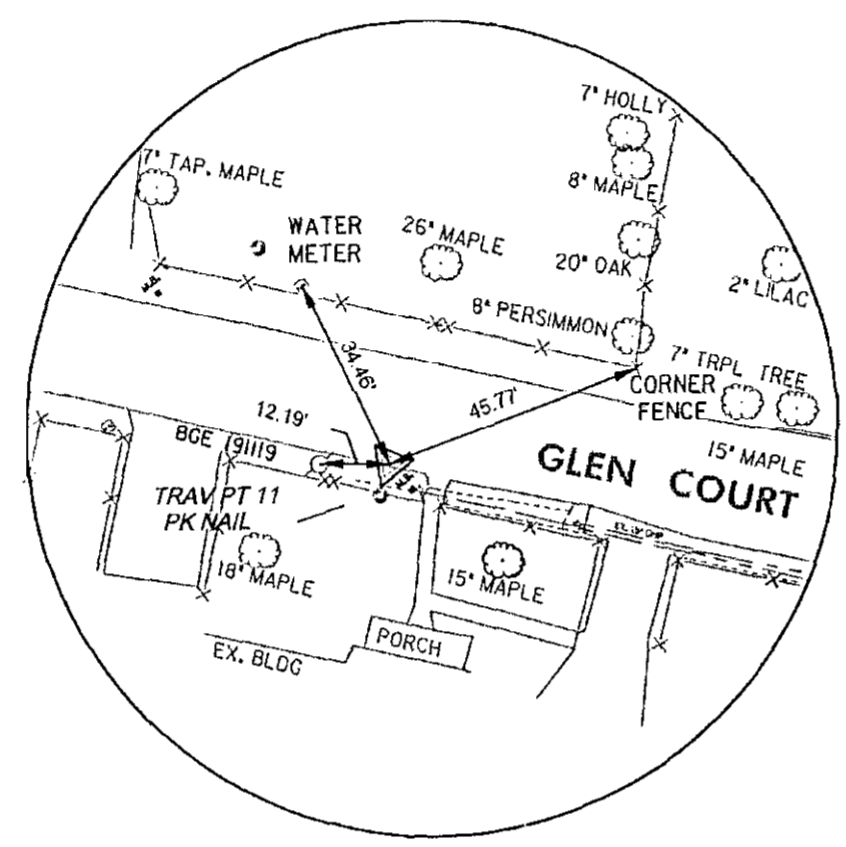


**TRAVERSE PT 11**  
 N 538341.1154  
 E 1365643.3886  
 ELEV. 215.33  
 NOT TO SCALE

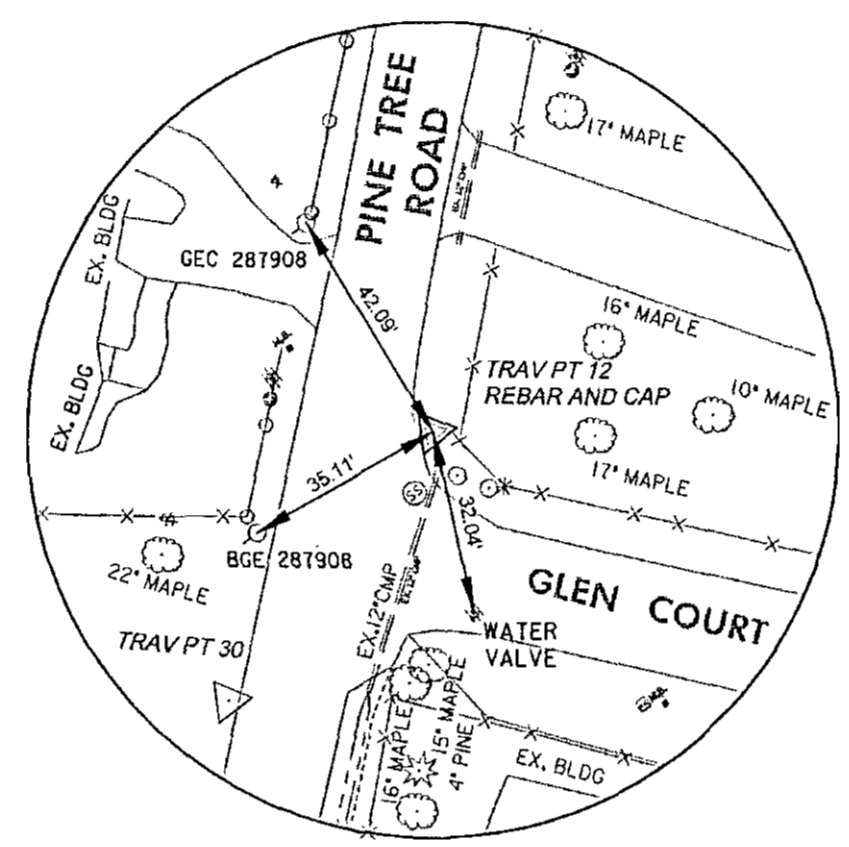


**TRAVERSE PT 12**  
 N 538535.0319  
 E 1365524.9414  
 ELEV. 215.07  
 NOT TO SCALE

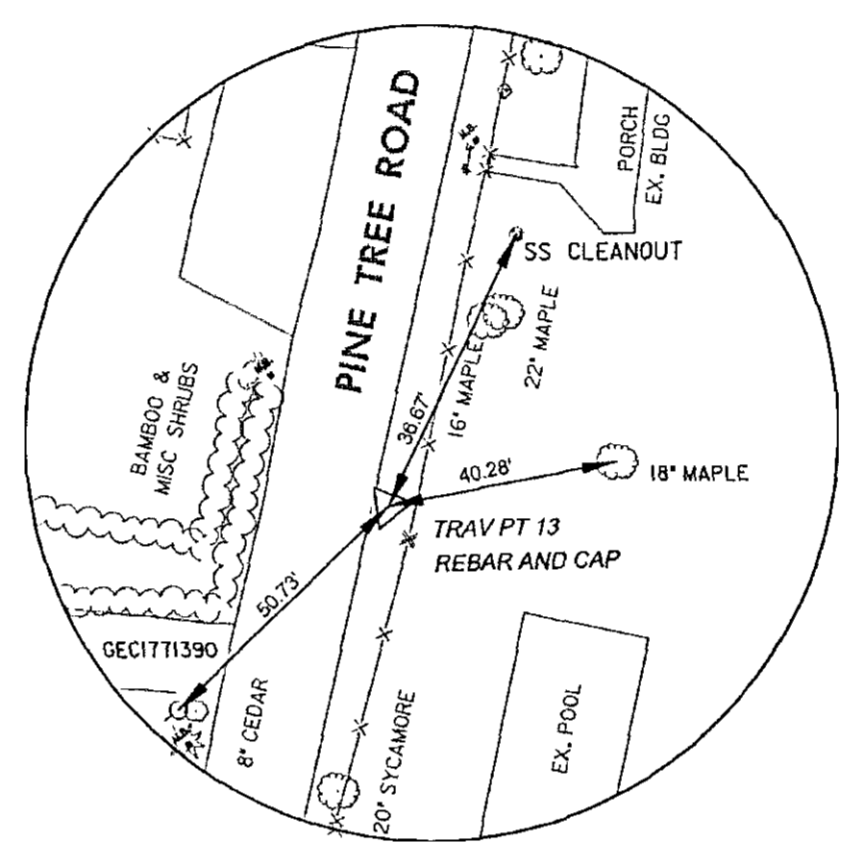


**TRAVERSE PT 13**  
 N 538707.4344  
 E 1365726.4567  
 ELEV. 220.48  
 NOT TO SCALE

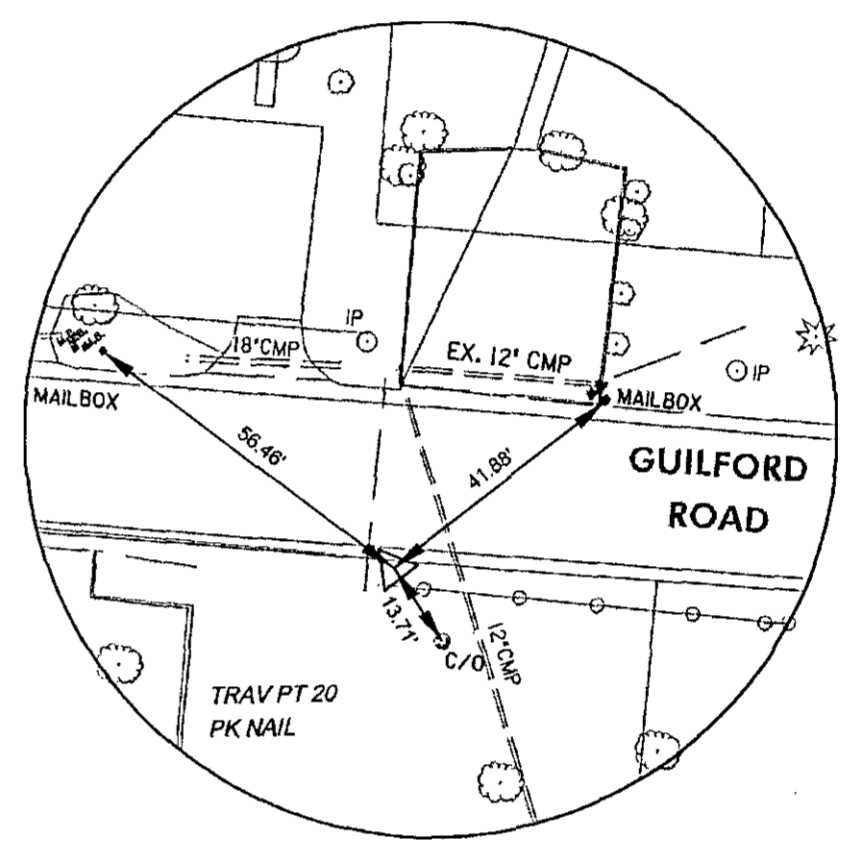


**TRAVERSE PT 20**  
 N 538842.0527  
 E 1365851.7894  
 ELEV. 225.86  
 NOT TO SCALE

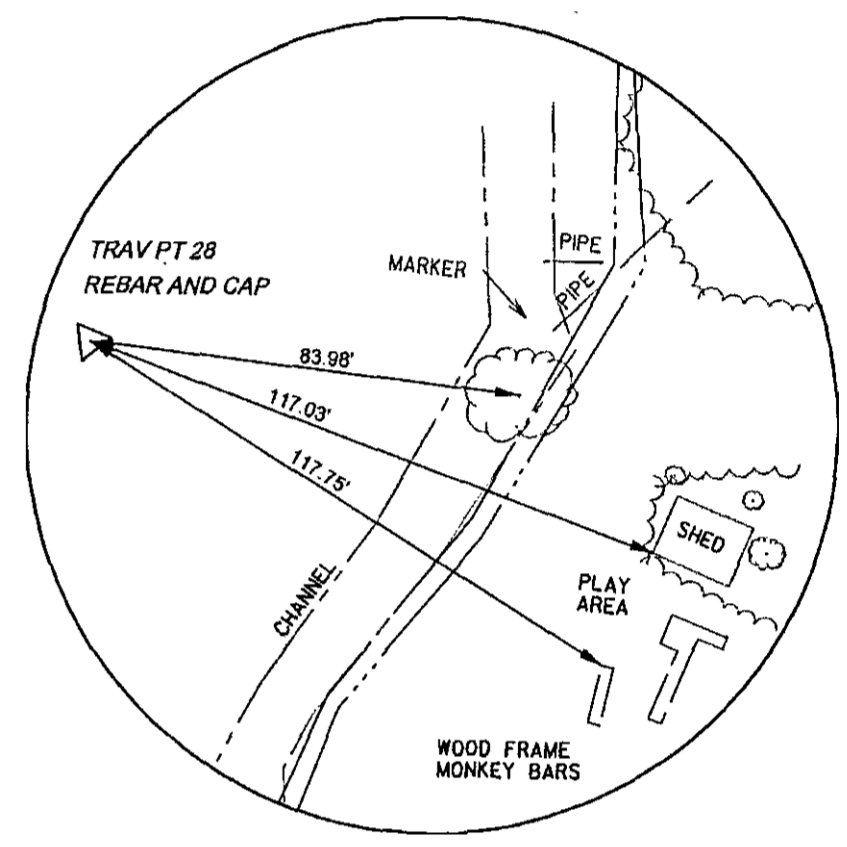

**TRAVERSE PT 28**  
 N 538762.8122  
 E 1365207.1308  
 ELEV. 203.96  
 NOT TO SCALE

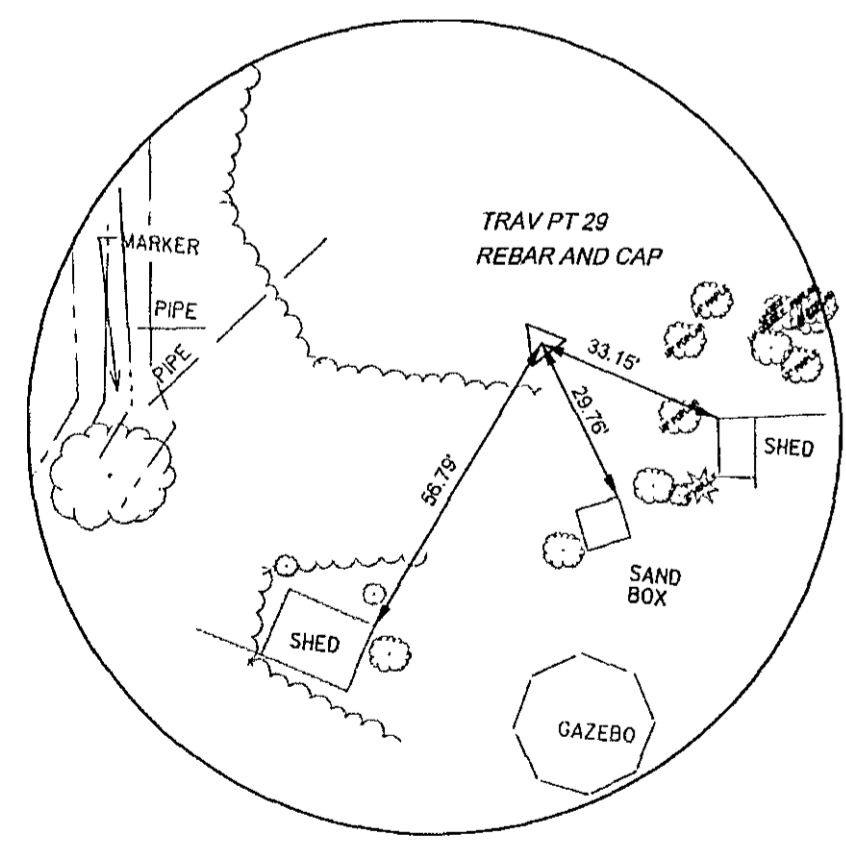

**TRAVERSE PT 29**  
 N 538675.2723  
 E 1365339.2353  
 ELEV. 208.10  
 NOT TO SCALE

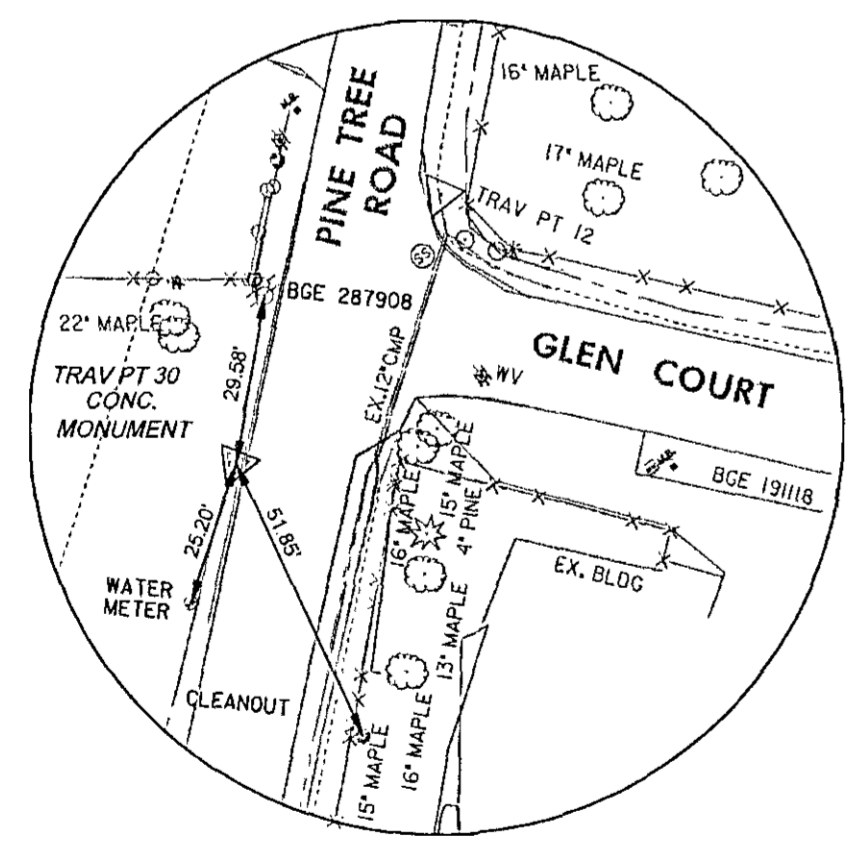

**TRAVERSE PT 30**  
 N 538520.1816  
 E 1365468.3333  
 ELEV. 214.81  
 NOT TO SCALE

CURVE DATA - PINE TREE DRIVE					
CURVE	DELTA	Dc	RADIUS	TANGENT	LENGTH
C-1	8°57'28.19" RT	28°38'52.40"	200.00'	15.67'	31.27'
C-2	8°24'45.38" RT	28°38'52.40"	200.00'	14.71'	29.37'
C-3	9°06'07.27" LT	76°23'39.74"	75.00'	5.97'	11.91'
C-4	9°31'51.63" RT	76°23'39.74"	75.00'	6.25'	12.48'
C-5	7°07'03.29" LT	28°13'28.28"	203.00'	12.63'	25.22'
C-6	7°07'03.29" RT	28°38'52.40"	200.00'	12.44'	24.85'
C-7	66°58'05.83" LT	154°51'12.45"	37.00'	24.48'	43.25'
C-8	7°31'49.41" LT	76°23'39.74"	75.00'	4.94'	9.86'
C-9	7°25'11.05" RT	76°23'39.74"	75.00'	4.86'	9.71'

CURVE DATA - GLEN COURT #1					
CURVE	DELTA	Dc	RADIUS	TANGENT	LENGTH
C-10	3°35'01.37" RT	28°38'52.40"	200.00'	6.26'	12.51'
C-11	3°12'27.22" LT	28°38'52.40"	200.00'	5.60'	11.20'
C-12	0°19'05.33" RT	2°51'53.24"	2000.00'	5.55'	11.11'
C-13	0°42'59.98" RT	5°43'46.48"	1000.00'	6.25'	12.51'
C-14	2°42'34.71" LT	5°43'46.48"	1000.00'	23.65'	47.29'

CURVE DATA - GLEN COURT #2					
CURVE	DELTA	Dc	RADIUS	TANGENT	LENGTH
C-15	84°13'13.98" RT	190°59'09.35"	30.00'	27.12'	44.10'
C-16	6°51'46.02" RT	28°38'52.40"	200.00'	11.99'	23.96'
C-17	65°04'00.00" RT	127°19'26.24"	45.00'	28.71'	51.01'
C-18	110°37'00.00" RT	136°25'06.68"	42.00'	60.67'	81.09'
C-19	93°14'00.00" RT	143°14'22.02"	40.00'	42.32'	65.09'


TRAVERSE POINTS CONTROL COORDINATES					
POINT NO.	NORTH	EAST	ELEVATION	DESCRIPTION	
TRAV PT 1	538626.7489	1366170.2973	226.58	REBAR & CAP	
TRAV PT 2	538842.0527	1365851.7894	225.86	PK NAIL	
TRAV PT 3	538630.6174	1365603.2568	217.95	PK NAIL	
TRAV PT 4	538411.4500	1365385.5394	213.71	PK NAIL	
TRAV PT 5	538173.8211	1365440.4791	210.53	PK NAIL	
TRAV PT 6	538043.8483	1365506.7161	208.77	REBAR & CAP	
TRAV PT 7	538145.7721	1365649.9951	211.10	PK NAIL	
TRAV PT 8	537942.9412	1365865.8135	199.62	PK NAIL	
TRAV PT 9	538099.5661	1365943.6905	204.72	PK NAIL	
TRAV PT 10	538256.8225	1365762.7583	212.29	PK NAIL	
TRAV PT 11	538341.1154	1365643.3886	215.33	PK NAIL	
TRAV PT 12	538535.0319	1365524.9414	215.07	REBAR & CAP	
TRAV PT 13	538707.4344	1365726.4567	220.48	REBAR & CAP	
TRAV PT 20	538842.0527	1365851.7894	225.86	PK NAIL	
TRAV PT 28	538762.8122	1365207.1308	203.96	REBAR & CAP	
TRAV PT 29	538675.2723	1365339.2353	208.10	REBAR & CAP	
TRAV PT 30	538520.1816	1365468.3333	214.81	CONC MON	

PINE TREE ROAD BASELINE CONSTRUCTION CONTROL COORDINATES		
STATION	NORTH	EAST
POB 99+78.41	538,846.8684	1,365,872.2163
PC 100+43.02	538,804.3946	1,365,823.5342
PT 100+74.29	538,785.7595	1,365,798.4647
PRC 100+74.29	538,785.7595	1,365,798.4647
PT 101+03.65	538,768.3688	1,365,774.8353
PC 104+37.99	538,550.9666	1,365,520.8164
PT 104+49.91	538,542.5346	1,365,512.4164
PRC 104+49.91	538,542.5346	1,365,512.4164
PT 104+62.39	538,533.7390	1,365,503.5886
PC 105+58.95	538,471.5041	1,365,429.7597
PT 105+84.17	538,454.0965	1,365,411.5363
PRC 105+84.17	538,454.0965	1,365,411.5363
PT 106+09.01	538,436.9462	1,365,393.5822
PC 106+14.64	538,433.3178	1,365,389.2778
PT 106+57.89	538,394.1498	1,365,377.7602
PC 107+72.77	538,284.3433	1,365,411.5366
PT 107+82.63	538,275.1390	1,365,415.0446
PC 107+98.16	538,261.0199	1,365,421.5173
PT 108+07.88	538,251.9540	1,365,424.9825
POE 110+43.20	538,027.1616	1,365,494.6040

GLEN COURT #2 BASELINE CONSTRUCTION CONTROL COORDINATES		
STATION	NORTH	EAST
POB 300+00.00	538,228.7954	1,365,747.4093
PC 300+24.63	538,244.8387	1,365,766.0904
PT 300+68.72	538,243.8176	1,365,806.3111
PC 301+00.92	538,221.6251	1,365,829.6444
PT 301+24.88	538,204.1167	1,365,845.9736
PC 302+47.00	538,109.9852	1,365,923.7704
PT 302+98.10	538,061.9489	1,365,929.7020
PC 303+98.87	537,970.9915	1,365,886.3293
PT 304+79.96	537,959.9518	1,365,818.1502
PC 306+88.08	538,109.9384	1,365,673.8686
PT 307+53.17	538,168.0145	1,365,676.6352
POE 308+46.46	538,228.7954	1,365,747.4093

GLEN COURT #1 BASELINE CONSTRUCTION CONTROL COORDINATES		
STATION	NORTH	EAST
POB 200+00.00	538,531.1015	1,365,500.4597
PC 201+02.10	538,453.0382	1,365,566.2640
PT 201+14.61	538,443.2277	1,365,574.0223
PC 201+31.58	538,429.5948	1,365,584.1271
PT 201+42.77	538,420.7910	1,365,591.0424
PC 202+44.81	538,342.3443	1,365,656.2938
PT 202+55.92	538,333.6921	1,365,663.2559
PC 203+02.29	538,297.4826	1,365,692.2268
PT 203+14.80	538,287.6673	1,365,699.9798
PC 203+28.95	538,276.5080	1,365,708.6816
PT 203+76.24	538,239.9154	1,365,738.6335
POE 203+90.39	538,229.1780	1,365,747.8548

GEOMETRIC LAYOUT PLAN  
SCALE: 1" = 50'

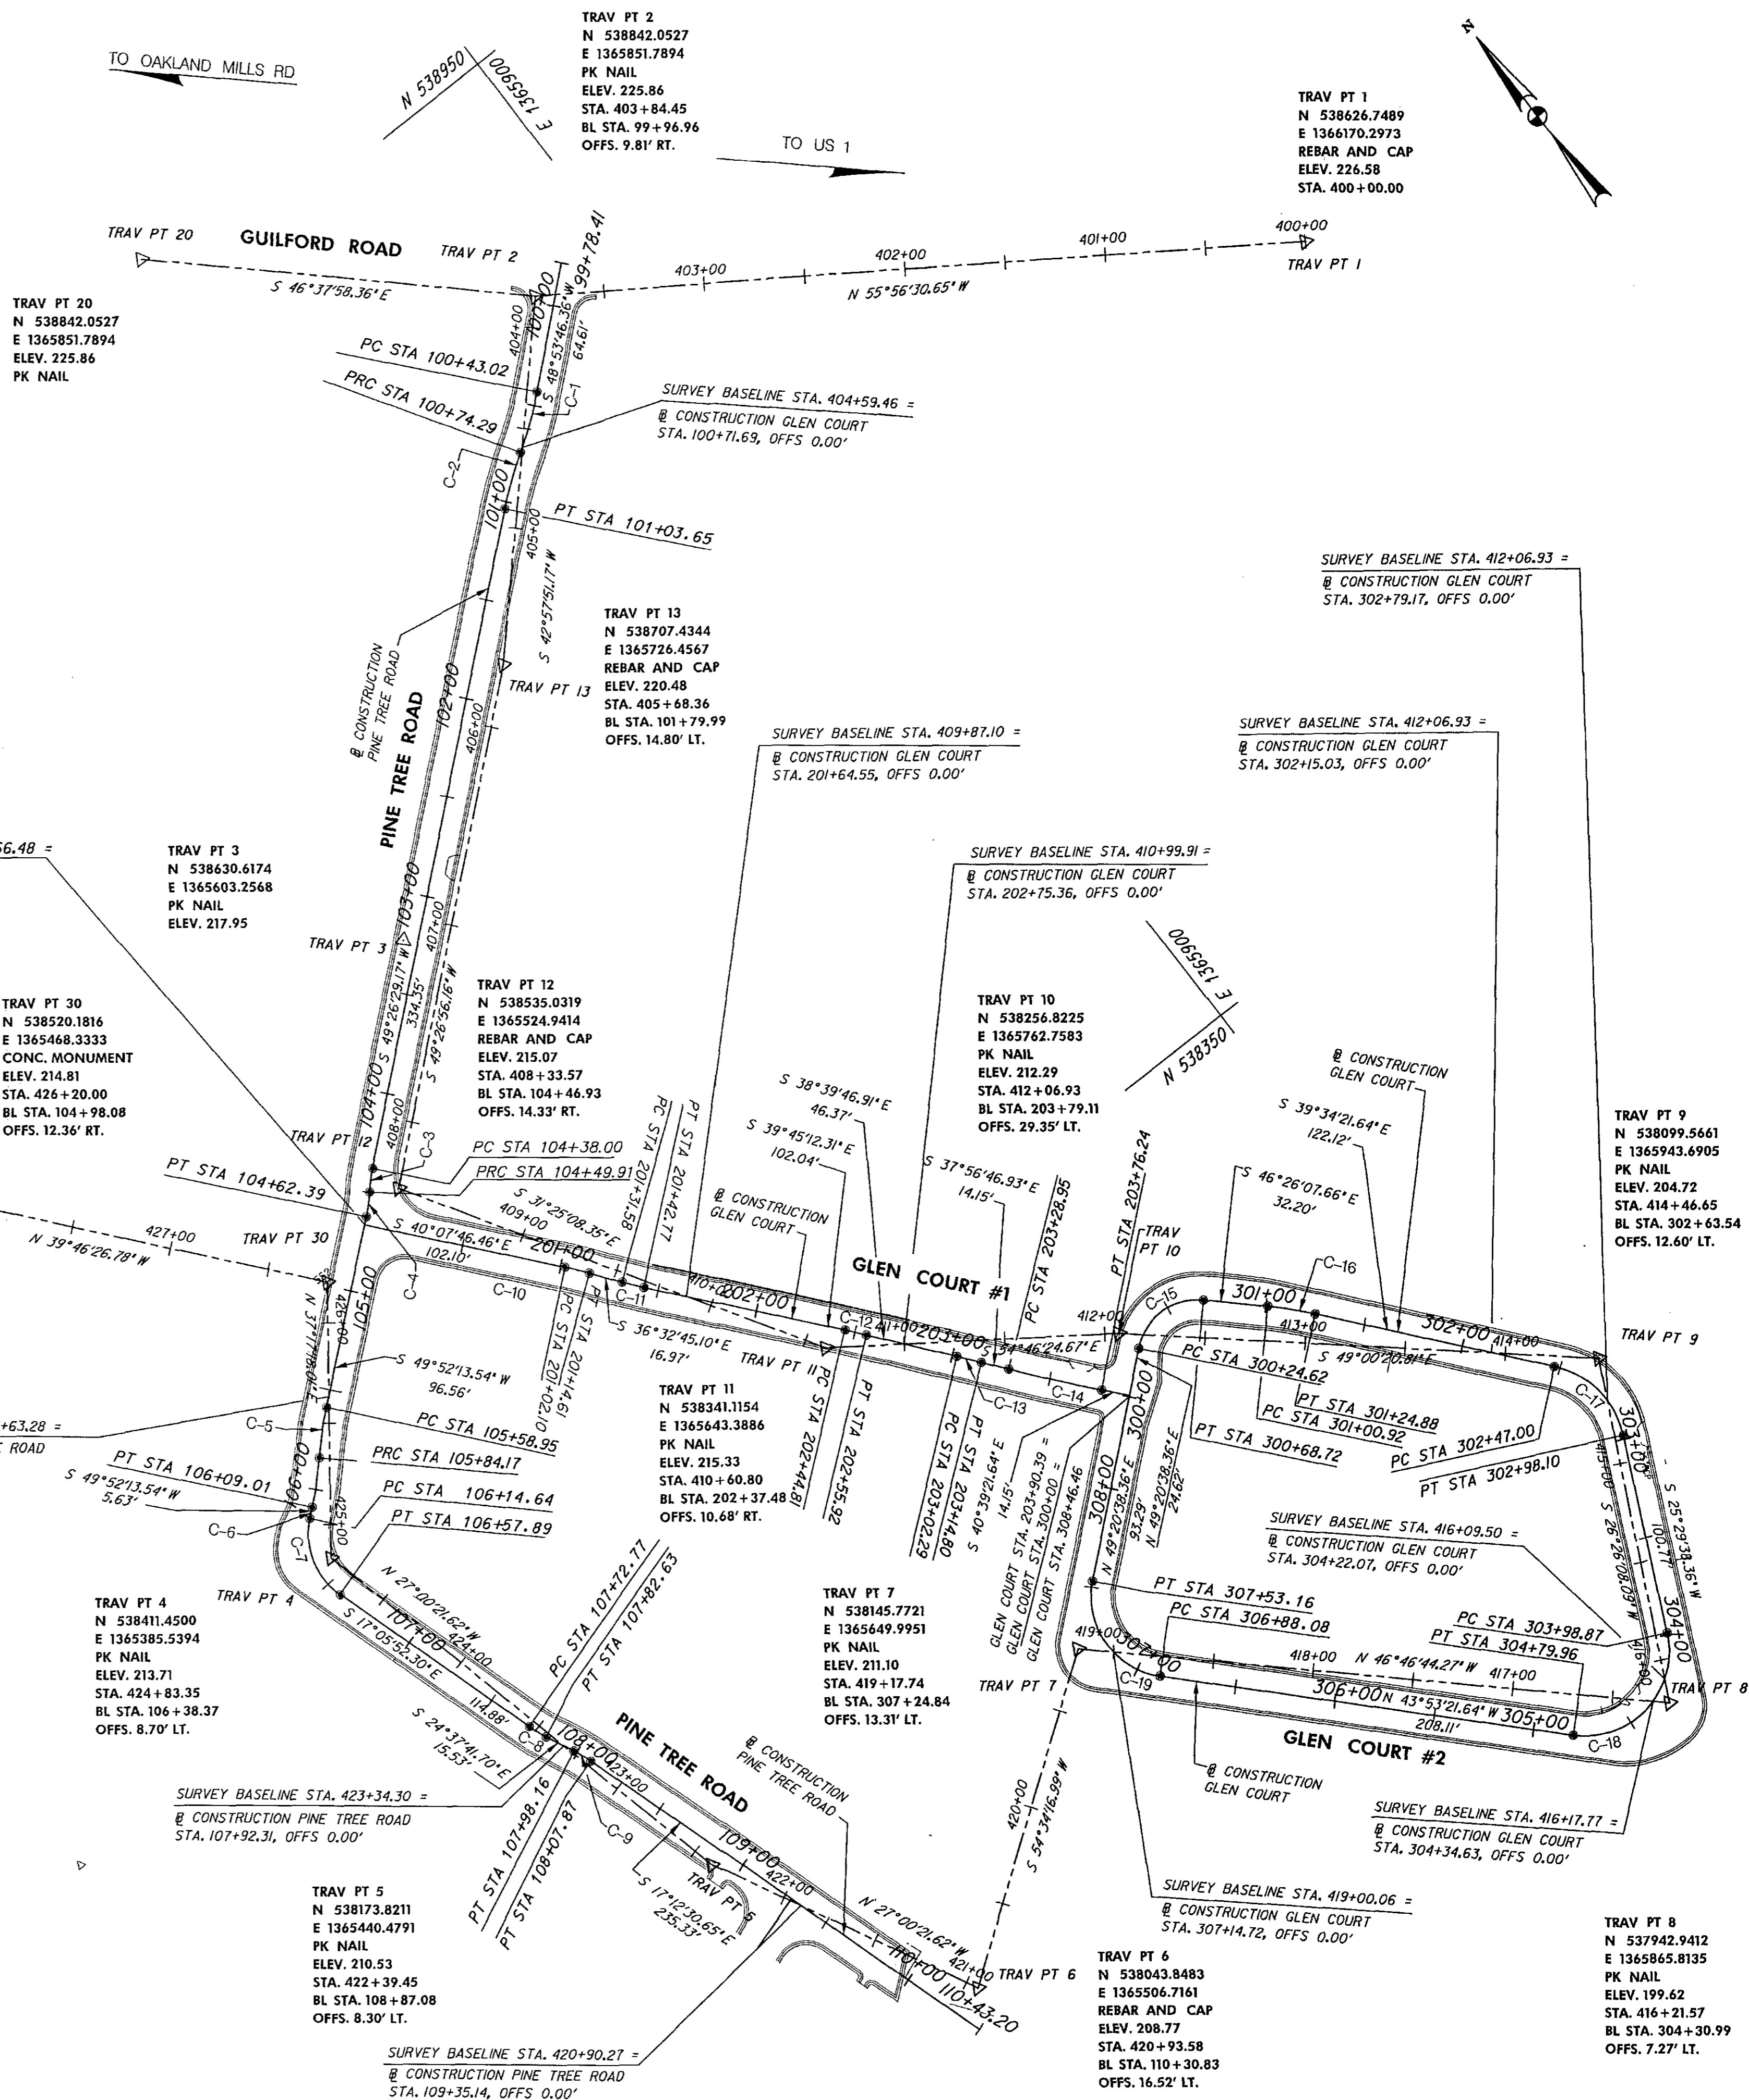

DEPARTMENT OF PUBLIC WORKS  
HOWARD COUNTY, MARYLAND



Engineers - Civil/Structural/Inspections  
4785 Dorsey Hall Drive  
Suite 124  
Ellicott City, Maryland 21042




DES: GWF/JW  
DRN: JRW  
CHK: GWF  
DATE: APRIL 2012

GEOMETRIC LAYOUT

PINE TREE ROAD/GLEN COURT  
DRAINAGE AND ROADWAY IMPROVEMENTS, PH. 1  
CAPITAL PROJECT D-1140  
ELECTION DISTRICT NO. 6  
HOWARD COUNTY, MARYLAND

SCALE:  
AS SHOWN  
SHEET  
4 OF 14A

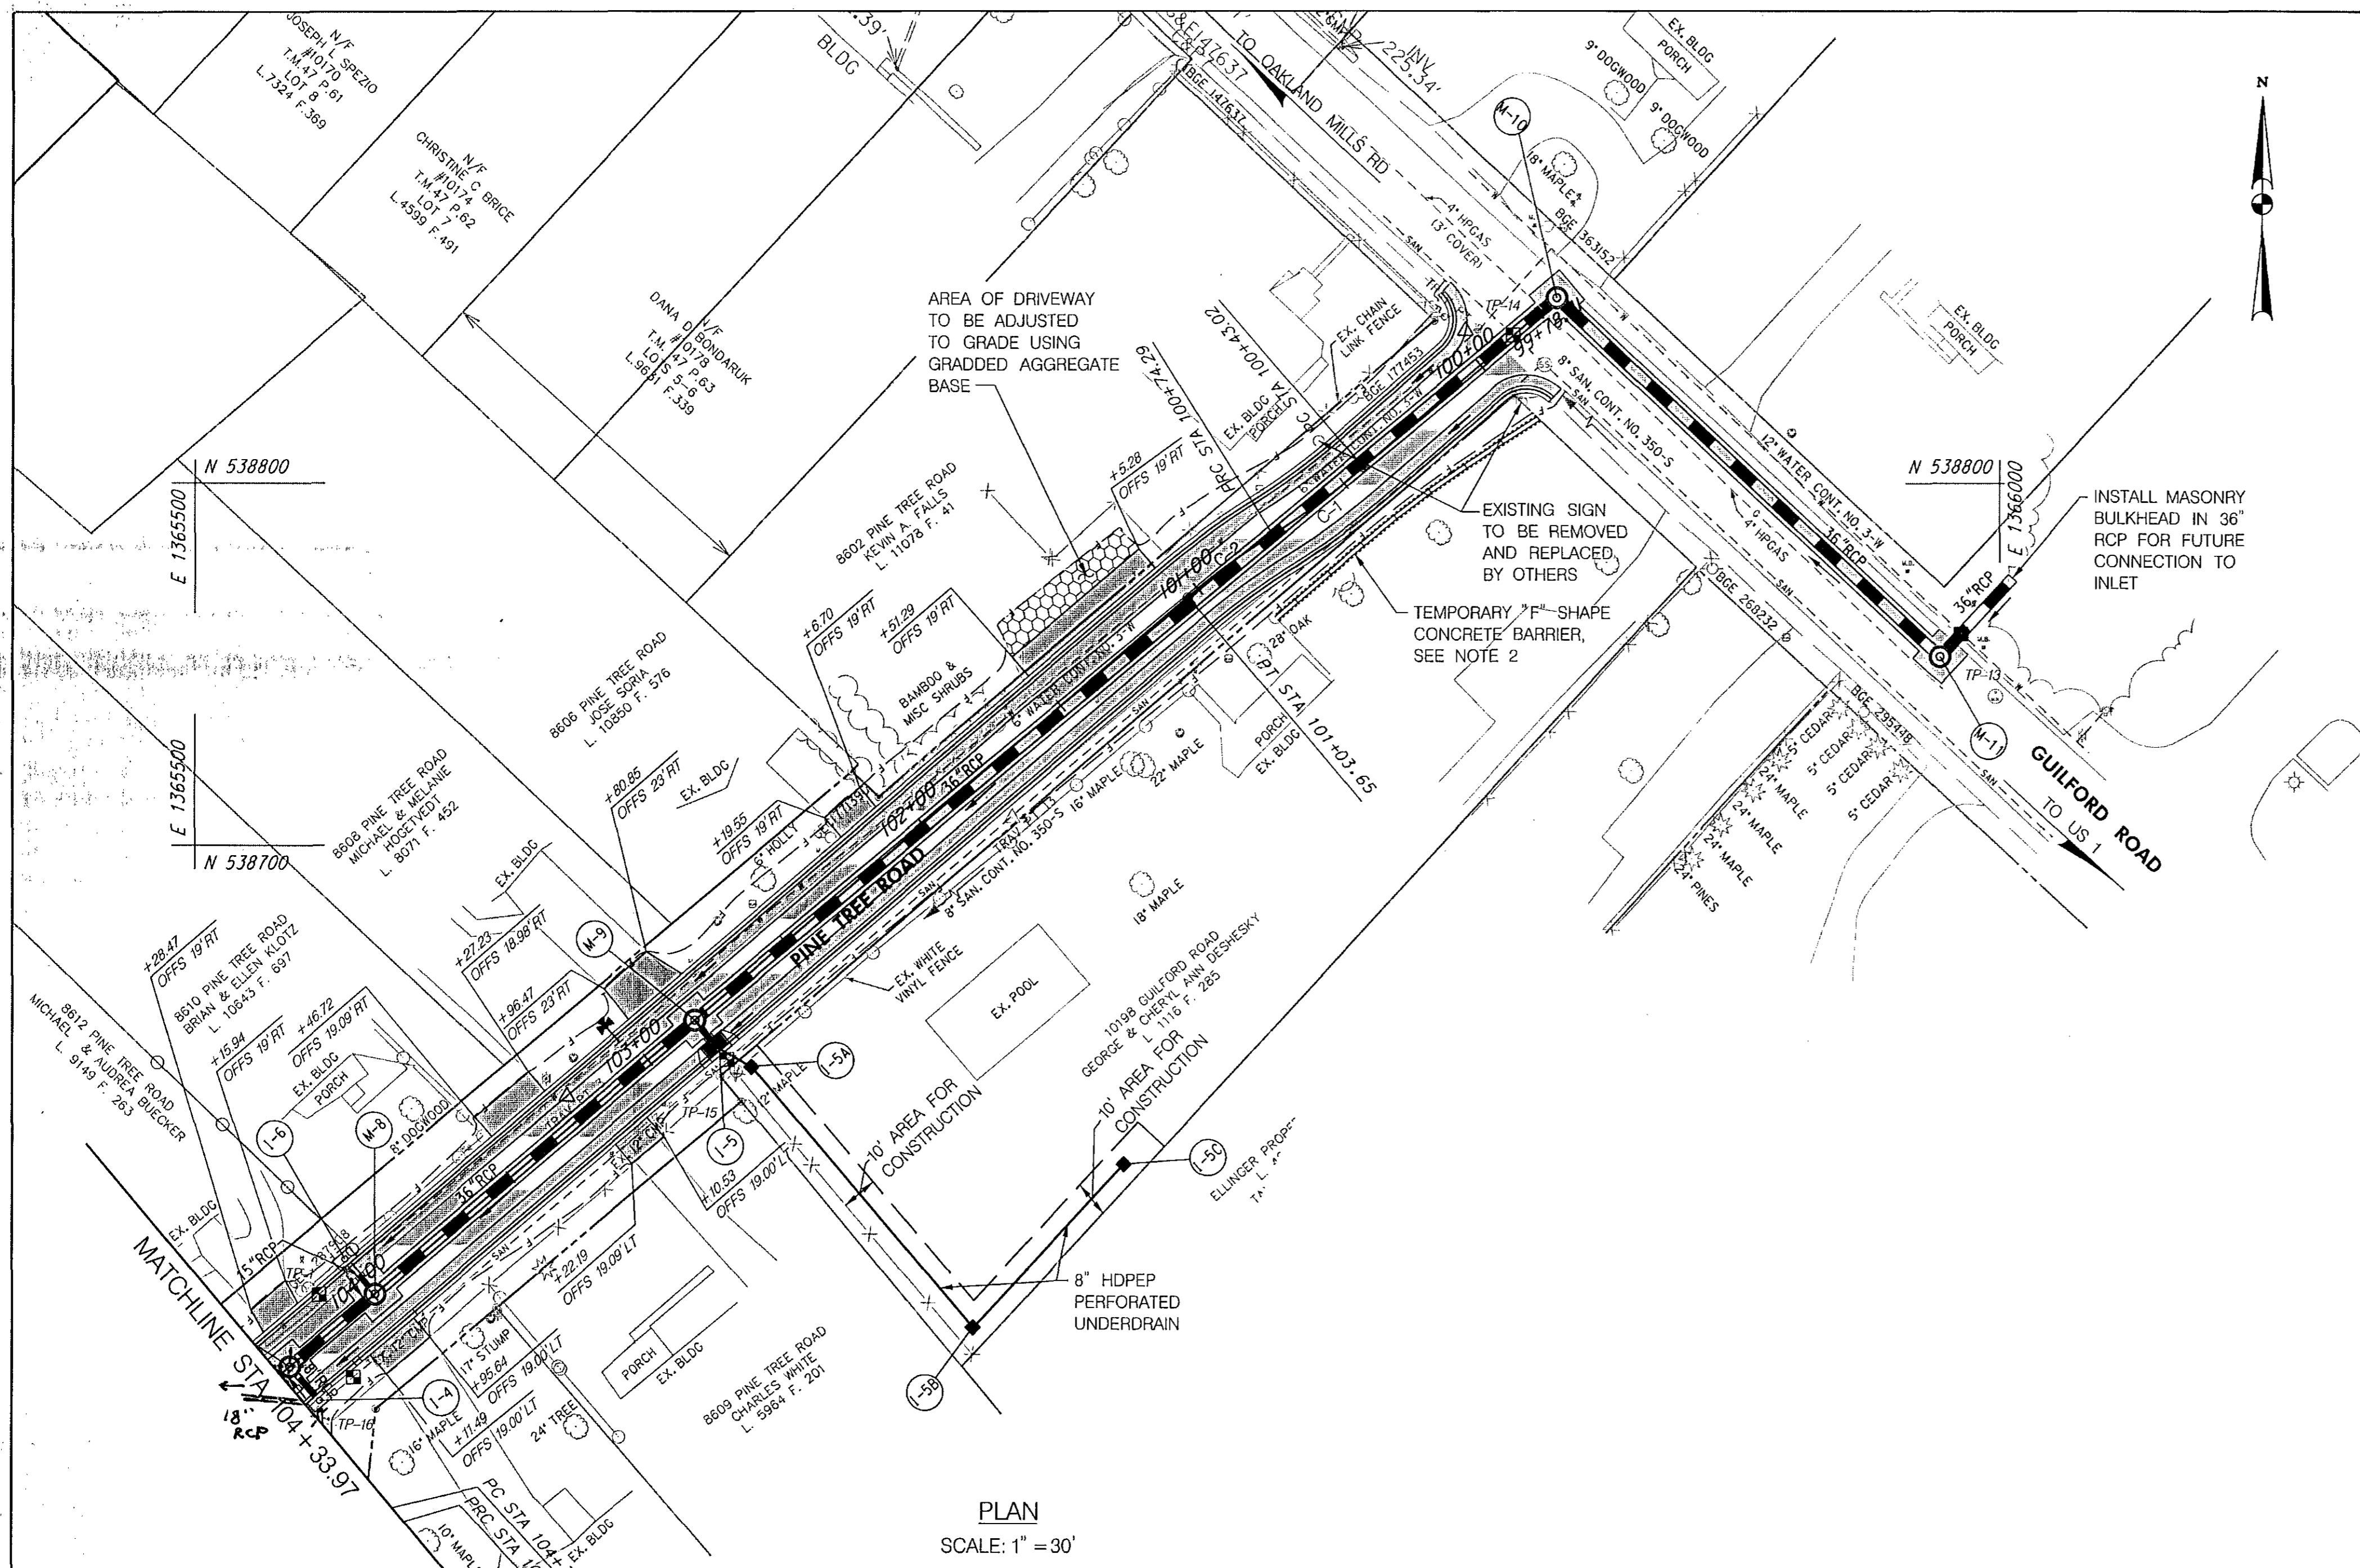

PLAN  
SCALE: 1" = 30'

NOTES:


- EXISTING WATER HOUSE CONNECTIONS (WHC) ARE PRESENT WITHIN AREA OF CONSTRUCTION. THE EXACT LOCATION IS NOT KNOWN AT PRESENT. PAY ITEM HAS BEEN INCLUDED FOR TEST PITTING AND CONTINGENT PAY ITEM IS INCLUDED FOR RELOCATION OF WHC.
- INSTALL 90 L.F. OF 'F'-SHAPE CONCRETE BARRIER STA. 99+98 TO 100+87, LT. TO PREVENT POSSIBLE VEHICULAR TRAFFIC ACROSS RESIDENTIAL PROPERTY. BARRIER TO BE REMOVED AFTER CONSTRUCTION IS COMPLETED. COST OF BARRIER, PLACEMENT & REMOVAL SHALL BE INCIDENTAL TO MAINTENANCE OF TRAFFIC PAY ITEM.

LEGEND

- PROPERTY LINE
- R.O.W. LINE
- == EX. 12" RCP
- == PROP. 15" RCP
- TP-1
- TEST PIT LOCATION
- PROPOSED RIP RAP
- PROPOSED HOT MIX ASPHALT PAVING
- PROPOSED GRINDING AND OVERLAY
- C F
- PROPOSED CUT OR FILL LINE
- PROPOSED DRIVEWAY GRADDED AGGREGATE BASE


- REMOVE EXISTING PIPE CULVERT  
STA. 103+18.5 TO 103+25, LT. - 17 LF  
STA. 103+93 TO 104+13, LT. - 20 LF
- REMOVE AND RESET EXISTING FENCE  
STA. 100+58 TO STA. 101+01, RT. - 50 LF  
STA. 103+48.5 TO STA. 104+12.5, RT. - 65 LF  
STA. 104+33 TO STA. 104+66, RT. - 35 LF  
NOTE - SEE ROADWAY PLAN, SHEET 6
- RELOCATE EXISTING FIRE HYDRANT  
(PER HO. CO. STD. DETAIL W-1.11)  
STA. 103+03, RT. - 1 EA
- RELOCATE / ADJUST EXISTING SANITARY CLEANOUT  
STA. 100+83, RT. - 1 EA  
STA. 102+60.5, RT. - 1 EA  
STA. 103+15, RT. - 1 EA
- RELOCATE / ADJUST EXISTING WATER VALVE  
STA. 101+60, RT. - 1 EA  
STA. 103+24, RT. - 1 EA
- RELOCATE / ADJUST EXISTING WATER METER  
STA. 100+70.5, RT. - 1 EA  
STA. 102+55, RT. - 1 EA  
STA. 103+58, RT. - 1 EA
- REMOVE EXISTING TREE  
STA. 102+03, RT. - 1 EA
- INSTALL 7-INCH COMBINATION CURB AND GUTTER  
STA. 99+95.24 TO STA. 100+05.17, RT. - 13 L.F.  
STA. 99+91.48 TO STA. 100+01.45, LT. - 13 L.F.  
(PROVIDE NOSE DOWN PER DETAIL R-3.02)
- RECONSTRUCT DRIVEWAY WITH P-I PAVEMENT  
STA. 101+05.28 TO STA. 101+51.29, RT. - 322 S.F.  
STA. 102+06.70 TO STA. 102+19.55, RT. - 90 S.F.  
STA. 102+77.31 TO STA. 102+96.86, RT. - 193 S.F.  
STA. 103+27.23 TO STA. 103+46.72, RT. - 137 S.F.  
STA. 103+10.53 TO STA. 103+22.19, LT. - 81 S.F.  
STA. 103+95.64 TO STA. 104+11.49, LT. - 110 S.F.  
STA. 104+17.32 TO STA. 104+30.20, RT. - 89 S.F.
- CONSTRUCT MODIFIED CURB AND GUTTER  
STA. 100+05.17(1) TO STA. 104+33.97, RT. - 446 L.F.  
STA. 100+01.45(1) TO STA. 104+33.97, LT. - 448 L.F.  
(1): TRANSITION CURB FROM 7" C&G TO MODIFIED C&G IN 10' DISTANCE
- GRIND EXISTING PAVEMENT  
STA. 99+92 TO STA. 104+33.97, RT. - 655 S.Y.

CONSTRUCTION ASBUILT CERTIFICATION  
I hereby certify the as-built information shown hereon (in red) is correct to the best of my knowledge and belief and that is the result of a field run survey performed under my direct supervision in accordance with the laws regulating land surveys in the State of Maryland.  
*Wayne F. Aubertin*  
Wayne F. Aubertin, Prof. L.S. Maryland Reg. #21330 Exp. 01/07/17  
Snider & Associates, Land Surveyors  
20270 Goldenrod Lane, Suite 110  
Germantown, MD 20876 Ph. 301-948-5100 Fax 301-948-1286

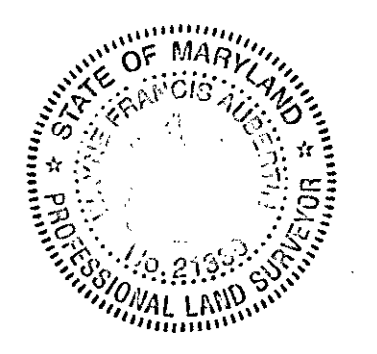

DEPARTMENT OF PUBLIC WORKS  
HOWARD COUNTY, MARYLAND  
Director of Public Works: *4/16/13*  
Chief, Bureau of Highways: *4-5-13*

**NOLAN**  
Associates, Inc.  
Engineers - Civil/Structural/Inspections  
4785 Dorsey Hall Drive  
Suite 124  
Ellicott City, Maryland 21042  
Phone: (410) 995-3851 Fax: (410) 995-1363

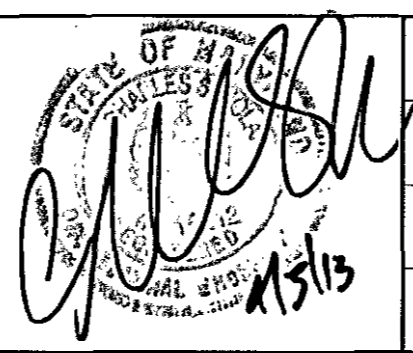


DES: GWF/JW	MND	1	Revise Qty for Grind Ex. Pav. to 670	6/7/13
DRN: JRW				
CHK: GWF				
DATE: FEB 2013	BY	NO.	REVISION	DATE

ROADWAY PLAN  
600' SCALE MAP NO. \_\_\_\_\_ BLOCK NO. \_\_\_\_\_

PINE TREE ROAD GLEN COURT  
DRAINAGE AND ROADWAY IMPROVEMENTS, PH. 1  
CAPITAL PROJECT D-1140  
ELECTION DISTRICT NO. 6  
HOWARD COUNTY, MARYLAND  
SCALE: AS SHOWN  
SHEET 5 OF 14A

AS BUILT

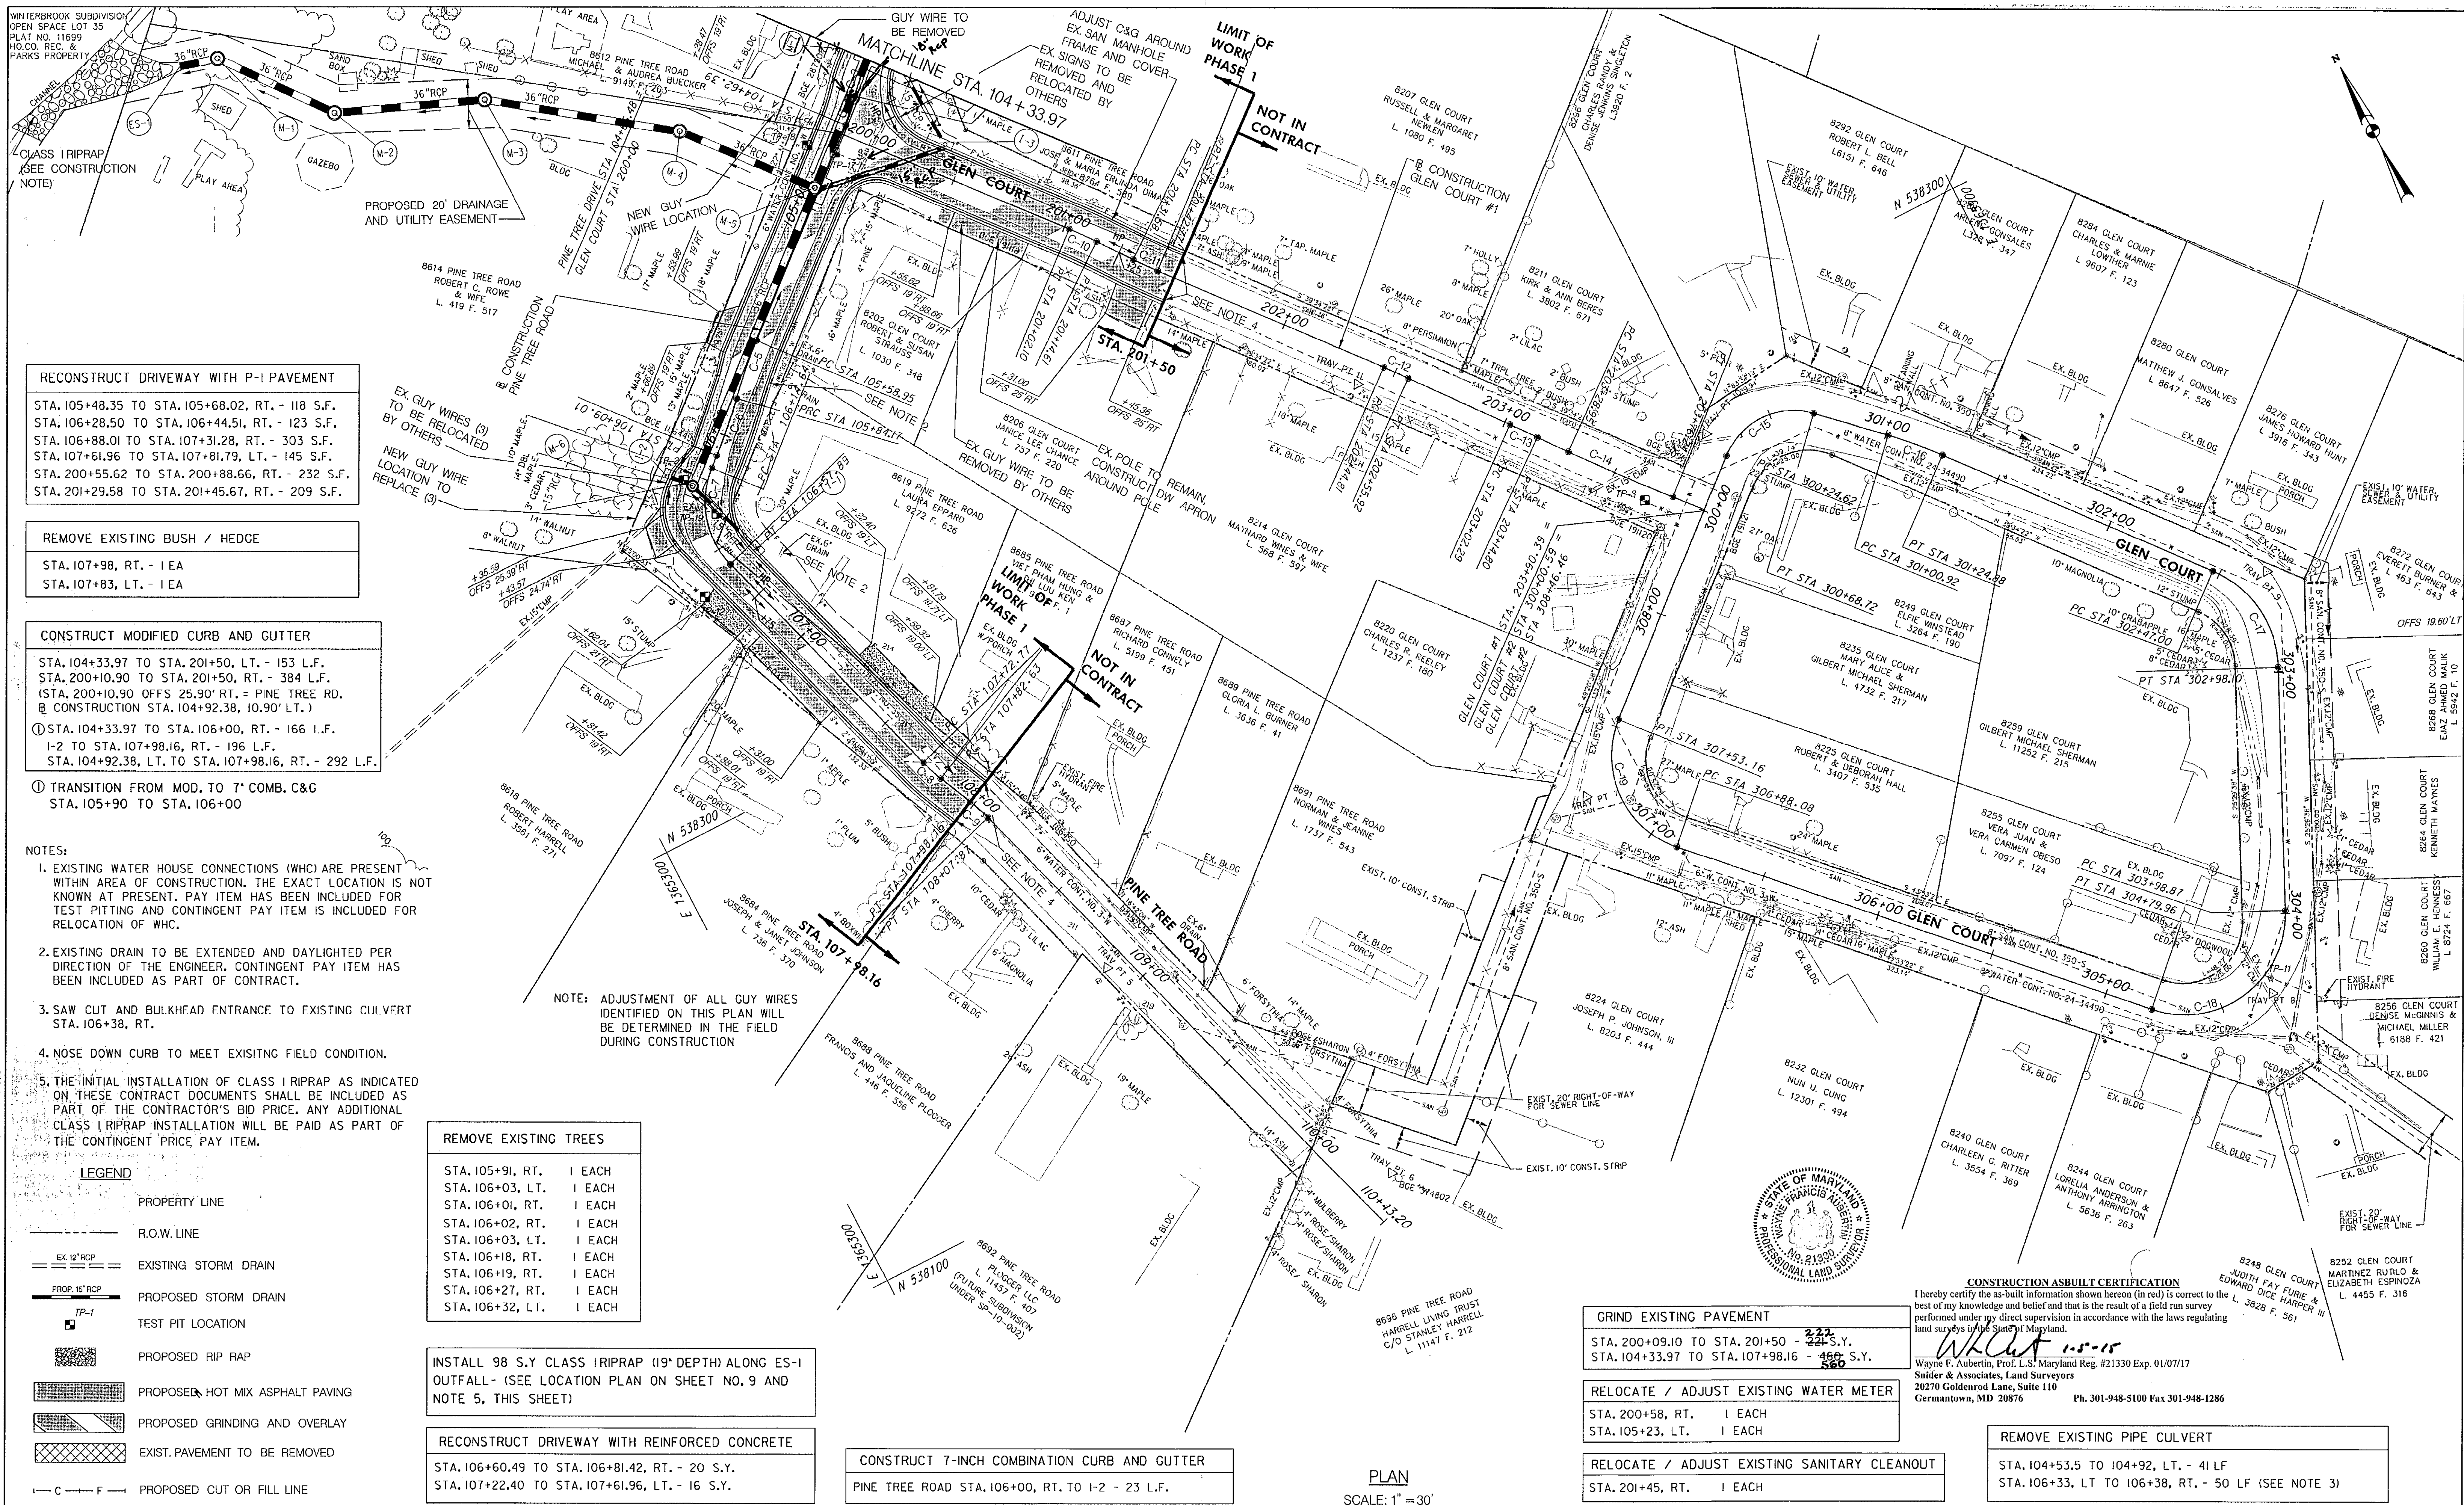

**RECONSTRUCT DRIVEWAY WITH P-I PAVEMENT**  
 STA. 105+48.35 TO STA. 105+68.02, RT. - 118 S.F.  
 STA. 106+28.50 TO STA. 106+44.51, RT. - 123 S.F.  
 STA. 106+88.01 TO STA. 107+31.28, RT. - 303 S.F.  
 STA. 107+61.96 TO STA. 107+81.79, LT. - 145 S.F.  
 STA. 200+55.62 TO STA. 200+88.66, RT. - 232 S.F.  
 STA. 201+29.58 TO STA. 201+45.67, RT. - 209 S.F.

**REMOVE EXISTING BUSH / HEDGE**  
 STA. 107+98, RT. - 1 EA  
 STA. 107+83, LT. - 1 EA

**CONSTRUCT MODIFIED CURB AND GUTTER**  
 STA. 104+33.97 TO STA. 201+50, LT. - 153 L.F.  
 STA. 200+10.90 TO STA. 201+50, RT. - 384 L.F.  
 (STA. 200+10.90 OFFS 25.90' RT. = PINE TREE RD.  
 @ CONSTRUCTION STA. 104+92.38, 10.90' LT.)  
 ① STA. 104+33.97 TO STA. 106+00, RT. - 166 L.F.  
 1-2 TO STA. 107+98.16, RT. - 196 L.F.  
 STA. 104+92.38, LT. TO STA. 107+98.16, RT. - 292 L.F.

① TRANSITION FROM MOD. TO 7" COMB. C&G  
 STA. 105+90 TO STA. 106+00

- NOTES:**
- EXISTING WATER HOUSE CONNECTIONS (WHC) ARE PRESENT WITHIN AREA OF CONSTRUCTION. THE EXACT LOCATION IS NOT KNOWN AT PRESENT. PAY ITEM HAS BEEN INCLUDED FOR TEST PITTING AND CONTINGENT PAY ITEM IS INCLUDED FOR RELOCATION OF WHC.
  - EXISTING DRAIN TO BE EXTENDED AND DAYLIGHTED PER DIRECTION OF THE ENGINEER. CONTINGENT PAY ITEM HAS BEEN INCLUDED AS PART OF CONTRACT.
  - SAW CUT AND BULKHEAD ENTRANCE TO EXISTING CULVERT STA. 106+38, RT.
  - NOSE DOWN CURB TO MEET EXISTING FIELD CONDITION.
  - THE INITIAL INSTALLATION OF CLASS I RIPRAP AS INDICATED ON THESE CONTRACT DOCUMENTS SHALL BE INCLUDED AS PART OF THE CONTRACTOR'S BID PRICE. ANY ADDITIONAL CLASS I RIPRAP INSTALLATION WILL BE PAID AS PART OF THE CONTINGENT PRICE PAY ITEM.

**REMOVE EXISTING TREES**

STA. 105+91, RT.	1 EACH
STA. 106+03, LT.	1 EACH
STA. 106+01, RT.	1 EACH
STA. 106+02, RT.	1 EACH
STA. 106+03, LT.	1 EACH
STA. 106+18, RT.	1 EACH
STA. 106+19, RT.	1 EACH
STA. 106+27, RT.	1 EACH
STA. 106+32, LT.	1 EACH

**INSTALL 98 S.Y CLASS I RIPRAP (19" DEPTH) ALONG ES-1 OUTFALL - (SEE LOCATION PLAN ON SHEET NO. 9 AND NOTE 5, THIS SHEET)**

**RECONSTRUCT DRIVEWAY WITH REINFORCED CONCRETE**  
 STA. 106+60.49 TO STA. 106+81.42, RT. - 20 S.Y.  
 STA. 107+22.40 TO STA. 107+61.96, LT. - 16 S.Y.



**CONSTRUCT 7-INCH COMBINATION CURB AND GUTTER**  
 PINE TREE ROAD STA. 106+00, RT. TO I-2 - 23 L.F.

**GRIND EXISTING PAVEMENT**  
 STA. 200+09.10 TO STA. 201+50 - 222 S.Y.  
 STA. 104+33.97 TO STA. 107+98.16 - 466 S.Y.

**RELOCATE / ADJUST EXISTING WATER METER**  
 STA. 200+58, RT. 1 EACH  
 STA. 105+23, LT. 1 EACH

**RELOCATE / ADJUST EXISTING SANITARY CLEANOUT**  
 STA. 201+45, RT. 1 EACH


**REMOVE EXISTING PIPE CULVERT**  
 STA. 104+53.5 TO 104+92, LT. - 41 LF  
 STA. 106+33, LT TO 106+38, RT. - 50 LF (SEE NOTE 3)

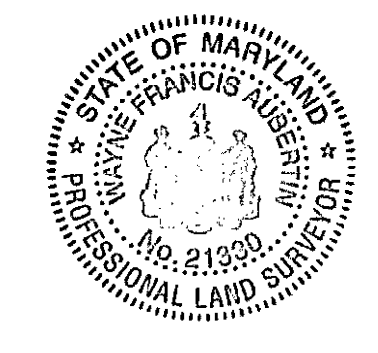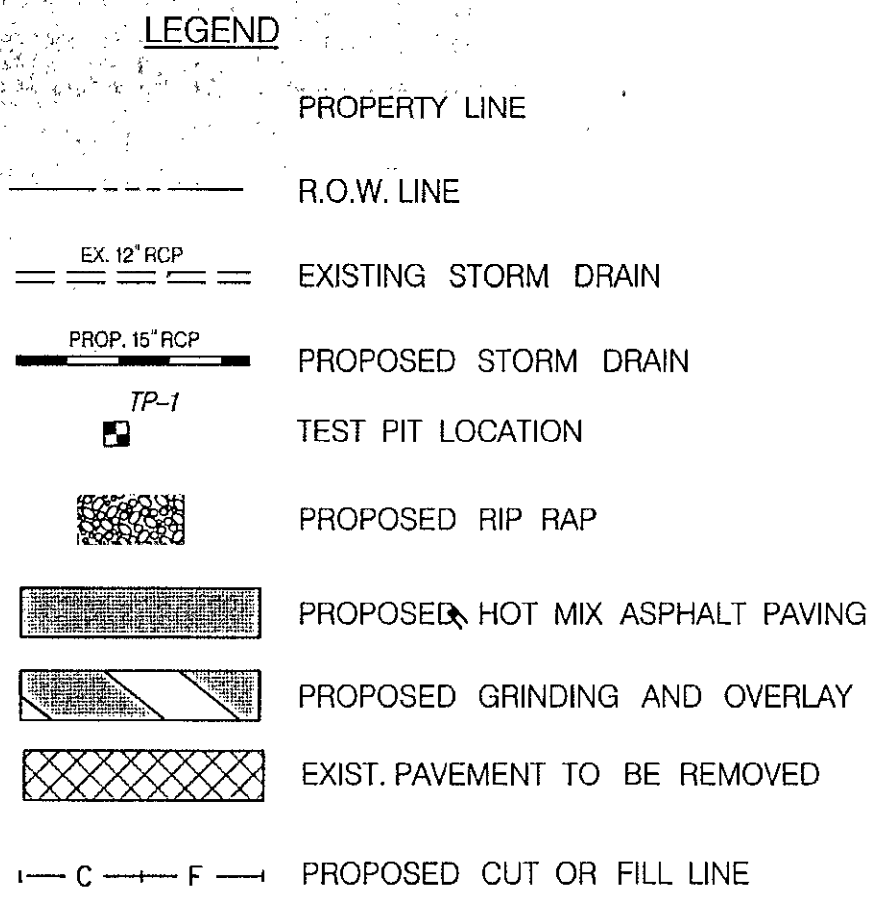

**CONSTRUCTION ASBUILT CERTIFICATION**  
 I hereby certify the as-built information shown hereon (in red) is correct to the best of my knowledge and belief and that is the result of a field run survey performed under my direct supervision in accordance with the laws regulating land surveys in the State of Maryland.  
 Wayne F. Aubertin, Prof. L.S. Maryland Reg. #21330 Exp. 01/07/17  
 Snider & Associates, Land Surveyors  
 20270 Goldenrod Lane, Suite 110  
 Germantown, MD 20876 Ph. 301-948-5100 Fax 301-948-1286

DEPARTMENT OF PUBLIC WORKS  
 HOWARD COUNTY, MARYLAND  
 Director of Public Works: [Signature]  
 Chief, Bureau of Engineering: [Signature]  
 Chief, Bureau of Highways: [Signature]

**NOLAN Associates, Inc.**  
 Engineers - Civil/Structural/Inspections  
 4785 Dorsey Hall Drive  
 Suite 124  
 Bellicott City, Maryland 21042  
 Phone: (410) 995-3661 Fax: (410) 995-1363

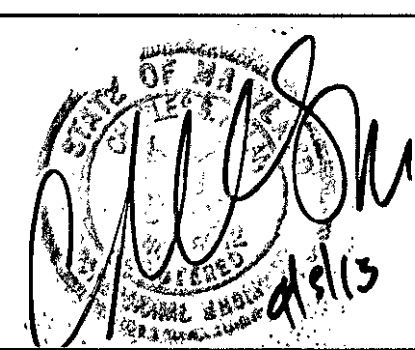

DES:	GWF/JW
DRN:	JRW
CHK:	GWF
DATE:	FEB 2013
BY:	
NO.:	
REVISION:	
DATE:	
600' SCALE MAP NO.:	
BLOCK NO.:	


**ROADWAY PLAN**

PINE TREE ROAD GLEN COURT  
 DRAINAGE AND ROADWAY IMPROVEMENTS, PH. 1  
 CAPITAL PROJECT D-1140  
 ELECTION DISTRICT NO. 6  
 HOWARD COUNTY, MARYLAND

SCALE: AS SHOWN  
 SHEET 6 OF 14A



**ASBUILT**

CONTROL POINTS						
CONTROL POINT	STATION	OFFSET	BASELINE	ELEVATION	NORTH	EAST
1	99+95.24	22.10' RT	PINE TREE RD	MEET EXIST.	538,852.45	1,365,845.01
2	100+05.17	10.90' RT	PINE TREE RD	225.26	538,837.49	1,365,844.88
3	99+91.48	20.10' LT	PINE TREE RD	MEET EXIST.	538,823.16	1,365,875.55
4	100+01.45	10.90' LT	PINE TREE RD	225.33	538,823.51	1,365,862.03
5	100+43.02	10.90' RT	PINE TREE RD	223.77	538,812.61	1,365,816.37
6	100+74.29	10.90' RT	PINE TREE RD	222.59	538,794.99	1,365,792.67
7	101+03.65	10.90' RT	PINE TREE RD	221.93	538,776.65	1,365,767.75
8	100+43.02	10.90' LT	PINE TREE RD	223.34	538,796.18	1,365,830.70
9	100+74.29	10.90' LT	PINE TREE RD	222.58	538,776.53	1,365,804.26
10	101+03.65	10.90' LT	PINE TREE RD	222.24	538,760.09	1,365,781.92
11	104+38.00	10.90' RT	PINE TREE RD	215.58	538,559.25	1,365,513.73
12	104+49.91	10.90' RT	PINE TREE RD	215.26	538,549.59	1,365,504.11
13	104+62.39	10.90' RT	PINE TREE RD	215.19	538,542.07	1,365,496.56
14	104+31.63	10.90' LT	PINE TREE RD	215.90	538,546.83	1,365,532.74
15	200+32.88	10.90' LT	GLEN COURT #1	215.90	538,512.99	1,365,529.99
16	200+25.90	10.90' RT	GLEN COURT #1	215.61	538,504.27	1,365,508.82
17	104+92.38	10.90' LT	PINE TREE RD	214.96	538,506.07	1,365,487.68
18	105+58.95	10.90' LT	PINE TREE RD	214.11	538,463.07	1,365,436.66
19	105+84.17	10.90' LT	PINE TREE RD	213.91	538,446.70	1,365,419.54
23	106+24.44	15.85' RT	PINE TREE RD	213.13	538,435.11	1,365,369.68
24	106+44.23	14.36' RT	PINE TREE RD	213.38	538,408.65	1,365,361.90
25	106+14.64	10.90' LT	PINE TREE RD	213.81	538,424.98	1,365,396.30
26	106+57.89	10.90' LT	PINE TREE RD	213.70	538,397.36	1,365,388.18
27	107+72.77	10.90' RT	PINE TREE RD	211.82	538,281.14	1,365,401.12
28	107+82.63	10.90' RT	PINE TREE RD	211.76	538,270.60	1,365,405.14
29	107+98.16	10.90' RT	PINE TREE RD	211.72	538,256.48	1,365,411.61
30	108+07.87	10.90' RT	PINE TREE RD	211.65	538,248.73	1,365,414.57
31	107+72.77	10.90' RT	PINE TREE RD	212.93	538,287.55	1,365,421.96
32	107+82.63	10.90' LT	PINE TREE RD	212.89	538,279.68	1,365,424.95
33	107+98.16	10.90' LT	PINE TREE RD	212.76	538,265.56	1,365,431.43
34	108+07.87	10.90' LT	PINE TREE RD	212.55	538,255.18	1,365,435.40
35	109+91.55	10.90' LT	PINE TREE RD	209.44	538,079.72	1,365,489.74
36	109+02.03	10.90' RT	PINE TREE RD	210.05	538,158.79	1,365,442.43
37	109+16.68	24.74' RT	PINE TREE RD	209.45	538,140.41	1,365,433.63
38	109+17.34	29.35' RT	PINE TREE RD	209.32	538,138.70	1,365,429.33
39	109+41.24	27.06' RT	PINE TREE RD	209.32	538,115.71	1,365,436.47
40	109+41.41	29.34' RT	PINE TREE RD	209.34	538,116.56	1,365,438.59
41	109+56.19	10.90' RT	PINE TREE RD	209.59	538,107.05	1,365,458.45
42	201+02.10	10.90' LT	GLEN COURT #1	216.69	538,460.06	1,365,574.60
43	201+4.61	10.90' LT	GLEN COURT #1	216.70	538,449.72	1,365,582.78
44	201+02.10	10.90' RT	GLEN COURT #1	216.56	538,446.01	1,365,557.93
45	201+4.61	10.90' RT	GLEN COURT #1	216.57	538,436.74	1,365,565.57
46	201+31.58	10.90' RT	GLEN COURT #1	216.52	538,423.07	1,365,575.40
47	201+44.75	10.90' RT	GLEN COURT #1	216.43	538,412.31	1,365,583.93
48	201+25.03	10.90' LT	GLEN COURT #1	216.66	538,441.35	1,365,588.99
49	201+44.75	10.90' LT	GLEN COURT #1	216.56	538,426.25	1,365,600.69
50	202+70.50	10.97' LT	GLEN COURT #1	214.86	538,329.15	1,365,680.93
51	202+92.07	10.90' LT	GLEN COURT #1	214.46	538,312.28	1,365,694.35
52	202+70.85	10.83' RT	GLEN COURT #1	215.05	538,315.27	1,365,664.13
53	202+91.51	10.90' RT	GLEN COURT #1	214.59	538,299.09	1,365,676.98
54	203+02.29	10.90' RT	GLEN COURT #1	214.26	538,304.29	1,365,700.74
55	203+14.80	10.90' LT	GLEN COURT #1	213.94	538,294.37	1,365,708.58
56	203+02.29	10.90' RT	GLEN COURT #1	214.31	538,290.67	1,365,683.72
57	203+14.80	10.90' RT	GLEN COURT #1	213.94	538,280.97	1,365,691.38
58	203+28.95	10.90' LT	GLEN COURT #1	213.62	538,283.21	1,365,717.28
59	203+73.45	10.90' LT	GLEN COURT #1	212.66	538,249.12	1,365,745.11
60	300+17.49	10.90' LT	GLEN COURT #2	212.47	538,248.46	1,365,753.58
61	203+76.39	10.90' RT	GLEN COURT #1	212.24	538,232.70	1,365,730.47
62	308+33.04	10.90' LT	GLEN COURT #2	212.19	538,228.33	1,365,730.13
63	300+69.84	12.90' LT	GLEN COURT #2	211.01	538,252.40	1,365,816.00
64	300+84.30	12.90' LT	GLEN COURT #2	210.67	538,211.87	1,365,744.43
65	308+33.16	10.90' RT	GLEN COURT #2	211.07	538,225.17	1,365,763.68
66	300+09.98	13.40' RT	GLEN COURT #2	210.95	538,236.62	1,365,773.25
67	300+24.62	10.90' RT	GLEN COURT #2	210.86	538,235.92	1,365,798.80
68	300+68.72	10.90' RT	GLEN COURT #2	210.18	538,213.73	1,365,822.13
69	301+00.92	10.90' RT	GLEN COURT #2	208.89	538,197.17	1,365,837.57
70	301+24.88	10.90' RT	GLEN COURT #2	207.98	538,114.47	1,365,934.20
71	302+49.56	11.00' LT	GLEN COURT #2	205.22	538,060.14	1,365,940.91
72	302+95.54	11.00' LT	GLEN COURT #2	202.96	538,103.04	1,365,915.37
73	302+47.00	10.90' RT	GLEN COURT #2	204.76	538,066.64	1,365,919.86
74	302+98.10	10.90' RT	GLEN COURT #2	202.98	537,975.68	1,365,876.49
75	303+98.87	10.90' RT	GLEN COURT #2	199.74	537,967.51	1,365,826.01

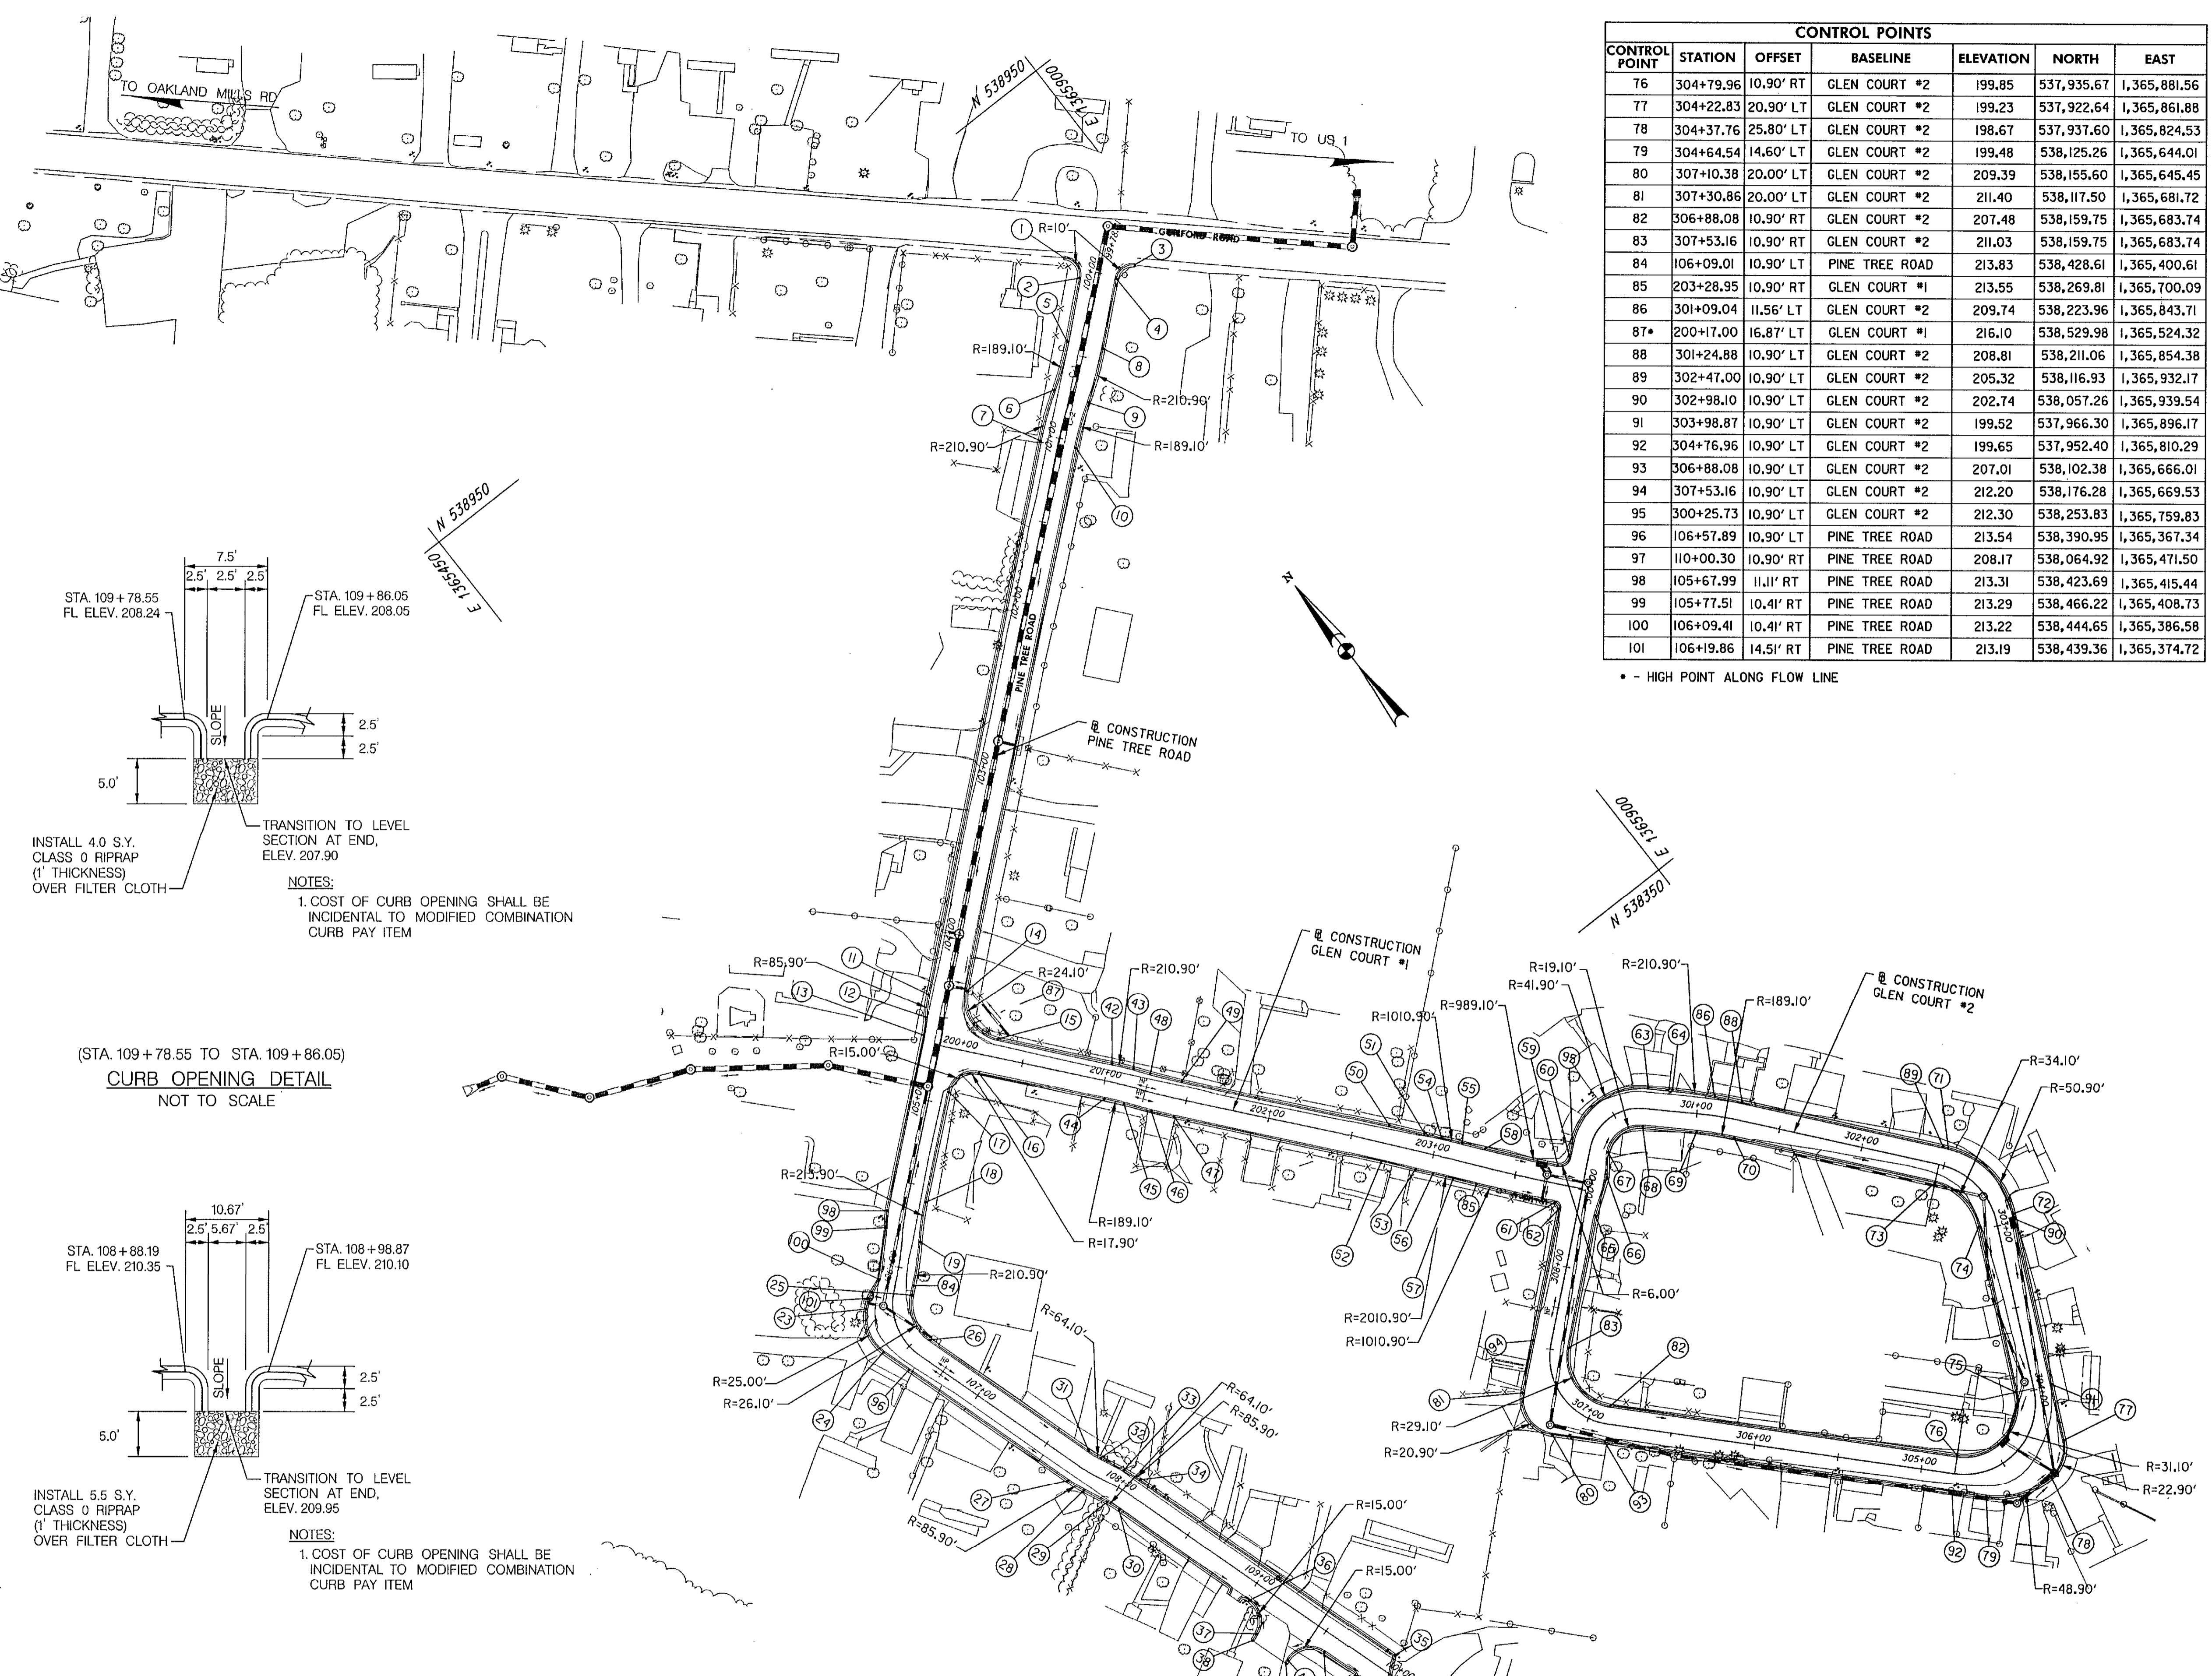

CONTROL POINTS						
CONTROL POINT	STATION	OFFSET	BASELINE	ELEVATION	NORTH	EAST
76	304+79.96	10.90' RT	GLEN COURT #2	199.85	537,935.67	1,365,881.56
77	304+22.83	20.90' LT	GLEN COURT #2	199.23	537,922.64	1,365,861.88
78	304+37.76	25.80' LT	GLEN COURT #2	198.67	537,937.60	1,365,824.53
79	304+64.54	14.60' LT	GLEN COURT #2	199.48	538,125.26	1,365,644.01
80	307+10.38	20.00' LT	GLEN COURT #2	209.39	538,155.60	1,365,645.45
81	307+30.86	20.00' RT	GLEN COURT #2	211.40	538,117.50	1,365,681.72
82	306+88.08	10.90' RT	GLEN COURT #2	207.48	538,159.75	1,365,683.74
83	307+53.16	10.90' RT	GLEN COURT #2	211.03	538,159.75	1,365,683.74
84	106+09.01	10.90' LT	PINE TREE ROAD	213.83	538,428.61	1,365,400.61
85	203+28.95	10.90' RT	GLEN COURT #1	213.55	538,269.81	1,365,700.09
86	301+09.04	11.56' LT	GLEN COURT #2	209.74	538,223.96	1,365,843.71
87*	200+17.00	16.87' LT	GLEN COURT #1	216.10	538,529.98	1,365,524.32
88	301+24.88	10.90' LT	GLEN COURT #2	208.81	538,211.06	1,365,854.38
89	302+47.00	10.90' LT	GLEN COURT #2	205.32	538,116.93	1,365,932.17
90	302+98.10	10.90' LT	GLEN COURT #2	202.74	538,057.26	1,365,939.54
91	303+98.87	10.90' LT	GLEN COURT #2	199.52	537,966.30	1,365,896.17
92	304+76.96	10.90' LT	GLEN COURT #2	199.65	537,952.40	1,365,810.29
93	306+88.08	10.90' LT	GLEN COURT #2	207.01	538,102.38	1,365,666.01
94	307+53.16	10.90' LT	GLEN COURT #2	212.20	538,176.28	1,365,669.53
95	300+25.73	10.90' LT	GLEN COURT #2	212.30	538,253.83	1,365,759.83
96	106+57.89	10.90' LT	PINE TREE ROAD	213.54	538,390.95	1,365,367.34
97	110+00.30	10.90' RT	PINE TREE ROAD	208.17	538,064.92	1,365,471.50
98	105+67.99	11.11' RT	PINE TREE ROAD	213.31	538,423.69	1,365,415.44
99	105+77.51	10.41' RT	PINE TREE ROAD	213.29	538,466.22	1,365,408.73
100	106+09.41	10.41' RT	PINE TREE ROAD	213.22	538,444.65	1,365,386.58
101	106+19.86	14.51' RT	PINE TREE ROAD	213.19	538,439.36	1,365,374.72

\* - HIGH POINT ALONG FLOW LINE

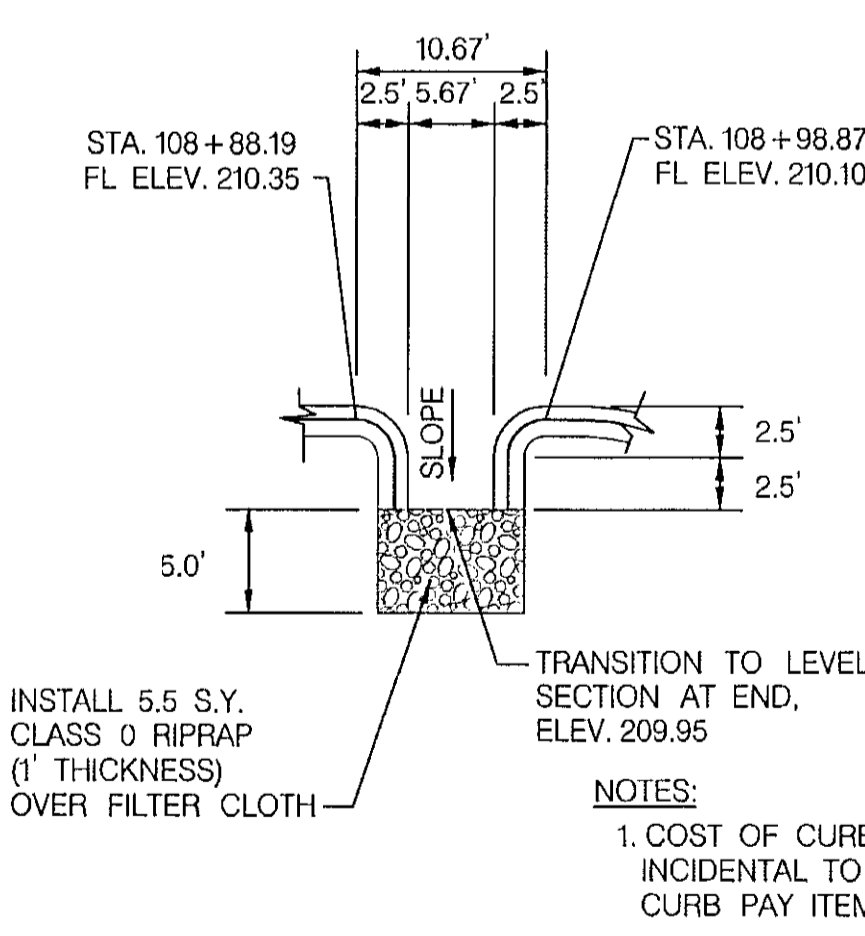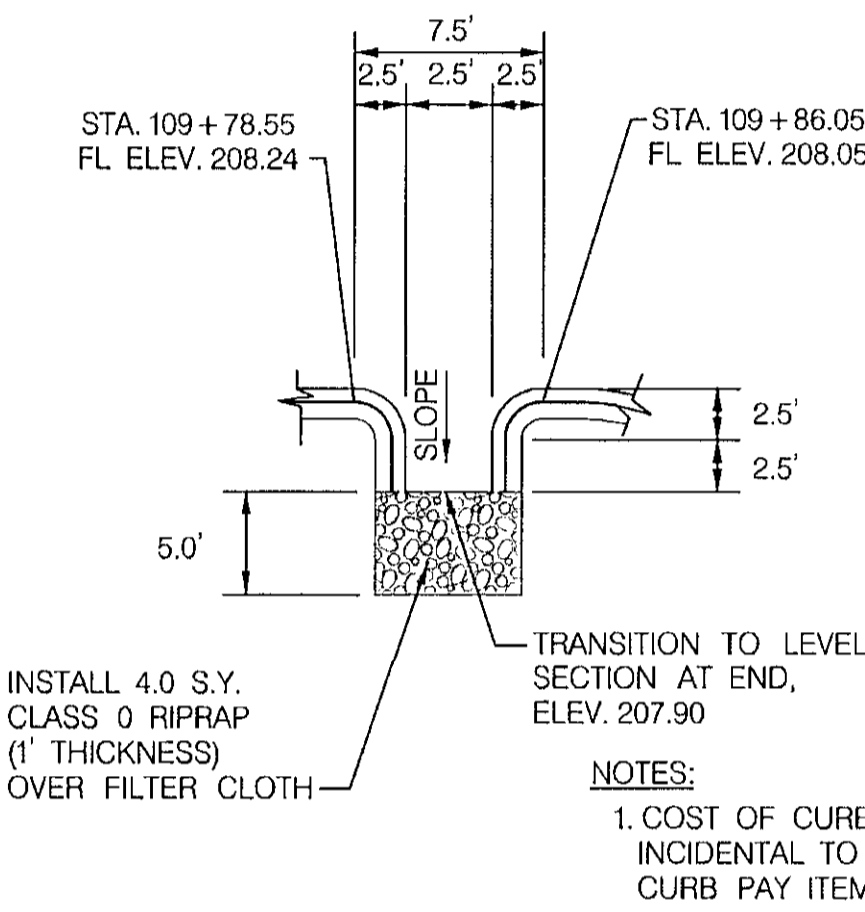

PLAN  
SCALE: 1" = 50'

DEPARTMENT OF PUBLIC WORKS  
HOWARD COUNTY, MARYLAND

*James R. ...*  
DIRECTOR OF PUBLIC WORKS  
DATE: 5/30/12

*Steve Shaver*  
CHIEF, TRANSPORTATION AND SPECIAL PROJECTS DIVISION  
DATE: 5/10/12

**NOLAN**  
Associates, Inc.  
Engineers - Civil/Structural/Inspections  
4785 Dorsey Hall Drive  
Suite 124  
Ellicott City, Maryland 21042  
Phone: (410) 995-3051 Fax: (410) 995-1363

*[Signature]*  
DATE: APRIL 2012


DES: GWF/JW					
DRN: JRW					
CHK: GWF					
DATE: APRIL 2012	BY	NO.	REVISION	DATE	600' SCALE MAP NO. BLOCK NO.

FLOW LINE CONTROL POINT LOCATION PLAN AND DETAILS

PINE TREE ROAD/GLEN COURT DRAINAGE AND ROADWAY IMPROVEMENTS, PH. 1  
CAPITAL PROJECT D-1140  
ELECTION DISTRICT NO. 6  
HOWARD COUNTY, MARYLAND


SCALE: AS SHOWN  
SHEET 7 OF 14A

TO BE CONSTRUCTED UNDER SAVAGE STONE, L.L.C. (KONTERRA LIMITED PARTNERSHIP) PROPERTY DRAINAGE IMPROVEMENTS PROJECT.

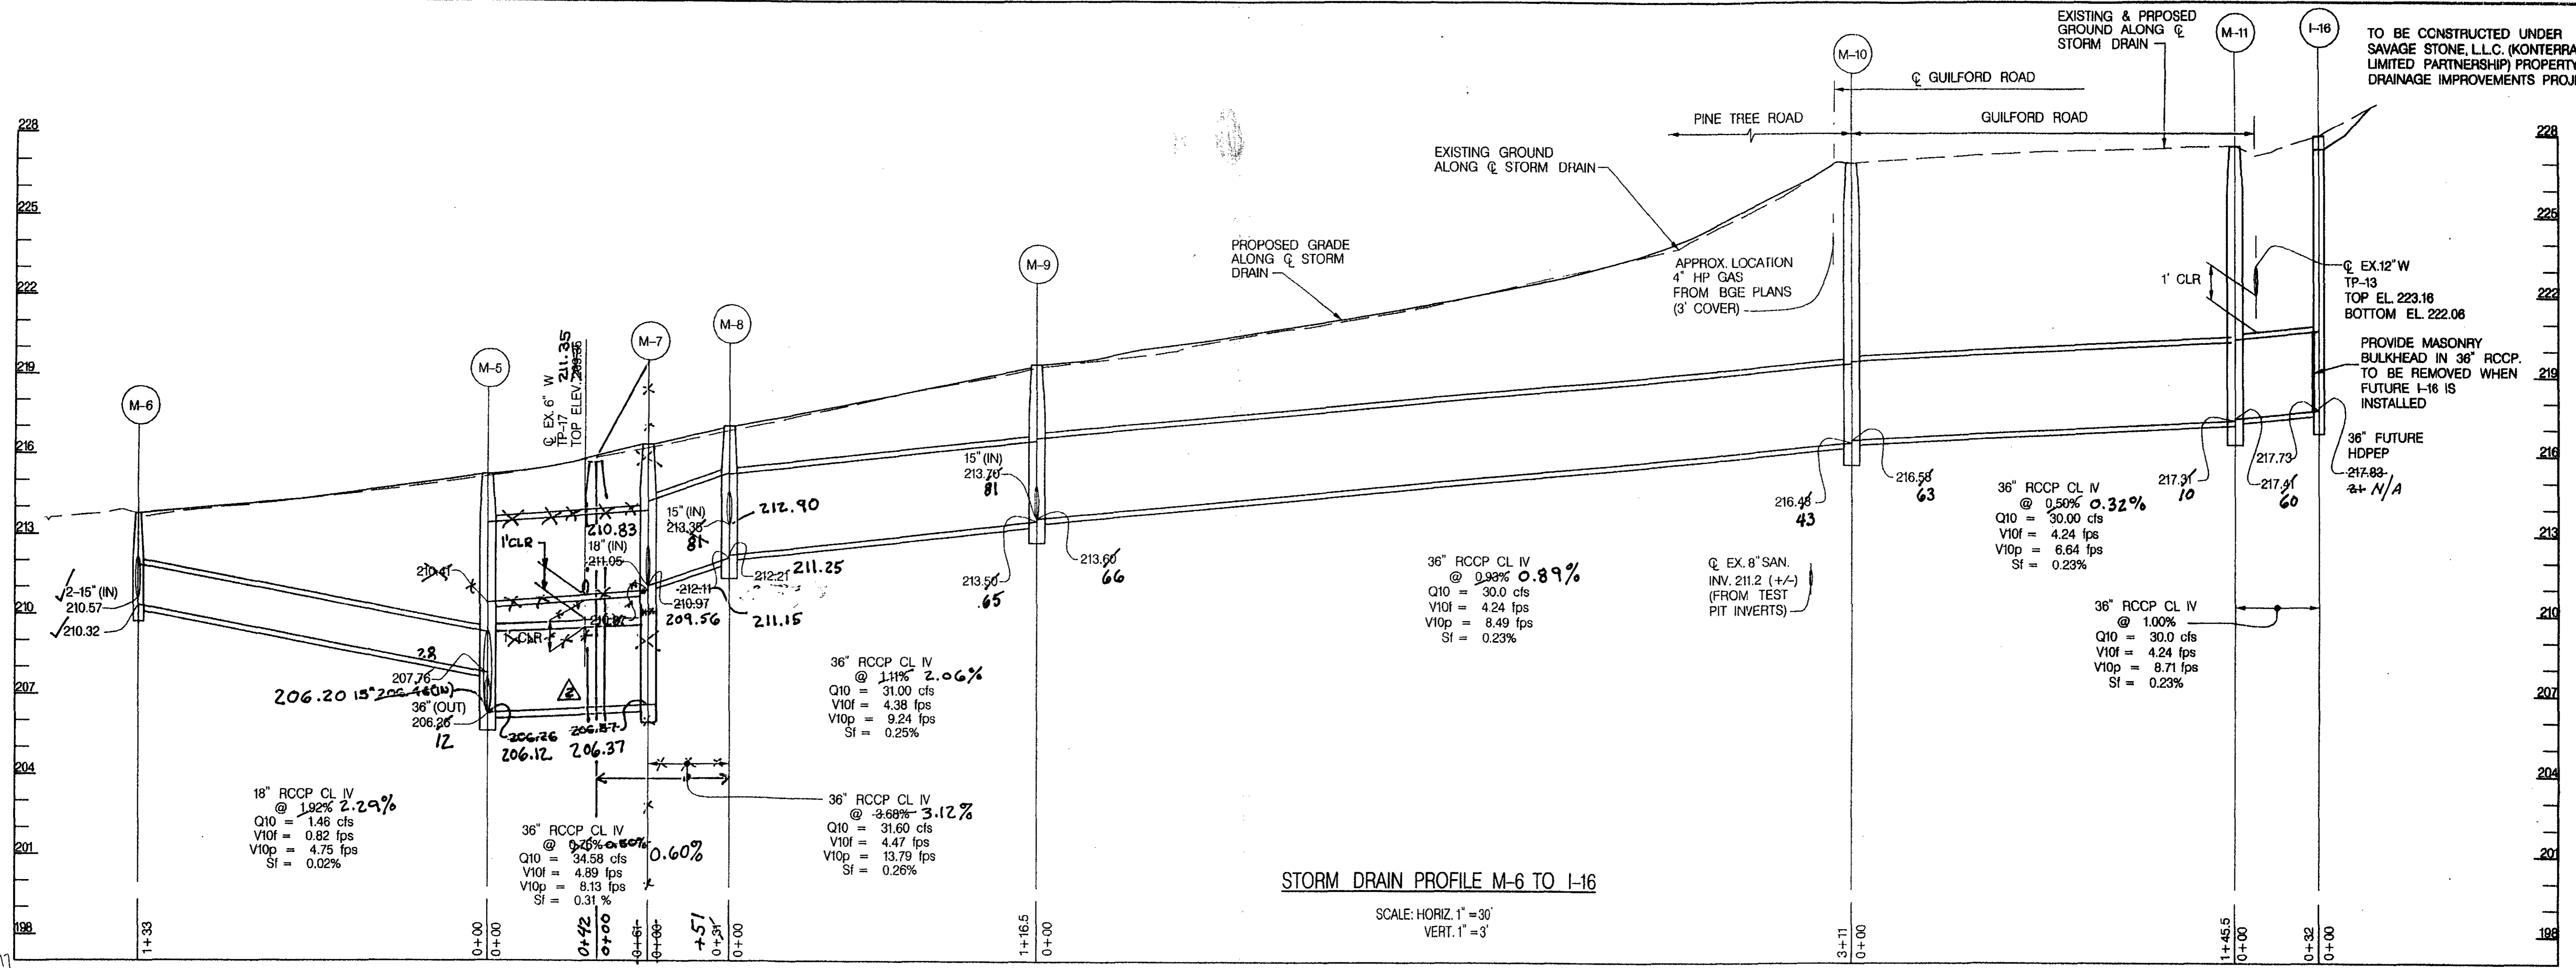


STORM DRAIN PROFILE M-6 TO I-16

SCALE: HORIZ. 1" = 30'  
VERT. 1" = 3'

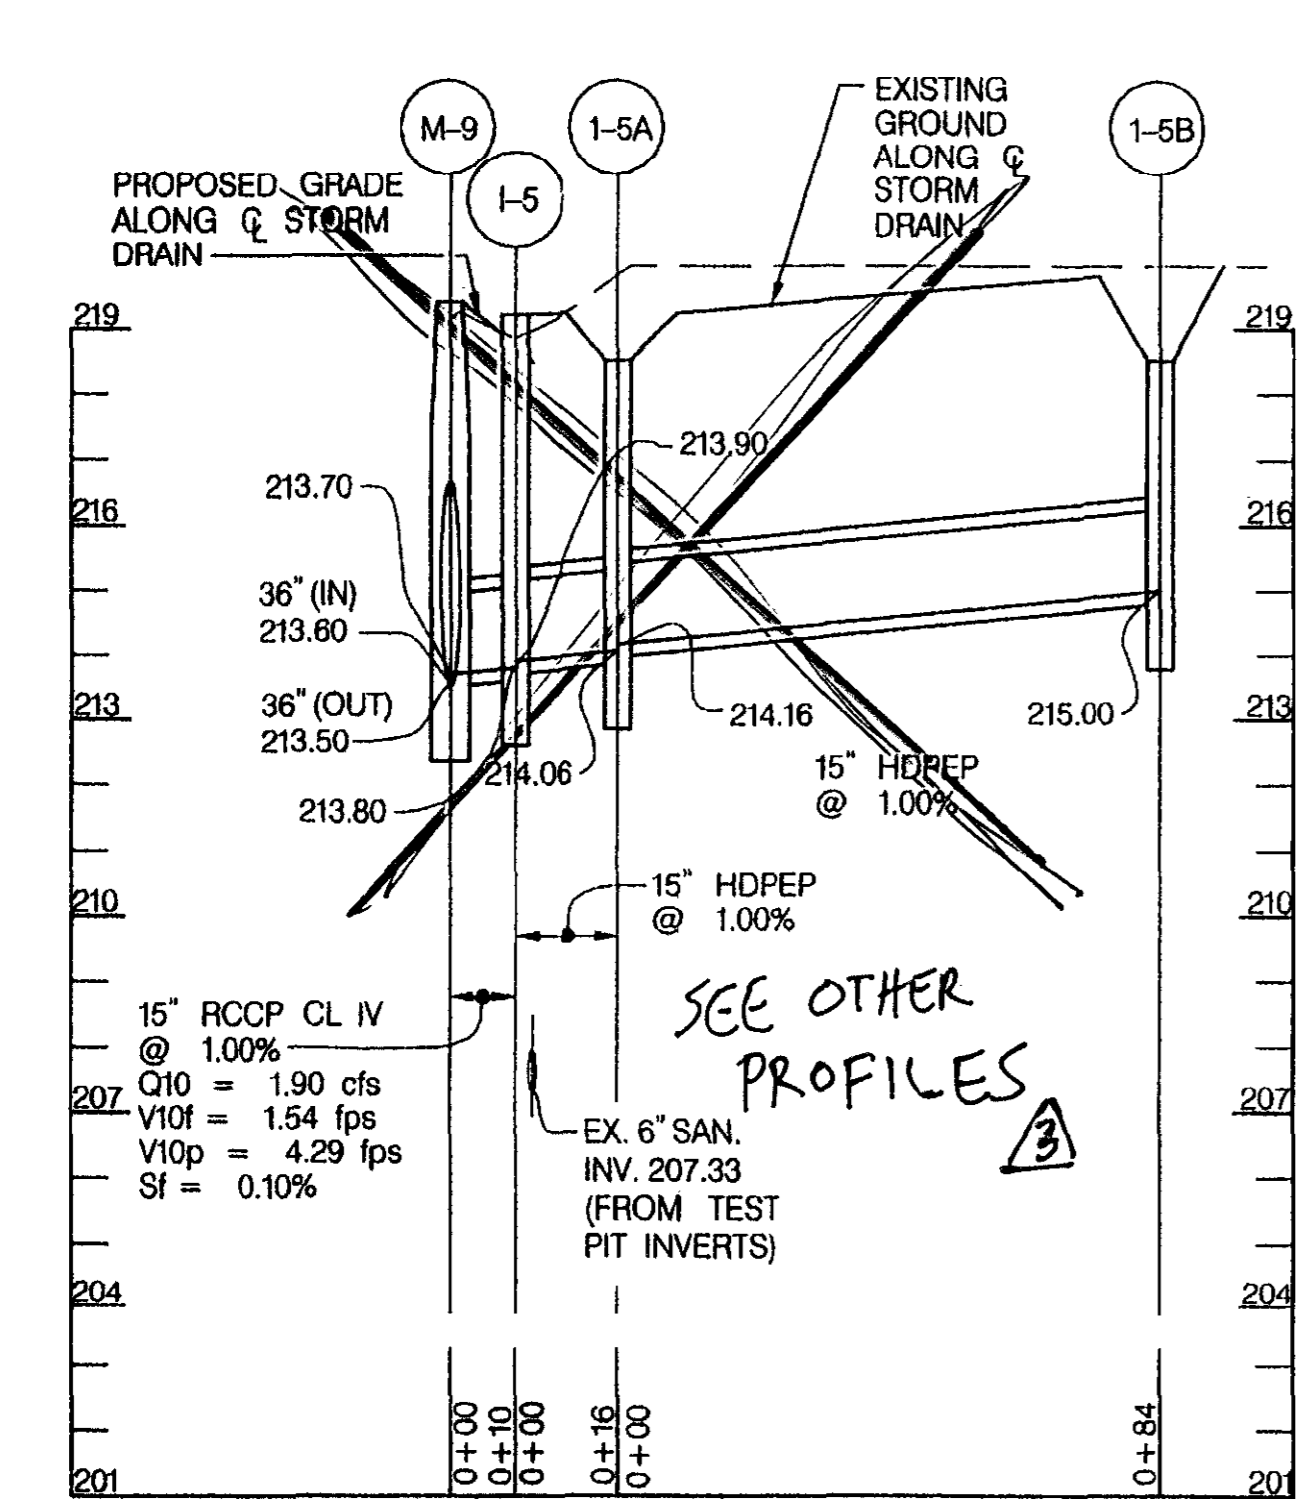


STORM DRAIN PROFILE M-9 TO I-5

SCALE: HORIZ. 1" = 30'  
VERT. 1" = 3'

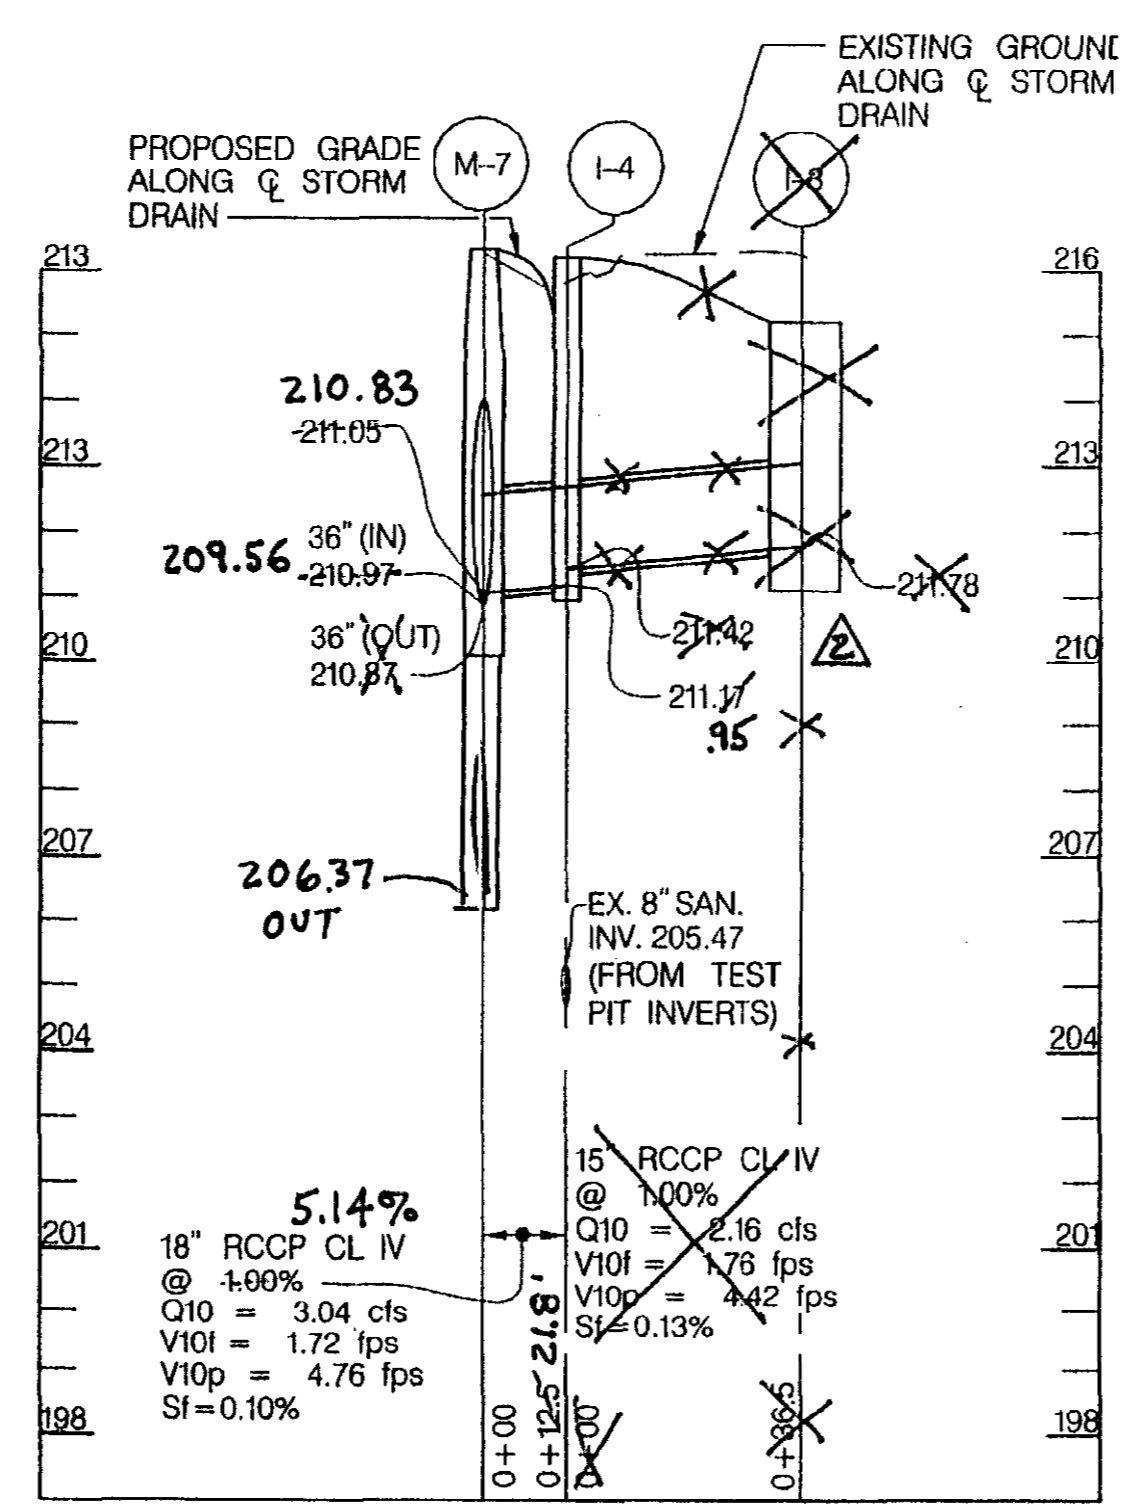


STORM DRAIN PROFILE M-7 TO I-3

SCALE: HORIZ. 1" = 30'  
VERT. 1" = 3'

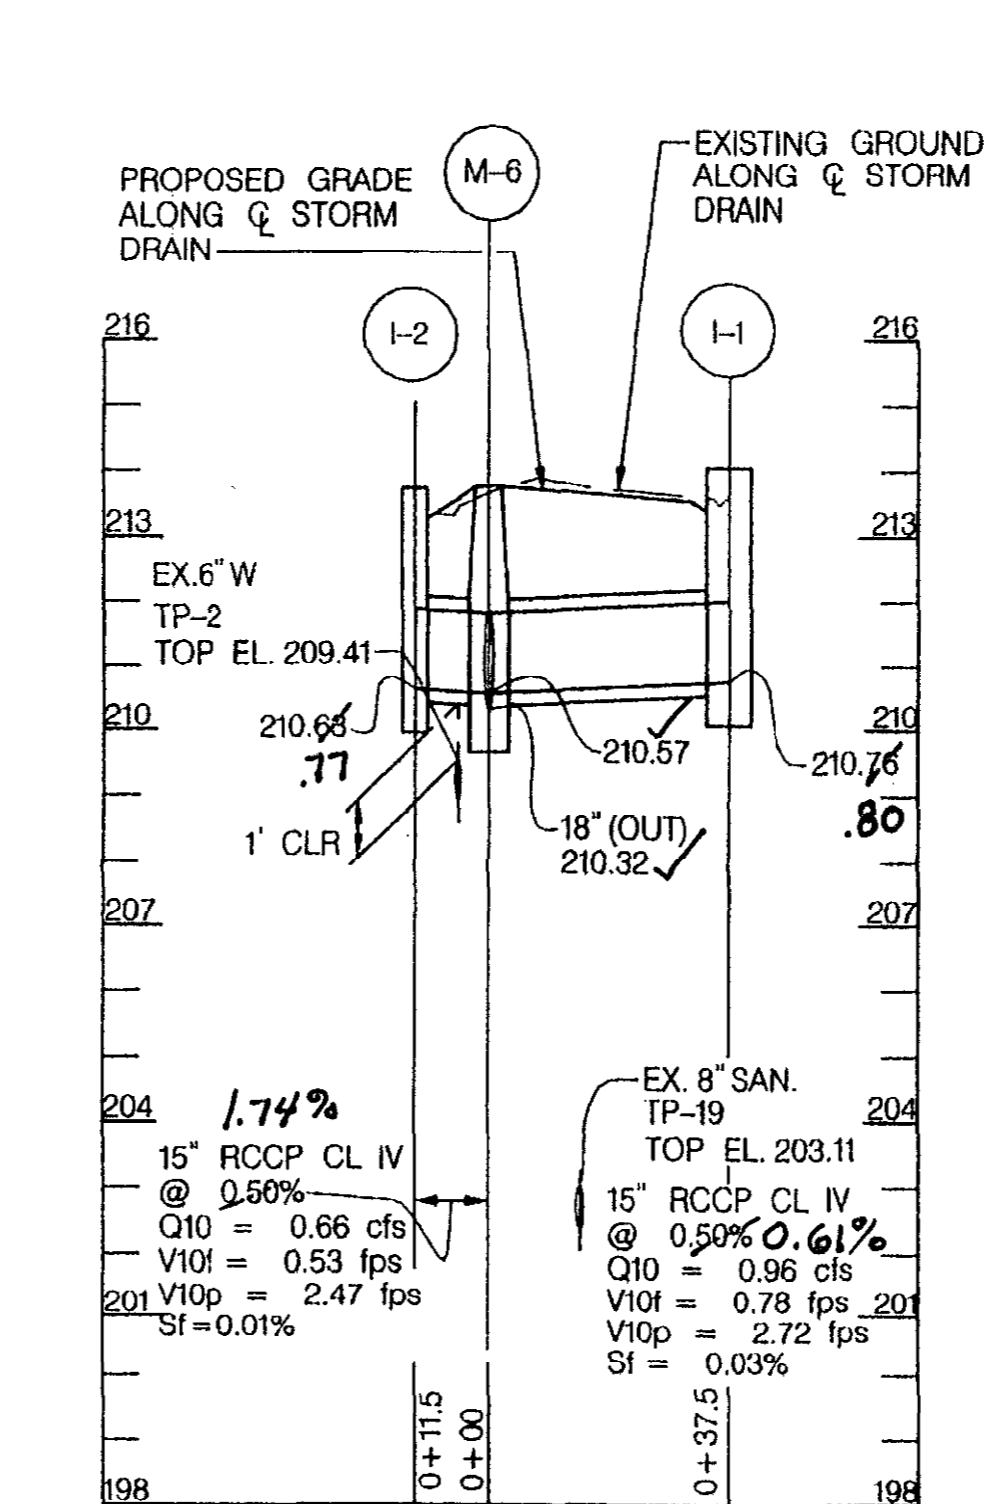


STORM DRAIN PROFILE I-2 TO I-1

SCALE: HORIZ. 1" = 30'  
VERT. 1" = 3'

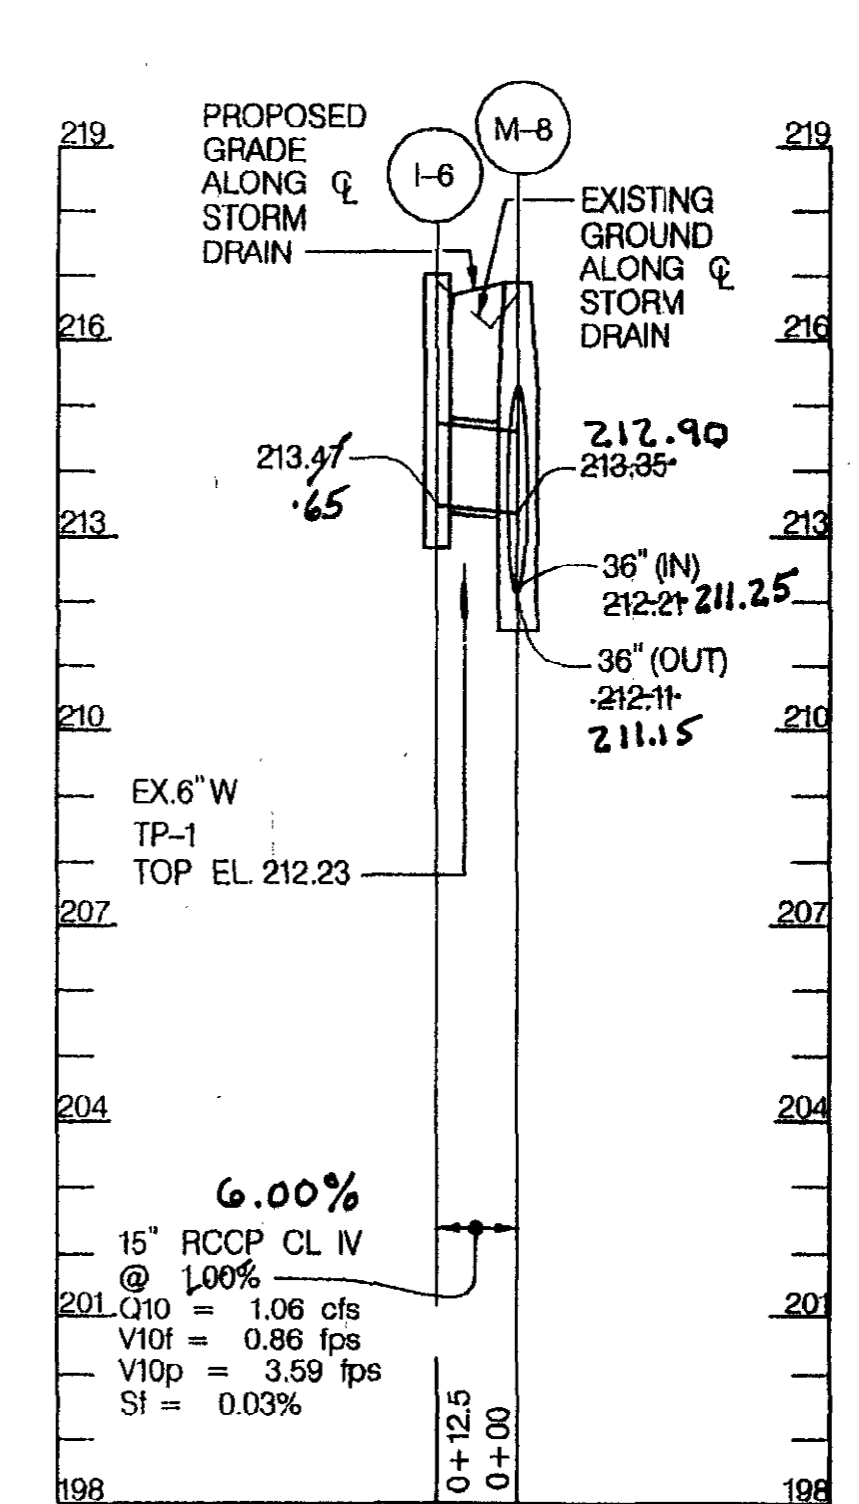

STORM DRAIN PROFILE I-6 TO M-8


SCALE: HORIZ. 1" = 30'  
VERT. 1" = 3'

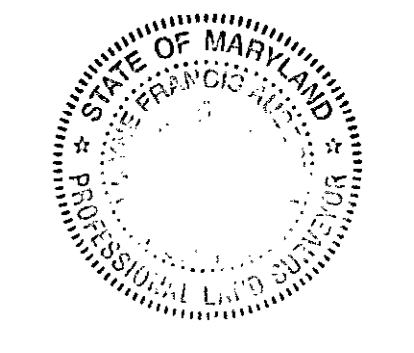

**CONSTRUCTION ASBUILT CERTIFICATION**  
I hereby certify the as-built information shown hereon (in red) is correct to the best of my knowledge and belief and that is the result of a field run survey performed under my direct supervision in accordance with the laws regulating land surveys in the State of Maryland.  
*Wayne F. Aubertin* 1-5-15  
Wayne F. Aubertin, Prof. L.S. Maryland Reg. #21330 Exp. 01/07/17  
Snider & Associates, Land Surveyors  
20270 Goldenrod Lane, Suite 110  
Germantown, MD 20876  
Ph. 301-948-5100 Fax 301-948-1286

DEPARTMENT OF PUBLIC WORKS  
HOWARD COUNTY, MARYLAND  
Director of Public Works: *John J. ...*  
Chief, Bureau of Engineering: *Thomas R. ...*  
Chief, Bureau of Highways: *William Z. ...*  
Chief, Transportation and Special Projects Division: *Steve Shaver*

**NOLAN**  
Associates, Inc.  
Engineers - Civil/Structural/Inspections  
4785 Dorsey Hall Drive  
Suite 124  
Ellicott City, Maryland 21042  
Phone: (410) 985-1303 Fax: (410) 985-1303

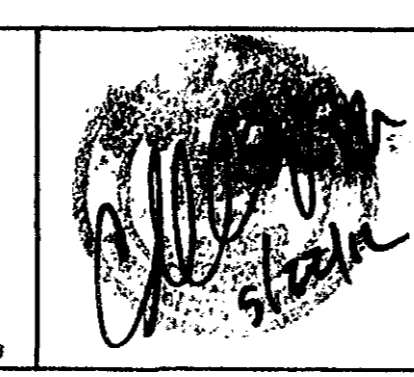


DES: GWF	GPI	Revise S.D. Profiles M-5 to M-7, I-3 to I-4	11/10/13
DRN: JW/JAH	MND	Profile on other sheet	1/1/16
CHK: GWF			
DATE: MAY 2010	BY: NO.	REVISION	DATE

SCALE: AS SHOWN  
SHEET 8 OF 14  
PINE TREE ROAD/GLEN COURT DRAINAGE AND ROADWAY IMPROVEMENTS  
CAPITAL PROJECT D-1140  
ELECTION DISTRICT NO. 6  
HOWARD COUNTY, MARYLAND

AS BUILT



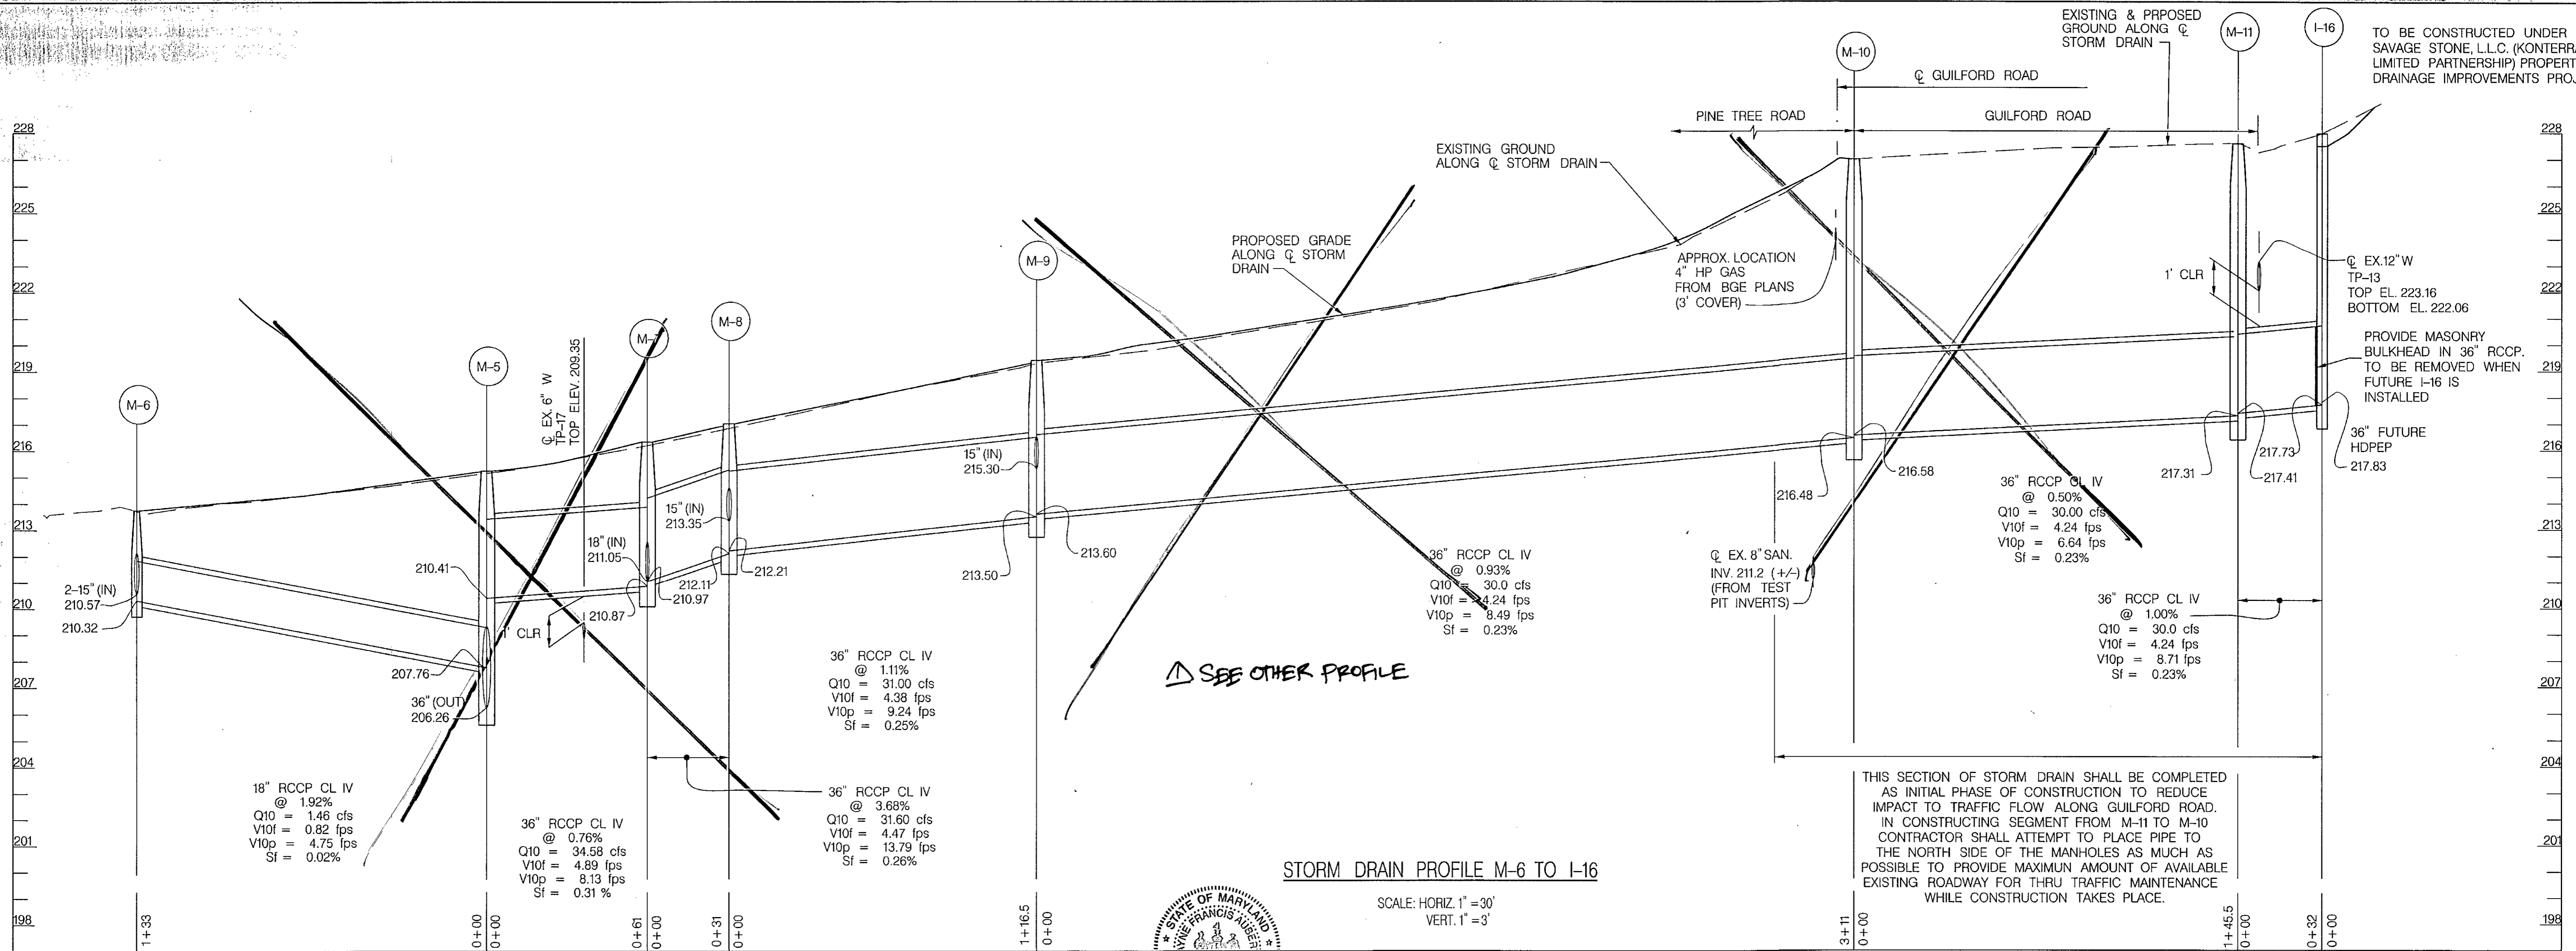


STORM DRAIN PROFILE M-6 TO I-16

SCALE: HORIZ. 1" = 30'  
VERT. 1" = 3'

THIS SECTION OF STORM DRAIN SHALL BE COMPLETED AS INITIAL PHASE OF CONSTRUCTION TO REDUCE IMPACT TO TRAFFIC FLOW ALONG GUILFORD ROAD. IN CONSTRUCTING SEGMENT FROM M-11 TO M-10 CONTRACTOR SHALL ATTEMPT TO PLACE PIPE TO THE NORTH SIDE OF THE MANHOLES AS MUCH AS POSSIBLE TO PROVIDE MAXIMUM AMOUNT OF AVAILABLE EXISTING ROADWAY FOR THRU TRAFFIC MAINTENANCE WHILE CONSTRUCTION TAKES PLACE.




**CONSTRUCTION ASBUILT CERTIFICATION**  
I hereby certify the as-built information shown hereon (in red) is correct to the best of my knowledge and belief and that is the result of a field run survey performed under my direct supervision in accordance with the laws regulating land surveys in the State of Maryland.  
*Wayne F. Aubertin 1-5-15*  
Wayne F. Aubertin, Prof. L.S. Maryland Reg. #21330 Exp. 01/07/17  
Snider & Associates, Land Surveyors  
20270 Goldenrod Lane, Suite 110  
Germantown, MD 20876 Ph. 301-948-5100 Fax 301-948-1286

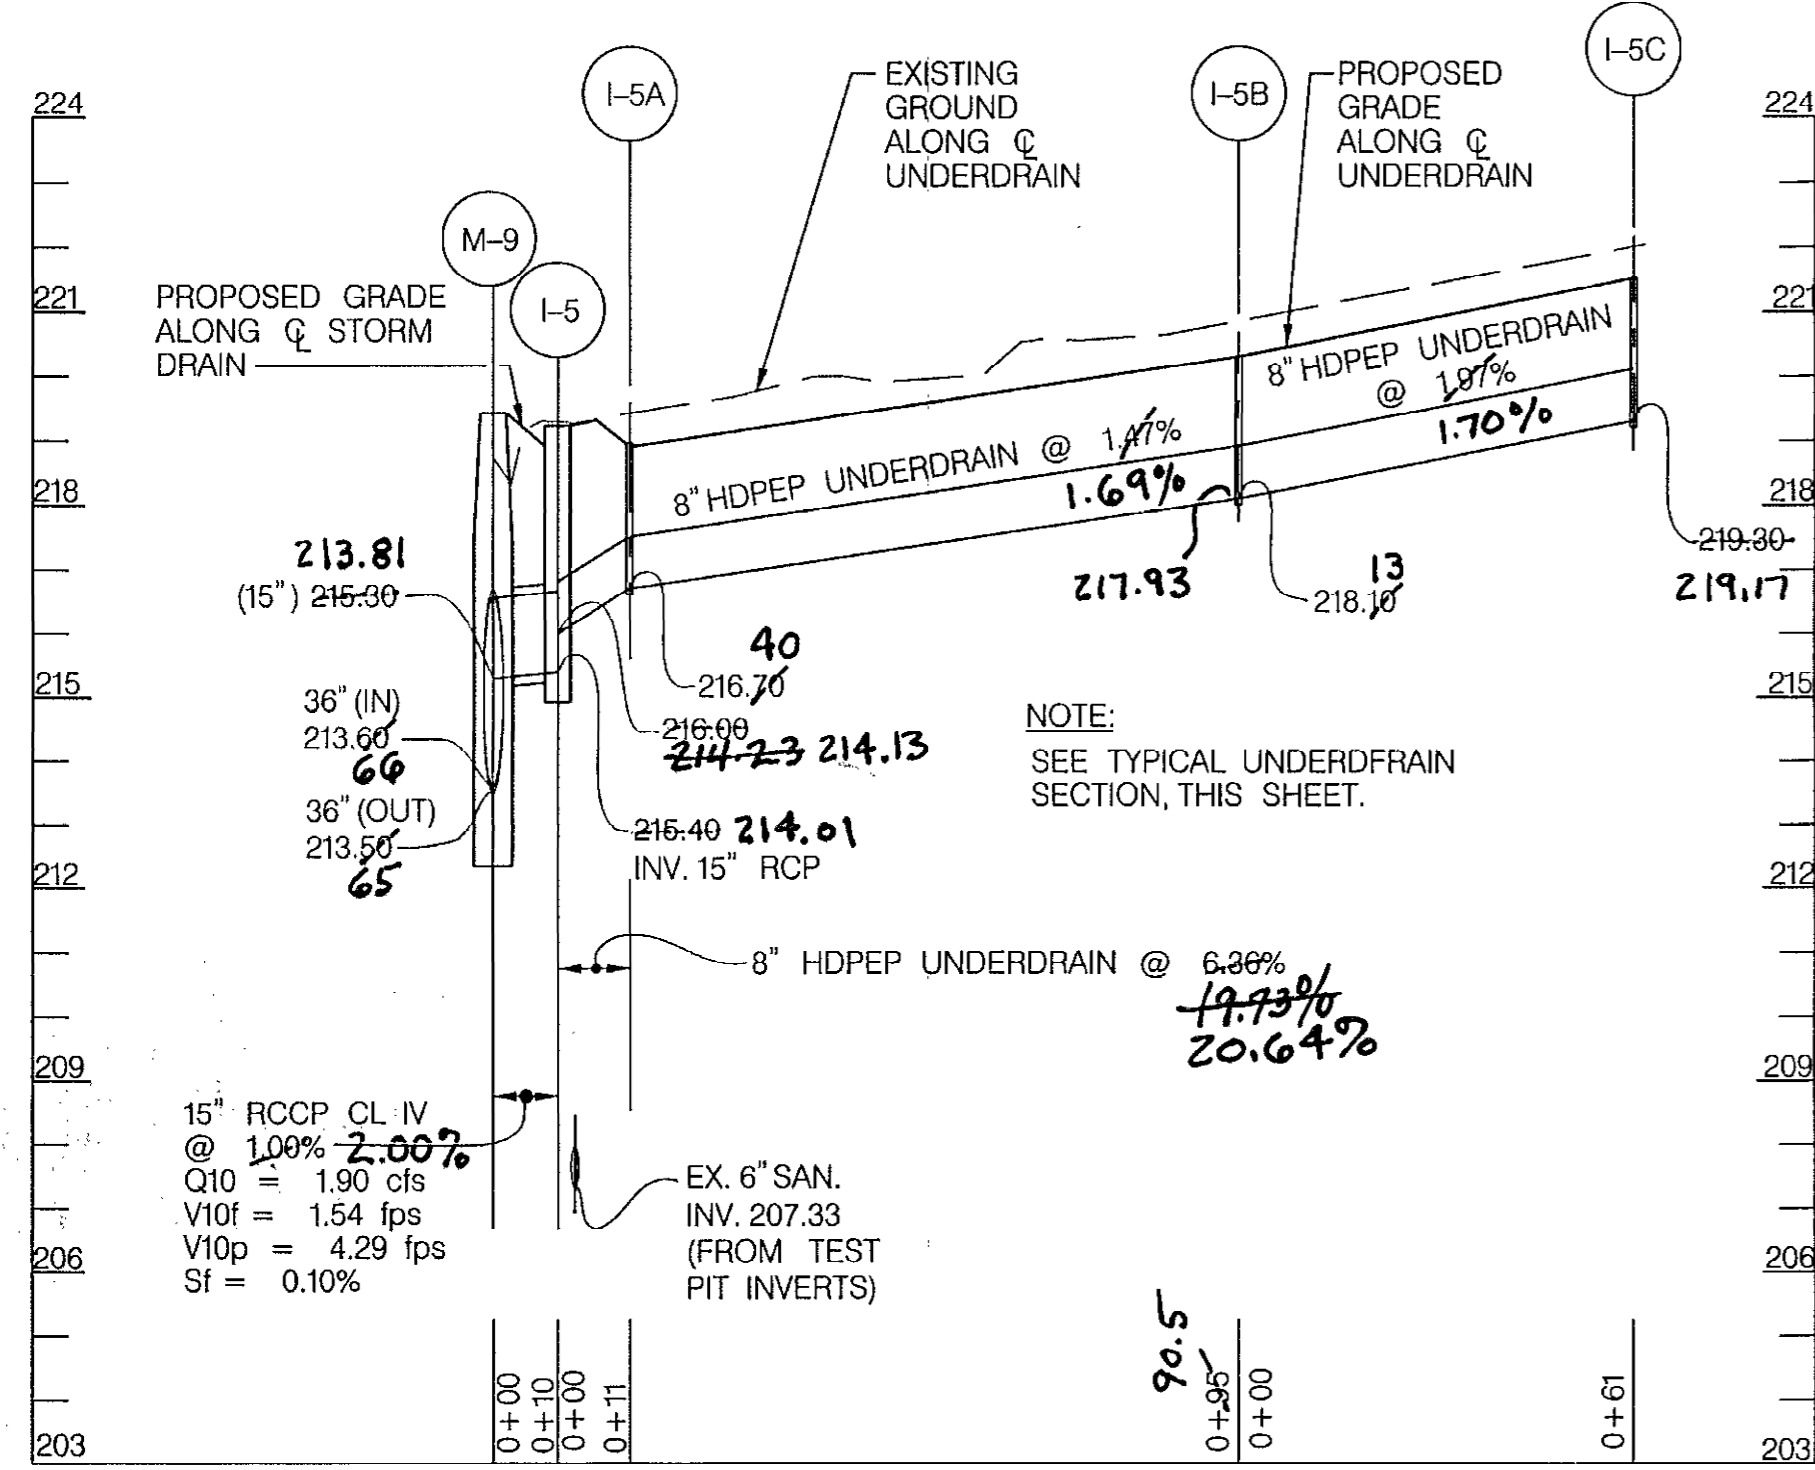


UNDERDRAIN PROFILE I-5 TO I-5C

SCALE: HORIZ. 1" = 30'  
VERT. 1" = 3'

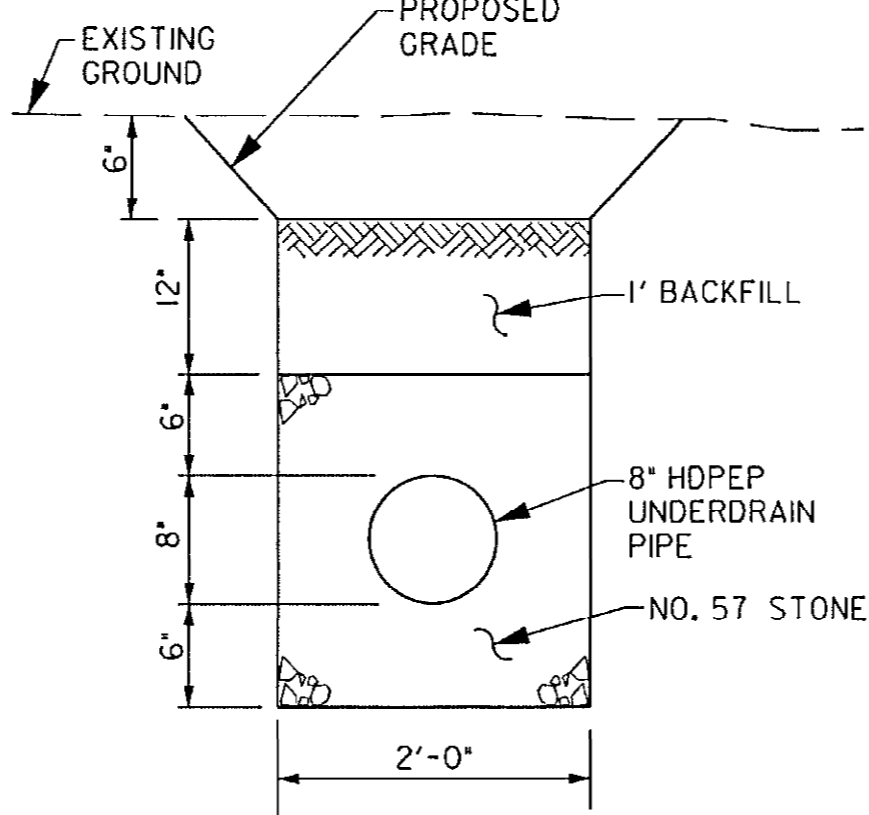


TYPICAL UNDERDRAIN SECTION  
NOT TO SCALE

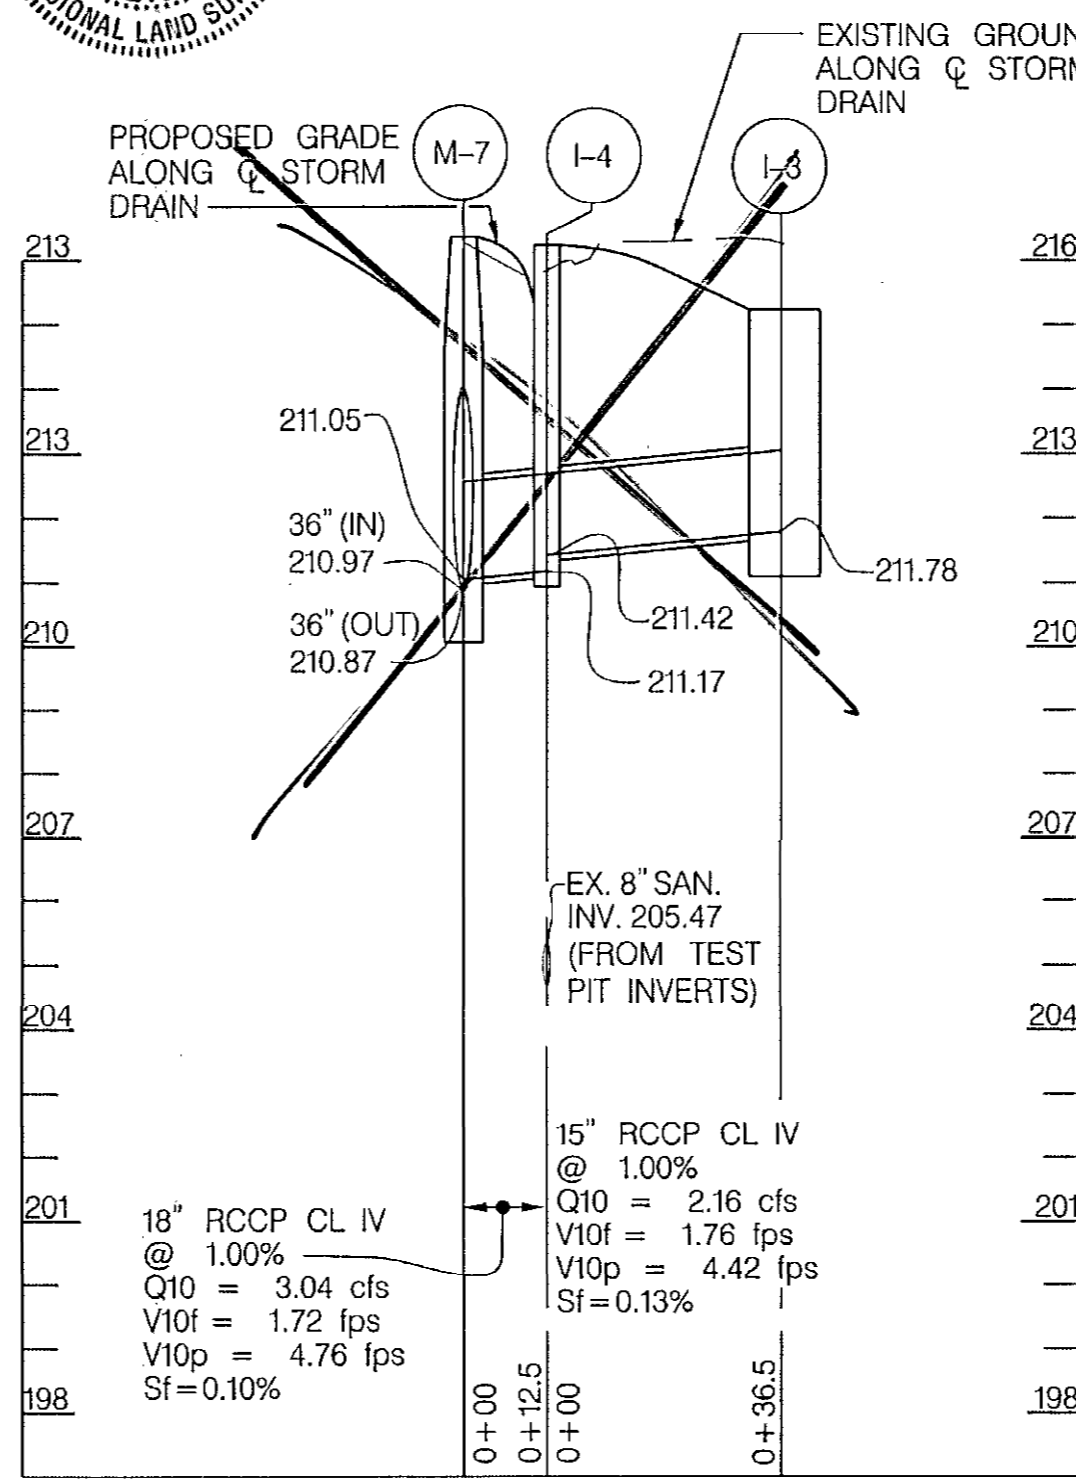


STORM DRAIN PROFILE M-7 TO I-3

SCALE: HORIZ. 1" = 30'  
VERT. 1" = 3'

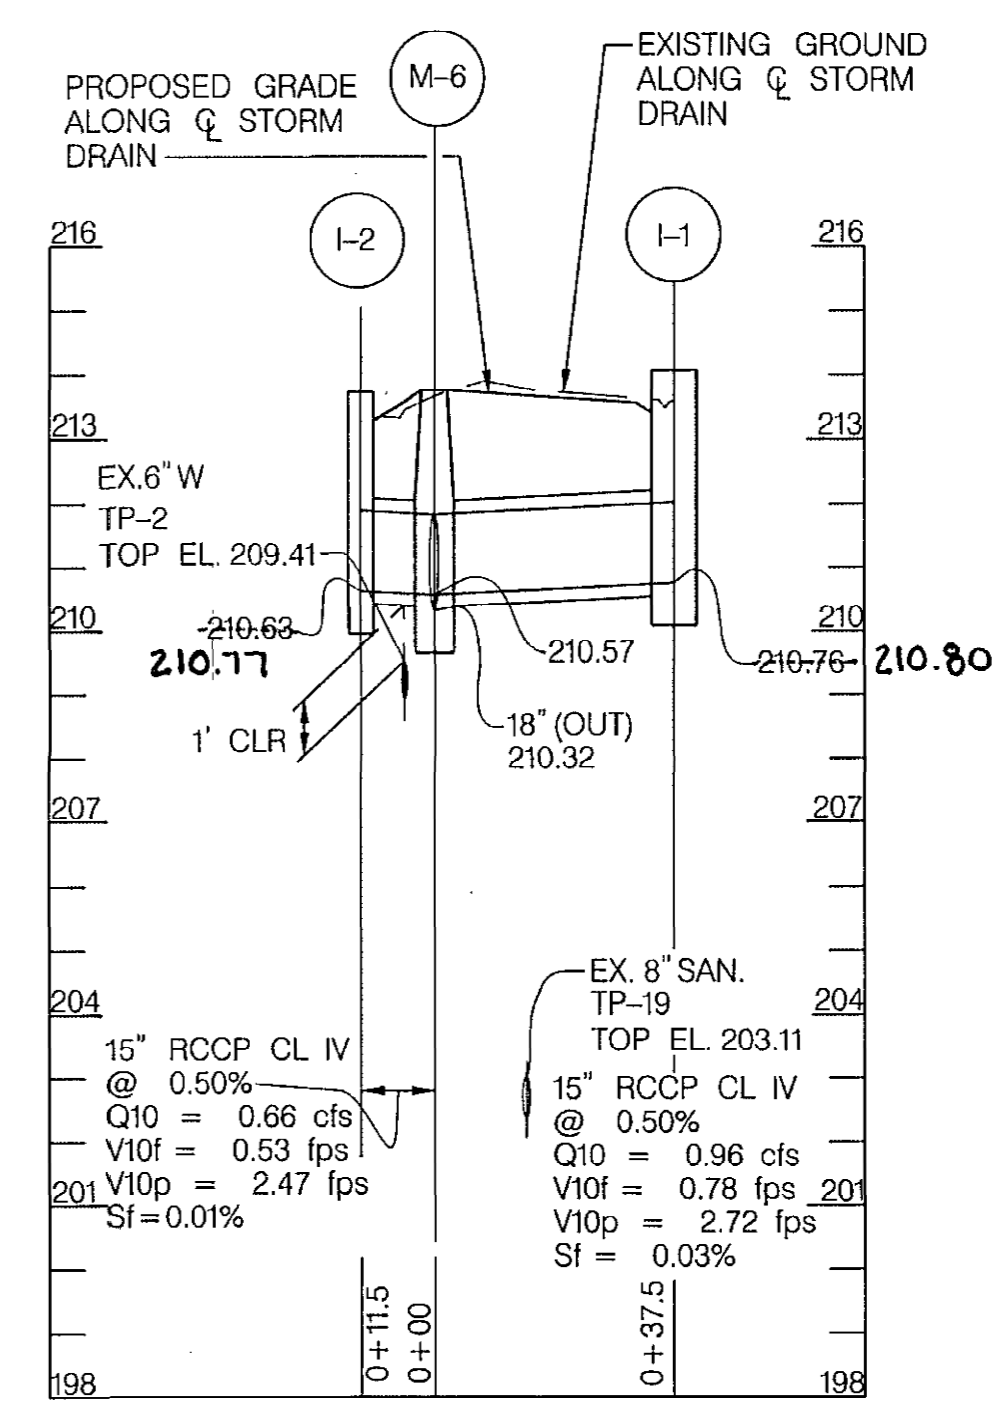

STORM DRAIN PROFILE I-2 TO I-1

SCALE: HORIZ. 1" = 30'  
VERT. 1" = 3'

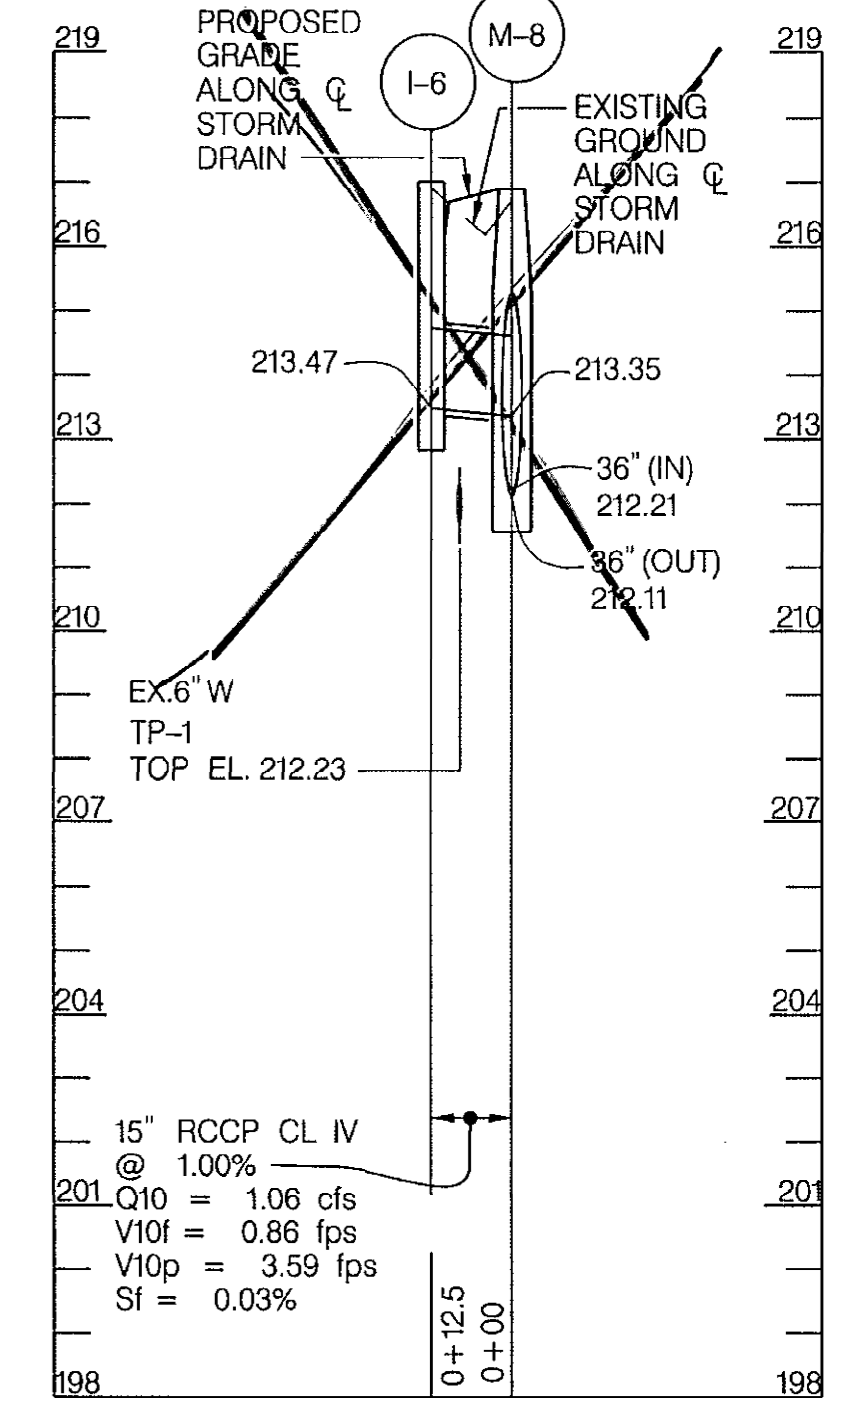


STORM DRAIN PROFILE I-6 TO M-8

SCALE: HORIZ. 1" = 30'  
VERT. 1" = 3'

DEPARTMENT OF PUBLIC WORKS  
HOWARD COUNTY, MARYLAND  
Director of Public Works: *Jan 9 Jan 4 19/13*  
Chief, Bureau of Engineering: *Thomas B. Butler 4/15/13*  
Chief, Bureau of Highways: *Steve Shover 4-9-13*  
Chief, Transportation and Special Projects Division: *Steve Shover 4/15/13*

**NOLAN** Associates, Inc.  
Engineers - Civil/Structural/Inspections  
4785 Dorsey Hall Drive  
Suite 124  
Ellicott City, Maryland 21042  
Phone: (410) 995-3551 Fax: (410) 995-1393

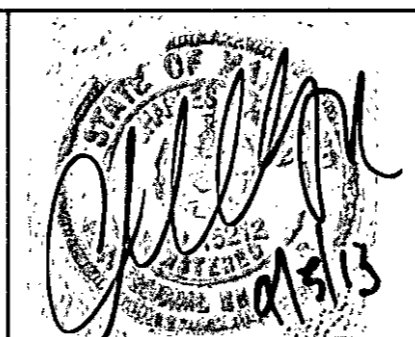

DES: GWF	MND	PROFILE ON OTHER SHEET	VMS
DRN: JW/JAH			
CHK: GWF			
DATE: MAY 2010	BY	NO.	REVISION



STORM DRAIN PROFILES

PINE TREE ROAD/GLEN COURT  
DRAINAGE AND ROADWAY IMPROVEMENTS, PH. 1  
CAPITAL PROJECT D-1140  
ELECTION DISTRICT NO. 6  
HOWARD COUNTY, MARYLAND

SCALE: AS SHOWN  
SHEET 8 OF 14A

ASBUILT

NOTE:  
COST AND INSTALLATION OF FILTER FABRIC SHALL BE INCIDENTAL TO CLASS I RIP RAP.

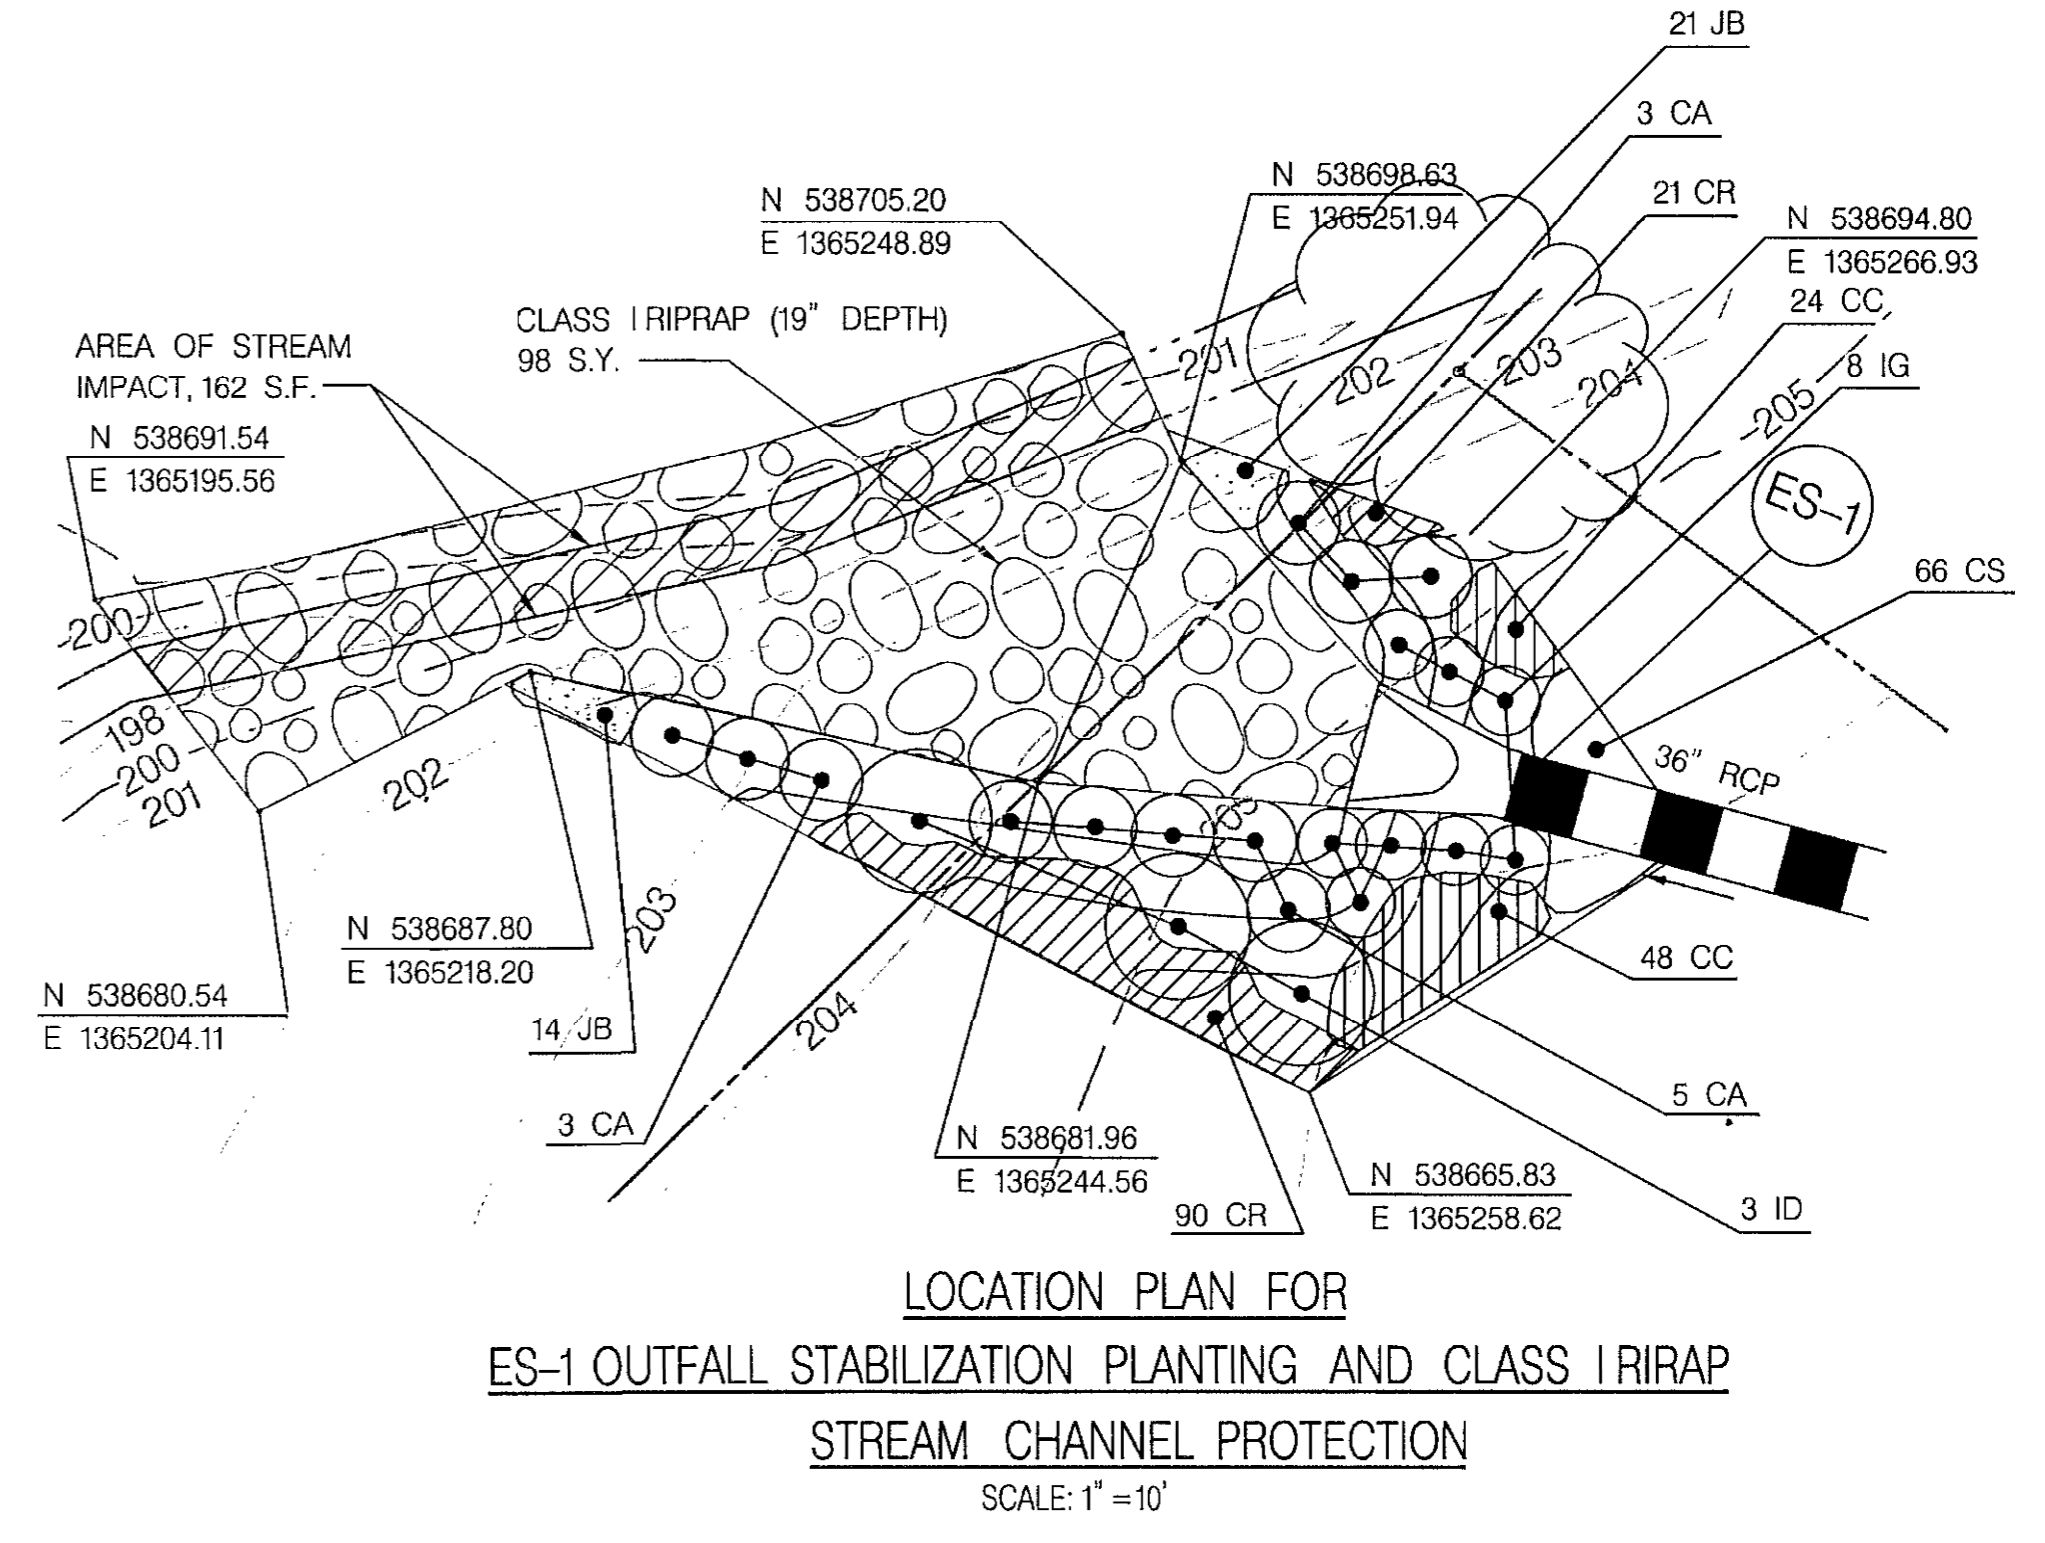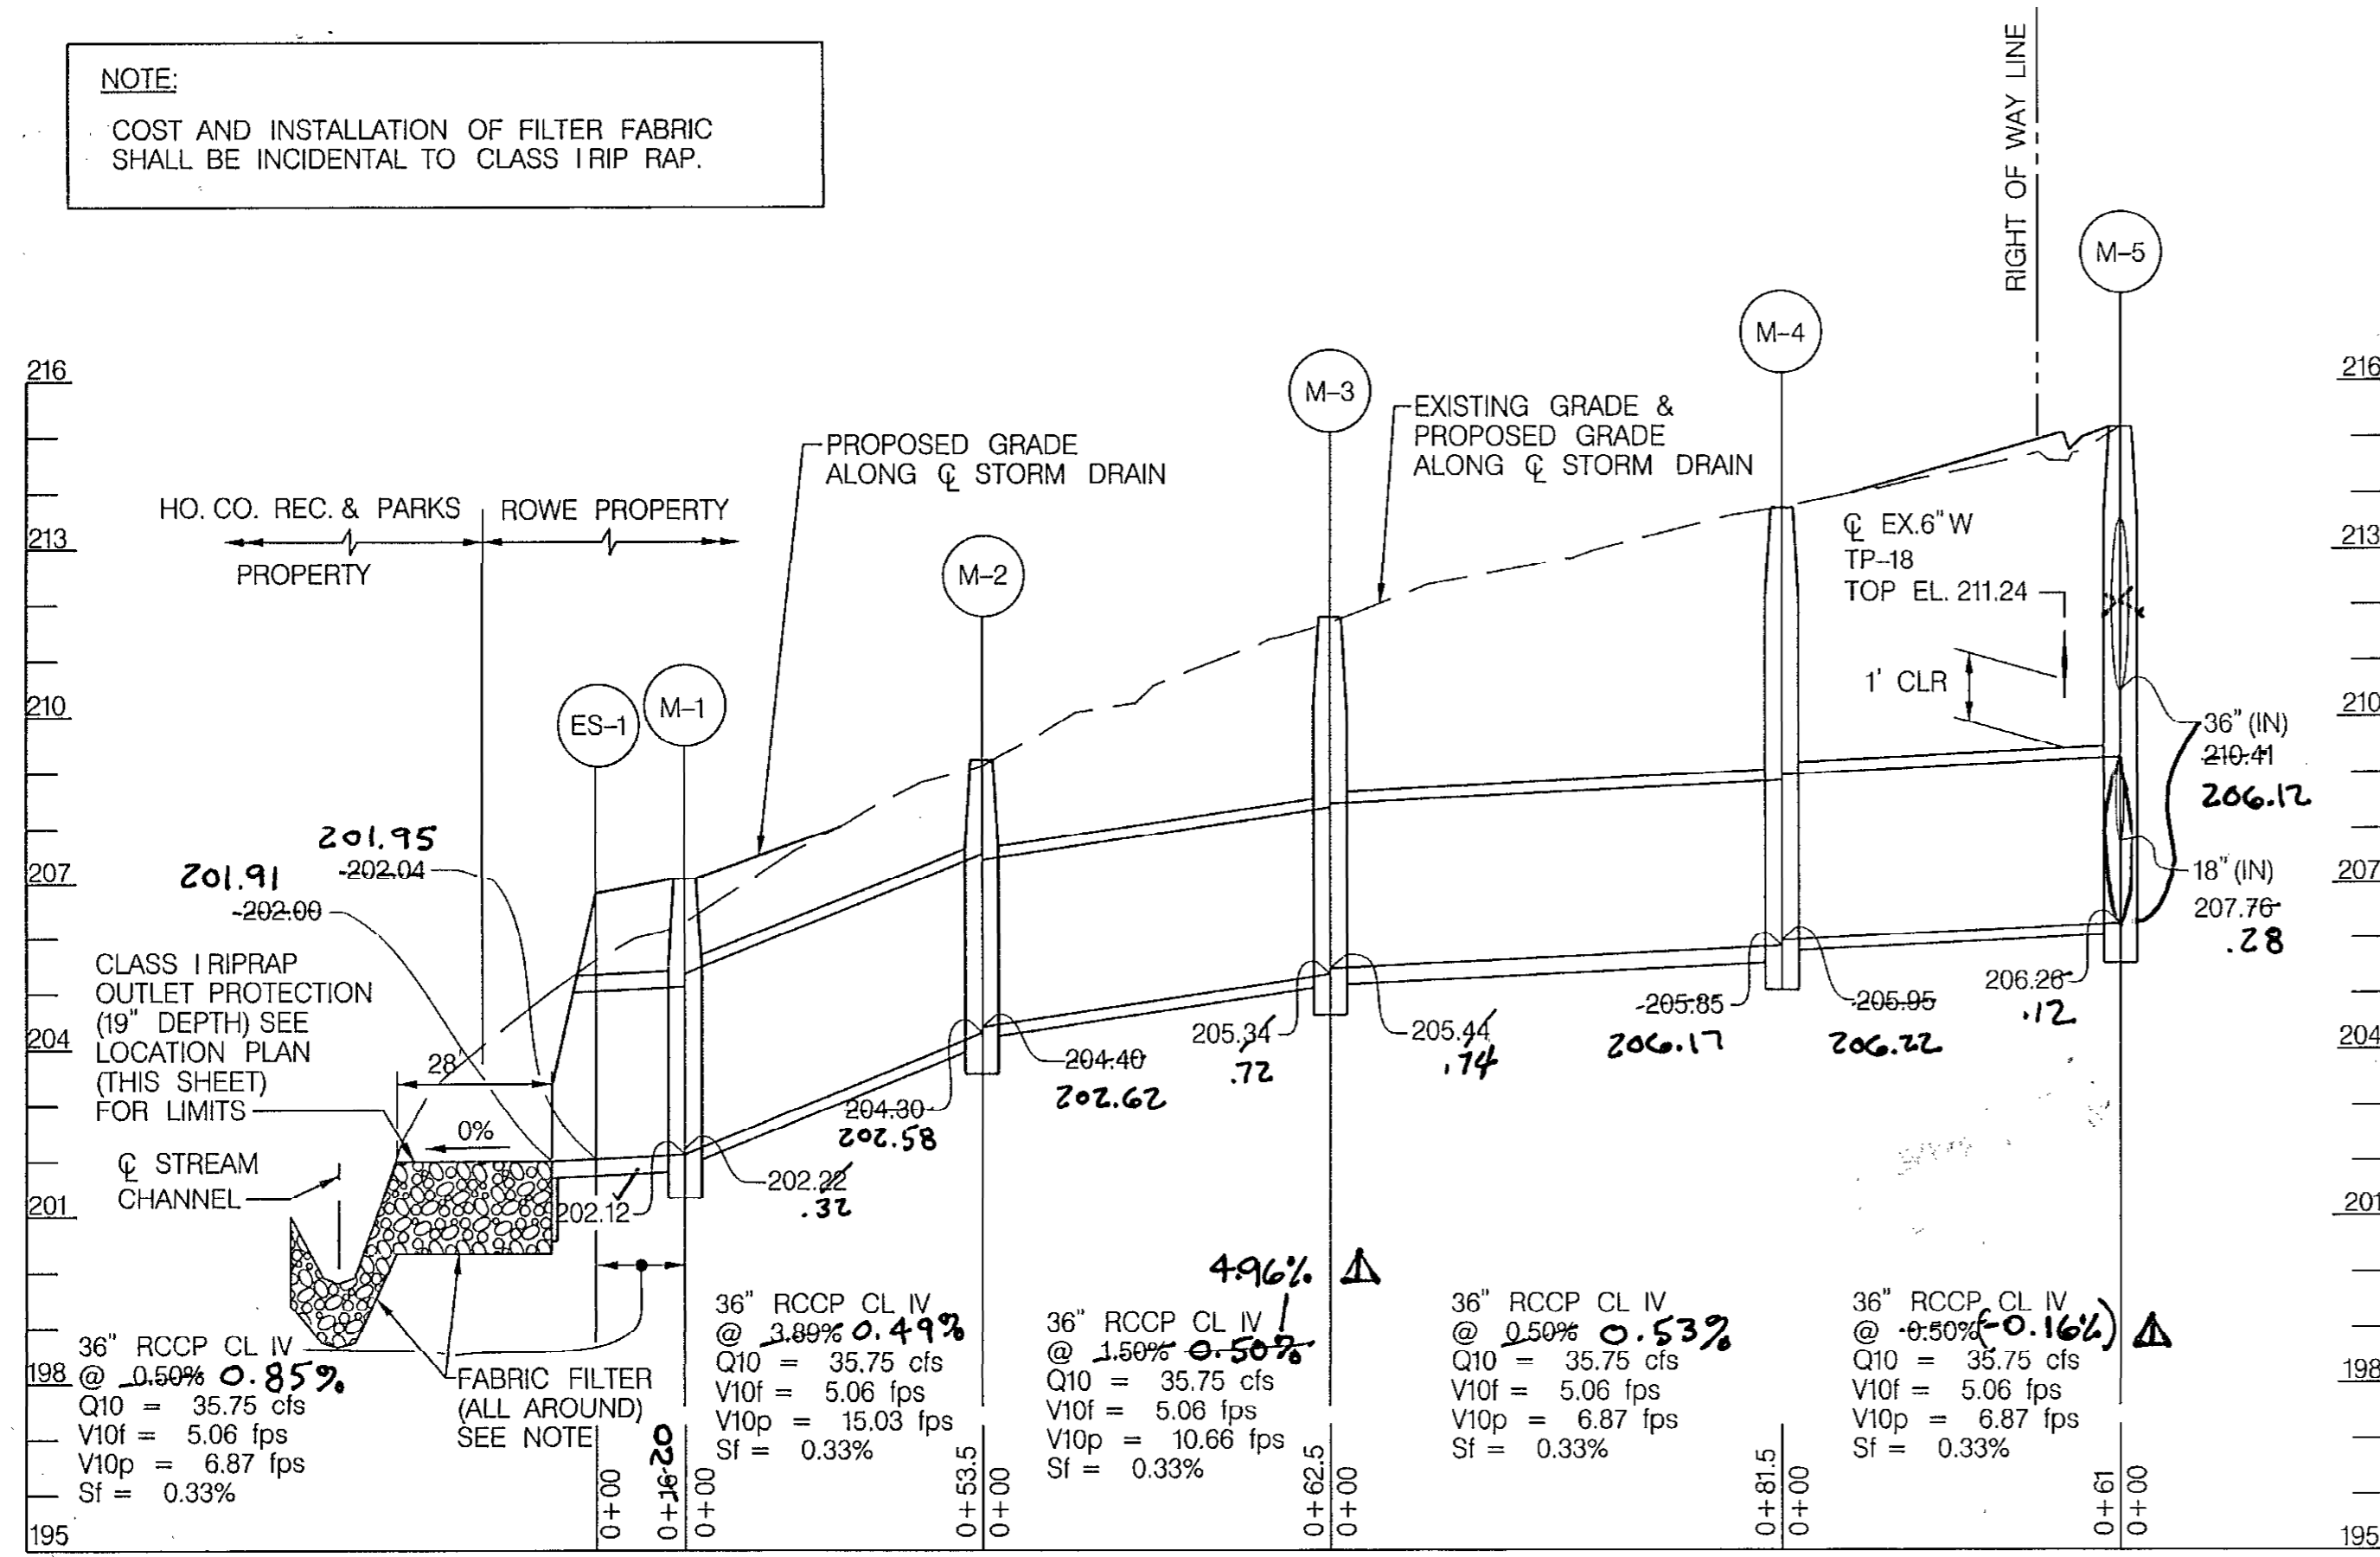


ES-1 OUTFALL STABILIZATION PLANTING LIST

SYMBOL	SCIENTIFIC NAME	COMMON NAME	SIZE	NUMBER
CA	CORNUS AMMOMUM	SILKY DOGWOOD	3G	11
ID	ILEX VERTICILLATA	HOLLY WINTERBERRY	3G	3
IG	ILEX GLABRA	INKBERRY	3G	8
HERBACEOUS PLANTS				
CC	CAREX CRISTATELLA	CRESTED SEDGE	0	72
CR	CAREX RETRORSA	RETROSE SEDGE	0	111
CS	CAREX SOUARROSA	NARROW-LEAVED CATTAIL-SEDE	0	66
JB	JUNCUS TOREYII	TORREY'S RUSH	0	35


\* ONE FOOT SPACING

CONSTRUCTION AS-BUILT CERTIFICATION  
I hereby certify the as-built information shown hereon (in red) is correct to the best of my knowledge and belief and that is the result of a field run survey performed under my direct supervision in accordance with the laws regulating land surveys in the State of Maryland.  
Wayne F. Aubertin, Prof. L.S. Maryland Reg. #21330 Exp. 01/07/17  
Snider & Associates, Land Surveyors  
20270 Goldenrod Lane, Suite 110  
Germantown, MD 20876 Ph. 301-948-5100 Fax 301-948-1286

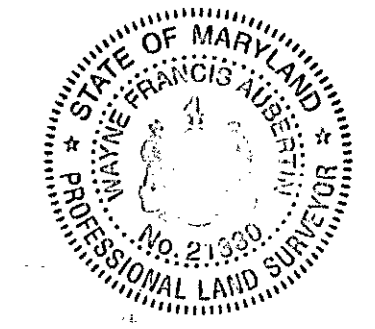

DEPARTMENT OF PUBLIC WORKS  
HOWARD COUNTY, MARYLAND  
Director of Public Works: *John A. Blair* 4/1/15  
Chief, Bureau of Engineering: *Thomas E. Kibler* 4/1/13  
Chief, Bureau of Highways: *Walter A. Kelly* 9-9-13  
Chief, Transportation and Special Projects Division: *Steve Sharan* 4/15/13

NOLAN Associates, Inc.  
Engineers - Civil/Structural/Inspections  
4785 Dorsey Hall Drive  
Suite 124  
Ellicott City, Maryland 21042  
Phone: 410-995-3851 Fax: 410-995-1383

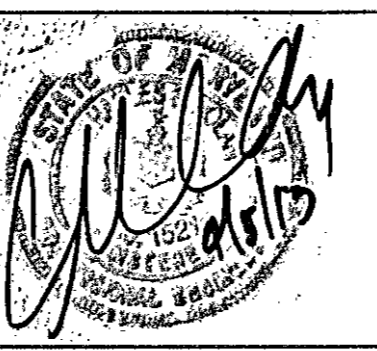

DES: CWF	MND	Δ	SLOPE CORRECTIONS FOR AS-BUILT	1/14/15
DRN: JW/JAH				
CHK: GWF				
DATE: MAY 2010	BY: NO.		REVISION	DATE

STORM DRAIN PROFILES  
600' SCALE MAP NO. \_\_\_\_\_ BLOCK NO. \_\_\_\_\_


PINE TREE ROAD/GLEN COURT  
DRAINAGE AND ROADWAY IMPROVEMENTS, PH. 1  
CAPITAL PROJECT D-1140  
ELECTION DISTRICT NO. 6  
HOWARD COUNTY, MARYLAND  
SHEET 9 OF 14A

AS BUILT

INLET	LOCATION	REMARKS
I-1	STA. 106+36.26 TO STA. 106+78.59, LT.	PER DETAIL R-3.06
I-2	END TRANSITION STA. 106+30.80, RT.	TRANSITION LENGTH FROM DOWN STATION END OF I-2 INLET TO STA. 106+30.8 LESS 15'. ADJUST TRANSITION WITHIN LIMITS.
I-3	END TRANSITION, STA. 200+59.28, LT. (SEE REMARKS)	7" COMBINATION CURB AND GUTTER SECTION TO RUN ALONG CURVE FILLET FROM END OF I-4 TO BEGINNING OF I-3
I-4	STA. 104+12.47, LT. TO I-3 (SEE REMARKS)	7" COMBINATION CURB AND GUTTER SECTION TO RUN ALONG CURVE FILLET FROM END OF I-4 TO BEGINNING OF I-3
I-5	STA. 102+66.8 TO STA. 102+99.3, LT.	PER DETAIL R-3.06
I-6	STA. 103+81.5 TO STA. 104+17.5, RT.	PER DETAIL R-3.06

FROM STRUCT.	TO STRUCT.	SIZE (IN.)	TYPE	LENGTH (FT.)
I-1	M-6	15'	RCCP CL IV	38
I-2	M-6	15'	RCCP CL IV	12
M-6	M-5	18"	RCCP CL IV	133
M-5	M-7	36"	RCCP CL IV	61
I-3	M-7	15'	RCCP CL IV	32.57
I-4	M-7	18"	RCCP CL IV	13
M-7	M-8	36"	RCCP CL IV	31
I-6	M-8	15'	RCCP CL IV	13
M-8	M-9	36"	RCCP CL IV	117
I-5	M-9	15'	RCCP CL IV	10
M-9	M-10	36"	RCCP CL IV	311
M-10	M-11	36"	RCCP CL IV	146
M-11	STUB (1)	36"	RCCP CL IV	32
ES-1	M-1	36"	RCCP CL IV	16
M-1	M-2	36"	RCCP CL IV	54
M-2	M-3	36"	RCCP CL IV	63
M-3	M-4	36"	RCCP CL IV	82
M-4	M-5	36"	RCCP CL IV	61
I-5B	I-5A	8"	HDPEP U.D.	95
I-5A	I-5	8"	HDPEP U.D.	11
I-5B	I-5C	8"	HDPEP U.D.	61

(1) END OF PIPE SHALL BE BULKHEADED WITH TEMPORARY MASONRY WALL

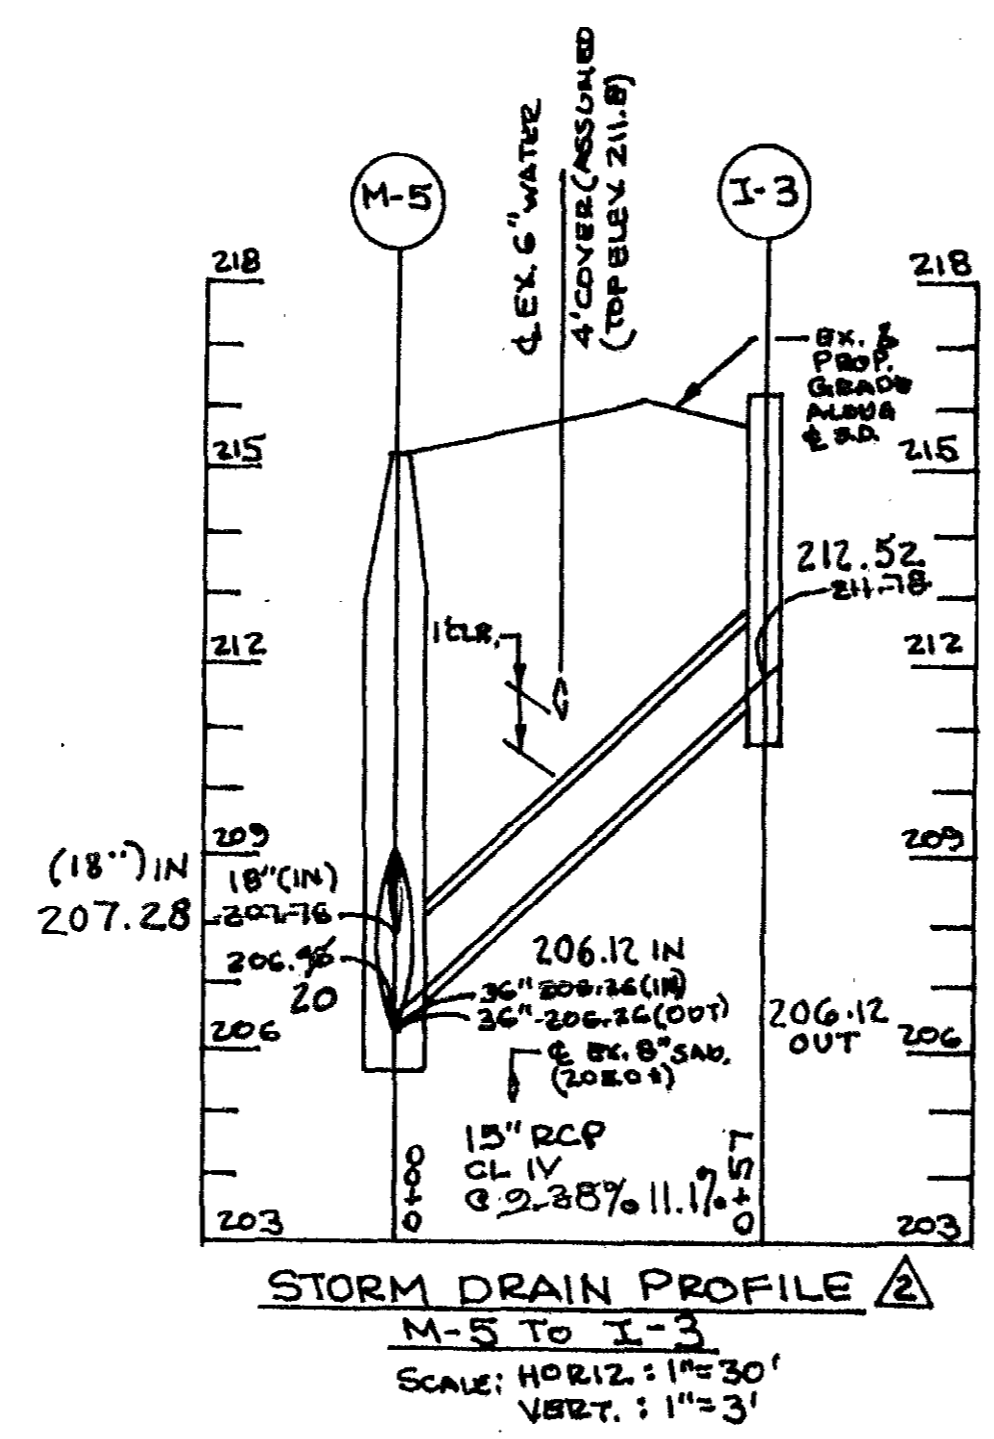


NO.	TYPE	LOCATION	INV. IN	INV. OUT	TOP EL.	STD. NO.	TOP EL.	INV. OUT	INV. IN
I-1	A-5 PRECAST INLET	STA. 106+60.59, 11.0' LT.	---	210.3680	214.0225	HO. CO. STD. D-4.01	---	---	---
I-2	A-5 PRECAST INLET	STA. 106+21.23, 16.75' RT.	---	210.6377	213.73	HO. CO. STD. D-4.01	214.22	---	---
I-3	A-10 PRECAST INLET	STA. 200+38.78, 11.0' LT.	---	211.78	216.22	HO. CO. STD. D-4.02	216.78	212.52	---
I-4	A-5 PRECAST INLET	STA. 104+30.47, 11.0' LT.	216.70	211.795	216.22	HO. CO. STD. D-4.01	216.90	---	---
I-5	PRECAST DOUBLE WR COMB. INLET	STA. 102+83, 11.0' LT.	216.70	216.00	218.90	HO. CO. STD. D-4.35	219.13	214.01	214.23 214.13
I-6	A-5 PRECAST INLET	STA. 103+99.5, 11.0' RT.	---	213.965	216.91	HO. CO. STD. D-4.01	217.20	---	---
I-5A	DRAINAGE BASIN	STA. 102+80, 20' LT.	216.3050	216.3039	219.0039	SEE NOTE 1	---	---	---
I-5B	DRAINAGE BASIN	STA. 102+80, 114.6' LT.	218.37	218.10	220.30	SEE NOTE 1	---	217.93	217.33
I-5C	DRAINAGE BASIN	STA. 102+19, 107.5' LT.	---	219.3017	221.55	SEE NOTE 1	220.86	---	---
M-1	60" DIA. PRECAST MANHOLE	N 538677.58 E 1365284.53	202.2832	202.12	207.3038	HO. CO. STD. G-5.11	---	---	---
M-2	60" DIA. PRECAST MANHOLE	N 538635.41 E 1365317.52	204.40	204.30	209.23	HO. CO. STD. G-5.11	208.78	202.58	202.62
M-3	60" DIA. PRECAST MANHOLE	N 538611.62 E 1365375.31	205.474	205.372	211.389	HO. CO. STD. G-5.11	---	---	---
M-4	60" DIA. PRECAST MANHOLE	N 538563.12 E 1365441.16	205.95	205.85	213.73	HO. CO. STD. G-5.11	214.12	206.17	206.22
M-5	60" DIA. PRECAST MANHOLE	STA. 104+91.5, 2.0' RT.	207.76 (18") 206.21 (36")	210.51 (15") 210.51 (15")	206.2612	215.2434	HO. CO. STD. G-5.11	---	207.28 (18") 206.12 (36") 206.20 (5")
M-6	48" DIA. PRECAST MANHOLE	STA. 106+23.4, 5.6' RT.	---	210.32	213.7597	HO. CO. STD. G-5.12	---	---	---
M-7	60" DIA. PRECAST MANHOLE	STA. 104+30.47, 0.0' RT.	211.05 (18") 210.97	210.87	216.3501	HO. CO. STD. G-5.11	---	206.37	210.83 (18") 209.56 (36")
M-8	60" DIA. PRECAST MANHOLE	STA. 103+99.5, 0.0' RT.	213.35 (18") 212.21 (36")	212.11	217.04	HO. CO. STD. G-5.11	216.75	211.15	212.90 (15") 211.25 (36")
M-9	60" DIA. PRECAST MANHOLE	STA. 102+83.0, 0.0' RT.	215.30 (15") 213.606 (36")	213.5065	219.923	HO. CO. STD. G-5.11	---	---	213.81 (15")
M-10	60" DIA. PRECAST MANHOLE	STA. 99+72.0, 0.0' RT.	---	216.5863	227.00	HO. CO. STD. G-5.11	226.93	---	---
M-11	60" DIA. PRECAST MANHOLE	N 538751.94 E 1365983.56	217.960	217.10	227.5970	HO. CO. STD. G-5.11	---	---	---
ES-1	CONC. END SECTION 36" DIA. PIPE	N 538681.78 E 1365269.22	202.04	202.00	---	HO. CO. STD. D-5.1	---	---	---

•• - TOP OF SLAB ELEVATION  
••• - TOP OF GRATE ELEVATION AT FLOW LINE

NOTES:


- DRAINAGE BASIN TO BE 12-INCH ADVANCED DRAINAGE SYSTEMS, INC. (ADS) DRAIN BASIN (PROD. CODE 2812AG) WITH STD H-20 GRATE (PROD. CODE 1299CGS) OR APPROVED EQUAL.
- ALL DRAINAGE STRUCTURES AND MANHOLES, EXCEPT FOR DRAINAGE BASINS SHALL BE FITTED WITH KNOCK-OUTS TO ACCOMMODATE 6-INCH UNDERDRAIN. CONTRACTOR SHALL FABRICATE STRUCTURES WITH 6-INCH BY 6-INCH OPENINGS LOCATED AT THE SAME ELEVATION OF INCOMING/OUTGOING STORM DRAIN PIPES. PER DIRECTION OF THE ENGINEER, THE CONTRACTOR SHALL ALSO PROVIDE 6-INCH PERFORATED PIPE WRAPPED IN FILTER CLOTH EXTENDING 12-INCHES OUT FROM STRUCTURE WALL ON ALL SIDES, THE UNDERDRAIN PIPE AND INLETS SHALL BE SURROUNDED BY NO. 57 STONES. THE COST OF KNOCK-OUTS, UNDERDRAIN, FILTER CLOTH AND STONE SHALL BE INCIDENTAL TO THE CONTRACT UNIT COST PER EACH STRUCTURE.
- ALL STORM DRAIN PIPE SHALL HAVE 6-INCH OF NO. 57 STONE BEDDING.

CONSTRUCTION ASBUILT CERTIFICATION  
I hereby certify the as-built information shown hereon (in red) is correct to the best of my knowledge and belief and that is the result of a field run survey performed under my direct supervision in accordance with the laws regulating land surveys in the State of Maryland.  
Wayne F. Rubink, Prof. L.S. Maryland Reg. #21330 Exp. 01/07/17  
Snider & Associates, Land Surveyors  
20270 Goldenrod Lane, Suite 110  
Germantown, MD 20876 Ph. 301-948-5100 Fax 301-948-1286

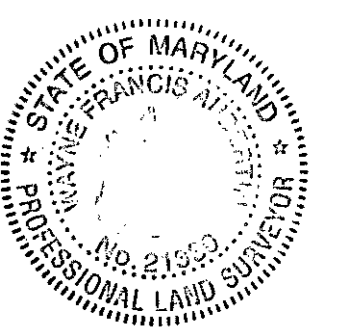

DEPARTMENT OF PUBLIC WORKS HOWARD COUNTY, MARYLAND Director of Public Works: <i>John J. Kelly</i> DATE: 4-9-13 Chief, Bureau of Engineering: <i>Steve Skowar</i> DATE: 4/15/13 Chief, Transportation and Special Projects Division		NOLAN Associates, Inc. Engineers - Civil/Structural/Inspections 4785 Dorsey Hall Drive Suite 124 Ellicott City, Maryland 21042 Phone: (410) 999-3661 Fax: (410) 999-1363		DES: GWF/JW DRN: JRW CHK: GWF DATE: FEB 2013		ADD M-5 TO I-3 S.D. PROFILE, REV. STRUCT. & PIPE SCH. 4/15/13		STORM DRAIN PROFILES DRAINAGE / PIPE STRUCTURE SCHEDULES AND INLET CURB AND GUTTER TRANSITION TABLE 600' SCALE MAP NO. _____ BLOCK NO. _____		PINE TREE ROADGLEN COURT DRAINAGE AND ROADWAY IMPROVEMENTS, PH. 1 CAPITAL PROJECT D-1140 ELECTION DISTRICT NO. 6 HOWARD COUNTY, MARYLAND SCALE: AS SHOWN SHEET 10 OF 14A	
--	--	--	--	---	--	---	--	---	--	--	--

AS BUILT

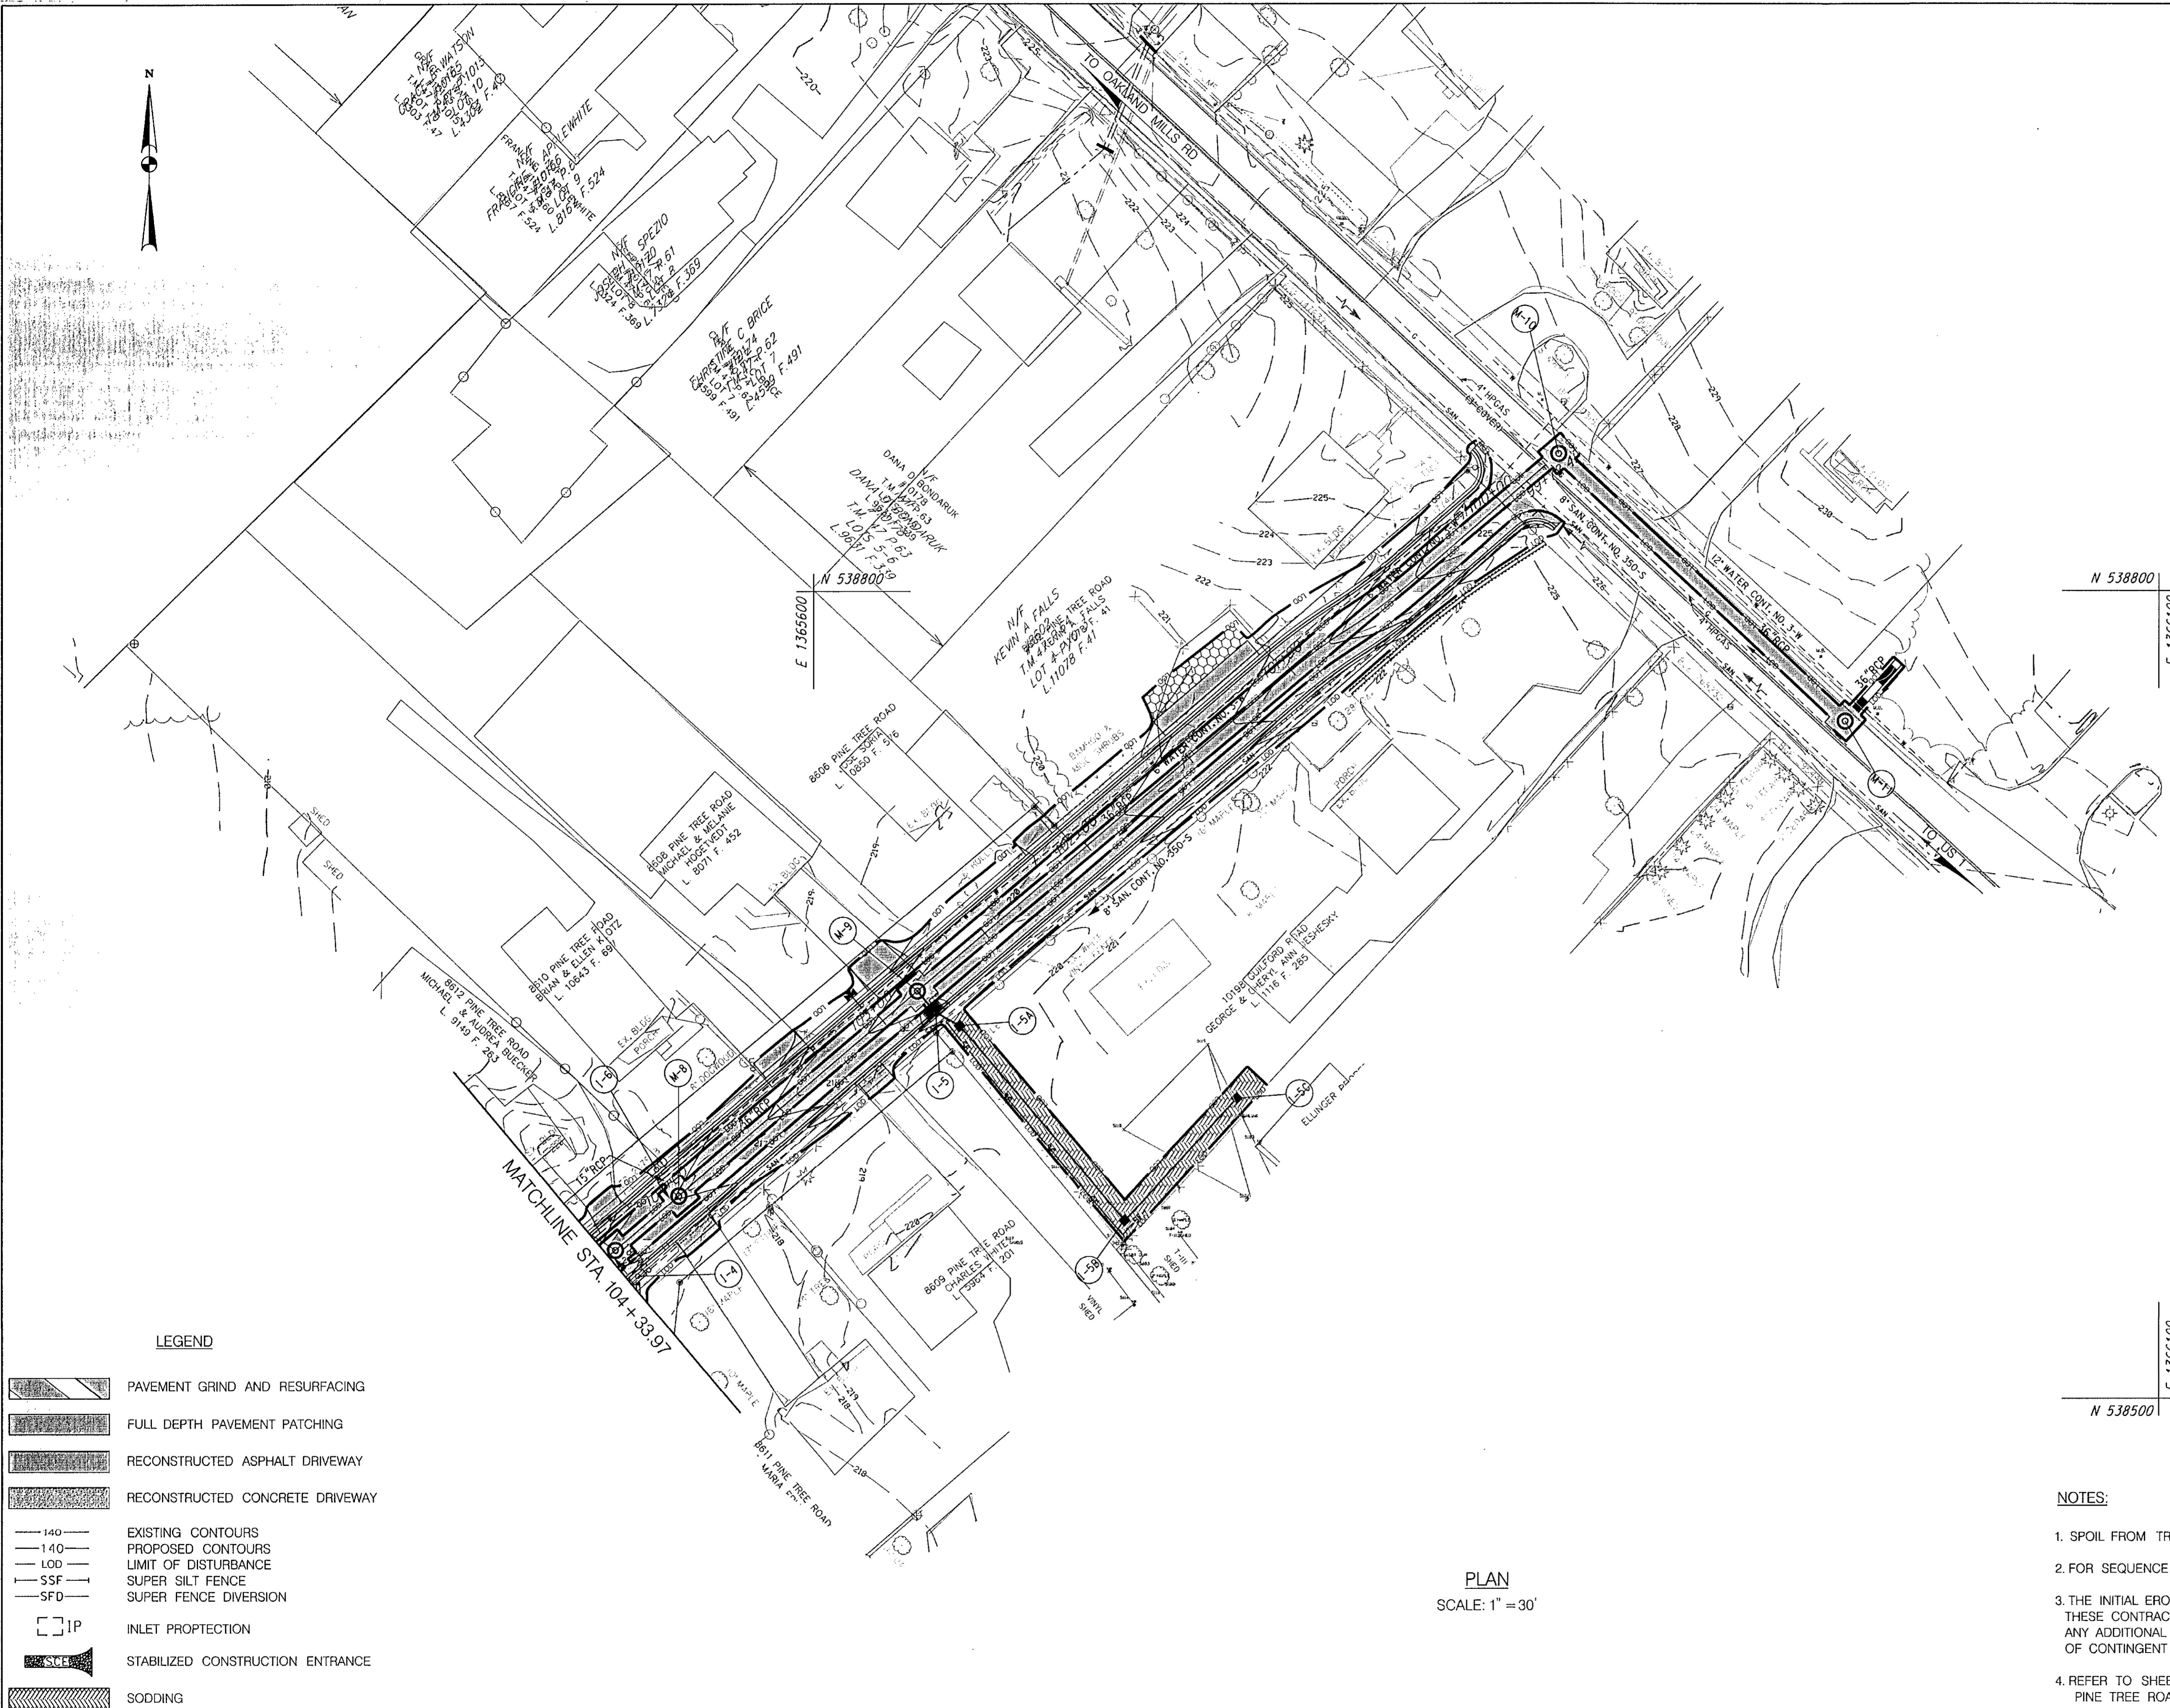

INSTALL SILT FENCE  
STA. 103+71 TO 103+85, LT - 120 L.F.

INSTALL TURFGRASS SOD  
STA. 102+08 TO 102+84, LT - 189 S.Y.

INSTALL INLET PROTECTION  
(SEE NOTE 1 UNDER SEQUENCE OF CONSTRUCTION ON SHEET 13)

I-4 - 1 EACH  
I-5 - 1 EACH  
I-6 - 1 EACH

**LEGEND**

- PAVEMENT GRIND AND RESURFACING
- FULL DEPTH PAVEMENT PATCHING
- RECONSTRUCTED ASPHALT DRIVEWAY
- RECONSTRUCTED CONCRETE DRIVEWAY
- EXISTING CONTOURS
- PROPOSED CONTOURS
- LOD
- SUPER SILT FENCE
- SUPER FENCE DIVERSION
- INLET PROTECTION
- STABILIZED CONSTRUCTION ENTRANCE
- SODDING

PLAN  
SCALE: 1" = 30'

**NOTES:**

1. SPOIL FROM TRENCHING OPERATION IS TO BE PLACED ON THE UPHILL SIDE OF EXCAVATION.
2. FOR SEQUENCE OF CONSTRUCTION, SEE SHEET 13.
3. THE INITIAL EROSION AND SEDIMENT CONTROL INSTALLATIONS AS INDICATED ON THESE CONTRACT DOCUMENTS SHALL BE INCLUDED AS PART OF THE CONTRACTOR'S BID PRICE. ANY ADDITIONAL EROSION AND SEDIMENT CONTROL DEVICE INSTALLATION WILL BE PAID AS PART OF CONTINGENT PRICE PAY ITEM.
4. REFER TO SHEETS 14 AND 14A FOR DETAIL ON MAINTENANCE OF TRAFFIC ON GUILFORD AND PINE TREE ROAD.

DEPARTMENT OF PUBLIC WORKS  
HOWARD COUNTY, MARYLAND

*Lauren A. Galt* 4/6/13  
DIRECTOR OF PUBLIC WORKS DATE

*Steve Sharpe* 4/9/13  
CHIEF, BUREAU OF HIGHWAYS DATE

*Thomas R. Butler* 4/11/13  
CHIEF, BUREAU OF ENGINEERING DATE

*Steve Sharpe* 4/15/13  
CHIEF, TRANSPORTATION AND SPECIAL PROJECTS DIVISION DATE

**NOLAN**  
Associates, Inc.  
Engineers - Civil/Structural/Inspections  
4785 Dorsey Hall Drive  
Suite 124  
Ellicott City, Maryland 21042  
Phone: (410) 995-3651 Fax: (410) 995-1363



DES: GWF/JW					
DRN: JRW					
CHK: GWF					
DATE: FEB 2013	BY	NO.	REVISION	DATE	


**EROSION AND SEDIMENT CONTROL PLAN**

600' SCALE MAP NO. \_\_\_\_\_ BLOCK NO. \_\_\_\_\_

PINE TREE ROAD GLEN COURT  
DRAINAGE AND ROADWAY IMPROVEMENTS, PH. 1  
CAPITAL PROJECT D-1140  
ELECTION DISTRICT NO. 6  
HOWARD COUNTY, MARYLAND

SCALE:  
AS SHOWN

SHEET  
II OF 14A

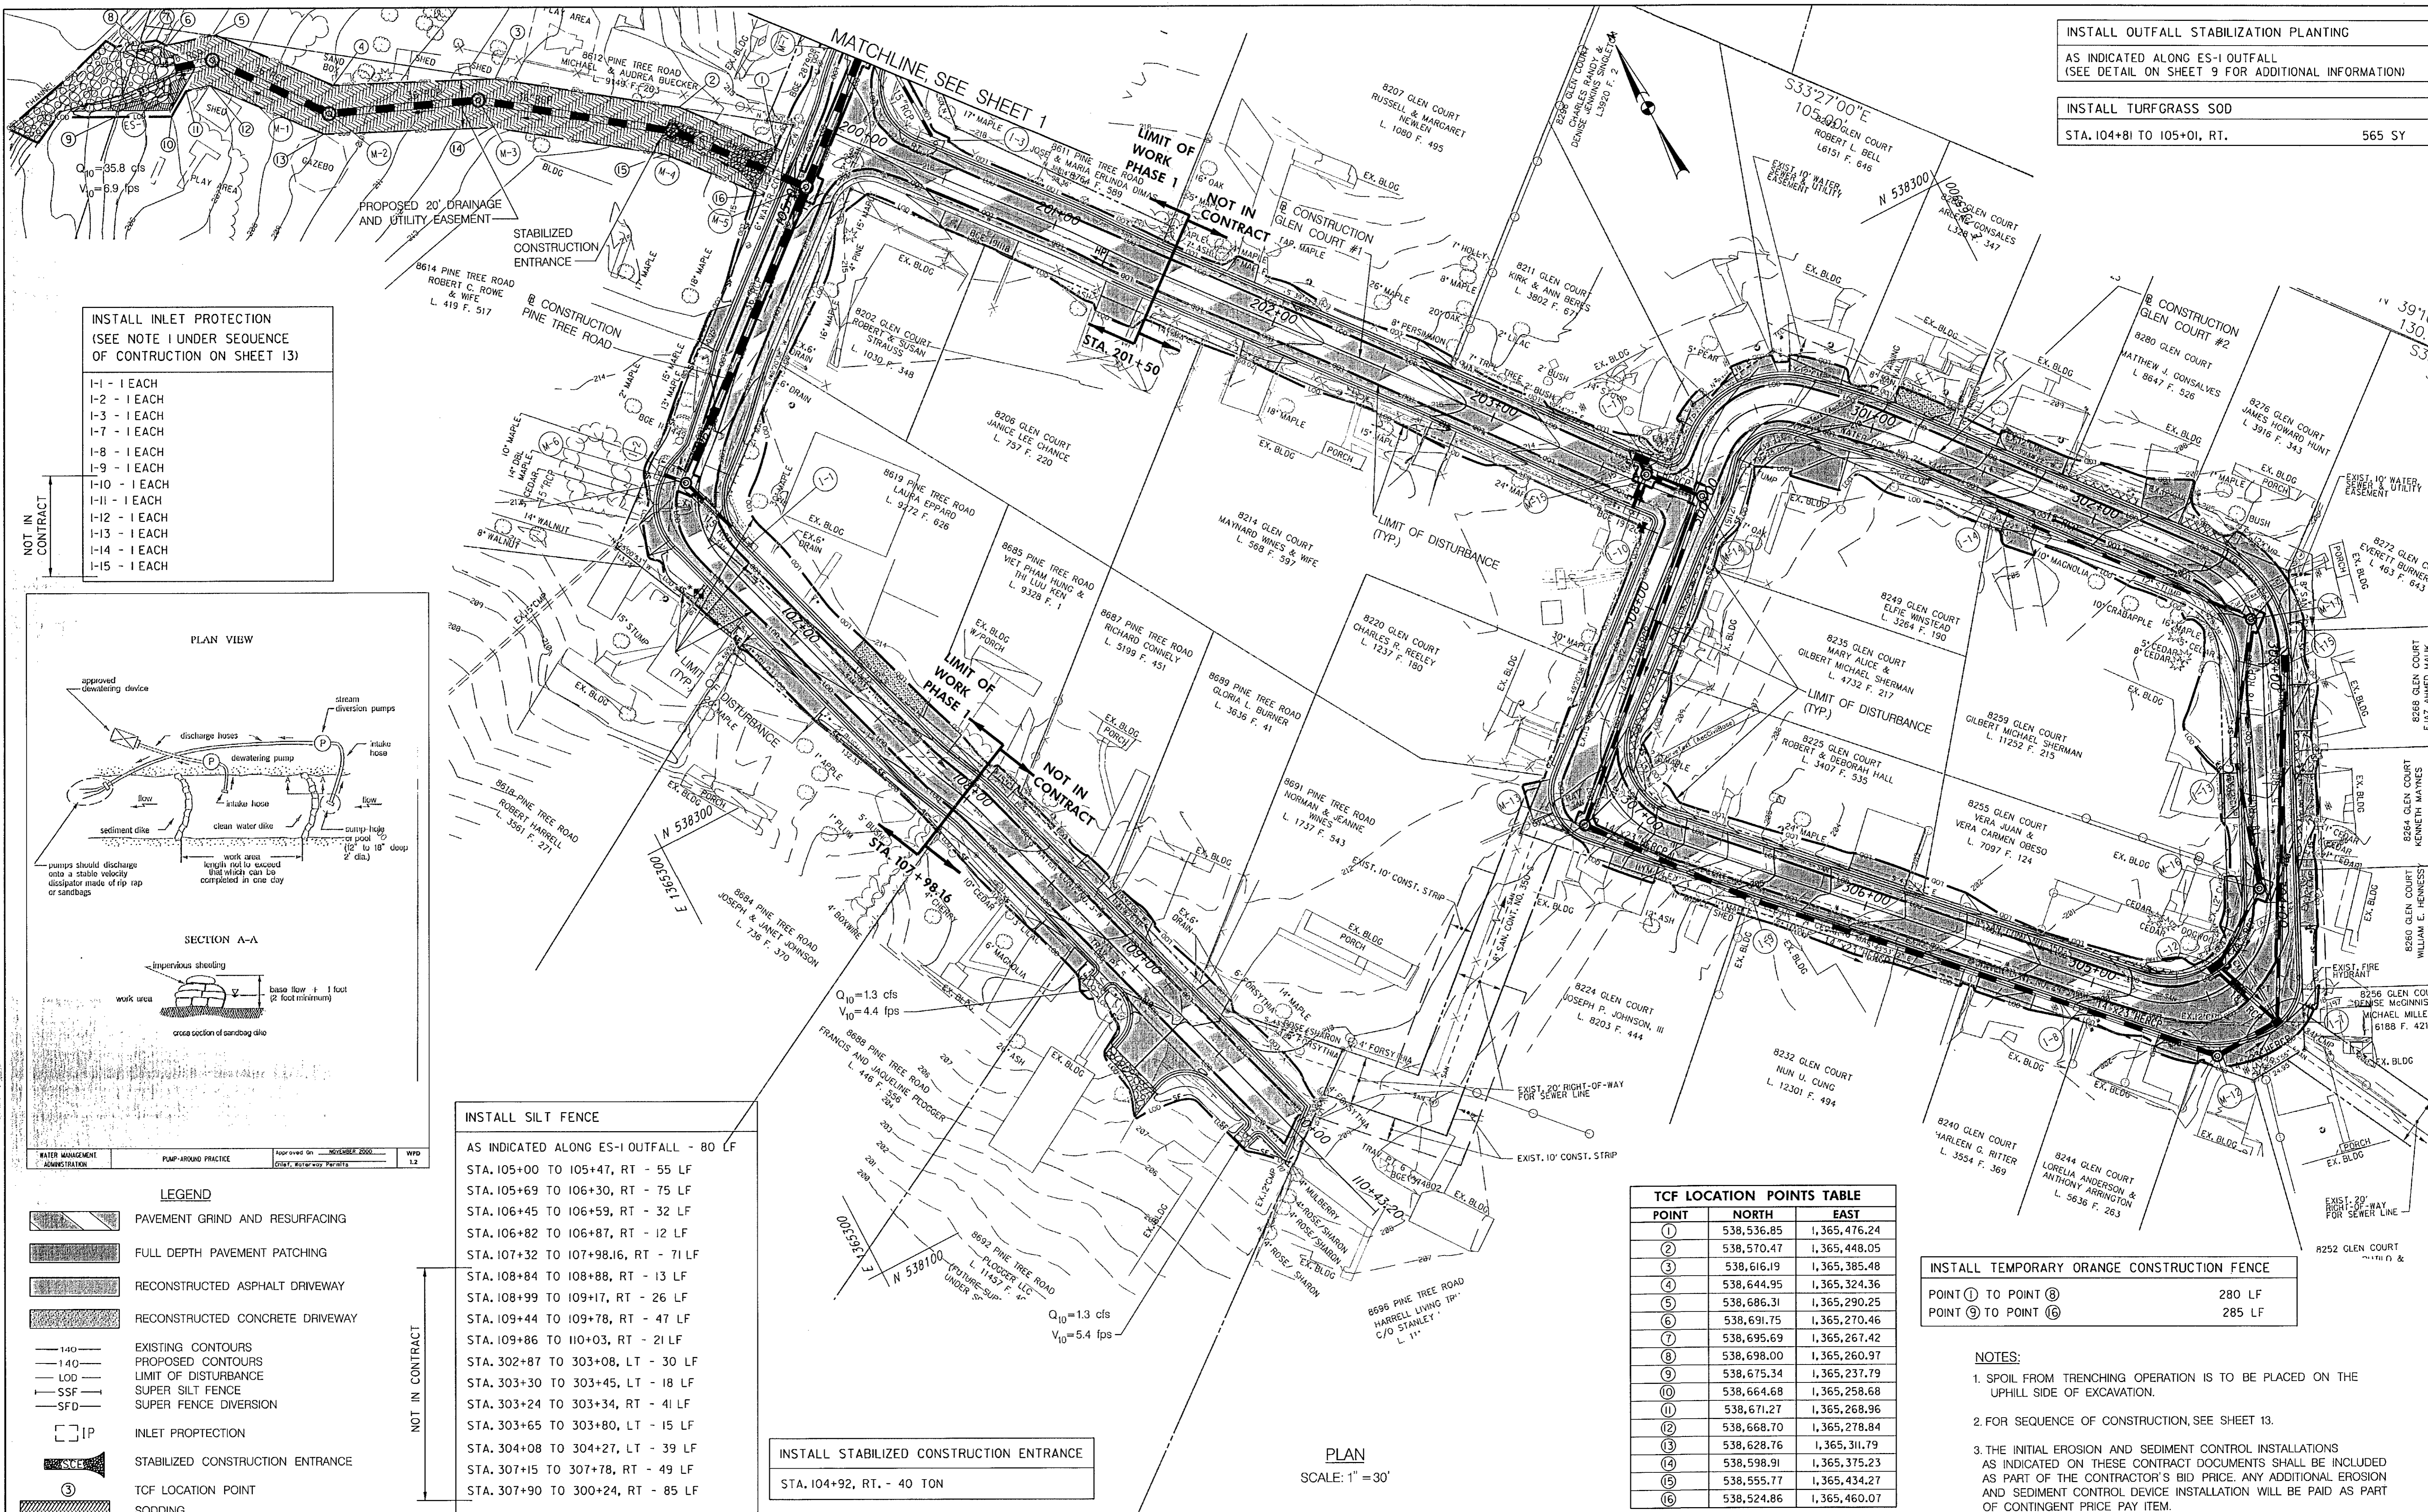


INSTALL OUTFALL STABILIZATION PLANTING  
 AS INDICATED ALONG ES-1 OUTFALL  
 (SEE DETAIL ON SHEET 9 FOR ADDITIONAL INFORMATION)

INSTALL TURFGRASS SOD  
 STA. 104+81 TO 105+01, RT. 565 SY

INSTALL INLET PROTECTION  
 (SEE NOTE 1 UNDER SEQUENCE  
 OF CONSTRUCTION ON SHEET 13)

I-1 - 1 EACH  
 I-2 - 1 EACH  
 I-3 - 1 EACH  
 I-7 - 1 EACH  
 I-8 - 1 EACH  
 I-9 - 1 EACH  
 I-10 - 1 EACH  
 I-11 - 1 EACH  
 I-12 - 1 EACH  
 I-13 - 1 EACH  
 I-14 - 1 EACH  
 I-15 - 1 EACH

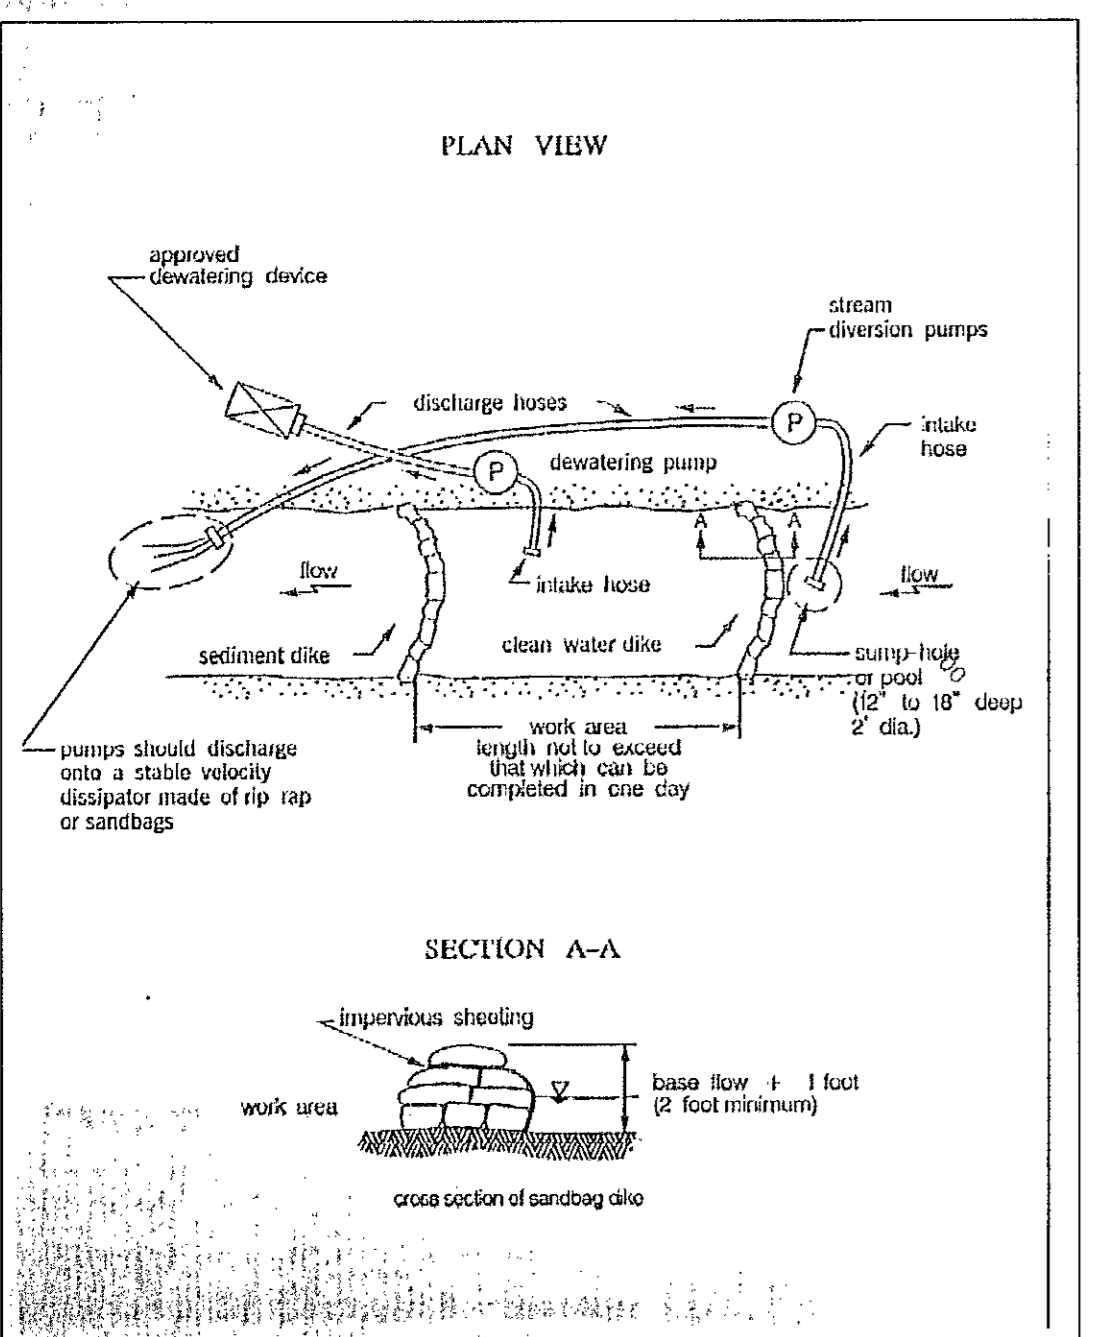

INSTALL SILT FENCE  
 AS INDICATED ALONG ES-1 OUTFALL - 80 LF

STA. 105+00 TO 105+47, RT - 55 LF  
 STA. 105+69 TO 106+30, RT - 75 LF  
 STA. 106+45 TO 106+59, RT - 32 LF  
 STA. 106+82 TO 106+87, RT - 12 LF  
 STA. 107+32 TO 107+98.16, RT - 71 LF  
 STA. 108+84 TO 108+88, RT - 13 LF  
 STA. 108+99 TO 109+17, RT - 26 LF  
 STA. 109+44 TO 109+78, RT - 47 LF  
 STA. 109+86 TO 110+03, RT - 21 LF  
 STA. 302+87 TO 303+08, LT - 30 LF  
 STA. 303+30 TO 303+45, LT - 18 LF  
 STA. 303+24 TO 303+34, RT - 41 LF  
 STA. 303+65 TO 303+80, LT - 15 LF  
 STA. 304+08 TO 304+27, LT - 39 LF  
 STA. 307+15 TO 307+78, RT - 49 LF  
 STA. 307+90 TO 300+24, RT - 85 LF

INSTALL STABILIZED CONSTRUCTION ENTRANCE  
 STA. 104+92, RT. - 40 TON

TCF LOCATION POINTS TABLE

POINT	NORTH	EAST
①	538,536.85	1,365,476.24
②	538,570.47	1,365,448.05
③	538,616.19	1,365,385.48
④	538,644.95	1,365,324.36
⑤	538,686.31	1,365,290.25
⑥	538,691.75	1,365,270.46
⑦	538,695.69	1,365,267.42
⑧	538,698.00	1,365,260.97
⑨	538,675.34	1,365,237.79
⑩	538,664.68	1,365,258.68
⑪	538,671.27	1,365,268.96
⑫	538,668.70	1,365,278.84
⑬	538,628.76	1,365,311.79
⑭	538,598.91	1,365,375.23
⑮	538,555.77	1,365,434.27
⑯	538,524.86	1,365,460.07

INSTALL TEMPORARY ORANGE CONSTRUCTION FENCE

POINT ① TO POINT ⑧ 280 LF  
 POINT ⑨ TO POINT ⑯ 285 LF

NOTES:

- SPOIL FROM TRENCHING OPERATION IS TO BE PLACED ON THE UPHILL SIDE OF EXCAVATION.
- FOR SEQUENCE OF CONSTRUCTION, SEE SHEET 13.
- THE INITIAL EROSION AND SEDIMENT CONTROL INSTALLATIONS AS INDICATED ON THESE CONTRACT DOCUMENTS SHALL BE INCLUDED AS PART OF THE CONTRACTOR'S BID PRICE. ANY ADDITIONAL EROSION AND SEDIMENT CONTROL DEVICE INSTALLATION WILL BE PAID AS PART OF CONTINGENT PRICE PAY ITEM.


- LEGEND
- PAVEMENT GRIND AND RESURFACING
  - FULL DEPTH PAVEMENT PATCHING
  - RECONSTRUCTED ASPHALT DRIVEWAY
  - RECONSTRUCTED CONCRETE DRIVEWAY
  - EXISTING CONTOURS
  - PROPOSED CONTOURS
  - LOD - LIMIT OF DISTURBANCE
  - SSF - SUPER SILT FENCE
  - SFD - SUPER FENCE DIVERSION
  - IP - INLET PROTECTION
  - SC - STABILIZED CONSTRUCTION ENTRANCE
  - TCF LOCATION POINT
  - SODDING

PLAN  
 SCALE: 1" = 30'

DEPARTMENT OF PUBLIC WORKS  
 HOWARD COUNTY, MARYLAND

Director of Public Works: *John A. ...* DATE: 4/12/13  
 Chief, Bureau of Highways: *Steve Sharver* DATE: 4/15/13

NOLAN Associates, Inc.  
 Engineers - Civil/Structural/Inspections  
 4785 Dorsey Hall Drive  
 Suite 124  
 Ellicott City, Maryland 21042  
 Phone: (410) 995-3851 Fax: (410) 995-1383

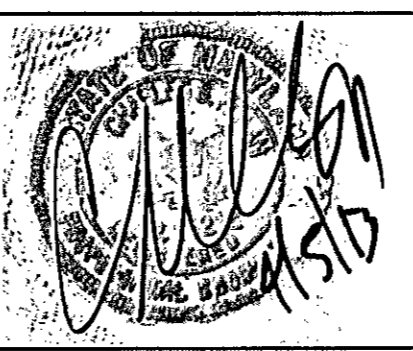

DES: GWF/JW  
 DRN: JRW  
 CHK: GWF  
 DATE: FEB 2013

EROSION AND SEDIMENT CONTROL PLAN

PINE TREE ROAD GLEN COURT  
 DRAINAGE AND ROADWAY IMPROVEMENTS, PH. 1  
 CAPITAL PROJECT D-1140  
 ELECTION DISTRICT NO. 6  
 HOWARD COUNTY, MARYLAND

SCALE: AS SHOWN  
 SHEET 12 OF 14A

**SPECIFICATIONS FOR VEGETATION ESTABLISHMENT**

**PERMANENT SEEDING NOTES**

Apply to graded or cleared areas not subject to immediate further disturbance where a permanent long-lived vegetative cover is needed.

Seedbed Preparation:—Loosen upper three inches of soil by raking, disking or other acceptable means before seeding, if not previously loosened.

Soil Amendments:—In lieu of soil test recommendations, use one of the following schedules:

1. Preferred—Apply 2 tons per acre dolomitic limestone (92 lbs/1000 sq. ft.) and 600 lbs per acre 10-10-10 fertilizer (14 lbs/1000 sq. ft.) before seeding. Harrow or disk into upper three inches of soil. At time of seeding, apply 400 lbs per acre 30-0-0 ureaform fertilizer (9 lbs/1000 sq. ft.)
2. Acceptable—Apply 2 tons per acre dolomitic limestone (92 lbs/1000 sq. ft.) and 1000 lbs. per acre 10-10-10 fertilizer (23 lbs/1000 sq. ft.) before seeding. Harrow or disk into upper three inches of soil.

Seeding—For the periods March 1 thru April 30, and August 1 thru October 15, seed with 60 lbs per acre (1.4 lbs/1000 sq. ft.) of Kentucky 31 Tall Fescue and 2 lbs per acre (.05 lbs/1000 sq. ft.) of weeping lovegrass. During the period of October 16 thru February 28, protect site by: Option (1) — 2 tons per acre of well anchored straw mulch and seed as soon as possible in the spring. Option (2) — Use sod. Option (3) — Seed with 60 lbs/acre Kentucky 31 Tall Fescue and mulch with 2 tons/acre well anchored straw.

Mulching—Apply 1-1/2 to 2 tons per acre (70 to 90 lbs/1000 sq. ft.) of unrotted small grain straw immediately after seeding. Anchor mulch immediately after application using mulch anchoring tool or 218 gallons per acre (5 gal/1000 sq. ft.) of emulsified asphalt on flat areas. On slopes 8 feet or higher, use 348 gallons per acre (8 gal/1000 sq. ft.) for anchoring.

Maintenance—Inspect all seeding areas and make needed repairs, replacements and reseedings.

**TEMPORARY SEEDING NOTES**

Apply to graded or cleared areas likely to be redisturbed where a short-term vegetative cover is needed.

Seedbed preparation:—Loosen upper three inches of soil by raking, disking or other acceptable means before seeding, if not previously loosened.

Soil Amendments:—Apply 600 lbs per acre 10-10-10 fertilizer (14 lbs/1000 sq. ft.).

Seeding—For periods March 1 thru April 30 and from August 15 thru November 15, seed with 2-1/2 bushel per acre of annual rye (3.2 lbs/1000 sq. ft.). For the period May 1 thru August 14, seed with 3 lbs per acre of weeping lovegrass (.07 lbs/1000 sq. ft.). For the period November 16 thru February 28, protect site by applying 2 tons per acre of well anchored straw mulch and seed as soon as possible in the spring, or use sod.

Mulching—Apply 1-1/2 to 2 tons per acre (70 to 90 lbs/1000 sq. ft.) of unrotted weed free small grain straw immediately after seeding. Anchor mulch immediately after application using mulch anchoring tool or 218 gal per acre (5 gal/1000 sq. ft.) of emulsified asphalt on flat areas. On slopes 8 ft. or higher, use 348 gal per acre (8 gal/1000 sq. ft.) for anchoring.

Refer to the 1994 MARYLAND STANDARDS AND SPECIFICATIONS FOR SOIL EROSION AND SEDIMENT CONTROL for additional rates and methods not covered.

**STANDARD SEDIMENT CONTROL NOTES**

1. A minimum of 24 hours notice must be given to the Howard County Department of Inspections, Licenses and Permits, Sediment Control Division prior to the start of any construction, (313-1850).
  2. All vegetative and structural practices are to be installed according to the provisions of this plan and are to be in conformance with the most current "MARYLAND STANDARDS AND SPECIFICATIONS FOR SOIL EROSION AND SEDIMENT CONTROL", and revisions thereto.
  3. Following initial soil disturbance or redisturbance, permanent or temporary stabilization shall be completed within: a) 7 calendar days for all perimeter sediment control structures, dikes, perimeter slopes and all slopes greater than 3:1, b) 14 days as to all other disturbed or graded areas on the project site.
  4. All sediment traps/basins shown must be fenced and warning signs posted around their perimeter in accordance with Vol. 1, Chapter 12, of the HOWARD COUNTY DESIGN MANUAL, Storm Drainage.
  5. All disturbed areas must be stabilized within the time period specified above in accordance with the 1994 MARYLAND STANDARDS AND SPECIFICATIONS FOR SOIL EROSION AND SEDIMENT CONTROL for permanent seeding (Sec.51), sod (Sec. 54), temporary seeding (Sec. 50) and mulching (Sec. 52). Temporary stabilization with mulch alone can only be done when recommended seeding dates do not allow for proper germination and establishment of grasses.
  6. All sediment control structures are to remain in place and are to be maintained in operative condition until permission for their removal has been obtained from the Howard County Sediment Control Inspector.
- |  |      |                       |
|--|------|-----------------------|
| 7. Site Analysis (Total Project)   |      |                       |
| Total Area of Site   | 2.13 | Acres                 |
| Area Disturbed   | 1.51 | Acres (0.80 Ac. PH.1) |
| Area to be roofed or paved   | 0.43 | Acres                 |
| Area to be vegetatively stabilized   | 0.94 | Acres                 |
| Total Cut  | 700  | Cu. Yds.              |
| Total Fill   | 500  | Cu. Yds.              |
| Offsite Waste/Borrow Area Location To Be Determined By Contractor at a site with an active grading permit. |      |                       |
- \*It is the responsibility of the contractor to identify the soil/borrow site and notify and gain the approval from the sediment control inspector of the site and its grading permit number at the time of construction.
8. Any sediment control practice which is disturbed by grading activity for placement of utilities must be repaired on the same day of disturbance.
  9. Additional sediment control must be provided, if deemed necessary by the Howard County Sediment Control Inspector.

**SPECIFICATIONS FOR TOPSOIL**

Definition: Placement of topsoil over a prepared subsoil prior to establishment of permanent vegetation.

Purpose: To provide a suitable soil medium for vegetative growth. Soils of concern have low moisture content, low nutrient levels, low pH, materials toxic to plants, and/or unacceptable soil gradation.

Conditions Where Practice Applies

1. This practice is limited to areas having 2:1 or flatter slopes where:
  - a. The texture of the exposed subsoil/parent material is not adequate to produce vegetative growth.
  - b. The soil material is so shallow that the rooting zone is not deep enough to support plants or furnish continuing supplies of moisture and plant nutrients.

- c. The original soil to be vegetated contains material toxic to plant growth.
- d. The soil is so acidic that treatment with limestone is not feasible.

For the purpose of these Standards and Specifications, areas having slopes steeper than 2:1 require special consideration and design for adequate stabilization. Areas having slopes steeper than 2:1 shall have the appropriate stabilization shown on the plans.

**Construction and Material Specifications**

Topsoil salvaged from the existing site may be used provided that it meets the standards as set forth in these specifications. Typically, the depth of topsoil to be salvaged for a given soil type can be found in the representative soil profile section in the Soil Survey published by USDA-SCS in cooperation with Maryland Agricultural Experiment Station.

Topsoil Specifications - Soil to be used as topsoil must meet the following:

- i. Topsoil shall be a loam, sandy loam, clay loam, silt loam, sandy clay loam, loamy sand. Other soils may be used if recommended by an agronomist or soil scientist and approved by the appropriate approval authority. Regardless, topsoil shall not be a mixture of contrasting textured subsoils and shall contain less than 5% by volume of cinders, stones, slag, coarse fragments, gravel, sticks, roots, trash, or other materials larger than 1 1/2" in diameter.
  - i. Topsoil must be free of plants or plant parts such as bermuda grass, quackgrass, Johnsongrass, nutsedge, poison ivy, thistle, or others as specified.
  - i. Where the subsoil is either highly acidic or composed of heavy clays, ground limestone shall be spread at the rate of 4-8 tons/acre (200-400 pounds per 1,000 square feet) prior to the placement of topsoil. Lime shall be distributed uniformly over designated areas and worked into the soil in conjunction with tillage operations as described in the following procedures.
- I. For sites having disturbed areas under 5 acres:
    - i. Place topsoil (if required) and apply soil amendments as specified in 20.0 Vegetative Stabilization - Section I - Vegetative Stabilization Methods and Materials.
  - II. For sites having disturbed areas over 5 acres:
    - i. On soil meeting Topsoil specifications, obtain test results dictating fertilizer and lime amendments required to bring the soil into compliance with the following:
      - a. pH for topsoil shall be between 6.0 and 7.5. If the tested soil demonstrates a pH of less than 6.0, sufficient lime shall be prescribed to raise the pH to 6.5 or higher.
      - b. Organic content of topsoil shall be not less than 1.5 percent by weight.
      - c. Topsoil having soluble salt content greater than 500 parts per million shall not be used.
      - d. No sod or seed shall be placed on soil which has been treated with soil sterilants or chemicals used for weed control until sufficient time has elapsed (14 days min.) to permit dissipation of phyto-toxic materials.

Note: Topsoil substitutes or amendments, as recommended by a qualified agronomist or soil scientist and approved by appropriate authority, may be used in lieu of natural topsoil.

- i. Place topsoil (if required) and apply soil amendments as specified in 20.0 Vegetative Stabilization - Section I - Vegetative Stabilization Methods and Materials.

**Topsoil Application**

- i. When topsoiling, maintain needed erosion and sediment control practices such as diversions, Grade Stabilization Structures, Earth Dikes, Slope Silt Fence and Sediment Traps and Basins.
- i. Grades on the areas to be topsoiled, which have been previously established, shall be maintained, albeit 4"-8" higher in elevation.
- i. Topsoil shall be uniformly distributed in a 4"-8" layer and lightly compacted to a minimum thickness of 4". Spreading shall be performed in such a manner that sodding or seeding can proceed with a minimum of additional soil preparation and tillage. Any irregularities in the surface resulting from topsoiling or other operations shall be corrected in order to prevent the formation of depressions or water pockets.
- ii. Topsoil shall not be placed while the topsoil or subsoil is in a frozen or muddy condition, when the subsoil is excessively wet or in a condition that may otherwise be detrimental to proper grading and seedbed preparation.

Alternative for Permanent Seeding - Instead of applying the full amounts of lime and commercial fertilizer, composted sludge and amendments may be applied as specified below:

- i. Composted Sludge Material for use as soil conditioner for sites having disturbed areas over 5 acres shall be tested to prescribe amendments and for sites having disturbed areas under 5 acres shall conform to the following requirements:
  - a. Composted sludge shall be supplied by, or originate from, a person or persons that are permitted (at the time of acquisition of the compost) by the Maryland Department of Environment under COMAR 26.04.06.
  - b. Composted sludge shall contain at least 1 percent nitrogen, 1.5 percent phosphorus, and 0.2 percent potassium and have a Ph of 7.0 to 8.0. If compost does not meet these requirements, the appropriate constituents must be added to meet the requirements prior to use.
  - c. Composted sludge shall be applied at the rate of 1 ton/1,000 square feet.
- i. Composted sludge shall be amended with a potassium fertilizer applied at the rate of 4 lb/1000 square feet, and 1/3 the normal lime application rate.

**SEQUENCE OF CONSTRUCTION**

1. OBTAIN GRADING PERMIT.
2. NOTIFY HOWARD COUNTY BUREAU OF INSPECTIONS AND PERMITS (410-313-1880) AT LEAST 48 HOURS BEFORE STARTING ANY WORK.
3. CONSTRUCT STORM DRAIN SYSTEM FROM M-10 TO '36" RCCP STUB OUT PROCEEDING UPGRADE WITH THE AMOUNT OF OPEN EXCAVATION THAT CAN BE BACKFILLED AND STABILIZED AT THE END OF WORK DAY. STABILIZATION TO INCLUDE METAL PLATES FOR OPEN SECTION OF ROADWAY. REFER TO STORM DRAIN PROFILE AND SHEET 14A FOR ADDITIONAL INFORMATION REGARDING MAINTENANCE OF TRAFFIC.
4. INSTALL TEMPORARY ORANGE CONSTRUCTION FENCE AND CONSTRUCT STORM DRAIN SYSTEM FROM ES-1 TO M-5 PROCEEDING UPGRADE WITH THE AMOUNT OF OPEN EXCAVATION THAT CAN BE BACKFILLED AND STABILIZED AT THE END OF WORK DAY (SEE NOTE 1 BELOW). INSTALL SILT FENCE AS SHOWN IN AREA OF ES-1. SILT FENCE TO REMAIN IN UNTIL SEEDING & PLANTING HAVE STABILIZED AREA. STABILIZATION TO INCLUDE METAL PLATES FOR OPEN SECTION OF ROADWAY. INSTALL RIPRAP AND OUTFALL STABILIZATION PLANTING ALONG ES-1 OUTFALL. INSTALL TURFGRASS SOD WITHIN LOD AS NOTED ON PLAN.
5. CONSTRUCT STORM DRAIN SYSTEM FROM I-1 TO M-5 PROCEEDING UPGRADE WITH THE AMOUNT OF OPEN EXCAVATION THAT CAN BE BACKFILLED AND STABILIZED AT THE END OF WORK DAY. STABILIZATION TO INCLUDE METAL PLATES FOR OPEN SECTION OF ROADWAY. (SEE NOTE NO. 2 BELOW)
6. CONSTRUCT STORM DRAIN SYSTEM FROM M-5 TO M-10, I-5 TO I-5C PROCEEDING UPGRADE WITH THE AMOUNT OF OPEN EXCAVATION THAT CAN BE BACKFILLED AND STABILIZED AT THE END OF WORK DAY. PLACE SOD ALONG STORM DRAIN FROM I-5A TO I-5C. STABILIZATION TO INCLUDE METAL PLATES FOR OPEN SECTION OF ROADWAY. (SEE NOTE NO. 2 BELOW).

7. CONSTRUCT STORM DRAIN SYSTEM FROM I-7 TO I-11 PROCEEDING UPGRADE WITH THE AMOUNT OF OPEN EXCAVATION THAT CAN BE BACKFILLED AND STABILIZED AT THE END OF WORK DAY. STABILIZATION TO INCLUDE METAL PLATES FOR OPEN SECTION OF ROADWAY. (SEE NOTE NO. 1 BELOW).

NOT IN CONTRACT

8. CONSTRUCT STORM DRAIN SYSTEM FROM I-7 TO I-14 PROCEEDING UPGRADE WITH THE AMOUNT OF OPEN EXCAVATION THAT CAN BE BACKFILLED AND STABILIZED AT THE END OF WORK DAY. STABILIZATION TO INCLUDE METAL PLATES FOR OPEN SECTION OF ROADWAY. (SEE NOTE NO. 2 BELOW).

9. CONSTRUCT STORM DRAIN SYSTEM FROM I-7 TO I-15 PROCEEDING UPGRADE WITH THE AMOUNT OF OPEN EXCAVATION THAT CAN BE BACKFILLED AND STABILIZED AT THE END OF WORK DAY. STABILIZATION TO INCLUDE METAL PLATES FOR OPEN SECTION OF ROADWAY. (SEE NOTE NO. 2 BELOW).

10. REMOVE EXISTING PAVEMENT PER ROADWAY PLANS AND EXCAVATE FULL DEPTH PAVEMENT SECTION ALONG PINE TREE ROAD AND GLEN COURT. LIMIT THE AMOUNT OF WORK THAT CAN BE DONE AND STABILIZED WITH GRADED AGGREGATE BASE (G.A.B.) AT THE END OF THE WORK DAY. (SEE NOTE NO. 3 BELOW).

11. CONSTRUCT CURB AND GUTTER ALONG PINE TREE ROAD & GLEN COURT ALONG WITH CURB OPENINGS AND RIPRAP AS PER PLANS.

12. CONSTRUCT FULL DEPTH PAVEMENT SECTION PER ROADWAY PLANS.

13. RECONSTRUCT DRIVEWAY ENTRANCES AS PER ROADWAY PLANS. LIMIT THE AMOUNT OF WORK THAT CAN BE EXCAVATED AND STABILIZED WITH G.A.B. AT THE END OF THE WORK DAY.

14. PROVIDE REQUIRED BACKFILL, TOPSOIL, SEED & MULCH FOR GRADE TIE-IN AREA BEHIND CURB AND GUTTER. LIMIT THE AMOUNT OF WORK THAT CAN BE BACKFILLED AND STABILIZED AT THE END OF THE WORK DAY. CARE SHALL BE TAKEN SO AS NOT TO DAMAGE EXISTING VEGETATION AND PRIVATE PROPERTY.

15. WITH THE APPROVAL OF THE SEDIMENT CONTROL INSPECTOR, REMOVE SEDIMENT CONTROL DEVICES, GRIND AND OVERLAY ROADWAYS PER ROADWAY PLANS.

**NOTES:**

1. INSTREAM WORK AT OUTFALL ES-1 SHALL BE DONE ONLY AFTER THERE IS A PERIOD OF NO FOR RAIN 72 HOURS PRIOR TO START OF WORK. SHOULD STREAM BASE FLOW BE ENCOUNTERED, THEN THE CONTRACTOR SHALL USE A PUMP AROUND DIVERSION PRACTICE AS SHOWN PER DETAIL 12 ON SHEET 12 TO DIVERT WATER AROUND WORK AREA UNTIL CLASS I RIP RAP HAS BEEN INSTALLED.

2. DETAILS HAVE BEEN PROVIDED FOR INLET PROTECTION. IT SHALL BE AT THE DISCRETION OF THE SEDIMENT CONTROL INSPECTOR BASED ON FIELD CONDITIONS TO IMPLEMENT THE INSTALLATION OF SAID PROTECTION. AS THE MAXIMUM DRAINAGE AREA (1/4 AC.) TO INLETS I-1, I-3, I-4, I-5, I-6, I-7, I-11, I-12, I-13 AND I-14 IS EXCEEDED THE INLET PROTECTION SHALL BE UPGRADED BY WRAPPING THE INLET WITH "SUPER SILT FENCE". THE SEDIMENT CONTROL INSPECTOR SHALL INSTRUCT THE CONTRACTOR AS TO PROPER PROCEDURE TO UPGRADE THE INLET PROTECTION. ANY ADDITIONAL COST TO PERFORM UPGRADE SHALL BE INCIDENTAL TO THE UNIT COST PAY ITEM FOR INLET PROTECTION.

3. DETAILS HAVE BEEN PROVIDED FOR SILT FENCE AND SUPER SILT FENCE DIVERSION. SAME DAY STABILIZATION HAS BEEN NOTED BUT DUE TO VARYING FIELD CONDITIONS, IT MAY BE NECESSARY TO IMPLEMENT THE INSTALLATION OF SAID CONTROL. IT SHALL BE AT THE DISCRETION OF THE SEDIMENT CONTROL INSPECTOR TO DIRECT THE IMPLEMENTATION OF THE CONTROLS BY THE CONTRACTOR TO DIVERT CLEAN OFF SITE WATER AROUND OR THROUGH THE CONSTRUCTION AREA. CONTINGENT QUANTITIES OF SILT FENCE AND SUPER SILT FENCE HAS BEEN INCLUDED IN THE CONTRACT TO COVER THE POSSIBLE IMPLEMENTATION.

Section IV - Sod: To provide quick cover on disturbed areas (2:1 grade or flatter).

**A. General specifications**

- i. Class of turfgrass sod shall be Maryland or Virginia State Certified or Approved. Sod labels shall be made available to the job foreman and inspector.
- ii. Sod shall be machine cut at a uniform soil thickness of 3/4", plus or minus 1/4", at the time of cutting. Measurement for thickness shall exclude top growth and thatch. Individual pieces of sod shall be cut to the suppliers width and length. Maximum allowable deviation from standard widths and lengths shall be 5 percent. Broken pads and torn or uneven ends will not be acceptable.
- iii. Standard size sections of sod shall be strong enough to support their own weight and retain their size and shape when suspended vertically with a firm grasp on the upper 10 percent of the section.
- iv. Sod shall not be harvested or transplanted when moisture content (excessively dry or wet) may adversely affect its survival.
- v. Sod shall be harvested, delivered, and installed within a period of 36 hours. Sod not transplanted within this period shall be approved by an agronomist or soil scientist prior to its installation.

**B. Sod Installation**

- i. During periods of excessively high temperature or in areas having dry subsoil, the subsoil shall be lightly irrigated immediately prior to laying the sod.
- ii. The first row of sod shall be laid in a straight line with subsequent rows placed parallel to and tightly wedged against each other. Lateral joints shall be staggered to promote more uniform growth and strength. Ensure that sod is not stretched or overlapped and that all joints are butted tight in order to prevent voids which would cause air drying of the roots.
- iii. Wherever possible, sod shall be laid with the long edges parallel to the contour and with staggering joints. Sod shall be rolled and tamped, pegged or otherwise secured to prevent slippage on slopes and to ensure solid contact between sod roots and the underlying soil surface.
- iv. Sod shall be watered immediately following rolling or tamping until the underside of the new sod pad and soil surface below the sod are thoroughly wet. The operations of laying, tamping and irrigating for any piece of sod shall be completed within eight hours.

**C. Sod Maintenance**

- i. In the absence of adequate rainfall, watering shall be performed daily or as often as necessary during the first week and in sufficient quantities to maintain moist soil to a depth of 4". Watering should be done during the heat of the day to prevent wilting.
- ii. After the first week, sod watering is required as necessary to maintain adequate moisture content.
- iii. The first mowing of sod should not be attempted until the sod is firmly rooted. No more than 1/3 of the grass leaf shall be removed by the initial cutting or subsequent cuttings. Grass height shall be maintained between 2" and 3" unless otherwise specified.


THIS PLAN IS FOR SEDIMENT AND EROSION CONTROL PURPOSE ONLY

**DEPARTMENT OF PUBLIC WORKS**

HOWARD COUNTY, MARYLAND

Director of Public Works: [Signature] 4/9/13  
 Chief, Bureau of Highways: [Signature] 4-9-13

Chief, Bureau of Engineering: [Signature] 4/9/13  
 Chief, Transportation and Special Projects Division: [Signature] 4/9/13

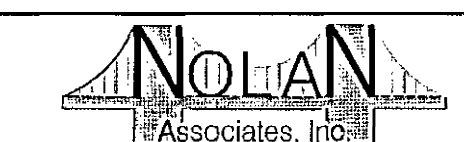

Engineers - Civil/Structural/Inspections  
 4785 Dorsey Hall Drive  
 Suite 124  
 Ellicott City, Maryland 21042  
 Phone: (410) 995-3861 Fax: (410) 995-1363







DES: GWF / JW			
DRN: JRW			
CHK: GWF			
DATE: FEB 2013	BY	NO.	REVISION

**EROSION AND SEDIMENT CONTROL NOTES AND DETAILS**

PINE TREE ROAD/GLEN COURT DRAINAGE AND ROADWAY IMPROVEMENTS, PH. 1  
 CAPITAL PROJECT D-1140  
 ELECTION DISTRICT NO. 6  
 HOWARD COUNTY, MARYLAND

SCALE: AS SHOWN  
 SHEET 13 OF 14A

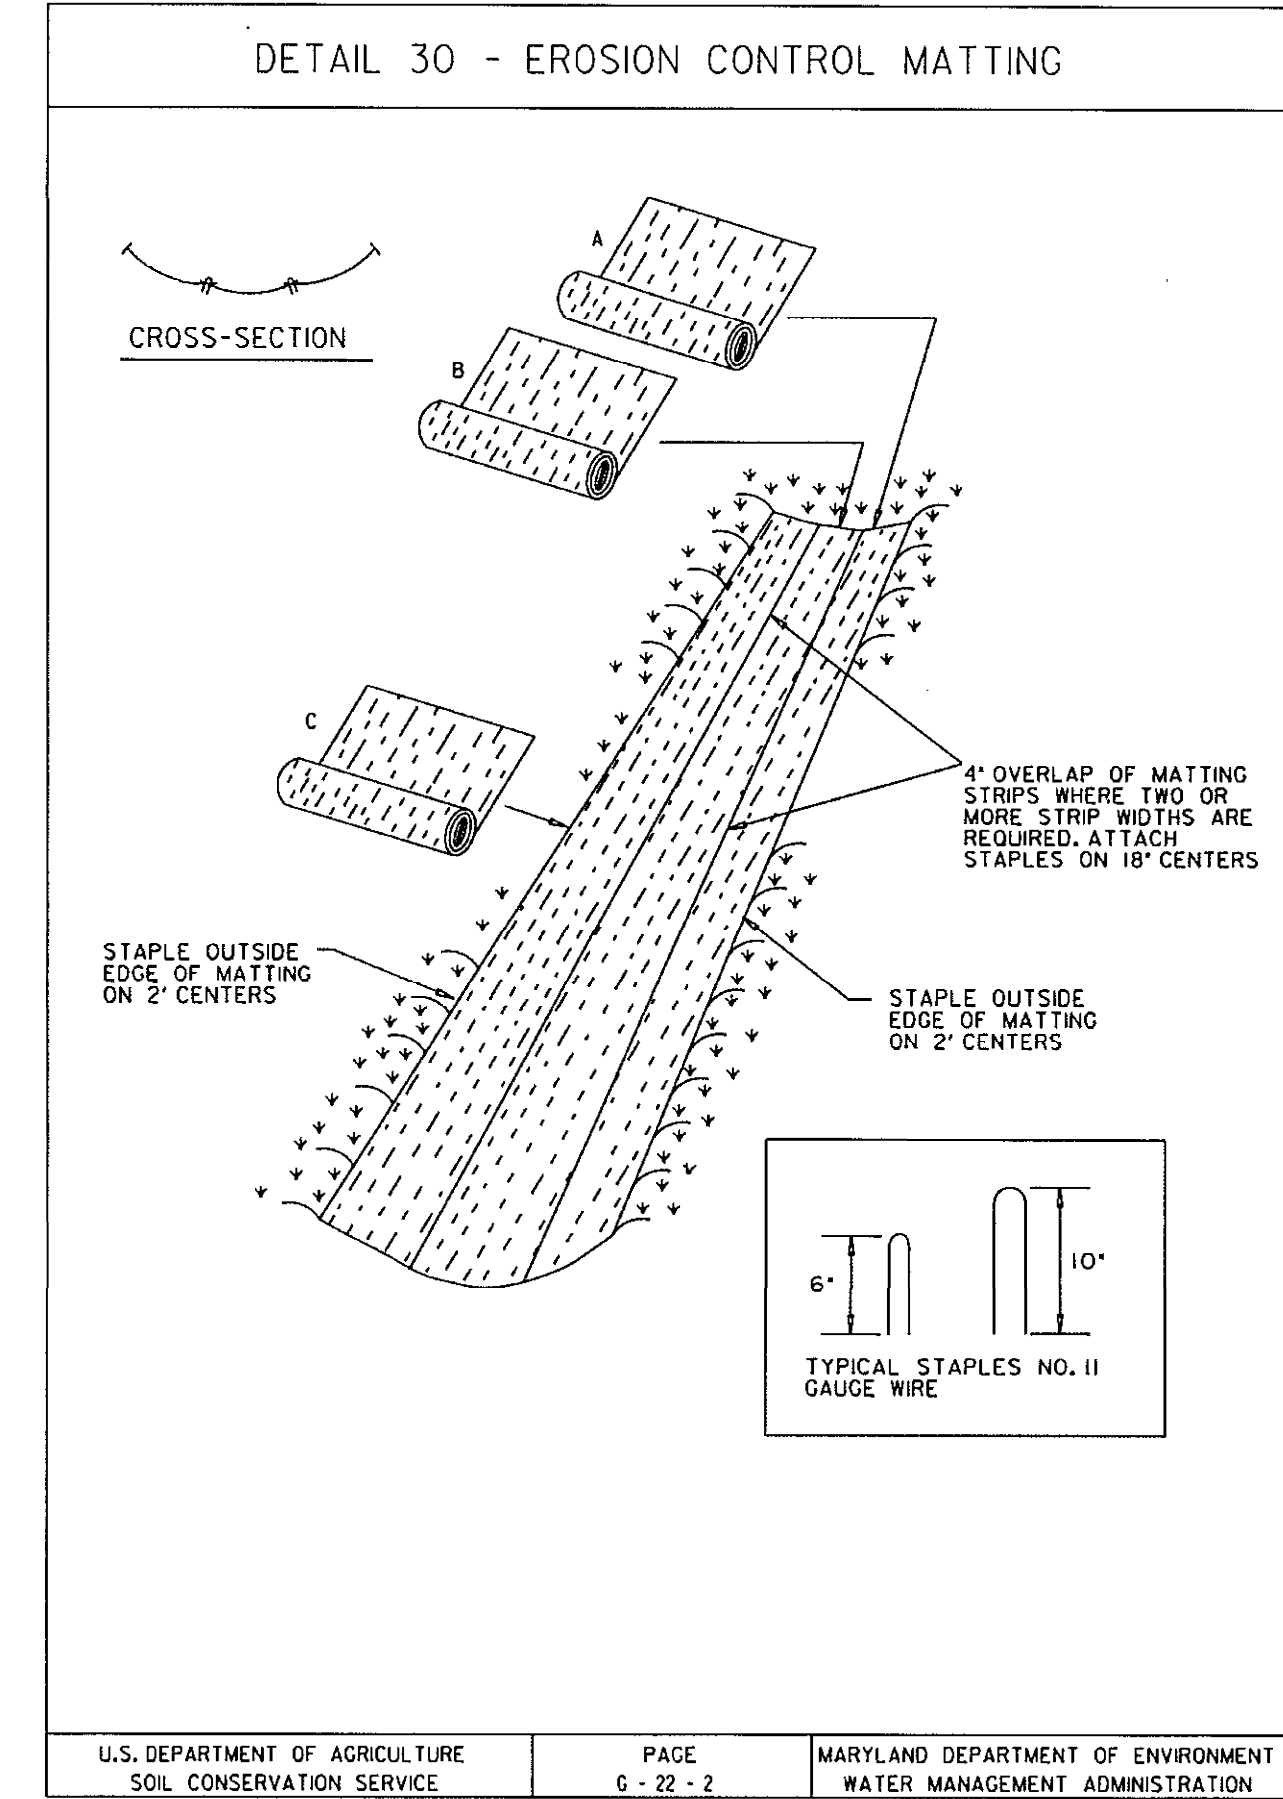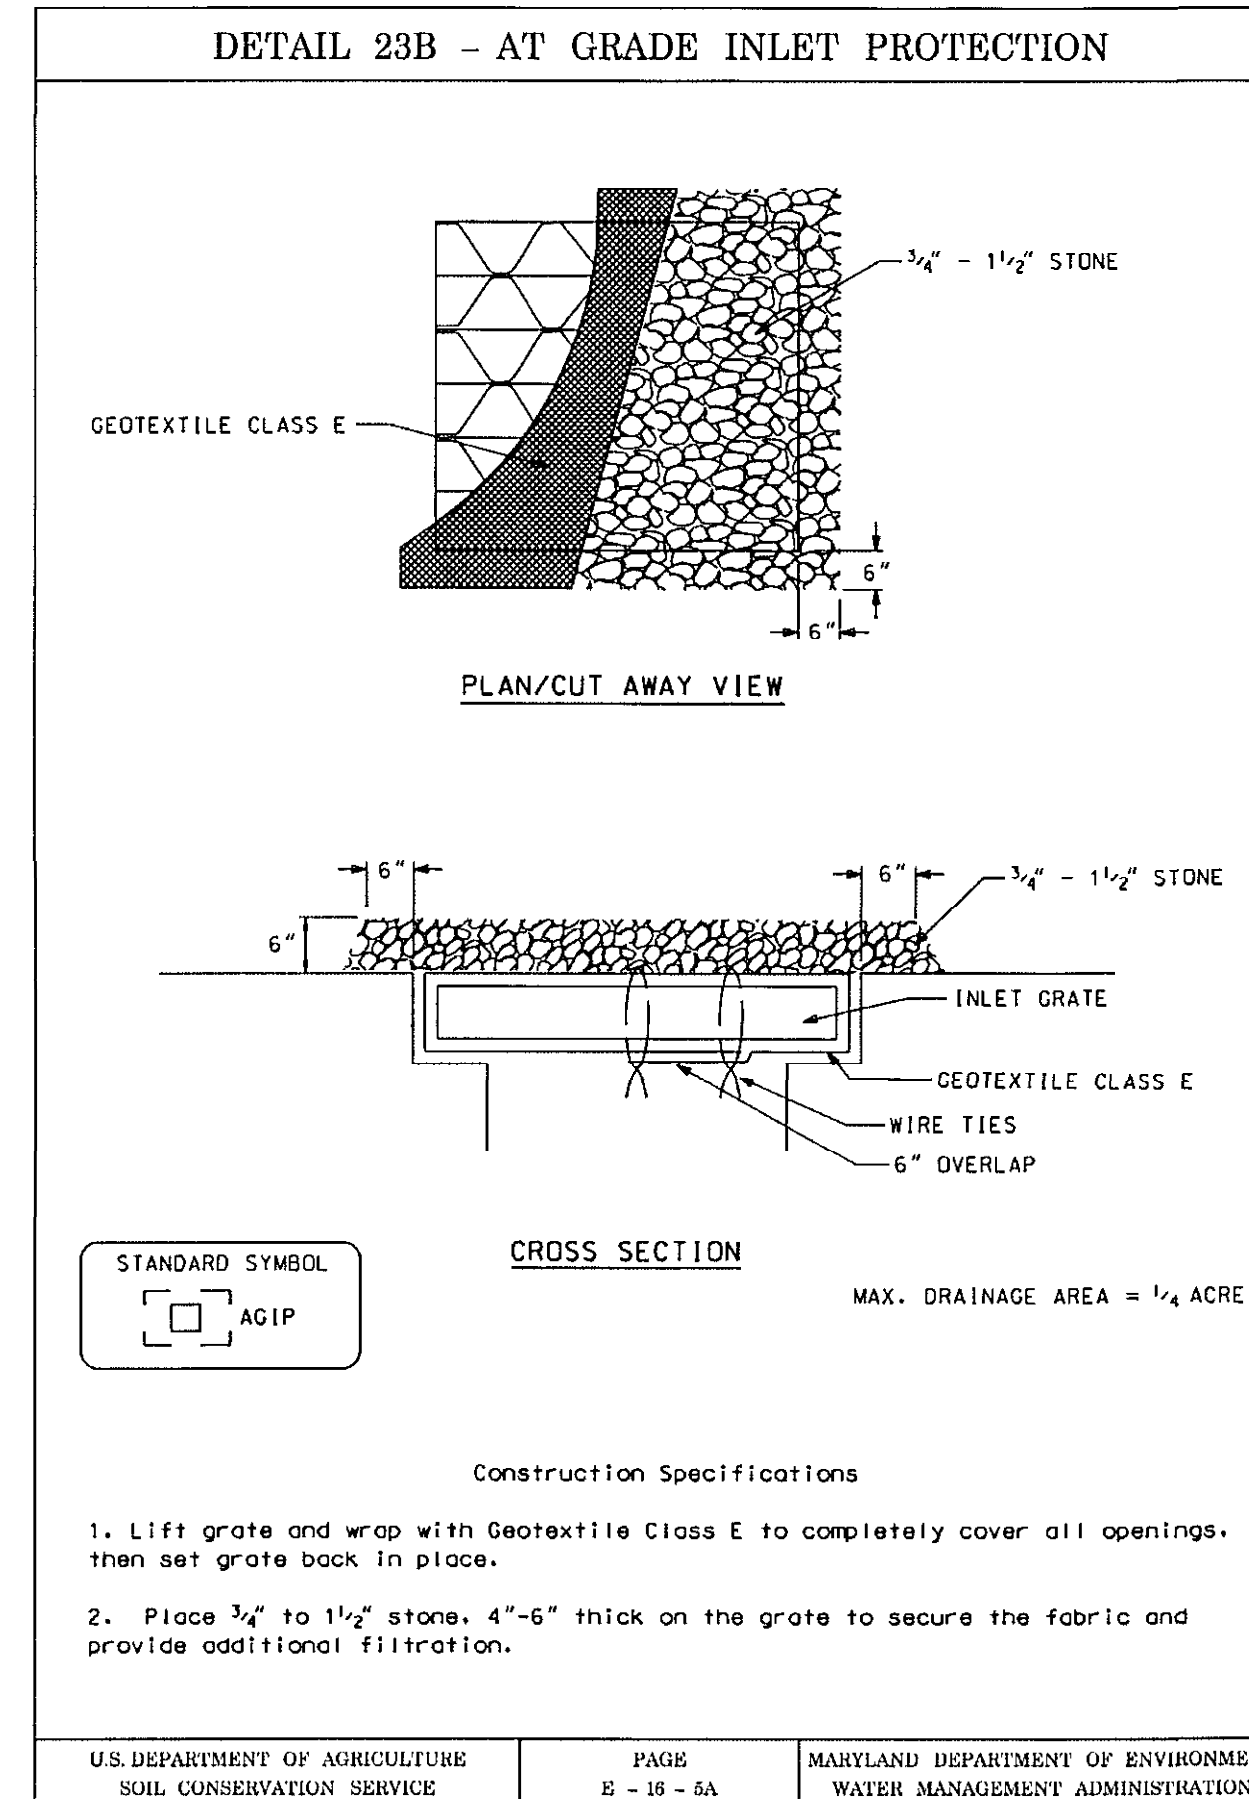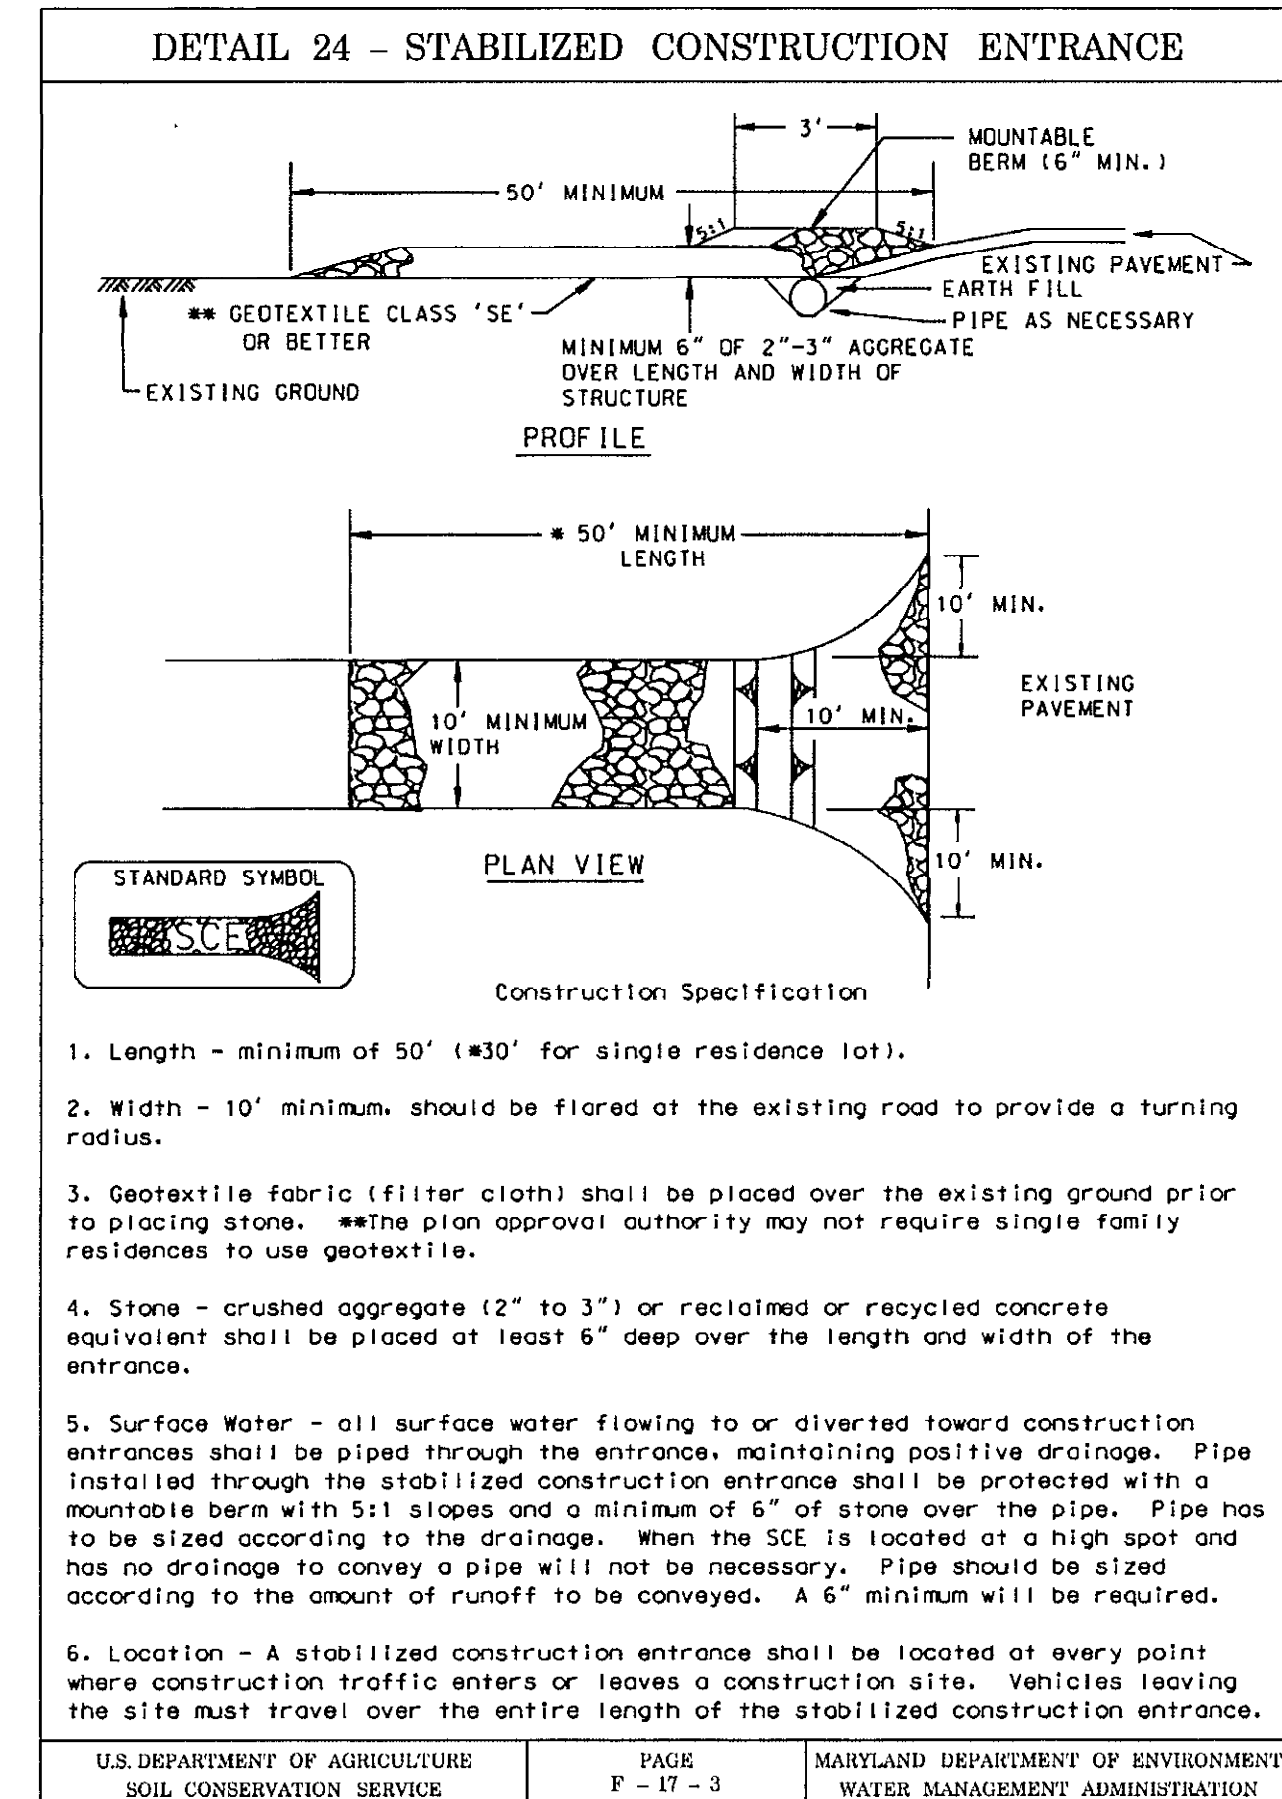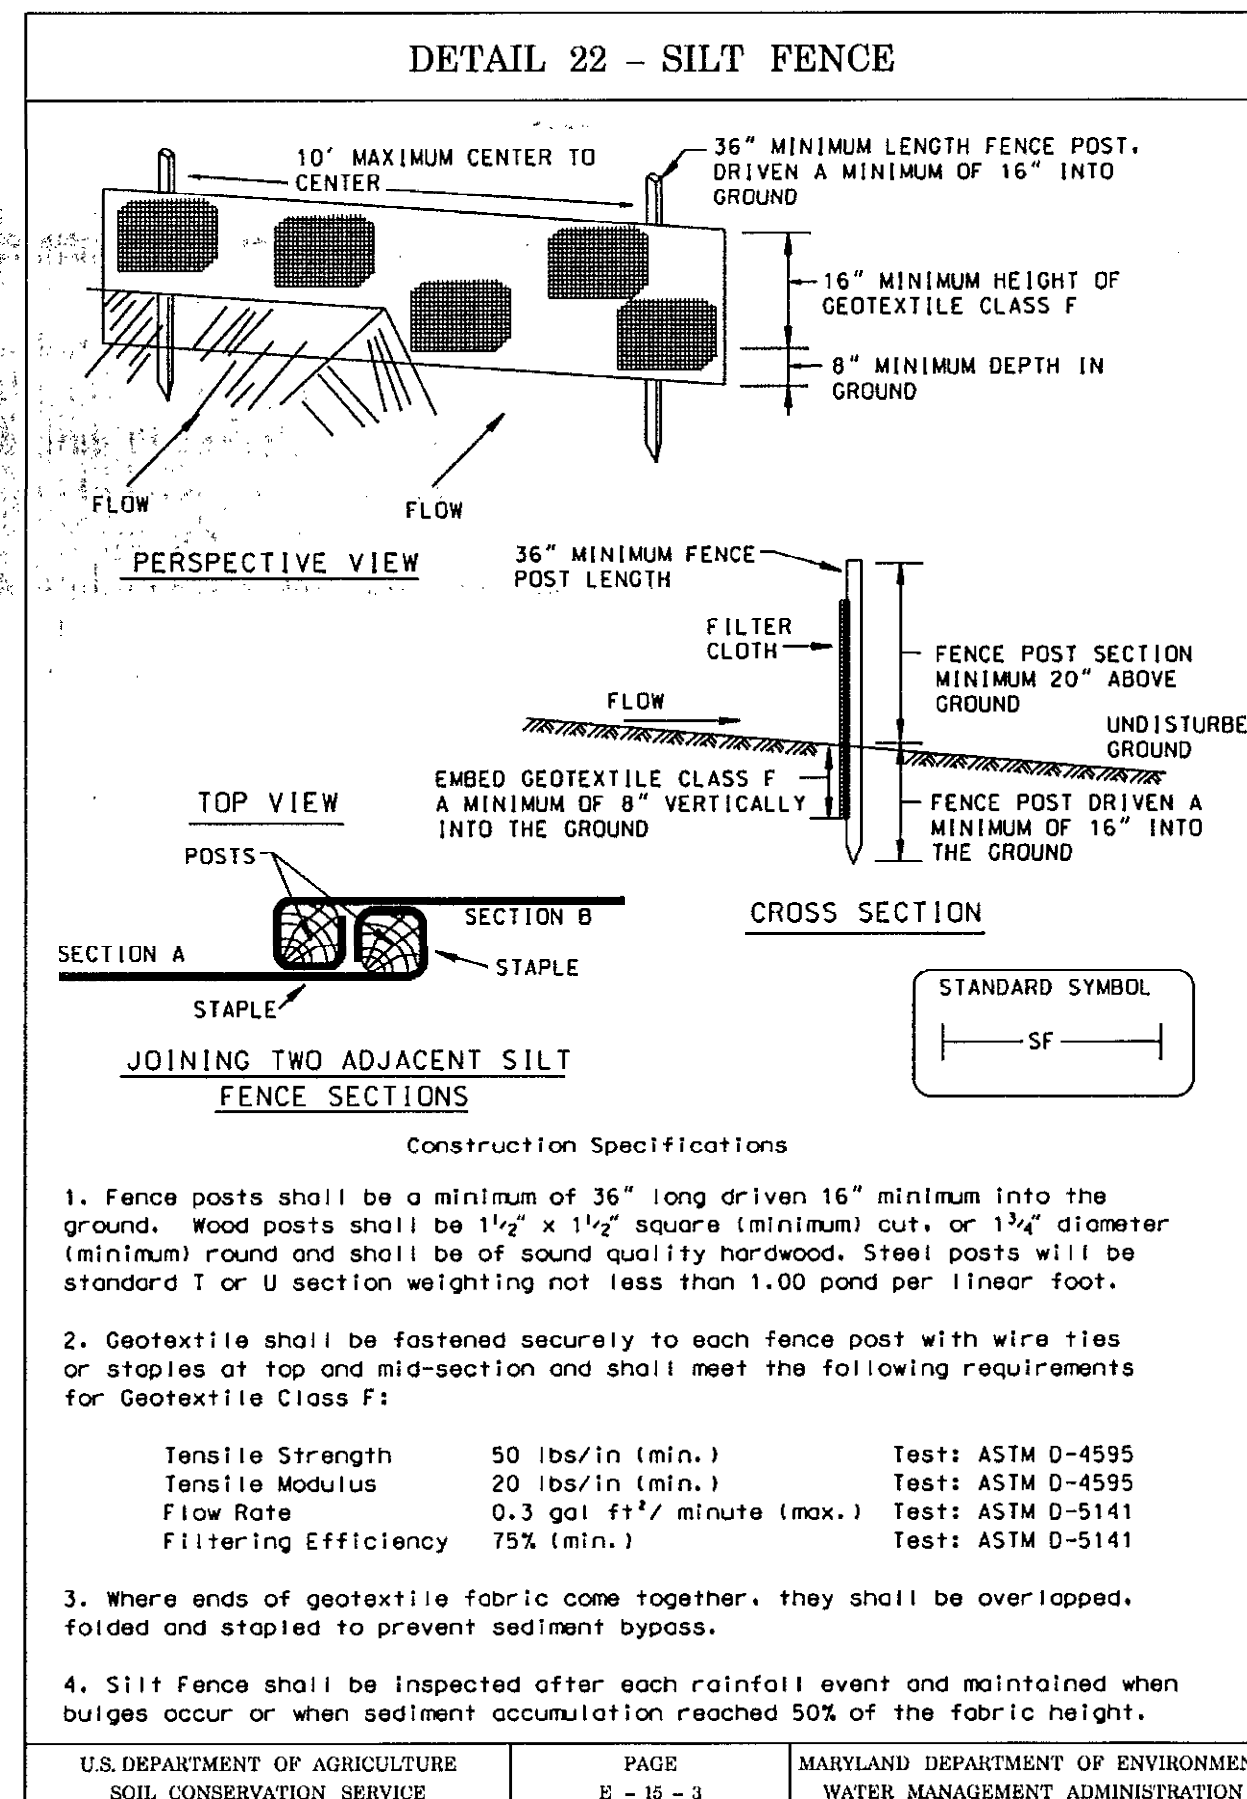





### SILT FENCE




**Silt Fence Design Criteria**

Slope Steepness	(Maximum) Slope Length	(Maximum) Silt Fence Length
Flatter than 50:1	unlimited	unlimited
50:1 to 10:1	125 feet	1,000 feet
10:1 to 5:1	100 feet	750 feet
5:1 to 3:1	60 feet	500 feet
3:1 to 2:1	40 feet	250 feet
2:1 and steeper	20 feet	125 feet

Note: In areas of less than 2% slope and sandy soils (USDA general classification system, soil Class A) maximum slope length and silt fence length will be unlimited. In these areas a silt fence may be the only perimeter control required.

U.S. DEPARTMENT OF AGRICULTURE SOIL CONSERVATION SERVICE PAGE E-15-3A MARYLAND DEPARTMENT OF ENVIRONMENT WATER MANAGEMENT ADMINISTRATION

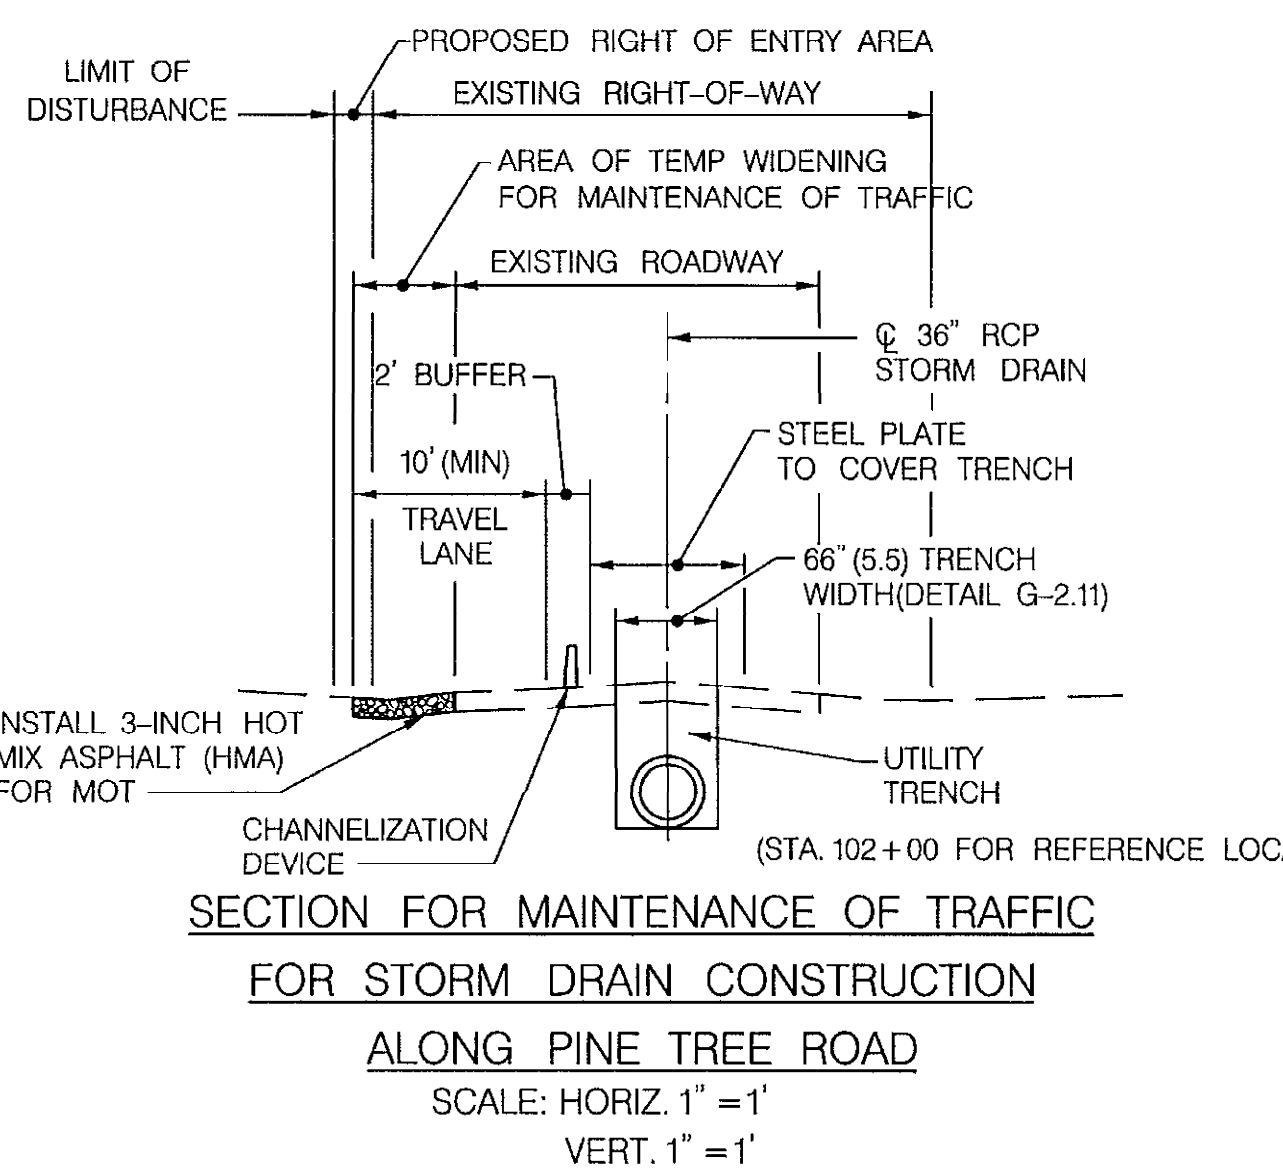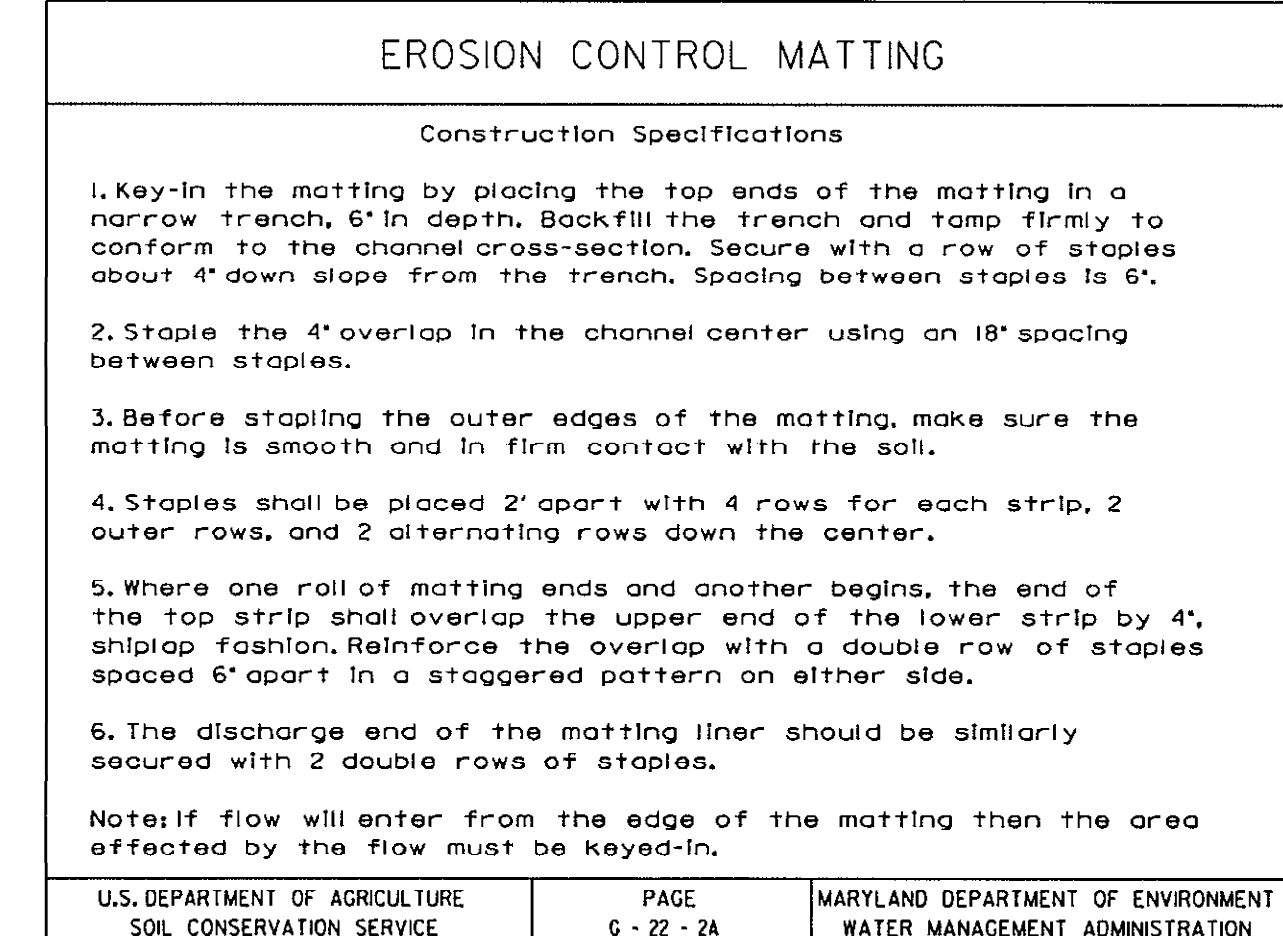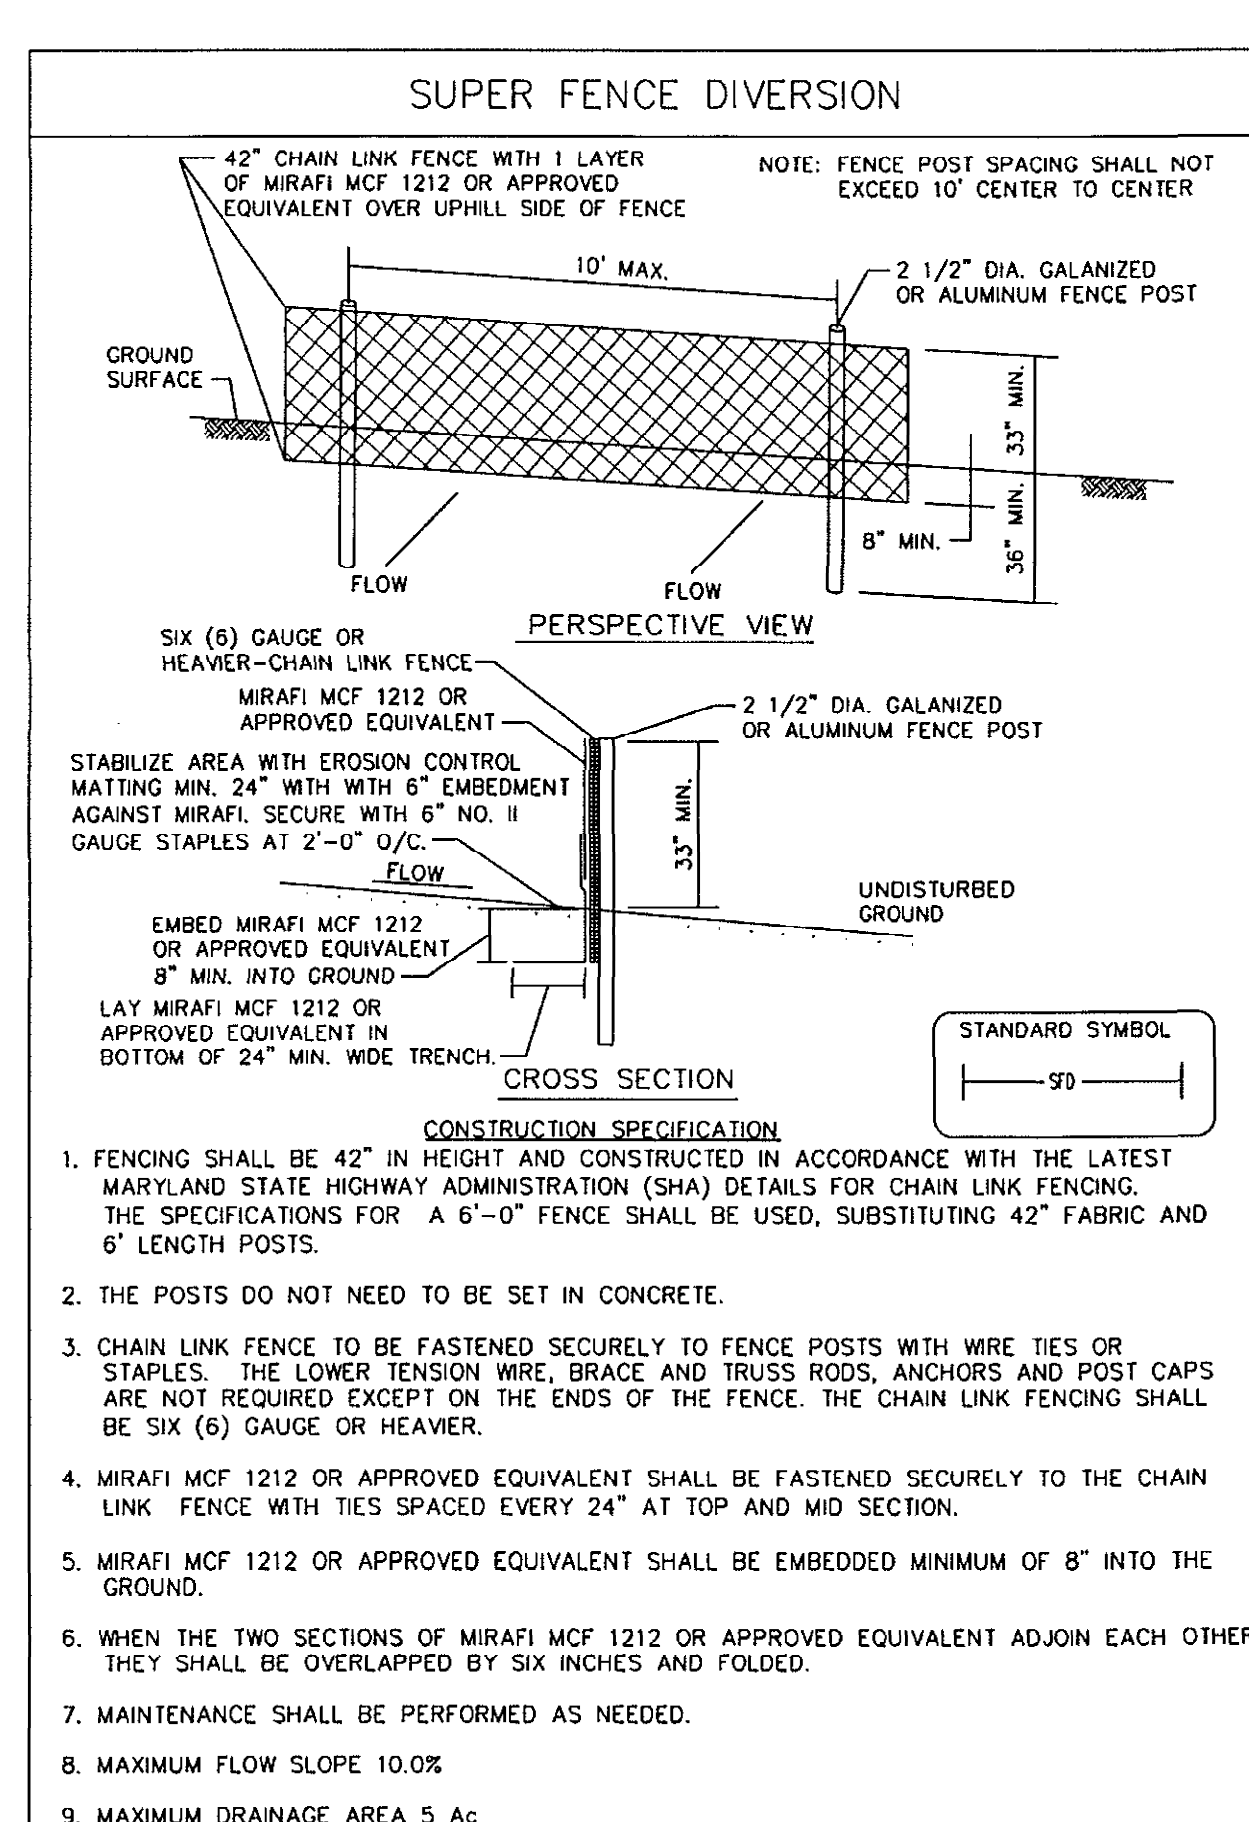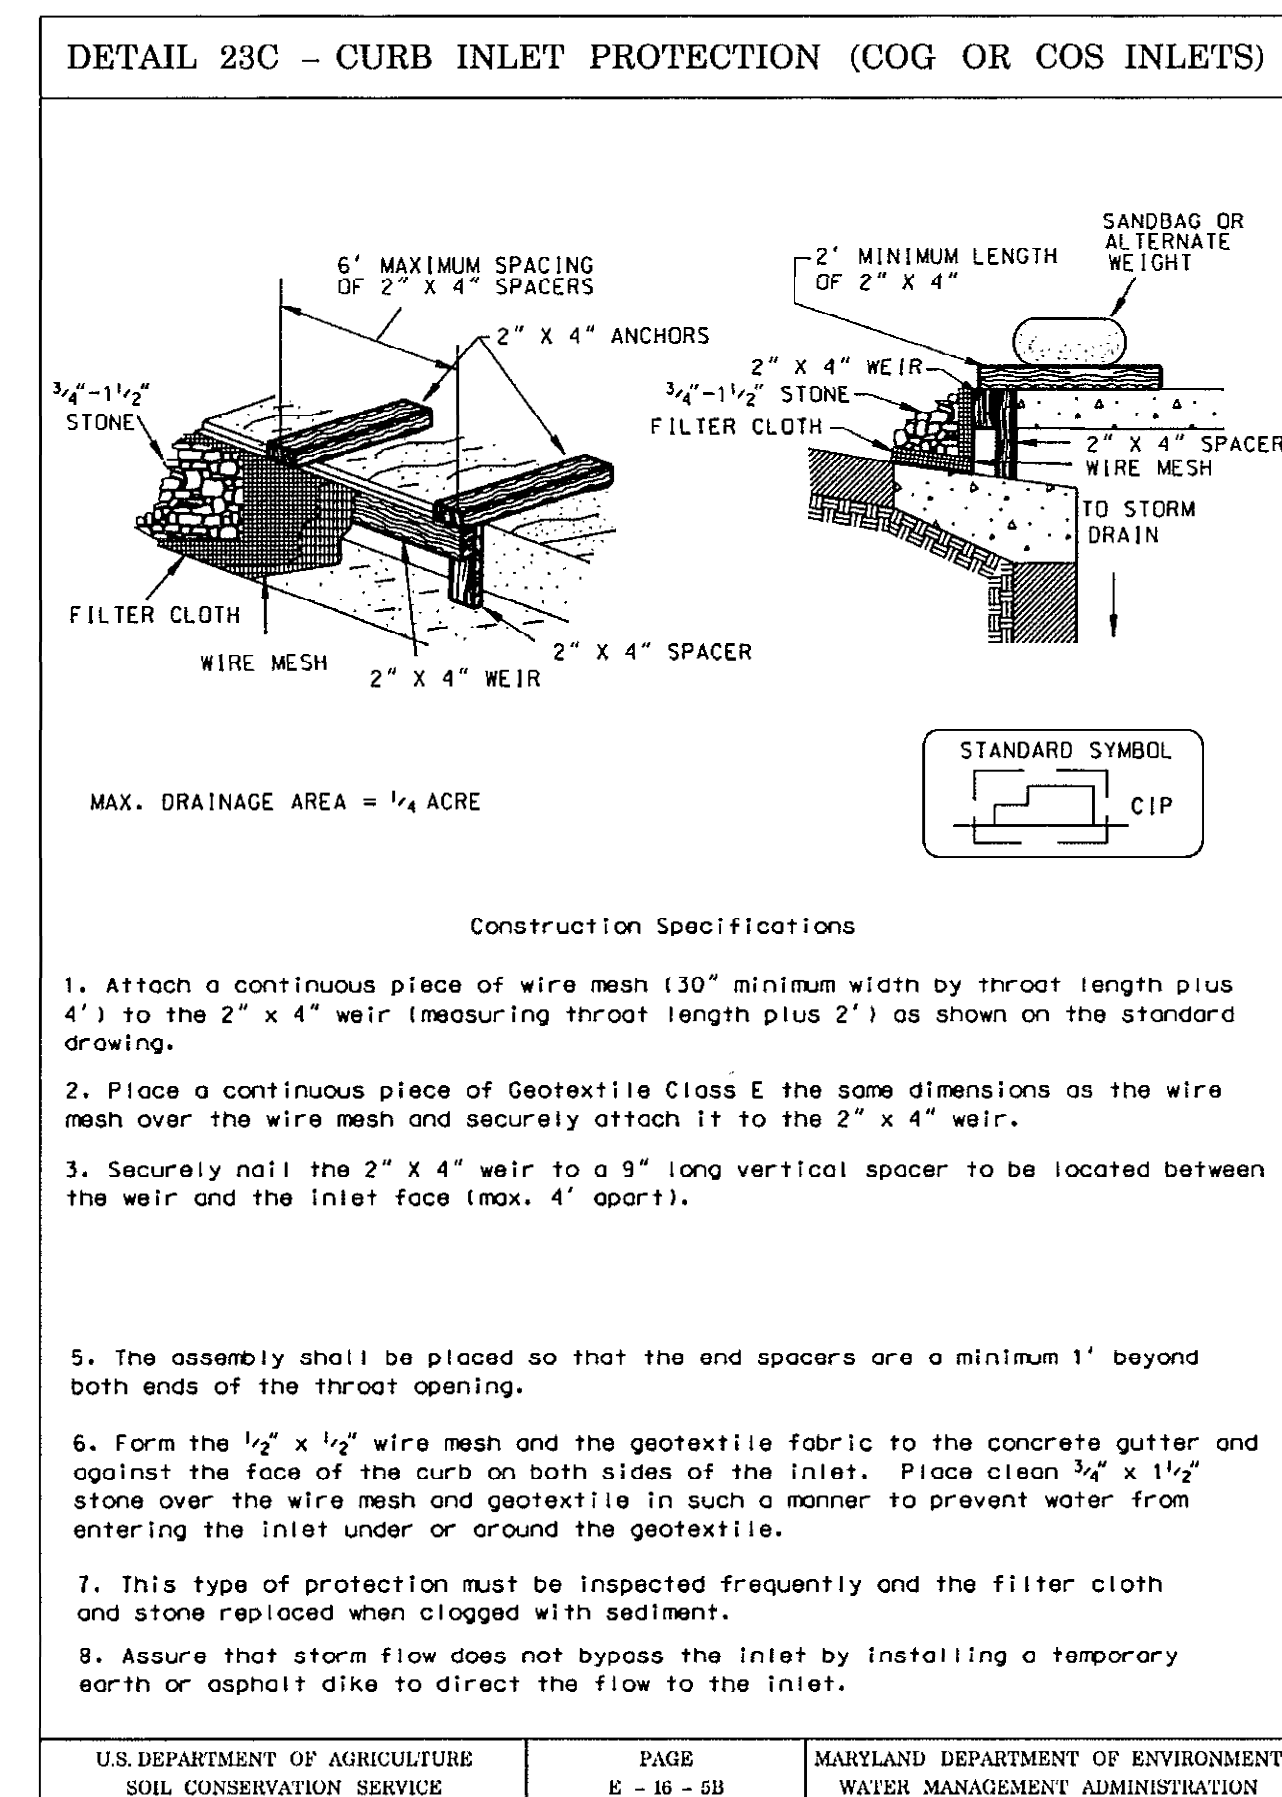

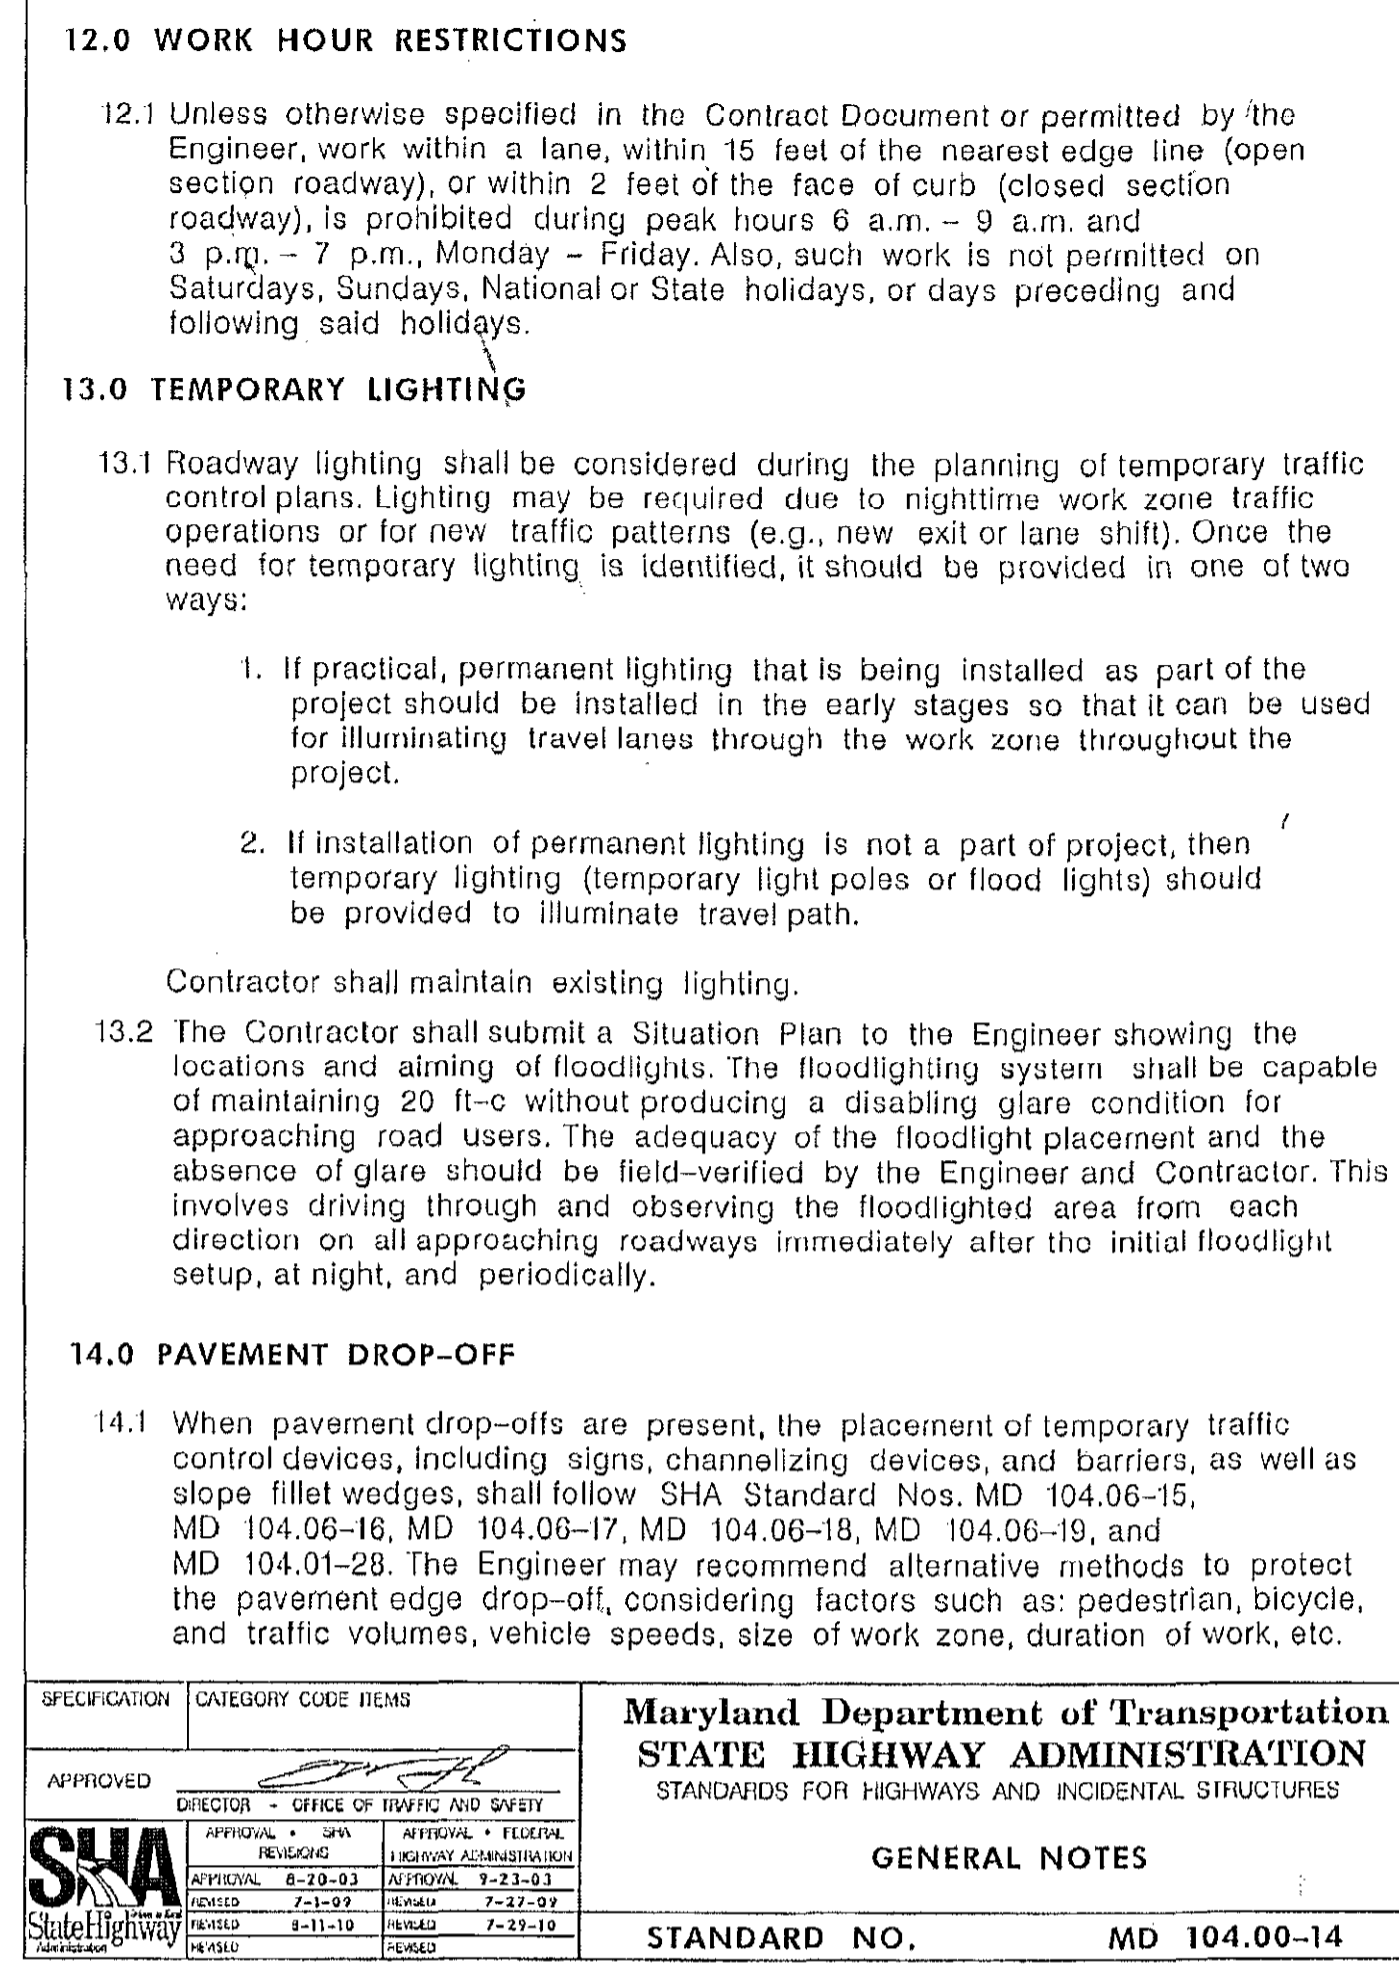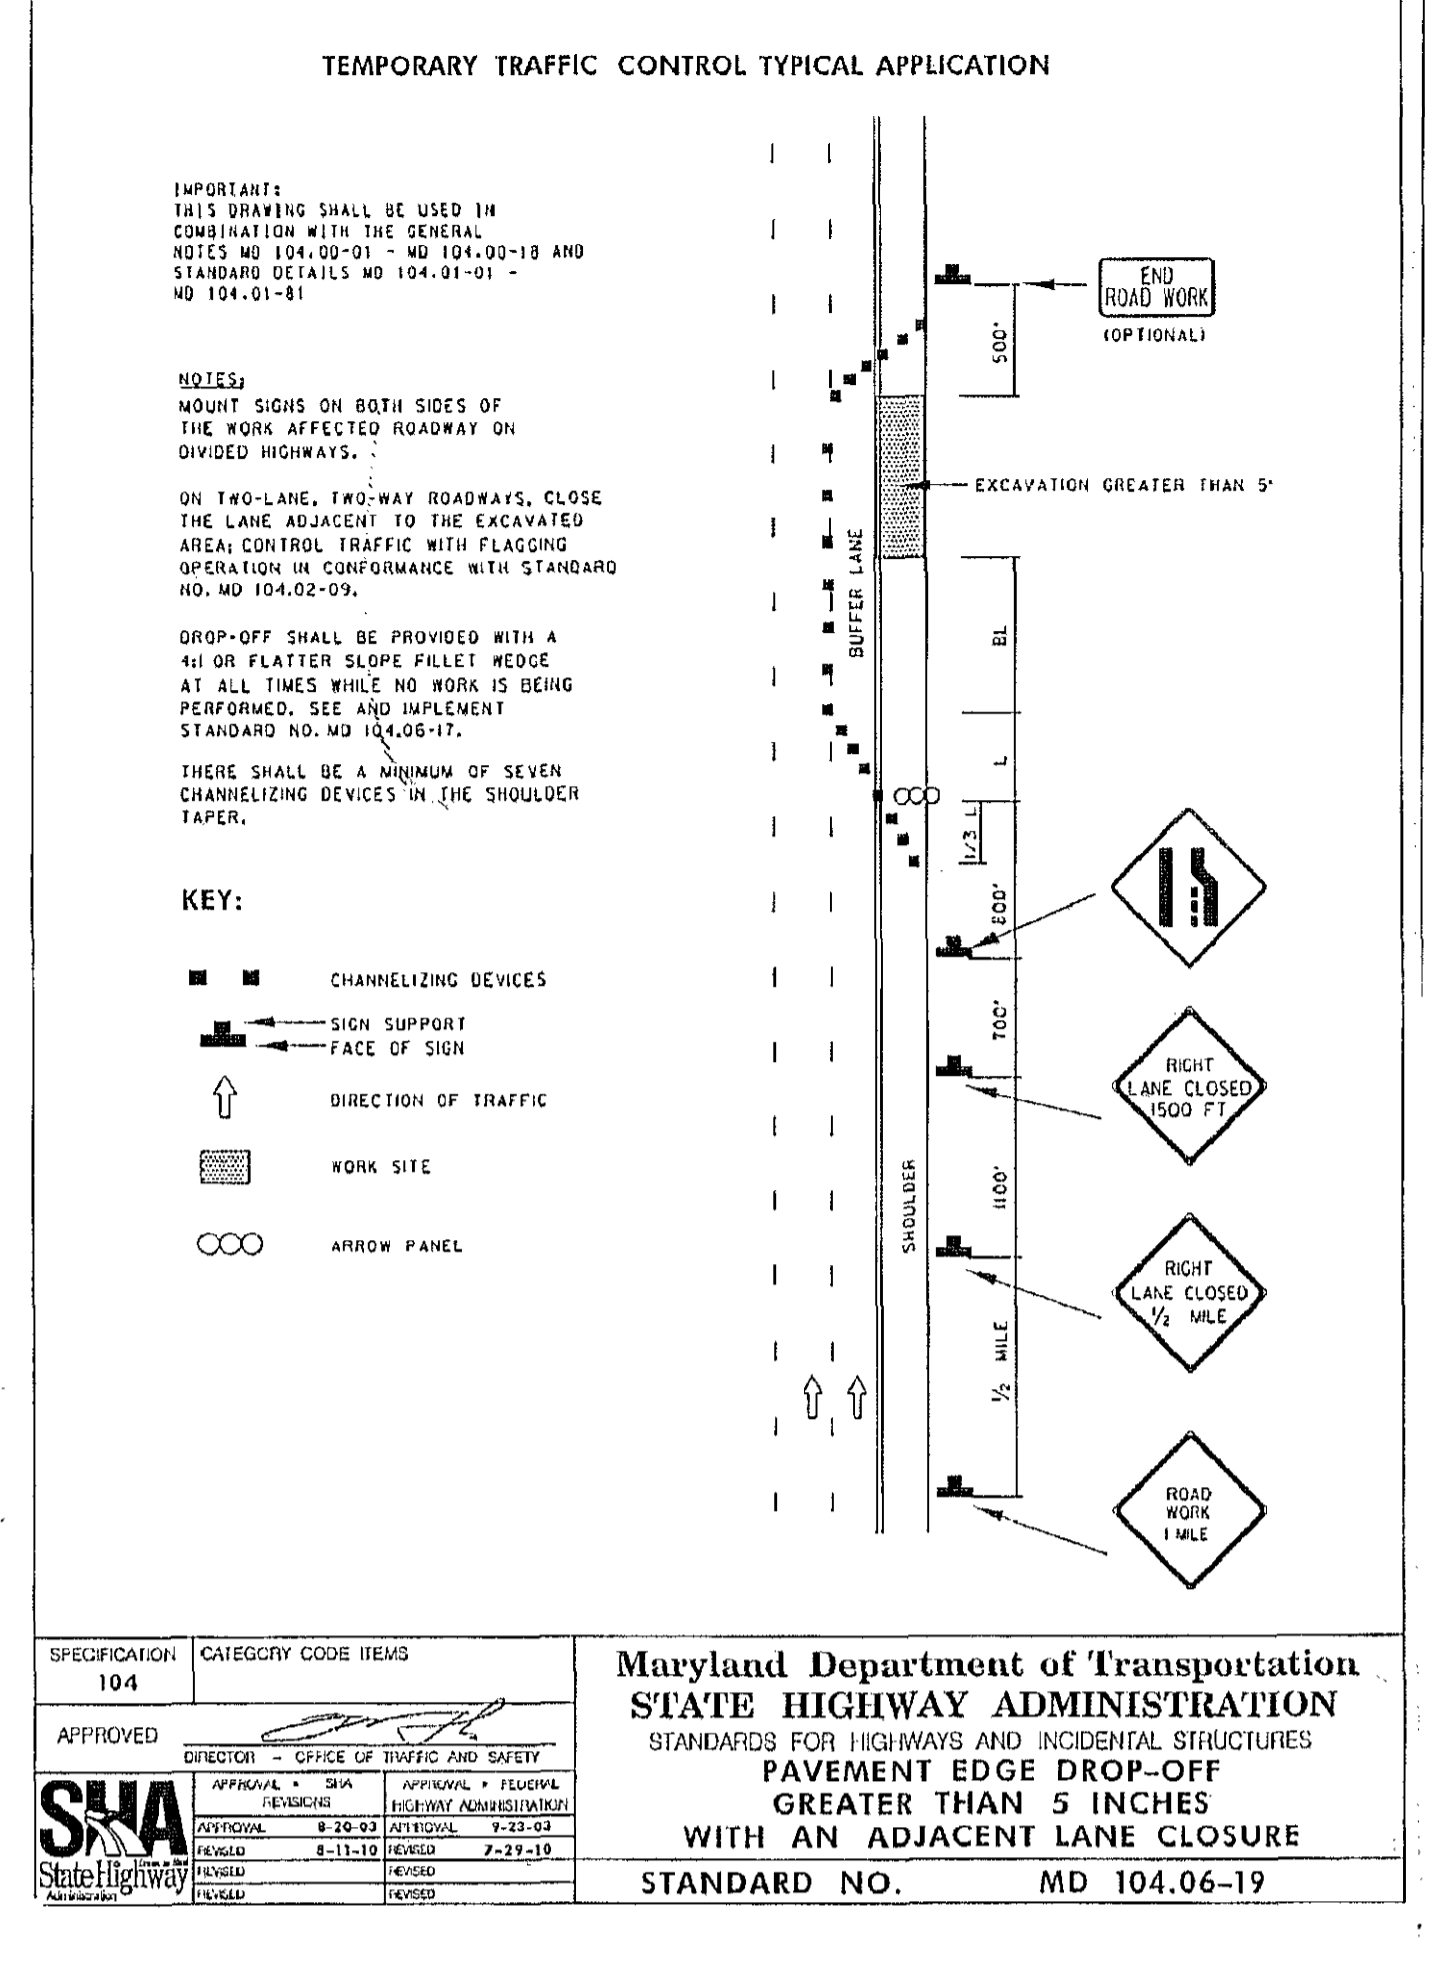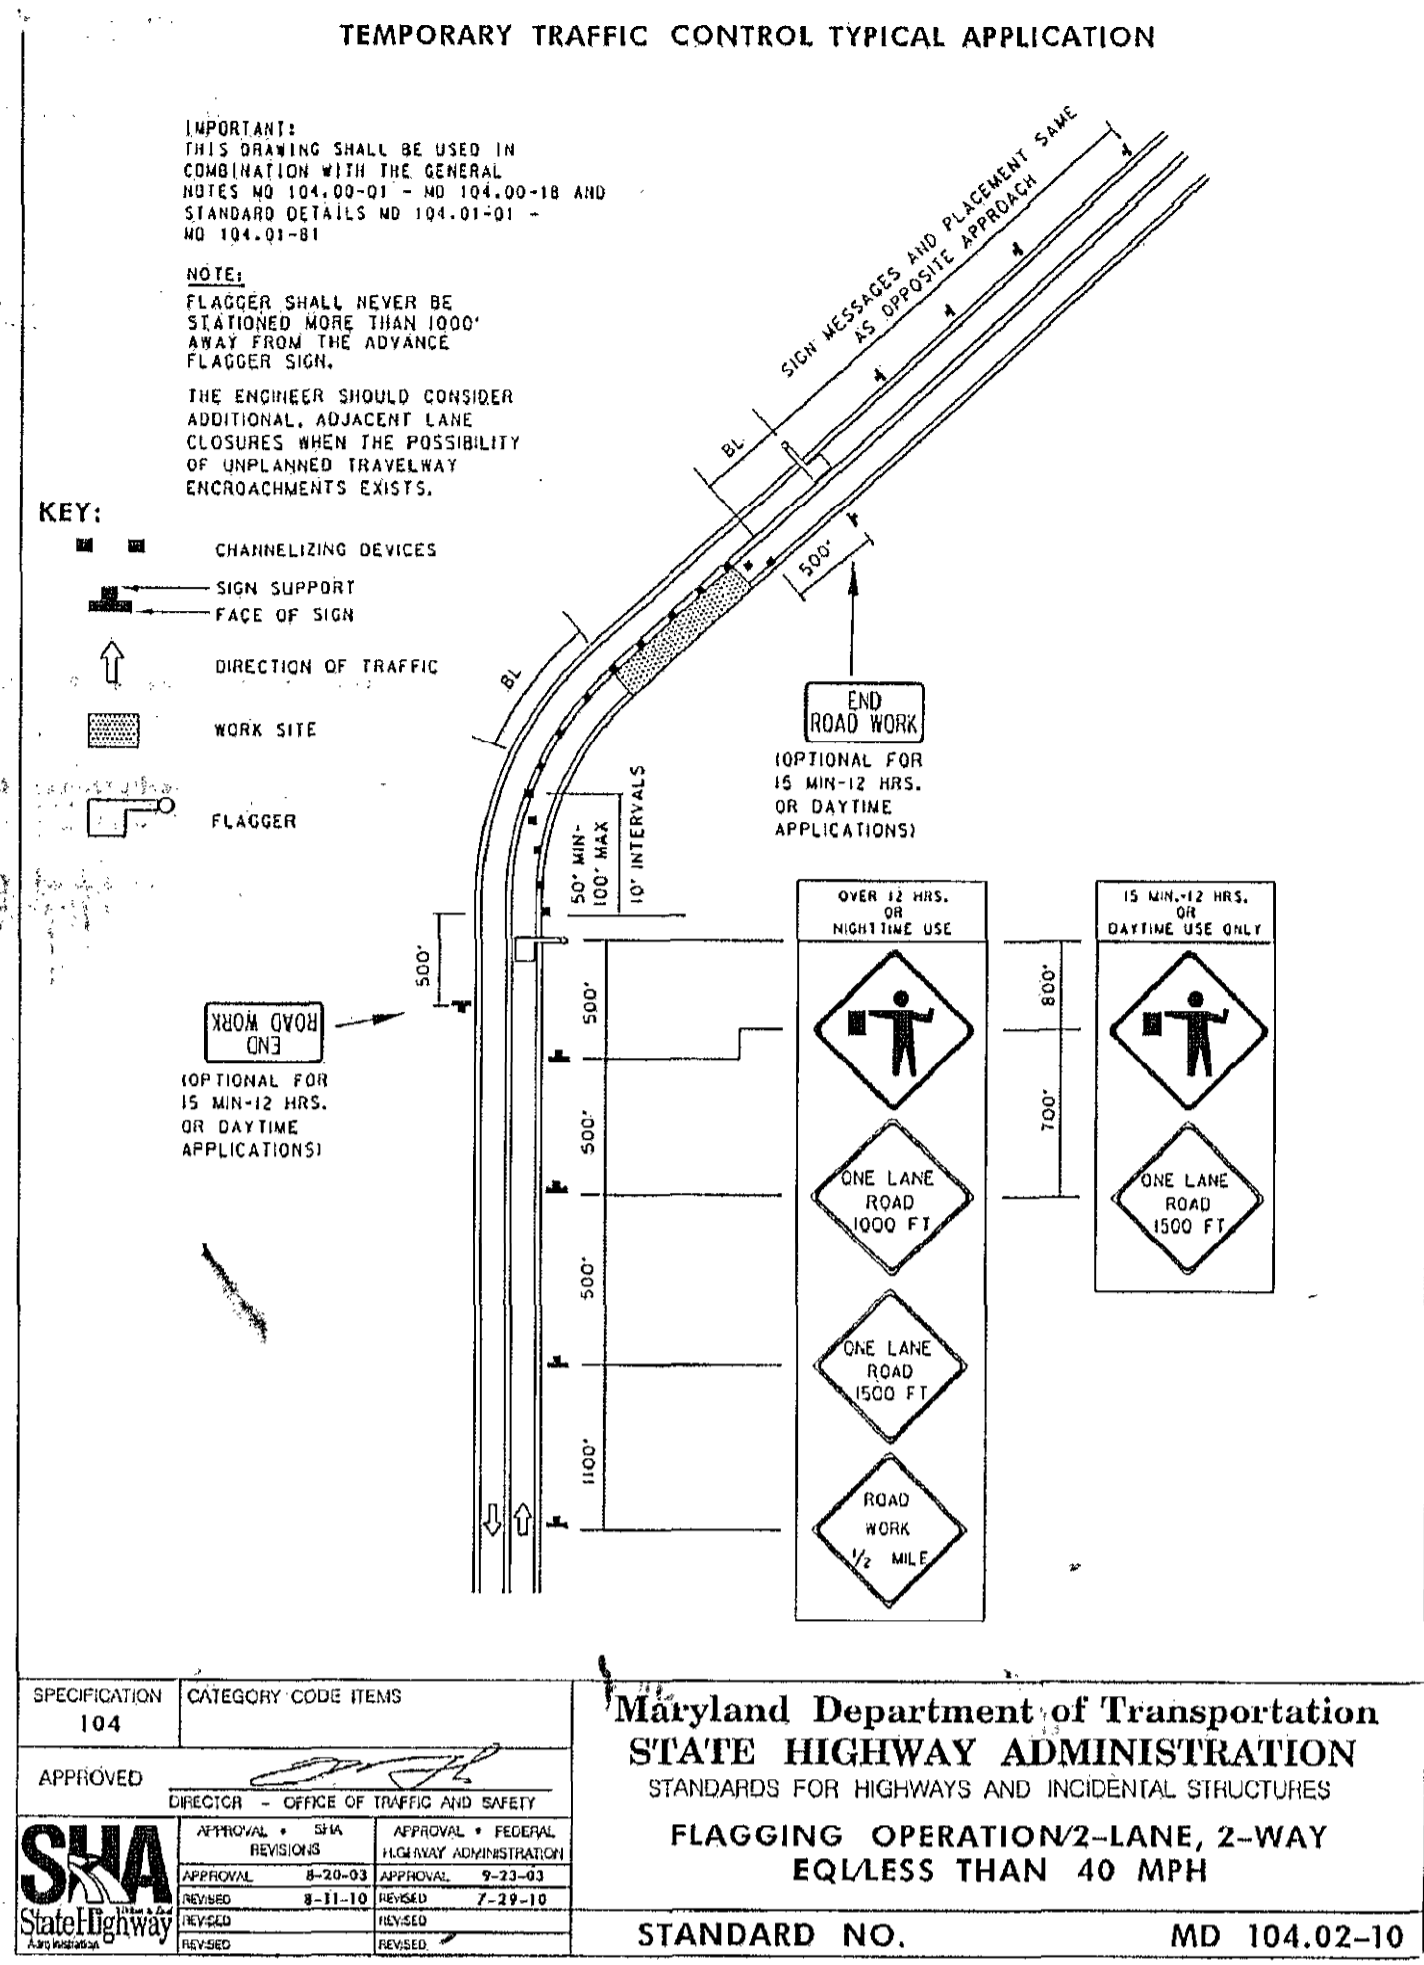

### GUILFORD ROAD MAINTENANCE OF TRAFFIC NOTES




(SEE GENERAL NOTE BELOW)

- FOR THE INSTALLATION OF THE STORM DRAIN ALONG GUILFORD ROAD FROM M-1 TO APPROXIMATELY 30 FEET BEYOND M-10, THE CONTRACTOR SHALL SUBMIT A MAINTENANCE OF TRAFFIC PLAN TO HOWARD COUNTY FOR APPROVAL PRIOR TO CONSTRUCTION.
- DETAILS HAVE BEEN PROVIDED TO AID THE CONTRACTOR IN PREPARATION OF THE MAINTENANCE OF TRAFFIC PLAN. CONSTRUCTION OF THE STORM DRAIN SYSTEM ALONG GUILFORD ROAD MAY BE CONSTRUCTED IN PHASES UTILIZING A FLAGGING OPERATION. AT LEAST ONE LANE OF TRAFFIC MUST BE MAINTAINED AT ALL TIMES ON GUILFORD ROAD OR A DETOUR PLAN MUST BE DEVELOPED AND APPROVED BY HOWARD COUNTY.
- WORK HOURS FOR CONSTRUCTION ACTIVITY SHALL BE BETWEEN THE HOURS OF 9 AM TO 3 PM AS STATED IN THE STD. NO. MD 104.00-14.
- QUANTITIES FOR SIGNAGE, CHANNALIZATION DEVICES (DRUMS) AND TEMPORARY "F" SHAPE CONCRETE BARRIER HAVE BEEN INCLUDED WITHIN THE SCHEDULE OF PRICES BASED ON APPLICABLE STANDARDS.
- STEEL PLATES SHALL BE USED TO COVER OPEN EXCAVATION TRENCHES THAT CANNOT BE BACKFILLED (PER DETAIL INCLUDED IN THE CONTRACT DRAWINGS) IN AREAS THAT MUST BE OPENED TO TRAFFIC AT THE END OF THE WORKDAY. EXISTING ROADWAY SURFACE SHALL BE GROUND OR MILLED TO ALLOW THE STEEL PLATES TO BE PLACED FLUSH WITH THE ROADWAY SURFACE. THE COST FOR THE STEEL PLATES, PAVEMENT GRINDING, ETC., SHALL BE INCIDENTAL TO THE STORM DRAIN LINEAR FOOT PAY PER ITEM.
- REDUCED SPEED SIGNS SHALL BE INCORPORATED INTO THE MAINTENANCE OF TRAFFIC PLAN FOR GUILFORD ROAD. THE POSTED REDUCED SPEED WILL BE PROVIDED TO THE CONTRACTOR BY HOWARD COUNTY.

### PINE TREE MAINTENANCE OF TRAFFIC

(SEE GENERAL NOTE BELOW)

- A DETAIL HAS BEEN PROVIDED ON SHEET 14 FOR USE IN THE CONSTRUCTION OF THE STORM DRAIN ALONG PINE TREE ROAD.
- MAINTENANCE OF TRAFFIC SHALL BE PROVIDED UTILIZING A FLAGGING OPERATION.
- STEEL PLATES SHALL BE USED TO COVER OPEN EXCAVATION TRENCHES THAT CANNOT BE BACKFILLED (PER DETAIL) IN AREAS THAT MUST BE OPENED TO TRAFFIC AT THE END OF THE WORK DAY. THE STEEL PLATES SHALL SIT FLAT ON THE PAVEMENT SURFACE AND SECURED WITH HMA FOR MAINTENANCE OF TRAFFIC.
- NOTE THAT ACCESS TO AND FROM RESIDENTIAL DRIVEWAYS MUST BE MAINTAINED AT ALL TIMES.
- IT SHALL BE THE CONTRACTOR'S RESPONSIBILITY TO MAKE ACCOMODATIONS FOR EMERGENCY VEHICLES INGRESS AND EGRESS DURING THE CONSTRUCTION PERIOD.

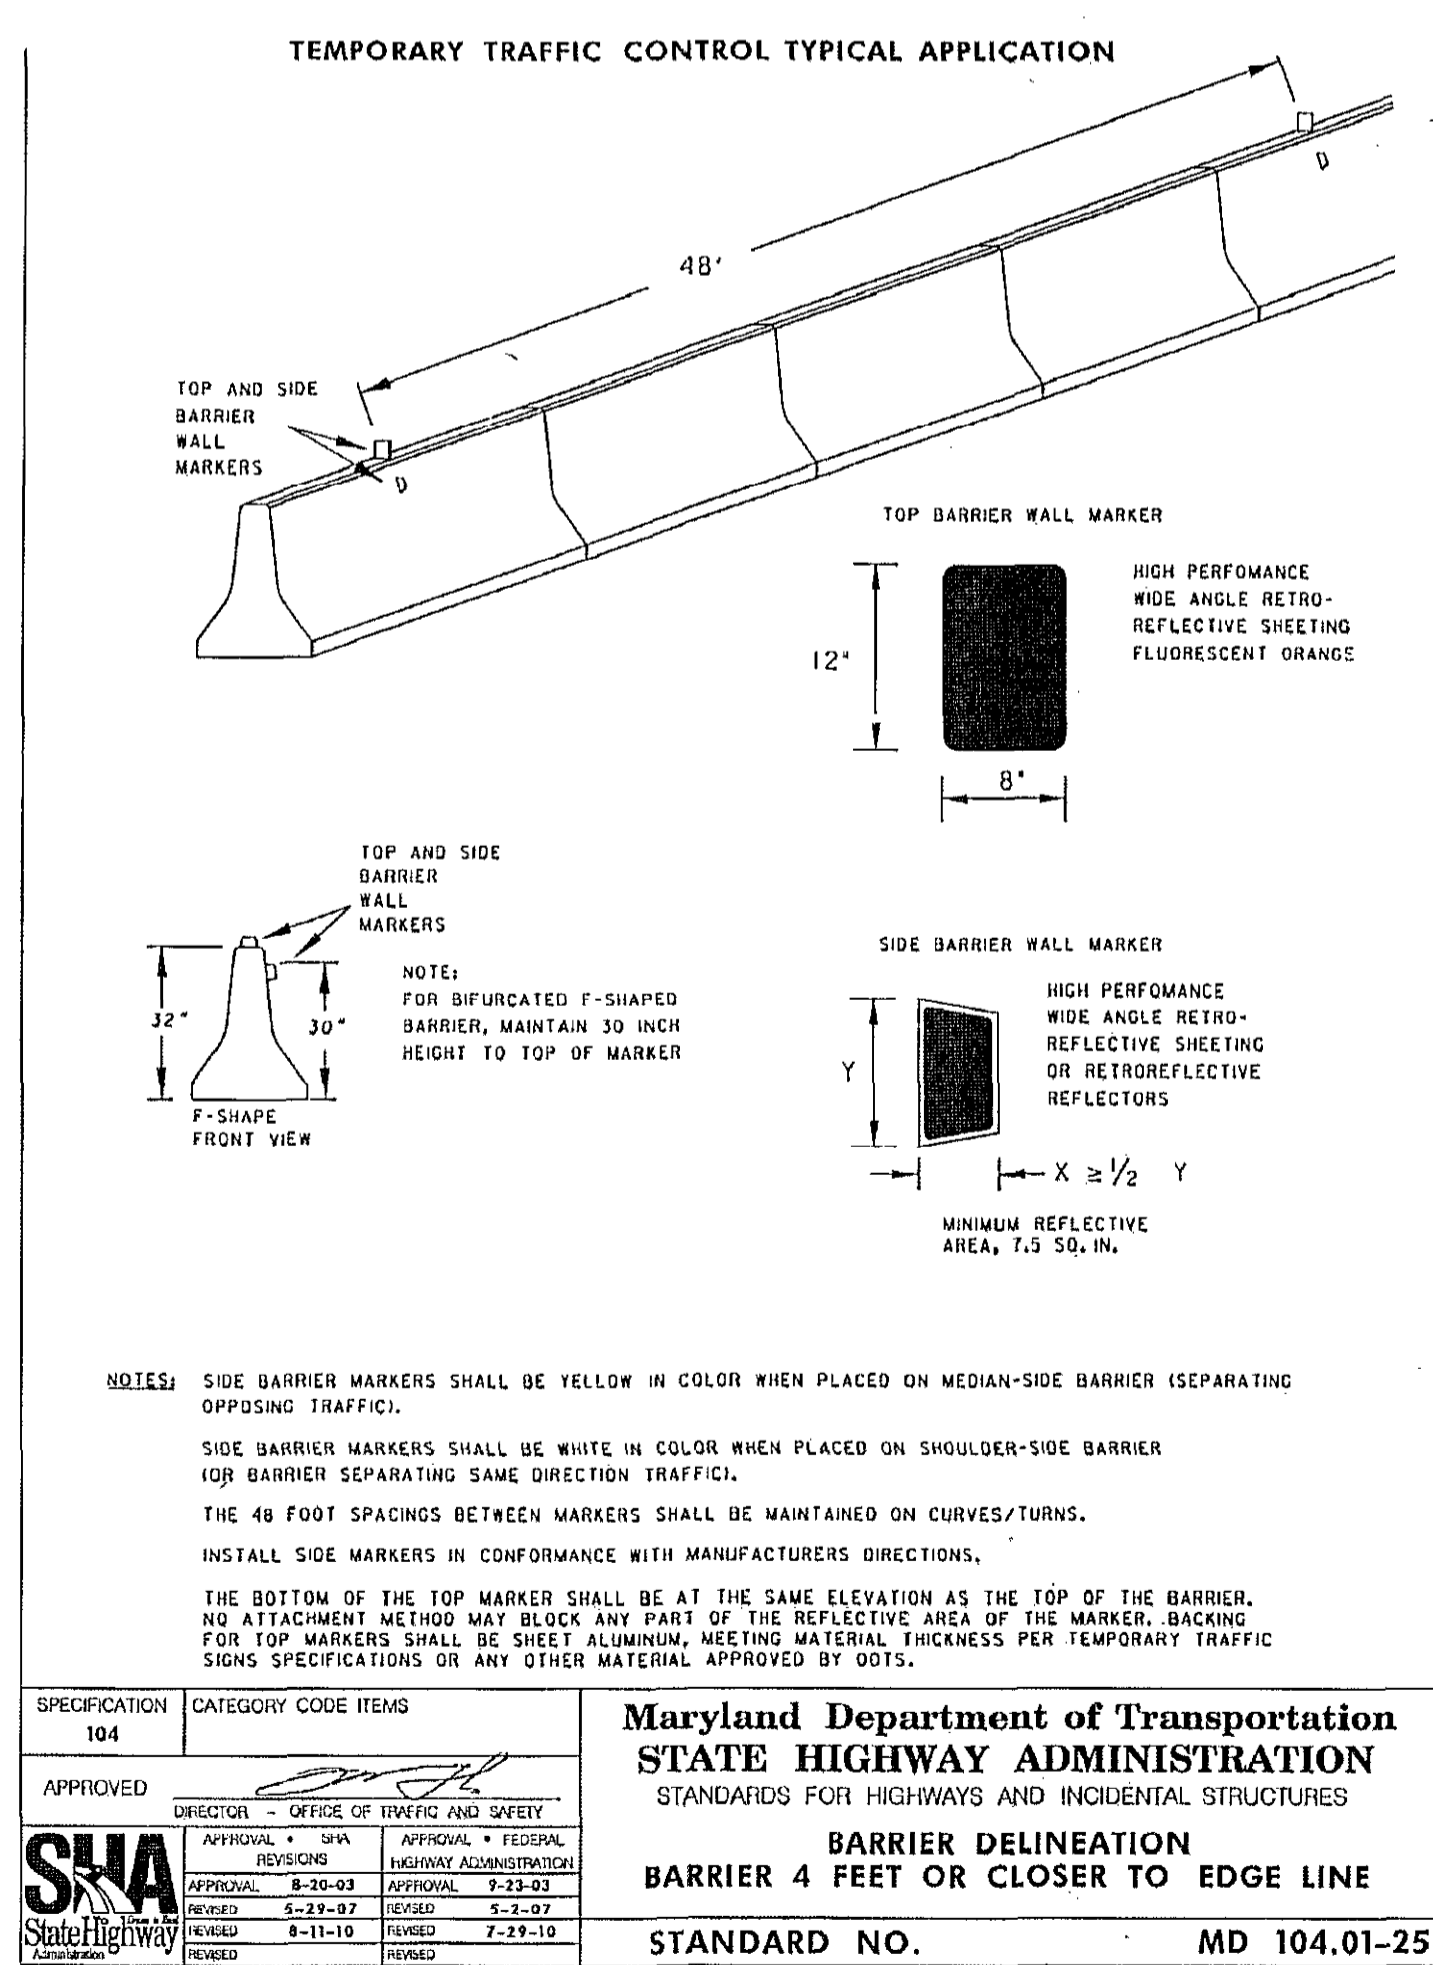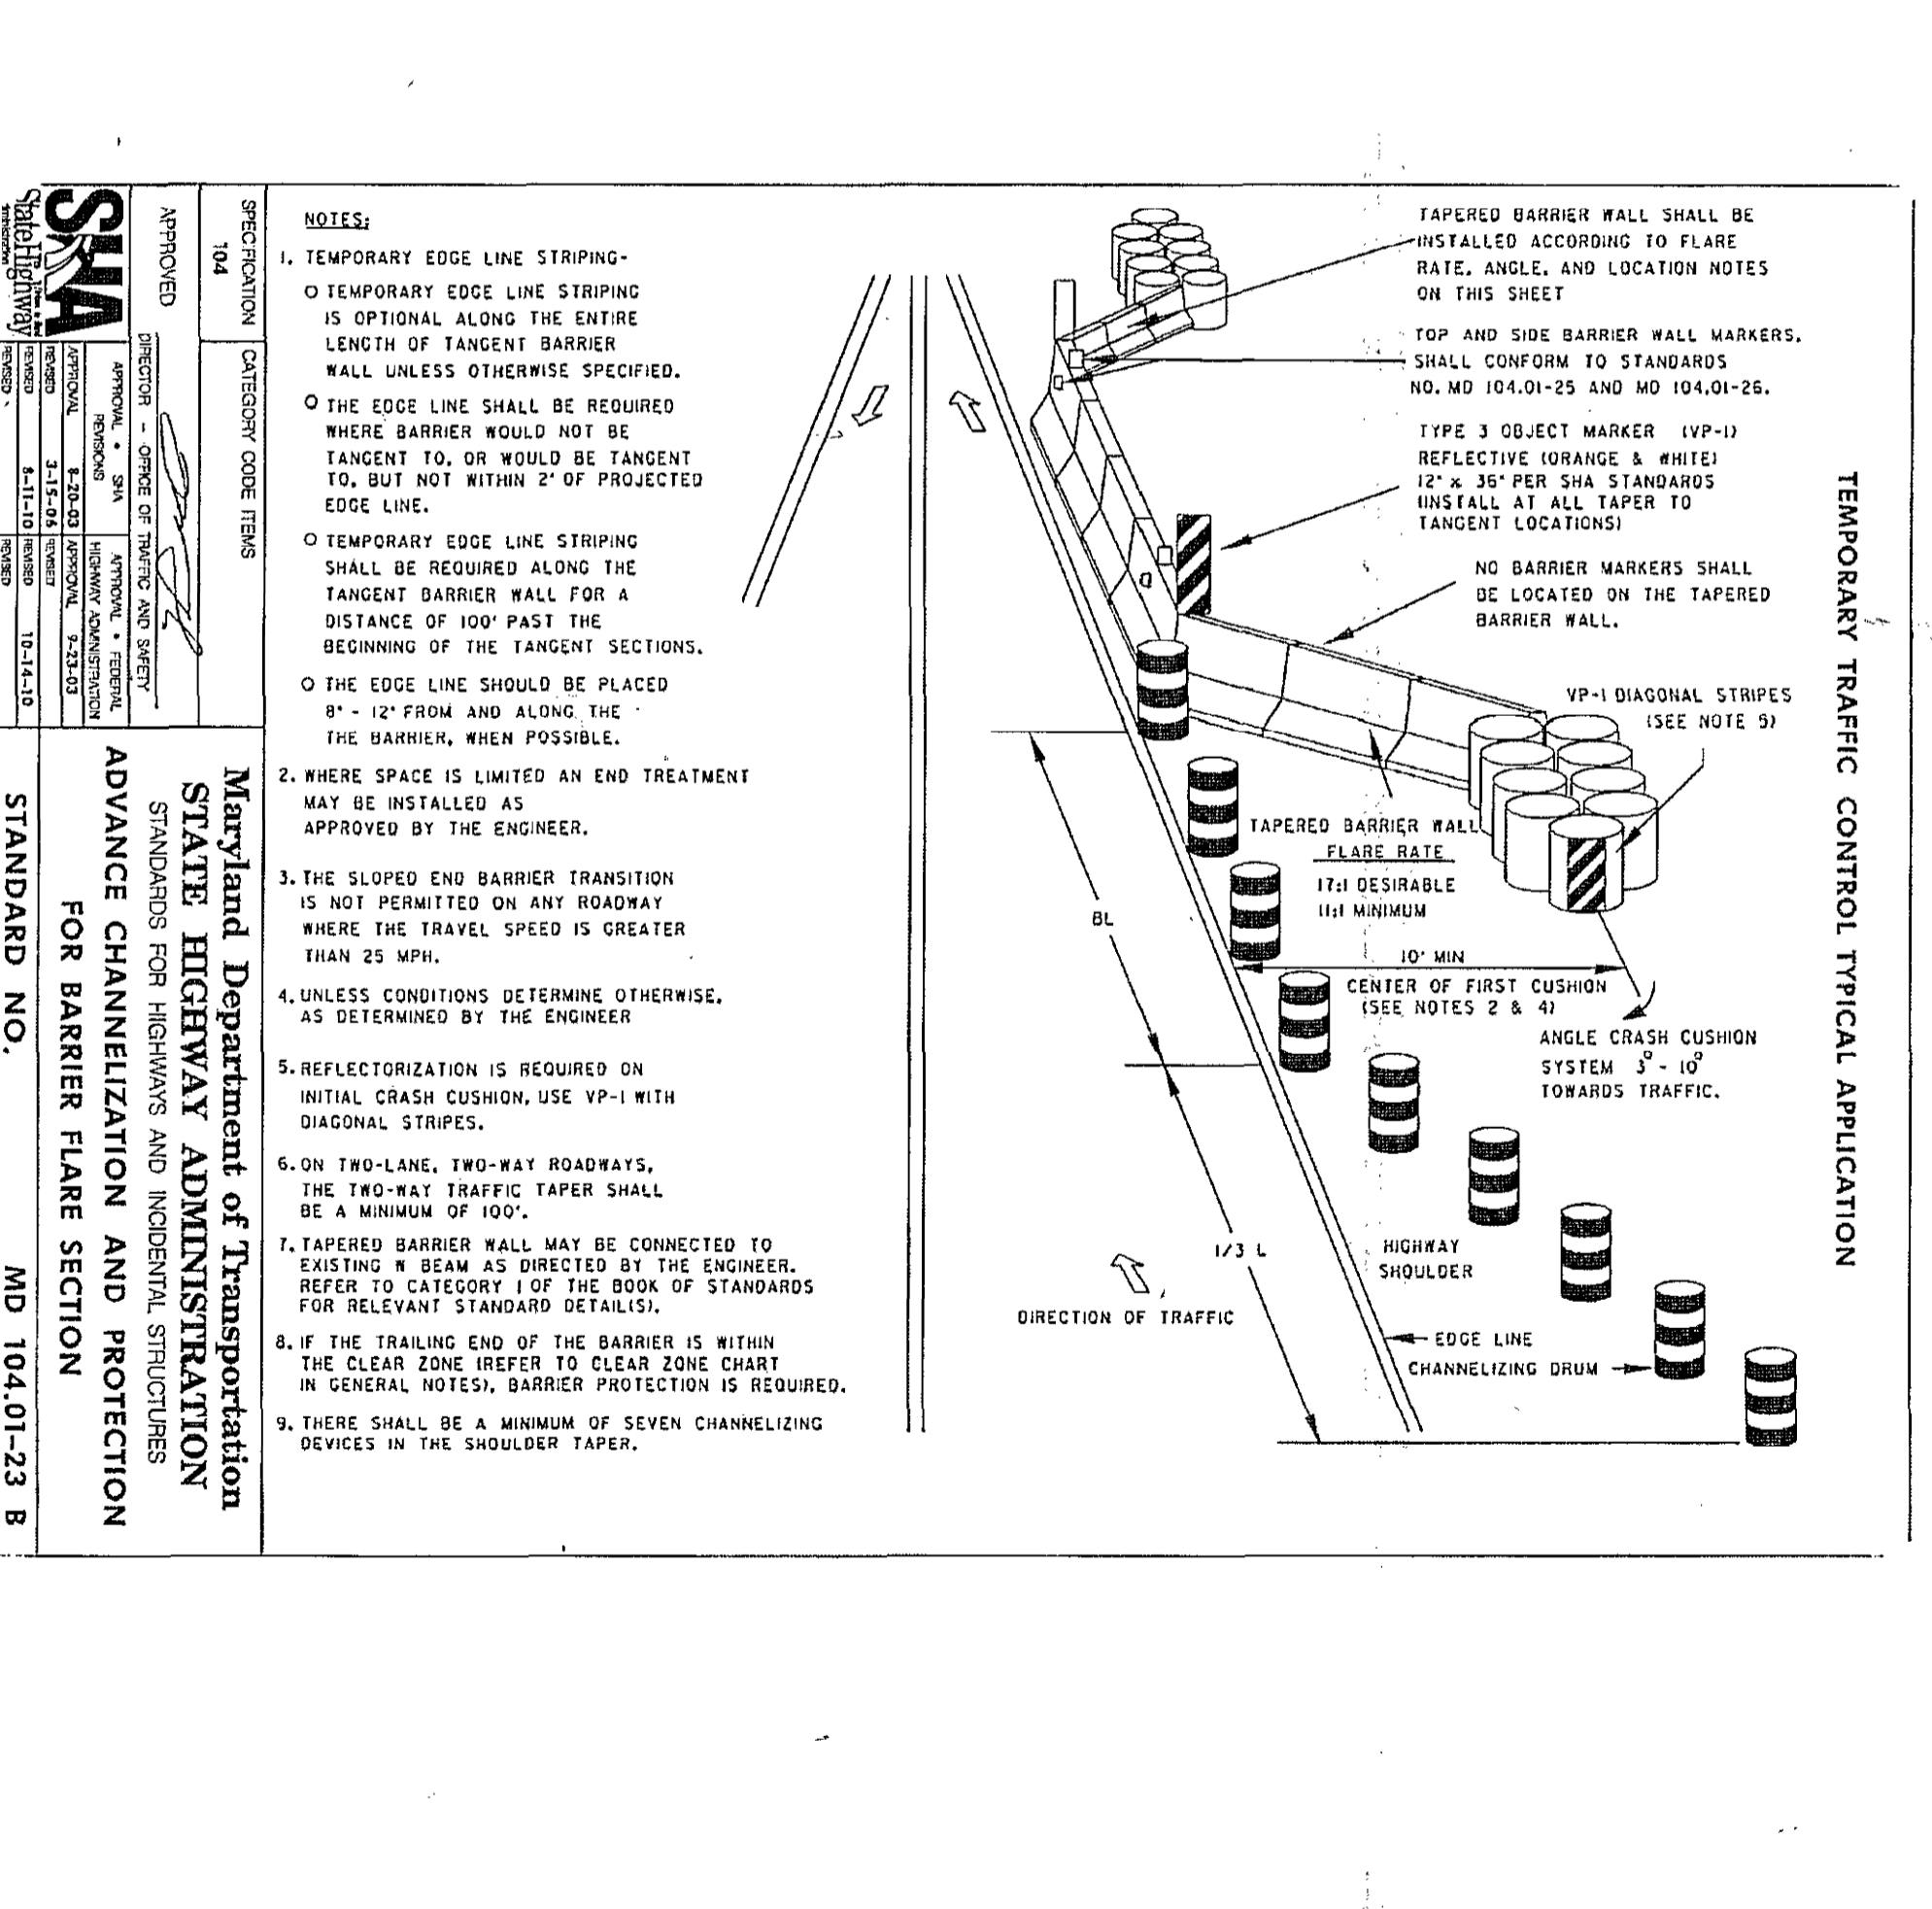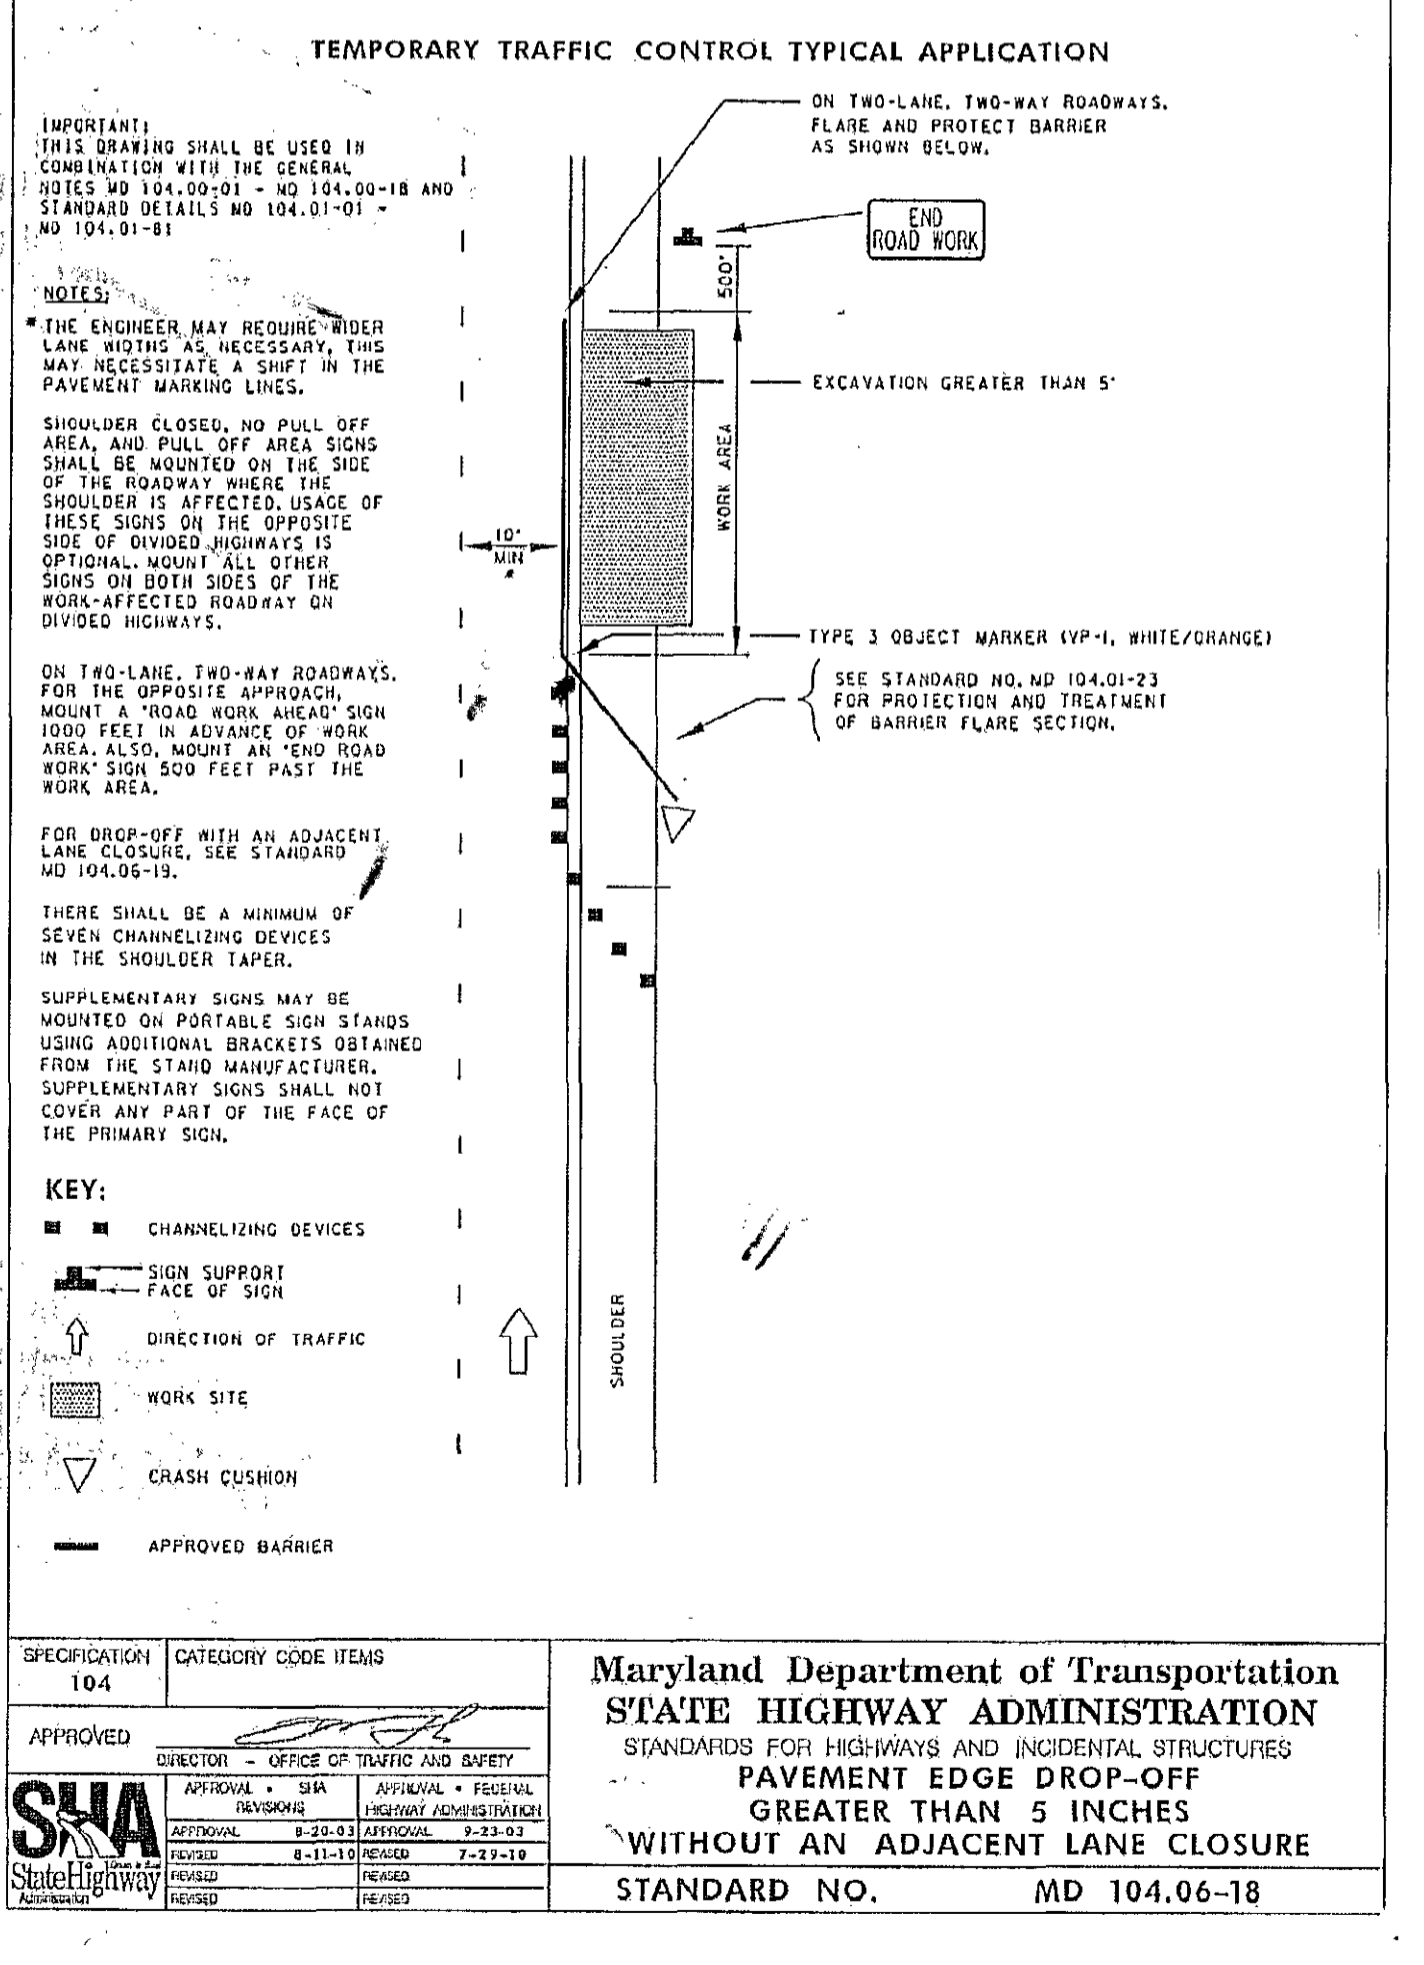

**GENERAL NOTE:**

THE INITIAL MAINTENANCE OF TRAFFIC (MOT) SET UP AS INDICATED ON THESE CONTRACT DOCUMENTS SHALL BE INCLUDED AS PART OF THE CONTRACTOR'S BID PRICE. ANY ADDITIONAL MOT ITEMS REQUIRED WILL BE PAID AS PART OF THE CONTINGENT PRICE PER PAY ITEM.

DEPARTMENT OF PUBLIC WORKS  
HOWARD COUNTY, MARYLAND

*[Signature]* 4/9/13  
DIRECTOR OF PUBLIC WORKS DATE

*[Signature]* 4/16/13  
CHIEF, BUREAU OF ENGINEERING DATE

*[Signature]* 4/16/13  
CHIEF, TRANSPORTATION AND SPECIAL PROJECTS DIVISION DATE

**NOLAN**  
Associates, Inc.  
Engineers - Civil/Structural/Inspections  
4785 Dorsey Hall Drive  
Suite 124  
Ellicott City, Maryland 21042  
Phone: (410) 995-3651 Fax: (410) 995-1363

DES: GWF/JW  
DRN: JRW  
CHK: GWF  
DATE: FEB 2013

NO.	REVISION	DATE

MAINTENANCE OF TRAFFIC  
DETAILS

DATE: 600' SCALE MAP NO. \_\_\_\_\_ BLOCK NO. \_\_\_\_\_

PINE TREE ROAD/GLEN COURT  
DRAINAGE AND ROADWAY IMPROVEMENTS, PH. 1  
CAPITAL PROJECT D-1140  
ELECTION DISTRICT NO. 6  
HOWARD COUNTY, MARYLAND

SCALE:  
AS SHOWN

SHEET  
14A OF 14A