

SHEET INDEX

1. TITLE SHEET
2. SITE PLAN
3. STORM DRAIN PROFILE
4. SEDIMENT AND EROSION CONTROL PLAN
5. SEDIMENT AND EROSION CONTROL NOTES AND DETAILS
6. LANDSCAPE PLAN

GENERAL NOTES:


1. ALL CONSTRUCTION SHALL BE IN ACCORDANCE WITH THE LATEST STANDARDS AND SPECIFICATIONS OF HOWARD COUNTY PLUS MSHA STANDARDS AND SPECIFICATIONS IF APPLICABLE.
2. THE CONTRACTOR SHALL NOTIFY "MISS UTILITY" AT 1-800-257-7777 AT LEAST FIVE (5) WORKING DAYS PRIOR TO ANY WORK BEING DONE.
3. THE CONTRACTOR SHALL NOTIFY THE DEPARTMENT OF PUBLIC WORKS/BUREAU OF ENGINEERING/CONSTRUCTION INSPECTION DIVISION AT (410) 313-1880 AT LEAST FIVE (5) WORKING DAYS PRIOR TO THE START OF WORK.
4. SURVEY OF THE SITE WAS PERFORMED BY AB CONSULTANTS, INC. - SEPTEMBER 2002.
5. WETLANDS WERE DELINEATED BY CHESAPEAKE ENVIRONMENTAL MANAGEMENT, INC. - AUGUST 2002.
6. COORDINATES AND ELEVATIONS ARE BASED ON PREVIOUS EBA ENGINEERING, INC. TRAVERSE AND CONTROL POINTS.
7. THE EXISTING INFORMATION SHOWN ON THESE PLANS WAS TAKEN FROM THE BEST AVAILABLE SOURCES AND SHALL BE VERIFIED BEFORE STARTING CONSTRUCTION. THE HOWARD COUNTY DOES NOT GUARANTEE THE COMPLETENESS OR THE CORRECTNESS OF THE SHOWN INFORMATION.
8. HTI CONTRACTORS SHALL TAKE ALL NECESSARY PRECAUTIONS TO PROTECT THE EXISTING UTILITIES AND MAINTAIN UNINTERRUPTED SERVICE. ANY DAMAGE INCURRED DUE TO HTI'S OPERATION SHALL BE REPAIRED IMMEDIATELY. ALL UTILITIES SHALL HAVE A CLEARANCE BY A MINIMUM OF 6 INCHES VERTICALLY AND A MINIMUM OF 5 FEET HORIZONTALLY.
9. SHOULD HTI DISCOVER DISCREPANCIES BETWEEN THE PLANS AND FIELD CONDITIONS, HTI SHALL NOTIFY KCI TECHNOLOGIES, INC. IMMEDIATELY TO RESOLVE THE SITUATION.
10. ALL PIPE ELEVATIONS SHOWN ARE INVERT ELEVATIONS.
11. HTI IS SOLELY RESPONSIBLE FOR CONSTRUCTION MEANS, METHODS, TECHNIQUES, SEQUENCES, PROCEDURES, AND SAFETY PRECAUTIONS AND PROGRAMS.
12. EXISTING FENCES DISTURBED BY THE WORK SHALL BE RECONSTRUCTED OR REPLACED IN A CONDITION EQUAL TO OR BETTER THAN PRESENT CONDITIONS, UNLESS OTHERWISE NOTED IN THE EASEMENT DOCUMENTS.
13. TRAFFIC CONTROL DEVICES, MARKINGS AND SIGNINGS SHALL BE IN ACCORDANCE WITH THE LATEST EDITION OF THE MANUAL OF UNIFORM TRAFFIC CONTROL DEVICES (MUTCD). ALL STREET AND REGULATORY SIGNS SHALL BE IN PLACE PRIOR TO THE PLACEMENT OF ANY ASPHALT.
14. TRAFFIC CONTROL SHALL BE PROVIDED DURING CONSTRUCTION. HOWARD COUNTY STANDARD DETAIL TE-11 SHALL APPLY.
15. PRIOR TO BEGINNING ANY CONSTRUCTION ACTIVITIES, A VIDEOTAPE AND PHOTOGRAPHS OF THE CHANNEL FROM THE PROPOSED STORM DRAIN OUTFALL TO ITS DOWNSTREAM CONFLUENCE SHALL BE TAKEN.

MDE PERMIT/TRACKING NUMBER- 200361475

HOWARD COUNTY
DEPARTMENT OF PUBLIC WORKS
NORTH LAUREL PARK
HOWARD COUNTY, MARYLAND
CAPITAL PROJECT No. D-1146

LEGEND

- LOD — LOD — LOD — LIMITS OF DISTURBANCE
- OSF — OSF — OSF — TREE PROTECTION FENCE
- SIP [] INLET PROTECTION
- SCF [] STABILIZED CONSTRUCTION ENTRANCE
- ⊗ TREE TO BE REMOVED
- EX. BUILDINGS
- WUS — WUS — WUS — WATERS OF THE U.S.
- X — X — X — FENCES
- ☼ ☼ EX. TREES
- PROP. TREES
- 150 — MAJOR CONTOUR
- 100 — MINOR CONTOUR
- UG — UG — UG — UNDERGROUND ELECTRIC
- ⊕ POWER POLE
- T — T — T — AERIAL TELEPHONE LINE

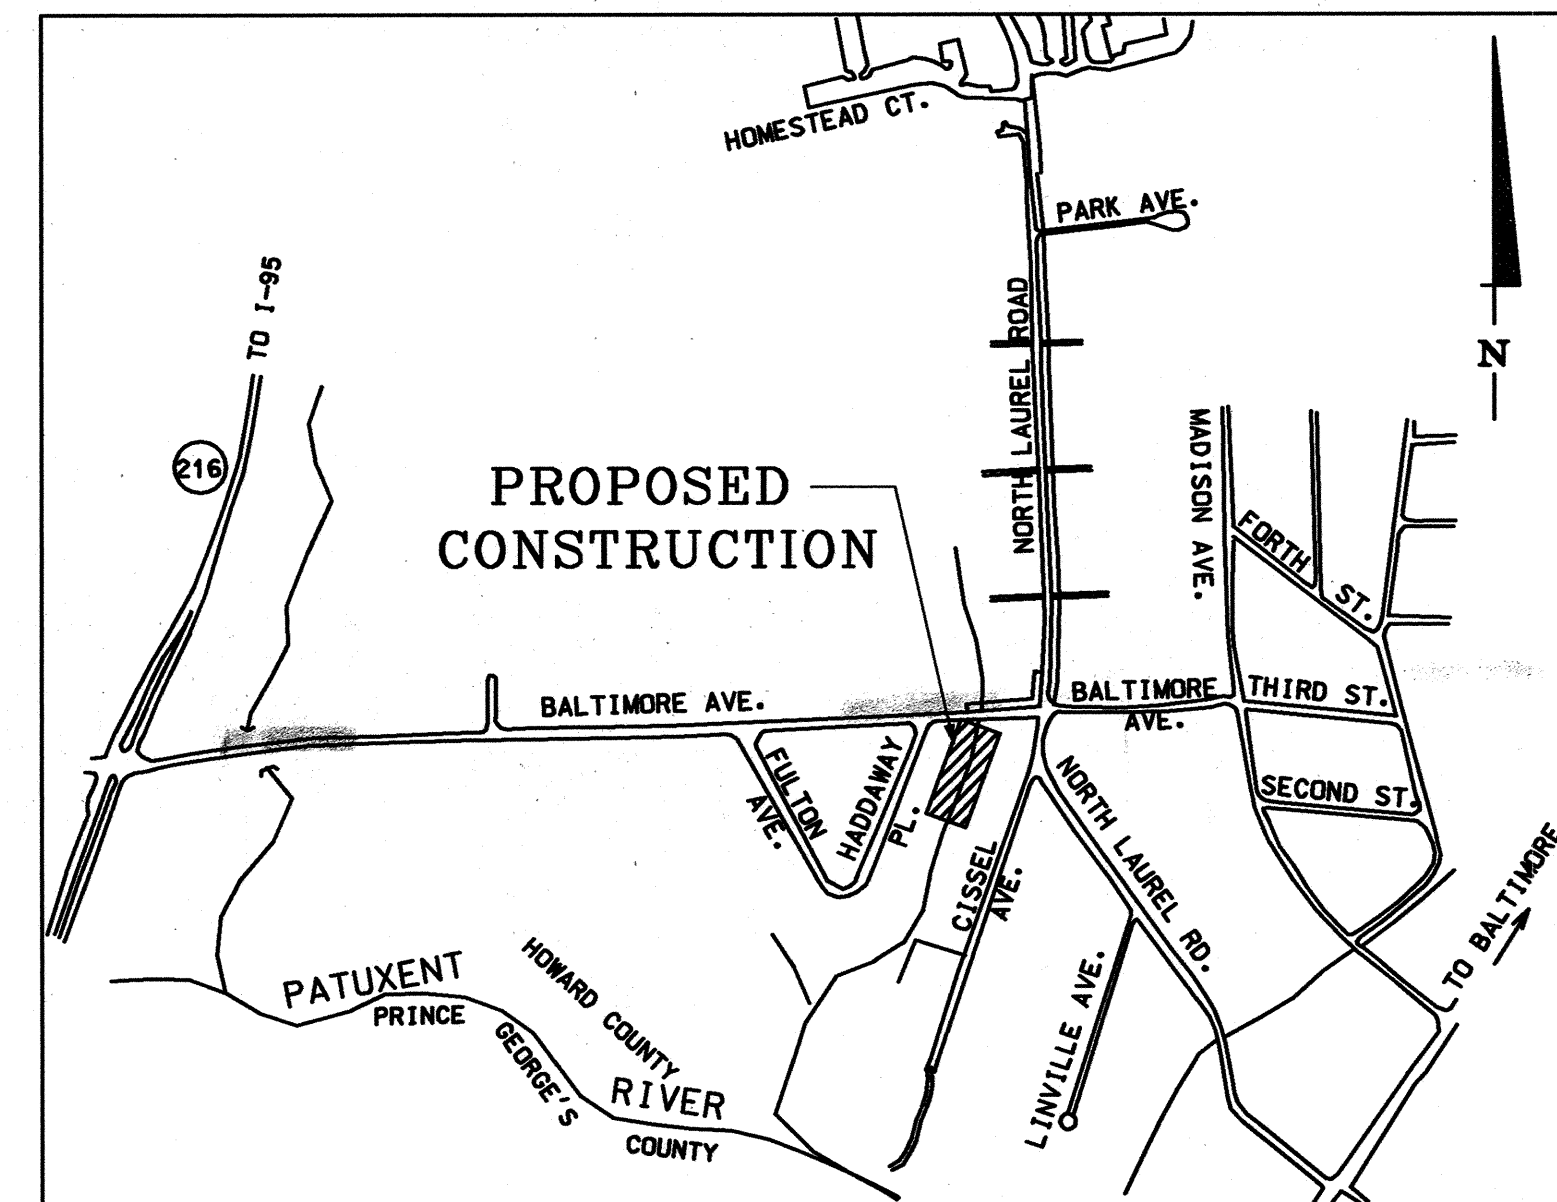

SCALE: 1" = 600'

DESIGN CERTIFICATE

I HEREBY CERTIFY THAT THIS PLAN FOR EROSION AND SEDIMENT CONTROL REPRESENTS A PRACTICAL AND WORKABLE PLAN BASED ON MY PERSONAL KNOWLEDGE OF THE SITE CONDITIONS AND IT WAS PREPARED IN ACCORDANCE WITH THE REQUIREMENTS OF HOWARD SOIL CONSERVATION DISTRICT.

6/21/03 DATE
Mark Richmond DESIGNER'S SIGNATURE
MARYLAND REGISTRATION NO. 16898 MARK RICHMOND PRINTED NAME
(P.E., R.L.S., OR R.L.A.)

OWNER'S/DEVELOPER'S CERTIFICATION

"I/WE HEREBY CERTIFY THAT ALL CLEARING, GRADING, CONSTRUCTION AND/OR DEVELOPMENT WILL BE DONE PURSUANT TO THIS PLAN AND THAT ANY RESPONSIBLE PERSONNEL INVOLVED IN THE CONSTRUCTION PROJECT WILL HAVE A CERTIFICATE OF ATTENDANCE AT A MARYLAND DEPARTMENT OF THE ENVIRONMENT APPROVED TRAINING PROGRAM FOR THE CONTROL OF SEDIMENT AND EROSION BEFORE BEGINNING THE PROJECT. I ALSO AUTHORIZE PERIODIC ON-SITE INSPECTION BY THE HOWARD SOIL CONSERVATION DISTRICT.

7/10/03 DATE
Howard E. Saltzman OWNER/DEVELOPER SIGNATURE
Howard E. Saltzman, Chief, Stormwater Management Division PRINTED NAME AND TITLE

REVIEWED FOR HOWARD COUNTY SOIL CONSERVATION DISTRICT AND MEETS TECHNICAL REQUIREMENTS.

Jin Ngwu/03 7/24/03 DATE
NATURAL RESOURCES CONSERVATION SERVICE

THIS DEVELOPMENT PLAN IS APPROVED FOR EROSION AND SEDIMENT CONTROL BY HOWARD SOIL CONSERVATION DISTRICT.

APPROVED
Howard Soil Conservation District 7/21/03 DATE

PLOTTED: 10:00 AM on Friday, June 27, 2003
FILE: m:\2003\0627\03\1128\1128.dwg


<p>DEPARTMENT OF PUBLIC WORKS HOWARD COUNTY, MARYLAND</p> <p>7/15/03 DATE Director of Public Works</p> <p>7/10/03 DATE Chief, Bureau of Environmental Services</p> <p>7/10/03 DATE Chief, Stormwater Management Division</p>	 KCI TECHNOLOGIES 10 North Park Drive Hunt Valley, MD 21030 Phone: (410) 316-7800 Fax: (410) 316-7817 www.kci.com	 Mark S. Richmond PROFESSIONAL ENGINEER	DES: DCD DRN: DJS CHK: MSR DATE: 6/03	<p>TITLE SHEET</p> <p>600' SCALE MAP NO. _____ BLOCK NO. _____</p>	<p>HOWARD COUNTY DEPARTMENT OF PUBLIC WORKS</p> <p>NORTH LAUREL PARK</p> <p>DRAINAGE IMPROVEMENTS</p> <p>CAPITAL PROJECT D-1146</p>	SCALE AS SHOWN SHEET 1 OF 6
--	---	--	--	--	---	-----------------------------------

EP-03-08

HADDAWAY PLACE

TRAVERSE 162

SURVEY CONTROL			
TRAVERSE	NORTHING	EASTING	ELEVATION
101	10372.9720	5000.0000	181.8600
150	10391.3704	4888.6009	179.5200
152	10703.5973	4837.4794	192.1000
153	10777.0081	4966.3004	202.6300
160	10393.9924	4843.5211	175.5950
161	10525.4776	4856.8521	180.3740
162	10445.1017	4643.4917	186.3990
163	10242.0849	4865.6200	172.7320

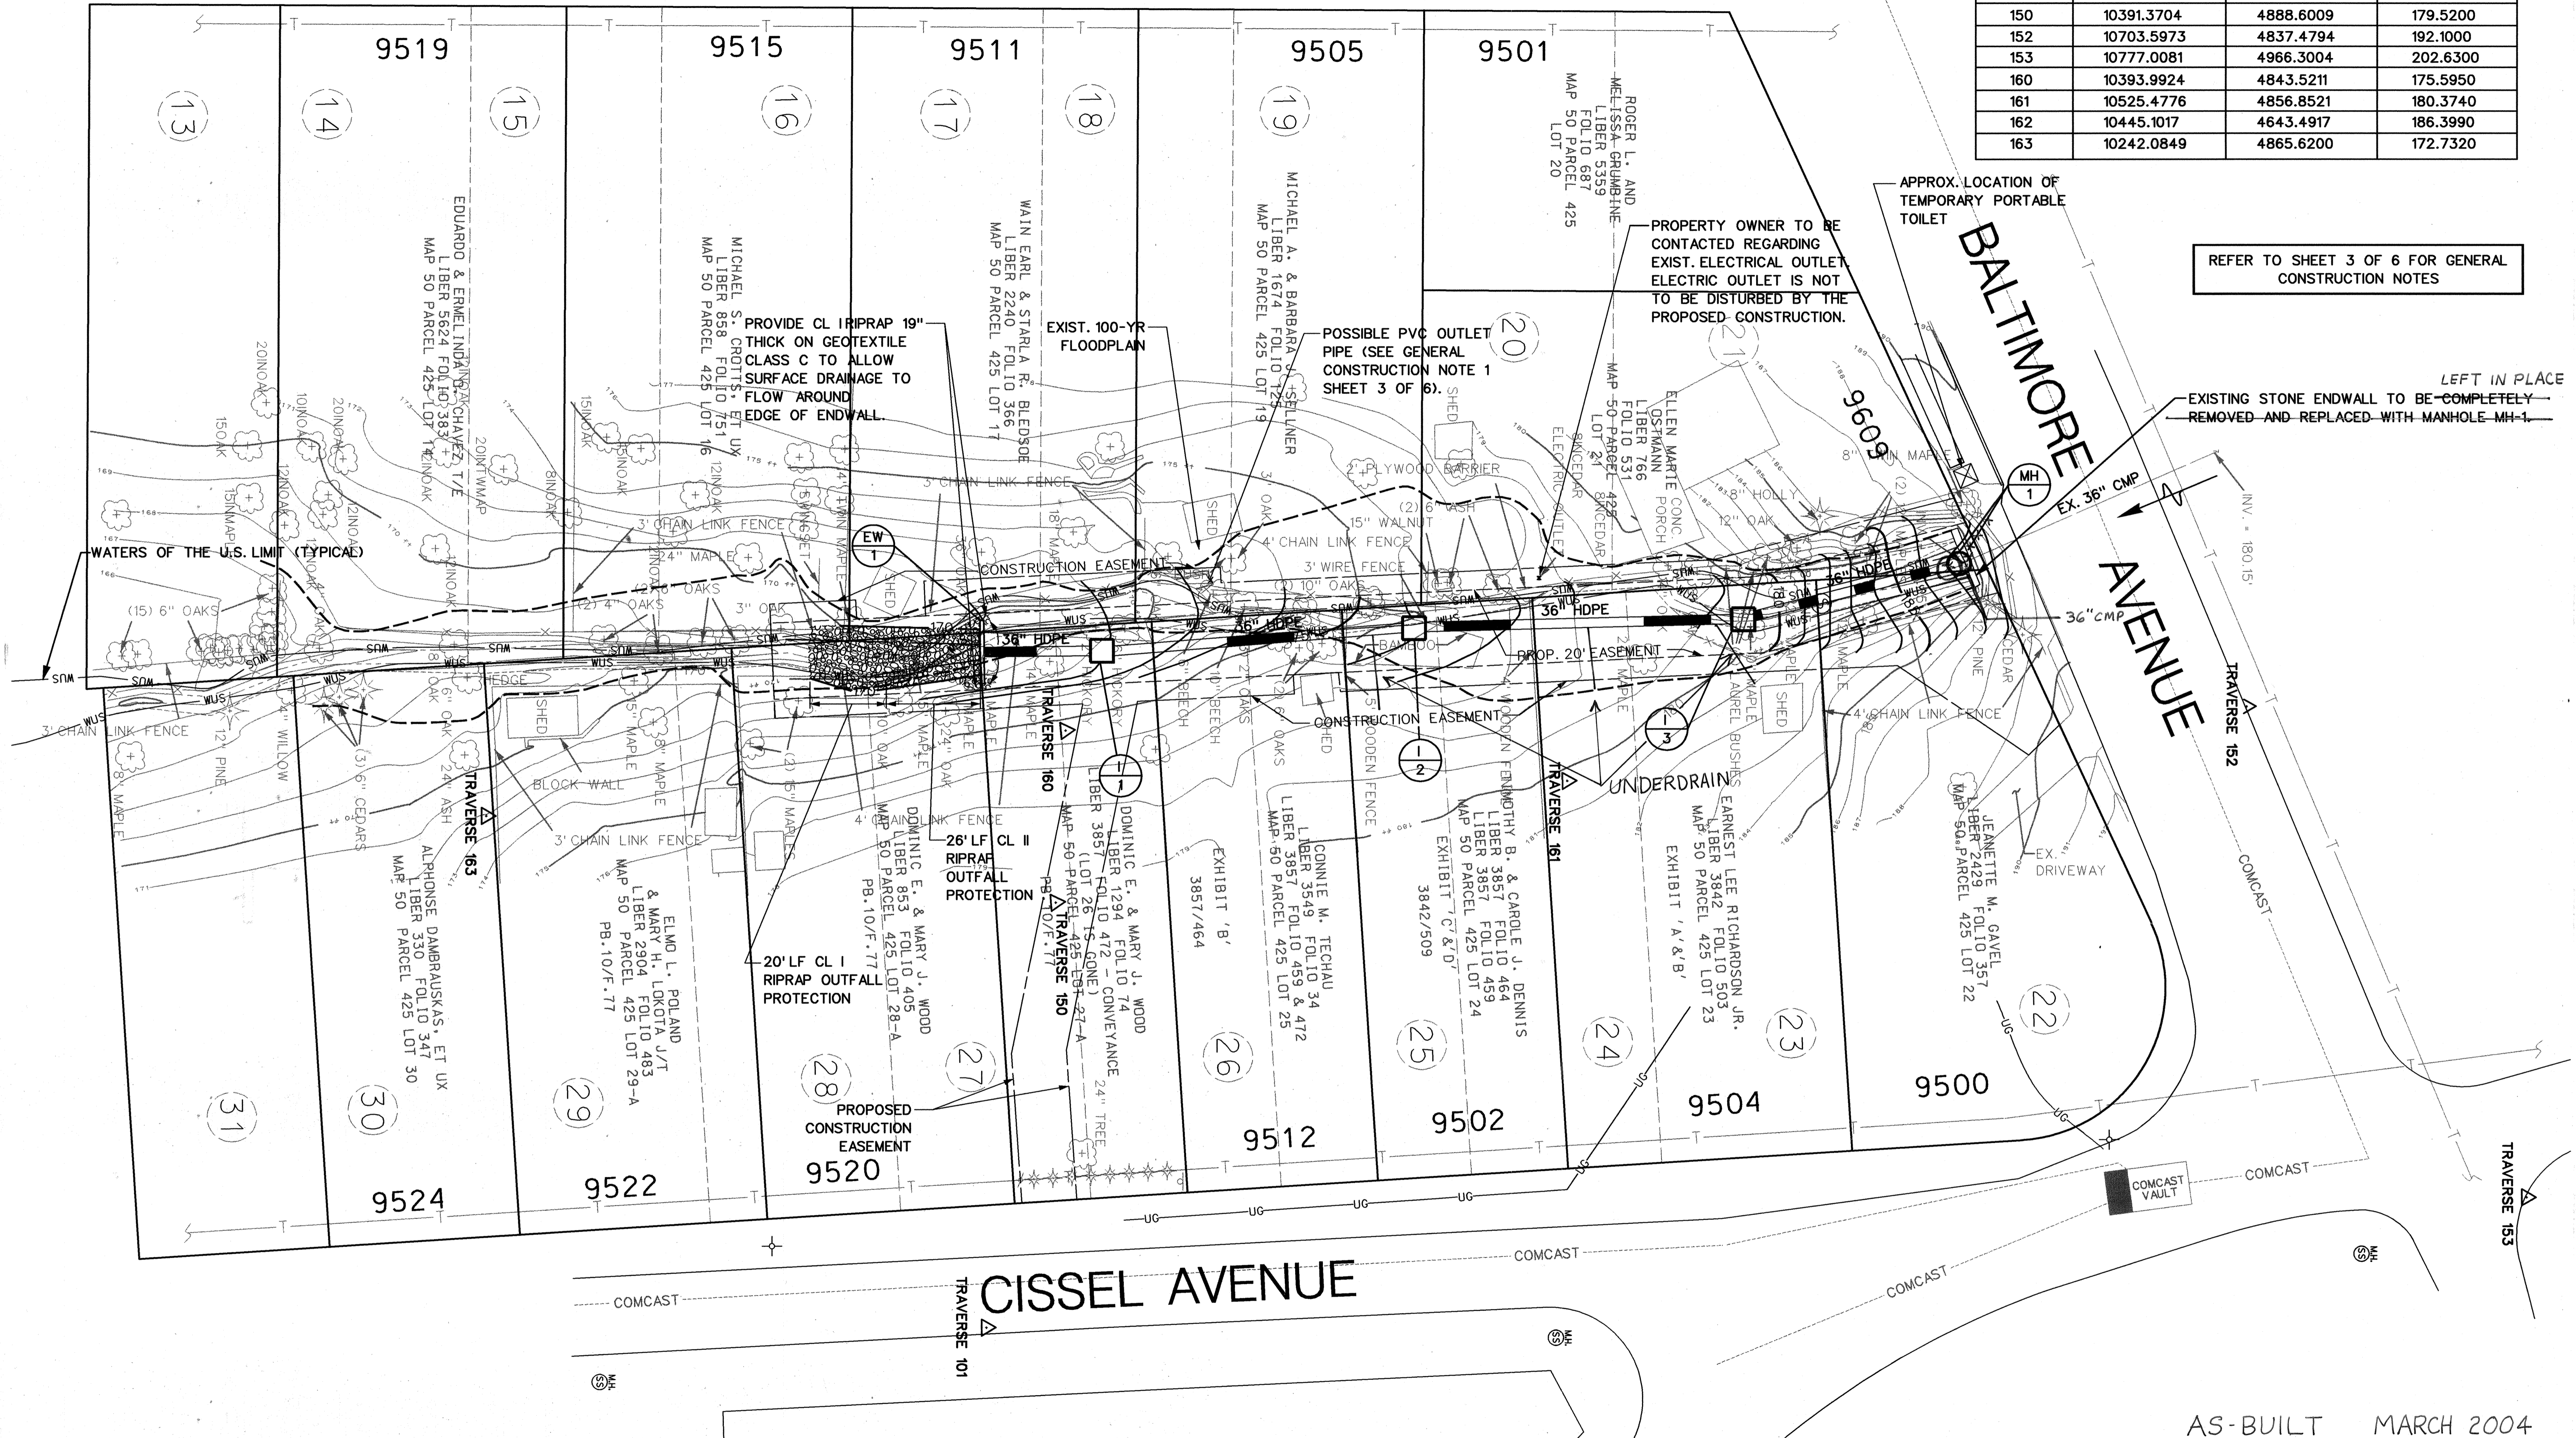

REFER TO SHEET 3 OF 6 FOR GENERAL CONSTRUCTION NOTES

EXISTING STONE ENDWALL TO BE COMPLETELY REMOVED AND REPLACED WITH MANHOLE MH-1

BALTIMORE AVENUE

CISSEL AVENUE

AS-BUILT MARCH 2004


PLOTTED: 10:01 AM on Friday, June 27, 2003
 FILE: m:\2001\010128\Drawings\9501.dgn

DEPARTMENT OF PUBLIC WORKS HOWARD COUNTY, MARYLAND		ENGINEERS PLANNERS SCIENTISTS CONSTRUCTION MANAGERS KCI TECHNOLOGIES 10 NORTH PARK DRIVE HUNT VALLEY, MD 21030 PHONE: (410) 316-7800 FAX: (410) 316-7817 www.kci.com	
[Signature] 7/15/03 DIRECTOR OF PUBLIC WORKS [Signature] 7/16/03 CHIEF, BUREAU OF HIGHWAYS	[Signature] 7/10/03 CHIEF, BUREAU OF ENVIRONMENTAL SERVICES	[Signature] 7/10/03 CHIEF, STORMWATER MANAGEMENT DIVISION	DATE

DES: DCD DRN: DJS CHK: MSR DATE: 6/03	BY NO. REVISION
--	-----------------

SITE PLAN	
DATE: 6/03	DATE: 6/03
600' SCALE MAP NO.	BLOCK NO.

HOWARD COUNTY DEPARTMENT OF PUBLIC WORKS NORTH LAUREL PARK DRAINAGE IMPROVEMENTS CAPITAL PROJECT D-1146	SCALE 1"=20' SHEET 2 OF 6
--	------------------------------------

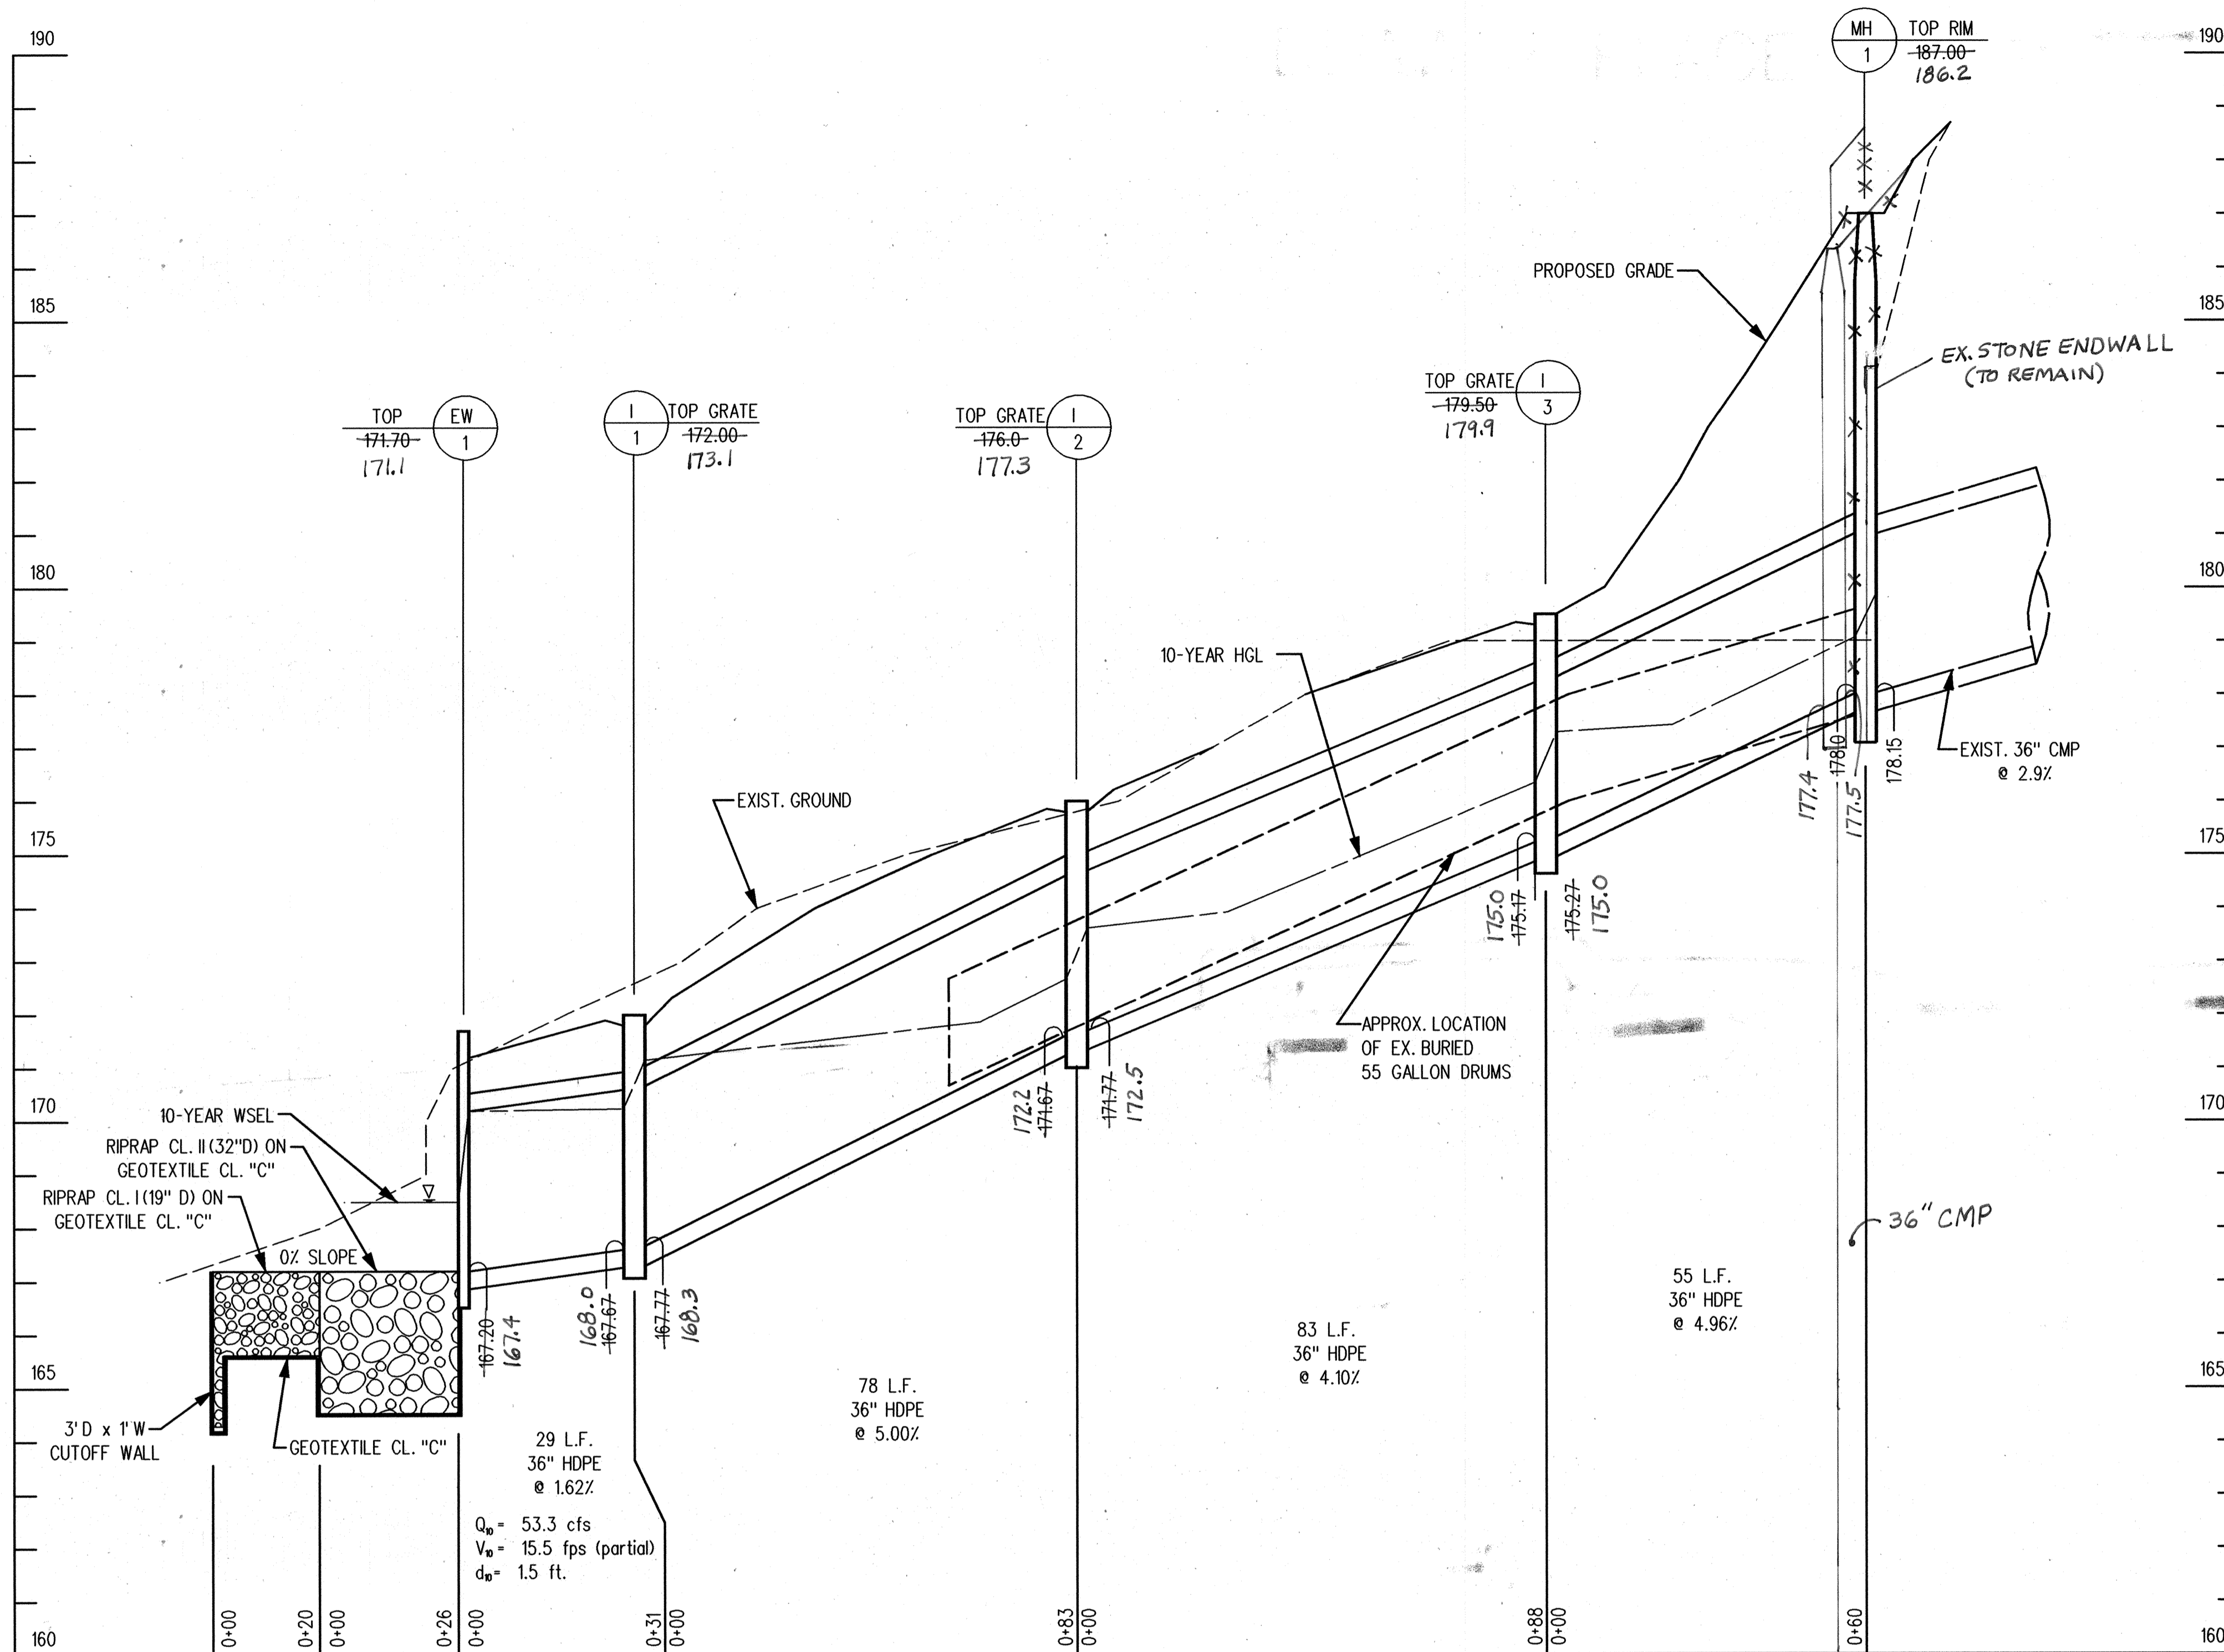

GENERAL CONSTRUCTION NOTES

1. ANY SUMP PUMP OR OTHER UNDER DRAIN PIPES CURRENTLY DISCHARGING INTO THE EXISTING CHANNEL SHALL BE EXTENDED AND CONNECTED TO THE NEAREST PROPOSED INLET TO INSURE POSITIVE DRAINAGE.
2. PROPOSED FENCES, BUILDING STRUCTURES, AND OTHER OBSTRUCTIONS SHALL NOT BE LOCATED WITHIN THE PROPOSED DRAINAGE EASEMENT.
3. THE EXISTING 55-GALLON DRUM STORM DRAIN PIPE SHALL BE REMOVED AND SHALL BE INCIDENTAL TO THE COST OF CONSTRUCTING THE PROPOSED STORM DRAIN PIPE.
4. ALL PROPOSED INLETS, MANHOLES, AND ENDWALLS SHALL BE PRECAST. ALL PROPOSED INLETS SHALL HAVE A 4' x 2.5' INSIDE DIMENSION. THE 4' DIMENSION SHALL BE ON THE SIDE OF THE INLET WITH THE 36" PIPE.
5. THE TRUNKS OF THE EXISTING TREES TO BE REMOVED SHALL BE CUT INTO FIREWOOD LENGTH LOGS AND LEFT ON THE SAME PROPERTY WHERE THE TREE WAS REMOVED FOR THE HOMEOWNER TO SPLIT AND USE, UNLESS OTHERWISE NOTED IN THE EASEMENT DOCUMENTS.
6. ALL STUMPS OF EXISTING TREES TO BE REMOVED THAT ARE WITHIN 3' OF THE PROPOSED STORM DRAIN PIPE, APPURTENANCES, AND RIPRAP OUTFALL PROTECTION SHALL BE REMOVED AND DISPOSED OF OFFSITE.
7. ALL INLETS SHALL HAVE 6" DIAMETER OPENINGS WITH HARDWARE CLOTH PLACED ON THE OUTSIDE OF THE OPENING. (REFER TO HOWARD CO. STD. SD-4.01, SD-4.02, AND SD-4.23. 6" DIAMETER OPENING TO BE USED IN LIEU OF 4" X 4" OPENING ON STD. DETAILS.)
8. THE GROUND WITHIN 6' OF EACH SIDE OF EACH YARD INLET SHALL BE FINE GRADED TO ALLOW FLOW INTO ALL FOUR SIDES OF THE INLET. SURFACE FLOW AT THE ENDWALL SHALL BE FINE GRADED TO GO AROUND THE EDGES OF THE ENDWALL ON THE RIPRAP AREAS SHOWN ON THE PLANS.
9. ANY EXCAVATED MATERIAL WITH BAMBOO ROOTS SHALL NOT BE USED AS BACKFILL FOR THIS PROJECT.

SCALE: HOR. 1" = 20'
VERT. 1" = 2'

STRUCTURE SCHEDULE

NO.	TYPE	HOWARD CO. STD. NO.	COORDINATES **	TOP ELEV.	INV. OUT	REMARKS
EW-1	TYPE "C" ENDWALL - 36-INCH	SD 5.21	N 10372.1490, E 4822.8822	-171.70	-167.20	
I-1	TYPE "D" INLET - MOD. 4' x 2.5'*	MOD. SD 4.11	N 10403.5920, E 4822.6370	-172.00	-167.60	OPENING TO BE PLACED ON ALL 4 SIDES
I-2	TYPE "D" INLET - MOD. 4' x 2.5'*	MOD. SD 4.11	N 10485.4800, E 4816.7910	-176.00	-171.67	OPENING TO BE PLACED ON ALL 4 SIDES
I-3	TYPE "D" INLET - MOD. 4' x 2.5'*	MOD. SD 4.11	N 10571.7660, E 4814.5440	-179.50	-175.17	OPENING TO BE PLACED ON ALL 4 SIDES
MH-1	5'-0" STD. PRECAST MANHOLE	G 5.13	N 10628.3870, E 4799.9100	-187.00	-178.00	REPLACE EXISTING ENDWALL

* SEE NOTE 4 THIS SHEET.
** COORDINATES ARE TO CENTER OF STRUCTURE.

SEE ABOVE FOR AS-BUILT ELEVATIONS

AS-BUILT MARCH 2004

PLOTTED: 10:01 AM on Friday, June 27, 2003
FILE: \\ms2000\0101028\N\Projects\83\8301.dgn

DEPARTMENT OF PUBLIC WORKS
HOWARD COUNTY, MARYLAND

John P. Shaw 7/15/03
DIRECTOR OF PUBLIC WORKS DATE

John P. Shaw 7/10/03
CHIEF, BUREAU OF ENVIRONMENTAL SERVICES DATE

Howard C. Salzman 7/10/03
CHIEF, STORMWATER MANAGEMENT DIVISION DATE

ENGINEERS
PLANNERS
SCIENTISTS
CONSTRUCTION MANAGERS

KCI
TECHNOLOGIES

10 NORTH PARK DRIVE
HUNT VALLEY, MD 21030
PHONE (410) 316-7800
FAX (410) 316-7817
www.kci.com



DES: DCD			
DRN: DJS			
CHK: MSR			
DATE: 6/03			
BY	NO.	REVISION	DATE

STORM DRAIN PROFILE

600' SCALE MAP NO. _____ BLOCK NO. _____

HOWARD COUNTY DEPARTMENT OF PUBLIC WORKS


**NORTH LAUREL PARK
DRAINAGE IMPROVEMENTS**

CAPITAL PROJECT D-1146

SCALE AS SHOWN
SHEET 3 OF 6

HADDADAWY PLACE

TRAVERSE 162

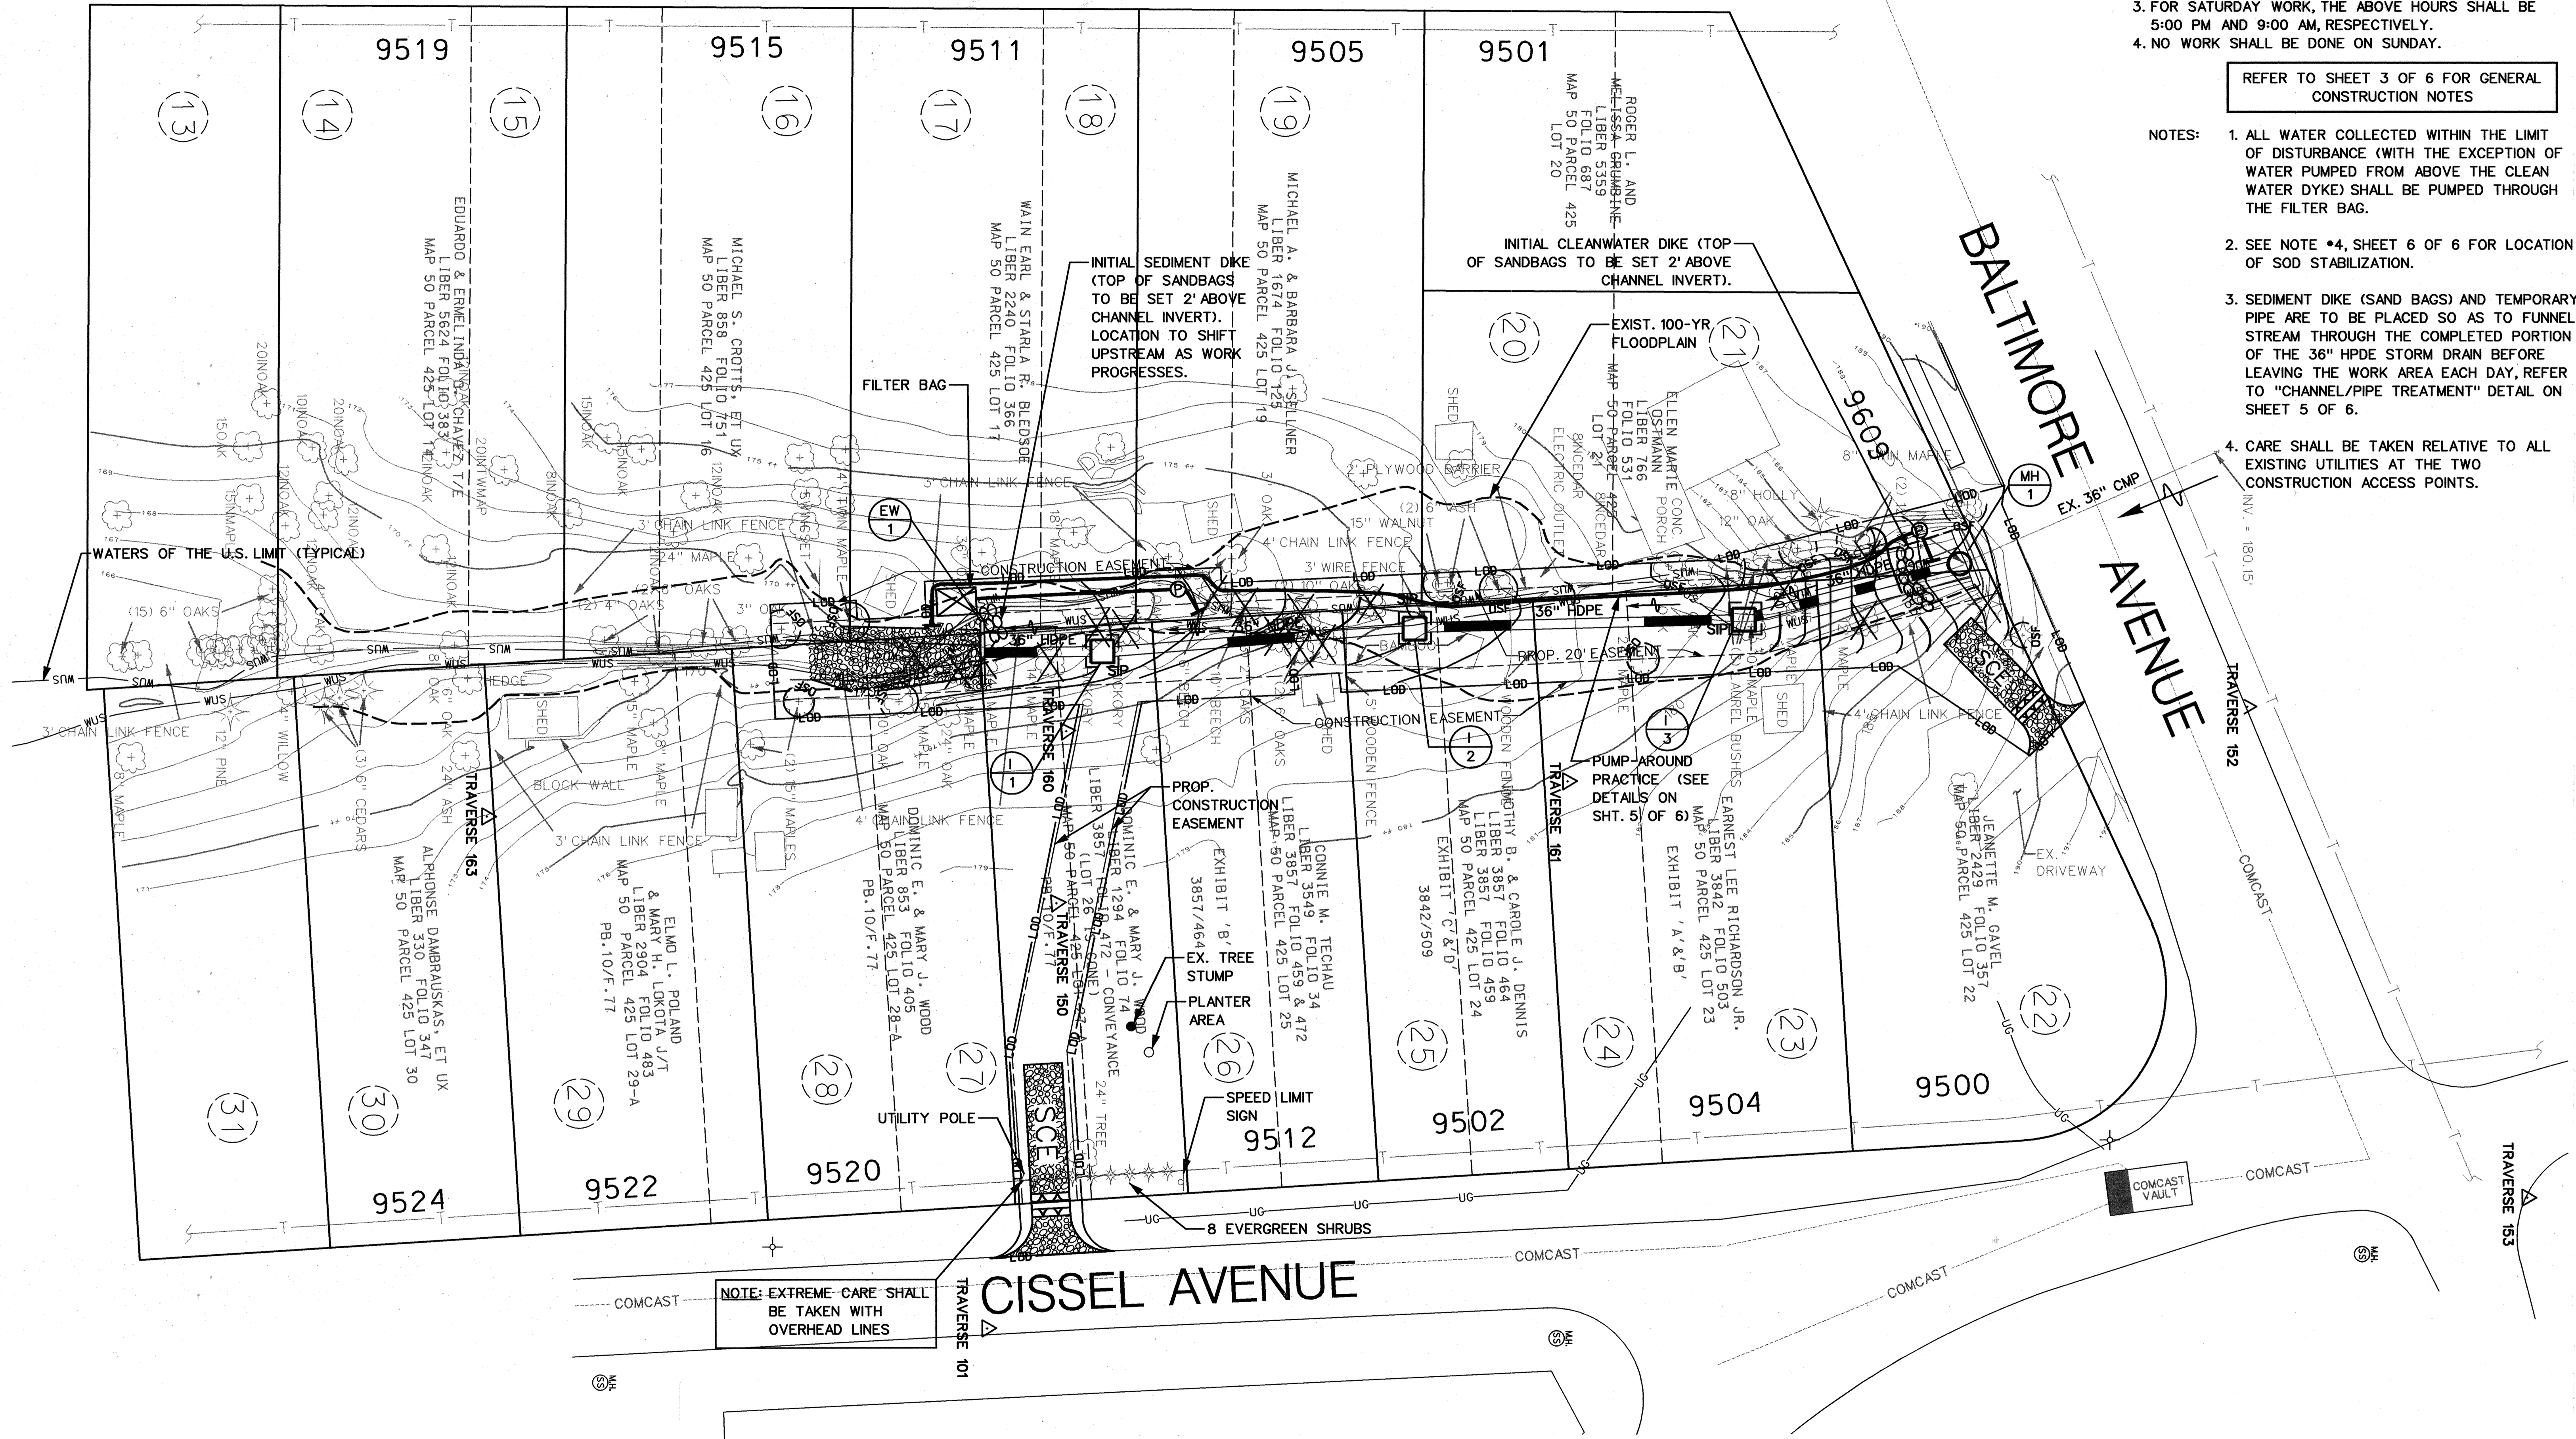

- TIME RESTRICTION NOTES:**
1. PUMPING IS NOT PERMITTED BETWEEN THE HOURS OF 7:00 PM AND 7:00 AM, MONDAY THROUGH FRIDAY.
 2. CONSTRUCTION EQUIPMENT SHALL NOT BE STARTED NOR RUN BETWEEN THE HOURS OF 7:00 PM AND 7:00 AM, MONDAY THROUGH FRIDAY.
 3. FOR SATURDAY WORK, THE ABOVE HOURS SHALL BE 5:00 PM AND 9:00 AM, RESPECTIVELY.
 4. NO WORK SHALL BE DONE ON SUNDAY.

REFER TO SHEET 3 OF 6 FOR GENERAL CONSTRUCTION NOTES


- NOTES:**
1. ALL WATER COLLECTED WITHIN THE LIMIT OF DISTURBANCE (WITH THE EXCEPTION OF WATER PUMPED FROM ABOVE THE CLEAN WATER DYKE) SHALL BE PUMPED THROUGH THE FILTER BAG.
 2. SEE NOTE #4, SHEET 6 OF 6 FOR LOCATION OF SOD STABILIZATION.
 3. SEDIMENT DIKE (SAND BAGS) AND TEMPORARY PIPE ARE TO BE PLACED SO AS TO FUNNEL STREAM THROUGH THE COMPLETED PORTION OF THE 36" HDPE STORM DRAIN BEFORE LEAVING THE WORK AREA EACH DAY, REFER TO "CHANNEL/PIPE TREATMENT" DETAIL ON SHEET 5 OF 6.
 4. CARE SHALL BE TAKEN RELATIVE TO ALL EXISTING UTILITIES AT THE TWO CONSTRUCTION ACCESS POINTS.

NOTE: EXTREME CARE SHALL BE TAKEN WITH OVERHEAD LINES

PLOTTED: 10:11 AM on Friday, June 27, 2003
 FILE: m:\2000\1010128\1010128.dwg
 PLOT: m:\2000\1010128\1010128.dwg

DEPARTMENT OF PUBLIC WORKS HOWARD COUNTY, MARYLAND	
Director of Public Works <i>[Signature]</i> DATE: 7/15/03	Chief, Bureau of Environmental Services <i>[Signature]</i> DATE: 7/10/03
Chief, Bureau of Highways <i>[Signature]</i> DATE: 7/10/03	Chief, Stormwater Management Division <i>[Signature]</i> DATE: 7/10/03

KCI TECHNOLOGIES
 ENGINEERS, PLANNERS, SCIENTISTS, CONSTRUCTION MANAGERS
 10 NORTH PARK DRIVE
 HUNTS VALLEY, MD 21030
 PHONE: (410) 316-7800
 FAX: (410) 316-7817
 WWW.KCI.COM

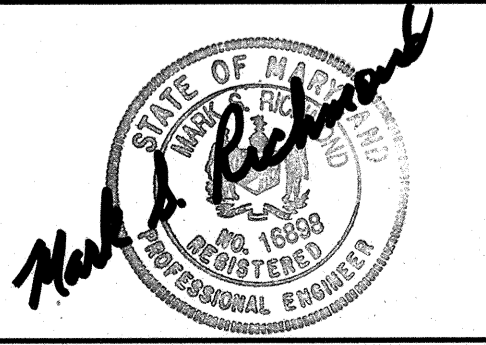


DES: DCD					
DRN: DJS					
CHK: MSR					
DATE: 6/03					
BY: NO.					


SEDIMENT AND EROSION CONTROL PLAN
 DATE: 6/03 SCALE MAP NO. BLOCK NO.

HOWARD COUNTY DEPARTMENT OF PUBLIC WORKS
 NORTH LAUREL PARK DRAINAGE IMPROVEMENTS
 CAPITAL PROJECT D-1146
 SCALE: 1"=20'
 SHEET: 4 OF 6


DETAIL 24 - STABILIZED CONSTRUCTION ENTRANCE

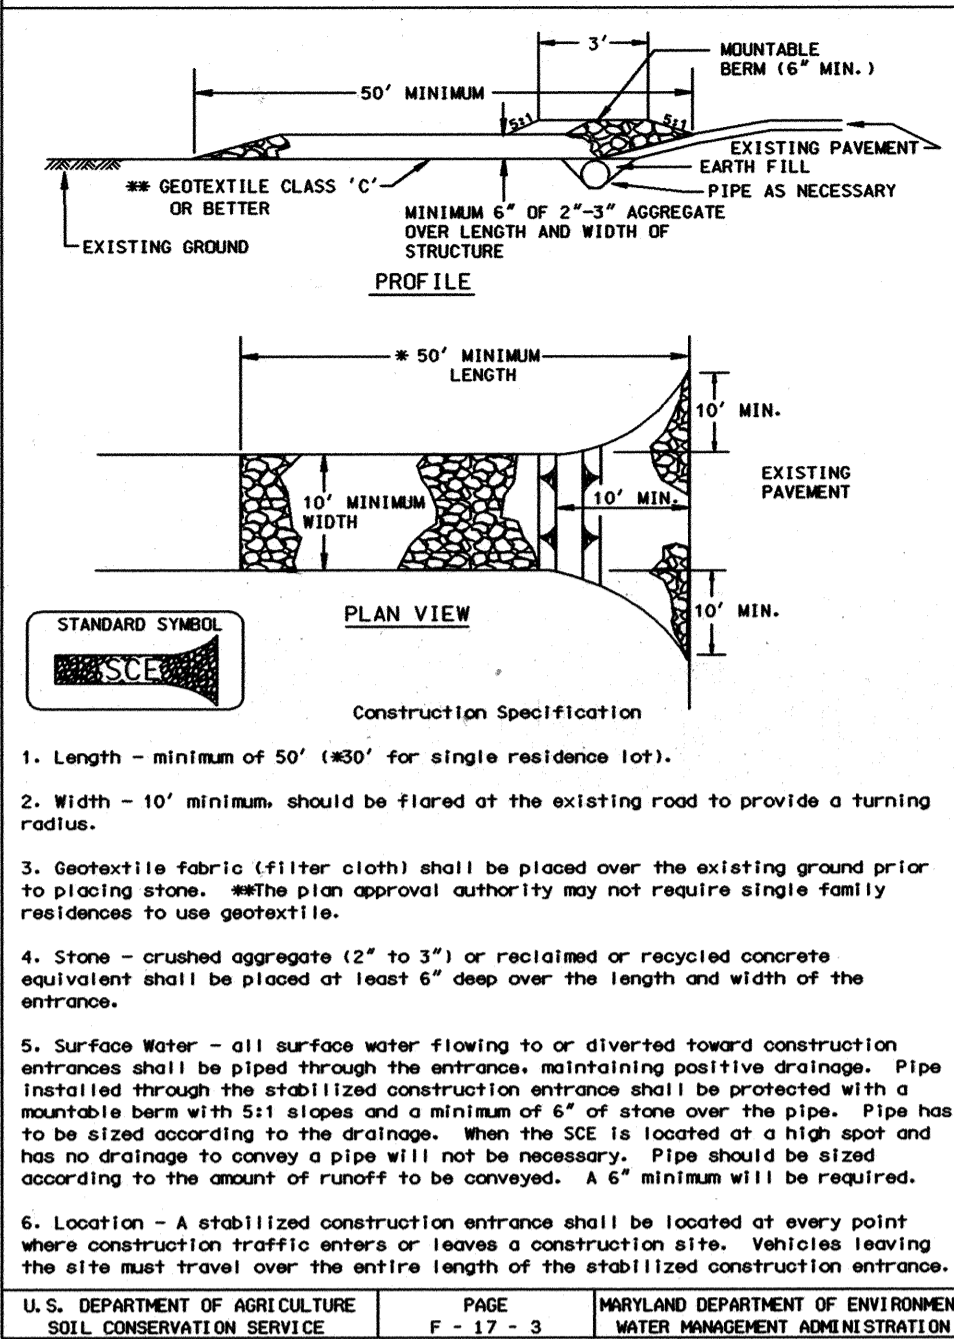

DETAIL 23A - STANDARD INLET PROTECTION

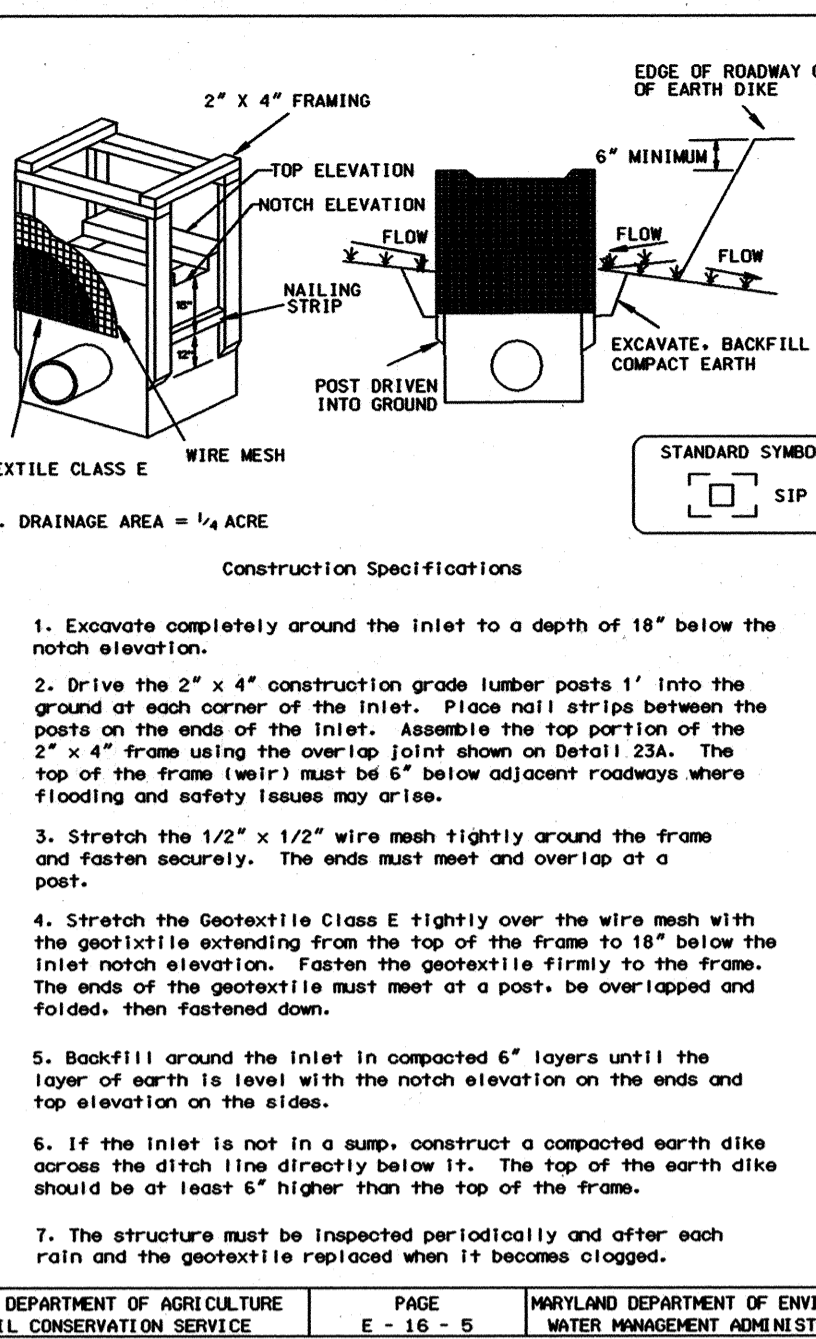


DETAIL 26 - ROCK OUTLET PROTECTION II

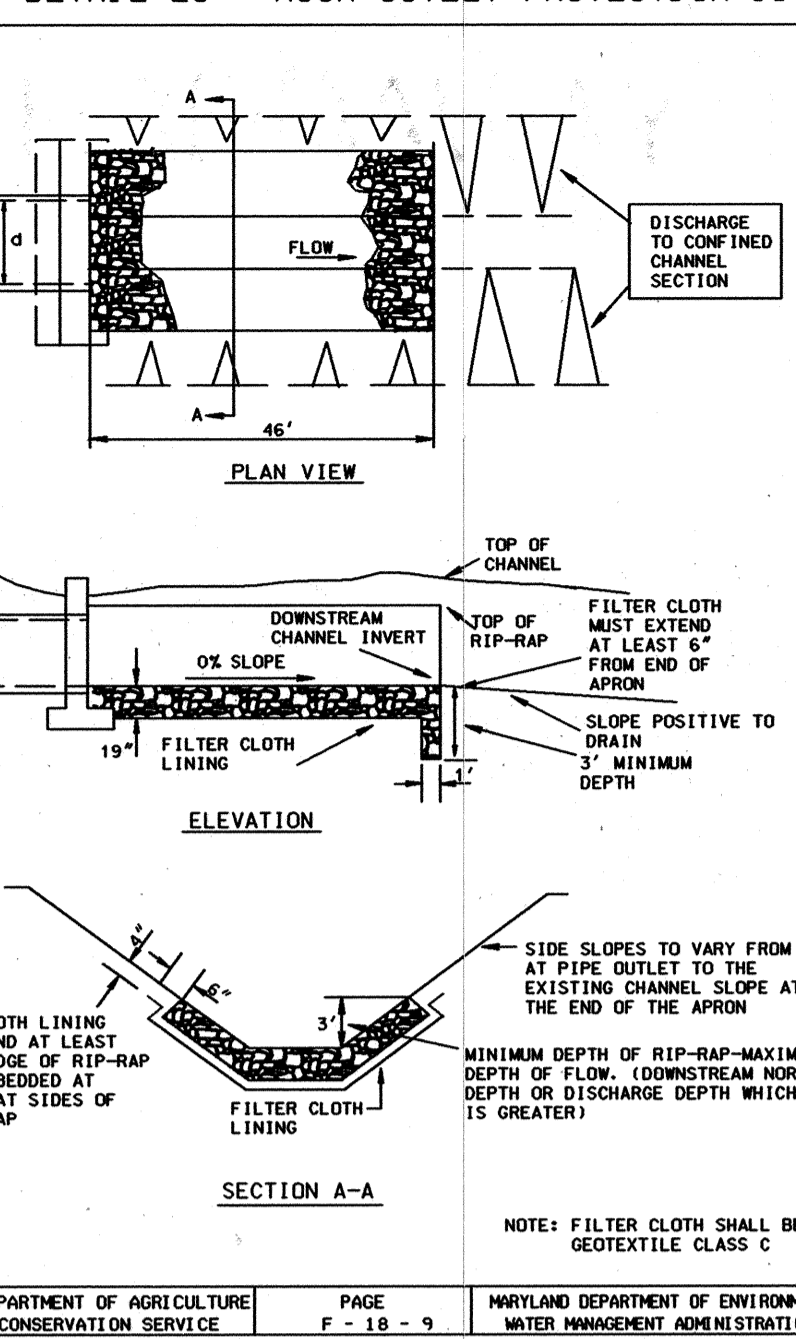

ROCK OUTLET PROTECTION II

Construction Specifications for rock outlet protection II, including requirements for rip-rap, geotextile, and stone placement.

SILT BAG DEWATERING DEVICE FOR PUMPED WATER

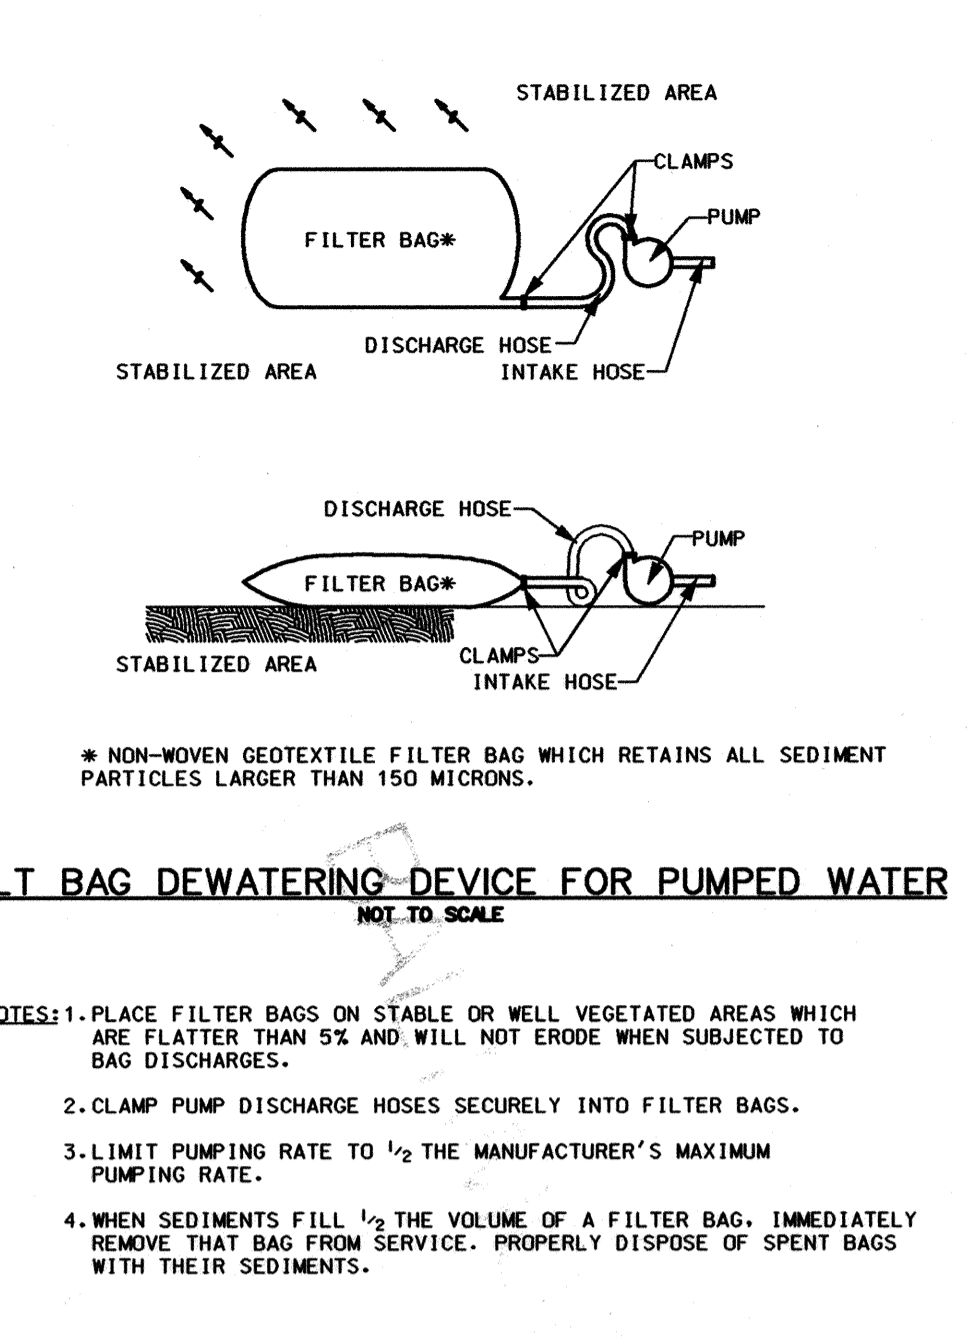

24.0 MATERIALS AND SPECIFICATIONS

Table 27: Geotextile Fabrics. Columns include Class, Apparent Opening Size (mm), Grab Tensile Strength (lb/min), and Burst Strength (psim).

HOWARD SOIL CONSERVATION DISTRICT

TEMPORARY SEEDING NOTES: Apply to graded or cleared areas likely to be re-disturbed...


HOWARD COUNTY CONSERVATION DISTRICT

STANDARD SEDIMENT CONTROL NOTES: A minimum of 48 hours notice must be given to the Howard County Department of Inspections...

MGCW TEMP. PUMP-AROUND PRACTICE

Temporary measure for dewatering in-channel construction sites. Description and implementation sequence.

DETAIL 1.2: PUMP-AROUND PRACTICE

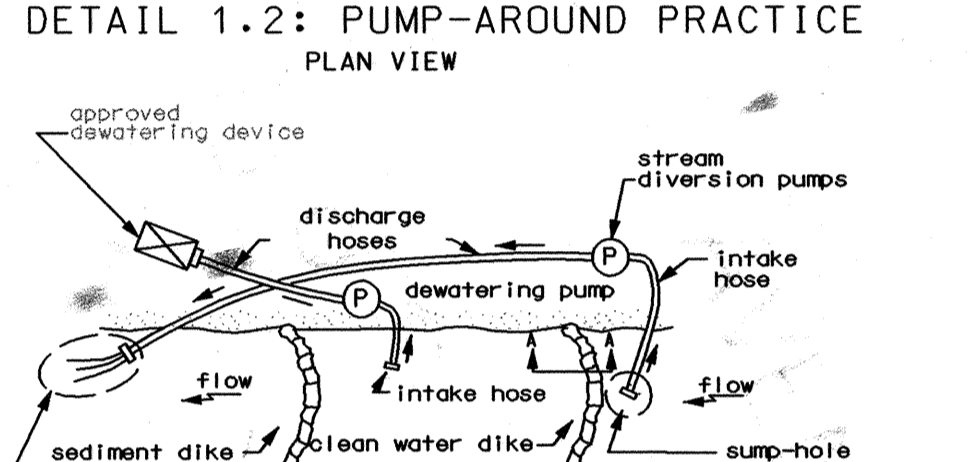

PROPERTIES SHALL BE DETERMINED IN ACCORDANCE WITH THE FOLLOWING PROCEDURES: APPARENT OPENING SIZE, GRAB TENSILE STRENGTH, BURST STRENGTH.

HOWARD COUNTY CONSERVATION DISTRICT STANDARD SEDIMENT CONTROL NOTES: 1. A minimum of 48 hours notice must be given...

IMPLEMENTATION SEQUENCE: 1. Construction activities including the installation of erosion and sediment control measures...

DESCRIPTION: The work shall consist of installing a temporary pump around and supporting measures to divert flow around in-stream construction sites.

TEMPORARY MEASURE FOR DEWATERING IN-CANAL CONSTRUCTION SITES: 1. A minimum of 48 hours notice must be given to the Howard County Department of Inspections...

HOWARD SOIL CONSERVATION DISTRICT PERMANENT SEEDING NOTES: Apply to graded or cleared areas not subject to immediate further disturbance...

HOWARD COUNTY CONSERVATION DISTRICT STANDARD SEDIMENT CONTROL NOTES: 1. A minimum of 48 hours notice must be given to the Howard County Department of Inspections...

IMPLEMENTATION SEQUENCE: 1. A minimum of 48 hours notice must be given to the Howard County Department of Inspections...

IMPLEMENTATION SEQUENCE: 1. Construction activities including the installation of erosion and sediment control measures...

TEMPORARY MEASURE FOR DEWATERING IN-CANAL CONSTRUCTION SITES: 1. A minimum of 48 hours notice must be given to the Howard County Department of Inspections...

HOWARD SOIL CONSERVATION DISTRICT PERMANENT SEEDING NOTES: Apply to graded or cleared areas not subject to immediate further disturbance...

HOWARD COUNTY CONSERVATION DISTRICT STANDARD SEDIMENT CONTROL NOTES: 1. A minimum of 48 hours notice must be given to the Howard County Department of Inspections...

IMPLEMENTATION SEQUENCE: 1. A minimum of 48 hours notice must be given to the Howard County Department of Inspections...

IMPLEMENTATION SEQUENCE: 1. Construction activities including the installation of erosion and sediment control measures...

TEMPORARY MEASURE FOR DEWATERING IN-CANAL CONSTRUCTION SITES: 1. A minimum of 48 hours notice must be given to the Howard County Department of Inspections...

DEPARTMENT OF PUBLIC WORKS HOWARD COUNTY, MARYLAND. Includes signatures and dates for Director of Public Works and Chief, Bureau of Environmental Services.

ENGINEERS PLANNERS SCIENTISTS CONSTRUCTION MANAGERS. KCI TECHNOLOGIES logo and contact information.

STATE OF MARYLAND seal and signature of Mark A. Schuchman, Director of Public Works.

EROSION AND SEDIMENT CONTROL NOTES AND DETAILS. Includes project information: DES: DCD, DRN: DJS, CHK: MSR, DATE: 6/03, BY: NO., REVISION, DATE: 600' SCALE MAP NO., BLOCK NO.

HOWARD COUNTY DEPARTMENT OF PUBLIC WORKS. NORTH LAUREL PARK DRAINAGE IMPROVEMENTS. CAPITAL PROJECT D-1146. SCALE: AS SHOWN, SHEET: 5 OF 6.

HADDAWAY PLACE


TRAVERSE 162

REFER TO SHEET 3 OF 6 FOR GENERAL CONSTRUCTION NOTES

RECOMMENDED TREE SPECIES

BOTANICAL NAME	COMMON NAME	SIZE	SPACING	TYPE	SYMBOL
Acer rubrum	Red Maple	1" cal.	SEE NOTE *1	B&B	○
Liriodendron tulipifera	Tulip Poplar	1" cal.	SEE NOTE *1	B&B	○
Fraxinus pennsylvanica	Green Ash	1" cal.	SEE NOTE *1	B&B	○
Quercus phellos	Willow Oak	1" cal.	SEE NOTE *1	B&B	○
Ilex x meserveae	Blue Princess Holly	3' height	SEE NOTE *2	B&B	○

- NOTES:
- TREES TO BE PLANTED AT LOCATIONS SHOWN AT APPROXIMATELY 17' ON CENTER LINEARLY. SPECIES TO BE SELECTED BY HOMEOWNERS FROM LIST ABOVE.
 - SHRUBS TO BE PLANTED AT LOCATIONS SHOWN AT 5.0' ON CENTER.
 - NEW TREES SHALL NOT BE PLANTED WITHIN THE PROPOSED 20' DRAINAGE EASEMENT.
 - ALL AREAS WITHIN THE L.O.D. SHALL HAVE 4" OF TOPSOIL APPLIED AND BE PERMANENTLY STABILIZED AS DESCRIBED IN PERMANENT SEEDING NOTES ON SHEET 5 OF 6.
 - SOD SHALL BE USED IN THE FOLLOWING LOCATIONS AND AS DESCRIBED IN SOLID SOD NOTES ON SHEET 5 OF 6.
 - 6' WIDE ALONG FLOW LINE OF PROPOSED SURFACE SWALE.
 - 6' OUTSIDE EACH PROPOSED INLET ON ALL FOUR SIDES OF INLET
 - 4" OF TOPSOIL SHALL BE APPLIED TO ALL SOD AREAS

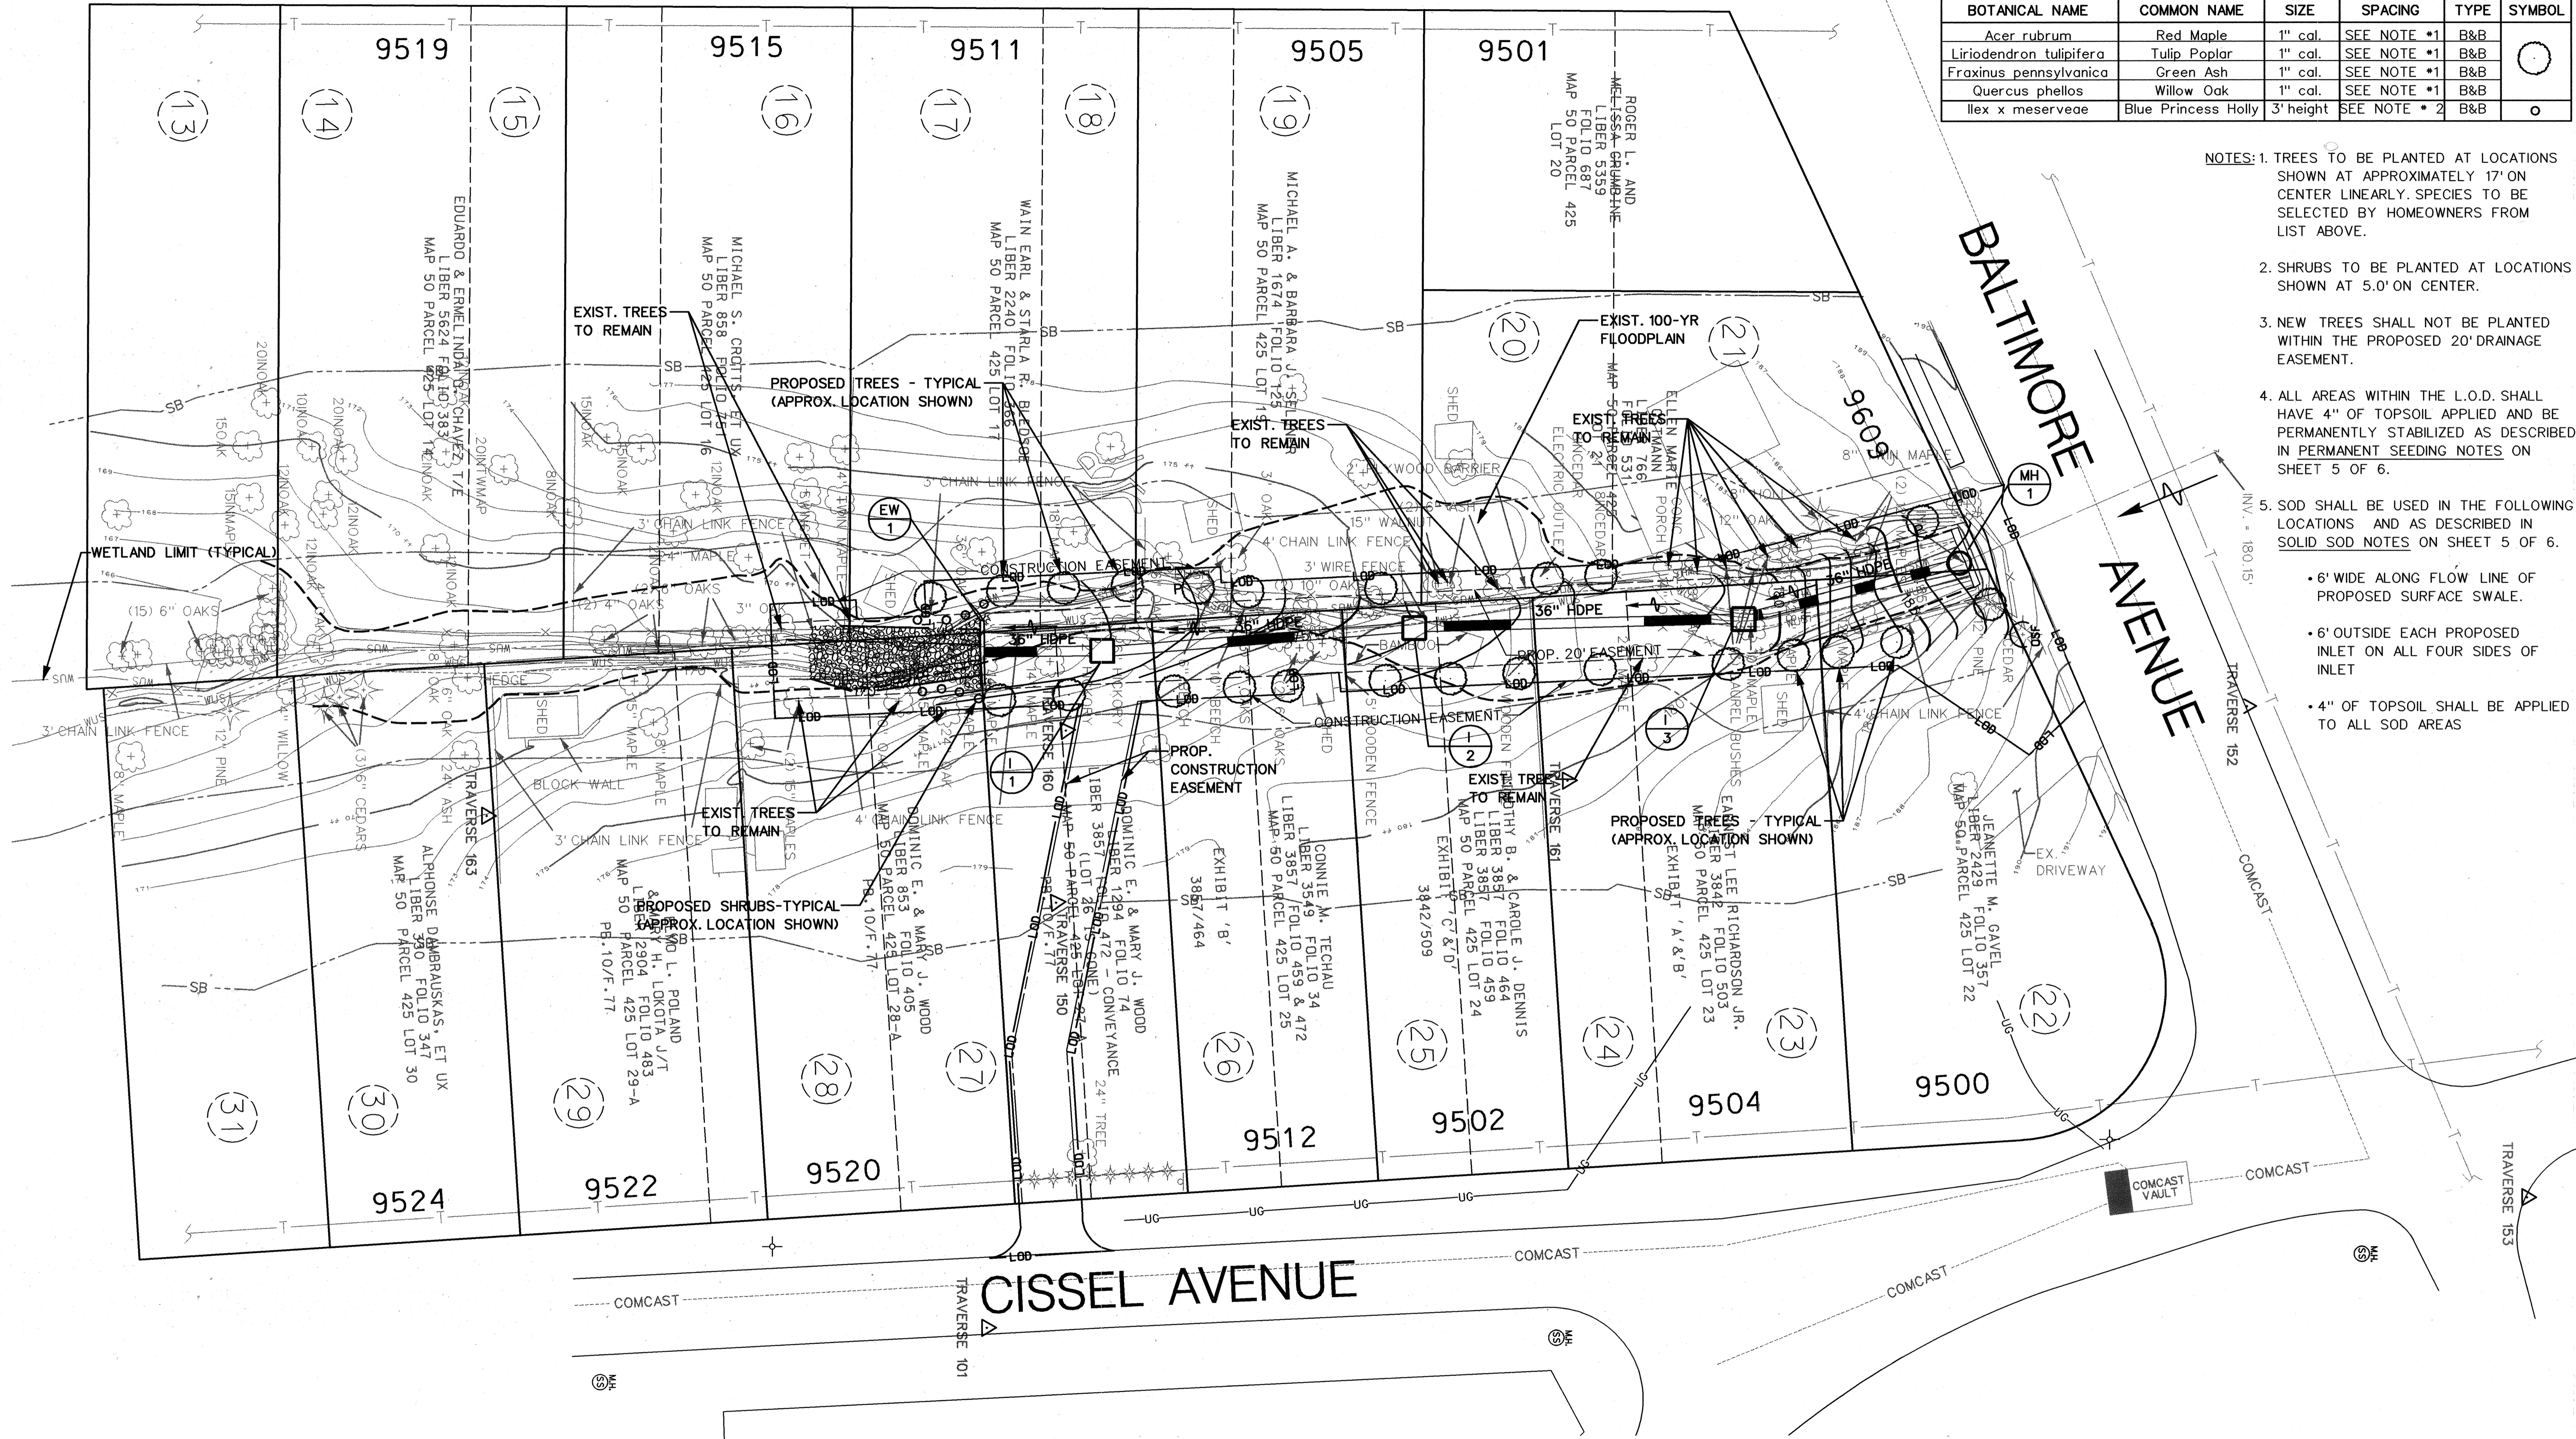

PLOTTED: 10:12 AM on Friday, June 27, 2003
 FILE: m:\2003\062728\NORTH LAUREL PARK.dwg

DEPARTMENT OF PUBLIC WORKS
HOWARD COUNTY, MARYLAND

Director of Public Works: *7/15/03*
 Chief, Bureau of Environmental Services: *7/10/03*
 Chief, Stormwater Management Division: *7/10/03*

KCI TECHNOLOGIES
 10 NORTH PARK DRIVE
 HUNT VALLEY, MD 21030
 Phone: (410) 316-7808
 Fax: (410) 316-7817
 www.kci.com

ENGINEERS
 PLANNERS
 SCIENTISTS
 CONSTRUCTION MANAGERS

STATE OF MARYLAND
 PROFESSIONAL ENGINEER

DES: DCD					
DRN: DJS					
CHK: MSR					
DATE: 6/03					
BY	NO.	REVISION			

LANDSCAPE PLAN

DATE: 6/03

600' SCALE MAP NO. _____

BLOCK NO. _____

HOWARD COUNTY DEPARTMENT OF PUBLIC WORKS

NORTH LAUREL PARK DRAINAGE IMPROVEMENTS

CAPITAL PROJECT D-1146

SCALE: 1"=20'

SHEET: 6 OF 6