

MATCHLINE A-A SEE SHEET 5 OF 10


**SEDIMENT BASIN NO. 1**

Drainage Area: 18.32 Ac.  
 Storage Required: 65,952 cu. ft. wet and dry  
 Storage Provided: 113,339 cu. ft. wet and dry  
 Riser Crest Elevation: 277.00 ✓  
 Bottom Basin Elevation: 272.00 ✓  
 Top Dam Elevation: 282.20 ✓  
 Draw-Down Wet Pool Elevation: 274.00 ✓  
 Basin Clean-Out Elevation: 273.00  
 Emergency Spillway Crest Elevation: 280.00 ✓  
 Design High Water Elevation: 281.16  
 See Detail Sheet 7 and 8 of 10

MATCHLINE A-A SEE SHEET 5 OF 10

**LEGEND**

Existing Contour		362
Proposed Contour		+82.52
Spot Elevation		
Existing Trees to Remain		
Utility Poles		
Stabilized Construction Entrance		
Silt Fence		SF
Super Silt Fence		SSF
Earth Dike		ED A-1
25' Mining Buffer		
Permit Limit		Permit Limit
Limit of Disturbance		LOD
Property Line		
Erosion Control Matting		
Temporary Initial Dam Contours		
Rip Rap Inflow Protection		RIP
Removable Pump Station		RPS

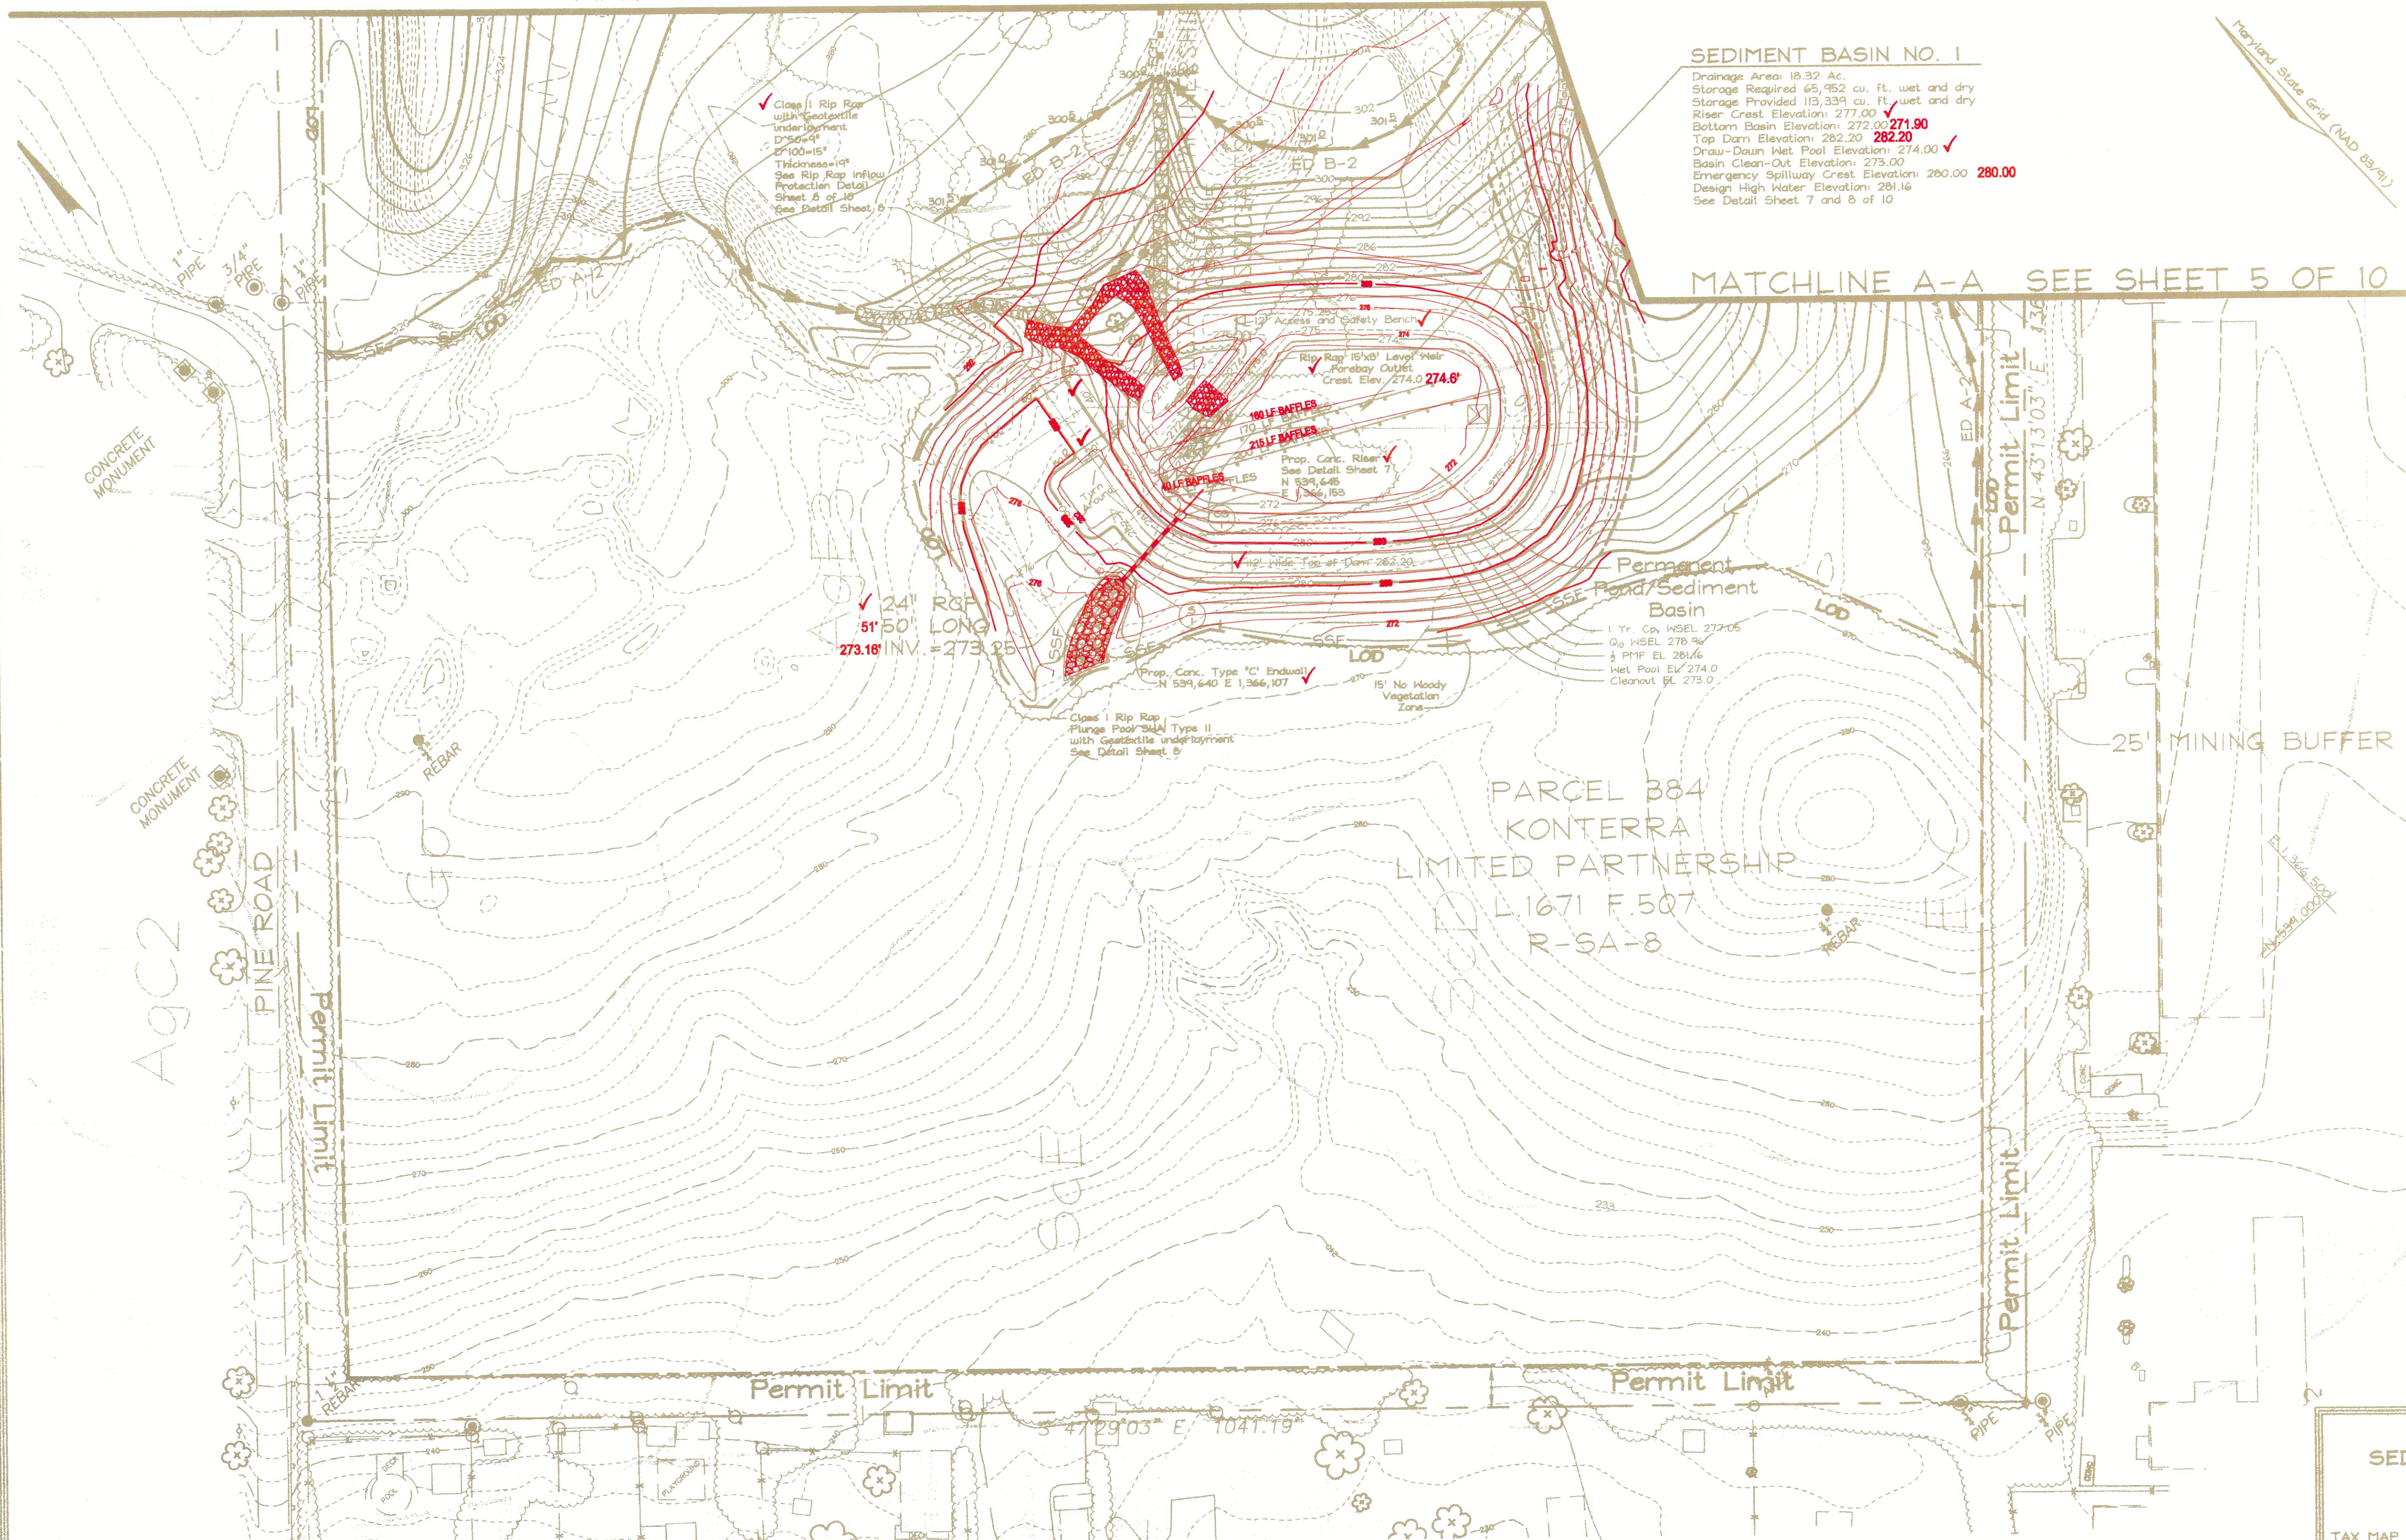

PARCEL 384  
 KONTERRA  
 LIMITED PARTNERSHIP  
 L1671 F.507  
 R-SA-8

AS-BUILT DATA  
 PREPARED BY:

**CME**  
**ENGINEERING**  
 CME ENGINEERING LP  
 27 East Main Street, Frostburg, MD 21532  
 301-689-1700 FAX: 301-689-5177  
 e-mail: info@cmemgmt.com

**PERMIT APPLICANT**  
 Savage Stone, LLC.  
 P.O. Box 850  
 Laurel MD 20725

**OWNER**  
 Konterra  
 Limited Partnership  
 P.O. Box 850  
 Laurel MD 20725

**GRADING AND  
 SEDIMENT & EROSION CONTROL PLAN  
 LAUREL LUMBER  
 MINE RECLAMATION PLAN**

TAX MAP 47 GRID 6  
 6TH ELECTION DISTRICT

PARCEL 384  
 HOWARD COUNTY, MARYLAND

REVIEWED FOR HOWARD SCD AND MEETS TECHNICAL REQUIREMENTS \*

*Jim Meyers* 11/17/06  
 USF - NATURAL RESOURCES CONSERVATION SERVICE DATE

THIS DEVELOPMENT PLAN IS APPROVED FOR SOIL EROSION AND SEDIMENT CONTROL BY THE HOWARD SOIL CONSERVATION DISTRICT \*

*John R. Blanton* 11/17/06  
 HOWARD SCD DATE

**ENGINEER'S CERTIFICATE**

I CERTIFY THAT THIS PLAN FOR SEDIMENT AND EROSION CONTROL REPRESENTS A PRACTICAL AND WORKABLE PLAN BASED ON MY PERSONAL KNOWLEDGE OF THE SITE CONDITIONS AND THAT IT WAS PREPARED IN ACCORDANCE WITH THE REQUIREMENTS OF THE HOWARD SOIL CONSERVATION DISTRICT.

*Zacharia Y. Fisch* 11/16/06  
 SIGNATURE OF ENGINEER DATE  
 ZACHARIA Y. FISCH

**PERMITTEE'S CERTIFICATE**

I/WE CERTIFY THAT ALL DEVELOPMENT AND CONSTRUCTION WILL BE DONE ACCORDING TO THIS PLAN FOR SEDIMENT AND EROSION CONTROL AND THAT ALL RESPONSIBLE PERSONNEL INVOLVED IN THE CONSTRUCTION PROJECT WILL HAVE A CERTIFICATE OF ATTENDANCE AT A DEPARTMENT OF THE ENVIRONMENT APPROVED TRAINING PROGRAM FOR THE CONTROL OF SEDIMENT AND EROSION BEFORE BEGINNING THE PROJECT. I ALSO AUTHORIZE PERIODIC ON-SITE INSPECTION BY THE HOWARD SOIL CONSERVATION DISTRICT.

*Tommy J. Schmidt* 11/16/06  
 SIGNATURE OF PERMITTEE DATE

25' MINING BUFFER


PLAN VIEW  
 SCALE: 1"=50'




**FSH Associates**  
 Engineers Planners Surveyors  
 6331 Howard Lane Ellicott City, MD 21117  
 Tel: 410-567-5200 Fax: 410-796-1962  
 E-mail: info@fshnet.com

DESIGN BY: SH  
 DRAWN BY: CRH/RJL  
 CHECKED BY: SH  
 SCALE: AS SHOWN  
 DATE: Nov. 16, 2006  
 P.L.O. No.: 3248  
 SHEET No.: 4 OF 10




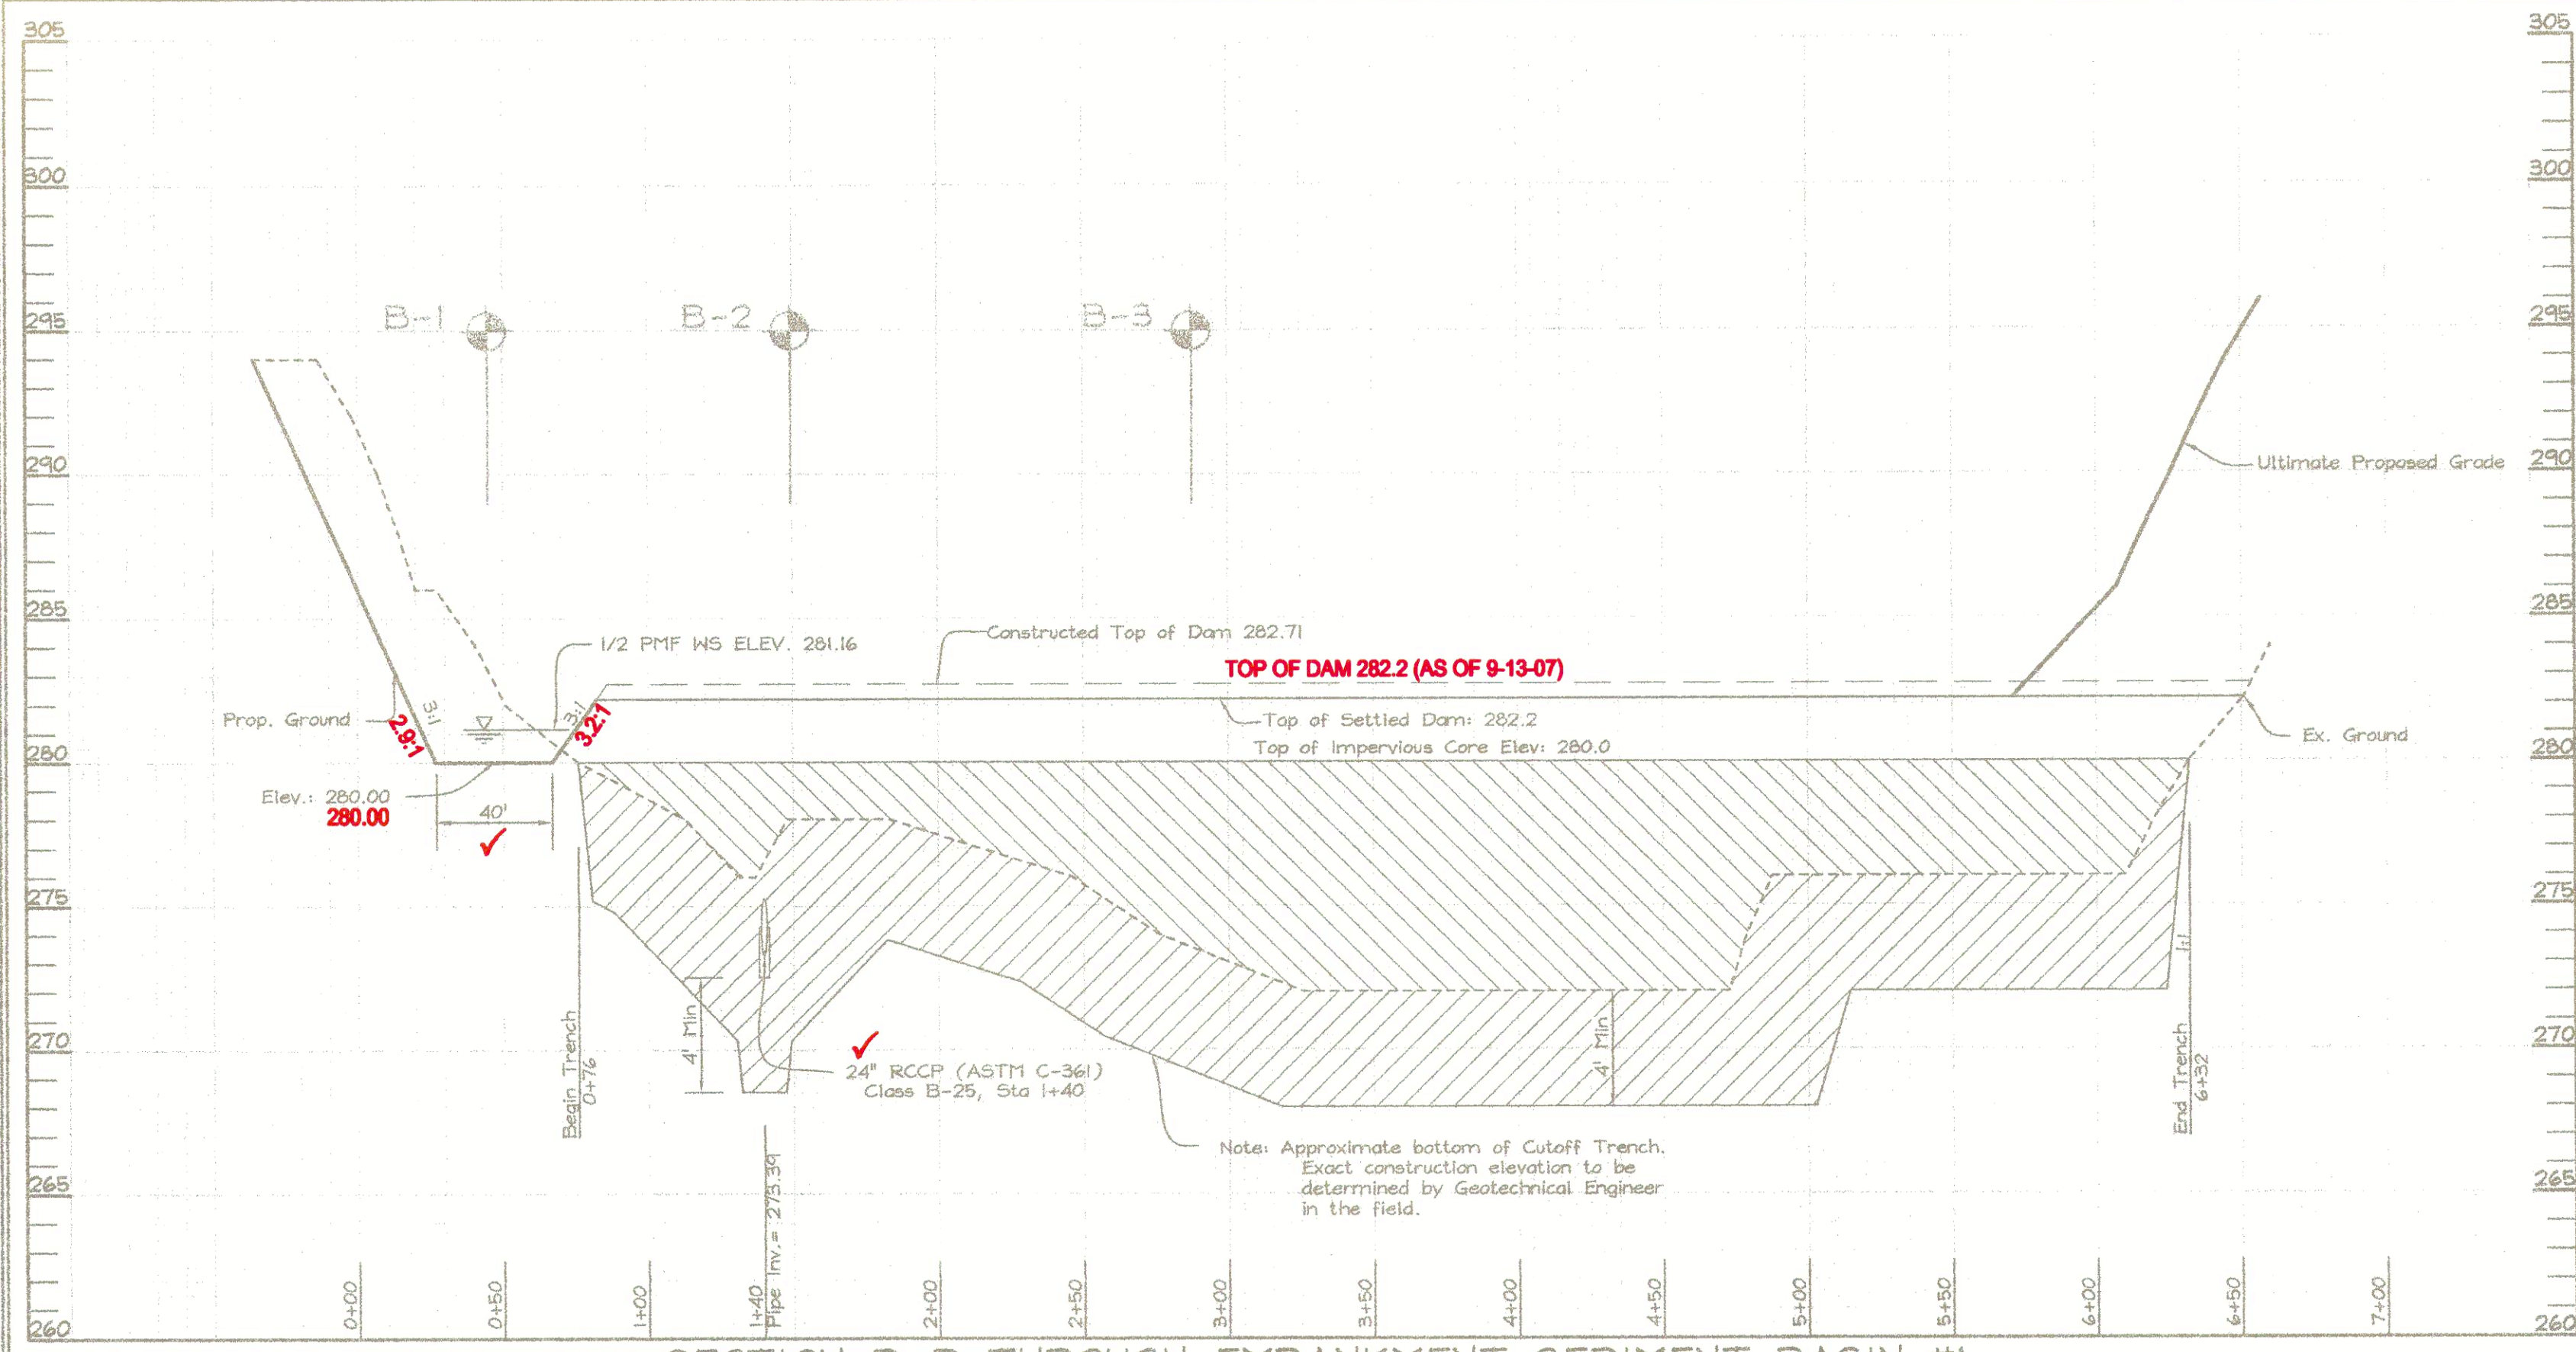


SECTION D-D THROUGH EMBANKMENT SEDIMENT BASIN #1  
SCALE: Hor.: 1"=50'  
Vert.: 1"=5'

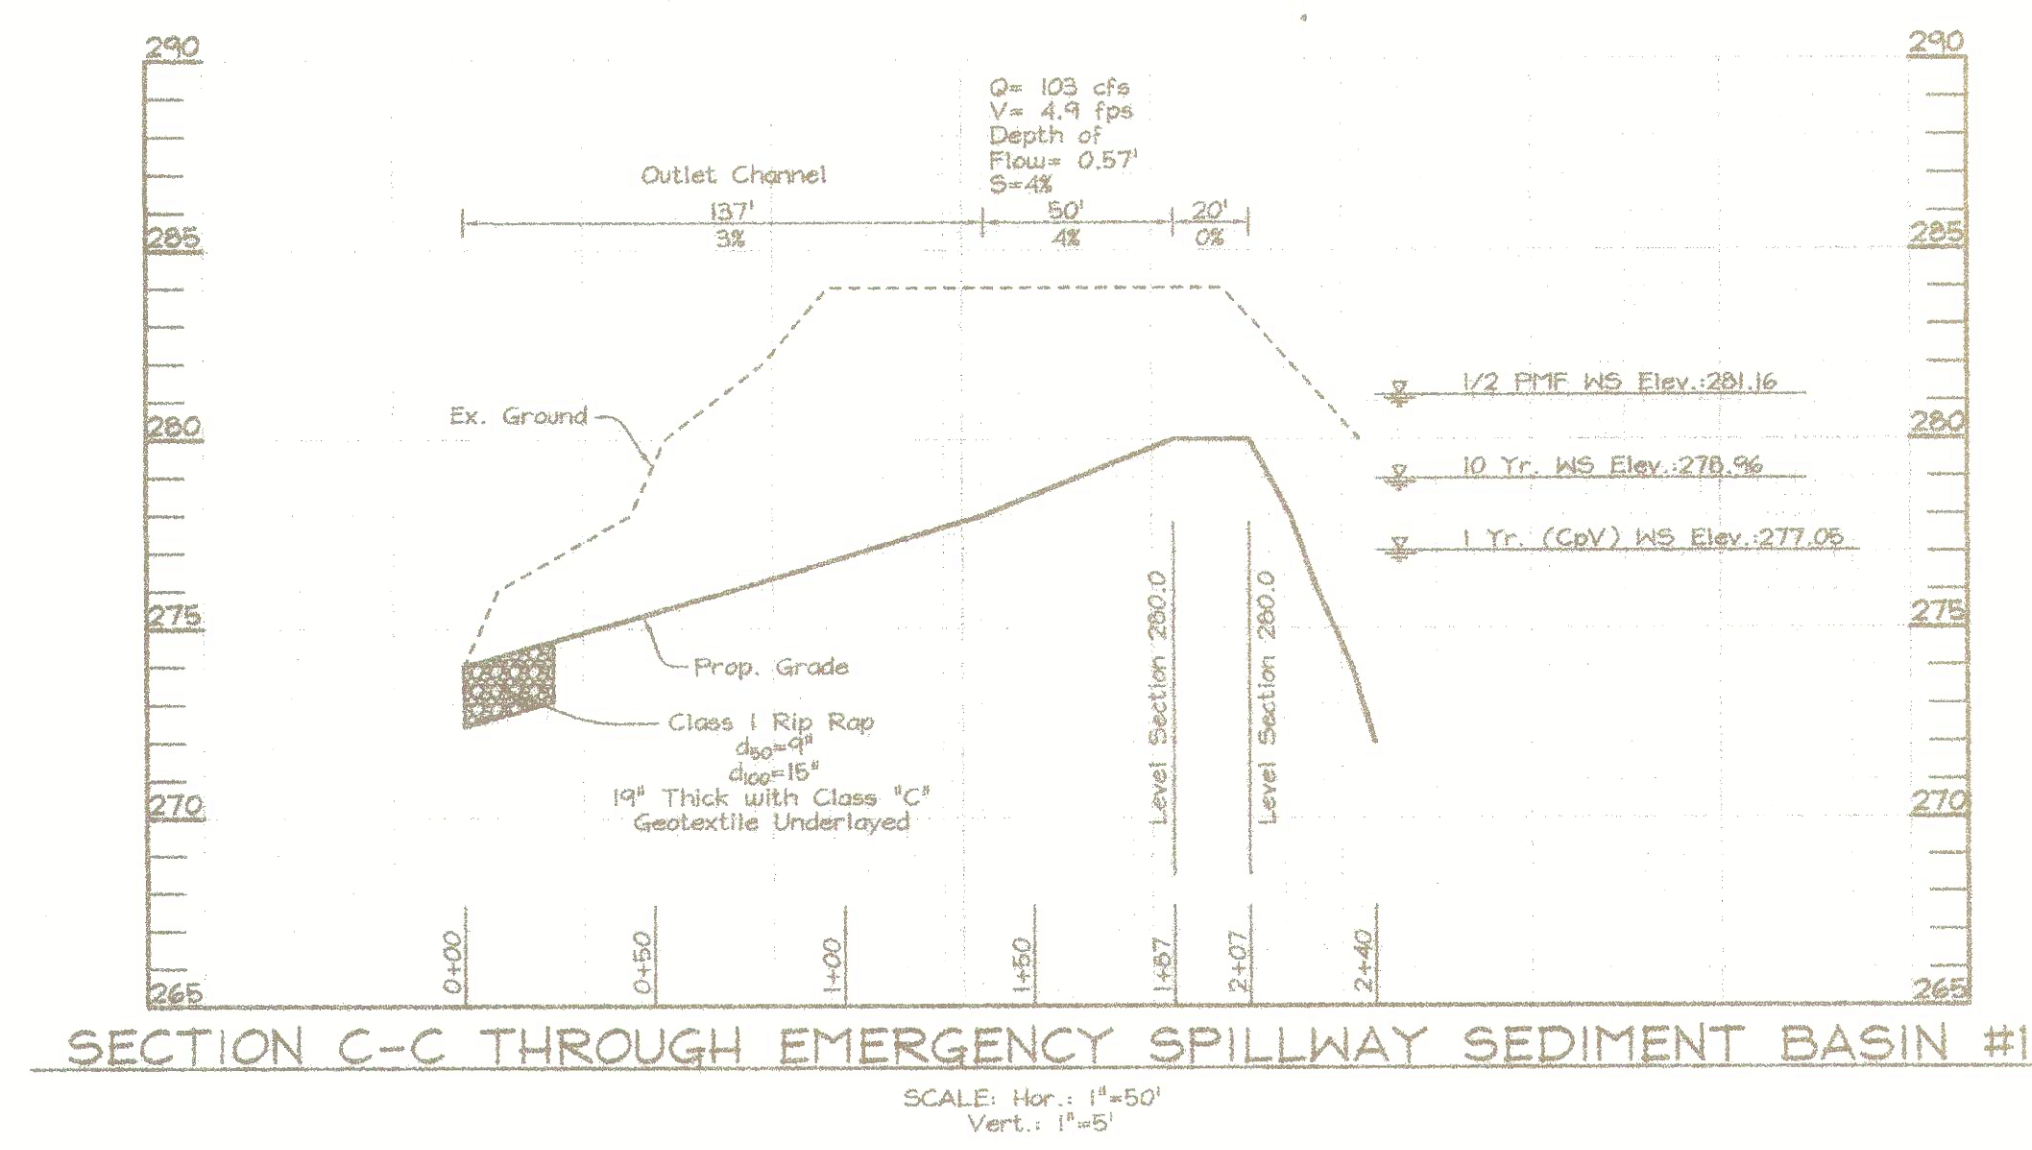

SECTION C-C THROUGH EMERGENCY SPILLWAY SEDIMENT BASIN #1  
SCALE: Hor.: 1"=50'  
Vert.: 1"=5'

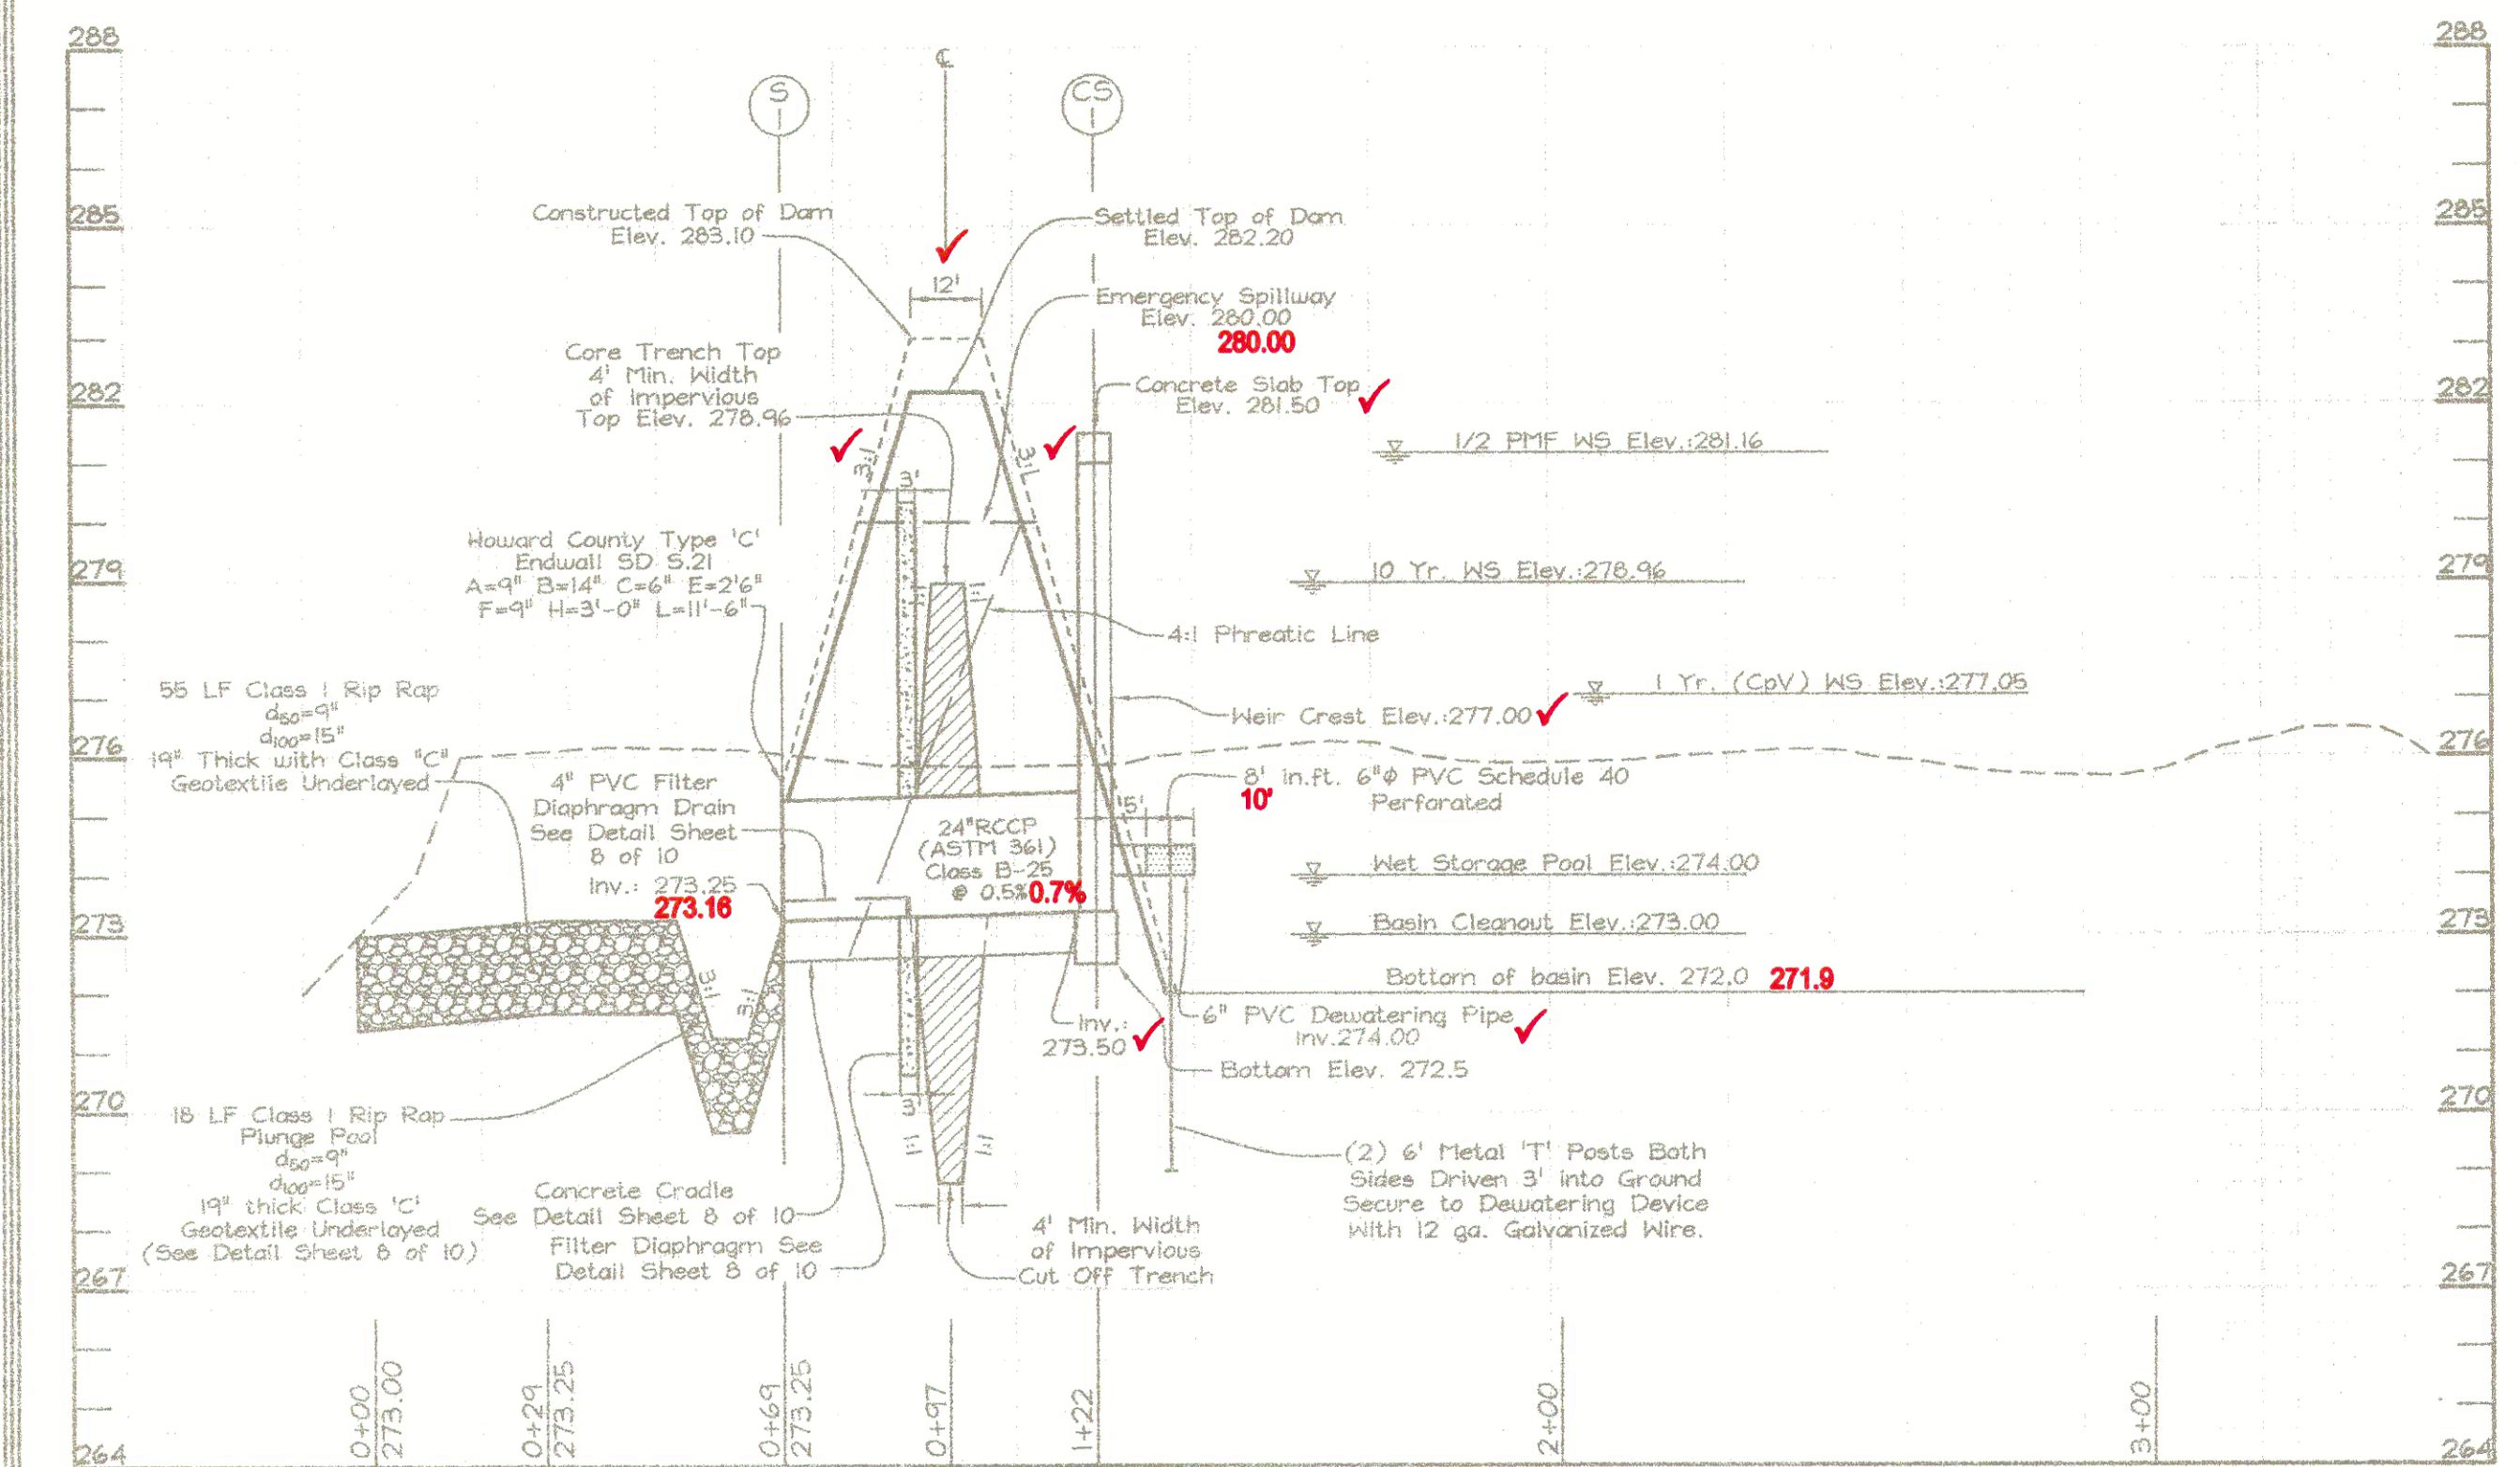

SECTION B-B THROUGH SEDIMENT BASIN  
SCALE: Hor.: 1"=30'  
Vert.: 1"=3'

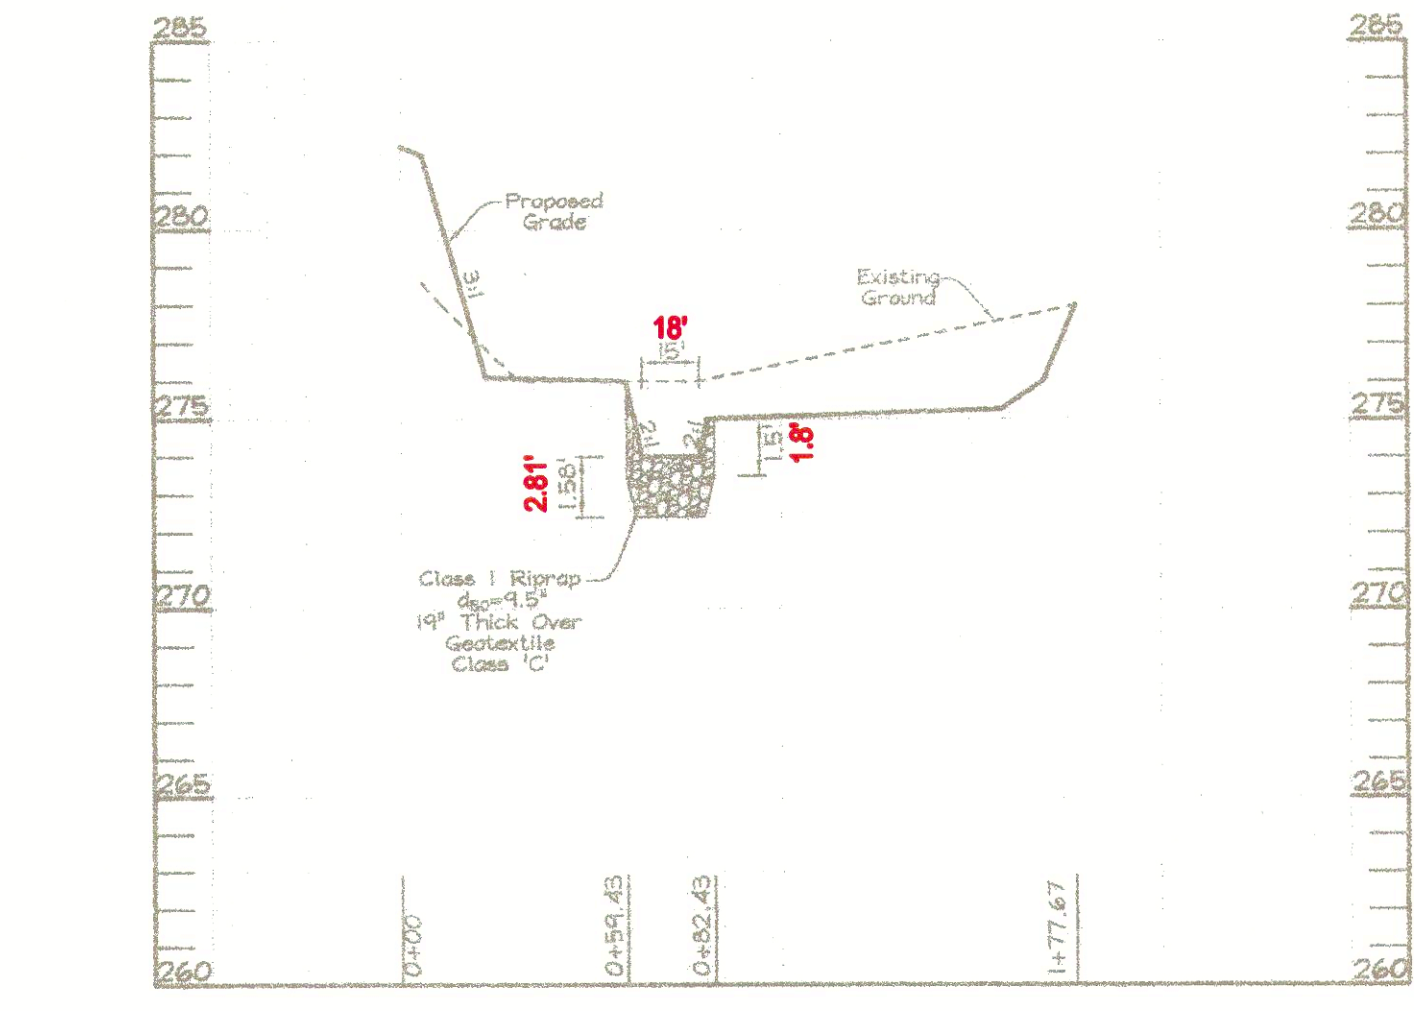

SECTION A-A THROUGH FOREBAY SEDIMENT BASIN #1  
SCALE: Hor.: 1"=50'  
Vert.: 1"=5'

	B-1 Surface Elev. 284.0	B-2 Surface Elev. 277.0	B-3 Surface Elev. 276.0
surface	Sandy SILT, Some Gravel, Reddish Brown, Moist, Medium Dense, (ML)	SILT, Some Sand, Trace Roots and Gravel, Brownish Red, Moist, Medium Dense, (ML)	SILT, With Gravel, Some Sand, Trace Roots and Gravel, Brown and Reddish Brown, Moist, Firm, (ML/Possible Fill)
5.0	Sandy SILT, Reddish Brown, to Orangeish Brown, Moist, Dense, (ML)	SILTY CLAY, Trace Sand, Brownish Red to Gray and Red, Very Stiff to Hard, (CL)	SILT, Some Sand, Trace Gravel, Tanish Gray to Orangeish Brown, Moist, Medium Dense to Dense, (ML)
10.0	SILT, with Sand, Reddish Brown and Gray, Very Dense, (ML)		
15.0	SILT, with Sand and Gravel, Moist, Very Dense, (ML)		

No groundwater encountered while drilling. At completion, hole dry and cased at 4.17/4.9' Topsoil: 3.0'

No groundwater encountered while drilling. At completion, hole dry and cased at 2.2/2.2' Topsoil: 2.0'

No groundwater encountered while drilling. At completion, hole dry and cased at 9.9/11.8' Topsoil: 4.0'

S.W.M. BORING PROFILES  
NOT TO SCALE

**SEDIMENT BASIN SCHEDULE**

1 Yr. WSEL = 277.07  
 10 Yr. WSEL = 279.94  
 1/2 PMF WSEL = 281.16  
 Top of Basin Dam Elevation = 282.20  
 Bottom of Basin Elevation: 272.0  
 Drainage Area to Basin = 18.32 ac.  
 Wet Storage Required = 1,600 cu. ft. x 18.32 ac. = 32,976 cu. ft.  
 Wet Storage Provided = 34,119 cu. ft. @ 274.0  
 Dry Storage Required = 32,976 cu. ft.  
 Dry Storage Provided = 79,220 @ 277.0  
 Clean-out elevation at 900 cu. ft. per ac. (16,488 cu. ft.) @ 403.0

**PERMIT APPLICANT**  
Savage Stone, LLC  
P.O. Box 850  
Laurel MD 20725

**OWNER**  
Kantarra  
Limited Partnership  
P.O. Box 850  
Laurel MD 20725

**AS-BUILT DATA PREPARED BY:**

**CME ENGINEERING**  
CME ENGINEERING LP  
27 East Main Street, Frostburg, MD 21532  
301-689-1700 FAX: 301-689-5177  
e-mail: info@cmeengmt.com

**SEDIMENT BASIN PROFILES**  
**LAUREL LUMBER**

TAX MAP 47 GRID 6  
6TH ELECTION DISTRICT

PARCEL 364  
HOWARD COUNTY, MARYLAND

DESIGN BY: SH  
DRAWN BY: CRH2/RL  
CHECKED BY: SH  
SCALE: AS SHOWN  
DATE: Nov. 16, 2006  
N.O. No.: 3268  
SHEET No.: 7 OF 10

**FSH Associates**  
Engineers Planners Surveyors  
6336 Howard Lane Erostburg, MD 21075  
Tel: 410-567-5200 Fax: 410-795-1582  
E-mail: info@fsnnet.com

REVIEWED FOR HOWARD SCD AND MEETS TECHNICAL REQUIREMENTS #

*Jim Moseley* 11/17/06  
USDA NATURAL RESOURCE CONSERVATION SERVICE DATE

THIS DEVELOPMENT PLAN IS APPROVED FOR SOIL EROSION AND SEDIMENT CONTROL BY THE HOWARD SOIL CONSERVATION DISTRICT #

*John K. Robinson* 11/17/06  
HOWARD SCD DATE

**ENGINEER'S CERTIFICATE**

I CERTIFY THAT THIS PLAN FOR SEDIMENT AND EROSION CONTROL REPRESENTS A PRACTICAL AND WORKABLE PLAN BASED ON MY PERSONAL KNOWLEDGE OF THE SITE CONDITIONS AND THAT IT WAS PREPARED IN ACCORDANCE WITH THE REQUIREMENTS OF THE HOWARD SOIL CONSERVATION DISTRICT.

*Zacharia Y. Fisch* 11/16/06  
SIGNATURE OF ENGINEER DATE  
ZACHARIA Y. FISCH

**PERMITTEE'S CERTIFICATE**

I/WE CERTIFY THAT ALL DEVELOPMENT AND CONSTRUCTION WILL BE DONE ACCORDING TO THIS PLAN FOR SEDIMENT AND EROSION CONTROL, AND THAT ALL RESPONSIBLE PERSONNEL INVOLVED IN THE CONSTRUCTION PROJECT WILL HAVE A CERTIFICATE OF ATTENDANCE AT A DEPARTMENT OF THE ENVIRONMENT APPROVED TRAINING PROGRAM FOR THE CONTROL OF SEDIMENT AND EROSION BEFORE BEGINNING THE PROJECT. I ALSO AUTHORIZE PERIODIC ON-SITE INSPECTION BY THE HOWARD SOIL CONSERVATION DISTRICT.

*Matthew J. Schmitt* 11/16/06  
SIGNATURE OF PERMITTEE DATE



**MARYLAND 378**  
**STORMWATER MANAGEMENT POND CONSTRUCTION SPECIFICATIONS**  
**CONSTRUCTION SPECIFICATIONS**

These specifications are appropriate to all ponds within the scope of the Standard for practice MD-378. All references to ASTM and AASHTO specifications apply to the most recent version.

**Site Preparation**  
 Areas designated for borrow areas, embankment, and structural works shall be cleared, grubbed and stripped of topsoil. All trees, vegetation, roots and other objectionable material shall be removed. Channel banks and shore breaks shall be sloped to no steeper than 1:1. All trees shall be cleared and grubbed within 15 feet of the low of the embankment.

Areas to be covered by the reservoir will be cleared of all trees, brush, logs, fences, rubbish and other objectionable material unless otherwise designated on the plans. Trees, brush, and stumps shall be cut approximately level with the ground surface for dry streamwater management ponds, a minimum of a 25-foot radius around the inlet structure shall be cleared.

All cleared and grubbed material shall be disposed of outside and below the limits of the dam and reservoir as directed by the owner or his representative. When specified, a sufficient quantity of topsoil will be stockpiled in a suitable location for use on the embankment and other designated areas.

**Earth Fill**  
 Material - The fill material shall be taken from approved designated borrow areas. It shall be free of roots, stumps, wood, rubbish, stones greater than 6", frozen or other objectionable materials. Fill material for the center of the embankment, and cut off trench shall conform to Unified Soil Classification GC, SC, CH, or CL and must have at least 30% passing the #20 sieve. Consideration may be given to the use of other materials in the embankment if designed by a geotechnical engineer. Such special designs must have construction supervised by a geotechnical engineer. Materials used in the outer shell of the embankment must have the vegetation of the quality required to prevent erosion of the embankment.

**Placement** - Areas on which fill is to be placed shall be aerated prior to placement of fill. Fill materials shall be placed in maximum 6 inch thick (before compaction) layers which are to be continuous over the entire length of the fill. The most permeable borrow material shall be placed in the downstream portions of the embankment. The original surface must be installed concurrently with fill placement and not excavated into the embankment.

**Compaction** - The movement of the hauling and spreading equipment over the fill shall be controlled so that the entire surface of each lift shall be traversed by not less than one track tread of heavy equipment or compaction roller. Fill material shall be compacted by a complete pass of a sheepsfoot roller, used on vibratory roller. Fill material shall contain sufficient moisture such that the required degree of compaction will be obtained with the equipment used. The fill material shall contain sufficient moisture so that if formed into a ball it will not crumble, yet not be so wet that water can be squeezed out.

When required by the reviewing agency the minimum required density shall not be less than 95% of maximum dry density with a moisture content within +/- 2% of the optimum. Each layer of fill shall be compacted as necessary to obtain that density, and is to be certified by the Engineer at the time of construction. All compaction is to be determined by AASHTO Method T-99 (Standard Proctor).

**Cut Off Trench** - The cutoff trench shall be excavated into impervious material along or parallel to the centerline of the embankment as shown on the plans. The bottom width of the trench shall be governed by the equipment used for excavation, with the minimum width being four feet. The depth shall be at least four feet below existing grade or as shown on the plans. The side slopes of the trench shall be 1 to 1 or flatter.


The backfill shall be compacted with construction equipment, rollers, or hand tampers to assure maximum density and minimum permeability.

**Embankment Core** - The core shall be parallel to the centerline of the embankment as shown on the plans. The top width of the core shall be a minimum of four feet. The height shall extend up to at least the 10 year water elevation or as shown on the plans. The side slopes shall be 1 to 1 or flatter. The core shall be compacted with construction equipment.

**Structure Backfill**  
 Backfill adjacent to pipes or structures shall be of the type and quality conforming to that specified for the adjoining fill material. The fill shall be placed in horizontal layers not to exceed four inches in thickness and compacted by hand tampers or other manually directed compaction equipment. The material needs to fill completely all spaces hand tampers or other manually directed compaction equipment. The material needs to fill completely all spaces under and adjacent to the pipe. At no time during the backfilling operation shall driven equipment be allowed to operate closer than four feet, measured horizontally, to any part of a structure. Under no circumstances shall equipment be driven over any part of a concrete structure or pipe, unless there is a compacted fill of 24" or greater over the structure or pipe.

**Structure backfill** may be flowable fill meeting the requirements of Maryland Department of Transportation, State Highway Administration Standard Specifications for Construction and Materials, Section 313 as modified. The mixture shall have a 100-200 psi 28 day unconfined compressive strength. The flowable fill shall have a minimum pH of 4.0 and a minimum resistivity of 5,000 ohm-cm. Flowable fill shall be placed such that minimum of 6" (measured perpendicular to the outside of the pipe) of flowable fill shall be under (bedding), over and on the sides of the pipe. It may be placed up to the spring line for rigid conduits. Average slump of the fill shall be 7" to assure flowability of the material. Adequate measures shall be taken (sand bags, etc.) to prevent flooding the pipe. When using flowable fill, all metal pipe shall be bituminous coated. Any adjoining soil fill shall be placed in horizontal layers not to exceed four inches in thickness and compacted by hand tampers or other manually directed compaction equipment. The material shall completely fill all voids adjacent to the flowable fill zone. At no time during the backfilling operation shall driven equipment be allowed to operate closer than four feet, measured horizontally, to any part of the structure. Under no circumstances shall equipment be driven over any part of a structure or pipe unless there is a compacted fill of 24" or greater over the structure or pipe. Backfill (flowable fill) shall be of the type and quality conforming to that specified for the core of the embankment or other embankment materials.

**Pipe Conduits**  
 All pipes shall be circular in cross section.

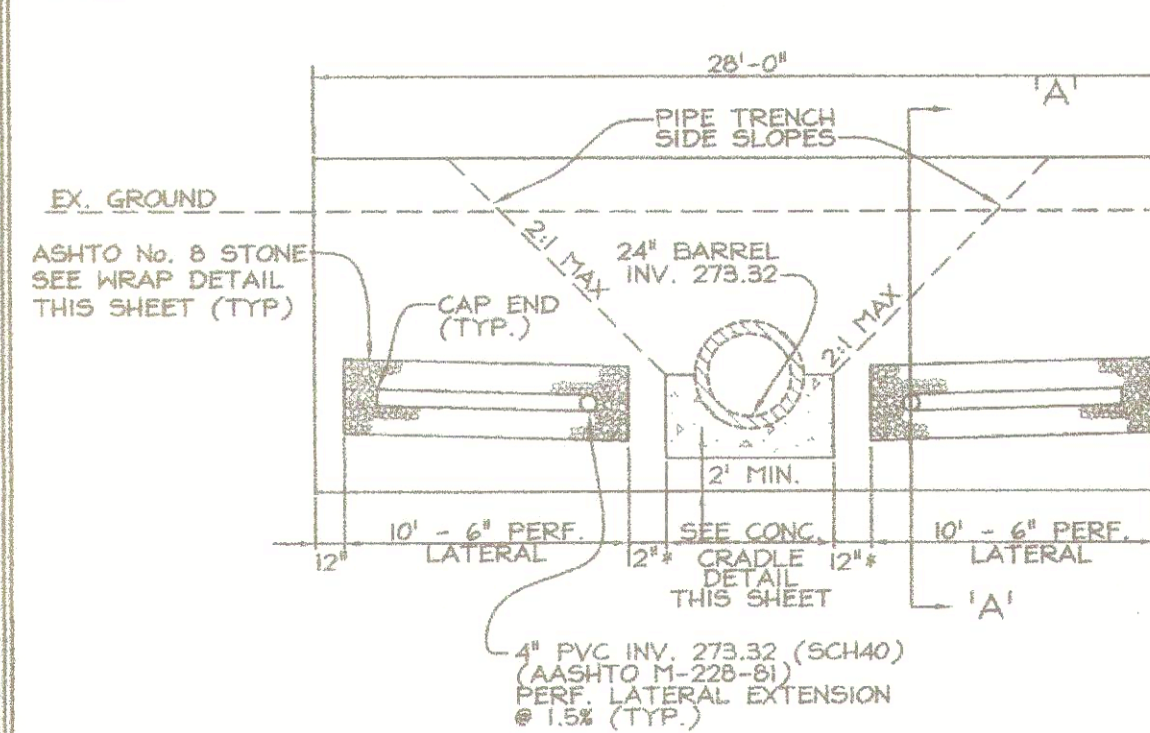

\* THIS WIDTH WILL VARY PRIOR TO THE END SECTION IN ORDER TO TAPER THE 4" DRAIN PIPE TO THE INTO THE TYPE 'C' ENDWALL OPENINGS (SEE DIAPHRAGM TIE INTO TYPE 'C' ENDWALL DETAIL THIS SHEET).

- FILTER DIAPHRAGM NOTES**
1. FILTER MATERIAL SHALL CONFORM TO ASTM C-33 (CONCRETE SAND).
  2. FILTER DIAPHRAGM SHALL BE CONSTRUCTED IN HORIZONTAL LAYERS 12 INCHES THICK (BEFORE COMPACTION).
  3. EACH LAYER SHALL BE HYDROCOMPACTED USING A SPRINKLER. MATERIAL MUST BE SATURATED.
  4. CARE SHALL BE TAKEN SO THAT THE FILTER MATERIAL IS NOT CONTAMINATED.
  5. ANY CONTAMINATED SAND SHALL BE REMOVED AND REPLACED WITH APPROVED MATERIAL.
  6. PROTECTIVE COVERING OVER THE SAND FILTER MAY BE REQUIRED BETWEEN LIFTS.
  7. ELBOWS SHALL BE USED FOR PVC INTERCONNECTIONS.
  8. CONTRACTOR SHALL BEND AND CONSTRUCT THE 4" PVC PIPE TO ENSURE PASSAGE THROUGH THE TYPE 'C' CONCRETE END SECTION AND CONCRETE CRADLE (THE 4" PVC OUTFALL IS DIMENSIONED ON TYPE 'C' ENDWALL DETAIL THIS SHEET).
  9. GEOTECHNICAL ENGINEER TO SPECIFY AND APPROVE FILTER MATERIAL AND PLACEMENT IN THE FIELD.

REVIEWED FOR HOWARD SCD AND MEETS TECHNICAL REQUIREMENTS \*  
 Jim Meyer 11/16/06 DATE  
 USDA - NATURAL RESOURCES CONSERVATION SERVICE  
 THIS DEVELOPMENT PLAN IS APPROVED FOR SOIL EROSION AND SEDIMENT CONTROL BY THE HOWARD SOIL CONSERVATION DISTRICT \*  
 John C. Johnson 11/16/06 DATE  
 HOWARD SCD

**OPERATION, MAINTENANCE AND INSPECTION**

INSPECTION OF THE POND(S) SHOWN HEREON SHALL BE PERFORMED AT LEAST ANNUALLY, IN ACCORDANCE WITH THE CHECKLIST AND REQUIREMENTS CONTAINED WITHIN USDA, SCS "STANDARDS AND SPECIFICATIONS FOR PONDS" (MD-378). THE POND OWNER(S) AND ANY HEIRS, SUCCESSORS, OR ASSIGNS SHALL BE RESPONSIBLE FOR THE SAFETY OF THE POND AND THE CONTINUED OPERATION, SURVEILLANCE, INSPECTION, AND MAINTENANCE THEREOF. THE POND OWNER(S) SHALL PROMPTLY NOTIFY THE H.D.E. DAM SAFETY DIVISION OF ANY UNUSUAL OBSERVATIONS THAT MAY BE INDICATIONS OF DISTRESS SUCH AS EXCESSIVE SEEPAGE, TURBID SEEPAGE, SLIDING OR SLUMPING.

- Reinforced Concrete Pipes** - All of the following criteria shall apply for reinforced concrete pipes
1. Materials - Reinforced concrete pipe shall have bell and spigot joints with rubber gaskets and shall equal or exceed ASTM C-361.
  2. Bedding - Reinforced concrete pipe conduits shall be laid in a concrete bedding/cradle for their entire length. This bedding/cradle shall consist of high slump concrete placed under the pipe and up the side of the pipe at least 3/8" of its outside diameter with a minimum thickness of 6" inches. Where a concrete cradle is not needed for section of this standard. Gravel bedding is not permitted.
  3. Laying pipe - Bell and spigot pipe shall be placed with the bell end upstream. Joints shall be made in accordance with recommendations of the manufacturer of the material. After the joints are sealed for the entire line, the bedding shall be placed so that all spaces under the pipe are filled. Care shall be exercised to prevent any deviation from the original line and grade of the pipe. The first joint must be located within 4 feet from the riser.
  4. Backfilling shall conform to "Structure Backfill".
  5. Other details (anti-seep collars, valves, etc.) shall be as shown on the drawings.
- Plastic Pipe** - The following criteria shall apply for plastic pipe
1. Materials - PVC pipe shall be PVC-1220 or PVC-1220 conforming to ASTM D-1785 or ASTM D-2241. Corrugated High Density Polyethylene (HDPE) pipe, couplings and fittings shall conform to the following: 4" - 10" inch pipe shall meet the requirements of AASHTO M252 Type 5, and 12" through 24" inch shall meet the requirements of AASHTO M24 Type 5.
  2. Joints and connections to anti-seep collars shall be completely watertight.
  3. Bedding - The pipe shall be firmly and uniformly bedded throughout its entire length. Where rock or soft/spongy or other unstable soil is encountered, such material shall be removed and replaced with suitable earth compacted to provide adequate support.
  4. Backfilling shall conform to "Structure Backfill".
  5. Other details (anti-seep collars, valves, etc.) shall be as shown on the drawings.

**Drainage Diaphragms** - When a drainage diaphragm is used, a registered professional engineer will supervise the design and construction inspection.

**Concrete**  
 Concrete shall meet the requirements of Maryland Department of Transportation, State Highway Administration Standard Specifications for Construction and Materials, Section 414, Mix No. 3.

**Rock Riprap**  
 Rock riprap shall meet the requirements of Maryland Department of Transportation, State Highway Administration Standard Specifications for Construction Materials, Section 311.


**Geotextile** shall be placed under all riprap and shall meet requirements of Maryland Department of Transportation, State Highway Administration Standard Specifications for Construction and Materials, Section 401.05, Class C.

**Care of Water during Construction**  
 All work on permanent structures shall be carried out in areas free from water. The contractor shall construct and maintain all temporary dikes, levees, cofferdams, drainage channels, and stream diversions necessary to protect to be occupied by the permanent works. The contractor shall also furnish, install, operate and maintain all necessary pumping and other equipment required for removal of water from various parts of the work and for maintaining the excavations, foundation, and other parts of the work free from water as required or directed by the engineer for constructing each part of the work free from water during the performance of all construction operations. During the placing and compacting of material in required excavations, the water level at the locations being refilled shall be maintained below the bottom of the excavation at such locations which may require draining the water pumps from which the water shall be pumped.


**Stabilization**  
 All borrow areas shall be graded to provide proper drainage and left in a slightly channel. All exposed surfaces of the embankment, spillway, spoil and borrow areas, and berms shall be stabilized by seeding, liming, fertilizing and mulching in accordance with the Natural Resources Conservation Service Standards and Specifications for Critical Area Planting (710-342) or as shown on the accompanying drawings.

**Erosion and Sediment Control**  
 Construction operations will be carried out in such a manner that erosion will be controlled and water and air pollution minimized. State and local laws concerning pollution abatement will be followed. Construction plans shall detail erosion and sediment control measures.


**Construction operations** will be carried out in such a manner that erosion will be controlled and water and air pollution minimized. State and local laws concerning pollution abatement will be followed. Construction plans shall detail erosion and sediment control measures.

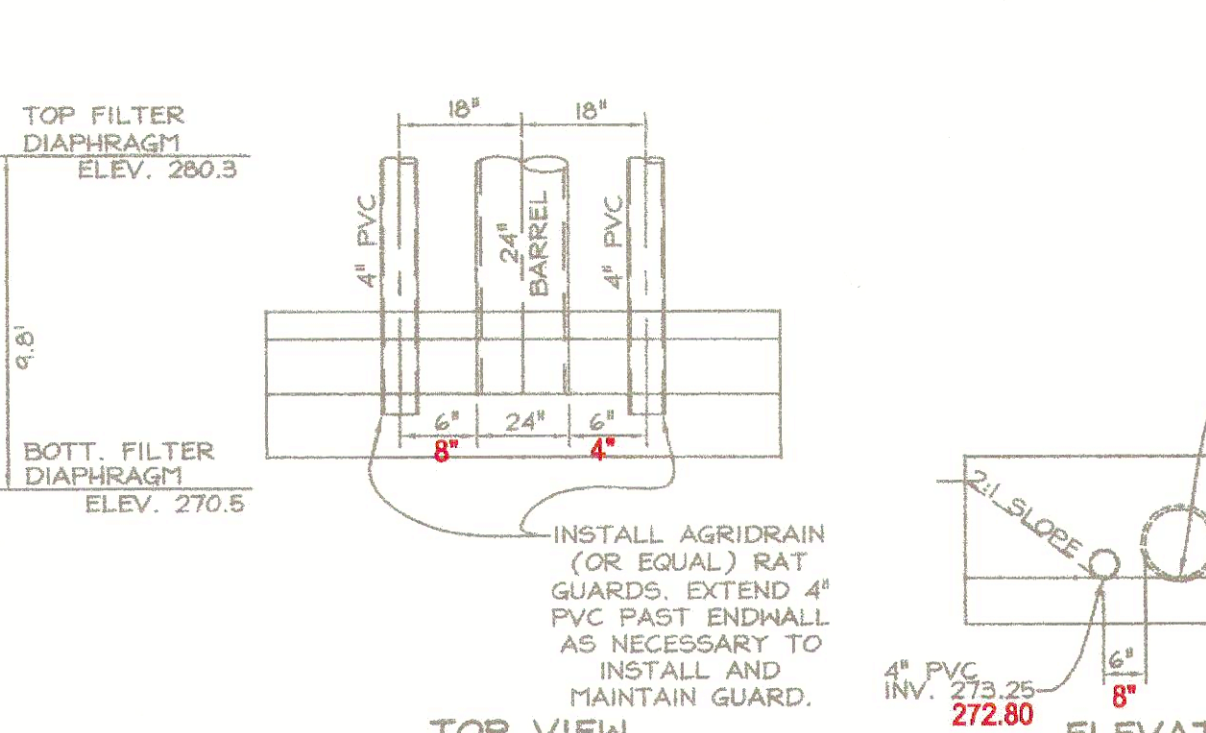


**FILTER DRAINAGE DIAPHRAGM OUTLET AT TYPE 'C' ENDWALL**  
 Not to scale

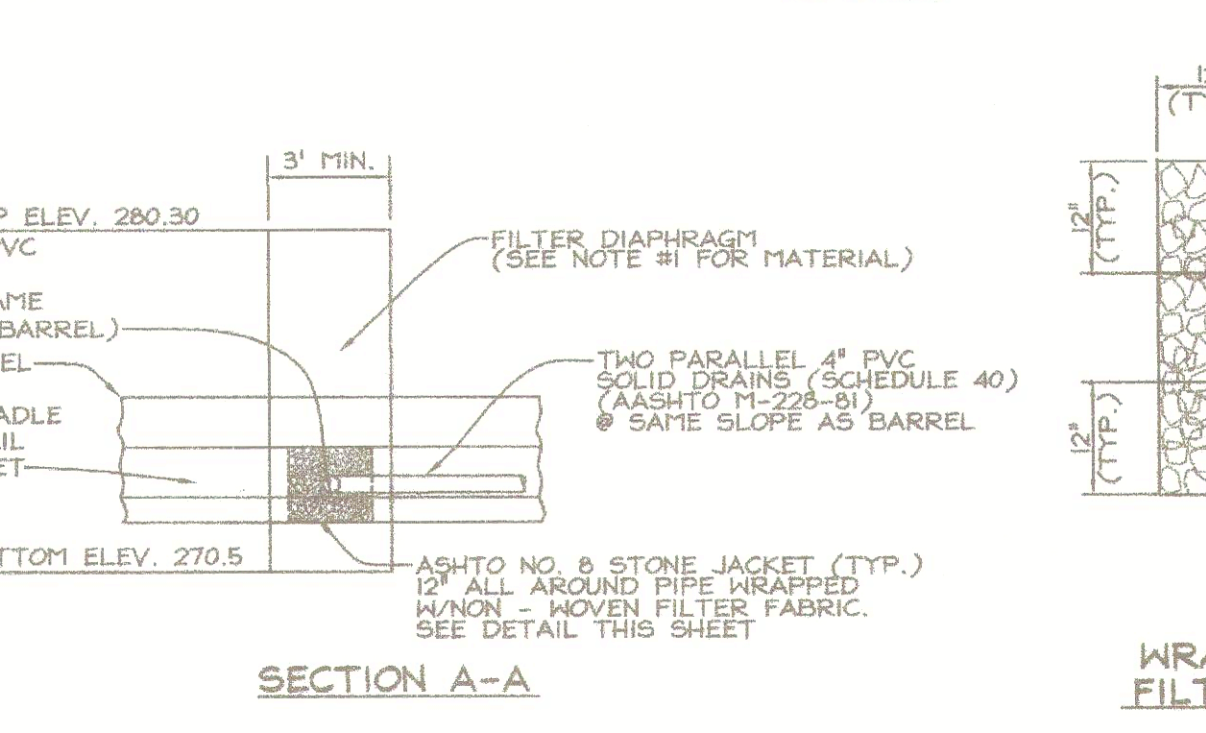

**ENGINEERS CERTIFICATE**  
 I, WE CERTIFY THAT THIS PLAN FOR SEDIMENT AND EROSION CONTROL REPRESENTS A PRACTICAL AND WORKABLE PLAN BASED ON MY PERSONAL KNOWLEDGE OF THE SITE CONDITIONS AND THAT IT WAS PREPARED IN ACCORDANCE WITH THE REQUIREMENTS OF THE HOWARD SOIL CONSERVATION DISTRICT.  
 Zacharia Y. Fisch 11/16/06 DATE  
 SIGNATURE OF ENGINEER  
 ZACHARIA Y. FISCH

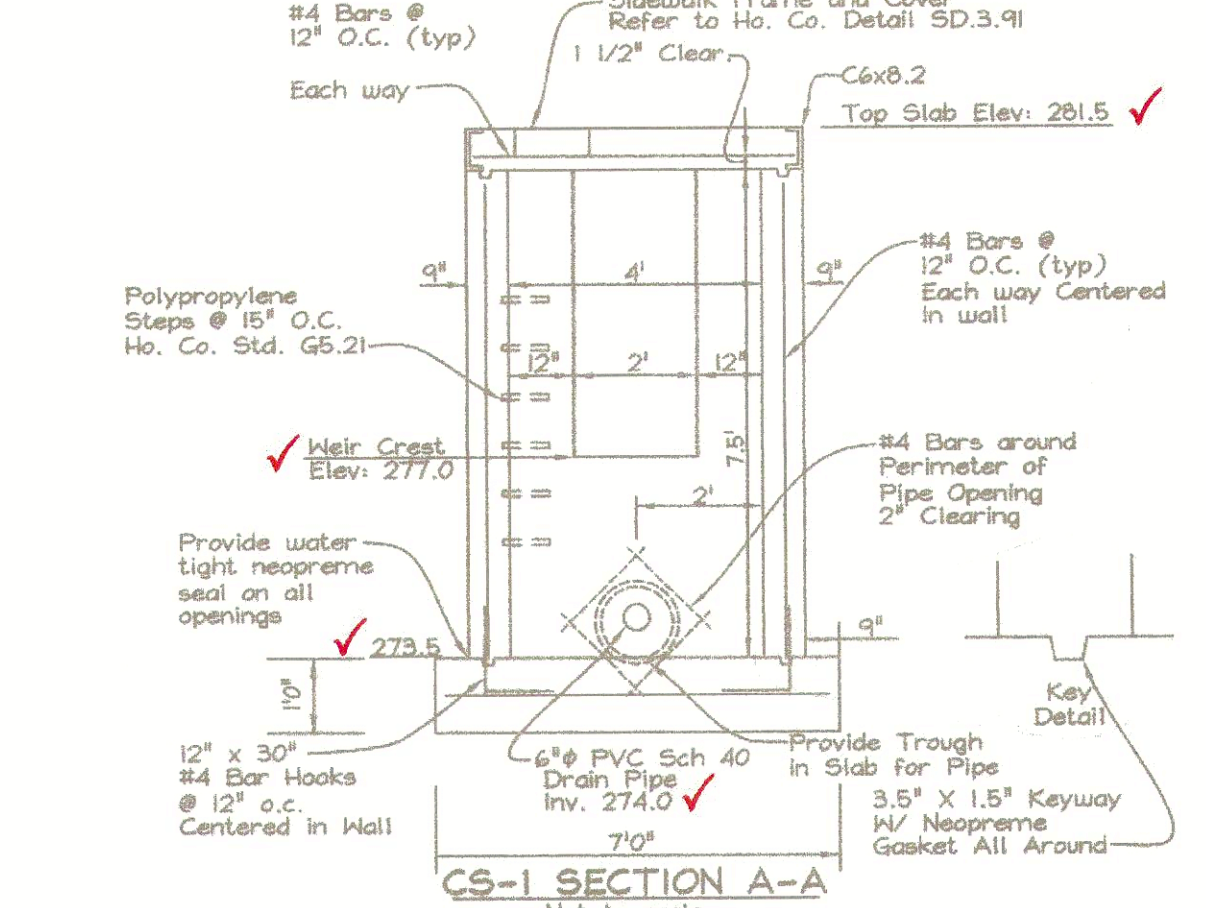


**CS-1 SECTION A-A**  
 Not to scale

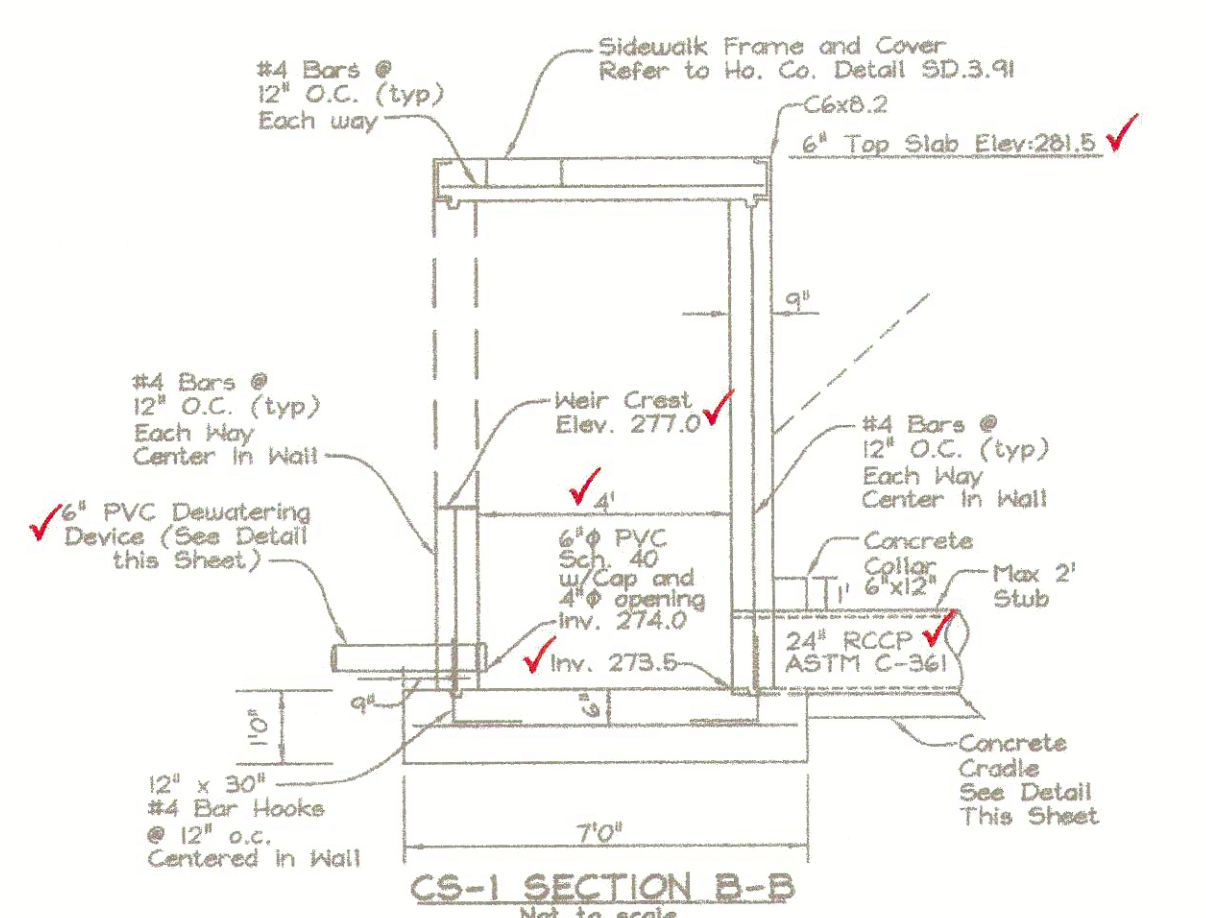


**CS-1 SECTION B-B**  
 Not to scale




**RIP RAP INFLOW PROTECTION TYPICAL CROSS SECTION DETAIL**  
 NOT TO SCALE

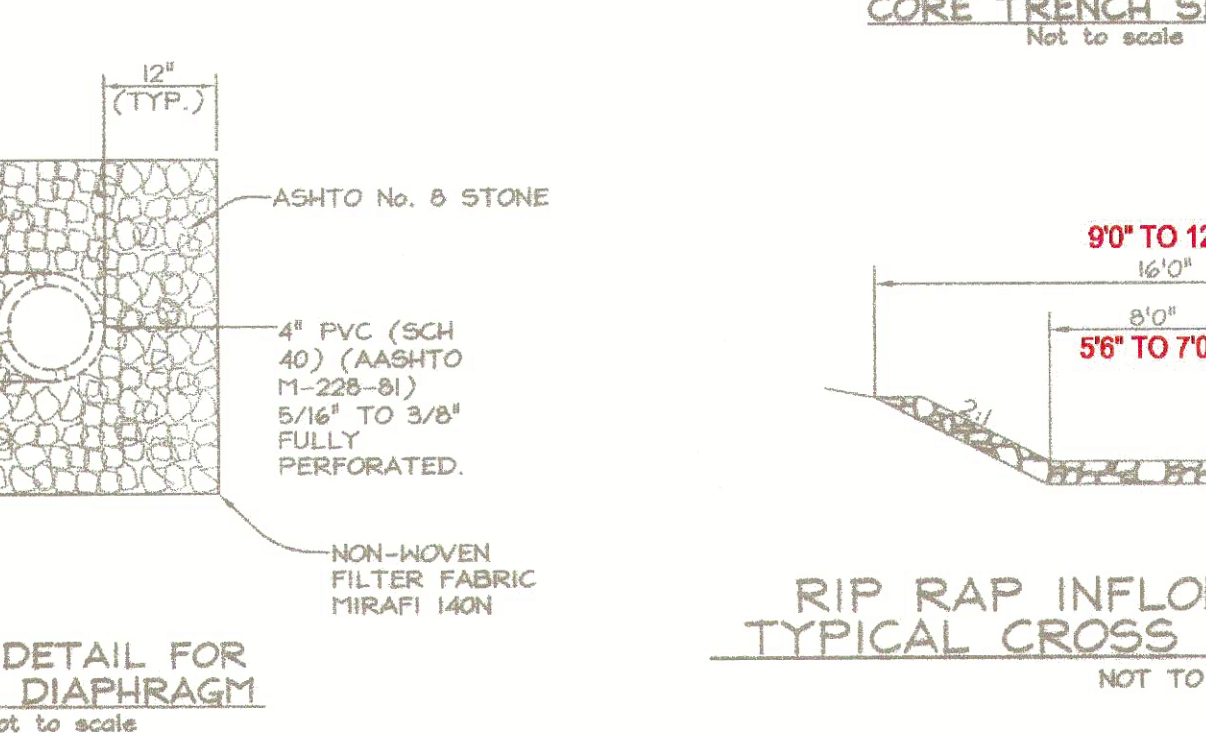


**PERMITTEE'S CERTIFICATE**  
 I, WE CERTIFY THAT ALL DEVELOPMENT AND CONSTRUCTION WILL BE DONE ACCORDING TO THIS PLAN FOR SEDIMENT AND EROSION CONTROL AND THAT ALL RESPONSIBLE PERSONNEL INVOLVED IN THE CONSTRUCTION PROJECT WILL HAVE A CERTIFICATE OF ATTENDANCE AT A DEPARTMENT OF THE ENVIRONMENT APPROVED TRAINING PROGRAM FOR THE CONTROL OF SEDIMENT AND EROSION BEFORE BEGINNING THE PROJECT. I ALSO AUTHORIZE PERIODIC ON-SITE INSPECTION BY THE HOWARD SOIL CONSERVATION DISTRICT.  
 Timothy J. Schmidt 11/16/06 DATE  
 SIGNATURE OF PERMITTEE

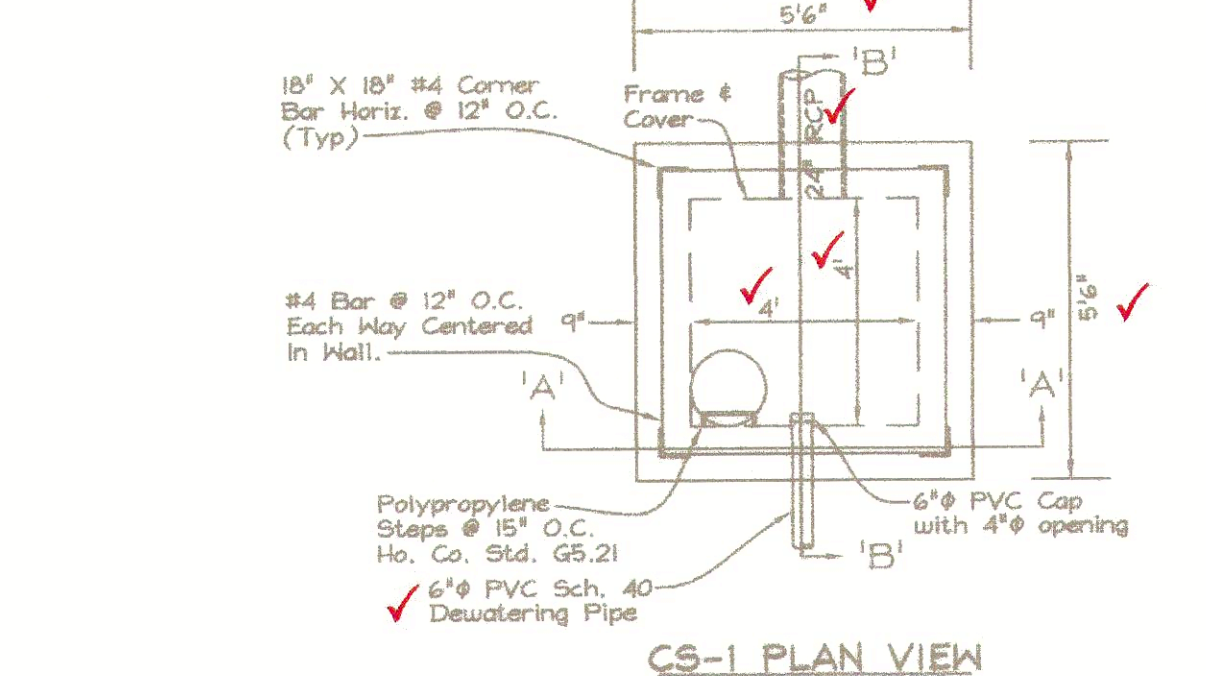


**CS-1 PLAN VIEW**  
 Not to scale

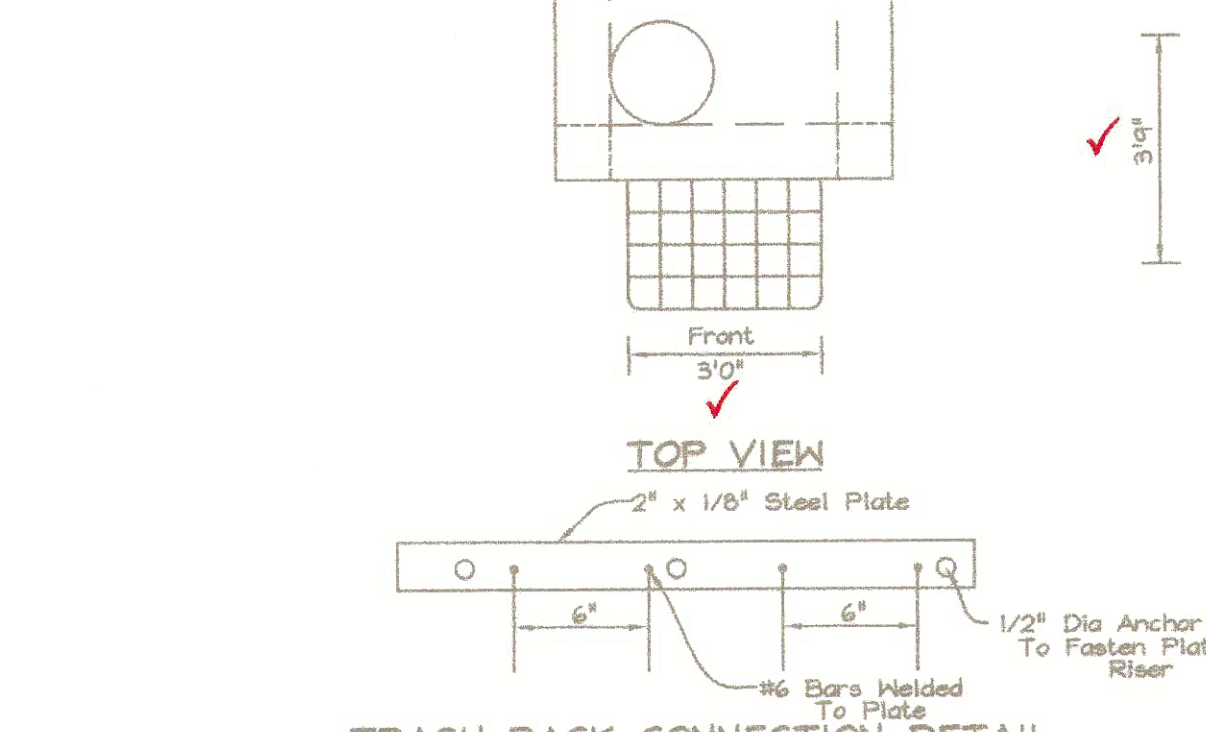


**TRASH RACK CONNECTION DETAIL**  
 Not to scale

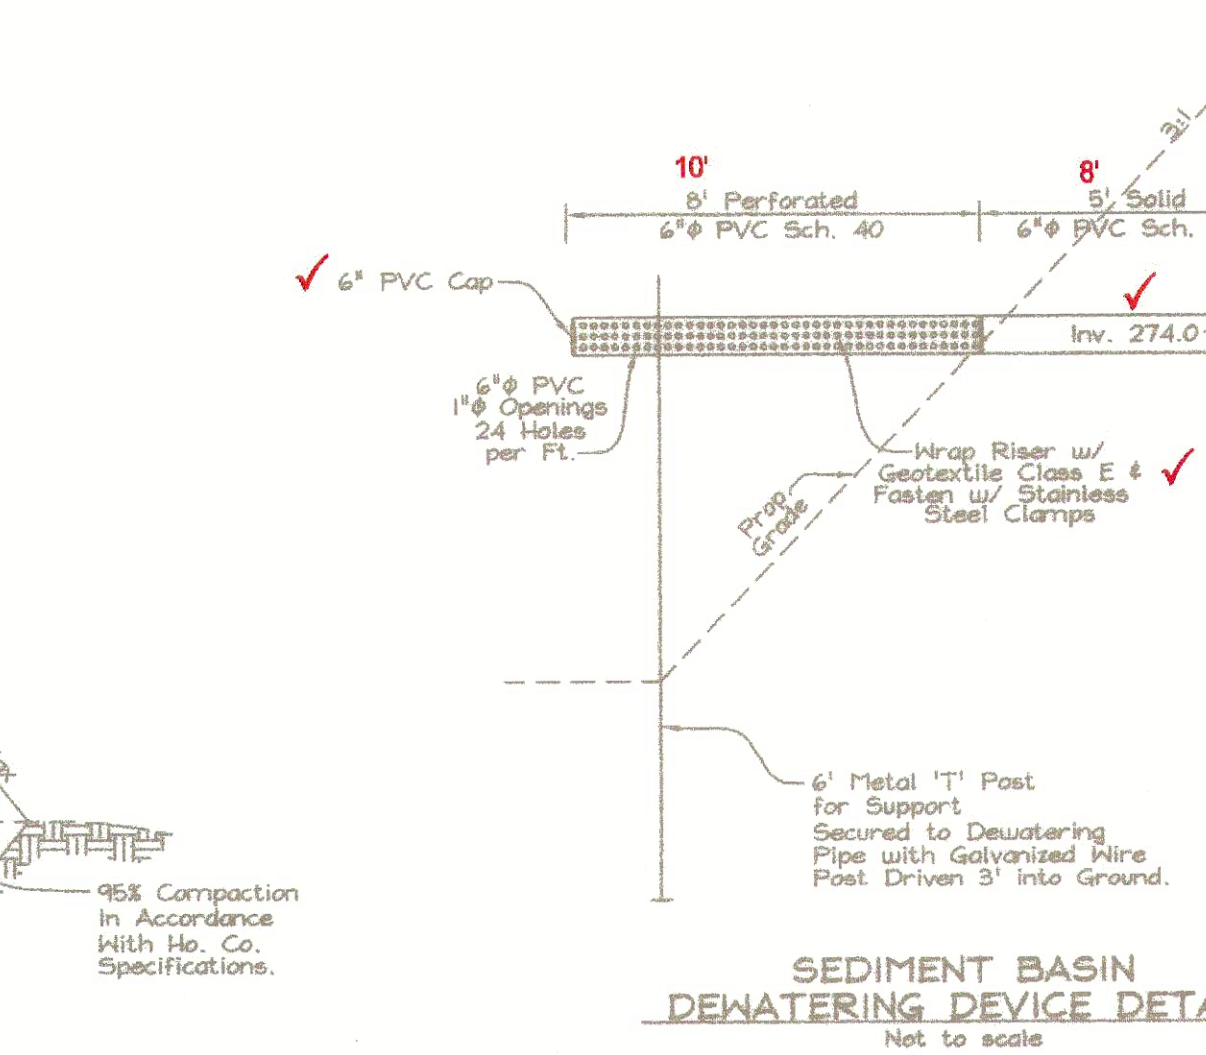


**SEDIMENT BASIN DEWATERING DEVICE DETAIL**  
 Not to scale

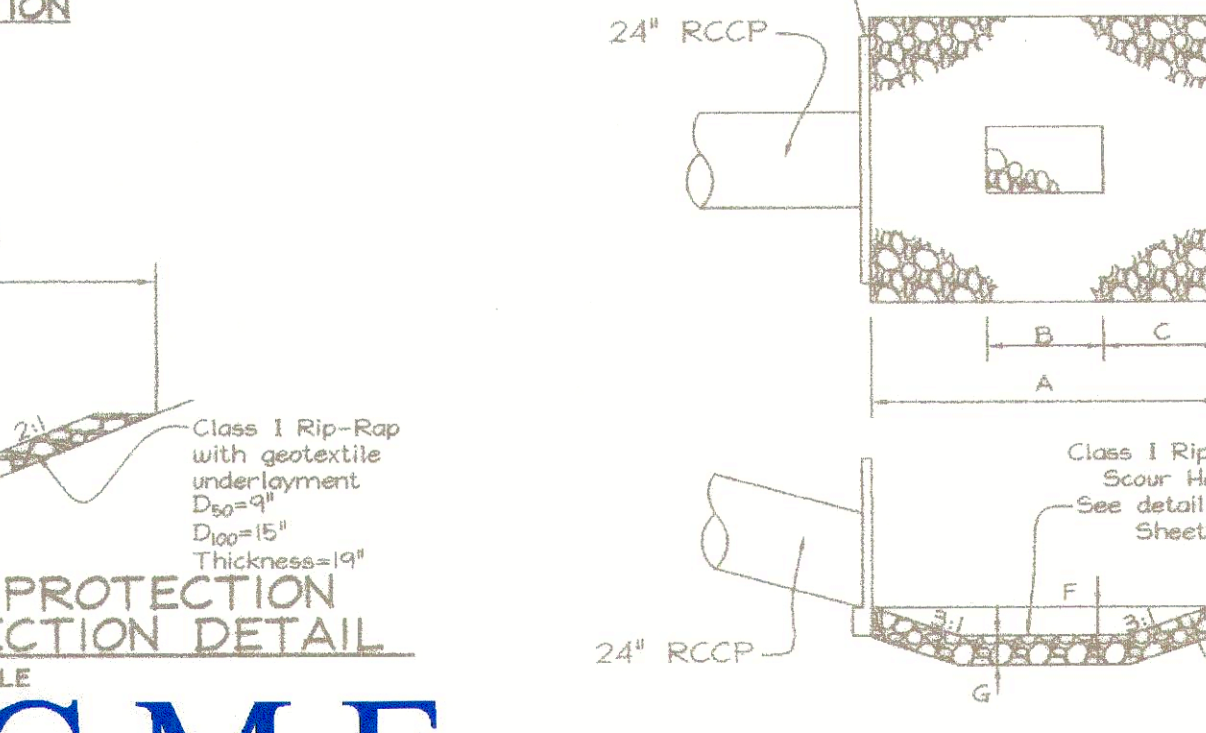


**PERVIOUS CORE AND CORE TRENCH SECTION**  
 Not to scale

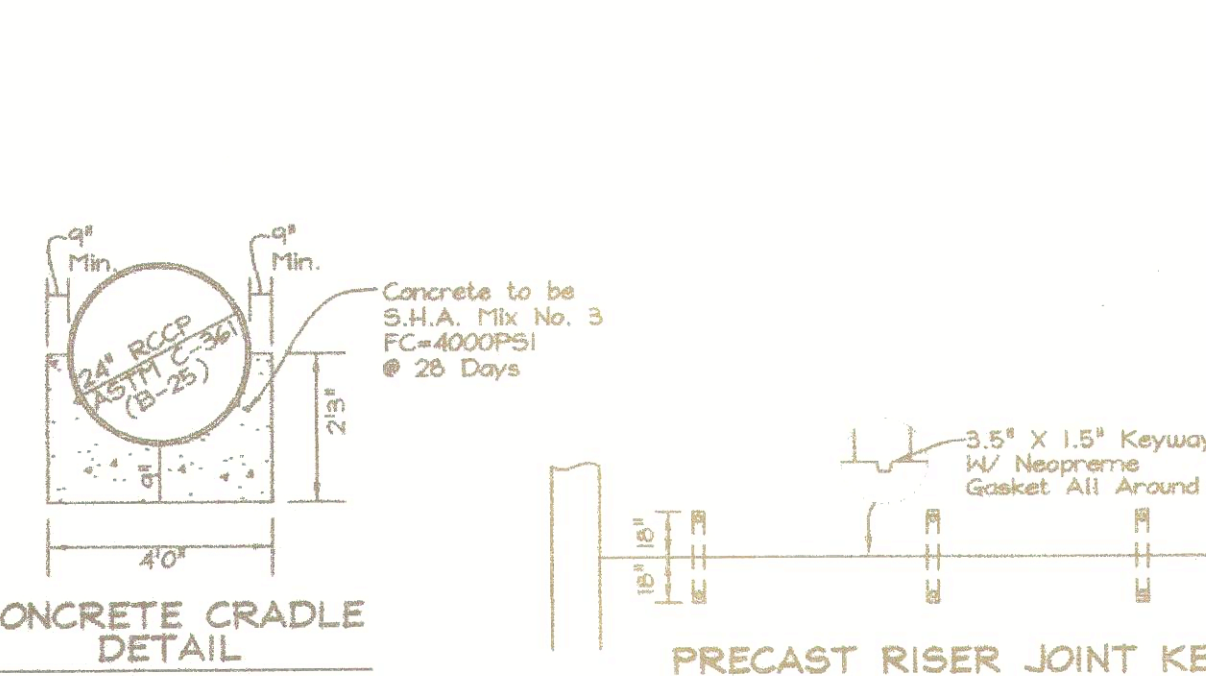


**CONCRETE GRADE DETAIL**  
 SCS TR-46 A-2 Not to scale

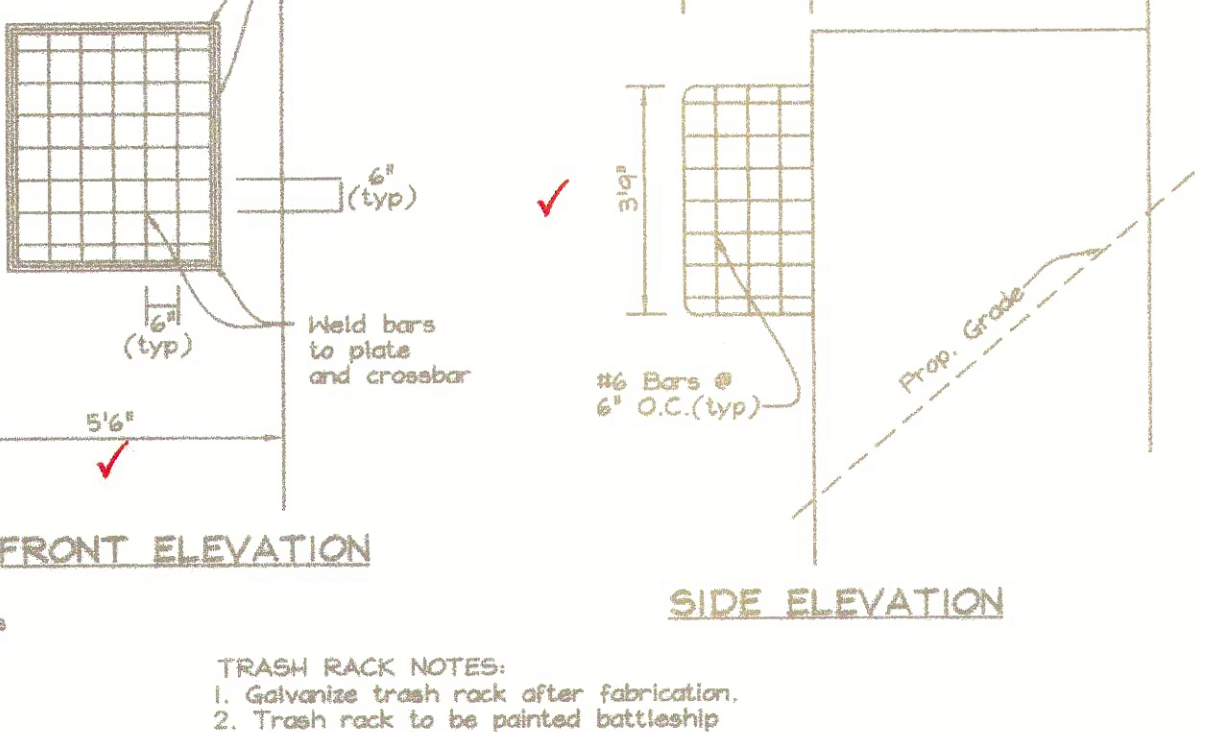

**PRECAST RISER JOINT KEY AND STRAPPING DETAIL**  
 Not to scale

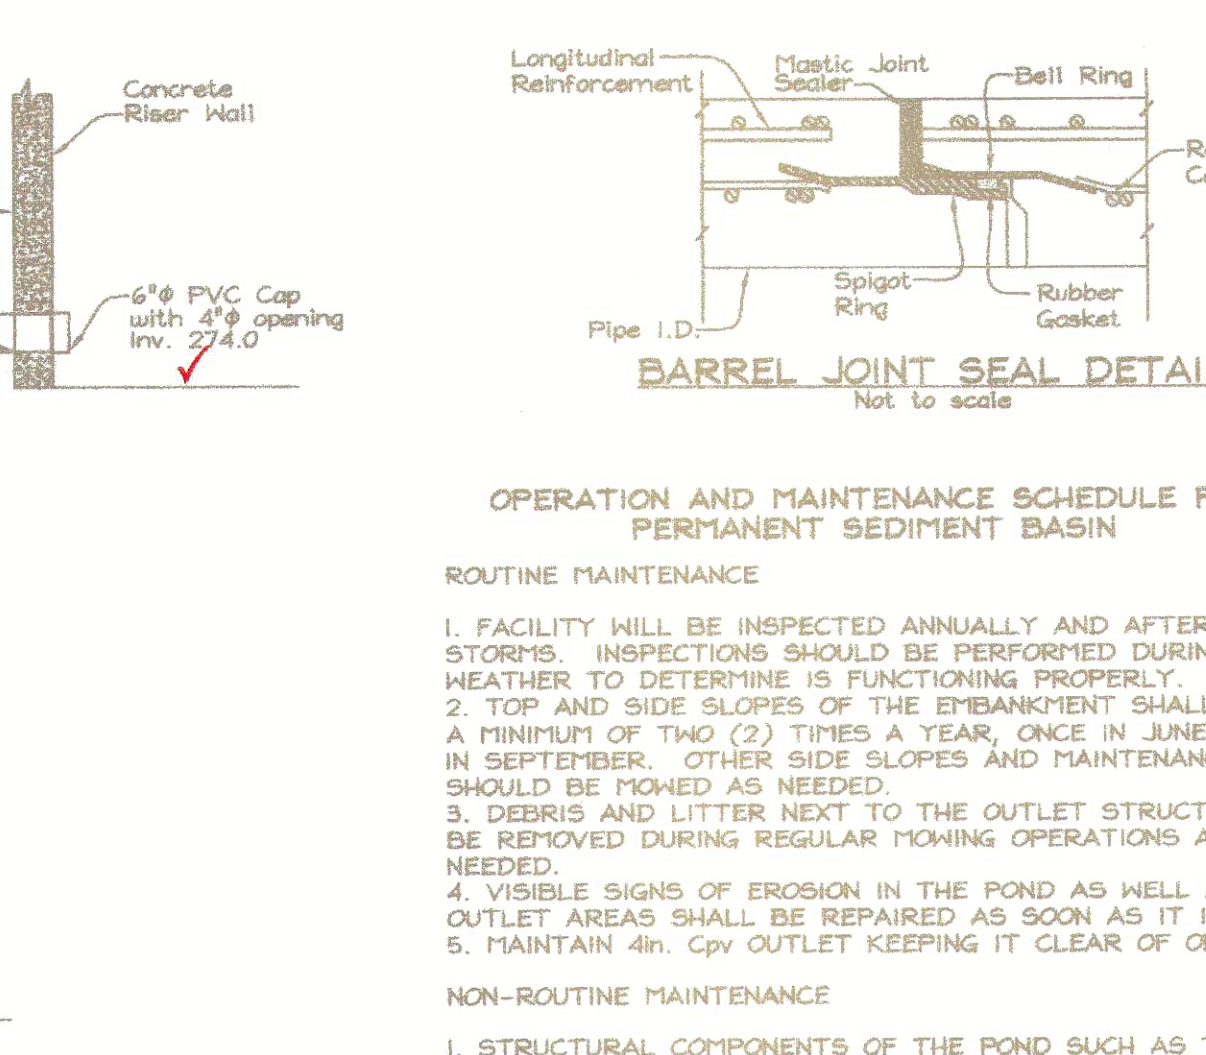

**BARREL JOINT SEAL DETAIL**  
 Not to scale

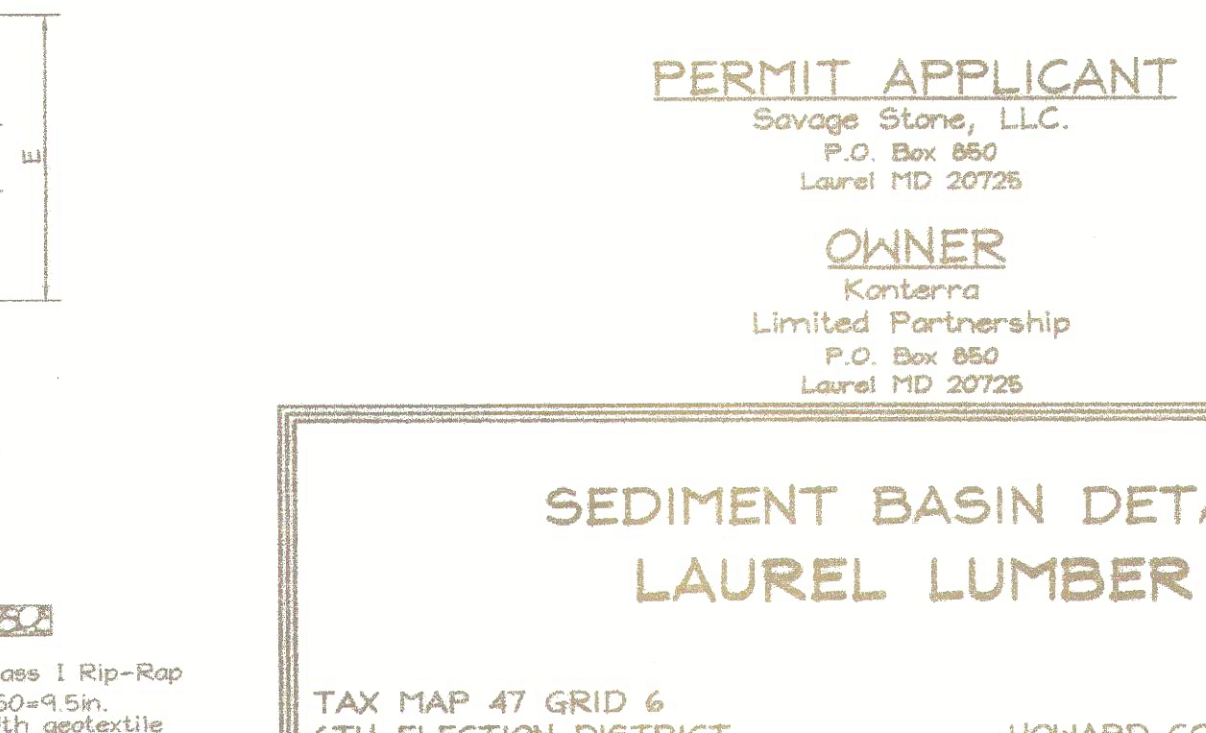

**PLUNGE POOL TABLE**  
 TYPICAL PLUNGE POOL DETAIL  
 NOT TO SCALE

**OPERATION AND MAINTENANCE SCHEDULE FOR PERMANENT SEDIMENT BASIN**

**ROUTINE MAINTENANCE**

1. FACILITY WILL BE INSPECTED ANNUALLY AND AFTER MAJOR STORMS. INSPECTIONS SHOULD BE PERFORMED DURING NET WEATHER TO DETERMINE IS FUNCTIONING PROPERLY.
2. TOP AND SIDE SLOPES OF THE EMBANKMENT SHALL BE MOWED A MINIMUM OF TWO (2) TIMES A YEAR, ONCE IN JUNE AND ONCE IN SEPTEMBER. OTHER SIDE SLOPES AND MAINTENANCE ACCESS SHOULD BE MOWED AS NEEDED.
3. DEBRIS AND LITTER NEXT TO THE OUTLET STRUCTURE SHALL BE REMOVED DURING REGULAR MOWING OPERATIONS AND AS NEEDED.
4. VISIBLE SIGNS OF EROSION IN THE POND AS WELL AS RIPRAP OUTLET AREAS SHALL BE REPAIRED AS SOON AS IT IS NOTICED.
5. MAINTAIN MIN. GPM OUTLET KEEPING IT CLEAR OF OBSTRUCTIONS.

**NON-ROUTINE MAINTENANCE**

1. STRUCTURAL COMPONENTS OF THE POND SUCH AS THE DAM, THE RISER, AND THE PIPES SHALL BE REPAIRED UPON DETECTION OF ANY DAMAGE. THE COMPONENTS SHOULD BE INSPECTED DURING ROUTINE MAINTENANCE OPERATIONS.
2. SEDIMENT SHOULD BE REMOVED WHEN ITS ACCUMULATION REACHES THE CLEANOUT ELEVATION OF 273.0.

**PERMIT APPLICANT**  
 Savage Stone, LLC.  
 P.O. Box 880  
 Laurel MD 20725

**OWNER**  
 Konterra  
 Limited Partnership  
 P.O. Box 880  
 Laurel MD 20725

**SEDIMENT BASIN DETAILS**  
**LAUREL LUMBER**

TAX MAP 47 GRID 6  
 6TH ELECTION DISTRICT

PARCEL 384  
 HOWARD COUNTY, MARYLAND

DESIGN BY: SH  
 DRAWN BY: CRH/RL  
 CHECKED BY: SH  
 SCALE: AS SHOWN  
 DATE: Nov. 16, 2006  
 W.O. No.: 3249  
 SHEET No.: 8 OF 10

**FSH Associates**  
 Engineers Planners Surveyors  
 6330 Howard Lane, Suite 200, MD 21075  
 Tel: 410-567-5200 Fax: 410-798-1562  
 E-mail: info@fshnet.com


**CME ENGINEERING LP**  
 AS-BUILT DATA PREPARED BY:  
 12 Village Parkway, Frostburg, MD 21532  
 301-689-1700 FAX: 301-689-5177  
 e-mail: info@cmeengmt.com




**GENERAL NOTES**

- Subject property zoned "R-SA-8" per 2/02/04 Comprehensive Zoning Plan.
- Gross area of property = 39.4 ac.±
- The Contractor shall notify the following utility companies or agencies at least five (5) working days before starting storm drain work shown on these plans:
  - State Highway Administration 410.531.5533
  - BGE(Contractor Services) 410.850.4620
  - BGE(Underground Damage Control) 410.787.9368
  - Miss Utility 1.800.257.7777
  - Howard County, Dept. of Public Works, Bureau of Utilities 410.313.4900
  - Howard County Health Department 410.313.2640
  - AT&T 1.800.252.1133
  - Verizon 1.800.743.0033/410.224.4210
- The contractor shall notify Miss Utility at 1-800-257-7777 at least 48 hours prior to any excavation work.
- This project received a waiver from having to prepare a Site Development Plan (WP-06-09B) (Section 16.123(a)(2) and 16.155(a)(1)) approved by Howard County Department of Planning & Zoning, planning director, on September 1, 2006.
- The project is in conformance with the latest Howard County Standards unless waivers have been approved.
- Boundary for the site was provided by Civil Mining Environmental Engineering, Inc. Topography provided by Patton Harris Rust Associates, flown by Harford Aerial Surveys.
- There are no floodplains, historic structures or cemeteries on-site.
- The coordinates shown hereon are based upon the Howard County Geodetic Control which is based on the Maryland State Plane Coordinate system. Howard County monument numbers 43GA and 43G6 were used for this project.
- Any damage to public right-of ways, paving or existing utilities will be corrected at the contractor's expense.
- Existing utilities are located by the use of any or all of the following: Road Construction Plans, Field Surveys, Public Water and Sewer Plans and other available record drawings. Approximate location of the existing utilities are shown for the contractor's information. Contractor shall locate existing utilities well in advance of construction activities and take all necessary precautions to protect the existing utilities and to maintain uninterrupted service. Any damage incurred due to the contractor's operation shall be repaired immediately at the contractor's expense.
- Soil compaction specifications, requirements, methods and materials are to be in accordance with the recommendations of the project Geotechnical Engineer.
- A jurisdictional determination of non-tidal wetlands and waterways was performed by MDE September 7, 2004. No regulated wetlands were present. One jurisdictional stream channel was identified and survey located as shown on these drawings.
- This site is subject to a Decision and Order from the Howard County Board Of Appeals Case No. BA95-58E, item No.14. "The Petitioner will fill the existing quarry at the back of Pine Road using overburden from the new quarry and other material."


# MINE RECLAMATION PLAN LAUREL LUMBER HOWARD COUNTY, MARYLAND

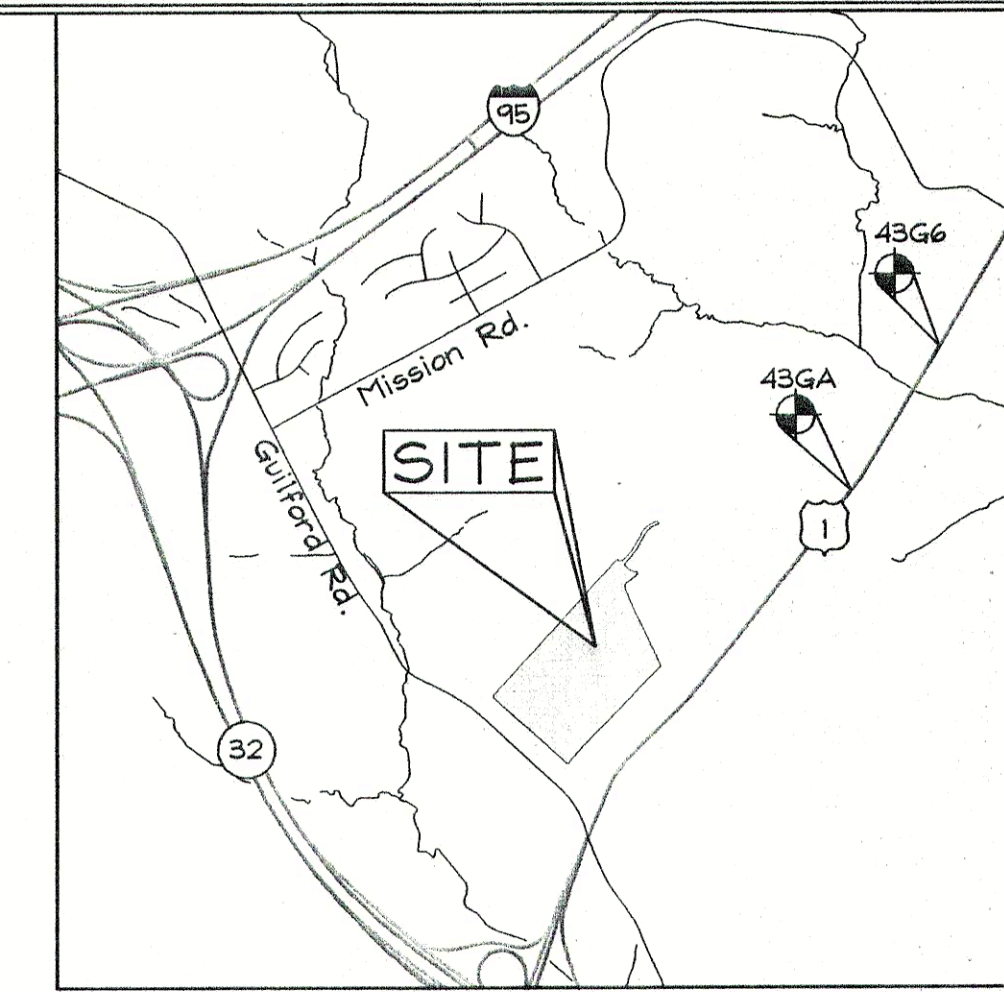

VICINITY MAP  
SCALE: 1"=2000'

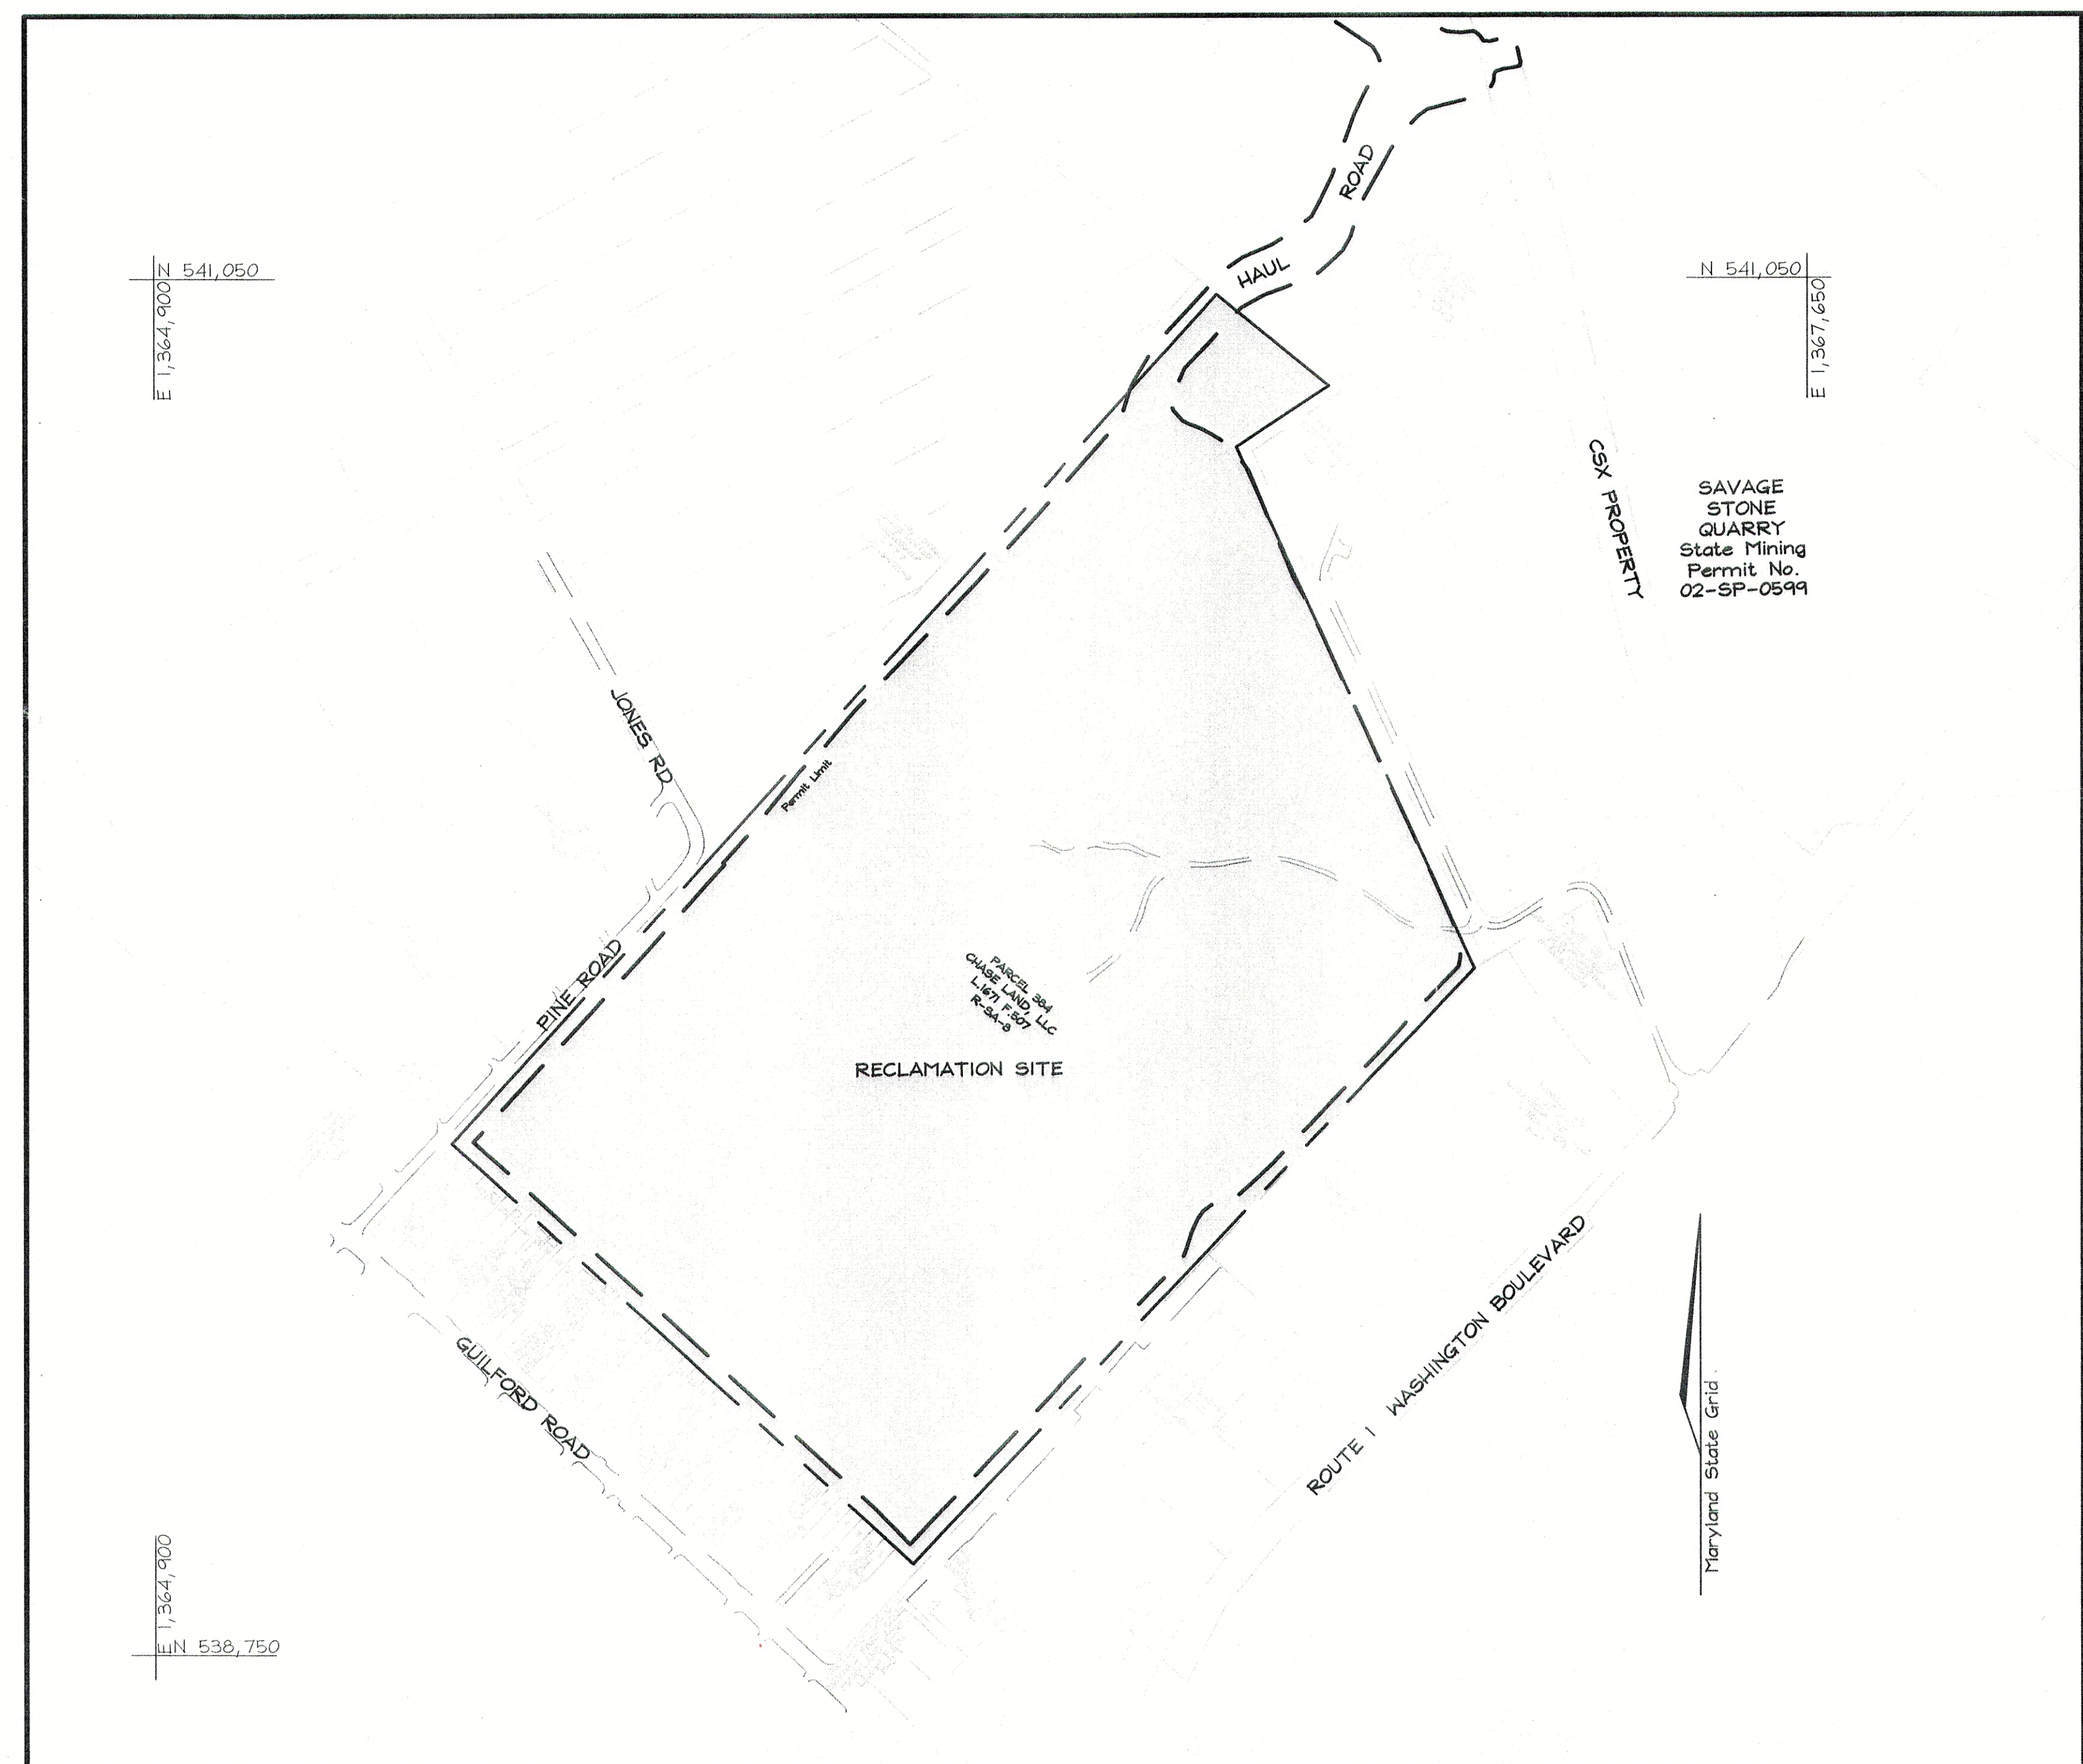

LOCATION MAP  
SCALE: 1"=200'

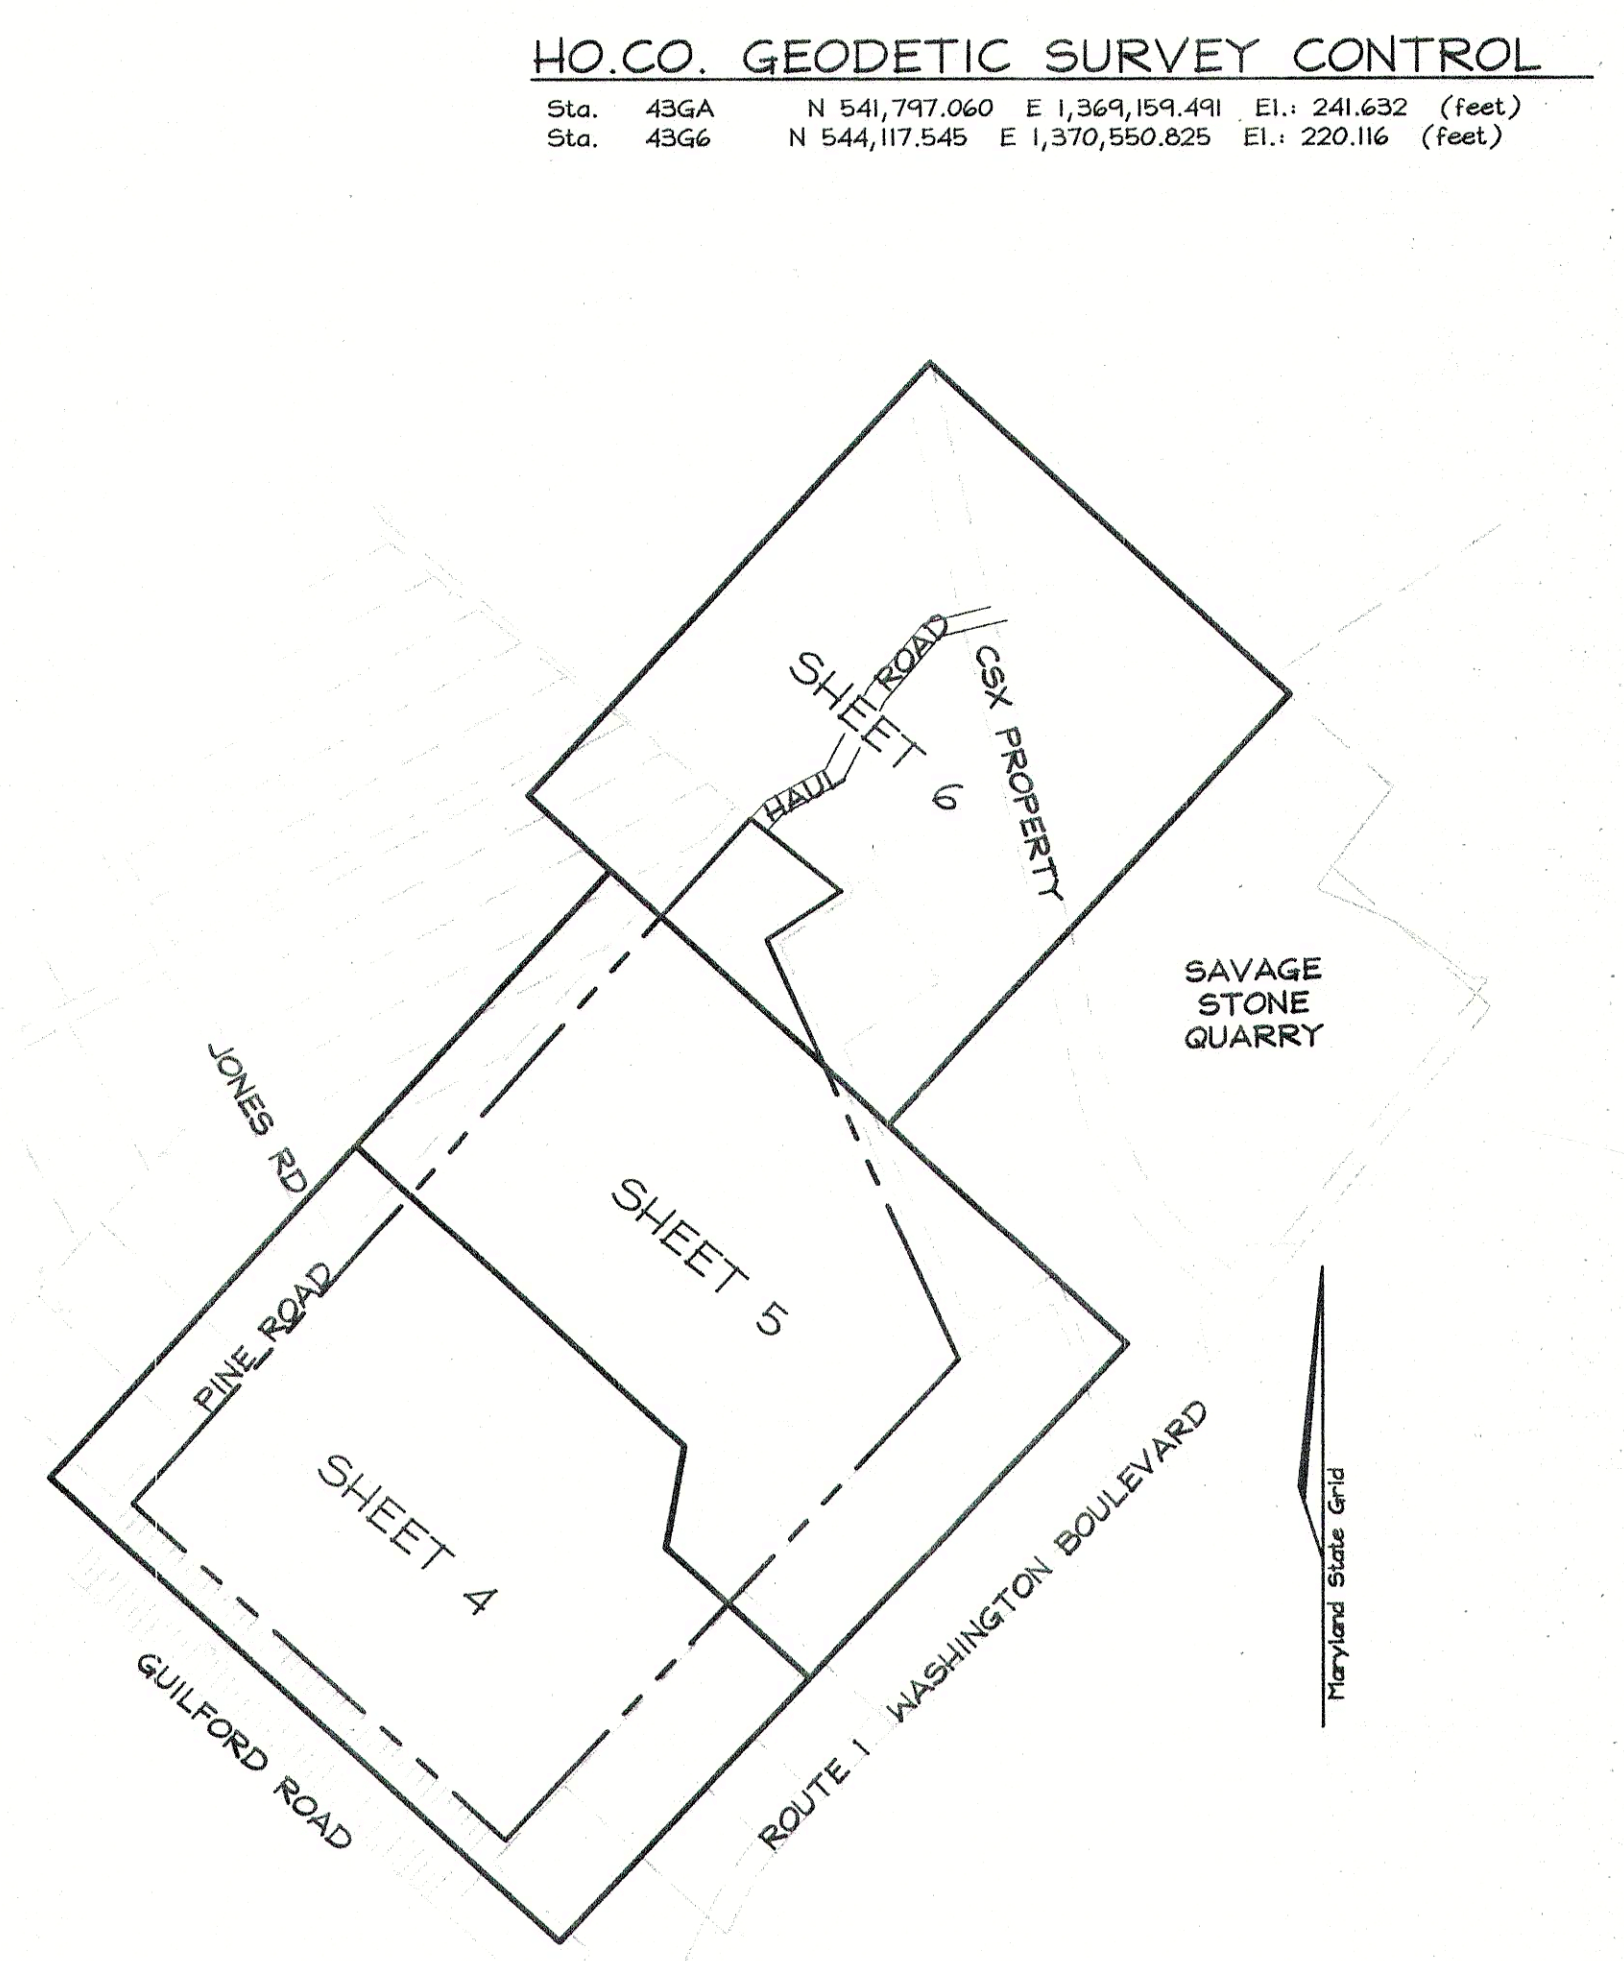

KEY MAP  
SCALE: 1"= 400'

SHEET INDEX	
DESCRIPTION	SHEET No.
Title Sheet	1 of 10
Existing Conditions & Adjacent Property Owners Map	2 of 10
Drainage Area Map	3 of 10
Grading, Sediment & Erosion Control Plan	4 of 10
Grading, Sediment & Erosion Control Plan	5 of 10
Grading, Sediment & Erosion Control Plan	6 of 10
Sediment Basin Profiles	7 of 10
Sediment Basin Details	8 of 10
Grading, Sediment & Erosion Control Notes and Details	9 of 10
Cross Sections	10 of 10

**PERMIT APPLICANT**  
Savage Stone, LLC.  
P.O. Box 850  
Laurel MD 20725

**OWNER**  
Konterra  
Limited Partnership  
P.O. Box 850  
Laurel MD 20725

**MINE RECLAMATION PLAN  
COVER SHEET  
LAUREL LUMBER**

TAX MAP 47 GRID 6  
6TH ELECTION DISTRICT

PARCEL 384  
HOWARD COUNTY, MARYLAND

REVIEWED FOR HOWARD SCD AND MEETS TECHNICAL REQUIREMENTS \*

*Jim Meyer* 11/17/06  
USDA NATURAL RESOURCES CONSERVATION SERVICE DATE

THIS DEVELOPMENT PLAN IS APPROVED FOR SOIL EROSION AND SEDIMENT CONTROL BY THE HOWARD SOIL CONSERVATION DISTRICT \*

*John R. Robertson* 11/17/06  
HOWARD SCD DATE

**ENGINEERS CERTIFICATE**


"I CERTIFY THAT THIS PLAN FOR SEDIMENT AND EROSION CONTROL REPRESENTS A PRACTICAL AND WORKABLE PLAN BASED ON MY PERSONAL KNOWLEDGE OF THE SITE CONDITIONS AND THAT IT WAS PREPARED IN ACCORDANCE WITH THE REQUIREMENTS OF THE HOWARD SOIL CONSERVATION DISTRICT."

*Zacharia Y. Fisch* 11/16/06  
SIGNATURE OF ENGINEER DATE  
ZACHARIA Y. FISCH

**PERMITTEE'S CERTIFICATE**

"I/WE CERTIFY THAT ALL DEVELOPMENT AND CONSTRUCTION WILL BE DONE ACCORDING TO THIS PLAN FOR SEDIMENT AND EROSION CONTROL AND THAT ALL RESPONSIBLE PERSONNEL INVOLVED IN THE CONSTRUCTION PROJECT WILL HAVE A CERTIFICATE OF ATTENDANCE AT A DEPARTMENT OF THE ENVIRONMENT APPROVED TRAINING PROGRAM FOR THE CONTROL OF SEDIMENT AND EROSION BEFORE BEGINNING THE PROJECT. I ALSO AUTHORIZE PERIODIC ON-SITE INSPECTION BY THE HOWARD SOIL CONSERVATION DISTRICT."

*Imoley J. Schmidt* 11/16/06  
SIGNATURE OF PERMITTEE DATE

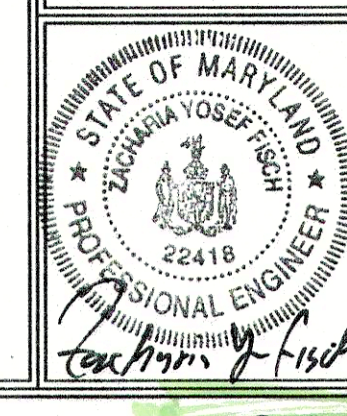


**FSH Associates**  
Engineers Planners Surveyors  
6339 Howard Lane Elkridge, MD 21075  
Tel: 410-567-5200 Fax: 410-796-1562  
E-mail: info@fshinc.com

DESIGN BY: SH  
DRAWN BY: GRH2/RL  
CHECKED BY: SH  
SCALE: AS SHOWN  
DATE: Nov 16, 2006  
W.O. No.: 3248  
SHEET No.: 1 OF 10

GP-06-86



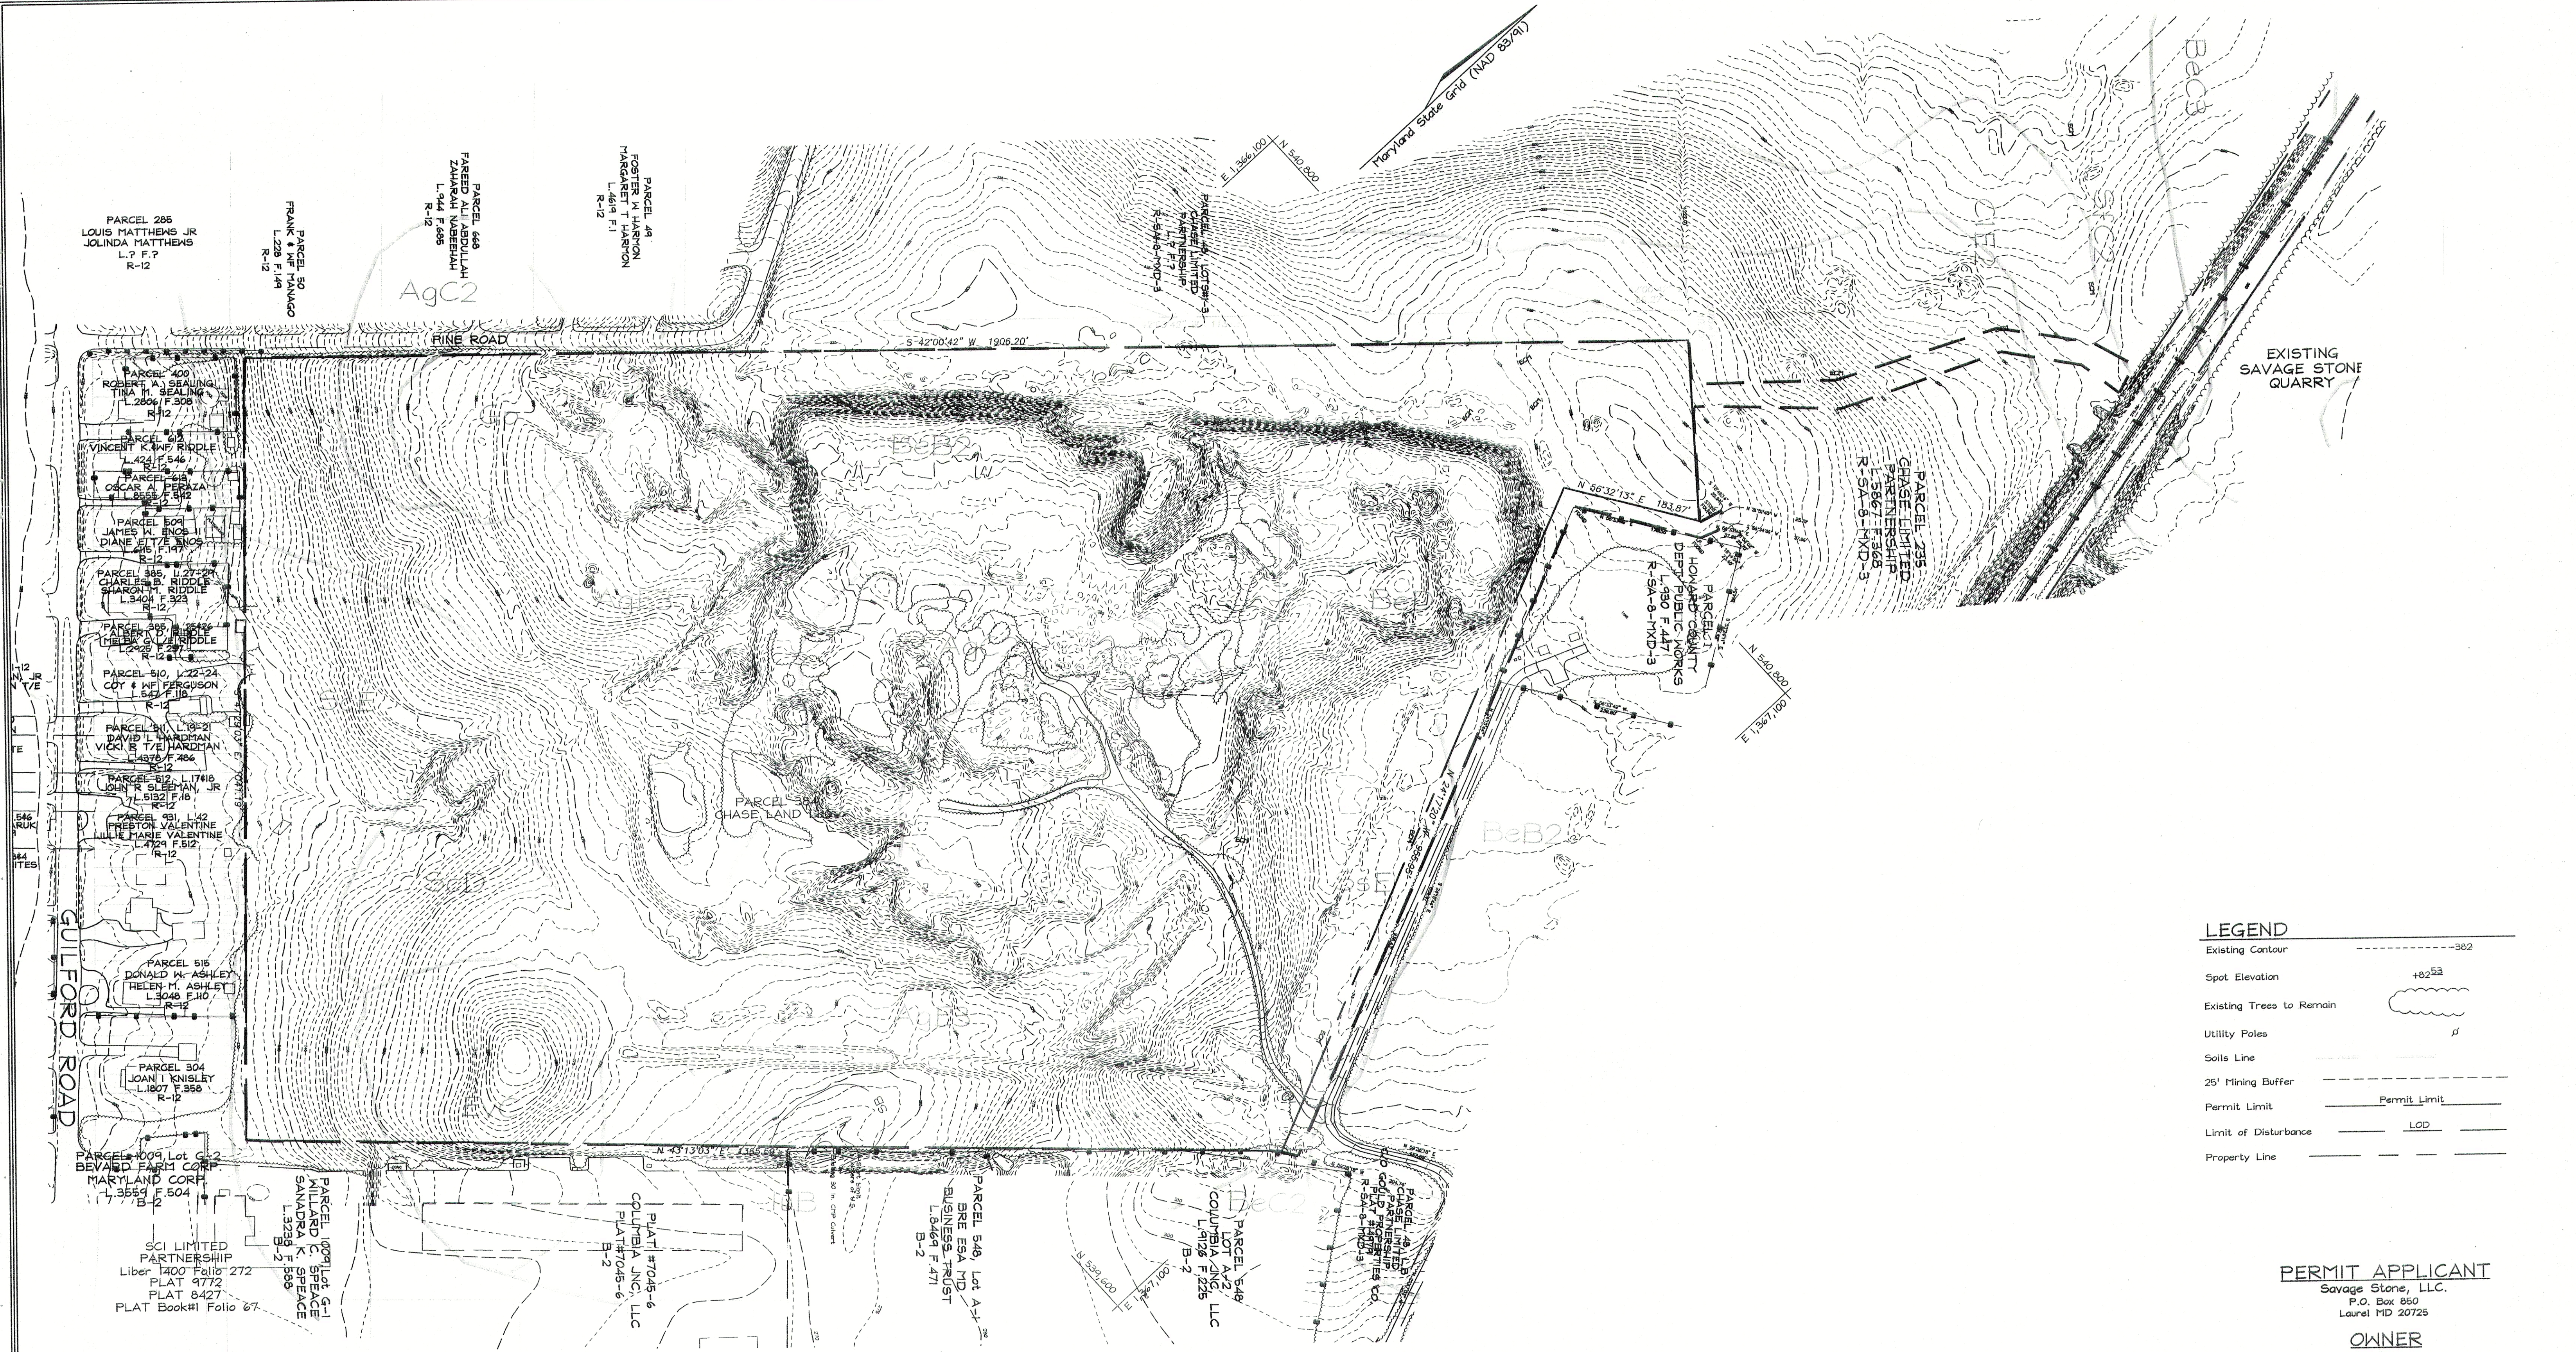

**LEGEND**

Existing Contour	---
Spot Elevation	+62.53
Existing Trees to Remain	(Symbol)
Utility Poles	⊥
Soils Line	---
25' Mining Buffer	---
Permit Limit	---
Limit of Disturbance	---
Property Line	---


**PERMIT APPLICANT**  
Savage Stone, LLC.  
P.O. Box 850  
Laurel MD 20725

**OWNER**  
Konterra  
Limited Partnership  
P.O. Box 850  
Laurel MD 20725

**EXISTING CONDITIONS AND ADJACENT PROPERTY OWNERS MAP LAUREL LUMBER**

TAX MAP 47 GRID 6  
6TH ELECTION DISTRICT

PARCEL 384  
HOWARD COUNTY, MARYLAND

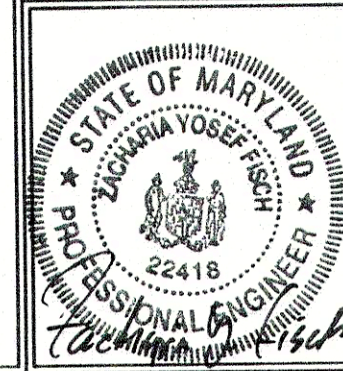

**FSH Associates**  
Engineers Planners Surveyors  
8318 Forest Street, Ellicott City, MD 21043  
Tel: 410-750-2251 Fax: 410-750-7350  
E-mail: info@fsha.biz


DESIGN BY: SH  
DRAWN BY: CRH2  
CHECKED BY: SH  
SCALE: As Shown  
DATE: Sept. 21, 2009  
P.L.O. No.: 3248  
SHEET No.: 2 OF 10

Parcel-Lot#	MAILING ADDRESS	Parcel-Lot#	MAILING ADDRESS	Parcel-Lot#	MAILING ADDRESS	Parcel-Lot#	MAILING ADDRESS	Parcel-Lot#	MAILING ADDRESS
400-37440	Robert & Tina Sealing 10314 Guilford Road Jessup, MD 20794-9534	510-22423	Coy & w/f Ferguson 10163 Guilford Road Jessup, MD 20794-9534	304-145	Joan Knisley 10195 Guilford Road Jessup, MD 20794-9534	548-Par.B	Chase Limited Part. 670 Guild Prop. Inv. Co. 1725 Lakeside Dr. Ste#900 Washington DC 20036	50-1	Frank & w/f Manago 5640 Pine Rd Jessup, MD 20794-9535
612-35436	Vincent & w/f Riddle 10145 Guilford Road Jessup, MD 20794-9534	511-19420	David & Vicki Hardman 10167 Guilford Road Jessup, MD 20794-9534	1009-G2	Beard Farm Corporation & Howard Corporation PO Box 417 Ellicott City, MD 21041	1	Howard County - DPW 3430 Court House Dr Ellicott City MD 21043	285-1	Lois & Jolinda Matthews, Jr 10131 Guilford Road Jessup, MD 20794-9534
613-33434	Oscar Peraza 10151 Guilford Road Jessup, MD 20794-9534	512-17418	John R. Siesman Jr 10171 Guilford Road Jessup, MD 20794-9534	1009-G1	Willard & Sandra Speace 6248 Painter Hill Ct Ellicott City, MD 21042	235	Chase Limited Part. 6995 Hurick Meadows Dr Beltsville MD 20705-6305	384	James Konterra Limited Part. PO Box 714 Laurel, MD 20725-0719
509-30431	James & Diane Enos II 10155 Guilford Road Jessup, MD 20794-9534	931-42	Preston & Little Valentine 10161 Guilford Road Jessup, MD 20794-9534	991-Par.B	SCI Limited Part. PO Box 417 Ellicott City, MD 21041	48-1,2,3	Chase Limited Part. 14504 Greenview Dr Laurel, MD 20708		
385-27426	Charles & Sharon Riddle 10154 Guilford Road Jessup, MD 20794-9534	931-41	Walter & Martha Shannon 10185 Guilford Road Jessup, MD 20794-9534	548-A1	BRE ESA MD Prop Bus. 100 Dunbar Street Sportland SC 29306	49-344	Foster & Margaret Harmon 8660 Pine Rd Jessup, MD 20794-9535		
385-25426	Albert & Melba Riddle 10161 Guilford Road Jessup, MD 20794-9534	515-6,748	Donald & Helen Ashley 10189 Guilford Road Jessup, MD 20794-9534	548-A2	Columbia Junction LLC PO Box 417 Jessup, MD 21041	668-2	Fareed Ali Abdullah Zaharah Yaseenah 8660 Pine Rd Jessup, MD 20794-9535		

**SOILS LEGEND**

SYMBOL	NAME / DESCRIPTION	SOIL GROUP
AgC2	Aura gravelly loam, 5 to 10 percent slopes, moderately eroded	B
AgE3	Aura gravelly loam, 10 to 30 percent slopes, severely eroded	B
BeD2	Beltsville silt loam, 1 to 5 percent slopes, moderately eroded	C
BeD2	Beltsville silt loam, 1 to 5 percent slopes, moderately eroded	C
BeD2	Beltsville silt loam, 1 to 5 percent slopes, moderately eroded	C
EVC	Evesboro loamy sand, 5 to 15 percent slopes	A
Gp	Gravel pits and quarries	C
ScD	Sandy and clayey loam, moderately sloping	C
ScE	Sandy and clayey loam, moderately steep	C
SaE	Sassafras soils, 15 to 40 percent slopes	B
BeC3	Beltsville silt loam, 5 to 10 percent slopes, severely eroded	C
CiE2	Chillum gravelly loam, 15 to 30 percent slopes, moderately eroded	C
SfC2	Sassafras gravelly sandy loam, 5 to 10 percent slopes, moderately eroded	B



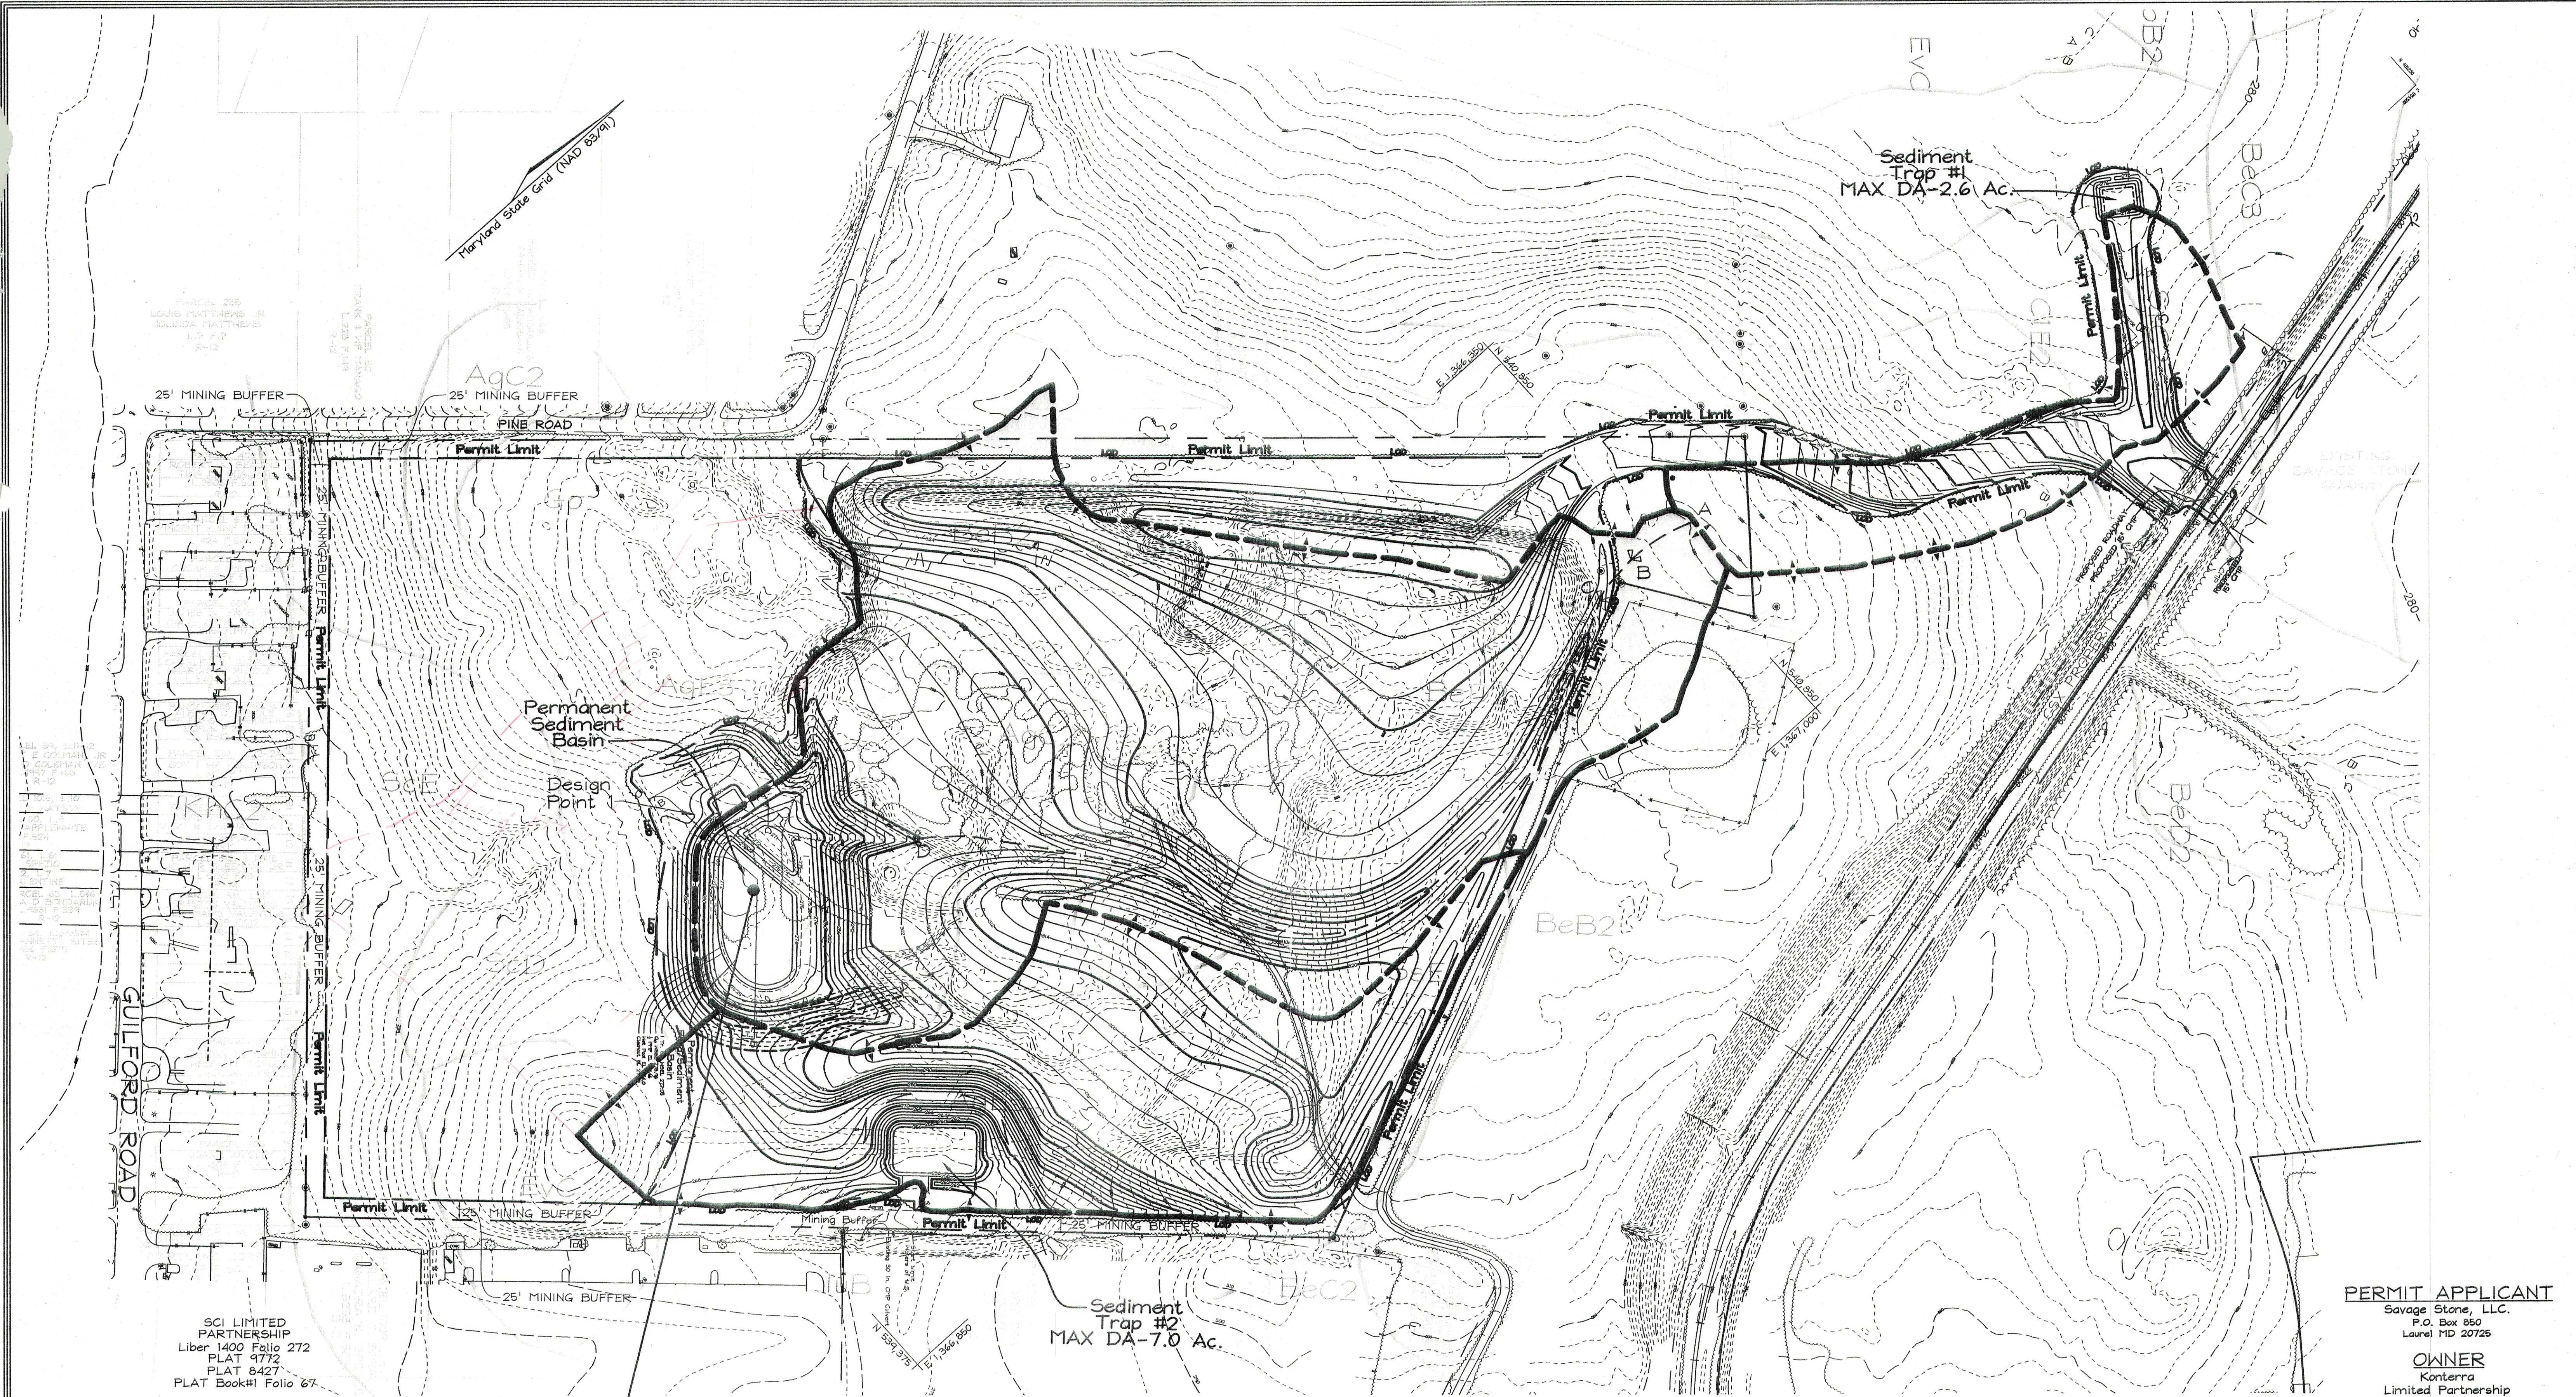

SCI LIMITED PARTNERSHIP  
 Liber 1400 Folio 272  
 PLAT 9772  
 PLAT 8427  
 PLAT Book#1 Folio 67

DA=18.32 Ac. Max. Tc=0.25 hr.  
 RCN=91  
 B -> C Soils  
 C -> D Soils

PLAN VIEW  
 Scale: 1"=100'

- LEGEND**
- Soils Line
  - Permit Limit
  - Limits of Disturbance
  - 25' Mining Buffer
  - Drainage Divide (Final)
  - Time of Concentration (1-Yr. + 10-Yr. Storms)
  - Meadow
  - Impervious surface
  - Forest - Good Conditions
  - Newly Graded

**FLOW PATH DESCRIPTION**

PATH	TYPE	LENGTH	SLOPE/SPEED
A-B	Sheet Flow	100 L.F.	5.0%
B-C	Shallow Conc.	70 L.F.	25%
C-D	Channel	1180 L.F.	4.0 FPS

**SOILS LEGEND**

SYMBOL	NAME / DESCRIPTION	SOIL GROUP
AqC2	Aura gravelly loam, 5 to 10 percent slopes, moderately eroded	B
AqE3	Aura gravelly loam, 10 to 30 percent slopes, severely eroded	B
BeB2	Beltville silt loam, 1 to 5 percent slopes, moderately eroded	C
BeD2	Beltville silt loam, 10 to 15 percent slopes, moderately eroded	C
EVC	Evesboro loamy sand, 5 to 15 percent slopes	A
Gp	Gravel pits and quarries	C
ScD	Sandy and clayey loam, moderately sloping	C
SsE	Sandy and clayey loam, moderately steep	C
SsE	Sassafras soils, 15 to 40 percent slopes	B
BeC3	Beltville silt loam, 5 to 10 percent slopes, severely eroded	C
CIE2	Chillum gravelly loam, 15 to 30 percent slopes, moderately eroded	C
SsC2	Sassafras gravelly sandy loam, 5 to 10 percent slopes, moderately eroded	B

**PERMIT APPLICANT**  
 Savage Stone, LLC.  
 P.O. Box 850  
 Laurel MD 20725

**OWNER**  
 Konterra  
 Limited Partnership  
 P.O. Box 850  
 Laurel MD 20725

**DRAINAGE AREA MAP  
 PROPOSED CONDITIONS  
 LAUREL LUMBER**

TAX MAP 47 GRID 6  
 6TH ELECTION DISTRICT

PARCEL 384  
 HOWARD COUNTY, MARYLAND

**FSH Associates**  
 Engineers Planners Surveyors  
 8318 Forest Street Ellicott City, MD 21043  
 Tel: 410-750-2251 Fax: 410-750-7350  
 E-mail: info@fsha.biz

DESIGN BY: SH  
 DRAWN BY: CRH2/RL  
 CHECKED BY: SH  
 SCALE: As Shown  
 DATE: Sept. 19, 2006  
 W.O. No.: 3248  
 SHEET No.: 3 OF 10



MATCHLINE A-A SEE SHEET 5 OF 10


**SEDIMENT BASIN NO. 1**

Drainage Area: 18.32 Ac.  
 Storage Required 65,952 cu. ft. wet and dry  
 Storage Provided 113,334 cu. ft. wet and dry  
 Riser Crest Elevation: 277.00  
 Bottom Basin Elevation: 272.00  
 Top Dam Elevation: 282.20  
 Draw-Down Wet Pool Elevation: 274.00  
 Basin Clean-Out Elevation: 273.00  
 Emergency Spillway Crest Elevation: 280.00  
 Design High Water Elevation: 281.16  
 See Detail Sheet 7 and 8 of 10

MATCHLINE A-A SEE SHEET 5 OF 10

**LEGEND**

- Existing Contour
- Proposed Contour
- Spot Elevation
- Existing Trees to Remain
- Utility Poles
- Stabilized Construction Entrance
- Silt Fence
- Super Silt Fence
- Earth Dike
- 25' Mining Buffer
- Permit Limit
- Limit of Disturbance
- Property Line
- Erosion Control Matting
- Temporary Initial Dam Contours
- Rip Rap Inflow Protection
- Removable Pump Station

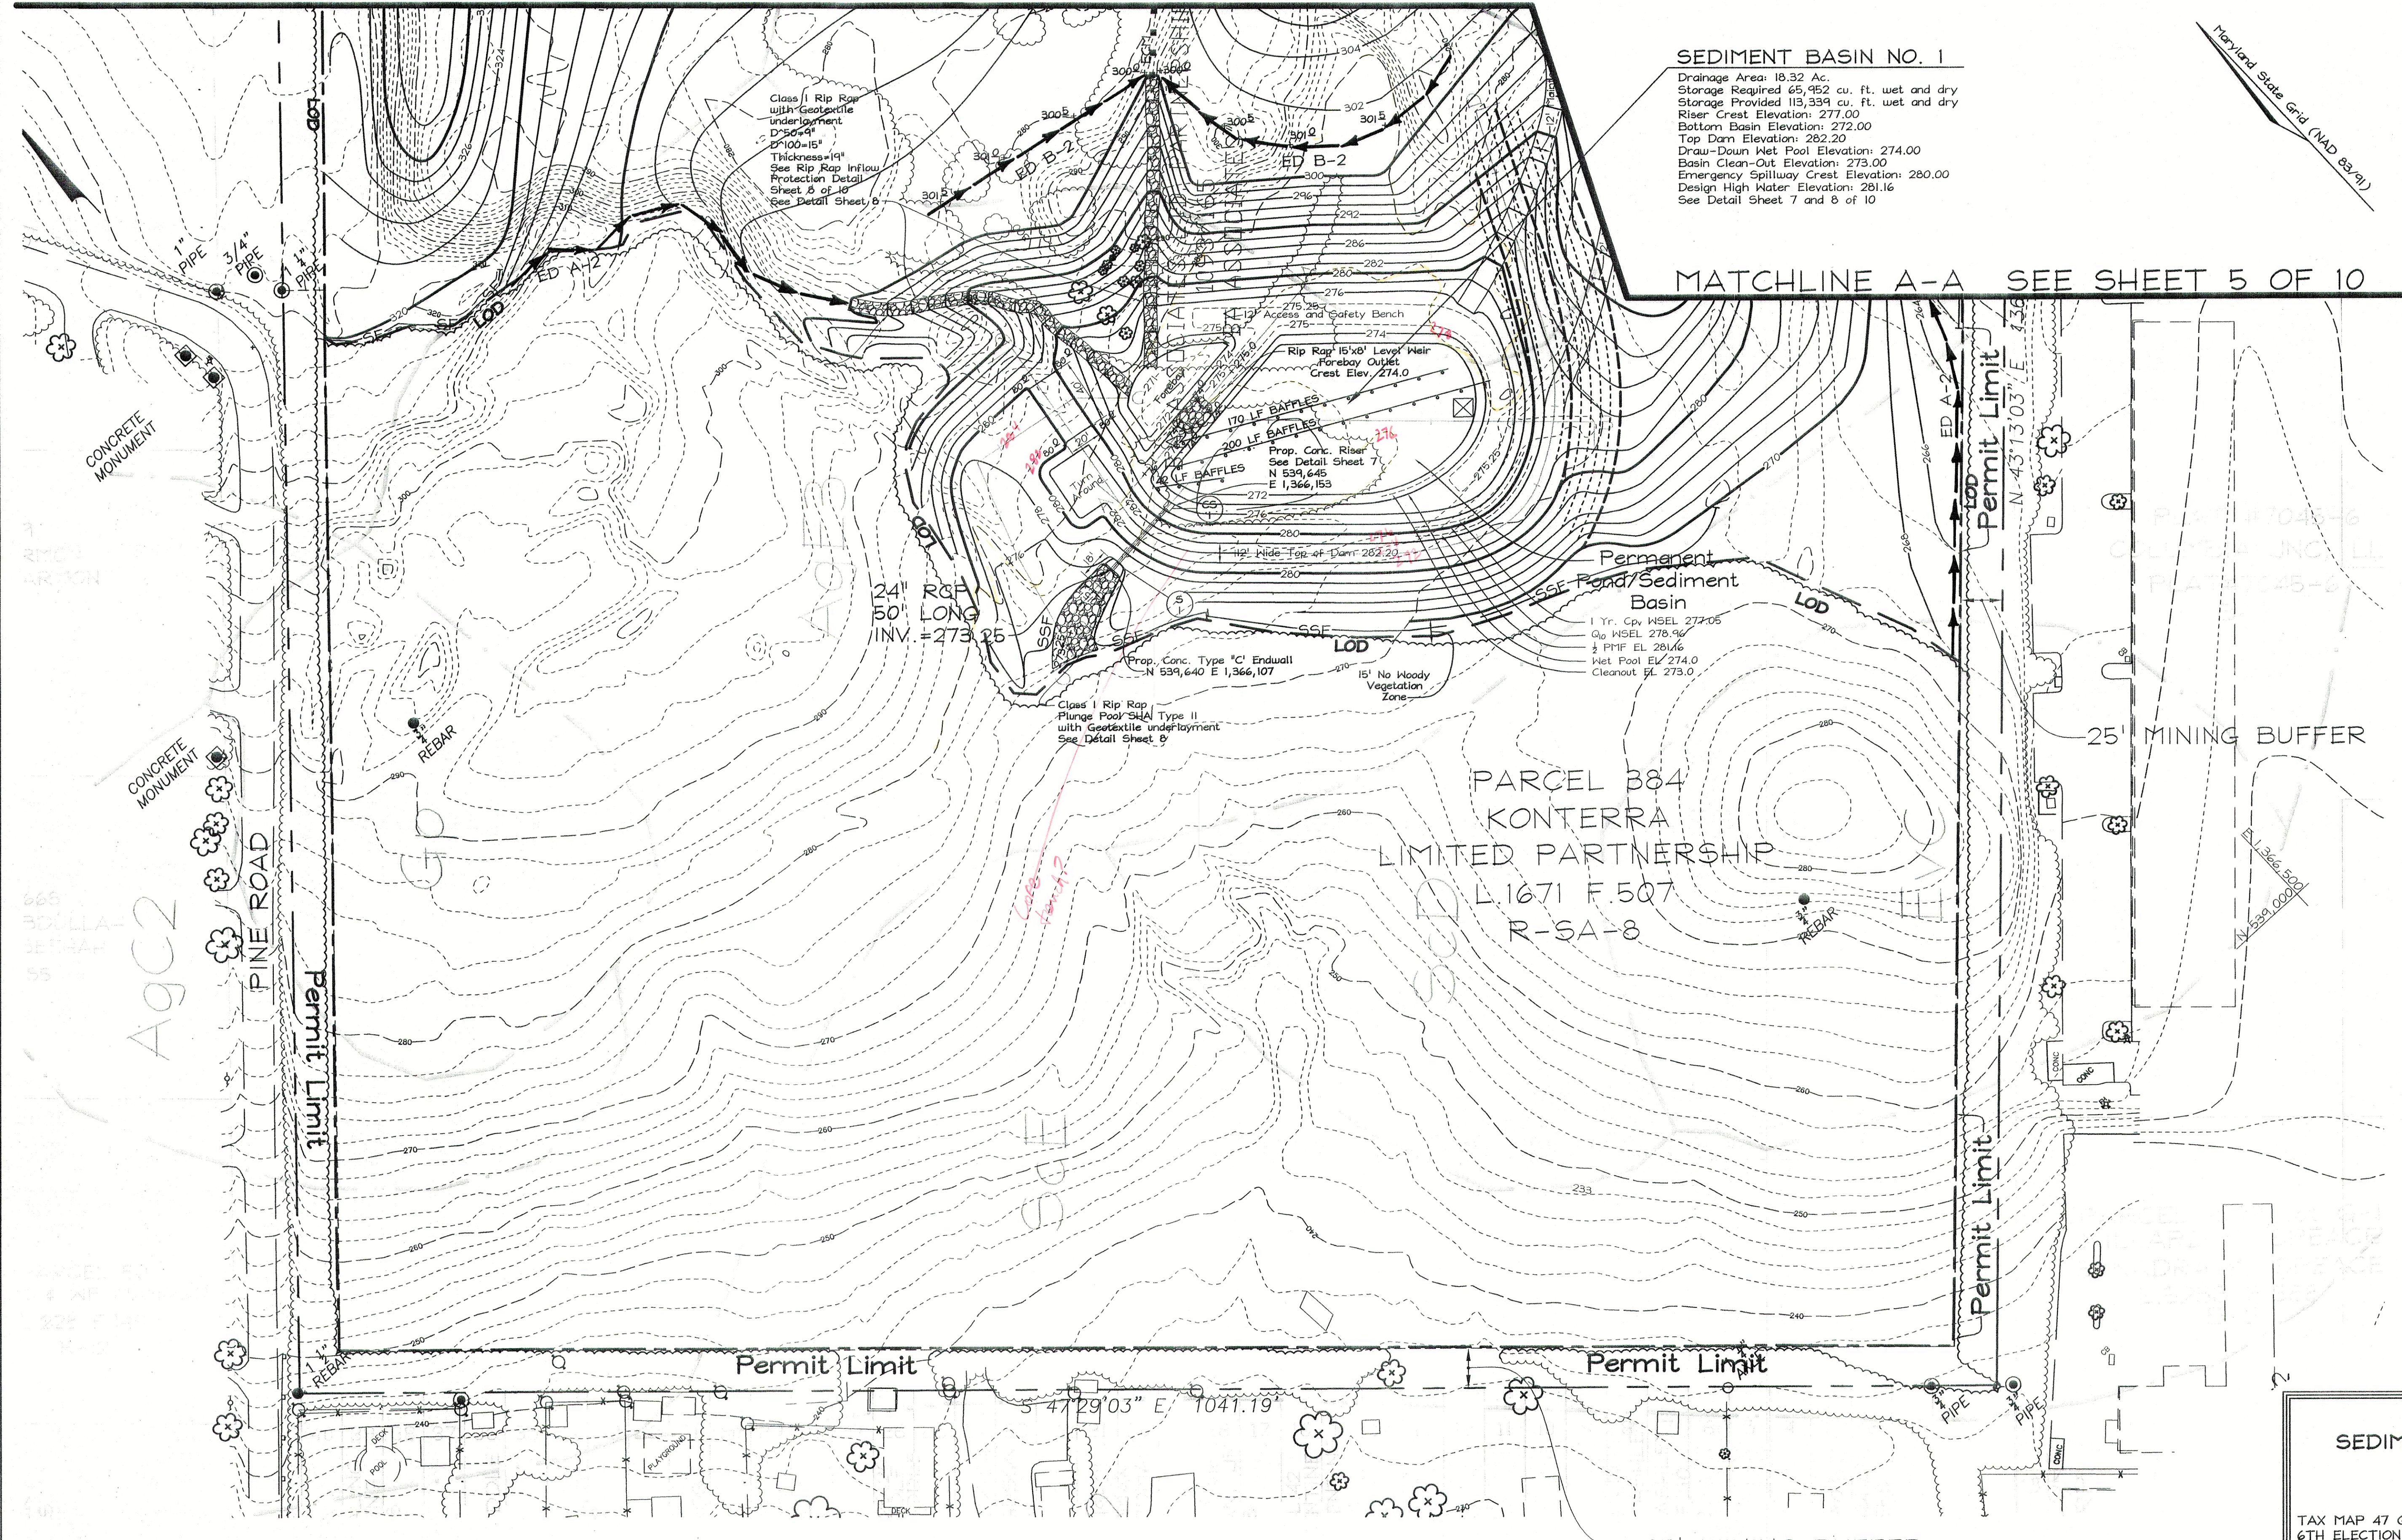

**PERMIT APPLICANT**

Savage Stone, LLC.  
 P.O. Box 850  
 Laurel MD 20725

**OWNER**

Konterra  
 Limited Partnership  
 P.O. Box 850  
 Laurel MD 20725

**GRADING AND  
 SEDIMENT & EROSION CONTROL PLAN  
 LAUREL LUMBER  
 MINE RECLAMATION PLAN**

TAX MAP 47 GRID 6  
 6TH ELECTION DISTRICT

PARCEL 384  
 HOWARD COUNTY, MARYLAND

REVIEWED FOR HOWARD SCD AND MEETS TECHNICAL REQUIREMENTS

*Jim Meyer*  
 USA - NATURAL RESOURCE CONSERVATION SERVICE  
 DATE: 11/16/06

THIS DEVELOPMENT PLAN IS APPROVED FOR SOIL EROSION AND SEDIMENT CONTROL BY THE HOWARD SOIL CONSERVATION DISTRICT

*John R. Robertson*  
 HOWARD SCD  
 DATE: 11/16/06

**ENGINEER'S CERTIFICATE**

I CERTIFY THAT THIS PLAN FOR SEDIMENT AND EROSION CONTROL REPRESENTS A PRACTICAL AND WORKABLE PLAN BASED ON MY PERSONAL KNOWLEDGE OF THE SITE CONDITIONS AND THAT IT WAS PREPARED IN ACCORDANCE WITH THE REQUIREMENTS OF THE HOWARD SOIL CONSERVATION DISTRICT.

*Zacharia Y. Fisch*  
 SIGNATURE OF ENGINEER  
 ZACHARIA Y. FISCH  
 DATE: 11/16/06


**PERMITTEE'S CERTIFICATE**

I/WE CERTIFY THAT ALL DEVELOPMENT AND CONSTRUCTION WILL BE DONE ACCORDING TO THIS PLAN FOR SEDIMENT AND EROSION CONTROL, AND THAT ALL RESPONSIBLE PERSONNEL INVOLVED IN THE CONSTRUCTION PROJECT WILL HAVE A CERTIFICATE OF ATTENDANCE AT A DEPARTMENT OF THE ENVIRONMENT APPROVED TRAINING PROGRAM FOR THE CONTROL OF SEDIMENT AND EROSION BEFORE BEGINNING THE PROJECT. I ALSO AUTHORIZE PERIODIC ON-SITE INSPECTION BY THE HOWARD SOIL CONSERVATION DISTRICT.

*Timothy J. Schmidt*  
 SIGNATURE OF PERMITTEE  
 DATE: 11/16/06

25' MINING BUFFER

**PLAN VIEW**  
 SCALE: 1"=50'

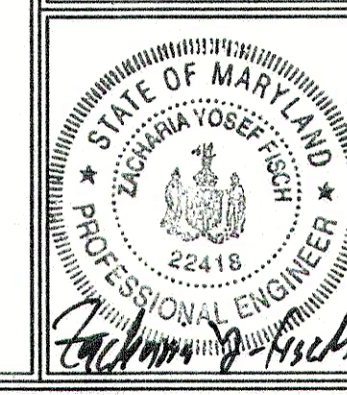


**FSH Associates**  
 Engineers Planners Surveyors  
 6339 Howard Lane Elkridge, MD 21075  
 Tel: 410-567-5200 Fax: 410-796-1562  
 E-mail: info@fsn.com

DESIGN BY: SH  
 DRAWN BY: CRH2/RL  
 CHECKED BY: SH  
 SCALE: AS SHOWN  
 DATE: Nov. 16, 2006  
 W.O. No.: 3248  
 SHEET No.: 4 OF 10



MATCHLINE B-B SEE SHEET 6 OF 10

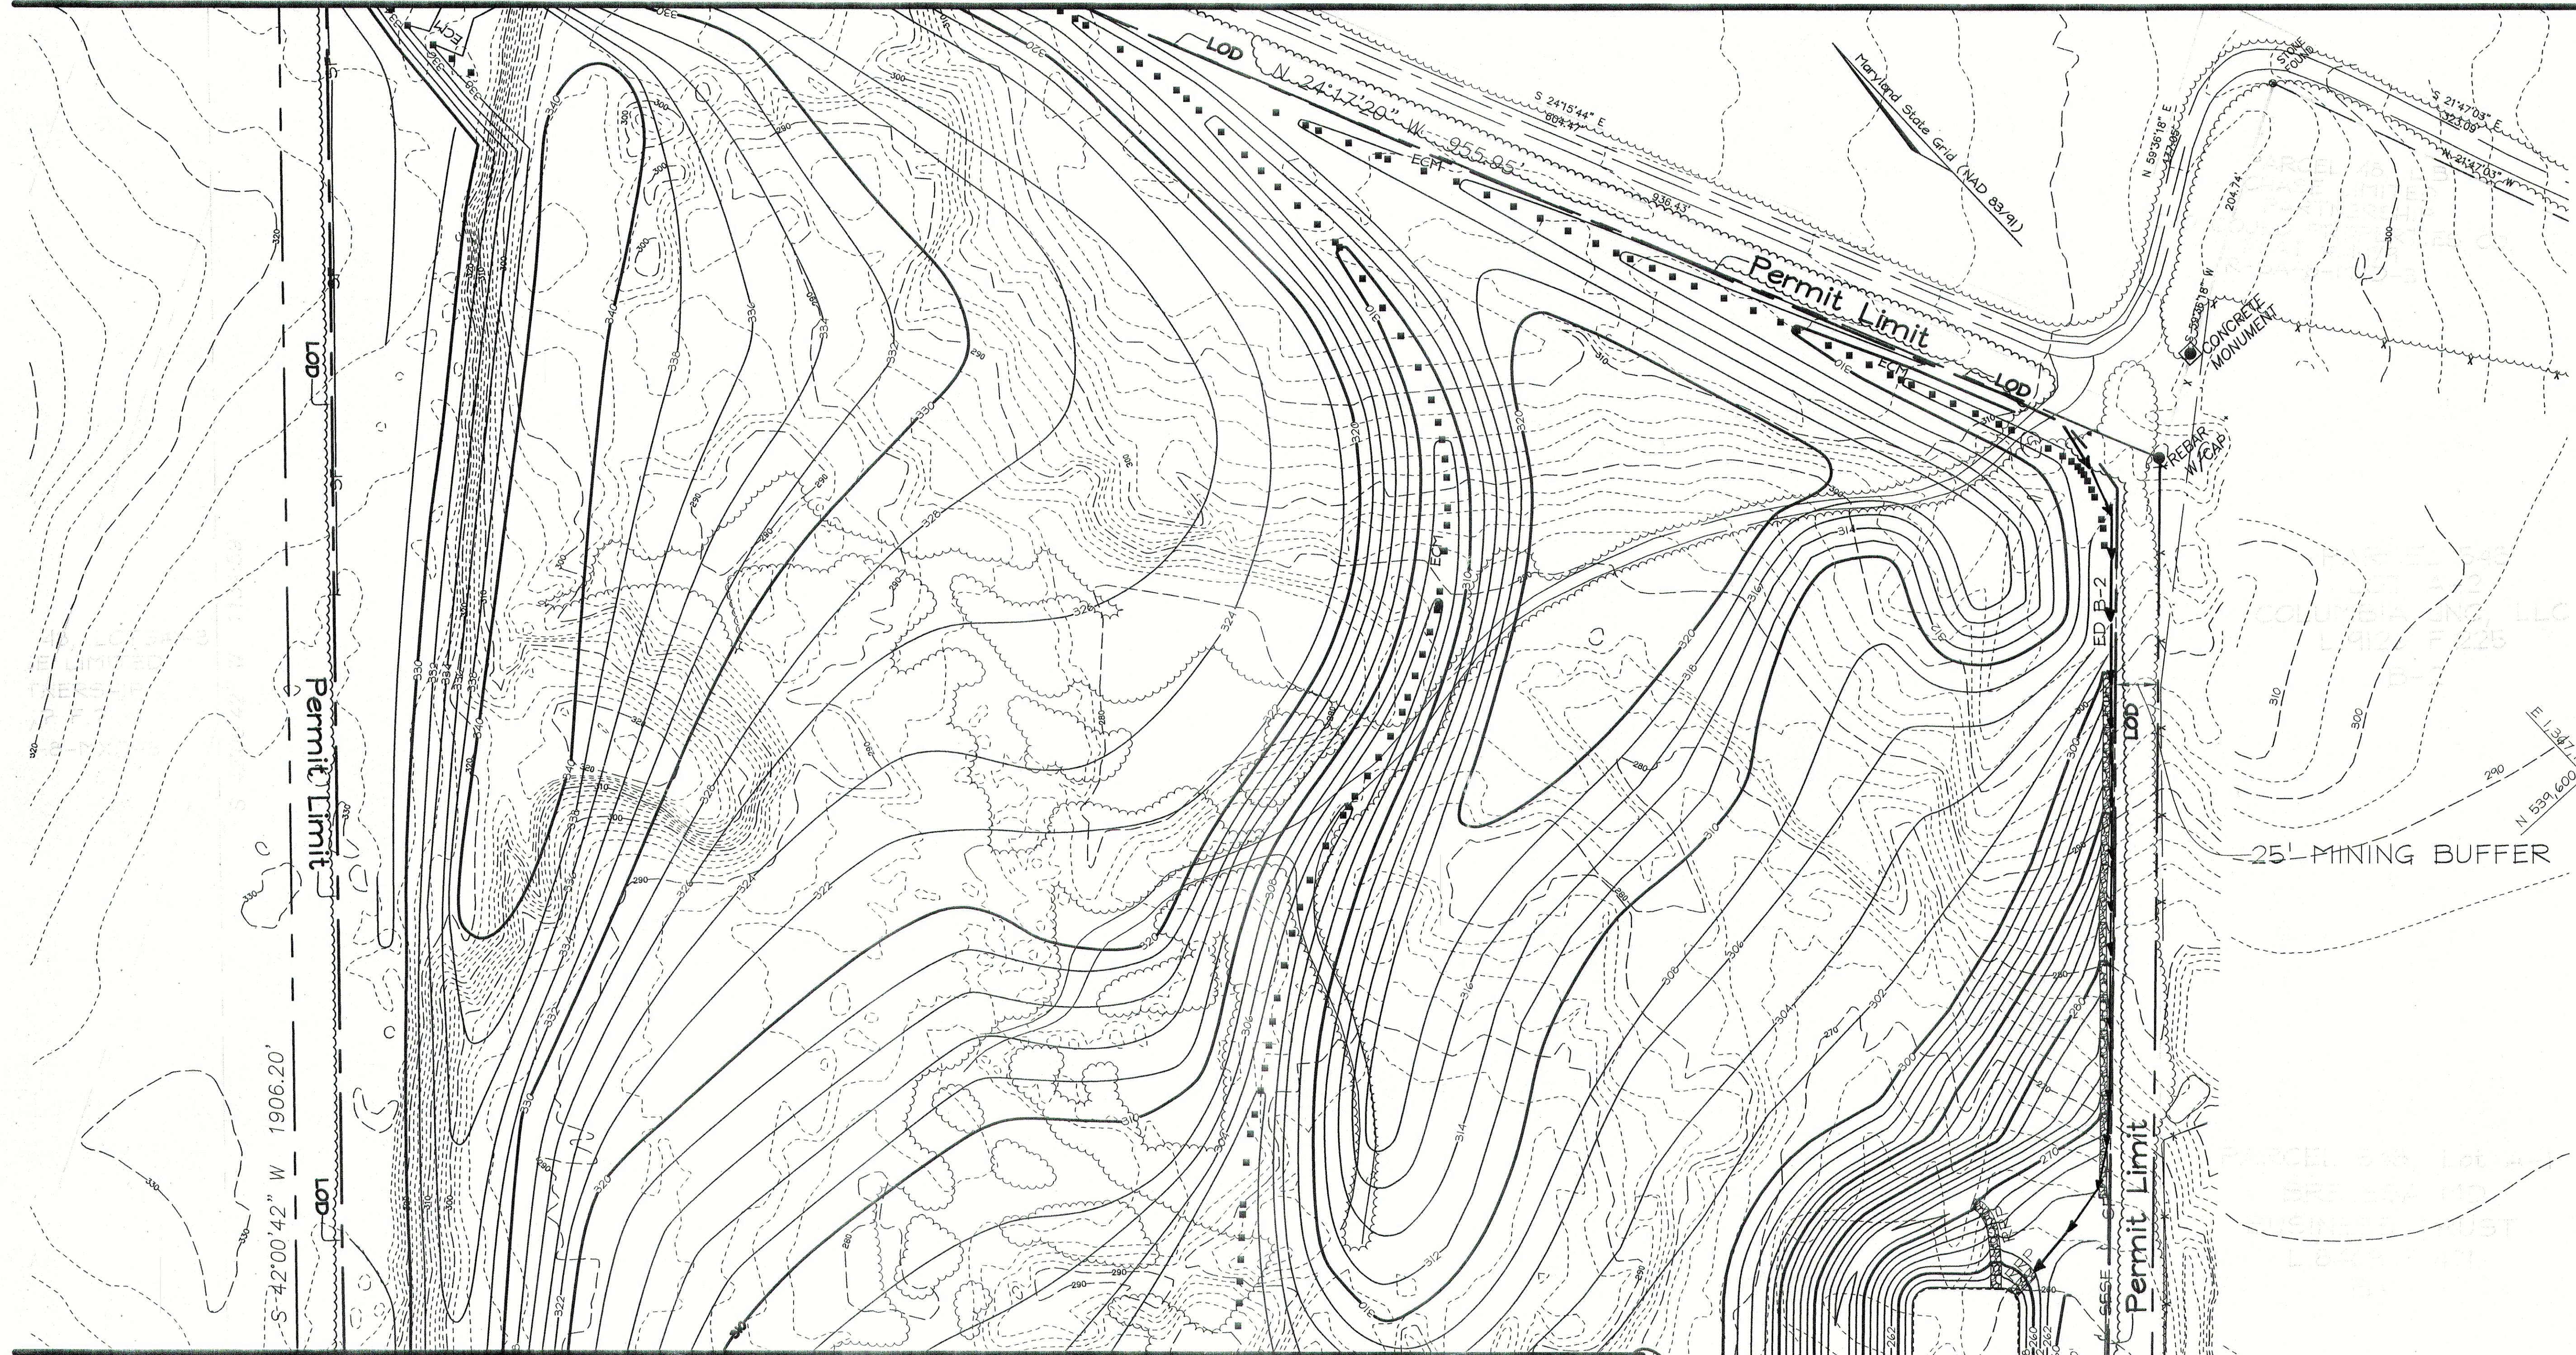

**LEGEND**

Existing Contour	---
Proposed Contour	---
Spot Elevation	+82.53
Existing Trees to Remain	(Symbol)
Utility Poles	(Symbol)
Stabilized Construction Entrance	(Symbol)
Silt Fence	SF
Super Silt Fence	SSF
Earth Dike	ED A-1
Permit Limit	Permit Limit
Limit of Disturbance	LOD
25' Mining Buffer	(Symbol)
Property Line	(Symbol)
Erosion Control Matting	(Symbol)
Temporary Initial Dam Contours	(Symbol)
Rip Rap Inflow Protection	RRP

MATCHLINE A-A SEE SHEET 4 OF 10

PLAN VIEW  
SCALE: 1"=50'

**TRAP SCHEDULE  
SEDIMENT TRAP NO. 2**

Type: ST IV  
 Drainage Area: 7.0 ac.  
 Storage Required: 12,600 cu. ft. wet and dry  
 Storage Provided: 16,780 cu. ft. wet and dry  
 Weir Length: 35 ft.  
 Apron Length: 10 ft.  
 Weir Crest Elevation: 260.0  
 Cleanout Elevation: 257.0  
 Bottom Trap Elevation: 255.7  
 Wet Storage Elevation: 258.0  
 Embankment Elevation: 262.0  
 See Detail Sheet 8 of 10

MATCHLINE A-A SEE SHEET 4 OF 10

**PERMIT APPLICANT**  
Savage Stone, LLC  
P.O. Box 850  
Laurel MD 20725

**OWNER**  
Konterra  
Limited Partnership  
P.O. Box 850  
Laurel MD 20725

**GRADING, SEDIMENT & EROSION  
CONTROL PLAN  
LAUREL LUMBER  
MINE RECLAMATION PLAN**

TAX MAP 47 GRID 6  
6TH ELECTION DISTRICT

PARCEL 384  
HOWARD COUNTY, MARYLAND

REVIEWED FOR HOWARD SCD AND MEETS TECHNICAL REQUIREMENTS

*Jim Meyer*  
USDA-NATURAL RESOURCES CONSERVATION SERVICE  
DATE: 11/16/06

THIS DEVELOPMENT PLAN IS APPROVED FOR SOIL EROSION AND SEDIMENT CONTROL BY THE HOWARD SOIL CONSERVATION DISTRICT

*John P. Robertson*  
HOWARD SCD  
DATE: 11/17/06

**ENGINEER'S CERTIFICATE**


I CERTIFY THAT THIS PLAN FOR SEDIMENT AND EROSION CONTROL REPRESENTS A PRACTICAL AND WORKABLE PLAN BASED ON MY PERSONAL KNOWLEDGE OF THE SITE CONDITIONS AND THAT IT WAS PREPARED IN ACCORDANCE WITH THE REQUIREMENTS OF THE HOWARD SOIL CONSERVATION DISTRICT.

*Zacharia Y. Fisch*  
SIGNATURE OF ENGINEER  
ZACHARIA Y. FISCH  
DATE: 11/16/06

**PERMITTEE'S CERTIFICATE**

I/WE CERTIFY THAT ALL DEVELOPMENT AND CONSTRUCTION WILL BE DONE ACCORDING TO THIS PLAN FOR SEDIMENT AND EROSION CONTROL, AND THAT ALL RESPONSIBLE PERSONNEL INVOLVED IN THE CONSTRUCTION PROJECT WILL HAVE A CERTIFICATE OF ATTENDANCE AT A DEPARTMENT OF THE ENVIRONMENT APPROVED TRAINING PROGRAM FOR THE CONTROL OF SEDIMENT AND EROSION BEFORE BEGINNING THE PROJECT. I ALSO AUTHORIZE PERIODIC ON-SITE INSPECTION BY THE HOWARD SOIL CONSERVATION DISTRICT.

*Timothy S. Schmitt*  
SIGNATURE OF PERMITTEE  
DATE: 11/16/06

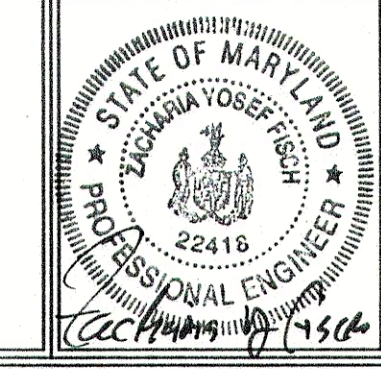


**FSH Associates**  
Engineers Planners Surveyors  
6339 Howard Lane Elkridge, MD 21075  
Tel: 410-567-5200 Fax: 410-796-1562  
E-mail: info@fsh.com

DESIGN BY: SH  
DRAWN BY: CRH2/RL  
CHECKED BY: SH  
SCALE: AS SHOWN  
DATE: Nov. 16, 2006  
P.L. No.: 3248  
SHEET No.: 5 OF 10



MATCHLINE B-B SEE SHEET 5 OF 10

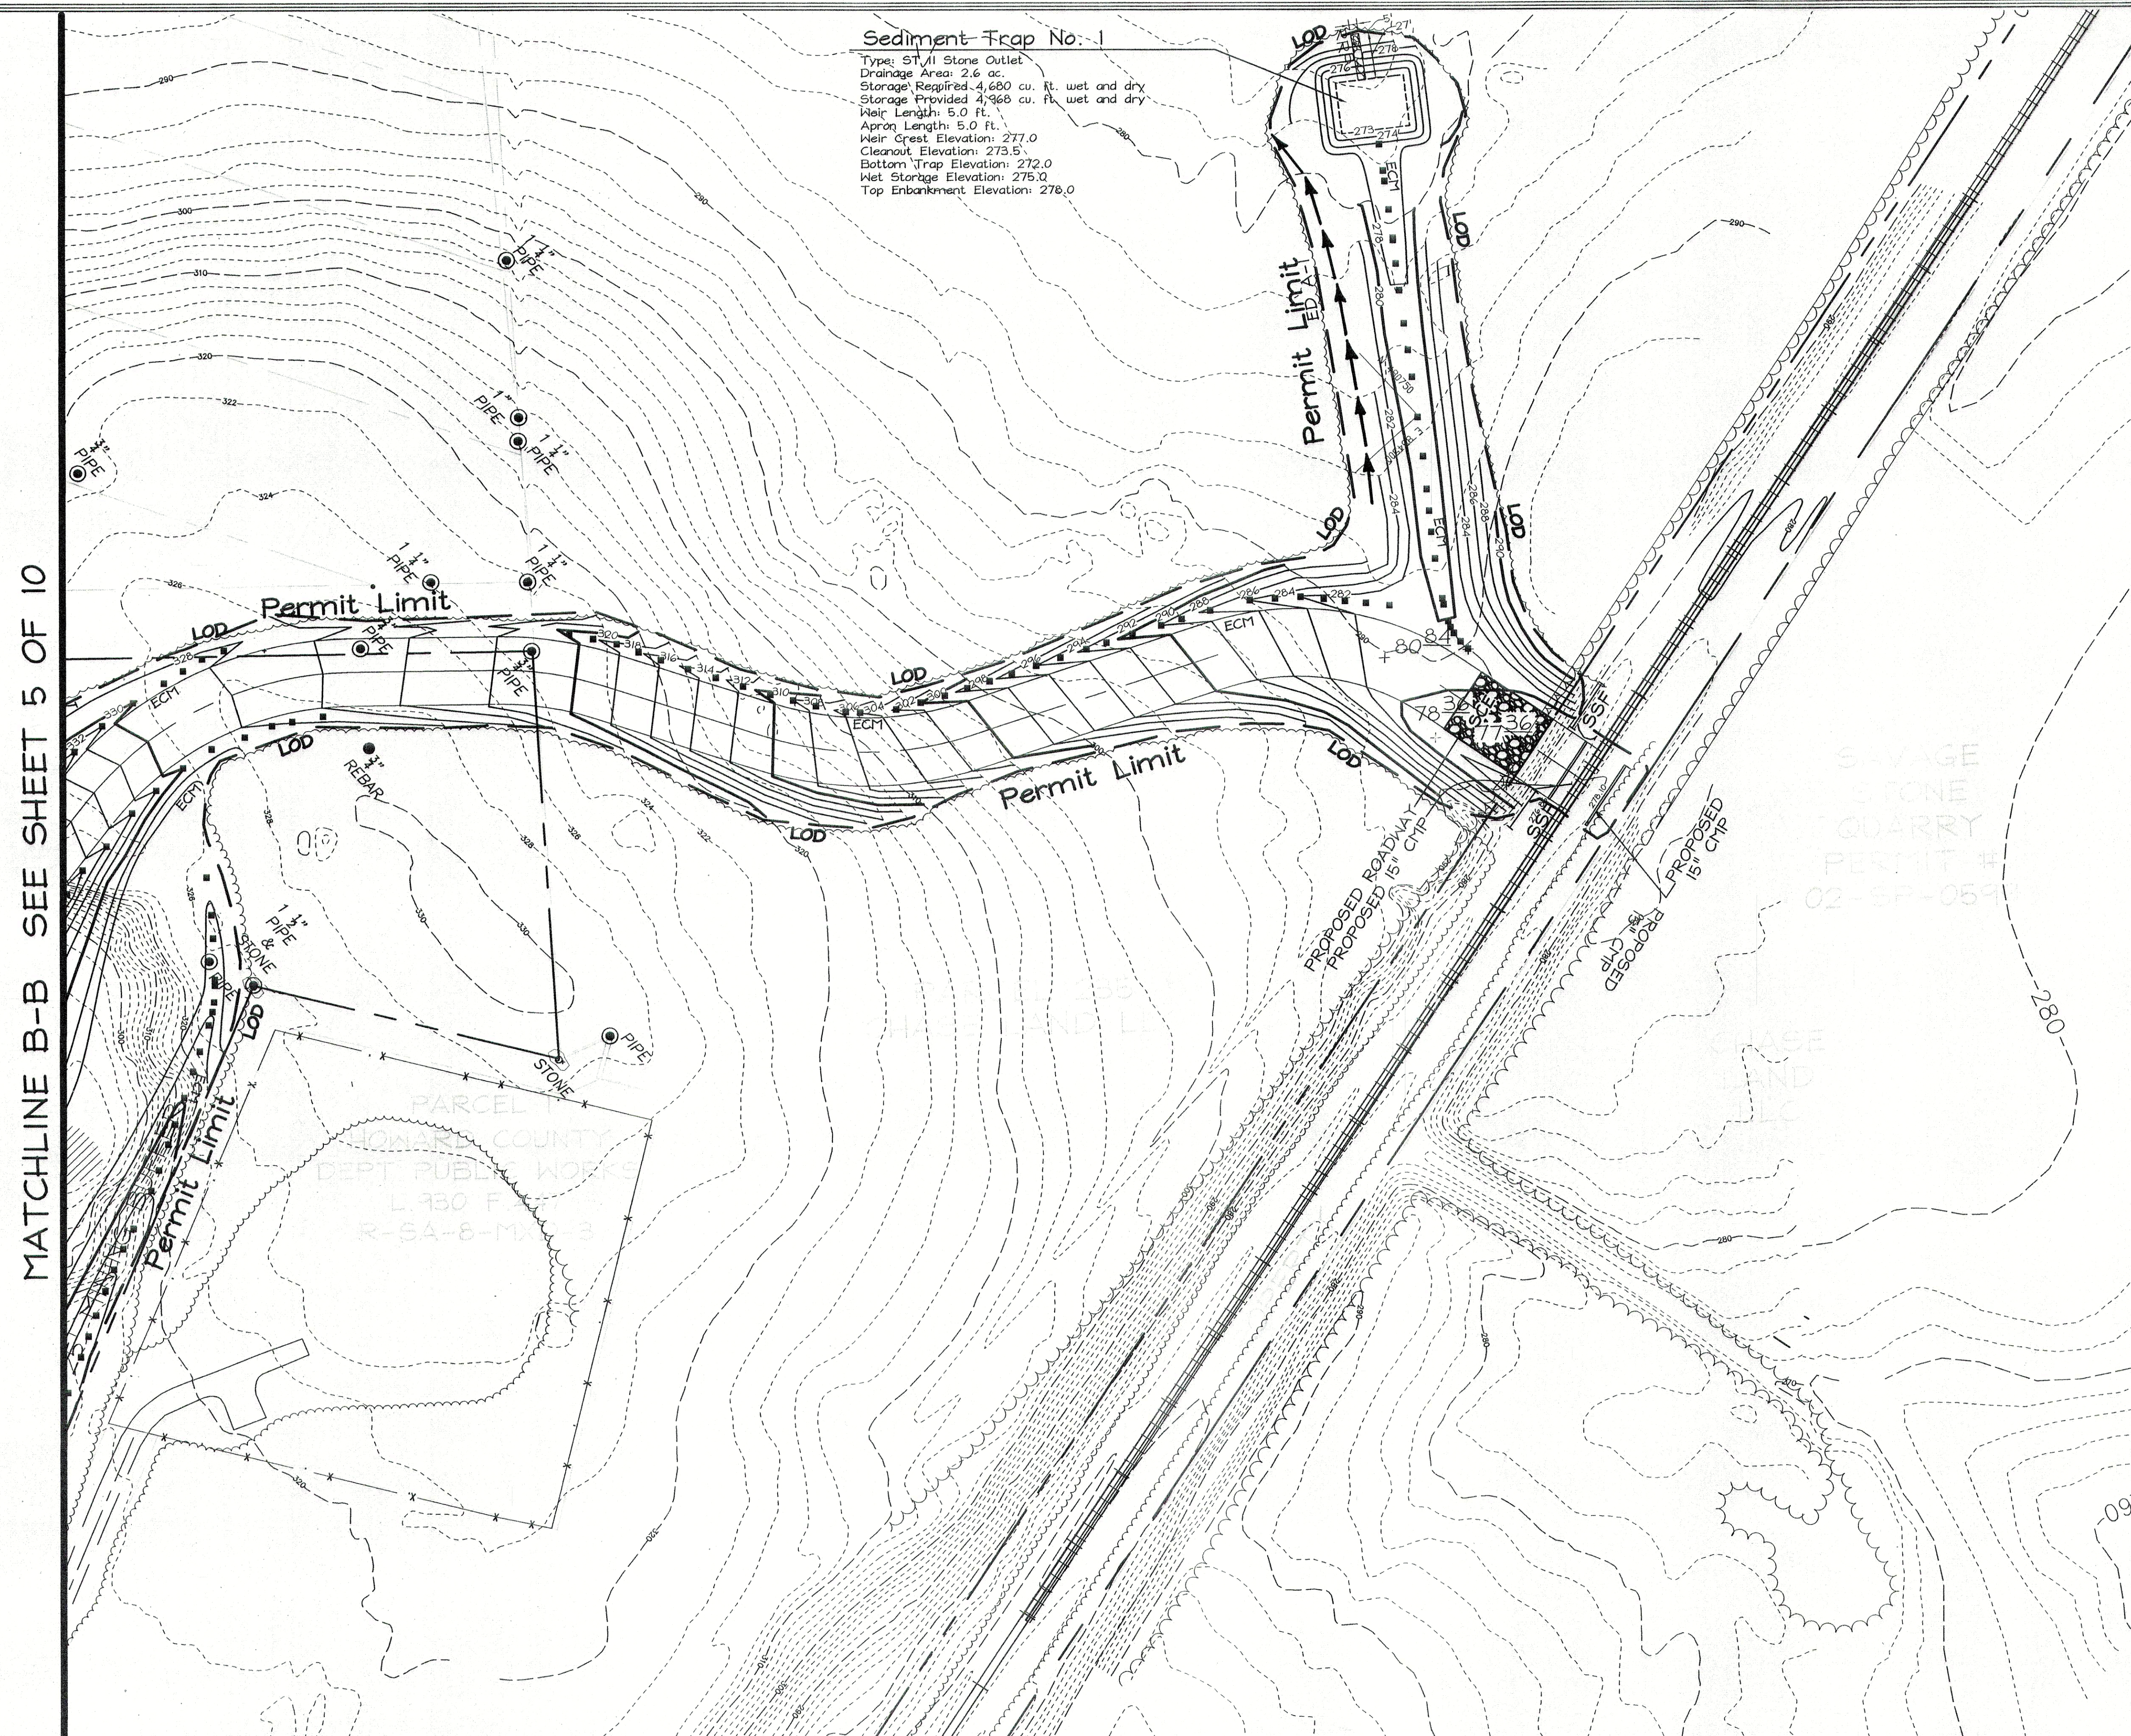

**Sediment Trap No. 1**  
 Type: STM Stone Outlet  
 Drainage Area: 2.6 ac.  
 Storage Required: 4,660 cu. ft. wet and dry  
 Storage Provided: 4,968 cu. ft. wet and dry  
 Weir Length: 5.0 ft.  
 Apron Length: 5.0 ft.  
 Weir Crest Elevation: 277.0  
 Cleanout Elevation: 273.5  
 Bottom Trap Elevation: 272.0  
 Wet Storage Elevation: 275.0  
 Top Embankment Elevation: 276.0

LEGEND	
Existing Contour	--- 382
Proposed Contour	--- 382
Spot Elevation	+82.53
Existing Trees to Remain	(Symbol)
Utility Poles	(Symbol)
Stabilized Construction Entrance	(Symbol)
Silt Fence	SF SF
Super Silt Fence	SSF SSF
Earth Dike	ED A-1
25' Mining Buffer	(Symbol)
Permit Limit	--- Permit Limit
Limit of Disturbance	--- LOD
Property Line	--- Property Line
Erosion Control Matting	(Symbol)
Temporary Initial Dam Contours	(Symbol)
Rip Rap Inflow Protection	RRP

- Notes:**
- Design of Rail Road Crossing and drainage at crossing by others.
  - For existing off site updated Topography, see SDP-99-134
  - Limit of Disturbance is Permit Limit on this sheet.

**PLAN VIEW**  
 SCALE: 1"=50'

**PERMIT APPLICANT**  
 Savage Stone, LLC  
 P.O. Box 850  
 Laurel MD 20725

**OWNER**  
 Konterra  
 Limited Partnership  
 P.O. Box 850  
 Laurel MD 20725

**GRADING, SEDIMENT & EROSION CONTROL PLAN**  
**LAUREL LUMBER MINE RECLAMATION PLAN**

TAX MAP 47 GRID 6  
 6TH ELECTION DISTRICT

PARCEL 384  
 HOWARD COUNTY, MARYLAND

REVIEWED FOR HOWARD SCD AND MEETS TECHNICAL REQUIREMENTS

*Jim Meyer* 11/16/06  
 USA-NATURAL RESOURCE CONSERVATION SERVICE  
 DATE

THIS DEVELOPMENT PLAN IS APPROVED FOR SOIL EROSION AND SEDIMENT CONTROL BY THE HOWARD SOIL CONSERVATION DISTRICT

*John R. Robinson* 11/16/06  
 HOWARD SCD  
 DATE

**ENGINEER'S CERTIFICATE**

"I CERTIFY THAT THIS PLAN FOR SEDIMENT AND EROSION CONTROL REPRESENTS A PRACTICAL AND WORKABLE PLAN BASED ON MY PERSONAL KNOWLEDGE OF THE SITE CONDITIONS AND THAT IT WAS PREPARED IN ACCORDANCE WITH THE REQUIREMENTS OF THE HOWARD SOIL CONSERVATION DISTRICT.

*Zacharia Y. Fisch* 11/16/06  
 SIGNATURE OF ENGINEER  
 ZACHARIA Y. FISCH  
 DATE

**PERMITTEE'S CERTIFICATE**


"I/WE CERTIFY THAT ALL DEVELOPMENT AND CONSTRUCTION WILL BE DONE ACCORDING TO THIS PLAN FOR SEDIMENT AND EROSION CONTROL, AND THAT ALL RESPONSIBLE PERSONNEL INVOLVED IN THE CONSTRUCTION PROJECT WILL HAVE A CERTIFICATE OF ATTENDANCE AT A DEPARTMENT OF THE ENVIRONMENT APPROVED TRAINING PROGRAM FOR THE CONTROL OF SEDIMENT AND EROSION BEFORE BEGINNING THE PROJECT. I ALSO AUTHORIZE PERIODIC ON-SITE INSPECTION BY THE HOWARD SOIL CONSERVATION DISTRICT.

*Timothy J. Schmeltz* 11/16/06  
 SIGNATURE OF PERMITTEE  
 DATE


**FSH Associates**  
 Engineers Planners Surveyors  
 8339 Howard Lane Ellicott City, MD 21075  
 Tel: 410-567-5200 Fax: 410-796-1562  
 E-mail: info@fshnet.com

DESIGN BY: SH  
 DRAWN BY: CRH/RL  
 CHECKED BY: SH  
 SCALE: AS SHOWN  
 DATE: Nov. 16, 2006  
 P.L.O. No.: 3248  
 SHEET No.: 6 OF 10




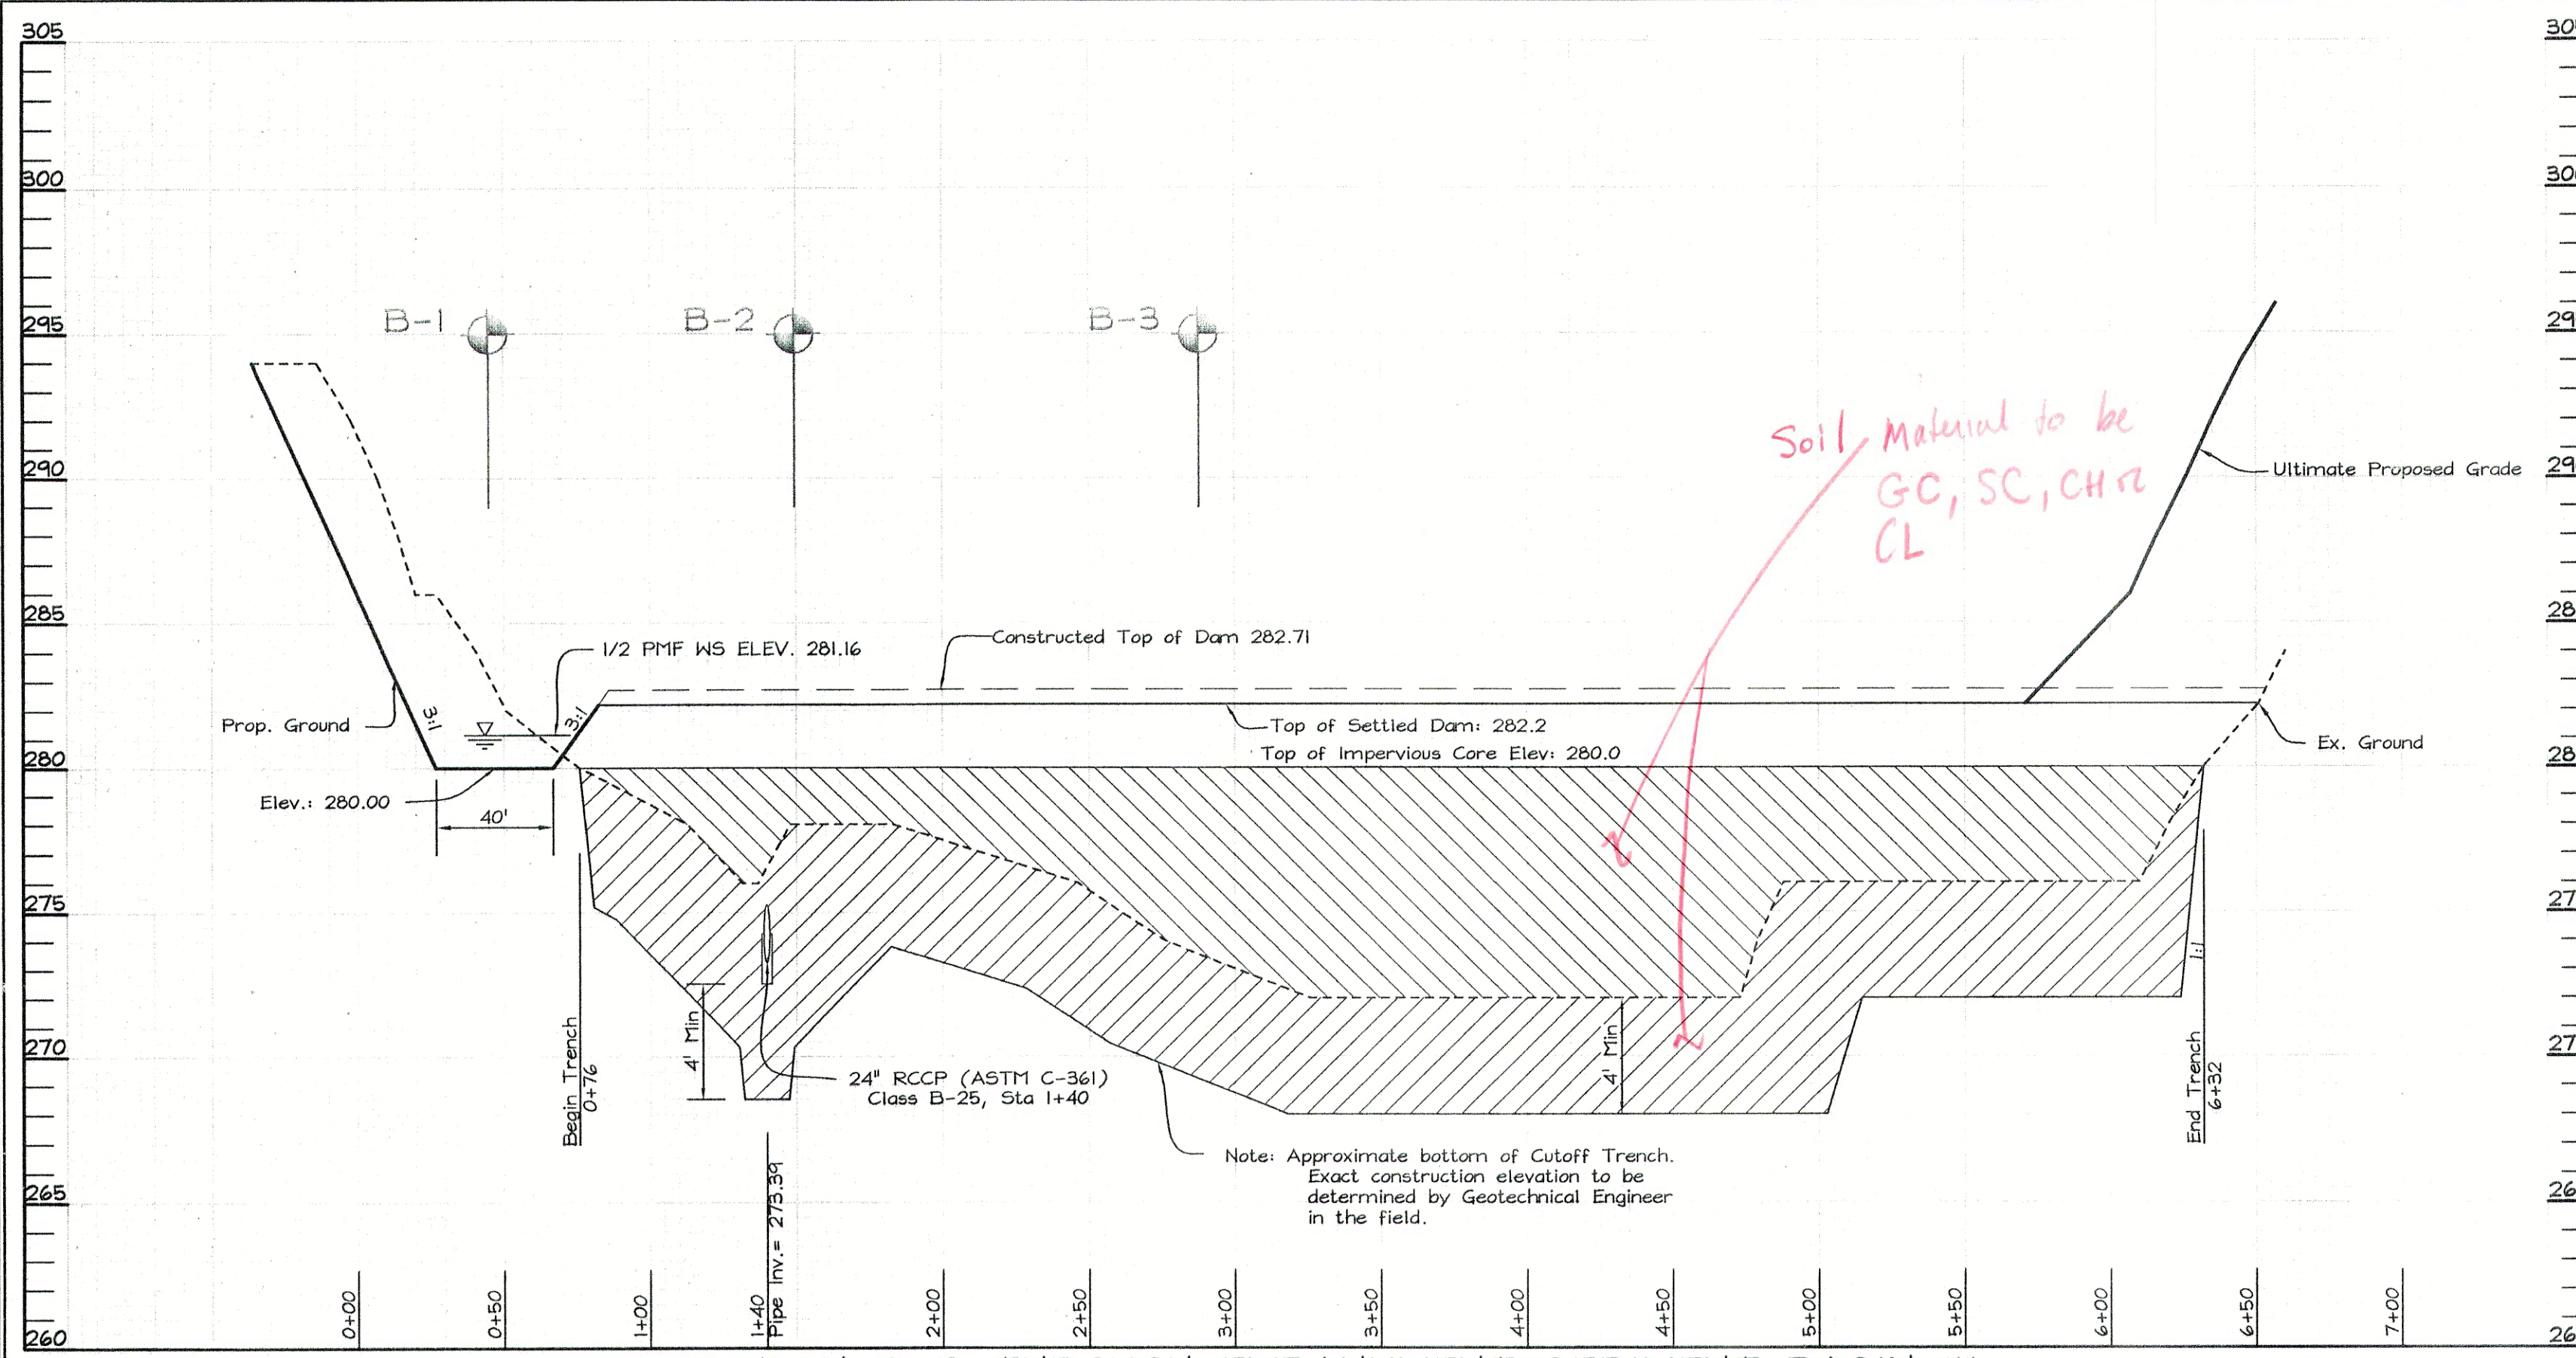


SECTION D-D THROUGH EMBANKMENT SEDIMENT BASIN #1  
SCALE: Hor.: 1"=50'  
Vert.: 1"=5'

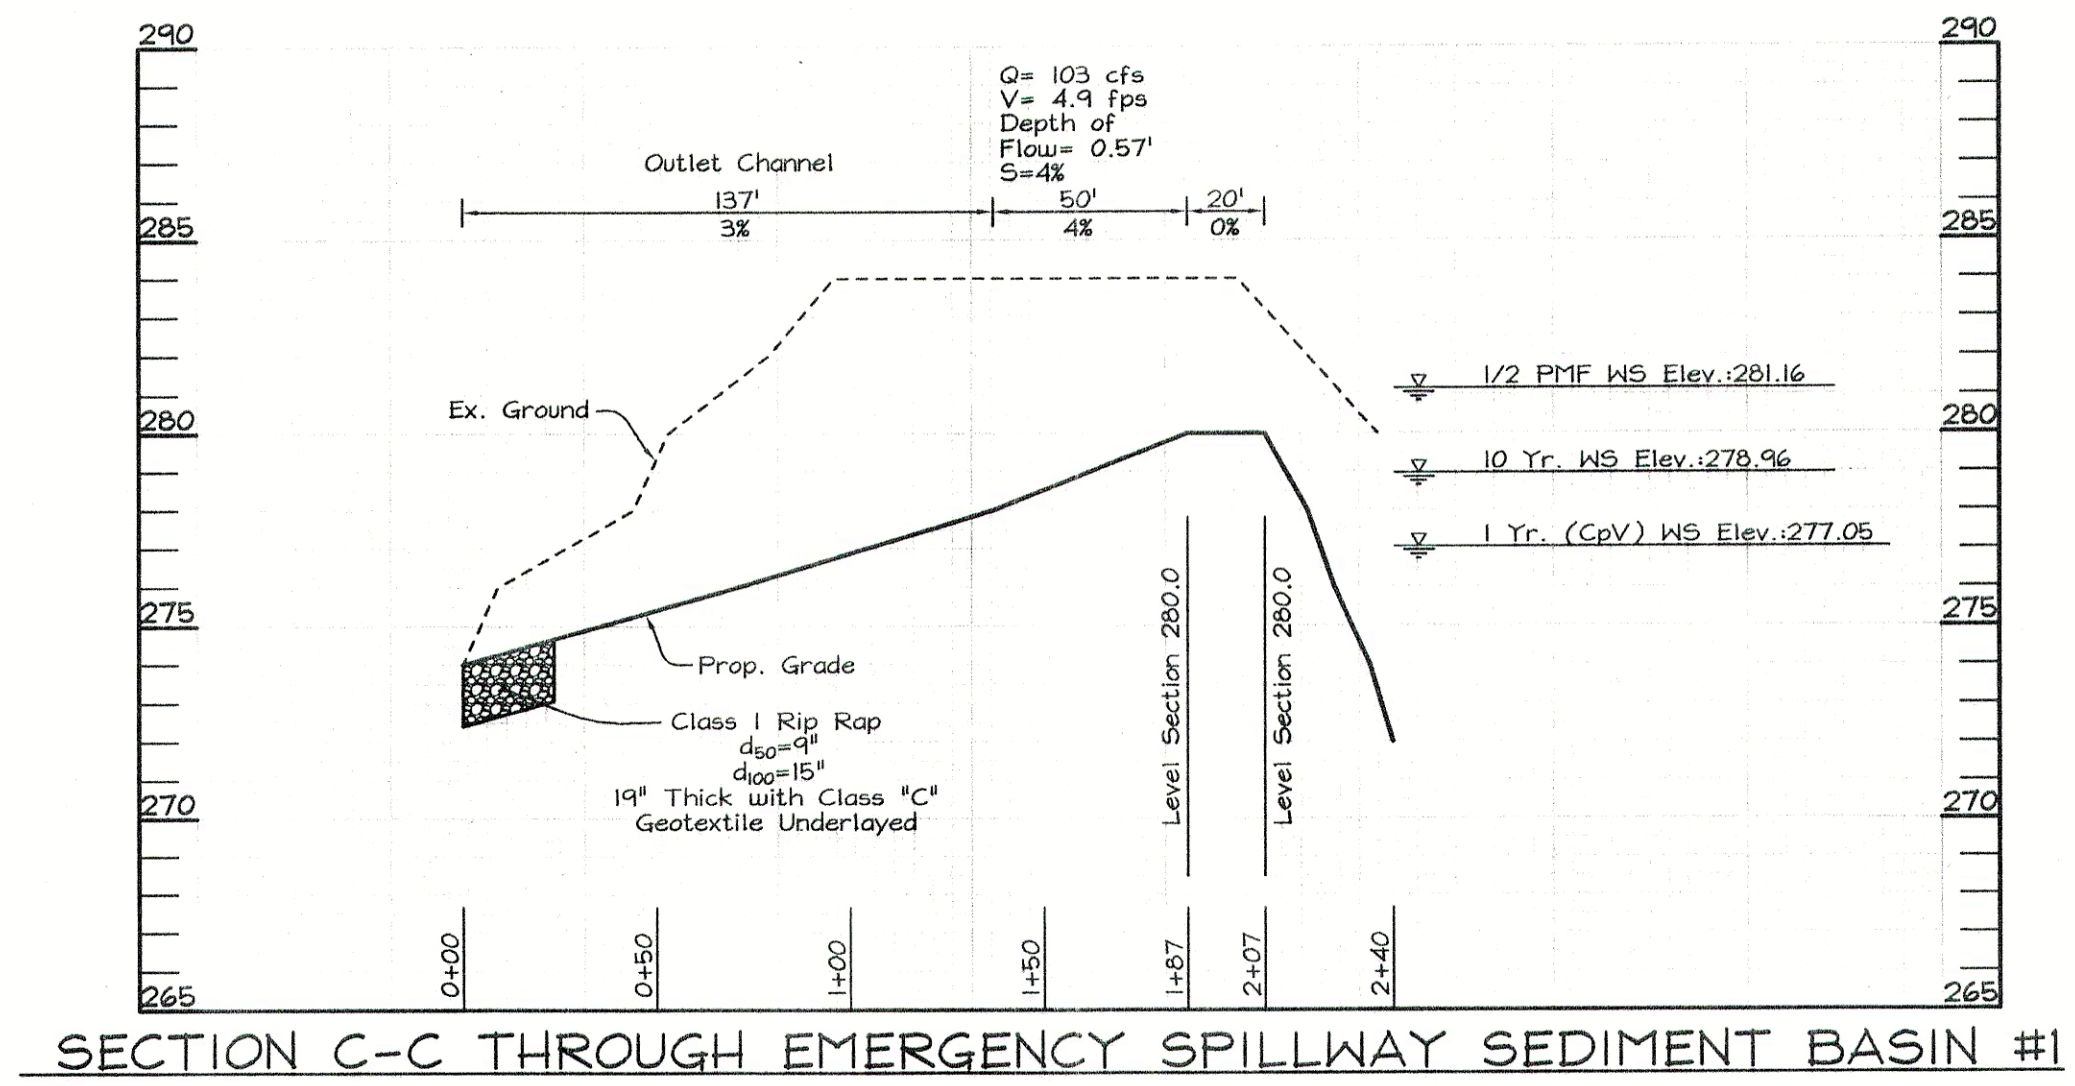

SECTION C-C THROUGH EMERGENCY SPILLWAY SEDIMENT BASIN #1  
SCALE: Hor.: 1"=50'  
Vert.: 1"=5'

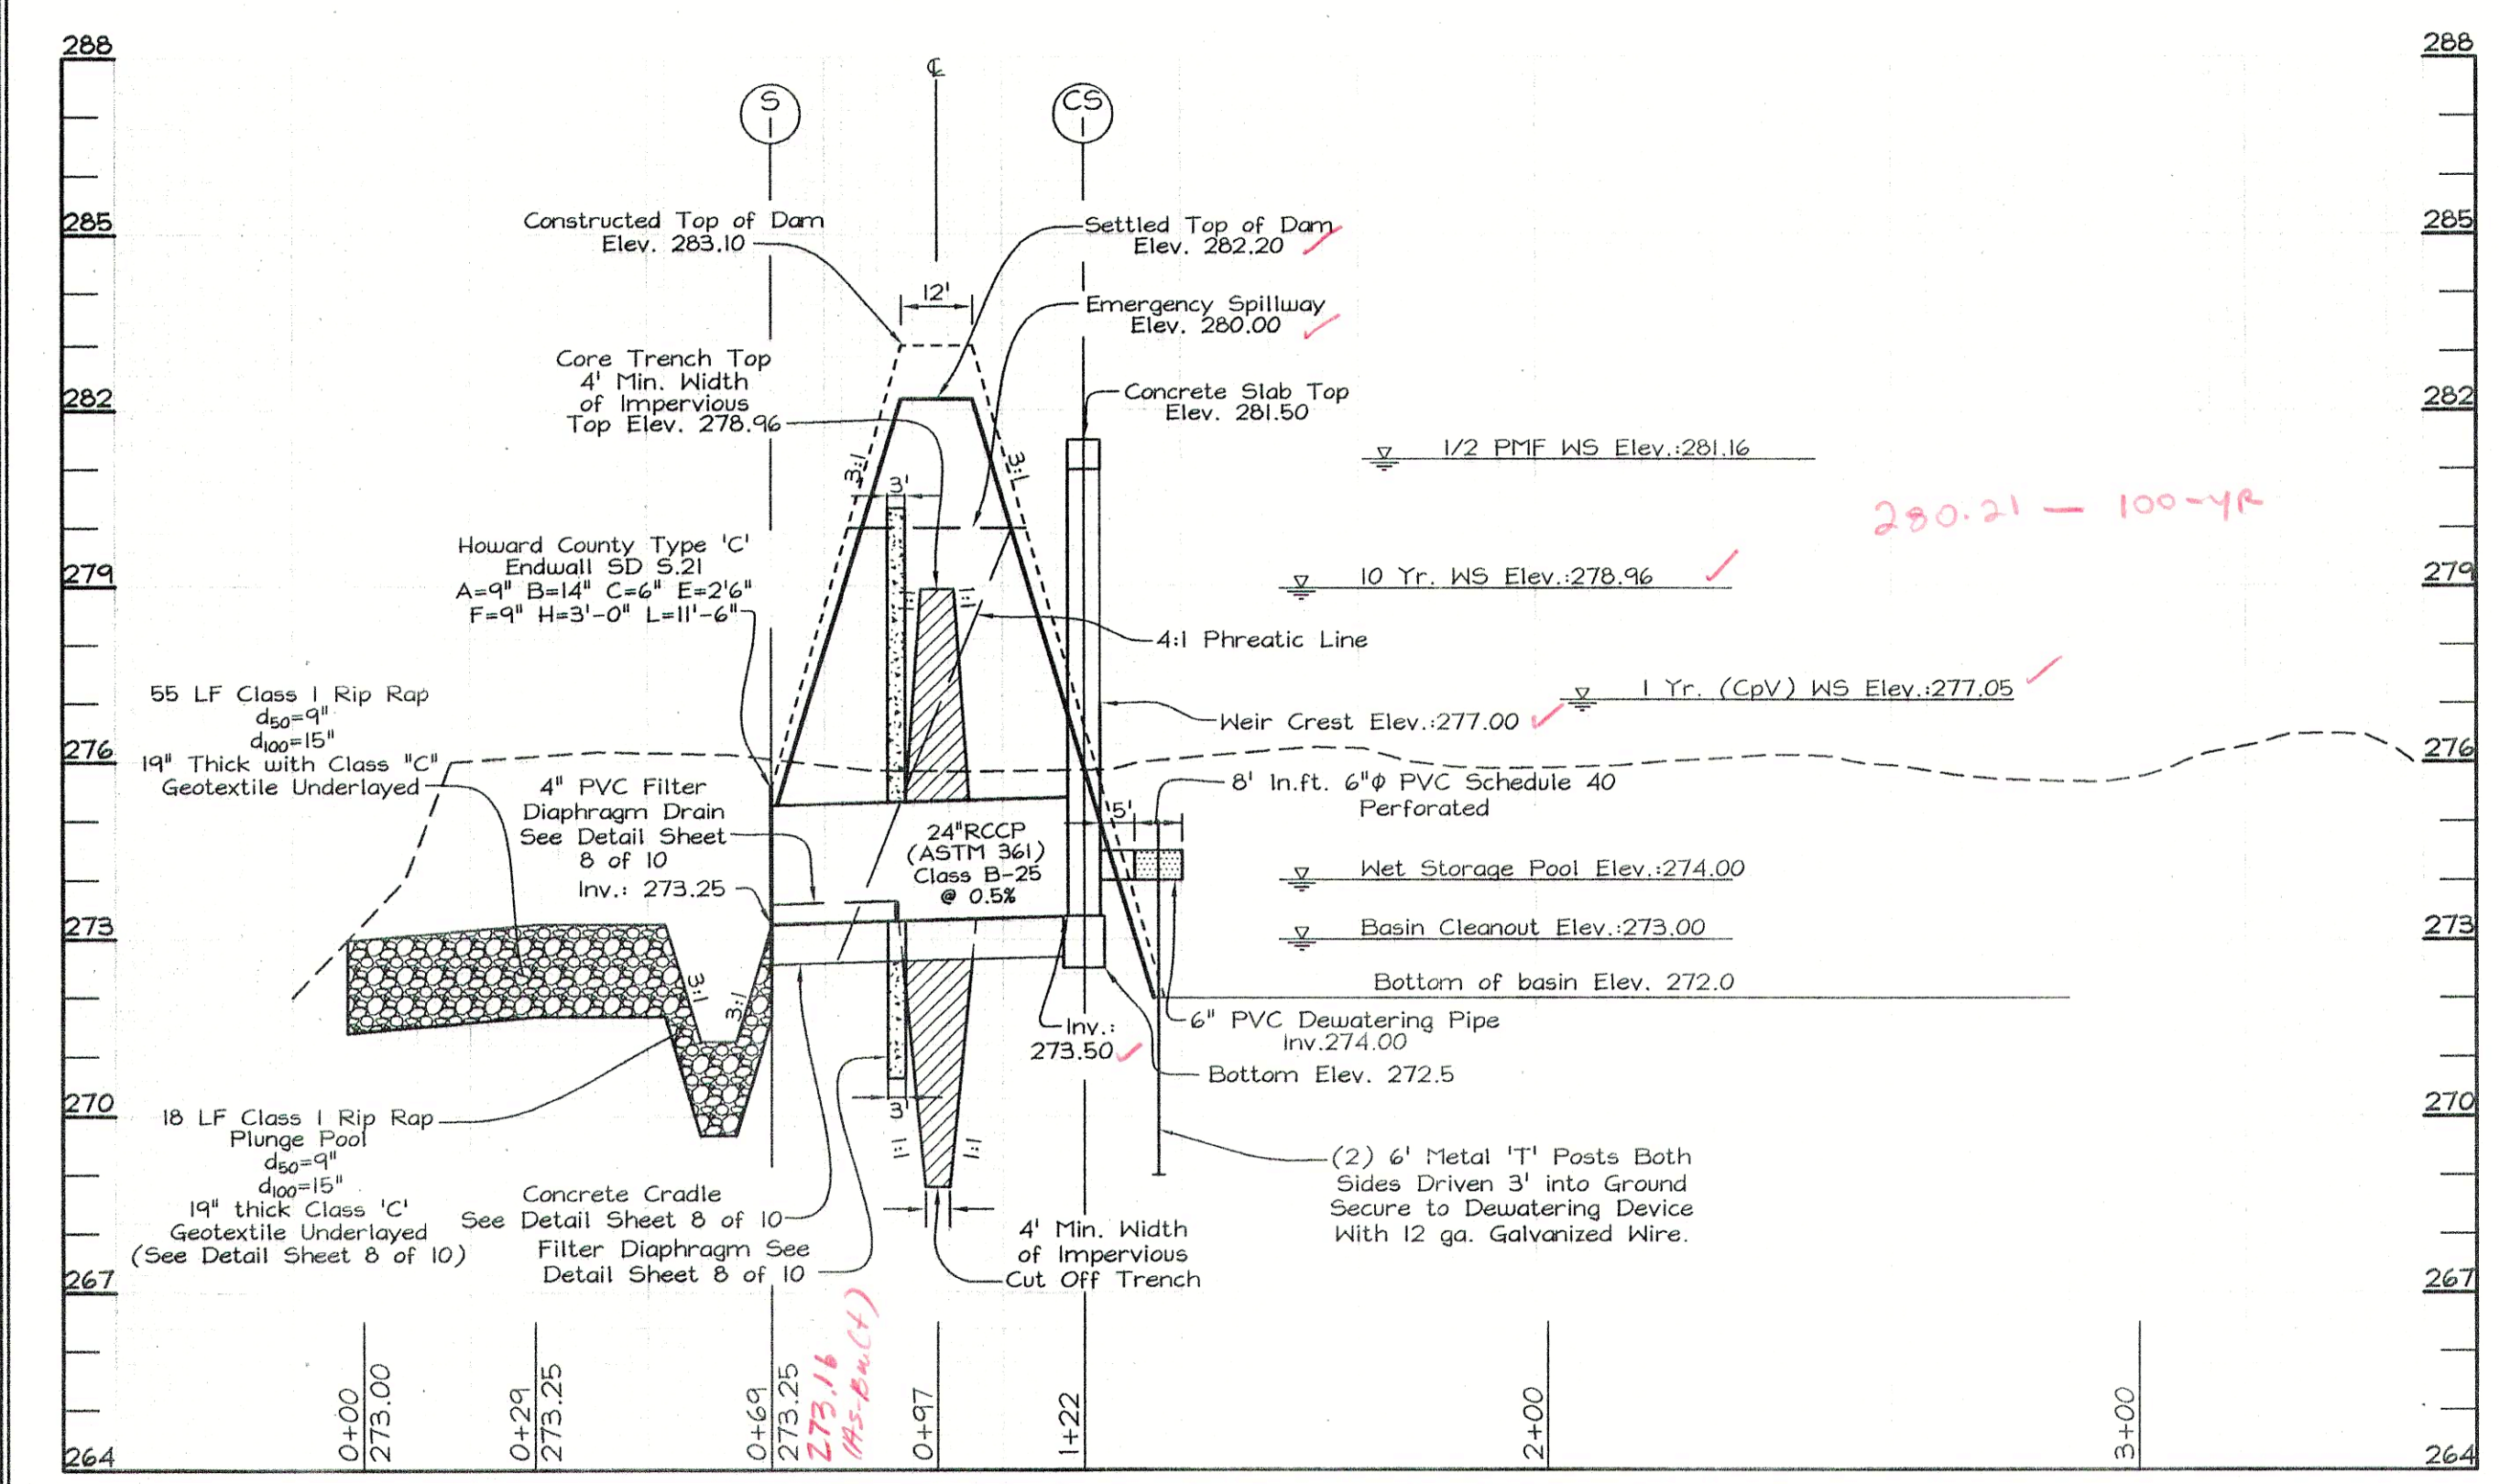

SECTION B-B THROUGH SEDIMENT BASIN  
SCALE: Hor.: 1"=30'  
Vert.: 1"=3'

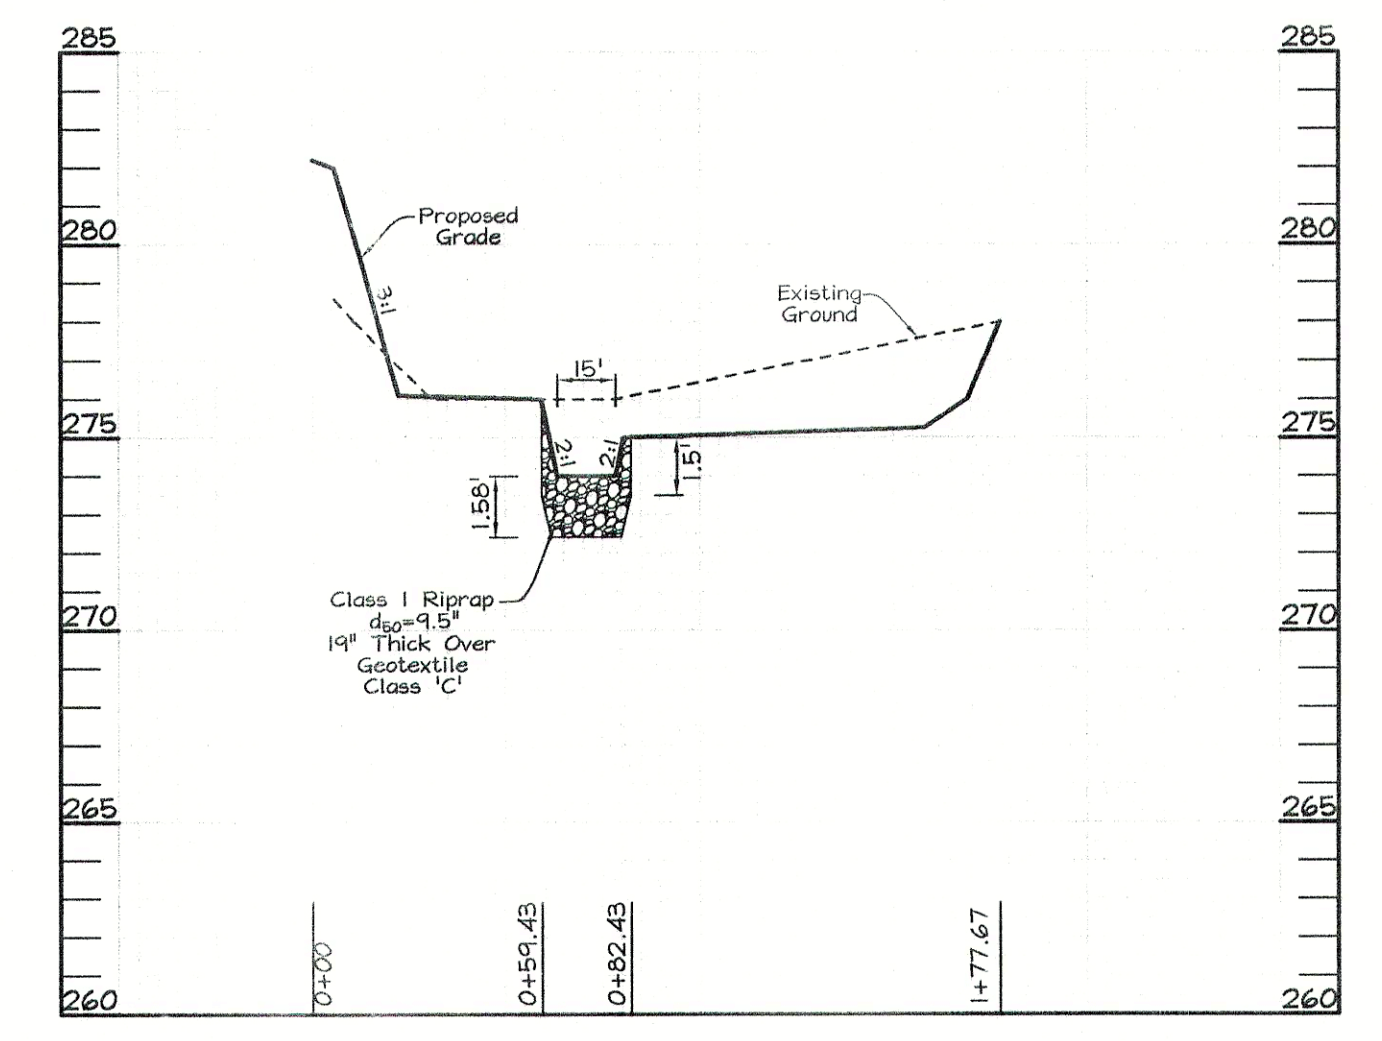

SECTION A-A THROUGH FOREBAY SEDIMENT BASIN #1  
SCALE: Hor.: 1"=50'  
Vert.: 1"=5'

	B-1	B-2	B-3
Surface	Surface Elev. 284.0	Surface Elev. 277.0	Surface Elev. 276.0
3.5	Sandy SILT, Some Gravel, Reddish Brown, Moist, Medium Dense, (ML)	SILT, Some Sand, Trace Roots and Gravel, Brownish Red, Moist, Medium Dense, (ML)	SILT, With Gravel, Some Sand, Trace Roots and Organics, Brown and Reddish Brown, Moist, Firm, (ML/Possible Fill)
5.0	Sandy SILT, Reddish Brown, to Orangeish Brown, Moist, Dense, (ML)	SILTY CLAY, Trace Sand, Brownish Red to Gray and Red, Very Stiff to Hard, (CL)	SILT, Some Sand, Trace Gravel, Tanish Gray to Orangeish Brown, Moist, Medium Dense to Dense, (ML)
10.0	SILT, with Sand, Reddish Brown and Gray, Very Dense, (ML)		
15.0	SILT, with Sand and Gravel, Moist, Very Dense, (ML)		SILTY CLAY, Brownish Red, Moist, Hard, (CL)

No groundwater encountered while drilling At completion, hole dry and caved at 9.7'/9.5' Topsoil: 3.0'

No groundwater encountered while drilling At completion, hole dry and caved at 12.2'/12.2' Topsoil: 6.0'

No groundwater encountered while drilling At completion, hole dry and caved at 9.9'/9.8' Topsoil: 6.0'

S.W.M. BORING PROFILES  
NOT TO SCALE

SEDIMENT BASIN SCHEDULE

1 Yr. WSEL = 277.07  
10 Yr. WSEL = 279.94  
1/2 PMF WSEL = 281.16  
Top of Basin Dam Elevation = 282.20  
Bottom of Basin Elevation: 272.0  
Drainage Area to Basin = 18.32 ac.  
Wet Storage Required = 1,800 cu. ft. x 18.32 ac. = 32,976 cu. ft.  
Wet Storage Provided = 34,119 cu. ft. @ 274.0  
Dry Storage Required = 32,976 cu. ft.  
Dry Storage Provided = 79,220 @ 277.0  
Clean-out elevation at 900 cu. ft. per ac. (16,488 cu. ft.) @ 403.0

PERMIT APPLICANT  
Savage Stone, LLC.  
P.O. Box 850  
Laurel MD 20725

OWNER  
Konterra  
Limited Partnership  
P.O. Box 850  
Laurel MD 20725

SEDIMENT BASIN PROFILES  
LAUREL LUMBER

TAX MAP 47 GRID 6  
6TH ELECTION DISTRICT

PARCEL 384  
HOWARD COUNTY, MARYLAND

REVIEWED FOR HOWARD SCD AND MEETS TECHNICAL REQUIREMENTS

Jim Meyer 11/17/06  
USDA NATURAL RESOURCES CONSERVATION SERVICE DATE

THIS DEVELOPMENT PLAN IS APPROVED FOR SOIL EROSION AND SEDIMENT CONTROL BY THE HOWARD SOIL CONSERVATION DISTRICT

John K. Roberts 11/17/06  
HOWARD SCD DATE

ENGINEERS CERTIFICATE

"I CERTIFY THAT THIS PLAN FOR SEDIMENT AND EROSION CONTROL REPRESENTS A PRACTICAL AND WORKABLE PLAN BASED ON MY PERSONAL KNOWLEDGE OF THE SITE CONDITIONS AND THAT IT WAS PREPARED IN ACCORDANCE WITH THE REQUIREMENTS OF THE HOWARD SOIL CONSERVATION DISTRICT."

Zacharia Y. Fisch 11/16/06  
SIGNATURE OF ENGINEER DATE  
ZACHARIA Y. FISCH

PERMITTEE'S CERTIFICATE

"I/WE CERTIFY THAT ALL DEVELOPMENT AND CONSTRUCTION WILL BE DONE ACCORDING TO THIS PLAN FOR SEDIMENT AND EROSION CONTROL, AND THAT ALL RESPONSIBLE PERSONNEL INVOLVED IN THE CONSTRUCTION PROJECT WILL HAVE A CERTIFICATE OF ATTENDANCE AT A DEPARTMENT OF THE ENVIRONMENT APPROVED TRAINING PROGRAM FOR THE CONTROL OF SEDIMENT AND EROSION BEFORE BEGINNING THE PROJECT. I ALSO AUTHORIZE PERIODIC ON-SITE INSPECTION BY THE HOWARD SOIL CONSERVATION DISTRICT."

Imolly J. Schmitt 11/16/06  
SIGNATURE OF PERMITTEE DATE

DESIGN BY: SH  
DRAWN BY: CRH2/RL  
CHECKED BY: SH  
SCALE: AS SHOWN  
DATE: Nov. 16, 2006  
W.O. No.: 3248  
SHEET No.: 7 OF 10

FSH Associates  
Engineers Planners Surveyors  
6339 Howard Lane Elkridge, MD 21075  
Tel: 410-567-5200 Fax: 410-796-1562  
E-mail: info@fsh.com



**MARYLAND 378  
STORMWATER MANAGEMENT POND CONSTRUCTION SPECIFICATIONS**

**CONSTRUCTION SPECIFICATIONS**

These specifications are appropriate to all ponds within the scope of the Standard for practice MD-378. All references to ASTM and AASHTO specifications apply to the most recent version.

**Site Preparation**

Areas designated for borrow areas, embankment, and structural works shall be cleared, grubbed and stripped of topsoil. All trees, vegetation, roots and other objectionable material shall be removed. Channel banks and shore breaks shall be sloped to no steeper than 1:1. All trees shall be cleared and grubbed within 15 feet of the toe of the embankment.

Areas to be covered by the reservoir will be cleared of all trees, brush, logs, fences, rubbish and other objectionable material unless otherwise designated on the plans. Trees, brush, and stumps shall be cut approximately level with the ground surface. For dry stormwater management ponds, a minimum of a 25-foot radius around the inlet structure shall be cleared.

All cleared and grubbed material shall be disposed of outside and below the limits of the dam and reservoir as directed by the owner or his representative. When specified, a sufficient quantity of topsoil will be stockpiled in a suitable location for use on the embankment and other designated areas.

**Earth Fill**

Material - The fill material shall be taken from approved designated borrow areas. It shall be free of rocks, stumps, wood, rubbish, stones greater than 4", frozen or other objectionable materials. Fill material for the center of the embankment, and cut off trench shall conform to Unified Soil Classification GC, SC, CH, or CL and must have at least 50% passing the #200 sieve. Consideration may be given to the use of other materials in the embankment if designed by a geotechnical engineer. Such special designs must have construction supervised by a geotechnical engineer. Materials used in the outer shell of the embankment must have the areas in which fill is to be placed shall be scuffed prior to placement of fill. Fill materials shall be placed in maximum 6 inch thick (before compaction) layers which are to be continuous over the entire length of the fill. The most permeable borrow material shall be placed in the downstream portions of the embankment. The principal spillway must be installed concurrently with fill placement and not excavation into the embankment.

Compaction - The movement of the hauling and spreading equipment over the fill shall be controlled so that the entire surface of each lift shall be traversed by not less than one track of heavy equipment or compaction shall be achieved by four complete passes of a sheepsfoot, rubber tired or vibratory roller. Fill material shall contain sufficient moisture such that the required degree of compaction will be obtained with the equipment used. The fill material shall contain sufficient moisture so that if formed into a ball it will not crumble, yet not be so wet that water can be squeezed out.

When required by the reviewing agency the minimum required density shall not be less than 95% of maximum dry density with a moisture content within +/- 2% of the optimum. Each layer of fill shall be compacted as necessary to obtain that density, and is to be certified by the Engineer at the time of construction. All compaction is to be determined by AASHTO Method T-99 (Standard Proctor).

Cut Off Trench - The cutoff trench shall be excavated into impervious material along or parallel to the centerline of the embankment as shown on the plans. The bottom width of the trench shall be governed by the equipment used for excavation, with the minimum width being four feet. The depth shall be at least four feet below existing grade or as shown on the plans. The side slopes of the trench shall be 1 to 1 or flatter.

The backfill shall be compacted with construction equipment, rollers, or hand tampers to assure maximum density and minimum permeability.


Embankment Core - The core shall be parallel to the centerline of the embankment as shown on the plans. The top width of the core shall be a minimum of four feet. The height shall extend up to at least the 10 year water elevation or as shown on the plans. The side slopes shall be 1 to 1 or flatter. The core shall be compacted with construction.

**Structure Backfill**


Backfill adjacent to pipes or structures shall be of the type and quality conforming to that specified for the adjoining fill material. The fill shall be placed in horizontal layers not to exceed four inches in thickness and compacted by hand tampers or other manually directed compaction equipment. The material needs to fill completely all spaces hand tampers or other manually directed compaction equipment. The material needs to fill completely all spaces under and adjacent to the pipe. At no time during the backfilling operation shall driven equipment be allowed to operate closer than four feet, measured horizontally, to any part of a structure. Under no circumstances shall equipment be driven over any part of a concrete structure or pipe, unless there is a compacted fill of 24" or greater over the structure or pipe.

Structure backfill may be floated fill meeting the requirements of Maryland Department of Transportation, State Highway Administration Standard Specifications for Construction and Materials, Section 310 as modified. The mixture shall have a 100-200 psi, 28 day unconfined compressive strength. The floatable fill shall have a minimum pH of 4.0 and a minimum resistivity of 2,000 ohm-cm. Material shall be placed such that minimum of 6" (measured perpendicular to the outside of the pipe) of floatable fill shall be under (bedding), over, and on the sides of the pipe. It only needs to extend up to the spring line for rigid conduits. Average slump of the fill shall be 7" to assure floatability of the material. Adequate measures shall be taken (sand bags, etc.) to prevent floating the pipe. When using floatable fill, all metal pipe shall be bituminous coated. Any adjoining soil fill shall be placed in horizontal layers not to exceed four inches in thickness and compacted by hand tampers or other manually directed compaction equipment. The material shall completely fill all voids adjacent to the floatable fill zone. At no time during the backfilling operation shall driven equipment be allowed to operate closer than four feet, measured horizontally, to any part of the structure. Under no circumstances shall equipment be driven over any part of a structure or pipe unless there is a compacted fill of 24" or greater over the structure or pipe. Backfill (floatable fill) zone shall be of the type and quality conforming to that specified for the core of the embankment or other embankment materials.

Pipe Conduits  
All pipes shall be circular in cross section.

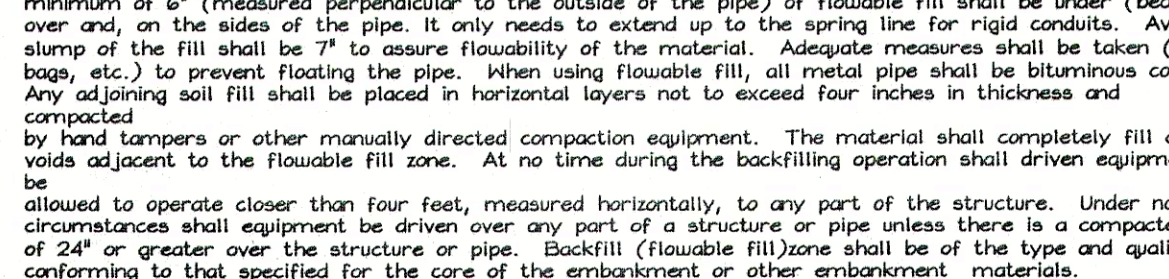

**EX. GROUND**  
ASHTO No. 8 STONE  
SEE WRAP DETAIL  
THIS SHEET (TYP.)

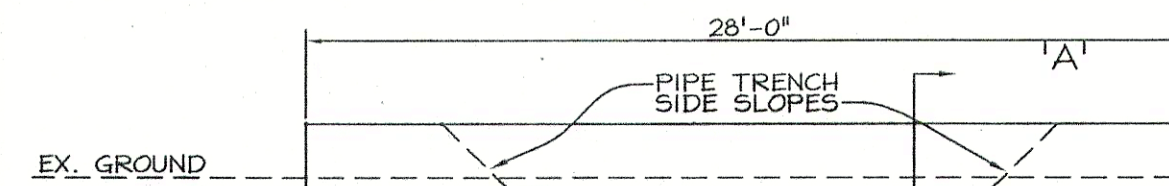

**TOP VIEW**  
**ELEVATION**

**INSTALL AGRIDRAIN (OR EQUAL) RAT GUARDS. EXTEND 4\"/>**

**INSTALL AGRIDRAIN (OR EQUAL) RAT GUARDS. EXTEND 4\"/>**

**OPERATION, MAINTENANCE AND INSPECTION**

INSPECTION OF THE POND(S) SHOWN HEREON SHALL BE PERFORMED AT LEAST ANNUALLY, IN ACCORDANCE WITH THE CHECKLIST AND REQUIREMENTS CONTAINED WITHIN USDA, SCS STANDARDS AND SPECIFICATIONS FOR PONDS (MD-378). THE POND OWNER(S) AND ANY HEIRS, SUCCESSORS, OR ASSIGNS SHALL BE RESPONSIBLE FOR THE SAFETY OF THE POND AND THE CONTINUED OPERATION, SURVEILLANCE, INSPECTION, AND MAINTENANCE THEREOF. THE POND OWNER(S) SHALL PROMPTLY NOTIFY THE M.D.E. DAM SAFETY DIVISION OF ANY UNUSUAL OBSERVATIONS THAT MAY BE INDICATIONS OF DISTRESS SUCH AS EXCESSIVE SEEPAGE, TURBID SEEPAGE, SLIDING OR SLUFFING.

**Reinforced Concrete Pipe** - All of the following criteria shall apply for reinforced concrete pipe:

- Materials - Reinforced concrete pipe shall have bell and spigot joints with rubber gaskets and shall equal or exceed ASTM C-361.
- Bedding - Reinforced concrete pipe conduits shall be laid in a concrete bedding/cradle for their entire length. This bedding/cradle shall consist of high slump concrete placed under the pipe and up the sides of the pipe at least 50% of its outside diameter with a minimum thickness of 6 inches. Where a concrete cradle is not needed for section of this standard, gravel bedding is not permitted.
- Laying pipe - Bell and spigot pipe shall be placed with the bell and upstream. Joints shall be made in accordance with recommendations of the manufacturer of the material. After the joints are sealed for the entire line, the bedding shall be placed so that all spaces under the pipe are filled. Care shall be exercised to prevent any deviation from the original line and grade of the pipe. The first joint must be located within 4 feet from the riser.
- Backfilling shall conform to "Structure Backfill".
- Other details (anti-seep collars, valves, etc.) shall be as shown on the drawings.

**Plastic Pipe** - The following criteria shall apply for plastic pipe:

- Materials - PVC pipe shall be PVC-1120 or PVC-1220 conforming to ASTM D-1785 or ASTM D-2241. Corrugated High Density Polyethylene (HDPE) pipe, coverings and tubing shall conform to the following: 4" -10" inch pipe shall meet the requirements of AASHTO M252 Type 5, and 12" through 24" inch shall meet the requirements of AASHTO M254 Type 5.
- Joints and connections to anti-seep collars shall be completely watertight.
- Bedding - The pipe shall be firmly and uniformly bedded throughout its entire length. Where rock or soft, spongy or other unstable soil is encountered, all such material shall be removed and replaced with suitable earth compacted to provide adequate support.
- Backfilling shall conform to "Structure Backfill".
- Other details (anti-seep collars, valves, etc.) shall be as shown on the drawings.

**Drainage Diaphragms** - When a drainage diaphragm is used, a registered professional engineer will supervise the design and construction inspection.

**Concrete**

Concrete shall meet the requirements of Maryland Department of Transportation, State Highway Administration Standard Specifications for Construction and Materials, Section 414, Mix No. 3.

**Rock Riprap**

Rock riprap shall meet the requirements of Maryland Department of Transportation, State Highway Administration Standard Specifications for Construction and Materials, Section 311.

Geotextile shall be placed under all riprap and shall meet requirements of Maryland Department of Transportation, State Highway Administration Standard Specifications for Construction and Materials, Section 421.04, Class C.

**Care of Water during Construction**


All work on permanent structures shall be carried out in areas free from water. The Contractor shall construct and maintain all temporary dikes, levees, cofferdams, drainage channels, and stream diversions necessary to protect to be occupied by the permanent works. The contractor shall also furnish, install, operate, and maintain all necessary pumping and other equipment required for removal of water from various parts of the work and for maintaining the excavations, foundation, and other parts of the work free from water as required or directed by the engineer for constructing each part of the work. After having served their purpose, all temporary protective works shall be removed or leveled and graded to the extent required to prevent obstruction in any degree whatsoever of the flow of water to the spillway or outlet works and so as not to interfere in any way with the operation or maintenance of the structure. Stream diversions shall be maintained until the fill flow can be passed through the permanent works. The removal of water from the required excavation and the foundation shall be accomplished in a manner and to the extent that will maintain stability of the excavated slopes and bottom required excavations and will allow satisfactory performance of all construction operations. During the placing and compacting of material in required excavations, the water level at the locations being refilled shall be maintained below the bottom of the excavation at such locations which may require draining the water sumps from which the water shall be pumped.

**Stabilization**


All borrow areas shall be graded to provide proper drainage and left in a slightly condition. All exposed surfaces of the embankment, spillway, spoil and borrow areas, and berms shall be stabilized by seeding, liming, fertilizing and mulching in accordance with the Natural Resources Conservation Service Standards and Specifications for Critical Area Planting (MD-342) or as shown on the accompanying drawings.

**Erosion and Sediment Control**


Construction operations will be carried out in such a manner that erosion will be controlled and water and air pollution minimized. State and local laws concerning pollution abatement will be followed. Construction plans shall detail erosion and sediment control measures.

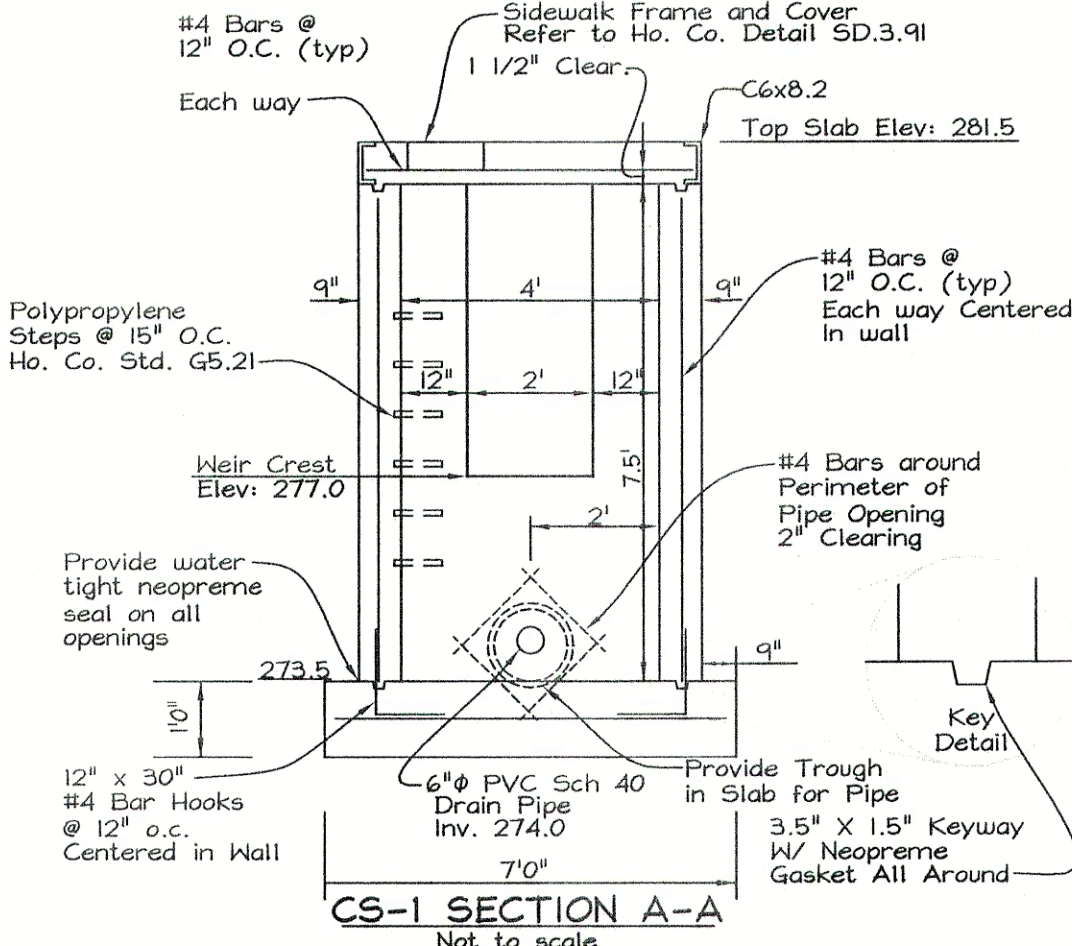


**CS-1 SECTION A-A**  
Not to scale

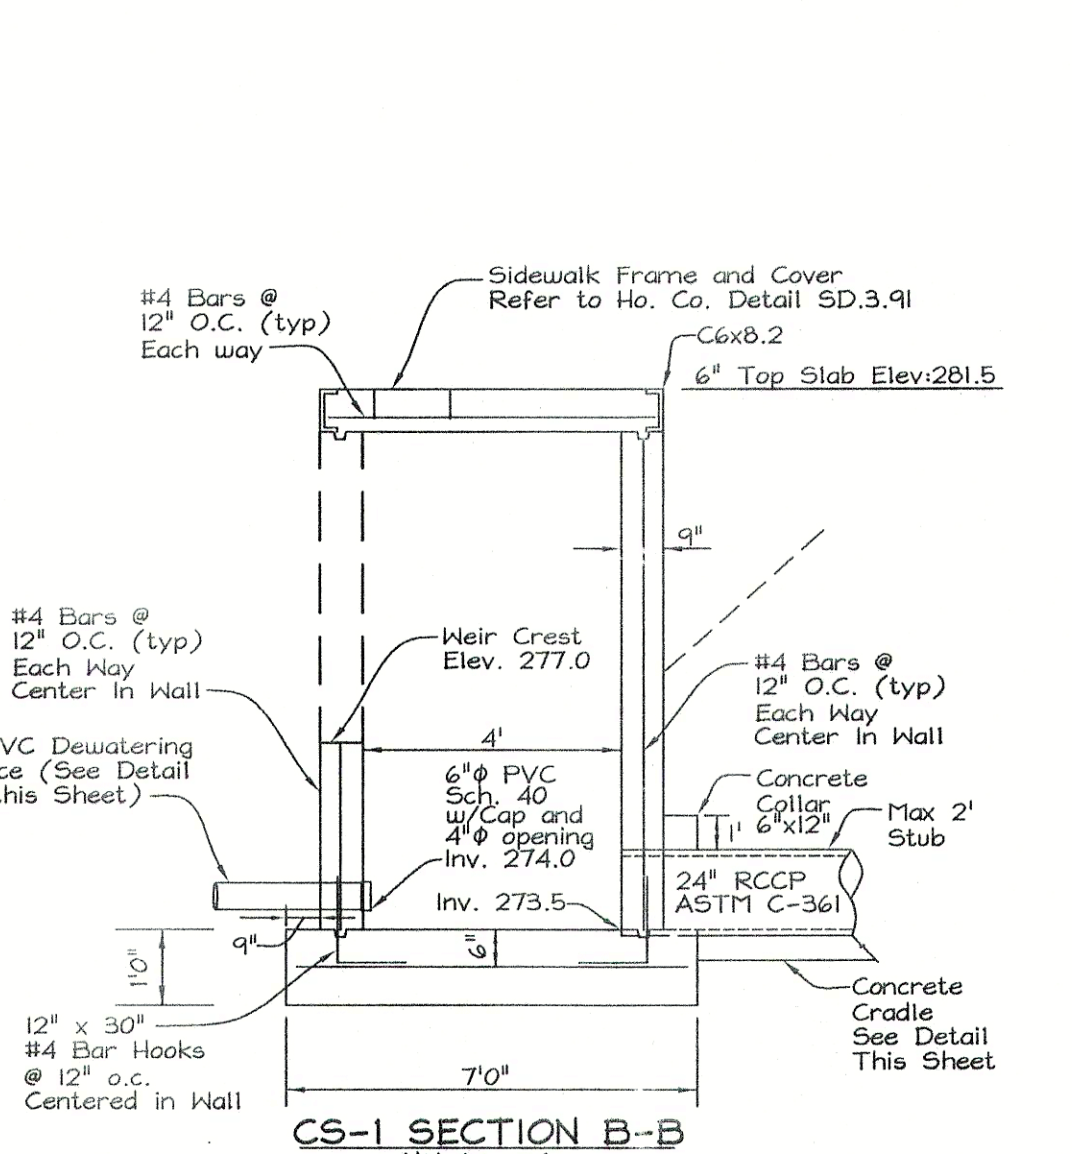


**CS-1 SECTION B-B**  
Not to scale

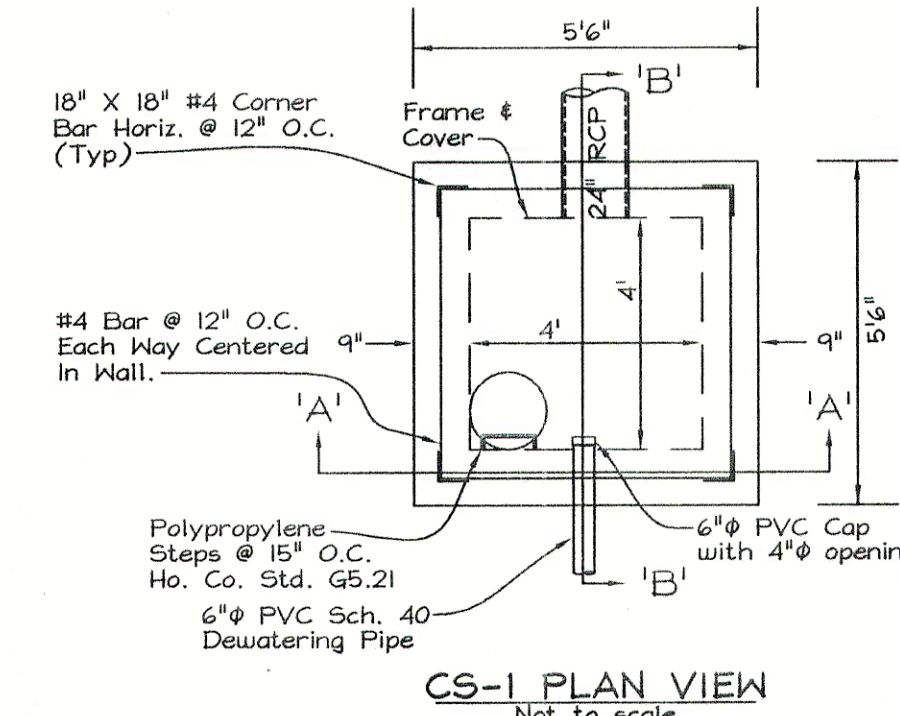


**CS-1 PLAN VIEW**  
Not to scale

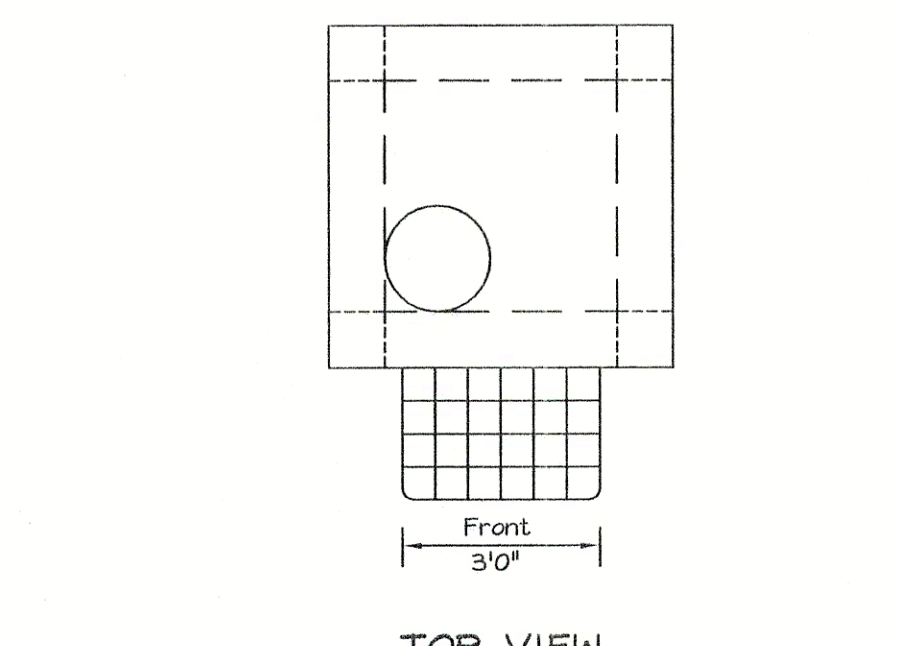


**TOP VIEW**  
Not to scale

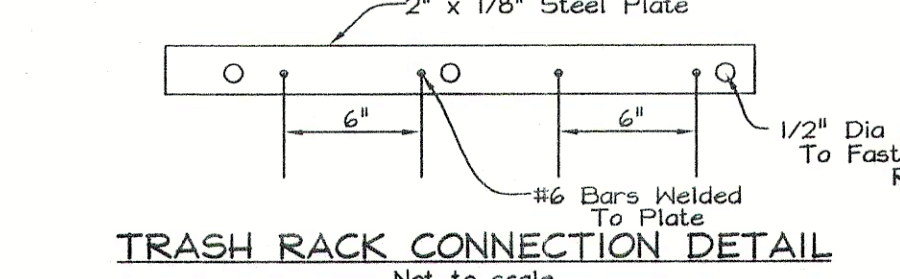


**TRASH RACK CONNECTION DETAIL**  
Not to scale

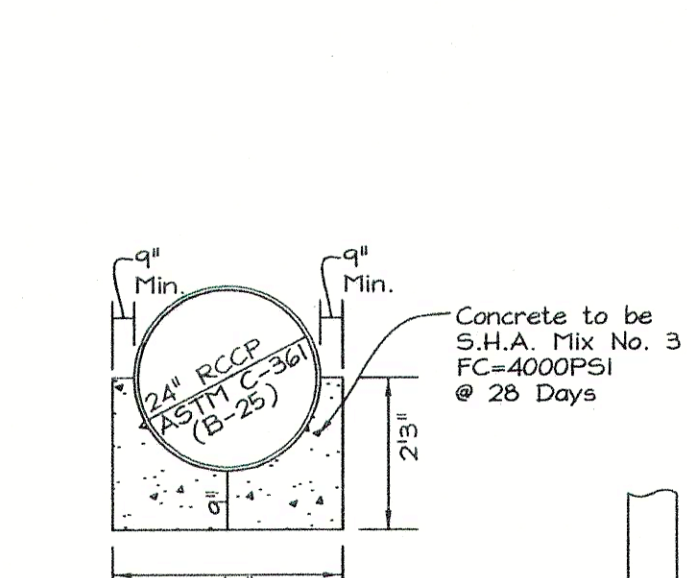


**CONCRETE CRADLE DETAIL**  
SCS TR-46 A-2  
Not to scale

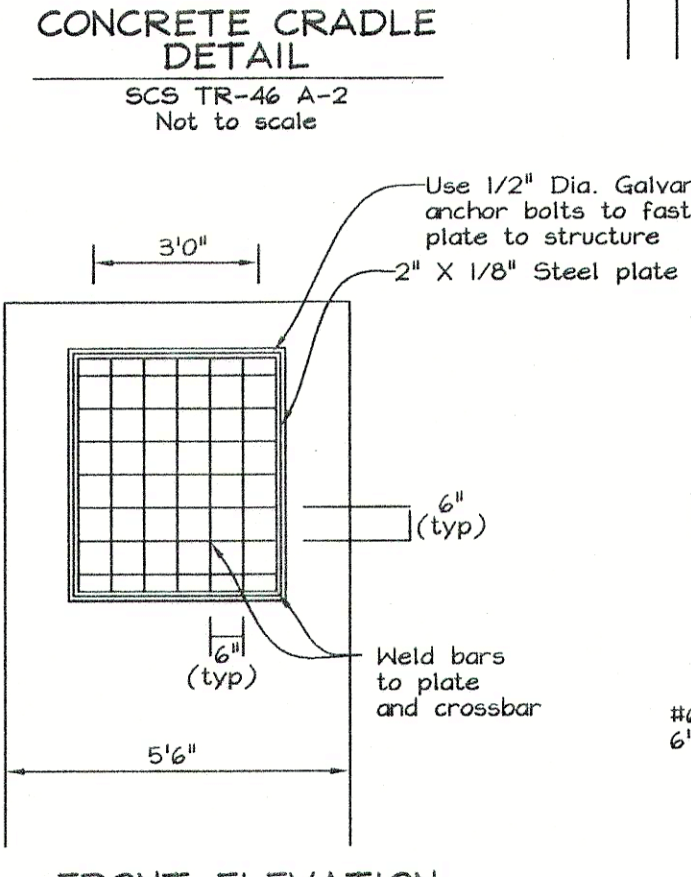

**FRONT ELEVATION**  
Not to scale

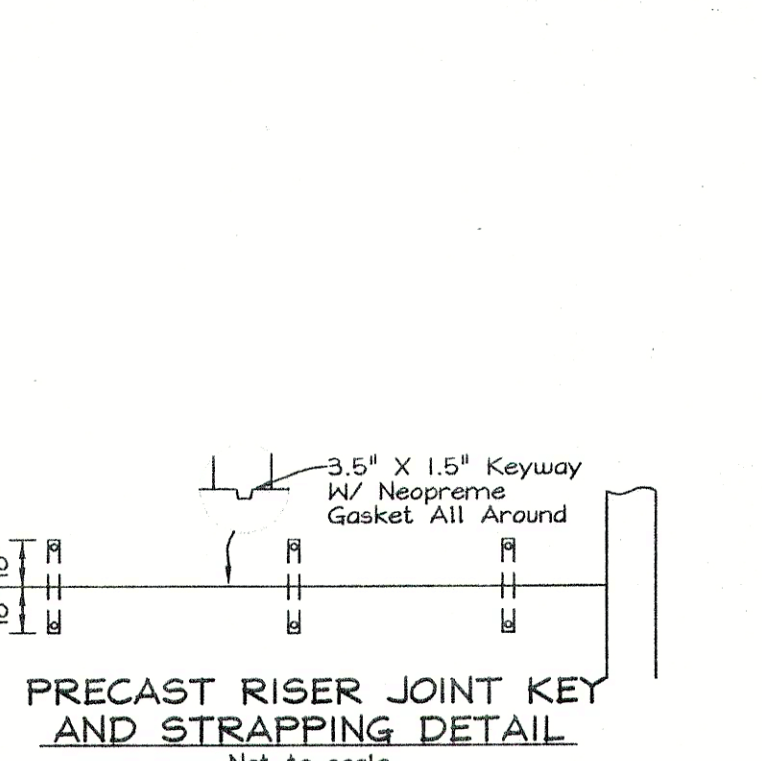

**PRECAST RISER JOINT KEY AND STRAPPING DETAIL**  
Not to scale

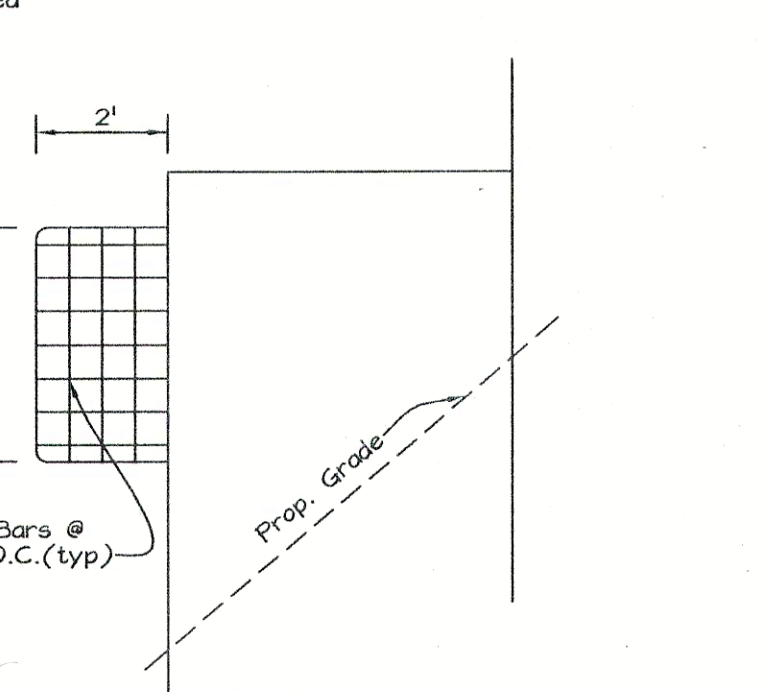


**SIDE ELEVATION**  
Not to scale

**TRASH RACK NOTES:**  
1. Galvanize trash rack after fabrication.  
2. Trash rack to be painted battleship gray.

**REMOVABLE TRASH RACK**

Not to scale

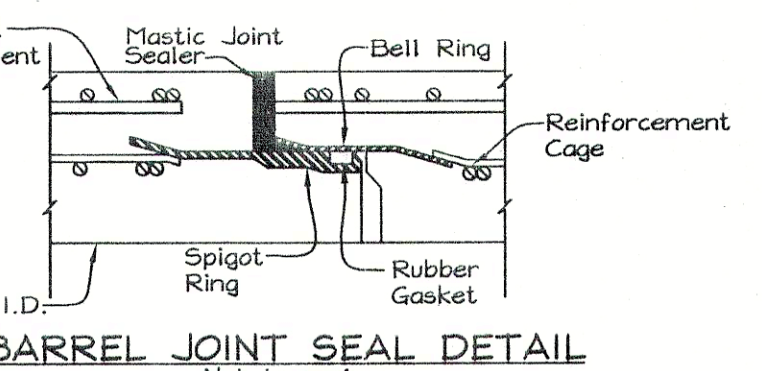

**BARREL JOINT SEAL DETAIL**  
Not to scale

**OPERATION AND MAINTENANCE SCHEDULE FOR PERMANENT SEDIMENT BASIN**

**ROUTINE MAINTENANCE**

- FACILITY WILL BE INSPECTED ANNUALLY AND AFTER MAJOR STORMS. INSPECTIONS SHOULD BE PERFORMED DURING WET WEATHER TO DETERMINE IS FUNCTIONING PROPERLY.
- TOP AND SIDE SLOPES OF THE EMBANKMENT SHALL BE MOWED A MINIMUM OF TWO (2) TIMES A YEAR, ONCE IN JUNE AND ONCE IN SEPTEMBER. OTHER SIDE SLOPES AND MAINTENANCE ACCESS SHOULD BE MOWED AS NEEDED.
- DEBRIS AND LITTER NEXT TO THE OUTLET STRUCTURE SHALL BE REMOVED DURING REGULAR MOWING OPERATIONS AND AS NEEDED.
- VISIBLE SIGNS OF EROSION IN THE POND AS WELL AS RIPRAP OUTLET AREAS SHALL BE REPAIRED AS SOON AS IT IS NOTICED.
- MAINTAIN 4in. Cpv OUTLET KEEPING IT CLEAR OF OBSTRUCTIONS.

**NON-ROUTINE MAINTENANCE**

- STRUCTURAL COMPONENTS OF THE POND SUCH AS THE DAM, THE RISER, AND THE PIPES SHALL BE REPAIRED UPON DETECTION OF ANY DAMAGE. THE COMPONENTS SHOULD BE INSPECTED DURING ROUTINE MAINTENANCE OPERATIONS.
- SEDIMENT SHOULD BE REMOVED WHEN ITS ACCUMULATION REACHES THE CLEANOUT ELEVATION OF 273.0.

**PERMIT APPLICANT**

Savage Stone, LLC.  
P.O. Box 850  
Laurel MD 20725

**OWNER**

Konterra  
Limited Partnership  
P.O. Box 850  
Laurel MD 20725

**SEDIMENT BASIN DETAILS  
LAUREL LUMBER**

TAX MAP 47 GRID 6  
6TH ELECTION DISTRICT

PARCEL 384  
HOWARD COUNTY, MARYLAND

**PLUNGE POOL TABLE**

OUTFALL	DIMENSIONS							REMARKS
	A	B	C	D	E	F	G	
S-1	18'	6'	6'	4'	15'	2'	19'	24" RCCP

**TYPICAL PLUNGE POOL DETAIL**  
NOT TO SCALE

**REVIEWED FOR HOWARD SCD AND MEETS TECHNICAL REQUIREMENTS**

Jim Meyer 11/16/06  
USDA-NATURAL RESOURCES CONSERVATION SERVICE DATE

John K. Johnson 11/16/06  
THIS DEVELOPMENT PLAN IS APPROVED FOR SOIL EROSION AND SEDIMENT CONTROL BY THE HOWARD SOIL CONSERVATION DISTRICT

Howard SCD DATE

**ENGINEER'S CERTIFICATE**

"I CERTIFY THAT THIS PLAN FOR SEDIMENT AND EROSION CONTROL REPRESENTS A PRACTICAL AND WORKABLE PLAN BASED ON MY PERSONAL KNOWLEDGE OF THE SITE CONDITIONS AND THAT IT HAS BEEN PREPARED IN ACCORDANCE WITH THE REQUIREMENTS OF THE HOWARD SOIL CONSERVATION DISTRICT."

Zacharia Y. Fisch 11/16/06  
SIGNATURE OF ENGINEER DATE

Howard SCD DATE

**PERMITTEE'S CERTIFICATE**

"I/WE CERTIFY THAT ALL DEVELOPMENT AND CONSTRUCTION WILL BE DONE ACCORDING TO THIS PLAN FOR SEDIMENT AND EROSION CONTROL AND THAT ALL RESPONSIBLE PERSONNEL INVOLVED IN THE CONSTRUCTION PROJECT WILL HAVE A CERTIFICATE OF ATTENDANCE AT A DEPARTMENT OF THE ENVIRONMENT APPROVED TRAINING PROGRAM FOR THE CONTROL OF SEDIMENT AND EROSION BEFORE BEGINNING THE PROJECT. I ALSO AUTHORIZE PERIODIC ON-SITE INSPECTION BY THE HOWARD SOIL CONSERVATION DISTRICT."

Timothy J. Schmidt 11/16/06  
SIGNATURE OF PERMITTEE DATE

Howard SCD DATE

**STATE OF MARYLAND**  
**PROFESSIONAL ENGINEER**  
**FSH Associates**  
Engineers Planners Surveyors  
6339 Howard Lane Ellicott City, MD 21075  
Tel: 410-567-5200 Fax: 410-795-1562  
E-mail: info@fshen.com

DESIGN BY: SH  
DRAWN BY: CRH2/RL  
CHECKED BY: SH  
SCALE: AS SHOWN  
DATE: Nov. 16, 2006  
I.O. No.: 3248  
SHEET No.: 8 OF 10



21.0 STANDARDS AND SPECIFICATIONS FOR TOPSOIL

SEDIMENT CONTROL NOTES

Definition: Placement of topsoil over a prepared subsoil prior to establishment of permanent vegetation.

Purpose: To provide a suitable soil medium for vegetation growth.

Conditions Where Practice Applies: This practice is limited to areas having 2:1 or flatter slopes where:

- 1. All vegetation and structural practices are to be installed according to the provisions of this plan and one to be in accordance with the MDA MARYLAND STANDARDS AND SPECIFICATIONS FOR SOIL EROSION AND SEDIMENT CONTROL and remains thereto.

Construction and Material Specifications: 1. Topsoil salvaged from the existing site may be used provided that it meets the standards as set forth in these specifications.

SEQUENCE OF CONSTRUCTION

- 1. Contact Maryland Department of Environment Planning Program Inspector 24 hours in advance of clearing and grading for a pre-construction meeting.
- 2. Clear for and install sediment control devices, including Permanent Basin, Traps #1 and #2, super silt fence, earth dikes, rail crossing protection with storm drain pipes each side, and silt fences.

PERMANENT SEEDING NOTES

APPLY TO GRADED OR CLEARED AREAS NOT SUBJECT TO IMMEDIATE FURTHER DISTURBANCE WHERE A PERMANENT LONG-LIVED VEGETATIVE COVER IS NEEDED.

Permanent Seeding Summary (Cool Weather Mix) table with columns for No., Species, Application Rate, Seeding Dates, Seeding Depths, Fertilizer Rate, and Lime Rate.


Permanent Seeding Summary (Warm Weather Mix) table with columns for No., Species, Application Rate, Seeding Dates, Seeding Depths, Fertilizer Rate, and Lime Rate.

TEMPORARY SEEDING NOTES

SEEDBED PREPARATION: Loosen upper three inches of soil by raking, disking or other acceptable means before seeding.


Temporary Seeding Summary table with columns for No., Species, Application Rate, Seeding Dates, Seeding Depths, Fertilizer Rate, and Lime Rate.

DETAIL 9 - STONE OUTLET SEDIMENT TRAP - ST II

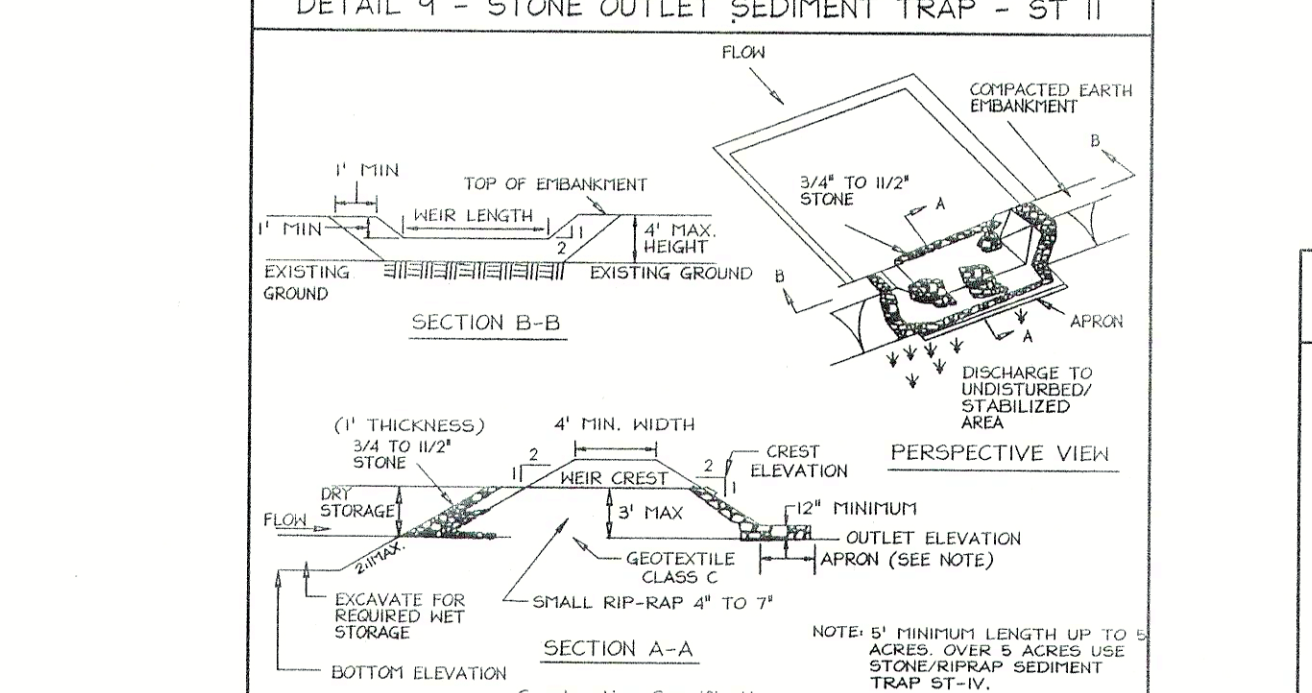


Construction Specifications: 1. Area under embankment shall be cleared, grubbed and stripped of any vegetation and rock mat.

DETAIL 5 - RIP-RAP INFLOW PROTECTION

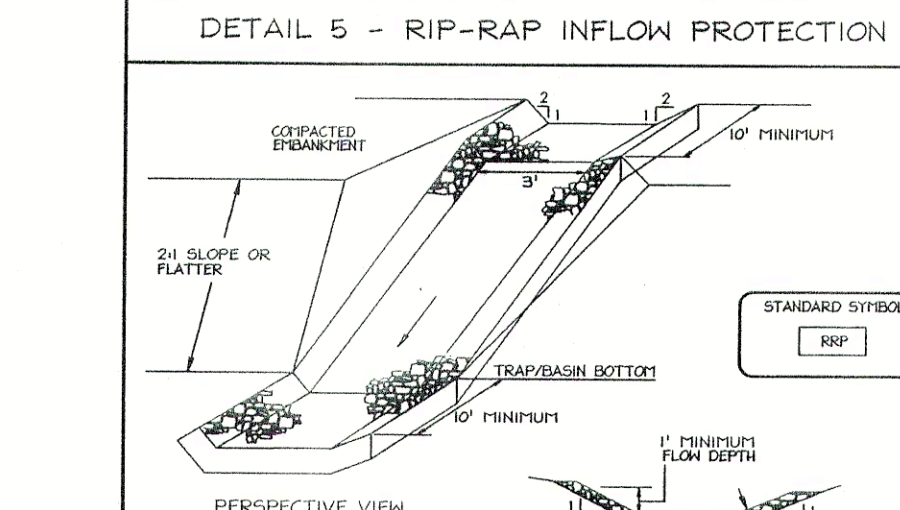


Construction Specifications: 1. Rip-rap lined inflow channels shall be 1' in depth, have a trapezoidal cross section with 2:1 or flatter side slopes and 3' (min.) bottom width.

DETAIL 24 - STABILIZED CONSTRUCTION ENTRANCE

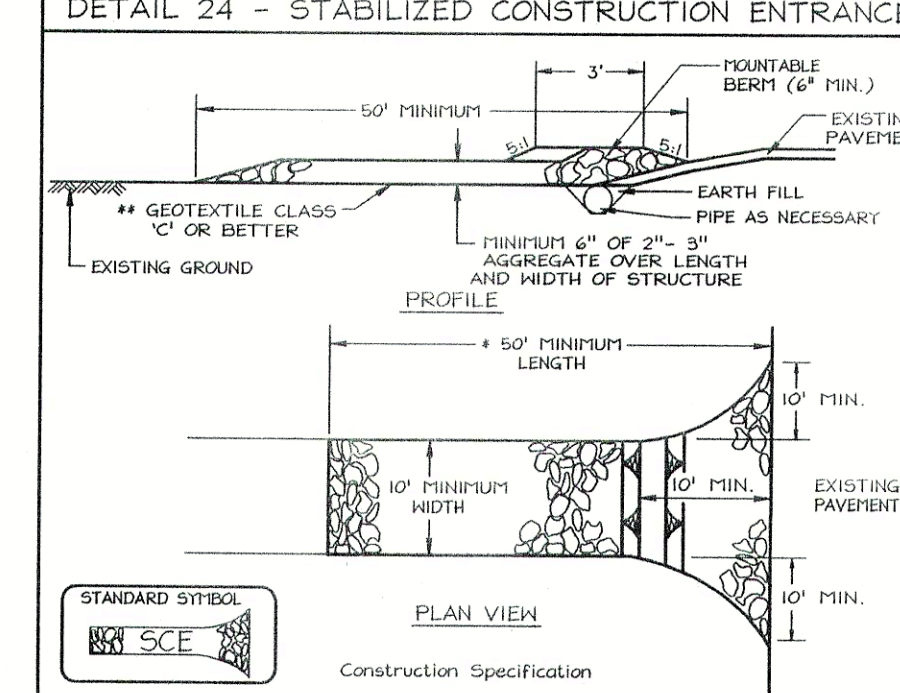


Construction Specifications: 1. Length - minimum of 50' (30' for a single residence lot).

DETAIL 18 - SEDIMENT BASIN BAFFLES

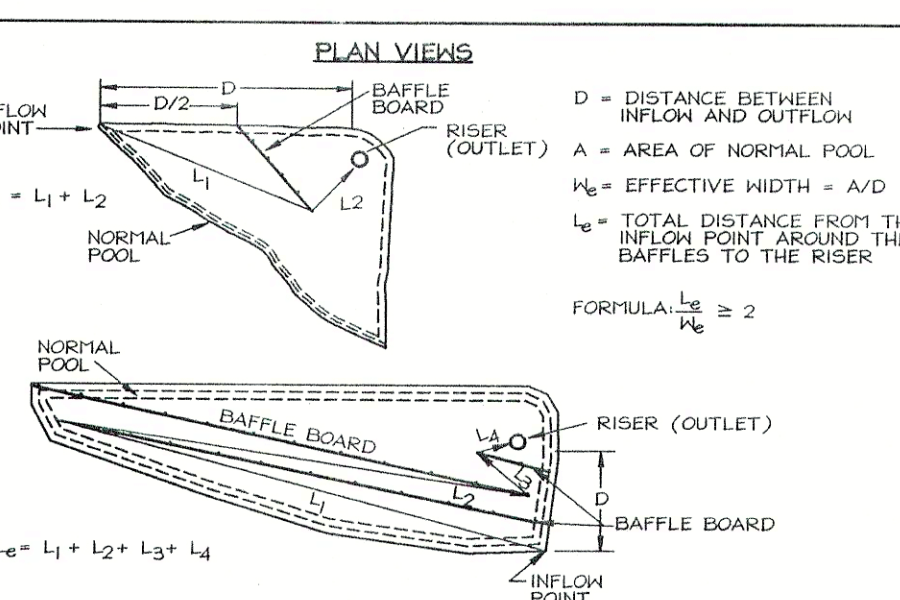


Construction Specifications: 1. Area under embankment shall be cleared, grubbed and stripped of any vegetation and rock mat.

DETAIL 1 - EARTH DIKE

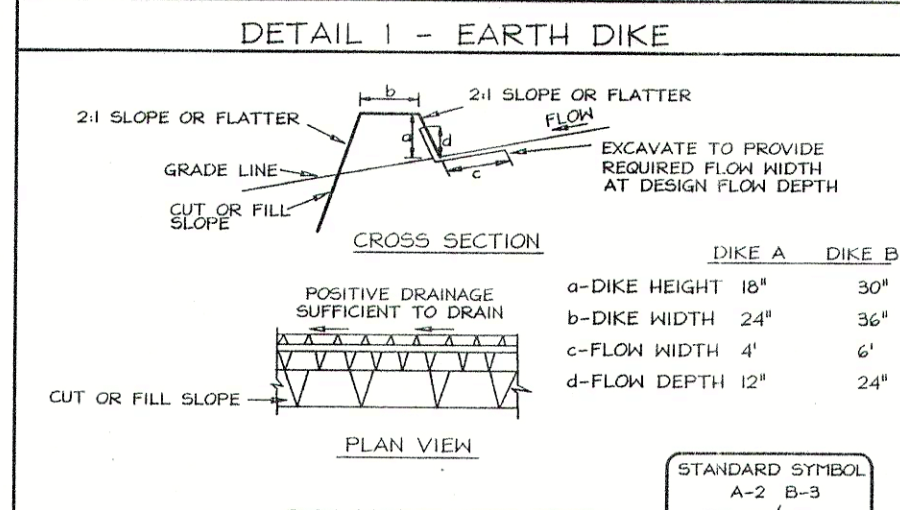


Construction Specifications: 1. Seed and cover with straw mulch.

DETAIL 10A - STONE RIP-RAP OUTLET SEDIMENT TRAP - ST IV

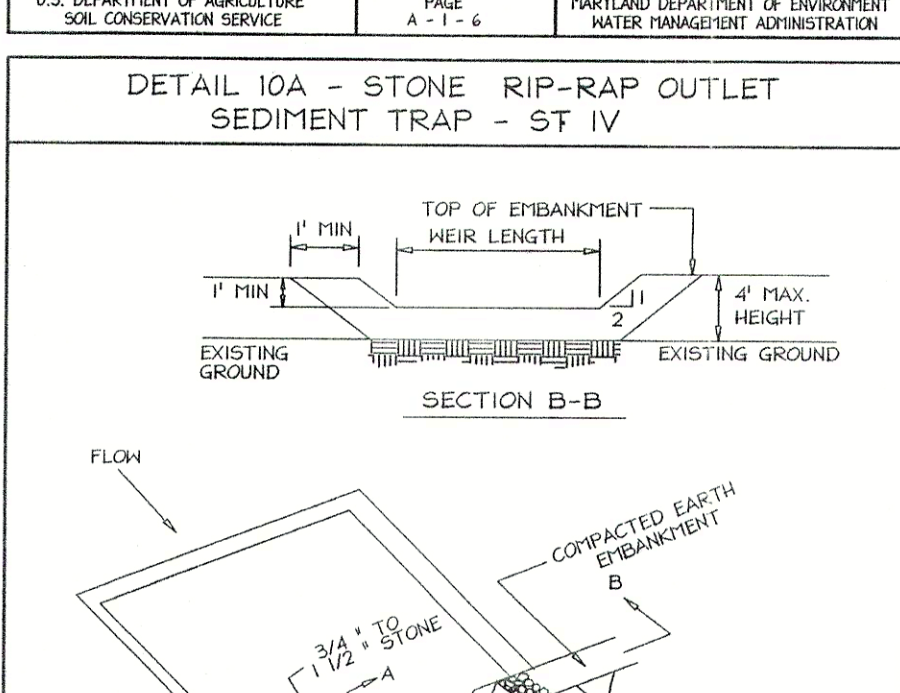


Construction Specifications: 1. The area under embankment shall be cleared, grubbed and stripped of any vegetation and rock mat.

DETAIL 22 - SILT FENCE

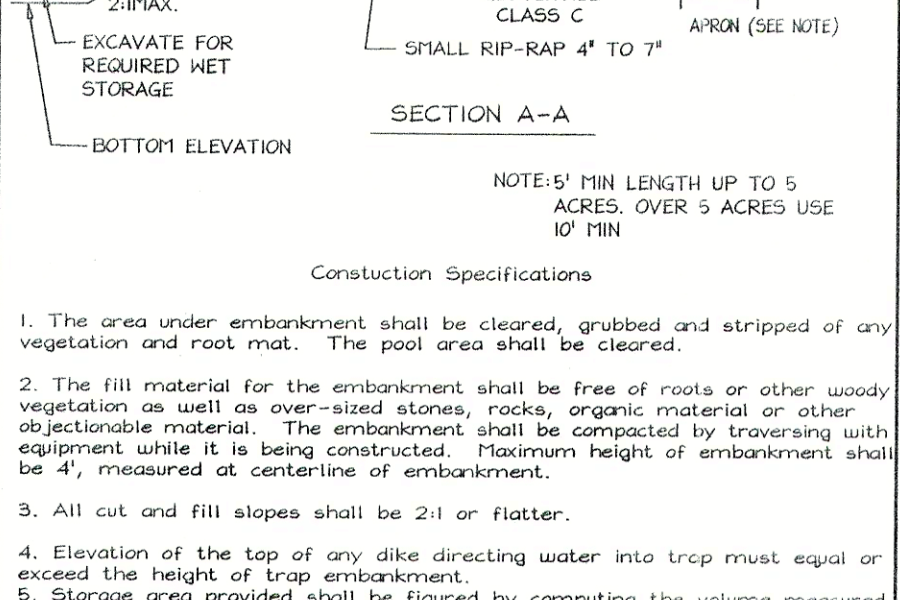


Construction Specifications: 1. Fence posts shall be a minimum of 3/4\"/>

DETAIL 33 - SUPER SILT FENCE

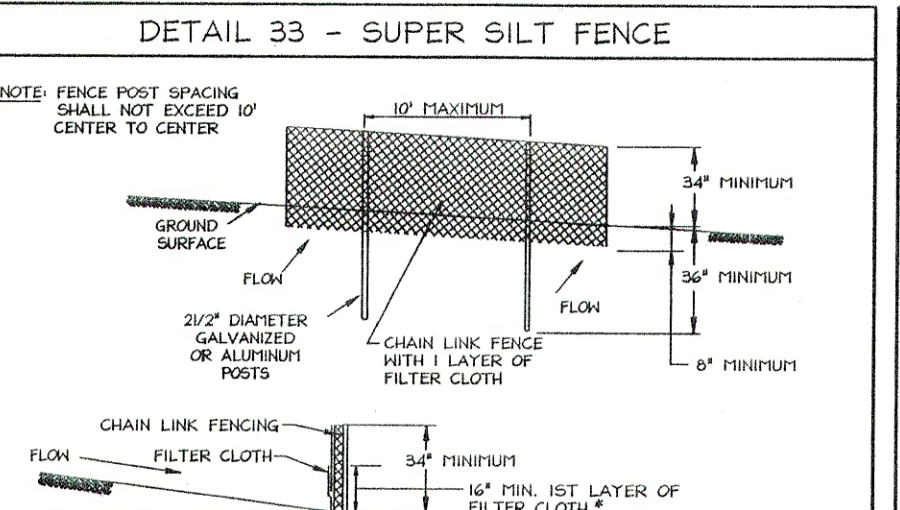


Construction Specifications: 1. Fencing shall be 42\"/>

DETAIL 20A - RENOVOABLE PUMPING STATION

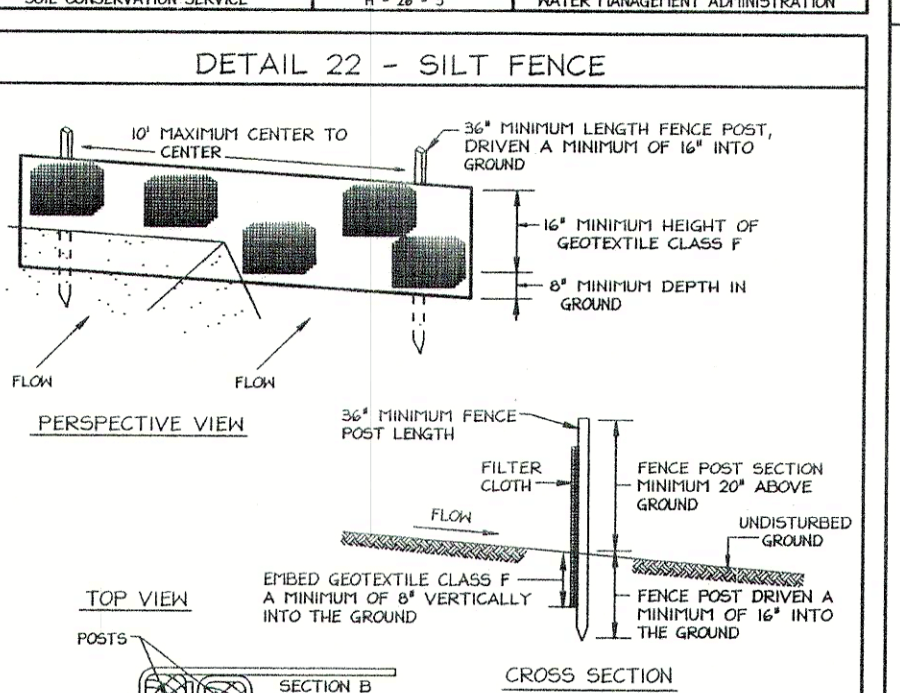

Construction Specifications: 1. The outer pipe should be 48\"/>

DETAIL 30 - EROSION CONTROL MATTING

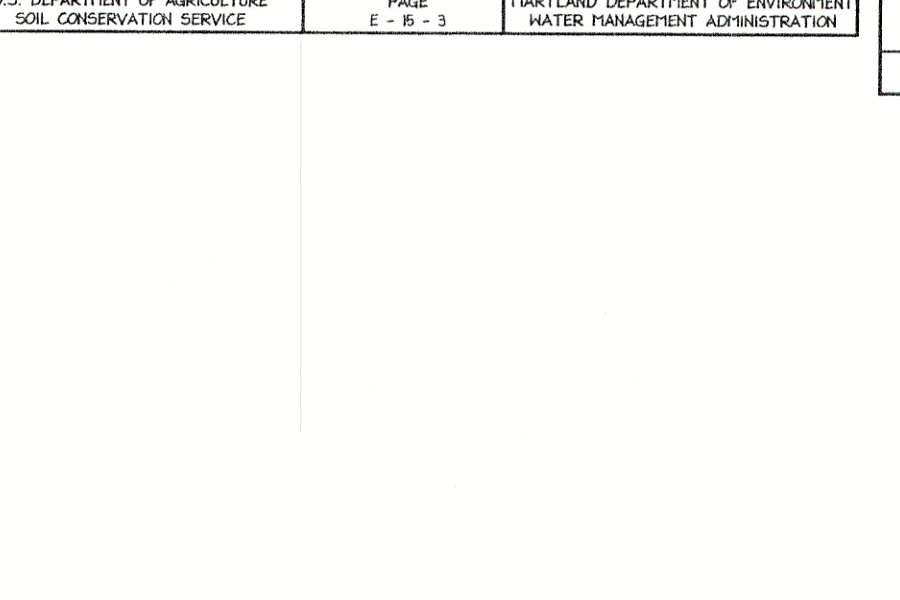

Construction Specifications: 1. Roll-in matting by placing the top ends of the matting in a narrow trench, 4\"/>

REVIEWED FOR HOWARD SCD AND MEETS TECHNICAL REQUIREMENTS. Includes signature of Jim M... and date 11/17/06.


ENGINEERS CERTIFICATE. I CERTIFY THAT THIS PLAN FOR SEDIMENT AND EROSION CONTROL REPRESENTS A PRACTICAL AND WORKABLE PLAN.

PERMITTEE'S CERTIFICATE. I/WE CERTIFY THAT ALL DEVELOPMENT AND CONSTRUCTION WILL BE DONE ACCORDING TO THIS PLAN FOR SEDIMENT AND EROSION CONTROL.

PERMIT APPLICANT: Savage Stone, LLC. P.O. Box 850, Laurel MD 20725.


OWNER: Konterra Limited Partnership. P.O. Box 850, Laurel MD 20725.

GRADING, SEDIMENT AND EROSION CONTROL NOTES AND DETAILS. LAUREL LUMBER. TAX MAP 47 GRID 6 6TH ELECTION DISTRICT. HOWARD COUNTY, MARYLAND.

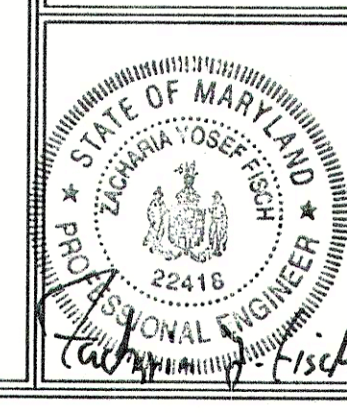


FSH Associates Engineers Planners Surveyors. 6339 Howard Lane Elkridge, MD 21075. 410-410-5200 Fax: 410-796-1562.




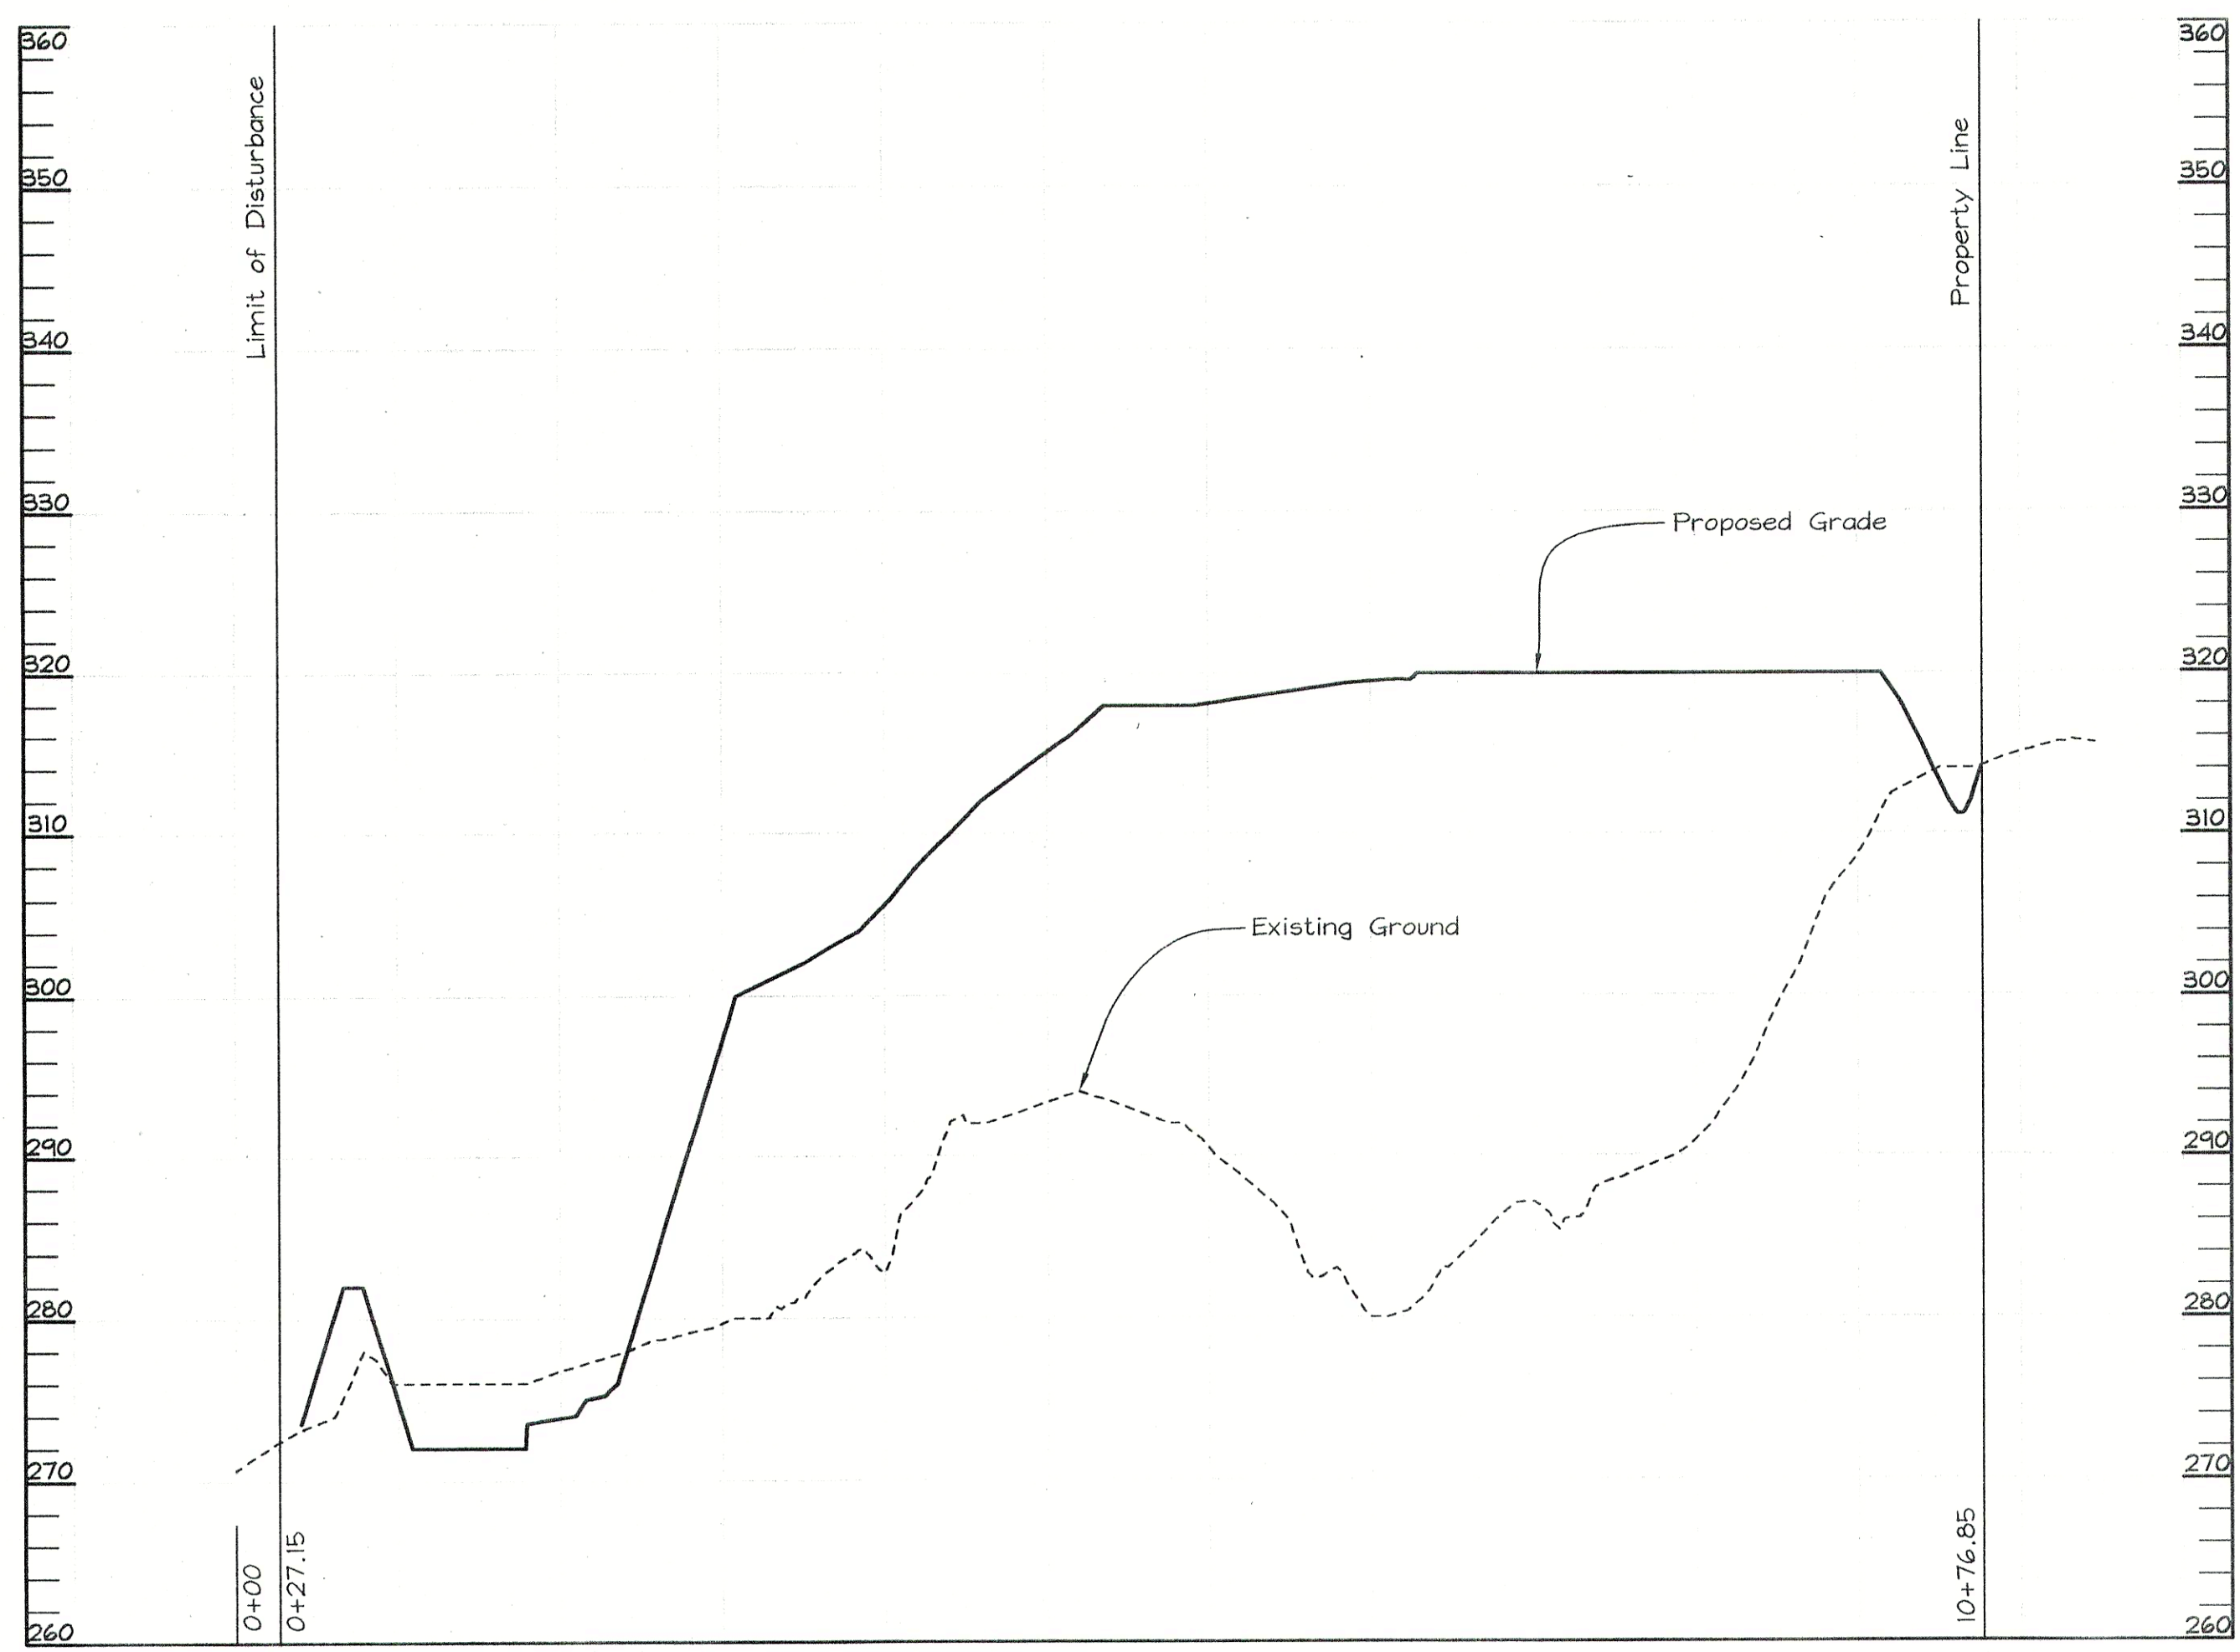


**SECTION A-A**  
Scale: Horizontal - 1"=100'  
Vertical - 1"=10'

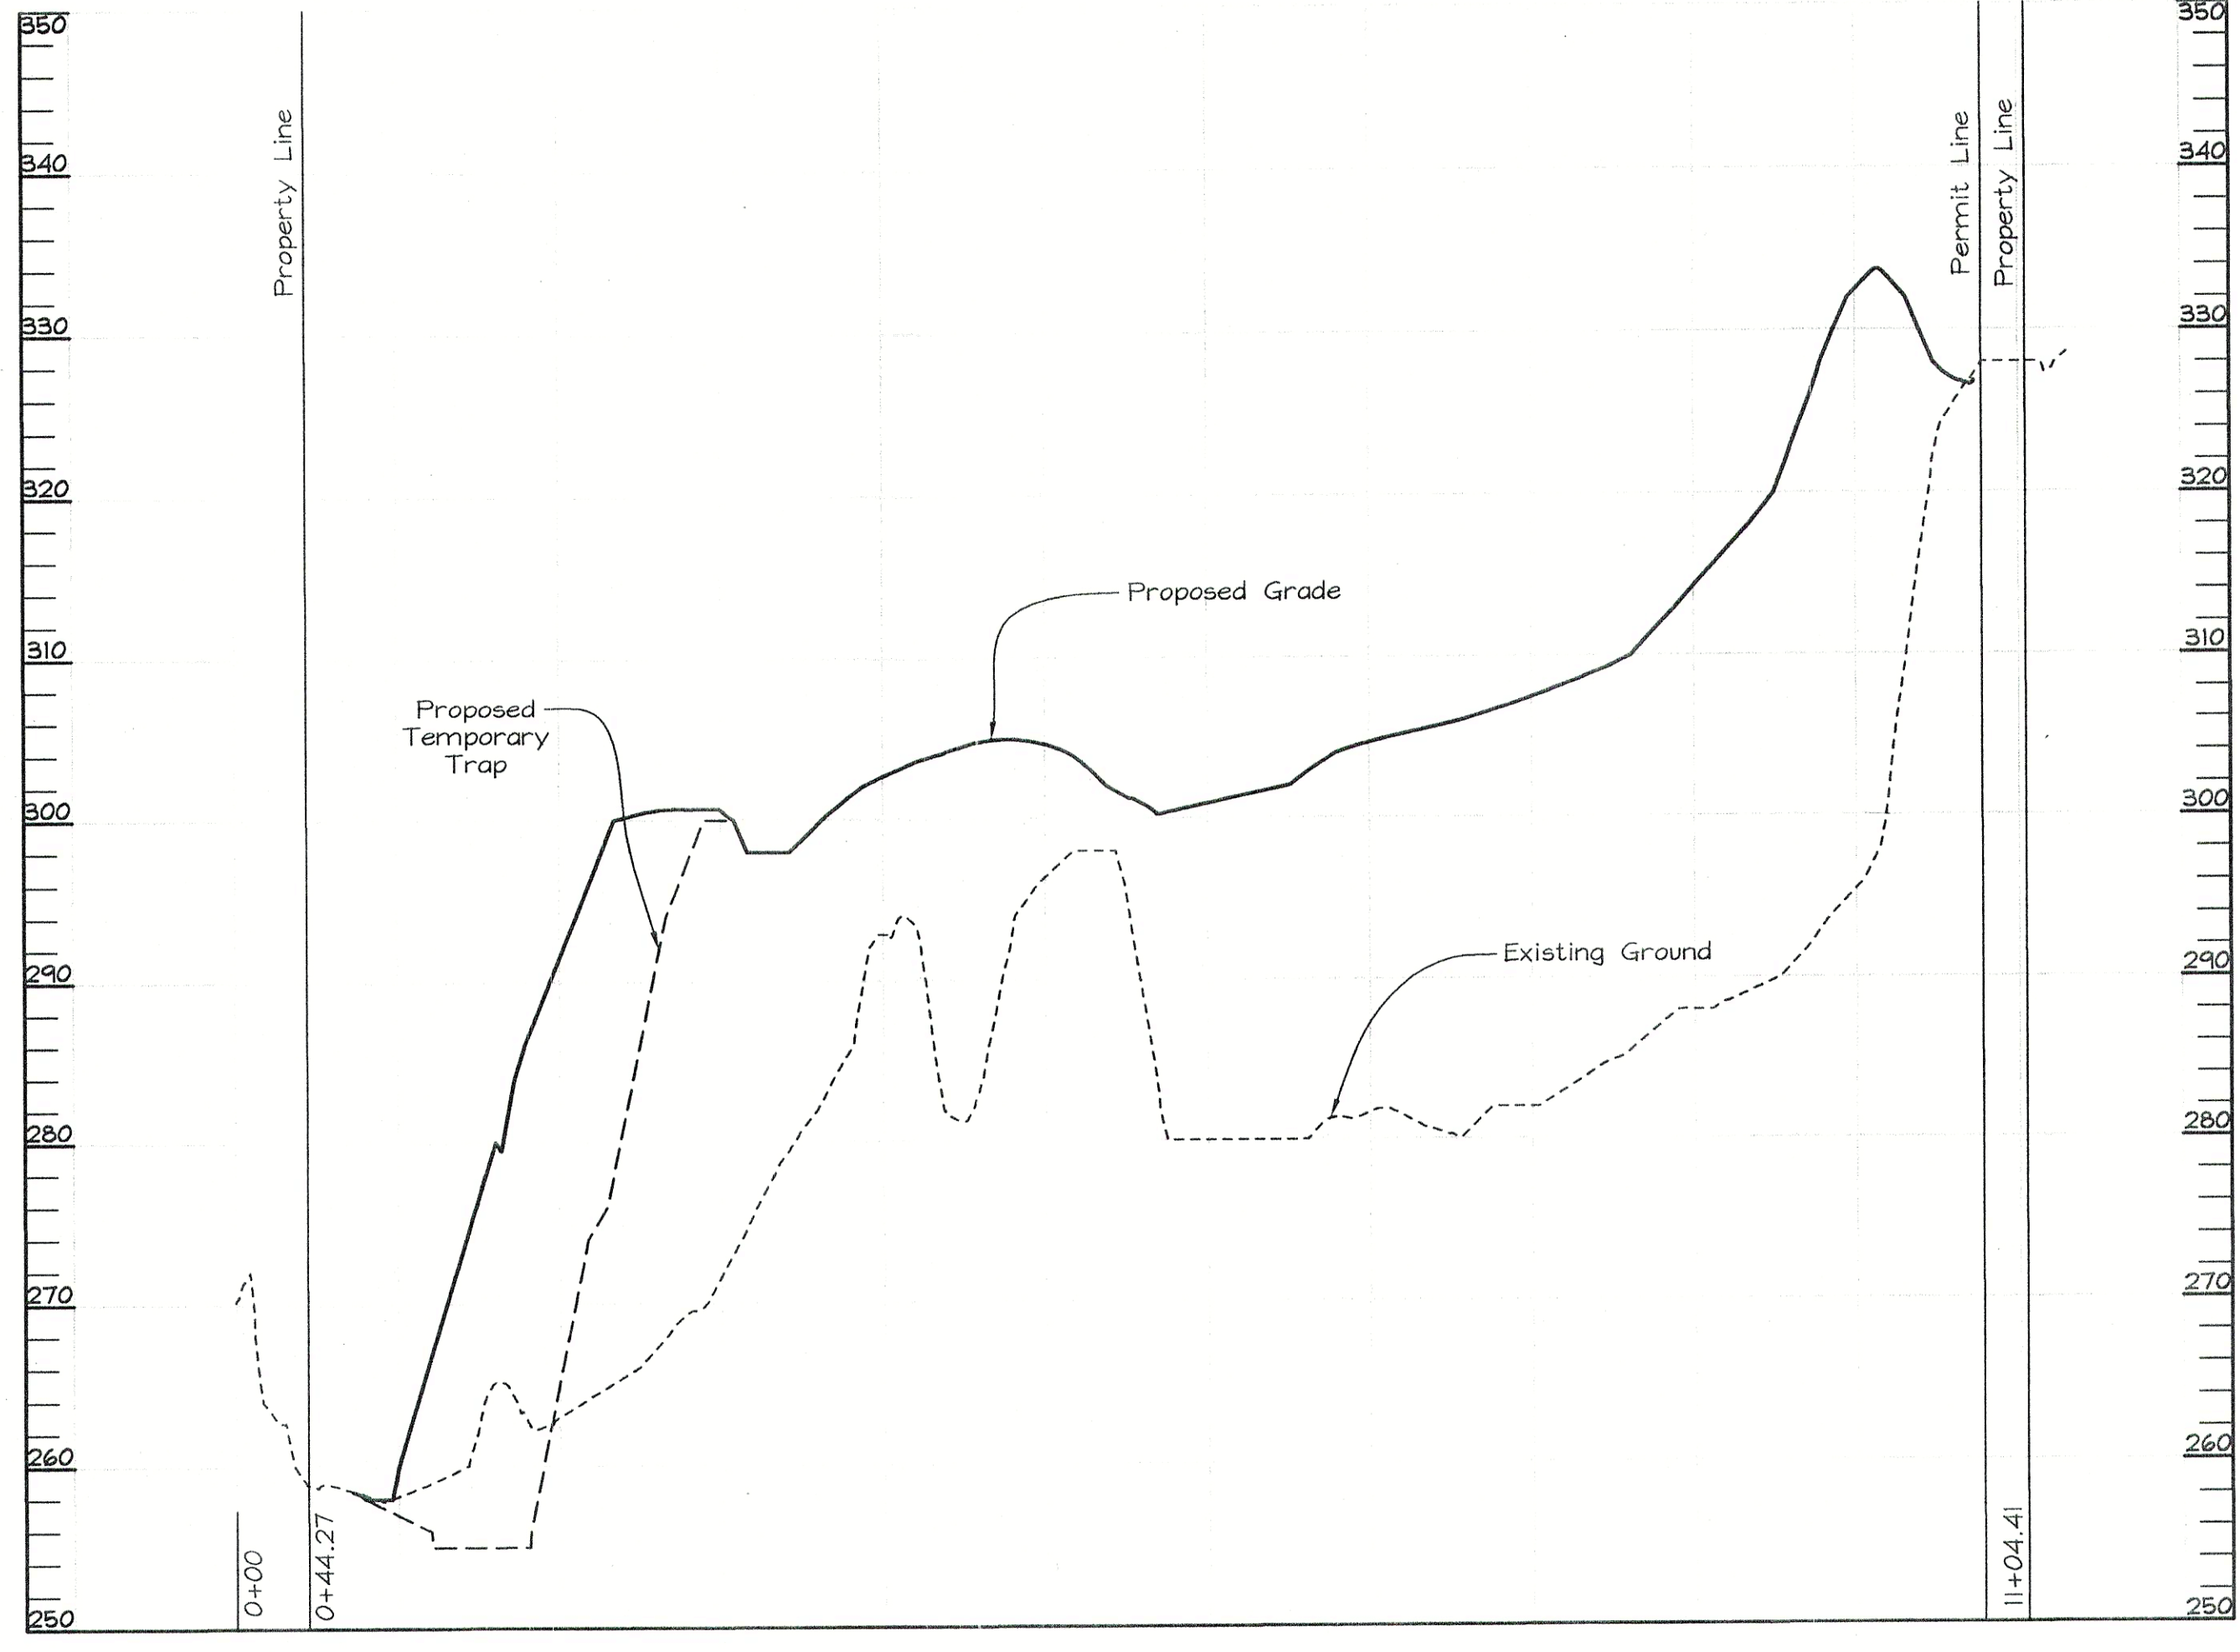

**SECTION B-B**  
Scale: Horizontal - 1"=100'  
Vertical - 1"=10'

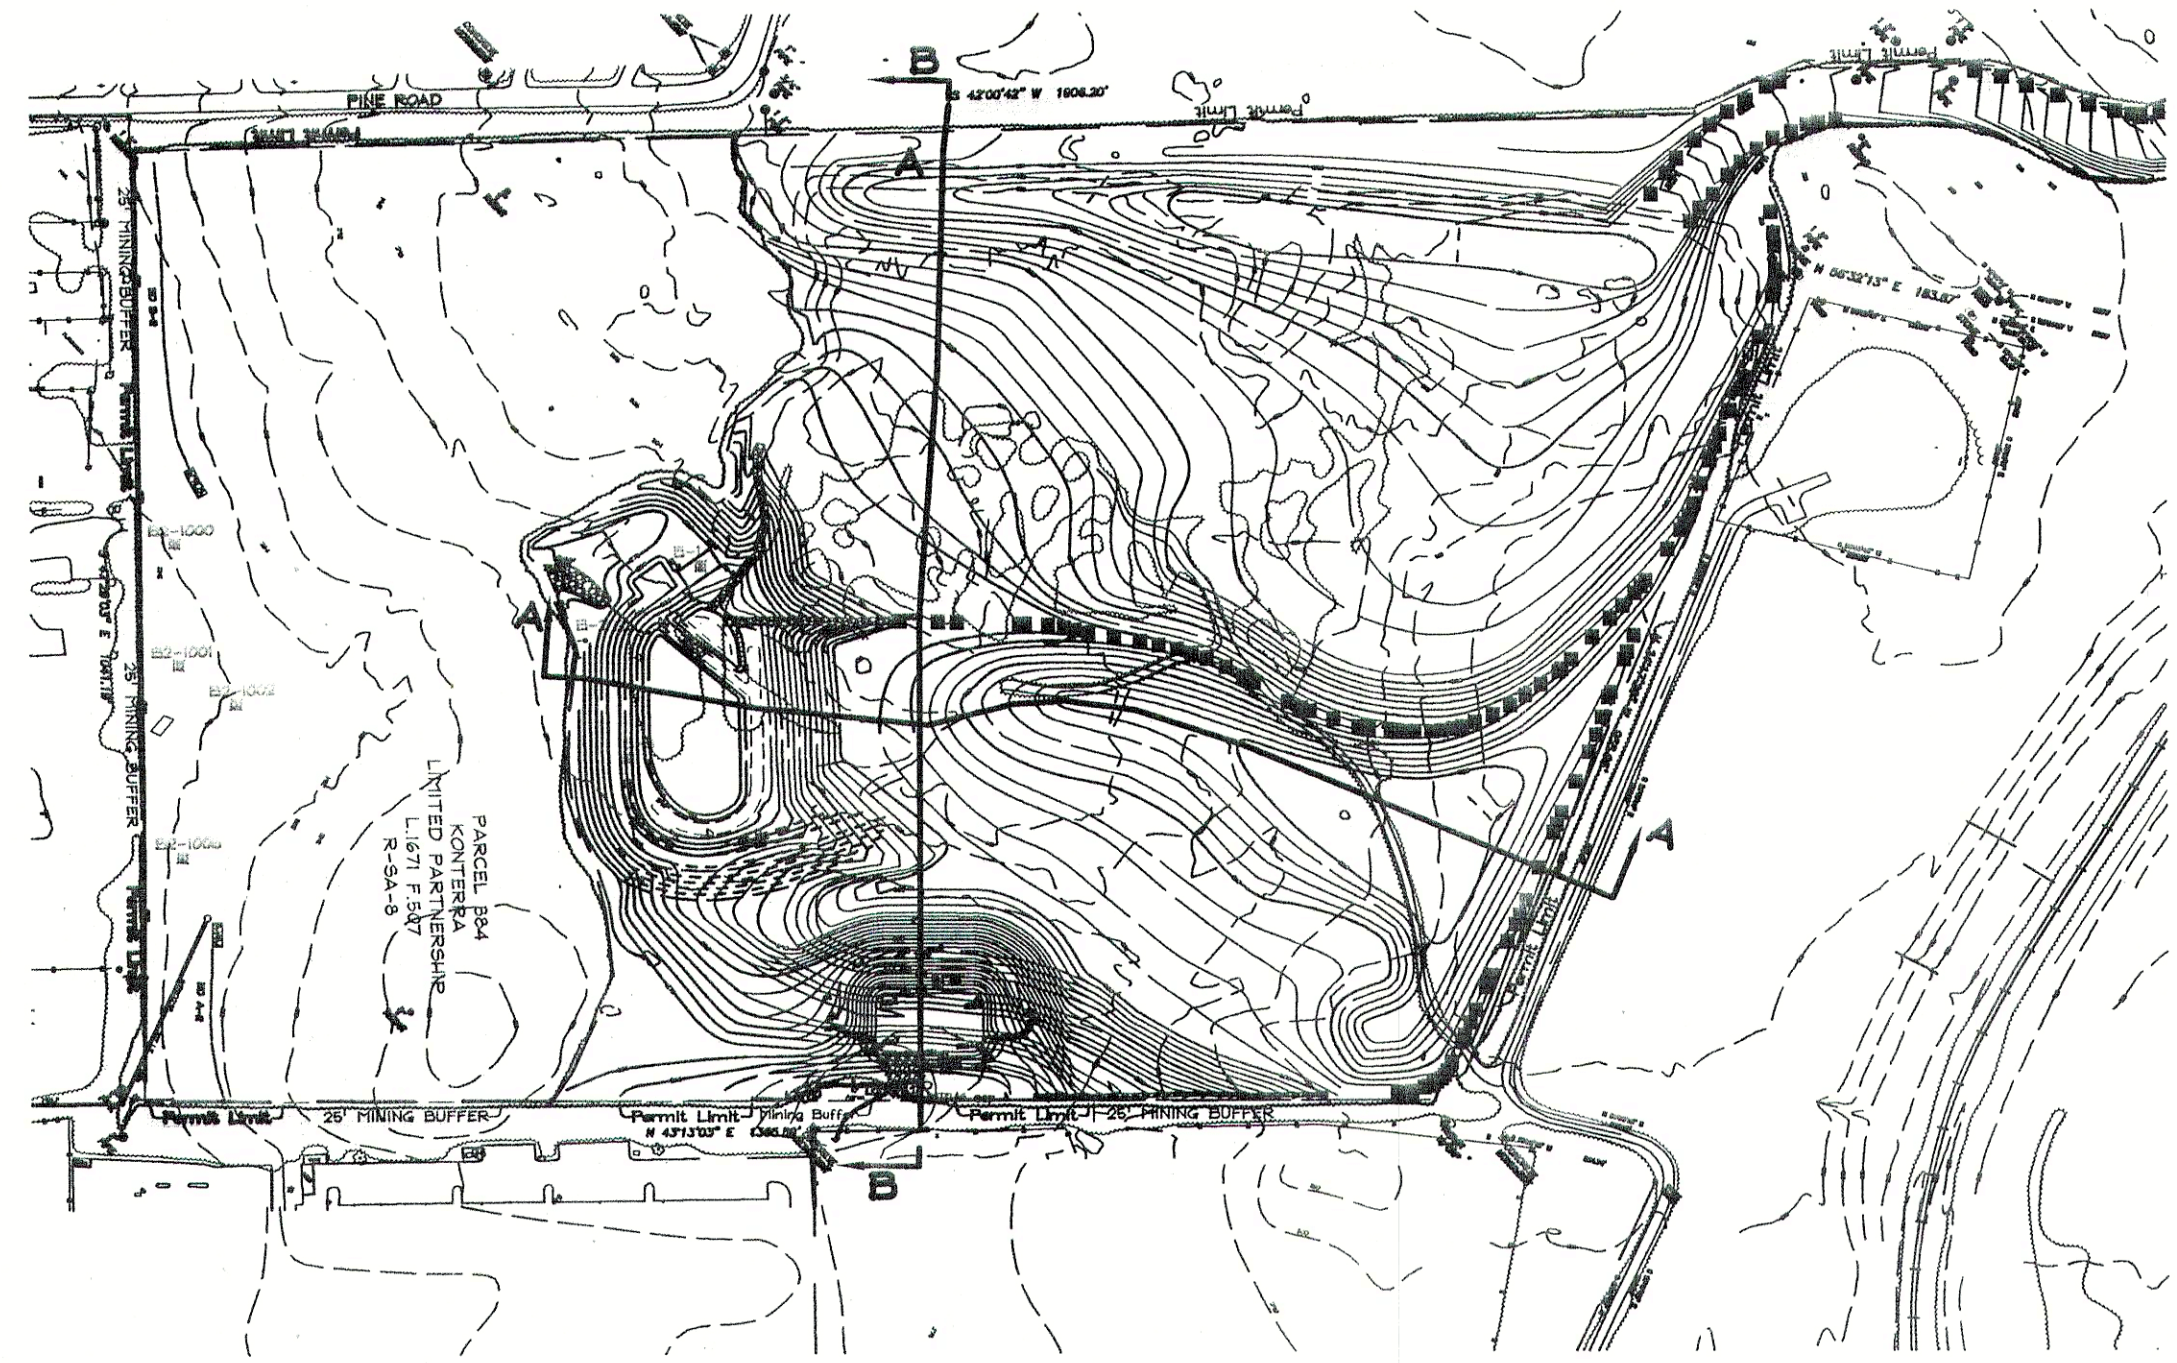

**PLAN VIEW**  
Scale: 1"=200'

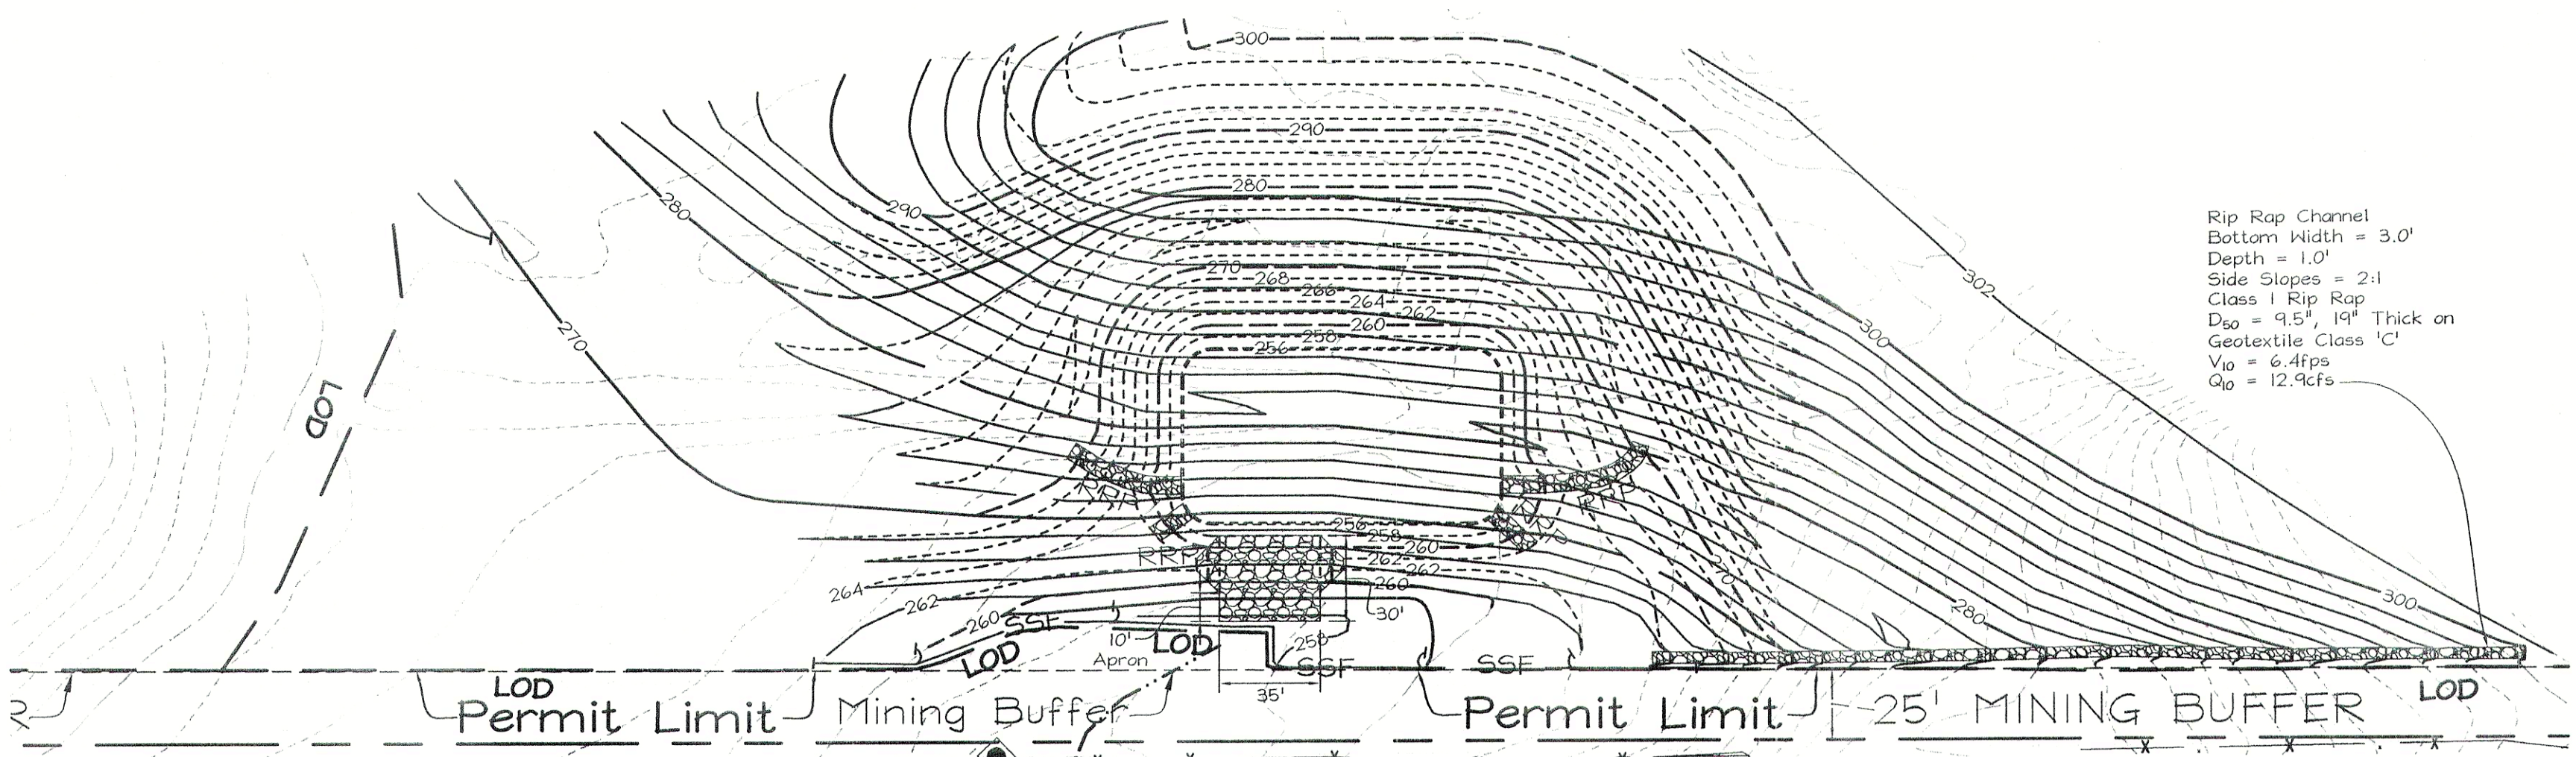

**SEDIMENT TRAP #2 - REMOVAL DETAIL**  
Scale: 1"=50'

**LEGEND**

- Pre-Existing Contour: - - - - - 362
- Proposed Contour: - - - - - 322
- Spot Elevation: +82.52
- Existing Trees to Remain: [Symbol]
- Utility Poles: [Symbol]
- Stabilized Construction Entrance: [Symbol]
- Silt Fence: SF
- Super Silt Fence: SSF
- Earth Dike: ED A-1
- 25' Mining Buffer: [Symbol]
- Permit Limit: Permit Limit
- Limit of Disturbance: LOD
- Property Line: [Symbol]
- Erosion Control Matting: [Symbol]
- Existing Contour: - - - - -
- Rip Rap Inflow Protection: RRP

**PERMIT APPLICANT**  
Savage Stone, LLC.  
P.O. Box 850  
Laurel MD 20725

**OWNER**  
Konterra  
Limited Partnership  
P.O. Box 850  
Laurel MD 20725

**CROSS SECTIONS**  
**LAUREL LUMBER**


TAX MAP 47 GRID 6  
6TH ELECTION DISTRICT

PARCEL 384  
HOWARD COUNTY, MARYLAND

REVIEWED FOR HOWARD SCD AND MEETS TECHNICAL REQUIREMENTS \*  
Jim M. [Signature] 11/17/06 DATE  
USDA - NATURAL RESOURCE CONSERVATION SERVICE  
THIS DEVELOPMENT PLAN IS APPROVED FOR SOIL EROSION AND SEDIMENT CONTROL BY THE HOWARD SOIL CONSERVATION DISTRICT \*  
John L. [Signature] 11/17/06 DATE  
HOWARD SCD

**ENGINEER'S CERTIFICATE**  
"I CERTIFY THAT THIS PLAN FOR SEDIMENT AND EROSION CONTROL REPRESENTS A PRACTICAL AND WORKABLE PLAN BASED ON MY PERSONAL KNOWLEDGE OF THE SITE CONDITIONS AND THAT IT WAS PREPARED IN ACCORDANCE WITH THE REQUIREMENTS OF THE HOWARD SOIL CONSERVATION DISTRICT."  
Zacharia Y. Fisch 11/16/06 DATE  
SIGNATURE OF ENGINEER  
ZACHARIA Y. FISCH

**PERMITTEE'S CERTIFICATE**  
"I/WE CERTIFY THAT ALL DEVELOPMENT AND CONSTRUCTION WILL BE DONE ACCORDING TO THIS PLAN FOR SEDIMENT AND EROSION CONTROL AND THAT ALL RESPONSIBLE PERSONNEL INVOLVED IN THE CONSTRUCTION PROJECT WILL HAVE A CERTIFICATE OF ATTENDANCE AT A DEPARTMENT OF THE ENVIRONMENT APPROVED TRAINING PROGRAM FOR THE CONTROL OF SEDIMENT AND EROSION BEFORE BEGINNING THE PROJECT. I ALSO AUTHORIZE PERIODIC ON-SITE INSPECTION BY THE HOWARD SOIL CONSERVATION DISTRICT."  
Molly J. Schmitt 11/16/06 DATE  
SIGNATURE OF PERMITTEE

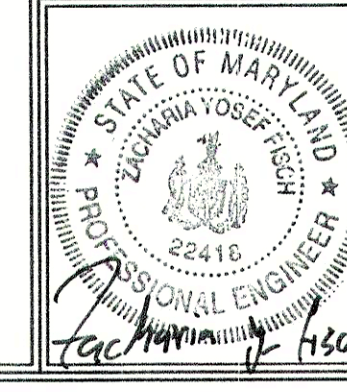

**FSH Associates**  
Engineers Planners Surveyors  
6333 Howard Lane Ellicott City, MD 21075  
Tel: 410-587-5200 Fax: 410-796-1562  
E-mail: info@fsh.com

DESIGN BY: SH  
DRAWN BY: GRH2/RL  
CHECKED BY: SH  
SCALE: AS SHOWN  
DATE: Nov. 16, 2006  
W.O. No.: 3248  
SHEET No.: 10 OF 10