


INDEX OF DRAWINGS


DRAWING NO.	TITLE
1	TITLE SHEET
2	GENERAL NOTES, LEGEND AND ABBREVIATIONS
3	CENTERLINE CONSTRUCTION STAKEOUT DATA
4	TRAFFIC CONTROL PLAN, CONSTRUCTION SEQUENCE AND SIGNING
5	TYPICAL ROAD SECTIONS AND DETAILS
6	PLAN - COMMERCIAL STREET STA. 416+00 TO STA. 416+50 FOUNDRY STREET STA. 520+75 TO STA. 521+50
7	PLAN - COMMERCIAL STREET STA. 416+50 TO STA. 427+68± FOUNDRY STREET STA. 521+50 TO STA. 533+58± COMMERCE STREET AND COMMERCIAL/FOUNDRY DRAIN
8	PROFILES - COMMERCIAL STREET STA. 416+00 TO STA. 427+68± FOUNDRY STREET STA. 520+75 TO STA. 533+58±
9	PROFILE - COMMERCE STREET
10	STORM DRAIN PROFILES - COMMERCIAL AND FOUNDRY STREETS (N. of Baltimore St.)
11	STORM DRAIN PROFILES - COMMERCIAL/FOUNDRY DRAIN (Baltimore St. to Jefferson St.)
12	SEDIMENT CONTROL PLAN - COMMERCIAL STREET STA. 416+50 TO STA. 427+68± FOUNDRY STREET STA. 521+50 TO STA. 533+58± COMMERCE STREET AND COMMERCIAL/FOUNDRY DRAIN
13	WATER MAIN RELOCATION - STA. 416+22 TO STA. 417+60 COMMERCIAL STREET
14	SUMMARY OF QUANTITIES

HOWARD COUNTY, MARYLAND
DEPARTMENT OF PUBLIC WORKS

SAVAGE AREA - PHASE B
ROAD AND STORM DRAIN IMPROVEMENTS
CAPITAL PROJECT NO. J-4-4008 B

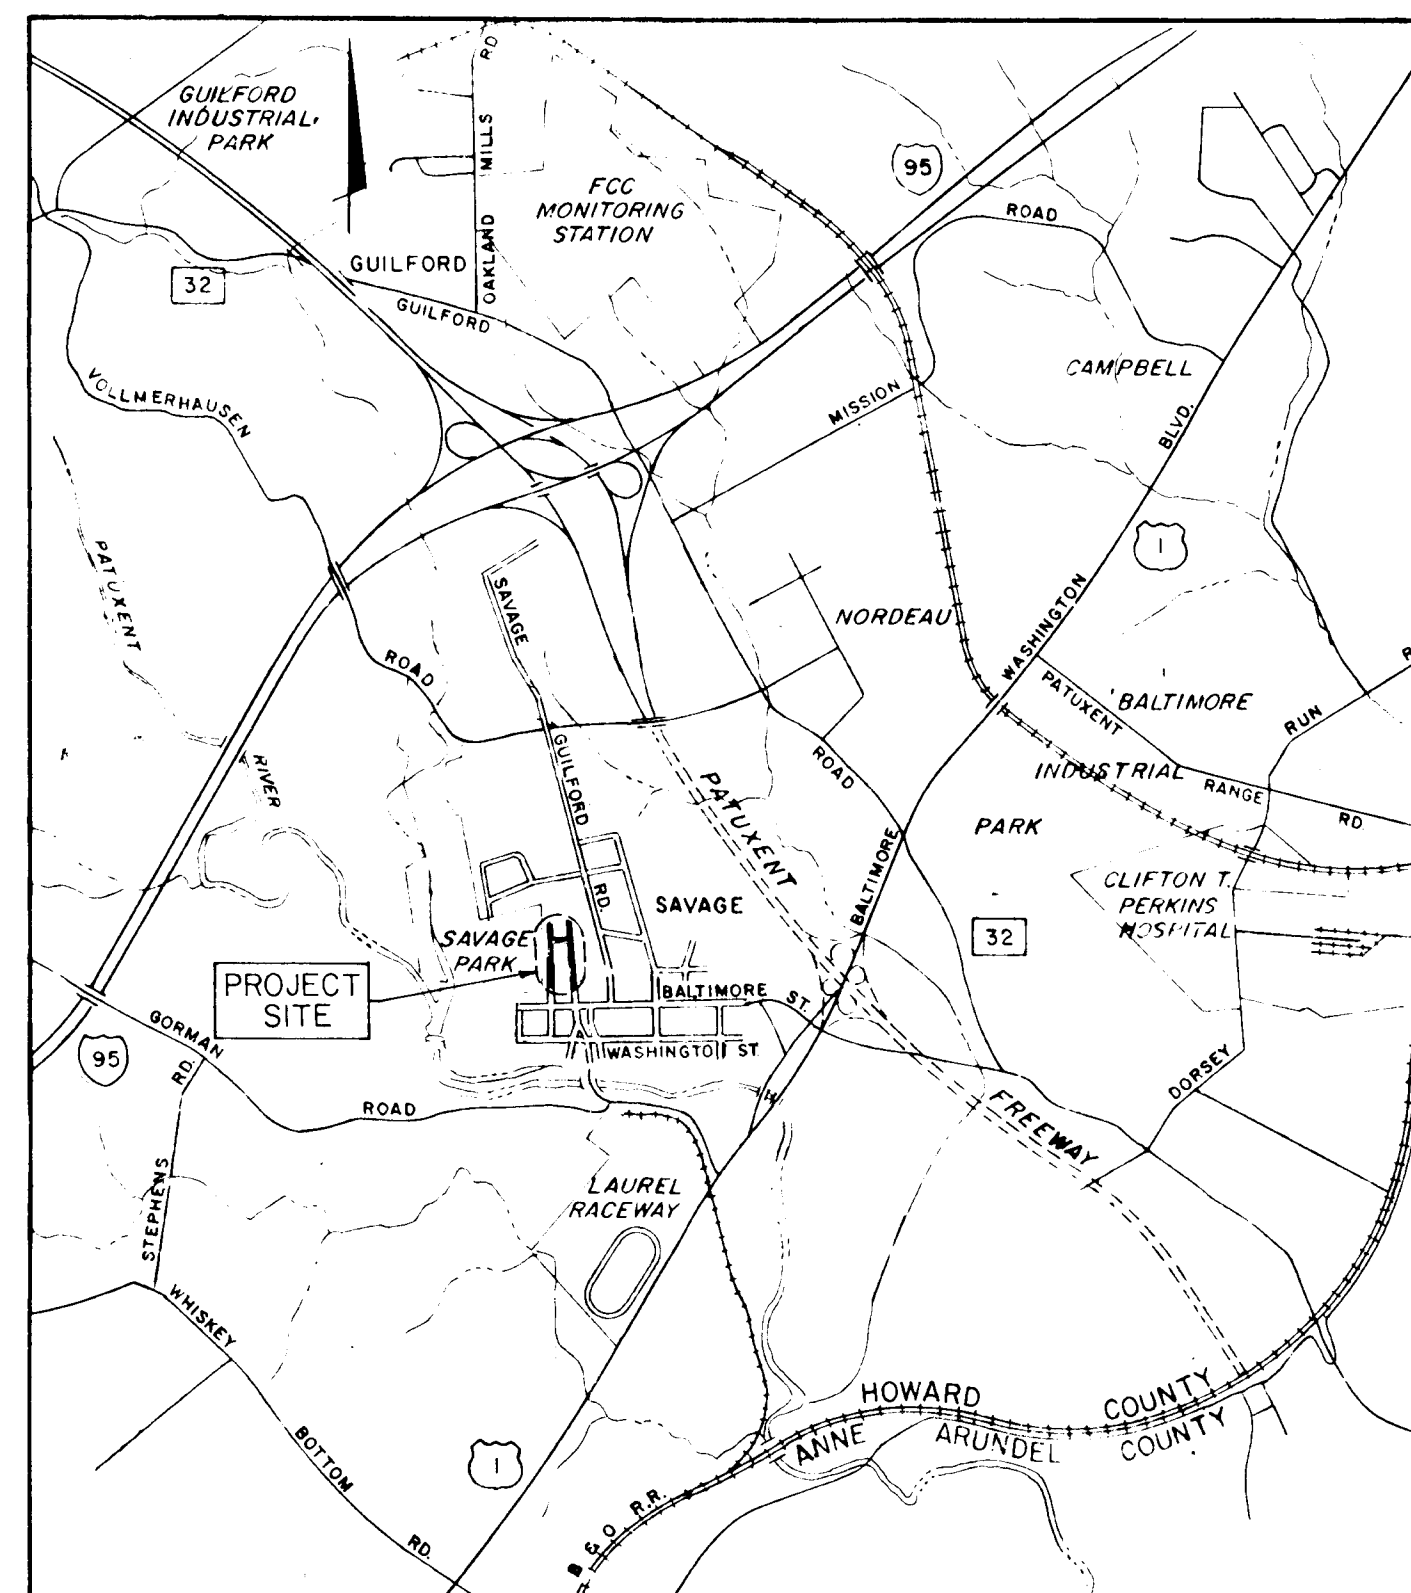

LOCATION MAP

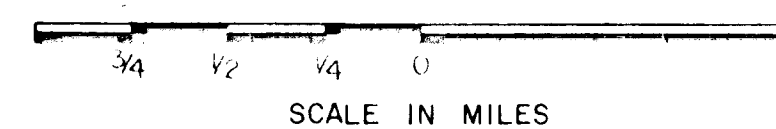

TABULATION OF LENGTHS		
STREET NAME	LENGTHS	
	FEET	MILES
Commercial St. Sta. 416+00 to Sta. 427+68.42	1163.42	0.221
Foundry St. Sta. 520+75 to Sta. 533+58.04	1283.04	0.243
Commerce St. Sta. 10+10.72 to Sta. 12+85.50	274.78	0.052
TOTAL	2726.24	0.516

By the Engineer:
"I certify that this plan for erosion and sediment control represents a practical and workable plan based on my personal knowledge of the site conditions and that it was prepared in accordance with the requirements of the Howard Soil Conservation District."

Kenneth L. Evans
Kenneth L. Evans
The Wilson T. Ballard Company

3-15-89
Date

By the County:
"I/We certify that all development and construction will be done according to this plan, and that any responsible personnel involved in the construction project will have a Certificate of Attendance at a Department of Natural Resources Approved Training Program for the Control of Sediment and Erosion before beginning the project."

William E. Riley, Chief
Bureau of Engineering

Date

Reviewed for Howard S.C.D.
and meets Technical Requirements

Signature Date

U.S. Soil Conservation Service

THIS DEVELOPMENT PLAN IS
APPROVED FOR SOIL EROSION AND
SEDIMENT CONTROL BY THE
HOWARD SOIL CONSERVATION
DISTRICT

Approved Date

Howard S.C.D.

NO.	DATE	DESCRIPTION OF REVISION	SIGNATURE

20124201

PUBLIC WORKS TY, MARYLAND F. BUREAU OF ENGINEERING DATE STORM DRAINS DIVISION DATE	PREPARED BY: THE WILSON T. BALLARD CO CONSULTING ENGINEERS OWINGS MILLS, MARYLAND TEL. NO. 363-0150		TITLE SHEET	SAVAGE AREA - PHASE B ROAD AND STORM DRAIN IMPROVEMENTS CAPITAL PROJECT NO. J-4-4008 B ELECTION DISTRICT NO. 6 HOWARD COUNTY, MARYLAND	DRAWING NO. <u>1</u> OF <u>14</u>	SCALE: AS SHOWN	K.L.E. DESIGNED BY K.L.E. CHECKED BY
	OBJECT				977		

HOWARD COUNTY MONUMENTS			
DESCRIPTION	COORDINATES		REMARKS
	NORTH	EAST	
NO. 1942003	475108.3848	849838.4063	CONC. MON. BRIDGE DL

WASHINGTON ST. & SVY.			
DESCRIPTION	STATION	COORDINATES	
		NORTH	EAST
T-1	110+00 WASHINGTON ST =310+00 FAIR ST.	474600.8499	848609.6835
M-1	114+37.37 WASHINGTON ST =410+00 COMMERCIAL ST.	474605.7795	849047.0296
T-14	114+57.74 WASHINGTON ST	474606.0091	849067.3983
F-2	118+18.73 WASHINGTON ST =510+00 FOUNDRY ST.	474609.4669	849428.3692
T-13	118+27.03 WASHINGTON ST	474609.5464	849436.6688
V-3	119+03.67 WASHINGTON ST =7+03.58 SAVAGE RD.	474610.4592	849513.3039
L-1	120+77.03 WASHINGTON ST =610+00 WILLIAM ST.	474612.5243	849686.6741
N-2	124+6.71 WASHINGTON ST =10+00 ENTR. RIVER ISLW	474614.5451	849856.3220
T-12	123+35.39 WASHINGTON ST	474615.6013	849944.9912
R-4	127+50.00 WASHINGTON ST =6+71.13 DRAINAGE SPUR	474622.4852	850359.5450

BALTIMORE ST. & SVY.			
DESCRIPTION	STATION	COORDINATES	
		NORTH	EAST
T-2	210+00 BALTIMORE ST =314+62.51 FAIR ST.	475063.2322	848598.6857
M-2	214+45.19 BALTIMORE ST =414+63.25 COMMERCIAL ST.	475069.0211	849043.8365
T-3	217+84.53 BALTIMORE ST	475073.4337	849383.1468
F-3	217+99.67 BALTIMORE ST =514+65.11 FOUNDRY ST.	475073.6287	849398.2835
F-4	218+05.45 BALTIMORE ST =520+00 FOUNDRY ST.	475073.7158	849405.0450
L-3	220+07.85 BALTIMORE ST =614+72.77 WILLIAM ST.	475076.3105	849606.4463
T-4	222+17.89 BALTIMORE ST =10+00 SAVAGE GULF RD.	475079.0137	849816.2678
R-6	2+5+25.00 BALTIMORE ST =11+52.59 DRAINAGE SPUR	475084.3240	850223.5492


SAVAGE RD. & SVY.			
DESCRIPTION	STATION	COORDINATES	
		NORTH	EAST
V-1	2+84.35 SAVAGE RD.	474204.3670	849597.9826
V-2	5+00 SAVAGE RD.	474419.5667	849584.0549

FOUNDRY ST. & SVY.			
DESCRIPTION	STATION	COORDINATES	
		NORTH	EAST
F-1	308+32.45 FOUNDRY ST. =7+65.81 COMMERCIAL MILL ENTR	474446.1828	849390.7128
V-4	512+79.52 FOUNDRY ST =10+00 SAVAGE RD.	474888.4016	849410.2894
F-5	529+35.85 FOUNDRY ST =12+95.60 COMMERCIAL ST.	476006.5725	849330.2856
F-6	533+00 FOUNDRY ST.	476369.5617	849301.1955

COMMERCIAL ST. & SVY.			
DESCRIPTION	STATION	COORDINATES	
		NORTH	EAST
M-3	423+83.26 COMMERCIAL ST =10+00 COMMERCIAL ST.	475989.0939	849035.2074
M-4	427+00 COMMERCIAL ST	476305.7040	849032.2381

WILLIAMS ST. & SVY.			
DESCRIPTION	STATION	COORDINATES	
		NORTH	EAST
L-2	612+32.24 WILLIAM ST	474836.5252	849625.3631

COMMERCIAL ST. & CONST.			
STATION	COORDINATES		
	NORTH	EAST	
423+83.26 COMMERCIAL ST. =9+98.02 COMMERCIAL ST.	475988.9765	849033.2259	
P.C. 424+00.00 COMMERCIAL ST.	476005.7139	849033.0690	
P.T. 427+41.00 COMMERCIAL ST.	476346.6981	849034.9455	

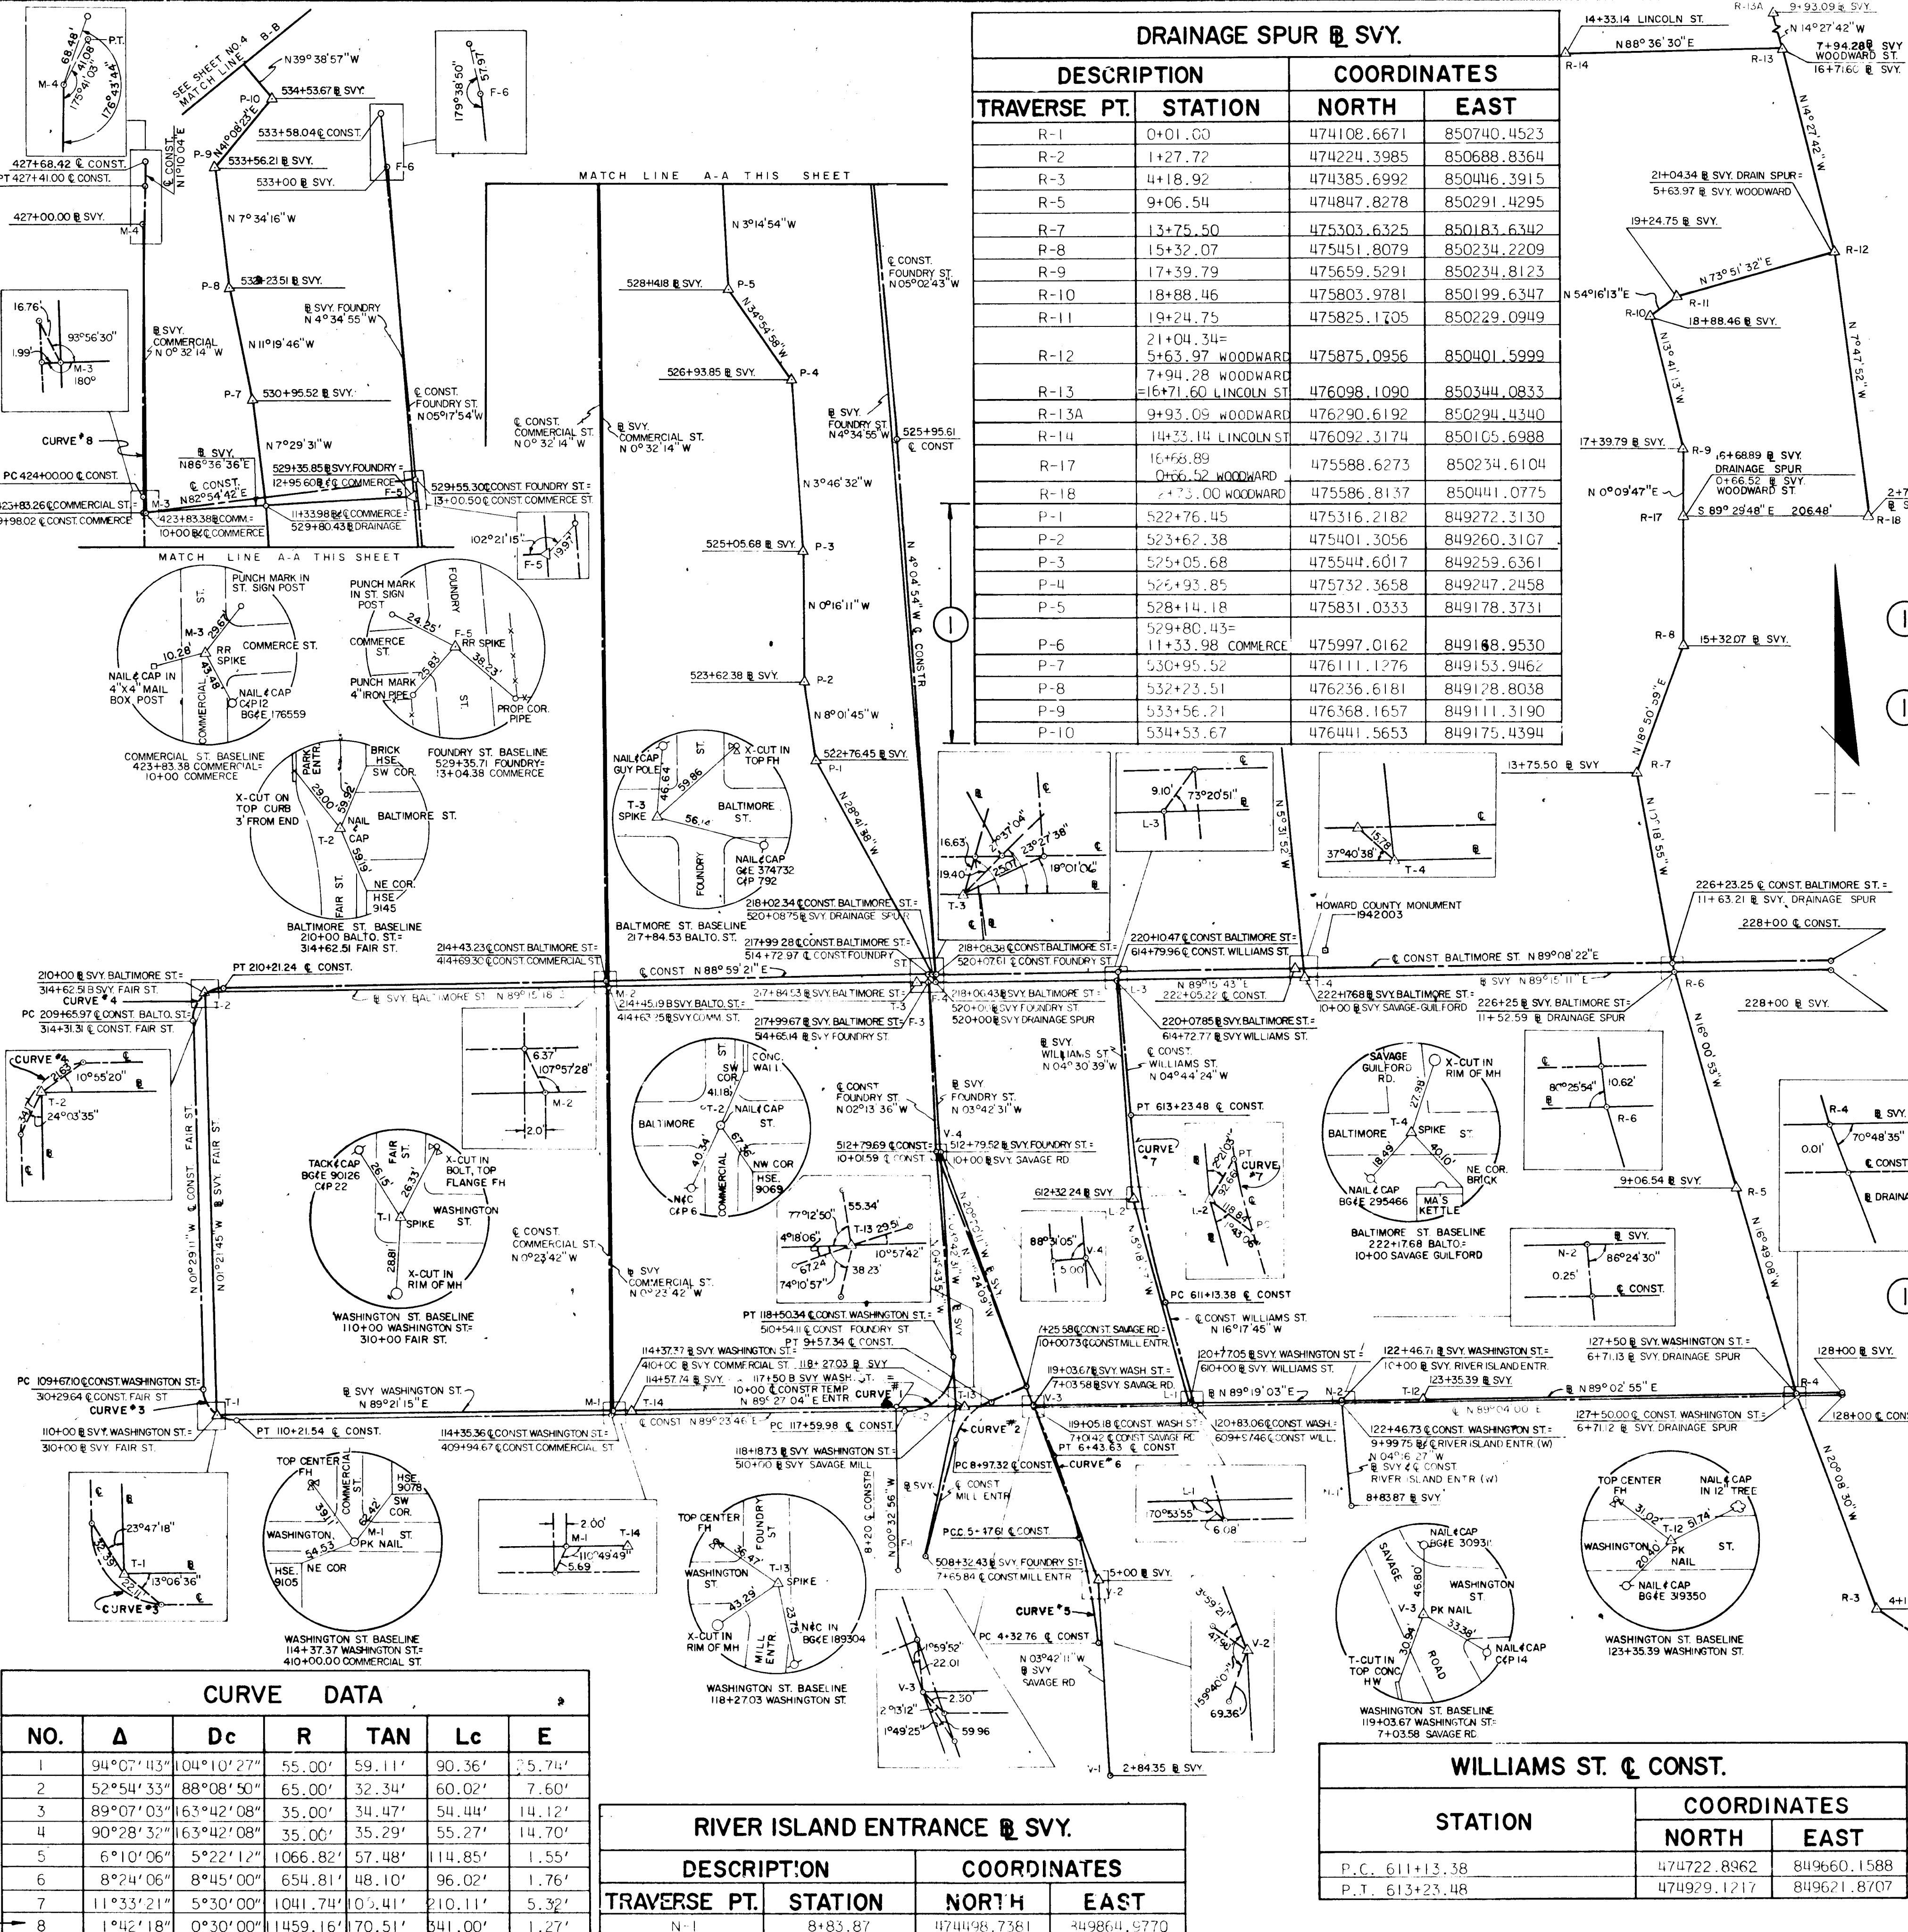

CURVE DATA						
NO.	Δ	Dc	R	TAN	Lc	E
1	94°07'43"	104'10'27"	55.00'	59.11'	90.36'	3.74'
2	52°54'33"	88°08'50"	65.00'	32.34'	60.02'	7.60'
3	89°07'03"	163°42'08"	35.00'	34.47'	54.44'	14.12'
4	90°28'32"	163°42'08"	35.00'	35.29'	55.27'	14.70'
5	6°10'06"	5°22'12"	1066.82'	57.48'	114.85'	1.55'
6	8°24'06"	8°45'00"	654.81'	48.10'	96.02'	1.76'
7	11°33'21"	5°30'00"	1041.74'	105.41'	210.11'	5.32'
8	1°42'18"	0°30'00"	1459.16'	170.51'	541.00'	1.27'

RIVER ISLAND ENTRANCE & SVY.			
DESCRIPTION	STATION	COORDINATES	
		NORTH	EAST
N-1	8+83.87	474496.7361	849864.9770

WILLIAMS ST. & CONST.			
STATION	COORDINATES		
	NORTH	EAST	
P.C. 611+13.38	474722.8362	849660.1588	
P.T. 613+23.48	474929.1217	849621.8707	

WASHINGTON ST. & CONST.			
STATION	COORDINATES		
	NORTH	EAST	
PC 103+57.10 =310+29.64 FAIR ST.	474630.1674	848595.9184	
PT 110+21.54	474536.0773	848631.2755	
=409+94.67 COMMERCIAL ST.	174600.4391	849045.0664	
PC 117+59.38 =510+54.11 FOUNDRY ST.	474663.3955	849423.9046	
119+05.18 =7+01.42 SAVAGE RD.	474608.7375	849514.8301	
=120+83.06 =609+97.46 WILLIAMS ST.	474611.6347	849692.6850	
=9+99.75 RIVER ISLAND ENTR.	474614.3005	849856.3403	
127+50.00 =6+71.12 DRAINAGE SPUR	474622.4973	850359.5406	

BALTIMORE ST. & CONST.			
STATION	COORDINATES		
	NORTH	EAST	
PC 209+65.97 =314+31.31 FAIR ST.	475031.7042	848585.4991	
PT 210+21.34	475067.6066	848619.8698	
214+43.23 =414+69.30 COMMERCIAL ST.	475075.0518	849041.7949	
217+99.28 =514+72.97 FOUNDRY ST. SOUTH	475081.3335	849397.7841	
218+02.34 =520+08.75 DRAINAGE SPUR	475081.3875	849400.8459	
218+08.38 =520+07.61 FOUNDRY ST. NORTH	475081.4940	849406.8830	
220+10.47 =614+79.96 WILLIAMS ST.	475085.0595	849608.9409	
222+05.21	475088.4954	849803.6573	
226+23.25 =11+63.21 DRAINAGE SPUR	475094.7735	850221.6474	

SAVAGE RD. & CONST.			
STATION	COORDINATES		
	NORTH	EAST	
P.C. 4+32.76	474350.2040	849584.0608	
P.C.C. 5+47.61	474463.2869	849564.2909	
P.T. 6+43.63	474554.9243	849535.3200	
7+25.58 =10+00.73 MILL ENTRANCE	474631.2295	849506.0145	


FOUNDRY ST. & CONST.			
STATION	COORDINATES		
	NORTH	EAST	
512+79.69 =10+01.59 SAVAGE RD.	474888.2073	849405.2932	
525+95.61	475668.0015	849365.0305	
529+35.30 =13+00.50 COMMERCIAL ST.	476026.3025	849333.3979	
533+58.04	476427.3211	849296.1086	

MILL ENTRANCE & CONST.			
STATION	COORDINATES		
	NORTH	EAST	
P.C. 8+97.32	474572.6652	849426.6010	
P.T. 9+57.34	474615.5030	849465.5740	
=10+00 =11+7+50 & SVY WASH. ST.	474608.8089	849359.6449	
8+20	474428.8171	849361.3692	

STAKEOUT DATA APPLICABLE TO THIS CONTRACT

DEPARTMENT OF PUBLIC WORKS
 HOWARD COUNTY, MARYLAND
 DIRECTOR OF PUBLIC WORKS DATE: _____
 CHIEF BUREAU OF ENGINEERING DATE: _____
 CHIEF ROADS, BRIDGE, STORM DRAIN DIVISION DATE: _____

PREPARED BY:
 THE WILSON T. BALLARD CO.
 CONSULTING ENGINEERS
 OWINGS MILLS, MARYLAND
 TEL. NO. 363-0150

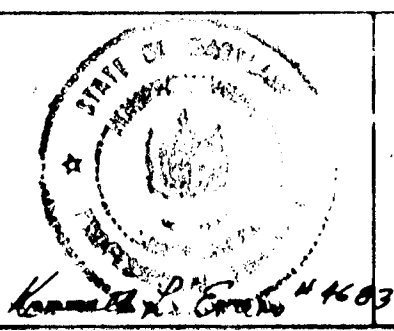

CENTERLINE CONSTRUCTION
 STAKEOUT DATA

SAVAGE AREA - PHASE B
 ROAD AND STORM DRAIN IMPROVEMENTS
 CAPITAL PROJECT NOS. J-4-4008B
 ELECTION DISTRICT NO. 6
 HOWARD COUNTY, MARYLAND

NO.	DATE	DESCRIPTION OF REVISION	SIGNATURE

DRAWING NO. 3 OF 14
 SCALE: 1" = 100'
 DESIGNED BY: _____
 DRAFTED BY: _____
 CHECKED BY: _____

SEQUENCE OF CONSTRUCTION

GENERAL

- The following sequence of operations refers specifically to the critical areas of work which must be completed during a certain construction stage may be commenced. The listed items under each stage are a suggested schedule of work to be followed to assure orderly progress to complete the project. The many items of work which may be performed during any of the stages without interrupting traffic or the construction scheduling and do not control the overall schedule of completion for the project are not listed.
- Prior to commencing any construction on this project the contractor shall submit a detailed progress schedule and sequence of constructions to the Howard County Bureau of Public Works for approval.
- Egress and ingress to properties located on streets under construction shall be maintained at all times. Thru traffic using the street shall be detoured as noted in the text and details that follow.
- One (1) lane, twelve (12) feet in width, shall be maintained on all streets within the project for emergency vehicle use for the duration of the project.
- During storm drain construction within the roadway, two-way traffic shall be maintained on one operating lane (nine (9) foot minimum clear width) with flagger control during work hours. Plating or backfilling of all excavations shall be required at the end of each working day and the street restored to two-lane two-way traffic.
- All standard regulatory and warning signs used for maintenance of traffic shall be accordance with the "Manual on Uniform Traffic Control Devices," (MUTCD 1978) and the Maryland edition of the booklet, "Standard Highway Signs". It shall be the responsibility of the contractor to produce the latest edition and supplements of each of these publications for his use.

CONSTRUCTION

- Construct the Commercial/Foundry drain.
- Construct the storm drain systems for Foundry and Commerce streets.
- Grade, construct curb&gutter and pave Foundry and Commerce streets.
- Construct the Commercial street water main relocation.
- Construct the Commercial street storm drain system.
- Grade, construct curb&gutter and pave Commercial street.

TRAFFIC CONTROL

- Provide flagger control at locations where construction vehicles enter and exit public roads.
- See General Note number 5.
- Close Foundry St. north of Baltimore St. and Commerce St. to through traffic. Maintain access to the area via Commercial St. and Baltimore St.
- See General Note number 5.
- See General Note number 5.
- Close Commercial St. to through traffic. Maintain access via Baltimore St., Foundry St. and Commerce St.


SIGN LOCATION AND MOUNTING NOTES

Signs shall be erected at the locations shown on the plans and/or directed by the engineer in accordance with the following criteria:

- Horizontal clearance between edge of sign and edge of roadway shall be two (2) feet.
- Vertical clearance between bottom edge of sign and ground shall be seven (7) feet except for barricade mounted signs where the bottom of the sign shall be at least one (1) foot off the ground.
- All maintenance of traffic signs shall be minimum in size unless otherwise noted on the plans and mounted on one (1) four (4) inch by four (4) inch treated wooden post placed in a one (1) foot diameter by five (5) foot deep pre-dug hole. The hole shall be backfilled using suitable material and tamped thoroughly to provide a rigid subsurface condition around the post. Sign panels shall be attached to the wooden post by 5/8" dia. stainless steel or clear anodized aluminum hex. head bolts with washers and nuts. Exceptions to the above is END CONSTRUCTION (G20-2) sign. The G20-2 sign shall be mounted on two (2) four (4) inch by four (4) inch supports.
- All advanced warning signs shall have one (1) low intensity flashing light attached to the top of the sign.

LEGEND

- ③ Construction Stage
- M4-10L MUTCD Sign Designation
- ▲ Ground Mounted Temporary Sign for Maintenance of Traffic
- Prop. Inlet and Pipe
- Prop. Headwall and Pipe
- Prop. Manhole
- — — — — Exist. Inlet and Pipe

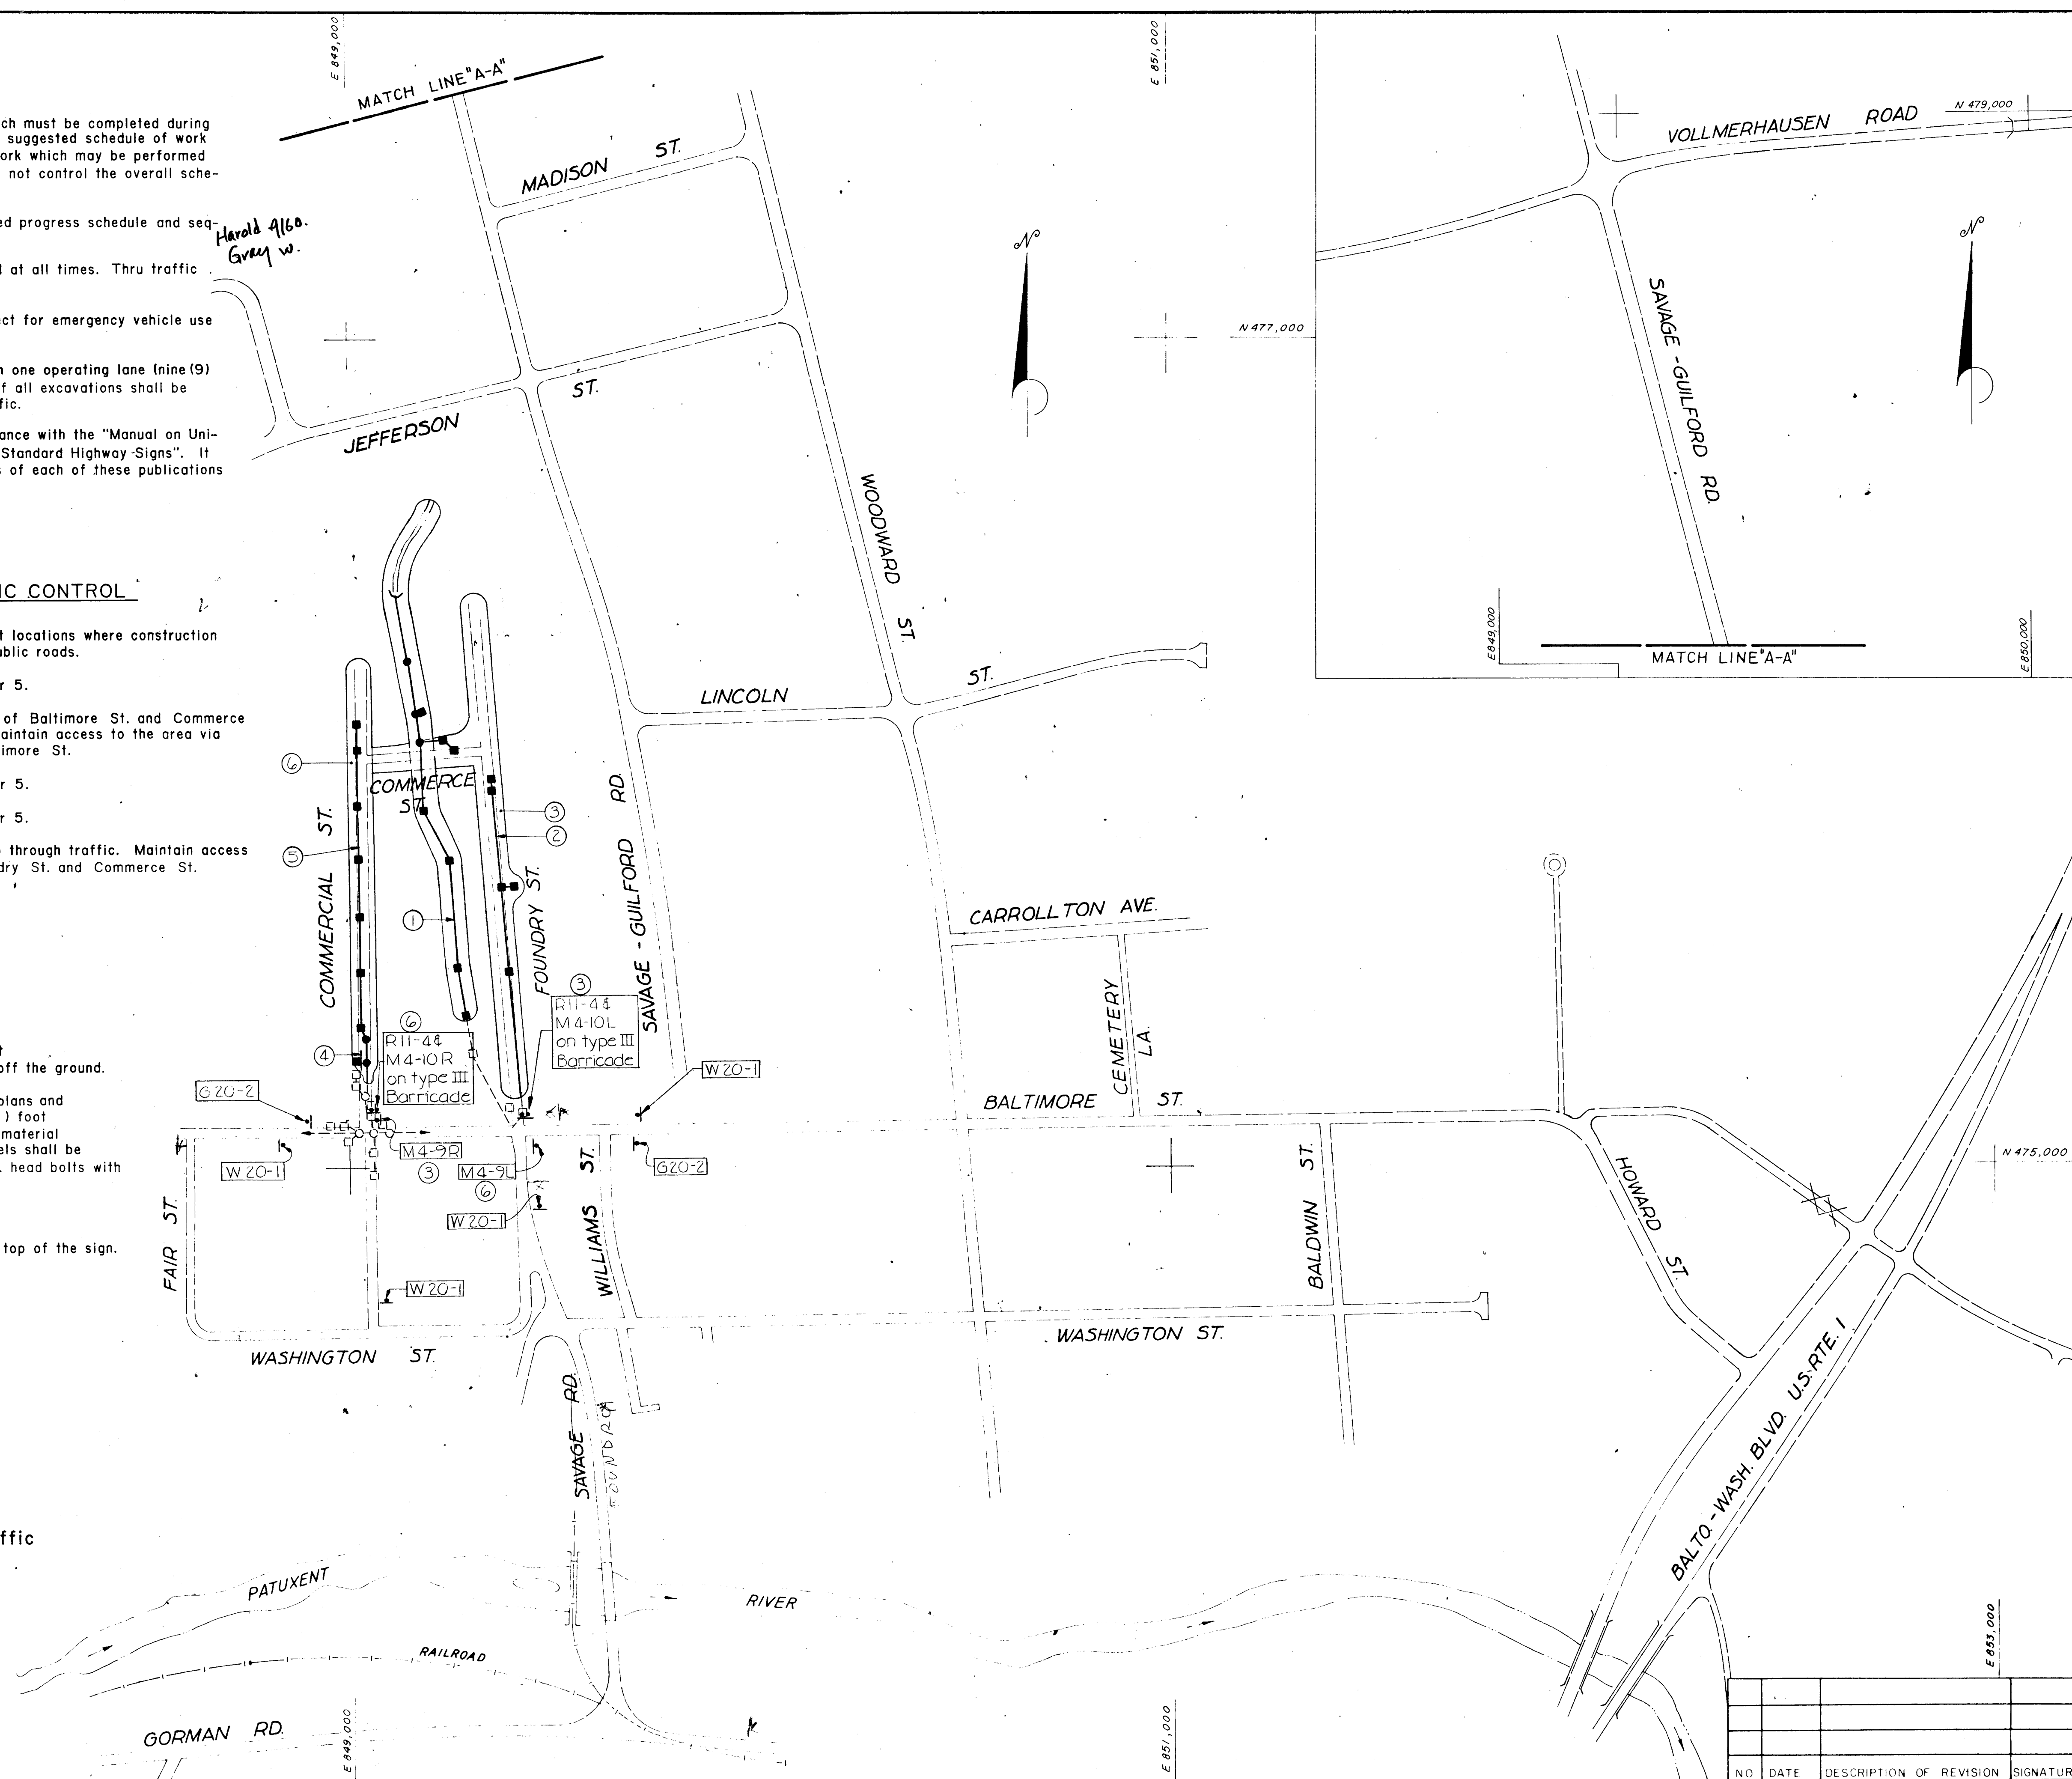

DEPARTMENT OF PUBLIC WORKS

HOWARD COUNTY, MARYLAND

PREPARED BY

THE WILSON T. BALLARD CO.
CONSULTING ENGINEERS
OWINGS MILLS, MARYLAND



TEL NO 363-0150

**TRAFFIC CONTROL PLAN,
CONSTRUCTION SEQUENCE
AND SIGNING**

**PHASE B
ROAD AND STORM DRAIN IMPROVEMENTS**
CAPITAL PROJECT NOS. J-4-4008 B
ELECTION DISTRICT NO. 6
HOWARD COUNTY, MARYLAND


NO.	DATE	DESCRIPTION OF REVISION	SIGNATURE

DRAWING
NO. 4
OF 14

SCALE
1"=200'

K.L.E.
DESIGNED BY
J.S.L.
DRAFTED BY
K.L.E.
CHECKED BY

DIRECTOR OF PUBLIC WORKS DATE
CHIEF - BUREAU OF ENGINEERING DATE
CHIEF ROADS, BRIDGES, STORM DRAINS DIVISION DATE

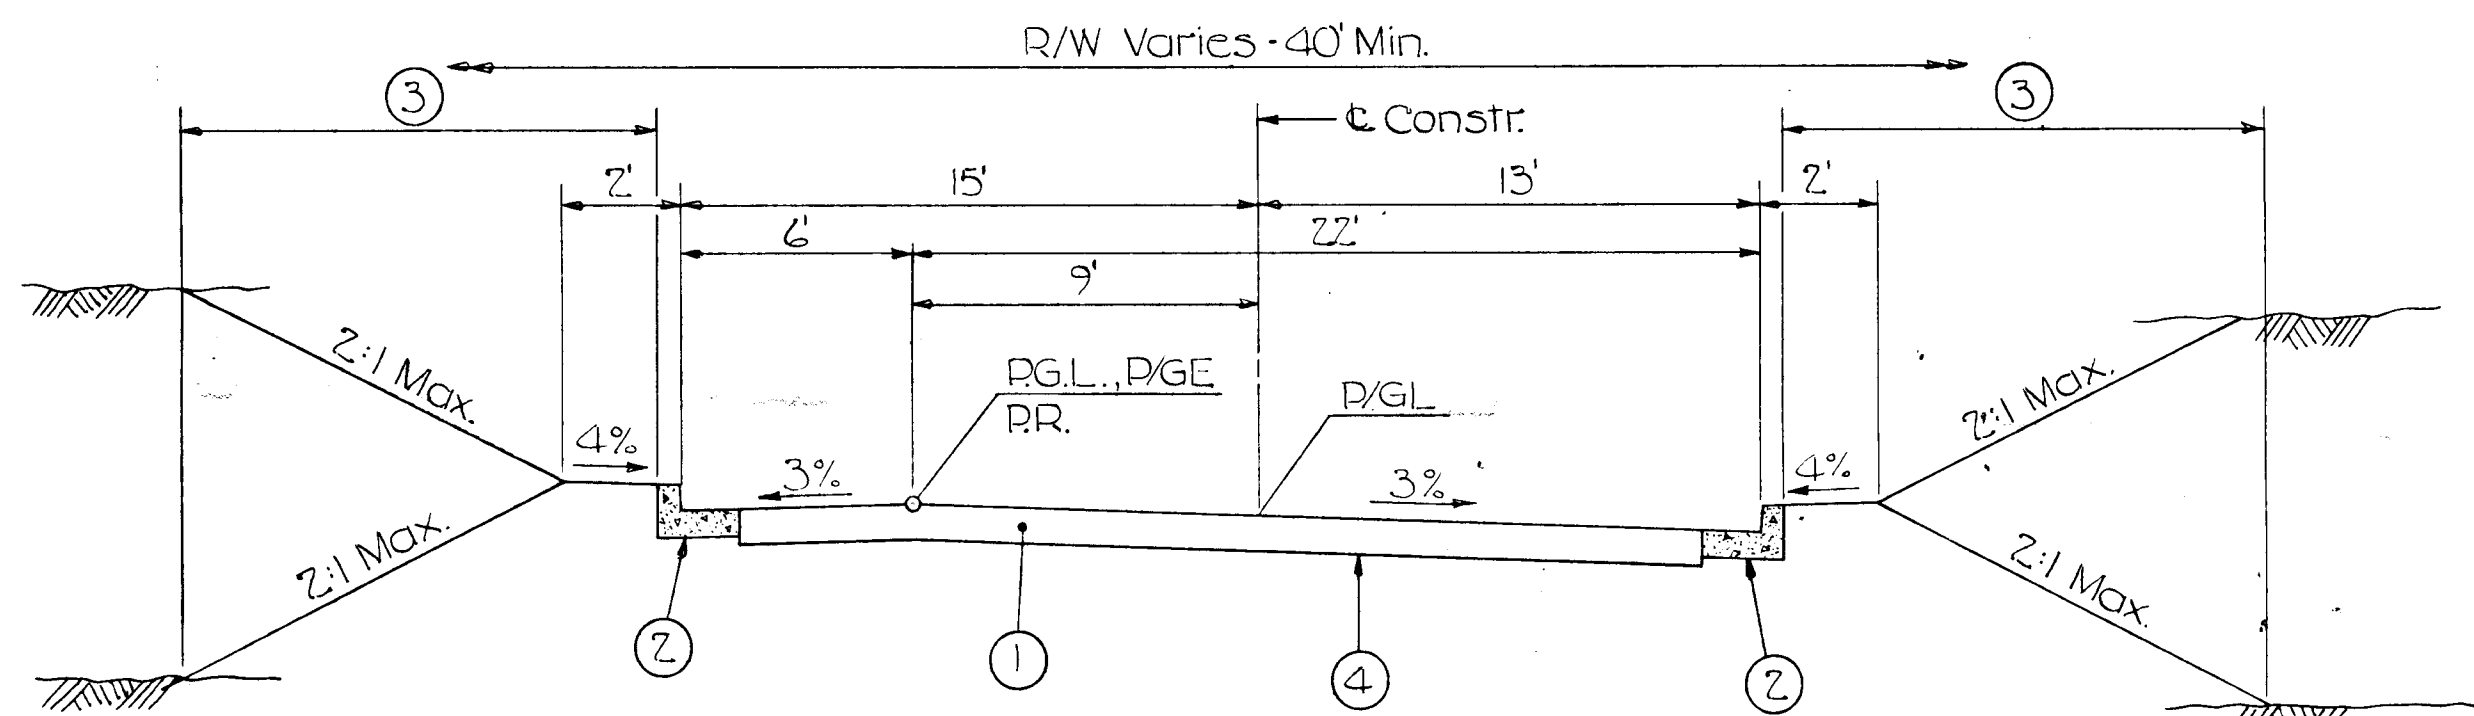


NOTE: Transition P.G.L., P/G.E. & P/R from C.Constr. at Sta. 416+00 to 9' Lt. C.Constr. at Sta. 416+90. Transition east curb line from 15' Rt. Sta. 416+00 to 13' Rt. Sta. 416+90.


**COMMERCIAL STREET
STA. 416+90 TO STA. 423+60**

GRADING NOTE

All cut & fill slopes shall be graded as indicated on the cross sections unless otherwise directed by the Engineer

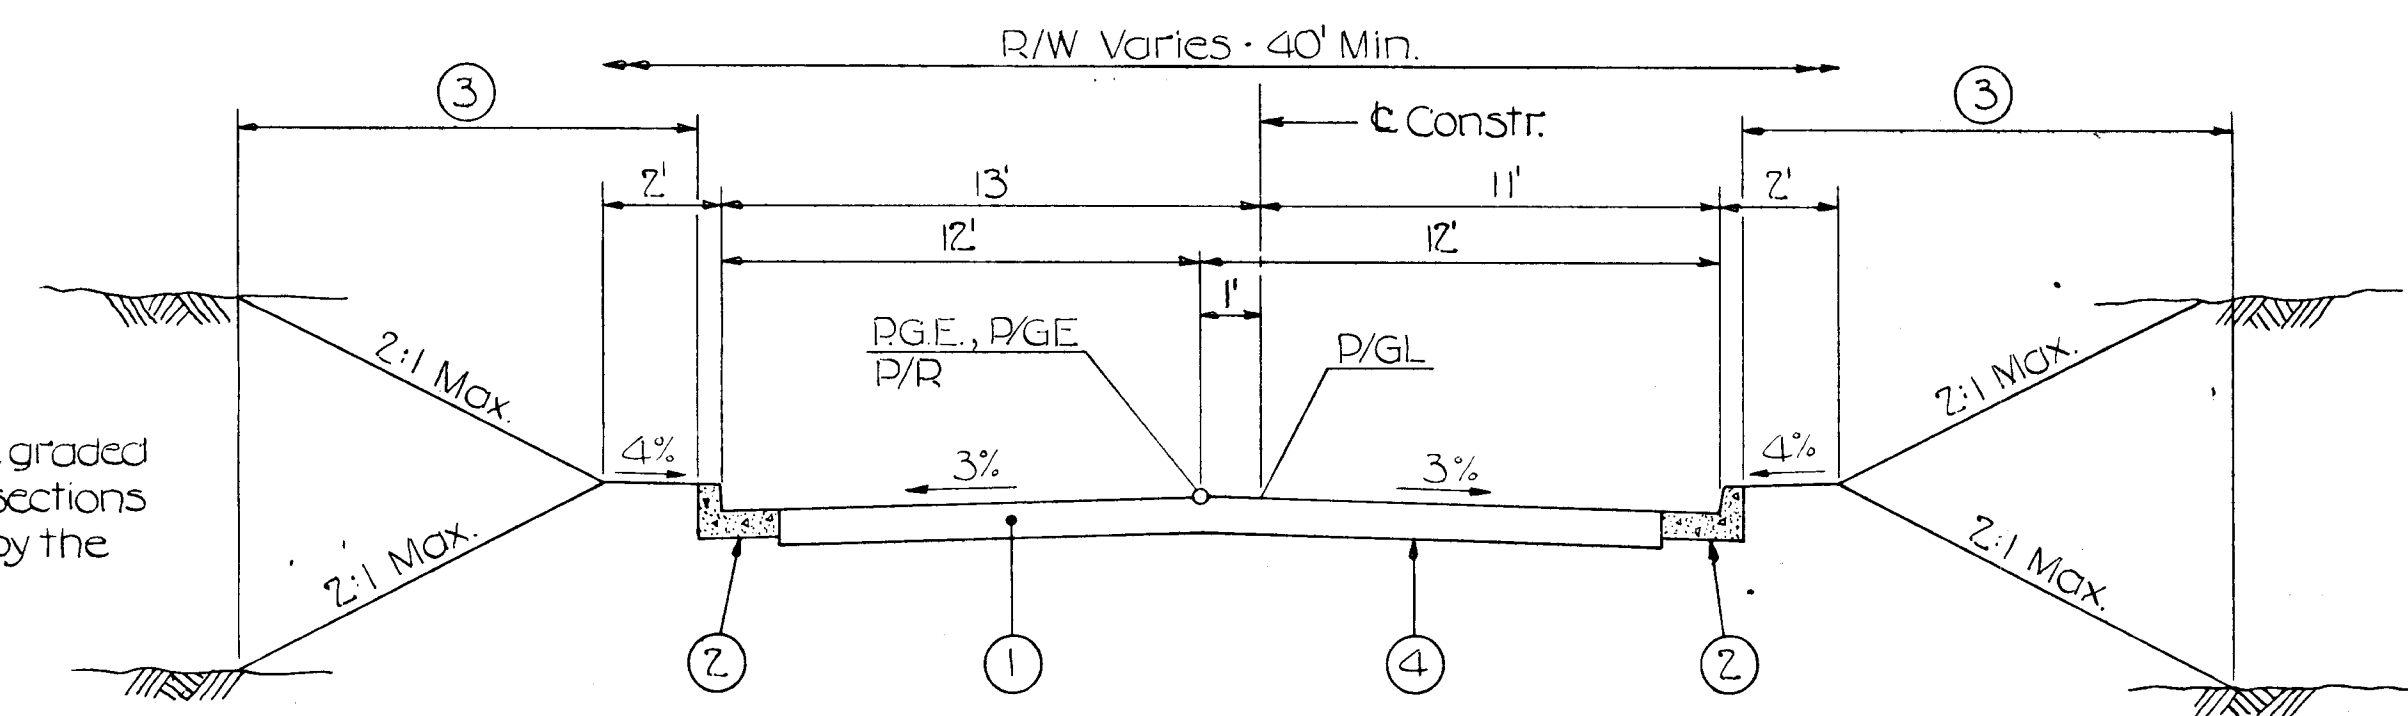


**COMMERCE STREET
STA. 10+34 TO STA. 12+64**

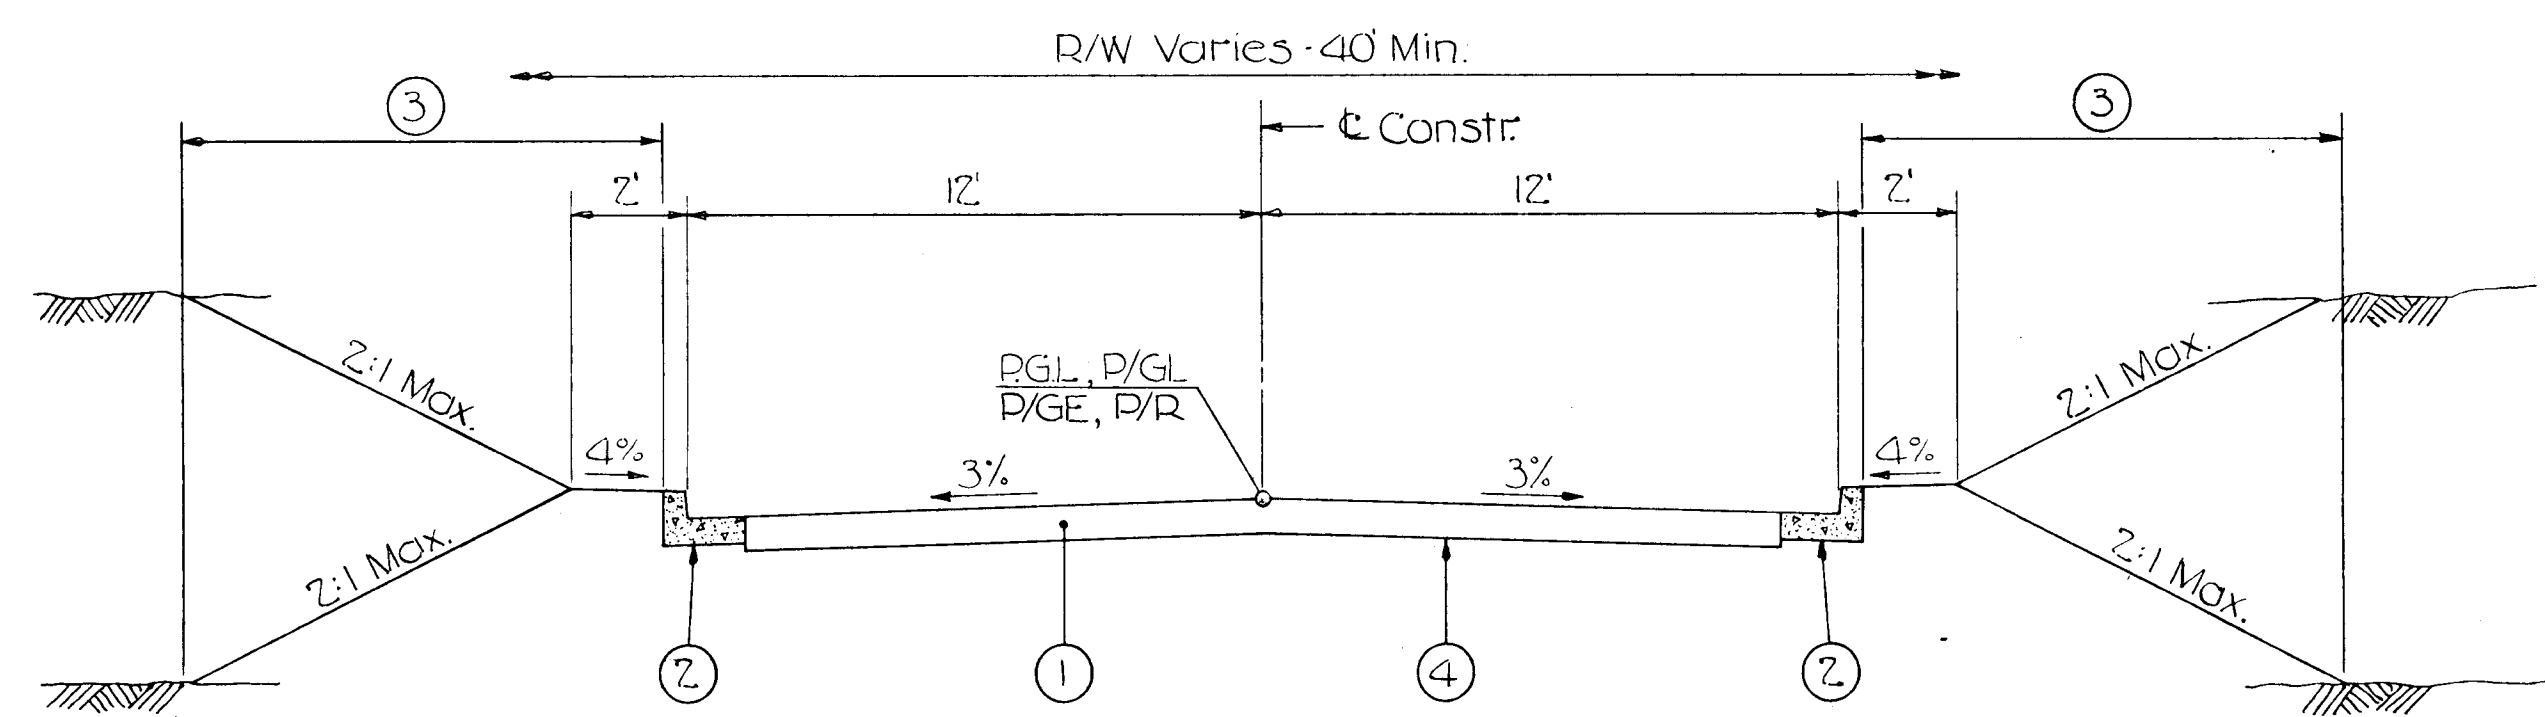


NOTE: Transition P.G.L., P/G.E. & P/R from 9' Lt. C.Constr. at Sta. 423+60 to C.Constr. at Sta. 424+50. Transition west curb line from 15' Lt. C.Constr. at Sta. 423+60 to 12' Lt. C.Constr. at Sta. 424+20.

**COMMERCIAL STREET
STA. 424+50 TO STA. 427+68.42**

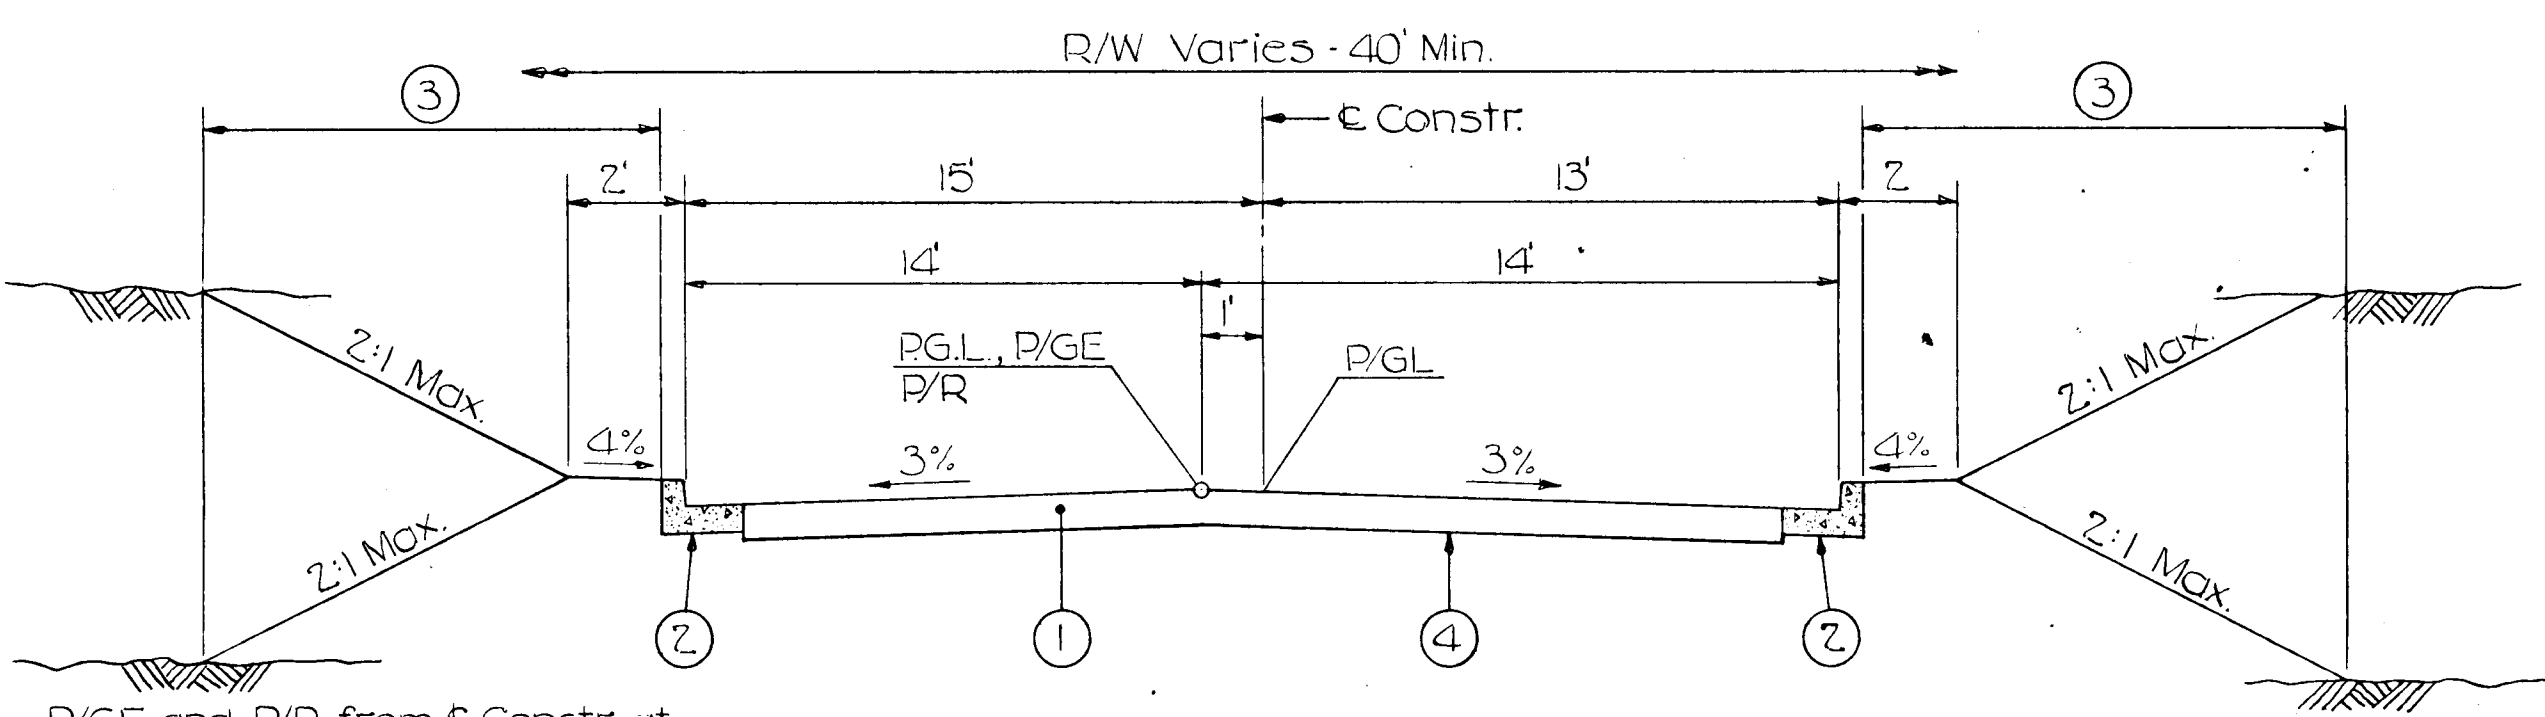


NOTE: Transition P.G.L., P/G.E. and P/R from C.Constr. at Sta. 520+75 to 1' Lt. C.Constr. at Sta. 521+00. Transition east curb line from 15' Rt. C.Constr. at Sta. 520+75 to 13' Rt. C.Constr. at Sta. 521+50.

**FOUNDRY STREET
STA. 521+00 TO STA. 529+23**

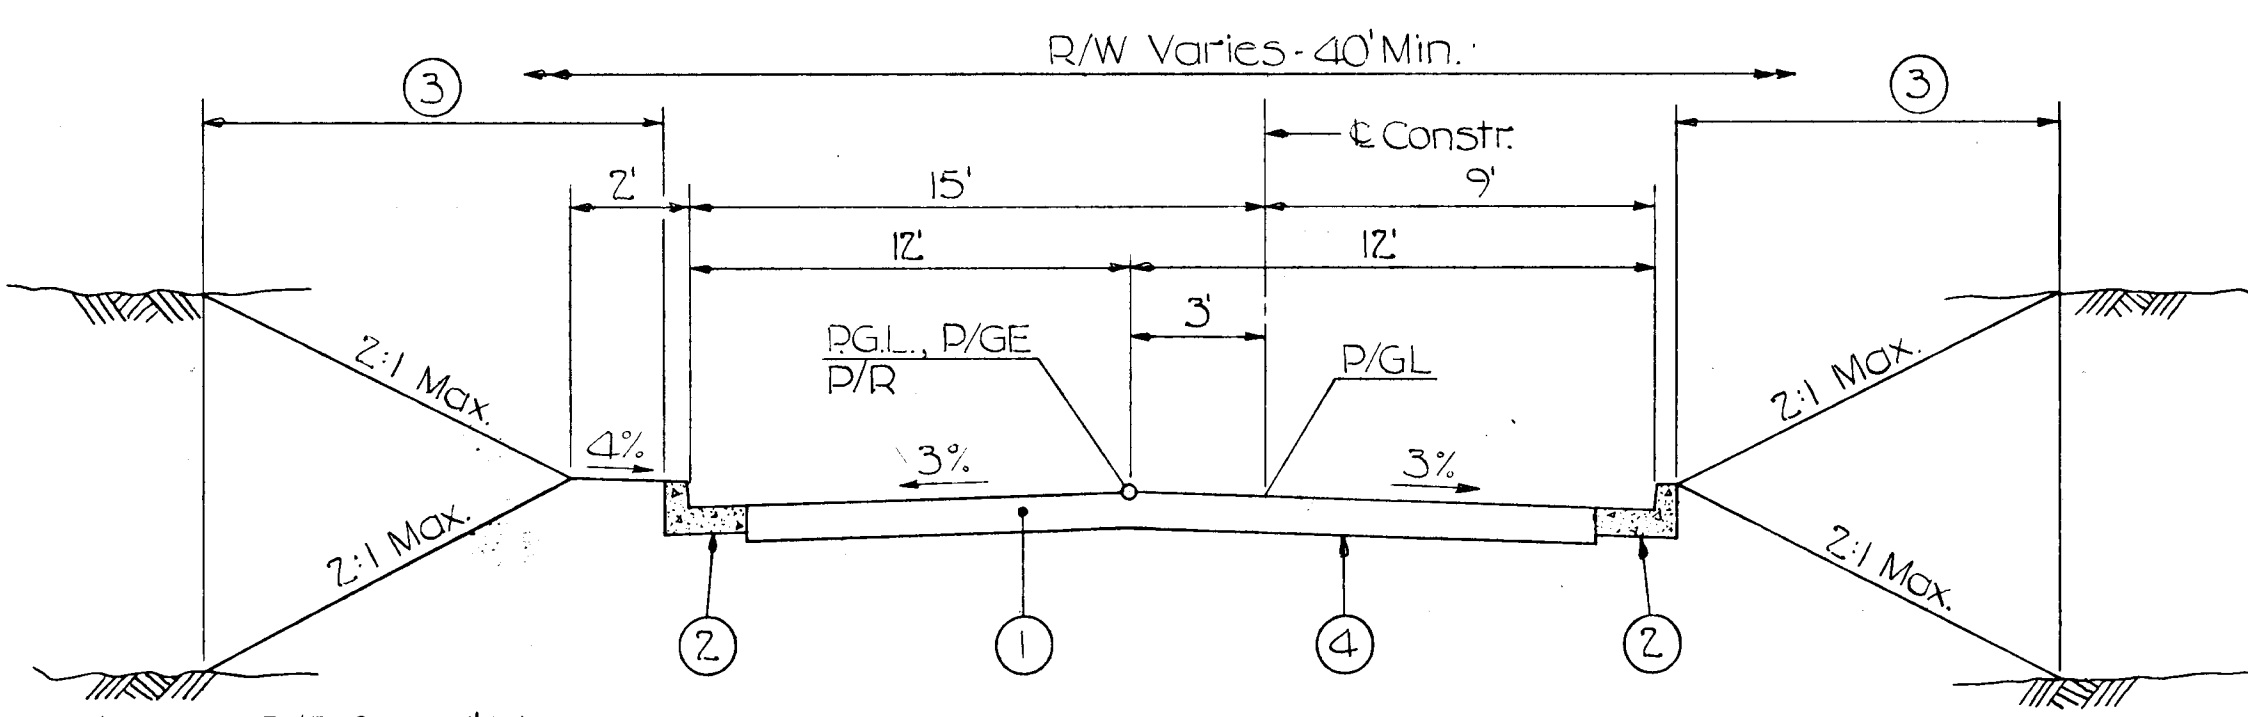


NOTE: Transition P.G.L., P/G.E. and P/R from 1' Lt. C.Constr. at Sta. 529+23 to 3' Lt. C.Constr. at Sta. 529+87. Transition east curb line from 13' Rt. C.Constr. at Sta. 529+23 to 9' Rt. C.Constr. at Sta. 529+87.


**FOUNDRY STREET
STA. 529+87.22 TO STA. 533+58.04**

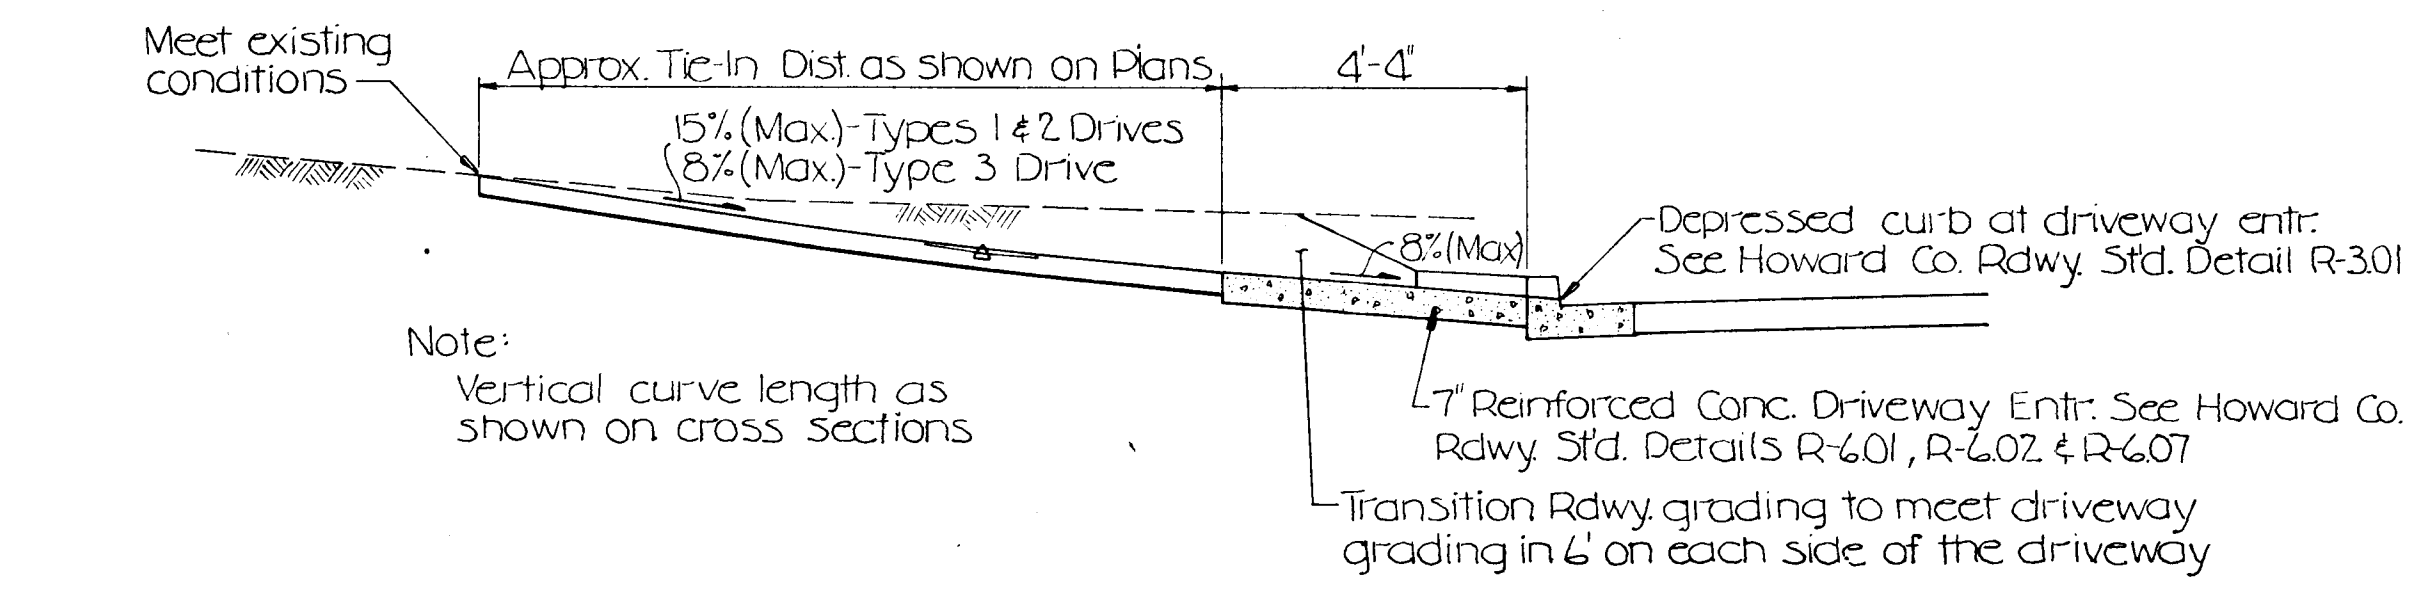

CUT AREAS

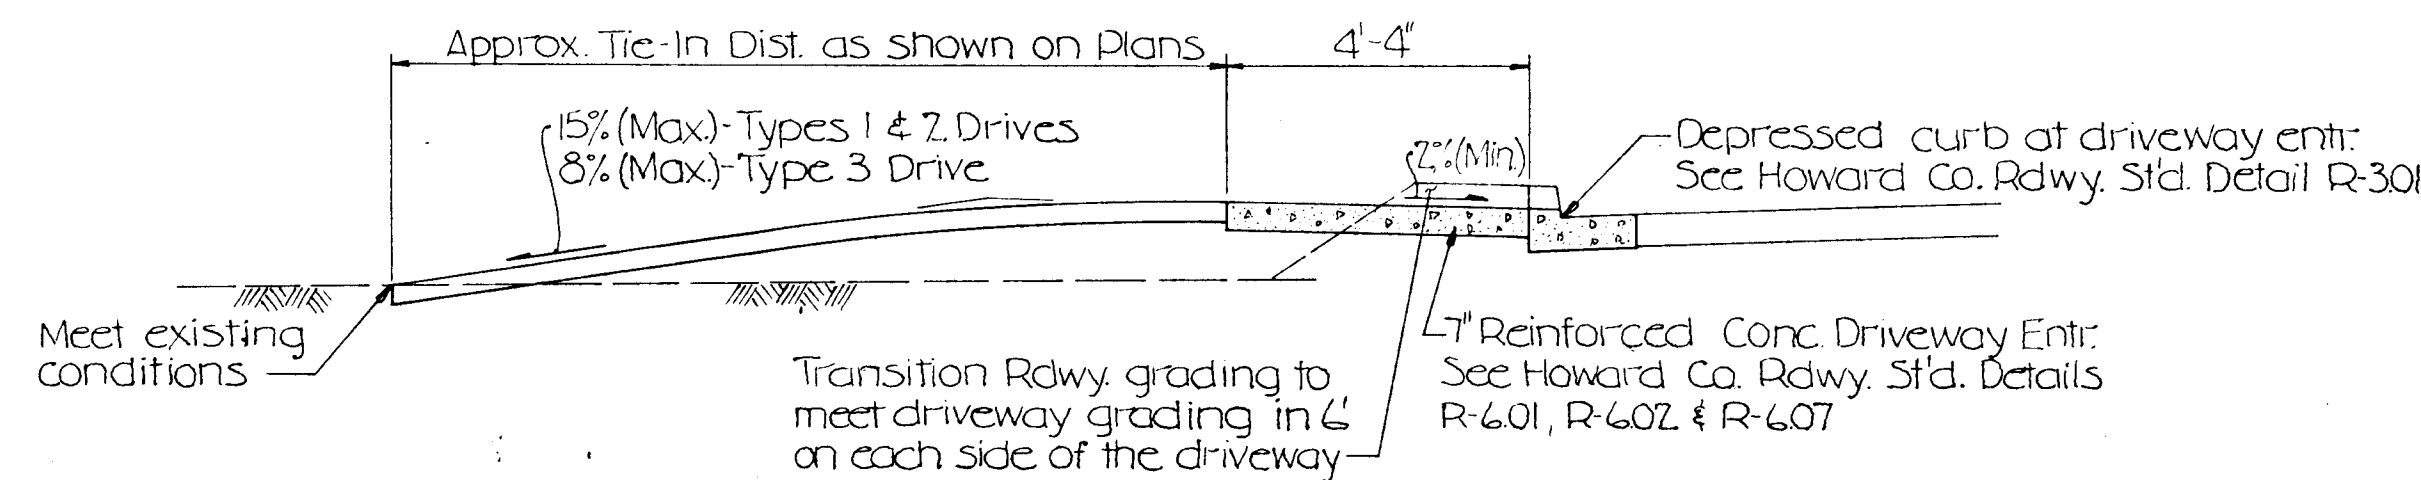

FILL AREAS

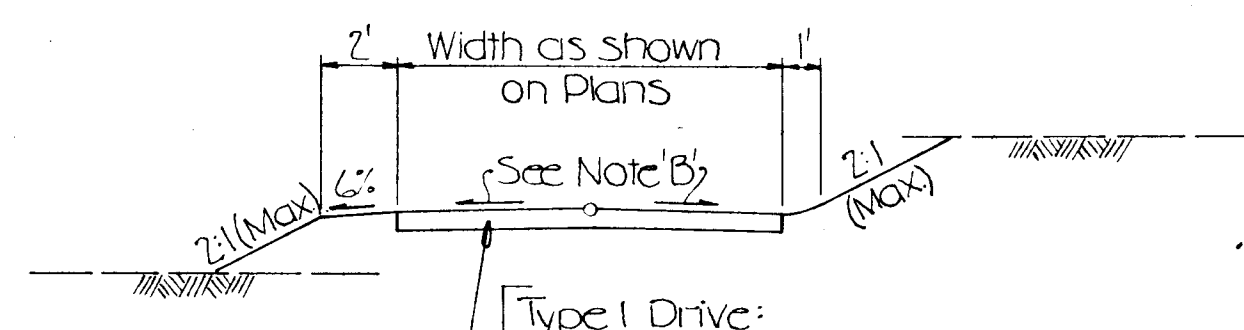


Note 'B'
Cross slope shall be transitioned to meet the grade of the public road and the cross slope of the existing entrance as directed by the Engineer.

- Type 1 Drive: 7" Plain Cement Concrete Pavt. (Md. S.H.A. Mix 6)
- Type 2 Drive: Howard Co. Paving Section P-8 (Full Depth)
- Type 3 Drive: 6" Gravel Surface Course (One Course)

TYPICAL SECTION

PRIVATE DRIVEWAY DETAILS

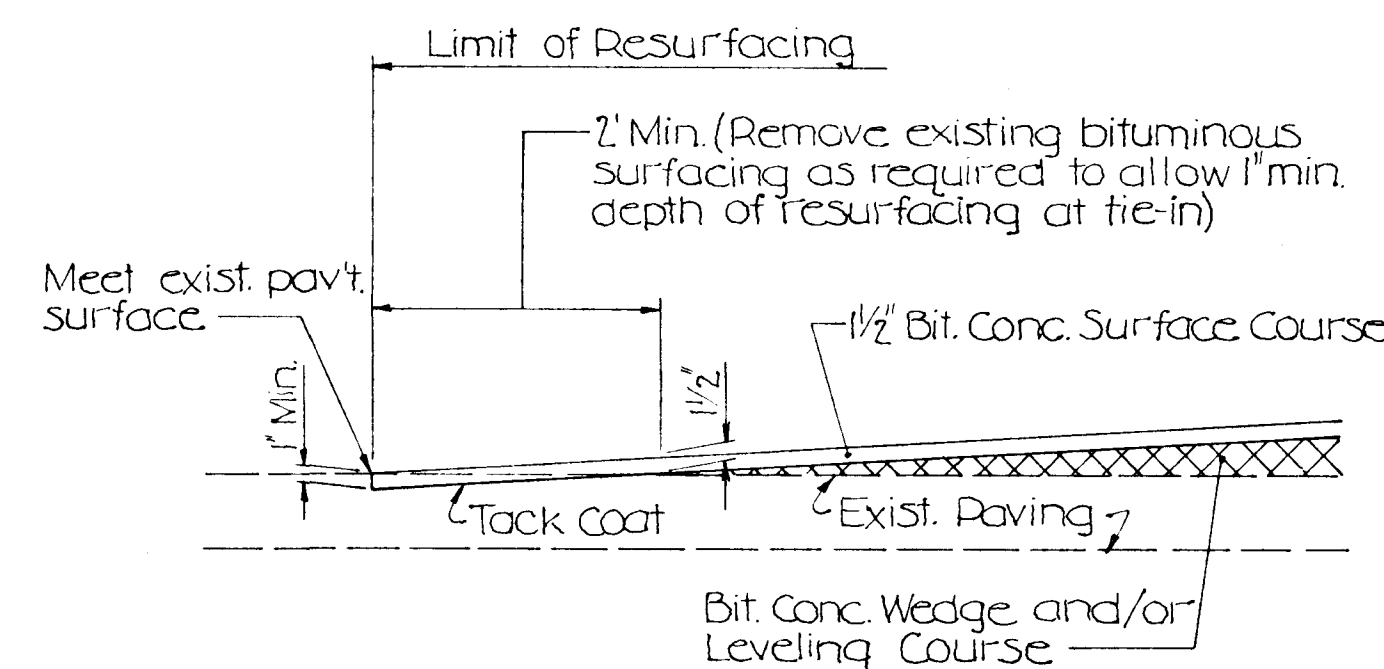


**TYPICAL DETAIL - BITUMINOUS
CONCRETE RESURFACING HEEL-IN**

TYPICAL SECTION LEGEND

- ① Standard Section P-3 Full Depth Bituminous Concrete Alternate or Granular Base Alternate (Granular Base is to extend under combination curb & gutter)
- ② Standard Combination Concrete Curb and Gutter
- ③ 2" Topsoil, Seed and Mulch
- ④ Limit of Class 1 Excavation

DEPARTMENT OF PUBLIC WORKS
HOWARD COUNTY, MARYLAND

PREPARED BY:
THE WILSON T. BALLARD CO.
CONSULTING ENGINEERS
OWINGS MILLS, MARYLAND
TEL. NO. 363-0150

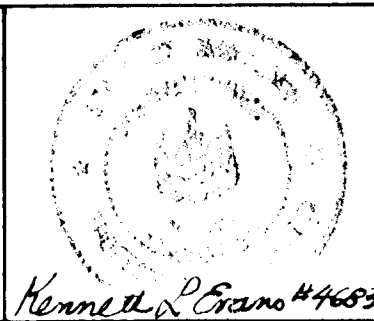

**TYPICAL ROAD SECTIONS
AND DETAILS**

SAVAGE AREA - PHASE B
ROAD AND STORM DRAIN IMPROVEMENTS
CAPITAL PROJECT NO. J-4-4008B
ELECTION DISTRICT NO. 6
HOWARD COUNTY, MARYLAND

NO.	DATE	DESCRIPTION OF REVISION	SIGNATURE

DRAWING NO. 5 OF 14	SCALE NONE	C.A.J. DESIGNED BY T.G.S. DRAFTED BY K.L.E. CHECKED BY
---------------------	------------	--

STORM DRAIN STRUCTURE SCHEDULE

STRUC. NO.	TYPE	LOCATION	TOP ELEV.	INV. OUT.
HW-1	Headwall	42' Rt. Sta. 119+77.5 Wash. St.	178.36	172.37
S-1	Spec. Struc.	215' Rt. Sta. 119+85.5 Wash. St.	168.45	172.50
I-35	Std. WR	15' Rt. Sta. 120+80 Wash. St.	192.45	185.00
I-36	Std. WR	15' Lt. Sta. 610+70.8 Williams St.	192.97	186.17
I-37	A-5	15' Rt. Sta. 611+12 Williams St.	194.00	190.40
I-32	Std. WR	15' Lt. Sta. 121+13.7 Wash. St.	193.51	186.80
I-33	Std. S	28' Lt. Sta. 121+14 Wash. St.	193.40	187.08
M-1	G5.02	10' Lt. Sta. 119+20 Wash. St.	188.38	179.45
I-4	Std. WRM	13' Rt. Sta. 7+58.1 Savage Rd.	191.52	183.80
I-5	Std. WRM	15' Lt. Sta. 7+95.4 Savage Rd.	197.61	186.40
I-1	Std. WR	15' Lt. Sta. 510+74.1 Foundry St.	210.64	195.00
M-2	G5.01	5' Rt. Sta. 118+05 Wash. St.	204.79	198.29
M-3	G5.01	12' Lt. Sta. 116+75 Wash. St.	213.74	207.80
I-2	Std. WR	15' Rt. Sta. 116+60 Wash. St.	215.28	211.74
I-3	Std. WR	15' Lt. Sta. 113+96.5 Wash. St.	228.68	225.18
I-6	Std. WR	15' Rt. Sta. 511+32.3 Foundry St.	196.11	188.81
I-7	Dbl. S	21' Lt. Sta. 511+61.7 Foundry St.	196.75	193.81
I-9	Std. WR	15' Lt. Sta. 513+10 Foundry St.	197.20	190.58
I-8	Std. S	24' Lt. Sta. 513+25 Foundry St.	196.50	192.79
M-5	G5.05	12.5' Lt. Sta. 514+50 Foundry St.	197.83	191.97
M-6	G5.05	4' Sta. 217+70 Balto. St.	199.07	192.25
I-10	A-10	18' Rt. Sta. 217+571 Balto. St.	199.47	195.90
I-11	Std. WR	18' Lt. Sta. 217+64.9 Balto. St.	199.58	195.80
M-7	G5.05	4' Sta. 215+01 Balto. St.	214.73	207.44
I-12	Std. WR	18' Lt. Sta. 215+00 Balto. St.	214.98	211.50
M-8	G5.05	4' Sta. 214+99 Balto. St.	217.24	209.95
I-13	Std. WR	15' Rt. Sta. 414+27.1 Commercial St.	217.85	213.84
I-14	Std. WR	15' Rt. Sta. 413+75 Commercial St.	219.95	214.84
I-21	Std. WR	15' Rt. Sta. 415+11.6 Commercial St.	218.37	211.98
I-22	Std. WR	15' Rt. Sta. 415+13.1 Commercial St.	218.71	215.35
M-11	G5.05	4' Sta. 415+66 Commercial St.	218.94	213.51
I-23	Std. WR	15' Lt. Sta. 415+26 Commercial St.	219.33	214.21
I-24	Std. WR	15' Lt. Sta. 416+03.5 Commercial St.	219.44	214.81
M-9	G5.01	4' Sta. 214+10 Balto. St.	220.72	212.80
I-15	A-10	18' Rt. Sta. 213+79.8 Balto. St.	221.54	216.54
I-16	Std. WR	18' Lt. Sta. 213+98 Balto. St.	221.66	218.18
I-17	Std. WR	18' Lt. Sta. 213+70 Balto. St.	223.34	219.48
M-10	G5.01	4' Sta. 210+00 Balto. St.	240.79	232.47
I-18	Std. WR	42' Lt. Sta. 210+01 Balto. St.	243.44	239.92
I-19	Std. WR	15' Rt. Sta. 313+42.74 Fair Street	240.78	234.35
I-20	A-10	15' Lt. Sta. 313+42.74 Fair Street	240.78	235.29
I-38	Std. WR	18' Rt. Sta. 218+39.1 Balto. St.	198.85	192.75
I-39	Std. WR	18' Lt. Sta. 218+43.1 Balto. St.	198.89	194.12
I-40	Std. S	28' Lt. Sta. 218+29 Balto. St.	197.52	194.62
S-4	Spec. Struc.	4' Const. Sta. 217+95 Balto. St.	198.74	192.34
I-62	A-10	15' Lt. Sta. 520+52.5 Foundry St.	198.35	184.04
I-61	A-10	15' Rt. Sta. 520+50.2 Foundry St.	198.18	193.45
I-37A	A-10	15' Rt. Sta. 411+72 Williams St.	195.85	192.90
I-13A	Std. WR	13' Rt. Sta. 6+41 Savage Rd.	183.96	179.85
E-1	End Section	22' Rt. Sta. 6+34 Savage Rd.		177.84
M-11A		Deleted (2-1-84)		

1) See Storm Drain Details SHT #36 2) With Reticular Grate 3) With Deflectors
 4) Brick Invert shall be One-half developed

STEP SCHEDULE

LOCATION	WIDTH	NO. RISERS
WASHINGTON STREET		
Rt. 110+79.1	4'	3
Lt. 111+14	3'	5
Rt. 111+41.5	4'	3
Lt. 112+03	4'	5
Rt. 113+05	4'	6
Rt. 113+75.5	9'	5
COMMERCIAL STREET		
Rt. 214+97	3'	3
Rt. 216+47.5	3'	3
Rt. 216+97.1	3'	3
Lt. 218+39.1	3'	2
Lt. 219+17	3'	3
Lt. 220+72.5	3'	4
FOUNDRY STREET		
Rt. 219+16.4	3.5'	8 (7'R)
Lt. 511+76	3'	

DRIVEWAY SCHEDULE


LOCATION	TYPE	WIDTH	APPROX. DIST. TO THE IN.
COMMERCIAL ST.			
Lt. 416+31	3	10'	18'
FOUNDRY ST.			
Rt. 521+33	3	10'	19'

THE FOLLOWING ITEMS OF WORK SHOWN ON THIS DRAWING ARE TO BE CONSTRUCTED UNDER CAPITAL PROJECT J-4-4008B.

- COMMERCIAL ST. NORTH OF BALTIMORE STREET:
 - THE RELOCATION OF AN EXISTING 6 INCH WATER MAIN FROM LT. STA. 416+22 AHEAD (SEE DWG. NO. 13)
 - THE EXTENSION OF THE 24 INCH STORM DRAIN NORTHERLY FROM THE STUB OUT OF MANHOLE M-11
 - THE GRADING, CURB & GUTTER, PAVING AND LANDSCAPING OF COMMERCIAL STREET FROM STA. 416+00 TO STA. 416+50
- FOUNDRY STREET NORTH OF BALTIMORE STREET:
 - THE EXTENSION OF THE 18 INCH STORM DRAIN NORTHERLY FROM THE STUB OUT OF INLET I-64
 - THE GRADING, CURB & GUTTER, PAVING AND LANDSCAPING OF FOUNDRY STREET FROM STA. 520+75 TO STA. 521+50
- THE INCIDENTALS DIRECTED BY THE ENGINEER TO PROPERLY TIE-IN THE NEW CONSTRUCTION TO THE WORK CONSTRUCTED UNDER CAPITAL PROJECT J-4-4008.

DEPARTMENT OF PUBLIC WORKS
 HOWARD COUNTY, MARYLAND
 CHIEF ROADS, BRIDGES, STORM DRAINS DIVISION

PREPARED BY:
 THE WILSON T. BALLARD CO.
 CONSULTING ENGINEERS
 OWINGS MILLS, MARYLAND
 TEL. NO. 363-0150

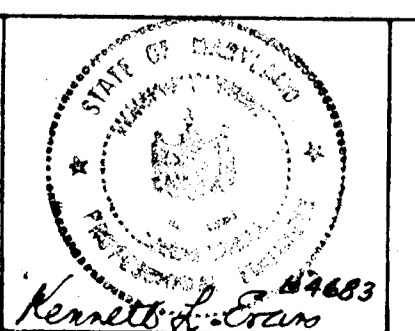


PLAN
 COMMERCIAL ST. STA. 416+00 TO STA. 416+50
 FOUNDRY ST. STA. 520+75 TO STA. 521+50

SAVAGE AREA - PHASE B
 ROAD AND STORM DRAIN IMPROVEMENTS
 CAPITAL PROJECT NOS. J-4-4008B
 ELECTION DISTRICT NO. 6
 HOWARD COUNTY, MARYLAND

NO.	DATE	DESCRIPTION OF REVISION	SIGNATURE

DRAWING NO. 6 OF 14
 SCALE: 1" = 50'
 K.L.E. DESIGNED BY
 T.G.S. DRAFTED BY
 K.L.E. CHECKED BY

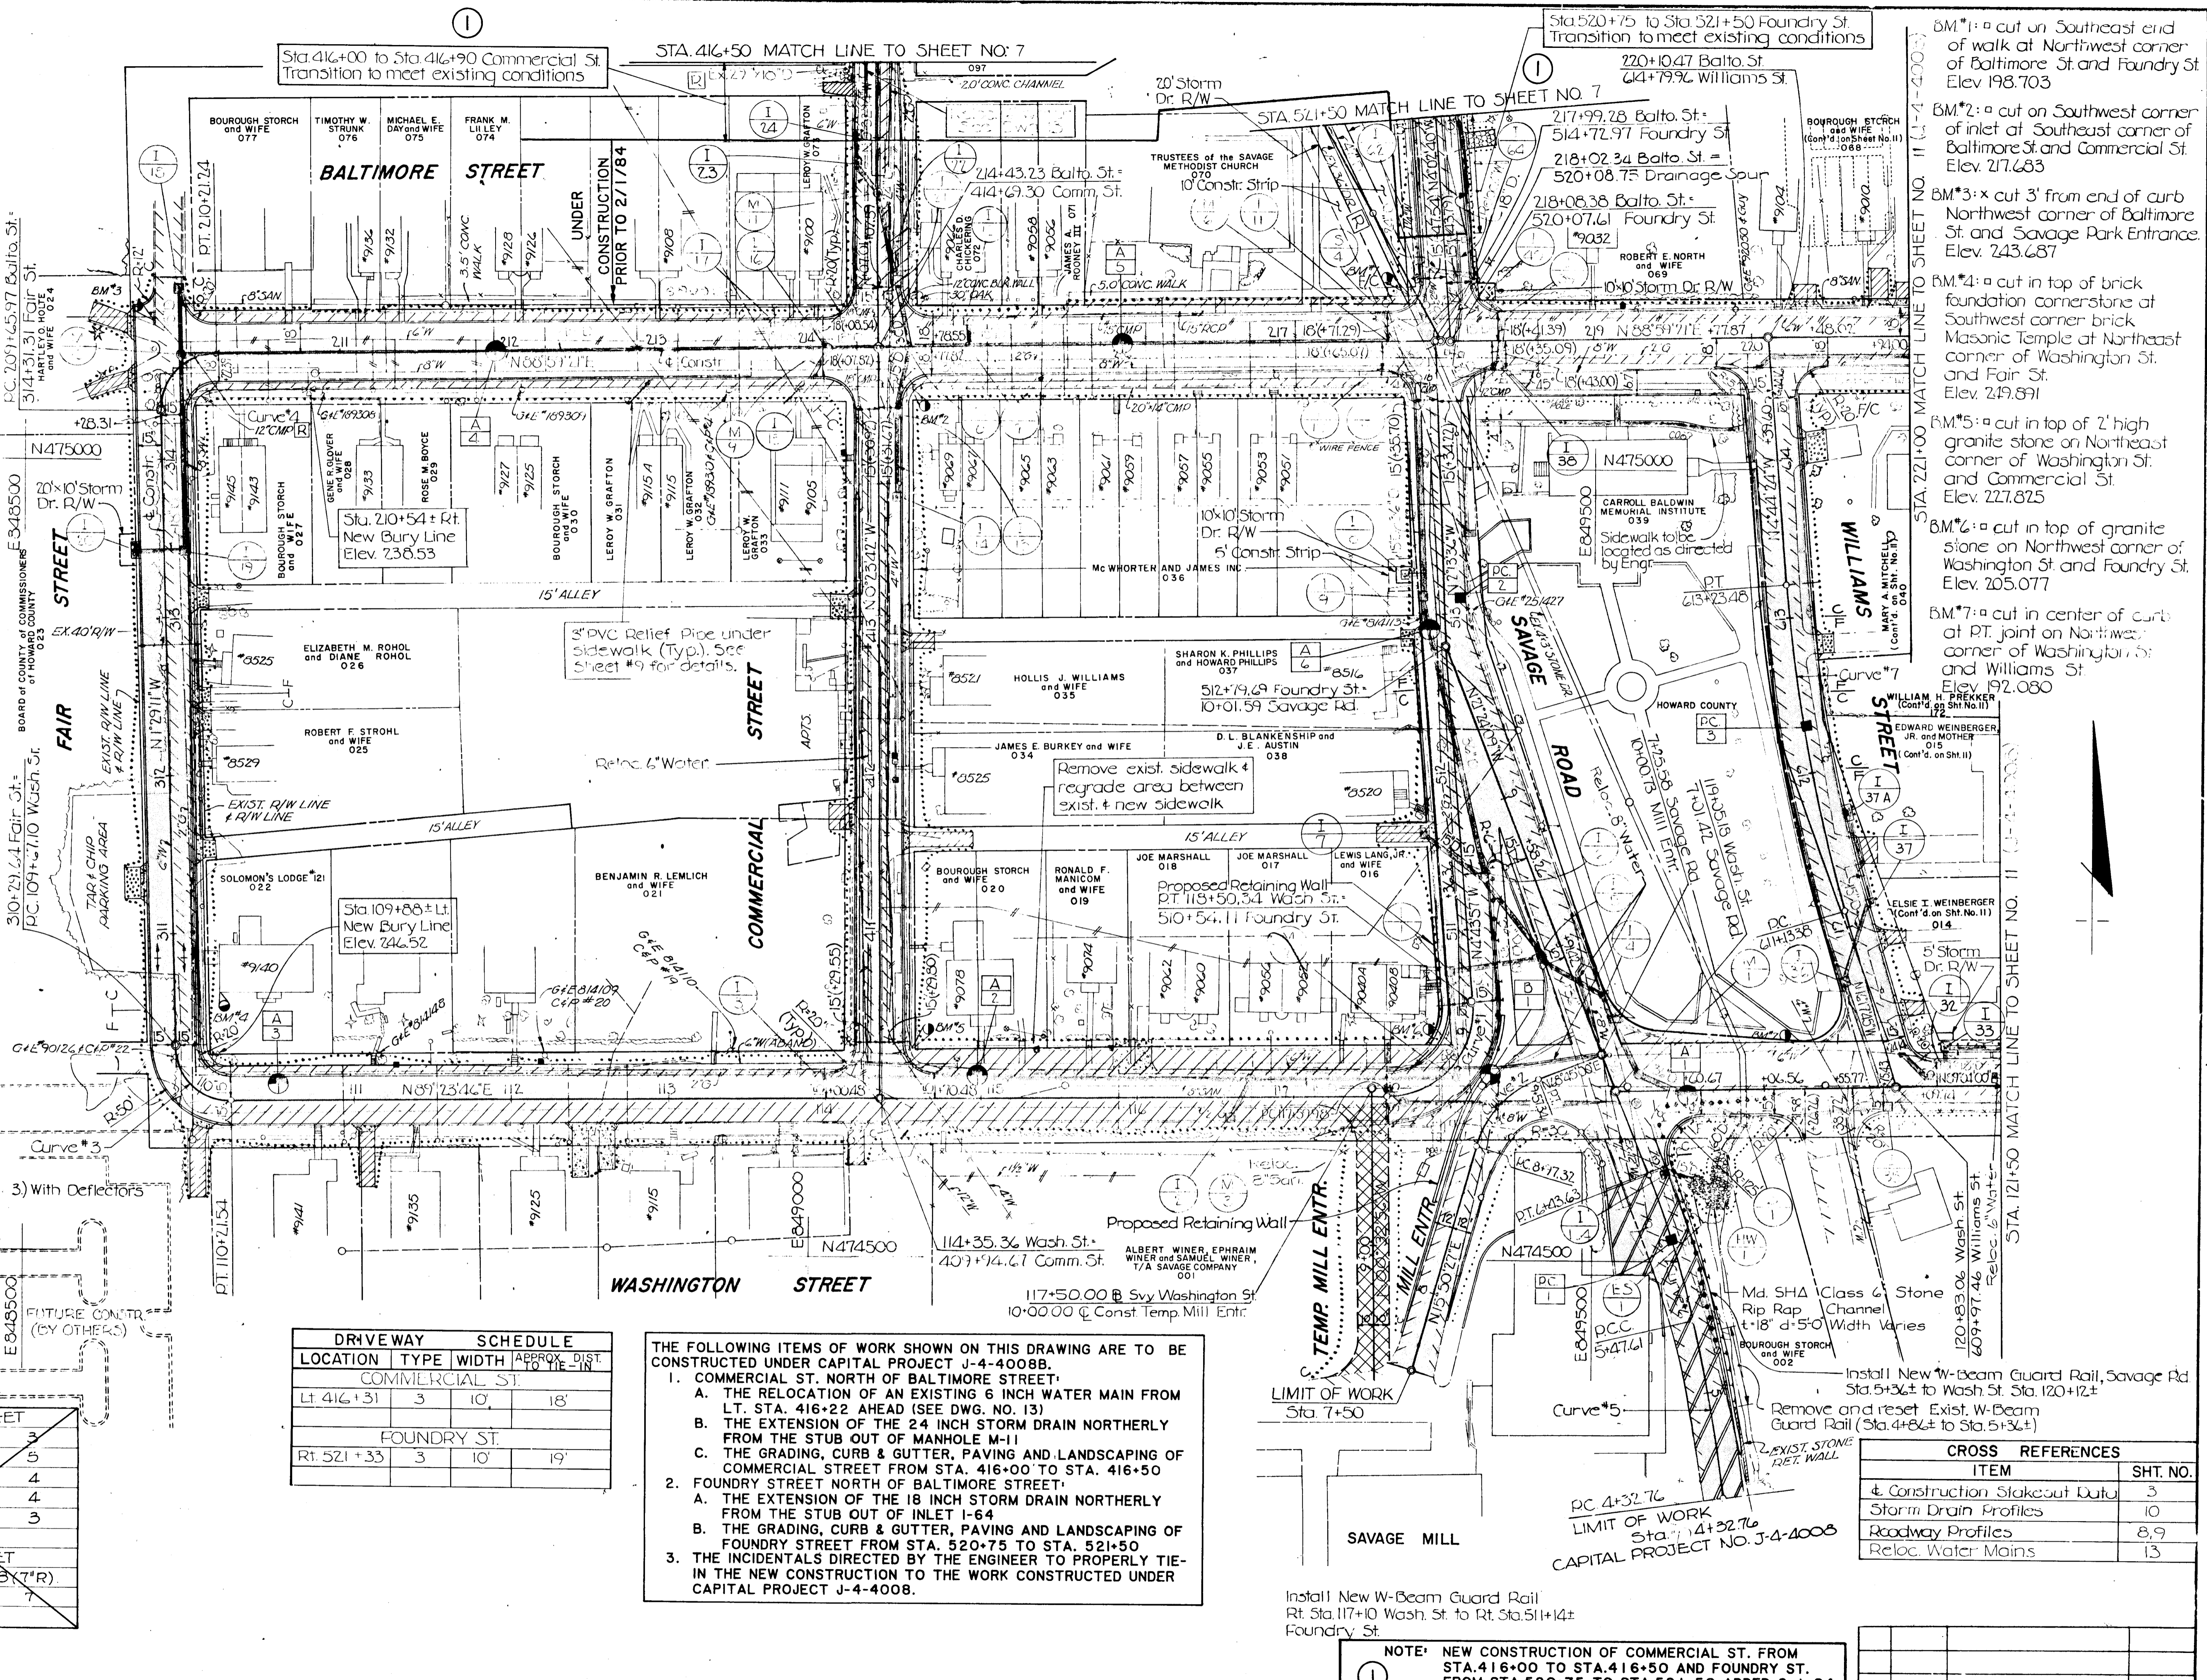

BM*1: a cut on Southeast end of walk at Northwest corner of Baltimore St. and Foundry St. Elev. 198.703
 BM*2: a cut on Southwest corner of inlet at Southeast corner of Baltimore St. and Commercial St. Elev. 217.683
 BM*3: x cut 3' from end of curb Northwest corner of Baltimore St. and Savage Park Entrance Elev. 243.687
 BM*4: a cut in top of brick foundation cornerstone at Southwest corner brick Masonic Temple at Northeast corner of Washington St. and Fair St. Elev. 219.891
 BM*5: a cut in top of 2' high granite stone on Northeast corner of Washington St. and Commercial St. Elev. 227.825
 BM*6: a cut in top of granite stone on Northwest corner of Washington St. and Foundry St. Elev. 205.077
 BM*7: a cut in center of curb at PT. joint on Northwest corner of Washington St. and Williams St. Elev. 192.080

Install New W-Beam Guard Rail Rt. Sta. 117+10 Wash. St. to Rt. Sta. 511+14 Foundry St.

NOTE: NEW CONSTRUCTION OF COMMERCIAL ST. FROM STA. 416+00 TO STA. 416+50 AND FOUNDRY ST. FROM STA. 520+75 TO STA. 521+50 ADDED 2-1-84


5/8" x 15/8" cut on granite stone on Northwest corner of Foundry St. and Commerce St. Elev. 230.630

Note: Transition Commercial St. east curb line from 15' Rt. C. Constr. at Sta. 416+00 to 13' Rt. C. Constr. at Sta. 416+90

DRIVEWAY SCHEDULE											
COMMERCIAL ST.				COMMERCE ST.				FOUNDRY STREET			
LOCATION	TYPE	WIDTH	APPROX. DIST. TO TIE-IN	LOCATION	TYPE	WIDTH	APPROX. DIST. TO TIE-IN	LOCATION	TYPE	WIDTH	APPROX. DIST. TO TIE-IN
Lt. 417+08	3	10'	5'	Rt. 10+48	1	11'	42'	Rt. 10+48	1	11'	42'
Lt. 417+71	3	10'	13'								
Lt. 417+90	3	10'	14'								
Rt. 418+75	2	10'	8'	Lt. 521+62	3	18'	5'				
Lt. 419+67	2	12'	12'	Lt. 522+62	3	10'	0'				
Rt. 419+67	1	25'	3'	Rt. 525+03	2	14'	7'				
Lt. 421+13	2	12'	8'	Lt. 525+72	1	10'	13'				
Rt. 421+33	1	10'	6'	Rt. 525+93	2	15'	8'				
Lt. 423+60	1	10'	35'	Lt. 526+87	3	11'	12'				
Rt. 424+76	2	12'	35'	Rt. 528+15	2	10'	23'				
Rt. 425+02	2	15'	22'	Lt. 528+61	3	10'	14'				
Lt. 425+16	2	13'	4'	Lt. 530+50	2	12'	10'				
Lt. 425+42	2	13'	18'	Lt. 530+74	3	10'	12'				
Rt. 425+45	3	10'	23'	Rt. 531+21	2	16'	19'				
Lt. 426+52	2	12'	4'	Lt. 531+97	2	17'	20'				
Lt. 427+36	2	10'	5'	Lt. 532+94	2	10'	22'				

Rt. Sta. 537+74+ To Rt. Sta. 538+74+ Drainage Spur
 1. Remove and stockpile existing Link Fence.
 2. Furnish and install temporary fence to adequately complete enclosure of swimming pool during construction.
 3. Remove existing fence along the existing drainage and utility easement line after construction in the area is completed.

Note A: See Concrete Channel Transition Details on Sheet No 35

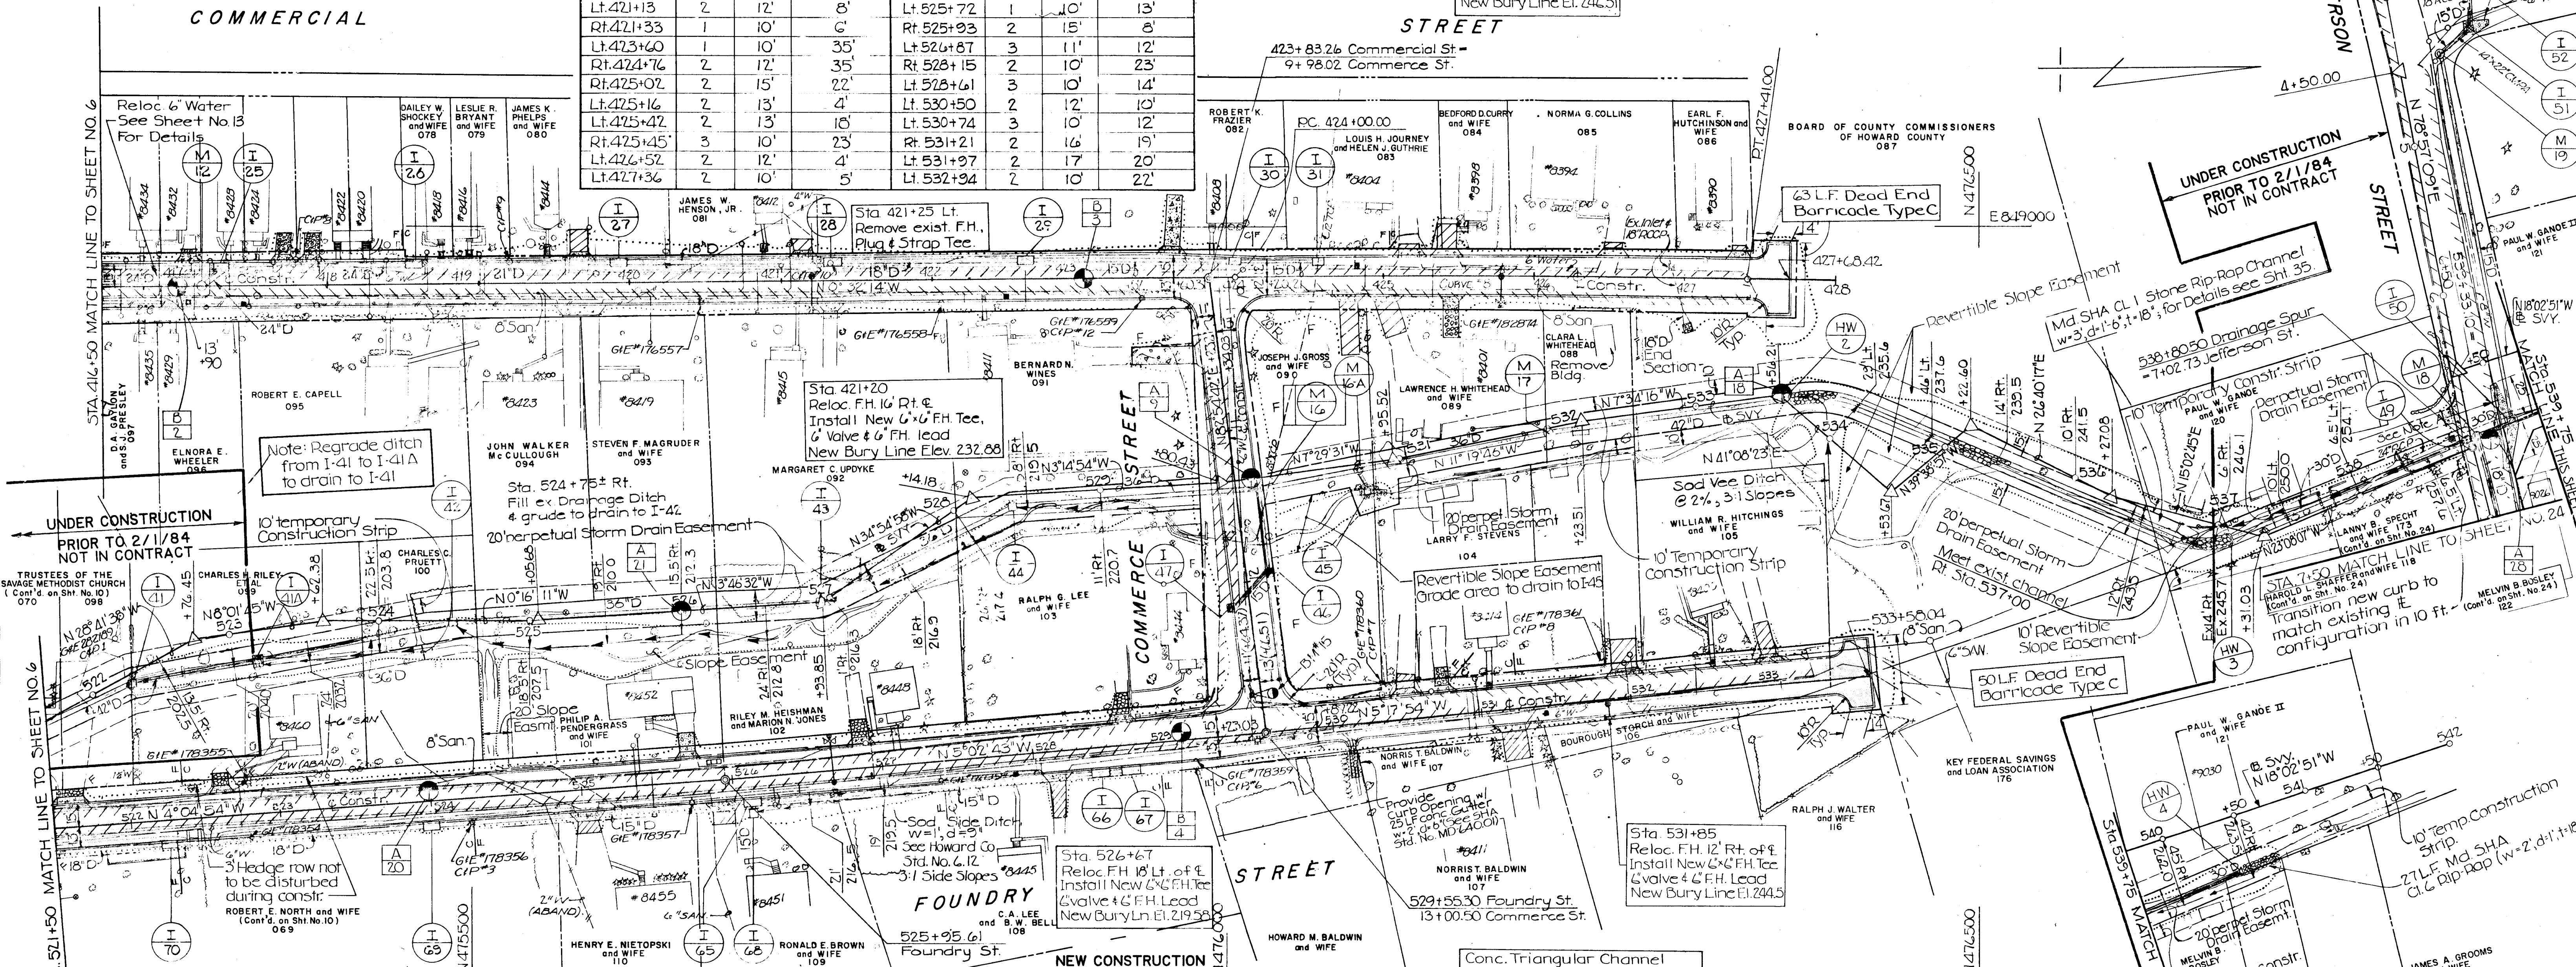

STORM DRAIN STRUCTURE SCHEDULE				
STRUC. NO.	TYPE	LOCATION	TOP ELEV.	INV. OUT.
M-12	G5.05	0' Offset, Sta. 417+17 Commercial St.	221.15	216.93
I-25	Std. WR	15' Lt. Sta. 417+28 Commercial St.	222.14	217.30
I-26	Std. WR	15' Lt. Sta. 418+59 Commercial St.	225.87	220.18
I-27	Std. WR	15' Lt. Sta. 419+92 Commercial St.	229.44	224.42
I-28	Std. WR	15' Lt. Sta. 421+31 Commercial St.	233.59	228.84
I-29	Std. WR	15' Lt. Sta. 422+02 Commercial St.	237.31	232.77
I-30	Std. WR	13.01' Lt. Sta. 424+00 Commercial St.	241.29	237.44
I-31	Std. WR	12' Lt. Sta. 424+56 Commercial St.	242.91	238.50
I-42	Dbl. S ^o	2' Rt. Sta. 524+50 Foundry St. Drainage Spur	207.00	202.00
I-43	Dbl. S ^o	0' Offset, Sta. 526+93 Foundry St. Drainage Spur	216.20	209.90
I-44	Dbl. S ^o	8' Rt. Sta. 528+41 Foundry St. Drainage Spur	219.40	214.40
M-16	G5.02	7' Rt. Sta. 530+06 Foundry St. Drainage Spur	222.79	219.80
I-45	Std. S	9' Rt. Sta. 530+75 Foundry St. Drainage Spur	225.20	222.20
I-46	A-5	13' Lt. Sta. 11+91.75 Commerce St.	231.30	226.67
I-47	A-5	11' Rt. Sta. 12+18.61 Commerce St.	231.11	227.48
I-41A	Dbl. S ^o	20' Rt. Sta. 523+18 Foundry St. Drainage Spur	203.00	197.70
I-41	Dbl. S ^o	6' Rt. Sta. 522+27 Foundry St. Drainage Spur	203.35	193.35
HW-3	A	8' Rt. Sta. 524+00 Foundry St. Drainage Spur	246.00	246.00
I-49	A-5	5' Lt. Sta. 6198 Jefferson St.	260.74	253.59
I-45	A-5	5' Lt. Sta. 6195 Jefferson St.	261.70	254.80

STORM DRAIN STRUCTURE SCHEDULE				
STRUC. NO.	TYPE	LOCATION	TOP ELEV.	INV. OUT.
I-59	Std. S	29' Lt. Sta. 6+90 Jefferson St.	261.00	257.70
HW-4	A	88' from 150' Jefferson St.	263.30	263.30
M-19	G5.05	58' Lt. Sta. 3+96 Jefferson St.	275.00	269.65
I-60	Std. S	4+31.5 Jefferson St.	275.10	272.25
I-61	Std. S	58' Lt. Sta. 3+96 Jefferson St.	276.00	273.05
I-70	A-10	13' Rt. Sta. 522+25 Foundry St.	203.62	200.20
I-69	A-10	13' Rt. Sta. 524+00 Foundry St.	209.43	206.00
I-65	A-10	13' Rt. Sta. 526+10 Foundry St.	217.21	212.00
I-68	Std. S	23' Rt. Sta. 526+10 Foundry St.	215.90	212.30
I-66	A-10	13' Rt. Sta. 528+45 Foundry St.	226.69	223.35
I-67	A-10	13' Rt. Sta. 528+65 Foundry St.	227.60	224.00
M-16A	G 5.02	4' Rt. Sta. 530+71 Foundry St. Drainage Spur	229.60	221.25
M-17	G 5.02	3' Rt. Sta. 532+00 Foundry St. Drainage Spur	238.40	229.65
HW-2	A	1' Lt. Sta. 533+02 Foundry St. Drainage Spur	233.90	233.90

STEP SCHEDULE			
LOCATION	WIDTH	NO. RISERS	
COMMERCIAL ST.			
Lt. 416+77	35'	1	
Rt. 416+78	4'	6	
Rt. 416+98	3'	7	
Lt. 417+34	3'	5	
Lt. 417+55	3'	3	
Lt. 418+07	3'	3	
Lt. 418+25	4'	2	
Rt. 418+40	3'	4	
Lt. 418+75	3'	2	
Lt. 418+95	4.7'	3	
Lt. 419+46	4'	7	
Lt. 420+89	3'	6	
Rt. 421+10	3'	2	
Rt. 422+34	3.3'	5	
Lt. 423+86	3'	3	
Lt. 425+50	3'	5	
FOUNDRY ST.			
Lt. 532+57	3'	3	

COMMERCIAL ST. CURVE NO. 8 DATA
 Δ = 1'42"18" Rt
 Dc = 0'30"00"
 R = 11,459.16'
 T = 170.51'
 Lc = 341.00'
 E = 1.27'

COMMERCIAL ST. LT. STA. 426+92±
 Remove exist. inlet grate, extend inlet walls and construct Type 'B' Manhole (Shallow) Top Slab, Frame and Cover.
 COMMERCIAL ST. RT. STA. 427+00±
 Install 18" R.C.C.P. Conc. End Section and construct 5'x5' Md. S.H.A. Cl. 6 Stone Rip-Rap Apron (T=12"). See Cross Sections

CROSS REFERENCES	
ITEM	SHEET NO.
Construction Stake-out Data	3
Commercial Street Profile	8
Foundry Street Profile	8
Commerce Street Profile	9
Storm Drain Profile	10 & 11

NOTE: ALL WORK SHOWN ON THIS DRAWING EXCEPT THE WORK INDICATED AS "UNDER CONSTRUCTION PRIOR TO 2-1-84" IS TO BE PERFORMED


DEPARTMENT OF PUBLIC WORKS
 HOWARD COUNTY, MARYLAND
 DIRECTOR OF PUBLIC WORKS DATE CHIEF BUREAU OF ENGINEERING DATE
 CHIEF ROADS, BRIDGES, STORM DRAINS DIVISION DATE

PREPARED BY:
 THE WILSON T. BALLARD CO.
 CONSULTING ENGINEERS
 OWINGS MILLS, MARYLAND
 TEL. NO. 363-0150

PLAN
 COMMERCIAL ST. STA. 416+ TO STA. 427+
 FOUNDRY ST. STA. 521+ TO STA. 533+
 COMMERCE ST.




SAVAGE AREA - PHASE B
 ROAD AND STORM DRAIN IMPROVEMENTS
 CAPITAL PROJECT NOS. J-4-4008 B
 ELECTION DISTRICT NO. 6
 HOWARD COUNTY, MARYLAND

NO.	DATE	DESCRIPTION OF REVISION	SIGNATURE
DRAWING NO. 7 OF 14			
SCALE: 1" = 50'			
K.L.E. DULGED BY			
R.A.W. DRAFTED BY			
K.L.E. CHECKED BY			





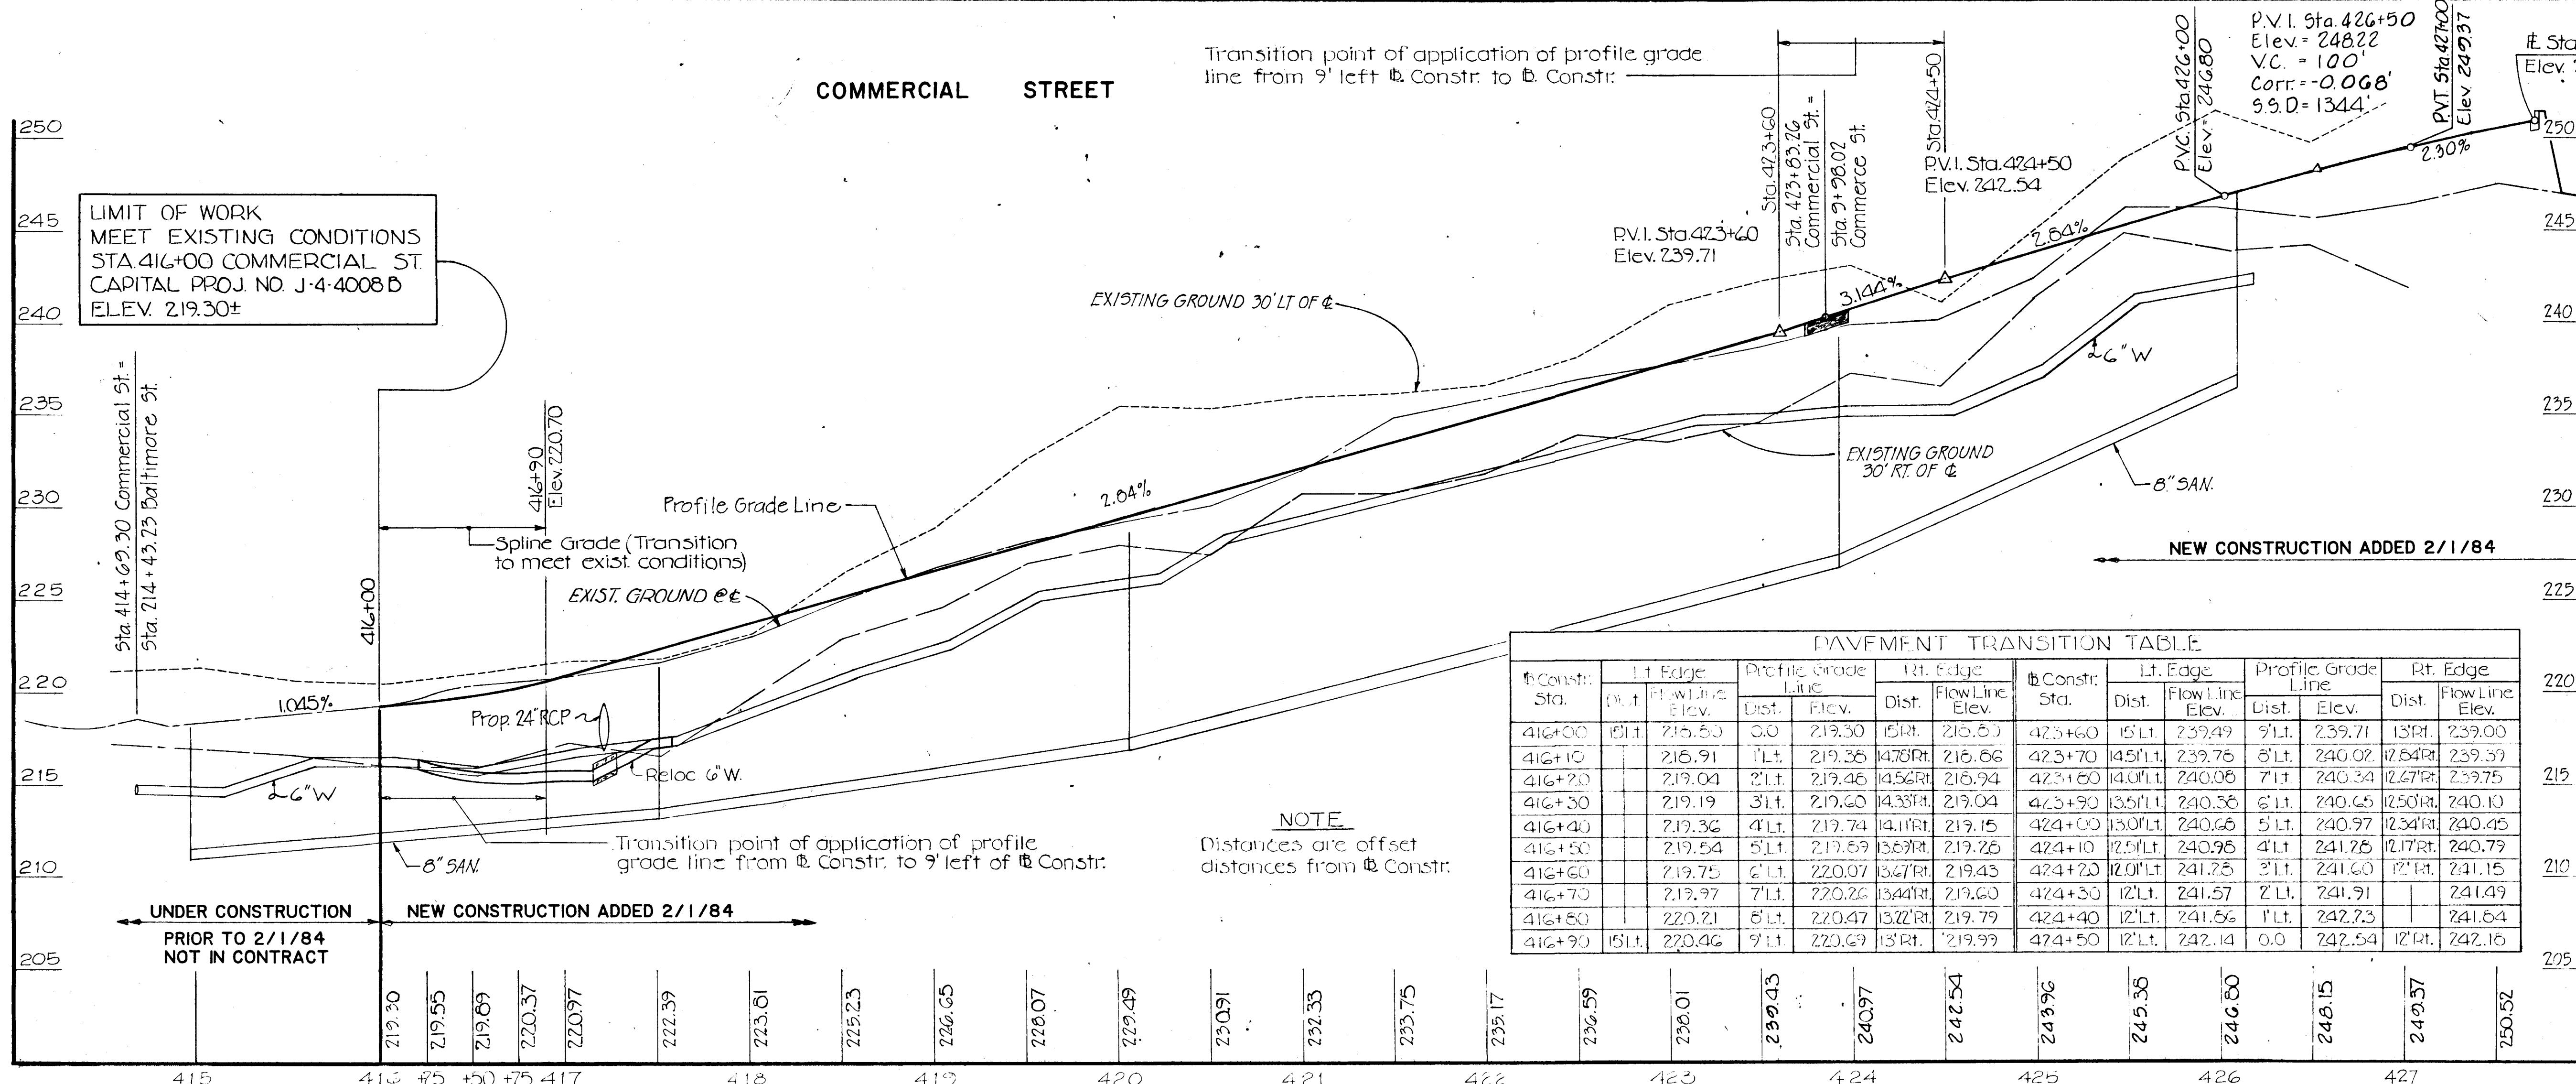


PAVEMENT TRANSITION TABLE

Const. Sta.	Lt. Edge		Profile Grade Line		Rt. Edge		Const. Sta.	Lt. Edge		Profile Grade Line		Rt. Edge	
	Dist.	Flow Line Elev.	Dist.	Elev.	Dist.	Flow Line Elev.		Dist.	Flow Line Elev.	Dist.	Elev.	Dist.	Flow Line Elev.
416+00	0.11	215.50	0.0	219.30	15.11	215.50	423+60	15.11	239.49	9.11	239.71	13.11	239.00
416+10		215.91	1.11	219.36	14.78	215.66	423+70	14.51	239.75	8.11	240.02	12.84	239.39
416+20		219.04	2.11	219.46	14.52	215.94	423+80	14.01	240.06	7.11	240.34	12.71	239.75
416+30		219.19	3.11	219.60	14.33	219.04	423+90	13.51	240.36	6.11	240.65	12.50	240.10
416+40		219.36	4.11	219.74	14.11	219.15	424+00	13.01	240.66	5.11	240.97	12.34	240.45
416+50		219.54	5.11	219.89	13.91	219.26	424+10	12.51	240.96	4.11	241.25	12.17	240.79
416+60		219.75	6.11	220.07	13.71	219.43	424+20	12.01	241.25	3.11	241.60	12.11	241.15
416+70		219.97	7.11	220.26	13.44	219.60	424+30	11.51	241.57	2.11	241.91		241.49
416+80		220.21	8.11	220.47	13.22	219.79	424+40	11.11	241.86	1.11	242.23		241.64
416+90	15.11	220.46	9.11	220.69	13.11	219.99	424+50	10.11	242.14	0.0	242.54	12.11	242.16

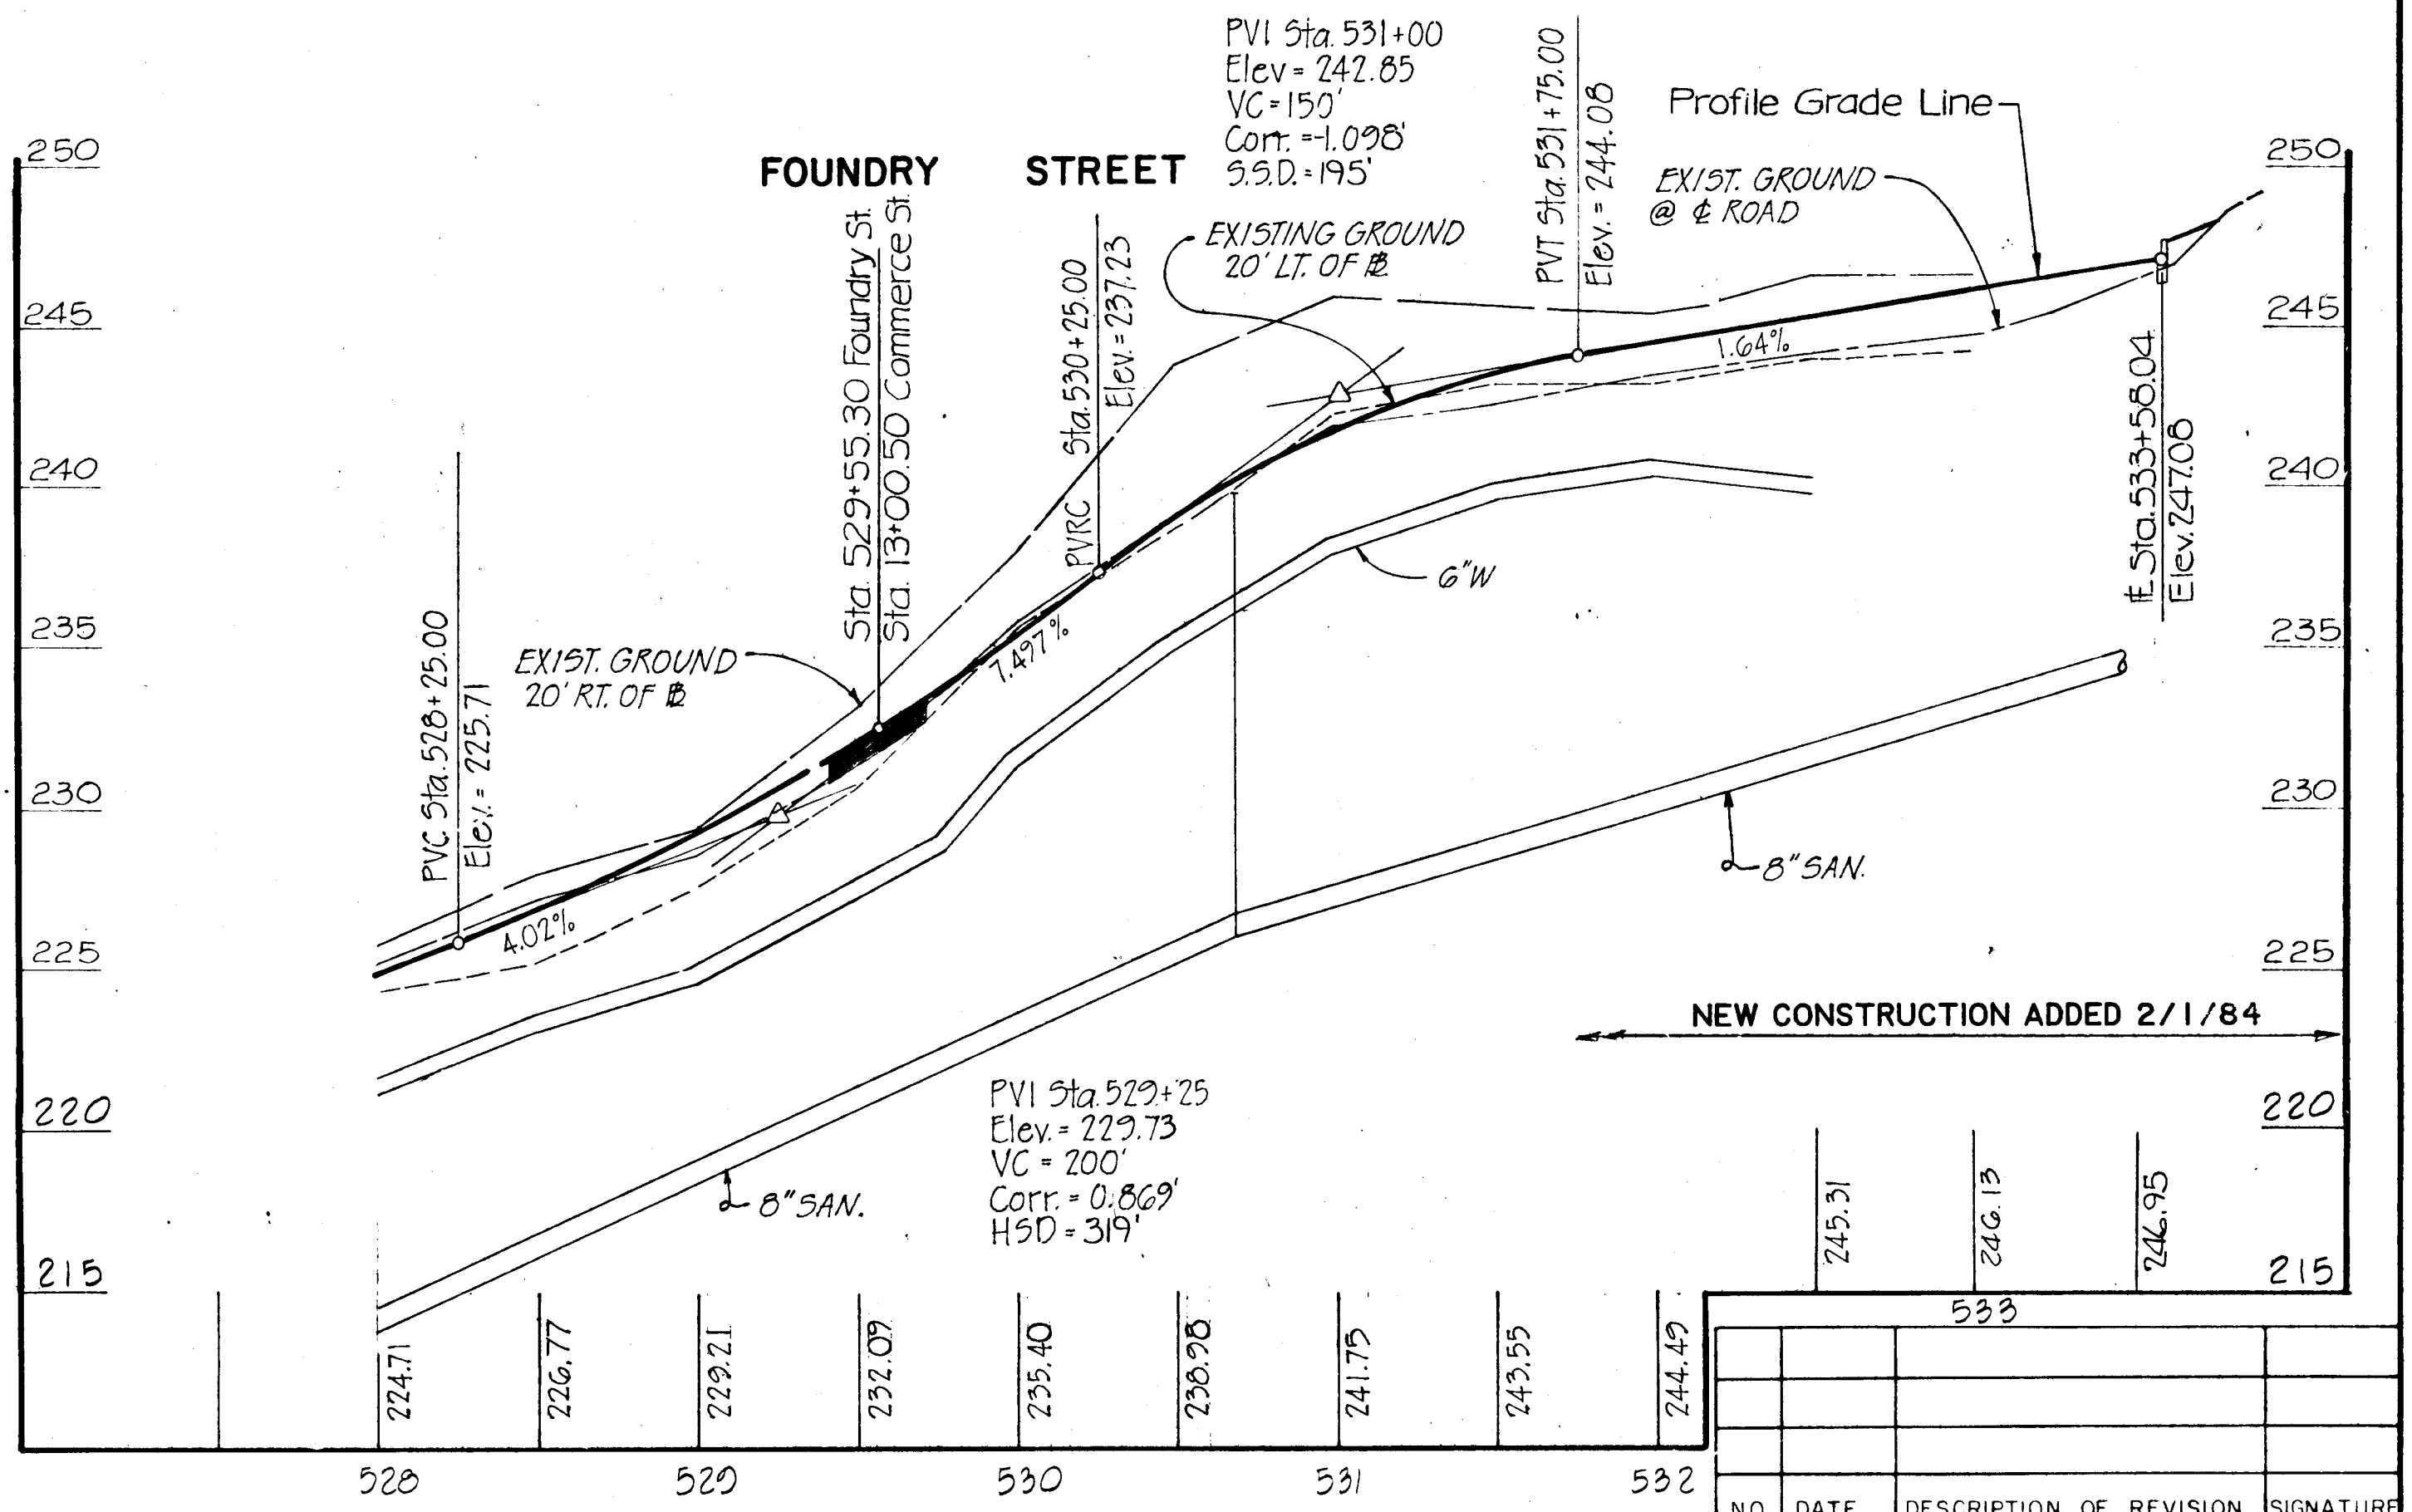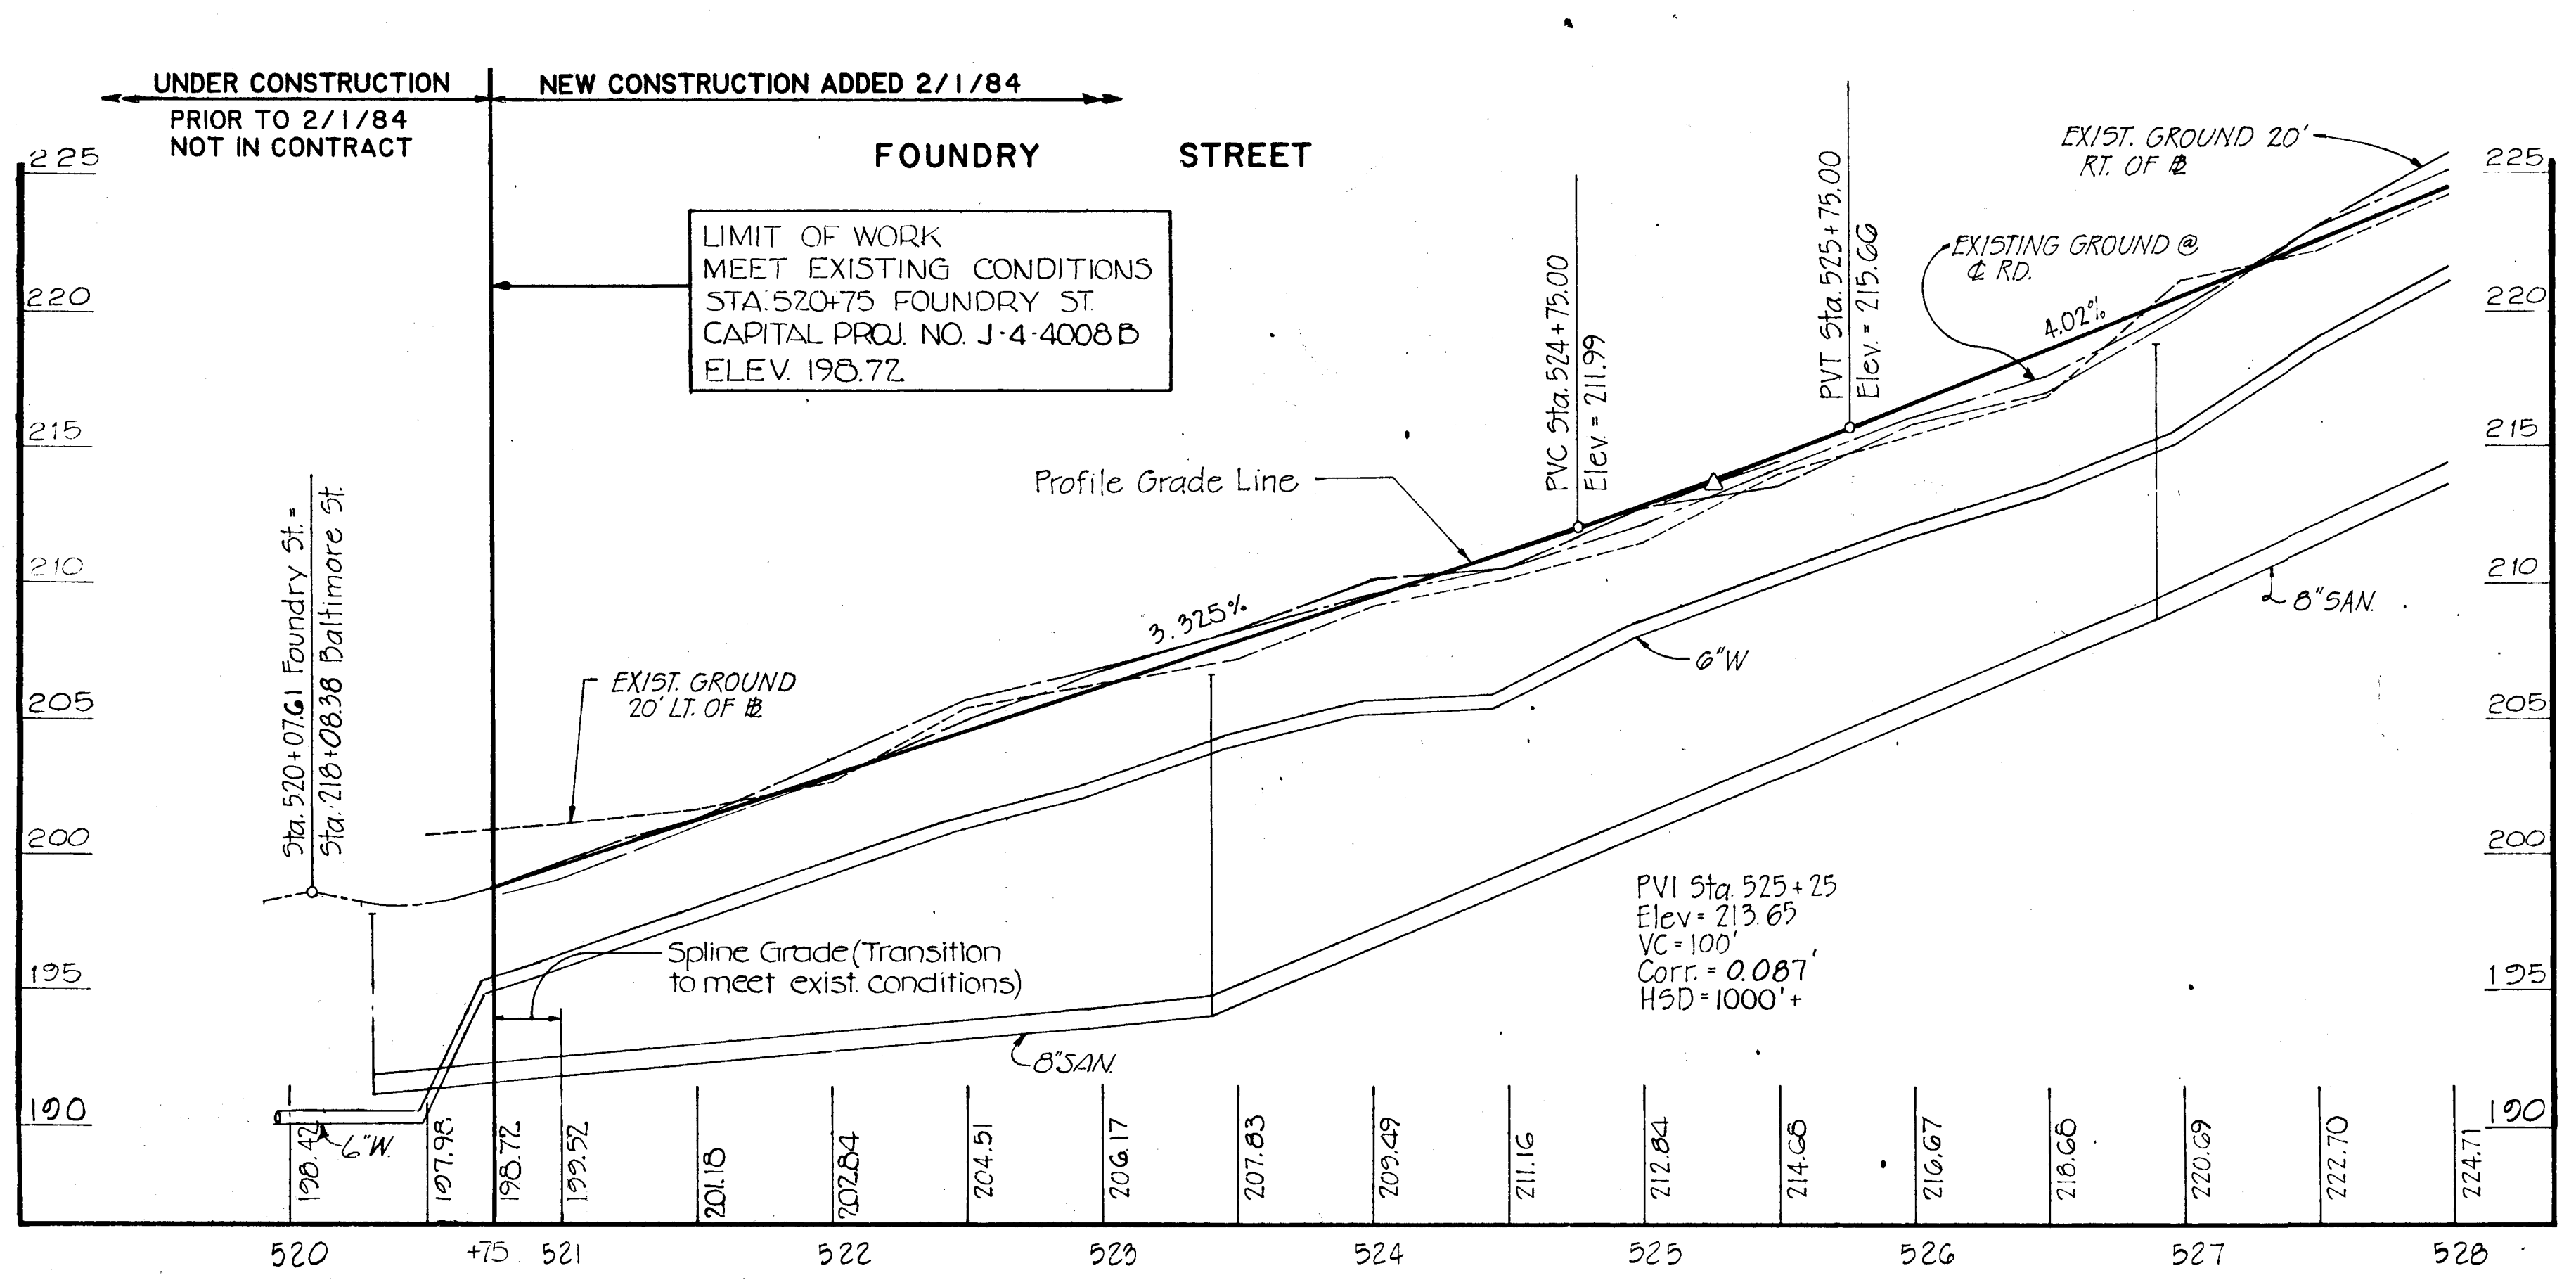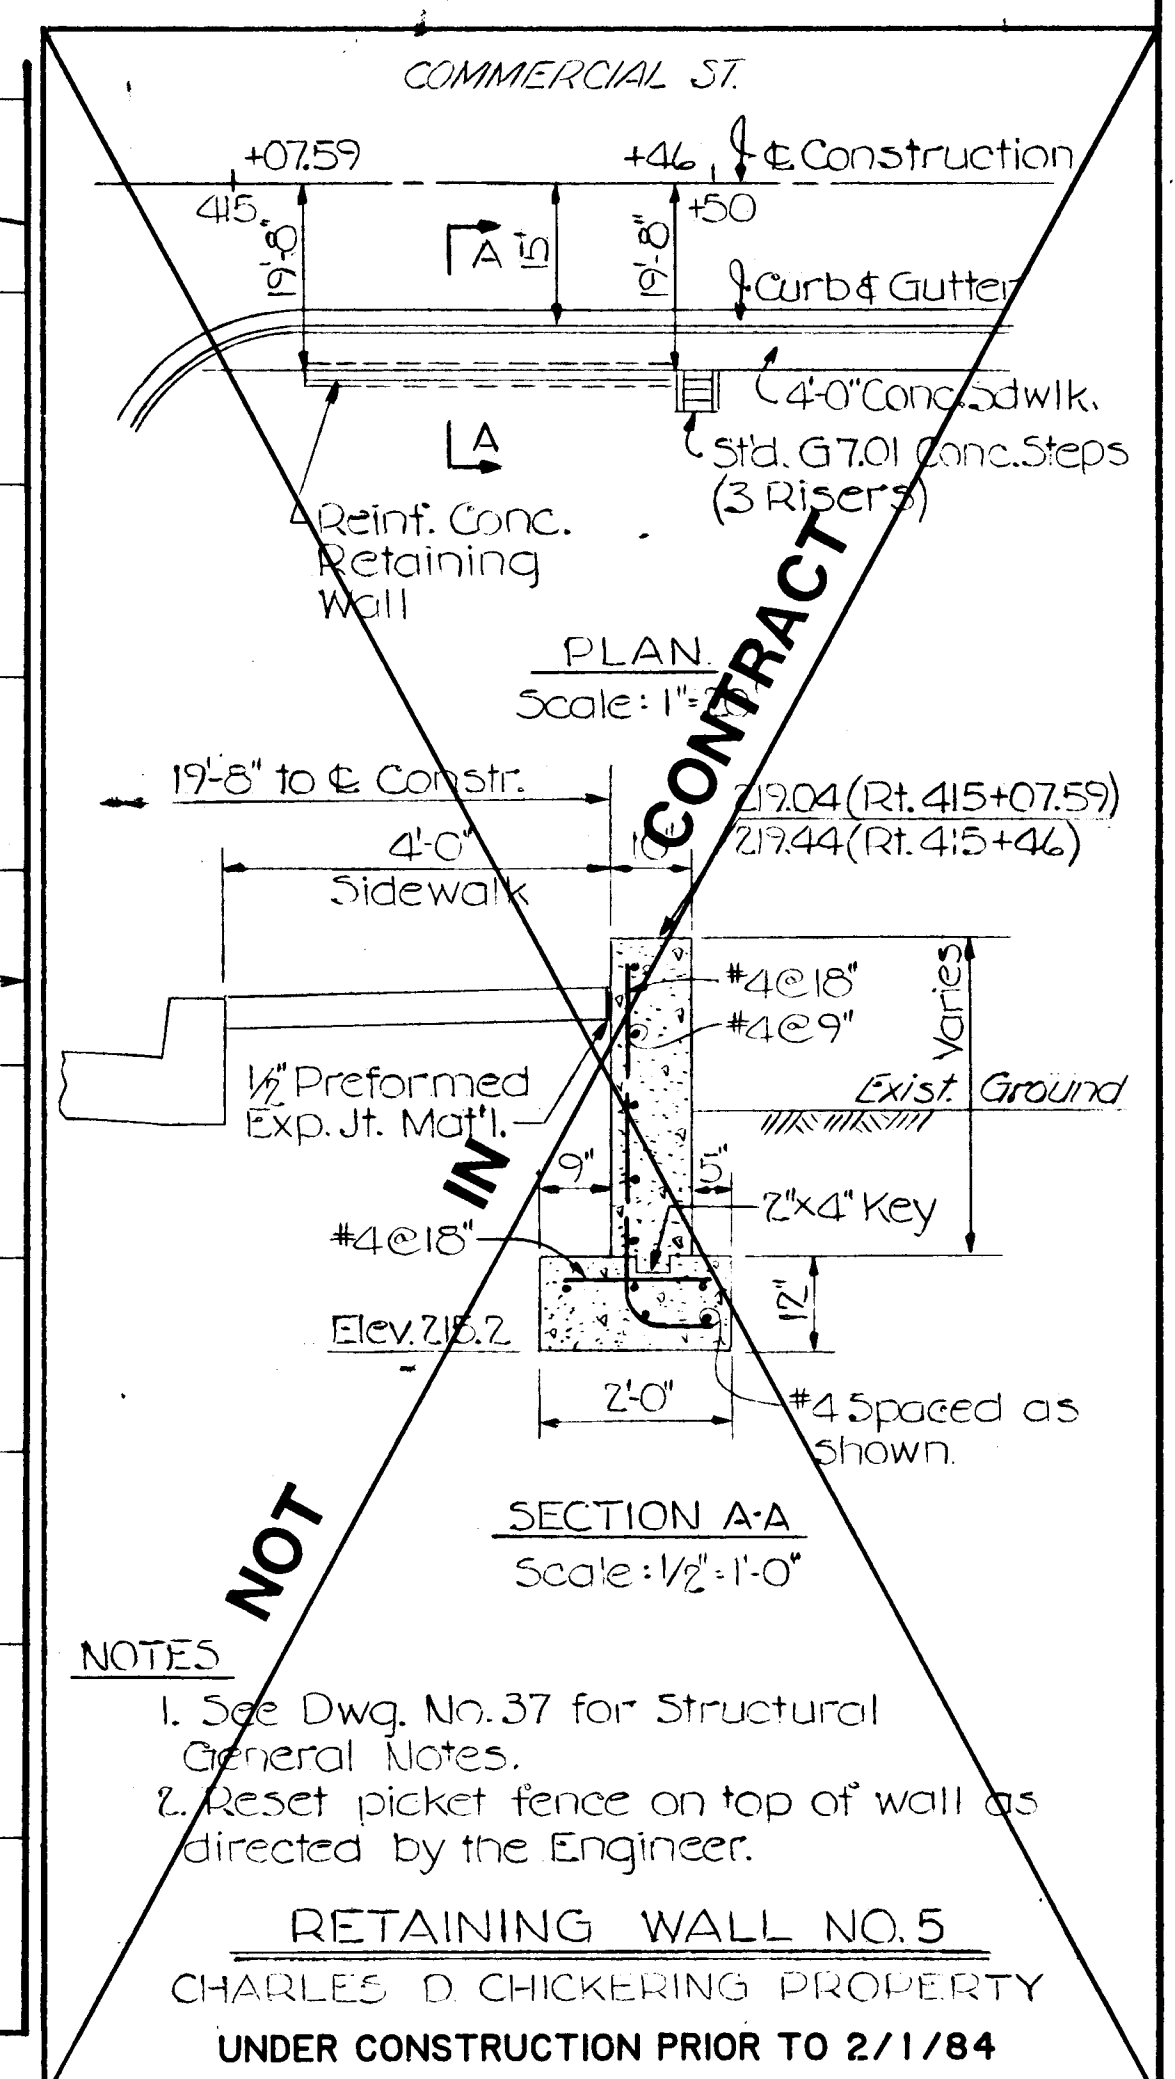


<p>DEPARTMENT OF PUBLIC WORKS HOWARD COUNTY, MARYLAND DIRECTOR OF PUBLIC WORKS DATE _____ CHIEF BUREAU OF ENGINEERING DATE _____ CHIEF ROADS, BRIDGES, STORM DRAINS DIVISION DATE _____</p>	<p>PREPARED BY: THE WILSON T. BALLARD CO. CONSULTING ENGINEERS OWINGS MILLS, MARYLAND TEL. NO. 363-0150</p>	<p>PROFILES COMMERCIAL ST. STA. 416+ TO STA. 427+ FOUNDRY ST. STA. 520+ TO STA. 533+</p>	<p>SAVAGE AREA - PHASE B ROAD AND STORM DRAIN IMPROVEMENTS CAPITAL PROJECT NOS. J-4-4008 B ELECTION DISTRICT NO. 6 HOWARD COUNTY, MARYLAND</p>												
<p>977</p>		<table border="1" style="width: 100%; border-collapse: collapse;"> <thead> <tr> <th>NO.</th> <th>DATE</th> <th>DESCRIPTION OF REVISION</th> <th>SIGNATURE</th> </tr> </thead> <tbody> <tr> <td> </td> <td> </td> <td> </td> <td> </td> </tr> <tr> <td> </td> <td> </td> <td> </td> <td> </td> </tr> </tbody> </table>		NO.	DATE	DESCRIPTION OF REVISION	SIGNATURE								
NO.	DATE	DESCRIPTION OF REVISION	SIGNATURE												
<p>DRAWING NO. 8 OF 14</p>		<p>SCALE: HORZ. 1"=50' VERT. 1"=5'</p>													
<p>DESIGNED BY: K.L.E. DRAFTED BY: R.A.W. CHECKED BY: K.L.E.</p>															

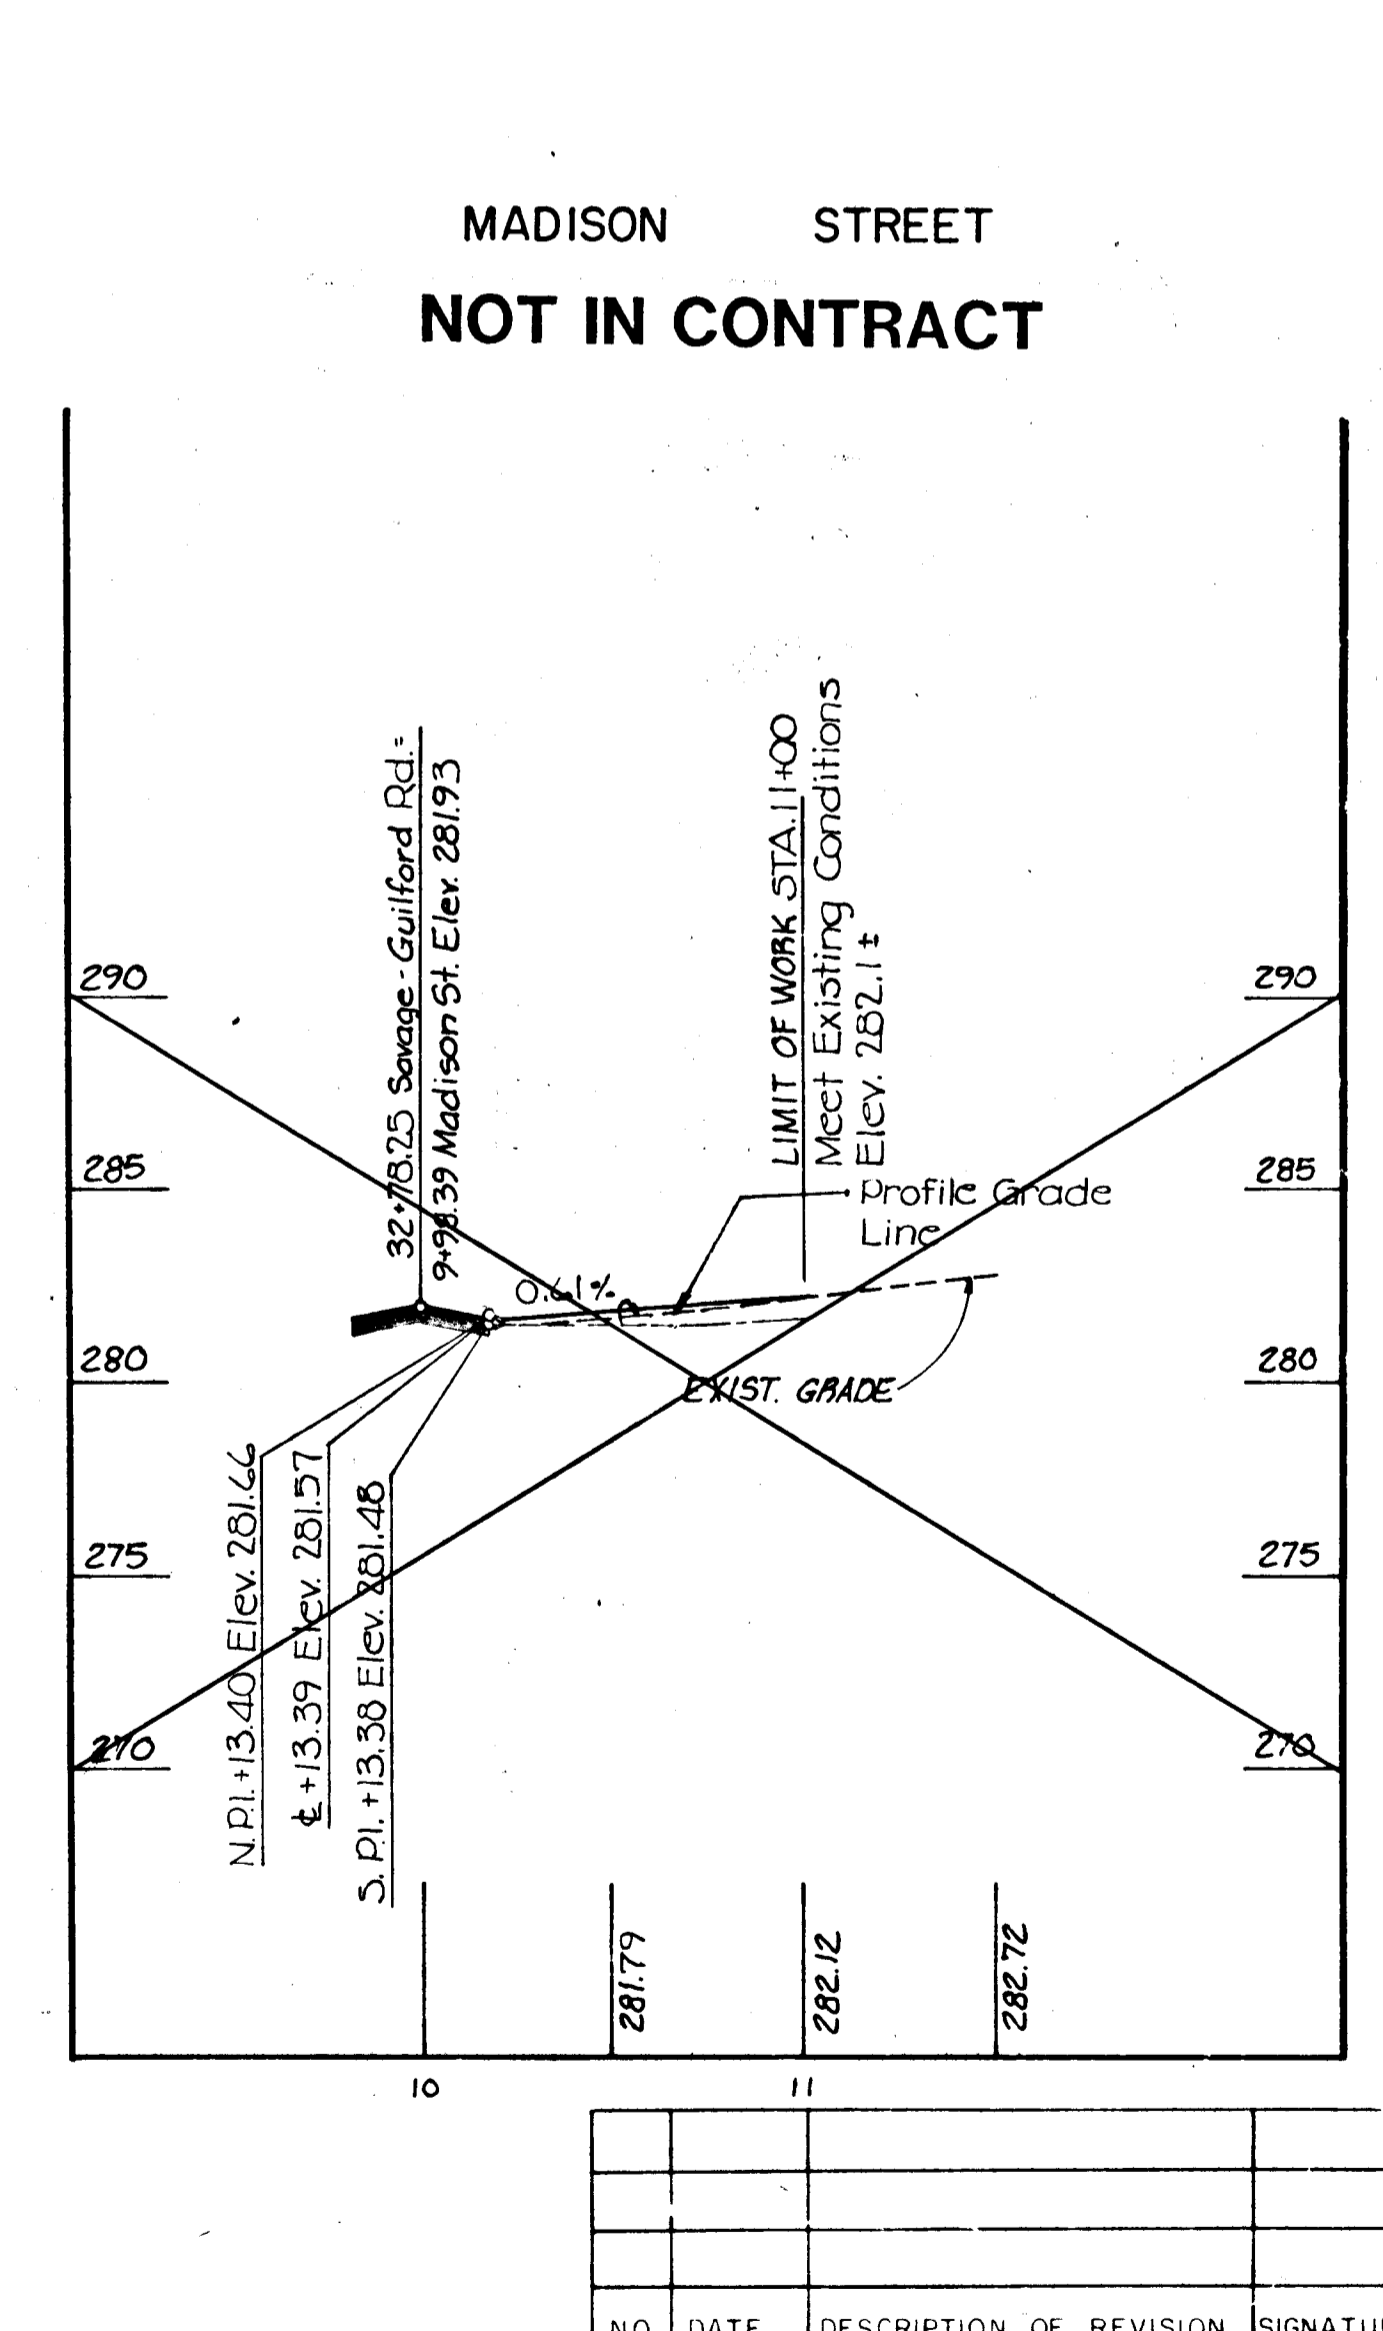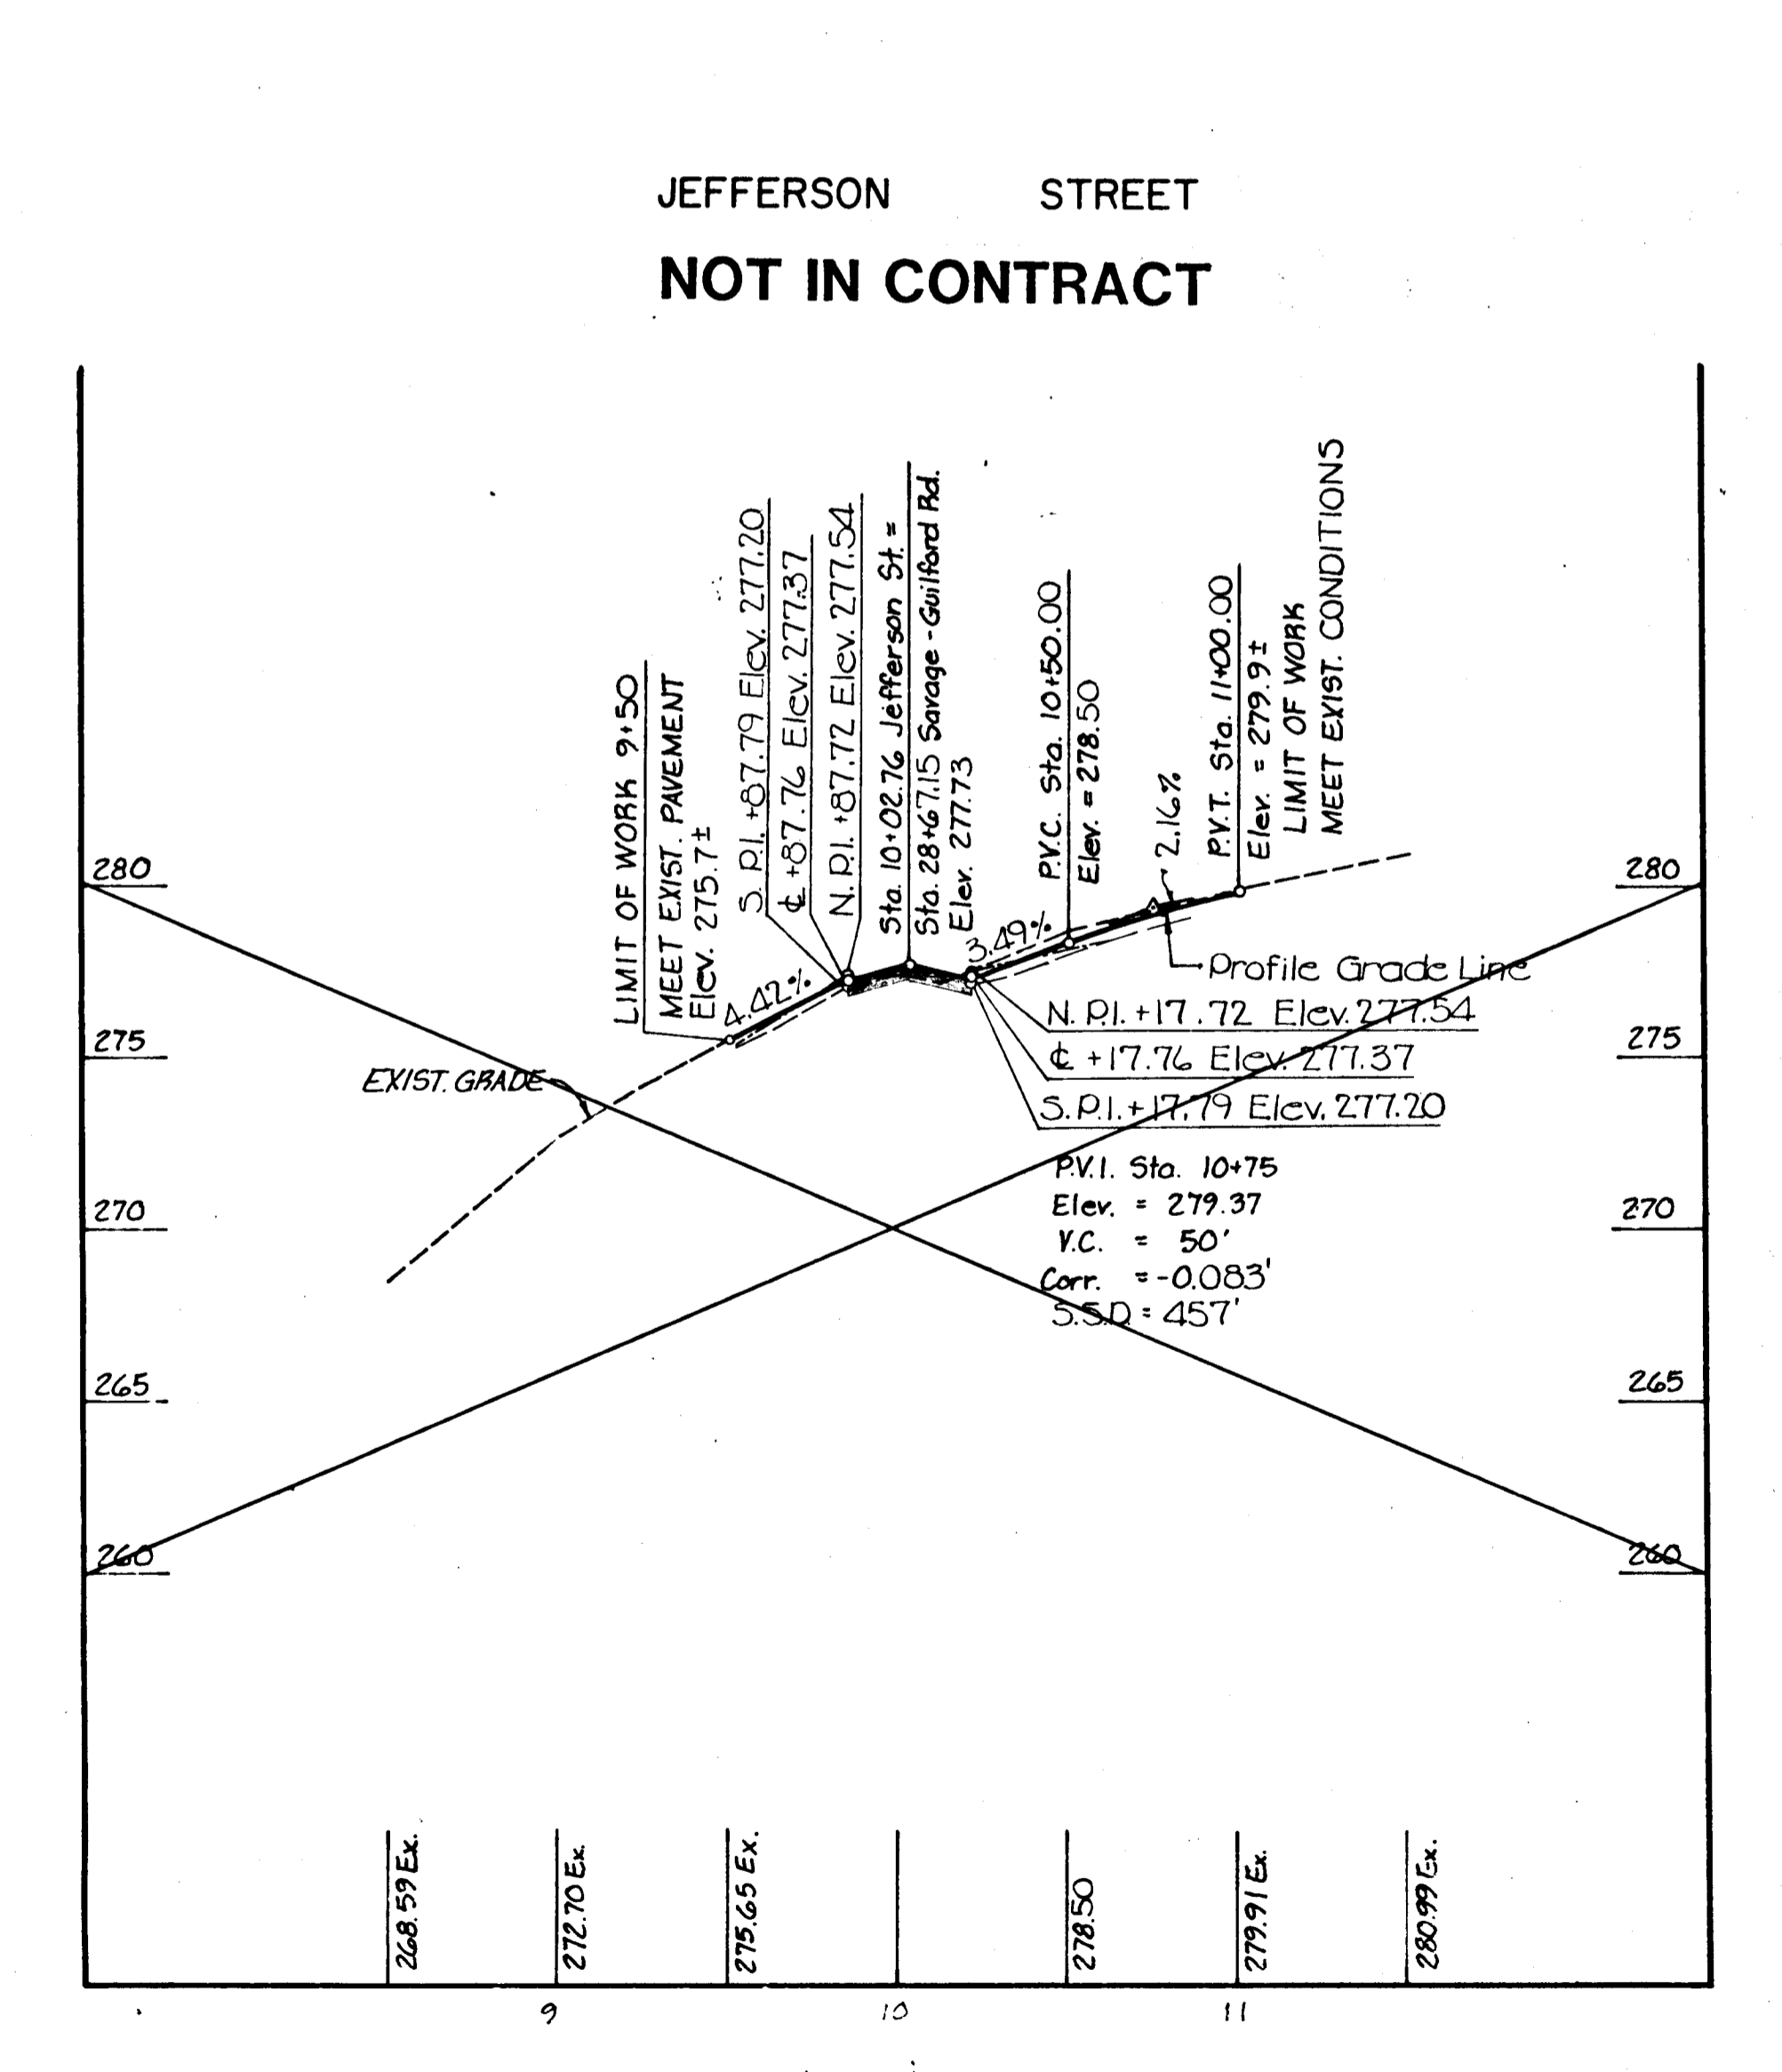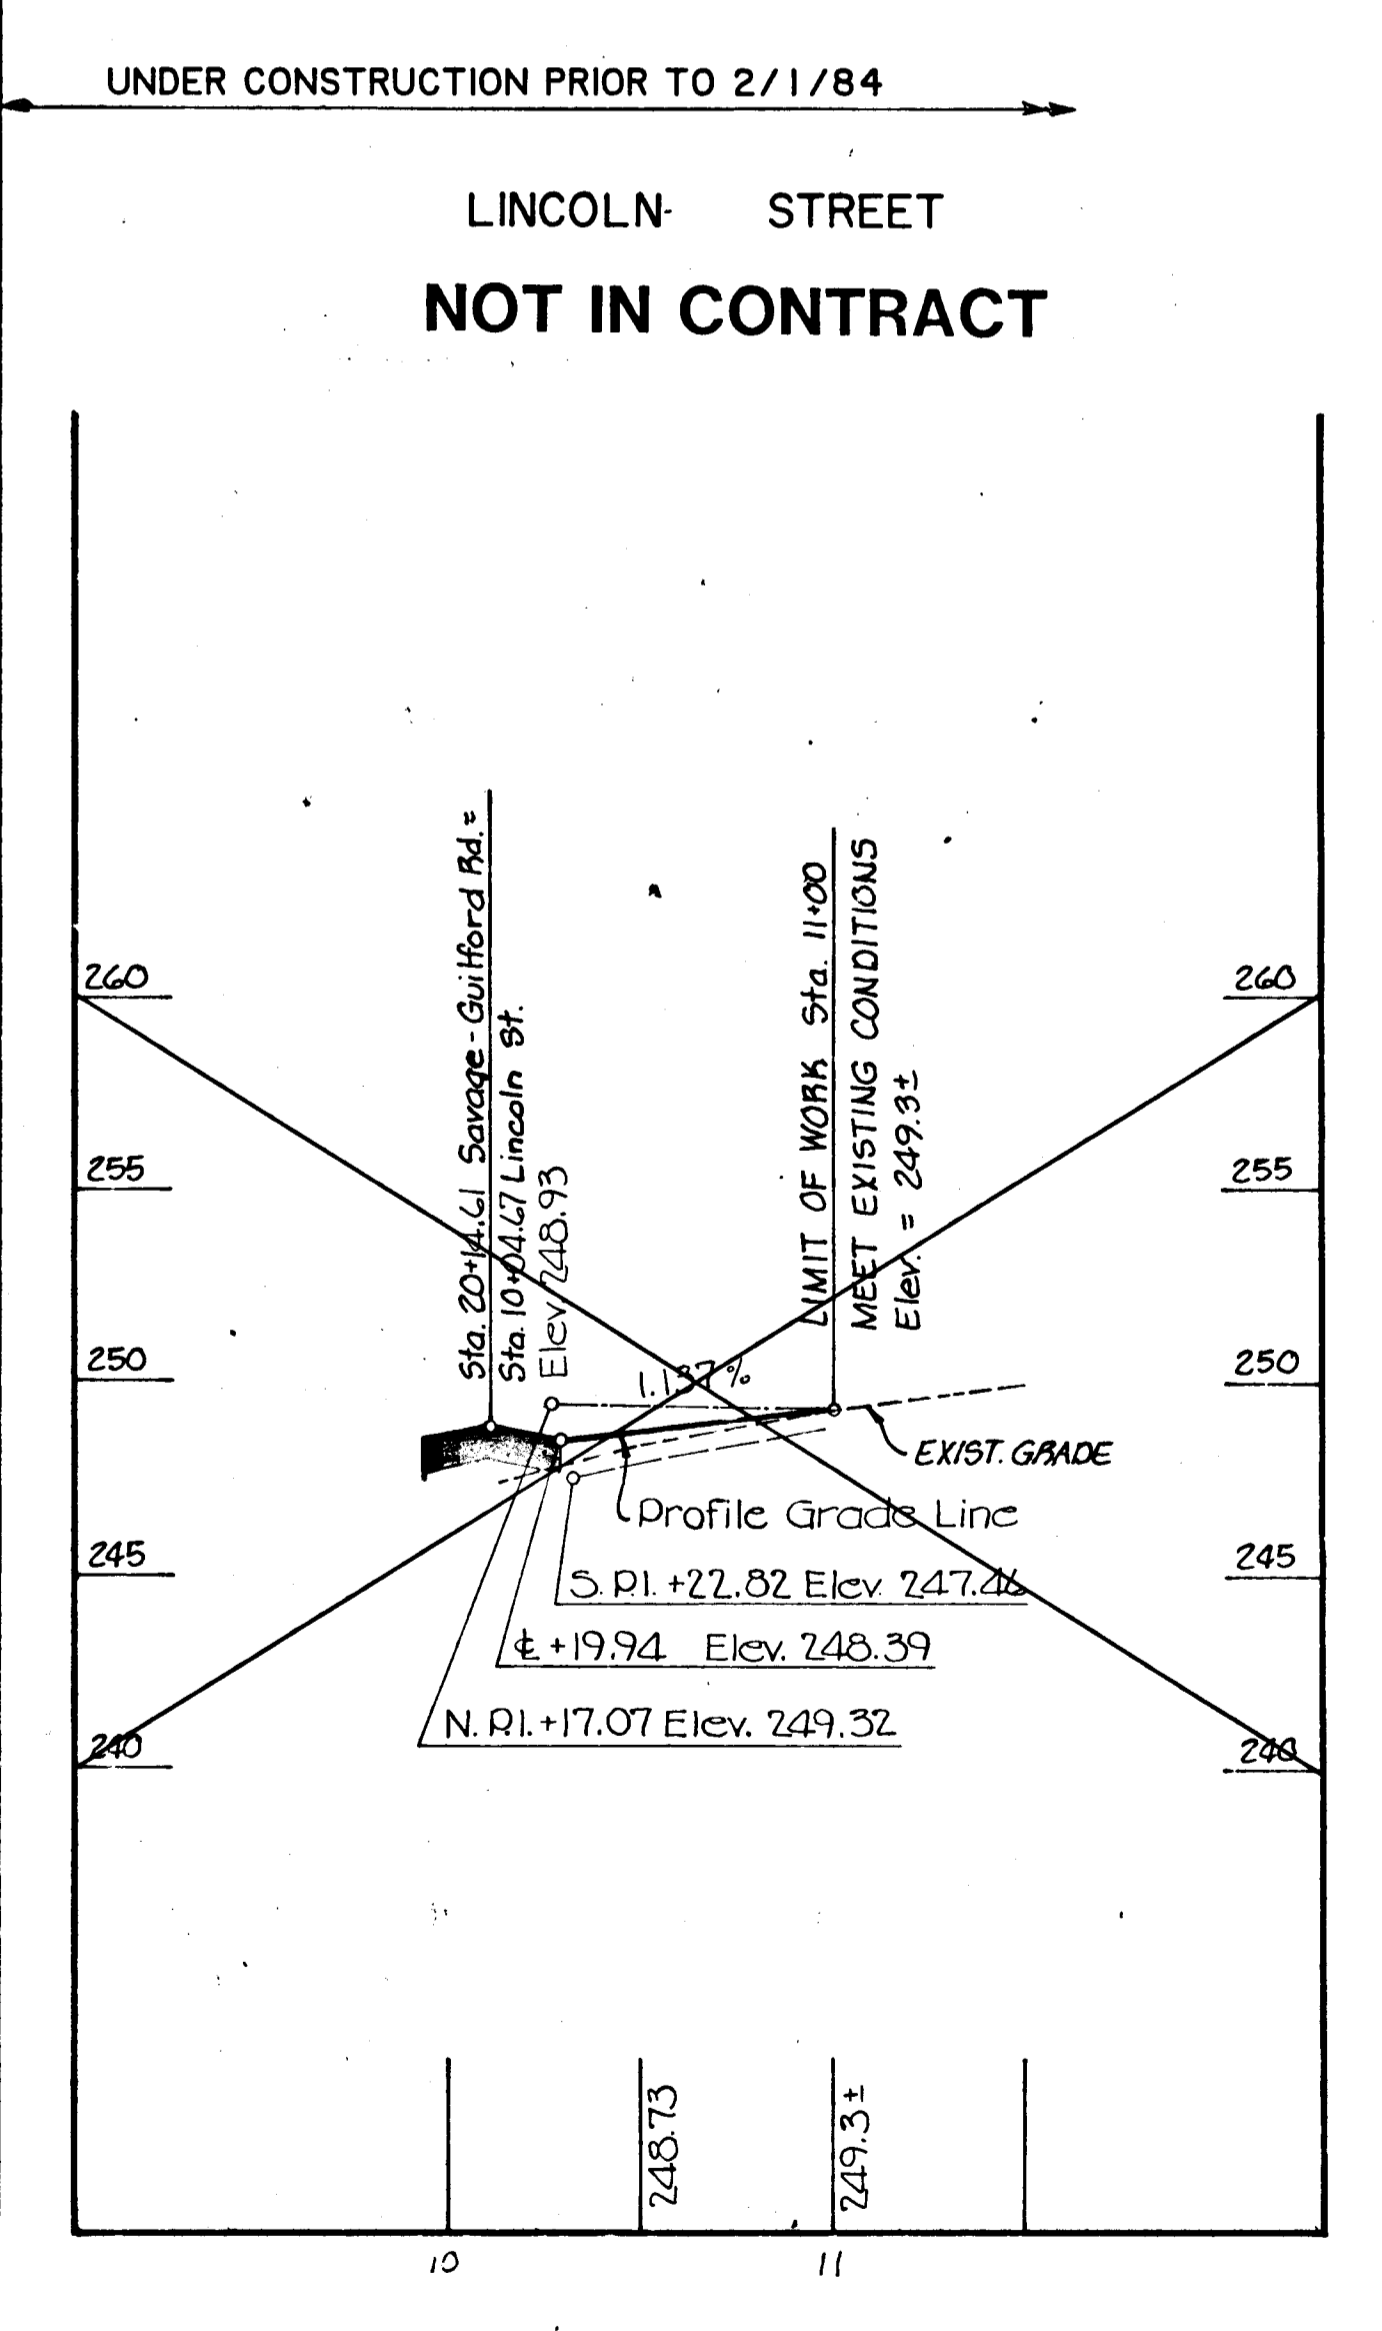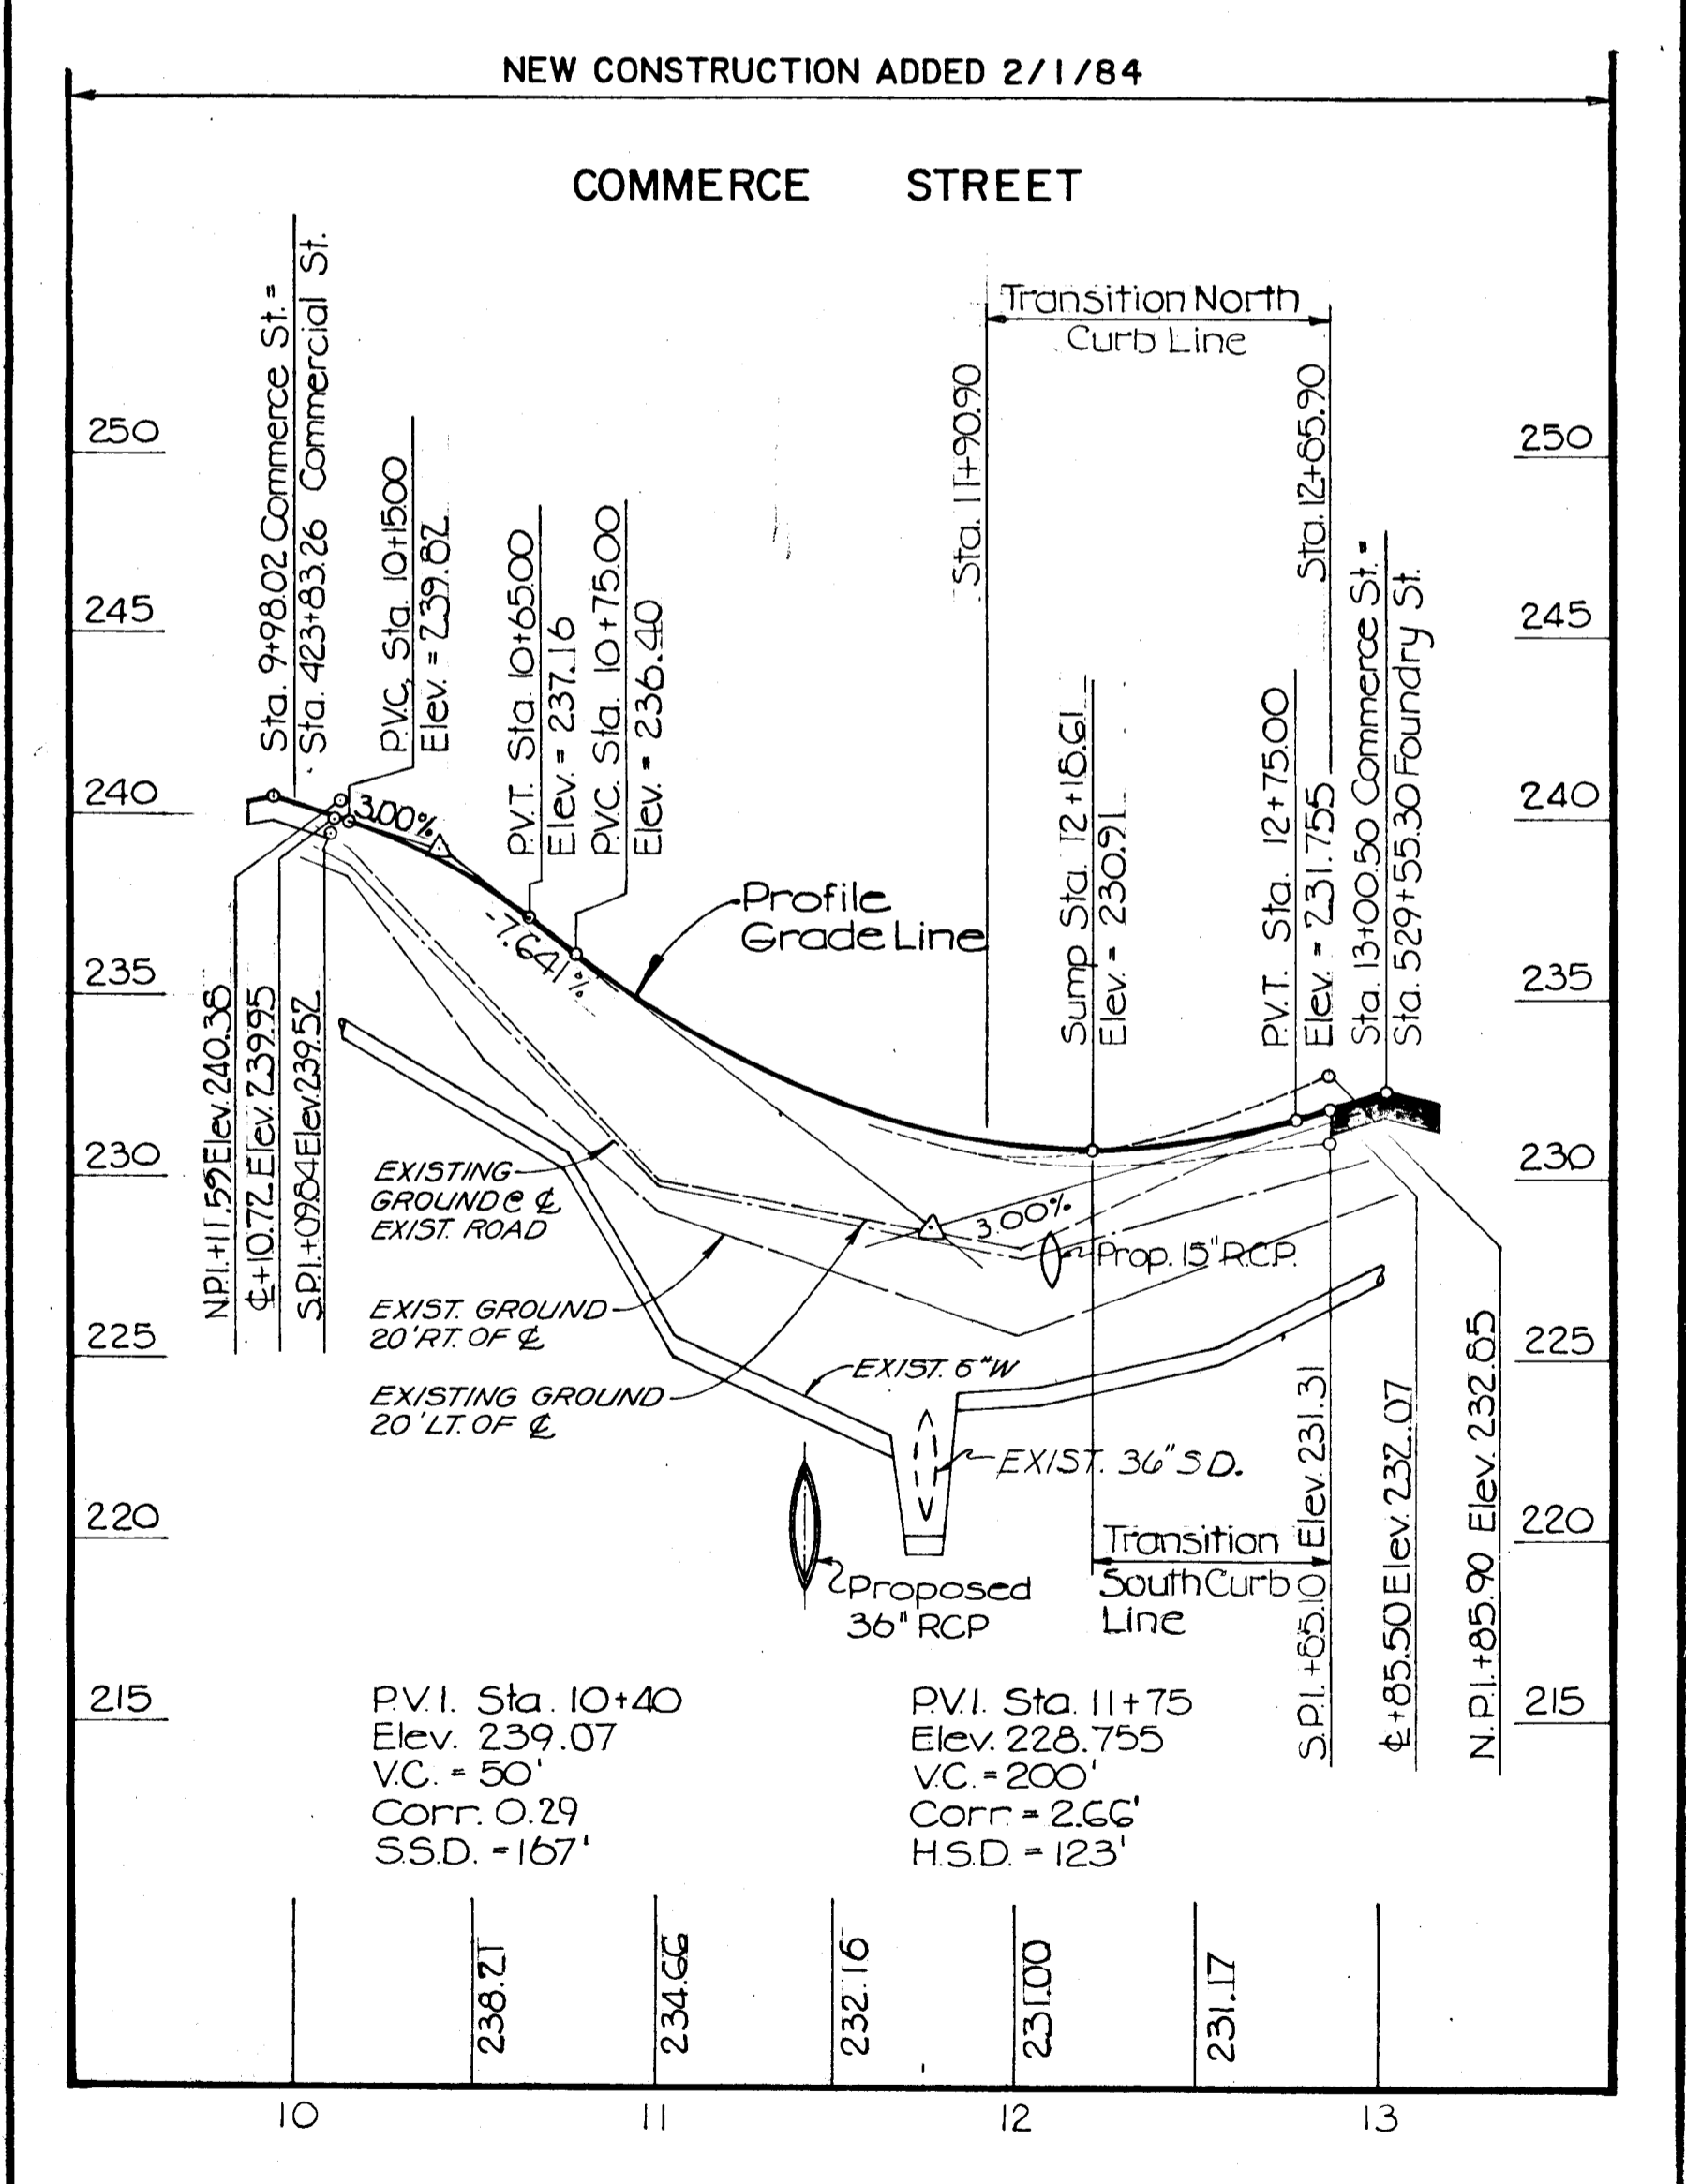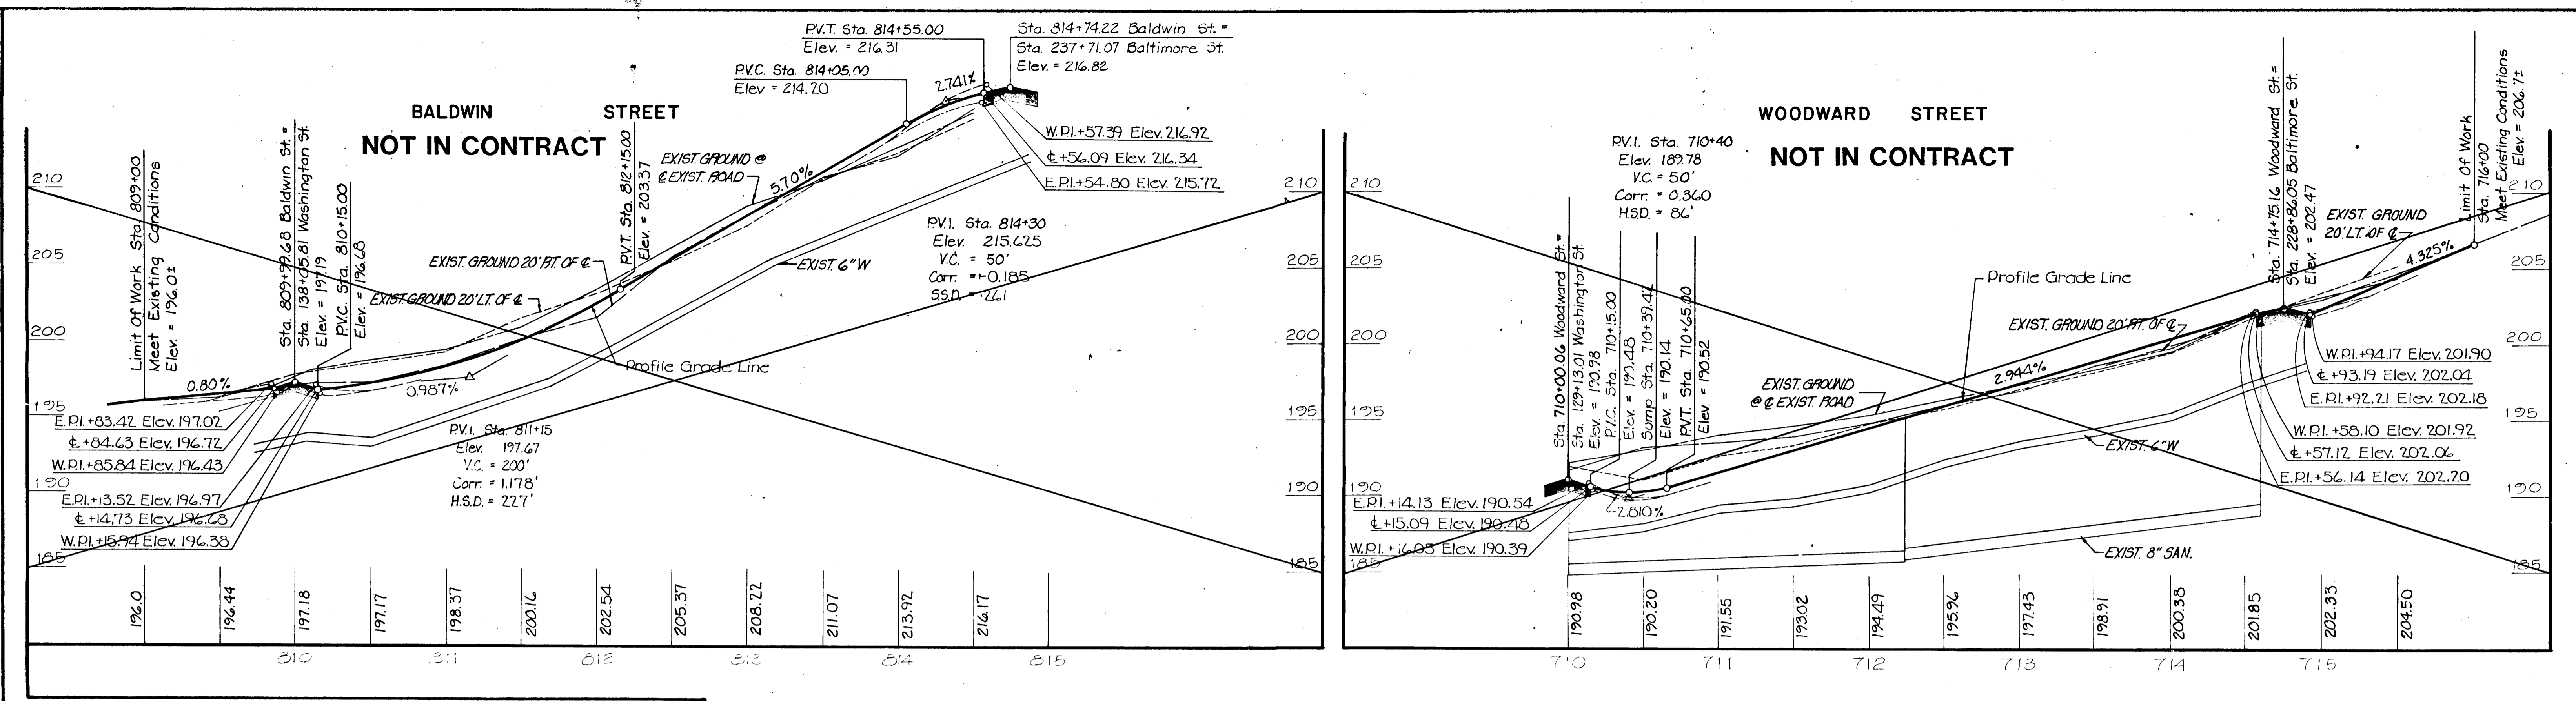

DEPARTMENT OF PUBLIC WORKS
HOWARD COUNTY, MARYLAND
DIRECTOR OF PUBLIC WORKS DATE CHIEF - BUREAU OF ENGINEERING DATE
CHIEF ROADS, BRIDGES, STORM DRAINS DIVISION DATE

PREPARED BY:
THE WILSON T. BALLARD CO.
CONSULTING ENGINEERS
OWINGS MILLS, MARYLAND
TEL. NO. 363-0150

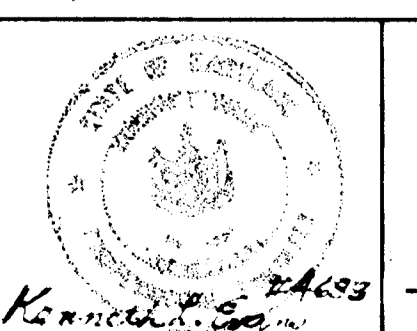

PROFILES
~~BALDWIN STREET, WOODWARD STREET,~~
~~COMMERCE STREET, LINCOLN STREET,~~
~~JEFFERSON STREET, AND MADISON STREET~~








SAVAGE AREA - PHASE B
ROAD AND STORM DRAIN IMPROVEMENTS
CAPITAL PROJECT NOS. J-4-4008 B
ELECTION DISTRICT NO. 6
HOWARD COUNTY, MARYLAND


NO.	DATE	DESCRIPTION OF REVISION	SIGNATURE

DRAWING NO. 9 OF 14 SCALE: HORZ. 1"=50' VERT. 1"=5'


KLE DESIGNED BY
DVM DRAFTED BY
KLE CHECKED BY

977

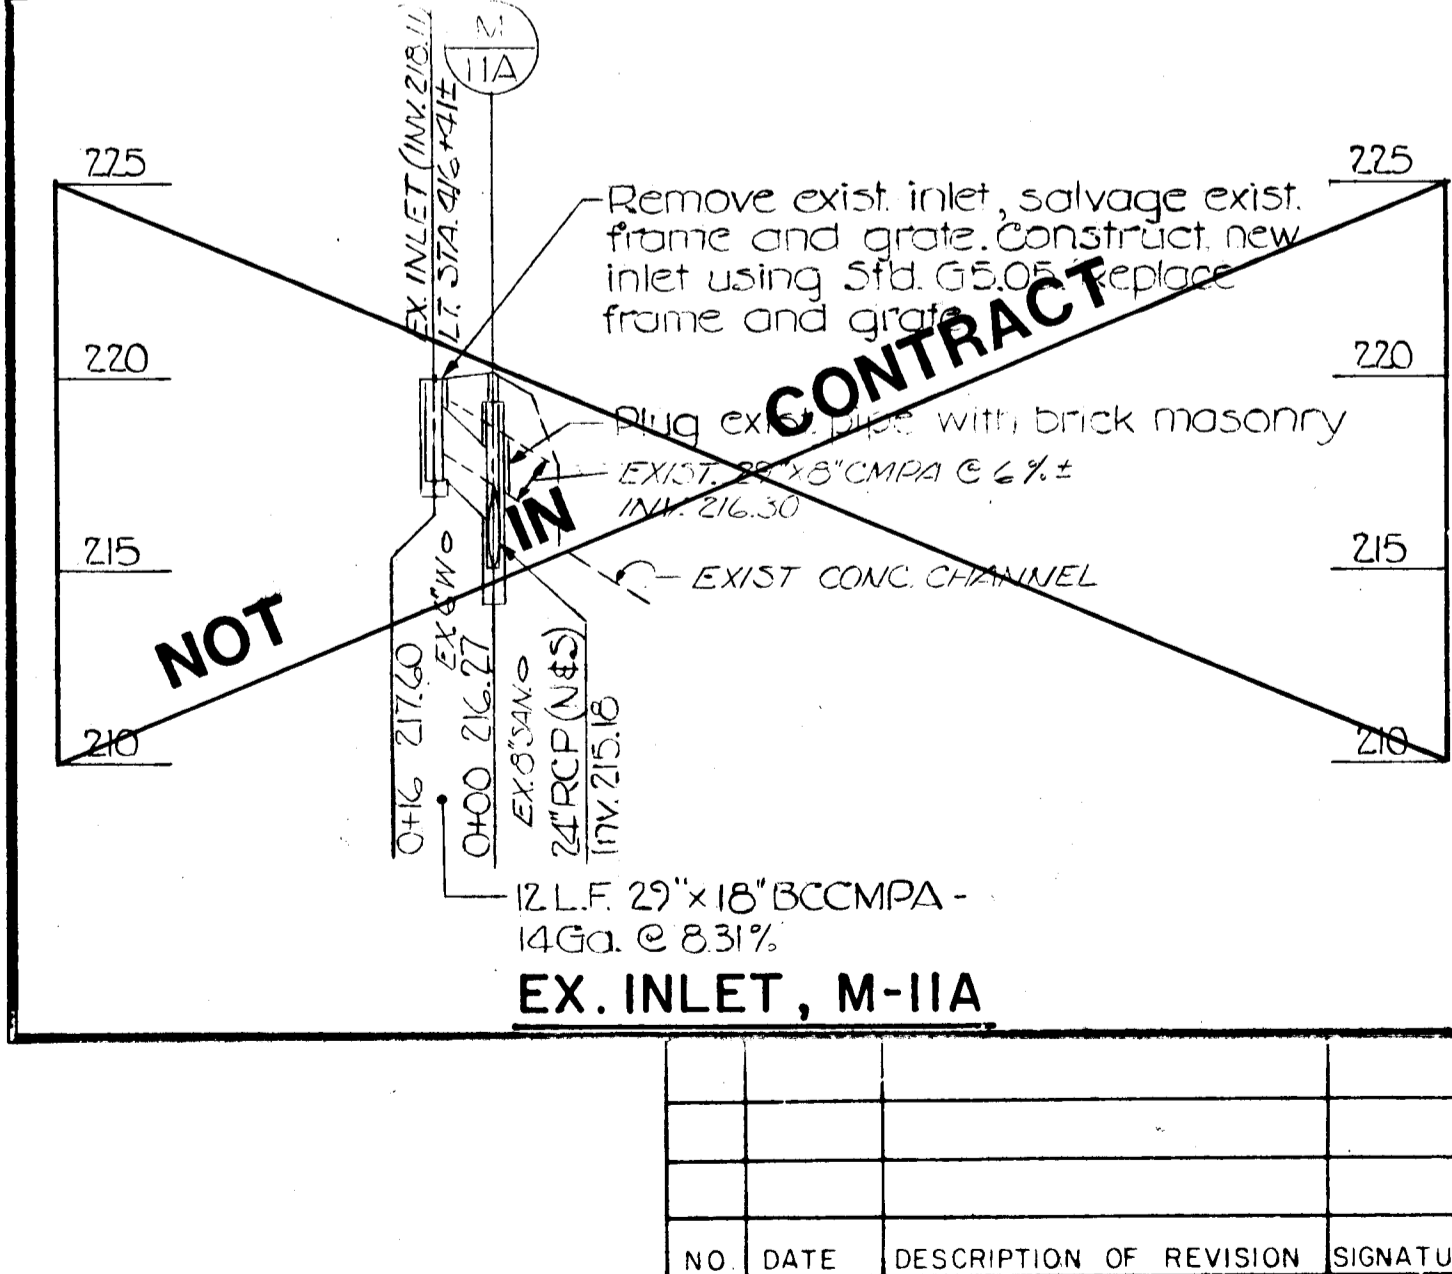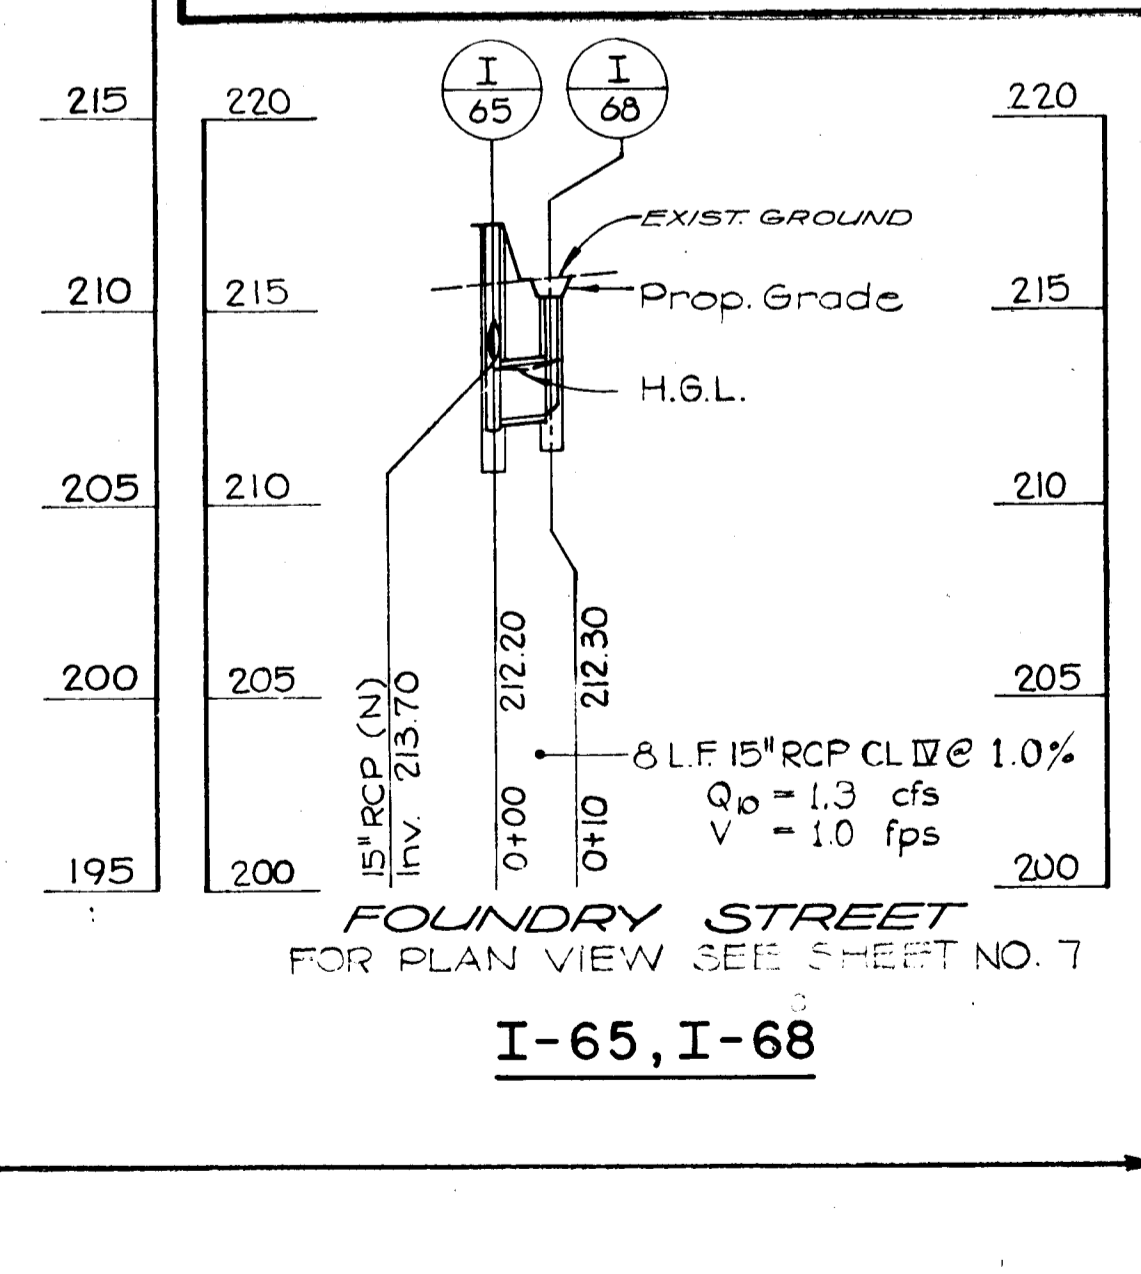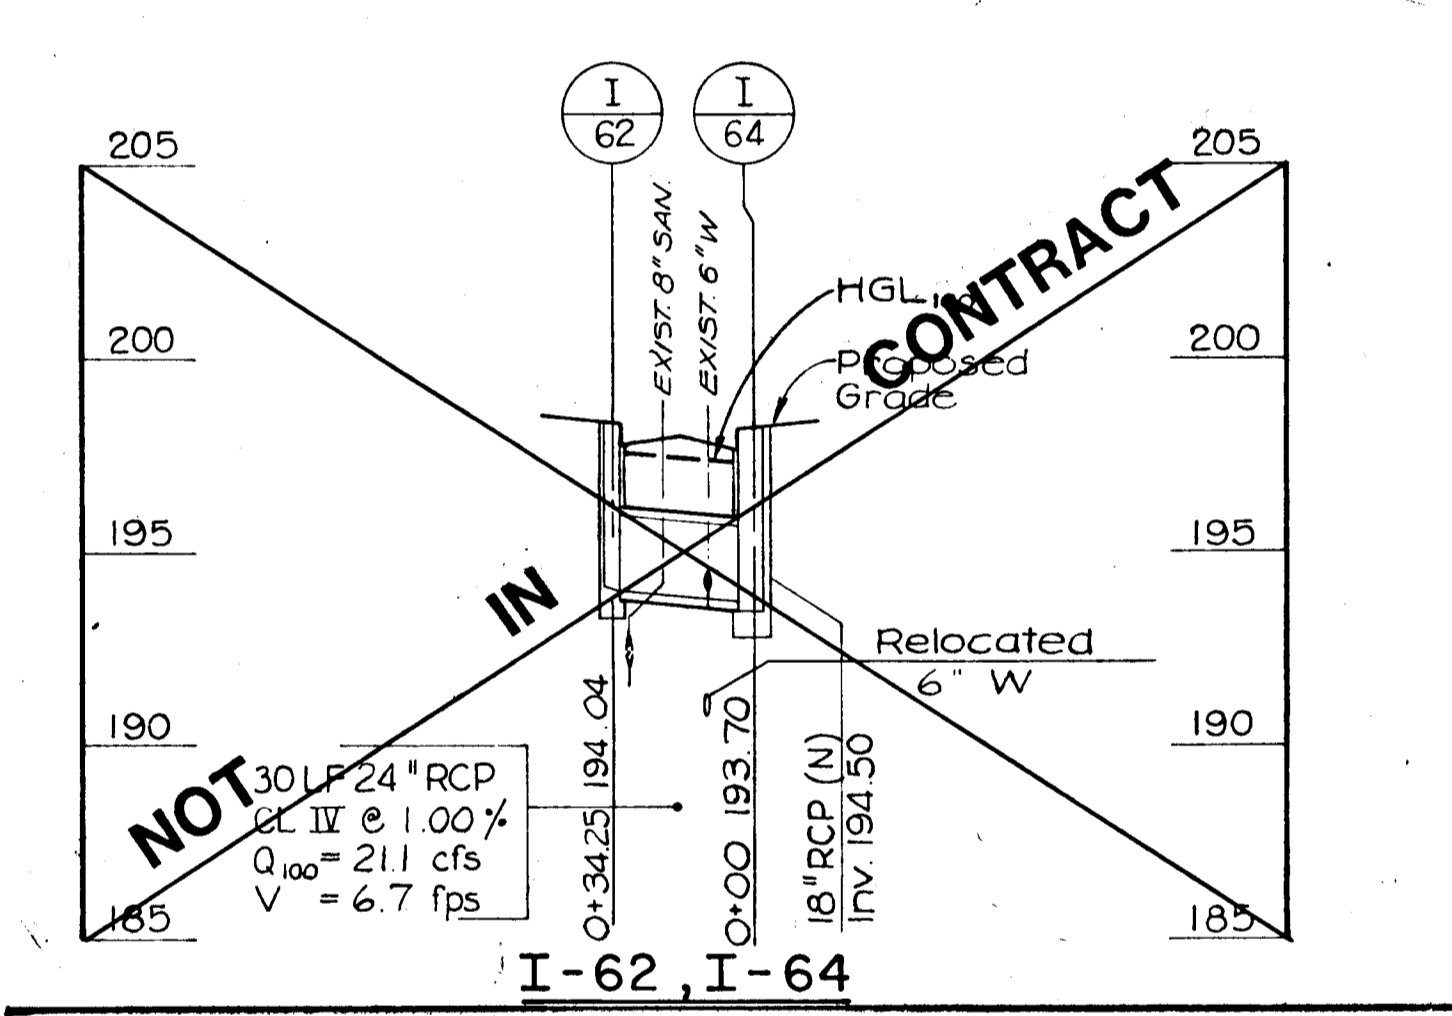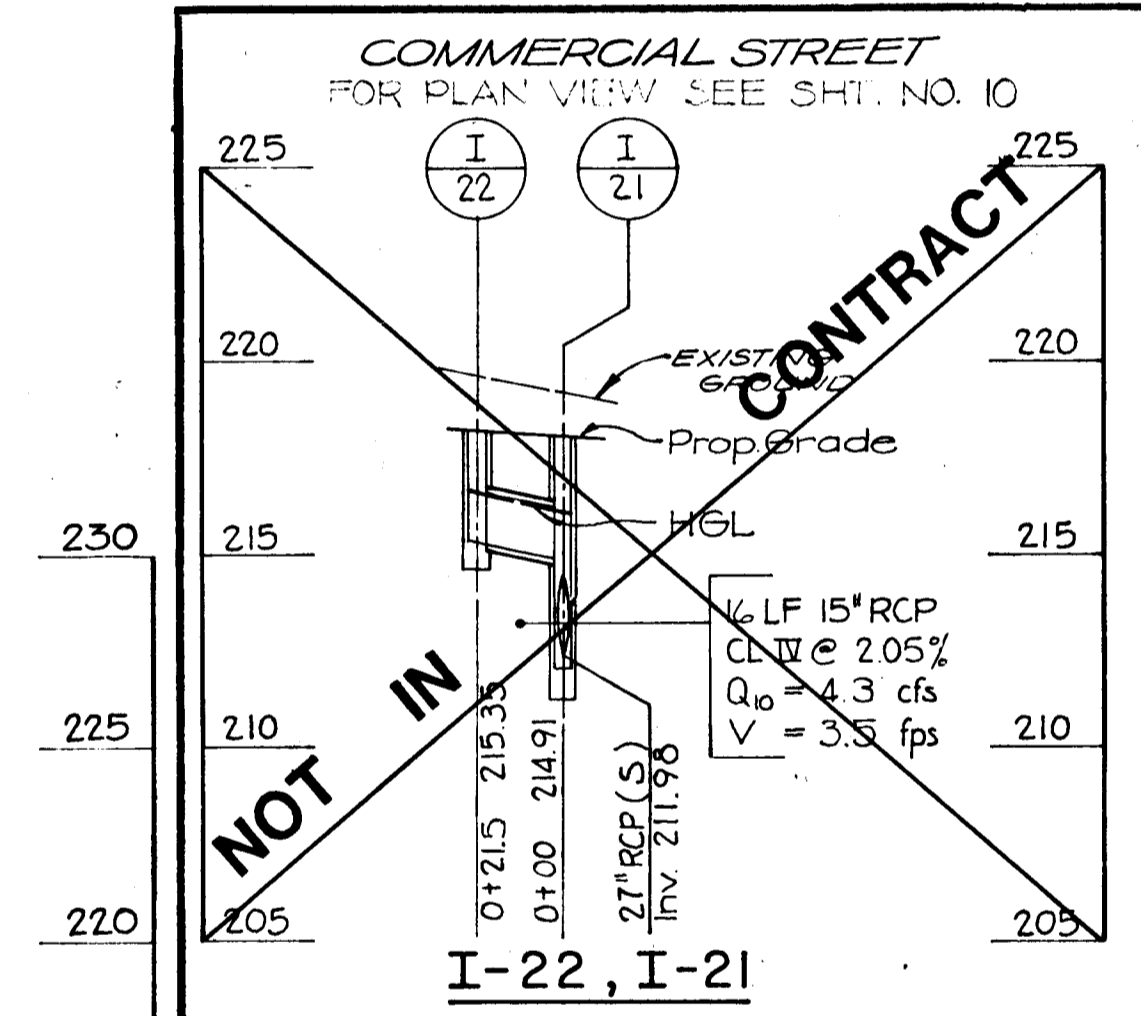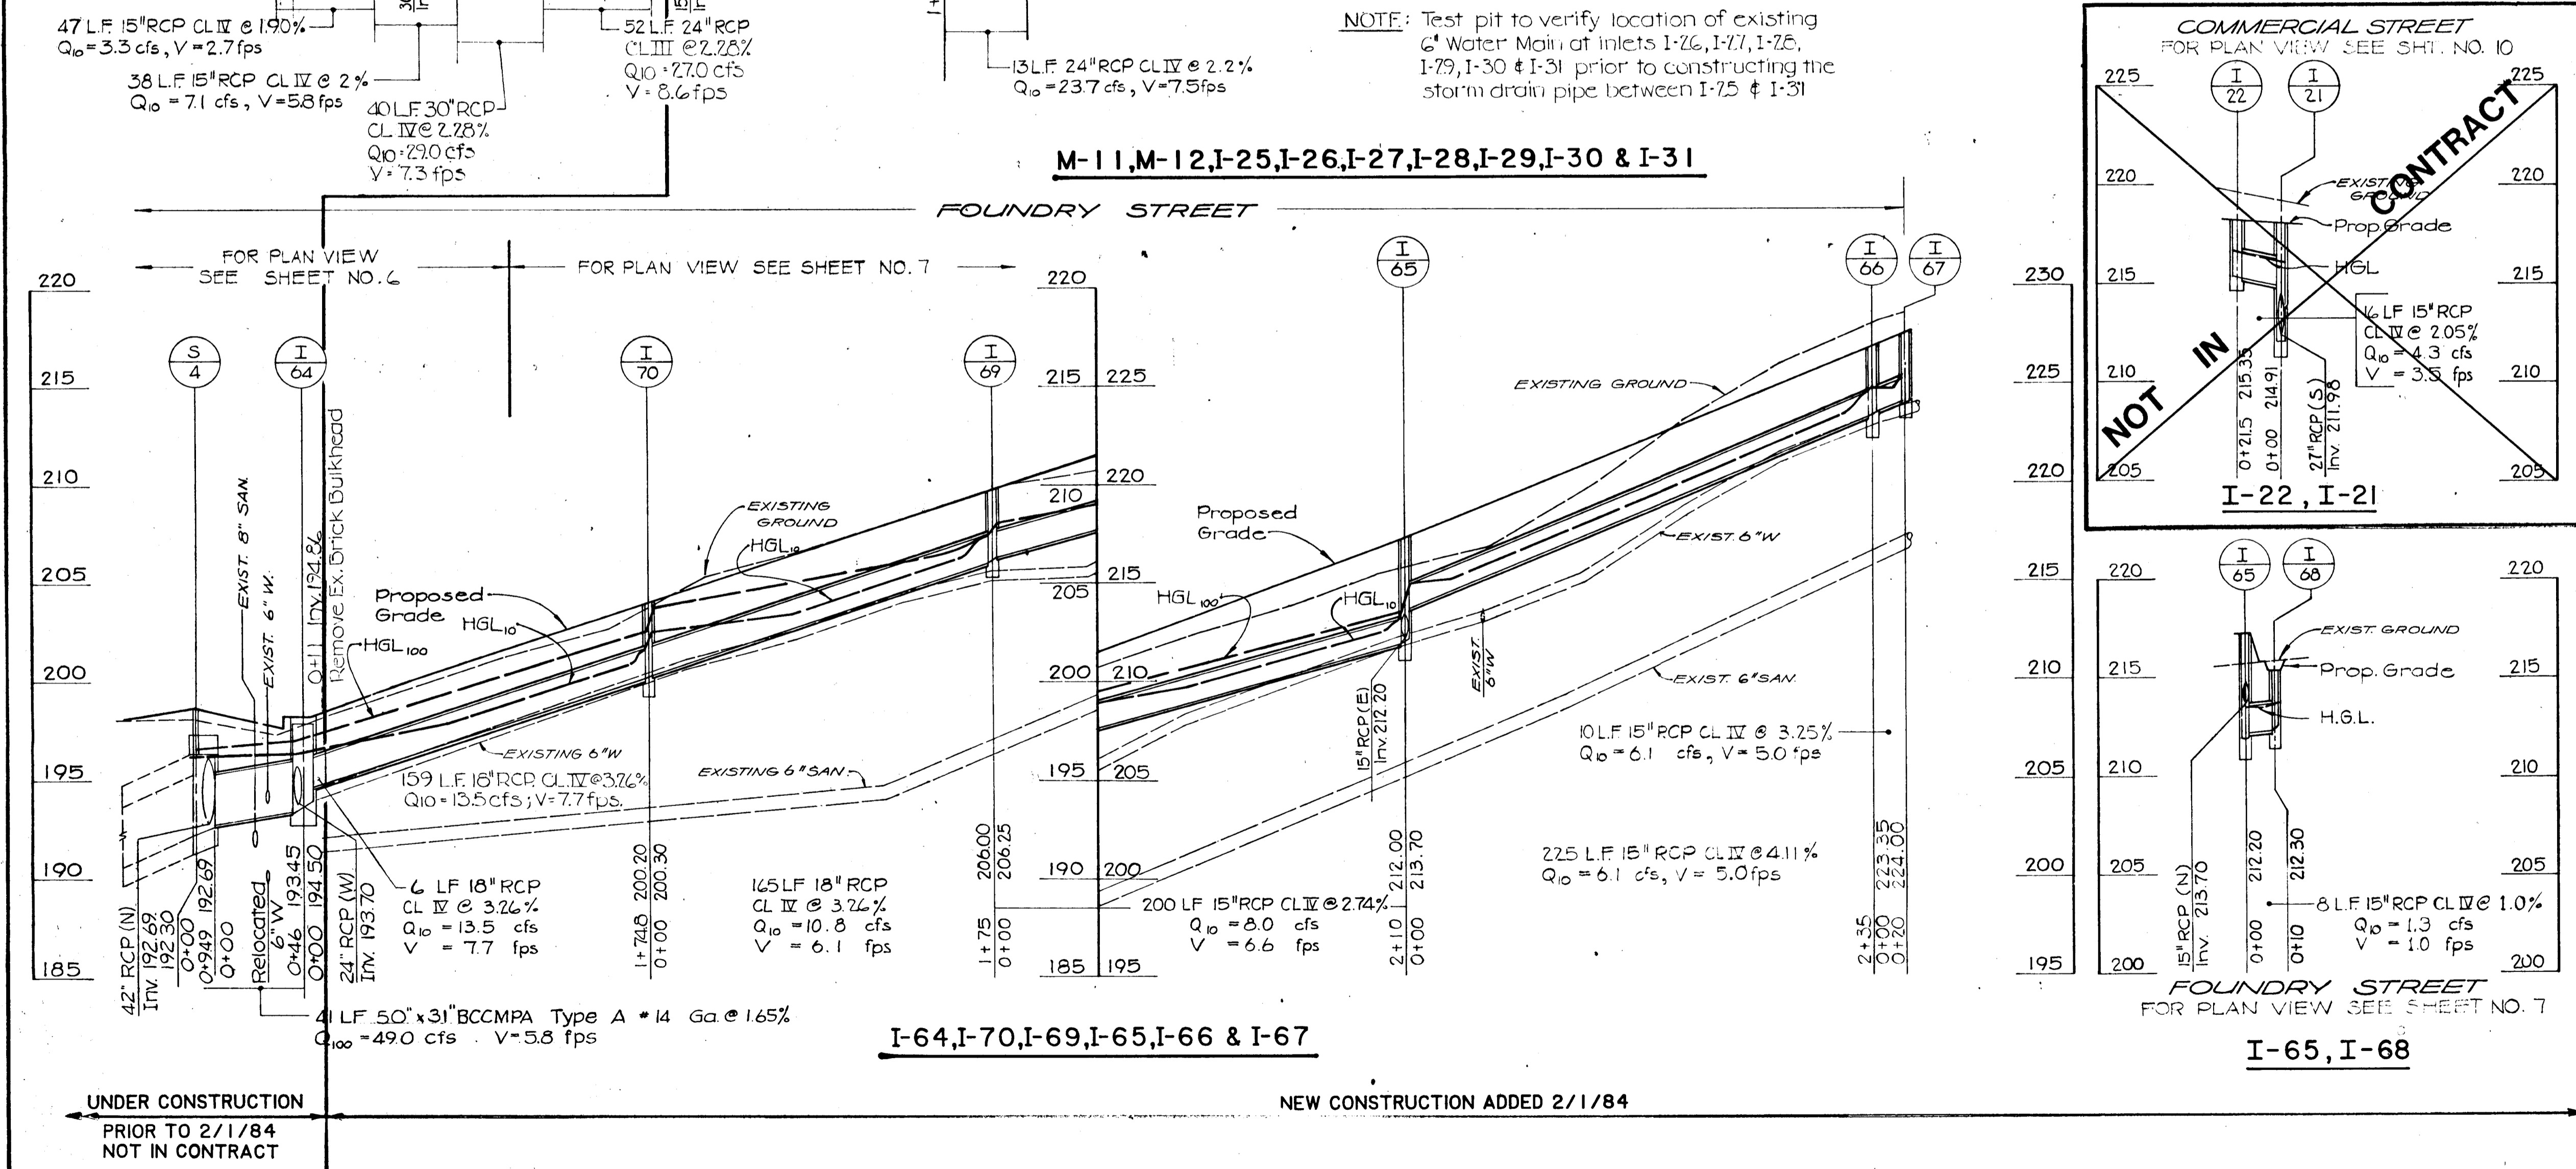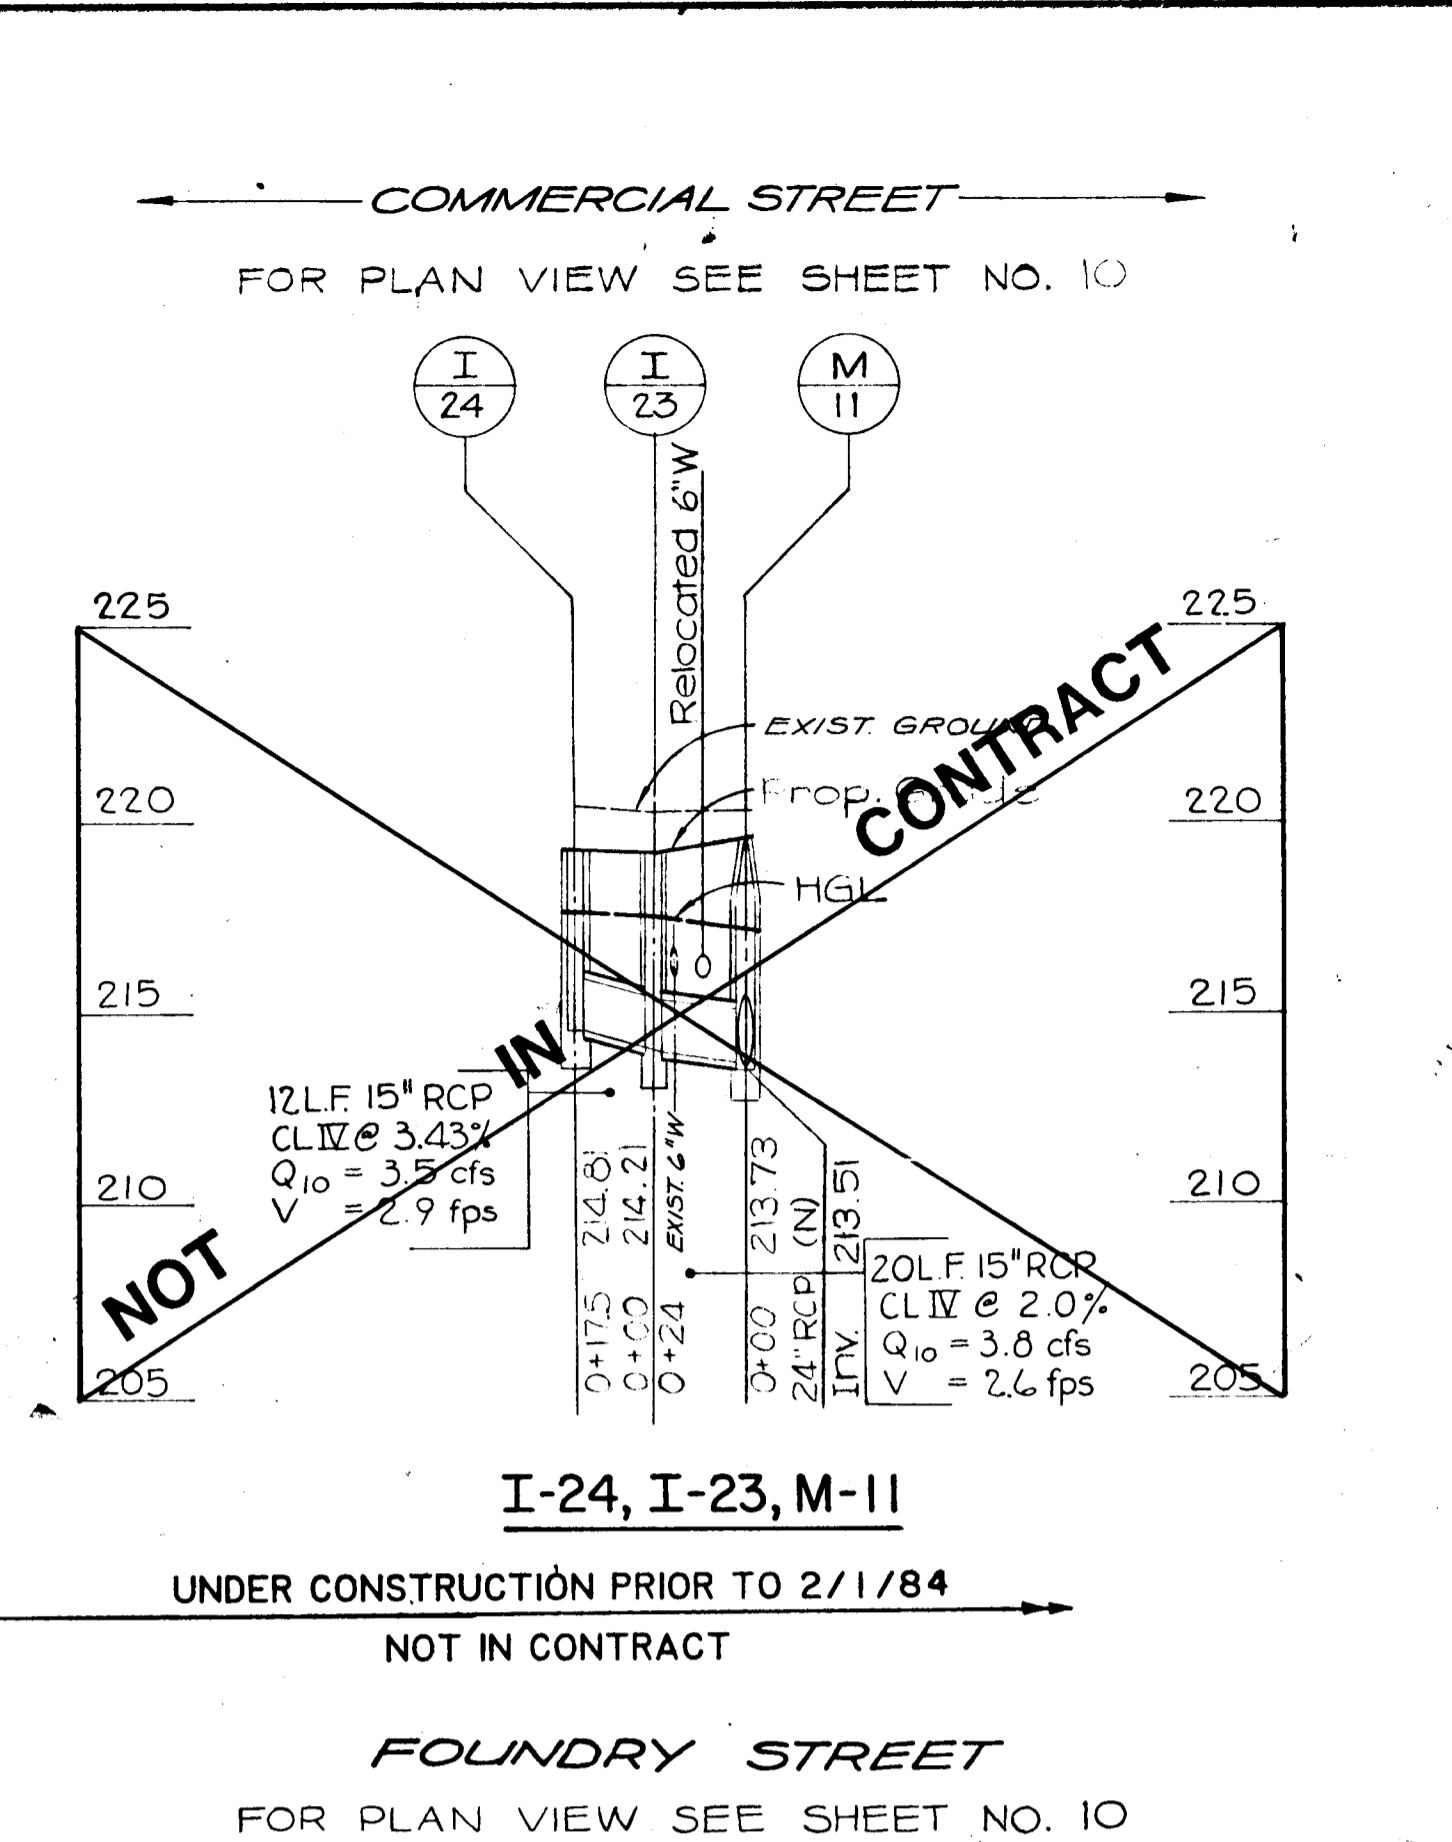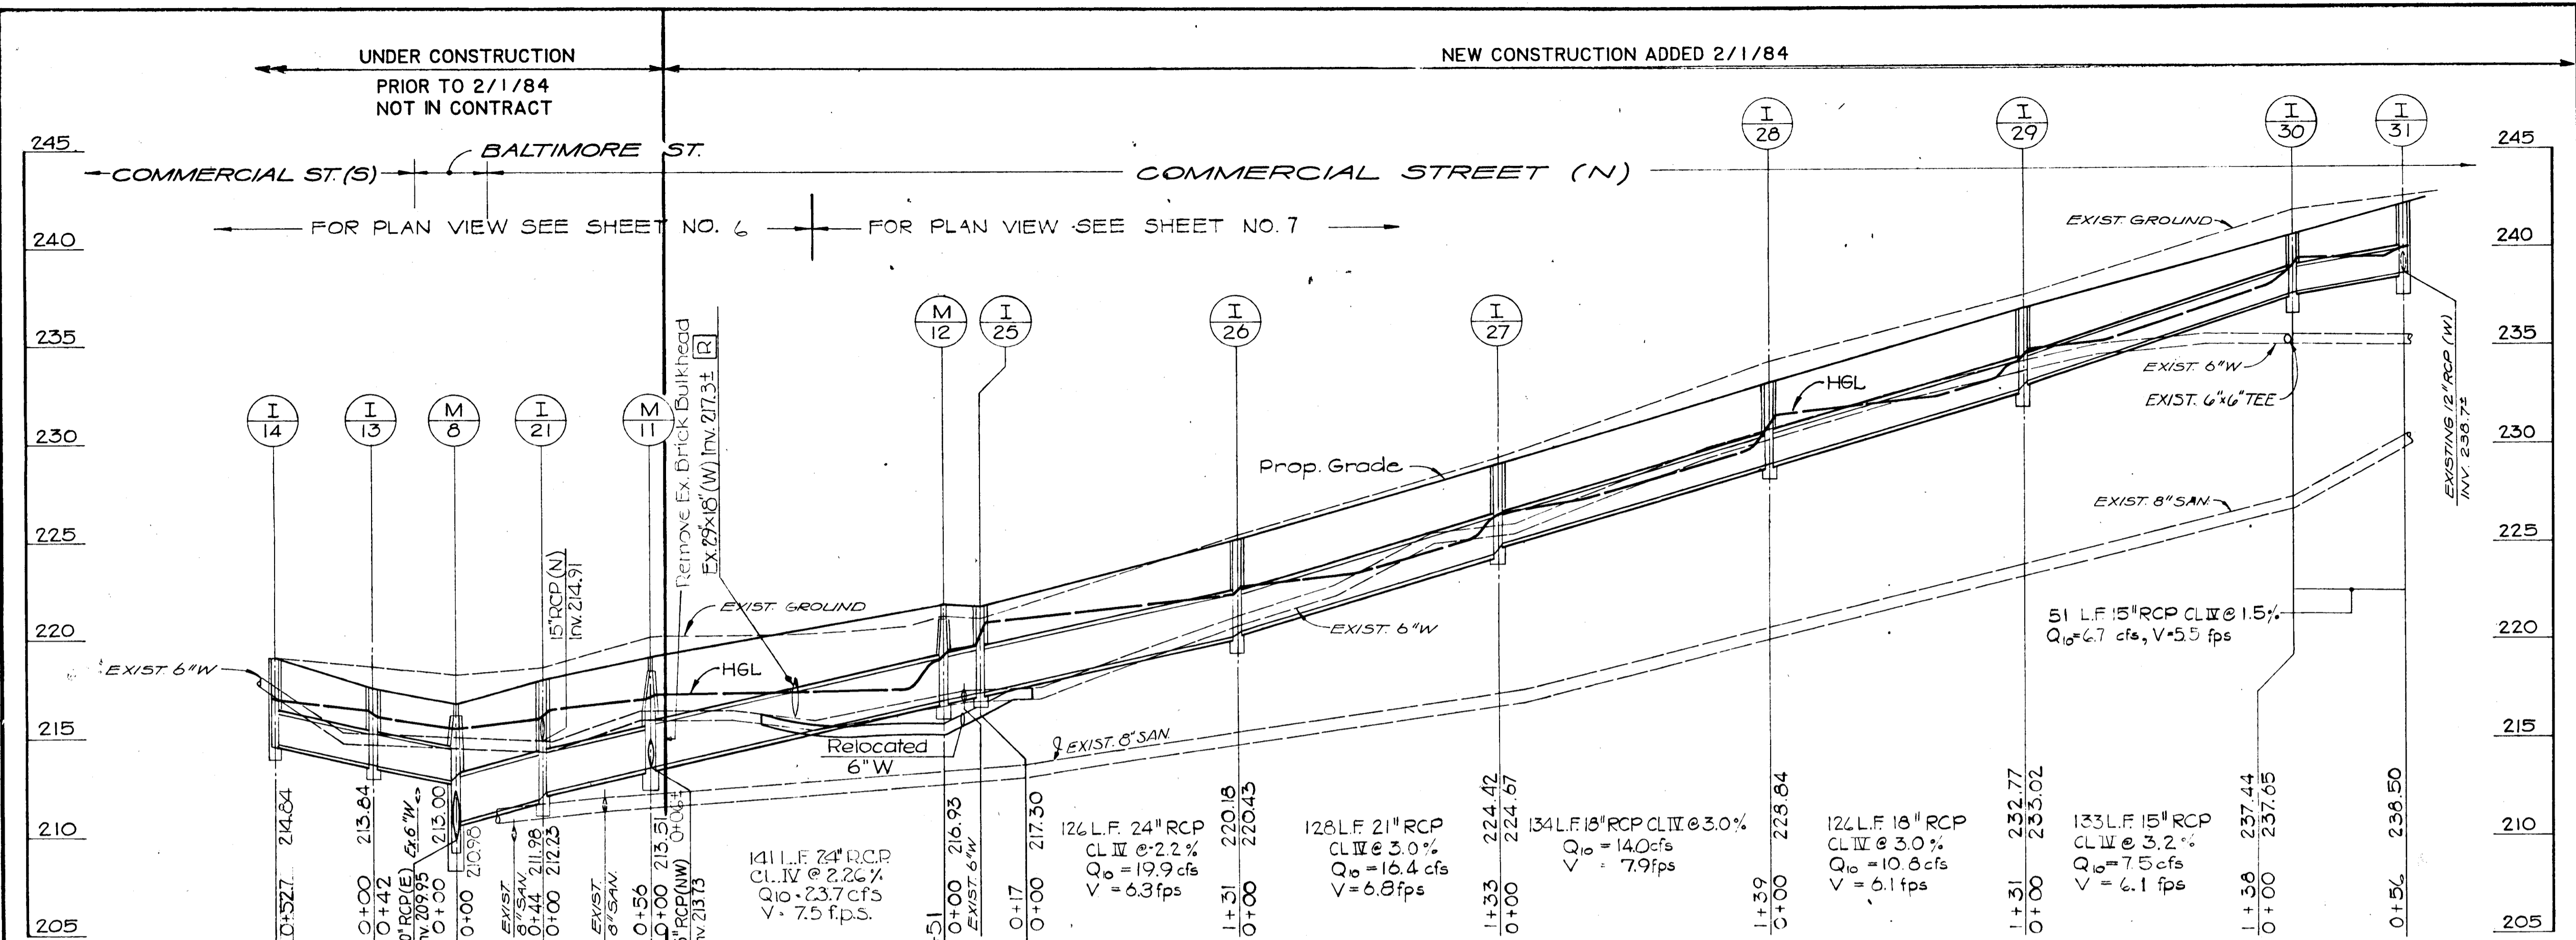

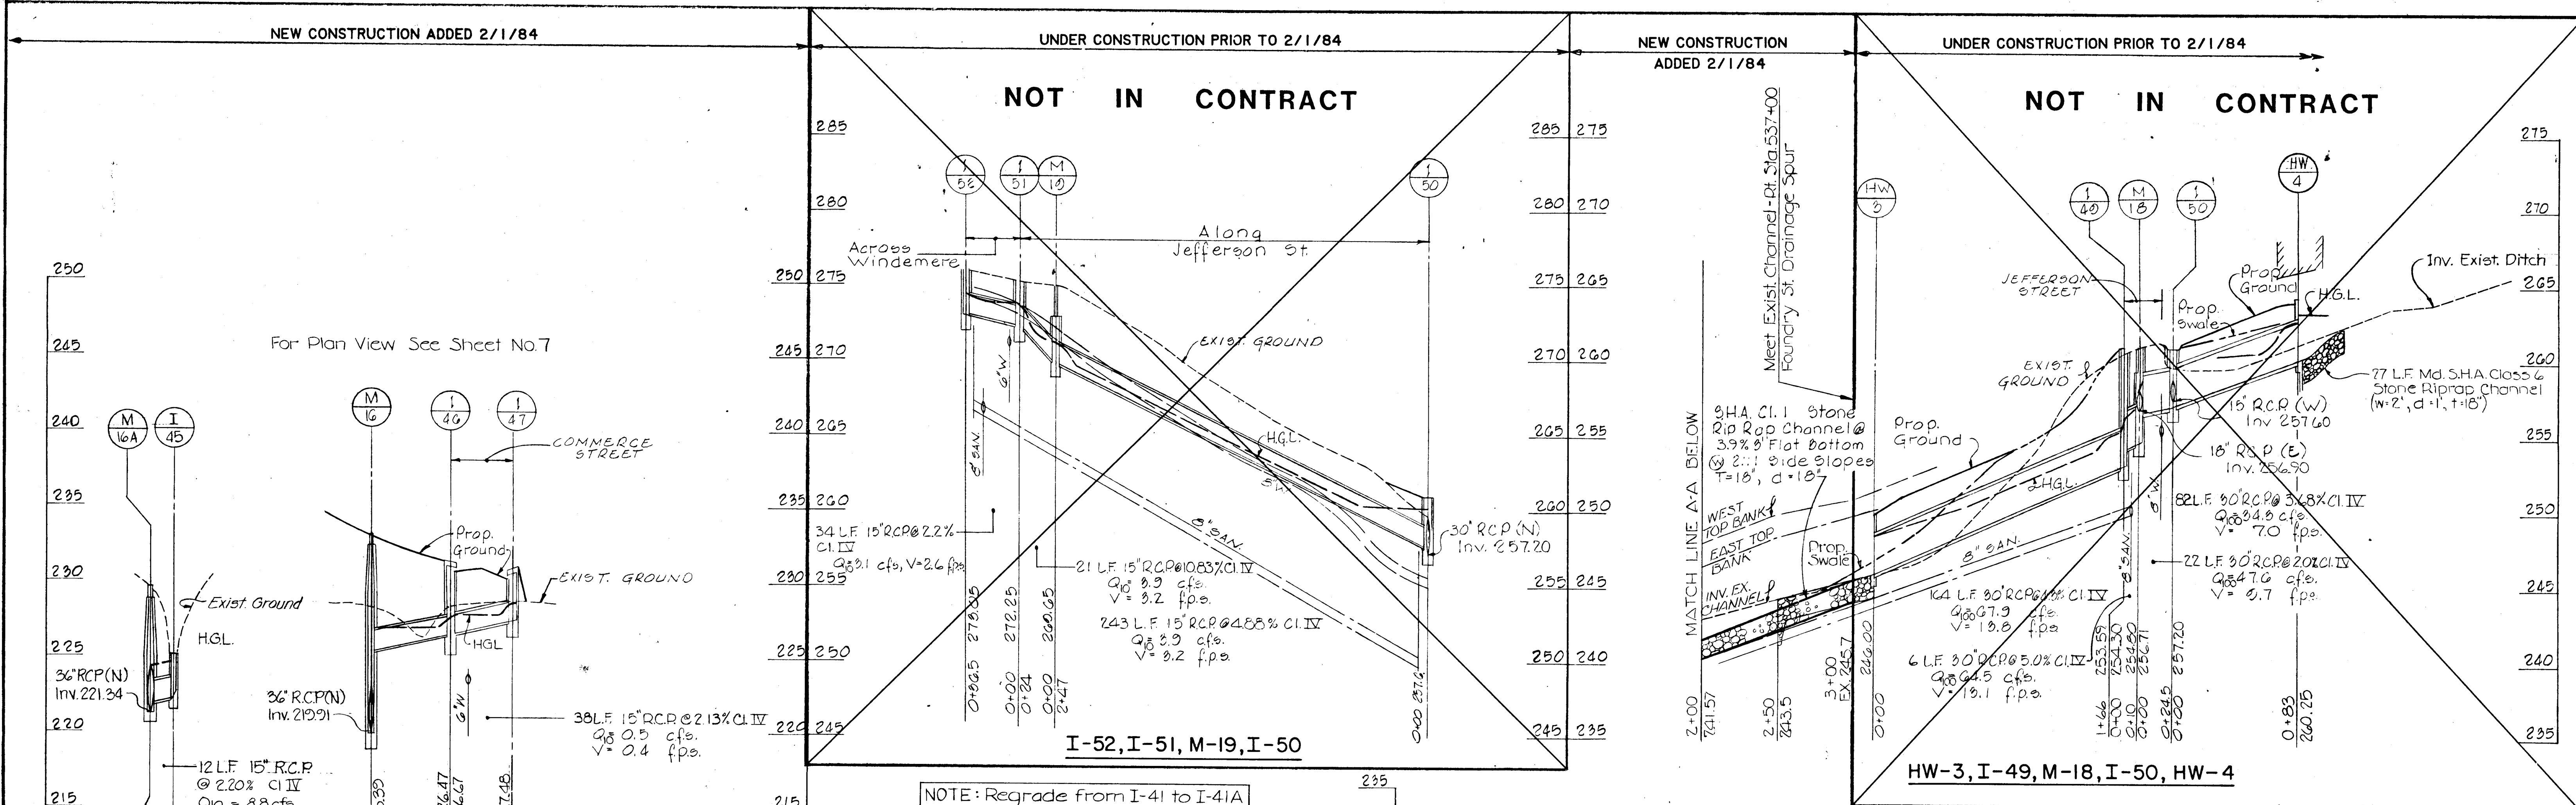


NOTE: Regrade from I-41 to I-41A as shown on the Cross Sections under this Contract

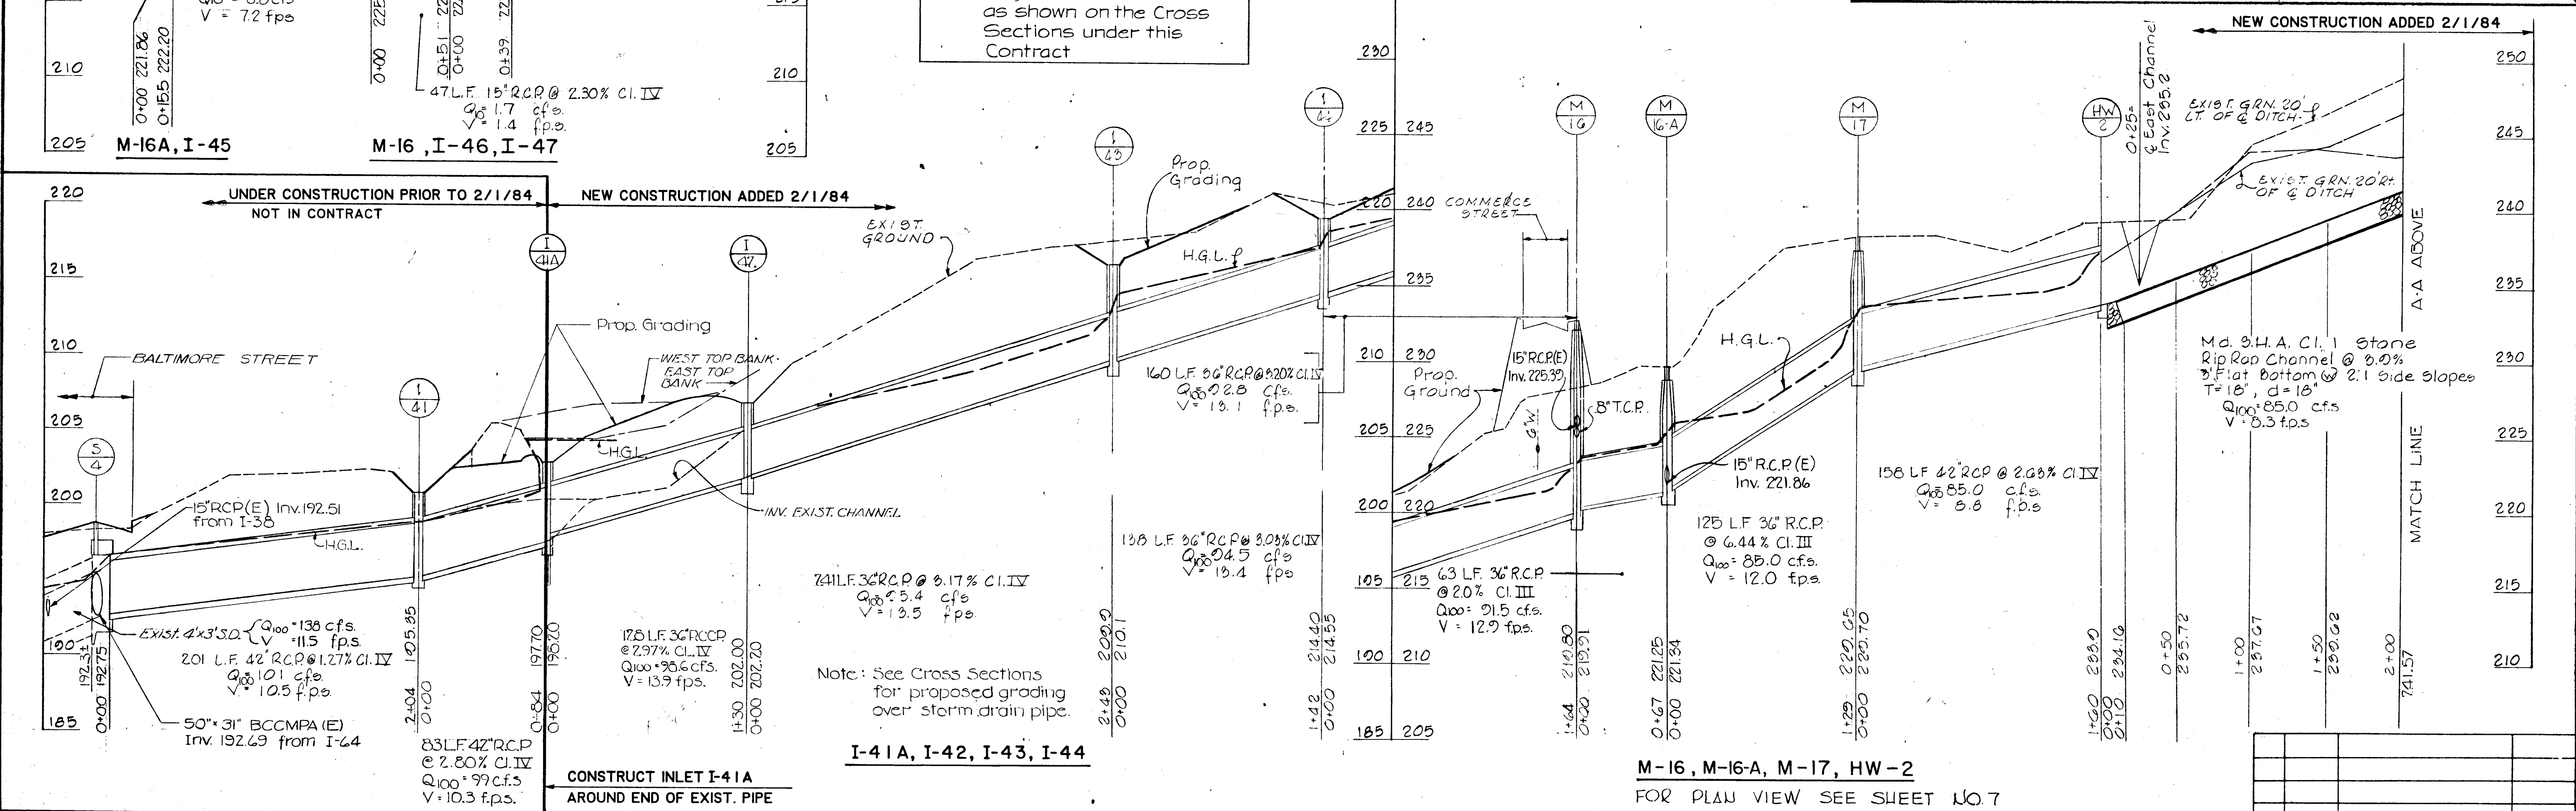

DEPARTMENT OF PUBLIC WORKS
 HOWARD COUNTY, MARYLAND
 DIRECTOR OF PUBLIC WORKS DATE CHIEF, BUREAU OF ENGINEERING DATE
 CHIEF ROADS, BRIDGES, STORM DRAINS DIVISION DATE

PREPARED BY:
 THE WILSON T. BALLARD CO.
 CONSULTING ENGINEERS
 OWINGS MILLS, MARYLAND
 TEL. NO. 363-0150

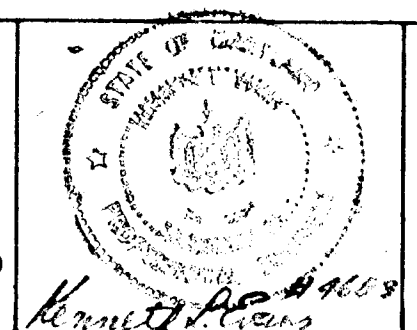

STORM DRAIN PROFILES
COMMERCIAL/FOUNDRY DRAIN
(BALTO. ST. TO JEFFERSON ST.)

SAVAGE AREA - PHASE B
ROAD AND STORM DRAIN IMPROVEMENTS
 CAPITAL PROJECT NOS. J-4-4008B
 ELECTION DISTRICT NO. 6
 HOWARD COUNTY, MARYLAND

NO.	DATE	DESCRIPTION OF REVISION	SIGNATURE


DRAWING NO. <u>11</u> OF <u>14</u>	SCALE: HORZ. 1"=50' VERT. 1"=5'	K.L.E. DESIGNED BY C.F. DRAFTED BY K.L.E. CHECKED BY
------------------------------------	---------------------------------	--

BM 15+4 cut on granite stone on Northwest corner of Foundry St. and Commerce St. Elev. 230.630

DRIVEWAY SCHEDULE											
COMMERCIAL ST.				COMMERCE ST.				FOUNDRY STREET			
LOCATION	TYPE	WIDTH	APPROX. DIST. TO TIE-IN	LOCATION	TYPE	WIDTH	APPROX. DIST. TO TIE-IN	LOCATION	TYPE	WIDTH	APPROX. DIST. TO TIE-IN
Lt. 417+08	3	10'	5'	Rt. 10+48	1	11'	42'	Rt. 10+18	1	10'	5'
Lt. 417+71	3	10'	13'								
Lt. 417+90	3	10'	14'								
Lt. 418+75	2	10'	8'								
Lt. 419+67	2	12'	16'								
Rt. 419+67	1	25'	3'								
Lt. 421+13	2	12'	8'	Lt. 521+62	3	10'	5'				
Rt. 421+33	1	10'	6'	Lt. 522+62	3	10'	9'				
Lt. 423+60	1	10'	35'	Rt. 525+03	2	14'	7'				
Rt. 424+76	2	12'	35'	Lt. 525+72	1	10'	13'				
Rt. 425+02	2	15'	22'	Rt. 525+93	2	15'	8'				
Lt. 425+16	2	13'	4'	Lt. 526+87	3	11'	12'				
Lt. 425+42	2	13'	18'	Lt. 528+15	2	10'	23'				
Rt. 425+45	3	10'	23'	Lt. 528+61	3	10'	14'				
Lt. 426+52	2	12'	4'	Lt. 530+50	2	12'	10'				
Lt. 427+36	2	10'	5'	Lt. 530+74	3	10'	12'				
				Rt. 531+21	2	16'	19'				
				Lt. 531+97	2	17'	20'				
				Lt. 532+94	2	10'	22'				

Rt. Sta. 537+74+ To Rt. Sta. 538+74+ Drainage Spur
 1. Remove and stockpile existing Chain Link fence
 2. Furnish and install temporary enclosure to adequately complete enclosure surrounding pool during construction
 3. Reset existing fence along the existing drainage and utility easement line after construction in the area is completed.

Note A: See Concrete Channel Transition Details on Sheet No 35

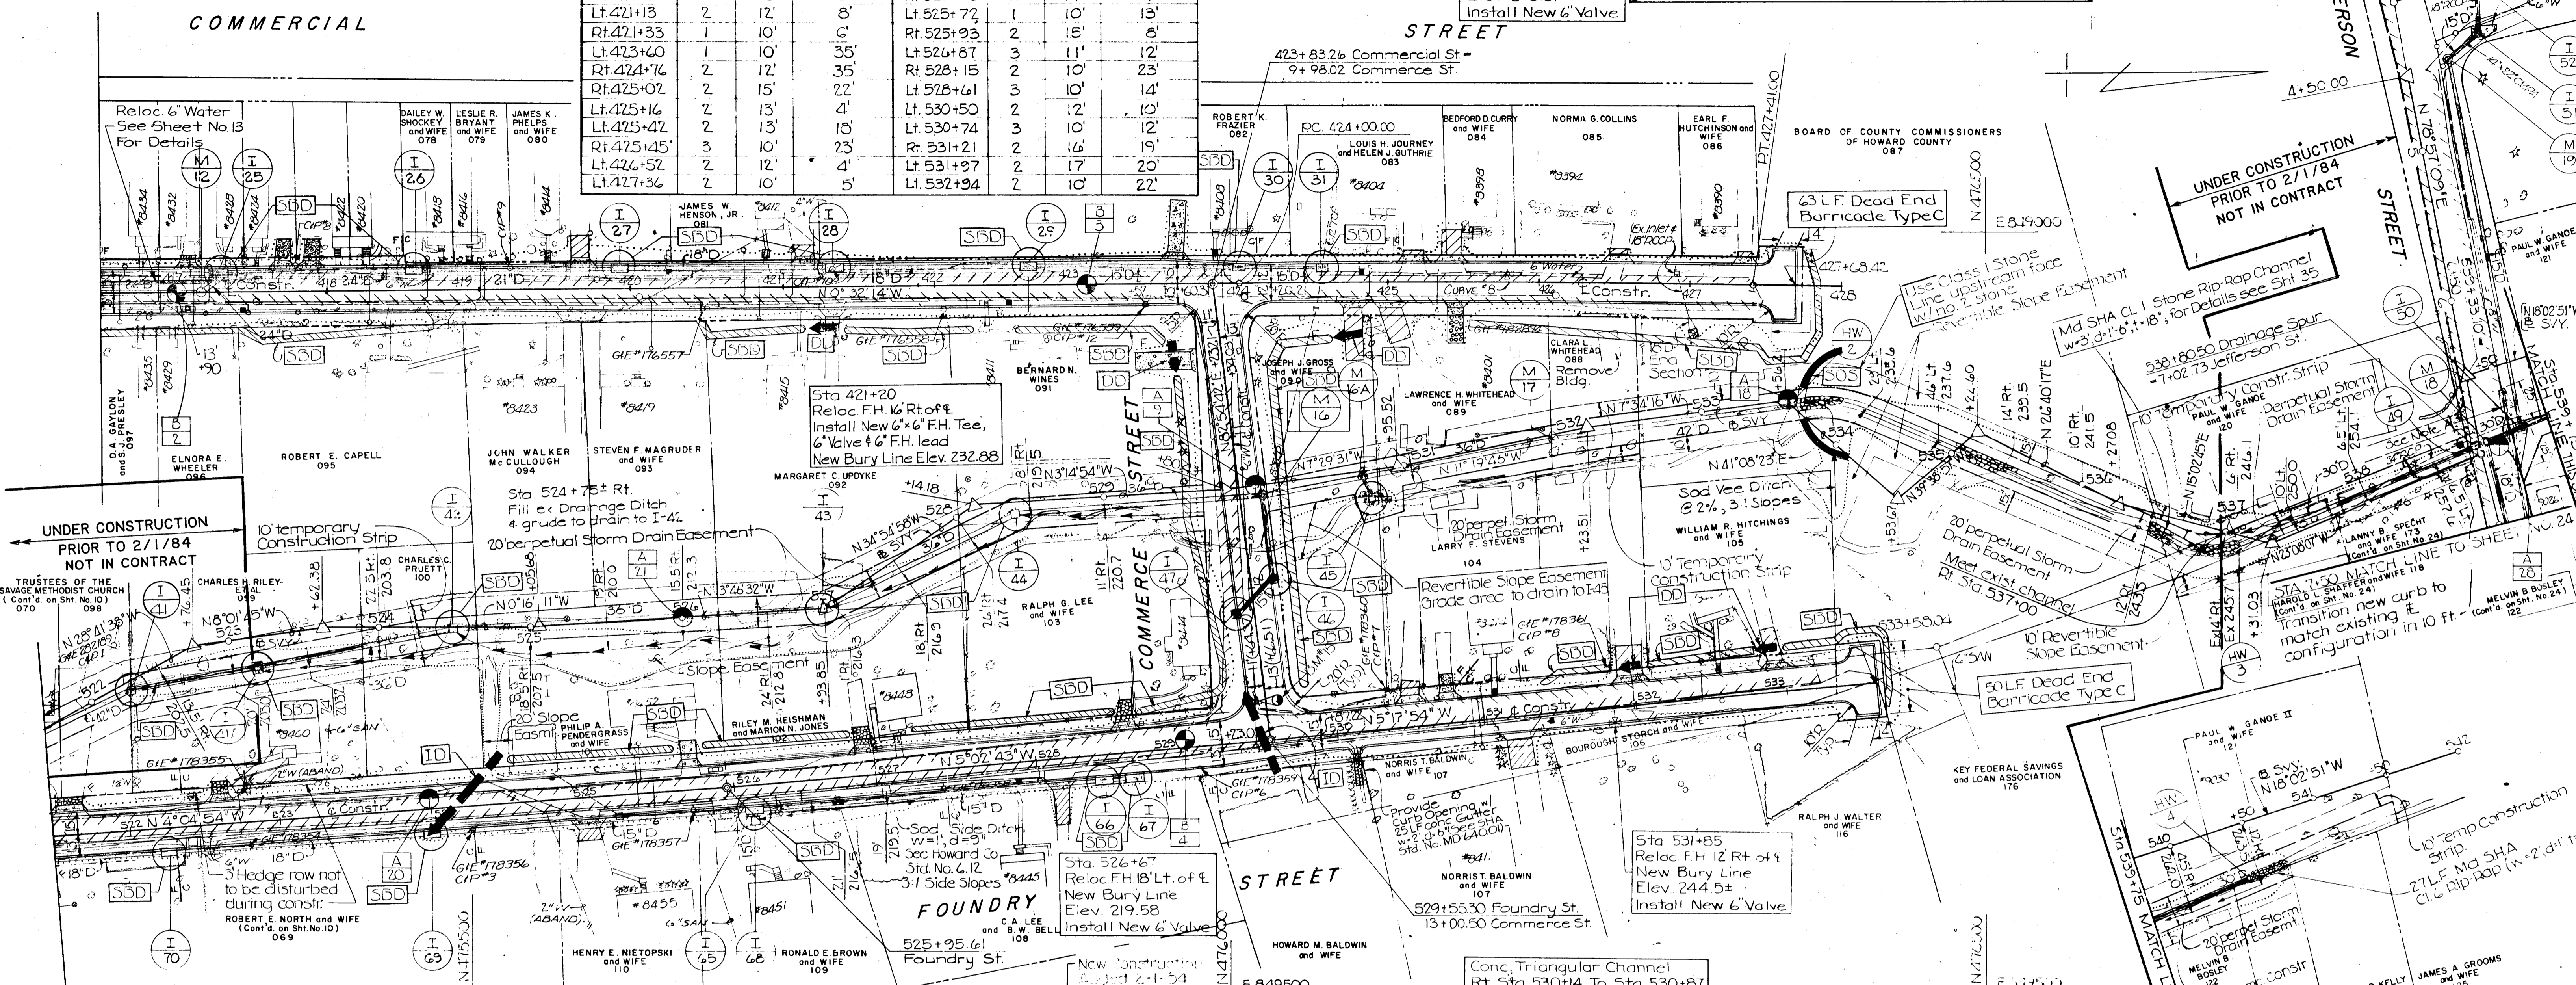

STORM DRAIN STRUCTURE SCHEDULE					
STRUC. NO.	TYPE	LOCATION	TOP ELEV.	INV. OUT.	
M-12	G5.05	0' Offset Sta. 417+17 Commercial	221.18	216.93	
I-25	Std WR	15' Lt. Sta. 417+28 Commercial	222.14	217.30	
I-26	Std WR	15' Lt. Sta. 418+59 Commercial	225.87	220.18	
I-27	Std WR	15' Lt. Sta. 419+92 Commercial	229.44	224.42	
I-28	Std WR	15' Lt. Sta. 421+31 Commercial	233.59	228.84	
I-29	Std WR	15' Lt. Sta. 422+62 Commercial	237.31	232.77	
I-30	Std WR	13.0' Lt. Sta. 424+00 Commercial	241.29	237.44	
I-31	Std WR	12' Lt. Sta. 424+56 Commercial	242.91	238.50	
I-42	Dbl. S	2' Rt. Sta. 524+50 Foundry St. Drainage Spur	207.00	202.00	
I-43	Dbl. S	0' Offset Sta. 526+93 Foundry St. Drainage Spur	216.20	209.90	
I-44	Dbl. S	8' Rt. Sta. 528+41 Foundry St. Drainage Spur	219.40	214.40	
M-16	G5.02	7' Rt. Sta. 530+06 Foundry St. Drainage Spur	233.16	219.80	
I-45	Std. S	19' Rt. Sta. 530+75 Foundry St. Drainage Spur	225.20	222.20	
I-46	A-5	13' Lt. Sta. 11+91.75 Commerce St.	231.30	226.67	
I-47	A-5	11' Rt. Sta. 12+18.61 Commerce St.	231.11	227.48	
I-41A	Dbl. S	20' Rt. Sta. 523+18 Foundry St. Drainage Spur	203.00	197.70	
I-41	Dbl. S	6' Rt. Sta. 522+27 Foundry St. Drainage Spur	200.80	195.35	
HW-3	A	0' Offset Sta. 524+00 Foundry St. Drainage Spur	246.00	246.00	
I-48	Std. S	6' Rt. Sta. 519+86 Jefferson St.	260.74	253.59	
M-18	G5.05	5' Lt. Sta. 6+95 Jefferson St.	261.70	254.80	

STORM DRAIN STRUCTURE SCHEDULE					
STRUC. NO.	TYPE	LOCATION	TOP ELEV.	INV. OUT.	
I-39	Std. S	29' Lt. Sta. 6+90 Jefferson St.	261.00	257.20	
HW-4	A	83' from T-500 (1st ditch)		263.30	
M-19	G5.05	28' Lt. Sta. 4+31.5 Jefferson St.	275.00	269.65	
I-51	Std. S	17' Lt. Sta. 4+31.5 Jefferson St.	275.10	272.25	
I-52	Std. S	58' Lt. Sta. 3+96 Jefferson St.	276.00	273.05	
I-10	A-10	13' Rt. Sta. 522+25 Foundry St.	203.82	200.20	
I-69	A-10	13' Rt. Sta. 524+00 Foundry St.	209.63	206.00	
I-65	A-10	13' Rt. Sta. 526+10 Foundry St.	217.21	212.00	
I-68	Std. S	23' Rt. Sta. 528+10 Foundry St.	215.90	212.30	
I-66	A-10	13' Rt. Sta. 528+45 Foundry St.	226.69	223.35	
I-67	A-10	13' Rt. Sta. 528+65 Foundry St.	227.60	224.00	
M-16A	G5.02	4' Rt. Sta. 530+71 Foundry St. Drainage Spur	229.60	221.25	
M-17	G5.02	3' Rt. Sta. 532+00 Foundry St. Drainage Spur	238.40	229.65	
HW-2	A	0' Offset Sta. 533+60 Foundry St. Drainage Spur		233.90	

STEP SCHEDULE			
LOCATION	WIDTH	NO. RISERS	
COMMERCIAL ST.			
Lt. 416+77	35'	1	
Rt. 416+78	4'	6	
Rt. 416+98	3'	7	
Lt. 417+34	3'	5	
Lt. 417+55	3'	3	
Lt. 418+07	3'	3	
Lt. 418+25	4'	2	
Rt. 418+40	3'	4	
Lt. 418+75	3'	2	
Lt. 418+95	4'	3	
Lt. 419+46	4'	7	
Lt. 420+89	3'	6	
Rt. 421+10	3'	2	
Rt. 422+34	33'	5	
Lt. 423+86	3'	3	
Lt. 425+50	3'	5	
FOUNDRY ST.			
Lt. 532+57	3'	3	

COMMERCIAL ST CURVE NO. 8 DATA
 A = 142.18' Rt
 D = 0'30"00"
 R = 11,459.16'
 T = 170.51'
 L = 341.00'
 E = 1.27'

COMMERCIAL ST LT. STA. 426+92±
 Remove exist. inlet grate, extend inlet walls and construct Type 'B' Manhole (Shallow) Top Slab, Frame and Cover.

COMMERCIAL ST RT. STA. 427+00±
 Install 18" R.C.C.P. Conc. End Section and construct 5'x5' Md. S.H.A. Cl. & Stone Rip-Rap Apron (T-12"). See Cross Sections

NOTE: ALL WORK SHOWN ON THIS DRAWING EXCEPT THE WORK INDICATED AS "UNDER CONSTRUCTION PRIOR TO 2-1-84" IS TO BE PERFORMED

CROSS REFERENCES		
ITEM	SHEET NO.	
Construction Stake-out Data	3	
Commercial Street Profile	8	
Foundry Street Profile	8	
Commerce Street Profile	9	
Storm Drain Profile	10 & 11	



DEPARTMENT OF PUBLIC WORKS
 HOWARD COUNTY, MARYLAND
 DIRECTOR OF PUBLIC WORKS DATE: _____
 CHIEF, BUREAU OF ENGINEERING DATE: _____
 CHIEF ROADS, BRIDGES, STORM DRAINS DIVISION DATE: _____

PREPARED BY: THE WILSON T. BALLARD CO
 CONSULTING ENGINEERS
 OWINGS MILLS, MARYLAND
 TEL. NO. 363-0150

SEDIMENT CONTROL PLAN
 COMMERCIAL ST. STA. 416+ TO STA. 427+
 FOUNDRY ST. STA. 521+ TO STA. 533+
 COMMERCE ST.

SAVAGE AREA - PHASE B
 ROAD AND STORM DRAIN IMPROVEMENTS
 CAPITAL PROJECT NOS. J-4-4008 B
 ELECTION DISTRICT NO. 6
 HOWARD COUNTY, MARYLAND

NO.	DATE	DESCRIPTION OF REVISION	SIGNATURE
DRAWING NO. 12 OF 14 <td></td> <td></td> <td></td>			
SCALE: 1" = 50'			
			K.L.E. DULGATED BY
			G.L.M. DRAFTED BY
			K.L.E. CHECKED BY


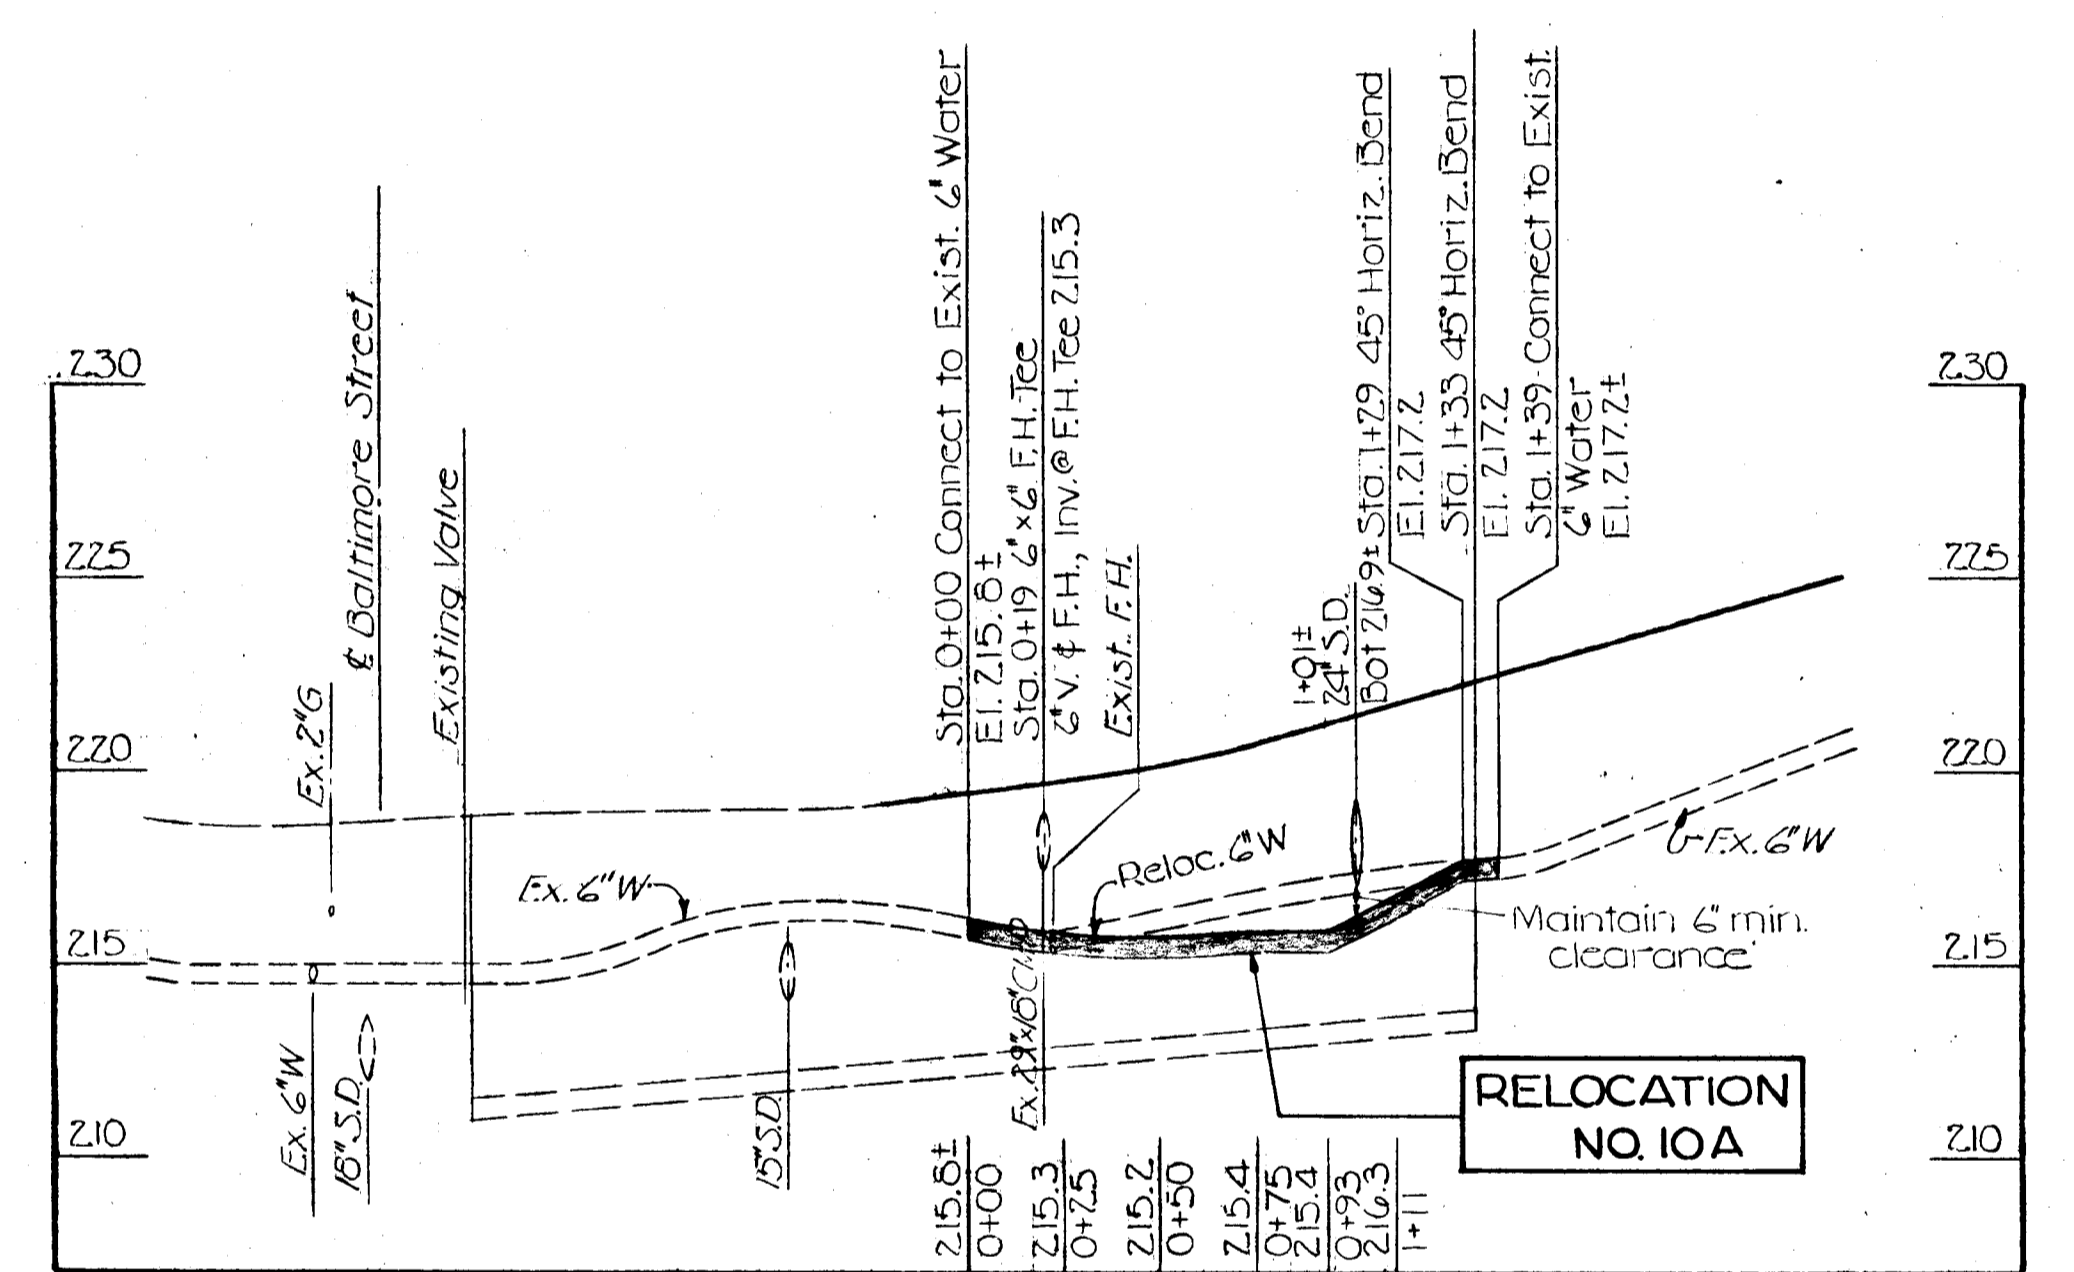
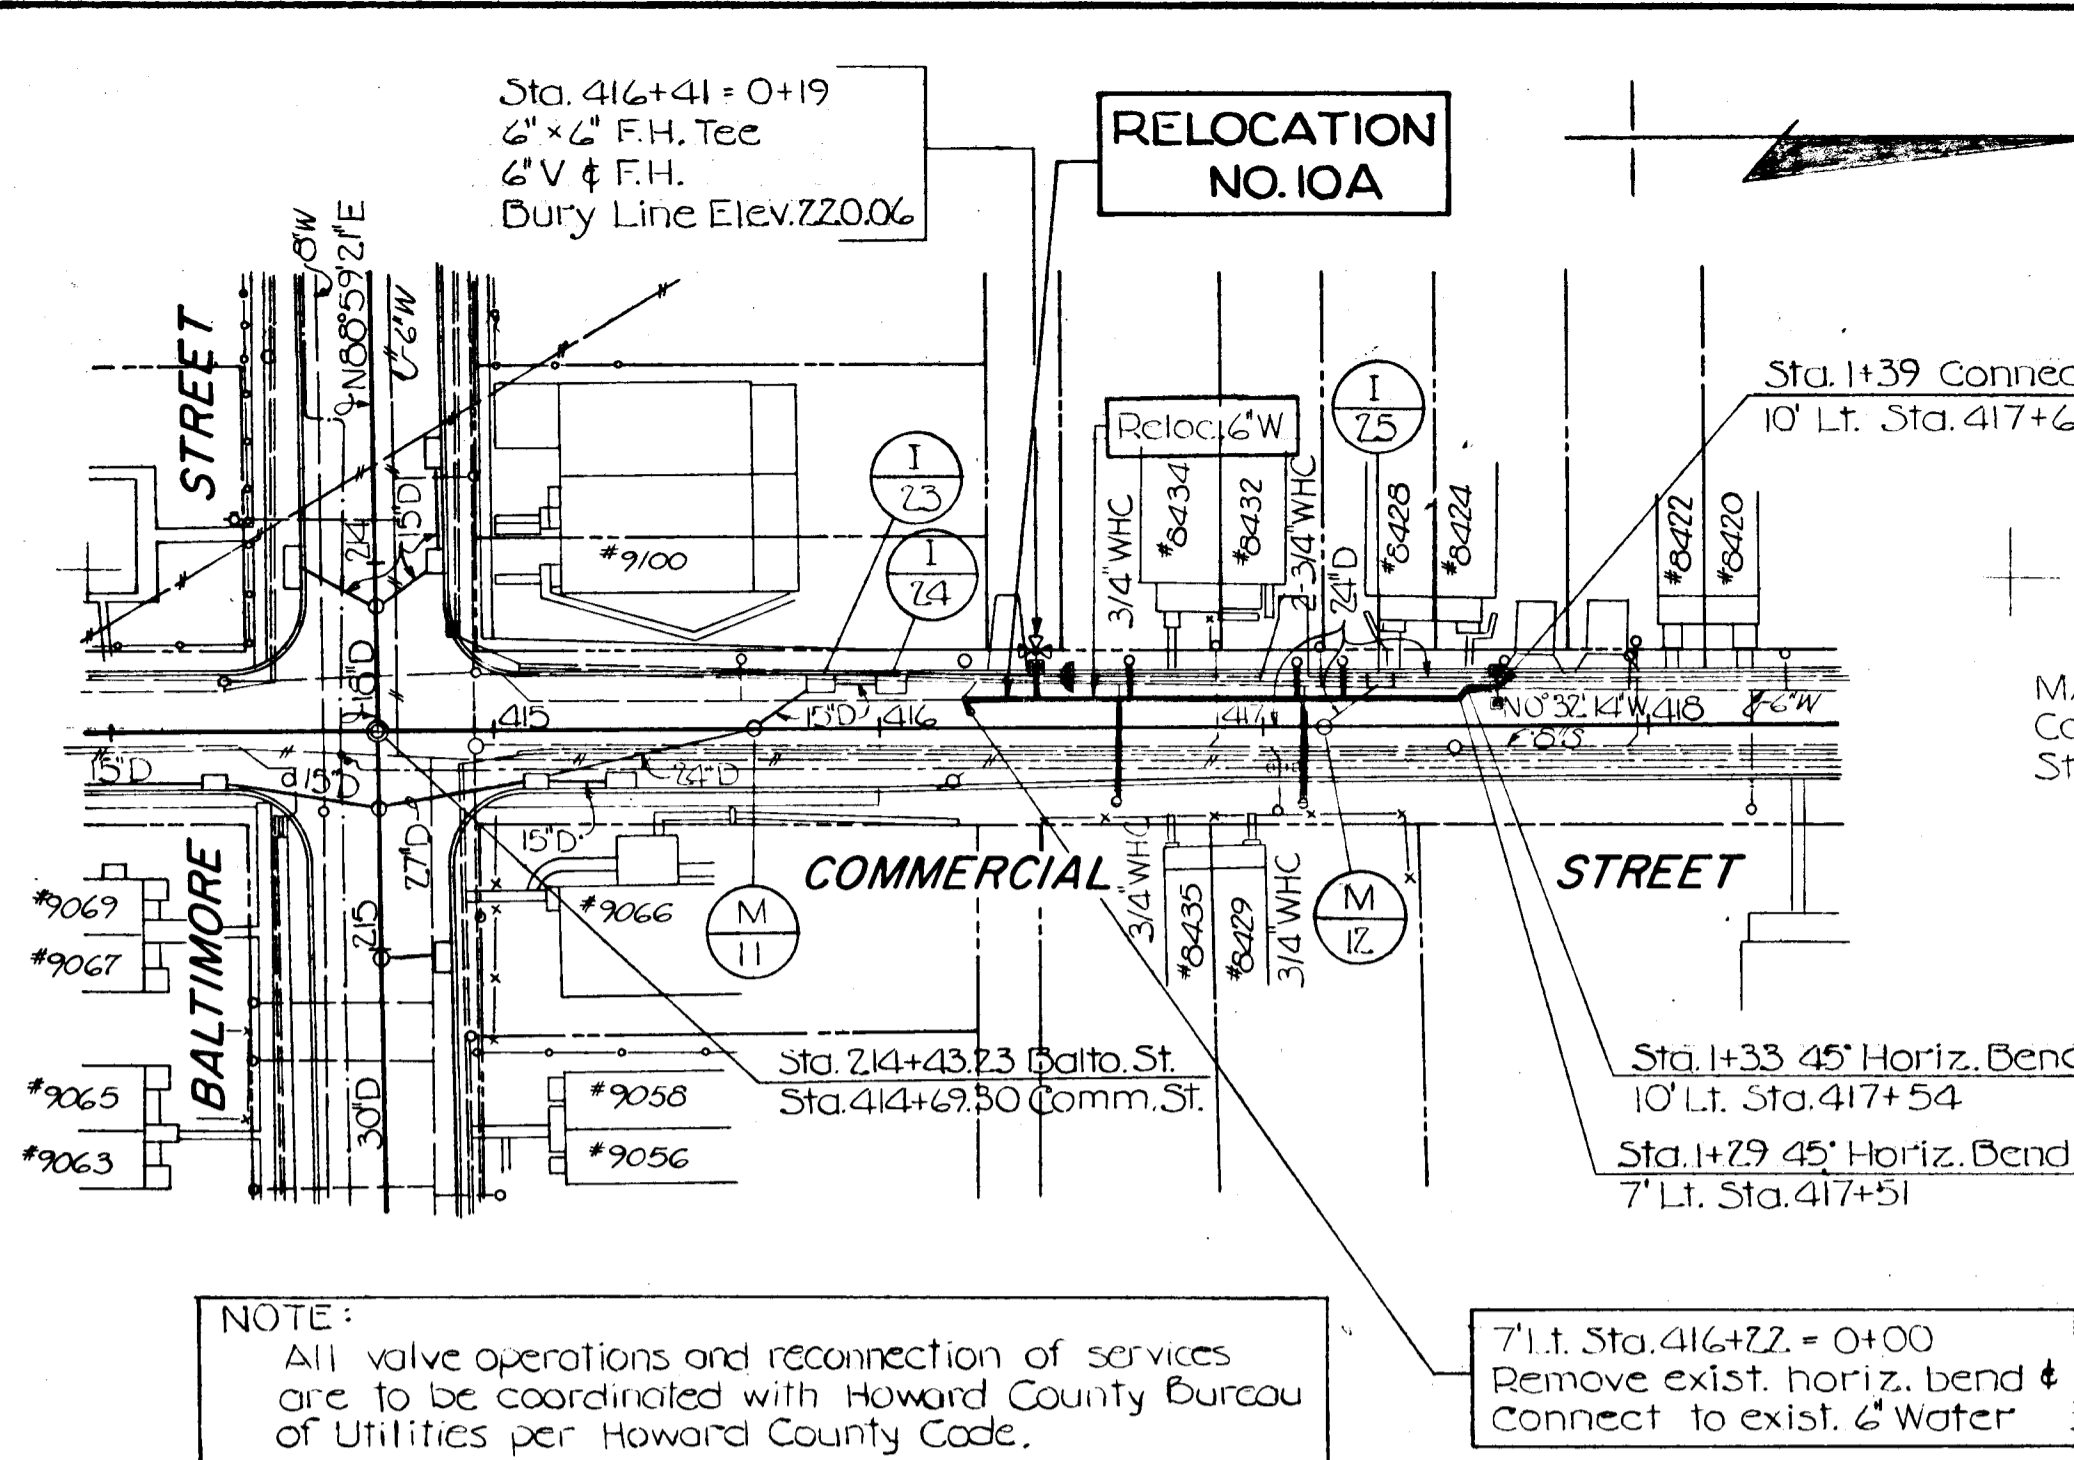


COMMERCIAL STREET


SUGGESTED SEQUENCE OF CONSTRUCTION, WATER RELOCATION NO. 10A

1. Install new 6" Water from Sta. 416+32 to Sta. 417+40 including fire hydrant at Sta. 416+41. Place temporary cap and blocking at Sta. 416+32 and Temporary Split Beam Buttress at Sta. 417+40±. Test new main.
2. Close existing valves at Commercial St. north of Baltimore Street and Commercial St. south of Commerce St.
3. Place temporary cap and buttress on the existing 6" Water Lt. Sta. 416+50 and open the Commercial St. valve south of Commerce St.
4. Remove the Temporary Cap and blocking at Sta. 416+32 and connect the new main to the existing main Lt. Sta. 416+22
5. Open the Commercial St. valve north of Baltimore St. and lay new water house connections to the new main. Connect the new water services to the existing services at the meter. Control existing water service at meter shut-off valve.
6. Pre-pour buttress for horizontal bend Lt. Sta. 417+51 and anchor for horizontal bend Lt. Sta. 417+34±.
7. Close existing valves at Commercial St. north of Baltimore St. and Commercial St. south of Commerce St. Cut existing main Lt. Sta. 417+60. Extend new main from Lt. Sta. 417+40 to Lt. Sta. 417+60 and make connection.
8. Open all valves after all buttresses and anchors are in place.

QUANTITIES - RELOCATION NO. 10A			
ITEM	ESTIMATED	AS BUILT	SUPPLIER
6in. Water	150 L.F.		
6in. 45° Bend	2 Ea.		
3in. x 6in. Tee	1 Ea.		
6in. Valve	1 Ea.		
Fire Hydrant	1 Ea.		
3/4in. Copper Water Service	86 L.F.		

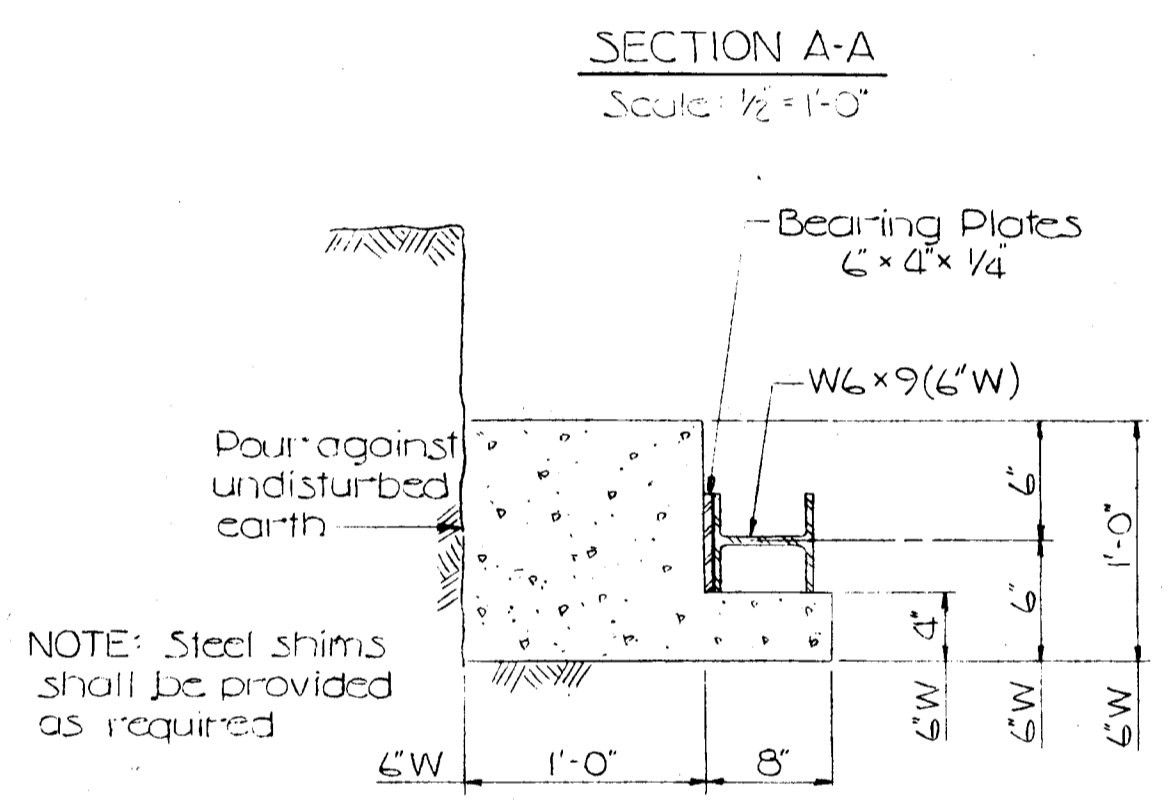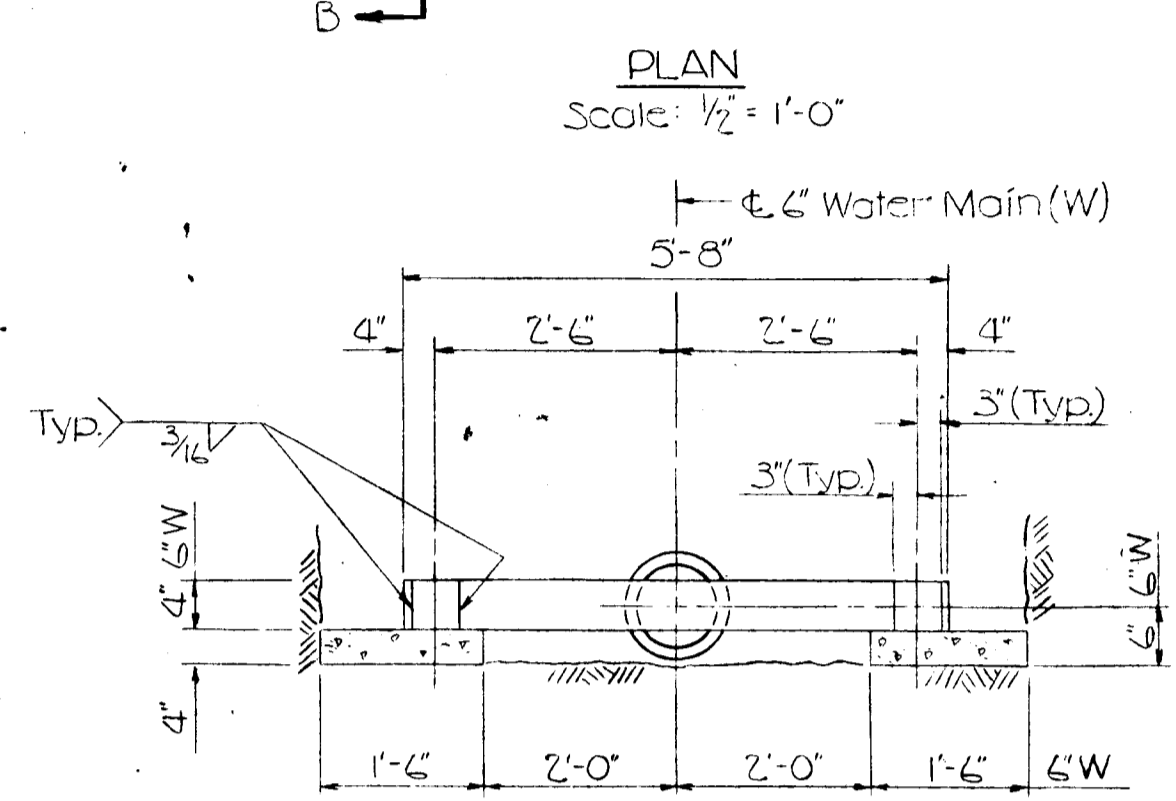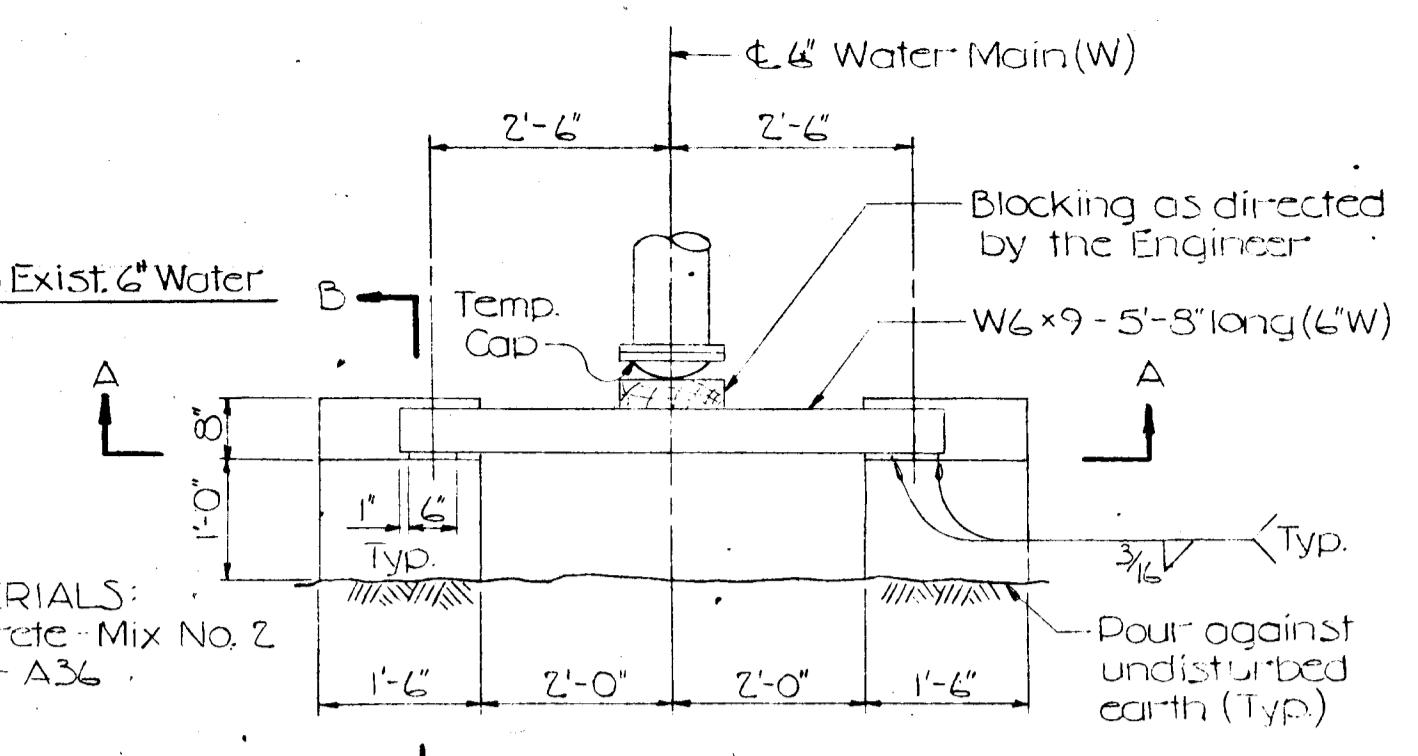

TEMPORARY SPLIT BEAM BUTTRESS DETAILS

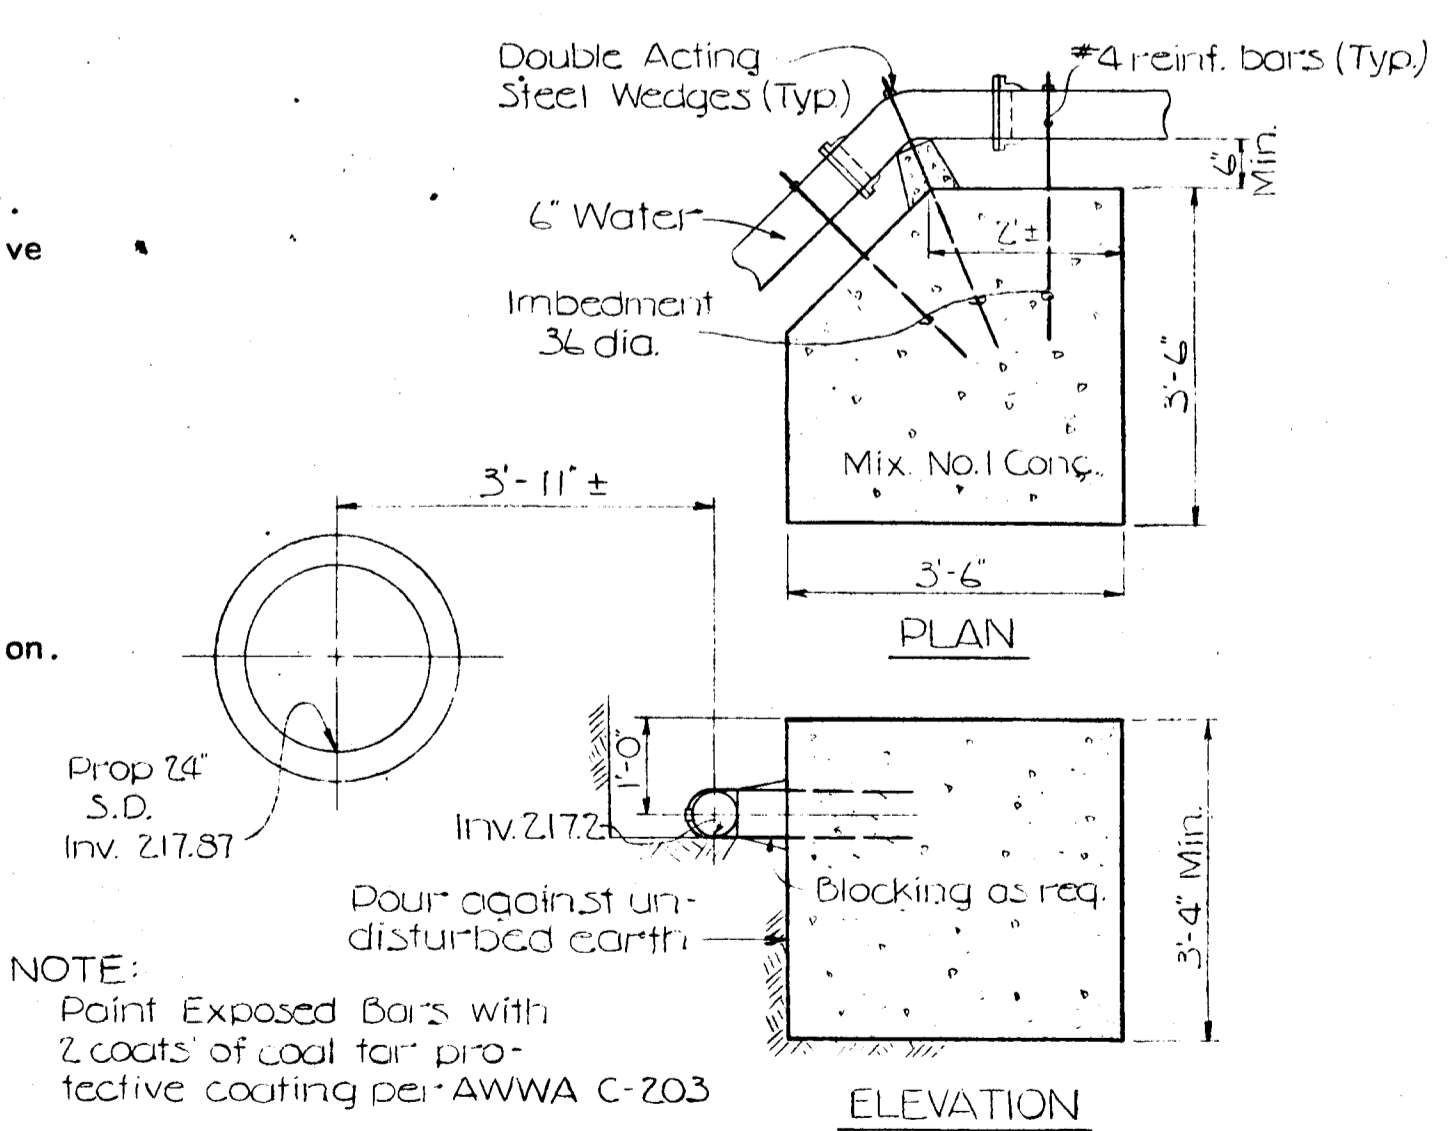

PRE-POURED HORIZONTAL ANCHOR

GENERAL NOTES

PART I - GENERAL

1. Approximate location of existing mains are shown. The contractor shall take all necessary precautions to protect existing mains and services and maintain uninterrupted supply. Any damage incurred shall be repaired immediately to the satisfaction of the Engineer, at the Contractor's expense.
2. All horizontal controls are based on Maryland State Coordinates.
3. All vertical controls are based on U.S.G.S. Datum.
4. All pipe elevations shown are invert elevations.
5. Clear all utilities by a minimum of 6'. Clear all poles by 2'-0" minimum or tunnel as required. Any cost incurred to the contractor for tunneling or bracing at poles shall be included in unit prices bid for excavation and backfill.
6. For details not shown on the drawings use Howard County Standard Details.
7. For materials and construction methods use Howard County Std. Specifications.
8. Contractor shall locate existing utilities a minimum of two (2) weeks in advance of construction operations in the vicinity of proposed utilities at his own expense.
9. Contractor shall notify the following utilities or agencies at least five (5) working days before starting work shown on these plans:
 - State Highway Administration - 531-5533
 - Baltimore Gas & Electric Company - Underground Electric Distribution Customer Service - 685-0123
 - Baltimore Gas & Electric Company - Underground Gas Distribution Customer Service - 585-0123
 - Engineering - "Damage Control" - 234-5621
 - "Miss Utility" - 1-559-0100
 - Chesapeake & Potomac (C&P) Telephone Company - 725-9976
 - American Telephone and Telegraph - Cable Location Division - 393-3553
 - Colonial Pipeline Company - 781-4641
 - Bureau of Utilities Howard County - 992-2366
10. Trees are to be protected from damage to maximum extent. Trees located within the construction strip are not to be removed or damaged by the contractor.
11. Contractor shall remove trees, stumps and roots along line of excavation as directed by the Engineer. Payment for such removal shall be included in the unit price bid for excavation and backfill.
12. Place regulation "Men Working" and warning signs as required to comply with Maryland State Highway Administration Manual of Traffic Control for Highway Construction and Maintenance Operations.

PART II - WATER


1. All water mains to be D.I.P. unless otherwise noted.
2. Top of all water mains to have a minimum of 3-1/2' cover unless otherwise noted.
3. Valves adjacent to tees shall be strapped to tees.
4. Block all fittings with concrete. Anchors and buttresses are to be high early strength concrete.
5. Bury line elevations on fire hydrants shall be set to the elevations shown on the drawings. All fire hydrants shall be strapped and buttressed with concrete in accordance with standard details. Soil around the fire hydrants to be compacted in accordance with Section 37.01-3 of the Std. Specifications.
6. All water house connections shall be to the existing type meter setting.
7. All water house connections are to be 3/4" unless otherwise indicated on the plans.
8. The contractor shall not operate any water main valves on the existing system. The Bureau of Utilities will operate the water main valves.

MODIFIED DIMENSIONS FOR BUTTRESSES FOR HORIZONTAL BENDS AND TEES

MINIMUM DIMENSIONS OF BUTTRESSES FOR HORIZONTAL BENDS (HOW. CO. ST'D. W 2.21)		
BEND	SIZE	
1/8 (45°)	A	1'-8"
	B	8"
	C	9"

MINIMUM DIMENSIONS OF BUTTRESSES FOR TEES (HOW. CO. ST'D. W 2.23)		
	SIZE OF BRANCH	
	6"	
H	9"	
I	1'-1"	
J	8"	
K	6"	

NOTE:
The dimensions for anchorages and buttresses are based on the static water pressure determined from a pool elevation of 410 plus a surge pressure of 100 p.s.f. and a presumptive soil bearing value of 2,000 p.s.f. Where actual field conditions are different the area of bearing shall be increased as determined by the Engineer.

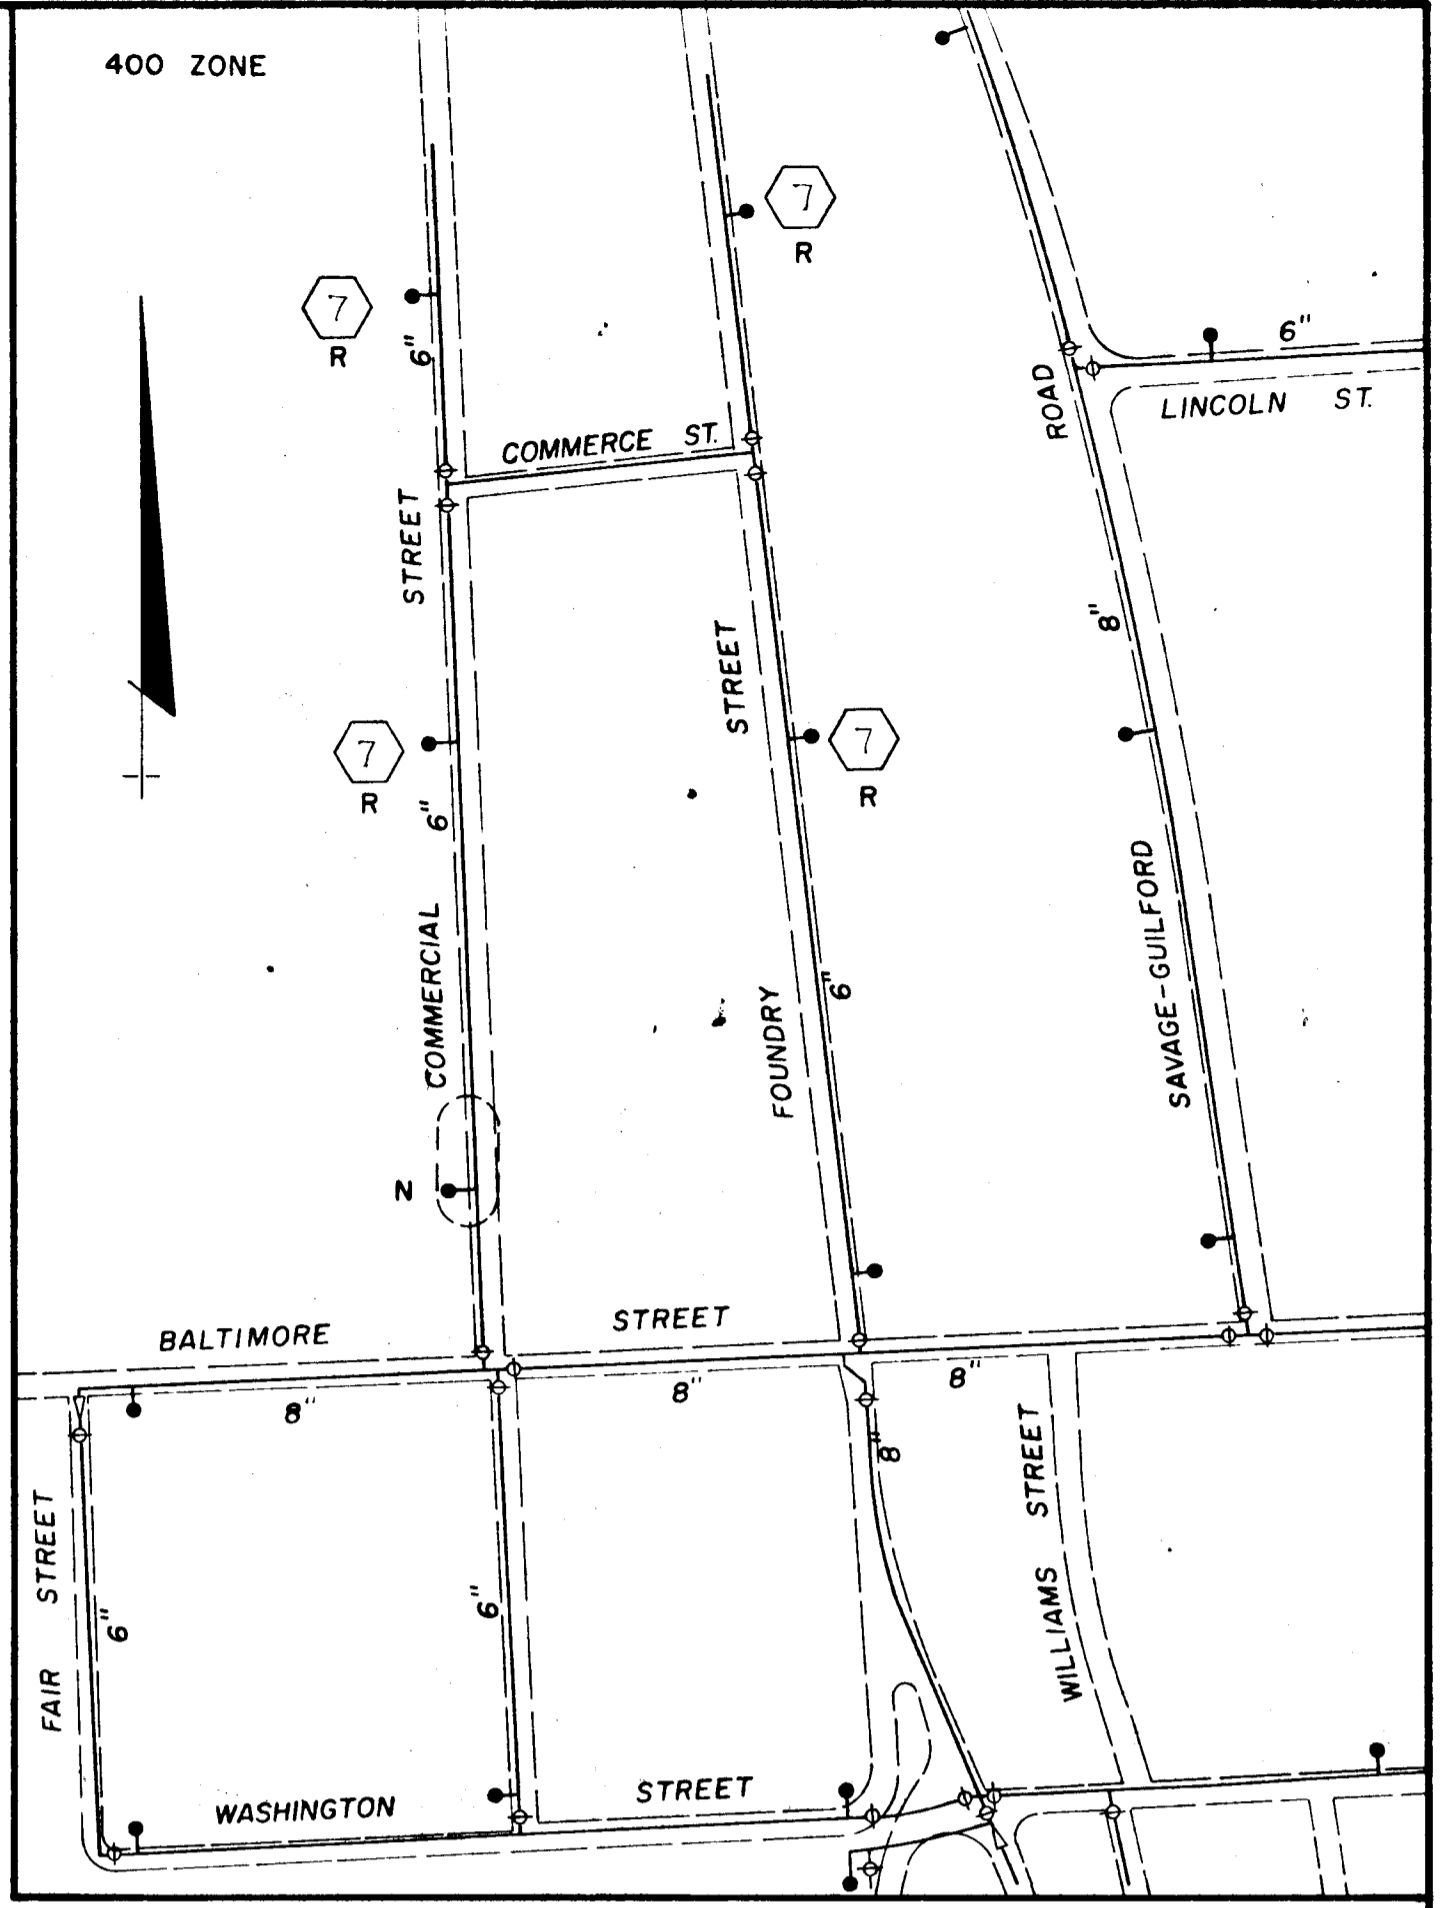

UTILITY LOCATION KEY PLAN

SCALE: 1" = 200'

KEY PLAN LEGEND

- 6" - Existing Water Main and Size
- Existing Water Valve
- Existing Fire Hydrant
- Approximate Limits of Relocation
- Existing Fire Hydrant to be relocated as shown on the referenced Plan Sheet Number
- R - Relocate Fire Hydrant
- N - Install new Fire Hydrant
- New Water Valve


UTILITY RELOCATION PLAN LEGEND

- Existing Utility
- Proposed Relocated Utility
- Temporary Cap and Split Buttress
- Temporary Cap and Blocking against exist. pipe

NO.	DATE	DESCRIPTION OF REVISION	SIGNATURE

DEPARTMENT OF PUBLIC WORKS
HOWARD COUNTY, MARYLAND
DIRECTOR OF PUBLIC WORKS
CHIEF, UTILITY DIVISION

PREPARED BY:
THE WILSON T. BALLARD CO.
CONSULTING ENGINEERS
OWINGS MILLS, MARYLAND
TEL. NO. 363-0150

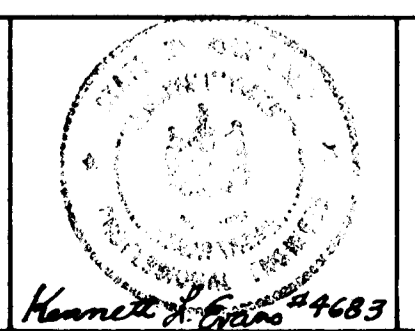

WATER MAIN RELOCATION
NO. 10A - STA. 416+22 TO STA. 417+60 COMMERCIAL ST.

SAVAGE AREA - PHASE B
ROAD AND STORM DRAIN IMPROVEMENTS
CAPITAL PROJECT NOS. J-8-4008B
ELECTION DISTRICT NO. 6
HOWARD COUNTY, MARYLAND

DRAWING NO. 13 OF 14
SCALE: HORIZ. 1"=50' VERT. 1"=5'
K.L.E. DESIGNED BY
T.G.S. DRAFTED BY
K.L.E. CHECKED BY

GRADING SUMMARY

LOCATION	CUT C.Y.	FILL C.Y.	TOPSOIL		ROOT MAT		CUT ADJUSTED C.Y.	CUT DENSIFIED C.Y.
			CUT C.Y.	FILL C.Y.	CUT C.Y.	FILL C.Y.		
COMMERCIAL STREET	1187	954	123	133		76	1064	904
FOUNDRY STREET	1410	191	114	76			1296	1102
COMMERCE STREET		1181		95				
TOTALS	2597	2326	237	304		76	2360	2006

SUMMARY OF EARTHWORK

CLASS 1 EXCAVATION

Cut 2597 C.Y.
 Plus top soil removed under fill 304
 Plus root mat removed under fill 76
 TOTAL CLASS 1 EXCAVATION 2977 C.Y.

EXCAVATION AVAILABLE FOR EMBANKMENT

Cut adjusted 2360 C.Y.
 Cut densified (85%) 2006
 Class 2 excavation available for embankment 629
 TOTAL EXCAVATION AVAILABLE FOR EMBANKMENT 2635 C.Y.

CLASS 2 EXCAVATION

From Cross Sections 898 C.Y.
 Loss due to handling & densification (30%) 269
 TOTAL CLASS 2 EXCAVATION AVAILABLE FOR EMB. 629 C.Y.

EMBANKMENT REQUIRED

Roadway embankment 2326 C.Y.
 Drainage Spur Embankment 656
 Refill for top soil (fill areas) 304
 Refill for root mat (fill areas) 76
 EMBANKMENT REQUIRED 3362 C.Y.
 TOTAL EXCAVATION AVAILABLE 2635 C.Y.
 APPARENT BORROW 727 C.Y.
 Plus 15% shrinkage 109 C.Y.
 BORROW EXCAVATION 836 C.Y.

PROPOSAL QUANTITIES

Item 201 Class 1 Excavation 3000 C.Y.
 Item 203 Class 2 Excavation 900 C.Y.
 Item 204 Borrow Excavation 1000 C.Y.

NOTE: The above grading analysis is based on the Granular Base Pavement Alternate. If full depth bituminous concrete pavement is used, the Class 1 Excavation will be approximately 2500 C.Y. and the Borrow Excavation will be approximately 1750 C.Y.

TOP SOIL ANALYSIS

TOP SOIL AVAILABLE FOR PLACEMENT

Top Soil removed in cut 237 C.Y.
 Top Soil removed under fill 304
 541 C.Y.
 Less Shrinkage Losses (15%) 81
 460 C.Y.

TOP SOIL REQUIRED

Top Soil Seeding and Mulching = 3105 S.Y. (From Plans and Cross Sections)
 SAY 3100 S.Y.
 Top Soil, Solid Sodding = 655 S.Y. (From Plans and Cross Sections)
 SAY 700 S.Y.
 TOTAL TOP SOIL 2" DEPTH REQUIRED = 2/3 x 3400 x 1/18 + 700 x 1/18 = 165 C.Y.
 TOTAL TOP SOIL 4" DEPTH REQUIRED = 1/3 x 3400 x 1/9 = 126
 TOTAL TOP SOIL REQUIRED 291 C.Y.

PROPOSAL QUANTITIES

Item 701 Placing salvaged Topsoil 2 inch depth 2300 S.Y.
 Item 702 Placing salvaged Topsoil 4 inch depth 1100 S.Y.
 Item 705 Seeding and Mulching 3400 S.Y.
 Item 706 Solid Sodding 700 S.Y.

SUMMARY OF QUANTITIES

ITEM NO.	PAY ITEM	UNIT	QUANTITY	CONTINGENT QUANTITY	PROPOSAL QUANTITY	ITEM NO.	PAY ITEM	UNIT	QUANTITY	CONTINGENT QUANTITY	PROPOSAL QUANTITY
PRELIMINARY ITEMS											
101	CLEARING AND GRUBBING	L.S.			L.S.						
102	ENGINEER'S FIELD OFFICE NO. 2	L.S.			L.S.						
103	MAINTENANCE OF TRAFFIC	L.S.			L.S.						
104	GRADED AGGREGATE SUB-BASE FOR MAINTENANCE OF TRAFFIC	TON		75	75						
105	BITUMINOUS CONCRETE FOR MAINTENANCE OF TRAFFIC	TON		50	50						
106	ARROW BOARD	U.Y.		8	8						
107	TEMPORARY TRAFFIC SIGNS	S.F.		110	110						
108	MOBILIZATION	L.S.			L.S.						
109	ADJUSTING AND REPLACING FENCES, SHRUBS, TREES, HEDGES, ETC.	L.S.			L.S.						
110	ADJUST EXISTING UTILITY APPURTENANCES TO FINISHED GRADE	Ea.		15	15						
EXCAVATION											
201	CLASS 1 EXCAVATION	C.Y.	3000		3000						
202	CLASS 1-A EXCAVATION	C.Y.		500	500						
203	CLASS 2 EXCAVATION	C.Y.	900		900						
204	BORROW EXCAVATION	C.Y.	1000		1000						
205	SELECT BORROW EXCAVATION	C.Y.		100	100						
206	TEST PIT EXCAVATION	C.Y.		25	25						
207	REMOVAL OF EXISTING CURB	L.F.		50	50						
208	REMOVAL OF EXISTING COMBINATION CURB AND GUTTER	L.F.		50	50						
209	REMOVAL OF EXISTING PAVEMENT	S.Y.		50	50						
210	REMOVAL OF EXISTING SIDEWALK	S.Y.		25	25						
211	REMOVAL OF EXISTING MASONRY	C.Y.		5	5						
DRAINAGE ITEMS											
301	CLASS 3 EXCAVATION FOR INCIDENTAL CONSTRUCTION	C.Y.		10	10						
302	TRIMMING EXISTING DITCHES	L.F.		50	50						
303	SELECTED BACKFILL	C.Y.		50	50						
304	BORROW FOR PIPE BACKFILL	C.Y.		100	100						
305	36 INCH R.C.C.P., CLASS 3	L.F.	188		188						
306	15 INCH R.C.C.P., CLASS 4	L.F.	724		724						
307	18 INCH R.C.C.P., CLASS 4	L.F.	584		584						
308	21 INCH R.C.C.P., CLASS 4	L.F.	128		128						
309	24 INCH R.C.C.P., CLASS 4	L.F.	280		280						
310	36 INCH R.C.C.P., CLASS 4	L.F.	667		667						
311	42 INCH R.C.C.P., CLASS 4	L.F.	158		158						
312	MIX NO. 1 CONCRETE FOR INCIDENTAL CONSTRUCTION	C.Y.		5	5						
313	STANDARD TYPE A HEADWALL FOR 42 INCH PIPE	Ea.	1		1						
314	STANDARD CONCRETE END SECTION FOR 18 INCH R.C.C.P.	Ea.	1		1						
315	STANDARD TYPE A-5 INLET, 3'-6" Min. DEPTH	Ea.	2		2						
316	STANDARD TYPE A-5 INLET, VERTICAL DEPTH	L.F.	2		2						
317	STANDARD TYPE A-10 INLET, 3'-6" Min. DEPTH	Ea.	5		5						
318	STANDARD TYPE A-10 INLET, VERTICAL DEPTH	L.F.	3		3						
319	STANDARD TYPE 'S' INLET, 3'-6" Min. DEPTH	Ea.	2		2						
320	STANDARD TYPE 'S' INLET, VERTICAL DEPTH	L.F.	1		1						
321	STANDARD DOUBLE TYPE 'S' INLET, 3'-6" Min. DEPTH	Ea.	4		4						
322	STANDARD DOUBLE TYPE 'S' INLET, VERTICAL DEPTH	L.F.	8		8						
323	STANDARD TYPE 'R' INLET, 3'-6" Min. DEPTH	Ea.	7		7						
324	STANDARD TYPE 'R' INLET, VERTICAL DEPTH	L.F.	5		5						
325	STANDARD G-5.02 MANHOLE, 8'-4" Min. DEPTH	Ea.	3		3						
326	STANDARD G-5.02 MANHOLE, VERTICAL DEPTH	L.F.	6		6						
327	STANDARD G-5.05 MANHOLE, 3'-10" Min. DEPTH	Ea.	1		1						
328	STANDARD G-5.05 MANHOLE, VERTICAL DEPTH	L.F.	1		1						
329	MIX NO. 3 CONCRETE FOR MISCELLANEOUS STRUCTURES	C.Y.		5	5						
330	BRICK MASONRY FOR MISCELLANEOUS STRUCTURES	C.Y.		5	5						
331	6 INCH PERFORATED CIRCULAR PIPE UNDERDRAIN	L.F.		100	100						
332	6 INCH CIRCULAR PIPE UNDERDRAIN OUTLETS	L.F.		25	25						
333	AGGREGATE BACKFILL FOR UNDERDRAIN	C.Y.		5	5						
334	STRAW BALES FOR SEDIMENT CONTROL	L.F.	2400		2400						
335	NO. 2 STONE FOR SEDIMENT CONTROL	TON	5		5						
336	5 INCH CONCRETE GUTTER	S.Y.	125		125						
337	CLASS 1 STONE FOR CHANNEL PROTECTION	S.Y.	340		340						
338	SHEETING AND SHORING LEFT IN PLACE	M.B.F.		10	10						
339	REMOVAL OF OLD PIPE CULVERTS, ANY SIZE	L.F.		50	50						
PAVING ITEMS											
501	6 INCH SURFACE COURSE USING BANK RUN GRAVEL BASE	S.Y.	150		150						
-- GRANULAR BASE ALTERNATE --											
502	6 INCH BASE COURSE USING GRADED AGGREGATE SUB-BASE	S.Y.	8590		8590						
503	ANTI-STRIPPING ADDITIVE FOR BITUMINOUS CONCRETE	Tr. Ton	2540		2540						
504	BITUMINOUS CONCRETE SURFACE, STONE AGGREGATE ALTERNATE	Ton	640		640						
504A	BITUMINOUS CONCRETE SURFACE, SLAG AGGREGATE ALTERNATE	Ton	640		640						
505	BITUMINOUS CONCRETE BASE, STONE AGGREGATE ALTERNATE	Ton	1900		1900						
505A	BITUMINOUS CONCRETE BASE, SLAG AGGREGATE ALTERNATE	Ton	1900		1900						
-- FULL DEPTH BITUMINOUS CONCRETE ALTERNATE --											
506	ANTI-STRIPPING ADDITIVE FOR BITUMINOUS CONCRETE	Tr. Ton	3355		3355						
507	BITUMINOUS CONCRETE SURFACE, STONE AGGREGATE ALTERNATE	Ton	640		640						
507A	BITUMINOUS CONCRETE SURFACE, SLAG AGGREGATE ALTERNATE	Ton	640		640						
508	BITUMINOUS CONCRETE BASE, STONE AGGREGATE ALTERNATE	Ton	2715		2715						
508A	BITUMINOUS CONCRETE BASE, SLAG AGGREGATE ALTERNATE	Ton	2715		2715						
509	BITUMINOUS CONCRETE FOR WEDGE AND/OR LEVELING COURSE	Ton		200	200						
510	7 INCH PLAIN CEMENT CONCRETE PAVEMENT	S.Y.	120		120						
511	7 INCH REINFORCED CEMENT CONCRETE PAVEMENT	S.Y.	250		250						
512	CALCIUM CHLORIDE	Ton		5	5						
SHOULDER ITEMS											
601	STANDARD TYPE A COMBINATION CURB AND GUTTER	L.F.	5430		5430						
602	4 INCH CONCRETE SIDEWALK	S.F.	380		380						
603	FLAGSTONE WALK	S.F.		100	100						
604	BRICK WALK	S.F.		100	100						
605	MIX NO. 2 CONCRETE FOR MISCELLANEOUS STRUCTURES	C.Y.	16		16						
606	ORNAMENTAL HANDRAIL FOR CONCRETE STAIRS	L.F.	100		100						
607	DEAD END BARRICADE, TYPE C	L.F.	113		113						
608	RESET EXISTING FENCE	L.F.		200	200						
LANDSCAPING ITEMS											
701	PLACING SALVAGED TOP SOIL, 2 INCH DEPTH	S.Y.	2300		2300						
702	PLACING SALVAGED TOP SOIL, 4 INCH DEPTH	S.Y.	1100		1100						
703	TEMPORARY MULCHING	S.Y.		500	500						
704	TEMPORARY SEEDING	S.Y.		500	500						
705	SEEDING AND MULCHING	S.Y.	3400		3400						
706	SOLID SODDING	S.Y.	700		700						
UTILITY ITEMS*											
801	6 INCH DUCTILE IRON PIPE AND FITTINGS	L.F.	232		232						
802	6 INCH VALVE AND ROADWAY BOX	Ea.	5		5						
803	3/4 INCH WATER SERVICE	L.F.	240		240						
804	RELOCATE EXISTING WATER METER, ANY SIZE	Ea.	30		30						
805	RELOCATE EXISTING FIRE HYDRANT	Ea.	4		4						
806	NEW FIRE HYDRANT	Ea.	1		1						
807	SPLIT BEAM BUTTRESS FOR 6 INCH WATER MAIN	Ea.	1		1						
808	HORIZONTAL CONCRETE ANCHOR FOR 6 INCH WATER MAIN	Ea.	1		1						
809	MIX NO. 3 CONCRETE FOR MISCELLANEOUS STRUCTURES	C.Y.		5	5						
810	BORROW FOR PIPE BACKFILL	C.Y.		10	10						
811	CLASS 3 EXCAVATION	C.Y.		5	5						
812	SELECTED BACKFILL	C.Y.		10	10						
813	SHEETING AND SHORING LEFT IN PLACE	M.B.F.		2	2						
814	MIX NO. 1 CONCRETE	C.Y.		5	5						
815	TEST PIT EXCAVATION	C.Y.		5	5						
816	CONTINGENT 6 INCH DUCTILE IRON PIPE AND FITTINGS	L.F.		150	150	</					