




HOWARD COUNTY, MARYLAND DEPARTMENT OF PUBLIC WORKS

INDEX OF SHEETS	
SHEET NOS.	DESCRIPTION
1	TITLE SHEET & LOCATION PLAN
2	TYPICAL SECTIONS & GENERAL NOTES
3	TYPICAL SECTIONS
4	TYPICAL SECTIONS & DETAILS
5	CONSTRUCTION - R/W LEGEND & DETAILS
6 & 7	SEDIMENT CONTROL DETAILS & EARTHWORK ANALYSIS
8	SEDIMENT & EROSION CONTROL DRAINAGE AREAS PLAN
9	PLAN & PROFILE STA. 54+00 TO STA. 67+00
10	PLAN & PROFILE STA. 67+00 TO STA. 80+00
11	PLAN & PROFILE STA. 80+00 TO STA. 89+20
12	PLAN & PROFILE STA. 89+20 TO STA. 95+05
13	CONNECTING ROAD PROFILES
14	STORM DRAIN PROFILES
15	STORM DRAIN PROFILES
16	STORM DRAIN PROFILES
17	TIMBER TIE RETAINING WALL & DETAILS LT STA. 71+89 TO STA. 73+00
18	HORIZONTAL & VERTICAL CONTROLS
19	BORING DATA
20 - 22	SEDIMENT & EROSION CONTROL PLAN
23 - 26	LANDSCAPING PLANS
27 & 28	STRIPING & PERMANENT SIGNING PLANS

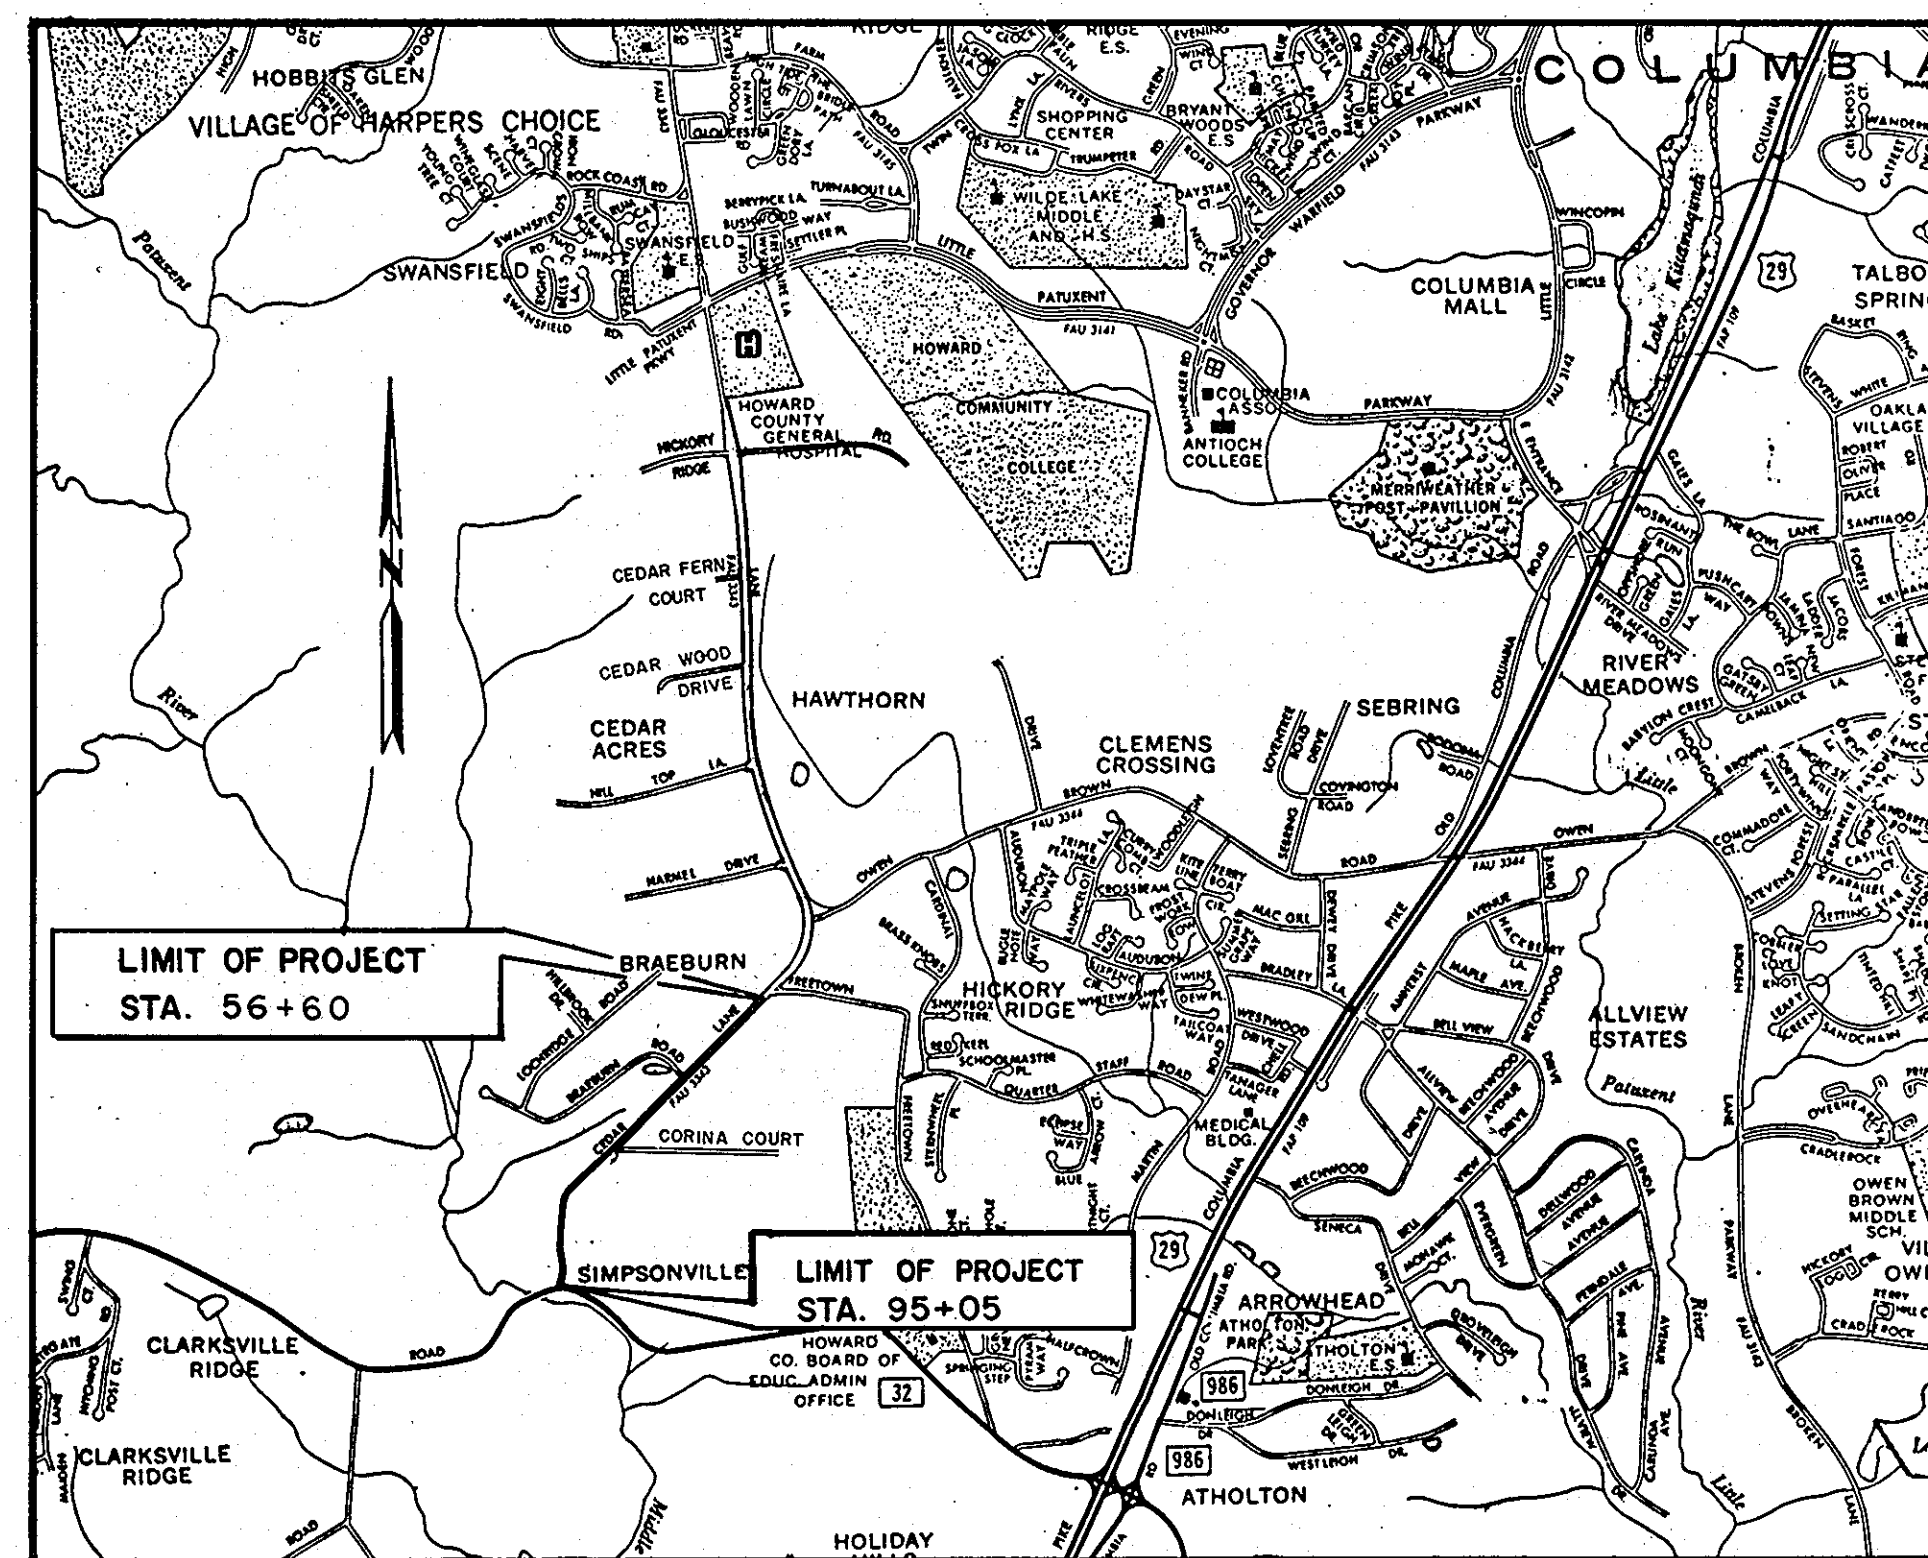

LOCATION MAP
SCALE: 1" = 2000'

CEDAR LANE (AS-BUILT) PHASE 2 SOUTH OF FREETOWN RD. TO GUILFORD RD. CAPITAL PROJECT J-4086


CERTIFICATION BY THE DEVELOPER
 "I/WE CERTIFY THAT ALL DEVELOPMENT AND/OR CONSTRUCTION WILL BE DONE ACCORDING TO THIS PLAN, AND THAT THE RESPONSIBLE PERSONNEL INVOLVED IN THIS CONSTRUCTION PROJECT WILL HAVE A CERTIFICATE OF ATTENDANCE AT THE DEPARTMENT OF THE ENVIRONMENT - APPROVED TRAINING PROGRAM FOR THE CONTROL OF SEDIMENT AND EROSION BEFORE BEGINNING THE PROJECT."
 Signature: *K. Co. & Ray* DATE: 11-8-98

CERTIFICATION BY THE ENGINEER
 "I CERTIFY THAT THIS PLAN FOR EROSION AND SEDIMENT CONTROL REPRESENTS A PRACTICAL AND WORKABLE PLAN BASED ON MY PERSONAL KNOWLEDGE OF THE SITE CONDITIONS AND THAT IT WAS PREPARED IN ACCORDANCE WITH THE REQUIREMENTS OF THE HOWARD SOIL CONSERVATION DISTRICT."
 Signature: *William P. Furdum* DATE: _____

REVIEWED FOR HOWARD S.C.D. NAME _____ AND MEETS TECHNICAL REQUIREMENTS
 Signature: *[Signature]* DATE: 7/12/90
 SIGNATURE U.S. SOIL CONSERVATION SERVICE


THIS DEVELOPMENT PLAN IS APPROVED FOR SOIL EROSION AND SEDIMENT CONTROL BY THE HOWARD SOIL CONSERVATION DISTRICT.
 Signature: *[Signature]* DATE: 7/12/90
 APPROVED BY HOWARD S.C.D.

955

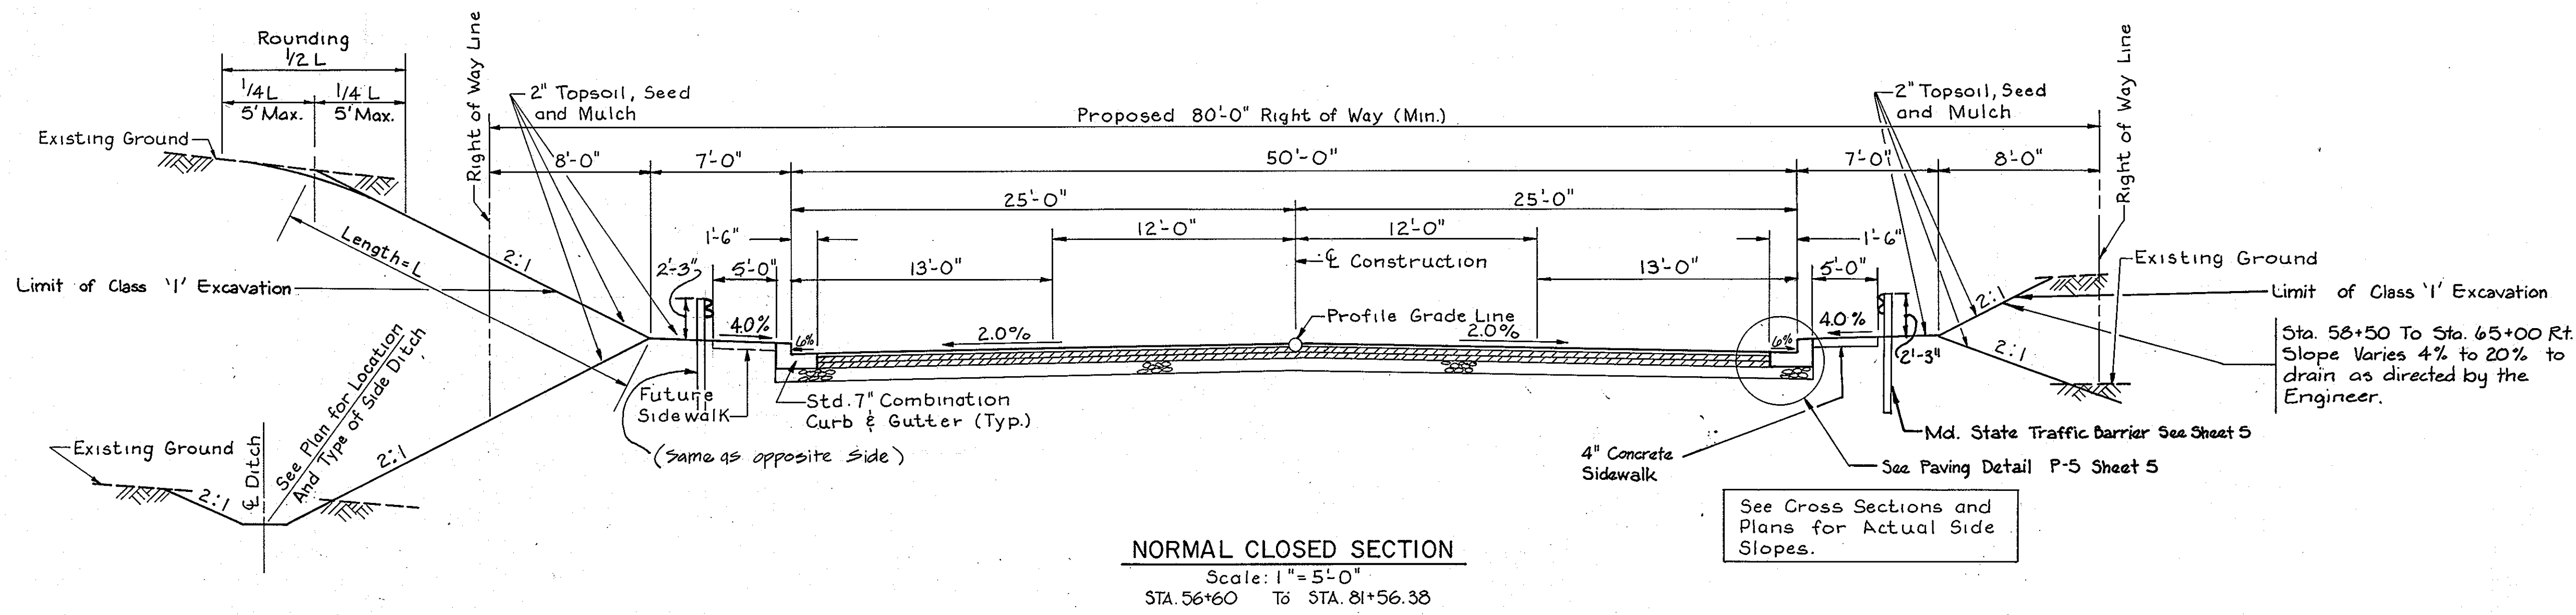

NORMAL CLOSED SECTION
 Scale: 1" = 5'-0"
 STA. 56+60 To STA. 81+56.38

See Cross Sections and Plans for Actual Side Slopes.

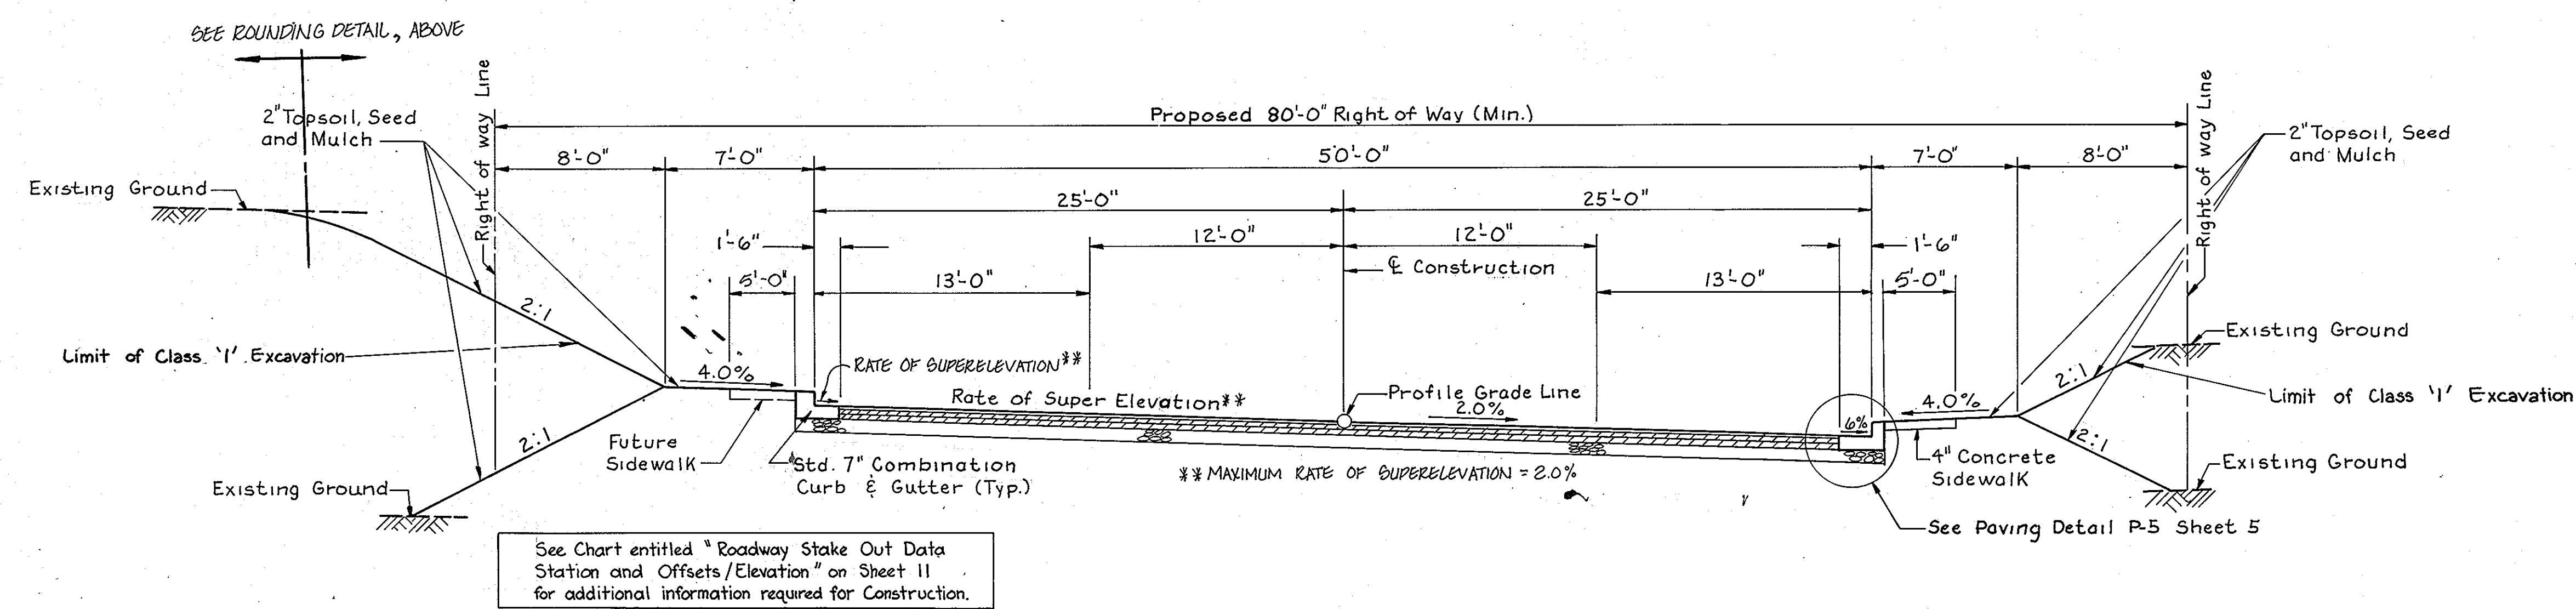

SUPERELEVATED CLOSED SECTION * (FOR ROADWAYS CURVED TO THE RIGHT)
 Scale: 1" = 5'-0"
 STA. 81+56.38 To STA. 85+00

See Cross Sections and Plans for Actual Side Slopes, and Roadway Cross Slopes.

* FOR SUPERELEVATED ROADWAYS CURVED TO THE LEFT, THE ROADWAY TYPICAL SECTION WOULD BE THE MIRROR IMAGE OF THIS TYPICAL SECTION.


GENERAL NOTES

- Right of Way Lines shown on these Plans are shown for assistance in interpreting the Plans; for any Fee Right of Way and Easement information see Right of Way Plans.
- Endwalls are not to be constructed until grading is completed. The types of endwalls are subject to modifications.
- Existing Private Sidewalks disturbed by the work shall be reconstructed. Steps shall be provided where necessary as a result of grading.
- All Pipes Elevation shown are invert Elevations.
- All Slopes and/or Disturbed Areas shall receive Solid Sodding on lawn areas and Seeding and Mulching for areas around trees and bushes except where otherwise indicated on the plans or as directed by the Engineer.
- The Contractor shall install and maintain all temporary Sediment Control Measures as shown on the drawings. However, any Sediment Control Measures not Specifically Indicated in the Contract Documents, but required as a result of the Contractor's Excavations or activities shall not be cause of Extra Payment.
- Location Points for Inlets, Manholes and Structures

Item	Horizontal Location	Vertical Location
Curb Type Inlets	Center Face of Curb	Top of Curb
Grate Type Inlets	Center of Grate	Top of Grate
Manholes	Center of Cover	Top of Cover
Structures w/Stack	Center of Cover	Top of Cover
Endwalls	Center of Wall	Top of Wall
- Approximate location of existing utilities are shown. The Contractor shall take all necessary precautions to protect existing utilities and to maintain uninterrupted service. Any damage incurred shall be repaired immediately to the satisfaction of the Engineer by the Contractor at the Contractor's expense.
- The Contractor shall locate Existing Utilities a minimum of two weeks in advance of construction operations in vicinity of utilities. Costs for locating existing utilities and for adjusting utility appurtenances to meet finished grades will be included in other items of the Contract.
- Contractor shall notify the following utilities or agencies at least five (5) days before starting work shown on these plans:
 - Miss Utility (collect) - 257-7777
 - Baltimore Gas & Electric Company, Underground Electric Distribution Engineering "Damage Control" - 234-6313
 - Baltimore Gas & Electric Company, Underground Gas Distribution Engineering - 234-5533
 - Chesapeake and Potomac Telephone Company - 597-8585
 - State Highway Administration - 531-5533
 - Howard Cable TV - 461-1156
 - Howard County Division of Traffic Engineering - 992-2430
- All manholes shall be 4'-0" inside diameter.
- Standard Details for this Contract shall be the Howard County Standard Details as Supplemented by the Maryland State Highway Administration Standard Details, Maryland State Standards and Specifications for Soil Erosion and Sediment Control and Manual on Uniform Traffic Control Devices of the U. S. Department of Transportation.
- Trees are to be protected from damage to the maximum extent.
- Contractor shall remove trees, stumps and roots along line of excavation as directed by the Engineer. Payment for such removal shall be included in the lump sum price bid for Clearing and Grubbing.
- Place regulation "Men Working" and warning signs as required to comply with Maryland State Highway Administration Manual of Traffic Control for Highway Construction and Maintenance Operations.
- Top Elevations of structures shall be adjusted in the field to meet existing conditions as directed by the Engineer.
- Grading shall be done in such a manner so as to insure positive drainage to the proposed inlet Structures.
- Horizontal and Vertical controls are based on the Maryland State Grid Coordinate System.
- Clearance between existing and proposed utilities shall be a minimum of 6". Clearance between all utility poles and proposed utilities shall be a minimum of 2'-0". Cost of bracing at poles shall be included in the bid for Storm Drain Lines.
- Size and type of pipe utilized for through-wall connections between Double A-10 Inlet installations will be equivalent to the outlet pipe.
- See Sheet No. 4 for Maintenance of Traffic Notes.
- Proposed culverts under driveways will be with std. end sections.

DEPARTMENT OF PUBLIC WORKS
 HOWARD COUNTY, MARYLAND
 Director of Public Works: James M. [Signature] 11/8/88
 Chief, Bureau of Engineering: [Signature] 11/8/88
 Chief, Division of Roads, Bridges and Storm Drainage: [Signature] 11/8/88

PURDUM & JESCHKE
 CONSULTING ENGINEERS
 LAND SURVEYORS
 1029 North Calvert Street
 Baltimore, Maryland 21202 301/837-0194

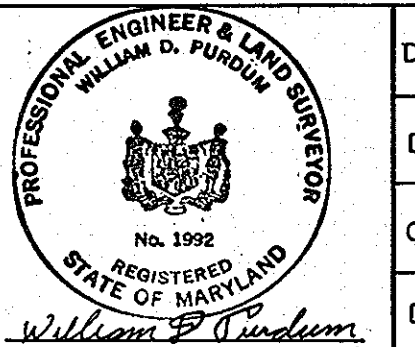

DES: JCT			
DRN: PVR			
CHK: WDF			
DATE 6/90			


TYPICAL SECTIONS &
 GENERAL NOTES
 CEDAR LANE - PHASE 2
 REVISION DATE 600' SCALE MAP NO. BLOCK NO.

SOUTH OF FREETOWN RD. TO GUILFORD RD.
 CAPITAL PROJECT J-4086
 ELECTION DISTRICT NO. 5
 HOWARD COUNTY, MARYLAND

SCALE AS SHOWN
 SHEET 2 OF 28




MAINTENANCE OF TRAFFIC

- All maintenance of traffic plans, materials, and devices shall be in accordance with the 1978 Manual on Uniform Traffic Control devices, and any subsequent addenda.
 - Access to all private driveways shall be maintained at all times between the hours of 3:00 p.m. and 9:00 a.m. Between the hours of 9:00 a.m. and 3:00 p.m., access shall be maintained except when prohibited by an open trench. All affected residents shall be notified at least one (1) hour prior to closing of any driveway.
 - Access to cross streets shall be maintained at all times.
 - Road Construction Ahead signs (W20-1) shall be placed in advance of any construction areas as follows:
 - On Cedar Lane, at 1500, feet in advance of construction.
 - On all other cross streets, minimum 250 feet in advance of construction.
 - Wherever else as directed by the Engineer.
- End Construction signs (G20-2) shall be placed on Cedar Lane minimum 250 feet beyond the end of any construction area.
- Where traffic is being maintained on one side of the road while construction takes place on the other, appropriate barriers, barricades, or drums shall be placed between the traveled way and the construction area. Approved Type A low intensity flashing warning lights shall be used during hours of darkness. Travel directions will be posted as shown on Traffic Control Plans (TCPS) in the Special Provisions.

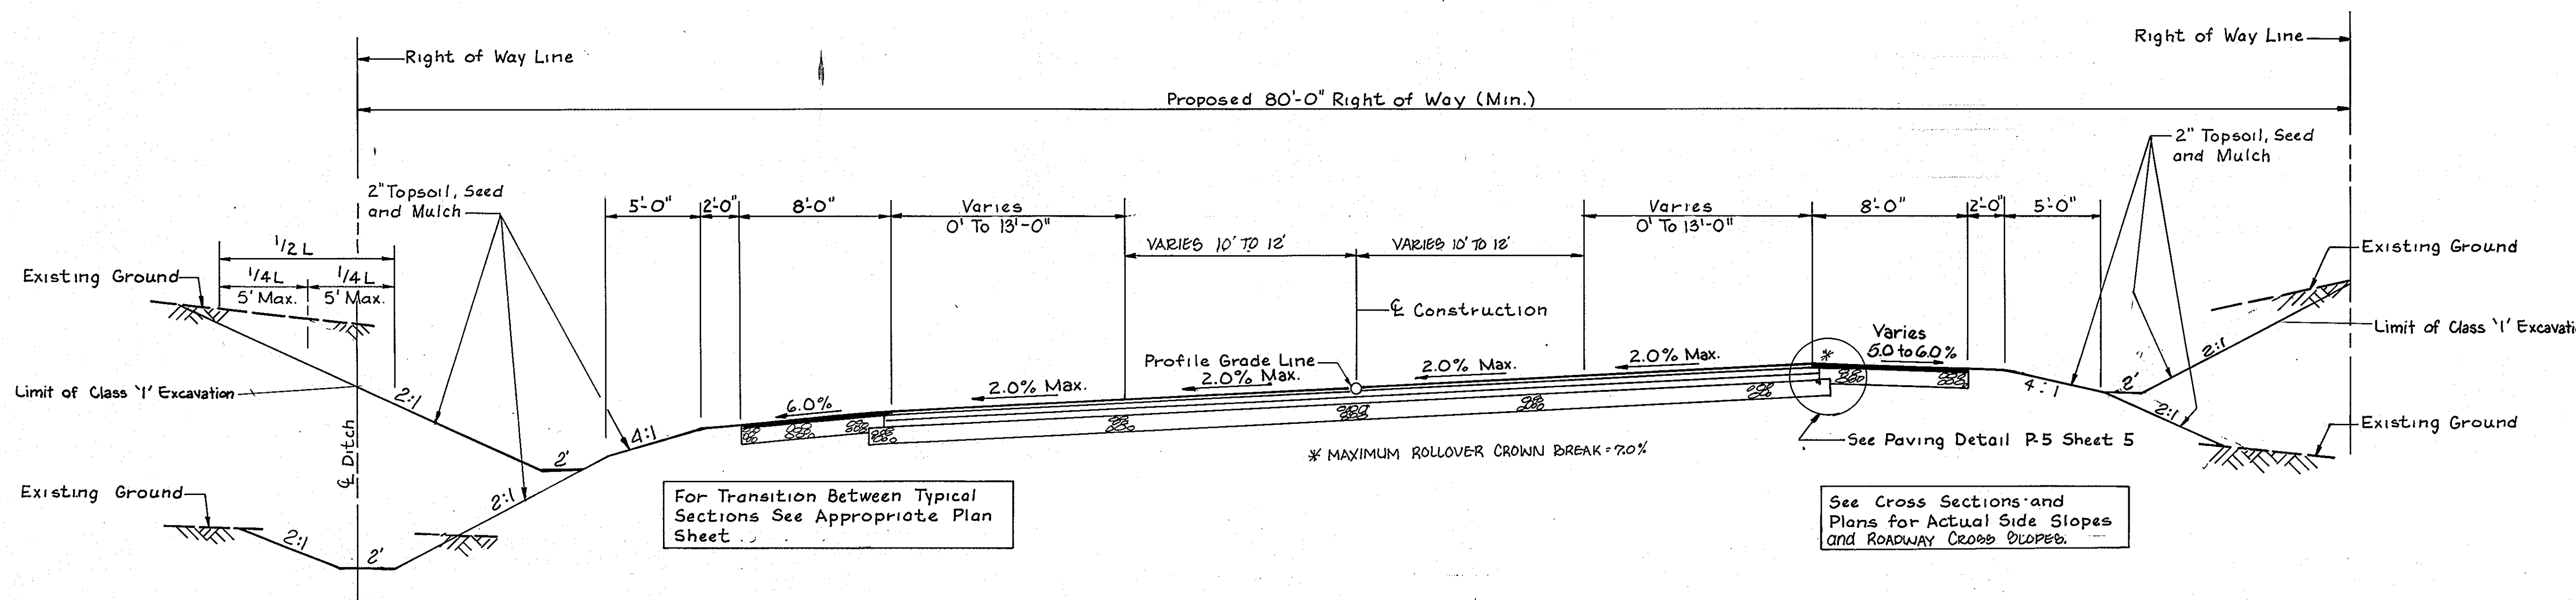

TRANSITION FROM 4-LANE (50'-0" WIDE)
TO 2-LANE (24'-0" WIDE)
Sta. 85+00 To Sta. 86+50

See Charts Entitled "Roadway Stake Out Data Station and Offsets/Elevations" on Sheet 11 for Additional Information Required for Construction.

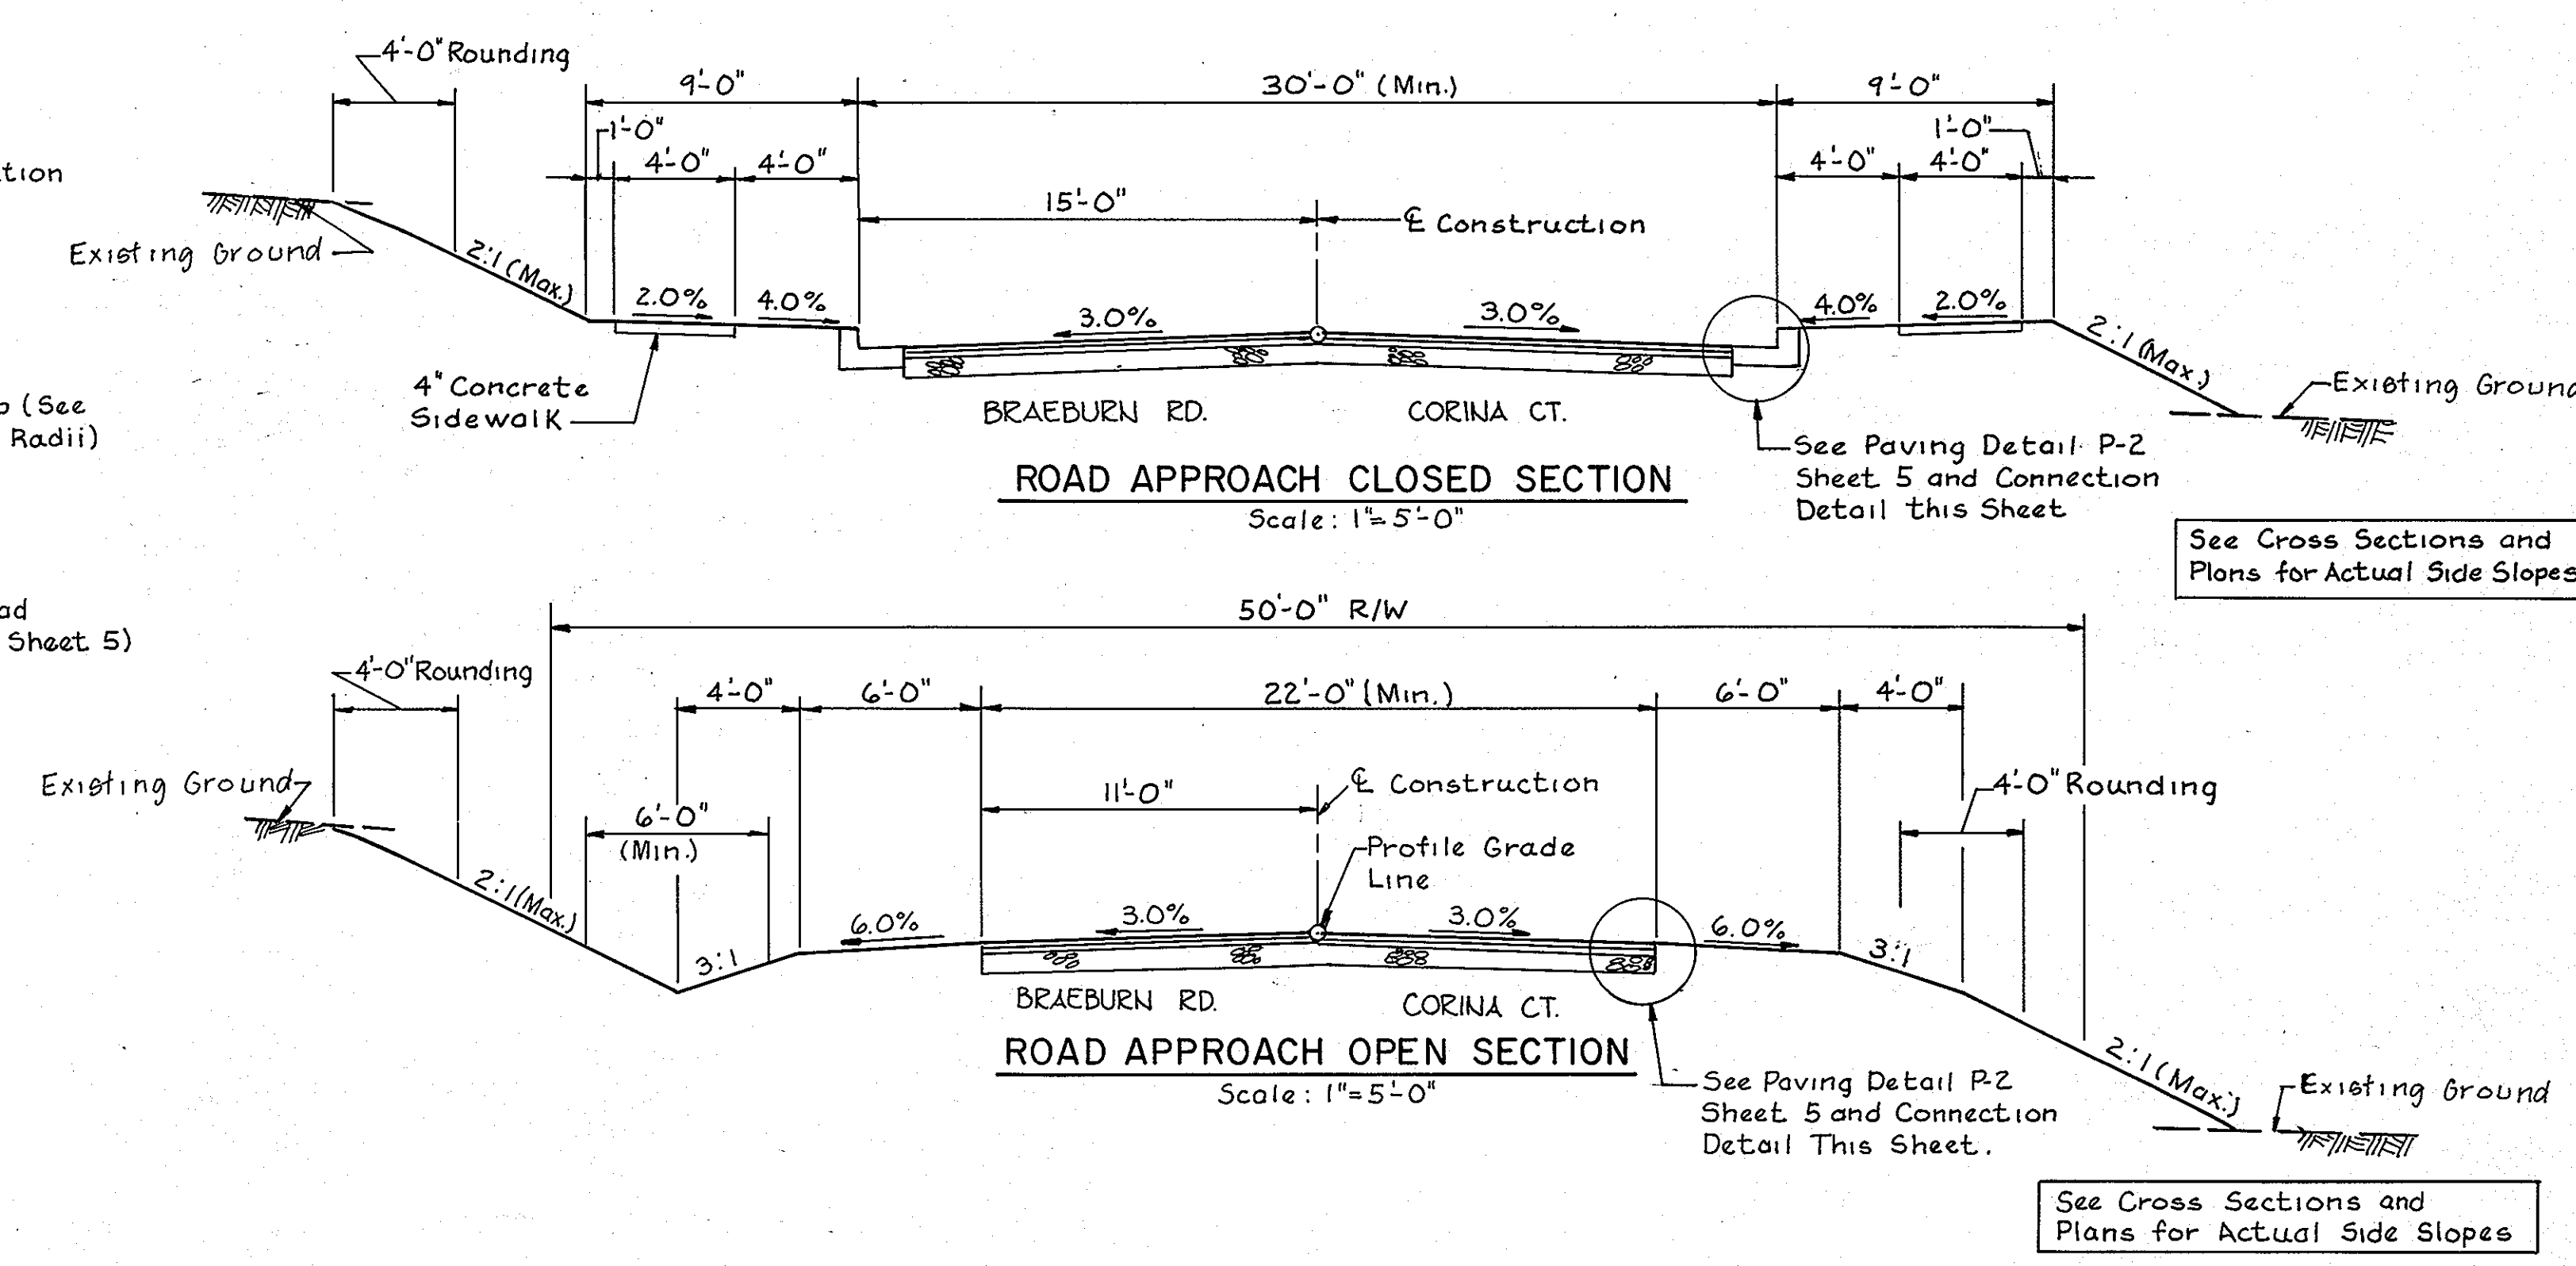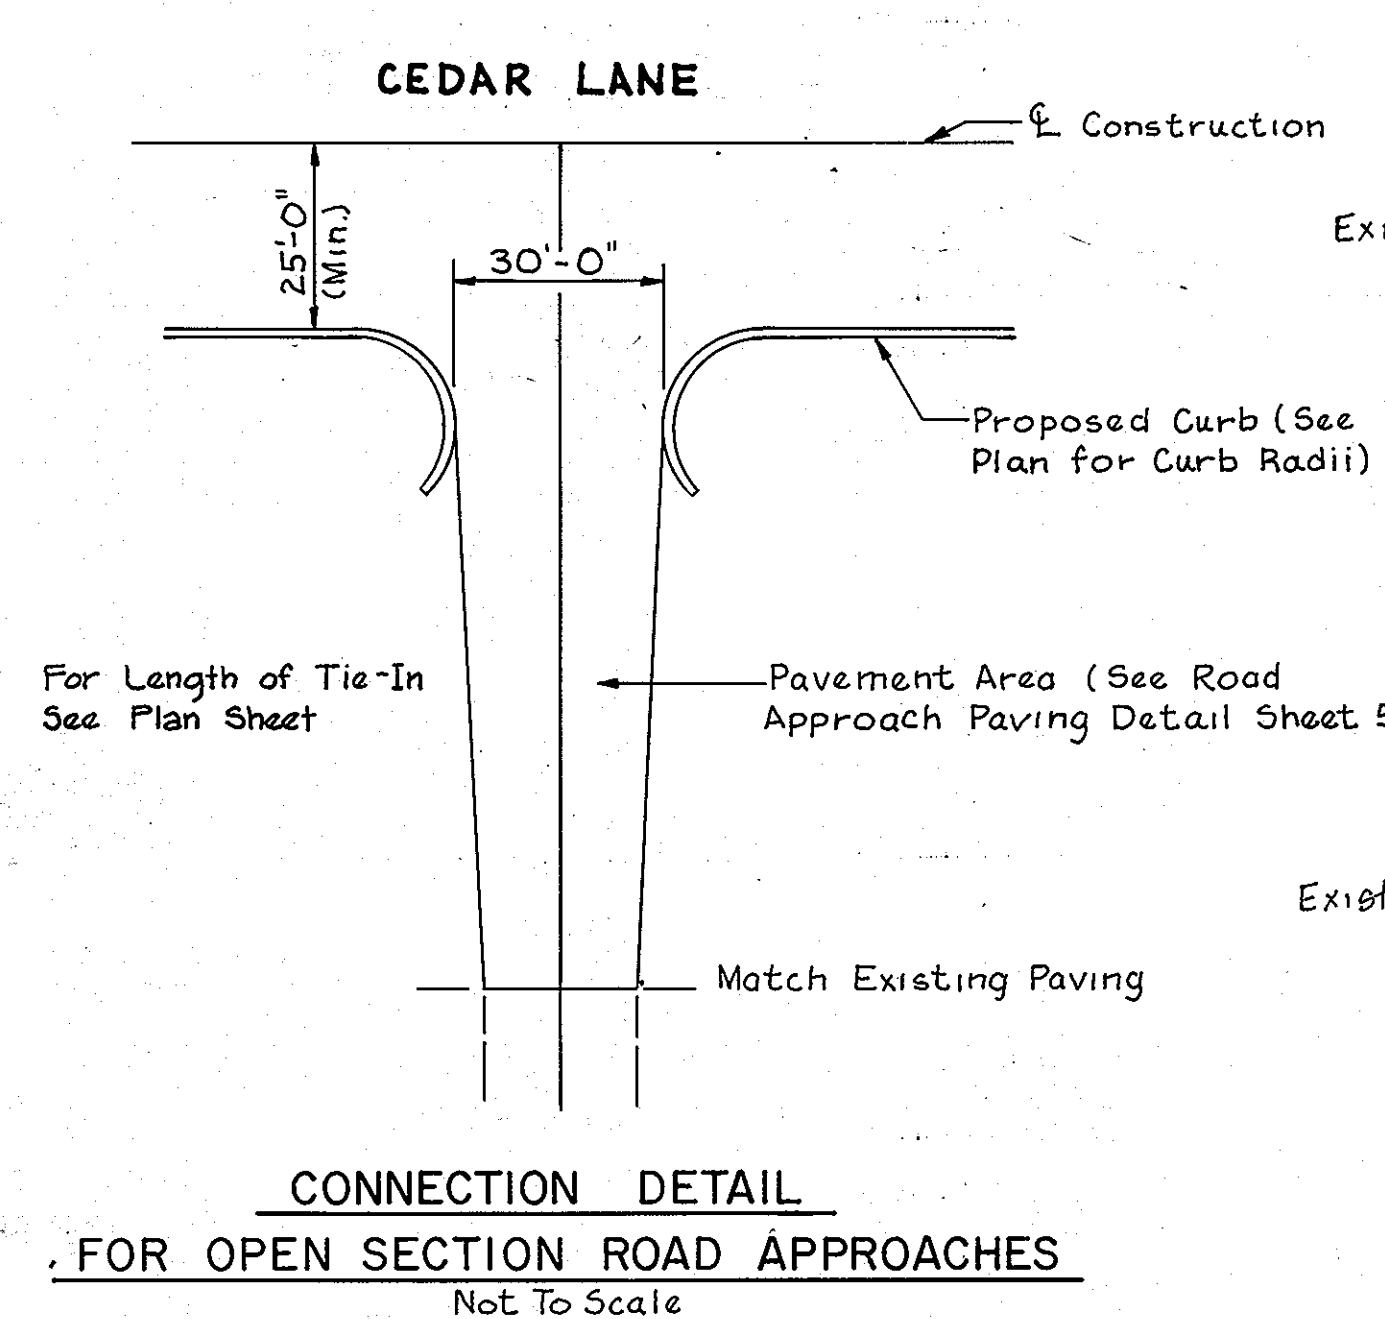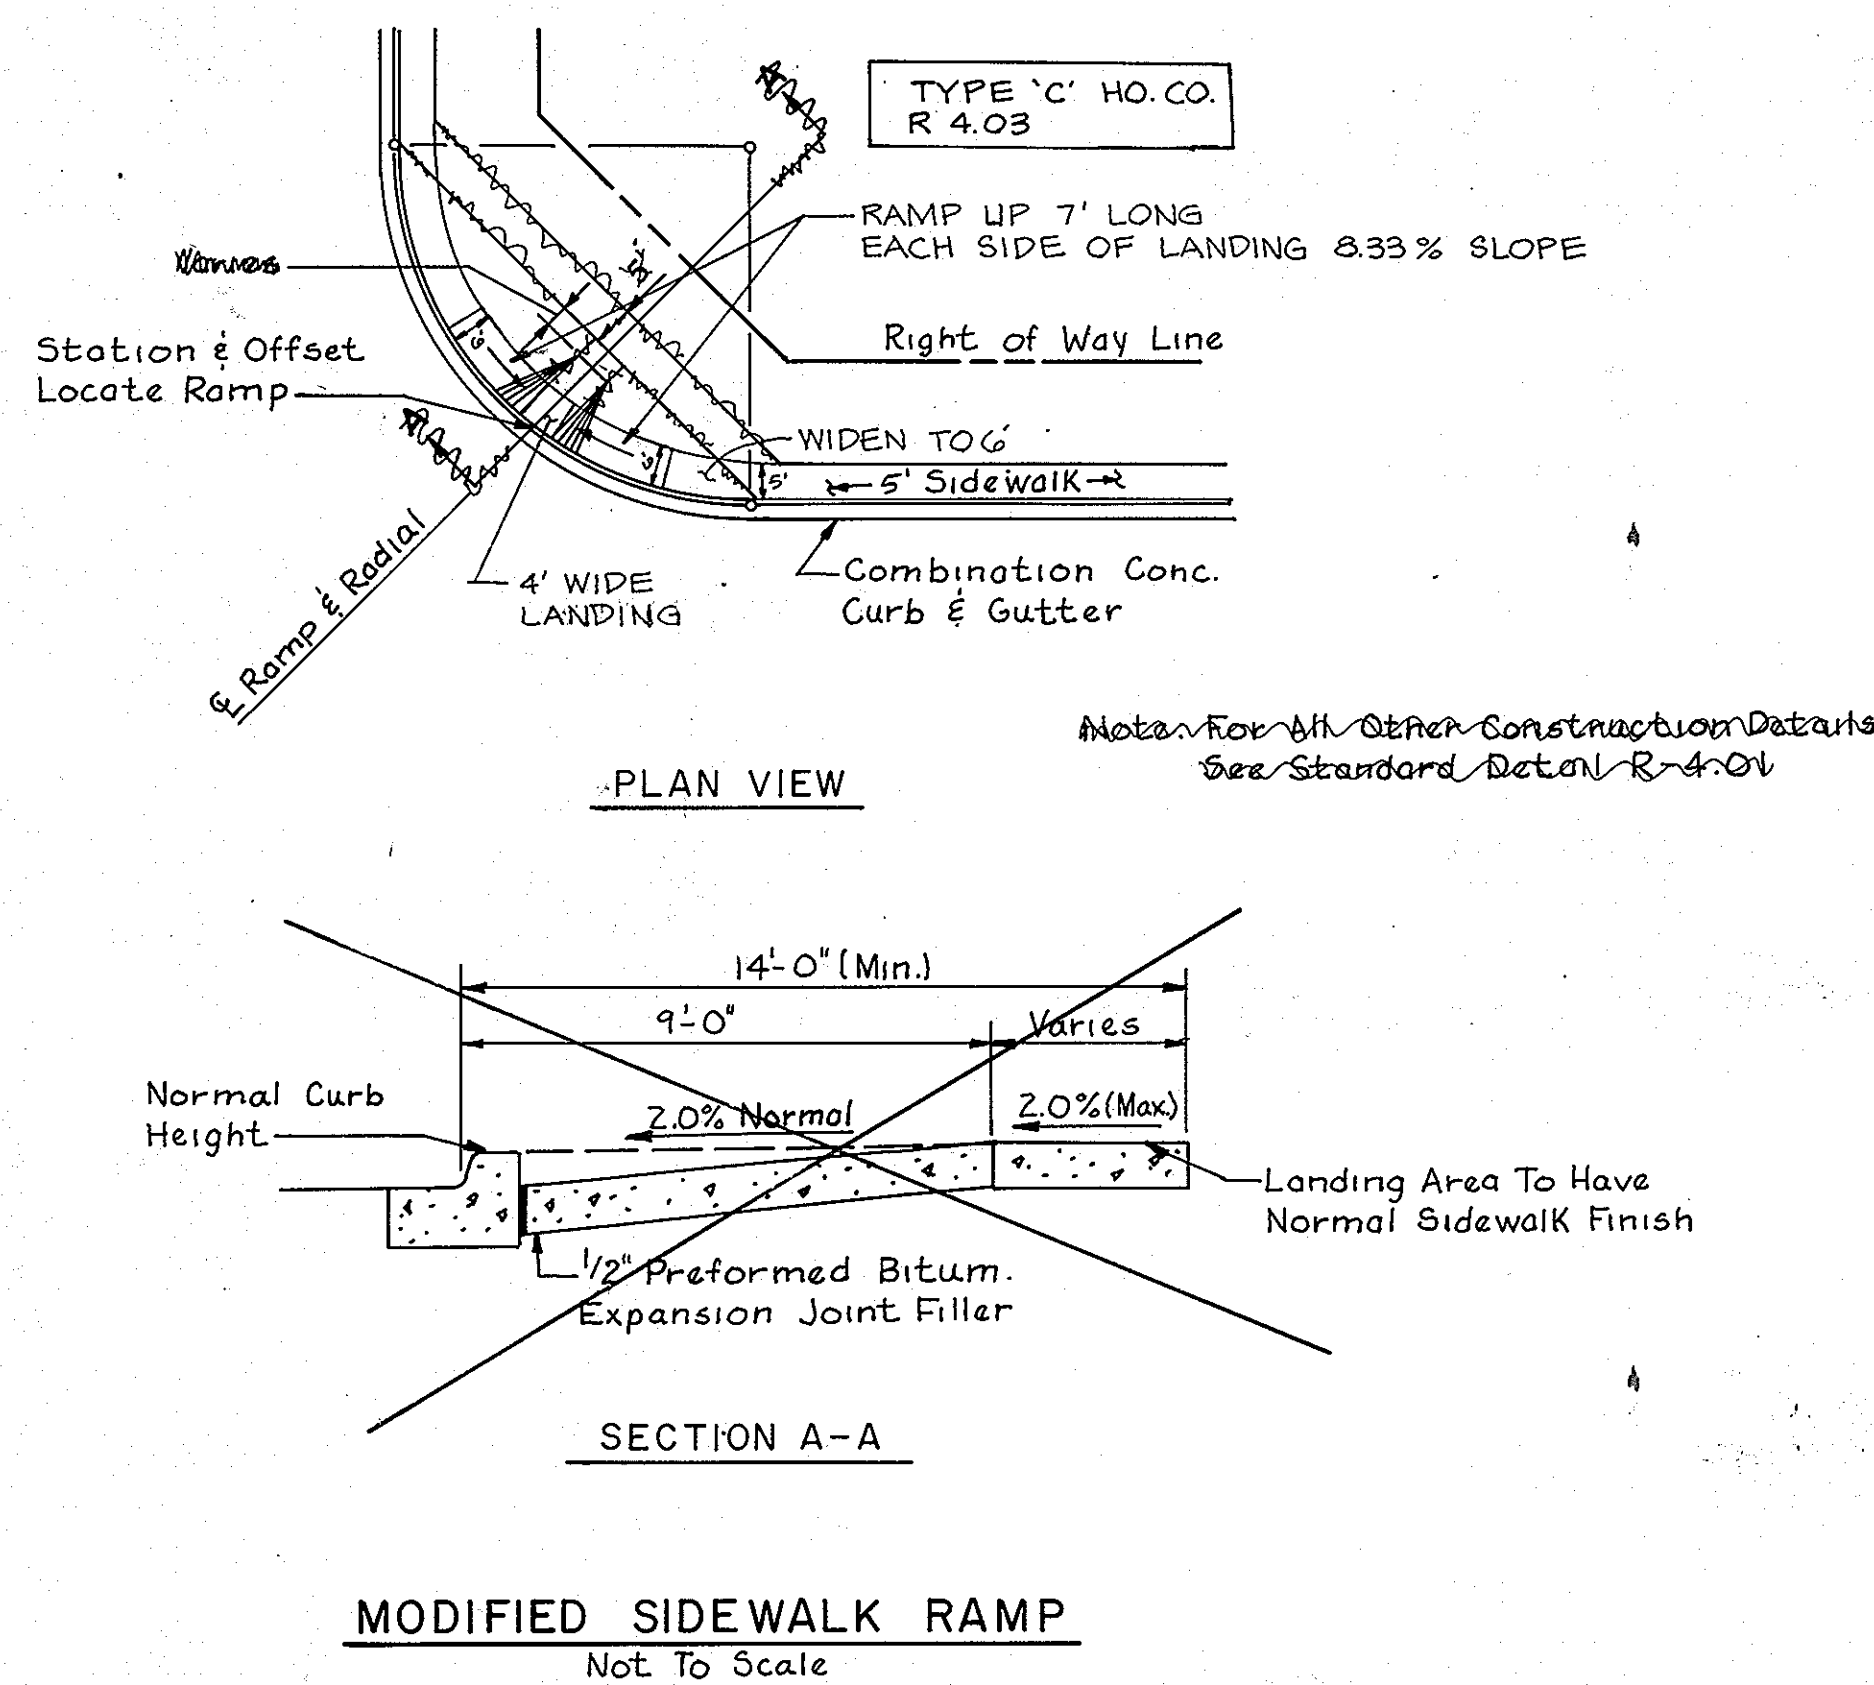

DEPARTMENT OF PUBLIC WORKS
HOWARD COUNTY, MARYLAND

James J. ... 11/8/88
DIRECTOR OF PUBLIC WORKS DATE

William D. ... 11/8/88
CHIEF, BUREAU OF ENGINEERING DATE

CHIEF, DIVISION OF ROADS, BRIDGES AND STORM DRAINAGE

PURDUM & JESCHKE
CONSULTING ENGINEERS
LAND SURVEYORS

1029 North Calvert Street
Baltimore, Maryland 21202 301/837-0194




DES: JCT	AS-BUILT	1/2/92
DRN: PWR		
CHK: WDP		
DATE: 6/90	BY	NO.
	REVISION	DATE

TYPICAL SECTIONS &
DETAILS
CEDAR LANE - PHASE 2


600' SCALE MAP NO. _____ BLOCK NO. _____

SOUTH OF FREETOWN RD. TO GUILFORD RD.
CAPITAL PROJECT J-4086
ELECTION DISTRICT NO. 5
HOWARD COUNTY, MARYLAND


SCALE AS SHOWN
SHEET 4 OF 28

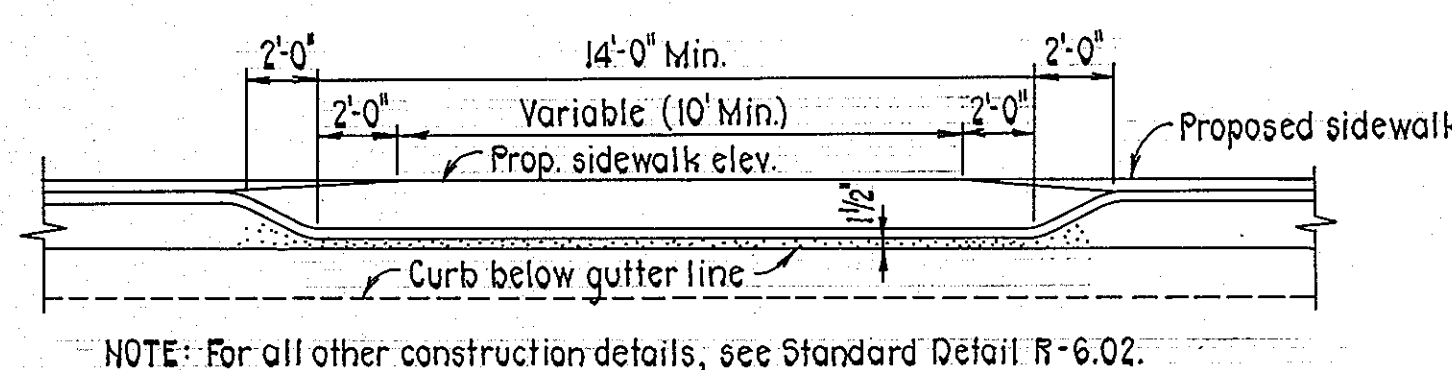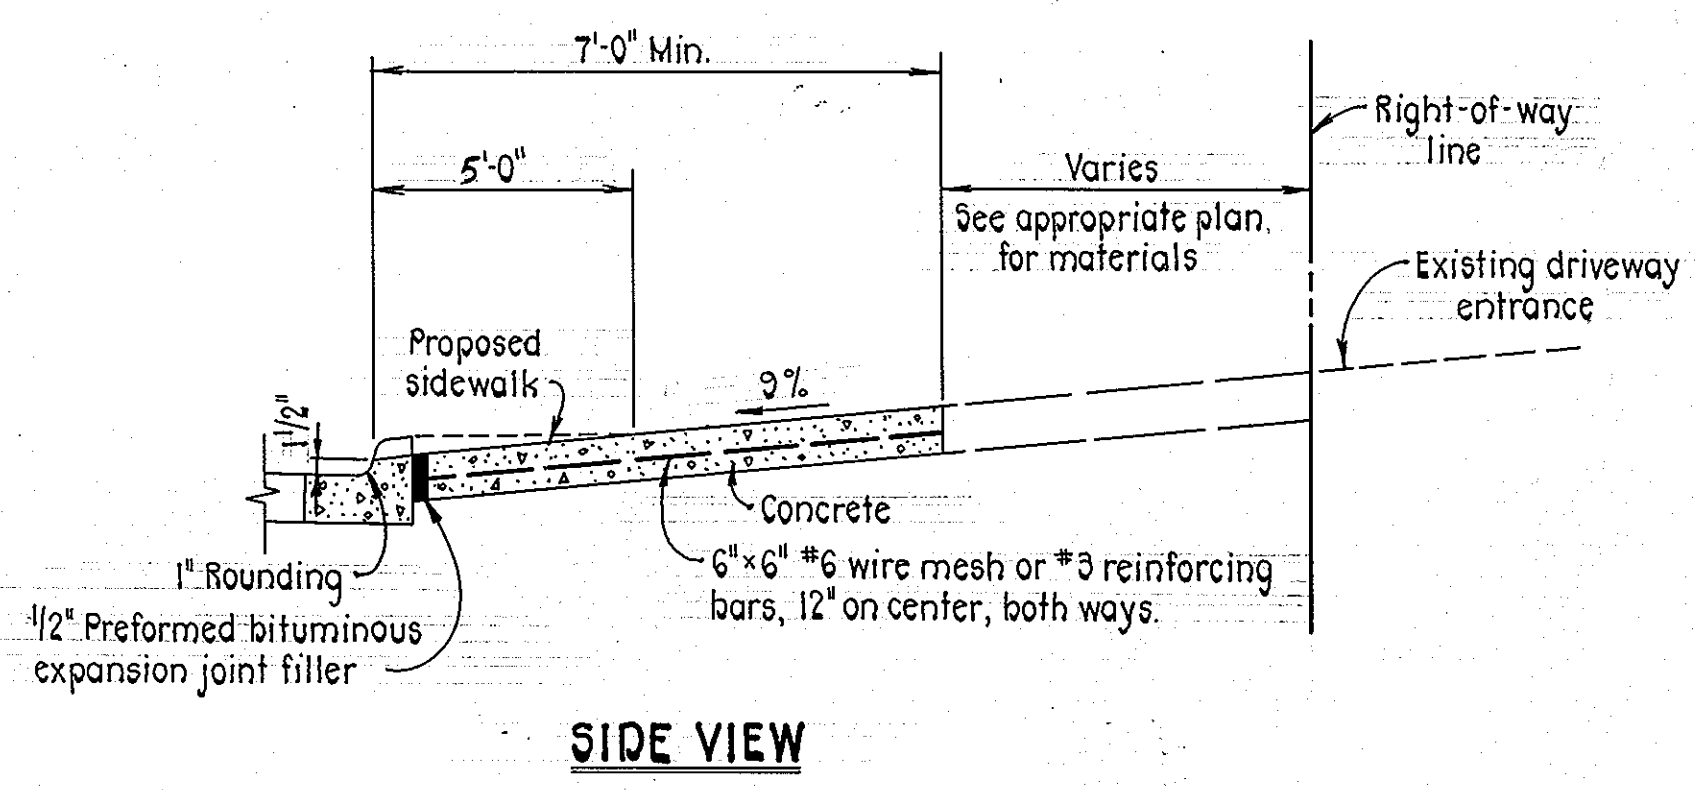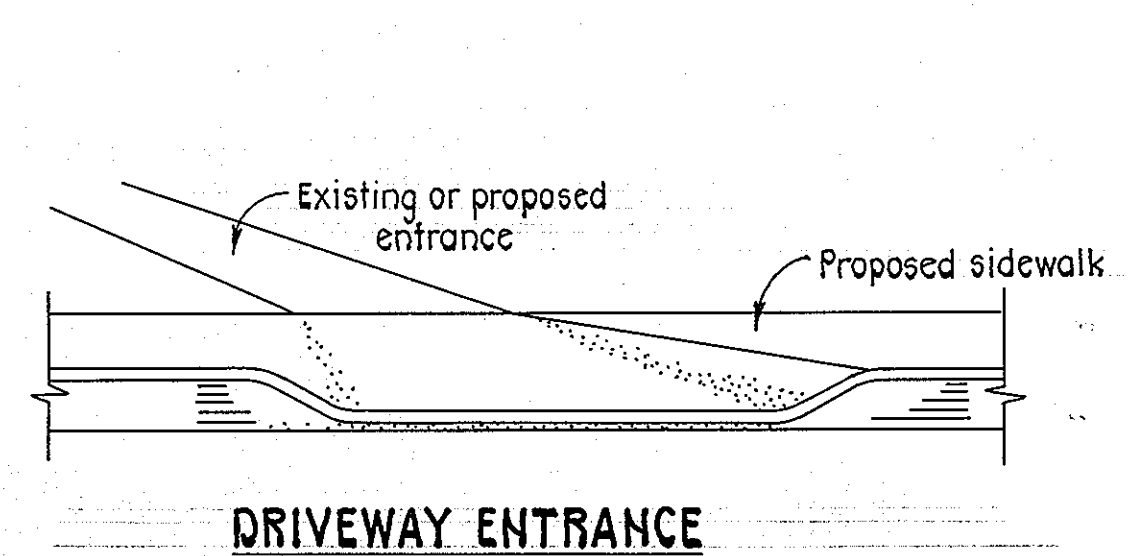


MODIFIED CLOSED-SECTION DRIVEWAY ENTRANCE DETAIL

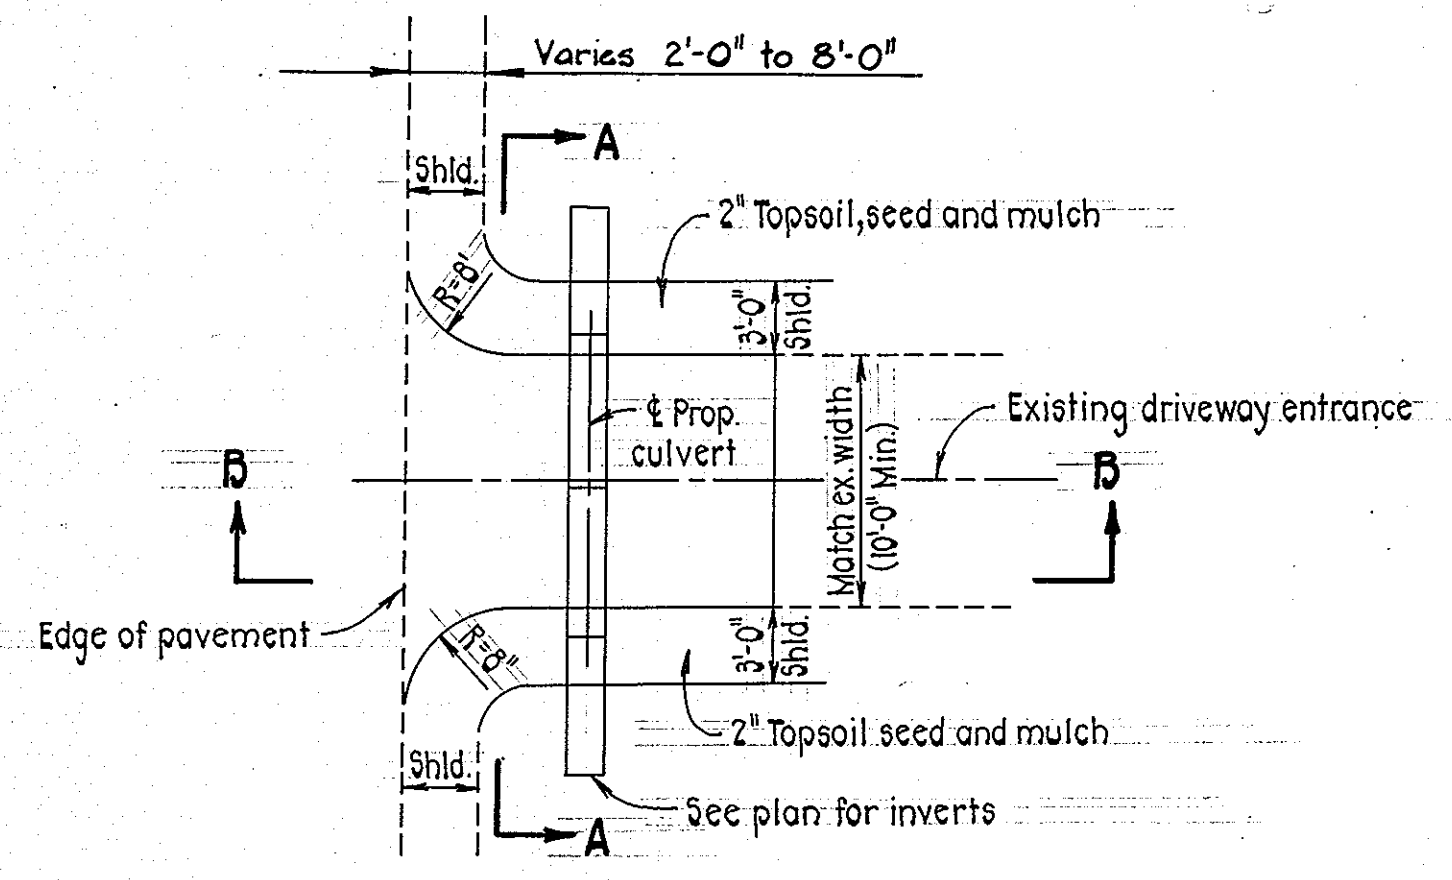

NOTE: For all other construction details, See standard detail R-6.06.

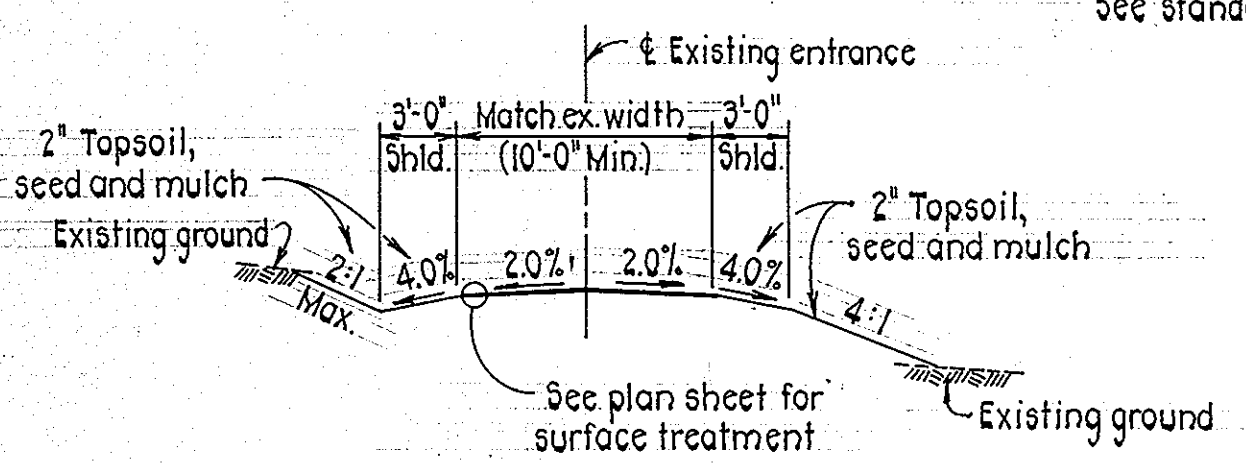


SECTION A-A

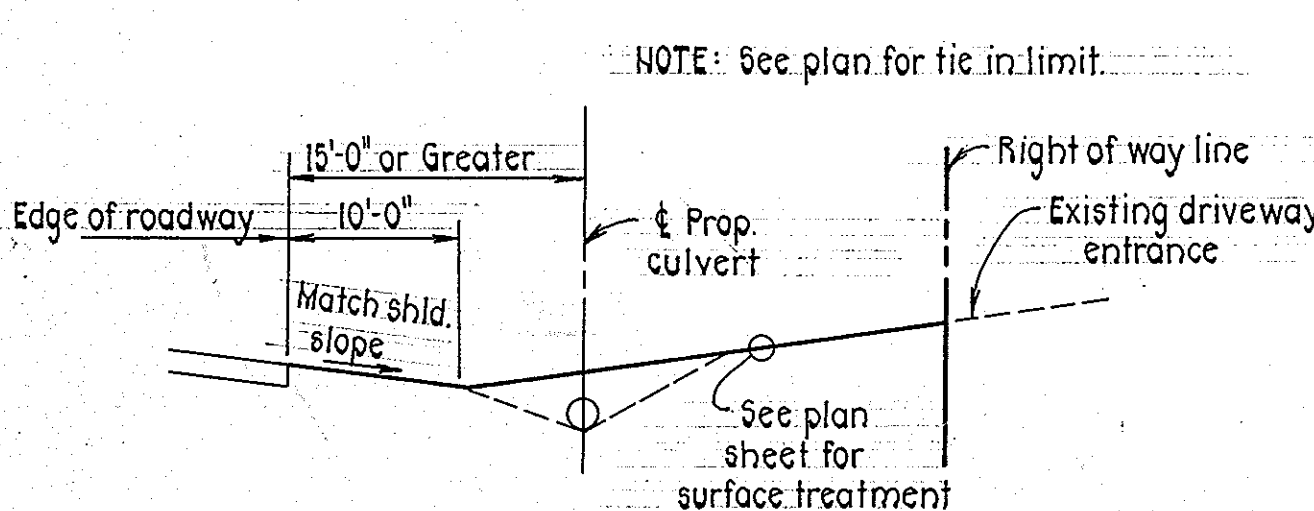


TYPICAL OPEN-SECTION DRIVEWAY ENTRANCE DETAIL

Not to Scale

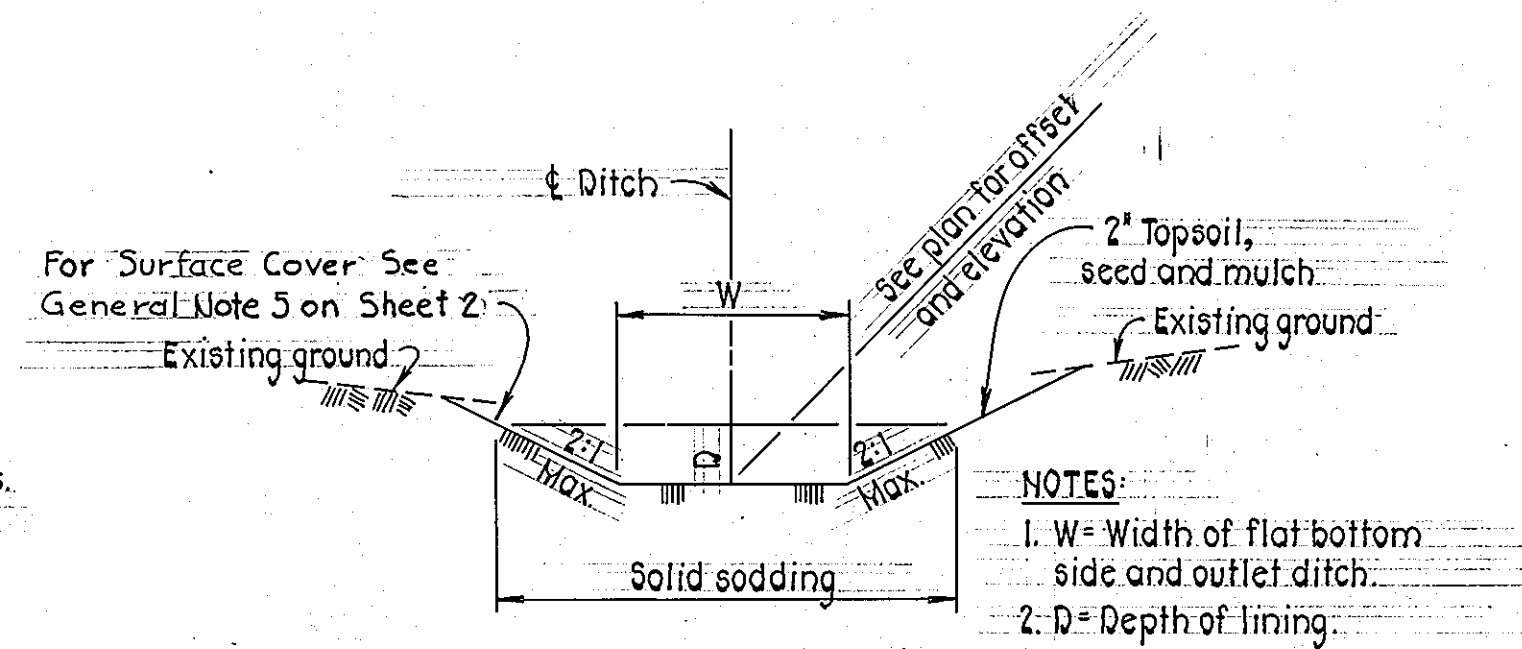

SOD SIDE DITCH

Not to Scale

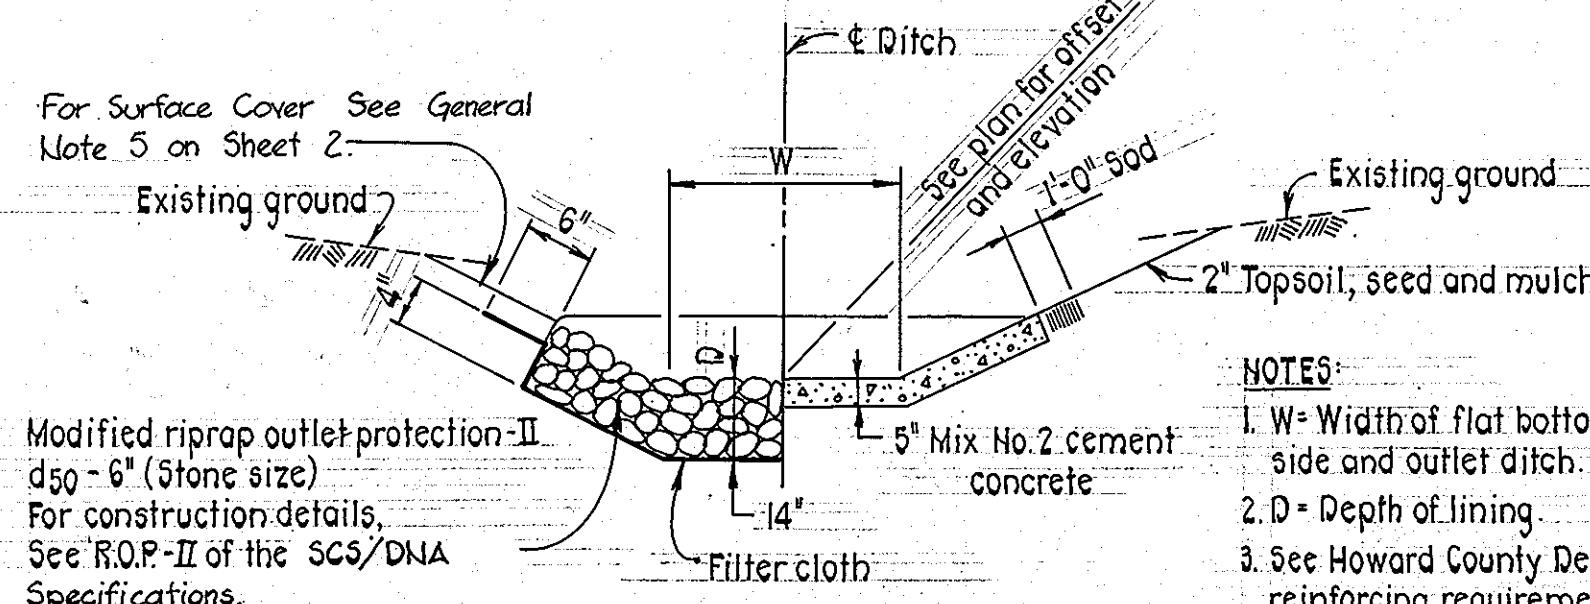



CONCRETE & RIPRAP SIDE AND OUTLET DITCH

Not to Scale

Construction code shown on plans

PROPOSED ROADWAY CONSTRUCTION LEGEND


- 1 Cedar Lane main line (See paving detail this sheet and typical section sheets 2, 3, & 4)
- 2 Road approach tie ins (See paving detail this sheet and typical section sheet 4)
- 3 Curb and gutter (See standard R-3.01)
- 4 Sidewalks (For materials see standard R-3.05)
- 5 Modified type "A" sidewalk ramp (See detail this sheet)
- 6 Storm drains
- 7 6" Base course, using graded aggregate base course (CR-6)
- 8 1" Bituminous concrete surface course, 4" Base course, using graded aggregate base course (CR-6)
- 9 7" Mix No. 2 plain cement concrete

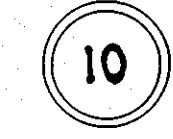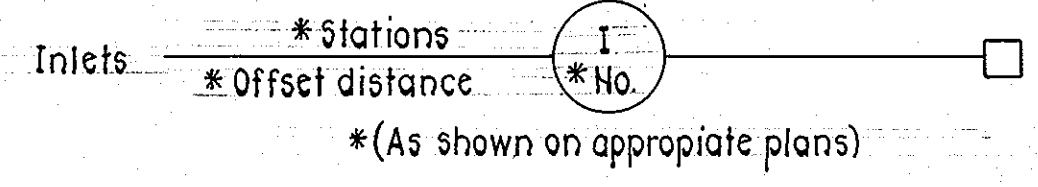

Md. State Traffic Barrier W Beam (Std. Nos. 660.01, 660.02, 660.03, 660.31, 660.32, 660.33, 660.34) For Location See Normal Closed Section Sheet 2 and appropriate plan sheets.

DRIVEWAY ENTRANCE TREATMENT LEGEND


(See modified closed section driveway entrance detail this sheet)

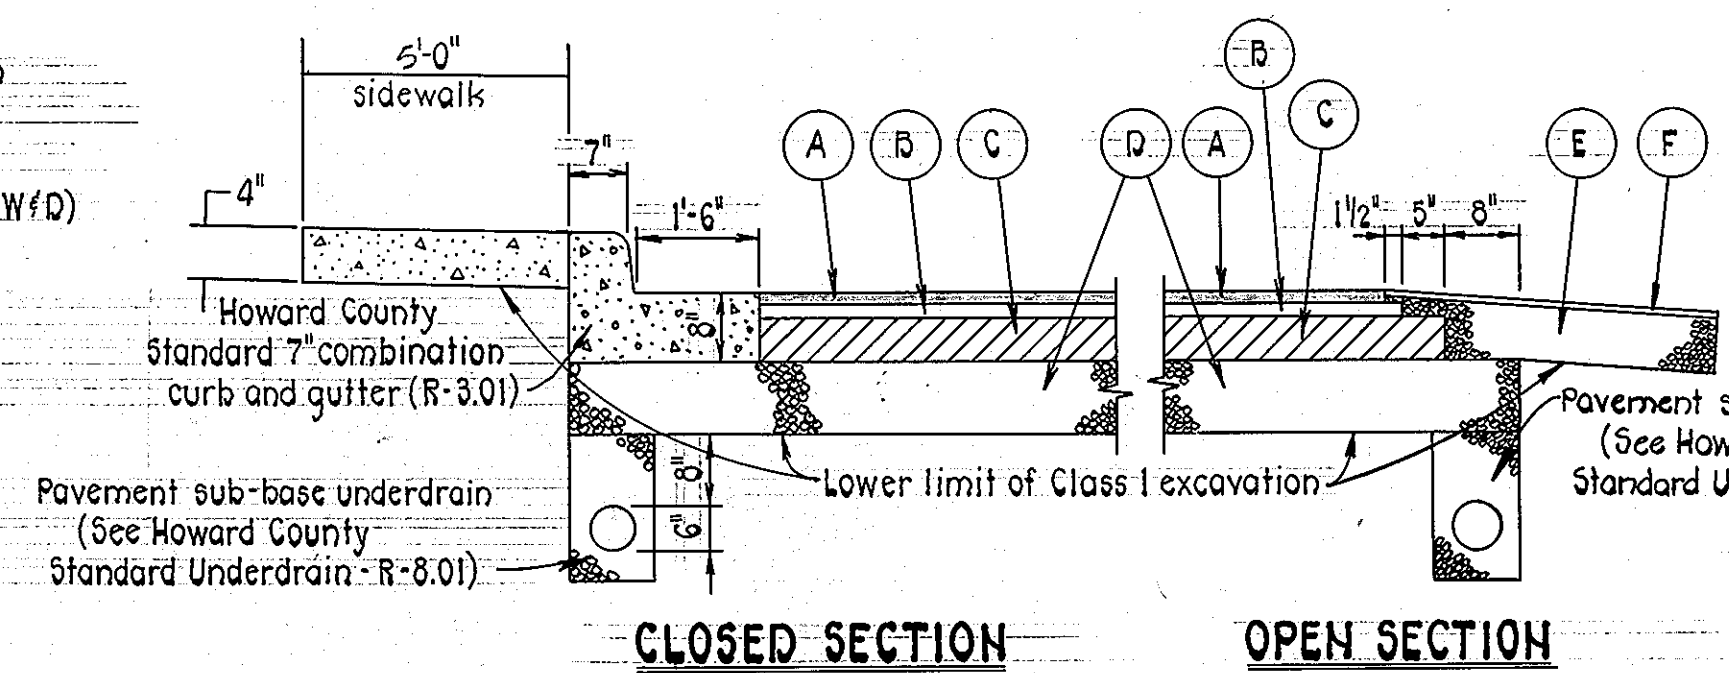

- A 1 1/2" Bituminous concrete surface (SN)
- B 1 1/2" Bituminous concrete base (BI)
- C 5" Bituminous concrete base (BI)
- D 8" Base course, using graded aggregate base course (CR-6)
- E 6" Base course, using graded aggregate base course (CR-6)
- F Double bituminous surface treatment

PROPOSED CEDAR LANE PAVING DETAIL P-5

Not to Scale

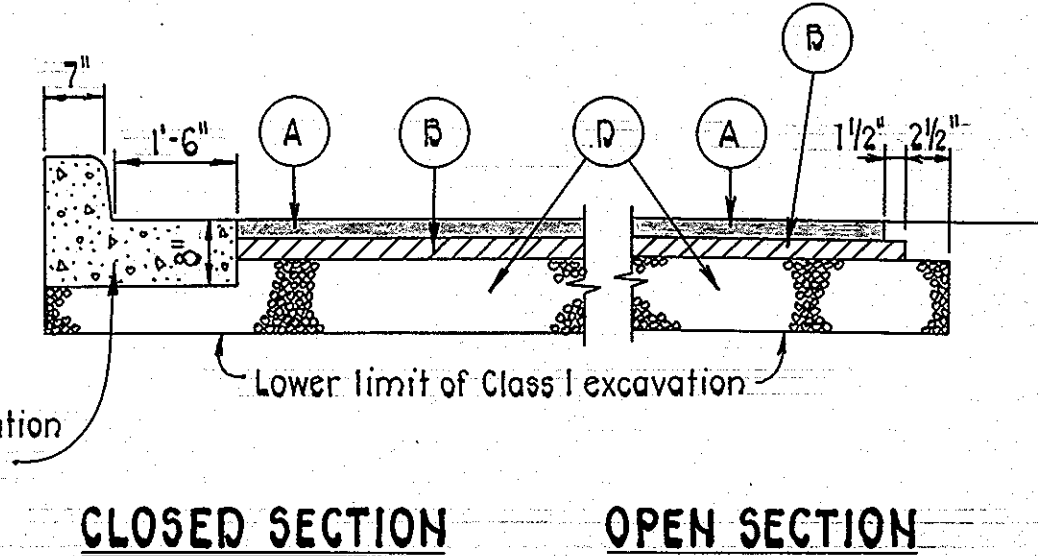

- A 1 1/2" Bituminous concrete surface (SN)
- B 2 1/2" Bituminous concrete base (BI)
- D 8" Base course, using graded aggregate base course (CR-6)

PROPOSED ROAD APPROACHES PAVING DETAIL P-2


Not to Scale

BRAEBURN ROAD CORINA COURT

DEPARTMENT OF PUBLIC WORKS
HOWARD COUNTY, MARYLAND
Director of Public Works: James J. ... 7/12/90
Chief, Bureau of Engineering: ... 11-8-88
Chief, Division of Roads, Bridges and Storm Drainage: ... 11/2/82



PURDUM & JESCHKE
CONSULTING ENGINEERS
LAND SURVEYORS
1029 North Calvert Street
Baltimore, Maryland 21202 301/837-0194

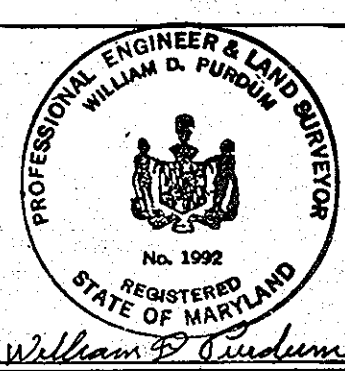

DES: JCT			
DRN: ARW			
CHK: WDP			
DATE: 6/90			
BY	NO.	REVISION	DATE

CONSTRUCTION - R/W
LEGEND & DETAILS
CEDAR LANE - PHASE 2
600' SCALE MAP NO. BLOCK NO.

SOUTH OF FREETOWN RD. TO GUILFORD RD.
CAPITAL PROJECT J-4086
ELECTION DISTRICT NO. 5
HOWARD COUNTY, MARYLAND

SCALE AS SHOWN
SHEET 5 of 28

SEDIMENT CONTROL NOTES

All vegetative and structural practices are to be installed according to the provisions of this plan and are to be in conformance with the 1983 MARYLAND STANDARDS AND SPECIFICATIONS FOR SOIL EROSION AND SEDIMENT CONTROL.

Any sediment control practice which is disturbed by grading activity for placement of utilities must be repaired on the same day of disturbance.

Additional sediment controls must be provided, if deemed necessary by the Howard County DPW sediment control inspector.

SEDIMENT CONTROL NOTES

- A minimum of 24 hours notice must be given to the Howard County Office of Inspection and Permits prior to the start of any construction (992-2437).
- All vegetative and structural practices are to be installed according to the provisions of this plan and are to be in conformance with the 1983 MARYLAND STANDARDS AND SPECIFICATIONS FOR SOIL EROSION AND SEDIMENT CONTROL.
- Following initial soil disturbance or redistribution, permanent or temporary stabilization shall be completed within: (a) 7 calendar days for all perimeter sediment control structures, dikes, perimeter slopes, and all slopes greater than 3:1, (b) 14 days as to all other disturbed or graded areas on the project site.
- All sediment traps/basins shown must be fenced and warning signs posted around their perimeter in accordance with Vol. 1, Chapter 12, Storm Drainage, of the HOWARD COUNTY DESIGN MANUAL.
- All disturbed areas must be stabilized within the time period specified above in accordance with the 1983 MARYLAND STANDARDS AND SPECIFICATIONS FOR SOIL EROSION AND SEDIMENT CONTROL for permanent seeding (Sec. 51), sod (Sec. 54), temporary seeding (Sec. 50), and mulching (Sec. 52). Temporary stabilizer with mulch along can only be done when recommended seeding dates do not allow proper germination and establishment of grasses.
- All sediment control structures are to remain in place and are to be maintained in operative condition until permission for their removal has been obtained from the Howard County Sediment Control Inspector.
- Site Analysis:
Total area of site R/W and Easements 10.84 acres
Area disturbed 9.18 acres
Area to be roofed or paved 4.03 acres
Area to be vegetatively stabilized 5.15 acres
Total cut 18,640 cu.yds.
Total fill 14,818 cu.yds.
Offsite waste/borrow area location To be determined by Contractor
- Any sediment control practice which is disturbed by grading activity for placement of utilities must be repaired on the same day of disturbance.
- Additional sediment controls must be provided, if deemed necessary by the Howard County DPW Sediment Control Inspector.
- On all sites with disturbed areas in excess of 2 acres, approval of the inspection agency shall be requested upon completion of installation of perimeter erosion and sediment controls, but before proceeding with any other earth disturbance or grading. Other building or grading inspection approvals may not be authorized until this initial approval by the inspection agency is made.
- See sheet Nos. 7 and 8 for additional Sediment and Erosion Control Notes and Details.

EARTHWORK SUMMARY

TOTAL CLASS I EXCAVATION	10,718 CY
Leaf Mulch Removal under Shallow Fill	- 69 CY
Cut From Grading Table	10,649 CY
Minus Class I-4 From Grading Table	-1143 CY
TOTAL CLASS I EXCAVATION	9,506 CY
Minus Topsoil Removed in Cut	-2,022 CY
Cut Adjusted From Grading Table	7,484 CY
Loss Due To Denatification (20%)	-1,446 CY
ESTIMATED CLASS I AVAILABLE FOR EMBANKMENT	6,038 CY

EXCAVATION AVAILABLE FOR EMBANKMENT	
Class 1 Excavation Denified	6038 CY
Class 2 Excavation Denified	5611 CY
Class 5 Excavation Denified	+ 301 CY
TOTAL EXCAVATION AVAILABLE FOR EMBANKMENT	11948 CY
EMBANKMENT REQUIRED	16283 CY
Leaf Mulch Removal Refill	+ 69 CY
Total Embankment Required	16352 CY
Available Excavation	-11948 CY
Estimated Borrow Excavation	4374 CY

CLASS 2 EXCAVATION	
From Grading Table 2843 CY	
TOTAL CLASS 2 EXCAVATION	6376 CY
Loss Due To Handling and Denatification (12%)	-765 CY
ESTIMATED CLASS 2 AVAILABLE FOR EMBANKMENT	5611 CY


CLASS 5 EXCAVATION	
From Grading Table 335 CY	
TOTAL CLASS 5 EXCAVATION	335 CY
Loss Due To Handling and Denatification (10%)	-34 CY
ESTIMATED CLASS 5 AVAILABLE FOR EMBANKMENT	301 CY

PROPOSAL QUANTITIES

CLASS I EXCAVATION	11000 CY
CLASS I-A EXCAVATION	1200 CY
CLASS 2 EXCAVATION	6400 CY
CLASS 5 EXCAVATION	400 CY
BORROW EXCAVATION	4300 CY

SILT FENCE

NOT TO SCALE

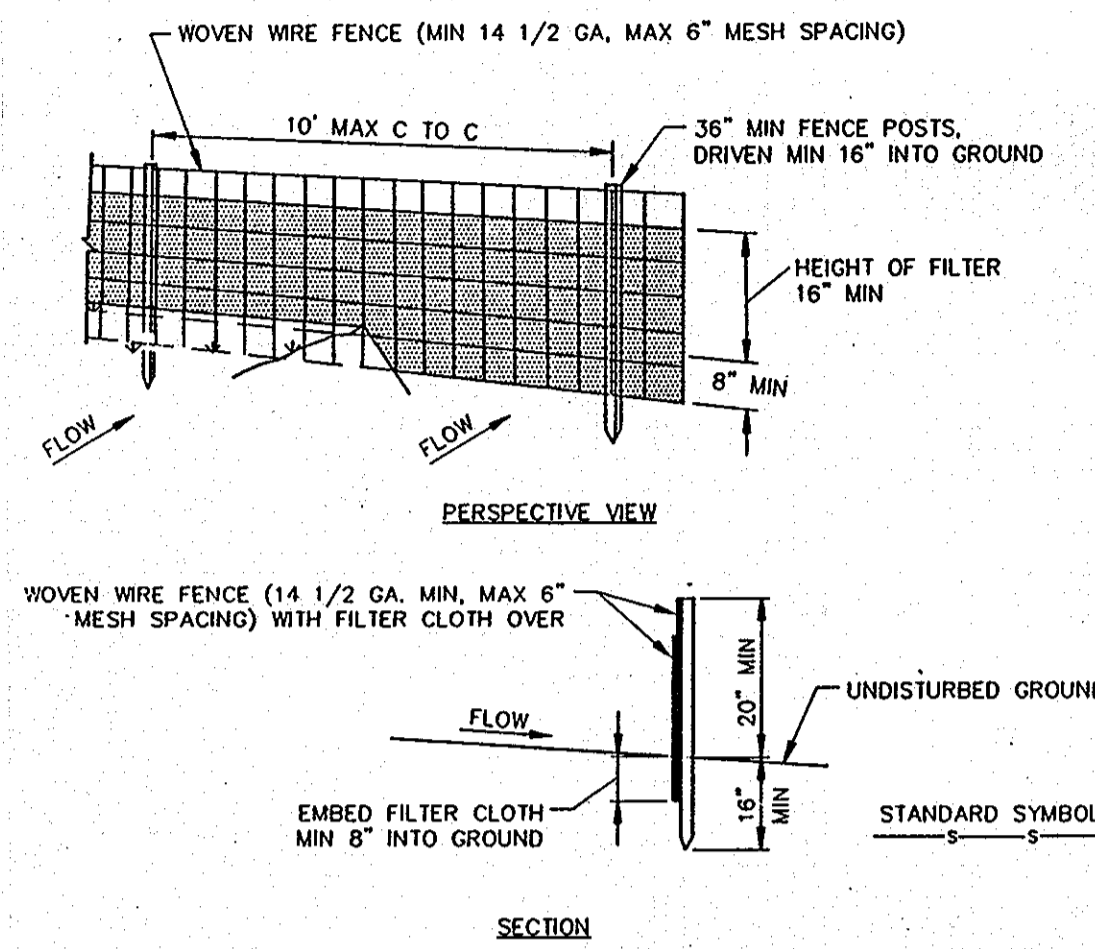


CONSTRUCTION NOTES FOR FABRICATED SILT FENCE

- WOVEN WIRE FENCE TO BE FASTENED SECURELY TO FENCE POSTS WITH WIRE NIES OR STAPLES.
- FILTER CLOTH TO BE FASTENED SECURELY TO WOVEN WIRE FENCE WITH NIES SPACED EVERY 24\"/>

STABILIZED CONSTRUCTION ENTRANCE

NOT TO SCALE

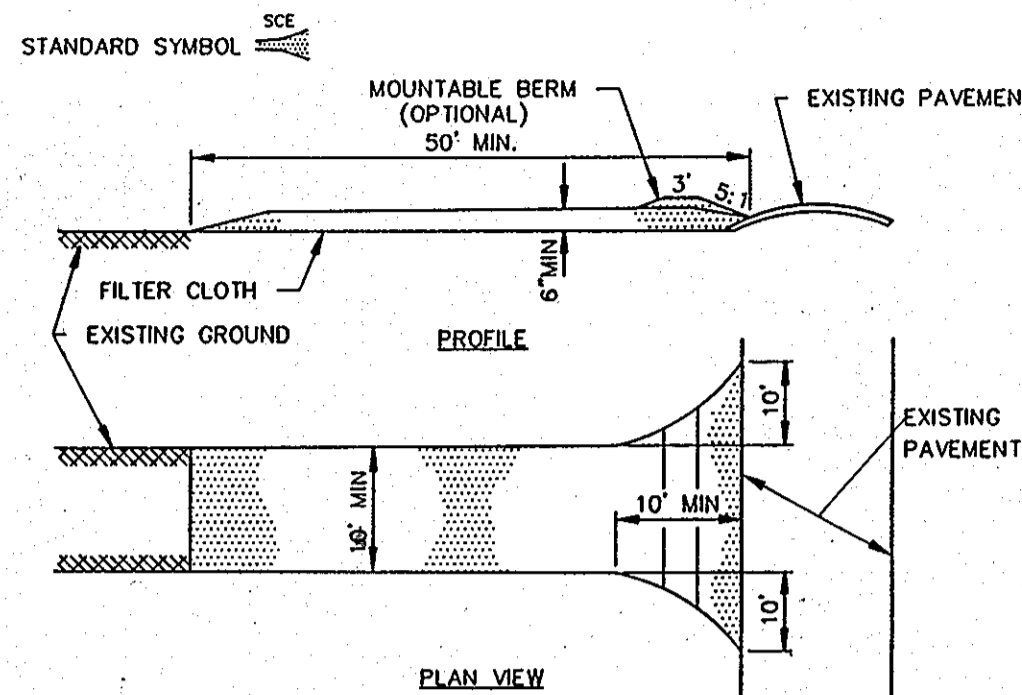

Stone size - Use 2\"/>

STABILIZED CONSTRUCTION ENTRANCE

GRADING TABLE

STATION	CUT	EMBANKMENT	TOPSOIL	UNSUITABLE MATERIAL	CLASS 2	CLASS 5	CUT ADJUST.	CUT DEN.	REMARKS	
FROM	TO		CUT	FILL						
56+50	65+50	2424		546			1948	1753	T/S In Open Areas, 8\"/>	
56+50	63+50	*891							*CL I-A Undercutting (Not Avail. for Embank.)	
56+50	67+00			3211					4\"/>	
58+50	60+00				69				Side Ditch	
65+00	67+00					511			Side Ditch	
67+00	80+00	9530								
67+00	76+00				1769	335			Side Ditch & Stormwater Management Pond Lt. Sta. 74+50	
68+00	74+00	3252		863			2389	1792	6\"/>	
68+00	72+00	693					693	624	Cut below 5\"/>	
70+50	73+50	*252							*CL I-A Undercutting (Not Avail. for Embank.)	
76+00	80+00	1270		207			1063	797	6\"/>	
78+50	80+00	128					128	115	Cut below 5\"/>	
BRAEBURN RD.										
0+50	1+30	170			396				Approach Road Rt. Sta. 68+61.48	
0+50	1+30	49					49	37	Side Ditch (S=25%)	
ENTRANCES										
LT. 73+70		2	10				2	2	(S=25%)	
LT. 75+36		4	40				4	3	(S=25%)	
80+00	85+50	1183		244			939	704	6\"/>	
80+00	89+00					1600			SIDE DITCH	
80+00	89+00			3122						
85+50	89+00	255		*162			93	74	*3\"/>	
CORINA CT.										
0+	1+75	89					89	67	Cut less than 5\"/>	
0+	1+75			68						
ENTRANCES										
RT. 84+81		2	14				2	2	(S=25%)	
RT. 85+01		2	16				2	2	(S=25%)	
RT. 85+92		2	18				2	2	(S=20%)	
LT. 88+29		4	52				4	3	(S=20%)	
89+00	95+50					1933			SIDE DITCH	
ENTRANCE										
RT. 91+08		74	2				74	59	(S=20%)	
TOTALS										
		10,646		16,283		2,022	69	6,376	7,484	6,038

NOTE: DENATIFICATION FACTORS VARY SEE REMARKS

PERMANENT SEEDING NOTES

Apply to graded or cleared areas not subject to immediate further disturbance where a permanent, long-lived vegetative cover is needed.

Seedbed Preparation: Loosen upper 3 inches of soil by raking, discing, or other acceptable means before seeding, if not previously loosened.

Soil Amendments: Use one of the following schedules:

- Preferred - Apply 2 tons per acre dolomitic limestone (92 lbs./1000 sq.ft.) and 600 lbs. per acre 10-10-10 fertilizer (14 lbs./1000 sq.ft.) before seeding. Barrow or disc into upper three inches of soil. At time of seeding, apply 400 lbs. per acre 30-0-0 ureaform fertilizer (9 lbs./1000 sq.ft.)
- Acceptable - Apply 2 tons per acre dolomitic limestone (92 lbs./1000 sq.ft.) and 1000 lbs. per acre 10-10-10 fertilizer (23 lbs./1000 sq.ft.) before seeding. Barrow or disc into upper three inches of soil.

Seeding: For the periods March 1 thru April 30 and August 1 thru October 15, seed with 20 lbs. per acre (1.4 lbs./1000 sq.ft.) of Kentucky 31 Tall Fescue. For the period May 1 thru July 31, seed with 60 lbs. of Kentucky 31 Tall Fescue per acre and 2 lbs. per acre (.05 lbs./1000 sq.ft.) of weeping lovegrass. During the period of October 16 thru February 28, protect site by: Option 1 - 2 tons per acre of well-anchored straw mulch, and seed as soon as possible in the spring. Option 2 - Use sod. Option 3 - Seed with 60 lbs. per acre Kentucky 31 Tall Fescue, and mulch with 2 tons per acre well-anchored straw.

Mulching: Apply 11 to 2 tons per acre (70 to 90 lbs./1000 sq.ft.) of unrotted small grain straw immediately after seeding. Anchor mulch immediately after application using mulch anchoring tool or 218 gallons per acre (5 gal./1000 sq.ft.) of emulsified asphalt on flat areas. On slopes 8 feet or higher, use 348 gallons per acre (8 gal./1000 sq.ft.) for anchoring.

Maintenance: Inspect all seeded areas, and make needed repairs, replacements, and reseedings.

TEMPORARY SEEDING NOTES

Apply to graded or cleared areas likely to be redisturbed where a short-term vegetative cover is needed.



Seedbed Preparation: Loosen upper three inches of soil by raking, discing, or other acceptable means before seeding, if not previously loosened.

Soil Amendments: Apply 600 lbs. per acre 10-10-10 fertilizer (14 lbs./1000 sq.ft.)

Seeding: For periods March 1 thru April 30 and from August 15 thru November 15, seed with 21 bushel per acre of annual rye (3.2 lbs./1000 sq.ft.). For the period May 1 thru August 14, seed with 3 lbs. per acre of weeping lovegrass (.07 lbs./1000 sq.ft.). For the period November 16 thru February 28, protect site by applying 2 tons per acre of well-anchored straw mulch, and seed as soon as possible in the spring, or use sod.

Mulching: Apply 11 to 2 tons per acre (70 to 90 lbs./1000 sq.ft.) of unrotted small grain straw immediately after seeding. Anchor mulch immediately after application using mulch anchoring tool or 218 gal. per acre (5 gal./1000 sq.ft.) of emulsified asphalt on flat areas. On slopes 8 feet or higher, use 348 gal. per acre (8 gal./1000 sq.ft.) for anchoring.

Refer to the 1983 MARYLAND STANDARDS AND SPECIFICATIONS FOR SOIL EROSION AND SEDIMENT CONTROL for rate and methods not covered.

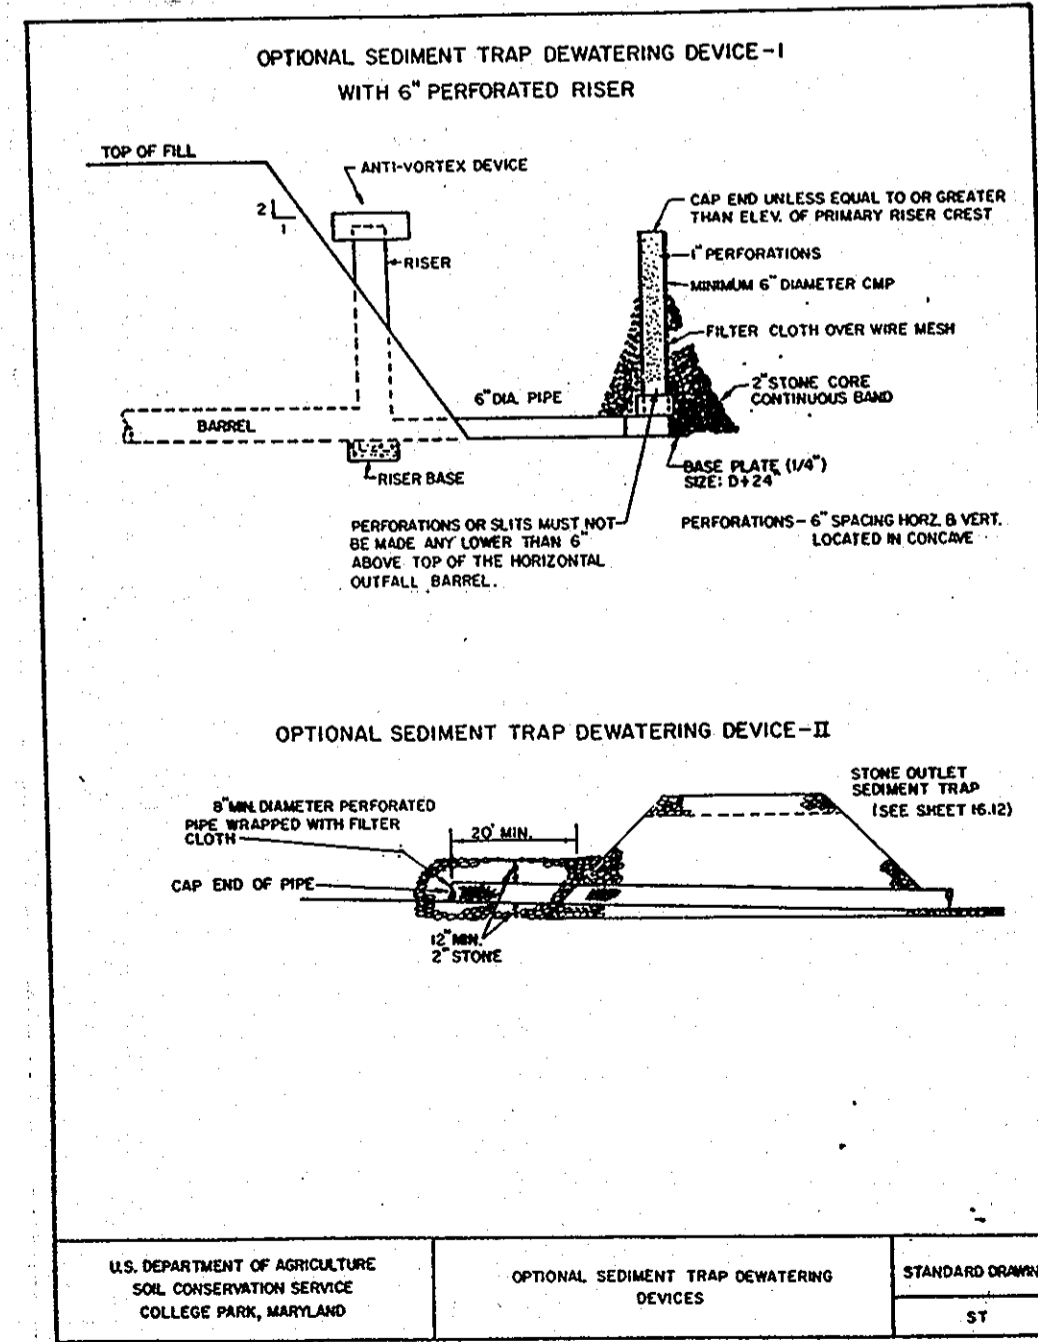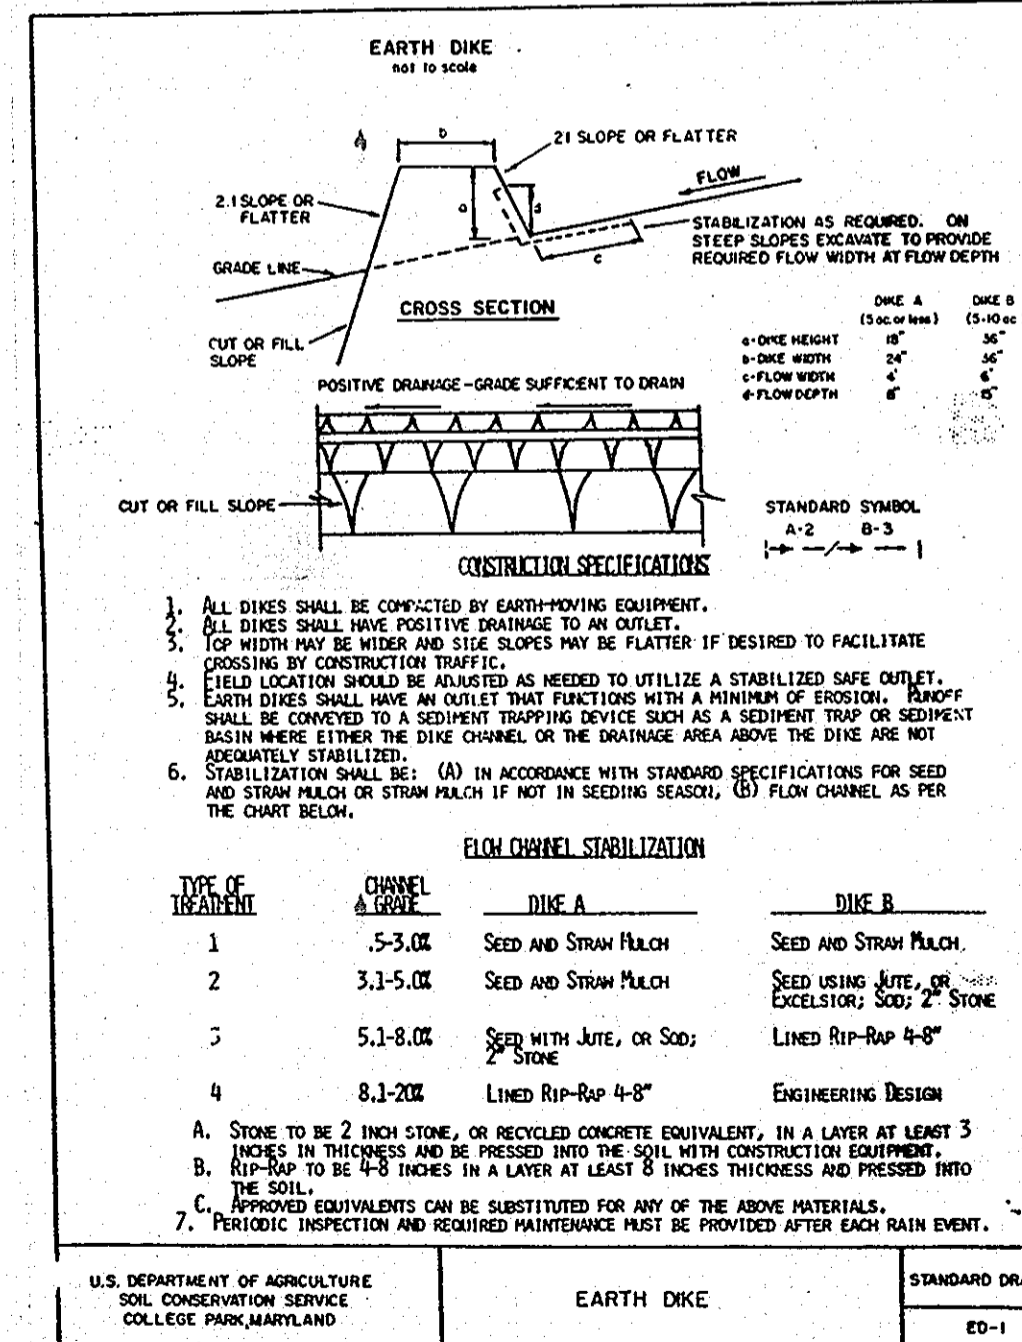


DEPARTMENT OF PUBLIC WORKS
HOWARD COUNTY, MARYLAND

James P. Chen 11/8/88 DATE
DIRECTOR OF PUBLIC WORKS


Richard S. Reddy 11/8/88 DATE
CHIEF, BUREAU OF ENGINEERING

William B. H. Anderson 11/8/88 DATE
CHIEF, DIVISION OF ROADS, BRIDGES AND STORM DRAINAGE

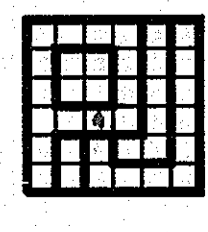

PURDUM & JESCHKE
CONSULTING ENGINEERS
LAND SURVEYORS

1029 North Calvert Street
Baltimore, Maryland 21202 301/837-0194

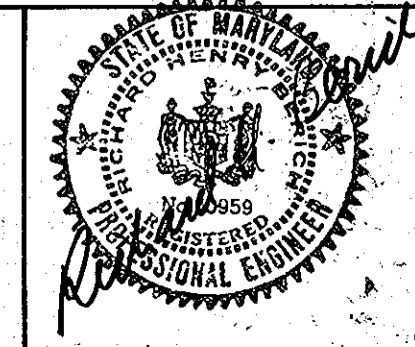










DES: JCT	DATE: 6/90
DRN: PWR	BY: NO.
CHK: WDP	REVISION
DATE: 6/90	REVISION

SEDIMENT CONTROL DETAILS &
EARTHWORK ANALYSIS
CEDAR LANE - PHASE 2





600' SCALE MAP NO. _____ BLOCK NO. _____

SOUTH OF FREETOWN RD. TO GUILFORD RD.
CAPITAL PROJECT J-4086
ELECTION DISTRICT NO. 5
HOWARD COUNTY, MARYLAND

SCALE AS SHOWN
SHEET
6 OF 28

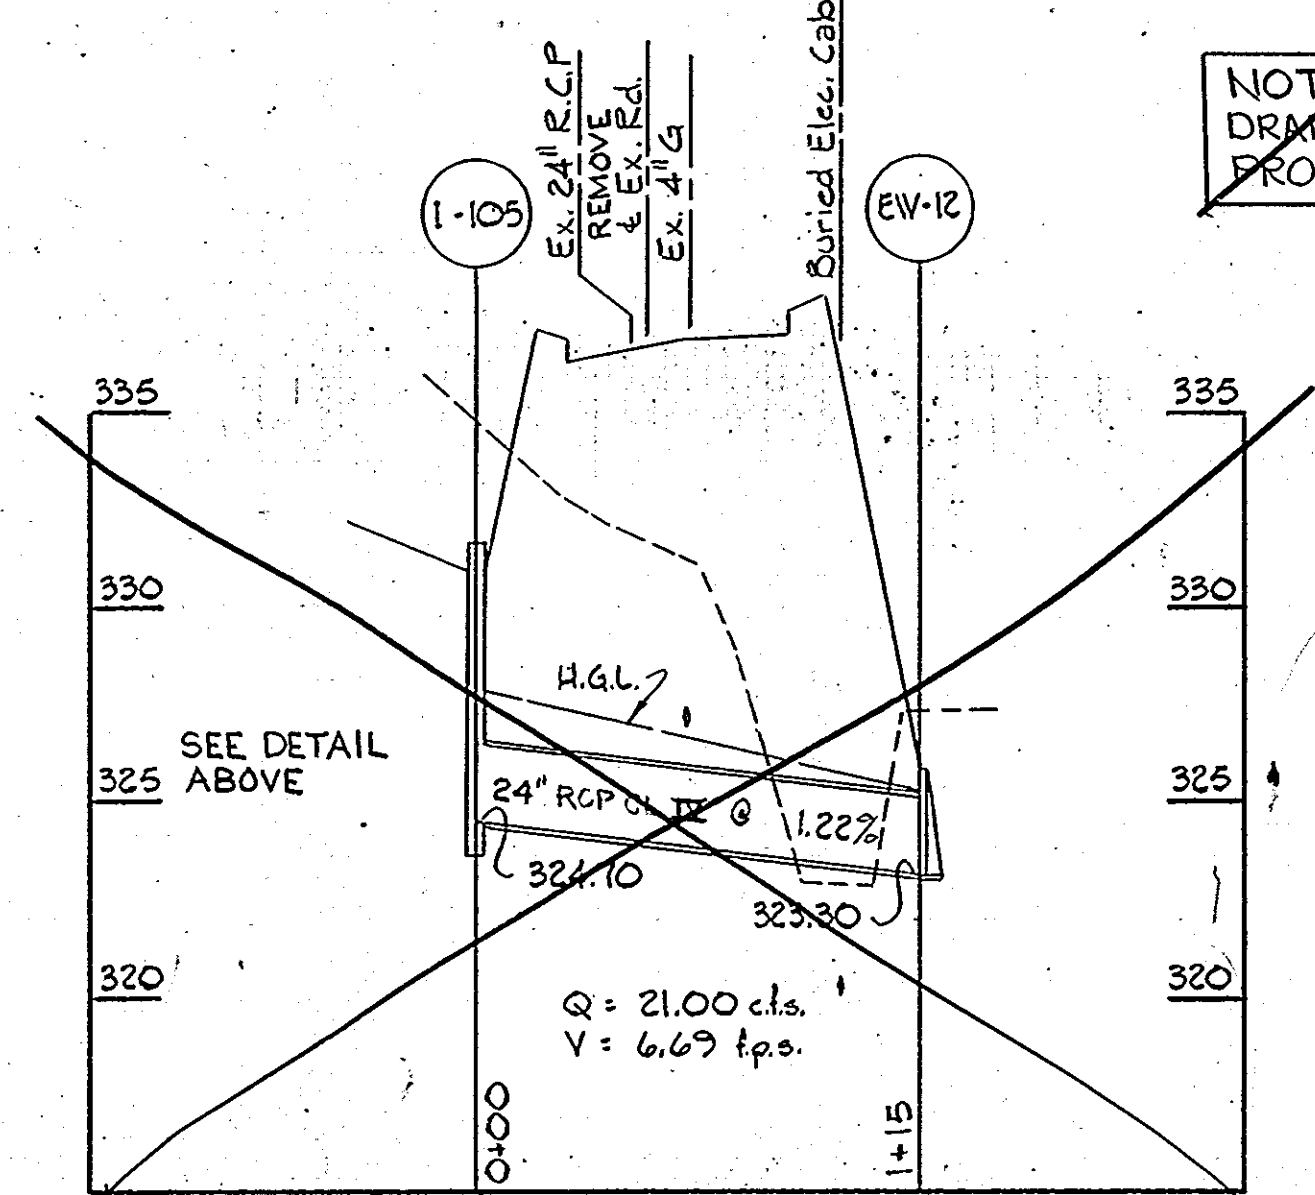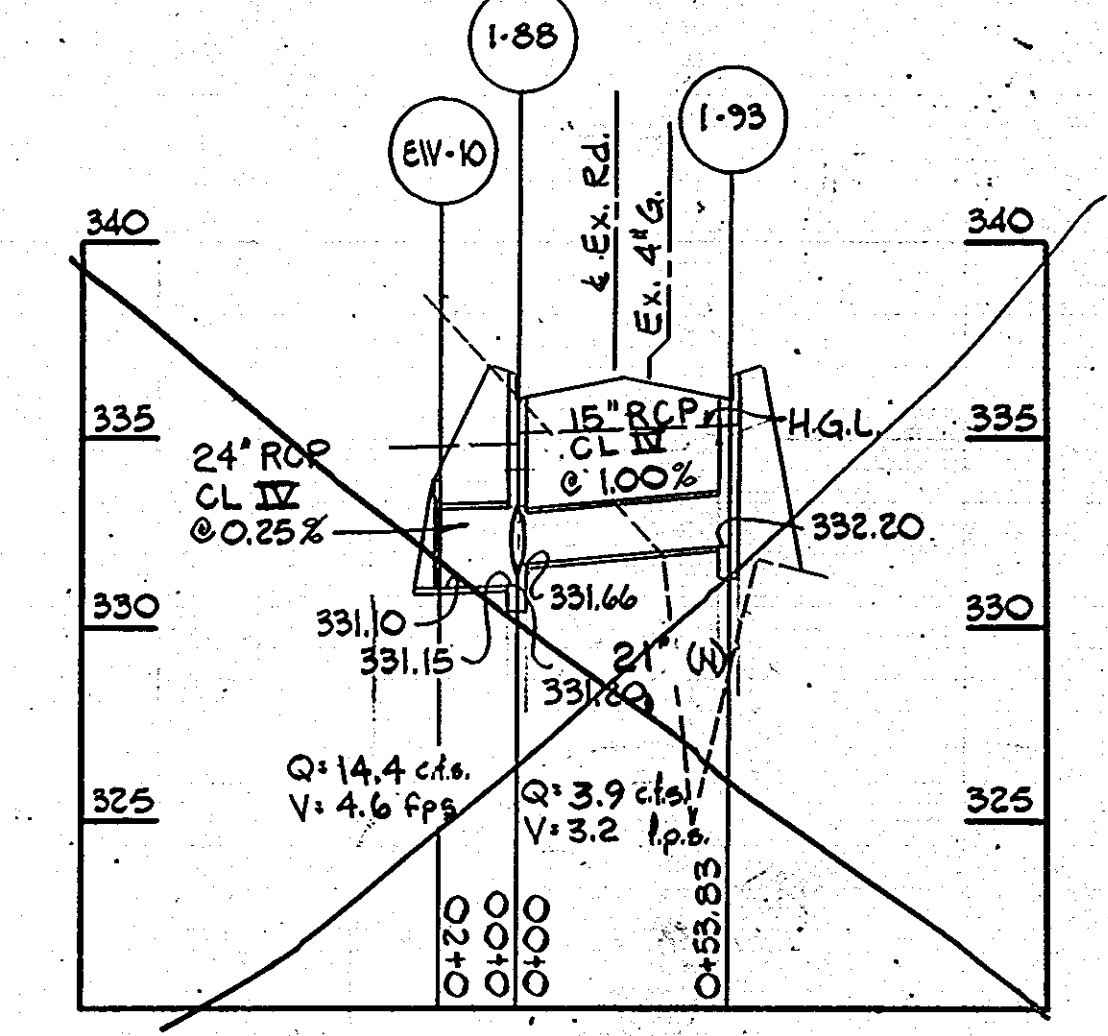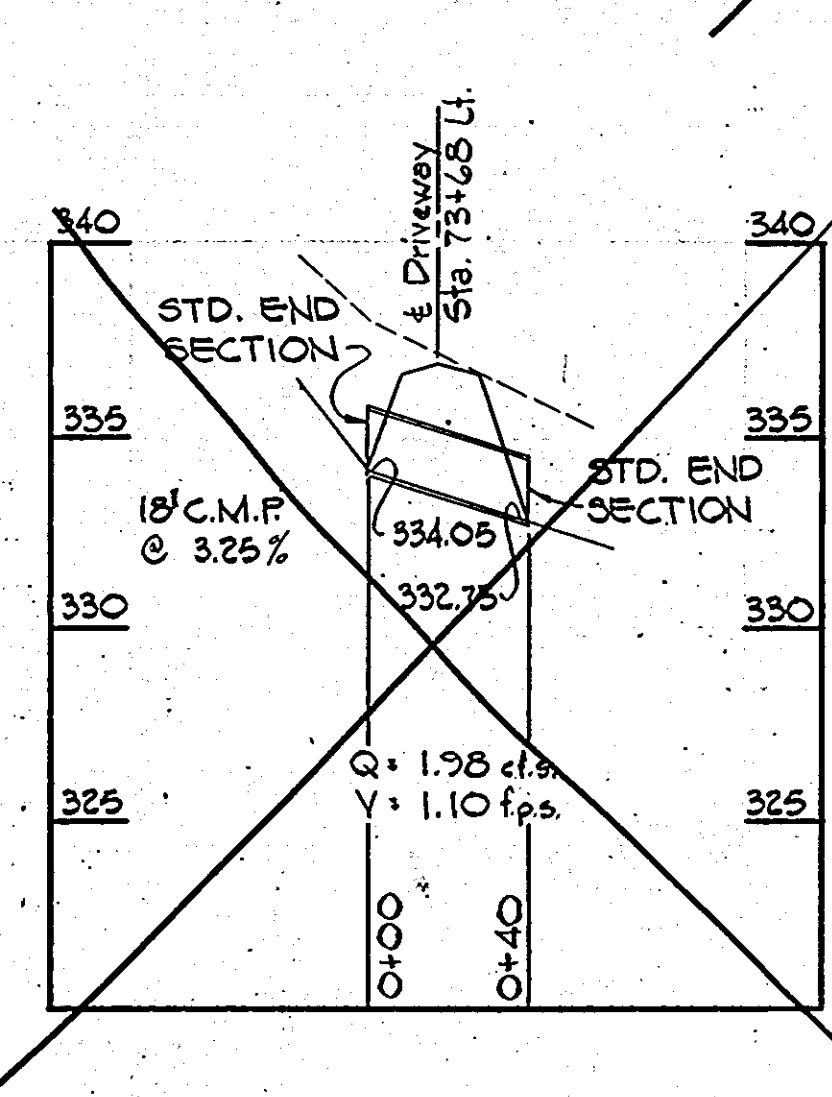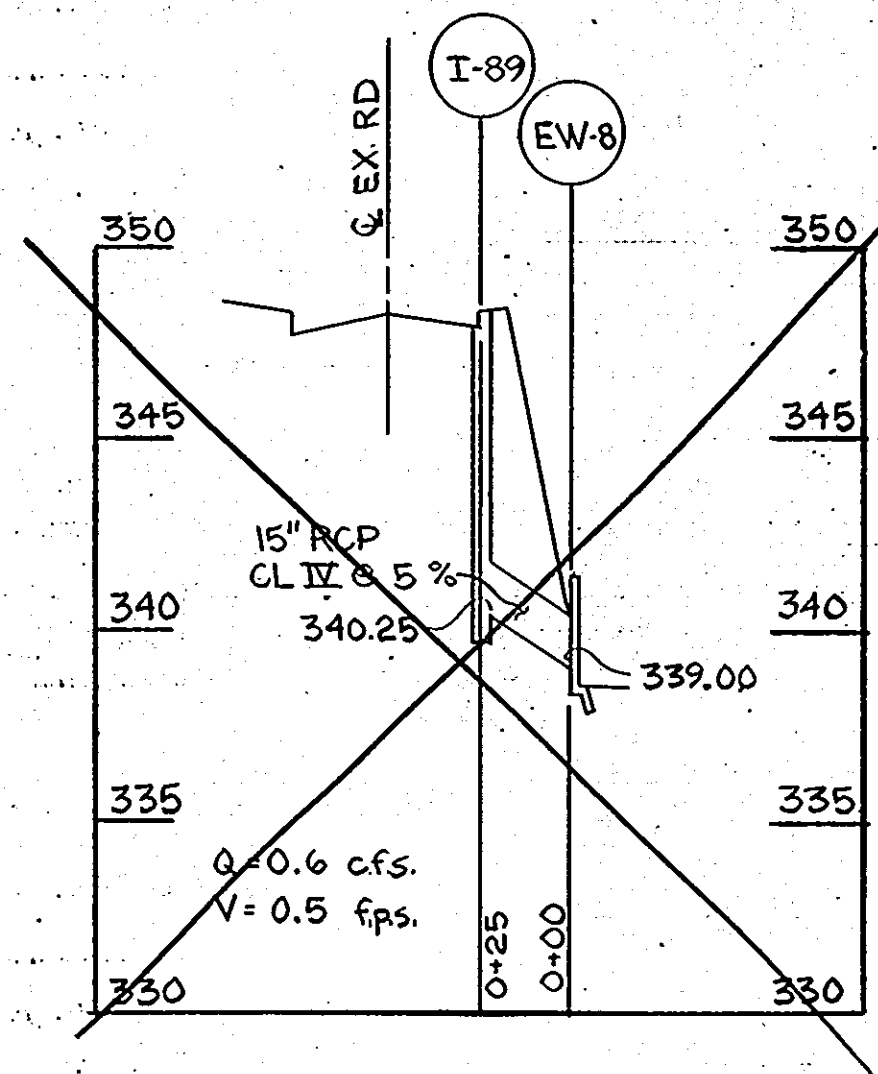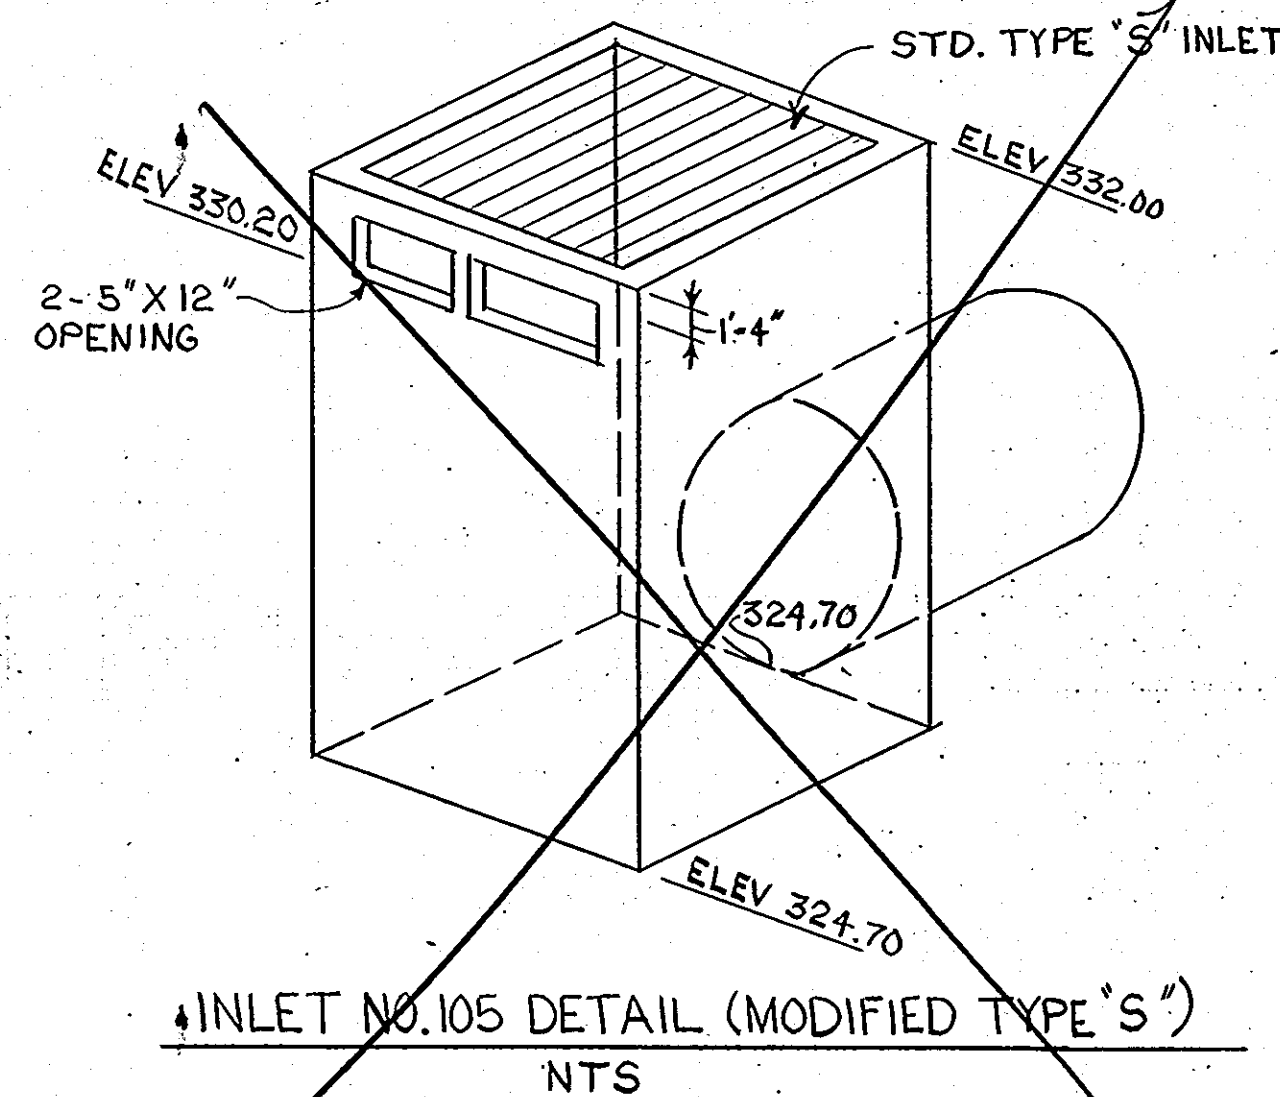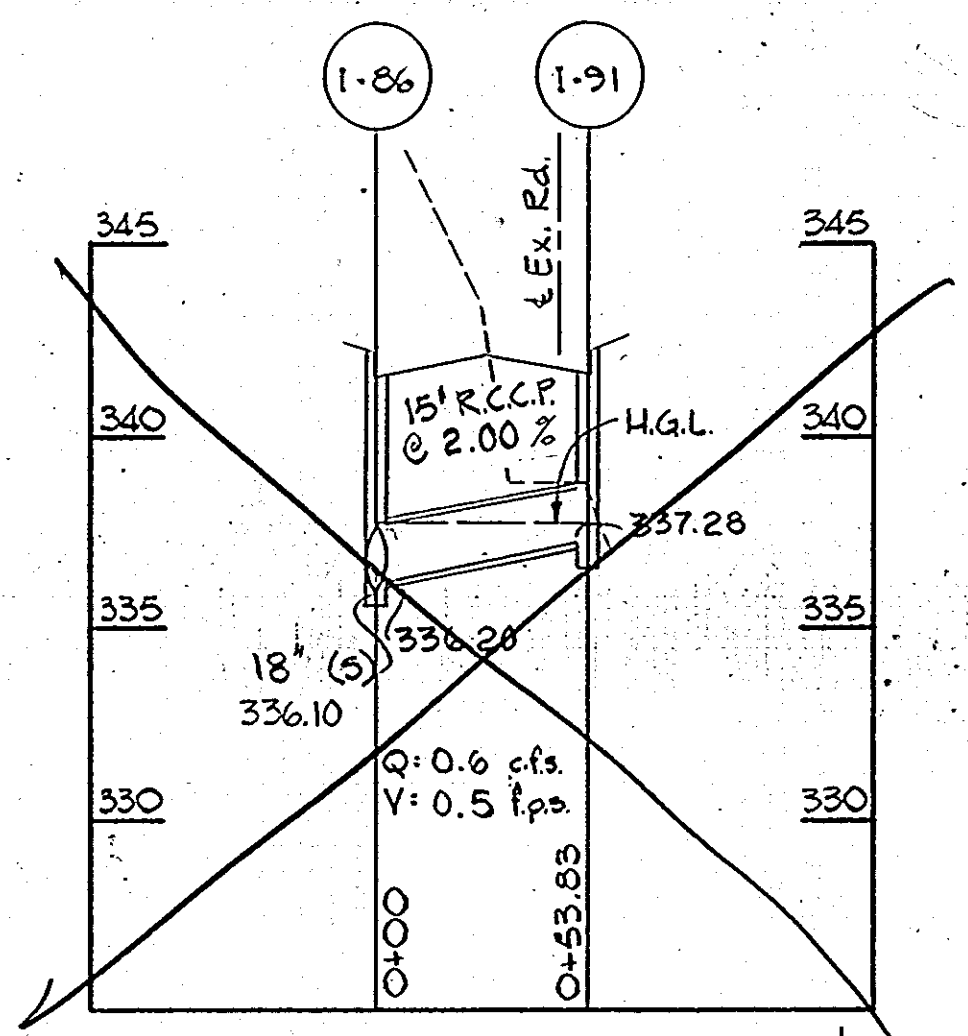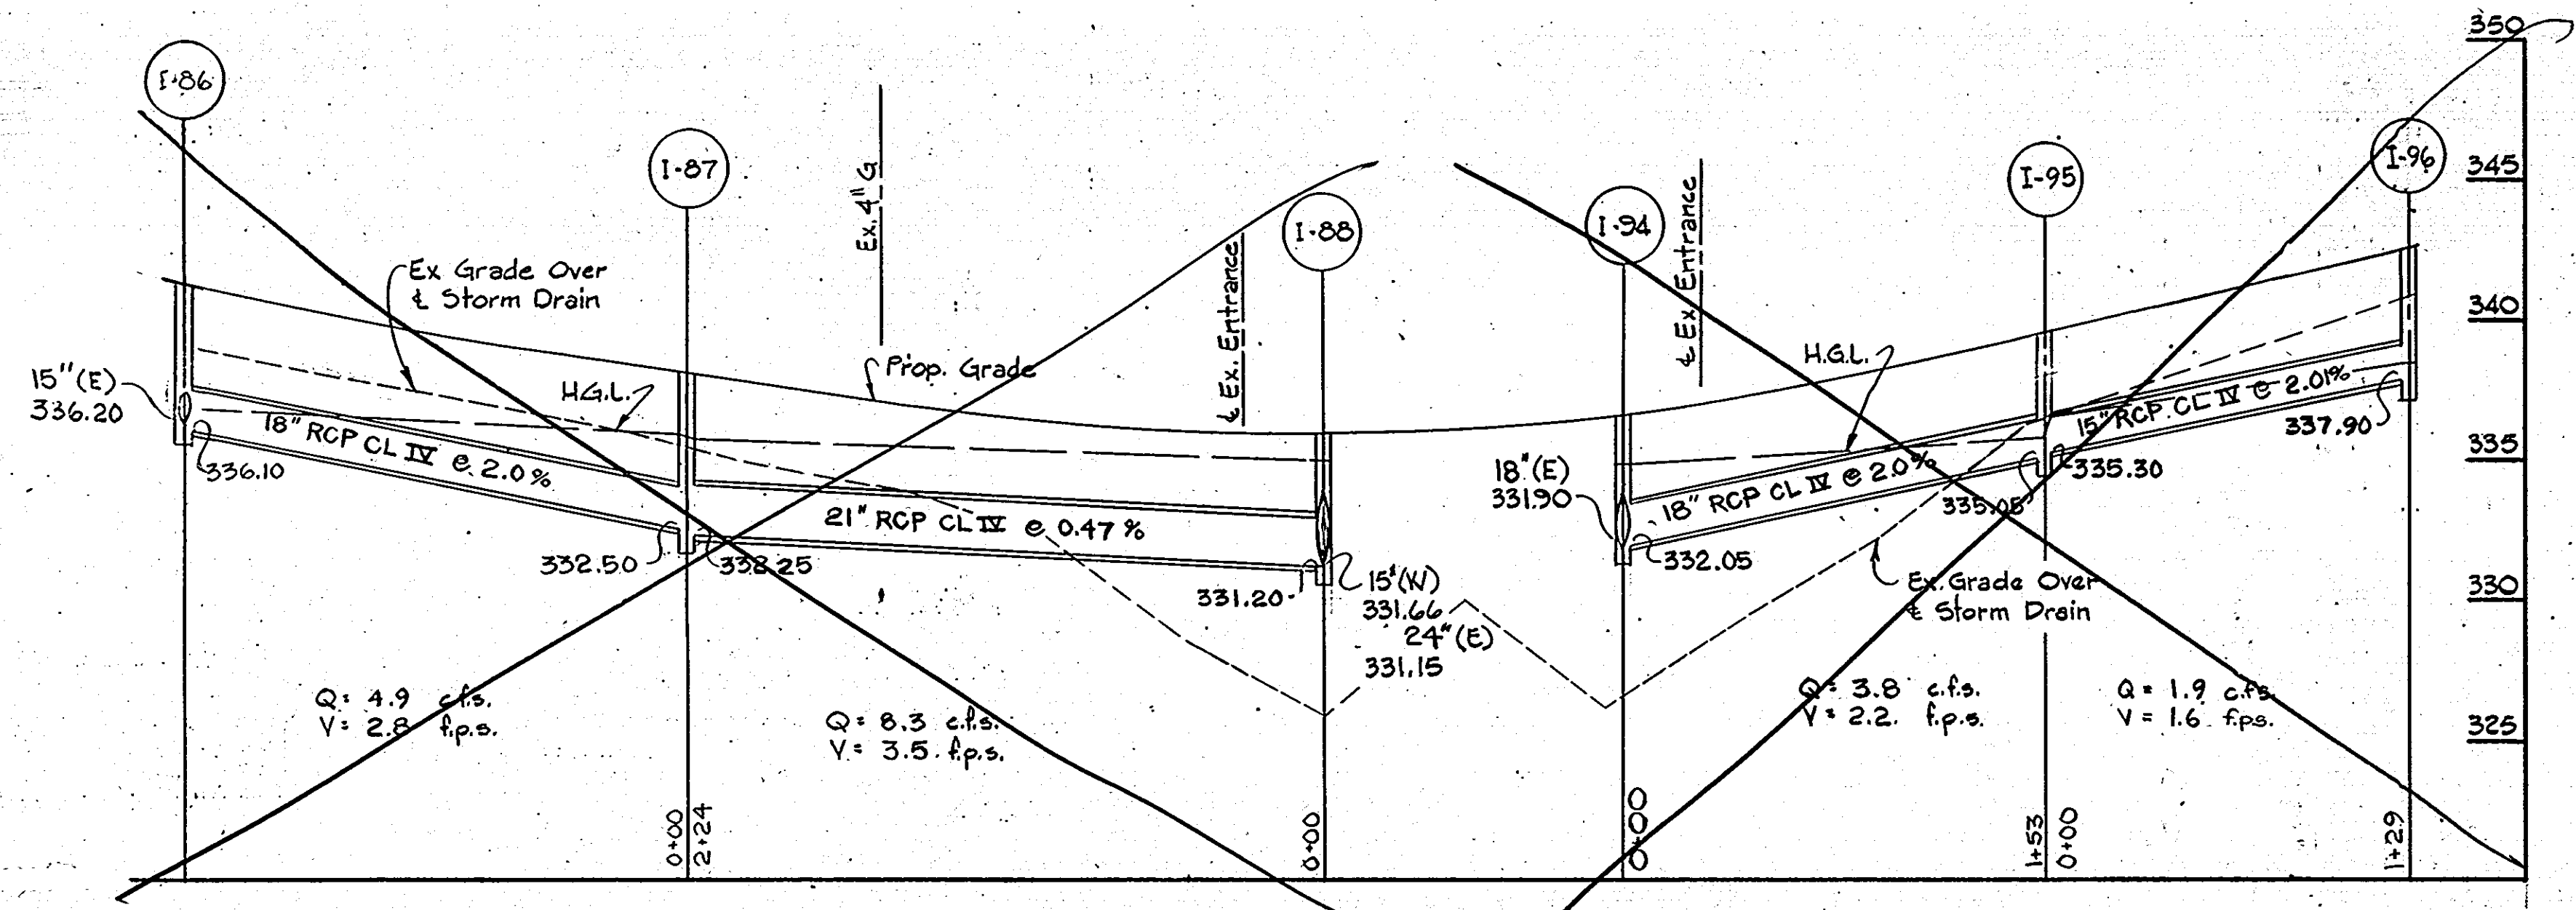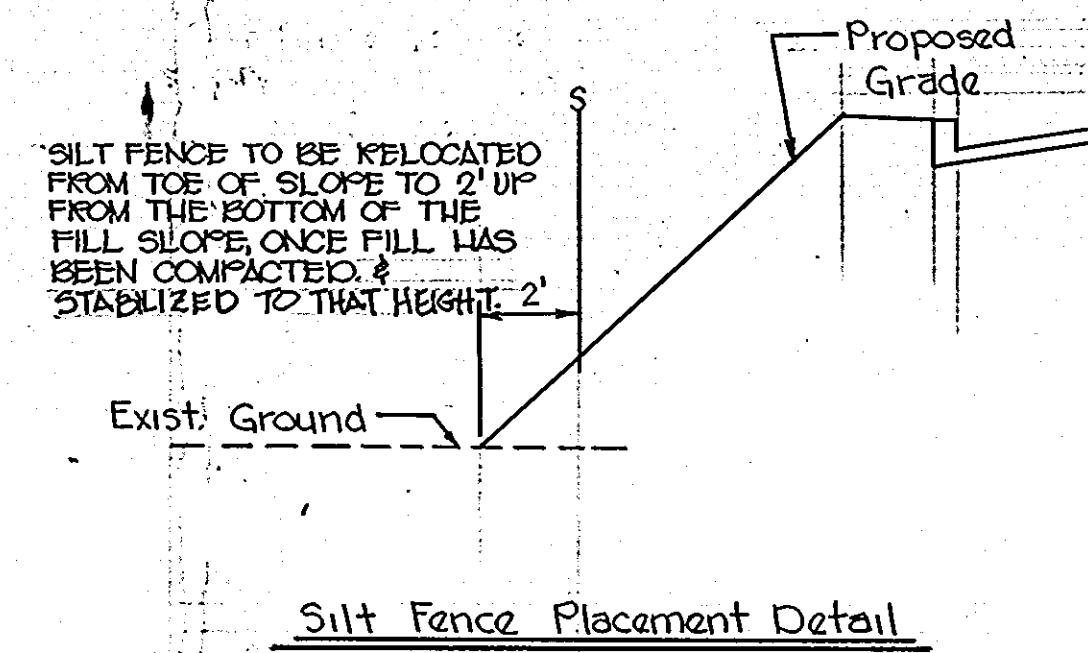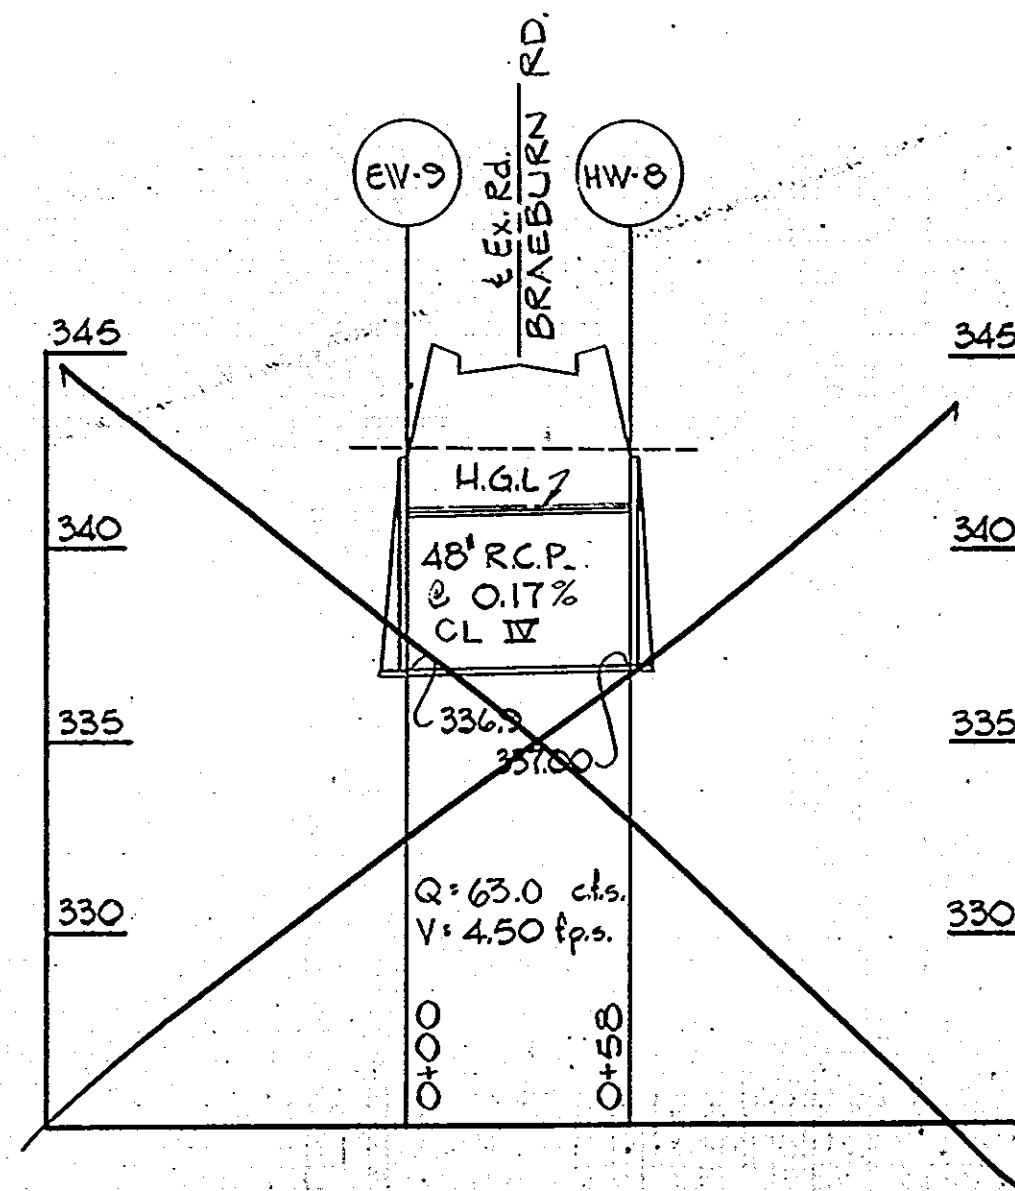


NOTE: ALL STORM DRAIN PIPE TO BE CLASS 4 UNLESS OTHERWISE STATED.

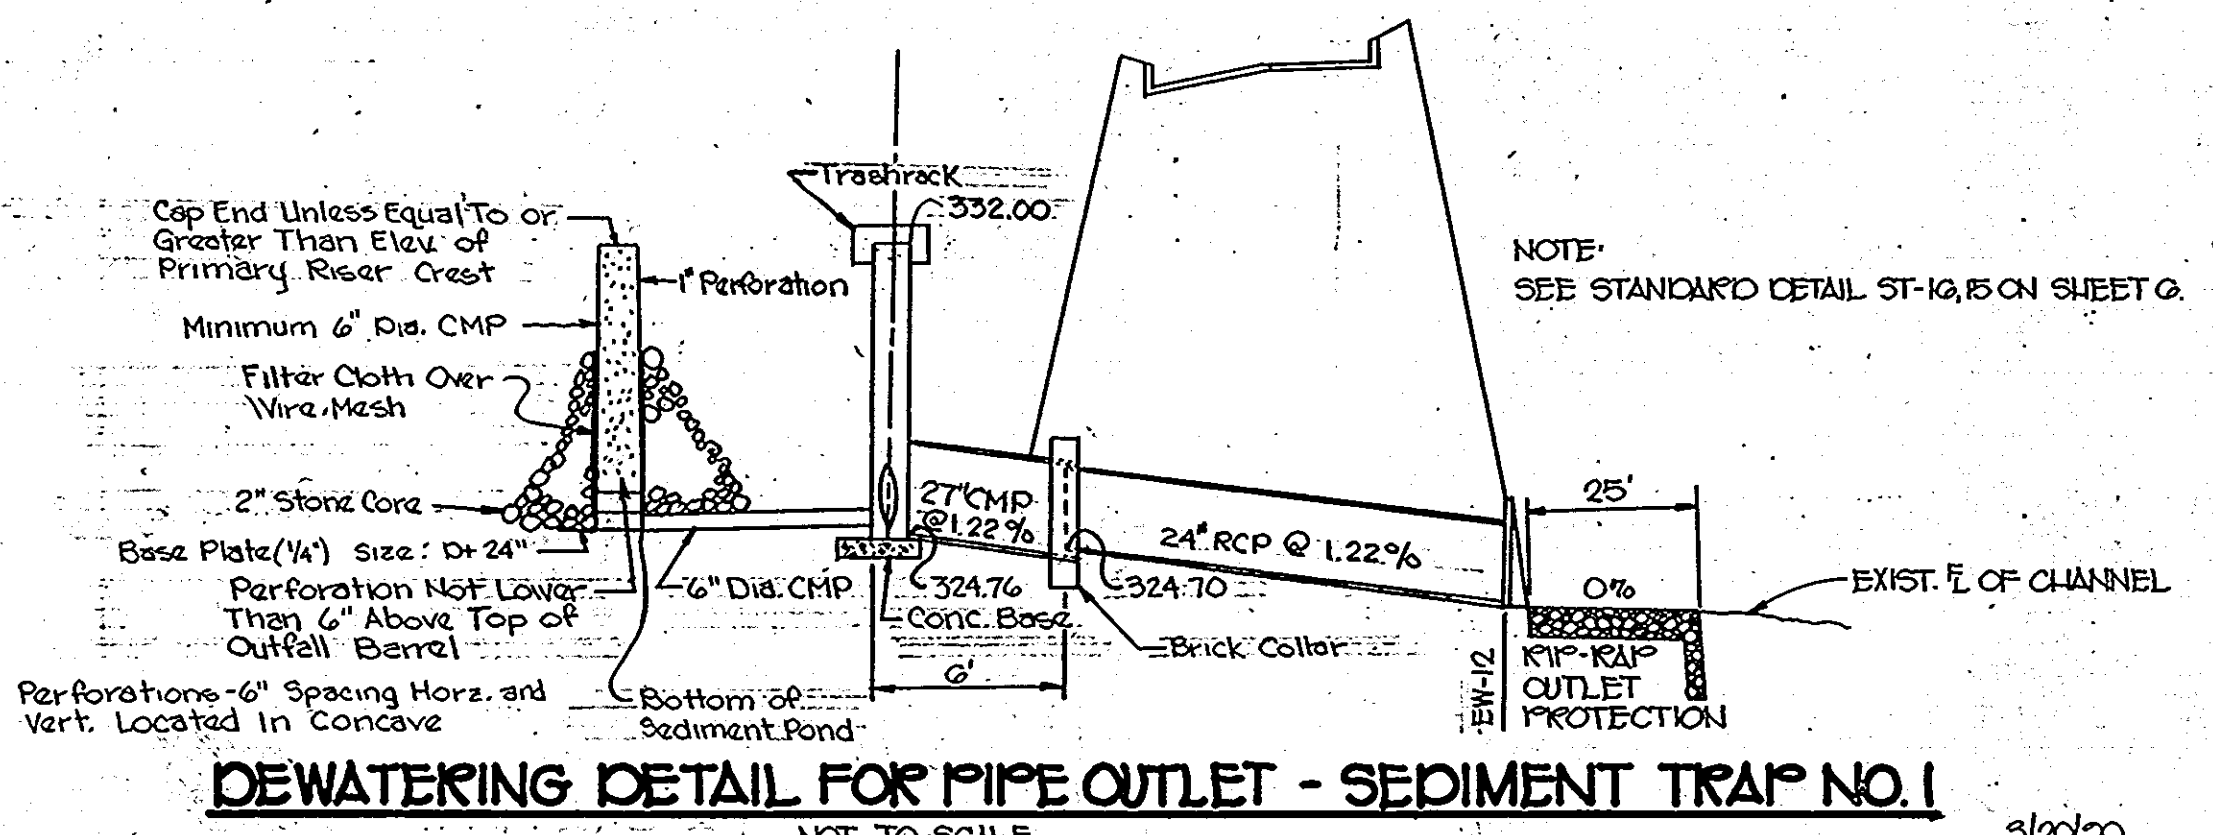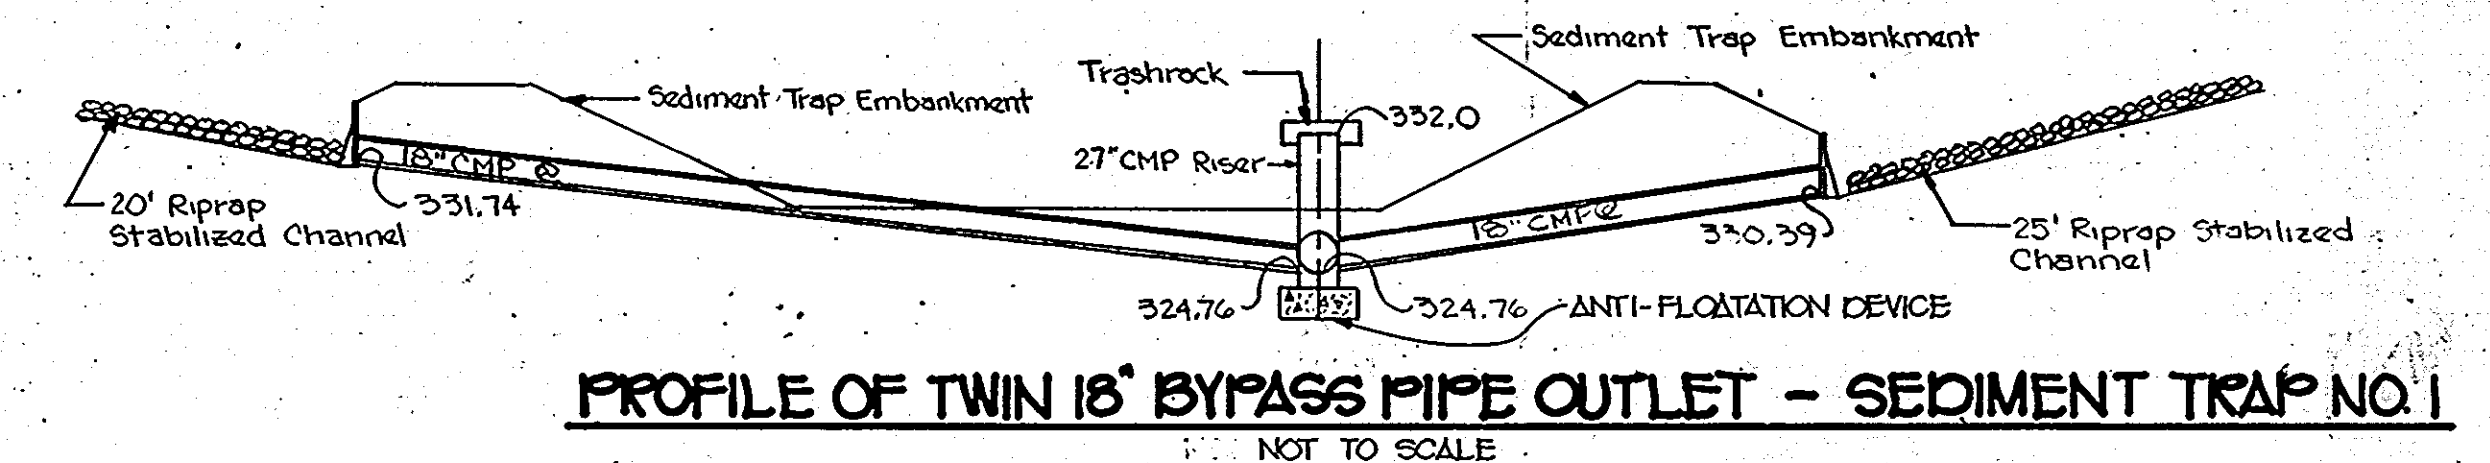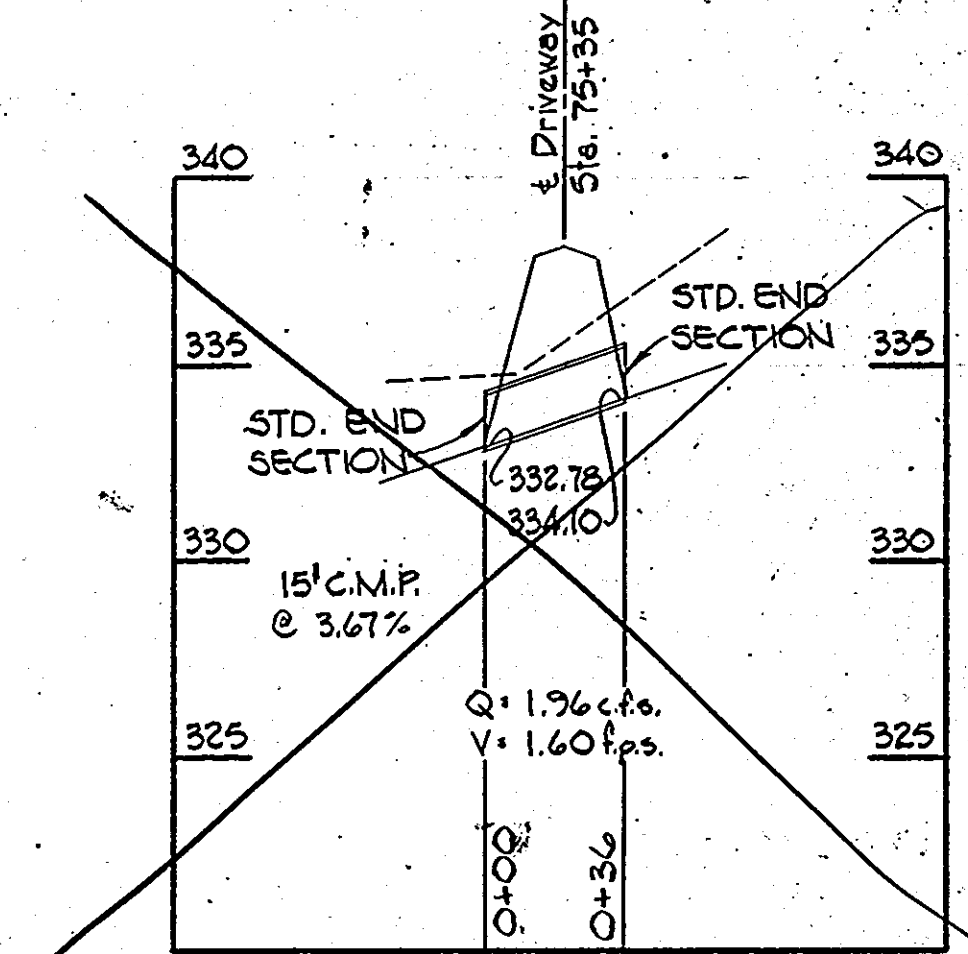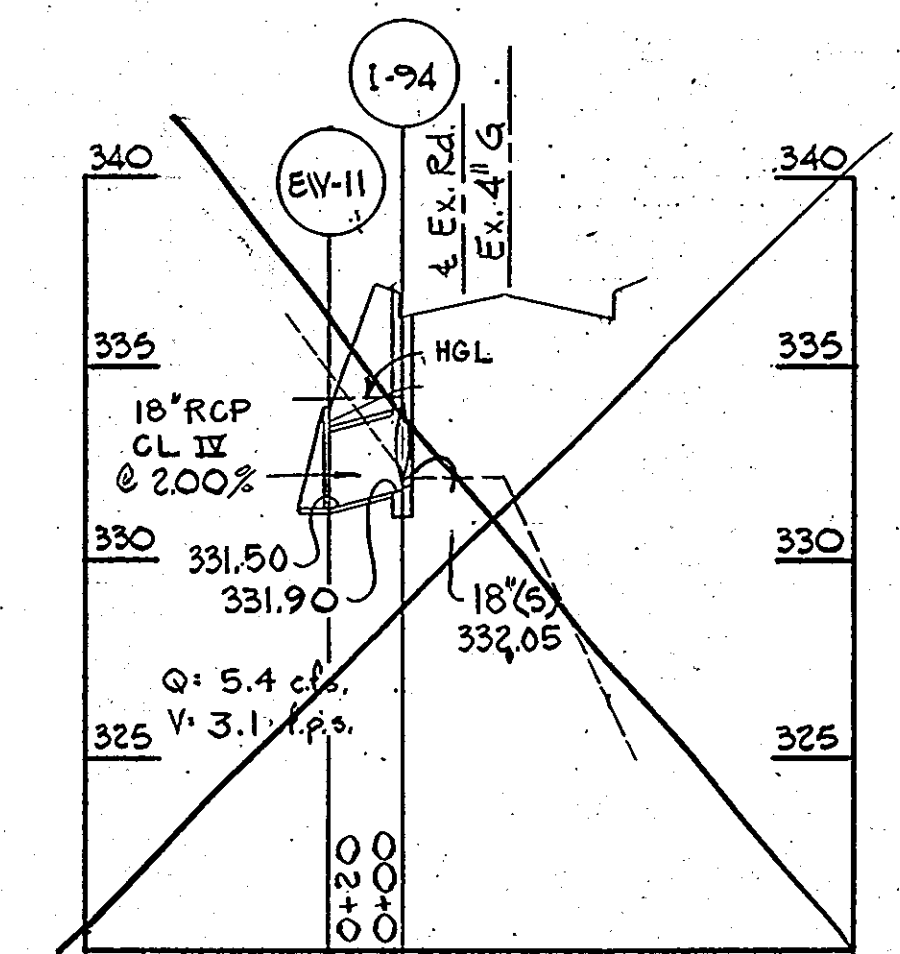

DEPARTMENT OF PUBLIC WORKS
HOWARD COUNTY, MARYLAND
James M. ...
DIRECTOR OF PUBLIC WORKS DATE
CHIEF, BUREAU OF ENGINEERING DATE

PURDUM & JESCHKE
CONSULTING ENGINEERS
LAND SURVEYORS
1029 North Calvert Street
Baltimore, Maryland 21202 301/837-0194

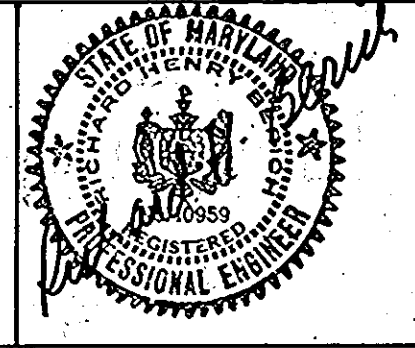


DES: JK			
DRN: RWW			
CHK: JCT			
DATE: 6/90	BY	NO.	REVISION

SEDIMENT & EROSION CONTROL PLAN
CEDAR LANE - PHASE 2
600' SCALE MAP NO. _____ BLOCK NO. _____

SOUTH OF FREETOWN RD. TO GUILFORD RD.
CAPITAL PROJECT J-4086
ELECTION DISTRICT NO. 5
HOWARD COUNTY, MARYLAND
SCALE
HORIZ. 1"=50'
VERT. 1"=5'
SHEET
7 OF 28


SEQUENCE OF CONSTRUCTION

1. Obtain all proper permits.
2. Notify Howard County SCS (at least 48 hours prior to beginning installation of Sediment and Erosion Control facilities (phone: 301/880-3450, HOWARD COUNTY SEDIMENT CONTROL INSPECTION DIVISION.)
3. Clear and grub areas on the north and south sides of the road for installing lined waterway and other sediment control measures from Sta. 56 + 50 to Sta. 85 + 50.
4. Install sediment and erosion control all fence and diversion berms as per approved plans.
5. Install sediment and erosion control basins.
6. Stabilize all disturbed areas with 14-day stabilization.
7. Install 24" RCP cross culvert and riprap outlet ditch for future SWM pond and pipe outlet sediment trap no. 1.
8. Construct 27" CMP riser and 27" CMP extension with 23" CMP collectors in pipe outlet sediment trap No. 1 on the south side of the road at Sta. 74 + 50.
9. Construct dike/levee around sediment trap No. 1.
10. Install 15" flexible pipe on the south side of the road in front of the stand of trees from Sta. 71 + 89 to Sta. 73 + 00.
11. Install 18" CMP driveway culvert and 15" CMP driveway culvert on the south side of the road at Sta. 73 + 70 and Sta. 75 + 34, respectively.
12. Construct lined waterway on the south side from Sta. 73 + 00 and the end of the 15" flexible pipe to the 18" CMP driveway culvert.
13. Construct temporary lined waterways on the south side of the road from the ends of the driveway culverts to the 18" CMP into the sediment trap no. 1.
14. Install curbs and inlets and drainage systems for stage II construction.
15. Install inlet sediment control as per curb inlet protection detail on sheet 8 of 22.
16. Connect inlet I-88 with pipe outlet sediment trap No. 1 with a temporary 15" CMP pipe.
17. Connect inlet I-93 with stone outlet sediment trap No. 2 with a temporary 15" CMP pipe.
18. Construct roadway improvements.
19. Stabilize all disturbed areas with permanent seeding.
20. Upon approval by Howard County SCS Inspector, remove sediment control measures of silt fence, stabilized swales, temporary flexible pipe, temporary 15" CMP from inlets 93 and 88, pipe riser at Trap No. 1 and sediment traps.
21. Construct yard inlet at 24" RCP in SWM facility at Sta. 74 + 50.
22. Stabilize all areas, disturbed by sediment and erosion control removal, with permanent seeding.

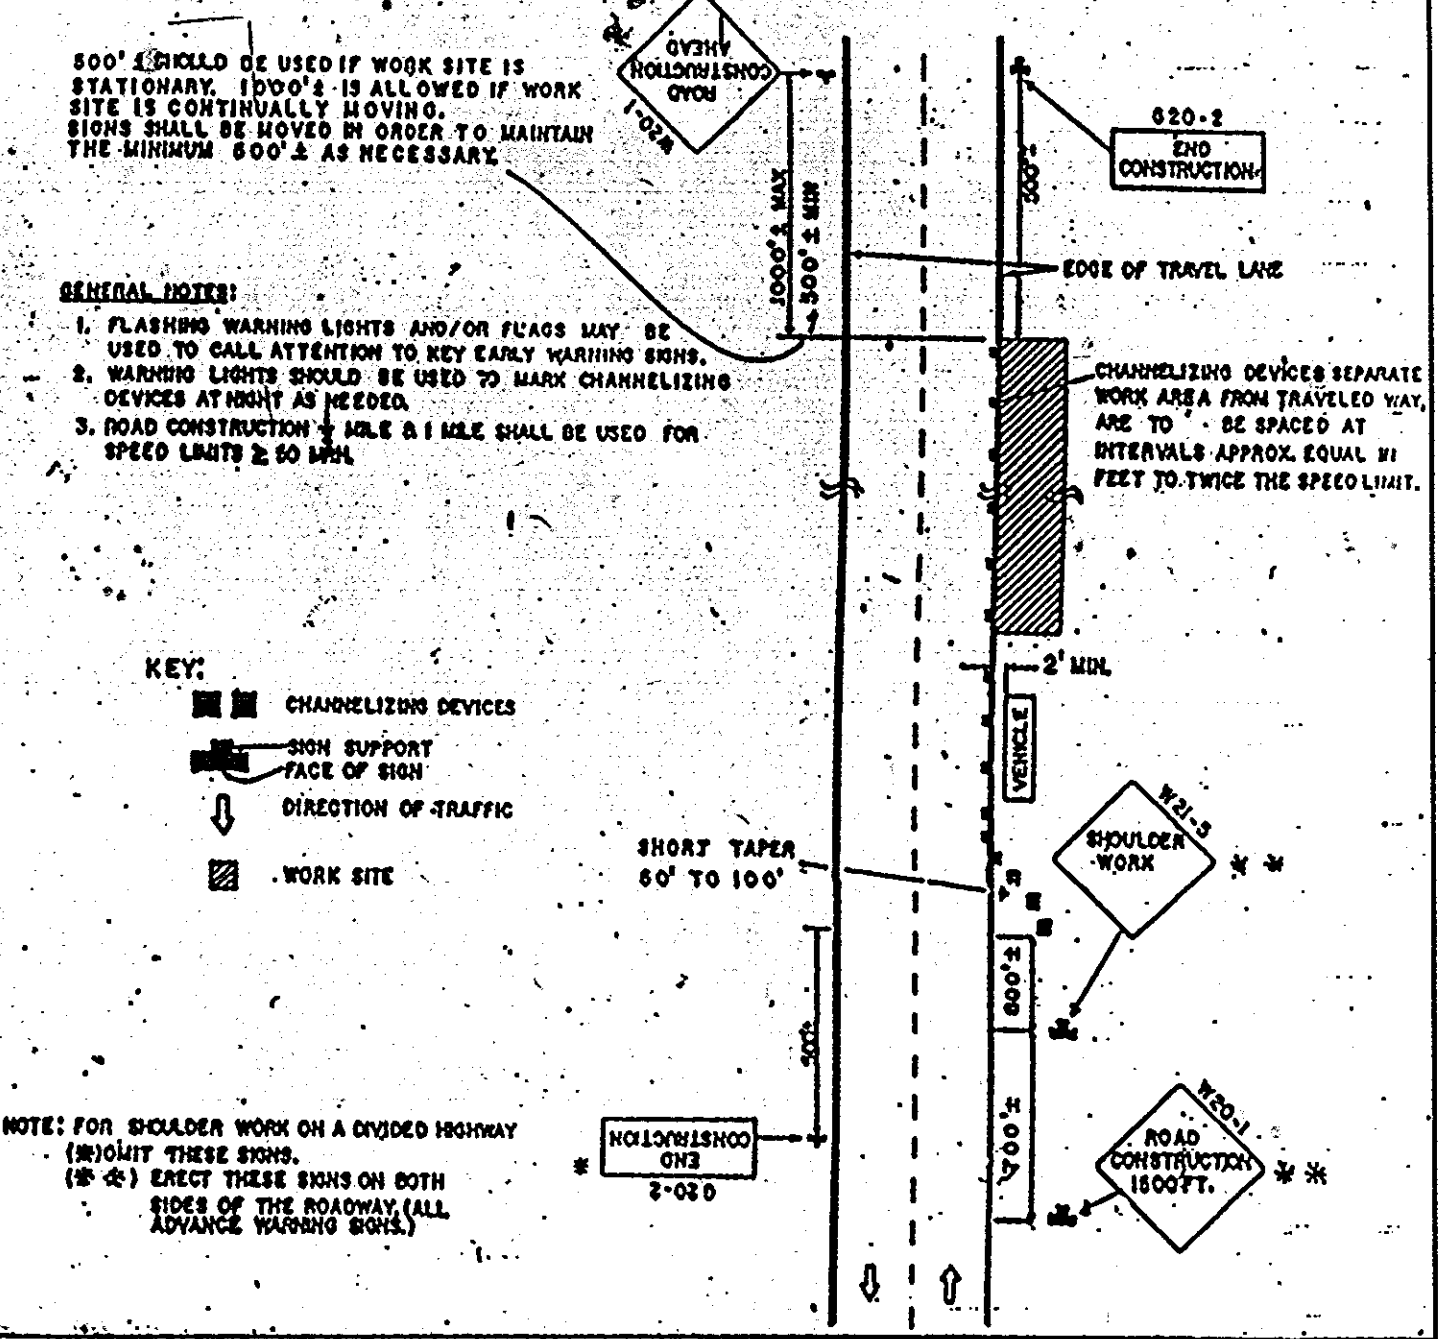


TYPICAL TRAFFIC CONTROL PLAN
STA. 56+60 TO STA. 95+05

NOTE: FOR ADDITIONAL MAINTENANCE OF TRAFFIC NOTES, SEE SHEET NO. 4.

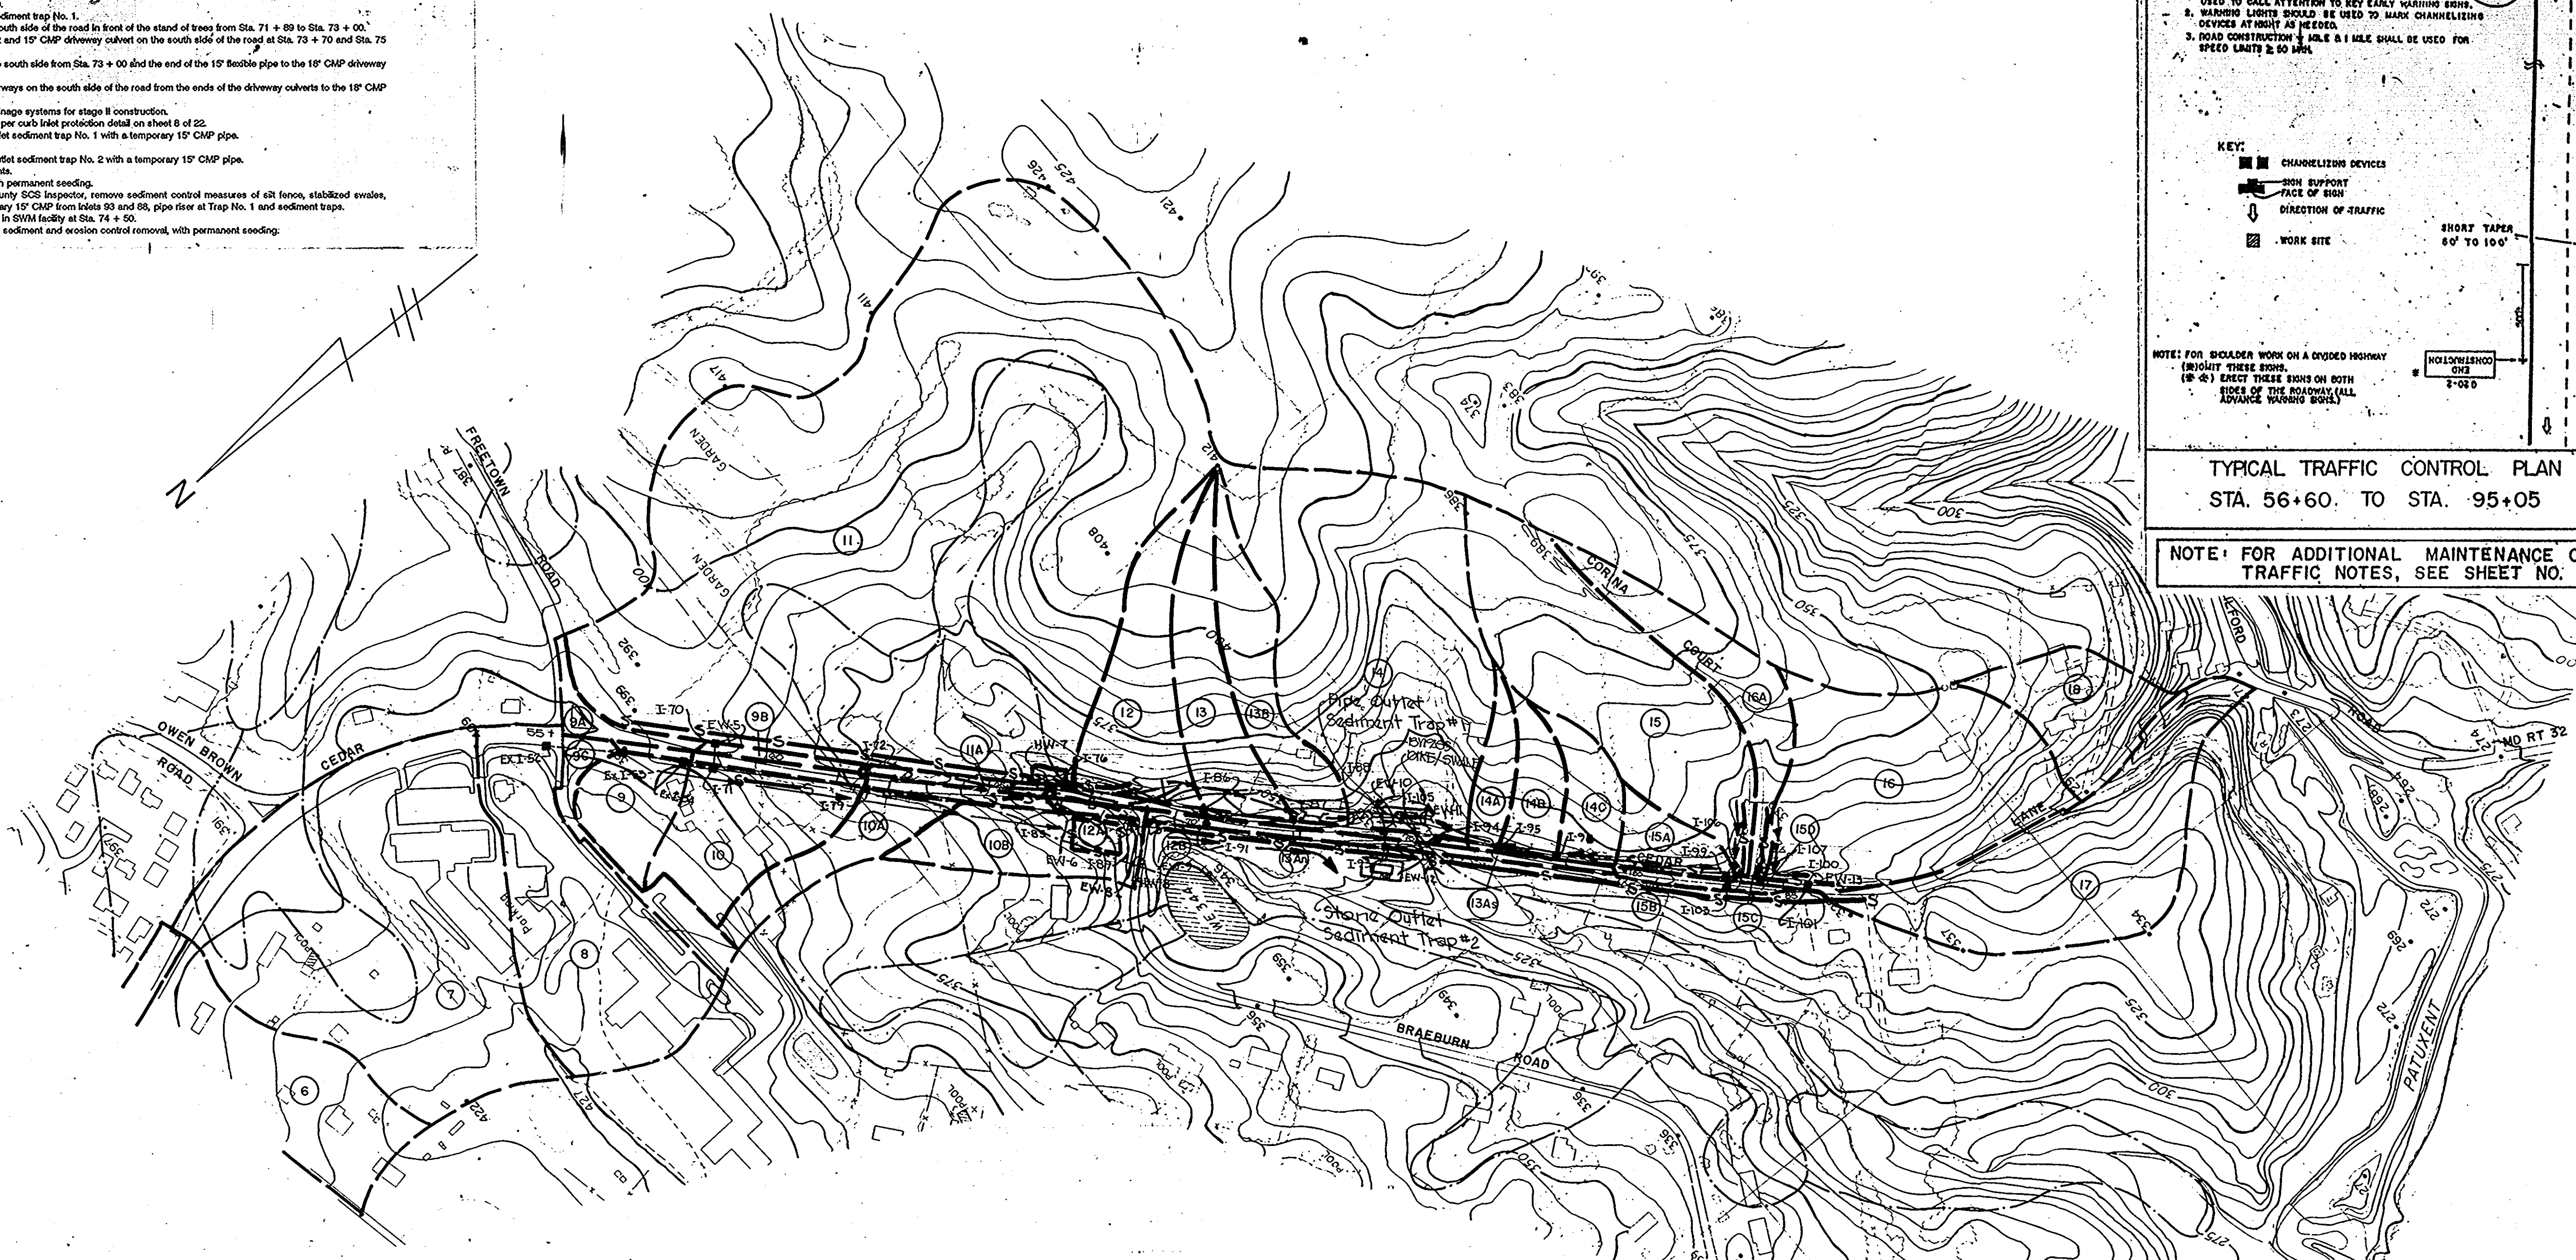


LEGEND

DRAINAGE AREA	---
HYDROLOGIC SOIL GROUP	---
SILT FENCE	S - S - S
LINED WATERWAY	→ → →
STONE OUTLET	□
SEDIMENT TRAP	□
PIPE OUTLET	□
SEDIMENT TRAP	□

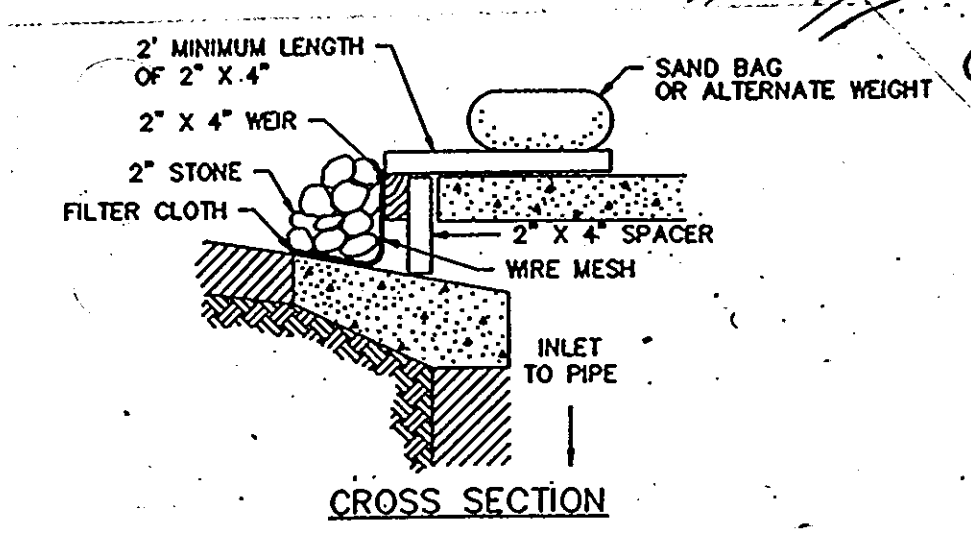

4/56 CURB INLET PROTECTION DETAIL

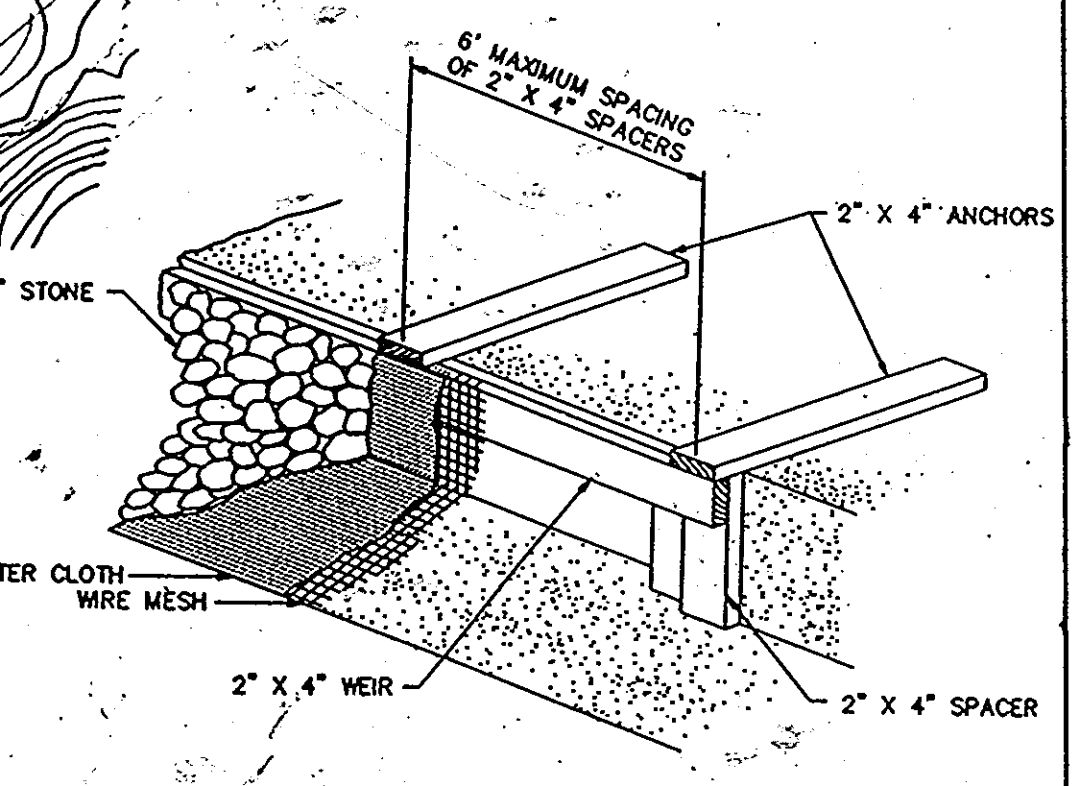

6" MAXIMUM SPACING OF 2" X 4" SPACERS

DEPARTMENT OF PUBLIC WORKS
HOWARD COUNTY, MARYLAND

Director of Public Works: *James R. ...* DATE: 7/11/90
 Chief, Bureau of Engineering: *Richard R. ...* DATE: 7/11/90
 Chief, Division of Roads, Bridges and Storm Drainage: *Charles ...* DATE: 7/11/90

PURDUM & JESCHKE
CONSULTING ENGINEERS
LAND SURVEYORS

1029 North Calvert Street
Baltimore, Maryland 21202 301/837-0194



DES:	
DRN:	
CHK:	
DATE 6/90	
BY	NO
REVISION	DATE

SEDIMENT & EROSION CONTROL
DRAINAGE AREAS
CEDAR LANE - PHASE 2

600' SCALE MAP NO. _____ BLOCK NO. _____

SOUTH OF FREETOWN RD. TO GUILFORD RD.
CAPITAL PROJECT J-4086
ELECTION DISTRICT NO. 5
HOWARD COUNTY, MARYLAND

SCALE: 1" = 200'
SHEET 8 OF 28

985

XXCE-90-008

NOTE: SEE SHEETS 6, 7, 8, 20, 21 & 22 FOR SOIL EROSION AND SEDIMENT CONTROL REQUIREMENTS.

LIMIT OF PAVING STA. 56+70

STA. 56+70 LT. TO STA. 59+85 LT. 300' SIDE DITCH W=2' D=1' SEE DETAIL SHEET 5

STA. 65+70± TO STA. 67+00 LT. TRAFFIC BARRIER W BEAM INCLUDES TYPE I END FLARES (SEE SHEET 5)

STA. 66+56 TO STA. 66+65 45' LT. 25' LT. HW-7

STA. 65+00 LT. TO STA. 67+00 LT. RIPRAP SIDE DITCH W=2' D=2' SEE DETAIL SHEET 5

CURVE DATA
 $\Delta = 65^{\circ} 25' 03''$
 $D_c = 6^{\circ} 30' 00''$
 $R = 881.47'$
 $T = 566.09'$
 $L = 1006.42'$
 $E = 166.12'$
 $PC = STA. 45+30.06$

CURVE DATA
 $\Delta = 1^{\circ} 14' 57.1''$
 $D_c = 1^{\circ} 00'$
 $R = 5729.58'$
 $T = 62.46'$
 $L = 124.92'$
 $TP = 912$

CURVE DATA
 $\Delta = 65^{\circ} 25' 03''$
 $D_c = 6^{\circ} 30' 00''$
 $R = 881.47'$
 $T = 566.09'$
 $L = 1006.42'$
 $E = 166.12'$
 $PC = STA. 45+30.06$

STA. 56+70 TO 58+50 MILL EXIST. PAVEMENT TO RECEIVE PROPOSED 1/2" BITUMINOUS CONC. SURFACE COURSE.

STA. 58+00 CONNECT NEW 18" SD. TO EXISTING INLET

STA. 55+70 TO 65+00 RT. EXTEND PROPOSED 5' SIDEWALK SLOPE TO MEET EXISTING SIDE SLOPE AND DRAIN TO PROPOSED ROADWAY AS DIRECTED BY THE ENGINEER


STA. 59+85 RT. GRADING AROUND EXIST. TREE TO BE MINIMIZED AS DIRECTED BY THE ENGINEER.

REMOVE EX. 18" AND 25"x16" CMPS STA. 58+00 TO 59+00

STA. 66+05± TO STA. 67+00 RT. TRAFFIC BARRIER W BEAM INCLUDES TYPE I END FLARE (SEE SHEET 5)


STA. 66+00 RT. TO STA. 67+00 RT. RIPRAP SIDE DITCH W=2' D=2' SEE DETAIL SHEET 5

FOR STORM DRAIN PROFILES SEE SHEET 14

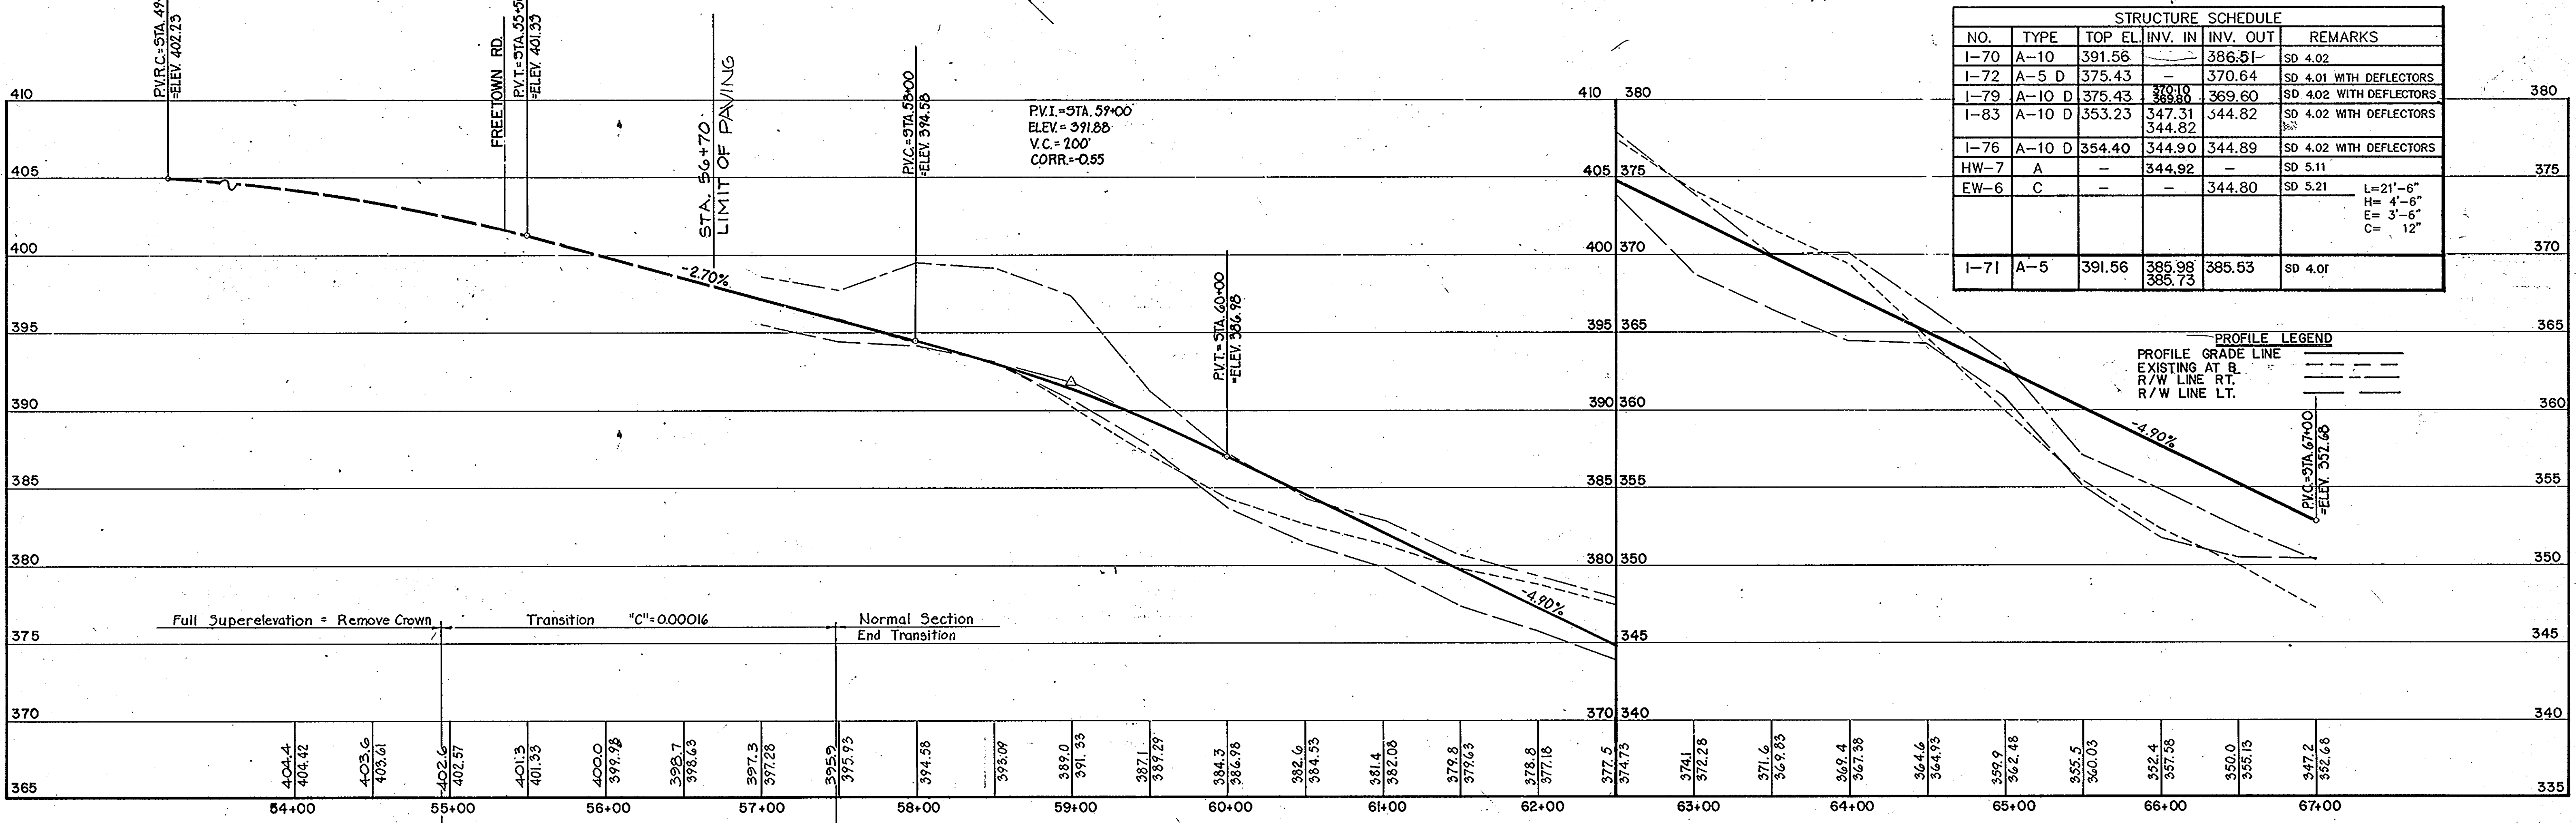

DEPARTMENT OF PUBLIC WORKS
 HOWARD COUNTY, MARYLAND
 Director of Public Works: [Signature]
 Chief, Bureau of Engineering: [Signature]
 Chief, Division of Roads, Bridges and Storm Drainage: [Signature]

PURDUM & JESCHKE
 CONSULTING ENGINEERS
 LAND SURVEYORS
 1029 North Calvert Street
 Baltimore, Maryland 21202 301/837-0194


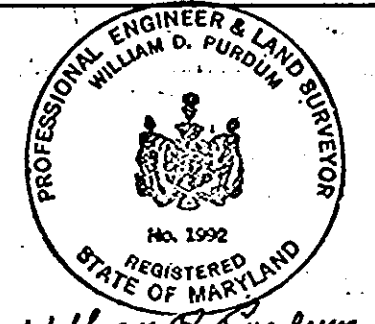


DES: JCT
 DRN: PWR
 CHK: WDP
 DATE: 6/90
 BY: [Signature]
 NO: [Blank]
 REVISION: [Blank]
 DATE: [Blank]

PLAN & PROFILE
 STA. 54+00 TO STA. 67+00
 CEDAR LANE - PHASE 2
 600' SCALE MAP NO. _____ BLOCK NO. _____

SOUTH OF FREETOWN RD. TO GUILFORD RD.
 CAPITAL PROJECT J-4086
 ELECTION DISTRICT NO. 5
 HOWARD COUNTY, MARYLAND

SCALE
 1"=50'
 SHEET
 9 OF 28

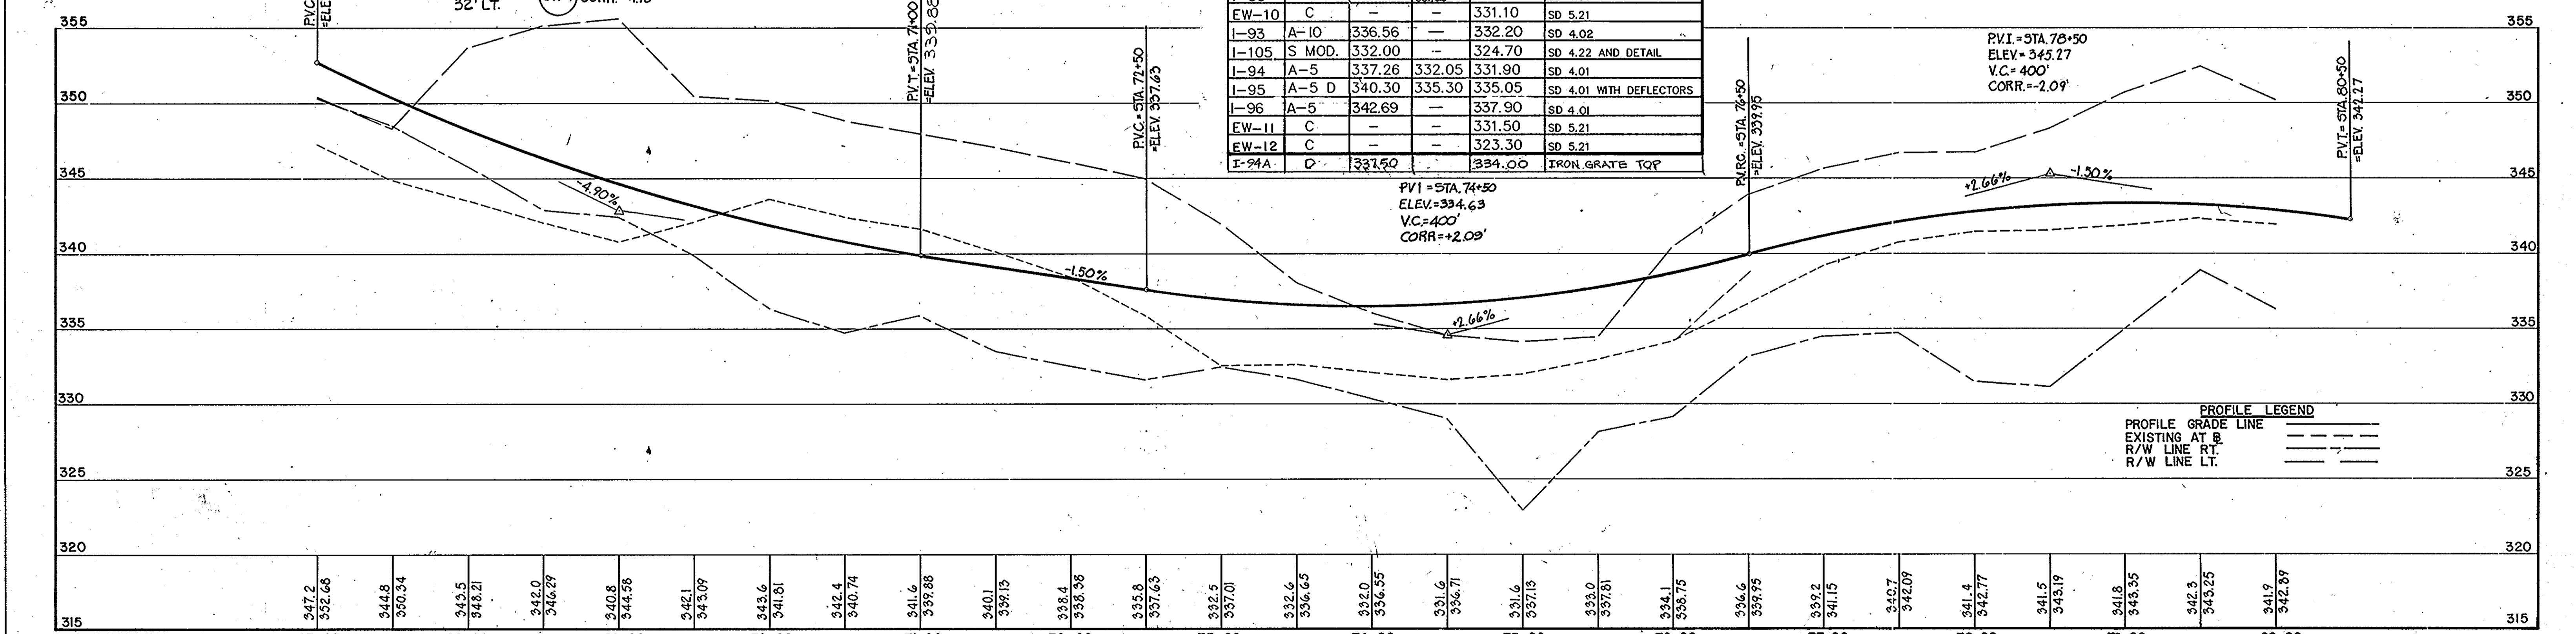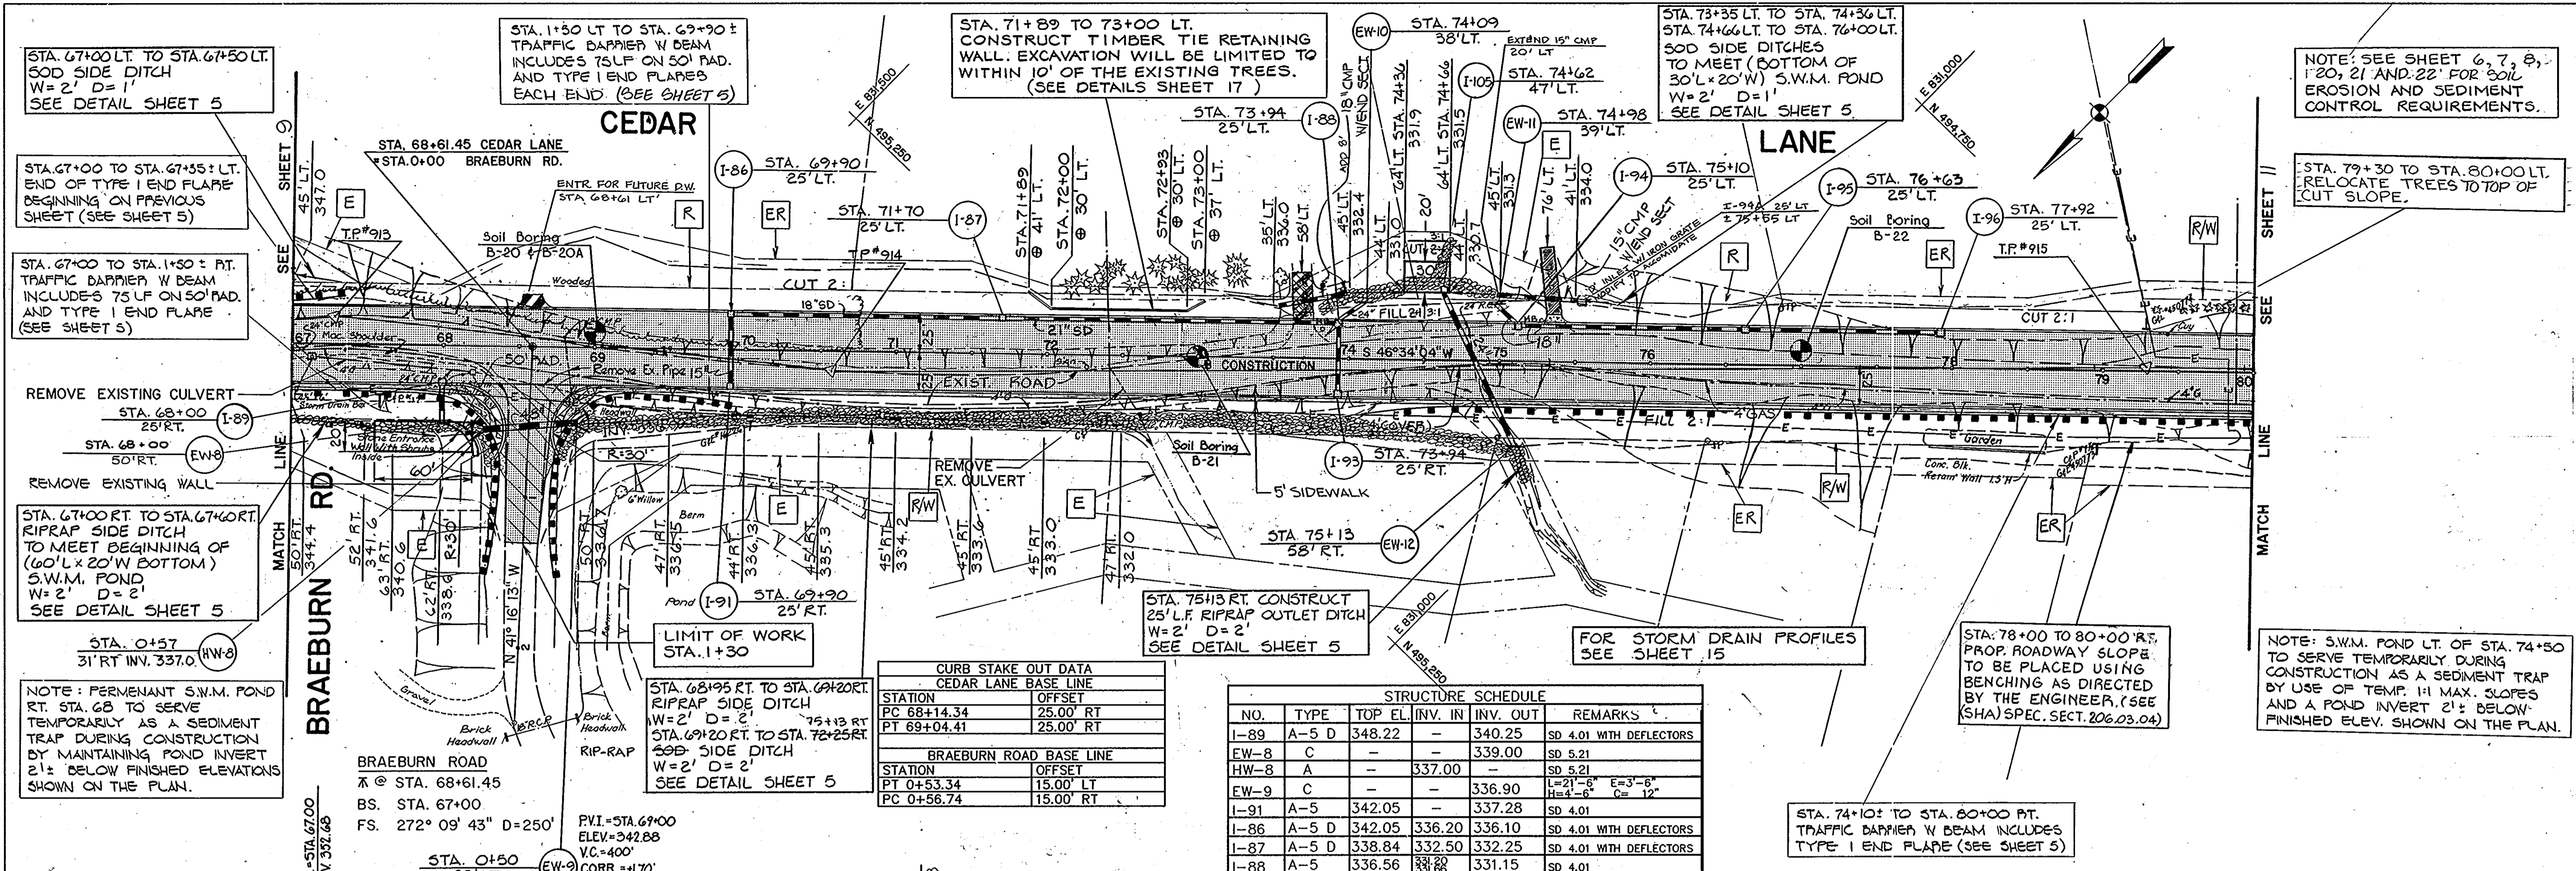

CURB STAKE OUT DATA CEDAR LANE BASE LINE	
STATION	OFFSET
PC 68+14.34	25.00' RT
PT 69+04.41	25.00' RT

BRAEBURN ROAD BASE LINE	
STATION	OFFSET
PT 0+53.34	15.00' LT
PC 0+56.74	15.00' RT

STRUCTURE SCHEDULE					
NO.	TYPE	TOP EL.	INV. IN	INV. OUT	REMARKS
I-89	A-5 D	348.22	-	340.25	SD 4.01 WITH DEFLECTORS
EW-8	C	-	-	339.00	SD 5.21
HW-8	A	-	337.00	-	SD 5.21
EW-9	C	-	-	336.90	SD 5.21
I-91	A-5	342.05	-	337.28	SD 4.01
I-86	A-5 D	342.05	336.20	336.10	SD 4.01 WITH DEFLECTORS
I-87	A-5 D	338.84	332.50	332.25	SD 4.01 WITH DEFLECTORS
I-88	A-5	336.56	-	331.15	SD 4.01
EW-10	C	-	-	331.10	SD 5.21
I-93	A-10	336.56	-	332.20	SD 4.02
I-105	S MOD.	332.00	-	324.70	SD 4.22 AND DETAIL
I-94	A-5	337.26	332.05	331.90	SD 4.01
I-95	A-5 D	340.30	335.30	335.05	SD 4.01 WITH DEFLECTORS
I-96	A-5	342.69	-	337.90	SD 4.01
EW-11	C	-	-	331.50	SD 5.21
EW-12	C	-	-	323.30	SD 5.21
I-94A	D	331.50	-	334.00	IRON GRATE TOP


PROFILE LEGEND	
PROFILE GRADE LINE	———
EXISTING AT B	-----
R/W LINE RT	—————
R/W LINE LT	—————

DEPARTMENT OF PUBLIC WORKS HOWARD COUNTY, MARYLAND DATE 11/18/88 CHIEF, BUREAU OF ENGINEERING DATE 11/18/88 CHIEF, DIVISION OF ROADS, BRIDGES AND STORM DRAINAGE	PURDUM & JESCHKE CONSULTING ENGINEERS LAND SURVEYORS 1029 North Calvert Street Baltimore, Maryland 21202 301/837-0194		DES: JCT	PLAN, & PROFILE	SOUTH OF FREETOWN RD. TO GUILFORD RD. CAPITAL PROJECT J-4086 ELECTION DISTRICT NO. 5 HOWARD COUNTY, MARYLAND	SCALE 1"=50'
			DRN: PWR	STA. 67+00 TO STA. 80+00 CEDAR LANE - PHASE 2		SHEET 10 of 28
DATE 6/90	BY NO. REVISION DATE	AS BUILT 1/21/92	600' SCALE MAP NO. BLOCK NO.	FINAL	XXCE90-010	

EXAMPLE:
 OFFSET LT. OR RT.
 ELEVATION

NOTES:
 OFFSETS AND ELEVATIONS SHOWN IN BLOCKS LOCATE PAVED SWALES ON PROPOSED DRIVEWAYS AT FINISHED GRADE

THE CONTRACTOR SHALL MODIFY STANDARD D'INLETS TO ACCOMMODATE PIPE REQUIRING WIDTHS GREATER THAN 30"

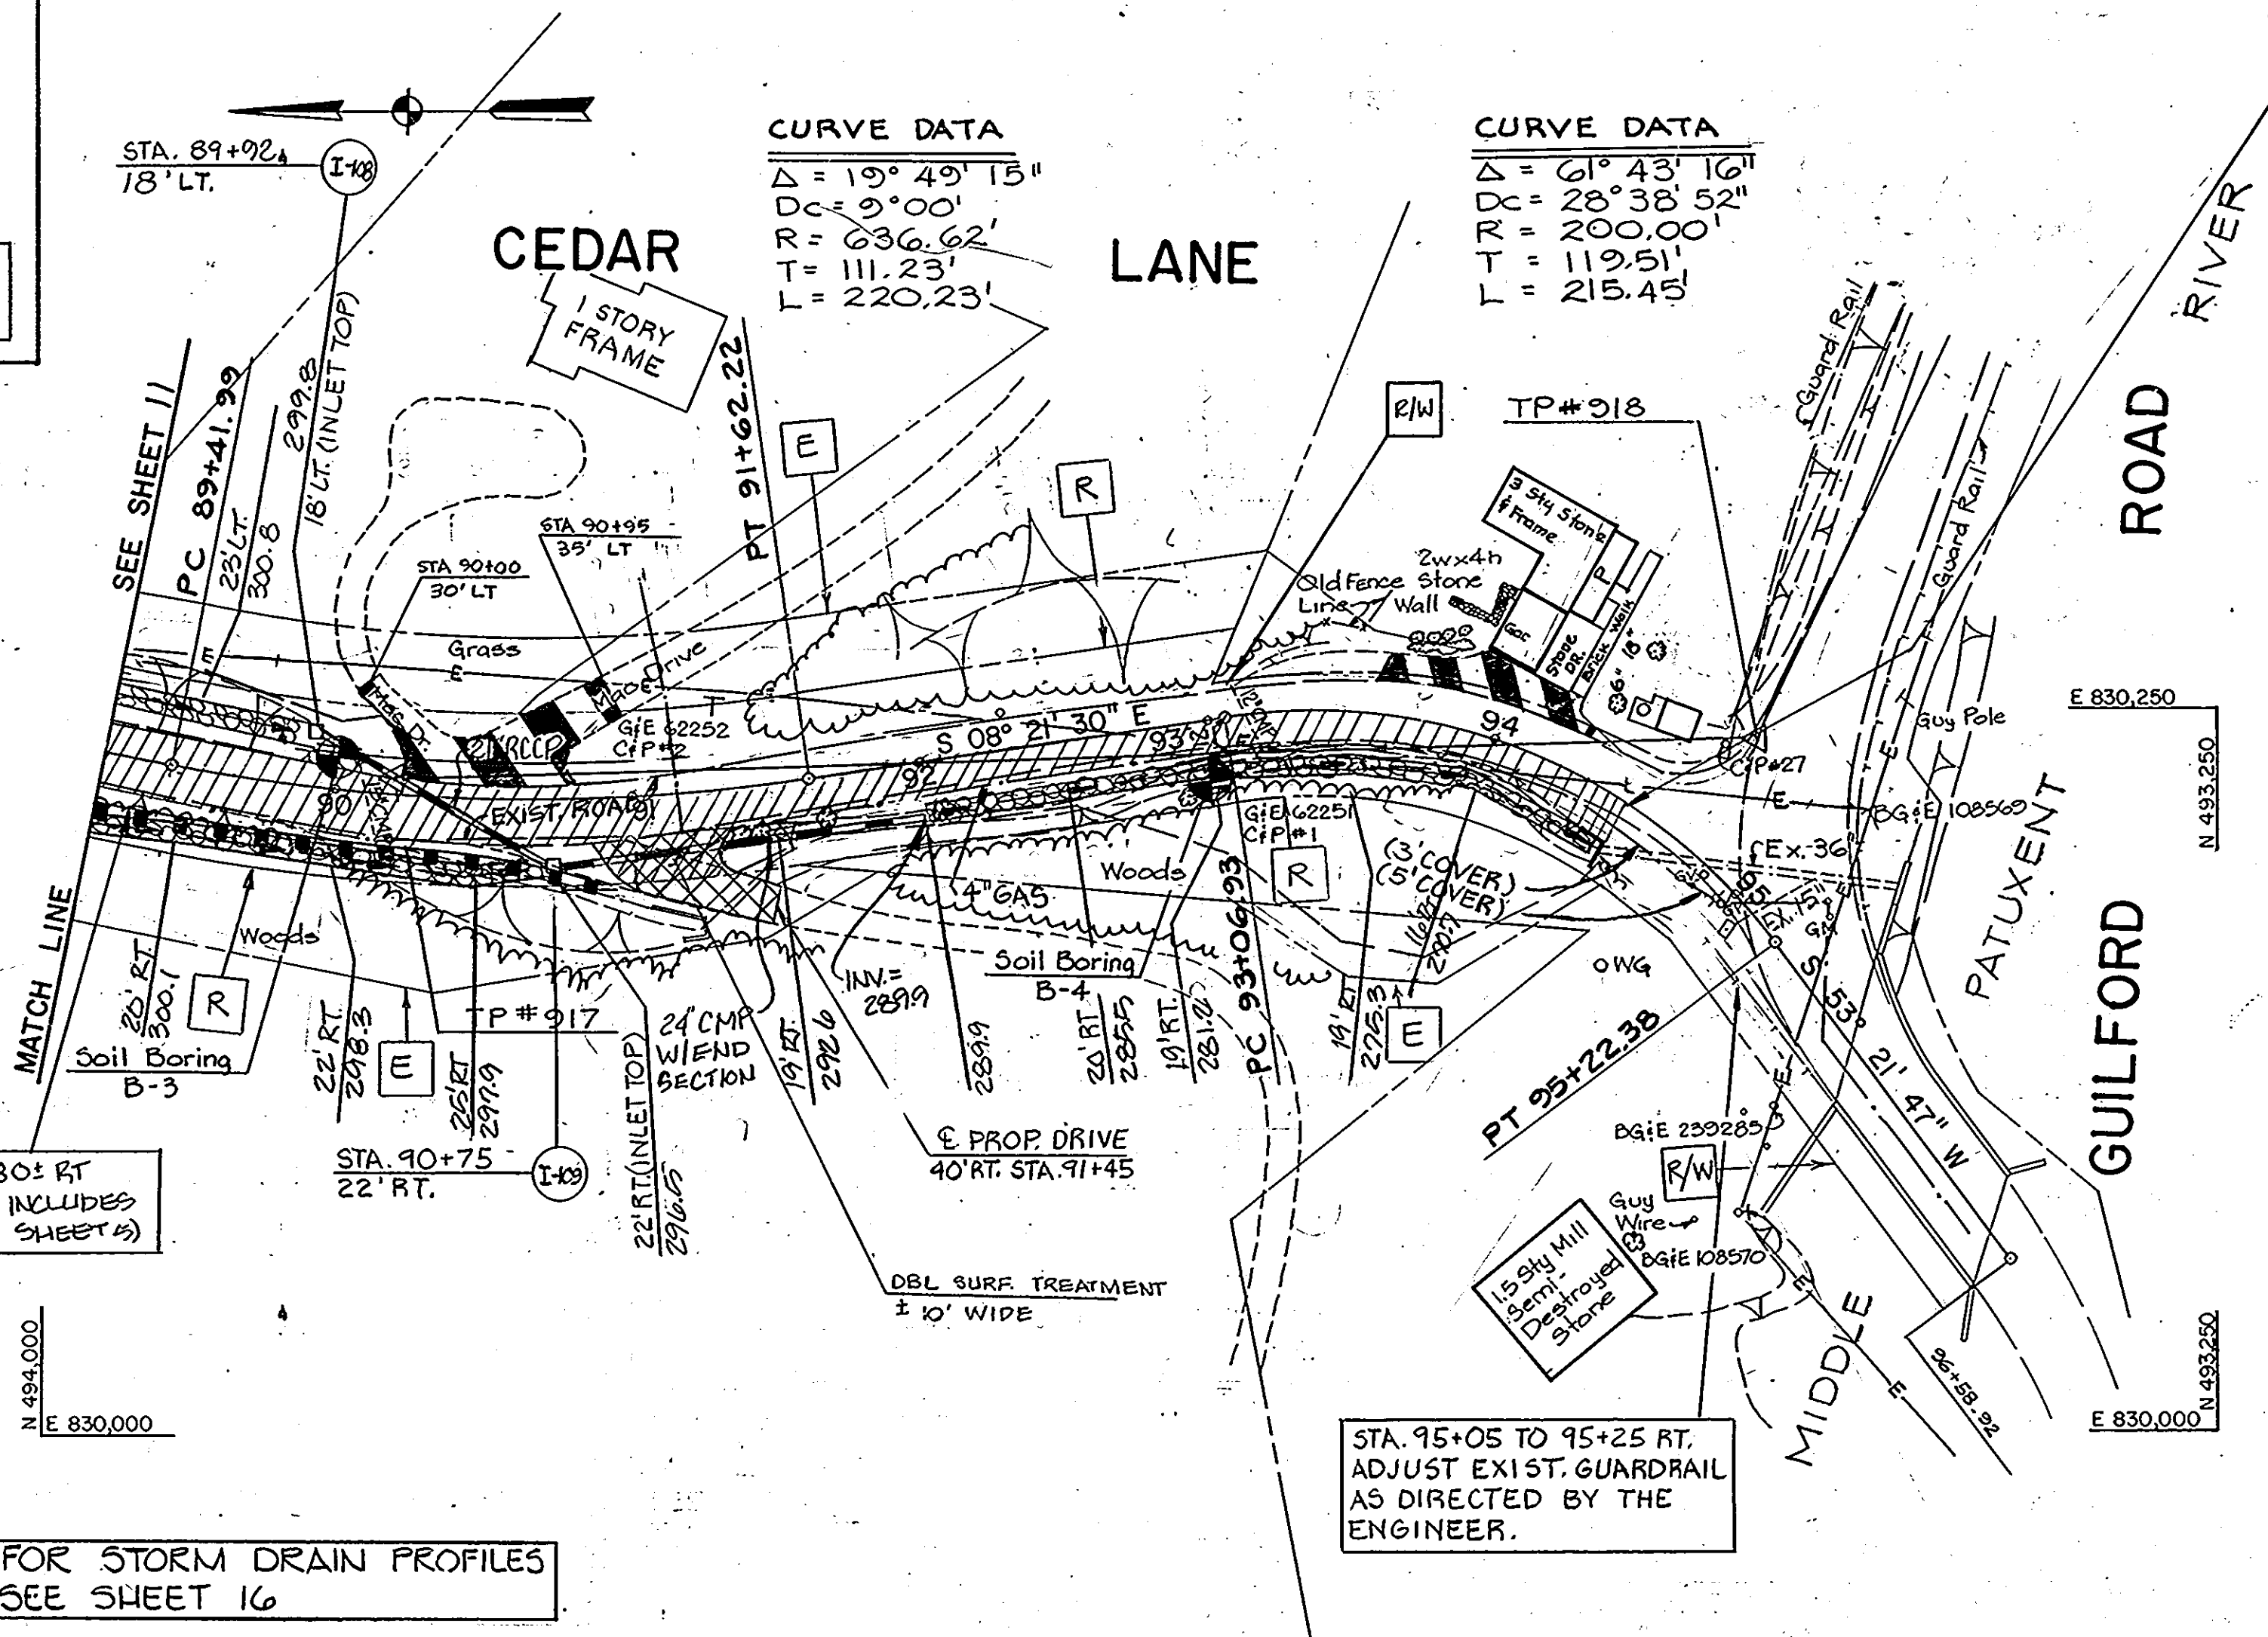

LIMIT OF WORK
 STA. 94+50

STA. 90+10 Remove Ex. Culvert


STA. 89+20 RT. TO STA. 94+50 RT.
 RIP RAP SIDE DITCH
 W=2' D=1'
 SEE DETAIL SHEET 5

STA. 89+20 LT. TO STA. 89+20 LT.
 RIP RAP SIDE DITCH
 W=2' D=1'
 SEE DETAIL SHEET 5

STA. 89+20 L TO STA. 90+80 R
 TRAFFIC BARRIER W/ BEAM INCLUDES
 TYPE 1 END FLARE (SEE SHEET 5)


STA. 95+05 TO 95+25 RT.
 ADJUST EXIST. GUARDRAIL
 AS DIRECTED BY THE
 ENGINEER.

NOTE: SEE SHEETS 6, 7, 8, 20, 21
 AND 22 FOR SOIL EROSION AND
 SEDIMENT CONTROL
 REQUIREMENTS.

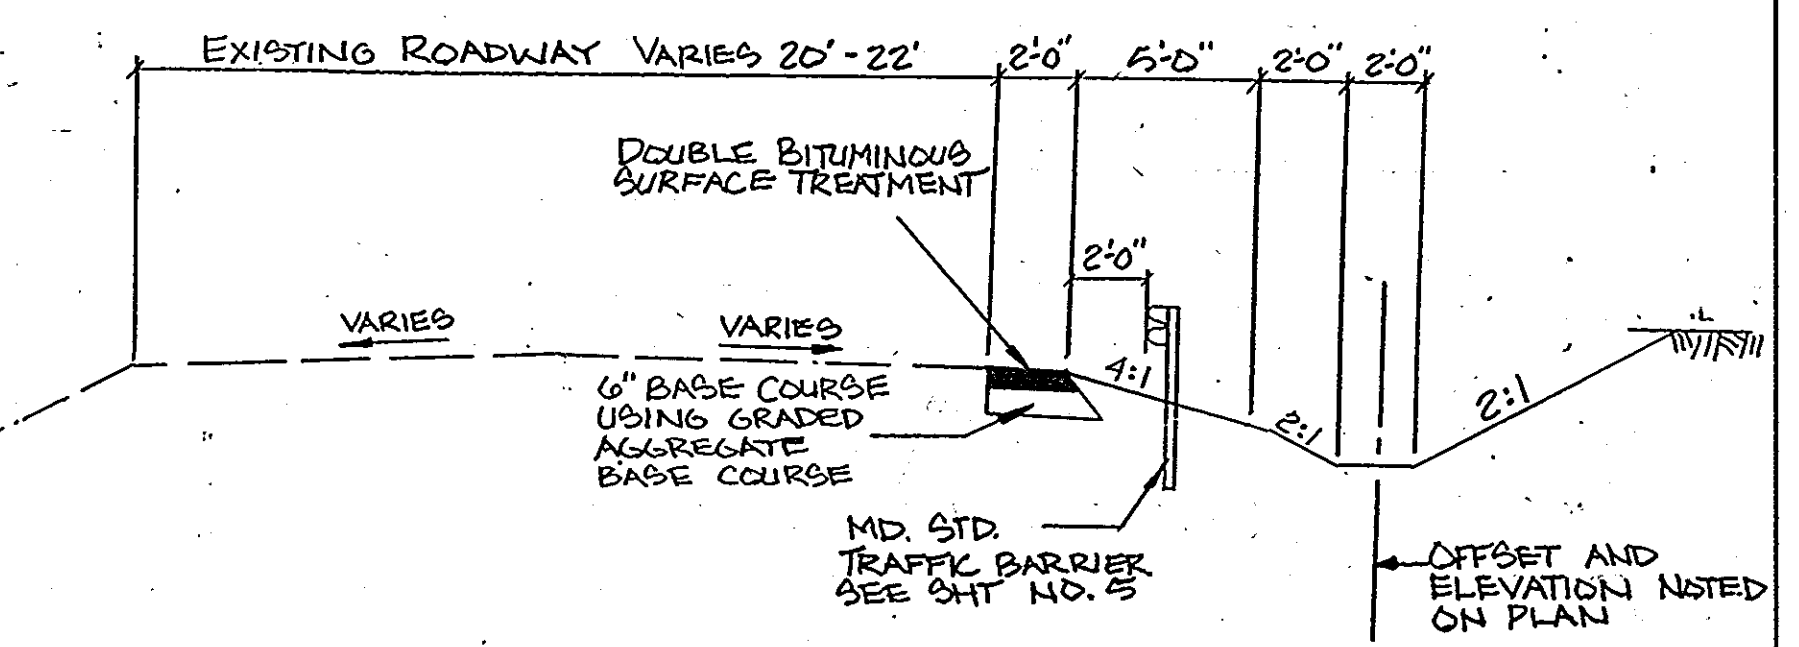

PROPOSED TYPICAL SECTION

NO SCALE
 STA. 89+00 TO 94+50

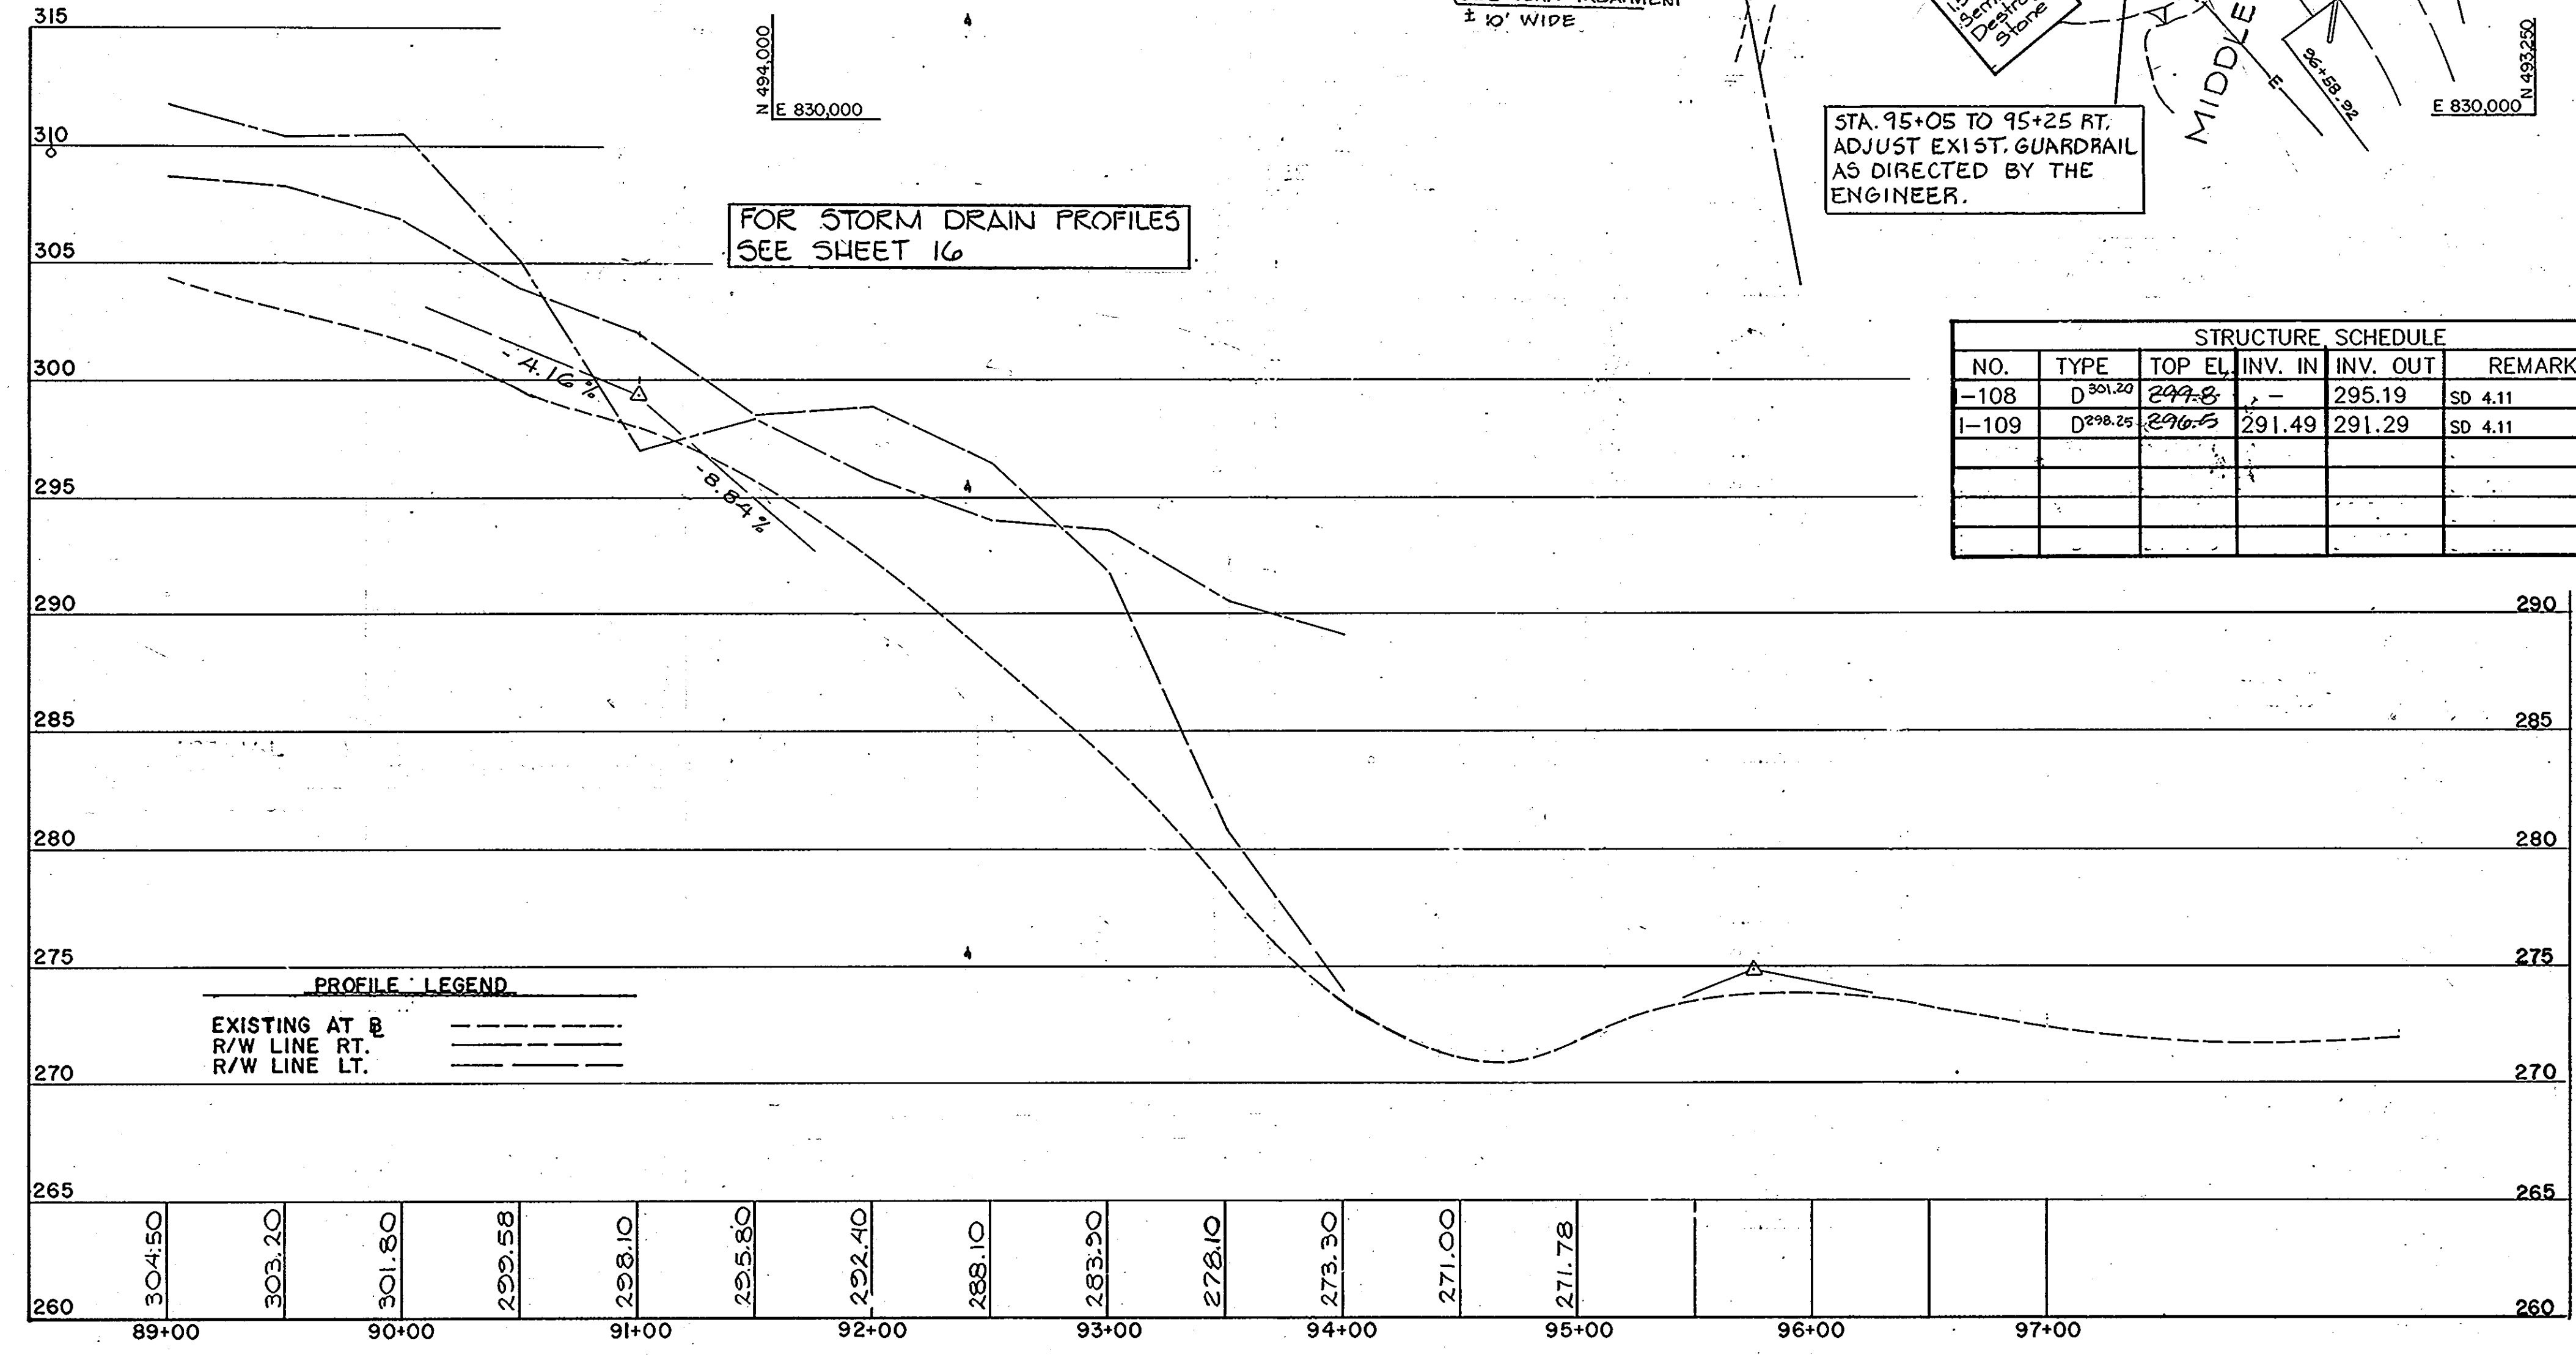


STRUCTURE SCHEDULE					
NO.	TYPE	TOP EL.	INV. IN	INV. OUT	REMARKS
-108	D 301.20	297.8	-	295.19	SD 4.11
I-109	D 298.25	296.8	291.49	291.29	SD 4.11

DEPARTMENT OF PUBLIC WORKS
 HOWARD COUNTY, MARYLAND

James M. Shaw 11/2/88
 DIRECTOR OF PUBLIC WORKS DATE

Richard E. Reddy 11-8-88
 CHIEF, BUREAU OF ENGINEERING DATE

Harold L. Williams 11/8/88
 CHIEF, DIVISION OF ROADS, BRIDGES AND STORM DRAINAGE DATE

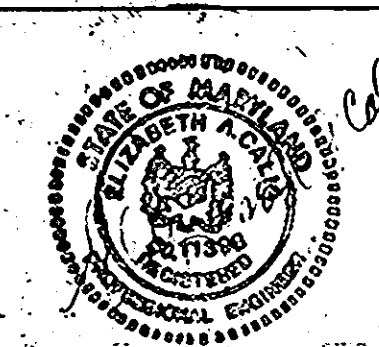

DES: JCT				
DRN: PWR				
CHK: WDP				
DATE: 6/90				
BY	NO.	REVISION	DATE	



PLAN & PROFILE
 STA. 89+20 TO STA. 94+50
 CEDAR LANE - PHASE 2

600' SCALE MAP NO. _____ BLOCK NO. _____

SOUTH OF FREETOWN RD. TO GUILFORD RD.
 CAPITAL PROJECT J-4086
 ELECTION DISTRICT NO. 5
 HOWARD COUNTY, MARYLAND

SCALE
 1"=50'

SHEET
 12 OF 28

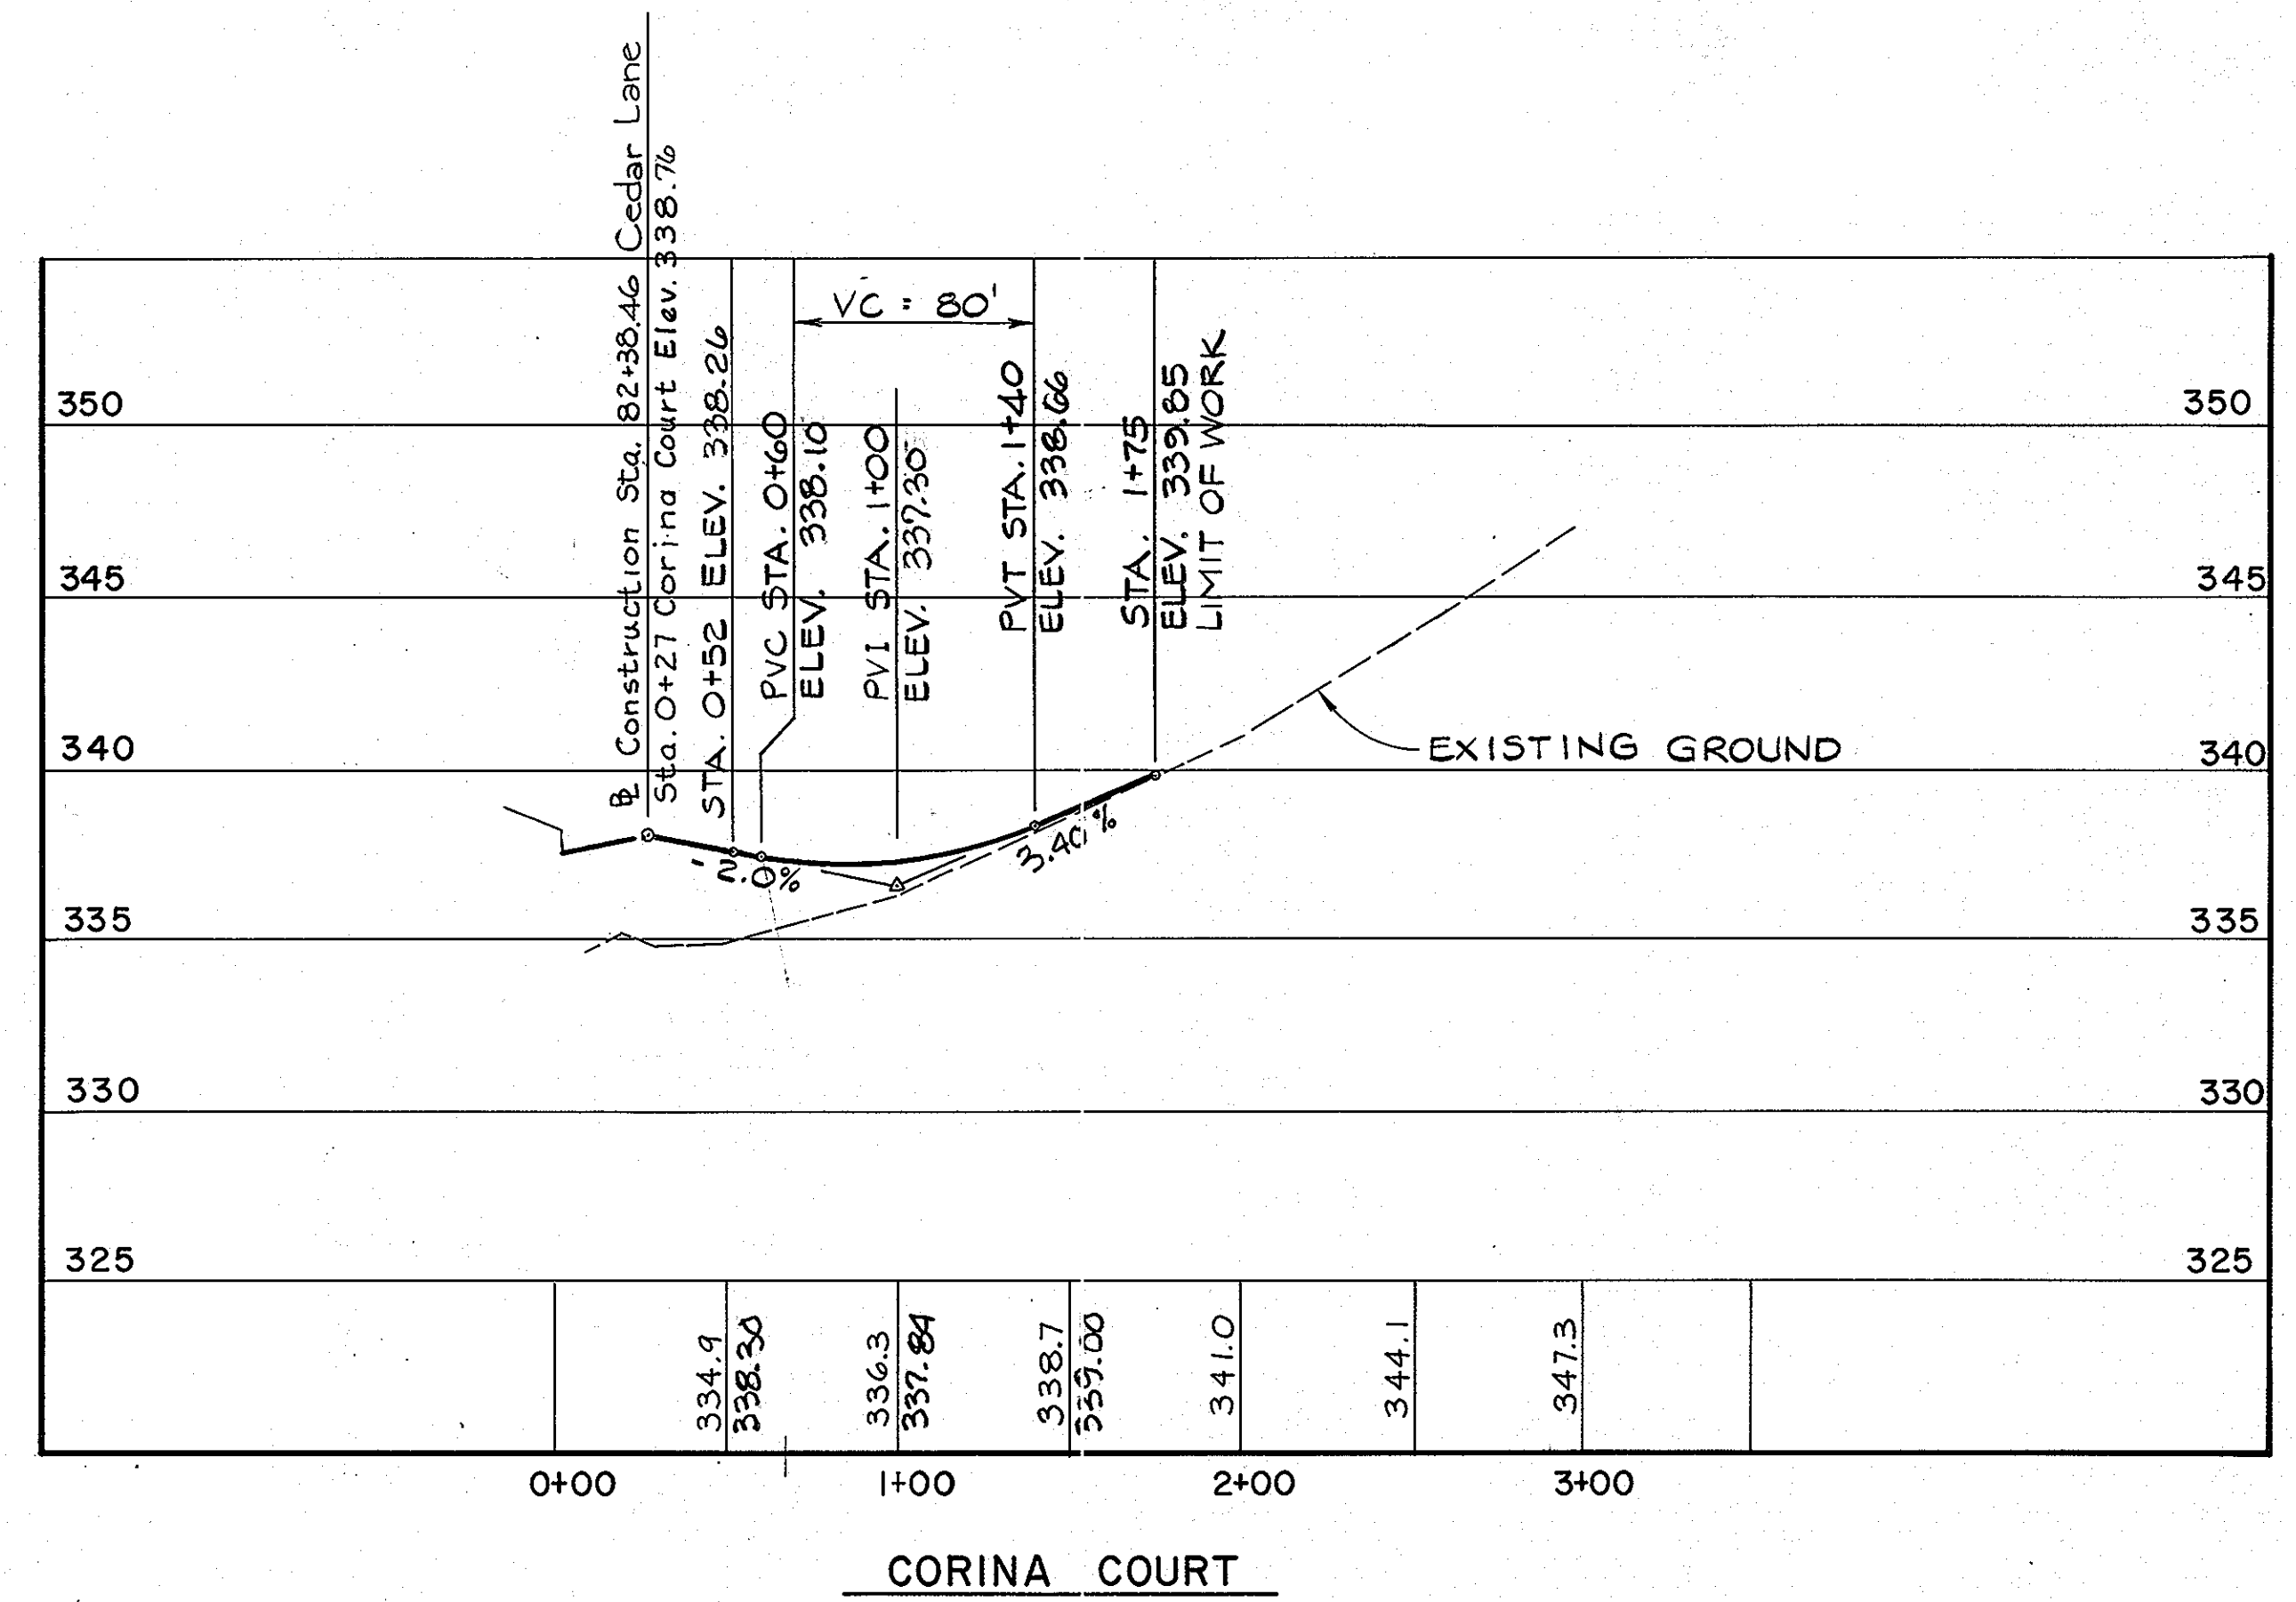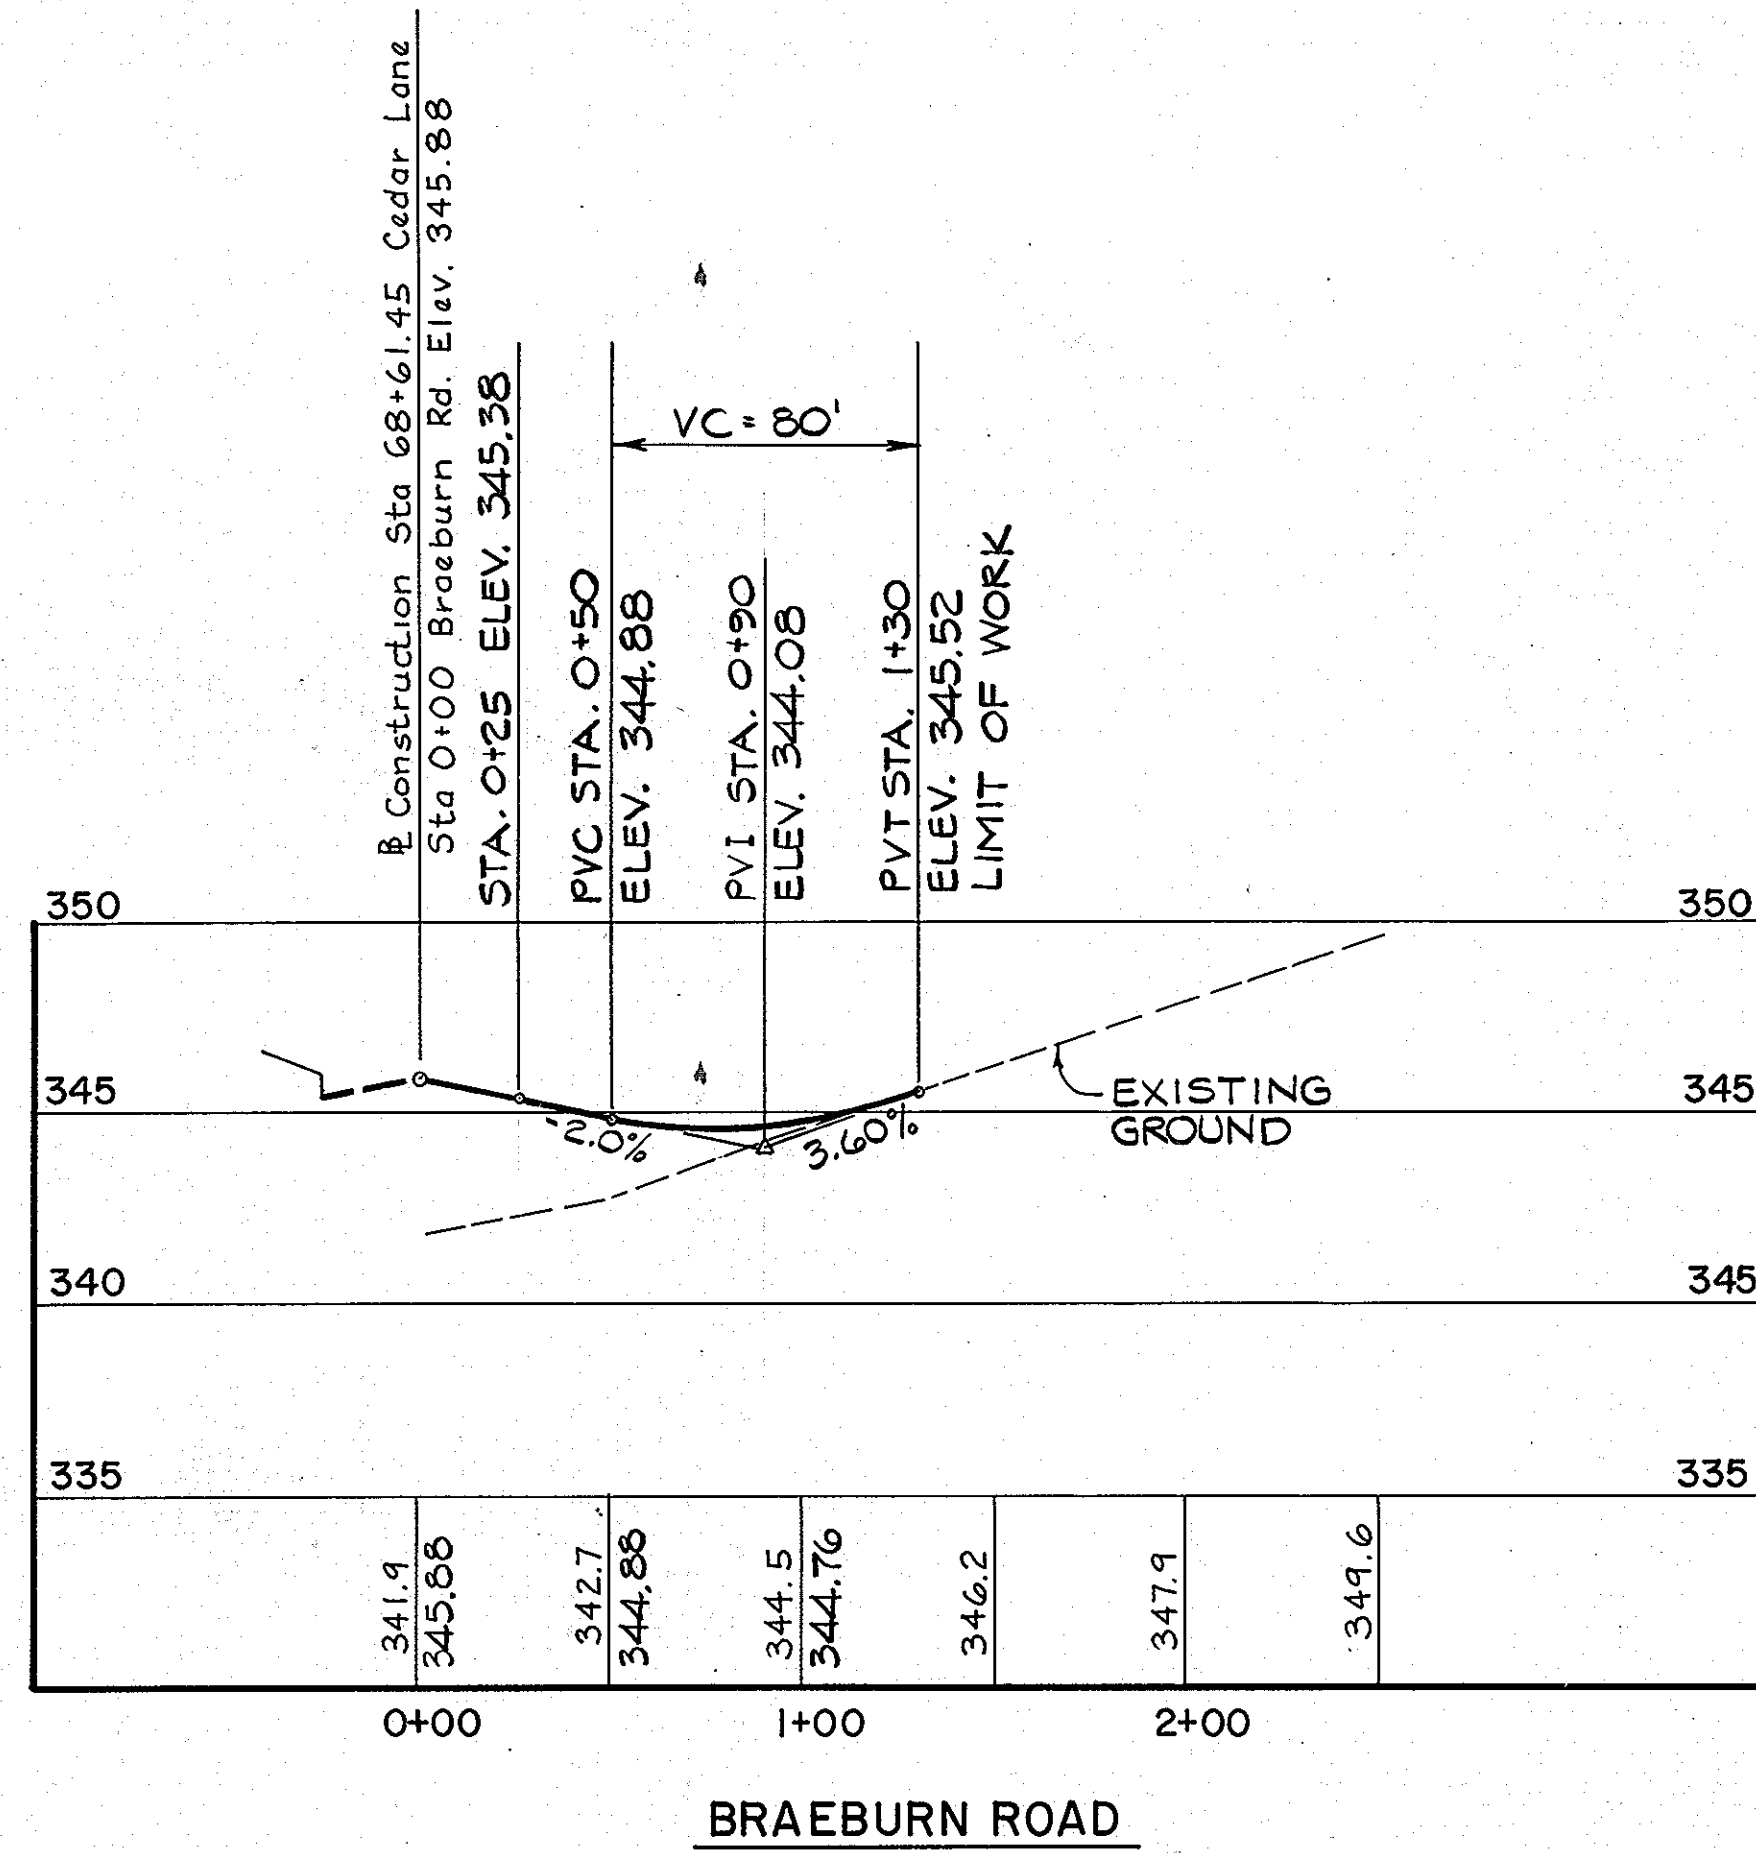


DEPARTMENT OF PUBLIC WORKS
HOWARD COUNTY, MARYLAND

James J. Lee 11/8/88
DIRECTOR OF PUBLIC WORKS DATE

William S. Riley 11/8/88
CHIEF, BUREAU OF ENGINEERING DATE

11/8/88
CHIEF, DIVISION OF ROADS, BRIDGES AND STORM DRAINAGE DATE

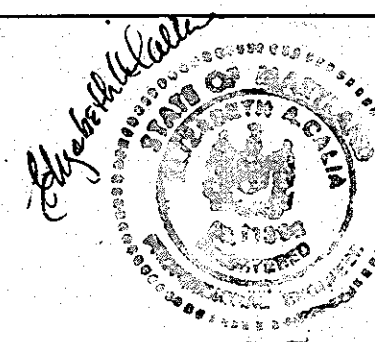

DES: JSN			
DRN: GMI			
CHK:			
DATE: 6/90			
BY	NO.	REVISION	DATE

CONNECTING ROAD PROFILES
CEDAR LANE - PHASE 2



SOUTH OF FREETOWN RD. TO GUILFORD RD.
CAPITAL PROJECT J-4086
ELECTION DISTRICT NO. 5
HOWARD COUNTY, MARYLAND

SCALE
HORIZ. 1"=50'
VERT. 1"=5'

SHEET
13 OF 28



600' SCALE MAP NO. _____ BLOCK NO. _____

FINAL XKCE-90-013

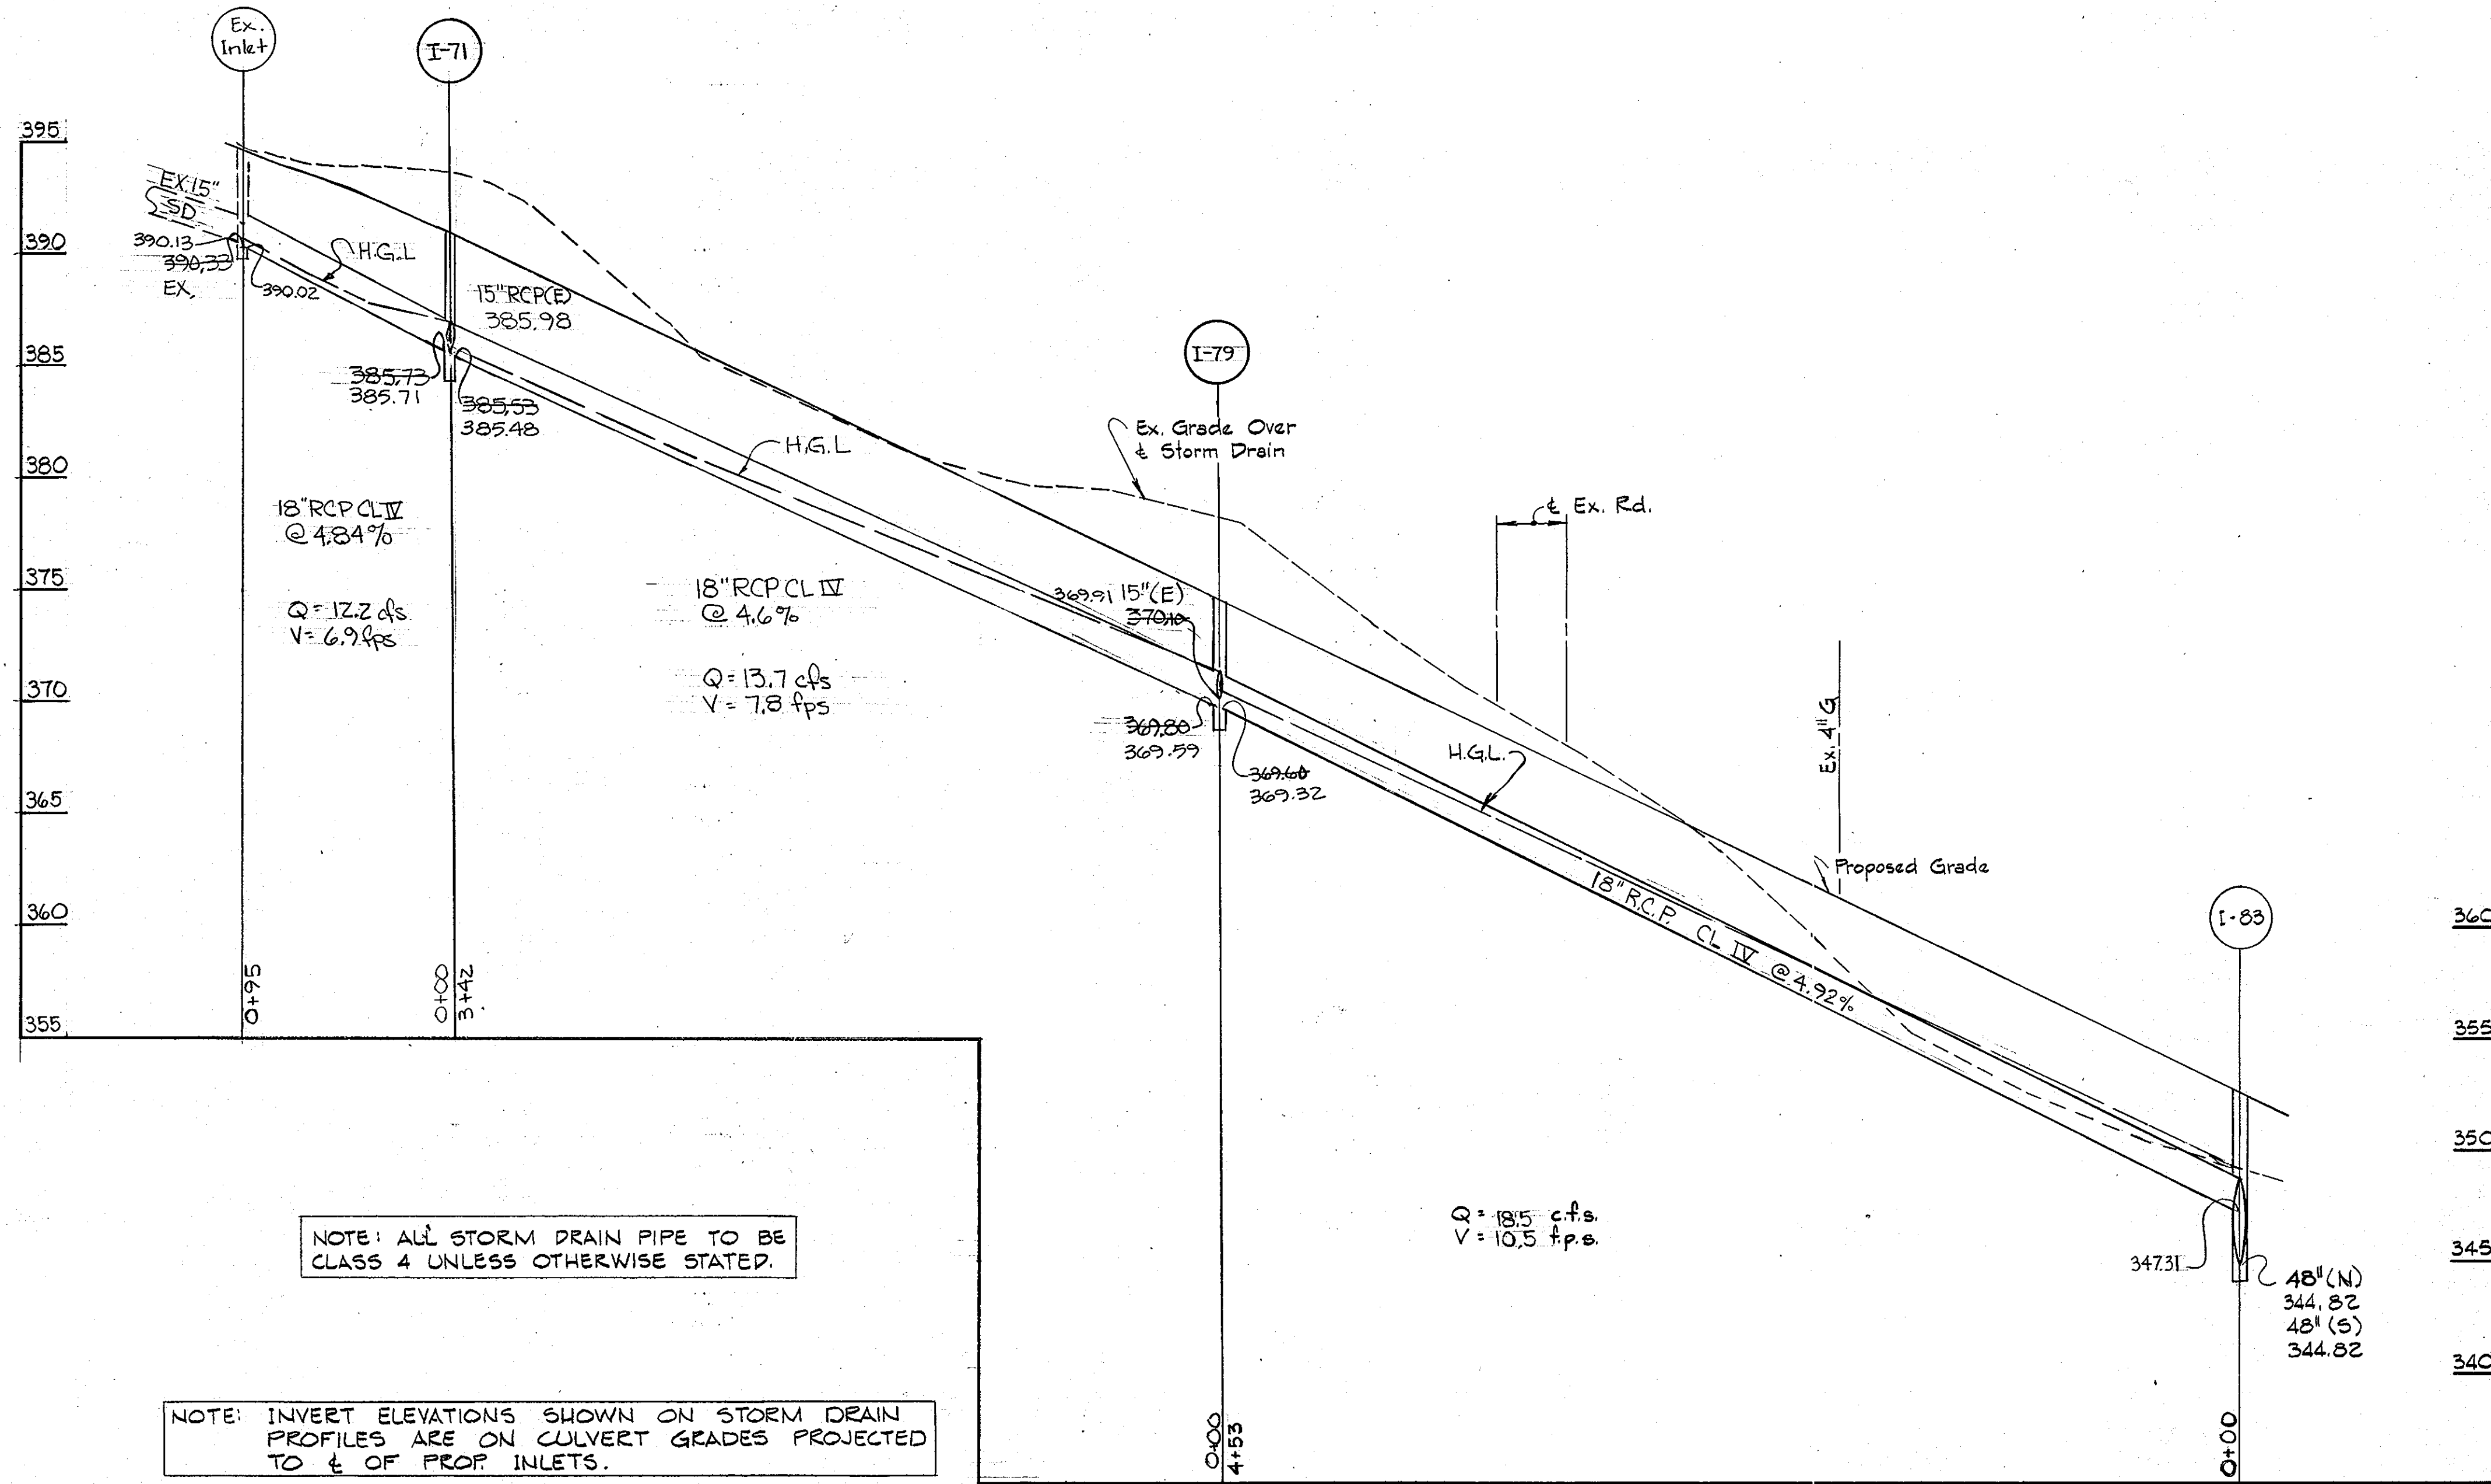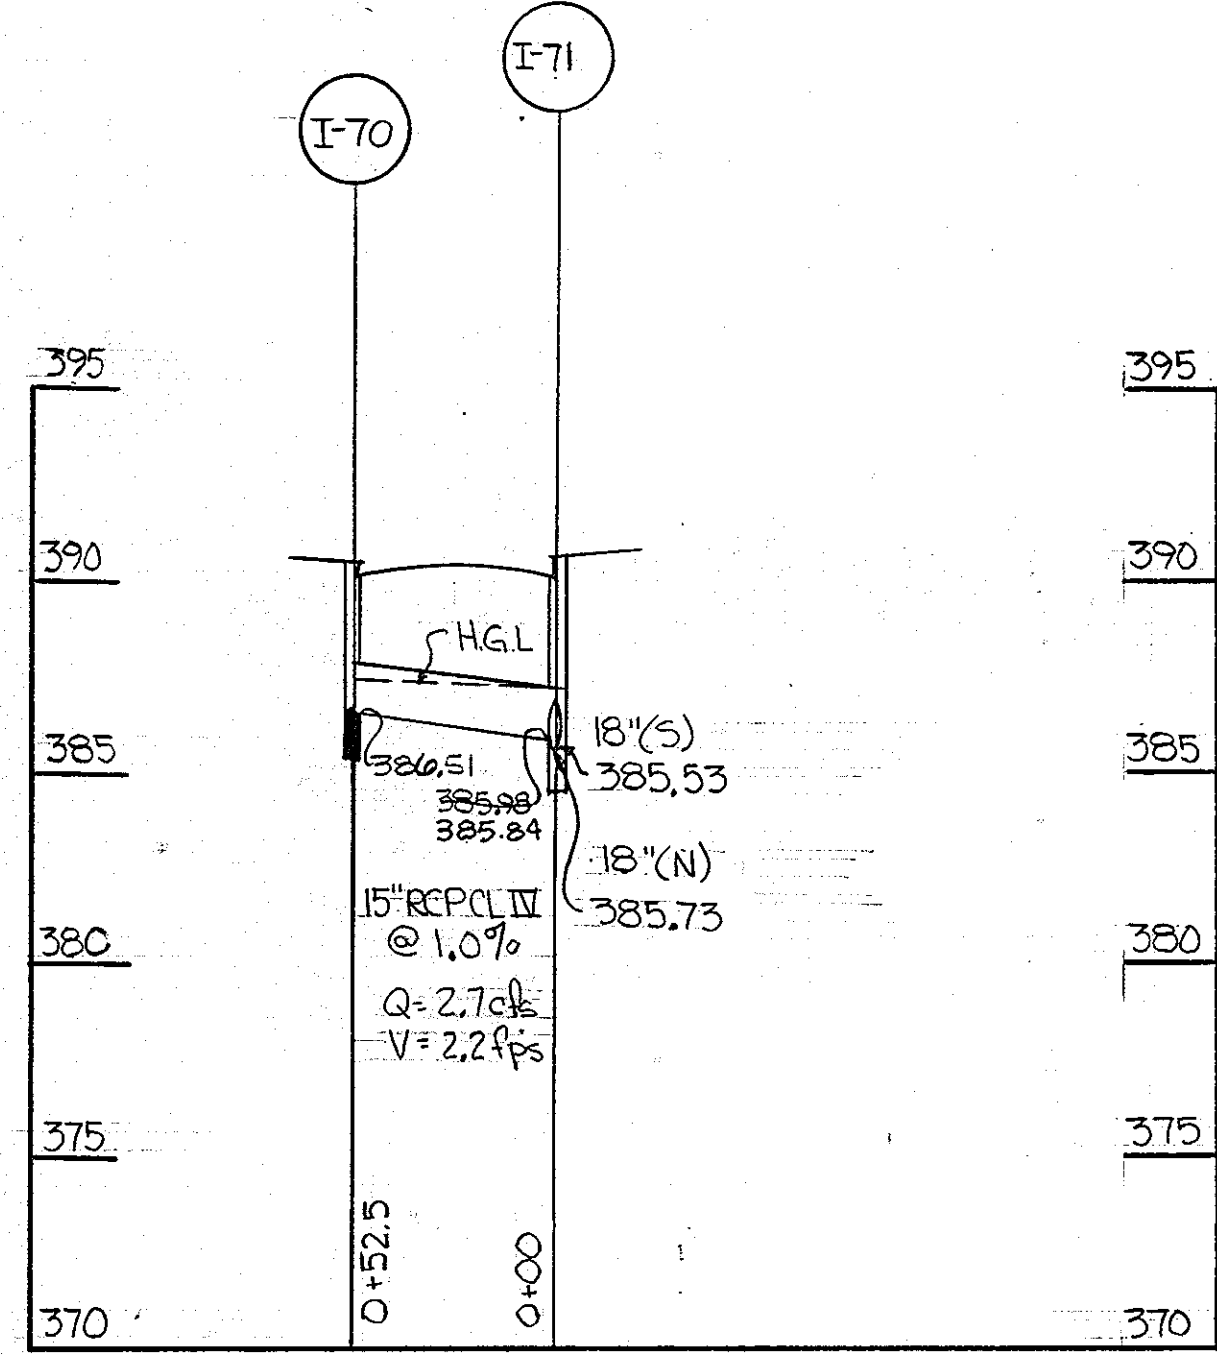

NOTE: ALL STORM DRAIN PIPE TO BE CLASS 4 UNLESS OTHERWISE STATED.

NOTE: INVERT ELEVATIONS SHOWN ON STORM DRAIN PROFILES ARE ON CULVERT GRADES PROJECTED TO ± OF PROP. INLETS.

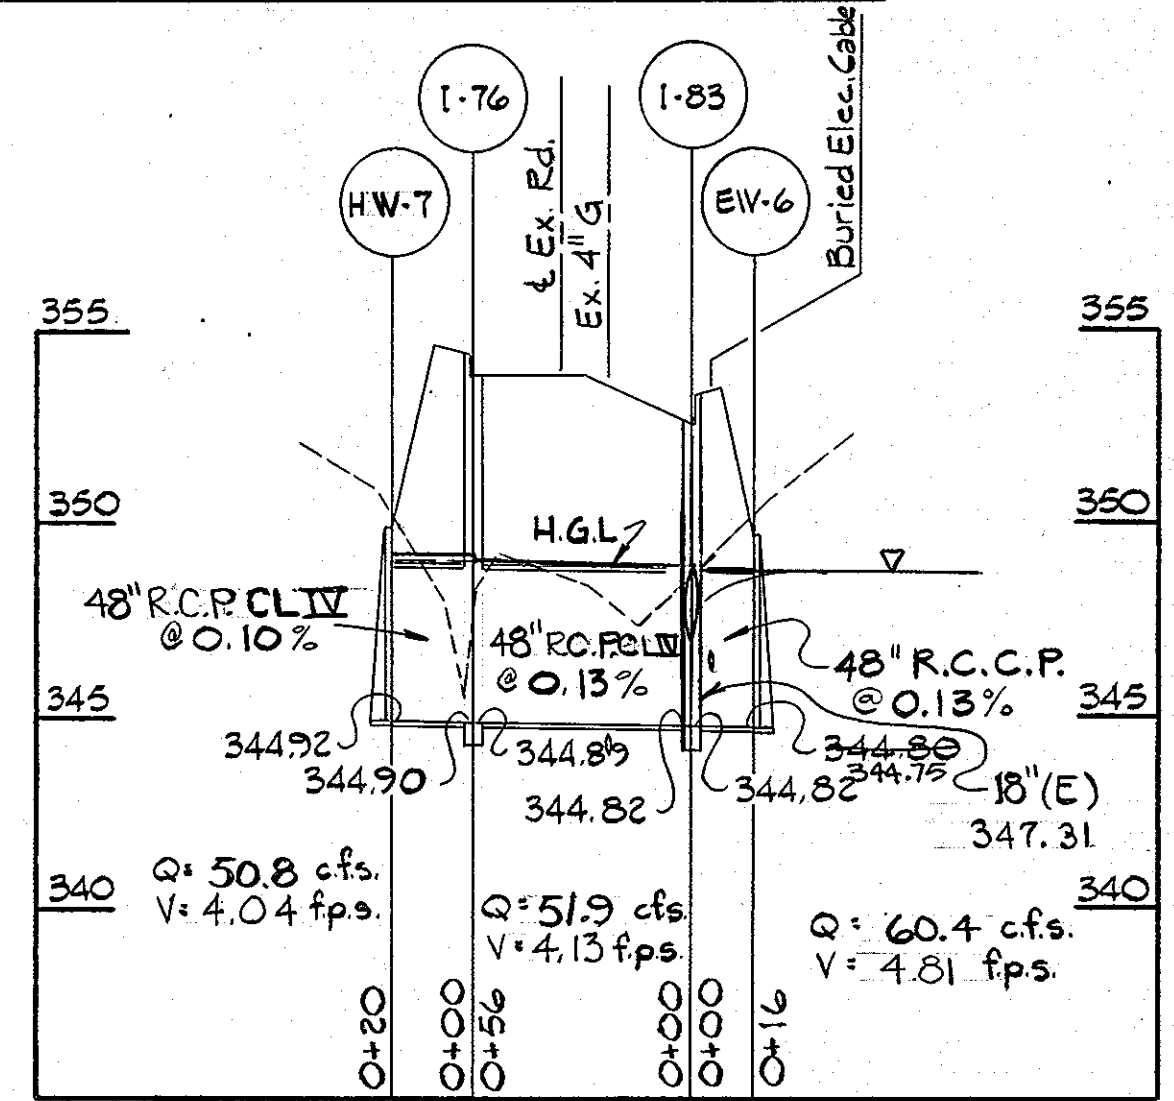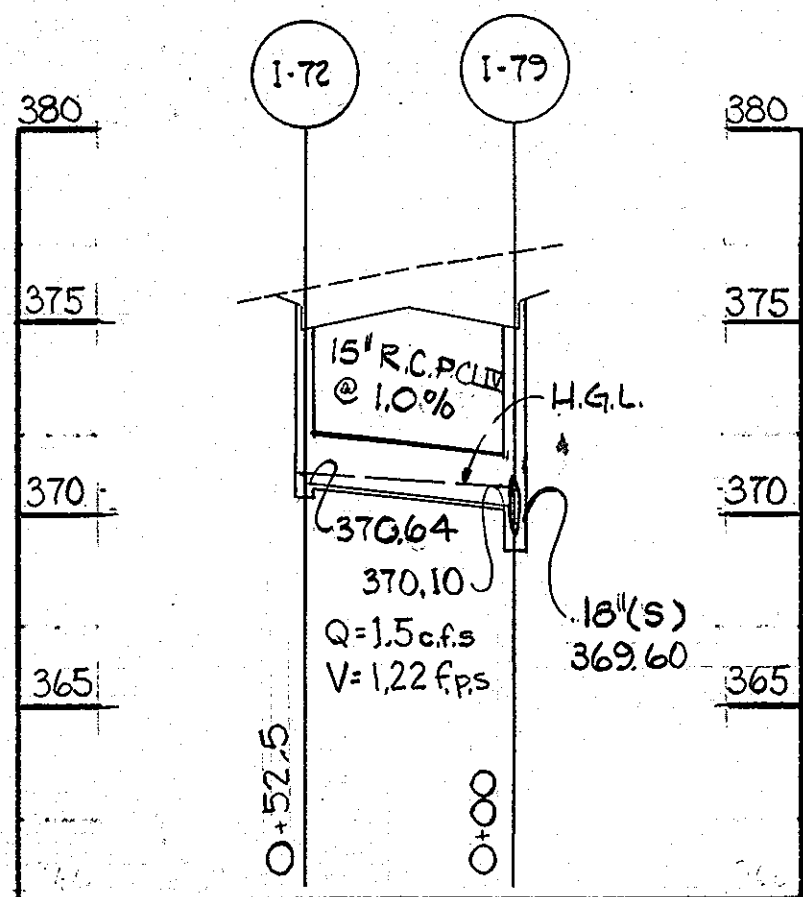

985


DEPARTMENT OF PUBLIC WORKS
HOWARD COUNTY, MARYLAND

James M. Shaw 11/8/88 *William D. Purdum & Sons* 11-8-88
DIRECTOR OF PUBLIC WORKS DATE CHIEF, BUREAU OF ENGINEERING DATE

William D. Purdum 11/8/88
CHIEF, DIVISION OF ROADS, BRIDGES AND STORM DRAINAGE DATE

PURDUM & JESCHKE
CONSULTING ENGINEERS
LAND SURVEYORS

1029 North Calvert Street
Baltimore, Maryland 21202 301/837-0194

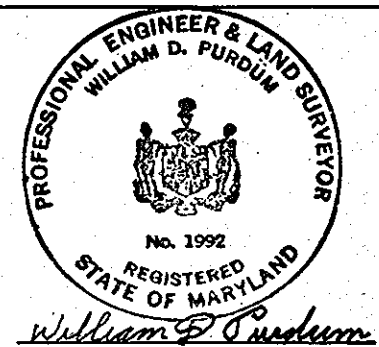

DES: JK			
DRN: PWR			
CHK: JCT			
DATE: 6/90			
BY	NO.	REVISION	DATE

STORM DRAIN PROFILES

CEDAR LANE - PHASE 2





600' SCALE MAP NO. _____ BLOCK NO. _____

SOUTH OF FREETOWN RD. TO GUILFORD RD.
CAPITAL PROJECT J-4086
ELECTION DISTRICT NO. 5
HOWARD COUNTY, MARYLAND




SCALE
HORIZ. 1"=50'
VERT. 1"=5'

SHEET
14 OF 28

FINAL XXCE-90-014

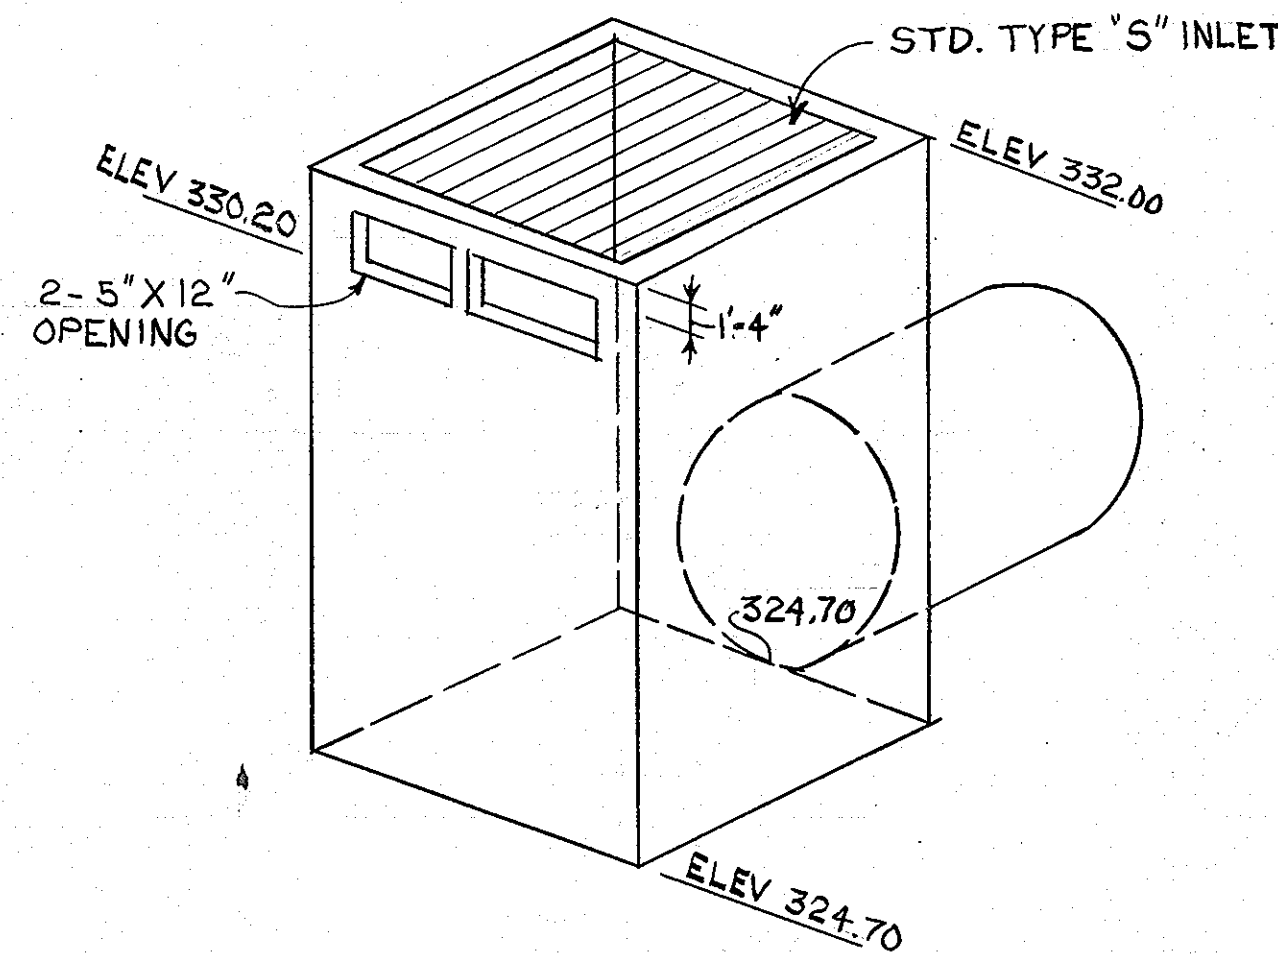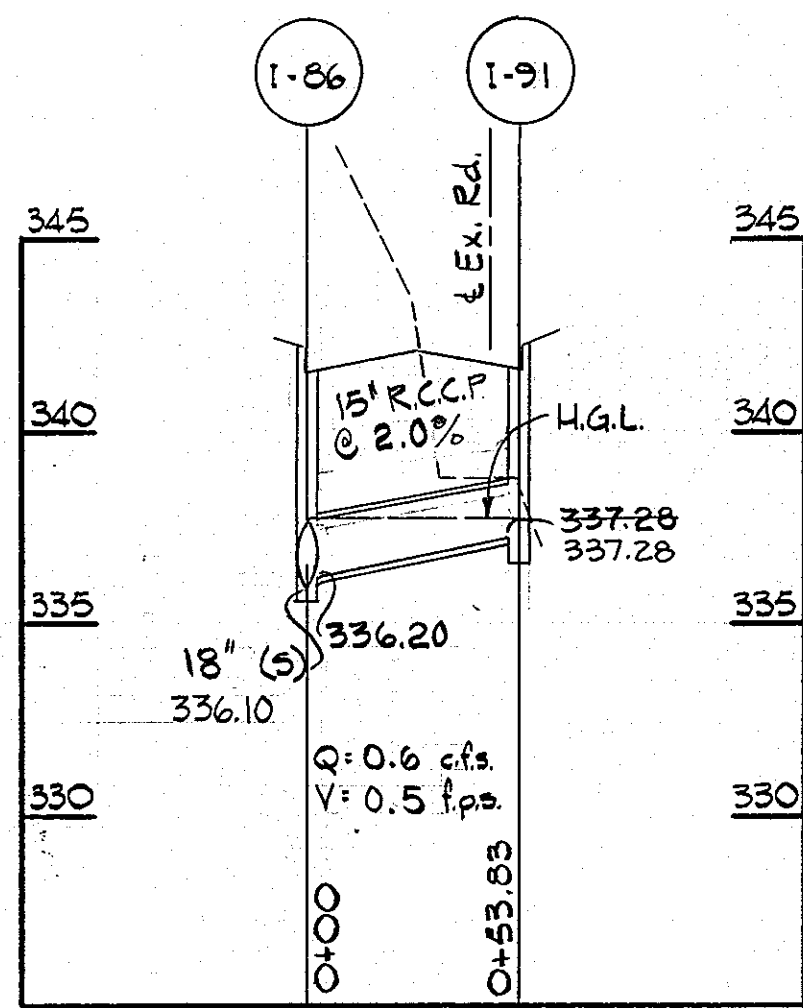
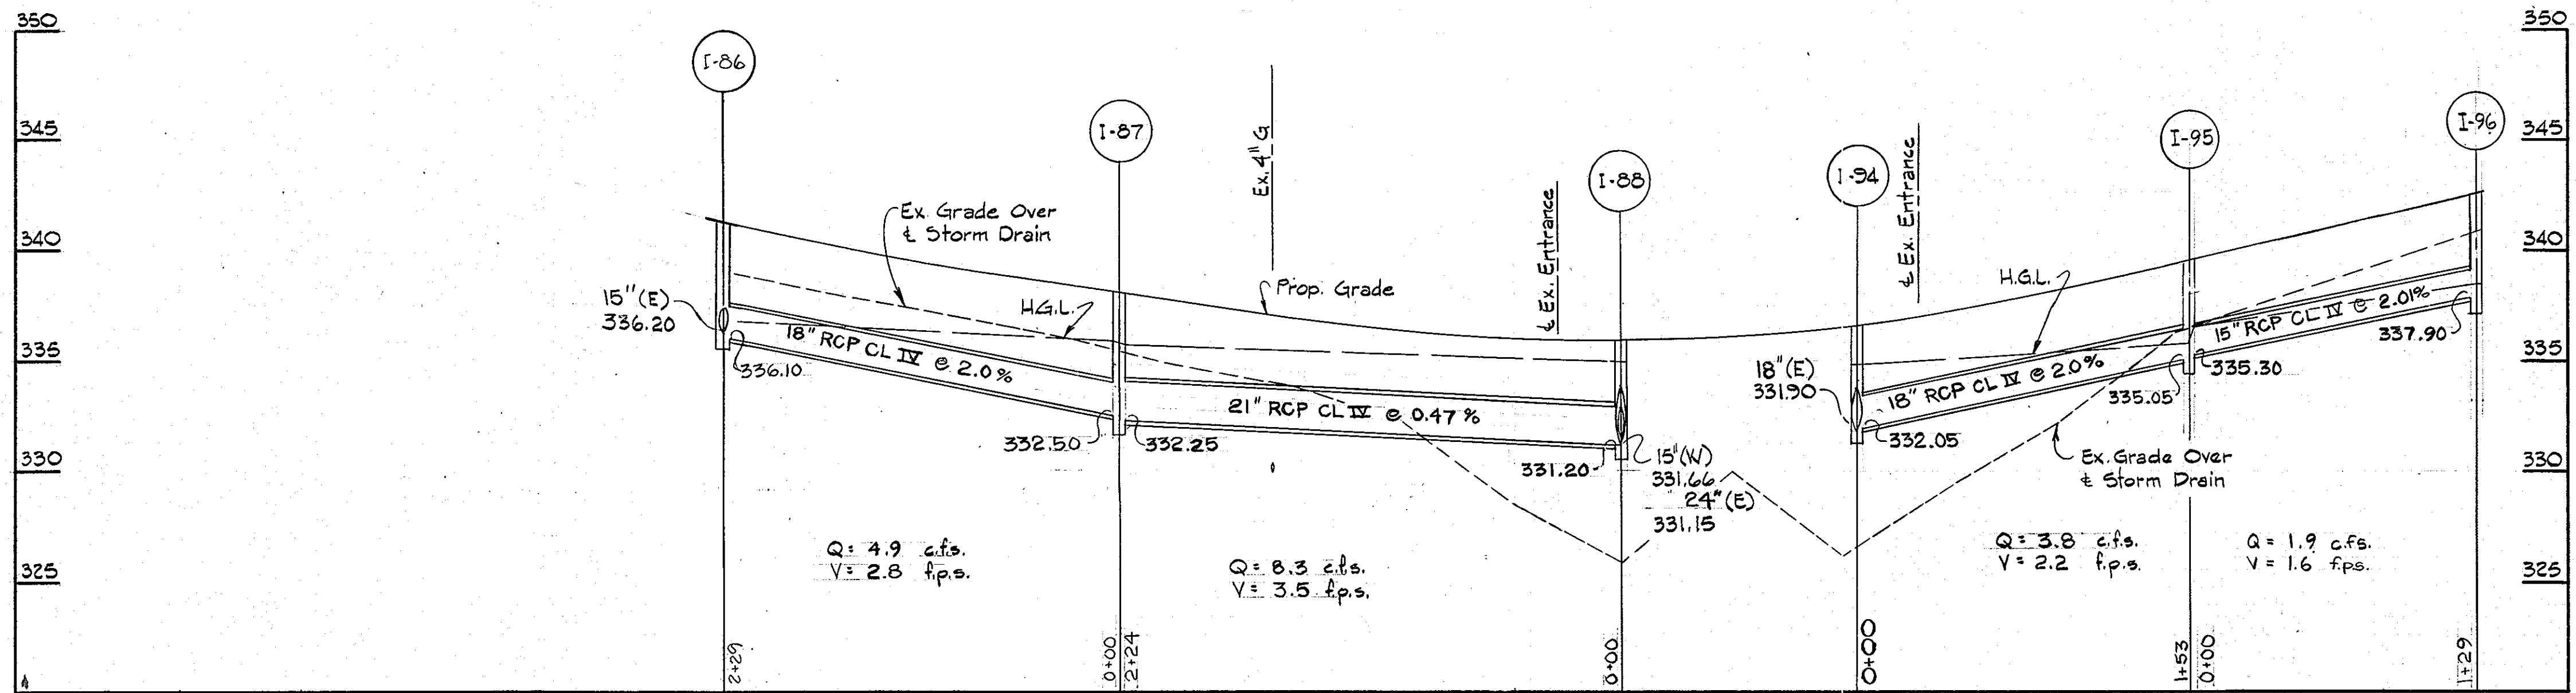
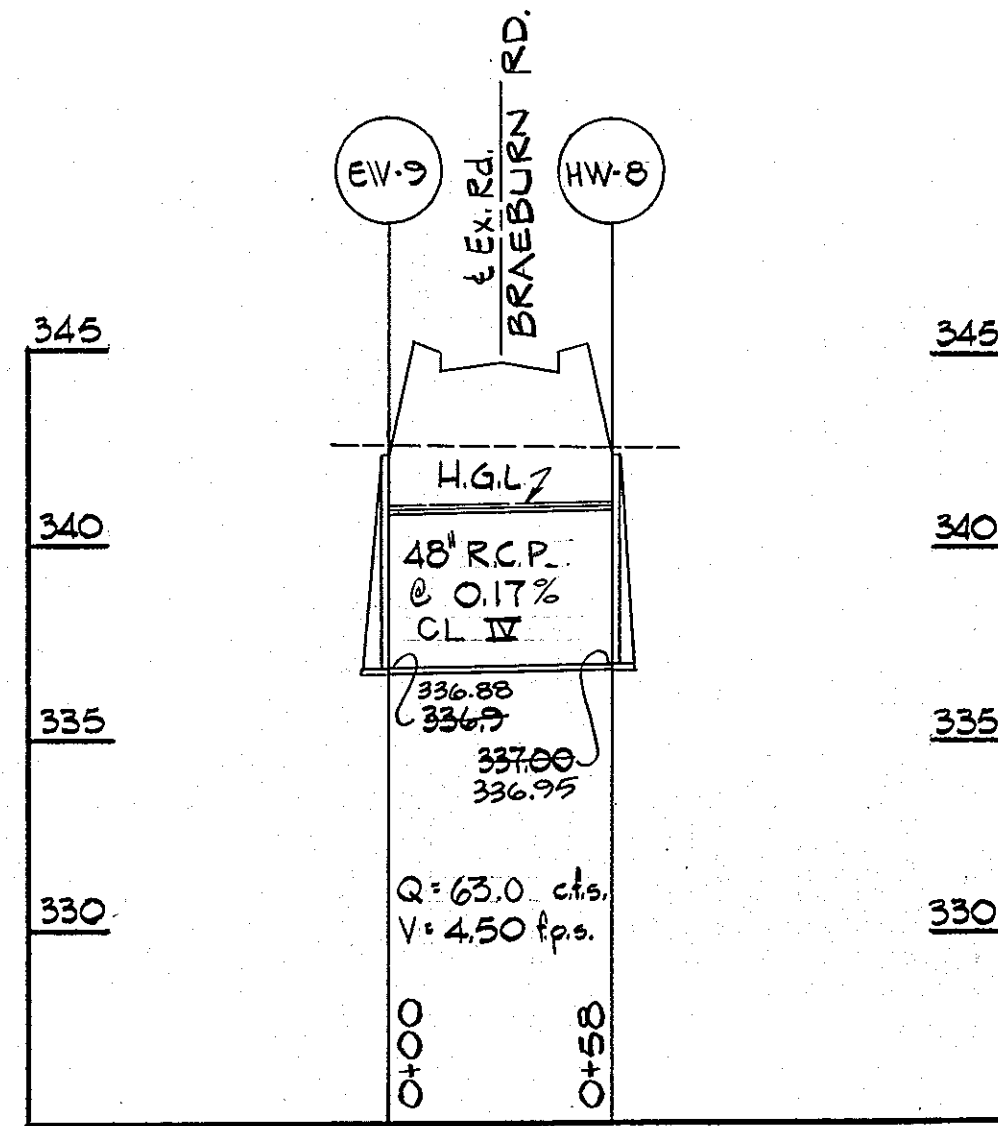


INLET NO. 105 DETAIL (MODIFIED TYPE "S")
NTS

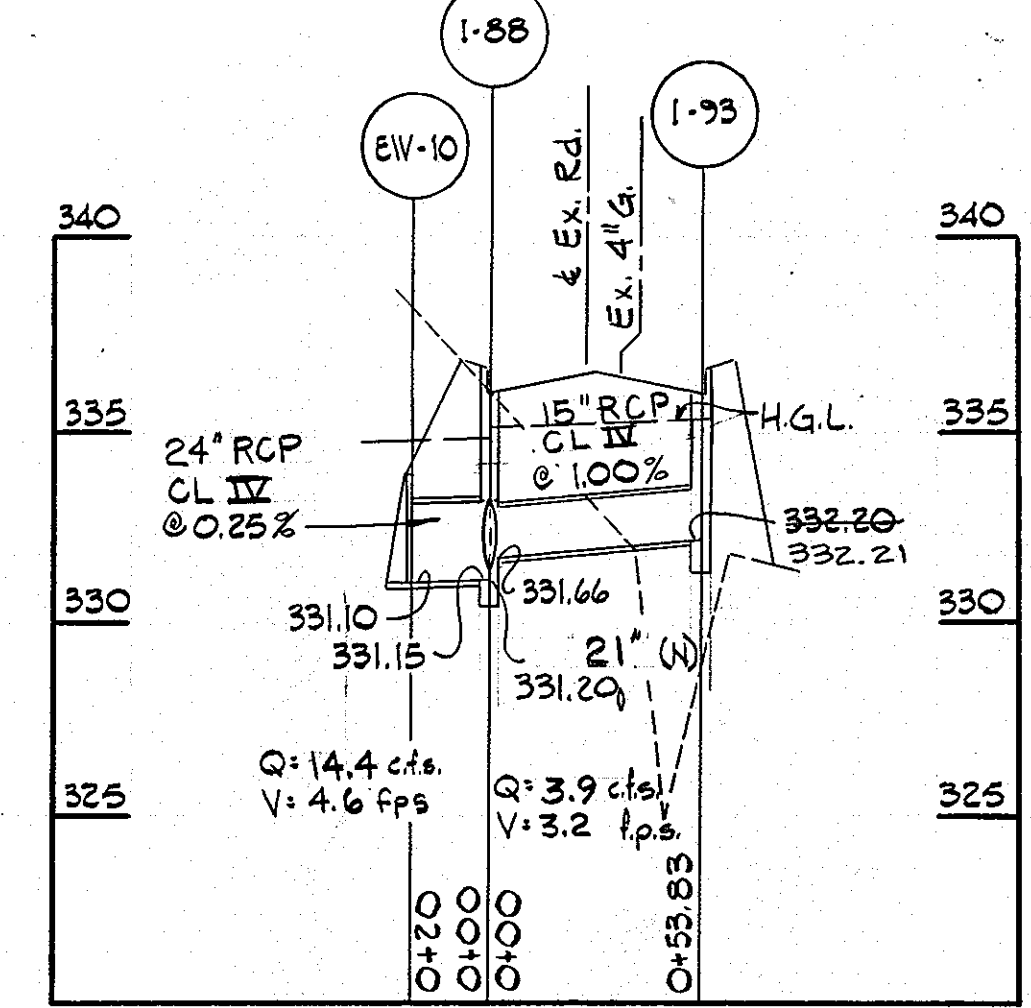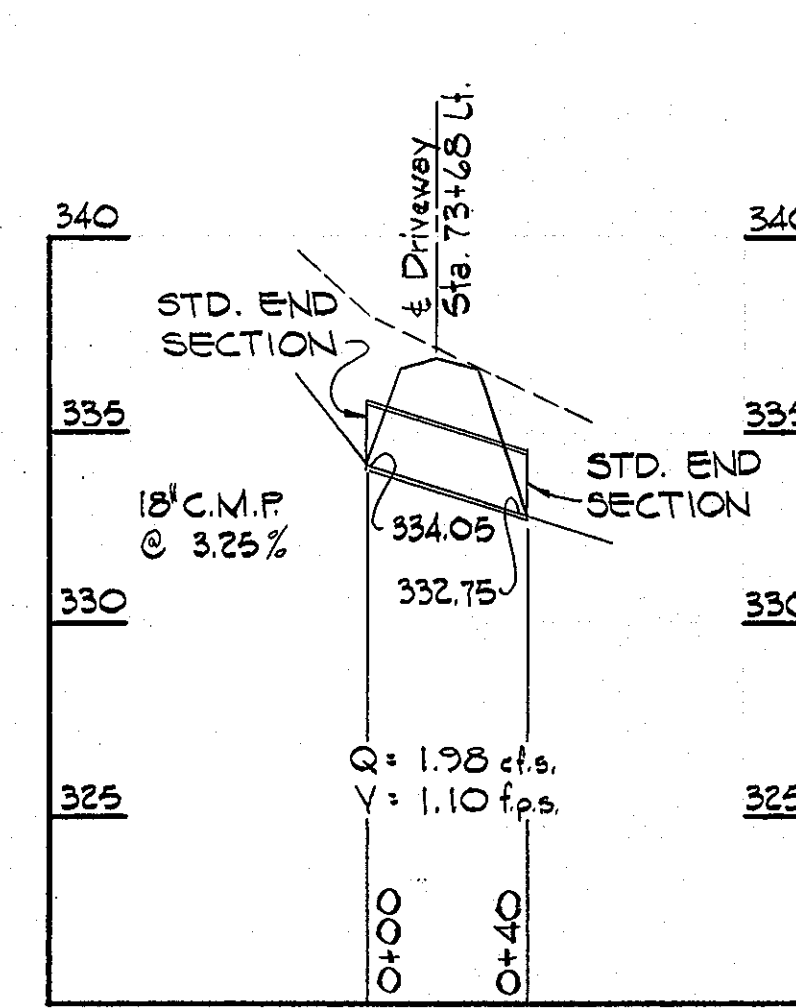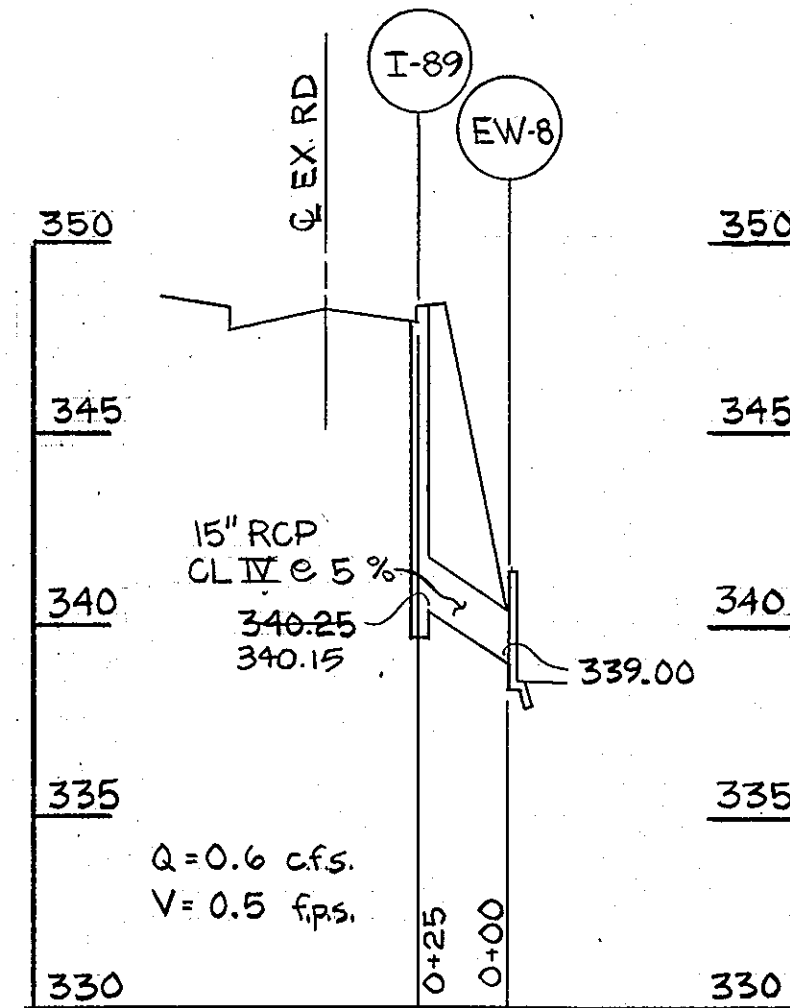


NOTE: INVERT ELEVATIONS SHOWN ON STORM DRAIN PROFILES ARE ON CULVERT GRADES PROJECT TO ϕ OF PROP. INLETS.

NOTE: ALL STORM DRAIN PIPE TO BE CLASS 4 UNLESS OTHERWISE STATED.

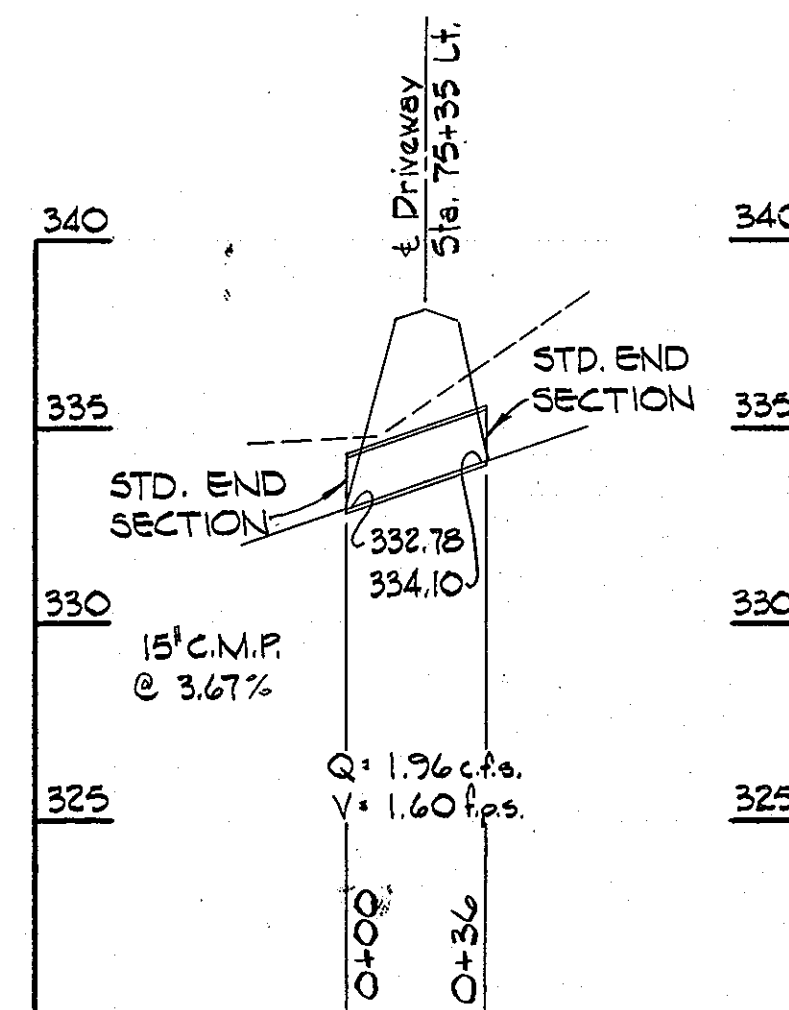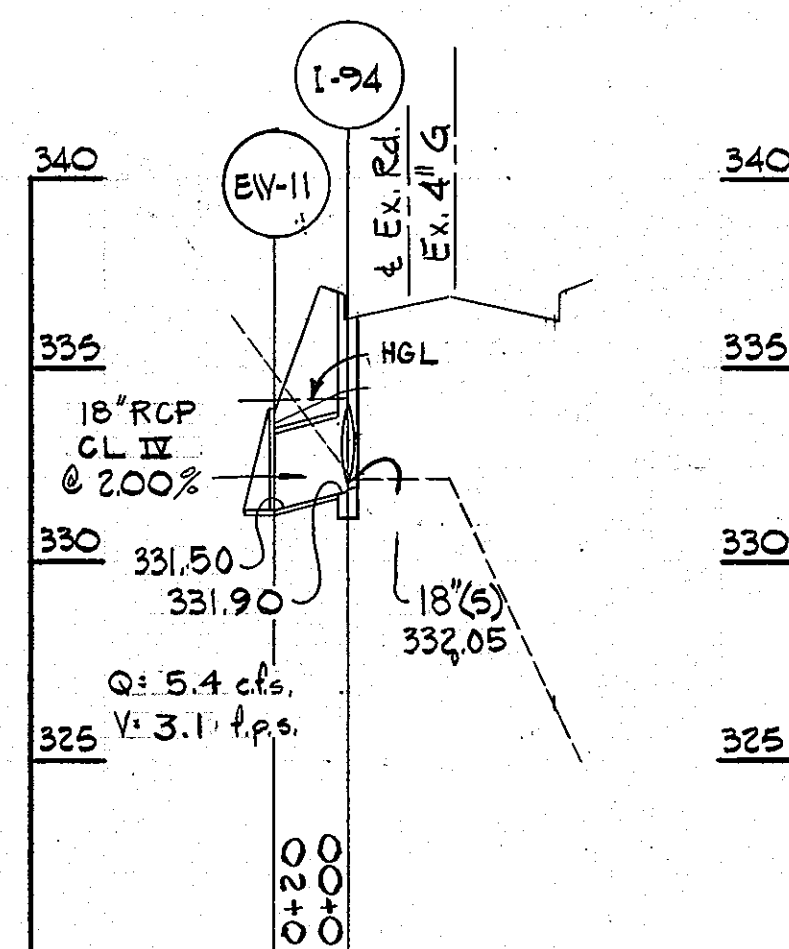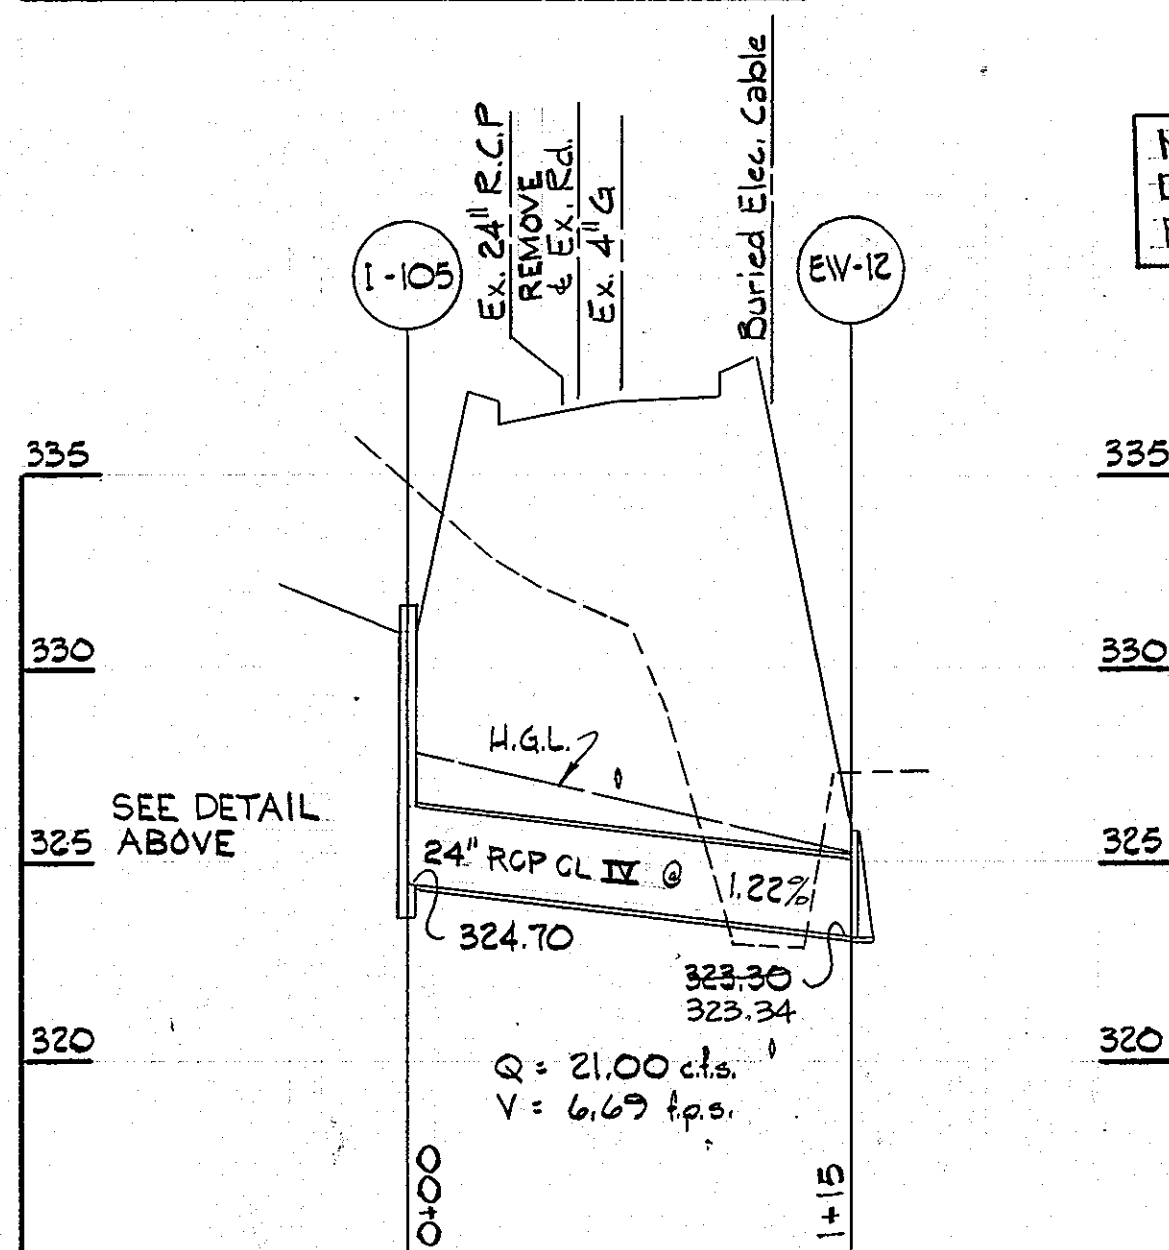


DEPARTMENT OF PUBLIC WORKS
HOWARD COUNTY, MARYLAND

James M. ...
DIRECTOR OF PUBLIC WORKS DATE
...
CHIEF, BUREAU OF ENGINEERING DATE
...
CHIEF, DIVISION OF ROADS, BRIDGES AND STORM DRAINAGE DATE

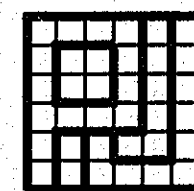

PURDUM & JESCHKE
CONSULTING ENGINEERS
LAND SURVEYORS
1029 North Calvert Street
Baltimore, Maryland 21202 301/837-0194

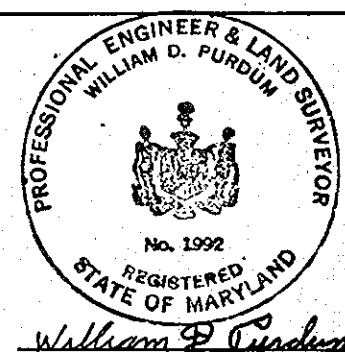


DES: JK				
DRN: R'WW				
CHK: JCT				
DATE: 6/90	BY	NO.	REVISION	DATE
			AS-BUILT	1/2/92

STORM DRAIN PROFILES
CEDAR LANE - PHASE 2


600' SCALE MAP NO. _____ BLOCK NO. _____

SOUTH OF FREETOWN RD. TO GUILFORD RD.
CAPITAL PROJECT J-4086
ELECTION DISTRICT NO. 5
HOWARD COUNTY, MARYLAND


SCALE
HORIZ. 1"=50'
VERT. 1"=5'
SHEET
15 OF 28

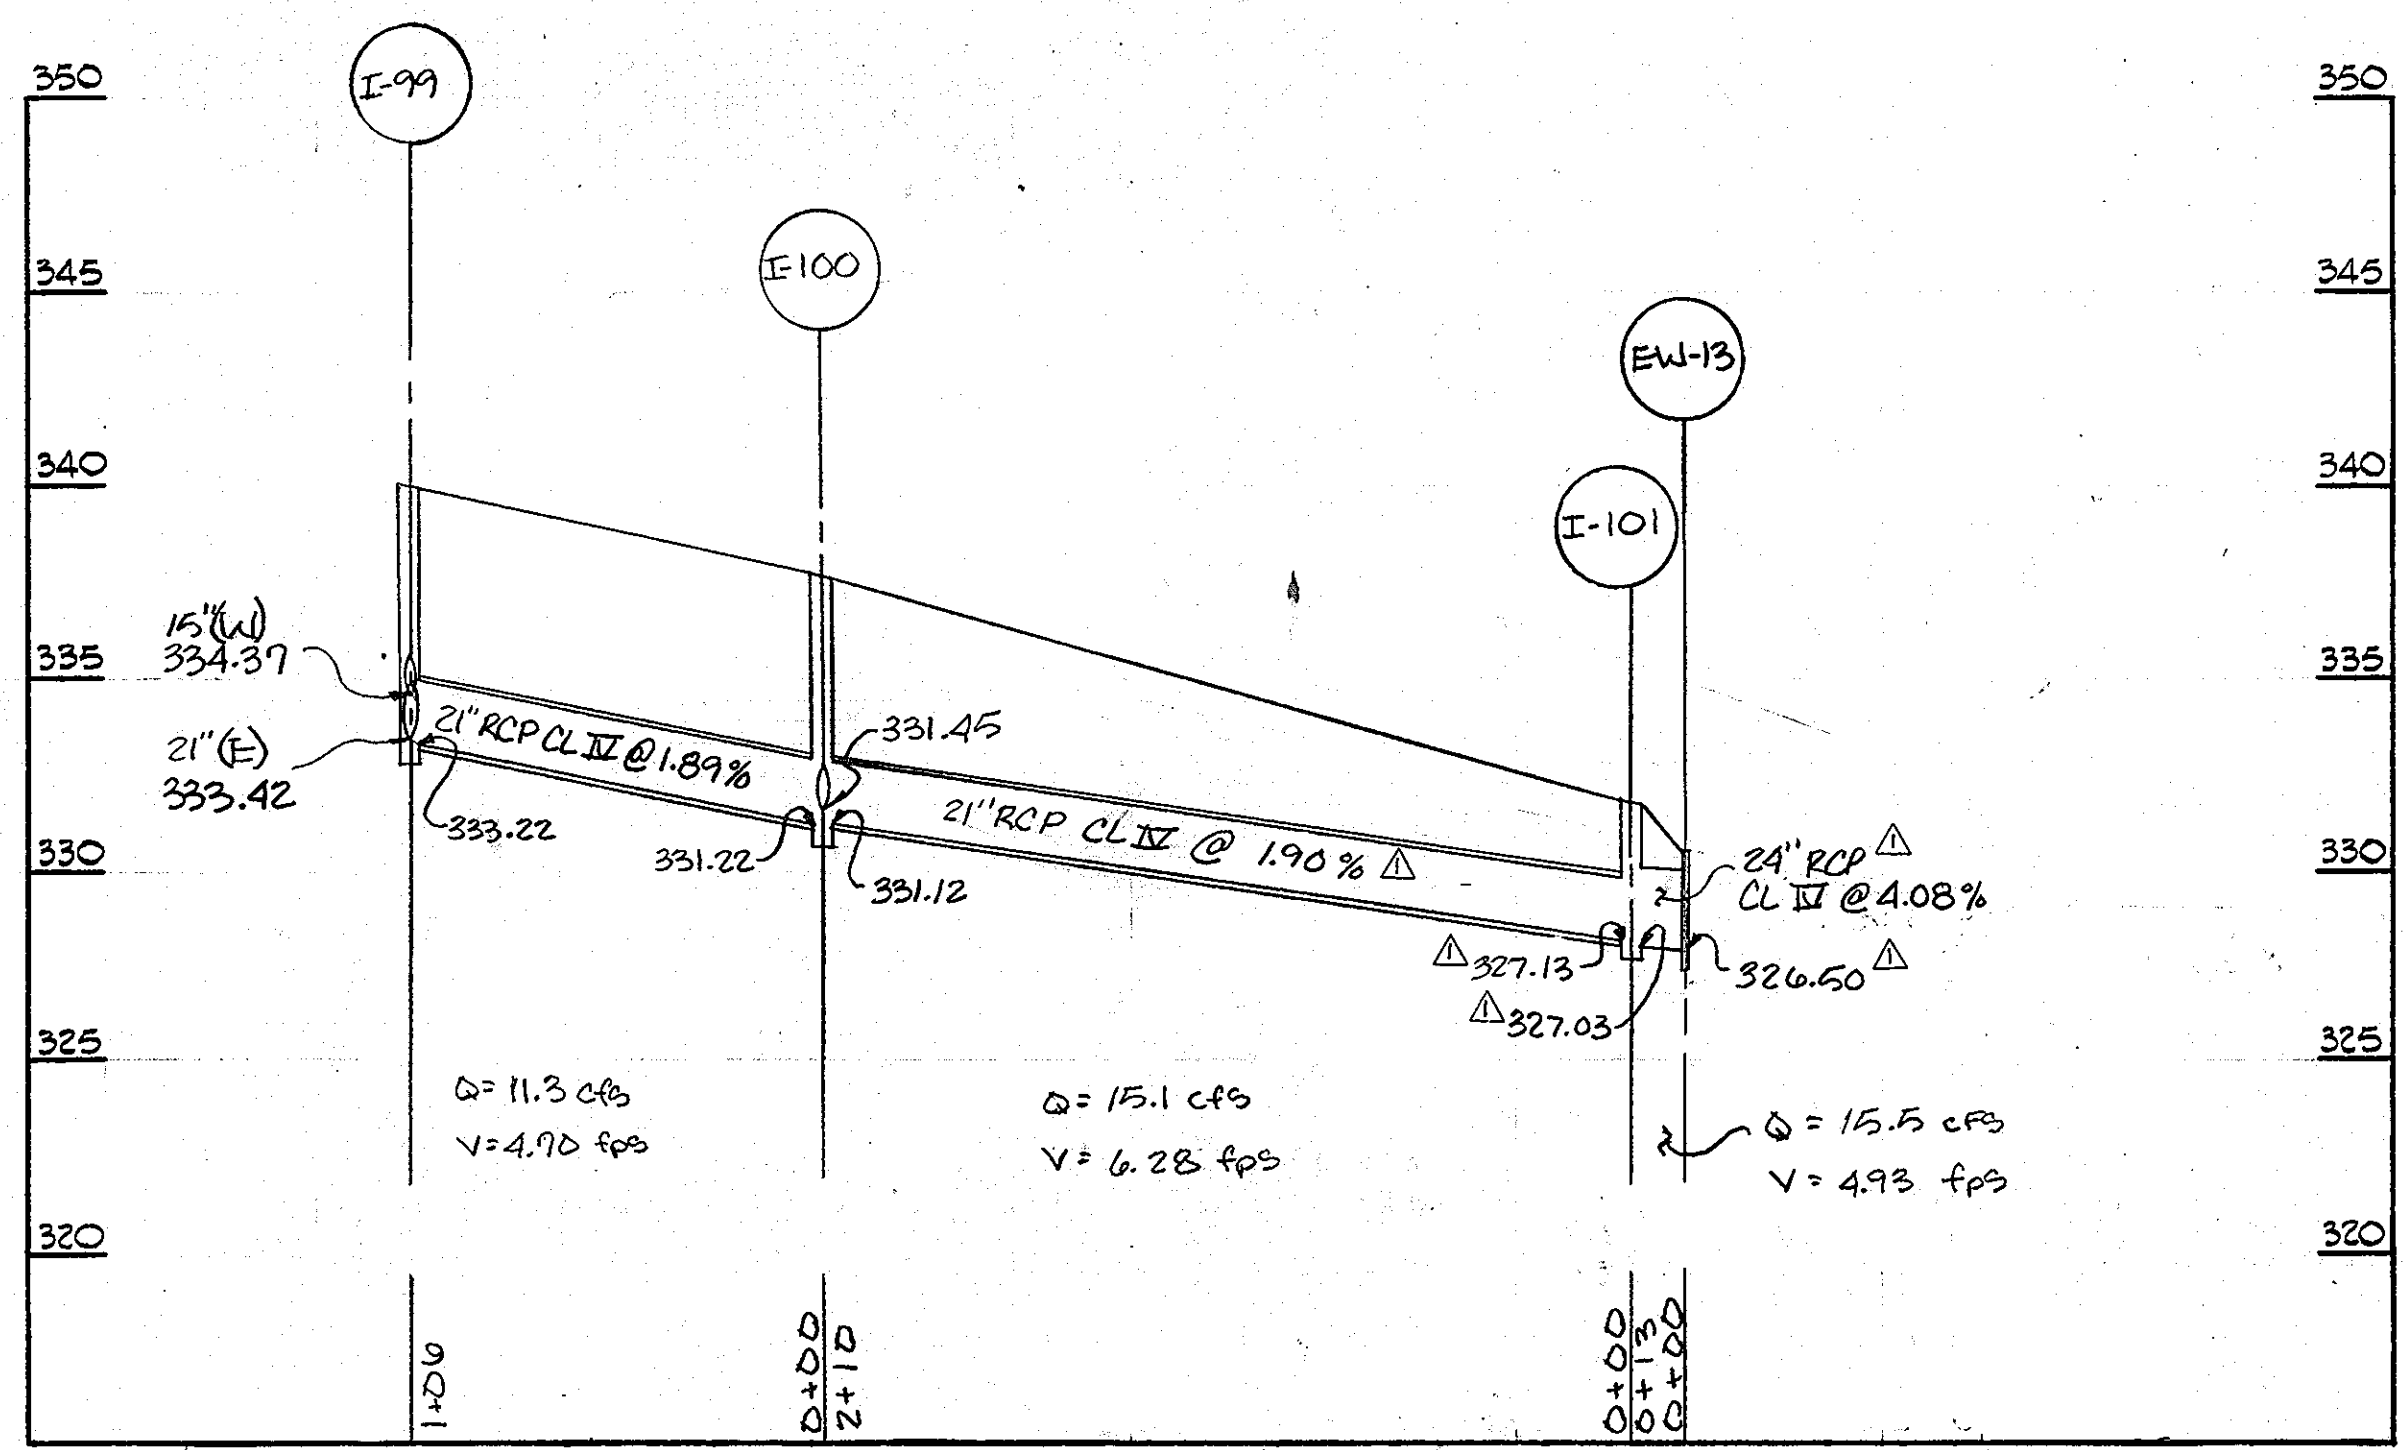


SCALE: HORIZ 1"=50'
VERT 1"=5'

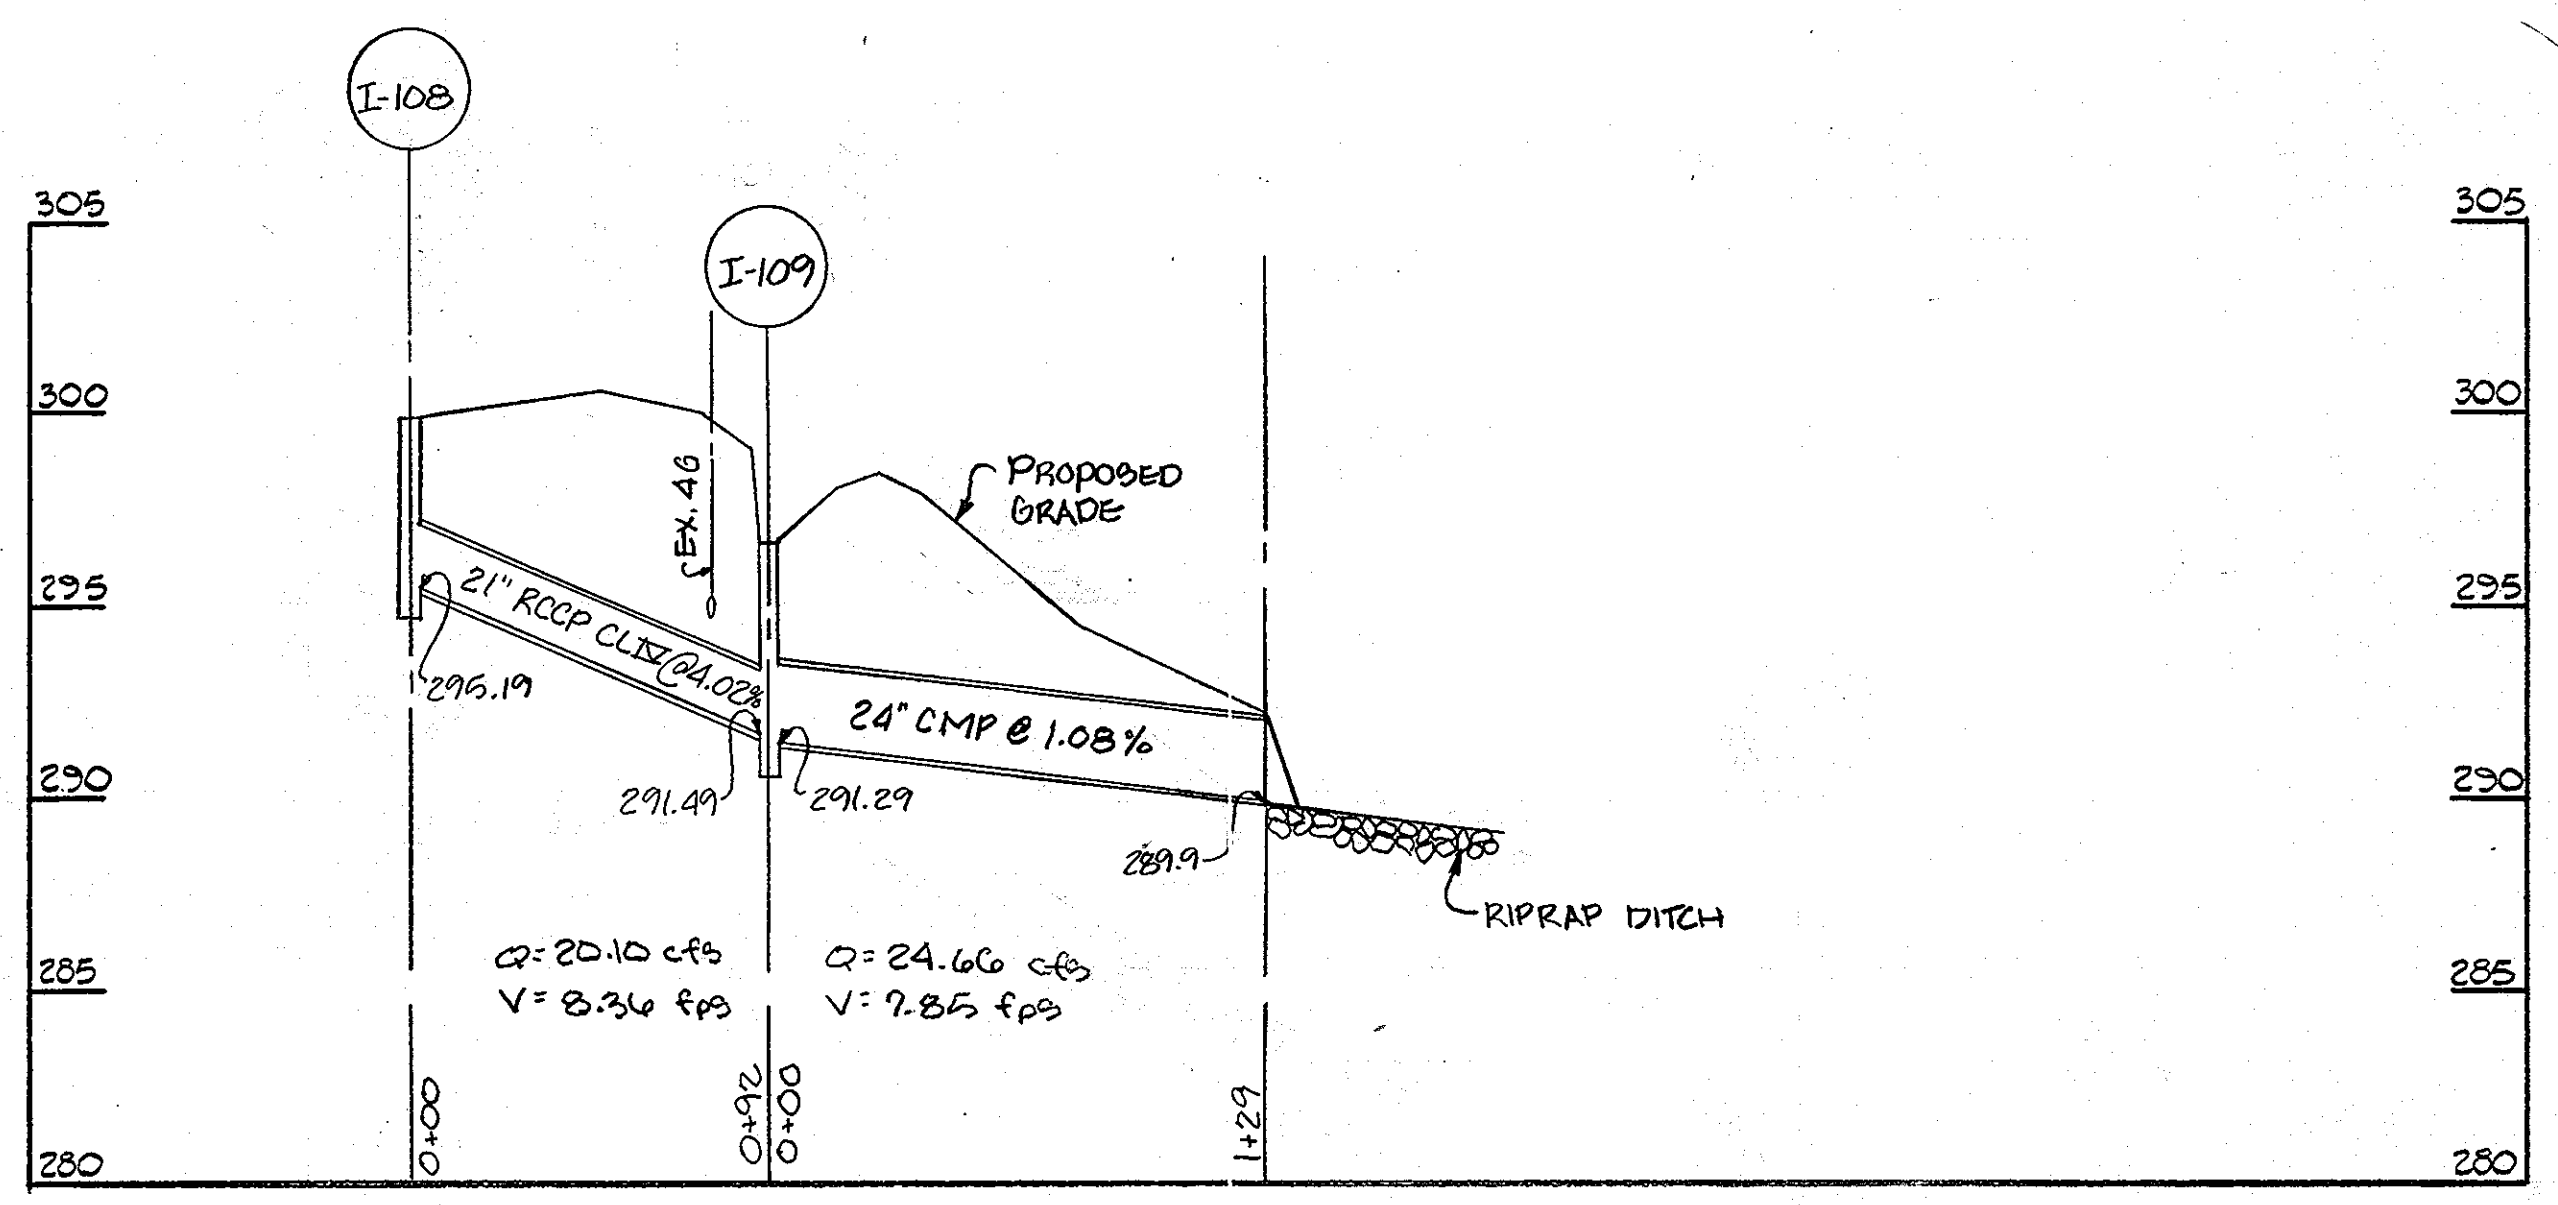


SCALE HORIZ 1"=50'
VERT 1"=5'

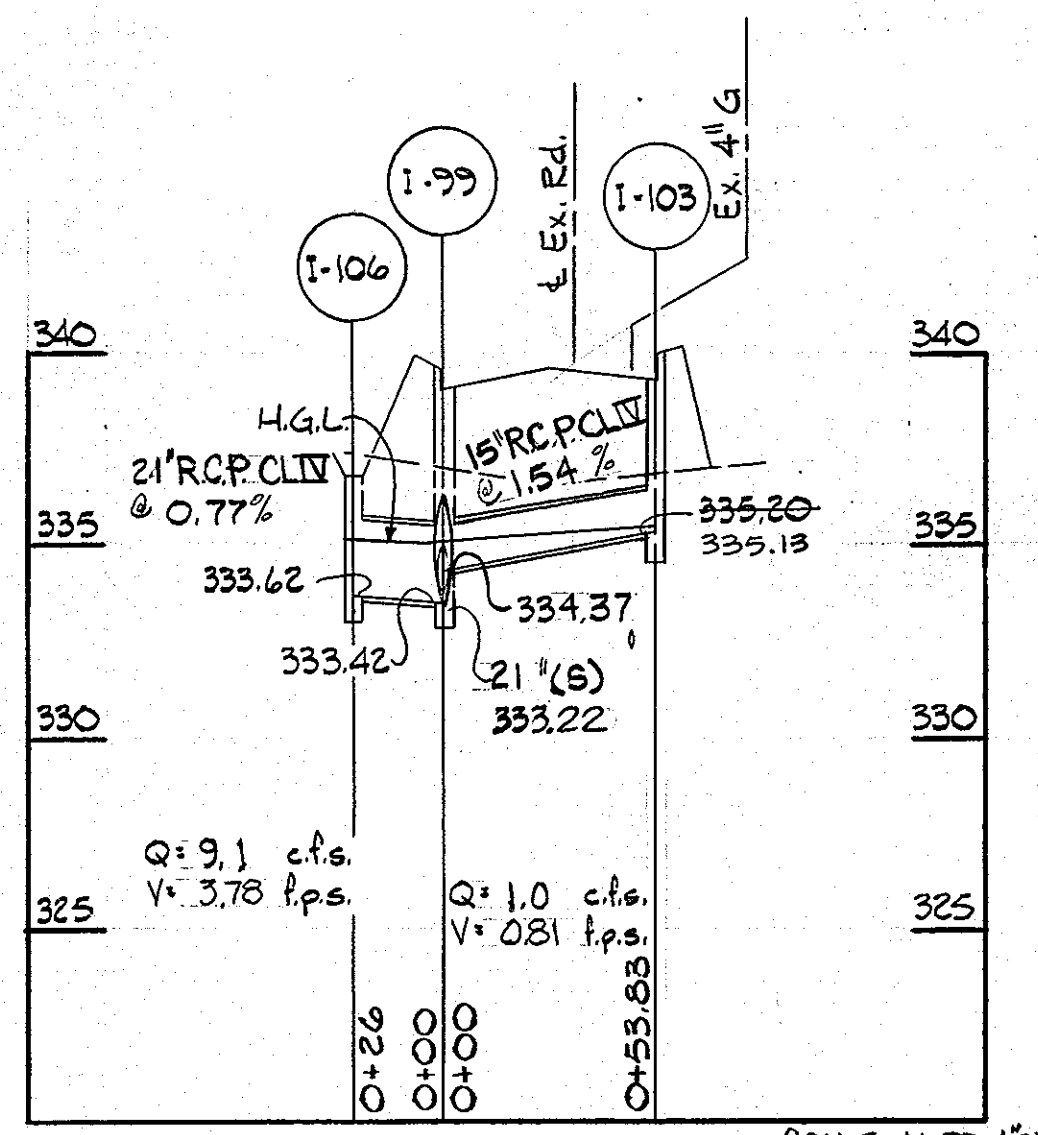


SCALE HORIZ 1"=50'
VERT 1"=5'

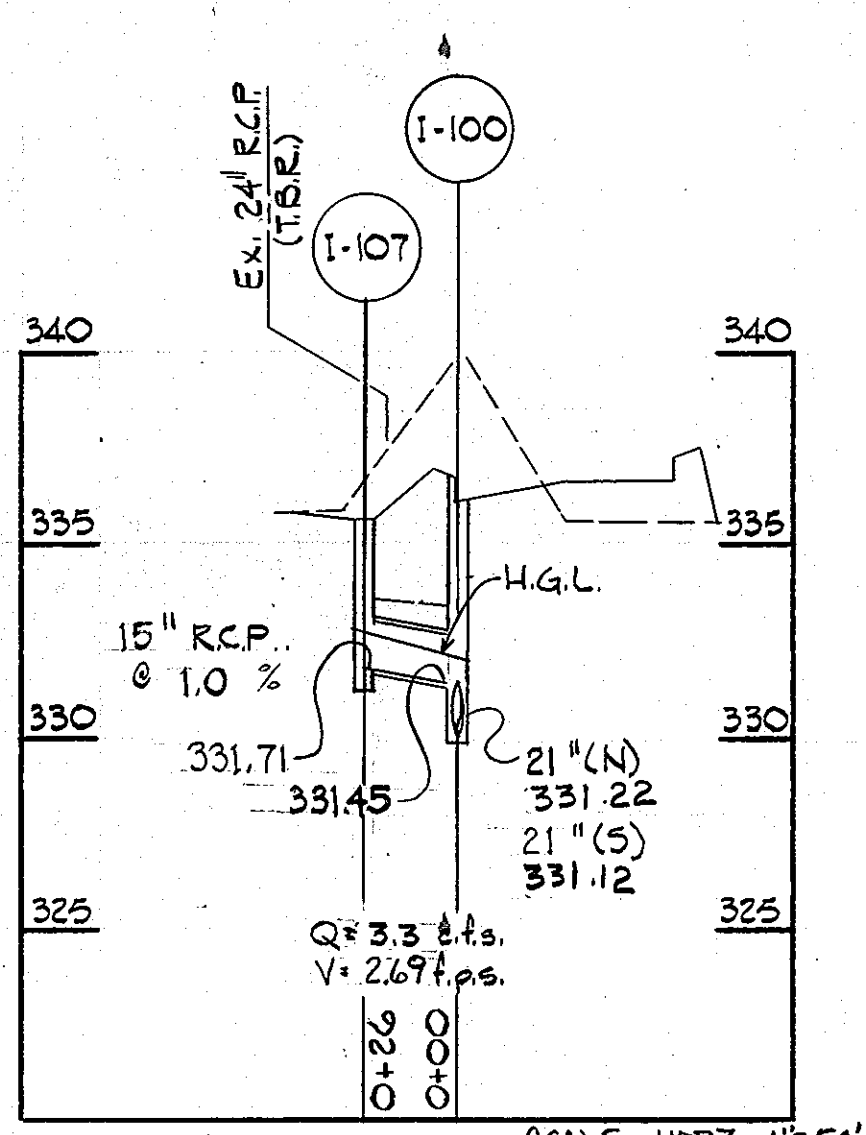


SCALE HORIZ 1"=50'
VERT 1"=5'

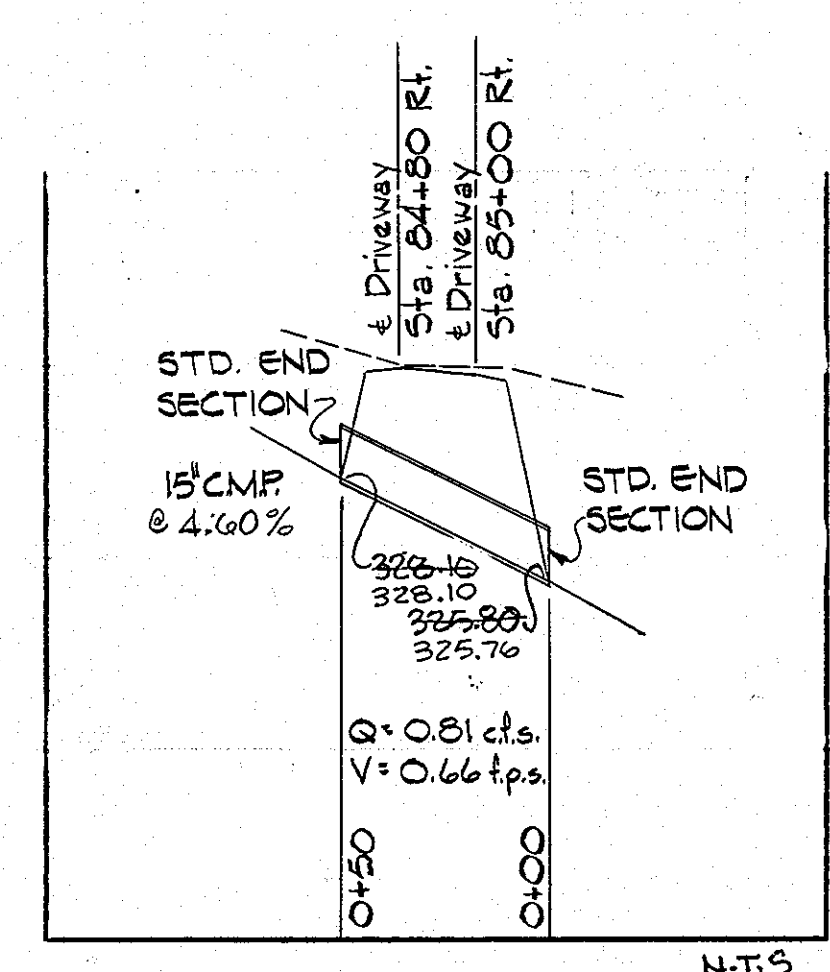

N.T.S

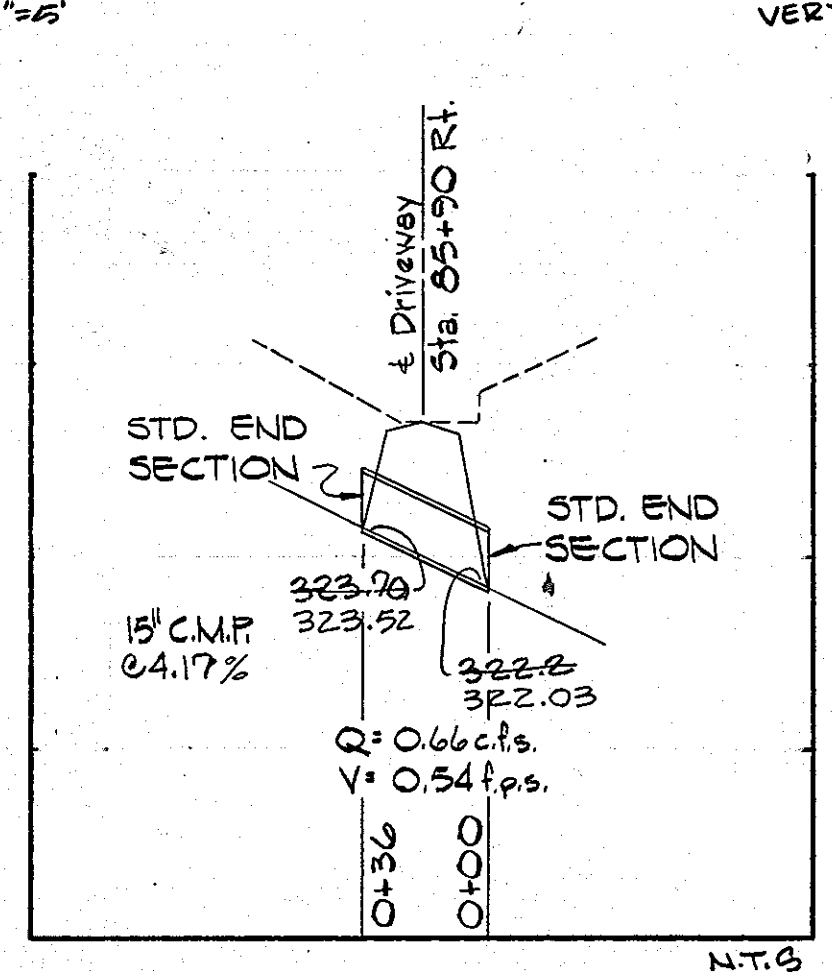

N.T.S

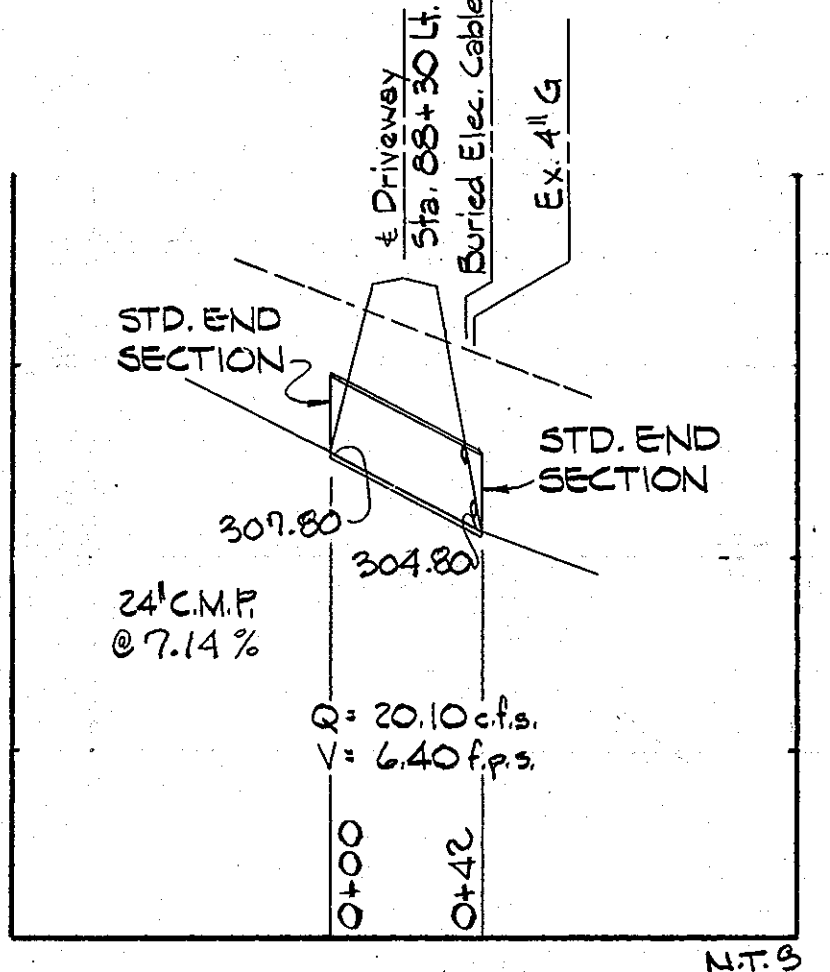

N.T.S

SHEET 11 - STORM DRAINS

SHEET 12 - STORM DRAINS

985

DEPARTMENT OF PUBLIC WORKS
HOWARD COUNTY, MARYLAND
James H. [Signature] Director of Public Works
[Signature] Chief, Bureau of Engineering
DATE: 11-8-88




DES: JON	DATE: 6/90
DRN: SMI	
CHK:	
BY:	
NO.:	
REVISION:	
DATE:	

STORM DRAIN PROFILES
CEDAR LANE - PHASE 2
600' SCALE MAP NO. _____ BLOCK NO. _____

SOUTH OF FREETOWN RD. TO GUILFORD RD.
CAPITAL PROJECT J-4086
ELECTION DISTRICT NO. 5
HOWARD COUNTY, MARYLAND


SCALE AS SHOWN
SHEET
16 OF 28

- NOTES:**
- Bottom of wall elevations are finished elevations.
 - Top of wall elevations are approximate due to nominal sizes of ties and are furnished as a convenience to the Contractor.
 - Horizontal header ties to be set approximately every third course, excepting the top course where they will be omitted. Spacing of horizontal header ties to be determined in the field to yield maximum clearance from existing trees using 3'-6" o/c minimum to 25'-6" o/c maximum except at corners and ends of wall. (see details this sheet). Toe nail ties minimum 4 per tie with 60 penny nails.
 - Vertical anchor ties to be spaced 16'-0" o/c minimum to 24'-0" o/c maximum except at corners and ends of wall. (see details this sheet). Toe nail ties to vertical anchor ties with 60 penny nails.
 - Ties to be treated and meet the requirements of No. 2 Southern Pine or better (see special provisions).

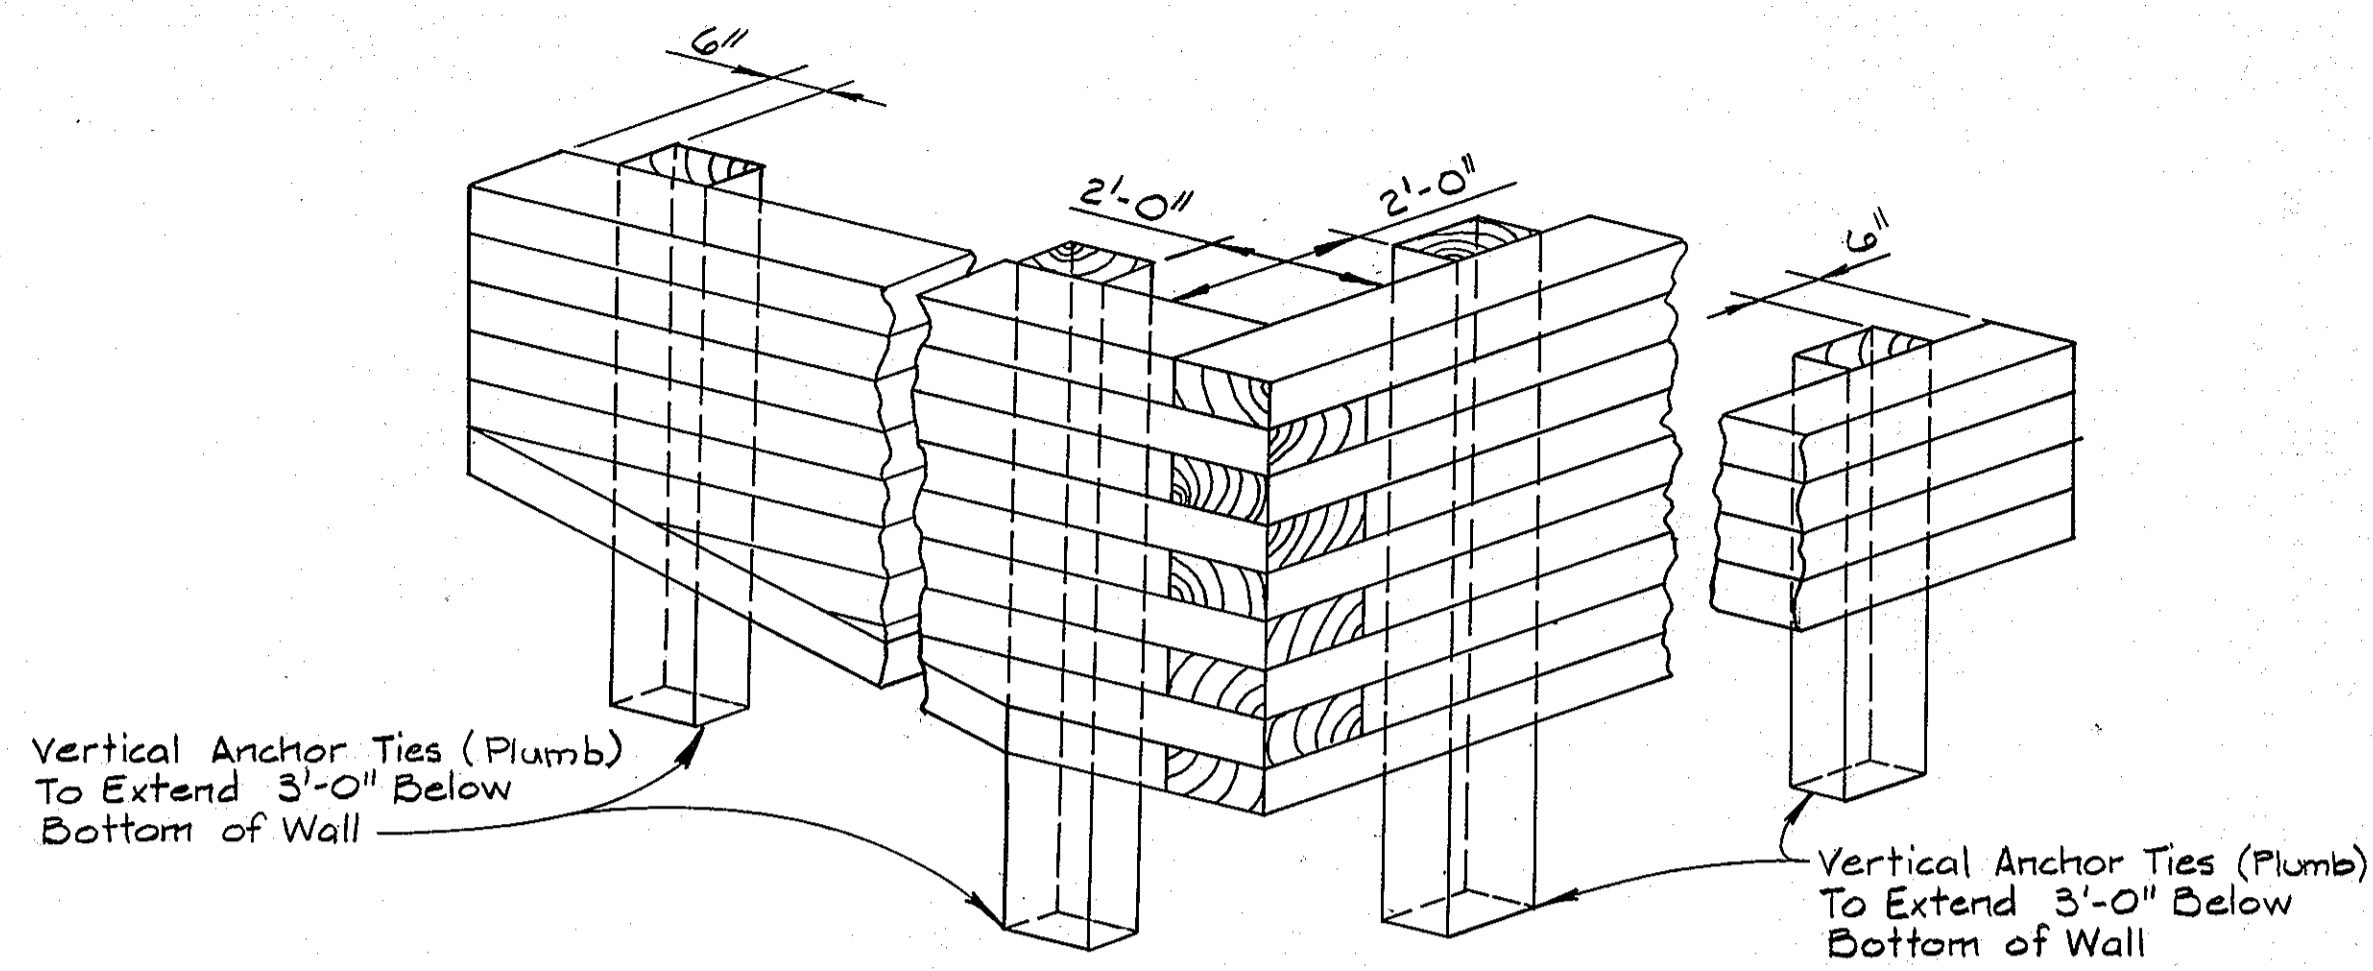


CORNER AND END OF WALL DETAIL

NOT TO SCALE

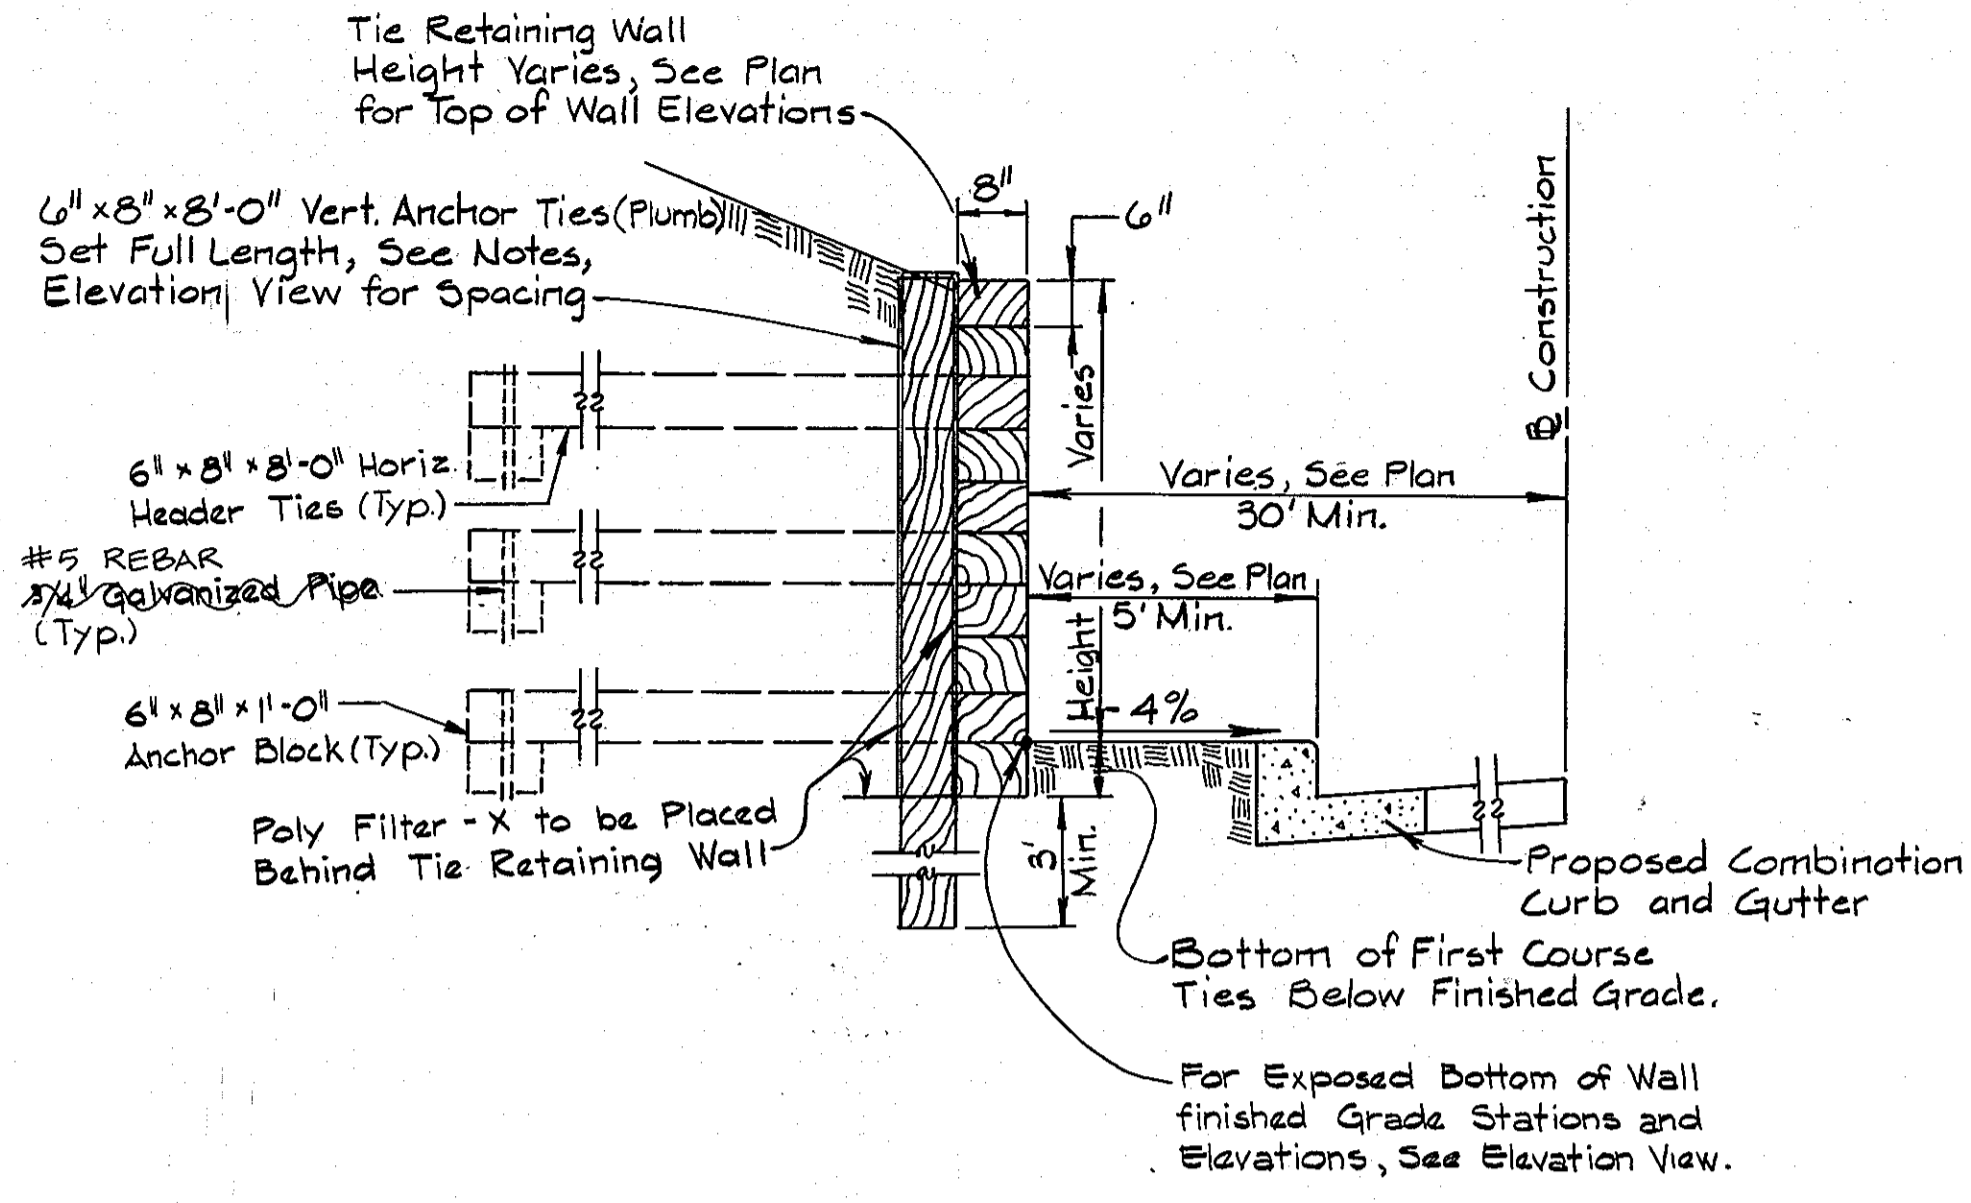

TYPICAL TIE RETAINING WALL

NOT TO SCALE

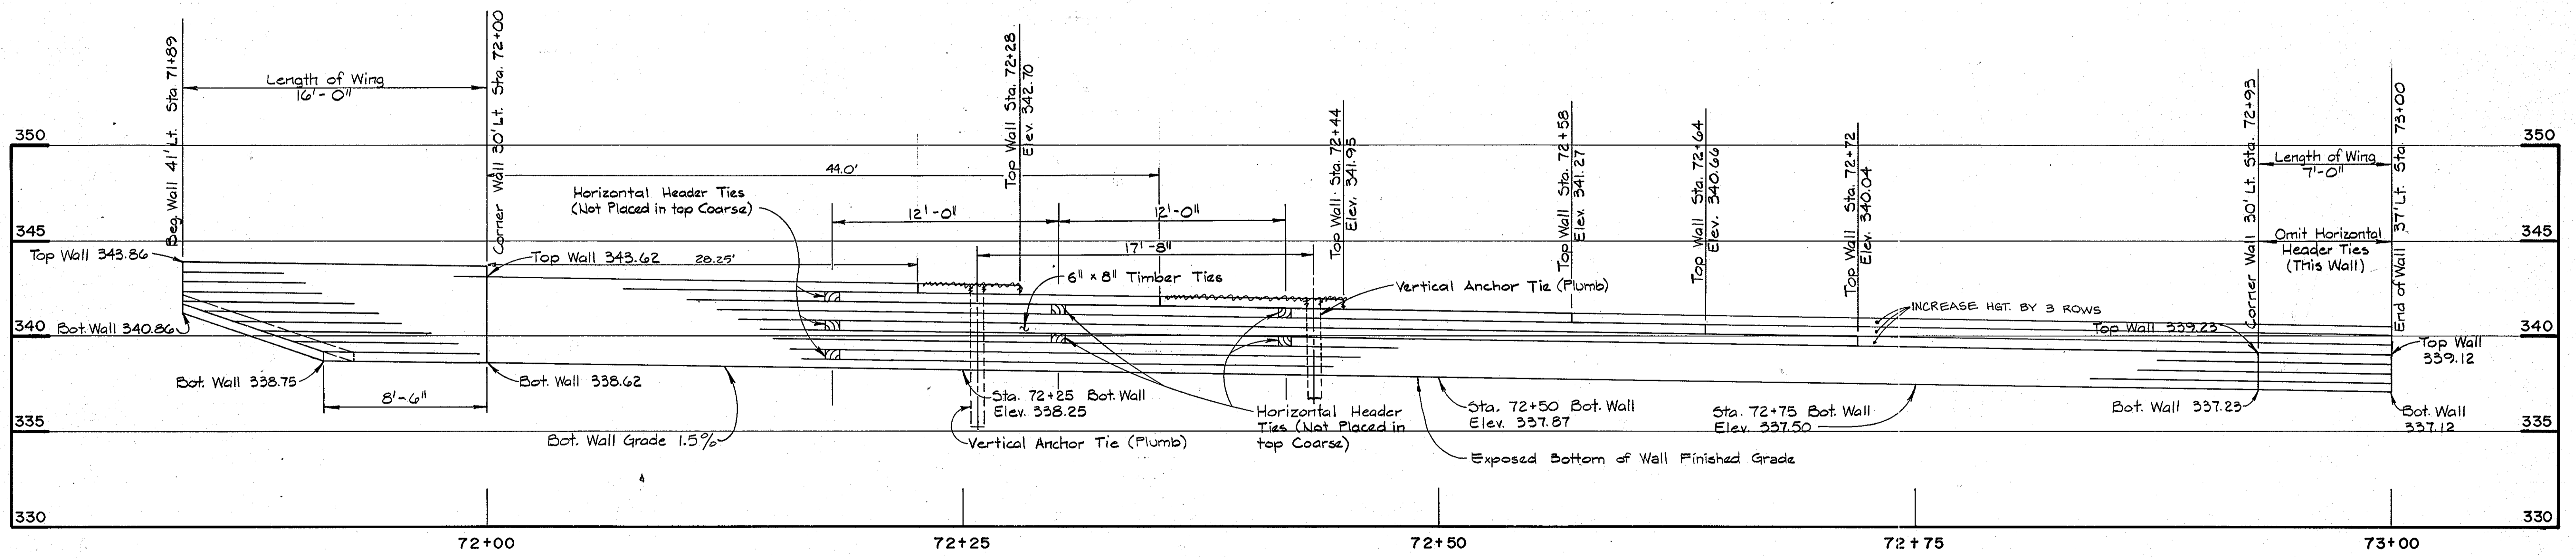

TIMBER TIE RETAINING WALL
LT. STA. 71+89 TO STA. 73+00

ELEVATION
SCALE: 1/4" = 1'-0"

DEPARTMENT OF PUBLIC WORKS
HOWARD COUNTY, MARYLAND


James McLean 11/15/88
DIRECTOR OF PUBLIC WORKS DATE

William D. Purdum 11/8/88
CHIEF, BUREAU OF ENGINEERING DATE

CHIEF, DIVISION OF ROADS, BRIDGES AND STORM DRAINAGE DATE

PURDUM & JESCHKE
CONSULTING ENGINEERS
LAND SURVEYORS

1029 North Calvert Street
Baltimore, Maryland 21202 301/837-0194

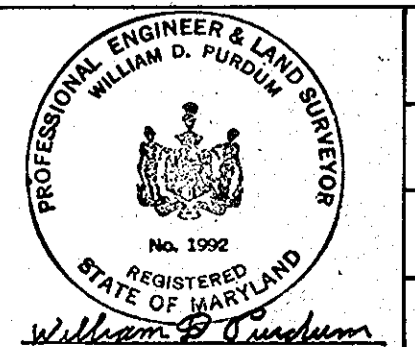

DES: JCT			
DRN: FWR			
CHK: WDP			
DATE: 6/90	NO. 2	AS-BUILT	1/2/92
	BY	REVISION	DATE

TIMBER TIE RETAINING WALL
& DETAILS
LT. STA. 71+89 TO STA. 73+00
CEDAR LANE - PHASE 2


600' SCALE MAP NO. _____ BLOCK NO. _____

SOUTH OF FREETOWN RD. TO GUILFORD RD.
CAPITAL PROJECT J-4086
ELECTION DISTRICT NO. 5
HOWARD COUNTY, MARYLAND


SCALE AS SHOWN
SHEET 17 OF 28

985

NOTE: CONTROL POINTS 1,2,3,4,5,6,7, & 8 SHOWN ON THIS SHEET ARE NOT PART OF THIS CONTRACT.

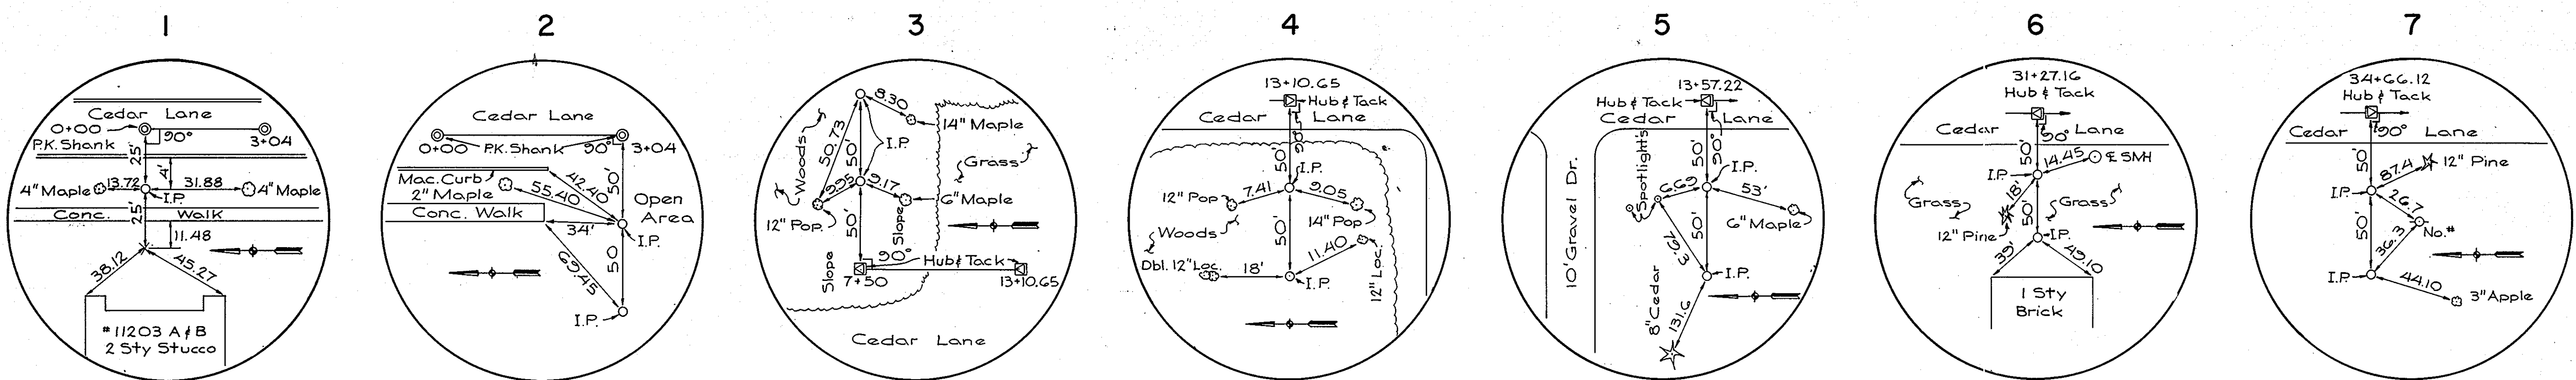

1 STA. 0+00
 N 501805.783
 E 832032.204
2 PC=STA. 3+04.00
 N 501505.362
 E 832078.747
3 PT=STA. 7+50.91
 N 501061.506
 E 832129.884
4 PC=STA. 13+10.65
 N 500503.367
 E 832172.219
5 PT=STA. 15+57.22
 N 500257.329
 E 832188.221
6 PC=STA. 31+27.16
 N 498689.685
 E 832273.252
7 EQUALITY STATION
 PT=STA. 34+67.05 = STA. 34+66.17
 N 498357.966
 E 832341.355

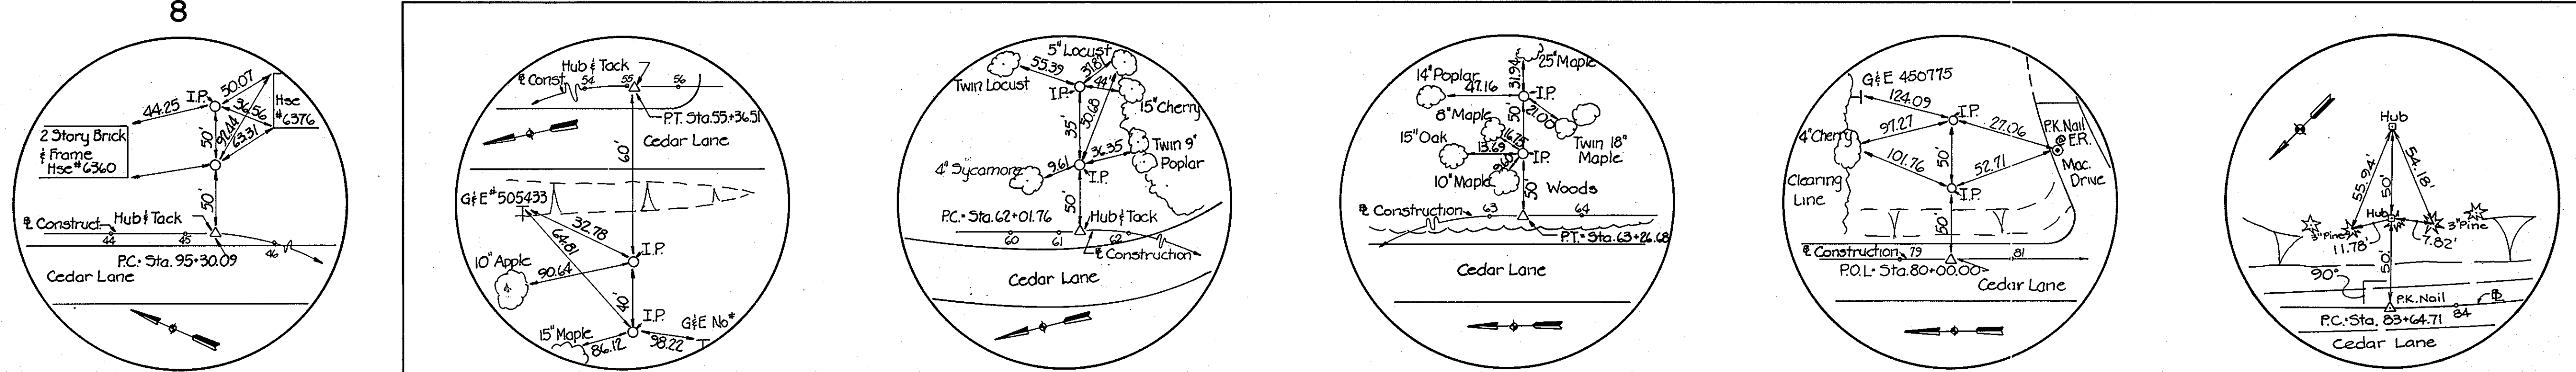


8 PC=STA. 45+30.09
 N 497358.836
 E 832706.963
9 PT=STA. 55+36.51
 N 496429.177
 E 832498.991
10 PC=STA. 62+01.76
 N 495961.395
 E 832025.978
11 PT=STA. 63+26.68
 N 495874.530
 E 831936.205
12 POL=STA. 80+00.00
 N 494724.129
 E 830721.059
13 PC=STA. 83+64.71
 N 494473.396
 E 830456.215


BM#107 Elev. 457.34
 Cut nail 1/4c. Southeast Corner Intersection of Cedar Lane & Hickory Ridge Rd. 30'± Southeast of Δ 907
BM#108 Elev. 427.21
 Cut nail East side of CIP#35, West side of Cedar Lane 70'± Northwest of Δ 908
BM#109 Elev. 404.69
 Cut nail East side of CIP#45, West side of Cedar Lane, 100'± South of Intersection of Hilltop Rd. 40'± Southwest of Δ 909
BM#110 Elev. 392.15
 Cut nail West side of GE#243871 Northwest Corner Intersection of Owen Brown & Cedar Lane 30'± North of Δ 910
BM#111 Elev. 410.31
 Cut nail, East Side of CIP#20 West Side Cedar Lane @ Entrance of Convalescent Home 40'± Northwest of Δ 911

BM#111-A Elev. 398.80
 Cut nail, East side of CIP#18, West side Intersection of Freetown Rd. & Cedar Lane.
BM#112 Elev. 381.74
 Cut nail set West side of 30 Locust tree, East side of Cedar Lane. 15'± Northeast of Δ 912
BM#113 Elev. 351.03
 Cut nail set in West side of GE#62262, West side of Cedar Lane, 100'± North of Intersection @ Braeburn Rd., 100'± West of Δ 913.
BM#114 Elev. 337.46
 PK. nail @ Edge of Road = Δ 914.
BM#115 Elev. 350.21
 Spike, West side of BGE#450774, 30'± East of Δ 915, East side of Cedar Lane.

BM#116 Elev. 317.15
 Cut nail West side of GE#132254, East side of Cedar Lane. 100'± Δ 916
BM#117 Elev. 303.39
 Spike, West side of GE#12252, East side of Cedar Lane, 300'± North of Route 32. 100'± South of Δ 917.

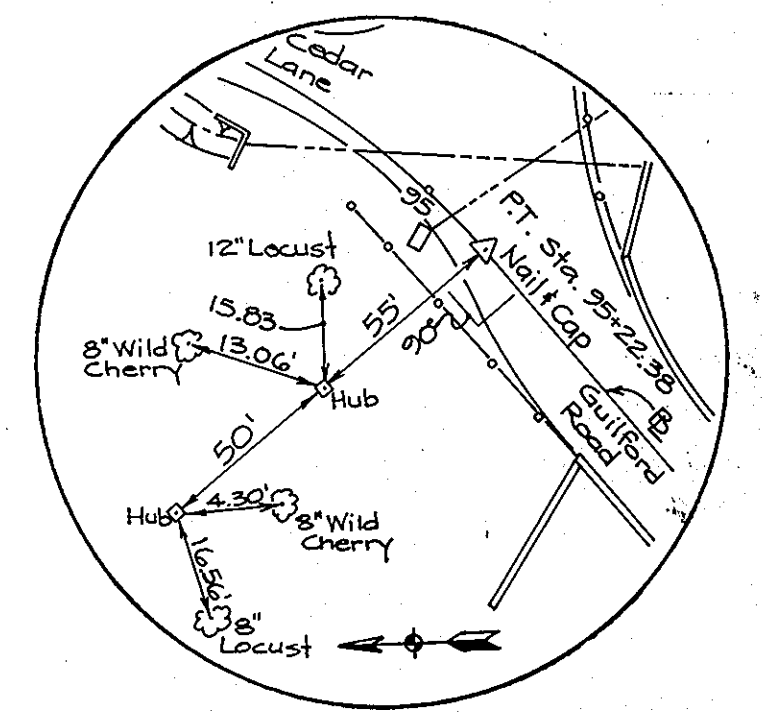

PT=STA. 95+22.38
 N 493402.334
 E 830169.333

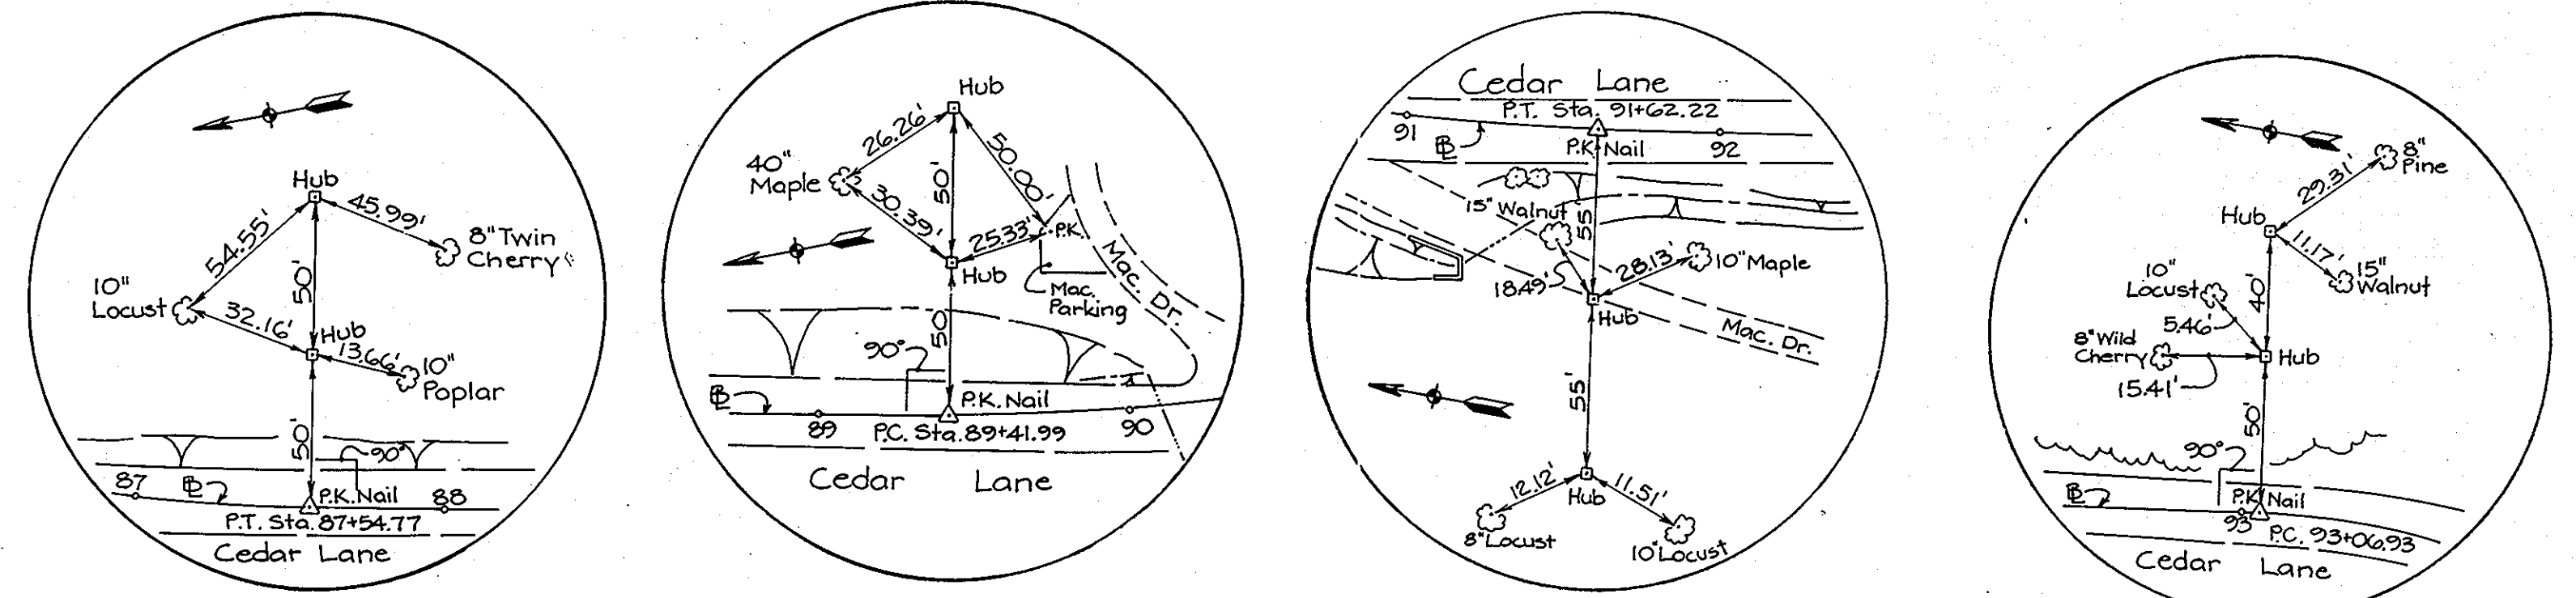


PT=STA. 87+54.77
 N 494137.604
 E 830269.966
P.C.=STA. 89+41.99
 N 493954.118
 E 830232.761
PT.=STA. 91+62.22
 N 493735.062
 E 830226.825
PC=STA. 93+06.93
 N 493591.892
 E 830247.860

NOTE: BM NOS. 107, 108, 109, 110, & 111 ARE OUTSIDE THE LIMITS OF THIS CONTRACT.

DEPARTMENT OF PUBLIC WORKS
 HOWARD COUNTY, MARYLAND
 Director of Public Works: [Signature] DATE: 11/2/85
 Chief, Bureau of Engineering: [Signature] DATE: 11/15/85
 Chief, Division of Roads, Bridges and Storm Drainage: [Signature] DATE: 11/15/85

PURDUM & JESCHKE
 CONSULTING ENGINEERS
 LAND SURVEYORS
 1029 North Calvert Street
 Baltimore, Maryland 21202 301/837-0194

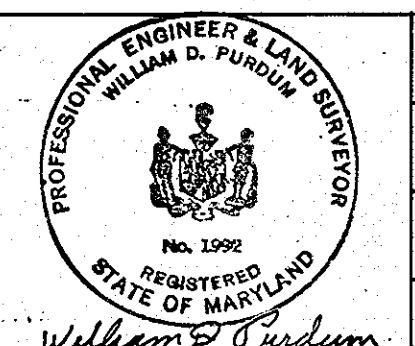

DES: JRL	
DRN: PWR	
CHK: WDP	
DATE: 10/90	
REVISION	DATE

HORIZONTAL & VERTICAL CONTROLS
 CEDAR LANE - PHASE 2
 600' SCALE MAP NO. _____ BLOCK NO. _____

SOUTH OF FREETOWN RD. TO GUILFORD RD.
 CAPITAL PROJECT J-4086
 ELECTION DISTRICT NO. 5
 HOWARD COUNTY, MARYLAND

SCALE N/A
 SHEET 18 OF 28


FINAL Xyce-90-018

BORING DATA

**HERBST & ASSOCIATES
FOR
JOHNSON, McCORDIC & THOMPSON
FOR**

HOWARD COUNTY DEPARTMENT OF PUBLIC WORKS — JAN. 7, 1981

with No. 500
BORING LOG

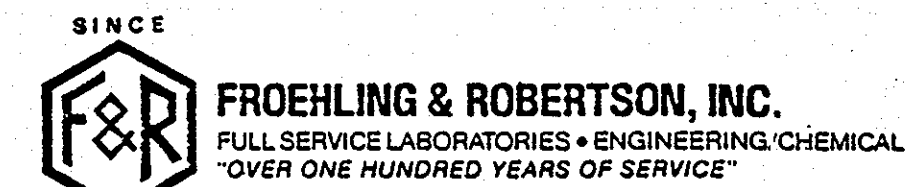

Report No. **068108** DATE **November 25, 1987**
 Made for: **Howard County Department of Public Works**
 Project: **Cedar Lane Improvement, Howard County, Maryland**

Boring No.	Depth (Ft.) From To	Description and Remarks
B-16 Sta. 57+00 15'L	0.0 1.5 1.5 4.5 4.5 6.0	Brown moist cf SAND, and silt, trace rock fragments Brown moist Clayey SILT, some mf sand, trace rock fragments Brown moist CLAY & SILT, little f sand (Eight days after completion, hole dry and caved @ 2.2'.)
B-17 Sta. 61+00 10'R	0.0 5.0 5.0 7.0	Dark gray to brown very moist CLAY & SILT, trace f sand and organic matter Tan moist micaceous mf SAND and clayey silt (Eight days after completion, water @ 2.0', hole caved @ 3.3'.)
B-18 Sta. 65+00 5'L	0.0 0.3 0.3 2.0 2.0 7.0	Topsoil and road stone Dark brown very moist Clayey SILT, little mf sand, trace rock fragments and mica Brown wet micaceous Clayey SILT, little mf sand, trace rock fragments (Eight days after completion, water @ 3.5', hole caved @ 5.9'.)
B-19 Sta. FT Rd. 2+50 10'L	0.0 1.0 1.0 6.0	Topsoil and root mat Brown wet CLAY & SILT, trace f sand (Eight days after completion, water @ 2.2', hole caved @ 2.3'.)
B-20 Sta. 69+00 10'L	0.0 0.2 0.2 7.0	Leaf mat and topsoil Brown moist cf SAND, some silt, trace to little rock fragments Auger Refusal @ 7.0'. (One day after completion, hole dry and caved @ 3.3'.)
B-20A Sta. 69+05 10'L	0.0 0.2 0.2 7.0	Leaf mat and topsoil Brown moist cf SAND, some silt, trace to little rock fragments Auger Refusal @ 7.0'. (One day after completion, hole dry and caved @ 5.3'.)
B-21 Sta. 73+00 CL	0.0 0.3 0.3 1.5 1.5 6.0	Crushed stone and topsoil Dark gray moist cf SAND, and clayey silt, trace rock fragments Tan very moist cf SAND, some silt, trace rock fragments (Eight days after completion, water @ 3.0', hole caved @ 4.5'.)
B-22 Sta. 77+00 10'L	0.0 0.2 0.2 2.0 2.0 3.0 3.0 6.0	Topsoil and road stone Brown very moist CLAY & SILT, little cf sand Brown moist cf SAND, and clay & silt, trace rock fragments Brown moist cf SAND, little silt, little rock fragments (One day after completion, hole dry and caved @ 4.3'.)
B-23 Sta. 81+00 5'L	0.0 0.3 0.3 6.0	Topsoil and road stone Brown moist micaceous cf SAND, some silt, trace rock fragments (One day after completion, hole dry and caved @ 4.5'.)

TEST PIT DATA

Test Pit	Description and Remarks
TP-1	2' x 6' x 7' deep - No pipe encountered
TP-2	3' x 4' x 5' deep - 12" steel water main encountered at a depth of 4.6' - 35' from base line of new road
TP-3	3' x 3' x 3.5' deep - 4 1/2" steel gas line encountered at a depth of 3.2' under white line on edge of existing pavement.
TP-4	3.5' x 4' x 6.5' deep - Tunnels under road 3' for gas line - 4 1/2" steel gas line encountered at a depth of 3.5' under white line on edge of existing pavement. Water line found at 11.5' from existing road edge.

Hole No. 1		Total Depth: 10.0 ft.	Elevation-Top of Hole: -	Hole Location: See Boring Location Plan		
Type of Boring: Hollow-stem Auger		Started: 10-23-87	Completed: 10-28-87	Driller: A. Wilhelm, CME-45		
Elevation	Depth	CLASSIFICATION OF MATERIALS (Description)	Sample Blows	Sample Depth (Feet)	% Core Recovery	REMARKS
0.2		Topsoil	8			
		Orangish/reddish-brown micaceous fine to medium SAND with some clayey silt, moist to damp, medium dense	7	1.5		
			4			
			5			N/C - 15.2%
			6	3.5		
			5			
			5			
			6	7.0		
			4			
			5			
			7	10.0		
		BORING TERMINATED @ 10.0 FEET				Boring dry upon completion

Hole No. 2		Total Depth: 10.0 ft.	Elevation-Top of Hole: -	Hole Location: See Boring Location Plan		
Type of Boring: Hollow-stem Auger		Started: 10-23-87	Completed: 10-23-87	Driller: A. Wilhelm, CME-45		
Elevation	Depth	CLASSIFICATION OF MATERIALS (Description)	Sample Blows	Sample Depth (Feet)	% Core Recovery	REMARKS
0.2		Topsoil	4			
		Medium brown slightly micaceous clayey silty fine to medium SAND with a trace of organic matter, moist, loose to medium dense	5	1.5		
			3			
			6	3.5		
			15			
			21			
			15	7.0		
			15			
			22			
			26	10.0		
		BORING TERMINATED @ 10.0 FEET				Boring dry upon completion

No. of Blows 140-lb. Hammer, 30-in. Fall, Required to Drive 2-in. O.D., 1.375 in I.D. Sample 6-in. The first 6 in. is considered to be a Seating Drive. The sum of the second and third 6 in. of penetration is termed the Penetration Resistance, N.

Hole No. 3		Total Depth: 10.0 ft.	Elevation-Top of Hole: -	Hole Location: See Boring Location Plan		
Type of Boring: Hollow-stem auger		Started: 10-23-87	Completed: 10-23-87	Driller: A. Wilhelm, CME-45		
Elevation	Depth	CLASSIFICATION OF MATERIALS (Description)	Sample Blows	Sample Depth (Feet)	% Core Recovery	REMARKS
0.2		Topsoil	7			
		Light brown slightly micaceous silty clayey fine to medium SAND with a trace of rock fragments/gravel, moist, medium dense	12	1.5		
			5			
			5			
			5	3.5		
			5			
			6			
			7			
			11	10.0		
		BORING TERMINATED @ 10.0 FEET				Boring dry upon completion


Hole No. 4		Total Depth: 18.7 ft.	Elevation-Top of Hole: -	Hole Location: See Boring Location Plan		
Type of Boring: Hollow-stem auger		Started: 10-23-87	Completed: 10-23-87	Driller: A. Wilhelm, CME-45		
Elevation	Depth	CLASSIFICATION OF MATERIALS (Description)	Sample Blows	Sample Depth (Feet)	% Core Recovery	REMARKS
0.2		Topsoil	7			
		Dark brown and black fine to medium SAND with a little gravel and organic material, moist, medium dense (Fill)	5	1.5		
			4			
			5			
			6	3.5		
			20			
			25			
			31	7.0		
			18			
			27			
			35	10.0		
			50			
			7	14.0		
		BORING TERMINATED @ 18.7 FEET				Free water initially encountered in Sample No. 2 (13.5'-14.0') After one hour, groundwater at 9.5 feet.

NOTE: Additional Boring data and Analysis is available from geotechnical investigations performed by Johnson, McCordic and Thompson and Herbst and Associates on January 7, 1981 and Froehling and Robertson, Inc. on November 25, 1987 for Howard County. Prospective Contractors shall avail themselves of additional information from the Howard County Department of Public Works, prior to submission of the proposal.


Hole No. 4, cont.		Total Depth: 18.7 ft.	Elevation-Top of Hole: -	Hole Location: See Boring Location Plan		
Type of Boring: Hollow-stem auger		Started: 10-23-87	Completed: 11-18-87	Driller: A. Wilhelm, CME-45		
Elevation	Depth	CLASSIFICATION OF MATERIALS (Description)	Sample Blows	Sample Depth (Feet)	% Core Recovery	REMARKS
		Black, tan, olive brown and white speckled micaceous fine to coarse SAND with decomposed rock fragments and a little silt, damp to wet, very dense (Weathered Rock)	50	18.7		Cont. from prior sheet
		SPLIT-SPOON SAMPLE & AUGER REFUSAL @ 18.7 FEET				

DEPARTMENT OF PUBLIC WORKS
HOWARD COUNTY, MARYLAND

James H. Law 11/18/87 *William D. Purdum* 11/28/88
 DIRECTOR OF PUBLIC WORKS DATE CHIEF, BUREAU OF ENGINEERING DATE
Sheila M. Anderson 11/18/87
 CHIEF, DIVISION OF ROADS, BRIDGES AND STORM DRAINAGE DATE

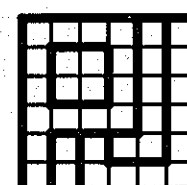

PURDUM & JESCHKE
 CONSULTING ENGINEERS
 LAND SURVEYORS
 1029 North Calvert Street
 Baltimore, Maryland 21202 301/837-0194

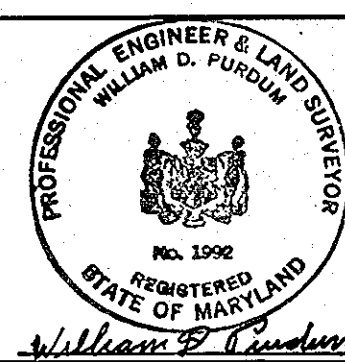

DES: JCT
 DRN: PWR
 CHK: WDF
 DATE: 6/90
 BY NO. REVISION DATE

BORING DATA
CEDAR LANE — PHASE 2
 600' SCALE MAP NO. _____ BLOCK NO. _____

SOUTH OF FRETOWN RD. TO GUILFORD RD.
 CAPITAL PROJECT J-4086
 ELECTION DISTRICT NO. 5
 HOWARD COUNTY, MARYLAND

SCALE
N/A
 SHEET
19 of 28

FINAL

XXCE-90-019

985

NOTE: SEE SHEETS 6, 7, & 8 FOR ADDITIONAL SOIL EROSION AND SEDIMENT CONTROL REQUIREMENTS.

LIMIT OF WORK STA. 56+60

CEDAR

LANE

CURVE DATA

CURVE DATA
 $\Delta = 65^\circ 25' 03''$
 $D_c = 6^\circ 30' 00''$
 $R = 881.47'$
 $T = 566.09'$
 $L = 1006.42'$
 $E = 166.12'$
 $PC = STA. 49+30.6$

NOTE: THIS SHEET IS INTENDED TO CONVEY INFORMATION PERTAINING TO PLACEMENT OF SEDIMENT AND EROSION CONTROLS ONLY. SEE ROAD CONSTRUCTION PLANS FOR ALL OTHER INFORMATION RELATED TO CONSTRUCTION OF CEDAR LANE.

STA. 56+70 TO 58+50 MILL EXIST. PAVEMENT TO RECEIVE PROPOSED 1/2" BITUMINOUS CONC. SURFACE COURSE.

STA. 58+00 CONNECT NEW 18" SD. TO EXISTING INLET

STA. 59+85 RT. GRADING AROUND EXIST. TREE TO BE MINIMIZED AS DIRECTED BY THE ENGINEER.


TEMP. RIPRAP LINED WATERWAY STA. 58+50 TO 65+00 RT. EXTEND PROPOSED 5' SIDEWALK SLOPE TO MEET EXISTING SIDE SLOPE AND DRAIN TO PROPOSED ROADWAY AS DIRECTED BY THE ENGINEER

STA. 66+05 ± TO STA. 67+00 RT. TRAFFIC DAMPER W BEAM INCLUDES TYPE I END FLARE (SEE SHEET 5)

STA. 66+00 RT. TO STA. 66+90 RT. SOD SIDE DITCH W=2' D=1'
 STA. 66+90 RT. TO STA. 67+00 RT. RIPRAP SIDE DITCH W=2' D=2'
 SEE DETAIL SHEET 5

STA. 65+70 ± TO STA. 67+00 LT. TRAFFIC DAMPER W BEAM INCLUDES TYPE I END FLARES (SEE SHEET 5)

STA. 65+00 LT. TO STA. 67+00 LT. SOD SIDE DITCH W=2' D=2'
 SEE DETAIL SHEET 5

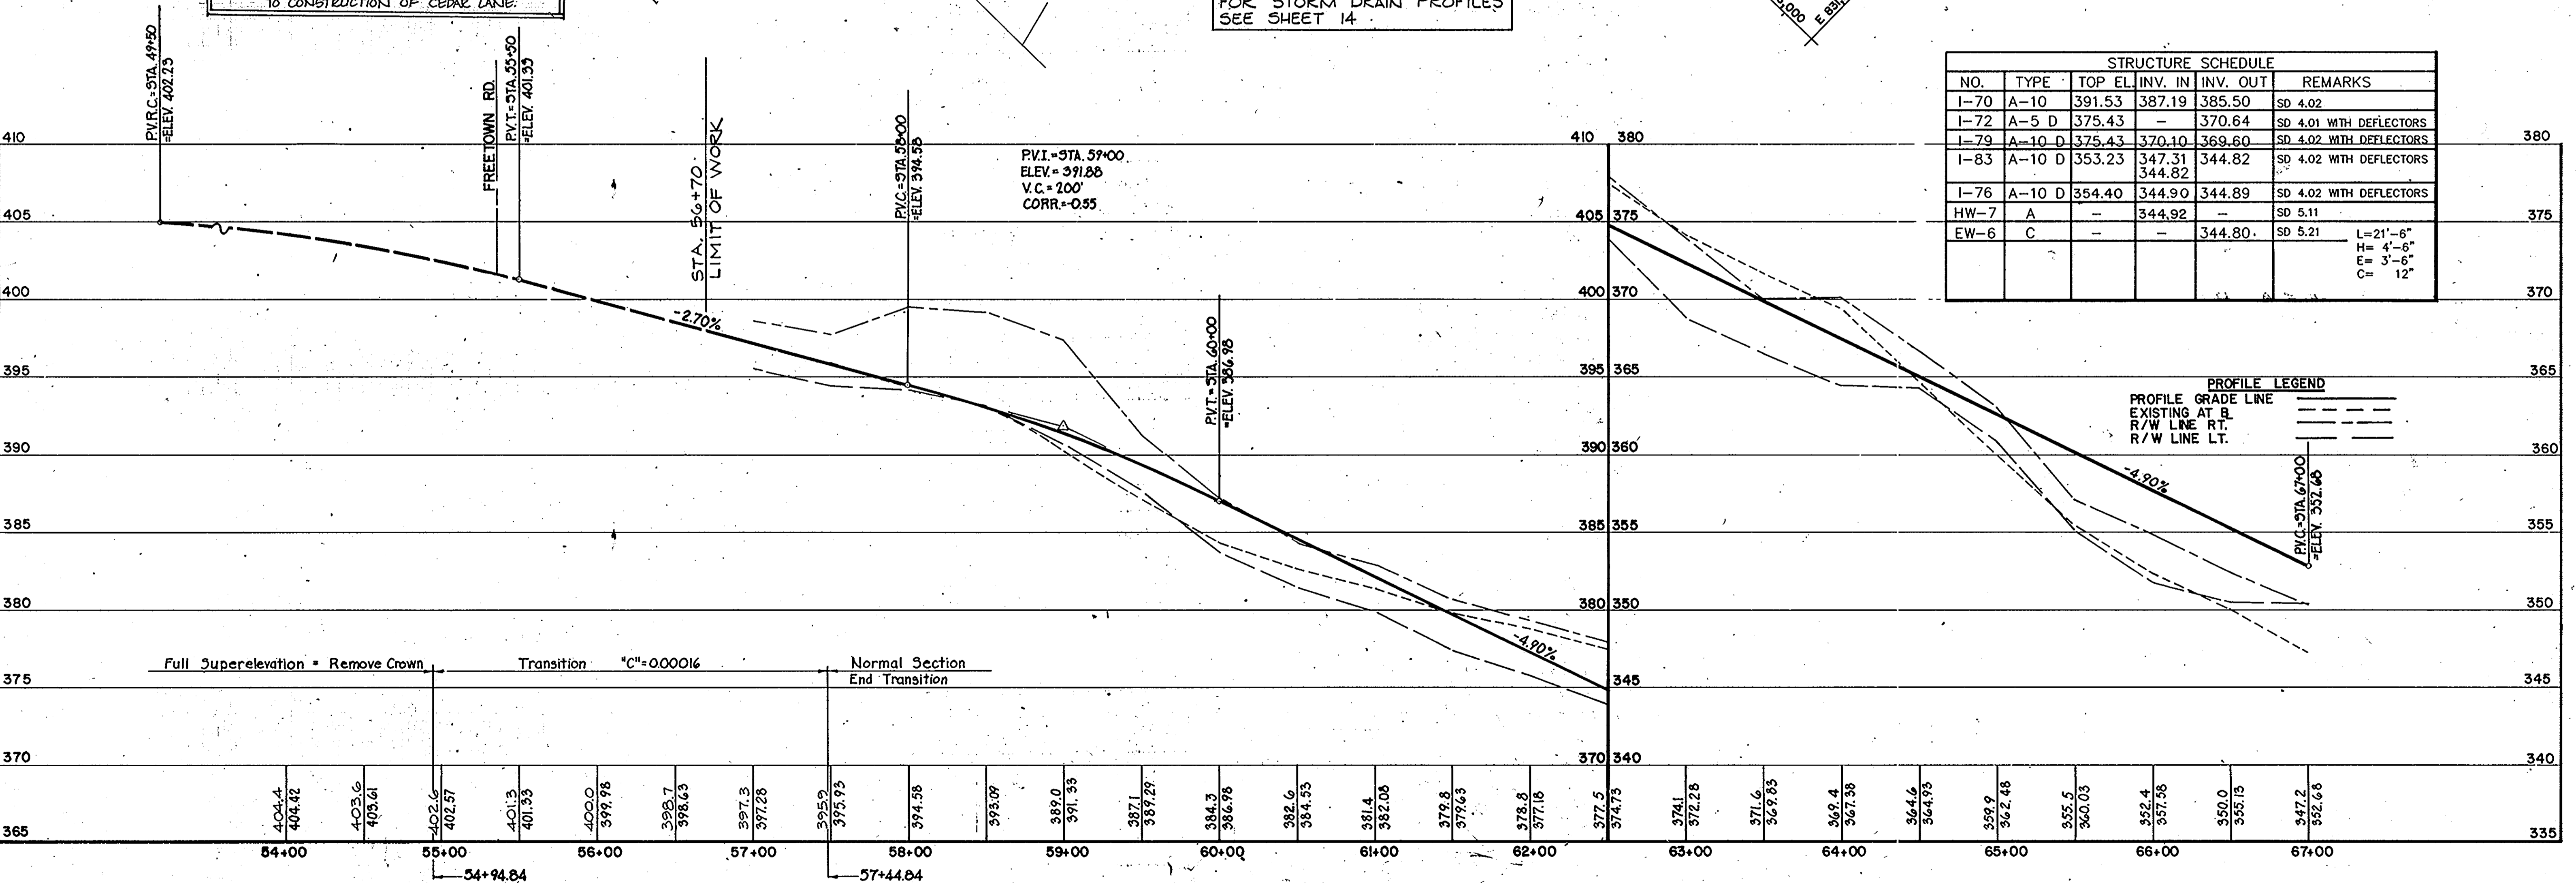

DEPARTMENT OF PUBLIC WORKS
 HOWARD COUNTY, MARYLAND
 Director of Public Works: James J. [Signature]
 Chief, Bureau of Engineering: [Signature]
 Chief, Division of Roads, Bridges and Storm Drainage: [Signature]

PURDUM & JESCHKE
 CONSULTING ENGINEERS
 LAND SURVEYORS
 1029 North Calvert Street
 Baltimore, Maryland 21202 301/837-0194




DES: JCT
 DRN: PWR
 CHK: WDP
 DATE: 6/90

SEDIMENT & EROSION CONTROL PLAN
 STA. 54+00 TO STA. 67+00
 CEDAR LANE - PHASE 2

SOUTH OF FREETOWN RD. TO GUILFORD RD.
 CAPITAL PROJECT J-4086
 ELECTION DISTRICT NO. 5
 HOWARD COUNTY, MARYLAND
 SCALE 1"=50'
 SHEET 20 OF 28

985

FINAL XXCE-90-020

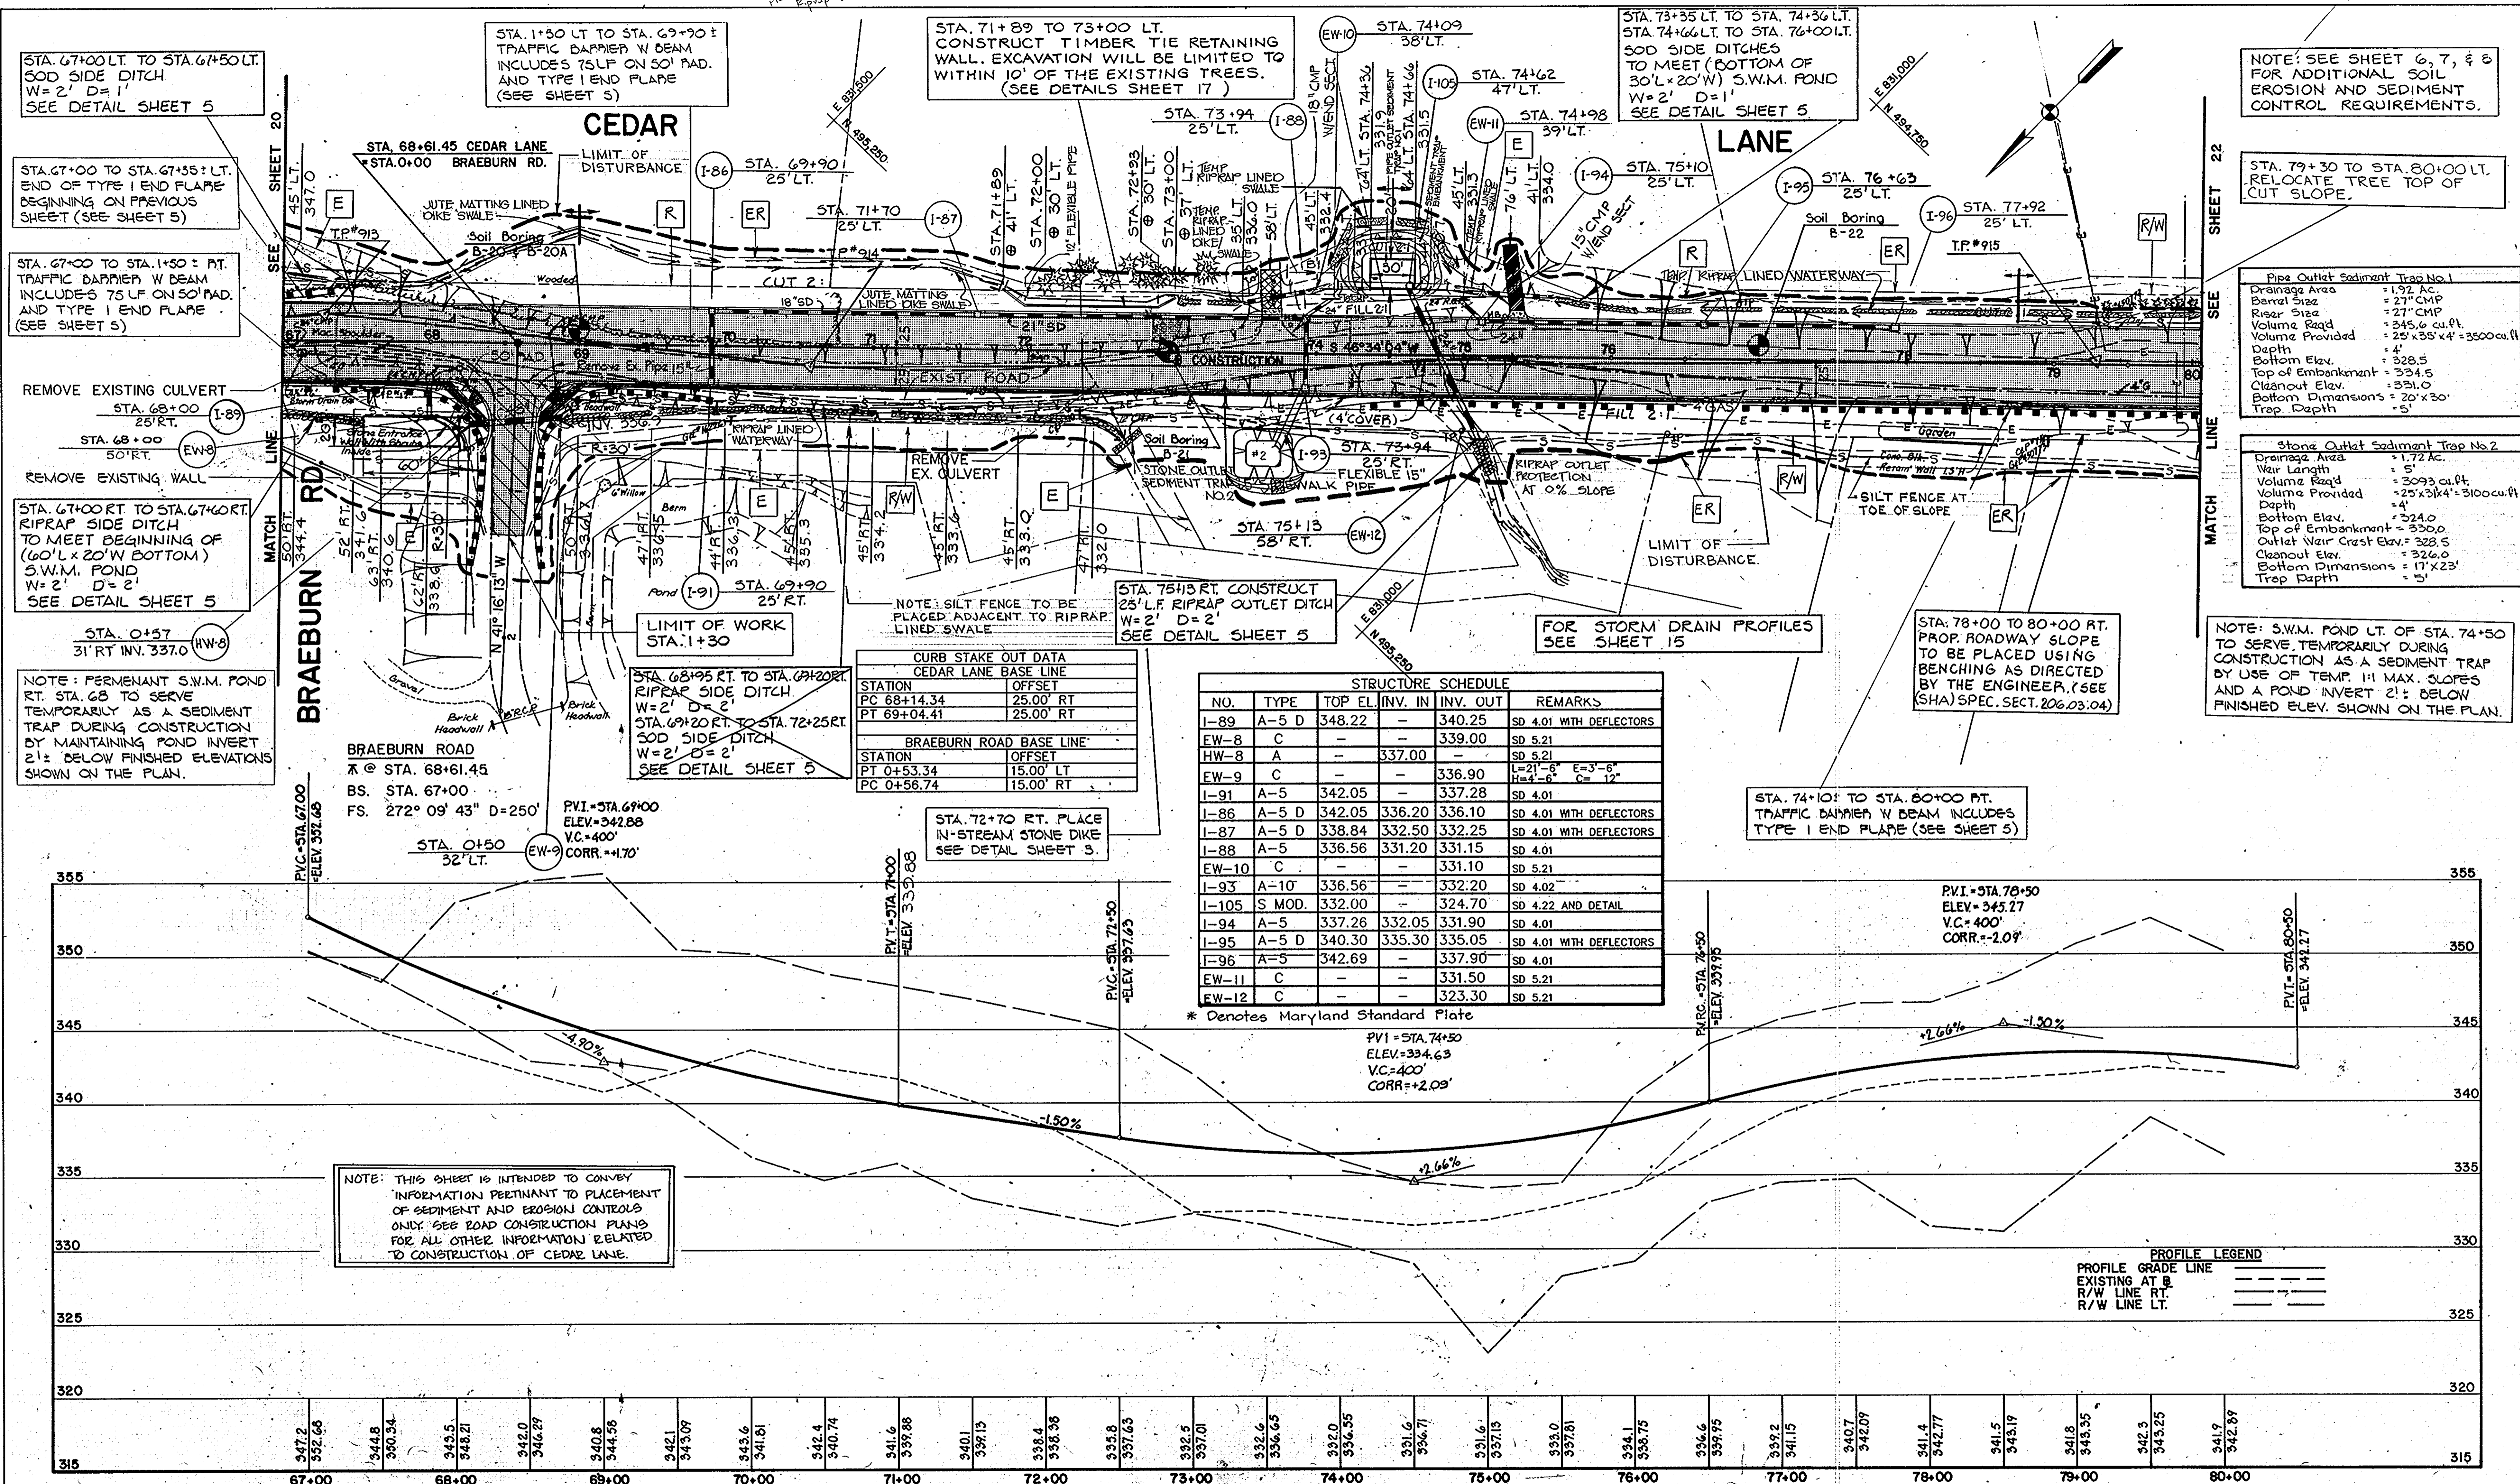

STA. 67+00 LT. TO STA. 67+50 LT.
SOD SIDE DITCH
W=2' D=1'
SEE DETAIL SHEET 5

STA. 67+00 TO STA. 67+55 LT.
END OF TYPE I END FLARE
BEGINNING ON PREVIOUS
SHEET (SEE SHEET 5)

STA. 67+00 TO STA. 1+50 = P.T.
TRAFFIC BARRIER W BEAM
INCLUDES 75 LF ON 50' PAD.
AND TYPE I END FLARE
(SEE SHEET 5)

REMOVE EXISTING CULVERT
STA. 68+00
25' RT.

REMOVE EXISTING WALL
STA. 67+00 RT. TO STA. 67+00 RT.
RIPRAP SIDE DITCH
TO MEET BEGINNING OF
(60' L x 20' W) S.W.M. POND
W=2' D=2'
SEE DETAIL SHEET 5

NOTE: PERMANENT S.W.M. POND
RT. STA. 68 TO SERVE
TEMPORARILY AS A SEDIMENT
TRAP DURING CONSTRUCTION
BY MAINTAINING POND INVERT
2' BELOW FINISHED ELEVATIONS
SHOWN ON THE PLAN.

STA. 1+50 LT. TO STA. 69+90 ±
TRAFFIC BARRIER W BEAM
INCLUDES 75 LF ON 50' PAD.
AND TYPE I END FLARE
(SEE SHEET 5)

STA. 71+89 TO 73+00 LT.
CONSTRUCT TIMBER TIE RETAINING
WALL. EXCAVATION WILL BE LIMITED TO
WITHIN 10' OF THE EXISTING TREES.
(SEE DETAILS SHEET 17)

STA. 73+35 LT. TO STA. 74+36 LT.
STA. 74+66 LT. TO STA. 76+00 LT.
SOD SIDE DITCHES
TO MEET (BOTTOM OF
30' L x 20' W) S.W.M. POND
W=2' D=1'
SEE DETAIL SHEET 5.

NOTE: SEE SHEET 6, 7, & 8
FOR ADDITIONAL SOIL
EROSION AND SEDIMENT
CONTROL REQUIREMENTS.

STA. 79+30 TO STA. 80+00 LT.
RELOCATE TREE TOP OF
CUT SLOPE.

Stone Outlet Sediment Trap No. 1
Drainage Area = 1.72 Ac.
Barrel Size = 21" CMP
Reser Size = 21" CMP
Volume Road = 345.6 cu.ft.
Volume Provided = 25' x 35' x 4' = 3500 cu.ft.
Depth = 4'
Bottom Elev. = 328.5
Top of Embankment = 334.5
Cleanout Elev. = 331.0
Bottom Dimensions = 20' x 20'
Trap Depth = 5'

Stone Outlet Sediment Trap No. 2
Drainage Area = 1.72 Ac.
Barrel Size = 21" CMP
Reser Size = 21" CMP
Volume Road = 3093 cu.ft.
Volume Provided = 25' x 31' x 4' = 3100 cu.ft.
Depth = 4'
Bottom Elev. = 324.0
Top of Embankment = 330.0
Outlet Weir Crest Elev. = 328.5
Cleanout Elev. = 326.0
Bottom Dimensions = 17' x 23'
Trap Depth = 5'

NOTE: S.W.M. POND LT. OF STA. 74+50
TO SERVE TEMPORARILY DURING
CONSTRUCTION AS A SEDIMENT TRAP
BY USE OF TEMP. 1:1 MAX. SLOPES
AND A POND INVERT 2' BELOW
FINISHED ELEV. SHOWN ON THE PLAN.

NOTE: SILT FENCE TO BE
PLACED ADJACENT TO RIPRAP
LINED SWALE

CURB STAKE OUT DATA
CEDAR LANE BASE LINE

STATION	OFFSET
PC 68+14.34	25.00' RT
PT 69+04.41	25.00' RT

BRAEBURN ROAD BASE LINE

STATION	OFFSET
PT 0+53.34	15.00' LT
PC 0+58.74	15.00' RT

STA. 75+13 RT. CONSTRUCT
25' L.F. RIPRAP OUTLET DITCH
W=2' D=2'
SEE DETAIL SHEET 5

FOR STORM DRAIN PROFILES
SEE SHEET 15


STA. 78+00 TO 80+00 RT.
PROP. ROADWAY SLOPE
TO BE PLACED USING
BENCHING AS DIRECTED
BY THE ENGINEER. (SEE
(SHA) SPEC. SECT. 206.03.04)

STA. 74+10 LT. TO STA. 80+00 RT.
TRAFFIC BARRIER W BEAM INCLUDES
TYPE I END FLARE (SEE SHEET 5)

STRUCTURE SCHEDULE

NO.	TYPE	TOP EL.	INV. IN.	INV. OUT	REMARKS
I-89	A-5 D	348.22	-	340.25	SD 4.01 WITH DEFLECTORS
EW-8	C	-	-	339.00	SD 5.21
HW-8	A	-	337.00	-	SD 5.21
EW-9	C	-	-	336.90	SD 5.21
I-91	A-5	342.05	-	337.28	SD 4.01
I-86	A-5 D	342.05	336.20	336.10	SD 4.01 WITH DEFLECTORS
I-87	A-5 D	338.84	332.50	332.25	SD 4.01 WITH DEFLECTORS
I-88	A-5	336.56	331.20	331.15	SD 4.01
EW-10	C	-	-	331.10	SD 5.21
I-93	A-10'	336.56	-	332.20	SD 4.02
I-105	S MOD.	332.00	-	324.70	SD 4.22 AND DETAIL
I-94	A-5	337.26	332.05	331.90	SD 4.01
I-95	A-5 D	340.30	335.30	335.05	SD 4.01 WITH DEFLECTORS
I-96	A-5	342.69	-	337.90	SD 4.01
EW-11	C	-	-	331.50	SD 5.21
EW-12	C	-	-	323.30	SD 5.21

* Denotes Maryland Standard Plate

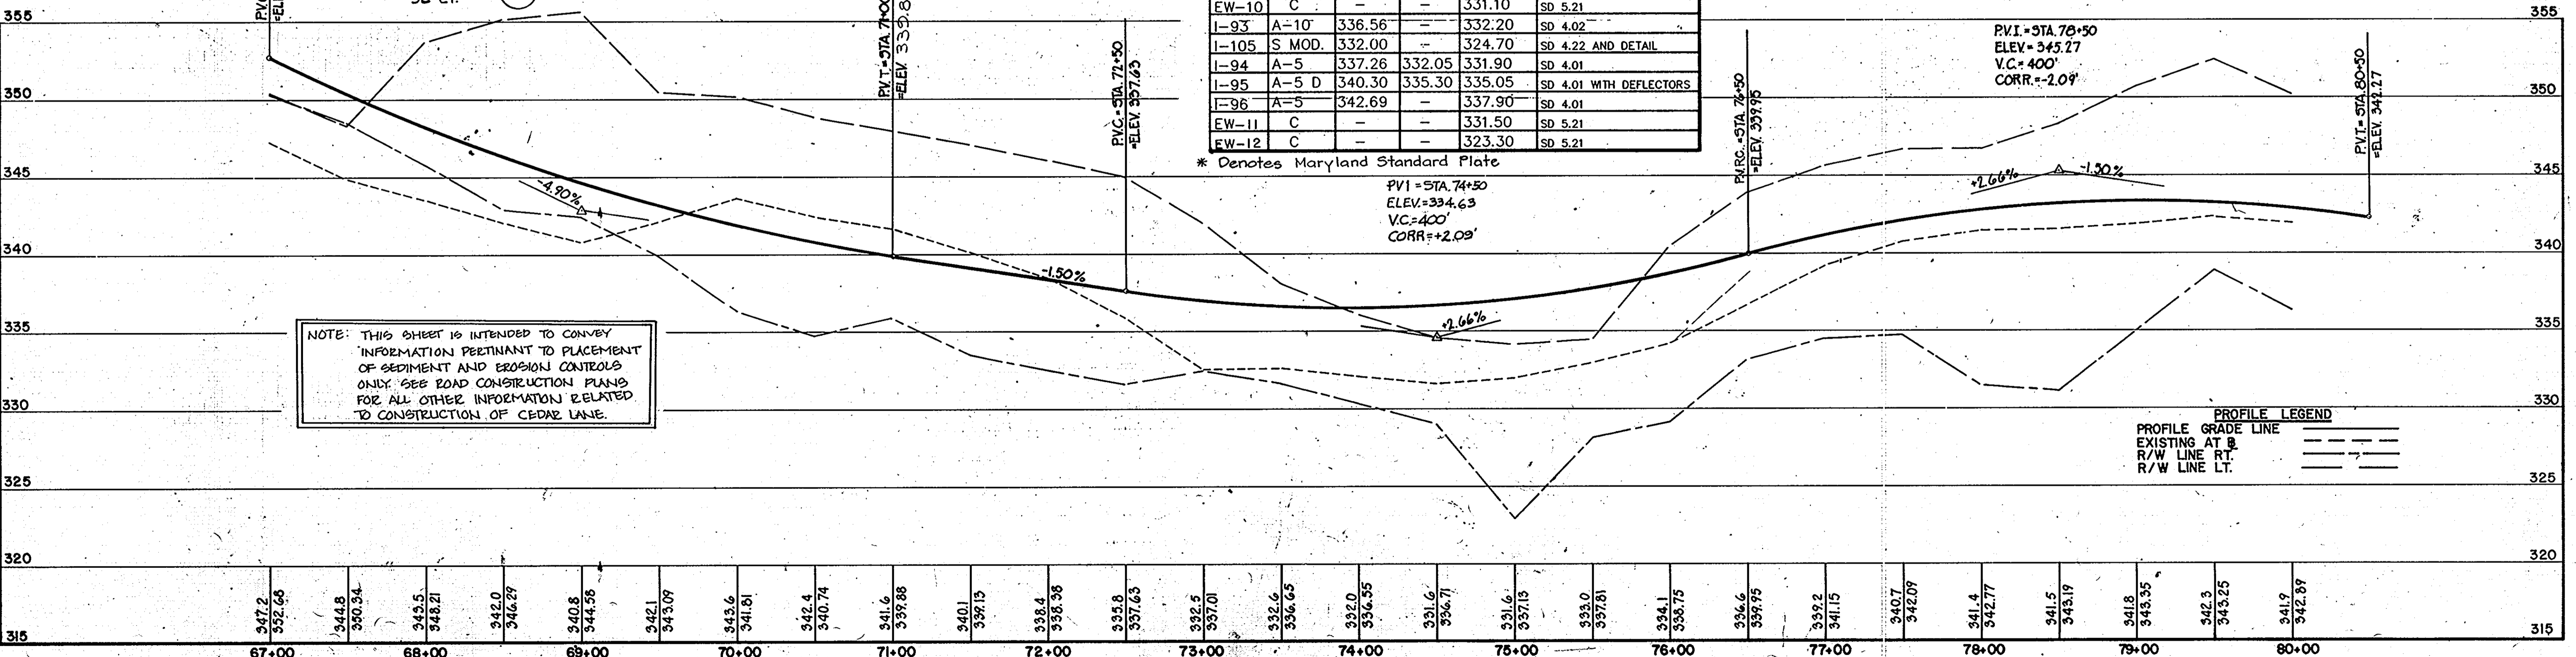

NOTE: THIS SHEET IS INTENDED TO CONVEY
INFORMATION PERTINANT TO PLACEMENT
OF SEDIMENT AND EROSION CONTROLS
ONLY. SEE ROAD CONSTRUCTION PLANS
FOR ALL OTHER INFORMATION RELATED
TO CONSTRUCTION OF CEDAR LANE.

PROFILE LEGEND
PROFILE GRADE LINE
EXISTING AT B
R/W LINE RT.
R/W LINE LT.

DEPARTMENT OF PUBLIC WORKS
HOWARD COUNTY, MARYLAND
11/18/88
DIRECTOR OF PUBLIC WORKS
CHIEF, BUREAU OF ENGINEERING
CHIEF, DIVISION OF ROADS, BRIDGES AND STORM DRAINAGE

PURDUM & JESCHKE
CONSULTING ENGINEERS
LAND SURVEYORS
1029 North Calvert Street
Baltimore, Maryland 21202 - 301/857-0194


DES: JCT
DRN: PWR
CHK: WDP
DATE: 6/90

SEDIMENT & EROSION CONTROL PLAN
STA. 67+00 TO STA. 80+00
CEDAR LANE - PHASE 2
600' SCALE MAP NO. BLOCK N.

SOUTH OF FREETOWN RD. TO GUILFORD RD.
CAPITAL PROJECT, J-4086
ELECTION DISTRICT NO. 5
HOWARD COUNTY, MARYLAND
SCALE 1"=50'
SHEET 21 OF 28

XXCE-90-021

NOTE: SEE SHEETS 6, 7, & 8 FOR ADDITIONAL SOIL EROSION AND SEDIMENT CONTROL REQUIREMENTS.

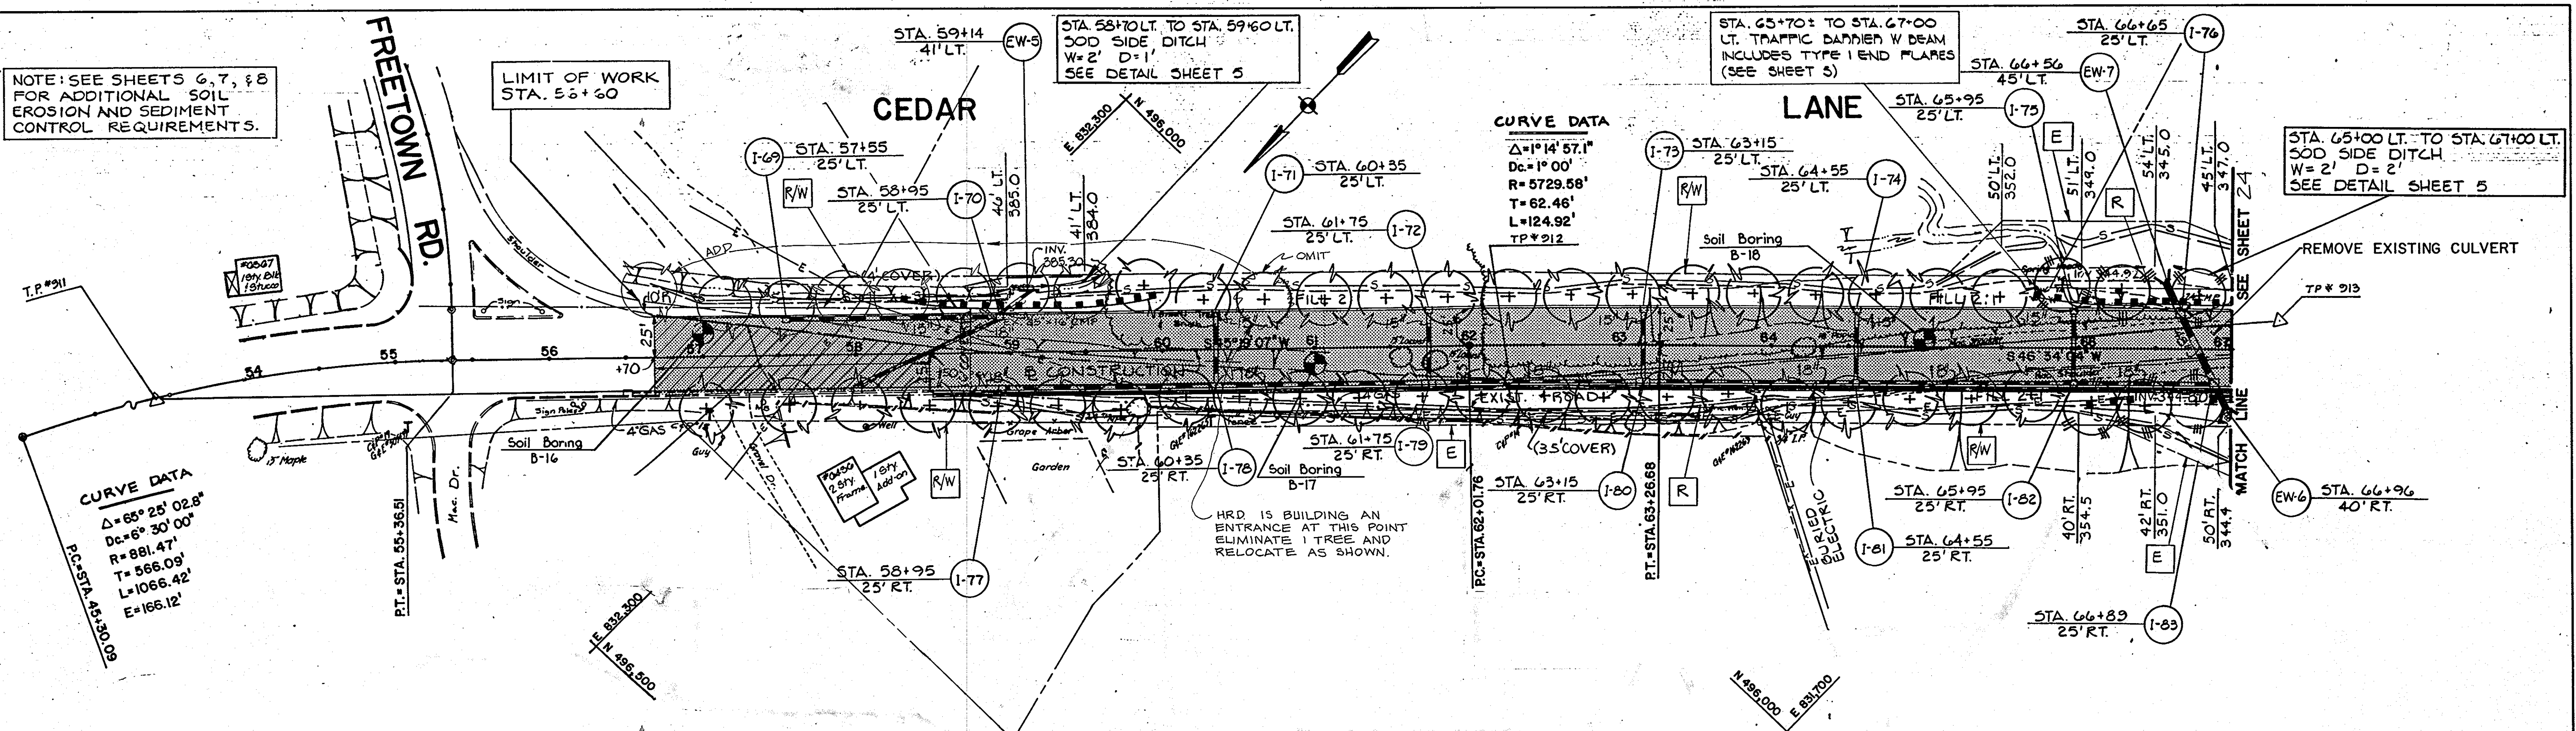


CURVE DATA
 $\Delta = 66^\circ 25' 02.8''$
 $D_c = 66^\circ 30' 00''$
 $R = 881.47'$
 $L = 1066.42'$
 $E = 166.12'$
 $PC = STA. 54+30.09$
 $PT = STA. 55+36.51$


CURVE DATA
 $\Delta = 1^\circ 14' 57.1''$
 $D_c = 1^\circ 00'$
 $R = 5729.58'$
 $L = 124.92'$
 $TP \# 212$

PLANT LIST

QTY.	SYMBOL	NAME	SIZE	REMARKS
42 44	(Symbol)	ACER RUBRUM RED MAPLE	2 1/2" - 3" CAL. 13' - 15' HGT.	B+B, FULL HEAD
44	(Symbol)	GINKGO BILOBA [MALE ONLY] MAIDEN HAIR TREE	2 1/2" - 3" CAL. 10' - 12' HGT.	B+B, FULL HEAD
25	(Symbol)	QUERCUS PALUSTRIS PIN OAK	2 1/2" - 3" CAL.	B+B, FULL HEAD
2	(Symbol)	ELIONYMUS ALATUS - BURNING BUSH	30" x 36"	B+B

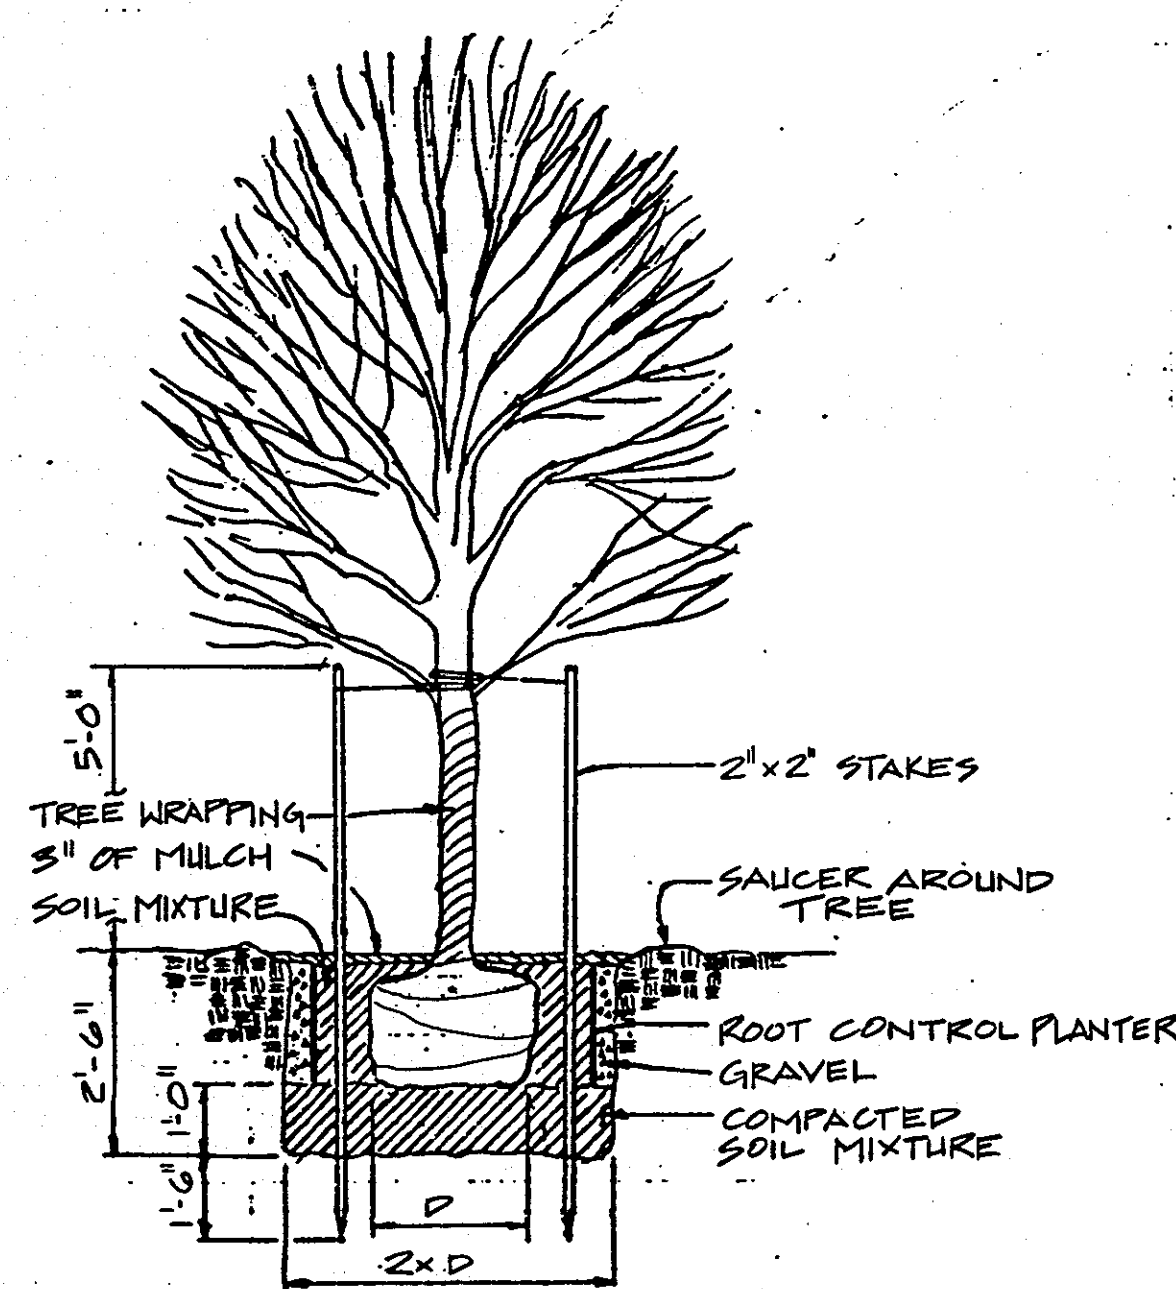

TYPICAL TREE PLANTING DETAIL
(NOT TO SCALE)

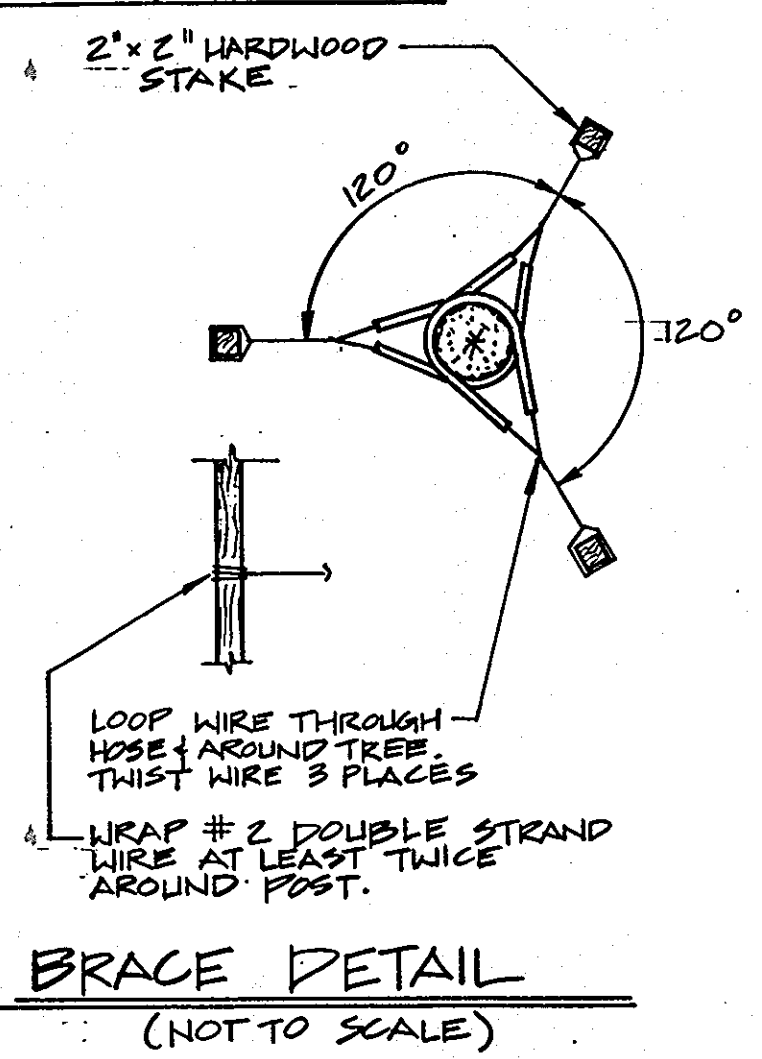

BRACE DETAIL
(NOT TO SCALE)

LANDSCAPING NOTES:

- NOTE: SHEET NO'S 23 THROUGH 26 ARE INTENDED TO CONVEY INFORMATION PERTINENT TO PLACEMENT OF STREET TREES AND LANDSCAPING DETAILS ONLY. SEE OTHER ROAD CONSTRUCTION PLANS FOR ALL OTHER INFORMATION RELATED TO CONSTRUCTION OF CEDAR LANE.
- CONTRACTOR SHALL FIELD VERIFY EXISTING UNDERGROUND UTILITIES BEFORE DIGGING.
 - TREES SHALL BE PLANTED 1' BEHIND THE FACE OF CURB, HOWEVER ACTUAL LOCATIONS OF TREES MAY VARY TO ACCOMMODATE FIELD CONDITIONS.
 - POLYETHYLENE ROOT CONTROL PLANTERS ARE REQUIRED FOR EACH TREE TO MINIMIZE ROOT SPREADING. ALL PLANTERS SHALL BE MANUFACTURED BY DEEP ROOT CORPORATION OF WESTMINSTER, CALIFORNIA (48" UNIVERSAL BARRIER STOCK UB-48-2) OR APPROVED EQUAL AND SHALL BE INSTALLED ACCORDING TO MANUFACTURER'S SPECIFICATIONS.
 - SEE SPECIFICATIONS FOR GENERAL PLANTING REQUIREMENTS.


985

DEPARTMENT OF PUBLIC WORKS
 HOWARD COUNTY, MARYLAND

James J. [Signature] 7/12/90 DATE
 DIRECTOR OF PUBLIC WORKS

Michael S. [Signature] 7/12/90 DATE
 CHIEF, BUREAU OF ENGINEERING

Christa [Signature] 7/12/90 DATE
 CHIEF, DIVISION OF ROADS, BRIDGES AND STORM DRAINAGE

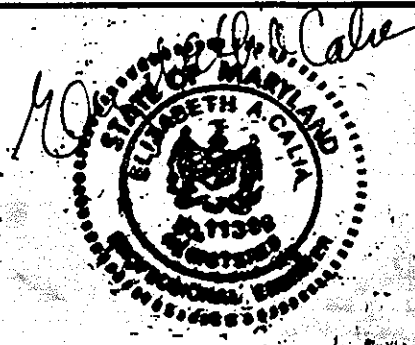


DES: JBN			
DRN: GMI			
DATE: 6/90	BY: [Signature]	NO: [Signature]	REVISION: [Signature]

LANDSCAPING PLAN
 STA. 54+00 TO STA. 67+00
CEDAR LANE - PHASE 2

SOUTH OF FREETOWN RD. TO GUILFORD RD.
 CAPITAL PROJECT J-4086
 ELECTION DISTRICT NO. 5
 HOWARD COUNTY, MARYLAND

SCALE
 1" = 50'

SHEET
 23 of 28

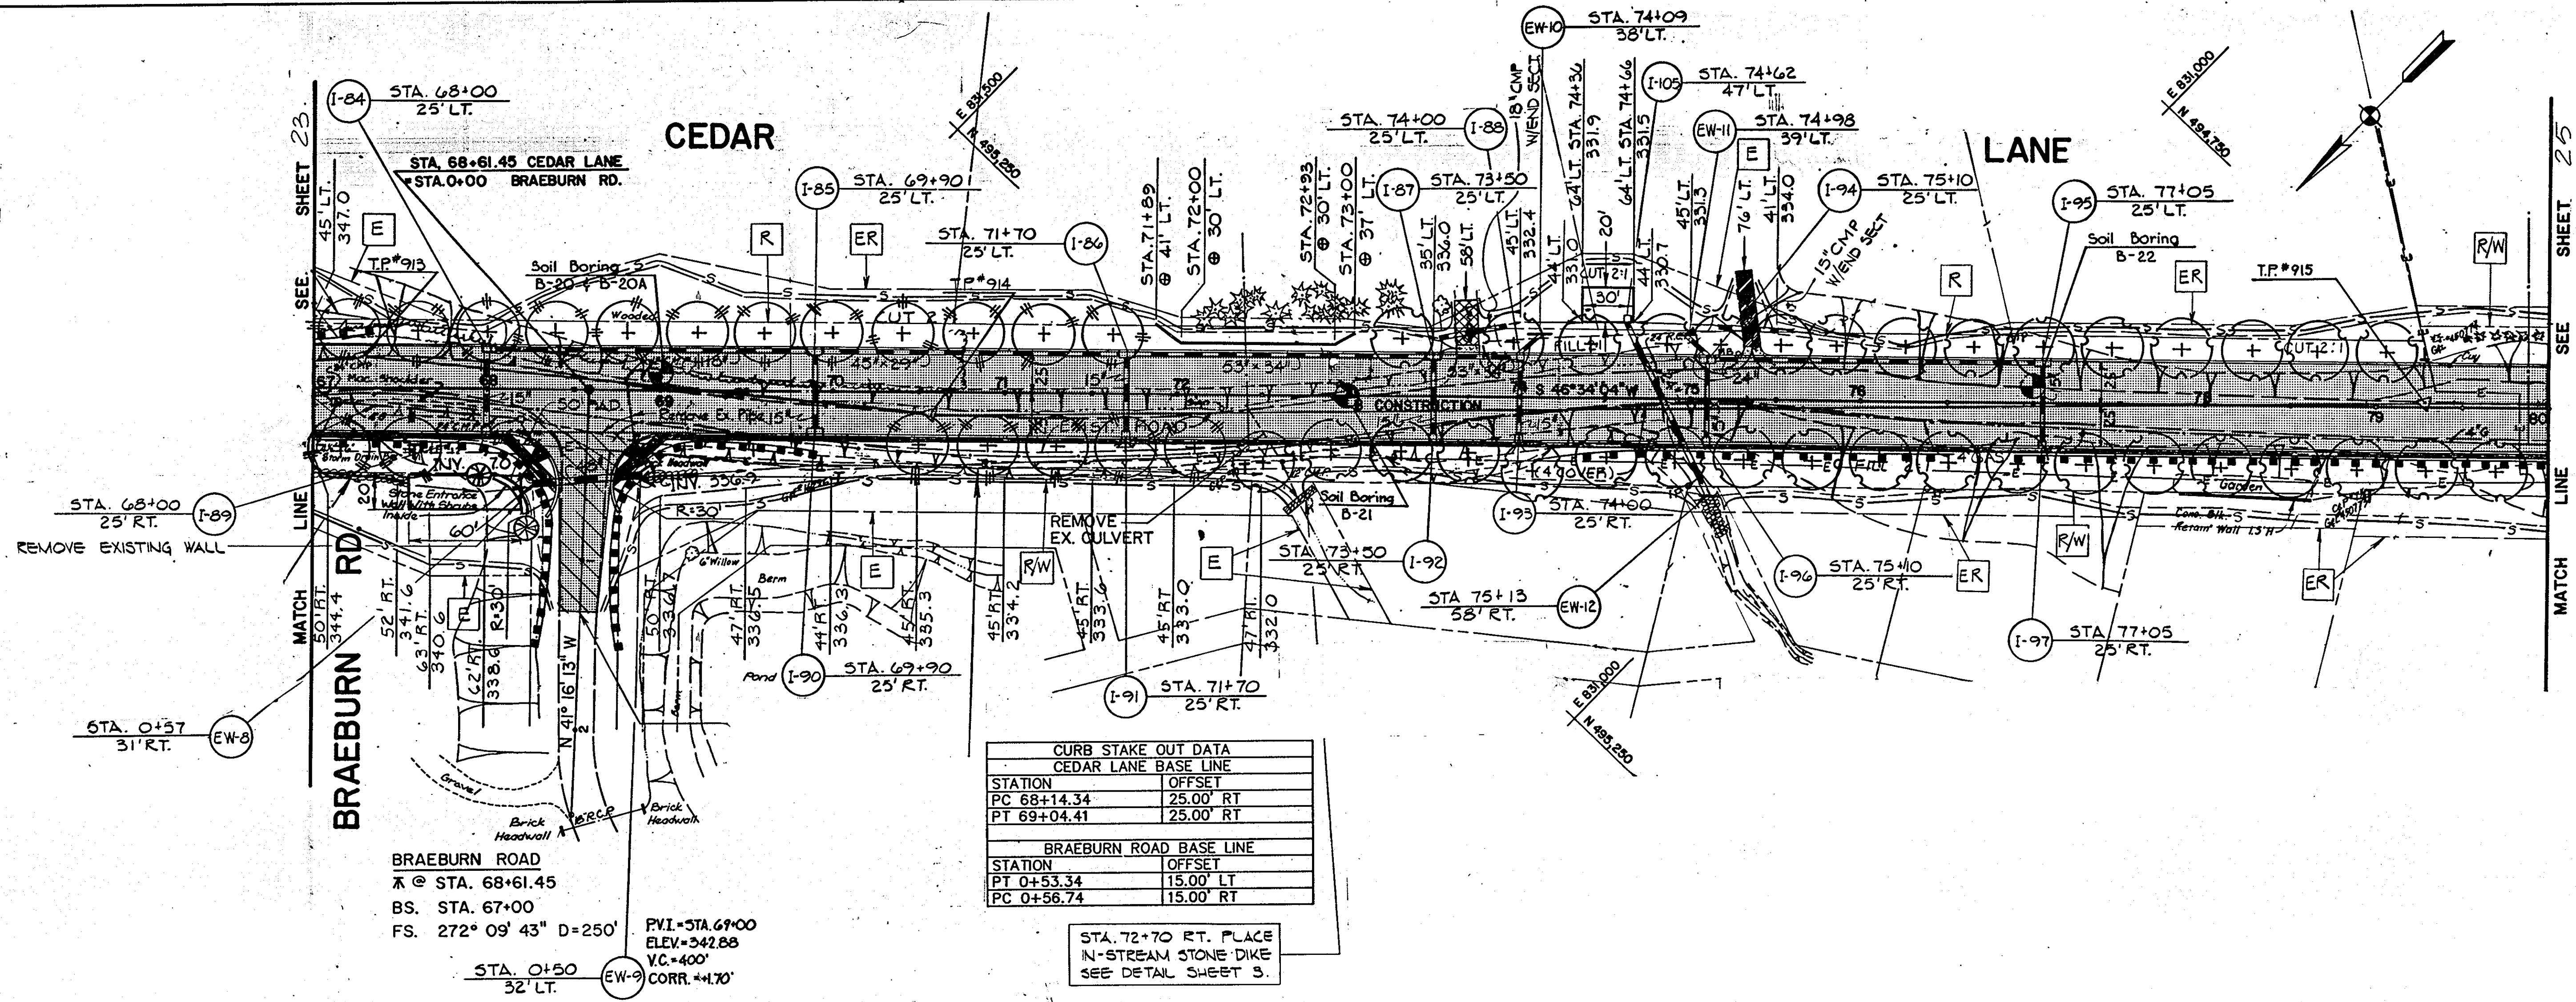

CURB STAKE OUT DATA	
CEDAR LANE BASE LINE	
STATION	OFFSET
PC 68+14.34	25.00' RT
PT 69+04.41	25.00' RT

BRAEBURN ROAD BASE LINE	
STATION	OFFSET
PT 0+53.34	15.00' LT
PC 0+56.74	15.00' RT

STA. 72+70 RT. PLACE
IN-STREAM STONE DIKE
SEE DETAIL SHEET 3.

BRAEBURN ROAD
 @ STA. 68+61.45
 BS. STA. 67+00
 FS. 272° 09' 43" D=250' PVI=STA. 67+00
 ELEV.=342.88
 V.C.=400' V.C. CORR.=+1.70'
 STA. 0+50 32' LT. EW-9

NOTE: SEE SHEET 23 FOR LANDSCAPING
 GENERAL NOTES AND LANDSCAPING
 DETAILS.

985

DEPARTMENT OF PUBLIC WORKS
 HOWARD COUNTY, MARYLAND
 Director of Public Works DATE 11/18/88
 Chief, Bureau of Engineering DATE 11/18/88
 Chief, Division of Roads, Bridges and Storm Drainage DATE 11/18/88




DES: JCT
 DRN: PWR
 CHK: WDP
 DATE: 11/80 BY NO. REVISION DATE

LANDSCAPING PLAN
 STA. 67+00 TO STA. 80+00
 CEDAR LANE - PHASE 2
 600' SCALE MAP NO. BLOCK NO.

SOUTH OF FREETOWN RD. TO GUILFORD RD.
 CAPITAL PROJECT J-4086
 ELECTION DISTRICT NO. 5
 HOWARD COUNTY, MARYLAND

SCALE
 1"=50'
 SHEET
 24 of 28

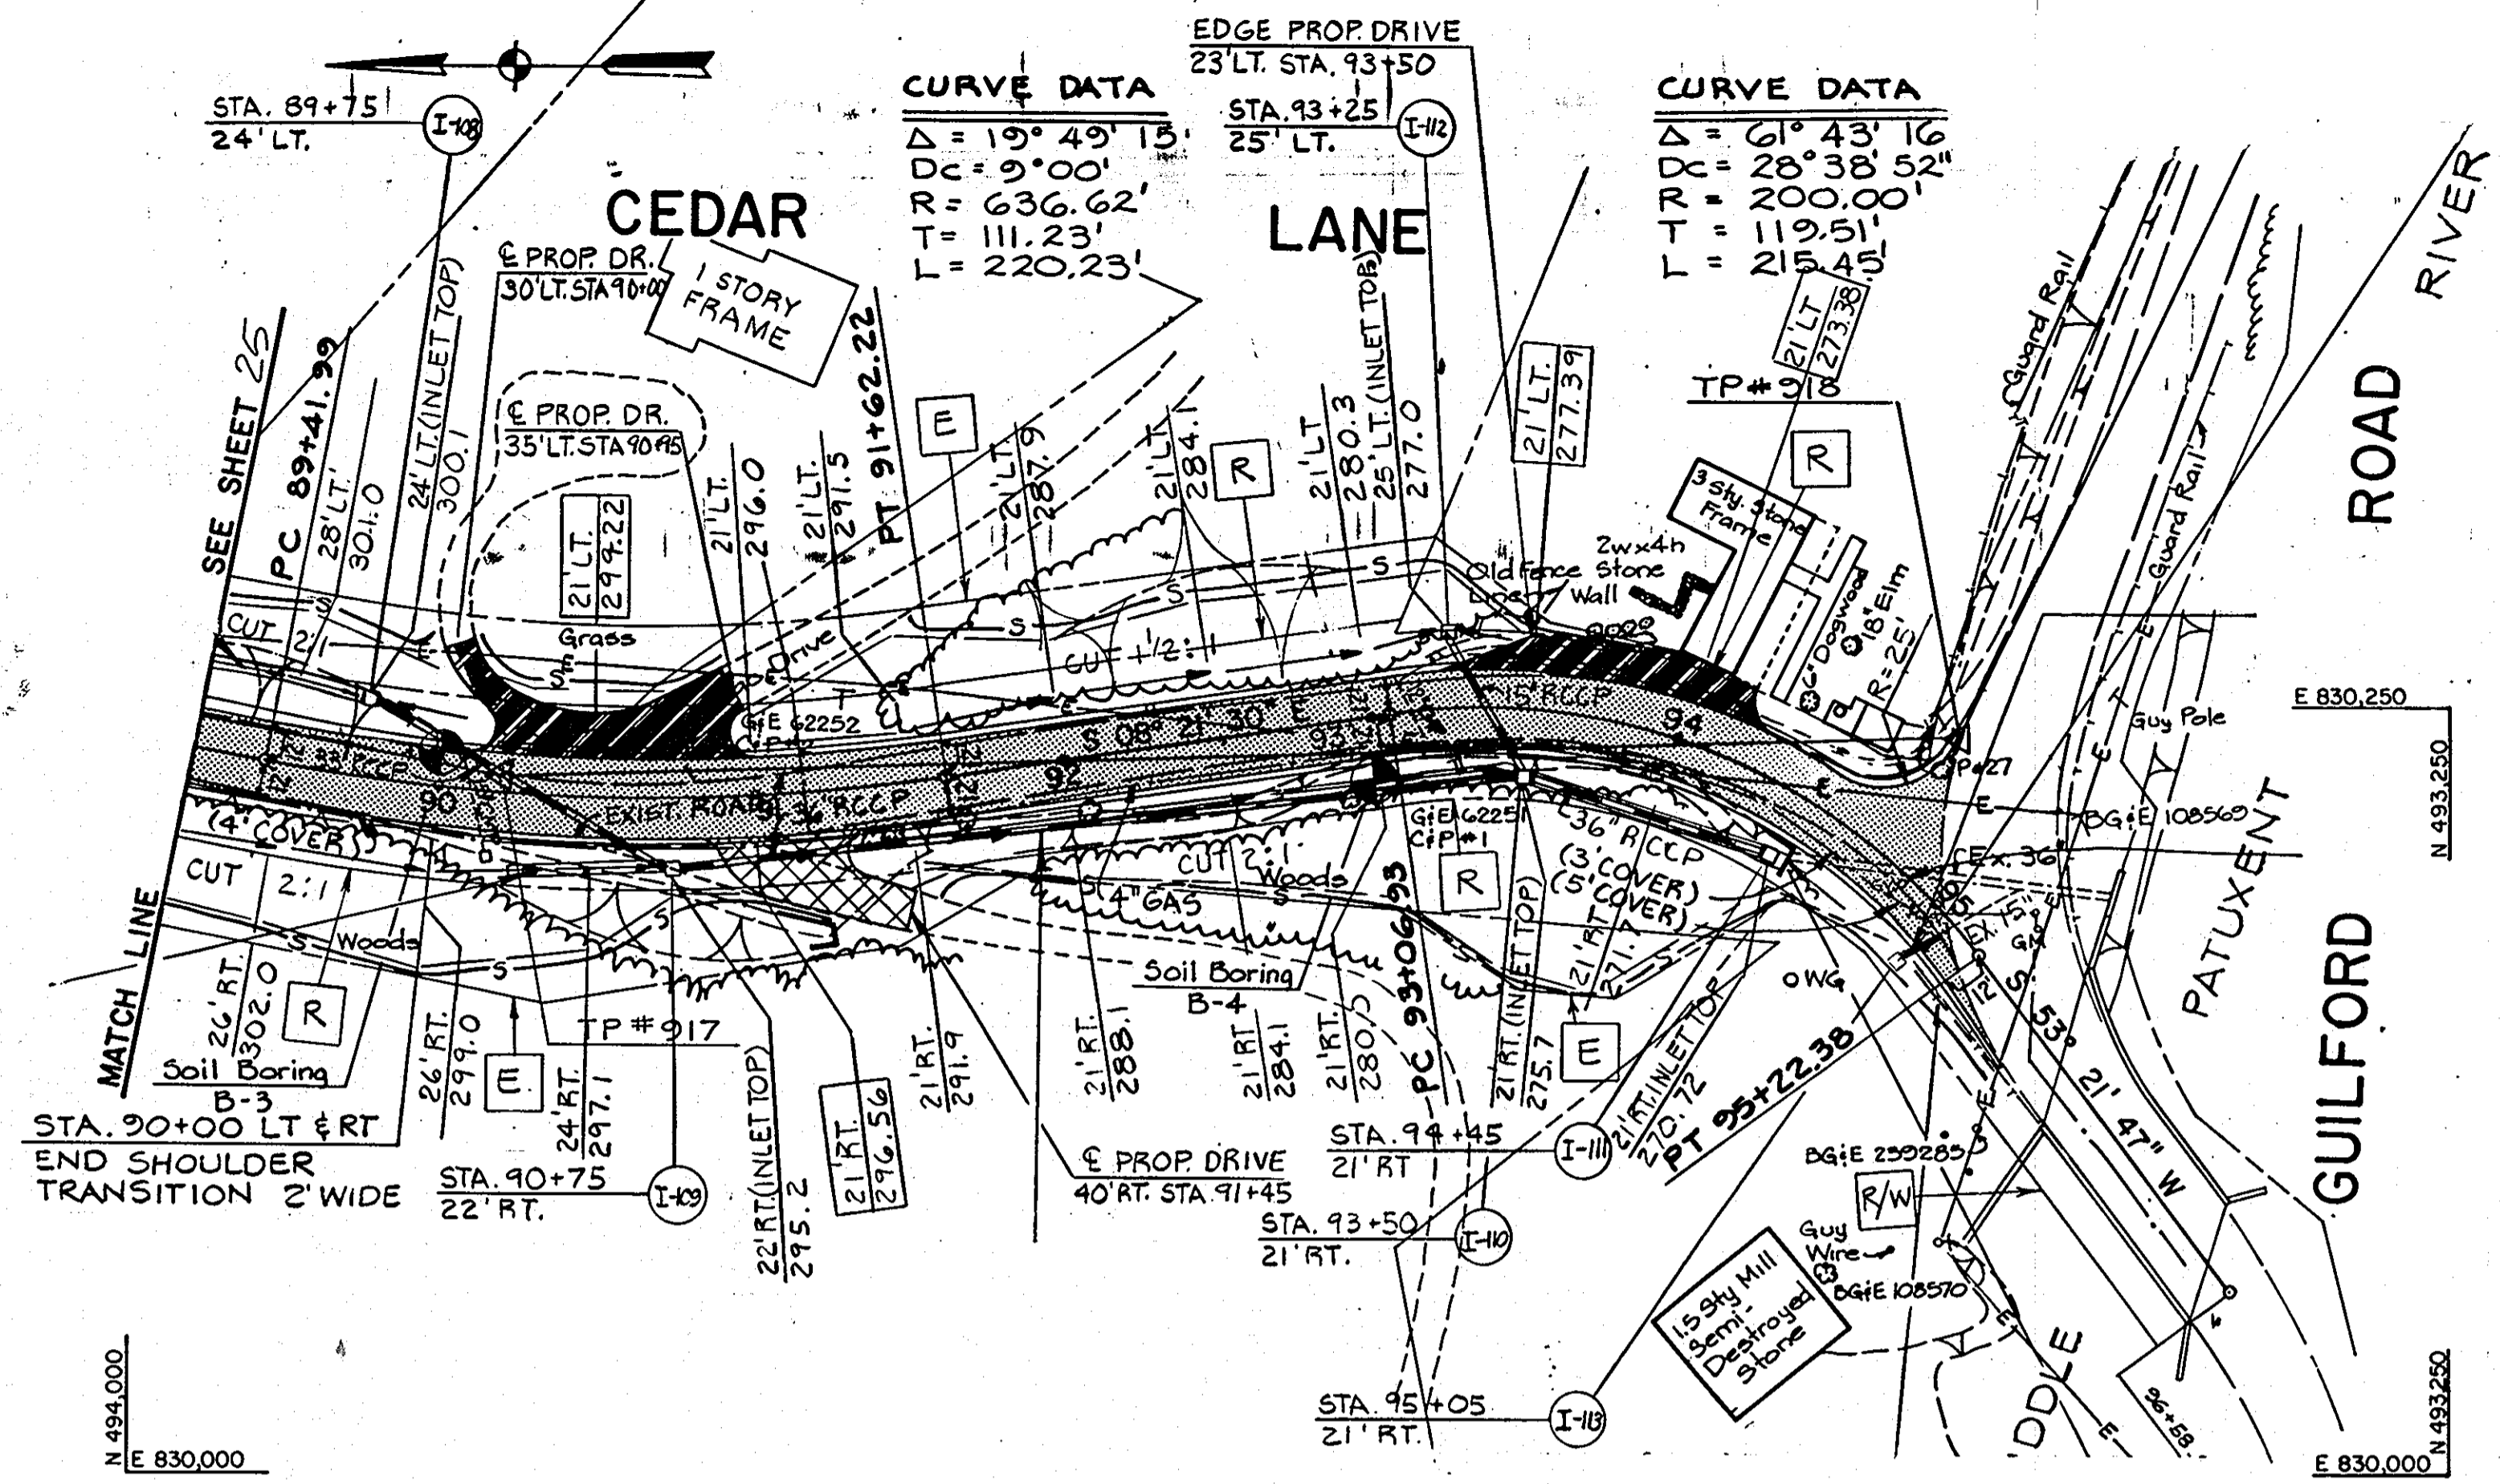

NOTE: SEE SHEET 23 FOR LANDSCAPING GENERAL NOTES AND LANDSCAPING DETAILS.

985

DEPARTMENT OF PUBLIC WORKS
HOWARD COUNTY, MARYLAND

James M. [Signature] 11/8/88 *[Signature]* 11-8-88
DIRECTOR OF PUBLIC WORKS DATE CHIEF, BUREAU OF ENGINEERING DATE

[Signature] 11/8/88
CHIEF, DIVISION OF ROADS, BRIDGES AND STORM DRAINAGE DATE



DES: JCT					
DRN: PWR					
CHK: WDP					
DATE: 6/90	BY	NO.	REVISION	DATE	




LANDSCAPING PLAN
STA. 89+20 TO STA. 95+05
CEDAR LANE - PHASE 2

600' SCALE MAP NO. _____ BLOCK NO. _____

SOUTH OF FREETOWN RD TO GUILFORD RD.
CAPITAL PROJECT J-4086
ELECTION DISTRICT NO. 5
HOWARD COUNTY, MARYLAND


XXCE-90-020

SCALE
1"=50'
SHEET
20 of 28

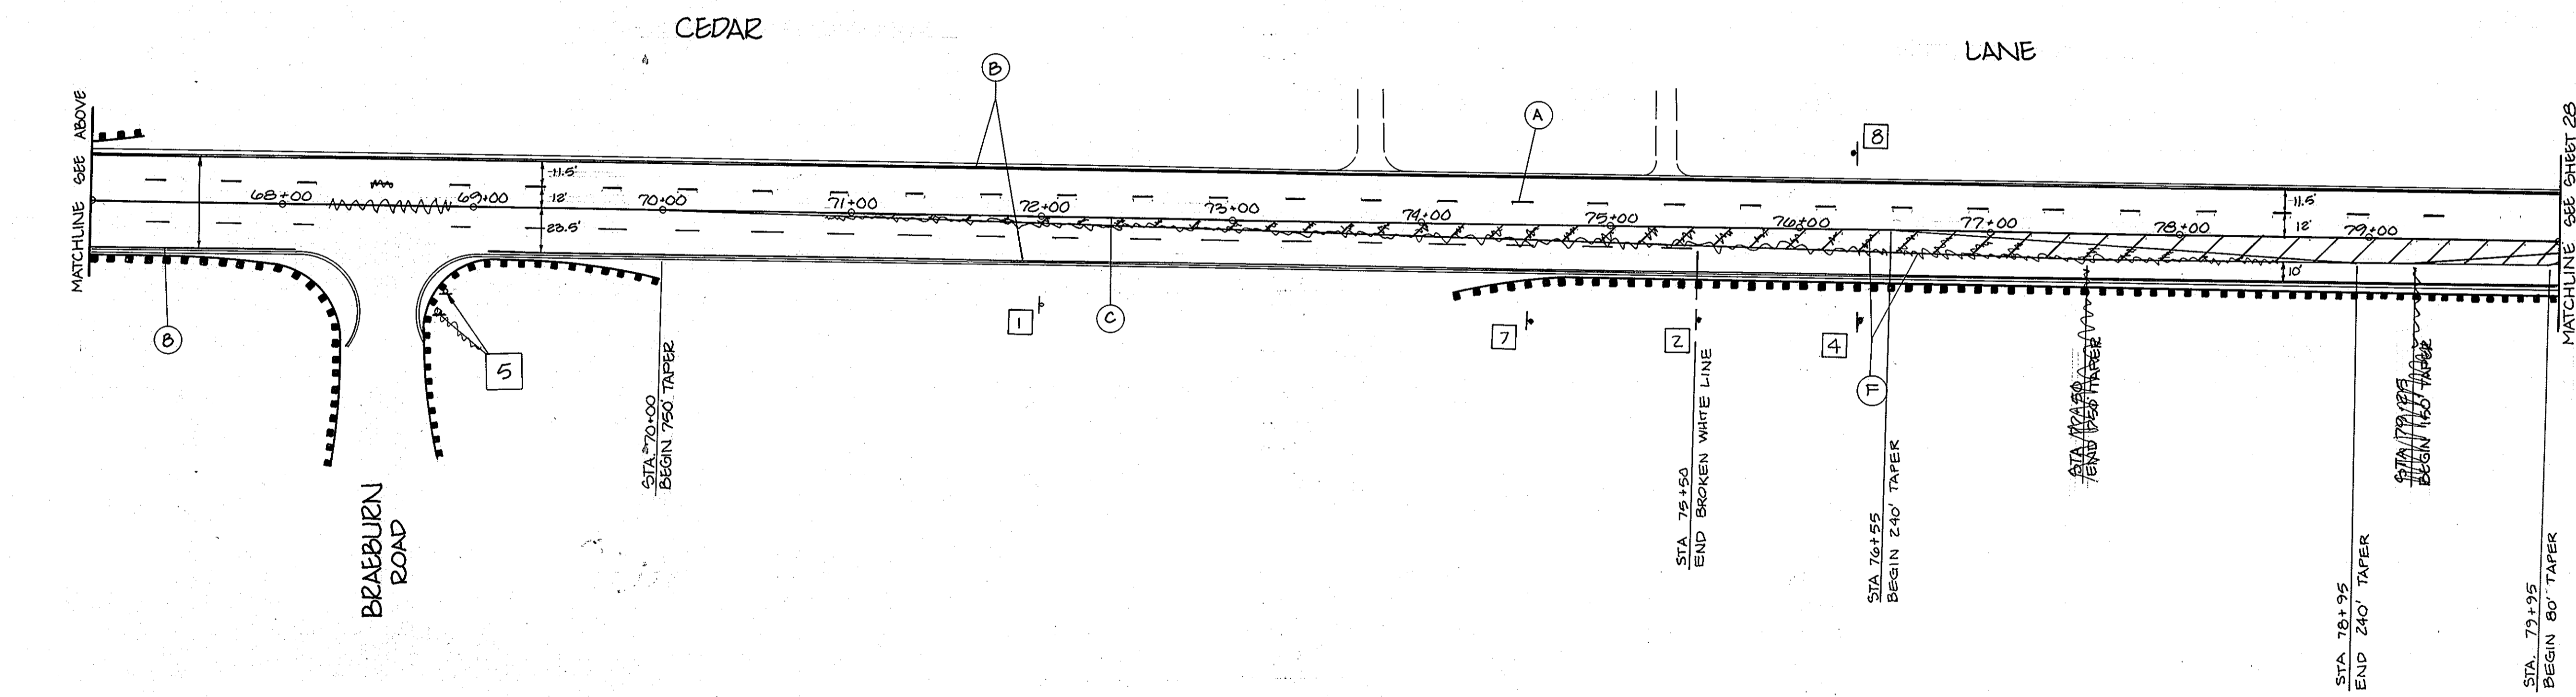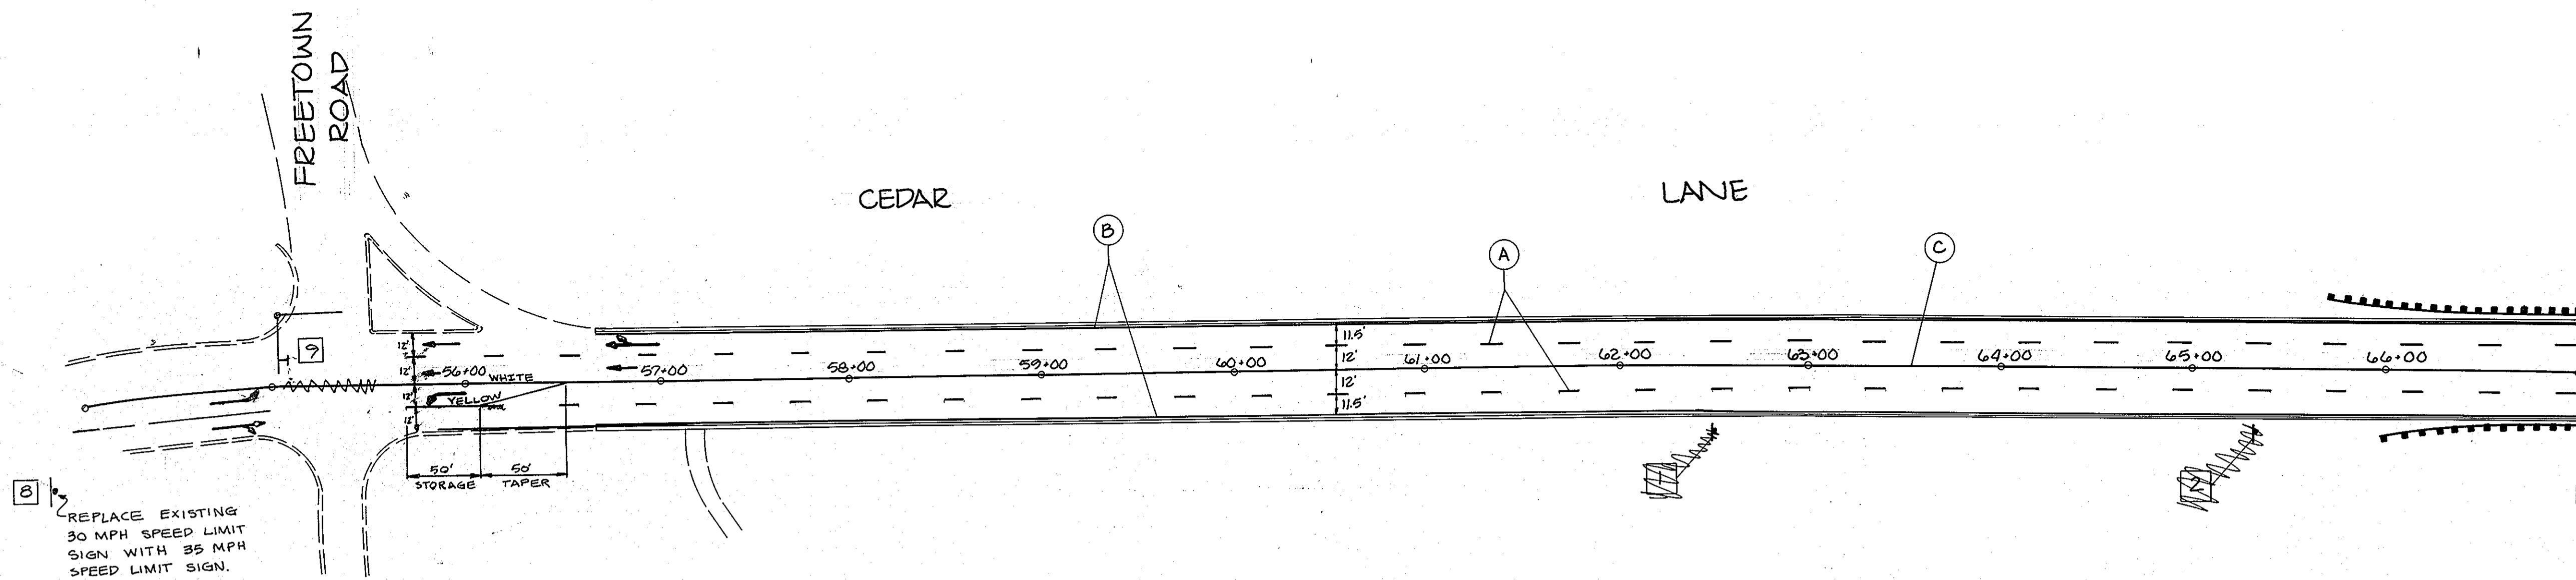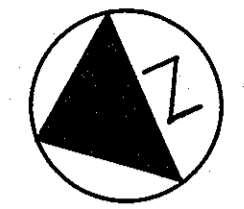

DEPARTMENT OF PUBLIC WORKS
HOWARD COUNTY, MARYLAND

James P. ... 7/12/90 DIRECTOR OF PUBLIC WORKS DATE
... .. 7-11-90 CHIEF, BUREAU OF ENGINEERING DATE
Elizabeth ... 7/12/90 CHIEF, DIVISION OF ROADS, BRIDGES AND STORM DRAINAGE DATE

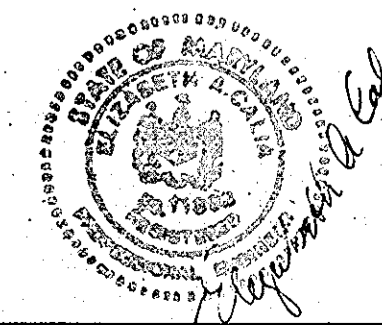

DES:	JGN			
DRN:	GMI			
CHK:				
DATE:	6/90			
HARMS & ASSOC.	Z	AS-BUILT	1/2/92	
BY:	NO.	REVISION	DATE	



STRIPING AND PERMANENT SIGNING PLAN
CEDAR LANE — PHASE 2
60' SCALE MAP NO. _____ BLOCK NO. _____

SOUTH OF FREETOWN RD. TO GUILFORD RD.
CAPITAL PROJECT J-4086
ELECTION DISTRICT NO. 5
HOWARD COUNTY, MARYLAND

SCALE AS SHOWN
SHEET 27 OF 28

985


XXCE-90-027

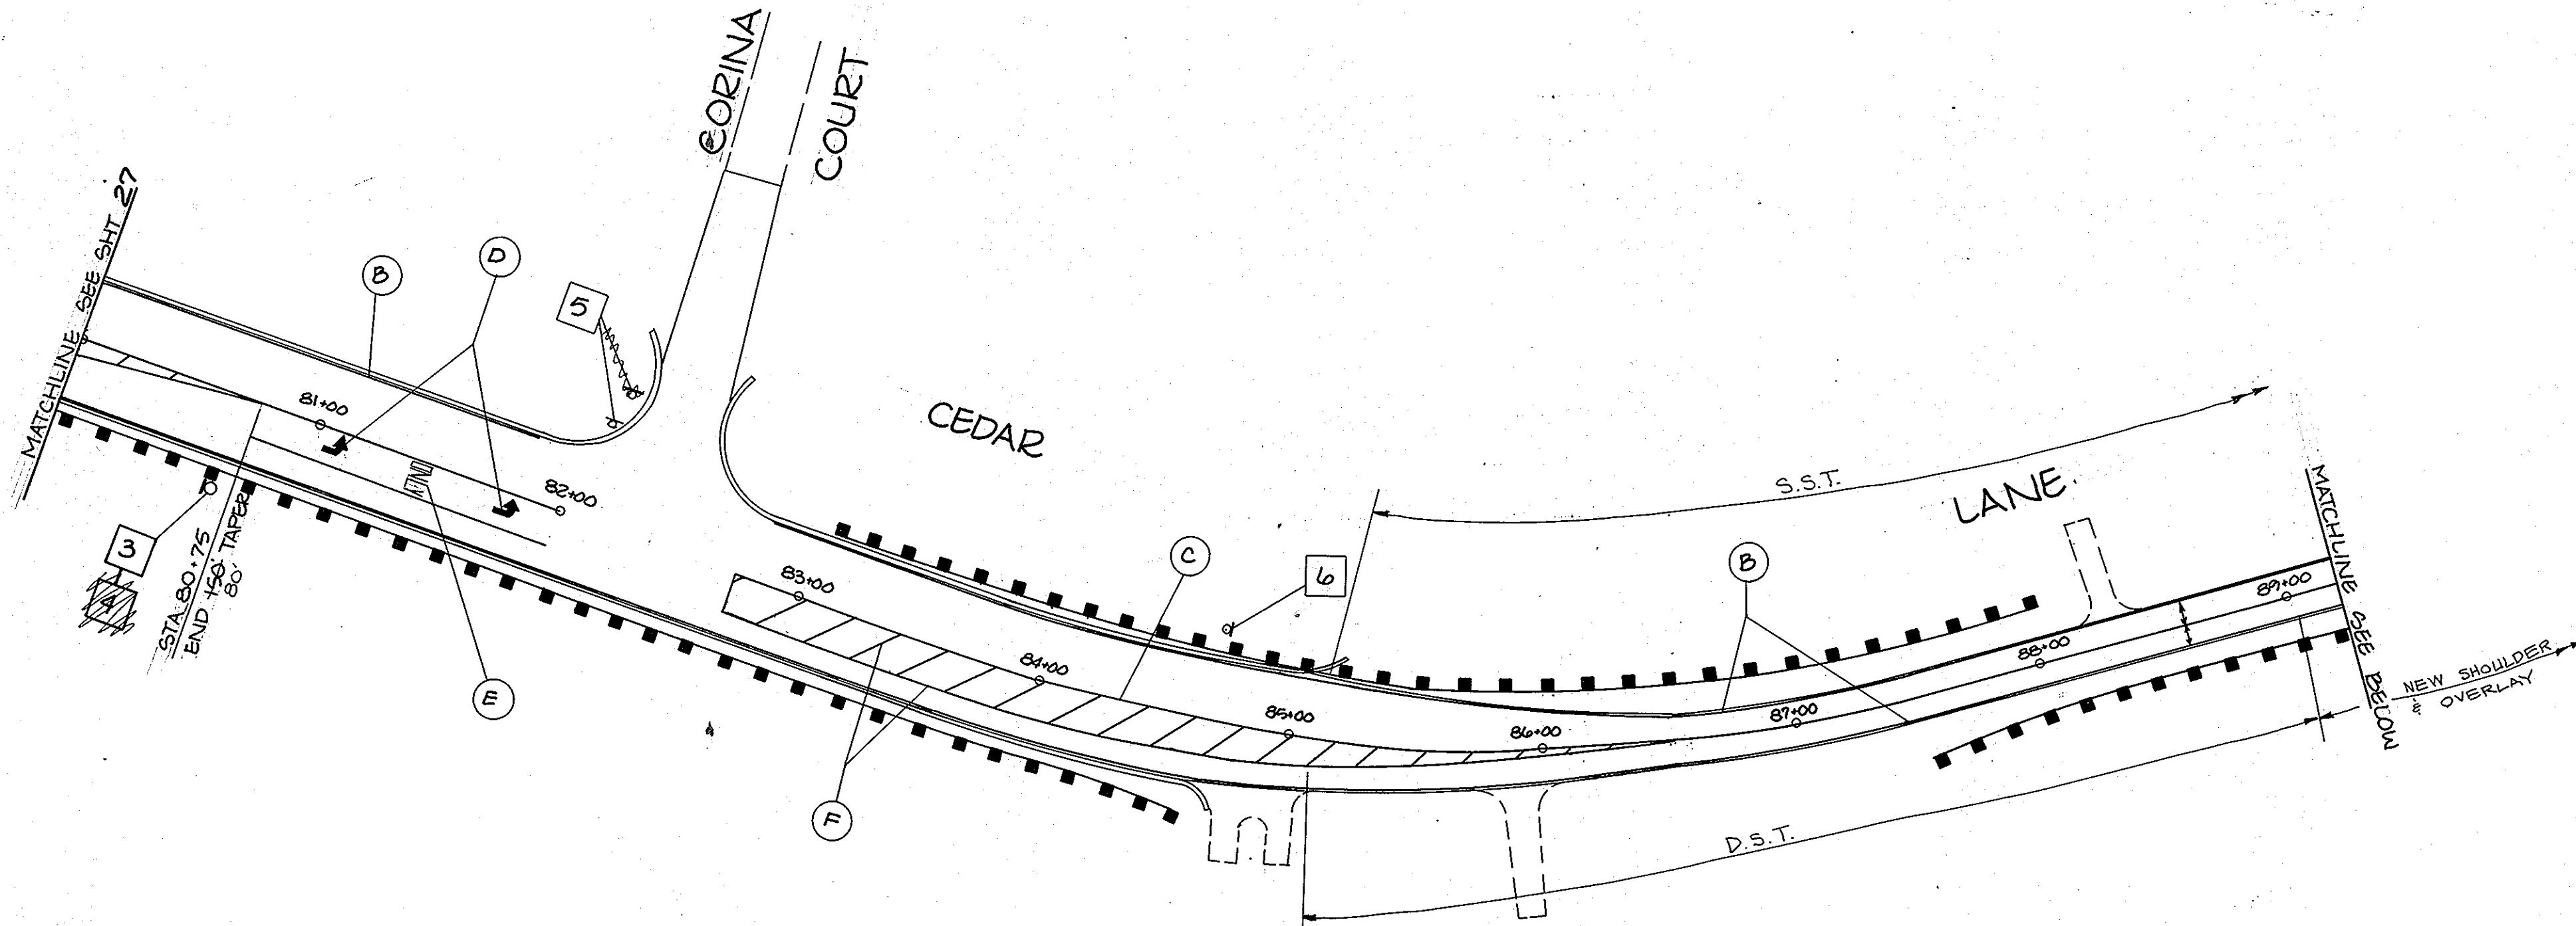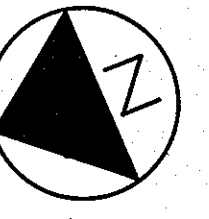

SIGN SCHEDULE			
SIGN NO.	MUTCD	SIZE	MESSAGE
1	W9-1 W9-2	36" x 36"	LEFT LANE ENDS LANE ENDS MERGE LEFT
2	W4-2	36" x 36"	
3	W1-1L	30" x 30"	
4	W3-1	36" x 36"	20 MPH
5	R1-1	30" x 30"	STOP
6	W2-2	30" x 30"	
7	R2-1	24" x 30"	SPEED LIMIT 30
8	R2-5A	24" x 30"	REDUCE SPEED AHEAD
9	R2-1	24" x 30"	SPEED LIMIT 35
9	R10-12	24" x 30"	LEFT YIELD ON GREEN ●

PAVEMENT MARKING DETAILS

- A. INSTALL 10 STRIPE WITH 30' GAP PAINTED WHITE PAVEMENT MARKING (4" WIDTH) AS SHOWN.
- B. INSTALL PAINTED WHITE PAVEMENT MARKING (4" WIDTH) AS SHOWN. 1 1/2' FROM FACE OF CURB.
- C. INSTALL PAINTED YELLOW PAVEMENT MARKINGS (4" WIDTH - CENTERLINES) AS SHOWN.
- D. INSTALL CURVED ARROW (SYMBOL) PREFORMED PAVEMENT MARKING (LEFT). SEE MUTCD 3B-20.
- E. INSTALL "ONLY" (WORD) PREFORMED PAVEMENT MARKING. SEE MUTCD 3B-20.
- F. INSTALL MEDIAN ISLAND FORMED BY PAVEMENT MARKINGS. SEE MUTCD 3B-10.

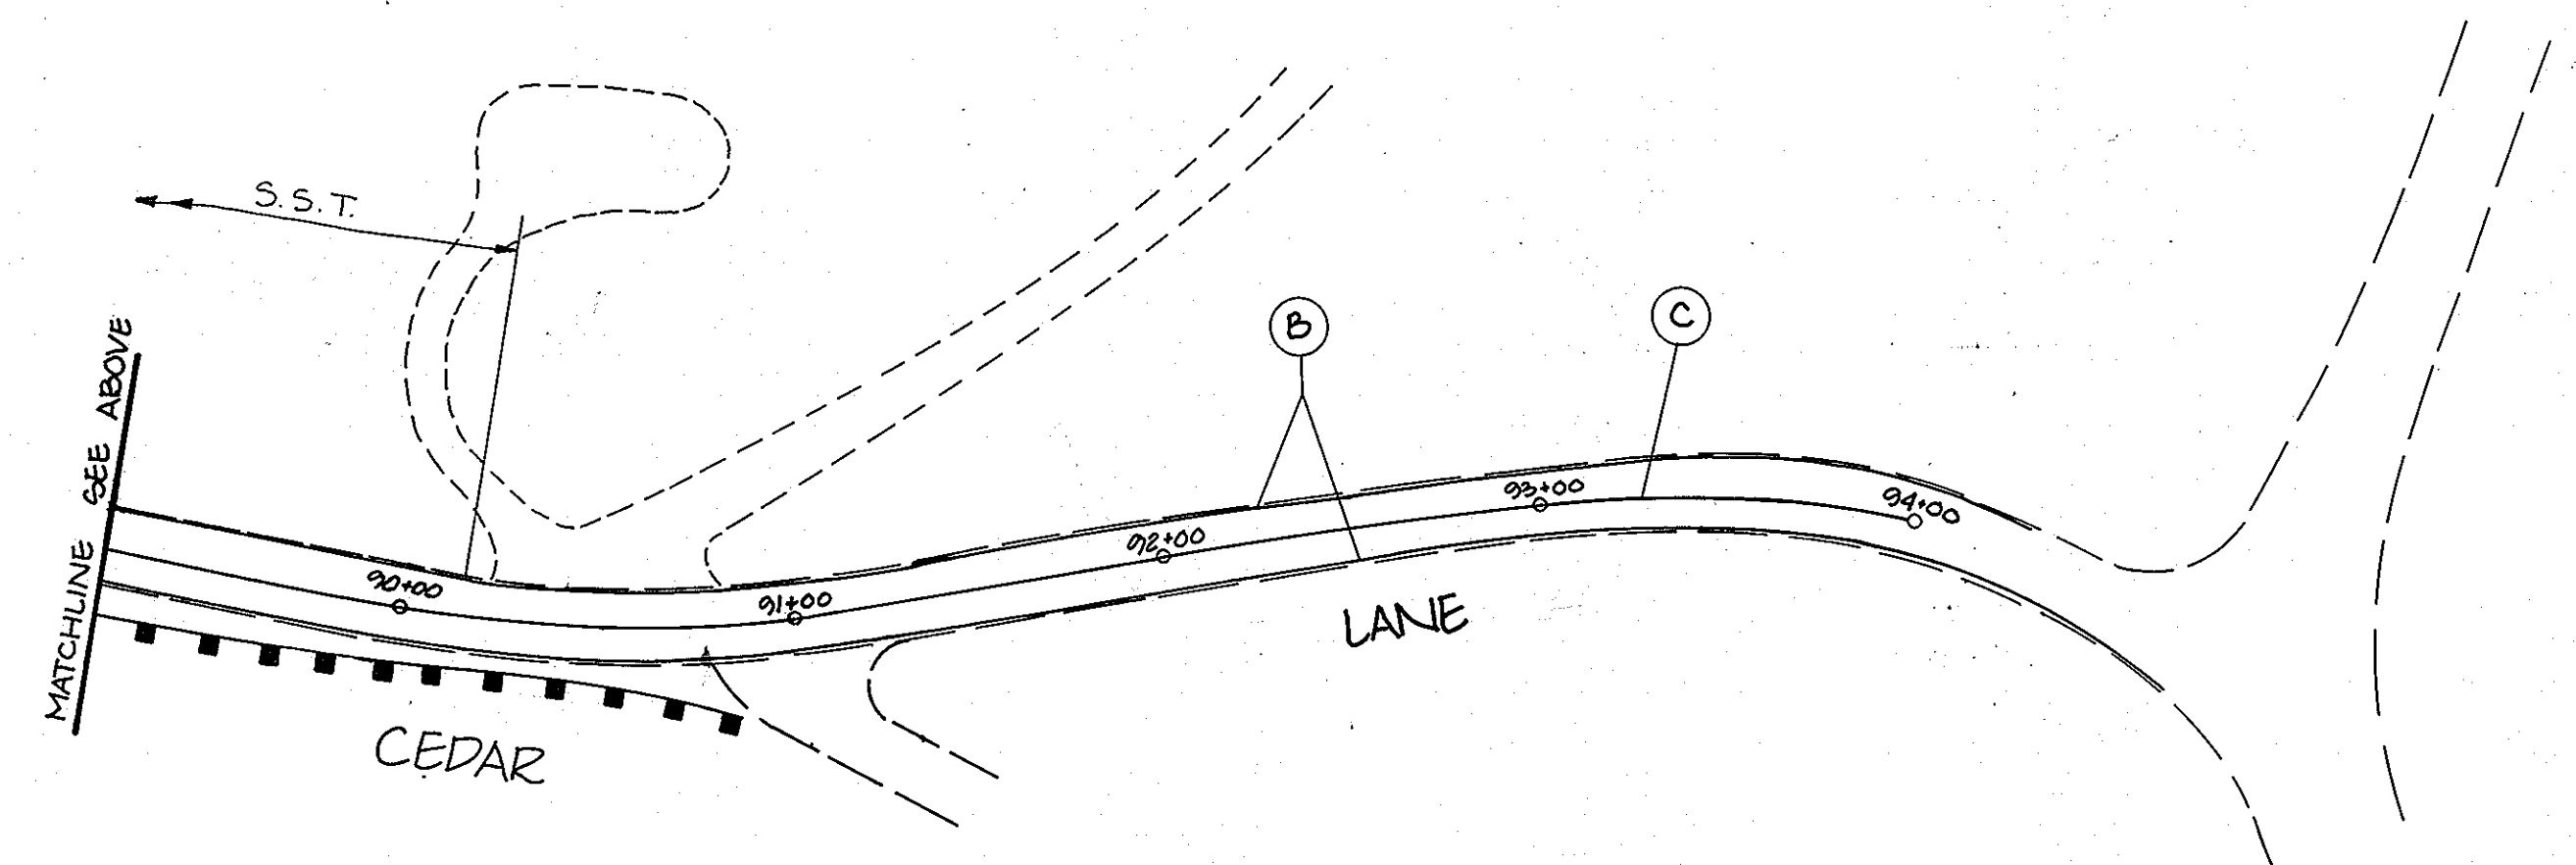

LEGEND	
TRAFFIC SIGN NO.	
TRAFFIC SIGN AND SUPPORT	
STRIPING TYPE NO.	

985

<p>DEPARTMENT OF PUBLIC WORKS HOWARD COUNTY, MARYLAND</p> <p><i>James W. ...</i> 7/12/90 DIRECTOR OF PUBLIC WORKS DATE</p> <p><i>William D. ...</i> 7/11/90 CHIEF, BUREAU OF ENGINEERING DATE</p> <p><i>Alvin ...</i> 7/12/90 CHIEF, DIVISION OF ROADS, BRIDGES AND STORM DRAINAGE DATE</p>		<p>DES: JBN</p> <p>DRN: 6M1</p> <p>CHK:</p> <p>DATE: 6/90</p> <p>BY: [Signature]</p>	<p>STRIPING AND PERMANENT SIGNING PLAN CEDAR LANE - PHASE 2</p> <p>MARKS & ASSOC. 2 AS-BUILT 1/2/92</p> <p>REVISION</p> <p>DATE: 6/90</p> <p>600' SCALE MAP NO. _____ BLOCK NO. _____</p>	<p>SOUTH OF FREETOWN RD. TO GUILFORD RD. CAPITAL PROJECT J-4086 ELECTION DISTRICT NO. 5 HOWARD COUNTY, MARYLAND</p>	<p>SCALE AS SHOWN</p> <p>SHEET 28 OF 28</p>
---	--	--	---	---	---