

# OAKLAND MILLS ROAD IMPROVEMENTS

## HOWARD COUNTY, MARYLAND

### SNOWDEN RIVER PARKWAY TO OLD MONTGOMERY ROAD

#### CAPITAL PROJECT NO. J-4095


1989 ADT = 9,200  
 2010 ADT = 10,000  
 DESIGN SPEED = 40 MPH  
 LENGTH = 2.2 MILES

#### CONVENTIONAL SYMBOLS

SYMBOL	DESCRIPTION
---	EXISTING CURB/CURB & GUTTER
---	PROPOSED CURB AND GUTTER
---	PROPERTY / LOT BOUNDARY
---	RIGHT-OF-WAY
---	PROPOSED FULL DEPTH PAVEMENT
T	UTILITY POLE
---	GAS MAIN VALVE COVER
○	ROADSIDE TREES (WITH DIAMETER)
---	STORM DRAIN & MANHOLE (EXISTING)
○	WATER MAIN VALVE COVER
○	EXISTING STORM DRAIN THROAT INLET
---	PROPOSED STORM DRAIN
---	EXISTING STORM DRAIN GRATE INLET
□	BOXES FOR UNDERGROUND UTILITIES
○	GUY WIRE
○	FIRE HYDRANT
□	TRANSFORMER BOX (POWER PLANT)
□	METAL PLATE
○	SIGNAL POLE
○	LIGHT POLE
---	WATER MAIN
---	SEWER MAIN
---	PAVEMENT & CURB TIE-IN AT CURB RETURNS
---	REVERTIBLE GRADING EASEMENTS
△	TRAVERSE POINT
---	REMOVE EXISTING PAVEMENT & REPLACE FULL DEPTH BETWEEN PROPOSED CURBS.
---	BURIED C&P CABLE WITHOUT CONDUIT
---	WITH
---	BG&E - BALTIMORE GAS & ELECTRIC CABLE
---	AREA FOR PAVEMENT RESURFACING
---	PROPOSED CENTERLINE (BASE LINE OF CONSTRUCTION)
---	PROPOSED SIDEWALK
---	MILL EXISTING PAVEMENT (1/2" DEPTH)
---	TEST PIT LOCATION
---	PAVEMENT CORING LOCATION
---	INLET PROTECTION FOR SEDIMENT CONTROL (SEE SHT. 16 FOR DETAIL)


#### GENERAL NOTES

- ALL CONSTRUCTION SHALL BE IN ACCORDANCE WITH HOWARD COUNTY DEPARTMENT OF PUBLIC WORKS "DESIGN MANUAL" VOLUME IV - STANDARD SPECIFICATIONS AND DETAILS FOR CONSTRUCTION, UNLESS OTHERWISE NOTED.
- THE CONTRACTOR SHALL NOTIFY MISS UTILITY AT LEAST FIVE WORKING DAYS PRIOR TO BEGINNING CONSTRUCTION.
- EXISTING UTILITIES AND OBSTRUCTIONS SHOWN ARE FROM THE BEST AVAILABLE INFORMATION AND SHALL BE VERIFIED BY THE CONTRACTOR PRIOR TO BEGINNING CONSTRUCTION. ANY DAMAGED UTILITIES DUE TO THE CONSTRUCTION OPERATION SHALL BE REPAIRED AT THE CONTRACTOR'S EXPENSE.
- AS PART OF THIS CONTRACT, IT SHALL BE THE CONTRACTOR'S RESPONSIBILITY TO REMOVE ALL THE EXISTING CURB, REALIGN, AND RESURFACE AND WIDEN OAKLAND MILLS ROAD IN ACCORDANCE WITH THE PLANS, PROFILES AND CROSS SECTIONS SHOWN ON THESE DRAWINGS. AT ALL ROADWAY AND CURBED DRIVEWAY ENTRANCE INTERSECTIONS, CURB AND GUTTER WILL BE PLACED TO JOIN THE EXISTING CURB AT THE CURB RETURN. THE CONTRACTOR SHALL ESTABLISH THE EXISTING CURB RADIUS WHERE CURBS ARE TO BE REPLACED AT STREET INTERSECTIONS AND DRIVEWAYS; NEW CURB & GUTTER SHALL BE PLACED AT THE EXISTING RADIUS, UNLESS OTHERWISE SHOWN.
- IT SHALL BE THE CONTRACTOR'S RESPONSIBILITY TO ADJUST ALL EXISTING VALVES, MANHOLES COVERS, ETC. LOCATED WITHIN THE PROPOSED PAVING AND SIDEWALK AREAS.
- THE CONTRACTOR SHALL RELOCATE ALL UTILITIES AS REQUIRED FOR THE ROAD IMPROVEMENTS.
- ALL B&E AND C&P LINES SHOWN HEREON ARE APPROXIMATE IN LOCATION & DEPICTION OF SAME MAY BE INCOMPLETE. FIELD ADJUSTMENT OF THE SEDIMENT CONTROL MEASURES AS SHOWN MAY BE REQUIRED, BASED UPON FIELD LOCATION OF THE UTILITIES. SAID ADJUSTMENTS WILL BE PERFORMED AS DIRECTED BY THE ENGINEER.
- THE CONTRACTOR SHALL PROVIDE HANDICAP RAMPS, PER HOWARD COUNTY STANDARDS R-4-01, AT ALL STREET INTERSECTIONS AND DRIVEWAYS WITH EXISTING AND PROPOSED SIDEWALKS RAMPS TO BE PROVIDED AT ALL CURBED DRIVEWAYS.
- IT IS THE CONTRACTOR'S RESPONSIBILITY TO ENSURE THAT ALL EXISTING CURB / CURB AND GUTTER IS REMOVED AS REQUIRED AND THAT A FULL DEPTH PAVEMENT SECTION ABUTS THE GUTTER PAN ALONG THE ENTIRE ROADWAY SURFACE.

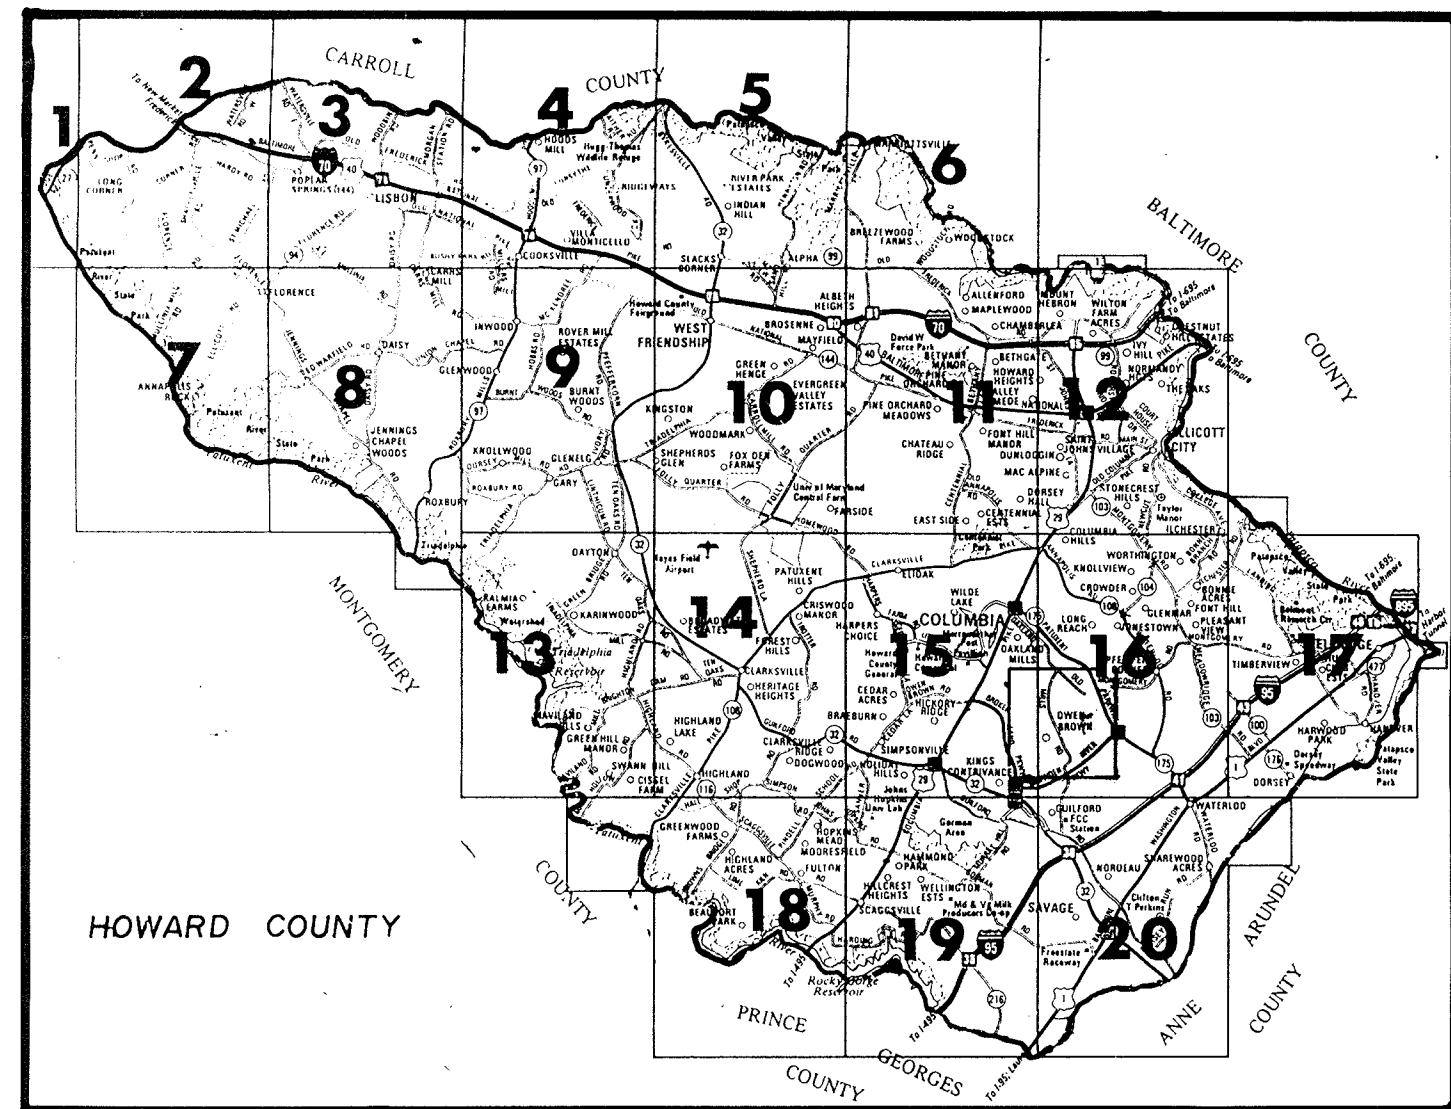

LOCATION MAP

SCALE : 1" = 2 1/2 MILES  
 OR 1" = 4 MILES

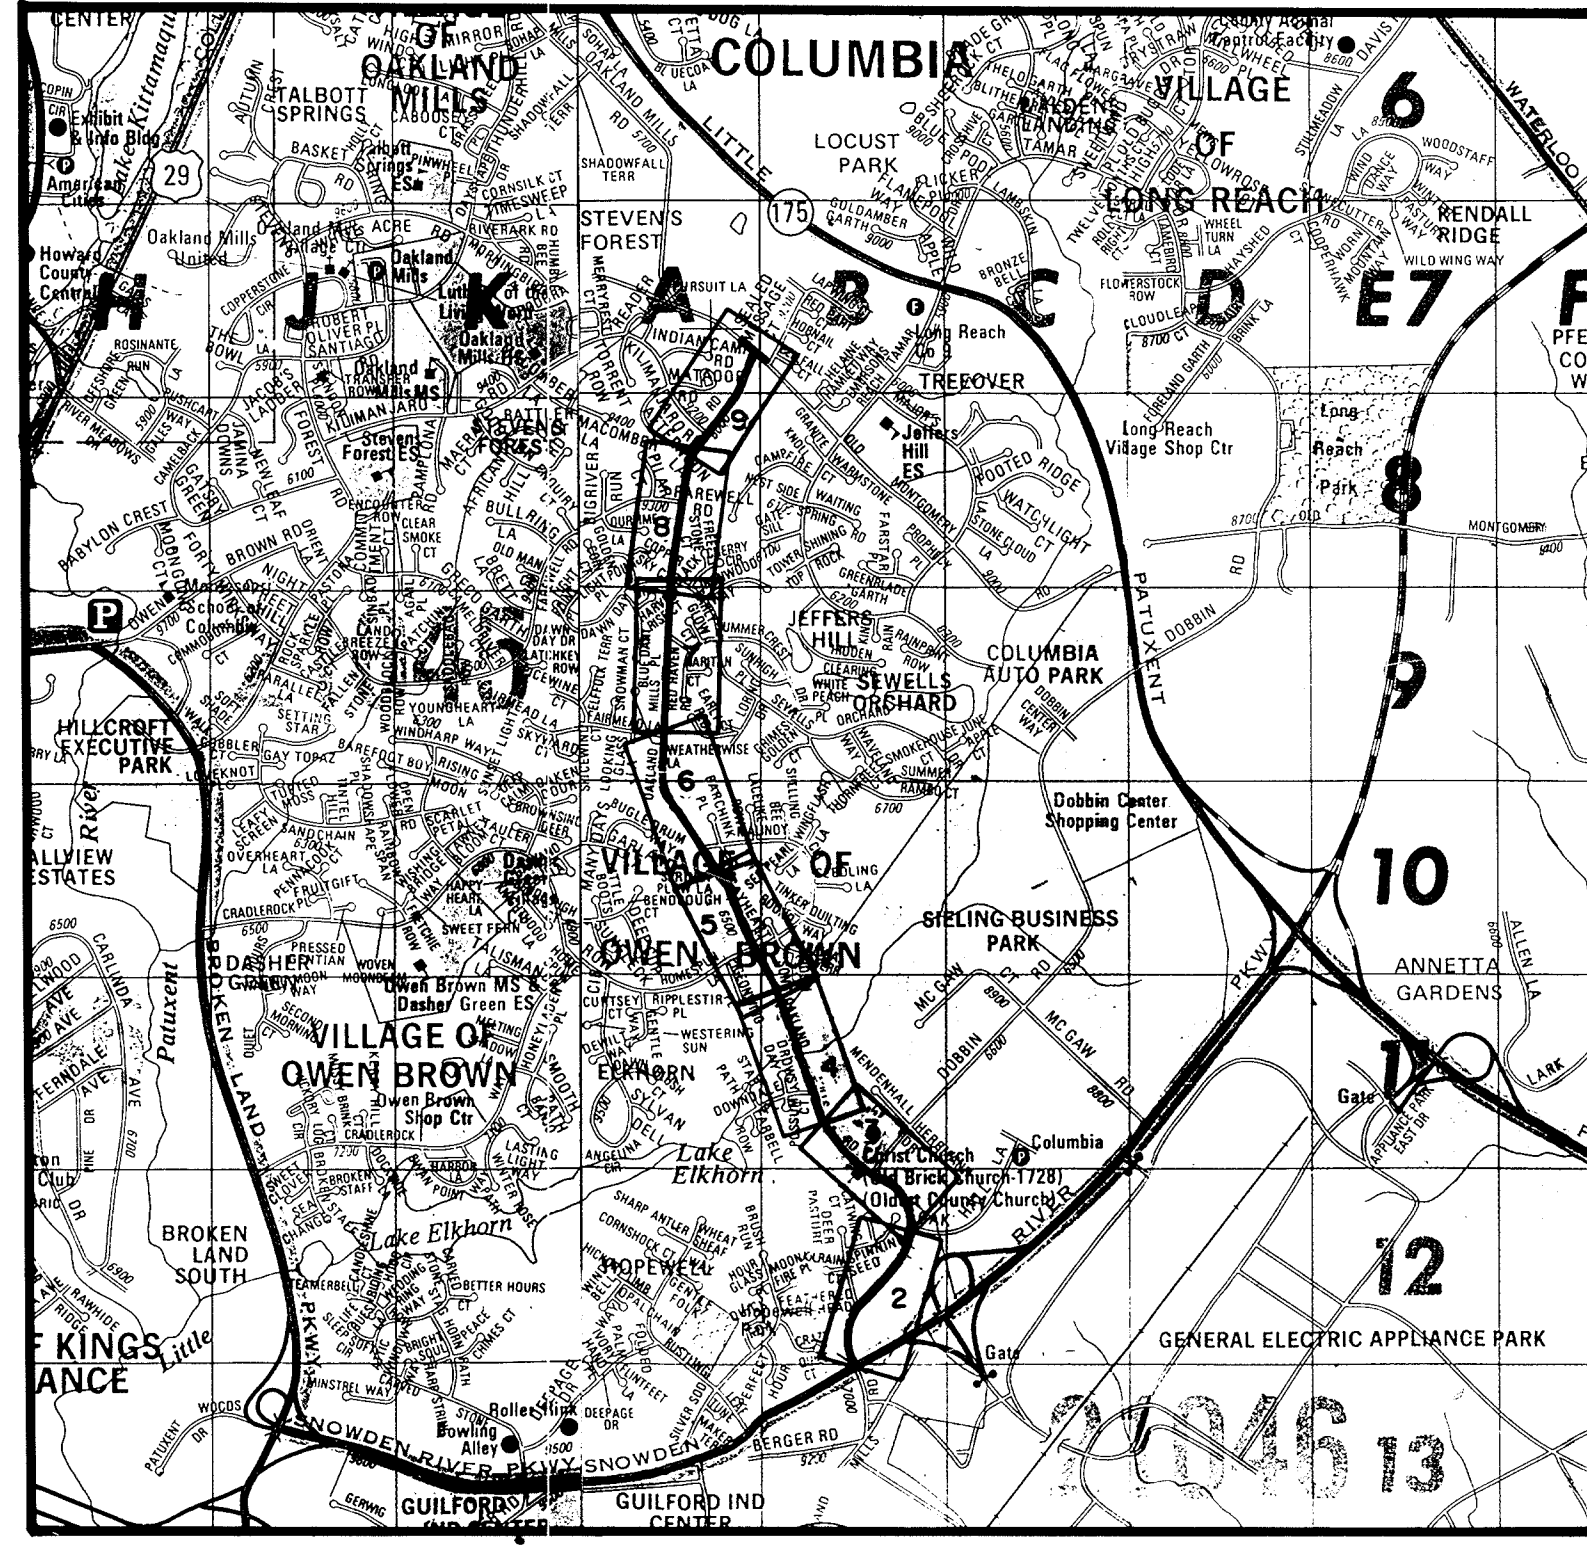

SITE LOCATION

SCALE: 1" = 2000'

#### DRAWING INDEX

- COVER SHEET
- PLAN AND PROFILE - STA. 0+00 TO STA. 14+00
- PLAN AND PROFILE - STA. 14+00 TO STA. 29+00
- PLAN AND PROFILE - STA. 29+00 TO STA. 44+00
- PLAN AND PROFILE - STA. 44+00 TO STA. 59+00
- PLAN AND PROFILE - STA. 59+00 TO STA. 74+50
- PLAN AND PROFILE - STA. 74+50 TO STA. 90+00
- PLAN AND PROFILE - STA. 90+00 TO STA. 105+50
- PLAN AND PROFILE - STA. 105+50 TO STA. 117+81.72
- TOP OF CURB PROFILE - STA. 0+00 TO STA. 29+00
- TOP OF CURB PROFILE - STA. 29+00 TO STA. 44+00
- TOP OF CURB PROFILE - STA. 44+00 TO STA. 59+00
- TOP OF CURB PROFILE - STA. 59+00 TO STA. 90+00
- TOP OF CURB PROFILE - STA. 90+00 TO STA. 117+81.72
- TYPICAL CROSS SECTIONS
- TYPICAL CROSS SECTIONS & EARTHWORK SUMMARY
- STORM DRAIN PROFILES
- STORM DRAIN PROFILES
- SEDIMENT CONTROL DETAILS & CONSTRUCTION SEQUENCES
- LANDSCAPING PLANS

THIS DEVELOPMENT PLAN IS APPROVED FOR SOIL EROSION AND SEDIMENT CONTROL BY THE HOWARD SOIL CONSERVATION DISTRICT

APPROVED: *[Signature]* DATE: 8/21/90  
 HOWARD S.C.D.

REVIEWED FOR HOWARD S.C.D. AND MEETS TECHNICAL REQUIREMENTS

*[Signature]* DATE: 8/22/90  
 S.S. SOIL CONSERVATION SERVICE

CERTIFICATION BY THE ENGINEER

"I CERTIFY THAT THIS PLAN FOR EROSION AND SEDIMENT CONTROL REPRESENTS A PRACTICAL AND WORKABLE PLAN BASED ON MY PERSONAL KNOWLEDGE OF THE SITE CONDITIONS AND THAT IT WAS PREPARED IN ACCORDANCE WITH THE REQUIREMENTS OF THE HOWARD SOIL CONSERVATION DISTRICT."

Michael N. Armstrong DATE: 7/31/89

CERTIFICATION BY THE DEVELOPER

"I/WE CERTIFY THAT ALL DEVELOPMENT AND/OR CONSTRUCTION WILL BE DONE ACCORDING TO THIS PLAN, AND THAT THE RESPONSIBLE PERSONAL INVOLVED IN THIS CONSTRUCTION PROJECT WILL HAVE A CERTIFICATE OF ATTENDANCE AT THE DEPARTMENT OF NATIONAL RESOURCES APPROVED TRAINING PROGRAM FOR THE CONTROL OF SEDIMENT AND EROSION BEFORE BEGINNING THE PROJECT."

*[Signature]* DATE: 8-21-90

BRUNING 44-132-69150

DEPARTMENT OF PUBLIC WORKS  
 HOWARD COUNTY, MARYLAND

*[Signature]* DATE: 8/22/90  
 DIRECTOR OF PUBLIC WORKS

*[Signature]* DATE: 8/22/90  
 CHIEF, BUREAU OF HIGHWAYS

*[Signature]* DATE: \_\_\_\_\_  
 CHIEF, DIVISION OF ROADS BRIDGES AND STORM DRAINAGE

ENGINEERING TECHNOLOGIES ASSOCIATES, INC.  
 ENGINEERS - PLANNERS - SURVEYORS

3408 ELLICOTT CENTER DRIVE SUITE 101  
 ELLICOTT CITY, MARYLAND 21043  
 (301) 461-9920

*[Signature]*

DES: KAP					
DRN: SGP					
CHK: MNA					
DATE: 8/30	BY	NO.	REVISION	DATE	

600' SCALE MAP NO. \_\_\_\_\_ BLOCK NO. \_\_\_\_\_

COVER SHEET

OAKLAND MILLS ROAD IMPROVEMENTS  
 6TH ELECTION DISTRICT HOWARD COUNTY, MARYLAND  
 CAPITAL PROJECT NO. J-4095


SCALE AS SHOWN

SHEET 1 OF 27



STORM DRAIN STRUCTURE SCHEDULE									
STRUCTURE	STATION	TYPE	TOP EL.	INV. IN	INV. OUT	REMARKS	HOWARD CO. STD. NO.	E. STR. OFFSET	
M-1	2+05-LEFT	STANDARD MANHOLE	359.08		351.58	PROPOSED STRUCTURE	0-5-11	30'-L.F.	
M-2	3+10-LEFT	STANDARD MANHOLE	359.48	358.25	358.14	PROPOSED STRUCTURE	0-5-11	20'-L.F.	
M-3	3+58-LEFT	STANDARD MANHOLE	359.58	349.25		PROPOSED STRUCTURE	0-5-11	30'-L.F.	
EX. INLET	4+64-RIGHT	A-5 INLET	355.58		351.36	EX. INLET TO BE REPLACED	SD 4.40	23.67 FT.	
I-1A	3+18-LEFT	TYPE #8 COMB.	359.11			EX. MH TO BE REPLACED BY INLET	SD 4.32	32'-L.F.	

\*NOTE: ALL COMBINATION INLET TOP ELEVATIONS ON ALL STORM DRAIN STRUCTURE SCHEDULES ARE TOP OF CURB.

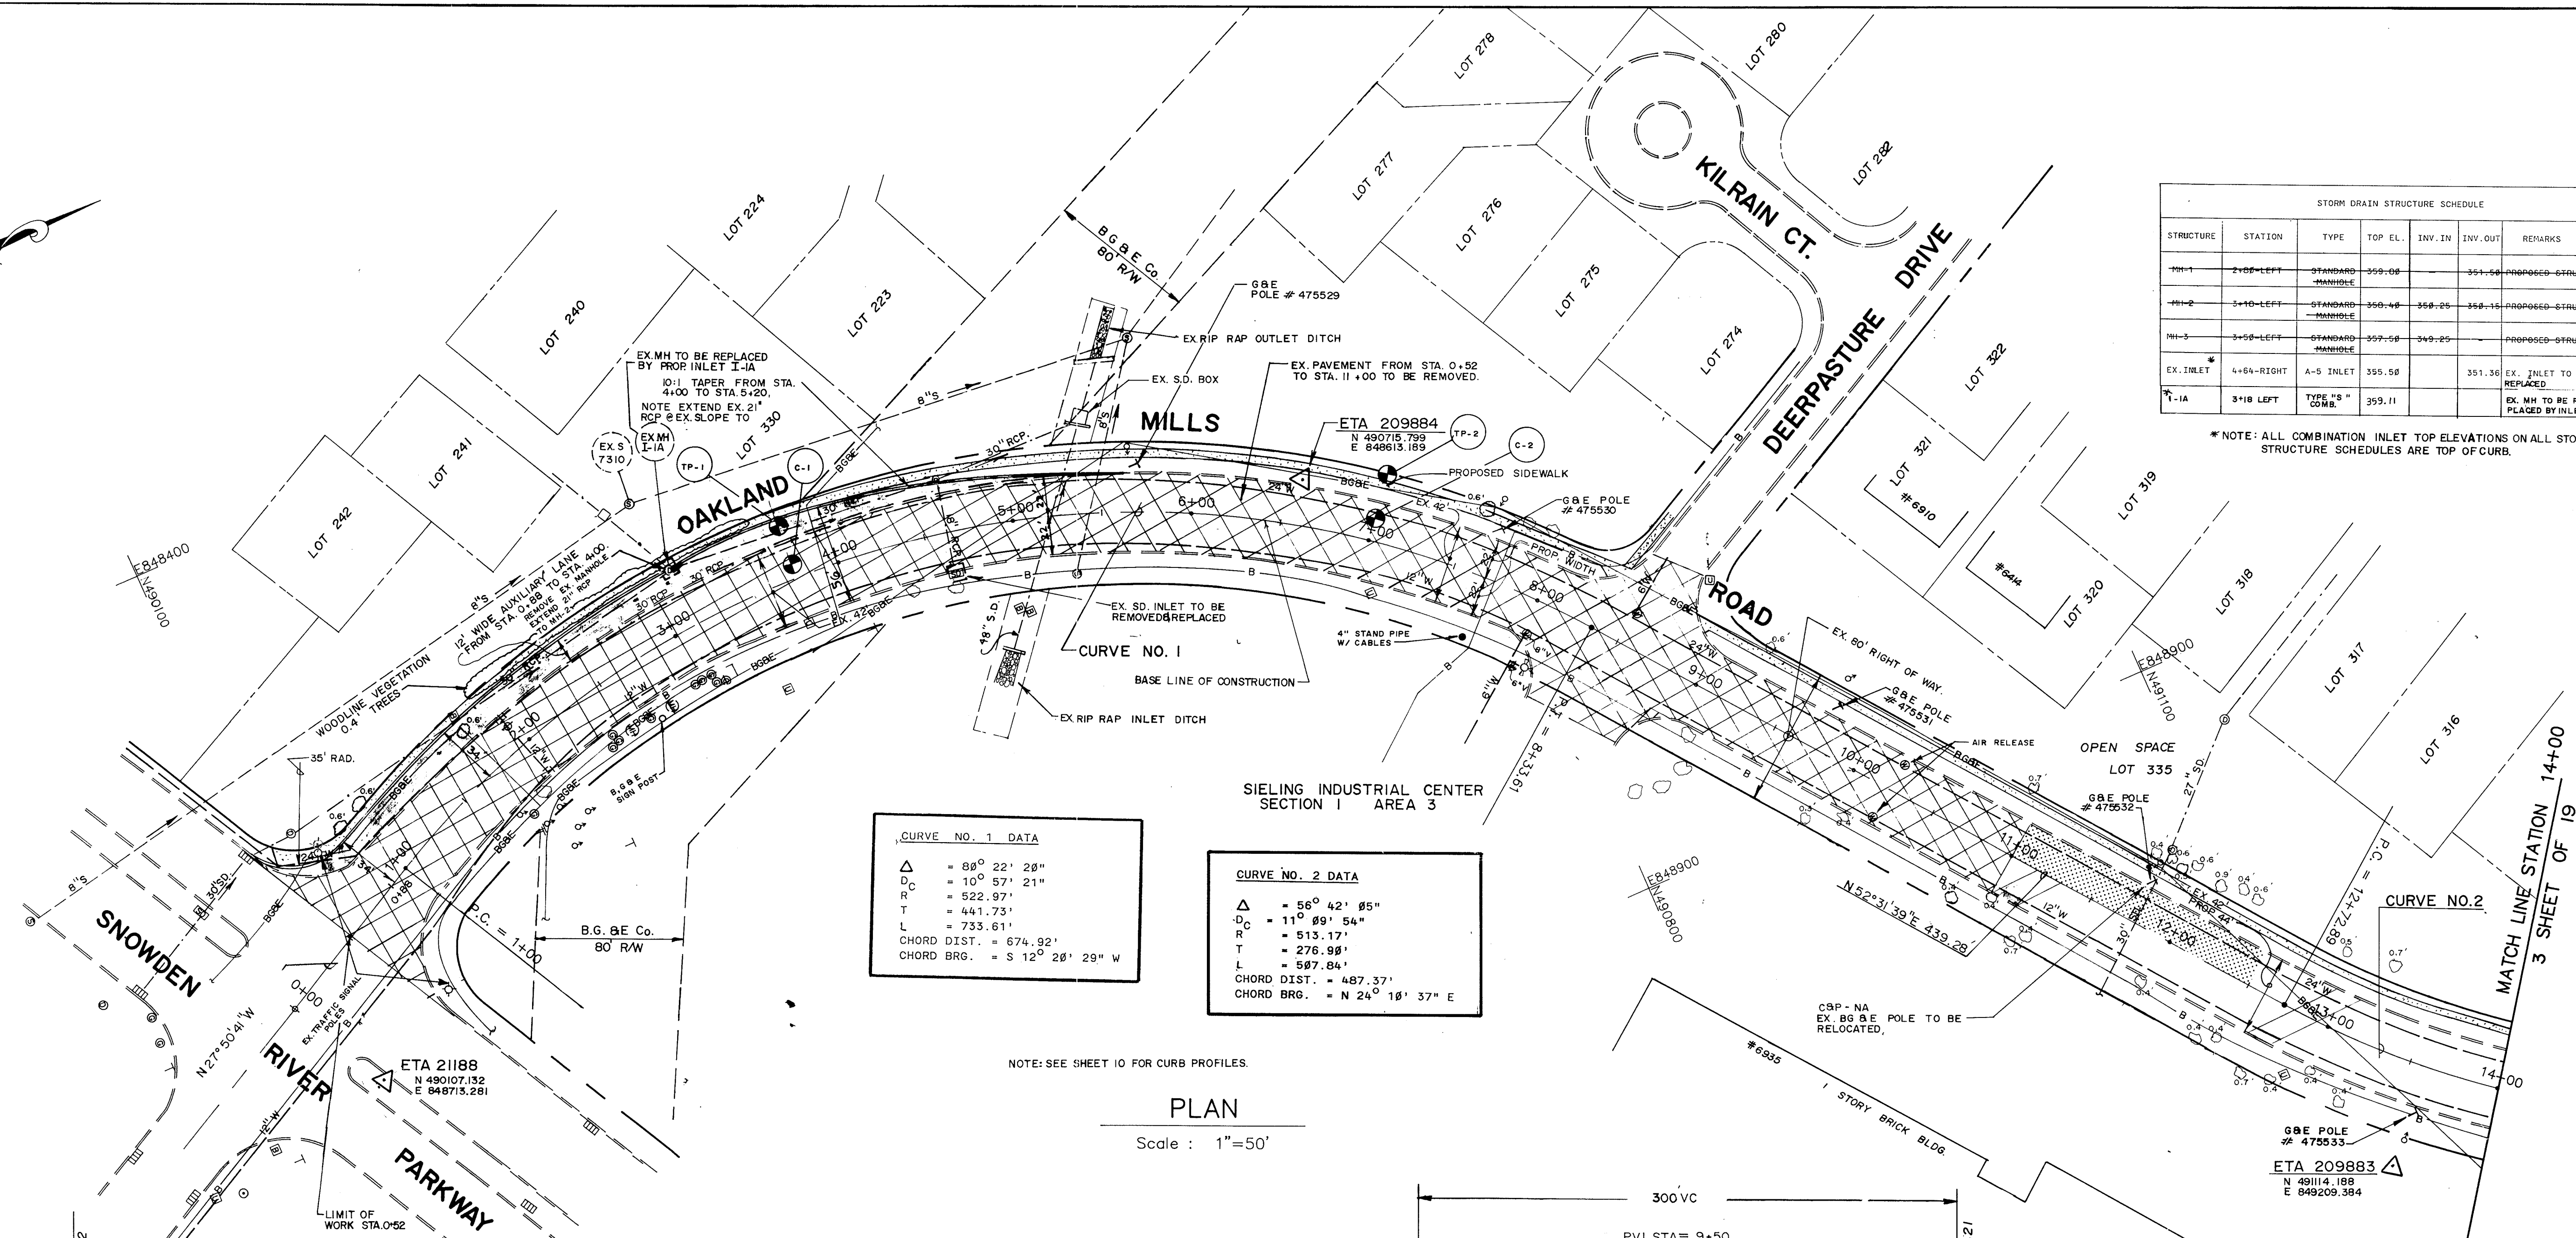

**CURVE NO. 1 DATA**

Δ	= 88° 22' 28"
D <sub>c</sub>	= 10° 57' 21"
R	= 522.97'
T	= 441.73'
L	= 733.61'
CHORD DIST.	= 674.92'
CHORD BRG.	= S 12° 28' 29" W


**CURVE NO. 2 DATA**

Δ	= 56° 42' 05"
D <sub>c</sub>	= 11° 09' 54"
R	= 513.17'
T	= 276.98'
L	= 587.04'
CHORD DIST.	= 487.37'
CHORD BRG.	= N 24° 18' 37" E

NOTE: SEE SHEET 10 FOR CURB PROFILES.

**PLAN**

Scale : 1"=50'

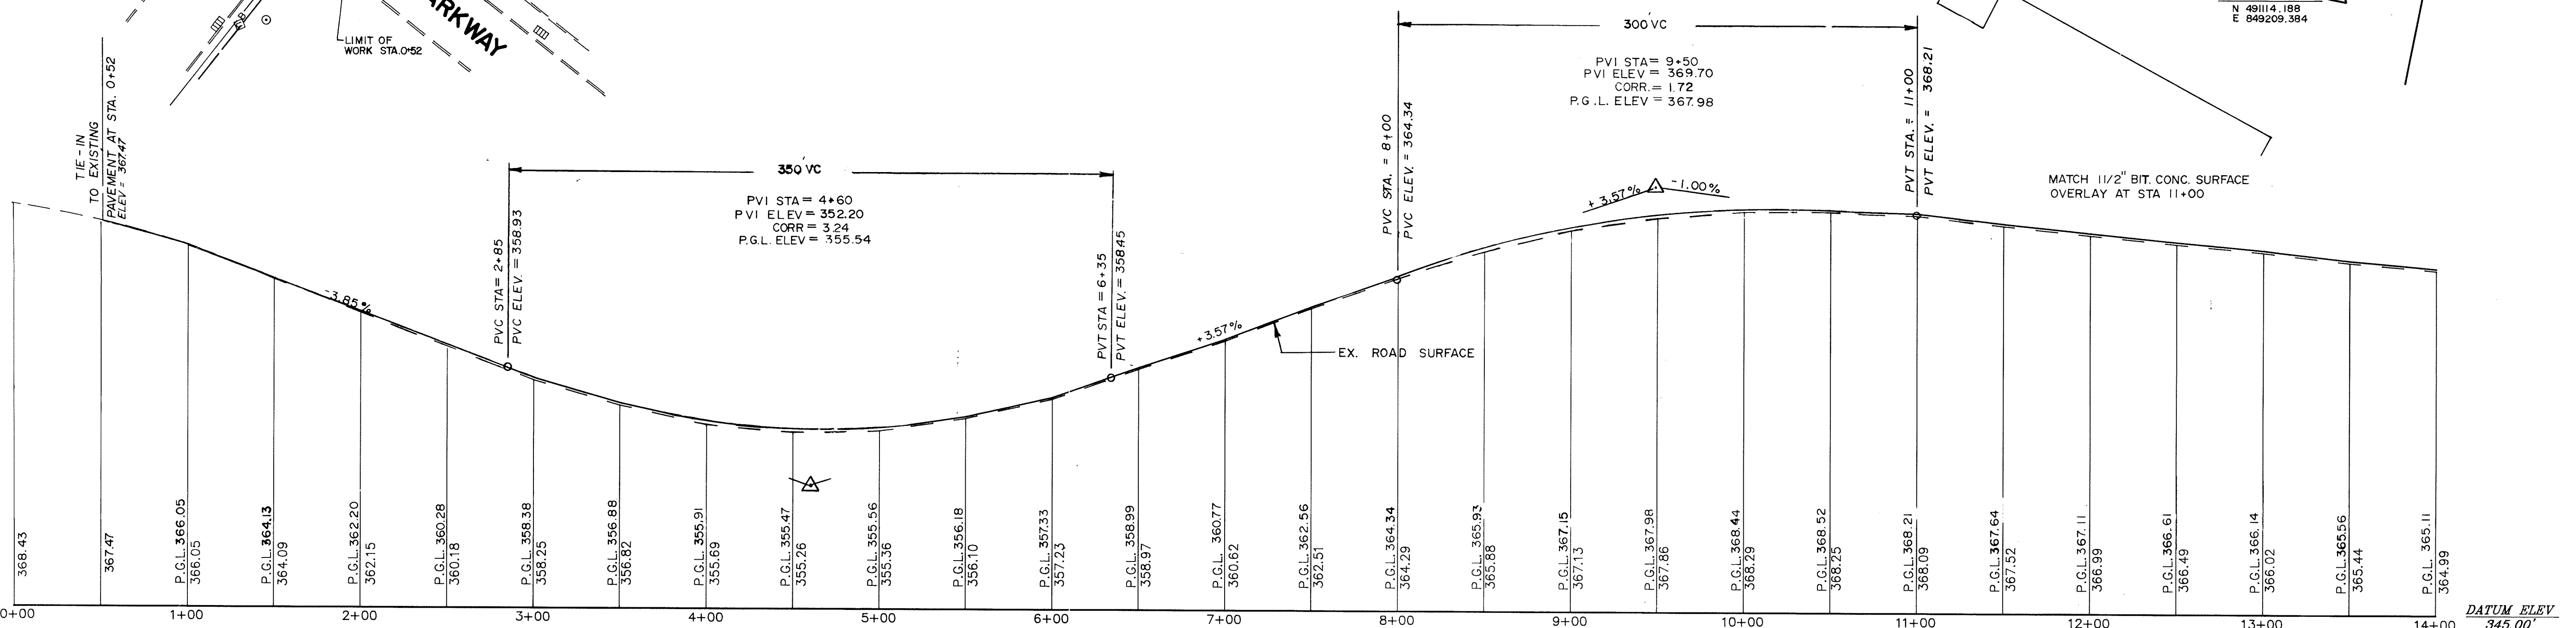

**PROFILE**

Scale : Horz. 1"=50'  
Vert. 1"=5'

DEPARTMENT OF PUBLIC WORKS  
HOWARD COUNTY, MARYLAND

*James P. ...*  
DIRECTOR OF PUBLIC WORKS

*Draville W. McElwain*  
CHIEF, BUREAU OF HIGHWAYS

*...*  
CHIEF, DIVISION OF ROADS, BRIDGES AND STORM DRAINAGE

ENGINEERING TECHNOLOGIES ASSOCIATES, INC.  
ENGINEERS - PLANNERS - SURVEYORS

3458 ELLICOTT CENTER DRIVE SUITE 101  
ELLICOTT CITY, MARYLAND 21043  
(301) 481-9800

*Michael A. Armstrong*  
REGISTERED PROFESSIONAL ENGINEER


DES:	JVP.				
DRN:	SGP.				
CHK:	MNA.				
DATE:	8/90				
BY:	NO.	REVISION	DATE	600' SCALE MAP NO.	BLOCK NO.

PLAN AND PROFILE - STA. 0+00 TO STA. 14+00

**OAKLAND MILLS ROAD IMPROVEMENTS**  
6<sup>TH</sup> ELECTION DISTRICT HOWARD COUNTY, MARYLAND  
CAPITAL PROJECT NO. : J-4095

SCALE AS SHOWN

SHEET 2 OF 27

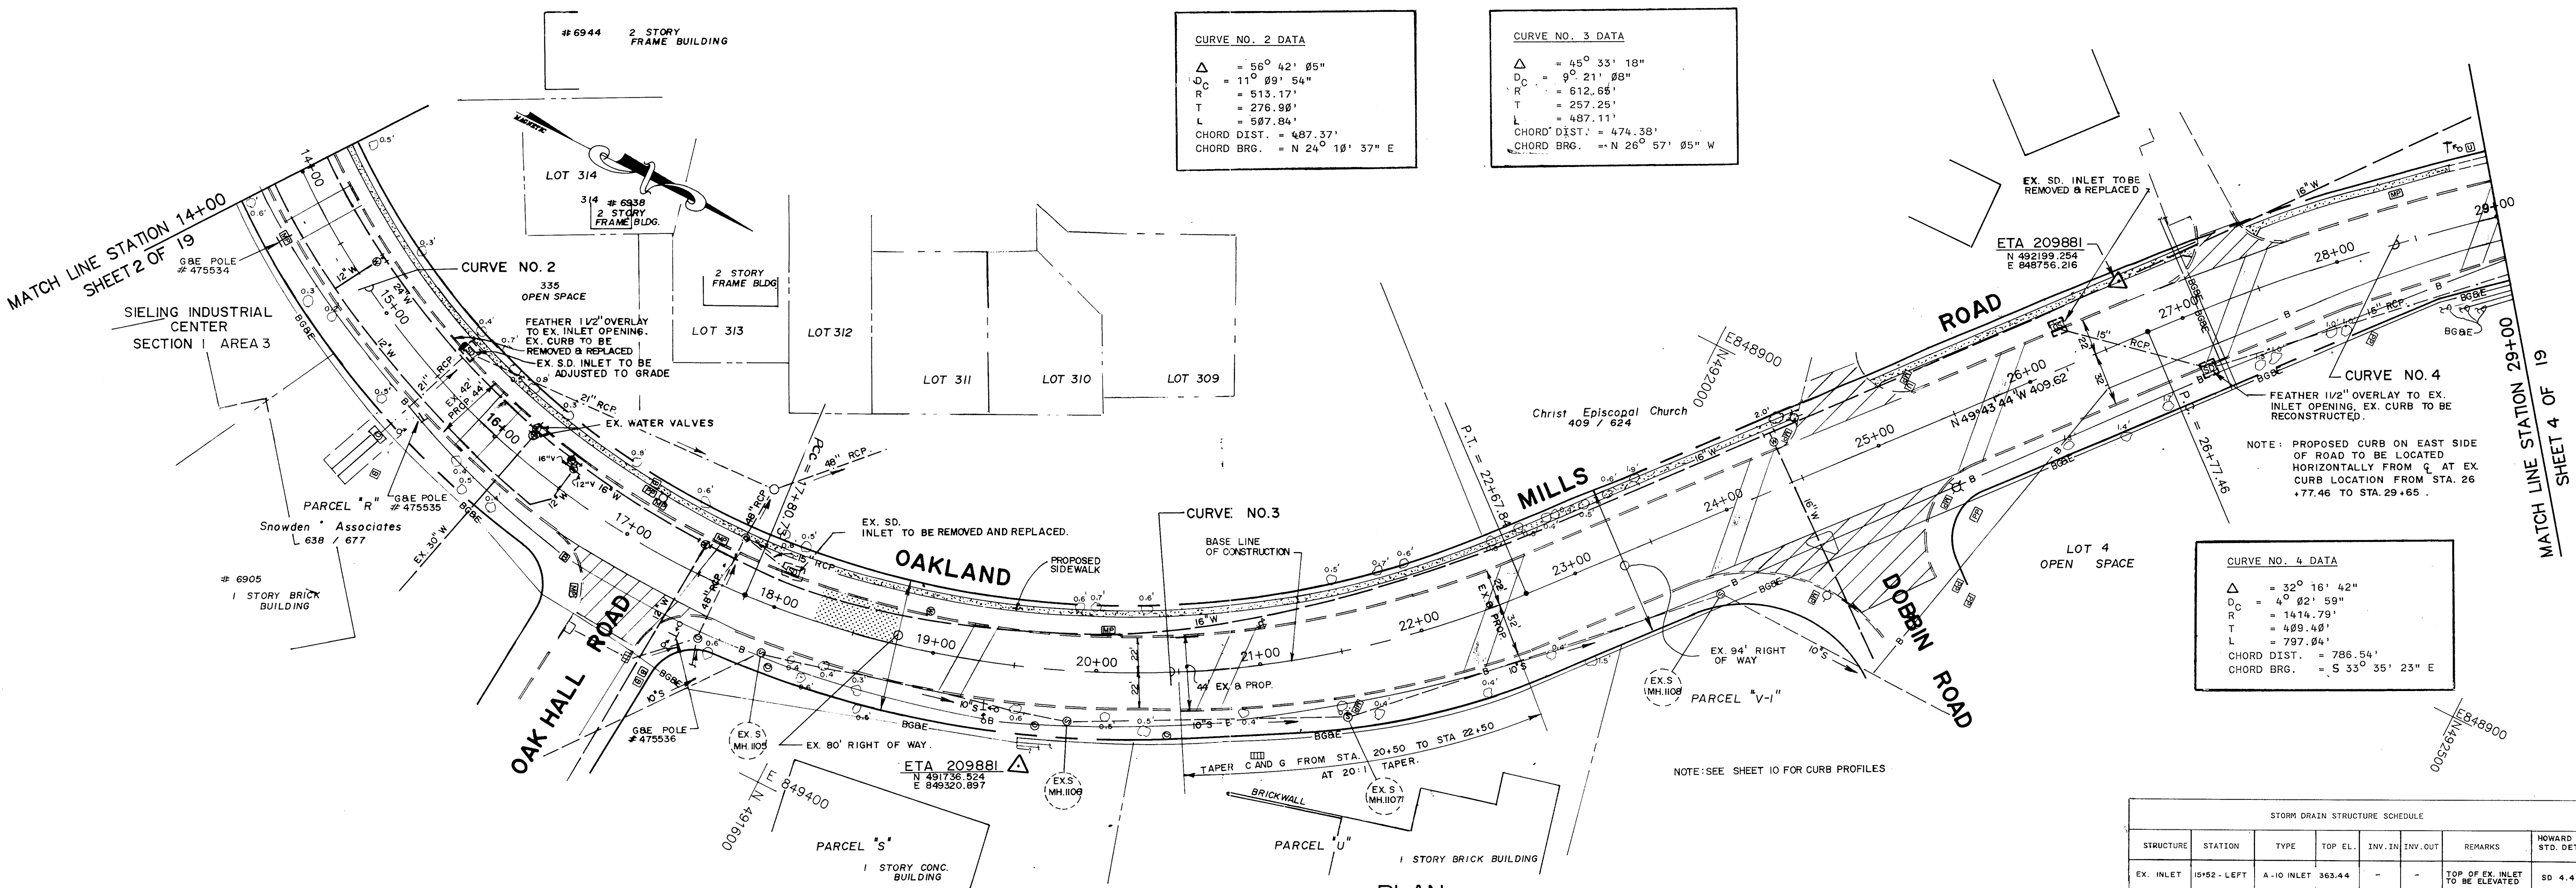

**CURVE NO. 2 DATA**

$\Delta = 56^\circ 42' 05''$   
 $D_C = 11^\circ 09' 54''$   
 $R = 513.17'$   
 $T = 276.98'$   
 $L = 597.84'$   
 $CHORD\ DIST. = 487.37'$   
 $CHORD\ BRG. = N 24^\circ 10' 37'' E$

**CURVE NO. 3 DATA**


$\Delta = 45^\circ 33' 18''$   
 $D_C = 9^\circ 21' 08''$   
 $R = 612.65'$   
 $T = 257.25'$   
 $L = 487.11'$   
 $CHORD\ DIST. = 474.38'$   
 $CHORD\ BRG. = N 26^\circ 57' 05'' W$

**CURVE NO. 4 DATA**

$\Delta = 32^\circ 16' 42''$   
 $D_C = 4^\circ 02' 59''$   
 $R = 1414.79'$   
 $T = 489.48'$   
 $L = 797.84'$   
 $CHORD\ DIST. = 786.54'$   
 $CHORD\ BRG. = S 33^\circ 35' 23'' E$

**STORM DRAIN STRUCTURE SCHEDULE**

STRUCTURE	STATION	TYPE	TOP EL.	INV. IN.	INV. OUT.	REMARKS	HOWARD CO. STD. DETAIL	E. STR. OFFSET
EX. INLET	15+52-LEFT	A-10 INLET	363.44	-	-	TOP OF EX. INLET TO BE ELEVATED	SD 4.41	23.67' LT
EX. INLET	18+03-LEFT	A-10 INLET	366.55	-	-	EX. INLET TO BE REPLACED	SD 4.41	23.67' LT
EX. INLET	26+27-LEFT	A-10 INLET	364.99	-	361.47	EX. INLET TO BE REPLACED	SD 4.41	23.67' LT
EX. INLET	27+02-RIGHT	A-10 INLET	362.20	-	-	TOP OF EX. INLET TO BE ELEVATED	SD 4.41	33.67' RT

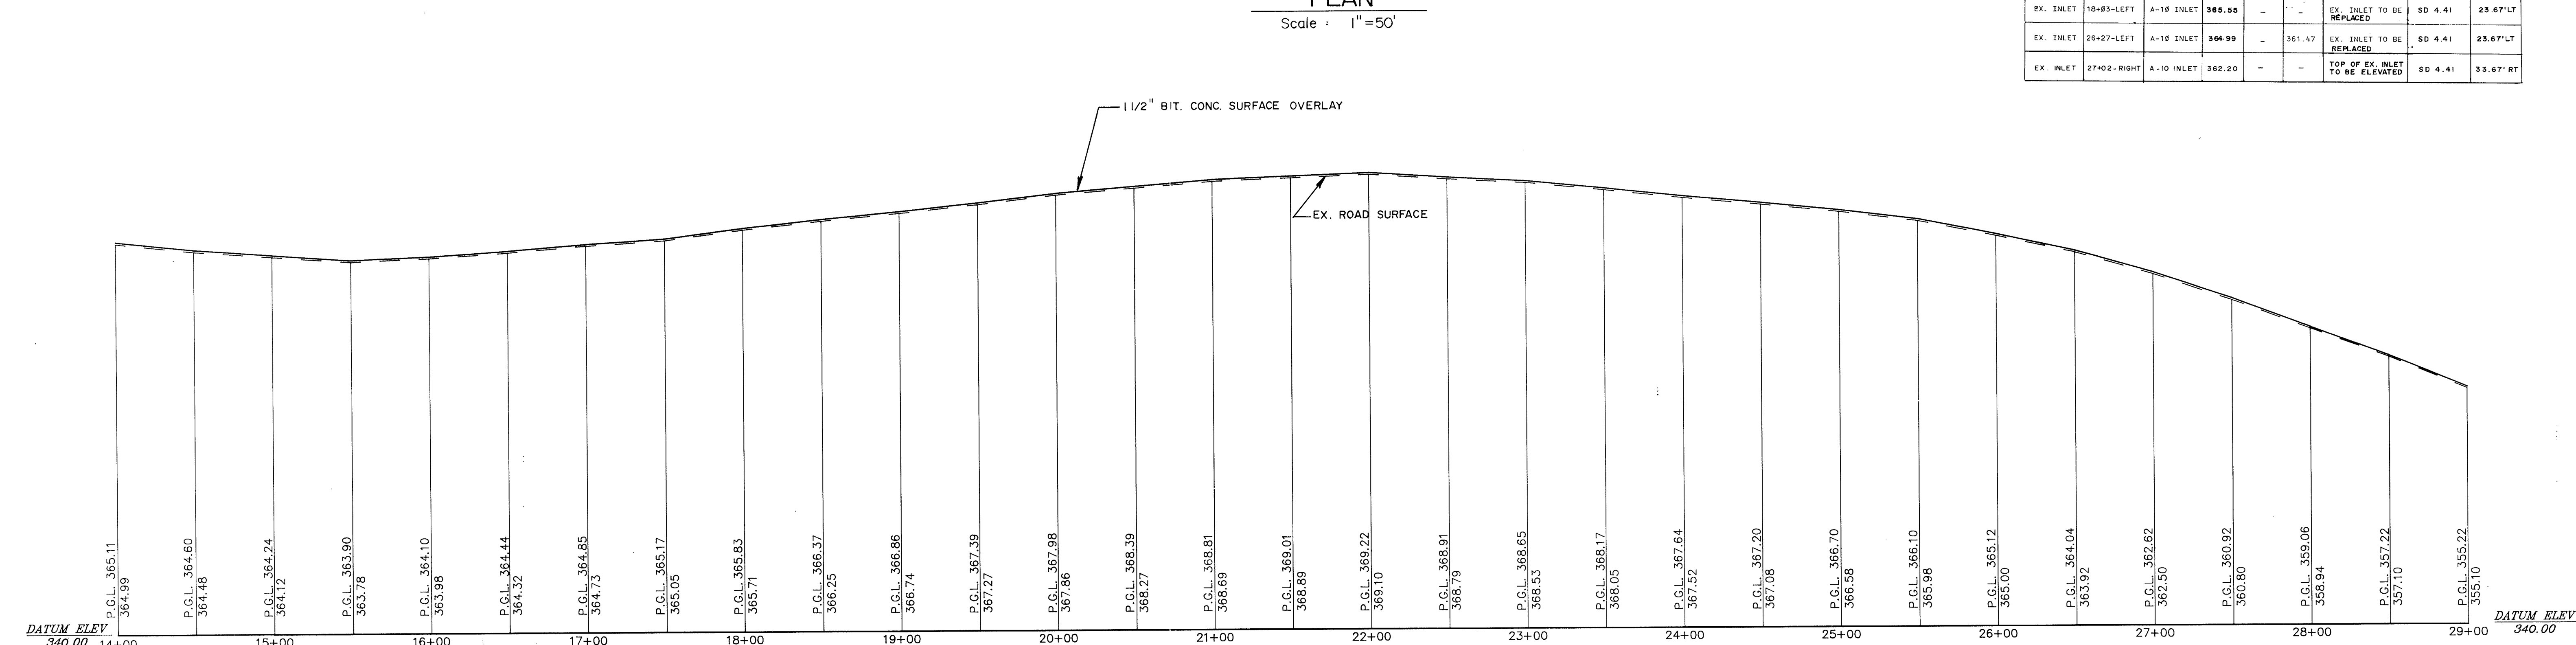

**PROFILE**

Scale: Horz. 1"=50', Vert. 1"=5'

STATION	P.G.L. ELEVATION
14+00	364.99
15+00	364.48
16+00	364.12
17+00	363.78
18+00	363.05
19+00	366.25
20+00	367.27
21+00	367.86
22+00	368.10
23+00	368.05
24+00	367.52
25+00	366.58
26+00	365.98
27+00	365.00
28+00	363.92
29+00	357.10

DEPARTMENT OF PUBLIC WORKS  
 HOWARD COUNTY, MARYLAND

*James P. Smith*  
 DIRECTOR OF PUBLIC WORKS

*[Signature]*  
 CHIEF, BUREAU OF ENGINEERING

ENGINEERING TECHNOLOGIES ASSOCIATES, INC.  
 ENGINEERS - PLANNERS - SURVEYORS

3458 ELLICOTT CENTER DRIVE SUITE 101  
 ELLICOTT CITY, MARYLAND 21043

DES: JVP  
 DRN: SGP  
 CHK: MNA

PLAN AND PROFILE - STA. 14+00 TO STA. 29+00

**OAKLAND MILLS ROAD IMPROVEMENTS**

6<sup>TH</sup> ELECTION DISTRICT HOWARD COUNTY, MARYLAND  
 CAPITAL PROJECT NO. J-4095

SCALE AS SHOWN

SHEET 3 OF 27






STRUCTURE	STATION	TYPE	TOP EL.	INV. IN.	INV. OUT.	REMARKS	HOWARD CO. STD. DETAIL	6" STR. OFFSET
I-4	51+22-RIGHT	5" OMB INLET	347.08	-	343.08	PROPOSED STRUCTURE	SD. 4.40	23.67' RT.
I-5	52+58-RIGHT	A-10 INLET	354.42	-	349.02	PROPOSED STRUCTURE	SD. 4.41	23.67' RT.
MH-6	51+22-RIGHT	STANDARD MANHOLE	347.29	343.68	343.47	EX. INLET TO BE REPLACED WITH STANDARD MANHOLE	0 5.11	16' RT.
EX. INLET	52+58-LEFT	A-10 INLET	354.00	-	348.76	EX. INLET TO BE REPLACED	SD. 4.41	23.67' LT.

SEDIMENT TRAP #3	
TYPE	STORM INLET TRAP
DRAINAGE AREA	0.57 AC.
VOLUME REQUIRED	1026 C.F.
VOLUME PROVIDED	1040 C.F.
BOTTOM SIZE	65" X 4"
DEPTH	2'
BOTTOM ELEV.	352.0'

SEDIMENT TRAP #2	
TYPE	STONE OUTLET TRAP
DRAINAGE AREA	0.43 AC.
VOLUME REQUIRED	774 C.F.
VOLUME PROVIDED	800 C.F.
BOTTOM SIZE	48" X 6"
DEPTH	2'
BOTTOM ELEV.	326.5'
4" STONE WINDOW	
CREST ELEV.	327.5'

CURVE NO. 5 DATA	
$\Delta$	= 12° 14' 00"
D.C.	= 1° 09' 00"
R	= 5729.58'
T	= 614.09'
L	= 1223.33'
CHORD DIST.	= 1221.01'
CHORD BRG.	= N 23° 34' 02" W

CURVE NO. 6 DATA	
$\Delta$	= 2° 34' 00"
D.C.	= 1° 09' 00"
R	= 5729.58'
T	= 128.36'
L	= 256.68'
CHORD DIST.	= 256.68'
CHORD BRG.	= N 36° 58' 02" W

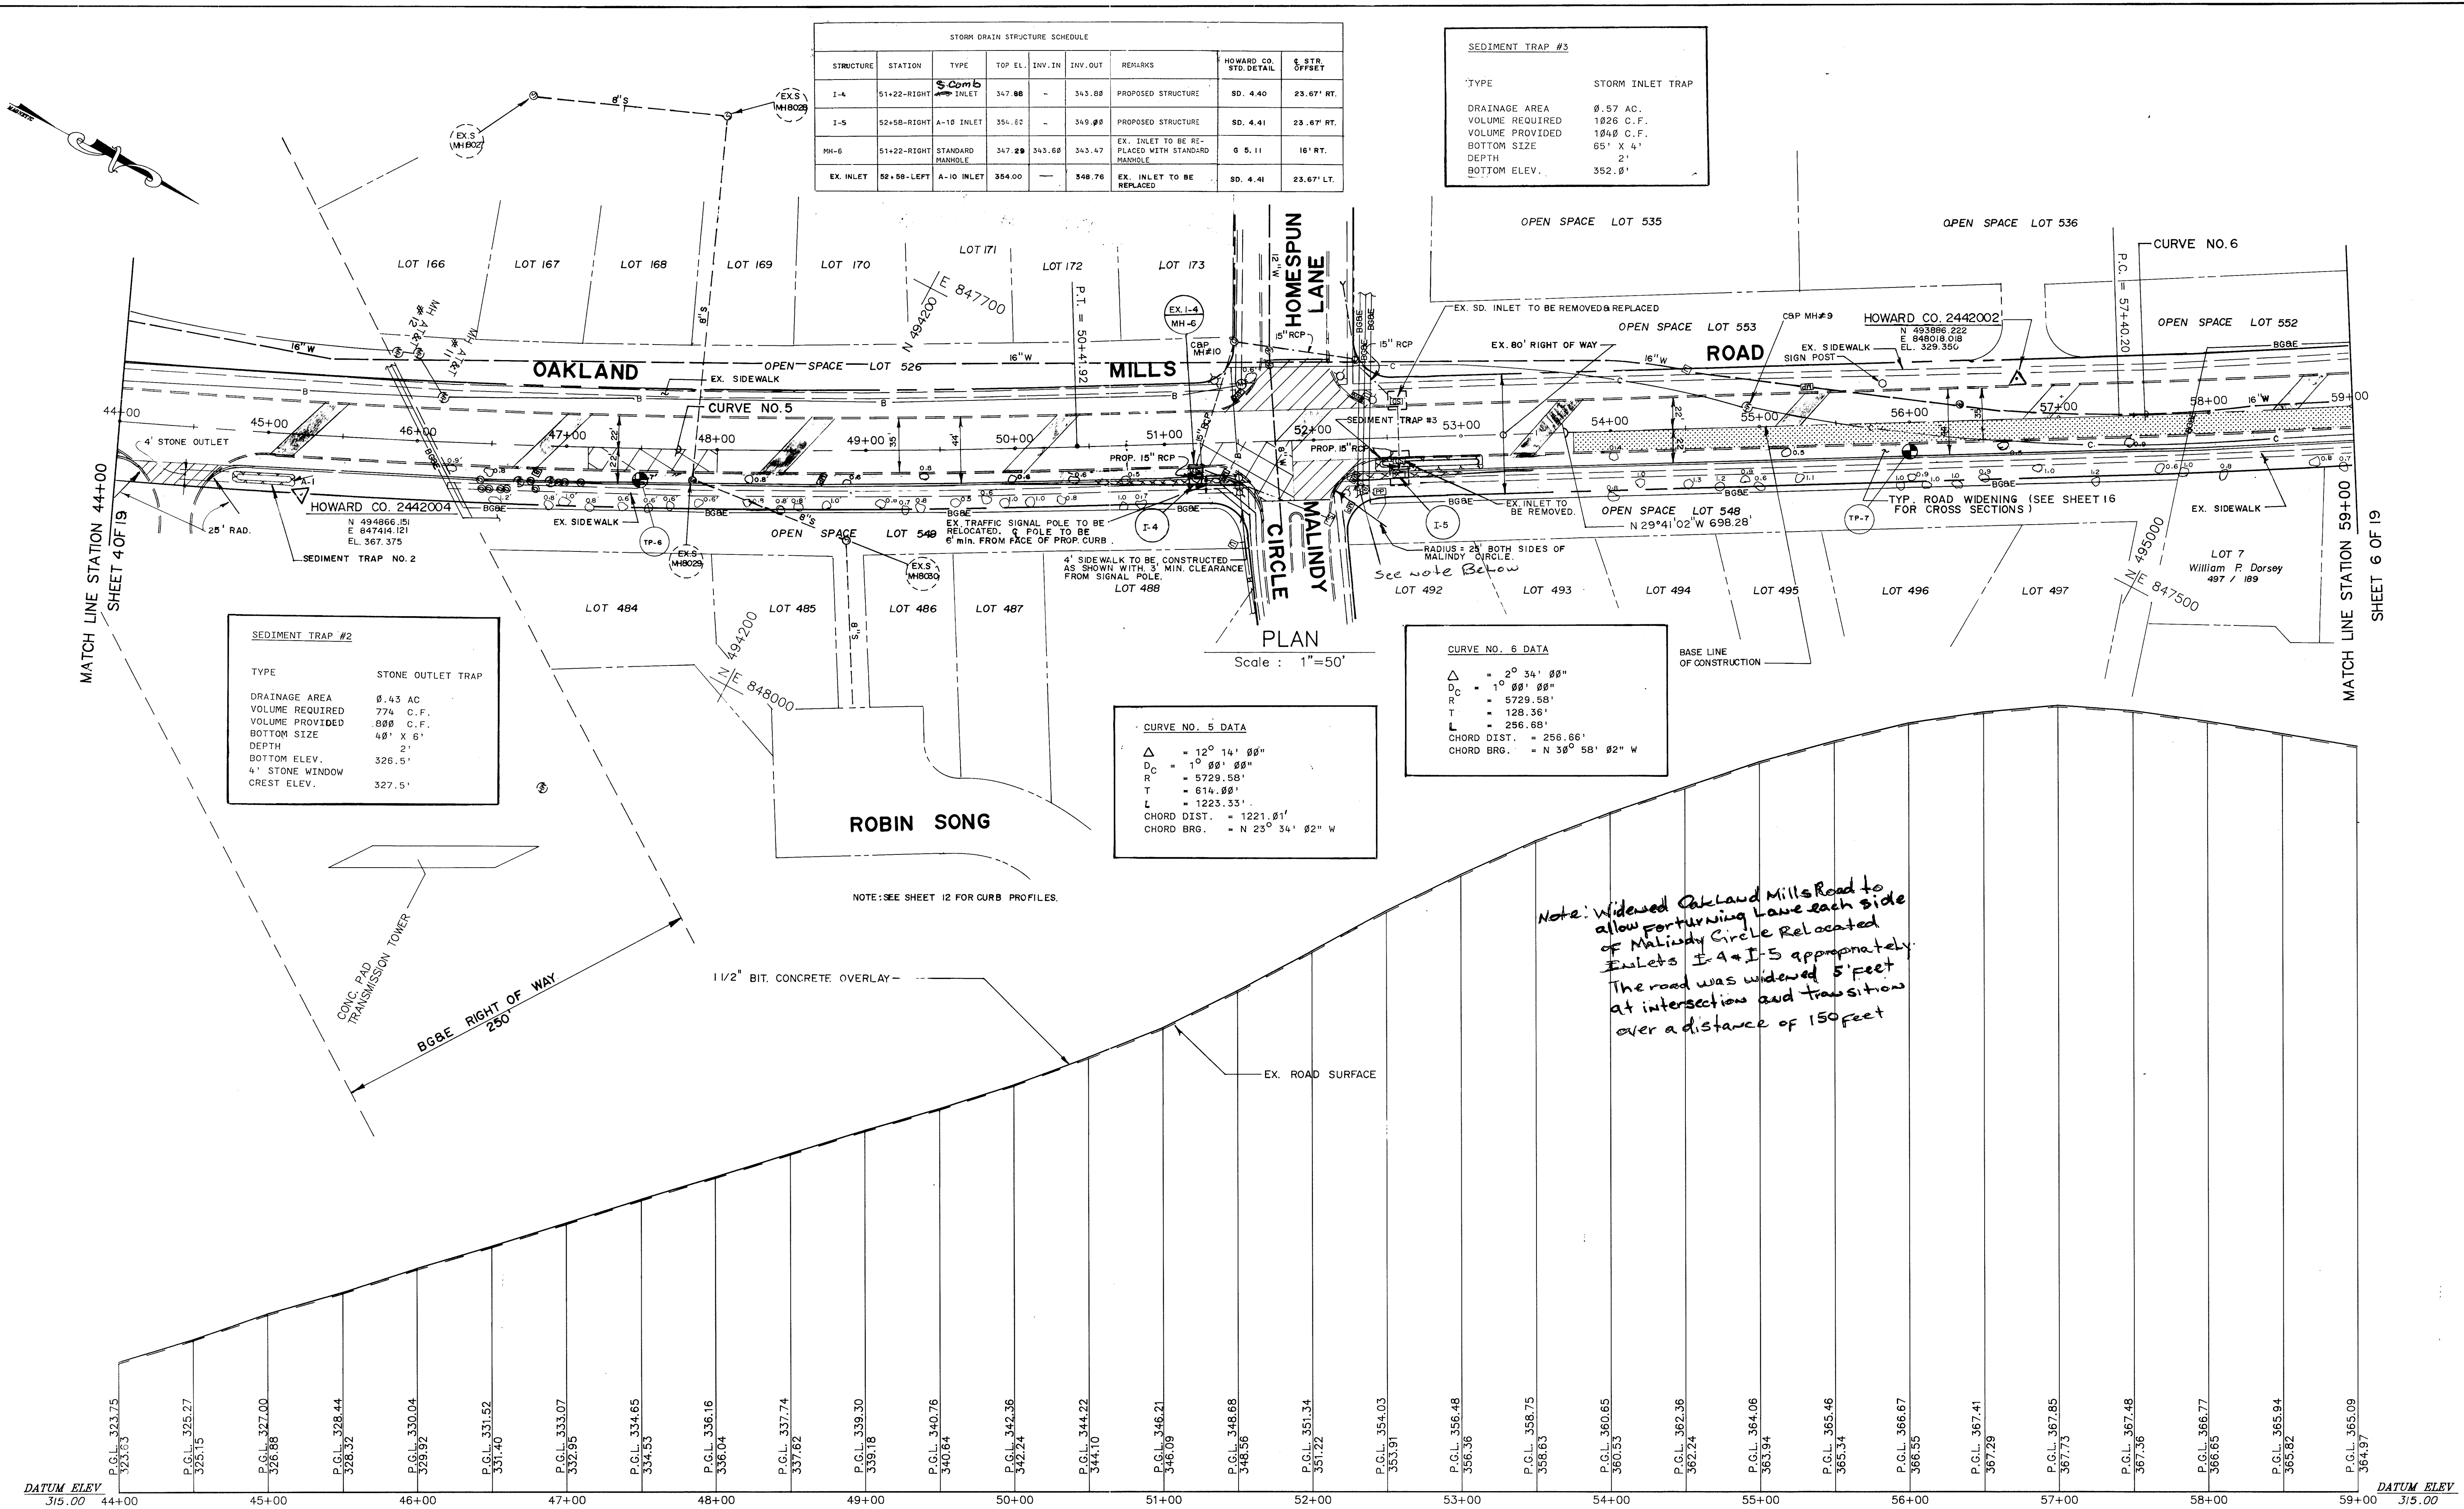

PROFILE	
DATE	8/90
BY	NO.
REVISION	
DATE	
600' SCALE MAP NO.	
BLOCK NO.	

DEPARTMENT OF PUBLIC WORKS  
HOWARD COUNTY, MARYLAND

*James J. Law* 8/22/90  
DIRECTOR OF PUBLIC WORKS DATE

*William B. Ray* 8-21-90  
CHIEF, BUREAU OF ENGINEERING DATE

*Oranville W. Weiland* 8/30/90  
CHIEF, BUREAU OF HIGHWAYS DATE

*Michael N. Armstrong* 8/30/90  
CHIEF, DIVISION OF ROADS, BRIDGES AND STORM DRAINAGE DATE

ENGINEERING TECHNOLOGIES ASSOCIATES, INC.  
ENGINEERS - PLANNERS - SURVEYORS

3458 ELLICOTT CENTER DRIVE SUITE 101  
ELLICOTT CITY, MARYLAND 21045  
(301) 461-9920

*Michael N. Armstrong*

DESIGNER	
DES:	JVP
DRN:	SGP
CHK:	MWA
DATE:	8/90
BY:	NO.
REVISION:	
DATE:	
600' SCALE MAP NO.:	
BLOCK NO.:	

PLAN AND PROFILE - STA. 44+00 TO STA. 59+00

**OAKLAND MILLS ROAD IMPROVEMENTS**

6<sup>TH</sup> ELECTION DISTRICT HOWARD COUNTY, MARYLAND  
CAPITAL PROJECT NO. : J-4095

SCALE AS SHOWN

SHEET 5 OF 27

As Built 2/19/92 CP




STORM DRAIN STRUCTURE SCHEDULE									
STRUCTURE	STATION	TYPE	TOP EL.	INV. IN	INV. OUT	REMARKS	HOWARD CO. C. STR.	STD. DETAIL	OFFSET
EX. INLET	68+37-LEFT	A-5 INLET	363.34	352.14	351.21	EX. INLET TO BE REPLACED	SD 4.01	24' LT.	
1-6	68+37-RIGHT	A-5 INLET	363.48	-	354.14	PROPOSED STRUCTURE	SD 4.01	24' RT.	
MH-9	62+01-RIGHT	STANDARD MANHOLE	364.21	359.89	359.91	EX. INLET TO BE REPLACED WITH STANDARD MANHOLE	0 5.11	16' RT.	
1-7	62+01-RIGHT	A-10 INLET	364.80	-	368.58	PROPOSED STRUCTURE	SD 4.41	23.67' RT.	
Deleted	38+18-RIGHT	A-10 INLET	372.59	368.88	361.73	PROPOSED STRUCTURE	SU 4.02	24' RT.	

**CURVE NO. 7 DATA**  
 $\Delta = 34^{\circ} 25' 08''$   
 $D_C = 5^{\circ} 38' 54''$   
 $R = 1814.39'$   
 $T = 314.17'$   
 $L = 689.33'$   
 CHORD DIST. = 688.21'  
 CHORD BRG. = S 15° 02' 32" E


**CURVE NO. 6 DATA**  
 $\Delta = 2^{\circ} 34' 00''$   
 $D_C = 1^{\circ} 00' 00''$   
 $R = 5729.58'$   
 $T = 128.36'$   
 $L = 256.68'$   
 CHORD DIST. = 256.66'  
 CHORD BRG. = N 30° 58' 02" W

**SEDIMENT TRAP #6**  
 TYPE: STORM INLET TRAP  
 DRAINAGE AREA: 2.2 AC.  
 VOLUME REQUIRED: 3968 C.F.  
 VOLUME PROVIDED: 4200 C.F.  
 BOTTOM SIZE: 120#15  
 DEPTH: 2'  
 BOTTOM ELEV.: 378'

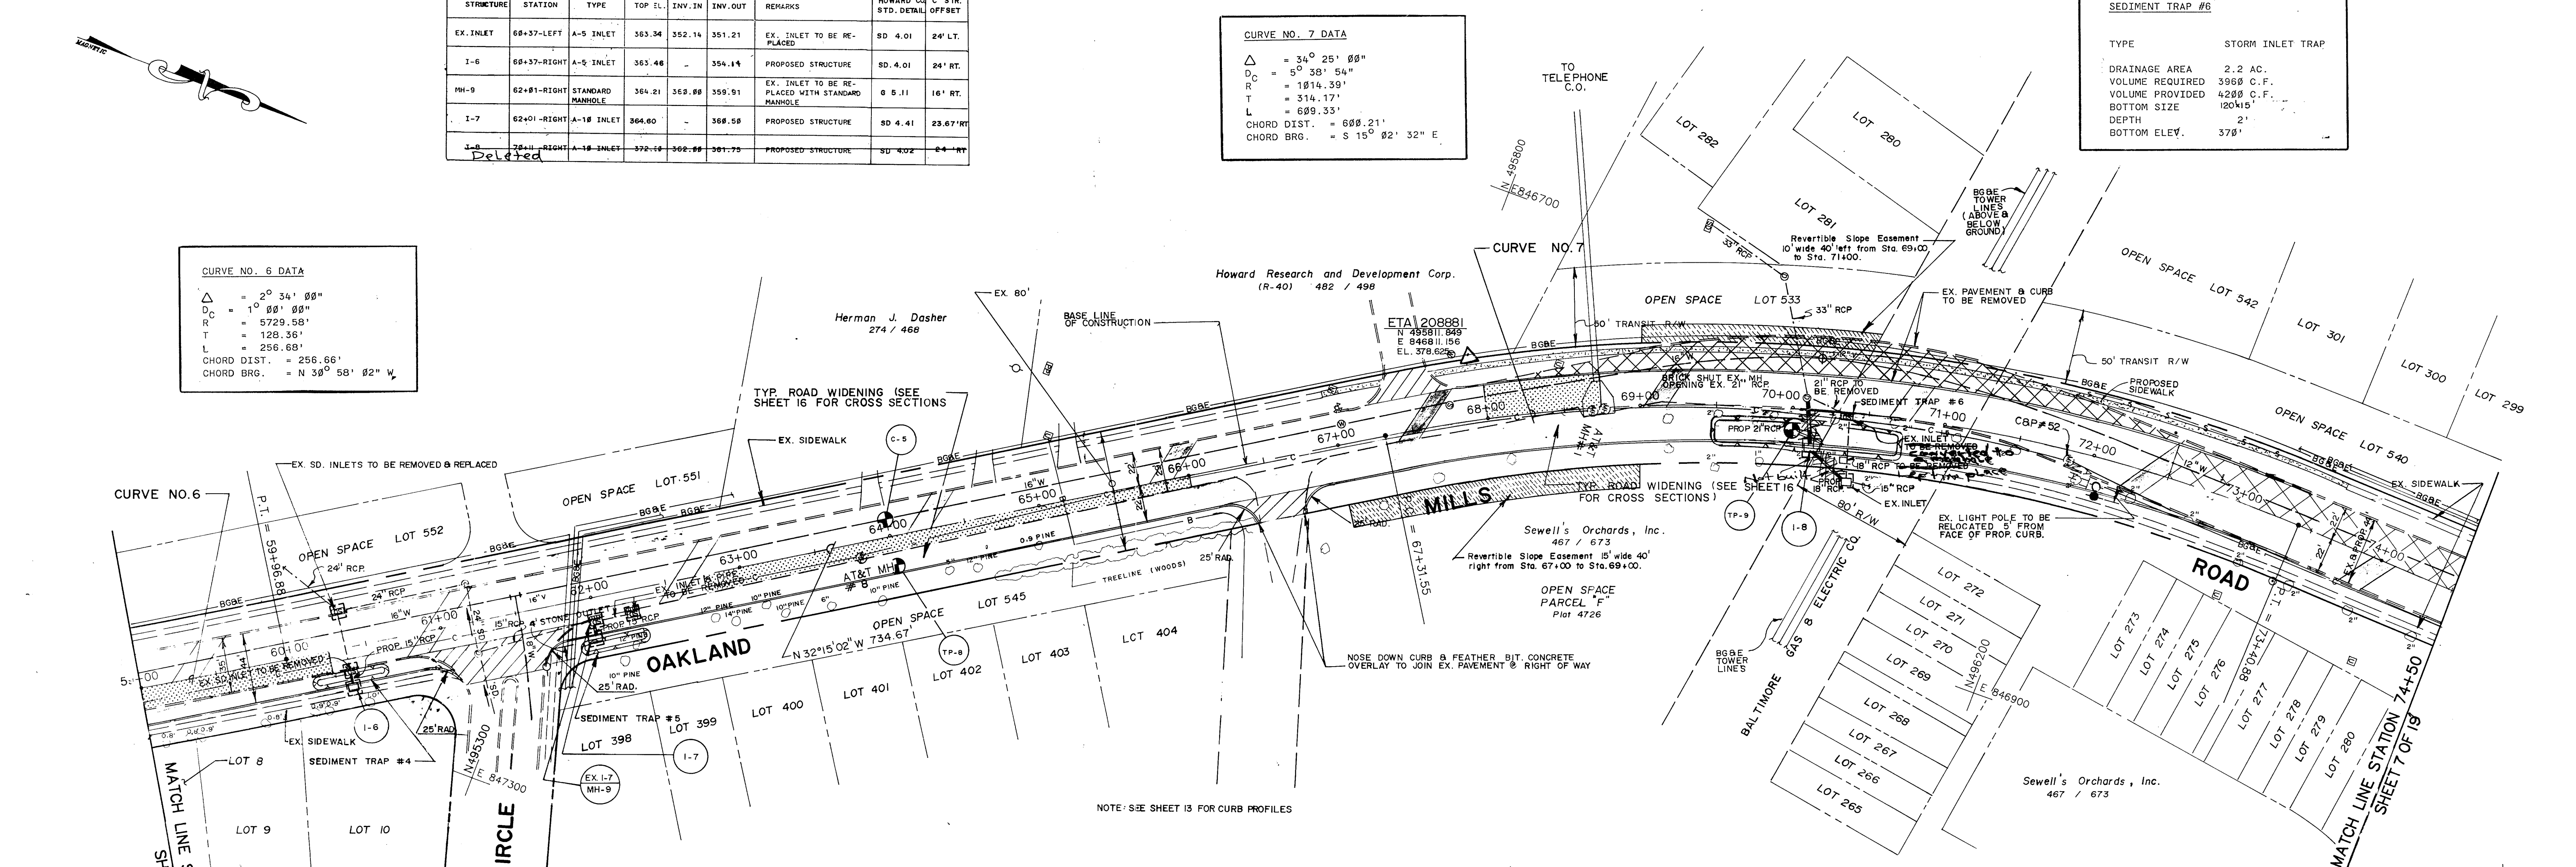

**SEDIMENT TRAP #5**  
 TYPE: STONE OUTLET TRAP  
 DRAINAGE AREA: 0.5 AC.  
 VOLUME REQUIRED: 900 C.F.  
 VOLUME PROVIDED: 1000 C.F.  
 BOTTOM SIZE: 6" X 50"  
 DEPTH: 2'  
 BOTTOM ELEV.: 363.0'  
 CREST ELEV.: 364.2'

**SEDIMENT TRAP #4**  
 TYPE: STORM INLET TRAP  
 DRAINAGE AREA: 0.32 AC.  
 VOLUME REQUIRED: 576 C.F.  
 VOLUME PROVIDED: 600 C.F.  
 BOTTOM SIZE: 2' X 50"  
 DEPTH: 2'  
 BOTTOM ELEV.: 361.0'

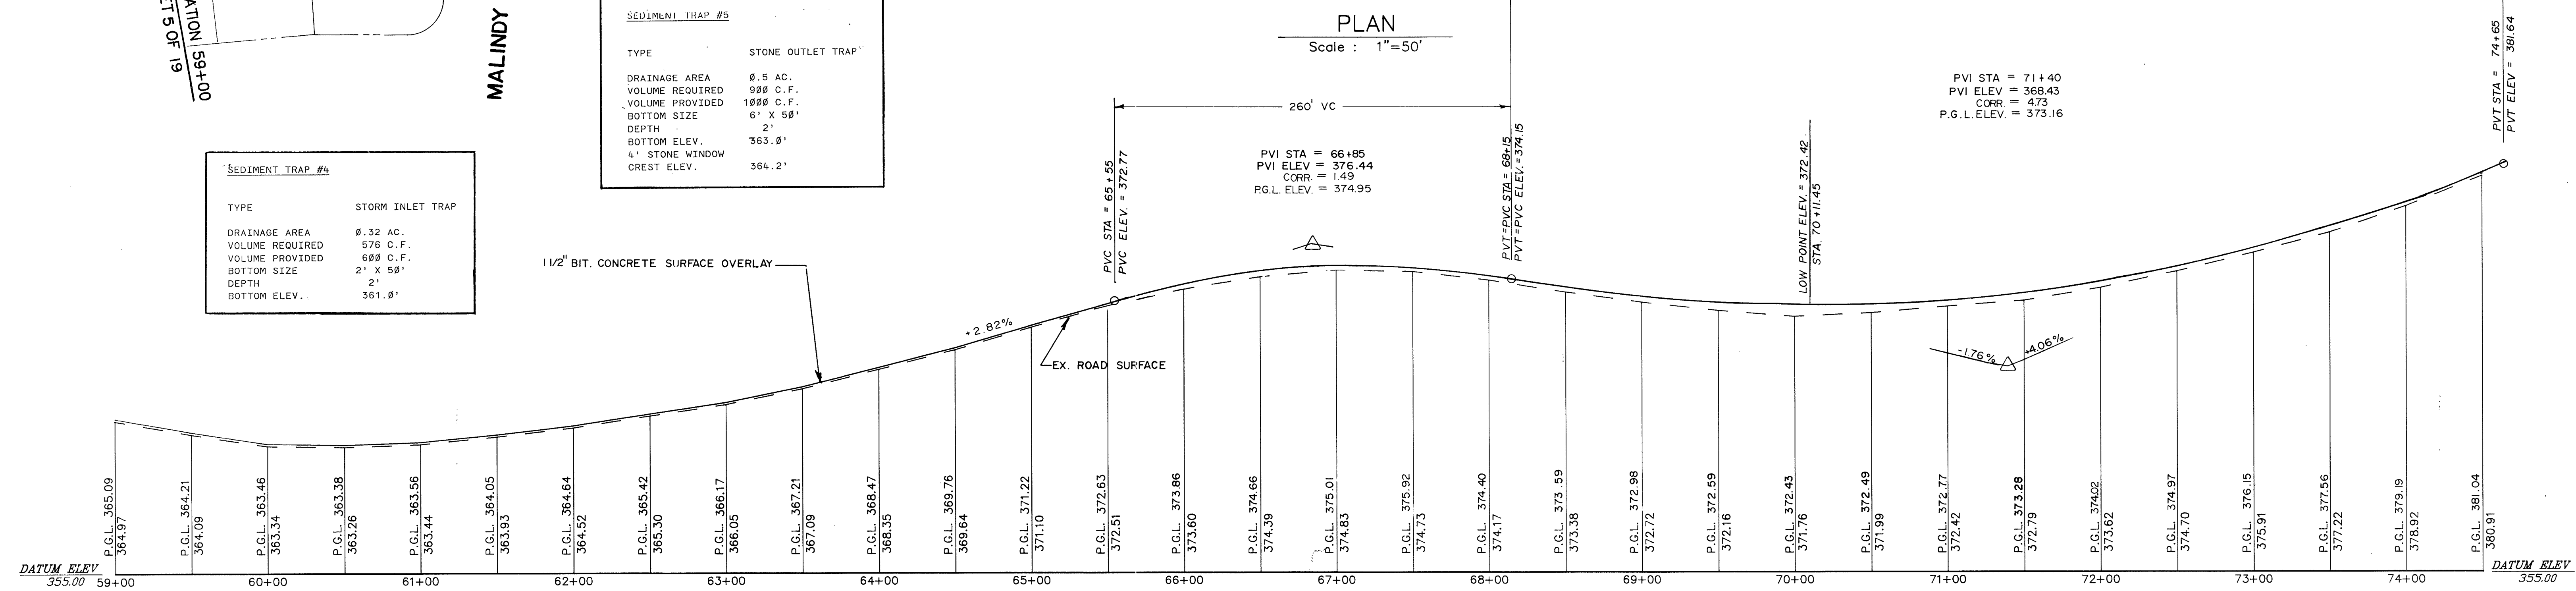

STATION	P.G.L. ELEV.
59+00	364.97
60+00	364.21
61+00	363.34
62+00	363.38
63+00	363.56
64+00	363.44
65+00	364.05
66+00	364.64
67+00	365.42
68+00	366.05
69+00	367.09
70+00	368.47
71+00	369.76
72+00	371.10
73+00	372.51
74+00	373.86
75+00	374.39
76+00	374.83
77+00	375.92
78+00	377.33
79+00	378.98
80+00	380.91

DEPARTMENT OF PUBLIC WORKS  
 HOWARD COUNTY, MARYLAND

ENGINEERING TECHNOLOGIES ASSOCIATES, INC.  
 ENGINEERS • PLANNERS • SURVEYORS  
 3458 ELLICOTT CENTER DRIVE SUITE 101  
 ELLICOTT CITY, MARYLAND 21043  
 (301) 481-9920

DES: JVP  
 DRN: SGP  
 CHK: MJA  
 DATE: 8/90

PLAN AND PROFILE - STA. 59+00 TO STA. 74+50  
**OAKLAND MILLS ROAD IMPROVEMENTS**  
 6TH ELECTION DISTRICT HOWARD COUNTY, MARYLAND  
 CAPITAL PROJECT NO. : J-4095

SCALE AS SHOWN  
 SHEET 6 OF 27

As built 2/19/92 CP

STORM DRAIN STRUCTURE SCHEDULE						
STRUCTURE	STATION	TYPE	TOP EL.	INV. IN	INV. OUT	REMARKS
MH-10	83+82-LEFT	STANDARD MANHOLE	481.48	386.98	386.74	EX. INLET TO BE REPLACED WITH STANDARD MANHOLE
I-9	84+15-LEFT	A-18 INLET	481.23	-	387.23	PROPOSED STRUCTURE
I-10	84+15-RIGHT	A-5 INLET	481.23	-	386.58	PROPOSED STRUCTURE
MH-11	83+82-RIGHT	STANDARD MANHOLE	400.90	325.88	384.73	EX. INLET TO BE REPLACED WITH STANDARD MANHOLE


SEDIMENT TRAP #8	
TYPE	STORM INLET TRAP
DRAINAGE AREA	1.88 AC
VOLUME REQUIRED	1888 C.F.
VOLUME PROVIDED	1888 C.F.
BOTTOM SIZE	18" x 5' 2"
DEPTH	2'
BOTTOM ELEVATION	398.8'

CURVE NO. 8 DATA	
$\Delta$	= 1° 46' 85"
$D_C$	= 1° 25' 36"
$R$	= 4815.98'
$T$	= 61.97'
$L$	= 123.92'
CHORD DIST.	= 123.92'
CHORD BRG.	= N 01° 16' 58" E

CURVE NO. 9 DATA	
$\Delta$	= 2° 34' 23"
$D_C$	= 1° 59' 24"
$R$	= 4954.85'
$T$	= 111.26'
$L$	= 222.48'
CHORD DIST.	= 222.46'
CHORD BRG.	= S 01° 41' 05" W

CURVE NO. 10 DATA	
$\Delta$	= 2° 25' 43"
$D_C$	= 0° 45' 18"
$R$	= 7598.29'
$T$	= 168.89'
$L$	= 321.73'
CHORD DIST.	= 321.71'
CHORD BRG.	= S 84° 11' 08" W


VILLAGE OF OWEN BROWN  
SECTION 4 AREA I

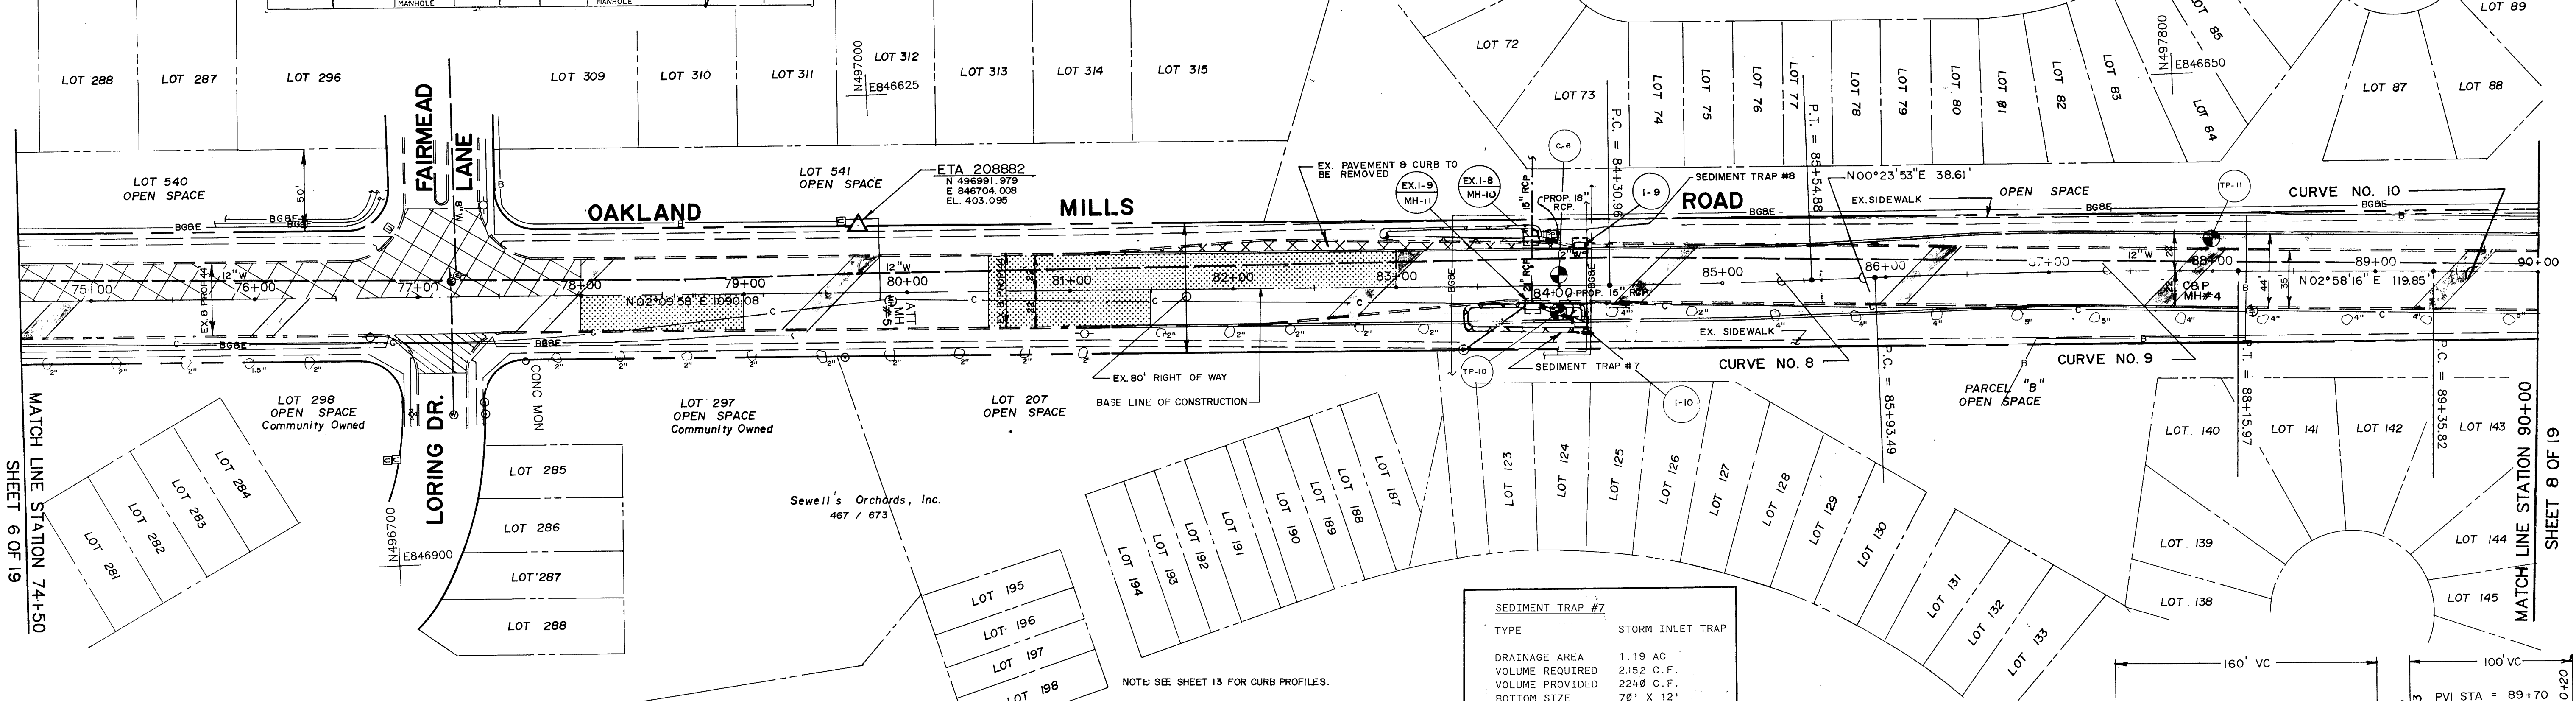

SEDIMENT TRAP #7	
TYPE	STORM INLET TRAP
DRAINAGE AREA	1.19 AC
VOLUME REQUIRED	2152 C.F.
VOLUME PROVIDED	2248 C.F.
BOTTOM SIZE	78" X 12"
DEPTH	2'
BOTTOM ELEV.	398.5'

NOTE: SEE SHEET 13 FOR CURB PROFILES.

PLAN  
Scale: 1"=50'

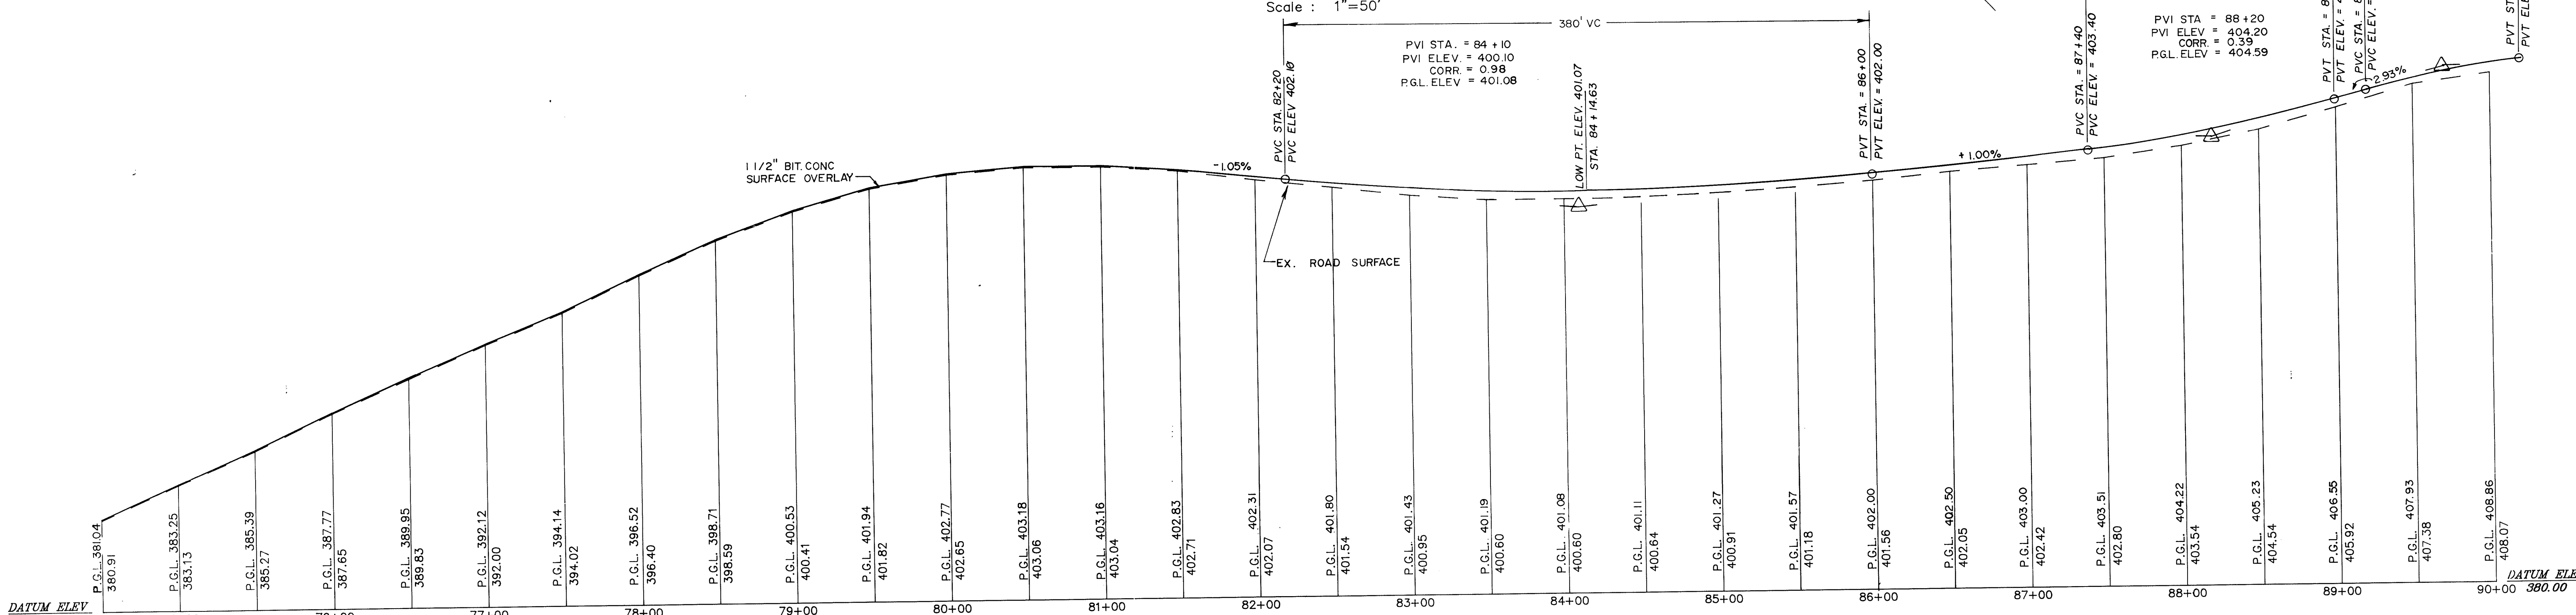

PROFILE  
Scale: Horz. 1"=50'  
Vert. 1"=5'

DEPARTMENT OF PUBLIC WORKS  
HOWARD COUNTY, MARYLAND

*James J. ...*  
DIRECTOR OF PUBLIC WORKS

*...*  
CHIEF, BUREAU OF ENGINEERING

*...*  
CHIEF, DIVISION OF ROADS, BRIDGES AND STORM DRAINAGE

ENGINEERING TECHNOLOGIES ASSOCIATES, INC.  
ENGINEERS - PLANNERS - SURVEYORS

3458 ELLICOTT CENTER DRIVE SUITE 101  
ELLCOTT CITY, MARYLAND 21043  
(301) 481-9920

*Michael A. Armstrong*

DES: JVP	BY NO.	REVISION	DATE
DRN: SGP			
CHK: MNA			
DATE: 8/90			

PLAN AND PROFILE - STA. 74+50 TO STA 90+00

**OAKLAND MILLS ROAD IMPROVEMENTS**  
6TH ELECTION DISTRICT HOWARD COUNTY, MARYLAND  
CAPITAL PROJECT NO. J-4095


As built 2/19/92 CP

SCALE AS SHOWN  
SHEET 7 OF 27

BRINING 44-132 89150



STORM DRAIN STRUCTURE SCHEDULE									
STRUCTURE	STATION	TYPE	TOP EL.	INV. IN	INV. OUT	REMARKS	HOWARD CO. STD. DETAIL	STR. OFFSET	
I-11	100+00	DOUBLE "5" RIGHT	400.65		397.1	PROPOSED STRUCTURE	SD 4.23	22' RT	
S-1	99+68-RIGHT	15" METAL END SECTION		399.0		PROPOSED STRUCTURE	SD 5.61	38' RT	

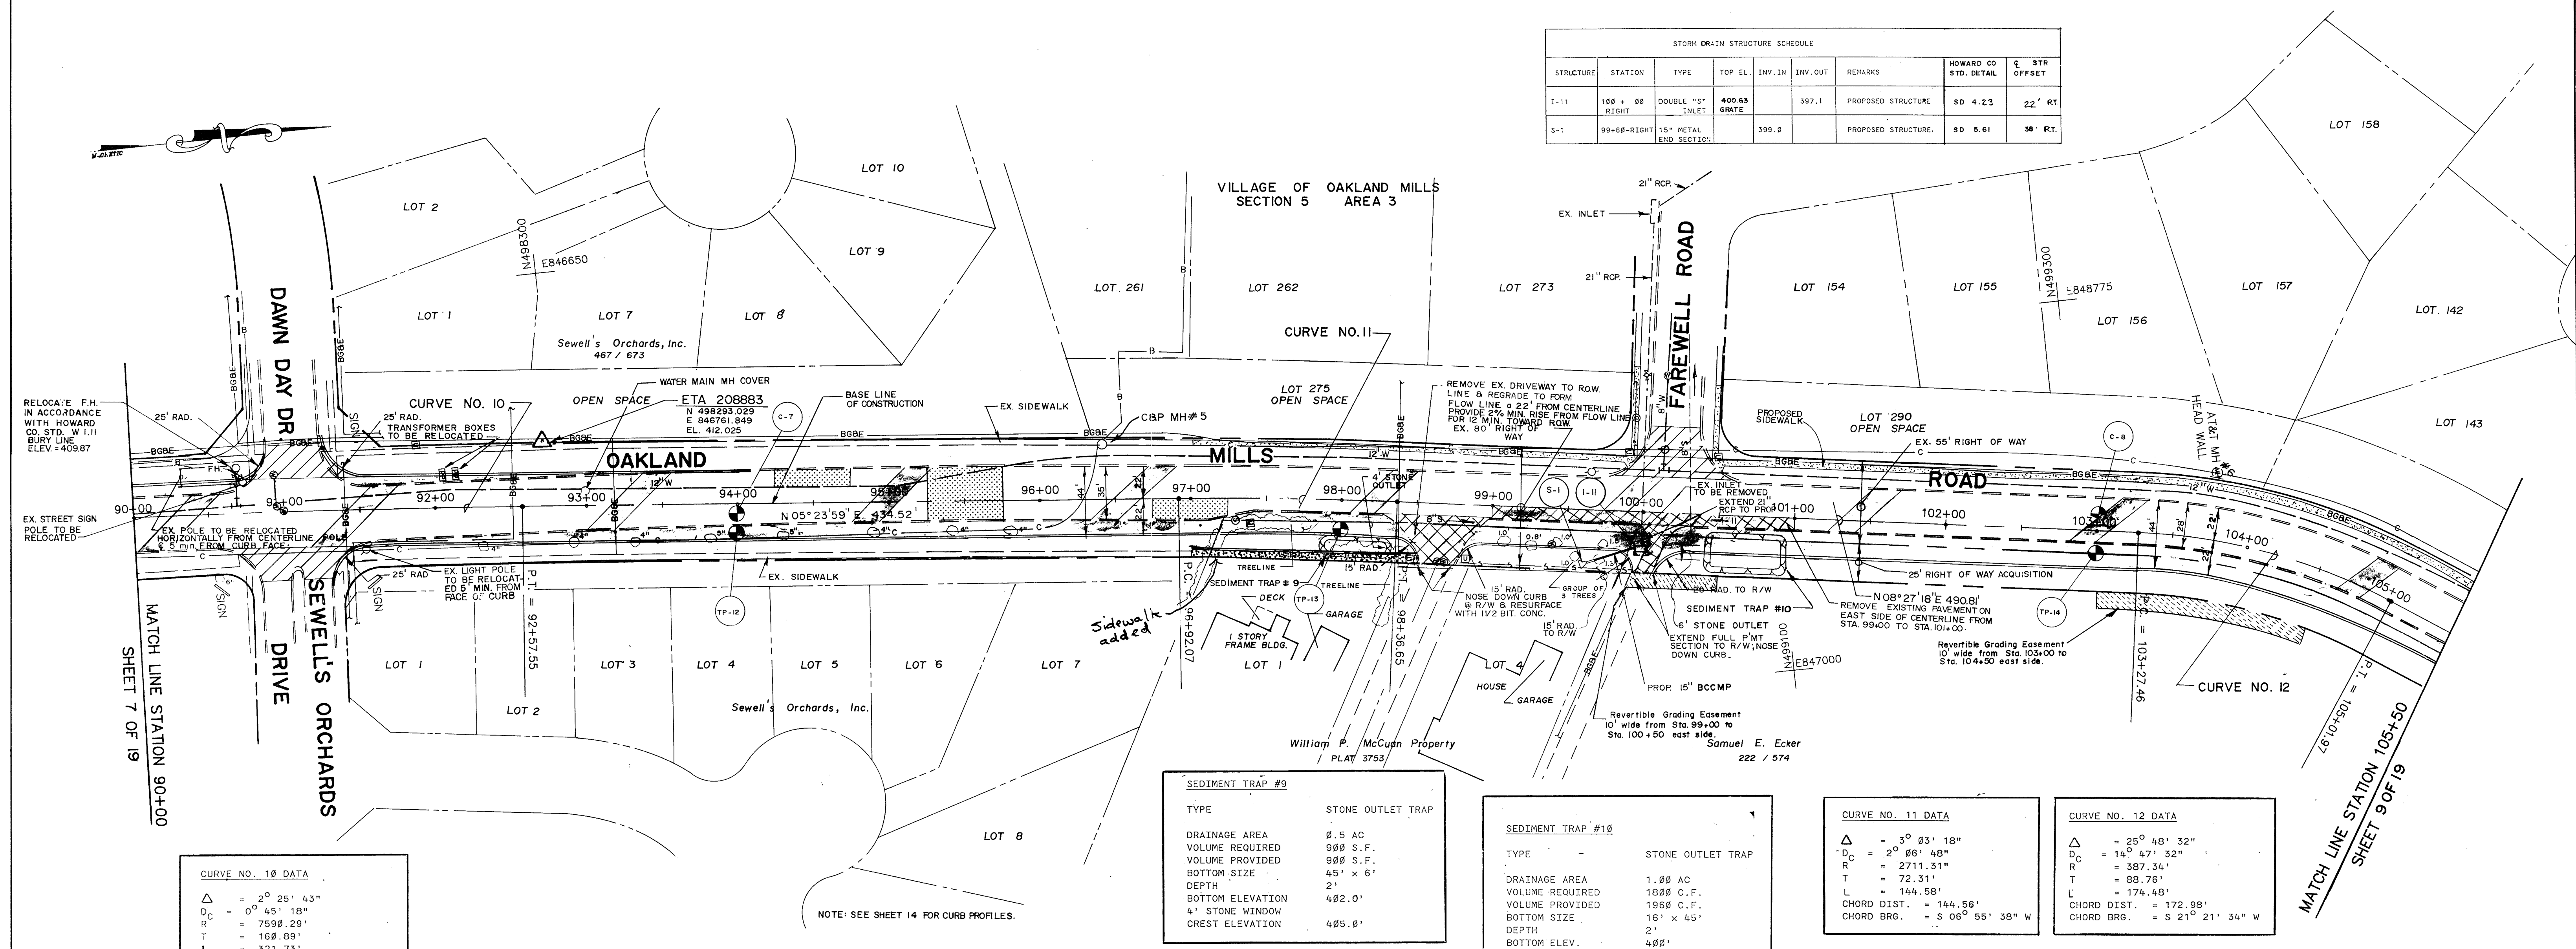


SEDIMENT TRAP #9	
TYPE	STONE OUTLET TRAP
DRAINAGE AREA	0.5 AC
VOLUME REQUIRED	900 S.F.
VOLUME PROVIDED	900 S.F.
BOTTOM SIZE	45' x 6'
DEPTH	2'
BOTTOM ELEVATION	402.0'
4" STONE WINDOW	
CREST ELEVATION	405.0'

SEDIMENT TRAP #10	
TYPE	STONE OUTLET TRAP
DRAINAGE AREA	1.00 AC
VOLUME REQUIRED	1800 C.F.
VOLUME PROVIDED	1960 C.F.
BOTTOM SIZE	16' x 45'
DEPTH	2'
BOTTOM ELEV.	400'
6" STONE WINDOW	
CREST ELEV.	401.5'

CURVE NO. 11 DATA	
$\Delta$	= 3° 03' 18"
$D_C$	= 2° 08' 48"
R	= 2711.31'
T	= 72.31'
L	= 144.58'
CHORD DIST.	= 144.56'
CHORD BRG.	= S 06° 55' 38" W

CURVE NO. 12 DATA	
$\Delta$	= 25° 48' 32"
$D_C$	= 11° 47' 32"
R	= 387.36'
T	= 88.76'
L	= 174.48'
CHORD DIST.	= 172.98'
CHORD BRG.	= S 21° 21' 34" W

CURVE NO. 10 DATA	
$\Delta$	= 2° 25' 43"
$D_C$	= 0° 45' 18"
R	= 7590.29'
T	= 168.89'
L	= 321.73'
CHORD DIST.	= 321.71'
CHORD BRG.	= S 04° 11' 08" W

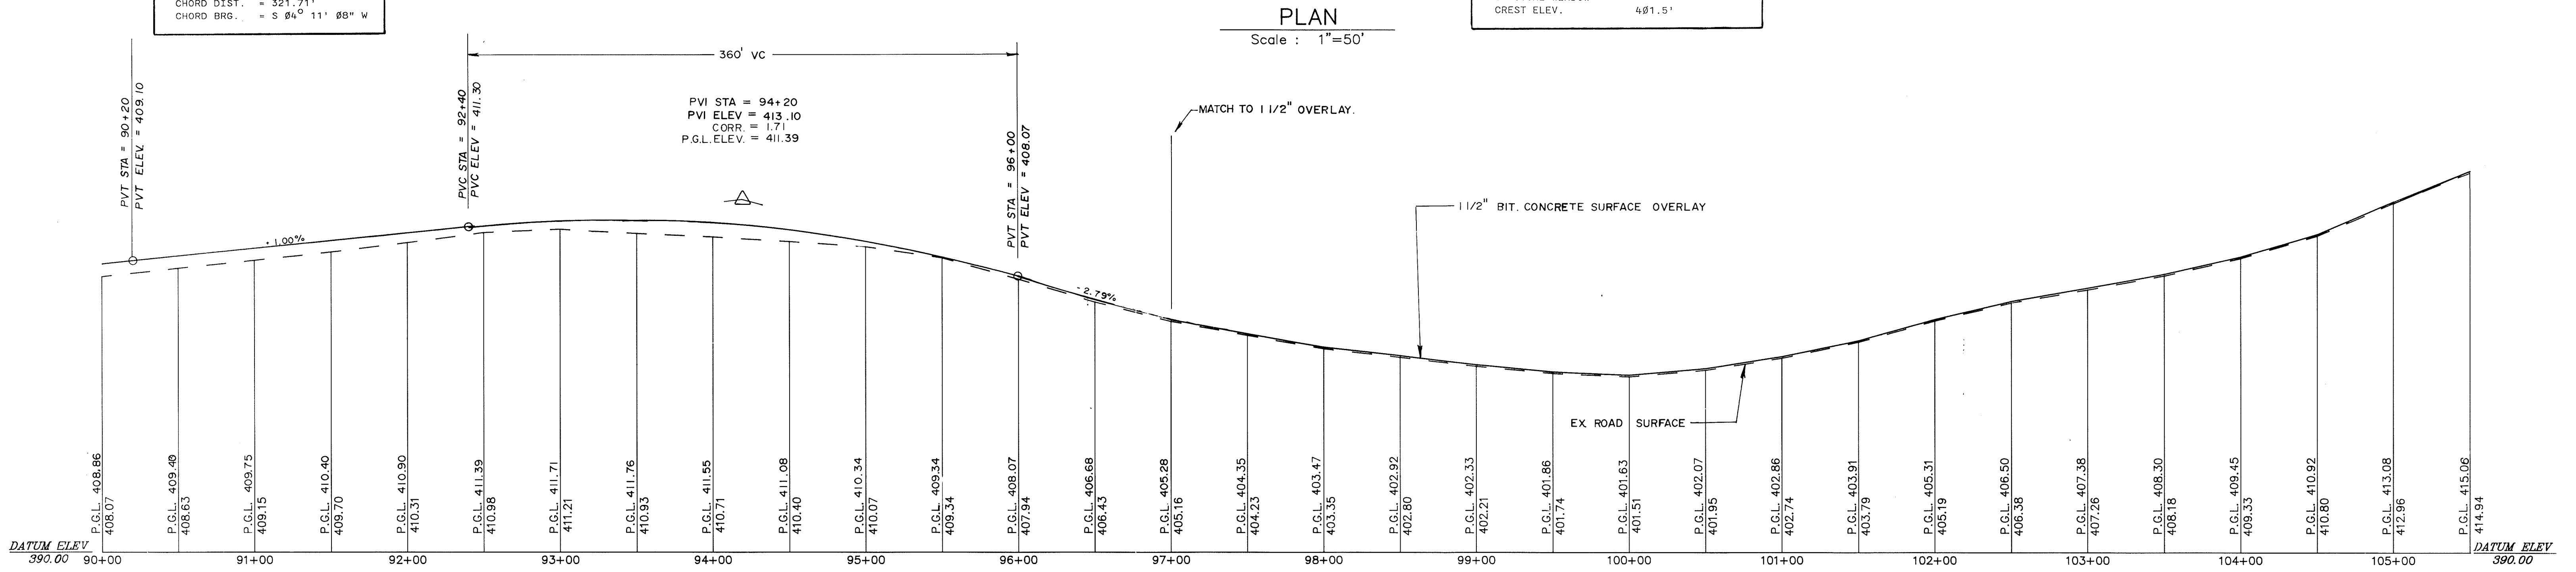

**PROFILE**  
Scale: Horz. 1"=50', Vert. 1"=5'

DEPARTMENT OF PUBLIC WORKS  
HOWARD COUNTY, MARYLAND

*James J. ...* 8/22/90  
DIRECTOR OF PUBLIC WORKS DATE

*Michael N. Armstrong* 8/22/90  
CHIEF, BUREAU OF HIGHWAYS DATE

*...* 8/22/90  
CHIEF, DIVISION OF ROADS, BRIDGES AND STORM DRAINAGE DATE

ENGINEERING TECHNOLOGIES ASSOCIATES, INC.  
ENGINEERS - PLANNERS - SURVEYORS

3456 ELLICOTT CENTER DRIVE SUITE 101  
ELLICOTT CITY, MARYLAND 21043  
(301) 461-9920

*Michael N. Armstrong*

DES: JVP					
DRN: SGP					
CHK: MNA					
DATE: 8/90					
BY	NO.	REVISION	DATE	600' SCALE MAP NO.	BLOCK NO.

As Built 2/19/92 CP



PLAN AND PROFILE - STA. 90+00 TO STA. 105+50

**OAKLAND MILLS ROAD IMPROVEMENTS**  
6TH ELECTION DISTRICT HOWARD COUNTY, MARYLAND  
CAPITAL PROJECT NO. J - 4095

SCALE AS SHOWN

SHEET 8 OF 27



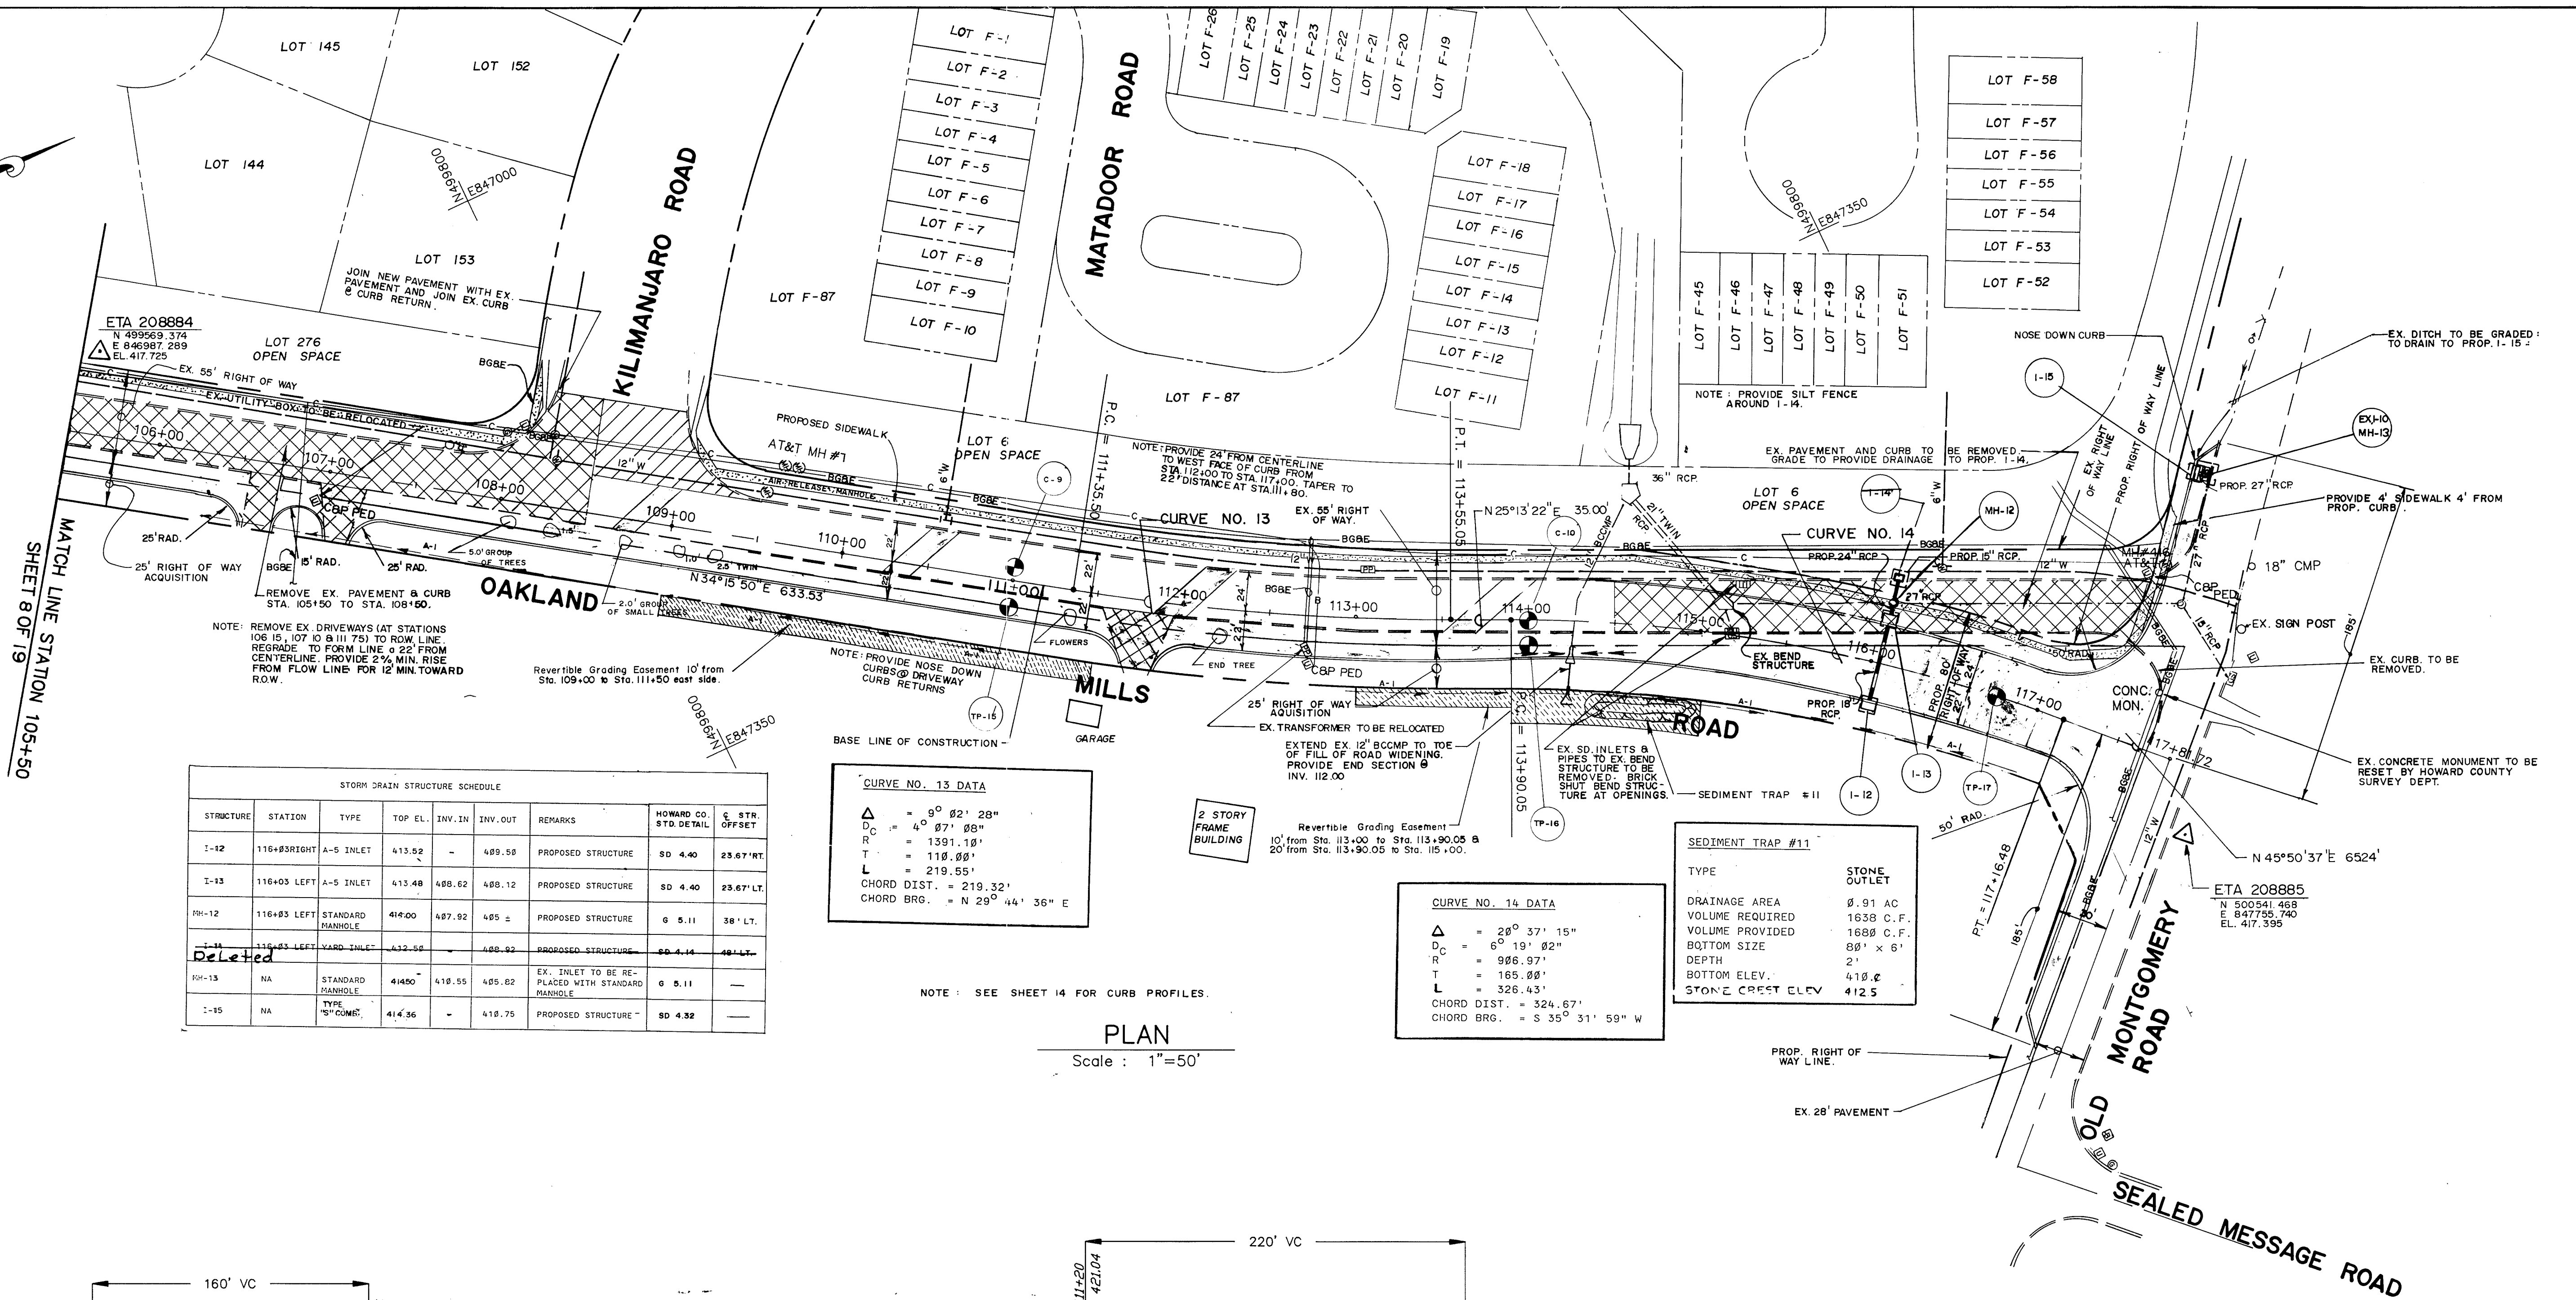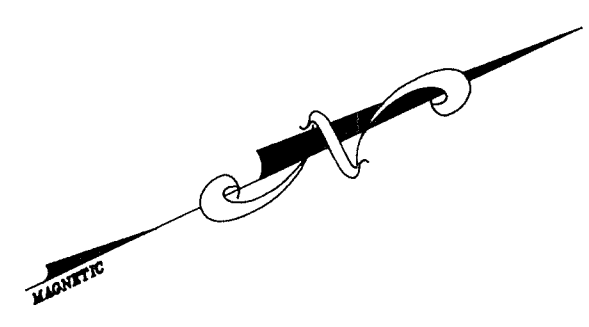

STORM DRAIN STRUCTURE SCHEDULE

STRUCTURE	STATION	TYPE	TOP EL.	INV. IN	INV. OUT	REMARKS	HOWARD CO. STD. DETAIL	E STR. OFFSET
1-12	116+93.87	A-5 INLET	415.92	-	489.50	PROPOSED STRUCTURE	SD 4.40	23.67' RT
1-13	116+03	LEFT A-5 INLET	415.48	488.62	488.12	PROPOSED STRUCTURE	SD 4.40	23.67' LT
10-12	116+83	LEFT STANDARD MANHOLE	419.00	487.92	485.±	PROPOSED STRUCTURE	6 5.11	38' LT
<del>1-11</del>	<del>116+43</del>	<del>LEFT HARD INLET</del>	<del>415.56</del>	<del>-</del>	<del>488.92</del>	<del>PROPOSED STRUCTURE</del>	<del>SD 4.14</del>	<del>48' LT</del>
10-13	NA	STANDARD MANHOLE	414.50	416.55	485.82	EX. INLET TO BE REPLACED WITH STANDARD MANHOLE	6 5.11	-
1-15	NA	TYPE "B" COMB.	414.36	-	418.75	PROPOSED STRUCTURE	SD 4.32	-

**CURVE NO. 13 DATA**

$\Delta = 9^{\circ} 02' 28''$   
 $D_c = 4^{\circ} 07' 08''$   
 $R = 1391.18'$   
 $T = 118.08'$   
 $L = 219.55'$   
 CHORD DIST. = 219.32'  
 CHORD BRG. = N 29° 44' 36" E

**CURVE NO. 14 DATA**


$\Delta = 28^{\circ} 37' 15''$   
 $D_c = 6^{\circ} 19' 02''$   
 $R = 996.97'$   
 $T = 165.08'$   
 $L = 326.43'$   
 CHORD DIST. = 324.67'  
 CHORD BRG. = S 35° 31' 59" W

**SEDIMENT TRAP #11**

TYPE: STONE OUTLET  
 DRAINAGE AREA: 0.91 AC  
 VOLUME REQUIRED: 1638 C.F.  
 VOLUME PROVIDED: 1688 C.F.  
 BOTTOM SIZE: 8" x 6"  
 DEPTH: 2'  
 BOTTOM ELEV.: 410.6'  
 STONE CREST ELEV.: 412.5'

NOTE: SEE SHEET 14 FOR CURB PROFILES.

PLAN  
Scale: 1"=50'

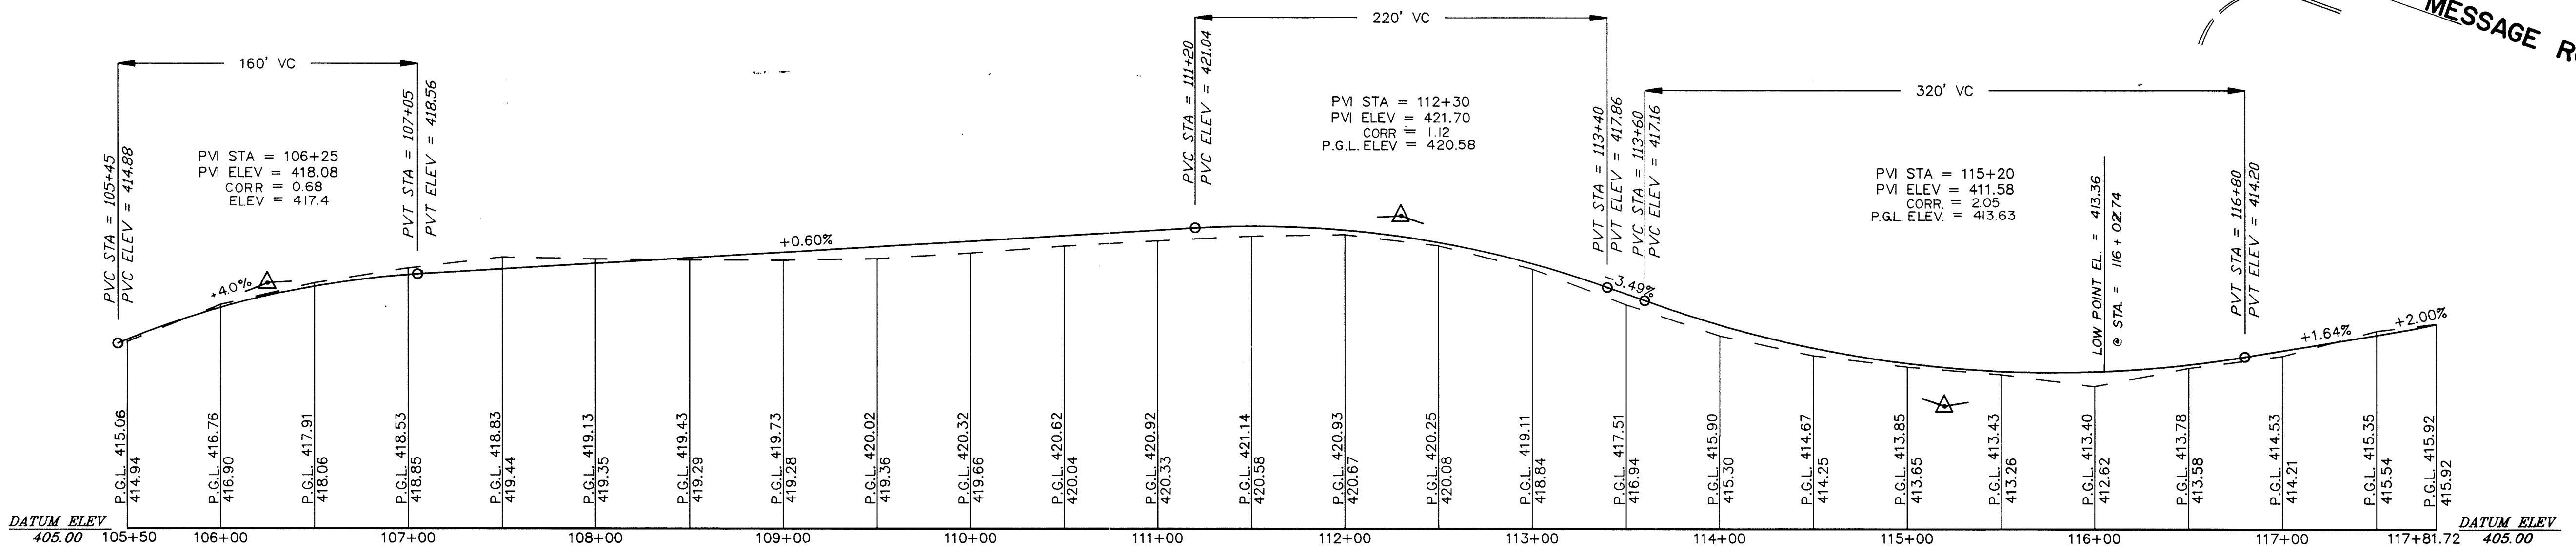

PROFILE  
Scale: Horz. 1"=50'  
Vert. 1"=5'

As Built 2/19/92 CP

DEPARTMENT OF PUBLIC WORKS  
HOWARD COUNTY, MARYLAND

*James W. Wickland* 8/22/90  
 DIRECTOR OF PUBLIC WORKS DATE  
*Granville W. Wickland* 8/22/90  
 CHIEF, BUREAU OF HIGHWAYS DATE

*Richard S. Rely* 8-21-90  
 CHIEF, BUREAU OF ENGINEERING DATE  
*Michael N. Armstrong* 8/2/90  
 CHIEF, DIVISION OF ROADS, BRIDGES AND STORM DRAINAGE DATE

ENGINEERING TECHNOLOGIES ASSOCIATES, INC.  
ENGINEERS • PLANNERS • SURVEYORS  
3458 ELLICOTT CENTER DRIVE SUITE 101  
ELLICOTT CITY, MARYLAND 21043  
(301) 481-3920

Michael N. Armstrong


DES: JVP	DATE: 8/90	BY: NO.	REVISION:	DATE:	600' SCALE MAP NO.:	BLOCK NO.:
DRN: 66P						
CHK: MNA						

PLAN AND PROFILE - STA. 105+50 TO STA. 117+81.72


**OAKLAND MILLS ROAD IMPROVEMENTS**  
6TH ELECTION DISTRICT HOWARD COUNTY, MARYLAND  
CAPITAL PROJECT NO.: J-4095

SCALE AS SHOWN

SHEET 9 OF 27

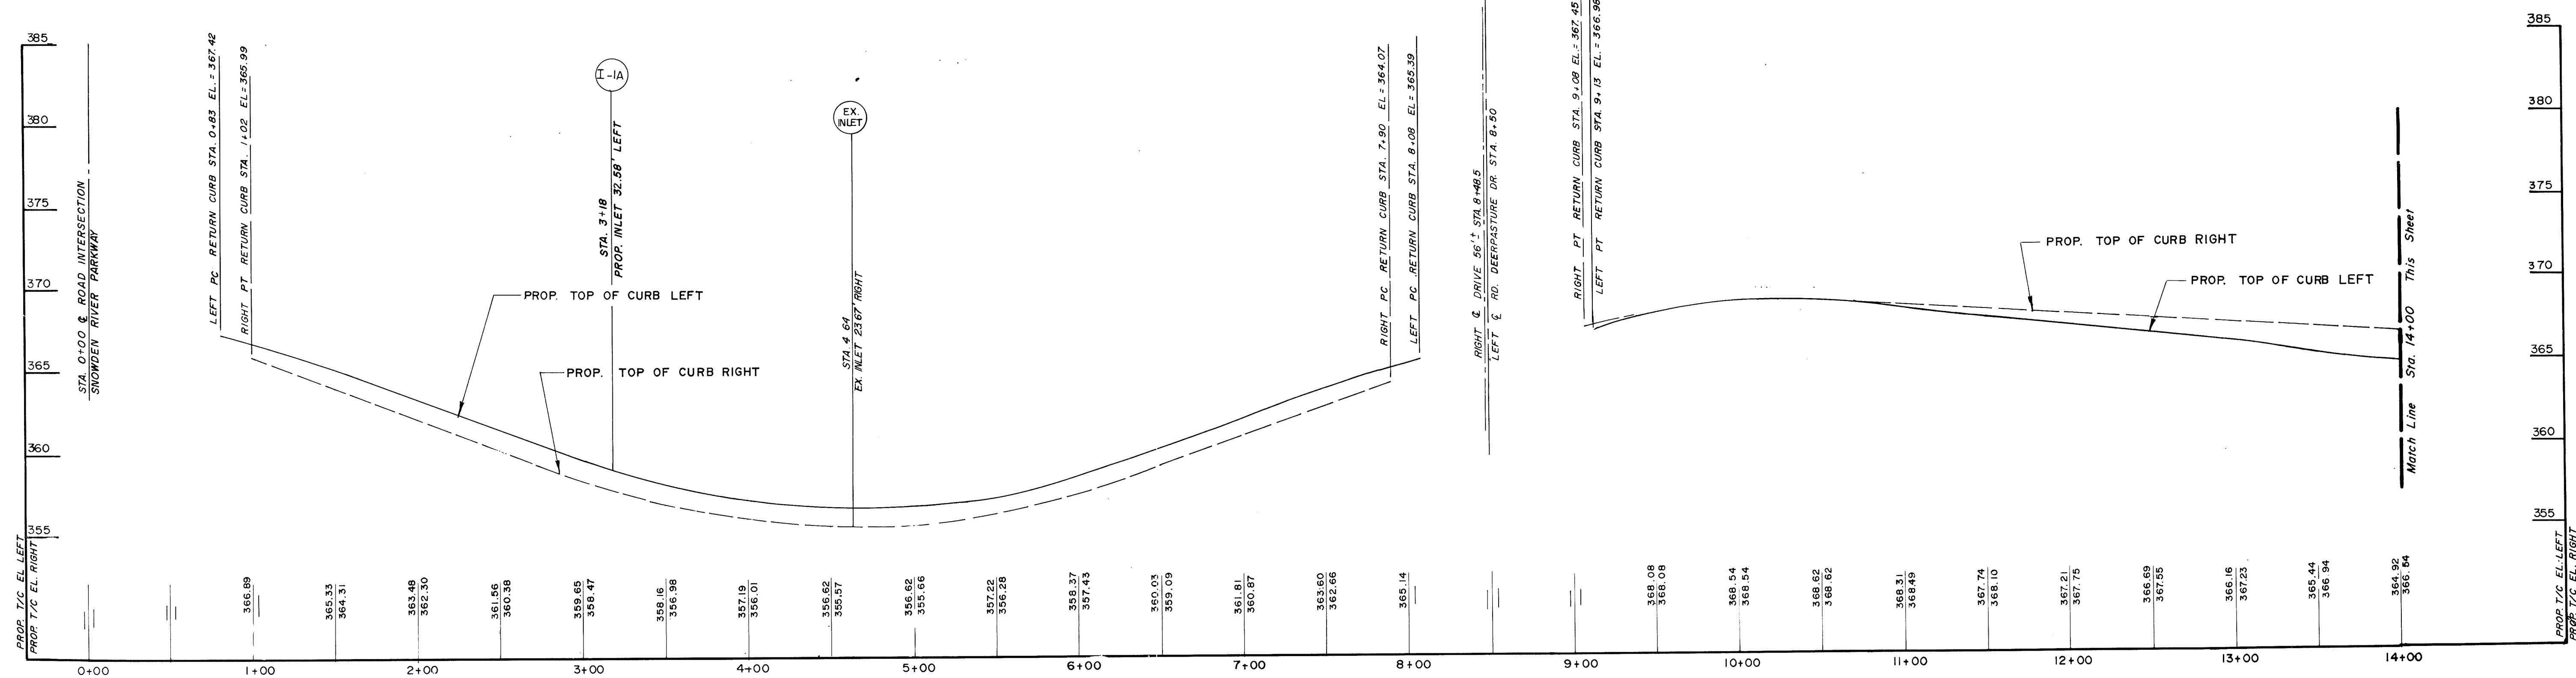

**PROFILE**  
 SCALE: HORZ. 1" = 50'  
 VERT. 1" = 5'

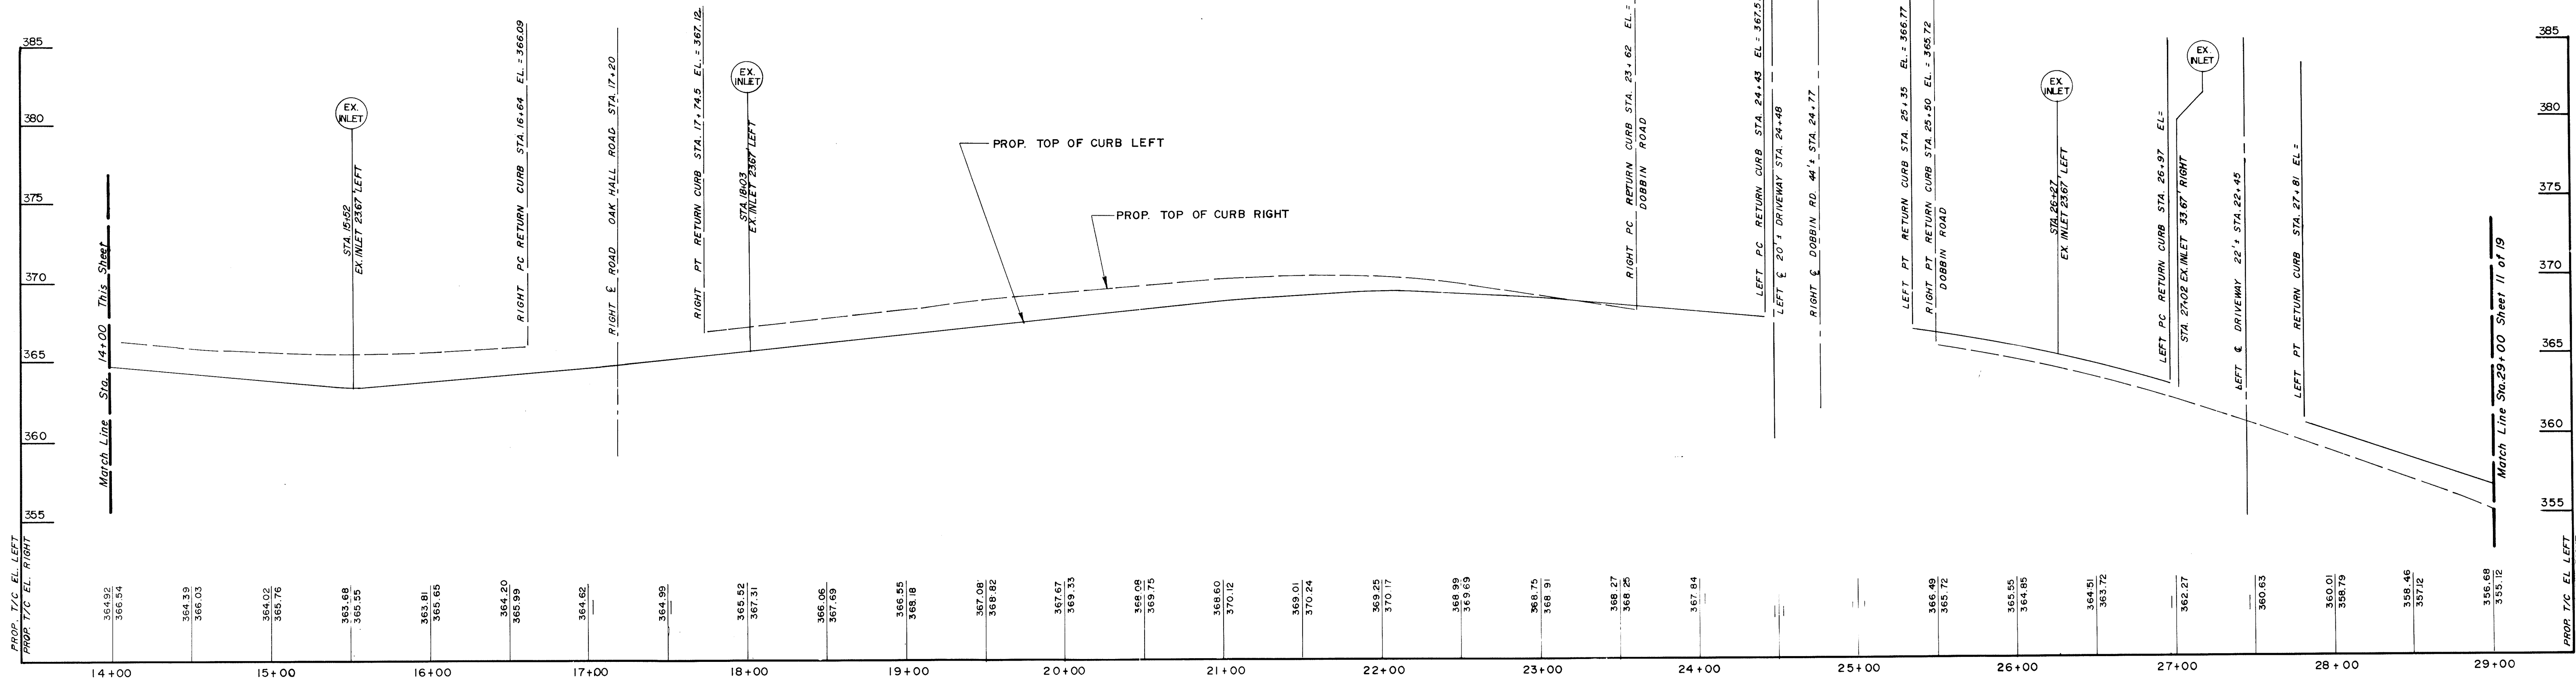

**PROFILE**  
 SCALE: HORZ. 1" = 50'  
 VERT. 1" = 5'

DEPARTMENT OF PUBLIC WORKS  
 HOWARD COUNTY, MARYLAND

ENGINEERING TECHNOLOGIES  
 ASSOCIATES, INC.  
 ENGINEERS - PLANNERS - SURVEYORS  
 3458 ELLICOTT CENTER DRIVE SUITE 101  
 ELLICOTT CITY, MARYLAND 21043  
 (301) 481-8920



*Michael T. Armistead*

ES	KAP				
PN	SGP				
HK	MNA				
DATE:	8/90	BY:	NO:	REVISION:	DATE:
		600 SCALE MAP NO.		BLOCK NO.	

TOP OF CURB PROFILE — STA. 0+00 TO STA. 29+00  
**OAKLAND MILLS ROAD IMPROVEMENTS**  
 6TH ELECTION DISTRICT HOWARD COUNTY, MARYLAND  
 CAPITAL PROJECT NO. J-4095

SCALE AS SHOWN  
 SHEET 10 OF 27



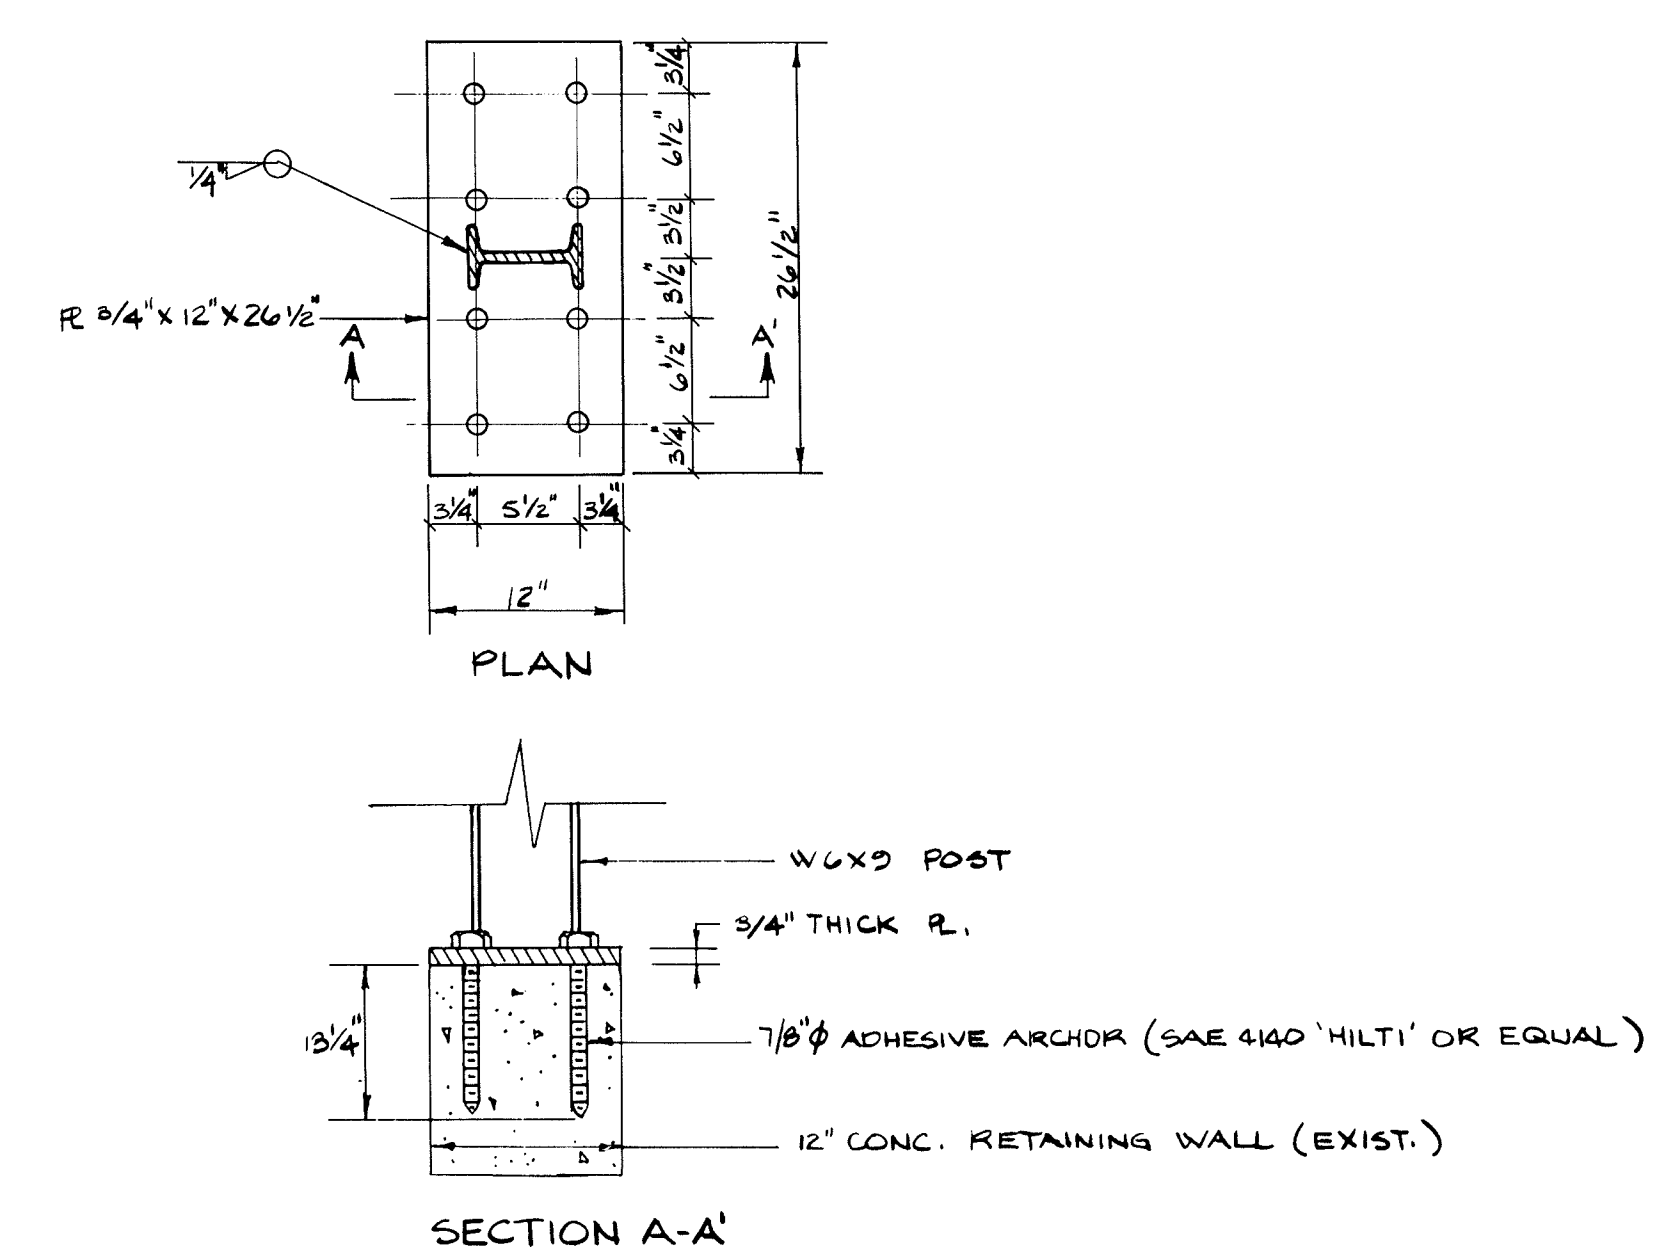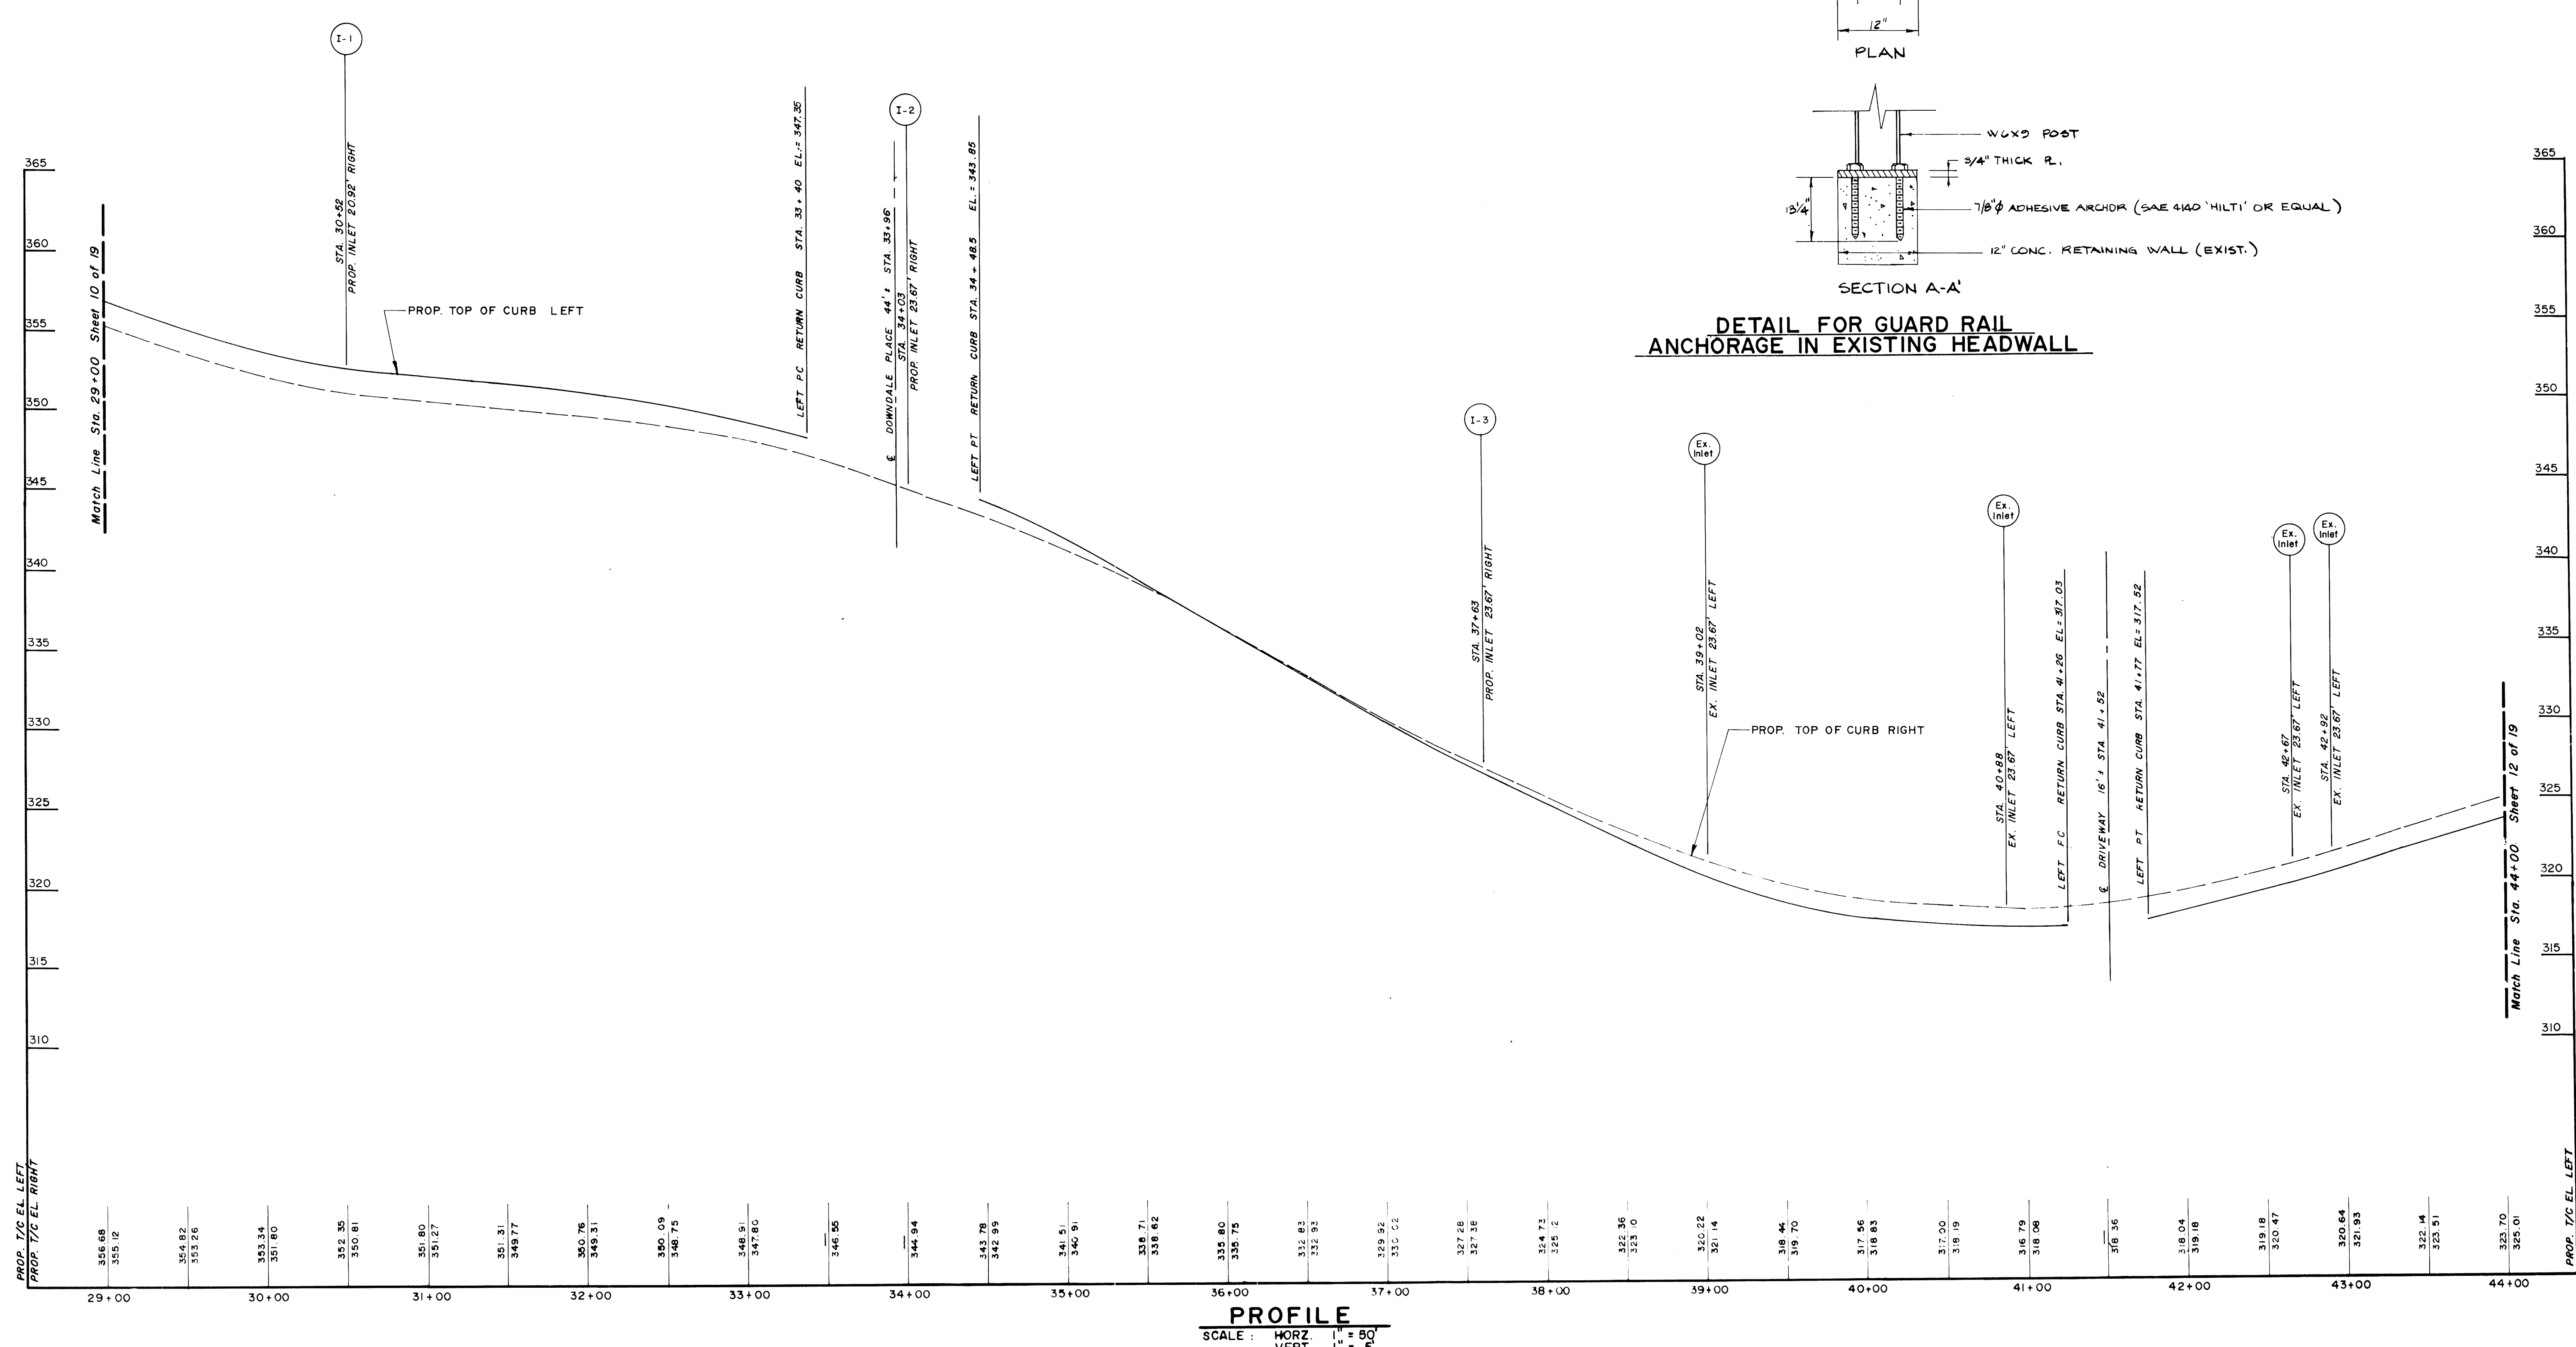

1661

DEPARTMENT OF PUBLIC WORKS  
HOWARD COUNTY, MARYLAND

*James J. ...* 8/22/90  
DIRECTOR OF PUBLIC WORKS DATE

*Michael N. ...* 8/22/90  
CHIEF, BUREAU OF ENGINEERING DATE

*Michael N. ...* 8/22/90  
CHIEF, DIVISION OF ROADS, BRIDGES AND STORM DRAINAGE DATE

ENGINEERING TECHNOLOGIES ASSOCIATES, INC.  
ENGINEERS - PLANNERS - SURVEYORS  
3456 ELLICOTT CENTER DRIVE SUITE 101  
ELlicOTT CITY, MARYLAND 21043  
(301) 461-9920

*Michael N. ...*

DES. KAP	BY	NO	REVISION	DATE	600 SCALE MAP NO	BLOCK NO.
DRN SGP						
CHK: MVA						
DATE: 8/20						

TOP OF CURB PROFILE — STA. 29+00 TO STA. 44+00

**OAKLAND MILLS ROAD IMPROVEMENTS**

6TH ELECTION DISTRICT HOWARD COUNTY, MARYLAND  
CAPITAL PROJECT NO.: J-4095


SCALE AS SHOWN

SHEET 11 OF 27








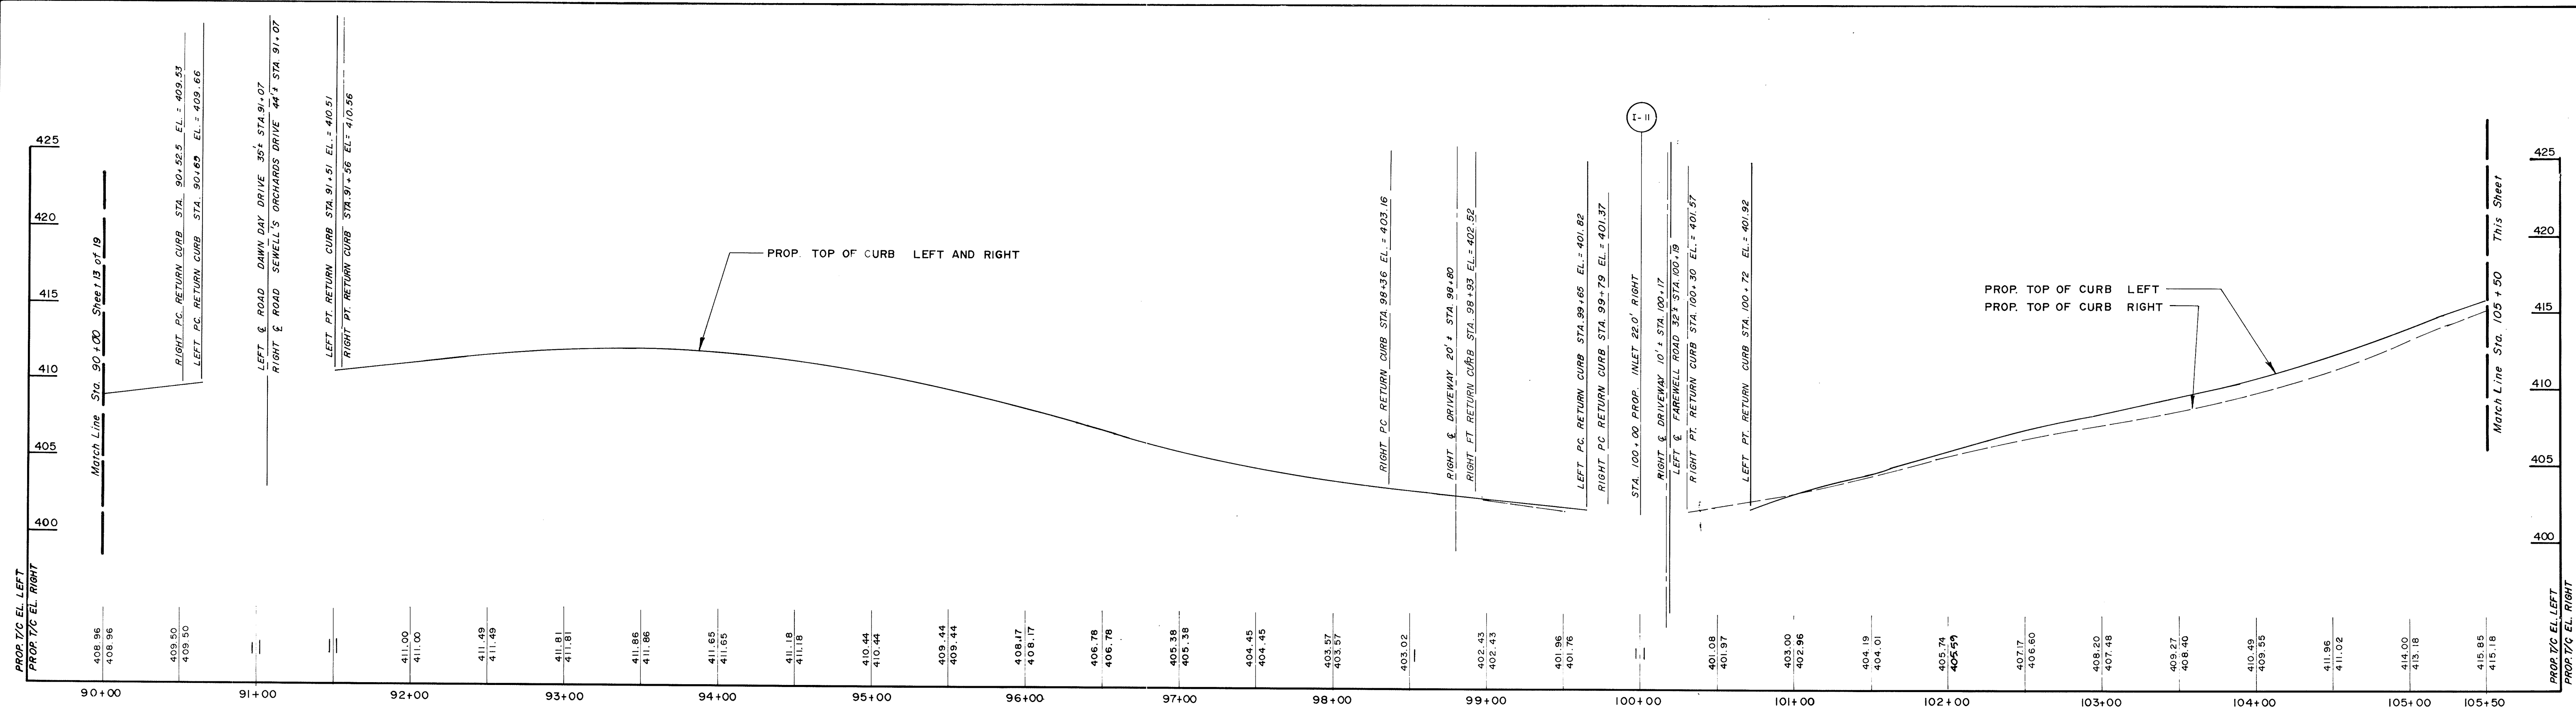

**PROFILE**  
 SCALE: HORIZ. 1" = 50'  
 VERT. 1" = 5'

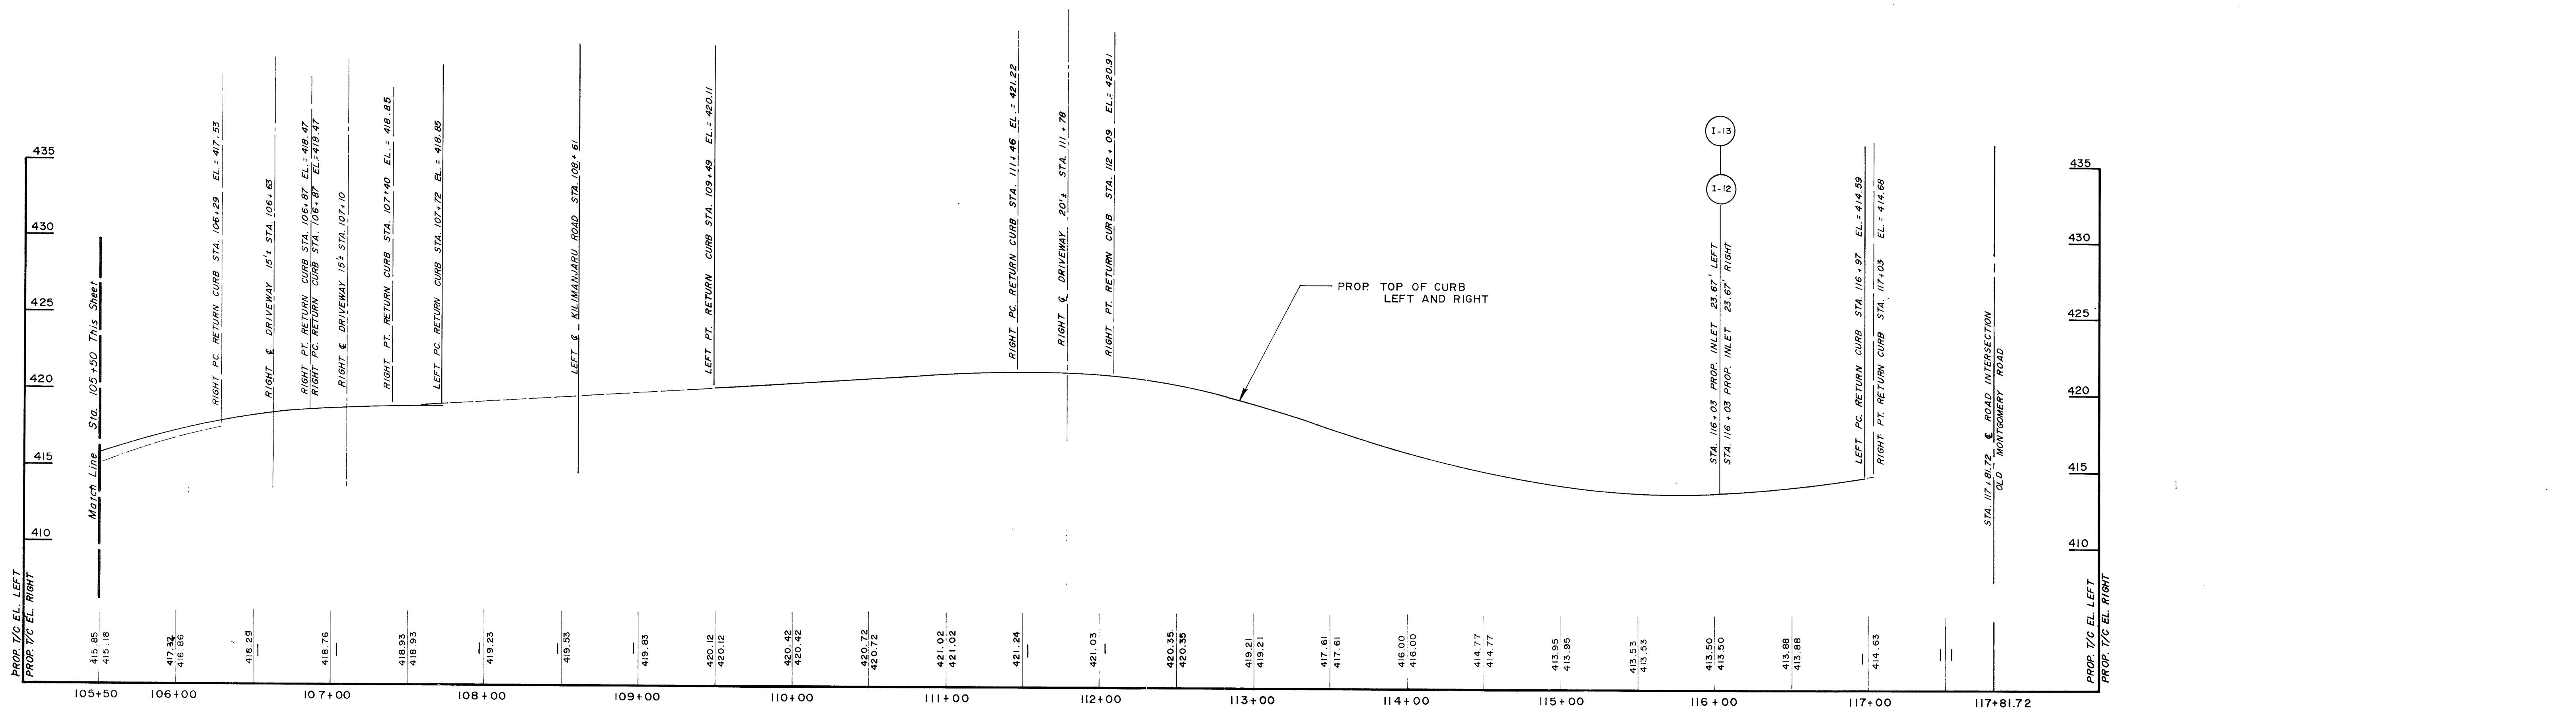

**PROFILE**  
 SCALE: HORIZ. 1" = 50'  
 VERT. 1" = 5'

DEPARTMENT OF PUBLIC WORKS  
 HOWARD COUNTY, MARYLAND

*James J. Su*  
 Director of Public Works DATE 8-21-90

*William S. Reay*  
 Chief, Bureau of Engineering DATE 8-21-90

*Donville W. Williams* 8/21/90  
 Chief, Bureau of Highways DATE 8/21/90

*Michael N. Armstrong*  
 Chief, Bridges and Storm Drainage DATE 8/21/90

ENGINEERING TECHNOLOGIES  
 ASSOCIATES, INC.

ENGINEERS • PLANNERS • SURVEYORS

3458 ELLICOTT CENTER DRIVE SUITE 101  
 ELLICOTT CITY, MARYLAND 21143  
 (301) 461-9920

*Michael N. Armstrong*

DES. KAP			
DRN. SGP			
CHK. MNA			
DATE: 8/90	BY: NO	REVISION	DATE

600 SCALE MAP NO.	BLOCK NO.
-------------------	-----------

TOP OF CURB PROFILE — STA. 90+00 TO STA. 117+81.72

**OAKLAND MILLS ROAD IMPROVEMENTS**

6TH ELECTION DISTRICT HOWARD COUNTY, MARYLAND  
 CAPITAL PROJECT NO.: J-4095


SCALE AS SHOWN

SHEET 14 OF 27



NOTES FOR SECTION FROM STA 0+52 TO STA. 11+00

- NOTES:
1. MATCH EXISTING PAVEMENT AT SNOWDEN RIVER PARKWAY (STA 0+52). TRANSITION ROADWAY TO FULL SUPERELEVATION AT 24 CROSS SLOPS AT STA 2+00.
  2. SUPERELEVATION RATES TO STA 2+00 AND FROM STA 7+50 TO STA 8+51 WILL BE PER EXISTING CONDITION. ROADWAY IS IN FULL SUPERELEVATION AT 2% CROSS SLOPE FROM STA 2+00 TO STA 7+50.
  3. CROSS SLOPES AT STA 8+50 WILL BE AT CONSTANT GRADE FROM P.G.L. TO PAVEMENT MATCH AT DEERPASTURE DRIVE AND SIELING INDUSTRIAL CENTER CURB RETURN.
  4. CROSS SLOPES FROM STA 9+00 TO STA 11+00 WILL BE PER EXISTING CONDITION.

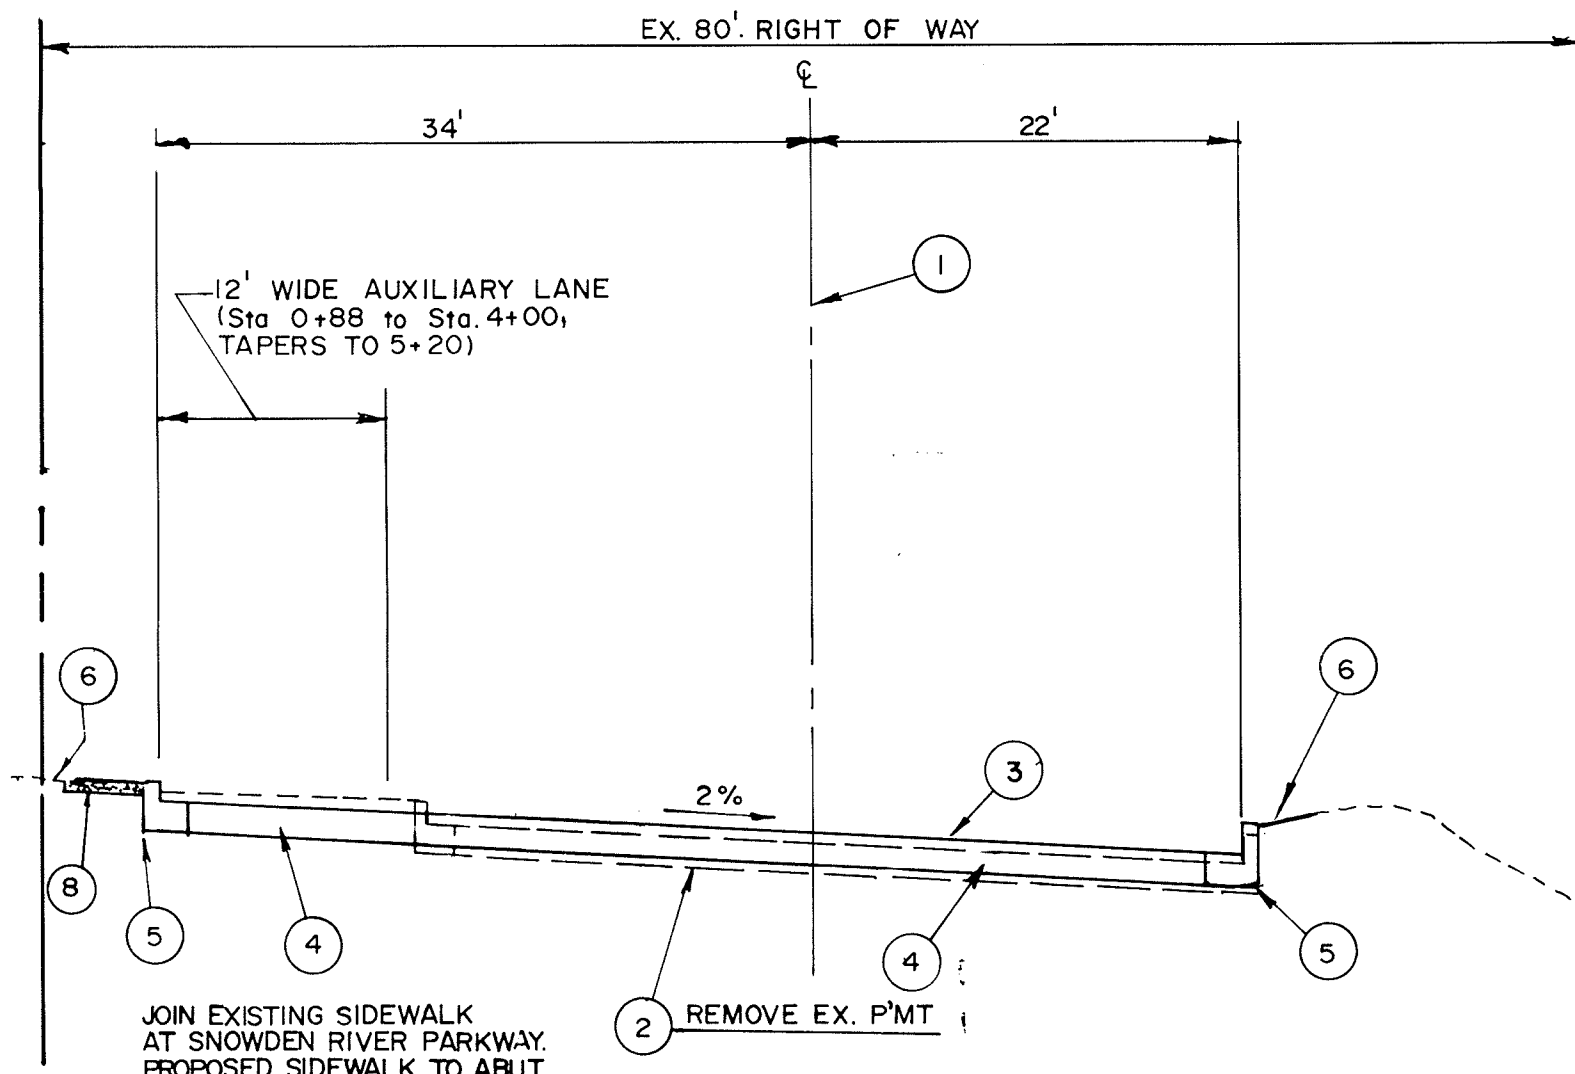


JOIN EXISTING SIDEWALK AT SNOWDEN RIVER PARKWAY. PROPOSED SIDEWALK TO ABUT CURB TO STA 4+00. TAPER DISTANCE FROM CURB TO 9' @ STA. 5+20

STA. 0+52 TO STA. 11+00  
No Scale


NOTE: A.L. EXISTING CURB & GUTTER (INCLUDING GUTTER PAN UNDER EXISTING RESURFACED AREAS) SHALL BE REMOVED. FULL PAVEMENT SECTION (PAVING SECTION P-3) SHALL BE PROVIDED BETWEEN PROPOSED CURB & GUTTER AND TIE-IN TO 1 1/2" SURFACE OVERLAY.

LEGEND


- 1 PROFILE GRADE LINE (P.G.L.)
- 2 EXISTING PAVEMENT SECTION
- 3 BITUMINOUS CONCRETE SURFACE OVERLAY
- 4 PAVING SECTION P-3
- 5 STANDARD COMB. CURB & GUTTER (HOWARD CO. STD. R-3.01)
- 6 2" TOPSOIL SEED & MULCH; TIE IN PROP. GRADE TO EX. GR @ 2%/MIN. DOWN SLOPE TOWARD CURB.
- 7 GUARDRAIL PLACED AT TOP OF SLOPE.
- 8 PROPOSED 4' WIDTH, 4" SIDEWALK WITH THE EXCEPTION OF AREAS WHERE SIDEWALK ABUTS THE CURB, IN WHICH CASE IT SHOULD BE 5' WIDE.
- 9 EXISTING SIDEWALK.

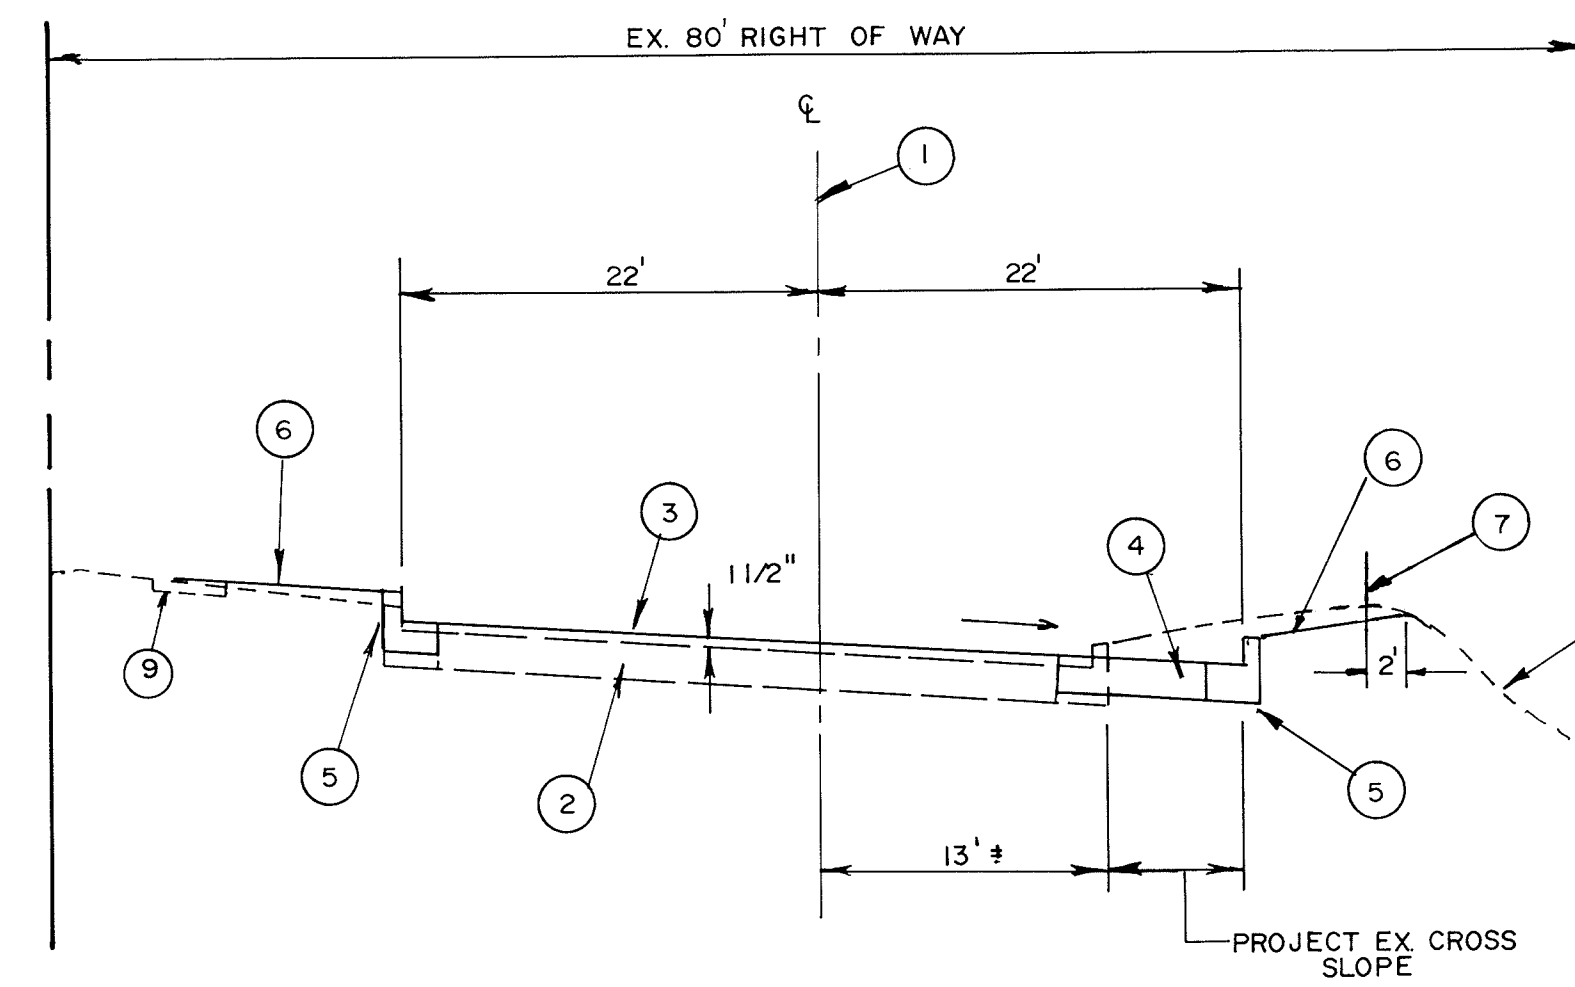


STA. 29+70 TO STA. 35+50  
No Scale

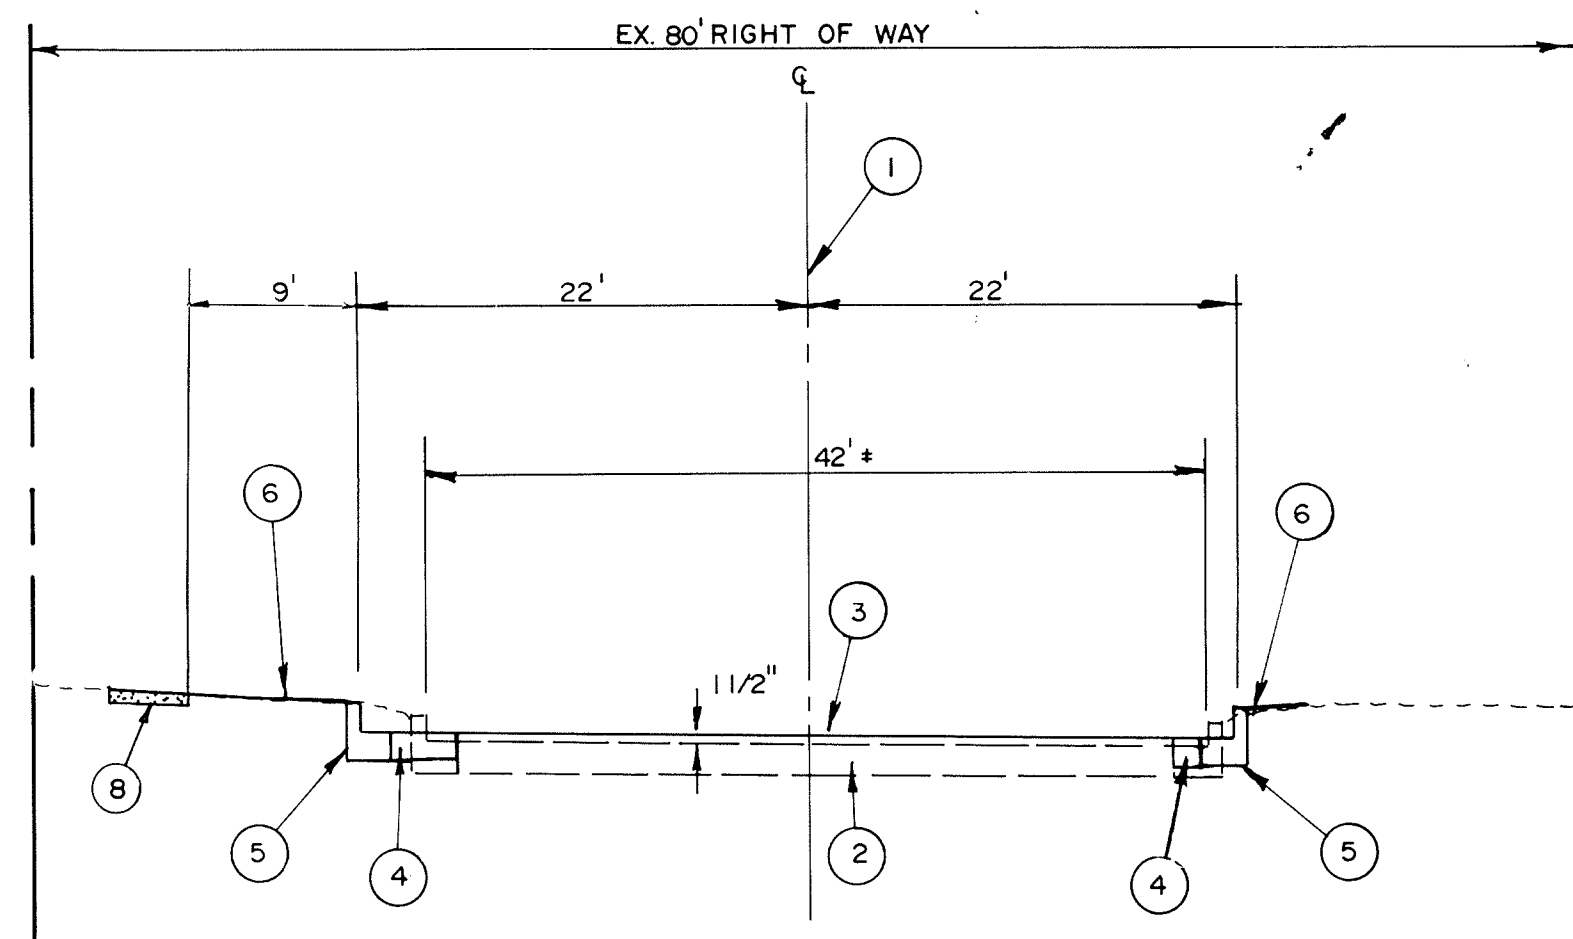


STA. 11+00 TO STA. 20+50  
No Scale

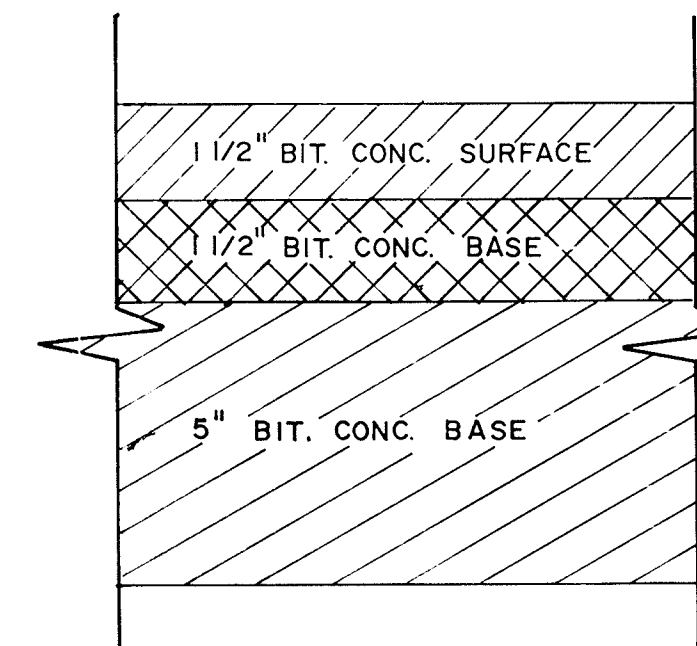


PAVING SECTION P-3  
No Scale

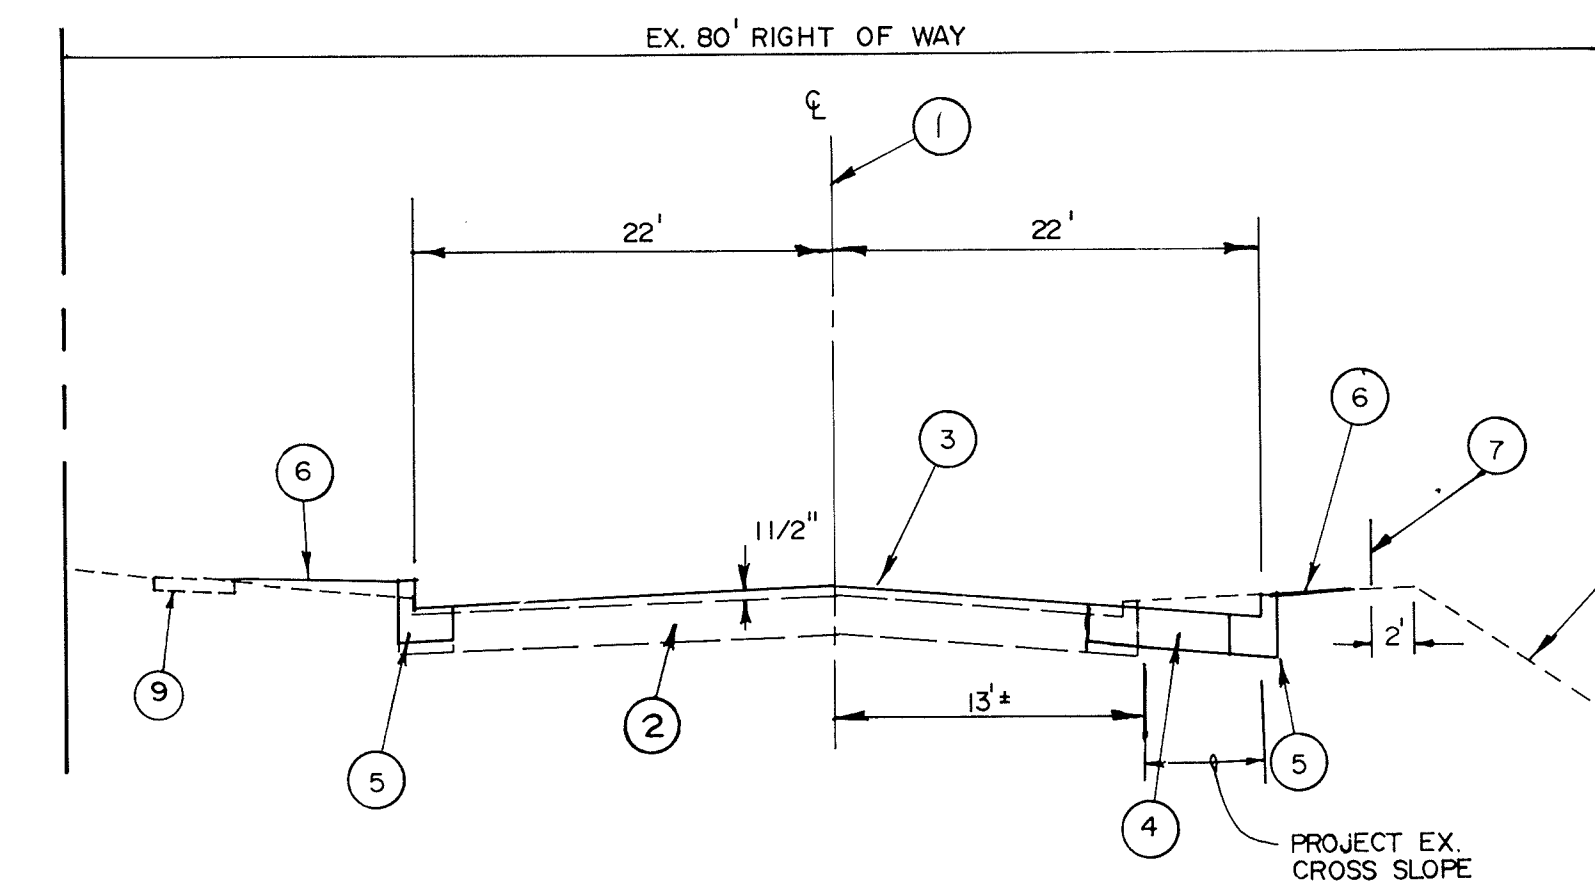

STA. 35+50 TO STA. 37+50  
No Scale

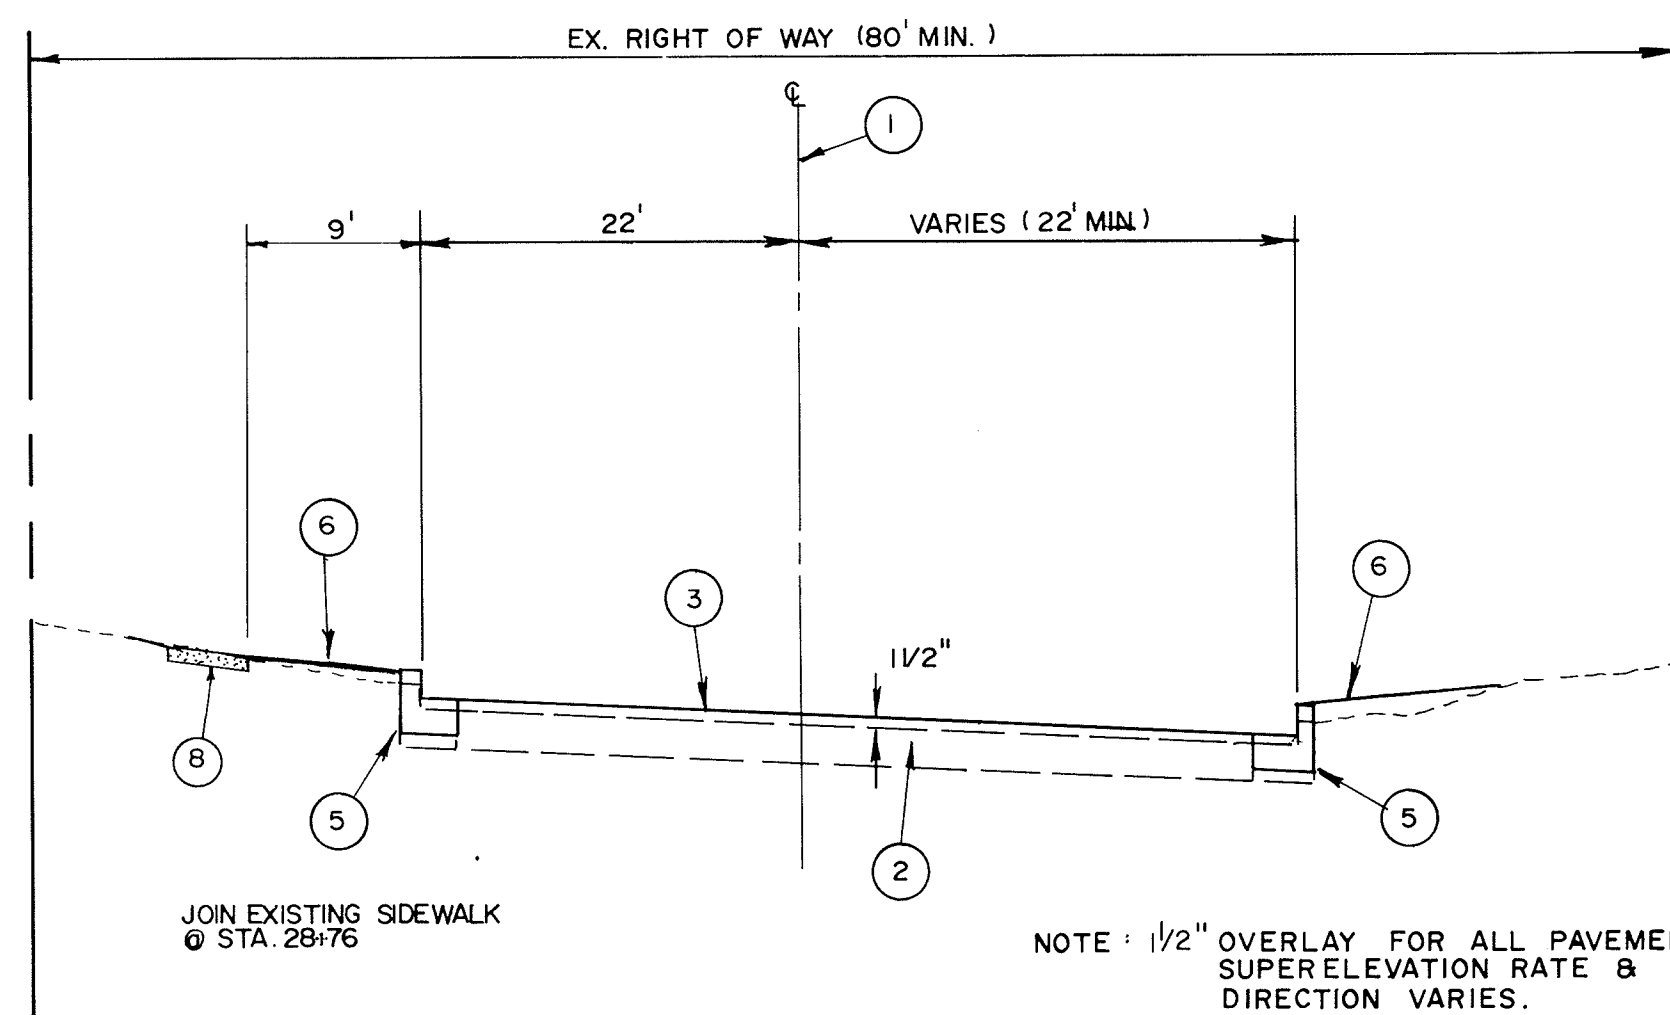

STA. 20+50 TO STA. 29+70  
No Scale

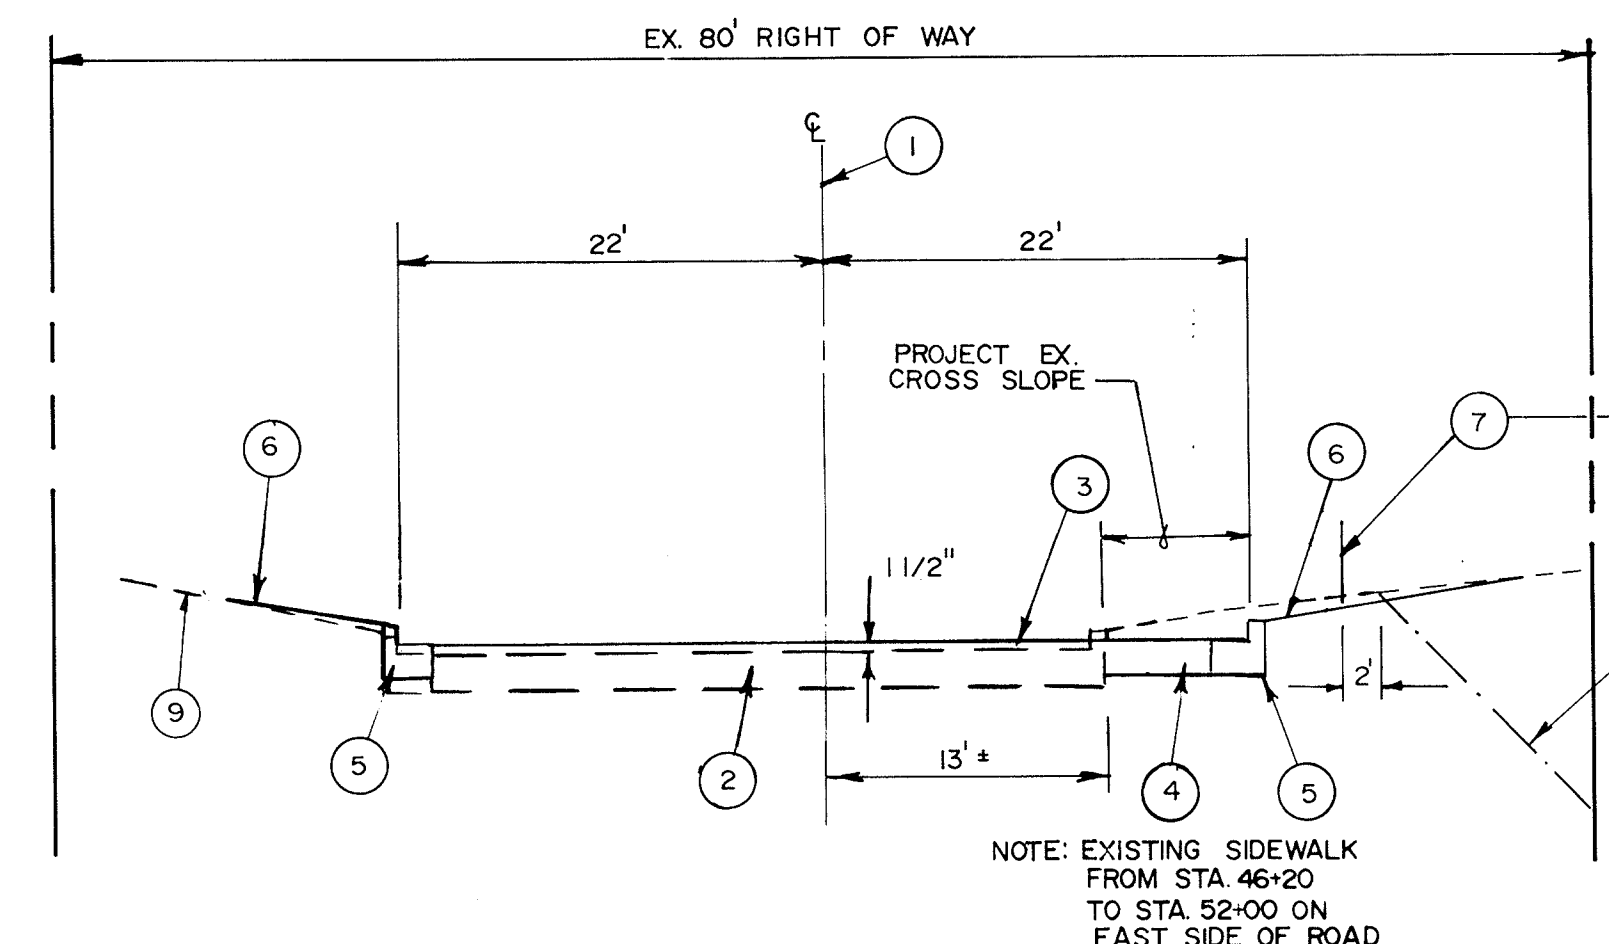

STA. 37+50 TO STA. 52+00  
No Scale

DEPARTMENT OF PUBLIC WORKS  
HOWARD COUNTY, MARYLAND

*James W. ...* 6/22/90  
DIRECTOR OF PUBLIC WORKS  
*James W. ...* 6/22/90  
CHIEF, BUREAU OF HIGHWAYS

*...* 6/22/90  
CHIEF BUREAU OF ENGINEERING  
DATE

*...* 6/22/90  
CHIEF, DIVISION OF ROADS,  
BRIDGES AND STORM DRAINAGE  
DATE


ENGINEERING TECHNOLOGIES  
ASSOCIATES, INC.  
ENGINEERS - PLANNERS - SURVEYORS  
2459 ELLICOTT CENTER DRIVE SUITE 101  
ELLICOTT CITY, MARYLAND 21043  
(301) 461-9920

*Michael N. Armstrong*

DES: JYP					
DRN: SGP					
CHK: MNA					
DATE: 6/90					
BY	NO.	REVISION	DATE	600' SCALE MAP NO.	BLOCK NO.




TYPICAL CROSS SECTIONS  
**OAKLAND MILLS ROAD IMPROVEMENTS**  
6TH ELECTION DISTRICT HOWARD COUNTY, MARYLAND  
CAPITAL PROJECT NO. J-4095

SCALE AS SHOWN  
SHEET 15 OF 27

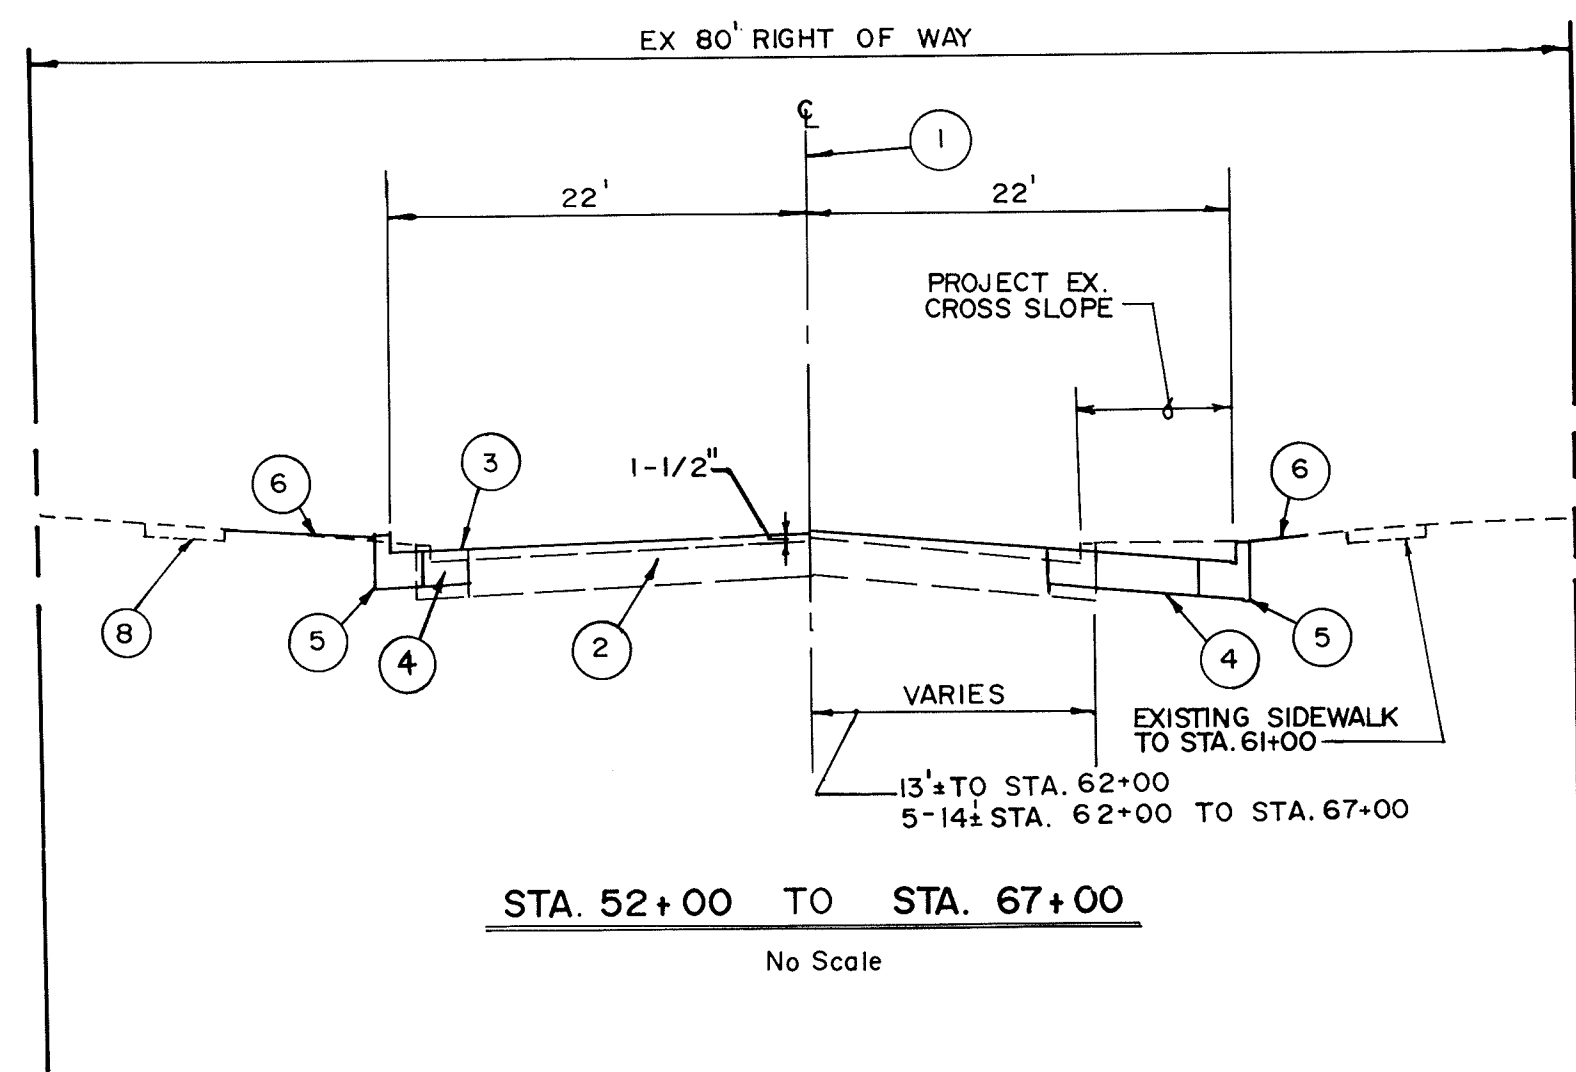




NOTE: ALL EXISTING CURB & GUTTER (INCLUDING GUTTER PAN UNDER EXISTING RESURFACED AREAS) SHALL BE REMOVED. FULL PAVEMENT SECTION (PAVING SECTION P-3) SHALL BE PROVIDED BETWEEN PROPOSED CURB & GUTTER AND TIE-IN TO 1 1/2" SURFACE OVERLAY.

- LEGEND**
- ① PROFILE GRADE LINE (P.G.L.)
  - ② EXISTING PAVEMENT SECTION
  - ③ BITUMINOUS CONCRETE SURFACE OVERLAY
  - ④ PAVING SECTION P-3
  - ⑤ STANDARD COMB. CURB & GUTTER (HOWARD COSTD.R 301)
  - ⑥ 2" TOPSOIL, SEED & MULCH TIE IN PROPOSED GRADE TO EX. GR. @ 2% MIN. SLOPE TOWARD CURB.
  - ⑦ PROPOSED 4' WIDTH 4" SIDEWALK AS REQUIRED BY SUBDIVISION REGULATIONS
  - ⑧ EXISTING SIDEWALK

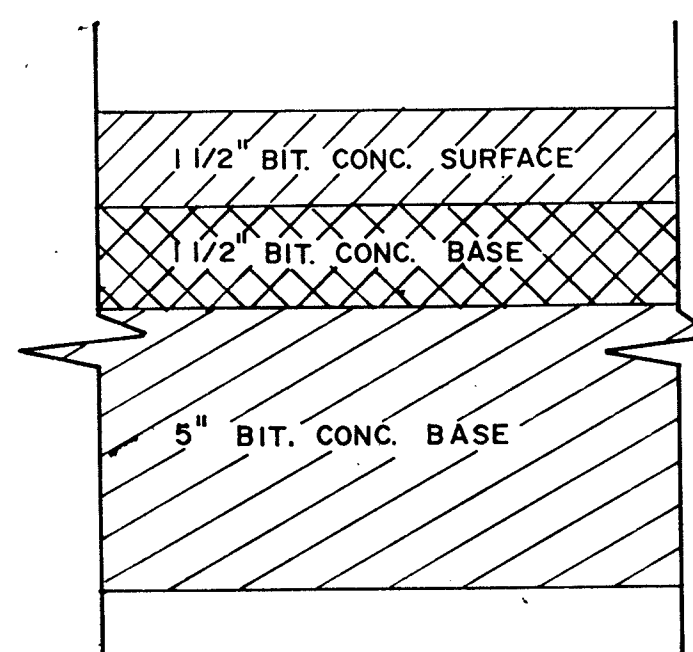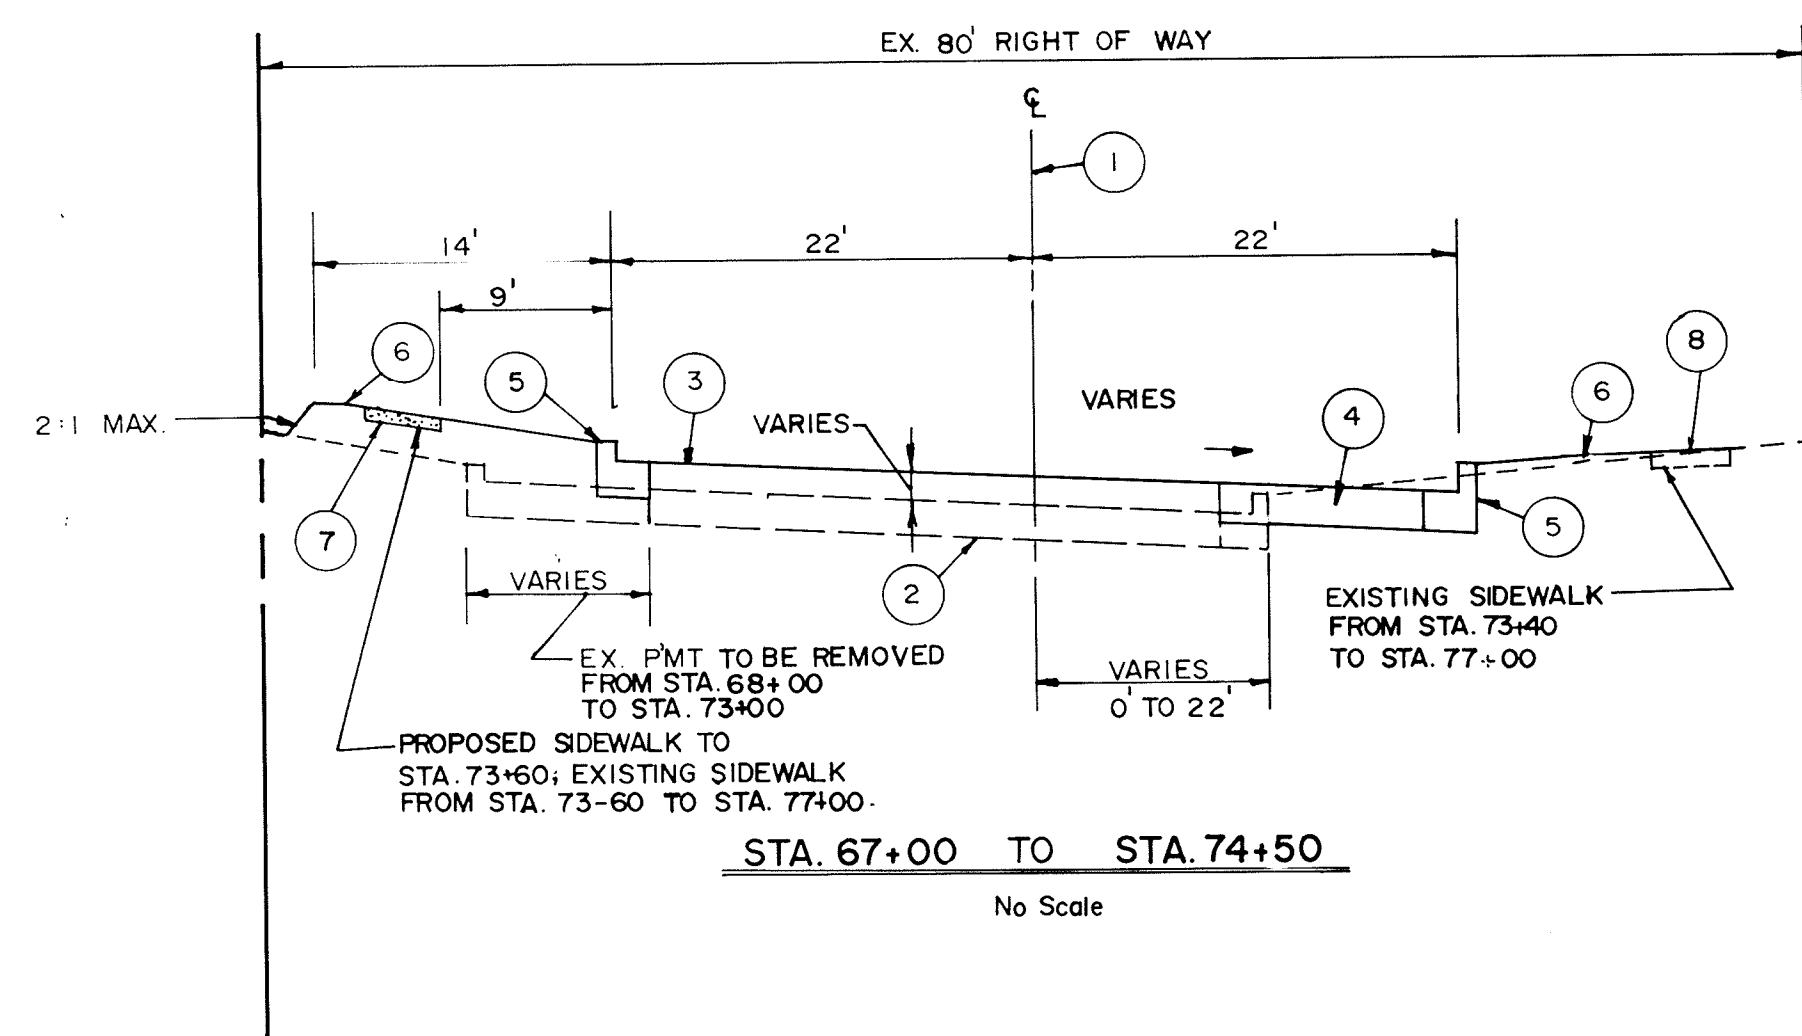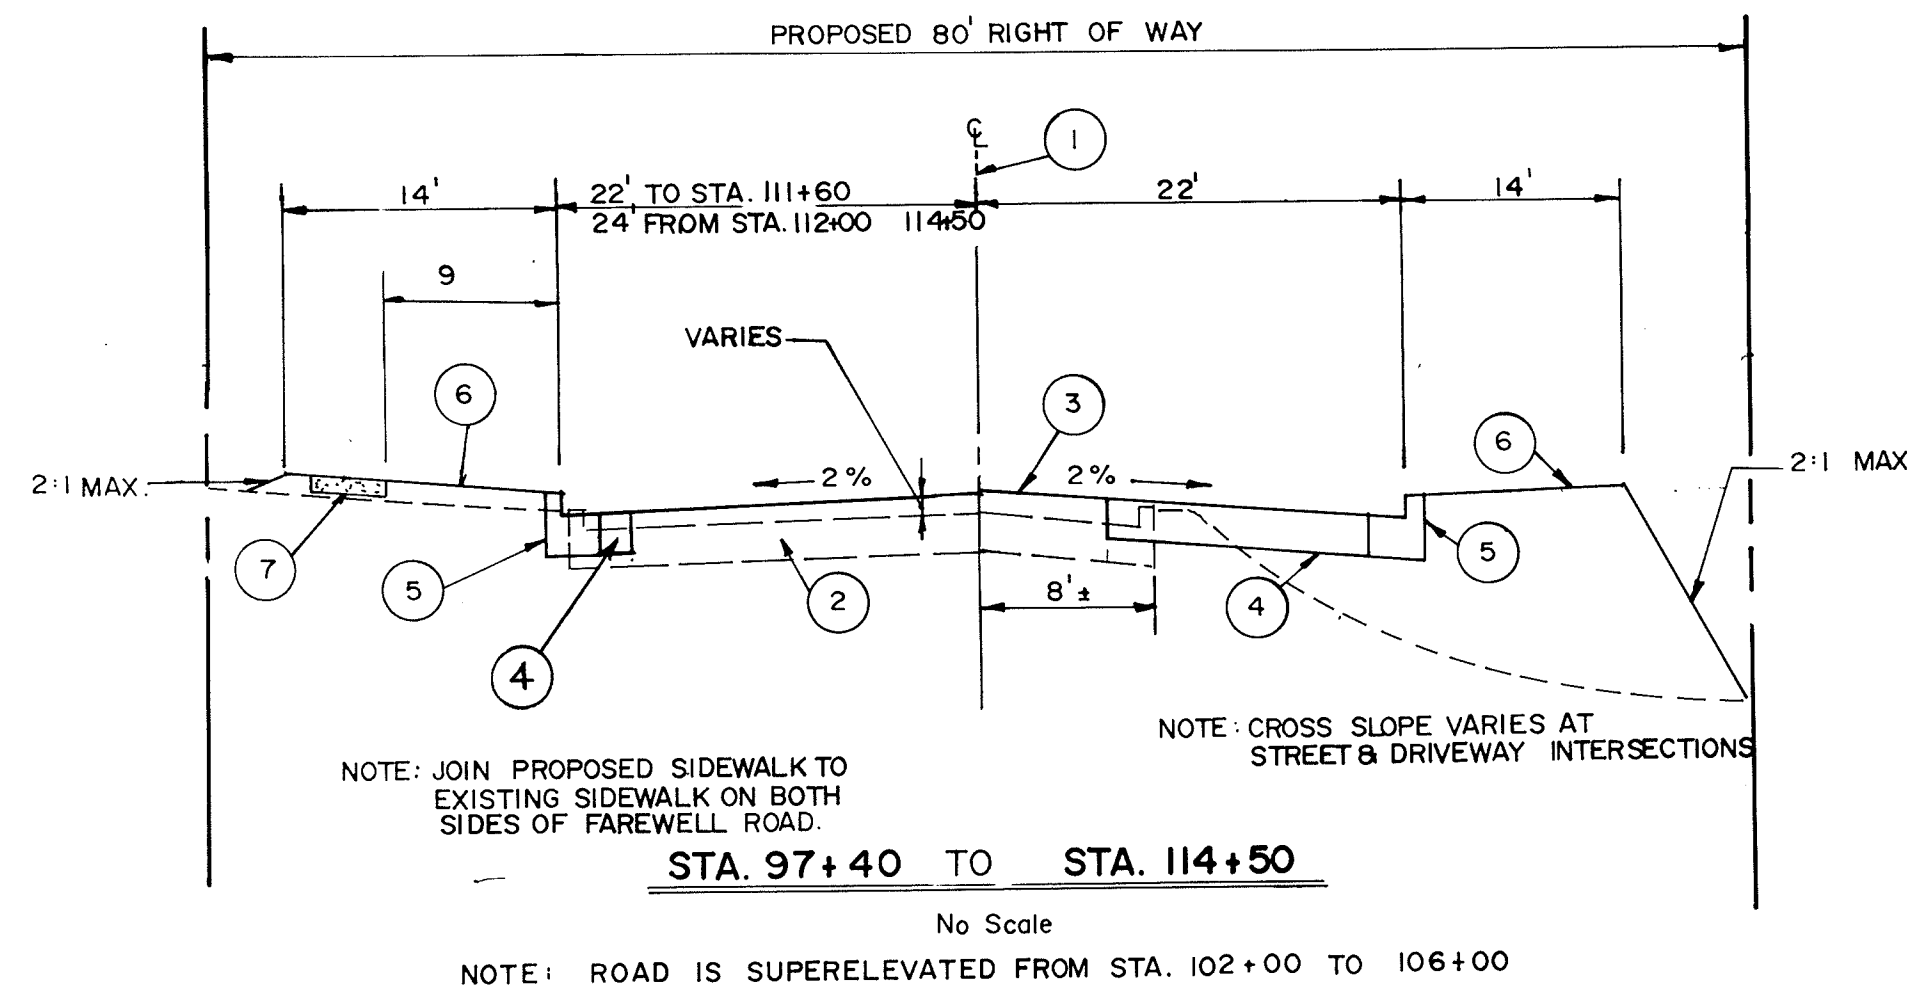

PAVING SECTION P-3

No Scale

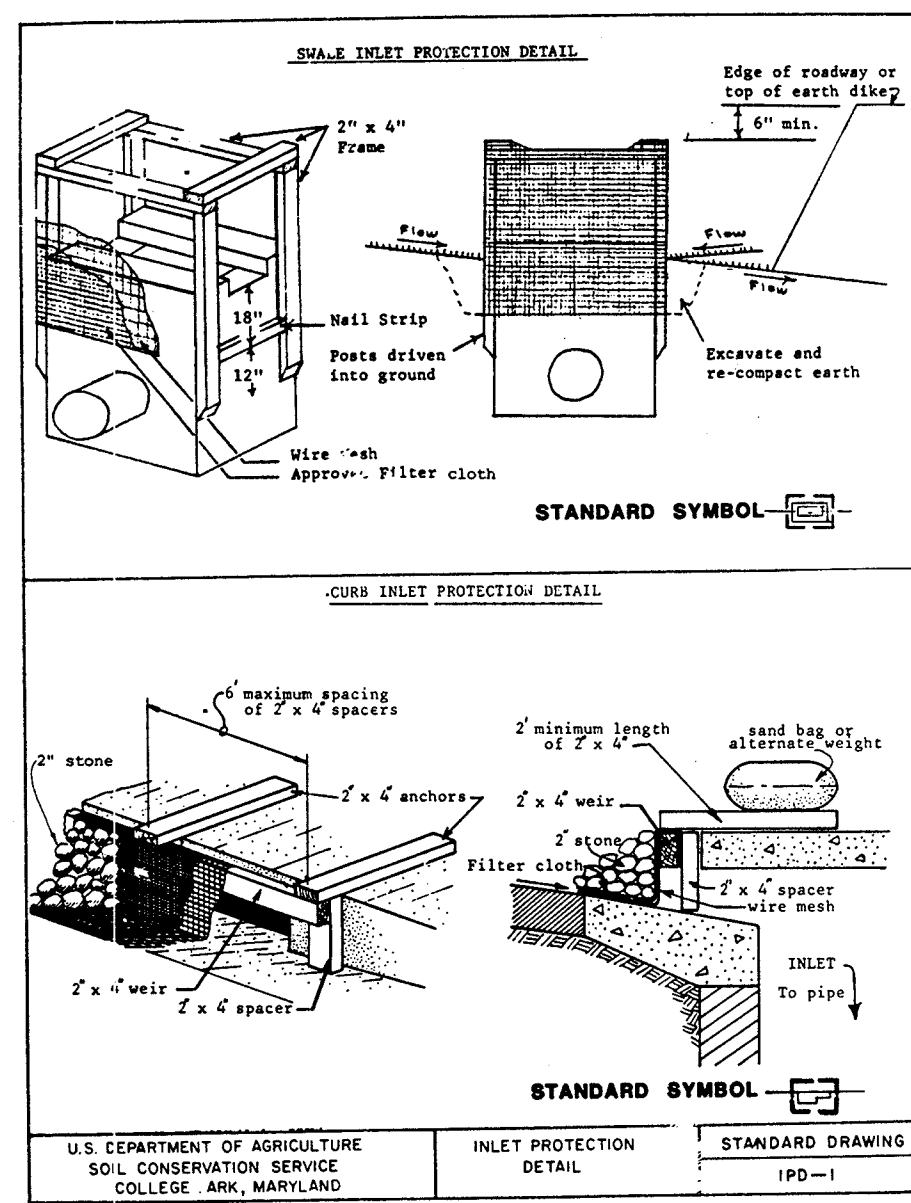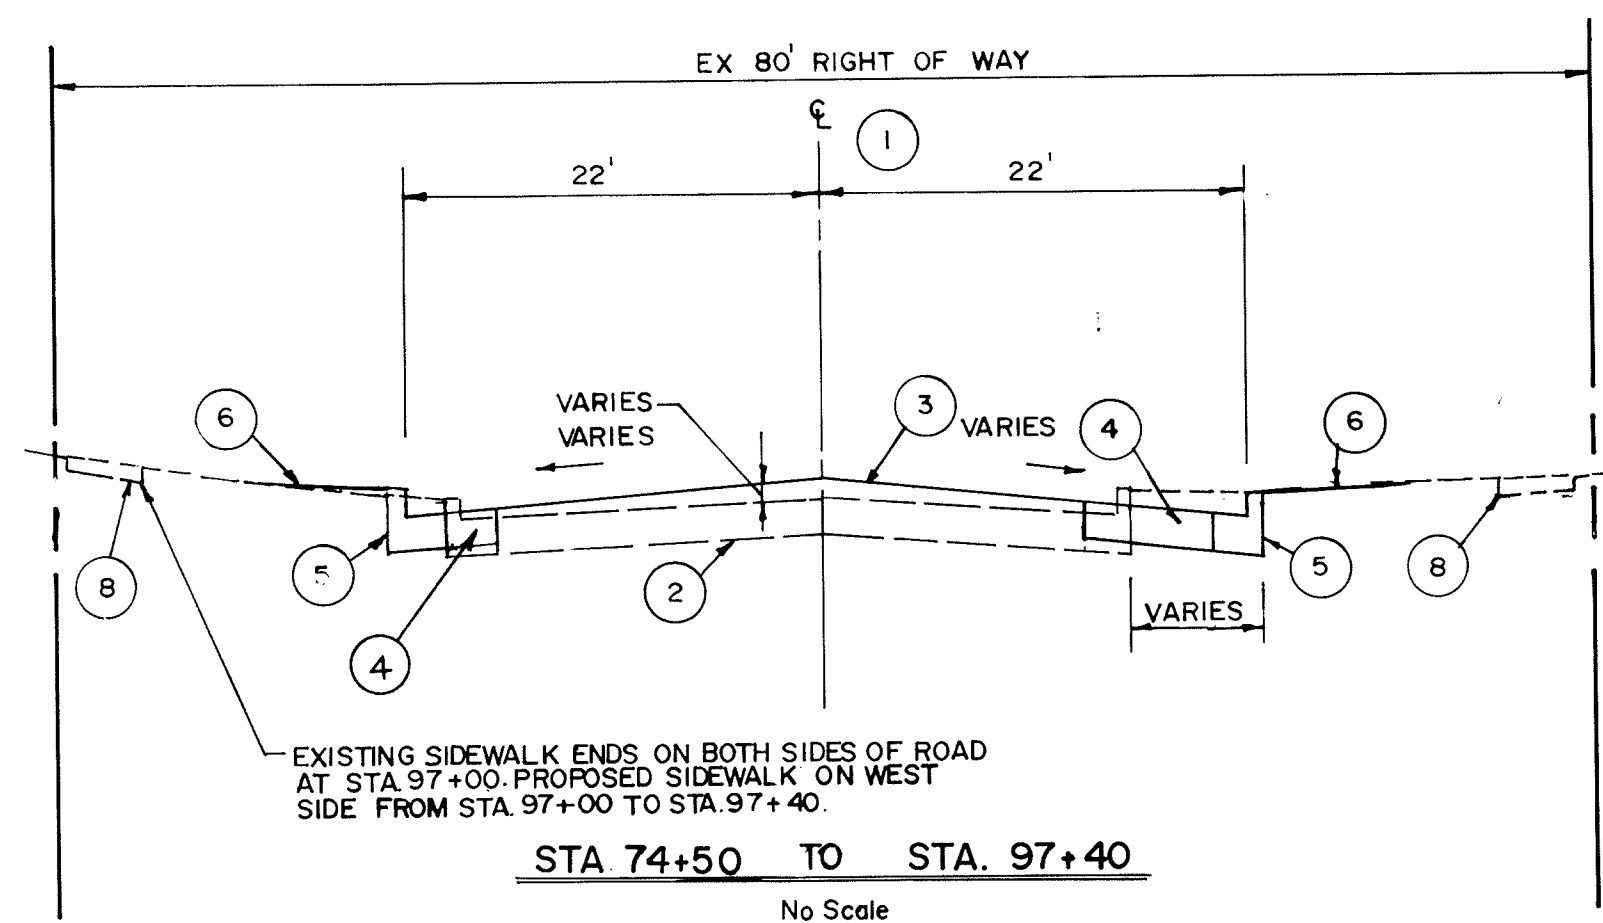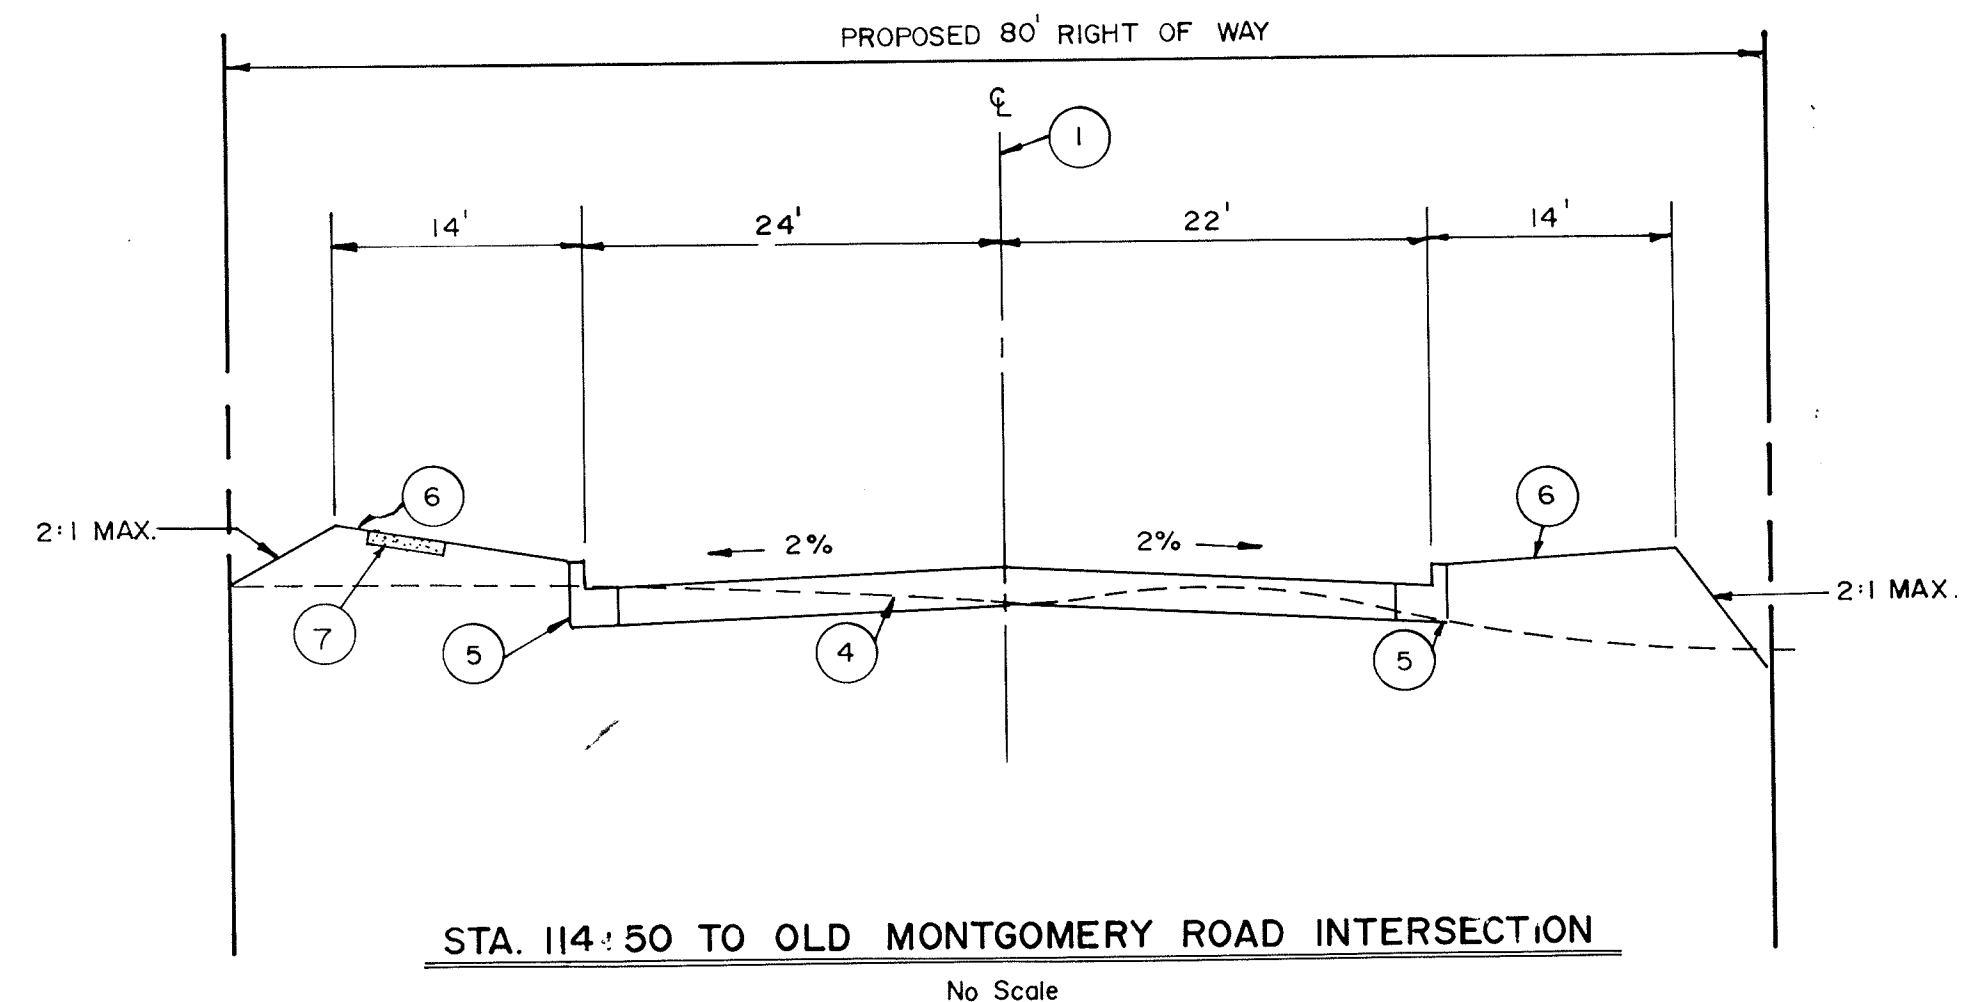

**EARTHWORK COMPUTATIONS**

SHEET NO.	FROM	TO	CUT (C.Y.)	FILL (C.Y.)	2" TOPSOIL IN EXCAVATION (C.Y.)	CLASS 2 EXCAVATION (C.Y.)	CLASS 1 ADJUSTMENT (C.Y.)
2	0+00	14+00	304	28	29	--	275
3	14+00	29+00	21	148	7	--	14
4	29+00	44+00	393	156	65	67	328
5	44+00	59+00	476	125	69	68	407
6	59+00	74+50	2260	303	173	215	2087
7	74+50	90+00	460	345	54	150	406
8	90+00	105+50	794	915	94	106	700
9	105+50	117+81.72	1020 9728	1521 3947	74 545	62 448	946 6105

**EARTHWORK SUMMARY**

Total Class 1 Excavation = 5,728 Cubic Yards  
 Total Class 1 Excavation Adjustment (Class 1 Excavation - 2" Topsoil) = 5,163 Cubic Yards  
 Total Topsoil In Excavation = 565 Cubic Yards  
 Total Class 2 Excavation = 668 Cubic Yards  
 Assuming 15% Shrinkage Factor, Total Material Available for fill = (668 + 5,163) (0.85) = 4,956 Cubic Yards  
 Total Fill = 3,541 Cubic Yards  
 Total Excess Material = 1,415 Cubic Yards

DEPARTMENT OF PUBLIC WORKS  
HOWARD COUNTY, MARYLAND

ENGINEERING TECHNOLOGIES  
ASSOCIATES, INC.

DES: JVP

DRN: SGR

CHK: MNA

DATE: 8/30

BY NO. REVISION

DATE 600' SCALE MAP NO. BLOCK NO.

TYPICAL CROSS SECTIONS & EARTHWORK SUMMARY

**OAKLAND MILLS ROAD IMPROVEMENTS**





6TH ELECTION DISTRICT HOWARD COUNTY, MARYLAND  
CAPITAL PROJECT NO. J-4095

SCALE AS SHOWN





SHEET 16 OF 27

Michael N. Armstrong



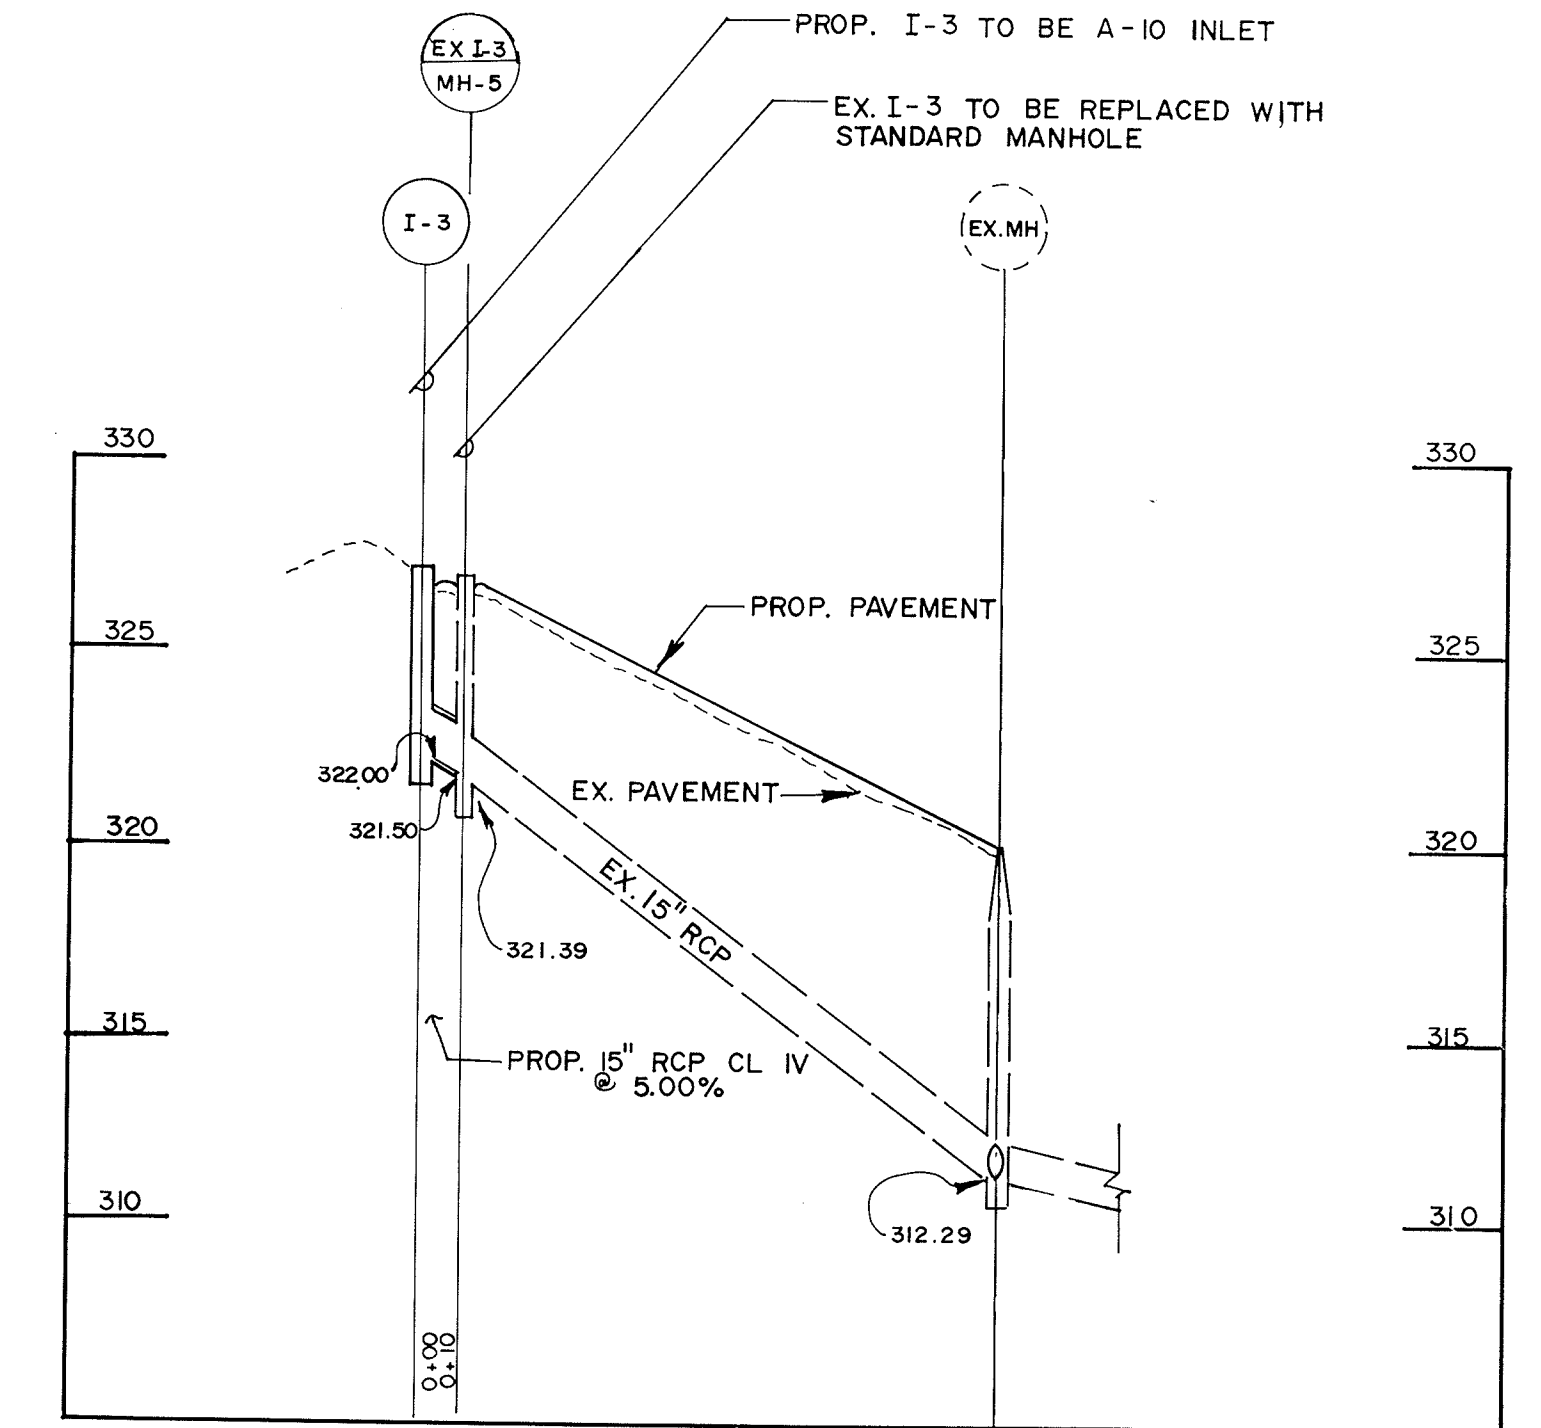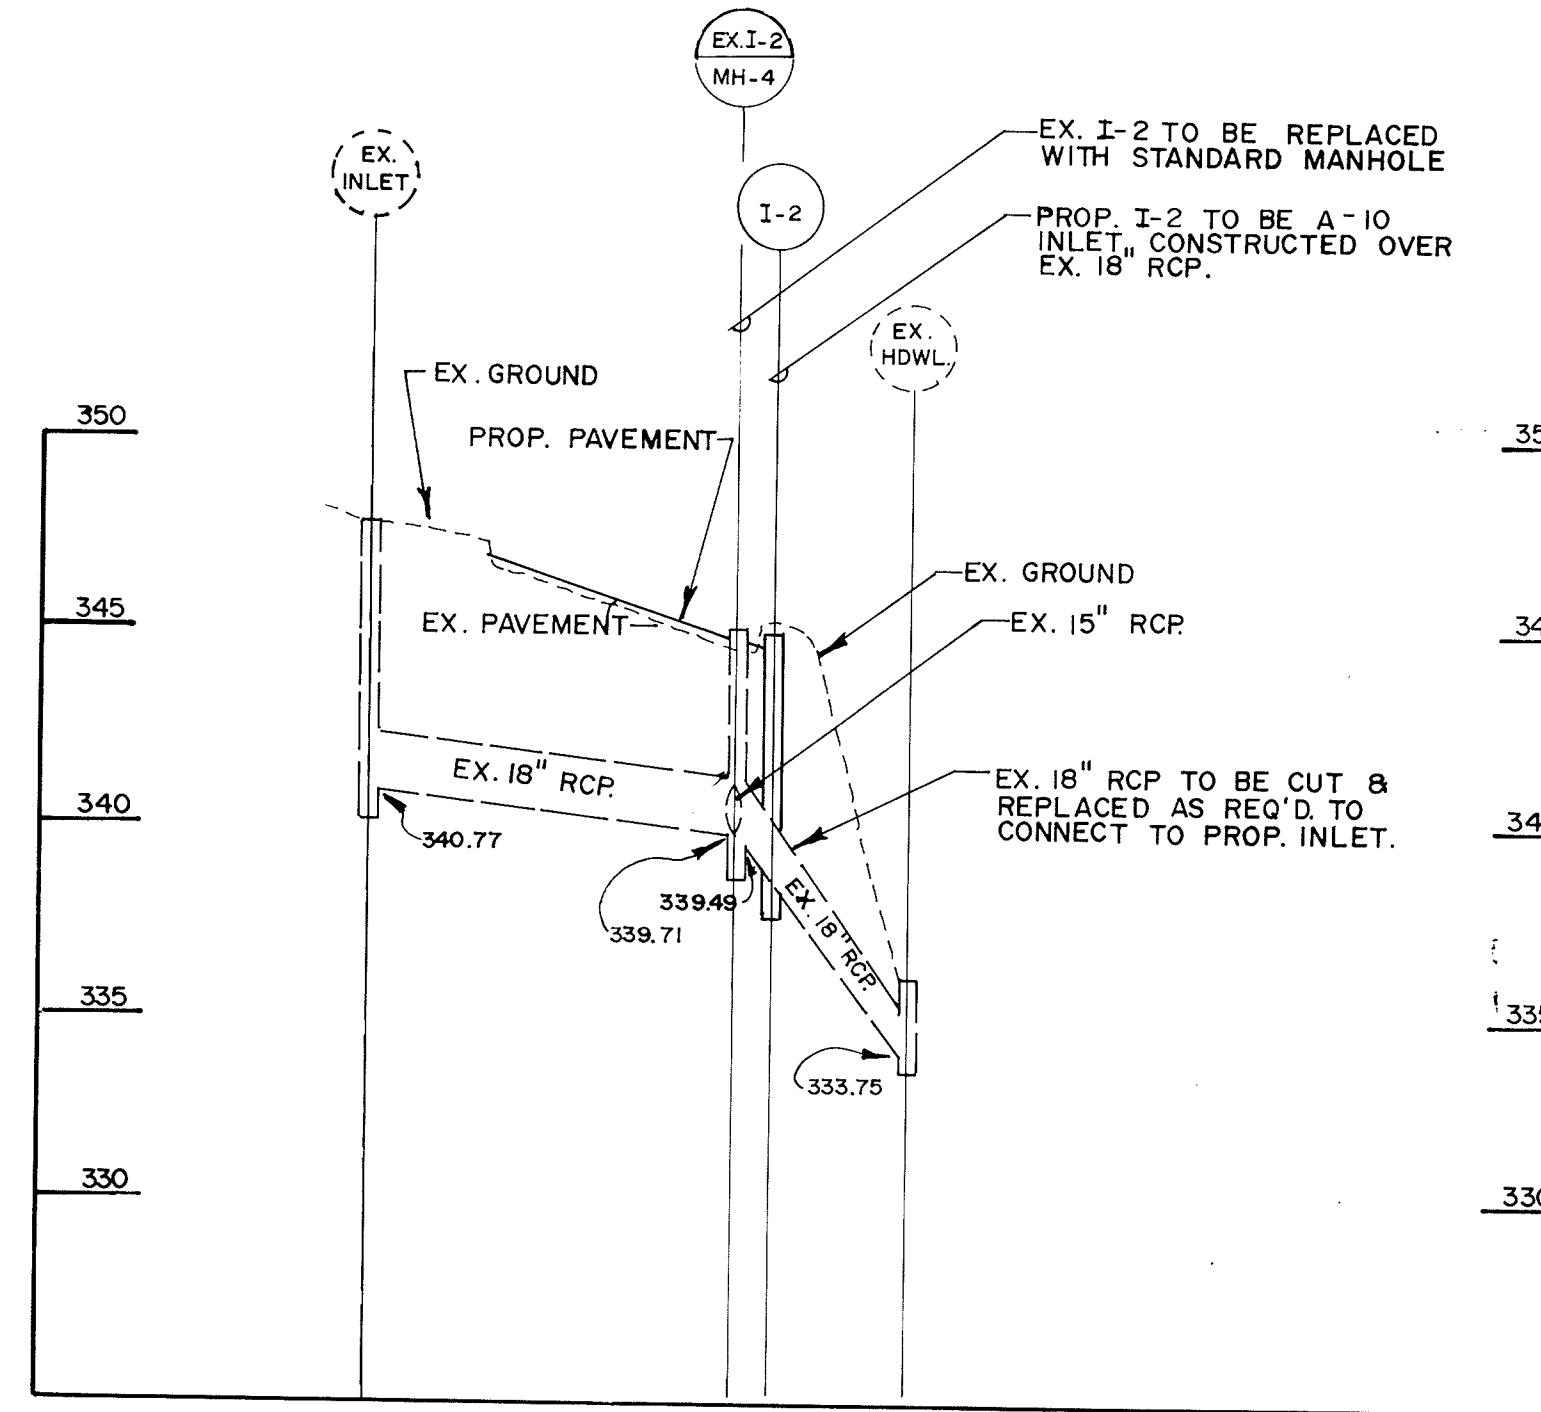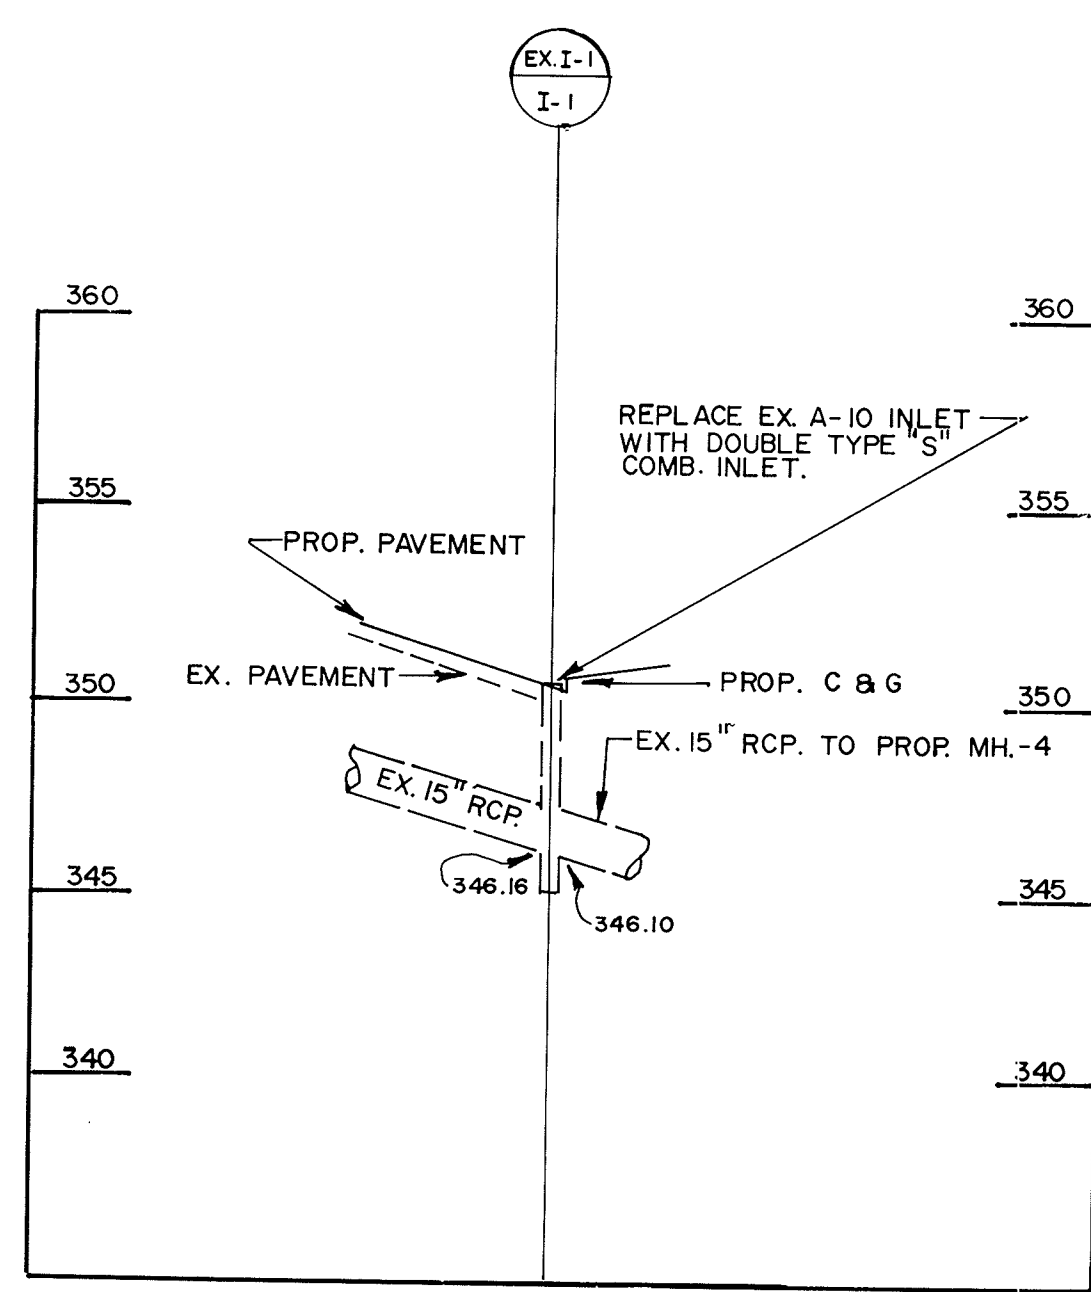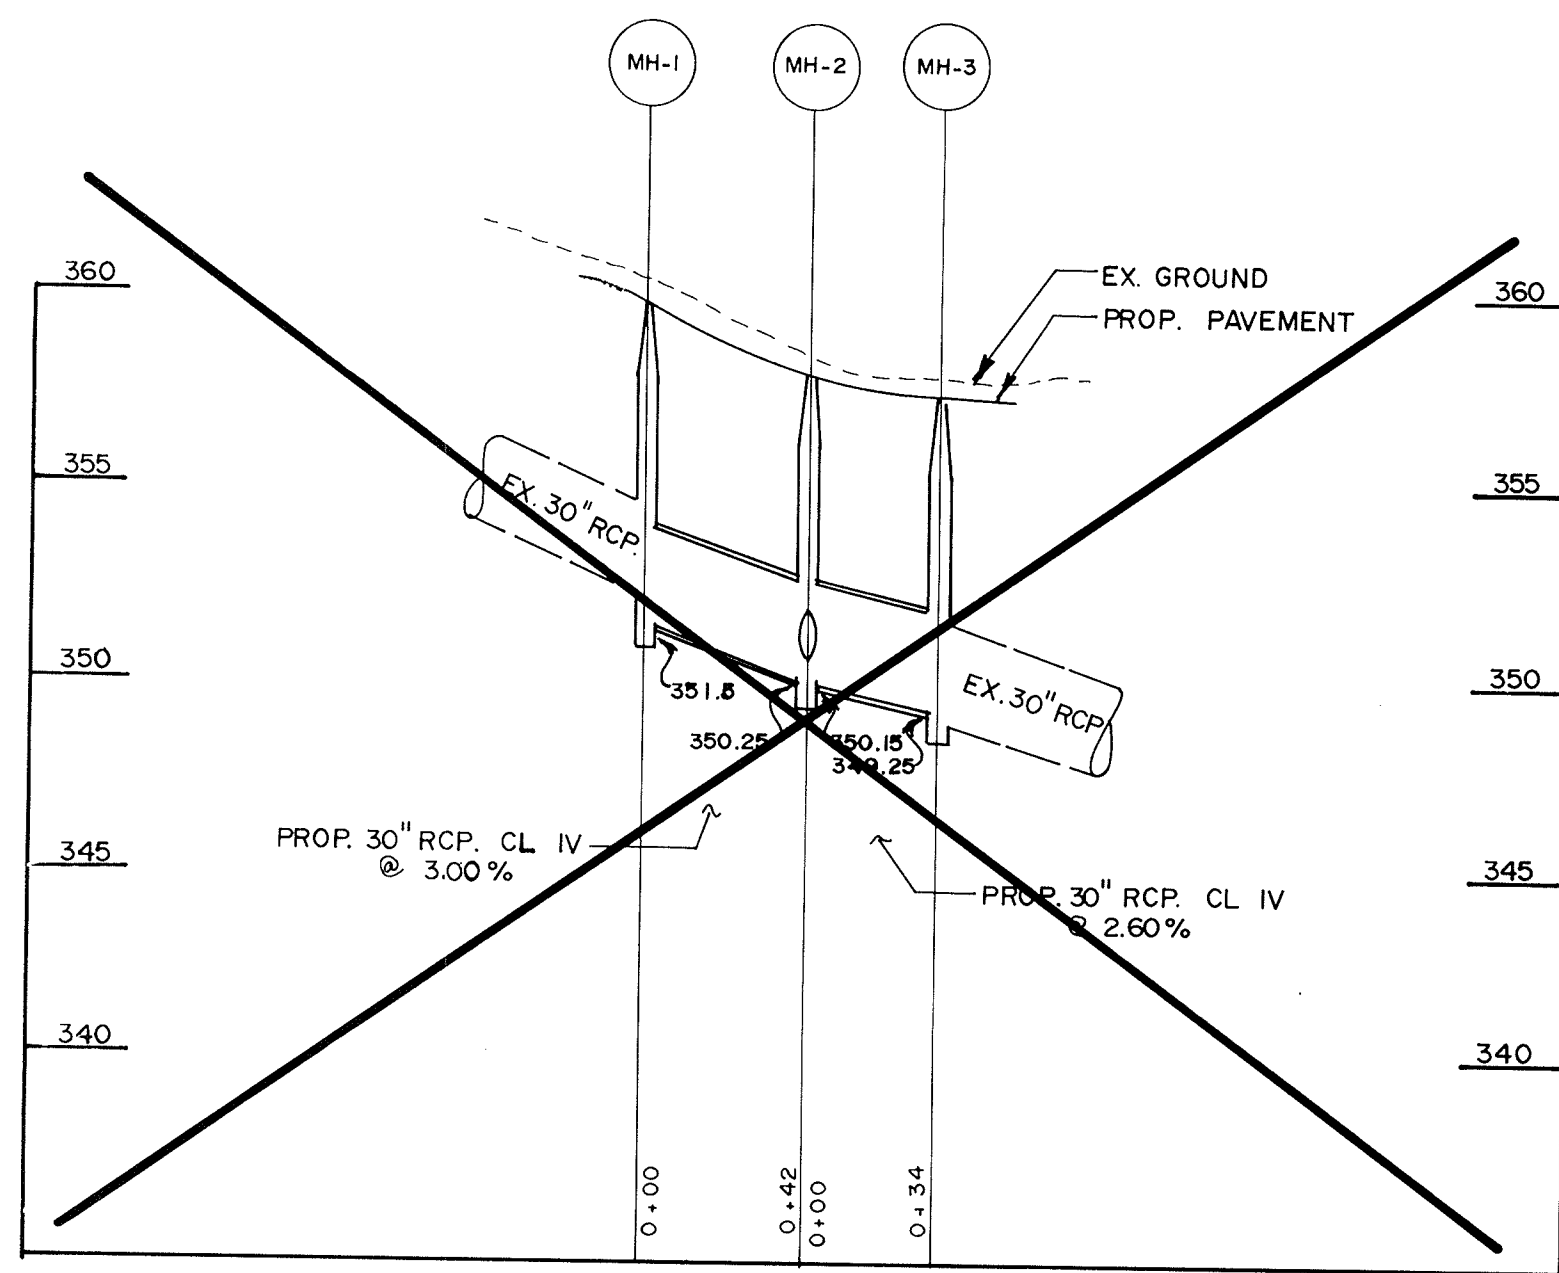

NOTES: (1) EXISTING PIPES TO BE EXTENDED SHALL BE EXTENDED FROM EXISTING PIPE AT JOINT AT SAME SLOPE AS EXISTING PIPE.  
 (2) AT SOME PROPOSED STRUCTURES TO BE PLACED OVER EXISTING STORM DRAIN PIPE, PIPE ALIGNMENT ADJUSTMENTS MAY BE REQUIRED IN ORDER TO ENSURE CONNECTION TO THE PROPOSED STRUCTURE. THE CONTRACTOR SHALL NOTIFY THE ENGINEER WHEN THIS SITUATION EXISTS IN THE FIELD. THE CONTRACTOR WILL INSTALL A HORIZONTAL BEND IN THE PIPE AS DIRECTED BY THE ENGINEER.

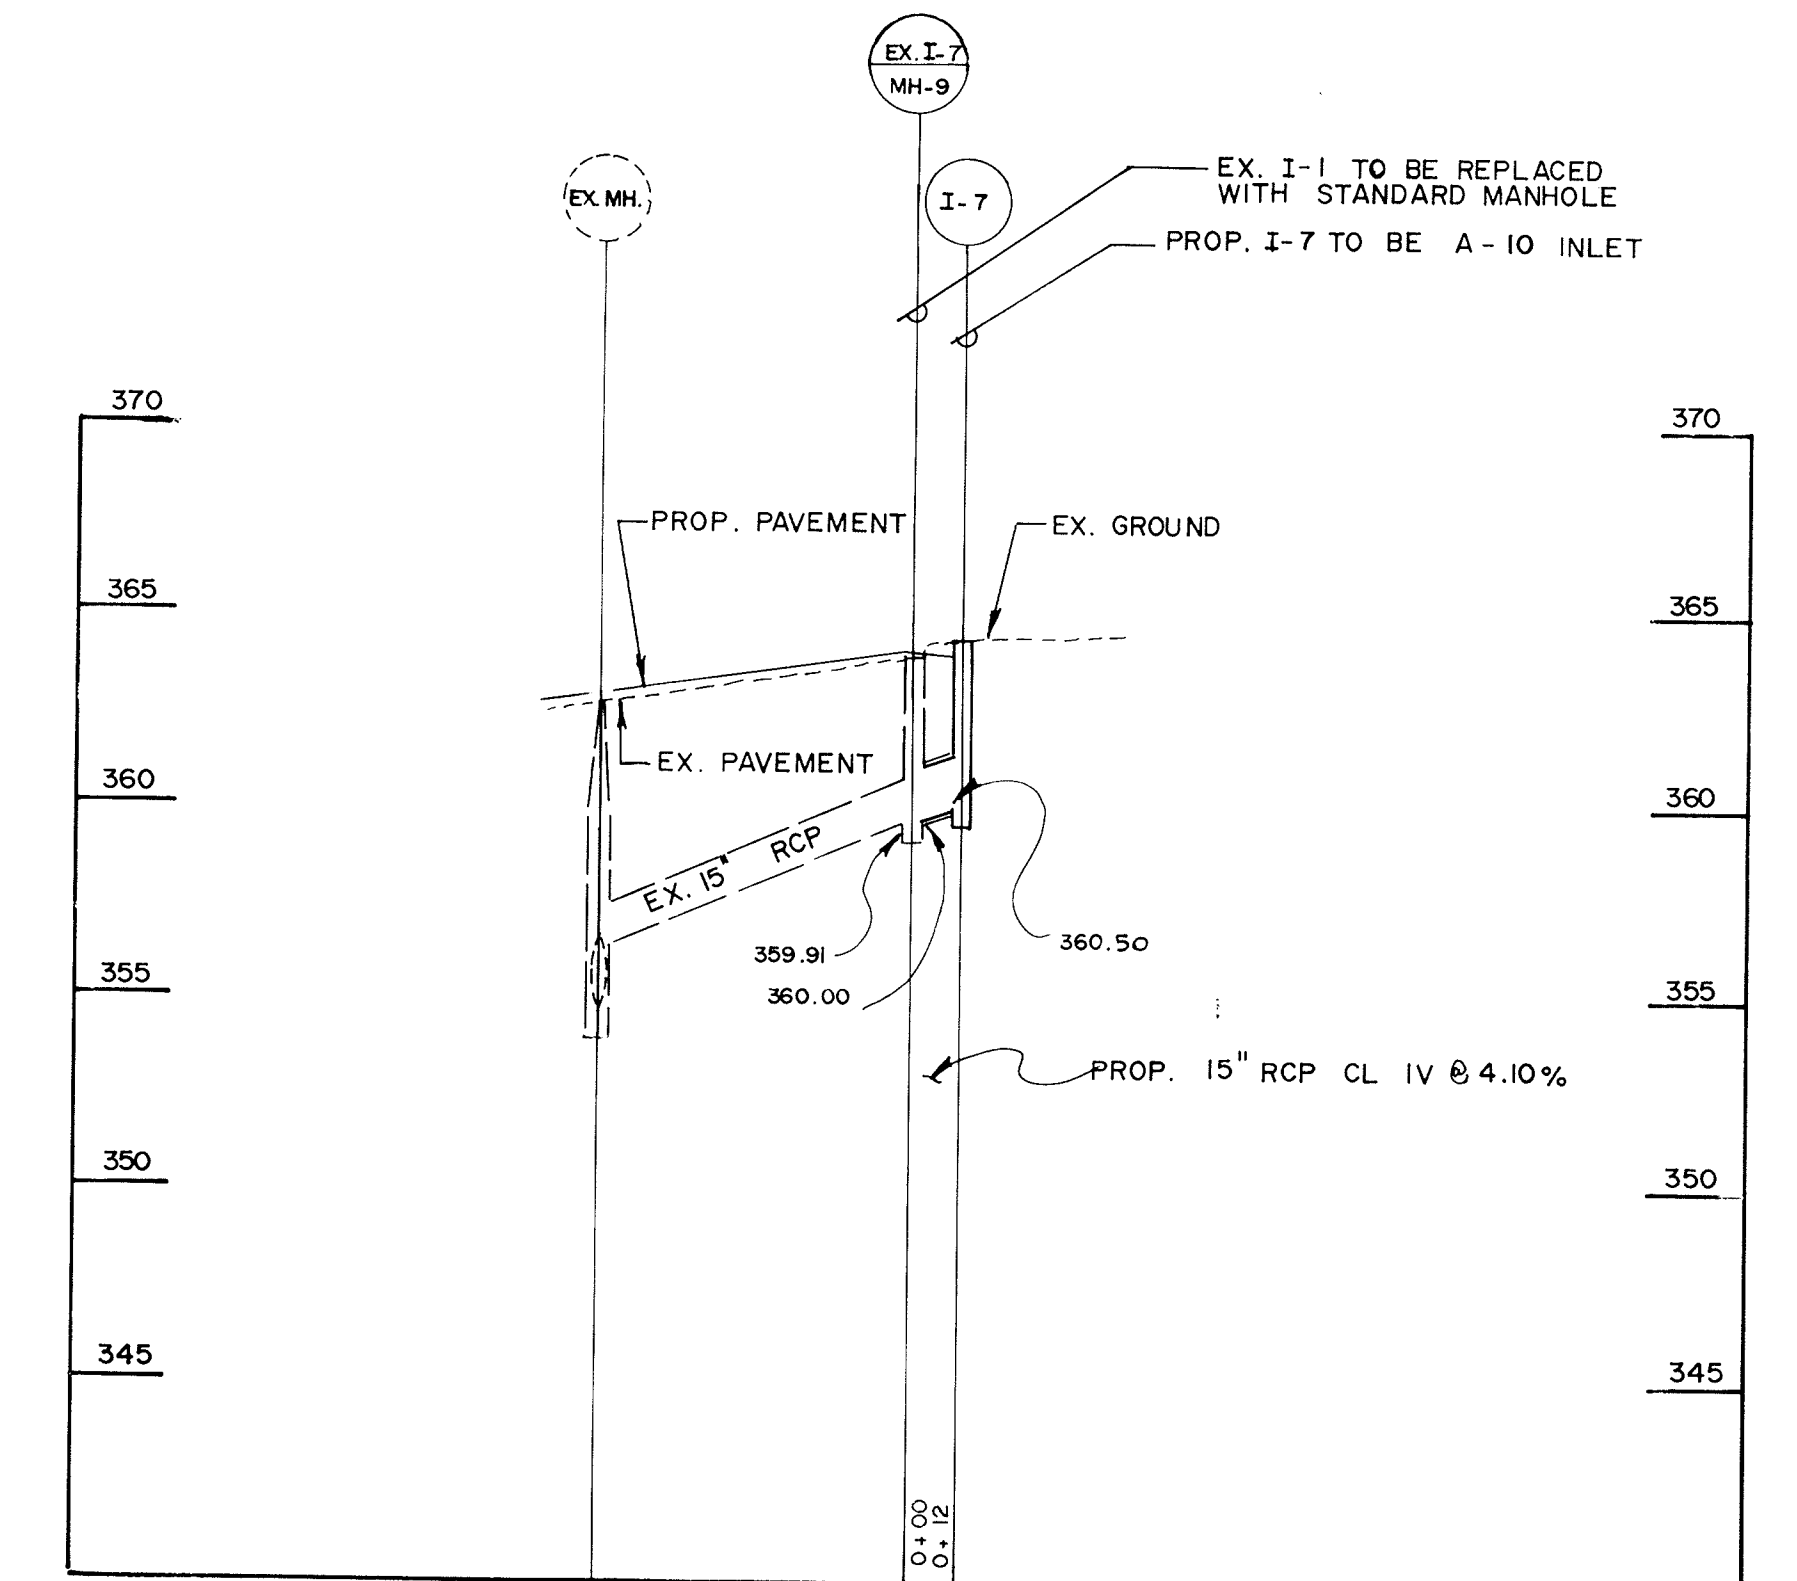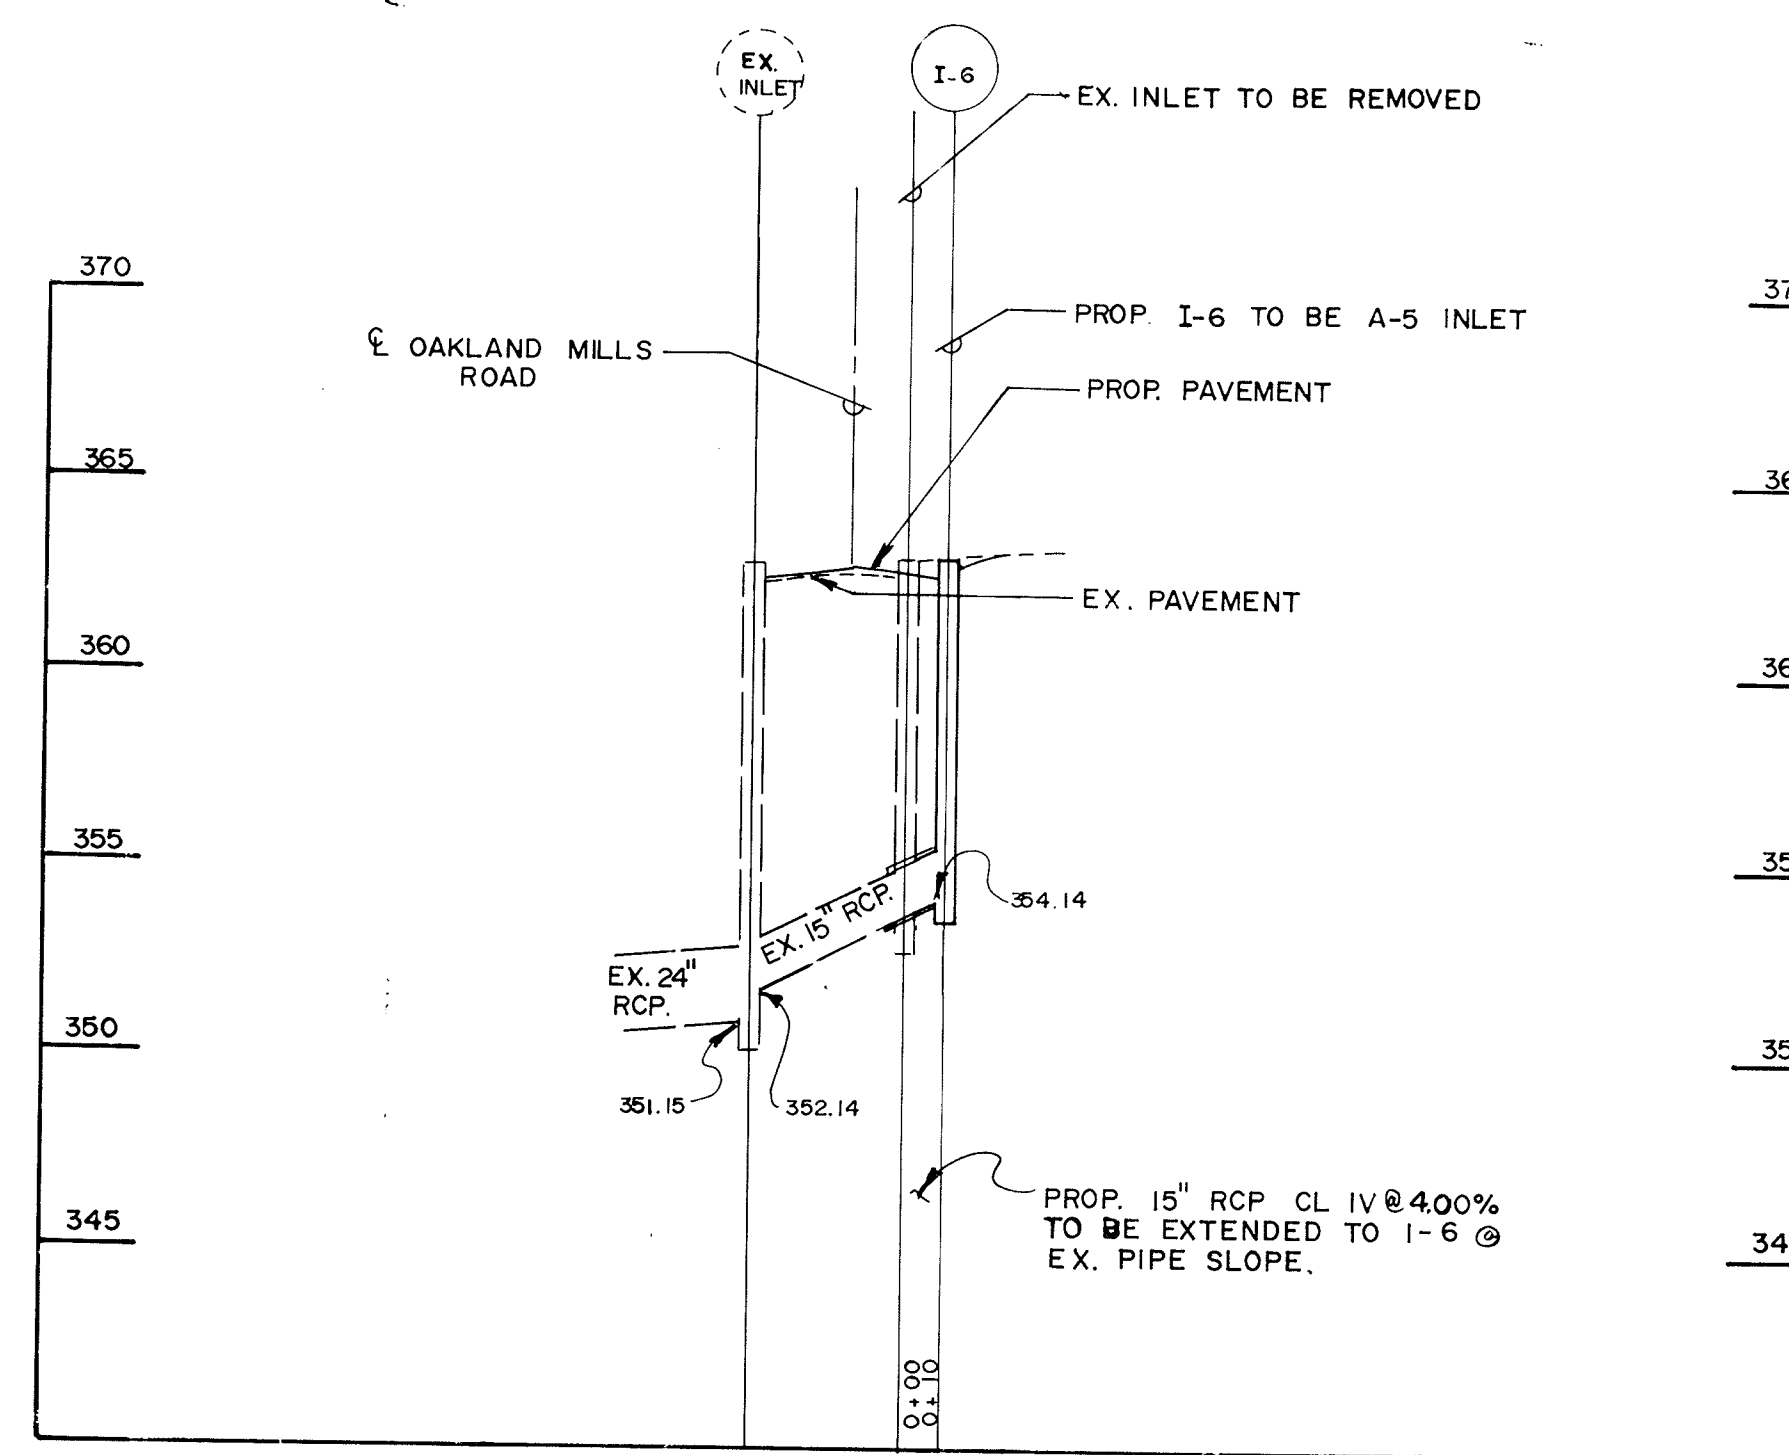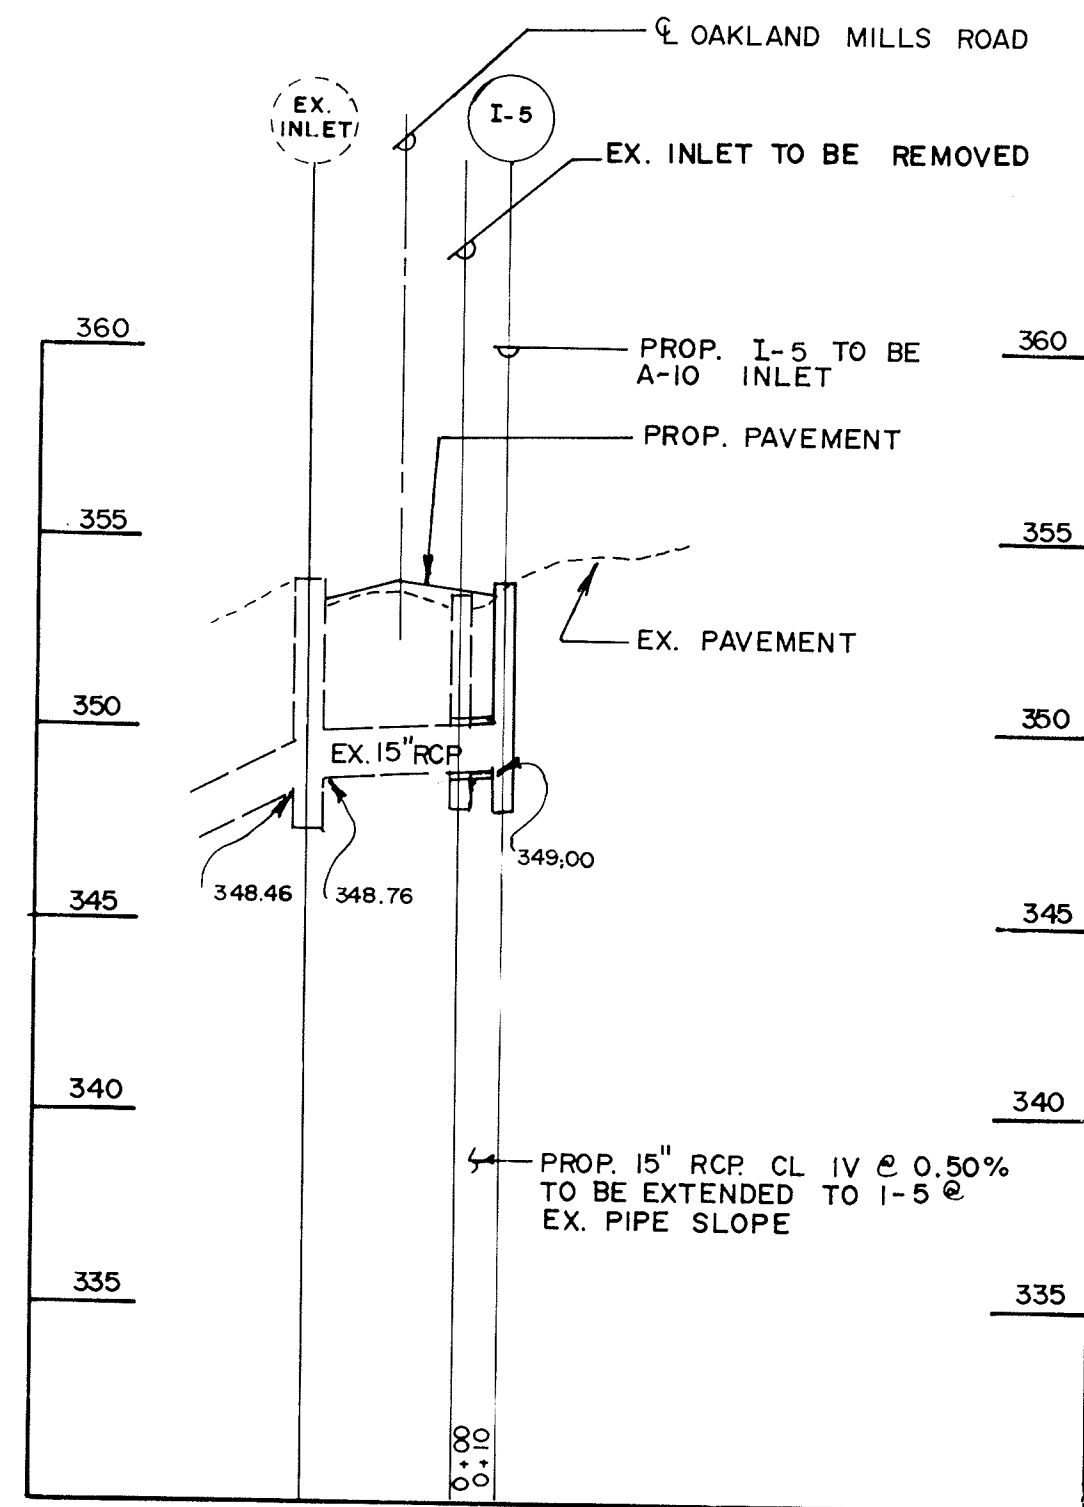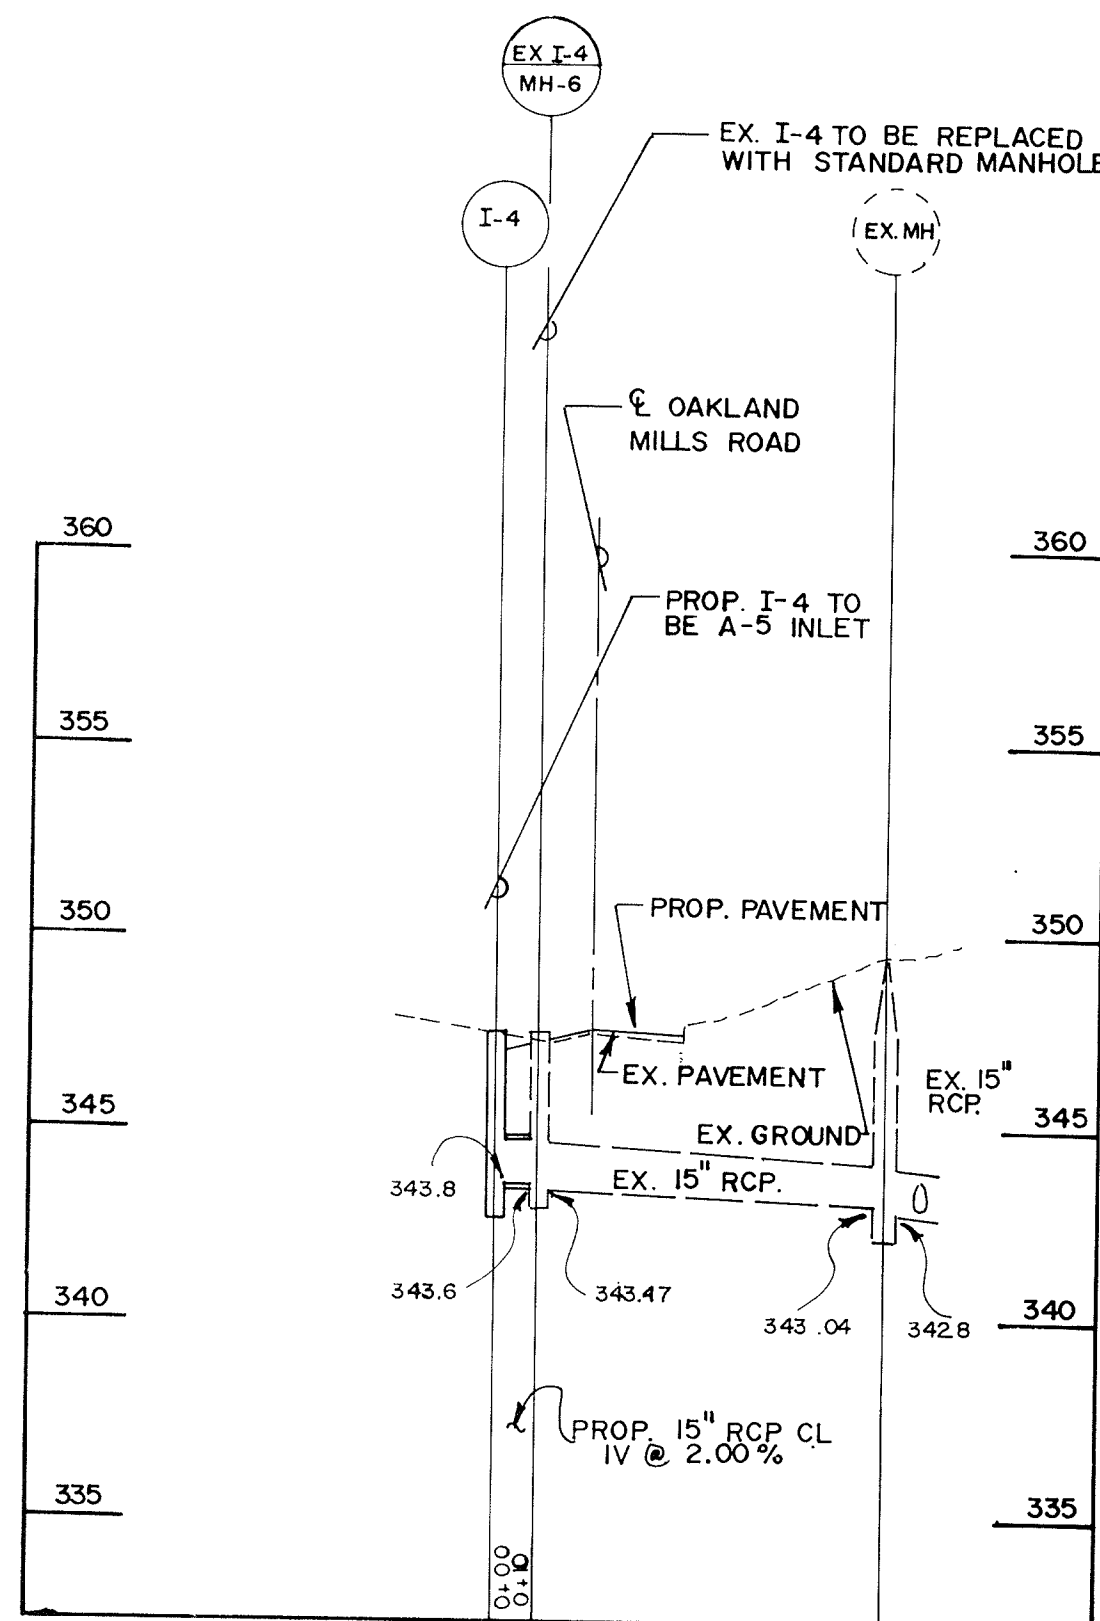

DEPARTMENT OF PUBLIC WORKS  
 HOWARD COUNTY, MARYLAND

James P. [Signature] 8/22/90  
 DIRECTOR OF PUBLIC WORKS DATE  
 [Signature] 8/21/90  
 CHIEF, BUREAU OF ENGINEERING DATE  
 Craville W. [Signature] 8/22/90  
 CHIEF, BUREAU OF HIGHWAYS DATE  
 [Signature] 8/22/90  
 CHIEF, DIVISION OF ROADS, BRIDGES AND STORM DRAINAGE DATE

ENGINEERING TECHNOLOGIES  
 ASSOCIATES, INC.

ENGINEERS, PLANNERS, SURVEYORS  
 3408 ELLICOTT CENTER DRIVE, SUITE 101  
 ELLICOTT CITY, MD. 21113  
 (301) 461-9920








Michael N. [Signature]

DES: JVP			
DRN: sap			
CHK: MNA			
DATE: 8/90	BY	NO.	REVISION

DATE	600' SCALE MAP NO.	BLOCK NO.
------	--------------------	-----------

STORM DRAIN PROFILES  
**OAKLAND MILLS ROAD IMPROVEMENTS**  
 6TH ELECTION DISTRICT HOWARD COUNTY, MARYLAND  
 CAPITAL PROJECT NO. J-4095

SCALE  
 Horiz. 1" = 50'  
 Vert. 1" = 5'  
 SHEET  
 17 OF 27

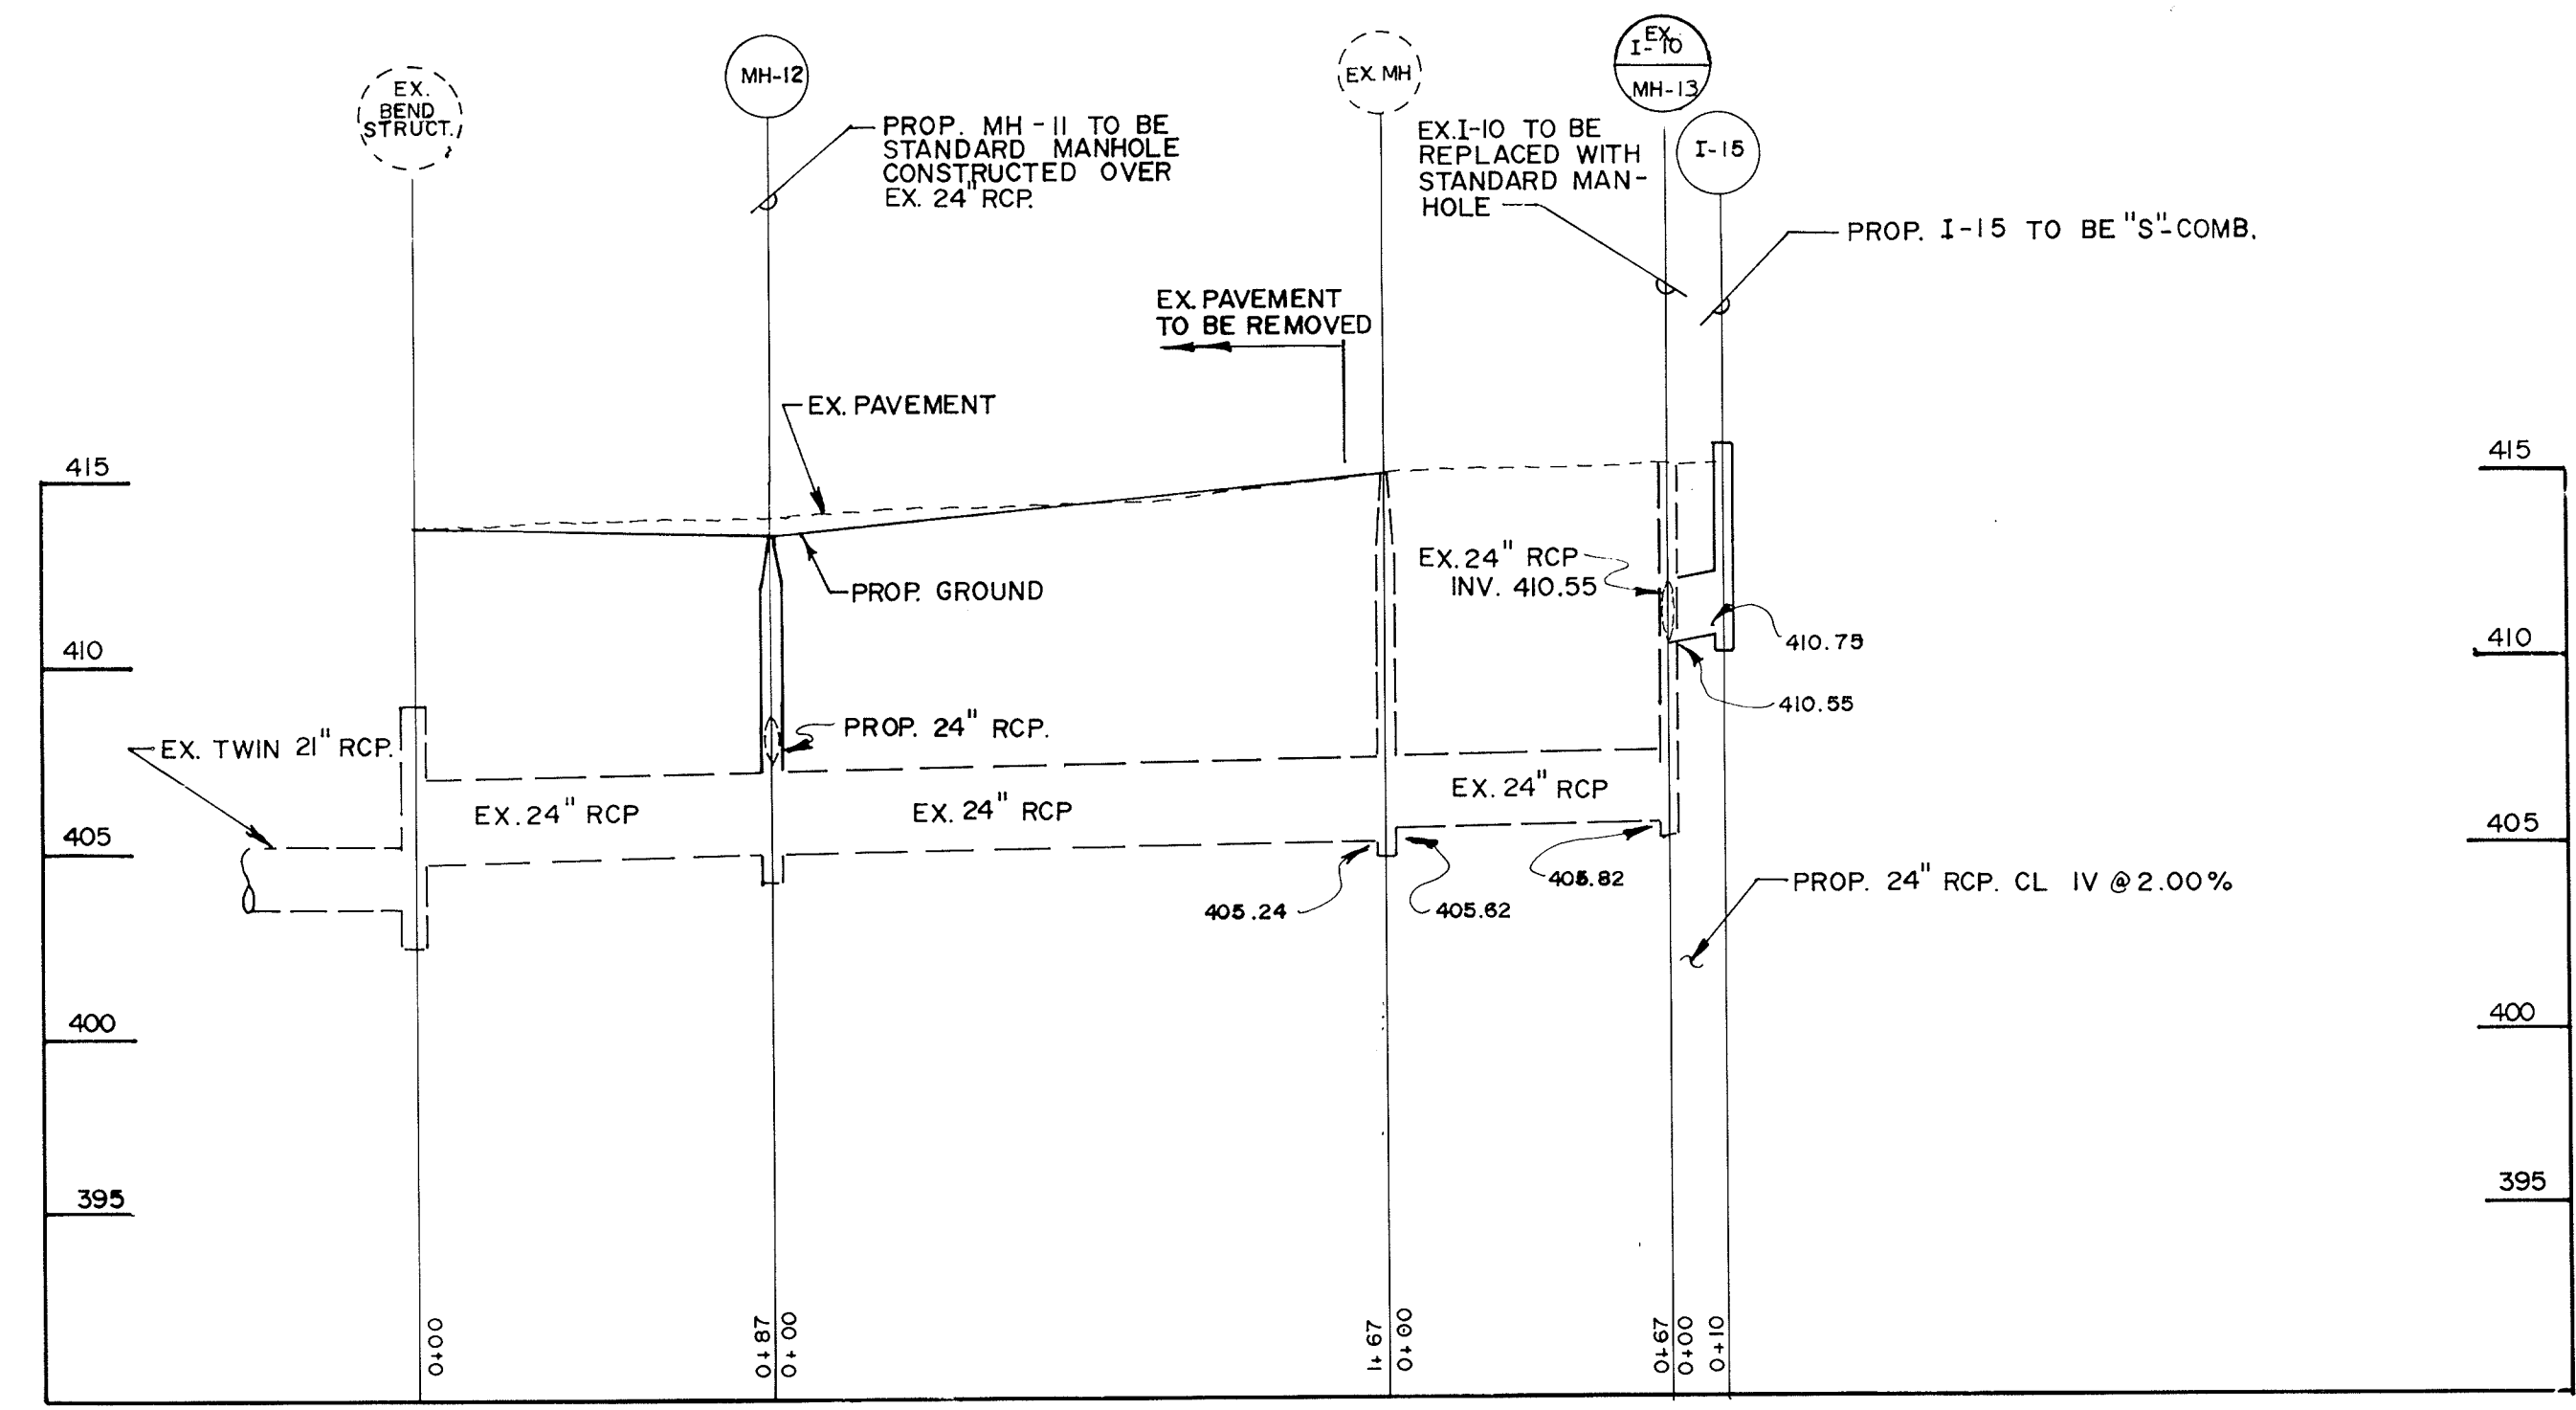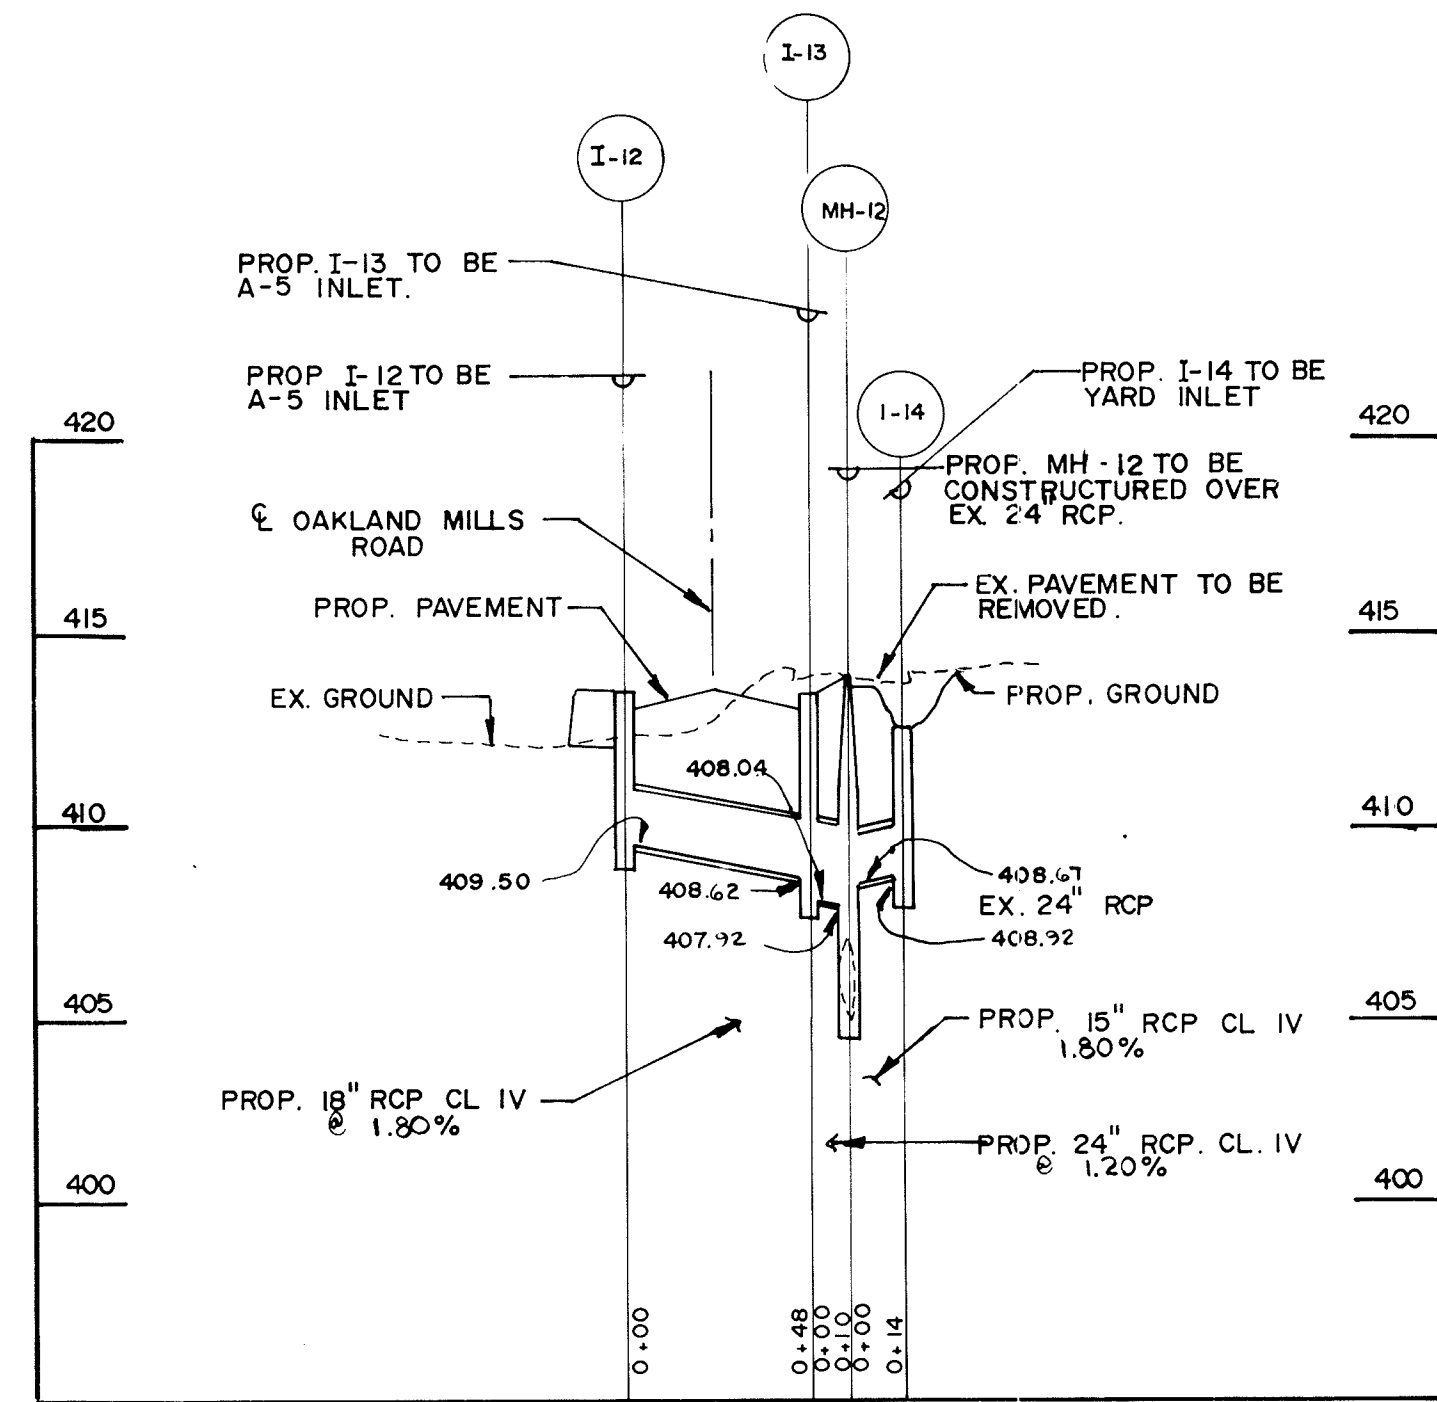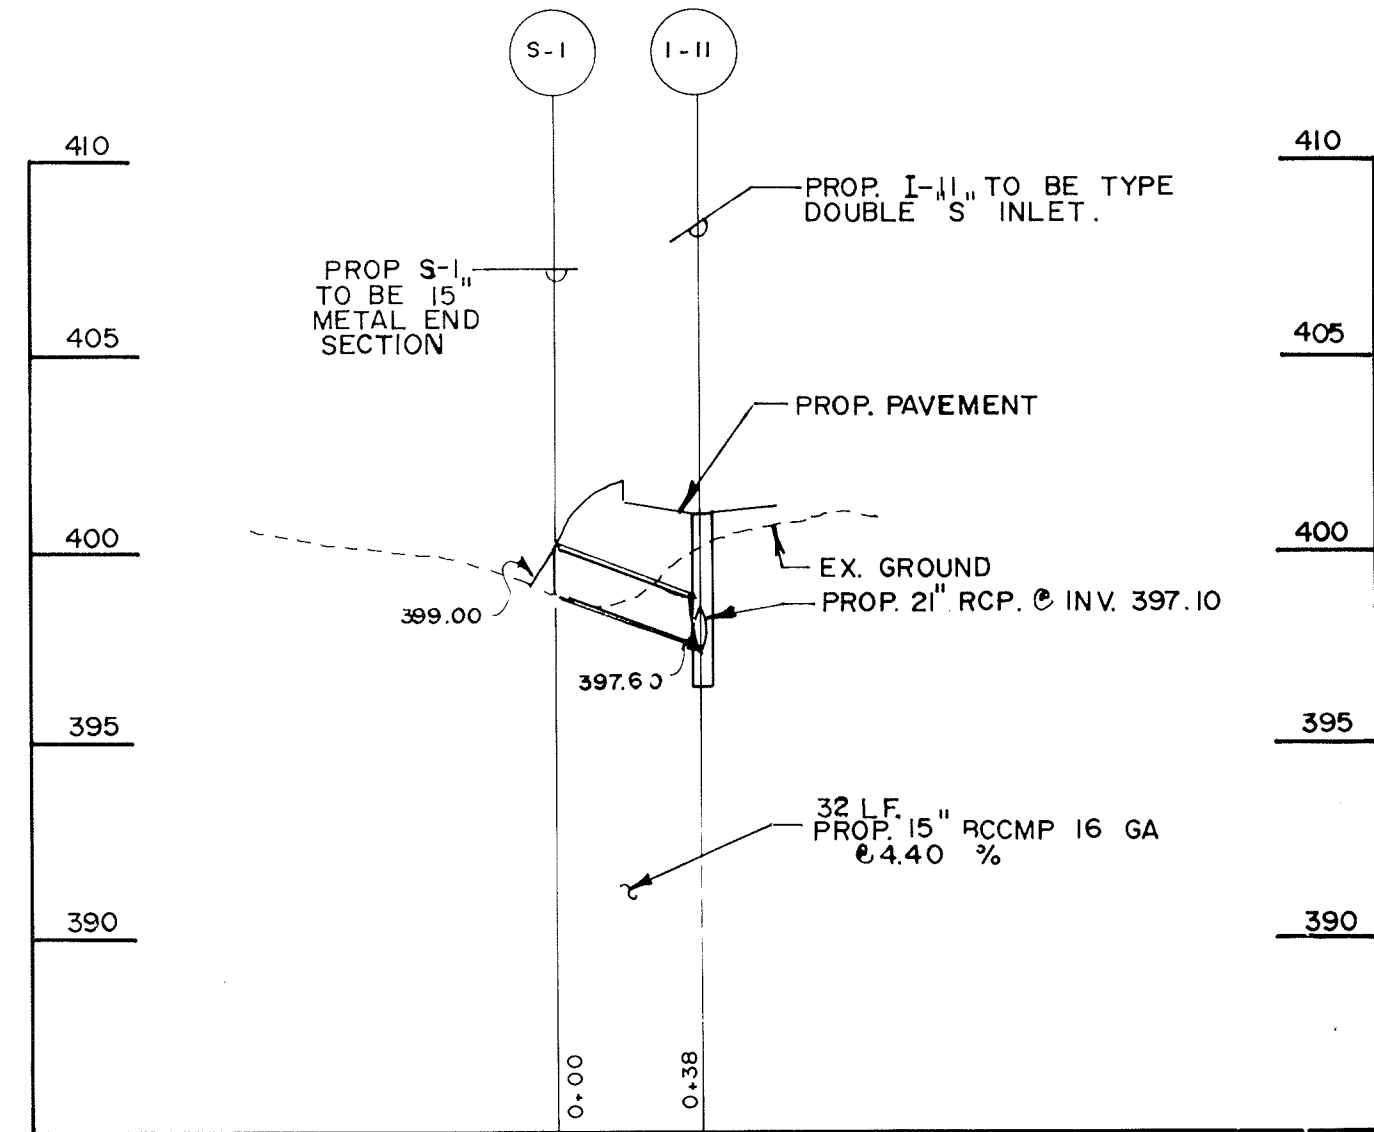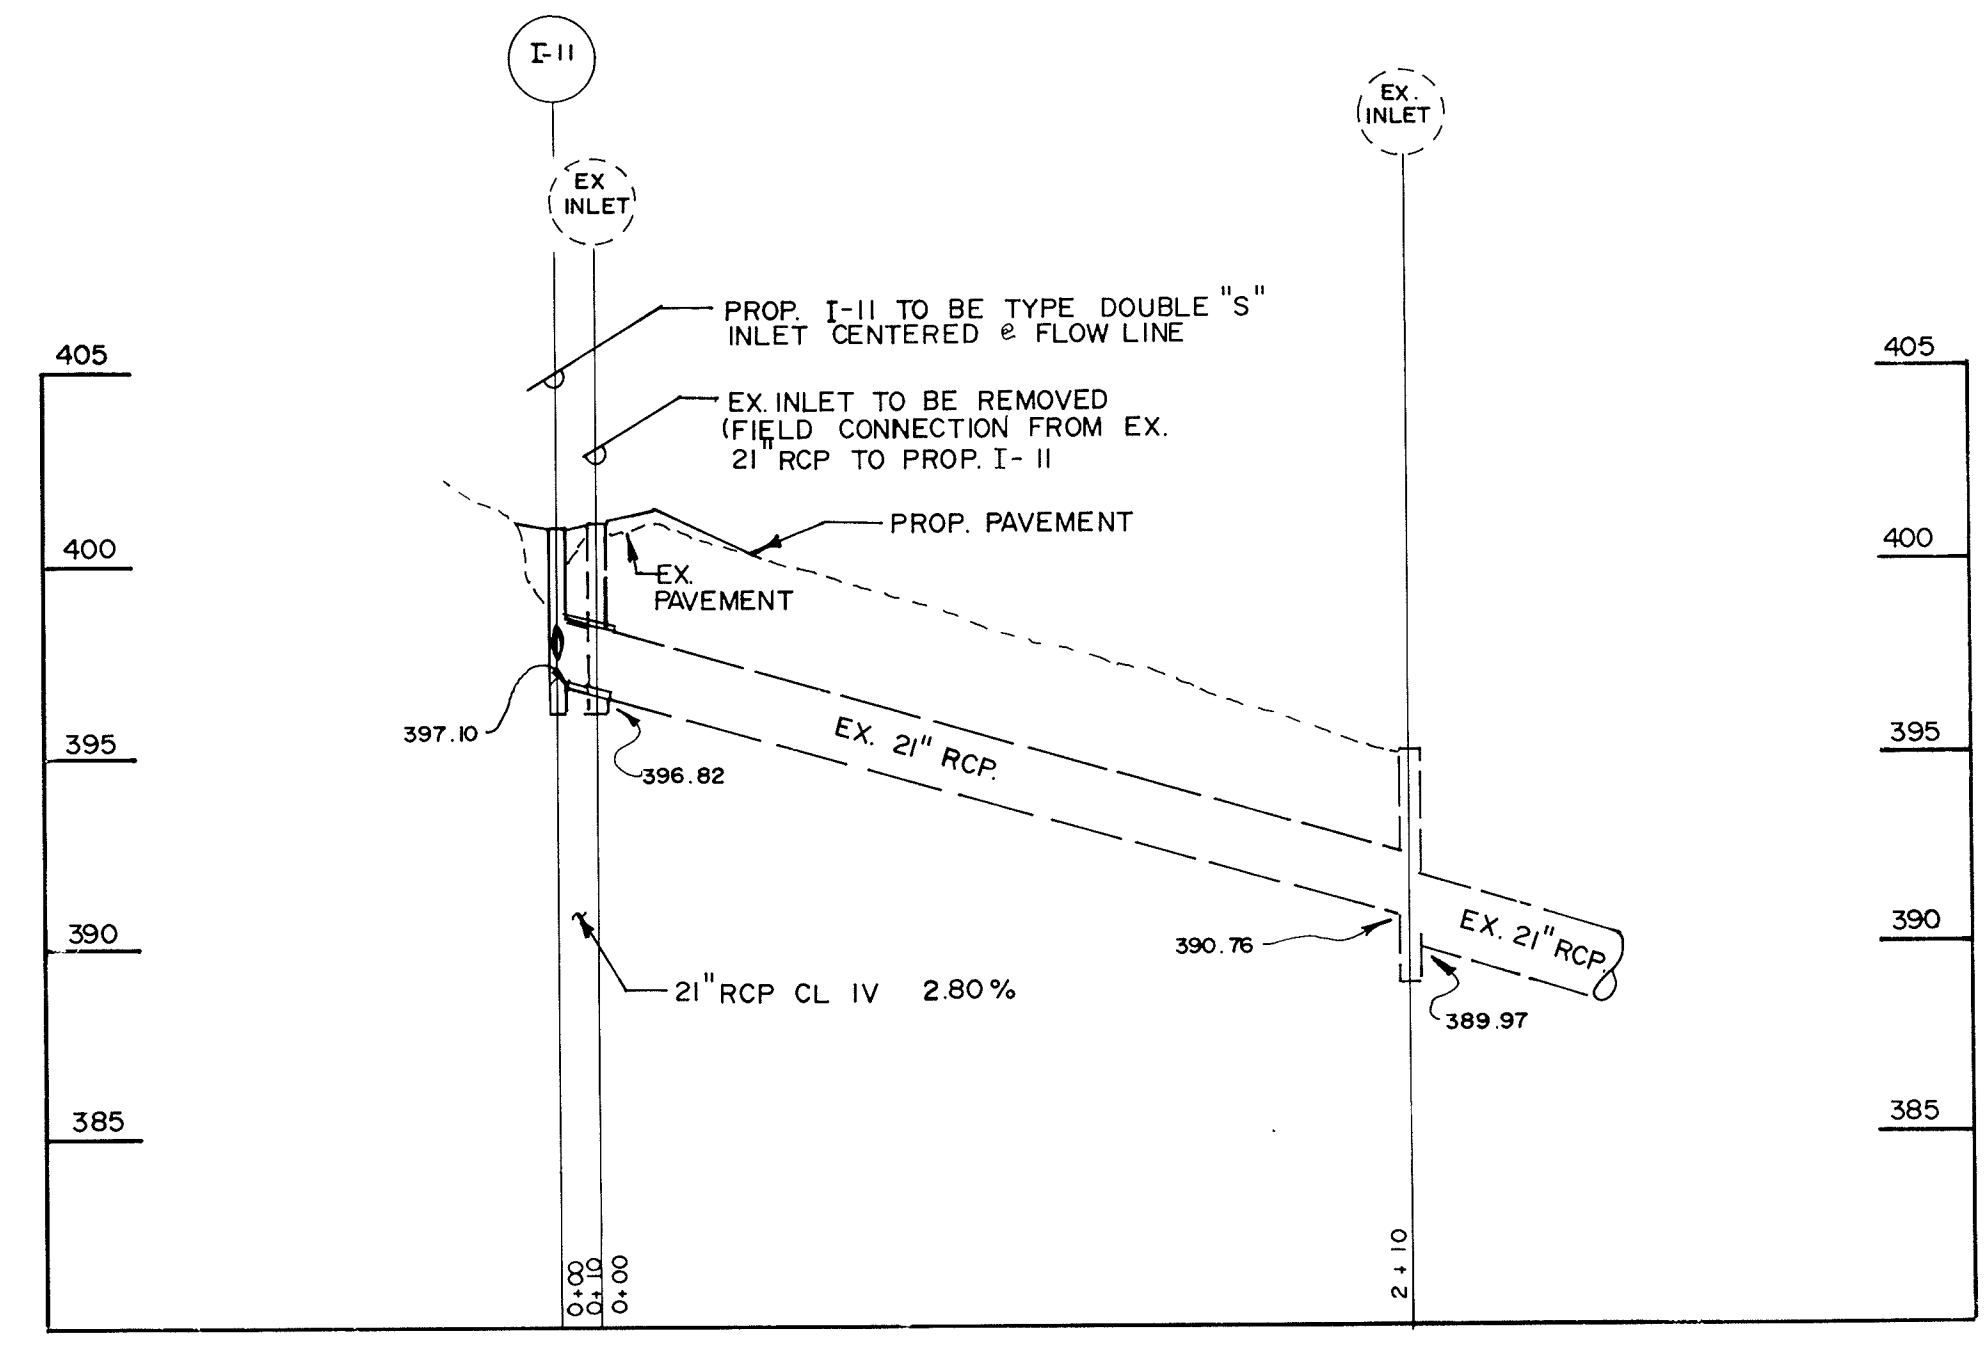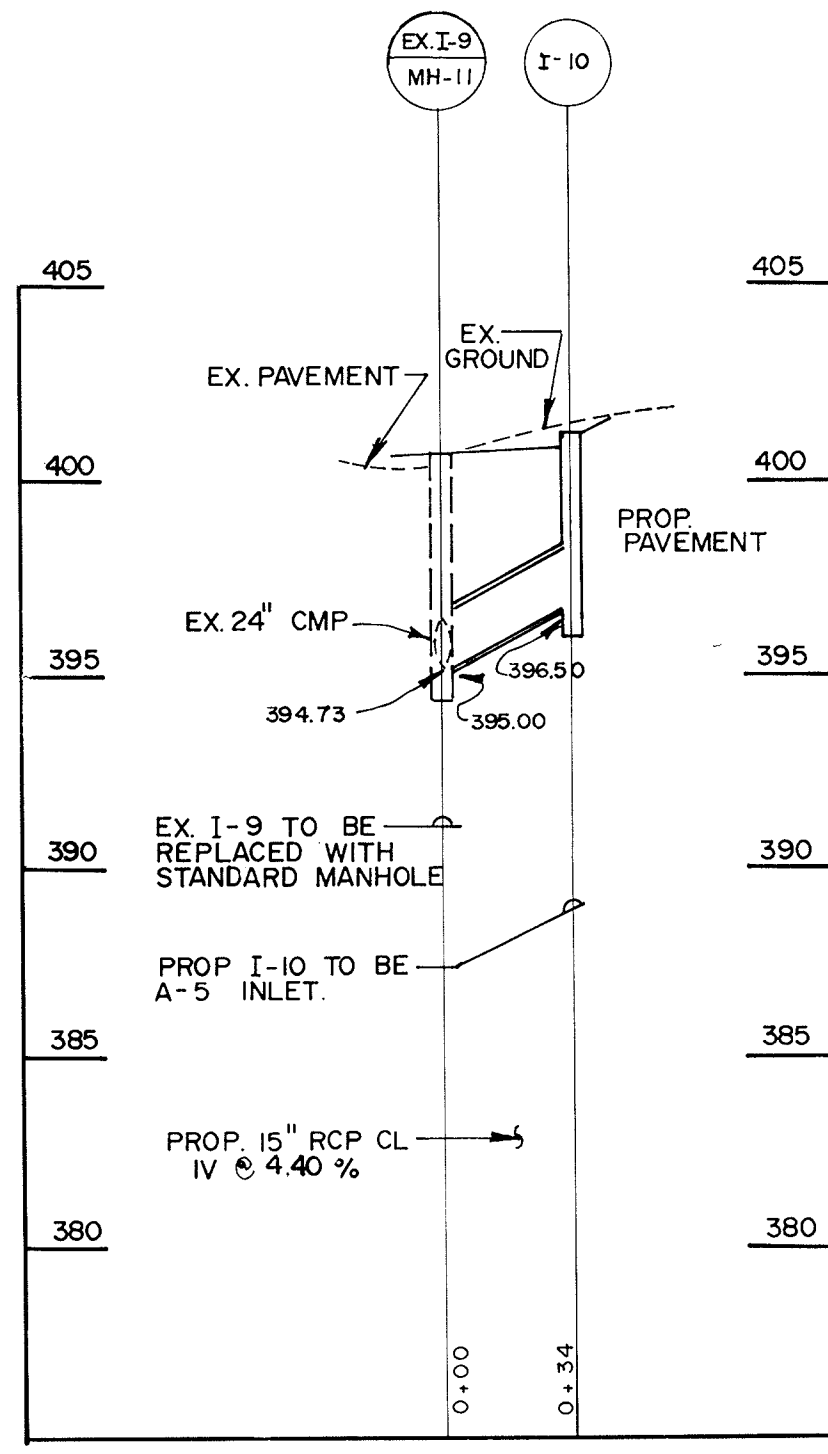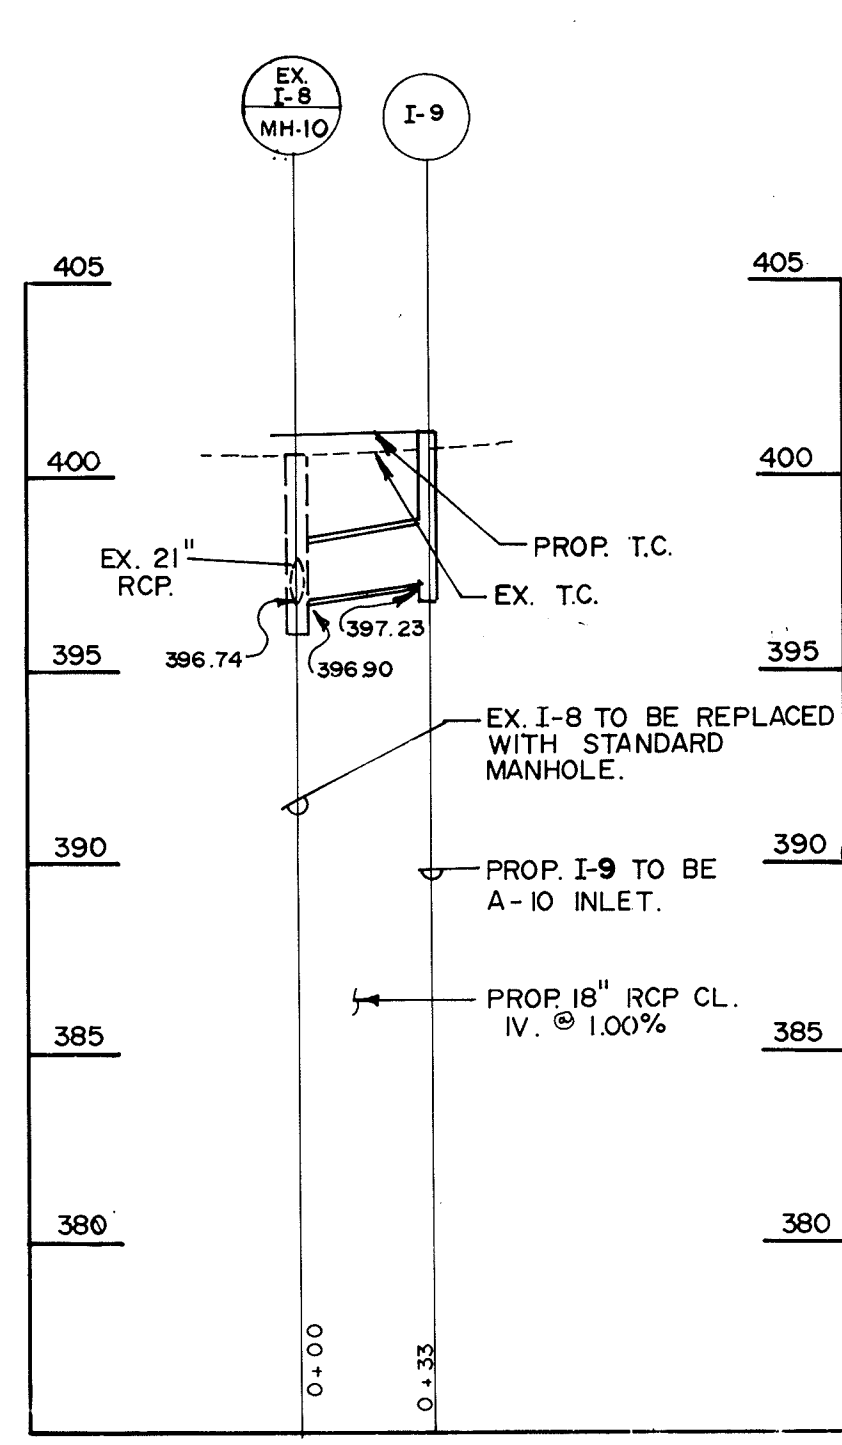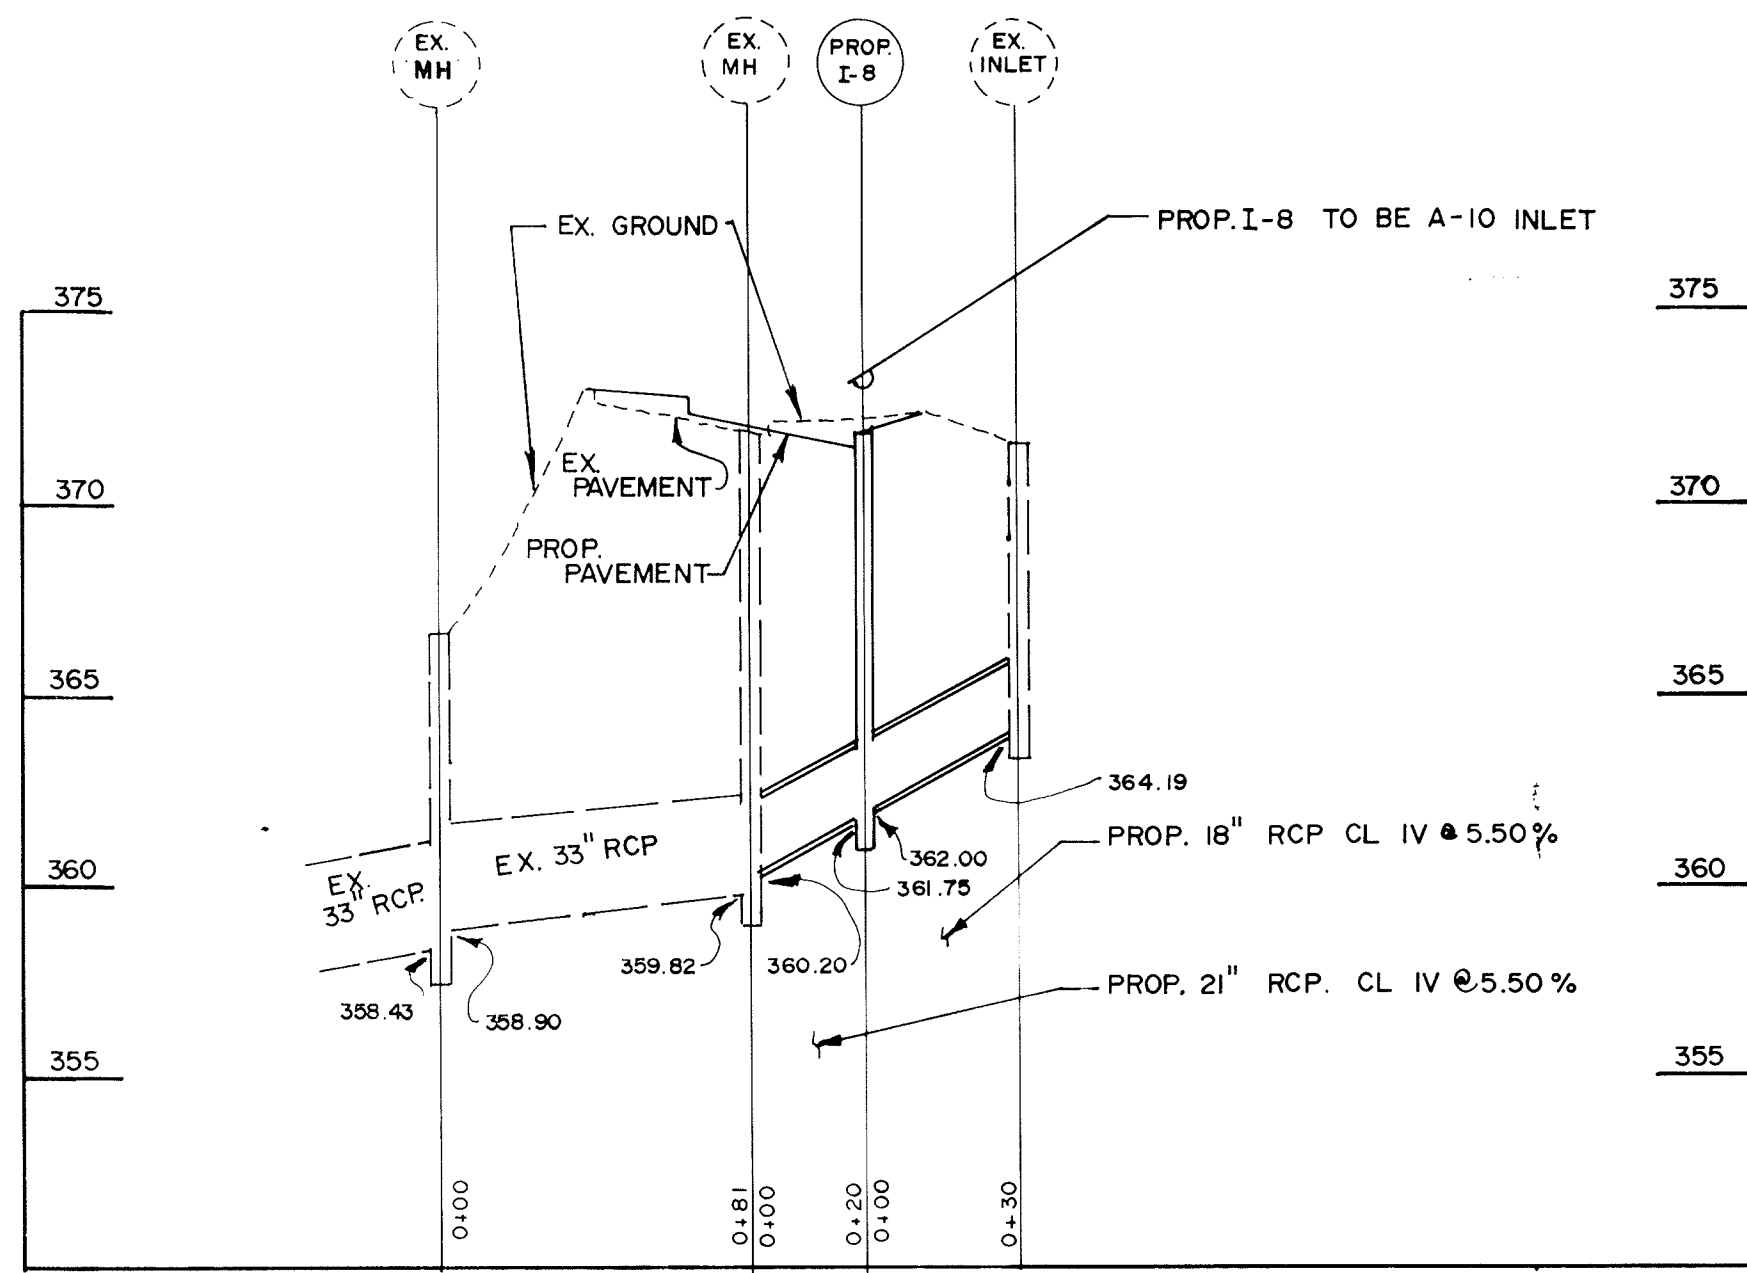

DEPARTMENT OF PUBLIC WORKS  
HOWARD COUNTY, MARYLAND

ENGINEERING TECHNOLOGIES ASSOCIATES, INC.

DES: JVP

DRN: eap

CHK: MNA

DATE: 8/90

BY NO. REVISION

DATE 600' SCALE MAP NO. BLOCK NO.

STORM DRAIN PROFILES

OAKLAND MILLS ROAD IMPROVEMENTS

6TH ELECTION DISTRICT HOWARD COUNTY, MARYLAND  
CAPITAL PROJECT NO. J-4095

SCALE





HOR. 1"=50'

VERT. 1"=5'



SHEET

18 OF 27



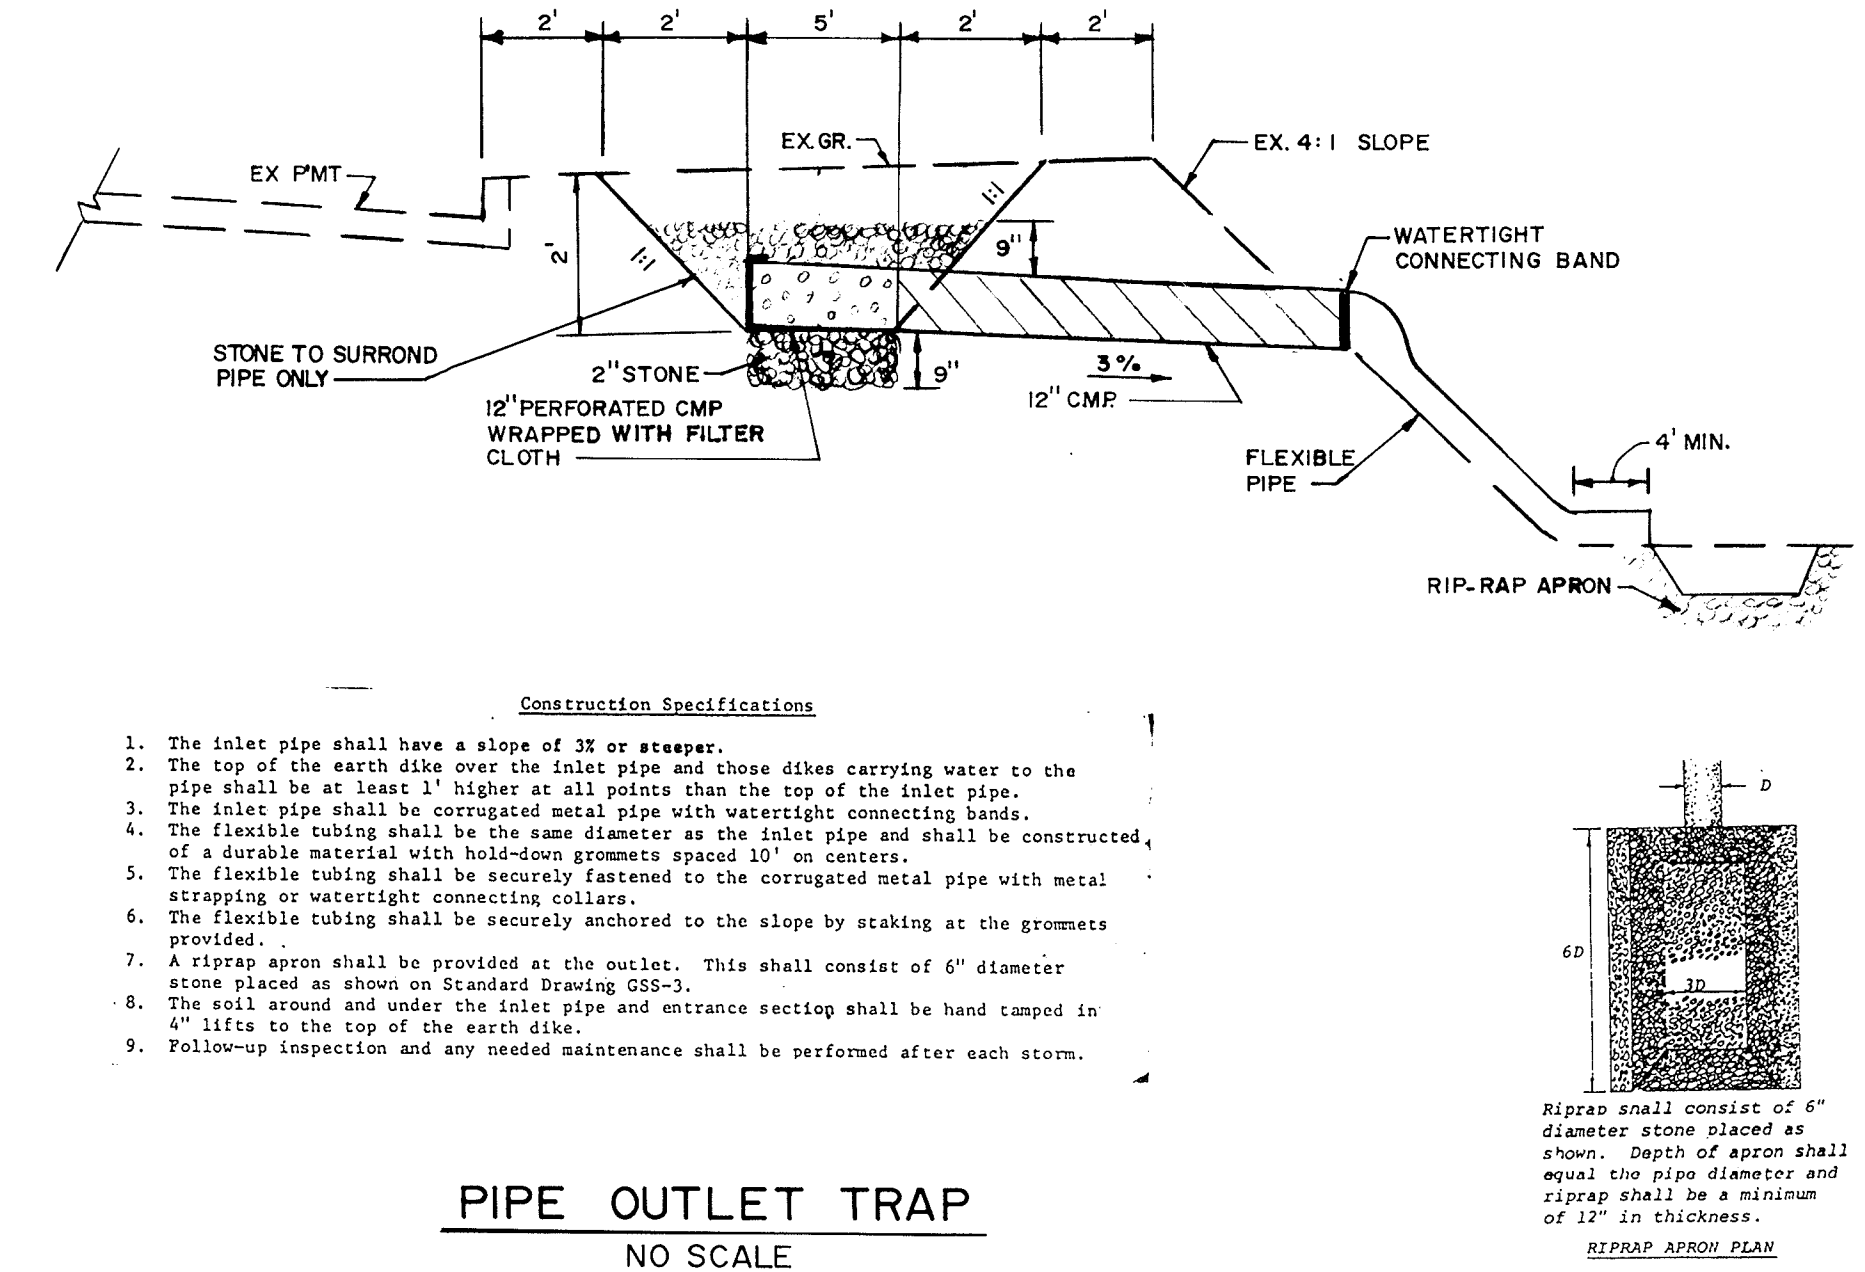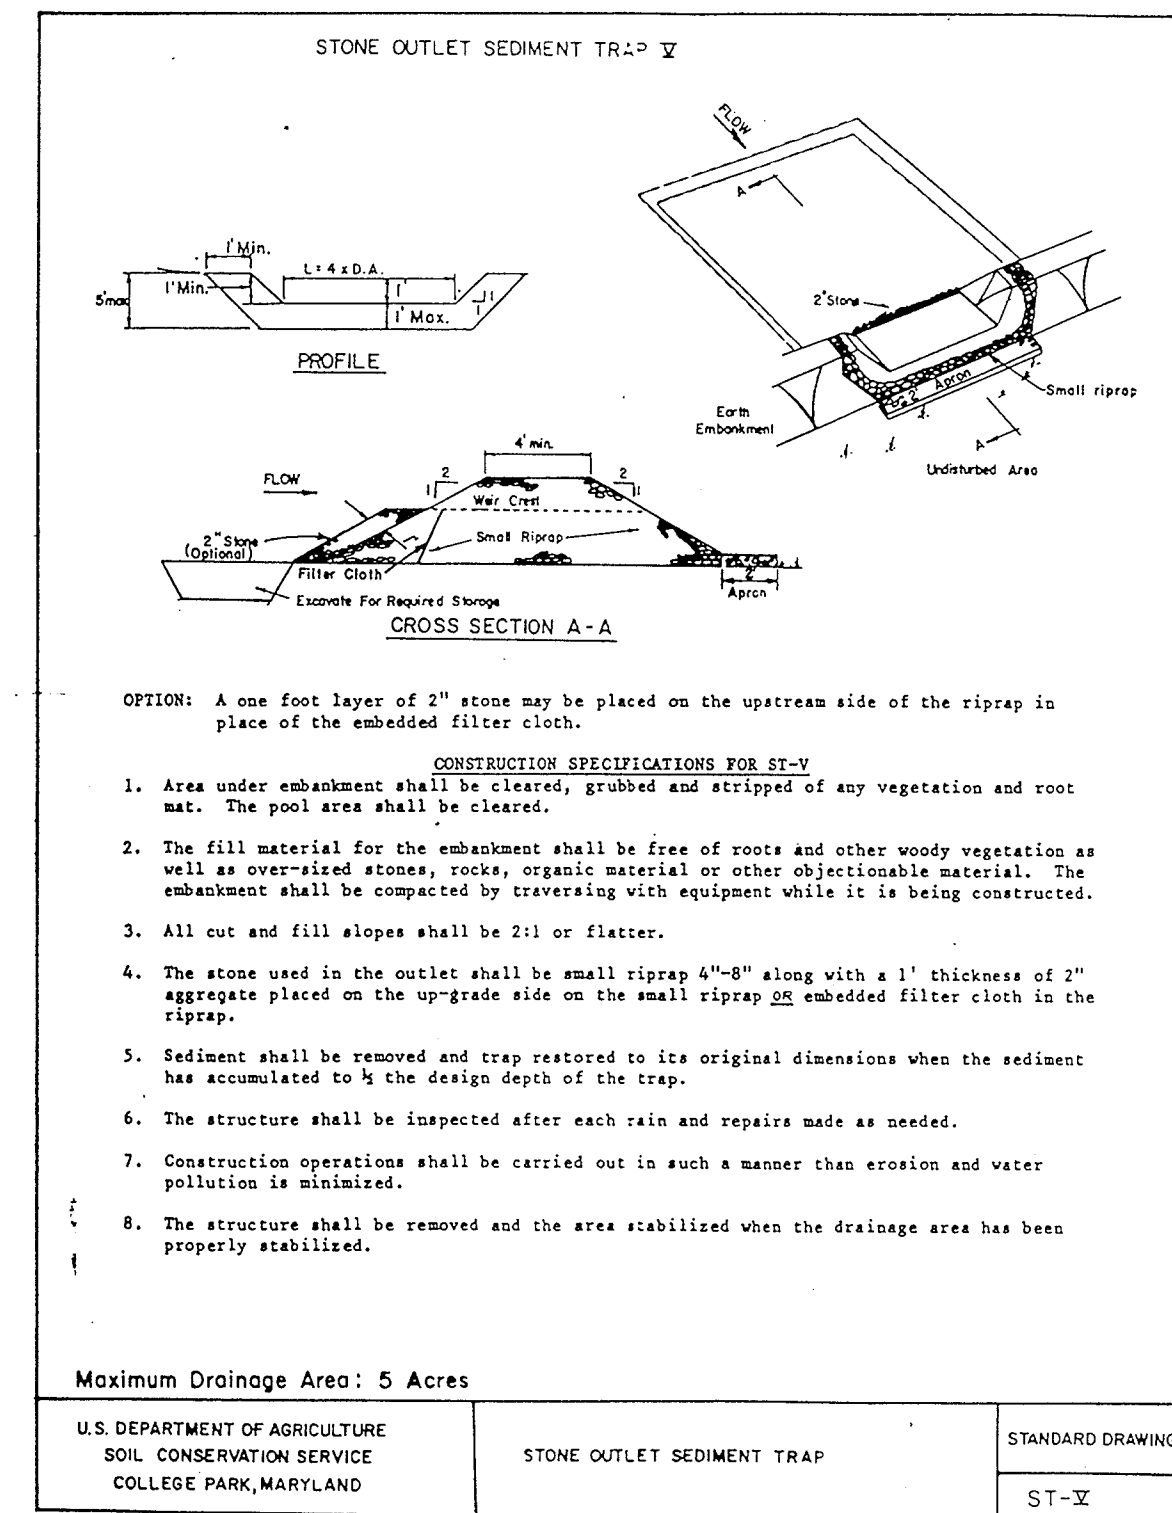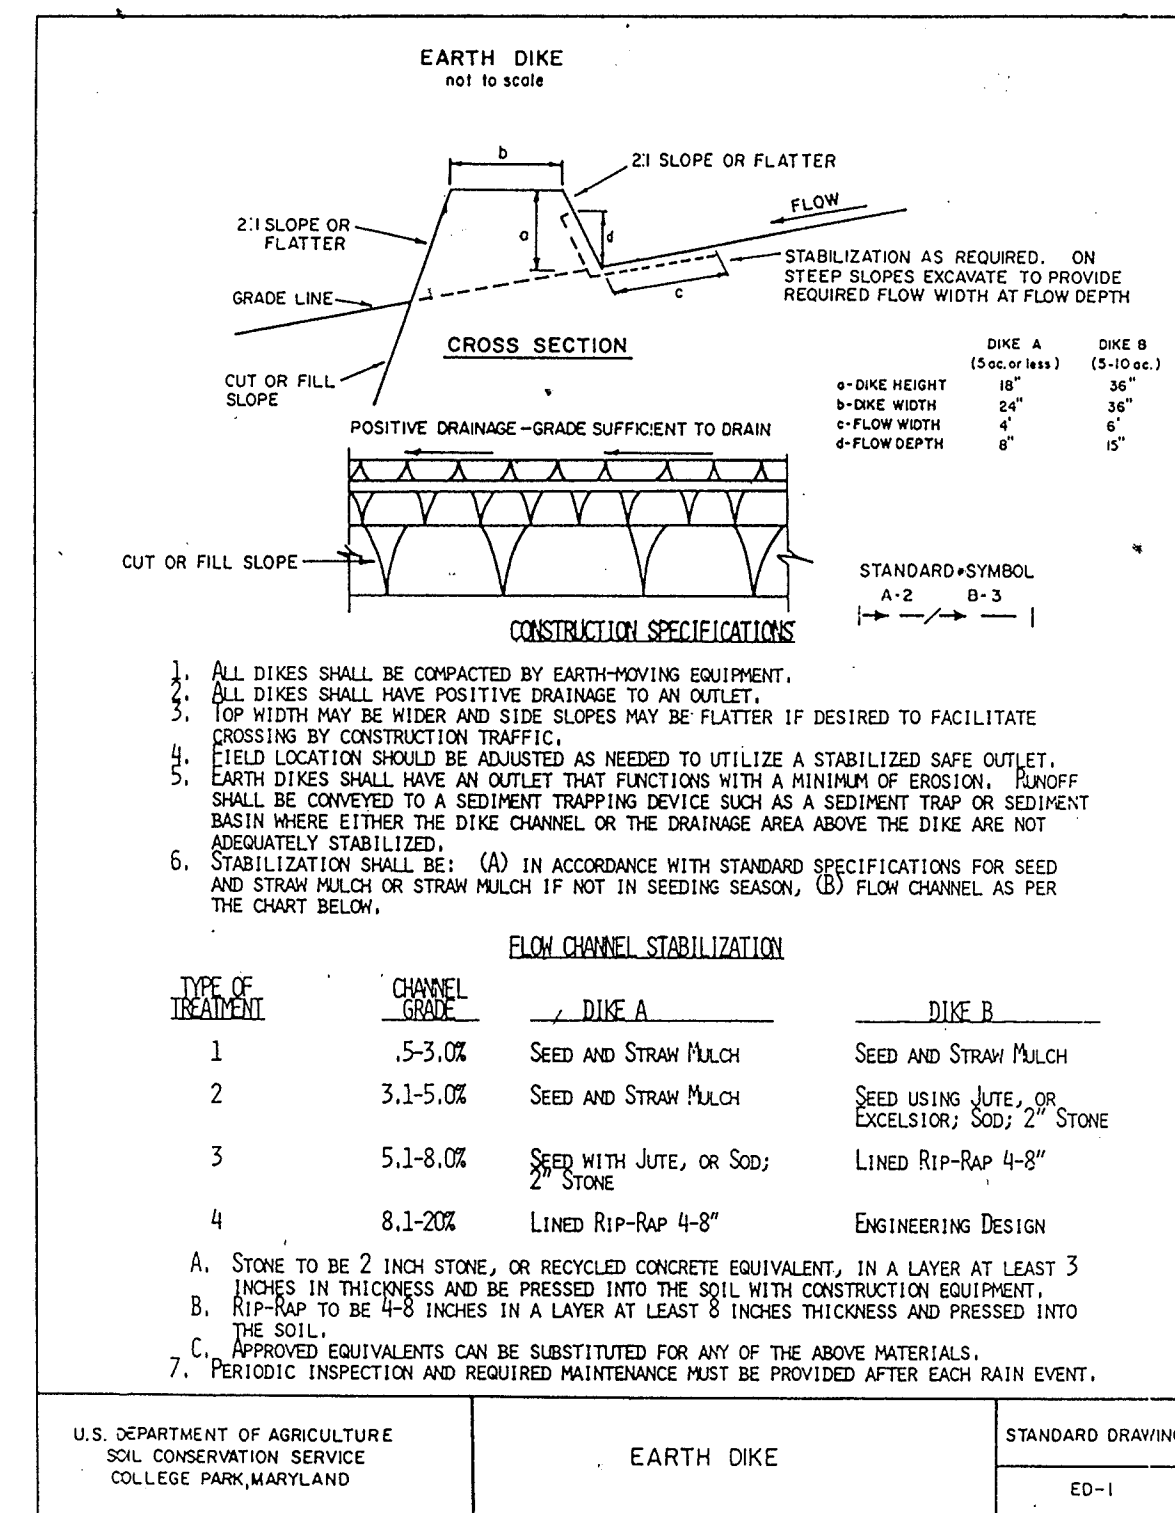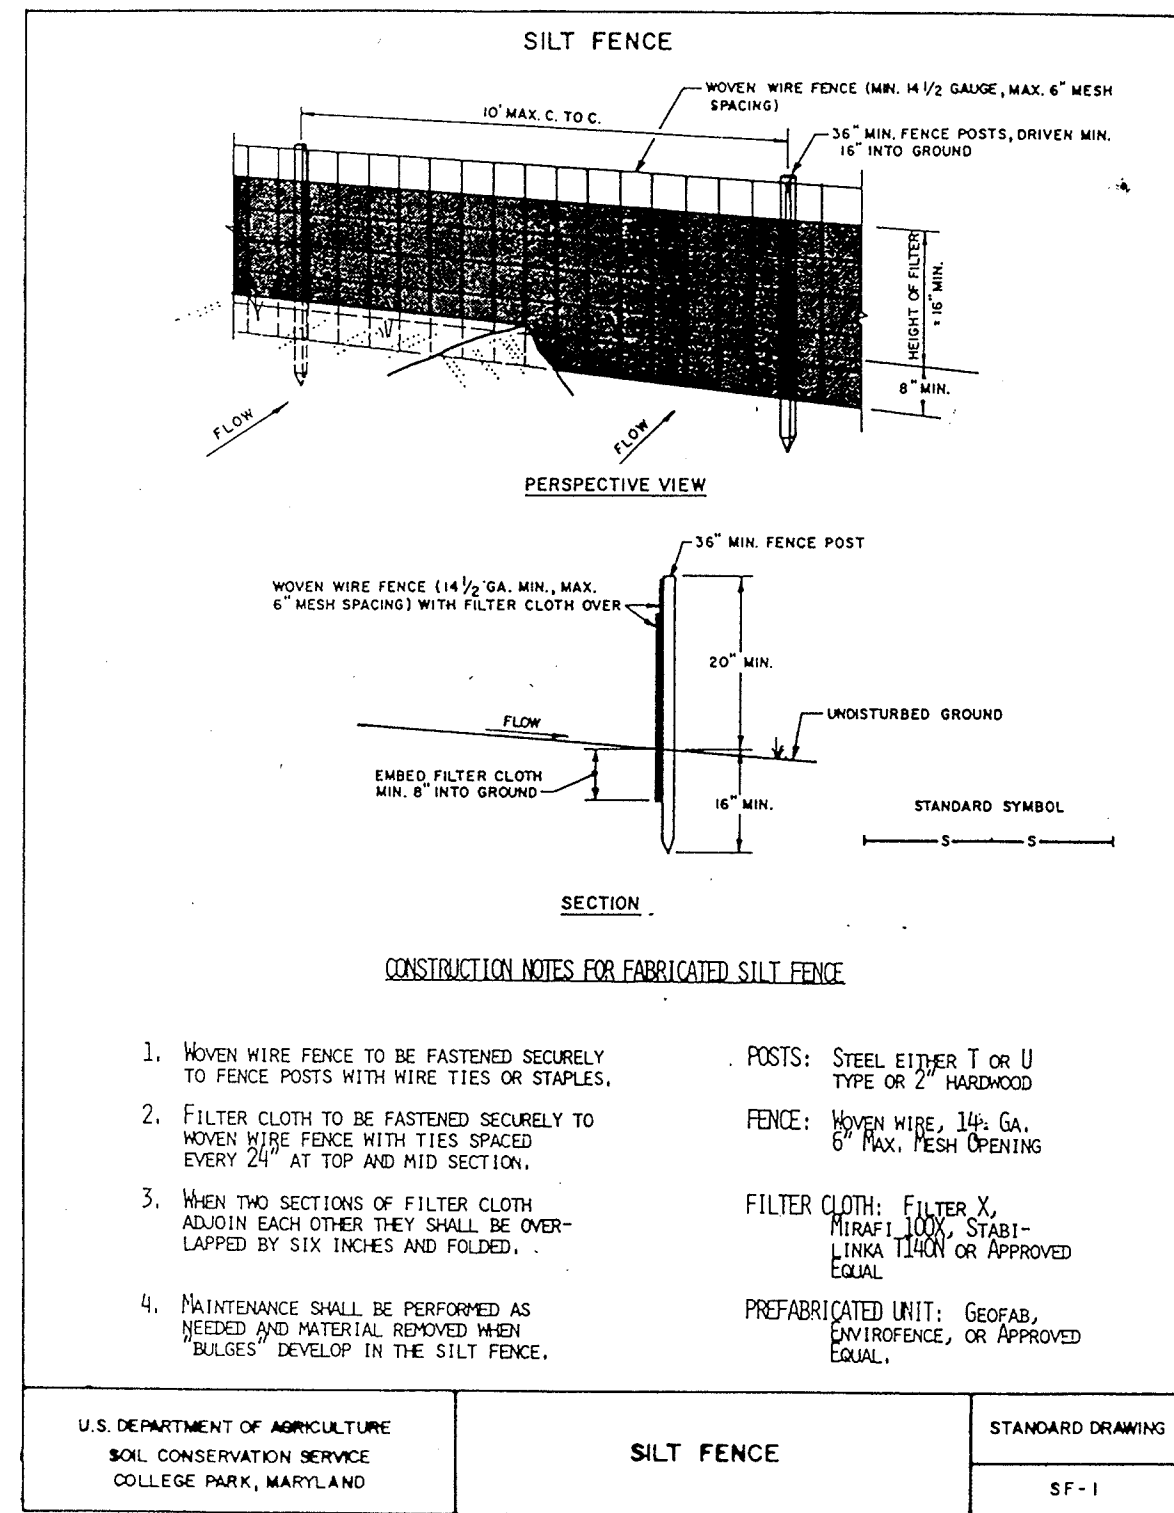

NOTE: CONSTRUCT PROPOSED INLET B CONNECT 2" RIP TO EX. MH; REMOVE EX. INLET B DIKE AS SHOWN ON THE PLANS IN CONJUNCTION WITH SEDIMENT TRAP INSTALLATION.

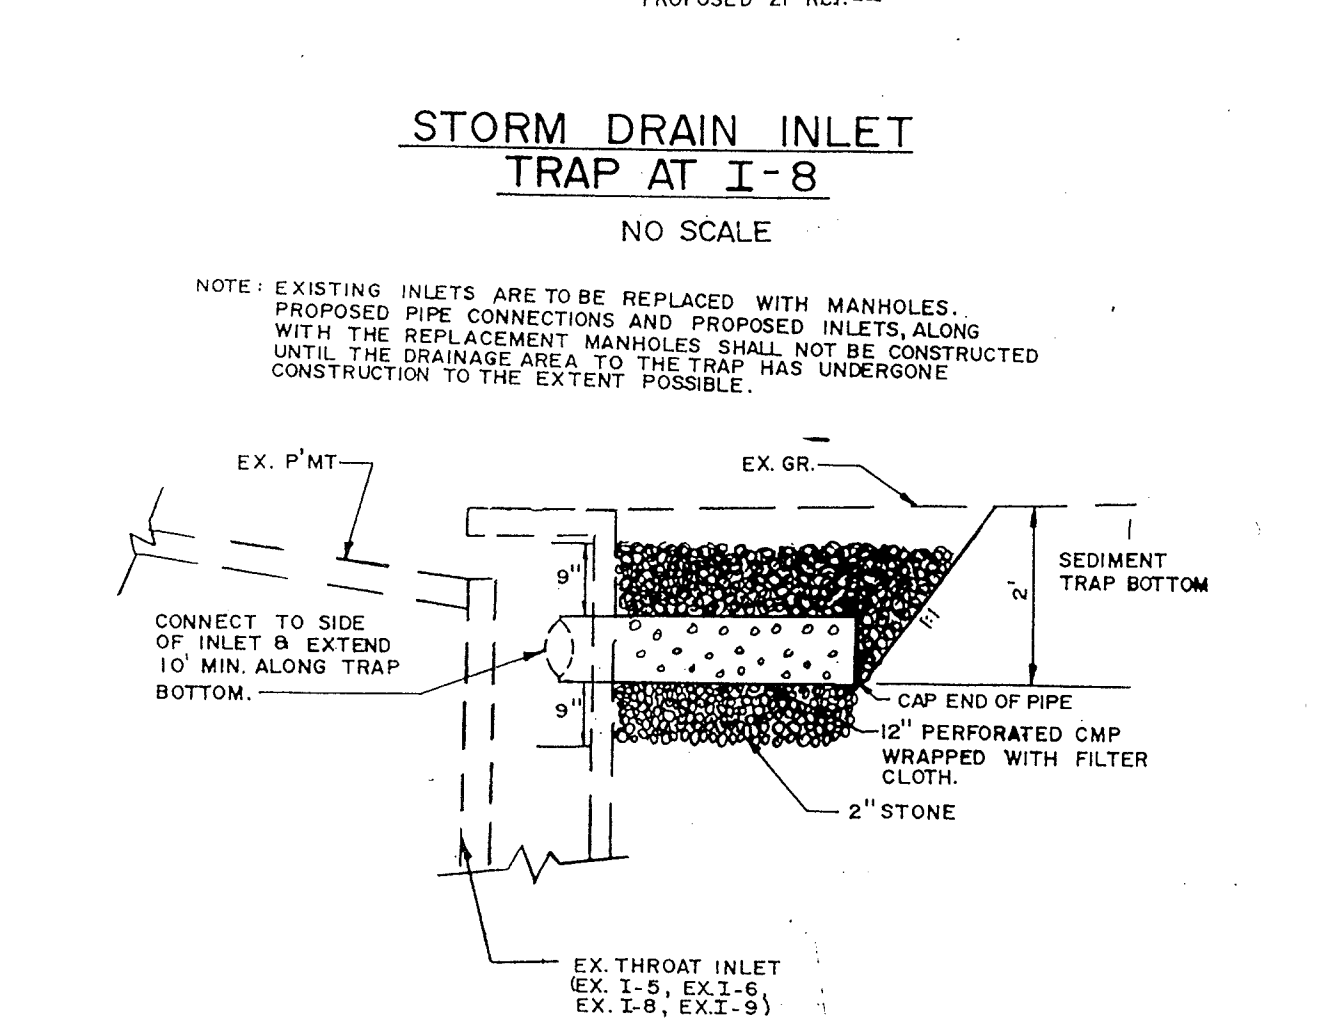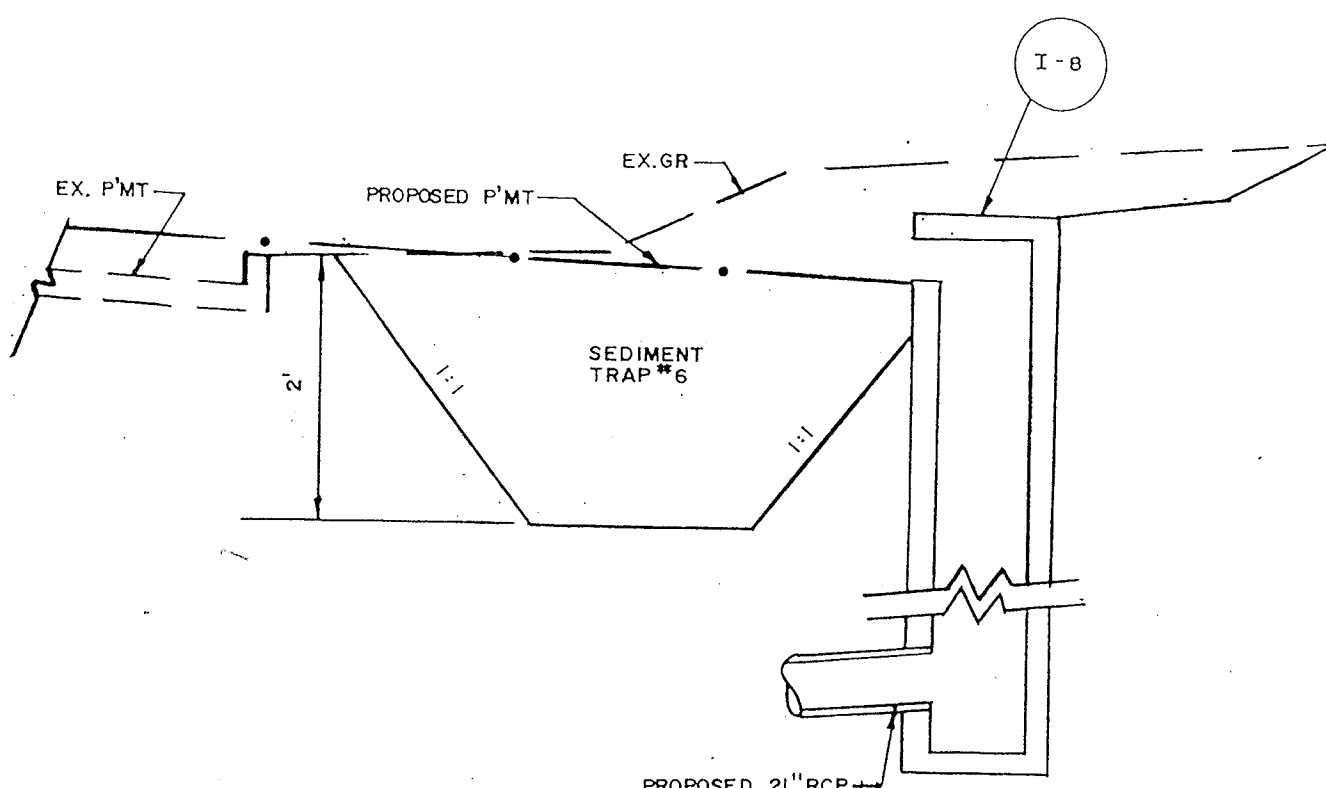

**SEDIMENT CONTROL NOTES**

- 1) A minimum of 24 hours notice must be given to the Howard County Office of Inspection and Permits prior to the start of any construction. (992-2437)
- 2) All vegetative and structural practices are to be installed according to the provisions of this plan and are to be in conformance with the 1983 MARYLAND STANDARDS AND SPECIFICATIONS FOR SOIL EROSION AND SEDIMENT CONTROL.
- 3) Following initial soil disturbance or redisturbance, permanent or temporary stabilization shall be completed within: a) 7 calendar days for all perimeter sediment control structures, dikes, perimeter slopes and all slopes greater than 3:1, b) 14 days as to all other disturbed or graded areas on the project site.
- 4) All sediment traps/basins shown must be fenced and warning signs posted around their perimeter in accordance with Vol. 1, Chapter 12, of the HOWARD COUNTY DESIGN MANUAL, Storm Drainage.
- 5) All disturbed areas must be stabilized within the time period specified above in accordance with the 1983 MARYLAND STANDARDS AND SPECIFICATIONS FOR SOIL EROSION AND SEDIMENT CONTROL for permanent seedings (Sec. 51) and (Sec. 52), temporary seedings (Sec. 50) and mulching (Sec. 52). Temporary stabilization with mulch alone can only be done when recommended seeding dates do not allow for proper germination and establishment of grasses.
- 6) All sediment control structures are to remain in place and are to be maintained in operative condition until permission for their removal has been obtained from the Howard County Sediment Control Inspector
- 7) Site Analysis:  
Total Area of Site 21.5 Acres  
Area Disturbed 19 Acres  
Area to be roofed or paved 12.5 Acres (INCLUDING SIDEWALK)  
Area to be vegetatively stabilized 6.5 Acres  
Total Cut 5300 Cu. Yds  
Total Fill 3400 Cu. Yds  
Offsite waste/borrow area location
- 8) Any sediment control practice which is disturbed by grading activity for placement of utilities must be repaired on the same day of disturbance.
- 9) Additional sediment controls must be provided, if deemed necessary by the Howard County DWS sediment control inspector.
- 10) On all sites with disturbed areas in excess of 2-acres, approval of the inspection agency shall be requested upon completion of installation of perimeter erosion and sediment controls, but before proceeding with any other earth disturbance or grading. Other holding or grading inspection approvals may not be authorized until this initial approval by the inspection agency is made.

**PERMANENT SEEDING NOTES**

Seedbed Preparation: Loosen upper 3 inches of soil by raking, disking or other acceptable means before seeding.

Soil Amendments: Use one of the following schedules:

- 1) Preferred - Apply 2 tons per acre dolomitic limestone (92 lbs./1000 square ft.) and 600 lbs. per acre 10-10-10 fertilizer (14 lbs./1000 square ft.) before seeding. Harrow or disc into upper three inches of soil. At time of seeding, apply 400 lbs. per acre 30-0-0 ureaform fertilizer (9 lbs./1000 square ft.)
- 2) Acceptable - Apply 2 tons per acre dolomitic limestone (92 lbs./1000 square ft.) and 1000 lbs. per acre 10-10-10 fertilizer (23 lbs./1000 square ft.) before seeding. Harrow or disc into upper three inches of soil.

Seeding: For the periods March 1 through April 30, and August 1 through October 15, seed with 60 lbs. per acre (1.4 lbs./1000 sq. ft.) of Kentucky 31 Tall Fescue. For the period May 1 through July 31, seed with 60 lbs. Kentucky 31 Tall Fescue per acre and 2 lbs. per acre (.05 lbs./1000 square ft.) of weeping lovegrass. During the period of October 16 through February 28, protect site by Option (1) 2 tons per acre of well anchored straw mulch and seed as soon as possible in the spring. Option (2) Use sod. Option (3) Seed with 60 lbs./acre Kentucky 31 Tall Fescue and mulch with 2 tons/acre well anchored straw.

Mulching: Apply 1 1/2 to 2 tons per acre (70 to 90 lbs./1000 sq. ft.) of unrotted small grain straw immediately after seeding. Anchor mulch immediately after application, using mulch anchoring tool or 218 gallons per acre (5 gal./1000 sq. ft.) of emulsified asphalt on flat areas. On slopes 8 feet or higher, use 348 gallons per acre (8 gal./1000 sq. ft.) for anchoring.

Maintenance: Inspect all seeded areas and make needed repairs, replacements and reseedings.

**TEMPORARY SEEDING NOTES**

Seedbed Preparation: Loosen upper 3 inches of soil by raking, disking or other acceptable means before seeding.

Soil Amendments: Apply 600 lbs. per acre 10-10-10 fertilizer (14 lbs./1000 sq. ft.)

Seeding: For periods March 1 through April 30 and from August 15 through November 15, seed with 2 1/2 lbs. per acre of annual ryegrass (3.2 lbs./1000 sq. ft.) For the period May 1 through August 14, seed with 3 lbs. per acre of weeping lovegrass (.07 lbs./1000 sq. ft.). For the period November 16 through February 28, protect the site by applying 2 tons per acre of well anchored straw mulch and seed as soon as possible. In the spring or use sod.

Mulching: Apply 1 1/2 to 2 tons per acre (70 to 90 lbs./1000 sq. ft.) of unrotted small grain straw immediately after seeding. Anchor mulch immediately after application using mulch anchoring tool or 218 gal. per acre (5 gal./1000 sq. ft.) of emulsified asphalt on flat areas. On slopes, 8 ft. or higher use 348 gal. per acre (8 gal./1000 sq. ft.) for anchoring.

TRAFFIC MAINTENANCE SEQUENCE  
(SEE SPECIFICATIONS FOR DETAILED INFORMATION)

FOR THE FOLLOWING SEQUENCE, IT SHALL BE UNDERSTOOD THAT ALL CONSTRUCTION AT INTERSECTION (ROADS AND DRIVEWAYS) SHALL BE DONE IN A MANNER WHICH ENSURES CONTINUOUS TRAFFIC ACCESS. IN ADDITION, STRICT ADHERENCE TO THE SEDIMENT CONTROL SEQUENCE OF CONSTRUCTION IS REQUIRED.

1. COMPLETE THE CONSTRUCTION FROM STATION 8+52 TO STATION 11+88.
  - A. DIVERT TRAFFIC TO PROVIDE TWO-WAY TRAFFIC ON NORTHBOUND LANES (SEE SPECIAL PROVISIONS).
  - B. CLOSE THE SOUTHBOUND LANES; REMOVE THE EXISTING PAVEMENT SECTION AND COMPLETE THE ROAD CONSTRUCTION TO THE CENTERLINE.
  - C. SWITCH TRAFFIC TO NORTHBOUND LANES & CLOSE SOUTHBOUND LANES (SEE SPECIAL PROVISIONS).
  - D. CLOSE THE NORTHBOUND LANES; REMOVE THE EXISTING PAVEMENT SECTION AND COMPLETE THE ROAD CONSTRUCTION.
- \* 2. COMPLETE THE ROAD CONSTRUCTION FROM STATION 11+88 TO STATION 29+78:
  - A. PROVIDE MINIMUM LONGITUDINAL SOUTHBOUND LANE CLOSURES AND COMPLETE CONSTRUCTION AT THE OAK HALL ROAD AND DOBBIN ROAD INTERSECTIONS (SEE SPECIAL PROVISIONS).
  - B. PROVIDE SOUTHBOUND LANE CLOSURES AND COMPLETE THE CONSTRUCTION TO THE ROAD CENTERLINE.
  - C. PROVIDE NORTHBOUND LANE CLOSURES AND COMPLETE THE CONSTRUCTION TO THE ROAD CENTERLINE.
3. COMPLETE THE ROAD CONSTRUCTION FROM STATION 29+78 TO STATION 67+88:
  - A. PROVIDE SOUTHBOUND LANE CLOSURES FROM THE CENTERLINE.
  - B. COMPLETE THE ROAD WIDENING CONSTRUCTION TO THE CENTERLINE.
  - C. PROVIDE NORTHBOUND LANE CLOSURES AND COMPLETE THE ROAD CONSTRUCTION.
4. COMPLETE THE ROAD CONSTRUCTION FROM STATION 67+88 TO STATION 73+88:
  - A. CLOSE THE EAST SIDE OF THE ROAD AT 22' FROM THE WEST EDGE OF PAVEMENT, AND COMPLETE THE ROAD CONSTRUCTION TO THE CENTERLINE.
  - B. CLOSE THE WEST SIDE OF THE ROAD FROM THE CENTERLINE; REMOVE THE EXISTING CURB AND PAVEMENT AS SHOWN ON THE PLANS AND COMPLETE THE ROAD CONSTRUCTION.
5. COMPLETE THE ROAD CONSTRUCTION FROM STATION 67+88 TO STATION 114+88:
  - A. ALTERNATE NORTHBOUND AND SOUTHBOUND LANE CLOSURES AND COMPLETE THE ROAD CONSTRUCTION TO STATION 81+88.
  - B. CLOSE THE EAST SIDE OF THE ROAD FROM THE CENTERLINE FROM STATION 81+88 TO STATION 85+88; COMPLETE THE ROAD CONSTRUCTION TO THE CENTERLINE.
  - C. CLOSE THE EAST SIDE OF THE ROAD AT 5' FROM THE CENTERLINE FROM STATION 85+88 TO STATION 87+88. REMOVE THE EXISTING CURB, CONSTRUCT CURB AND GUTTER AND PREPARE THE SUBGRADE FOR WIDENING. CLOSE THE ROAD FROM THE CENTERLINE AND COMPLETE THE CONSTRUCTION TO THE CENTERLINE.
  - D. CLOSE THE WEST SIDE OF THE ROAD FROM THE CENTERLINE FROM STATION 81+88 TO STATION 93+88. COMPLETE THE ROAD CONSTRUCTION TO STATION 87+88. (FROM STATION 87+88, COMPLETE THE CONSTRUCTION TO THE CENTERLINE.)
  - E. CLOSE THE EAST SIDE OF THE ROAD FROM THE CENTERLINE FROM STATION 87+88 TO STATION 185+88; COMPLETE THE ROAD CONSTRUCTION TO THE CENTERLINE.

\*NOTE: REFER TO SPECIAL PROVISIONS FOR TRAFFIC DIVERSION PATTERNS FOR ITEMS 2 THRU 6.

F. CLOSE THE WEST SIDE OF THE ROAD FROM THE CENTERLINE FROM STATION 93+88 TO STATION 185+88; COMPLETE THE ROAD CONSTRUCTION.

G. CLOSE THE EAST SIDE OF THE ROAD FROM THE CENTERLINE FROM STATION 185+88 TO STATION 188+88. REMOVE THE EXISTING PAVEMENT TO THE CENTERLINE; CONSTRUCT THE ROAD TO THE CENTERLINE.

H. CLOSE THE WEST SIDE OF THE ROAD FROM THE CENTERLINE FROM STATION 185+88 TO STATION 188+88. REMOVE THE EXISTING PAVEMENT AND COMPLETE THE ROAD CONSTRUCTION.

I. CLOSE THE EAST SIDE OF THE ROAD FROM THE CENTERLINE FROM STATION 185+88 TO STATION 114+88; COMPLETE THE ROAD CONSTRUCTION TO THE CENTERLINE.

J. CLOSE THE WEST SIDE OF THE ROAD FROM THE CENTERLINE FROM STATION 188+88 TO STATION 114+88; COMPLETE THE ROAD CONSTRUCTION.

G. COMPLETE THE ROAD CONSTRUCTION FROM STATION 114+88 TO OLD MONTGOMERY ROAD.
 

- A. REMOVE THE EXISTING PAVEMENT FROM THE CENTERLINE ON THE EAST SIDE OF THE ROAD FROM STATION 114+88 TO 115+25. CONSTRUCT I-12 AND INSTALL THE 18" RCP TO A POINT BEYOND THE ROAD CENTERLINE. CONSTRUCT THE EAST SIDE OF THE ROAD FROM THE CENTERLINE FROM STATION 114+88 TO STATION 117+88. CLOSE THE EASTBOUND LANE OF OLD MONTGOMERY ROAD AS REQUIRED AND COMPLETE THE CONSTRUCTION OF THE EAST SIDE OF THE ROAD TO STATION 117+88.
- B. OPEN THE NEWLY CONSTRUCTED ROAD SECTION TO TRAFFIC; CLOSE TRAFFIC ON THE ORIGINAL ROAD, AND COMPLETE THE STORM DRAINAGE CONSTRUCTION FROM I-12 TO MH-11.
- C. REMOVE THE PAVEMENT SECTION OF THE ORIGINAL ROAD; COMPLETE CONSTRUCTION OF THE WEST SIDE OF THE NEW ROAD FROM STATION 114+88 TO OLD MONTGOMERY ROAD AS REQUIRED TO COMPLETE CONSTRUCTION OF THE AUXILIARY LANE.

**SEQUENCE OF CONSTRUCTION**

NOTE: CONSTRUCTION OF THE ENTIRE LENGTH OF ROAD SHALL BE DIVIDED INTO VARIOUS SEGMENTS. EACH SEGMENT SHALL BE DEFINED BY THE DRAINAGE AREA TO A SPECIFIED SEDIMENT TRAP. ALL INLETS, EXISTING AND PROPOSED, SHALL BE PROTECTED FROM SEDIMENT PRIOR TO CONSTRUCTION.

1. COMPLETE THE INSTALLATION OF SEDIMENT CONTROL MEASURES FOR THE SEGMENT TO BE CONSTRUCTED PRIOR TO ANY DISTURBANCE.
2. GRADE THE ROAD TO SUBGRADE IN THE SEGMENT OF CONSTRUCTION. GRADING SHALL BE DONE IN A MANNER WHICH ENSURES POSITIVE DRAINAGE TO THE SEDIMENT TRAP. EXCESS EXCAVATION FOR THE ROAD SHALL BE REMOVED FROM THE AREA OF CONSTRUCTION.
3. CONSTRUCT CURB AND GUTTER AND PAVE THE ROAD ACCORDING TO THE TRAFFIC MAINTENANCE SEQUENCE. RELOCATE AND ADJUST EXISTING UTILITIES AS REQUIRED AND INSTALL STORM DRAIN SYSTEMS AND ALL ROADWAY APPURTENANCES. SEDIMENT TRAPS IN EACH SEGMENT SHALL REMAIN FUNCTIONAL UNTIL ALL OTHER AREAS OF THE SEGMENT HAVE BEEN PAVED.
4. VEGETATIVELY STABILIZE ALL DISTURBED AREAS IN EACH SEGMENT AFTER THE ROAD CONSTRUCTION FOR THE SPECIFIC SEGMENT HAS BEEN COMPLETED.
5. REMOVE SEDIMENT CONTROL MEASURES (UPON INSPECTOR'S APPROVAL) AFTER THE WORK FOR A SPECIFIC SEGMENT IS COMPLETE. STABILIZE THE AFFECTED AREAS IMMEDIATELY.

DEPARTMENT OF PUBLIC WORKS  
HOWARD COUNTY, MARYLAND

James J. Sullivan 8/21/90  
DIRECTOR OF PUBLIC WORKS DATE

Chief, Bureau of Engineering DATE

Lawrence M. McLeans 8/22/90  
CHIEF DIVISION OF ROADS, BRIDGES AND STORM DRAINAGE DATE

ENGINEERING TECHNOLOGIES  
ASSOCIATES, INC.

ENGINEERS, PLANNERS, SURVEYORS

3458 ELLICOTT CENTER DRIVE, SUITE 101  
ELLICOTT CITY, MD. 21043  
9001-481-9920

Richard N. Armstrong

DES: JVP

DRN: 699

CHK: MJA

DATE: 8/90

BY NO. REVISION DATE

600' SCALE MAP NO. BLOCK NO.

SEDIMENT CONTROL DETAILS & CONSTRUCTION SEQUENCES



**OAKLAND MILLS ROAD IMPROVEMENTS**

ELECTION DISTRICT HOWARD COUNTY, MARYLAND  
CAPITAL PROJECT NO. J-4095

SCALE AS SHOWN

SHEET 19 OF 27




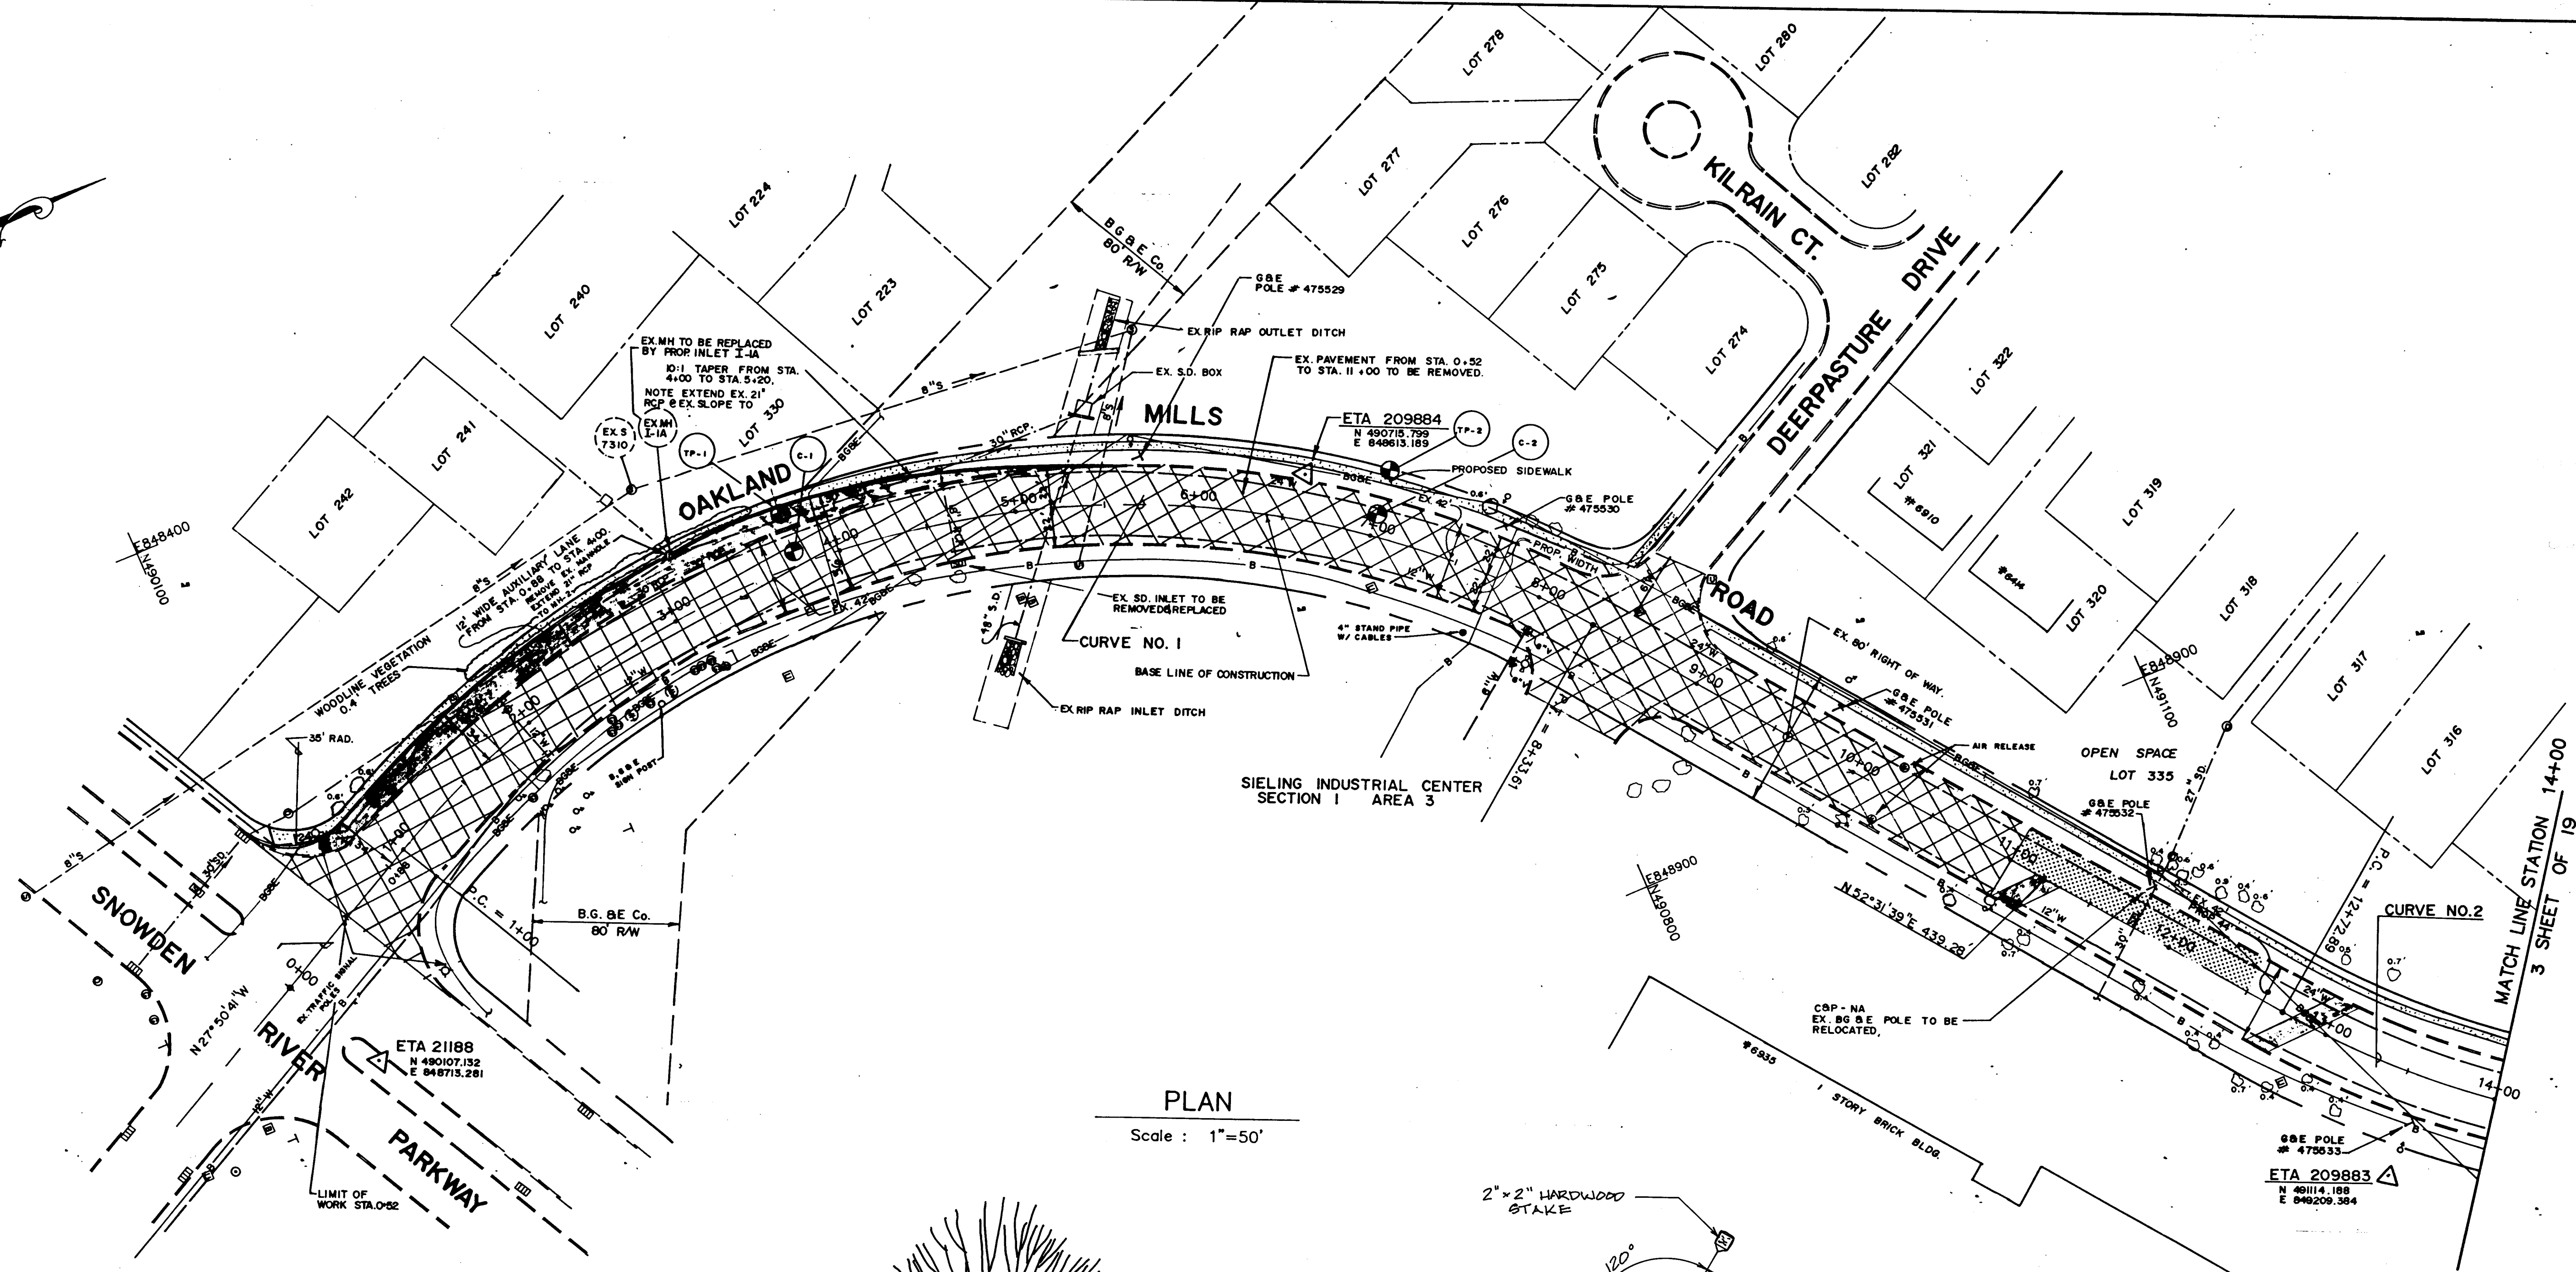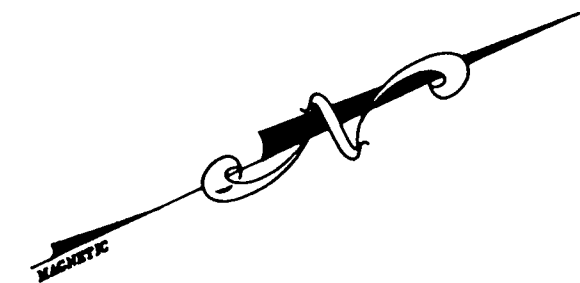


PLAN

Scale: 1"=50'

PLANT LIST				
QTY.	SYMBOL	NAME	SIZE	REMARKS
53		CRATAEGUS FLOWERING HAWTHORNE	2 1/2'-3' CAL.	B+B, FULL HEAD
32		SOPHORA JAPONICA JAPANESE PAGODA TREE	2 1/2'-3' CAL.	B+B, FULL HEAD
67		ACER RUBRUM RED MAPLES	2 1/2'-3' CAL. 13'-15' HGT	B+B, FULL HEAD
67		GLEDITZIA TRIACANTHOS INERMIS THORNLESS HONEY LOCUST	2 1/2'-3' CAL.	B+B, FULL HEAD
38		TRANSPLANTED		

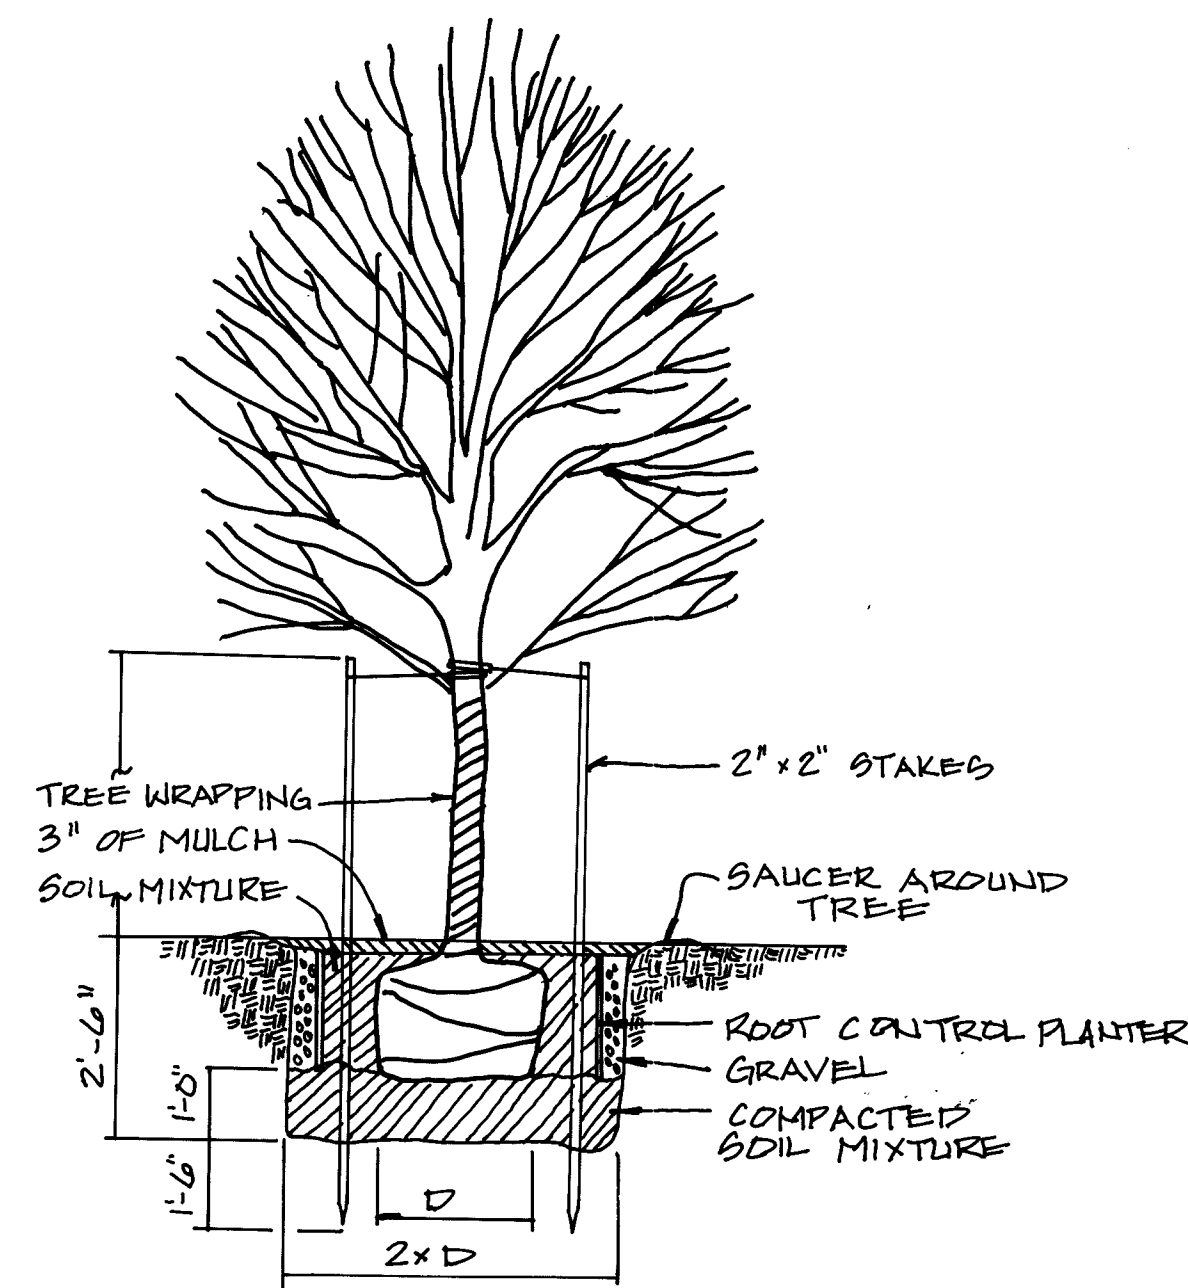

TYPICAL TREE PLANTING DETAIL  
NOT TO SCALE

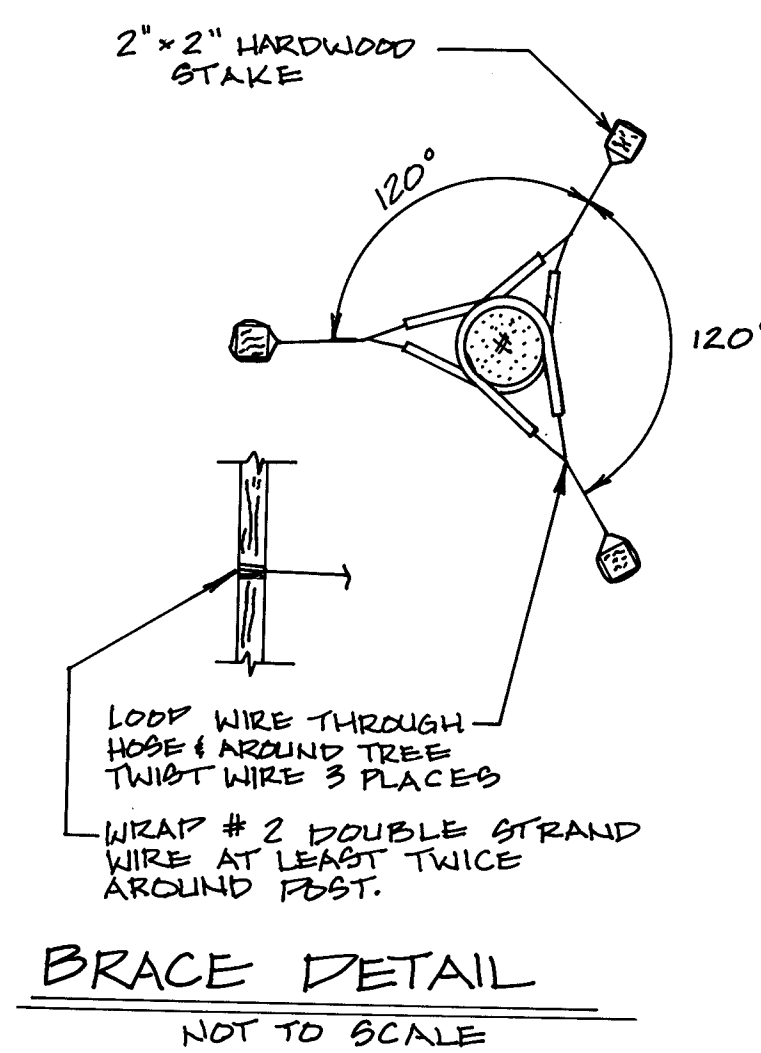

BRACE DETAIL  
NOT TO SCALE


LANDSCAPING NOTES

SHEET NO'S 20 THROUGH 27 ARE INTENDED TO CONVEY INFORMATION PERTINENT TO PLACEMENT OF STREET TREES AND LANDSCAPING DETAILS ONLY. SEE OTHER ROAD CONSTRUCTION PLANS FOR ALL OTHER INFORMATION RELATED TO CONSTRUCTION OF OAKLAND MILLS ROAD.

- CONTRACTOR SHALL FIELD VERIFY EXISTING UNDERGROUND UTILITIES BEFORE DIGGING.
- TREES SHALL BE PLANTED 7' BEHIND THE FACE OF CURB, HOWEVER ACTUAL LOCATIONS OF TREES MAY VARY TO ACCOMMODATE FIELD CONDITIONS.
- POLYETHYLENE ROOT CONTROL PLANTERS ARE REQUIRED FOR EACH TREE TO MINIMIZE ROOT SPREADING. ALL PLANTERS SHALL BE MANUFACTURED BY DEEP ROOT CORPORATION OF WESTMINISTER, CALIFORNIA (48" UNIVERSAL BARRIER, STOCK UB-48-2) OR APPROVED EQUAL AND SHALL BE INSTALLED ACCORDING TO MANUFACTURER'S SPECIFICATIONS.
- SEE SPECIFICATIONS FOR GENERAL PLANTING REQUIREMENTS.

DEPARTMENT OF PUBLIC WORKS  
HOWARD COUNTY, MARYLAND

ENGINEERING TECHNOLOGIES  
ASSOCIATES, INC.  
ENGINEERS - PLANNERS - SURVEYORS  
2488 ELICOTT CENTER DRIVE SUITE 101  
ELICOTT CITY, MARYLAND 21043  
(301) 461-9920

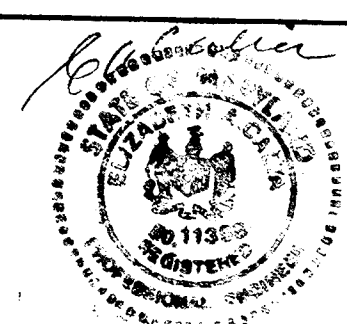

DES: GMI			
DRN: GMI			
CHK: JN			
DATE: 8/100	BY	NO.	REVISION

DATE: 8/100 BY NO. REVISION DATE 600' SCALE MAP NO. BLOCK NO.


LANDSCAPING PLAN

OAKLAND MILLS ROAD IMPROVEMENTS  
6TH ELECTION DISTRICT HOWARD COUNTY, MARYLAND  
CAPITAL PROJECT NO. J-4095

SCALE AS SHOWN  
SHEET 20 OF 27

1601



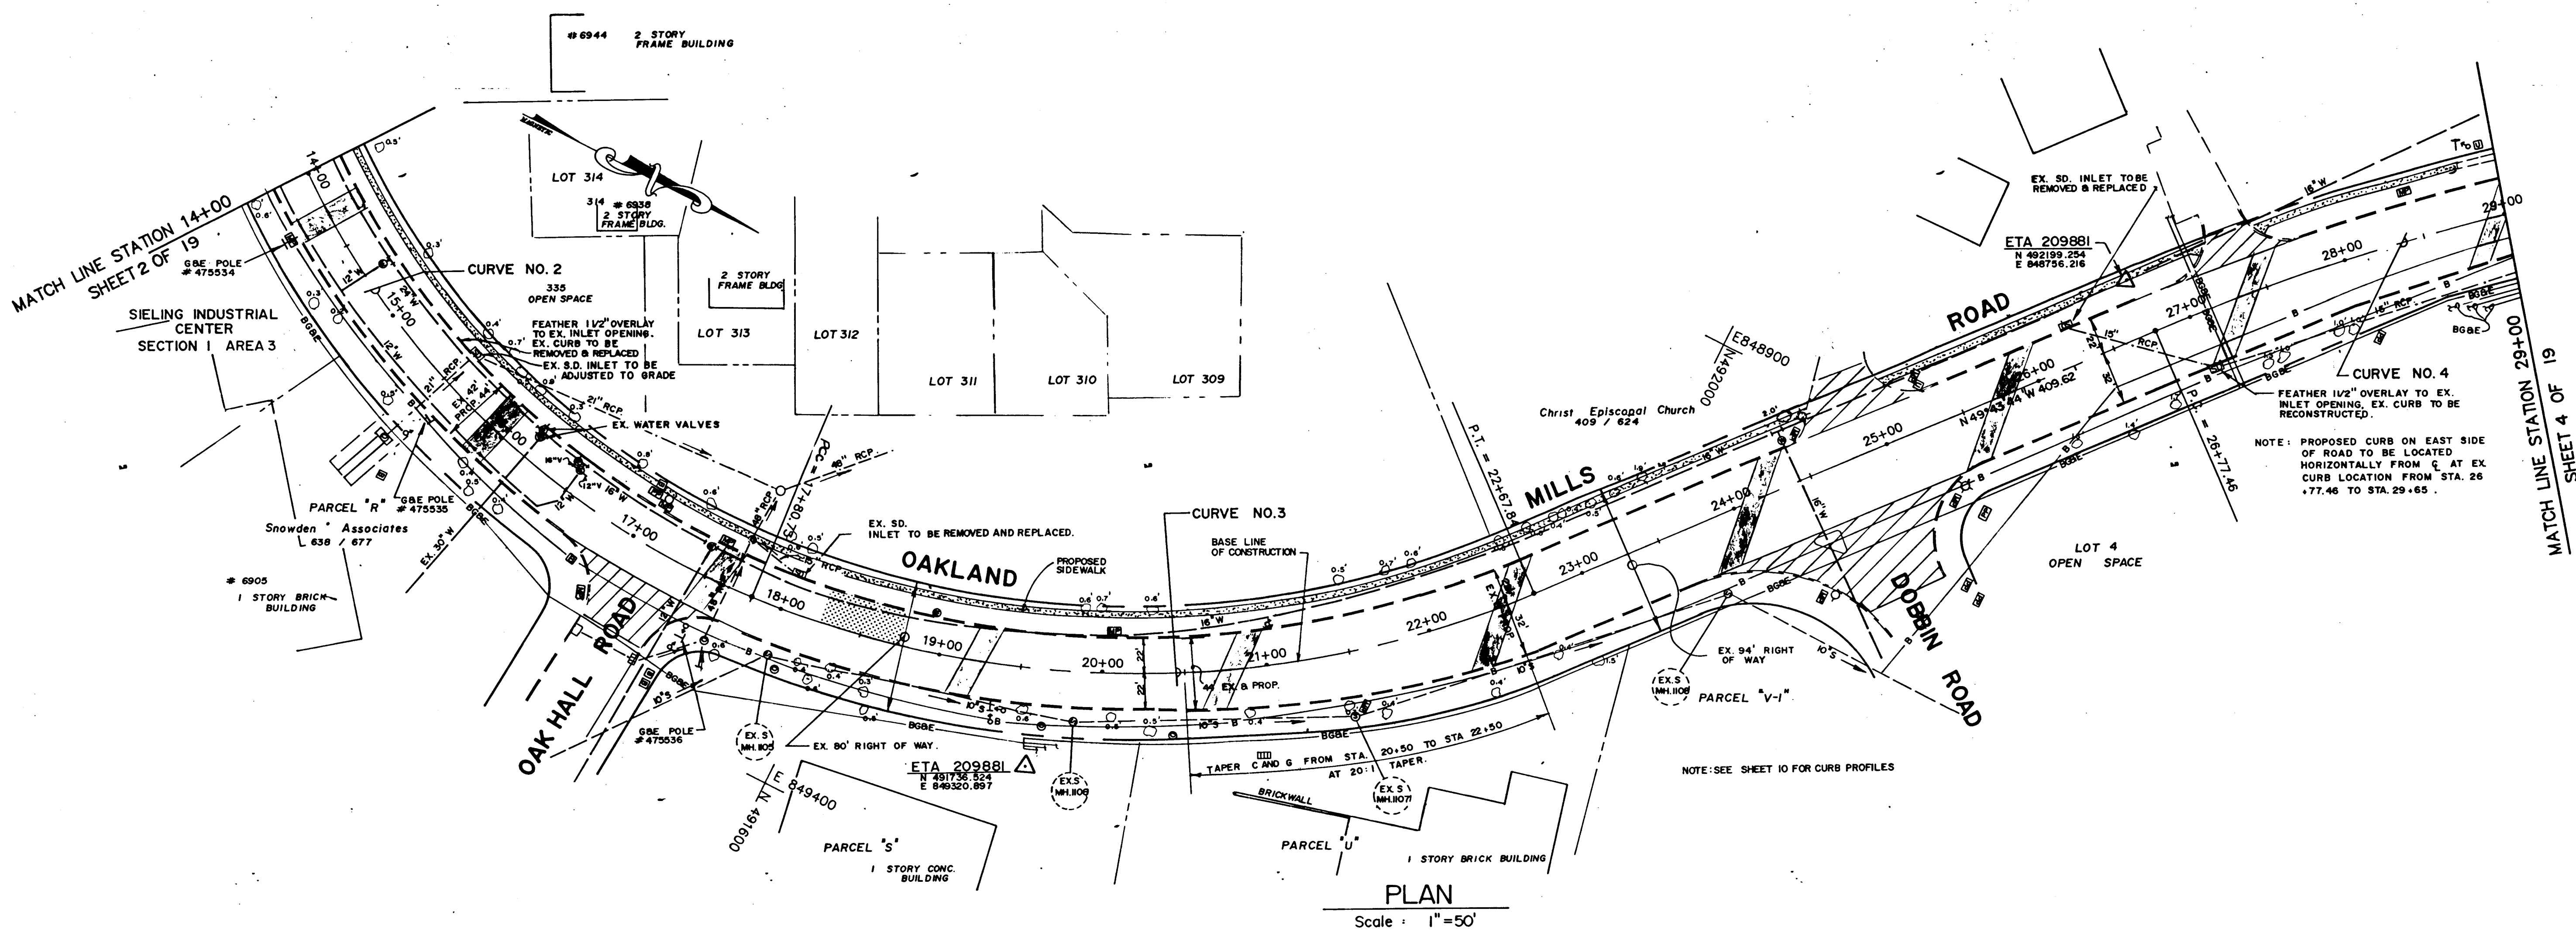


PLAN  
Scale: 1"=50'

NOTE: SEE SHEET 20 FOR LANDSCAPING GENERAL NOTES AND LANDSCAPING DETAILS.

1601

DEPARTMENT OF PUBLIC WORKS HOWARD COUNTY, MARYLAND Director of Public Works: <i>James W. ...</i> DATE: <i>2/21/90</i> Chief, Bureau of Engineering: <i>...</i> DATE: <i>2-21-90</i> Chief, Bureau of Highways: <i>...</i> DATE: <i>2/21/90</i> Chief, Division of Roads, Bridges and Storm Drainage: <i>...</i> DATE: <i>2/21/90</i>		ENGINEERING TECHNOLOGIES ASSOCIATES, INC. ENGINEERS - PLANNERS - SURVEYORS 3400 ELICOTT CENTER DRIVE SUITE 101 ELICOTT CITY, MARYLAND 21043 (301) 481-9920		DES: SMH DRN: SMH CHK: JJJ DATE: 2/90		LANDSCAPING PLAN <b>OAKLAND MILLS ROAD IMPROVEMENTS</b> 6TH ELECTION DISTRICT HOWARD COUNTY, MARYLAND CAPITAL PROJECT NO. J-4095		SCALE AS SHOWN SHEET 21 OF 27
BRUNING 44-132 69190				STATE OF MARYLAND DEPARTMENT OF PUBLIC WORKS HOWARD COUNTY ENGINEERING TECHNOLOGIES ASSOCIATES, INC. LICENSE NO. 111111		600' SCALE MAP NO. _____ BLOCK NO. _____		

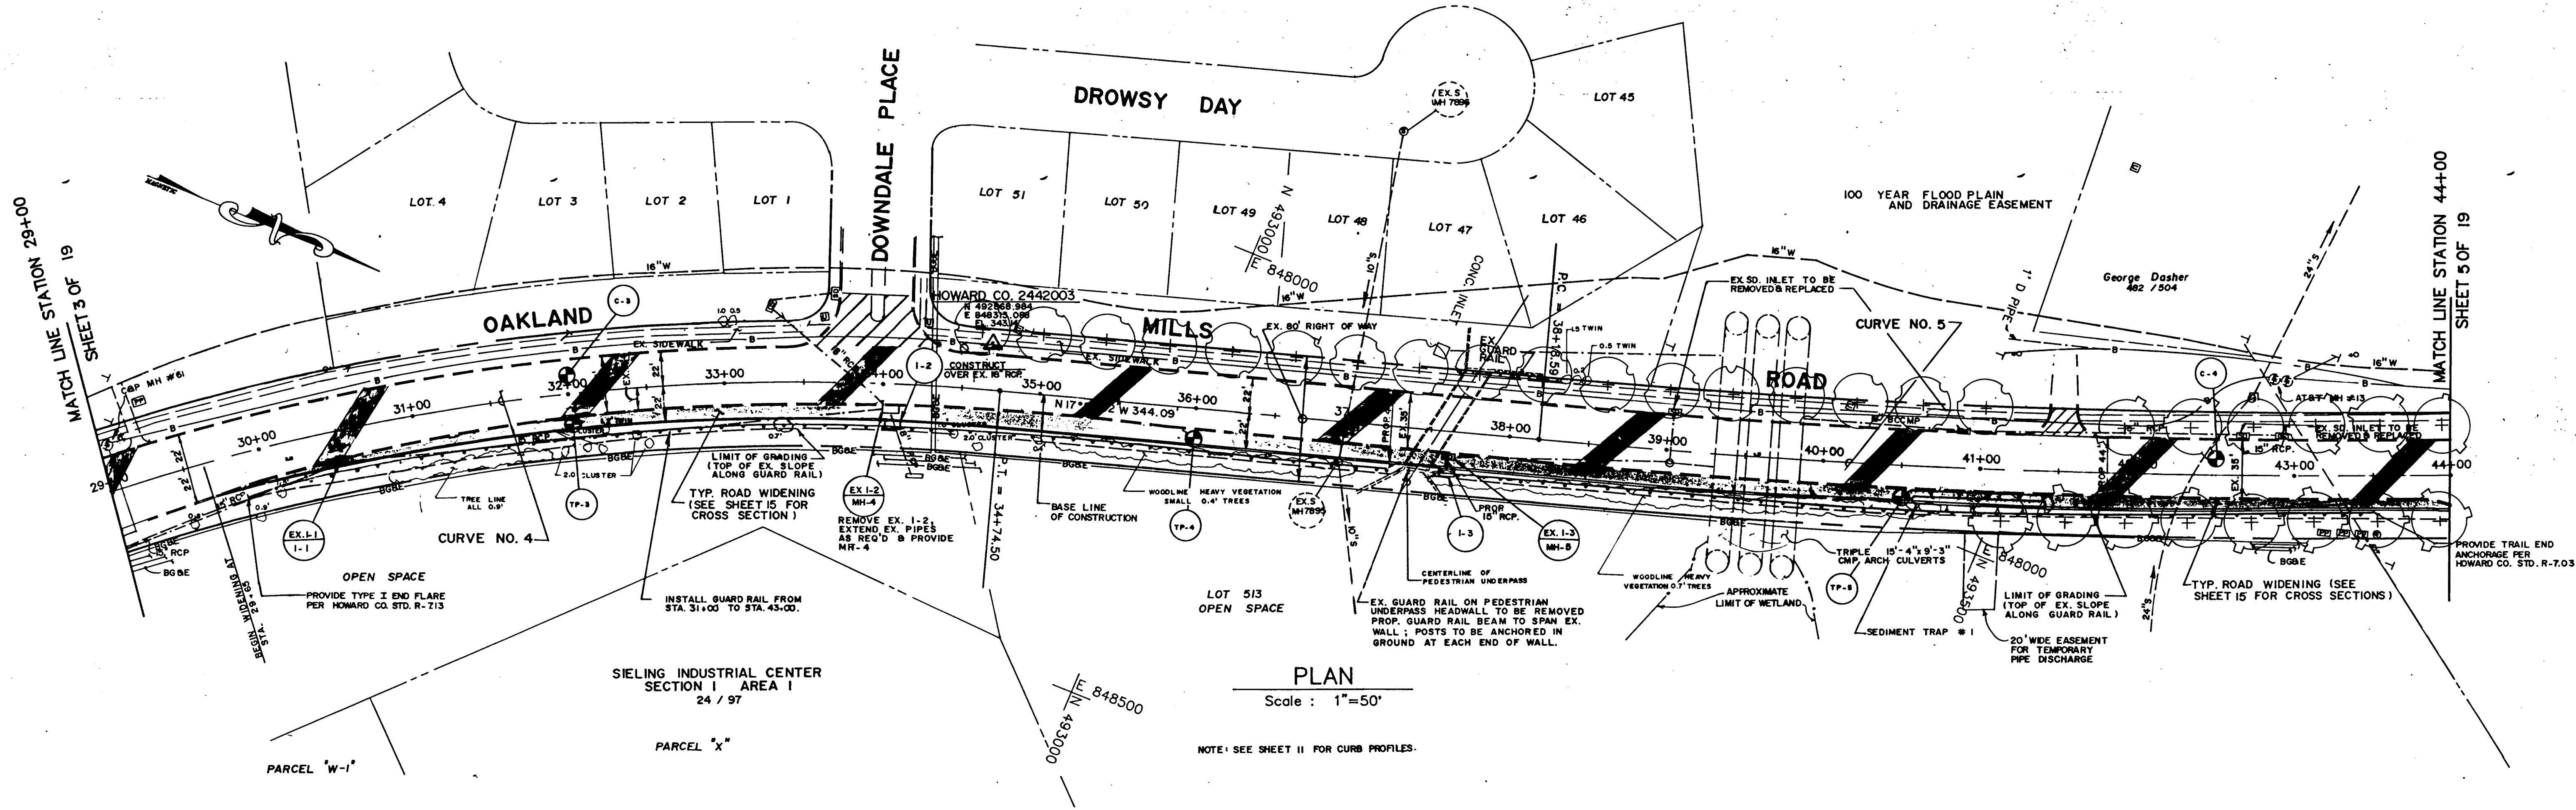

**PLAN**  
Scale: 1"=50'


NOTE: SEE SHEET 11 FOR CURB PROFILES.

NOTE: SEE SHEET 20 FOR LANDSCAPING  
GENERAL NOTES AND LANDSCAPING  
DETAILS.

1601

DEPARTMENT OF PUBLIC WORKS HOWARD COUNTY, MARYLAND Director of Public Works: <i>James P. ...</i> 8/22/90 Chief, Bureau of Highways: <i>Francis W. ...</i> 8/22/90		ENGINEERING TECHNOLOGIES ASSOCIATES, INC. ENGINEERS - PLANNERS - SURVEYORS 3450 BELLCOTT CENTER DRIVE SUITE 101 BELLCOTT CITY, MARYLAND 21043 (301) 461-1020		DES: GMI DRN: GMI CHK: JN DATE: 8/90		LANDSCAPING PLAN <b>OAKLAND MILLS ROAD IMPROVEMENTS</b> 6TH ELECTION DISTRICT HOWARD COUNTY, MARYLAND CAPITAL PROJECT NO. J-4095		SCALE AS SHOWN  SHEET 22 OF 27
Chief, Bureau of Engineering: <i>...</i> 8/22/90 Chief, Division of Roads, Bridges and Storm Drainage: <i>...</i> 8/22/90		BY NO. REVISION DATE 600' SCALE MAP NO. BLOCK NO.						



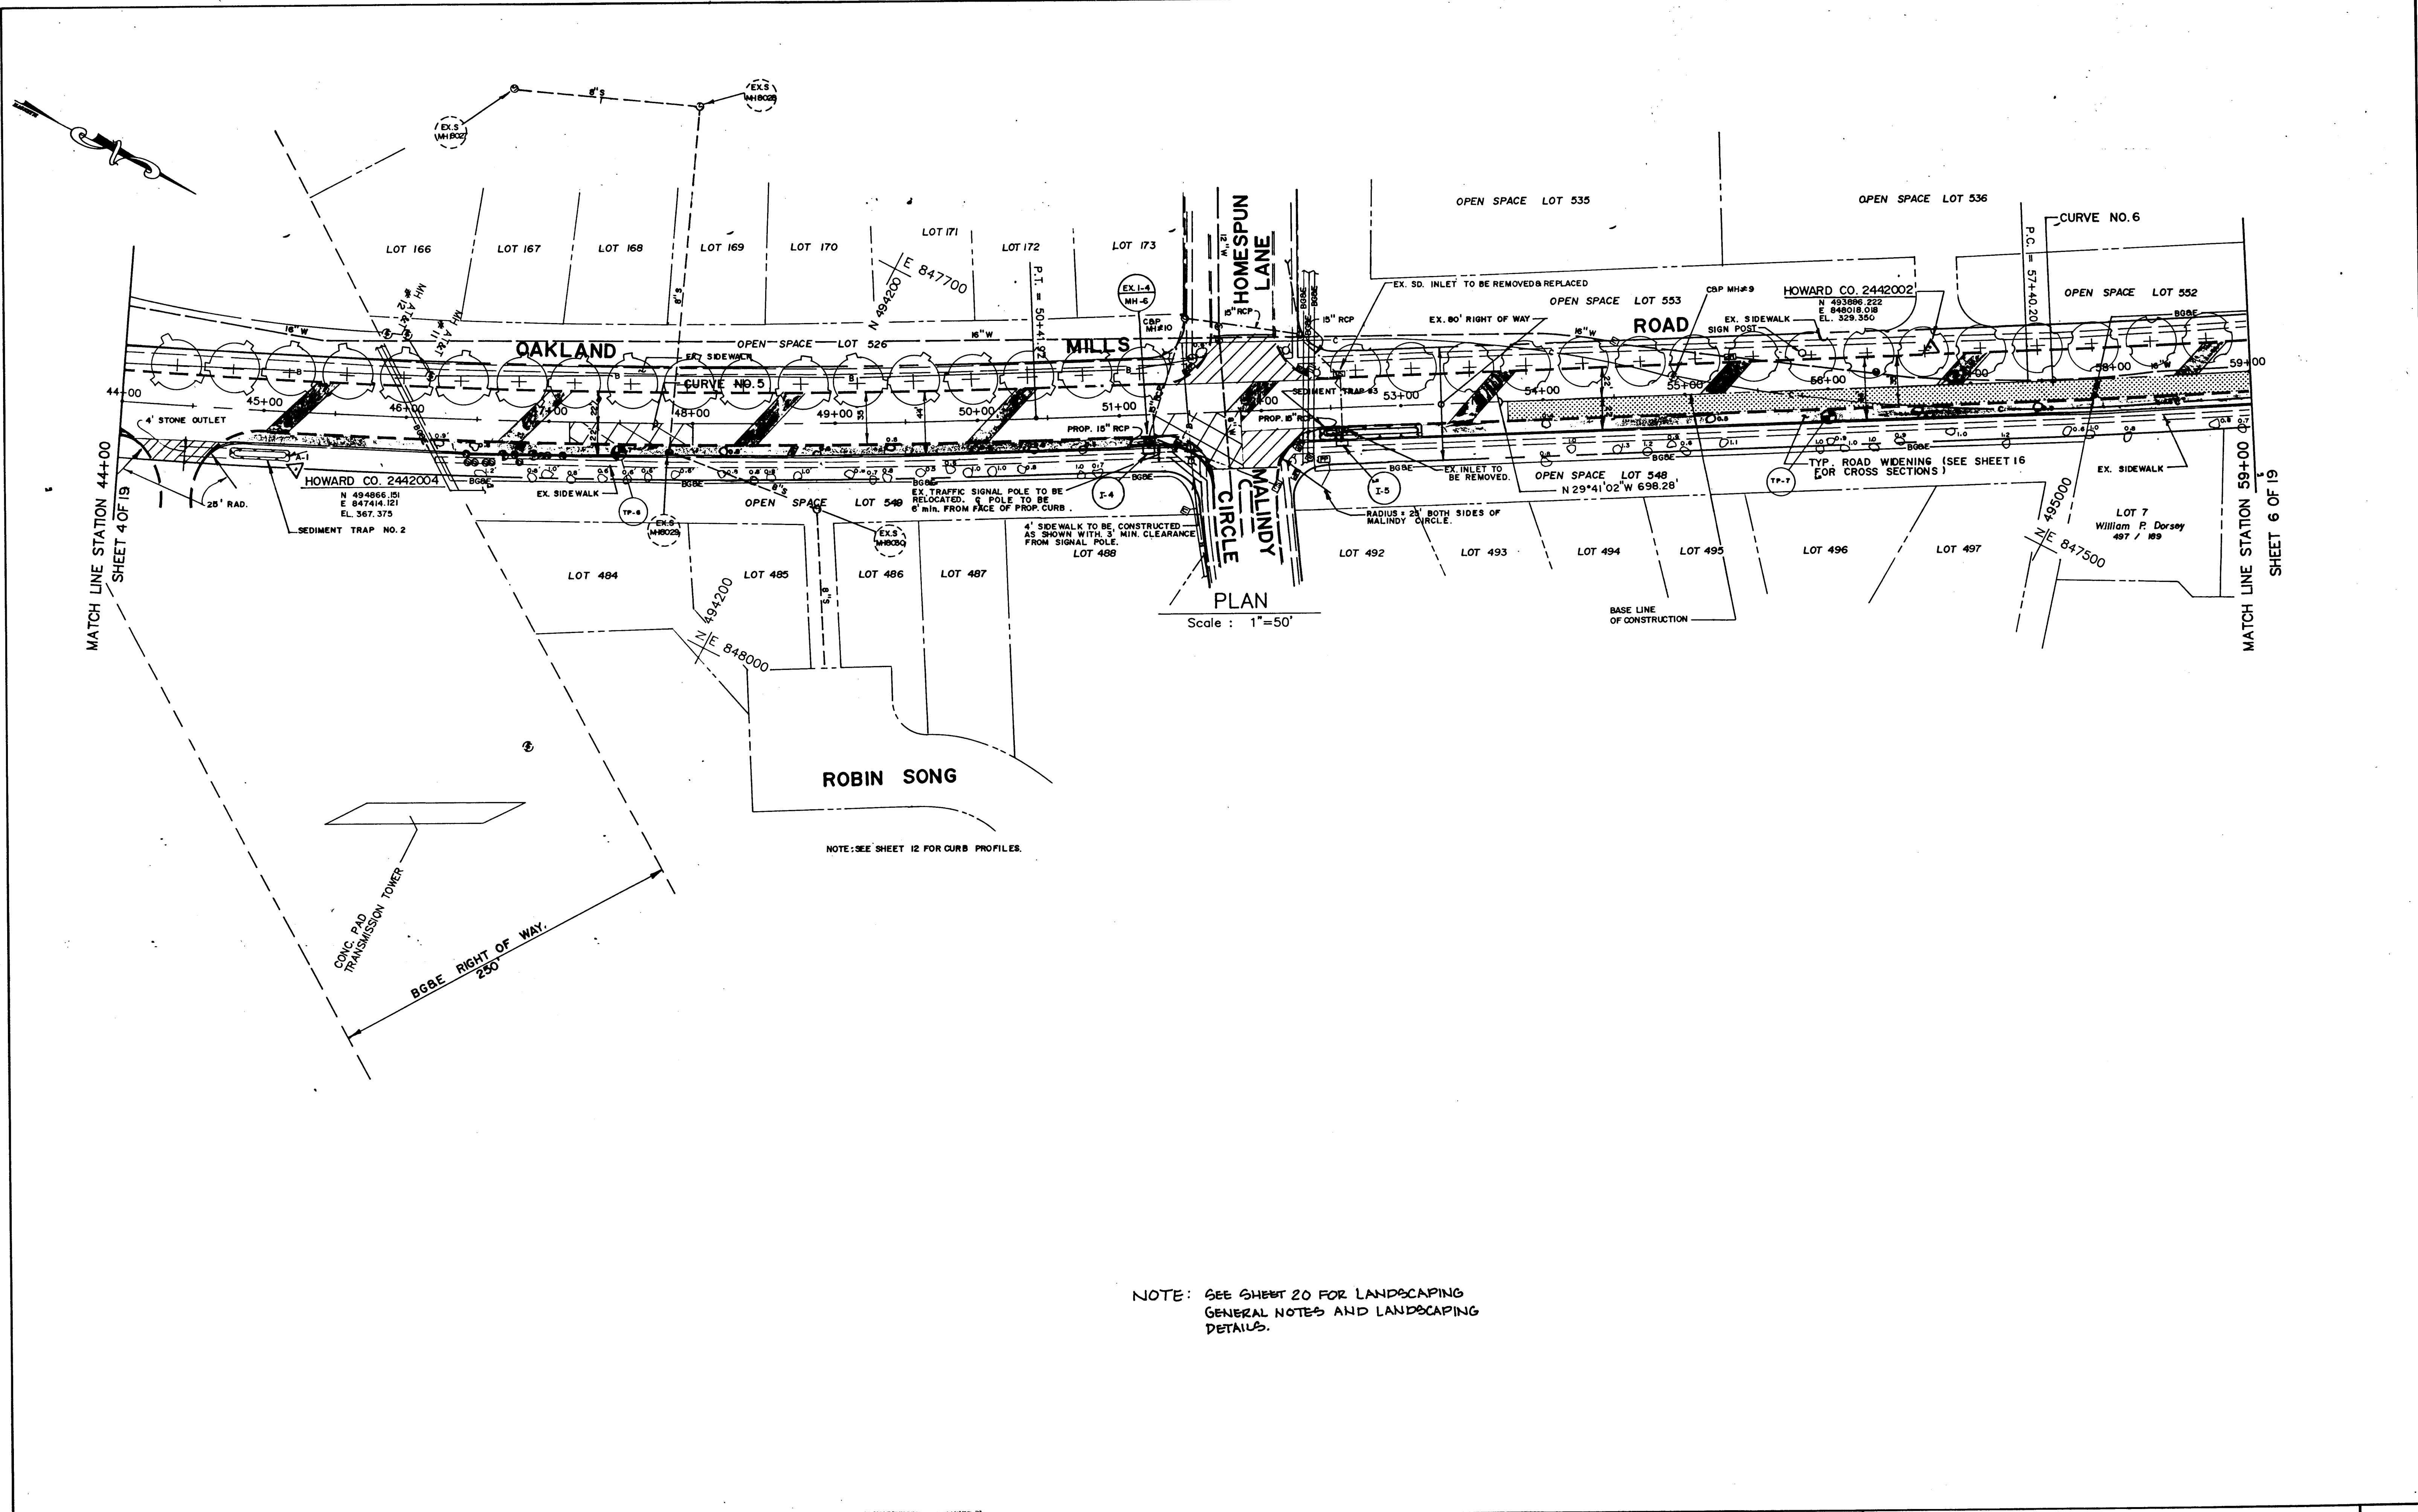



NOTE: SEE SHEET 20 FOR LANDSCAPING GENERAL NOTES AND LANDSCAPING DETAILS.

NOTE: SEE SHEET 12 FOR CURB PROFILES.

1001

BRUNING 44-132 69150

DEPARTMENT OF PUBLIC WORKS HOWARD COUNTY, MARYLAND Director of Public Works: <i>James J. Lee</i> DATE: 8/21/90 Chief, Bureau of Highways: <i>Lawrence M. Weiland</i> DATE: 8/21/90		ENGINEERING TECHNOLOGIES ASSOCIATES, INC. ENGINEERS - PLANNERS - SURVEYORS 2400 ELLICOTT CENTER DRIVE SUITE 101 ELLICOTT CITY, MARYLAND 21040 (301) 461-0020		DES: GM/_____ DRN: GM/_____ CHK: JN/_____ DATE: 8/90		LANDSCAPING PLAN <b>OAKLAND MILLS ROAD IMPROVEMENTS</b> 6 <sup>TH</sup> ELECTION DISTRICT HOWARD COUNTY, MARYLAND CAPITAL PROJECT NO. J-4095		SCALE AS SHOWN SHEET 23 OF 27
Chief, Bureau of Engineering: <i>William B. Red</i> DATE: 8-21-90 Chief, Division of Roads, Bridges and Storm Drainage: <i>Elizabeth A. ...</i> DATE: 8/90		STATE OF MARYLAND Seal of the State of Maryland		BY NO. REVISION DATE 600' SCALE MAP NO. BLOCK NO.				

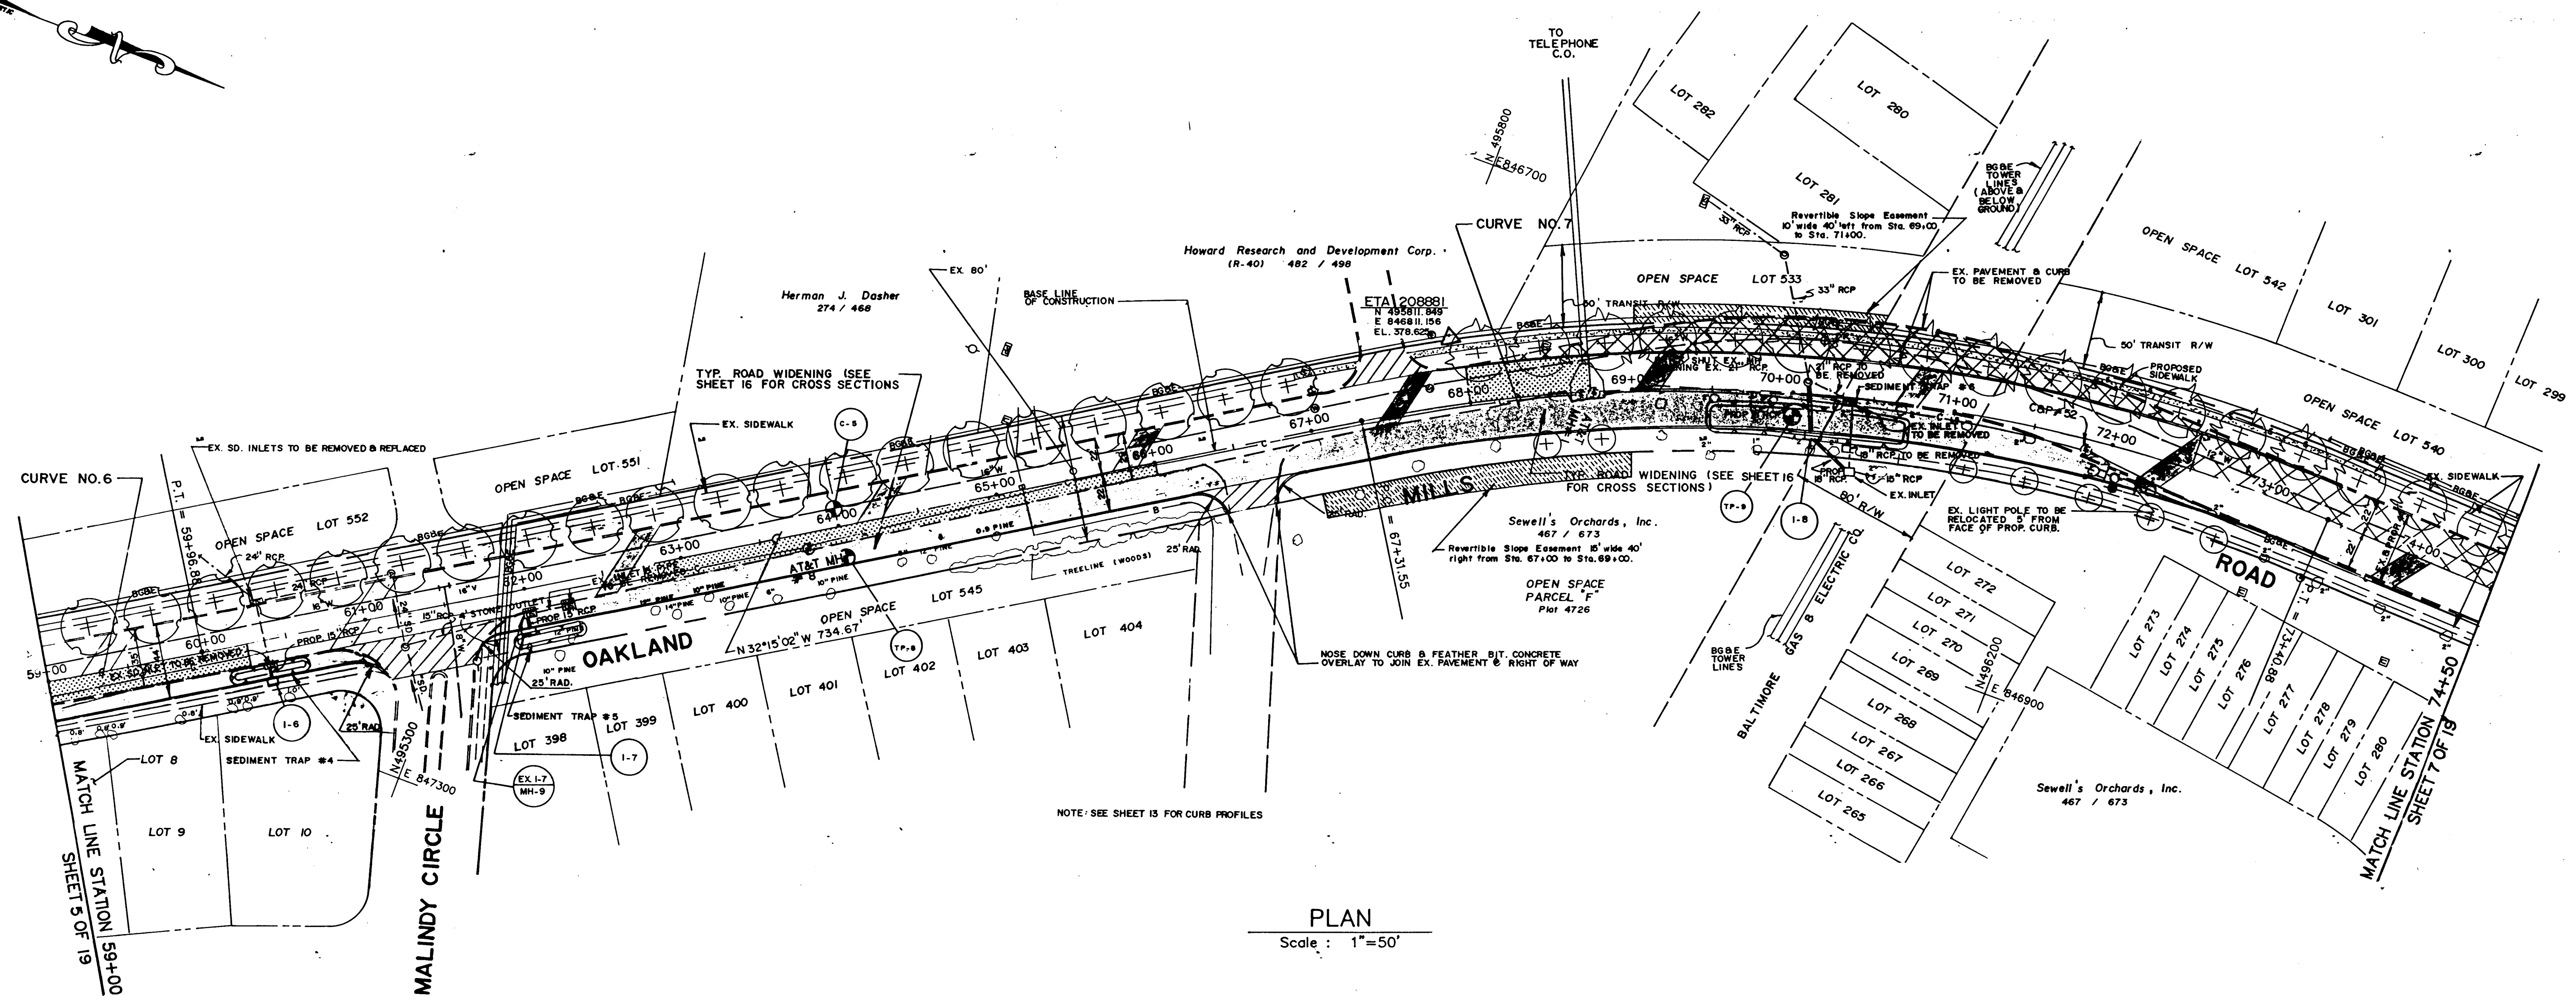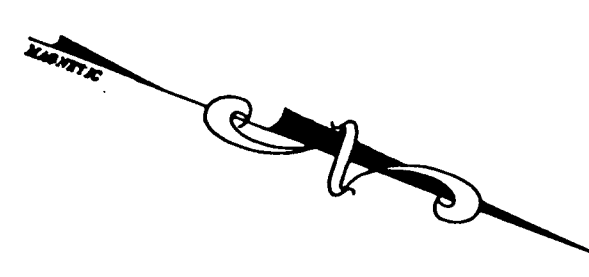

PLAN  
Scale: 1"=50'


NOTE: SEE SHEET 13 FOR CURB PROFILES

NOTE: SEE SHEET 20 FOR LANDSCAPING GENERAL NOTES AND LANDSCAPING DETAILS.

1601

DEPARTMENT OF PUBLIC WORKS HOWARD COUNTY, MARYLAND <i>James P. Lewis</i> 8/22/90 DIRECTOR OF PUBLIC WORKS DATE <i>William S. Ray</i> 8/22/90 CHIEF, BUREAU OF ENGINEERING DATE <i>Drummond W. Wallace</i> 8/24/90 CHIEF, BUREAU OF HIGHWAYS DATE <i>Christopher J. Calce</i> 8/24/90 CHIEF, DIVISION OF ROADS, BRIDGES AND STORM DRAINAGE DATE		ENGINEERING TECHNOLOGIES ASSOCIATES, INC. ENGINEERS - PLANNERS - SURVEYORS 2468 ELLICOTT CENTER DRIVE SUITE 101 ELLICOTT CITY, MARYLAND 21042 (301) 461-9800				DES: B/M DRN: B/M CHK: J/N DATE: 8/90		LANDSCAPING PLAN <b>OAKLAND MILLS ROAD IMPROVEMENTS</b> 6TH ELECTION DISTRICT HOWARD COUNTY, MARYLAND CAPITAL PROJECT NO. J-4095		SCALE AS SHOWN SHEET 24 OF 27	
				BY NO. REVISION DATE		600' SCALE MAP NO. BLOCK NO.					



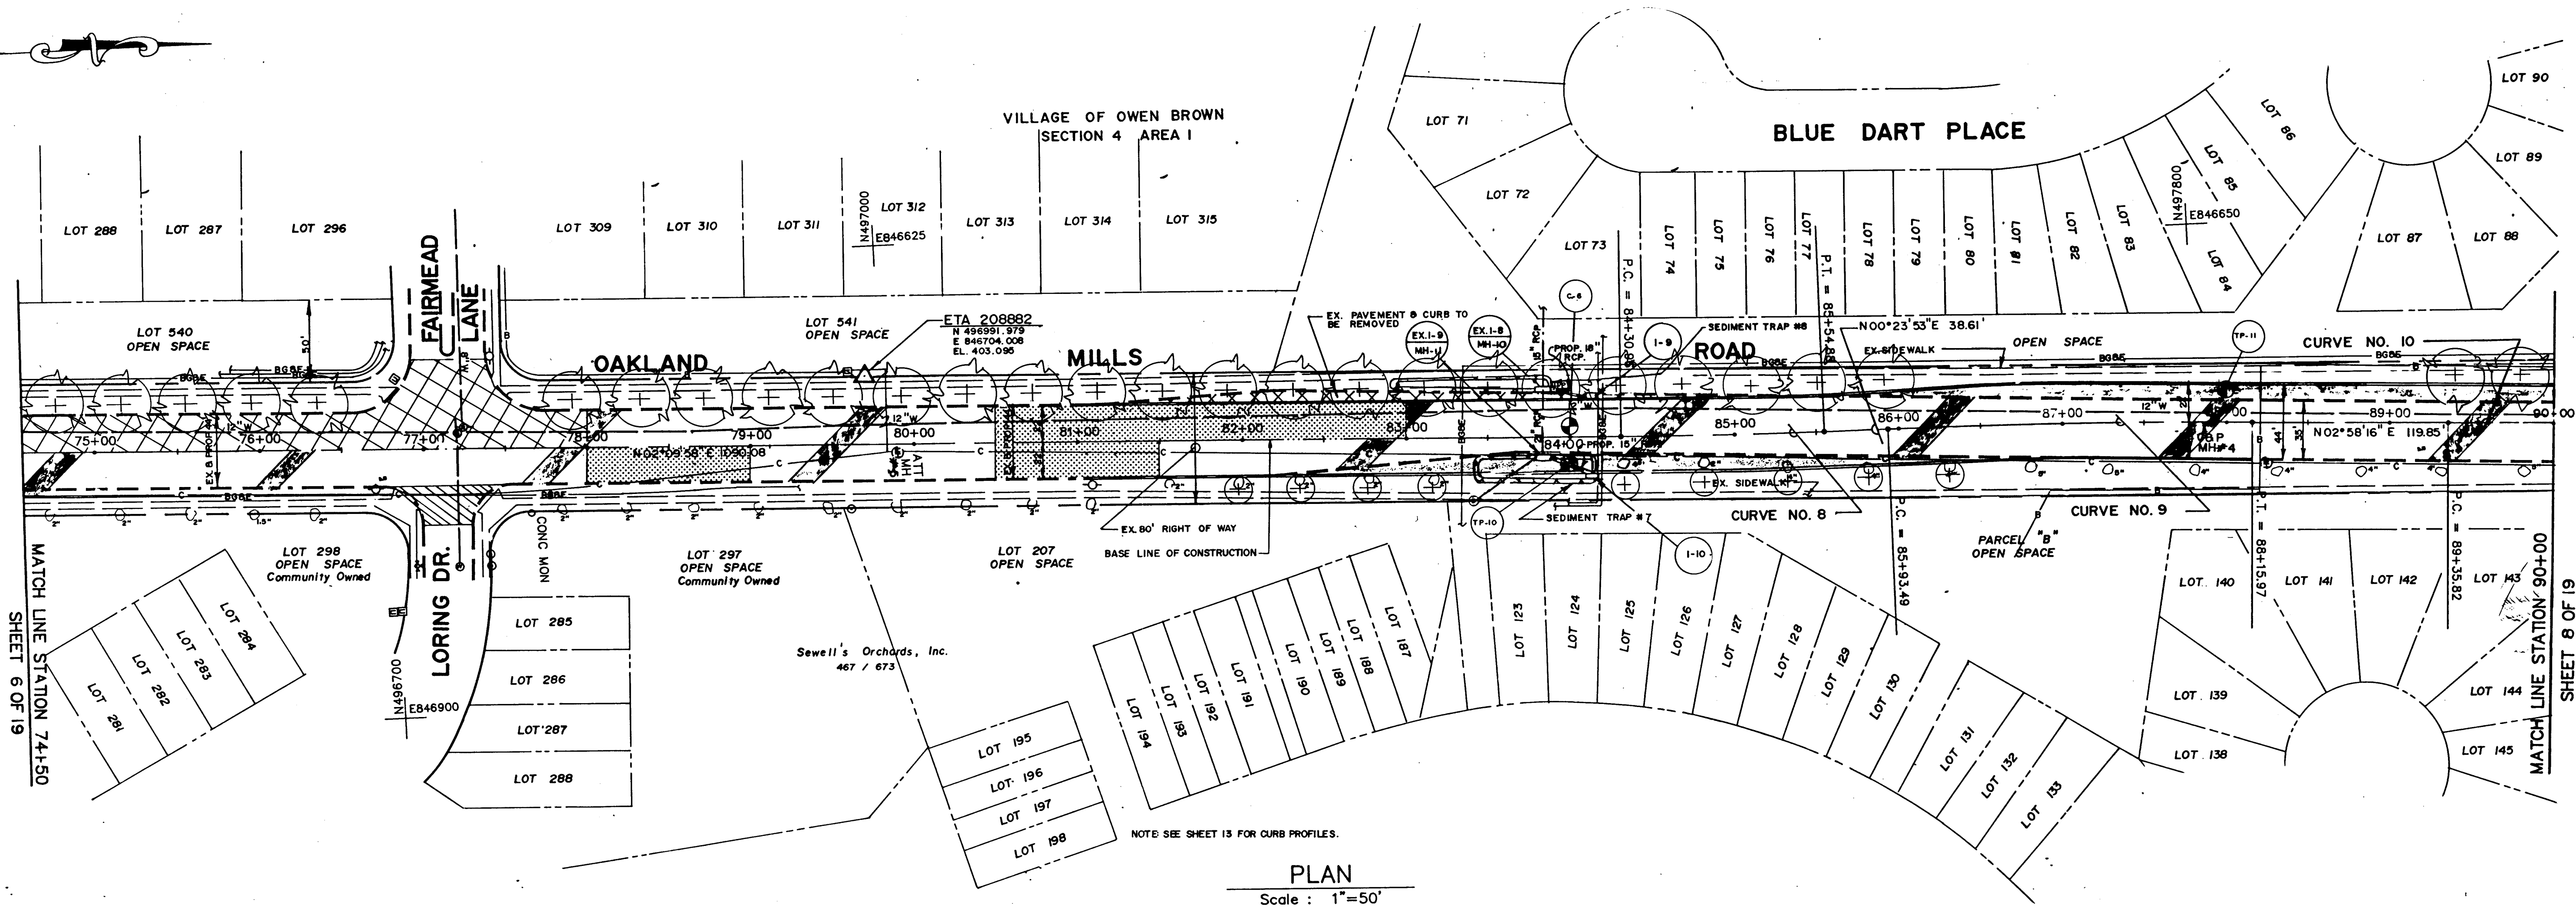

PLAN  
Scale: 1"=50'

NOTE: SEE SHEET 20 FOR LANDSCAPING GENERAL NOTES AND LANDSCAPING DETAILS.

BRUNING 44-132 89150

1091


DEPARTMENT OF PUBLIC WORKS  
HOWARD COUNTY, MARYLAND

*James W. ...*  
DIRECTOR OF PUBLIC WORKS  
DATE: 8-20-90

*William H. ...*  
CHIEF, BUREAU OF HIGHWAYS  
DATE: 8-20-90

*...*  
CHIEF, DIVISION OF ROADS, BRIDGES AND STORM DRAINAGE  
DATE: 8-20-90

ENGINEERING TECHNOLOGIES ASSOCIATES, INC.  
ENGINEERS - PLANNERS - SURVEYORS  
2458 ELLICOTT CENTER DRIVE SUITE 101  
ELLICOTT CITY, MARYLAND 21043  
(301) 481-9600

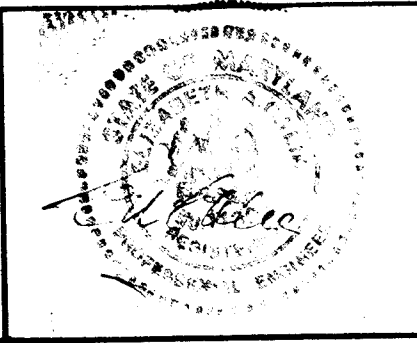

DES: GMI					
DRN: GMI					
CHK: JN					
DATE: 8/90	BY	NO.	REVISION	DATE	600' SCALE MAP NO. BLOCK NO.

LANDSCAPING PLAN

**OAKLAND MILLS ROAD IMPROVEMENTS**  
6<sup>TH</sup> ELECTION DISTRICT HOWARD COUNTY, MARYLAND  
CAPITAL PROJECT NO. J-4095

SCALE AS SHOWN  
SHEET 23 OF 27



