


# HOWARD COUNTY, MARYLAND DEPARTMENT OF PUBLIC WORKS

## COURT AVENUE RETAINING WALL CAPITAL PROJECT J-4137

### INDEX OF DRAWINGS

SHEET NO.	TITLE
1	TITLE SHEET
2	SITE PLAN AND GENERAL NOTES
3	GEOMETRIC LAYOUT, WALL ELEVATION AND BORING LOGS
4	TYPICAL SECTIONS AND MISCELLANEOUS DETAILS
5	STANDARD DETAILS AND SEDIMENT AND EROSION CONTROL NOTES

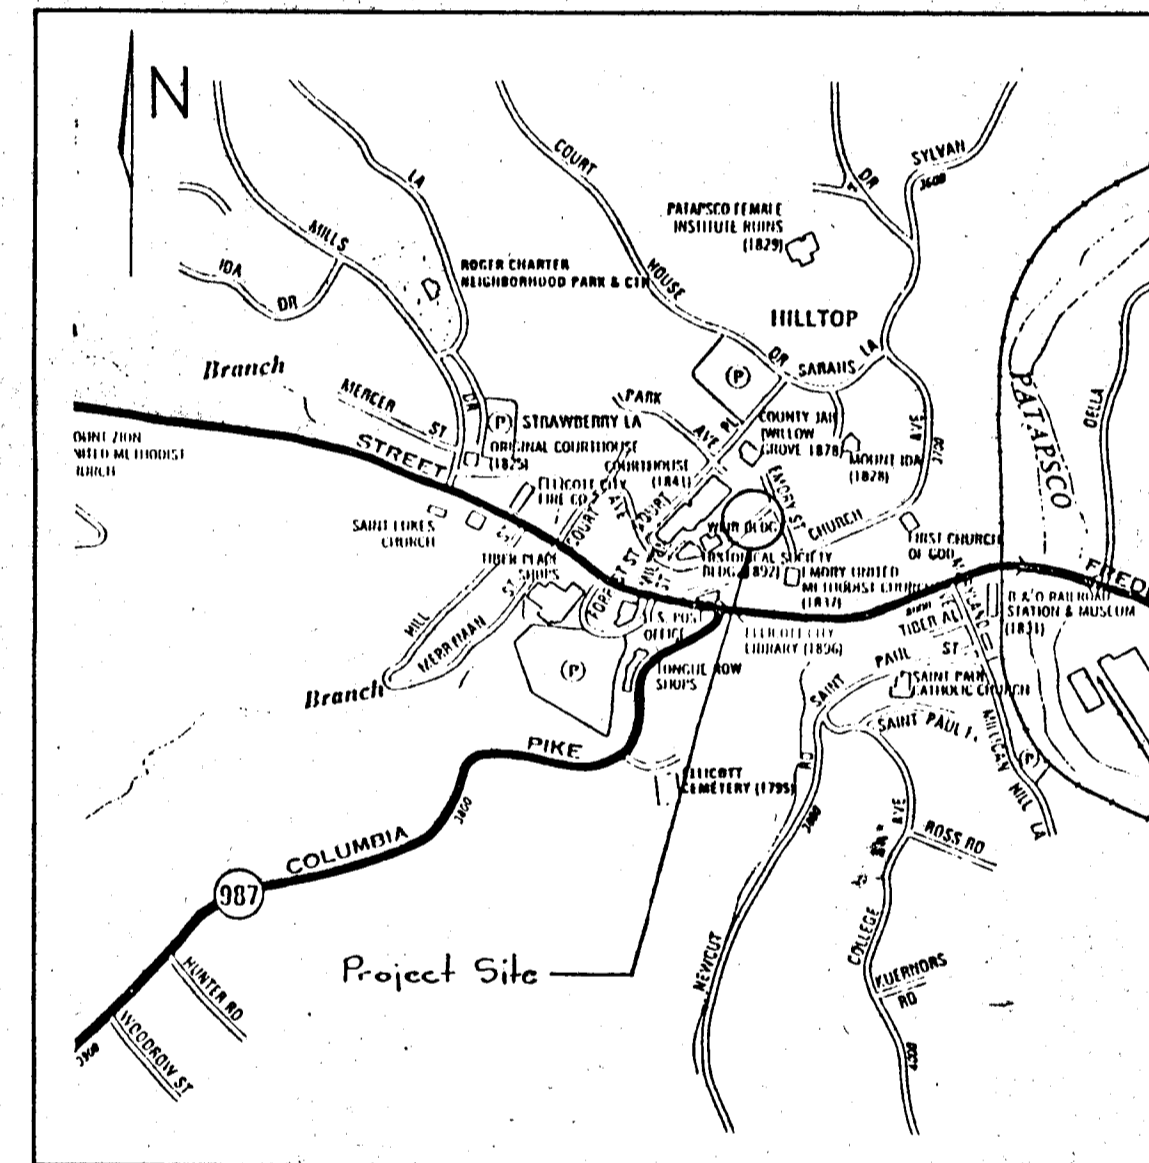

LOCATION MAP  
SCALE: 1"=600'

THE LOCATIONS OF UTILITIES SHOWN ON THE PLANS ARE FOR INFORMATION AND GUIDANCE ONLY. NO GUARANTEE IS MADE AS TO THE ACCURACY OF SAID LOCATIONS.

RIGHT-OF-WAY LINES AS SHOWN ON THESE PLANS ARE FOR ASSISTANCE IN INTERPRETING THE PLANS. THESE LINES DO NOT REPRESENT THE OFFICIAL PROPERTY ACQUISITION LINES. FOR OFFICIAL FEE RIGHT-OF-WAY AND EASEMENT INFORMATION REFER TO THE APPROPRIATE RIGHT-OF-WAY PLATS.

By the Owner/Developer:

"I/We certify that all development and construction will be done according to this plan, and that any responsible personnel involved in the construction project will have a Certificate of Attendance at a Department of the Environment Approved Training Program for the Control of Sediment and Erosion Control Practices, as required by the Department of the Environment and the Howard County Department of Public Works."

*Renald G. Lapsen*

Signature of Owner/Developer  
Print name below signature

6/10/94

Date

By the Engineer:

"I certify that this plan for erosion and sediment control represents a practical and workable plan based on my personal knowledge of the site conditions and that it was prepared in accordance with the requirements of the Howard Soil Conservation District."

*John E. Nolan, P.E.*

Signature of Engineer  
Print name below signature

6/10/94

Date

Review for HOWARD S.C.D. and meets Technical Requirements

*J. M. Wayfield*  
U.S. Soil Conservation Service

Date

THIS DEVELOPMENT PLAN IS APPROVED FOR SOIL EROSION AND SEDIMENT CONTROL BY THE HOWARD SOIL CONSERVATION DISTRICT

*John R. Rhoads*  
Howard S.C.D.

Date


C179AZ01

DEPARTMENT OF PUBLIC WORKS HOWARD COUNTY, MARYLAND <i>Ronald G. Lapsen</i> 6/14/94 DIRECTOR OF PUBLIC WORKS <i>Charles M. Donahue</i> 6/14/94 CHIEF, BUREAU OF HIGHWAYS		NOLAN ASSOCIATES, INC. ENGINEERS - CIVIL/STRUCTURAL/INSPECTIONS P.O. BOX 2579 COLUMBIA, MARYLAND 21045 PHONE (410) 995-3651 FAX: (410) 995-1363				DES: Y.C.W. DRN: J.S.N. CHK: C.S.N. DATE: 05/18/94		TITLE SHEET		COURT AVENUE RETAINING WALL CAPITAL PROJECT J-4137 ELECTION DISTRICT NO. 2 ELLICOTT CITY, MARYLAND		SCALE AS SHOWN SHEET 1 OF 5
CHIEF, BUREAU OF ENGINEERING DATE: 6/10/94		CHIEF, DIVISION OF TRANSPORTATION PROJECTS AND WATERSHED MANAGEMENT DATE: 4/10/94		BY NO. REVISION		DATE 600' SCALE MAP NO. BLOCK NO.		DATE 6/16/94				

**GENERAL NOTES**

- SPECIFICATIONS: —HOWARD COUNTY DESIGN MANUAL VOLUME IV, DATED OCTOBER 1990  
—SHA SPECIFICATIONS DATED OCTOBER 1993
- AASHTO STANDARD SPECIFICATIONS FOR HIGHWAY BRIDGES DATED 1992 FOR DESIGN INCLUDING ALL INTERIM SPECIFICATIONS.
- CONCRETE DESIGN: SERVICE LOAD DESIGN METHOD  
FC=1,200 PSI.
- REINFORCING STEEL DESIGN: FS=24,000 PSI.
- LOADING: 2'-0" SURCHARGE
- CONCRETE: ALL CONCRETE SHALL BE MIX NO. 3 (3,500 PSI).
- REINFORCING STEEL: REINFORCING STEEL SHALL CONFORM TO ASTM A 615, GRADE 60. MINIMUM COVER FOR ANY BAR SHALL BE 2" UNLESS OTHERWISE NOTED. WITH THE EXCEPTION OF BARS AT THE BOTTOM AND SIDES OF ALL FOOTINGS WHICH SHALL HAVE 3" MINIMUM COVER.
- ONLY GRADE 60 CAN BE USED ON THIS PROJECT
- ALL KEYS ARE NOMINAL SIZE.

KEYS: EXISTING STRUCTURE: ALL DIMENSIONS AFFECTED BY THE GEOMETRICS, AND/OR LOCATION OF THE EXISTING STRUCTURE SHALL BE CHECKED IN THE FIELD BY THE CONTRACTOR, BEFORE ANY CONSTRUCTION IS DONE, AND BEFORE ANY REINFORCING STEEL, ETC. IS ORDERED OR FABRICATED. IT SHALL BE THE RESPONSIBILITY OF THE CONTRACTOR TO SUPPLY THE ENGINEER WITH ALL FIELD DIMENSIONS REQUIRED TO CHECK DETAIL DRAWINGS. THE ± MARKS SHOWN WITH DIMENSIONS AND STATIONS DO NOT INDICATE ANY DEGREE OF PRECISION. THE MARKS (±) INDICATE EXISTING DIMENSIONS AND STATIONS THAT MAY VARY AND DO REQUIRE FIELD VERIFICATION BY THE CONTRACTOR.

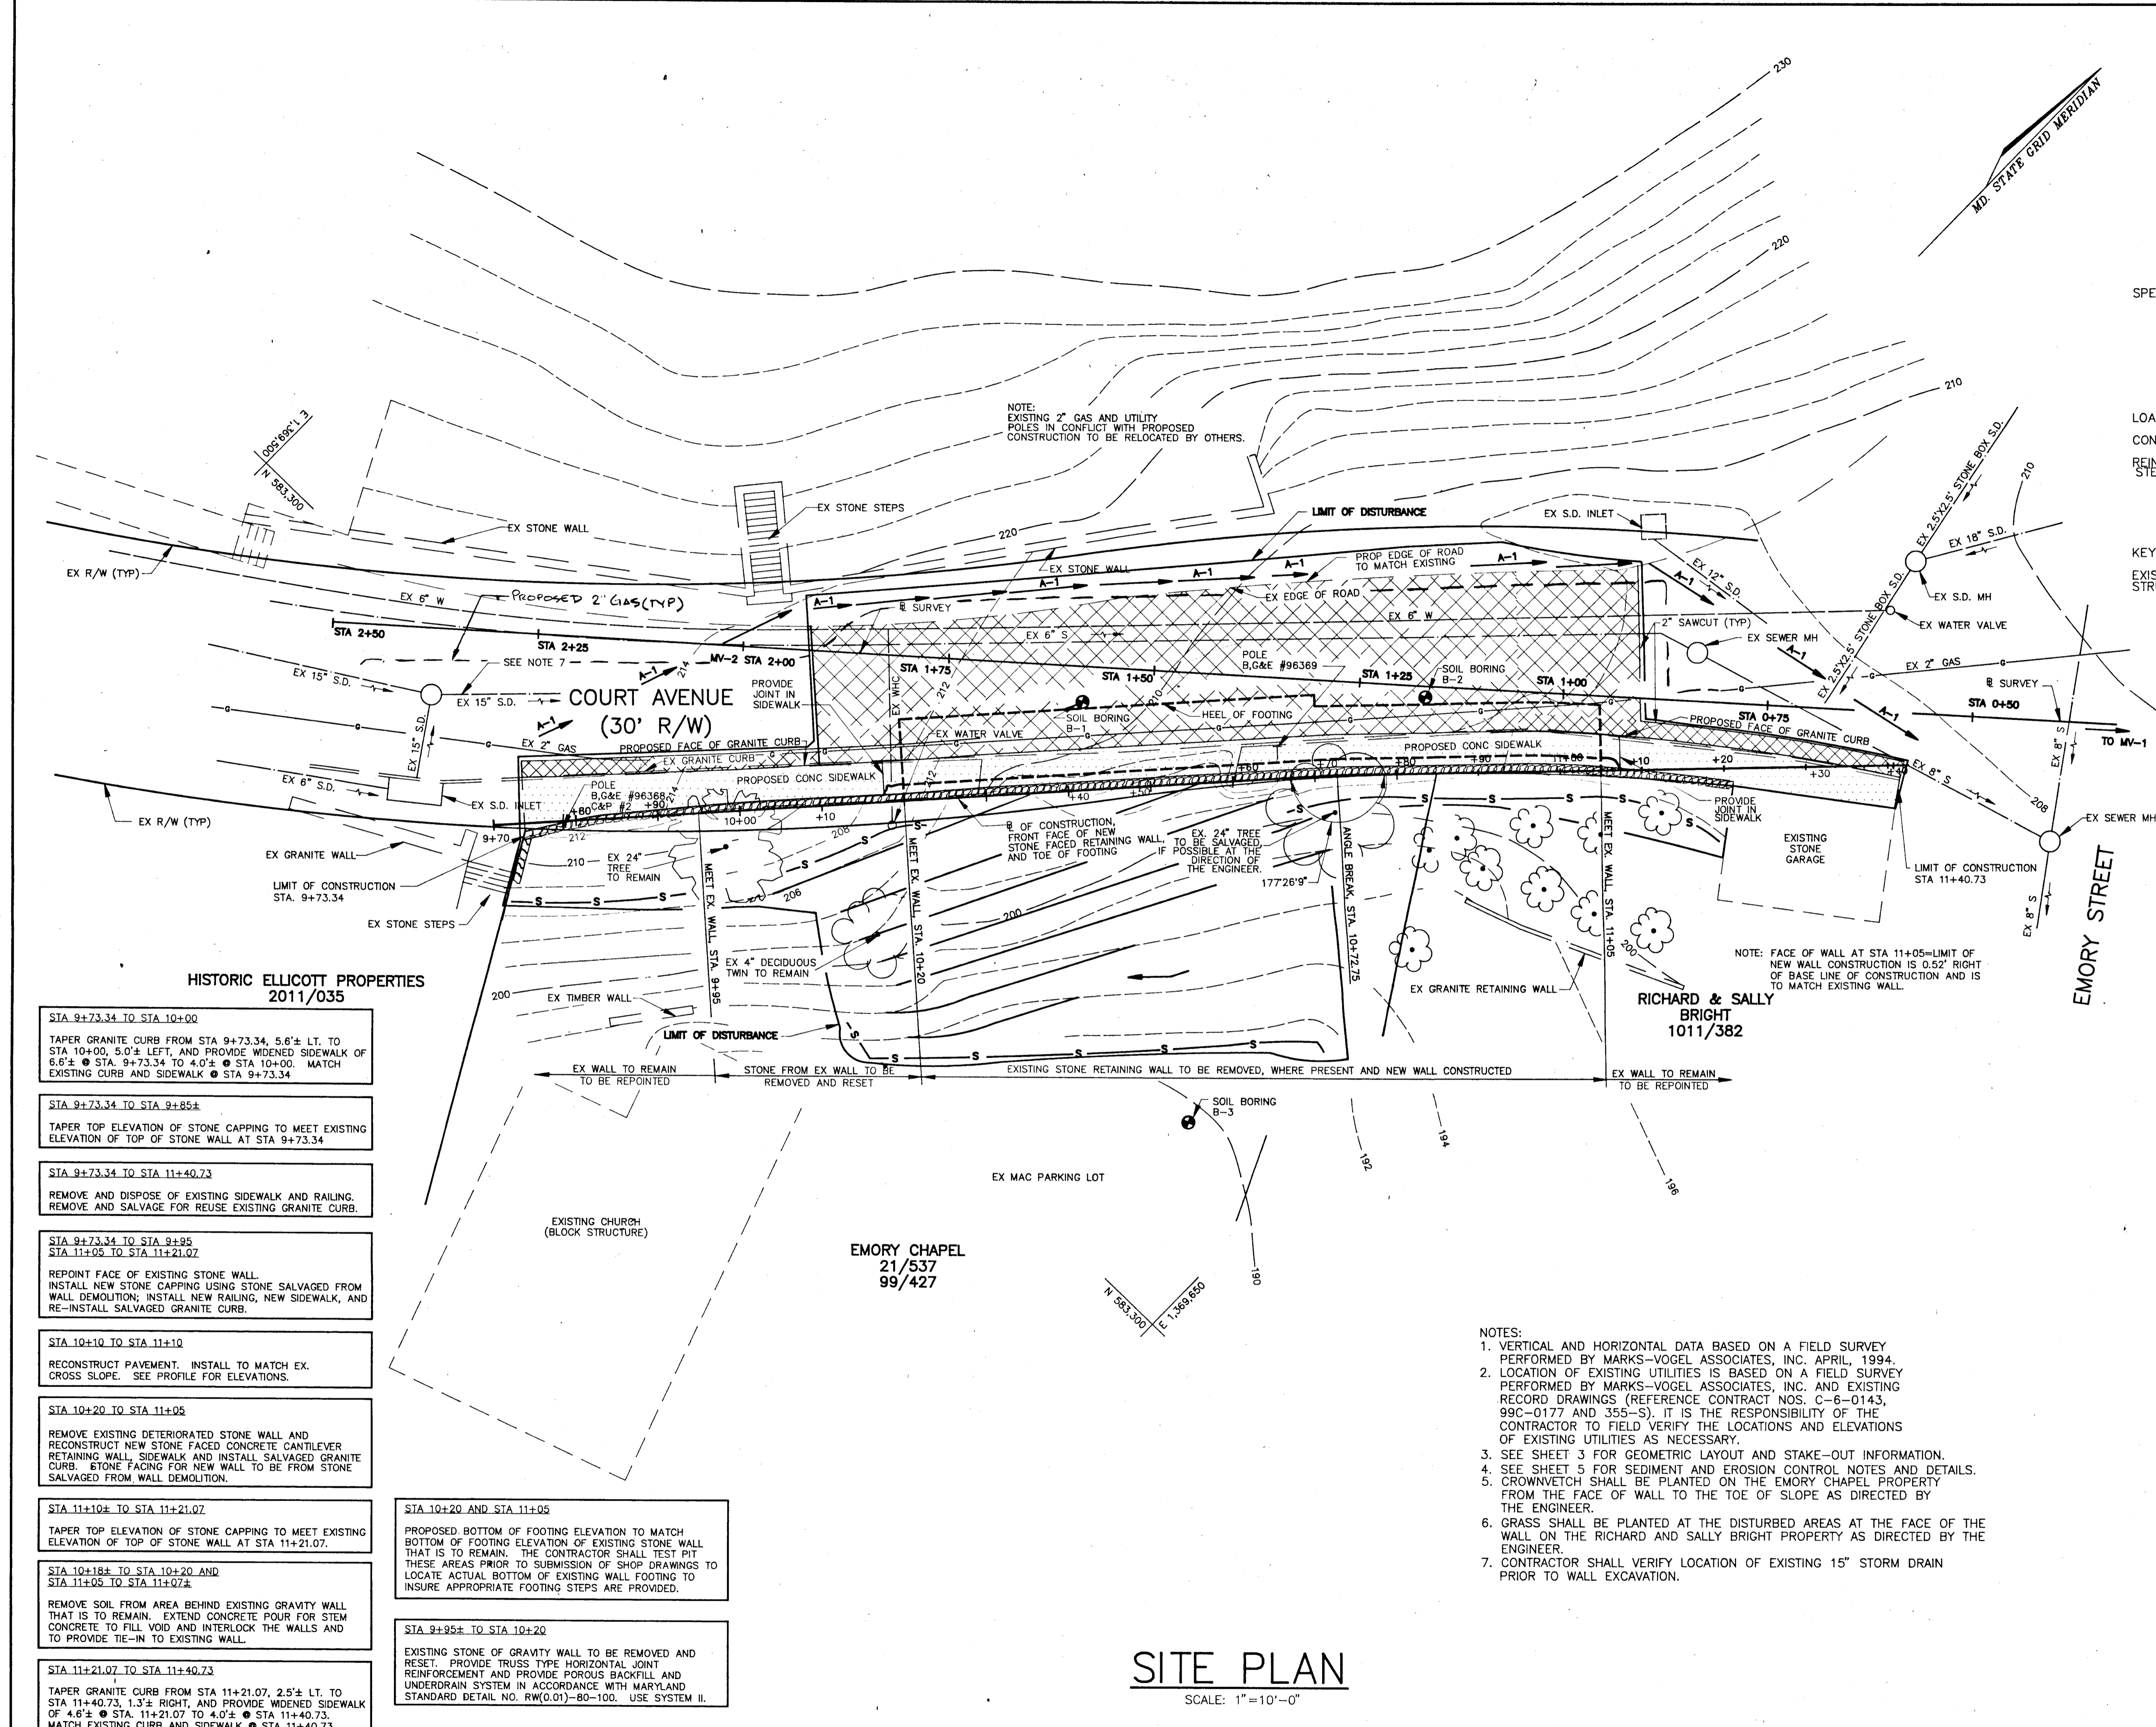

- HISTORIC ELLICOTT PROPERTIES 2011/035**
- STA 9+73.34 TO STA 10+00  
TAPER GRANITE CURB FROM STA 9+73.34, 5.6'± LT. TO STA 10+00, 5.0'± LEFT, AND PROVIDE WIDENED SIDEWALK OF 6.6'± @ STA 9+73.34 TO 4.0'± @ STA 10+00. MATCH EXISTING CURB AND SIDEWALK @ STA 9+73.34
  - STA 9+73.34 TO STA 9+85±  
TAPER TOP ELEVATION OF STONE CAPPING TO MEET EXISTING ELEVATION OF TOP OF STONE WALL AT STA 9+73.34
  - STA 9+73.34 TO STA 11+40.73  
REMOVE AND DISPOSE OF EXISTING SIDEWALK AND RAILING. REMOVE AND SALVAGE FOR REUSE EXISTING GRANITE CURB.
  - STA 9+73.34 TO STA 9+95  
STA 11+09 TO STA 11+21.07  
REPOINT FACE OF EXISTING STONE WALL. INSTALL NEW STONE CAPPING USING STONE SALVAGED FROM WALL DEMOLITION; INSTALL NEW RAILING, NEW SIDEWALK, AND RE-INSTALL SALVAGED GRANITE CURB.
  - STA 10+10 TO STA 11+10  
RECONSTRUCT PAVEMENT. INSTALL TO MATCH EX. CROSS SLOPE. SEE PROFILE FOR ELEVATIONS.
  - STA 10+20 TO STA 11+05  
REMOVE EXISTING DETERIORATED STONE WALL AND RECONSTRUCT NEW STONE FACED CONCRETE CANTILEVER RETAINING WALL. SIDEWALK AND INSTALL SALVAGED GRANITE CURB. STONE FACING FOR NEW WALL TO BE FROM STONE SALVAGED FROM WALL DEMOLITION.
  - STA 11+10± TO STA 11+21.07  
TAPER TOP ELEVATION OF STONE CAPPING TO MEET EXISTING ELEVATION OF TOP OF STONE WALL AT STA 11+21.07.
  - STA 10+18± TO STA 10+20 AND STA 11+05 TO STA 11+07±  
REMOVE SOIL FROM AREA BEHIND EXISTING GRAVITY WALL THAT IS TO REMAIN. EXTEND CONCRETE POUR FOR STEM CONCRETE TO FILL VOID AND INTERLOCK THE WALLS AND TO PROVIDE TIE-IN TO EXISTING WALL.
  - STA 11+21.07 TO STA 11+40.73  
TAPER GRANITE CURB FROM STA 11+21.07, 2.5'± LT. TO STA 11+40.73, 1.3'± RIGHT, AND PROVIDE WIDENED SIDEWALK OF 4.6'± @ STA 11+21.07 TO 4.0'± @ STA 11+40.73. MATCH EXISTING CURB AND SIDEWALK @ STA 11+40.73.

- STA 10+20 AND STA 11+05  
PROPOSED BOTTOM OF FOOTING ELEVATION TO MATCH BOTTOM OF FOOTING ELEVATION OF EXISTING STONE WALL THAT IS TO REMAIN. THE CONTRACTOR SHALL TEST PIT THESE AREAS PRIOR TO SUBMISSION OF SHOP DRAWINGS TO LOCATE ACTUAL BOTTOM OF EXISTING WALL FOOTING TO INSURE APPROPRIATE FOOTING STEPS ARE PROVIDED.
- STA 9+95± TO STA 10+20  
EXISTING STONE OF GRAVITY WALL TO BE REMOVED AND RESET. PROVIDE TRUSS TYPE HORIZONTAL JOINT REINFORCEMENT AND PROVIDE POROUS BACKFILL AND UNDERDRAIN SYSTEM IN ACCORDANCE WITH MARYLAND STANDARD DETAIL NO. RW(0.01)-80-100. USE SYSTEM II.

**SITE PLAN**  
SCALE: 1"=10'-0"

**LEGEND**

- STONE WALL FACING OR STONE CAPPING
- PROPOSED SIDEWALK
- PROPOSED ROAD RECONSTRUCTION
- TYPE A-1 EARTH DIKE
- SILT FENCE
- 2 FT CONTOUR
- 10 FT CONTOUR
- EX SEWER LINE
- EX WATER LINE
- EX STORM DRAIN
- EX RIGHT-OF-WAY
- SOIL BORING
- EX TREE
- EX 2" GAS
- PROP GRADE

- NOTES:
- VERTICAL AND HORIZONTAL DATA BASED ON A FIELD SURVEY PERFORMED BY MARKS-VOGEL ASSOCIATES, INC. APRIL, 1994.
  - LOCATION OF EXISTING UTILITIES IS BASED ON A FIELD SURVEY PERFORMED BY MARKS-VOGEL ASSOCIATES, INC. AND EXISTING RECORD DRAWINGS (REFERENCE CONTRACT NOS. C-6-0143, 99C-0177 AND 355-S). IT IS THE RESPONSIBILITY OF THE CONTRACTOR TO FIELD VERIFY THE LOCATIONS AND ELEVATIONS OF EXISTING UTILITIES AS NECESSARY.
  - SEE SHEET 3 FOR GEOMETRIC LAYOUT AND STAKE-OUT INFORMATION.
  - SEE SHEET 5 FOR SEDIMENT AND EROSION CONTROL NOTES AND DETAILS.
  - CROWNVECH SHALL BE PLANTED ON THE EMORY CHAPEL PROPERTY FROM THE FACE OF WALL TO THE TOE OF SLOPE AS DIRECTED BY THE ENGINEER.
  - GRASS SHALL BE PLANTED AT THE DISTURBED AREAS AT THE FACE OF THE WALL ON THE RICHARD AND SALLY BRIGHT PROPERTY AS DIRECTED BY THE ENGINEER.
  - CONTRACTOR SHALL VERIFY LOCATION OF EXISTING 15" STORM DRAIN PRIOR TO WALL EXCAVATION.

DEPARTMENT OF PUBLIC WORKS  
HOWARD COUNTY, MARYLAND

Director of Public Works: [Signature] DATE: 6/10/94

Chief, Bureau of Engineering: [Signature] DATE: 6/10/94

Chief, Bureau of Highways: [Signature] DATE: 6/10/94

Chief, Division of Transportation Projects and Watershed Management: [Signature] DATE: 6/10/94

NOLAN ASSOCIATES, INC.  
ENGINEERS - CIVIL/STRUCTURAL/INSPECTIONS

P.O. BOX 2579  
COLUMBIA, MARYLAND 21045

PHONE: (410) 995-3851 FAX: (410) 995-1363



DES:	Y.C.W.				
DRN:	J.S.N.				
CHK:	C.S.N.				
DATE:	05/18/94	BY:	NO.	REVISION	DATE


**SITE PLAN AND GENERAL NOTES**

600' SCALE MAP NO. \_\_\_\_\_ BLOCK NO. \_\_\_\_\_

COURT AVENUE RETAINING WALL  
CAPITAL PROJECT J-4137  
ELECTION DISTRICT NO. 2  
ELLICOTT CITY, MARYLAND


SCALE AS SHOWN

SHEET 2 OF 5

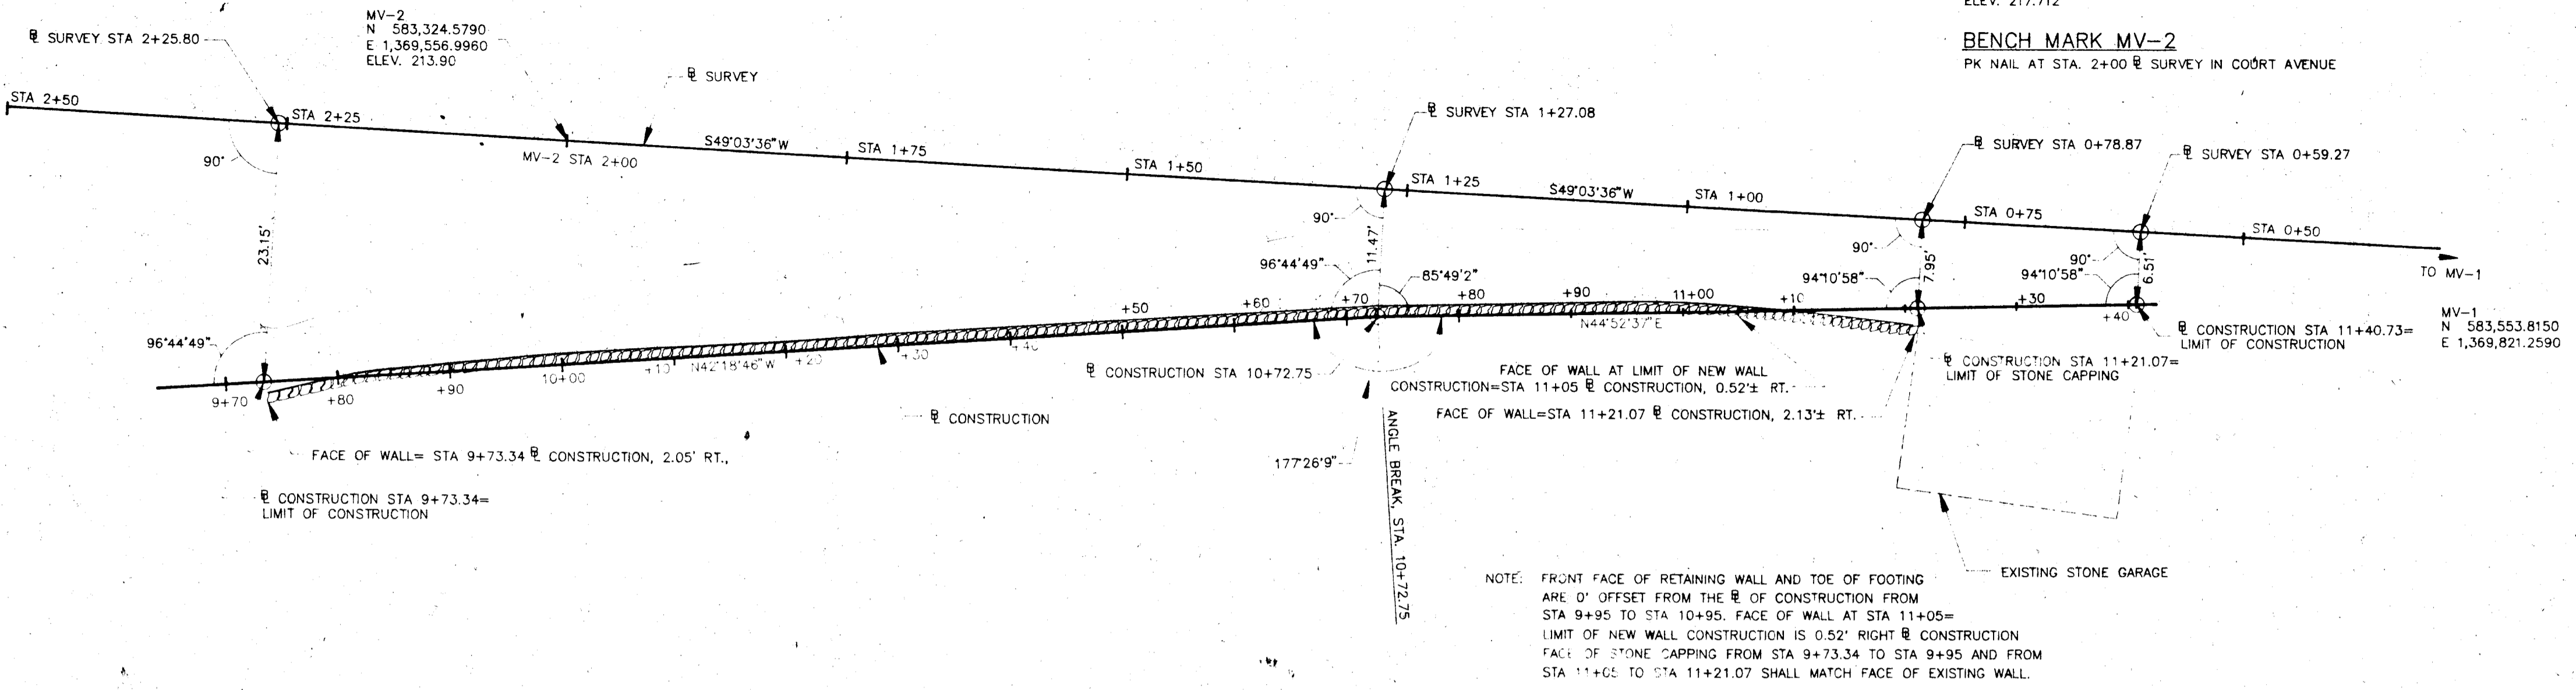

### GEOMETRIC LAYOUT AND STAKEOUT PLAN

SCALE: 1"=10'-0"

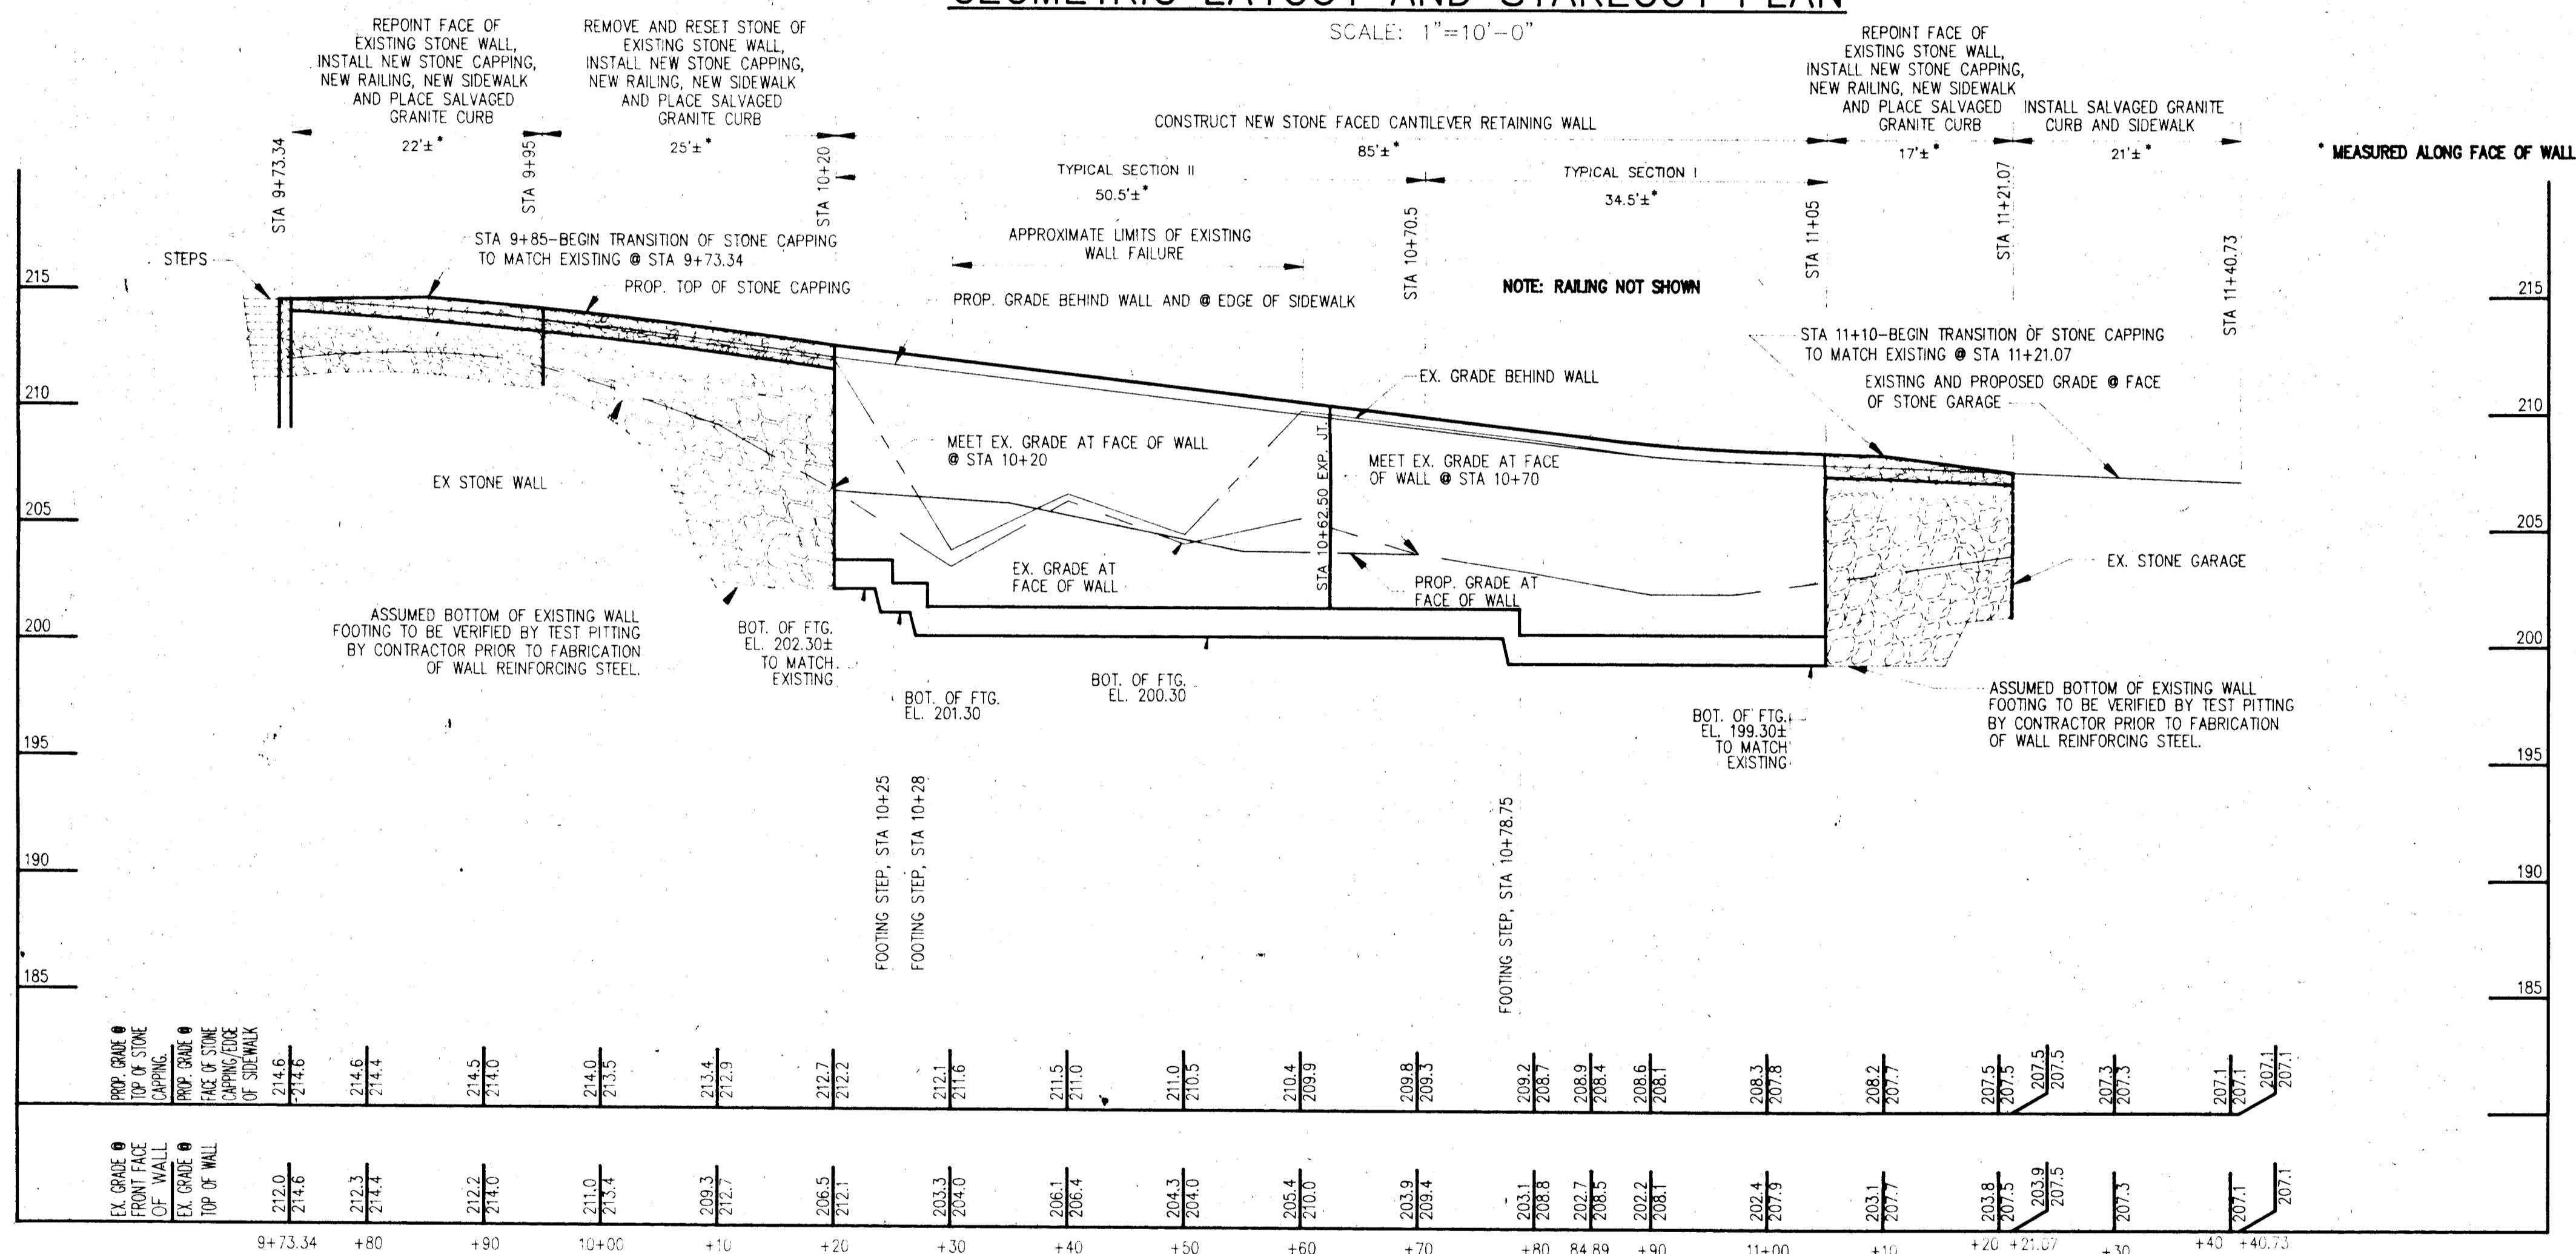

### WALL ELEVATION

SCALE: HORIZONTAL 1"=10'-0" VERTICAL 1"=5'-0"

CONTRACTED WITH: **Nolan Assoc.** BORING # 2 PAGE 1 of 1  
 PROJECT NAME: **Court Ave Howard Co.** JOB # 94043  
 LOCATION: **Ellicott City Md.**  
 Datum: Hammer WY 140 Lbs Hole Diameter 8" Foreman B.S. Taylor  
 Surface Elev. Fl Hammer Drop 30 in Rock Core Diam Inspector  
 Date Started 3-23-99 Pipe Size in Boring Method HSA Date Completed 3-23-99

ELEVATION	SOIL DESCRIPTION	STRATA DEPTH	DEPTH SCALE	SAMPLE			BORING & SAMPLING NOTES
				Core	No.	Depth	
1.3"	Asphalt concrete, Brown, Grey, Green & White Moist, Med Dense to Loose to Very Dense Mnemonic: Sully sand w/ decomposed rock & quartz.	1.3"		D	7-9-11	2 1/2	14
2.5"				D	12	2 1/2	10
5.0"				D	49	3	1/8
7.5"				D	51	4 1/2	3
10.0"				D	51	5 1/2	3
15.0"				D	50	12	2
18.3"	End of Boring	18.3"					Encountered Rock @ 12.0' Auger Refusal @ 15.3'

CONTRACTED WITH: **Nolan Assoc.** BORING # 3 PAGE 1 of 1  
 PROJECT NAME: **Court Ave Howard Co.** JOB # 94043  
 LOCATION: **Ellicott City Md.**  
 Datum: Hammer WY 140 Lbs Hole Diameter 8" Foreman B.S. Taylor  
 Surface Elev. Fl Hammer Drop 30 in Rock Core Diam Inspector  
 Date Started 3-23-99 Pipe Size in Boring Method HSA Date Completed 3-23-99

ELEVATION	SOIL DESCRIPTION	STRATA DEPTH	DEPTH SCALE	SAMPLE			BORING & SAMPLING NOTES
				Core	No.	Depth	
1.3"	Asphalt concrete, Brown, Grey, Green, & White Moist, Med Dense to Very Loose to Very Dense Mnemonic: Sully sand w/ decomposed rock & quartz.	1.3"		D	7-8	1 1/2	10
2.5"				D	2-3	2 1/2	15.8.5
5.0"				D	5	3 1/2	6
7.5"				D	4	4 1/2	6
10.0"				D	5-7	4 1/2	6
14.3"	End of Boring	14.3"					Encountered Rock @ 14.0' Auger Refusal @ 14.3'

CONTRACTED WITH: **Nolan Assoc.** BORING # 3 PAGE 1 of 1  
 PROJECT NAME: **Court Ave Howard Co.** JOB # 94043  
 LOCATION: **Ellicott City Md.**  
 Datum: Hammer WY 140 Lbs Hole Diameter 8" Foreman B.S. Taylor  
 Surface Elev. Fl Hammer Drop 30 in Rock Core Diam Inspector  
 Date Started 3-23-99 Pipe Size in Boring Method HSA Date Completed 3-23-99


ELEVATION	SOIL DESCRIPTION	STRATA DEPTH	DEPTH SCALE	SAMPLE			BORING & SAMPLING NOTES
				Core	No.	Depth	
1.0"	Asphalt concrete, Brown Orange, Black Moist, Very loose to Very Dense Mnemonic: Sully sand w/ decomposed rock & quartz.	1.0"		I	1-3	1 1/2	12
2.5"				I	4-8	2 1/2	14
5.0"				D	8	3 1/2	14
7.5"				D	5	4 1/2	6
9.0"	End of Boring	9.0"					Encountered Rock @ 8.5'

SAMPLE CONDITIONS	SAMPLER TYPE	GROUNDWATER DEPTH	BORING METHOD
D - Desaturated	DS - Driven Soil Spoon	At Completion	FI - USA
U - Undisturbed	PT - Pierce Sampler	After	FL - HSA
L - Lost	CA - Continuous Flight Auger	After 24 Hrs	DC - Continuous Flight Auger
	RC - Rock Core		DC - Drilling Casing
			MD - Mud Drilling

\*STANDARD PENETRATION TEST DRIVING 2 in. OD SAMPLER 1 FT WITH 140 lb HAMMER FALLING 30 in. COUNT MADE AT 6 in INTERVALS

DEPARTMENT OF PUBLIC WORKS  
 HOWARD COUNTY, MARYLAND  
 Director of Public Works: **James G. Lewis** 6/10/04  
 Chief, Bureau of Engineering: **Charles M. Daniels** 6/10/04  
 Chief, Division of Transportation Projects and Watershed Management: **Charles M. Daniels** 6/10/04

NOLAN ASSOCIATES, INC.  
 ENGINEERS - CIVIL/STRUCTURAL/INSPECTIONS  
 P.O. BOX 2579  
 COLUMBIA, MARYLAND 21045  
 PHONE: (410) 995-3651 FAX: (410) 995-1363

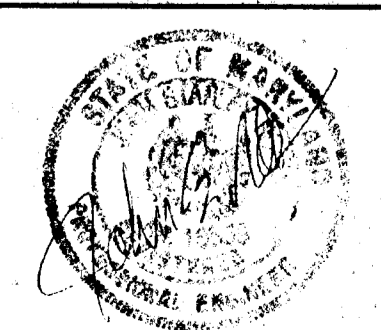


DES:	Y.C.W.				
DRN:	J.S.N.				
CHK:	C.S.N.				
DATE:	05/18/94	BY:	NO.	REVISION:	DATE

GEOMETRIC LAYOUT  
 WALL ELEVATION AND  
 BORING LOGS

600' SCALE MAP NO. \_\_\_\_\_ BLOCK NO. \_\_\_\_\_

COURT AVENUE RETAINING WALL  
 CAPITAL PROJECT J-4137  
 ELECTION DISTRICT NO. 2  
 ELICOTT CITY, MARYLAND


SCALE AS SHOWN  
 SHEET 3 OF 5

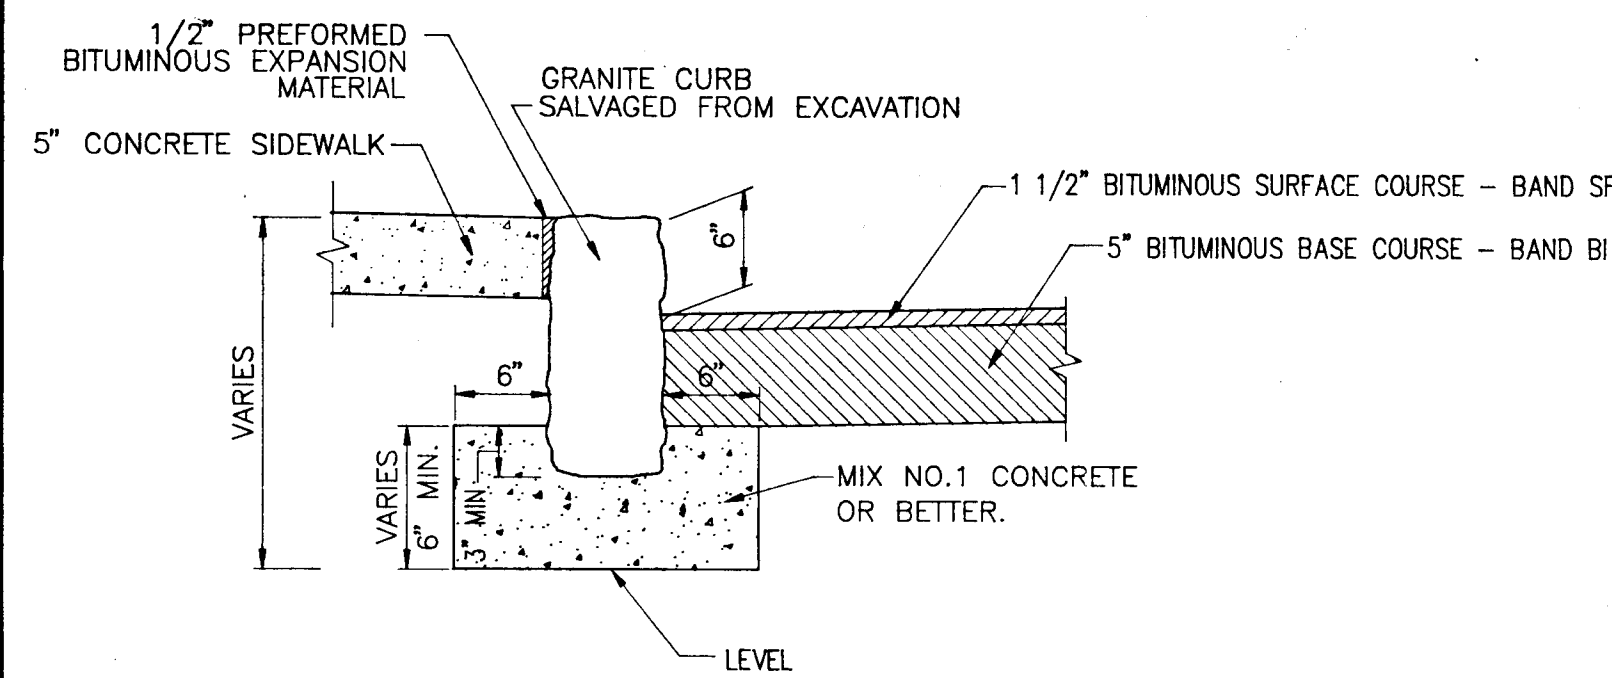

**GRANITE CURB DETAIL**

NOT TO SCALE

ALL BURRS TO BE GROUND OFF TO PROVIDE A SMOOTH FINISH.

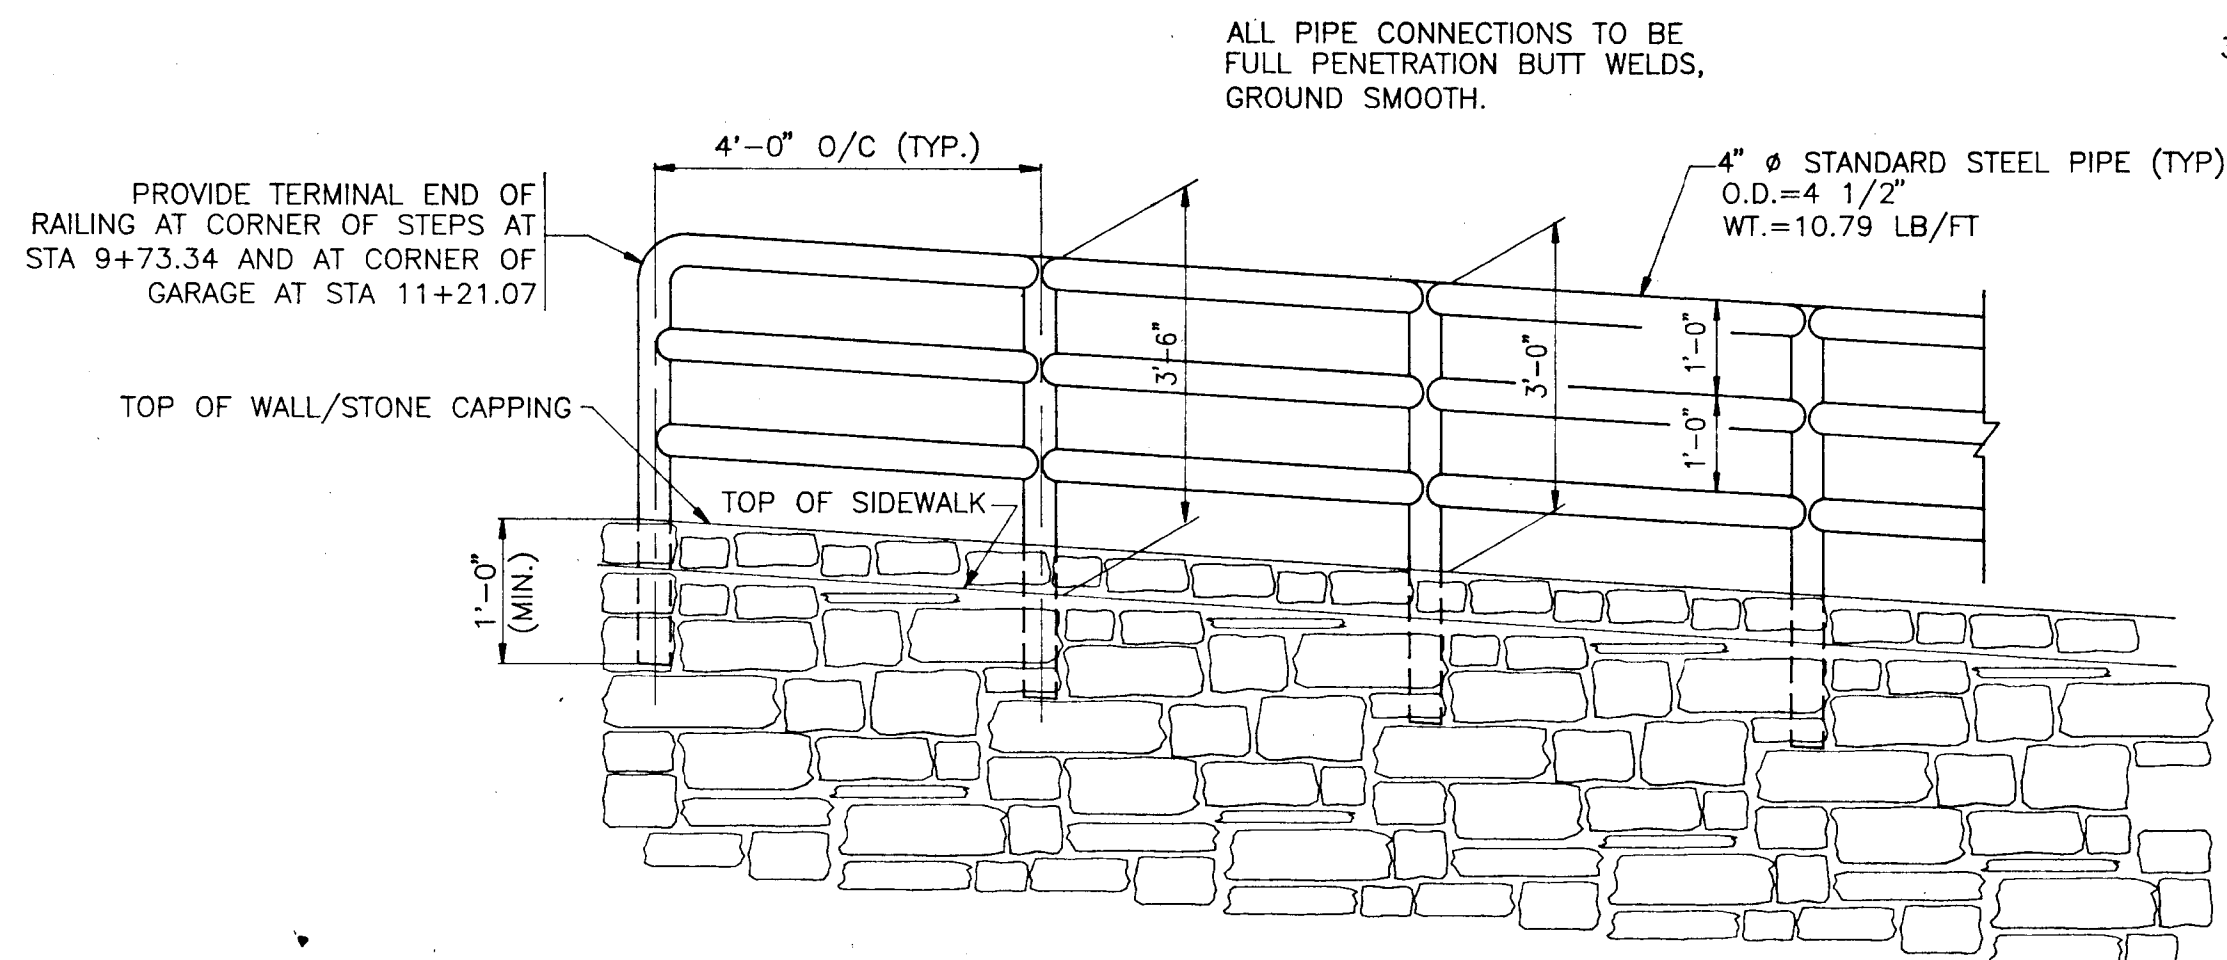


**TYPICAL RAILING ELEVATION**

SCALE: 1/2"=1'-0"


**GENERAL RAILING NOTES**

- STEEL SHALL CONFORM TO ASTM A-53, STANDARD STRENGTH.
- WELDMENTS SHALL BE THOROUGHLY CLEANED AFTER FABRICATION.
- ENTIRE RAILING SHALL BE PAINTED AS FOLLOWS:
  - PRIMER PRETREATMENT CONFORMING TO FEDERAL SPECIFICATION M.I.L.-P-15328 B (FORMULA 117)
  - ONE COAT OF SSPC PAINT 25 SHOP COAT - SEE LATEST SHA SPECIFICATION
  - ONE COAT OF SSPC PAINT 25 TINTED-FIRST FIELD COAT SEE LATEST SHA SPECIFICATIONS.
  - ONE COAT OF GRAY ALKID - SECOND FIELD COAT. SEE LATEST SHA SPECIFICATIONS.
  - A FINISH COAT OF BLACK EQUIPMENT ENAMEL - SEE LATEST SHA SPECIFICATIONS.

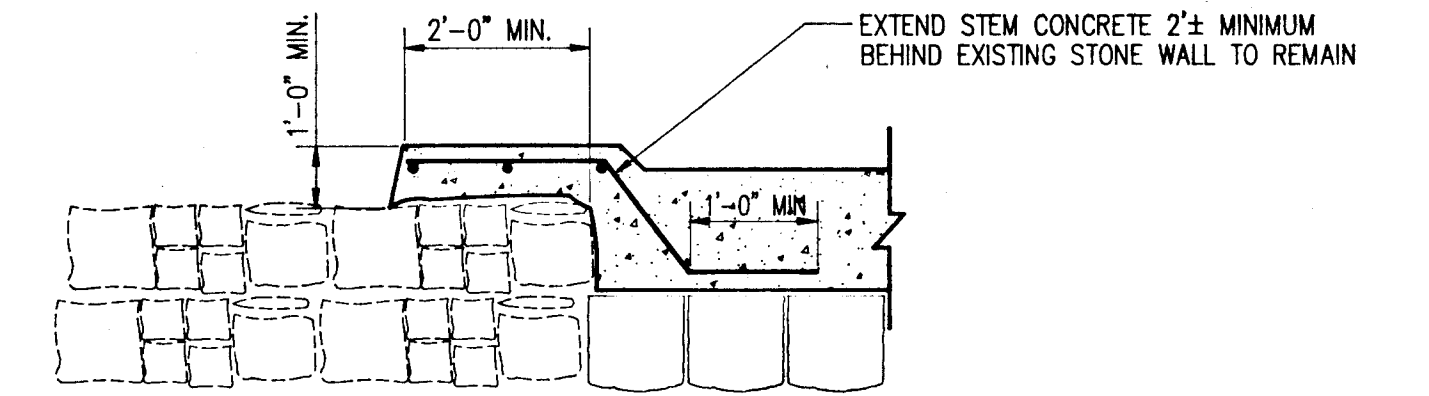

**WALL END DETAIL AT EXISTING WALL**


NOT TO SCALE

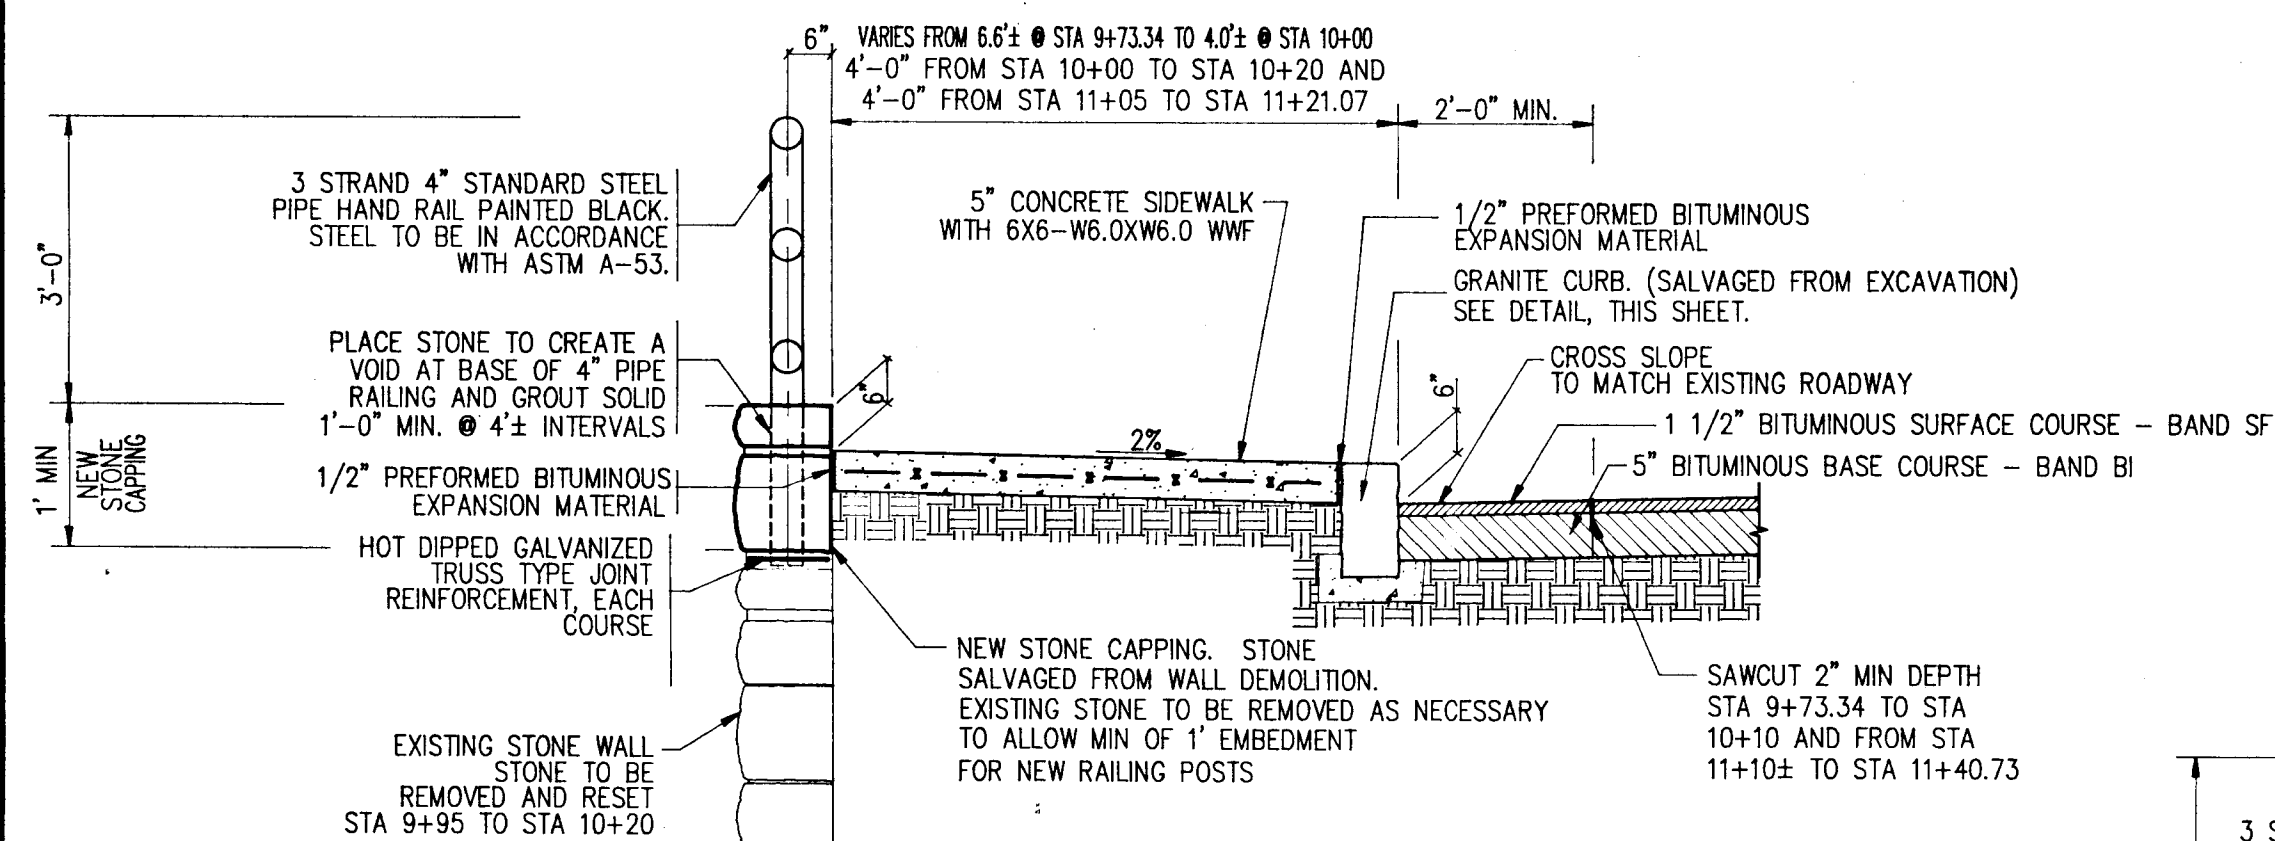

**TYPICAL SECTION**


**STA 9+73.34 TO STA 10+20  
STA 11+05 TO STA 11+21.07**

SCALE: 1/2"=1'-0"

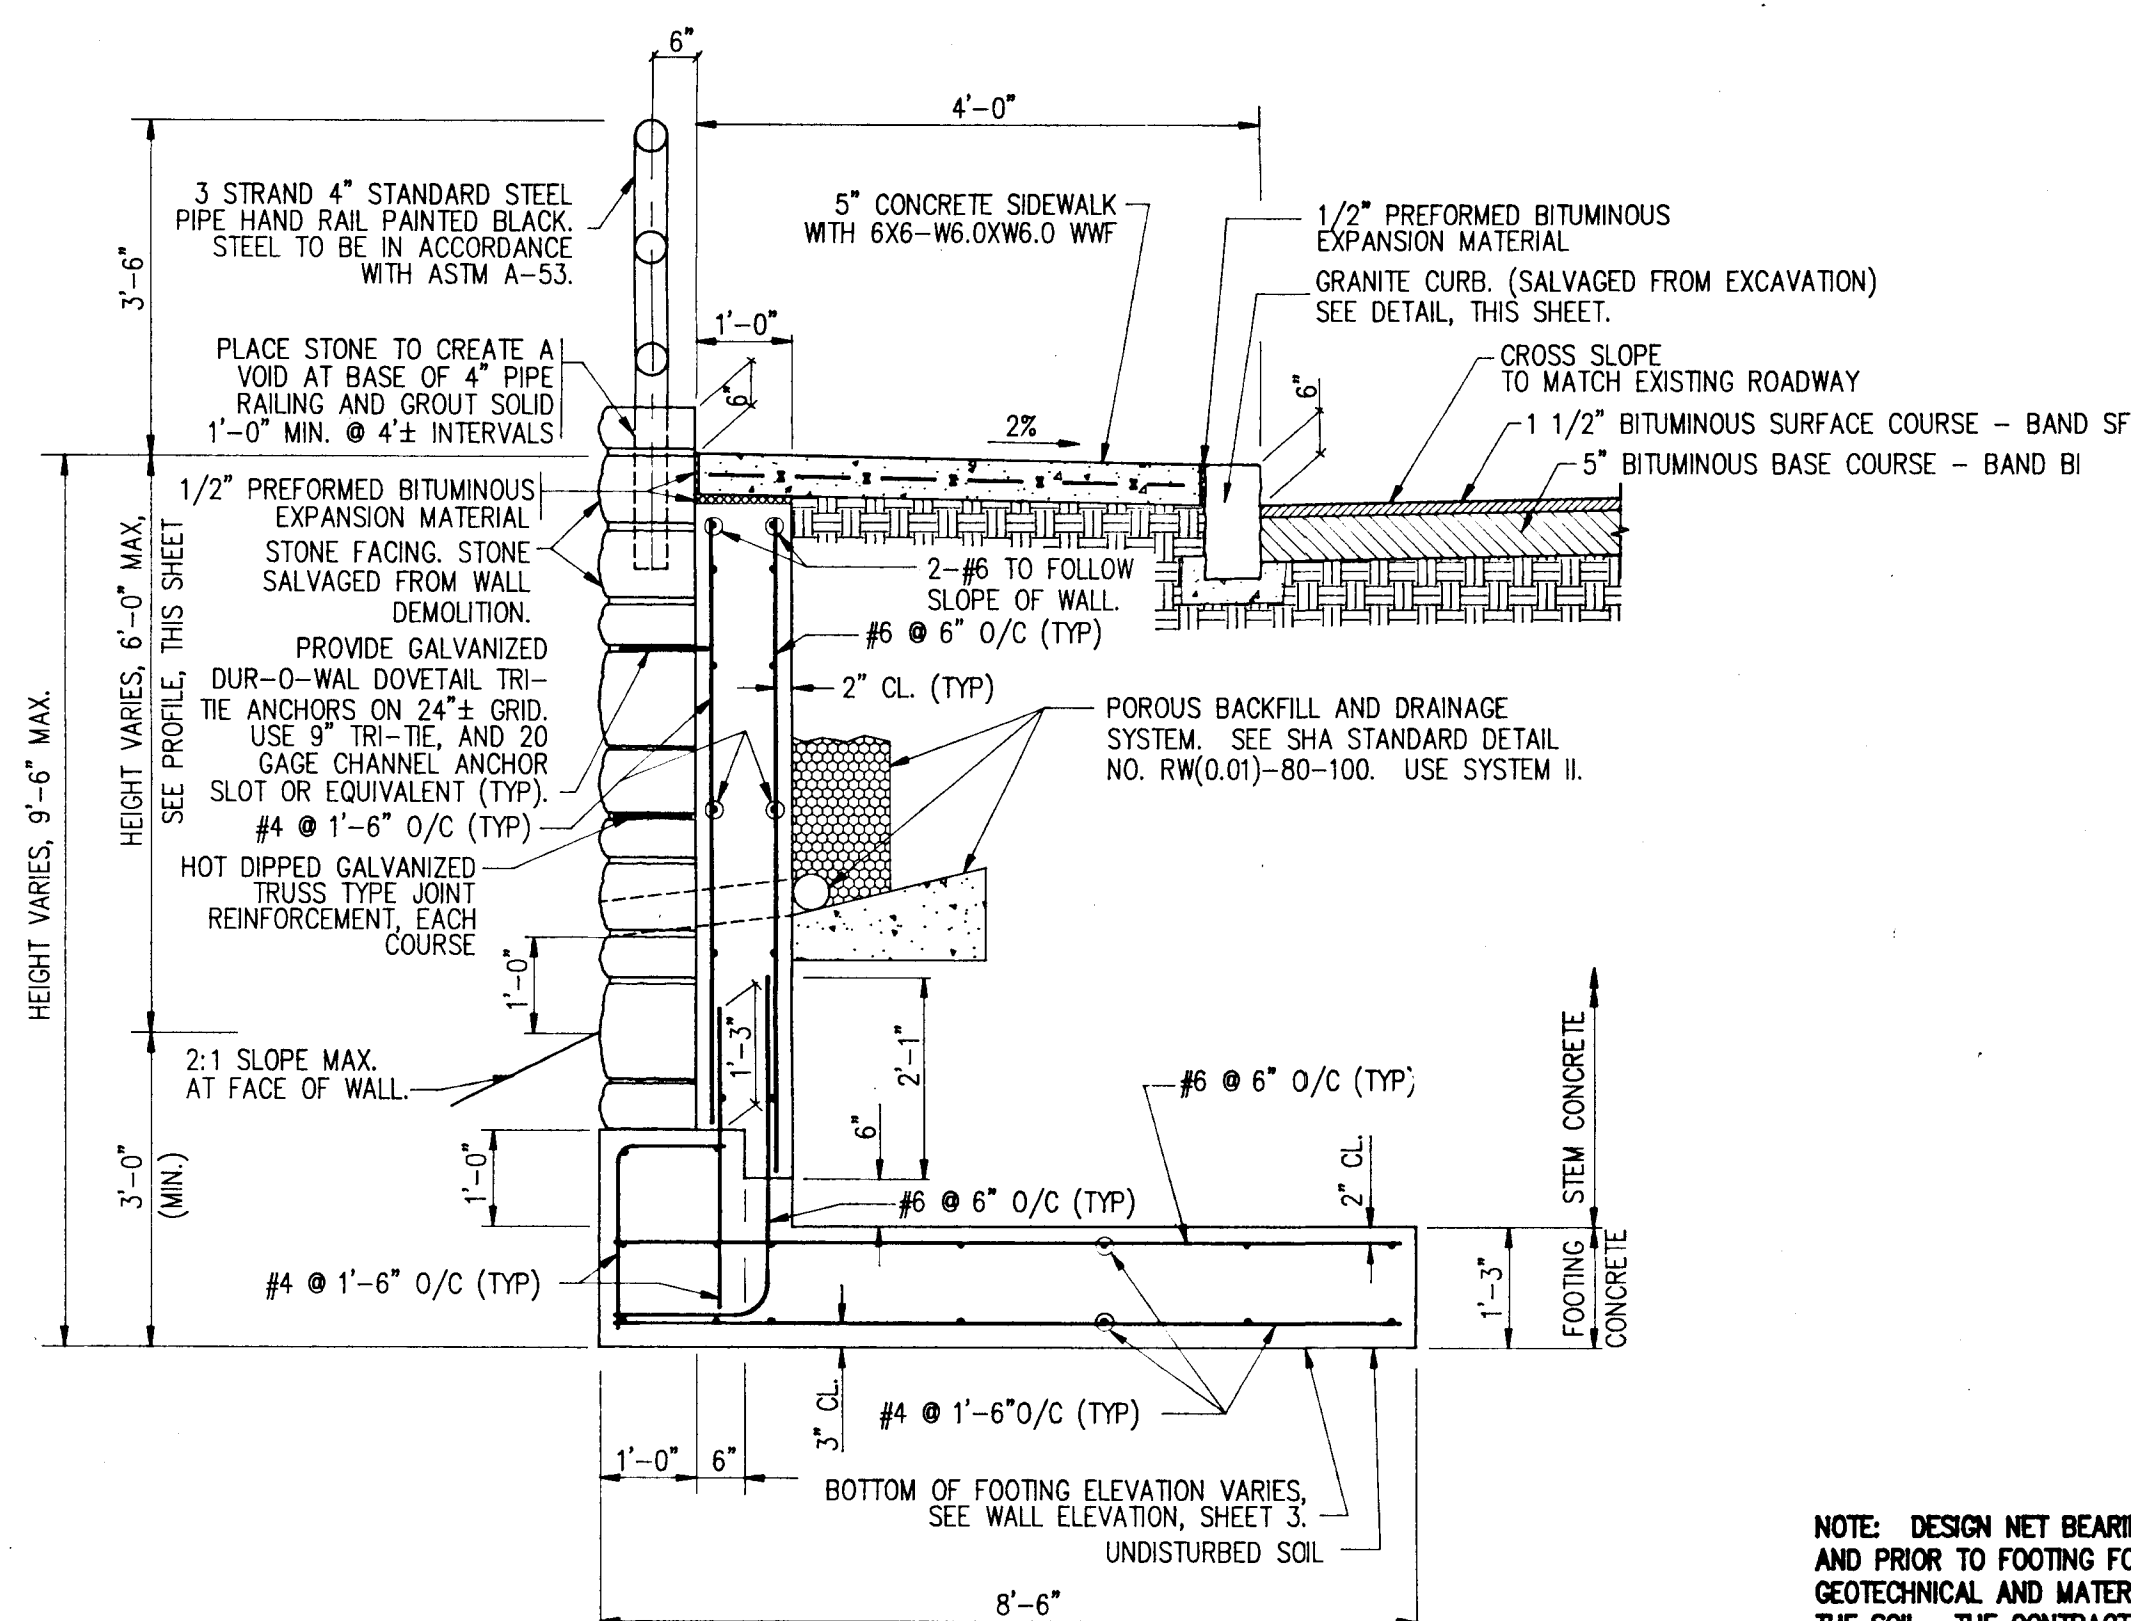

**TYPICAL SECTION I  
STA 10+70.50 TO STA 11+05**

SCALE: 1/2"=1'-0"

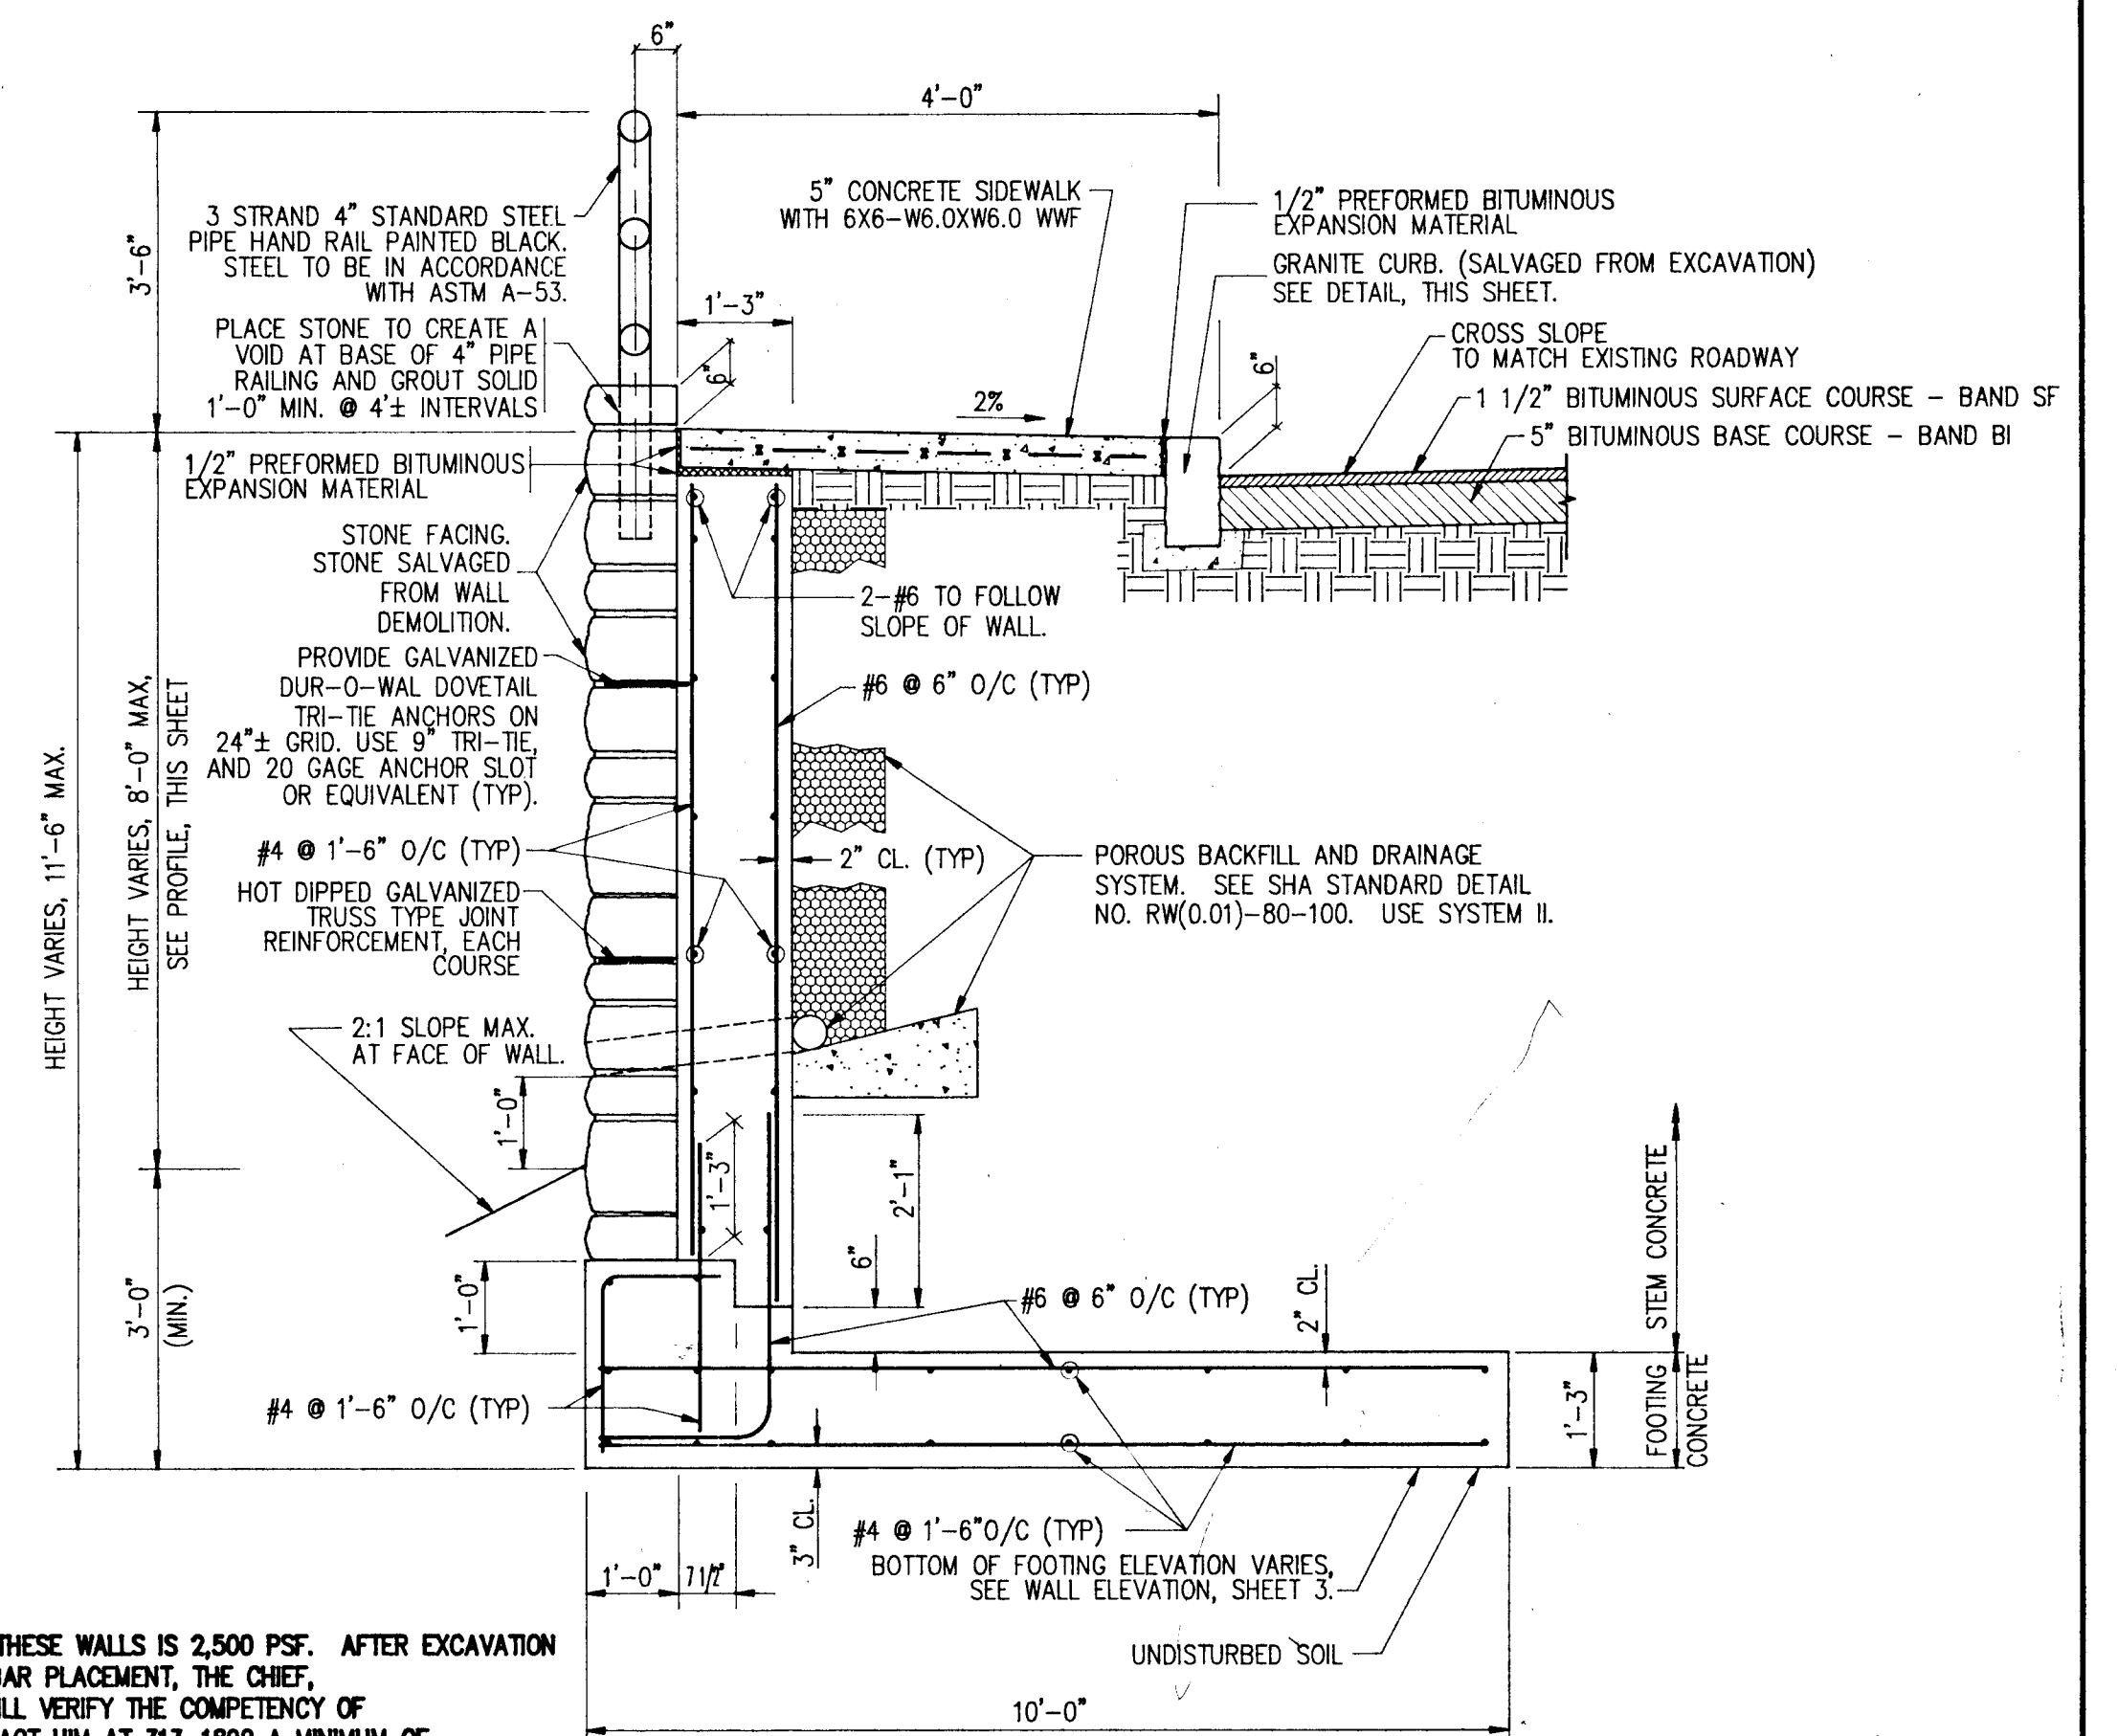

**TYPICAL SECTION II  
STA 10+20 TO STA 10+70.50**

SCALE: 1/2"=1'-0"

NOTE: DESIGN NET BEARING VALUE FOR THESE WALLS IS 2,500 PSF. AFTER EXCAVATION AND PRIOR TO FOOTING FORMING AND REBAR PLACEMENT, THE CHIEF, GEOTECHNICAL AND MATERIALS DIVISION WILL VERIFY THE COMPETENCY OF THE SOIL. THE CONTRACTOR SHALL CONTACT HIM AT 313-1892 A MINIMUM OF THREE (3) WORKING DAYS IN ADVANCE TO SCHEDULE THE INVESTIGATION. THE ENGINEER SHALL BE PRESENT DURING THE VERIFICATION.

DEPARTMENT OF PUBLIC WORKS  
HARDWY COUNTY, MARYLAND

*James A. ...* 6/10/94  
DIRECTOR OF PUBLIC WORKS DATE

*Robert ...* 6/10/94  
CHIEF, BUREAU OF ENGINEERING DATE

*...* 6-14-94  
CHIEF, DIVISION OF TRANSPORTATION PROJECTS DATE

*...* 6-14-94  
CHIEF, DIVISION OF TRANSPORTATION PROJECTS AND WATERSHED MANAGEMENT DATE

NOLAN ASSOCIATES, INC.  
ENGINEERS - CIVIL/STRUCTURAL/INSPECTIONS

P.O. BOX 2579  
COLUMBIA, MARYLAND 21045

PHONE: (410) 996-8661 FAX: (410) 996-1363



DES:	Y.C.W.				
DRN:	J.S.N.				
CHK:	C.S.N.				
DATE:	05/18/94	BY:	NO.	REVISION	DATE

TYPICAL SECTIONS, AND  
MISCELLANEOUS DETAILS

600' SCALE MAP NO. \_\_\_\_\_ BLOCK NO. \_\_\_\_\_


COURT AVENUE RETAINING WALL  
CAPITAL PROJECT J-4137  
ELECTION DISTRICT NO. 2  
ELLCOTT CITY, MARYLAND

SCALE AS SHOWN  
SHEET 4 OF 5






Slope	LOCATION CATEGORY		
	A	B	C
1:1	2'-0"	2'-0"	1'-0"
1 1/2:1	3'-0"	2'-0"	1'-0"
2:1	4'-0"	2'-0"	1'-0"
2 1/2:1	5'-0"	2'-0"	1'-0"
3:1	6'-0"	2'-0"	1'-0"
4:1	7'-0"	2'-0"	1'-0"
5:1	8'-0"	2'-0"	1'-0"
6:1	9'-0"	2'-0"	1'-0"
8:1	10'-0"	2'-0"	1'-0"
10:1	11'-0"	2'-0"	1'-0"

**LOCATION CATEGORY**

- Class A locations shall be top of curb with 12" or more of concrete below curb on each side, no bedding, per AASHTO M 31, Section 4.02.
- Class B locations shall be top of curb with 12" or more of concrete below curb on each side, no bedding, per AASHTO M 31, Section 4.02.
- Class C locations shall be top of curb with 12" or more of concrete below curb on each side, no bedding, per AASHTO M 31, Section 4.02.

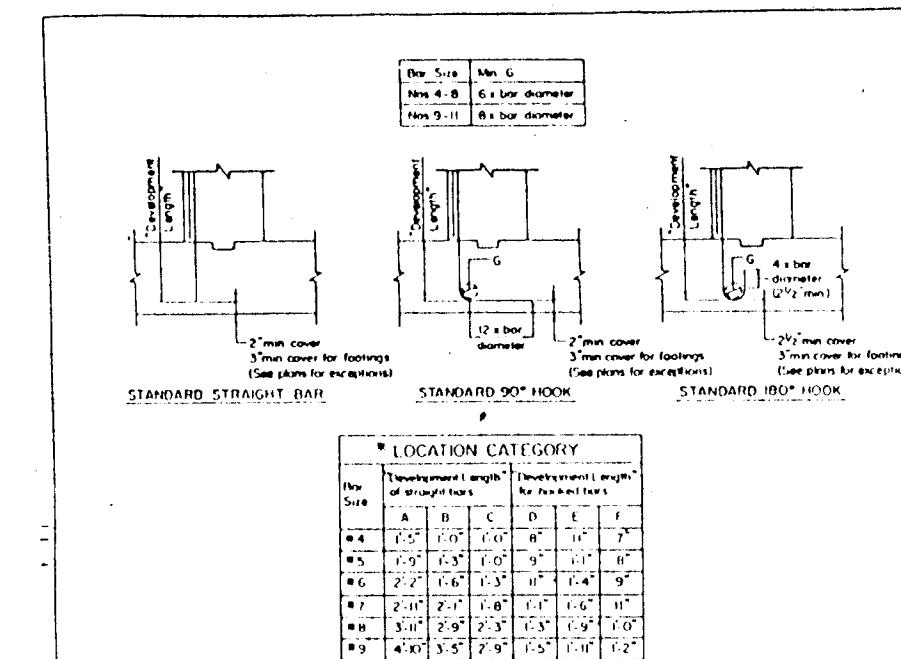

Slope	LOCATION CATEGORY		
	A	B	C
1:1	2'-0"	2'-0"	1'-0"
1 1/2:1	3'-0"	2'-0"	1'-0"
2:1	4'-0"	2'-0"	1'-0"
2 1/2:1	5'-0"	2'-0"	1'-0"
3:1	6'-0"	2'-0"	1'-0"
4:1	7'-0"	2'-0"	1'-0"
5:1	8'-0"	2'-0"	1'-0"
6:1	9'-0"	2'-0"	1'-0"
8:1	10'-0"	2'-0"	1'-0"
10:1	11'-0"	2'-0"	1'-0"

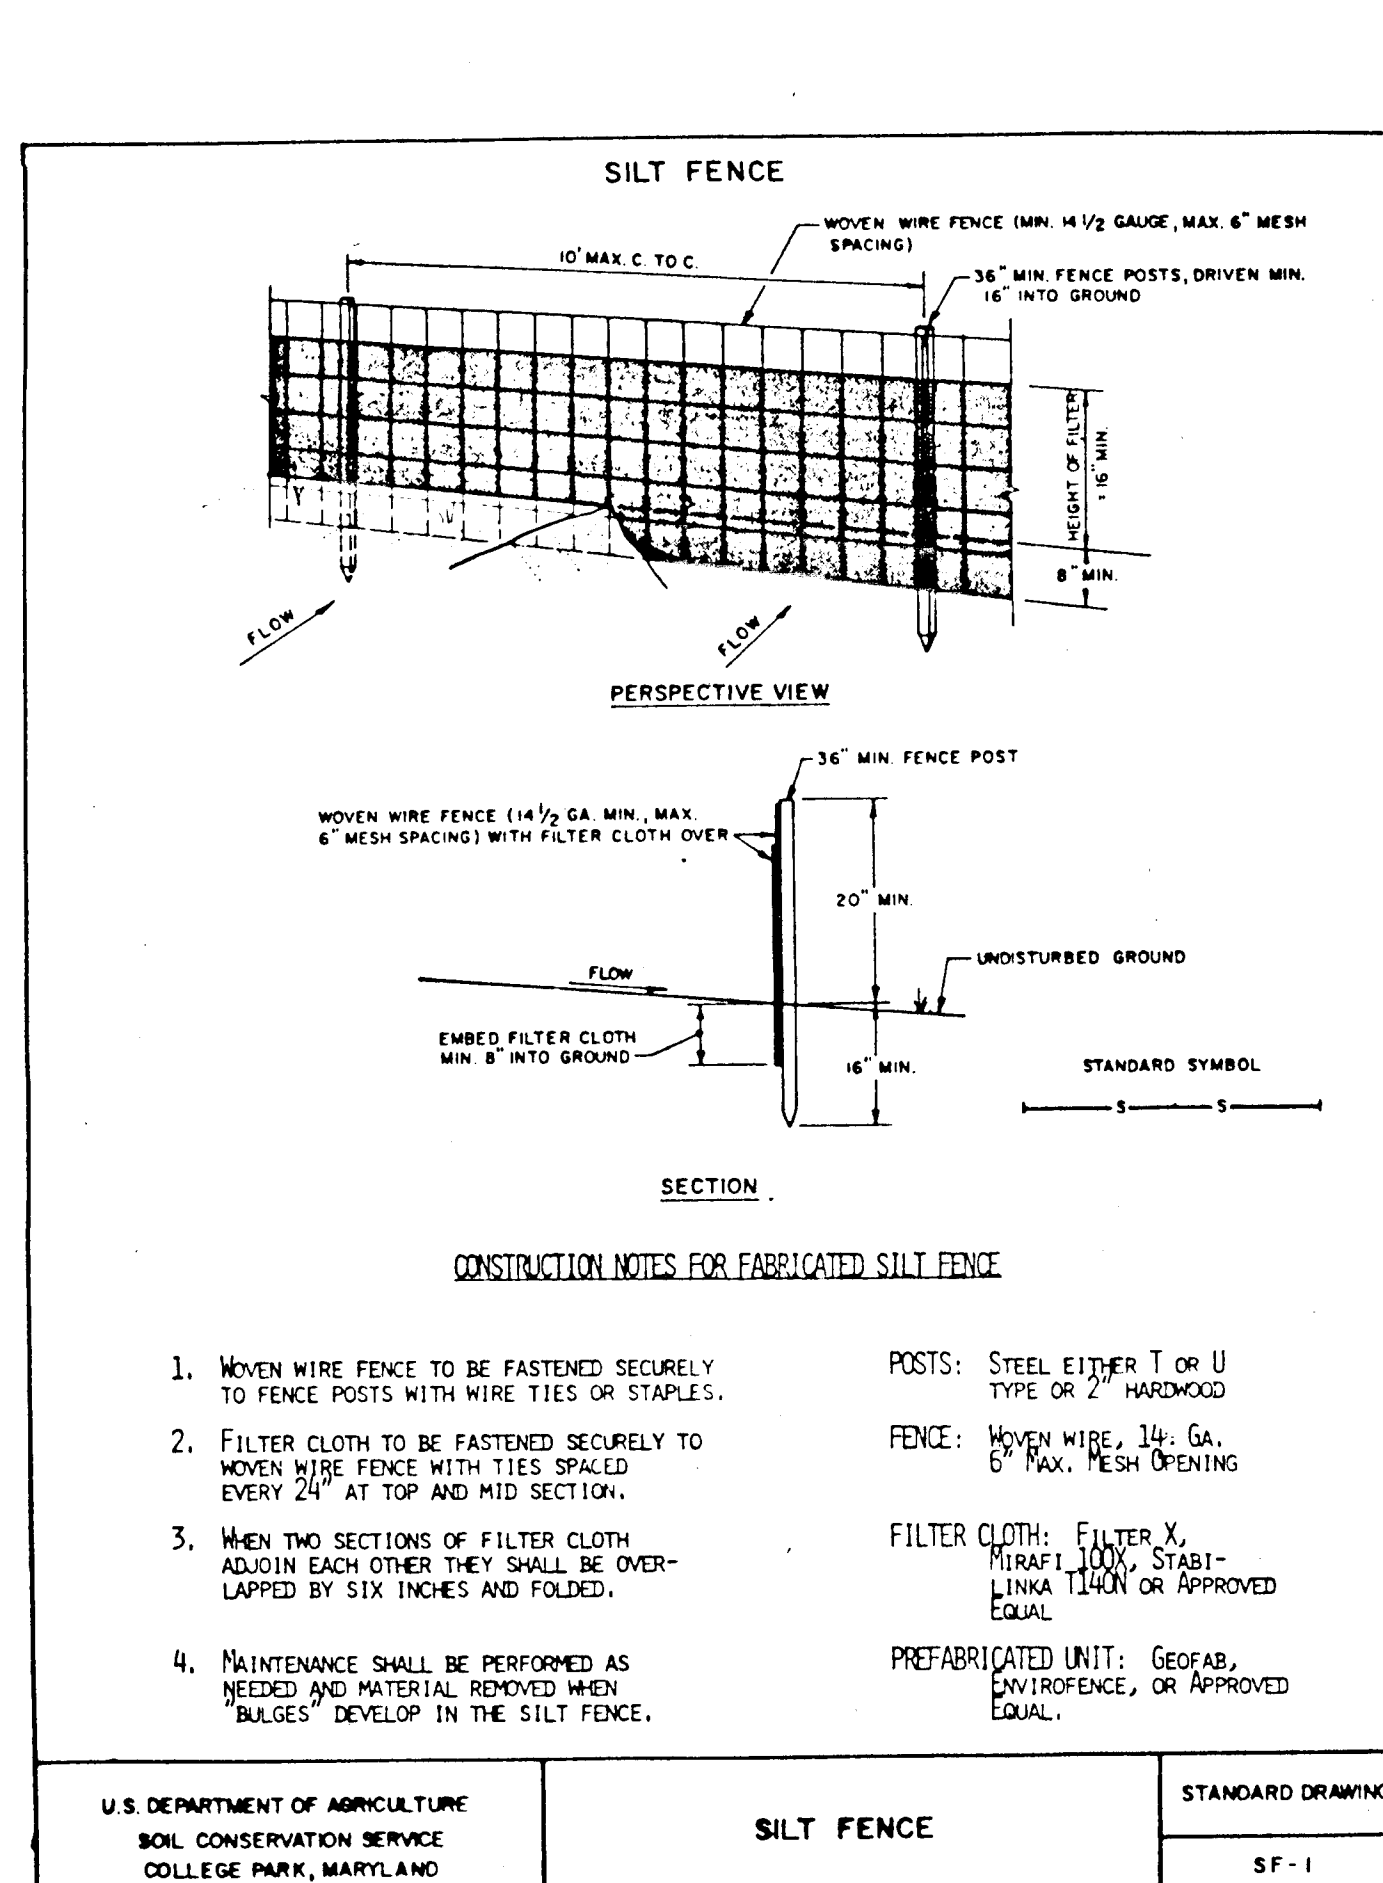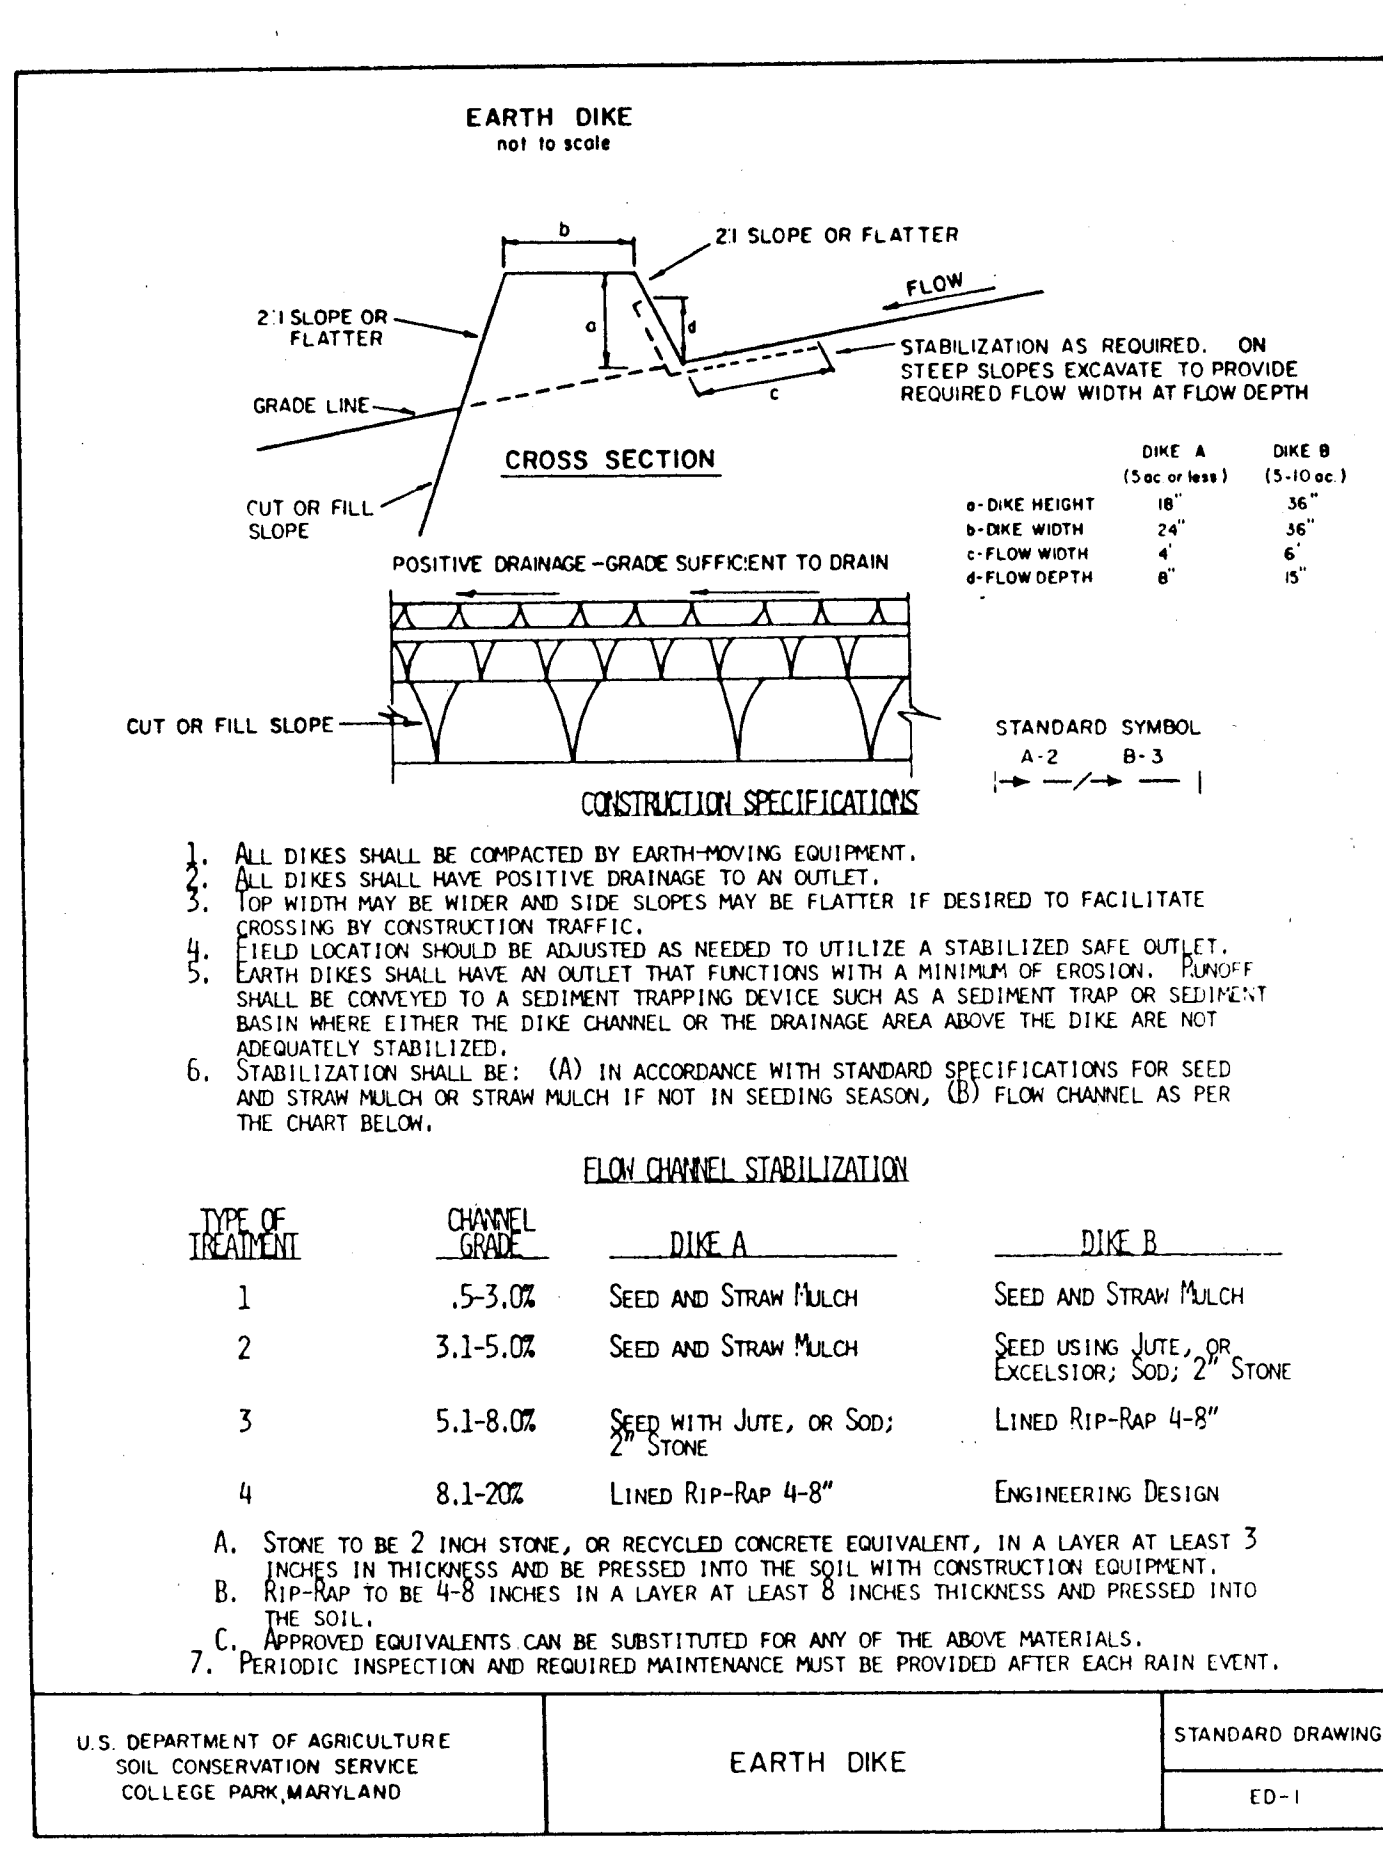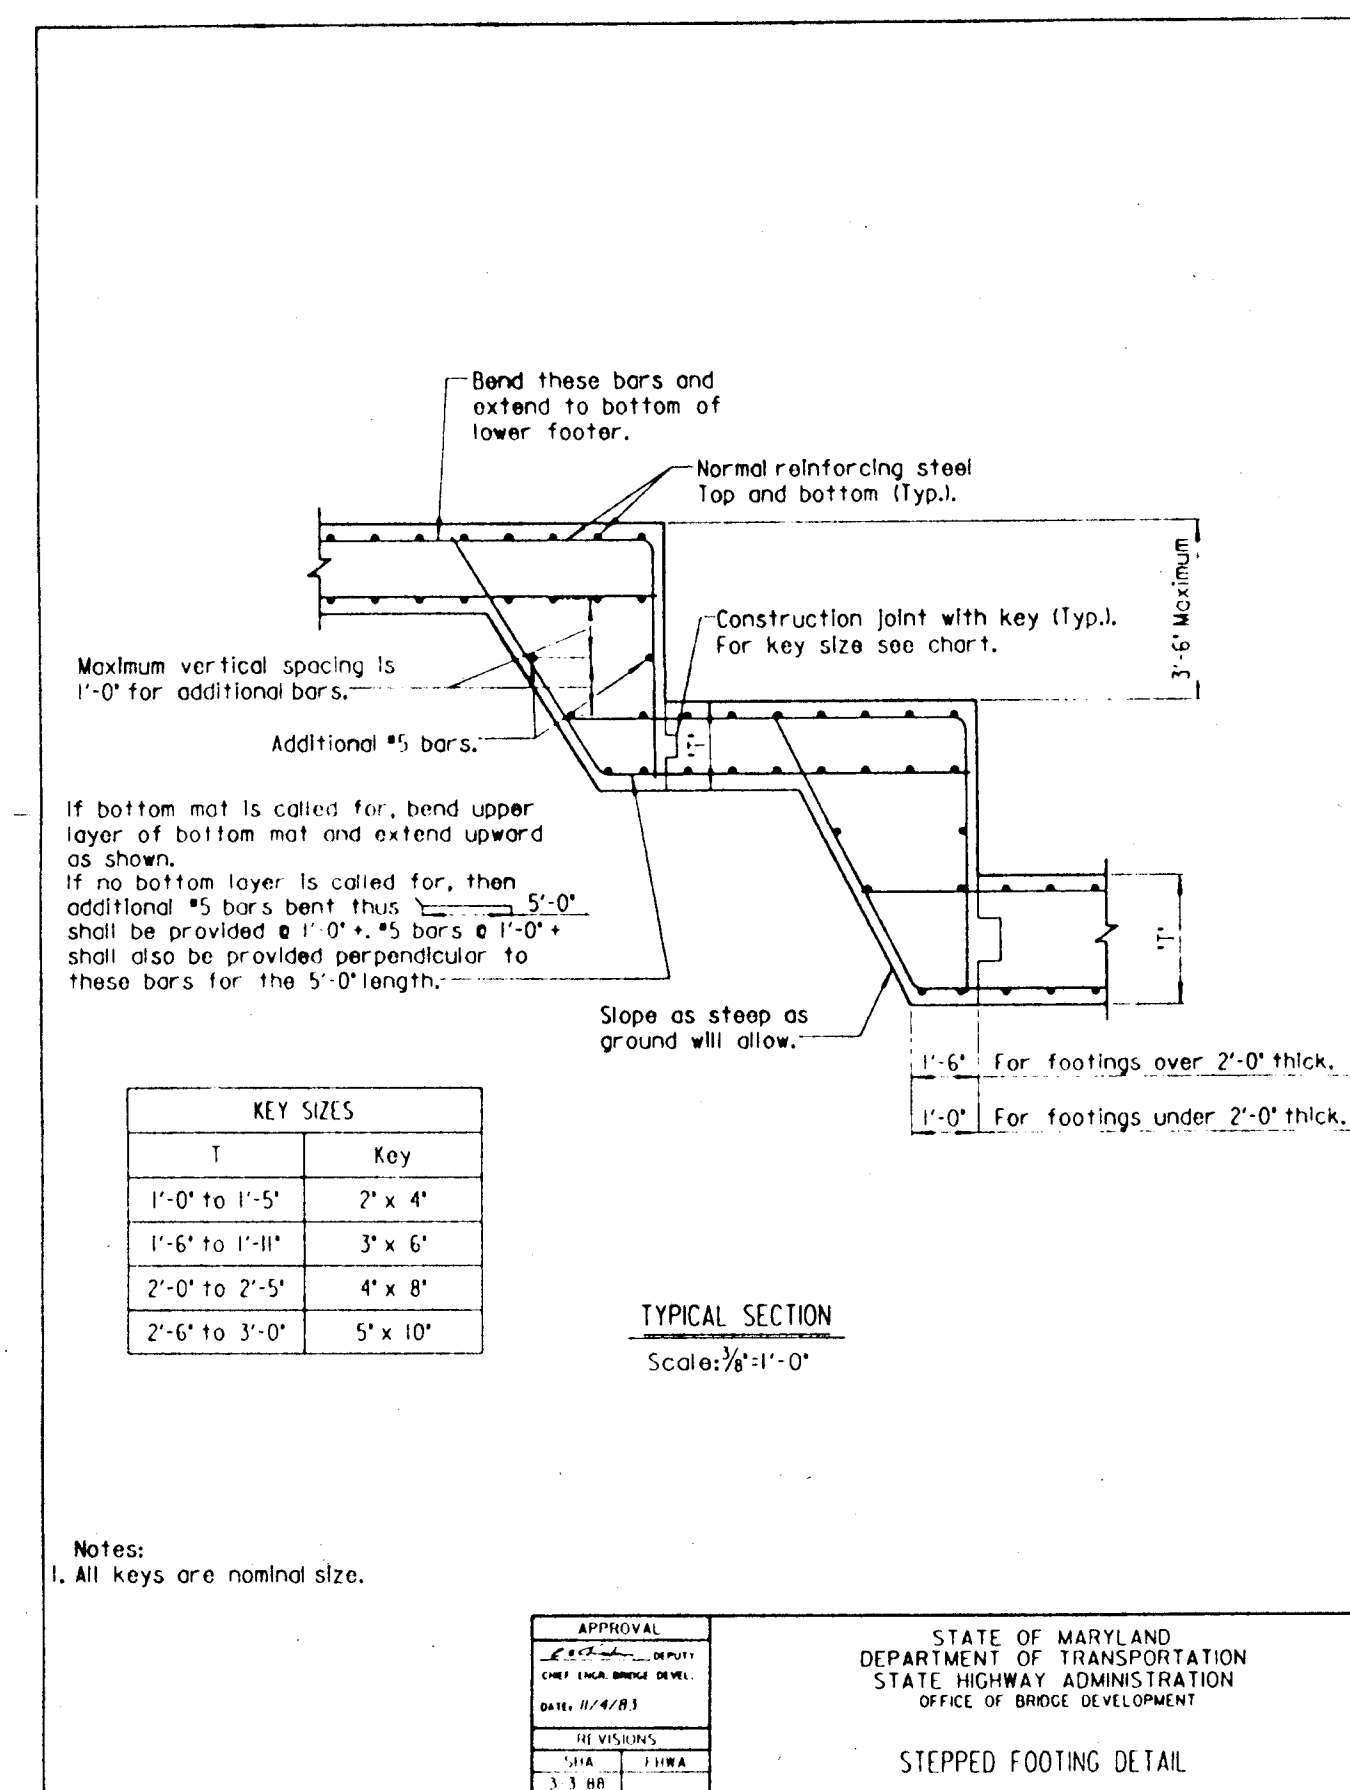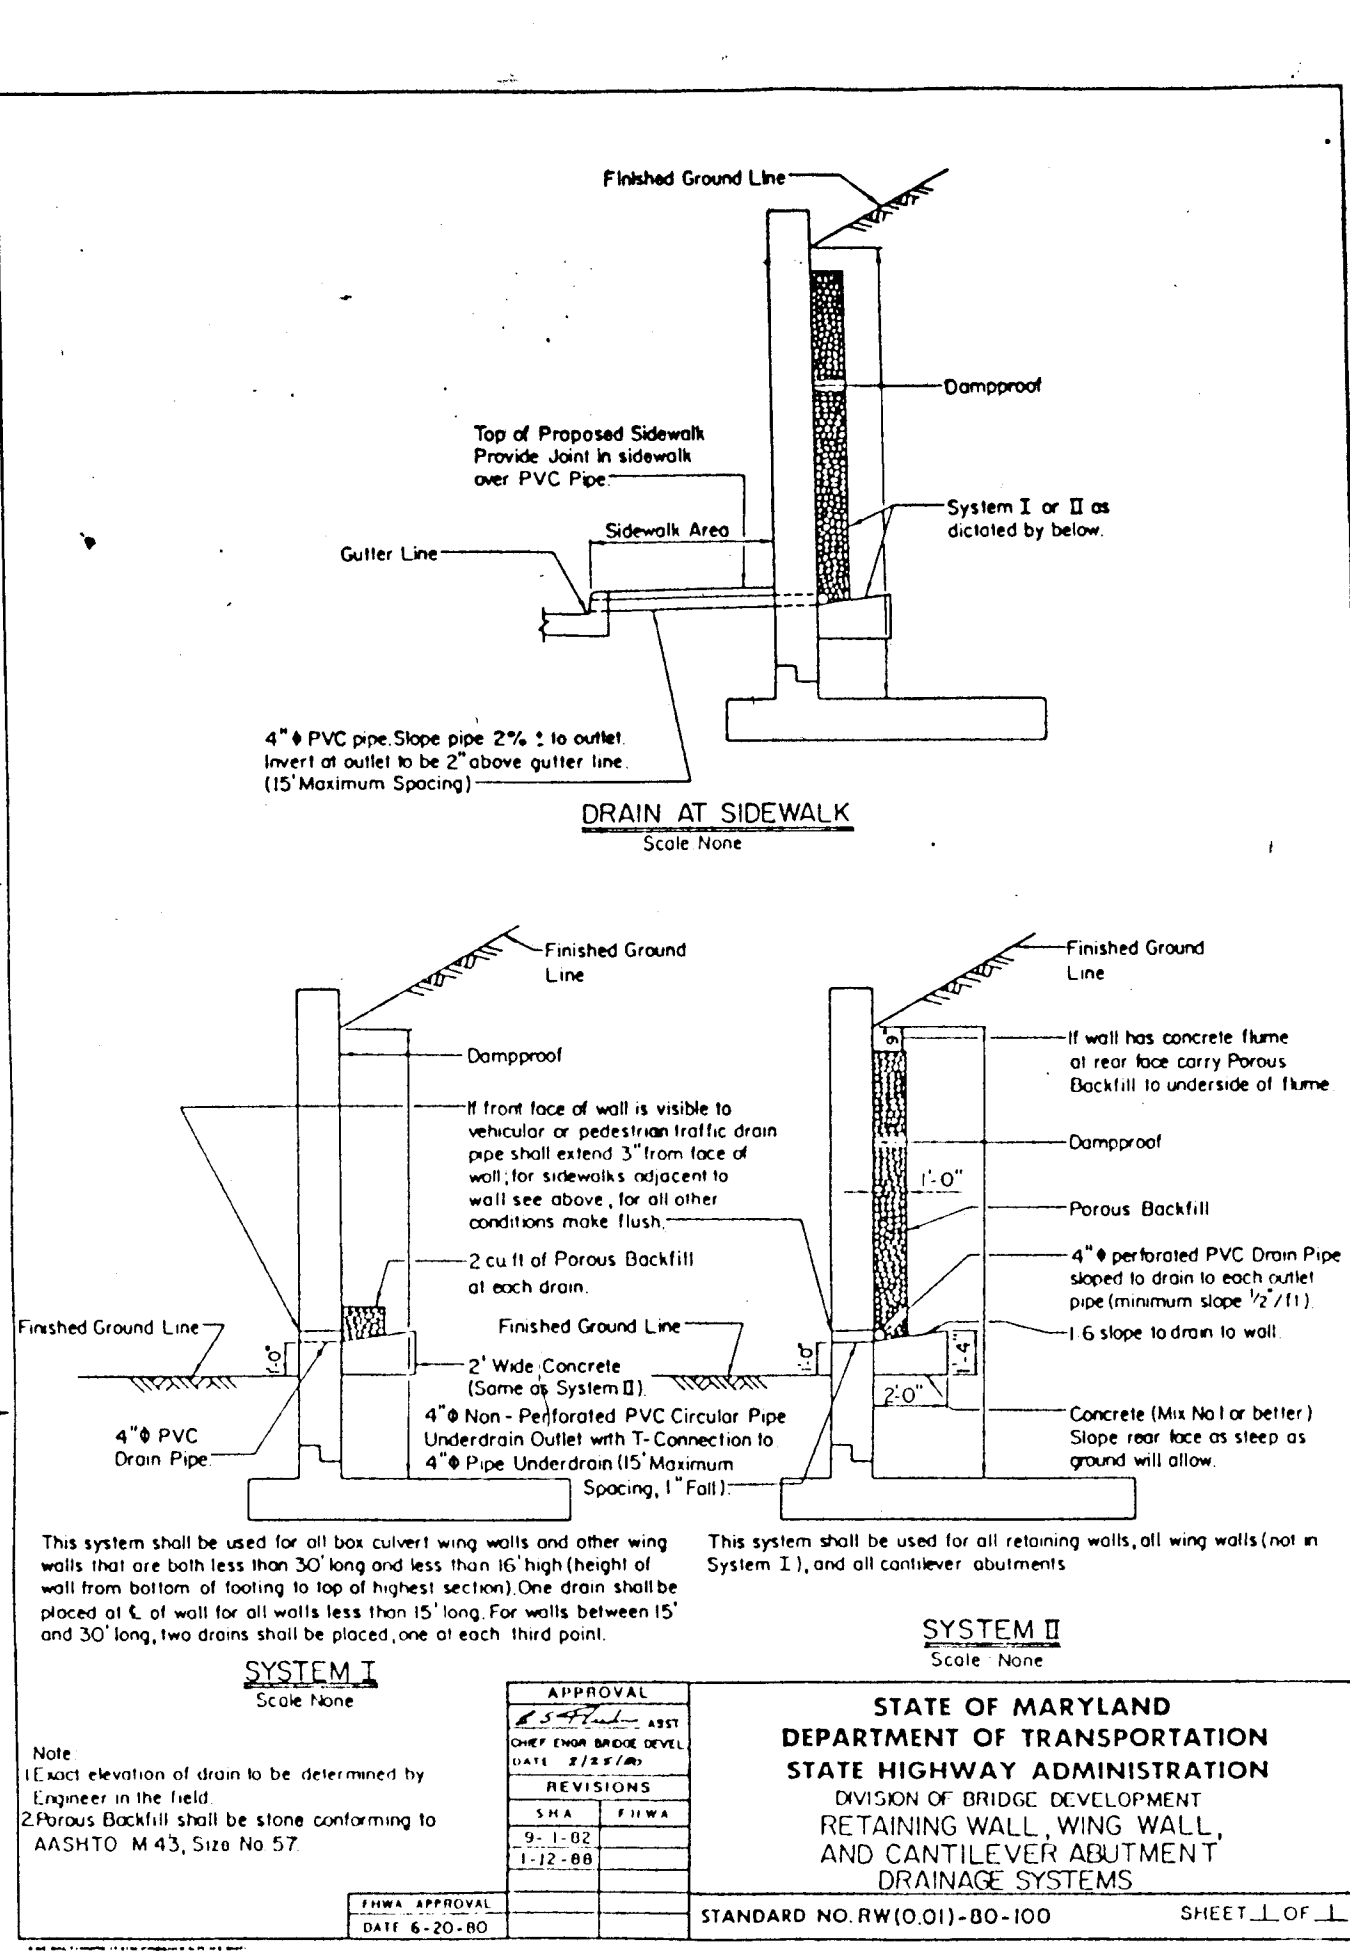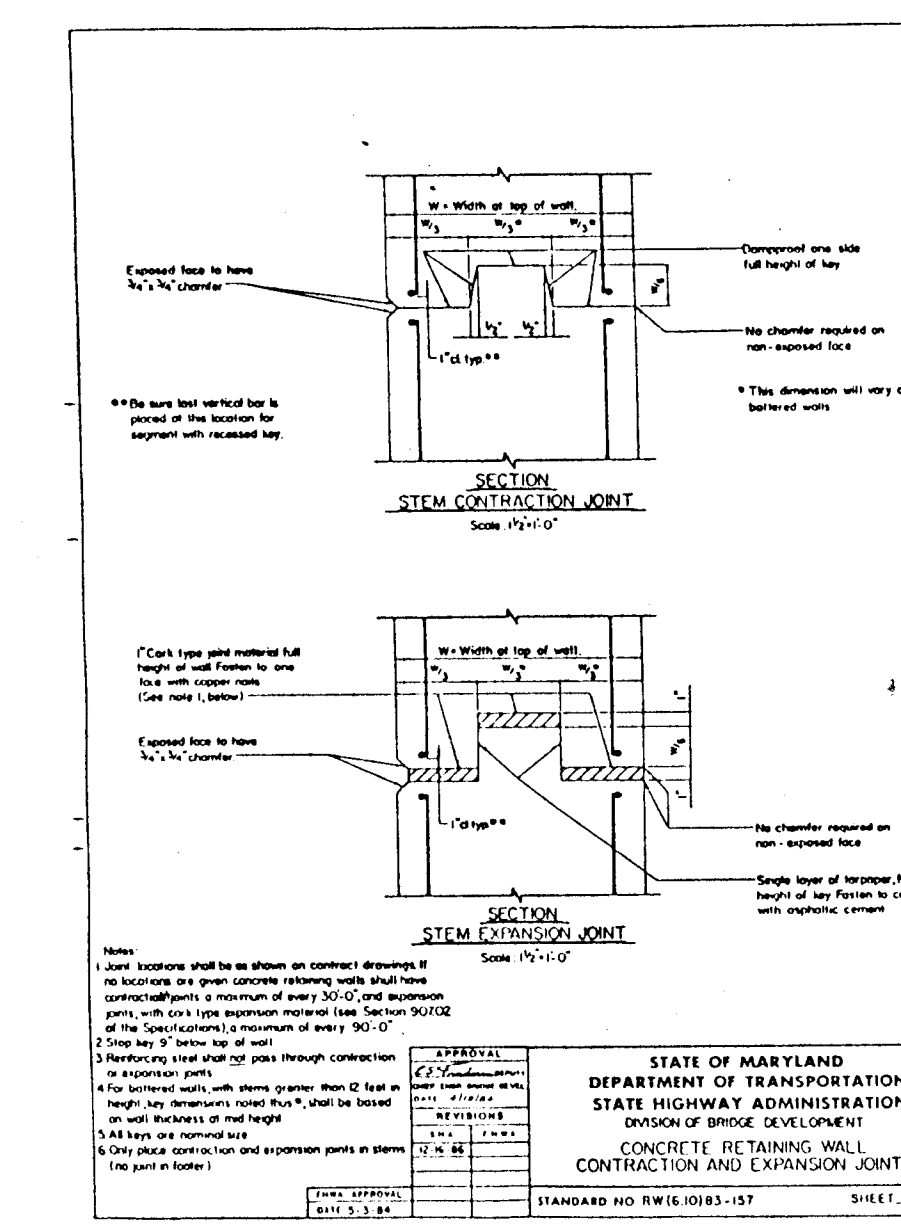

**PERMANENT SEEDING NOTES**

Apply to graded or cleared areas not subject to immediate further disturbance where a permanent long-lived vegetative cover is needed.

**Seedbed Preparation:**—Loosen upper three inches of soil by raking, disking or other acceptable means before seeding, if not previously loosened.

**Soil Amendments:**—In lieu of soil test recommendations, use one of the following schedules:

- Preferred:**—Apply 2 tons per acre dolomitic limestone (92 lbs/1000 sq. ft.) and 600 lbs per acre 10-10-10 fertilizer (14 lbs/1000 sq. ft.) before seeding. Harrow or disk into upper three inches of soil. At time of seeding, apply 400 lbs per acre 30-0-0 ureaform fertilizer (9 lbs/1000 sq. ft.)
- Acceptable:**—Apply 2 tons per acre dolomitic limestone (92 lbs/1000 sq. ft.) and 1000 lbs per acre 10-10-10 fertilizer (23 lbs/1000 sq. ft.) before seeding. Harrow or disk into upper three inches of soil.

**Seeding:**—For the periods March 1 thru April 30, and August 1 thru October 15, seed with 60 lbs per acre (1.4 lbs/1000 sq. ft.) of Kentucky 31 Tall Fescue. For the period May 1 thru July 31, seed with 60 lbs Kentucky 31 Tall Fescue per acre and 2 lbs per acre (.05 lbs/1000 sq. ft.) of weeping lovegrass. During the period of October 16 thru February 28, protect site by: Option (1) - 2 tons per acre of well anchored straw mulch and seed as soon as possible in the spring. Option (2) - Use sod. Option (3) - Seed with 60 lbs/acre Kentucky 31 Tall Fescue and mulch with 2 tons/acre well anchored straw.

**Mulching:**—Apply 1-1/2 to 2 tons per acre (70 to 90 lbs/1000 sq. ft.) of unrotted small grain straw immediately after seeding. Anchor mulch immediately after application using mulch anchoring tool or 218 gallons per acre (5 gal/1000 sq. ft.) of emulsified asphalt on flat areas. On slopes 8 ft or higher, use 348 gallons per acre (8 gal/1000 sq. ft.) for anchoring.

**Maintenance:**—Inspect all seeding areas and make needed repairs, replacements and reseedings.

**TEMPORARY SEEDING NOTES**

Apply to graded or cleared areas likely to be redisturbed where a short-term vegetative cover is needed.

**Seedbed preparation:**—Loosen upper three inches of soil by raking, disking or other acceptable means before seeding, if not previously loosened.

**Soil Amendments:**—Apply 600 lbs per acre 10-10-10 fertilizer (14 lbs/1000 sq. ft.)

**Seeding:**—For periods March 1 thru April 30 and from August 15 thru October 15, seed with 2-1/2 bushel per acre of annual ryegrass (3.2 lbs/1000 sq. ft.). For the period May 1 thru August 14, seed with 3 lbs per acre of weeping lovegrass (.07 lbs/1000 sq. ft.). For the period November 16 thru February 28, protect site by applying 2 tons per acre of well anchored straw mulch and seed as soon as possible in the spring, or use sod.

**Mulching:**—Apply 1-1/2 to 2 tons per acre (70 to 90 lbs/1000 sq. ft.) of unrotted weed free small grain straw immediately after seeding. Anchor mulch immediately after application using mulch anchoring tool or 218 gal per acre (5 gal/1000 sq. ft.) of emulsified asphalt on flat areas. On slopes 8 ft or higher, use 348 gal per acre (8 gal/1000 sq. ft.) for anchoring.

Refer to the 1983 MARYLAND STANDARDS AND SPECIFICATIONS FOR SOIL EROSION AND SEDIMENT CONTROL for additional rates and methods not covered.

**STANDARD SEDIMENT CONTROL NOTES**

- A minimum of 48 hours notice must be given to the Howard County Department of Inspections, Licenses and Permits, Sediment Control Division prior to the start of any construction, (313-1850).
- All vegetative and structural practices are to be installed according to the provisions of this plan and are to be in conformance with the most current "MARYLAND STANDARDS AND SPECIFICATIONS FOR SOIL EROSION AND SEDIMENT CONTROL", and revisions thereto.
- Following initial soil disturbance or redisturbance, permanent or temporary stabilization shall be completed within: a) 7 calendar days for all perimeter sediment control structures, dikes, perimeter slopes and all slopes greater than 3:1, b) 14 days as to all other disturbed or graded areas on the project site.
- All sediment traps basins shown must be fenced and warning signs posted around their perimeter in accordance with Vol. 1, Chapter 12, of the HOWARD COUNTY DESIGN MANUAL, Storm Drainage.
- All disturbed areas must be stabilized within the time period specified above in accordance with the 1983 MARYLAND STANDARDS AND SPECIFICATIONS FOR SOIL EROSION AND SEDIMENT CONTROL for permanent seeding (Sec. 51), sod (Sec. 54), temporary seeding (Sec. 50) and mulching (Sec. 52). Temporary stabilization with mulch alone can only be done when recommended seeding dates do not allow for proper germination and establishment of grasses.
- All sediment control structures are to remain in place and are to be maintained in operative condition until permission for their removal has been obtained from the Howard County Sediment Control Inspector.
- Site Analysis
 

Total Area of Site	0.10	Acres
Area Disturbed	0.05	Acres
Area to be roofed of paved	0.05	Acres
Area to be vegetatively stabilized	0.01	Acres
Total Cut	500	Cu. Yds.
Total Fill	50	Cu. Yds.
Offsite Waste/Borrow Area Location	To Be Determined By Contractor	
- Any sediment control practice which is disturbed by grading activity for placement of utilities must be repaired on the same day of disturbance.
- Additional sediment control must be provided, if deemed necessary by the Howard County Sediment Control Inspector.
- On all sites with disturbed areas in excess of 2 acres, approval of the inspection agency shall be requested upon completion of installation of perimeter erosion and sediment controls, but before proceeding with any other earth disturbance or grading. Other building or grading inspection approvals may not be authorized until this initial approval by the inspection agency is made.
- Trenches for the construction of utilities is limited to three pipe lengths or that which can be backfilled and stabilized within one working day, whichever is shorter.

THIS DEVELOPMENT PLAN IS APPROVED FOR SOIL CONSERVATION SERVICE BY

Reviewed for HOWARD COUNTY S.C.D. and meets Sediment Control Requirements

J. A. Winkler, Jr. District Engineer

Approved: John R. Roberts, District Engineer

**SEQUENCE OF CONSTRUCTION**

- Obtain grading permit for the project.
- Install sediment controls as shown on the site plan.
- Excavate for wall reconstruction.
- Construct concrete cantilever retaining wall, and reset stone gravity wall in accordance with the limits shown on the plans.
- Backfill behind wall.
- Construct new stone facing for concrete cantilever wall; construct new railing, sidewalk, and replace salvaged granite curb.
- Repoint face of remaining wall.
- Reconstruct pavement as shown on the plans and as directed by the engineer.
- Regrade slope of the front face of retaining wall in accordance with the contours shown on the site plan.
- After the site is stabilized and permission is granted by the Sediment Control Inspector, remove sediment controls and stabilize any remaining disturbed areas.

DEPARTMENT OF PUBLIC WORKS  
 HOWARD COUNTY, MARYLAND

DATE: 6/10/94

DATE: 6/10/94

NOLAN ASSOCIATES, INC.  
 ENGINEERS - CIVIL/STRUCTURAL/INSPECTIONS

P.O. BOX 2579  
 COLUMBIA, MARYLAND 21045

PHONE: (410) 995-8651 FAX: (410) 995-1363

DES: Y.C.W.  
 DRN: J.S.N.  
 CHK: C.S.N.

DATE: 05/18/94

STANDARD DETAILS AND SEDIMENT AND EROSION CONTROL NOTES

600' SCALE MAP NO. BLOCK NO.

COURT AVENUE RETAINING WALL  
 CAPITAL PROJECT J-4137  
 ELECTION DISTRICT NO. 2  
 ELLICOTT CITY, MARYLAND


SCALE AS SHOWN

SHEET 5 OF 5

# HOWARD COUNTY, MARYLAND DEPARTMENT OF PUBLIC WORKS

## COURT AVENUE RETAINING WALL CAPITAL PROJECT J-4137

SHEET NO.	INDEX OF DRAWINGS TITLE
1	TITLE SHEET
2	SITE PLAN AND GENERAL NOTES
3	GEOMETRIC LAYOUT, WALL ELEVATION AND BORING LOGS
4	TYPICAL SECTIONS AND MISCELLANEOUS DETAILS
5	STANDARD DETAILS AND SEDIMENT AND EROSION CONTROL NOTES

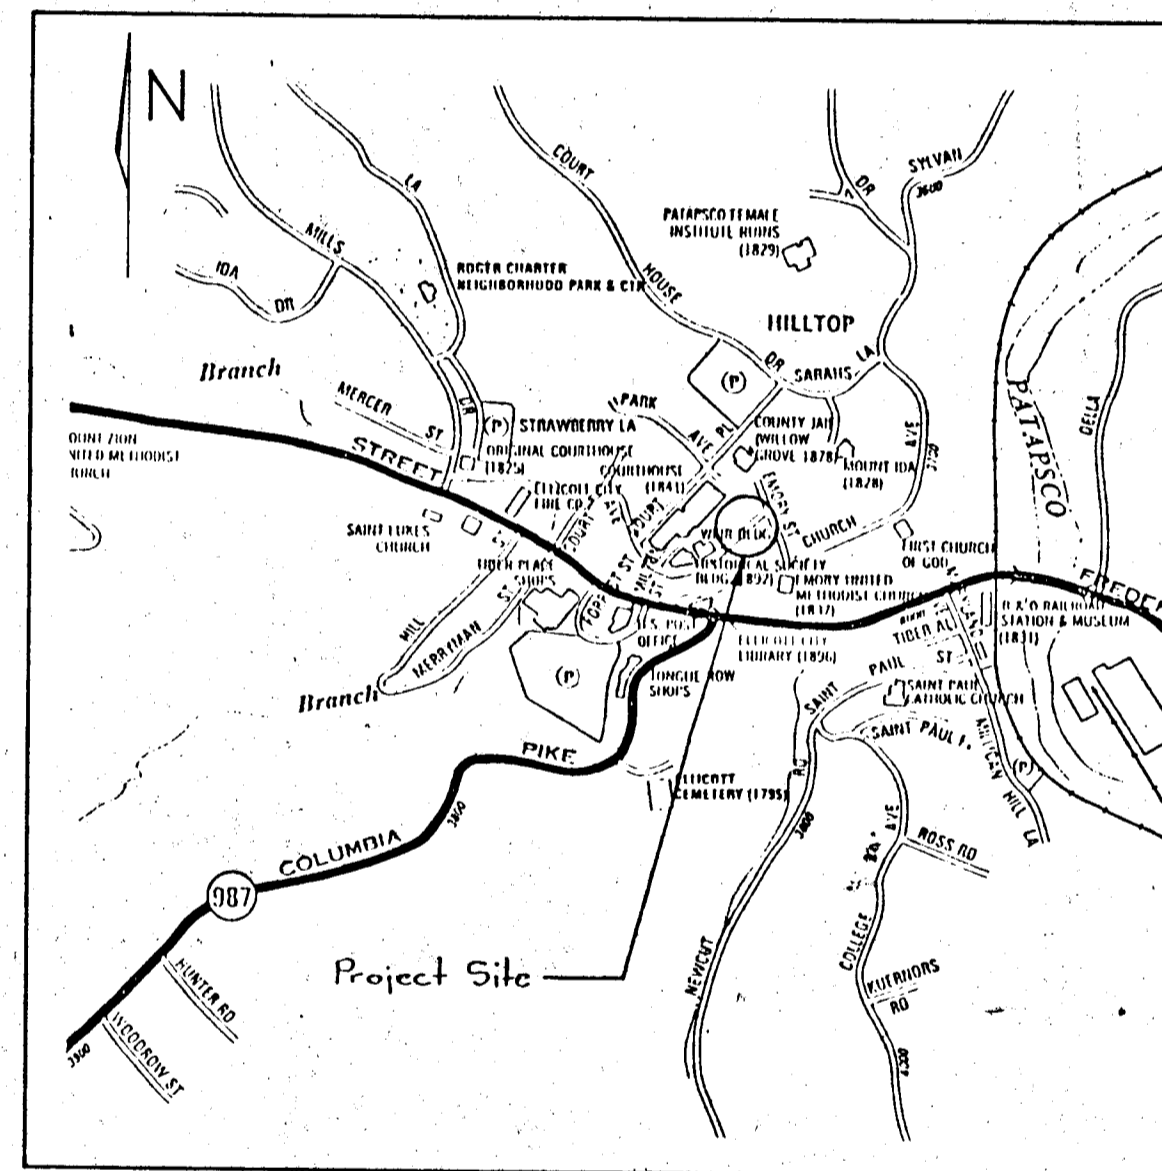

**LOCATION MAP**  
SCALE: 1"=600'

THE LOCATIONS OF UTILITIES SHOWN ON THE PLANS ARE FOR INFORMATION AND GUIDANCE ONLY. NO GUARANTEE IS MADE AS TO THE ACCURACY OF SAID LOCATIONS.

RIGHT-OF-WAY LINES AS SHOWN ON THESE PLANS ARE FOR ASSISTANCE IN INTERPRETING THE PLANS. THESE LINES DO NOT REPRESENT THE OFFICIAL PROPERTY ACQUISITION LINES. FOR OFFICIAL FEE RIGHT-OF-WAY AND EASEMENT INFORMATION REFER TO THE APPROPRIATE RIGHT-OF-WAY PLATS.

By the Owner/Developer:

"I/We certify that all development and construction will be done according to this plan, and that any responsible personnel involved in the construction project will have a Certificate of Attendance at a Department of the Environment Approved Training Program for the Control of Sediment and Erosion before beginning the project. I also authorize periodic on-site inspection by the Howard Soil Conservation District."

*Ronald G. Lapsen*  
 \_\_\_\_\_  
 Ronald G. Lapsen  
 Signature of Owner/Developer  
 Print name below signature

6/10/04  
 \_\_\_\_\_  
 Date

By the Engineer:

"I certify that this plan for erosion and sediment control represents a practical and workable plan based on my personal knowledge of the site conditions and that it was prepared in accordance with the requirements of the Howard Soil Conservation District."

*John S. Nolan*  
 \_\_\_\_\_  
 John S. Nolan, P.E.  
 Signature of Engineer  
 Print name below signature

6/10/04  
 \_\_\_\_\_  
 Date

Review for HOWARD S.C.D. and meets Technical Requirements

*J. M. Worfield*  
 \_\_\_\_\_  
 J. M. Worfield  
 U.S. Soil Conservation Service  
 Service

6/16/04  
 \_\_\_\_\_  
 Date

THIS DEVELOPMENT PLAN IS APPROVED FOR SOIL EROSION AND SEDIMENT CONTROL BY THE HOWARD SOIL CONSERVATION DISTRICT

*John R. Roberts*  
 \_\_\_\_\_  
 John R. Roberts  
 Howard S.C.D.

6/16/04  
 \_\_\_\_\_  
 Date

C179BZ01

DEPARTMENT OF PUBLIC WORKS HOWARD COUNTY, MARYLAND <i>Roman P. Lewis</i> 6/14/04 DIRECTOR OF PUBLIC WORKS DATE <i>Andrew M. Daniels</i> 6-14-04 CHIEF, BUREAU OF HIGHWAYS DATE	NOLAN ASSOCIATES, INC. ENGINEERS - CIVIL/STRUCTURAL/INSPECTIONS P.O. BOX 2579 COLUMBIA, MARYLAND 21045 PHONE: (410) 995-3851 FAX: (410) 995-1363		DES: Y.C.W. DRN: J.S.N. CHK: C.S.N. DATE: 05/18/04 BY: NO.	REVISION DATE:	TITLE SHEET 600' SCALE MAP NO. _____ BLOCK NO. _____	COURT AVENUE RETAINING WALL CAPITAL PROJECT J-4137 ELECTION DISTRICT NO. 2 ELICOTT CITY, MARYLAND	SCALE AS SHOWN SHEET 1 OF 5
---	--	--	--	-------------------	---	--	--------------------------------

**GENERAL NOTES**

SPECIFICATIONS: -HOWARD COUNTY DESIGN MANUAL VOLUME IV, DATED OCTOBER 1990  
 -SHA SPECIFICATIONS DATED OCTOBER 1993

AASHTO STANDARD SPECIFICATIONS FOR HIGHWAY BRIDGES DATED 1992 FOR DESIGN INCLUDING ALL INTERIM SPECIFICATIONS.

CONCRETE DESIGN: SERVICE LOAD DESIGN METHOD  
 FC=1,200 PSI.

REINFORCING STEEL DESIGN: FS=24,000 PSI.

LOADING: 2'-0" SURCHARGE


CONCRETE: ALL CONCRETE SHALL BE MIX NO. 3 (3,500 PSI).

REINFORCING STEEL: REINFORCING STEEL SHALL CONFORM TO ASTM A 615, GRADE 60. MINIMUM COVER FOR ANY BAR SHALL BE 2" UNLESS OTHERWISE NOTED. WITH THE EXCEPTION OF BARS AT THE BOTTOM AND SIDES OF ALL FOOTINGS WHICH SHALL HAVE 3" MINIMUM COVER.

ONLY GRADE 60 CAN BE USED ON THIS PROJECT

ALL KEYS ARE NOMINAL SIZE.

KEYS: EXISTING STRUCTURE: ALL DIMENSIONS AFFECTED BY THE GEOMETRICS, AND/OR LOCATION OF THE EXISTING STRUCTURE SHALL BE CHECKED IN THE FIELD BY THE CONTRACTOR, BEFORE ANY CONSTRUCTION IS DONE, AND BEFORE ANY REINFORCING STEEL, ETC., IS ORDERED OR FABRICATED. IT SHALL BE THE RESPONSIBILITY OF THE CONTRACTOR TO SUPPLY THE ENGINEER WITH ALL FIELD DIMENSIONS REQUIRED TO CHECK DETAIL DRAWINGS. THE ± MARKS SHOWN WITH DIMENSIONS AND STATIONS DO NOT INDICATE ANY DEGREE OF PRECISION. THE MARKS (±) INDICATE EXISTING DIMENSIONS AND STATIONS THAT MAY VARY AND DO REQUIRE FIELD VERIFICATION BY THE CONTRACTOR.

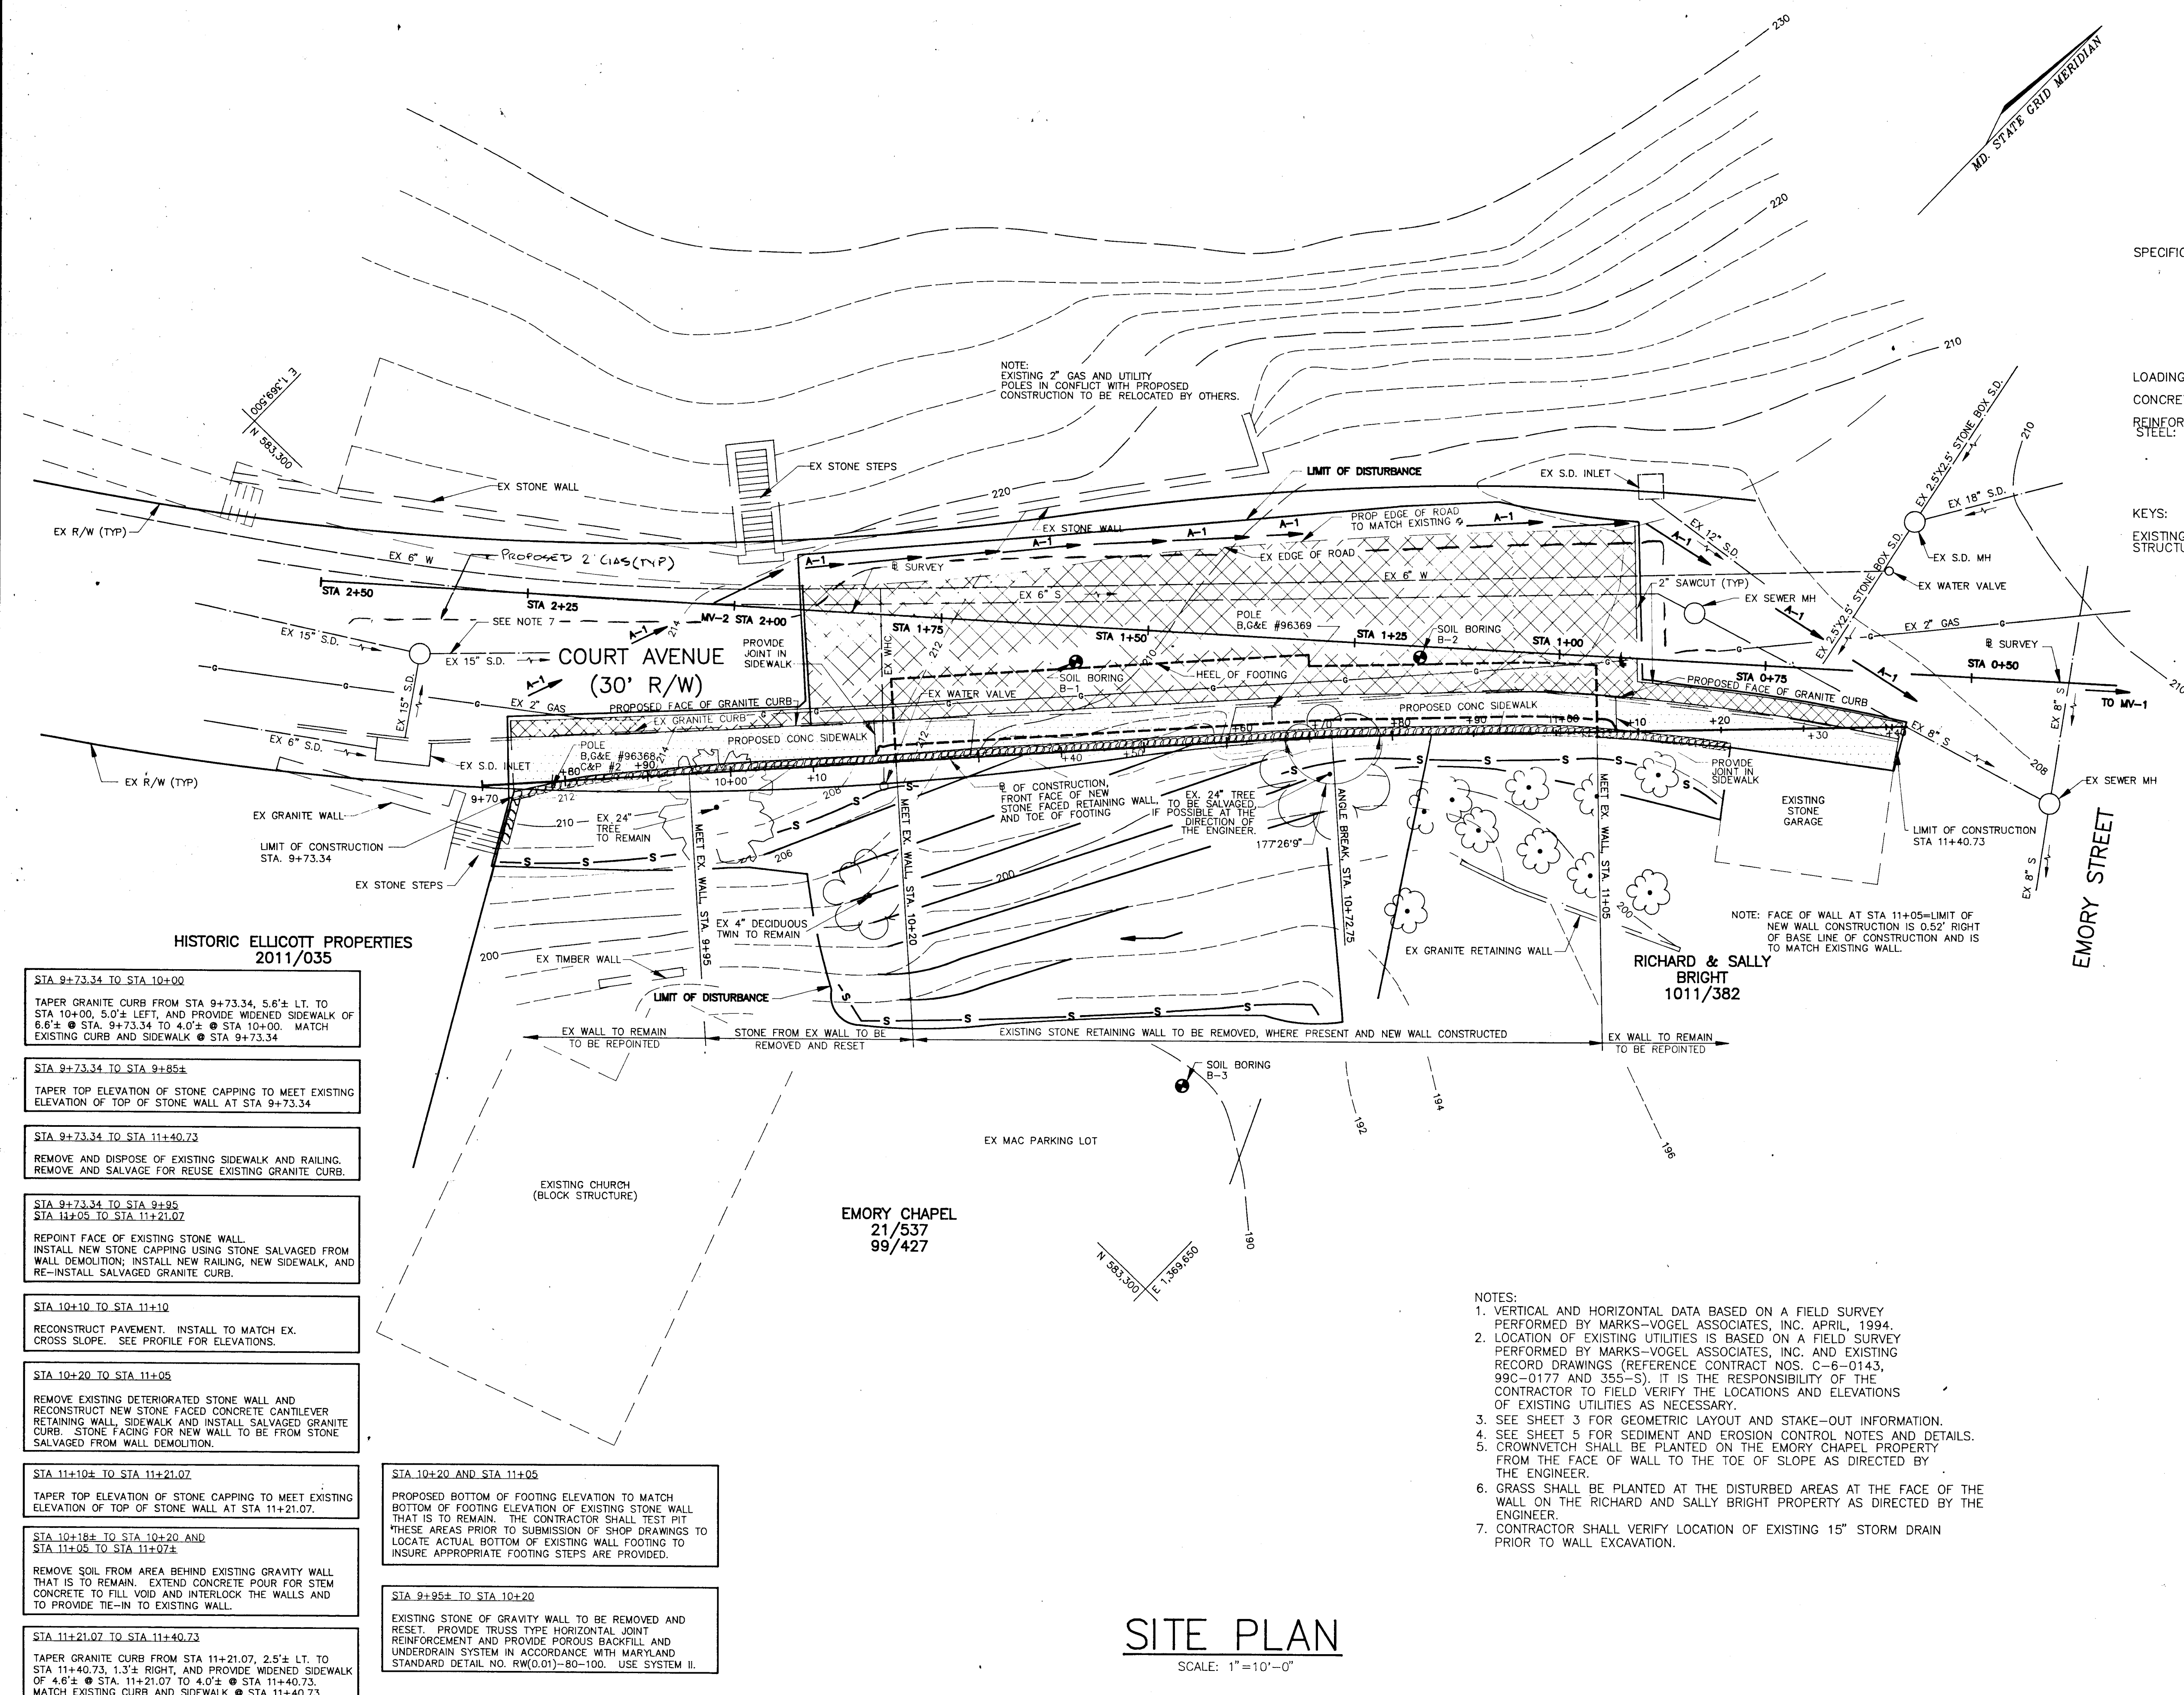

- HISTORIC ELLICOTT PROPERTIES 2011/035**
- STA 9+73.34 TO STA 10+00  
 TAPER GRANITE CURB FROM STA 9+73.34, 5.6'± LT. TO STA 10+00, 5.0'± LEFT, AND PROVIDE WIDENED SIDEWALK OF 8.8'± @ STA 9+73.34 TO 4.0'± @ STA 10+00. MATCH EXISTING CURB AND SIDEWALK @ STA 9+73.34
  - STA 9+73.34 TO STA 9+85±  
 TAPER TOP ELEVATION OF STONE CAPPING TO MEET EXISTING ELEVATION OF TOP OF STONE WALL AT STA 9+73.34
  - STA 9+73.34 TO STA 11+40.73  
 REMOVE AND DISPOSE OF EXISTING SIDEWALK AND RAILING. REMOVE AND SALVAGE FOR REUSE EXISTING GRANITE CURB.
  - STA 9+73.34 TO STA 9+95  
 STA 11+05 TO STA 11+21.07  
 REPOINT FACE OF EXISTING STONE WALL. INSTALL NEW STONE CAPPING USING STONE SALVAGED FROM WALL DEMOLITION; INSTALL NEW RAILING, NEW SIDEWALK, AND RE-INSTALL SALVAGED GRANITE CURB.
  - STA 10+10 TO STA 11+10  
 RECONSTRUCT PAVEMENT. INSTALL TO MATCH EX. CROSS SLOPE. SEE PROFILE FOR ELEVATIONS.
  - STA 10+20 TO STA 11+05  
 REMOVE EXISTING DETERIORATED STONE WALL AND RECONSTRUCT NEW STONE FACED CONCRETE CANTILEVER RETAINING WALL, SIDEWALK AND INSTALL SALVAGED GRANITE CURB. STONE FACING FOR NEW WALL TO BE FROM STONE SALVAGED FROM WALL DEMOLITION.
  - STA 11+10± TO STA 11+21.07  
 PROPOSED BOTTOM OF FOOTING ELEVATION TO MATCH BOTTOM OF FOOTING ELEVATION OF EXISTING STONE WALL THAT IS TO REMAIN. THE CONTRACTOR SHALL TEST PIT THESE AREAS PRIOR TO SUBMISSION OF SHOP DRAWINGS TO LOCATE ACTUAL BOTTOM OF EXISTING WALL FOOTING TO INSURE APPROPRIATE FOOTING STEPS ARE PROVIDED.
  - STA 9+95± TO STA 10+20  
 EXISTING STONE OF GRAVITY WALL TO BE REMOVED AND RESET. PROVIDE TRUSS TYPE HORIZONTAL JOINT REINFORCEMENT AND PROVIDE POROUS BACKFILL AND UNDERDRAIN SYSTEM IN ACCORDANCE WITH MARYLAND STANDARD DETAIL NO. RW(0.01)-80-100. USE SYSTEM II.
  - STA 10+10± TO STA 10+20 AND STA 11+05± TO STA 11+07±  
 REMOVE SOIL FROM AREA BEHIND EXISTING GRAVITY WALL THAT IS TO REMAIN. EXTEND CONCRETE POUR FOR STEM CONCRETE TO FILL VOID AND INTERLOCK THE WALLS AND TO PROVIDE TIE-IN TO EXISTING WALL.
  - STA 11+21.07 TO STA 11+40.73  
 TAPER GRANITE CURB FROM STA 11+21.07, 2.5'± LT. TO STA 11+40.73, 1.3'± RIGHT, AND PROVIDE WIDENED SIDEWALK OF 4.6'± @ STA 11+21.07 TO 4.0'± @ STA 11+40.73. MATCH EXISTING CURB AND SIDEWALK @ STA 11+40.73.

**LEGEND**

- STONE WALL FACING OR STONE CAPPING
- PROPOSED SIDEWALK
- PROPOSED ROAD RECONSTRUCTION
- A-1 TYPE A-1 EARTH DIKE
- S-S SILT FENCE
- 2 FT CONTOUR
- 10 FT CONTOUR
- EX SEWER LINE
- EX WATER LINE
- EX STORM DRAIN
- EX RIGHT-OF-WAY
- SOIL BORING
- EX TREE
- EX 2" GAS
- PROP GRADE

- NOTES:**
- VERTICAL AND HORIZONTAL DATA BASED ON A FIELD SURVEY PERFORMED BY MARKS-VOGEL ASSOCIATES, INC. APRIL, 1994.
  - LOCATION OF EXISTING UTILITIES IS BASED ON A FIELD SURVEY PERFORMED BY MARKS-VOGEL ASSOCIATES, INC. AND EXISTING RECORD DRAWINGS (REFERENCE CONTRACT NOS. C-6-0143, 99C-0177 AND 355-S). IT IS THE RESPONSIBILITY OF THE CONTRACTOR TO FIELD VERIFY THE LOCATIONS AND ELEVATIONS OF EXISTING UTILITIES AS NECESSARY.
  - SEE SHEET 3 FOR GEOMETRIC LAYOUT AND STAKE-OUT INFORMATION.
  - SEE SHEET 5 FOR SEDIMENT AND EROSION CONTROL NOTES AND DETAILS.
  - CROWNVECH SHALL BE PLANTED ON THE EMORY CHAPEL PROPERTY FROM THE FACE OF WALL TO THE TOE OF SLOPE AS DIRECTED BY THE ENGINEER.
  - GRASS SHALL BE PLANTED AT THE DISTURBED AREAS AT THE FACE OF THE WALL ON THE RICHARD AND SALLY BRIGHT PROPERTY AS DIRECTED BY THE ENGINEER.
  - CONTRACTOR SHALL VERIFY LOCATION OF EXISTING 15" STORM DRAIN PRIOR TO WALL EXCAVATION.


**SITE PLAN**

SCALE: 1"=10'-0"

DEPARTMENT OF PUBLIC WORKS HOWARD COUNTY, MARYLAND DATE: 6/10/04 CHIEF, BUREAU OF ENGINEERING		NOLAN ASSOCIATES, INC. ENGINEERS - CIVIL/STRUCTURAL/INSPECTIONS P.O. BOX 2579 COLUMBIA, MARYLAND 21045 PHONE: (410) 995-9851 FAX: (410) 995-1983		DES: Y.C.W. DRN: J.S.N. CHK: C.S.N. DATE: 05/18/94		SITE PLAN AND GENERAL NOTES 600' SCALE MAP NO. _____ BLOCK NO. _____		COURT AVENUE RETAINING WALL CAPITAL PROJECT J-4137 ELECTION DISTRICT NO. 2 ELLICOTT CITY, MARYLAND		SCALE AS SHOWN SHEET 2 OF 5
--	--	--	--	---	--	---	--	---	--	--------------------------------


HOWARD COUNTY BENCH MARK BM B-3143-AD  
 IRON ROD SET FLUSH IN TOP OF CONCRETE CURB OF COURT AVENUE  
 ELEV. 217.712

BENCH MARK MV-2  
 PK NAIL AT STA. 2+00 SURVEY IN COURT AVENUE

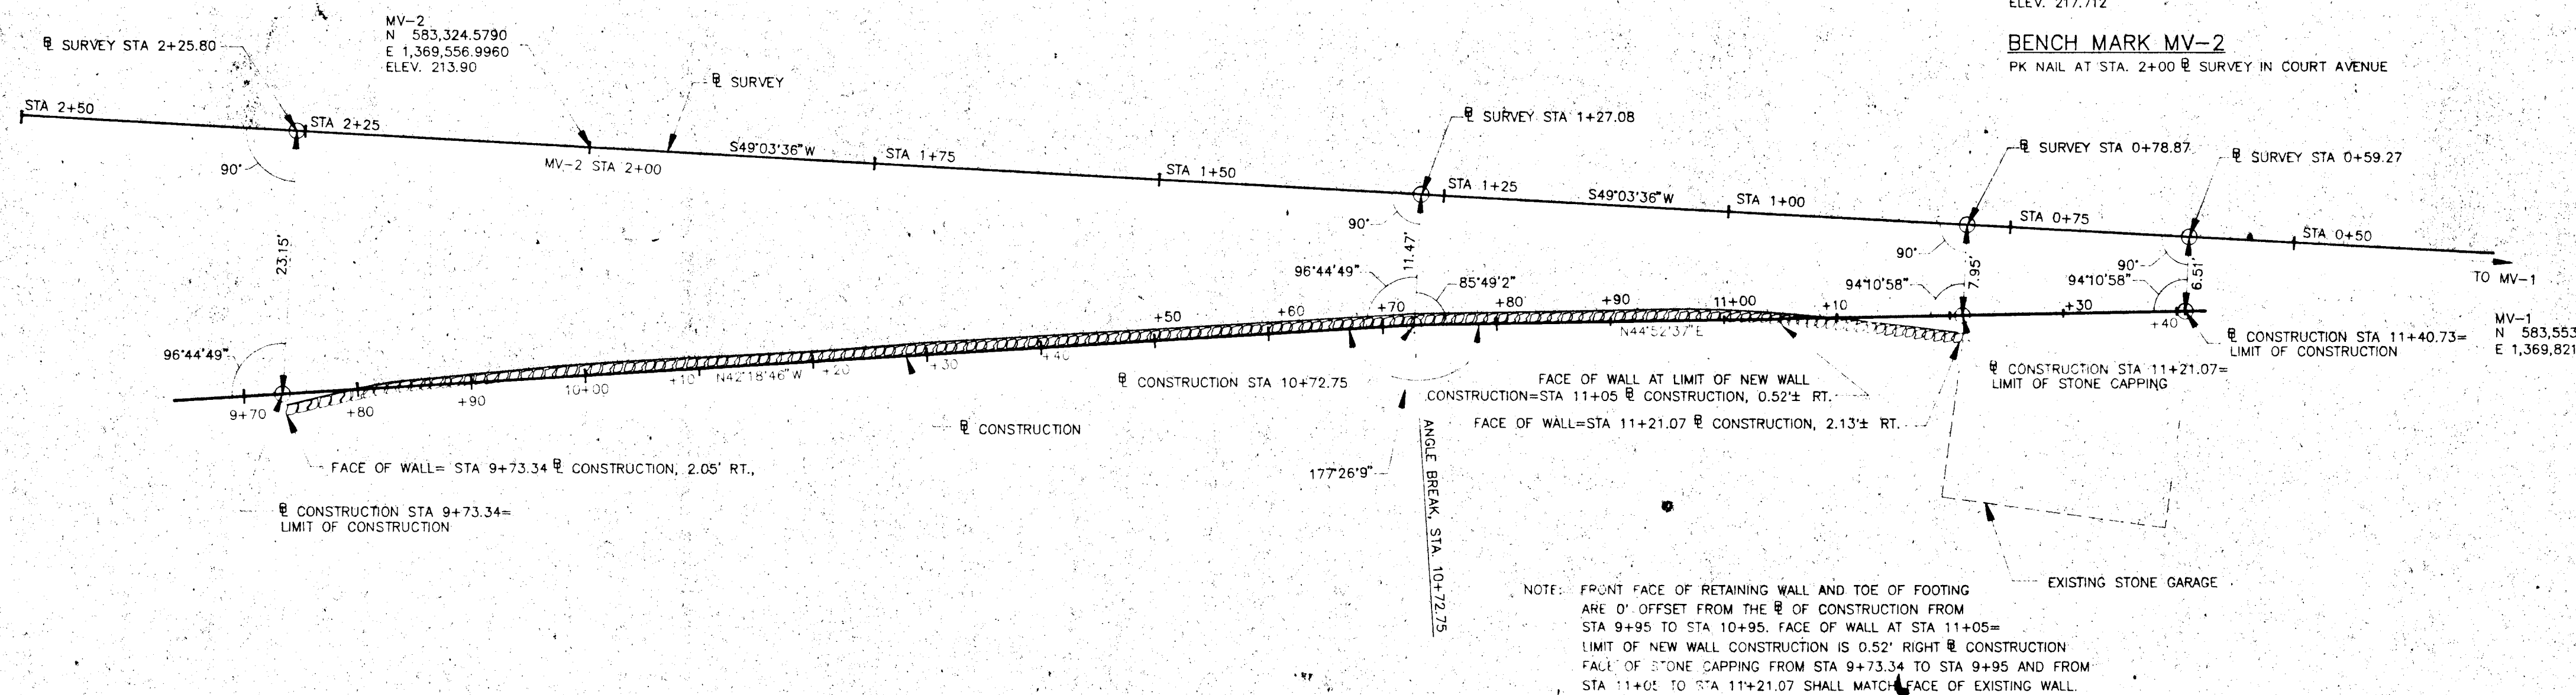

**GEOMETRIC LAYOUT AND STAKEOUT PLAN**

SCALE: 1"=10'-0"

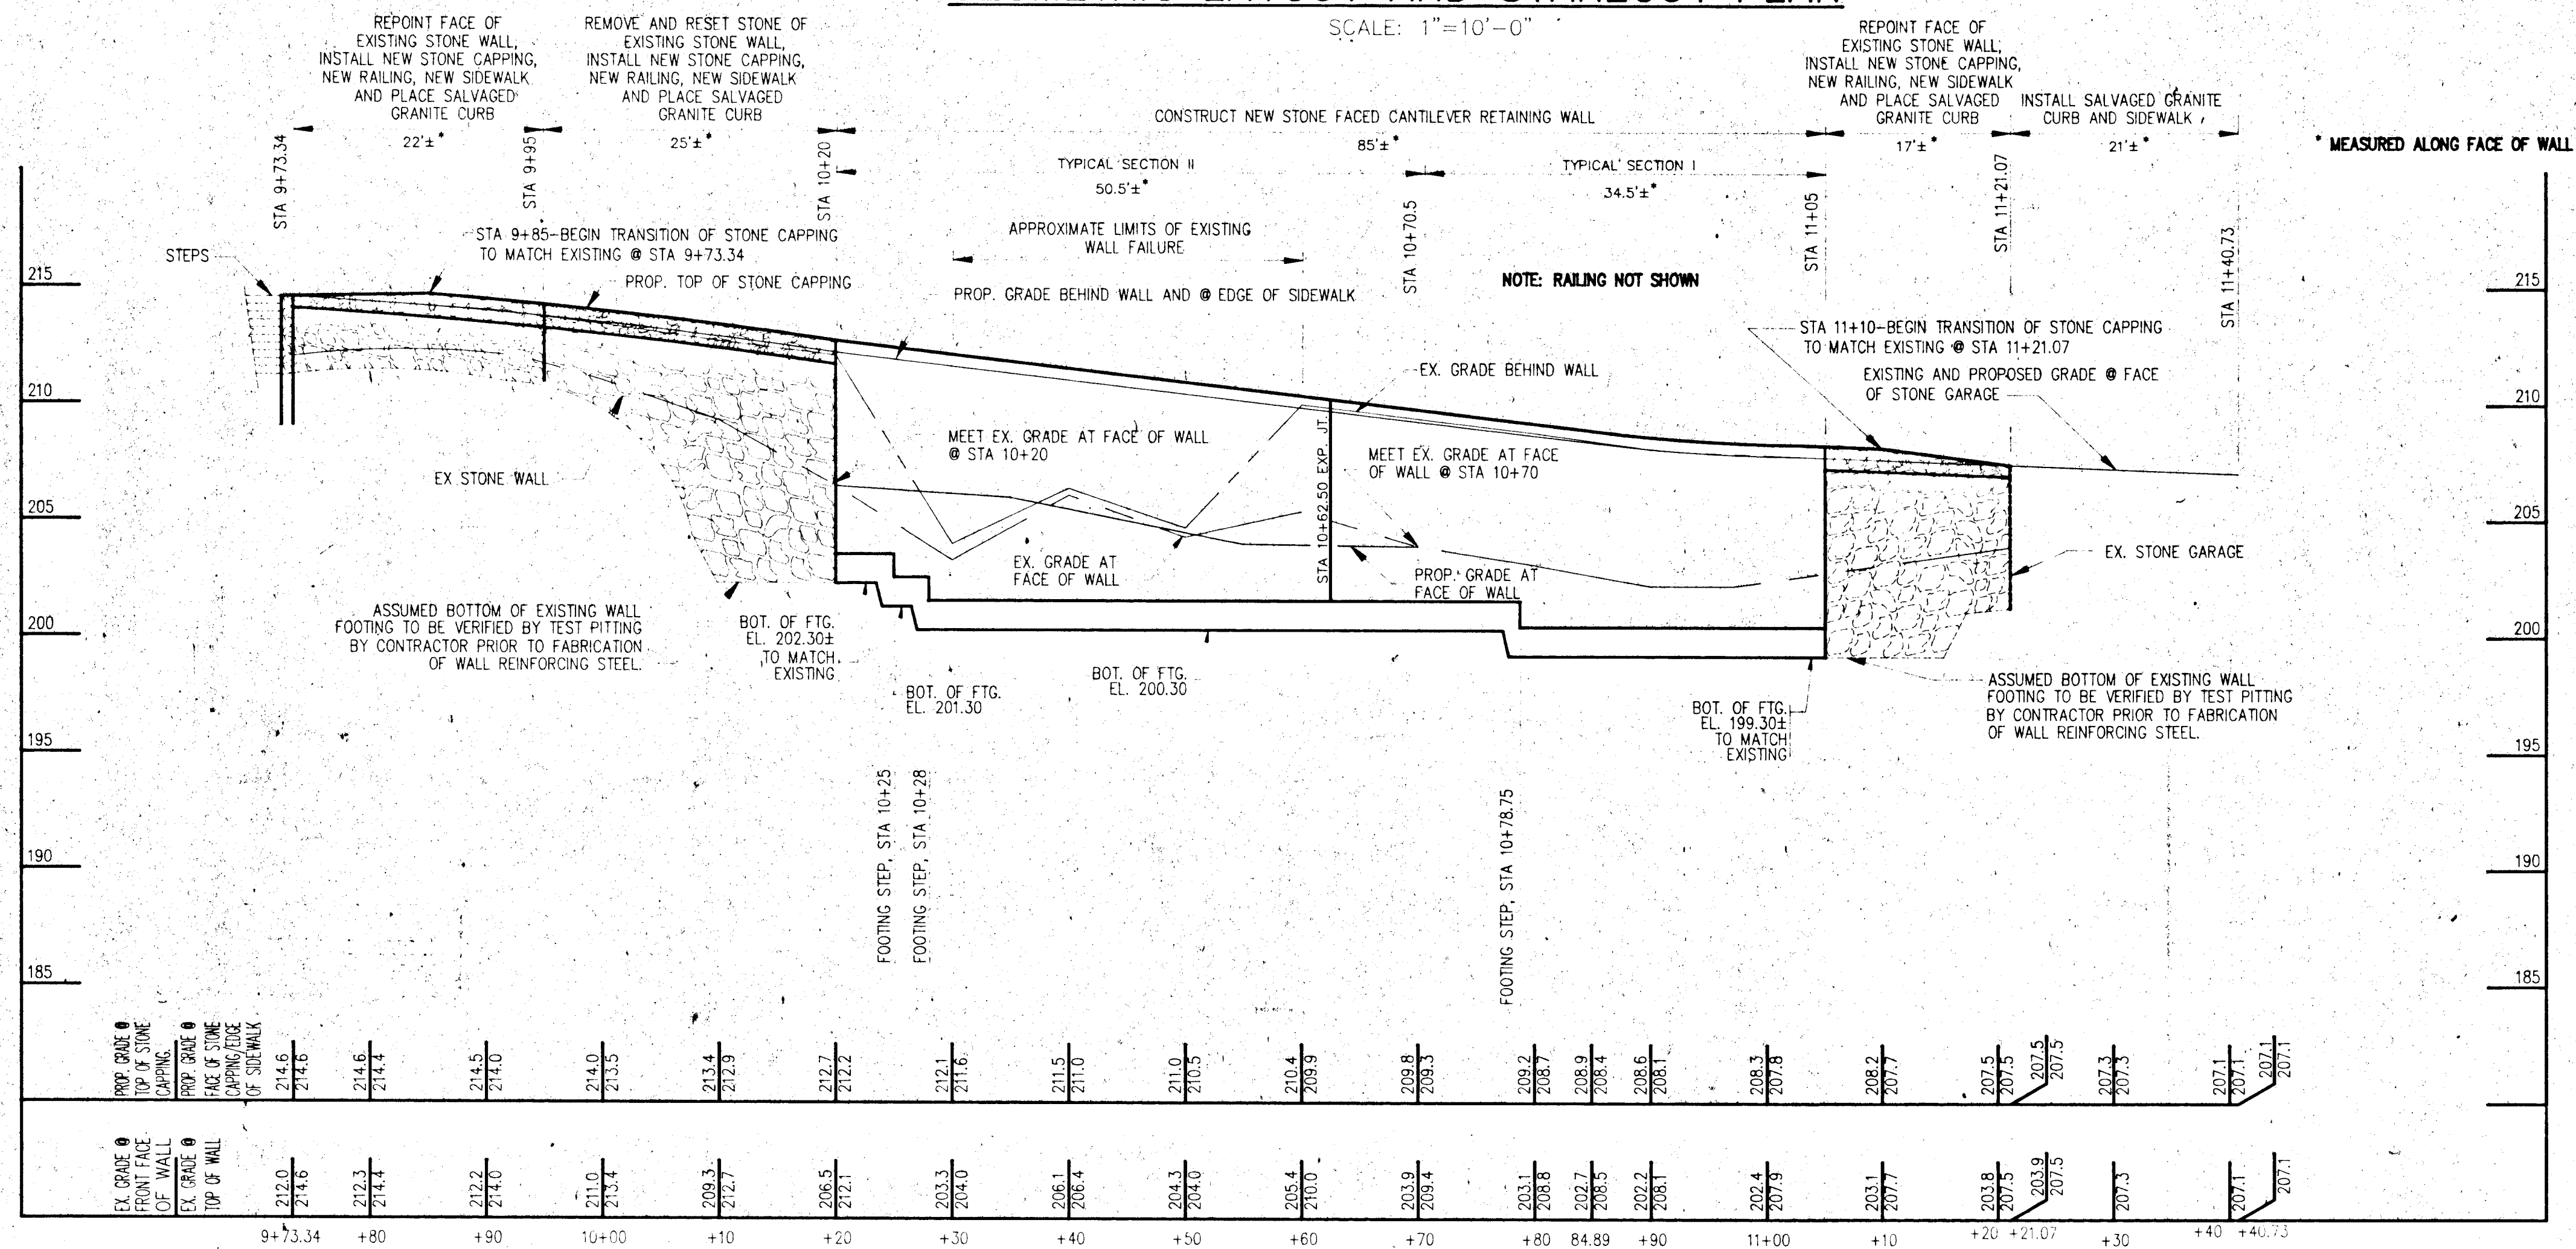

**WALL ELEVATION**

SCALE: HORIZONTAL 1"=10'-0"  
 VERTICAL 1"=5'-0"

CONTRACTED WITH: **NOLAN ASSOC.** BORING # 1 PAGE 1 of 1  
 PROJECT NAME: **Court Ave Howard Co** JOB # 94043  
 LOCATION: **Ellicott City Md**  
 Datum: **Hammer Drop** Lbs Hole Diameter: **8"** Foreman: **B. J. Taylor**  
 Surface Elev: **Fl** Hammer Drop: **30** in Rock Core Diam: **Inspector**  
 Date Started: **3-23-94** Pipe Size: **30** in Boring Method: **HSA** Date Completed: **3-23-94**

ELEVATION	SOIL DESCRIPTION	STRATA DEPTH	DEPTH SCALE	SAMPLE	BORING & SAMPLING NOTES
1.5'	Asphalt concrete	1.5'-0.0'			
2.5'	Brown, Grey, Green & White Moist med Dense to loose to very dense micaceous fine sand w/ decomposed rock & quartz.	2.5'-0.0'	1	1 2/3 14	
5.0'		5.0'-0.0'	2	2 2/3 10	
7.5'		7.5'-0.0'	3	3 2/3 8	
10.0'		10.0'-0.0'	4	4 2/3 3	
15.0'		15.0'-0.0'	5 1/2		
18.3'	End of Boring	18.3'			Encountered Rock @ 18.3' Auger Refusal 18.3'

CONTRACTED WITH: **NOLAN ASSOC.** BORING # 2 PAGE 1 of 1  
 PROJECT NAME: **Court Ave Howard Co** JOB # 94043  
 LOCATION: **Ellicott City Md**  
 Datum: **Hammer Drop** Lbs Hole Diameter: **8"** Foreman: **B. J. Taylor**  
 Surface Elev: **Fl** Hammer Drop: **30** in Rock Core Diam: **Inspector**  
 Date Started: **3-23-94** Pipe Size: **30** in Boring Method: **HSA** Date Completed: **3-23-94**

ELEVATION	SOIL DESCRIPTION	STRATA DEPTH	DEPTH SCALE	SAMPLE	BORING & SAMPLING NOTES
1.3'	Asphalt concrete	1.3'-0.0'			
2.5'	Brown, Grey, Green, & White Moist med Dense to very loose to very dense micaceous silty sand w/ decomposed rock & quartz.	2.5'-0.0'	1	1 2/3 10	Bag Sample taken from 1.5-8.5
5.0'		5.0'-0.0'	2	2 2/3 5	
7.5'		7.5'-0.0'	3	3 2/3 5	
10.0'		10.0'-0.0'	4	4 2/3 5	
14.3'	End of Boring	14.3'			Encountered Rock @ 14.3' Auger Refusal @ 14.3'

CONTRACTED WITH: **NOLAN ASSOC.** BORING # 3 PAGE 1 of 1  
 PROJECT NAME: **Court Ave Howard Co** JOB # 94043  
 LOCATION: **Ellicott City Md**  
 Datum: **Hammer Drop** Lbs Hole Diameter: **8"** Foreman: **B. J. Taylor**  
 Surface Elev: **Fl** Hammer Drop: **30** in Rock Core Diam: **Inspector**  
 Date Started: **3-23-94** Pipe Size: **30** in Boring Method: **HSA** Date Completed: **3-23-94**


ELEVATION	SOIL DESCRIPTION	STRATA DEPTH	DEPTH SCALE	SAMPLE	BORING & SAMPLING NOTES
1.0'	Asphalt concrete	1.0'-0.0'			
2.5'	Brown, Grey, Black, Moist med Dense to loose fine micaceous silty sand w/ decomposed rock & quartz.	2.5'-0.0'	1	1 2/3 12	
5.0'		5.0'-0.0'	3	3 2/3 18	
7.5'		7.5'-0.0'	8	8 2/3 14	
9.0'		9.0'-0.0'	8	8 2/3 9	End of boring? Rock @ 8.5'

SAMPLE CONDITIONS	SAMPLER TYPE	GROUNDWATER DEPTH	FI	BORING METHOD
D - Desiccated	DS - Driven Split Spoon	At Completion	FI	HSA - Hollow Stem Auger
I - Intact	PT - Pressed Shelby Tube	Alter / Hrs	FI	CFA - Continuous Flight Auger
U - Undisturbed	CA - Continuous Flight Auger	Alter / 24 Hrs	FI	DC - Driving Casing
L - Lost	RC - Rock Core			MD - Mud Drilling

STANDARD PENETRATION TEST DRIVING 2 in OD SAMPLER 1 ft WITH 140 lb HAMMER FALLING 30 in. COUNT MADE AT 5 in INTERVALS

DEPARTMENT OF PUBLIC WORKS  
 HOWARD COUNTY, MARYLAND  
 Director of Public Works: **James J. Lewis** DATE: **6/10/94**  
 Chief, Bureau of Engineering: **Robert J. Esom** DATE: **6/10/94**  
 Chief, Bureau of Highways: **Andrew M. Daniel** DATE: **6/14/94**  
 Chief, Division of Transportation Projects and Watershed Management: **Elvira M. Williams** DATE: **6/10/94**

**NOLAN ASSOCIATES, INC.**  
 ENGINEERS - CIVIL/STRUCTURAL/INSPECTIONS  
 P.O. BOX 2579  
 COLUMBIA, MARYLAND 21045  
 PHONE: (410) 995-9651 FAX: (410) 995-1363

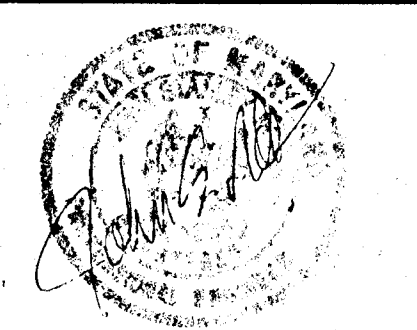


DES: Y.C.W.			
DRN: J.S.N.			
CHK: C.S.N.			
DATE: 05/18/94			
BY: NO.		REVISION	
		DATE	

**GEOMETRIC LAYOUT WALL ELEVATION AND BORING LOGS**  
 600' SCALE MAP NO. \_\_\_\_\_ BLOCK NO. \_\_\_\_\_

**COURT AVENUE RETAINING WALL**  
 CAPITAL PROJECT J-4137  
 ELECTION DISTRICT NO. 2  
 ELICOTT CITY, MARYLAND


SCALE AS SHOWN  
 SHEET 3 OF 5



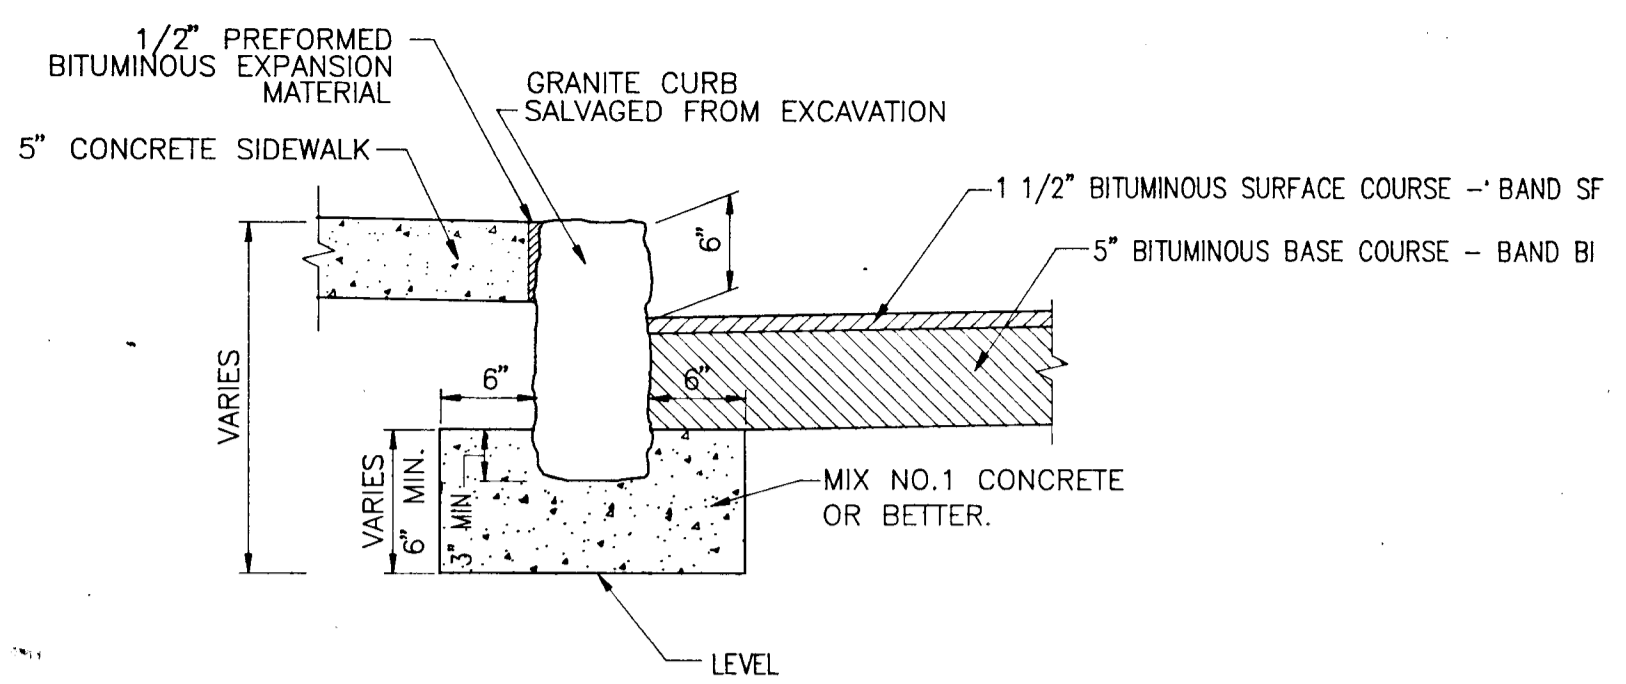

**GRANITE CURB DETAIL**

NOT TO SCALE

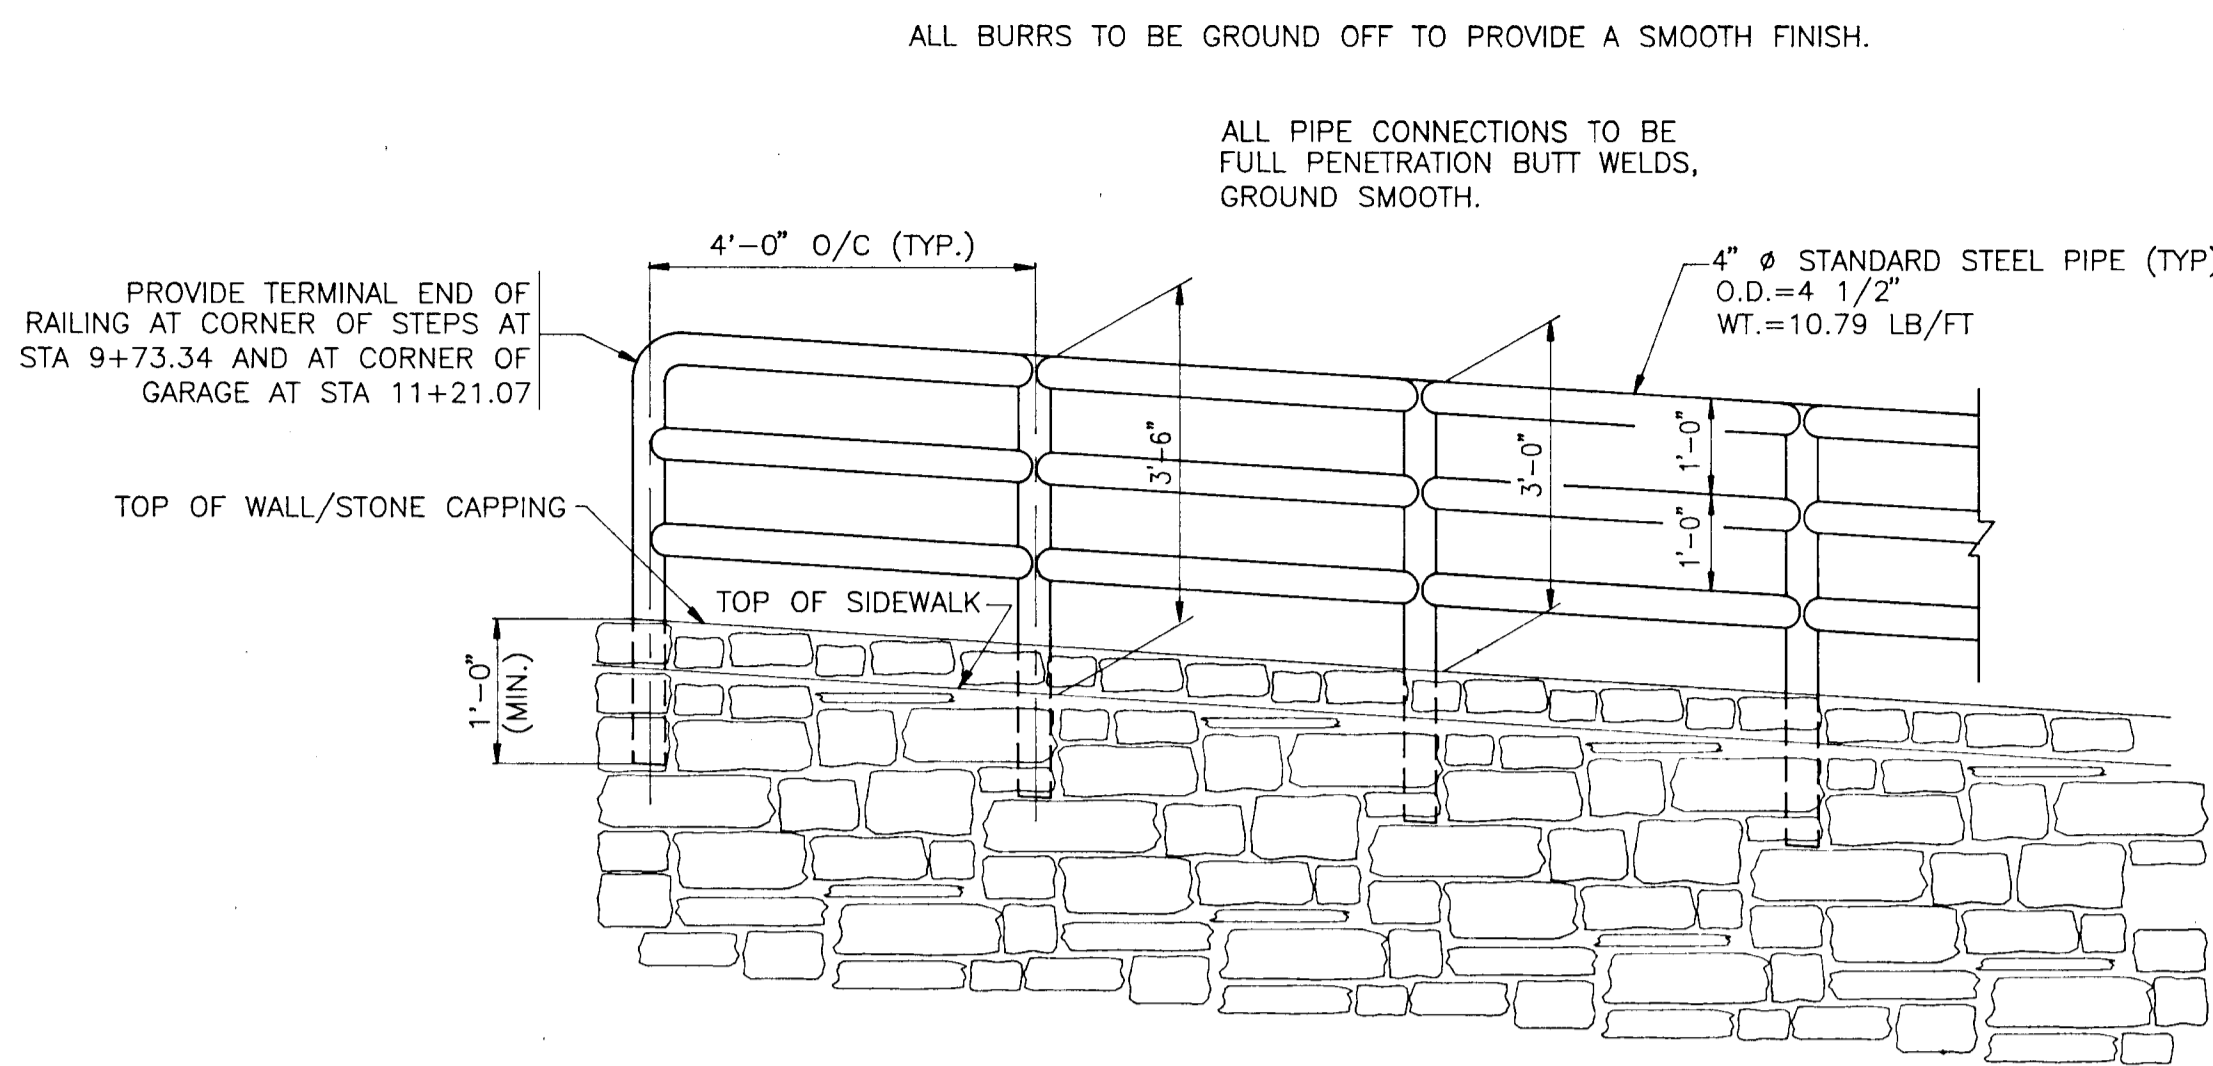


**TYPICAL RAILING ELEVATION**

SCALE: 1/2"=1'-0"


**GENERAL RAILING NOTES**

1. STEEL SHALL CONFORM TO ASTM A-53, STANDARD STRENGTH.
2. WELDMENTS SHALL BE THOROUGHLY CLEANED AFTER FABRICATION.
3. ENTIRE RAILING SHALL BE PAINTED AS FOLLOWS:
  - A. PRIMER PRETREATMENT CONFORMING TO FEDERAL SPECIFICATION MIL-P-15328 B (FORMULA 117)
  - B. ONE COAT OF SSPC PAINT 25 SHOP COAT - SEE LATEST SHA SPECIFICATION
  - C. ONE COAT OF SSPC PAINT 25 TINTED-FIRST FIELD COAT - SEE LATEST SHA SPECIFICATIONS.
  - D. ONE COAT OF GRAY ALKYD - SECOND FIELD COAT. SEE LATEST SHA SPECIFICATIONS.
  - E. A FINISH COAT OF BLACK EQUIPMENT ENAMEL - SEE LATEST SHA SPECIFICATIONS.

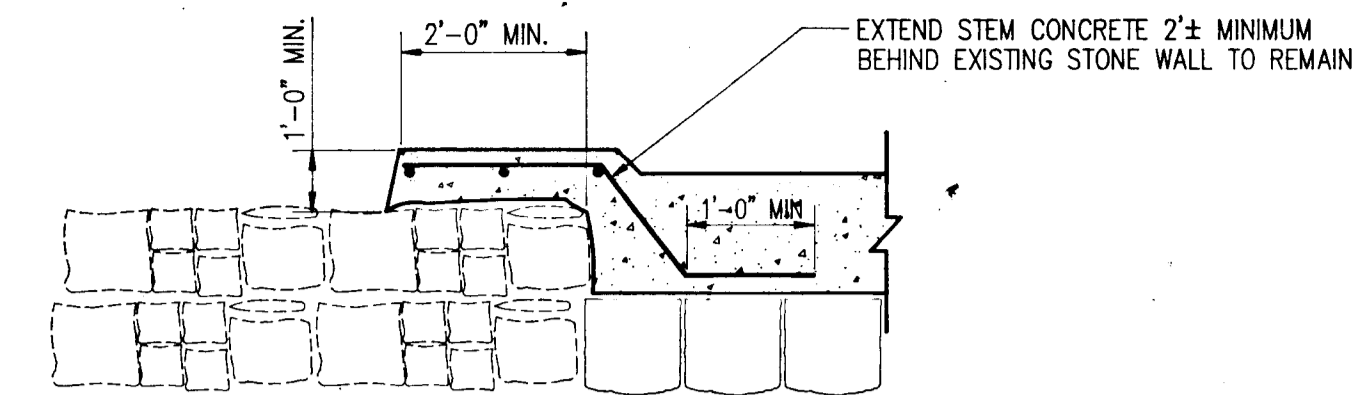


**WALL END DETAIL AT EXISTING WALL**

NOT TO SCALE

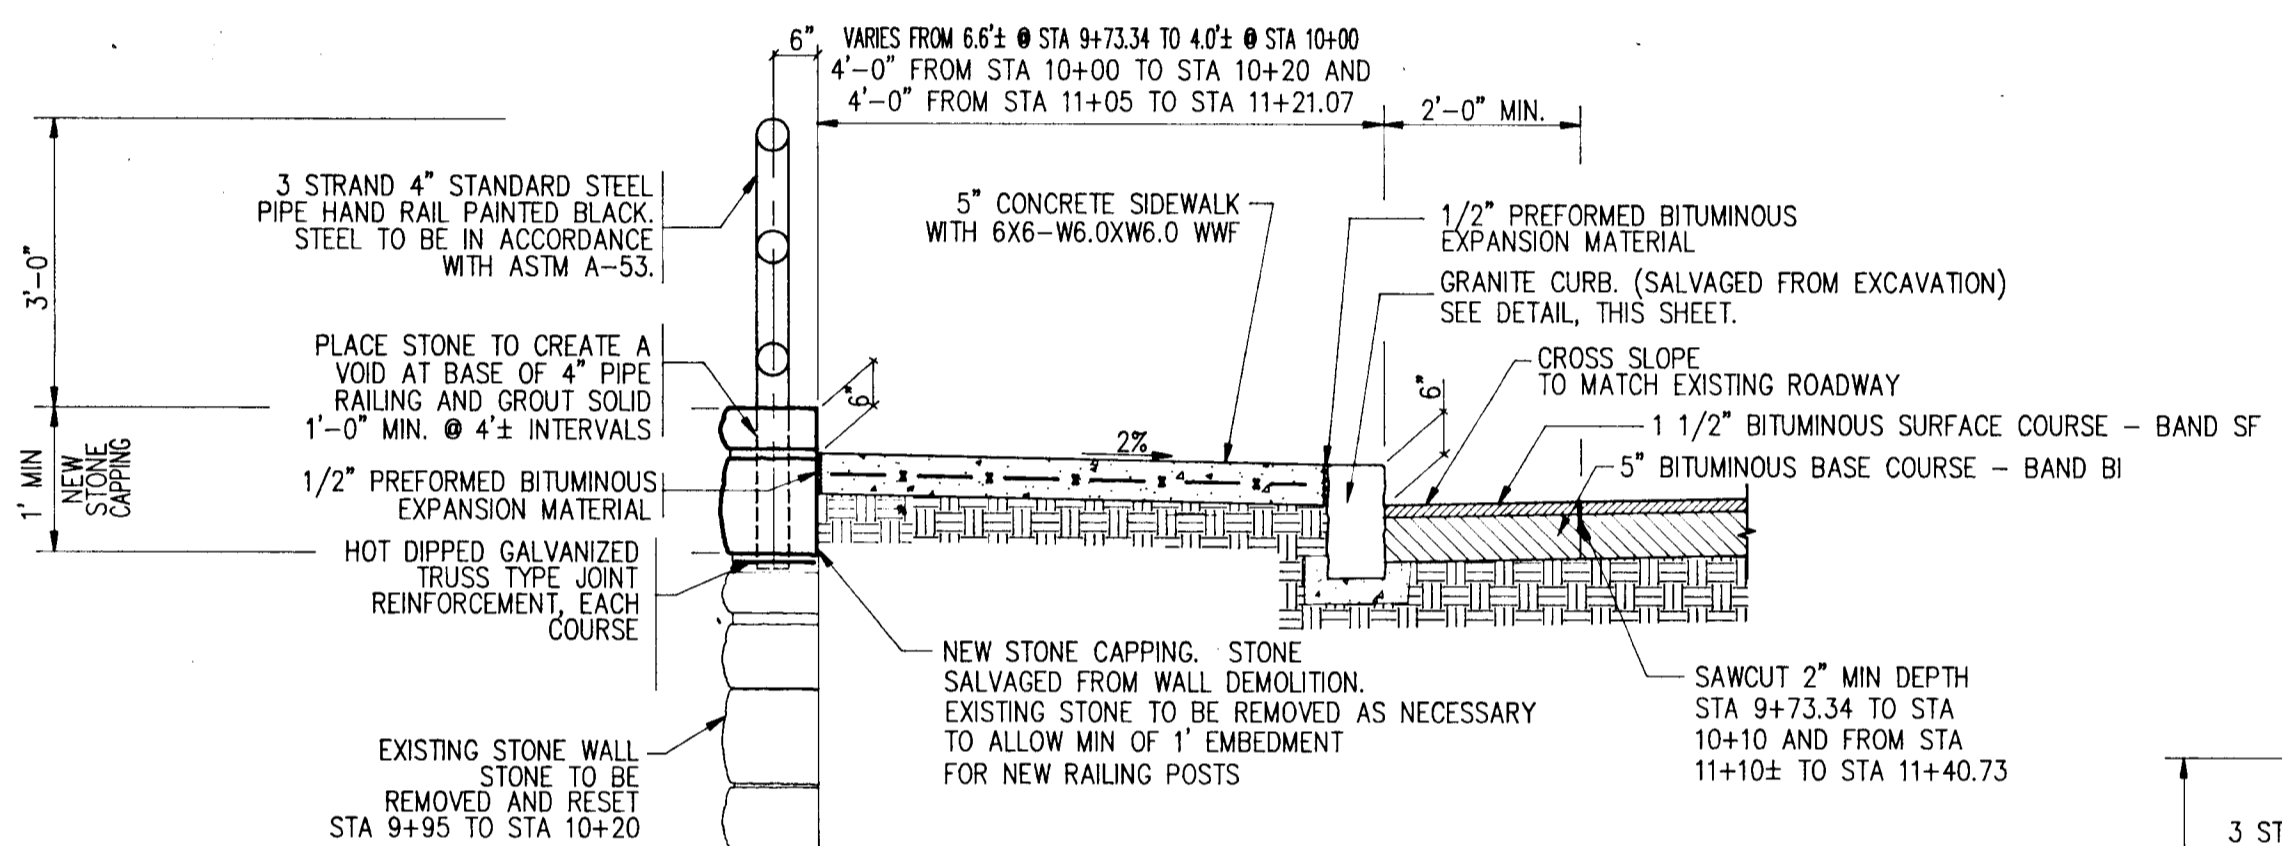


**TYPICAL SECTION  
STA 9+73.34 TO STA 10+20  
STA 11+05 TO STA 11+21.07**

SCALE: 1/2"=1'-0"

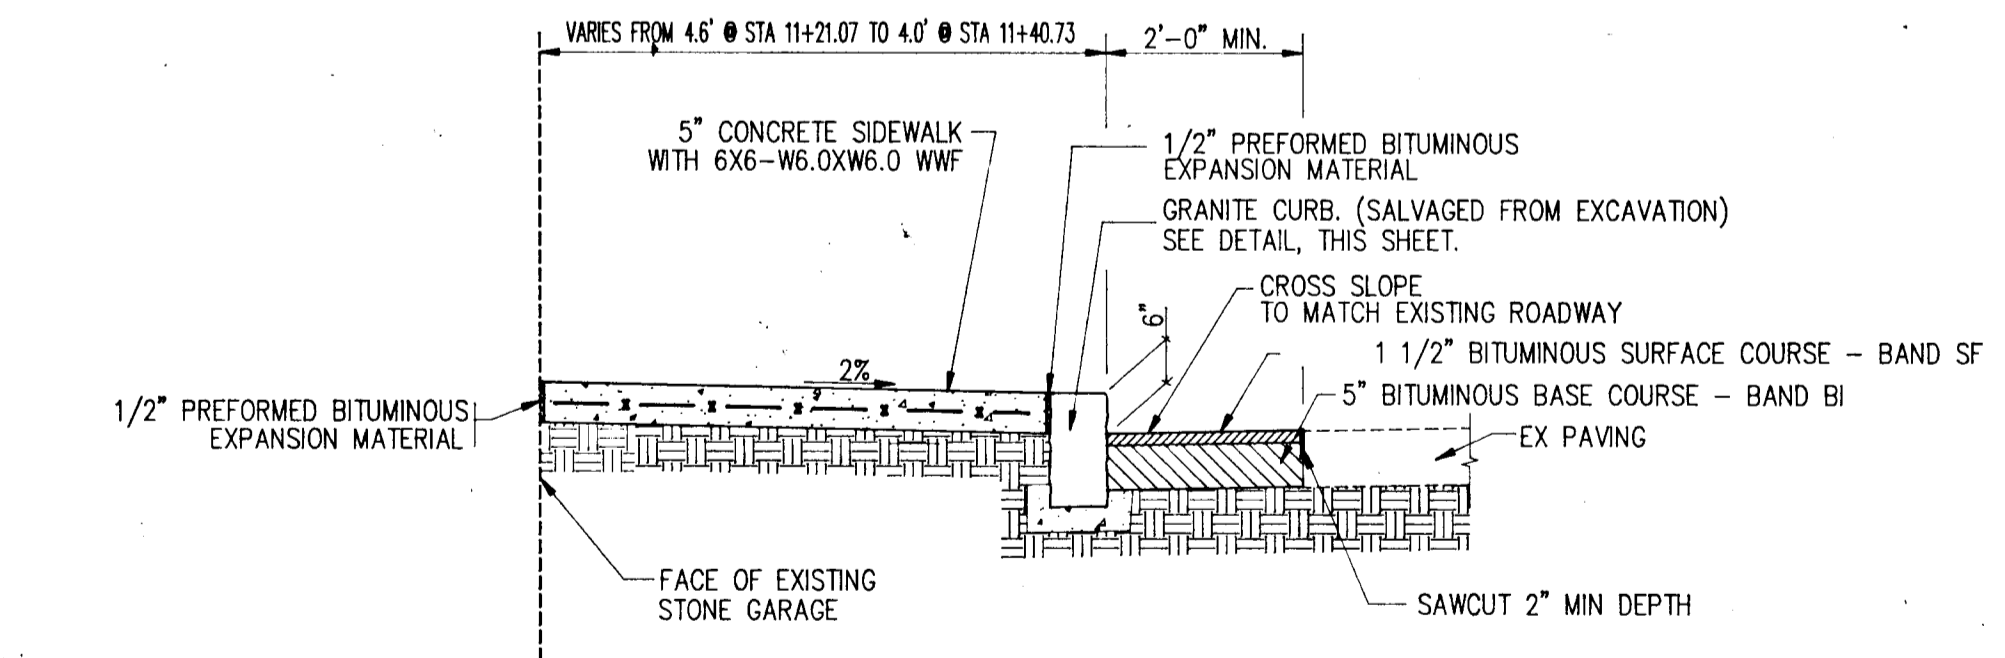


**TYPICAL SECTION  
STA 11+21.07 TO STA 11+40.73**

SCALE: 1/2"=1'-0"

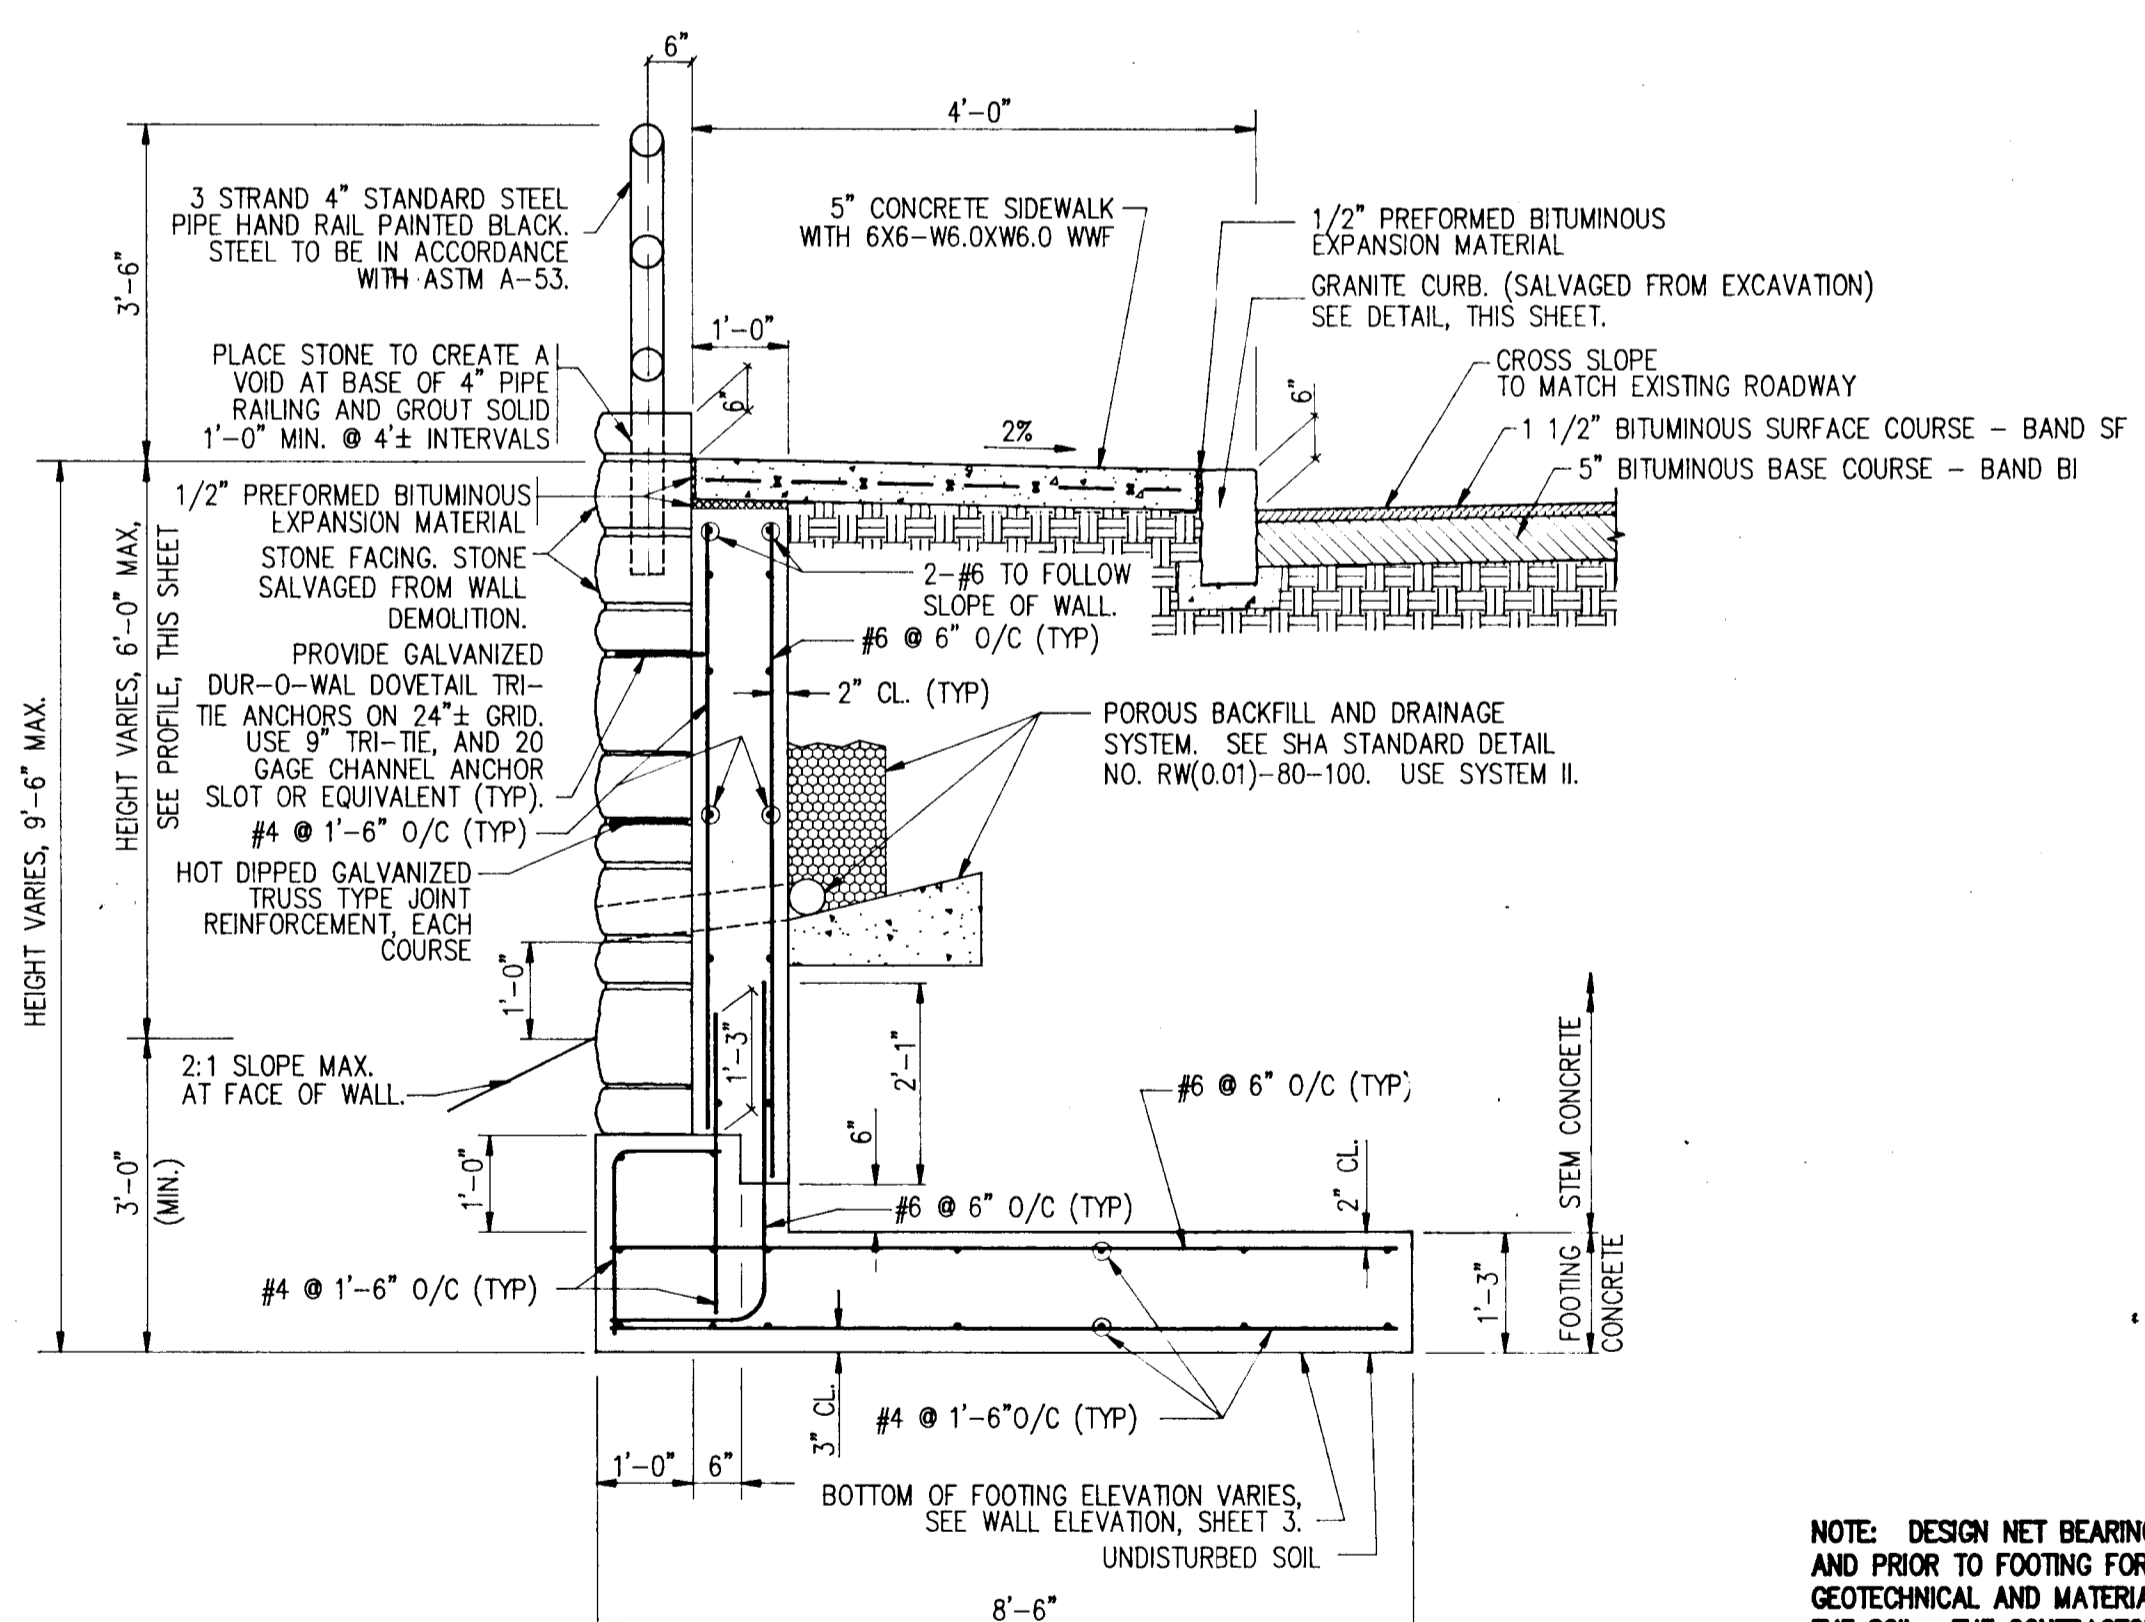

**TYPICAL SECTION I  
STA 10+70.50 TO STA 11+05**

SCALE: 1/2"=1'-0"

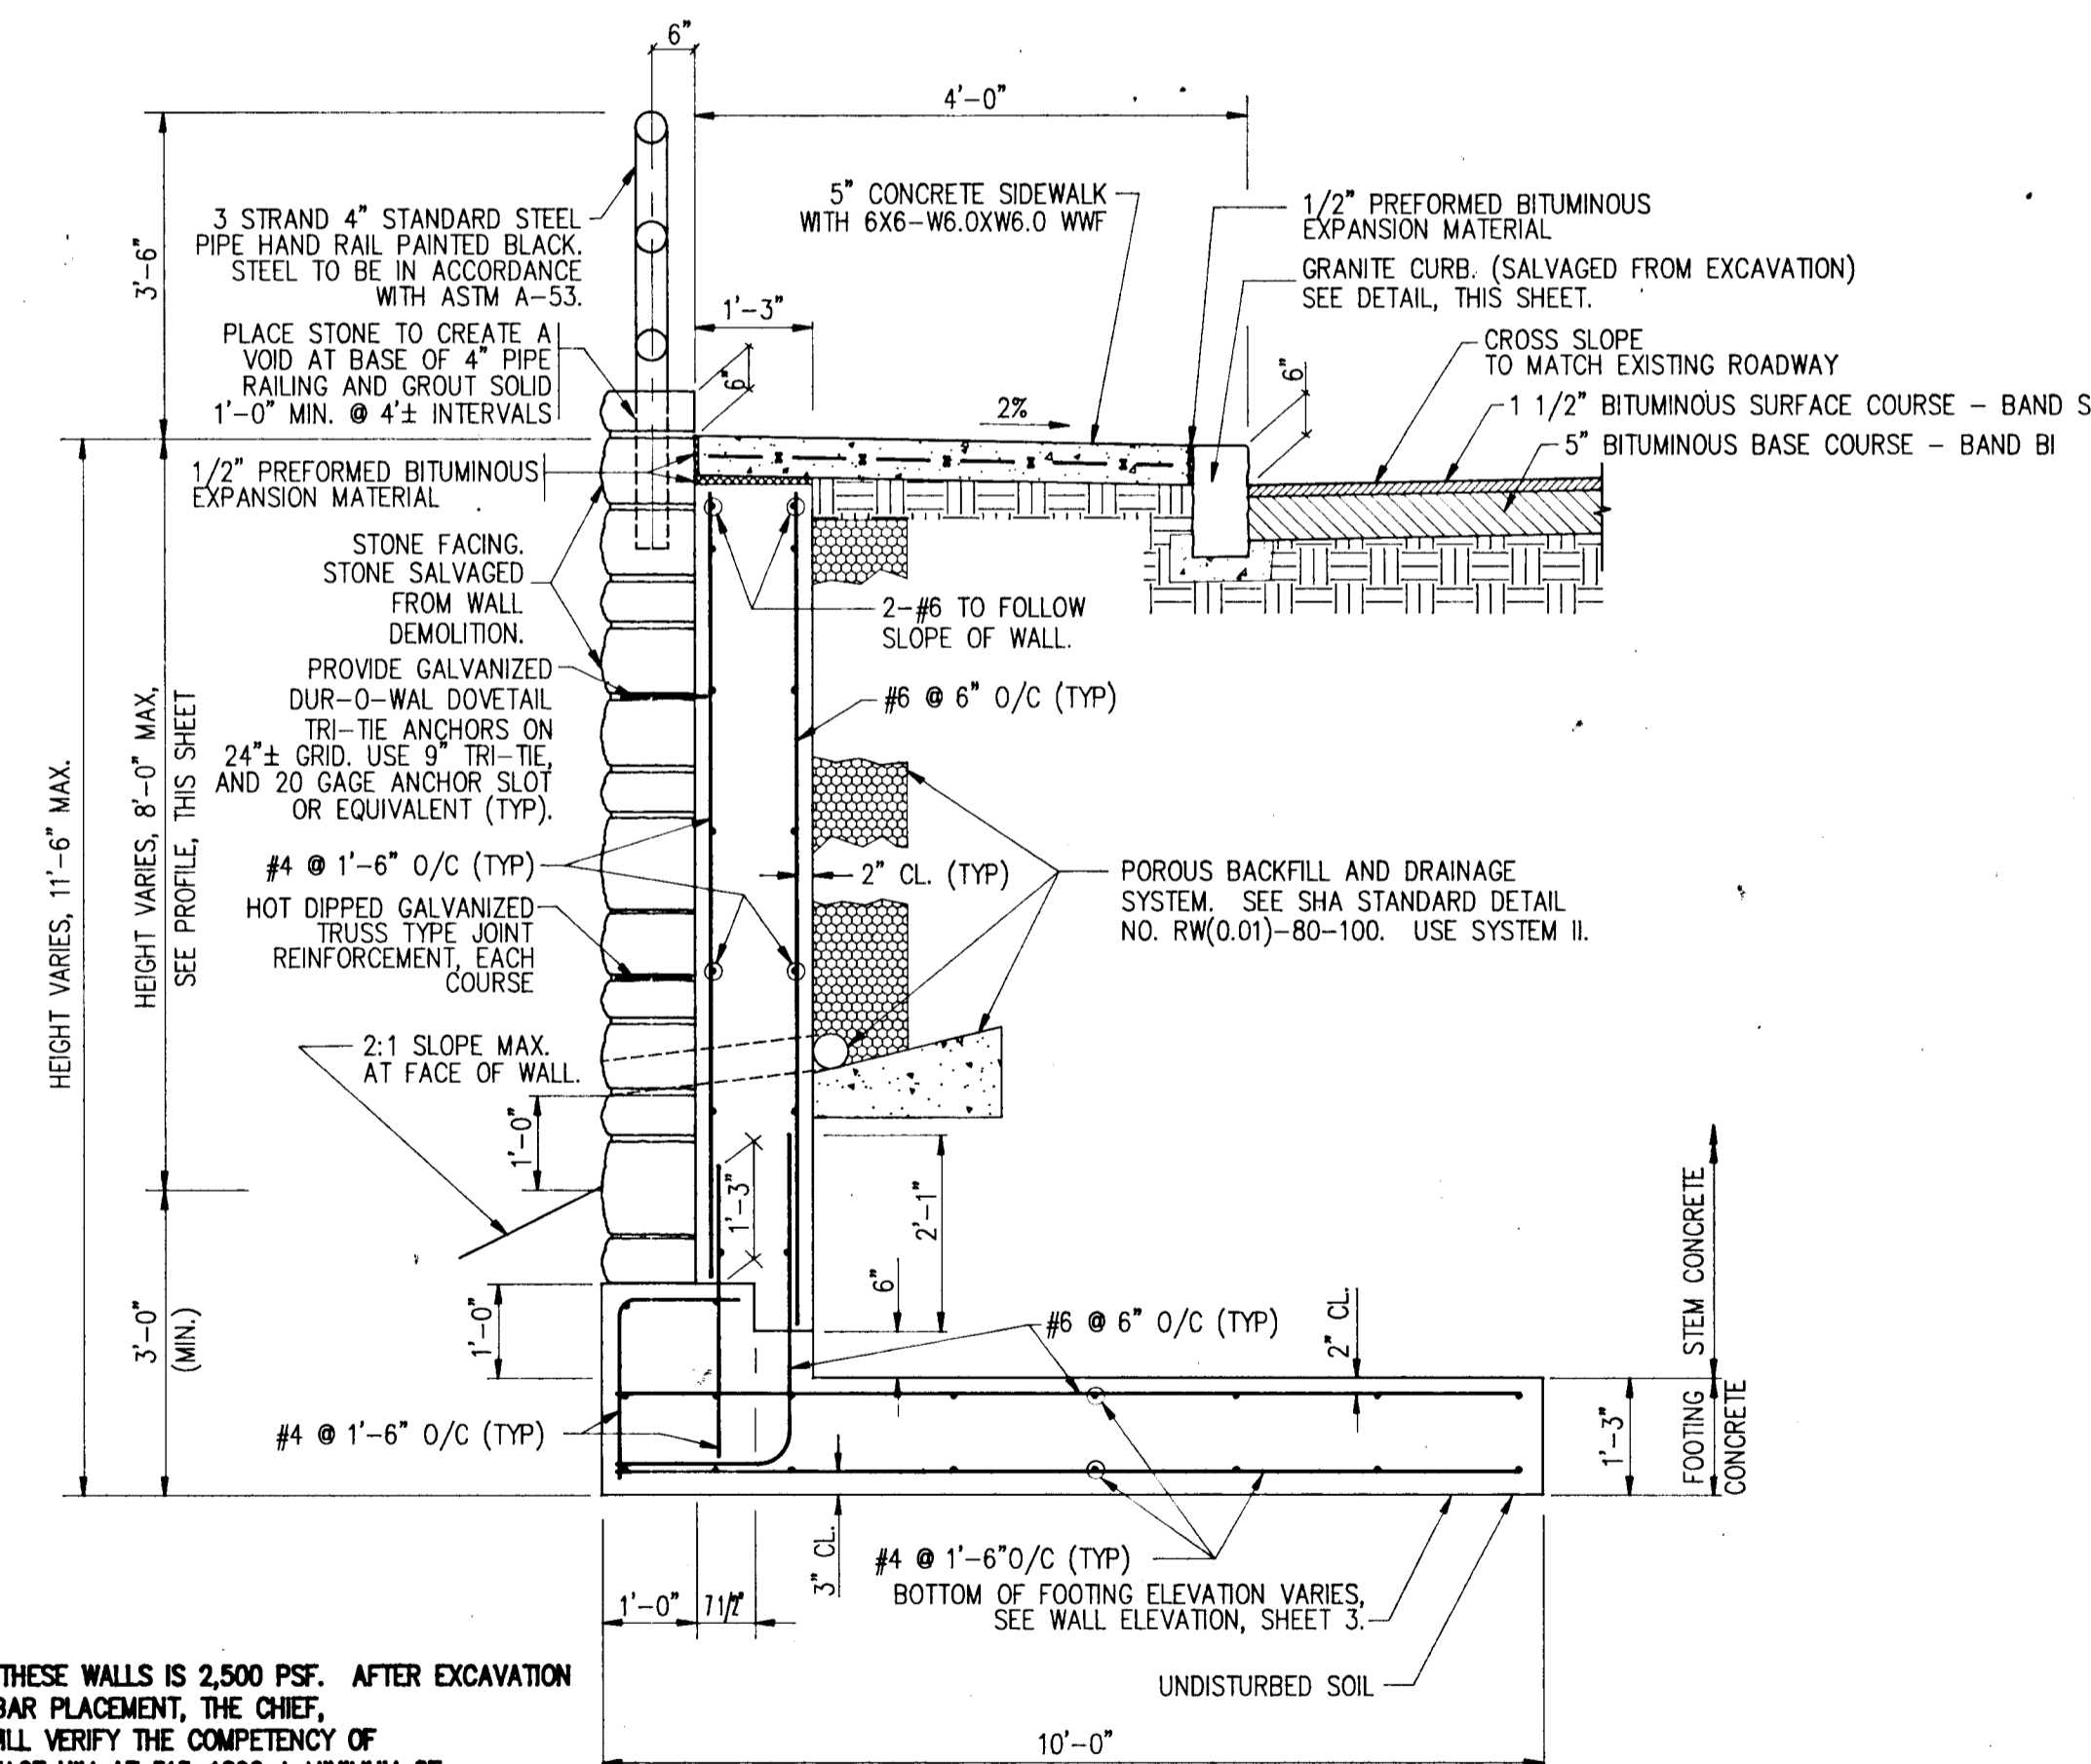

**TYPICAL SECTION II  
STA 10+20 TO STA 10+70.50**

SCALE: 1/2"=1'-0"

NOTE: DESIGN NET BEARING VALUE FOR THESE WALLS IS 2,500 PSF. AFTER EXCAVATION AND PRIOR TO FOOTING FORMING AND REBAR PLACEMENT, THE CHIEF, GEOTECHNICAL AND MATERIALS DIVISION WILL VERIFY THE COMPETENCY OF THE SOIL. THE CONTRACTOR SHALL CONTACT HIM AT 313-1892 A MINIMUM OF THREE (3) WORKING DAYS IN ADVANCE TO SCHEDULE THE INVESTIGATION. THE ENGINEER SHALL BE PRESENT DURING THE VERIFICATION.

DEPARTMENT OF PUBLIC WORKS  
HOWARD COUNTY, MARYLAND

*Lawrence Nolan* 6/10/94  
DIRECTOR OF PUBLIC WORKS DATE

*Robert J. Nelson* 6/10/94  
CHIEF, BUREAU OF ENGINEERING DATE


*Robert J. Nelson* 6/14/94  
CHIEF, DIVISION OF TRANSPORTATION PROJECTS DATE

*Robert J. Nelson* 6/14/94  
CHIEF, DIVISION OF TRANSPORTATION PROJECTS AND WATERSHED MANAGEMENT DATE

NOLAN ASSOCIATES, INC.  
ENGINEERS - CIVIL/STRUCTURAL/INSPECTIONS

P.O. BOX 2579  
COLUMBIA, MARYLAND 21045

PHONE: (410) 995-3651 FAX: (410) 995-1363

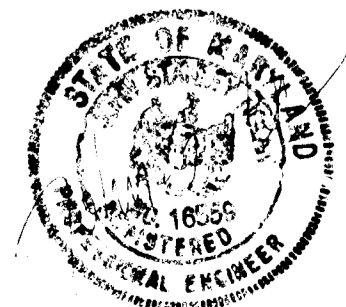

DES:	Y.C.W.			
DRN:	J.S.N.			
CHK:	C.S.N.			
DATE:	05/18/94			
BY:	NO.			
REVISION:				
DATE:				



TYPICAL SECTIONS, AND  
MISCELLANEOUS DETAILS

600' SCALE MAP NO. \_\_\_\_\_ BLOCK NO. \_\_\_\_\_

COURT AVENUE RETAINING WALL  
CAPITAL PROJECT J-4137  
ELECTION DISTRICT NO. 2  
ELLCOTT CITY, MARYLAND






SCALE AS SHOWN

SHEET 4 OF 5

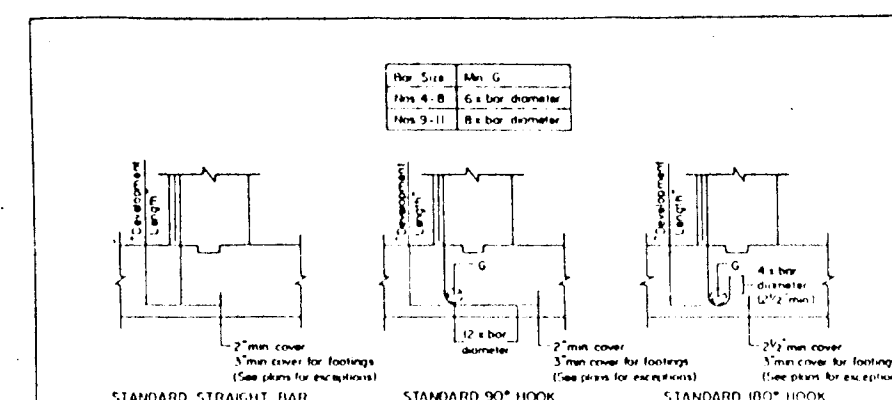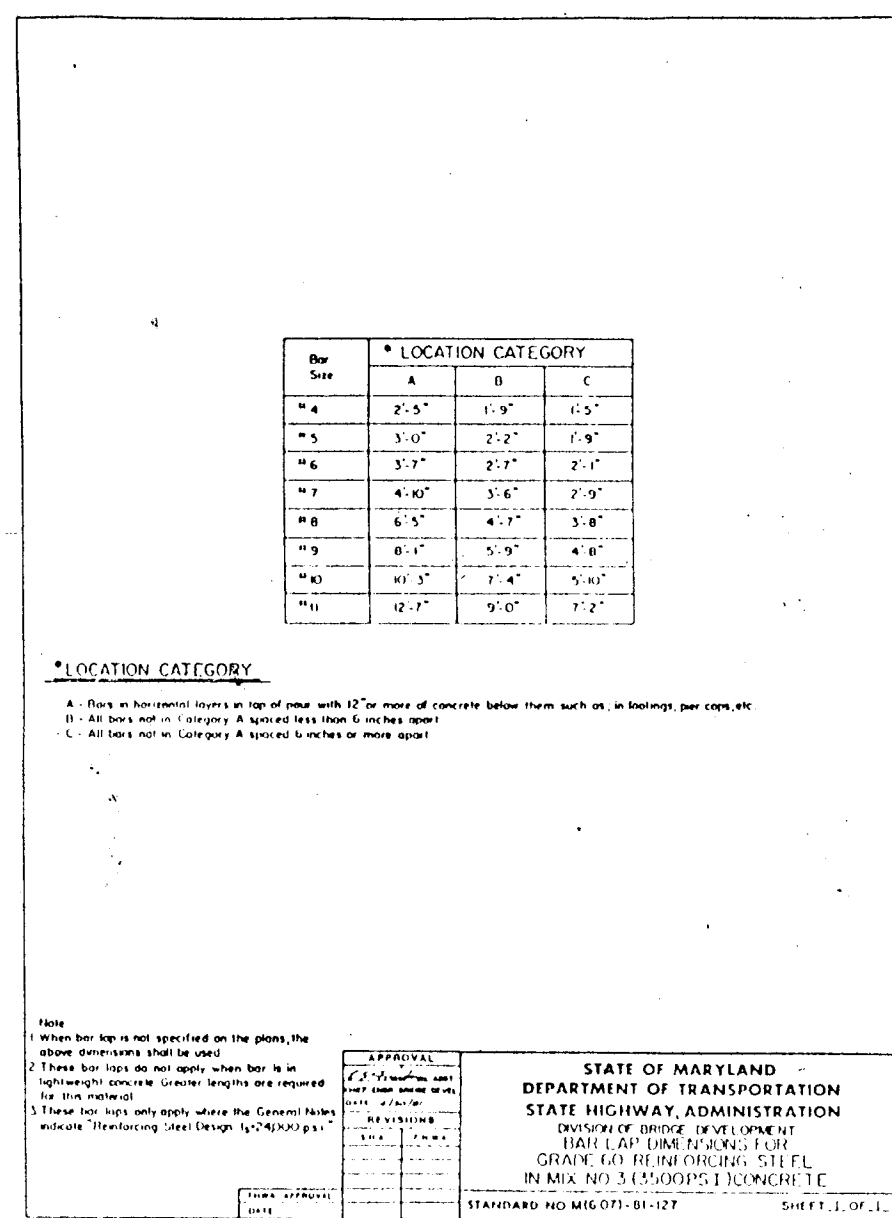

STATE OF MARYLAND  
DEPARTMENT OF TRANSPORTATION  
STATE HIGHWAY ADMINISTRATION  
DIVISION OF BRIDGE DEVELOPMENT  
OFFICE OF BRIDGE DESIGN  
CONCRETE RETAINING WALLS,  
CANTILEVER ABUTMENT  
DRAINAGE SYSTEMS  
STANDARD NO. RW(01)-100 SHEET 1 OF 1

APPROVAL	DATE	BY
APPROVED	11-27-88	J.S.N.
DESIGNED	11-27-88	J.S.N.

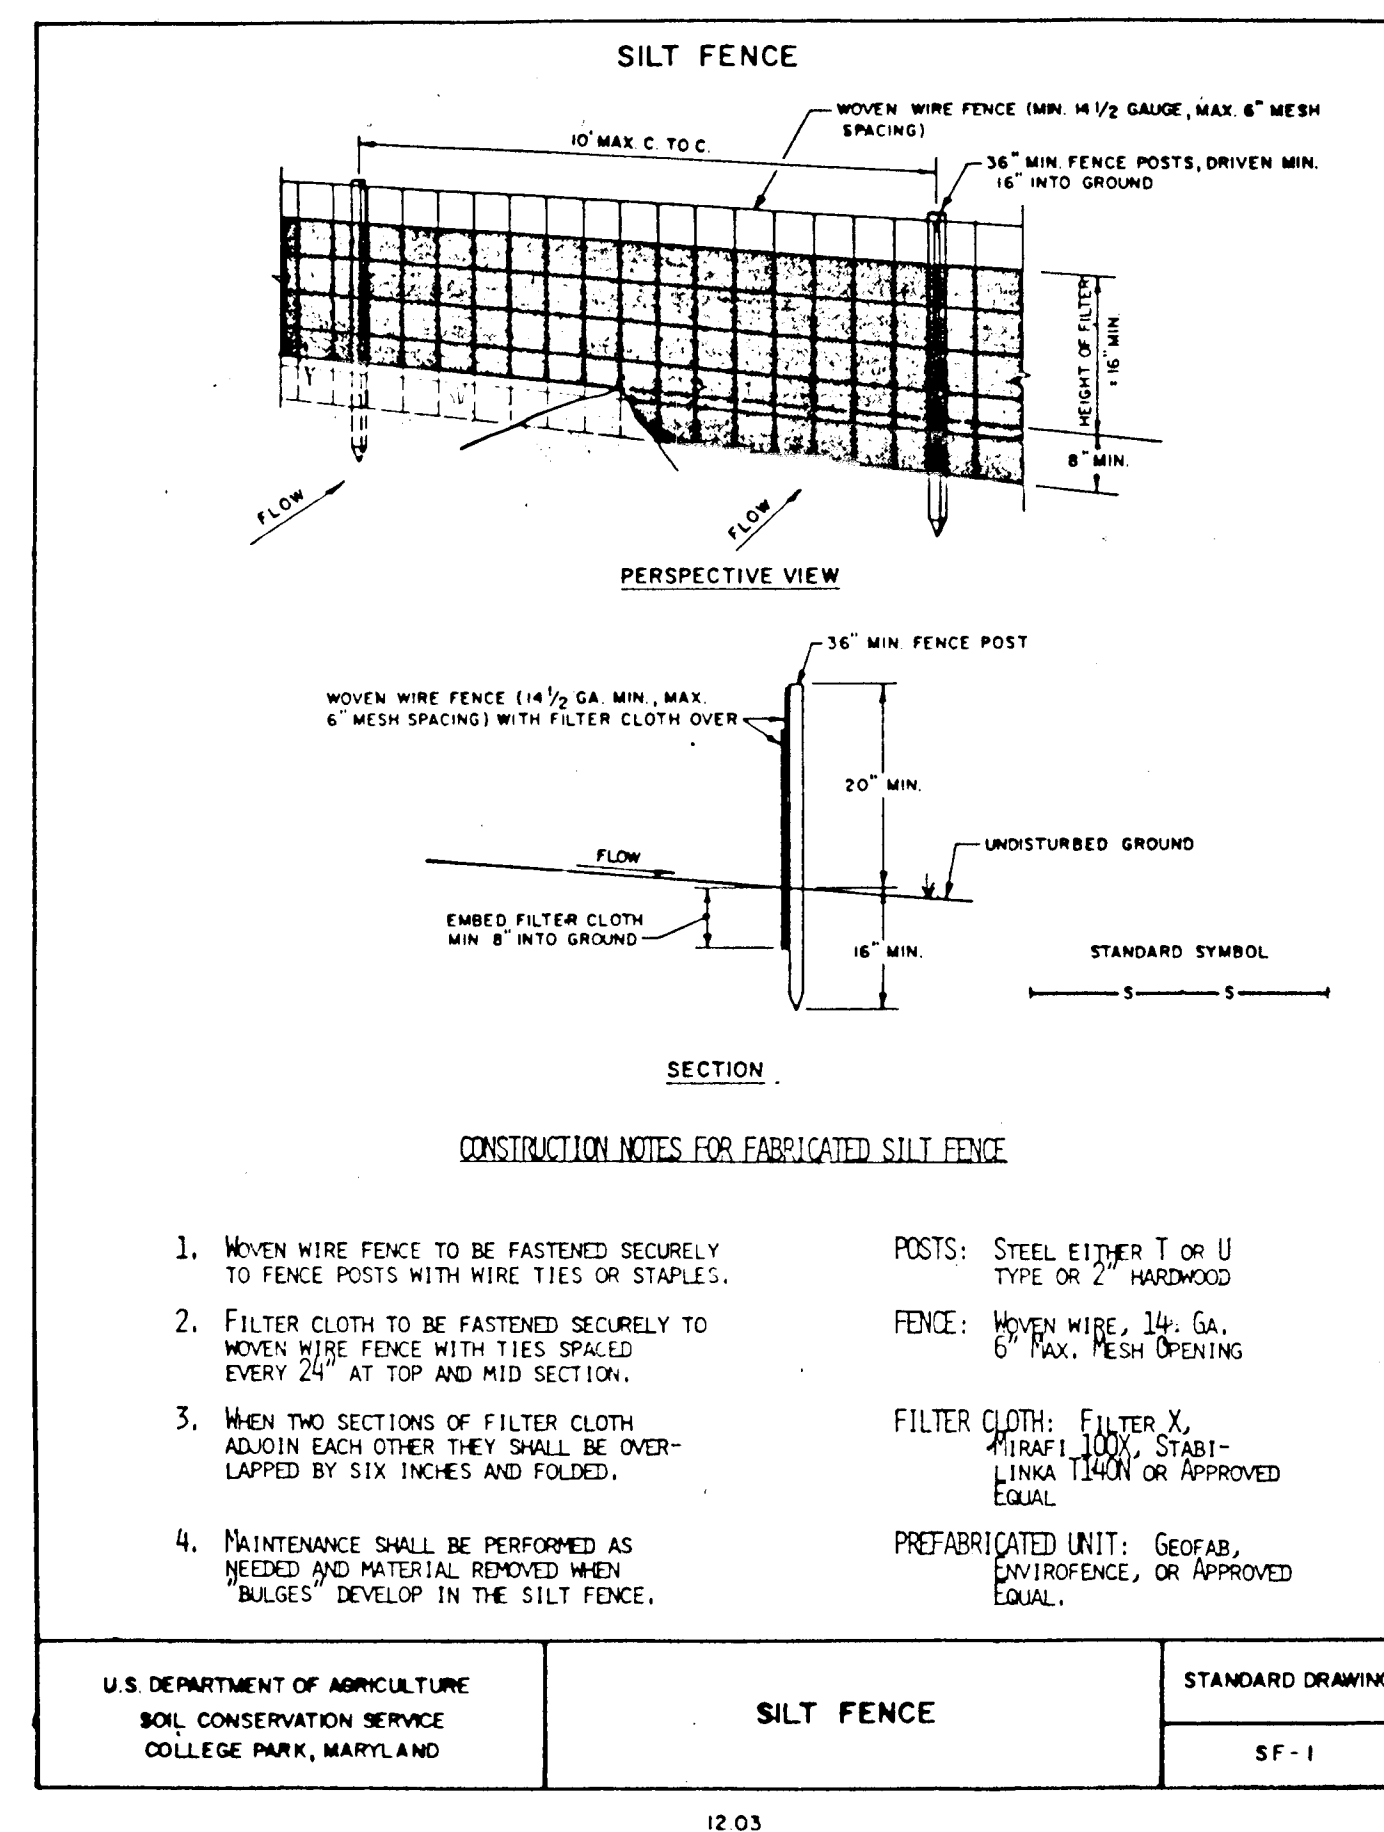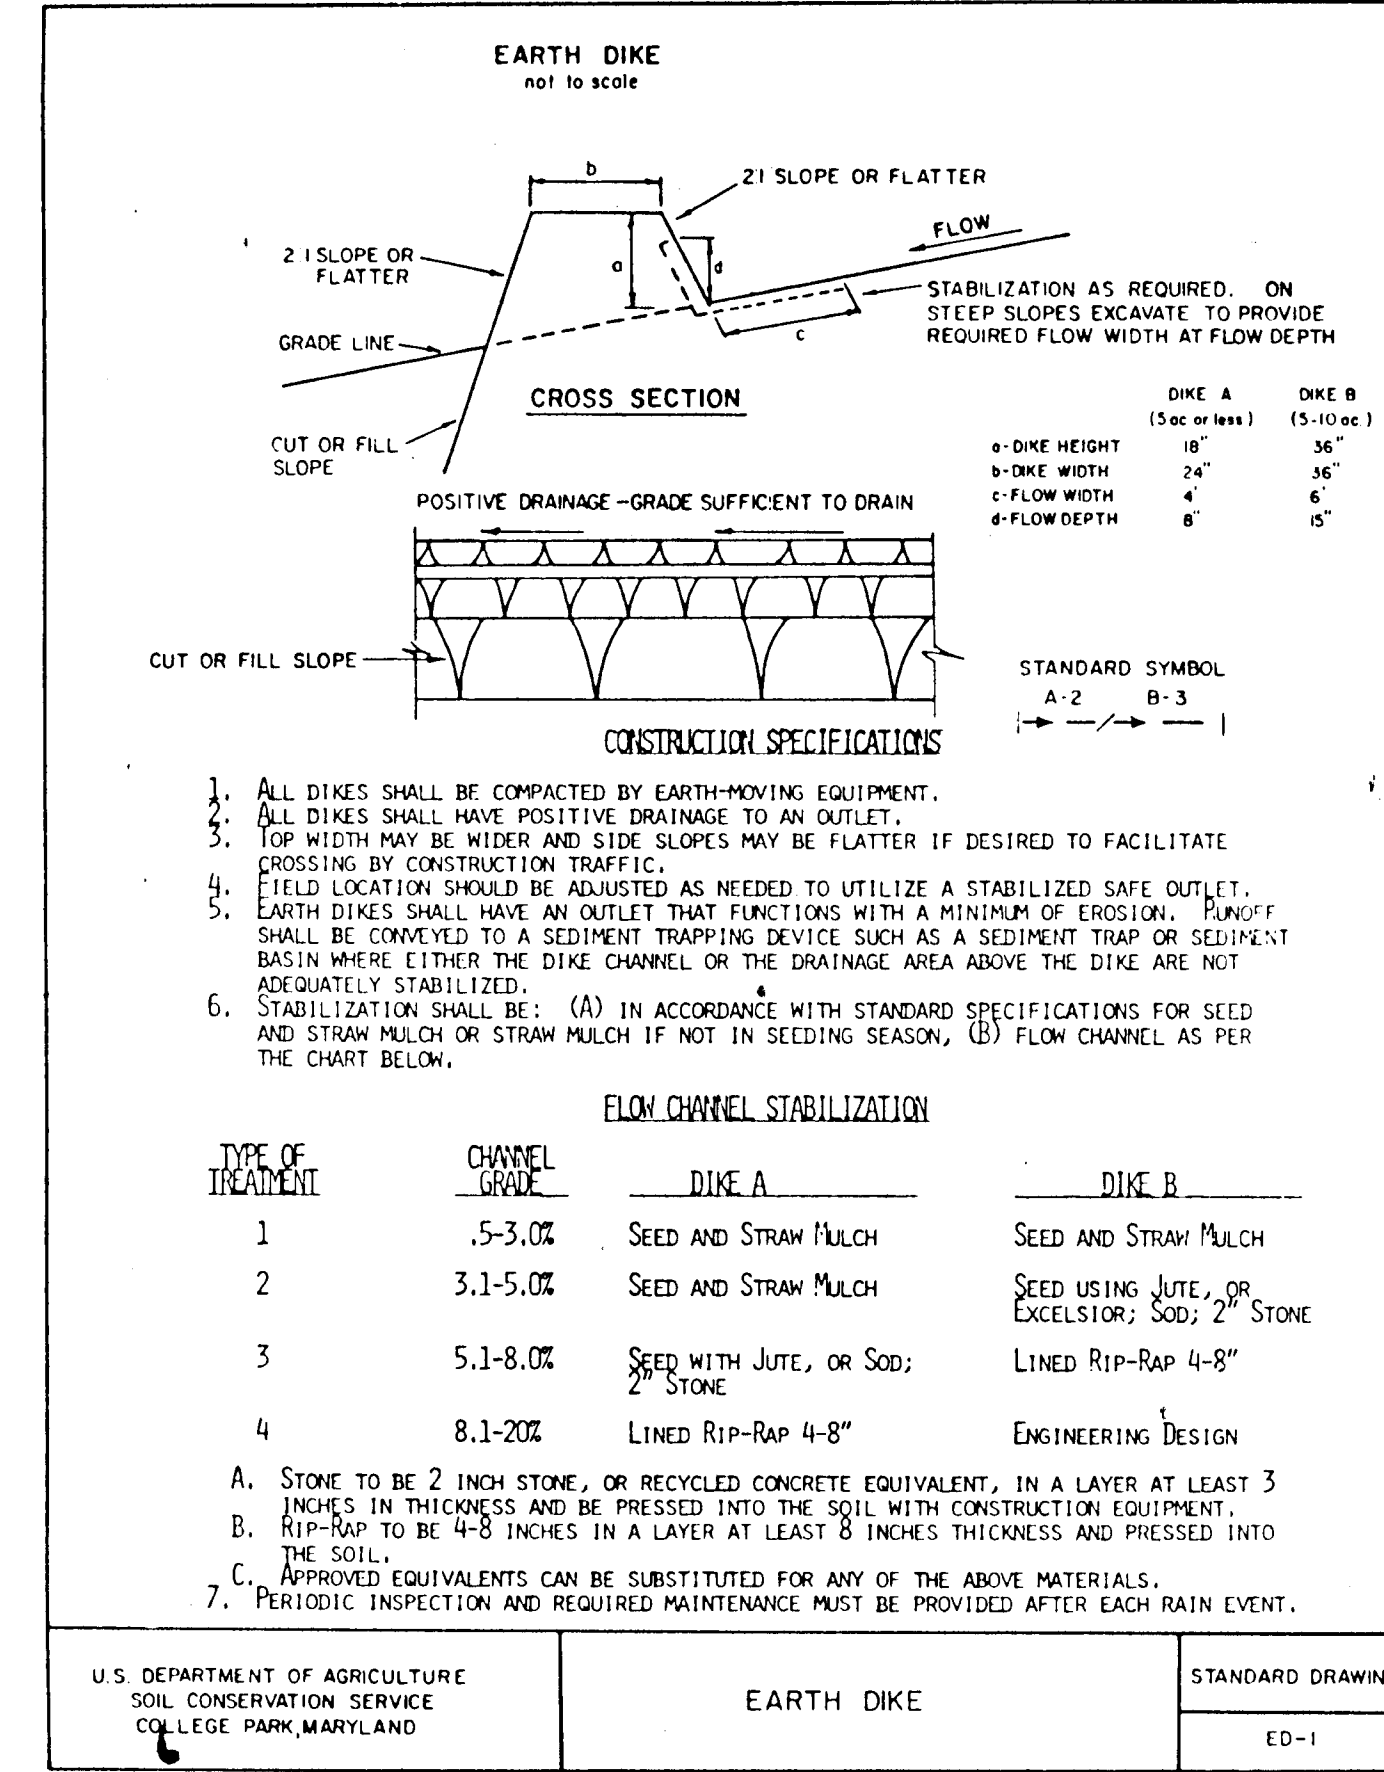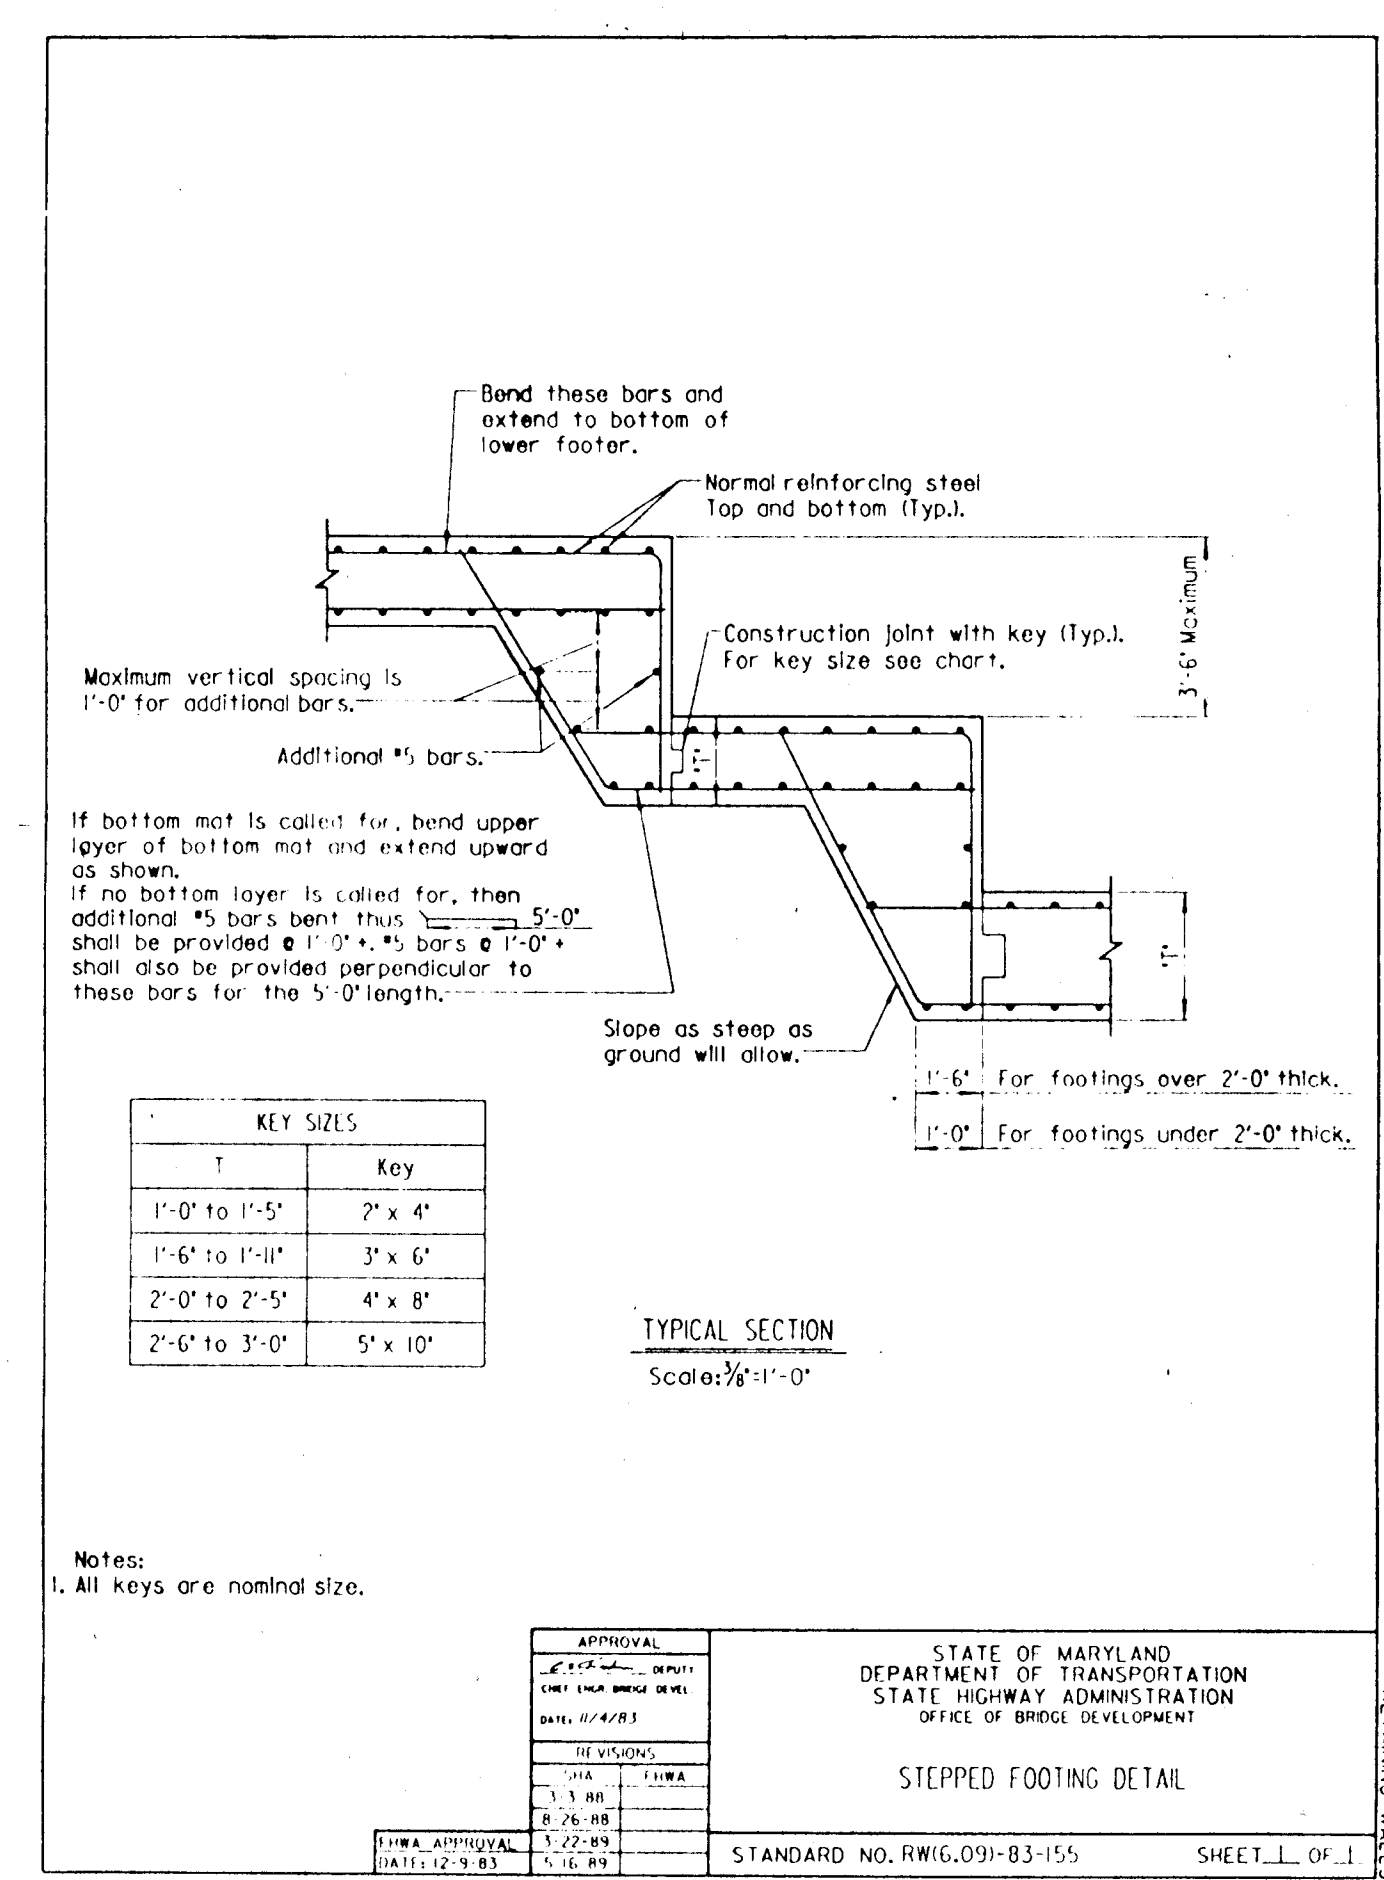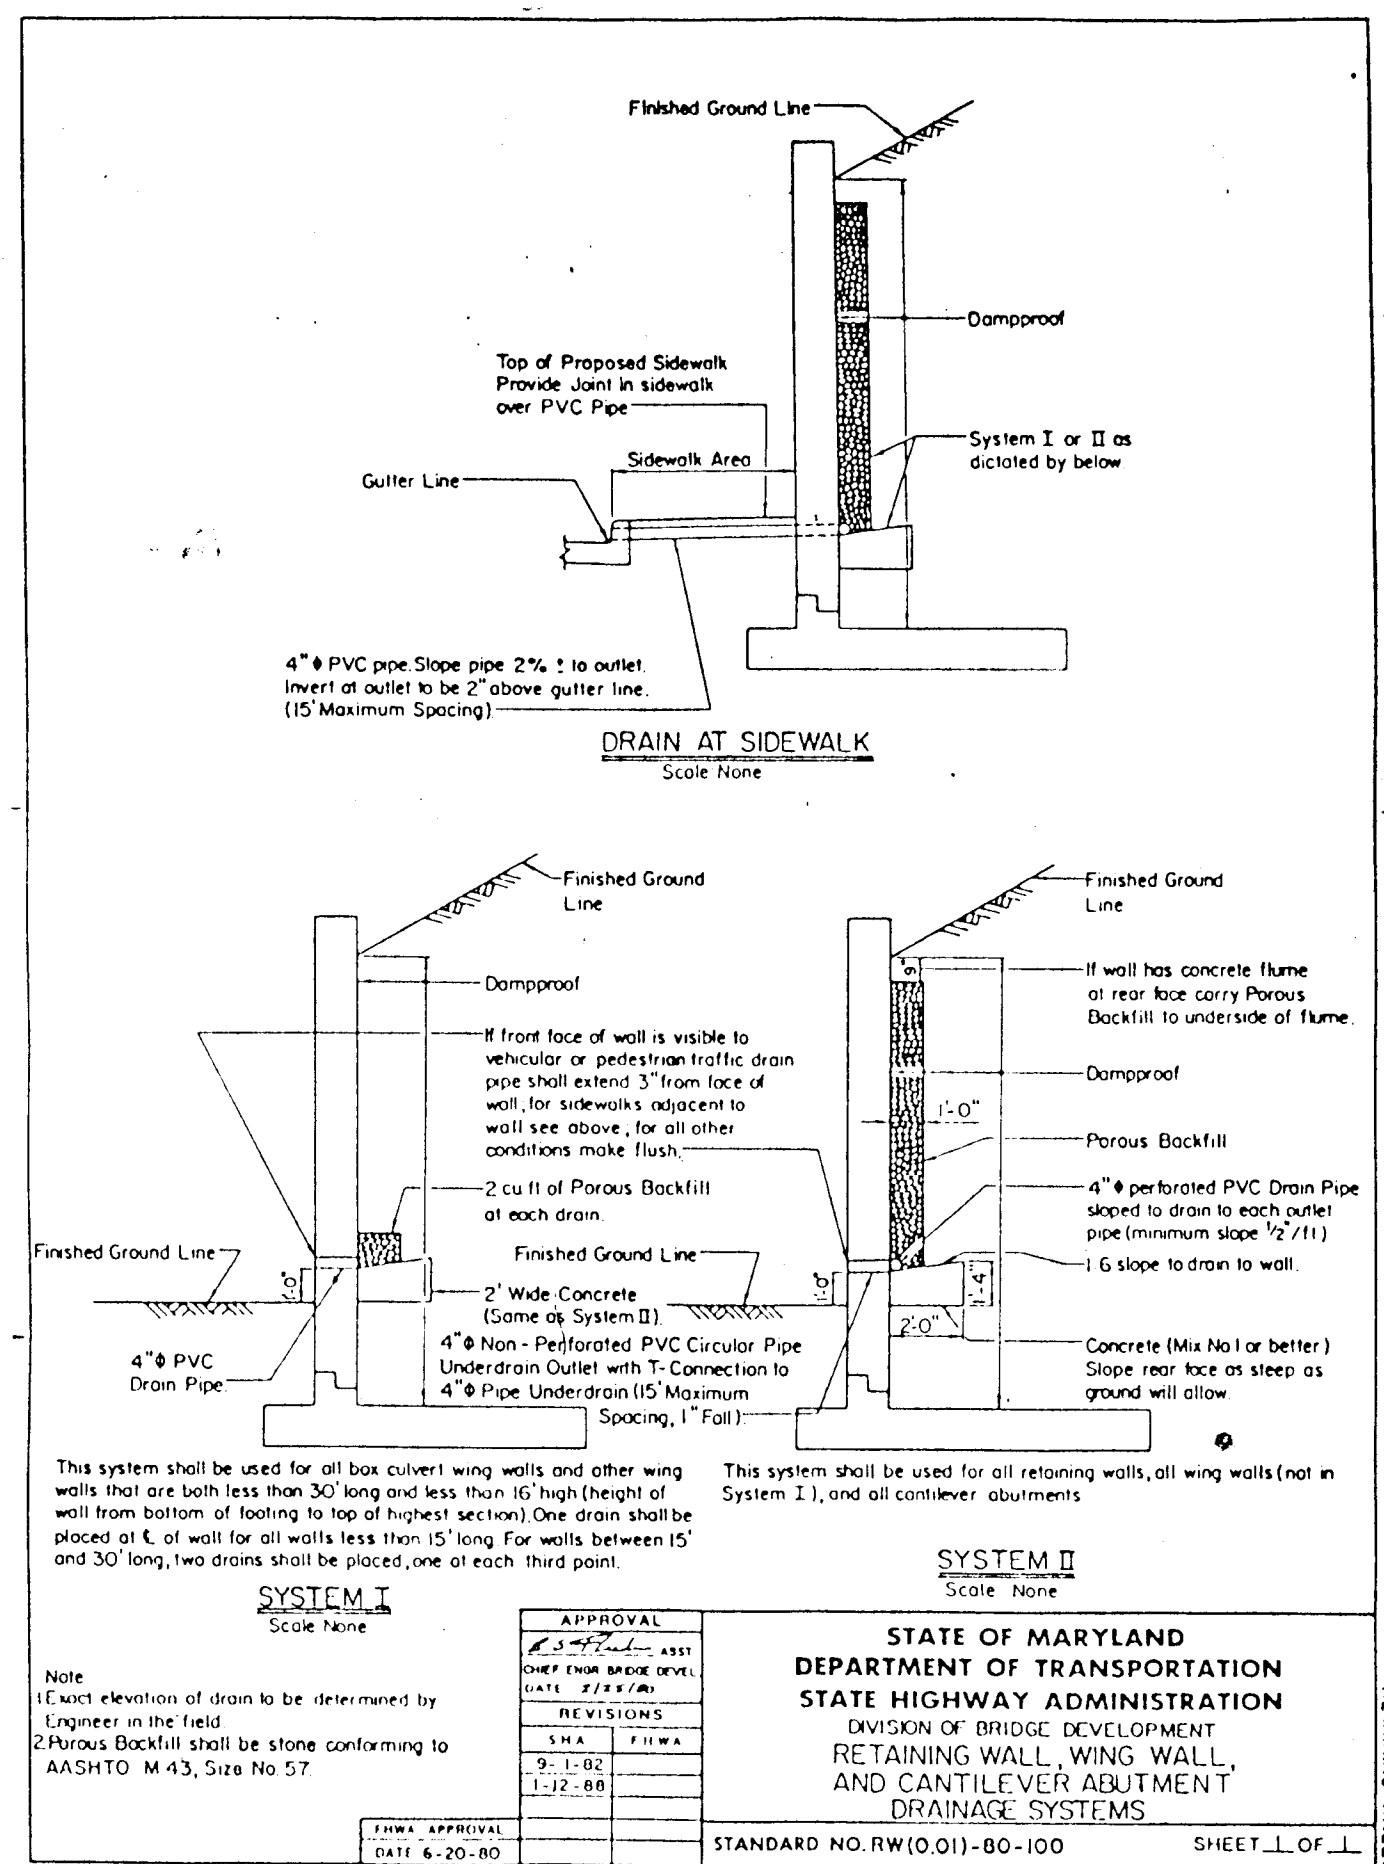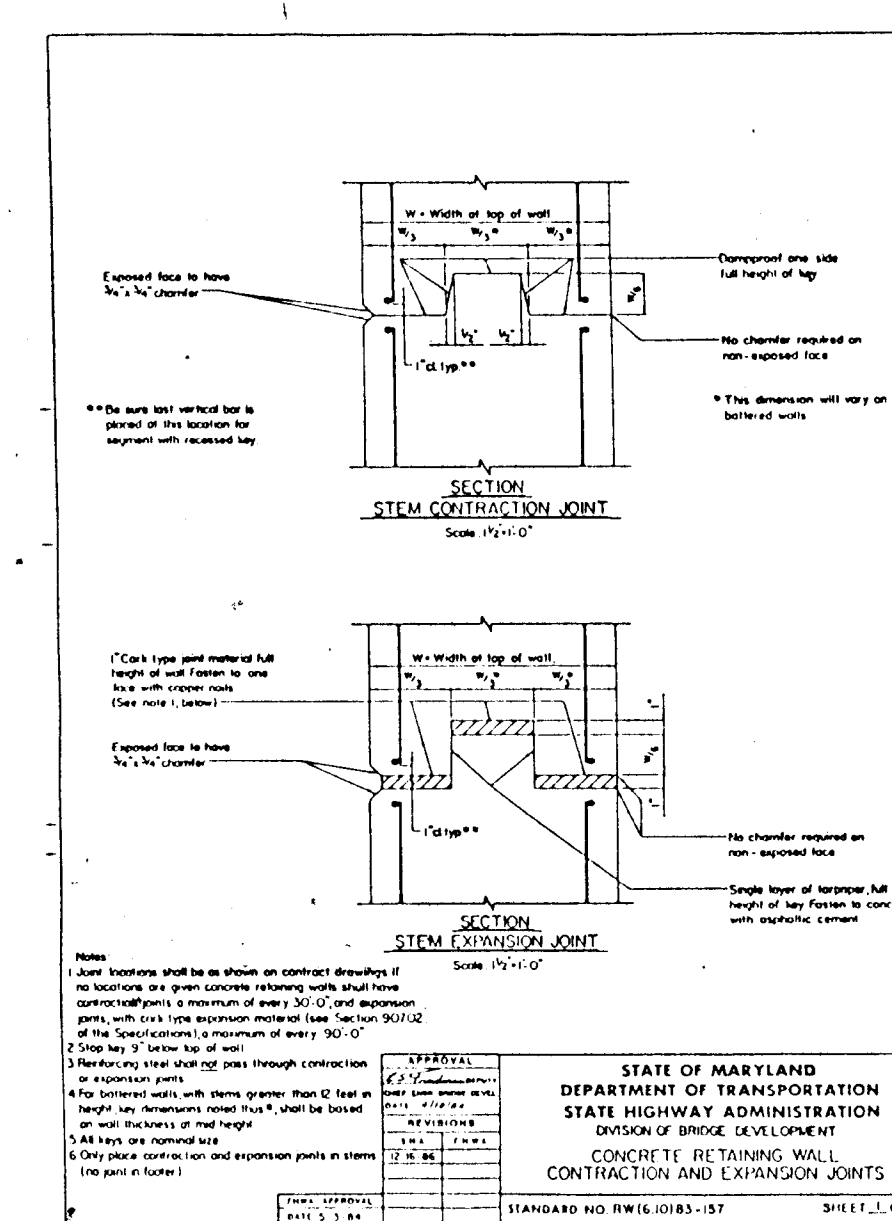

**PERMANENT SEEDING NOTES**

Apply to graded or cleared areas not subject to immediate further disturbance where a permanent long-lived vegetative cover is needed.

**Seedbed Preparation:** Loosen upper three inches of soil by raking, disking or other acceptable means before seeding, if not previously loosened.

**Soil Amendments:** In lieu of soil test recommendations, use one of the following schedules:

- Preferred--Apply 2 tons per acre dolomitic limestone (92 lbs/1000 sq. ft.) and 600 lbs per acre 10-10-10 fertilizer (14 lbs/1000 sq. ft.) before seeding. Harrow or disk into upper three inches of soil. At time of seeding, apply 400 lbs per acre 30-0-0 uream fertilizer (9 lbs/1000 sq. ft.)
- Acceptable--Apply 2 tons per acre dolomitic limestone (92 lbs/1000 sq. ft.) and 1000 lbs per acre 10-10-10 fertilizer (23 lbs/1000 sq. ft.) before seeding. Harrow or disk into upper three inches of soil.

**Seeding:** For the periods March 1 thru April 30, and August 1 thru October 15, seed with 60 lbs per acre (1.4 lbs/1000 sq. ft.) of Kentucky 31 Tall Fescue. For the period May 1 thru July 31, seed with 60 lbs Kentucky 31 Tall Fescue per acre and 2 lbs per acre (0.5 lbs/1000 sq. ft.) of weeping lovegrass. During the period of October 16 thru February 28, protect site by: Option (1) - 2 tons per acre of well anchored straw mulch and seed as soon as possible in the spring. Option (2) - Use sod. Option (3) - Seed with 60 lbs/acre Kentucky 31 Tall Fescue and mulch with 2 tons/acre well anchored straw.

**Mulching:** Apply 1-1/2 to 2 tons per acre (70 to 90 lbs/1000 sq. ft.) of unrotted small grain straw immediately after seeding. Anchor mulch immediately after application using mulch anchoring tool or 218 gal/ton per acre (5 gal/1000 sq. ft.) of emulsified asphalt on flat areas. On slopes 8 feet or higher, use 348 gallons per acre (8 gal/1000 sq. ft.) for anchoring.

**Maintenance:** Inspect all seeding areas and make needed repairs, replacements and reseeding.

**TEMPORARY SEEDING NOTES**

Apply to graded or cleared areas likely to be redisturbed where a short-term vegetative cover is needed.

**Seedbed Preparation:** Loosen upper three inches of soil by raking, disking or other acceptable means before seeding, if not previously loosened.

**Soil Amendments:** Apply 600 lbs per acre 10-10-10 fertilizer (14 lbs/1000 sq. ft.)

**Seeding:** For periods March 1 thru April 30 and from August 15 thru October 15, seed with 2-1/2 bushel per acre of annual rye (3.2 lbs/1000 sq. ft.). For the period May 1 thru August 14, seed with 3 lbs per acre of weeping lovegrass (0.7 lbs/1000 sq. ft.). For the period November 16 thru February 28, protect site by applying 2 tons per acre of well anchored straw mulch and seed as soon as possible in the spring, or use sod.

**Mulching:** Apply 1-1/2 to 2 tons per acre (70 to 90 lbs/1000 sq. ft.) of unrotted weed free small grain straw immediately after seeding. Anchor mulch immediately after application using mulch anchoring tool or 218 gal/ton per acre (5 gal/1000 sq. ft.) of emulsified asphalt on flat areas. On slopes 8 ft. or higher, use 348 gal per acre (8 gal/1000 sq. ft.) for anchoring.

Refer to the 1983 MARYLAND STANDARDS AND SPECIFICATIONS FOR SOIL EROSION AND SEDIMENT CONTROL for additional rates and methods not covered.

- STANDARD SEDIMENT CONTROL NOTES**
- A minimum of 48 hours notice must be given to the Howard County Department of Inspections, Licenses and Permits, Sediment Control Division prior to the start of any construction, (313-1850).
  - All vegetative and structural practices are to be installed according to the provisions of this plan and are to be in conformance with the most current "MARYLAND STANDARDS AND SPECIFICATIONS FOR SOIL EROSION AND SEDIMENT CONTROL", and revisions thereto.
  - Following initial soil disturbance or redisturbance, permanent or temporary stabilization shall be completed within: a) 7 calendar days for all perimeter sediment control structures, dikes, perimeter slopes and all slopes greater than 3:1, b) 14 days as to all other disturbed or graded areas on the project site.
  - All sediment traps/basins shown must be fenced and warning signs posted around their perimeter in accordance with Vol. 1, Chapter 12, of the HOWARD COUNTY DESIGN MANUAL, Storm Drainage.
  - All disturbed areas must be stabilized within the time period above in accordance with the 1983 MARYLAND STANDARDS AND SPECIFICATIONS FOR SOIL EROSION AND SEDIMENT CONTROL for permanent seeding (Sec. 51), sod (Sec. 54), temporary seeding (Sec. 50) and mulching (Sec. 52). Temporary stabilization with mulch alone can only be done when recommended seeding dates do not allow for proper germination and establishment of grasses.
  - All sediment control structures are to remain in place and are to be maintained in operative condition until permission for their removal has been obtained from the Howard County Sediment Control Inspector.
  - Site Analysis
 

Total Area of Site	0.10	Acres
Area Disturbed	0.05	Acres
Area to be roofed or paved	0.05	Acres
Area to be vegetatively stabilized	0.01	Acres
Total Cut	500	Cu. Yds.
Total Fill	50	Cu. Yds.
Offsite Waste/Borrow Area Location	To Be Determined By Contractor	
  - Any sediment control practice which is disturbed by grading activity for placement of utilities must be repaired on the same day of disturbance.
  - Additional sediment control must be provided, if deemed necessary by the Howard County Sediment Control Inspector.
  - On all sites with disturbed areas in excess of 2 acres, approval of the inspection agency shall be requested upon completion of installation of perimeter erosion and sediment controls, but before proceeding with any other earth disturbance or grading. Other building or grading inspection approvals may not be authorized until this approval by the inspection agency is made.
  - Trenches for the construction of utilities is limited to three pipe lengths or that which can be backfilled and stabilized within one working day, whichever is shorter.

THIS DEVELOPMENT PLAN IS APPROVED FOR SOIL EROSION AND SEDIMENT CONTROL BY THE HOWARD COUNTY DEPARTMENT OF INSPECTIONS, LICENSES AND PERMITS, SEDIMENT CONTROL DIVISION.

Approved: *John R. Robinson*, S.C.D. Director

Reviewed for HOWARD COUNTY: *J. A. Warfield*, S.C.D. and meets Technical Requirements of the U.S. Soil Conservation Service

- SEQUENCE OF CONSTRUCTION**
- Obtain grading permit for the project.
  - Install sediment controls as shown on the site plan.
  - Excavate for wall reconstruction.
  - Construct concrete cantilever retaining wall, and reset stone gravity wall in accordance with the limits shown on the plans.
  - Backfill behind wall.
  - Construct new stone facing for concrete cantilever wall; construct new railing, sidewalk, and replace salvaged granite curb.
  - Repoint face of retaining wall.
  - Reconstruct pavement as shown on the plans and as directed by the engineer.
  - Regrade slope of the front face of retaining wall in accordance with the contours shown on the site plan.
  - After the site is stabilized and permission is granted by the Sediment Control Inspector, remove sediment controls and stabilize any remaining disturbed areas.

DEPARTMENT OF PUBLIC WORKS  
HOWARD COUNTY, MARYLAND

*Paul J. Lewis*, Director of Public Works  
*Andrew M. Daniels*, Chief, Bureau of Highways

DATE: 6/10/94

NOLAN ASSOCIATES, INC.  
ENGINEERS - CIVIL/STRUCTURAL/INSPECTIONS

P.O. BOX 2579  
COLUMBIA, MARYLAND 21045  
PHONE: (410) 995-3651 FAX: (410) 995-1383

DES: Y.C.W.  
DRN: J.S.N.  
CHK: C.S.N.  
DATE: 05/18/94

STANDARD DETAILS AND SEDIMENT AND EROSION CONTROL NOTES

600' SCALE MAP NO. \_\_\_\_\_ BLOCK NO. \_\_\_\_\_

COURT AVENUE RETAINING WALL  
CAPITAL PROJECT J-4137  
ELECTION DISTRICT NO. 2  
ELLCOTT CITY, MARYLAND

SCALE AS SHOWN  
SHEET 5 OF 5

**LOCATION CATEGORY**

Site	* LOCATION CATEGORY		
	A	B	C
1	2'-5"	4'-9"	1'-5"
2	3'-0"	2'-7"	1'-0"
3	3'-7"	2'-7"	2'-7"
4	4'-0"	3'-4"	2'-0"
5	4'-5"	4'-7"	3'-8"
6	4'-7"	5'-7"	4'-8"
7	5'-0"	7'-2"	5'-4"
8	5'-7"	9'-0"	7'-7"

**LOCATION CATEGORY**

A. Rank in descending order on top of curb with 2" or more of concrete, thereby, then such as to bridge, per caput.

B. All base soil in category A. Support top of curb on bridge.

C. All base soil in category A. Support to bridge to curb cap.

**APPROVAL**

STATE OF MARYLAND  
DEPARTMENT OF TRANSPORTATION  
STATE HIGHWAY ADMINISTRATION  
DIVISION OF BRIDGE DEVELOPMENT  
OFFICE OF BRIDGE DEVELOPMENT  
CONSTRUCTION AND EXPANSION JOINTS  
STANDARD NO. RW(01)-107 SHEET 1 OF 1

**APPROVAL**

STATE OF MARYLAND  
DEPARTMENT OF TRANSPORTATION  
STATE HIGHWAY ADMINISTRATION  
DIVISION OF BRIDGE DEVELOPMENT  
OFFICE OF BRIDGE DEVELOPMENT  
CONSTRUCTION AND EXPANSION JOINTS  
STANDARD NO. RW(01)-108 SHEET 1 OF 1

**APPROVAL**

STATE OF MARYLAND  
DEPARTMENT OF TRANSPORTATION  
STATE HIGHWAY ADMINISTRATION  
DIVISION OF BRIDGE DEVELOPMENT  
OFFICE OF BRIDGE DEVELOPMENT  
CONSTRUCTION AND EXPANSION JOINTS  
STANDARD NO. RW(01)-109 SHEET 1 OF 1

**FINISHED GROUND LINE**

**DRAIN AT SIDEWALK**

Scale None

4" PVC Slope Pipe 2% to outlet  
Invert at outlet to be 2" above gutter line  
(15 Maximum Spacing)

**APPROVAL**

STATE OF MARYLAND  
DEPARTMENT OF TRANSPORTATION  
STATE HIGHWAY ADMINISTRATION  
DIVISION OF BRIDGE DEVELOPMENT  
OFFICE OF BRIDGE DEVELOPMENT  
RETAINING WALL, WING WALL,  
AND CANTILEVER ABUTMENT  
DRAINAGE SYSTEMS  
STANDARD NO. RW(01)-100 SHEET 1 OF 1

**FINISHED GROUND LINE**

**STEPPED FOOTING DETAIL**

Scale: 3/4" = 1'-0"

**KEY SIZES**

T	Key
1'-0" to 1'-5"	2" x 4"
1'-6" to 1'-10"	3" x 6"
2'-0" to 2'-5"	4" x 8"
2'-6" to 3'-0"	5" x 10"

**APPROVAL**

STATE OF MARYLAND  
DEPARTMENT OF TRANSPORTATION  
STATE HIGHWAY ADMINISTRATION  
DIVISION OF BRIDGE DEVELOPMENT  
OFFICE OF BRIDGE DEVELOPMENT  
RETAINING WALL, WING WALL,  
AND CANTILEVER ABUTMENT  
DRAINAGE SYSTEMS  
STANDARD NO. RW(01)-155 SHEET 1 OF 1

**EARTH DIKE**

not to scale

**CROSS SECTION**

2:1 SLOPE OR FLATTER

2:1 SLOPE OR FLATTER

GRADE LINE

CUT OR FILL SLOPE

STABILIZATION AS REQUIRED, ON STEEP SLOPES EXCAVATE TO PROVIDE REQUIRED FLOW WIDTH AT FLOW DEPTH

DIKE A (5'-6" or less)	DIKE B (5'-10" or 1')
a-DIKE HEIGHT	6'
b-DIKE WIDTH	24"
c-FLOW WIDTH	4'
d-FLOW DEPTH	8"

**CONSTRUCTION SPECIFICATIONS**

- ALL DIKES SHALL BE COMPACTED BY EARTH-MOVING EQUIPMENT.
- ALL DIKES SHALL HAVE POSITIVE DRAINAGE TO AN OUTLET.
- TOP WIDTH MAY BE WIDER AND SIDE SLOPES MAY BE FLATTER IF DESIRED TO FACILITATE CROSSING BY CONSTRUCTION TRAFFIC.
- FIELD LOCATION SHOULD BE ADJUSTED AS NEEDED TO UTILIZE A STABILIZED SAFE OUTLET.
- EARTH DIKES SHALL HAVE AN OUTLET THAT FUNCTIONS WITH A MINIMUM OF EROSION. RUNOFF SHALL BE CONVEYED TO A SEDIMENT TRAPPING DEVICE SUCH AS A SEDIMENT TRAP OR SEDIMENT BASIN WHERE EITHER THE DIKE CHANNEL OR THE DRAINAGE AREA ABOVE THE DIKE ARE NOT ADEQUATELY STABILIZED.
- STABILIZATION SHALL BE: (A) IN ACCORDANCE WITH STANDARD SPECIFICATIONS FOR SEED AND STRAW MULCH OR STRAW MULCH IF NOT IN SEEDING SEASON, (B) FLOW CHANNEL AS PER THE CHART BELOW.

TYPE OF TREATMENT	CHANNEL GRADE	DIKE A SEED AND STRAW MULCH	DIKE B SEED USING JUTE, OR EXCELISOR; SOG; 2" STONE	DIKE B LINED RIP-RAP 4-8"	ENGINEERING DESIGN
1	5-3.0%				
2	3.1-5.0%				
3	5.1-8.0%				
4	8.1-20%				

**FLOW CHANNEL STABILIZATION**

- STONE TO BE 2 INCH STONE, OR RECYCLED CONCRETE EQUIVALENT, IN A LAYER AT LEAST 3 INCHES THICKNESS AND BE PRESSED INTO THE SOIL WITH CONSTRUCTION EQUIPMENT.
- RIIP-RAP TO BE 4-8 INCHES IN A LAYER AT LEAST 8 INCHES THICKNESS AND PRESSED INTO THE SOIL.
- APPROVED EQUIVALENTS CAN BE SUBSTITUTED FOR ANY OF THE ABOVE MATERIALS.
- PERIODIC INSPECTION AND REQUIRED MAINTENANCE MUST BE PROVIDED AFTER EACH RAIN EVENT.

**APPROVAL**

U.S. DEPARTMENT OF AGRICULTURE  
SOIL CONSERVATION SERVICE  
COLLEGE PARK, MARYLAND

**EARTH DIKE**

STANDARD DRAWING ED-1

**SILT FENCE**

10" MAX C.T.O.C.

WOVEN WIRE FENCE (MM 1/2 GAUGE, MAX 6" MESH SPACING)

36" MIN FENCE POSTS, DRIVEN MIN 4' INTO GROUND

HEIGHT OF FENCE 4' MIN.

8" MIN.

**PERSPECTIVE VIEW**

**SECTION**

WOVEN WIRE FENCE (1/2) GA MIN, MAX 6" MESH SPACING WITH FILTER CLOTH OVER

36" MIN FENCE POST

20" MIN

UNDISTURBED GROUND

18" MIN

EMBED FILTER CLOTH MIN 8" INTO GROUND

**CONSTRUCTION NOTES FOR FABRICATED SILT FENCE**

- WOVEN WIRE FENCE TO BE FASTENED SECURELY TO FENCE POSTS WITH WIRE TIES OR STAPLES.
- FILTER CLOTH TO BE FASTENED SECURELY TO WOVEN WIRE FENCE WITH TIES SPACED EVERY 24" AT TOP AND MID SECTION.
- WHEN TWO SECTIONS OF FILTER CLOTH ADJOIN EACH OTHER THEY SHALL BE OVERLAPPED BY SIX INCHES AND FOLDED.
- MAINTENANCE SHALL BE PERFORMED AS NEEDED AND MATERIAL REMOVED WHEN "BULGES" DEVELOP IN THE SILT FENCE.

**POSTS:** STEEL EITHER T OR U TYPE OR 2" HARDWOOD

**FENCE:** WOVEN WIRE, 1/2 GA, 6" MAX. MESH OPENING

**FILTER CLOTH:** FILTER X, MIRAFIL, STABILINKA 140N OR APPROVED EQUAL

**PREFABRICATED UNIT:** GEOPAB, DYNROFENCE, OR APPROVED EQUAL.

**APPROVAL**

U.S. DEPARTMENT OF AGRICULTURE  
SOIL CONSERVATION SERVICE  
COLLEGE PARK, MARYLAND

**SILT FENCE**

STANDARD DRAWING SF-1

**PERMANENT SEEDING NOTES**

- Apply to graded or cleared areas not subject to immediate further disturbance where a permanent long-lived vegetative cover is needed.
- Seedbed Preparation:** Loosen upper three inches of soil by raking, disking or other acceptable means before seeding, if not previously loosened.
- Soil Amendments:** In lieu of soil test recommendations, use one of the following schedules:
- Preferred:** Apply 2 tons per acre dolomitic limestone (92 lbs/1000 sq. ft.) and 600 lbs per acre 10-10-10 fertilizer (14 lbs/1000 sq. ft.) before seeding. Harrow or disk into upper three inches of soil. At time of seeding, apply 400 lbs per acre 30-0-0 ureamform fertilizer (9 lbs/1000 sq. ft.)
  - Acceptable:** Apply 2 tons per acre dolomitic limestone (92 lbs/1000 sq. ft.) and 1000 lbs per acre 10-10-10 fertilizer (23 lbs/1000 sq. ft.) before seeding. Harrow or disk into upper three inches of soil.
- Seeding:** For the periods March 1 thru April 30, and August 1 thru October 15, seed with 60 lbs per acre (1.4 lbs/1000 sq. ft.) of Kentucky 31 Tall Fescue. For the period May 1 thru July 31, seed with 60 lbs Kentucky 31 Tall Fescue per acre and 2 lbs per acre (.05 lbs/1000 sq. ft.) of weeping lovegrass. During the period of October 16 thru February 28, protect site by Option (1) - 2 tons per acre of well anchored straw mulch and seed as soon as possible in the spring. Option (2) - Use sod. Option (3) - Seed with 60 lbs/acre Kentucky 31 Tall Fescue and mulch with 2 tons/acre well anchored straw.
- Mulching:** Apply 1-1/2 to 2 tons per acre (70 to 90 lbs/1000 sq. ft.) of unrotted small grain straw immediately after seeding. Anchor mulch immediately after application using mulch anchoring tool or 218 gallons per acre (5 gal/1000 sq. ft.) of emulsified asphalt on flat areas. On slopes 8 feet or higher, use 348 gallons per acre (8 gal/1000 sq. ft.) for anchoring.
- Maintenance:** Inspect all seeding areas and make needed repairs, replacements and reseeding.

**TEMPORARY SEEDING NOTES**

- Apply to graded or cleared areas likely to be redisturbed where a short-term vegetative cover is needed.
- Seedbed preparation:** Loosen upper three inches of soil by raking, disking or other acceptable means before seeding, if not previously loosened.
- Soil Amendments:** Apply 600 lbs per acre 10-10-10 fertilizer (14 lbs/1000 sq. ft.)
- Seeding:** For periods March 1 thru April 30 and from August 15 thru October 15, seed with 2-1/2 bushel per acre of annual rye (3.2 lbs/1000 sq. ft.). For the period May 1 thru August 14, seed with 3 lbs per acre of weeping lovegrass (.07 lbs/1000 sq. ft.). For the period November 16 thru February 28, protect site by applying 2 tons per acre of well anchored straw mulch and seed as soon as possible in the spring, or use sod.
- Mulching:** Apply 1-1/2 to 2 tons per acre (70 to 90 lbs/1000 sq. ft.) of unrotted weed free small grain straw immediately after seeding. Anchor mulch immediately after application using mulch anchoring tool or 218 gal per acre (5 gal/1000 sq. ft.) of emulsified asphalt on flat areas. On slopes 8 ft. or higher, use 348 gal per acre (8 gal/1000 sq. ft.) for anchoring.
- Refer to the 1983 MARYLAND STANDARDS AND SPECIFICATIONS FOR SOIL EROSION AND SEDIMENT CONTROL for additional rates and methods not covered.

**STANDARD SEDIMENT CONTROL NOTES**

- A minimum of 48 hours notice must be given to the Howard County Department of Inspections, Licenses and Permits, Sediment Control Division prior to the start of any construction, (313-1850).
- All vegetative and structural practices are to be installed according to the provisions of this plan and are to be in conformance with the most current MARYLAND STANDARDS AND SPECIFICATIONS FOR SOIL EROSION AND SEDIMENT CONTROL, and revisions thereto.
- Following initial soil disturbance or redisturbance, permanent or temporary stabilization shall be completed within: a) 7 calendar days for all perimeter sediment control structures, dikes, perimeter slopes and all slopes greater than 3:1; b) 14 days as to all other disturbed or graded areas on the project site.
- All sediment traps/basins shown must be fenced and warning signs posted around their perimeter in accordance with Vol. 1, Chapter 12, of the HOWARD COUNTY DESIGN MANUAL, Storm Drainage.
- All disturbed areas must be stabilized within the time period specified above in accordance with the 1983 MARYLAND STANDARDS AND SPECIFICATIONS FOR SOIL EROSION AND SEDIMENT CONTROL for permanent seeding (Sec.51), sod (Sec. 54), temporary seeding (Sec. 50) and mulching (Sec. 52). Temporary stabilization with mulch alone can only be done when recommended seeding dates do not allow for proper germination and establishment of grasses.
- All sediment control structures are to remain in place and are to be maintained in operative condition until permission for their removal has been obtained from the Howard County Sediment Control Inspector.
- Site Analysis
 

Total Area of Site	0.10	Acres
Area Disturbed	0.05	Acres
Area to be roofed of paved	0.05	Acres
Area to be vegetatively stabilized	0.01	Acres
Total Cut	500	Cu. Yds.
Total Fill	50	Cu. Yds.
Offsite Waste/Borrow Area Location	To Be Determined By Contractor	
- Any sediment control practice which is disturbed by grading activity for placement of utilities must be repaired on the same day of disturbance.
- Additional sediment control must be provided, if deemed necessary by the Howard County Sediment Control Inspector.
- On all sites with disturbed areas in excess of 2 acres, approval of the inspection agency shall be requested upon completion of installation of perimeter erosion and sediment controls, but before proceeding with any other earth disturbance or grading. Other building or grading inspection approvals may not be authorized until this initial approval by the inspection agency is made.
- Trenches for the construction of utilities is limited to three pipe lengths or that which can be backfilled and stabilized within one working day, whichever is shorter.

THIS DEVELOPMENT PLAN IS APPROVED FOR SOIL EROSION AND SEDIMENT CONTROL BY THE HOWARD COUNTY DEPARTMENT OF INSPECTIONS, LICENSES AND PERMITS, SEDIMENT CONTROL DIVISION.

Reviewed for HOWARD S.O.D. and meets Technical Requirements

*J. A. Wardfield, JPM* Date 6/10/94

Approved *John R. Keltner, S/O, S.C.D.* Date 6/10/94

U.S. Soil Conservation Service

**SEQUENCE OF CONSTRUCTION**

- Obtain grading permit for the project.
- Install sediment controls as shown on the site plan.
- Excavate for wall reconstruction.
- Construct concrete cantilever retaining wall, and reset stone gravity wall in accordance with the limits shown on the plans.
- Backfill behind wall.
- Construct new stone facing for concrete cantilever wall; construct new railing, sidewalk, and replace salvaged granite curb.
- Repoint face of retaining wall.
- Reconstruct pavement as shown on the plans and as directed by the engineer.
- Regrade slope of the front face of retaining wall in accordance with the contours shown on the site plan.
- After the site is stabilized and permission is granted by the Sediment Control Inspector, remove sediment controls and stabilize any remaining disturbed areas.

DEPARTMENT OF PUBLIC WORKS  
HOWARD COUNTY, MARYLAND

*James P. Lewis* DATE 6/10/94  
DIRECTOR OF PUBLIC WORKS

*Robert M. Daniels* DATE 6-10-94  
CHIEF, BUREAU OF HIGHWAYS

NOLAN ASSOCIATES, INC.  
ENGINEERS - CIVIL/STRUCTURAL/INSPECTIONS

P.O. BOX 2579  
COLUMBIA, MARYLAND 21045  
PHONE: (410) 995-3651 FAX: (410) 995-1383

*Elizabeth Anderson* DATE 6/10/94  
CHIEF, DIVISION OF TRANSPORTATION  
PROJECTS AND WATERSHED MANAGEMENT

DES: Y.C.W.

DRN: J.S.N.

CHK: C.S.N.

DATE: 05/18/94




BY NO. REVISION DATE 600' SCALE MAP NO. BLOCK NO.

**STANDARD DETAILS AND SEDIMENT AND EROSION CONTROL NOTES**

COURT AVENUE RETAINING WALL  
CAPITAL PROJECT J-4137  
ELECTION DISTRICT NO. 2  
ELLCOTT CITY, MARYLAND

SCALE AS SHOWN

SHEET 5 OF 5

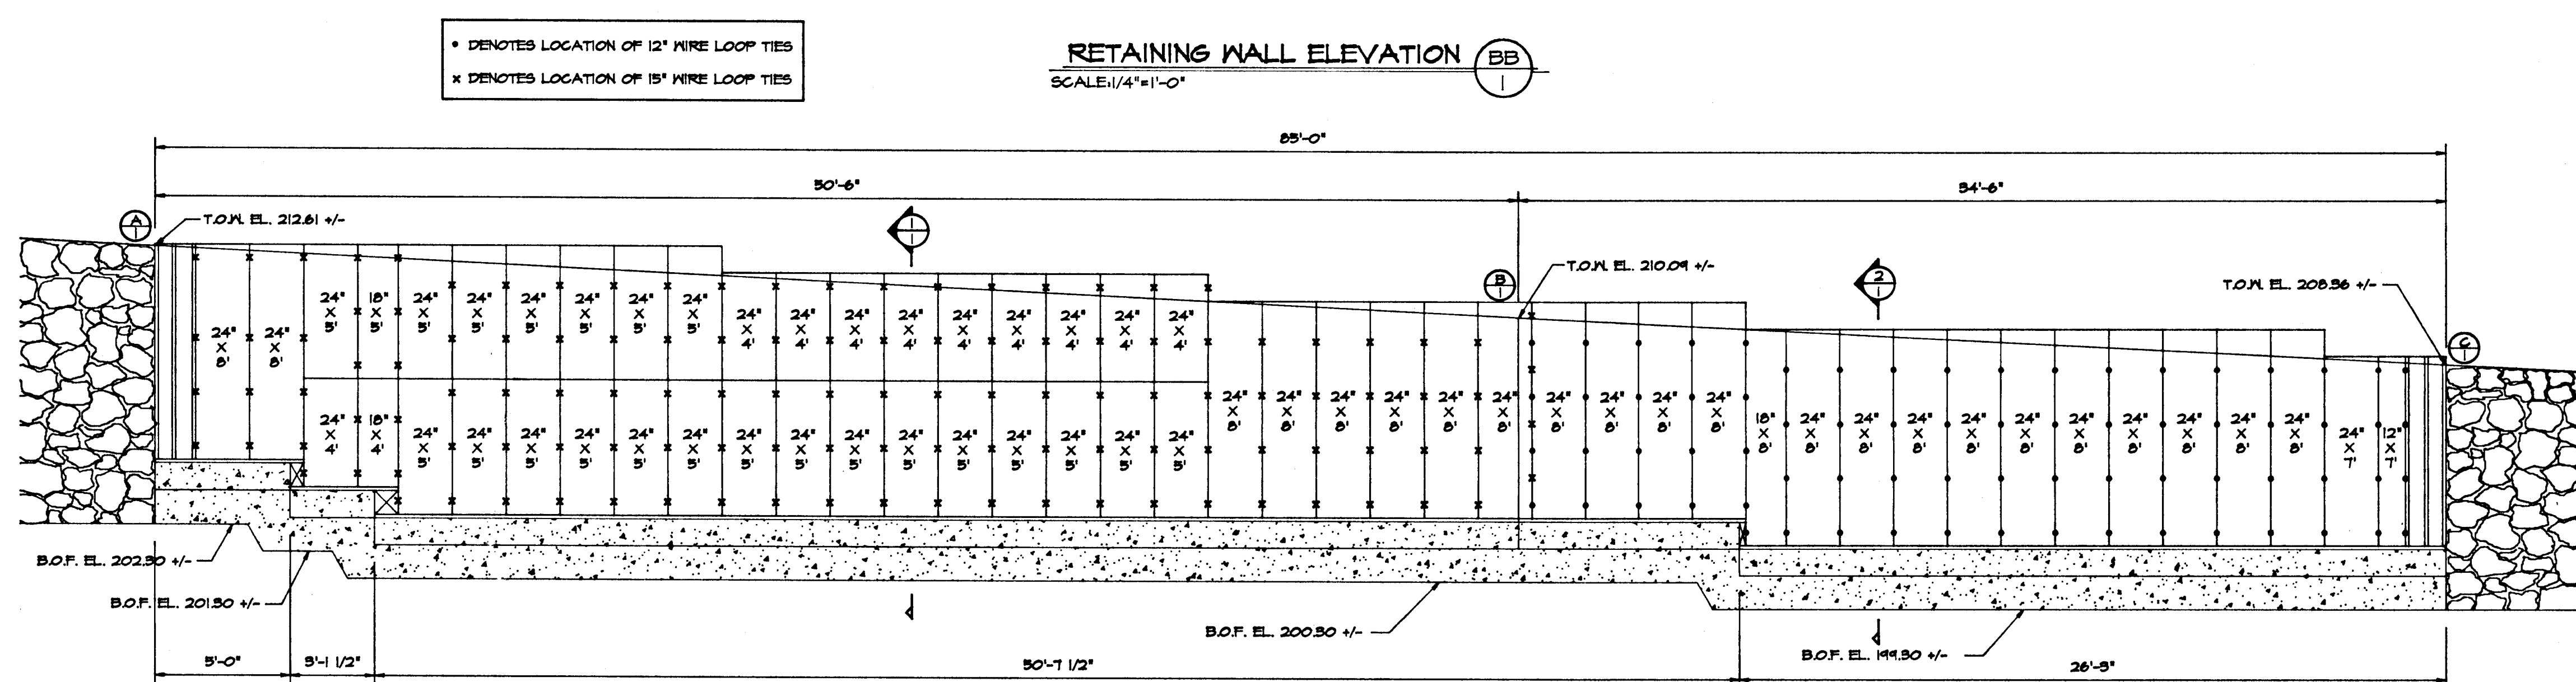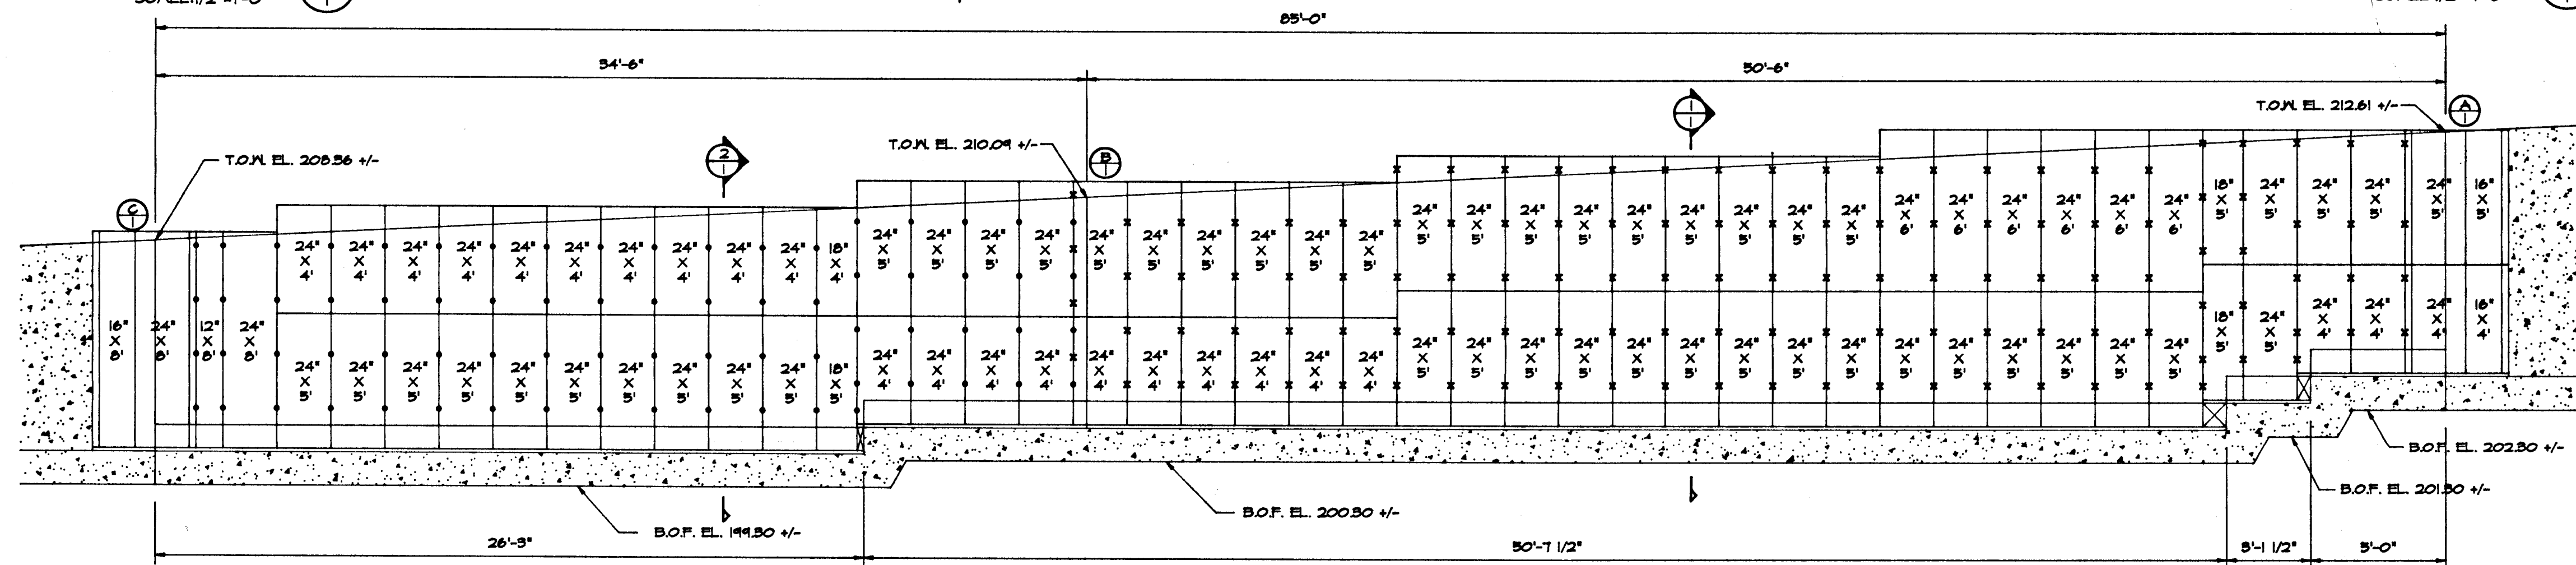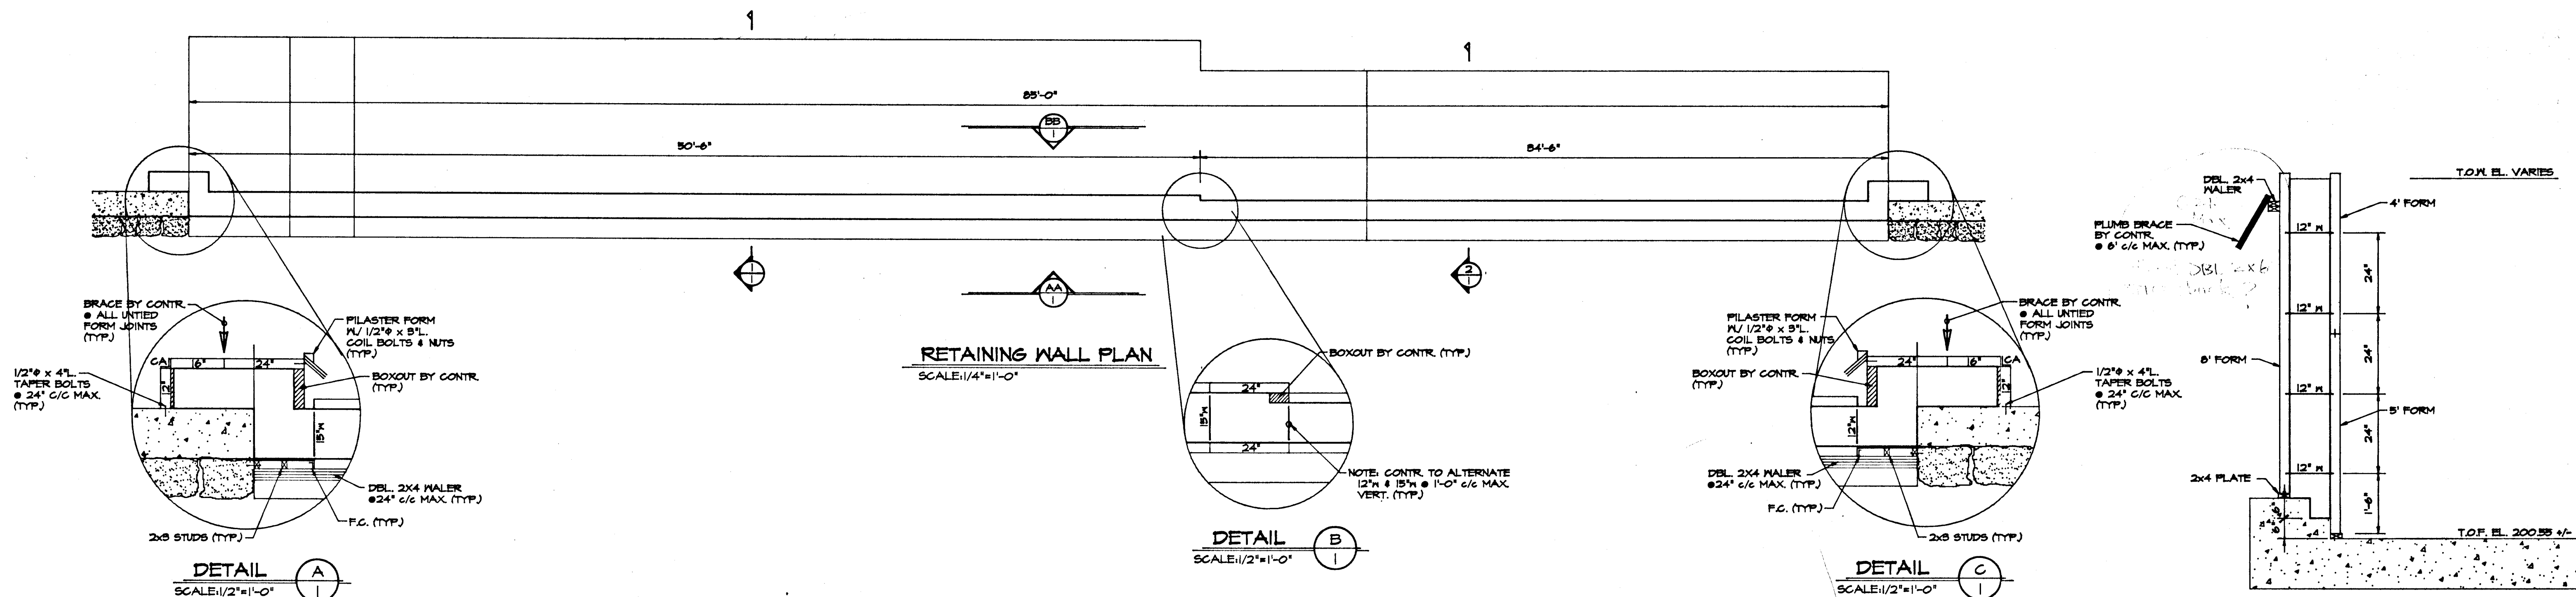

**SECTION 2**  
SCALE: 1/2"=1'-0"

APPROVED AS SUBMITTED     REVISE AND RETURN  
 APPROVED AS NOTED     NOT ACCEPTABLE

Review is for general compliance with contract documents. No contract requirements are waived.

*[Signature]* NOLAN ASSOCIATES, INC. Date: 10/21/94

**SECTION 1**  
SCALE: 1/2"=1'-0"

HOWARD COUNTY BUREAU OF ENGINEERING  
ROADS, BRIDGES & STORM DRAINAGE DIVISION

APPROVED  
 APPROVED AS NOTED  
 DISAPPROVED  
 RESUBMIT

The responsibility for the design, construction and guarantee to comply with these special specifications rests with the contractor.


*[Signature]* Date: 11/23/94

Contractor to certify and verify prior to submit to the Engineer for Review. See Rev. 10.24 of the Co. Specs.


C179CZ01

NOTES OR SPECIAL CONDITIONS:		<b>DWG MK DEFINITION</b> 24" P HANDSET FORM PANEL, 24" WIDE 9(24) 9 PANELS, EACH 24" WIDE IC 6" x 6" INSIDE CORNER PANEL CA 3" x 3" OUTSIDE CORNER ANGLE 8"W 6" WIDE METAL FILLER PANEL WWWB 680 LB CAP WALKWAY BRACKET 10" PF 10" WIDE PILASTER PANEL 4"x45 4"x4" x 45" CORNER PANEL 8" WF 8" WOOD FILLER, BY CONTR FC STEEL SUPPORT ANGLE @ WF W & B WOOD WALE & BRACE, BY CONTR BLKHD WOOD BULKHEAD, BY CONTR BOX WOOD BOXOUT, BY CONTR		<b>DWG MK DEFINITION</b> 408 4" WIDE 8' LONG CRANESSET PANEL 5W06 TWO 5x6.7 STEEL WALE x 6' LONG 8W12 TWO 8x11.5 STEEL WALE x 12' CLIP E ANGLE CONN. PANEL TO WALER SF46 SCAFFOLD FRAME, 4' WIDE x 6' HIGH XB4 X-BRACE FOR SF SPA @ 4' O.C. C01 COUPLERS FOR SF R1 5/8" # PIN FOR SF SC-2 SCREW JACK FOR SF, 1.9" x 26" THD PH69 6"x 9" BASE PLATE FOR SF UH48 4"x 8" U-HEAD FOR SF 12" ST SNAPTEE FOR WOOD FORM, 12" WALL BIP BUILT-IN-PLACE WOOD FORM TOC TOP OF CONCRETE		<b>CONCRETE FORM DESIGN NOTES:</b> FORM TYPE ALUMINUM FRAME    STEEL FRAME    OTHER: DESIGN PRESSURE, PSF 32 LPSF ACI POUR RATE EQUIV 6/yr ACI TEMPERATURE EQUIV TO DEG WALER TYPE WOOD WALER SIZE DEL. 2x4 WALER SCAFFOLD CLASS DECK JOIST TYPE FORM SKIN OR DECKING 1/2" M. L. PLY BIRCH TIE TYPE WIRE LOOP TIE ULT TENS STRENGTH 7500 lbs TIE BREAKBACK 1" CONCRETE FORMS AND TIES ARE DESIGNED PER ACI 347-78, ANSI A10.9-70, OSHA 29CFR1926.700 & 701, AND AIA 201-77-2.2.4 SPECIFICATIONS.		ANY ILLUSTRATION FURNISHED ABOVE BY FORM SERVICES, INC. IS TO PROVIDE A SUGGESTED METHOD OF ASSEMBLY OF FSI PRODUCTS ONLY. SUCH ILLUSTRATION IS NOT DIRECTIVE, AND DOES NOT CONTAIN ENGINEERING DETAIL ON FSI PRODUCTS, NOR DOES IT INFER ENGINEERING ANALYSIS BY FORM SERVICES, INC. OF THE STRUCTURE UNDER CONSTRUCTION. IT IS THE RESPONSIBILITY OF THE LESSEE OR BUYER TO PREPARE ALL DRAWINGS FOR CONSTRUCTION PURPOSES CONSISTENT WITH SAFE PRACTICES AND OVERALL PROJECT OBJECTIVES.		<b>REV. DESCRIPTION DATE</b> 10-4 REV. RET. WALL END DETAILS HARNICK CONSTRUCTION COURT AVENUE RETAINING WALL ELLICOTT CITY, MD. CAPITAL PROJECT # J-4157 "NEW RETAINING WALL" SALES & CONTRACT INFO: GENE DORE DRAWINGS & DETAILS: MARK AUSPRESSER SUPPLIES & SHIPMENTS:	<b>FORM SERVICES, INC.</b> CONCRETE FORMING EQUIPMENT & ACCESSORIES BALTO. METRO 789-5900 WATS (Md., Va., Pa., Del., W. Va., Wash. D.C.) 800-638-3395 P.O. Box 60, Linthicum Heights, Md. 21090-0060 PROJ. NO: 94248 SHEET NO: 1 REV. NO: 1
------------------------------	--	---	--	---	--	---	--	---	--	--	--


8 | 7 | 6 | 5 | 4 | 3 | 2 | 1

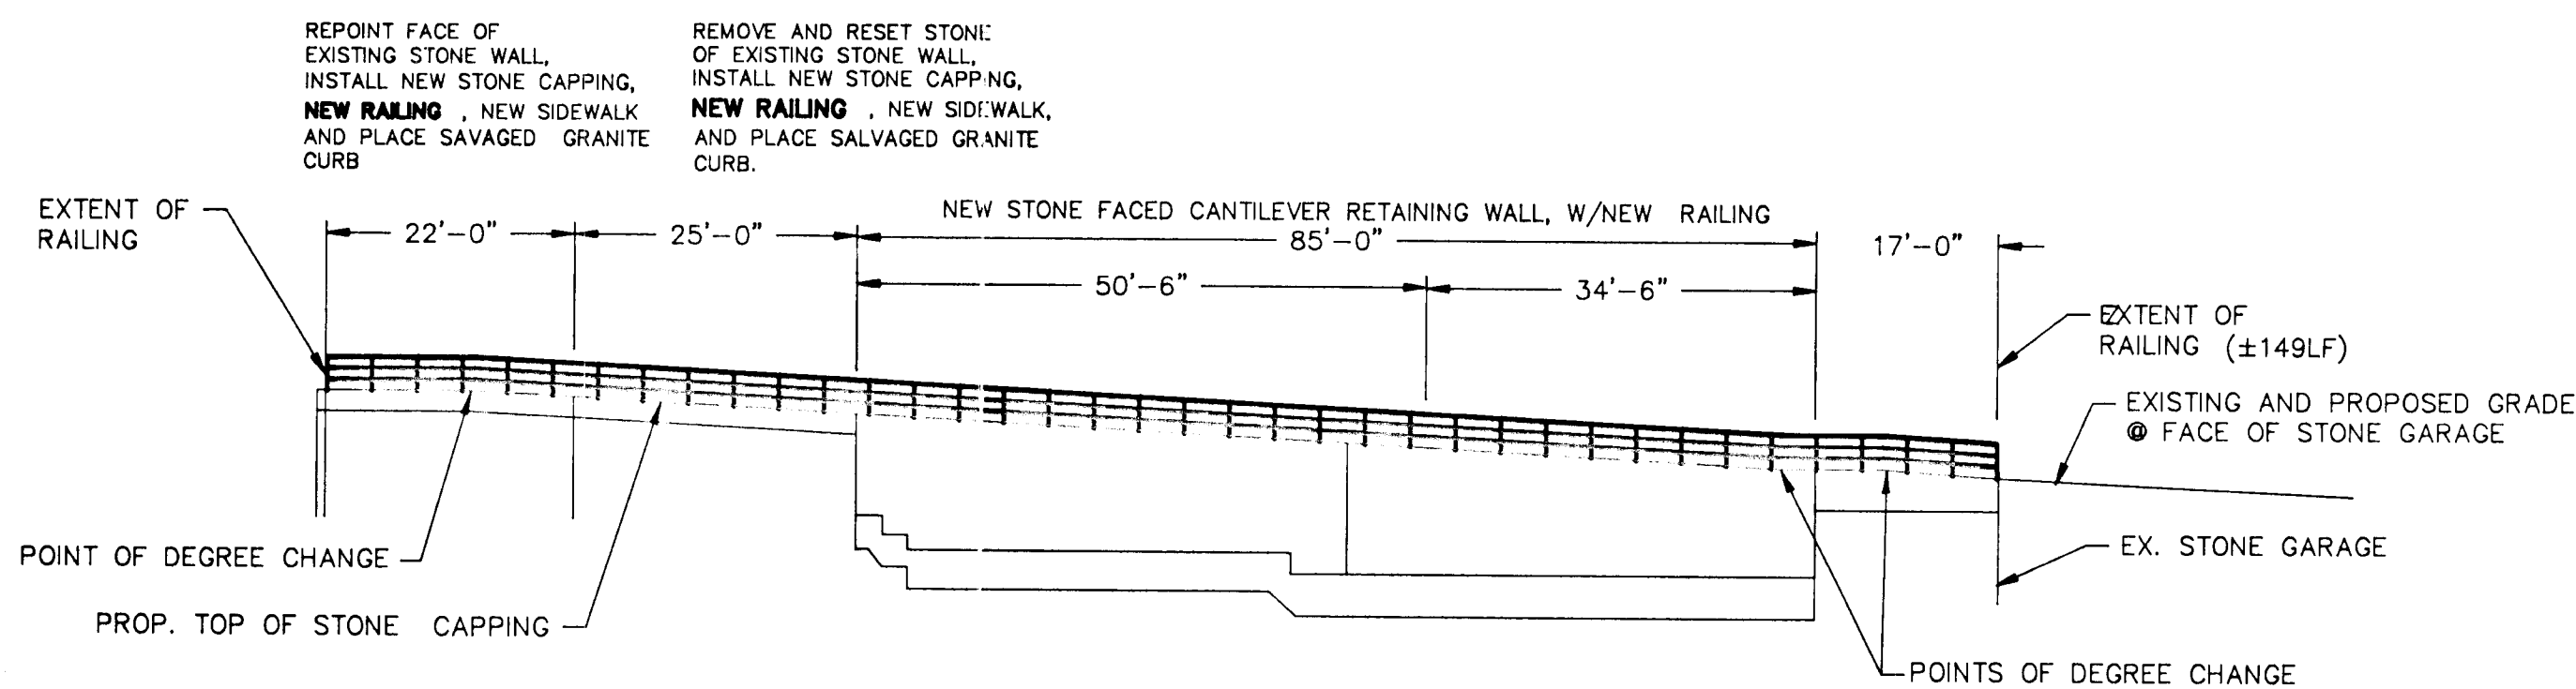


**RAILING ELEVATION**  
SCALE: 3/16"=1'-0"

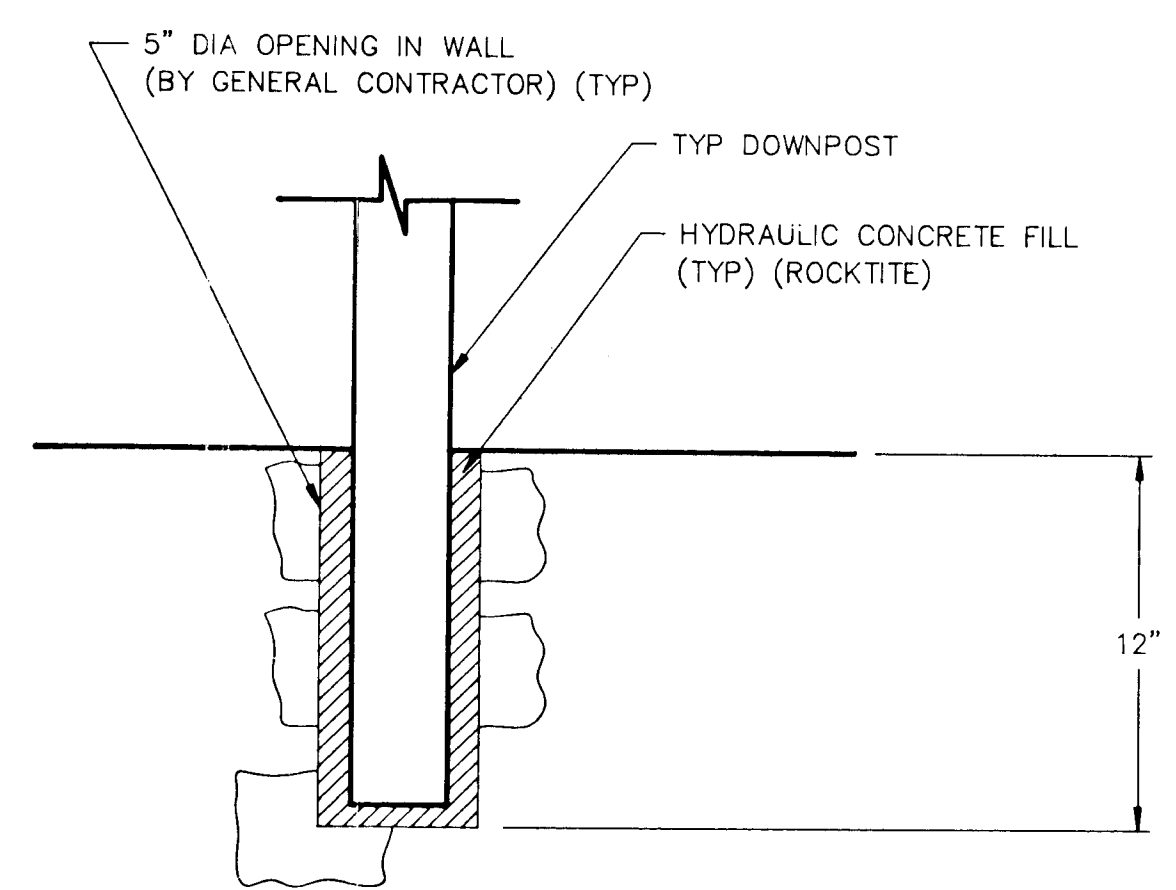

**DOWNPOST INSTALLATION DETAIL**  
SCALE: 6"=1'-0"

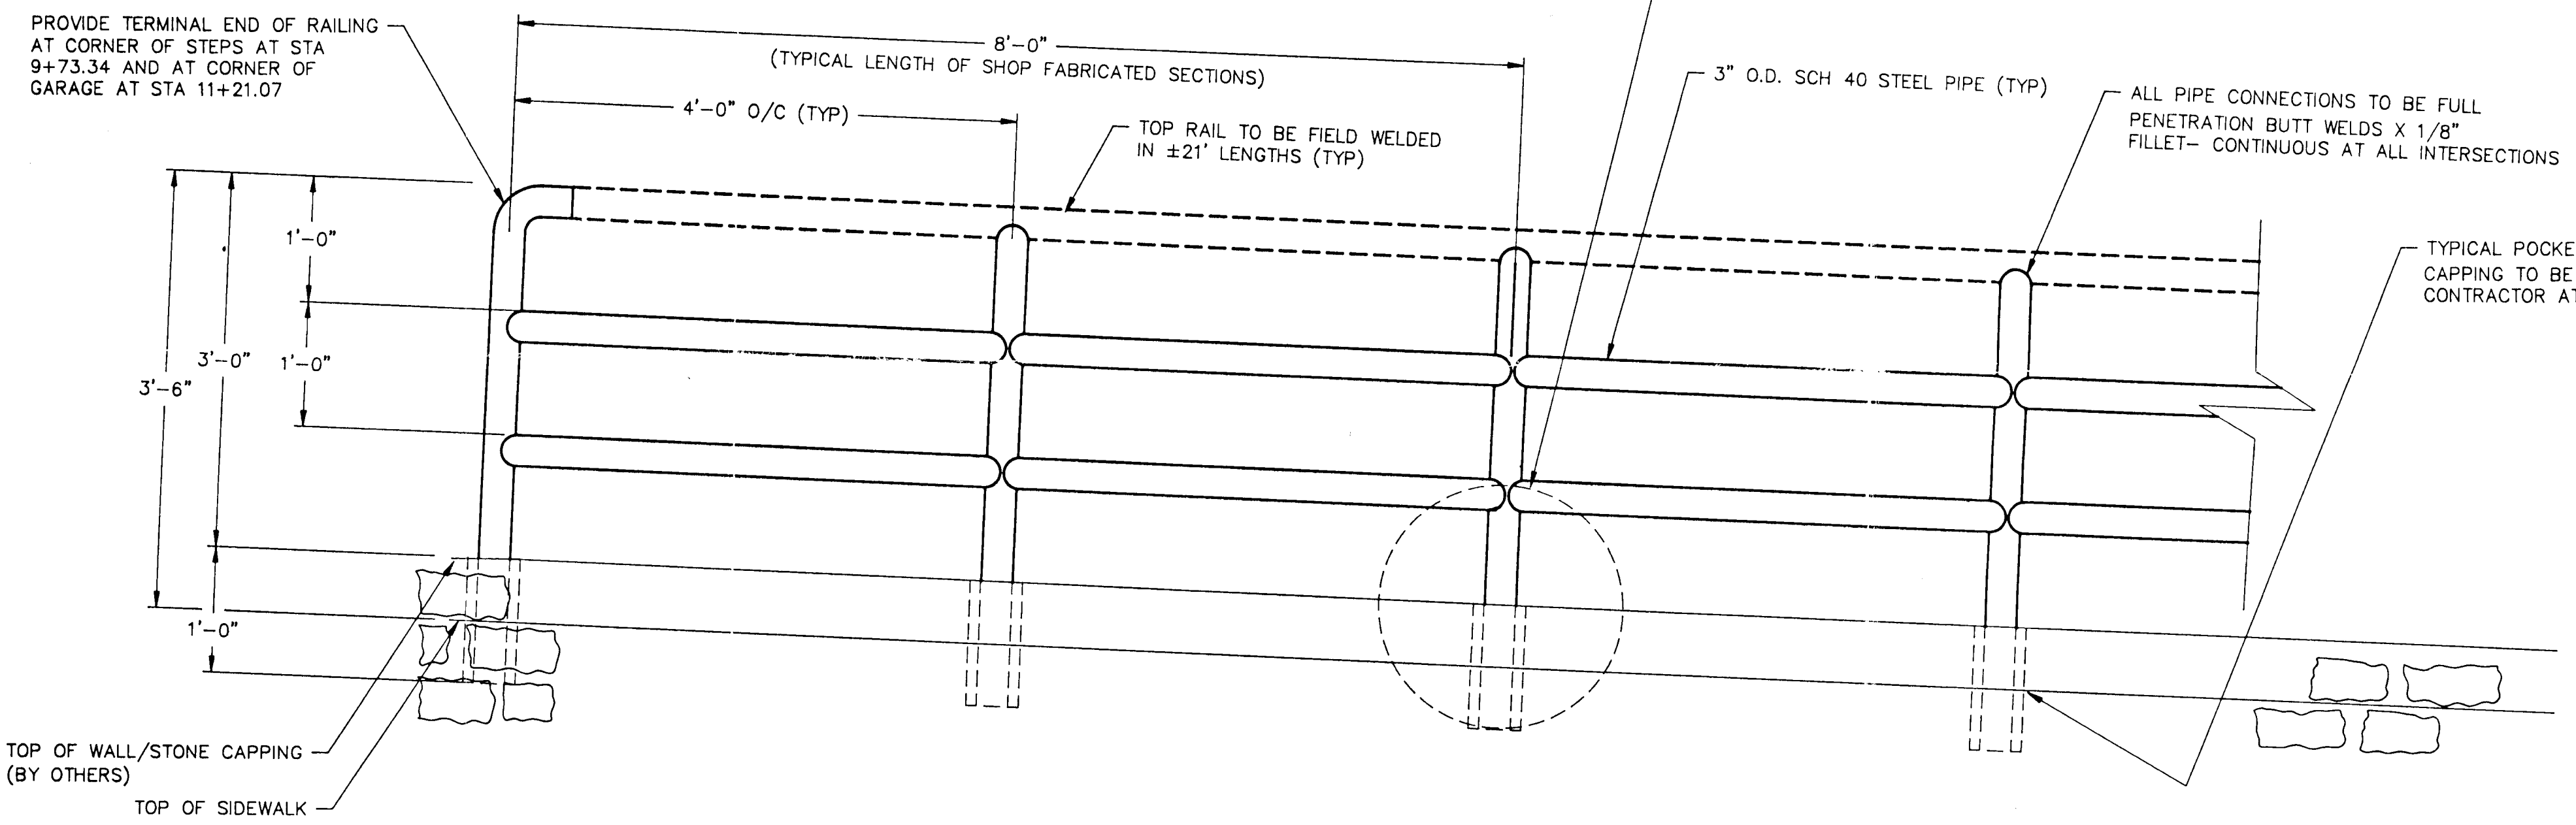

**TYPICAL RAILING ELEVATION**  
SCALE: 3"=1'-0"

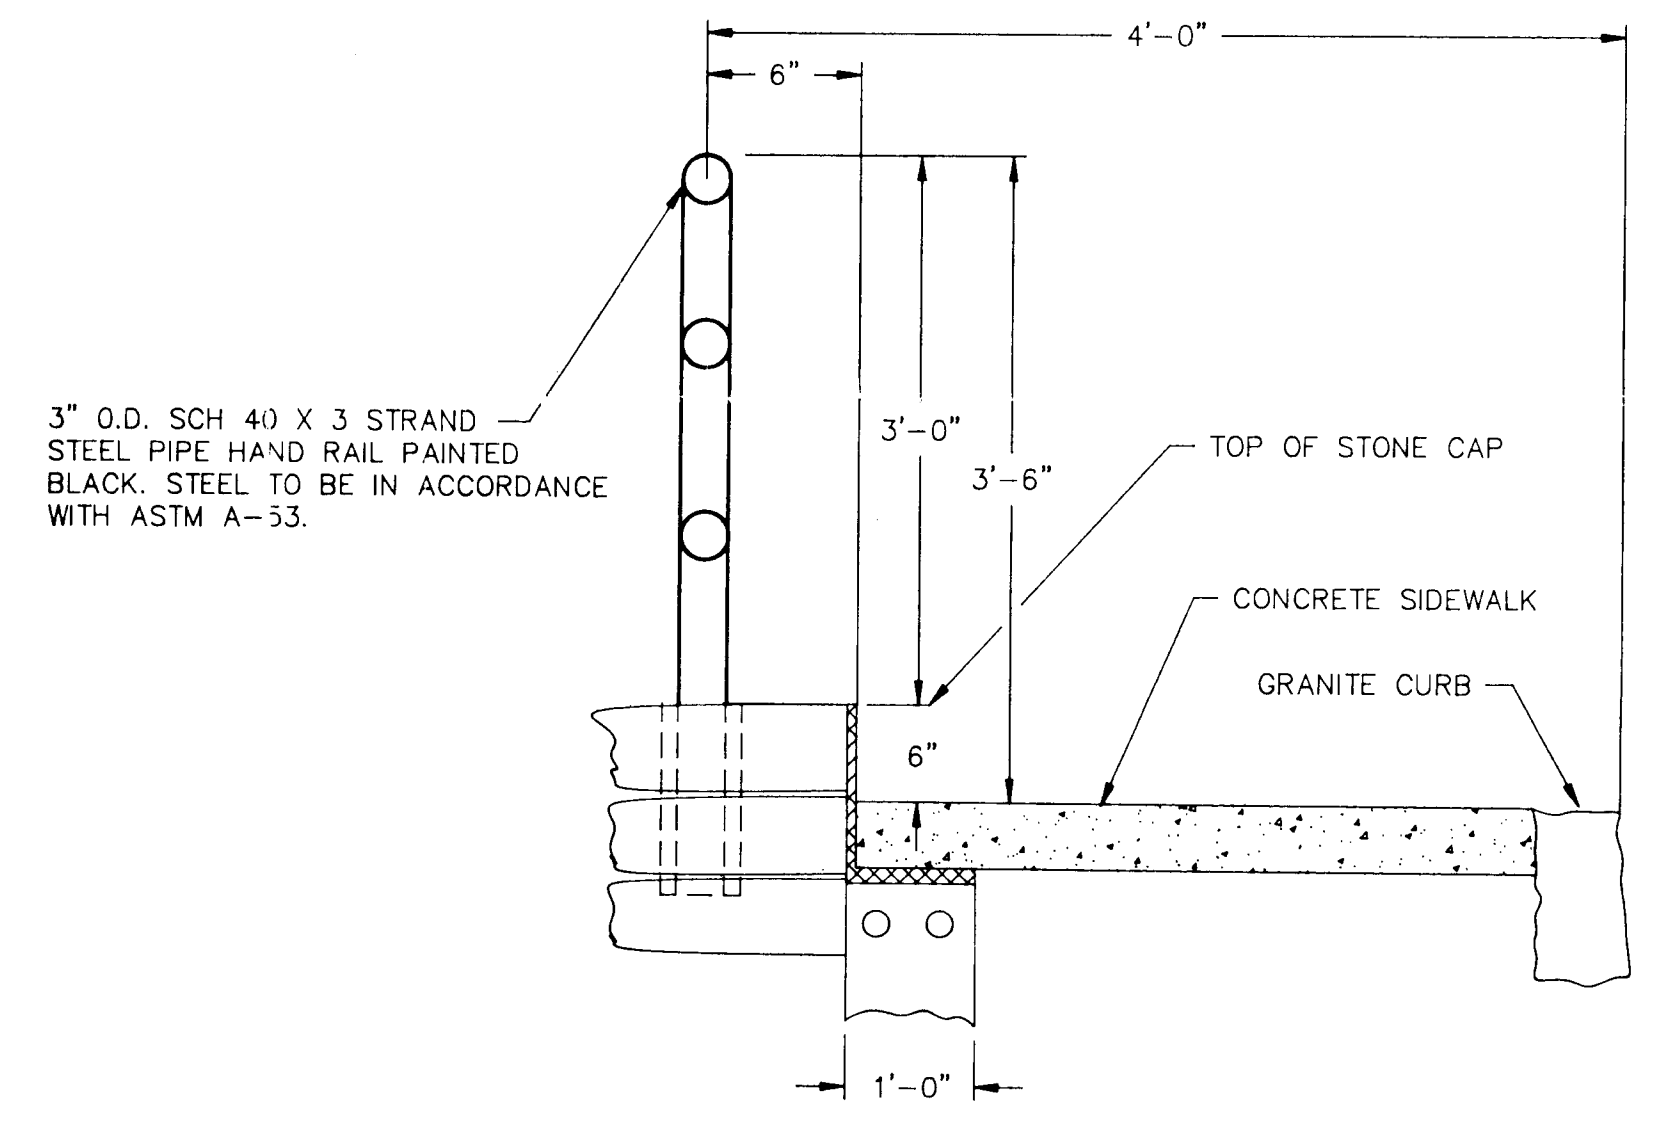

**RAILING SECTION**  
SCALE: 3"=1'-0"


**NOTES:**

1. STEEL SHALL CONFORM TO ASTM A-53, STANDARD STRENGTH.
2. WELDMENTS SHALL BE THOROUGHLY CLEANED AFTER FABRICATION.
3. ALL BURRS TO BE GROUND OFF TO PROVIDE A SMOOTH FINISH.
4. ALL PRE-TREATMENT, SHOP PRIMER, FINISH PAINT AND TOUCH-UP FIELD PRIMER AND PAINT TO BE 100% PRODUCTS BY SHERWIN-WILLIAMS.
5. TOP RAILING, SHOWN IN DASHED LINES, IS TO BE FIELD WELDED IN ±21 FOOT LENGTHS.

*Handwritten signature and initials*



<b>BLACKWELL'S WELDING, INC.</b>		
9416 FIFTH STREET LAUREL, MARYLAND 20723		
TITLE <b>COURT AVENUE RETAINING WALL RAILING ELLCOTT CITY, MD.</b>		
SIZE DWG NO.	<b>D BW24000</b>	<b>A1</b>
SCALE 3/16" = 1'	SHEET 1 OF 1	

8 | 7 | 6 | 5 | 4 | 3 | 2 | 1

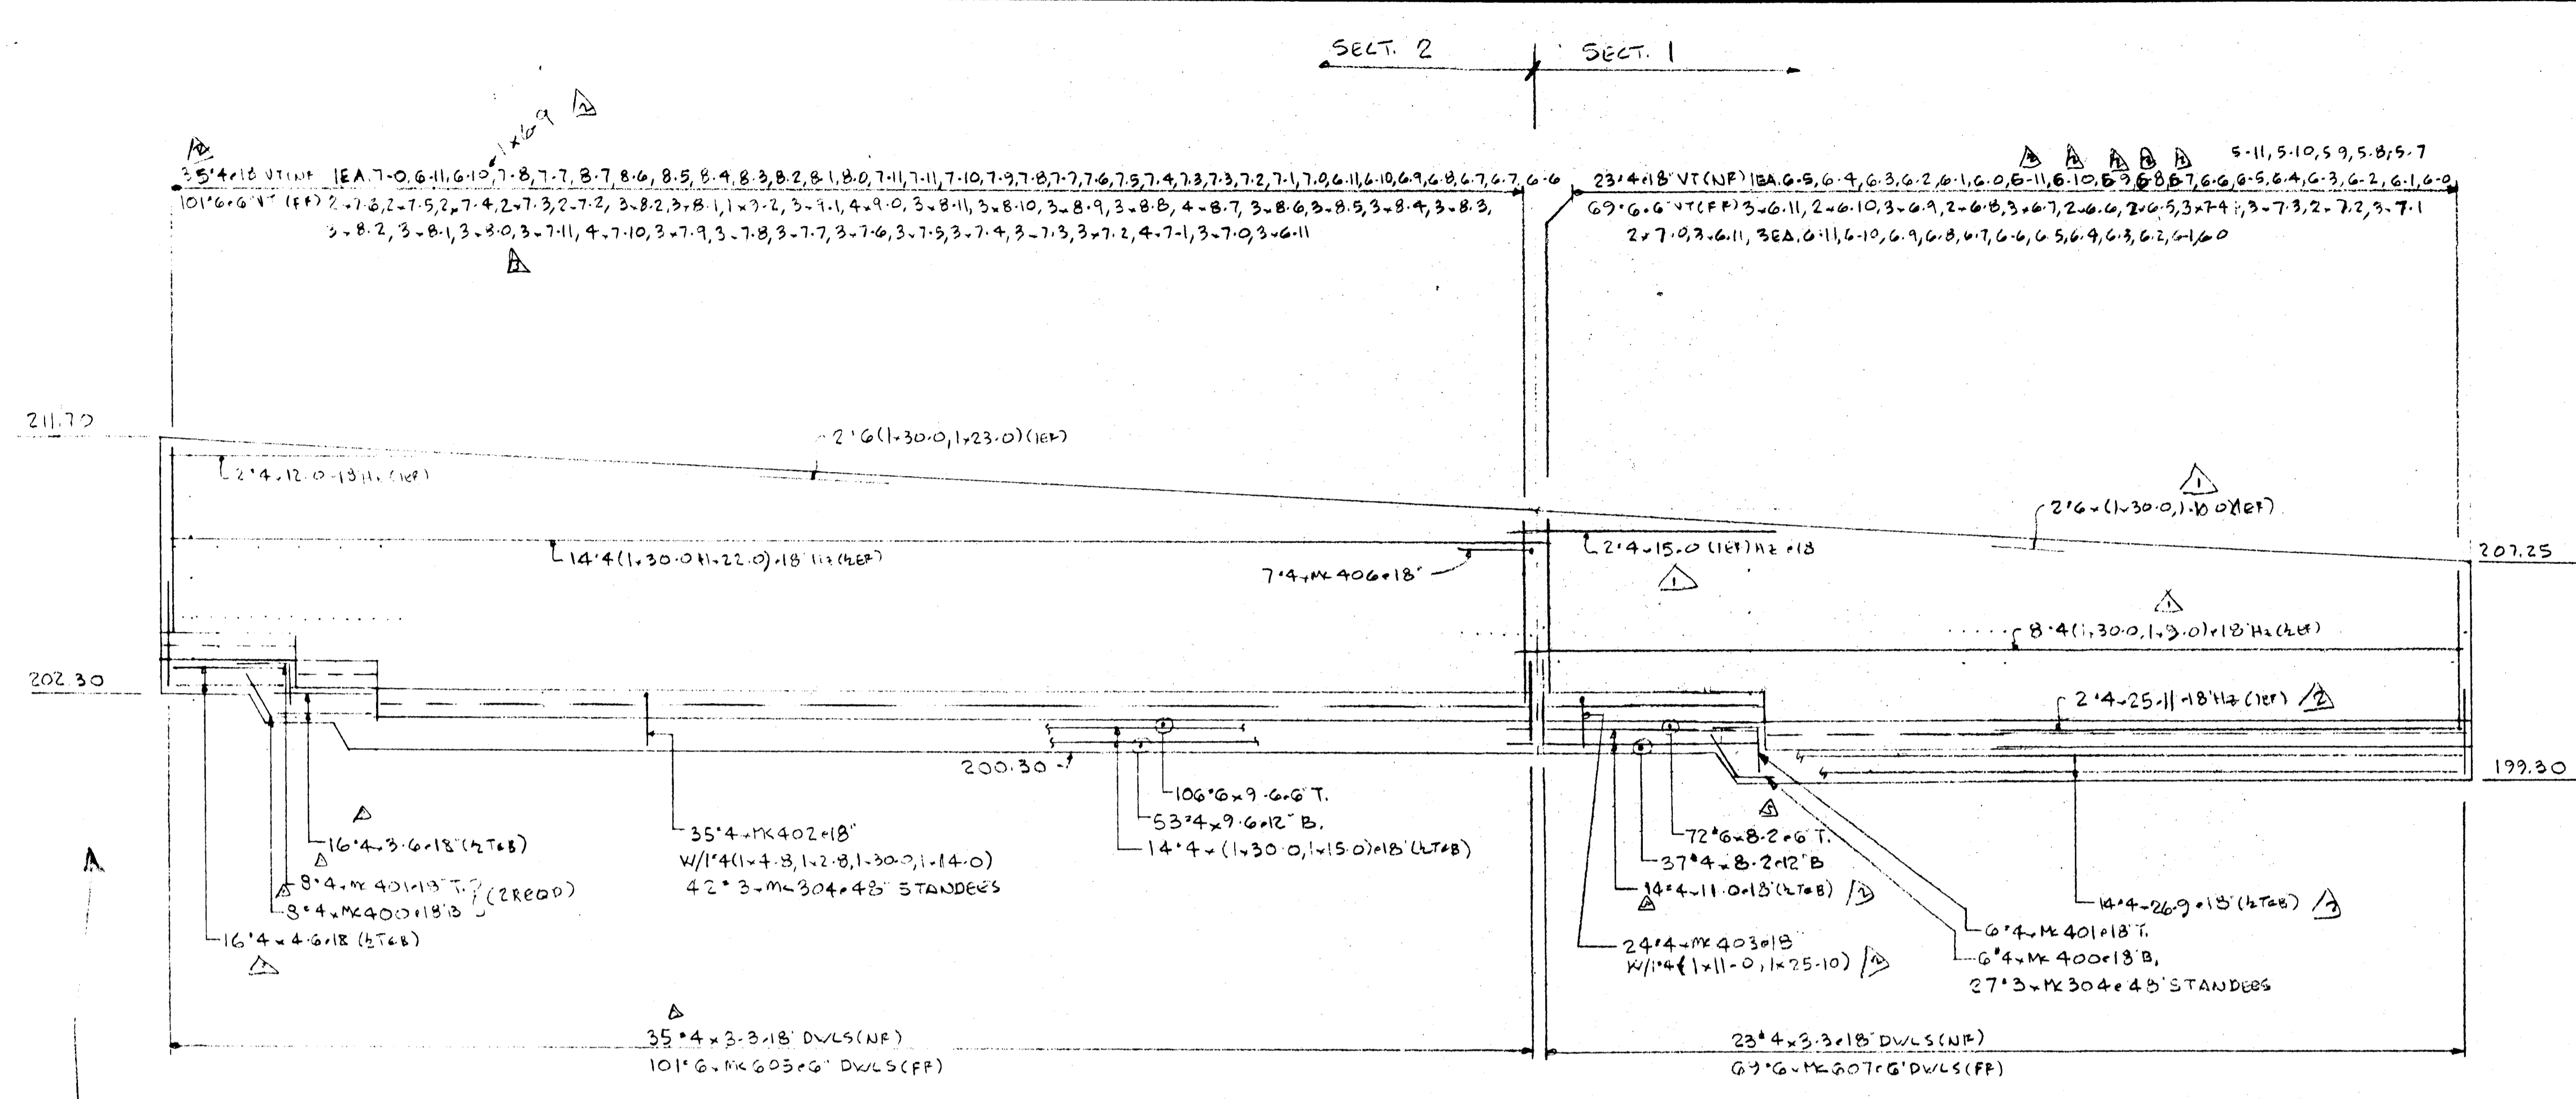

ELEVATION

Make transition to existing wall as per direction from County Engineer.

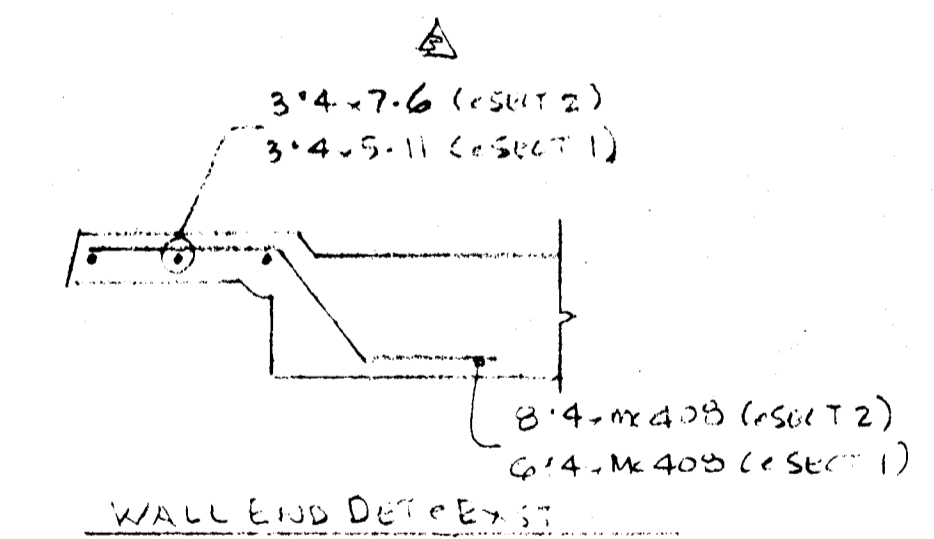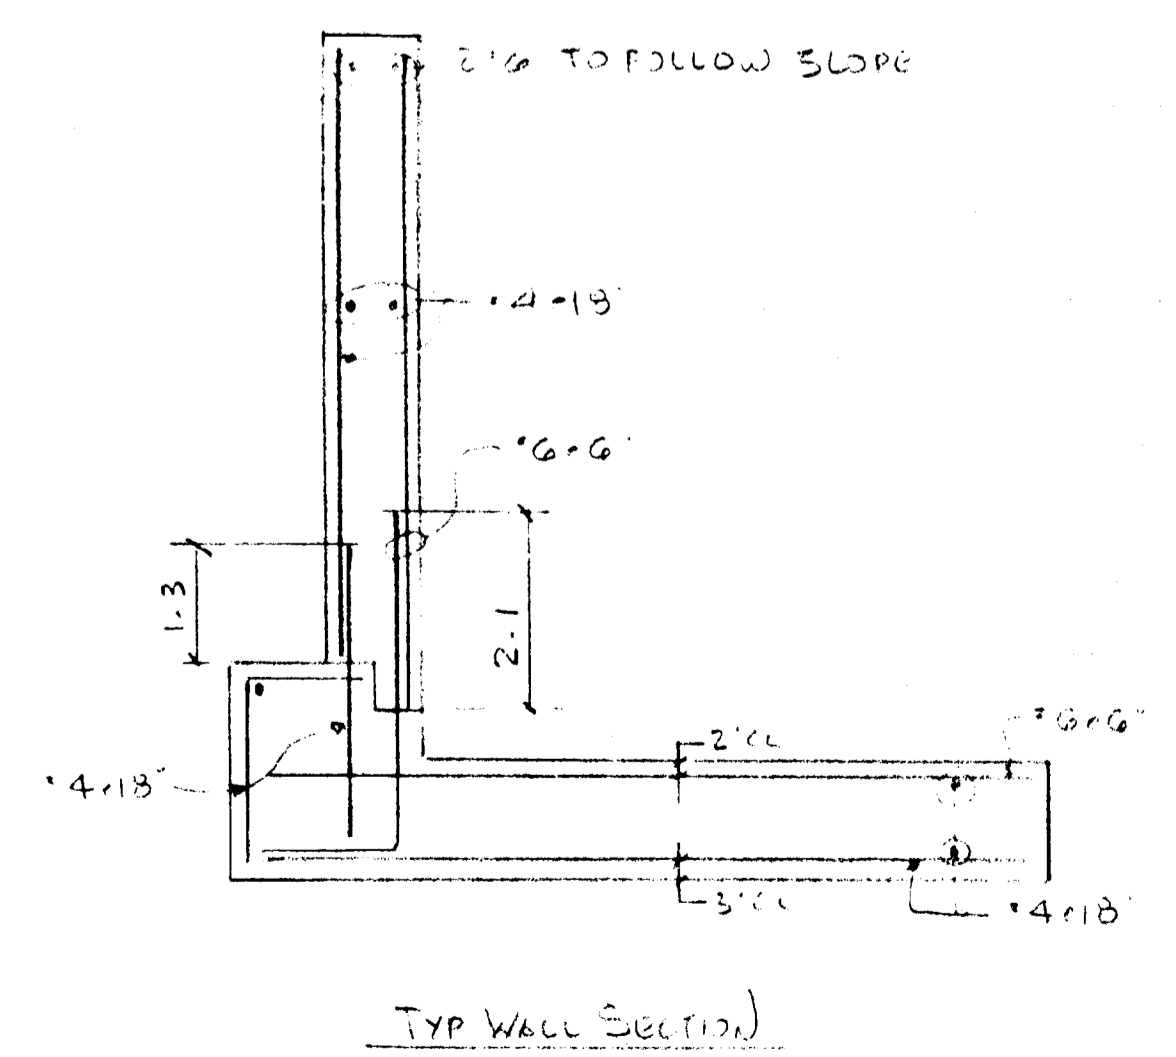

EDWARD COUNTY BUREAU OF ENGINEERING  
ROADS, BRIDGES & STORM DRAINAGE DIVISION  
APPROVED AS NOTED  
11/13/94

APPROVED AS SUBMITTED  
APPROVED AS NOTED  
REVISIONS FOR CONSTRUCTION  
11/12/94

Warwick Supply & Equip. Co. Inc.  
CERTIFYS FOLLOWING ITEMS:  
1. EXACT WALL LENGTH HAS BEEN VERIFIED  
2. EXISTING FOOTING ELEVATION AT STA. 10+20 = 208.24 AND STA. 11+05 = 200.83

M. J. M...  
11/1/94

JOB NUMBER		CUSTOMER NAME		JOB NAME	
6062B1		WARWICK SUPPLY & EQUIP CO		COURT AVE RET. WALL	
NO	DATE	DESCRIPTION	ISSUED FOR	DATE	DESCRIPTION
4	10-28-96	Per Approval			
3	10-24-96	Final Approval			
2	10-13-96	Approval			
1	9-21-94	Approval			

LEGEND		BAR LAPS		ALL REINFORCING: GR. 60								
O.F. - Outside Face	I.F. - Inside Face	NUMBER OF BAR DIAMETERS AS INDICATED BELOW (1-0 MIN. LAP)		ALL BAR SPLICES								
H. - Horizontal	V. - Vertical	BAR SIZE										
Dwls. - Dowels	E.R. - Each Row	3	4	5	6	7	8	9	10	11		
Fig. - Footing	B.S. - Brick Scaff	20	1-0	1-0	1-1	1-3	1-6	1-8	1-8	1-11	2-2	2-5
El. - Elevation	E.W. - Each Way	24	1-0	1-0	1-3	1-6	1-9	2-0	2-4	2-7	2-10	
T.F. - Top of Footing	B.F. - Bottom of Footing	30	1-0	1-3	1-7	1-11	2-3	2-6	2-10	3-3	3-7	
T.W. - Top of Wall	B.W. - Bottom of Wall	36	1-2	1-6	1-11	2-3	2-8	3-0	3-5	3-10	4-3	
∅ - Each at	U.O.N. - Unless otherwise noted	40	1-3	1-8	2-1	2-6	2-11	3-4	3-10	4-3	4-9	
∅ - Center Line	N.F. - Near Face	1. ALL BAR LENGTHS HAVE BEEN DETAILED IN 3" INCREMENTS WHERE POSSIBLE, IN ACCORDANCE WITH STANDARD PRACTICE...										
F.F. - Far Face	G.B. - Grade Beam	2. THIS DRAWING TO BE USED IN CONJUNCTION WITH ARCHITECTURAL AND STRUCTURAL ENGINEER'S PLANS...										
M.K. - Mark	N.I.C. - not in contract	3. DRAWING CANNOT BE ACCEPTED FOR FABRICATION UNLESS ALL QUESTIONS ARE ANSWERED...										
		4. WE CANNOT BE HELD RESPONSIBLE FOR CONSTRUCTION DIMENSIONS INDICATED ON THIS DRAWING...										

NO.	DATE	ISSUED FOR
4	10-28-96	Final Approval
3	10-24-96	Final Approval
2	10-13-96	Approval
1	9-21-94	Approval

Brocker / TAYLOR-DAVIS	
STRUCTURE	COURT AVE RET. WALL
LOCATION	ELLIOTT CITY, MD
ARCHITECT	
ENGINEER	JOSEPH ASSOC
DRAWN BY	1/c
CHECKED BY	
CONTRACTOR	WARWICK SUPPLY & EQUIP CO.
DATE	9-20-94
DRAWING COVERS	REIN COMP.
DRAWING NO.	6062B1-1

C179E201