

HALL SHOP ROAD AT BROWNS BRIDGE ROAD




INDEX OF SHEETS

- 1 TITLE SHEET
- 2 TYPICAL SECTIONS & DETAILS
- 3-4 ROADWAY PLANS
- 5 ROADWAY PROFILES
- 6 STORM DRAIN PROFILES & DETAILS
- 7-8 EROSION AND SEDIMENT CONTROL PLANS
- 9-12 EROSION AND SEDIMENT CONTROL NOTES AND DETAILS
- 13 STORMWATER MANAGEMENT PLAN
- 14 ROADWAY MARKING AND SIGNING PLANS
- 15-16 MAINTENANCE OF TRAFFIC PLANS
- 17 SOIL BORING LOGS
- 18-21 ROADWAY CROSS SECTIONS

5th ELECTION DISTRICT HOWARD COUNTY, MARYLAND CAPITAL PROJECT NO. J-4164

GENERAL NOTES

1. THE CONTRACTOR SHALL NOTIFY THE HOWARD COUNTY DEPARTMENT OF PUBLIC WORKS/BUREAU OF ENGINEERING CONSTRUCTION INSPECTION DIVISION AT 410-313-1880 AND MISS UTILITY AT 1-800-257-7777 AT LEAST FIVE (5) WORKING DAYS BEFORE STARTING WORK.
2. COORDINATES SHOWN HEREON ARE BASED ON THE MARYLAND STATE REFERENCE SYSTEM NAD 83/91 AS PROJECTED BY HOWARD COUNTY PROJECT CONTROL STATIONS 40FA AND 40FB. VERTICAL DATUM IS NGVD29.
 - 40FA
N: 548,106.916
E: 1,328,421.356
ELEV.: 497.793 (NGVD29)
HOWARD COUNTY DISK
 - 40FB
N: 548,470.381
E: 1,326,000.771
ELEV.: 505.119 (NGVD29)
3. ALL CONSTRUCTION SHALL BE IN ACCORDANCE WITH THE LATEST STANDARDS AND SPECIFICATIONS OF HOWARD COUNTY.
4. ALL WORK SHALL COMPLY WITH ALL APPLICABLE PROVISIONS OF THE 2011 MARYLAND STANDARDS AND SPECIFICATIONS FOR SOIL EROSION AND SEDIMENT CONTROL, ISSUED BY THE MARYLAND DEPARTMENT OF THE ENVIRONMENT AND THE NATURAL RESOURCES CONSERVATION SERVICE.
5. TOPOGRAPHIC SURVEYS WERE PERFORMED BY URS CORPORATION (AECOM) IN NOVEMBER 2000.
6. THE PROPERTY LINES AND EASEMENT LINES ARE INDICATED ON PLAT NOS. J-4164-01 THROUGH J-4164-08.
7. SHOULD THE CONTRACTOR DISCOVER DISCREPANCIES BETWEEN THE PLANS AND THE FIELD CONDITIONS, THE ENGINEER IS TO BE NOTIFIED IMMEDIATELY TO RESOLVE THE SITUATION. SHOULD THE CONTRACTOR MAKE FIELD CORRECTIONS OR ADJUSTMENTS WITHOUT NOTIFYING THE ENGINEER, THEN THE CONTRACTOR ASSUMES ALL RESPONSIBILITY FOR THOSE CHANGES.
8. CONTRACTOR IS SOLELY RESPONSIBLE FOR CONSTRUCTION MEANS, METHOD, TECHNIQUES, SEQUENCES, PROCEDURES, AND SAFETY PRECAUTIONS AND PROGRAMS.
9. APPROXIMATE UTILITIES ARE SHOWN FROM AVAILABLE RECORDS. THE CONTRACTOR SHALL TAKE ALL NECESSARY PRECAUTIONS TO PROTECT THE EXISTING UTILITIES AND MAINTAIN UNINTERRUPTED SERVICE. ANY DAMAGE INCURRED DUE TO CONTRACTOR'S OPERATION SHALL BE REPAIRED IMMEDIATELY AT THE CONTRACTOR'S EXPENSE.
10. UTILITY CONTACTS:
 - BGE: (410)-597-7920 (ELECTRIC)
 - BGE: (410)-291-4844 (GAS)
 - VERIZON: (410)-224-9285
 - WORLDCOMM: (301)-630-7094
11. ALL PIPE ELEVATIONS SHOWN ARE INVERT ELEVATIONS.
12. TRAFFIC CONTROL DEVICES:
 - A.) THE R-1 ("STOP") SIGN AND THE STREET NAME SIGN (SNS) ASSEMBLY FOR THIS DEVELOPMENT MUST BE INSTALLED BEFORE THE BASE PAVING IS COMPLETED.
 - B.) THE TRAFFIC CONTROL DEVICE LOCATIONS SHOWN ON THE PLANS ARE APPROXIMATE AND MUST BE FIELD APPROVED BY HOWARD COUNTY TRAFFIC DIVISION (410-313-2430) PRIOR TO THE INSTALLATION OF ANY OF THE TRAFFIC CONTROL DEVICES.
 - C.) ALL TRAFFIC CONTROL DEVICES AND THEIR LOCATION SHALL BE IN ACCORDANCE WITH THE LATEST EDITION OF THE "MARYLAND MANUAL ON UNIFORM TRAFFIC CONTROL DEVICES" (MDMUTCD).
 - D.) ALL SIGN POSTS USED FOR TRAFFIC CONTROL SIGNS INSTALLED IN THE COUNTY RIGHT-OF-WAY SHALL BE MOUNTED ON A 2" GALVANIZED STEEL PERFORATED ("QUICK PUNCH"), SQUARE TUBE POST (1/4 GAUGE) INSERTED INTO A 2-1/2" GALVANIZED STEEL PERFORATED SQUARE TUBE SLEEVE (1/2 GAUGE) - 3' LONG. THE ANCHOR SHALL NOT EXTEND MORE THAN TWO "QUICK PUNCH" HOLES ABOVE GROUND LEVEL. A GALVANIZED STEEL POLE CAP SHALL BE MOUNTED ON TOP OF EACH POST.

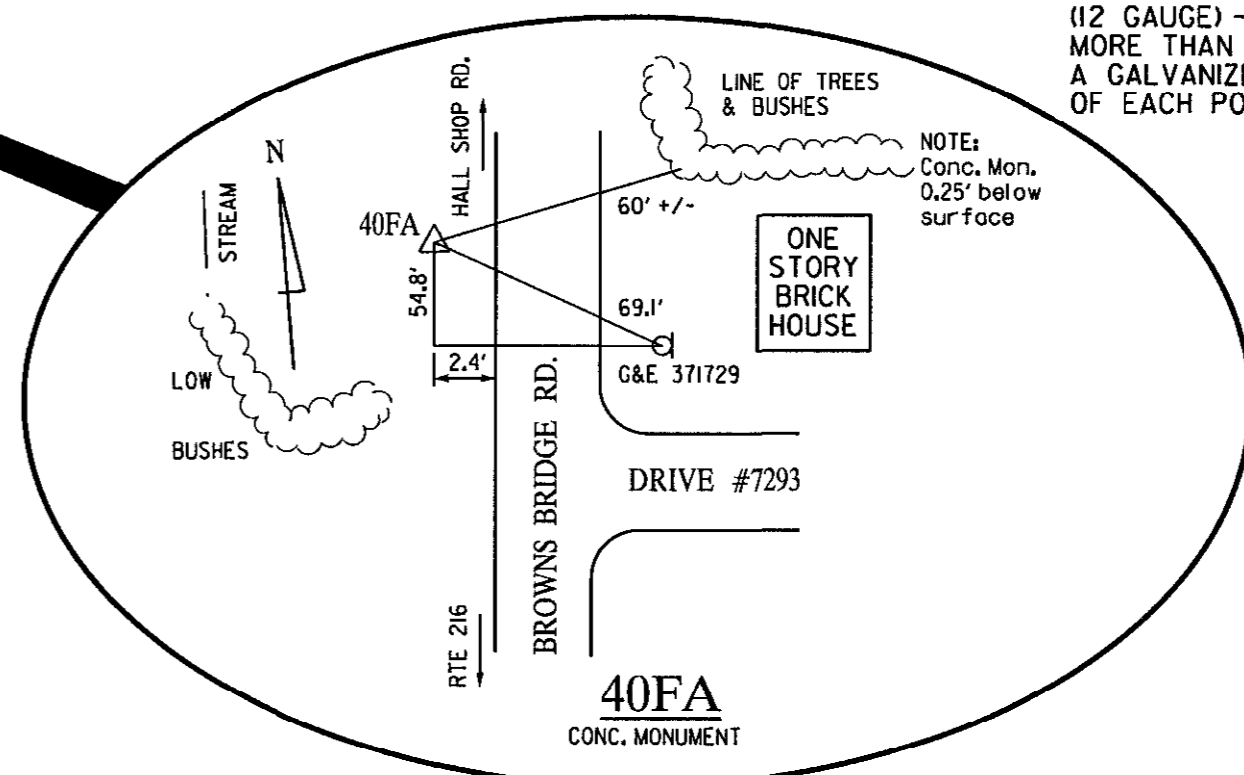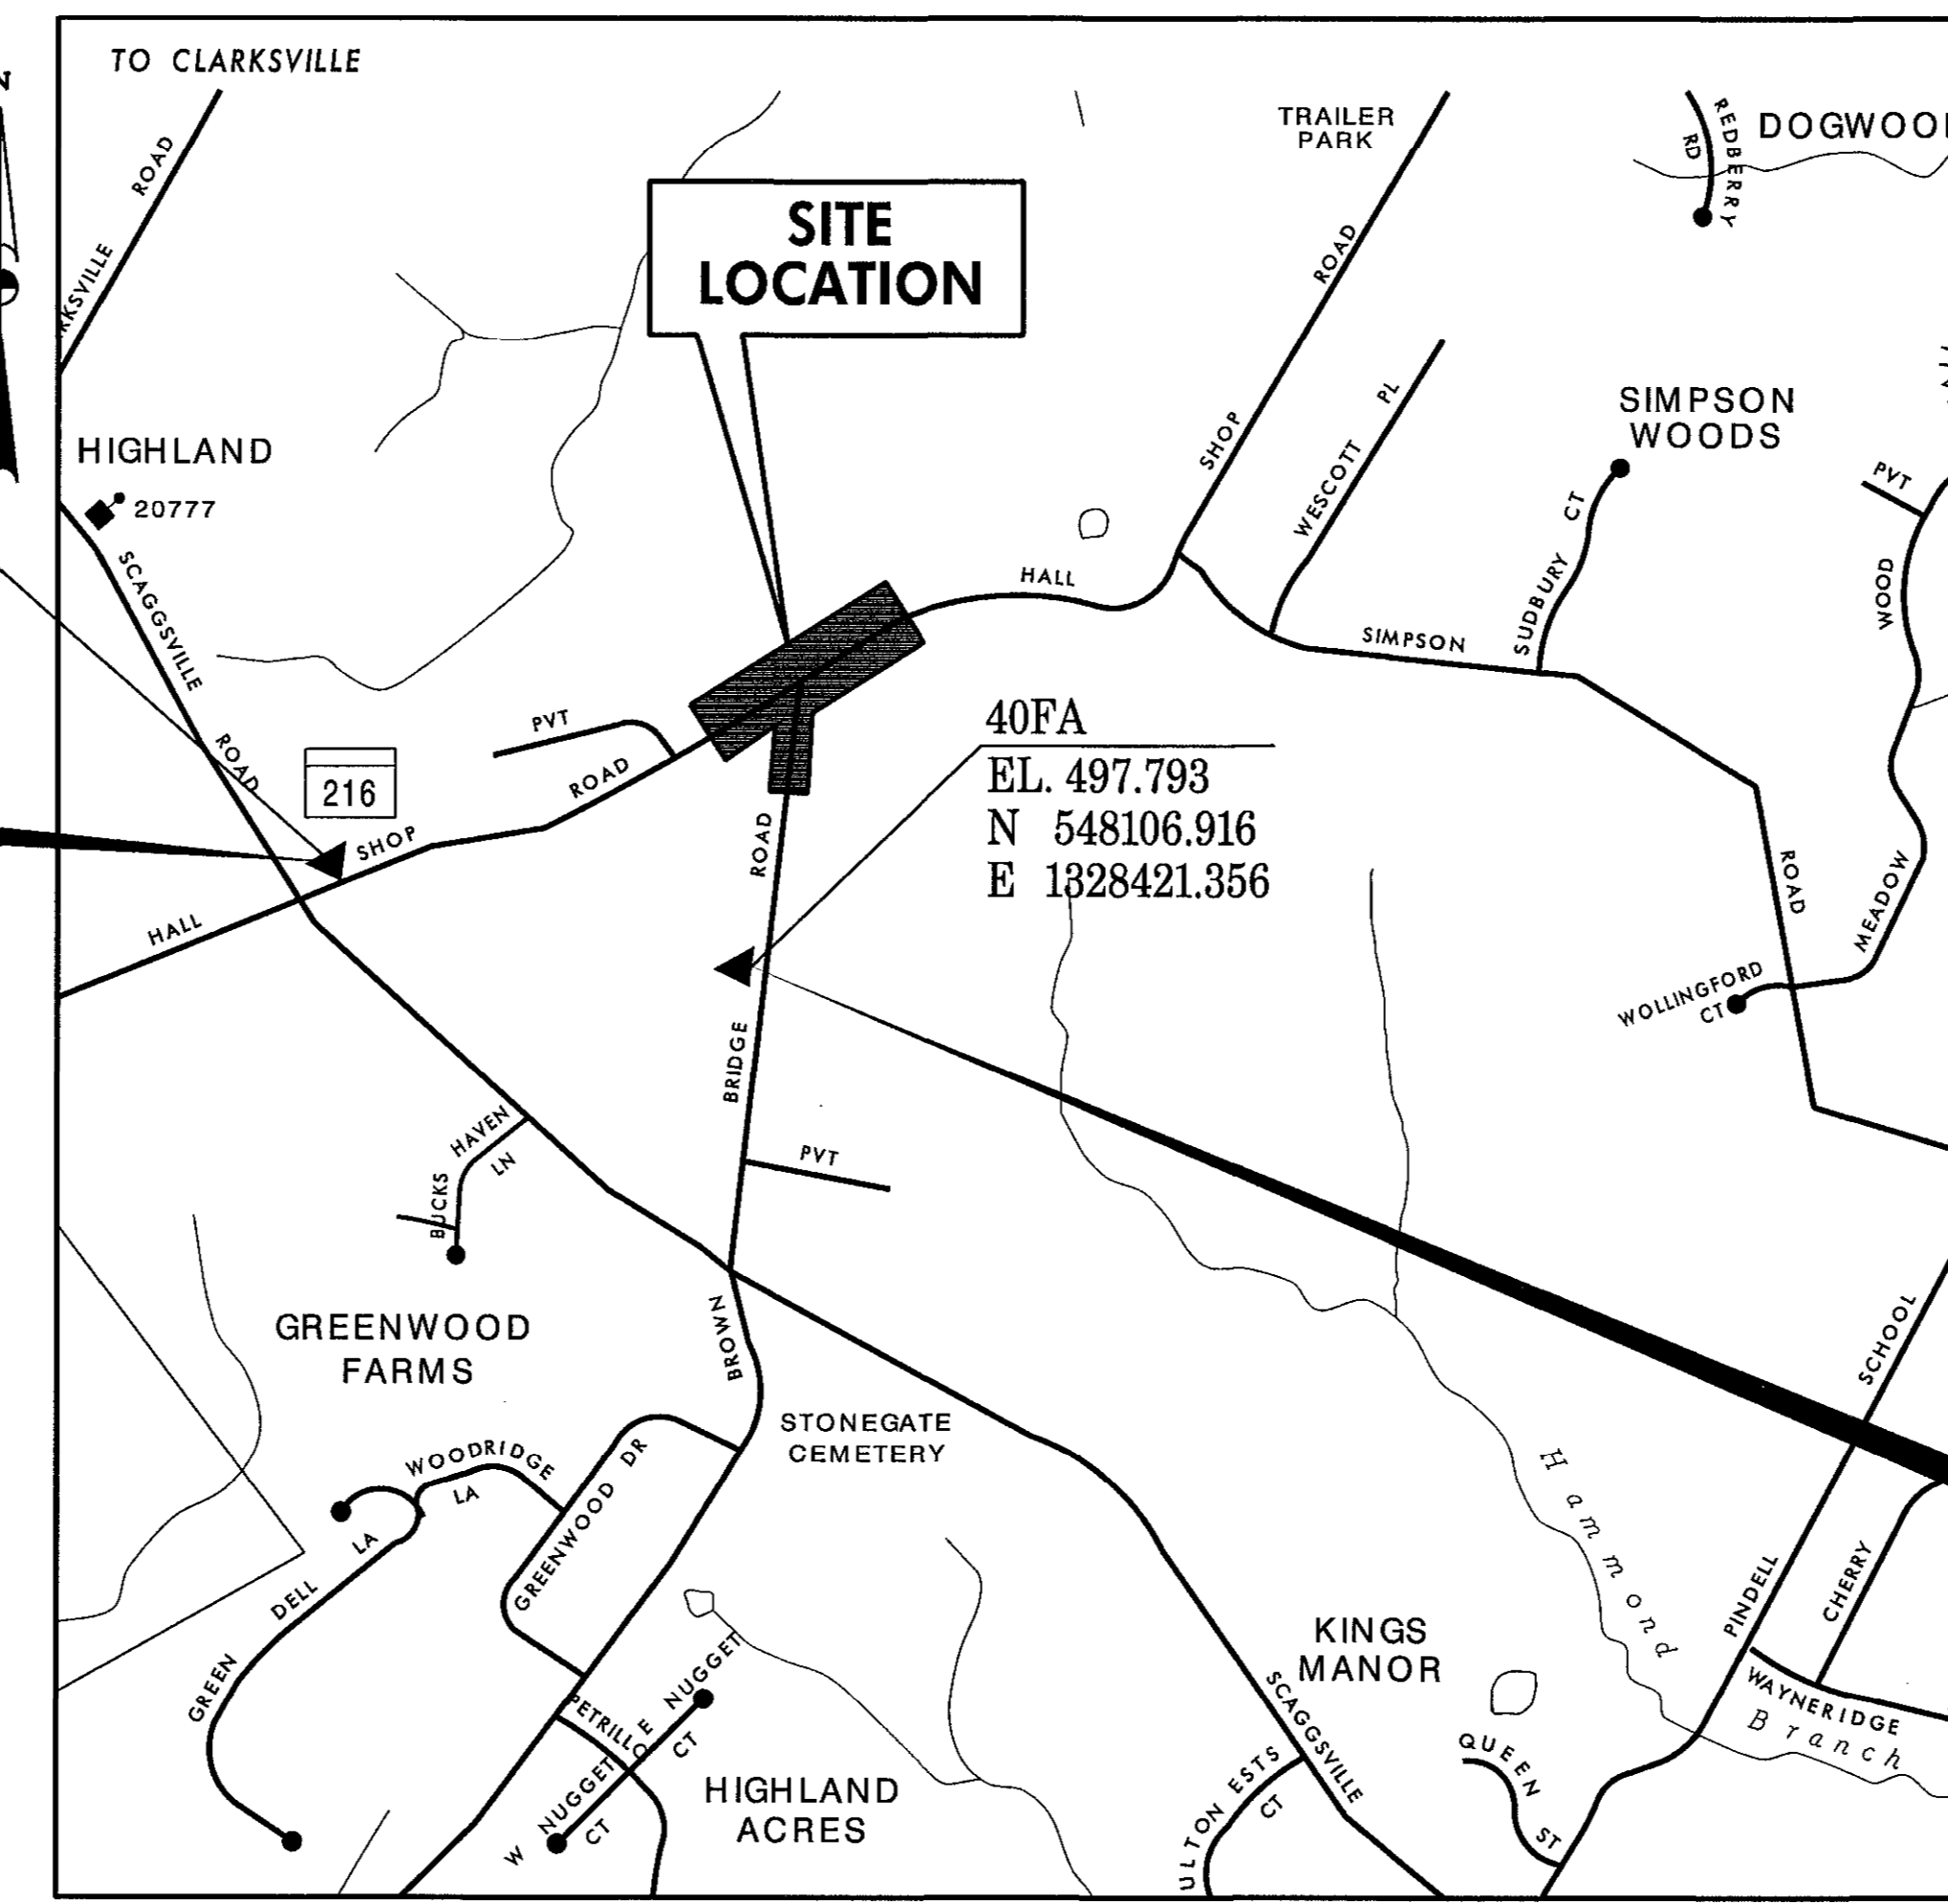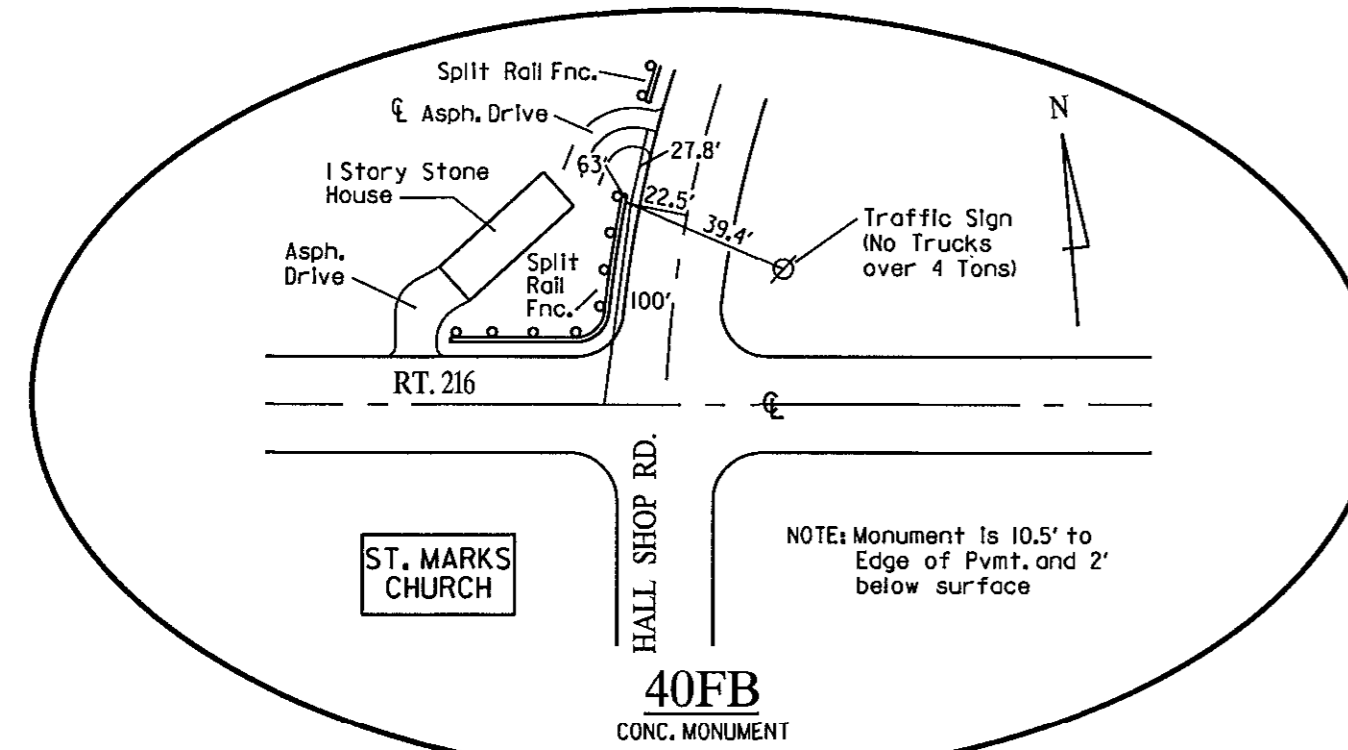

DESIGN CERTIFICATION:
"I HEREBY CERTIFY THAT THIS PLAN HAS BEEN DESIGNED IN ACCORDANCE WITH CURRENT MARYLAND EROSION AND SEDIMENT CONTROL LAWS, REGULATIONS, AND STANDARDS, THAT IT REPRESENTS A PRACTICAL AND WORKABLE PLAN BASED ON MY PERSONAL KNOWLEDGE OF THE SITE, AND THAT IT WAS PREPARED IN ACCORDANCE WITH THE REQUIREMENTS OF THE HOWARD SOIL CONSERVATION DISTRICT."

DESIGNER'S SIGNATURE: DAVID F. MORICONI
DATE: 1-10-18
MD REGISTRATION NO. 16156
(P.E., R.L.S., OR R.L.A. (CIRCLE ONE))

OWNERS/DEVELOPER CERTIFICATION:
"I/WE HEREBY CERTIFY THAT ANY CLEARING, GRADING, CONSTRUCTION, OR DEVELOPMENT WILL BE DONE PURSUANT TO THIS APPROVED EROSION AND SEDIMENT CONTROL PLAN, INCLUDING INSPECTING AND MAINTAINING CONTROLS, AND THAT THE RESPONSIBLE PERSONNEL INVOLVED IN THE CONSTRUCTION PROJECT WILL HAVE A CERTIFICATE OF TRAINING AT A MARYLAND DEPARTMENT OF THE ENVIRONMENT (MDE) APPROVED TRAINING PROGRAM FOR THE CONTROL ON EROSION AND SEDIMENT PRIOR TO BEGINNING THE PROJECT. I CERTIFY RIGHT-OF-ENTRY FOR PERIODIC ON-SITE EVALUATION BY HOWARD COUNTY, THE HOWARD SOIL CONSERVATION DISTRICT AND/OR MDE."

OWNER'S/DEVELOPER'S SIGNATURE: Thomas August
DATE: 1/11/2018

HOWARD SCD SIGNATURE BLOCK:
THIS PLAN IS APPROVED FOR SOIL EROSION AND SEDIMENT CONTROL BY THE HOWARD SOIL CONSERVATION DISTRICT.

HOWARD SOIL CONSERVATION DISTRICT: [Signature]
DATE: 1/11/18

PROFESSIONAL CERTIFICATION:
"I HEREBY CERTIFY THAT DOCUMENTS WERE PREPARED OR APPROVED BY ME, AND THAT I AM A DULY LICENSED PROFESSIONAL ENGINEER UNDER THE LAWS OF THE STATE OF MARYLAND, LICENSE NO. 16156, EXPIRATION DATE: 8/28/2018."

DESIGN DESIGNATION		
ROADWAY	HALL SHOP ROAD	BROWNS BRIDGE ROAD
DESIGN SPEED	40 M.P.H.	35 M.P.H.
FUNCTIONAL CLASSIFICATION	COLLECTOR	COLLECTOR

DEPARTMENT OF PUBLIC WORKS
HOWARD COUNTY, MARYLAND

CHIEF, BUREAU OF HIGHWAYS: [Signature] 1/23/18
CHIEF, BUREAU OF ENGINEERING: [Signature] 1/23/18
CHIEF, TRANSPORTATION AND SPECIAL PROJECTS DIVISION: [Signature] 1/23/18
DIRECTOR OF PUBLIC WORKS: [Signature] 1/23/18



DES: RLL			
DRN: BJK			
CHK: DTM			
DATE: 12/17	BY: NO.	REVISION	DATE


TITLE SHEET

SCALE MAP NO. 35 BLOCK NO. 19


HALL SHOP ROAD AT
BROWNS BRIDGE ROAD

ELECTION DISTRICT NO. 5
CAPITAL PROJECT J-4164

SCALE AS SHOWN
SHEET 1 OF 21

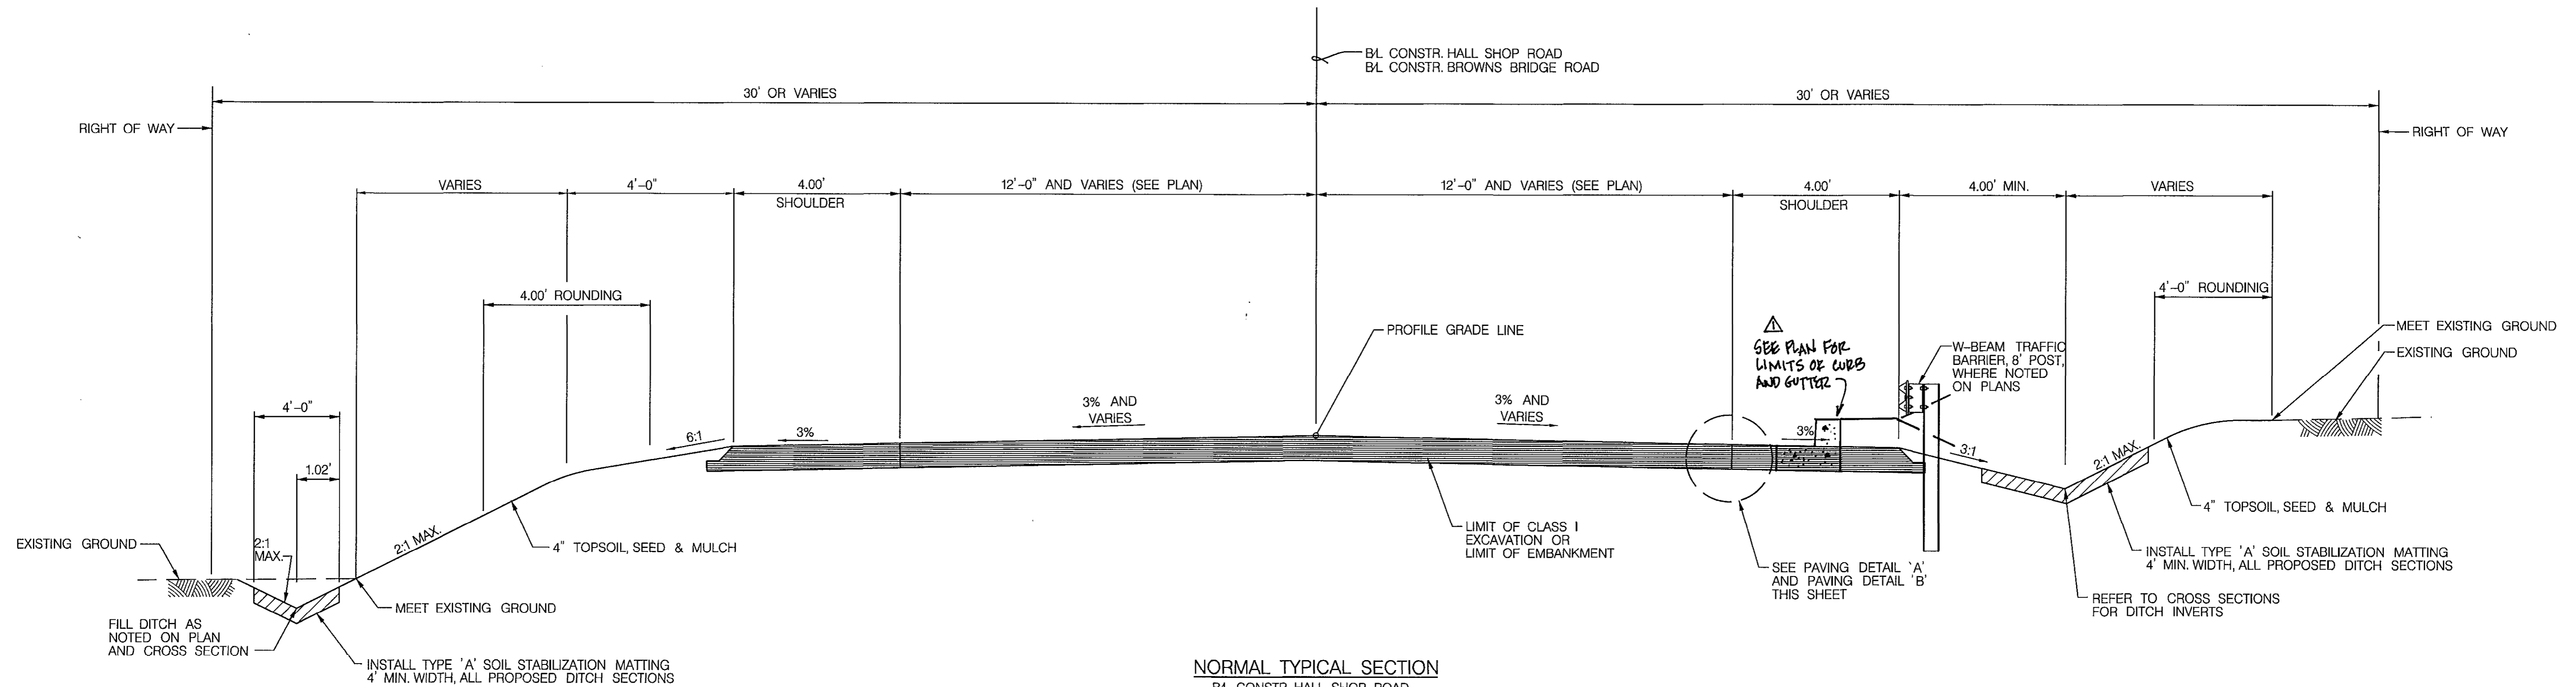


NORMAL TYPICAL SECTION
 BL CONSTR. HALL SHOP ROAD
 STA. 10+00 TO STA. 19+00
 BL CONSTR. BROWNS BRIDGE ROAD
 STA. 101+60.98 TO STA. 104+37.53
 NOT TO SCALE

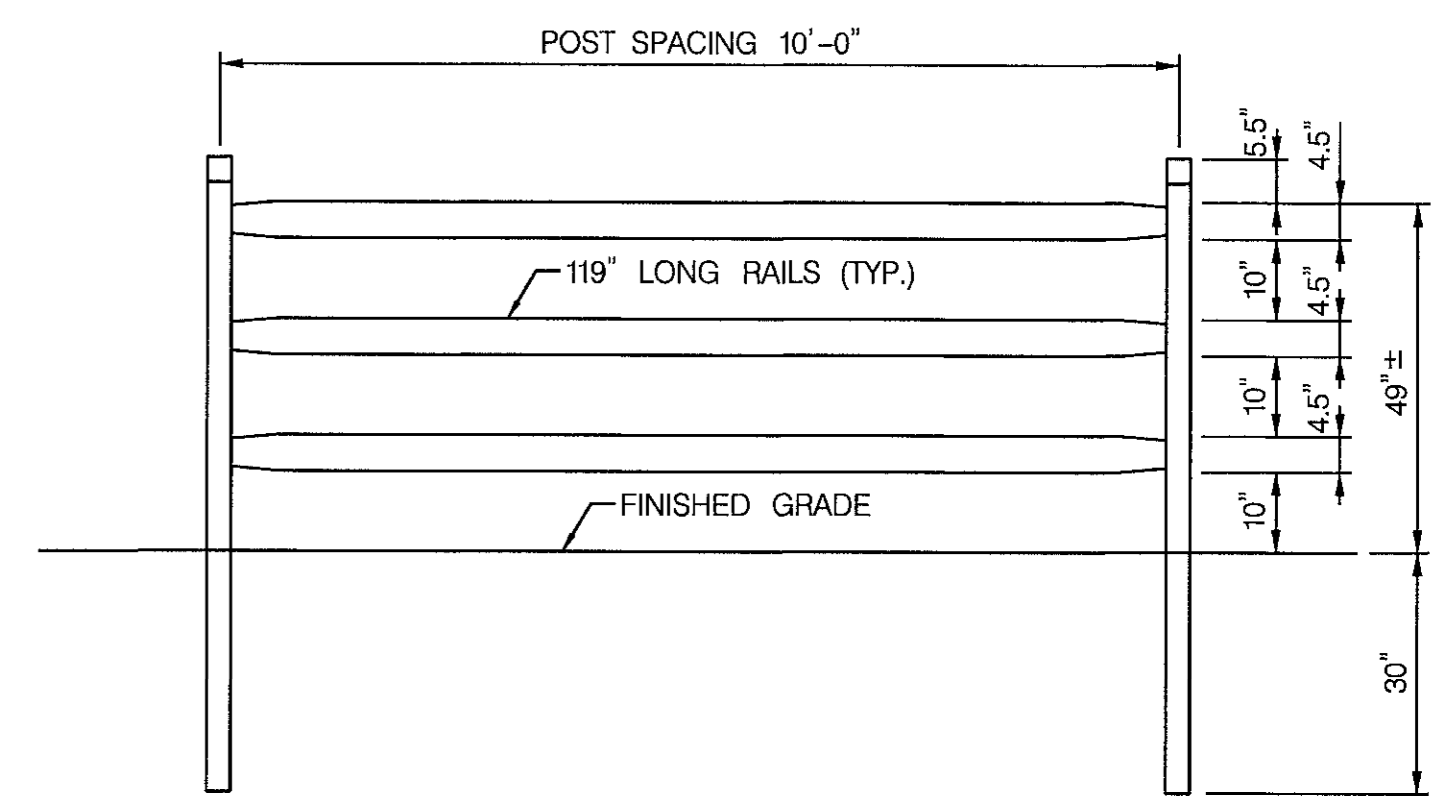


3 RAIL CEDAR SPLIT RAIL FENCE
 NOT TO SCALE


ALL DIMENSIONS ARE APPROXIMATE MEASUREMENTS. DIMENSIONS WILL VARY WITH POST INSTALLATION DEPTH. POST SPACING WILL VARY WITH LENGTH OF RAILS AND INSTALLATION PROCEDURE.

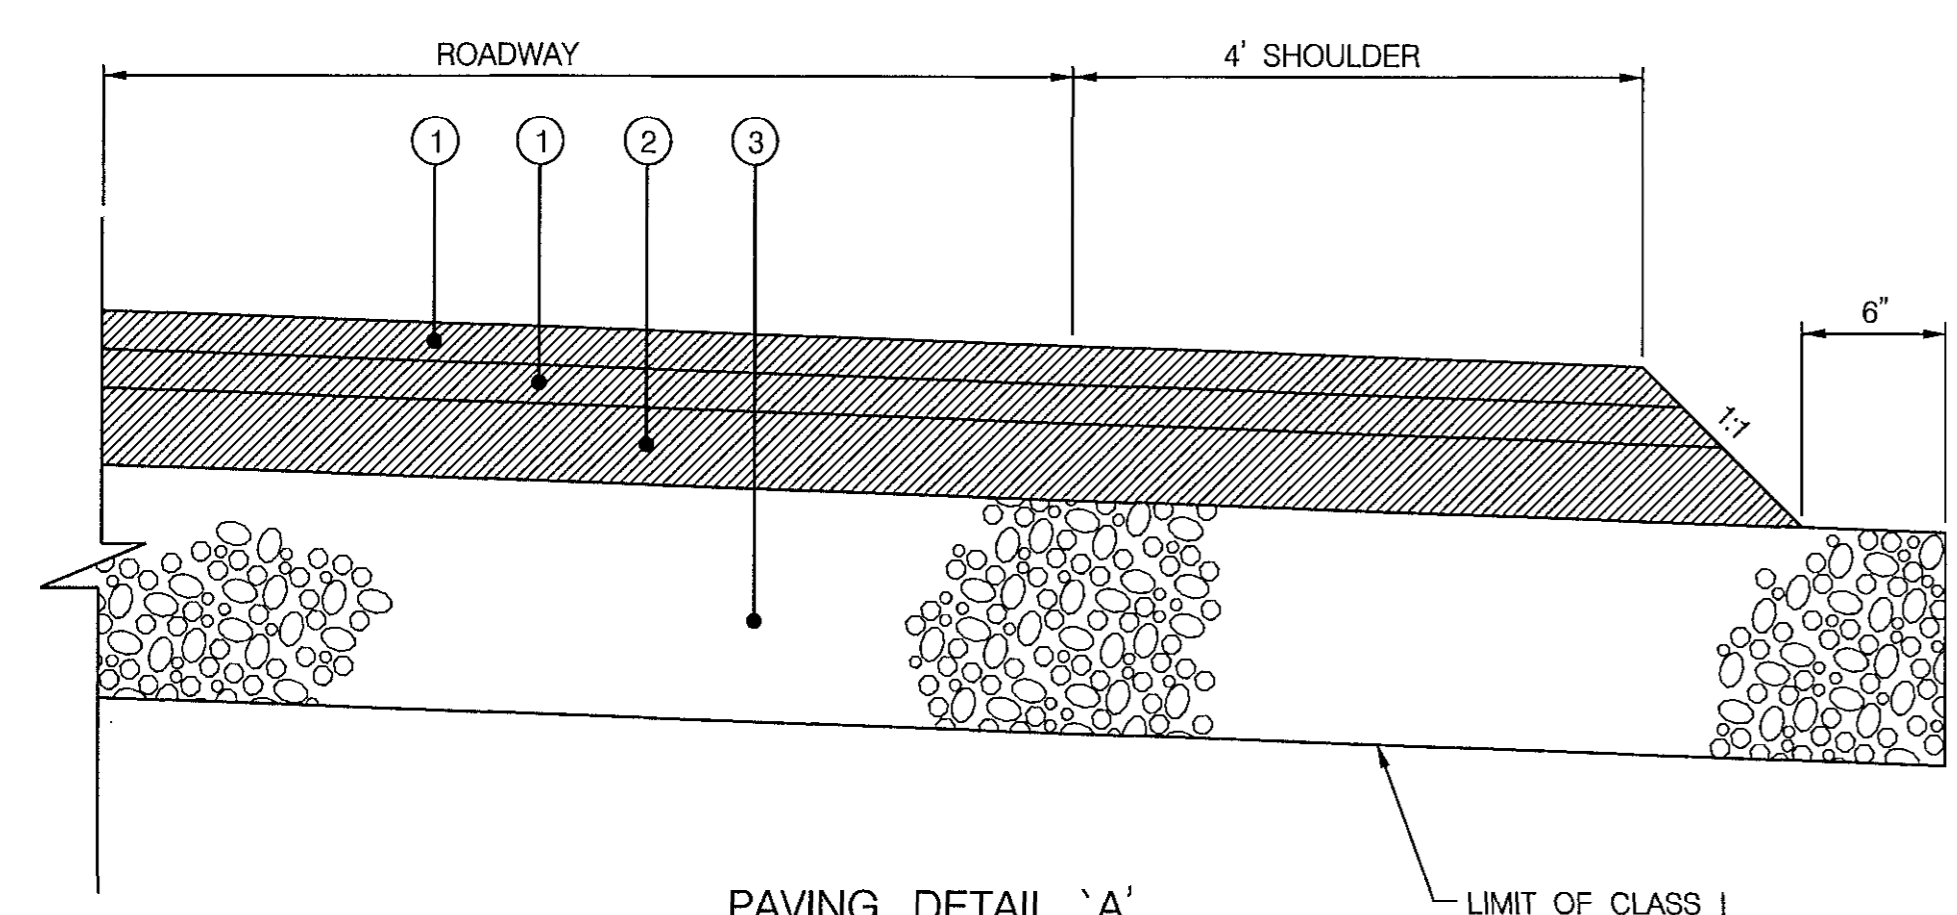

PAVING DETAIL 'A'
 HALL SHOP ROAD AND
 BROWNS BRIDGE ROAD
 NOT TO SCALE

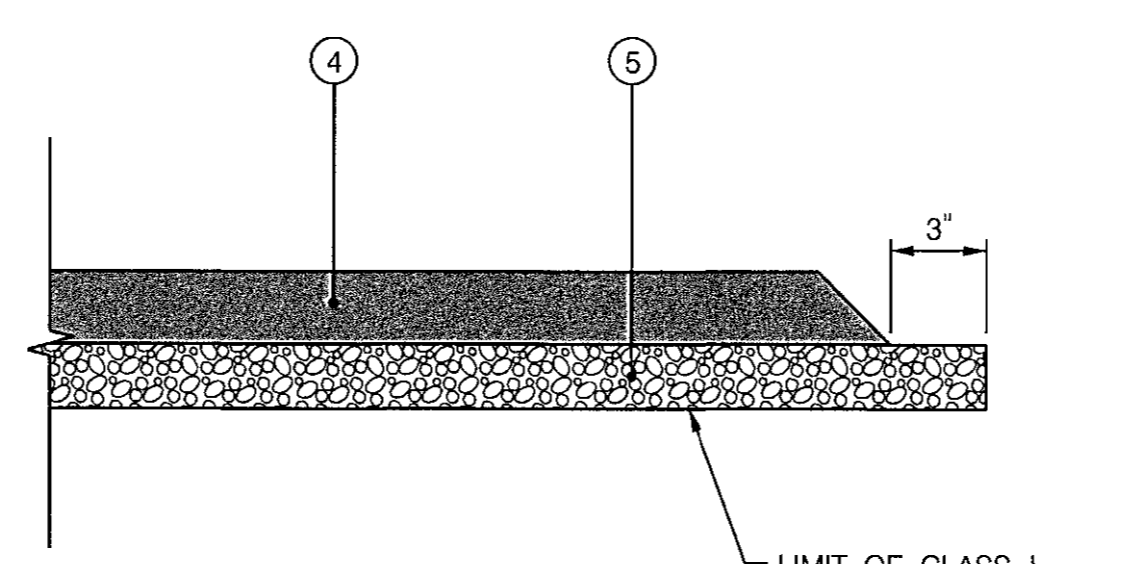

PAVING DETAIL 'B'
 DRIVEWAYS
 NOT TO SCALE

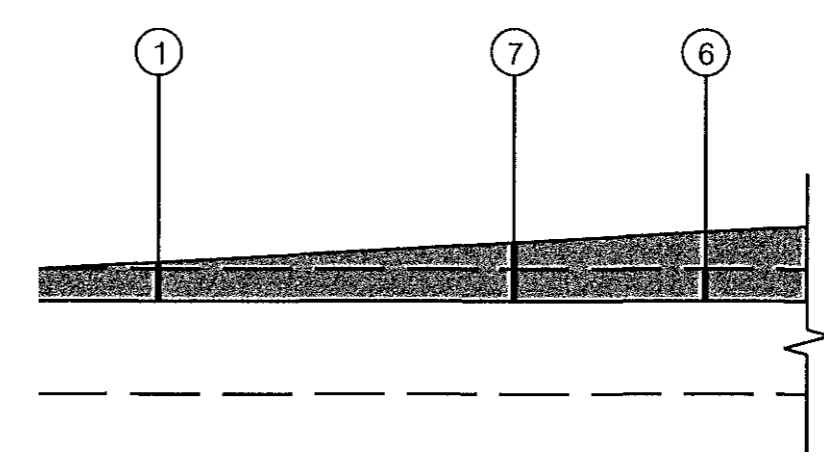


PAVING DETAIL 'C'
 GRIND & OVERLAY AT TIE-INS
 (TRANSITION AS PER SECTION 504.03.09)
 NOT TO SCALE

LEGEND

- ① 2" HOT MIX ASPHALT SUPERPAVE 12.5 MM FOR SURFACE, PG 64-22
- ② 6" HOT MIX ASPHALT SUPERPAVE 19.0 MM FOR BASE, PG 64-22 (2-3" LIFTS)
- ③ 6" BASE COURSE USING GRADED AGGREGATE
- ④ 3" HOT MIX ASPHALT SUPERPAVE 12.5 MM FOR SURFACE, PG 64-22
- ⑤ 4" BASE COURSE USING GRADED AGGREGATE
- ⑥ GRINDING 0" TO 2"
- ⑦ HOT MIX ASPHALT SUPERPAVE 12.5 MM FOR WEDGE/LEVEL, PG 64-22

Professional Certification: I hereby certify that these documents were prepared or approved by me, and that I am a duly licensed professional engineer under the laws of the State of Maryland.
 License No. 16156, Expiration Date: 8-28-18

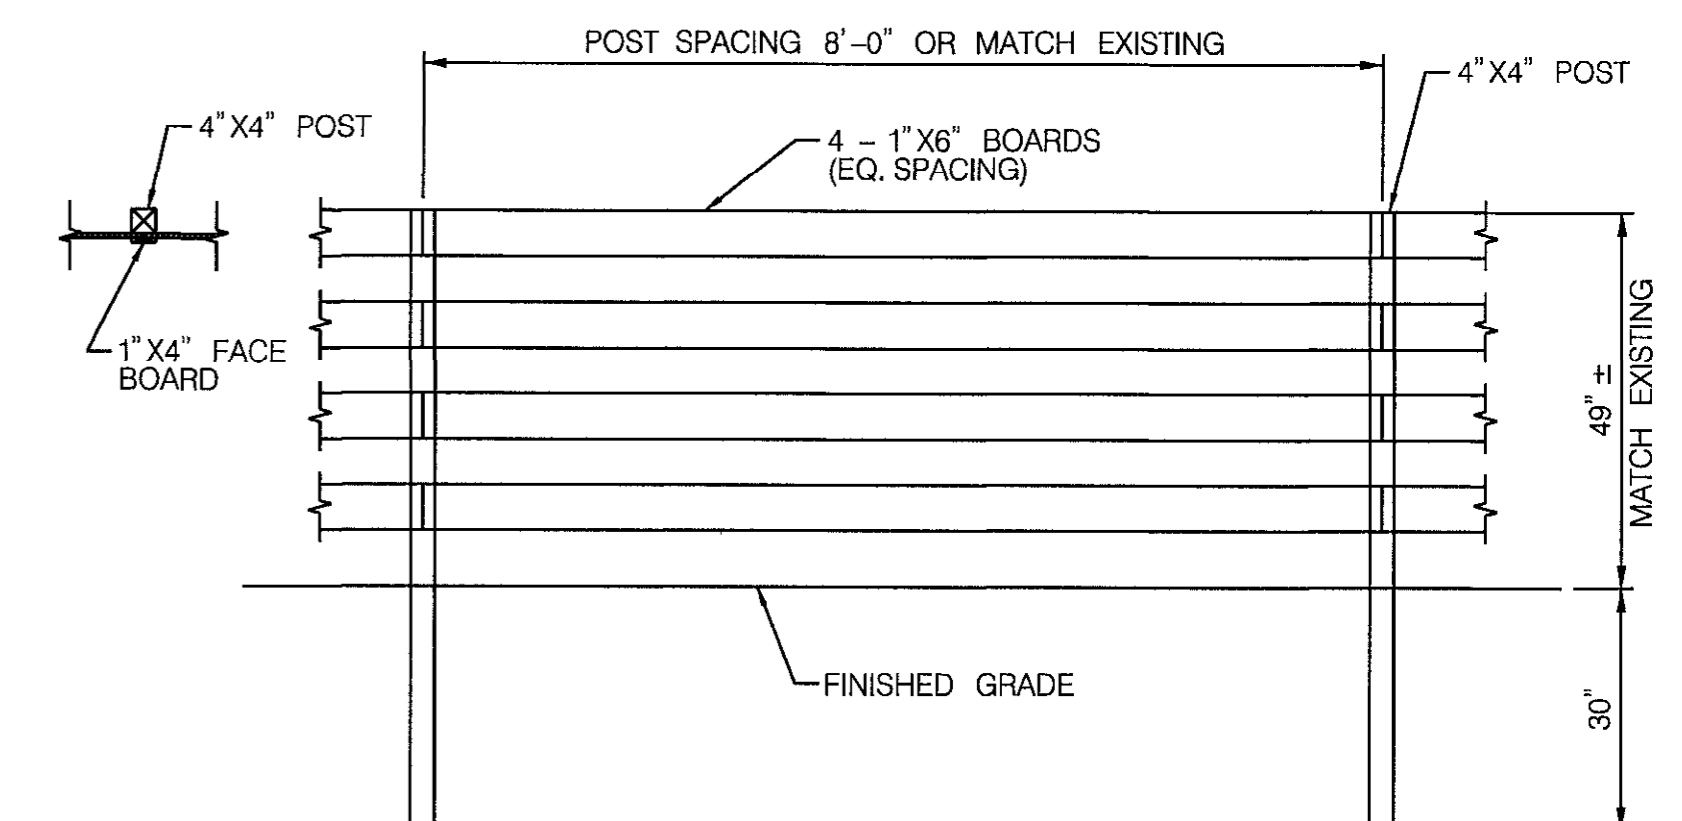

NOT INSTALLED BOARD FENCE
 NOT TO SCALE


DEPARTMENT OF PUBLIC WORKS
 HOWARD COUNTY, MARYLAND

Mesmer 1/23/18
 CHIEF, BUREAU OF HIGHWAYS DATE

Thomas & Sullivan 1/23/18
 CHIEF, BUREAU OF ENGINEERING DATE

Radwan 1/23/18
 CHIEF, TRANSPORTATION AND SPECIAL PROJECTS DIVISION DATE

Joseph 1/23/18
 DIRECTOR OF PUBLIC WORKS DATE

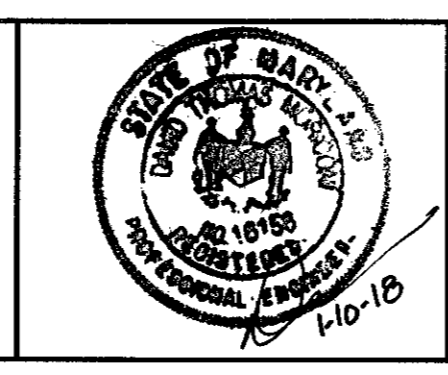

DES:	RLI		
DRN:	BJK		
CHK:	DTM		
DATE:	12/17		
BY:	AS-BUILT SURVEY		
NO.:			
REVISION:			
DATE:	1/28/19		



TYPICAL SECTIONS & DETAILS

SCALE MAP NO. 35 BLOCK NO. 19

HALL SHOP ROAD AT BROWNS BRIDGE ROAD

ELECTION DISTRICT NO. 5
 CAPITAL PROJECT J-4164

SCALE AS SHOWN
 SHEET 2 OF 21

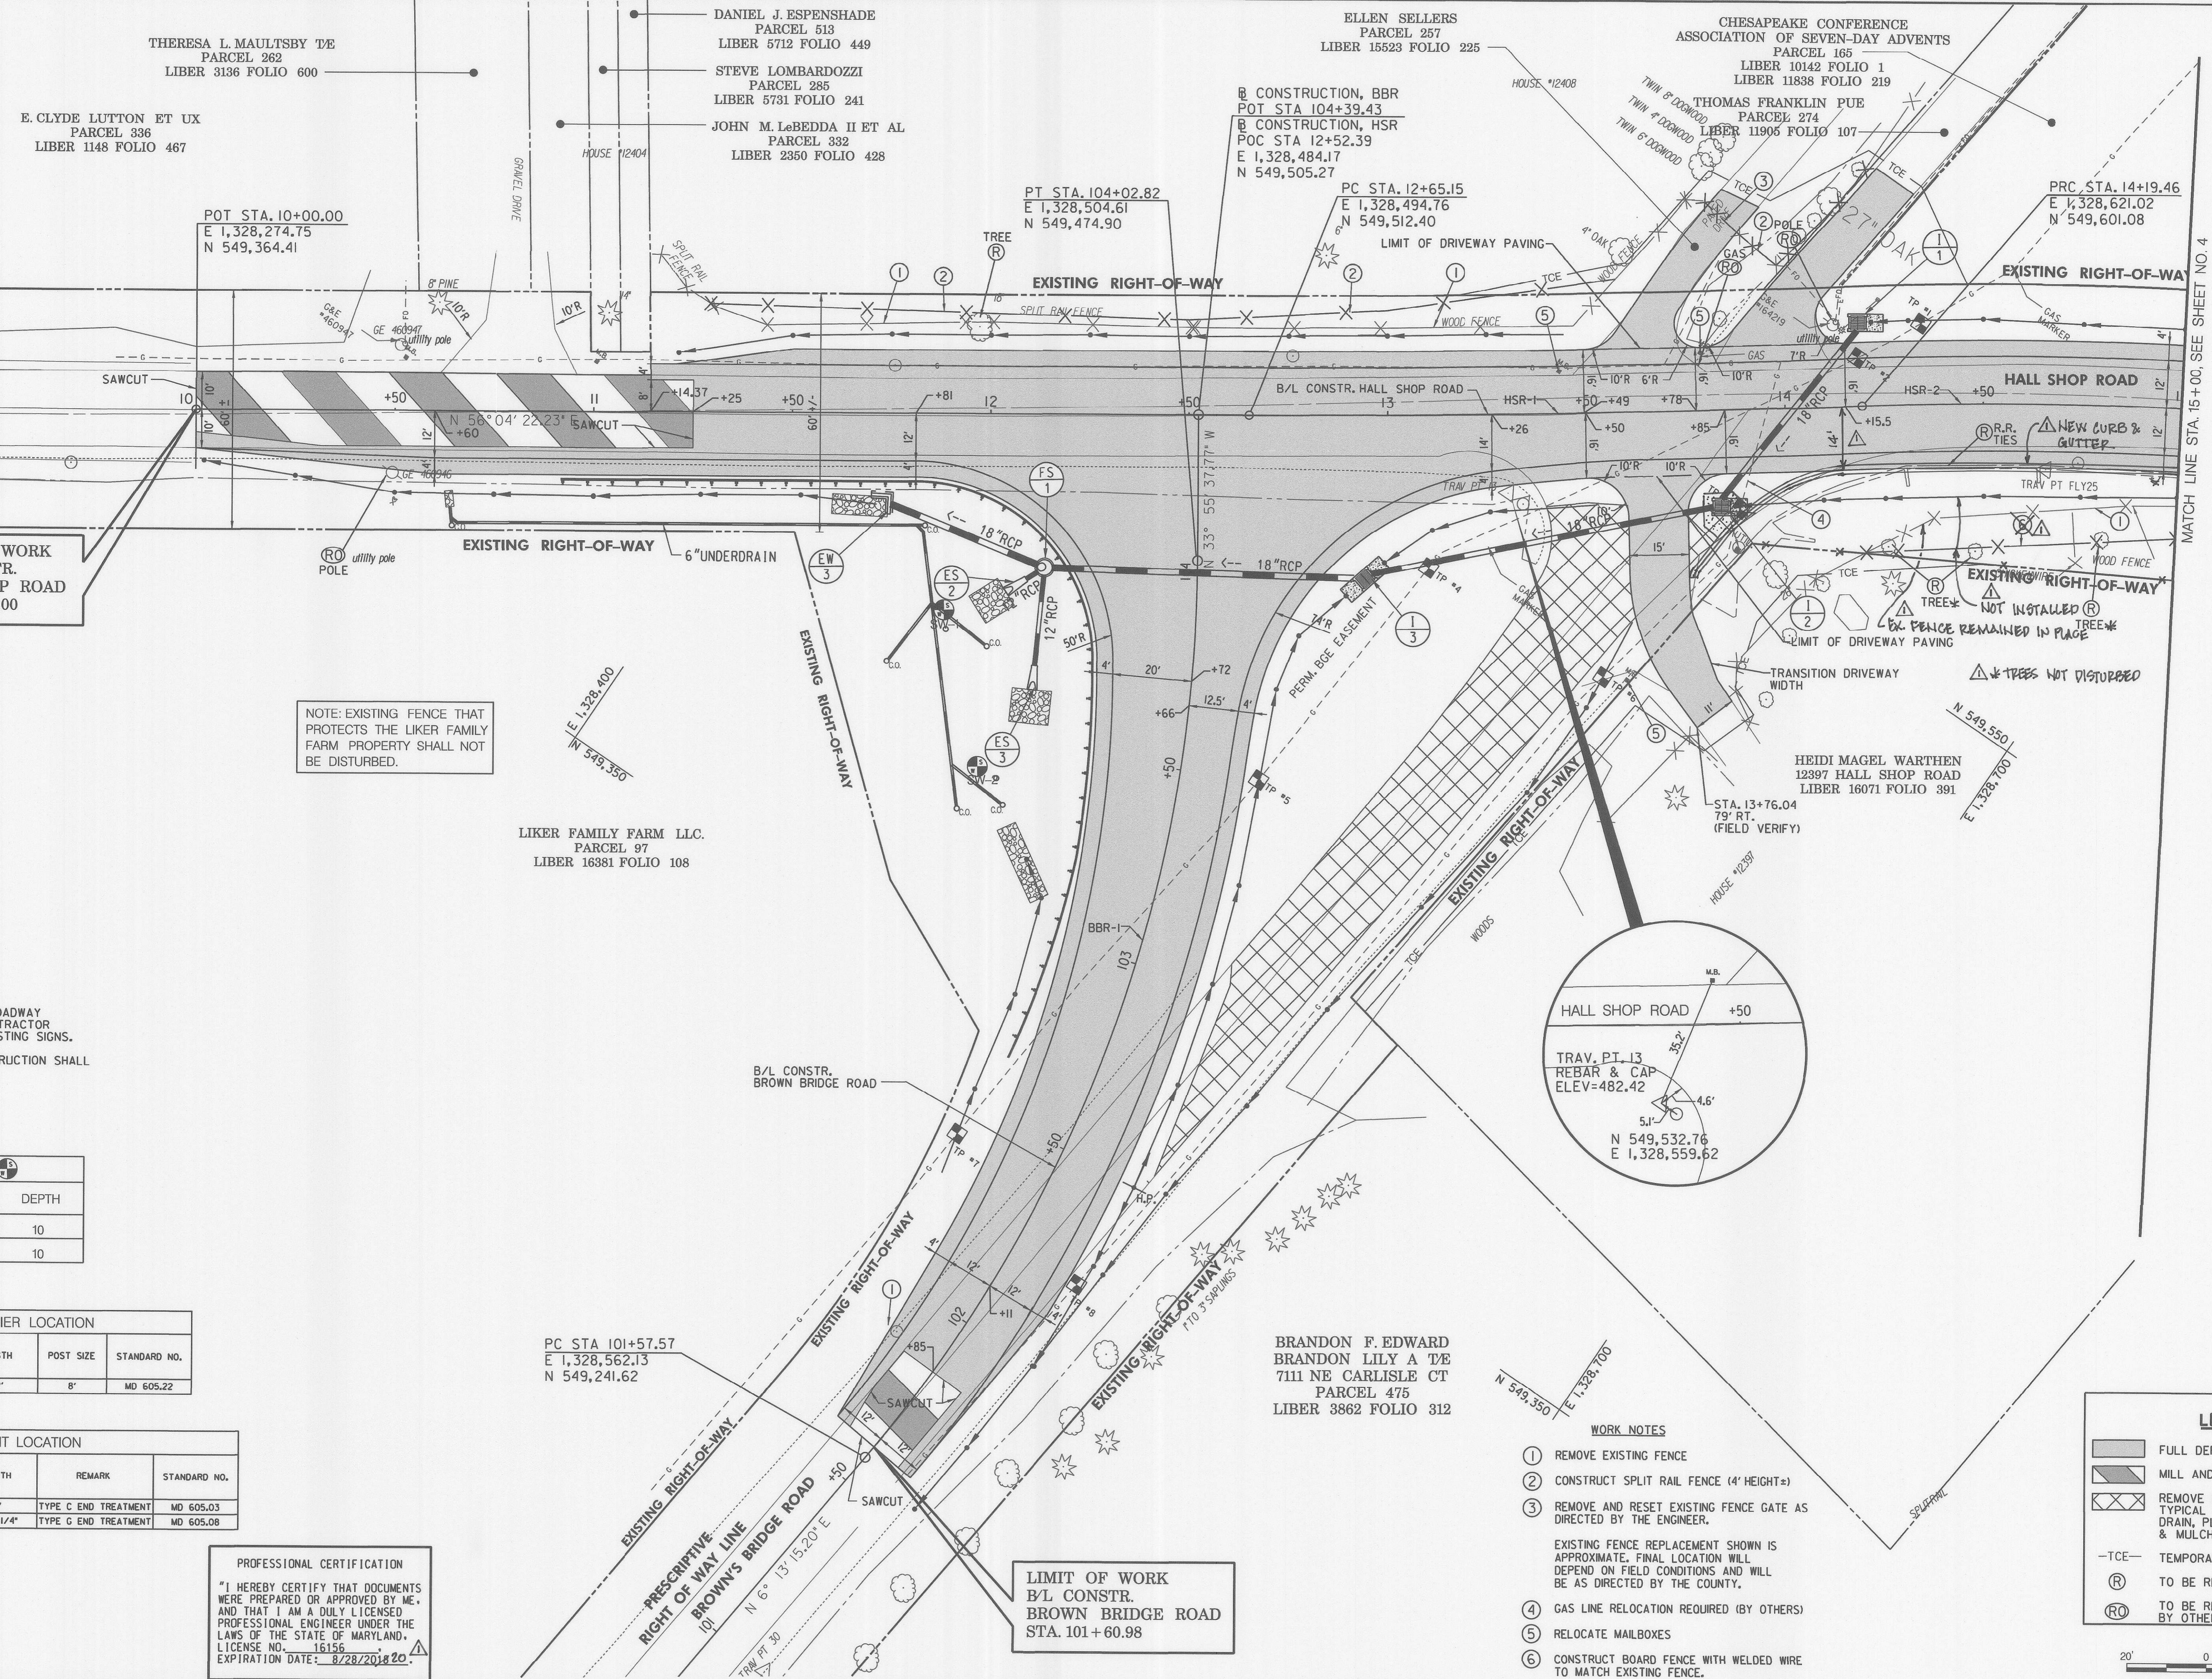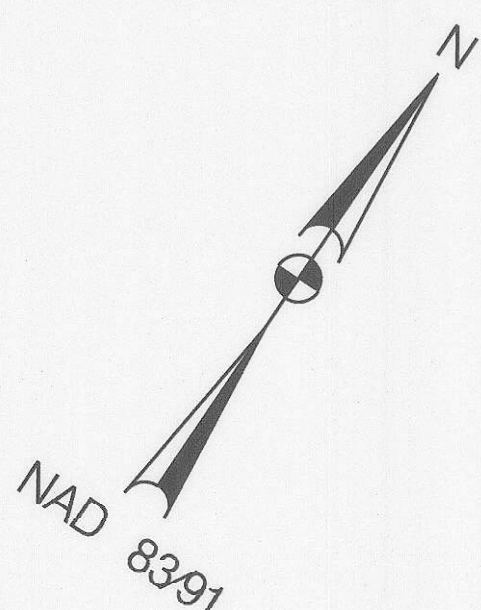

HSR-1
P.I. STA. 13+42.32
C = 2° 18' 52.43" (LT)
D = 1° 30' 00.00"
R = 3,819.72
T = 77.16
L = 154.30
E = 0.78

HSR-2
P.I. STA. 14+72.28
C = 6° 19' 56.64" (RT)
D = 6° 00' 00.00"
R = 954.93
T = 52.82
L = 105.54
E = 1.46

BBR-1
P.I. STA. 102+85.47
C = 40° 08' 52.96" (LT)
D = 16° 22' 12.80"
R = 350.00
T = 127.90
L = 245.25
E = 22.64

LIMIT OF WORK
B/L CONSTR.
HALL SHOP ROAD
STA. 10+00.00

NOTE: EXISTING FENCE THAT
PROTECTS THE LIKER FAMILY
FARM PROPERTY SHALL NOT
BE DISTURBED.

- NOTES:
- UNLESS OTHERWISE NOTED ON THE 'ROADWAY MARKING AND SIGNING PLAN', THE CONTRACTOR SHALL REMOVE AND REPLACE ALL EXISTING SIGNS.
 - ALL MAIL BOXES AFFECTED BY CONSTRUCTION SHALL BE REMOVED AND RESET.

NO.	NORTHING	EASTING	DEPTH
SWM-1	549,428.616	1,328,458.710	10
SWM-2	549,400.907	1,328,487.766	10


W-BEAM TRAFFIC BARRIER LOCATION						
BEGIN STATION	END STATION	LENGTH	POST SIZE	STANDARD NO.		
11+42	17.0' RT	103+10	22.0' LT	192"	8"	MD 605.22

END TREATMENT LOCATION						
BEGIN STATION	END STATION	LENGTH	REMARK	STANDARD NO.		
10+92	17.0' RT	11+42	17.0' RT	50'	TYPE C END TREATMENT	MD 605.03
102+76	23.0' LT	103+10	21.0' LT	39'-3 1/4"	TYPE C END TREATMENT	MD 605.08

PROFESSIONAL CERTIFICATION
"I HEREBY CERTIFY THAT DOCUMENTS WERE PREPARED OR APPROVED BY ME, AND THAT I AM A DULY LICENSED PROFESSIONAL ENGINEER UNDER THE LAWS OF THE STATE OF MARYLAND. LICENSE NO. 16156 EXPIRATION DATE: 8/28/2018"

- WORK NOTES
- REMOVE EXISTING FENCE
 - CONSTRUCT SPLIT RAIL FENCE (4' HEIGHT±)
 - REMOVE AND RESET EXISTING FENCE GATE AS DIRECTED BY THE ENGINEER.
 - GAS LINE RELOCATION REQUIRED (BY OTHERS)
 - RELOCATE MAILBOXES
 - CONSTRUCT BOARD FENCE WITH WELDED WIRE TO MATCH EXISTING FENCE.
- EXISTING FENCE REPLACEMENT SHOWN IS APPROXIMATE. FINAL LOCATION WILL BE AS DIRECTED BY THE COUNTY.

LEGEND	
	FULL DEPTH PAVEMENT
	MILL AND OVERLAY
	REMOVE EXISTING PAVEMENT OUTSIDE TYPICAL SECTION AND GRADE TO DRAIN, PLACE 4" TOPSOIL, AND SEED & MULCH
-TCE-	TEMPORARY CONSTRUCTION EASEMENT
(R)	TO BE REMOVED
(R)	TO BE REMOVED/RELOCATED BY OTHERS

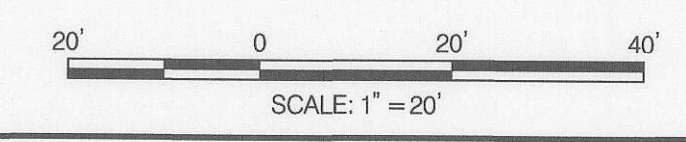

DEPARTMENT OF PUBLIC WORKS
HOWARD COUNTY, MARYLAND

Matthew J. ... 1/23/2018
CHIEF, BUREAU OF HIGHWAYS DATE

Thomas ... 1/23/18
CHIEF, BUREAU OF ENGINEERING DATE

... 1/22/18
CHIEF, TRANSPORTATION AND SPECIAL PROJECTS DIVISION DATE

... 1/23/16
DIRECTOR OF PUBLIC WORKS DATE




DES:	RLI				
DRN:	BJK				
CHK:	DTM				
DATE:	12/17	BY:	DTM	AS-BUILT SURVEY	1/28/19
			NO.	REVISION	DATE

ROADWAY PLAN
STA. 10+00 TO 15+00

HALL SHOP ROAD AT
BROWNS BRIDGE ROAD

SCALE
1" = 20'

SHEET
3 OF 21

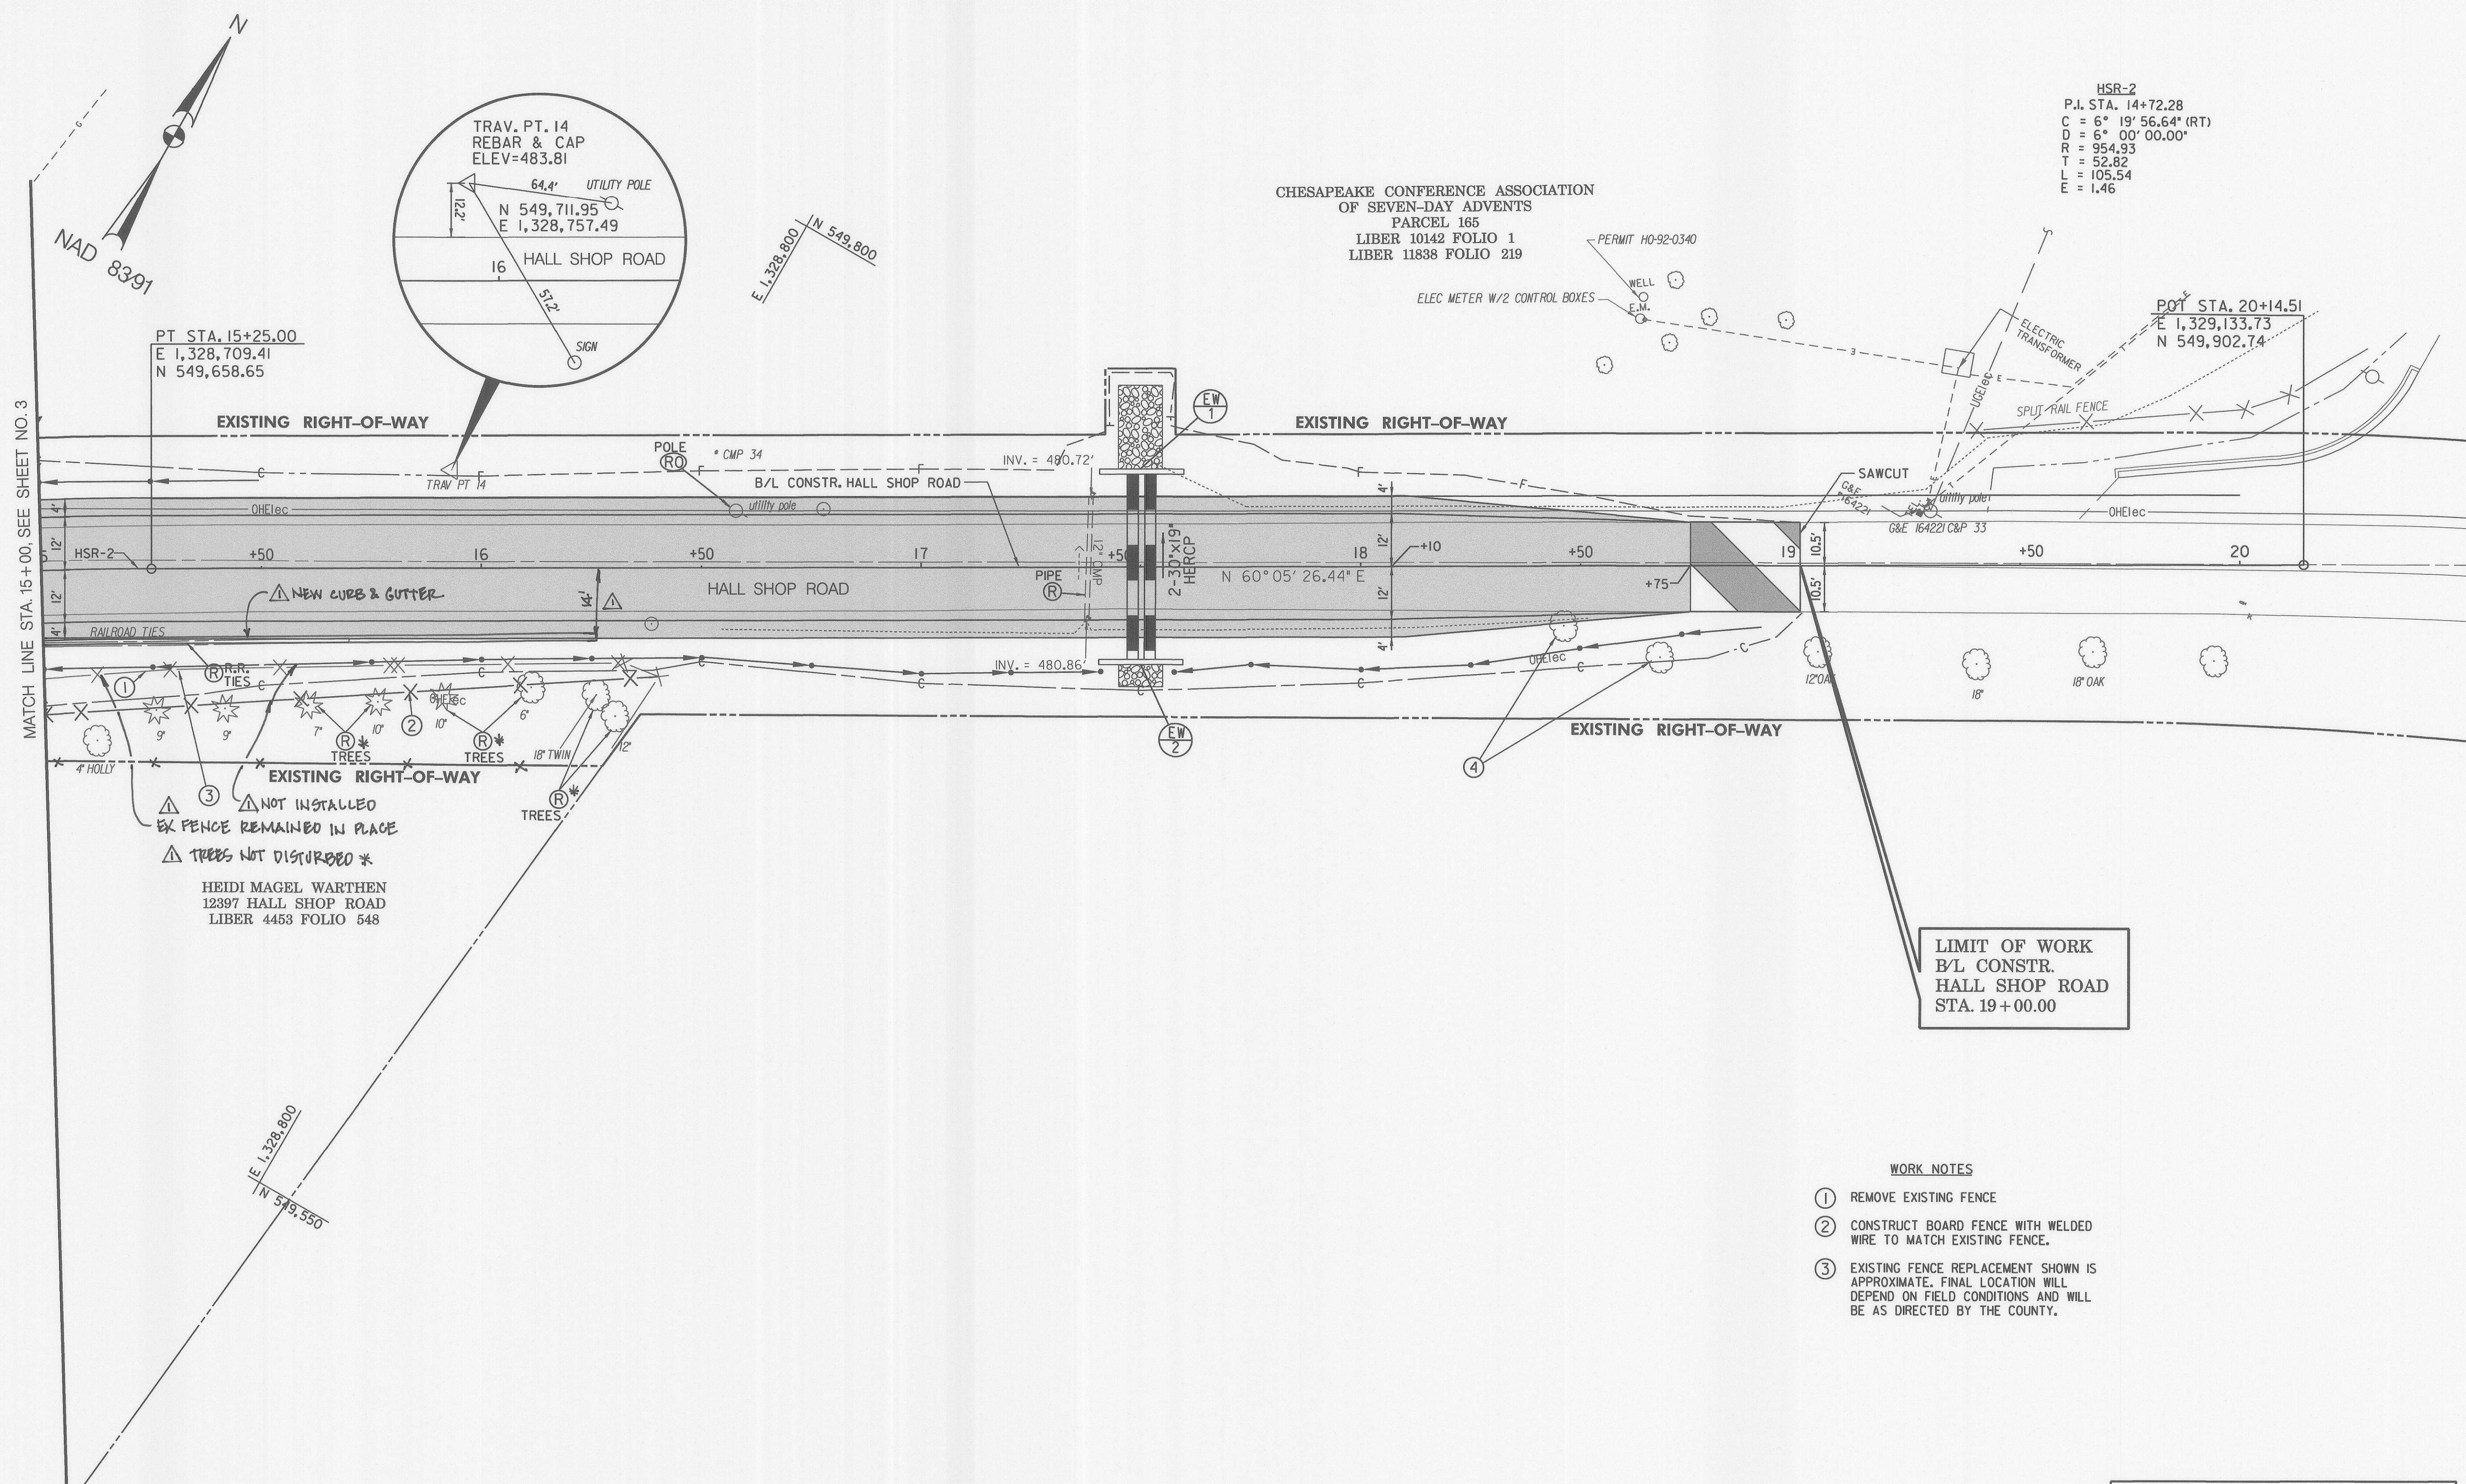

HSR-2
 P.I. STA. 14+72.28
 C = 6° 19' 56.64" (RT)
 D = 6° 00' 00.00"
 R = 954.93
 T = 52.82
 L = 105.54
 E = 1.46

CHESAPEAKE CONFERENCE ASSOCIATION
 OF SEVEN-DAY ADVENTS
 PARCEL 165
 LIBER 10142 FOLIO 1
 LIBER 11838 FOLIO 219

PT STA. 15+25.00
 E 1,328,709.41
 N 549,658.65

POT STA. 20+14.51
 E 1,329,133.73
 N 549,902.74

EXISTING RIGHT-OF-WAY

EXISTING RIGHT-OF-WAY

EXISTING RIGHT-OF-WAY

EXISTING RIGHT-OF-WAY

NOT INSTALLED
 EX FENCE REMAINED IN PLACE
 TREES NOT DISTURBED *

HEIDI MAGEL WARTHEN
 12397 HALL SHOP ROAD
 LIBER 4453 FOLIO 548


LIMIT OF WORK
 B/L CONSTR.
 HALL SHOP ROAD
 STA. 19+00.00

WORK NOTES

- 1 REMOVE EXISTING FENCE
- 2 CONSTRUCT BOARD FENCE WITH WELDED WIRE TO MATCH EXISTING FENCE.
- 3 EXISTING FENCE REPLACEMENT SHOWN IS APPROXIMATE. FINAL LOCATION WILL DEPEND ON FIELD CONDITIONS AND WILL BE AS DIRECTED BY THE COUNTY.

LEGEND

- FULL DEPTH PAVEMENT
- MILL AND OVERLAY
- REMOVE EXISTING PAVEMENT OUTSIDE TYPICAL SECTION AND GRADE TO DRAIN, PLACE 4" TOPSOIL, AND SEED & MULCH
- TCE- TEMPORARY CONSTRUCTION EASEMENT
- TO BE REMOVED
- TO BE REMOVED/RELOCATED BY OTHERS

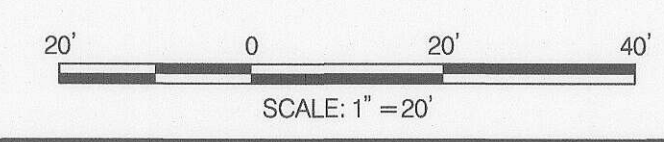

PROFESSIONAL CERTIFICATION
 "I HEREBY CERTIFY THAT DOCUMENTS WERE PREPARED OR APPROVED BY ME, AND THAT I AM A DULY LICENSED PROFESSIONAL ENGINEER UNDER THE LAWS OF THE STATE OF MARYLAND, LICENSE NO. 16156, EXPIRATION DATE: 8/28/2019."

DEPARTMENT OF PUBLIC WORKS
 HOWARD COUNTY, MARYLAND

M. M. M... 1/23/2018
 CHIEF, BUREAU OF HIGHWAYS DATE

M. M. M... 1/23/18
 CHIEF, BUREAU OF ENGINEERING DATE

J. K. J... 1/23/18
 DIRECTOR OF PUBLIC WORKS DATE



DES:	RL			
DRN:	BJK			
CHK:	DTM			
DATE:	12/17	DTM	AS-BUILT SURVEY	1-28-19
		BY	NO.	REVISION


ROADWAY PLAN
 STA. 15+00 TO 19+00

SCALE MAP NO. 35 BLOCK NO. 19

HALL SHOP ROAD AT
 BROWNS BRIDGE ROAD


ELECTION DISTRICT NO. 5
 CAPITAL PROJECT J-4164

SCALE
 1" = 20'
 SHEET
 4 OF 21

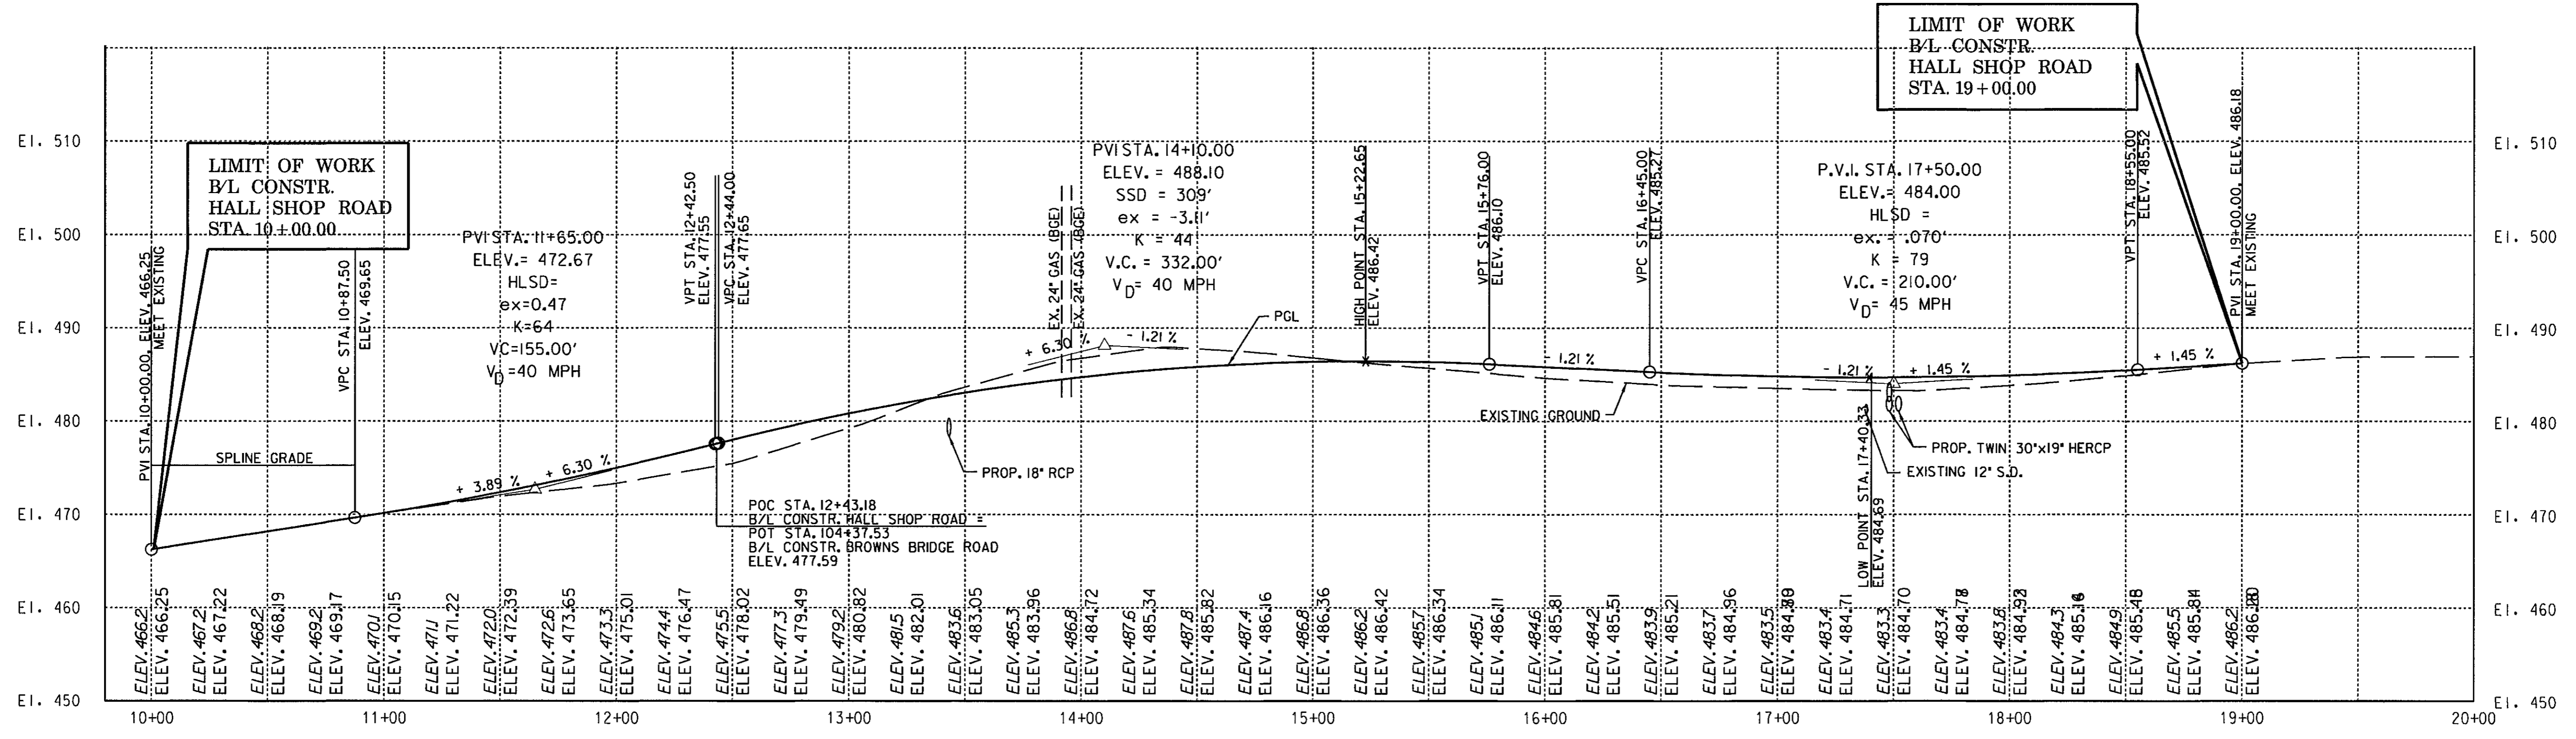

HALL SHOP ROAD PROFILE

SCALE: HORIZ 1"=40'
VERT 1"=10'

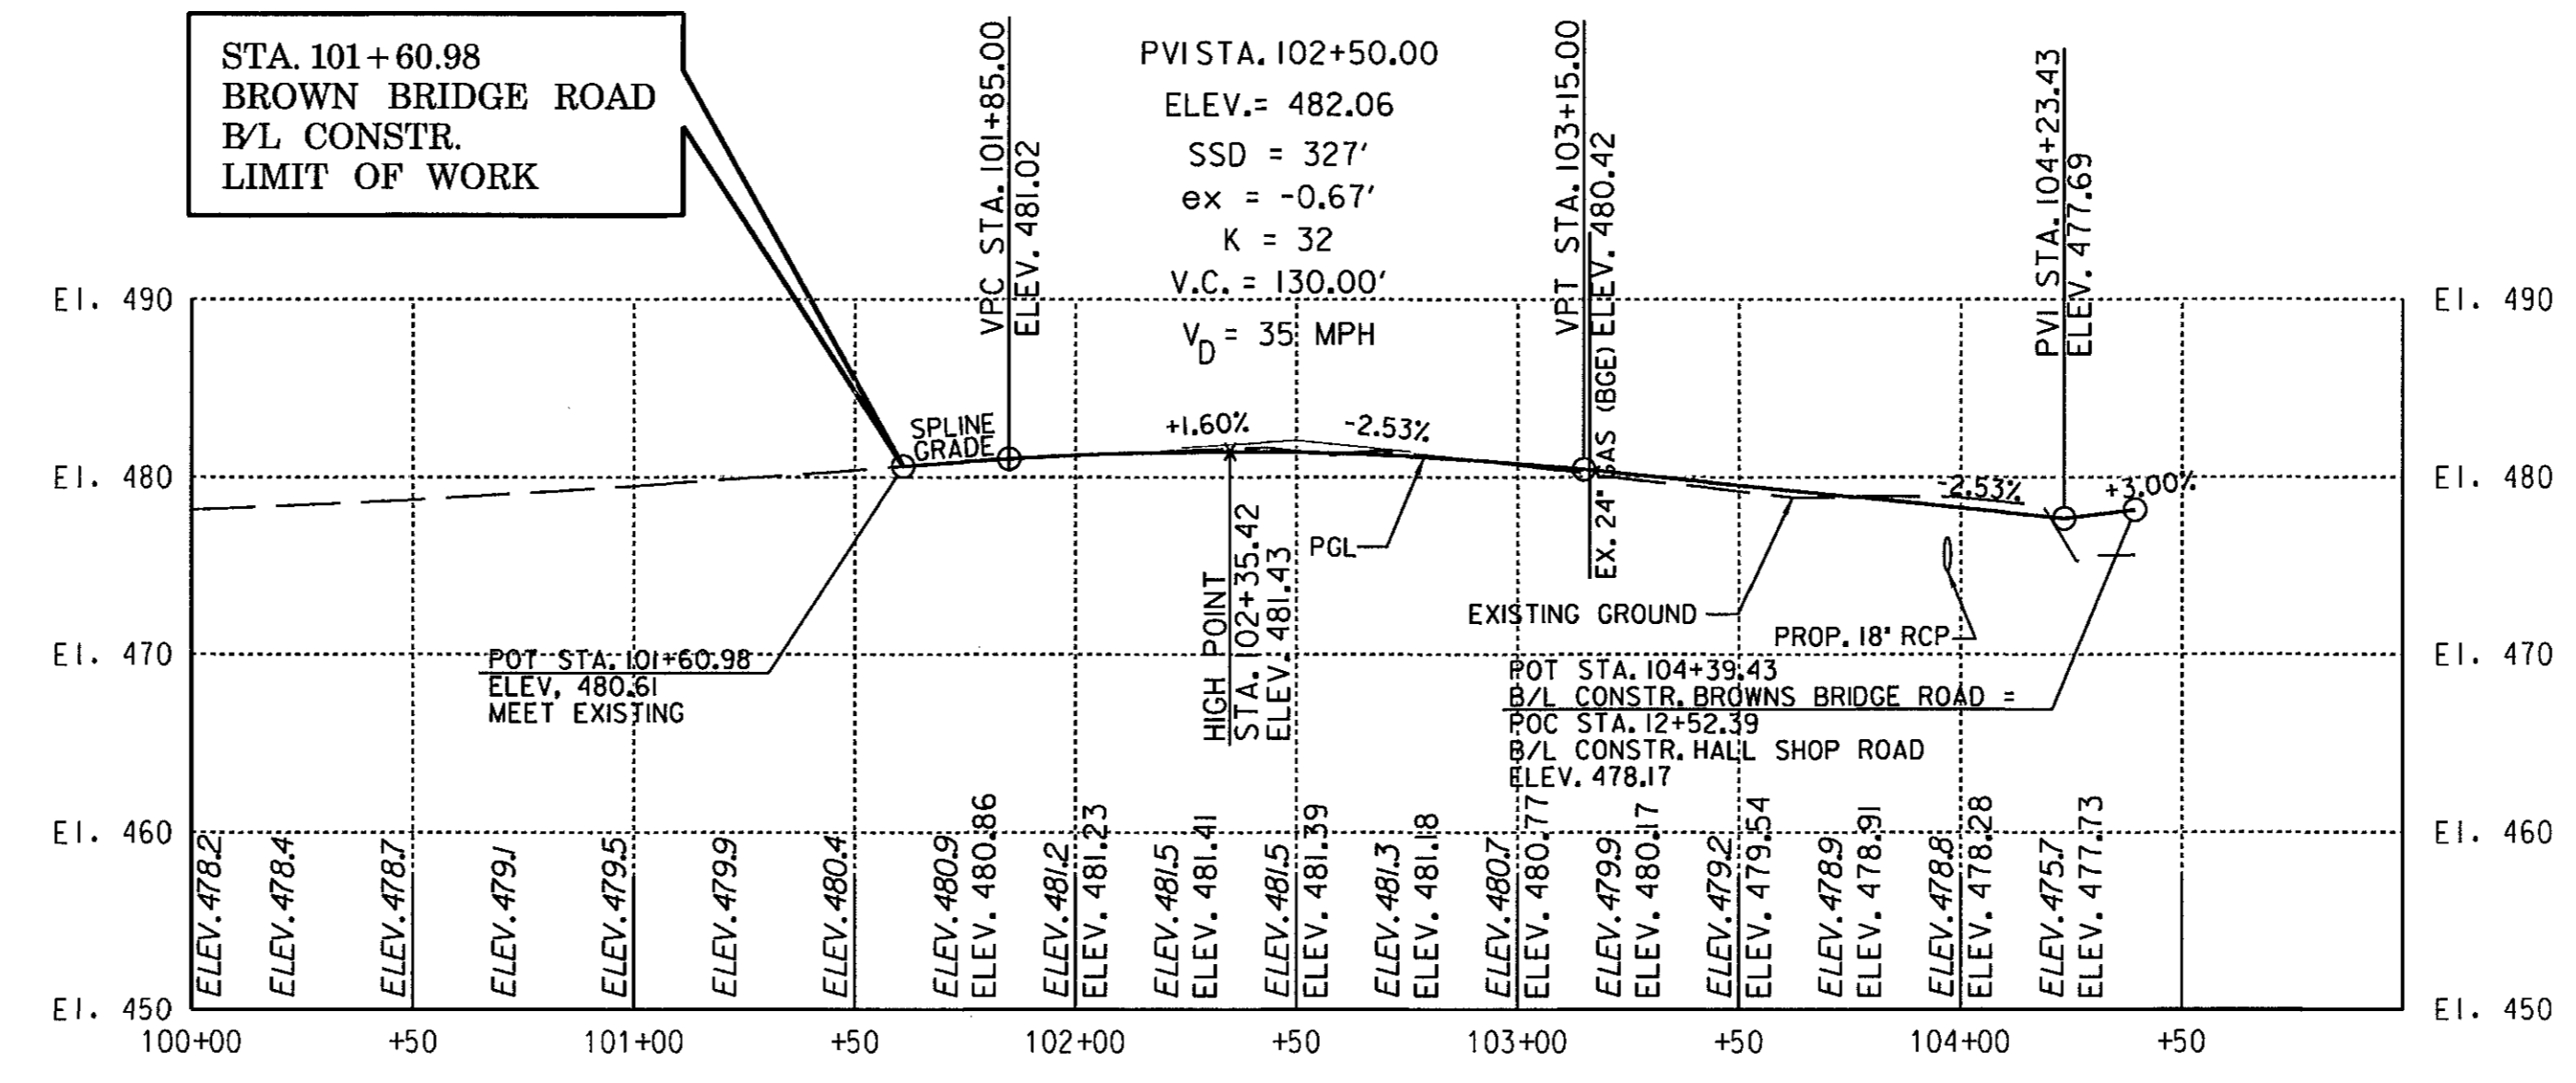

BROWNS BRIDGE ROAD PROFILE

SCALE: HORIZ 1"=40'
VERT 1"=10'


PROFESSIONAL CERTIFICATION
 "I HEREBY CERTIFY THAT DOCUMENTS WERE PREPARED OR APPROVED BY ME, AND THAT I AM A DULY LICENSED PROFESSIONAL ENGINEER UNDER THE LAWS OF THE STATE OF MARYLAND.
 LICENSE NO. 16156
 EXPIRATION DATE: 8/28/2018"

DEPARTMENT OF PUBLIC WORKS
 HOWARD COUNTY, MARYLAND

Mesmer 1/23/18
 CHIEF BUREAU OF HIGHWAYS DATE

Thomas E. Sullivan 1/23/18
 CHIEF, BUREAU OF ENGINEERING DATE

Jan 1/23/18
 DIRECTOR OF PUBLIC WORKS DATE

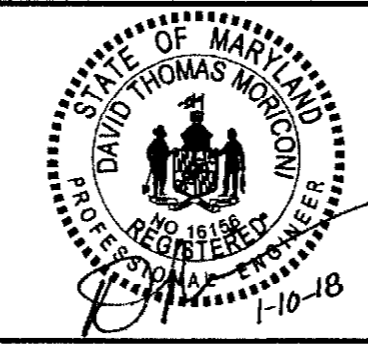


DES: RLL			
DRN: BJK			
CHK: DTM			
DATE: 12/17			
BY NO.		REVISION	

ROADWAY PROFILES


HALL SHOP ROAD AT BROWNS BRIDGE ROAD

ELECTION DISTRICT NO. 5
 CAPITAL PROJECT J-4164


SCALE AS SHOWN
 SHEET 5 OF 21

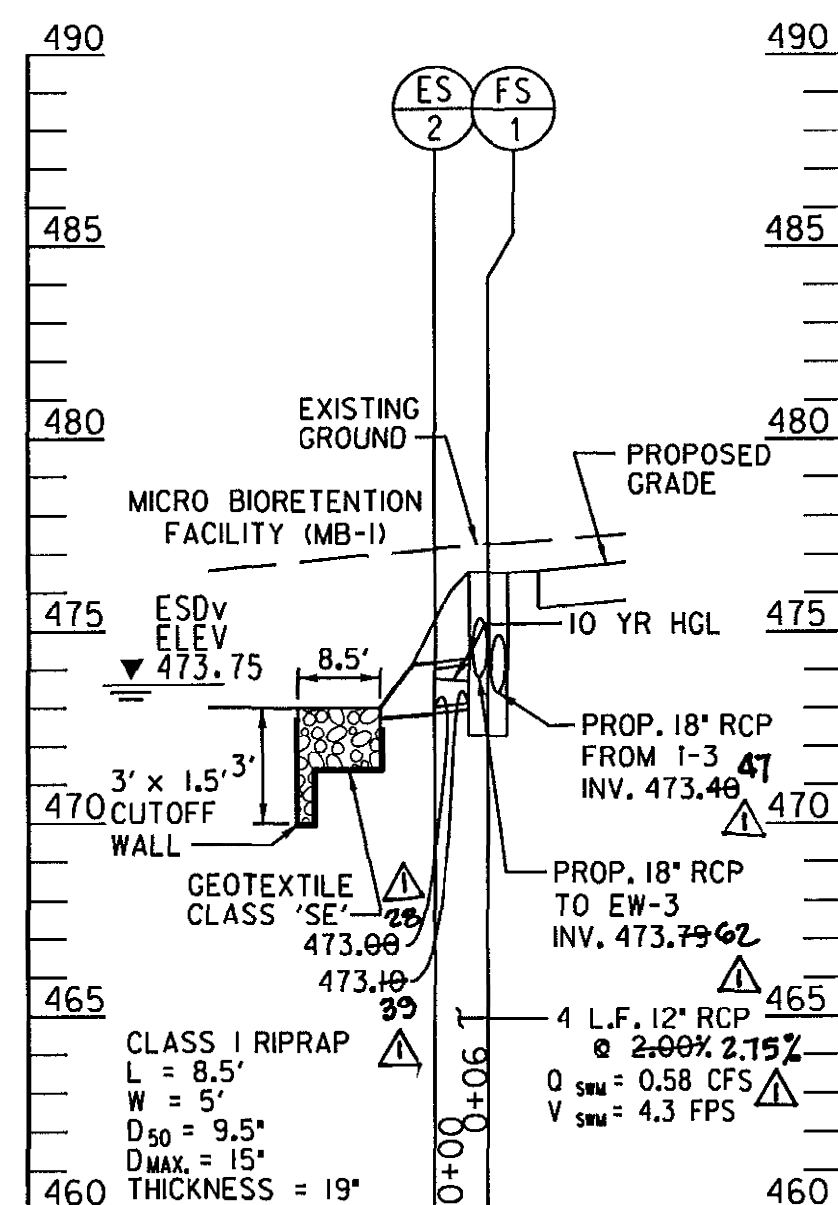


ES-2 TO FS-1

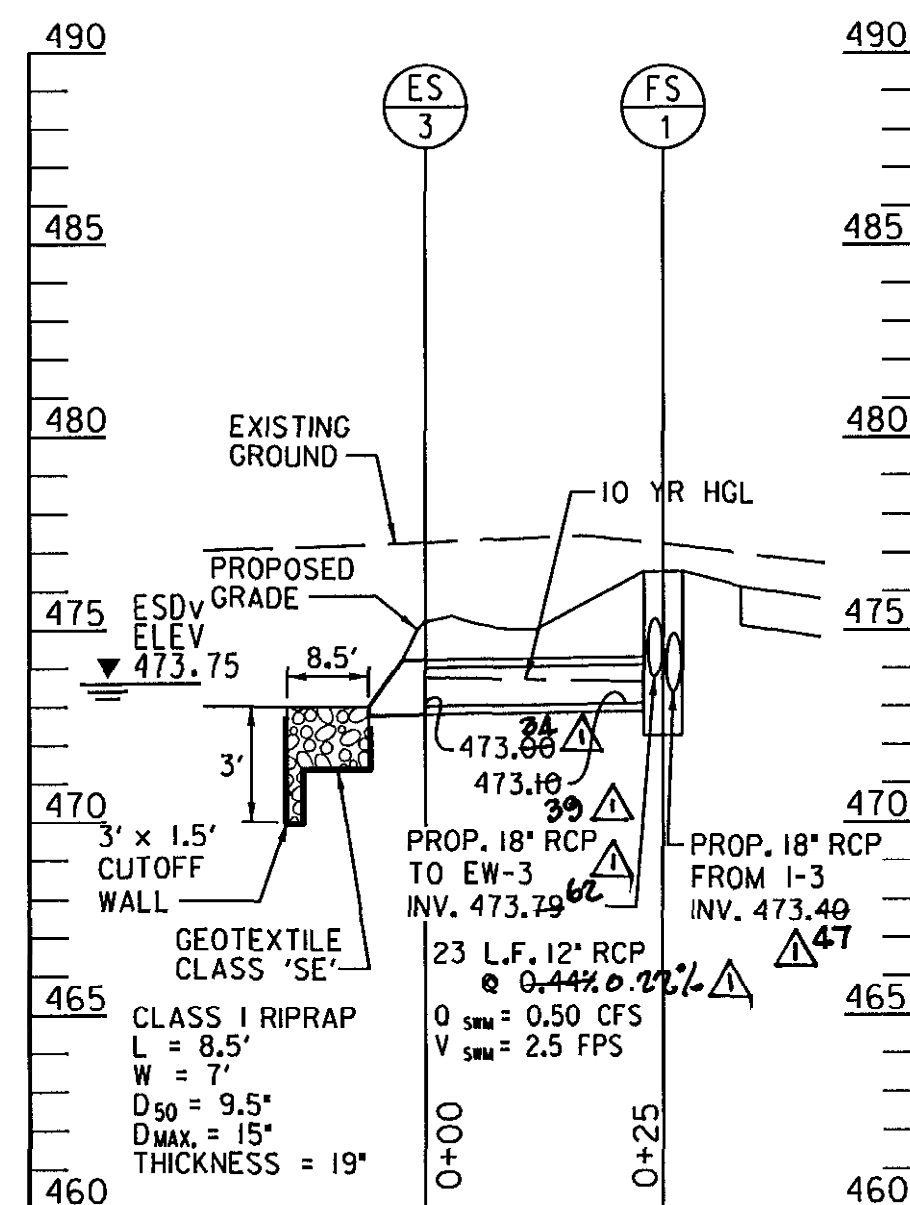

ES-3 TO FS-1

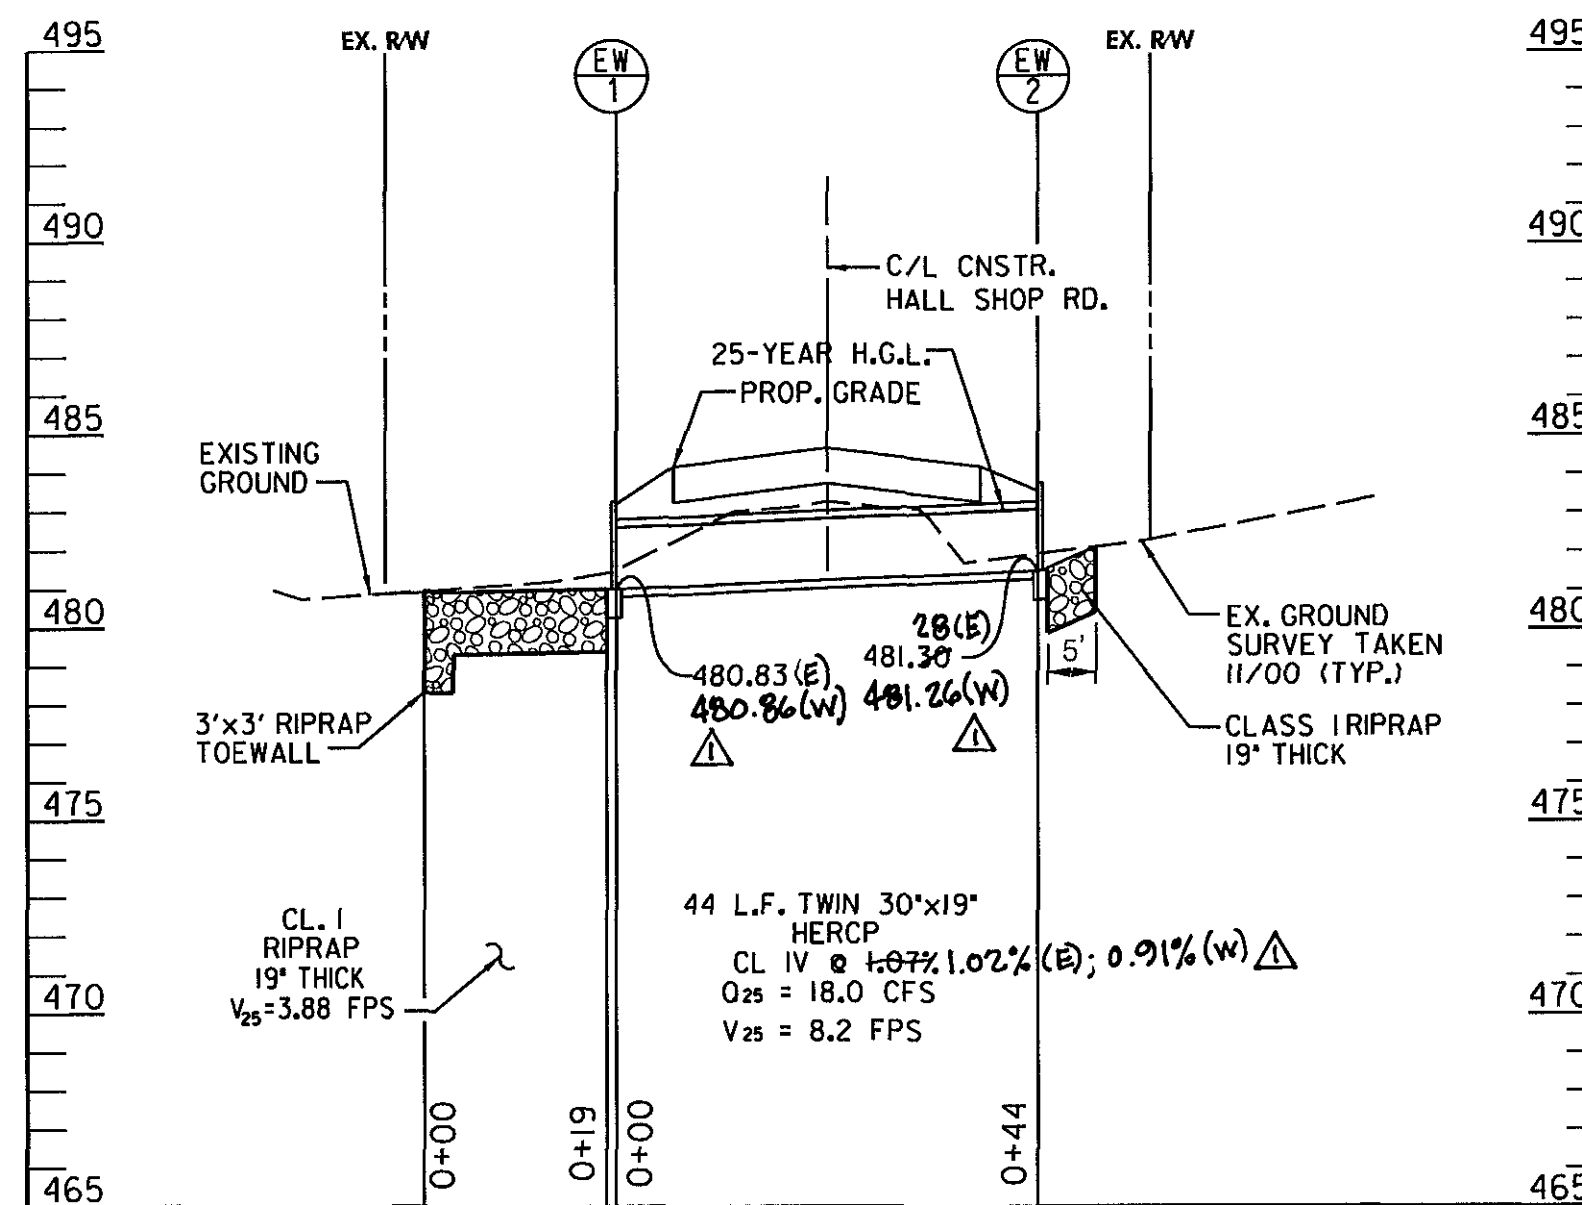

EW-2 TO EW-1

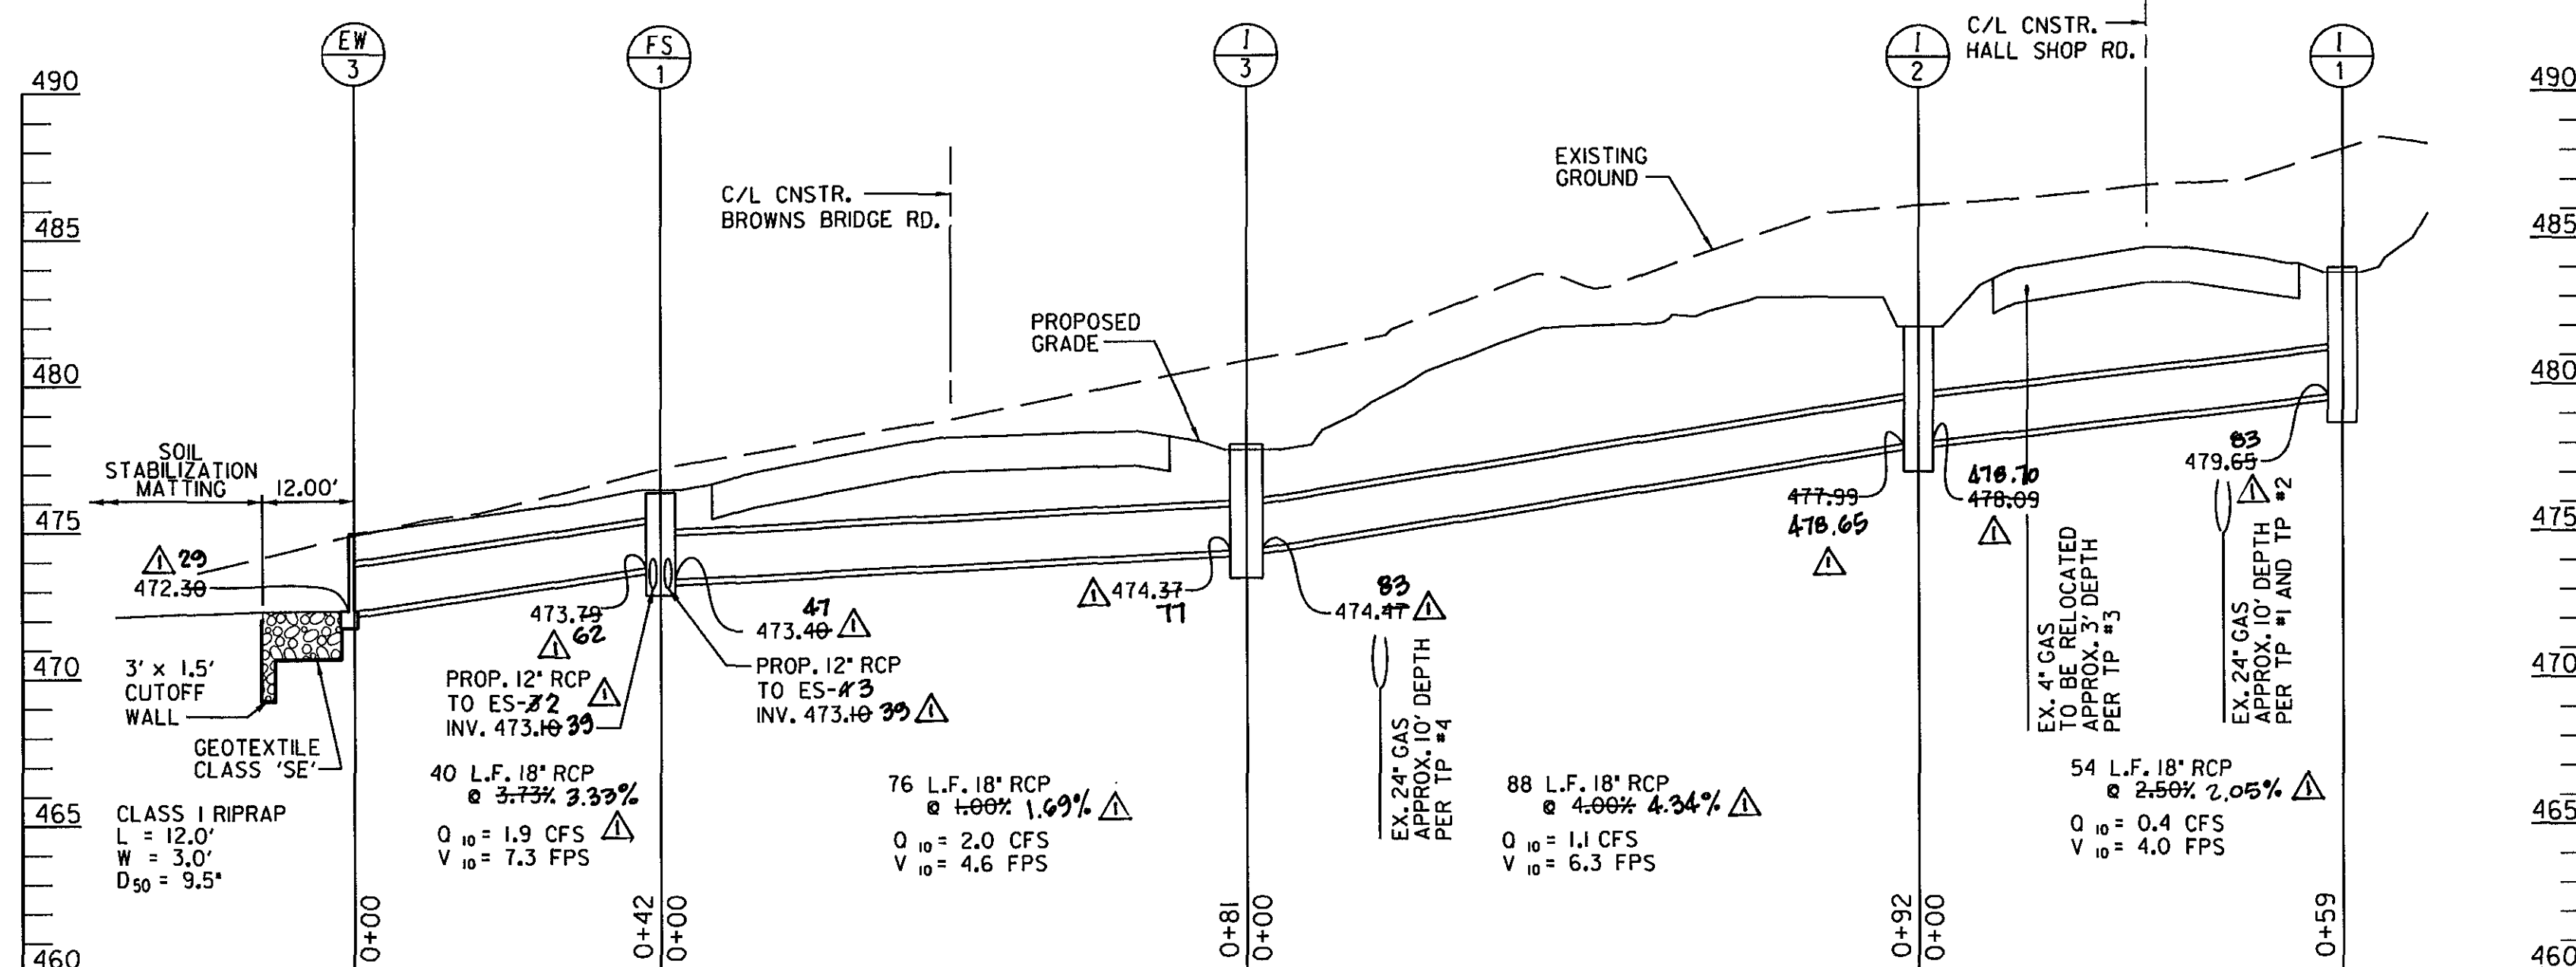


EW-3 TO I-1

STATION NO.	WORK POINT				STRUCTURE TYPE	HOWARD COUNTY STD. NO. *	TOP OF GRATE OR COVER ELEVATION	INVERT ELEVATION		REMARKS
	STATION	OFFSET	NORTHING	EASTING				IN	OUT	
I-1	14+19.00	20.92' LT.	549,617.68	1,328,608.29	OPEN END GRATE-PRECAST	D-4.36	484.67	479.66	83	
I-2	13+83.44	24.31' RT.	549,560.19	1,328,606.06	OPEN END GRATE-PRECAST	D-4.36	483.92	478.99	478.65	
I-3	12+94.31	41.20' RT.	549,494.75	1,328,542.15	OPEN END GRATE-PRECAST	D-4.36	477.75	474.77	83	
ES-2	12+09.19	41.49' RT.	549,446.74	1,328,471.49	CONCRETE END SECTION	D-5.51	---	---	473.99	
ES-3	12+11.42	63.19' RT.	549,429.97	1,328,485.45	CONCRETE END SECTION	D-5.51	---	---	473.99	
EW-1	17+50.00	21.00' LT.	549,789.16	1,328,894.23	CONCRETE END WALL	MODIFIED D-5.21	---	---	480.83	
EW-2	17+50.00	21.00' RT.	549,752.65	1,328,914.92	CONCRETE END WALL	MODIFIED D-5.21	---	---	481.30	
EW-3	11+74.88	22.80' RT.	549,443.09	1,328,432.58	CONCRETE END WALL	MD 356.01	---	---	---	
FS-1	12+17.63	40.98' RT.	549,451.74	1,328,473.68	PRECAST MANHOLE	MD 384.03	477.14	473.40	473.39 / 473.19 / 473.79	

* UNLESS NOTED OTHERWISE

NOTES:

- WORK POINT FOR INLETS ARE CENTER OF THE PROPOSED STRUCTURES. FOR END SECTIONS AND END WALLS, WORK POINT IS AT THE INVERT LOCATION AS SHOWN ON THE PROFILES.
- EW-1 AND EW-2 SHALL BE DESIGNED TO ACCOMMODATE TWIN 30"x19" HERCP PIPES (SEE MODIFIED ENDWALL DETAIL THIS SHEET). HOWARD COUNTY STD. NO. SD-5.21 SHALL BE USED AS A BASIS FOR ENDWALL REINFORCEMENT WITH THE DIMENSIONS INDICATED ON ENDWALL DETAIL ADJUSTED ACCORDINGLY.

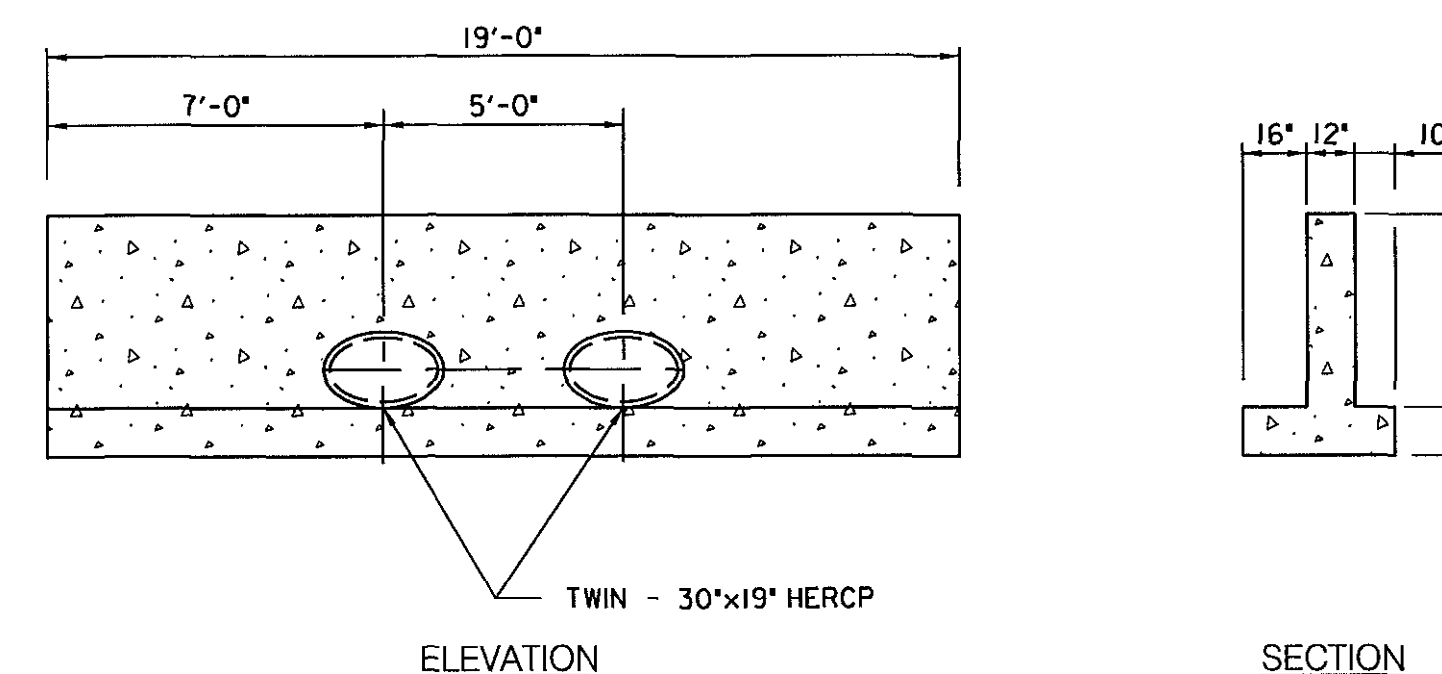


MODIFIED ENDWALL DETAIL
SCALE 1" = 4'

REFER TO HOWARD COUNTY STANDARD NO. S-5.21 FOR ADDITIONAL INFORMATION. SEE NOTE 2 ABOVE

PROFESSIONAL CERTIFICATION
"I HEREBY CERTIFY THAT DOCUMENTS WERE PREPARED OR APPROVED BY ME, AND THAT I AM A DULY LICENSED PROFESSIONAL ENGINEER UNDER THE LAWS OF THE STATE OF MARYLAND. LICENSE NO. 16156 EXPIRATION DATE: 8/28/2018"

DEPARTMENT OF PUBLIC WORKS
HOWARD COUNTY, MARYLAND
CHIEF BUREAU OF HIGHWAYS
CHIEF BUREAU OF ENGINEERING
CHIEF, TRANSPORTATION AND SPECIAL PROJECTS DIVISION

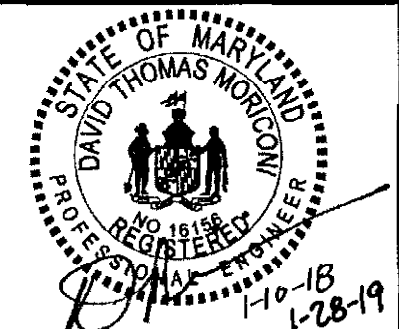


DES:	RLI				
DRN:	BJK				
CHK:	DTM				
DATE:	12/17	DTM	AS-BUILT SURVEY	1-28-19	
BY:	NO.	NO.	REVISION	DATE	

STORM DRAIN PROFILES AND DETAILS

HALL SHOP ROAD AT BROWNS BRIDGE ROAD
ELECTION DISTRICT NO. 5
CAPITAL PROJECT J-4164

SCALE AS SHOWN
SHEET 6 OF 21

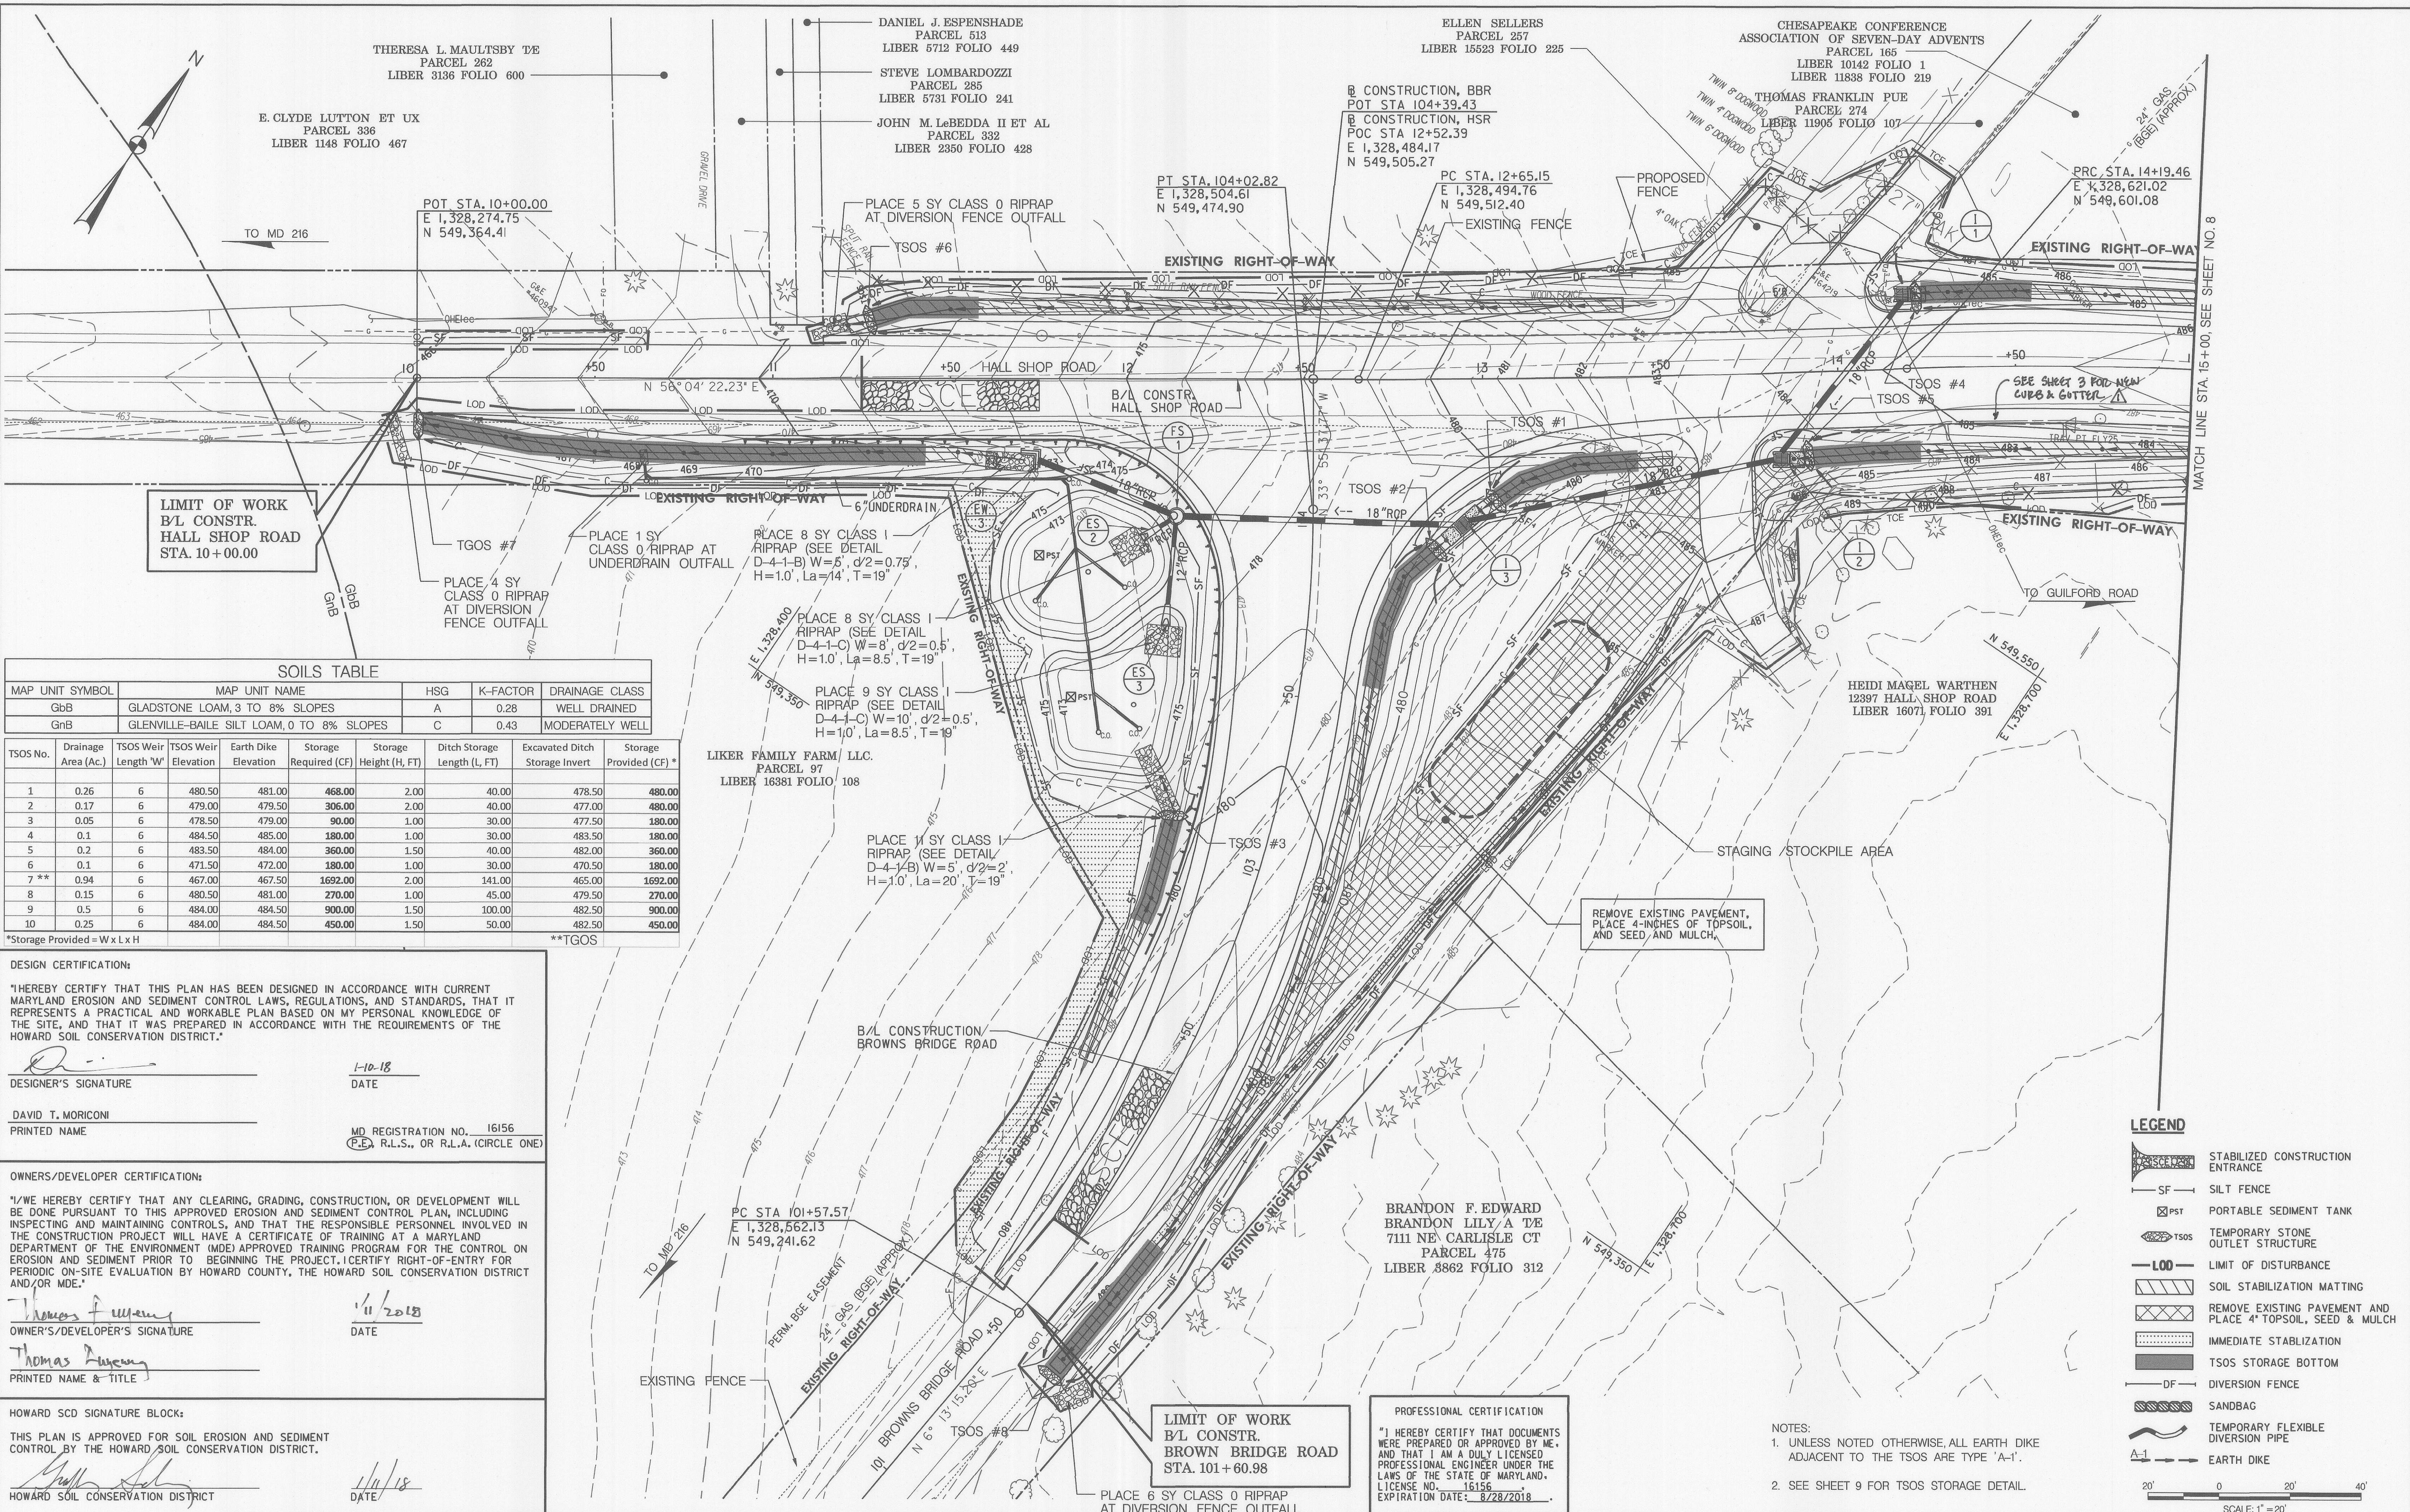

SOILS TABLE

MAP UNIT SYMBOL	MAP UNIT NAME	HSG	K-FACTOR	DRAINAGE CLASS
GbB	GLADSTONE LOAM, 3 TO 8% SLOPES	A	0.28	WELL DRAINED
GnB	GLENVILLE-BAILE SILT LOAM, 0 TO 8% SLOPES	C	0.43	MODERATELY WELL

TSOS No.	Drainage Area (Ac.)	TSOS Weir Length 'W'	TSOS Weir Elevation	Earth Dike Elevation	Storage Required (CF)	Storage Height (H, FT)	Ditch Storage Length (L, FT)	Excavated Ditch Storage Invert	Storage Provided (CF) *
1	0.26	6	480.50	481.00	468.00	2.00	40.00	478.50	480.00
2	0.17	6	479.00	479.50	306.00	2.00	40.00	477.00	480.00
3	0.05	6	478.50	479.00	90.00	1.00	30.00	477.50	180.00
4	0.1	6	484.50	485.00	180.00	1.00	30.00	483.50	180.00
5	0.2	6	483.50	484.00	360.00	1.50	40.00	482.00	360.00
6	0.1	6	471.50	472.00	180.00	1.00	30.00	470.50	180.00
7**	0.94	6	467.00	467.50	1692.00	2.00	141.00	465.00	1692.00
8	0.15	6	480.50	481.00	270.00	1.00	45.00	479.50	270.00
9	0.5	6	484.00	484.50	900.00	1.50	100.00	482.50	900.00
10	0.25	6	484.00	484.50	450.00	1.50	50.00	482.50	450.00

*Storage Provided = W x L x H
**TGOS

DESIGN CERTIFICATION:
 "I HEREBY CERTIFY THAT THIS PLAN HAS BEEN DESIGNED IN ACCORDANCE WITH CURRENT MARYLAND EROSION AND SEDIMENT CONTROL LAWS, REGULATIONS, AND STANDARDS, THAT IT REPRESENTS A PRACTICAL AND WORKABLE PLAN BASED ON MY PERSONAL KNOWLEDGE OF THE SITE, AND THAT IT WAS PREPARED IN ACCORDANCE WITH THE REQUIREMENTS OF THE HOWARD SOIL CONSERVATION DISTRICT."

DESIGNER'S SIGNATURE: *David T. Moriconi* DATE: 1-10-18
 DAVID T. MORICONI MD REGISTRATION NO. 16156
 PRINTED NAME (P.E.) R.L.S., OR R.L.A. (CIRCLE ONE)

OWNERS/DEVELOPER CERTIFICATION:
 "I/WE HEREBY CERTIFY THAT ANY CLEARING, GRADING, CONSTRUCTION, OR DEVELOPMENT WILL BE DONE PURSUANT TO THIS APPROVED EROSION AND SEDIMENT CONTROL PLAN, INCLUDING INSPECTING AND MAINTAINING CONTROLS, AND THAT THE RESPONSIBLE PERSONNEL INVOLVED IN THE CONSTRUCTION PROJECT WILL HAVE A CERTIFICATE OF TRAINING AT A MARYLAND DEPARTMENT OF THE ENVIRONMENT (MDE) APPROVED TRAINING PROGRAM FOR THE CONTROL ON EROSION AND SEDIMENT PRIOR TO BEGINNING THE PROJECT. I CERTIFY RIGHT-OF-ENTRY FOR PERIODIC ON-SITE EVALUATION BY HOWARD COUNTY, THE HOWARD SOIL CONSERVATION DISTRICT AND/OR MDE."

OWNER'S/DEVELOPER'S SIGNATURE: *Thomas A. Fleming* DATE: 1/11/2018
 THOMAS A. FLEMING
 PRINTED NAME & TITLE

HOWARD SCD SIGNATURE BLOCK:
 THIS PLAN IS APPROVED FOR SOIL EROSION AND SEDIMENT CONTROL BY THE HOWARD SOIL CONSERVATION DISTRICT.
 HOWARD SOIL CONSERVATION DISTRICT DATE: 1/11/18

PROFESSIONAL CERTIFICATION
 "I HEREBY CERTIFY THAT DOCUMENTS WERE PREPARED OR APPROVED BY ME, AND THAT I AM A DULY LICENSED PROFESSIONAL ENGINEER UNDER THE LAWS OF THE STATE OF MARYLAND. LICENSE NO. 16156 EXPIRATION DATE: 8/28/2018"

NOTES:
 1. UNLESS NOTED OTHERWISE, ALL EARTH DIKE ADJACENT TO THE TSOS ARE TYPE 'A-1'.
 2. SEE SHEET 9 FOR TSOS STORAGE DETAIL.

LEGEND

- STABILIZED CONSTRUCTION ENTRANCE
- SILT FENCE
- PORTABLE SEDIMENT TANK
- TEMPORARY STONE OUTLET STRUCTURE
- LIMIT OF DISTURBANCE
- SOIL STABILIZATION MATTING
- REMOVE EXISTING PAVEMENT AND PLACE 4" TOPSOIL, SEED & MULCH
- IMMEDIATE STABILIZATION
- TSOS STORAGE BOTTOM
- DIVERSION FENCE
- SANDBAG
- TEMPORARY FLEXIBLE DIVERSION PIPE
- EARTH DIKE

SCALE: 1" = 20'

DEPARTMENT OF PUBLIC WORKS
 HOWARD COUNTY, MARYLAND

Maureen 1/23/18 DATE
 CHIEF, BUREAU OF HIGHWAYS

Thomas A. Fleming 1/23/18 DATE
 CHIEF, BUREAU OF ENGINEERING

James B. 1/23/18 DATE
 DIRECTOR OF PUBLIC WORKS

AECOM

STATE OF MARYLAND
 DAVID THOMAS MORICONI
 PROFESSIONAL ENGINEER
 LICENSE NO. 16156
 EXPIRES 8/28/2018

DES:	RLI
DRN:	BJK
CHK:	DTM
DATE:	12/17
BY:	DTM
NO.:	AS-BUILT
REVISION:	
DATE:	1-28-18


EROSION & SED. CONTROL PLAN
 STA. 10+00 TO 15+00

SCALE MAP NO. 35 BLOCK NO. 19

HALL SHOP ROAD AT BROWNS BRIDGE ROAD

ELECTION DISTRICT NO. 5
 CAPITAL PROJECT J-4164

SCALE 1" = 20'
 SHEET 7 OF 21

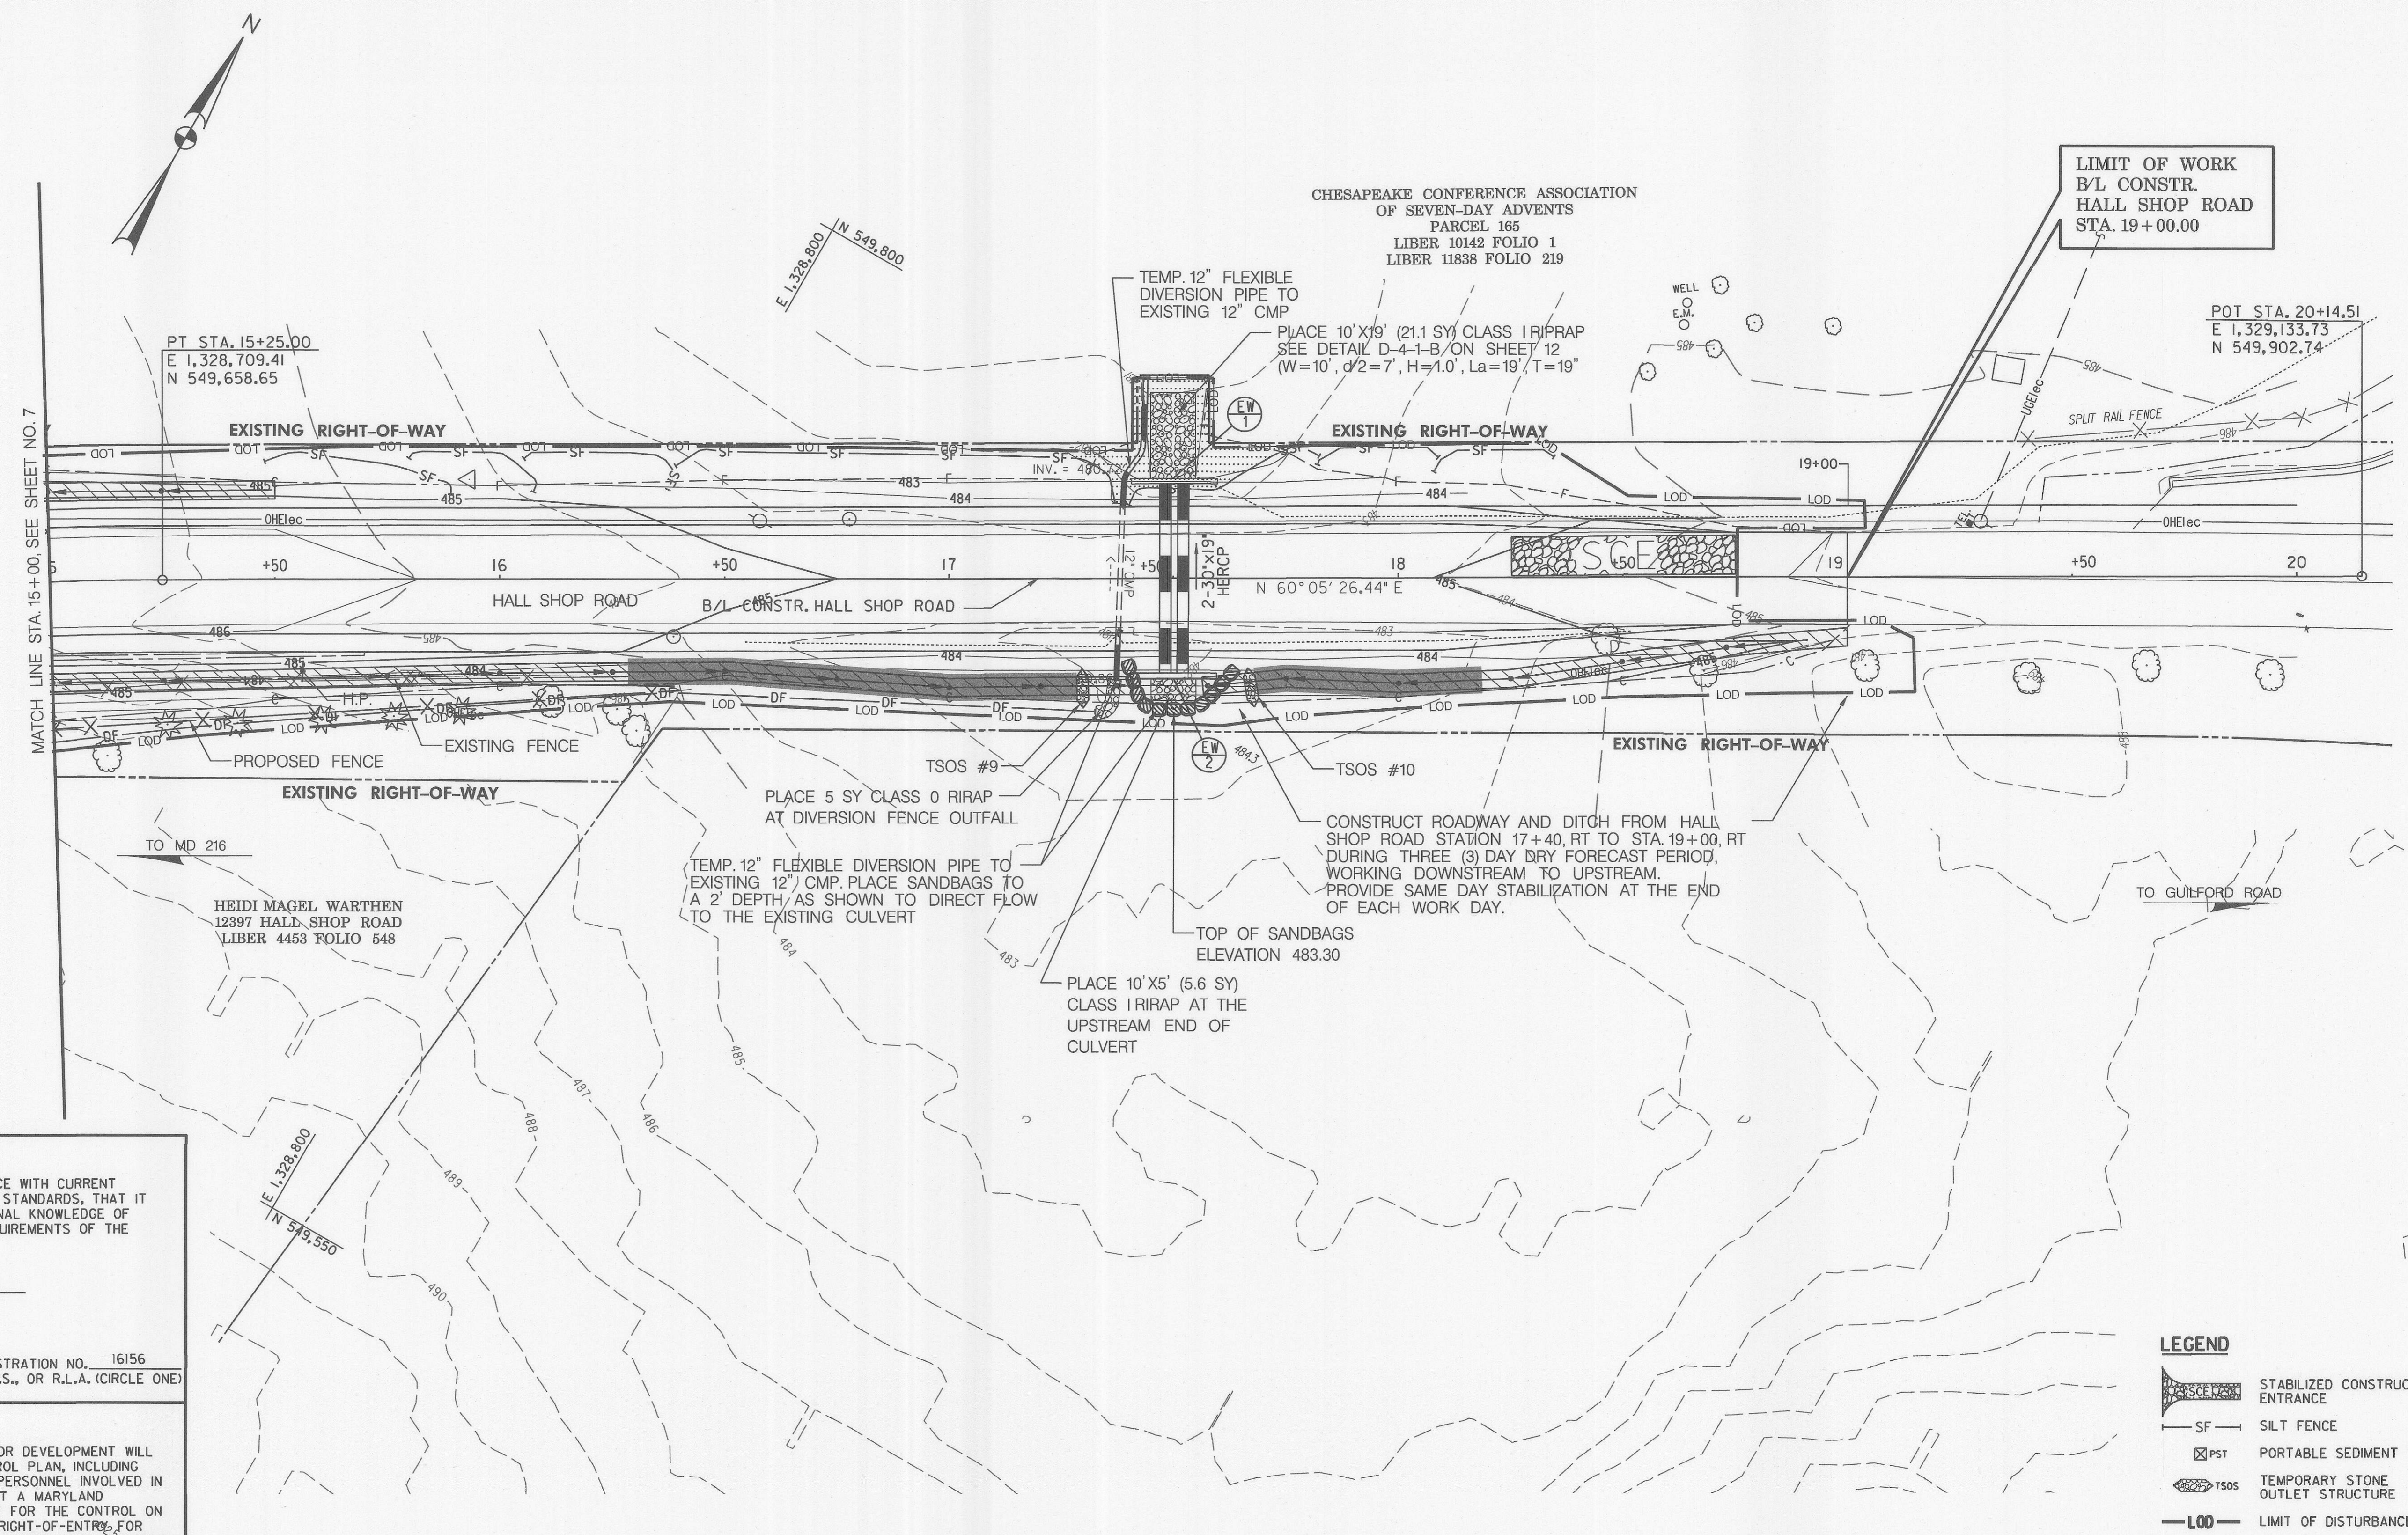

DESIGN CERTIFICATION:
 I HEREBY CERTIFY THAT THIS PLAN HAS BEEN DESIGNED IN ACCORDANCE WITH CURRENT MARYLAND EROSION AND SEDIMENT CONTROL LAWS, REGULATIONS, AND STANDARDS, THAT IT REPRESENTS A PRACTICAL AND WORKABLE PLAN BASED ON MY PERSONAL KNOWLEDGE OF THE SITE, AND THAT IT WAS PREPARED IN ACCORDANCE WITH THE REQUIREMENTS OF THE HOWARD SOIL CONSERVATION DISTRICT.

DESIGNER'S SIGNATURE: *David T. Moriconi*
 DATE: 1-10-18
 PRINTED NAME: DAVID T. MORICONI
 MD REGISTRATION NO. 16156
 (P.E.) R.L.S., OR R.L.A. (CIRCLE ONE)

OWNERS/DEVELOPER CERTIFICATION:
 I/WE HEREBY CERTIFY THAT ANY CLEARING, GRADING, CONSTRUCTION, OR DEVELOPMENT WILL BE DONE PURSUANT TO THIS APPROVED EROSION AND SEDIMENT CONTROL PLAN, INCLUDING INSPECTING AND MAINTAINING CONTROLS, AND THAT THE RESPONSIBLE PERSONNEL INVOLVED IN THE CONSTRUCTION PROJECT WILL HAVE A CERTIFICATE OF TRAINING AT A MARYLAND DEPARTMENT OF THE ENVIRONMENT (MDE) APPROVED TRAINING PROGRAM FOR THE CONTROL ON EROSION AND SEDIMENT PRIOR TO BEGINNING THE PROJECT. I CERTIFY RIGHT-OF-ENTRANCE FOR PERIODIC ON-SITE EVALUATION BY HOWARD COUNTY, THE HOWARD SOIL CONSERVATION DISTRICT AND/OR MDE.

OWNER'S/DEVELOPER'S SIGNATURE: *Thomas Avey*
 DATE: 1/11/2018
 PRINTED NAME & TITLE: Thomas Avey

HOWARD SCD SIGNATURE BLOCK:
 THIS PLAN IS APPROVED FOR SOIL EROSION AND SEDIMENT CONTROL BY THE HOWARD SOIL CONSERVATION DISTRICT.

HOWARD SOIL CONSERVATION DISTRICT SIGNATURE: *Scott A. ...*
 DATE: 1/10/18

PROFESSIONAL CERTIFICATION
 I HEREBY CERTIFY THAT DOCUMENTS WERE PREPARED OR APPROVED BY ME, AND THAT I AM A DULY LICENSED PROFESSIONAL ENGINEER UNDER THE LAWS OF THE STATE OF MARYLAND, LICENSE NO. 16156, EXPIRATION DATE: 8/28/2018.

LEGEND

- STABILIZED CONSTRUCTION ENTRANCE
- SILT FENCE
- PORTABLE SEDIMENT TANK
- TEMPORARY STONE OUTLET STRUCTURE
- LIMIT OF DISTURBANCE
- SOIL STABILIZATION MATTING
- REMOVE EXISTING PAVEMENT AND PLACE 4" TOPSOIL, SEED & MULCH
- IMMEDIATE STABILIZATION
- TSOS STORAGE BOTTOM
- DIVERSION FENCE
- SANDBAG
- TEMPORARY FLEXIBLE DIVERSION PIPE
- EARTH DIKE


SCALE: 1" = 20'

NOTES:
 1. UNLESS NOTED OTHERWISE, ALL EARTH DIKE ADJACENT TO THE TSOS ARE TYPE 'A-1'.
 2. SEE SHEET 9 FOR TSOS STORAGE DETAIL.
 3. ALL SOILS ARE Gbb. SEE SHEET 7 FOR SOILS TABLE.

DEPARTMENT OF PUBLIC WORKS
 HOWARD COUNTY, MARYLAND

CHIEF BUREAU OF HIGHWAYS: *Mark ...* DATE: 1/22/18
 CHIEF, TRANSPORTATION AND SPECIAL PROJECTS DIVISION: *Bob ...* DATE: 1/22/18

CHIEF, BUREAU OF ENGINEERING: *Thomas ...* DATE: 1/22/18
 DIRECTOR OF PUBLIC WORKS: *Paul ...* DATE: 1/22/18

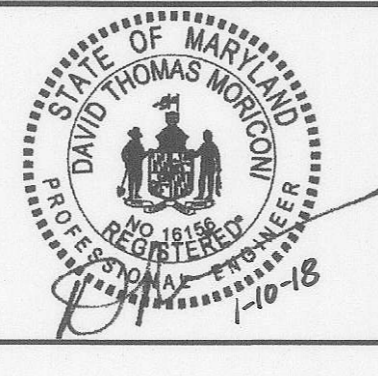

DES:	RLL				
DRN:	BJK				
CHK:	DTM				
DATE:	12/17	BY	NO.	REVISION	DATE

EROSION & SED. CONTROL PLAN
 STA. 15+00 TO 19+00

HALL SHOP ROAD AT
 BROWNS BRIDGE ROAD
 ELECTION DISTRICT NO. 5
 CAPITAL PROJECT J-4164

SCALE
 1" = 20'
 SHEET
 8 OF 21

SEQUENCE OF CONSTRUCTION

THE FOLLOWING SEQUENCE OF CONSTRUCTION DESCRIBES, IN PART, THE STEPS REQUIRED TO COMPLETE THE PROPOSED WORK. CONTRACTOR IS RESPONSIBLE FOR DETERMINING INTERIM SEQUENCE OF CONSTRUCTION, MEANS, METHODS, MATERIALS, LABOR AND/OR EQUIPMENT NECESSARY TO SATISFACTORILY CONSTRUCT THE FEATURES AS SHOWN ON THE PLANSET. IT SHALL BE CLEARLY UNDERSTOOD THAT FAILURE TO SPECIFICALLY MENTION ANY WORK WHICH WOULD NORMALLY BE REQUIRED TO COMPLETE THE PROJECT SHALL NOT RELIEVE THE CONTRACTOR'S RESPONSIBILITY TO COMPLETE THE PROJECT TO THE OWNER'S SATISFACTION.

1. OBTAIN THE GRADING PERMITS PRIOR TO CONSTRUCTION. (1 DAY)
2. NOTIFY HOWARD COUNTY AT 410-313-1855 AT LEAST 48 HOURS PRIOR TO THE START OF CONSTRUCTION (1 DAY).
3. REFER TO THE MAINTENANCE OF TRAFFIC PLANS CONTAINED IN THIS SET OF PLANS AND IMPLEMENT THE DETOUR (5 DAYS).
4. WITH THE APPROVAL OF THE INSPECTOR, INSTALL STABILIZED CONSTRUCTION ENTRANCES (SCE) AS SHOWN ON THE EROSION AND SEDIMENT CONTROL PLANS. THE SCE SHALL BE RELOCATED AND REHABILITATED AS NEEDED OR AS DIRECTED BY THE ENGINEER THROUGHOUT CONSTRUCTION.
5. CLEAR AND GRUB FOR THE INSTALLATION OF THE PERIMETER EROSION AND SEDIMENT CONTROL MEASURES AS NOTED BELOW (3 DAYS).
6. CONTRACTOR SHALL USE STAGING/STOCKPILE AREA AS INDICATED ON THE PLANS OR AS APPROVED BY THE ENGINEER. DO NOT REMOVE THE EXISTING PAVEMENT AT THE STAGING/STOCKPILE AREA UNTIL THE STAGING/STOCKPILE AREA IS NO LONGER NEEDED. INSTALL SILT FENCE AROUND LOW SIDE OF STOCKPILE AREA. (1 DAY)
7. INSTALL THE FOLLOWING PERIMETER EROSION AND SEDIMENT CONTROL DEVICES. (5 DAYS)
 - A. SILT FENCE
 - STA. 15+50, LT TO STA. 18+40, LT, HALL SHOP RD, AS INDICATED
 - STA. 101+65, LT TO STA. 104+20, LT, BROWNS BRIDGE RD
 - B. DIVERSION FENCE
 - STA. 10+00, RT TO STA. 11+65, RT, HALL SHOP RD
 - STA. 101+60, RT TO STA. 103+80, RT, BROWNS BRIDGE RD
 - STA. 11+20, LT TO STA. 13+40, LT, HALL SHOP RD
 - STA. 14+75, RT TO STA. 17+32, RT, HALL SHOP RD
 - C. TEMPORARY STONE OUTLET STRUCTURE (TSOS) WITH EARTH DIKE
 - STA. 11+25, LT HALL SHOP RD (#6)
 - STA. 10+00, RT HALL SHOP RD (#7)
 - STA. 101+50, RT, BROWNS BRIDGE RD (#8)
 - STA. 17+30, RT HALL SHOP RD (#9)
 - STA. 17+68, RT HALL SHOP RD (#10)
 - D. TEMPORARY CULVERT EXTENSION (12" FLEXIBLE PIPE)
 - STA. 17+40, LT/RT, HALL SHOP RD
8. WITH THE APPROVAL OF THE INSPECTOR, CLEAR AND GRUB THE REMAINDER OF THE SITE AS NEEDED. (2 DAYS)
9. CONSTRUCT AND STABILIZE DITCH FROM HALL SHOP ROAD STA. 10+00 TO 11+75, RT, EXCAVATE STORAGE AREA UPSLOPE OF TSOS #7. (5 DAYS)
10. INSTALL STORM DRAIN SYSTEM EW-3 TO FS-1, FS-1 TO I-3, I-3 TO I-2, I-2 TO I-1. INSTALL TSOS # 1, 2, 4 & 5 WITH STORAGE UPSLOPE OF EACH TSOS. PLUG FS-1 OUTLETS TO ES-2 & ES-3. (15 DAYS)
11. CONSTRUCT AND STABILIZE REMAINDER OF HALL SHOP ROAD AND BROWNS BRIDGE ROAD SIDE DITCHES AND TSOS #3 WITH UPSLOPE STORAGE. (10 DAYS)
12. BEGIN CONSTRUCTION OF HALL SHOP ROAD AND BROWNS BRIDGE ROAD. ONCE PAVEMENT BASE IS PLACED, BEGIN EXCAVATION FOR MICRO-BIORETENTION. INSTALL SILT FENCE FROM STA. 103+15, LT, TO STA. 114+20, LT BROWNS BRIDGE ROAD. CONSTRUCT NEW TWIN CULVERT, HEADWALLS AND RIPRAP. PLACE SANDBAGS AT EW-2. (35 DAYS)
13. CONSTRUCT REMAINDER OF MICRO-BIORETENTION, INSTALL UNDERDRAIN, UNDERDRAIN OUTLET, CLEANOUTS AND STABILIZED OUTLET. USE PORTABLE SEDIMENT TANKS TO DEWATER SEDIMENT LADEN WATER ENCOUNTERED. INSTALL ES-2 AND ES-3, PIPES TO FS-1, RIPRAP OUTLET PROTECTION, AND STABILIZE. (15 DAYS)
14. ONCE THE MICRO-BIORETENTION FACILITIES ARE STABLE, UNPLUG OPENINGS TO MICRO-BIORETENTION AT FS-1. (2 DAYS)
15. COMPLETE PAVING FOR HALL SHOP ROAD. (10 DAYS)
16. REMOVE EXISTING BROWNS BRIDGE ROAD, STOCKPILE AREA AND GRADE TO FINAL GRADE AS SHOWN IN THE PLANS, WORKING UPSTREAM TO DOWNSTREAM. STABILIZE ANY DISTURBED AREAS AT THE END OF EACH WORK DAY. DO NOT REMOVE THE PAVEMENT AT THE STAGING/STOCKPILE AREA AT THIS TIME. (5 DAYS)


SEQUENCE OF CONSTRUCTION (CON'T)

17. ONCE THE SIDE DITCHES ARE STABILIZED AND WITH THE APPROVAL OF THE SEDIMENT CONTROL INSPECTOR, REMOVE TSOS. STABILIZE DITCHES TO FINAL GRADE. (10 DAYS)
18. REMOVE DIVERSION FENCES AND RIPRAP OUTFALLS. REMOVE SANDBAGS AT EW-2. (5 DAYS)
19. STABILIZE REMAINING DISTURBED AREAS WITH TOPSOIL, PERMANENT SEEDING AND MULCHING AS NEEDED. (5 DAYS)
20. CONTRACTOR SHALL CLEAN ALL PIPES INSTALLED AS PART OF THIS PROJECT AFTER ALL UPSTREAM AREAS HAVE BEEN STABILIZED, BUT PRIOR TO THE REMOVAL OF TSOS CONTROLS AS MENTIONED ABOVE. (2 DAYS)
21. UPON THE HOWARD CO. INSPECTOR'S APPROVAL, REMOVE ALL REMAINING EROSION AND SEDIMENT CONTROL DEVICES AND STABILIZE THE REMAINING AREAS WITH PERMANENT SEEDING. (5 DAYS)

NOTE: THE TIME LINE EXCLUDES WEATHER RELATED DELAYS.

SEQUENCE OF CONSTRUCTION - GENERAL NOTES

1. UTILITIES AND STORM DRAINS SHOWN ON THE EROSION AND SEDIMENT CONTROL PLANS ARE FOR THE GUIDANCE OF THE CONTRACTOR ONLY. CONTRACTOR SHALL CALL "MISS UTILITY" AT 1-800-257-7777 48 HOURS PRIOR TO THE START OF WORK. THE EXCAVATOR MUST NOTIFY ALL PUBLIC UTILITY COMPANIES WITH UNDERGROUND UTILITIES IN THE AREA OF THE PROPOSED EXCAVATION AND HAVE THOSE UTILITIES LOCATED BY THE UTILITY COMPANIES PRIOR TO COMMENCING EXCAVATION.
2. THE EROSION AND SEDIMENT CONTROL MEASURES MUST BE IN PLACE AND FUNCTIONING PRIOR TO CLEARING THE ENTIRE SITE. CLEAR AND GRUB FOR EROSION AND SEDIMENT CONTROL MEASURES OR DEVICES ONLY ON COMMENCEMENT OF CONSTRUCTION.
3. INSTALL STABILIZED CONSTRUCTION ENTRANCES, AND OTHER EROSION SEDIMENT CONTROL DEVICES AS PER THE EROSION AND SEDIMENT CONTROL PLANS. THE LOCATIONS FOR STABILIZED CONSTRUCTION ENTRANCES SHOWN ON THE PLANS ARE APPROXIMATE, AND EXACT LOCATIONS SHALL BE DETERMINED IN THE FIELD WITH APPROVAL FROM THE ENGINEER AND INSPECTOR.
4. MAINTAIN ALL SEDIMENT CONTROL PRACTICES ACCORDING TO THE MARYLAND 2011 STANDARDS UNTIL THE ENTIRE SITE IS STABILIZED.
5. CONTRACTOR SHALL LOCATE THE STAGING AND STOCKPILE AREA AND IS RESPONSIBLE FOR PROVIDING ANY ADDITIONAL EROSION CONTROLS FOR STAGING AND STOCKPILE AREAS AS REQUIRED BY THE INSPECTOR.
6. CLEAR AND GRUB AND PROCEED TO CONSTRUCTION ACCORDING TO THE SEQUENCE SPECIFIED ON THE TRAFFIC CONTROL PLAN SHEETS.
7. STORM DRAIN SYSTEMS SHALL ALWAYS BE CONSTRUCTED FROM THE DOWNSTREAM ENDS. INLET PROTECTIONS SHALL BE INSTALLED AT EXISTING INLETS BEFORE ANY DISTURBANCE IN THE WORK AREA. NO DISTURBED AREA SHALL BE LEFT UNSTABILIZED OVERNIGHT UNLESS THE RUN OFF IS DIRECTED TO AN MDE APPROVED SEDIMENT CONTROL DEVICE. CONTRACTOR SHALL USE PORTABLE SEDIMENT TANK TO DEWATER THE WORKING AREA DURING CONSTRUCTION.
8. CONSTRUCTION SHALL BE COMPLETED IN SEQUENCE LISTED ON THIS SHEET.
9. MAINTAIN ACCESS TO PRIVATE RESIDENCES AT ALL TIMES. ROADWAY SUBBASE SHALL BE STABILIZED WITH GRADED AGGREGATE BASE MATERIAL AT THE END OF EACH WORK DAY.

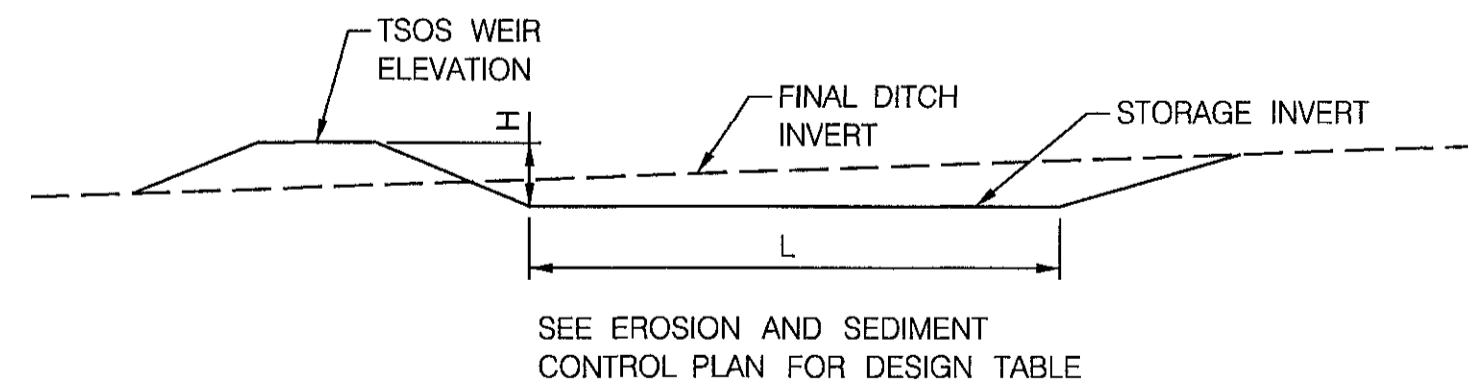

TSOS STORAGE DETAIL
NOT TO SCALE

PROFESSIONAL CERTIFICATION
"I HEREBY CERTIFY THAT DOCUMENTS WERE PREPARED OR APPROVED BY ME, AND THAT I AM A FULLY LICENSED PROFESSIONAL ENGINEER UNDER THE LAWS OF THE STATE OF MARYLAND. LICENSE NO. 16156 EXPIRATION DATE: 8/28/2018"

HOWARD SOIL CONSERVATION DISTRICT (HSCD) STANDARD SEDIMENT CONTROL NOTES

1. A PRE-CONSTRUCTION MEETING MUST OCCUR WITH THE HOWARD COUNTY DEPARTMENT OF PUBLIC WORKS, CONSTRUCTION INSPECTION DIVISION (CID), 410-313-1855 AFTER THE FUTURE LOD AND PROTECTED AREAS ARE MARKED CLEARLY IN THE FIELD. A MINIMUM OF 48 HOUR NOTICE TO CID MUST BE GIVEN AT THE FOLLOWING STAGES:
 - A. PRIOR TO THE START OF EARTH DISTURBANCE,
 - B. UPON COMPLETION OF THE INSTALLATION OF PERIMETER EROSION AND SEDIMENT CONTROLS, BUT BEFORE PROCEEDING WITH ANY OTHER EARTH DISTURBANCE OR GRADING,
 - C. PRIOR TO THE START OF ANOTHER PHASE OF CONSTRUCTION OR OPENING OF ANOTHER GRADING UNIT,
 - D. PRIOR TO THE REMOVAL OR MODIFICATION OF SEDIMENT CONTROL PRACTICES.
2. OTHER BUILDING OR GRADING INSPECTION APPROVALS MAY NOT BE AUTHORIZED UNTIL THIS INITIAL APPROVAL BY THE INSPECTION AGENCY IS MADE. OTHER RELATED STATE AND FEDERAL PERMITS SHALL BE REFERENCED TO ENSURE COORDINATION AND TO AVOID CONFLICTS WITH THIS PLAN.
3. ALL VEGETATIVE AND STRUCTURAL PRACTICES ARE TO BE INSTALLED ACCORDING TO THE PROVISIONS OF THIS PLAN AND ARE TO BE IN CONFORMANCE WITH THE 2011 MARYLAND STANDARDS AND SPECIFICATIONS FOR SOIL EROSION AND SEDIMENT CONTROL, AND REVISIONS THERETO.
4. FOLLOWING INITIAL SOIL DISTURBANCE OR RE-DISTURBANCE, PERMANENT OR TEMPORARY STABILIZATION IS REQUIRED WITHIN THREE (3) CALENDAR DAYS AS TO THE SURFACE OF ALL PERIMETER CONTROLS, DIKES, SWALES, DITCHES, PERIMETER SLOPES, AND ALL SLOPES STEEPER THAN 3 HORIZONTAL TO 1 VERTICAL (3:1); AND SEVEN (7) CALENDAR DAYS AS TO ALL OTHER DISTURBED AREAS ON THE PROJECT SITE EXCEPT FOR THOSE AREAS UNDER ACTIVE GRADING.
5. ALL DISTURBED AREAS MUST BE STABILIZED WITHIN THE TIME PERIOD SPECIFIED ABOVE IN ACCORDANCE WITH THE 2011 MARYLAND STANDARDS AND SPECIFICATIONS FOR SOIL EROSION AND SEDIMENT CONTROL FOR TOPSOIL (SEC. B-4-2), PERMANENT SEEDING (SEC. B-4-5), TEMPORARY SEEDING (SEC. B-4-4) AND MULCHING (SEC. B-4-3). TEMPORARY STABILIZATION WITH MULCH ALONE CAN ONLY BE APPLIED BETWEEN THE FALL AND SPRING SEEDING DATES IF THE GROUND IS FROZEN. INCREMENTAL STABILIZATION (SEC. B-4-1) SPECIFICATIONS SHALL BE ENFORCED IN AREAS WITH >15' OF CUT AND/OR FILL. STOCKPILES (SEC. B-4-8) IN EXCESS OF 20 FT. MUST BE BENCHED WITH STABLE OUTLET. ALL CONCENTRATED FLOW, STEEP SLOPE, AND HIGHLY ERODIBLE AREAS SHALL RECEIVE SOIL STABILIZATION MATTING (SEC. B-4-6).
6. ALL SEDIMENT CONTROL STRUCTURES ARE TO REMAIN IN PLACE, AND ARE TO BE MAINTAINED IN OPERATIVE CONDITION UNTIL PERMISSION FOR THEIR REMOVAL HAS BEEN OBTAINED FROM THE CID.

SITE ANALYSIS:

TOTAL AREA OF SITE: 1.77 ACRES
 AREA DISTURBED: 1.77 ACRES
 AREA TO BE ROOFED OR PAVED: 0.92 ACRES
 AREA TO BE VEGETATIVELY STABILIZED: 0.85 ACRES
 TOTAL CUT: 2,290 CU. YDS.
 TOTAL FILL: 390 CU. YDS. HOCO LANDFILL / SITE WITH OFFSITE WASTE/BORROW AREA LOCATION: ACTIVE GRADING PERMIT

7. ANY SEDIMENT CONTROL PRACTICE WHICH IS DISTURBED BY GRADING ACTIVITY FOR PLACEMENT OF UTILITIES MUST BE REPAIRED ON THE SAME DAY OF DISTURBANCE.
8. ADDITIONAL SEDIMENT CONTROL MUST BE PROVIDED, IF DEEMED NECESSARY BY THE CID. THE SITE AND ALL CONTROLS SHALL BE INSPECTED BY THE CONTRACTOR WEEKLY; AND THE NEXT DAY AFTER EACH RAIN EVENT. A WRITTEN REPORT BY THE CONTRACTOR, MADE AVAILABLE UPON REQUEST, IS PART OF EVERY INSPECTION AND SHOULD INCLUDE:
 - INSPECTION DATE
 - INSPECTION TYPE (ROUTINE, PRE-STORM EVENT, DURING RAIN EVENT)
 - NAME AND TITLE OF INSPECTOR
 - WEATHER INFORMATION (CURRENT CONDITIONS AS WELL AS TIME AND AMOUNT OF LAST RECORDED PRECIPITATION)
 - BRIEF DESCRIPTION OF PROJECT'S STATUS (E.G., PERCENT COMPLETE) AND/OR CURRENT ACTIVITIES
 - EVIDENCE OF SEDIMENT DISCHARGES
 - IDENTIFICATION OF PLAN DEFICIENCIES
 - IDENTIFICATION OF SEDIMENT CONTROLS THAT REQUIRE MAINTENANCE
 - IDENTIFICATION OF MISSING OR IMPROPERLY INSTALLED SEDIMENT CONTROLS
 - COMPLIANCE STATUS REGARDING THE SEQUENCE OF CONSTRUCTION AND STABILIZATION REQUIREMENTS
 - PHOTOGRAPHS
 - MONITORING/SAMPLING
 - MAINTENANCE AND/OR CORRECTIVE ACTION PERFORMED
 - OTHER INSPECTION ITEMS AS REQUIRED BY THE GENERAL PERMIT FOR STORMWATER ASSOCIATED WITH CONSTRUCTION ACTIVITIES (NPDES, MDE).

9. TRENCHES FOR THE CONSTRUCTION OF UTILITIES IS LIMITED TO THREE PIPE LENGTHS OR THAT WHICH CAN AND SHALL BE BACK-FILLED AND STABILIZED BY THE END OF EACH WORKDAY, WHICHEVER IS SHORTER.
10. ANY MAJOR CHANGES OR REVISIONS TO THE PLAN OR SEQUENCE OF CONSTRUCTION MUST BE REVIEWED AND APPROVED BY THE HSCD PRIOR TO PROCEEDING WITH CONSTRUCTION. MINOR REVISIONS MAY ALLOWED BY THE CID PER THE LIST OF HSCD-APPROVED FIELD CHANGES.
11. DISTURBANCE SHALL NOT OCCUR OUTSIDE THE L.O.D. A PROJECT IS TO BE SEQUENCED SO THAT GRADING ACTIVITIES BEGIN ON ONE GRADING UNIT (MAXIMUM ACREAGE OF 20 AC. PER GRADING UNIT) AT A TIME. WORK MAY PROCEED TO A SUBSEQUENT GRADING UNIT WHEN AT LEAST 50 PERCENT OF THE DISTURBED AREA IN THE PRECEDING GRADING UNIT HAS BEEN STABILIZED AND APPROVED BY THE CID. UNLESS OTHERWISE SPECIFIED AND APPROVED BY THE CID, NO MORE THAN 30 ACRES CUMULATIVELY MAY BE DISTURBED AT A GIVEN TIME.
12. WASH WATER FROM ANY EQUIPMENT, VEHICLES, WHEELS, PAVEMENT, AND OTHER SOURCES MUST BE TREATED IN A SEDIMENT BASIN OR OTHER APPROVED WASHOUT STRUCTURE.
13. TOPSOIL SHALL BE STOCKPILED AND PRESERVED ON-SITE FOR REDISTRIBUTION ONTO FINAL GRADE.
14. ALL SILT FENCE AND SUPER SILT FENCE SHALL BE PLACED ON-THE-CONTOUR, AND BE IMBRICATED AT 25' MINIMUM INTERVALS, WITH LOWER ENDS CURLED UPHILL BY 2' IN ELEVATION.
15. STREAM CHANNELS MUST NOT BE DISTURBED DURING THE FOLLOWING RESTRICTED TIME PERIODS (INCLUSIVE):
 - USE I AND IP MARCH 1 - JUNE 15
 - USE III AND IIIIP OCTOBER 1 - APRIL 30
 - USE IV MARCH 1 - MAY 31
16. A COPY OF THIS PLAN, THE 2011 MARYLAND STANDARDS AND SPECIFICATIONS FOR SOIL EROSION AND SEDIMENT CONTROL, AND ASSOCIATED PERMITS SHALL BE ON-SITE AND AVAILABLE WHEN THE SITE IS ACTIVE.

DESIGN CERTIFICATION:

"HEREBY CERTIFY THAT THIS PLAN HAS BEEN DESIGNED IN ACCORDANCE WITH CURRENT MARYLAND EROSION AND SEDIMENT CONTROL LAWS, REGULATIONS, AND STANDARDS, THAT IT REPRESENTS A PRACTICAL AND WORKABLE PLAN BASED ON MY PERSONAL KNOWLEDGE OF THE SITE, AND THAT IT WAS PREPARED IN ACCORDANCE WITH THE REQUIREMENTS OF THE HOWARD SOIL CONSERVATION DISTRICT."

DESIGNER'S SIGNATURE: *David T. Moriconi* DATE: 1-10-18
 DAVID T. MORICONI PRINTED NAME M.D. REGISTRATION NO. 16156 (P.E.) R.L.S., OR R.L.A. (CIRCLE ONE)

OWNERS/DEVELOPER CERTIFICATION:


"I/WE HEREBY CERTIFY THAT ANY CLEARING, GRADING, CONSTRUCTION, OR DEVELOPMENT WILL BE DONE PURSUANT TO THIS APPROVED EROSION AND SEDIMENT CONTROL PLAN, INCLUDING INSPECTING AND MAINTAINING CONTROLS, AND THAT THE RESPONSIBLE PERSONNEL INVOLVED IN THE CONSTRUCTION PROJECT WILL HAVE A CERTIFICATE OF TRAINING AT A MARYLAND DEPARTMENT OF THE ENVIRONMENT (MDE) APPROVED TRAINING PROGRAM FOR THE CONTROL ON EROSION AND SEDIMENT PRIOR TO BEGINNING THE PROJECT. I CERTIFY RIGHT-OF-ENTRY FOR PERIODIC ON-SITE EVALUATION BY HOWARD COUNTY, THE HOWARD SOIL CONSERVATION DISTRICT AND/OR MDE."

OWNER'S/DEVELOPER'S SIGNATURE: *Thomas Aughey* DATE: 1/11/2018
 THOMAS AUGHEY PRINTED NAME & TITLE

HOWARD SCD SIGNATURE BLOCK:

THIS PLAN IS APPROVED FOR SOIL EROSION AND SEDIMENT CONTROL BY THE HOWARD SOIL CONSERVATION DISTRICT.
 HOWARD SOIL CONSERVATION DISTRICT DATE: 1/11/18

DEPARTMENT OF PUBLIC WORKS
 HOWARD COUNTY, MARYLAND
 CHIEF BUREAU OF HIGHWAYS: *Wesley* DATE: 1/22/18
 CHIEF BUREAU OF ENGINEERING: *Thomas B. Buller* DATE: 1/24/18
 DIRECTOR OF PUBLIC WORKS: *Gregory* DATE: 1/23/18

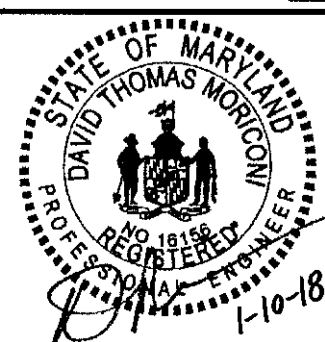

DES:	RLI			
DRN:	BJK			
CHK:	DTM			
DATE:	12/17			
BY	NO.	REVISION	DATE	

EROSION AND SEDIMENT CONTROL NOTES AND DETAILS
 SCALE MAP NO. 35 BLOCK NO. 19

HALL SHOP ROAD AT BROWNS BRIDGE ROAD
 ELECTION DISTRICT NO. 5
 CAPITAL PROJECT J-4164
 SHEET 9 OF 21

B-4.2 STANDARDS AND SPECIFICATIONS

FOR

SOIL PREPARATION, TOPSOILING, AND SOIL AMENDMENTS

Definition

The process of preparing the soils to sustain adequate vegetative stabilization.

Purpose

To provide a suitable soil medium for vegetative growth.

Conditions Where Practice Applies

Where vegetative stabilization is to be established.

Criteria

- A. Soil Preparation
1. Temporary Stabilization
a. Seedbed preparation consists of loosening soil to a depth of 3 to 5 inches by means of suitable agricultural or construction equipment...
b. Apply fertilizer and lime as prescribed on the plans.
c. Incorporate lime and fertilizer into the top 3 to 5 inches of soil by disking or other suitable means.
2. Permanent Stabilization
a. A soil test is required for any earth disturbance of 5 acres or more. The minimum soil conditions required for permanent vegetative establishment are:
i. Soil pH between 6.0 and 7.0.
ii. Soluble salts less than 500 parts per million (ppm).
iii. Soil contains less than 40 percent clay but enough fine grained material (greater than 30 percent silt plus clay) to provide the capacity to hold a moderate amount of moisture.
iv. Soil contains 1.5 percent minimum organic matter by weight.
v. Soil contains sufficient pore space to permit adequate root penetration.
b. Application of amendments or topsoil is required if on-site soils do not meet the above conditions.
c. Graded areas must be maintained in a true and even grade as specified on the approved plan, then scarified or otherwise loosened to a depth of 3 to 5 inches.
d. Apply soil amendments as specified on the approved plan or as indicated by the results of a soil test.
e. Mix soil amendments into the top 3 to 5 inches of soil by disking or other suitable means.
B. Topsoiling
1. Topsoil is placed over prepared subsoil prior to establishment of permanent vegetation.
2. Topsoil salvaged from an existing site may be used provided it meets the standards as set forth in these specifications.
3. Topsoiling is limited to areas having 2:1 or flatter slopes where:
a. The texture of the exposed subsoil/parent material is not adequate to produce vegetative growth.
b. The soil material is so shallow that the rooting zone is not deep enough to support plants or furnish continuing supplies of moisture and plant nutrients.
c. The original soil to be vegetated contains material toxic to plant growth.
d. The soil is so acidic that treatment with limestone is not feasible.
4. Areas having slopes steeper than 2:1 require special consideration and design.
5. Topsoil Specifications: Soil to be used as topsoil must meet the following criteria:
a. Topsoil must be a loam, sandy loam, clay loam, silt loam, sandy clay loam, or loamy sand.
b. Topsoil must be free of noxious plants or plant parts such as Bermuda grass, quack grass, Johnson grass, mud sedge, poison ivy, thistle, or others as specified.
c. Topsoil substitutes or amendments, as recommended by a qualified agronomist or soil scientist and approved by the appropriate approval authority, may be used in lieu of natural topsoil.
6. Topsoil Application
a. Erosion and sediment control practices must be maintained when applying topsoil.
b. Uniformly distribute topsoil in a 5 to 8 inch layer and lightly compact to a minimum thickness of 4 inches.
c. Topsoil must not be placed if the topsoil or subsoil is in a frozen or muddy condition.
C. Soil Amendments (Fertilizer and Lime Specifications)
1. Soil tests must be performed to determine the exact ratios and application rates for both lime and fertilizer on sites having disturbed areas of 5 acres or more.
2. Fertilizers must be uniform in composition, free flowing and suitable for accurate application by appropriate equipment.
3. Lime materials must be ground limestone (hydrated or burnt lime) may be substituted except when hydroseeding which contains at least 50 percent total oxides (calcium oxide plus magnesium oxide).
4. Lime and fertilizer are to be evenly distributed and incorporated into the top 3 to 5 inches of soil by disking or other suitable means.
5. Where the subsoil is either highly acidic or composed of heavy clays, spread ground limestone at the rate of 4 to 8 tons/acre (200-400 pounds per 1,000 square feet) prior to the placement of topsoil.

B-4.3 STANDARDS AND SPECIFICATIONS

FOR

SEEDING AND MULCHING

Definition

The application of seed and mulch to establish vegetative cover.

Purpose

To protect disturbed soils from erosion during and at the end of construction.

Conditions Where Practice Applies

To the surface of all perimeter controls, slopes, and any disturbed area not under active grading.

Criteria

- A. Seeding
1. Specifications
a. All seed must meet the requirements of the Maryland State Seed Law. All seed must be subject to re-testing by a recognized seed laboratory.
b. Mulch alone may be applied between the fall and spring seeding dates only if the ground is frozen.
c. Inoculants: The inoculant for treating legume seed in the seed mixtures must be a pure culture of nitrogen fixing bacteria prepared specifically for the species.
d. Sod or seed must not be placed on soil which has been treated with soil sterilants or chemicals used for weed control until sufficient time has elapsed (14 days min.) to permit dissipation of phyto-toxic materials.
2. Application
a. Dry Seeding: This includes use of conventional drop or broadcast spreaders.
i. Incorporate seed into the subsoil at the rates prescribed on Temporary Seeding Table B.1, Permanent Seeding Table B.3, or site-specific seeding summaries.
ii. Apply seed in two directions, perpendicular to each other.
b. Drill or Cultipacker Seeding: Mechanized seeders that apply and cover seed with soil.
i. Cultipacking seeders are required to bury the seed in such a fashion as to provide at least 1/4 inch of soil covering.
ii. Apply seed in two directions, perpendicular to each other.
c. Hydroseeding: Apply seed uniformly with hydroseeder (slurry includes seed and fertilizer).
i. If fertilizer is being applied at the time of seeding, the application rates should not exceed the following: nitrogen, 100 pounds per acre total of soluble nitrogen; P2O5 (phosphorous), 200 pounds per acre; K2O (potassium), 200 pounds per acre.
ii. Lime: Use only ground agricultural limestone (up to 3 tons per acre may be applied by hydroseeding).
iii. Mix seed and fertilizer on site and seed immediately and without interruption.
iv. When hydroseeding do not incorporate seed into the soil.
B. Mulching
1. Mulch Materials (in order of preference)
a. Straw consisting of thoroughly threshed wheat, rye, oat, or barley and reasonably bright in color.
b. Wood Cellulose Fiber Mulch (WCFM) consisting of specially prepared wood cellulose processed into a uniform fibrous physical state.
i. WCFM is to be dyed green or contain a green dye in the package that will provide an appropriate color to facilitate visual inspection of the uniformly spread slurry.
ii. WCFM, including dye, must contain no germination or growth inhibiting factors.
iii. WCFM materials are to be manufactured and processed in such a manner that the wood cellulose fiber mulch will remain in uniform suspension in water under agitation and will blend with seed, fertilizer and other additives to form a homogeneous slurry.
iv. WCFM material must not contain elements or compounds at concentration levels that will be phyto-toxic.
v. WCFM must conform to the following physical requirements: fiber length of approximately 10 millimeters, diameter approximately 1 millimeter, pH range of 4.0 to 8.5, ash content of 1.6 percent maximum and water holding capacity of 90 percent minimum.
2. Application
a. Apply mulch to all seeded areas immediately after seeding.
b. When straw mulch is used, spread it over all seeded areas at the rate of 2 tons per acre to a uniform loose depth of 1 to 2 inches.
c. Wood cellulose fiber used as mulch must be applied at a net dry weight of 1500 pounds per acre.
3. Anchoring
a. Perform mulch anchoring immediately following application of mulch to minimize loss by wind or water.
i. A mulch anchoring tool is a tractor drawn implement designed to punch and anchor mulch into the soil surface a minimum of 2 inches.
ii. This practice is most effective on large areas, but is limited to flatter slopes where equipment can operate safely.

PROFESSIONAL CERTIFICATION
I HEREBY CERTIFY THAT DOCUMENTS WERE PREPARED OR APPROVED BY ME AND THAT I AM A DULY LICENSED PROFESSIONAL ENGINEER UNDER THE LAWS OF THE STATE OF MARYLAND. LICENSE NO. 16156 EXPIRATION DATE: 8/28/2018

- ii. Wood cellulose fiber may be used for anchoring straw. Apply the fiber binder at a net dry weight of 750 pounds per acre.
iii. Synthetic binders such as Acrylic DLR (Agro-Tack), DCA-70, Petroset, Terra Tax II, Terra Tack AR or other approved equal may be used.
iv. Lightweight plastic netting may be stapled over the mulch according to manufacturer recommendations.

B-4.4 STANDARDS AND SPECIFICATIONS

FOR

TEMPORARY STABILIZATION

Definition

To stabilize disturbed soils with vegetation for up to 6 months.

Purpose

To use fast growing vegetation that provides cover on disturbed soils.

Conditions Where Practice Applies

Exposed soils where ground cover is needed for a period of 6 months or less. For longer duration of time, permanent stabilization practices are required.

Criteria

- 1. Select one or more of the species or seed mixtures listed in Table B.1 for the appropriate Plant Hardiness Zone (from Figure B.3), and enter them in the Temporary Seeding Summary below along with application rates, seeding dates and seeding depths.
2. For sites having soil tests performed, use and show the recommended rates by the testing agency.
3. When stabilization is required outside of a seeding season, apply seed and mulch or straw mulch alone as prescribed in Section B-4.3-A.1.b and maintain until the next seeding season.

Temporary Seeding Summary

Table with columns: No., Species, Application Rate (lb/ac), Seeding Dates, Seeding Depths, Fertilizer Rate (10-20-20), Lime Rate. Includes rows for CEREAL RYE and FOXTAIL MILLET.

B-4.5 STANDARDS AND SPECIFICATIONS

FOR

PERMANENT STABILIZATION

Definition

To stabilize disturbed soils with permanent vegetation.

Purpose

To use long-lived perennial grasses and legumes to establish permanent ground cover on disturbed soils.

Conditions Where Practice Applies

Exposed soils where ground cover is needed for 6 months or more.

Criteria

- A. Seed Mixtures
1. General Use
a. Select one or more of the species or mixtures listed in Table B.3 for the appropriate Plant Hardiness Zone (from Figure B.3) and based on the site condition or purpose found on Table B.2.
b. Additional planting specifications for exceptional sites such as shorelines, stream banks, or dunes or for special purposes such as wildlife or aesthetic treatment may be found in USDA-NRCS Technical Field Office Guide, Section 342 - Critical Area Planning.
c. For sites having disturbed area over 5 acres, use and show the rates recommended by the soil testing agency.
d. For areas receiving low maintenance, apply urea form fertilizer (46-0-0) at 3 1/2 pounds per 1000 square feet (150 pounds per acre) at the time of seeding in addition to the soil amendments shown in the Permanent Seeding Summary.
2. Turfgrass Mixtures
a. Areas where turfgrass may be desired include lawns, parks, playgrounds, and commercial sites which will receive a medium to high level of maintenance.
b. Select one or more of the species or mixtures listed below based on the site conditions or purpose.
i. Kentucky Bluegrass: Full Sun Mixture: For use in areas that receive intensive management.
ii. Kentucky Bluegrass/Perennial Rye: Full Sun Mixture: For use in full sun areas where rapid establishment is necessary.
iii. Tall Fescue/Kentucky Bluegrass: Full Sun Mixture: For use in drought prone areas and/or for areas receiving low to medium management.
iv. Kentucky Bluegrass/Fine Fescue: Shade Mixture: For use in areas with shade in Bluegrass lawns.

Notes: Select turfgrass varieties from those listed in the most current University of Maryland Publication, Agronomy Memo #77, "Turfgrass Cultivar Recommendations for Maryland"

Choose certified material. Certified material is the best guarantee of cultivar purity. The certification program of the Maryland Department of Agriculture, Turf and Seed Section, provides a reliable means of consumer protection and assures a pure genetic line

- c. Ideal Times of Seeding for Turf Grass Mixtures
Western MD: March 15 to June 1, August 1 to October 1 (Hardiness Zones: 5b, 6a)
Central MD: March 1 to May 15, August 15 to October 15 (Hardiness Zone: 6b)
Southern MD, Eastern Shore: March 1 to May 15, August 15 to October 15 (Hardiness Zones: 7a, 7b)
d. Till areas to receive seed by disking or other approved methods to a depth of 2 to 4 inches, level and rake the areas to prepare a proper seedbed.
e. If soil moisture is deficient, supply new seedlings with adequate water for plant growth.

Permanent Seeding Summary

Table with columns: No., Species, Application Rate (lb/ac), Seeding Dates, Seeding Depths, Fertilizer Rate (10-20-20) (N, P2O5, K2O), Lime Rate. Includes rows for TALL FESCUE and SOD.

B. Sod: To provide quick cover on disturbed areas (2:1 grade or flatter).

- 1. General Specifications
a. Class of turfgrass sod must be Maryland State Certified.
b. Sod must be machine cut at a uniform soil thickness of 3/4 inch, plus or minus 1/8 inch.
c. Standard size sections of sod must be strong enough to support their own weight and retain their size and shape when suspended vertically with a firm grasp on the upper 10 percent of the section.
d. Sod must not be harvested or transplanted when moisture content (excessively dry or wet) may adversely affect its survival.
e. Sod must be harvested, delivered, and installed within a period of 36 hours.
2. Sod Installation
a. During periods of excessively high temperature or in areas having dry subsoil, lightly irrigate the subsoil immediately prior to laying the sod.
b. Lay the first row of sod in a straight line with subsequent rows placed parallel to it and tightly wedged against each other.
c. Wherever possible, lay sod with the long edges parallel to the contour and with staggering joints.
d. Water the sod immediately following rolling and tamping until the underside of the new sod pad and soil surface below the sod are thoroughly wet.
3. Sod Maintenance
a. In the absence of adequate rainfall, water daily during the first week or as often and sufficiently as necessary to maintain moist soil to a depth of 4 inches.
b. After the first week, sod watering is required as necessary to maintain adequate moisture content.
c. Do not mow until the sod is firmly rooted.

DESIGN CERTIFICATION:

I HEREBY CERTIFY THAT THIS PLAN HAS BEEN DESIGNED IN ACCORDANCE WITH CURRENT MARYLAND EROSION AND SEDIMENT CONTROL LAWS, REGULATIONS, AND STANDARDS, THAT IT REPRESENTS A PRACTICAL AND WORKABLE PLAN BASED ON MY PERSONAL KNOWLEDGE OF THE SITE, AND THAT IT WAS PREPARED IN ACCORDANCE WITH THE REQUIREMENTS OF THE HOWARD SOIL CONSERVATION DISTRICT.

DESIGNER'S SIGNATURE: Thomas Moriconi, DATE: 1-10-18, PRINTED NAME: THOMAS MORICONI, MD REGISTRATION NO. 16156, P.E. R.L.S., OR R.L.A. (CIRCLE ONE)

OWNERS/DEVELOPER CERTIFICATION:

I/WE HEREBY CERTIFY THAT ANY CLEARING, GRADING, CONSTRUCTION, OR DEVELOPMENT WILL BE DONE PURSUANT TO THIS APPROVED EROSION AND SEDIMENT CONTROL PLAN, INCLUDING INSPECTING AND MAINTAINING CONTROLS, AND THAT THE RESPONSIBLE PERSONNEL INVOLVED IN THE CONSTRUCTION PROJECT WILL HAVE A CERTIFICATE OF TRAINING AT A MARYLAND DEPARTMENT OF THE ENVIRONMENT (MDE) APPROVED TRAINING PROGRAM FOR THE CONTROL ON EROSION AND SEDIMENT PRIOR TO BEGINNING THE PROJECT.

OWNER'S/DEVELOPER'S SIGNATURE: Thomas Auyang, DATE: 1/11/2018, PRINTED NAME & TITLE: THOMAS AUYANG

HOWARD SCD SIGNATURE BLOCK:

THIS PLAN IS APPROVED FOR SOIL EROSION AND SEDIMENT CONTROL BY THE HOWARD SOIL CONSERVATION DISTRICT.

HOWARD SOIL CONSERVATION DISTRICT SIGNATURE, DATE: 1/11/18

DEPARTMENT OF PUBLIC WORKS HOWARD COUNTY, MARYLAND. Includes signatures of Chief Bureau of Highways and Chief Transportation and Special Projects Division.











AECOM logo and signature of Director of Engineering.

Professional Engineer Seal for David Thomas Moriconi, License No. 16156, Expiration Date 8/28/2018.

Table with columns: DES, DRN, CHK, DATE, BY, NO., REVISION, DATE. Includes values: RLL, BJK, DTM, 12/17.

EROSION AND SEDIMENT CONTROL NOTES AND DETAILS. SCALE MAP NO. 35 BLOCK NO. 19.

HALL SHOP ROAD AT BROWNS BRIDGE ROAD. ELECTION DISTRICT NO. 5. CAPITAL PROJECT J-4164. SCALE N/A. SHEET 1.Q OF 2.1.

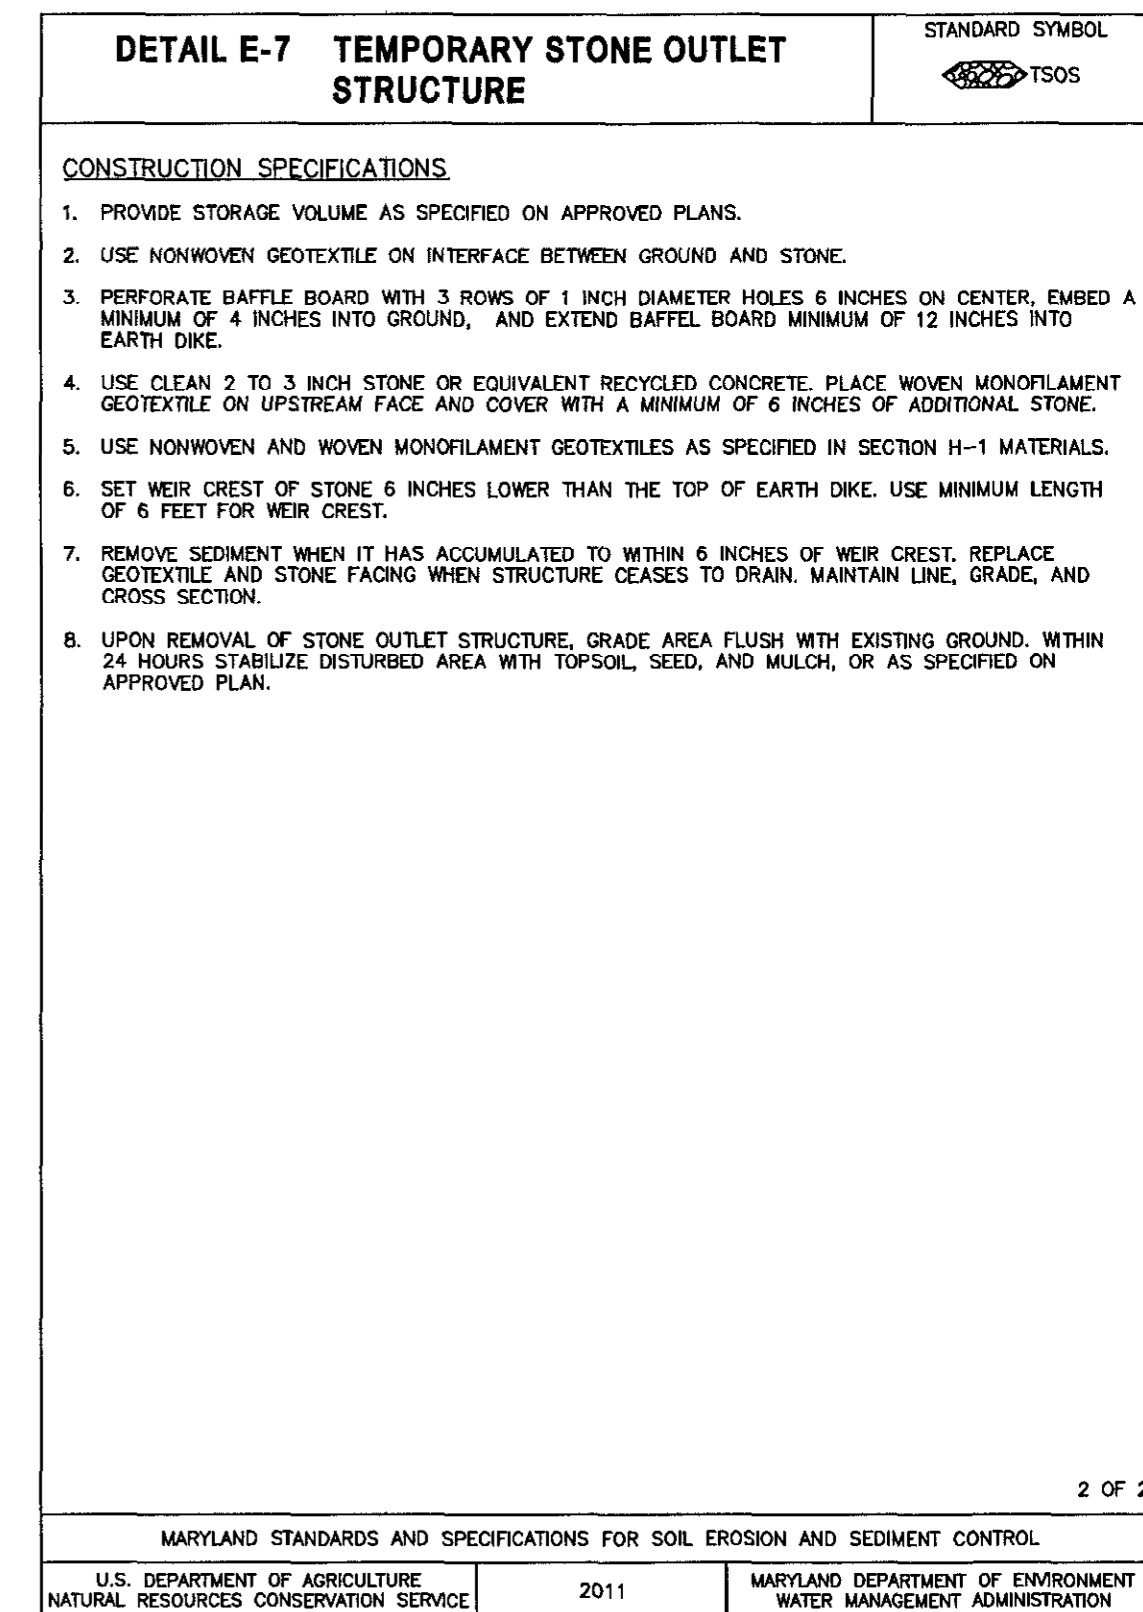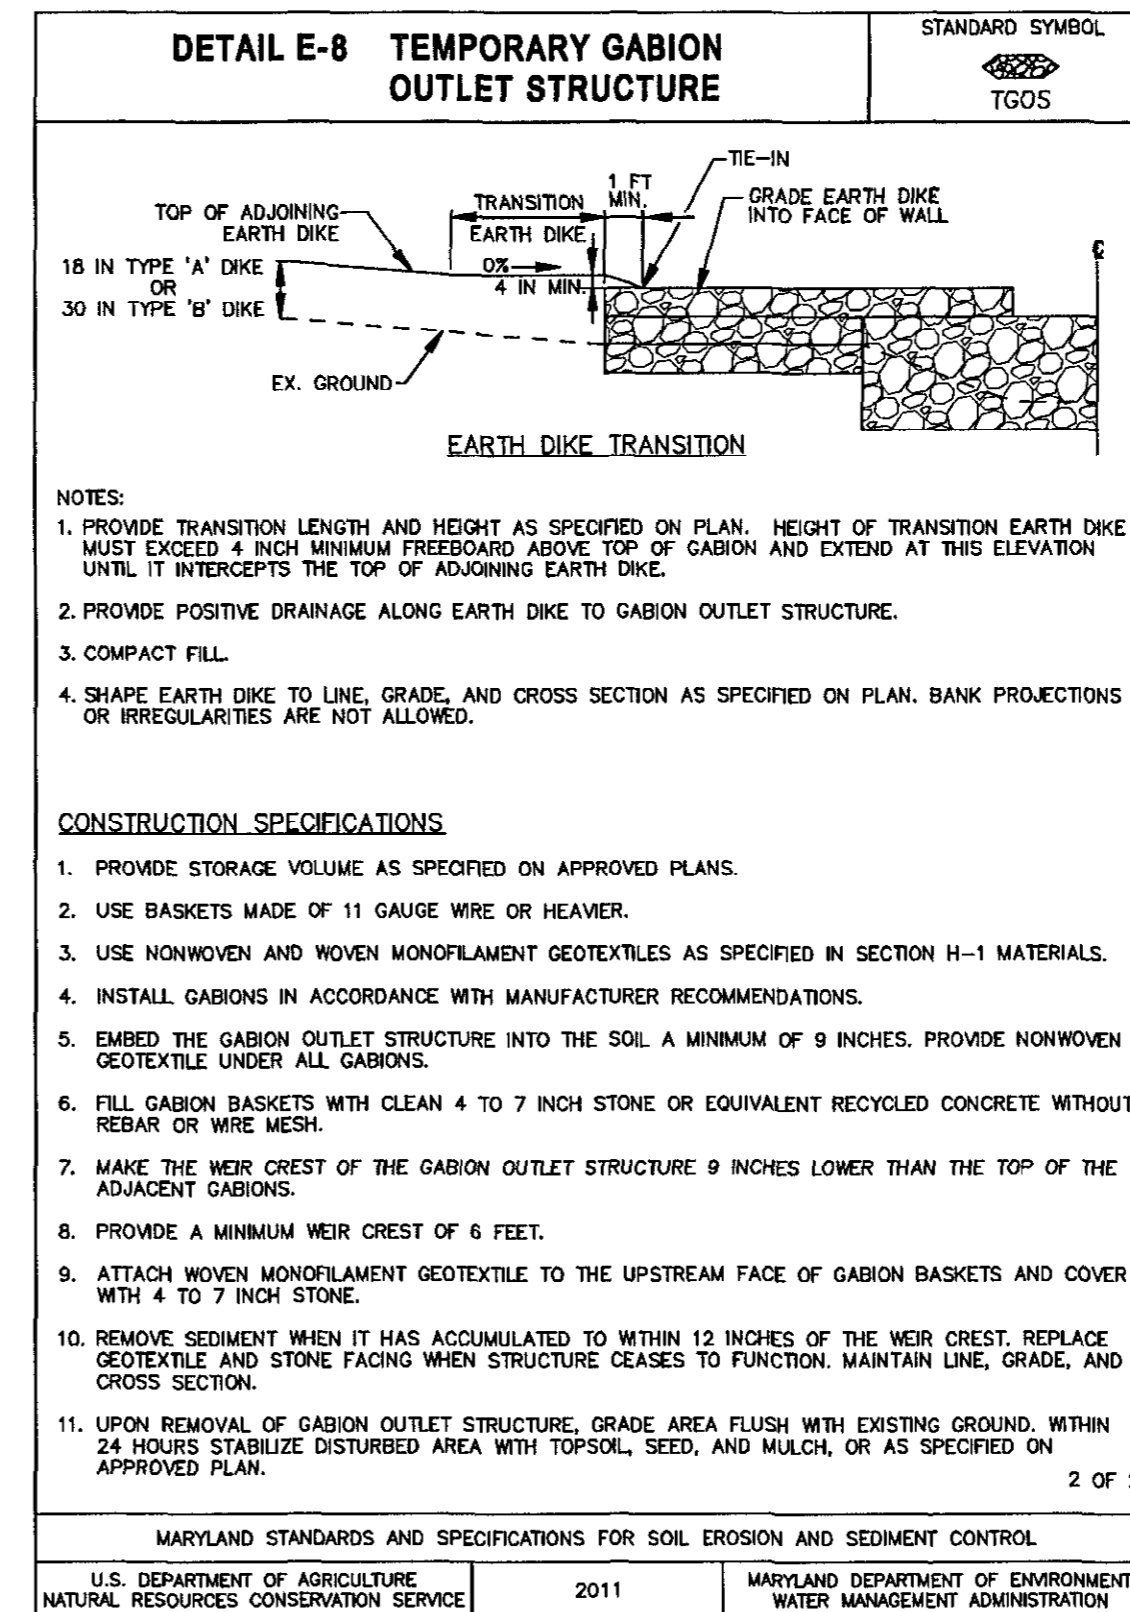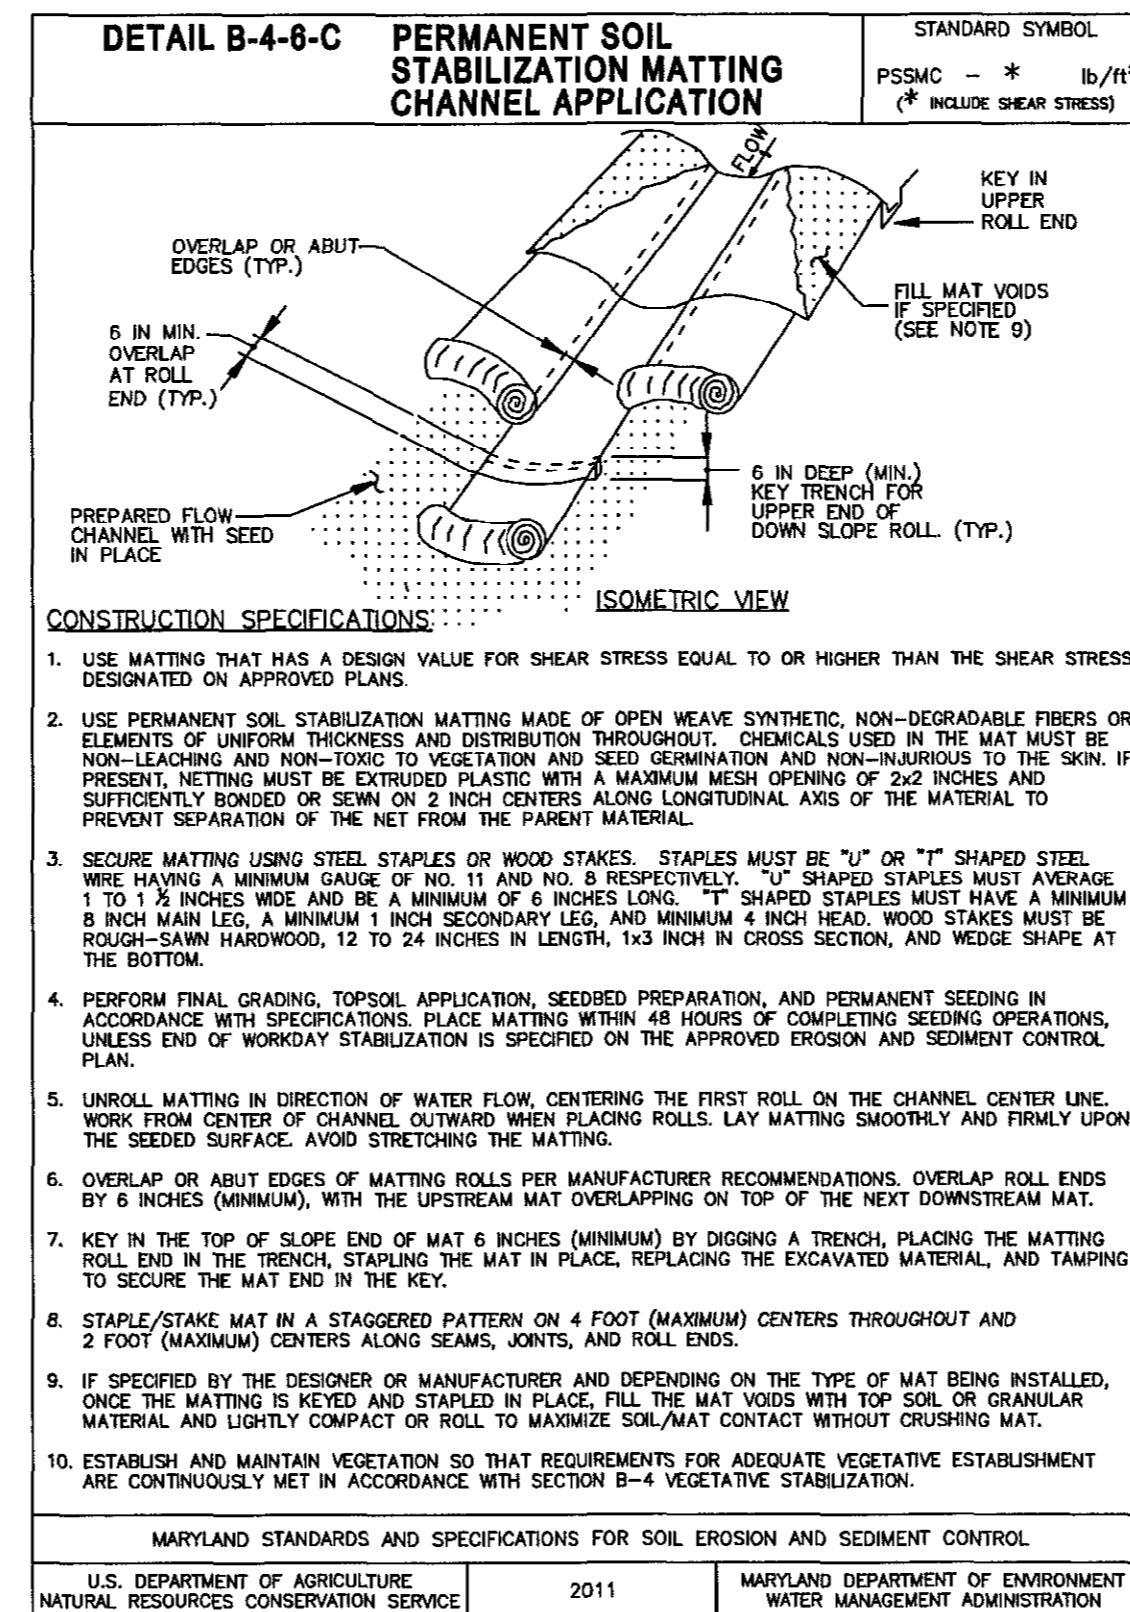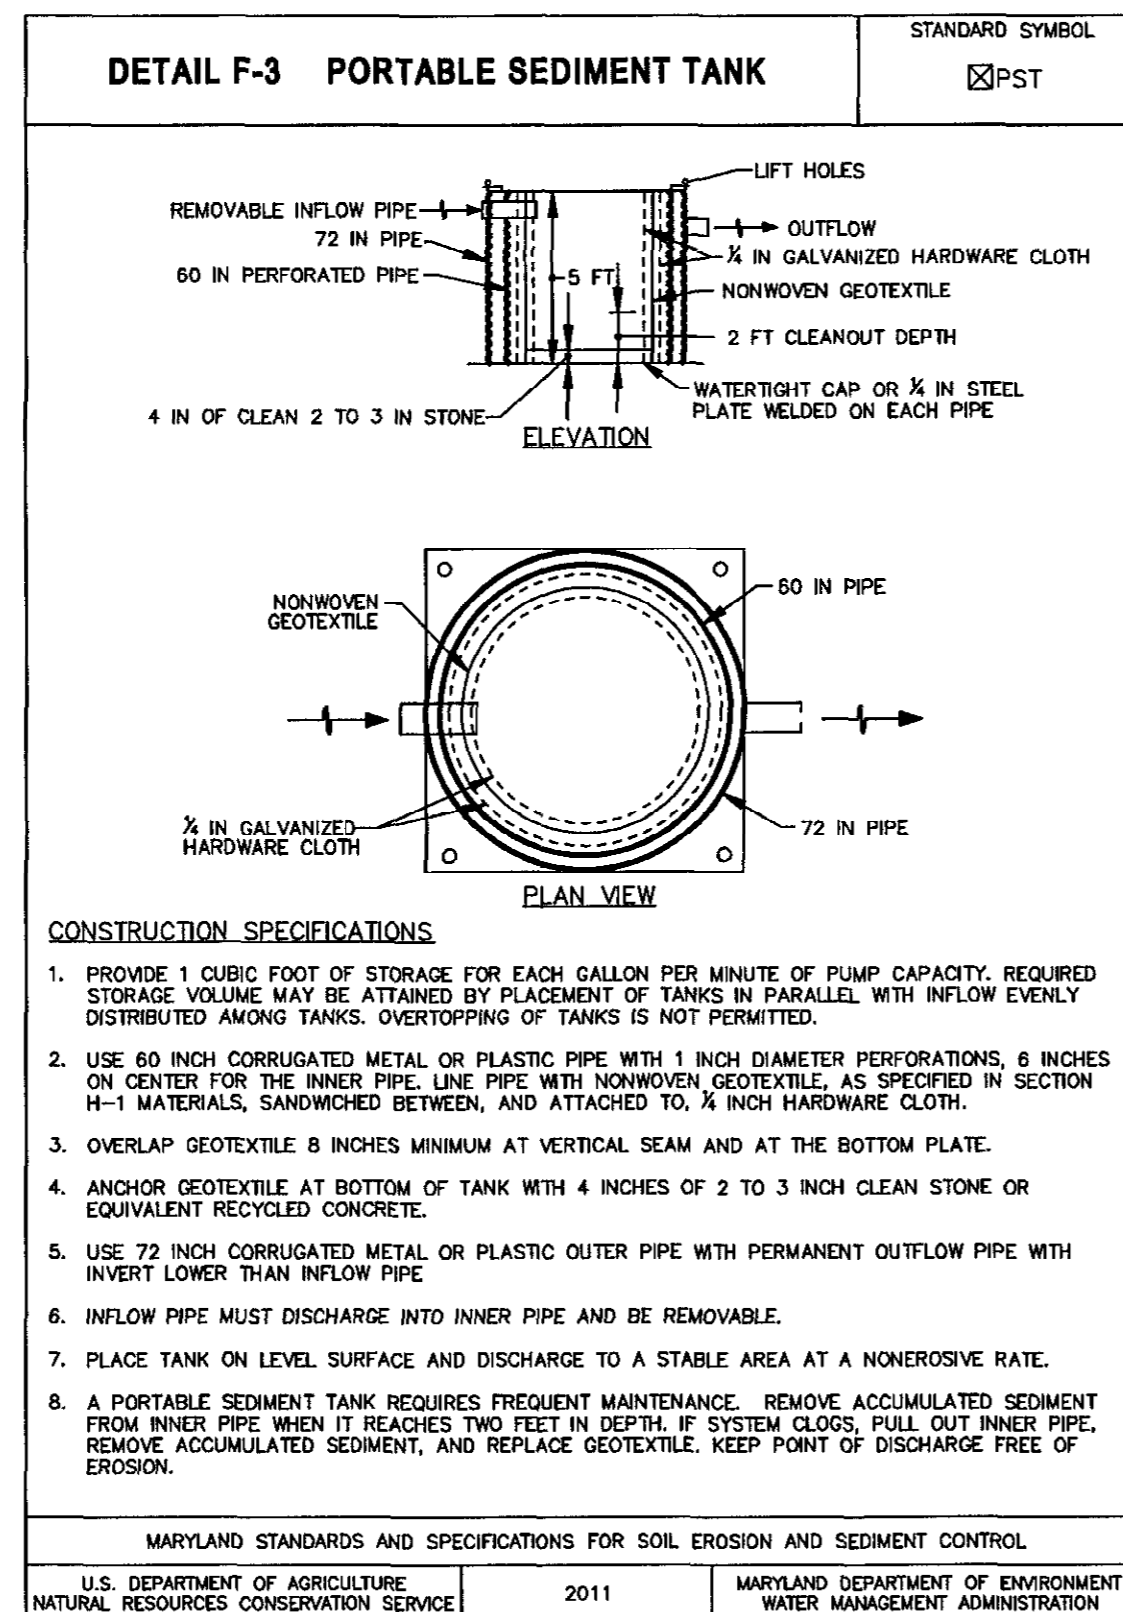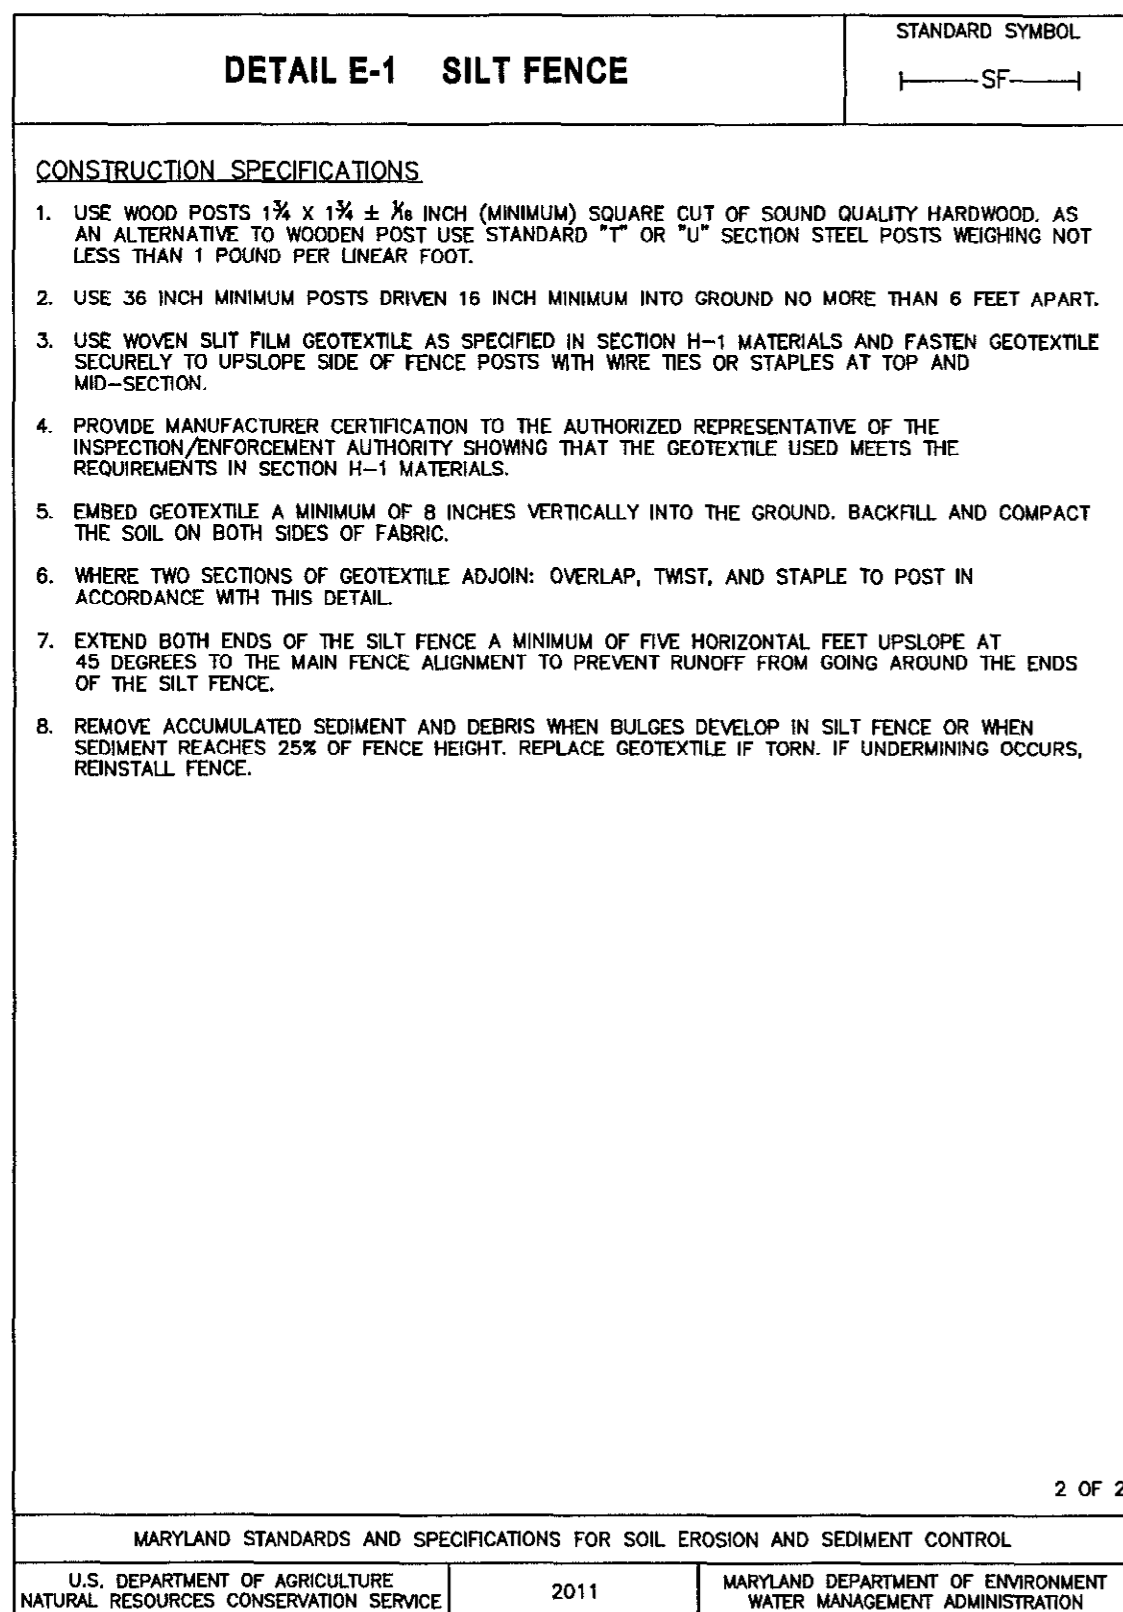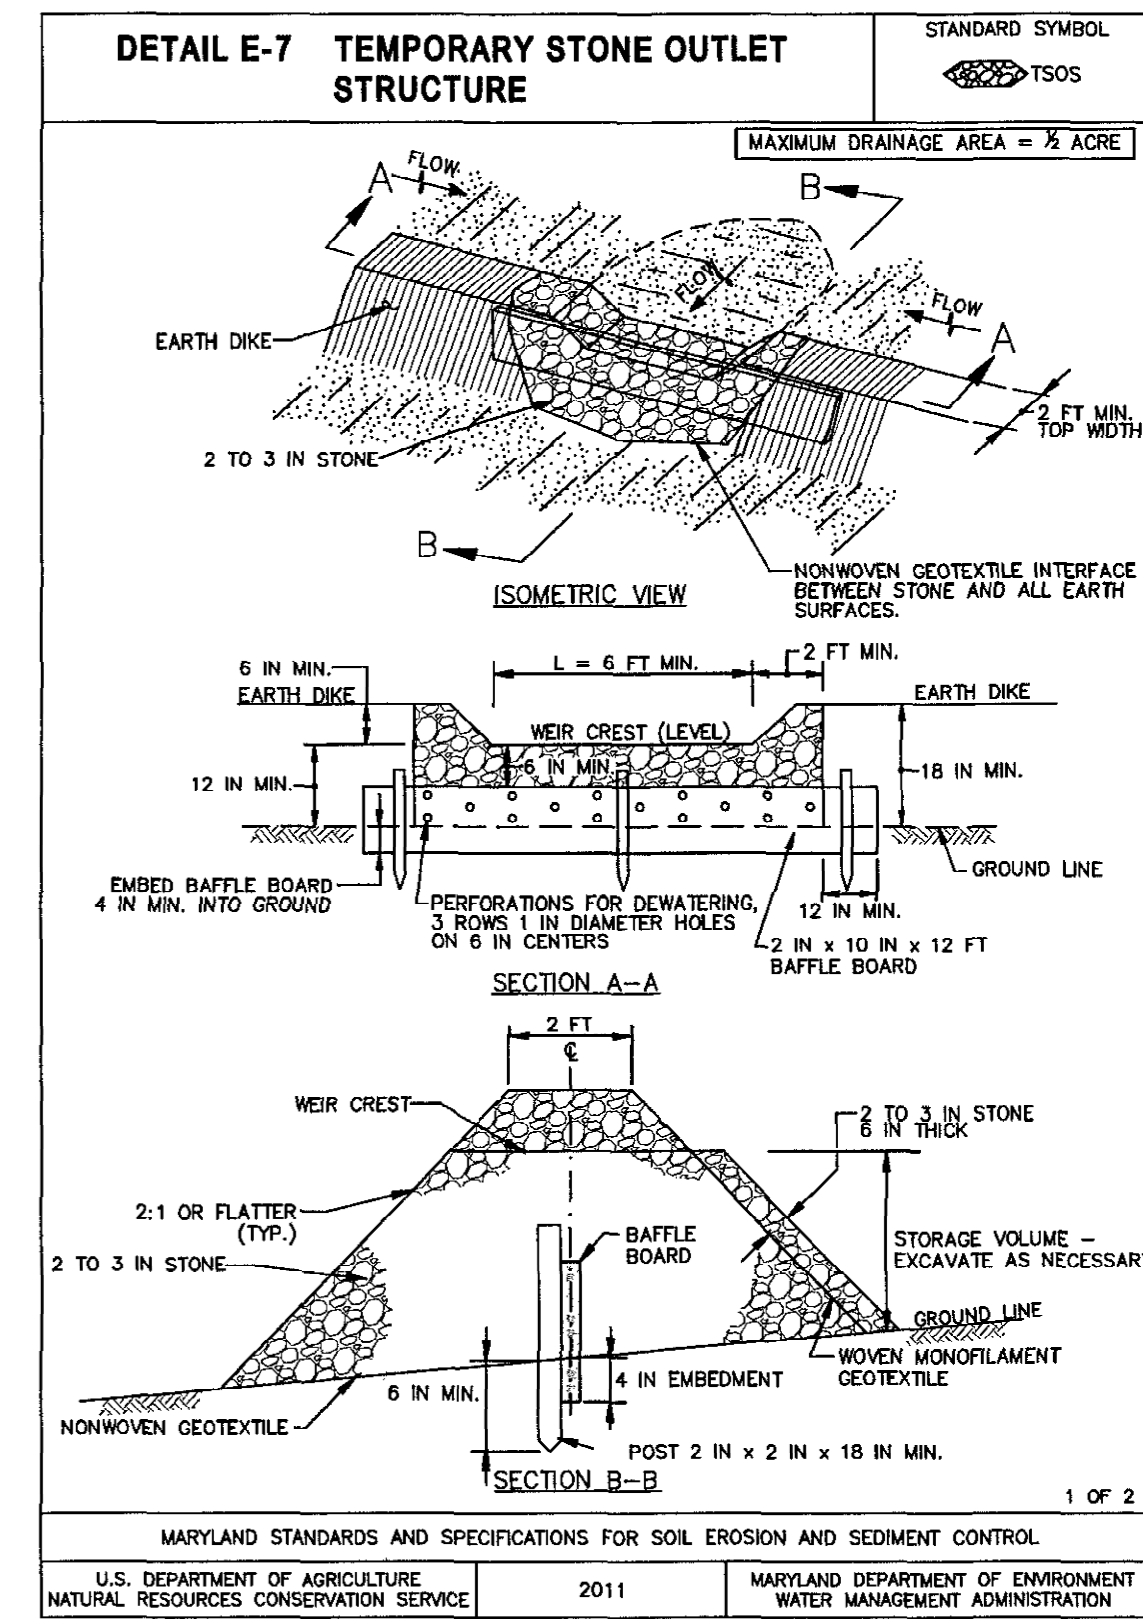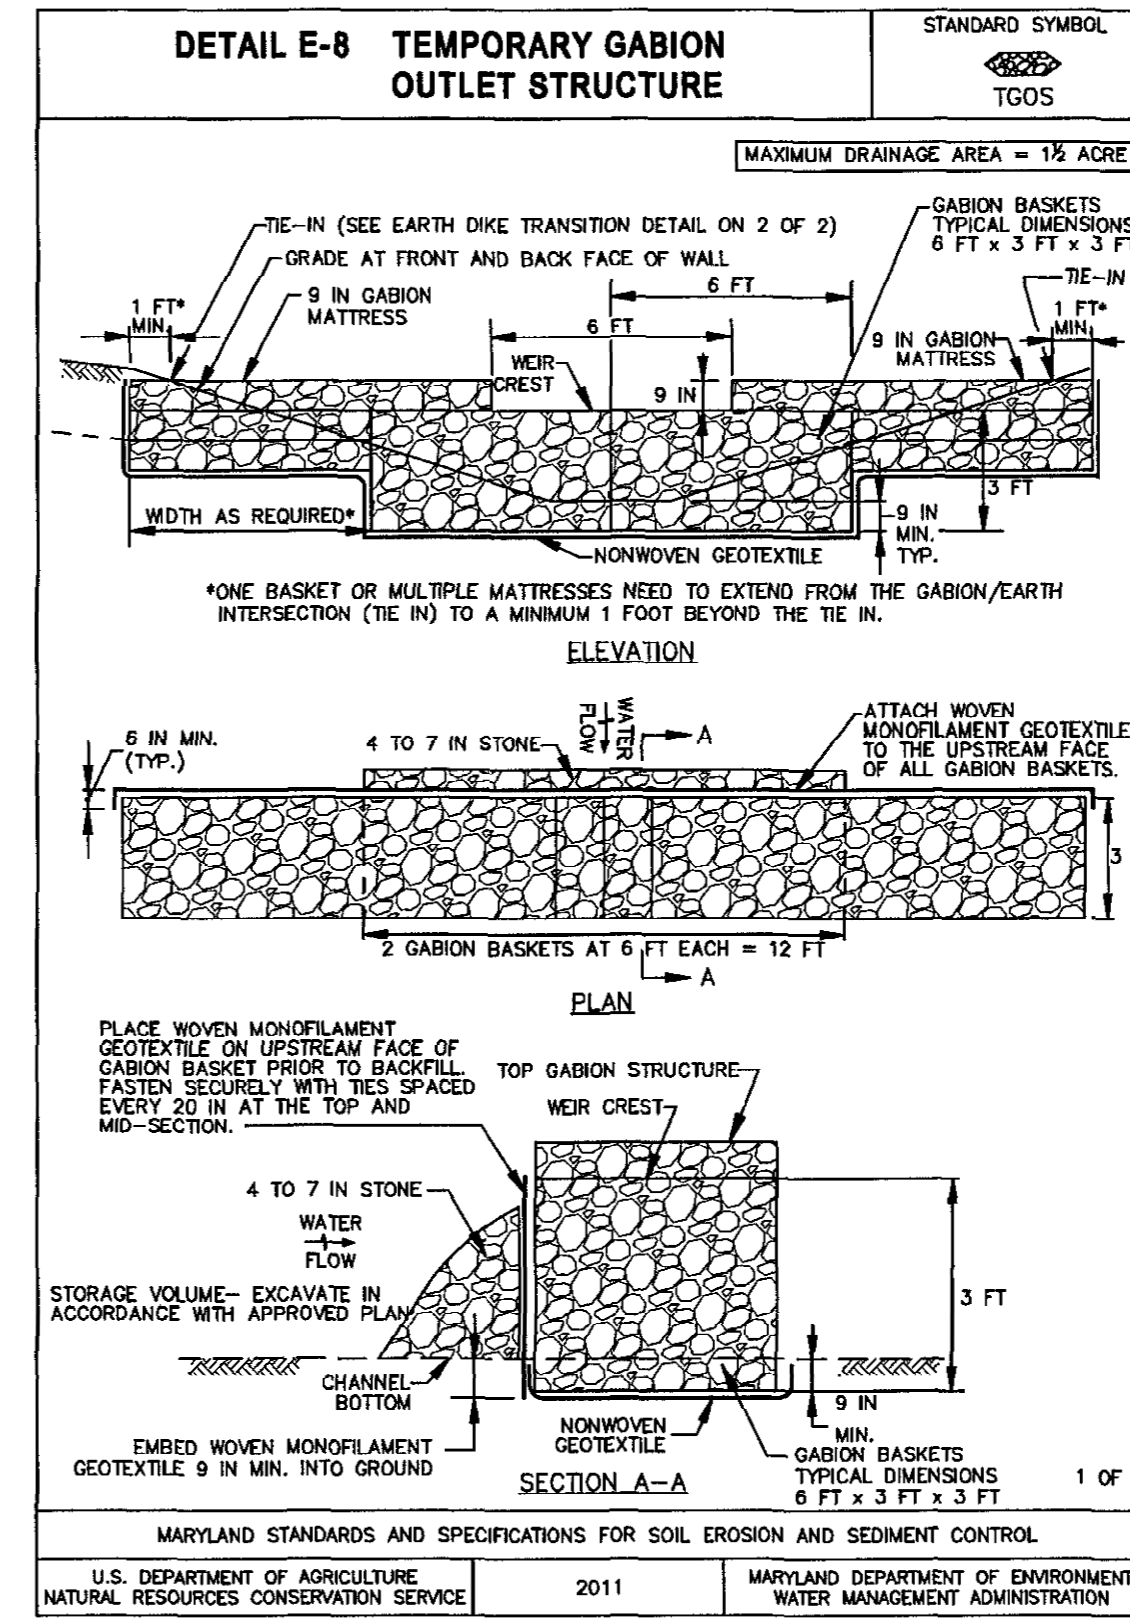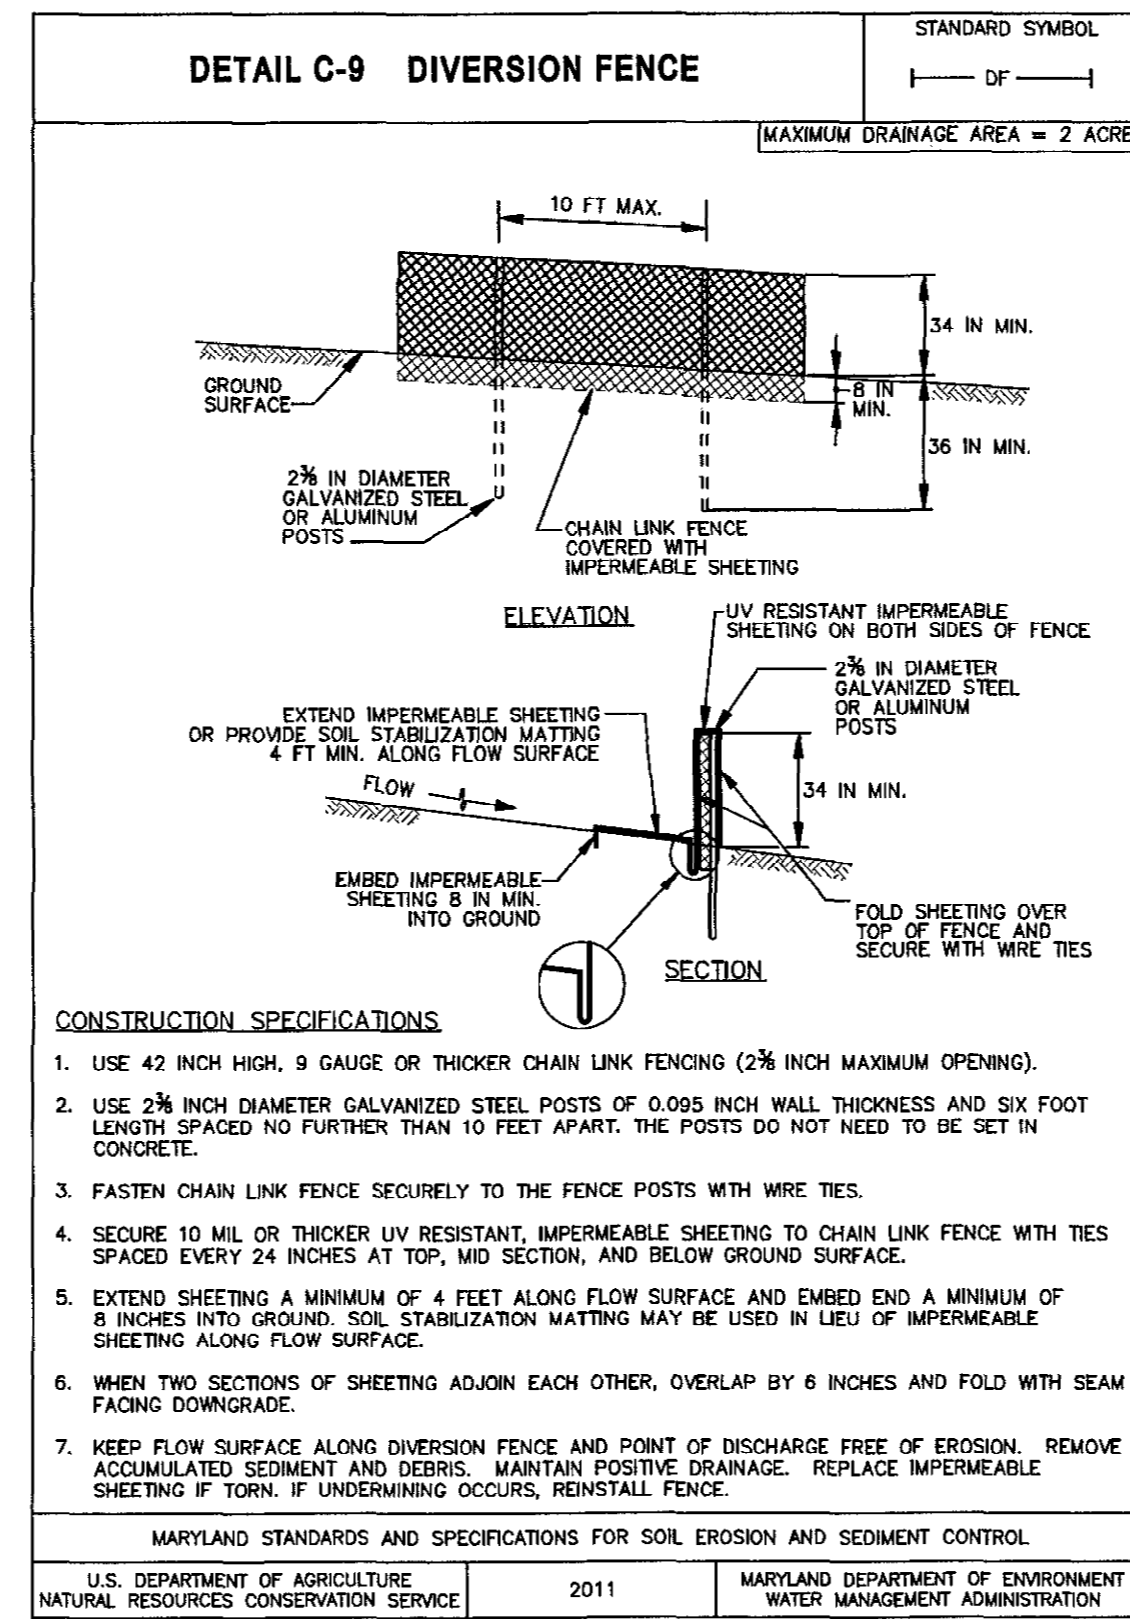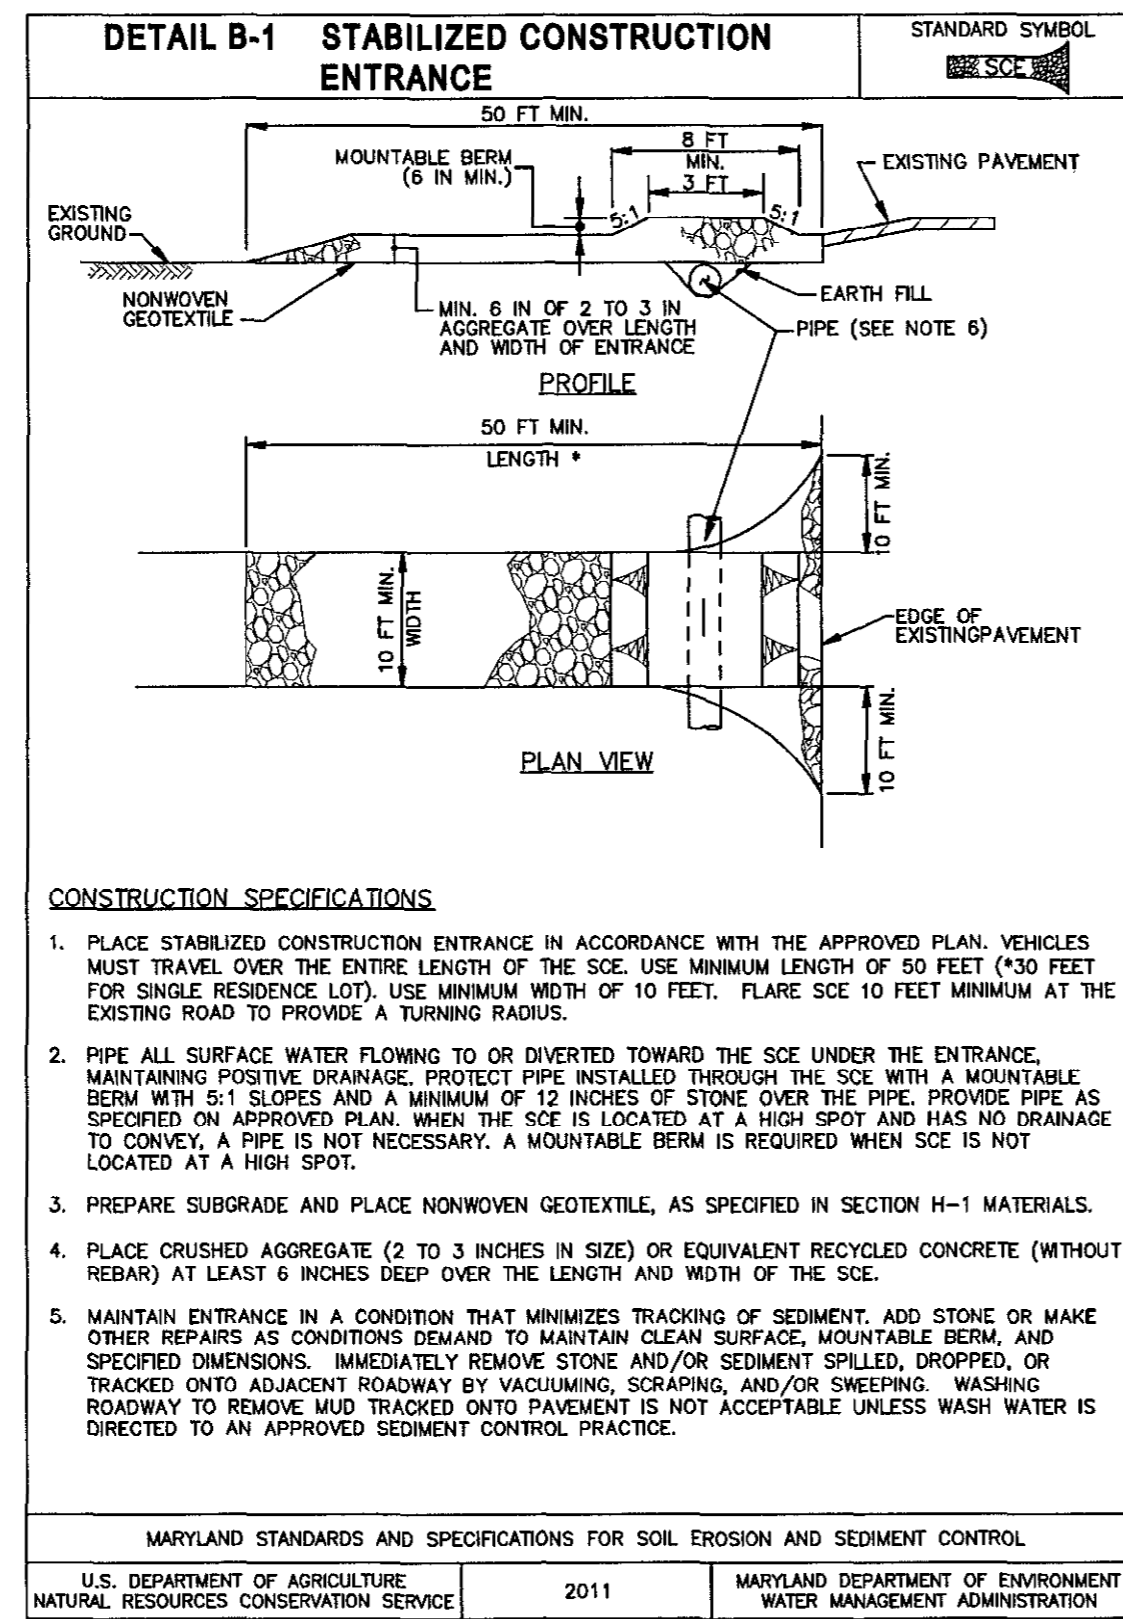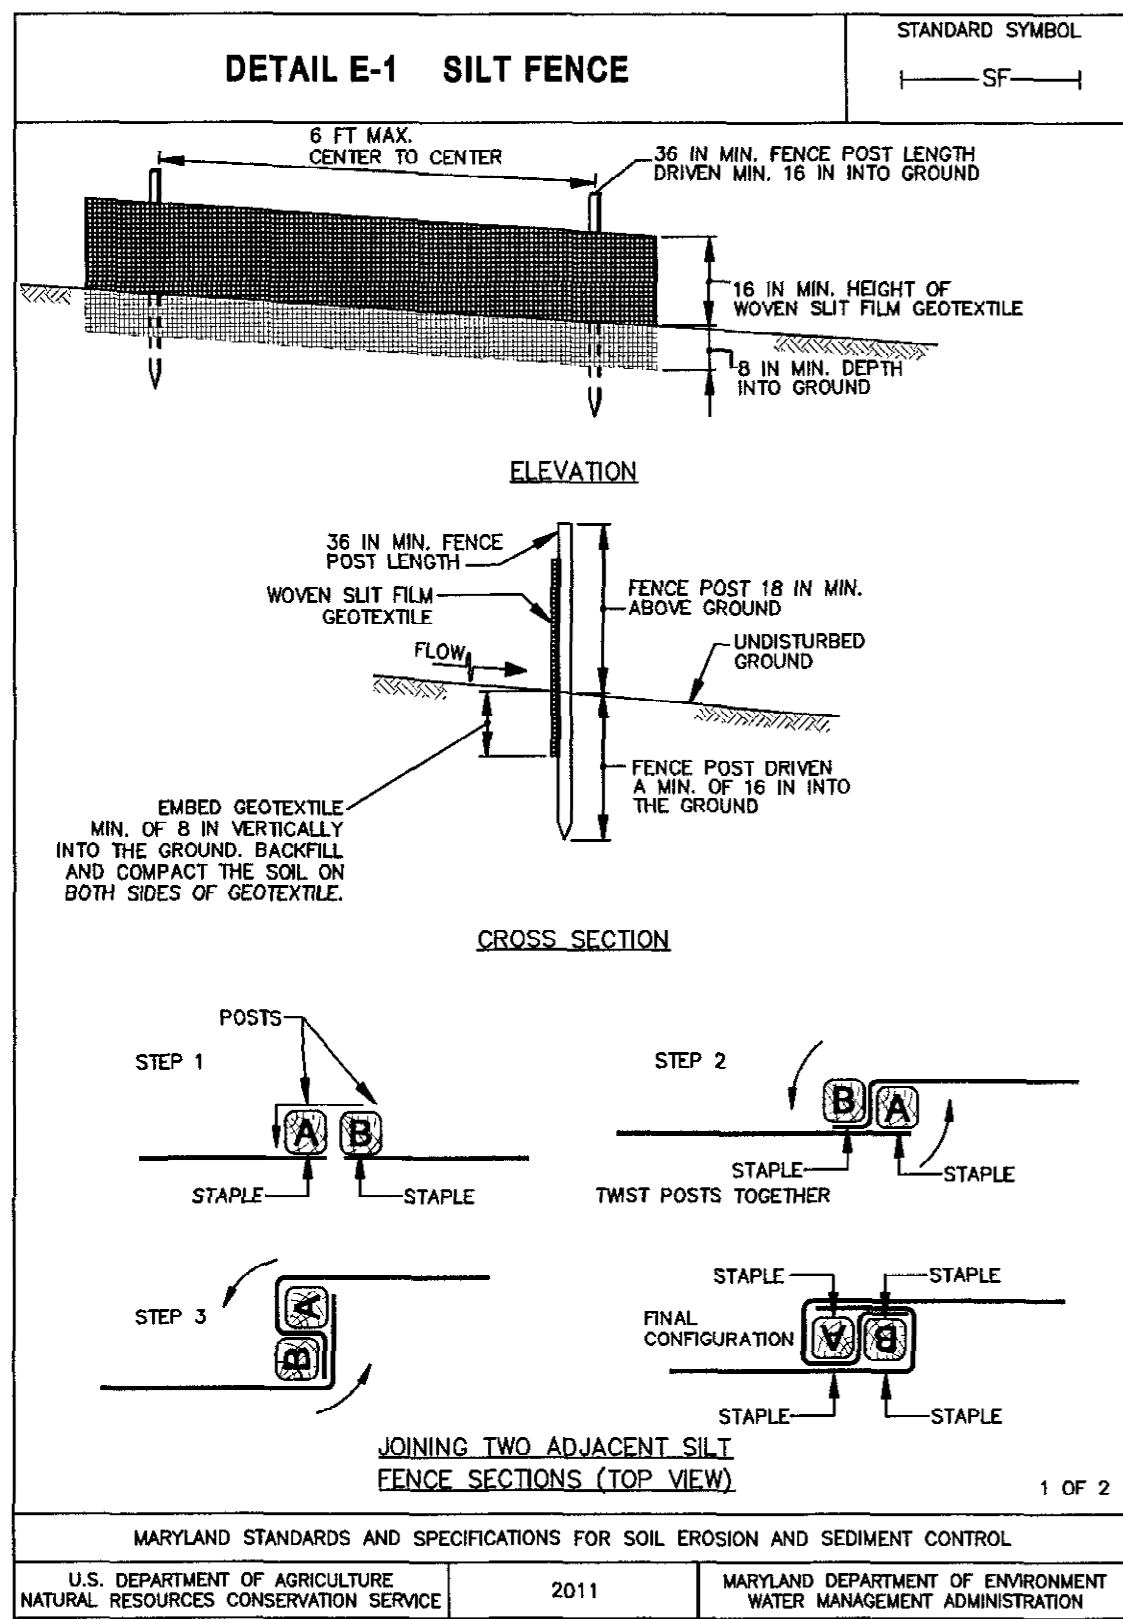

HOWARD SCD SIGNATURE BLOCK:

THIS PLAN IS APPROVED FOR SOIL EROSION AND SEDIMENT CONTROL BY THE HOWARD SOIL CONSERVATION DISTRICT.

[Signature] 1/11/18
HOWARD SOIL CONSERVATION DISTRICT DATE

DEPARTMENT OF PUBLIC WORKS
HOWARD COUNTY, MARYLAND

[Signature] 1/23/18
CHIEF, BUREAU OF HIGHWAYS DATE

[Signature] 1/23/18
CHIEF, BUREAU OF ENGINEERING DATE

[Signature] 1/23/18
DIRECTOR OF PUBLIC WORKS DATE

PROFESSIONAL CERTIFICATION

"I HEREBY CERTIFY THAT DOCUMENTS WERE PREPARED OR APPROVED BY ME, AND THAT I AM A DULY LICENSED PROFESSIONAL ENGINEER UNDER THE LAWS OF THE STATE OF MARYLAND. LICENSE NO. 16156 EXPIRATION DATE: 8/28/2018"

[Signature] 1/11/18
THOMAS A. MORICONI
DATE

OWNERS/DEVELOPER CERTIFICATION:

"I/WE HEREBY CERTIFY THAT ANY CLEARING, GRADING, CONSTRUCTION, OR DEVELOPMENT WILL BE DONE PURSUANT TO THIS APPROVED EROSION AND SEDIMENT CONTROL PLAN, INCLUDING INSPECTING AND MAINTAINING CONTROLS, AND THAT THE RESPONSIBLE PERSONNEL INVOLVED IN THE CONSTRUCTION PROJECT WILL HAVE A CERTIFICATE OF TRAINING AT A MARYLAND DEPARTMENT OF THE ENVIRONMENT (MDE) APPROVED TRAINING PROGRAM FOR THE CONTROL ON EROSION AND SEDIMENT PRIOR TO BEGINNING THE PROJECT. I CERTIFY RIGHT-OF-ENTRY FOR PERIODIC ON-SITE EVALUATION BY HOWARD COUNTY, THE HOWARD SOIL CONSERVATION DISTRICT AND/OR MDE."

[Signature] 1/11/2018
OWNER'S/DEVELOPER'S SIGNATURE DATE

[Signature]
THOMAS A. MORICONI
PRINTED NAME & TITLE

DESIGN CERTIFICATION:

"I HEREBY CERTIFY THAT THIS PLAN HAS BEEN DESIGNED IN ACCORDANCE WITH CURRENT MARYLAND EROSION AND SEDIMENT CONTROL LAWS, REGULATIONS, AND STANDARDS, THAT IT REPRESENTS A PRACTICAL AND WORKABLE PLAN BASED ON MY PERSONAL KNOWLEDGE OF THE SITE, AND THAT IT WAS PREPARED IN ACCORDANCE WITH THE REQUIREMENTS OF THE HOWARD SOIL CONSERVATION DISTRICT."

[Signature] 1-10-18
DESIGNER'S SIGNATURE DATE

DAVID T. MORICONI
PRINTED NAME

MD REGISTRATION NO. 16156
(P.E.) R.L.S., OR R.L.A. (CIRCLE ONE)

EROSION AND SEDIMENT CONTROL NOTES AND DETAILS

HALL SHOP ROAD AT BROWNS BRIDGE ROAD

ELECTION DISTRICT NO. 5
CAPITAL PROJECT J-4164

SCALE N/A

SHEET 11 OF 21

BY NO. REVISION DATE

SCALE MAP NO. 35 BLOCK NO. 19

B-4.8 STANDARDS AND SPECIFICATIONS

FOR STOCKPILE AREA

Definition

A mound or pile of soil protected by appropriately designed erosion and sediment control measures.

Purpose

To provide a designated location for the temporary storage of soil that controls the potential for erosion, sedimentation, and changes to drainage patterns.

Conditions Where Practice Applies

Stockpile areas are utilized when it is necessary to salvage and store soil for later use.

Criteria

- The stockpile location and all related sediment control practices must be clearly indicated on the erosion and sediment control plan.
- The footprint of the stockpile must be sized to accommodate the anticipated volume of material and based on a side slope ratio no steeper than 2:1. Benching must be provided in accordance with Section B-3 Land Grading.
- Runoff from the stockpile area must drain to a suitable sediment control practice.
- Access the stockpile area from the upgrade side.
- Clear water runoff into the stockpile area must be minimized by use of a diversion device such as an earth dike, temporary swale or diversion fence. Provisions must be made for discharging concentrated flow in a non-erosive manner.
- Where runoff concentrates along the toe of the stockpile fill, an appropriate erosion/sediment control practice must be used to intercept the discharge.
- Stockpiles must be stabilized in accordance with the 3/7 day stabilization requirement as well as Standard B-4-1 Incremental Stabilization and Standard B-4-4 Temporary Stabilization.
- If the stockpile is located on an impervious surface, a liner should be provided below the stockpile to facilitate cleanup. Stockpiles containing contaminated material must be covered with impermeable sheeting.

Maintenance

The stockpile area must continuously meet the requirements for Adequate Vegetative Establishment in accordance with Section B-4 Vegetative Stabilization. Side slopes must be maintained at no steeper than a 2:1 ratio. The stockpile area must be kept free of erosion. If the vertical height of a stockpile exceeds 20 feet for 2:1 slopes, 30 feet for 3:1 slopes, or 40 feet for 4:1 slopes, benching must be provided in accordance with Section B-3 Land Grading.

B.43

MGWC 1.5: SANDBAG/STONE CHANNEL DIVERSION



DESCRIPTION

The work should consist of installing sandbag or stone flow diversions for the purpose of erosion control when construction activities occur within the stream channel.

EFFECTIVE USES & LIMITATIONS

Diversions are used to isolate work areas from flow during the construction of in-stream projects. Diversions which have an insufficient flow capacity can fail and severely erode the disturbed channel section under construction. Therefore, in-channel construction activities should occur only during periods of low rainfall. This temporary measure may not be practical in large channels.

MATERIAL SPECIFICATIONS

Materials for sandbag and stone stream diversions should meet the following requirements:

- Riprap:** Riprap should be washed and have a minimum diameter of 6 inches (0.15 meters).
- Sandbags:** Sandbags should consist of materials which are resistant to ultra-violet radiation, tearing, and puncture and should be woven tightly enough to prevent leakage of the fill material (i.e., sand, fine gravel, etc.).
- Sheeting:** Sheeting should consist of polyethylene or other materials which are impervious and resistant to puncture and tearing.

INSTALLATION GUIDELINES


All erosion and sediment control devices, including dewatering basins, should be implemented as the first order of business according to a plan approved by the WMA or local authority. Installation should proceed from upstream to downstream during periods of low flow. If necessary, silt fence or straw bales should be installed around the perimeter of the work area.

Sandbag/stone diversions can be used independently or as components of other stream diversion techniques. Installation of this measure should proceed as follows (refer to Detail 1.5):

- The diversion structure should be installed from upstream to downstream.
- The height of the sandbag/stone diversion should be a function of the duration of the project in the stream reach. For projects with a duration less than 2 weeks, the height of the diversion should be one half the streambank height, measured from the channel bed, plus 1 foot (0.3 meters) or bankfull height, whichever is greater. For projects of longer duration, the top of the sandbag or stone diversion should correspond to bankfull height. For diversion structures utilizing sandbags, the stream bed should be hand prepared prior to placement of the base layer of sandbags in order to ensure a water tight fit. Additionally, it may be necessary to prepare the bank in a similar fashion.
- All excavated material should be deposited and stabilized in an approved area outside the 100-year floodplain unless otherwise authorized by the WMA.
- Sediment-laden water from the construction area should be pumped to a dewatering basin.
- Sheeting on the diversion should be positioned such that the upstream portion covers the downstream portion with at least a 18-inch (0.45 meters) overlap.
- Sandbag or stone diversions should not obstruct more than 45% of the stream width. Additionally, bank stabilization measures should be placed in the constricted section if accelerated erosion and bank scour are observed during the construction time or if project time is expected to last more than 2 weeks.
- Prior to removal of these temporary structures, any accumulated sediment should be removed, deposited and stabilized in an approved area outside the 100-year floodplain unless otherwise authorized by the WMA.
- Sediment control devices are to remain in place until all disturbed areas are stabilized in accordance with an approved sediment and erosion control plan and the inspecting authority approves their removal.


**Maryland's Guidelines To Waterway Construction
DETAIL 1.5: SANDBAG/STONE DIVERSION**

TRANSVERSE SECTION VIEW

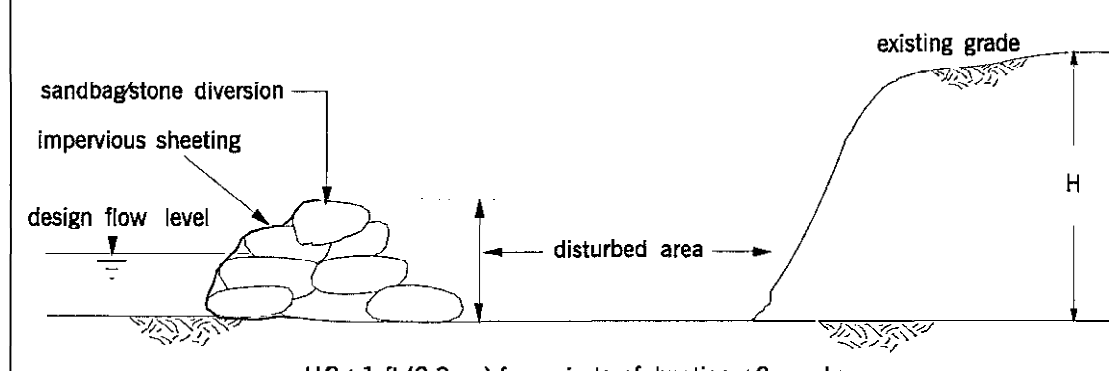

H2 + 1 ft (0.3 m) for projects of duration < 2 weeks;
2-year flood elevation for projects of longer duration


PLAN VIEW

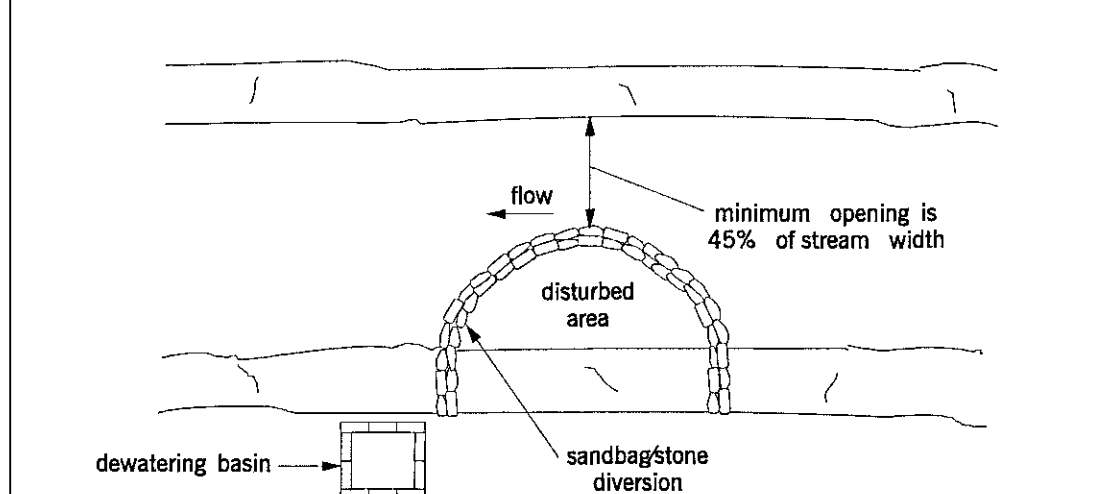

TEMPORARY INSTREAM CONSTRUCTION MEASURES REVISED NOVEMBER 2000 PAGE 15 - 3 MARYLAND DEPARTMENT OF THE ENVIRONMENT WATER MANAGEMENT ADMINISTRATION

DETAIL C-6 CLEAR WATER DIVERSION PIPE

STANDARD SYMBOL
CWS-13
DESCRIPTION CWS-13 REFERS TO 12 INCH CLEAR WATER DIVERSION

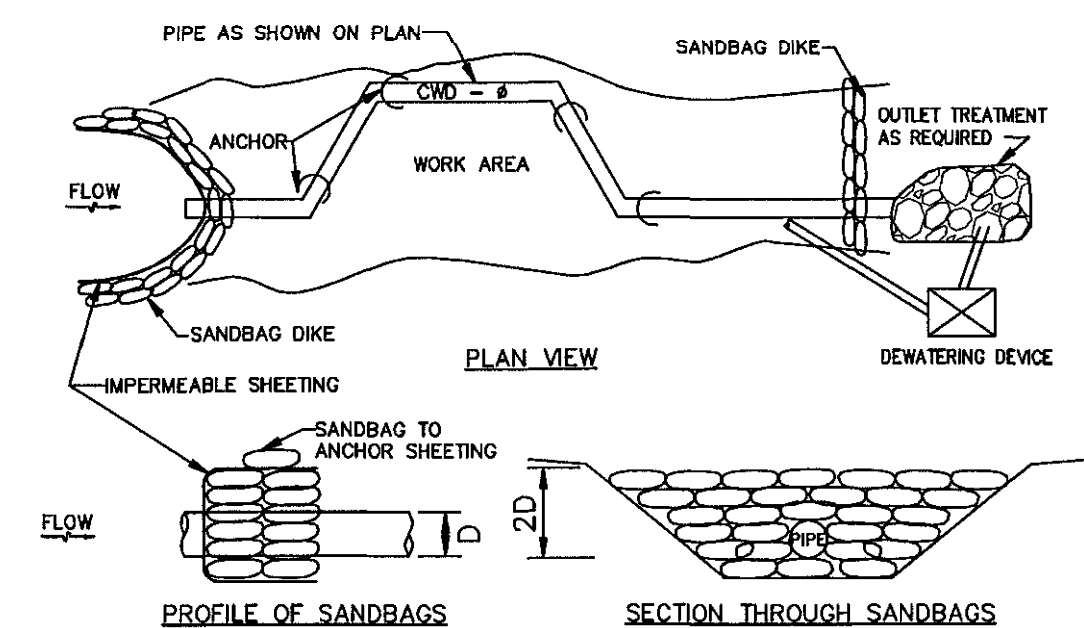


CONSTRUCTION SPECIFICATIONS

- FLEXIBLE PIPE IS PREFERRED, HOWEVER, CORRUGATED METAL PIPE OR EQUIVALENT PVC PIPE CAN BE USED. MAKE ALL JOINTS WATERTIGHT.
- FOR SANDBAGS USE MATERIALS THAT ARE RESISTANT TO ULTRA-VIOLET RADIATION, TEARING, AND PUNCTURE AND WOVEN TIGHTLY ENOUGH TO PREVENT LEAKAGE OF FILL MATERIAL.
- USE 10 MIL OR THICKER, UV RESISTANT, IMPERMEABLE SHEETING OR OTHER APPROVED MATERIAL THAT IS IMPERMEABLE AND RESISTANT TO PUNCTURING AND TEARING.
- PLACE IMPERMEABLE SHEETING SUCH THAT UPGRADE PORTION OVERLAPS DOWNGRADE PORTION BY A MINIMUM OF 18 INCHES.
- SET HEIGHT OF SANDBAG DIKE AT TWICE THE PIPE DIAMETER. MAINTAIN HEIGHT ALONG LENGTH OF SANDBAG DIKE. PLACE DOUBLE ROW OF SANDBAGS.
- AT A MINIMUM, SECURELY ANCHOR DIVERSION PIPE AT EACH DOWNGRADE JOINT.
- SET OUTLET END OF DIVERSION PIPE LOWER THAN INLET END.
- PROVIDE OUTLET PROTECTION AS REQUIRED ON APPROVED PLAN.
- DEWATER WORK AREA USING AN APPROVED EROSION AND SEDIMENT CONTROL PRACTICE AS SPECIFIED ON APPROVED PLAN.
- KEEP POINT OF DISCHARGE FREE OF EROSION. MAINTAIN WATER TIGHT CONNECTIONS AND POSITIVE DRAINAGE. REPLACE SANDBAGS AND IMPERMEABLE SHEETING IF TORN.

MARYLAND STANDARDS AND SPECIFICATIONS FOR SOIL EROSION AND SEDIMENT CONTROL
U.S. DEPARTMENT OF AGRICULTURE NATURAL RESOURCES CONSERVATION SERVICE 2011 MARYLAND DEPARTMENT OF ENVIRONMENT WATER MANAGEMENT ADMINISTRATION

DETAIL C-1 EARTH DIKE

STANDARD SYMBOL
A-1
DESCRIPTION A-1 REFERS TO 24 HOUR EARTH DIKE

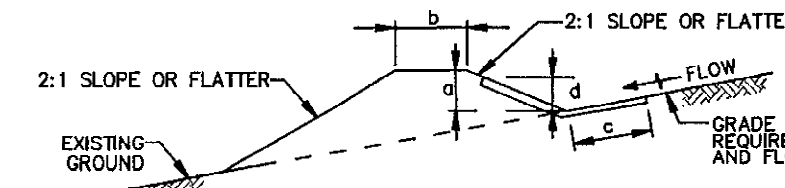

DIKE TYPE	A		B	
	DIKE HEIGHT	DIKE WIDTH	DIKE HEIGHT	DIKE WIDTH
CONTINUOUS GRADE 0.5% MIN. TO 10% MAX. SLOPE	18 IN. MIN.	24 IN. MIN.	30 IN. MIN.	36 IN. MIN.
a - DIKE HEIGHT			4 FT. MIN.	6 FT. MIN.
b - DIKE WIDTH			12 IN. MIN.	24 IN. MIN.

FLOW CHANNEL STABILIZATION

- A-1 SEED WITH STRAW MULCH AND TACK. (NOT ALLOWED FOR CLEAR WATER DIVERSION.)
- A-2/B-2 SEED WITH SOIL STABILIZATION MATTING OR LINE WITH SOD.
- A-3/B-3 4 TO 7 INCH STONE OR EQUIVALENT RECYCLED CONCRETE PRESSED INTO SOIL A MINIMUM OF 7 INCHES AND FLUSH WITH GROUND.

CONSTRUCTION SPECIFICATIONS

- REMOVE AND DISPOSE OF ALL TREES, BRUSH, STUMPS, OBSTRUCTIONS, AND OTHER OBJECTIONABLE MATERIAL SO AS NOT TO INTERFERE WITH PROPER FUNCTION OF EARTHDIKE.
- EXCAVATE OR SHAPE EARTH DIKE TO LINE, GRADE, AND CROSS SECTION AS SPECIFIED. BANK PROTECTIONS OR OTHER IRREGULARITIES ARE NOT ALLOWED.
- COMPACT FILL.
- CONSTRUCT FLOW CHANNEL ON AN UNINTERRUPTED, CONTINUOUS GRADE, ADJUSTING THE LOCATION DUE TO FIELD CONDITIONS AS NECESSARY TO MAINTAIN POSITIVE DRAINAGE.
- PROVIDE OUTLET PROTECTION AS REQUIRED ON APPROVED PLAN.
- STABILIZE EARTH DIKE WITHIN THREE DAYS OF INSTALLATION. STABILIZE FLOW CHANNEL FOR CLEAR WATER DIVERSION WITHIN 24 HOURS OF INSTALLATION.
- MAINTAIN LINE, GRADE, AND CROSS SECTION. REMOVE ACCUMULATED SEDIMENT AND DEBRIS, AND MAINTAIN POSITIVE DRAINAGE. KEEP EARTH DIKE AND POINT OF DISCHARGE FREE OF EROSION, AND CONTINUOUSLY MEET REQUIREMENTS FOR ADEQUATE VEGETATIVE ESTABLISHMENT IN ACCORDANCE WITH SECTION B-4 VEGETATIVE STABILIZATION.
- UPON REMOVAL OF EARTH DIKE, GRADE AREA FLUSH WITH EXISTING GROUND. WITHIN 24 HOURS OF REMOVAL STABILIZE DISTURBED AREA WITH TOPSOIL, SEED, AND MULCH, OR AS SPECIFIED ON APPROVED PLAN.

MARYLAND STANDARDS AND SPECIFICATIONS FOR SOIL EROSION AND SEDIMENT CONTROL
U.S. DEPARTMENT OF AGRICULTURE NATURAL RESOURCES CONSERVATION SERVICE 2011 MARYLAND DEPARTMENT OF ENVIRONMENT WATER MANAGEMENT ADMINISTRATION

C.5

DESIGN CERTIFICATION:
"I HEREBY CERTIFY THAT THIS PLAN HAS BEEN DESIGNED IN ACCORDANCE WITH CURRENT MARYLAND EROSION AND SEDIMENT CONTROL LAWS, REGULATIONS, AND STANDARDS, THAT IT REPRESENTS A PRACTICAL AND WORKABLE PLAN BASED ON MY PERSONAL KNOWLEDGE OF THE SITE, AND THAT IT WAS PREPARED IN ACCORDANCE WITH THE REQUIREMENTS OF THE HOWARD SOIL CONSERVATION DISTRICT."
1-10-18
DESIGNER'S SIGNATURE
DAVID T. MORICONI
PRINTED NAME
MD REGISTRATION NO. 16156
(P.E.) R.L.S., OR R.L.A. (CIRCLE ONE)


OWNERS/DEVELOPER CERTIFICATION:
"I/WE HEREBY CERTIFY THAT ANY CLEARING, GRADING, CONSTRUCTION, OR DEVELOPMENT WILL BE DONE PURSUANT TO THIS APPROVED EROSION AND SEDIMENT CONTROL PLAN, INCLUDING INSPECTING AND MAINTAINING CONTROLS, AND THAT THE RESPONSIBLE PERSONNEL INVOLVED IN THE CONSTRUCTION PROJECT WILL HAVE A CERTIFICATE OF TRAINING AT A MARYLAND DEPARTMENT OF THE ENVIRONMENT (MDE) APPROVED TRAINING PROGRAM FOR THE CONTROL ON EROSION AND SEDIMENT PRIOR TO BEGINNING THE PROJECT. I CERTIFY RIGHT-OF-ENTRY FOR PERIODIC ON-SITE EVALUATION BY HOWARD COUNTY, THE HOWARD SOIL CONSERVATION DISTRICT AND/OR MDE."
1/11/2018
OWNER'S/DEVELOPER'S SIGNATURE
THOMAS AUYANG
PRINTED NAME & TITLE

HOWARD SCD SIGNATURE BLOCK:
THIS PLAN IS APPROVED FOR SOIL EROSION AND SEDIMENT CONTROL BY THE HOWARD SOIL CONSERVATION DISTRICT.
1/11/18
HOWARD SOIL CONSERVATION DISTRICT

PROFESSIONAL CERTIFICATION
"I HEREBY CERTIFY THAT DOCUMENTS WERE PREPARED OR APPROVED BY ME, AND THAT I AM A DULY LICENSED PROFESSIONAL ENGINEER UNDER THE LAWS OF THE STATE OF MARYLAND. LICENSE NO. 16156 EXPIRATION DATE: 8/28/2018"

DETAIL D-4-1-A ROCK OUTLET PROTECTION I

STANDARD SYMBOL
[ROP1]
DISCHARGE TO SEMI-CONFINED CHANNEL SECTION

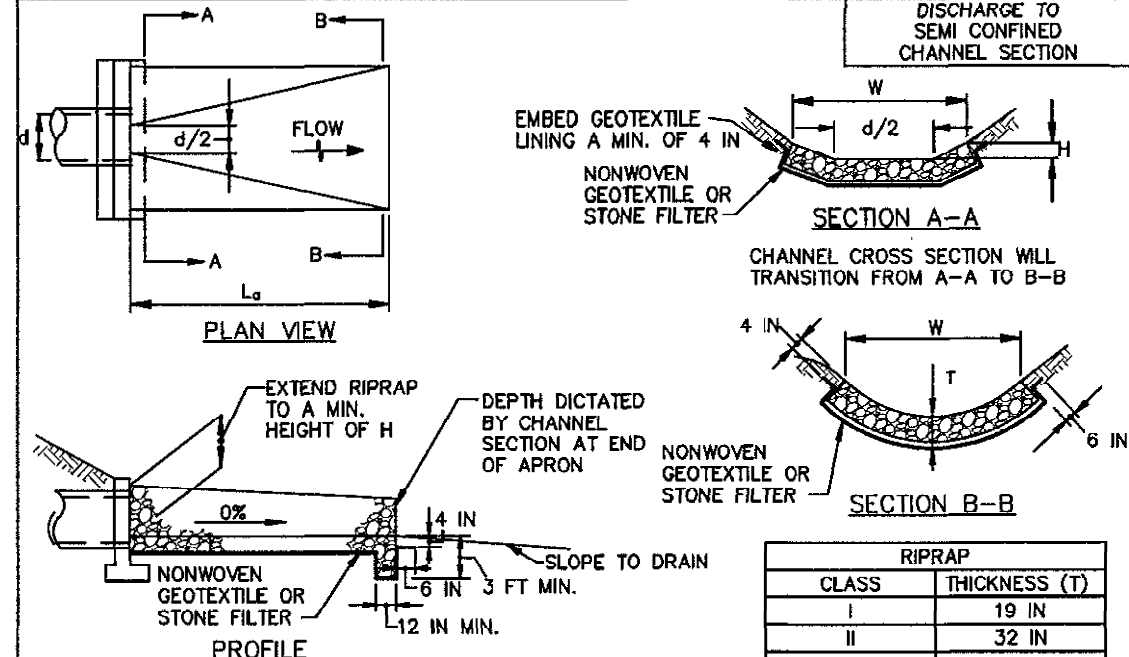


- CONSTRUCTION SPECIFICATIONS**
- RRIPAP AND STONE MUST CONFORM TO THE SPECIFIED CLASS.
 - USE NONWOVEN GEOTEXTILE AS SPECIFIED IN SECTION H-1 MATERIALS, AND PROTECT FROM PUNCTURING, CUTTING, OR TEARING. REPAIR ANY DAMAGE OTHER THAN AN OCCASIONAL SMALL HOLE BY PLACING ANOTHER PIECE OF GEOTEXTILE OVER THE DAMAGED PART OR BY COMPLETELY REPLACING THE GEOTEXTILE. PROVIDE A MINIMUM OF ONE FOOT OVERLAP FOR ALL REPAIRS AND FOR JOINING TWO PIECES OF GEOTEXTILE TOGETHER.
 - PREPARE THE SUBGRADE FOR GEOTEXTILE OR STONE FILTER (3/4 TO 1 1/2 INCH STONE FOR 6 INCH MINIMUM DEPTH) AND RRIPAP TO THE REQUIRED LINES AND GRADES. COMPACT ANY FILL REQUIRED IN THE SUBGRADE TO A DENSITY OF APPROXIMATELY THAT OF THE SURROUNDING UNDISTURBED MATERIAL.
 - EXTEND GEOTEXTILE AT LEAST 6 INCHES BEYOND EDGES OF RRIPAP AND EMBED AT LEAST 4 INCHES AT SIDES OF RRIPAP.
 - CONSTRUCT RRIPAP OUTLET TO FULL COURSE THICKNESS IN ONE OPERATION AND IN SUCH A MANNER AS TO AVOID DISPLACEMENT OF UNDERLYING MATERIALS. PLACE STONE FOR RRIPAP OUTLET IN A MANNER THAT WILL ENSURE THAT IT IS REASONABLY HOMOGENEOUS WITH THE SMALLER STONES AND SPALLS FILLING THE VOIDS BETWEEN THE LARGER STONES. PLACE RRIPAP IN A MANNER TO PREVENT DAMAGE TO THE STONE FILTER BLANKET OR GEOTEXTILE. HAND PLACE TO THE EXTENT NECESSARY.
 - WHERE NO ENDWALL IS USED, CONSTRUCT THE UPSTREAM END OF THE APRON SO THAT THE WIDTH IS TWO TIMES THE DIAMETER OF THE OUTLET PIPE, AND EXTEND THE STONE UNDER THE OUTLET BY A MINIMUM OF 18 INCHES.
 - CONSTRUCT APRON WITH 0% SLOPE ALONG ITS LENGTH AND WITHOUT OBSTRUCTIONS. PLACE STONE SO THAT IT BLENDS IN WITH EXISTING GROUND.
 - MAINTAIN LINE, GRADE, AND CROSS SECTION. KEEP OUTLET FREE OF EROSION. REMOVE ACCUMULATED SEDIMENT AND DEBRIS. AFTER HIGH FLOWS INSPECT FOR SCOUR AND DISCLOSED RRIPAP. MAKE NECESSARY REPAIRS IMMEDIATELY.

MARYLAND STANDARDS AND SPECIFICATIONS FOR SOIL EROSION AND SEDIMENT CONTROL
U.S. DEPARTMENT OF AGRICULTURE NATURAL RESOURCES CONSERVATION SERVICE 2011 MARYLAND DEPARTMENT OF ENVIRONMENT WATER MANAGEMENT ADMINISTRATION

DETAIL D-4-1-B ROCK OUTLET PROTECTION II

STANDARD SYMBOL
[ROPII]
DISCHARGE TO UNCONFINED CHANNEL OR FLAT AREA

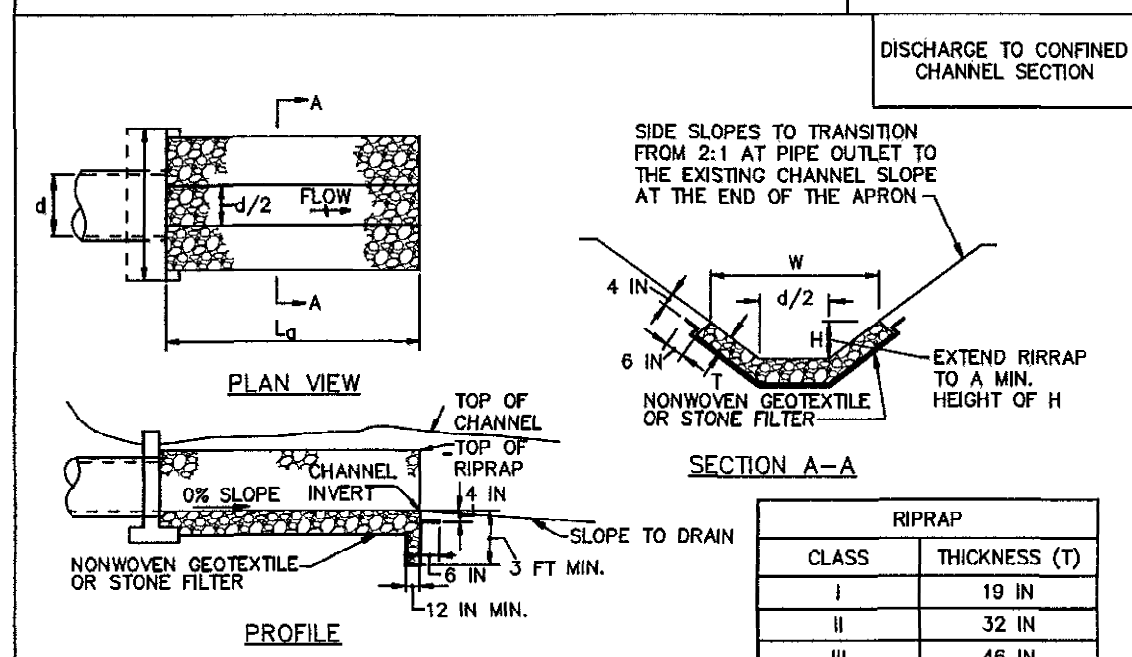


- CONSTRUCTION SPECIFICATIONS**
- RRIPAP AND STONE MUST CONFORM TO THE SPECIFIED CLASS.
 - USE NONWOVEN GEOTEXTILE AS SPECIFIED IN SECTION H-1 MATERIALS, AND PROTECT FROM PUNCTURING, CUTTING, OR TEARING. REPAIR ANY DAMAGE OTHER THAN AN OCCASIONAL SMALL HOLE BY PLACING ANOTHER PIECE OF GEOTEXTILE OVER THE DAMAGED PART OR BY COMPLETELY REPLACING THE GEOTEXTILE. PROVIDE A MINIMUM OF ONE FOOT OVERLAP FOR ALL REPAIRS AND FOR JOINING TWO PIECES OF GEOTEXTILE TOGETHER.
 - PREPARE THE SUBGRADE FOR GEOTEXTILE OR STONE FILTER (3/4 TO 1 1/2 INCH STONE FOR 6 INCH MINIMUM DEPTH) AND RRIPAP TO THE REQUIRED LINES AND GRADES. COMPACT ANY FILL REQUIRED IN THE SUBGRADE TO A DENSITY OF APPROXIMATELY THAT OF THE SURROUNDING UNDISTURBED MATERIAL.
 - EXTEND GEOTEXTILE AT LEAST 6 INCHES BEYOND EDGES OF RRIPAP AND EMBED AT LEAST 4 INCHES AT SIDES OF RRIPAP.
 - CONSTRUCT RRIPAP OUTLET TO FULL COURSE THICKNESS IN ONE OPERATION AND IN SUCH A MANNER AS TO AVOID DISPLACEMENT OF UNDERLYING MATERIALS. PLACE STONE FOR RRIPAP OUTLET IN A MANNER THAT WILL ENSURE THAT IT IS REASONABLY HOMOGENEOUS WITH THE SMALLER STONES AND SPALLS FILLING THE VOIDS BETWEEN THE LARGER STONES. PLACE RRIPAP IN A MANNER TO PREVENT DAMAGE TO THE STONE FILTER BLANKET OR GEOTEXTILE. HAND PLACE TO THE EXTENT NECESSARY.
 - WHERE NO ENDWALL IS USED, CONSTRUCT THE UPSTREAM END OF THE APRON SO THAT THE WIDTH IS TWO TIMES THE DIAMETER OF THE OUTLET PIPE, AND EXTEND THE STONE UNDER THE OUTLET BY A MINIMUM OF 18 INCHES.
 - CONSTRUCT APRON WITH 0% SLOPE ALONG ITS LENGTH AND WITHOUT OBSTRUCTIONS. PLACE STONE SO THAT IT BLENDS IN WITH EXISTING GROUND.
 - MAINTAIN LINE, GRADE, AND CROSS SECTION. KEEP OUTLET FREE OF EROSION. REMOVE ACCUMULATED SEDIMENT AND DEBRIS. AFTER HIGH FLOWS INSPECT FOR SCOUR AND DISCLOSED RRIPAP. MAKE NECESSARY REPAIRS IMMEDIATELY.

MARYLAND STANDARDS AND SPECIFICATIONS FOR SOIL EROSION AND SEDIMENT CONTROL
U.S. DEPARTMENT OF AGRICULTURE NATURAL RESOURCES CONSERVATION SERVICE 2011 MARYLAND DEPARTMENT OF ENVIRONMENT WATER MANAGEMENT ADMINISTRATION

D.21

DETAIL D-4-1-C ROCK OUTLET PROTECTION III


STANDARD SYMBOL
[ROPIII]
DISCHARGE TO AN UNCONFINED CHANNEL OR FLAT AREA

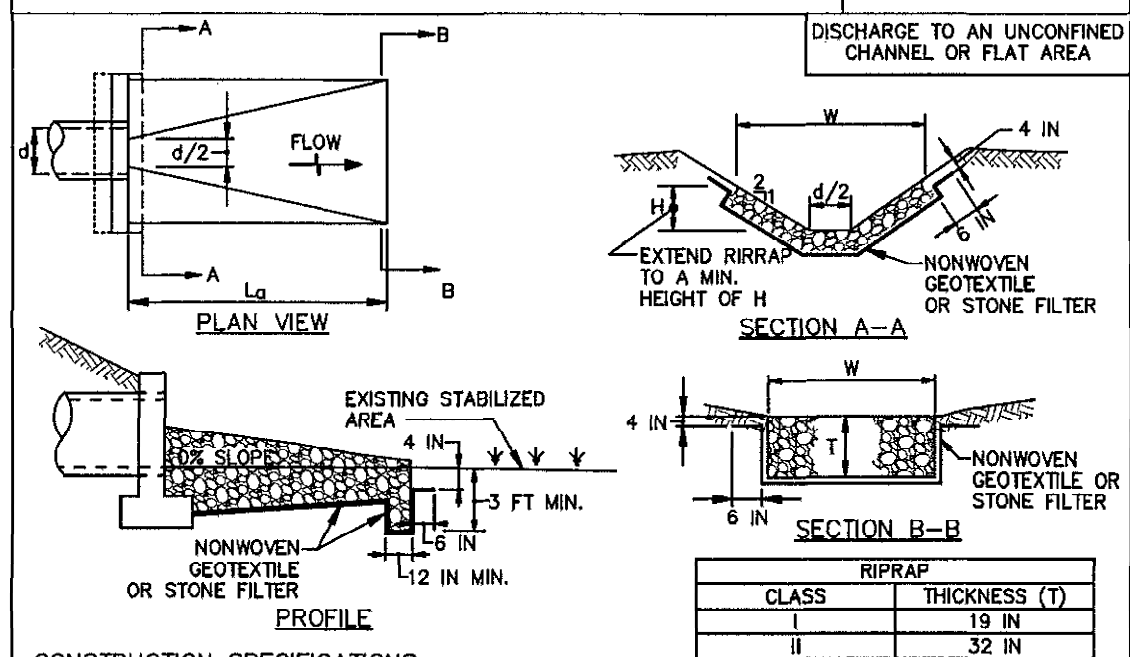

- CONSTRUCTION SPECIFICATIONS**
- RRIPAP AND STONE MUST CONFORM TO THE SPECIFIED CLASS.
 - USE NONWOVEN GEOTEXTILE, AS SPECIFIED IN SECTION H-1 MATERIALS, AND PROTECT FROM PUNCTURING, CUTTING, OR TEARING. REPAIR ANY DAMAGE OTHER THAN AN OCCASIONAL SMALL HOLE BY PLACING ANOTHER PIECE OF GEOTEXTILE OVER THE DAMAGED PART OR BY COMPLETELY REPLACING THE GEOTEXTILE. PROVIDE A MINIMUM OF ONE FOOT OVERLAP FOR ALL REPAIRS AND FOR JOINING TWO PIECES OF GEOTEXTILE TOGETHER.
 - PREPARE THE SUBGRADE FOR GEOTEXTILE OR STONE FILTER (3/4 TO 1 1/2 INCH STONE FOR 6 INCH MINIMUM DEPTH) AND RRIPAP TO THE REQUIRED LINES AND GRADES. COMPACT ANY FILL REQUIRED IN THE SUBGRADE TO A DENSITY OF APPROXIMATELY THAT OF THE SURROUNDING UNDISTURBED MATERIAL.
 - EXTEND GEOTEXTILE AT LEAST 6 INCHES BEYOND EDGES OF RRIPAP AND EMBED AT LEAST 4 INCHES AT SIDES OF RRIPAP.
 - CONSTRUCT RRIPAP OUTLET TO FULL COURSE THICKNESS IN ONE OPERATION AND IN SUCH A MANNER AS TO AVOID DISPLACEMENT OF UNDERLYING MATERIALS. PLACE STONE FOR RRIPAP OUTLET IN A MANNER THAT WILL ENSURE THAT IT IS REASONABLY HOMOGENEOUS WITH THE SMALLER STONES AND SPALLS FILLING THE VOIDS BETWEEN THE LARGER STONES. PLACE RRIPAP IN A MANNER TO PREVENT DAMAGE TO THE STONE FILTER BLANKET OR GEOTEXTILE. HAND PLACE TO THE EXTENT NECESSARY.
 - WHERE NO ENDWALL IS USED, CONSTRUCT THE UPSTREAM END OF THE APRON SO THAT THE WIDTH IS TWO TIMES THE DIAMETER OF THE OUTLET PIPE, AND EXTEND THE STONE UNDER THE OUTLET BY A MINIMUM OF 18 INCHES.
 - CONSTRUCT APRON WITH 0% SLOPE ALONG ITS LENGTH AND WITHOUT OBSTRUCTIONS. PLACE STONE SO THAT IT BLENDS IN WITH EXISTING GROUND.
 - MAINTAIN LINE, GRADE, AND CROSS SECTION. KEEP OUTLET FREE OF EROSION. REMOVE ACCUMULATED SEDIMENT AND DEBRIS. AFTER HIGH FLOWS INSPECT FOR SCOUR AND DISCLOSED RRIPAP. MAKE NECESSARY REPAIRS IMMEDIATELY.

MARYLAND STANDARDS AND SPECIFICATIONS FOR SOIL EROSION AND SEDIMENT CONTROL
U.S. DEPARTMENT OF AGRICULTURE NATURAL RESOURCES CONSERVATION SERVICE 2011 MARYLAND DEPARTMENT OF ENVIRONMENT WATER MANAGEMENT ADMINISTRATION

DEPARTMENT OF PUBLIC WORKS
HOWARD COUNTY, MARYLAND
1/23/18
1/23/18
1/23/18



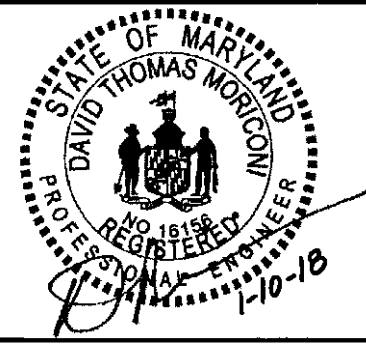


DES: RLL			
DRN: BJK			
CHK: DTM			
DATE: 12/17			
BY NO.		REVISION	DATE

EROSION AND SEDIMENT CONTROL NOTES AND DETAILS


SCALE MAP NO. 35 BLOCK NO. 19

HALL SHOP ROAD AT BROWNS BRIDGE ROAD
ELECTION DISTRICT NO. 5
CAPITAL PROJECT J-4164
SCALE N/A
SHEET 12 OF 21

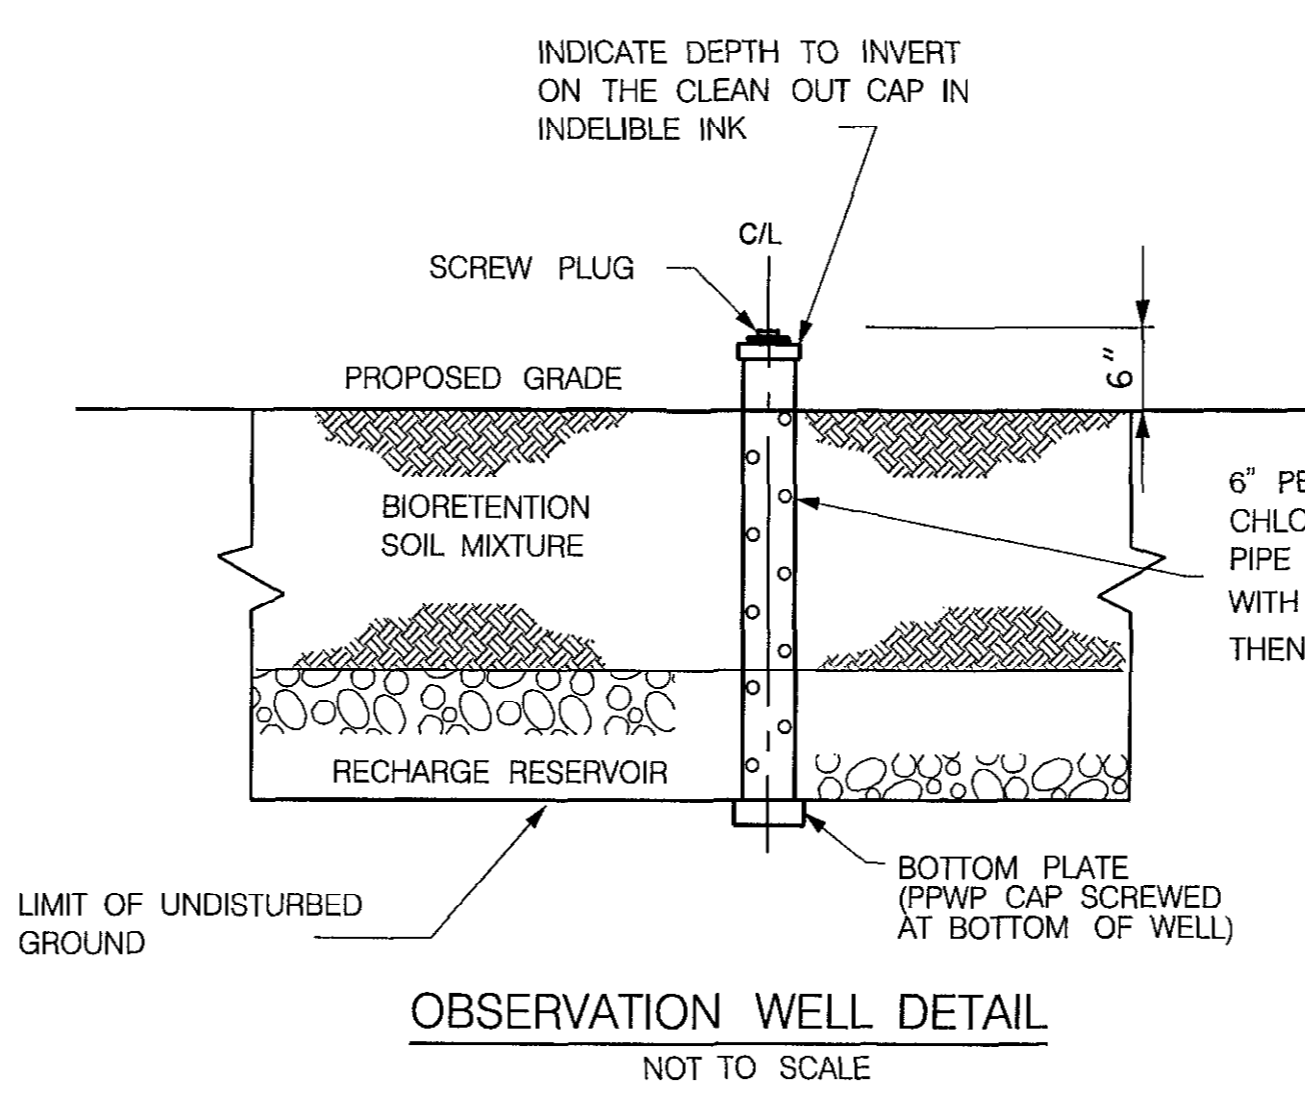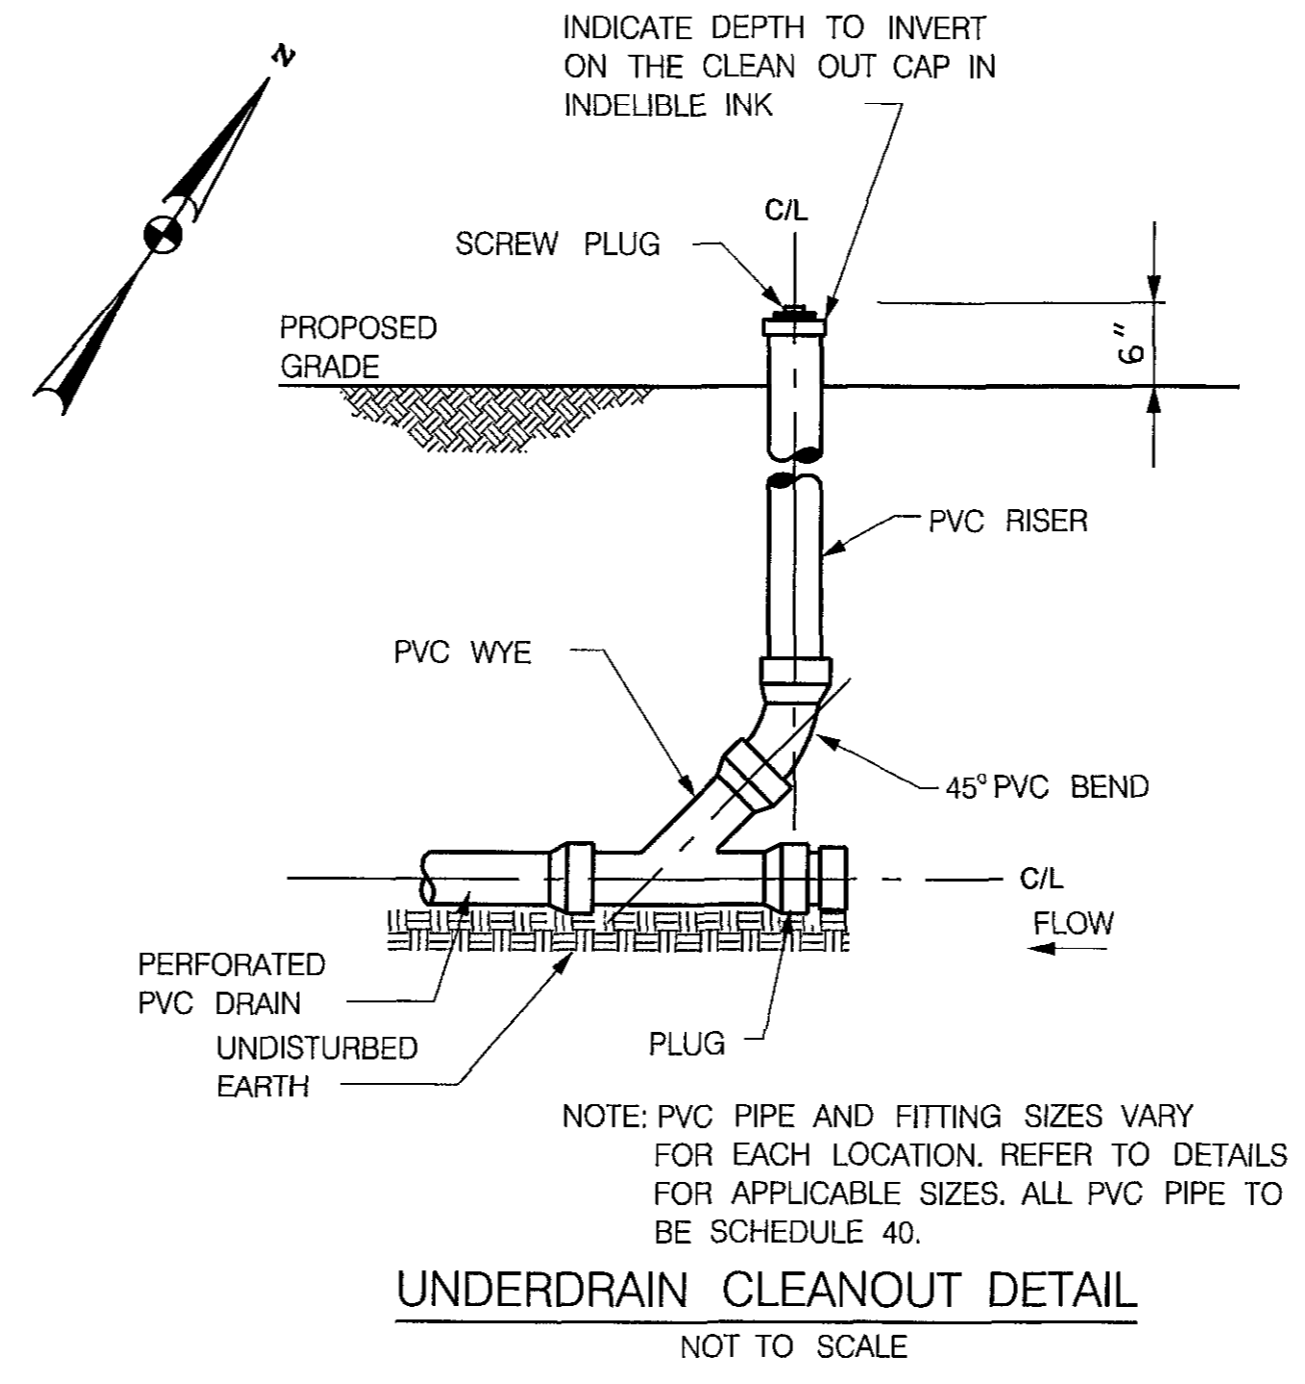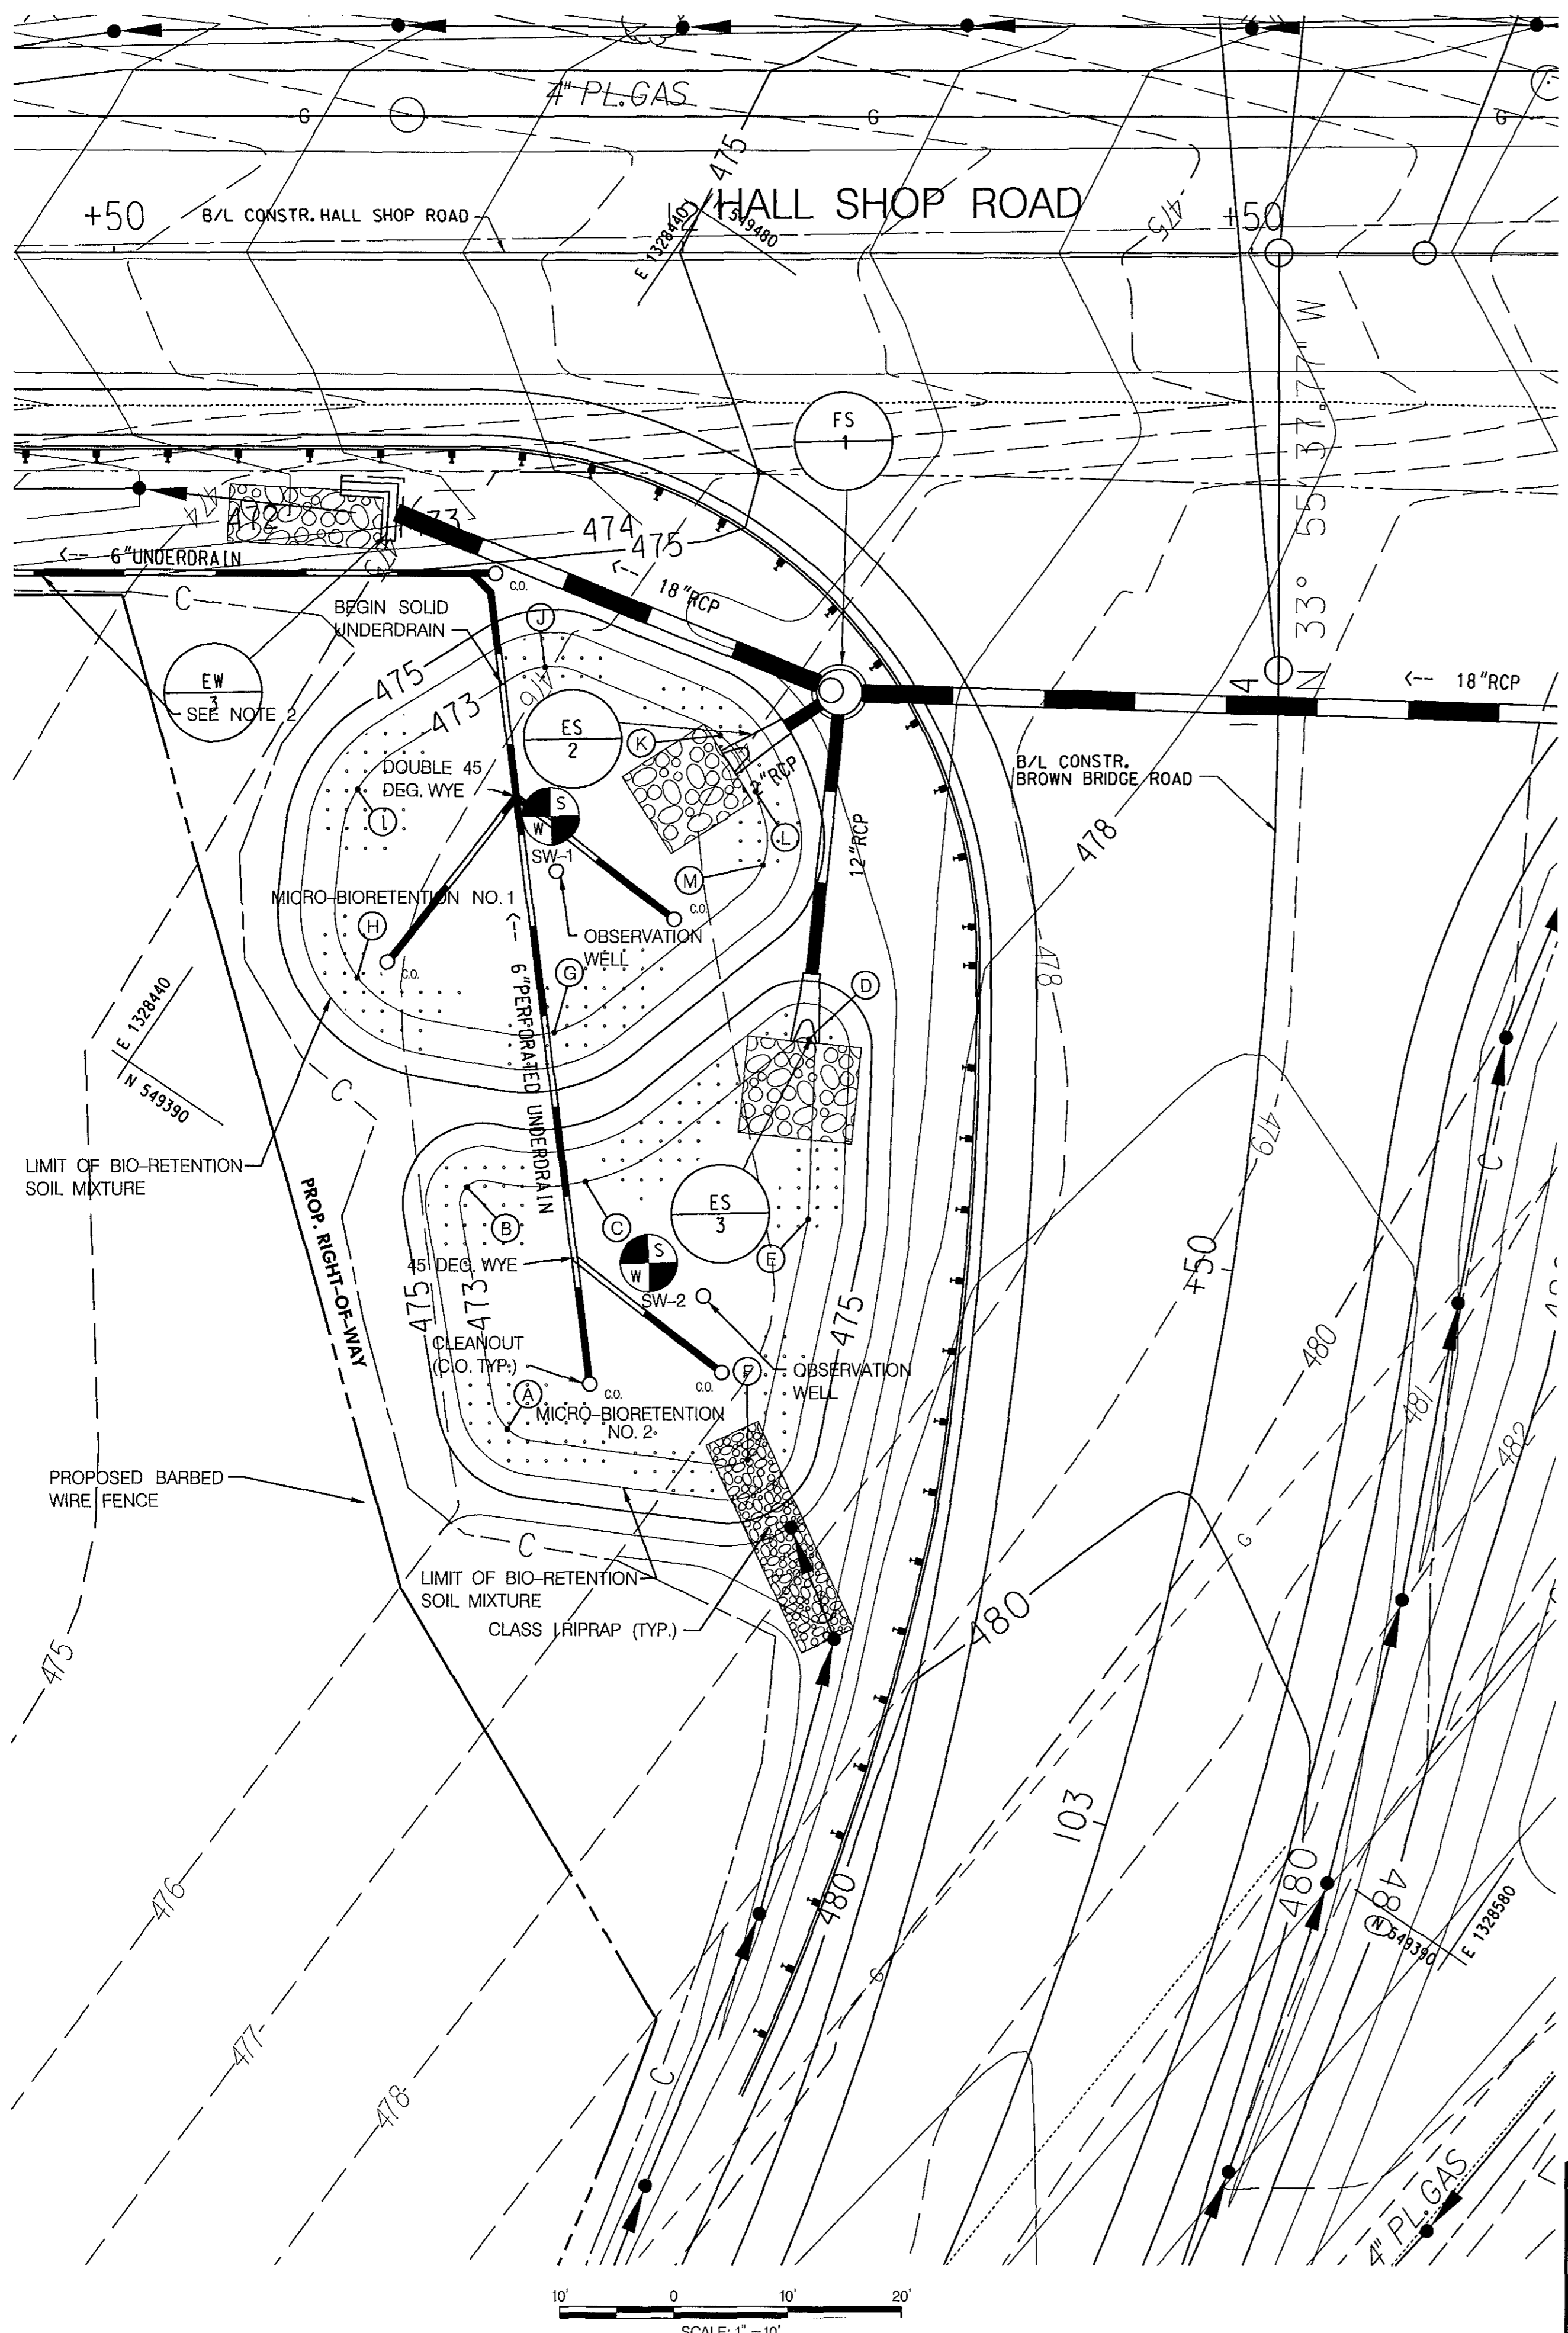

FACILITY CONTROL POINTS

NO.	NORTHING	EASTING
A	549,381.869	1,328,485.668
B	549,397.498	1,328,470.807
C	549,403.676	1,328,479.183
D	549,425.034	1,328,488.454
E	549,411.930	1,328,497.252
F	549,391.430	1,328,504.688
G	549,413.025	1,328,469.572
H	549,407.361	1,328,452.543
I	549,421.052	1,328,443.342
J	549,439.146	1,328,450.986
K	549,442.741	1,328,467.095
L	549,440.421	1,328,472.448
M	549,435.436	1,328,476.576

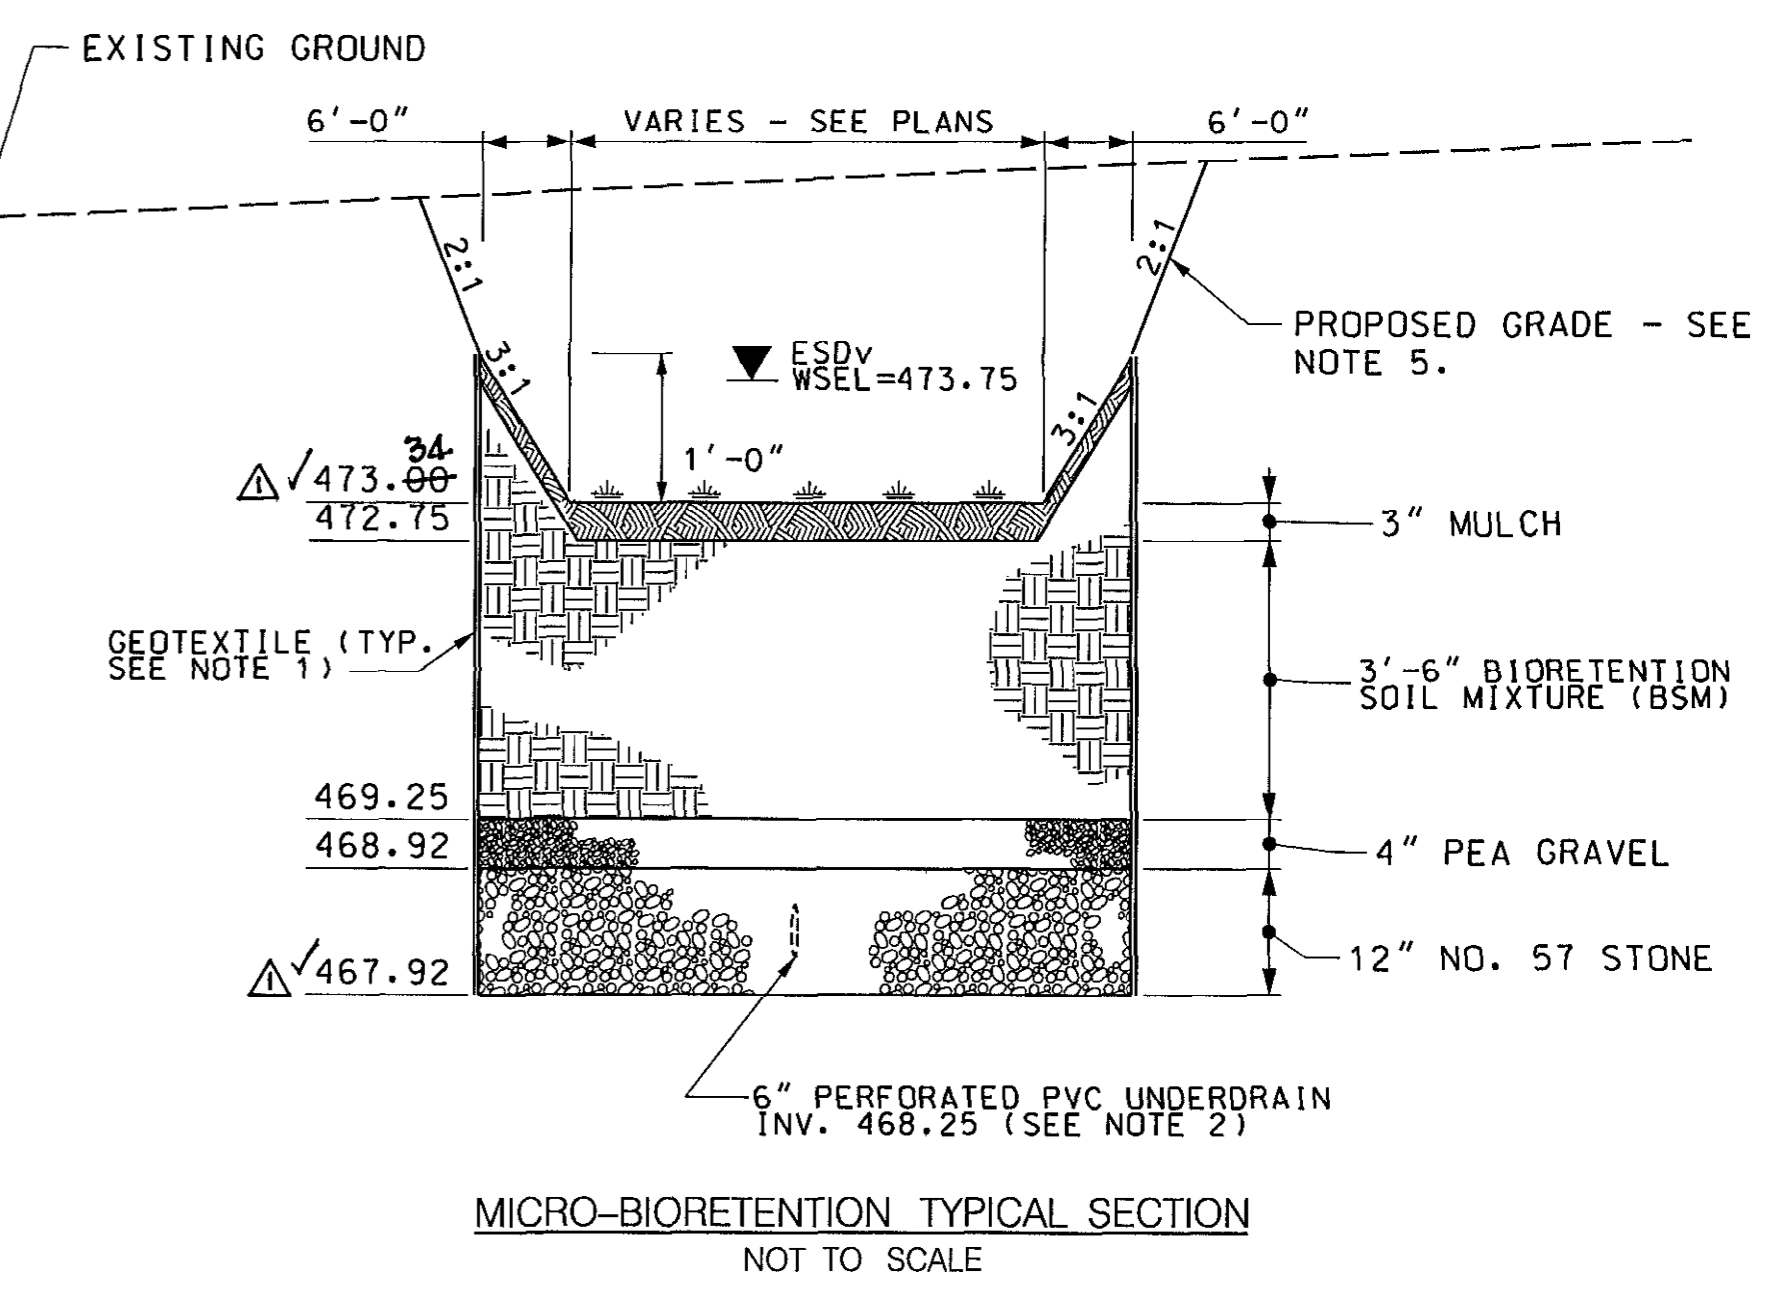

- NOTES:
1. GEOTEXTILE, CLASS PE TYPE III, NON-WOVEN, TO COMPLETELY ENVELOPE SIDES (PERIMETER) OF FILTER MEDIA. FILTER FABRIC IS NOT TO BE PLACED ON THE BOTTOM OR TOP OR THE FILTER MEDIA.
 2. GRADE PERFORATED PVC UNDERDRAIN AT A SLOPE OF 0.50% TO THE OUTFALL FROM UPSTREAM INVERT OF 468.25. REFER TO THE EROSION AND SEDIMENT CONTROL PLAN FOR THE EXTENT OF THE UNDERDRAIN OUTLET.
 3. REFER TO THE SPECIFICATIONS FOR THE BIORETENTION SOIL MIX.
 4. SEE DRAINAGE PROFILES FOR LIMITS OF RIPRAP.
 5. PLACE 4" TOPSOIL AND STABILIZE WITH PERMANENT SEED AND MULCH.

As-Built Inspection Tabulations/Checklist for Microbioretention #1:
HSCD No.: EP-12-001

Accepted by Howard Soil Conservation District:
Name _____ Date _____

ACTIVITY	DESIGNED	AS-BUILT	DIFFERENCE	INSPECTOR INITIALS	ACCEPTANCE DATE
As-Built Survey	N/A	✓	-		
Filter Bed Area (L x W)	884 SF	✓	-		
Filter Bed Surface Elevation	473.00	473.28	+0.28		
Filter Inlet Pipe Size	N/A	✓	-		
Filter Inlet Pipe Elevation	N/A	✓	-		
Outlet Pipe (Underdrain) Size	6"	✓	-		
Outlet Pipe (Underdrain) Elevation	467.89	N/A	N/A		

CONNECTED TO MAIN G⁺ OUTFALL

ACTIVITY	DESIGNED	AS-BUILT	DIFFERENCE	INSPECTOR INITIALS	ACCEPTANCE DATE
Runoff Diverted					
Drainage area stabilized prior to installation					
Facility area cleared					
Facility location staked out					
Excavated to proper size and location*					
Stable side slopes					
Lateral slopes finished according to plans					
Subsoils not compacted during construction					
Underdrain system and observation well installed according to plans*					
Planting soil tested and approved according to specifications					
Planting soil placed according to plans					
Placement of geotextiles and filter fabric according to plans*					
Placement of sand filter layer (if applicable)					
Placement of gravel diaphragm*					
Appurtenant conveyance systems (diversion structures, pre-filters, filters, inlet, outlets, orifices and flow distribution structures) installed according to plan*					
A drop of at least 6 inches at the inlet					
Pretreatment facilities in place					
Planting installed according to plans (see checklist on SWM planting plan)*					
Mulch Layer installed according to details					
Maintenance access installed according to plan and details					
Final grading and permanent stabilization completed					

* AB Inspector required to perform inspection on site for these steps as required by COMAR 26.17.02.10

As-Built Inspection Tabulations/Checklist for Microbioretention #2:
HSCD No.: EP-12-001

Accepted by Howard Soil Conservation District:
Name _____ Date _____

ACTIVITY	DESIGNED	AS-BUILT	DIFFERENCE	INSPECTOR INITIALS	ACCEPTANCE DATE
As-Built Survey	N/A	✓	-		
Filter Bed Area (L x W)	755 SF	✓	-		
Filter Bed Surface Elevation	473.00	473.34	+0.34		
Filter Inlet Pipe Size	N/A	✓	-		
Filter Inlet Pipe Elevation	N/A	✓	-		
Outlet Pipe (Underdrain) Size	6"	✓	-		
Outlet Pipe (Underdrain) Elevation	468.17	N/A	N/A		

ACTIVITY	DESIGNED	AS-BUILT	DIFFERENCE	INSPECTOR INITIALS	ACCEPTANCE DATE
Runoff Diverted					
Drainage area stabilized prior to installation					
Facility area cleared					
Facility location staked out					
Excavated to proper size and location*					
Stable side slopes					
Lateral slopes finished according to plans					
Subsoils not compacted during construction					
Underdrain system and observation well installed according to plans*					
Planting soil tested and approved according to specifications					
Planting soil placed according to plans					
Placement of geotextiles and filter fabric according to plans*					
Placement of sand filter layer (if applicable)					
Placement of gravel diaphragm*					
Appurtenant conveyance systems (diversion structures, pre-filters, filters, inlet, outlets, orifices and flow distribution structures) installed according to plan*					
A drop of at least 6 inches at the inlet					
Pretreatment facilities in place					
Planting installed according to plans (see checklist on SWM planting plan)*					
Mulch Layer installed according to details					
Maintenance access installed according to plan and details					
Final grading and permanent stabilization completed					

* AB Inspector required to perform inspection on site for these steps as required by COMAR 26.17.02.10

PROFESSIONAL CERTIFICATION
"I HEREBY CERTIFY THAT DOCUMENTS WERE PREPARED OR APPROVED BY ME, AND THAT I AM A DULY LICENSED PROFESSIONAL ENGINEER UNDER THE LAWS OF THE STATE OF MARYLAND. LICENSE NO. 16156 EXPIRATION DATE: 8/28/2018"

DEPARTMENT OF PUBLIC WORKS
HOWARD COUNTY, MARYLAND

Michael J. ...
CHIEF, BUREAU OF HIGHWAYS
DATE: 11/21/18

Thomas B. ...
CHIEF, BUREAU OF ENGINEERING
DATE: 11/23/18

...
DIRECTOR OF PUBLIC WORKS
DATE: 11/23/18

AECOM

STATE OF MARYLAND
THOMAS MORRISON
PROFESSIONAL ENGINEER
LICENSE NO. 16156
EXPIRATION DATE: 8/28/2018

DES:	RLI				
DRN:	BJK				
CHK:	DTM				
DATE:	12/17				
BY:	AS-BUILT				
NO.:					
REVISION:					
DATE:	1/28/19				



STORMWATER MANAGEMENT PLAN

SCALE MAP NO. 35 BLOCK NO. 19

HALL SHOP ROAD AT BROWNS BRIDGE ROAD


ELECTION DISTRICT NO. 5
CAPITAL PROJECT J-4164

SCALE AS SHOWN
SHEET 13 OF 21

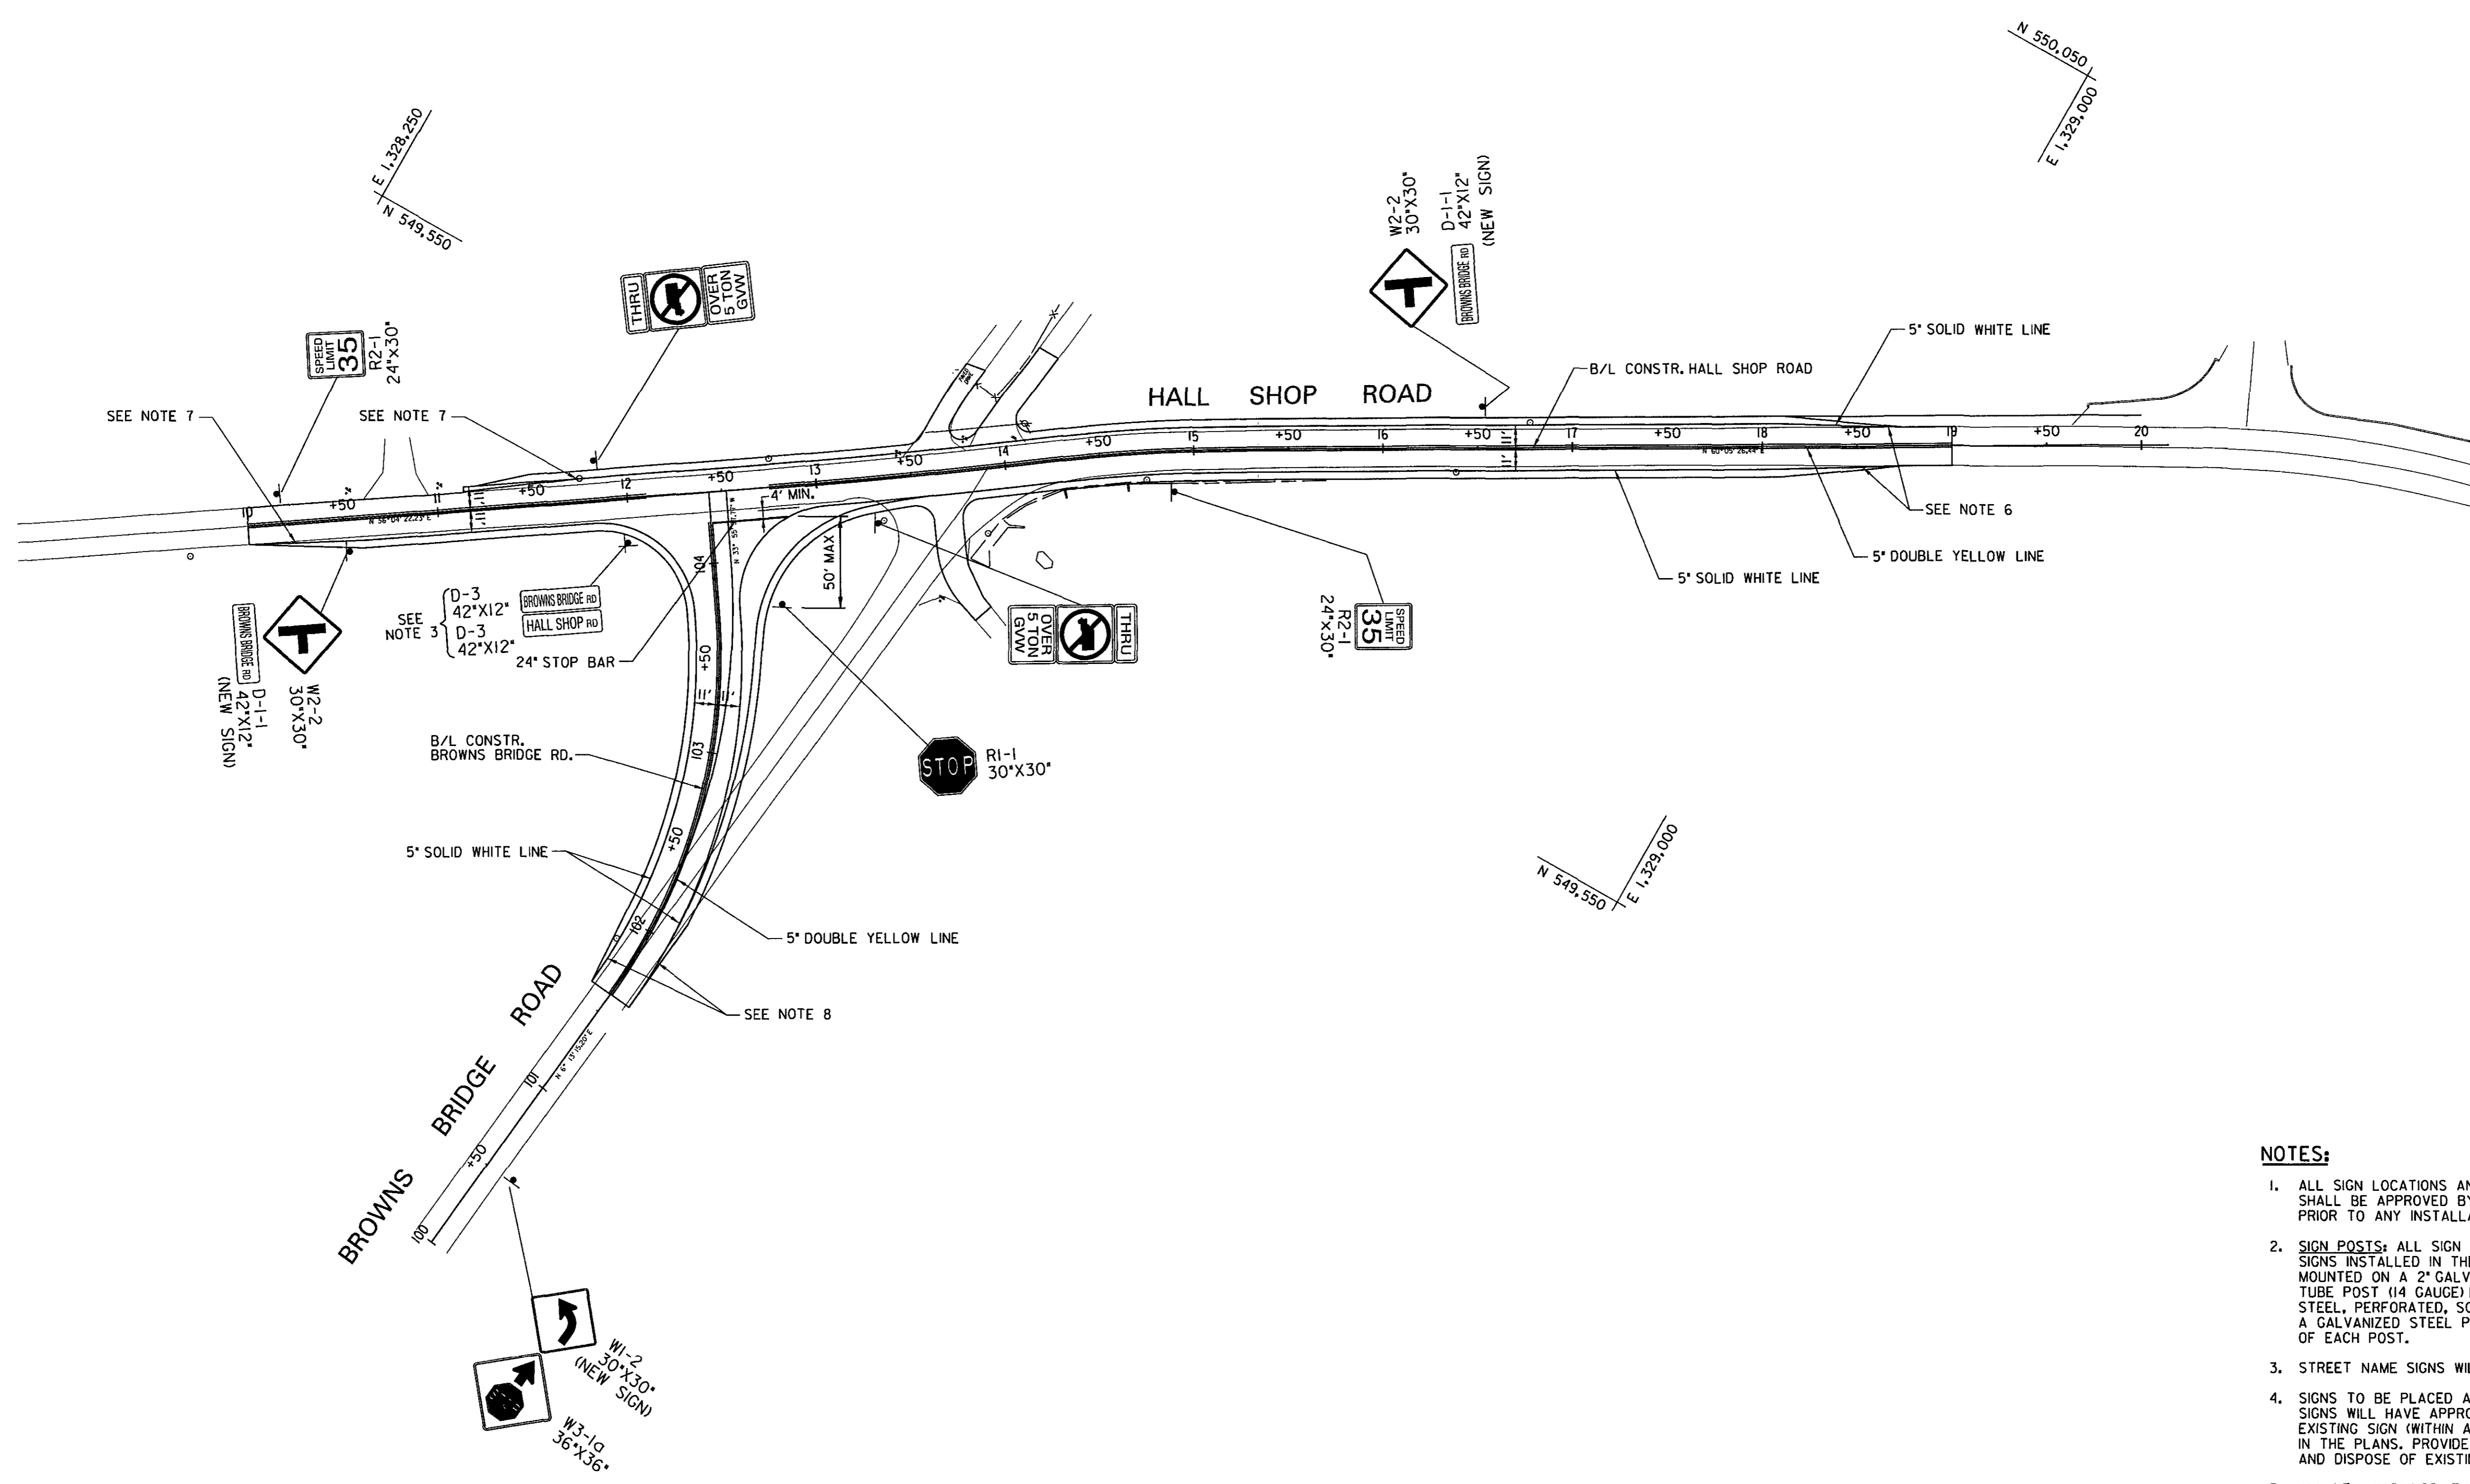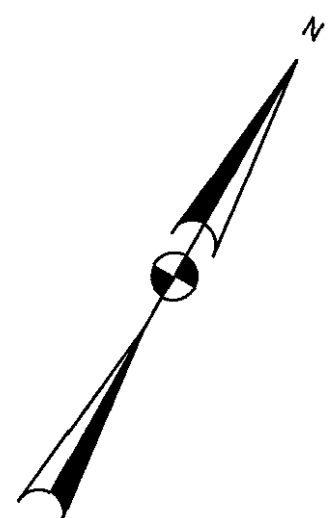

- NOTES:**
- ALL SIGN LOCATIONS AND THE PAVEMENT MARKING LAYOUT SHALL BE APPROVED BY THE TRAFFIC DIVISION (410-313-5752) PRIOR TO ANY INSTALLATION.
 - SIGN POSTS:** ALL SIGN POSTS USED FOR TRAFFIC CONTROL SIGNS INSTALLED IN THE COUNTY RIGHT-OF-WAY SHALL BE MOUNTED ON A 2" GALVANIZED STEEL, PERFORATED, SQUARE TUBE POST (14 GAUGE) INSERTED INTO A 2 1/2" GALVANIZED STEEL, PERFORATED, SQUARE TUBE SLEEVE (12 GAUGE) - 3' LONG. A GALVANIZED STEEL POLE CAP SHALL BE MOUNTED ON TOP OF EACH POST.
 - STREET NAME SIGNS WILL BE PROVIDED BY THE COUNTY.
 - SIGNS TO BE PLACED AT THE SHOWN LOCATIONS. RELOCATED SIGNS WILL HAVE APPROXIMATELY THE SAME LOCATION AS THE EXISTING SIGN (WITHIN A 15' RANGE) UNLESS OTHERWISE INDICATED IN THE PLANS. PROVIDE A NEW SIGN AND SUPPORT AND REMOVE AND DISPOSE OF EXISTING SIGN AND SUPPORT. (SEE NOTE 2 ABOVE).
 - ALL NEW MARKINGS (EXCEPT STOP BAR) SHALL BE 3M 380I-ES MARKING TAPE (5" WIDE). THE STOP BAR SHALL BE THERMOPLASTIC OR A HEAT APPLIED PREFORMED MARKING MATERIAL.
 - STRIPING SHALL BE TAPERED BEGINNING AT STA. 18+07 TO MEET EXISTING STRIPING AT STA. 18+75.
 - STRIPING SHALL BE TAPERED BEGINNING AT STA. 10+60 TO MEET EXISTING STRIPING AT STA. 10+00.
 - STRIPING SHALL BE TAPERED BEGINNING AT STA. 102+11 TO MEET EXISTING STRIPING AT STA. 101+61.

PROFESSIONAL CERTIFICATION
 "I HEREBY CERTIFY THAT DOCUMENTS WERE PREPARED OR APPROVED BY ME, AND THAT I AM A DULY LICENSED PROFESSIONAL ENGINEER UNDER THE LAWS OF THE STATE OF MARYLAND.
 LICENSE NO. 16156
 EXPIRATION DATE: 8/28/2018

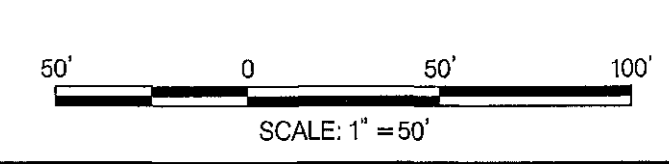


DEPARTMENT OF PUBLIC WORKS
 HOWARD COUNTY, MARYLAND

Adm. Jue
 CHIEF, TRANSPORTATION AND SPECIAL PROJECTS DIVISION
 DATE: 12/11/18

James B. Bollen
 CHIEF, BUREAU OF ENGINEERING
 DATE: 12/11/18

John A. ...
 DIRECTOR OF PUBLIC WORKS
 DATE: 12/11/18

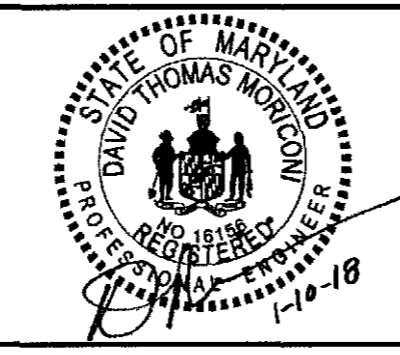

DES:	RLL			
DRN:	BJK			
CHK:	DTM			
DATE:	12/17			
BY:	NO.	REVISION	DATE	

ROADWAY MARKING AND SIGNING PLAN


SCALE MAP NO. 35 BLOCK NO. 19

HALL SHOP ROAD AT BROWNS BRIDGE ROAD

ELECTION DISTRICT NO. 5
 CAPITAL PROJECT J-4164

SCALE
 1"=50'

SHEET
 14 OF 21

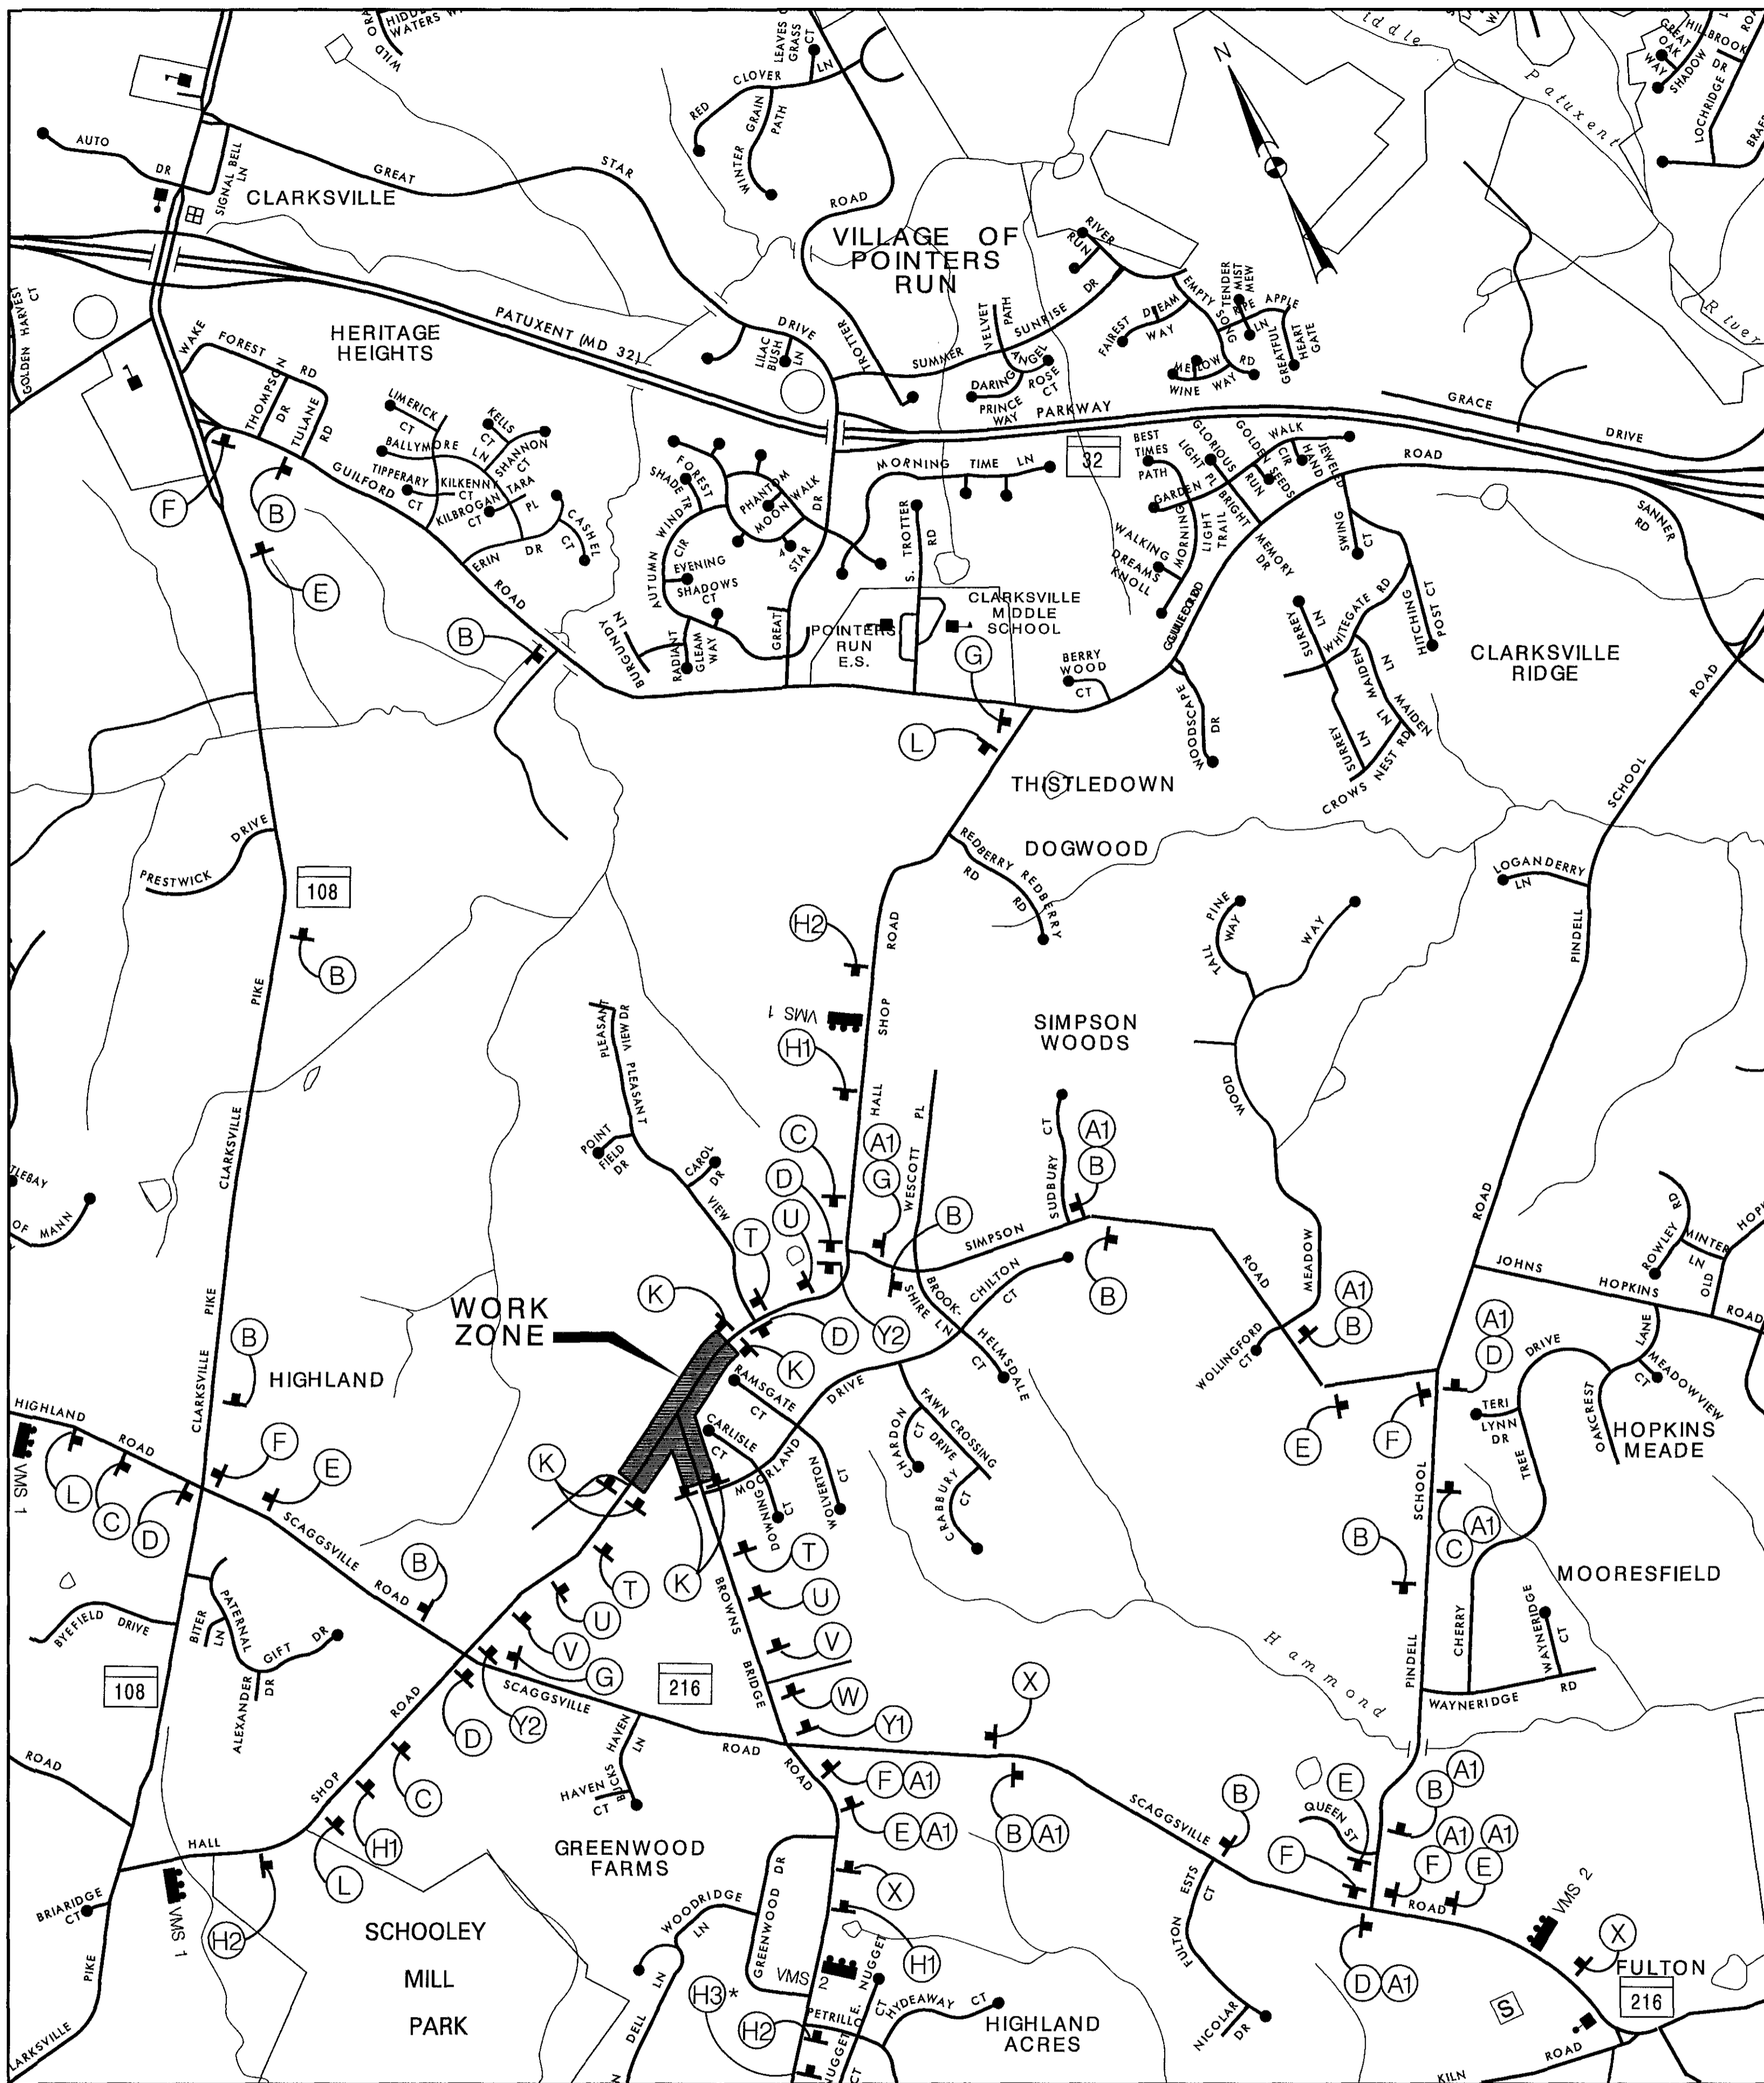

*PLACED ONE MILE SOUTH OF MD 216
DETOUR MAP
 SCALE: 1" = 1000'

PROFESSIONAL CERTIFICATION
 "I HEREBY CERTIFY THAT DOCUMENTS WERE PREPARED OR APPROVED BY ME, AND THAT I AM A DULY LICENSED PROFESSIONAL ENGINEER UNDER THE LAWS OF THE STATE OF MARYLAND. LICENSE NO. 18156, EXPIRATION DATE: 8/28/2018."

<p>TEMPORARY TRAFFIC CONTROL TYPICAL APPLICATION</p> <p>IMPORTANT: THIS SIGNING SHALL BE USED IN COMBINATION WITH THE GENERAL NOTES NO. 104.02-01 - NO. 104.02-18 AND STANDARD DETAILS NO. 104.01-01 - NO. 104.01-14.</p> <p>NOTES: SHOULDER CLOSED SIGNS ARE REQUIRED IN PLACE OF SHOULDER WORK SIGNS WHEN THE SHOULDER IS CLOSED BY A PHYSICAL BARRIER REFER TO STANDARD NO. 104.02-14.</p> <p>WHEN WORK INVOLVES A PAVEMENT EDGE DROP-OFF, REFER TO STANDARD NOS. NO. 104.02-11 TO NO. 104.02-13.</p> <p>KEY: CHANNELING DEVICES SIGN SUPPORT FACE OF SIGN DIRECTION OF TRAFFIC WORK SITE</p>	<p>TEMPORARY TRAFFIC CONTROL TYPICAL APPLICATION</p> <p>IMPORTANT: THIS SIGNING SHALL BE USED IN COMBINATION WITH THE GENERAL NOTES NO. 104.02-01 - NO. 104.02-18 AND STANDARD DETAILS NO. 104.01-01 - NO. 104.01-14.</p> <p>NOTES: FLAGGERS SHALL NEVER BE STATIONED MORE THAN 100' FROM THE ADVANCE FLASHER SIGN.</p> <p>KEY: CHANNELING DEVICES SIGN SUPPORT FACE OF SIGN DIRECTION OF TRAFFIC WORK SITE FLASHER</p>	<p>TEMPORARY TRAFFIC CONTROL TYPICAL APPLICATION</p> <p>IMPORTANT: THIS SIGNING SHALL BE USED IN COMBINATION WITH THE GENERAL NOTES NO. 104.02-01 - NO. 104.02-18 AND STANDARD DETAILS NO. 104.01-01 - NO. 104.01-14.</p> <p>NOTES: FLAGGERS SHALL NEVER BE STATIONED MORE THAN 100' FROM THE ADVANCE FLASHER SIGN.</p> <p>KEY: CHANNELING DEVICES SIGN SUPPORT FACE OF SIGN DIRECTION OF TRAFFIC WORK SITE FLASHER</p>
<p>SECTION 104 CATEGORY CODE 100 SNA APPROVED: [Signature] DATE: 8-23-13 PROJECT: 104-02-02</p>	<p>Maryland Department of Transportation STATE HIGHWAY ADMINISTRATION STANDARDS FOR HIGHWAYS AND INCIDENTAL STRUCTURES SHOULDER WORK/2-LANE, 2-WAY EQL/LESS THAN 40 MPH STANDARD NO. MD 104.02-02</p>	<p>Maryland Department of Transportation STATE HIGHWAY ADMINISTRATION STANDARDS FOR HIGHWAYS AND INCIDENTAL STRUCTURES FLAGGING OPERATION/2-LANE, 2-WAY EQL/LESS THAN 40 MPH STANDARD NO. MD 104.02-10</p>

<p>5" LETTERS BROWNS BR RD</p> <p>D-3(2) 30" x 9" BLK/WHT MOUNT ON TOP OF EVERY M4-8a AND M4-9 DETOUR SIGN AS DIRECTED BY THE ENGINEER</p>	<p>5" LETTERS HALL SHOP RD</p> <p>D-3(2) 30" x 9" BLK/WHT MOUNT ON TOP OF EVERY M4-8a AND M4-9 DETOUR SIGN AS DIRECTED BY THE ENGINEER</p>	<p>HALL SHOP RD DETOUR M4-9 30" x 24"</p>	<p>HALL SHOP RD DETOUR M4-9 30" x 24"</p>	<p>HALL SHOP RD DETOUR M4-9 30" x 24"</p>	<p>HALL SHOP RD DETOUR M4-9 30" x 24"</p>	<p>HALL SHOP RD DETOUR M4-9 30" x 24"</p>	<p>HALL SHOP RD DETOUR M4-9 30" x 24"</p>
<p>DETOUR 1500 FT W20-2 48" x 48"</p>	<p>ROAD CLOSED TYPE III BARRICADE 2 TYPE 2B LIGHT R11-2 48" x 30"</p>	<p>DETOUR M4-10L 48" x 18"</p>	<p>ROAD CLOSED 1 MILE AHEAD LOCAL TRAFFIC ONLY TYPE II BARRICADE 2 TYPE B LIGHTS R11-3a - 60" x 30"</p>	<p>DETOUR M4-10R 48" x 18"</p>	<p>ROAD CLOSED 500 FT W20-3 48" x 48"</p>	<p>ROAD CLOSED 1000 FT W20-3 48" x 48"</p>	<p>ROAD CLOSED 1500 FT W20-3 48" x 48"</p>
<p>DETOUR 1/2 MILE W20-2 48" x 48"</p>	<p>NOTICE HALL SHOP ROAD (AT BROWNS BRIDGE RD) CLOSED FOLLOW DETOUR MAX. WIDTH 60"</p>	<p>8" LETTERS (BK/YELLOW) 7" LETTERS (BK/WHITE) 6" LETTERS (BK/WHITE) 8" LETTERS (BK/WHITE) 6" LETTERS (BK/WHITE)</p>	<p>NOTICE BROWNS BRIDGE ROAD (AT HALL SHOP ROAD) CLOSED FOLLOW DETOUR MAX. WIDTH 60"</p>	<p>8" LETTERS (BK/YELLOW) 7" LETTERS (BK/WHITE) 6" LETTERS (BK/WHITE) 8" LETTERS (BK/WHITE) 6" LETTERS (BK/WHITE)</p>	<p>ROAD CLOSED 1/2 MILE AHEAD LOCAL TRAFFIC ONLY TYPE II BARRICADE 2 TYPE B LIGHTS R11-3a - 60" x 30"</p>	<p>ROAD CLOSED 1/2 MILE AHEAD LOCAL TRAFFIC ONLY TYPE II BARRICADE 2 TYPE B LIGHTS R11-3a - 60" x 30"</p>	<p>ROAD CLOSED 1/2 MILE W20-3 48" x 48"</p>
<p>DETOUR 1 MILE W20-2 48" x 48"</p>	<p>NOTES</p> <ol style="list-style-type: none"> THIS PLAN SHALL BE INSTALLED WITH TCP ON SHEET 16. CONTACT TRAFFIC ENGINEER (410-313-5752) PRIOR TO FABRICATING SIGNS. ALL SIGN LOCATIONS SHALL BE APPROVED BY THE TRAFFIC DIVISION PRIOR TO INSTALLATION OF ANY SIGNS. ALL DETOUR SIGNS SHALL BE COVERED WITH OPAQUE MATERIAL UNTIL DAY ROAD IS CLOSED. ALL SIGN LOCATIONS SHOWN ON THE PLAN ARE APPROXIMATE. EXACT LOCATIONS TO BE DETERMINED IN THE FIELD. CONTACT THE TRAFFIC DIVISION AT 410-313-2430 WHEN THE CONTRACTOR IS READY TO SPOT THE LOCATIONS FOR THE SIGNS. 		<p>NOTICE BROWNS BRIDGE ROAD (AT HALL SHOP ROAD) CLOSED FOLLOW DETOUR MAX. WIDTH 60"</p>	<p>8" LETTERS (BK/YELLOW) 7" LETTERS (BK/WHITE) 6" LETTERS (BK/WHITE) 8" LETTERS (BK/WHITE) 6" LETTERS (BK/WHITE)</p>	<p>ROAD CLOSED 1/2 MILE AHEAD LOCAL TRAFFIC ONLY TYPE II BARRICADE 2 TYPE B LIGHTS R11-3a - 60" x 30"</p>		
<p>VMS 1 HALL SHOP RD TO CLOSE ON OR ABOUT XX-XX INFO 410-313 XXXX</p>	<p>VMS 2 BROWN BRIDGE ROAD TO CLOSE ON OR ABOUT XX-XX INFO 410-313 XXXX</p>	<p>VARIABLE MESSAGE SIGN (VMS) 10 DAYS BEFORE CLOSURE TO CLOSURE</p>	<p>VMS 1 HALL SHOP RD CLOSED FOLLOW DETOUR INFO 410-313 XXXX</p>	<p>VMS 2 BROWN BRIDGE ROAD CLOSED FOLLOW DETOUR INFO 410-313 XXXX</p>			

SUGGESTED SEQUENCE OF TRAFFIC CONTROL ACTIVITIES FOR MAINTENANCE OF TRAFFIC DURING CONSTRUCTION

1. TRAFFIC CONTROL DEVICES SHALL BE INSTALLED AS SHOWN ON THE PLANS FOR THIS PHASE.


DEPARTMENT OF PUBLIC WORKS
 HOWARD COUNTY, MARYLAND

CHIEF, BUREAU OF HIGHWAYS
 DATE: 1/23/18

CHIEF, BUREAU OF ENGINEERING
 DATE: 1/23/18

CHIEF, TRANSPORTATION AND SPECIAL PROJECTS DIVISION
 DATE: 1/23/18

DIRECTOR OF PUBLIC WORKS
 DATE: 1/23/18

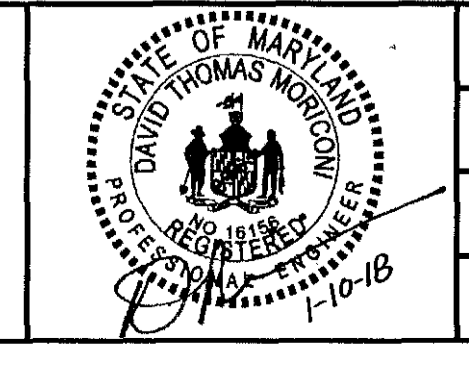

DES: RLL			
DRN: BJK			
CHK: DTM			
DATE: 12/17	BY NO.	REVISION	DATE



**MAINTENANCE OF TRAFFIC
 DETOUR PLAN
 PHASE I**

SCALE MAP NO. 35 BLOCK NO. 19

**HALL SHOP ROAD AT
 BROWNS BRIDGE ROAD**

ELECTION DISTRICT NO. 5
 CAPITAL PROJECT J-4164


SCALE AS SHOWN
 SHEET 15 OF 21

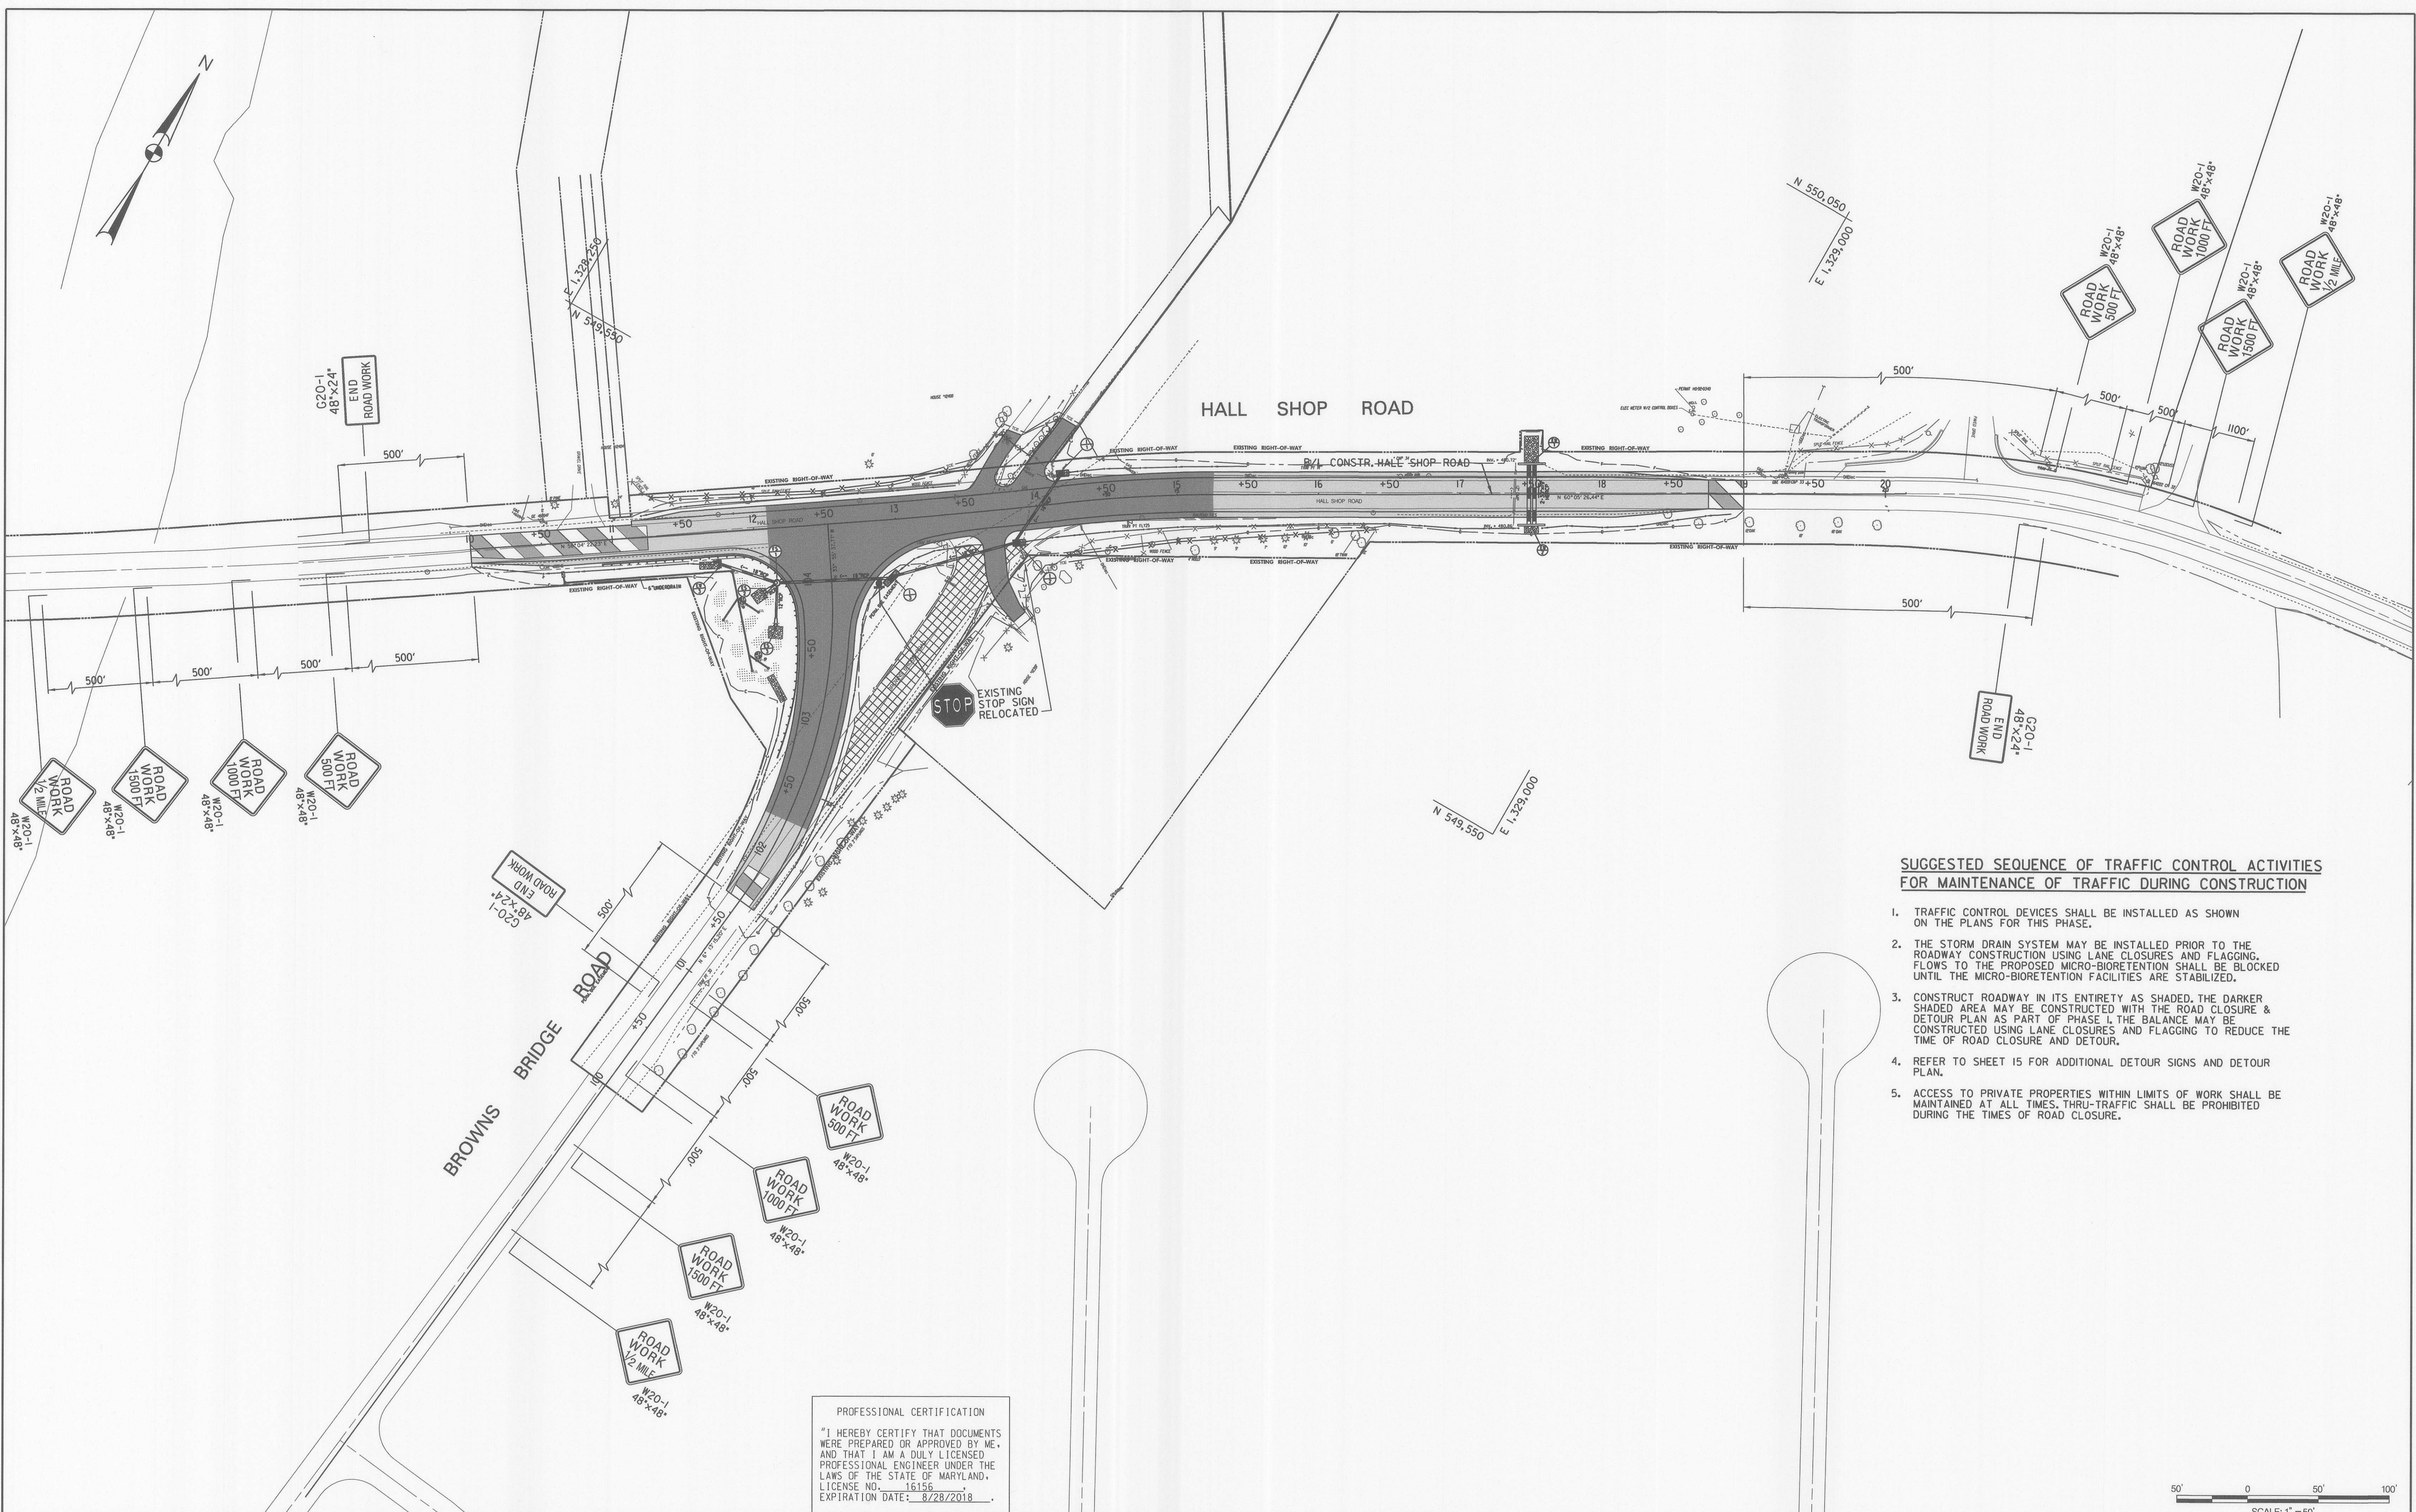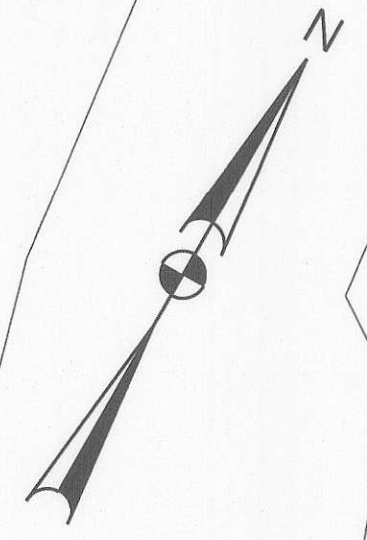

SUGGESTED SEQUENCE OF TRAFFIC CONTROL ACTIVITIES FOR MAINTENANCE OF TRAFFIC DURING CONSTRUCTION

1. TRAFFIC CONTROL DEVICES SHALL BE INSTALLED AS SHOWN ON THE PLANS FOR THIS PHASE.
2. THE STORM DRAIN SYSTEM MAY BE INSTALLED PRIOR TO THE ROADWAY CONSTRUCTION USING LANE CLOSURES AND FLAGGING. FLOWS TO THE PROPOSED MICRO-BIORETENTION SHALL BE BLOCKED UNTIL THE MICRO-BIORETENTION FACILITIES ARE STABILIZED.
3. CONSTRUCT ROADWAY IN ITS ENTIRETY AS SHADED. THE DARKER SHADED AREA MAY BE CONSTRUCTED WITH THE ROAD CLOSURE & DETOUR PLAN AS PART OF PHASE I. THE BALANCE MAY BE CONSTRUCTED USING LANE CLOSURES AND FLAGGING TO REDUCE THE TIME OF ROAD CLOSURE AND DETOUR.
4. REFER TO SHEET 15 FOR ADDITIONAL DETOUR SIGNS AND DETOUR PLAN.
5. ACCESS TO PRIVATE PROPERTIES WITHIN LIMITS OF WORK SHALL BE MAINTAINED AT ALL TIMES. THRU-TRAFFIC SHALL BE PROHIBITED DURING THE TIMES OF ROAD CLOSURE.

PROFESSIONAL CERTIFICATION
 "I HEREBY CERTIFY THAT DOCUMENTS WERE PREPARED OR APPROVED BY ME, AND THAT I AM A DULY LICENSED PROFESSIONAL ENGINEER UNDER THE LAWS OF THE STATE OF MARYLAND.
 LICENSE NO. 16156
 EXPIRATION DATE: 8/28/2018

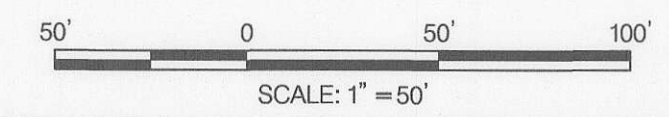

DEPARTMENT OF PUBLIC WORKS
 HOWARD COUNTY, MARYLAND

M. Meunier 1/23/2018
 CHIEF, BUREAU OF HIGHWAYS DATE

Roman & Butler 1/22/18
 CHIEF, BUREAU OF ENGINEERING DATE

Ray H. 1/23/18
 DIRECTOR OF PUBLIC WORKS DATE

Gregory J. 1/22/18
 CHIEF, TRANSPORTATION AND SPECIAL PROJECTS DIVISION DATE



DES:	RL			
DRN:	BJK			
CHK:	DTM			
DATE:	12/17			
BY	NO.	REVISION	DATE	

**MAINTENANCE OF TRAFFIC PLAN
 PHASE II**

SCALE MAP NO. 35 BLOCK NO. 19

**HALL SHOP ROAD AT
 BROWNS BRIDGE ROAD**

ELECTION DISTRICT NO. 5
 CAPITAL PROJECT J-4164

SCALE
 1"=50'

SHEET
 16 OF 21

Project Name: Hall Shop Road at Browns Bridge Road					Borehole No.: SWM-1					
Project Number: 20834588.00000					Location: Clarksville, Md					
Date Started: 2-20-13			Date Completed: 2-20-13		Driller: Andrew McCallister					
Drilling Company: TLB Associates, INC.					Elevation: 477		Sheet 1 of 1			
North: 549428.616			East: 1328458.71		Station:		Offset:			
Depth:	Sample No.	Blow Count:	Recovery:	Sampled:	Description:	Graphic Log	USCS:	Remarks:		
								Top Soil 3"		
	B-1	1-3-3-5	10"		Brown CLAY, with sand, trace mica, moist, soft.		CL			
				2						
	B-2	5-12-10-7	12"		Brown SILT, with sand, moist, stiff.		ML			
				4						
5	B-3	5-5-6-8	15"		Tan brown SAND, with silt, moist, medium dense.		SM			
				6						
	B-4	10-11-9-11	12"		White and orange, Silty SAND, moist, medium dense.		SM			
				8						
	B-5	5-5-7-7	15"							
				10				Boring caved at 3' at completion Dry at completion		
4 North Park Drive, Suite 300 Hunt Valley, MD 21030 Tel: (410)785-7220 Fax: (410)785-8818					Inspected By: Peter Daloni Signature:					

Project Name: Hall Shop Road at Browns Bridge Road					Borehole No.: SWM-2					
Project Number: 20834588.00000					Location: Clarksville, Md					
Date Started: 2-20-13			Date Completed: 2-20-13		Driller: Andrew McCallister					
Drilling Company: TLB Associates, INC.					Elevation: 477		Sheet 1 of 1			
North: 549400.907			East: 1328487.766		Station:		Offset:			
Depth:	Sample No.	Blow Count:	Recovery:	Sampled:	Description:	Graphic Log	USCS:	Remarks:		
								Top Soil 3"		
	B-1	1-1-3-3	15"		Brown SILT, trace sand, some clay, moist, soft.		ML			
				2						
	B-2	4-7-9-12	18"		Brown SILT, some sand, moist, medium stiff.		ML			
				4						
5	B-3	4-7-9-9	10"		Tan brown Sandy SILT, moist, stiff.		ML			
				6						
	B-4	9-9-9-9	20"		Grey and brown, Silty SAND, moist, medium dense.		SM			
				8						
	B-5	5-4-5-3	18"		White coarse SAND, some silt, moist, loose.		SM			
				10				Boring caved at 3' at completion Dry at completion		
4 North Park Drive, Suite 300 Hunt Valley, MD 21030 Tel: (410)785-7220 Fax: (410)785-8818					Inspected By: Peter Daloni Signature:					

PROFESSIONAL CERTIFICATION
 "I HEREBY CERTIFY THAT DOCUMENTS WERE PREPARED OR APPROVED BY ME, AND THAT I AM A DULY LICENSED PROFESSIONAL ENGINEER UNDER THE LAWS OF THE STATE OF MARYLAND.
 LICENSE NO. 16156
 EXPIRATION DATE: 8/28/2018


DEPARTMENT OF PUBLIC WORKS
 HOWARD COUNTY, MARYLAND

Michael J. ... 1/23/18
 CHIEF BUREAU OF HIGHWAYS DATE

Thomas E. ... 1/23/18
 CHIEF, BUREAU OF ENGINEERING DATE

... 1/23/18
 CHIEF, TRANSPORTATION AND SPECIAL PROJECTS DIVISION DATE

... 1-10-18
 DIRECTOR OF PUBLIC WORKS DATE

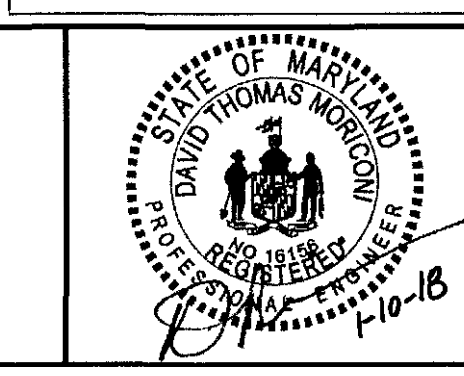

DES:	RLI				
DRN:	BJK				
CHK:	DTM				
DATE:	12/17				
BY:	NO.				
REVISION					
DATE					


SOIL BORING LOGS

SCALE MAP NO. 35 BLOCK NO. 19

HALL SHOP ROAD AT
 BROWNS BRIDGE ROAD

ELECTION DISTRICT NO. 5
 CAPITAL PROJECT J-4164

SCALE N.T.S.
 SHEET 17 OF 21

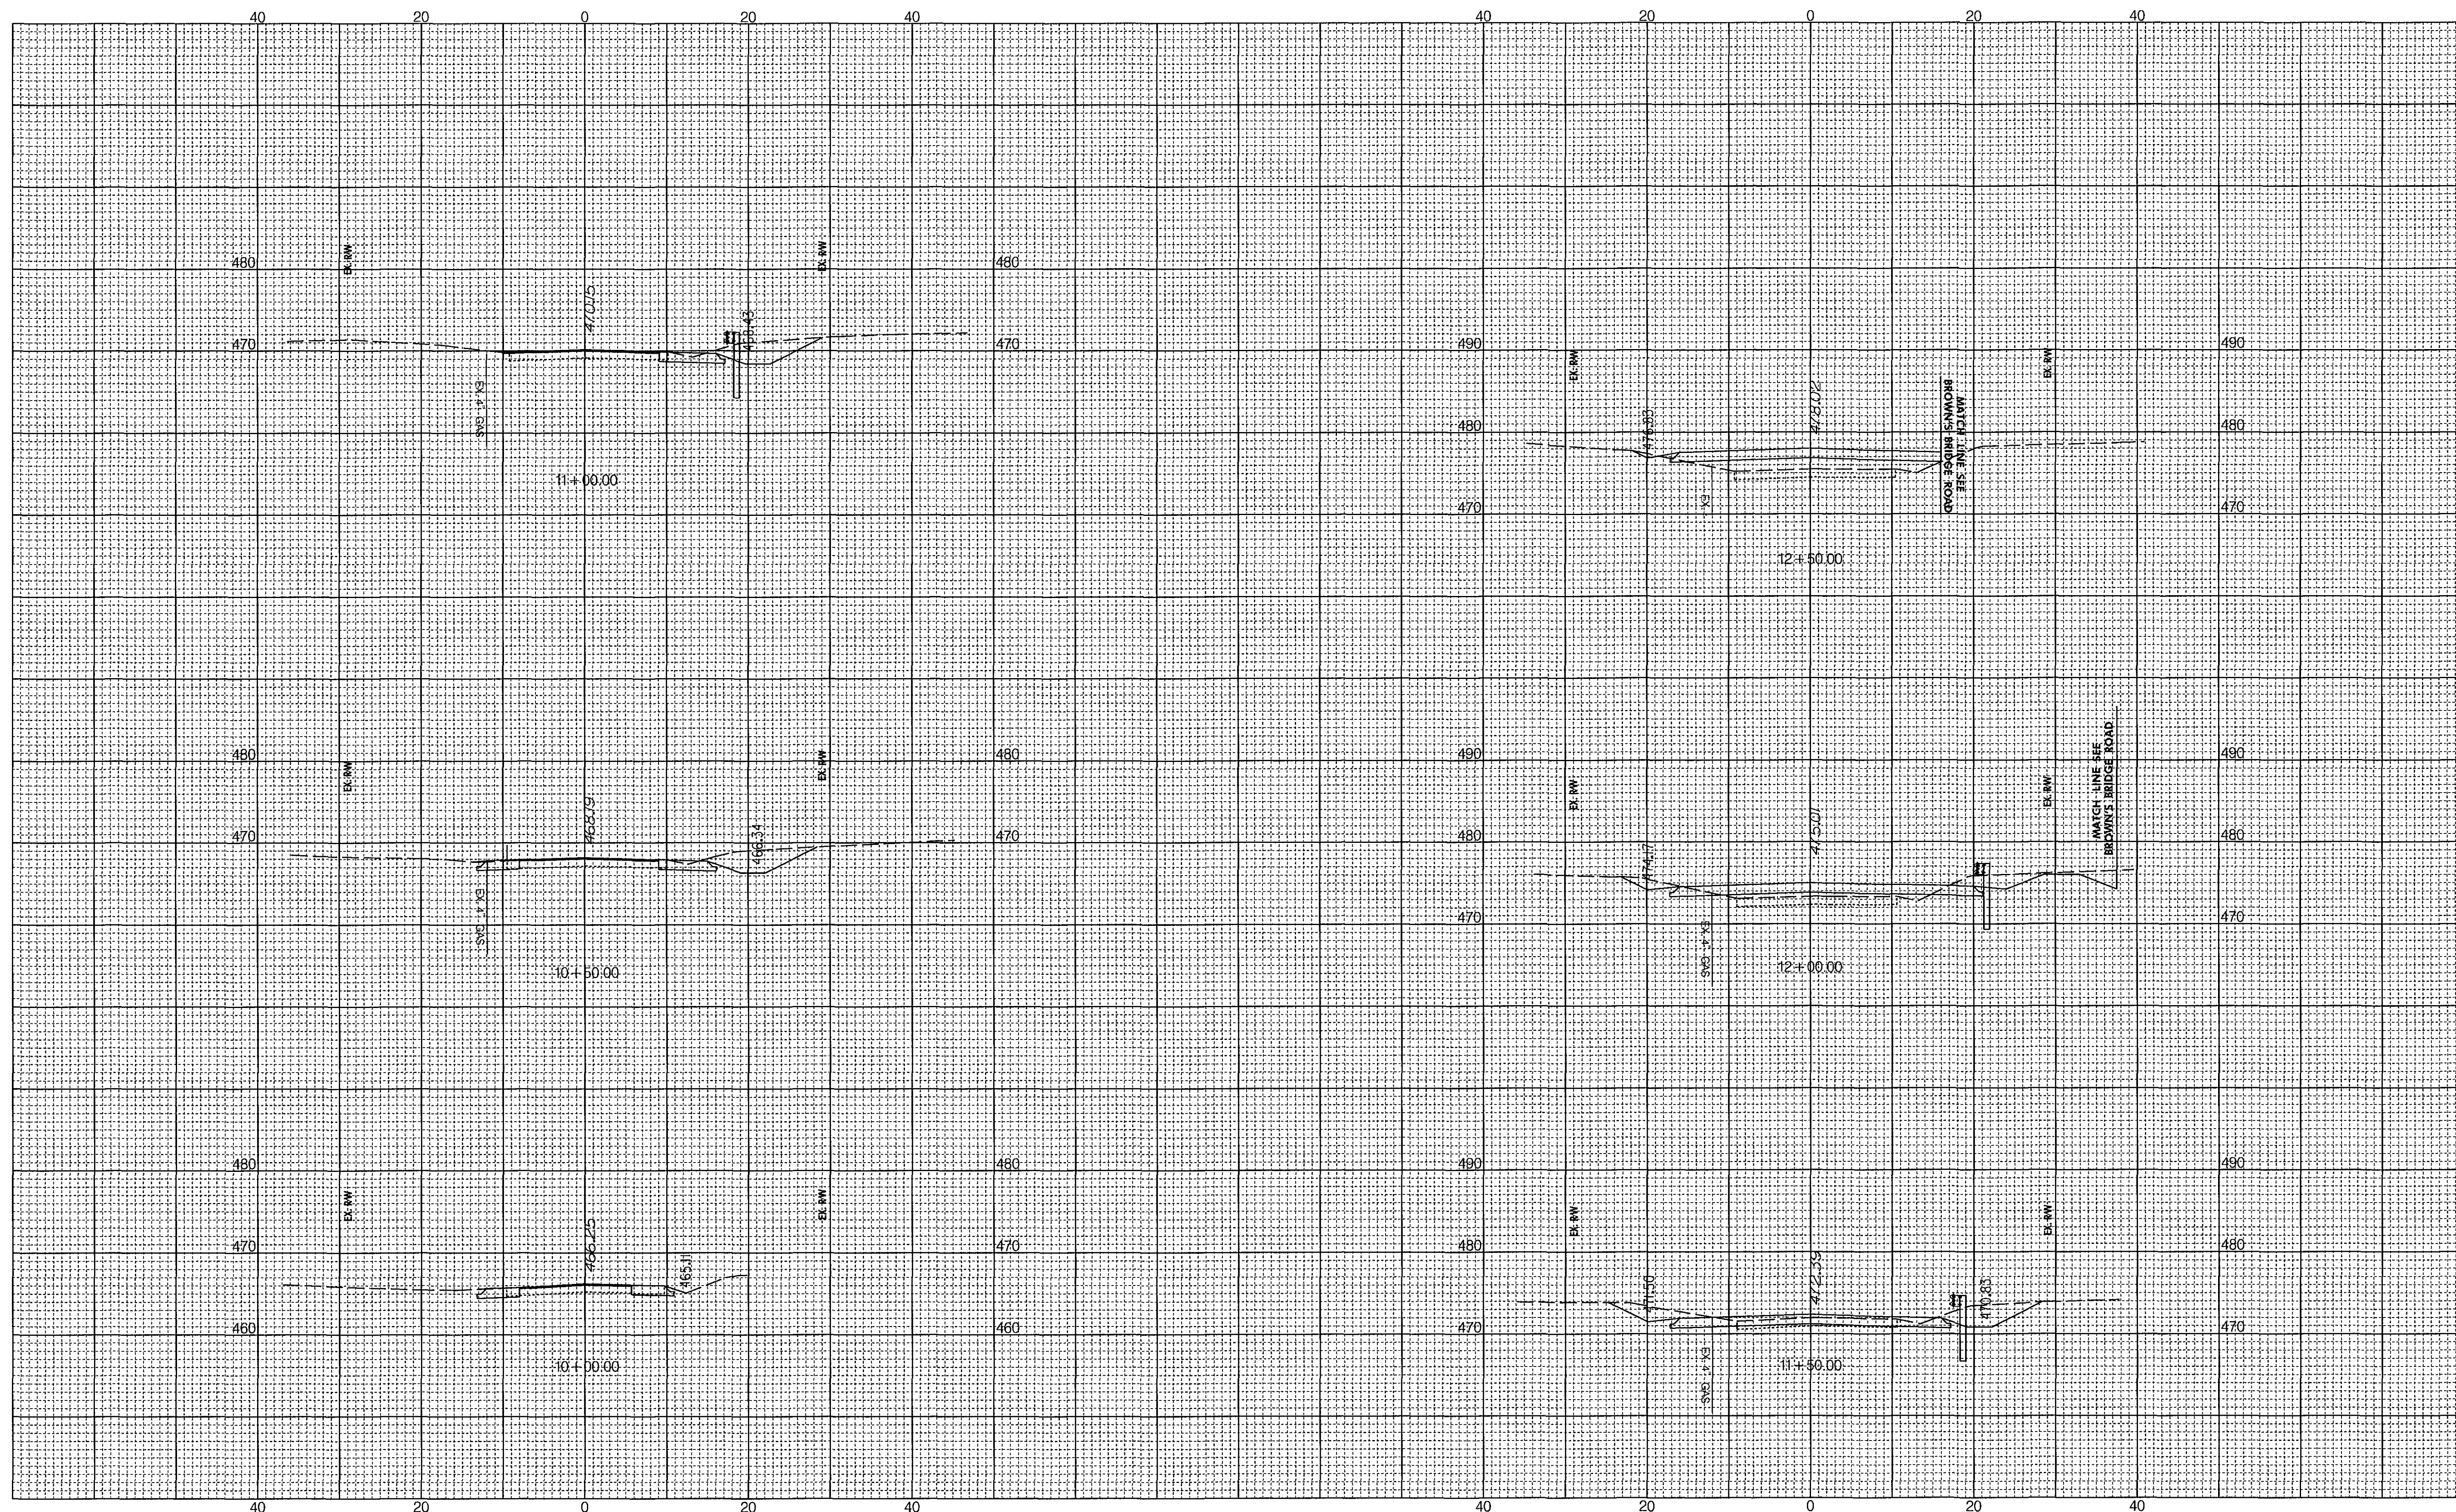

HALL SHOP ROAD

Professional Certification. I hereby certify that these documents were prepared or approved by me, and that I am a duly licensed professional engineer under the laws of the State of Maryland.
 License No. 16156, Expiration Date 8-28-18

DEPARTMENT OF PUBLIC WORKS
 HOWARD COUNTY, MARYLAND

CHIEF, BUREAU OF HIGHWAYS
M. Merino 1/23/2018
 DATE

CHIEF, BUREAU OF ENGINEERING
James E. Butler 1/23/18
 DATE

CHIEF, TRANSPORTATION AND SPECIAL PROJECTS DIVISION
Ken J. R. 1/23/18
 DATE

DIRECTOR OF PUBLIC WORKS
 DATE




DES:	RLI			
DRN:	BJK			
CHK:	DTM			
DATE:	10/17			
BY	NO.	REVISION	DATE	

CROSS SECTIONS
 STA. 10+00.00 TO 12+50.00

HALL SHOP ROAD AT
 BROWNS BRIDGE ROAD
 ELECTION DISTRICT NO. 5
 CAPITAL PROJECT J-4164

SCALE MAP NO. 35 BLOCK NO. 19

SCALE
 H 1"=10'
 V 1"=10'
 SHEET
 1B OF 21

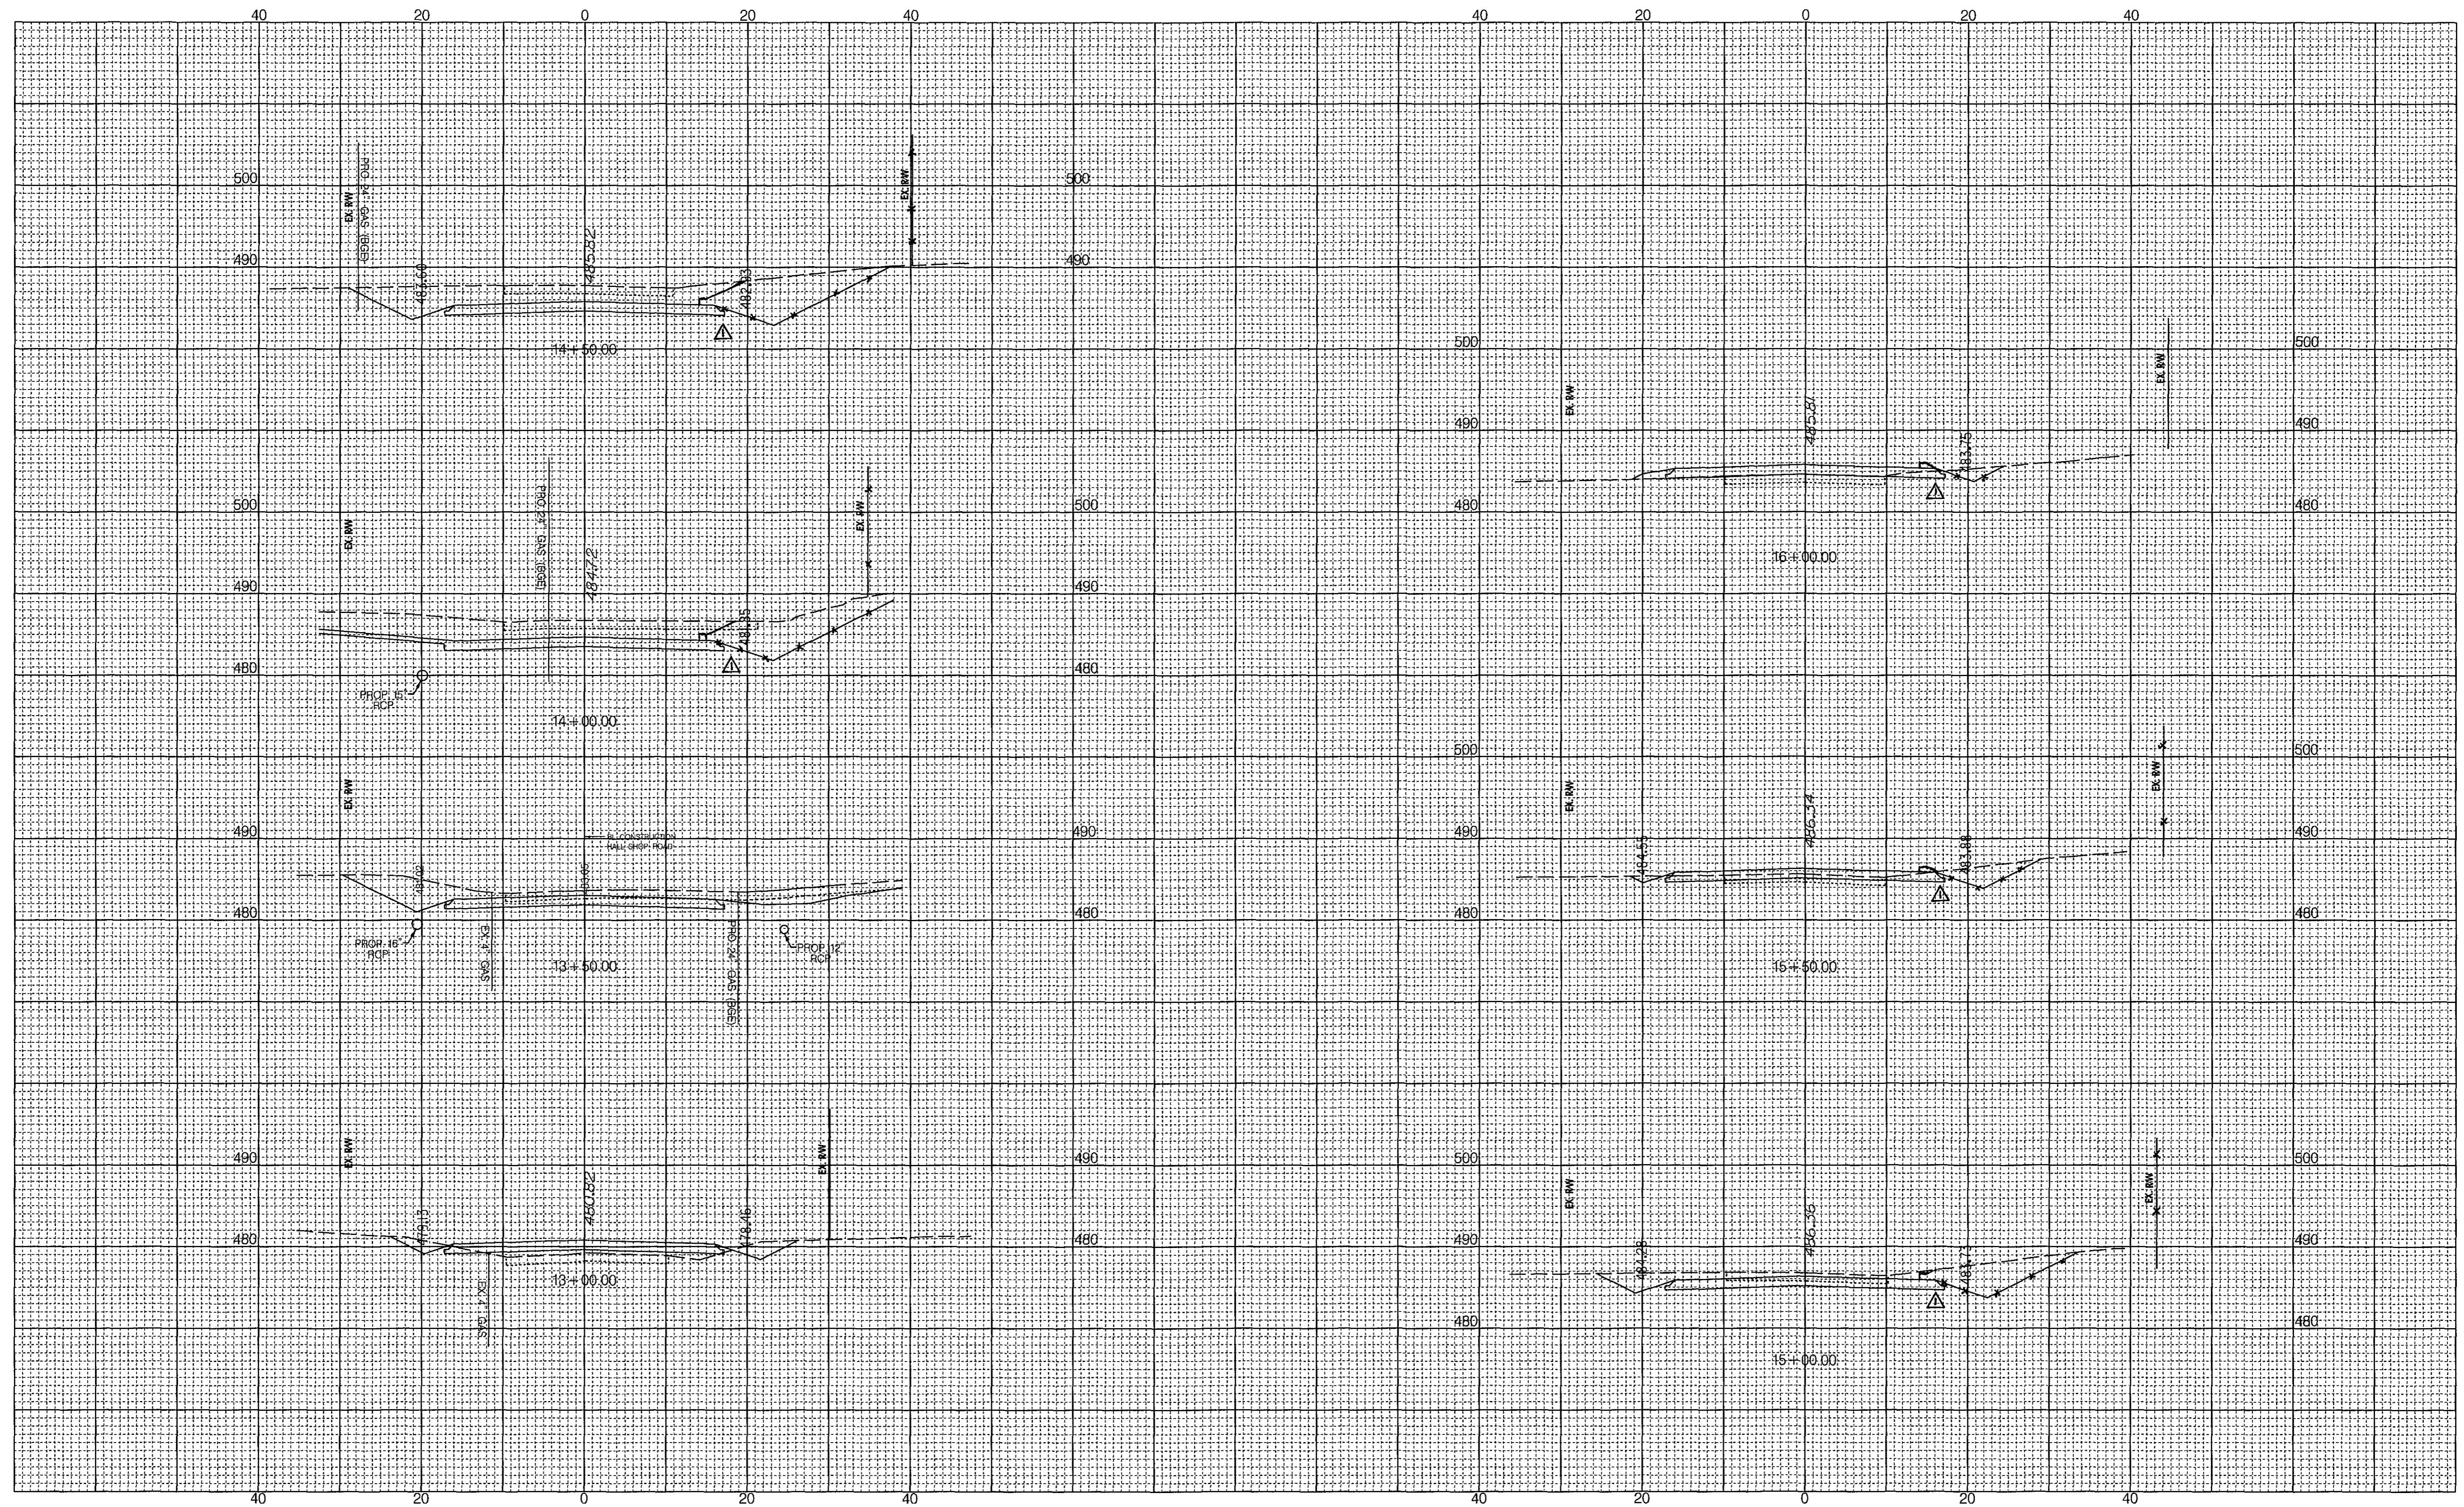

Professional Certification. I hereby certify that these documents were prepared or approved by me, and that I am a duly licensed professional engineer under the laws of the State of Maryland.
 License No. 16156 Expiration Date: 8-28-18-20

HALL SHOP ROAD


DEPARTMENT OF PUBLIC WORKS
 HOWARD COUNTY, MARYLAND

M. Williams 1/23/18
 CHIEF BUREAU OF HIGHWAYS DATE

Thomas S. Keller 1/23/18
 CHIEF, BUREAU OF ENGINEERING DATE

Redmond 1/23/18
 CHIEF, TRANSPORTATION AND SPECIAL PROJECTS DIVISION DATE

John R. 1/23/18
 DIRECTOR OF PUBLIC WORKS DATE

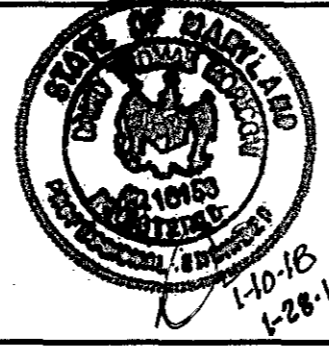


DES: RLL	
DRN: BJK	
CHK: DTM	
DATE: 10/17	
DRM BY: NO.	AS-BUILT
REVISION	
DATE: 1-28-19	

CROSS SECTIONS
 STA. 13+00.00 TO 16+00.00

HALL SHOP ROAD AT
 BROWNS BRIDGE ROAD
 ELECTION DISTRICT NO. 5
 CAPITAL PROJECT J-4164

SCALE
 H 1"=1'
 V 1"=1'
 SHEET
 19 OF 2

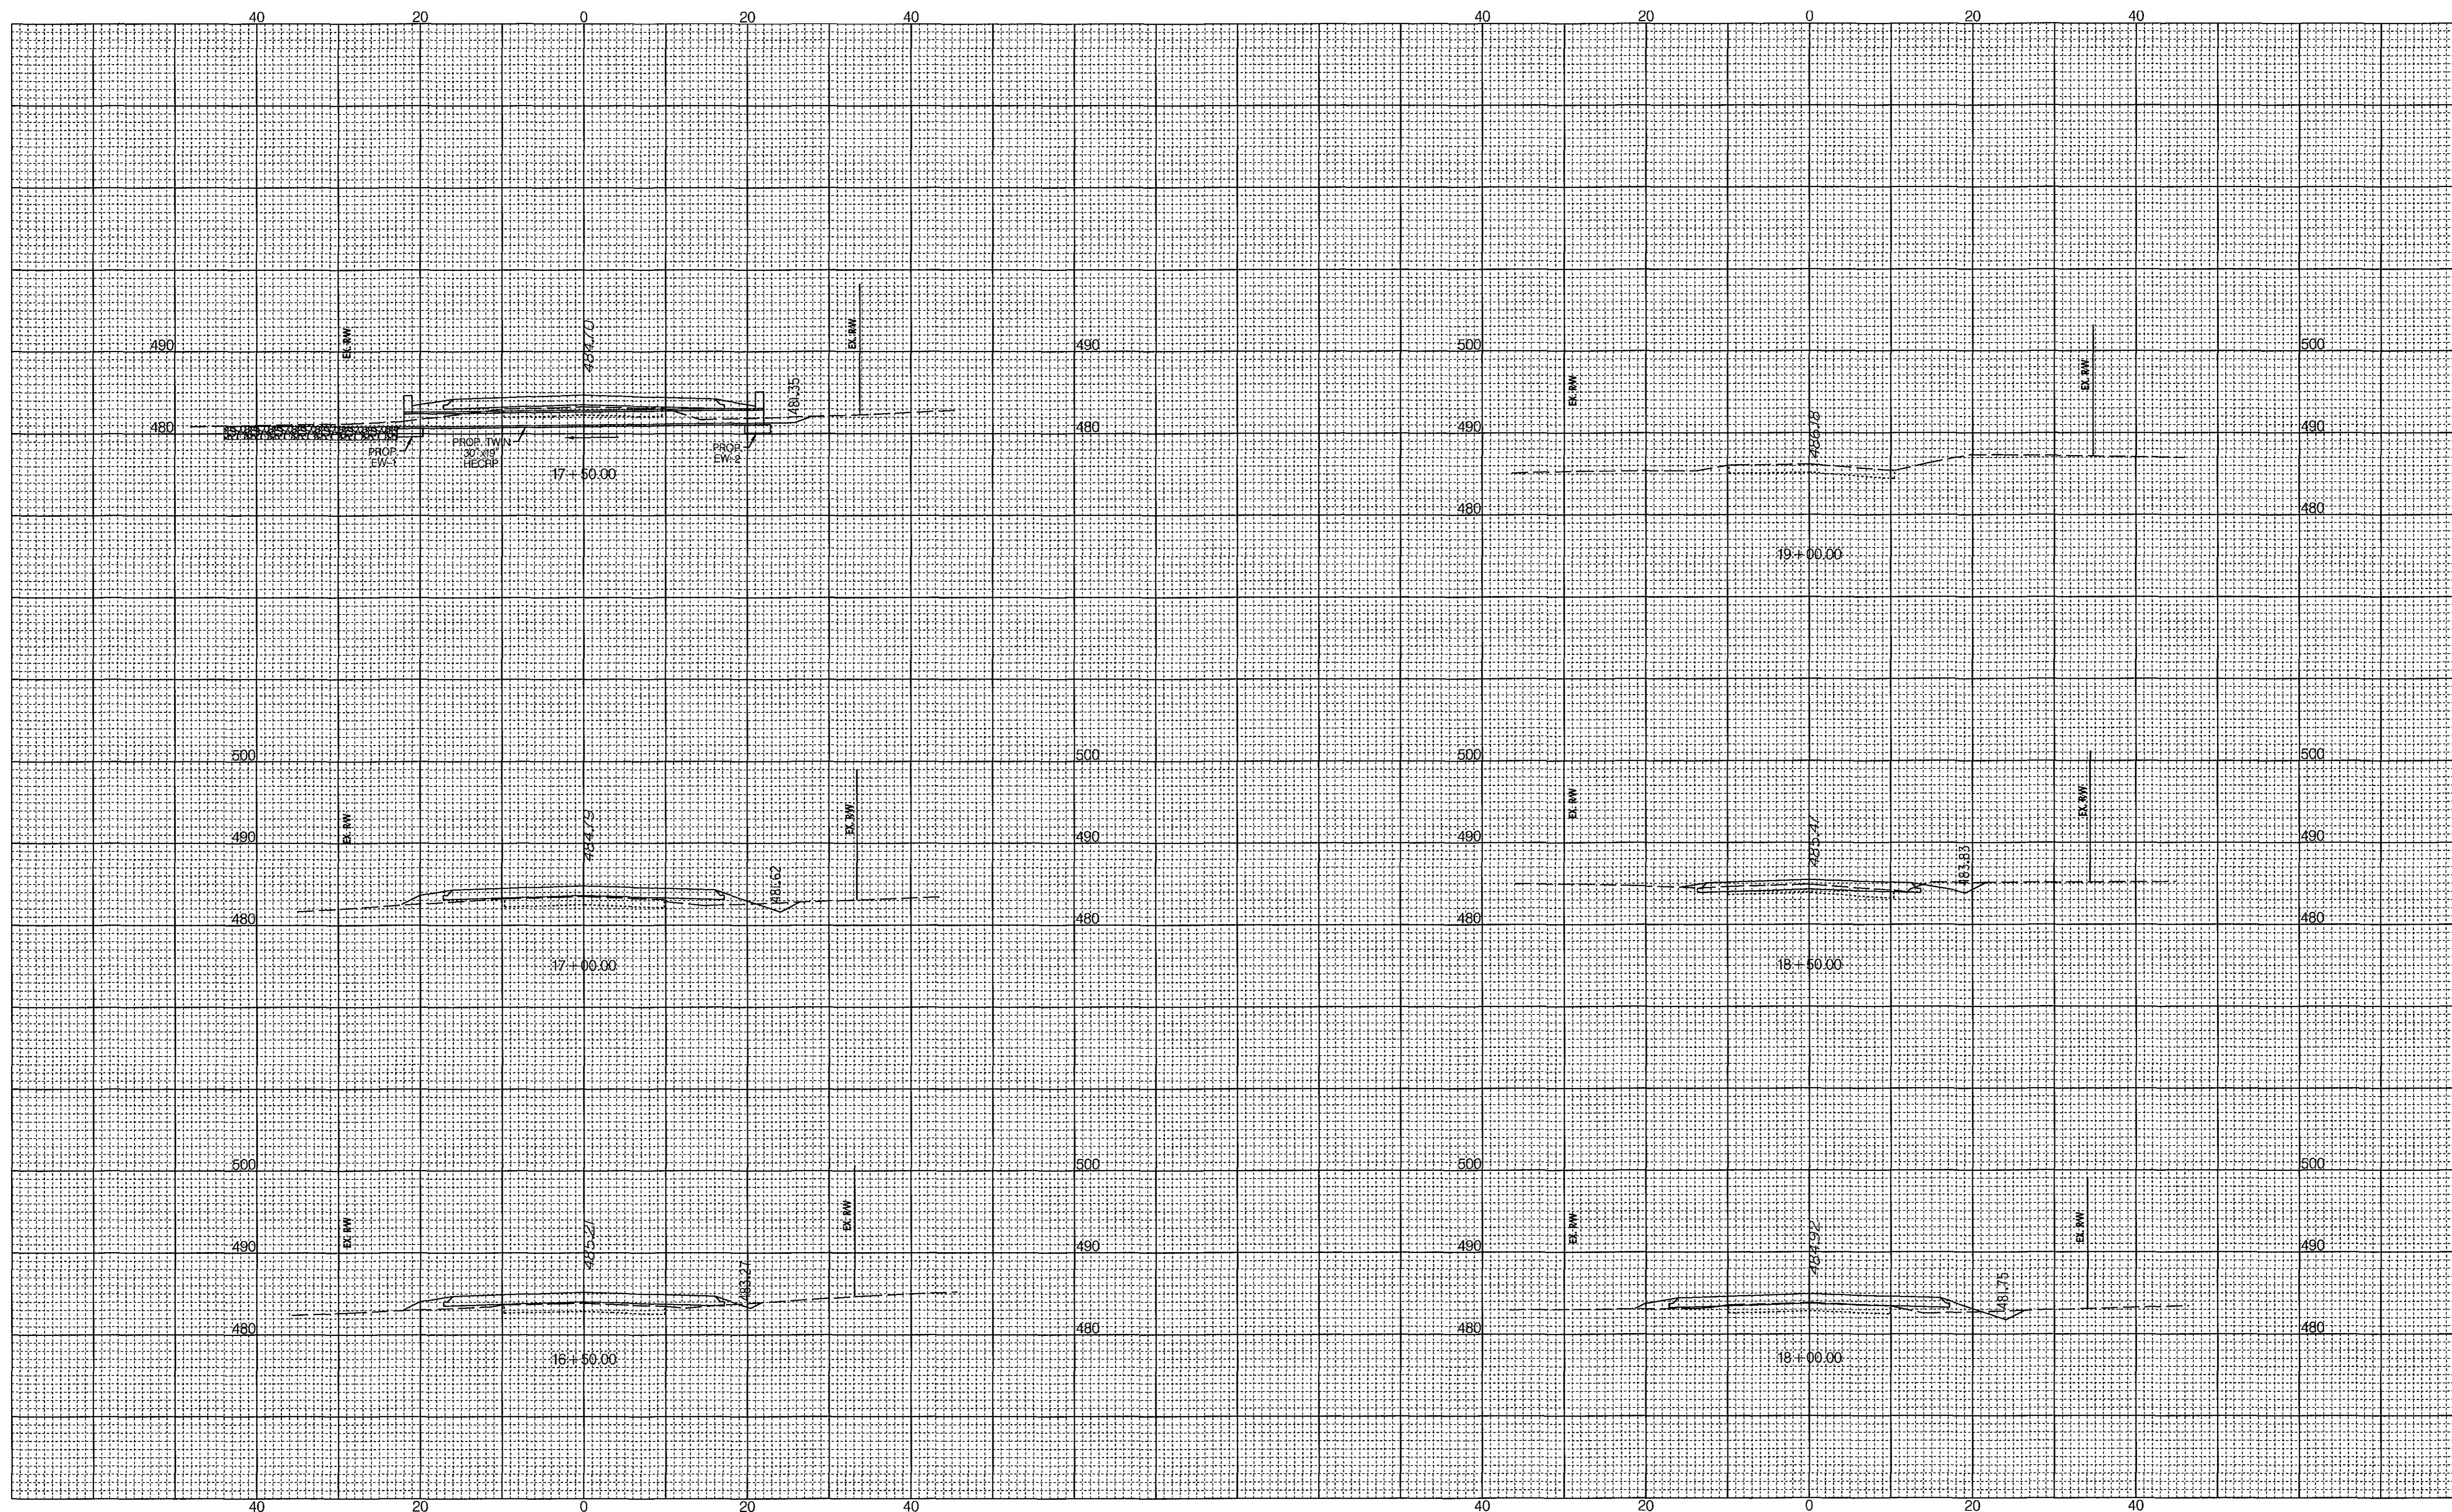

HALL SHOP ROAD

Professional Certification. I hereby certify that these documents were prepared or approved by me, and that I am a duly licensed professional engineer under the laws of the State of Maryland.
 License No. 16156, Expiration Date 8-28-18


DEPARTMENT OF PUBLIC WORKS
 HOWARD COUNTY, MARYLAND

Michael J. ... 1/23/2018
 CHIEF, BUREAU OF HIGHWAYS DATE

James R. ... 1/23/18
 CHIEF, BUREAU OF ENGINEERING DATE

James R. ... 1/23/18
 DIRECTOR OF PUBLIC WORKS DATE

PREPARED BY
URS
 4 NORTH PARK DRIVE
 HUNT VALLEY, MARYLAND
 TEL: (410) 785-7220

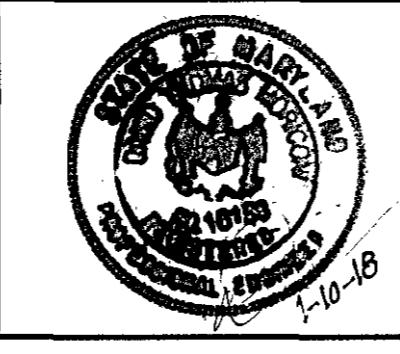

DES: RLL			
DRN: BJK			
CHK: DTM			
DATE: 10/17			
BY	NO.	REVISION	DATE

CROSS SECTIONS
 STA. 16+50.00 TO 19+00.00


SCALE MAP NO. 35 BLOCK NO. 19

HALL SHOP ROAD AT
 BROWNS BRIDGE ROAD

ELECTION DISTRICT NO. 5
 CAPITAL PROJECT J-4164

SCALE
 H 1"=10'
 V 1"=10'

SHEET
 20 OF 21

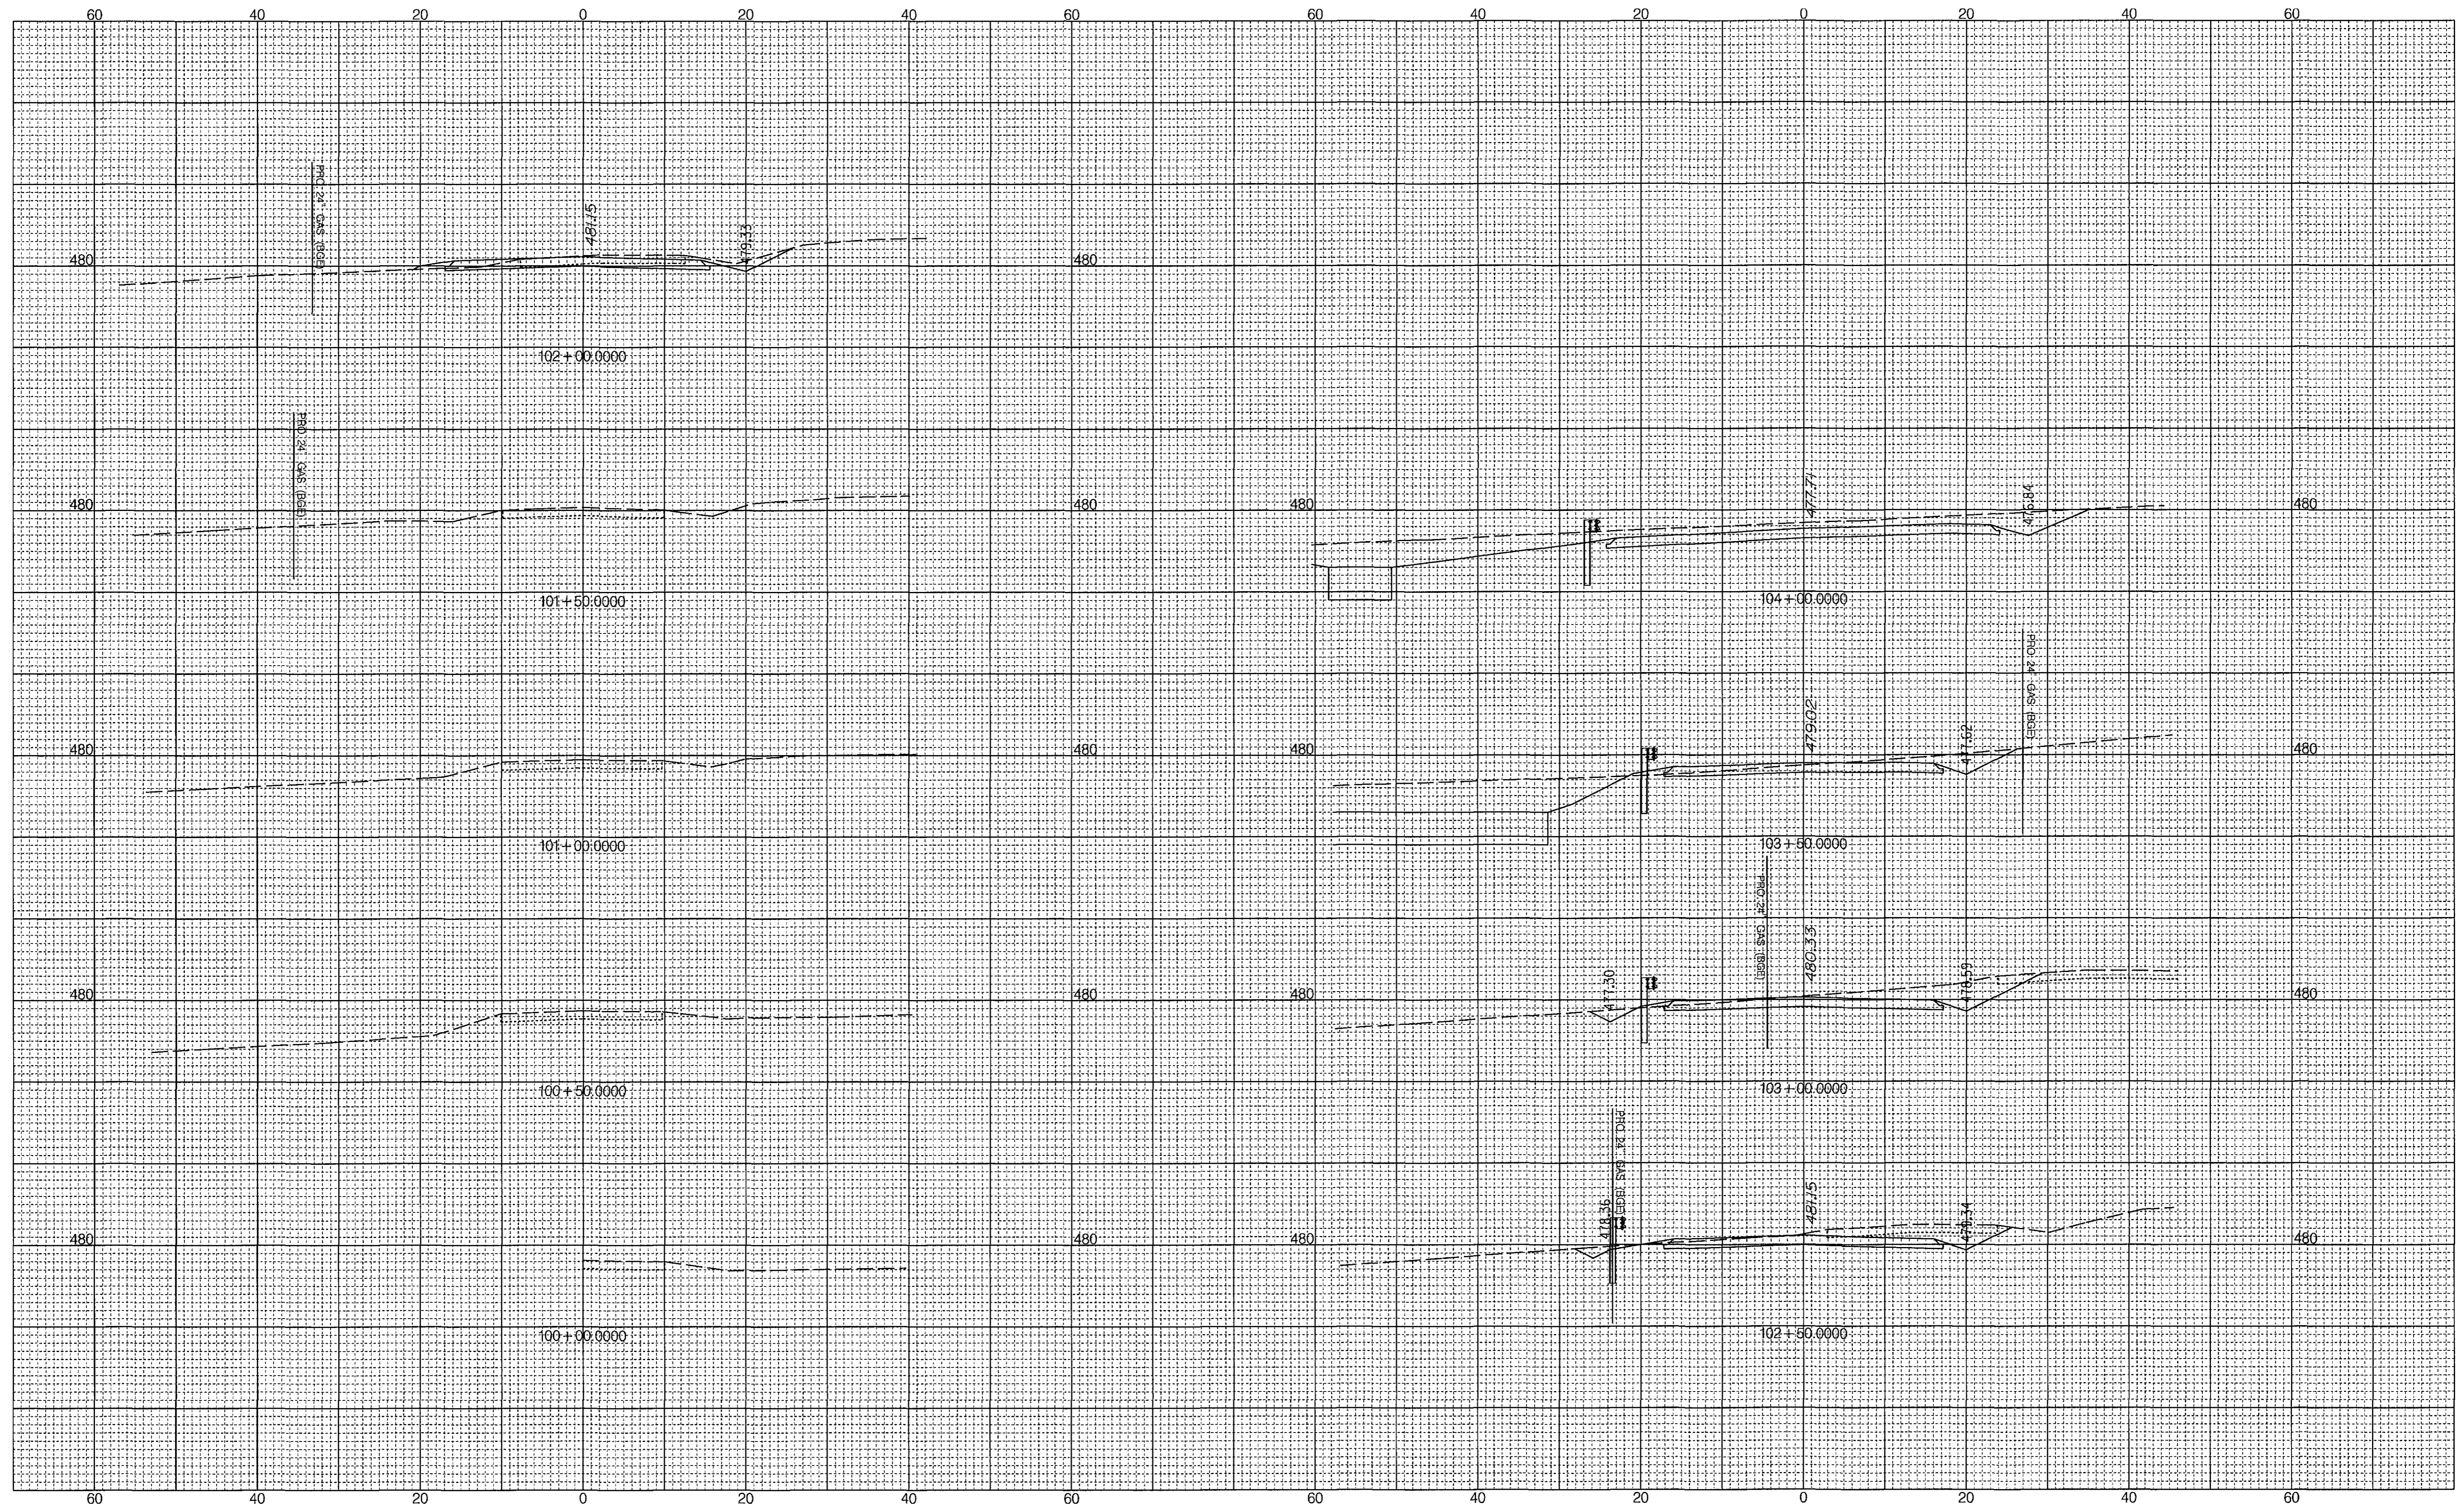

BROWN'S BRIDGE ROAD

Professional Certification. I hereby certify that these documents were prepared or approved by me, and that I am a duly licensed professional engineer under the laws of the State of Maryland.
 License No. 16156, Expiration Date: 9-28-18

DEPARTMENT OF PUBLIC WORKS
 HOWARD COUNTY, MARYLAND

CHIEF, BUREAU OF HIGHWAYS: *M. M. Butler* 1/23/18
 CHIEF, BUREAU OF ENGINEERING: *M. M. Butler* 1/23/18
 CHIEF, TRANSPORTATION AND SPECIAL PROJECTS DIVISION: *J. J. K.* 1/23/18
 DIRECTOR OF PUBLIC WORKS: *J. J. K.* 1/23/18

PREPARED BY
URS
 4 NORTH PARK DRIVE
 HUNT VALLEY, MARYLAND
 TEL: (410) 785-7220



DES: RLL		
DRN: BJK		
CHK: DTM		
DATE: 10/17		
BY	NO.	REVISION
		DATE

CROSS SECTIONS
 STA. 100+00.00 TO 104+00.00

SCALE MAP NO. 35 BLOCK NO. 19

HALL SHOP ROAD AT
 BROWNS BRIDGE ROAD

ELECTION DISTRICT NO. 5
 CAPITAL PROJECT J-4164

SCALE
 1"=10'

SHEET
 21 OF 21