



# Howard County, Maryland - Department of Public Works

## McKENZIE ROAD ROADWAY AND STORMDRAIN IMPROVEMENTS


### CAPITAL PROJECT NO. J-4164-10

#### INDEX OF SHEETS

- TITLE SHEET
- TYPICAL SECTIONS AND DETAILS
- SPEED TABLE
- GEOMETRIC LAYOUT SHEET GS-1
- GEOMETRIC LAYOUT SHEET GS-2
- CURB GEOMETRY SHEET
- PLAN SHEET PS-1
- PLAN SHEET PS-2
- PLAN SHEET PS-3
- PLAN SHEET PS-4
- PROFILE SHEET
- EROSION AND SEDIMENT CONTROL GENERAL NOTES 1
- EROSION AND SEDIMENT CONTROL GENERAL NOTES 2
- EROSION AND SEDIMENT CONTROL PLAN SHEET EP-1
- EROSION AND SEDIMENT CONTROL PLAN SHEET EP-2
- EROSION AND SEDIMENT CONTROL PLAN SHEET EP-3
- EROSION AND SEDIMENT CONTROL PLAN SHEET EP-4
- STORMDRAIN PROFILE PP-1
- STORMDRAIN PROFILE PP-2
- MINI-ROUNDBOUT MARKING AND SIGNING PLAN
- TRAFFIC CONTROL GENERAL NOTES AND SIGN LEGEND
- TRAFFIC CONTROL PLAN SHEET TP-1: STAGE 1
- TRAFFIC CONTROL PLAN SHEET TP-2: STAGE 2
- TRAFFIC CONTROL PLAN SHEET TP-3: (THORNBROOK ROAD INTERSECTION)


#### NOTE:

\*EROSION AND SEDIMENT CONTROL WILL BE STRICTLY ENFORCED\*

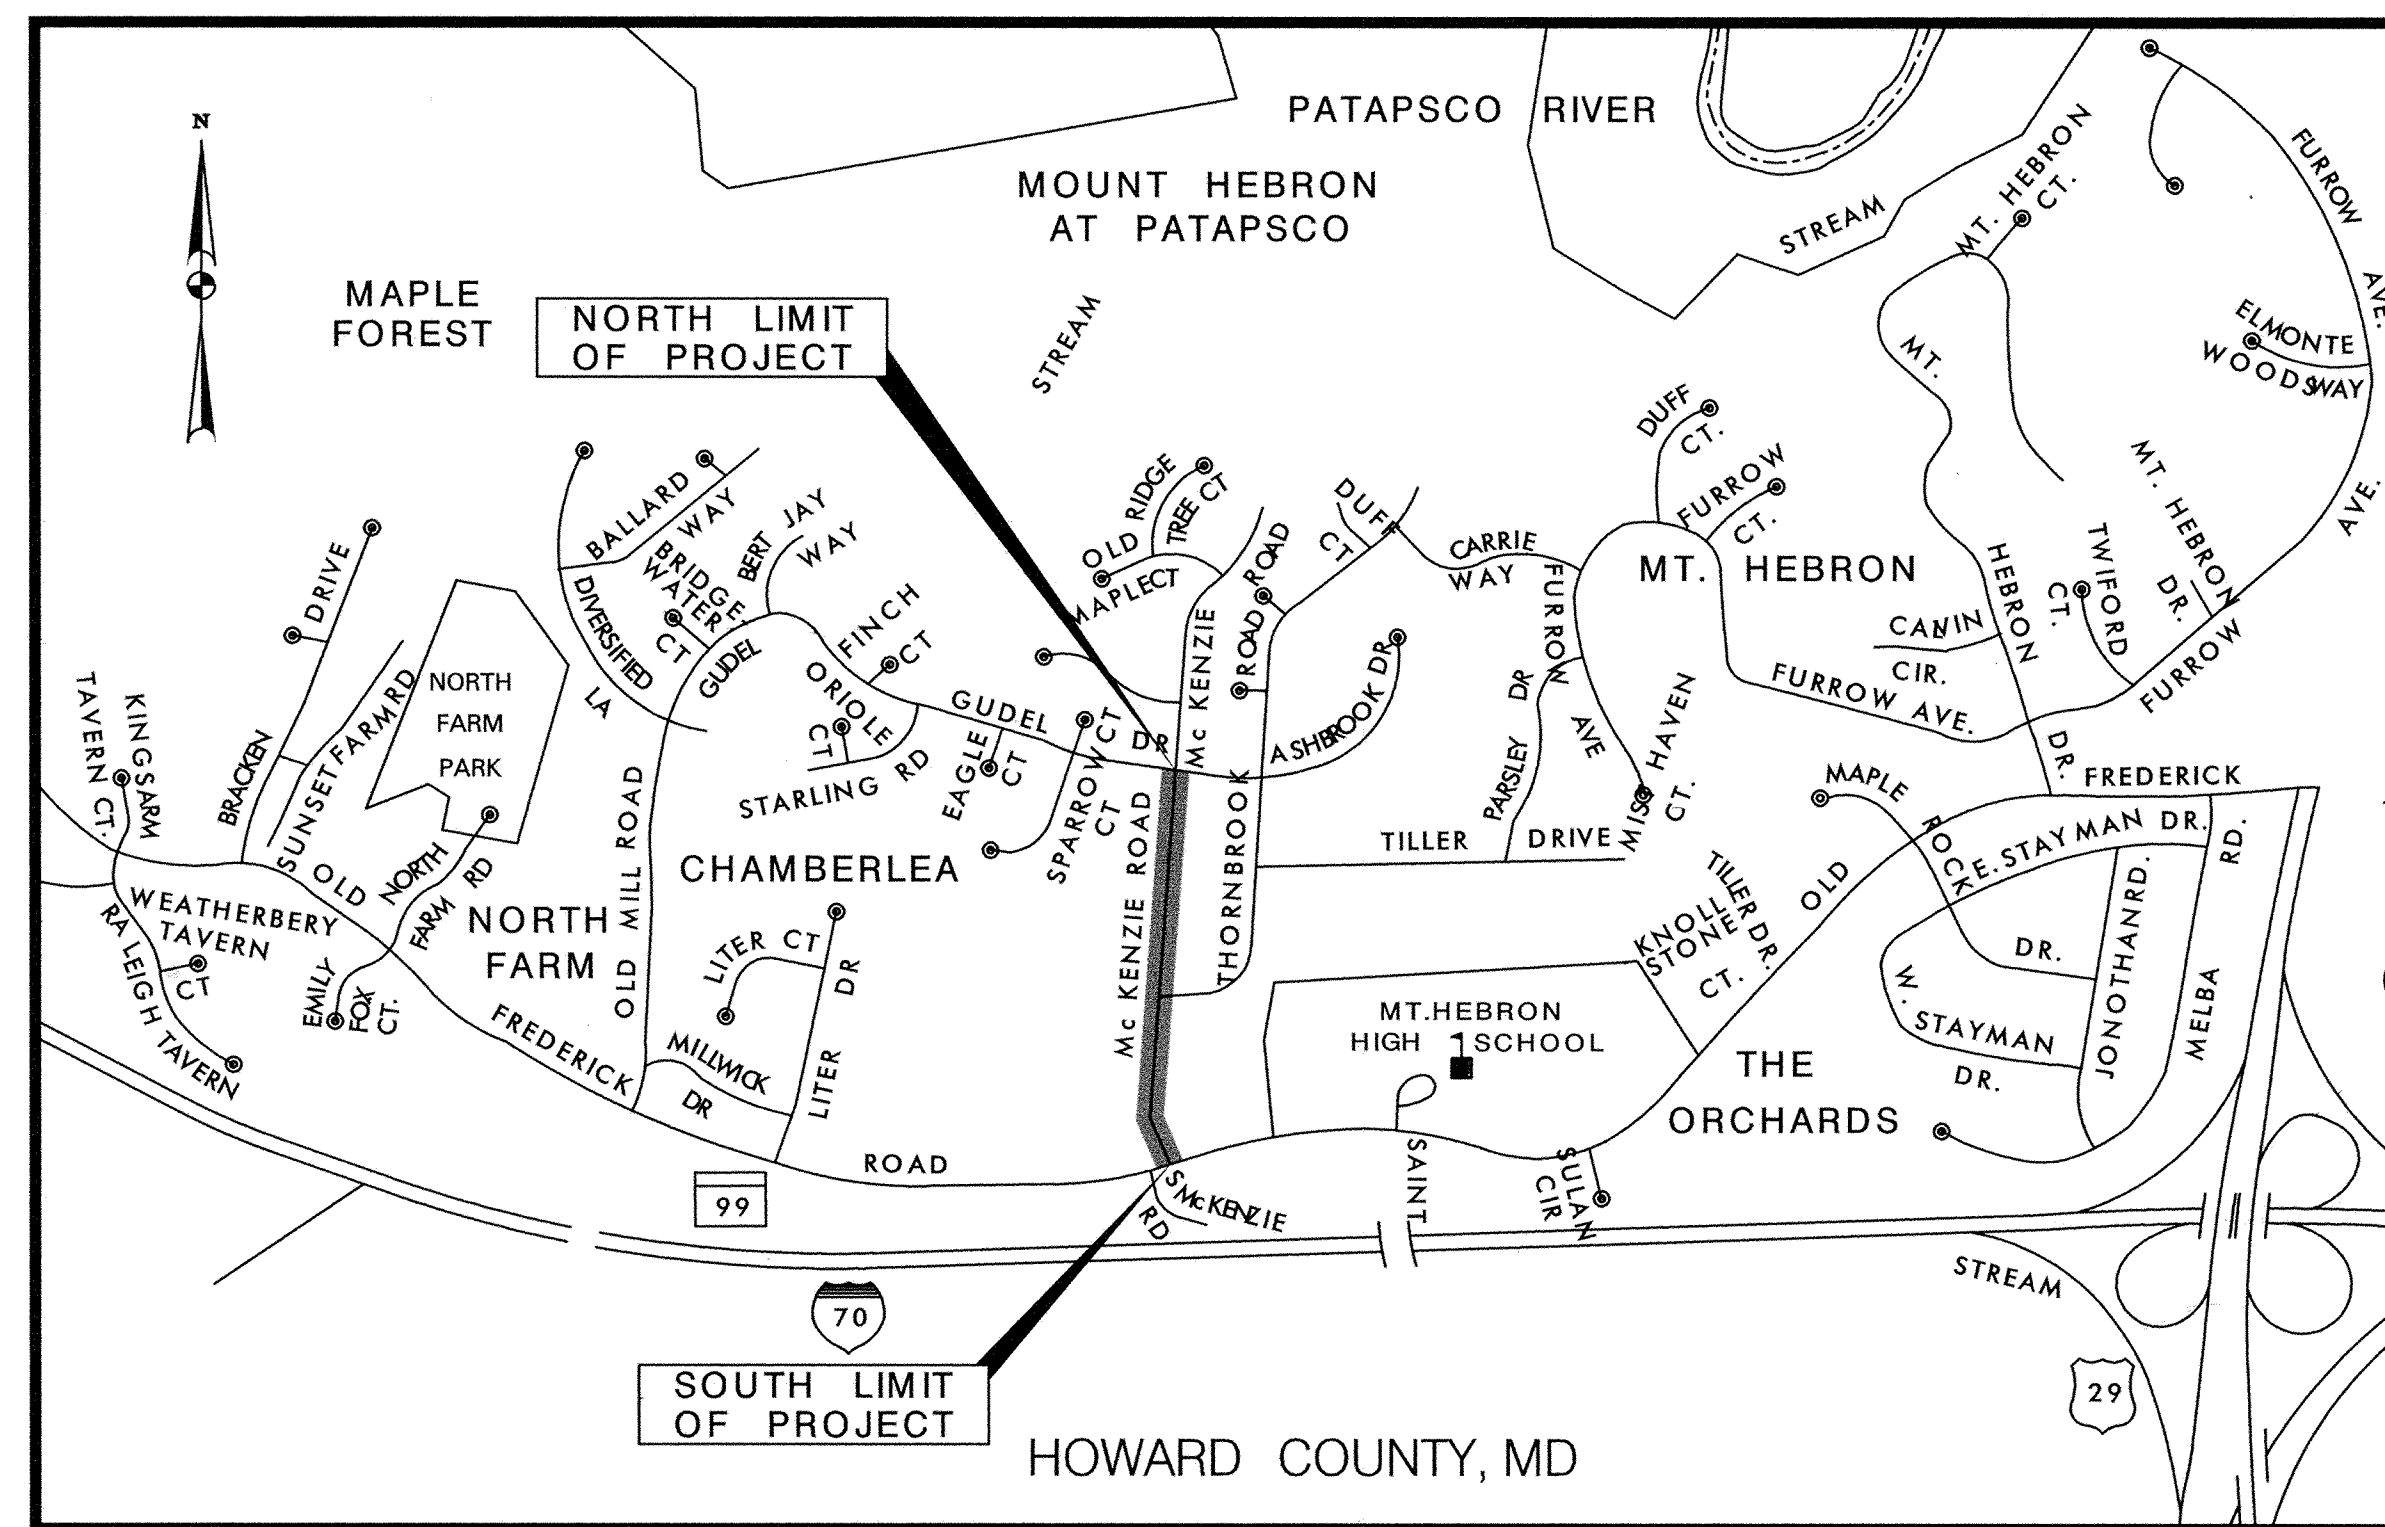

PROJECT LENGTH: 0.40 MILES

SCALE: 1" = 1000'

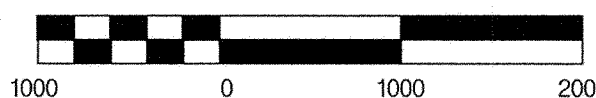

#### CONVENTIONAL SIGNS

|                                      |  |                     |  |
|--------------------------------------|--|---------------------|--|
| PROPOSED MEDIAN BARRIER              |  | PROPOSED CULVERT    |  |
| ELECTRICAL HAND BOX - SIGNALS        |  | EXISTING CULVERT    |  |
| BURIED UTILITY LINES & NO. OF CABLES |  | EXISTING DROP INLET |  |
| STATE, COUNTY OR CITY LINES          |  | UTILITY POLE        |  |
| PROPOSED TRAFFIC BARRIER             |  | MARSH               |  |
| EXISTING TRAFFIC BARRIER             |  | HEDGE               |  |
| FENCE LINE                           |  | GROUND ELEVATION    |  |
| RIGHT OF WAY LINE                    |  | GRADE ELEVATION     |  |
| EXISTING ROADWAY                     |  | CUT LIMIT           |  |
| RAILROAD                             |  | FILL LIMIT          |  |
| BASE OR SURVEY LINE                  |  |                     |  |
| FIRE HYDRANT                         |  |                     |  |


#### GENERAL NOTES

- ALL STATIONING AND DIMENSIONING ARE TO BE FIELD VERIFIED BY THE CONTRACTOR.
- APPROXIMATE LOCATIONS OF EXISTING UTILITIES ARE SHOWN. THE CONTRACTOR SHALL TAKE ALL NECESSARY PRECAUTIONS TO PROTECT EXISTING UTILITIES AND TO MAINTAIN UNINTERRUPTED SERVICE. ANY DAMAGE INCURRED SHALL BE REPAIRED IMMEDIATELY TO THE SATISFACTION OF THE HOWARD COUNTY ENGINEER BY THE CONTRACTOR AND AT THE CONTRACTOR'S EXPENSE. CONTRACTOR SHALL NOTIFY THE FOLLOWING UTILITIES OR AGENCIES AT LEAST FIVE WORKING DAYS BEFORE STARTING WORK SHOWN ON THESE PLANS:
  - MISS UTILITY 1-800-257-7777
  - CONSTRUCTION INSPECTION DIVISION, HOWARD COUNTY 410-313-1880
  - STATE HIGHWAY ADMINISTRATION DISTRICT 7- 301-624-8100
  - BALTIMORE GAS & ELECTRIC COMPANY - UNDERGROUND ELECTRIC 410-855-6958
  - BALTIMORE GAS & ELECTRIC COMPANY - GAS ENGINEERING AND CONSTRUCTION 410-291-5834
  - DISTRIBUTION CUSTOMER SERVICE 685-0123
  - ENGINEERING DAMAGE CONTROL 234-5621
  - BELL ATLANTIC TELEPHONE 1-800-870-0000
  - AMERICAN TELEPHONE & TELEGRAPH CABLE LOCATION DIVISION 393-3553
  - COLONIAL PIPELINE COMPANY 781-4641
  - BUREAU OF UTILITIES, HOWARD COUNTY 410-313-4900
  - COMCAST CABLE 888-793-1800
- THE CONTRACTOR SHALL CONTACT THE HOWARD COUNTY CONSTRUCTION INSPECTION DIVISION OF ENGINEERING FOR VERIFICATION AND/OR INFORMATION REGARDING:
  - A. EXISTING/PROPOSED RIGHT-OF-WAY
  - B. UTILITY RELOCATION
  - C. MAINTENANCE OF TRAFFIC DURING CONSTRUCTION
  - D. EROSION/SEDIMENT CONTROL CERTIFICATION AND PERMIT
  - E. HORIZONTAL/VERTICAL CONTROL
  - F. GRADING PERMIT
- PLACE REGULATION 'ROAD WORK' AND WARNING SIGNS AS REQUIRED TO COMPLY WITH THE MANUAL ON UNIFORM TRAFFIC CONTROL DEVICES (MUTCD) FOR HIGHWAY CONSTRUCTION AND MAINTENANCE OPERATIONS AT LIMIT OF WORK ALONG COUNTY ROADWAYS. COMPLY WITH HOWARD COUNTY STANDARD SPECIFICATIONS AND DETAILS.
- ALL GRADING SHALL BE LIMITED TO EXISTING R.O.W. AND EASEMENTS INCLUDING SIDE SLOPES AND STABILIZATION, FOLLOWING INITIAL SOIL DISTURBANCE OR REDISTURBANCE, PERMANENT OR TEMPORARY STABILIZATION SHALL BE COMPLETED IN ACCORDANCE WITH THE SEDIMENT CONTROL NOTES AND DETAILS.
- FOR DETAILS NOT SHOWN ON THESE DRAWINGS, AND FOR MATERIALS AND CONSTRUCTION METHODS, THE CONTRACTOR SHALL ABIDE BY THE HOWARD COUNTY STANDARDS AND SPECIFICATIONS, THE PROJECT INVITATION FOR BID BOOKLET, THE SPECIAL PROVISIONS AND THE MARYLAND STATE HIGHWAY ADMINISTRATION'S 'BOOK OF STANDARDS FOR HIGHWAY AND INCIDENTAL STRUCTURES' AND 'STANDARD SPECIFICATIONS FOR CONSTRUCTION AND MATERIALS.' IN THE EVENT OF ANY DISCREPANCY BETWEEN THESE SOURCES, THE SPECIAL PROVISIONS SHALL GOVERN.
- ALL CONSTRUCTION SHALL BE IN ACCORDANCE WITH THE LATEST STANDARDS AND SPECIFICATIONS OF HOWARD COUNTY PLUS MD SHA STANDARDS AND SPECIFICATIONS.
- STAGING AND STOCKPILE AREA WILL BE DETERMINED BY CONTRACTOR, AND AS APPROVED BY THE RESIDENT ENGINEER.
- COORDINATES SHOWN HEREON ARE BASED ON MARYLAND STATE REFERENCE SYSTEM NAD 83 AS PROJECTED BY HOWARD COUNTY GEODETIC CONTROL STATION NO. 17EA AND NO. 17EB.
- HORIZONTAL SITE CONTROL IS NAD88 , VERTICAL SITE CONTROL IS NGVD29.
- SITE SURVEY WAS PERFORMED BY URS ON OCTOBER 1999.




09/27/03 10:00 AM C:\Users\james.panning\My Documents\Projects\Howard\2003-02\111111.dgn

|  |  |  |  |  |  |   |  |                      |  |   |  |   |  |
|--|--|--|--|--|--|---|--|----------------------|--|---|--|---|--|
| DEPARTMENT OF PUBLIC WORKS<br>HOWARD COUNTY, MARYLAND<br><i>James M. Panning</i> 9/29/03<br>DEPARTMENT OF PUBLIC WORKS DATE<br><i>Evelyn E. Jahn</i> 9/22/03<br>CHIEF, TRANSPORTATION AND SPECIAL PROJECTS DIVISION DATE |  | <br>HUNT VALLEY, MARYLAND<br><b>URS</b><br>HUNT VALLEY, MARYLAND |  | <br>RJM ENGINEERING, INC.<br>CONSULTING ENGINEERS<br>COLUMBIA, MARYLAND<br>TEL: (410) 730-1001 FAX: (410) 730-5403 |  | DES: _____<br>DRN: _____<br>CHK: _____<br>DATE: _____ |  | BY NO. REVISION DATE |  | <b>TITLE SHEET</b><br>No.: _____ DATE: 9/03 |  | <b>McKENZIE ROAD ROADWAY AND STORMDRAIN IMPROVEMENTS</b><br>HOWARD COUNTY, MARYLAND<br>CAPITAL PROJECT NO. J-4164-10<br>SCALE AS SHOWN<br>SHEET 1 OF 24 |  |
|--|--|--|--|--|--|---|--|----------------------|--|---|--|---|--|

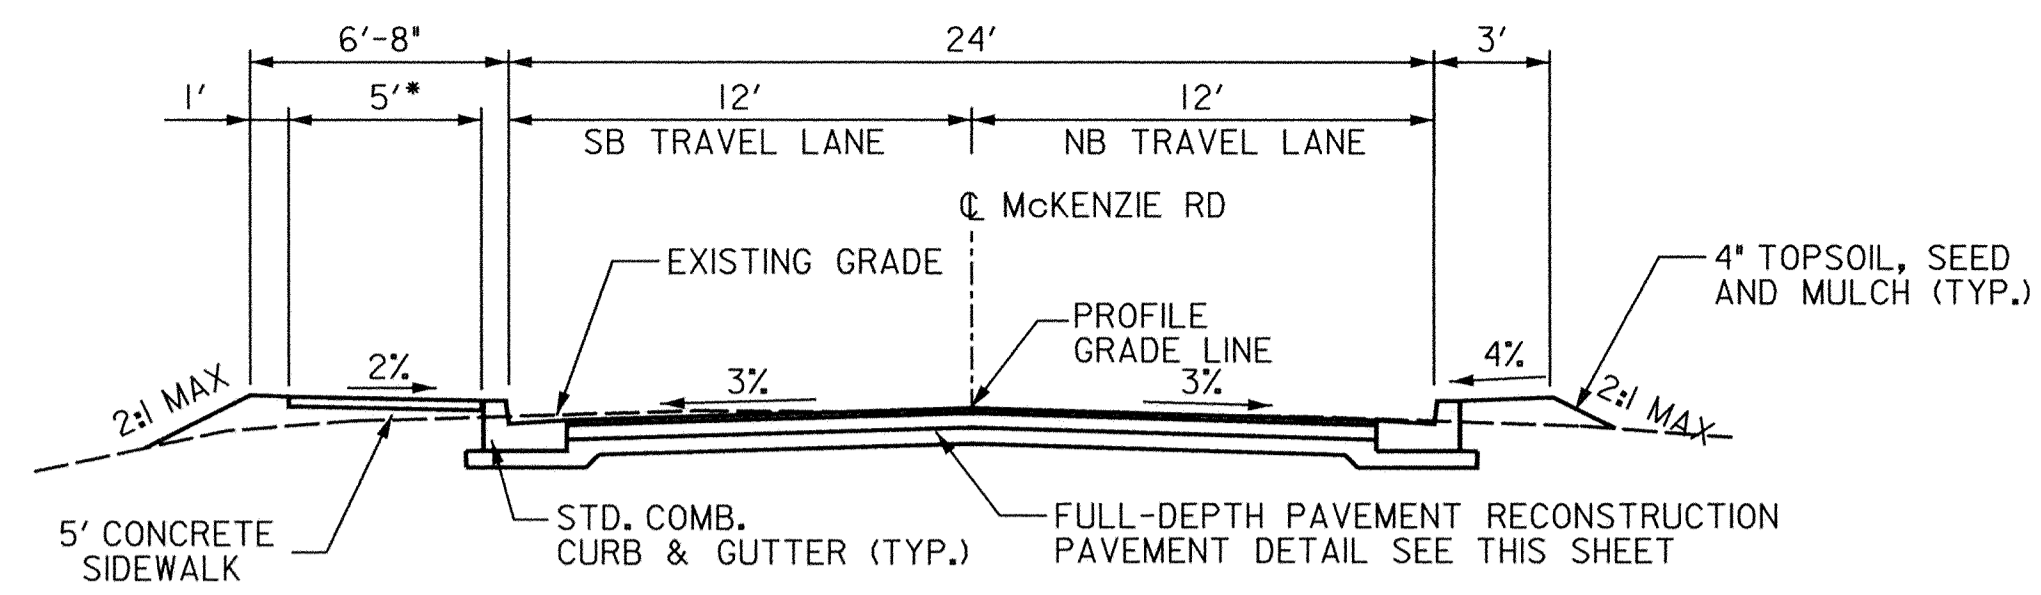


**TYPICAL SECTION**

STA. 100+85.00 TO 109+6.10  
 STA. 109+6.10 TO 109+27.22:  
 TRANSITION FROM 5' TO 4' SIDEWALK AND  
 TRANSITION FROM 0' TO 2'-4" OPEN SPACE

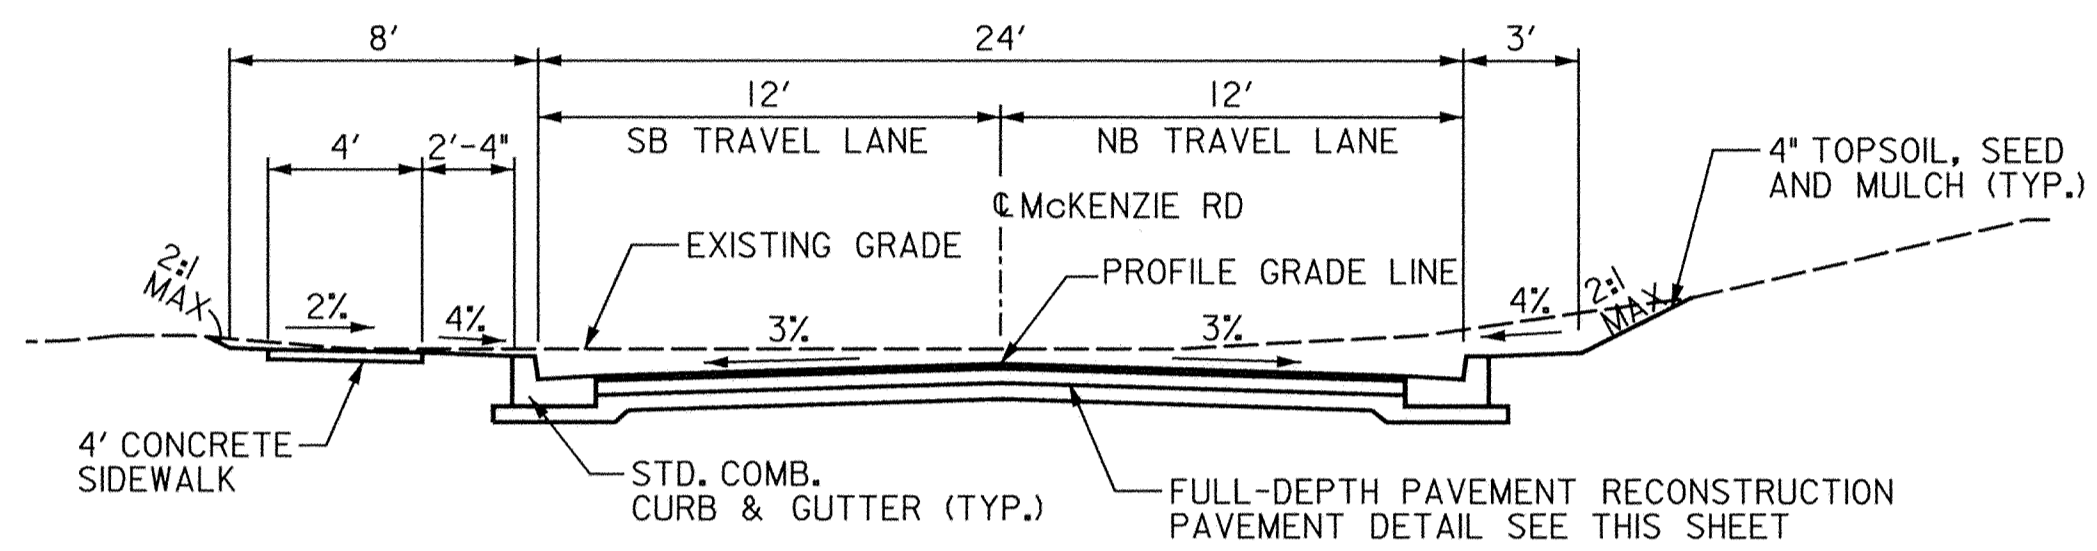


**TYPICAL SECTION**

STA. 109+27.22 TO 115+54.38  
 STA. 116+41.27 TO 120+56.02

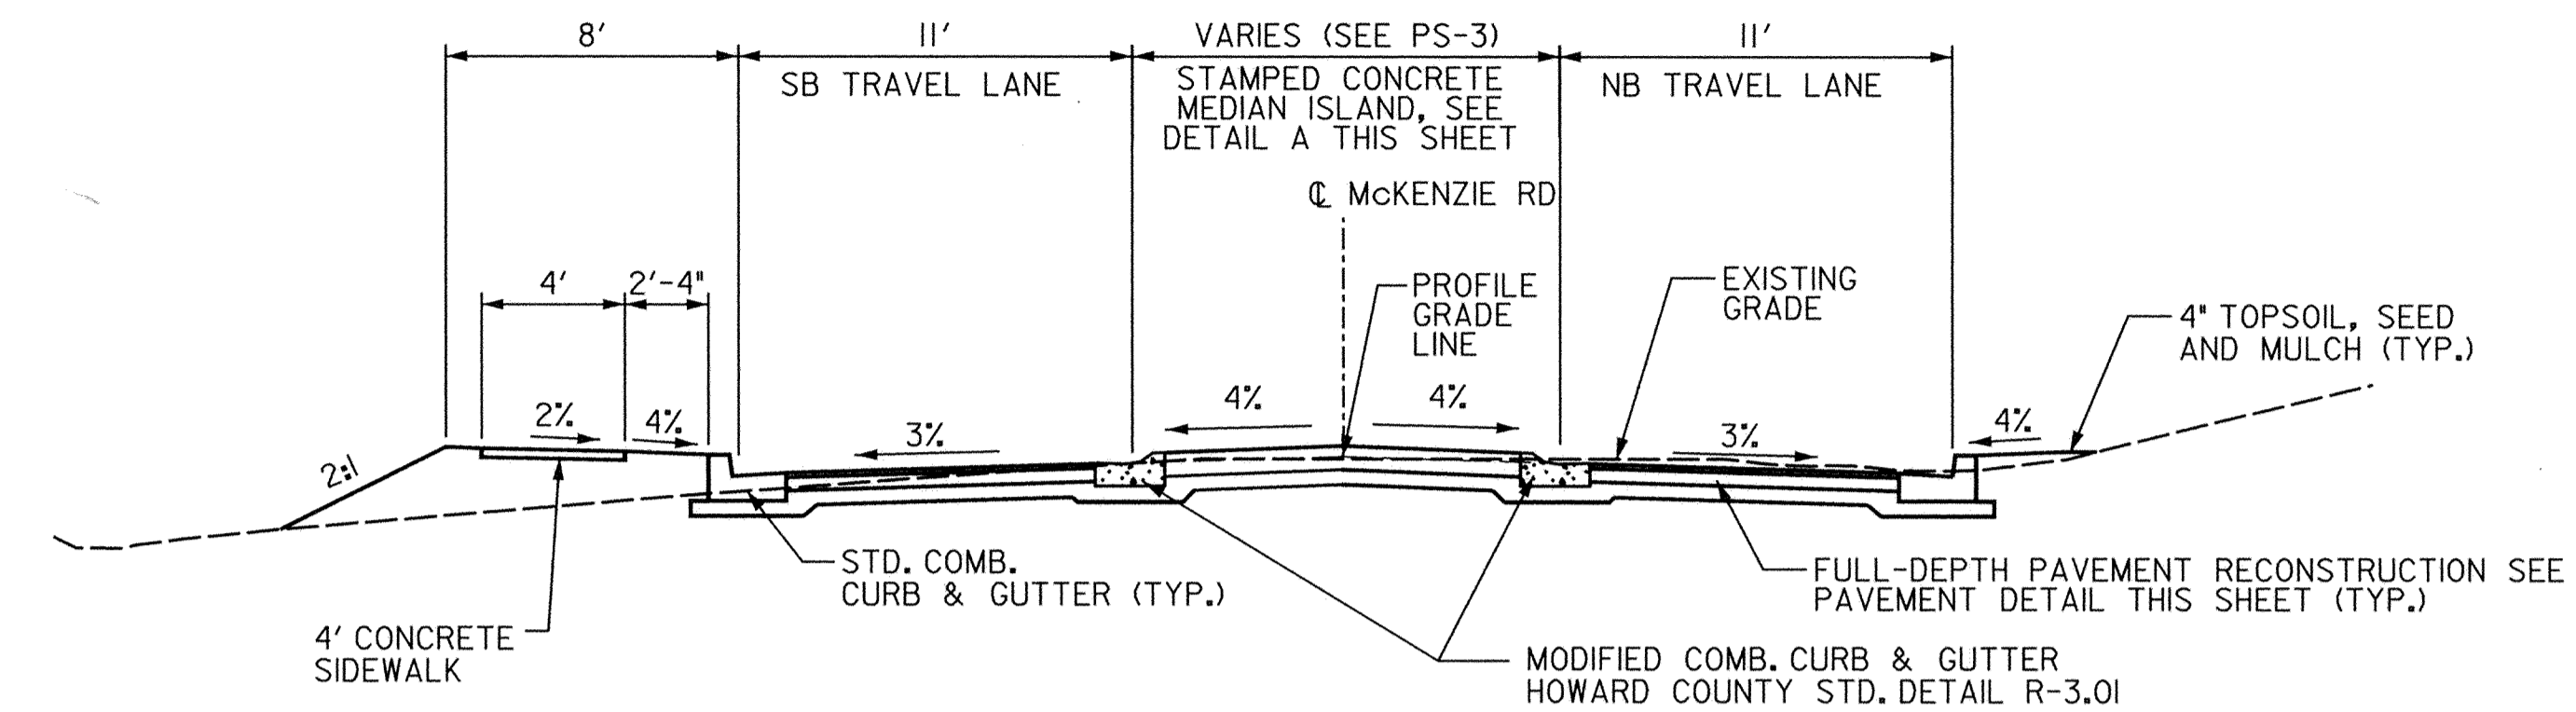


**TYPICAL SECTION - MEDIAN ISLAND AT STA. 116+00**

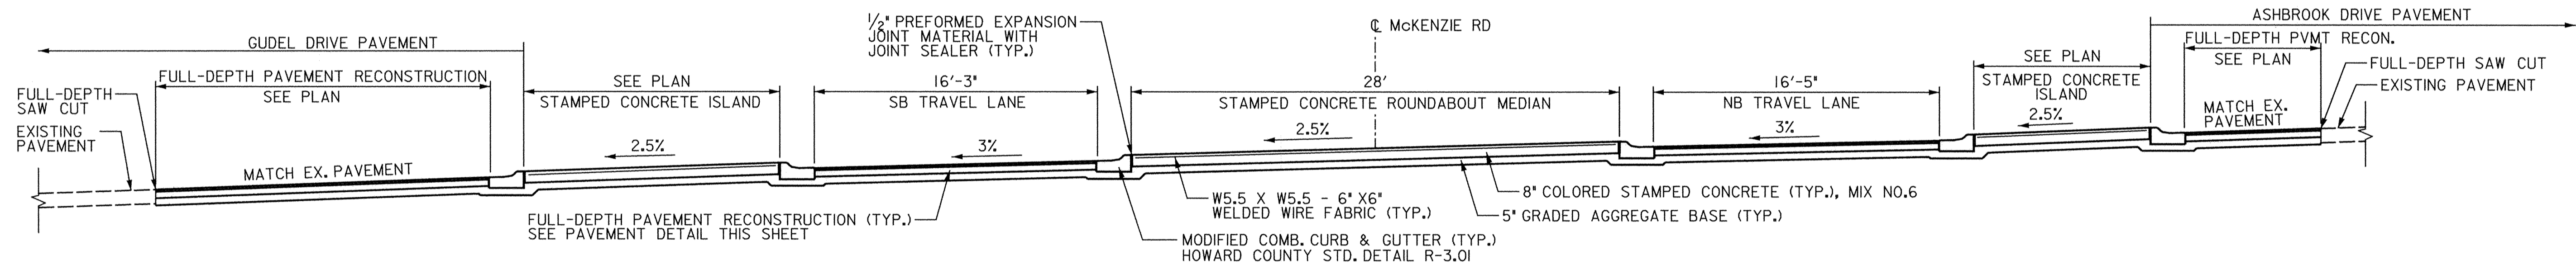


**CROSS SECTION THROUGH ROUNDABOUT AT ASHBROOK INTERSECTION**

STA. 121+30.85

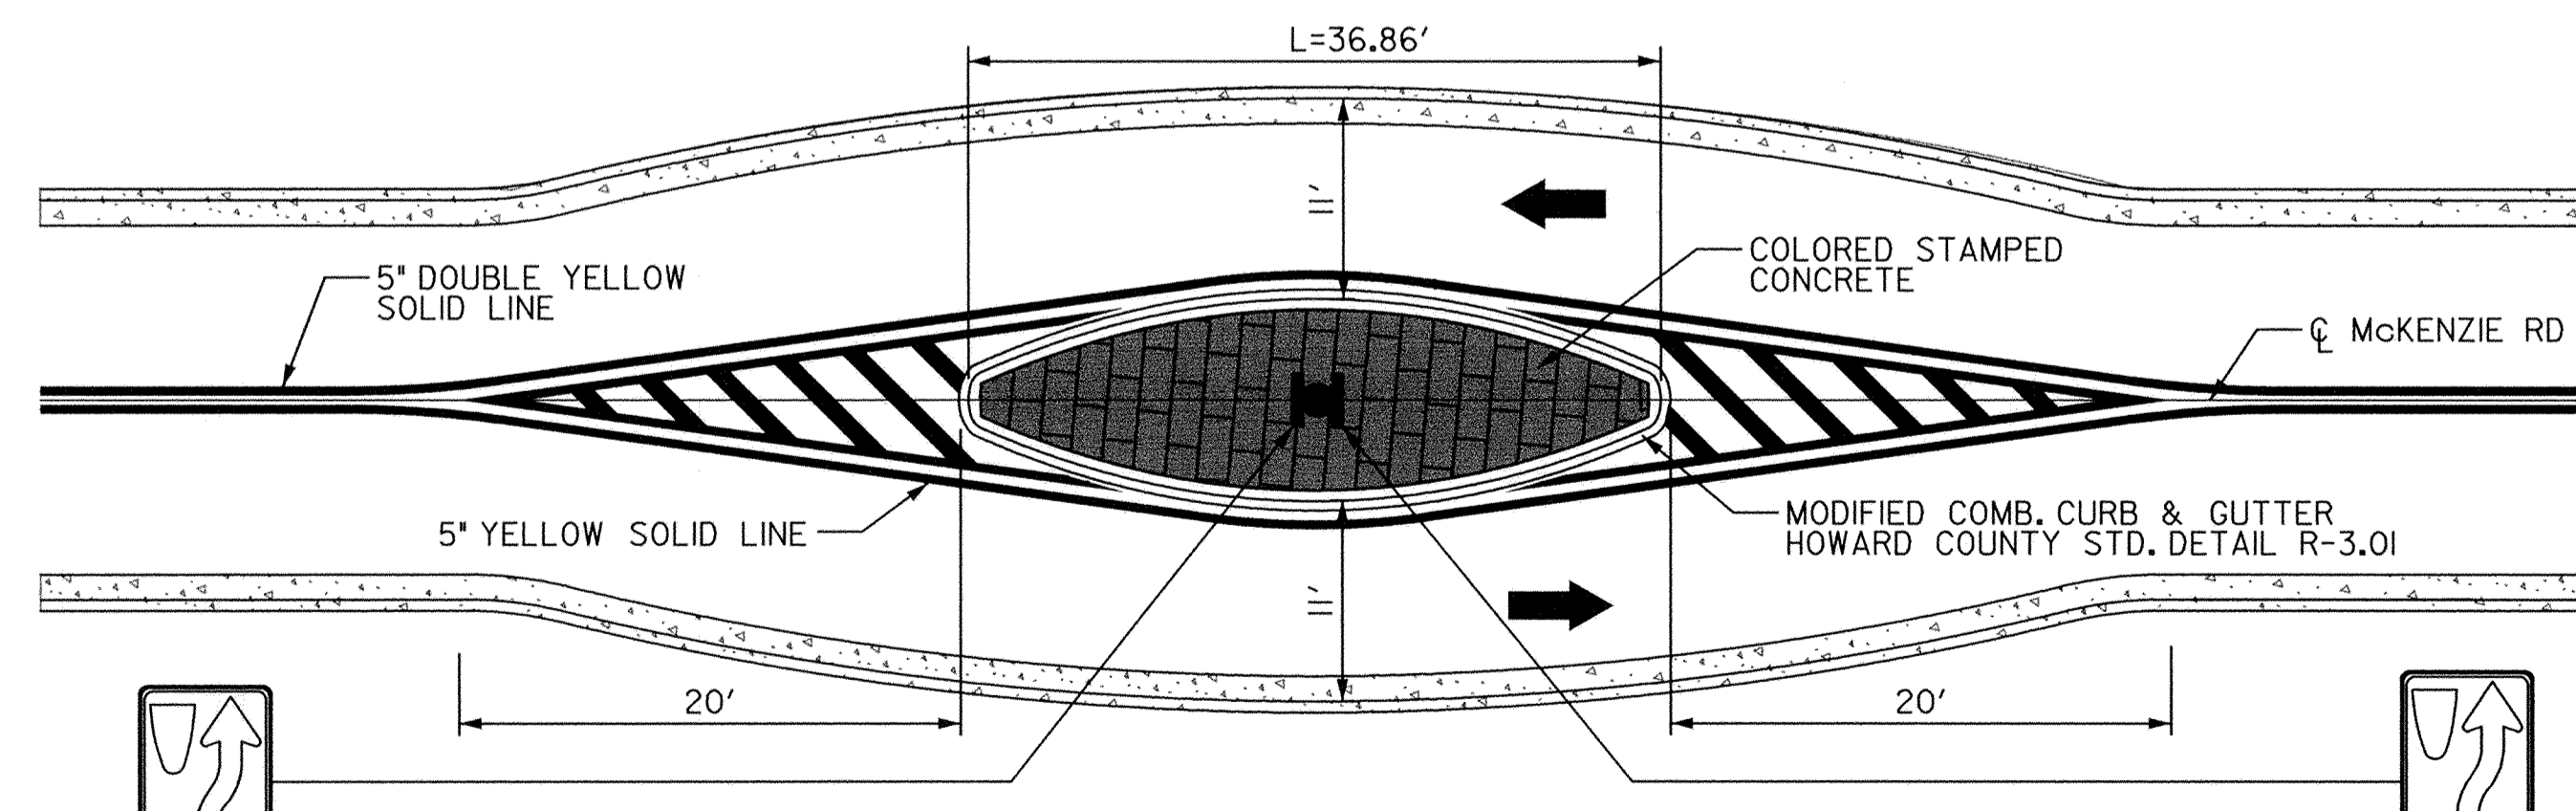

**DETAIL A-: MEDIAN @ STA. 116+00**

NOT TO SCALE

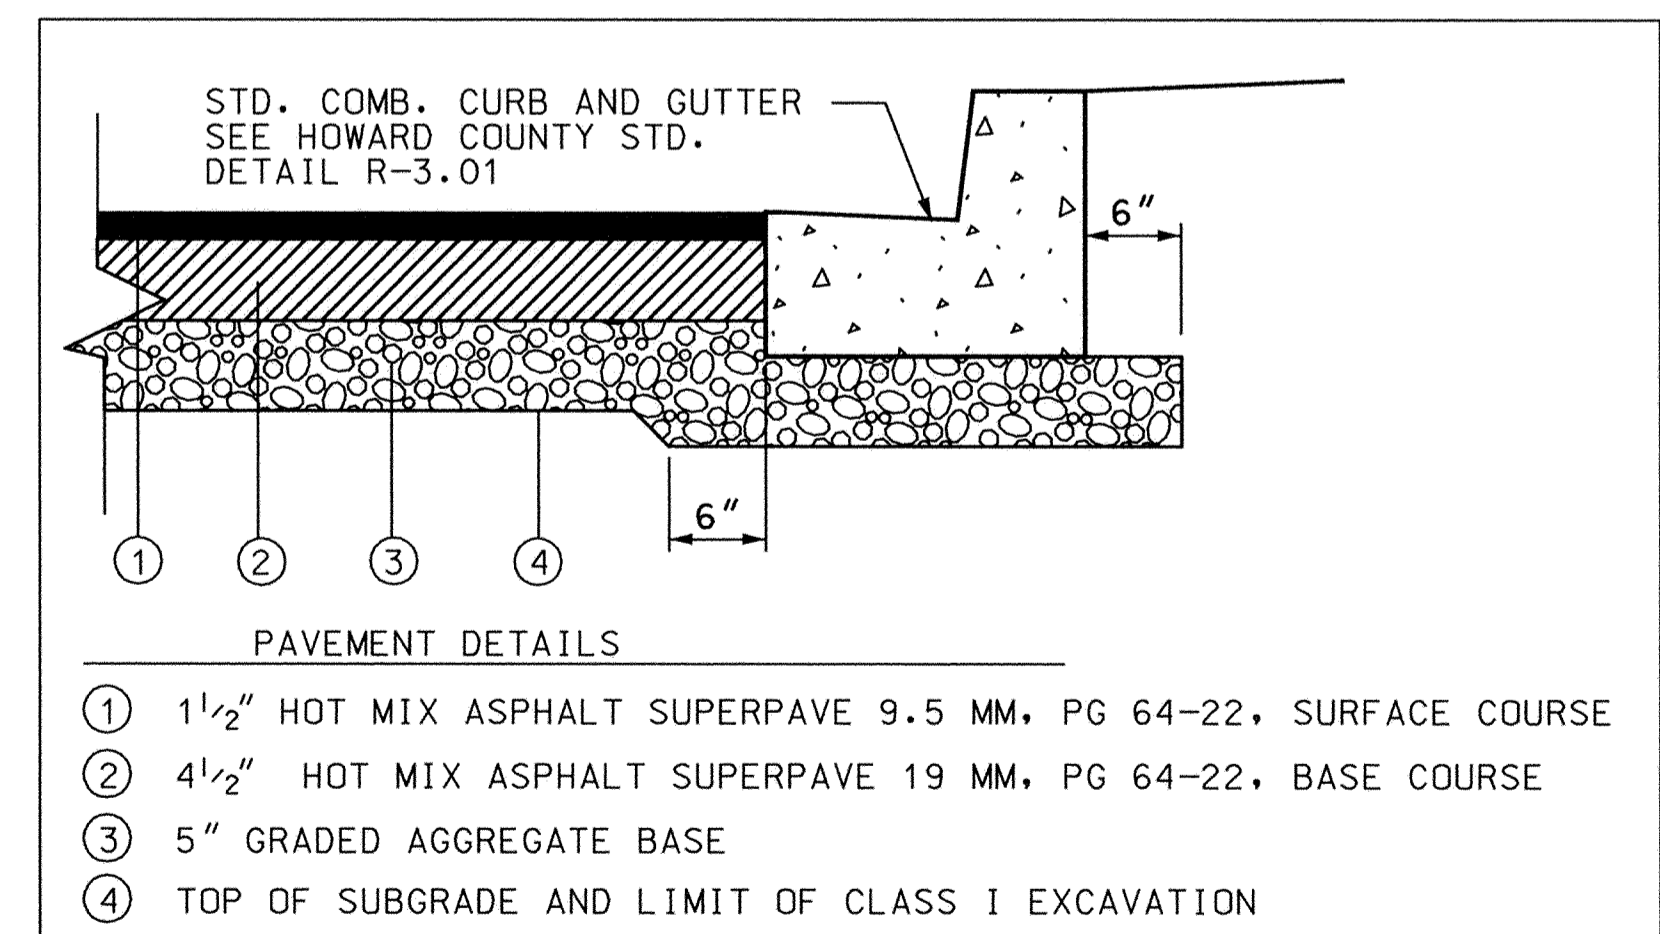

**PAVEMENT DETAIL**

NTS

- ① 1 1/2" HOT MIX ASPHALT SUPERPAVE 9.5 MM, PG 64-22, SURFACE COURSE
- ② 4 1/2" HOT MIX ASPHALT SUPERPAVE 19 MM, PG 64-22, BASE COURSE
- ③ 5" GRADED AGGREGATE BASE
- ④ TOP OF SUBGRADE AND LIMIT OF CLASS I EXCAVATION

DEPARTMENT OF PUBLIC WORKS  
 HOWARD COUNTY, MARYLAND

*[Signatures]*  
 DATE 9/22/03  
 DATE 9/22/03  
 DATE 9-24-03

URS  
 HUNT VALLEY, MARYLAND

**RJM**  
 RJM ENGINEERING, INC.  
 CONSULTING ENGINEERS  
 COLUMBIA, MARYLAND

|       |    |     |          |      |
|-------|----|-----|----------|------|
| DES:  |    |     |          |      |
| DRN:  |    |     |          |      |
| CHK:  |    |     |          |      |
| DATE: | BY | NO. | REVISION | DATE |

**TYPICAL SECTIONS AND DETAILS SHEET**


NO.: \_\_\_\_\_ DATE: 9/03

**McKENZIE ROAD ROADWAY AND STORMDRAIN IMPROVEMENTS**


HOWARD COUNTY, MARYLAND  
 CAPITAL PROJECT NO. J-4164-10

SCALE AS SHOWN  
 SHEET 2 OF 24



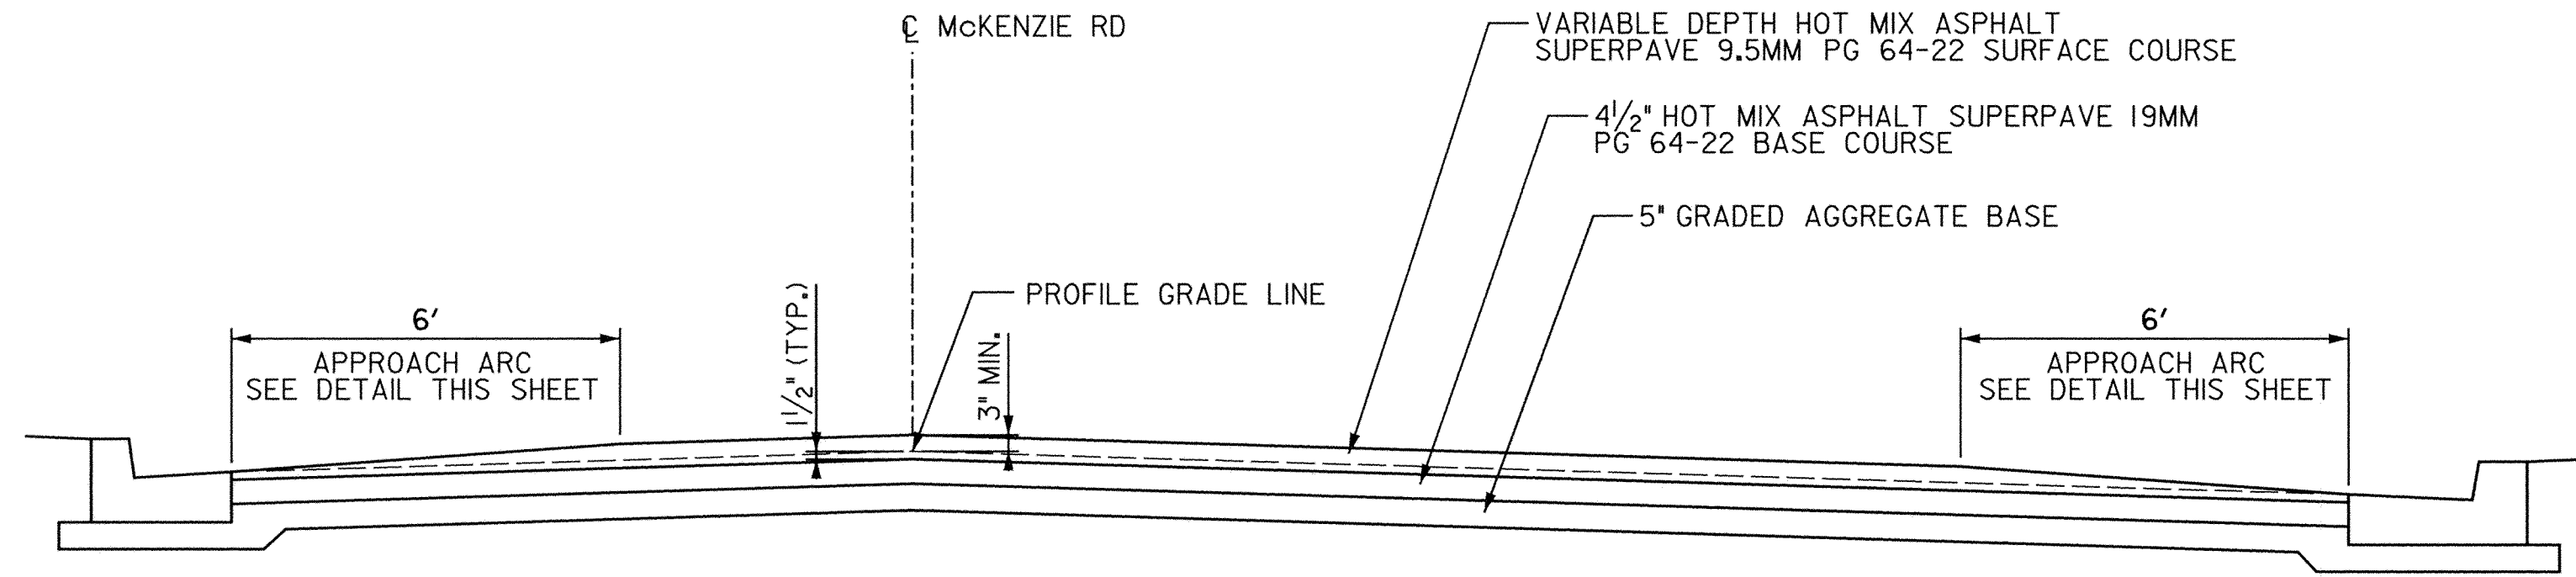


**TYPICAL SECTION - SPEED TABLE**

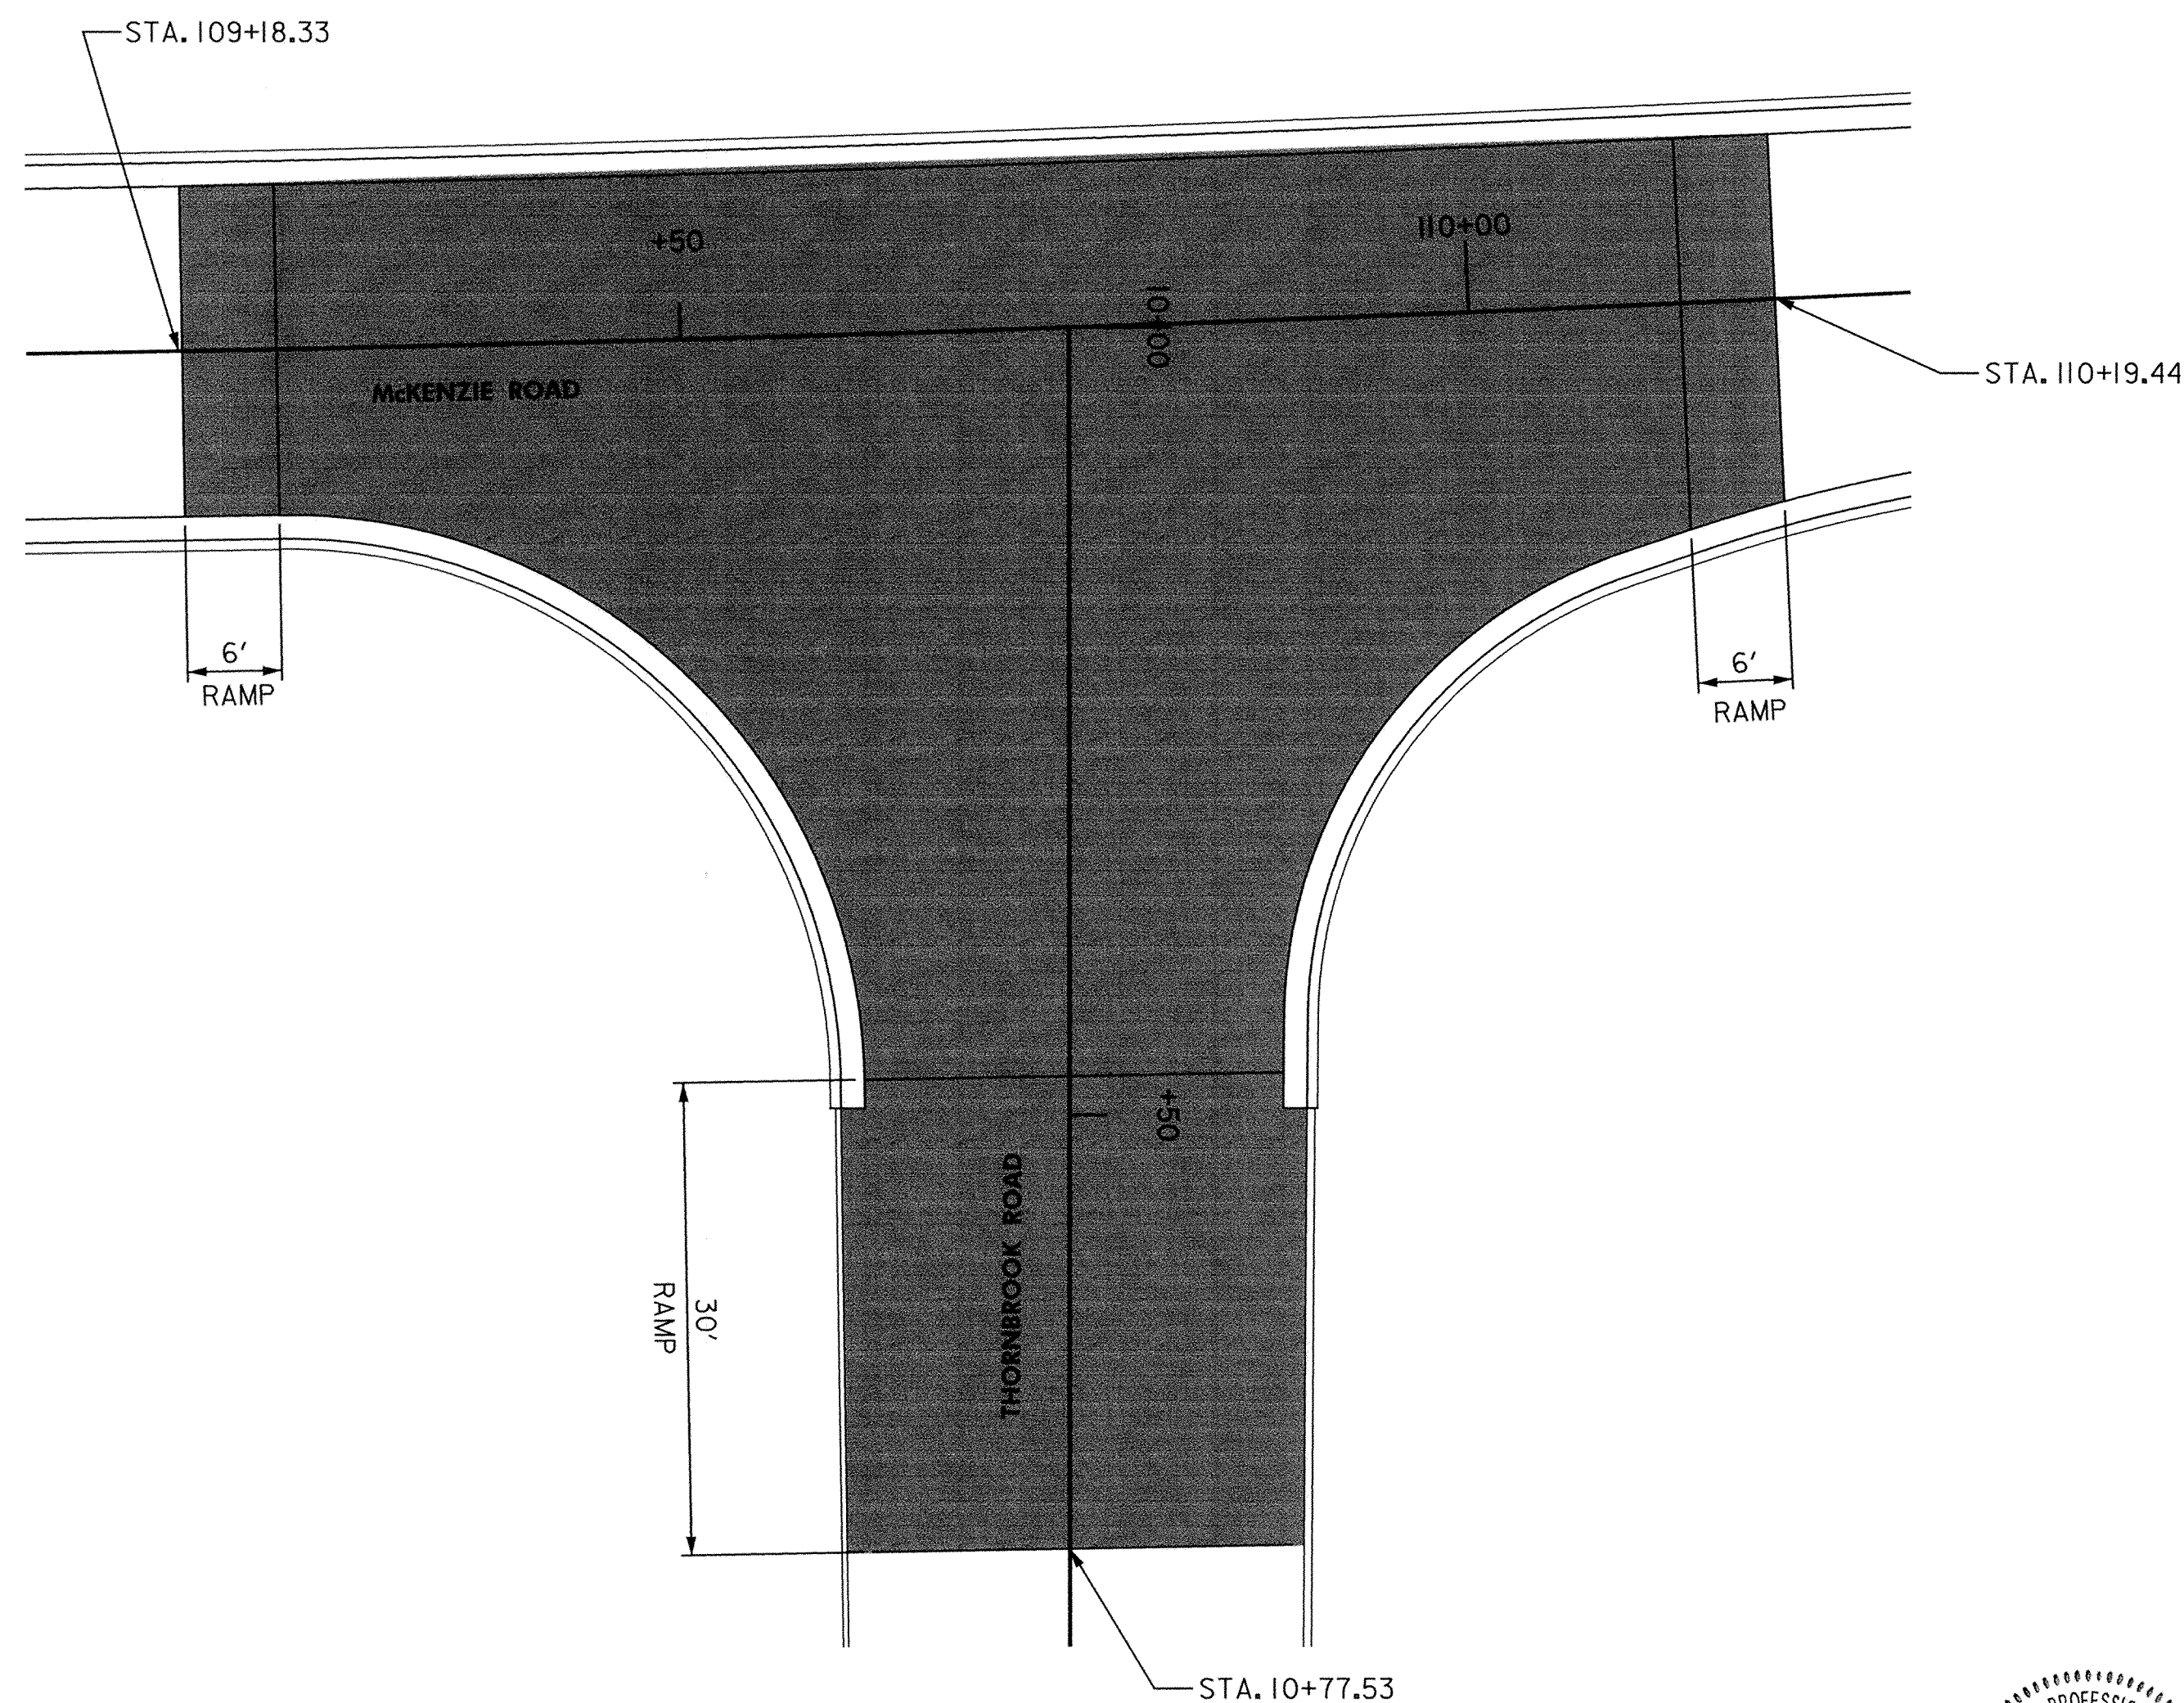

**THREE LEGGED SPEED TABLE LOCATIONS  
(INTERSECTION OF McKENZIE ROAD AND THORNBROOK ROAD)**


SCALE: NOT TO SCALE

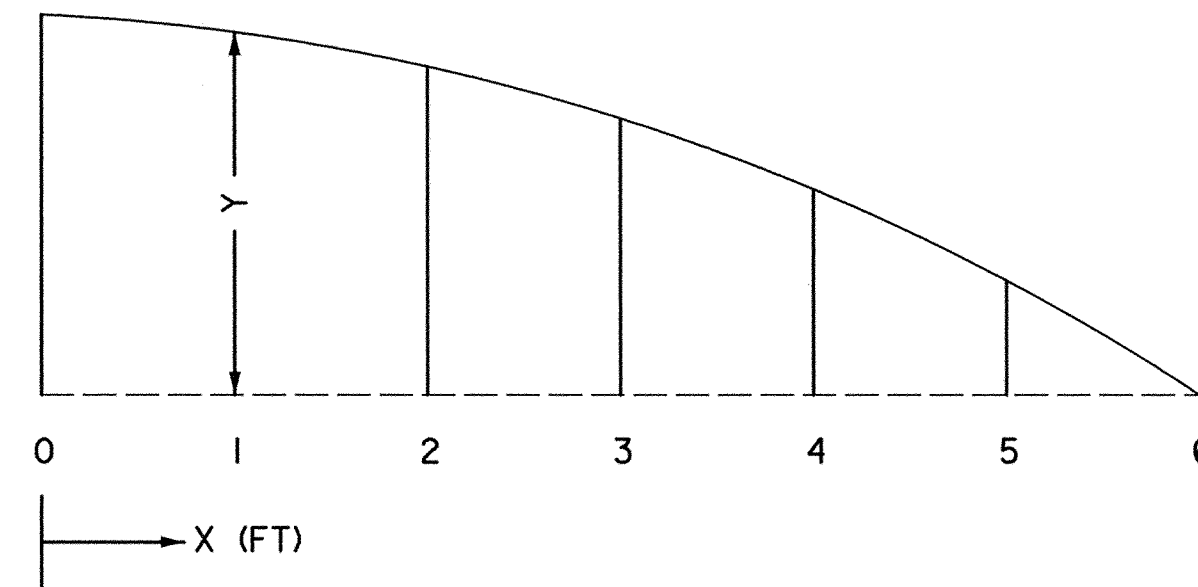

**APPROACH ARC DETAIL**

NOT TO SCALE

| X (FT) | Y (FT) | Y (IN) |
|--------|--------|--------|
| 0      | 0.25   | 3.0    |
| 1      | 0.243  | 2.92   |
| 2      | 0.222  | 2.64   |
| 3      | 0.188  | 2.25   |
| 4      | 0.139  | 1.67   |
| 5      | 0.077  | 0.92   |
| 6      | 0      | 0      |

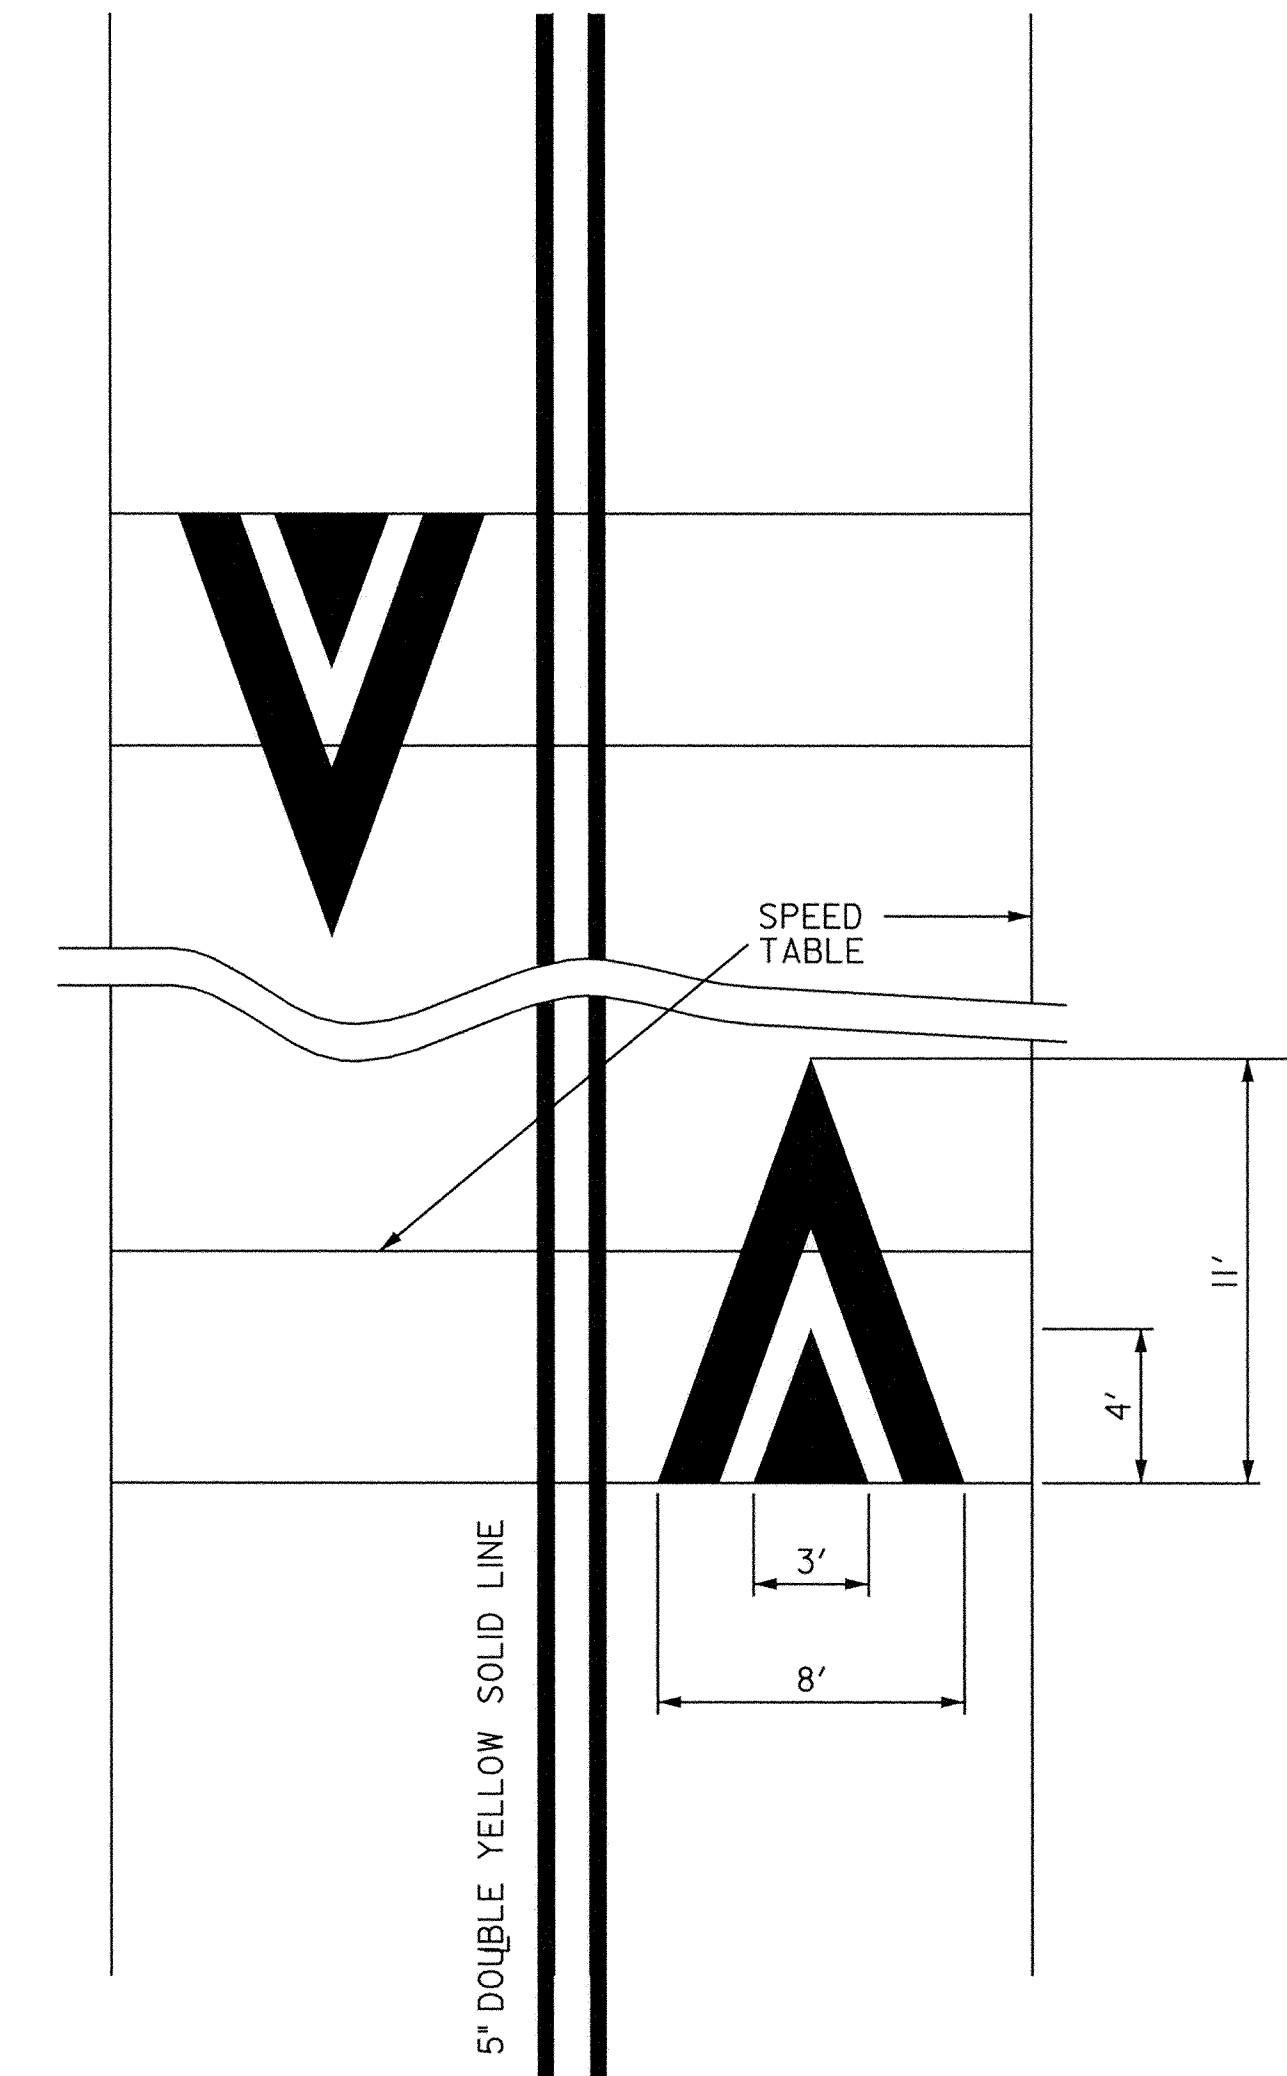

**TYPICAL MARKING DETAIL**

NOT TO SCALE




DEPARTMENT OF PUBLIC WORKS  
HOWARD COUNTY, MARYLAND

*Jan 7/03* 9/22/03  
DATE  
DEPARTMENT OF PUBLIC WORKS

*Edlyn E. Dore* 9/22/03  
DATE  
CHIEF, TRANSPORTATION AND SPECIAL PROJECTS DIVISION

*Richard P. ...* 9/22/03  
DATE  
CHIEF, BUREAU OF ENGINEERING

*William Z. ...* 9-24-03  
DATE  
CHIEF, BUREAU OF HIGHWAYS

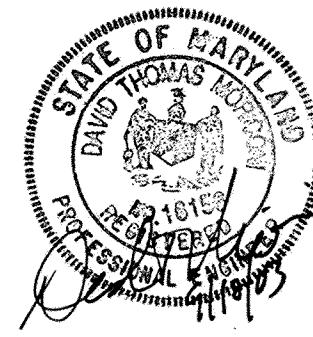

**URS**  
HUNT VALLEY, MARYLAND

**RJM**  
RJM ENGINEERING, INC.  
CONSULTING ENGINEERS  
COLUMBIA, MARYLAND

TELE: 410/730-1001 FAX: 410/730-5403

|       |    |     |          |      |  |
|-------|----|-----|----------|------|--|
| DES:  |    |     |          |      |  |
| DRN:  |    |     |          |      |  |
| CHK:  |    |     |          |      |  |
| DATE: | BY | NO. | REVISION | DATE |  |

**SPEED TABLE**

NO.: \_\_\_\_\_ DATE: 9/03


**McKENZIE ROAD ROADWAY  
AND STORMDRAIN IMPROVEMENTS**

HOWARD COUNTY, MARYLAND  
CAPITAL PROJECT NO. J-4164-10


SCALE AS SHOWN

SHEET 3 OF 24


**LIMIT OF WORK**  
 CONT. NO. J-4164-10  
 McKENZIE ROAD  
 STA. 100+27.26

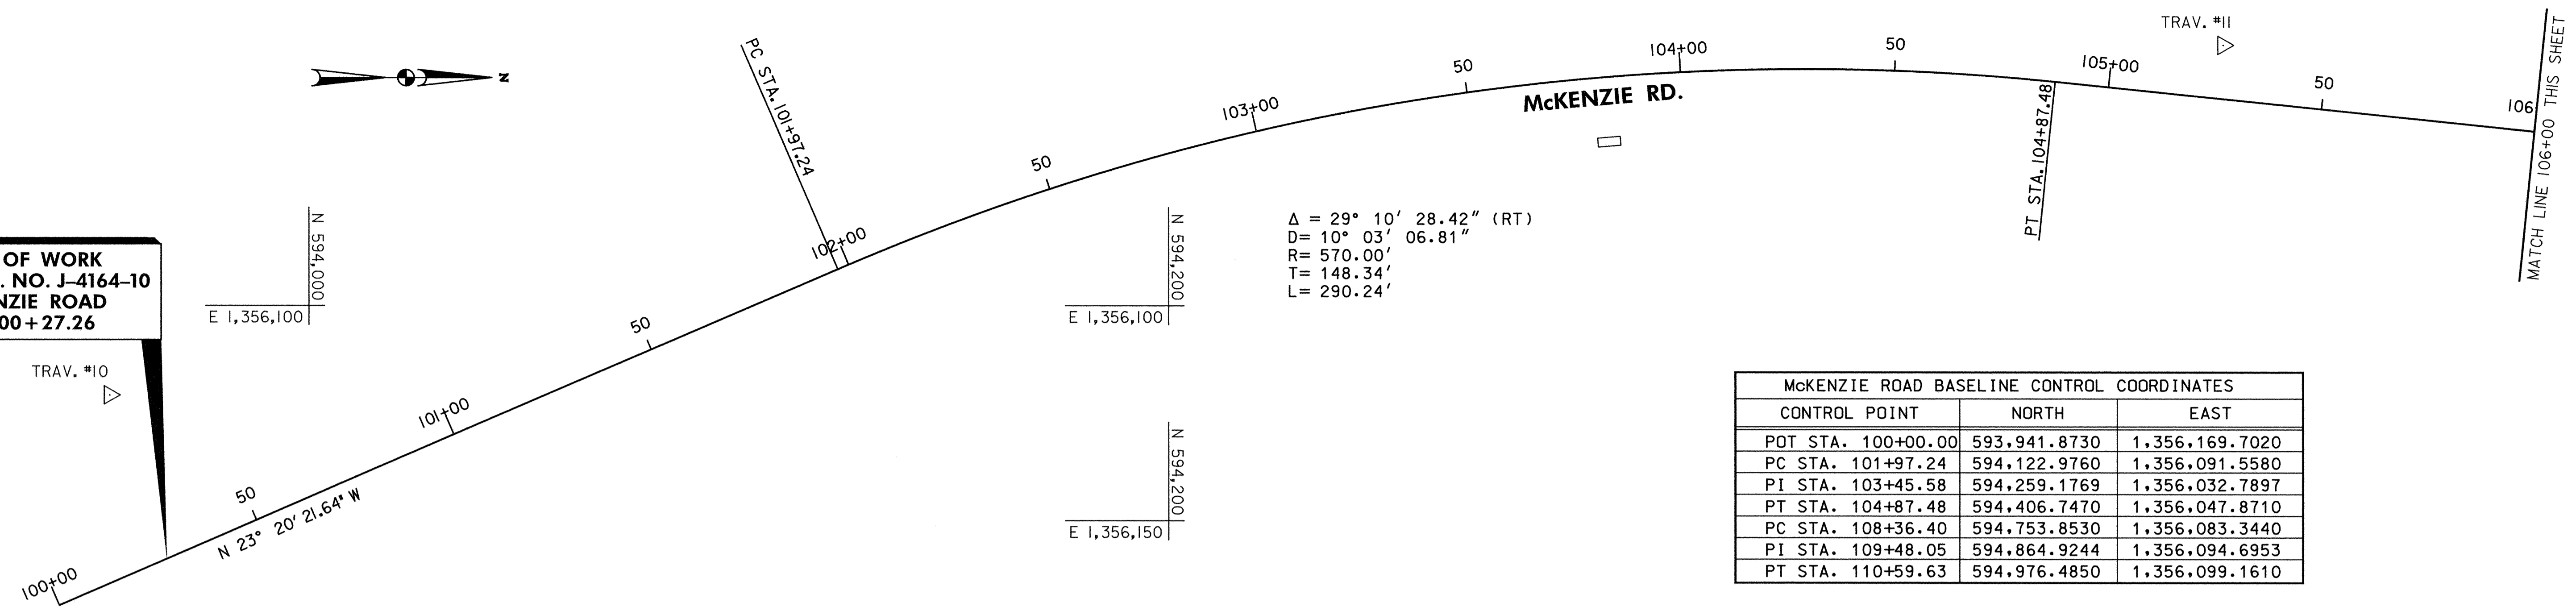


| McKENZIE ROAD BASELINE CONTROL COORDINATES |              |                |
|--|--------------|----------------|
| CONTROL POINT                              | NORTH        | EAST           |
| POT STA. 100+00.00                         | 593,941.8730 | 1,356,169.7020 |
| PC STA. 101+97.24                          | 594,122.9760 | 1,356,091.5580 |
| PI STA. 103+45.58                          | 594,259.1769 | 1,356,032.7897 |
| PT STA. 104+87.48                          | 594,406.7470 | 1,356,047.8710 |
| PC STA. 108+36.40                          | 594,753.8530 | 1,356,083.3440 |
| PI STA. 109+48.05                          | 594,864.9244 | 1,356,094.6953 |
| PT STA. 110+59.63                          | 594,976.4850 | 1,356,099.1610 |

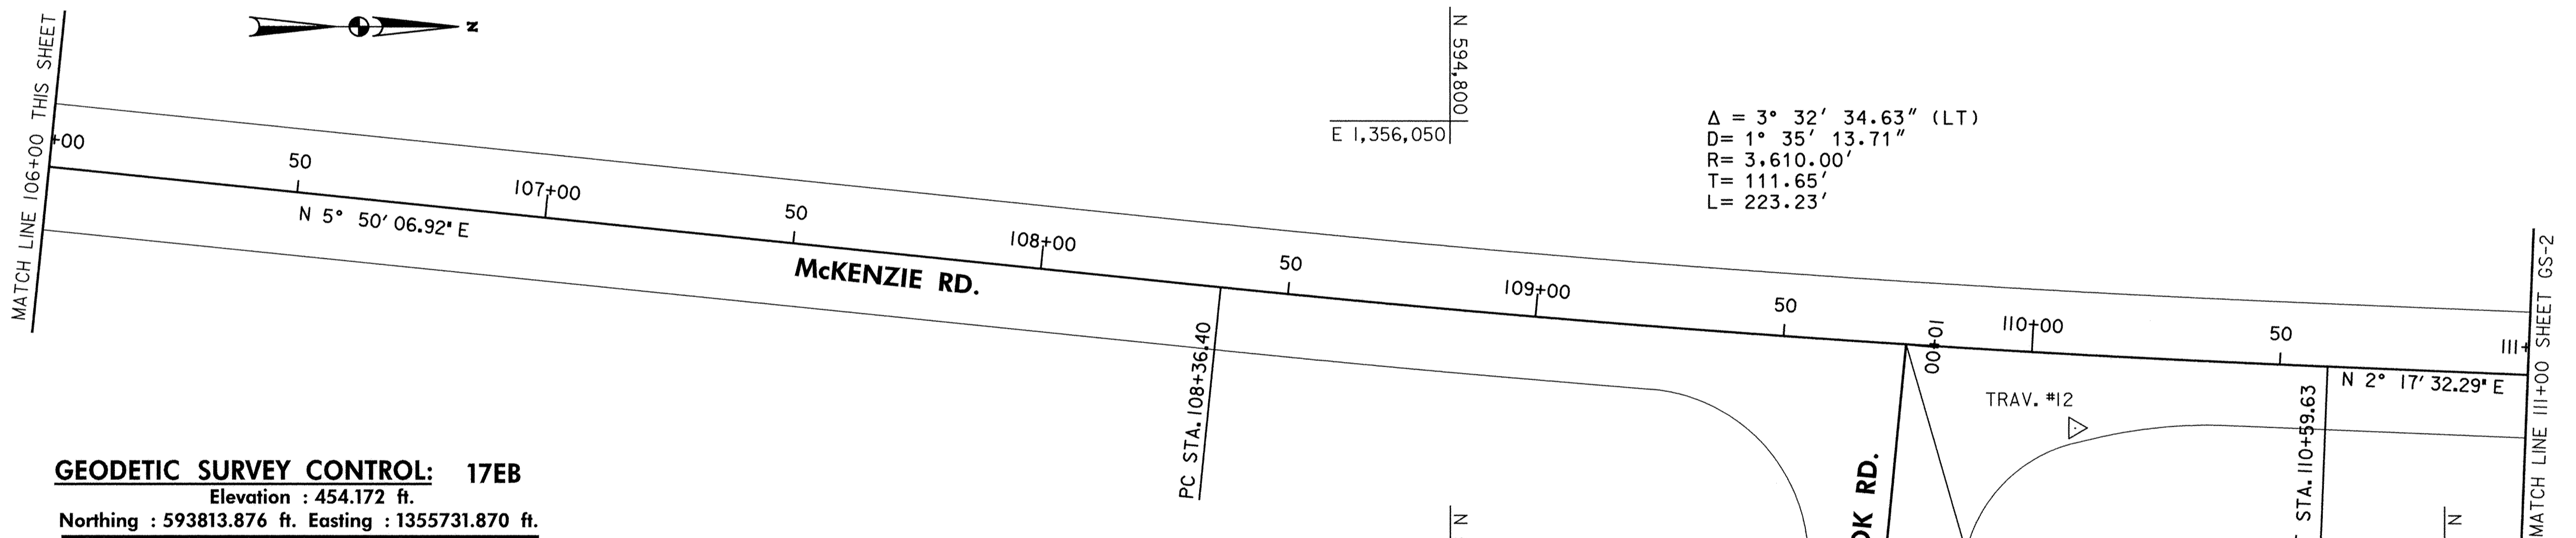


**GEODETTIC SURVEY CONTROL: 17EA**  
 Elevation : 479.462 ft.  
 Northing : 594357.618 ft. Easting : 1357519.371 ft.

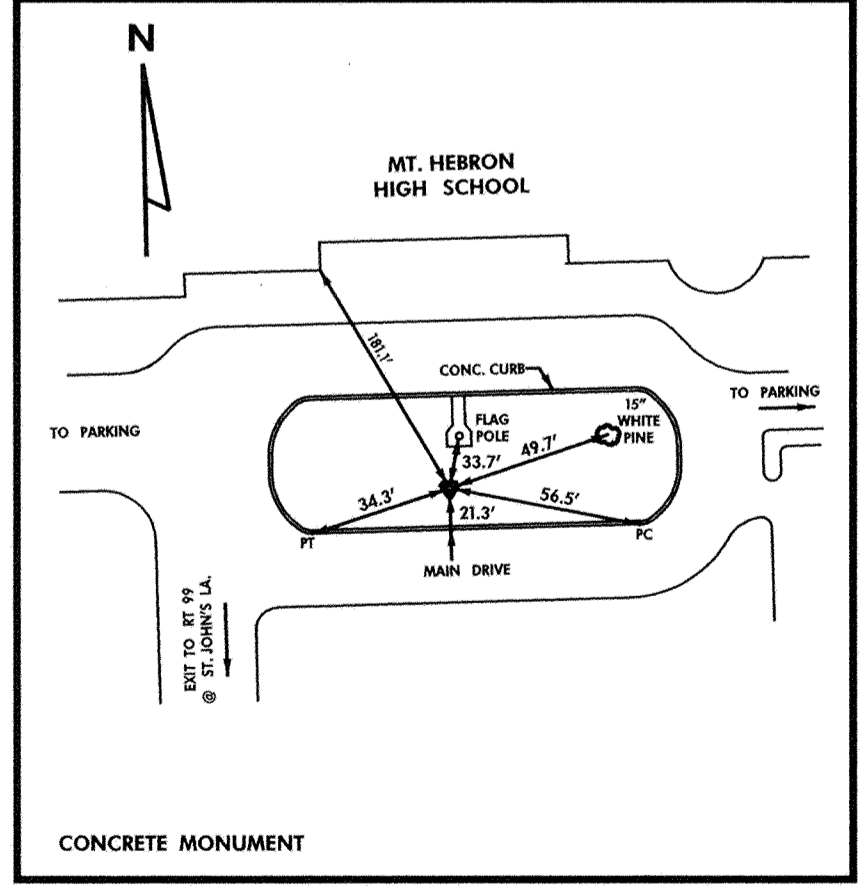

**GEODETTIC SURVEY CONTROL: 17EB**  
 Elevation : 454.172 ft.  
 Northing : 593813.876 ft. Easting : 1355731.870 ft.

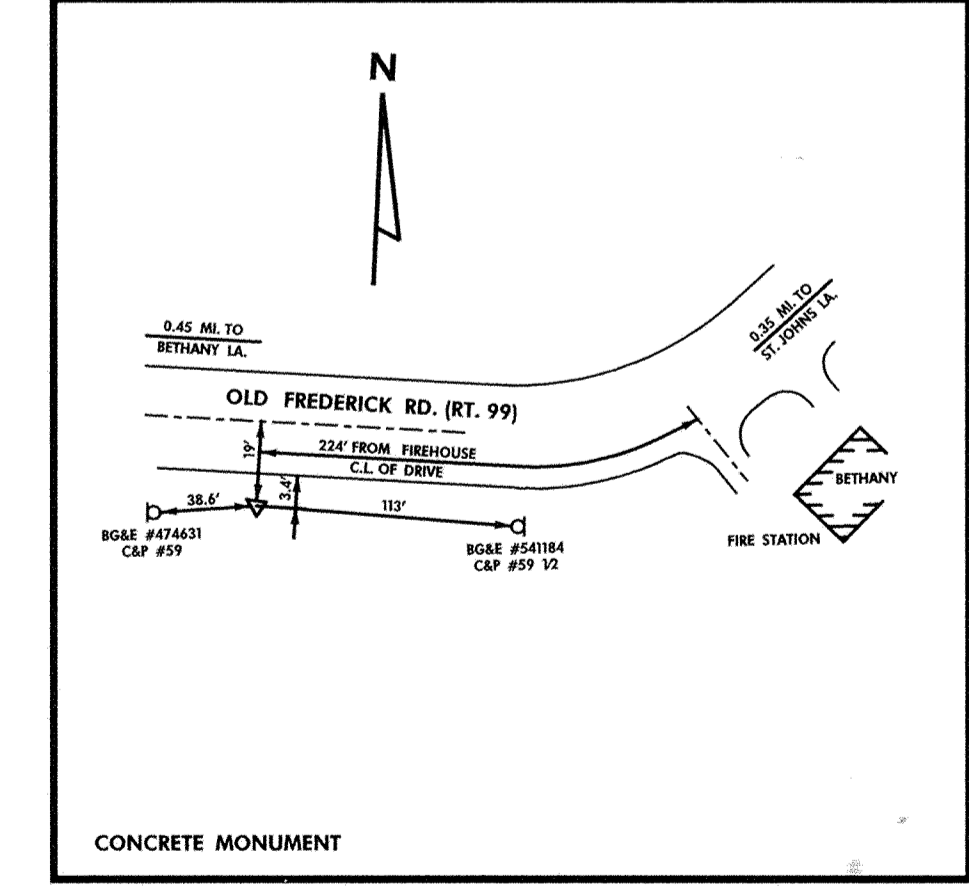


| CONTROL POINTS |              |                |
|----------------|--------------|----------------|
| CONTROL POINT  | NORTH        | EAST           |
| TRAV 10        | 593,953.5717 | 1,356,120.9294 |
| TRAV 11        | 594,445.9143 | 1,356,039.3153 |
| TRAV 12        | 594,925.5961 | 1,356,111.5476 |
| TRAV 13        | 595,317.6345 | 1,356,107.0275 |
| TRAV 14        | 595,661.7865 | 1,356,146.0366 |
| TRAV 15        | 596,041.1278 | 1,356,212.9679 |

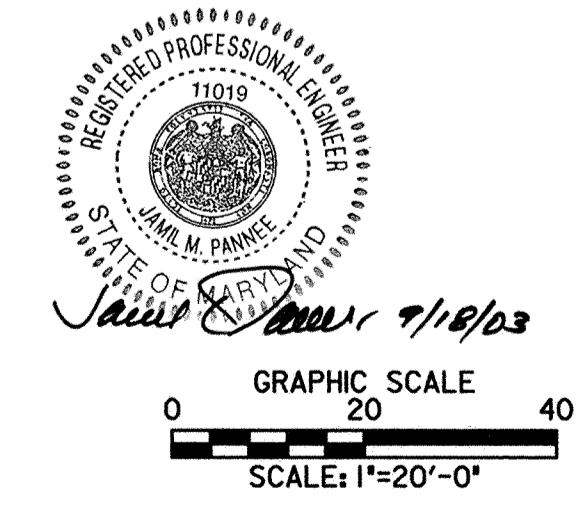

| THORNBROOK ROAD BASELINE CONTROL COORDINATES |              |                |
|--|--------------|----------------|
| CONTROL POINT                                | NORTH        | EAST           |
| POT STA. 10+00.00                            | 594,891.6298 | 1,356,094.7628 |
| POT STA. 11+12.80                            | 594,880.6093 | 1,356,207.0269 |


|  |  |  |  |       |    |     |          |  |  |  |
|--|--|--|--|-------|----|-----|----------|--|--|--|
| DEPARTMENT OF PUBLIC WORKS<br>HOWARD COUNTY, MARYLAND<br><i>James M. Pannell</i> 9/22/03<br>CHIEF, BUREAU OF ENGINEERING<br><i>William F. White</i> 9-29-03<br>CHIEF, BUREAU OF HIGHWAYS |  |  |  | DES:  |    |     |          | <b>GEOMETRIC LAYOUT</b><br><b>SHEET GS-1</b> | <b>McKENZIE ROAD ROADWAY</b><br><b>AND STORMDRAIN IMPROVEMENTS</b><br>HOWARD COUNTY, MARYLAND<br>CAPITAL PROJECT NO. J-4164-10 | SCALE<br>AS<br>SHOWN<br>SHEET<br>4 OF 24 |
|  |  |  |  | DRN:  |    |     |          |  |  |  |
| HUNT VALLEY, MARYLAND<br>RJM ENGINEERING, INC.<br>CONSULTING ENGINEERS<br>COLUMBIA, MARYLAND<br>TELE: 410/730-1001 FAX: 410/730-5403   |  |  |  | CHK:  |    |     |          |  |  |  |
|  |  |  |  | DATE: | BY | NO. | REVISION | DATE   |  |  |



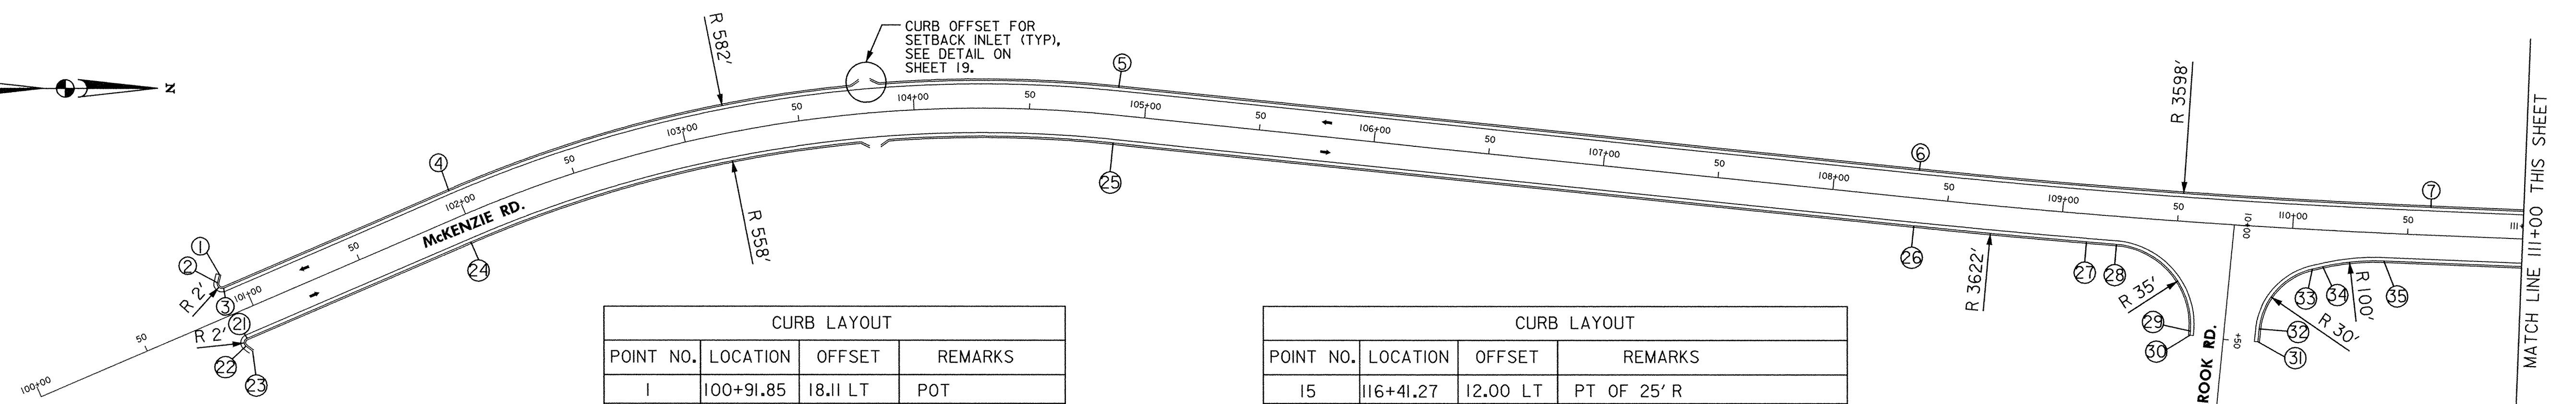

| CURB LAYOUT |           |          |               |
|-------------|-----------|----------|---------------|
| POINT NO.   | LOCATION  | OFFSET   | REMARKS       |
| 1           | 100+91.85 | 18.11 LT | POT           |
| 2           | 100+89.66 | 15.20 LT | PC OF 2' R    |
| 3           | 100+91.26 | 12.00 LT | PT OF 2' R    |
| 4           | 101+97.24 | 12.00 LT | PC OF 582' R  |
| 5           | 104+87.48 | 12.00 LT | PT OF 582' R  |
| 6           | 108+36.40 | 12.00 LT | PC OF 3598' R |
| 7           | 110+59.63 | 12.00 LT | PT OF 3598' R |
| 8           | 111+34.42 | 12.00 LT | PC OF 4582' R |
| 9           | 114+52.81 | 12.00 LT | PT OF 4582' R |
| 10          | 115+54.52 | 12.00 LT | PC OF 25' R   |
| 11          | 115+59.63 | 12.53 LT | PT OF 25' R   |
| 12          | 115+65.21 | 13.69 LT | PC OF 160' R  |
| 13          | 116+30.58 | 13.69 LT | PT OF 160' R  |
| 14          | 116+36.17 | 12.53 LT | PC OF 25' R   |


| CURB LAYOUT |           |          |                          |
|-------------|-----------|----------|--------------------------|
| POINT NO.   | LOCATION  | OFFSET   | REMARKS                  |
| 15          | 116+41.27 | 12.00 LT | PT OF 25' R              |
| 16          | 120+56.02 | 12.00 LT | PC OF 120' R             |
| 17          | 120+87.88 | 16.31 LT | PT OF 120' R             |
| 18          | 120+90.76 | 17.10 LT | PC OF 30' R              |
| 19          | 9+56.59   | 17.26 RT | PT OF 30' R, ASHBROOK DR |
| 20          | 9+43.86   | 17.20 RT | POT, ASHBROOK DR         |
| 21          | 100+91.82 | 12.00 RT | PT OF 2' R               |
| 22          | 100+90.09 | 15.00 RT | PC OF 2' R               |
| 23          | 100+91.85 | 18.06 RT | POT                      |
| 24          | 101+97.24 | 12.00 RT | PC OF 558' R             |
| 25          | 104+87.48 | 12.00 RT | PT OF 558' R             |
| 26          | 108+36.40 | 12.00 RT | PC OF 3622' R            |
| 27          | 109+11.28 | 12.00 RT | PT OF 3622' R            |
| 28          | 109+24.30 | 12.02 RT | PC OF 35' R              |

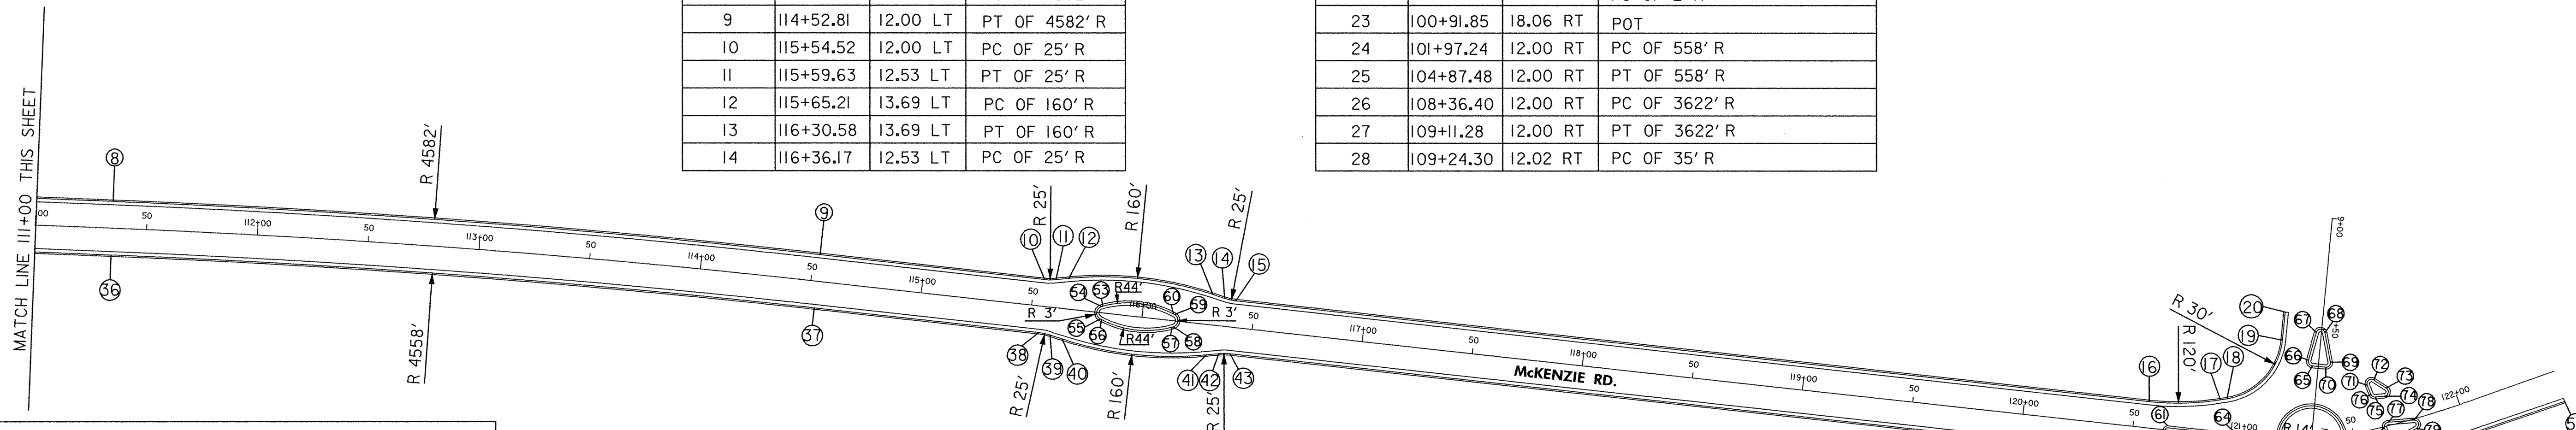

| CURB LAYOUT |           |          |                             |
|-------------|-----------|----------|-----------------------------|
| POINT NO.   | LOCATION  | OFFSET   | REMARKS                     |
| 29          | 10+47.81  | 14.51 RT | PT OF 35' R, THORN BROOK RD |
| 30          | 10+49.57  | 14.51 RT | POT, THORN BROOK RD         |
| 31          | 10+49.57  | 15.05 LT | POT, THORN BROOK RD         |
| 32          | 10+43.91  | 15.09 LT | PC OF 30' R, THORN BROOK RD |
| 33          | 110+9.45  | 17.12 RT | PT OF 30' R                 |
| 34          | 110+13.90 | 15.83 RT | PC OF 100' R                |
| 35          | 110+40.13 | 12.05 RT | PT OF 100' R                |
| 36          | 111+34.42 | 12.00 RT | PC OF 4558' R               |
| 37          | 114+52.81 | 12.00 RT | PT OF 4558' R               |
| 38          | 115+54.52 | 12.00 RT | PC OF 25' R                 |
| 39          | 115+59.63 | 12.53 RT | PT OF 25' R                 |
| 40          | 115+65.21 | 13.69 RT | PC OF 160' R                |
| 41          | 116+30.58 | 13.69 RT | PT OF 160' R                |
| 42          | 116+36.17 | 12.53 RT | PC OF 25' R                 |
| 43          | 116+41.27 | 12.00 RT | PT OF 25' R                 |
| 44          | 120+75.44 | 12.00 RT | PC OF 40' R                 |
| 45          | 10+53.62  | 15.97 RT | PT OF 40' R, ASHBROOK DR    |
| 46          | 10+54.38  | 15.96 RT | POT, ASHBROOK DR            |
| 47          | 10+54.38  | 14.07 LT | POT, ASHBROOK DR            |
| 48          | 10+52.92  | 14.05 LT | PC OF 45' R, ASHBROOK DR    |
| 49          | 121+58.25 | 22.97 RT | PT OF 45' R                 |
| 50          | 121+88.03 | 15.60 RT | PC OF 100' R                |

| CURB LAYOUT |           |          |                         |
|-------------|-----------|----------|-------------------------|
| POINT NO.   | LOCATION  | OFFSET   | REMARKS                 |
| 51          | 122+4.11  | 14.07 RT | PT OF 100' R            |
| 52          | 122+45.28 | 14.54 RT | POT                     |
| 53          | 115+81.91 | 3.00 LT  | PT OF 44' R             |
| 54          | 115+81.38 | 2.79 LT  | PC OF 3' R              |
| 55          | 115+81.38 | 2.79 LT  | PT OF 3' R              |
| 56          | 115+81.91 | 3.00 RT  | PC OF 44' R             |
| 57          | 116+13.89 | 3.00 RT  | PT OF 44' R             |
| 58          | 116+14.42 | 2.79 RT  | PC OF 3' R              |
| 59          | 116+14.42 | 2.79 RT  | PT OF 3' R              |
| 60          | 116+13.89 | 3.00 RT  | PC OF 44' R             |
| 61          | 120+65.64 | 2.00 LT  | PC OF 2' R              |
| 62          | 120+65.64 | 2.00 RT  | PT OF 2' R              |
| 63          | 120+96.69 | 2.00 RT  | PC OF 2' R              |
| 64          | 120+96.69 | 2.00 LT  | PT OF 2' R              |
| 65          | 9+66.88   | 2.65 RT  | PC OF 2' R, ASHBROOK DR |
| 66          | 9+64.53   | 4.62 RT  | PT OF 2' R, ASHBROOK DR |
| 67          | 9+51.61   | 2.32 RT  | PC OF 2' R, ASHBROOK DR |
| 68          | 9+51.41   | 1.57 LT  | PT OF 2' R, ASHBROOK DR |
| 69          | 9+64.32   | 5.28 LT  | PC OF 2' R, ASHBROOK DR |
| 70          | 9+66.88   | 3.36 LT  | PT OF 2' R, ASHBROOK DR |
| 71          | 121+61.35 | 20.06 LT | PC OF 2' R              |

| CURB LAYOUT |           |          |                         |
|-------------|-----------|----------|-------------------------|
| POINT NO.   | LOCATION  | OFFSET   | REMARKS                 |
| 72          | 121+64.91 | 21.74 LT | PT OF 2' R              |
| 73          | 121+69.76 | 16.78 LT | PC OF 2' R              |
| 74          | 121+67.88 | 13.45 LT | PT OF 2' R              |
| 75          | 121+63.73 | 14.09 LT | PC OF 2' R              |
| 76          | 121+62.02 | 15.77 LT | PT OF 2' R              |
| 77          | 121+66.60 | 1.49 LT  | PC OF 2' R              |
| 78          | 121+78.06 | 0.54 RT  | PT OF 2' R              |
| 79          | 121+78.12 | 4.46 RT  | PC OF 2' R              |
| 80          | 121+66.74 | 7.21 RT  | PT OF 2' R              |
| 81          | 121+64.28 | 5.27 RT  | PC OF 2' R              |
| 82          | 121+64.28 | 0.48 RT  | PT OF 2' R              |
| 83          | 10+33.26  | 0.49 RT  | PC OF 2' R, ASHBROOK DR |
| 84          | 10+35.41  | 1.51 LT  | PT OF 2' R, ASHBROOK DR |
| 85          | 10+44.16  | 0.81 LT  | PC OF 2' R, ASHBROOK DR |
| 86          | 10+44.38  | 3.15 RT  | PT OF 2' R, ASHBROOK DR |
| 87          | 10+35.63  | 4.83 RT  | PC OF 2' R, ASHBROOK DR |
| 88          | 10+33.26  | 2.87 RT  | PT OF 2' R, ASHBROOK DR |

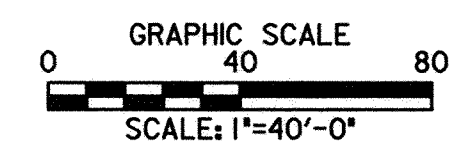

DEPARTMENT OF PUBLIC WORKS  
HOWARD COUNTY, MARYLAND

*James M. Pineau* 9/22/03  
DATE  
CHIEF, TRANSPORTATION AND SPECIAL PROJECTS DIVISION

*Robert D. Eason* 9/22/03  
DATE  
CHIEF, BUREAU OF ENGINEERING

*William F. Madala* 9-22-03  
DATE  
CHIEF, BUREAU OF HIGHWAYS



**URS**  
HUNT VALLEY, MARYLAND



RJM ENGINEERING, INC.  
CONSULTING ENGINEERS  
COLUMBIA, MARYLAND  
TEL: 410/730-1001 FAX: 410/730-5403

|       |    |     |          |      |
|-------|----|-----|----------|------|
| DES:  |    |     |          |      |
| DRN:  |    |     |          |      |
| CHK:  |    |     |          |      |
| DATE: | BY | NO. | REVISION | DATE |

**CURB GEOMETRY SHEET**

**McKENZIE ROAD ROADWAY AND STORMDRAIN IMPROVEMENTS**

HOWARD COUNTY, MARYLAND  
CAPITAL PROJECT NO. J-4164-10

SCALE AS SHOWN  
SHEET 6 OF 24

NO.: \_\_\_\_\_ DATE: 9/03

| RELOCATE EX. MAILBOX<br>(SEE DETAIL A THIS SHEET) |           |
|---|-----------|
| STATION   | OFFSET    |
| 103+26  | 15.83' LT |
| 104+70  | 13.02' LT |
| 105+12  | 11.72' RT |

| RECONSTRUCT CONCRETE DRIVEWAY |               |
|-------------------------------|---------------|
| STATION                       | QUANTITY (SY) |
| 102+95.67 LT                  | 35.23         |
| 104+89.34 LT                  | 18.18         |

| RECONSTRUCT ASPHALT DRIVEWAY |               |
|------------------------------|---------------|
| STATION                      | QUANTITY (SY) |
| 102+79.12 RT                 | 27.73         |
| 103+16.20 RT                 | 25.52         |
| 104+39.69 RT                 | 22.16         |
| 104+98.17 RT                 | 9.42          |

| ROTATE SANITARY MANHOLE |        |
|-------------------------|--------|
| STATION                 | OFFSET |
| 105+64                  | 12' LT |


| CONSTRUCT STD. COMB. CURB AND GUTTER |            |               |
|--------------------------------------|------------|---------------|
| FROM STATION                         | TO STATION | QUANTITY (LF) |
| 100+91.85 LT                         | 106+00 LT  | 515           |
| 100+91.85 RT                         | 106+00 RT  | 515           |

| ADJUST COVER ON MANHOLE |          |
|-------------------------|----------|
| STATION                 | OFFSET   |
| 103+61                  | 15.2' LT |


| REMOVE HEDGES |            |               |
|---------------|------------|---------------|
| FROM STATION  | TO STATION | QUANTITY (LF) |
| 103+72 LT     | 106+00 LT  | 228'          |

| CLEAN EXISTING PIPE CULVERT |            |               |
|-----------------------------|------------|---------------|
| STATION                     | SIZE/TYPER | QUANTITY (LF) |
| 103+60 LT                   | 24" CMP    | 17'           |


| CONSTRUCT 4" CONCRETE SIDEWALK |            |               |
|--------------------------------|------------|---------------|
| FROM STATION                   | TO STATION | QUANTITY (SF) |
| 100+90 LT                      | 106+00 LT  | 2398          |

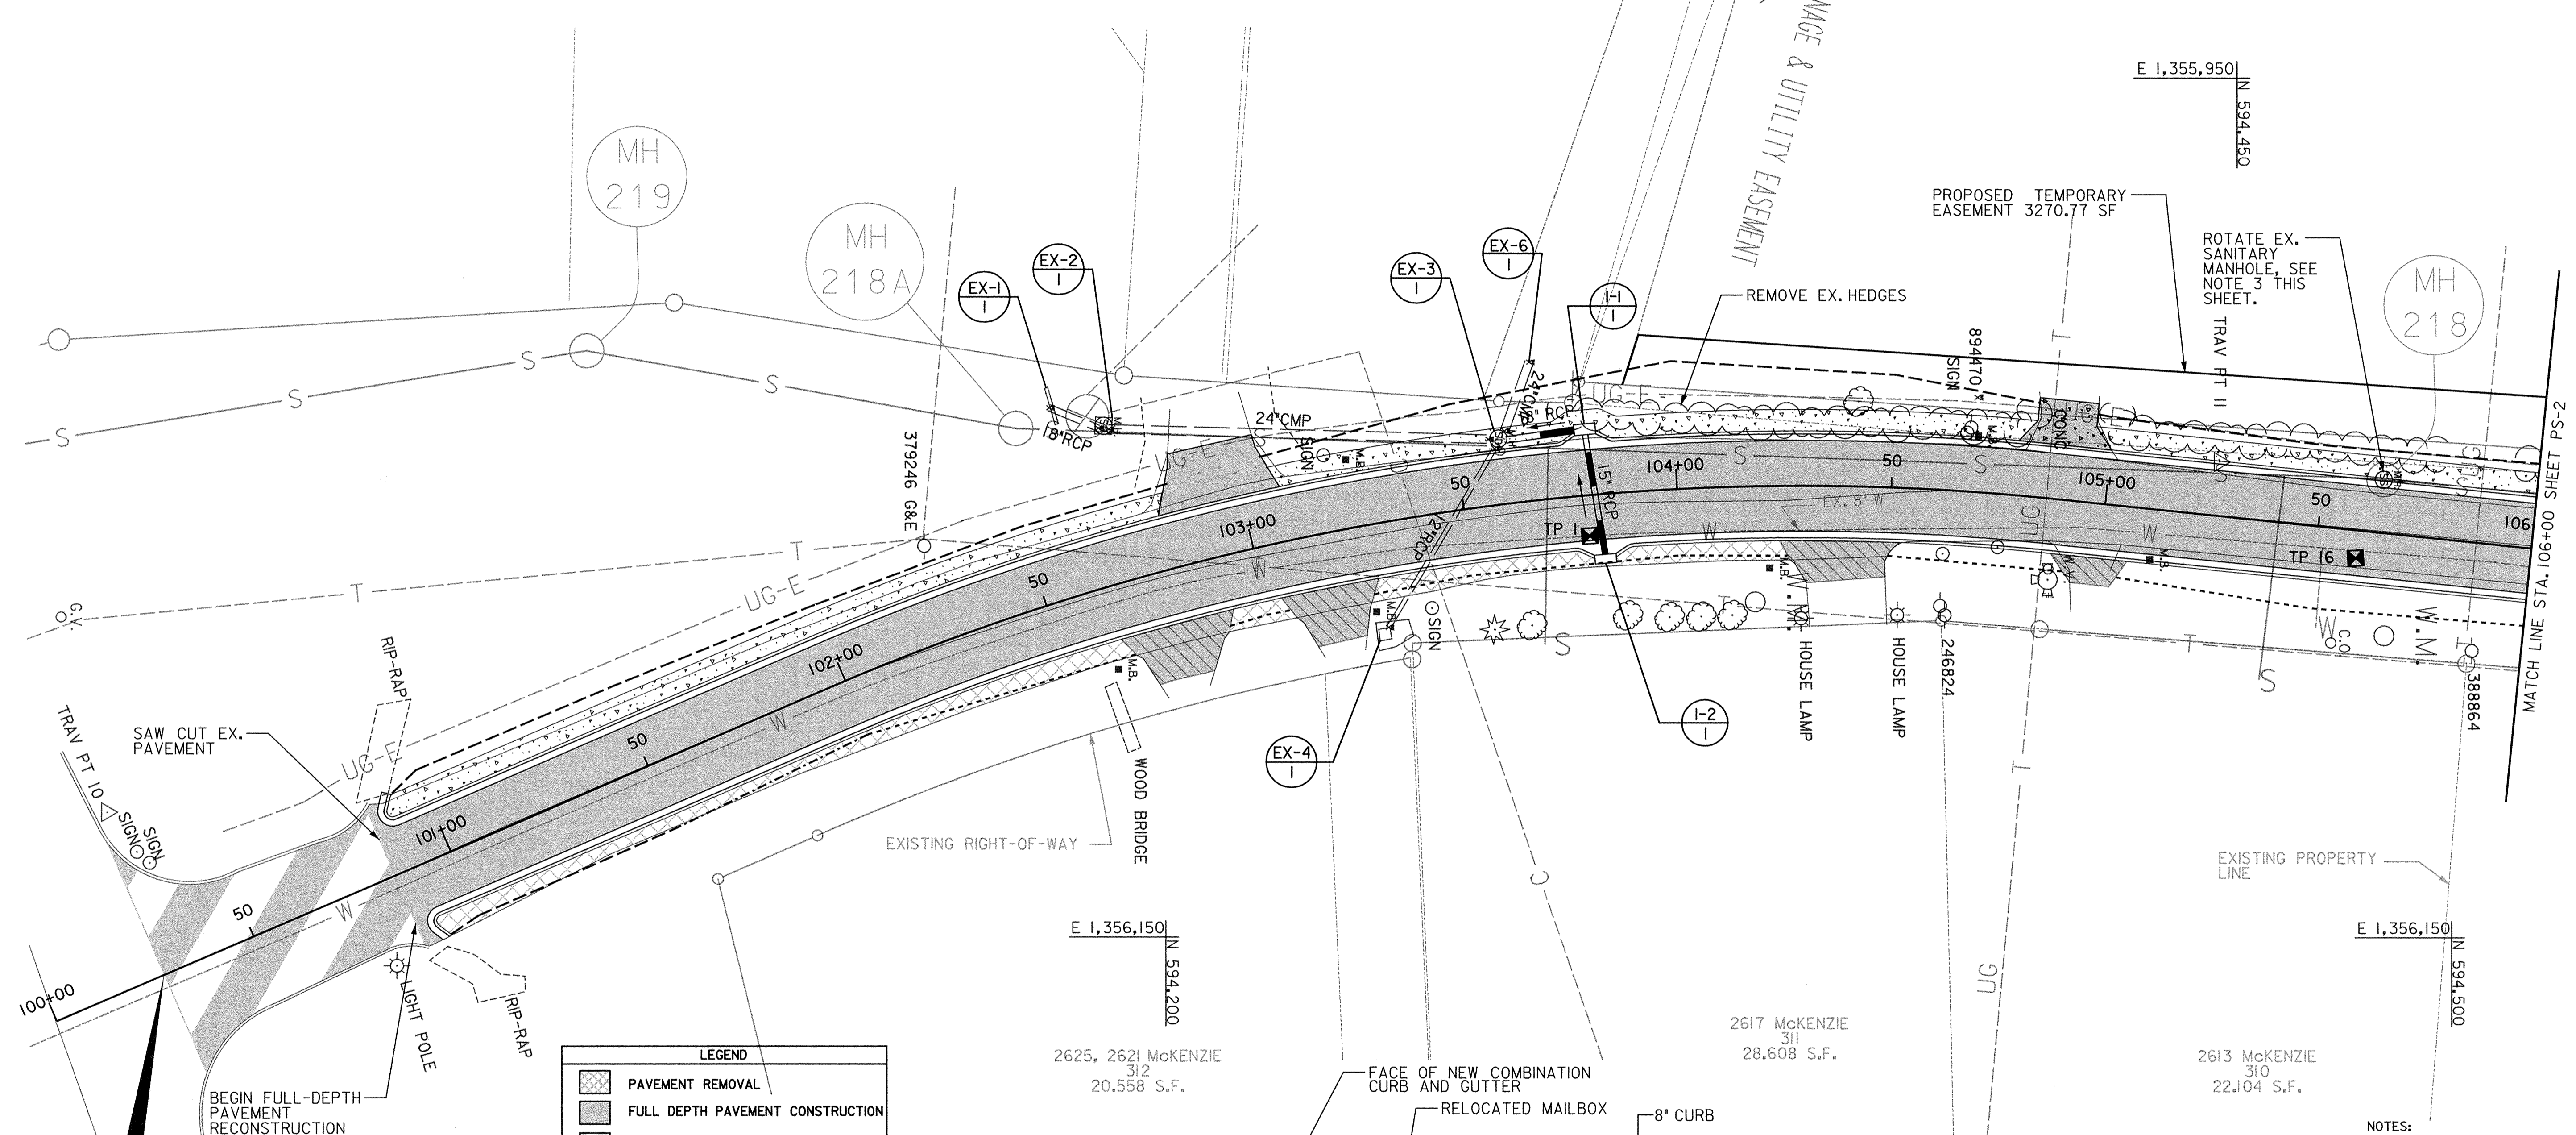

| LEGEND   |                                  |
|----------|----------------------------------|
| [Symbol] | PAVEMENT REMOVAL                 |
| [Symbol] | FULL DEPTH PAVEMENT CONSTRUCTION |
| [Symbol] | MILL AND RESURFACE (SEE NOTE 1)  |
| [Symbol] | PROPOSED CONCRETE SIDEWALK       |
| [Symbol] | PROPOSED MEDIANS                 |
| [Symbol] | RECONSTRUCT ASPHALT DRIVEWAY     |
| [Symbol] | RECONSTRUCT CONCRETE DRIVEWAY    |
| [Symbol] | EXIST. RIGHT-OF-WAY              |
| [Symbol] | TEST PIT                         |

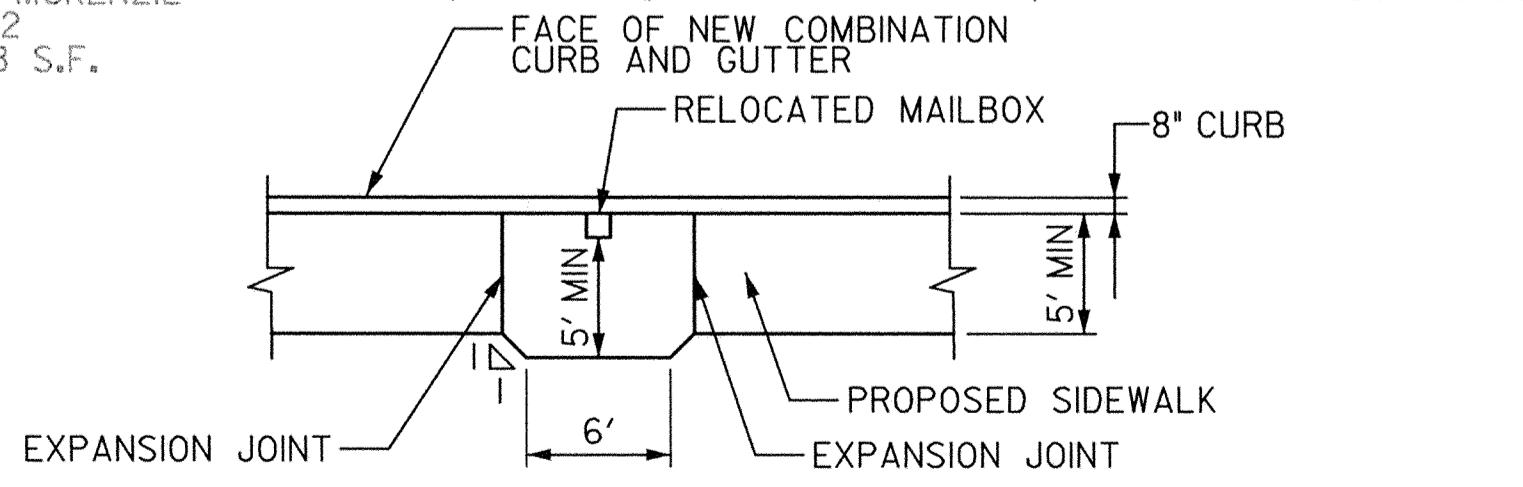

DETAIL A - MAILBOX RELOCATION PLAN  
\*FOR USE IN AREAS WHERE SIDEWALK IS ADJACENT TO CURB

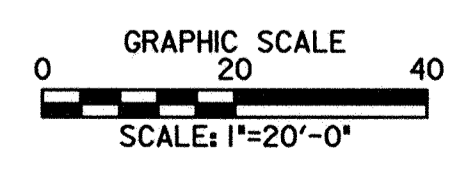

- NOTES:
- CONTRACTOR SHALL MILL AND RESURFACE 1" EXISTING PAVEMENT WITH 1" HOT MIX ASPHALT SUPERPAVE 9.5 MM PG64-22 SURFACE COURSE BETWEEN STA. 100+27.26 AND 100+85.00.
  - EXISTING CURBS ALONG MCKENZIE ROAD AT STATION 100+90 SHALL BE TAPERED DOWN TO CREATE CURB OPENING.
  - EXISTING SANITARY MANHOLES 218 AND 216 SHALL BE ROTATED AS DETAILED IN THE SPECIFICATIONS.
  - SEE APPENDIX I OF SPECIFICATIONS FOR TEST PIT RESULTS.

DEPARTMENT OF PUBLIC WORKS  
HOWARD COUNTY, MARYLAND

*[Signature]* 9/22/03  
DATE

*[Signature]* 9/22/03  
DATE

*[Signature]* 9/22/03  
DATE

**URS**  
HUNT VALLEY, MARYLAND

**RJM**  
RJM ENGINEERING, INC.  
CONSULTING ENGINEERS  
COLUMBIA, MARYLAND

TELE: 410/730-1001 FAX: 410/730-5403

|       |    |     |          |      |  |
|-------|----|-----|----------|------|--|
| DES:  |    |     |          |      |  |
| DRN:  |    |     |          |      |  |
| CHK:  |    |     |          |      |  |
| DATE: | BY | NO. | REVISION | DATE |  |

**PLAN SHEET PS-1**

NO.: \_\_\_\_\_ DATE: 9/03

**MCKENZIE ROAD ROADWAY AND STORMDRAIN IMPROVEMENTS**

HOWARD COUNTY, MARYLAND  
CAPITAL PROJECT NO. J-4164-10

SCALE AS SHOWN  
SHEET 7 OF 24

| STATION | OFFSET    |
|---------|-----------|
| 106+35  | 10.50' RT |
| 107+39  | 11.57' RT |
| 108+70  | 12.38' LT |
| 109+12  | 14.17' LT |
| 110+21  | 12.22' RT |
| 110+23  | 12.68' LT |

| FROM STATION | TO STATION | QUANTITY (LF) |
|--------------|------------|---------------|
| 106+00 LT    | 111+00 LT  | 500.0         |
| 106+00 RT    | 109+59 RT  | 381.0         |
| 109+88 RT    | 111+00 RT  | 134.0         |

| STATION | OFFSET    |
|---------|-----------|
| 109+67  | 16.82' LT |

| FROM STATION | TO STATION | OFFSET  | QUANTITY (LF) |
|--------------|------------|---------|---------------|
| 107+51 LT    | 107+56 LT  | 193' LT | 93            |

| STATION   | QUANTITY (SY) |
|-----------|---------------|
| 107+46 LT | 18.93         |
| 108+54 LT | 25.97         |
| 109+35 LT | 14.90         |
| 110+53 LT | 17.35         |

| STATION   | QUANTITY (SY) |
|-----------|---------------|
| 106+59 RT | 12.58         |
| 107+57 RT | 15.73         |




| FROM STATION | TO STATION | QUANTITY (SF) |
|--------------|------------|---------------|
| 106+00 LT    | 111+00 LT  | 2027          |

| STATION | OFFSET   | QUANTITY (EA) |
|---------|----------|---------------|
| 110+2.1 | 15.5' RT | 1             |


| STATION  | OFFSET   | QUANTITY (EA) |
|----------|----------|---------------|
| 109+30.8 | 14.7' RT | 1             |

| FROM STATION                  | TO STATION                    | QUANTITY (LF) |
|-------------------------------|-------------------------------|---------------|
| 109+34.50 RT<br>(@ MCKENZIE)  | 10+49.57 RT<br>(@ THORNBROOK) | 46.8          |
| 10+49.57 LT<br>(@ THORNBROOK) | 110+19.40 RT<br>(@ MCKENZIE)  | 54.7          |

| FROM STATION | TO STATION | SIZE/TYPE | QUANTITY (LF) |
|--------------|------------|-----------|---------------|
| 107+70 RT    | 107+69 LT  | 12" CMP   | 36            |
| 108+49 RT    | 109+27 RT  | 18" CMP   | 80            |
| 109+34 RT    | 110+01 RT  | UNKNOWN   | 67            |

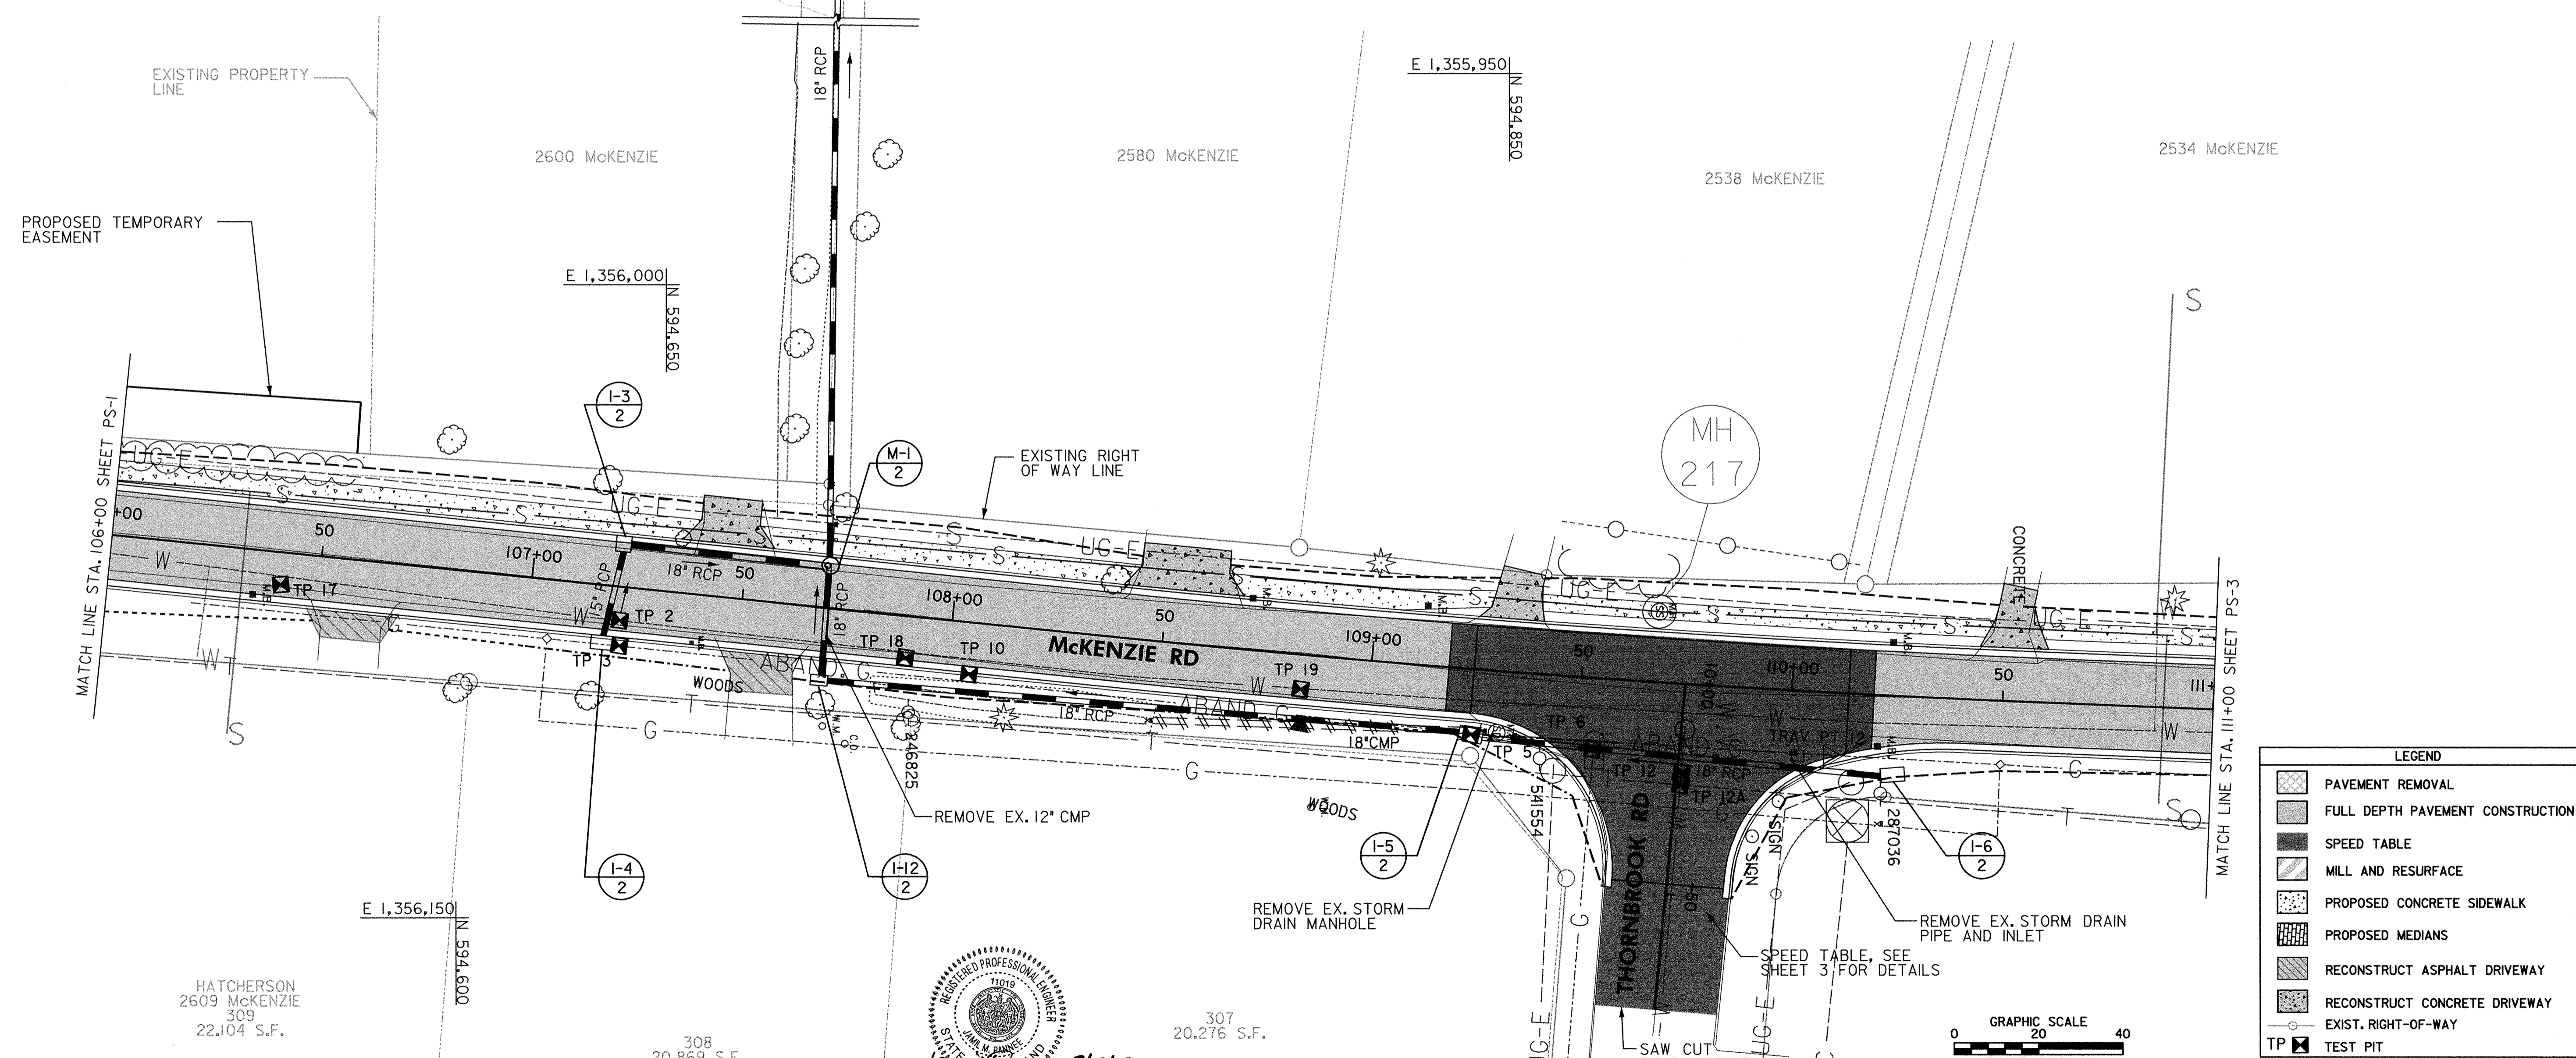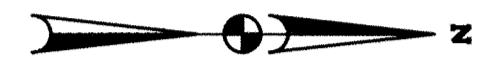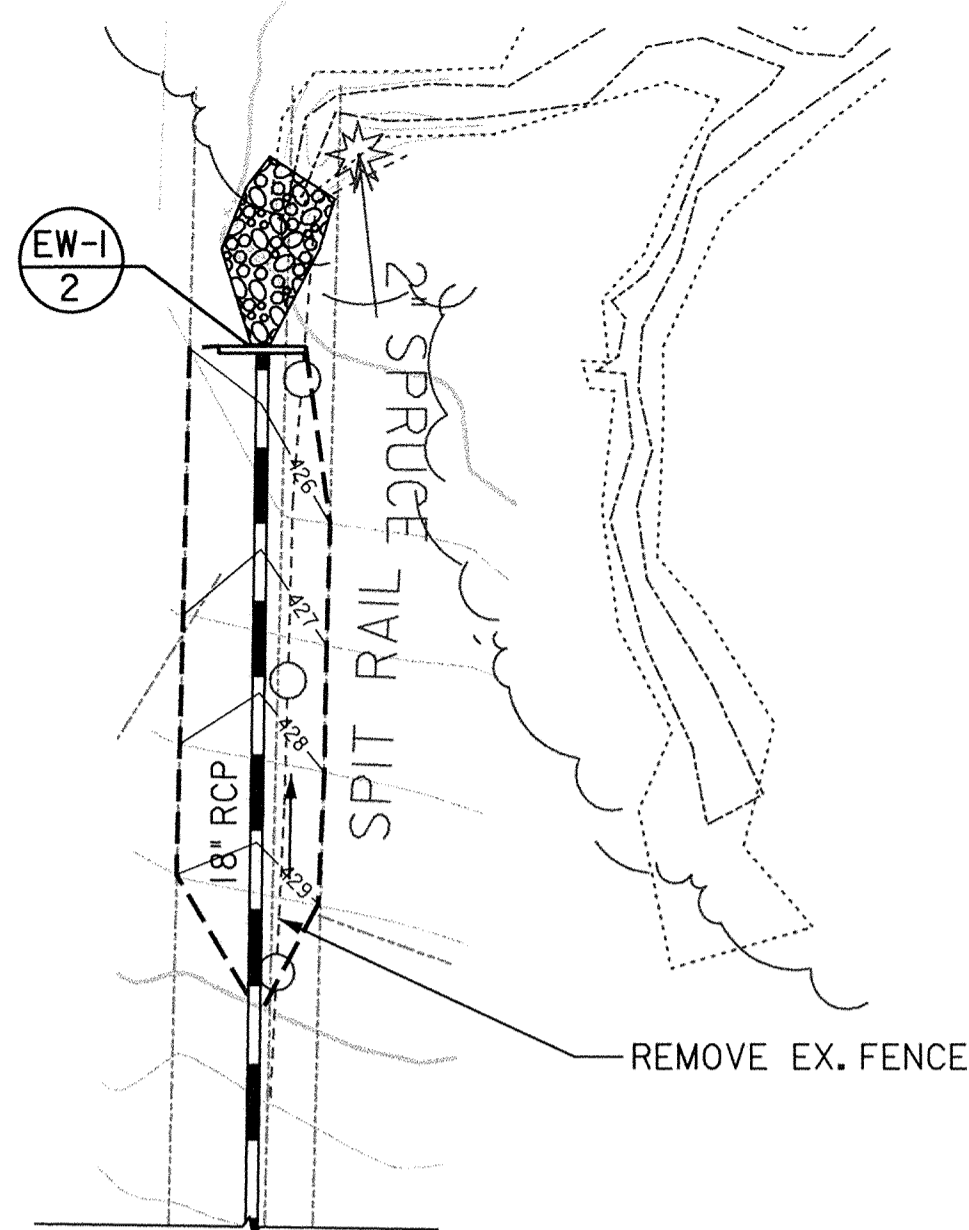

| LEGEND   |                                  |
|----------|----------------------------------|
| [Symbol] | PAVEMENT REMOVAL                 |
| [Symbol] | FULL DEPTH PAVEMENT CONSTRUCTION |
| [Symbol] | SPEED TABLE                      |
| [Symbol] | MILL AND RESURFACE               |
| [Symbol] | PROPOSED CONCRETE SIDEWALK       |
| [Symbol] | PROPOSED MEDIANS                 |
| [Symbol] | RECONSTRUCT ASPHALT DRIVEWAY     |
| [Symbol] | RECONSTRUCT CONCRETE DRIVEWAY    |
| [Symbol] | EXIST. RIGHT-OF-WAY              |
| [Symbol] | TEST PIT                         |

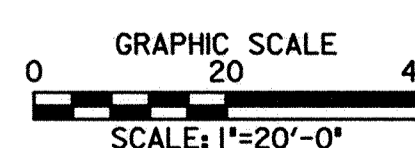

HATCHELSON  
2609 MCKENZIE  
309  
22.104 S.F.

308  
20,869 S.F.

307  
20,276 S.F.



DEPARTMENT OF PUBLIC WORKS  
HOWARD COUNTY, MARYLAND

*[Signature]* 9/22/03  
DATE

*[Signature]* 9/22/03  
DATE

*[Signature]* 9-24-03  
DATE

**URS**  
HUNT VALLEY, MARYLAND

**RJM**  
RJM ENGINEERING, INC.  
CONSULTING ENGINEERS  
COLUMBIA, MARYLAND

|       |    |     |          |      |
|-------|----|-----|----------|------|
| DES:  |    |     |          |      |
| DRN:  |    |     |          |      |
| CHK:  |    |     |          |      |
| DATE: | BY | NO. | REVISION | DATE |

**PLAN SHEET PS-2**

NO.: \_\_\_\_\_ DATE: 9/03

**McKENZIE ROAD ROADWAY AND STORMDRAIN IMPROVEMENTS**

HOWARD COUNTY, MARYLAND  
CAPITAL PROJECT NO. J-4164-10

SCALE AS SHOWN  
SHEET 8 OF 24

09/22/03  
 C:\Users\jv\Documents\HowardCo\_McKenzie\0309-22\030922.mxd



| RELOCATE EX. MAILBOX |          |
|----------------------|----------|
| STATION              | OFFSET   |
| 111+51.0             | 10.8' LT |
| 111+84.5             | 9.85' LT |
| 112+46.5             | 12.5' LT |
| 113+79.2             | 17.4' LT |
| 114+29.0             | 17.0' LT |
| 115+19.1             | 19.0' LT |
| 115+52.6             | 17.9' LT |
| 112+48.9             | 11.7' RT |
| 113+9.2              | 12.0' RT |
| 116+35.1             | 12.6' RT |

| CONSTRUCT STD. COMB. CURB & GUTTER |            |               |
|------------------------------------|------------|---------------|
| FROM STATION                       | TO STATION | QUANTITY (LF) |
| 111+00 RT                          | 117+00 RT  | 601           |
| 111+00 LT                          | 117+00 LT  | 601           |

| CONSTRUCT ASPHALT DRIVEWAY |               |  |
|----------------------------|---------------|--|
| STATION                    | QUANTITY (SY) |  |
| 112+31 RT                  | 20.0          |  |
| 113+27 RT                  | 10.0          |  |
| 114+23 RT                  | 16.8          |  |
| 115+11 RT                  | 18.6          |  |
| 116+51 RT                  | 11.6          |  |

| CONSTRUCT CONCRETE DRIVEWAY |               |  |
|-----------------------------|---------------|--|
| STATION                     | QUANTITY (SY) |  |
| 111+69.7 LT                 | 16.8          |  |
| 112+58.8 LT                 | 18.7          |  |
| 113+87.4 LT                 | 19.6          |  |
| 114+36.8 LT                 | 20.8          |  |
| 115+30.6 LT                 | 24.1          |  |
| 115+62.4 LT                 | 18.9          |  |

| ADJUST COVER ON MANHOLE |        |
|-------------------------|--------|
| STATION                 | OFFSET |
| 111+8.4                 | 17' LT |


| ROTATE SANITARY MANHOLE |        |
|-------------------------|--------|
| STATION                 | OFFSET |
| 113+54                  | 12' LT |

| CONSTRUCT MODIFIED COMB. CURB & GUTTER |            |               |
|--|------------|---------------|
| FROM STATION                           | TO STATION | QUANTITY (LF) |
| 115+79.5                               | 116+16.3   | 82.1          |


| CONSTRUCT COLORED STAMPED CONCRETE * |            |               |
|--------------------------------------|------------|---------------|
| FROM STATION                         | TO STATION | QUANTITY (SF) |
| 115+80.5                             | 116+15.3   | 256.0         |

| REMOVAL OF EXISTING INLET |          |               |
|---------------------------|----------|---------------|
| STATION                   | OFFSET   | QUANTITY (EA) |
| 115+48.0                  | 18.7' LT | 1             |
| 115+51.8                  | 20.7' RT | 1             |
| 115+70.8                  | 20.2' LT | 1             |

| REMOVAL OF EXISTING PIPE CULVERTS |             |           |               |
|-----------------------------------|-------------|-----------|---------------|
| FROM STATION                      | TO STATION  | SIZE/TYPE | QUANTITY (LF) |
| 113+77.7 LT                       | 113+95.7 LT | 15" CMP   | 19.5          |
| 114+28.4 LT                       | 114+46.3 LT | 15" CMP   | 20.0          |
| 115+8.4 LT                        | 115+46.3 LT | 15" CMP   | 39.9          |
| 115+48.3 LT                       | 115+50.3 RT | 12" CMP   | 29.5          |
| 115+45.7 LT                       | 115+47.5 LT | UNKNOWN   | 26.7          |
| 115+49.2 LT                       | 115+70.3 LT | 15" CMP   | 21.2          |

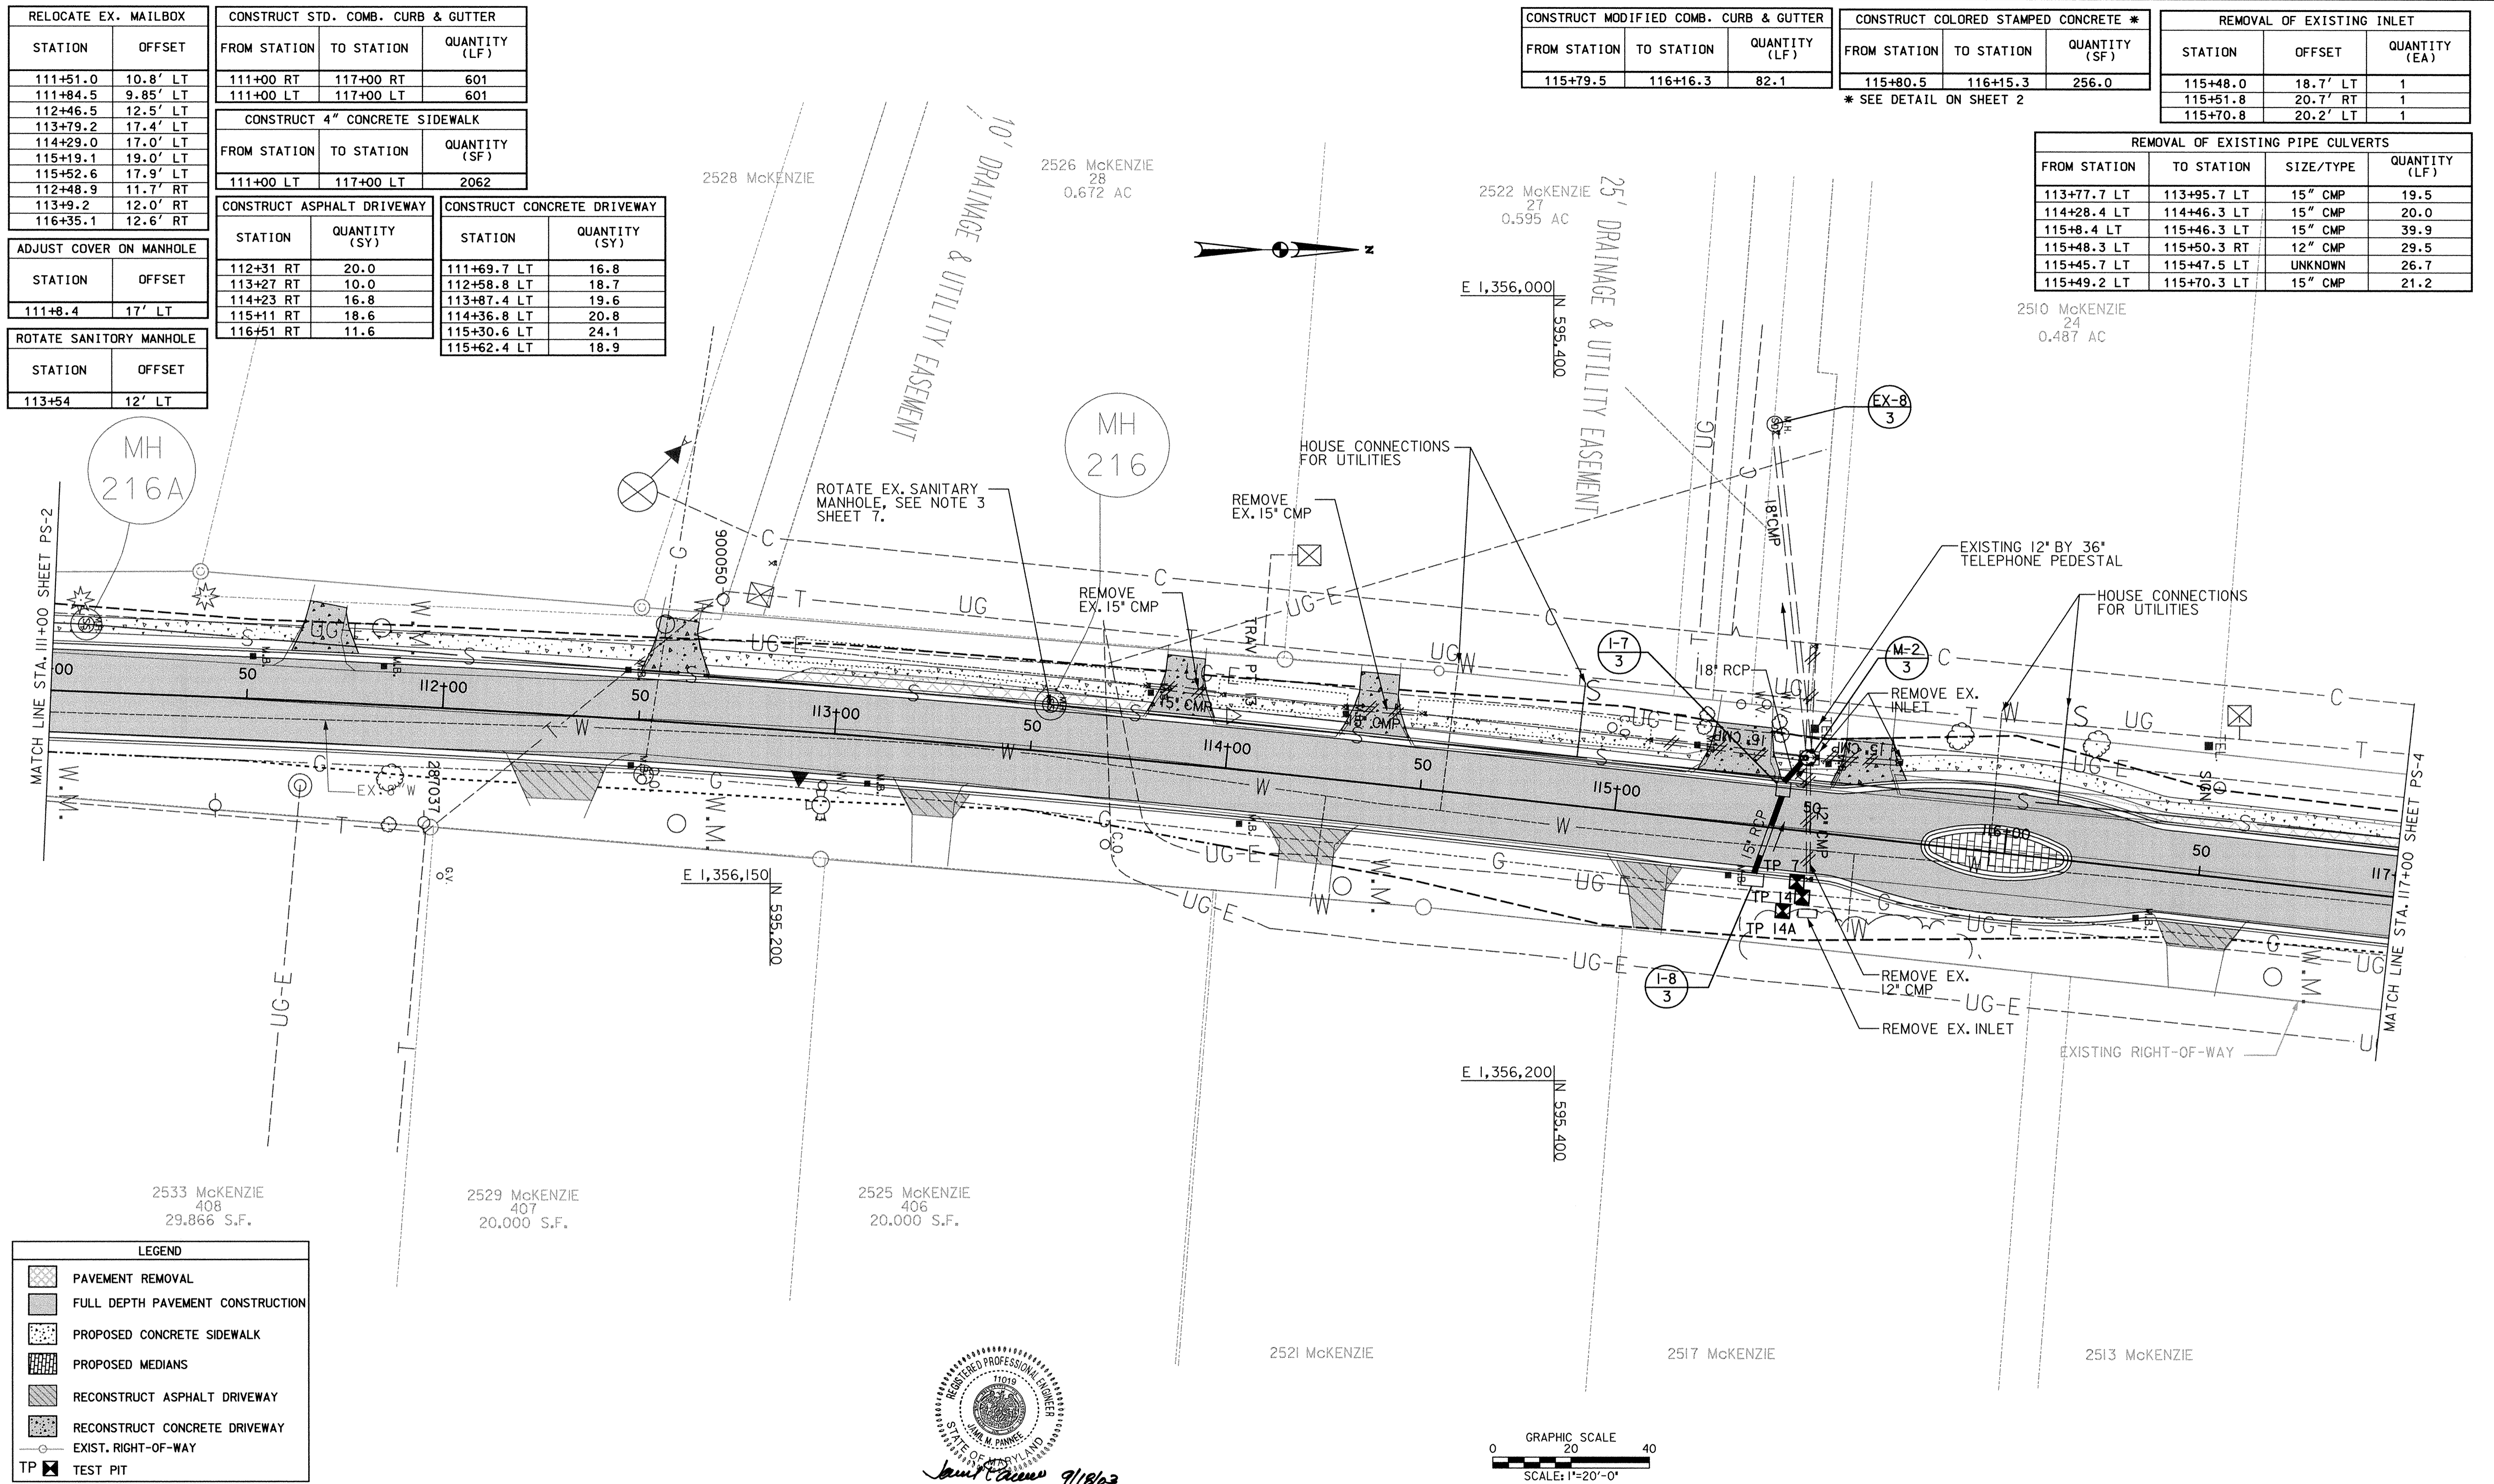

| LEGEND   |                                  |
|----------|----------------------------------|
| [Symbol] | PAVEMENT REMOVAL                 |
| [Symbol] | FULL DEPTH PAVEMENT CONSTRUCTION |
| [Symbol] | PROPOSED CONCRETE SIDEWALK       |
| [Symbol] | PROPOSED MEDIANS                 |
| [Symbol] | RECONSTRUCT ASPHALT DRIVEWAY     |
| [Symbol] | RECONSTRUCT CONCRETE DRIVEWAY    |
| [Symbol] | EXIST. RIGHT-OF-WAY              |
| [Symbol] | TP TEST PIT                      |

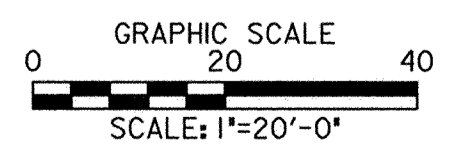

DEPARTMENT OF PUBLIC WORKS  
HOWARD COUNTY, MARYLAND

*[Signature]* 9/29/03  
CHIEF, BUREAU OF ENGINEERING

*[Signature]* 9/22/03  
CHIEF, BUREAU OF HIGHWAYS

**URS**  
HUNT VALLEY, MARYLAND

**RJM**  
RJM ENGINEERING, INC.  
CONSULTING ENGINEERS  
COLUMBIA, MARYLAND

|       |    |     |          |      |
|-------|----|-----|----------|------|
| DES:  |    |     |          |      |
| DRN:  |    |     |          |      |
| CHK:  |    |     |          |      |
| DATE: | BY | NO. | REVISION | DATE |

**PLAN SHEET PS-3**

**McKENZIE ROAD ROADWAY AND STORMDRAIN IMPROVEMENTS**

HOWARD COUNTY, MARYLAND  
CAPITAL PROJECT NO. J-4164-10


SCALE AS SHOWN  
SHEET 9 OF 24

| RELOCATE EX. MAILBOX |          | CONSTRUCT STD. COMB. CURB AND GUTTER |              |               | CONSTRUCT ASPHALT DRIVEWAY |               | CONSTRUCT MODIFIED COMB. CURB AND GUTTER |            |               | CONSTRUCT COLORED STAMPED CONCRETE |            |               | REMOVAL OF EXISTING PIPE CULVERTS |             |           |               | REMOVAL OF EXISTING INLET |           |               | REMOVE EXISTING CURB AND GUTTER |            |               |
|----------------------|----------|--------------------------------------|--------------|---------------|----------------------------|---------------|--|------------|---------------|------------------------------------|------------|---------------|-----------------------------------|-------------|-----------|---------------|---------------------------|-----------|---------------|---------------------------------|------------|---------------|
| STATION              | OFFSET   | FROM STATION                         | TO STATION   | QUANTITY (LF) | STATION                    | QUANTITY (SY) | FROM STATION                             | TO STATION | QUANTITY (LF) | FROM STATION                       | TO STATION | QUANTITY (SF) | FROM STATION                      | TO STATION  | SIZE/TYPE | QUANTITY (LF) | STATION                   | OFFSET    | QUANTITY (EA) | FROM STATION                    | TO STATION | QUANTITY (SY) |
| 117+49               | 20.4' LT | 117+00 LT                            | 9+43.86 RT   | 443           | 117+63 RT                  | 12.00         | 120+64                                   | 120+98     | 69            | 121+17                             | 121+45     | 615.7         | 118+59.3 LT                       | 118+79.0 LT | 12" CMP   | 19.7          | 120+63                    | 23.4' LT  | 1             | 120+96 RT                       | 10+54 RT   | 41.1          |
| 117+54               | 20.2' LT | 117+00 RT                            | 10+54.38 RT  | 438           | 117+64 LT                  | 20.35         | 121+16                                   | 121+46     | 95            | 121+62                             | 121+71     | 24.5          | 119+55.4 LT                       | 119+75.2 LT | 12" CMP   | 19.8          | 120+83 LT                 | 9+44 RT   | 62.6          | 120+83 LT                       | 9+44 RT    | 62.6          |
| 117+75               | 19.3' LT | 10+54.38 LT                          | 122+45.28 RT | 136           | 118+74 RT                  | 11.54         | 121+61                                   | 121+72     | 28            | 121+67                             | 121+79     | 55.4          | 120+63 RT                         | 120+63 LT   | 15" CMP   | 38.0          | 10+54 LT                  | 121+81 RT | 72.0          | 119+56                          | 14.8' LT   |               |
| 117+82               | 18.6' LT |                                      |              | 119+56               | 14.8' LT |                                      |              | 120+54               | 19.8' LT |                                      |              | 117+85               | 12.3' RT |                                      |              | 118+93               | 10.3' RT |                                      |              | 119+93               | 12.7' RT |                                      |              
| RELOCATE EXISTING SIGN  |          | CONSTRUCT 4" CONCRETE SIDEWALK * |            |               |
|-------------------------|----------|----------------------------------|------------|---------------|
| STATION                 | OFFSET   | FROM STATION                     | TO STATION | QUANTITY (SF) |
| 121+4.6                 | 27.5' LT | 117+00 LT                        | 9+56.58 RT | 1400          |
| ADJUST COVER ON MANHOLE |          | SIDEWALK EXTENSION               |            | 2400          |
| STATION                 | OFFSET   |                                  |            |               |
| 117+54                  | 16' LT   |                                  |            |               |
| 121+30                  | 2' RT    |                                  |            |               |



| CONSTRUCT CONCRETE DRIVEWAY |               |
|-----------------------------|---------------|
| STATION                     | QUANTITY (SY) |
| 117+29 LT                   | 26.52         |
| 118+69 LT                   | 18.93         |
| 119+65 LT                   | 20.72         |

\* SIDEWALK RAMPS WILL BE INCIDENTAL TO SIDEWALK.

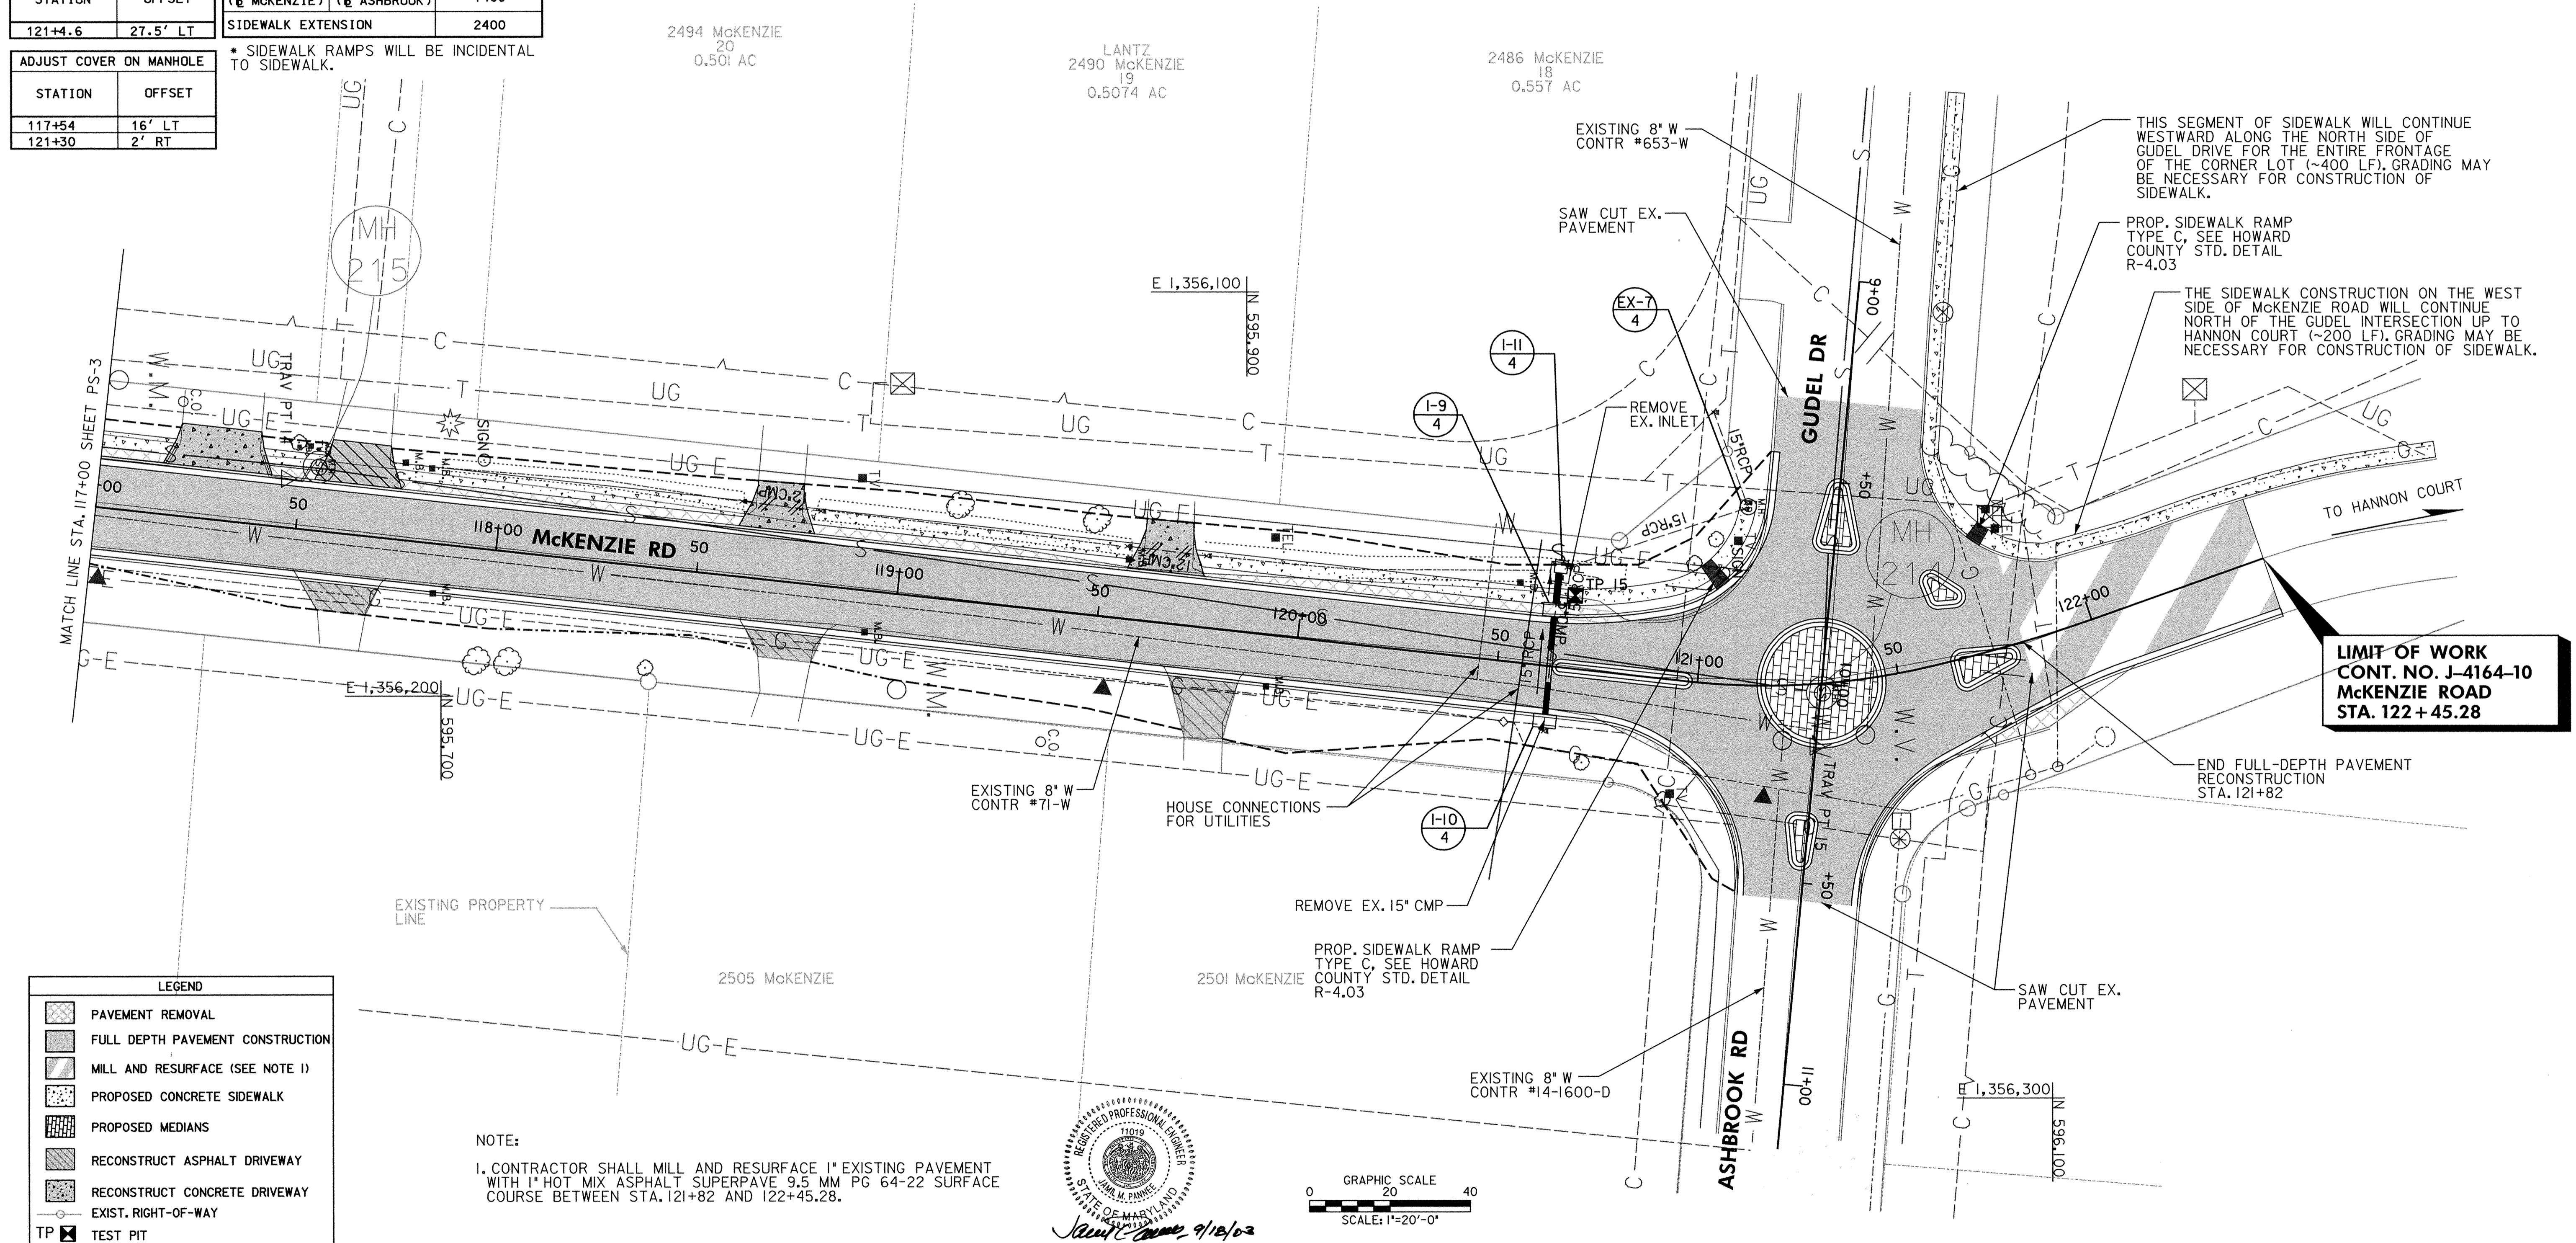

| LEGEND   |                                  |
|----------|----------------------------------|
| [Symbol] | PAVEMENT REMOVAL                 |
| [Symbol] | FULL DEPTH PAVEMENT CONSTRUCTION |
| [Symbol] | MILL AND RESURFACE (SEE NOTE 1)  |
| [Symbol] | PROPOSED CONCRETE SIDEWALK       |
| [Symbol] | PROPOSED MEDIANS                 |
| [Symbol] | RECONSTRUCT ASPHALT DRIVEWAY     |
| [Symbol] | RECONSTRUCT CONCRETE DRIVEWAY    |
| [Symbol] | EXIST. RIGHT-OF-WAY              |
| [Symbol] | TEST PIT                         |

NOTE:  
 1. CONTRACTOR SHALL MILL AND RESURFACE 1" EXISTING PAVEMENT WITH 1" HOT MIX ASPHALT SUPERPAVE 9.5 MM PG 64-22 SURFACE COURSE BETWEEN STA. 121+82 AND 122+45.28.

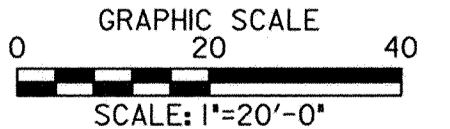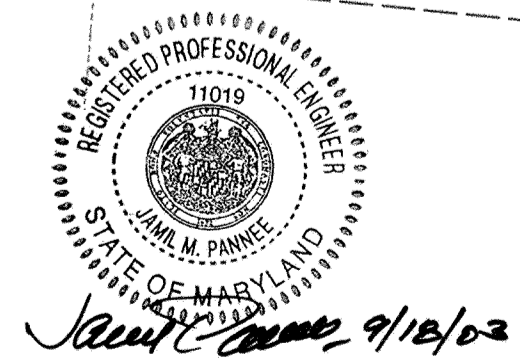

DEPARTMENT OF PUBLIC WORKS  
 HOWARD COUNTY, MARYLAND  
 9/21/03  
 9/22/03

URS  
 HUNT VALLEY, MARYLAND




RJM ENGINEERING, INC.  
 CONSULTING ENGINEERS  
 COLUMBIA, MARYLAND

|       |         |
|-------|---------|
| DES:  |         |
| DRN:  |         |
| CHK:  |         |
| DATE: | 9/12/03 |

| BY | NO. | REVISION | DATE |
|----|-----|----------|------|
|    |     |          |      |

McKENZIE ROAD ROADWAY AND STORMDRAIN IMPROVEMENTS  
 HOWARD COUNTY, MARYLAND  
 CAPITAL PROJECT NO. J-4164-10  
 PLAN SHEET PS-4  
 NO.: DATE: 9/03

SCALE AS SHOWN  
 SHEET 10 OF 24

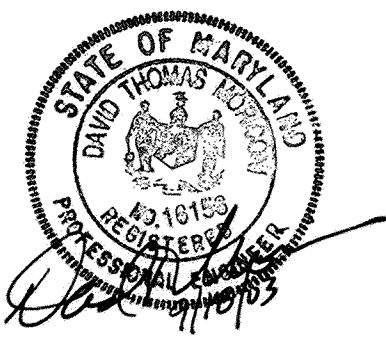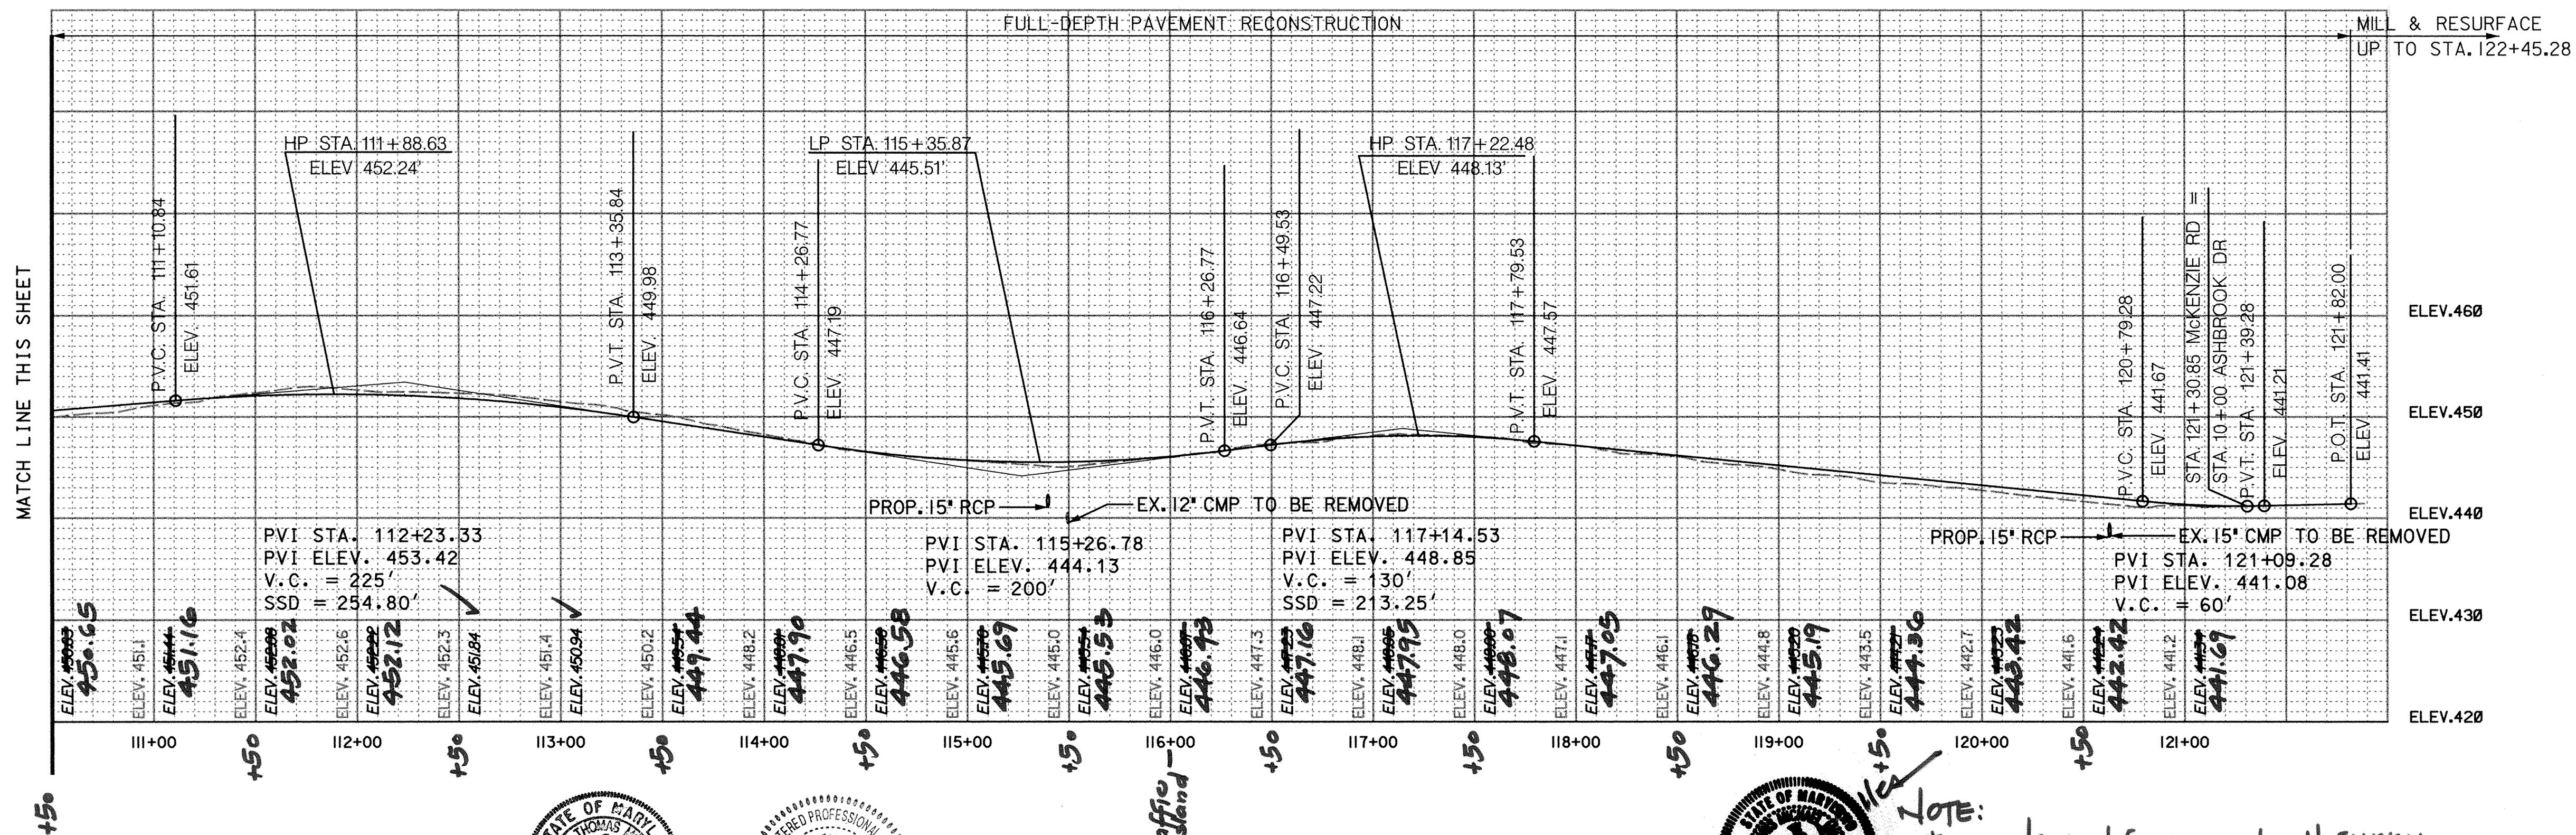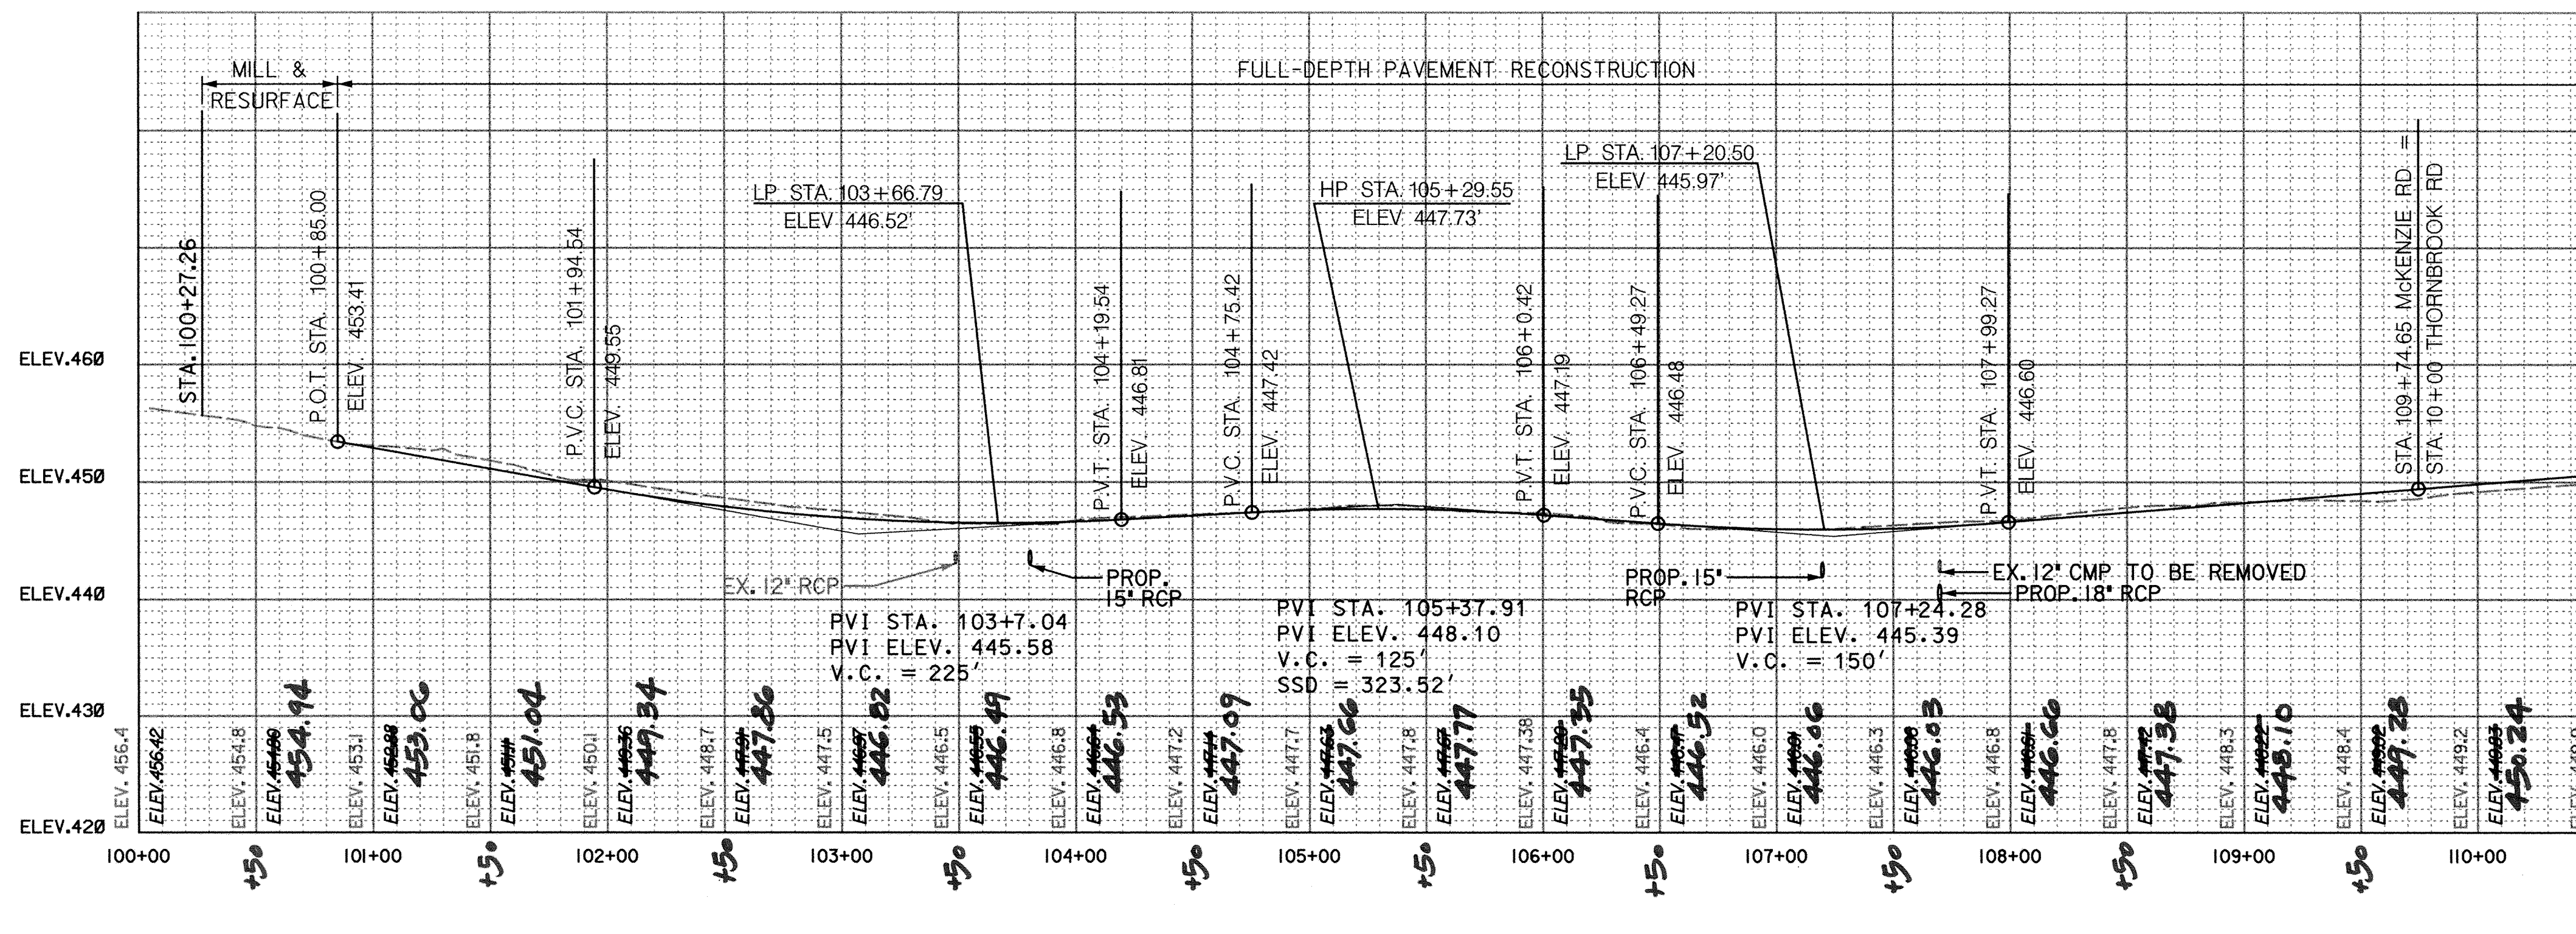


NOTE:  
This is to certify an as-built survey  
of the centerline profile was made in November 2004  
\* As-built remarks are shown in red!

DEPARTMENT OF PUBLIC WORKS  
HOWARD COUNTY, MARYLAND

*James E. Jones* 9/22/03  
CHIEF, BUREAU OF ENGINEERING  
*Evelyn E. Jones* 9/22/03  
CHIEF, TRANSPORTATION AND SPECIAL PROJECTS DIVISION

*William J. Walker* 9-24-03  
CHIEF, BUREAU OF HIGHWAYS

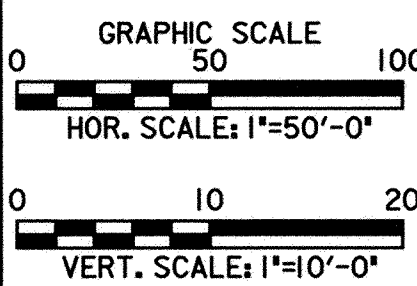

HUNT VALLEY, MARYLAND



RJM ENGINEERING, INC.  
CONSULTING ENGINEERS  
COLUMBIA, MARYLAND

TEL: 410-730-1001 FAX: 410-730-5403

|           |  |
|-----------|--|
| DES:      |  |
| DRN:      |  |
| CHK:      |  |
| DATE:     |  |
| BY:       |  |
| NO.:      |  |
| REVISION: |  |
| DATE:     |  |

PROFILE SHEET

**McKENZIE ROAD ROADWAY AND STORMDRAIN IMPROVEMENTS**

HOWARD COUNTY, MARYLAND  
CAPITAL PROJECT NO. J-4164-10

SCALE AS SHOWN  
SHEET 11 OF 24

NO.: DATE: 9/03

**Pipe Conduits**

All pipes shall be circular in cross section.

**Corrugated Metal Pipe**

All of the following criteria shall apply for corrugated metal pipe:

1. **Materials - (Steel Pipe)** - This pipe and its appurtenances shall be galvanized and conform to the requirements of AASHTO Specifications M-36 and M-218. It shall be fully bituminous coated and shall conform to the requirements of AASHTO Specification M-190 Type A with watertight coupling bands or flanges. Any bituminous coating damaged or otherwise removed shall be replaced with cold applied bituminous coating compound.

**Materials - (Polymer Coated Steel Pipe)** - Steel pipes with polymeric coatings shall have a minimum coating thickness of 0.01 inch (10 mil) on both sides of the pipe. This pipe and its appurtenances shall conform to the requirements of AASHTO Specifications M-245 and M-246 with watertight coupling bands or flanges.

**Materials - (Aluminum Coated Steel Pipe)** - This pipe and its appurtenances shall conform to the requirements of AASHTO Specification M-274 with watertight coupling bands or flanges. Aluminum coated steel pipe when used with flowable fill shall be fully bituminous coated per requirements of AASHTO Specification M-190 Type A. Any aluminum coating damaged or otherwise removed shall be replaced with cold applied bituminous coating compound. Aluminum surfaces that are to be in contact with concrete shall be painted with one coat of zinc chromate primer.

**Materials - (Aluminum Pipe)** - This pipe and its appurtenances shall conform to the requirements of AASHTO Specification M-196 or M-211 with watertight coupling bands or flanges. Aluminum pipe, when used with flowable fill, shall be fully bituminous coated per requirements of AASHTO Specification M-190 Type A. Aluminum surfaces that are to be in contact with concrete shall be painted with one coat of zinc chromate primer. Hot-dip galvanized bolts may be used for connection. The pH of the surrounding soils shall be between 4 and 9.

2. **Coupling bands, anti-seep collars, end sections, etc.** must be composed of the same material as the pipe. Metals must be insulated from dissimilar materials with use of rubber or plastic insulating materials at least 24 mils in thickness.

3. **Connections** - All connections with pipes must be completely watertight. The drain pipe or barrel connection to the riser shall be welded all around when the pipe and riser are metal. Anti-seep collars shall be connected to the pipe in such a manner as to be completely watertight. Dimple bands are not considered to be watertight.

All connections shall use a rubber or neoprene gasket when joining pipe sections. The end of each pipe shall be rerolled an adequate number of corrugations to accommodate the band width. The following type connections are acceptable for pipes less than 24 inches in diameter: Flanges on both ends of the pipe with a circular gasket, pre-punched to the flange bolt circle sandwiched between adjacent flanges; a 12-inch wide standard lag type band with 12-inch wide by 3/8-inch thick closed cell circular neoprene gasket; and a 12-inch wide lugger type band with O-ring gaskets having a minimum diameter of 1/2-inch greater than the corrugation depth. Pipes 24 inches in diameter and larger shall be connected by a 24-inch long annular corrugated band using a minimum of four (4) rods and lugs, two on each connecting pipe end. A 24-inch wide by 1/8-inch thick closed cell circular neoprene gasket will be installed with 12 inches on the end of each pipe. Flanged joints with gaskets are also acceptable.

Helically corrugated pipe shall have either continuously welded seams or have lock seams with internal caulking or a neoprene bead.

4. **Bedding** - The pipe shall be firmly and uniformly bedded throughout its entire length. Where rock or soft, spongy or other unstable soil is encountered, all such material shall be removed and replaced with suitable earth compacted to provide adequate support.

5. **Backfilling** shall conform to "Structure Backfill."

6. Other details (anti-seep collars, valves, etc.) shall be as shown on the drawings.

**Reinforced Concrete Pipe**

All of the following criteria shall apply for reinforced concrete pipe:

1. **Materials** - Reinforced concrete pipe shall have bell and spigot joints with rubber gaskets and shall equal or exceed ASTM C 361.

2. **Bedding** - All reinforced concrete pipe conduits shall be laid in a concrete bedding for their entire length. This bedding shall consist of high slump concrete placed under the pipe and up the sides of the pipe at least 50 percent of its outside diameter with a minimum thickness of 6 inches, or as shown on the drawings.

3. **Laying Pipe:** Bell and spigot pipe shall be placed with the bell and upstream. Joints shall be made in accordance with recommendations of the manufacturer of the material. After the joints are sealed for the entire line, the bedding shall be placed so that all spaces under the pipe are filled. Care shall be exercised to prevent any deviation from the original line and grade of the pipe. The first joint must be located within 2 feet from the riser.

4. **Backfilling** shall conform to "Structure Backfill."

5. Other details (anti-seep collars, valves, etc.) shall be as shown on the drawings.

**Polyvinyl Chloride (PVC) Pipe**

All of the following criteria shall apply for polyvinyl chloride (PVC) pipe:

1. **Materials** - PVC pipe shall be PVC-1120 or PVC-1220 conforming to ASTM D 1785 or ASTM D 2241.

2. **Joints and connections** to anti-seep collars shall be completely watertight.

3. **Bedding** - The pipe shall be firmly and uniformly bedded throughout its entire length. Where rock or soft, spongy or other unstable soil is encountered, all such material shall be removed and replaced with suitable earth compacted to provide adequate support.

4. **Backfilling** shall conform to "Structure Backfill."

5. Other details (anti-seep collars, valves, etc.) shall be as shown on the drawings.

**Concrete**

Concrete shall meet the requirements of Maryland Department of Transportation, State Highway Administration Standard Specifications for Construction and Materials, Section 414, Mix No. 3.

**Rock Riprap**

Rock riprap shall meet the requirements of Maryland Department of Transportation, State Highway Administration Standard Specifications for Construction and Materials, Section 901.

Filter cloth shall be placed under all riprap and shall meet the requirements of Maryland Department of Transportation, State Highway Administration Standard Specifications for Construction and Materials, Section 921.09, Class C.

**Care of Water During Construction**

All work on permanent structures shall be carried out in areas free from water. The Contractor shall construct and maintain all temporary dikes, levees, cofferdams, drainage channels, and stream diversions necessary to protect the areas to be occupied by the permanent works. The Contractor shall also furnish, install, operate, and maintain all necessary pumping and other equipment required for removal of water from various parts of the work and for maintaining the excavation in a manner and to the extent that will maintain stability of the excavation slopes and bottom of required excavations and will allow satisfactory performance of all construction operations. During the placing and compacting of material in required excavations, the water level at the locations being refilled shall be maintained below the bottom of the excavation at such locations which may require draining the water sumps from which the water shall be pumped.

**Stabilization**

All borrow areas shall be graded to provide proper drainage and left in a slightly condition. All exposed surfaces of the embankment, spillway, spoil, and borrow areas, berms shall be stabilized by seeding, liming, fertilizing, and mulching in accordance with the Maryland Soil Conservation Service Standards and Specifications for Critical Area Planting (MS-342) or as shown on the accompanying drawings.

**Erosion and Sediment Control**

Construction operations will be carried out in such a manner that erosion will be controlled and water and air pollution minimized. State and local laws concerning pollution abatement will be followed. Construction plans shall detail erosion and sediment control measures.

**PERMANENT SEEDING NOTES**

Apply to graded or cleared areas not subject to immediate further disturbance where a permanent long-lived vegetative cover is needed.

Seedbed preparation: loosen upper 3 inches of soil by raking, discing, or other acceptable means before seeding. If not previously loosened.

Soil amendments: in lieu of soil test recommendations, use one of the following schedules:

- 1) Preferred - apply 2 tons per acre dolomitic limestone (92 lbs. per 1,000 square feet) and 600 lbs. per acre 10-10-10 fertilizer (14 lbs. per 1,000 square feet) before seeding. Harrow or disc into upper inches of soil. At time of seeding, apply 400 lbs. per acre 30-0-0 ureaform fertilizer (9 lbs. per 1,000 square feet).
- 2) Acceptable - apply 2 tons per acre dolomitic limestone (92 lbs. per 1,000 square feet) and 1,000 lbs. per acre 10-10-10 fertilizer (23 lbs. per 1,000 square feet) before seeding. Harrow or disc into upper 3 inches of soil.

Seeding: for the period March 1 through April 30 and from August 1 through October 15, seed with 60 lbs. per acre (1.4 lbs. per 1,000 square feet) of Kentucky 31 tall fescue. For the period May 1 through July 31, seed with 60 lbs. per acre (1.4 lbs. per 1,000 square feet) of Kentucky 31 tall fescue per acre and 2 lbs. per acre (0.05 lbs. per 1,000 square feet) of weeping lovegrass. During the period October 16 through February 28, protect site by one of the following options:

- 1) 2 tons per acre of well-anchored mulch straw and seed as soon as possible in the spring.
- 2) Use sod.
- 3) Seed with 60 lbs. per acre Kentucky 31 tall fescue and mulch with 2 tons per acre well anchored straw.

Mulching: apply 12% to 2 tons per acre (70 to 90 lbs. per 1,000 square feet) of unrotted small grain straw immediately after seeding. Anchor mulch immediately after application using mulch anchoring tool or 2.8 gallons per acre (5 gallons per 1,000 square feet) of emulsified asphalt on flat areas, on slopes, 8 feet or higher use 347 gallons per acre (8 gallons per 1,000 square feet) for anchoring.

Maintenance: inspect all seeded areas and make needed repairs, replacements, and reseeding.

**TEMPORARY SEEDING NOTES**

Apply to graded or cleared areas likely to be redistributed where a short-term vegetative cover is needed.

Seedbed preparation: loosen upper 3 inches of soil by raking, discing, or other acceptable means before seeding.

Soil amendments: apply 600 lbs. per acre 10-10-10 fertilizer (14 lbs. per 1,000 square feet).

Seeding: For periods March 1 through April 30 and from August 15 through November 15, seed with 1.76 bushels per acre of annual ryegrass (3.2 lbs. per 1,000 square feet) for the period May through August 14, seed with 3 lbs. per acre of weeping lovegrass (0.07 lbs. per 1,000 square feet), or for the period November 16 through February 28, protect site by apply mulch 2 tons per acre or well anchored straw mulch and seed as soon as possible in the spring or use sod.

Mulching: Apply 12% to 2 tons per acre (70 to 90 lbs. per 1,000 square feet) of unrotted small grain straw immediately after seeding. Anchor mulch immediately after application using mulch anchoring tool or 2.8 gallons per acre (5 gallons per 1,000 square feet) of emulsified asphalt on flat areas, on slopes, 8 feet or higher use 347 gallons per acre (8 gallons per 1,000 square feet) for anchoring.

Refer to the 1994 Maryland standards and specifications for soil erosion and sediment control for rate and methods not covered.

**STANDARD SEDIMENT CONTROL NOTES**

1. A minimum of 48 hours notice must be given to the Howard County Department of Inspections, Licenses and Permits, sediment control division prior to the start of any construction (313-1855).
2. All vegetative and structural practices are to be installed according to the provisions of this plan and are to be in accordance with the 1994 Maryland standards and specifications for soil erosion and sediment control and revisions thereto.
3. Following initial soil disturbance or redistribution, permanent or temporary stabilization shall be completed within:
  - a) 7 calendar days for all perimeter sediment control structures, dikes, perimeter slopes, and all slopes steeper than 3:1.
  - b) 14 days as to all other disturbed or graded areas on the project site.
4. All sediment traps/basins shown must be fenced and warning signs posted around the perimeter in accordance with volume 1, chapter 7, of the Howard County design manual, storm drainage.
5. All disturbed areas must be stabilized within the time period specified above in accordance with the 1994 Maryland standards and specifications for soil erosion and sediment control for permanent seeding, sod, temporary seeding, and mulching (section g), temporary stabilization with mulch alone shall only be done when recommended seeding dates do not allow for proper germination and establishment of grasses.
6. All sediment control structures are to remain in place and are to be maintained in operative condition until permission for their removal has been obtained from the Howard County sediment control inspector.
7. Site analysis:
  - Area disturbed - 2.25 acres
  - Area to be roofed or paved - 1.64 acres
  - Area to be vegetatively stabilized - 0.61 acres
  - Total fill - 850 cubic yards
  - Total fill - 1244 cubic yards
  - Off-site waste site - Howard County landfill
  - Off-site borrow site - approved site with current and active grading permit
8. Any sediment control practice which is disturbed by grading activity or placement of utilities must be repaired on the same day of disturbance.
9. Additional sediment controls must be provided, if deemed necessary by the Howard County sediment control inspector.
10. On all sites with disturbed areas in excess of 2 acres, approval of the inspection agency shall be requested upon completion of installation of perimeter erosion and sediment controls, but before proceeding with any other earth disturbance or grading. Other building or grading inspection approvals may not be authorized until this initial approval by the inspection agency is made.
11. Trenches for the construction of utilities is limited to three pipe lengths or that which shall be backfilled and stabilized within one working day, whichever is shorter.
12. Site grading will begin only after all perimeter sediment control measures have been installed and are in a functioning condition.
13. Sediment will be removed from traps when its depth reaches clean out elevation shown on the plans.
14. Cut and fill quantities provided under site analysis do not represent bid quantities. These quantities do not distinguish between topsoil, structural or embankment material, nor do they reflect consideration of removal of unstable material. The contractor shall familiarize himself with site conditions which may affect the work.



**DEVELOPER'S CERTIFICATION**

"I/WE CERTIFY THAT ALL DEVELOPMENT AND CONSTRUCTION WILL BE DONE ACCORDING TO THIS PLAN, AND THAT ANY RESPONSIBLE PERSONNEL INVOLVED IN THE CONSTRUCTION PROJECT WILL HAVE A CERTIFICATE OF ATTENDANCE AT A DEPARTMENT OF THE ENVIRONMENT APPROVED TRAINING PROGRAM FOR THE CONTROL OF SEDIMENT AND EROSION BEFORE BEGINNING THE PROJECT. I ALSO AUTHORIZE PERIODIC ON-SITE INSPECTION BY THE HOWARD SOIL CONSERVATION DISTRICT"

*James E. Jones* (Acting Chief) DATE 9/26/03  
SIGNATURE OF DEVELOPMENT

**ENGINEER'S CERTIFICATION**

"I CERTIFY THAT THIS PLAN FOR EROSION AND SEDIMENT CONTROL REPRESENTS A PRACTICAL AND WORKABLE PLAN BASED ON MY PERSONAL KNOWLEDGE OF THE SITE CONDITIONS AND THAT IT WAS PREPARED IN ACCORDANCE WITH THE REQUIREMENTS OF THE HOWARD SOIL CONSERVATION DISTRICT."

*James E. Jones* DATE 9/25/03  
RJM ENGINEERING, INC.  
5525 TWIN KNOLLS ROAD  
SUITE 332  
COLUMBIA, MD 21045  
(410)730-1001

REVIEWED FOR HOWARD SOIL CONSERVATION DISTRICT AND MEETS TECHNICAL REQUIREMENTS

*Jim Munro* 9/29/03  
U.S. NATURAL RESOURCES CONSERVATION SERVICE DATE

THIS DEVELOPMENT IS APPROVED FOR EROSION AND SEDIMENT CONTROL BY HOWARD SOIL CONSERVATION DISTRICT.

*Gulley* 9/29/03  
HOWARD SOIL CONSERVATION DISTRICT DATE

DEPARTMENT OF PUBLIC WORKS  
HOWARD COUNTY, MARYLAND

*James E. Jones* 9/29/03  
DEPARTMENT OF PUBLIC WORKS DATE  
*William J. Mahan* 9/25/03  
CHIEF, BUREAU OF HIGHWAYS DATE



HUNT VALLEY, MARYLAND



RJM ENGINEERING, INC.  
CONSULTING ENGINEERS  
COLUMBIA, MARYLAND

TEL: 410/730-1001 FAX: 410/730-5403

|       |    |     |          |      |  |
|-------|----|-----|----------|------|--|
| DES:  |    |     |          |      |  |
| DRN:  |    |     |          |      |  |
| CHK:  |    |     |          |      |  |
| DATE: | BY | NO. | REVISION | DATE |  |


**EROSION AND SEDIMENT CONTROL GENERAL NOTES 1**

NO.: \_\_\_\_\_ DATE: 9/03

**McKENZIE ROAD ROADWAY AND STORMDRAIN IMPROVEMENTS**



HOWARD COUNTY, MARYLAND  
CAPITAL PROJECT NO. J-4164-10

SCALE AS SHOWN  
SHEET 120F24

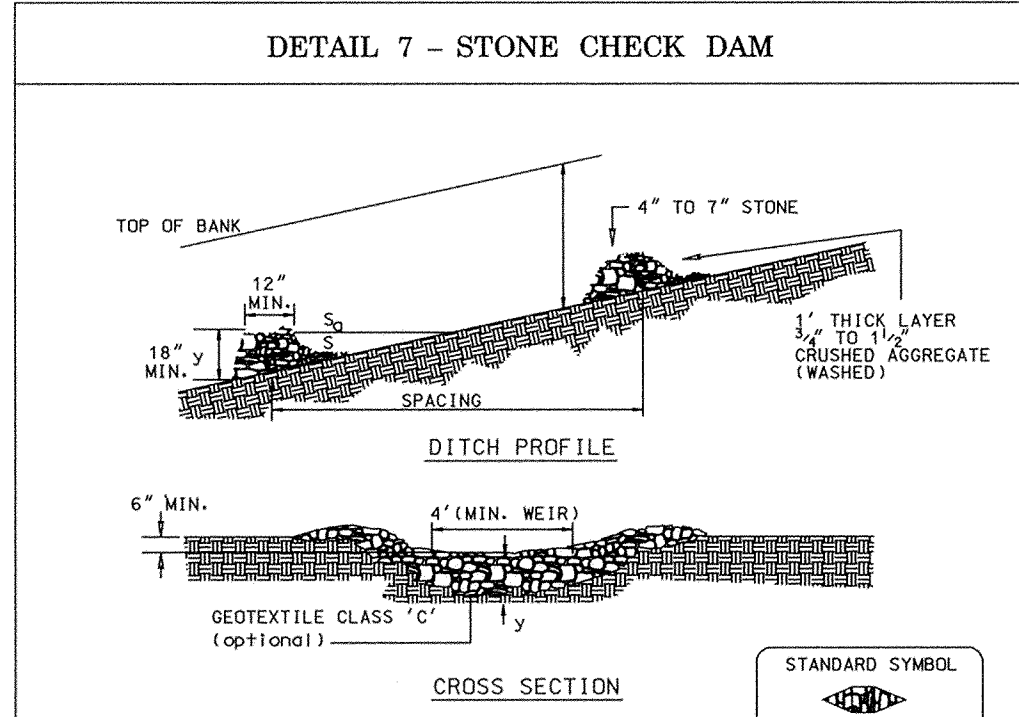


| STANDARD STONE CHECK DAM DESIGN |                           |
|---------------------------------|---------------------------|
| SLOPE                           | SPACING                   |
| 2:1 or less                     | 80'                       |
| 2:1 to 4:1                      | 40'                       |
| 4:1 to 7:1                      | 25'                       |
| 7:1 to 10:1                     | 15'                       |
| over 10:1                       | Use lined waterway design |

- Construction Specifications**
- Swales and ditches shall be prepared in accordance with the construction specifications described in Section A-2, Standards and Specifications for Temporary Swale.
  - The check dam shall be constructed of 4"-7" stone. The stone shall be placed so that it completely covers the width of the channel and keyed into the channel bottom.
  - The top of the check dam shall be constructed so the center is approximately 6" lower than the outer edges, forming a weir that "water" can flow across.
  - The maximum height of the check dam at the center shall not exceed 2'.
  - The upstream side of the check dam shall be lined with approximately 1" of 3/4" to 1 1/2" crushed aggregate.

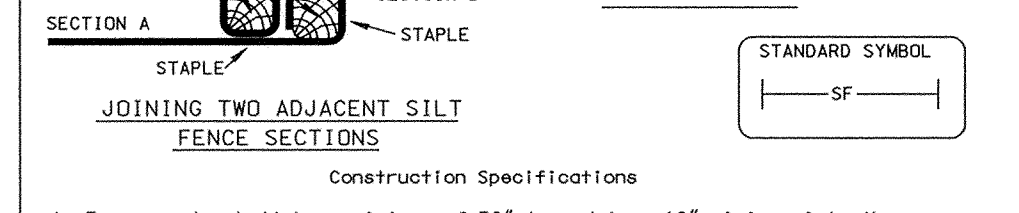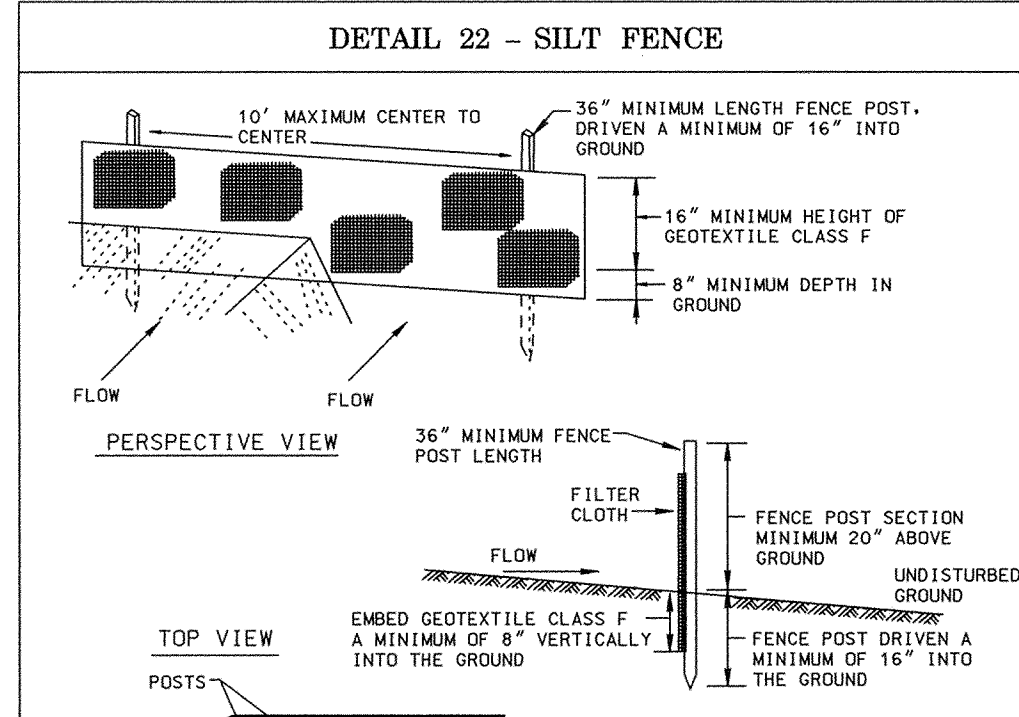


- Construction Specifications**
- Fence posts shall be a minimum of 36" long driven 16" minimum into the ground. Wood posts shall be 1 1/2" x 1 1/2" square (minimum) cut, or 1 1/4" diameter (minimum) round and shall be of sound quality hardwood. Steel posts will be standard T or U section weighing not less than 1.00 pound per linear foot.
  - Geotextile shall be fastened securely to each fence post with wire ties or staples of top and mid-section and shall meet the following requirements for Geotextile Class F:
 


|                      |  |                |
|----------------------|--|----------------|
| Tensile Strength     | 50 lb/in (min.)                        | Test: MSMT 509 |
| Tensile Modulus      | 20 lb/in (min.)                        | Test: MSMT 509 |
| Flow Rate            | 0.3 gal ft <sup>2</sup> /minute (max.) | Test: MSMT 322 |
| Filtering Efficiency | 75% (min.)                             | Test: MSMT 322 |
  - Where ends of geotextile fabric come together, they shall be overlapped, folded and stapled to prevent sediment bypass.
  - Silt Fence shall be inspected after each rainfall event and maintained when bulges occur or when sediment accumulation reached 50% of the fabric height.

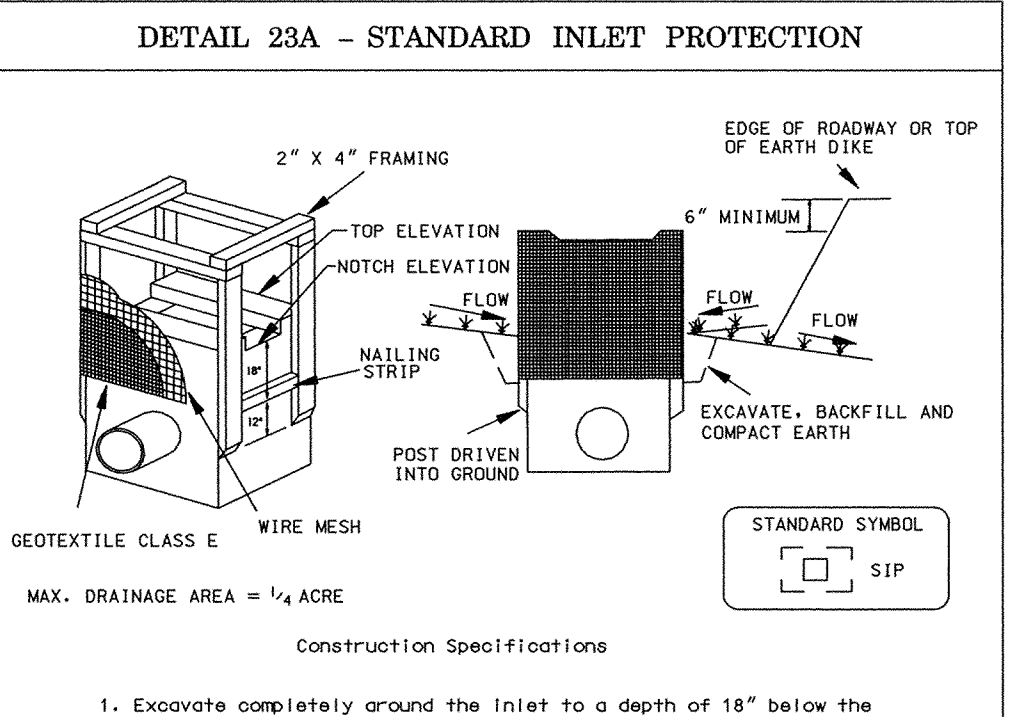


- Construction Specifications**
- Excavate completely around the inlet to a depth of 18" below the notch elevation.
  - Drive the 2" x 4" construction grade lumber posts 1' into the ground at each corner of the inlet. Place nail strips between the posts on the ends of the inlet. Assemble the top portion of the 2" x 4" frame using the overlap joint shown on Detail 23A. The top of the frame (weir) must be 6" below adjacent roadways where flooding and safety issues may arise.
  - Stretch the 1/2" x 1/2" wire mesh tightly around the frame and fasten securely. The ends must meet and overlap at a post.
  - Stretch the Geotextile Class E tightly over the wire mesh with the geotextile extending from the top of the frame to 18" below the inlet notch elevation. Fasten the geotextile firmly to the frame. The ends of the geotextile must meet at a post, be overlapped and folded, then fastened down.
  - Backfill around the inlet in compacted 6" layers until the layer of earth is level with the notch elevation on the ends and top elevation on the sides.
  - If the inlet is not in a sump, construct a compacted earth dike across the ditch line directly below it. The top of the earth dike should be at least 6" higher than the top of the frame.
  - The structure must be inspected periodically and after each rain and the geotextile replaced when it becomes clogged.

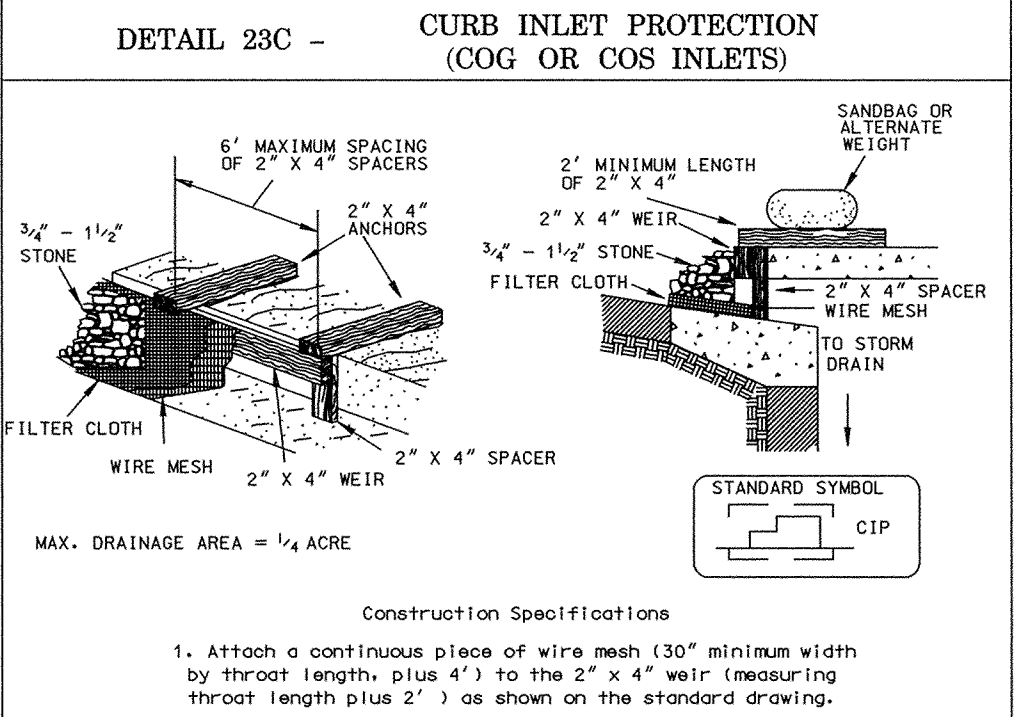


- Construction Specifications**
- Attach a continuous piece of wire mesh (30" minimum width by throat length, plus 4") to the 2" x 4" weir (measuring throat length plus 2") as shown on the standard drawing.
  - Place a continuous piece of Geotextile Class E the same dimensions as the wire mesh over the wire mesh and securely attach it to the 2" x 4" weir.
  - Securely nail the 2" x 4" weir to a 9" long vertical spacer to be located between the weir and the inlet face (max. 4" apart).
  - Place the assembly against the inlet throat and nail (minimum 2" lengths of 2" x 4" to the top of the weir at spacer locations). These 2" x 4" anchors shall extend across the inlet under or around the geotextile.
  - The assembly shall be placed so that the end spacers are a minimum 1' beyond both ends of the throat opening.
  - Form the 1/2" x 1/2" wire mesh and the geotextile fabric to the concrete gutter and against the face of the curb on both sides of the inlet. Place clean 3/4" x 1 1/2" stone over the wire mesh and geotextile in such a manner to prevent water from entering the inlet under or around the geotextile.
  - This type of protection must be inspected frequently and the filter cloth and stone replaced when clogged with sediment.
  - Assure that storm flow does not bypass the inlet by installing a temporary earth or asphalt dike to direct the flow to the inlet.

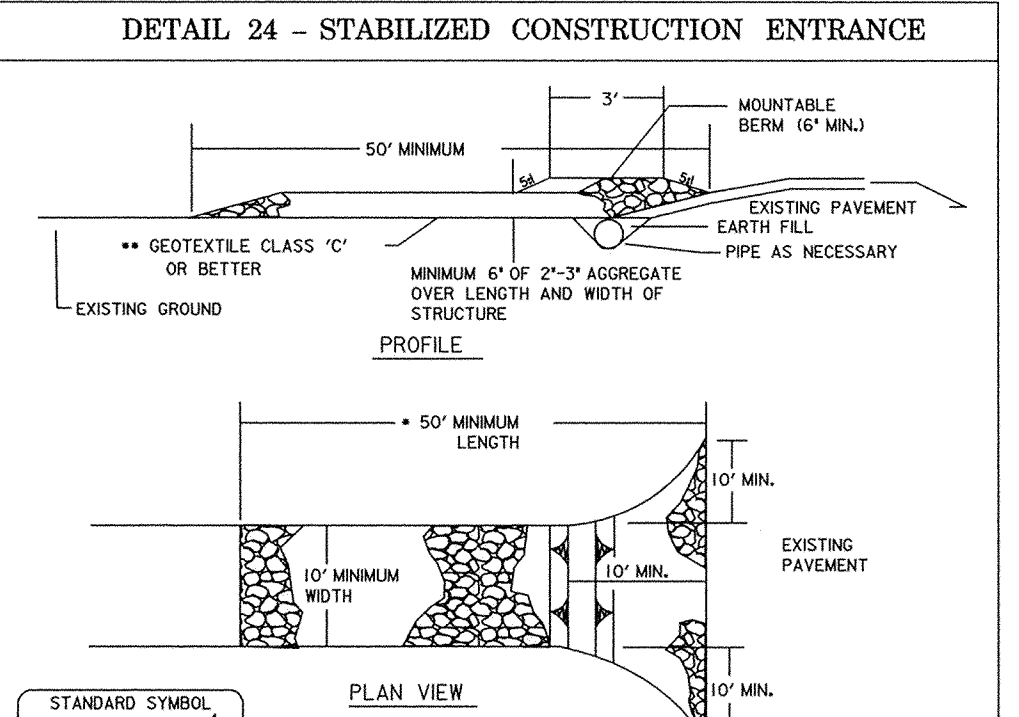

- Construction Specifications**
- Length - minimum of 50' x 30' for single residence lot.
  - Width - 10' minimum, should be flared at the existing road to provide a turning radius.
  - Geotextile fabric (filter cloth) shall be placed over the existing ground prior to placing stone. The plan approval authority may not require single family residences to use geotextile.
  - Stone - crushed aggregate (2" to 3") or reclaimed or recycled concrete equivalent shall be placed at least 6" deep over the length and width of the entrance.
  - Surface Water - all surface water flowing to or diverted toward construction entrances shall be piped through the entrance, maintaining positive drainage. Pipe installed through the stabilized construction entrance shall be protected with a mountable berm with 5d spikes and a minimum of 6" of stone over the pipe. Pipe has to be sized according to the drainage. When the SCE is located at a high spot and has no drainage to convey a pipe will not be necessary. Pipe should be sized according to the amount of runoff to be conveyed. A 6" minimum will be required.
  - Location - A stabilized construction entrance shall be located at every point where construction traffic enters or leaves a construction site. Vehicles leaving the site must travel over the entire length of the stabilized construction entrance.


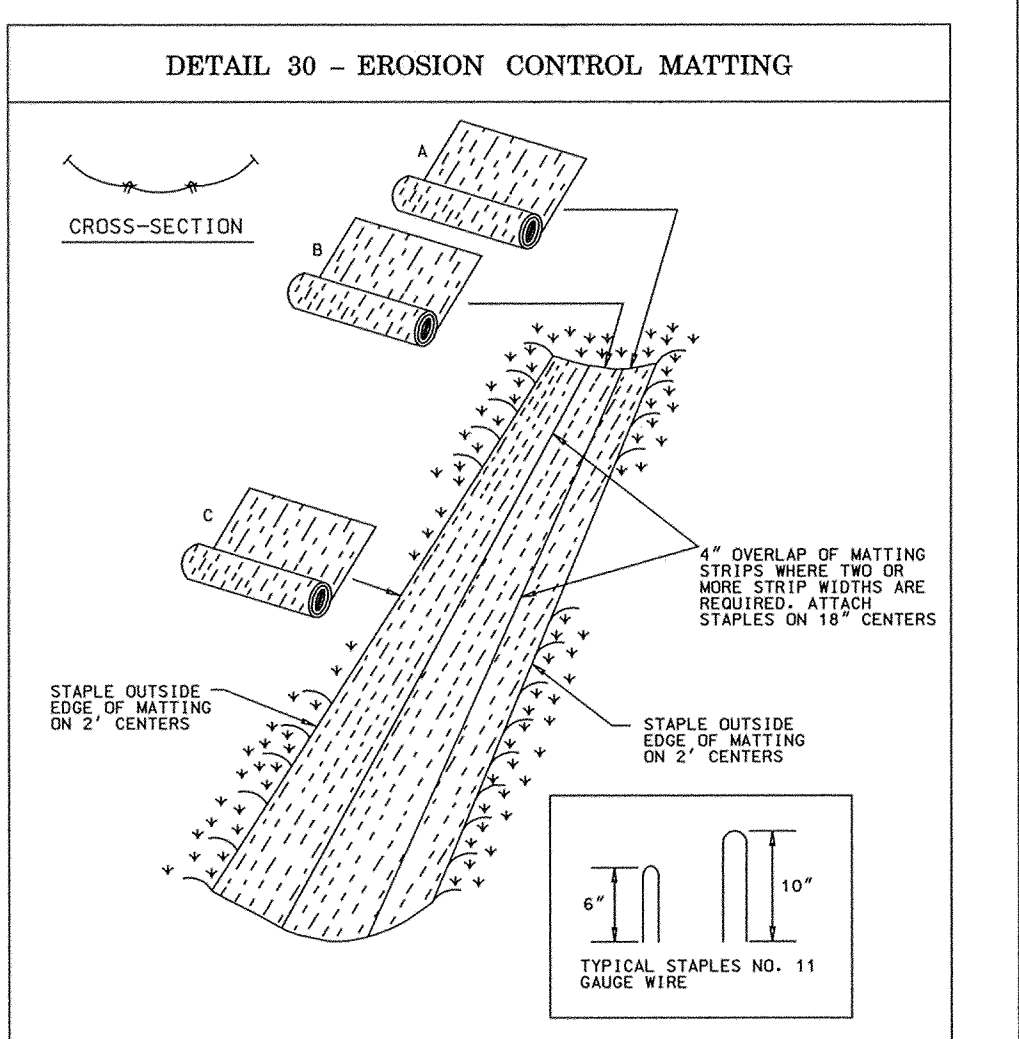


- EROSION CONTROL MATTING**
- Construction Specifications**
- Key-in the matting by placing the top ends of the matting in a narrow trench, 6" in depth. Backfill the trench and tamp firmly to conform to the channel cross-section. Secure with a row of staples about 4" down slope from the trench. Spacing between staples is 6".
  - Staple the 4" overlap in the channel center using an 18" spacing between staples.
  - Before stapling the outer edges of the matting, make sure the matting is smooth and in firm contact with the soil.
  - Staples shall be placed 2' apart with 4 rows for each strip, 2 outer rows, and 2 alternating rows down the center.
  - Where one roll of matting ends and another begins, the end of the top strip shall overlap the upper end of the lower strip by 4", strip in fashion. Reinforce the overlap with a double row of staples spaced 6" apart in a staggered pattern on either side.
  - The discharge end of the matting liner should be similarly secured with 2 double rows of staples.
- Note: If flow will enter from the edge of the matting then the area affected by the flow must be keyed-in.

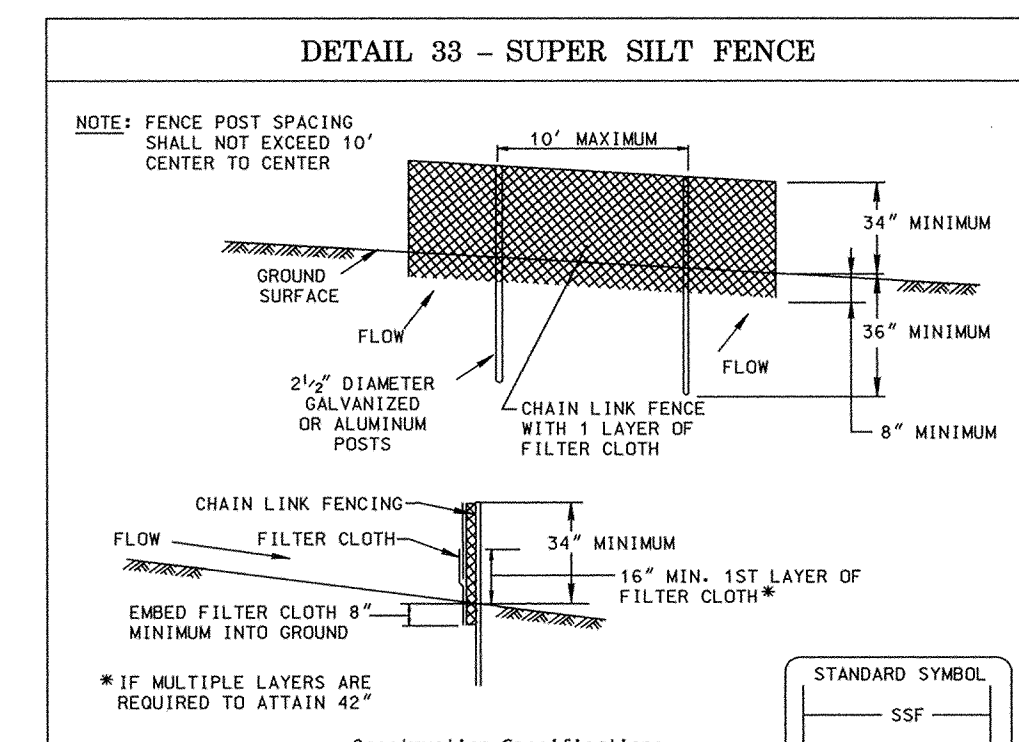

- Construction Specifications**
- Fencing shall be 42" in height and constructed in accordance with the latest Maryland State Highway details for Chain Link Fencing. The specification for a 6' fence shall be used, substituting 42" fabric and 6' length posts.
  - Chain link fence shall be fastened securely to the fence posts with wire ties. The lower tension wire, brace and truss rods, drive anchors and post caps are not required except on the ends of the fence.
  - Filter cloth shall be fastened securely to the chain link fence with ties spaced every 24" at the top and mid section.
  - Filter cloth shall be embedded a minimum of 8" into the ground.
  - When two sections of filter cloth adjoin each other, they shall be overlapped by 6" and folded.
  - Maintenance shall be performed as needed and silt bulldges removed when "bulges" develop in the silt fence or when silt reaches 50% of fence height.
  - Filter cloth shall be fastened securely to each fence post with wire ties or staples at top and mid section and shall meet the following requirements for Geotextile Class F:
 

|                      |  |                |
|----------------------|--|----------------|
| Tensile Strength     | 50 lb/in (min.)                        | Test: MSMT 509 |
| Tensile Modulus      | 20 lb/in (min.)                        | Test: MSMT 509 |
| Flow Rate            | 0.3 gal ft <sup>2</sup> /minute (max.) | Test: MSMT 322 |
| Filtering Efficiency | 75% (min.)                             | Test: MSMT 322 |

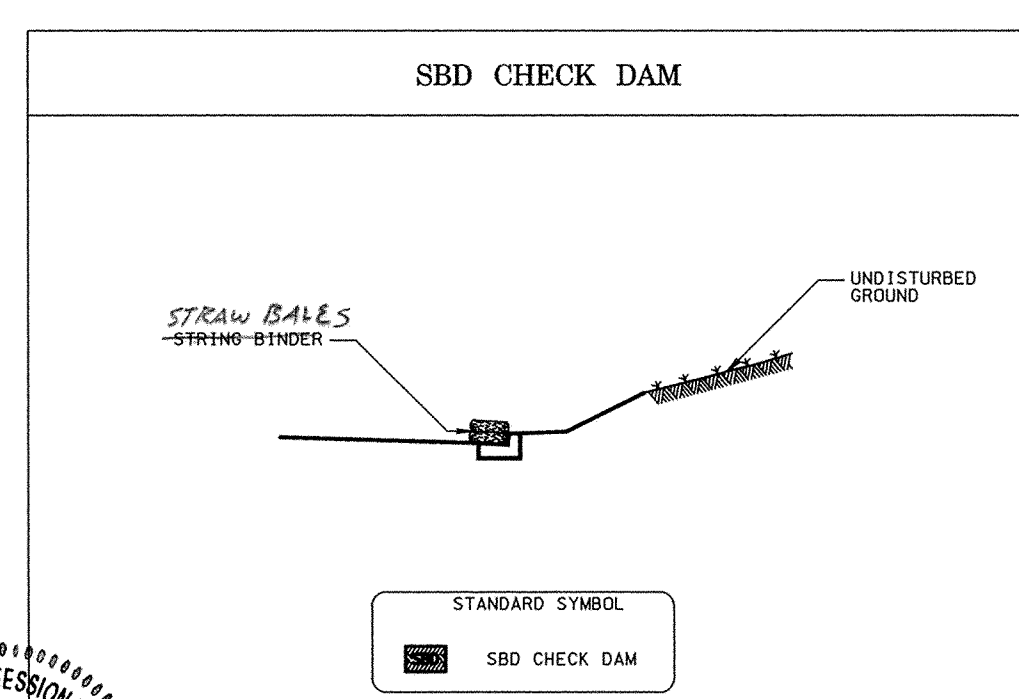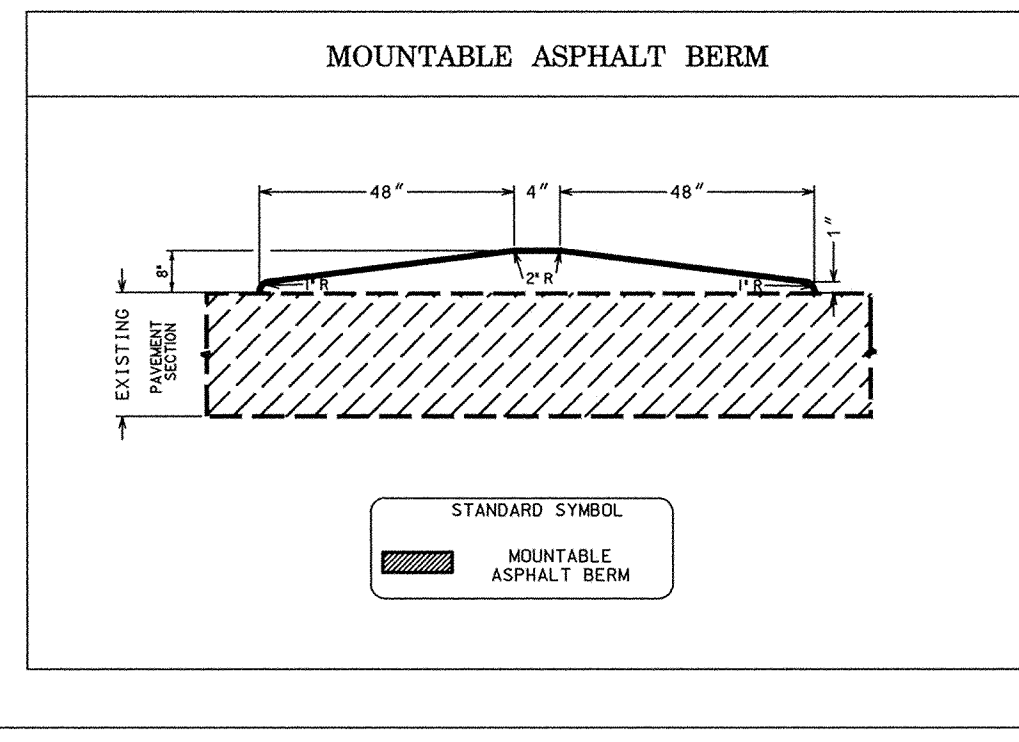

**SEQUENCE OF CONSTRUCTION**  
**EROSION AND SEDIMENT CONTROL**

| DURATION (DAYS) | STEP ACTION   |
|-----------------|---|
| --              | 1. THE CONTRACTOR SHALL OBTAIN A GRADING PERMIT BEFORE ANY TYPE OF CONSTRUCTION IS TO START.  |
| --              | 2. THE CONTRACTOR SHALL NOTIFY THE HOWARD COUNTY DEPARTMENT OF PUBLIC WORKS AT LEAST SEVEN (7) DAYS PRIOR TO INITIATION OF THE PROJECT AND FIVE (5) DAYS AFTER WORK ENDS.                                 |
| --              | 3. UTILITIES AND STORM DRAINS SHOWN ON THE EROSION AND SEDIMENT CONTROL PLANS ARE FOR THE GUIDANCE OF THE CONTRACTOR ONLY. ALL UTILITIES SHALL BE CONSTRUCTED AS SHOWN ON THE ROADWAY PLANS.              |
| --              | 4. MAINTAIN ALL SEDIMENT CONTROL PRACTICES ACCORDING TO THE MARYLAND 1994 STANDARDS AND COUNTY REGULATIONS UNTIL THE ENTIRE SITE IS STABILIZED.   |
| --              | 5. THE EROSION AND SEDIMENT CONTROL MEASURES MUST BE IN PLACE AND FUNCTIONING PRIOR TO THE CLEARING, CLEAR AND GRUB FOR EROSION AND SEDIMENT CONTROL MEASURES OR DEVICES ONLY.                            |
| 15              | 6. INSTALL PERIMETER CONTROLS AS REQUIRED FOR CONSTRUCTION.   |
| 60              | 7. GRADE ALL DISTURBED SLOPES TO DRAIN AS INDICATED ON THE PLANS. CONSTRUCT STORM DRAINS AS SHOWN. INSTALL INLET PROTECTION AS REQUIRED.  |
| 120             | 8. CONSTRUCT PAVEMENT, CURBS AND GUTTERS, SIDEWALKS, TRAFFIC CIRCLES AS SHOWN. CONSTRUCT ONLY THOSE AREAS THAT CAN BE STABILIZED IN THE SAME WORKING DAY. INSTALL STRAW BALE DIKE CHECK DAMS AS REQUIRED. |
| 10              | 9. PLACE TOPSOIL, SEED AND MULCH ON ALL UNPAVED AREAS CONSTRUCTED AS DIRECTED BY THE ENGINEER. INSTALL EROSION CONTROL MATTING AS SHOWN.  |
| --              | 10. SEDIMENT CONTROL DEVICES ARE TO REMAIN IN PLACE UNTIL ALL DISTURBED AREAS ARE STABILIZED WITH GROWTH AND HOWARD COUNTY DEPARTMENT OF PUBLIC WORKS APPROVES THEIR REMOVAL.                             |
| --              | 11. REMOVE EROSION AND SEDIMENT CONTROL DEVICES. STABILIZE ALL REMAINING DISTURBED AREAS.   |

**AS-BUILT CERTIFICATION**

I HEREBY CERTIFY THAT THE FACILITY SHOWN ON THIS PLAN WAS CONSTRUCTED AS SHOWN ON THE "AS-BUILT" PLANS AND MEETS THE APPROVED PLANS AND SPECIFICATIONS.

PE NO. \_\_\_\_\_  
DATE \_\_\_\_\_

**CERTIFY MEANS TO STATE OR DECLARE A PROFESSIONAL OPINION BASED UPON ON-SITE INSPECTIONS AND MATERIAL TESTS WHICH ARE CONDUCTED DURING CONSTRUCTION. THE ON-SITE INSPECTIONS AND MATERIAL TESTS ARE THOSE INSPECTIONS AND TESTS DEEMED SUFFICIENT AND APPROPRIATE BY COMMONLY ACCEPTED ENGINEERING STANDARDS. DOES NOT MEAN OR IMPLY A GUARANTEE BY THE ENGINEER NOR DOES AN ENGINEER'S CERTIFICATION RELIEVE ANY OTHER PARTY FROM MEETING REQUIREMENTS IMPOSED BY CONTRACT, EMPLOYMENT, OR OTHER MEANS, INCLUDING MEETING COMMONLY ACCEPTED INDUSTRY PRACTICES.**

**BY THE ENGINEER:**

I CERTIFY THAT THIS PLAN FOR EROSION AND SEDIMENT CONTROL REPRESENTS A PRACTICAL AND WORKABLE PLAN BASED ON MY PERSONAL KNOWLEDGE OF THE SITE CONDITIONS. THIS PLAN WAS PREPARED IN ACCORDANCE WITH THE REQUIREMENTS OF THE HOWARD SOIL CONSERVATION DISTRICT.

ENGINEER: *Janae P. Owen* DATE: 9/15/03

THESE PLANS HAVE BEEN REVIEWED FOR THE HOWARD SOIL CONSERVATION DISTRICT AND MEET THE TECHNICAL REQUIREMENTS FOR SOIL EROSION AND SEDIMENT CONTROL.

*Jim Myers* DATE: 9/29/03  
NATURAL RESOURCES CONSERVATION SERVICE

THESE PLANS FOR SOIL EROSION AND SEDIMENT CONTROL MEET THE REQUIREMENTS OF THE HOWARD SOIL CONSERVATION DISTRICT.

*John A. ...* DATE: 9/29/03  
HOWARD SOIL CONSERVATION DISTRICT

DEPARTMENT OF PUBLIC WORKS  
HOWARD COUNTY, MARYLAND

*James P. ...* 9/22/03  
DEPARTMENT OF PUBLIC WORKS DATE

*Robert ...* 9/22/03  
CHIEF, BUREAU OF ENGINEERING DATE

*Elizabeth ...* 9/22/03  
CHIEF, TRANSPORTATION AND SPECIAL PROJECTS DIVISION DATE

*William ...* 9-24-03  
CHIEF, BUREAU OF HIGHWAYS DATE

URS  
HUNT VALLEY, MARYLAND

*David Thomas ...*  
STATE OF MARYLAND  
DAVID THOMAS  
REGISTERED PROFESSIONAL ENGINEER  
NO. 12102  
EXPIRES 12/31/03

RJM ENGINEERING, INC.  
CONSULTING ENGINEERS  
COLUMBIA, MARYLAND

*Richard ...* 9/18/03

| DES: | DRN: | CHK: | DATE: | BY | NO. | REVISION | DATE |
|------|------|------|-------|----|-----|----------|------|
|      |      |      |       |    |     |          |      |

**EROSION AND SEDIMENT CONTROL**  
**GENERAL NOTES 2**

NO.: \_\_\_\_\_ DATE: 9/03

**McKENZIE ROAD ROADWAY AND STORMDRAIN IMPROVEMENTS**

HOWARD COUNTY, MARYLAND  
CAPITAL PROJECT NO. J-4164-10

| SCALE AS SHOWN |
|----------------|
| SHEET 13 OF 24 |





| ITEM DESCRIPTION                   | QUANTITY |
|------------------------------------|----------|
| STABILIZED CONSTRUCTION ENTRANCE * | 50 TON   |
| SUPER SILT FENCE                   | 970 LF   |
| SBD CHECK DAM                      | 18 EA    |
| CLASS I RIPRAP                     | 66 SF    |
| STONE CHECK DAM                    | 1 EA     |
| CURB INLET PROTECTION (CIP)        | 1 EA     |
| STANDARD INLET PROTECTION (SIP)    | 3 EA     |
| EROSION CONTROL MATTING            | 225 SY   |


\* QUANTITY FOR ONE STABILIZED CONSTRUCTION ENTRANCE NOT SHOWN HAS BEEN PROVIDED AND SHALL BE PLACED AS DETERMINED BY THE INSPECTOR.

NOTE:

SBD CHECK DAMS SHALL BE PLACED PERPENDICULAR TO THE CURBS, SPACED AT APPROXIMATELY 50' AS DIRECTED BY THE ENGINEER.

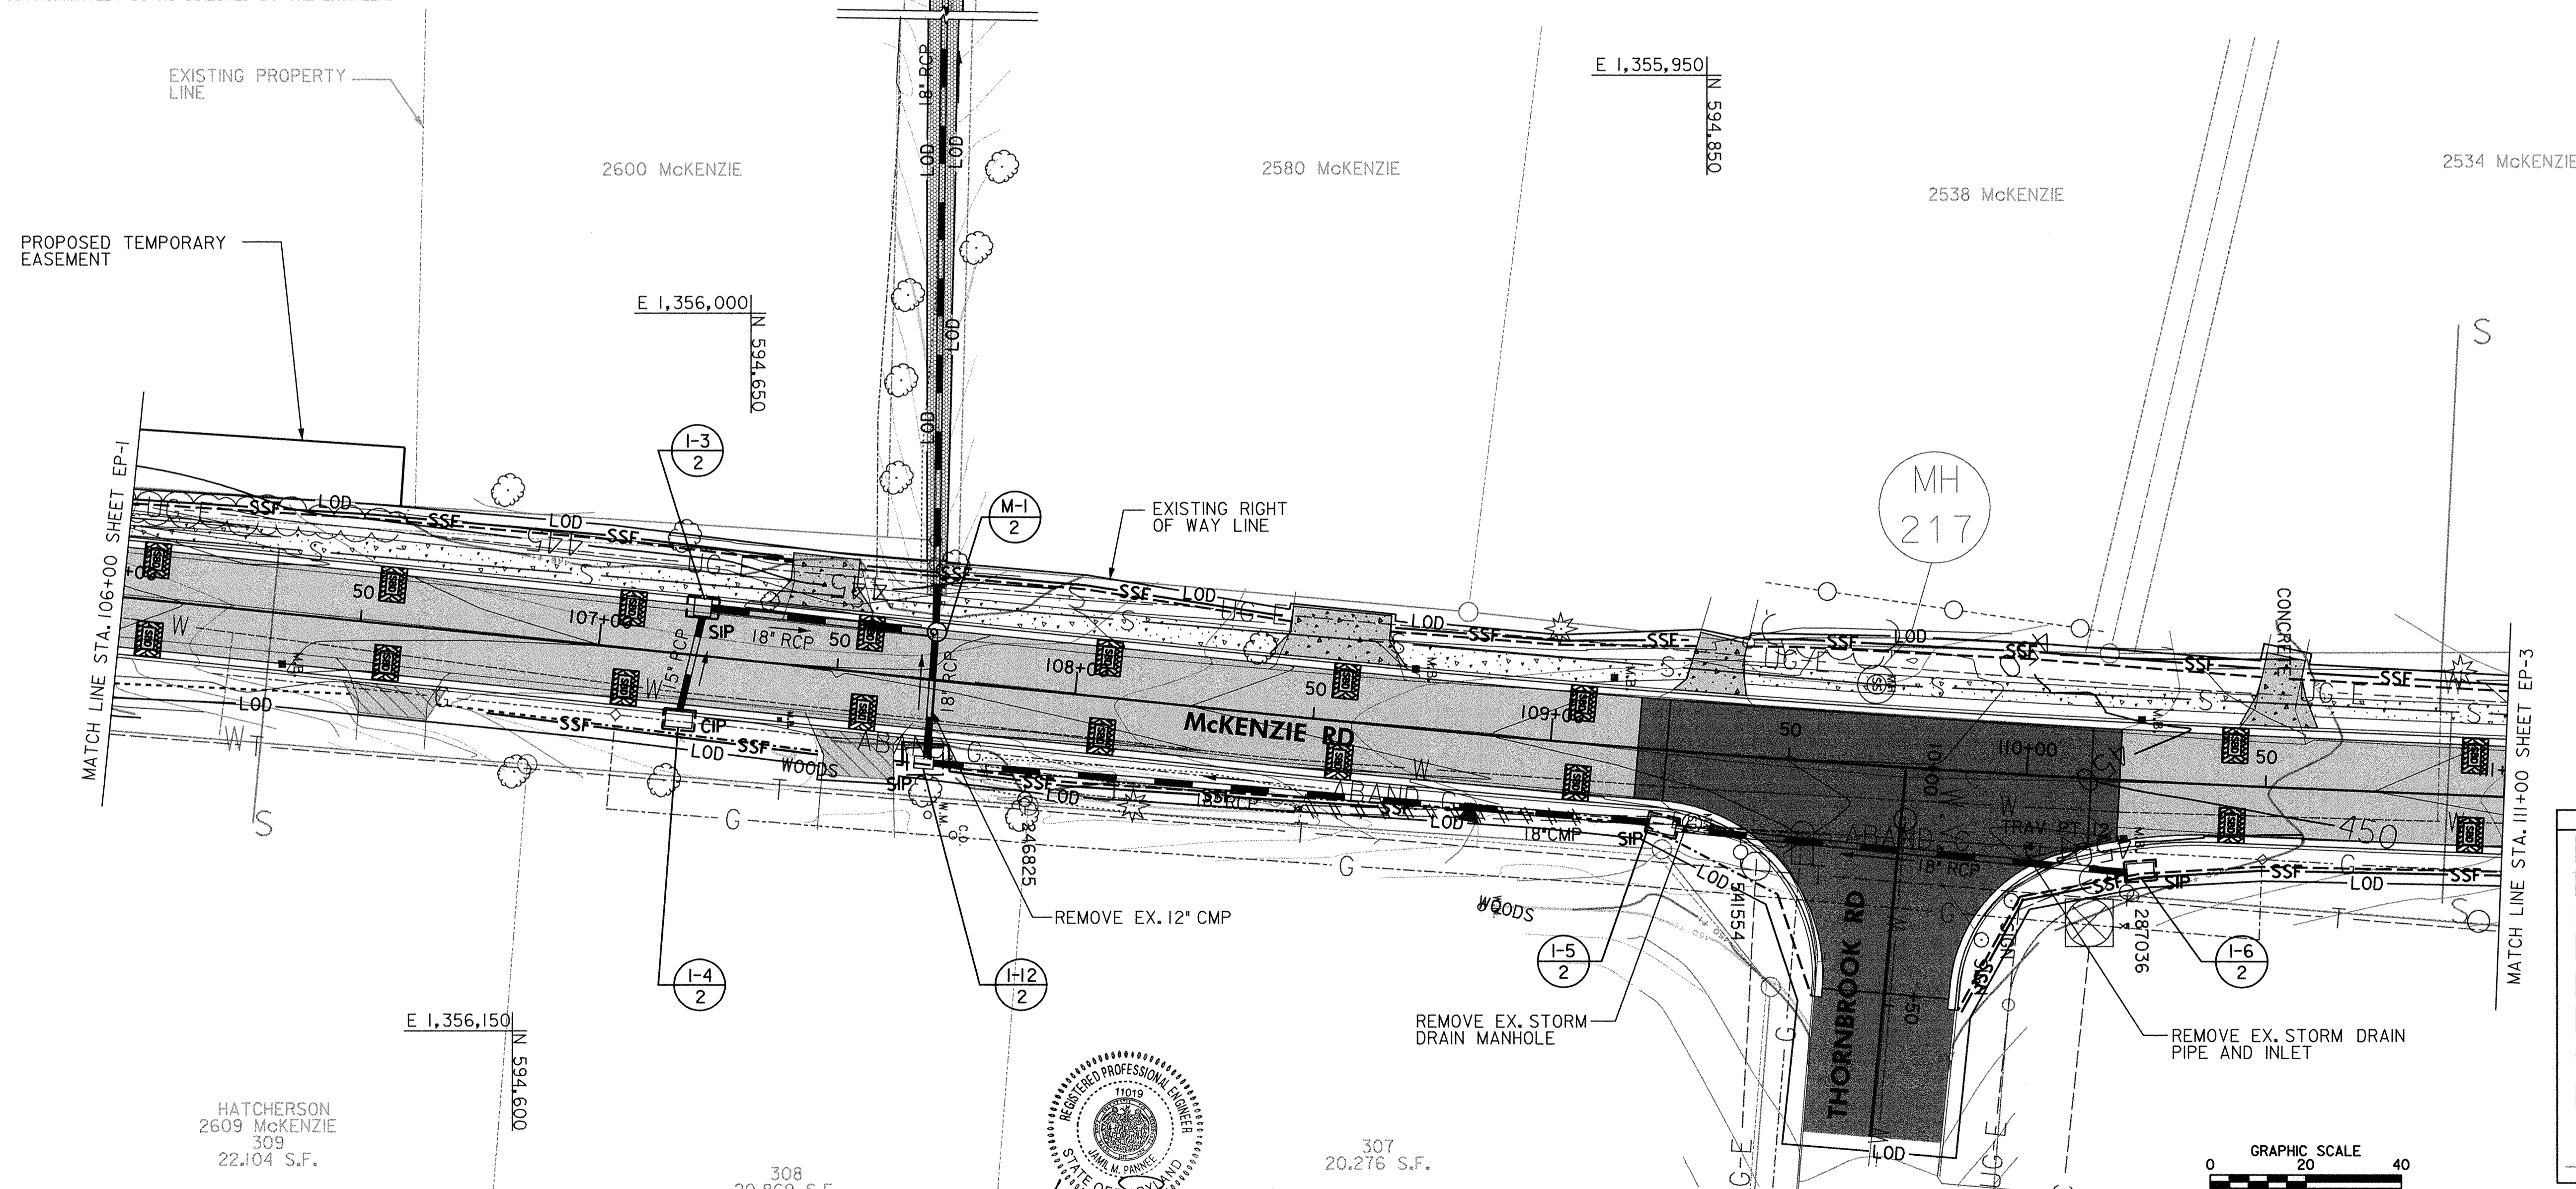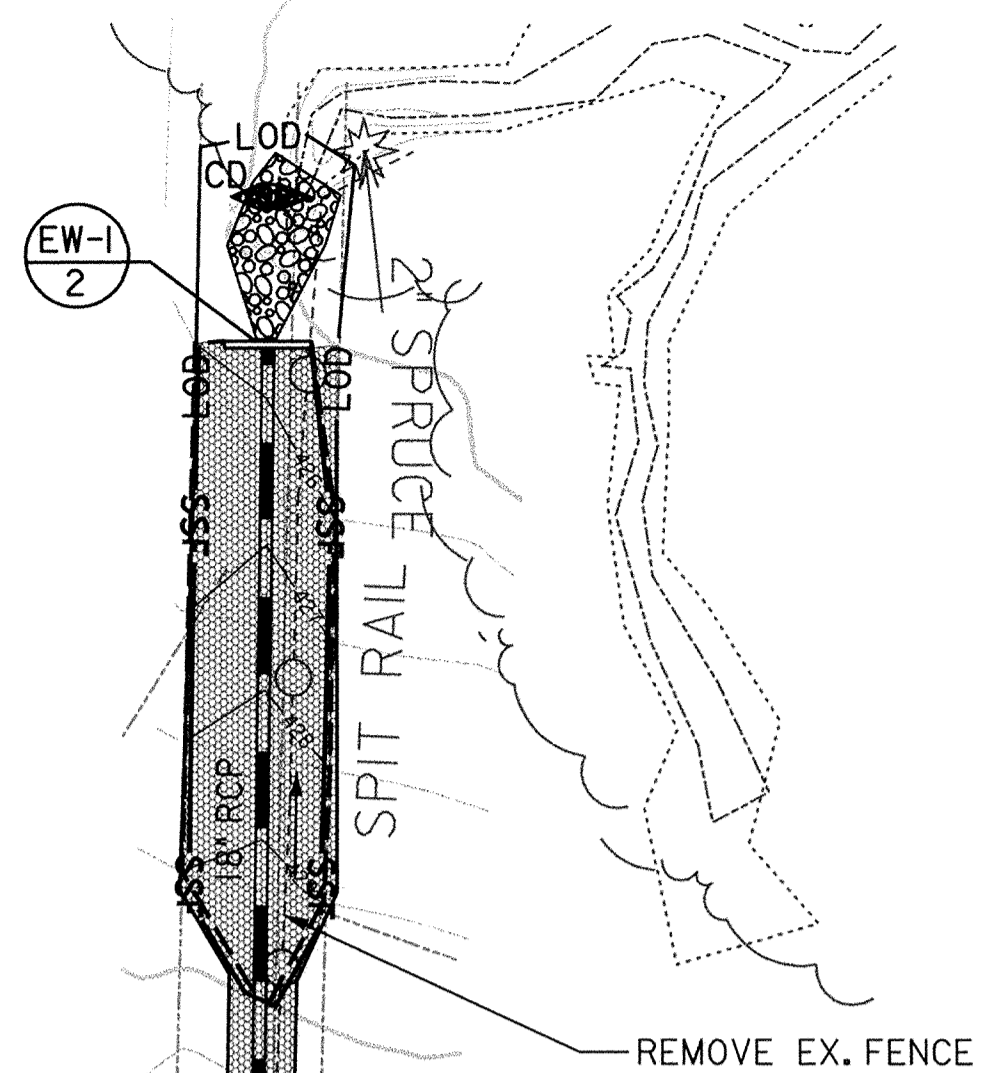

| LEGEND    |                                  |
|-----------|----------------------------------|
| [Pattern] | PAVEMENT REMOVAL                 |
| [Pattern] | FULL DEPTH PAVEMENT CONSTRUCTION |
| [Pattern] | SPEED TABLE                      |
| [Pattern] | MILL AND RESURFACE               |
| [Pattern] | PROPOSED CONCRETE SIDEWALK       |
| [Pattern] | PROPOSED MEDIANS                 |
| [Pattern] | RECONSTRUCT ASPHALT DRIVEWAY     |
| [Pattern] | RECONSTRUCT CONCRETE DRIVEWAY    |
| [Pattern] | INSTALL EROSION CONTROL MATTING  |
| [Symbol]  | EXIST. RIGHT-OF-WAY              |

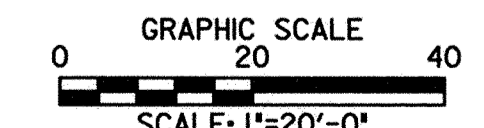

HATCHELSON  
2609 McKENZIE  
309  
22.104 S.F.


308  
20.869 S.F.

307  
20.276 S.F.



DEPARTMENT OF PUBLIC WORKS  
HOWARD COUNTY, MARYLAND

*James J. ...* 9/22/03  
DEPARTMENT OF PUBLIC WORKS DATE  
*William J. ...* 9/22/03  
CHIEF, TRANSPORTATION AND SPECIAL PROJECTS DIVISION DATE

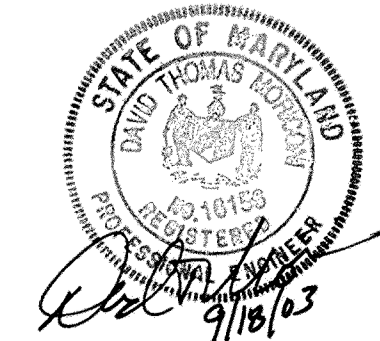

**URS**  
HUNT VALLEY, MARYLAND

**RJM**  
RJM ENGINEERING, INC.  
CONSULTING ENGINEERS  
COLUMBIA, MARYLAND

|           |  |
|-----------|--|
| DES:      |  |
| DRN:      |  |
| CHK:      |  |
| DATE:     |  |
| BY:       |  |
| NO.:      |  |
| REVISION: |  |
| DATE:     |  |

**EROSION AND SEDIMENT CONTROL PLAN SHEET EP-2**

**McKENZIE ROAD ROADWAY AND STORMDRAIN IMPROVEMENTS**

HOWARD COUNTY, MARYLAND  
CAPITAL PROJECT NO. J-4164-10


SCALE AS SHOWN  
SHEET 15 OF 24

NO.: \_\_\_\_\_ DATE: 9/03


| ITEM DESCRIPTION                   | QUANTITY |
|------------------------------------|----------|
| STABILIZED CONSTRUCTION ENTRANCE * | 50 TON   |
| SUPER SILT FENCE                   | 600 LF   |
| SBD CHECK DAM                      | 24 EA    |
| CURB INLET PROTECTION (CIP)        | 1 EA     |
| STANDARD INLET PROTECTION (SIP)    | 1 EA     |

\* QUANTITY FOR ONE STABILIZED CONSTRUCTION ENTRANCE NOT SHOWN HAS BEEN PROVIDED AND SHALL BE PLACED AS DETERMINED BY THE INSPECTOR.

NOTE:  
SBD CHECK DAMS SHALL BE PLACED PERPENDICULAR TO THE CURB, SPACED AT APPROXIMATELY 50' AS DIRECTED BY THE ENGINEER.

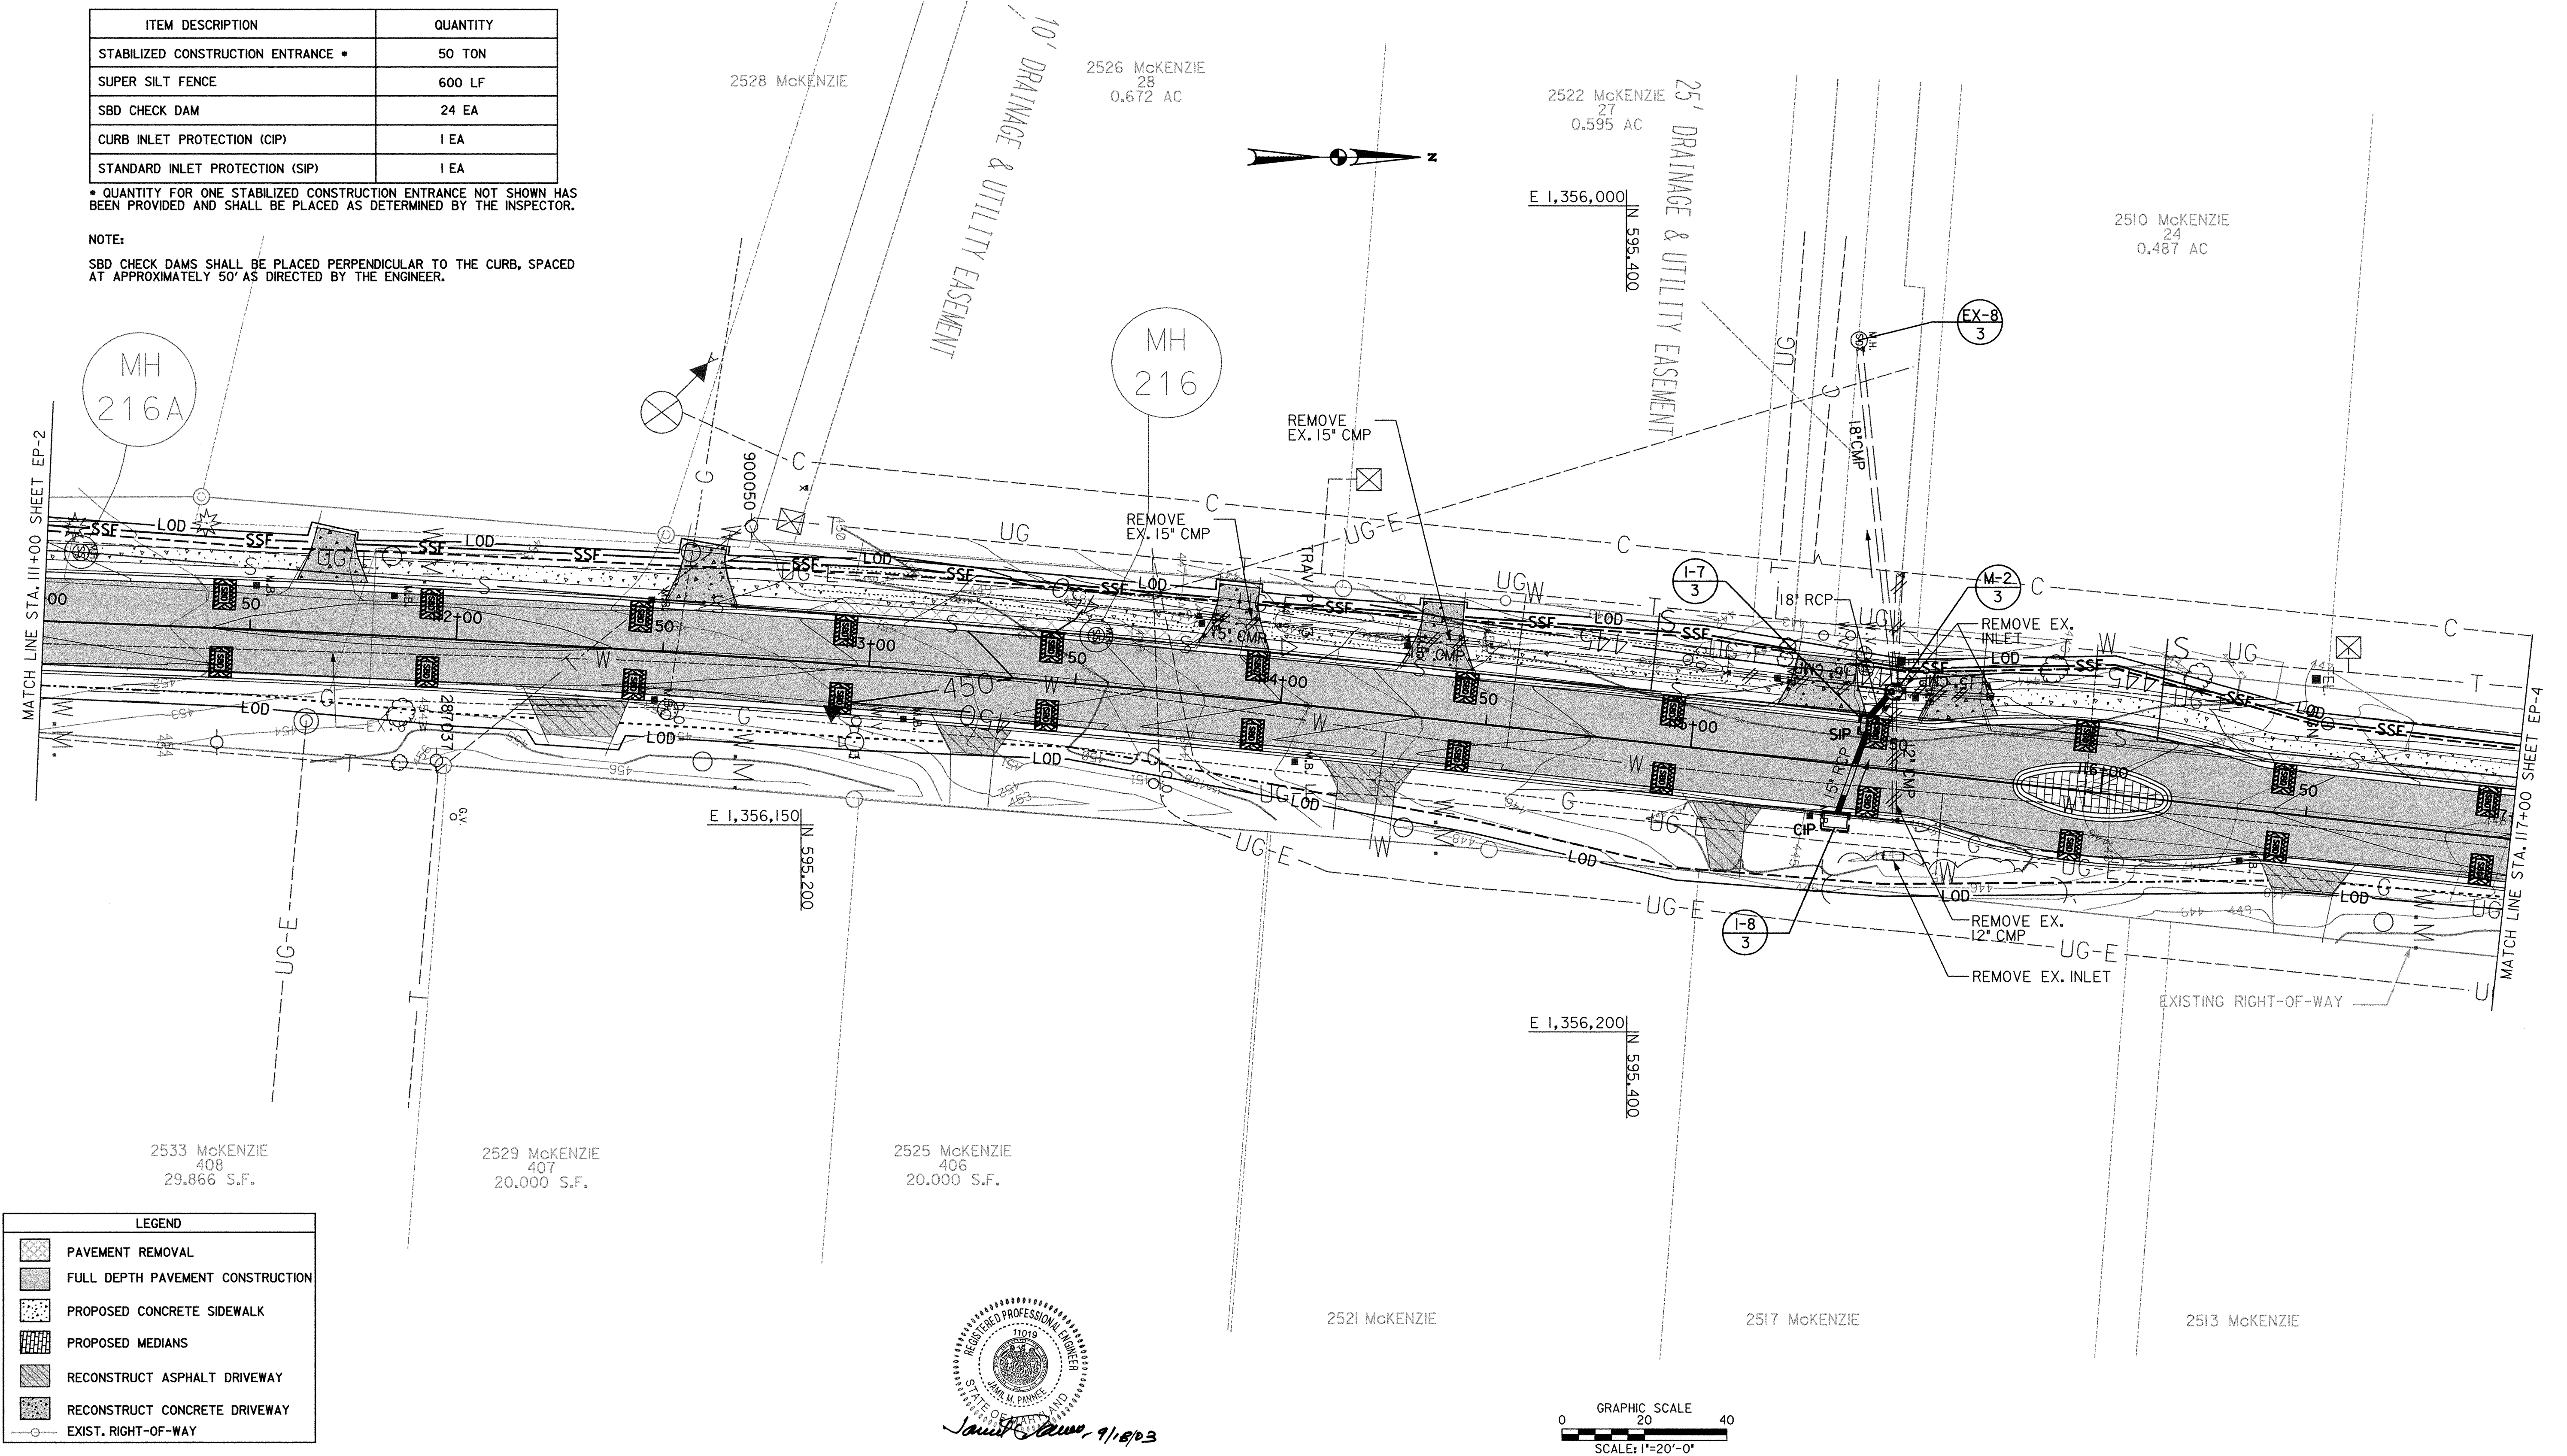

| LEGEND |                                  |
|--------|----------------------------------|
|        | PAVEMENT REMOVAL                 |
|        | FULL DEPTH PAVEMENT CONSTRUCTION |
|        | PROPOSED CONCRETE SIDEWALK       |
|        | PROPOSED MEDIANS                 |
|        | RECONSTRUCT ASPHALT DRIVEWAY     |
|        | RECONSTRUCT CONCRETE DRIVEWAY    |
|        | EXIST. RIGHT-OF-WAY              |

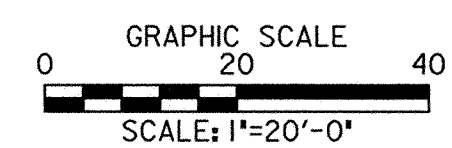

DEPARTMENT OF PUBLIC WORKS  
HOWARD COUNTY, MARYLAND

*Jan M. ...* 9/22/03  
CHIEF, BUREAU OF ENGINEERING

*Paul ...* 9/22/03  
CHIEF, BUREAU OF HIGHWAYS

**URS**  
HUNT VALLEY, MARYLAND

**RJM**  
RJM ENGINEERING, INC.  
CONSULTING ENGINEERS  
COLUMBIA, MARYLAND

|       |    |     |          |      |  |
|-------|----|-----|----------|------|--|
| DES:  |    |     |          |      |  |
| DRN:  |    |     |          |      |  |
| CHK:  |    |     |          |      |  |
| DATE: | BY | NO. | REVISION | DATE |  |

**EROSION AND SEDIMENT CONTROL PLAN SHEET EP-3**

NO.: \_\_\_\_\_ DATE: 9/03

**McKENZIE ROAD ROADWAY AND STORMDRAIN IMPROVEMENTS**


HOWARD COUNTY, MARYLAND  
CAPITAL PROJECT NO. J-4164-10

SCALE AS SHOWN

SHEET 16 OF 24



| ITEM DESCRIPTION                 | QUANTITY |
|----------------------------------|----------|
| STABILIZED CONSTRUCTION ENTRANCE | 50 TON   |
| SUPER SILT FENCE                 | 425 LF   |
| SBD CHECK DAM                    | 16 EA    |
| ASPHALT BERM                     | 64 LF    |
| CURB INLET PROTECTION (CIP)      | 2 EA     |
| STANDARD INLET PROTECTION (SIP)  | 1 EA     |


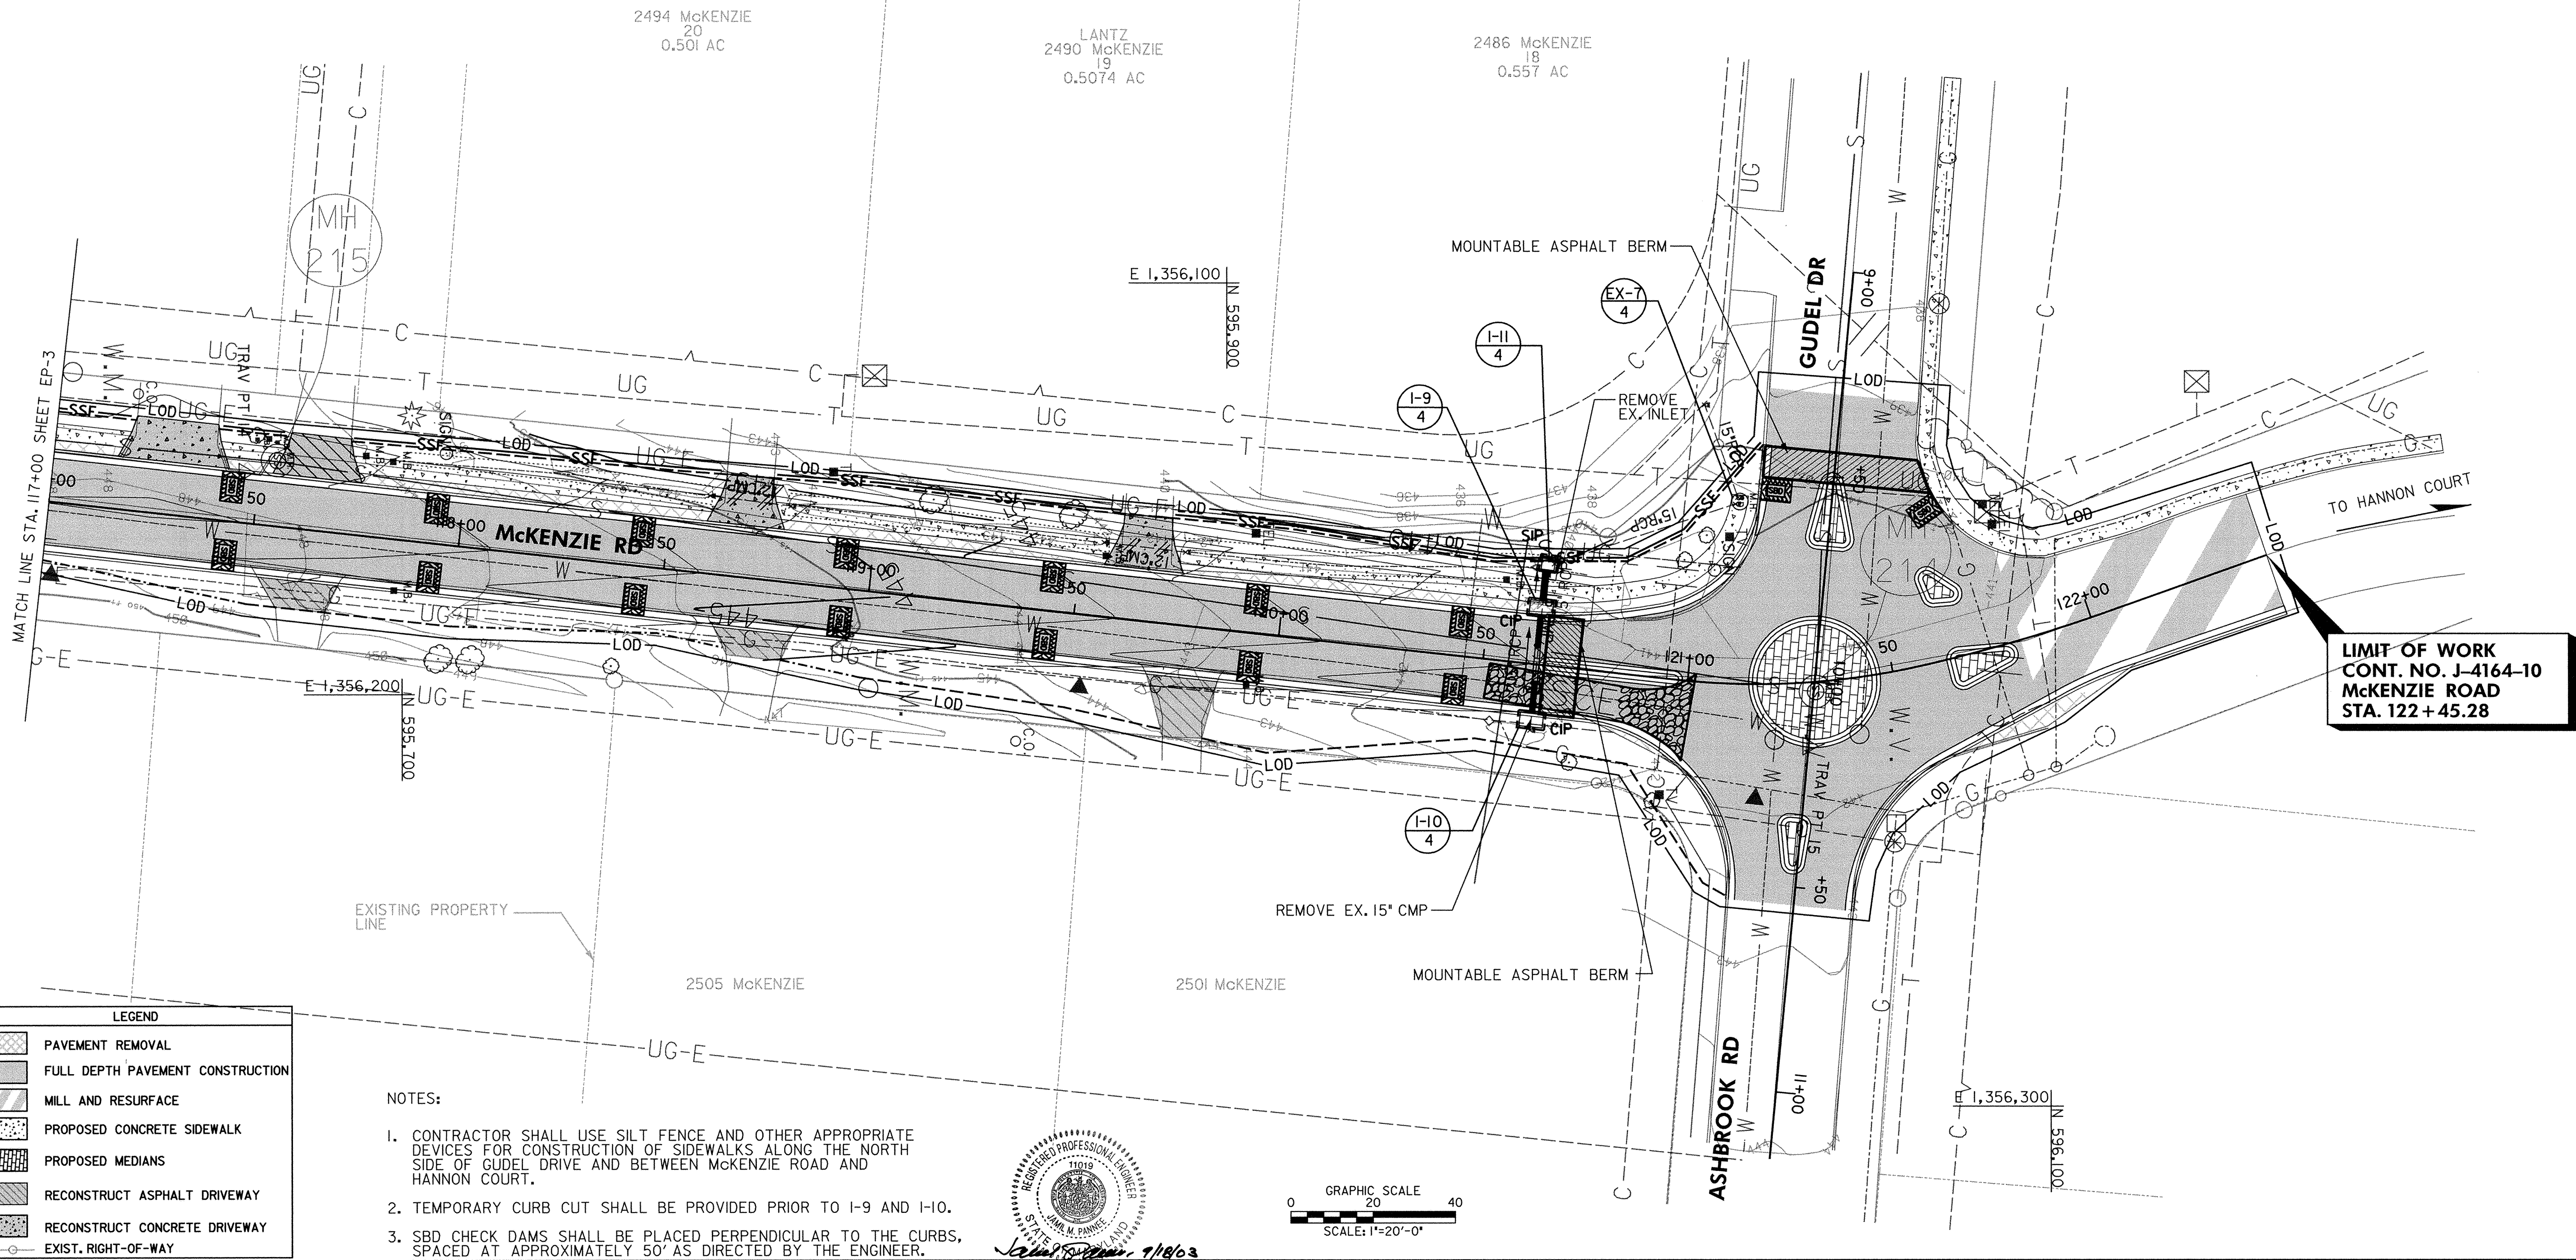


**LEGEND**


|  |                                  |
|--|----------------------------------|
|  | PAVEMENT REMOVAL                 |
|  | FULL DEPTH PAVEMENT CONSTRUCTION |
|  | MILL AND RESURFACE               |
|  | PROPOSED CONCRETE SIDEWALK       |
|  | PROPOSED MEDIANS                 |
|  | RECONSTRUCT ASPHALT DRIVEWAY     |
|  | RECONSTRUCT CONCRETE DRIVEWAY    |
|  | EXIST. RIGHT-OF-WAY              |

**NOTES:**


- CONTRACTOR SHALL USE SILT FENCE AND OTHER APPROPRIATE DEVICES FOR CONSTRUCTION OF SIDEWALKS ALONG THE NORTH SIDE OF GUDEL DRIVE AND BETWEEN McKENZIE ROAD AND HANNON COURT.
- TEMPORARY CURB CUT SHALL BE PROVIDED PRIOR TO I-9 AND I-10.
- SBD CHECK DAMS SHALL BE PLACED PERPENDICULAR TO THE CURBS, SPACED AT APPROXIMATELY 50' AS DIRECTED BY THE ENGINEER.

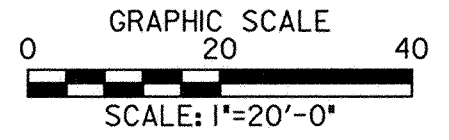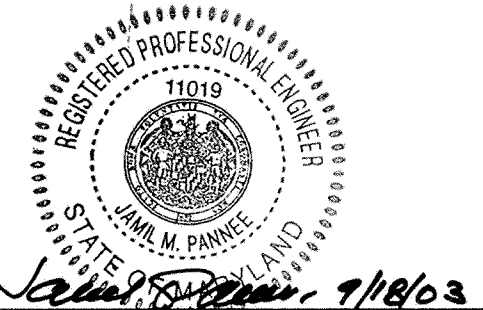


|   |                                  |  |       |    |     |          |   |  |                |
|---|----------------------------------|--|-------|----|-----|----------|---|--|----------------|
| DEPARTMENT OF PUBLIC WORKS<br>HOWARD COUNTY, MARYLAND<br><br>DATE: 9/22/03<br>CHIEF, TRANSPORTATION AND SPECIAL PROJECTS DIVISION | <br>URS<br>HUNT VALLEY, MARYLAND | <br>RJM ENGINEERING, INC.<br>CONSULTING ENGINEERS<br>COLUMBIA, MARYLAND<br>TEL#4101730-1001 FAX#4101730-5403 | DES:  |    |     |          | <b>EROSION AND SEDIMENT CONTROL PLAN SHEET EP-4</b> | <b>McKENZIE ROAD ROADWAY AND STORMDRAIN IMPROVEMENTS</b><br><br>HOWARD COUNTY, MARYLAND<br>CAPITAL PROJECT NO. J-4164-10 | SCALE AS SHOWN |
|   |                                  |  | DRN:  |    |     |          |   |  |                |
|   |                                  |  | CHK:  |    |     |          |   |  |                |
|   |                                  |  | DATE: | BY | NO. | REVISION | DATE  | NO.:   | DATE: 9/03     |

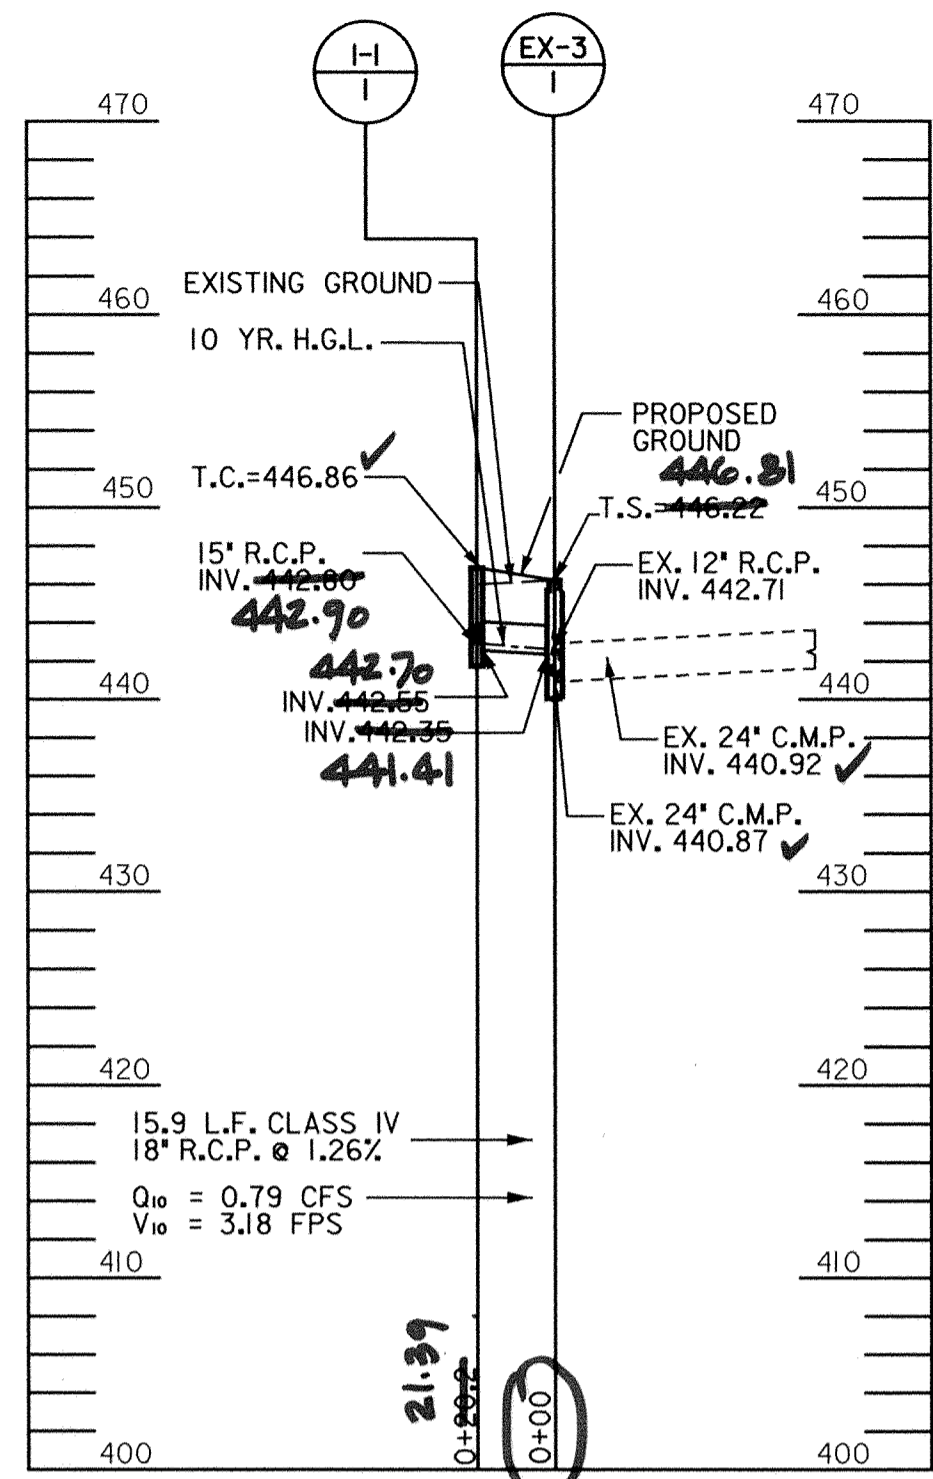


STA. 103+59.96 LT

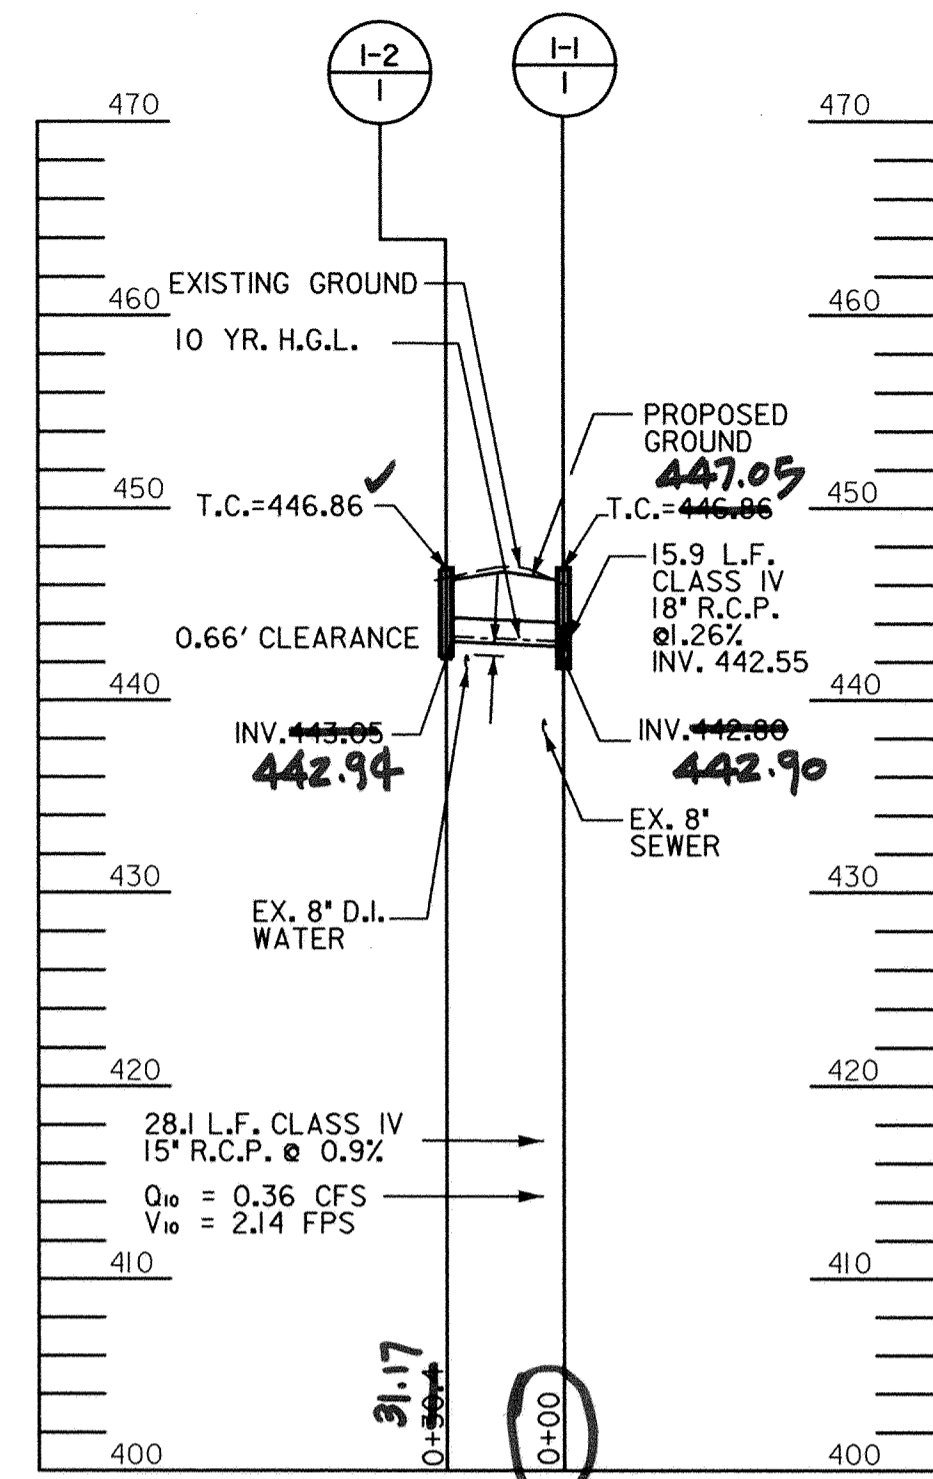


STA. 103+79.52 LT

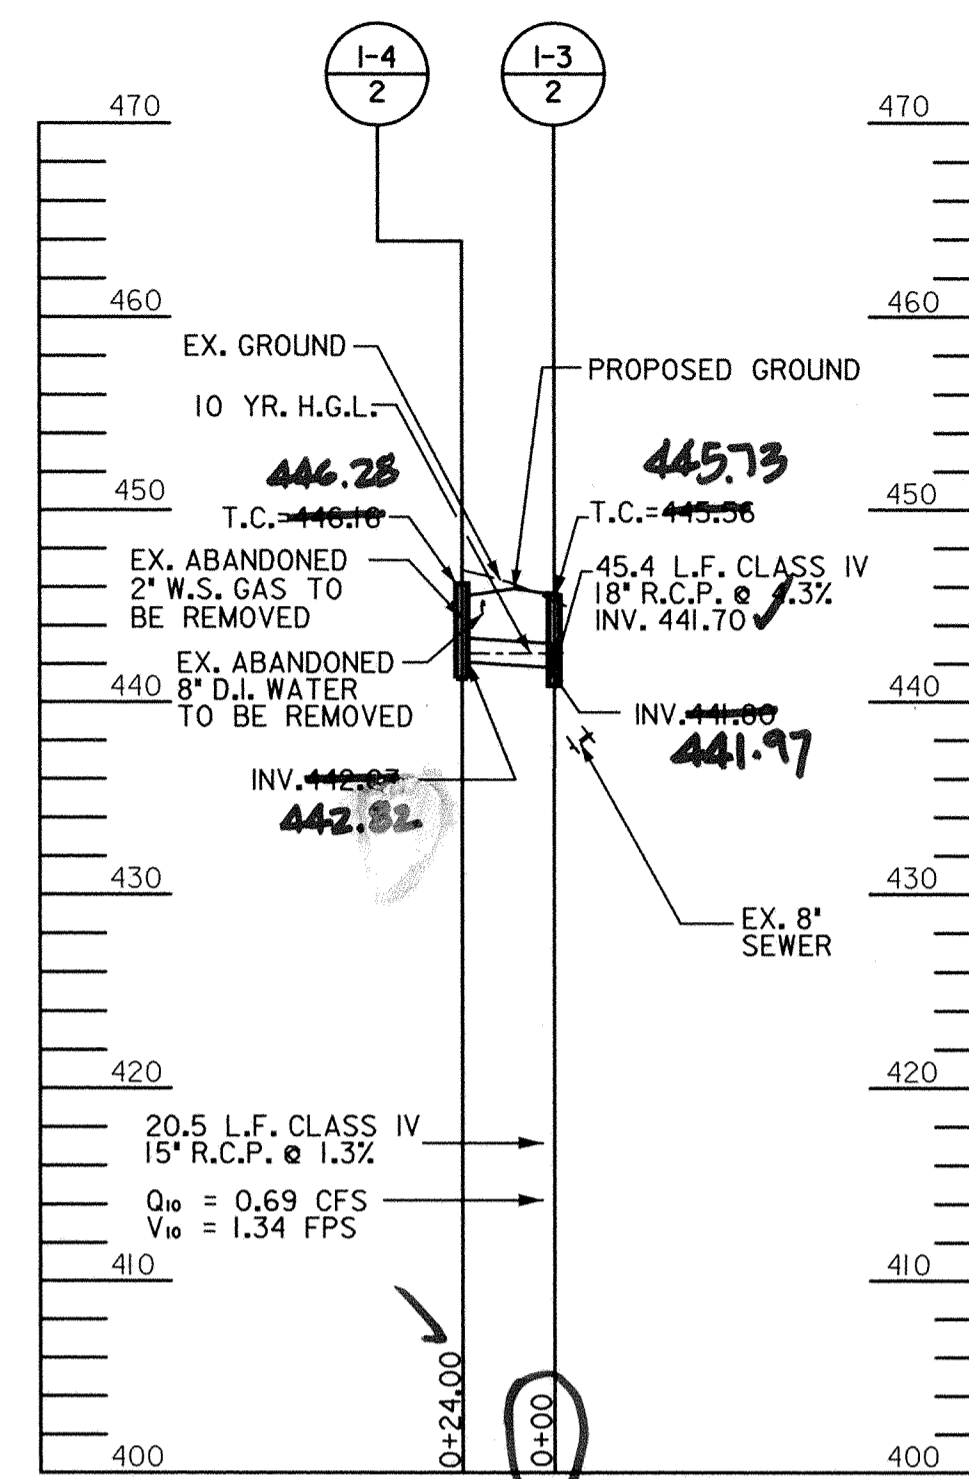


STA. 107+20.87 LT

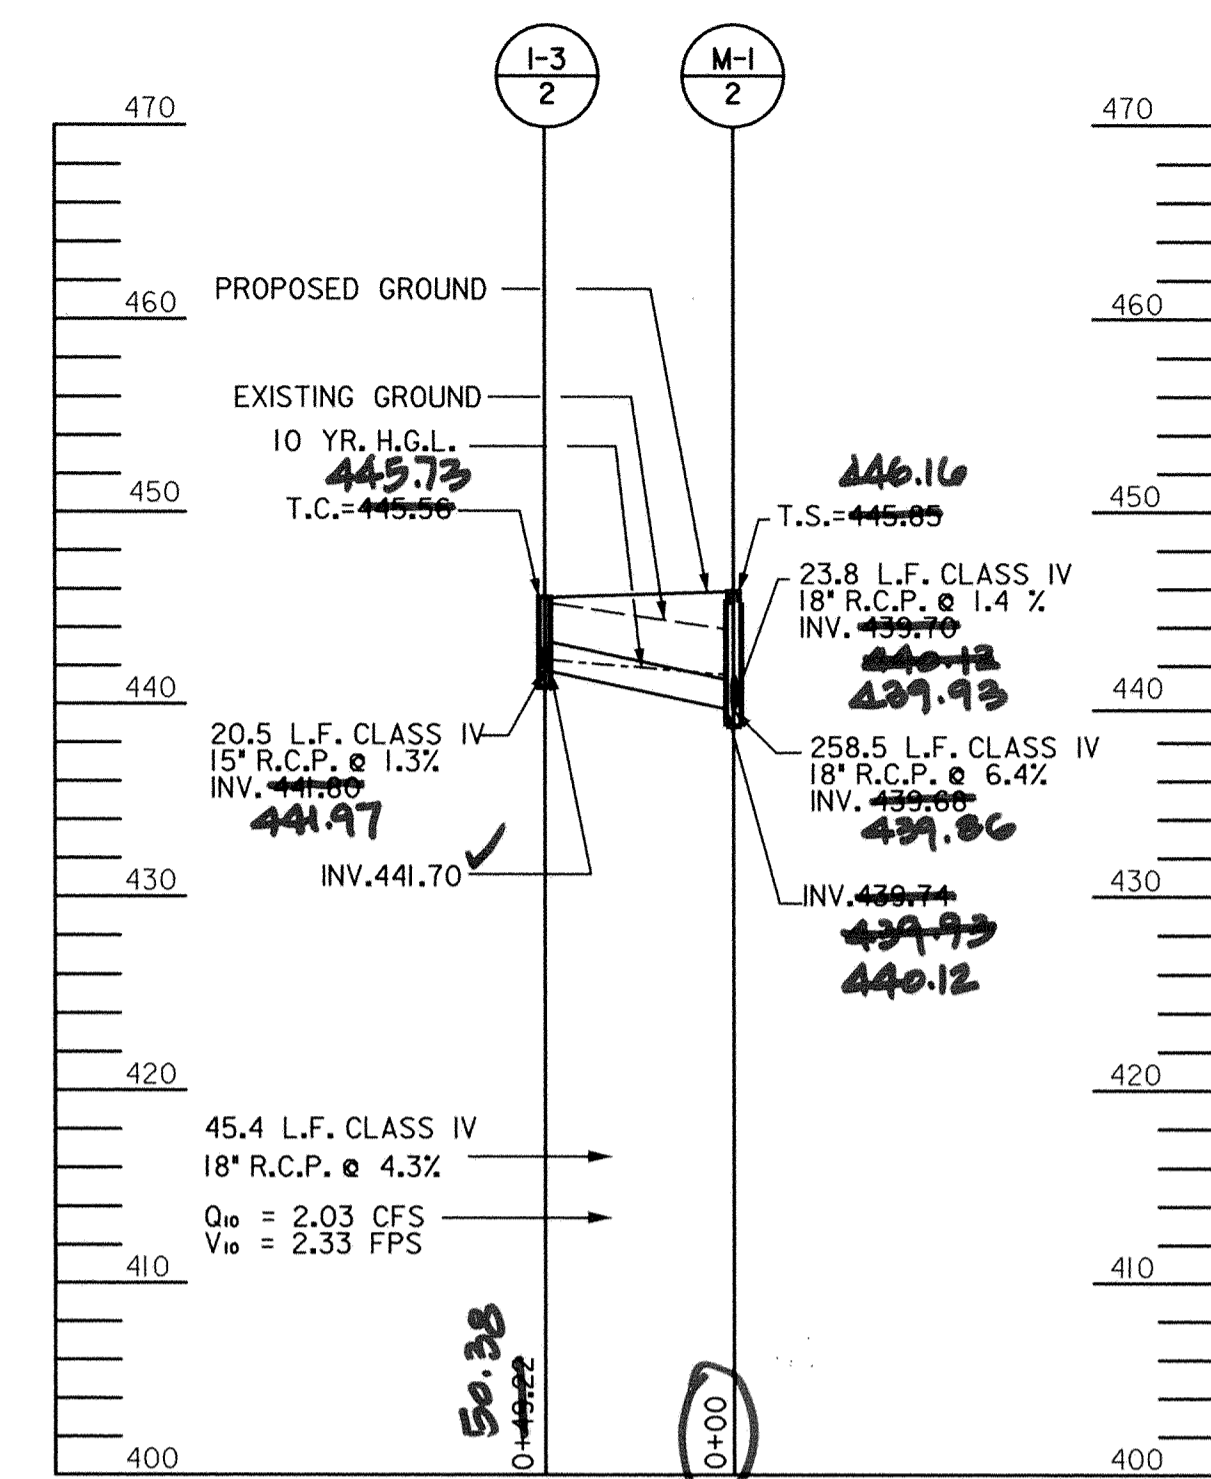


STA. 107+69.53 LT

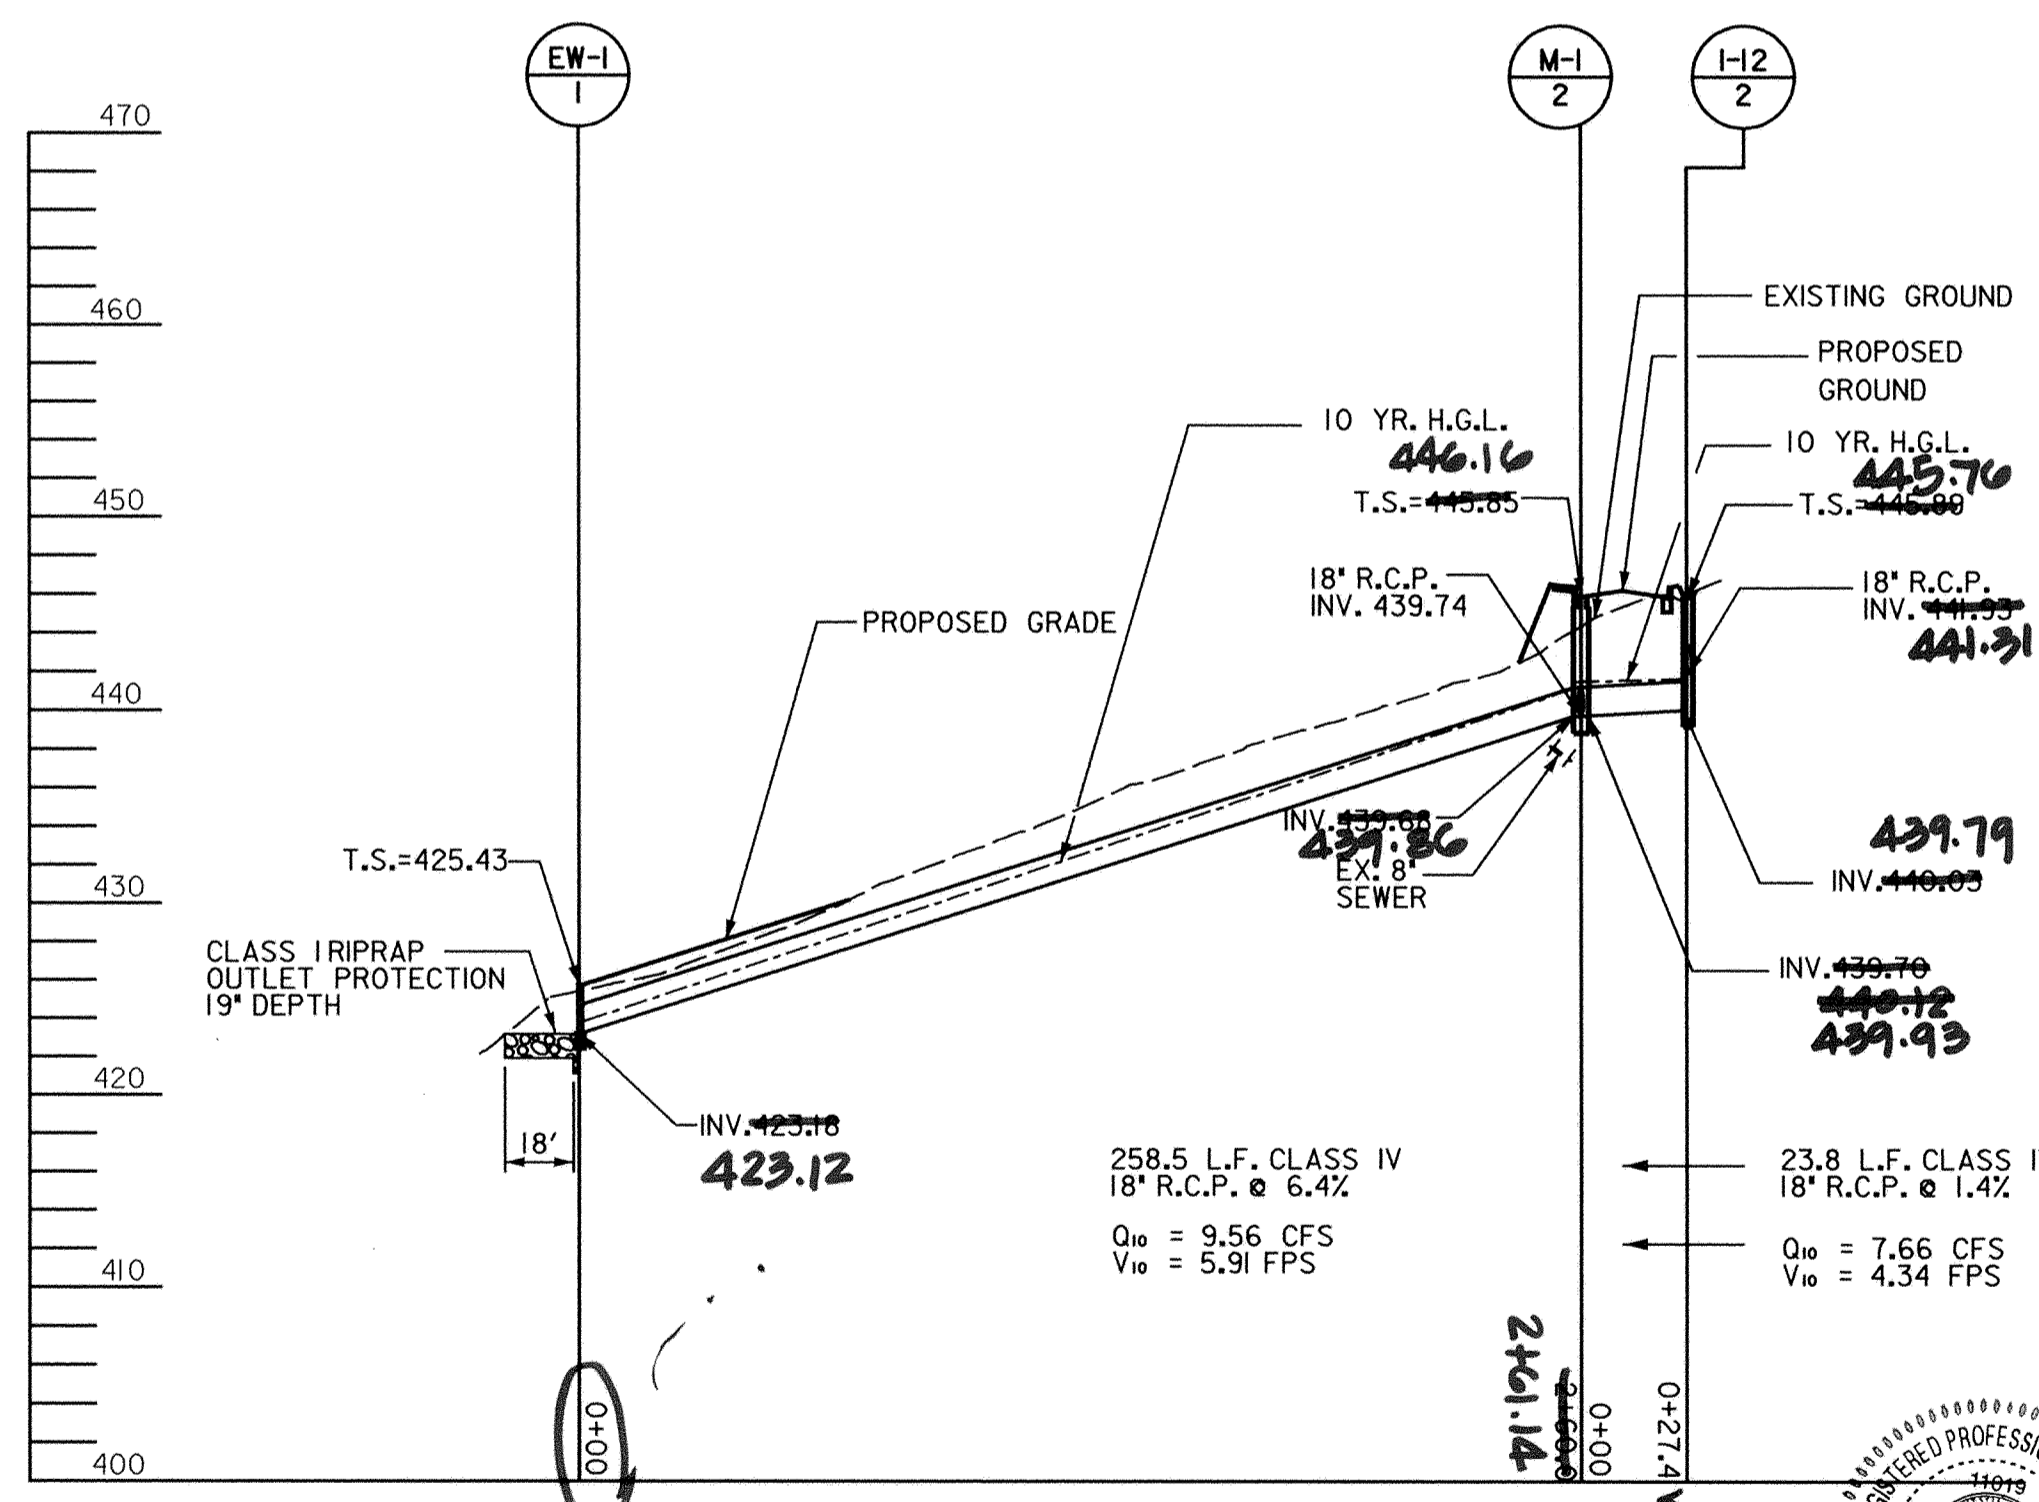

STA. 107+43.63 LT

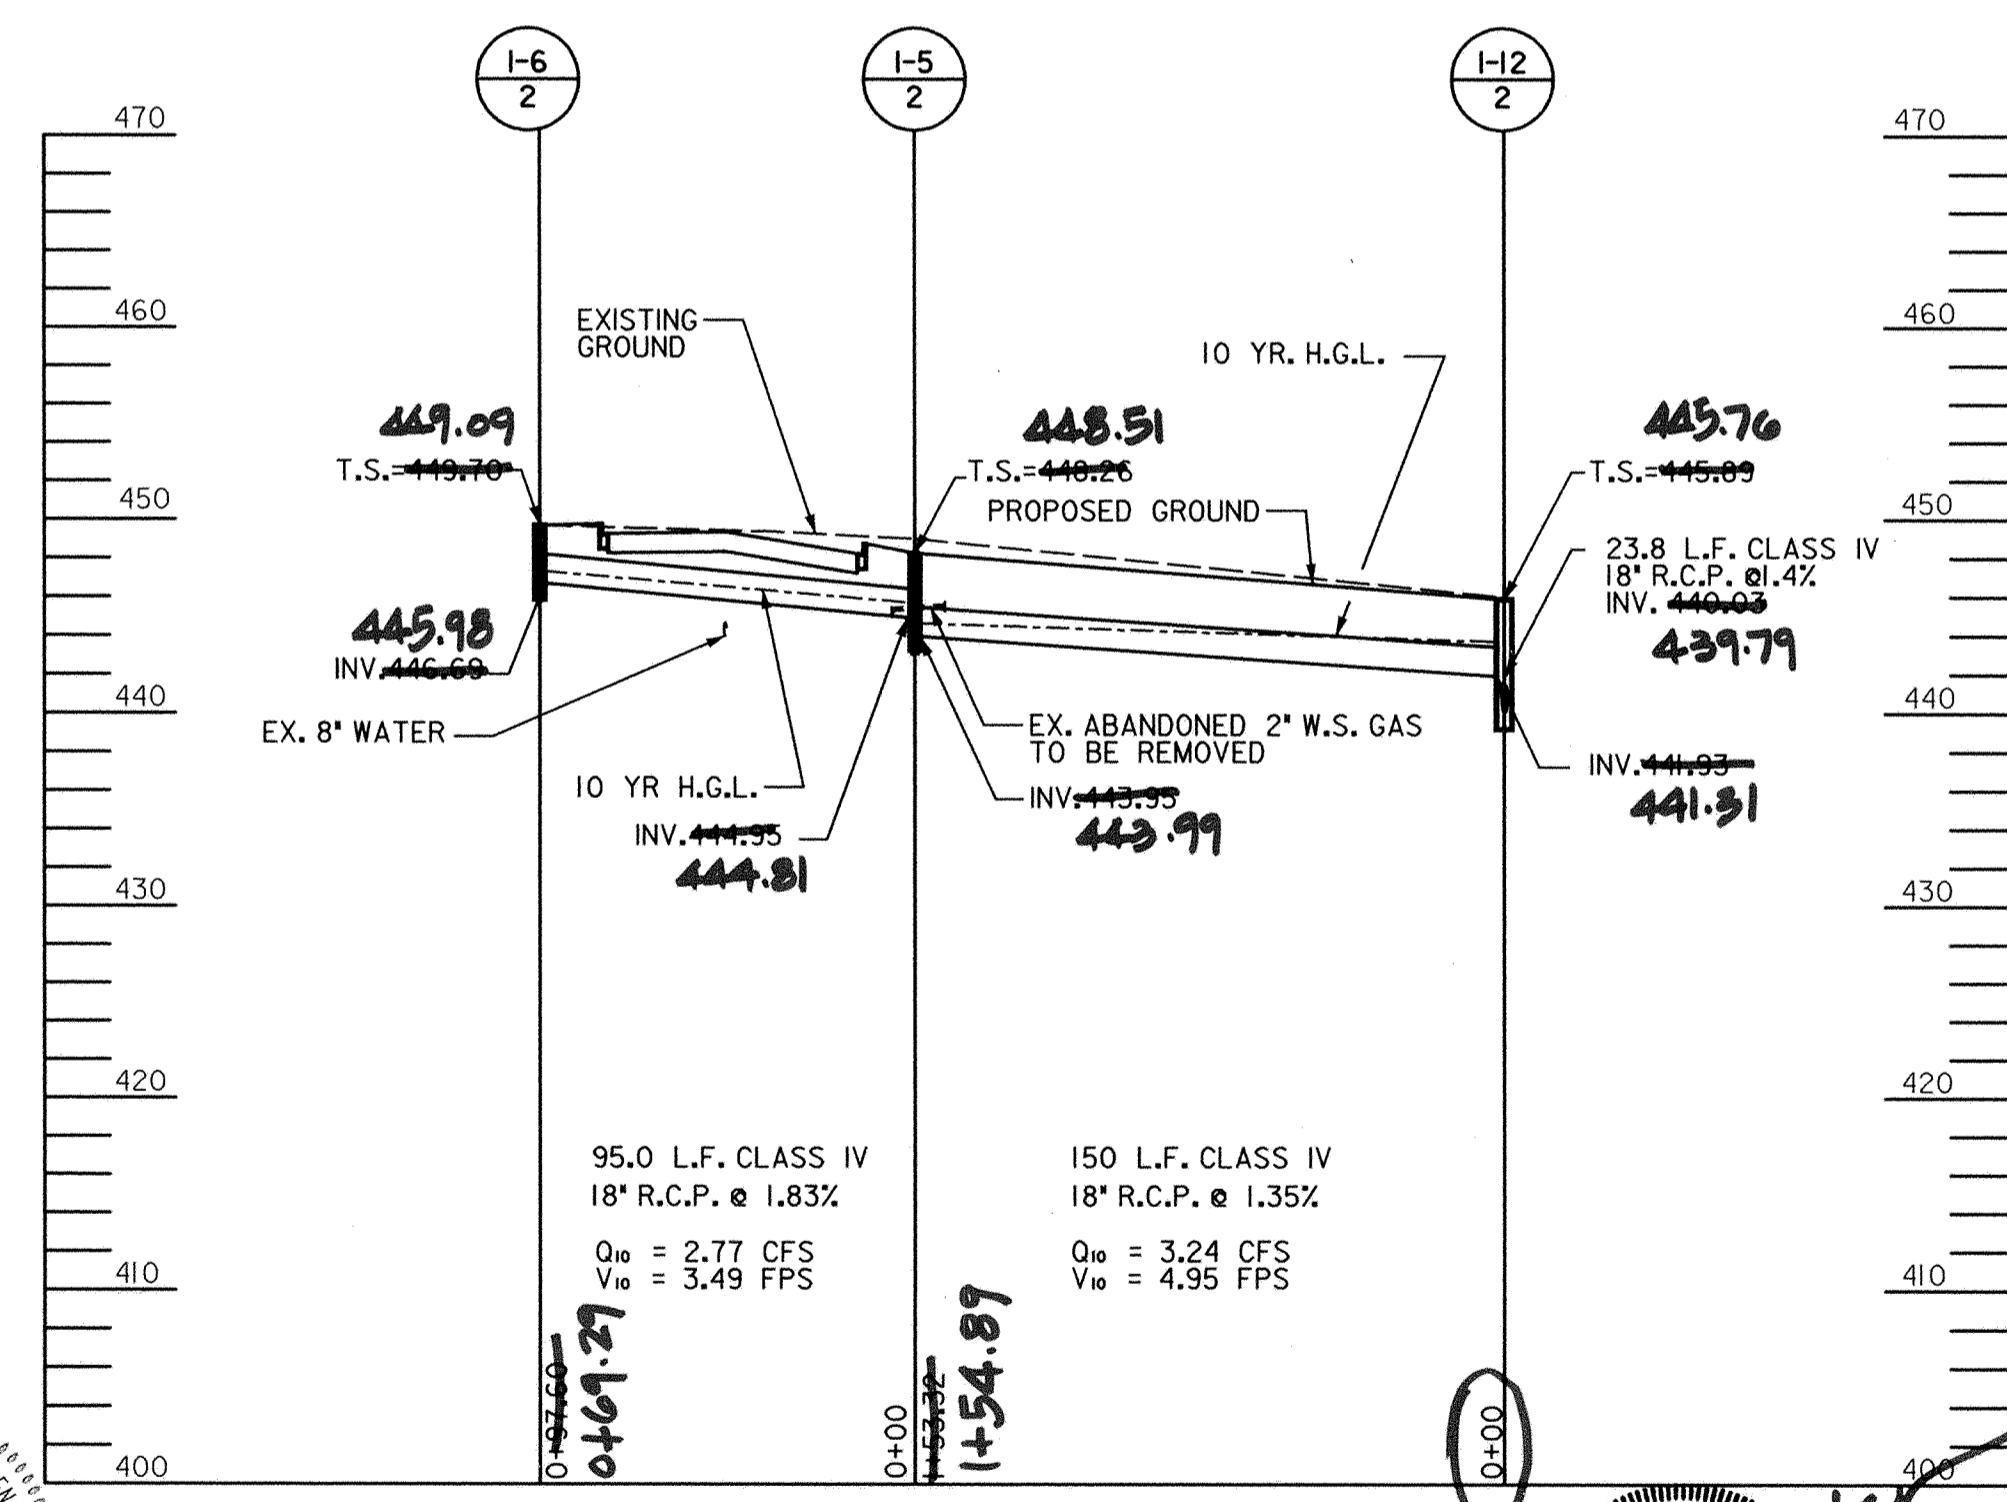

STA. 107+70.36 RT

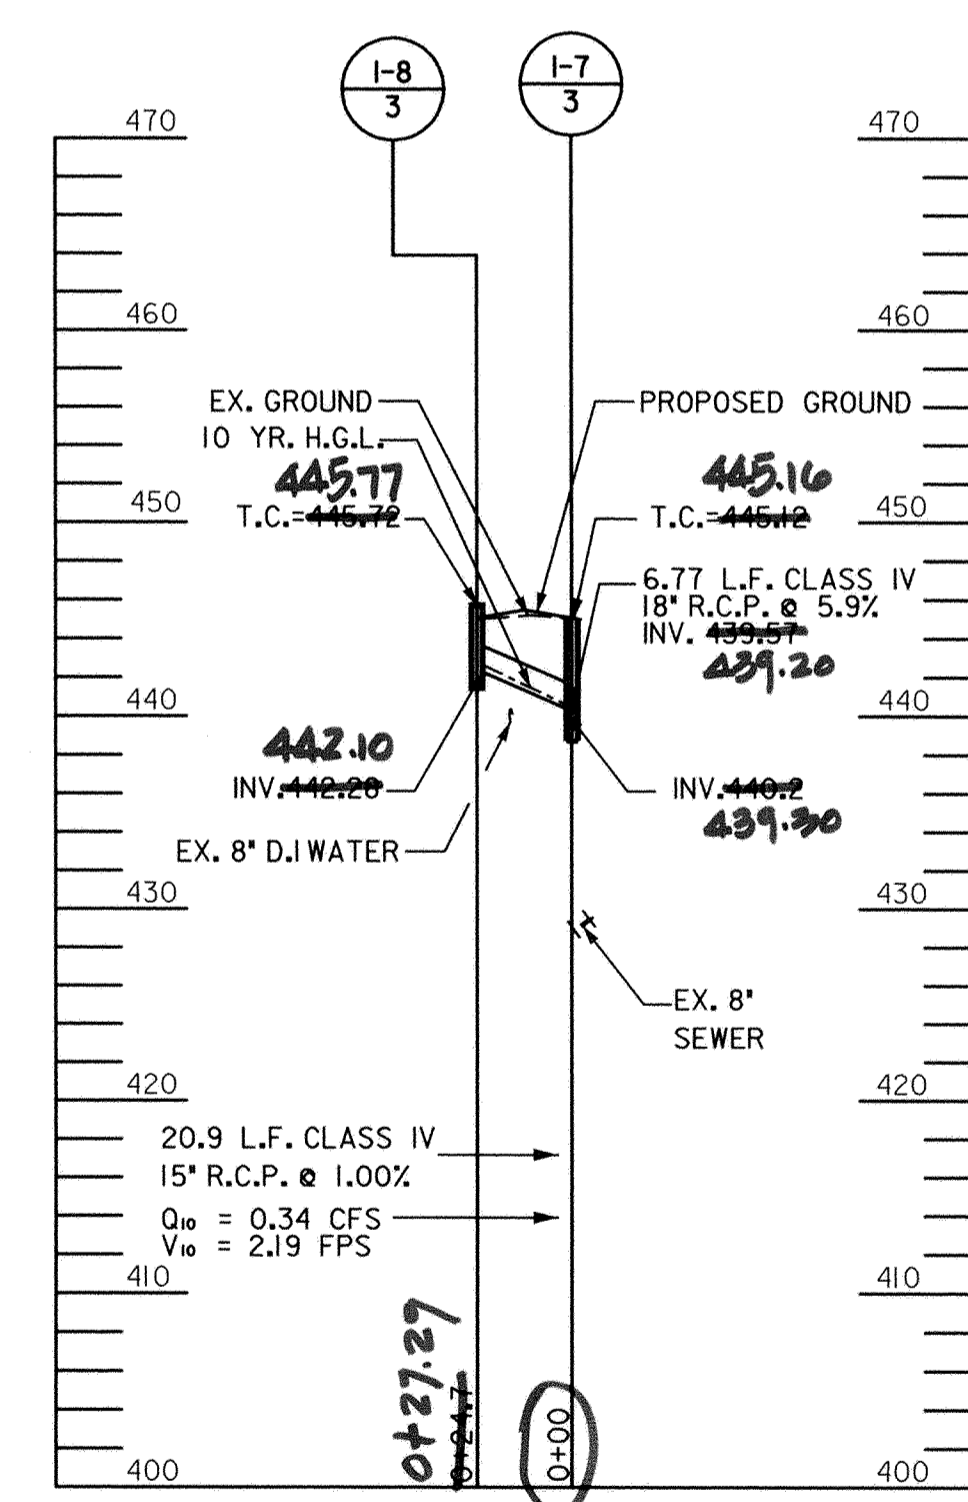


STA. 115+41.97 LT



Note: This is to certify an as-built survey of storm drain structures and inverts was made in November 2004. \*As-built remarks are shown in red!

DEPARTMENT OF PUBLIC WORKS  
 HOWARD COUNTY, MARYLAND  
 DATE: 9/25/03  
 DATE: 9/25/03  
 DATE: 9/25/03

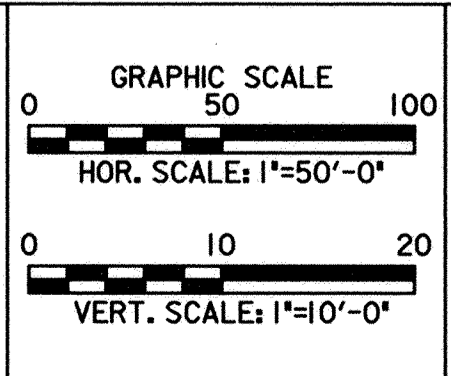


**URS**  
 HUNT VALLEY, MARYLAND  
**RJM**  
 RJM ENGINEERING, INC.  
 CONSULTING ENGINEERS  
 COLUMBIA, MARYLAND  
 TELE: 410/730-1001 FAX: 410/730-5403

|           |  |
|-----------|--|
| DES:      |  |
| DRN:      |  |
| CHK:      |  |
| DATE:     |  |
| BY:       |  |
| NO.:      |  |
| REVISION: |  |
| DATE:     |  |

**STORMDRAIN PROFILE PP-1**  
 NO.: \_\_\_\_\_ DATE: 9/03

**McKENZIE ROAD ROADWAY AND STORMDRAIN IMPROVEMENTS**  
 HOWARD COUNTY, MARYLAND  
 CAPITAL PROJECT NO. J-4164-10

SCALE AS SHOWN  
 SHEET 18 OF 24

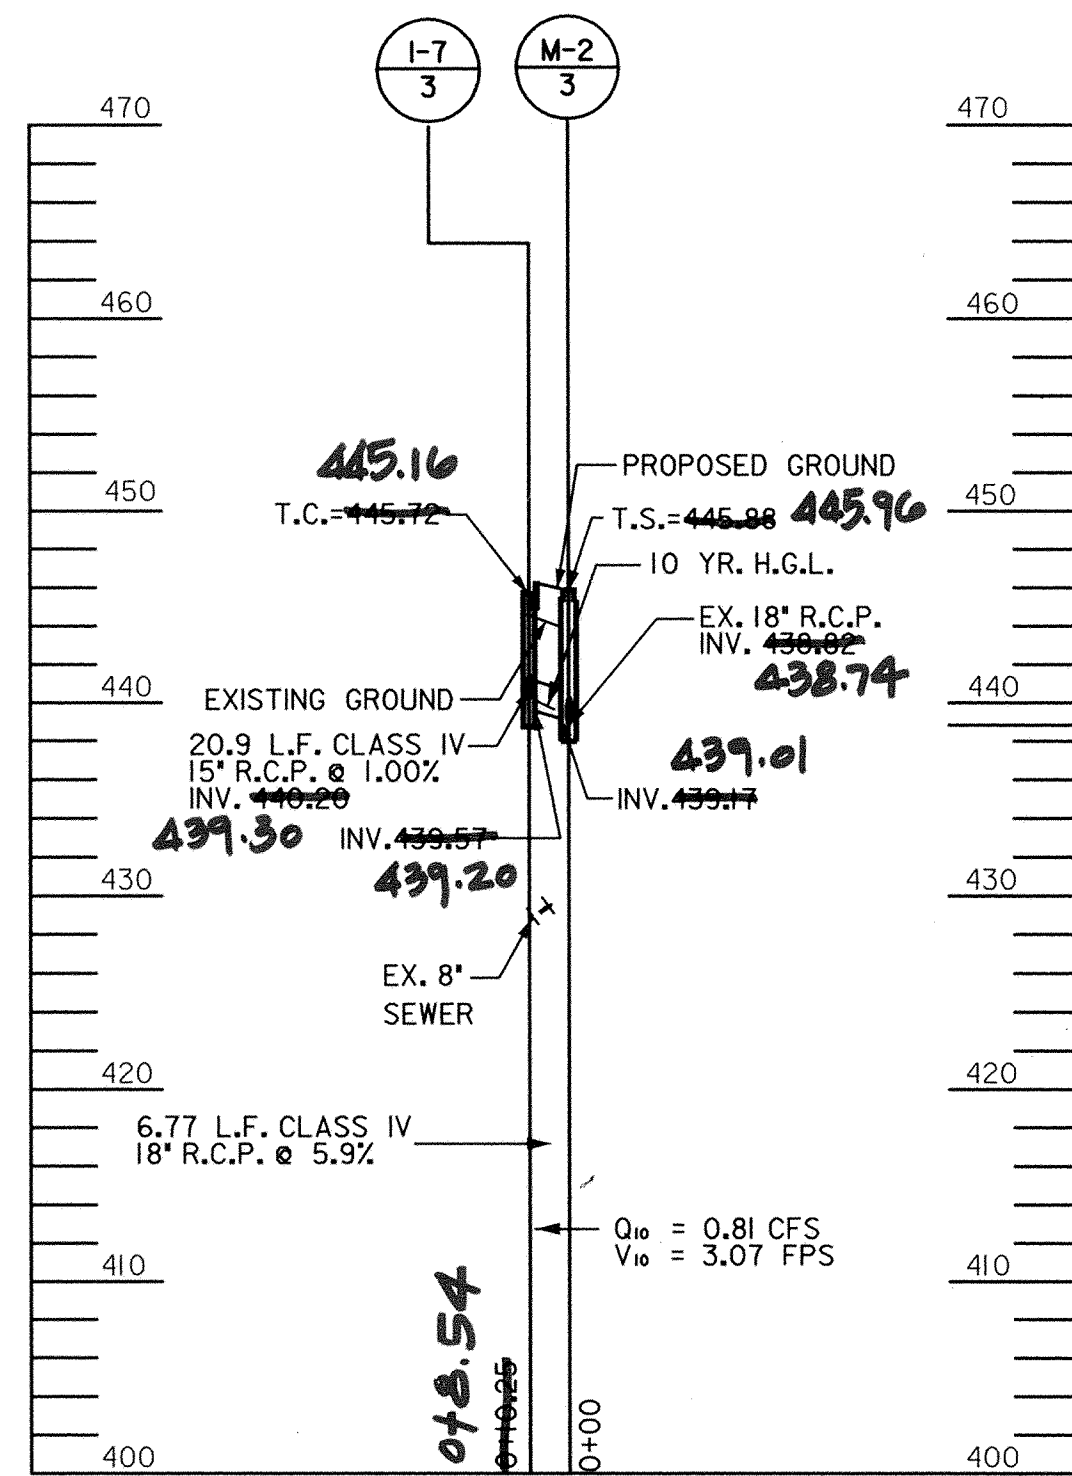


STA. 115+47.53 LT

**PIPE SCHEDULE**


| PIPE SCHEDULE |      |      |           |        |
|---------------|------|------|-----------|--------|
| FROM          | TO   | SIZE | TYPE      | LENGTH |
| I-1           | EX-3 | 18"  | RCP, CL 4 | 15.9'  |
| I-2           | I-1  | 15"  | RCP, CL 4 | 28.1'  |
| I-4           | I-3  | 15"  | RCP, CL 4 | 20.5'  |
| I-3           | M-1  | 18"  | RCP, CL 4 | 45.4'  |
| M-1           | EW-1 | 18"  | RCP, CL 4 | 258.5' |
| I-6           | I-5  | 18"  | RCP, CL 4 | 95'    |
| I-5           | I-12 | 18"  | RCP, CL 4 | 150'   |
| I-12          | M-1  | 18"  | RCP, CL 4 | 23.8'  |
| I-8           | I-7  | 15"  | RCP, CL 4 | 20.9'  |
| I-7           | M-2  | 18"  | RCP, CL 4 | 6.77'  |
| I-10          | I-9  | 15"  | RCP, CL 4 | 24.2'  |
| I-9           | I-11 | 15"  | RCP, CL 4 | 7.6'   |

| DRAINAGE STRUCTURE SCHEDULE |         |          |                                  |                            |
|-----------------------------|---------|----------|----------------------------------|----------------------------|
| STRUCTURE NO.               | STATION | OFFSET   | TYPE                             | REF.                       |
| I-1                         | 103+80  | 16' LT.  | STD. 'A-5' INLET (SETBACK INLET) | SD-4.01, DETAIL THIS SHEET |
| I-2                         | 103+79  | 16' RT.  | STD. 'A-5' INLET (SETBACK INLET) | SD-4.01, DETAIL THIS SHEET |
| I-3                         | 107+21  | 10' LT.  | STD. WR INLET                    | SD-4.37                    |
| I-4                         | 107+22  | 12' RT.  | STD. 'A-10' INLET                | SD-4.02                    |
| I-5                         | 109+25  | 14' RT.  | STD. WR INLET                    | SD-4.37                    |
| I-6                         | 110+24  | 17' RT.  | STD. OPEN END GRATE INLET        | SD-4.36                    |
| I-12                        | 107+70  | 17' RT.  | STD. TYPE 'E' INLET              | SD-4.21                    |
| M-1                         | 107+69  | 15' LT.  | STD. 48" DIA. MANHOLE            | G-5.12                     |
| EW-1                        | 107+51  | 209' LT. | STD. TYPE 'C' ENDWALL            | SD-5.51                    |
| I-7                         | 115+42  | 10' LT.  | STD. WR INLET                    | SD-4.37                    |
| I-8                         | 115+39  | 12' RT.  | STD. 'A-5' INLET                 | SD-4.01                    |
| I-9                         | 120+63  | 12' LT.  | STD. 'A-10' INLET                | SD-4.02                    |
| I-10                        | 120+63  | 12' RT.  | STD. 'A-10' INLET                | SD-4.02                    |
| I-11                        | 120+63  | 25' LT.  | STD. 'S' INLET                   | SD-4.22                    |
| M-2                         | 115+47  | 19' LT.  | STD. 48" DIA. MANHOLE            | G-5.12                     |

NOTE: THE OFFSET TO THE DRAINAGE STRUCTURES IS MEASURED TO THE FACE OF THE CURB (WHERE APPLICABLE), OR TO THE CENTER OF THE STRUCTURES.


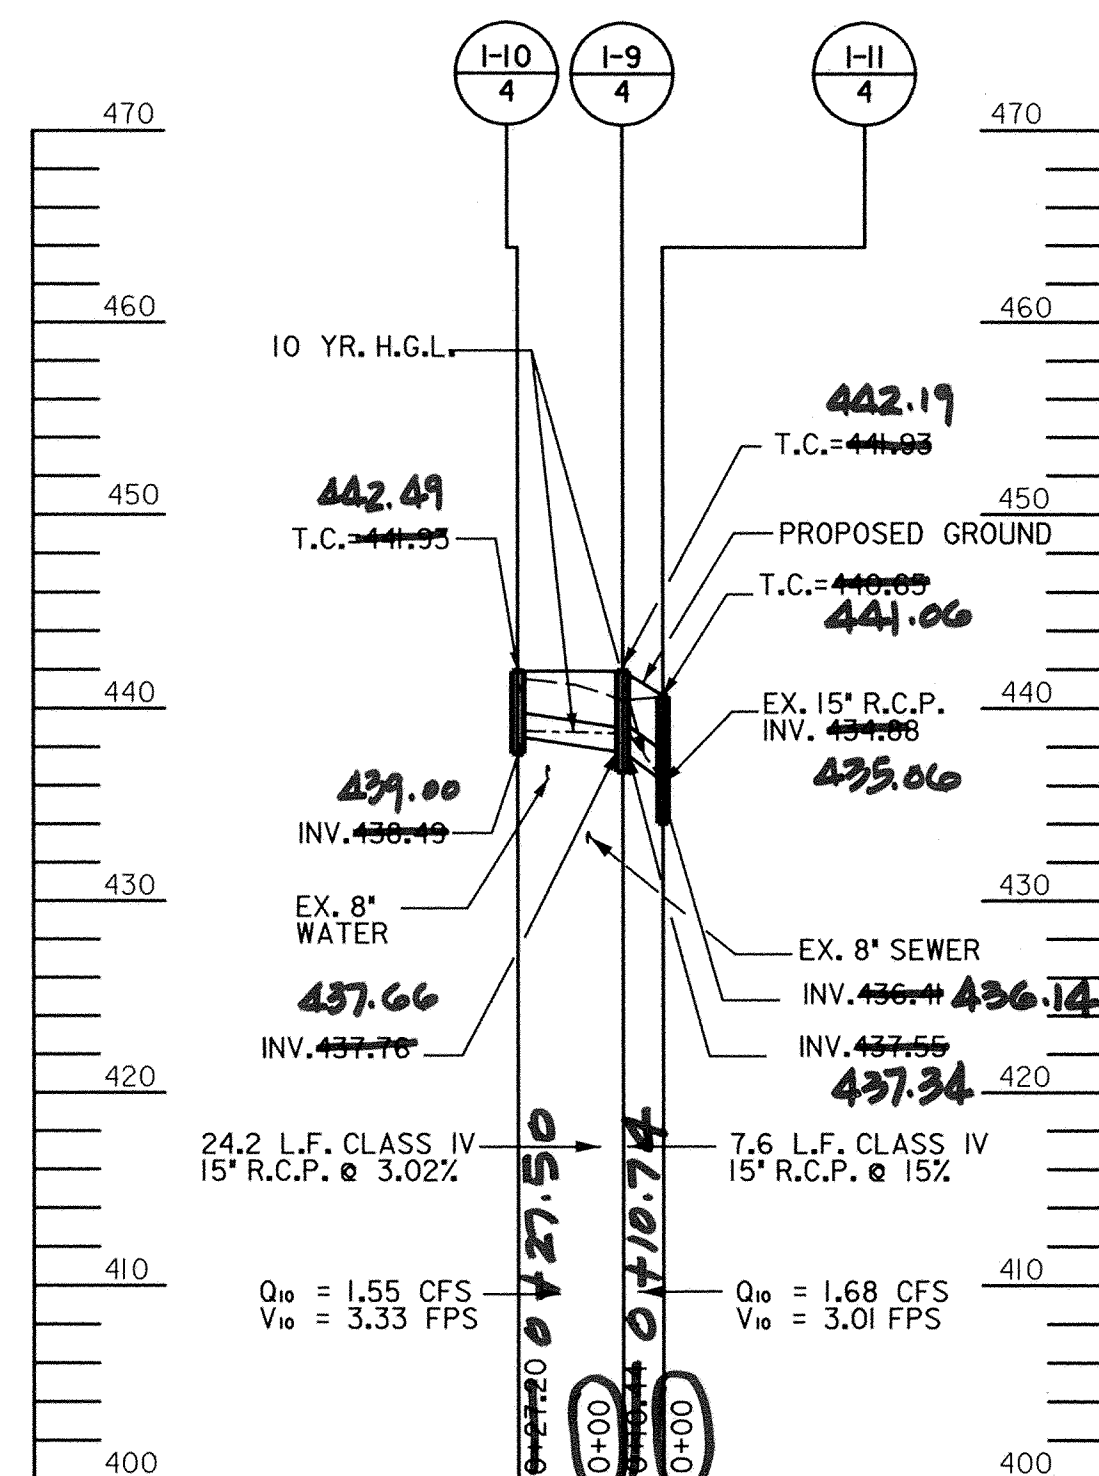


STA. 120+63.19 LT

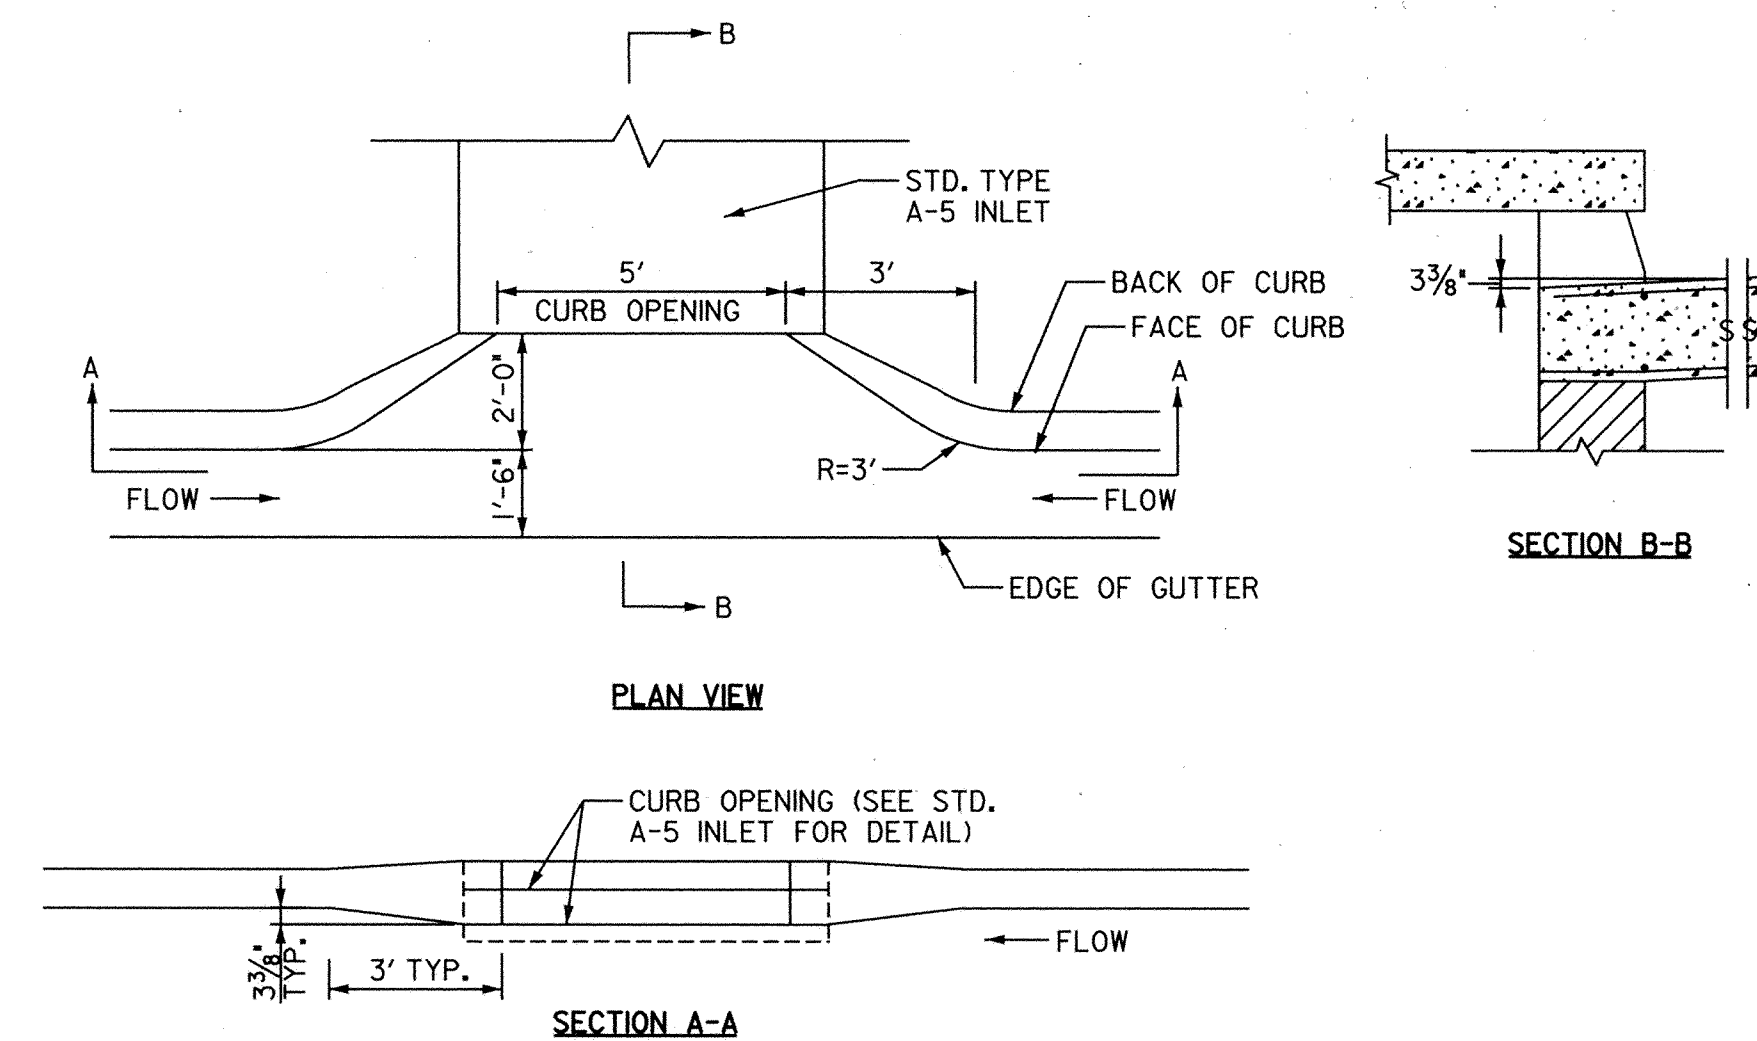




**DETAIL - CURB OFFSET AND MODIFIED SETBACK TYPE A-5 INLET**

SCALE: N.T.S.

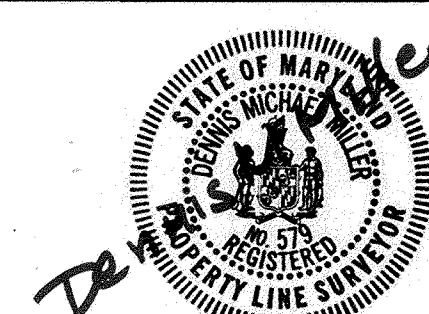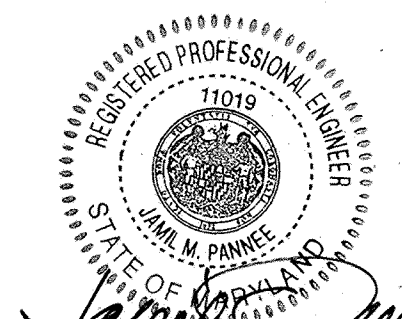

Note: This is to certify an as-built survey of storm drain structures and inverts was made in November 2004. \* As-built remarks are shown in red!


|   |  |   |  |   |  |  |  |   |  |                                |  |  |  |                                |  |
|---|--|---|--|---|--|--|--|---|--|--------------------------------|--|--|--|--------------------------------|--|
| DEPARTMENT OF PUBLIC WORKS<br>HOWARD COUNTY, MARYLAND<br><i>Jan P. Chu</i> 9/25/03<br>DEPARTMENT OF PUBLIC WORKS<br>CHIEF, TRANSPORTATION AND SPECIAL PROJECTS DIVISION |  | GRAPHIC SCALE<br>0 50 100<br>HOR. SCALE: 1"=50'-0"<br>0 10 20<br>VERT. SCALE: 1"=10'-0" |  | <b>URS</b><br>HUNT VALLEY, MARYLAND                 |  | <b>RJM</b><br>RJM ENGINEERING, INC.<br>CONSULTING ENGINEERS<br>COLUMBIA, MARYLAND<br>TEL: 410-730-1001 FAX: 410-730-5403 |  | DES: _____<br>DRN: _____<br>CHK: _____<br>DATE: _____ |  | <b>STORMDRAIN PROFILE PP-2</b> |  | <b>McKENZIE ROAD ROADWAY AND STORMDRAIN IMPROVEMENTS</b><br>HOWARD COUNTY, MARYLAND<br>CAPITAL PROJECT NO. J-4164-10 |  | SCALE AS SHOWN<br>SHEET 120F24 |  |
| <i>William F. Johnson</i> 9/25/03<br>CHIEF, BUREAU OF ENGINEERING   |  | <i>William F. Johnson</i> 9/25/03<br>CHIEF, BUREAU OF HIGHWAYS                          |  | BY: _____ NO.: _____<br>REVISION: _____ DATE: _____ |  | NO.: _____ DATE: 9/03  |  |   |  |                                |  |  |  |                                |  |

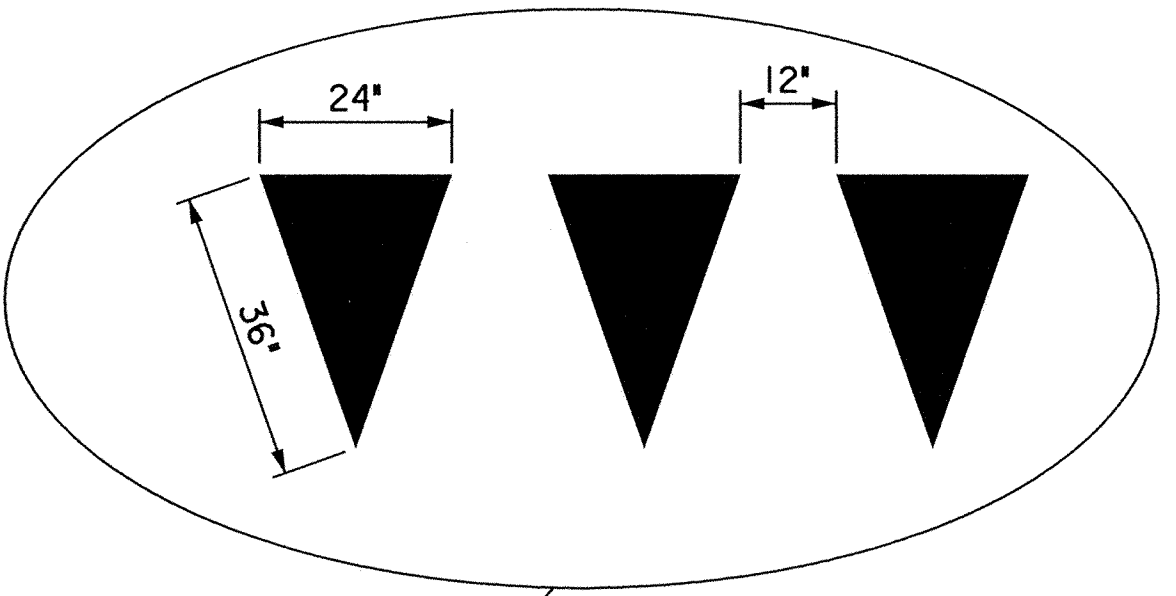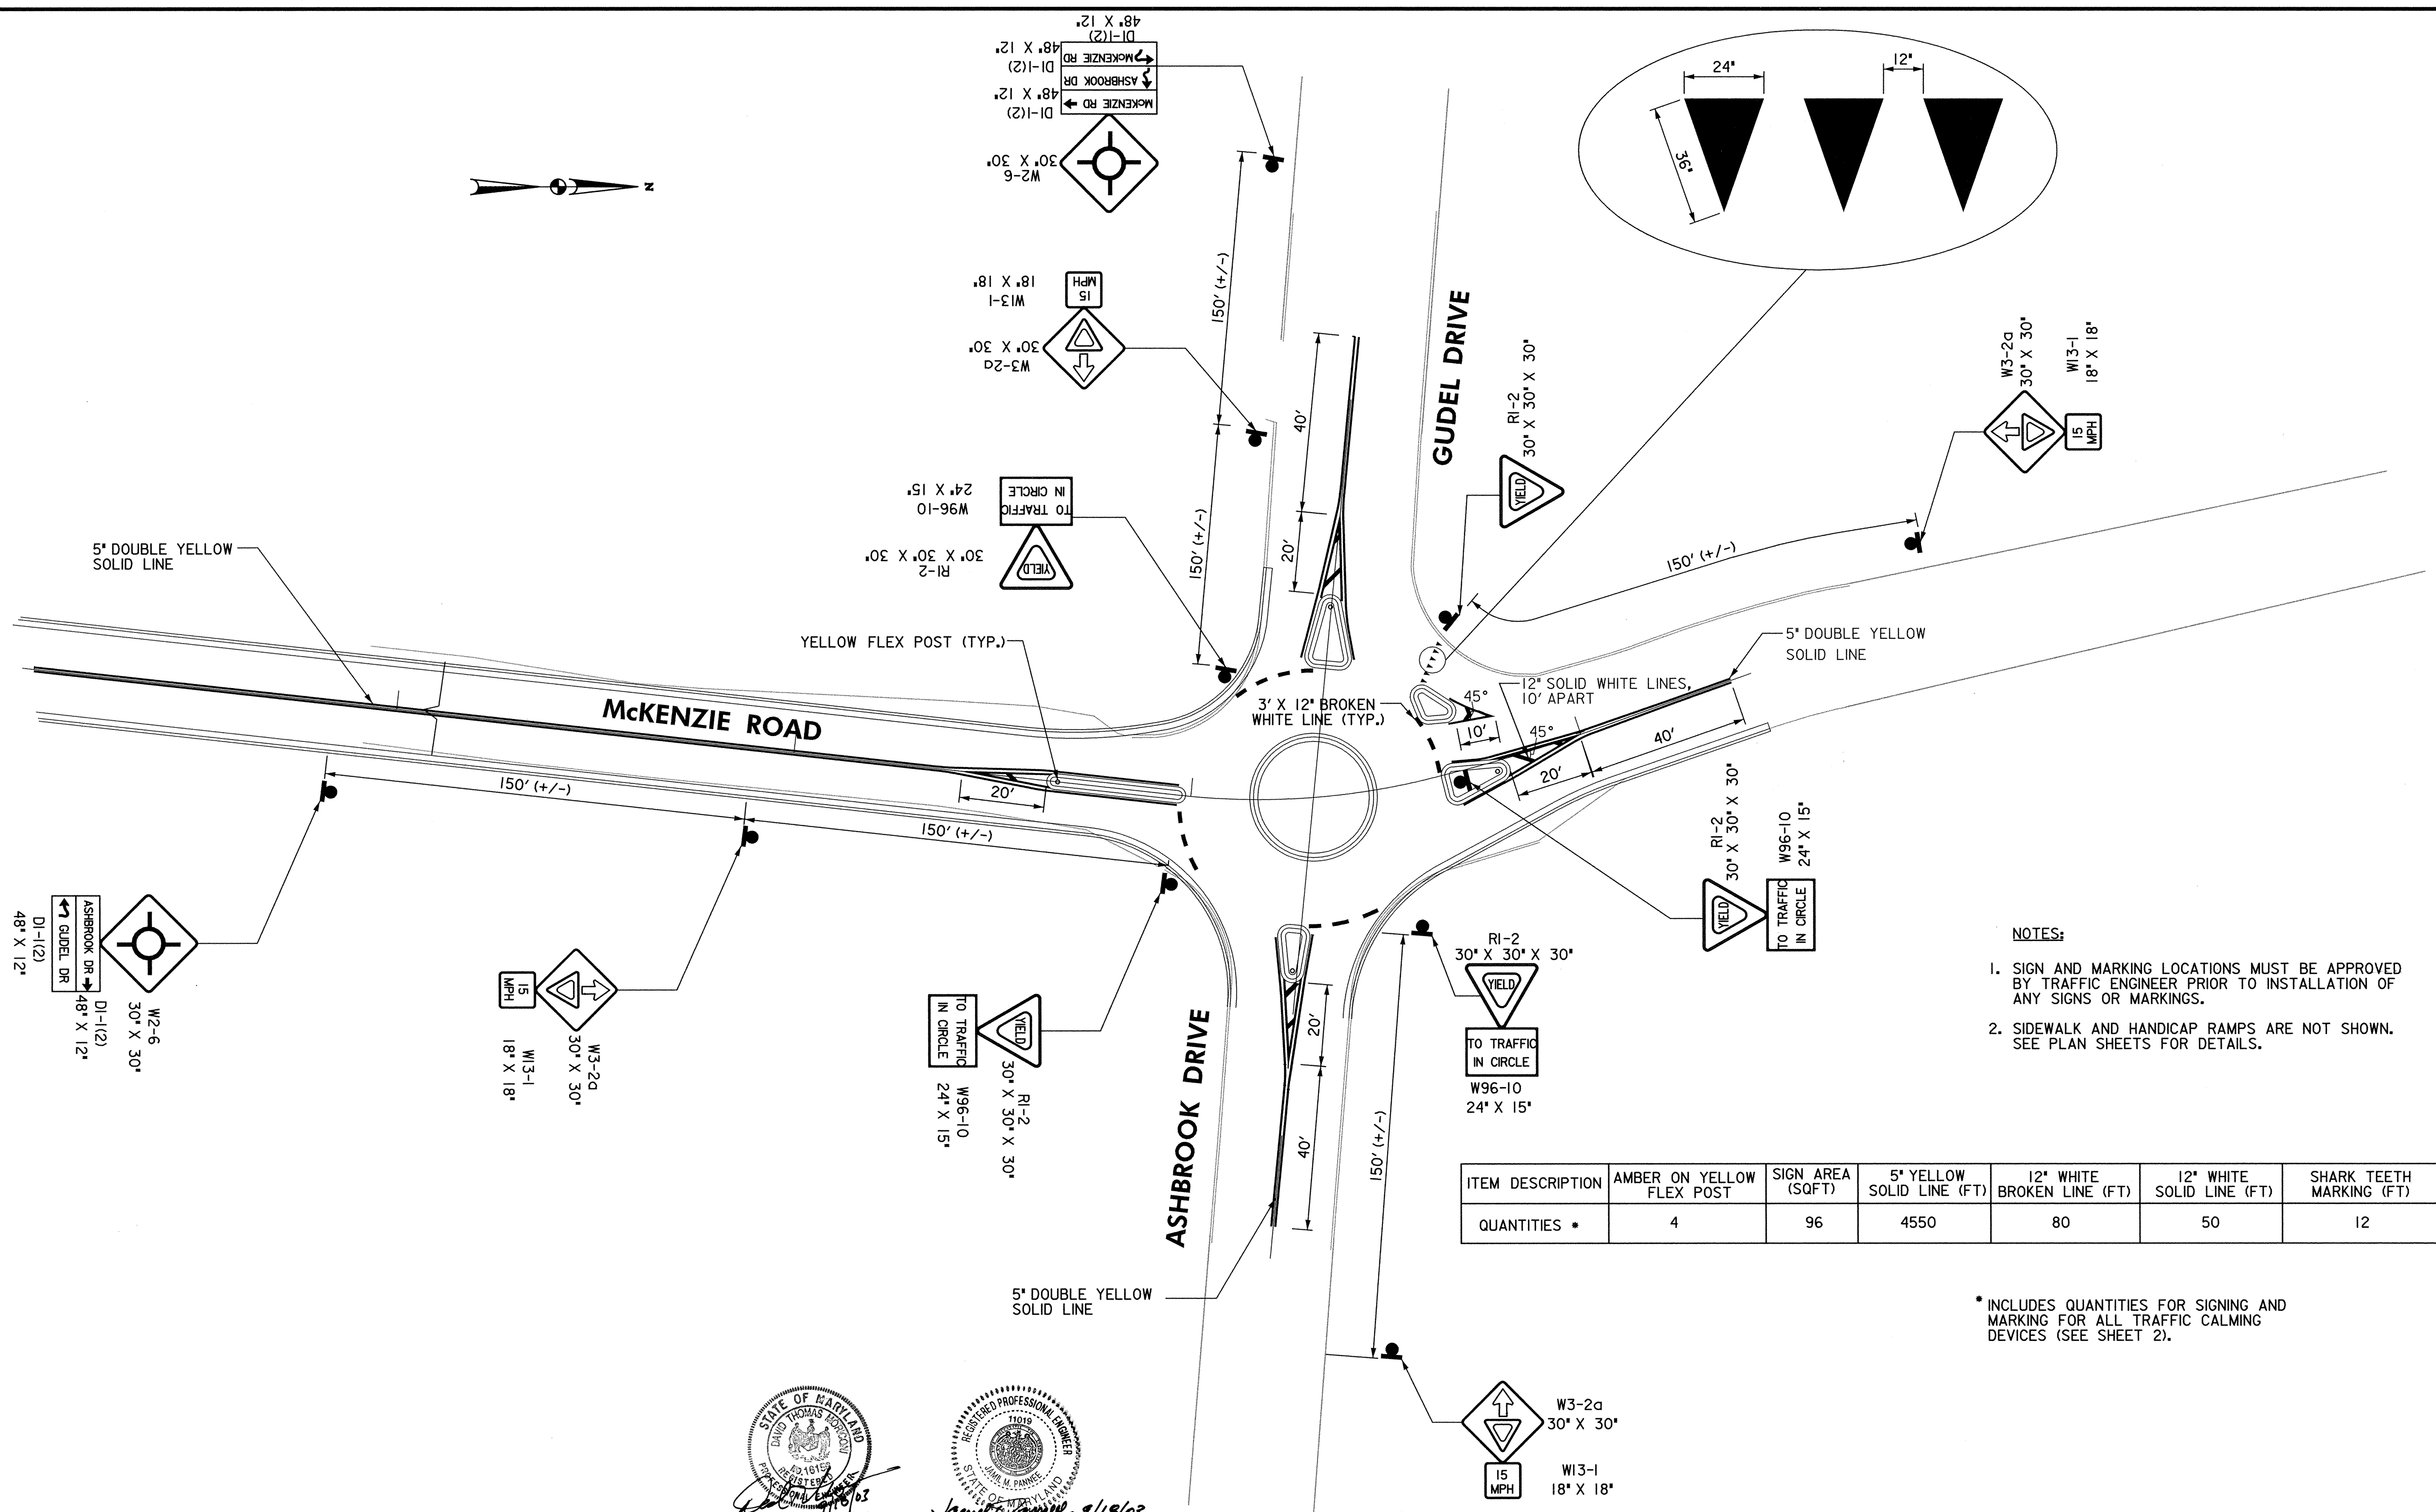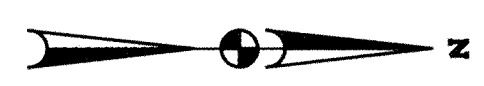

- NOTES:**
- SIGN AND MARKING LOCATIONS MUST BE APPROVED BY TRAFFIC ENGINEER PRIOR TO INSTALLATION OF ANY SIGNS OR MARKINGS.
  - SIDEWALK AND HANDICAP RAMPS ARE NOT SHOWN. SEE PLAN SHEETS FOR DETAILS.

| ITEM DESCRIPTION | AMBER ON YELLOW FLEX POST | SIGN AREA (SQFT) | 5" YELLOW SOLID LINE (FT) | 12" WHITE BROKEN LINE (FT) | 12" WHITE SOLID LINE (FT) | SHARK TEETH MARKING (FT) |
|------------------|---------------------------|------------------|---------------------------|----------------------------|---------------------------|--------------------------|
| QUANTITIES *     | 4                         | 96               | 4550                      | 80                         | 50                        | 12                       |

\* INCLUDES QUANTITIES FOR SIGNING AND MARKING FOR ALL TRAFFIC CALMING DEVICES (SEE SHEET 2).

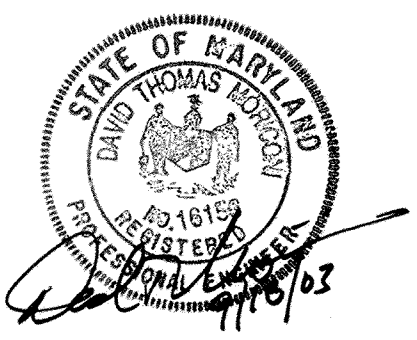


DEPARTMENT OF PUBLIC WORKS  
HOWARD COUNTY, MARYLAND

*James E. Smith* 9/22/03  
DATE

*William E. Madala* 9/22/03  
DATE

CHIEF, TRANSPORTATION AND SPECIAL PROJECTS DIVISION

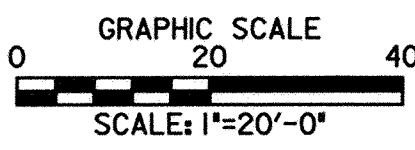

**URS**  
HUNT VALLEY, MARYLAND

**RJM**  
RJM ENGINEERING, INC.  
CONSULTING ENGINEERS  
COLUMBIA, MARYLAND

TELE: 410/730-1001 FAX: 410/730-5403

|       |    |     |          |      |
|-------|----|-----|----------|------|
| DES:  |    |     |          |      |
| DRN:  |    |     |          |      |
| CHK:  |    |     |          |      |
| DATE: | BY | NO. | REVISION | DATE |

**MINI- ROUNDABOUT MARKING AND SIGNING PLAN AT ASHBROOK DRIVE**

NO.: \_\_\_\_\_ DATE: 9/03

**McKENZIE ROAD ROADWAY AND STORMDRAIN IMPROVEMENTS**














HOWARD COUNTY, MARYLAND  
CAPITAL PROJECT NO. J-4164-10

SCALE AS SHOWN

SHEET 200F24

GENERAL NOTES

- ALL STANDARD REGULATORY AND WARNING SIGNS USED FOR MAINTENANCE OF TRAFFIC SHALL BE IN ACCORDANCE WITH LATEST APPROVED EDITIONS OF THE "MANUAL ON UNIFORM TRAFFIC CONTROL DEVICES", THE MARYLAND DEPARTMENT OF TRANSPORTATION STATE HIGHWAY ADMINISTRATION (SHA) "STANDARD SIGN BOOK", AND THE HOWARD COUNTY "STANDARD SPECIFICATIONS AND DETAILS FOR CONSTRUCTION". THE MARYLAND STATE HIGHWAY ADMINISTRATION'S TEMPORARY TRAFFIC CONTROL REFERENCE MANUAL STANDARDS SHALL BE USED WHEN REFERENCED. IT SHALL BE THE RESPONSIBILITY OF THE CONTRACTOR TO PROCURE AND UTILIZE THE LATEST EDITION AND SUPPLEMENTS OF EACH OF THE PUBLICATIONS.
- DURING CONSTRUCTION OF STAGE 1 AND 2, ACCESS TO MCKENZIE ROAD FOR LOCAL TRAFFIC SHALL BE PROVIDED.
- ALL EXISTING SIGNS IN CONFLICT WITH THE PROPOSED MAINTENANCE OF TRAFFIC SCHEME SHALL BE COVERED. AFTER EACH STAGE OF WORK IS COMPLETE, THE CONTRACTOR SHALL UNCOVER EXISTING SIGNS AS SOON AS POSSIBLE OR AS DIRECTED BY THE ENGINEER TO IMPROVE OVERALL PROJECT SAFETY. NO SECTION OF ROADWAY SHALL BE OPEN TO TRAFFIC UNTIL ALL EXISTING SIGNS AND PERMANENT MARKINGS ARE RESTORED.
- ALL WORK ZONE SIGNS SHALL BE FIELD LOCATED AND APPROVED BY TRAFFIC ENGINEER PRIOR TO INSTALLATION OF ANY SIGNS.
- DETOUR PLAN FOR STAGE 1 IS IN EFFECT DURING WORK HOURS. AFTER EACH WORK DAY, ALL DETOUR SIGNS SHALL BE REMOVED, COVERED, OR TURNED AWAY FROM INCOMING TRAFFIC.
- ALL EXISTING TRAFFIC SIGNAL SUPPORT STRUCTURES AND SIGNS SHALL BE MAINTAINED DURING CONSTRUCTION.
- ALL PLASTIC DRUMS SHALL BE WEIGHTED WITH SAND BAGS OR OTHER APPROVED MATERIALS TO WITHSTAND WIND LOADS.
- CONTRACTOR SHALL MONITOR ALL TRAFFIC CONTROL DEVICES (DRUMS, SIGNS, ETC.) 24 HOURS A DAY AND 7 DAYS A WEEK AND IMMEDIATELY CORRECT ANY DAMAGE DUE TO TRAFFIC OR WEATHER RELATED CONDITIONS. THE CONTRACTOR WILL NEED A CERTIFIED TRAFFIC CONTROL MANAGER FOR THE PROJECT.

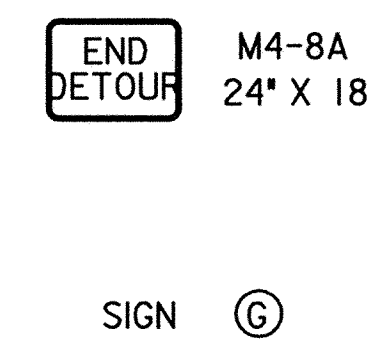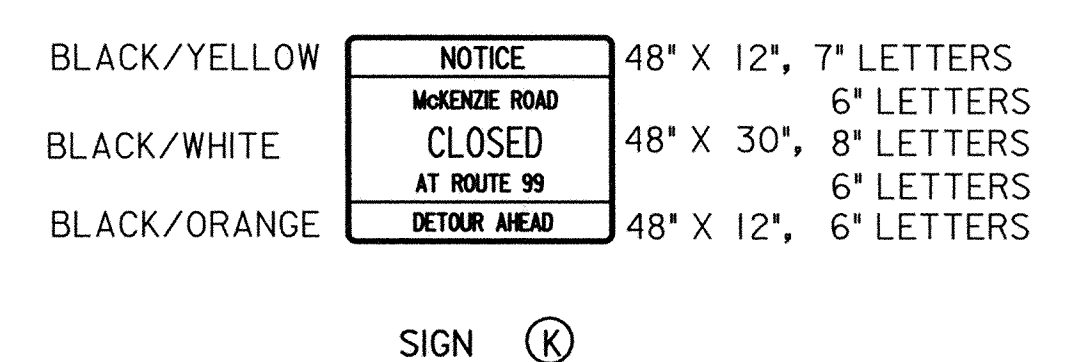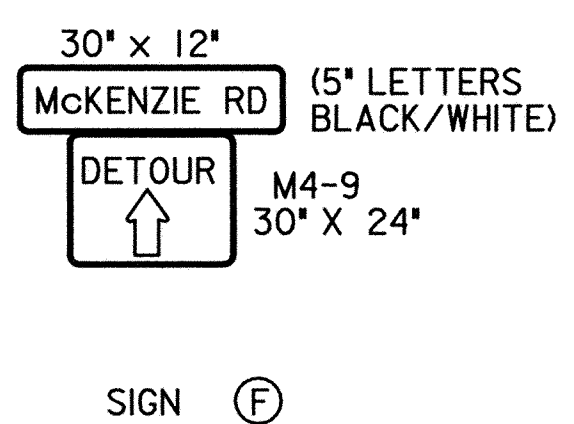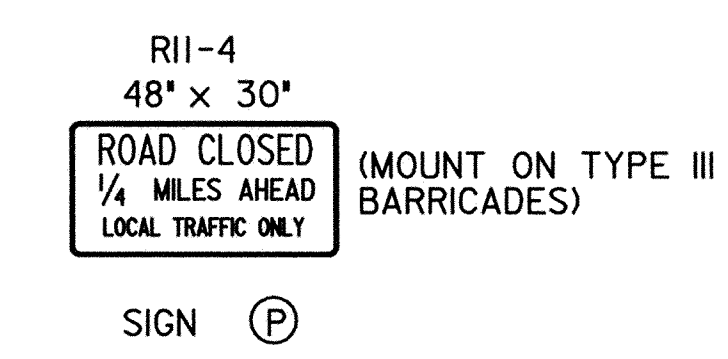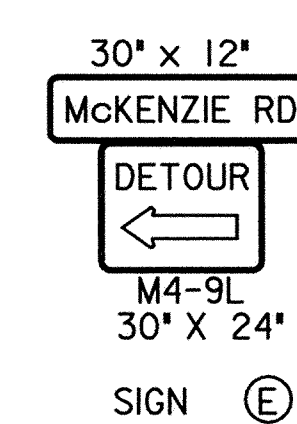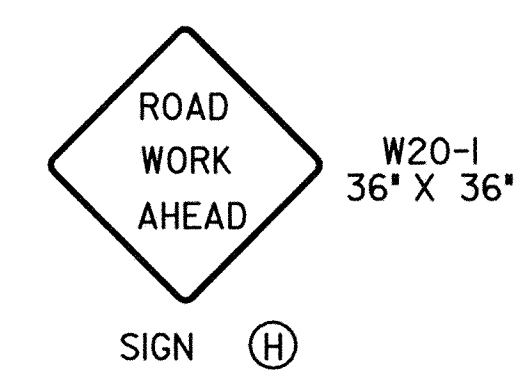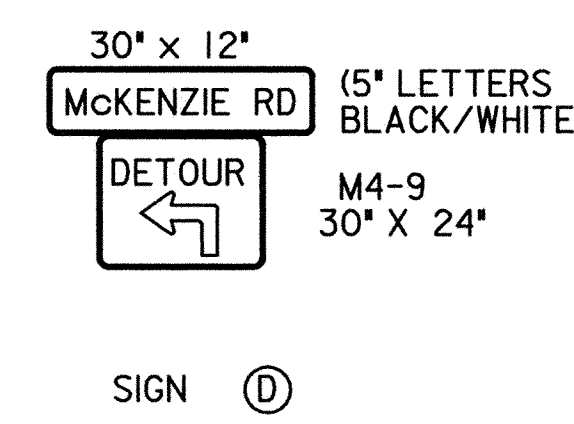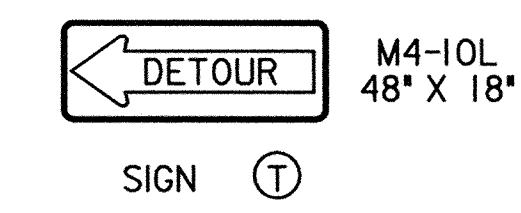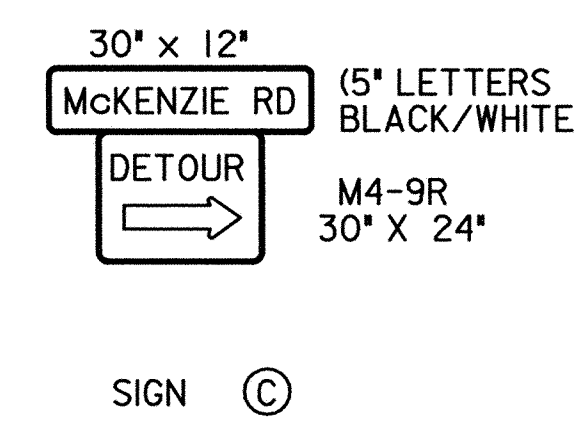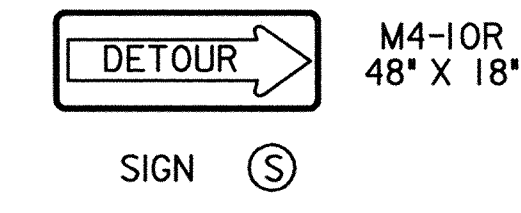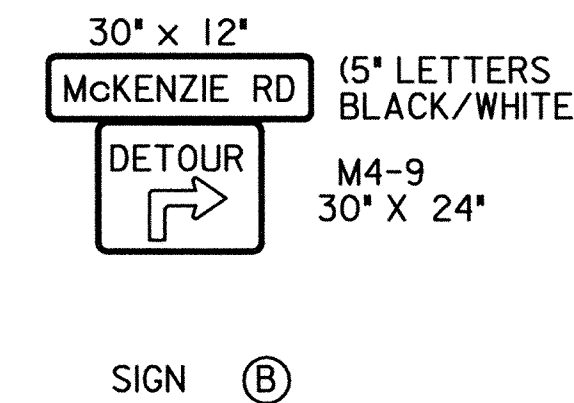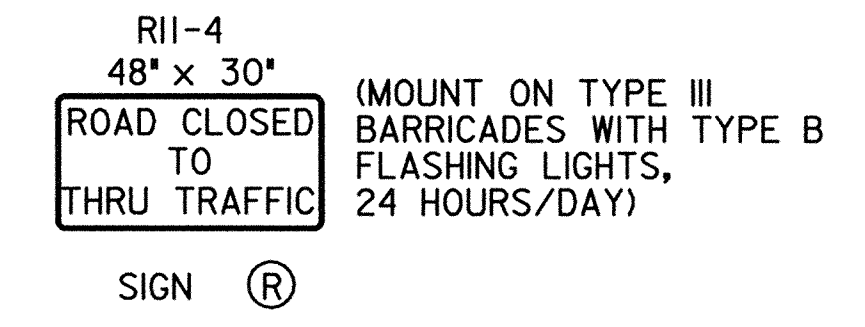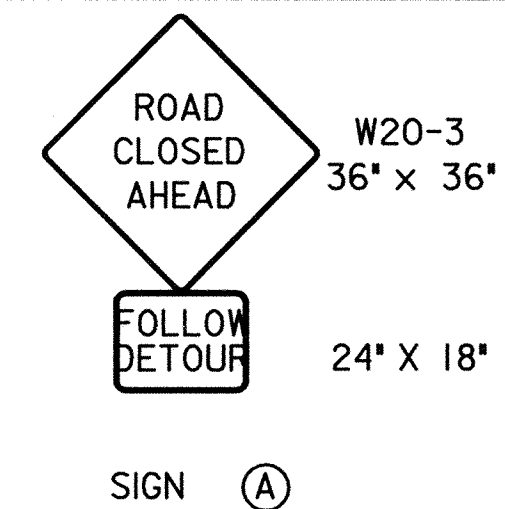

**SIGN LEGEND**  
SCALE: N.T.S.




*David M. Pinner*, 9/18/03

|  |  |                              |  |  |  |   |   |  |  |                                  |
|--|--|------------------------------|--|--|--|---|---|--|--|----------------------------------|
| DEPARTMENT OF PUBLIC WORKS<br>HOWARD COUNTY, MARYLAND<br><i>James J. Jones</i> 9/22/03<br>DEPARTMENT OF PUBLIC WORKS DATE<br><i>William E. Jones</i> 9/22/03<br>CHIEF, TRANSPORTATION AND SPECIAL PROJECTS DIVISION DATE |  | URS<br>HUNT VALLEY, MARYLAND |  | RJM ENGINEERING, INC.<br>CONSULTING ENGINEERS<br>COLUMBIA, MARYLAND<br>TEL: 410/730-1001 FAX: 410/730-5403 |  | DES: _____<br>DRN: _____<br>CHK: _____<br>DATE: _____ | BY: _____ NO.: _____<br>REVISION: _____ DATE: _____ | TRAFFIC CONTROL<br>GENERAL NOTES<br>AND SIGN LEGEND<br>NO.: _____ DATE: 9/03 | MCKENZIE ROAD ROADWAY<br>AND STORMDRAIN IMPROVEMENTS<br>HOWARD COUNTY, MARYLAND<br>CAPITAL PROJECT NO. J-4164-10 | SCALE AS SHOWN<br>SHEET 21 OF 24 |
|--|--|------------------------------|--|--|--|---|---|--|--|----------------------------------|

MOUNT HEBRON

AT PATAPSCO


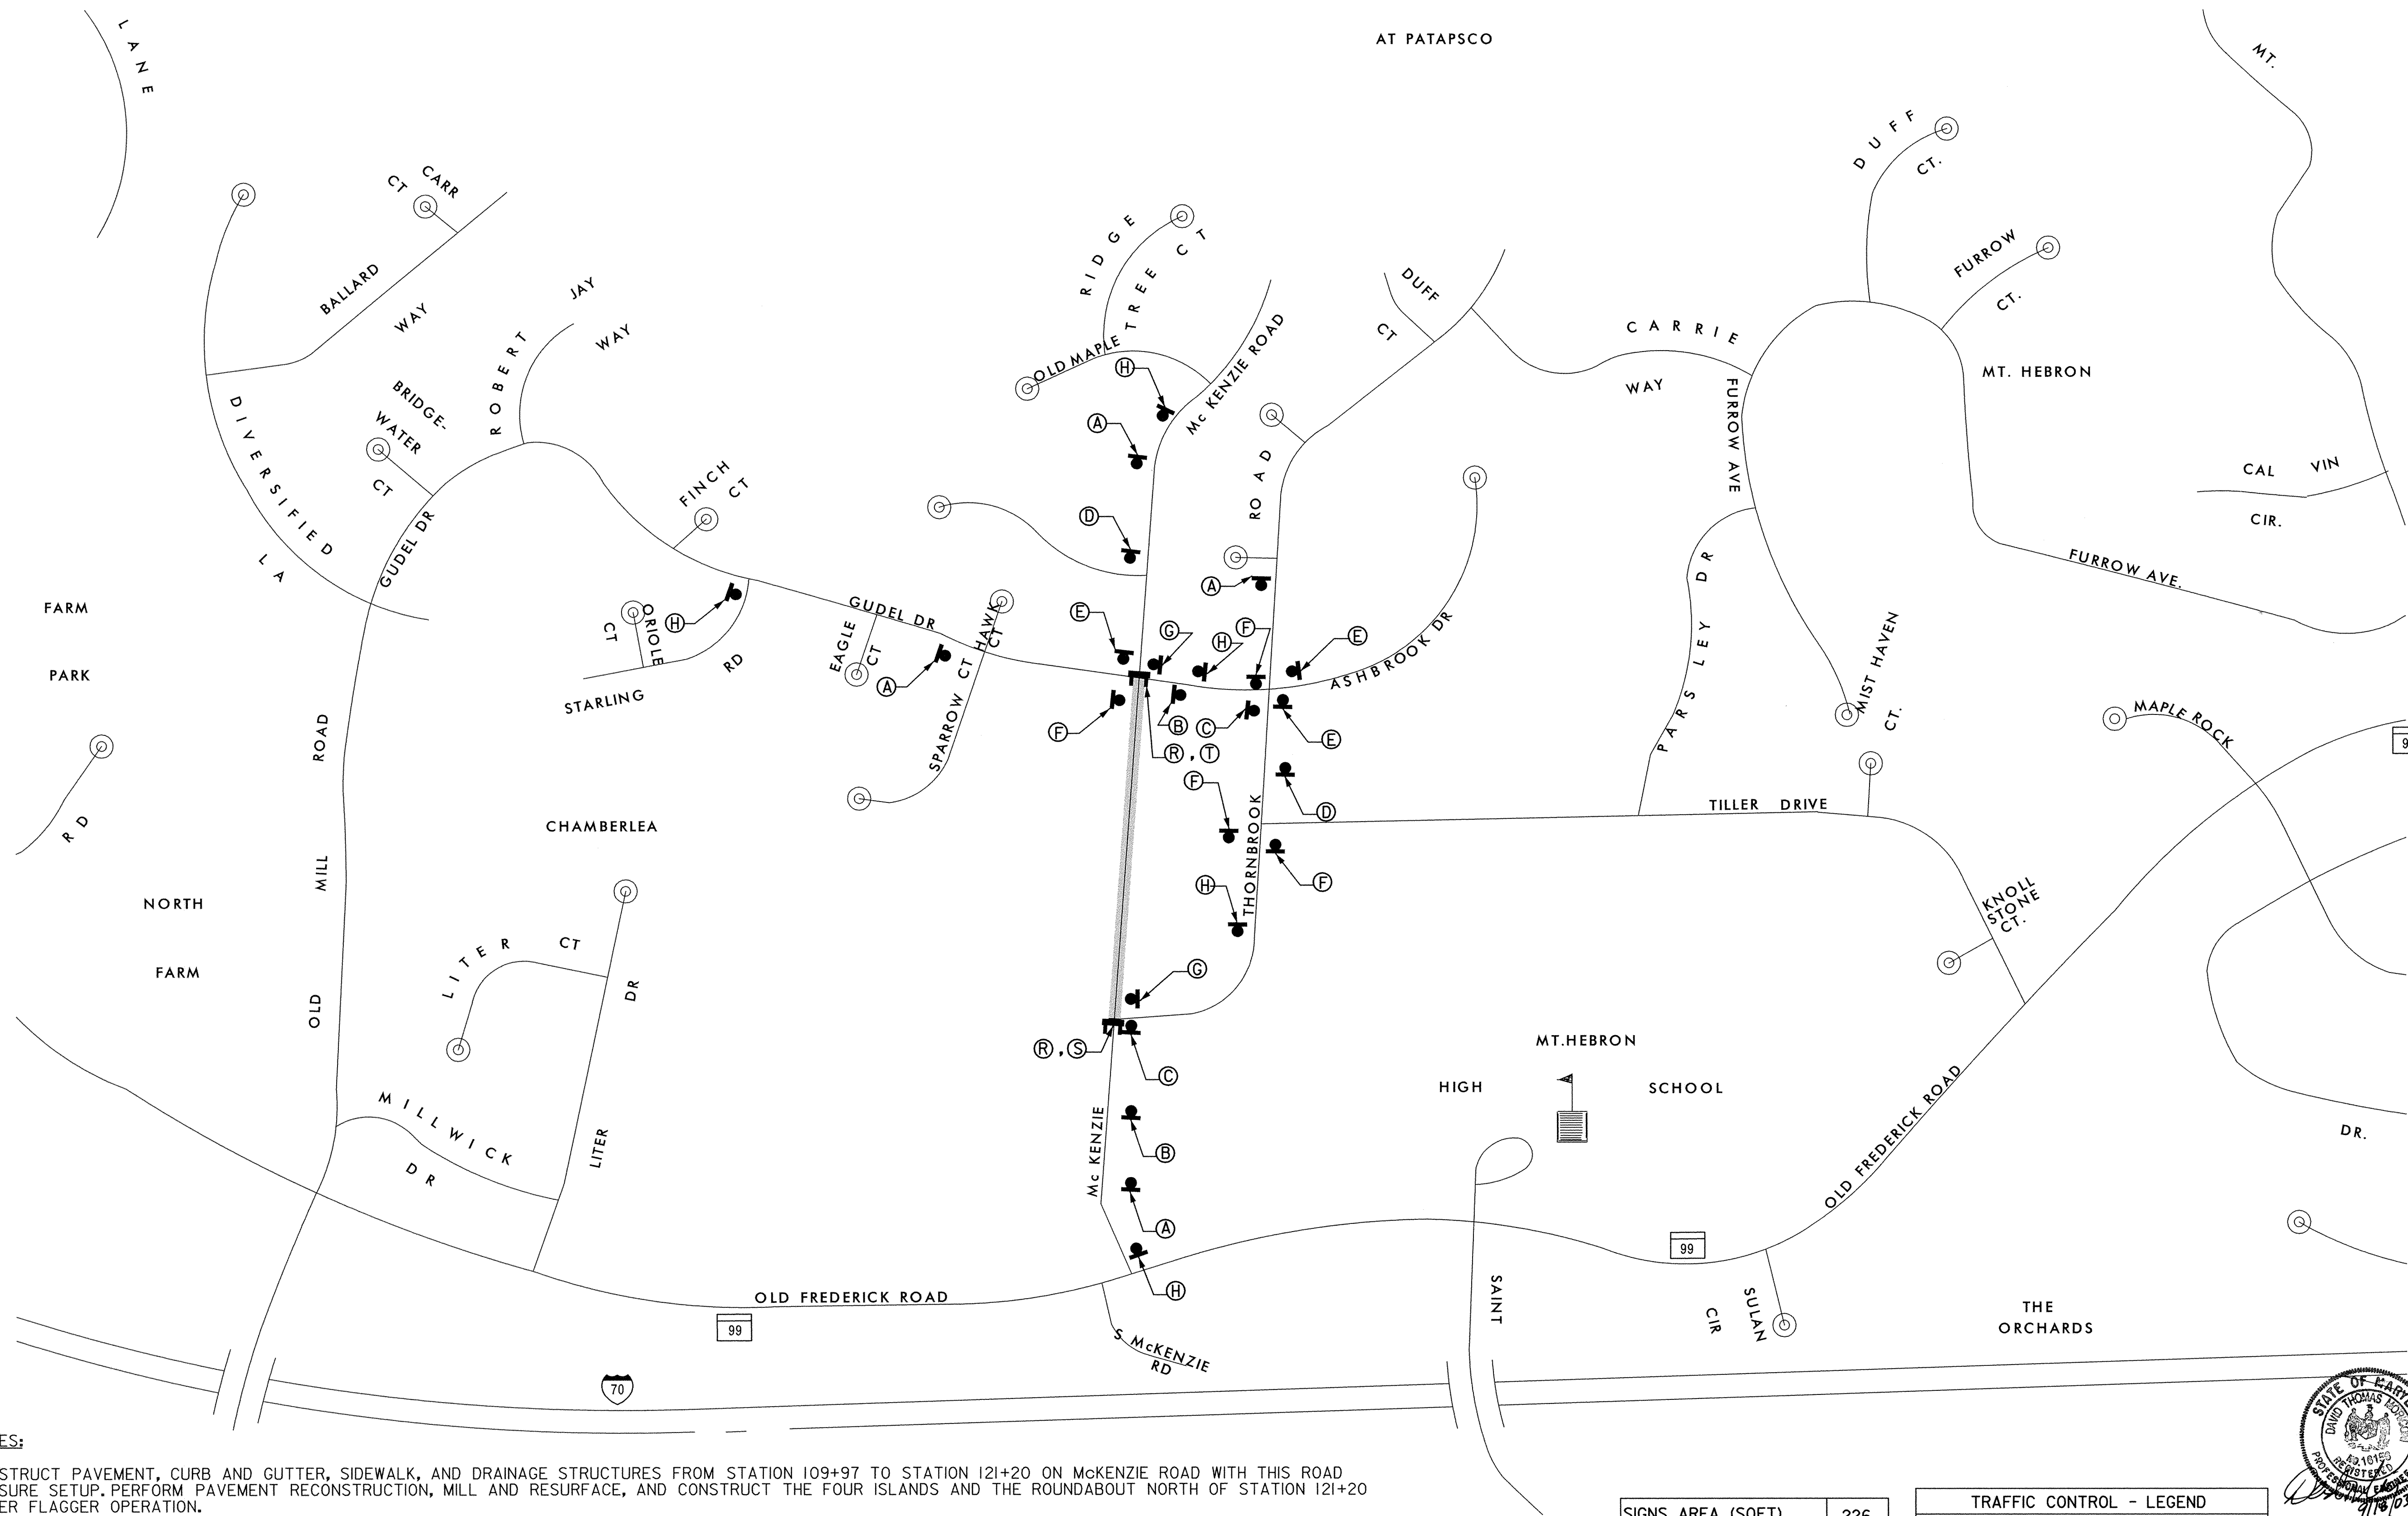


NOTES:

1. CONSTRUCT PAVEMENT, CURB AND GUTTER, SIDEWALK, AND DRAINAGE STRUCTURES FROM STATION 109+97 TO STATION 121+20 ON MCKENZIE ROAD WITH THIS ROAD CLOSURE SETUP. PERFORM PAVEMENT RECONSTRUCTION, MILL AND RESURFACE, AND CONSTRUCT THE FOUR ISLANDS AND THE ROUNDABOUT NORTH OF STATION 121+20 UNDER FLAGGER OPERATION.
2. SEE TRAFFIC CONTROL PLAN SHEET TP-3 FOR DETAILED CONSTRUCTION SEQUENCE AT THORNBROOK ROAD.
3. THIS TRAFFIC CONTROL SET UP IS ONLY FOR WORKING HOURS BETWEEN 9 AM AND 4 PM. CONTRACTOR SHALL OPEN ROADS TO TRAFFIC DURING NON-WORKING HOURS.

|                         |     |
|-------------------------|-----|
| SIGNS AREA (SQFT)       | 226 |
| TYPE III BARRICADE (EA) | 4   |
| TRAFFIC DRUMS (EA)      | 8   |

| TRAFFIC CONTROL - LEGEND |                       |
|--------------------------|-----------------------|
|                          | PROPOSED CONSTRUCTION |

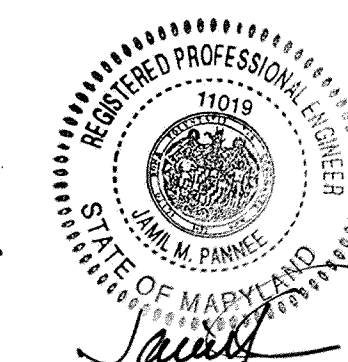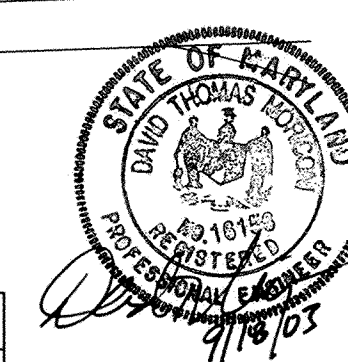


STAGE 1

DEPARTMENT OF PUBLIC WORKS  
HOWARD COUNTY, MARYLAND

*Janet Chu* 9/22/03  
CHIEF, TRANSPORTATION AND SPECIAL PROJECTS DIVISION

*William J. Mahler* 9/22/03  
CHIEF, BUREAU OF HIGHWAYS

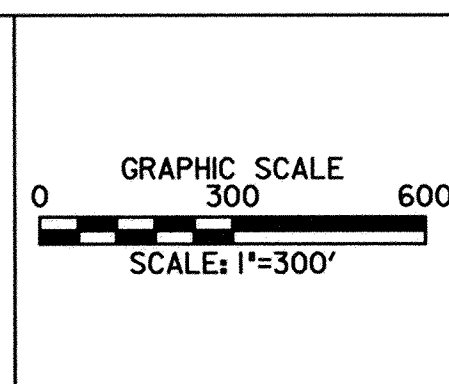

**URS**  
HUNT VALLEY, MARYLAND

**RJM**  
RJM ENGINEERING, INC.  
CONSULTING ENGINEERS  
COLUMBIA, MARYLAND

|       |    |     |          |      |
|-------|----|-----|----------|------|
| DES:  |    |     |          |      |
| DRN:  |    |     |          |      |
| CHK:  |    |     |          |      |
| DATE: | BY | NO. | REVISION | DATE |

**TRAFFIC CONTROL PLAN SHEET TP-1**

NO.: \_\_\_\_\_ DATE: 9/03

**MCKENZIE ROAD ROADWAY AND STORMDRAIN IMPROVEMENTS**


HOWARD COUNTY, MARYLAND  
CAPITAL PROJECT NO. J-4164-10

SCALE AS SHOWN

SHEET 220F24

MOUNT HEBRON

AT PATAPSCO

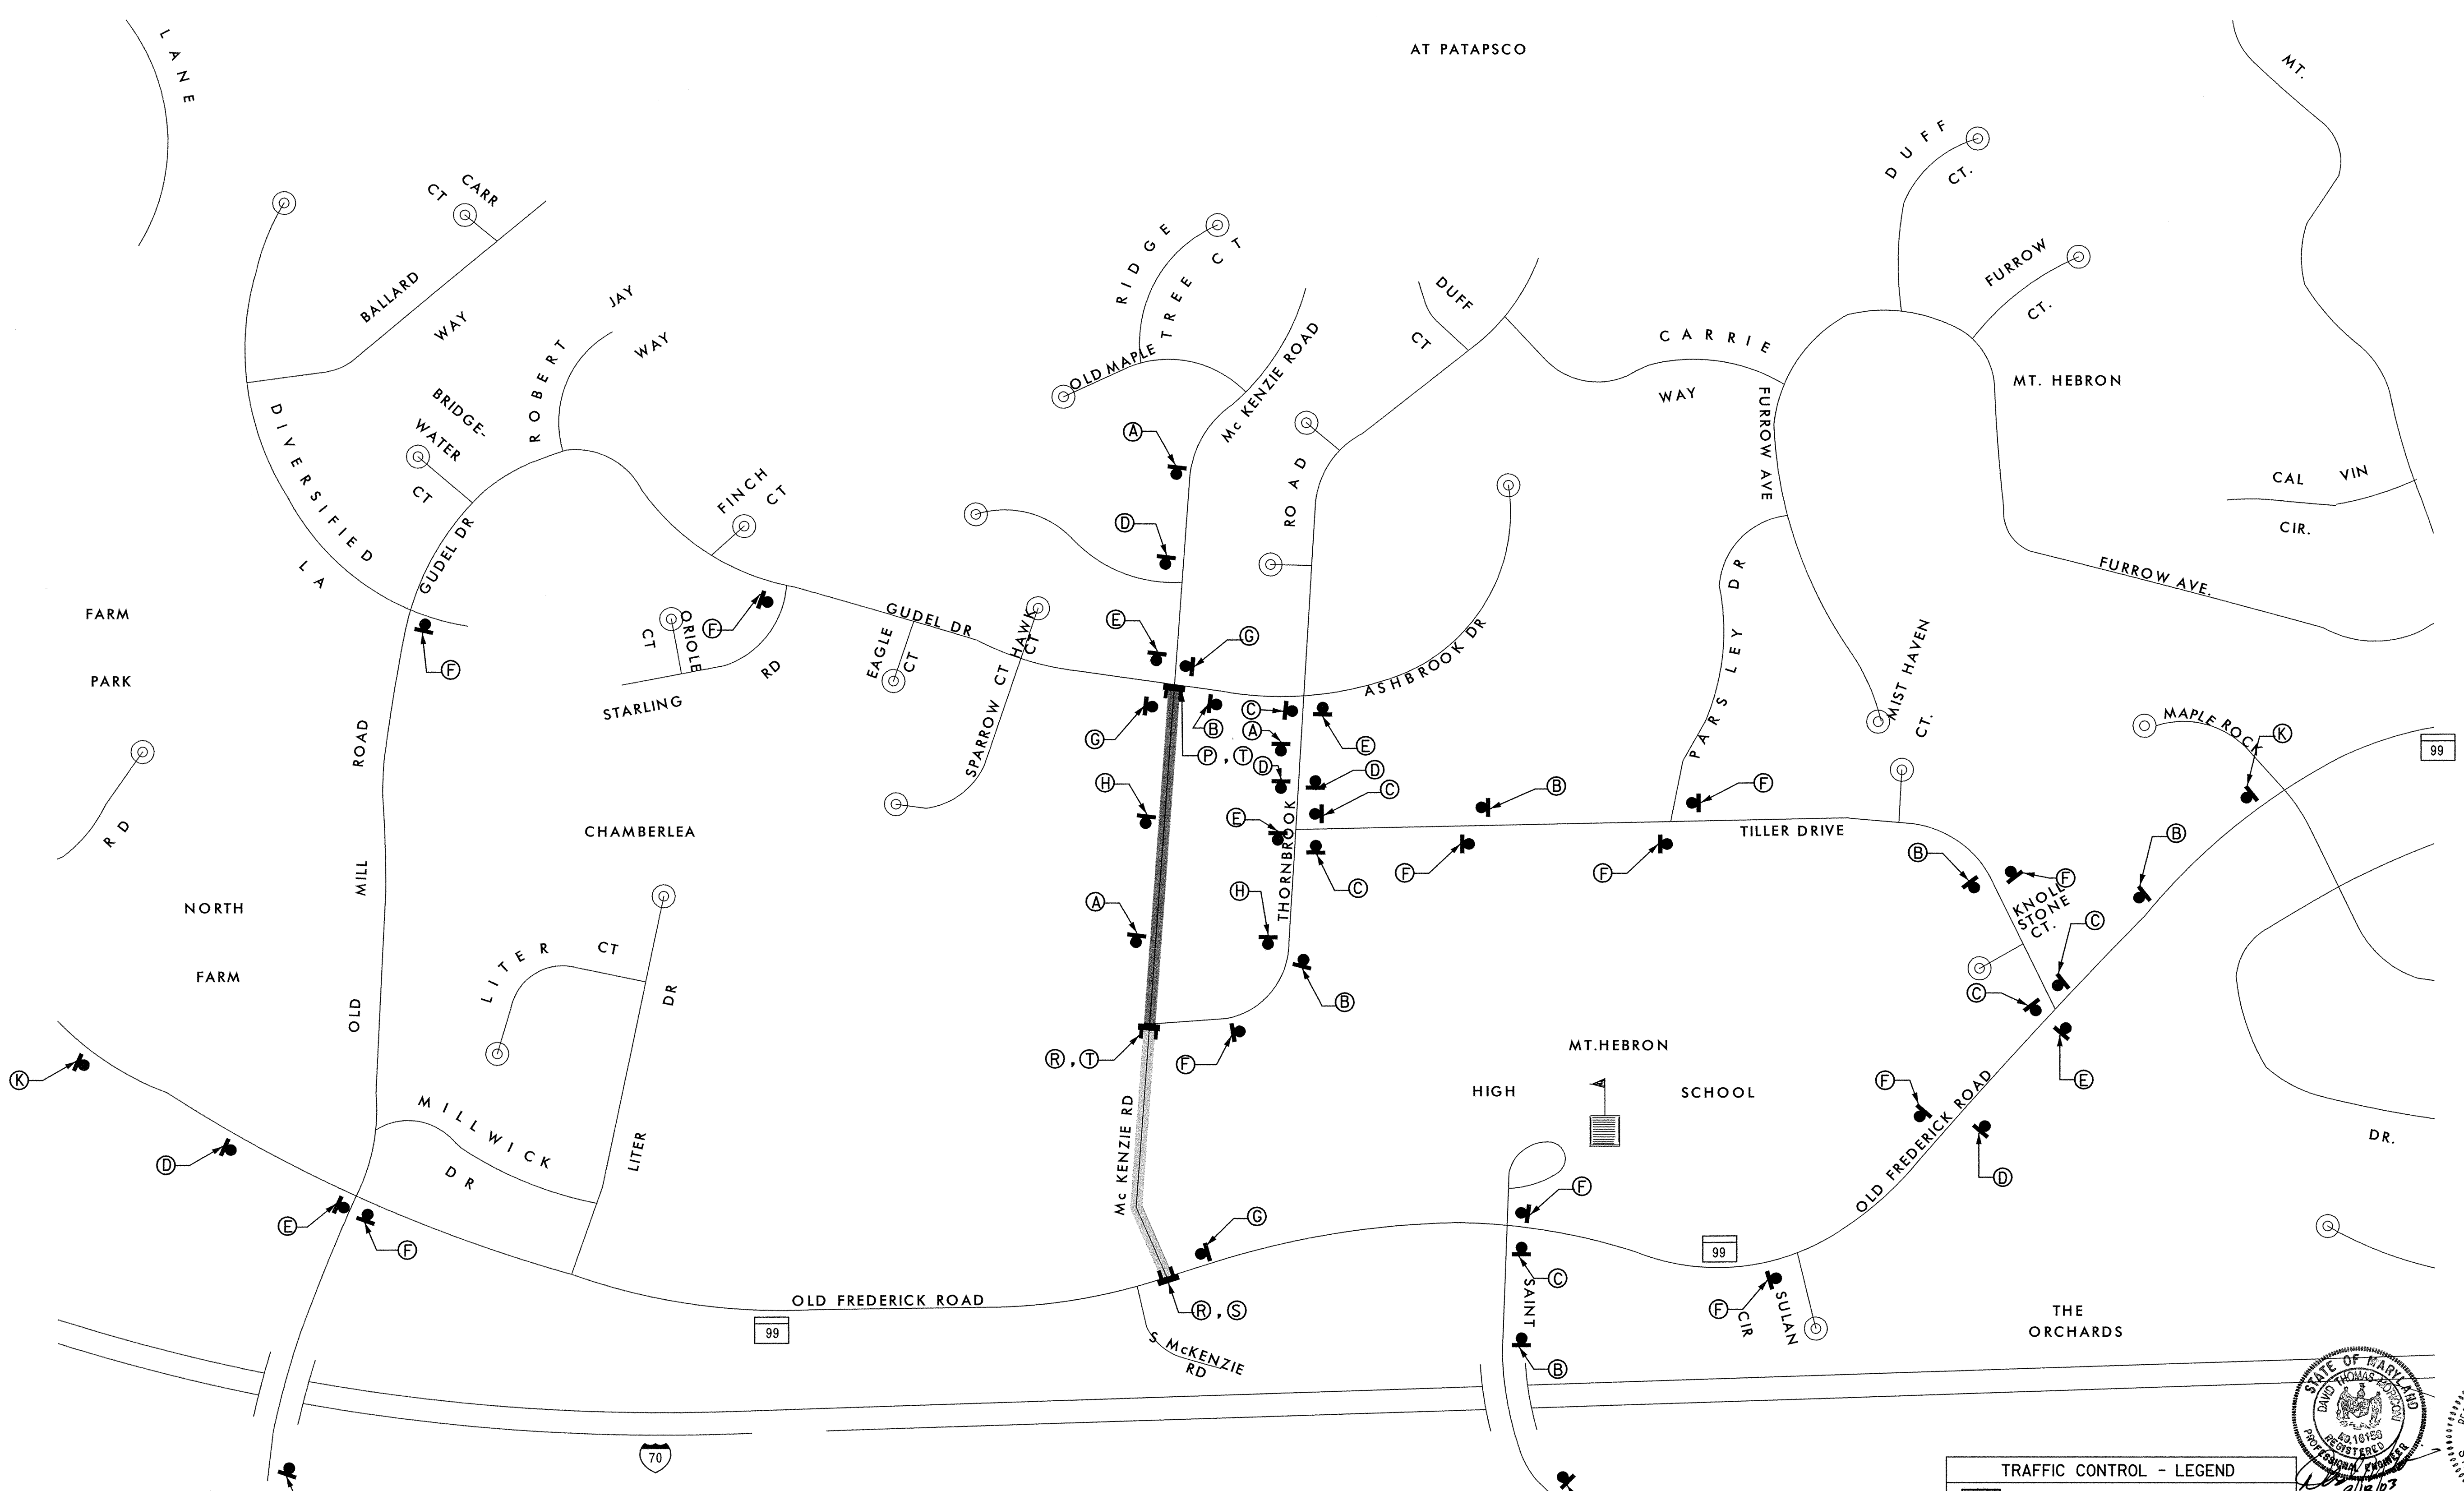


NOTES:

1. CONSTRUCT PAVEMENT, CURB AND GUTTER, SIDEWALK, AND DRAINAGE STRUCTURES FROM STATION 100+27 TO STATION 109+73 ON McKENZIE ROAD DURING THIS STAGE.
2. SEE TRAFFIC CONTROL PLAN SHEET TP-3 FOR DETAILED CONSTRUCTION SEQUENCE AT THORNBROOK ROAD.

TRAFFIC CONTROL - LEGEND

- COMPLETED CONSTRUCTION
- PROPOSED CONSTRUCTION

|                         |     |
|-------------------------|-----|
| SIGNS AREA (SQFT)       | 423 |
| TYPE III BARRICADE (EA) | 5   |
| TRAFFIC DRUMS (EA)      | 10  |

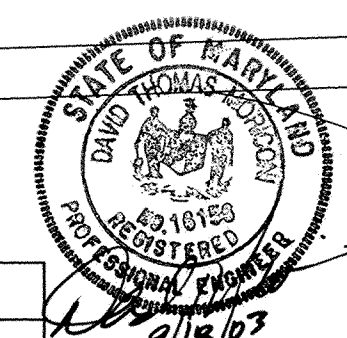


*White* 9/18/03

STAGE 2

DEPARTMENT OF PUBLIC WORKS  
HOWARD COUNTY, MARYLAND

*Janich* 9/22/03  
 DEPARTMENT OF PUBLIC WORKS DATE  
*White* 9/22/03  
 CHIEF, TRANSPORTATION AND SPECIAL PROJECTS DIVISION DATE

*William J. White* 9/22/03  
 CHIEF, BUREAU OF ENGINEERING DATE  
*William J. White* 9.24.03  
 CHIEF, BUREAU OF HIGHWAYS DATE

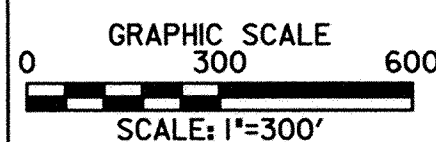

HUNT VALLEY, MARYLAND



RJM ENGINEERING, INC.  
CONSULTING ENGINEERS  
COLUMBIA, MARYLAND

TEL: 410/730-1001 FAX: 410/730-5403

|       |    |     |          |      |  |
|-------|----|-----|----------|------|--|
| DES:  |    |     |          |      |  |
| DRN:  |    |     |          |      |  |
| CHK:  |    |     |          |      |  |
| DATE: | BY | NO. | REVISION | DATE |  |

TRAFFIC CONTROL  
PLAN SHEET TP-2

NO.: \_\_\_\_\_ DATE: 9/03


McKENZIE ROAD ROADWAY  
AND STORMDRAIN IMPROVEMENTS


HOWARD COUNTY, MARYLAND  
CAPITAL PROJECT NO. J-4164-10


SCALE  
AS  
SHOWN

SHEET  
230F24

TRAFFIC CONTROL - LEGEND

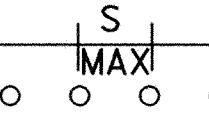
 PLASTIC DRUM SPACING EQUALS TO 10 FEET UNLESS NOTED OTHERWISE OR AS DIRECTED BY THE ENGINEER.



 PROPOSED CONSTRUCTION

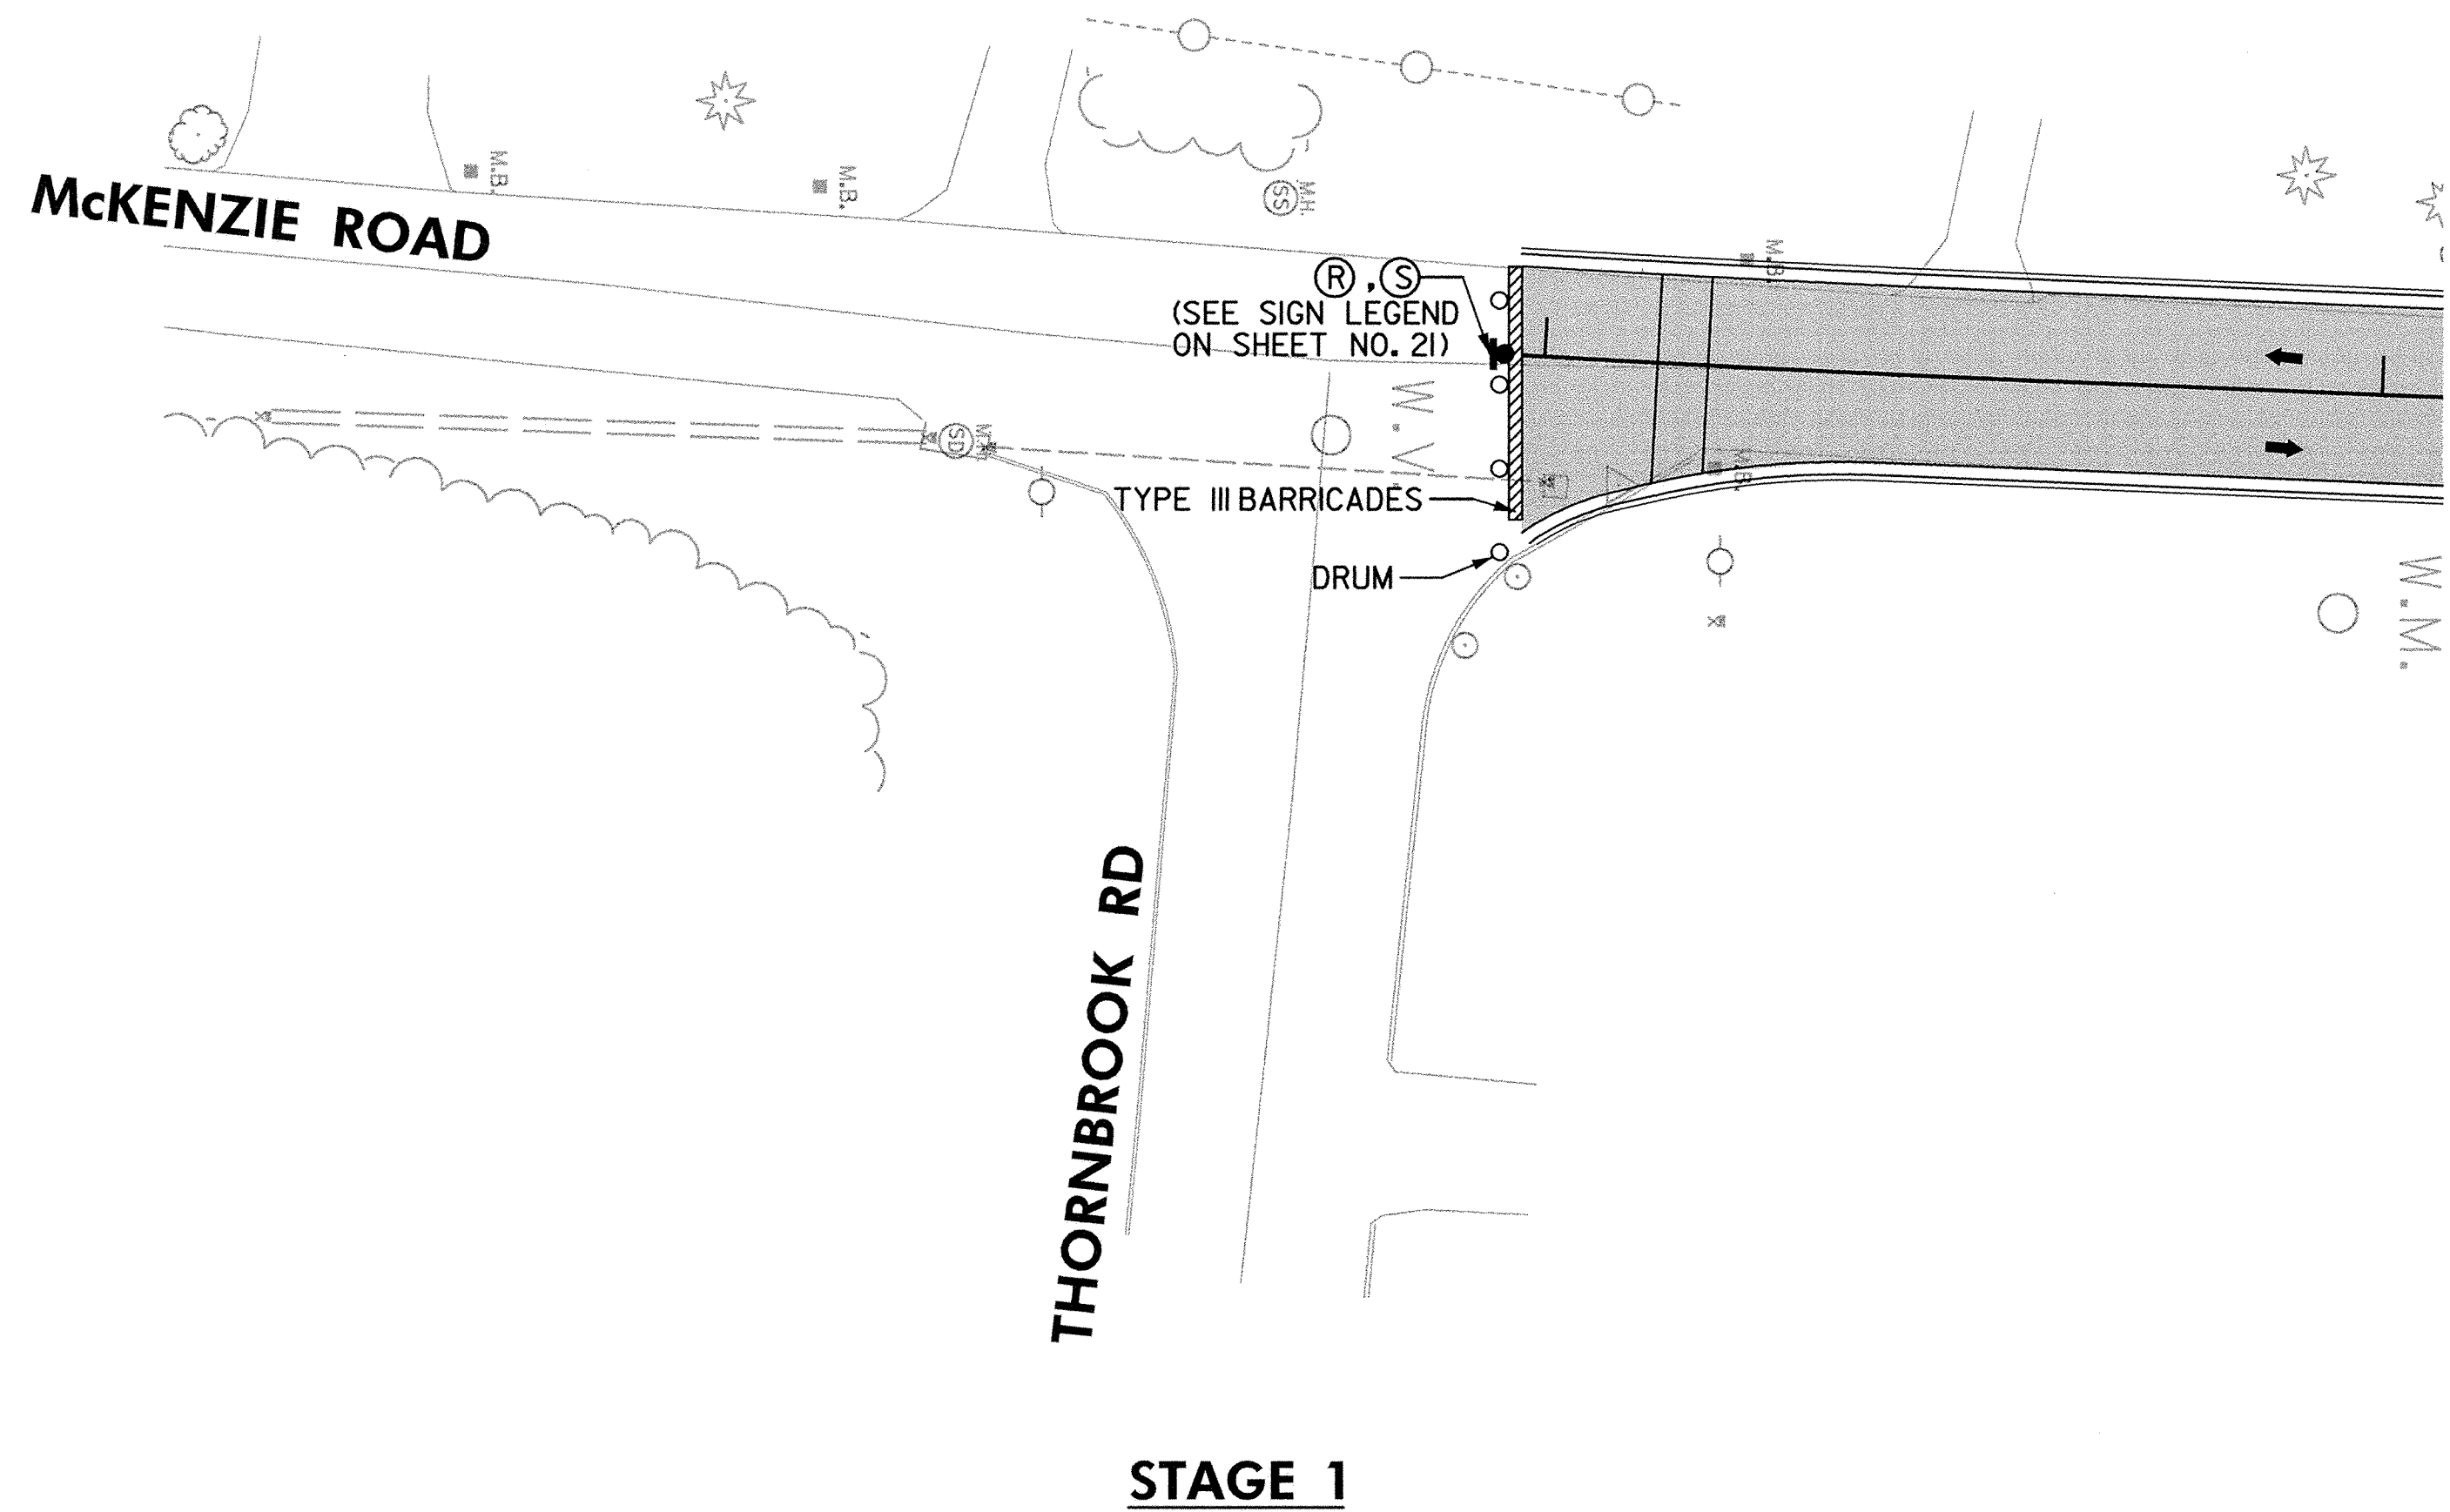



NOTES:


1. CONSTRUCT PAVEMENT, CURB AND GUTTER, SIDEWALK AND DRAINAGE STRUCTURES FROM STA. 109+97 TO STA. 121+20 ON McKENZIE ROAD.
2. SEE TRAFFIC CONTROL PLAN SHEET TP-1 FOR SIGNS AND LOCATIONS. SEE ALSO THE GENERAL NOTES ON SHEET NO. 21.
3. USE FLAGGER OPERATION FOR CONSTRUCTION OF THE AREA BETWEEN STA. 109+73 AND 109+97.

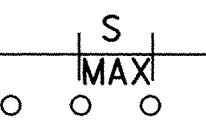TRAFFIC CONTROL - LEGEND


 PLASTIC DRUM SPACING EQUALS TO 10 FEET UNLESS NOTED OTHERWISE OR AS DIRECTED BY THE ENGINEER.


 COMPLETED CONSTRUCTION


 PROPOSED CONSTRUCTION

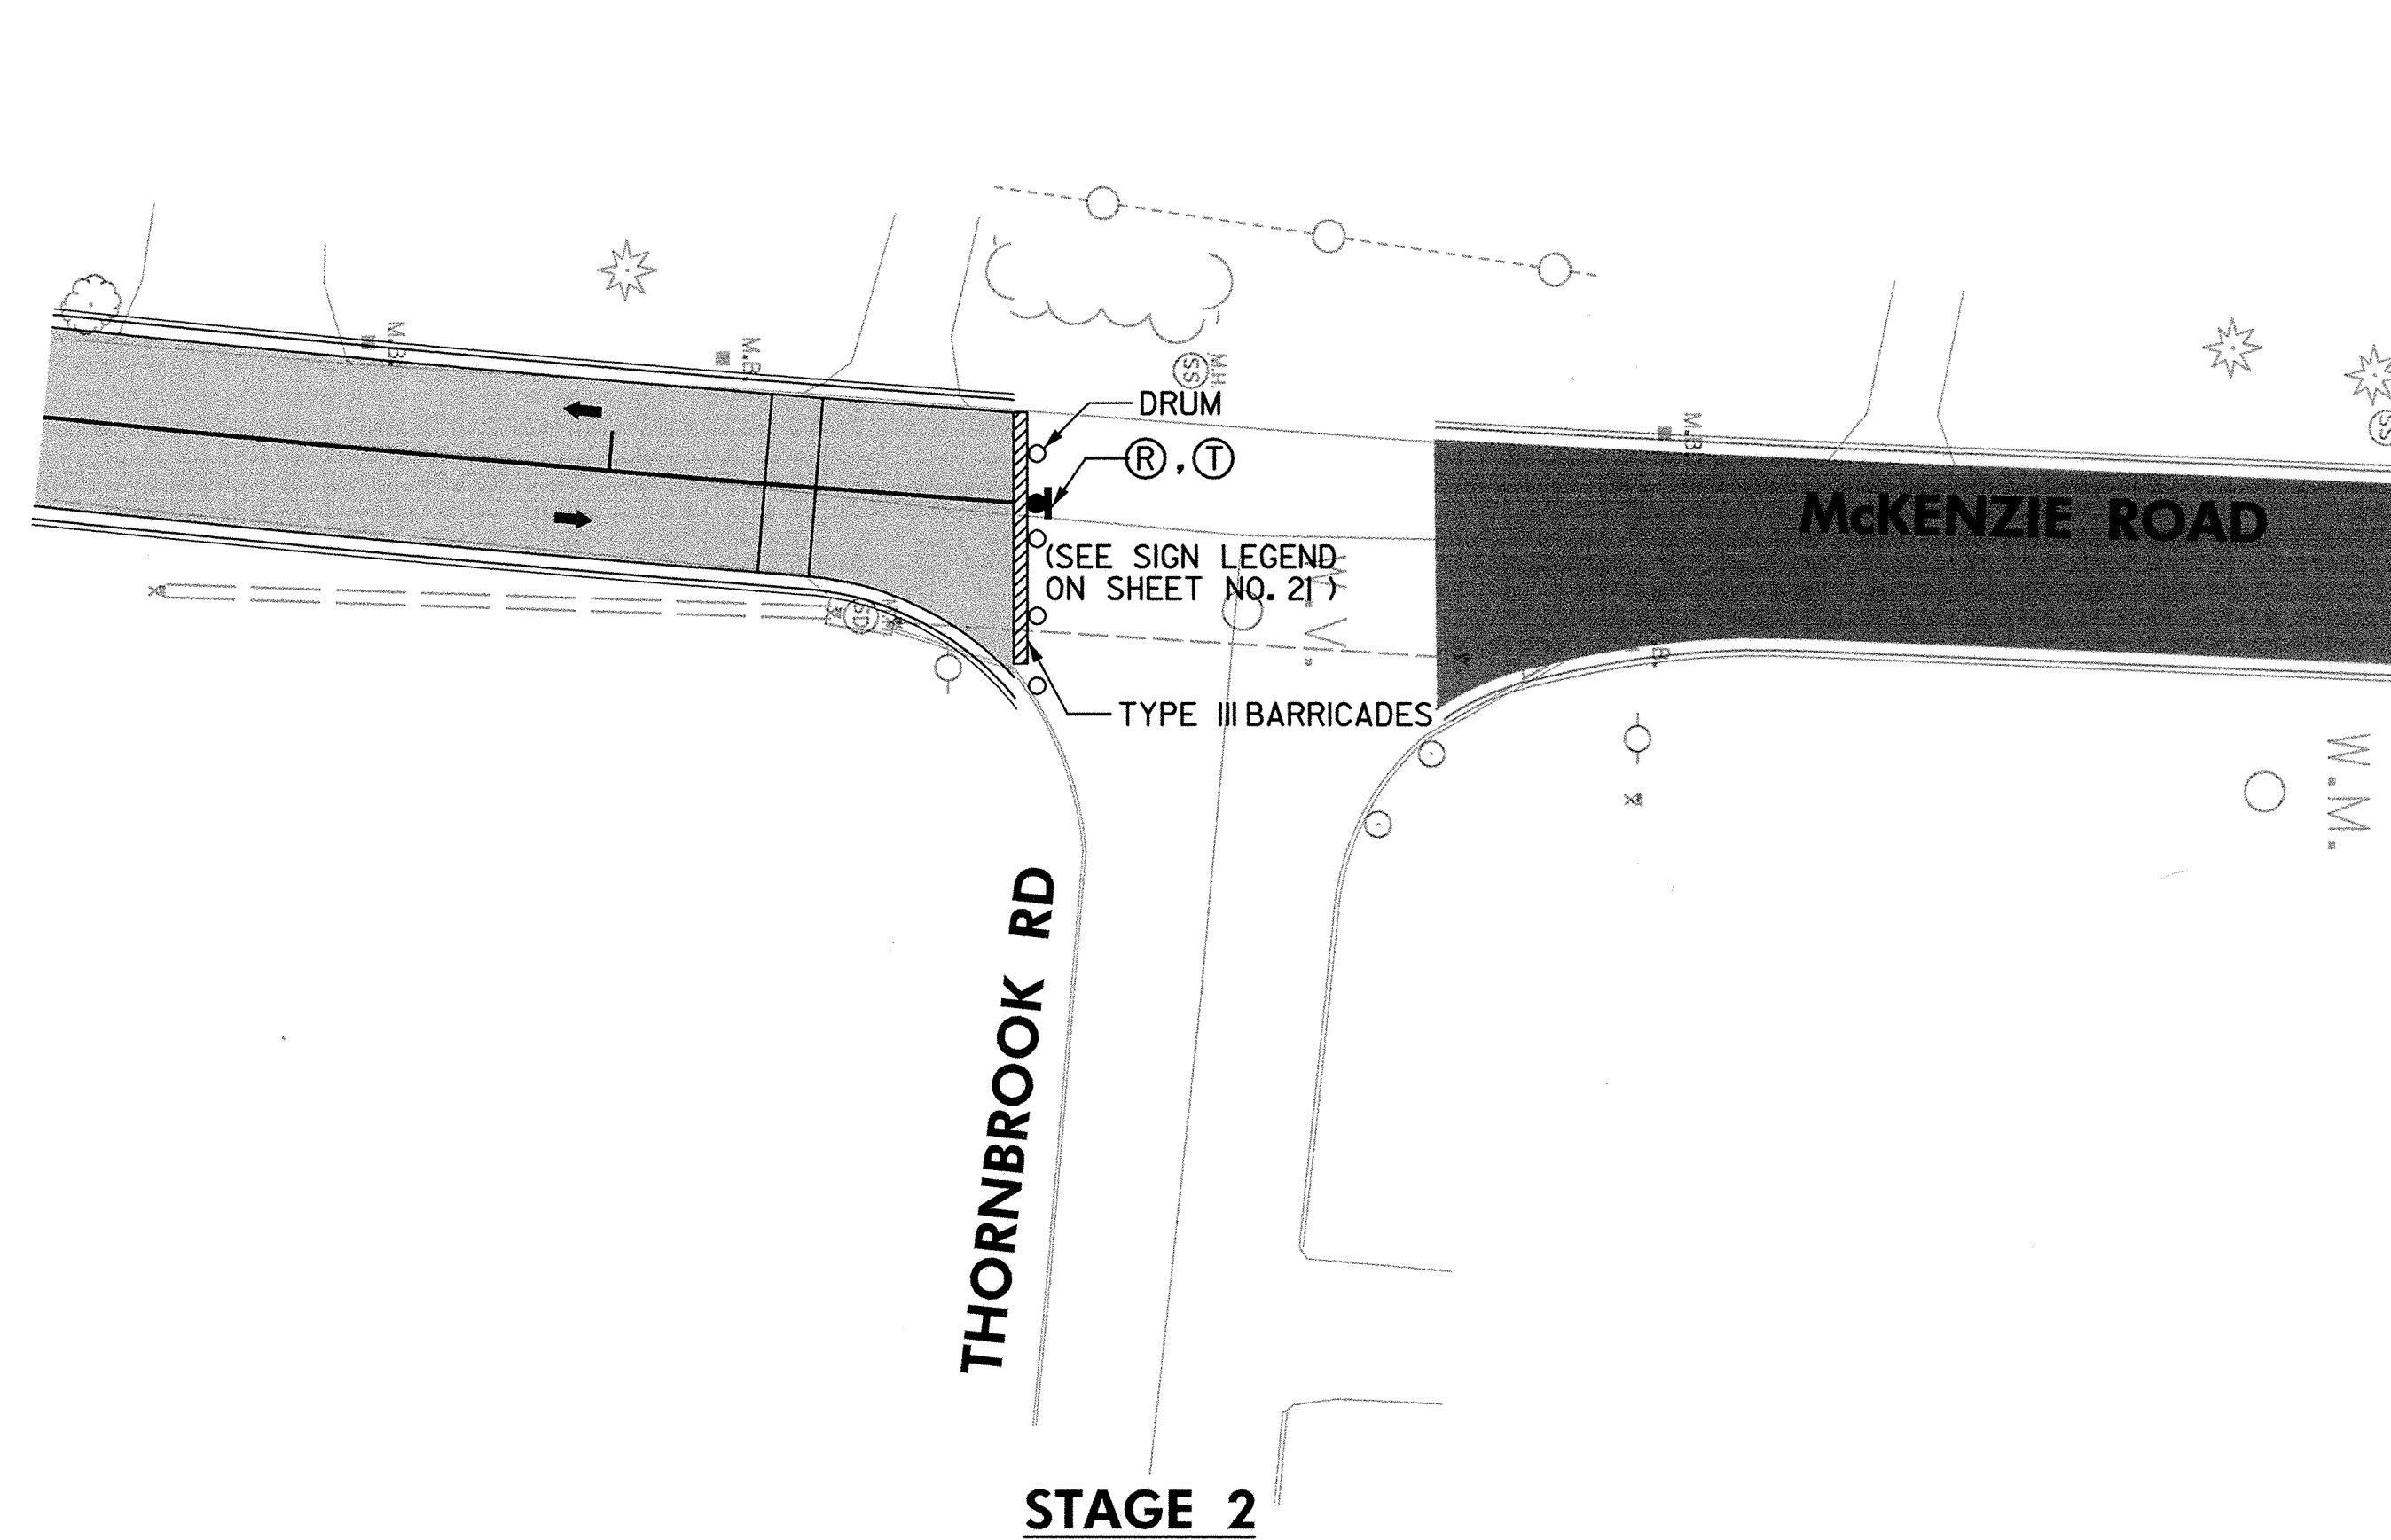


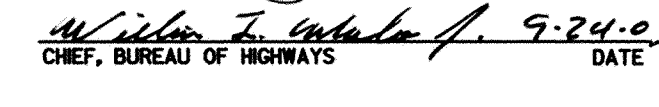



NOTES:

1. CONSTRUCT PAVEMENT, CURB AND GUTTER, SIDEWALK AND DRAINAGE STRUCTURES FROM STA. 100+23 TO STA. 109+73 ON McKENZIE ROAD.
2. SEE TRAFFIC CONTROL PLAN SHEET TP-2 FOR SIGNS AND LOCATIONS. SEE ALSO THE GENERAL NOTES ON SHEET NO. 21.



DEPARTMENT OF PUBLIC WORKS  
HOWARD COUNTY, MARYLAND

 9/29/03  
 DEPARTMENT OF PUBLIC WORKS DATE  
 9/22/03  
 CHIEF, BUREAU OF ENGINEERING DATE  
 9/22/03  
 CHIEF, TRANSPORTATION AND SPECIAL PROJECTS DIVISION DATE  
 9/24/03  
 CHIEF, BUREAU OF HIGHWAYS DATE

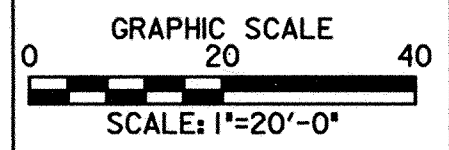

**URS**  
HUNT VALLEY, MARYLAND

**RJM**  
RJM ENGINEERING, INC.  
CONSULTING ENGINEERS  
COLUMBIA, MARYLAND  
TELE: 410/730-1001 FAX: 410/730-5403

|       |    |     |          |      |
|-------|----|-----|----------|------|
| DES:  |    |     |          |      |
| DRN:  |    |     |          |      |
| CHK:  |    |     |          |      |
| DATE: | BY | NO. | REVISION | DATE |

**TRAFFIC CONTROL  
PLAN SHEET 3**

NO.: \_\_\_\_\_ DATE: 9/03

**McKENZIE ROAD ROADWAY  
AND STORMDRAIN IMPROVEMENTS**

HOWARD COUNTY, MARYLAND  
CAPITAL PROJECT NO. J-4164-10

SCALE  
AS  
SHOWN  
SHEET  
240F24