


U.S. 40 WATER SERVICE MAIN REPLACEMENT

CAPITAL PROJECT NO. W-8311 CONTRACT NO. 44-4731 HOWARD COUNTY, MARYLAND

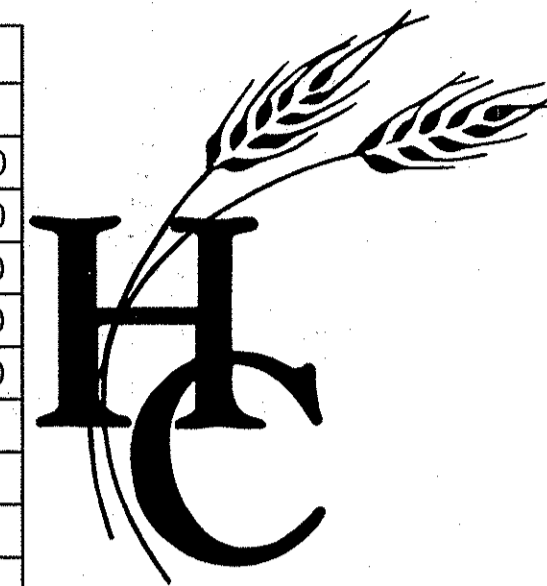


NO.	INDEX OF SHEETS
1	TITLE SHEET
2	8" WATER LINE PLAN & PROFILE STATION 0+00 - 9+50
3	8" WATER LINE PLAN & PROFILE STATION 9+50 - 20+00
4	8" WATER LINE PLAN & PROFILE STATION 20+00 - 30+50
5	8" WATER LINE PLAN & PROFILE STATION 30+50 - 41+00
6	8" WATER LINE PLAN & PROFILE STATION 41+00 - 51+50
7	8" WATER LINE PLAN & PROFILE STATION 51+50 - 60+51
8	MISCELLANEOUS DETAILS AND SEQUENCE OF CONSTRUCTION
9	MISCELLANEOUS DETAILS
10	EROSION & SEDIMENT CONTROL DETAILS
11	TRAFFIC CONTROL DETAILS
12	CORROSION PROTECTION DETAILS
13	CORROSION PROTECTION DETAILS

LEGEND	
	EXIST. WATER MAIN / VALVE VAULT
	PROP. WATER MAIN
	TEMP. WATER MAIN
	EXIST. WATER MAIN TO BE ABANDONED
	EXIST. SEWER MAIN / MANHOLE
	EXIST. STORM DRAIN
	EXIST. GAS
	EXIST. ELECTRIC (UNDERGROUND)
	EXIST. ELECTRIC (ABOVE GROUND)
	EXIST. CABLE TV
	EXIST. TELEPHONE (UNDERGROUND)
	EXIST. TELEPHONE (ABOVE GROUND)
	RIGHT OF WAY
	GUARDRAIL
	FENCE
	PROPERTY LINE
	SILT FENCE
	LIMITS OF DISTURBANCE
	ROAD CENTERLINE
	TRAVERSE
	STREAM / WATERWAY EDGE
	630 W 550 WATER PRESSURE ZONE BOUNDARY
	SHRUB
	VALVE
	FIRE HYDRANT
	BGE POLE
	STREET SIGN
	ROAD DELINEATOR
	BORING LOCATION
	CONTINUITY TEST STATION
	SAN. MANHOLE IDENTIFICATION
	TEST PIT LOCATION
	CIP

QUANTITIES				
NAME OF UTILITY CONTRACTOR: RUSTLER CONSTRUCTION				
SURVEY AND DRAFTING DIVISION AS-BUILT DATE: 9/2/2014				
ITEMS	QUANTITIES ESTIMATED	QUANTITIES	AS-BUILT	MANUFACTURER / SUPPLIER
WATER				
8" Water Pipe	6,067 L.F.	6,110.5	C900 DR-18	NATIONAL PIPE & PLASTICS
6" Water Pipe	296 L.F.	302.5	C900 DR-18	NATIONAL PIPE & PLASTICS
6" Valve and Roadway Box	12 EA.	14	GATE	MUELLER CO.
6" Valve and Roadway Box	24 EA.	23	GATE	MUELLER CO.
8" X 8" Tee	7 EA.	7	MECHANICAL JT.	TYLER UNION
8" X 6" Tee	20 EA.	22	MECHANICAL JT.	TYLER UNION
Test Station	20 EA.	20	VAULT	PRISM PRECAST PRODUCTS
Fire Hydrant	10 EA.	10	5"	MUELLER CO.

Note: 6" water pipe and 6" valve & roadway box quantities include 6" services that are not shown on plans, but are represented on the Water Services Table on Sheet 8.

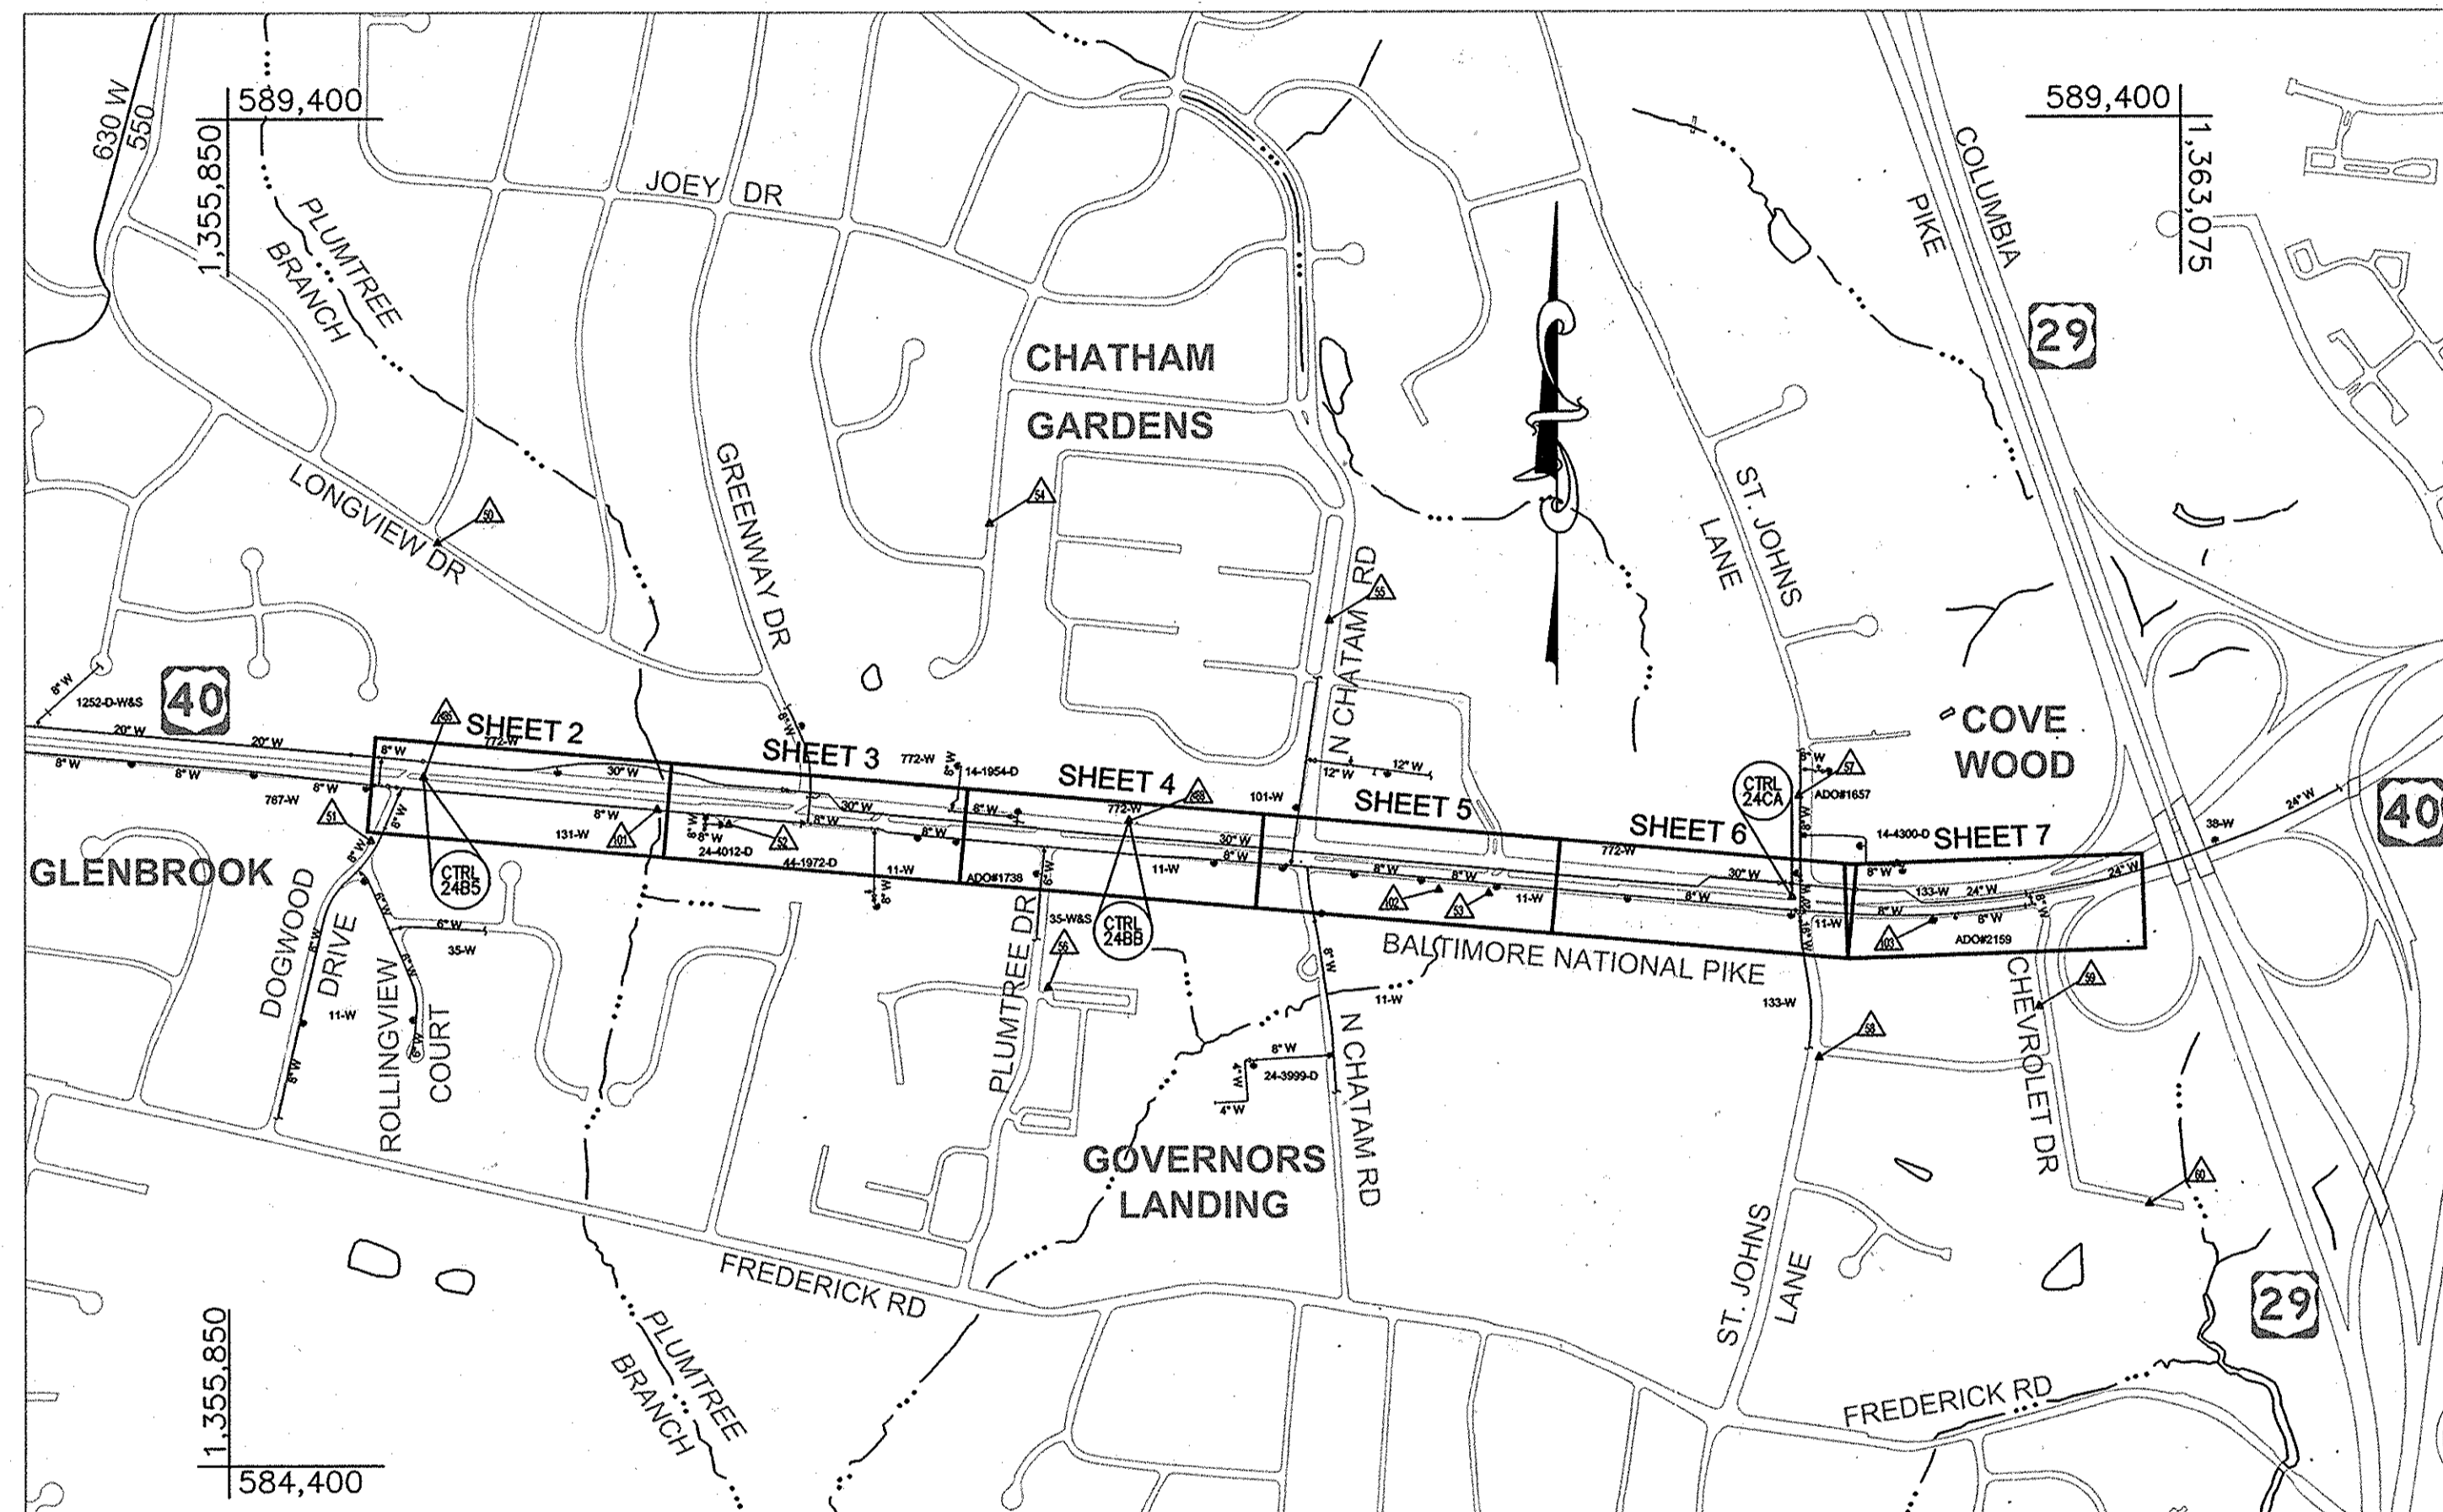

WATER ZONE PRESSURE: 550W
TEST GRADIENT: #330
DRAINAGE AREA: PATAPSCO

VICINITY MAP
SCALE: 1" = 600'

HORIZONTAL AND VERTICAL CONTROL BASED ON MARYLAND NAD83 (91) (HORIZONTAL) AND NAVD88 (VERTICAL) DATUM.
HOWARD COUNTY GEODETIC SURVEY CONTROL NUMBERS:
NO. 2485 NO. 2488 NO. 24CA
N 586,956.27 N 586,791.24 N 586,506.22
E 1,356,570.78 E 1,359,181.16 E 1,361,634.27
ELEV. 390.17 ELEV. 386.13 ELEV. 398.25

PART I

- GENERAL NOTES**
- Approximate locations of existing mains are shown. The contractor shall take all necessary precautions to protect existing mains and services and maintain uninterrupted service. Any damage incurred shall be repaired immediately to the satisfaction of the Engineer at the contractor's expense.
 - Topographic field surveys were performed on November 2011 by Harford Aerial and J.A. Rice Inc.
 - Horizontal and Vertical Survey Controls:
The coordinates shown on the drawings are based on Maryland State Reference System NAD '83/91 as projected by Howard County Geodetic Control Stations No. 2485, No. 2488 and No. 24CA.
All vertical controls are based on NAVD '88. Vertical controls provided on the drawings are aluminum stamped discs.
 - All pipe elevations shown are invert elevations unless otherwise noted on the plans.
 - Clear all utilities by a minimum of 12 inches. Clear all poles by 5'-0" minimum or tunnel as required unless otherwise noted. The owner has contacted the utility companies and has made arrangements for bracing of poles as shown on the drawings. In the event the contractor's work requires the bracing of additional poles, any cost incurred by the owner for the bracing of additional poles or damages shall be deducted from monies owed the contractor. The contractor shall coordinate with the utility companies to schedule the bracing of the poles.
 - For details not shown on the drawing, and for materials and construction methods, use Howard County Design Manual, Volume IV, Standard Specifications and Details for Construction (Latest Edition). The contractor shall have a copy of Volume IV on the job.
 - Where test pits have been made on existing utilities, they are noted by the symbol at the locations of the test pits. A note or notes containing the results of the test pit or pits is included on the drawings. Existing utilities in the vicinity of the proposed work for which test pits have not been dug shall be located by the contractor two weeks in advance of construction operations at his own expense.
 - The contractor shall notify the following utility companies or agencies at least five working days before starting work shown on these plans:

AT & T	1-800-252-1133
BGE (Construction Services)	410-637-8713
BGE (Emergency)	410-685-0123
Bureau of Utilities	410-313-4900
Colonial Pipeline Company	410-795-1390
Miss Utility	1-800-257-7777
State Highway Administration (District 7 Office)	301-624-8100
State Highway Administration (Signal Shop)	410-787-7650
Verizon	1-800-743-0033

- Trees and shrubs are to be protected from damage to the maximum extent. Trees and shrubs located within the construction strip are not to be removed or damaged by the contractor.
- The contractor shall remove trees, stumps and roots along the line of excavation. Payment for such removal shall be included in the unit price bid for construction of the main.
- The contractor shall notify the Bureau of Highways, Howard County, at (410)-313-7450 at least five working days before open cutting or boring/jacking of any County road for laying water/sewer mains or house connections. The approval of these drawings will constitute compliance with DPW requirements per Section 18.114(a) of the Howard County Code.
- The contractor shall coordinate any disruption of traffic signals, sensors and wiring with Maryland State Highway Administration, Office of Traffic and Safety.
- Working hours shall be limited to 9am - 3pm and 8pm - 5am. See specifications for acceptable working days. In the event of a double lane closure, the contractor shall be limited to working hours of 8pm-5am.

PART II - WATER

- All water mains to be C-900 or Fusible C-905 unless otherwise noted. There shall be no deflection of PVC pipe joints or bending of AWWA C-900 pipe.
- Tops of all water mains to have a minimum of 3'-6" of cover unless otherwise noted.
- Valves adjacent to tees shall be strapped to tees.
- All fittings shall be buttressed or anchored with concrete in accordance with the Standard Details unless otherwise provided for on the drawings.
- Fire hydrants shall be set to the bury line elevations shown on the drawings. All fire hydrants shall be restrained and buttressed with concrete in accordance with the Standard Details. The soil around the fire hydrant shall be compacted in accordance with Section 1000 and 1005 of the Standard Specifications.
- The contractor shall not operate any water main valves on the existing water system.
- Tracer wires and continuity test stations shall be installed on all DIP and PVC water mains in accordance with the Howard County Design Manual.
- For PVC water mains, all records for the Quality Control and Qualification Test Requirements noted in Section 5.1 of the AWWA Standard C900 for PVC pressure pipe shall be submitted with the pipe material certifications or shop drawings prior to approval of the material for use. The test records shall be for the pipe to be installed under this contract. All PVC pipe shall contain markings to allow cross referencing of the pipe supplied to the test records received.
- Unless otherwise noted on the plans or in the specifications, seventeen (17) pound sacrificial anodes shall be installed on all valves and metallic fittings used with PVC water mains in accordance with Volume IV, Standard Specifications and Details for Construction. Magnesium anodes shall be installed on all valves and ductile iron fittings including restraints and harnesses. Zinc anodes shall be installed on all stainless steel fittings and saddles used with PVC mains. All "tees" used with PVC mains shall be ductile iron. See Corrosion Protection Details Sheets 12 & 13.
- The contractor shall notify Howard County DPW as any unknown utility services are encountered. Contractor shall reconnect all active water services encountered.
- The contractor shall verify that existing water lines and valves are restrained prior to removal of existing water line, at connection locations. Contractor shall provide thrust blocking and/or deadmen anchors on the existing water system where there is no existing thrust projection.
- The contractor shall abandon existing waterline in place unless otherwise indicated on the plans. Contractor shall cap all cut or open ends, remove existing valve roadway boxes and abandon existing valves in place. The contractor shall be responsible for removal and disposal of existing waterline where indicated to be replaced in-kind.
- The contractor shall mill and overlay asphalt for the full lane width for any lane encroached by the utility trench more than 1 linear foot, per SHA specifications. Prior to excavation, Contractor shall notify Howard County DPW if utility trench will encroach more than one lane. The contractor shall also mill and overlay 50 linear feet beyond the limits of the new 8-inch waterline and 50 linear feet into named street intersections. See limit of disturbance for detail.
- For ada ramp improvements, contractor shall replace one additional sidewalk panel to transition from new ada ramp to existing sidewalks narrower than 5-feet.

HOWARD SOIL CONSERVATION DISTRICT CERTIFICATION:

THIS DEVELOPMENT PLAN IS APPROVED FOR SOIL EROSION AND SEDIMENT CONTROL BY THE HOWARD SOIL CONSERVATION DISTRICT.

John Roberto 3/14/13
HOWARD SCD DATE

ENGINEER'S DESIGN CERTIFICATION:

"I CERTIFY THAT THIS PLAN FOR EROSION AND SEDIMENT CONTROL REPRESENTS A PRACTICAL AND WORKABLE PLAN BASED ON MY PERSONAL KNOWLEDGE OF THE SITE CONDITIONS AND THAT IT WAS PREPARED IN ACCORDANCE WITH THE REQUIREMENTS OF THE HOWARD SOIL CONSERVATION DISTRICT."

Nathan C. Atkinson 3/11/13
SIGNATURE OF ENGINEER DATE
NATHAN C. ATKINSON, P.E.

OWNER'S / DEVELOPER'S CERTIFICATION:

"I/WE CERTIFY THAT ALL DEVELOPMENT AND CONSTRUCTION WILL BE DONE ACCORDING TO THIS PLAN, AND THAT ANY RESPONSIBLE PERSONNEL INVOLVED IN THE CONSTRUCTION PROJECT WILL HAVE A CERTIFICATE OF ATTENDANCE AT A DEPARTMENT OF THE ENVIRONMENT APPROVED TRAINING PROGRAM FOR THE CONTROL OF SEDIMENT AND EROSION BEFORE BEGINNING THE PROJECT. I ALSO AUTHORIZE PERIODIC ON-SITE INSPECTION BY THE HOWARD SOIL CONSERVATION DISTRICT."

Kevin Dismore 3/11/13
BUREAU OF ENGINEERING DATE
DEPARTMENT OF PUBLIC WORKS

DEPARTMENT OF PUBLIC WORKS
HOWARD COUNTY, MARYLAND

Ray G. Smith 3/13/13
DIRECTOR OF PUBLIC WORKS DATE

Morgan S. Suttler 3/13/13
CHIEF, BUREAU OF ENGINEERING DATE

Silvia C. Lee 3/13/13
CHIEF, BUREAU OF UTILITIES DATE

Clayton L. Lee 3/12/13
CHIEF, UTILITY DESIGN DIVISION DATE

URS
MONTGOMERY PARK BUSINESS CENTER
1800 WASHINGTON BOULEVARD, SUITE 410
BALTIMORE, MARYLAND 21230
(410) 468-0875

Professional Certification
I hereby certify that these documents were prepared or approved by me, and that I am a duly licensed professional engineer under the laws of the State of Maryland, License No. 28917, Expiration Date: 08/01/13
NATHAN C. ATKINSON

DESIGN:	NCA		
DRAWN:	BJW		
CHK:	EMT		
DATE:	3/7/13		
NO.	REVISION	DATE	BY
1	REMOVE TEMPORARY WATER SERVICE, REVISE ALIGNMENT	9/3/2013	URS
2	RELOCATE PROPOSED FIRE HYDRANT	10/4/2013	URS
3	ADD PROP. 6" AND 8" VALVES AND ROADWAY BOXES	11/15/2013	URS
4	REVISE 8" WATERLINE VERTICAL ALIGNMENT	11/22/2013	URS
5	ADD MODIFICATIONS TO EXISTING GUARDRAIL	2/3/2014	URS

TITLE SHEET

U.S. 40 WATER SERVICE MAIN REPLACEMENT
CAPITAL PROJECT NO. W-8311
CONTRACT NO. 44-4731
6TH ELECTION DISTRICT
HOWARD COUNTY, MARYLAND


SCALE:
AS SHOWN
SHEET
1 OF 13

AS-BUILT 1/2015





Manhole #	Invert	Rim Elevation
1498	354.16	370.51 +/-
1497	353.16	368.02 +/-

Station	Fitting	Northing	Easting	Invert
0+40.00	1.50" HD COUPLING (VERT.)	586,917.12	1,356,533.76	384.80
1+00.00	0.25" HD COUPLING (VERT.)	586,911.69	1,356,593.52	384.81
2+00.00	1.00" HD COUPLING (VERT.)	586,902.64	1,356,693.11	384.39
2+50.00	8"x6" TEE	586,898.12	1,356,742.90	383.31
2+50.00	6" VALVE & ROADWAY BOX	586,893.51	1,356,742.48	383.31
2+50.00	FIRE HYDRANT (4'-6" BURY)	586,888.64	1,356,742.04	383.31
2+56.00	TEST STATION	586,887.89	1,356,748.00	-
3+80.00	1.00" HD COUPLING (VERT.)	586,886.35	1,356,872.37	380.49
4+60.00	0.50" HD COUPLING (VERT.)	586,879.12	1,356,952.04	377.36
6+00.00	8"x6" TEE	586,866.45	1,357,091.47	373.11
6+00.00	6" VALVE & ROADWAY BOX	586,861.83	1,357,091.05	373.11
6+00.00	FIRE HYDRANT (4'-6" BURY)	586,857.91	1,357,090.69	373.11
6+06.00	TEST STATION	586,857.27	1,357,096.66	-
8+20.00	0.75" HD COUPLING (VERT.)	586,846.54	1,357,310.56	366.42
9+25.00	8"x6" TEE	586,837.04	1,357,415.13	364.82
9+25.00	6" VALVE & ROADWAY BOX	586,832.43	1,357,414.71	364.82
9+25.00	FIRE HYDRANT (4'-6" BURY)	586,828.50	1,357,414.36	364.82
9+31.00	TEST STATION	586,827.76	1,357,420.31	-

TEST PIT NUMBER	TYPE OF UTILITY	TOP DEPTH
TH 1G	6" WRAPPED STEEL GAS PIPE	3.76

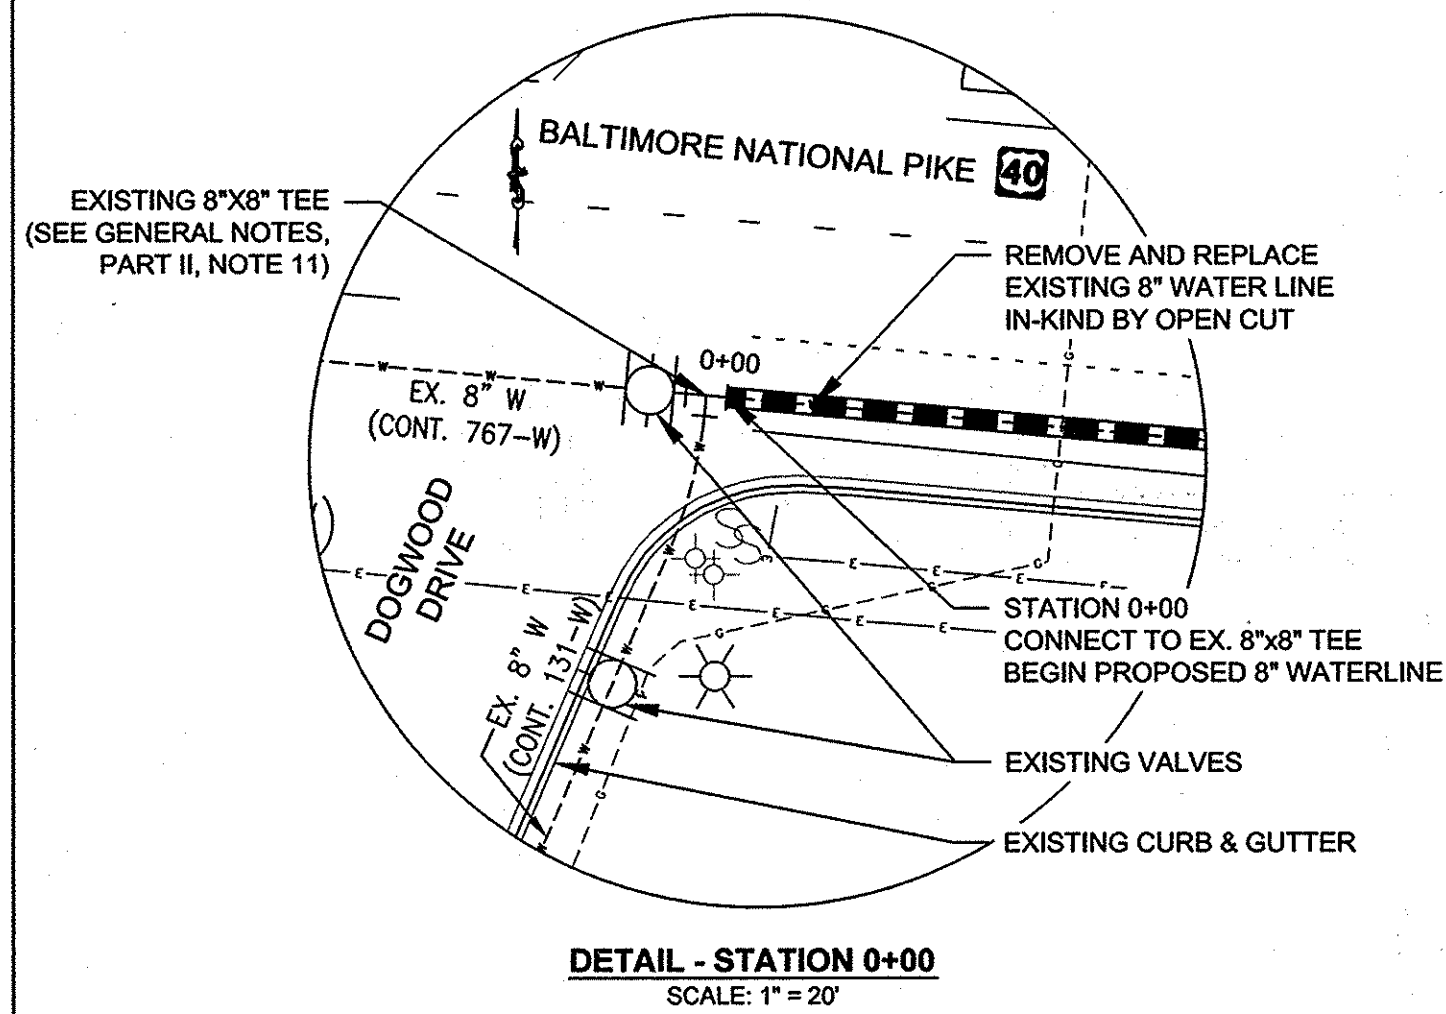

POINT	NORTHING	EASTING	ELEVATION
24B5	586,956.27	1,356,570.78	390.17
101	586,834.61	1,357,434.96	370.99

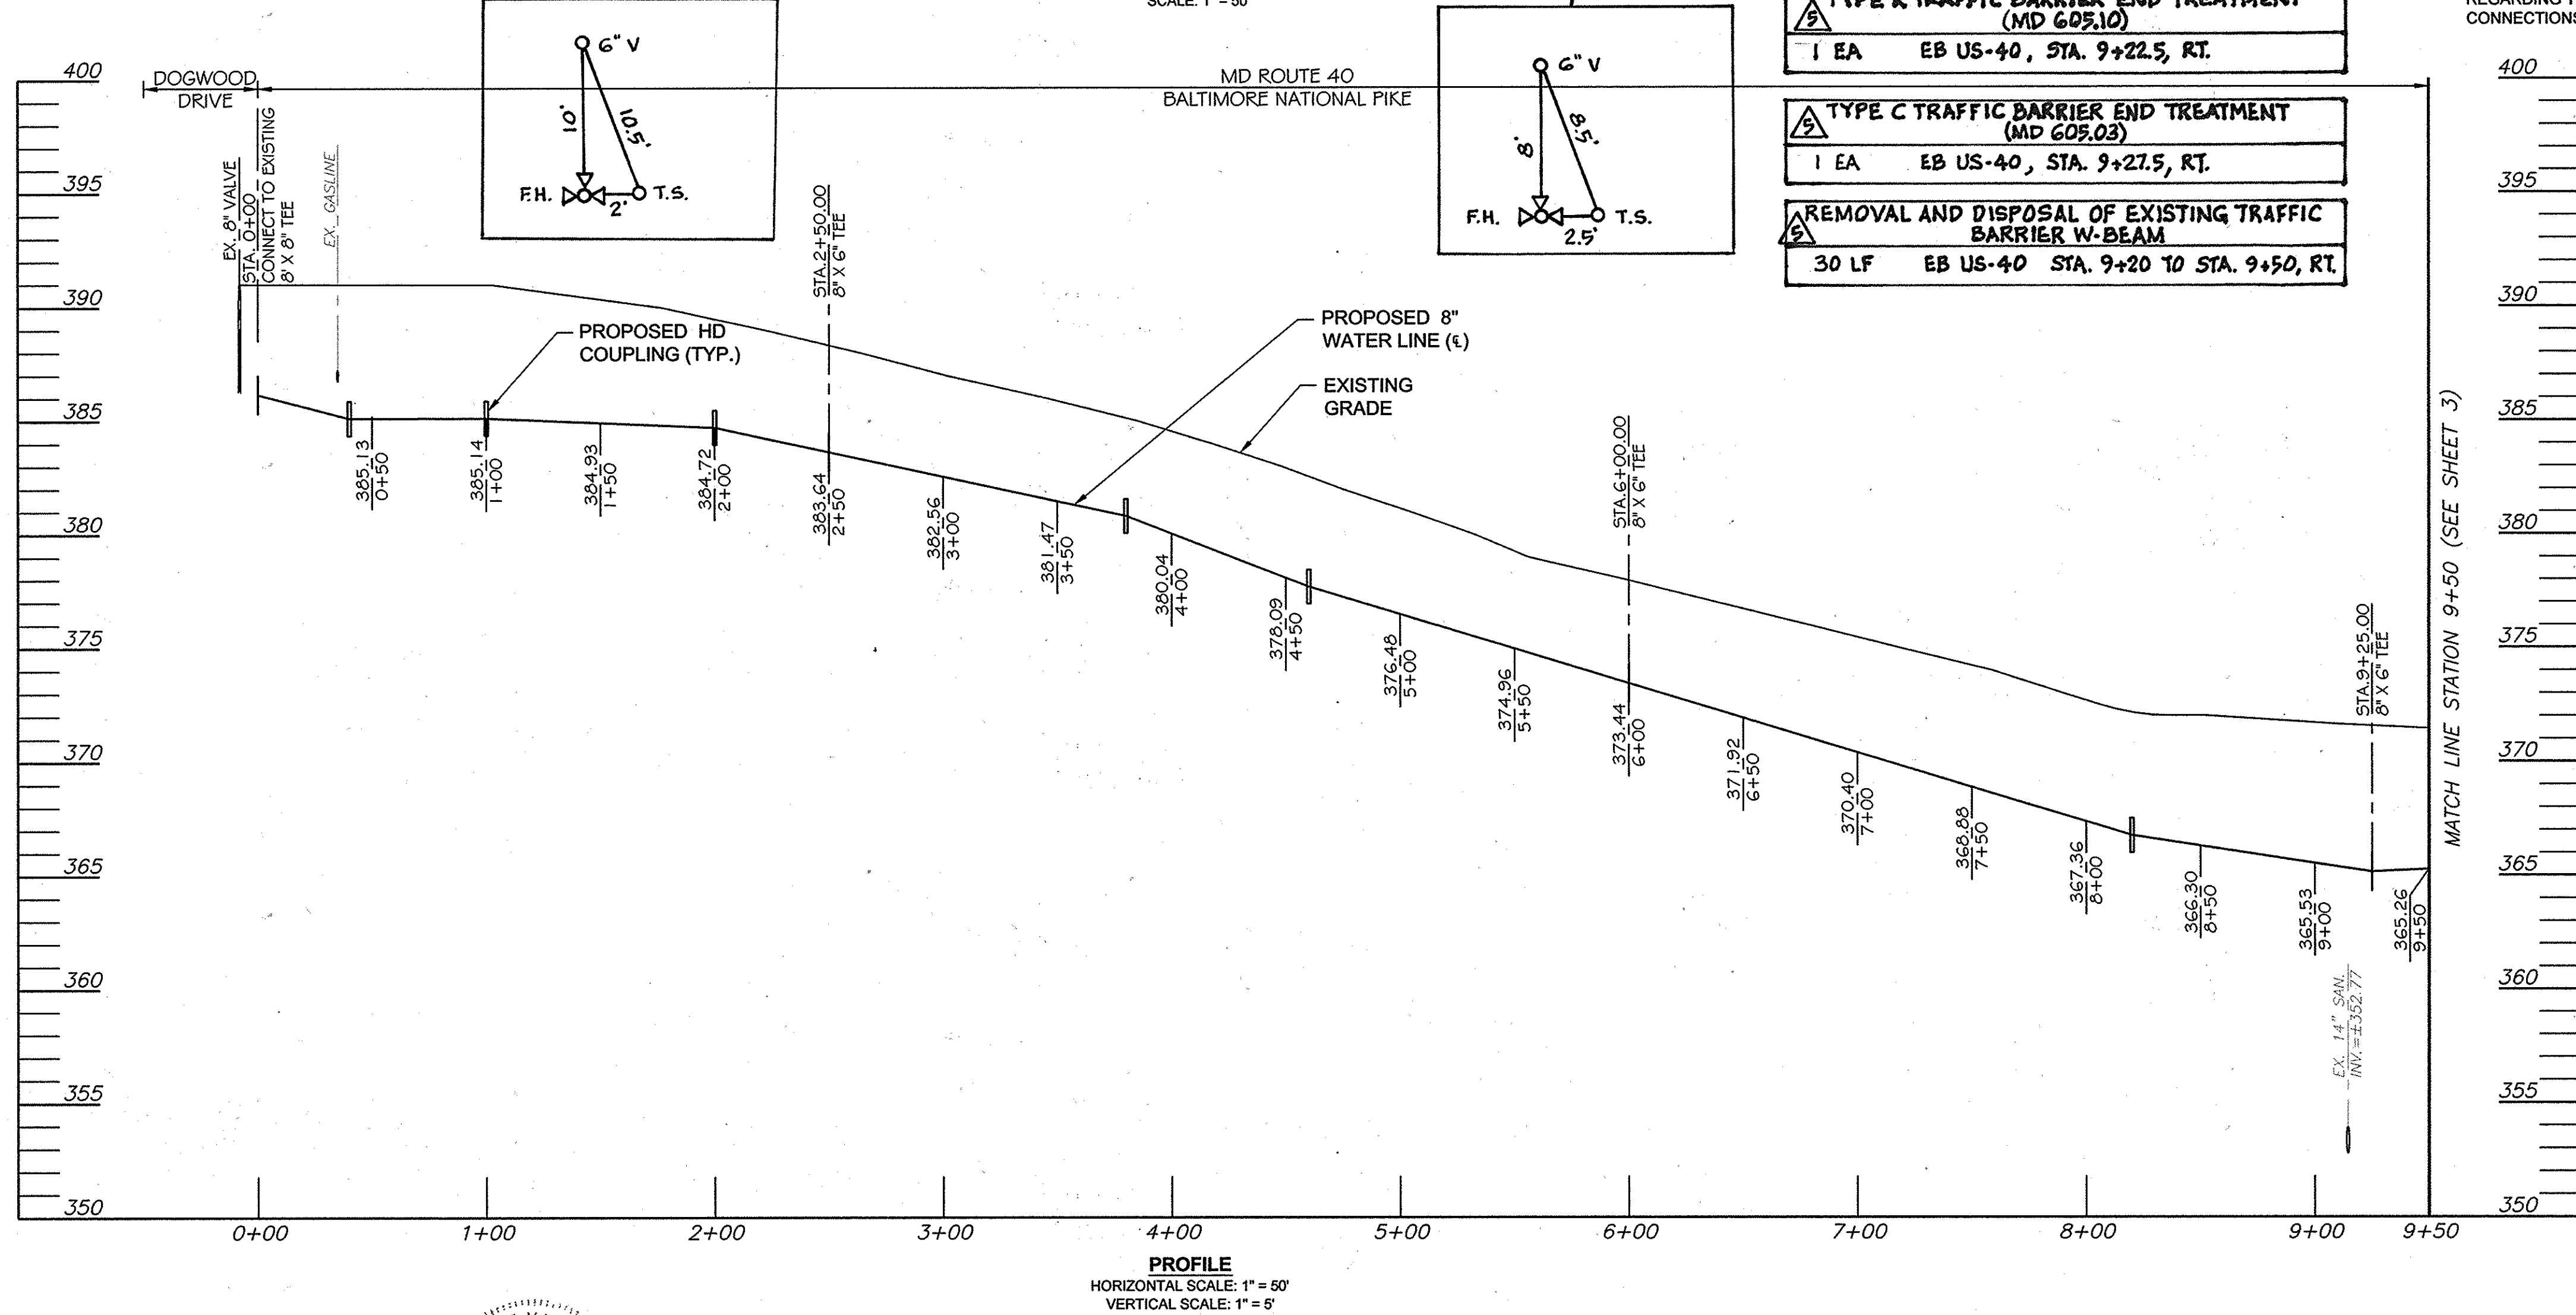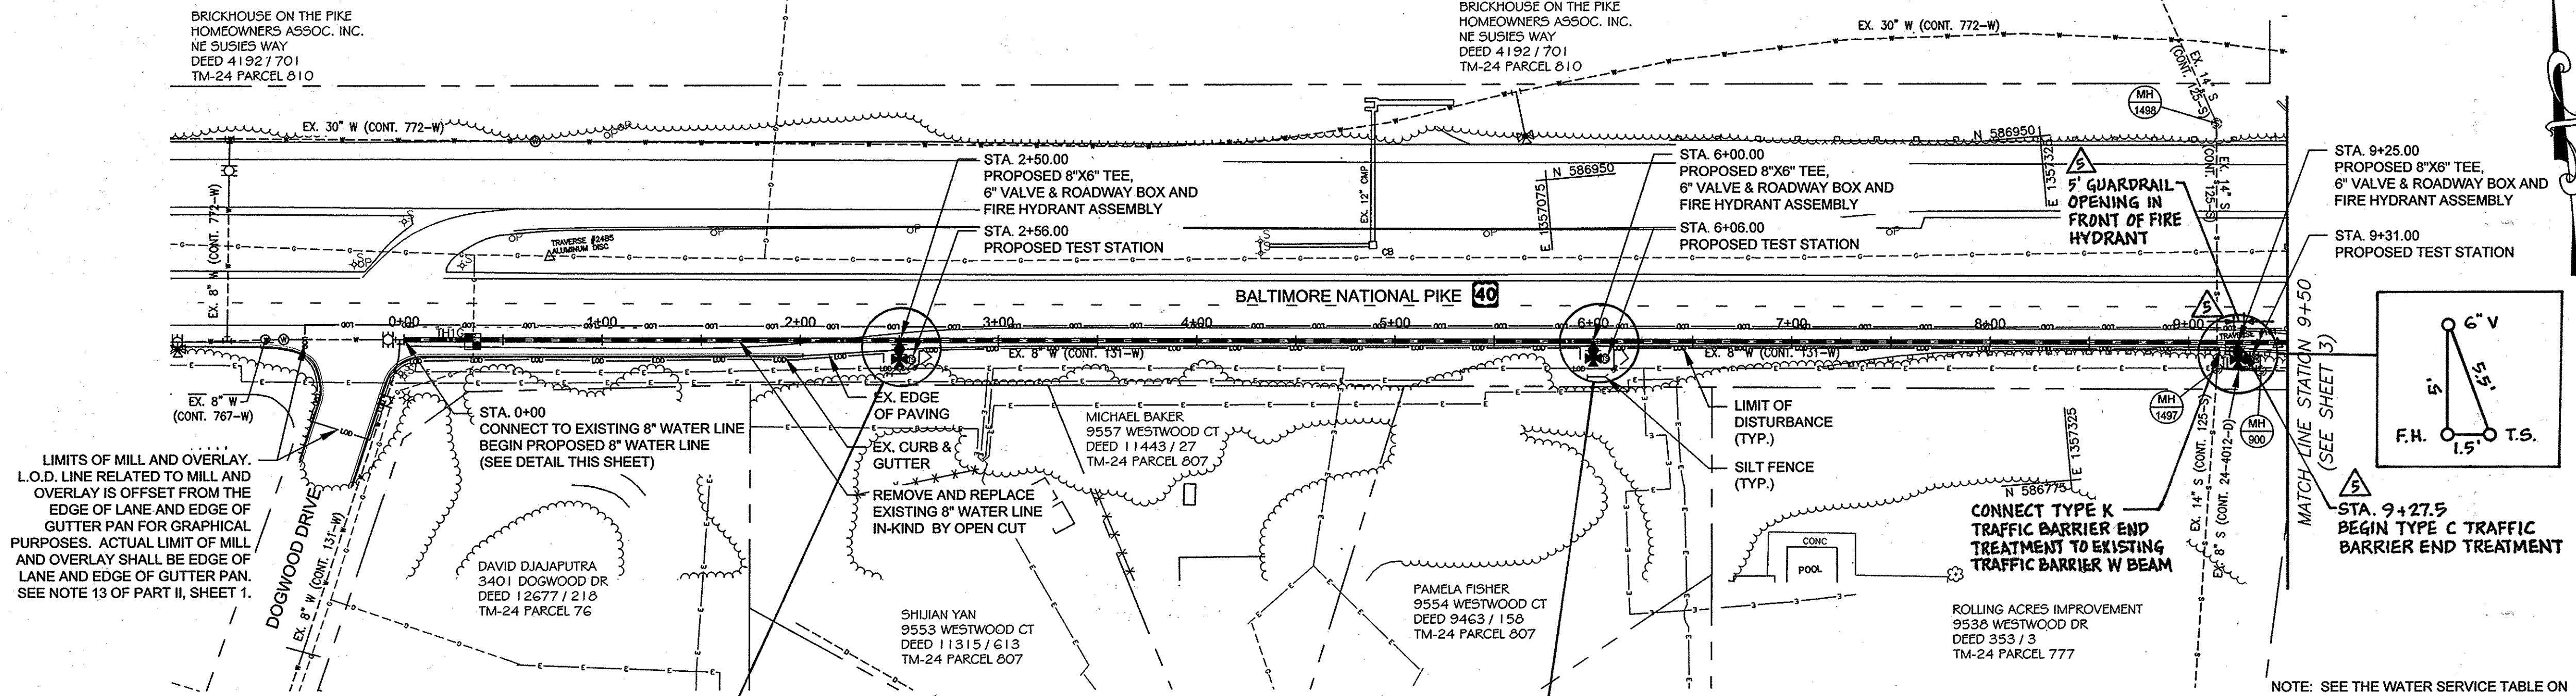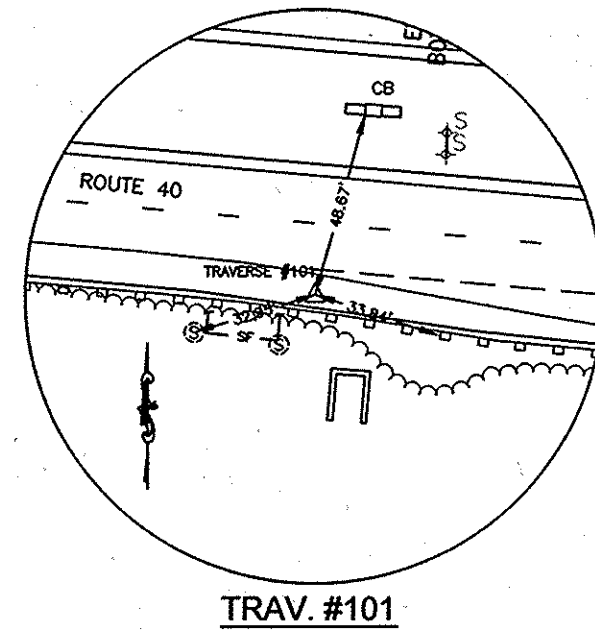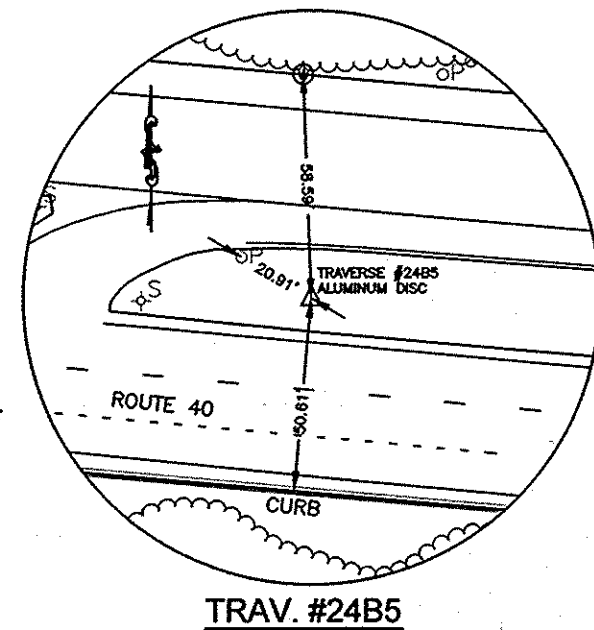

- TYPE K TRAFFIC BARRIER END TREATMENT (MD 605.10)**
1 EA EB US-40, STA. 9+22.5, RT.
- TYPE C TRAFFIC BARRIER END TREATMENT (MD 605.03)**
1 EA EB US-40, STA. 9+27.5, RT.
- REMOVAL AND DISPOSAL OF EXISTING TRAFFIC BARRIER W-BEAM**
30 LF EB US-40 STA. 9+20 TO STA. 9+50, RT.

DEPARTMENT OF PUBLIC WORKS
HOWARD COUNTY, MARYLAND

Director of Public Works: *[Signature]* 3/13/13
Chief, Bureau of Utilities: *[Signature]* 3/13/13

Chief, Bureau of Engineering: *[Signature]* 3/13/13
Chief, Utility Design Division: *[Signature]* 3/12/13

URS
MONTGOMERY PARK BUSINESS CENTER
1800 WASHINGTON BOULEVARD, SUITE 410
BALTIMORE, MARYLAND 21230
(410) 468-0875

Professional Certification
I hereby certify that these documents were prepared or approved by me, and that I am a duly licensed professional engineer under the laws of the State of Maryland, License No. 28817, Expiration Date: 08/01/13

NATHAN C. ATKINSON

DESIGN:	DRAWN:	CHK:	DATE:	NO.	REVISION	DATE	BY
NCA	BJW	EMT	3/7/13				
					ADD MODIFICATIONS TO EXISTING GUARDRAIL	2/3/2014	URS

8" WATER MAIN
PLAN AND PROFILE
STATION 0+00 - 9+50

600' SCALE MAP NO. 24
BLOCK NO. 12


U.S. 40 WATER SERVICE MAIN REPLACEMENT
CAPITAL PROJECT NO. W-8311
CONTRACT NO. 44-4731
6TH ELECTION DISTRICT
HOWARD COUNTY, MARYLAND

SCALE:
AS SHOWN

SHEET
2 OF 13

AS-BUILT 1/2015




WATER MAIN STAKE-OUT SCHEDULE				
Station	Fitting	Northing	Easting	Invert
10+00.00	0.75" HD COUPLING (VERT.)	586,830.25	1,357,489.83	365.11
11+25.04	8" x 8" TEE	586,818.94	1,357,614.35	367.31
11+40.00	0.75" HD COUPLING (VERT.)	586,817.55	1,357,629.25	367.58
13+40.00	1.50" HD COUPLING (VERT.)	586,799.04	1,357,828.39	373.72
14+60.00	3.00" HD COUPLING (VERT.)	586,787.93	1,357,947.87	374.27
14+78.98	8" x 8" TEE	586,786.17	1,357,966.78	375.39
14+78.98	8" VALVE & ROADWAY BOX	586,781.56	1,357,966.35	375.39
14+95.14	8" VALVE & ROADWAY BOX	586,784.68	1,357,982.86	376.28
15+04.74	8" x 8" TEE	586,783.79	1,357,992.42	376.81
15+09.00	TEST STATION	586,771.98	1,357,995.61	-
15+19.00	8" x 6" TEE	586,783.11	1,358,002.66	377.44
15+19.00	6" VALVE & ROADWAY BOX	586,778.50	1,358,002.22	377.44
15+19.00	FIRE HYDRANT (5'-6" BURY)	586,771.46	1,358,001.55	377.44
15+40.00	2.25" HD COUPLING (VERT.)	586,780.54	1,358,027.53	378.82
15+69.00	TEST STATION	586,766.78	1,358,097.34	-
15+79.00	8" x 6" TEE	586,777.40	1,358,062.39	379.49
15+79.00	6" VALVE & ROADWAY BOX	586,772.79	1,358,061.95	379.49
15+79.00	FIRE HYDRANT (5'-6" BURY)	586,769.75	1,358,061.28	379.49
17+50.00	1/8 BEND (HORIZ.)	586,761.20	1,358,236.64	382.59
17+59.00	1/8 BEND (HORIZ.)	586,769.72	1,358,242.08	382.68
17+66.89	8" x 8" TEE	586,764.63	1,358,253.86	382.84
17+80.00	METER CONNECTION	586,763.37	1,358,267.54	383.08
18+46.74	METER CONNECTION	586,757.33	1,358,332.88	384.26
18+73.30	8" x 6" TEE	586,754.83	1,358,359.86	384.73
18+73.30	6" VALVE & ROADWAY BOX	586,753.67	1,358,359.76	384.73
18+79.96	TEST STATION	586,729.26	1,358,364.34	-
18+99.00	1/8 BEND (HORIZ.)	586,752.98	1,358,381.46	385.15
19+00.00	1/8 BEND (HORIZ.)	586,747.57	1,358,386.02	385.24
19+10.00	1.00" HD COUPLING (VERT.)	586,746.71	1,358,395.98	385.42
19+34.20	METER CONNECTION	586,744.65	1,358,420.09	385.58
20+00.00	0.50" HD COUPLING (VERT.)	586,739.03	1,358,485.65	385.22

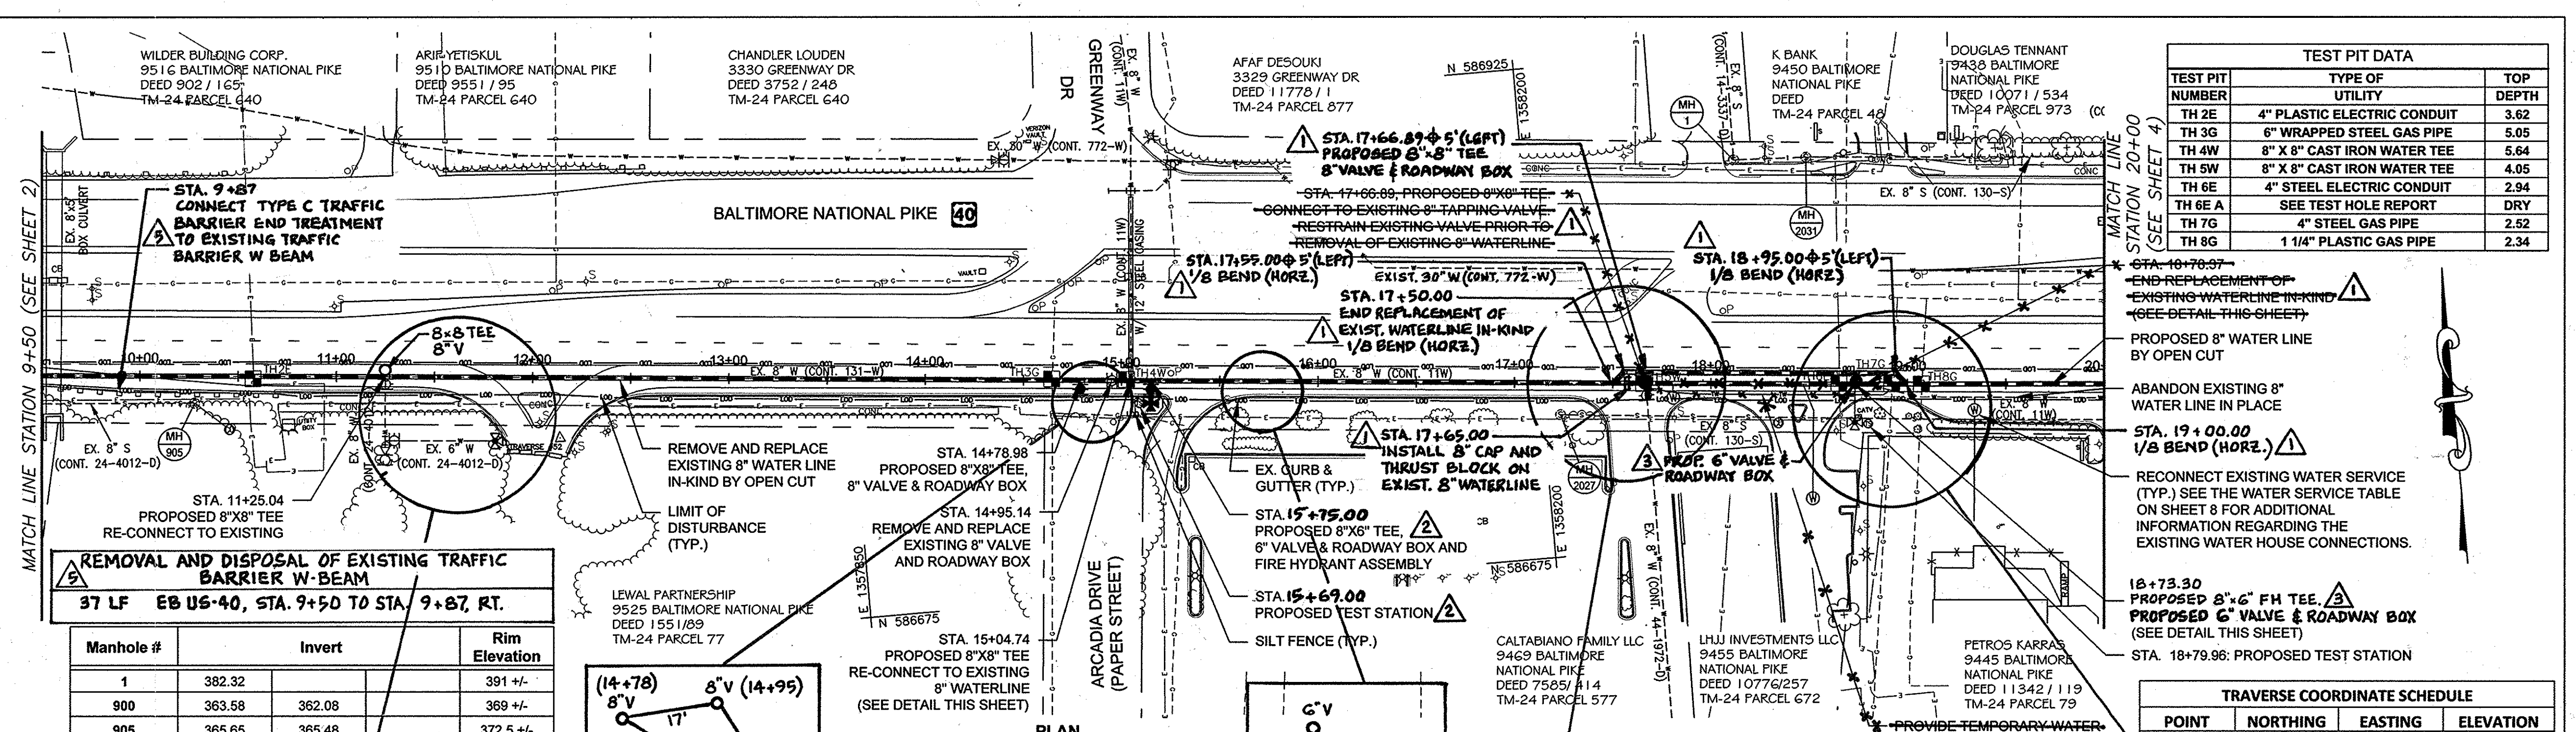

Manhole #	Invert	Rim Elevation
1	382.32	391 +/-
900	363.58	369 +/-
905	365.65	372.5 +/-
2027	308.68	308.68 +/-
2031	382.22	390.6 +/-

TEST PIT DATA		
TEST PIT NUMBER	TYPE OF UTILITY	TOP DEPTH
TH 2E	4" PLASTIC ELECTRIC CONDUIT	3.62
TH 3G	6" WRAPPED STEEL GAS PIPE	5.05
TH 4W	8" x 8" CAST IRON WATER TEE	5.64
TH 5W	8" x 8" CAST IRON WATER TEE	4.05
TH 6E	4" STEEL ELECTRIC CONDUIT	2.94
TH 6E A	SEE TEST HOLE REPORT	DRY
TH 7G	4" STEEL GAS PIPE	2.52
TH 8G	1 1/4" PLASTIC GAS PIPE	2.34

TRAVERSE COORDINATE SCHEDULE			
POINT	NORTHING	EASTING	ELEVATION
52	586,780.17	1,357,700.32	376.13

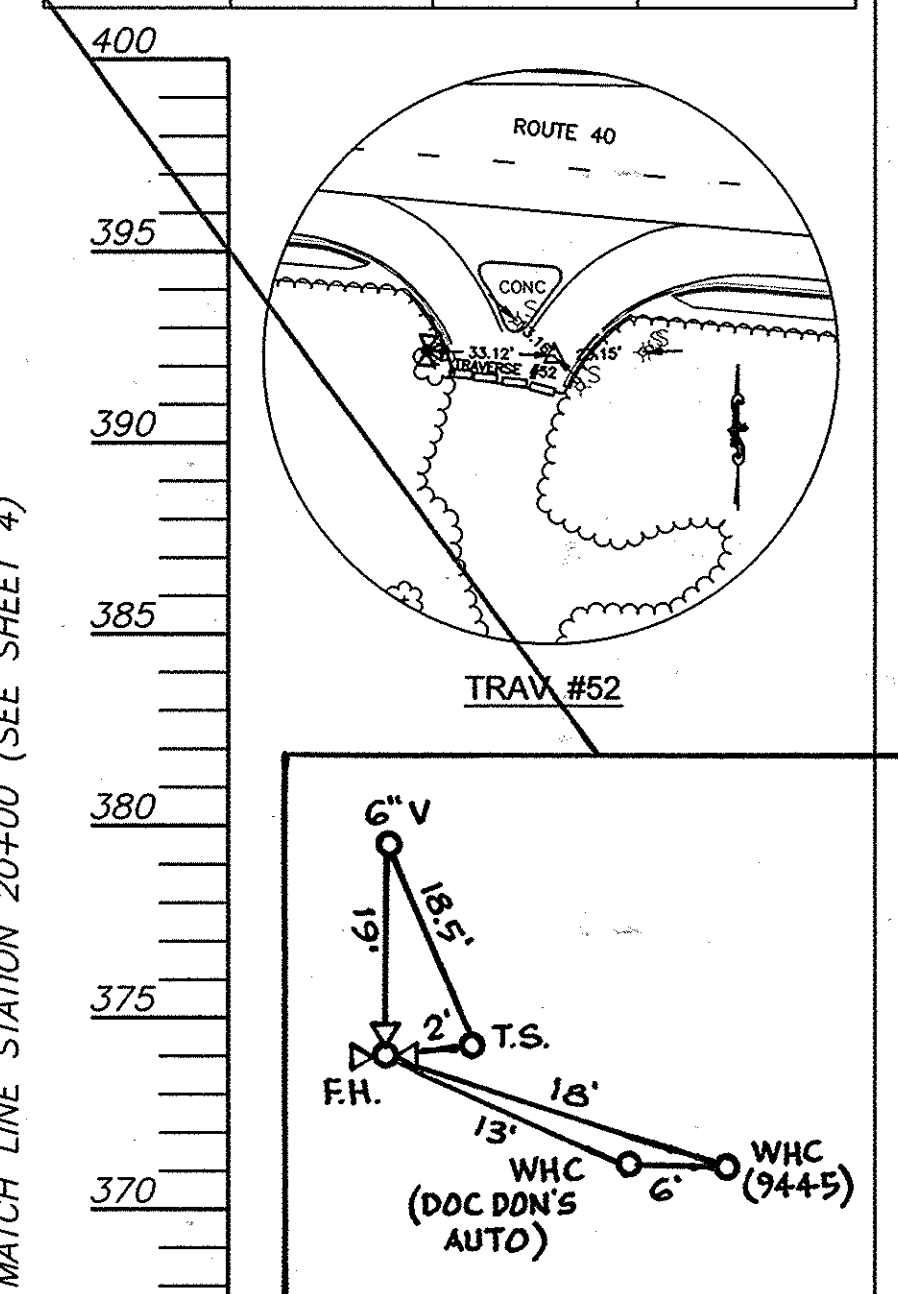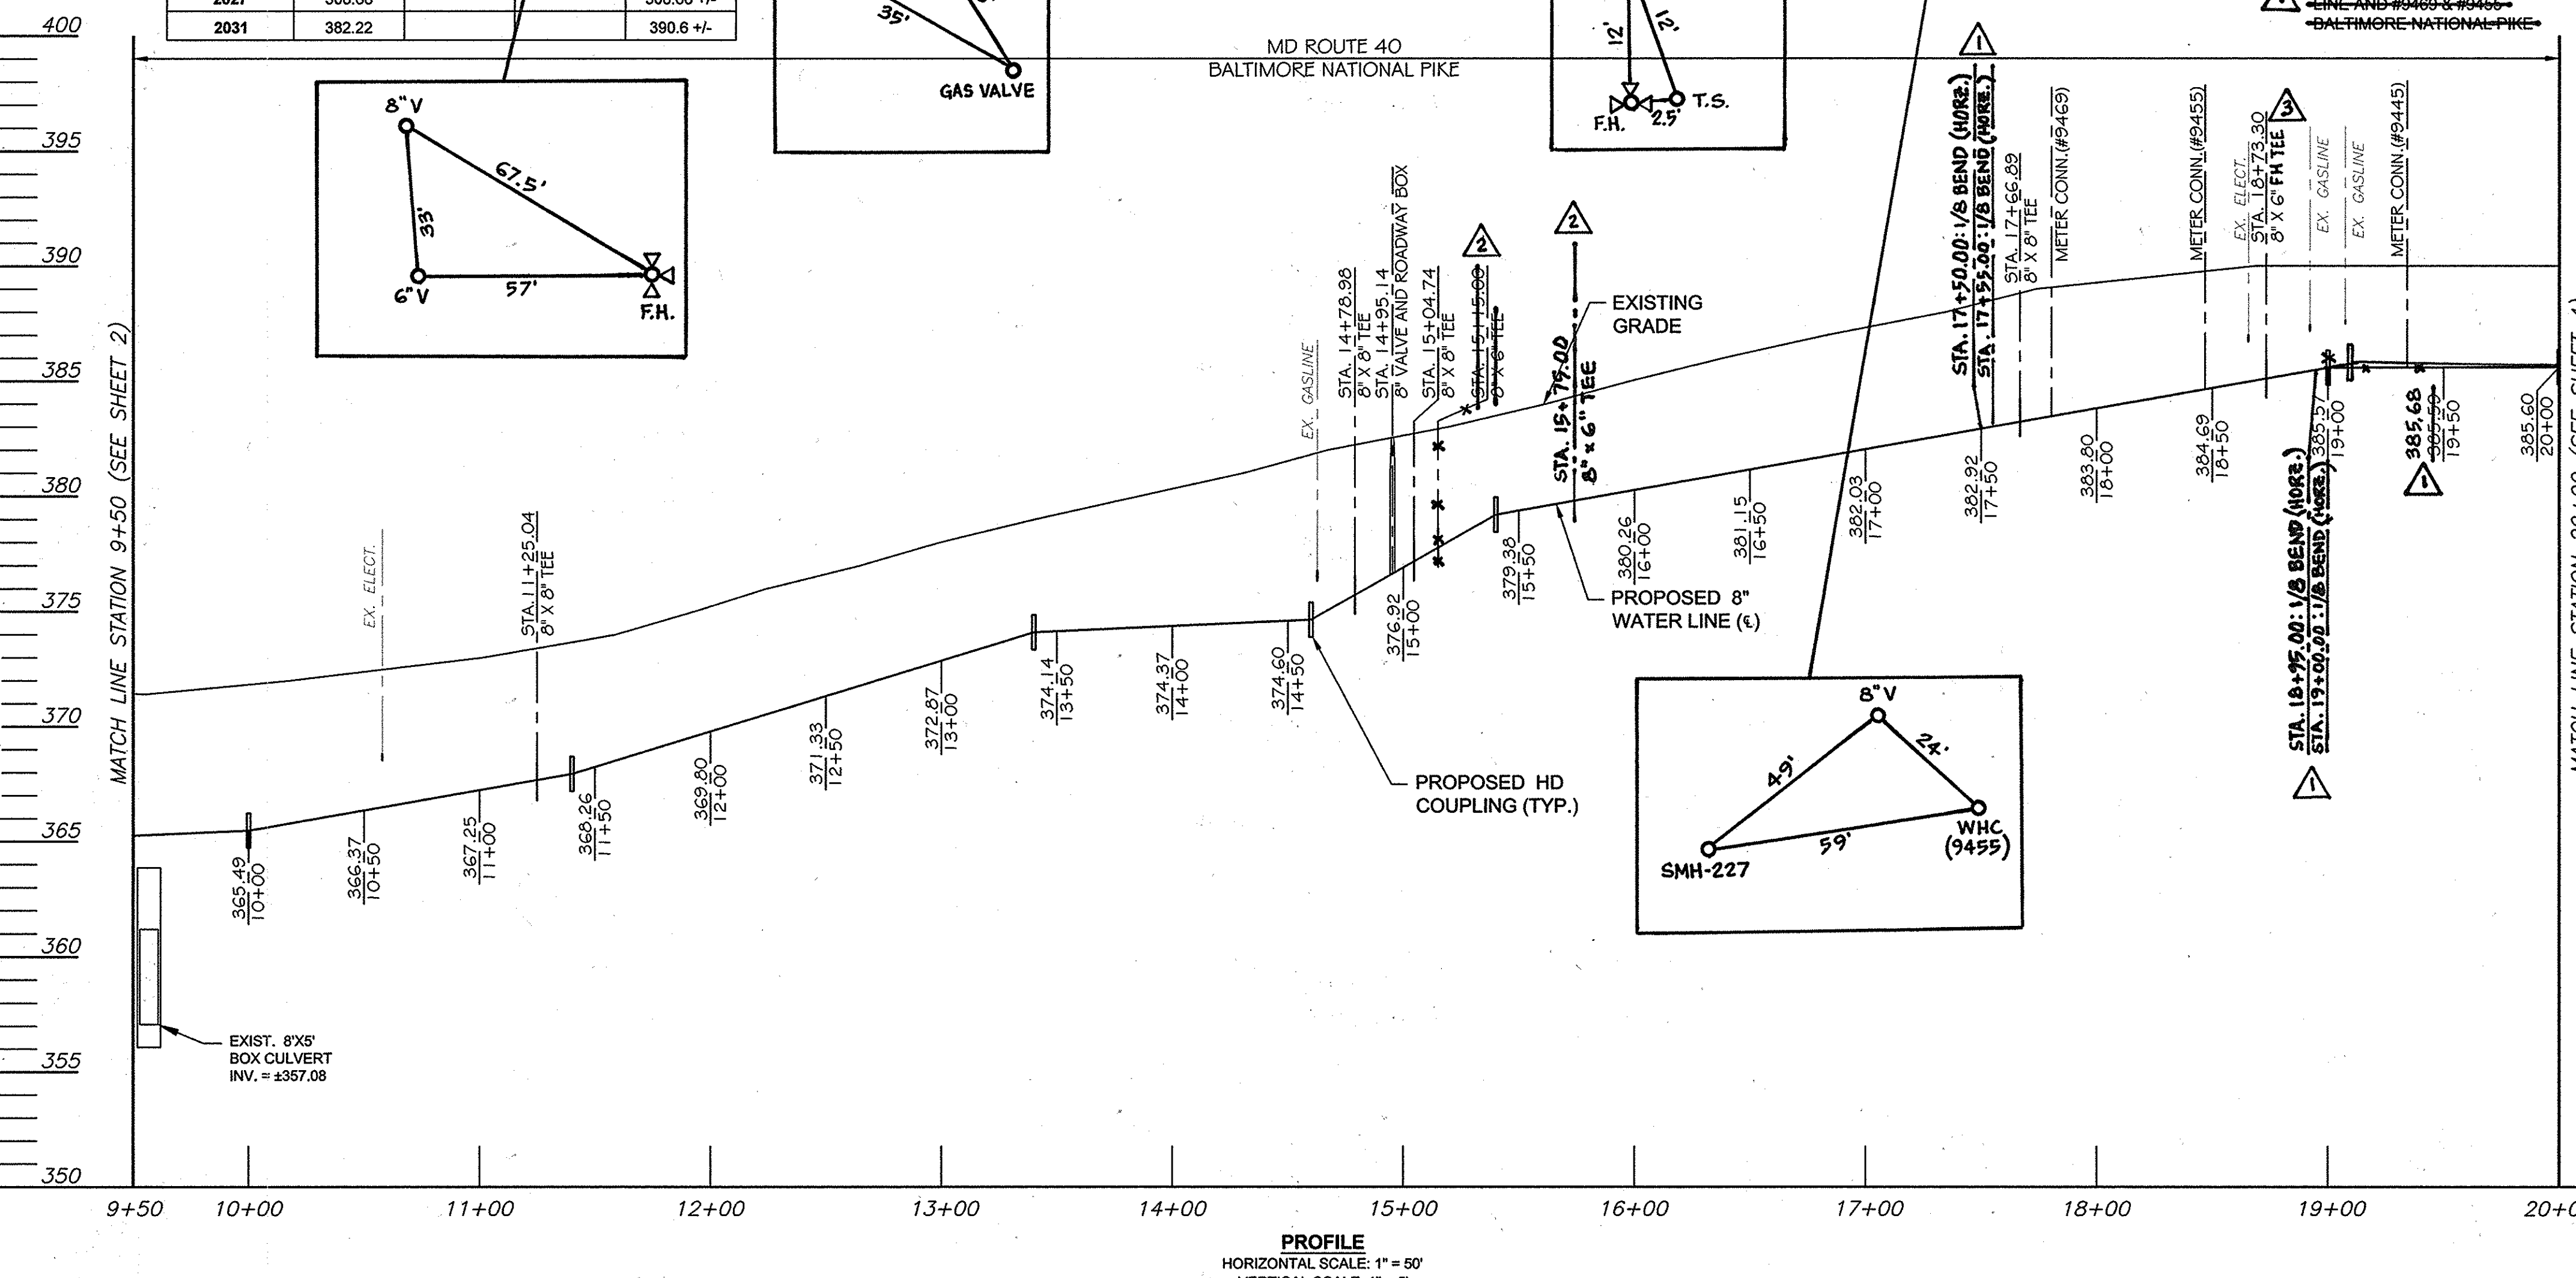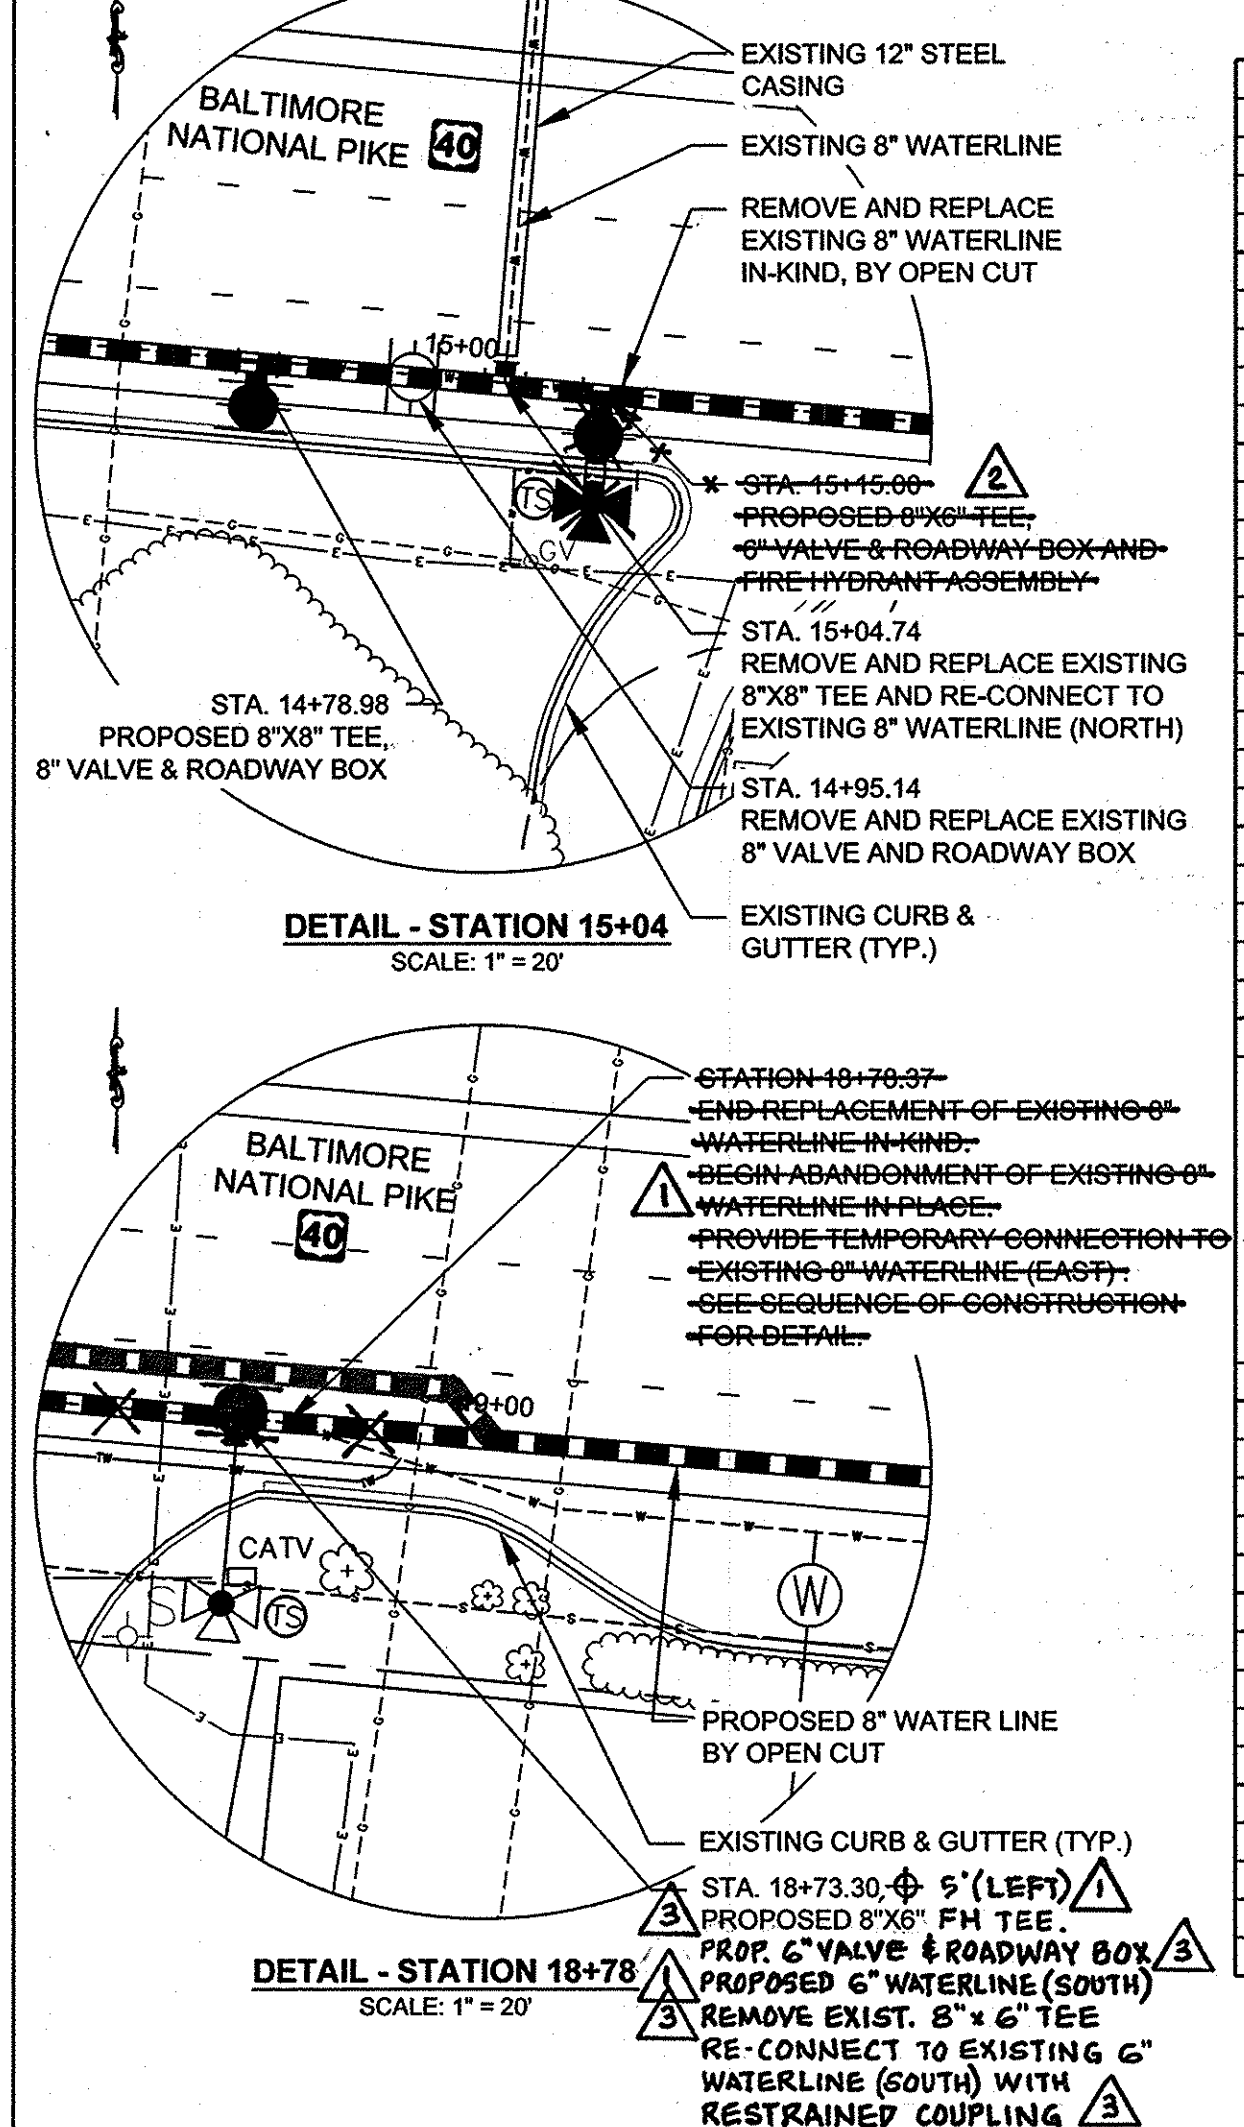

DEPARTMENT OF PUBLIC WORKS
HOWARD COUNTY, MARYLAND

Director of Public Works: *Jan P. Van* 3/3/13
Chief, Bureau of Engineering: *Momas & Suttler* 3/13/13
Chief, Bureau of Utilities: *Shirley* 3/12/13
Chief, Utility Design Division: *Ch. Dea* 3/12/13

URS
MONTGOMERY PARK BUSINESS CENTER
1800 WASHINGTON BOULEVARD, SUITE 410
BALTIMORE, MARYLAND 21230
(410) 468-0875

Professional Certification
I hereby certify that these documents were prepared or approved by me, and that I am a duly licensed professional engineer under the laws of the State of Maryland, License No. 28517, Expiration Date: 08/01/13
NATHAN C. ATKINSON

NO.	REVISION	DATE	BY
1	REMOVE TEMP. WATER SERVICE, REVISE ALIGNMENT	9/13/2013	URS
2	RELOCATE PROPOSED FIRE HYDRANT	10/4/2013	URS
3	ADD PROP. 6" VALVE AND ROADWAY BOX	11/15/2013	URS
4	ADD MODIFICATIONS TO EXISTING GUARDRAIL	2/3/2014	URS


8" WATER MAIN
PLAN AND PROFILE
STATION 9+50 - 20+00

U.S. 40 WATER SERVICE MAIN REPLACEMENT
CAPITAL PROJECT NO. W-8311
CONTRACT NO. 44-4731
6TH ELECTION DISTRICT
HOWARD COUNTY, MARYLAND

SCALE: AS SHOWN
SHEET 3 OF 13





AS-BUILT 1/2015

Manhole #	Invert	Rim Elevation
2024	376.31	387.00 +/-
2025	378.84	389.38 +/-
2026	380.16	390.21 +/-
2028	375.26	384.80 +/-
2029	377.72	386.80 +/-
2030	380.09	391.10 +/-

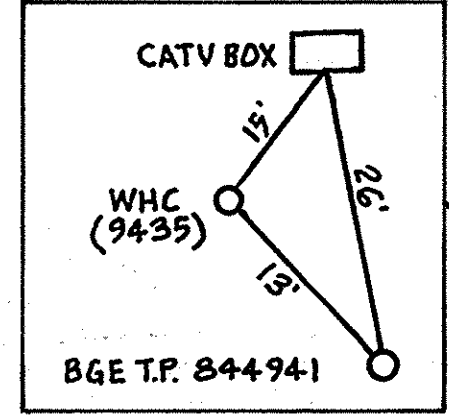

Station	Fitting	Northing	Easting	Invert
21+00.00	0.50" HD COUPLING (VERT.)	586,730.48	1,358,585.29	383.98
21+08.75	METER CONNECTION	586,729.73	1,358,594.01	383.95
21+59.45	8" x 6" TEE	586,725.40	1,358,644.52	383.74
21+72.46	6" VALVE & ROADWAY BOX	586,724.24	1,358,644.42	383.74
21+66.84	TEST STATION	586,711.58	1,358,650.72	-
22+16.78	METER CONNECTION	586,720.38	1,358,700.63	383.51
23+08.00	1.00" HD COUPLING (VERT.)	586,712.86	1,358,764.51	383.16
23+84.69	8" VALVE & ROADWAY BOX	586,705.21	1,358,868.84	381.94
23+85.83	8" x 6" REDUCER	586,696.61	1,358,869.20	381.91
23+85.84	8" VALVE AND ROADWAY BOX	586,700.59	1,358,869.58	381.31
23+85.86	8" x 6" TEE	586,705.20	1,358,870.03	381.31
23+87.03	6" VALVE & ROADWAY BOX	586,705.09	1,358,871.20	381.29
24+20.00	3.0" HD COUPLING (VERT.)	586,702.05	1,358,904.02	380.57
24+64.00	TEST STATION	586,676.29	1,358,945.82	-
24+70.00	8" x 6" TEE	586,697.43	1,358,953.81	382.11
24+70.00	6" VALVE & ROADWAY BOX	586,692.82	1,358,953.38	382.11
24+70.00	FIRE HYDRANT (6" BURY)	586,675.89	1,358,951.81	382.11
25+00.00	2.50" HD COUPLING (VERT.)	586,694.67	1,358,983.68	383.04
25+26.92	METER CONNECTION	586,692.18	1,359,010.49	382.69
27+57.33	METER CONNECTION	586,670.92	1,359,239.91	379.73
27+69.00	TEST STATION	586,652.96	1,359,249.97	-
27+75.00	8" x 6" TEE	586,669.29	1,359,257.51	379.51
27+75.00	6" VALVE & ROADWAY BOX	586,664.68	1,359,257.08	379.51
27+75.00	FIRE HYDRANT (6" BURY)	586,652.55	1,359,255.96	379.51
28+00.00	1.00" HD COUPLING (VERT.)	586,666.98	1,359,282.40	379.18
28+60.00	0.50" HD COUPLING (VERT.)	586,661.45	1,359,342.14	379.46
29+41.38	METER CONNECTION	586,653.94	1,359,423.18	379.13

TEST PIT NUMBER	TYPE OF UTILITY	TOP DEPTH
TH 9G	SEE TEST HOLE REPORT	DRY
TH 9G A	1" UNKNOWN COPPER PIPE	3.62
TH 10G	1" STEEL GAS PIPE	2.26
TH 11E	(6) 3/4" ELECTRIC CABLES	3.14
TH 12E	4" PLASTIC TELEPHONE CONDUIT	3.45
TH 12E A	(4) 1 1/2" CTV CABLES	3.50
TH 13W	8" CAST IRON WATER PIPE	4.76
TH 14G	4" WRAPPED STEEL GAS PIPE	5.10
TH 15T	(3) 4" PLASTIC TELEPHONE CONDUITS	3.65
TH 16W	8" CAST IRON WATER PIPE	3.84
TH 17E	4" PLASTIC TELEPHONE CONDUIT	2.65
TH 17E A	6" STEEL TELEPHONE CONDUIT	2.98
TH 17E B	4" PLASTIC TELEPHONE CONDUIT	3.10
TH 18G	1/2" PLASTIC GAS PIPE	2.62

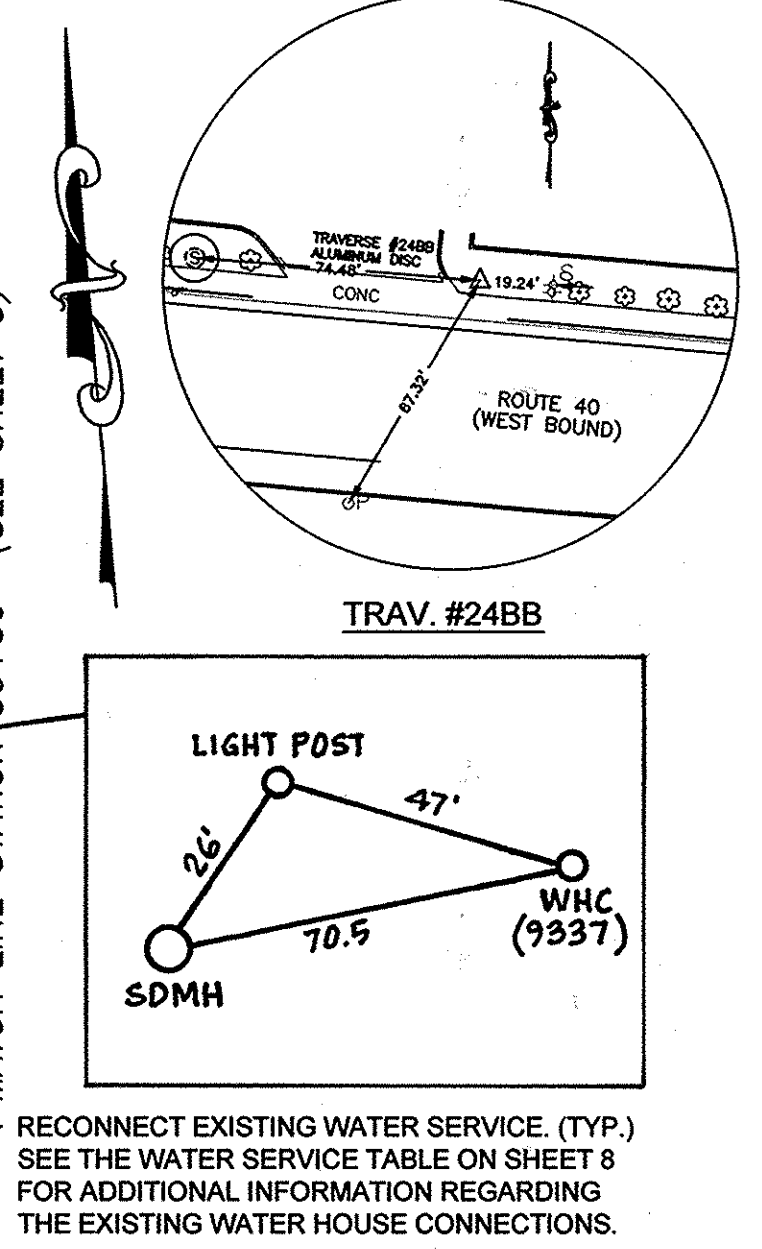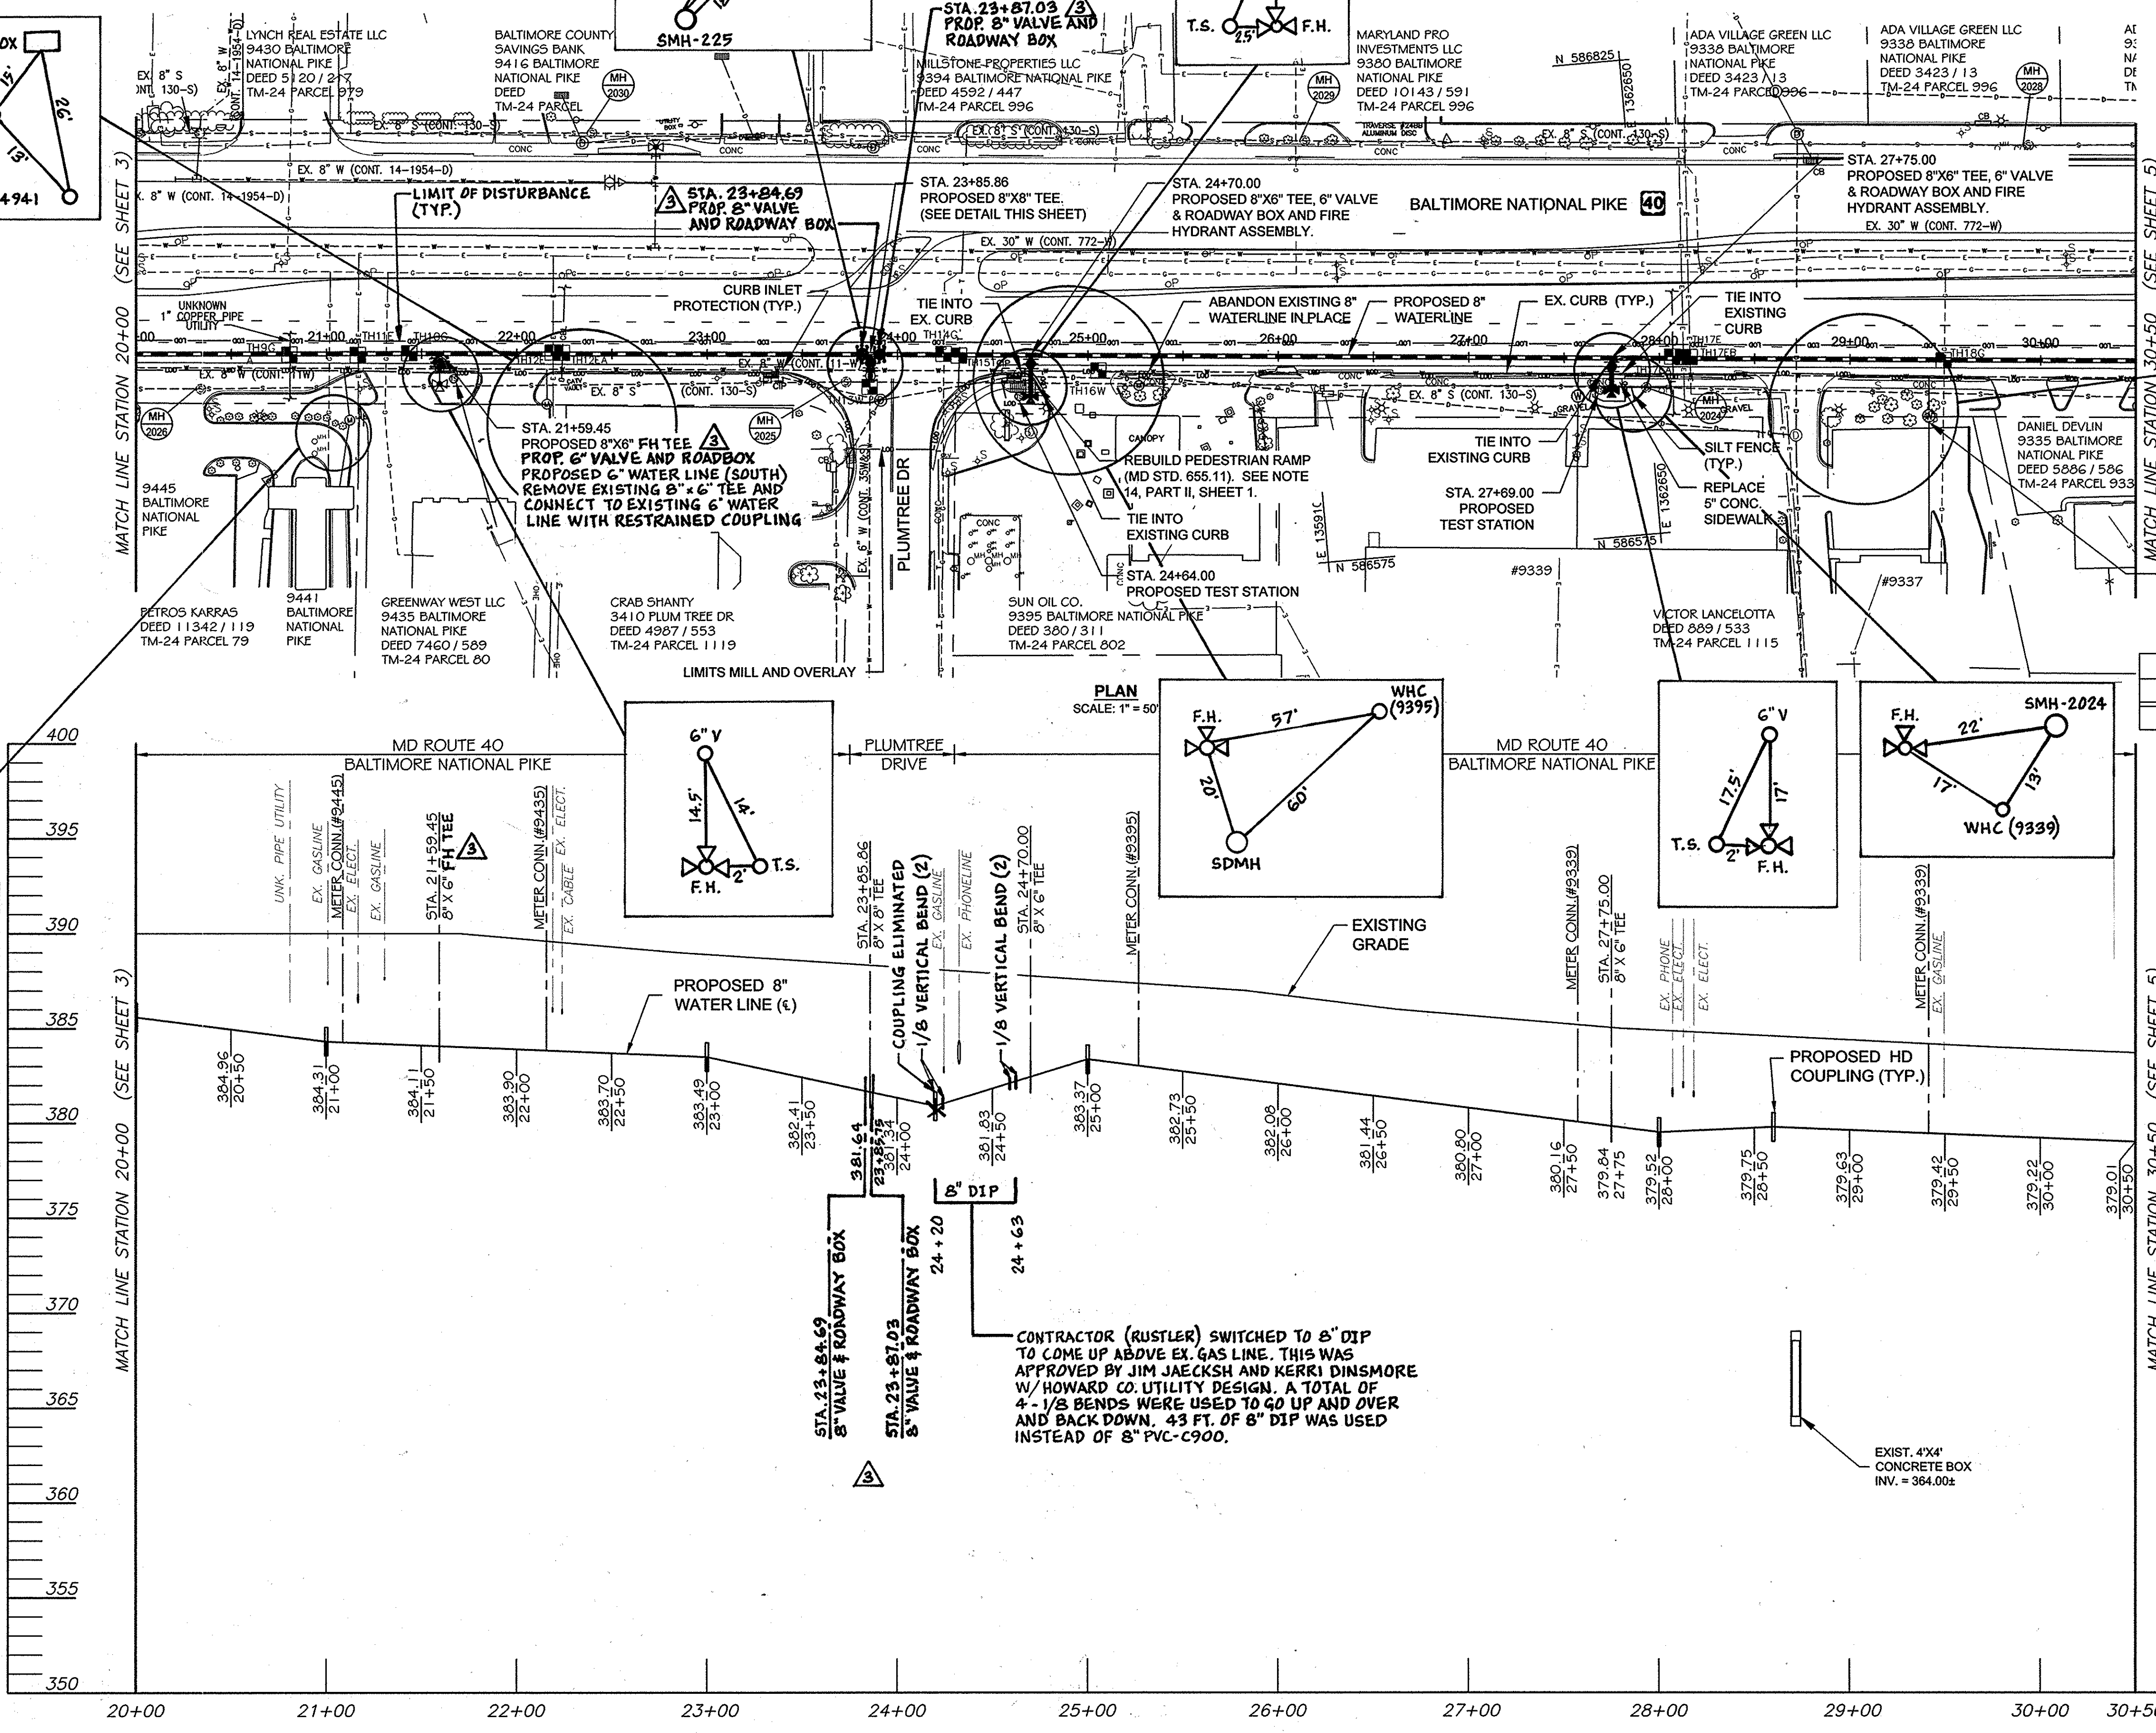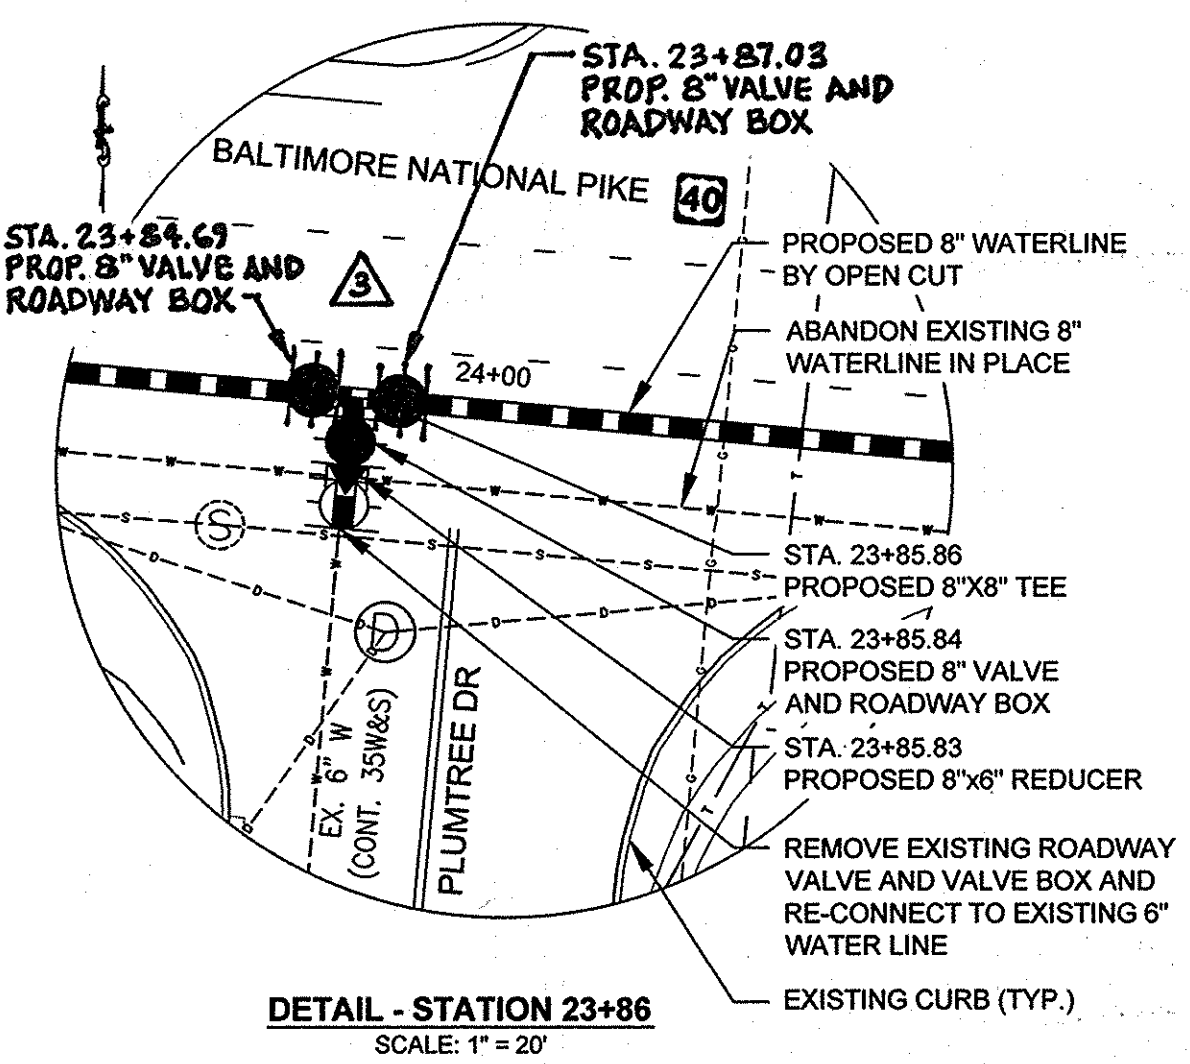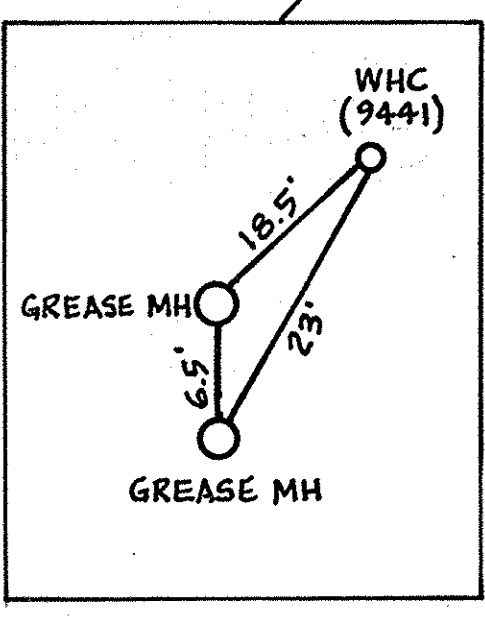

POINT	NORTHING	EASTING	ELEVATION
24BB	586,791.24	1,359,181.16	386.13

DEPARTMENT OF PUBLIC WORKS
HOWARD COUNTY, MARYLAND

Director of Public Works: *[Signature]* 5/13/13
Chief, Bureau of Engineering: *[Signature]* 3/13/13

Chief, Bureau of Utilities: *[Signature]* 3/12/13
Chief, Utility Design Division: *[Signature]* 3/12/13

URS
MONTGOMERY PARK BUSINESS CENTER
1800 WASHINGTON BOULEVARD, SUITE 410
BALTIMORE, MARYLAND 21230
(410) 468-0875

Professional Certification
I hereby certify that these documents were prepared or approved by me, and that I am a duly licensed professional engineer under the laws of the State of Maryland, License No. 22817, Expiration Date: 08/01/13
NATHAN C. ATKINSON

DESIGN:	DATE:	BY:
NCA	11/15/2013	URS
BLW		
EMT		
NO.		

8" WATER MAIN
PLAN AND PROFILE
STATION 20+00 - 30+50

U.S. 40 WATER SERVICE MAIN REPLACEMENT
CAPITAL PROJECT NO. W-8311
CONTRACT NO. 44-4731
6TH ELECTION DISTRICT
HOWARD COUNTY, MARYLAND

SCALE: AS SHOWN
SHEET 4 OF 13



AS-BUILT 1/2015

WATER MAIN STAKE-OUT SCHEDULE				
Station	Fitting	Northing	Easting	Invert
30+51.05	METER CONNECTION	586,643.82	1,359,532.38	378.68
30+65.85	TEST STATION	586,625.35	1,359,545.53	-
30+72.67	8" x 6" TEE	586,641.82	1,359,553.91	378.59
30+72.67	6" VALVE & ROADWAY BOX	586,640.69	1,359,553.82	378.59
30+89.58	METER CONNECTION	586,640.26	1,359,570.74	378.92
32+58.84	METER CONNECTION	586,624.64	1,359,739.28	377.82
32+75.85	TEST STATION	586,606.21	1,359,774.66	-
32+81.92	8" x 6" TEE	586,622.51	1,359,762.26	377.73
32+81.92	6" VALVE & ROADWAY BOX	586,621.35	1,359,762.15	377.73
33+02.84	8" VALVE & ROADWAY BOX	586,620.58	1,359,783.09	377.64
33+10.11	8" x 8" TEE	586,619.91	1,359,790.33	377.61
33+10.15	8" VALVE & ROADWAY BOX	586,623.71	1,359,790.76	377.61
33+45.55	0.75" HD COUPLING (VERT.)	586,616.36	1,359,825.60	377.47
33+62.39	6" VALVE & ROADWAY BOX	586,614.67	1,359,842.35	377.62
33+63.56	8" x 8" TEE	586,614.55	1,359,843.51	377.63
33+63.56	8" VALVE & ROADWAY BOX	586,609.94	1,359,843.13	377.63
33+64.73	8" VALVE & ROADWAY BOX	586,614.44	1,359,844.68	377.64
33+79.61	1.50" HD COUPLING (VERT.)	586,612.99	1,359,859.49	377.77
34+25.90	0.75" HD COUPLING (VERT.)	586,608.48	1,359,905.56	376.98
35+03.54	1/8 BEND (HOR.)	586,600.90	1,359,982.83	376.66
35+11.68	1/8 BEND (HOR.)	586,606.08	1,359,989.11	376.62
35+59.87	TEST STATION	586,586.53	1,360,035.70	-
35+66.47	8" x 6" TEE	586,601.07	1,360,043.67	376.40
35+66.47	6" VALVE & ROADWAY BOX	586,599.90	1,360,043.56	376.40
35+93.90	8" VALVE & ROADWAY BOX	586,598.56	1,360,070.98	376.28
36+68.86	METER CONNECTION	586,591.70	1,360,145.63	375.98
38+08.75	8" x 6" TEE	586,578.90	1,360,284.93	375.40
38+08.75	6" VALVE & ROADWAY BOX	586,577.74	1,360,284.84	375.40
38+15.09	TEST STATION	586,561.21	1,360,289.67	-
38+50.54	1/8 BEND (VERT.)	586,575.08	1,360,326.55	375.23
38+52.01	1/8 BEND (VERT.)	586,574.95	1,360,328.01	375.19
38+71.56	1/8 BEND (VERT.)	586,573.16	1,360,347.48	375.67
38+73.02	1/8 BEND (VERT.)	586,573.02	1,360,348.93	375.12
39+67.06	METER CONNECTION	586,564.42	1,360,442.58	374.32
40+68.76	METER CONNECTION	586,555.12	1,360,543.85	373.46
40+78.63	8" x 6" TEE	586,554.21	1,360,553.68	373.37
40+78.63	6" VALVE & ROADWAY BOX	586,553.05	1,360,553.57	373.37
40+84.32	TEST STATION	586,539.46	1,360,558.04	-
41+00.00	2.00" HD COUPLING (VERT.)	586,532.26	1,360,574.96	373.19

TEST PIT DATA		
TEST PIT NUMBER	TYPE OF UTILITY	TOP DEPTH
TH 19G	2" WRAPPED STEEL GAS PIPE	3.08
TH 20G	2" WRAPPED STEEL GAS PIPE	2.57
TH 21W	8" DUCTILE IRON WATER PIPE	3.75
TH 22W	SEE TEST HOLE REPORT	DRY
TH 23T	(6) 4" PLASTIC TELEPHONE CONDUITS	4.98
TH 24G	12" DUCTILE IRON WATER PIPE	4.60
TH 25G	2" WRAPPED STEEL GAS PIPE	2.50
TH 26E	5" STEEL ELECTRIC CONDUIT	3.76
TH 27E	5" STEEL ELECTRIC CONDUIT	3.40
TH 28G	6" STEEL GAS PIPE	2.82

Manhole #	Invert	Rim Elevation
954	389.23	380.40 +/-
955	371.14	381.40 +/-
956	371.70	383.55 +/-
2021	370.08	381.21 +/-
2022	371.88	383.50 +/-
2023	374.16	385.30 +/-

TRAVERSE COORDINATE SCHEDULE			
POINT	NORTHING	EASTING	ELEVATION
53	586,520.50	1,360,511.69	377.37
102	586,534.34	1,360,327.28	379.99

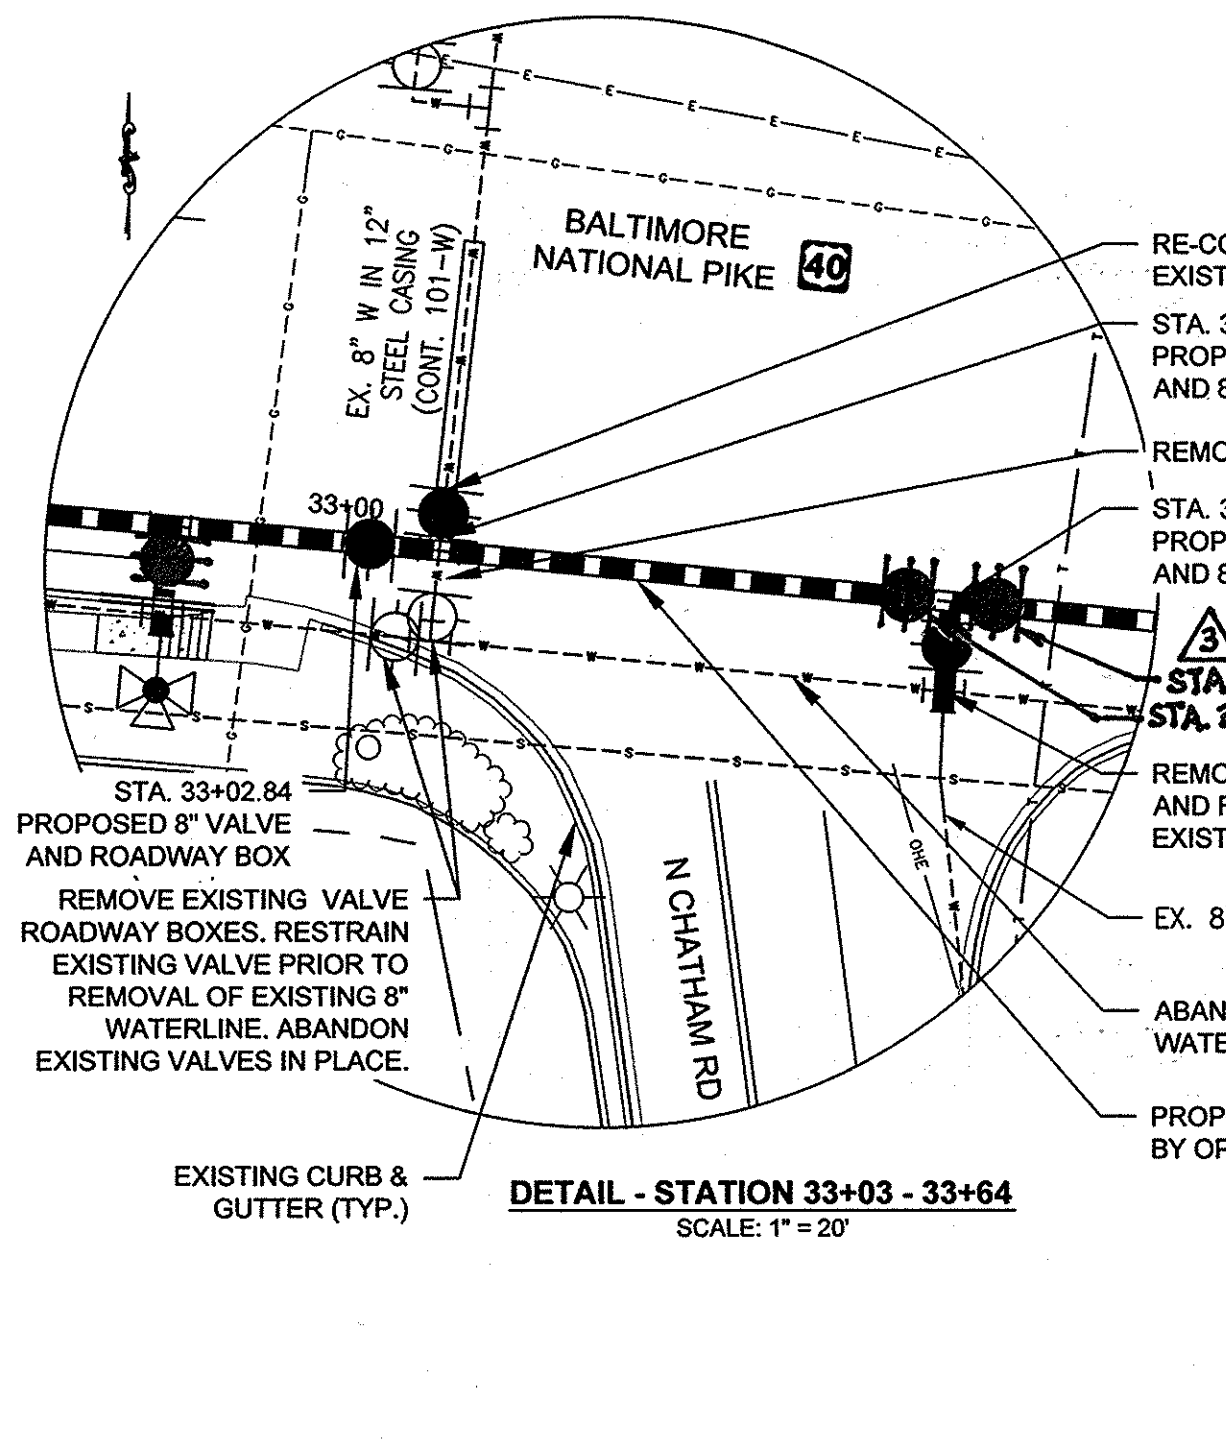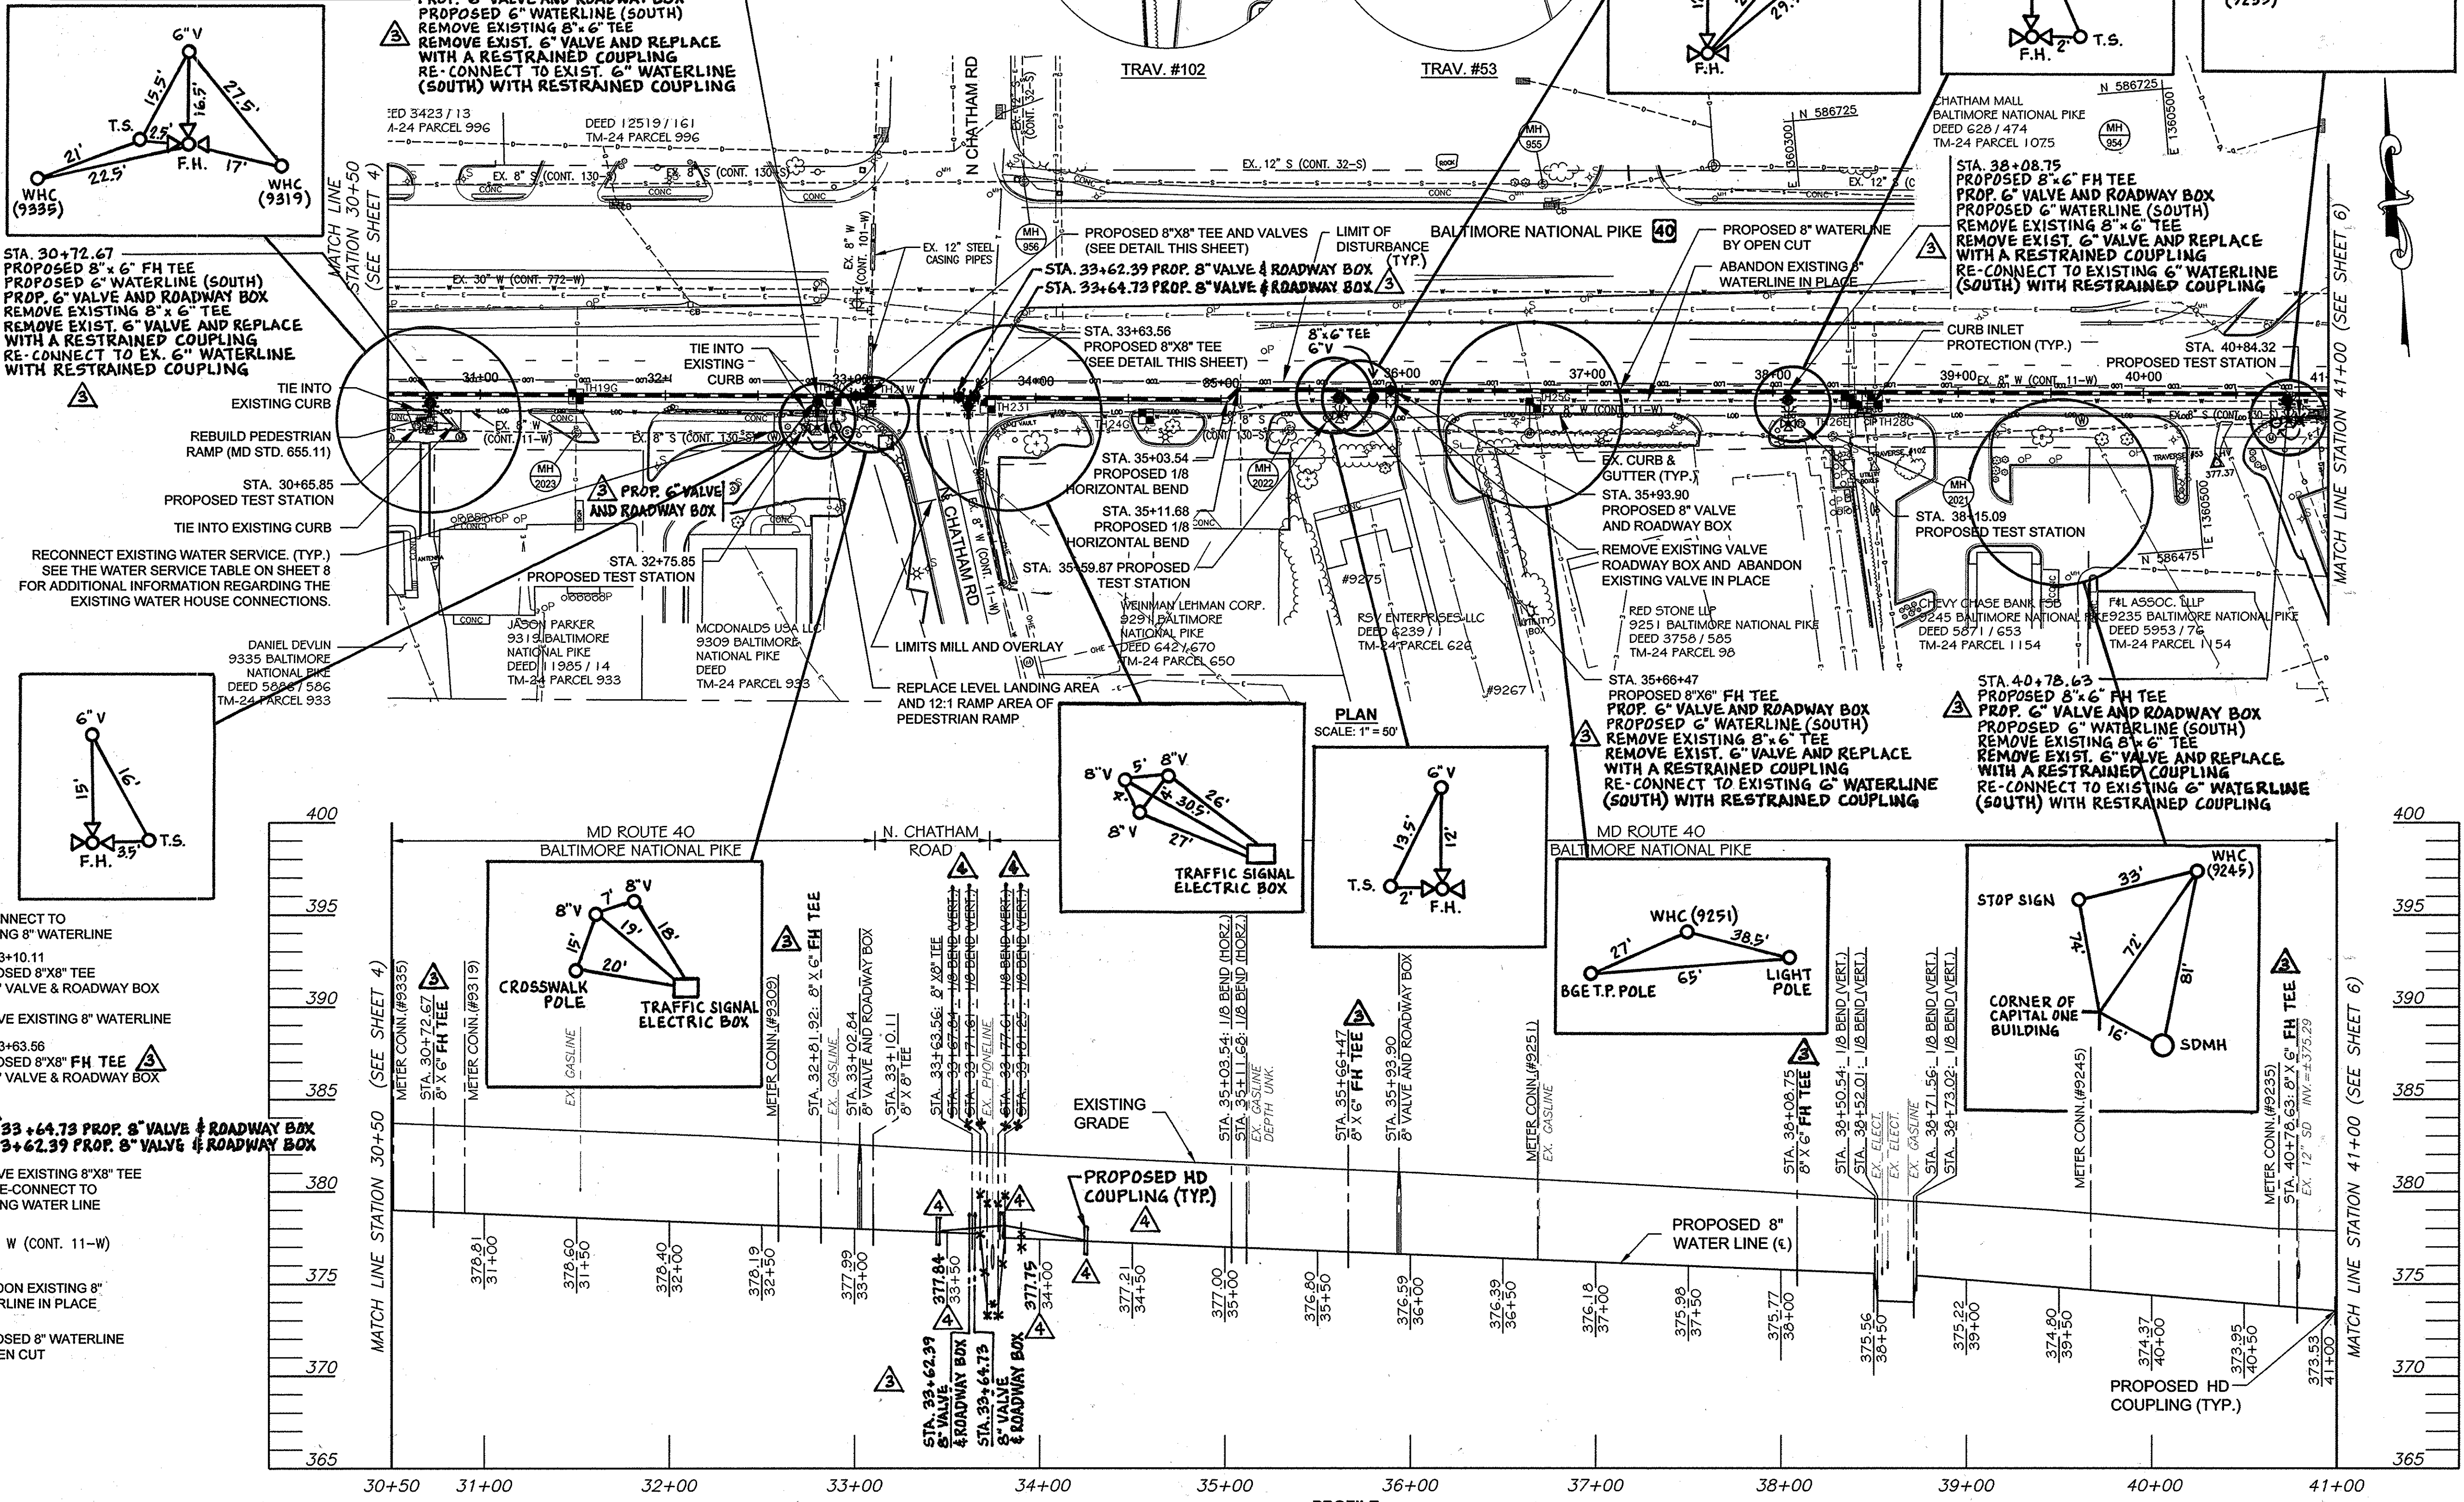

DEPARTMENT OF PUBLIC WORKS
 HOWARD COUNTY, MARYLAND
 Director of Public Works: *Jan G. Van* 3/13/13
 Chief, Bureau of Engineering: *Thomas R. Kotler* 3/13/13
 Chief, Bureau of Utilities: *Silvia C. Lewis* 3/13/13
 Chief, Utility Design Division: *W.D.* 3/12/13

URS
 MONTGOMERY PARK BUSINESS CENTER
 1800 WASHINGTON BOULEVARD, SUITE 410
 BALTIMORE, MARYLAND 21230
 (410) 468-0875

Professional Certification
 I hereby certify that these documents were prepared or approved by me, and that I am a duly licensed professional engineer under the laws of the State of Maryland, License No. 22817, Expiration Date: 08/01/13
 NATHAN C. ATKINSON

NO.	REVISION	DATE	BY
1	ADD PROP. 6" AND 8" VALVES & ROADWAY BOXES	11/15/2013	URS
2	REVISE 8" WATERLINE VERTICAL ALIGNMENT	11/22/2013	URS

8" WATER MAIN
 PLAN AND PROFILE
 STATION 30+50 - 41+00
 600' SCALE MAP NO. 24 BLOCK NO. 12

U.S. 40 WATER SERVICE MAIN REPLACEMENT
 CAPITAL PROJECT NO. W-8311
 CONTRACT NO. 44-4731
 6TH ELECTION DISTRICT
 HOWARD COUNTY, MARYLAND
 SCALE: AS SHOWN
 SHEET 5 OF 13



AS-BUILT 1/2015

Manhole #	Invert		Rim Elevation
953	367.53	364.00	377.30 +/-
1171	365.50	364.50	377.60 +/-
1172	375.48		385.60 +/-
1173	383.30		393.50 +/-
2017	368.32 (W)	363.06	378.23 +/-
2018	365.17	364.17	377.43 +/-
2019	372.48		383.50 +/-
2020	385.76		397.13 +/-

RECONNECT EXISTING WATER SERVICE. (TYP.) SEE THE WATER SERVICE TABLE ON SHEET 8 FOR ADDITIONAL INFORMATION REGARDING THE EXISTING WATER HOUSE CONNECTIONS.

WATER MAIN STAKE-OUT SCHEDULE				
Station	Fitting	Northing	Easting	Invert
41+20.00	2.50" HD COUPLING (VERT.)	586,550.43	1,360,594.88	372.32
41+82.11	METER CONNECTION	586,544.75	1,360,656.73	372.34
41+88.10	METER CONNECTION	586,544.20	1,360,662.69	372.34
42+74.00	TEST STATION	586,520.72	1,360,746.80	
42+80.00	8"x6" TEE	586,535.79	1,360,754.21	372.37
42+80.00	6" VALVE & ROADWAY BOX	586,531.18	1,360,753.78	372.37
42+80.00	FIRE HYDRANT (4'-6" BURY)	586,520.32	1,360,752.78	372.37
45+00.00	1.50" HD COUPLING (VERT.)	586,515.66	1,360,973.28	372.42
45+26.69	METER CONNECTION	586,513.72	1,360,999.86	373.10
46+14.78	8"x6" TEE	586,505.16	1,361,087.58	375.32
46+14.78	6" VALVE & ROADWAY BOX	586,503.98	1,361,087.65	375.32
46+21.07	TEST STATION	586,488.16	1,361,092.34	
46+51.68	1/8 BEND (HOR.)	586,501.78	1,361,124.33	376.26
46+63.41	1/8 BEND (HOR.)	586,492.77	1,361,131.83	376.55
46+69.41	0.50" HD COUPLING (VERT.)	586,492.22	1,361,137.80	376.71
46+97.28	METER CONNECTION	586,489.69	1,361,165.56	377.64
48+15.30	METER CONNECTION	586,478.98	1,361,283.09	381.59
49+44.00	TEST STATION	586,457.53	1,361,410.37	
49+50.00	8"x6" TEE	586,466.76	1,361,417.23	386.10
49+50.00	6" VALVE & ROADWAY BOX	586,462.15	1,361,416.81	386.10
49+50.00	FIRE HYDRANT (6'-0" BURY)	586,457.12	1,361,416.36	386.10
49+78.61	METER CONNECTION	586,464.17	1,361,445.73	387.05
50+20.00	0.50" HD COUPLING (VERT.)	586,460.41	1,361,486.95	388.44
50+79.92	METER CONNECTION	586,454.97	1,361,546.62	391.07
51+16.88	1.33" HD COUPLING (VERT.)	586,451.62	1,361,583.43	392.69

TEST PIT DATA		
TEST PIT NUMBER	TYPE OF UTILITY	TOP DEPTH
TH 29G	(3) 1" ELECTRIC CABLES	3.28
TH 29G A	SEE TEST HOLE REPORT	DRY
TH 30G	8" DUCTILE IRON WATER PIPE	3.42
TH 31W	8" DUCTILE IRON WATER PIPE	4.34
TH 32G	1" WRAPPED STEEL GAS PIPE	2.66
TH 33G	1/2" PLASTIC GAS PIPE	3.78
TH 33G A	6" PLASTIC ELECTRIC CONDUIT	2.62

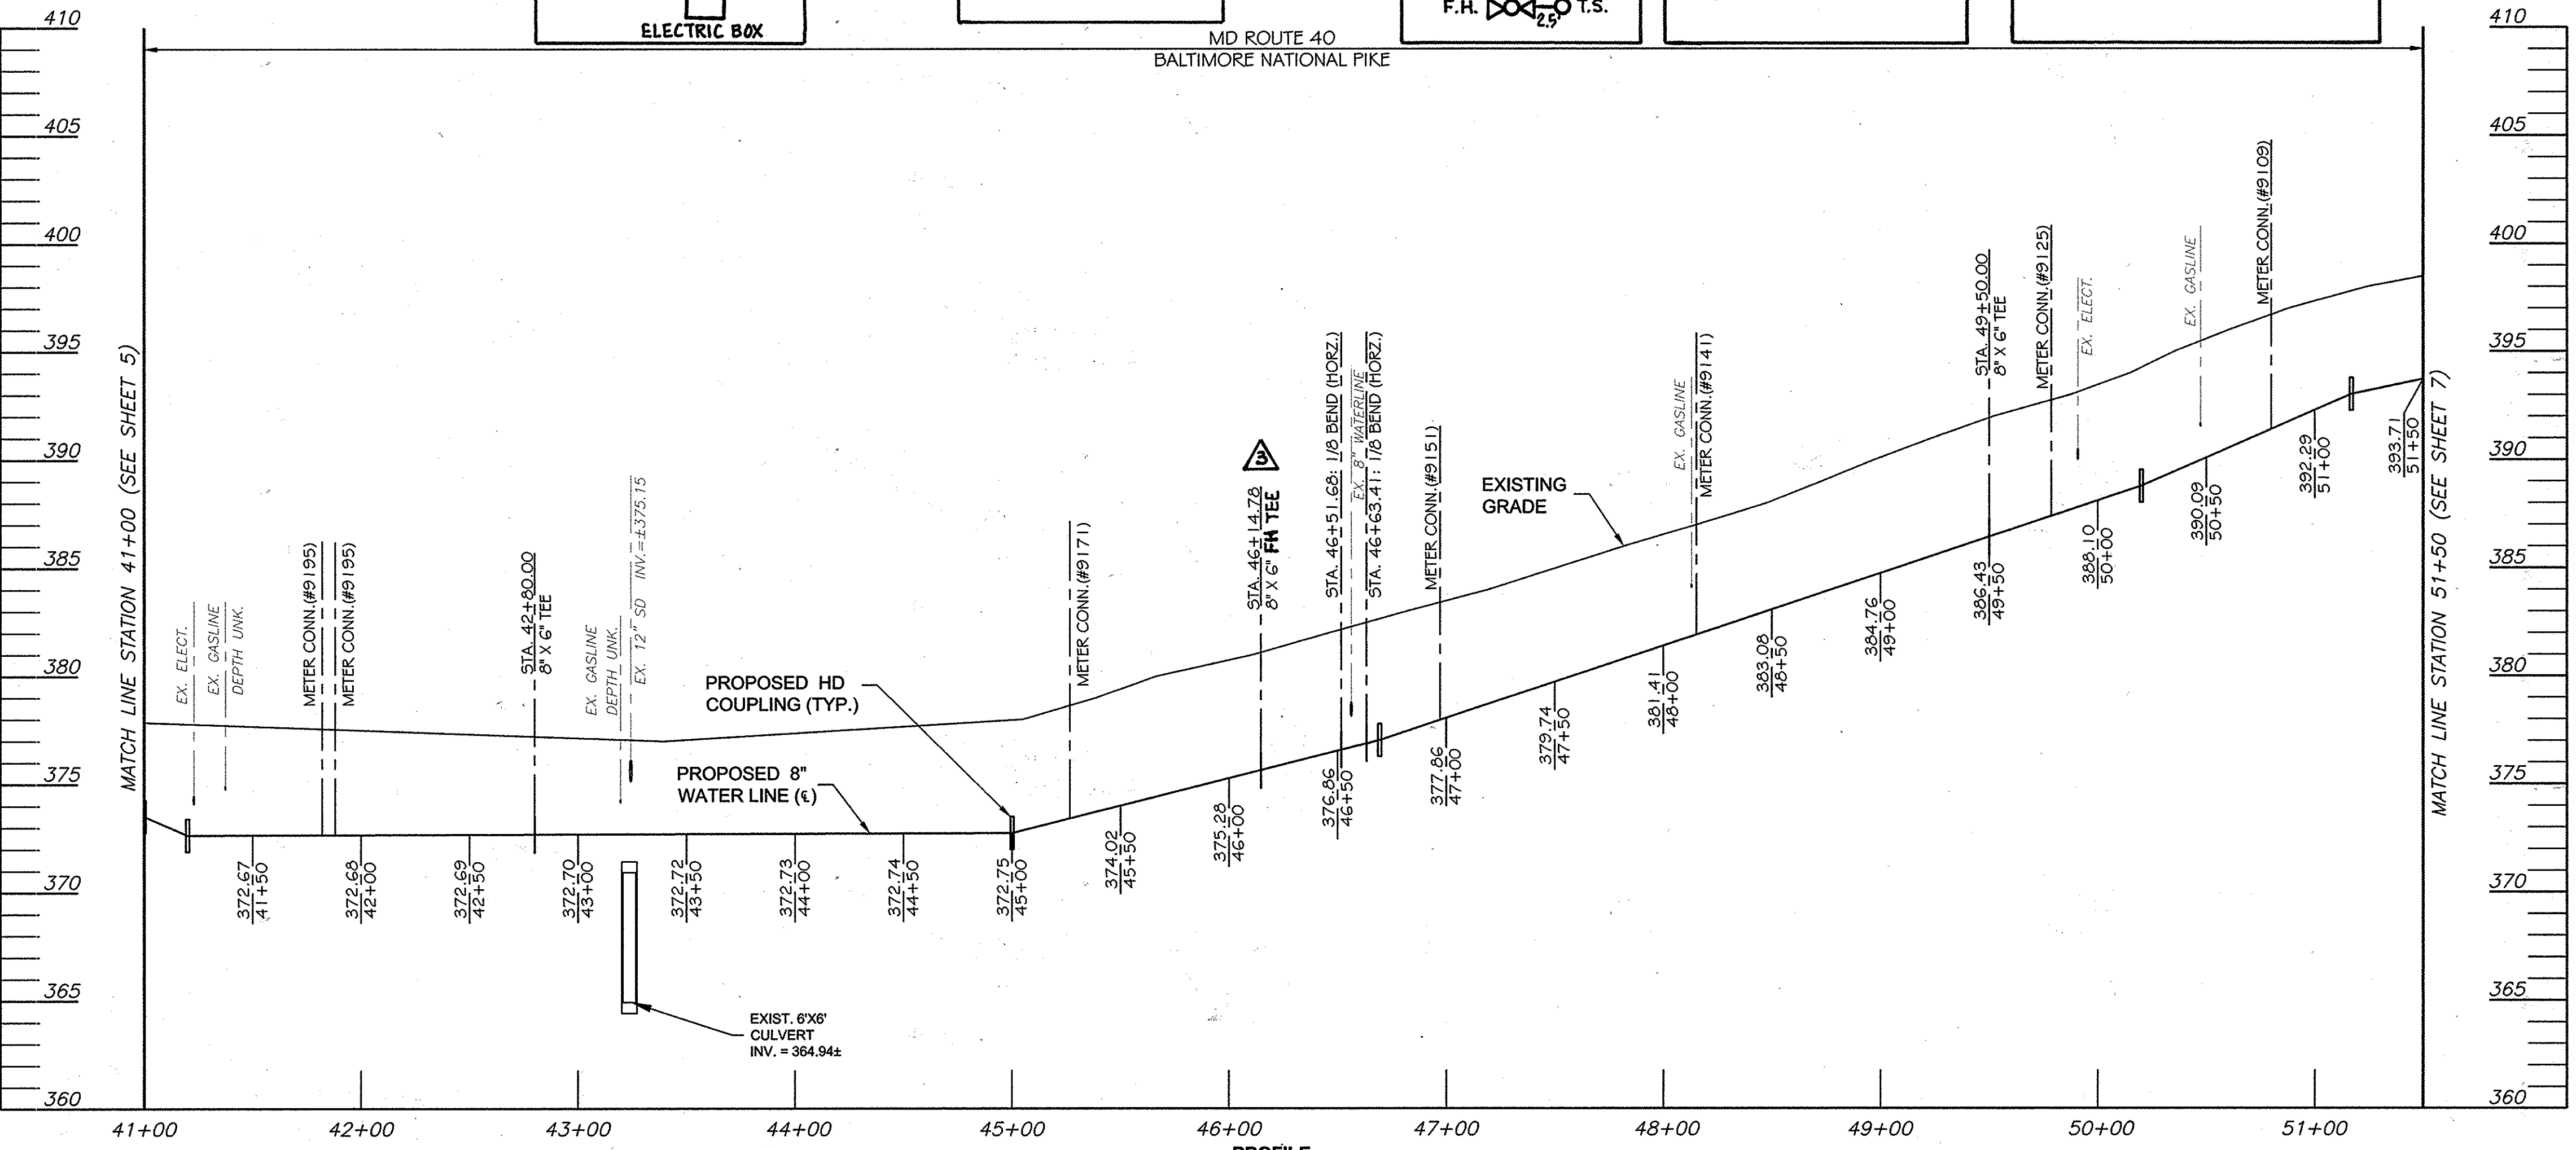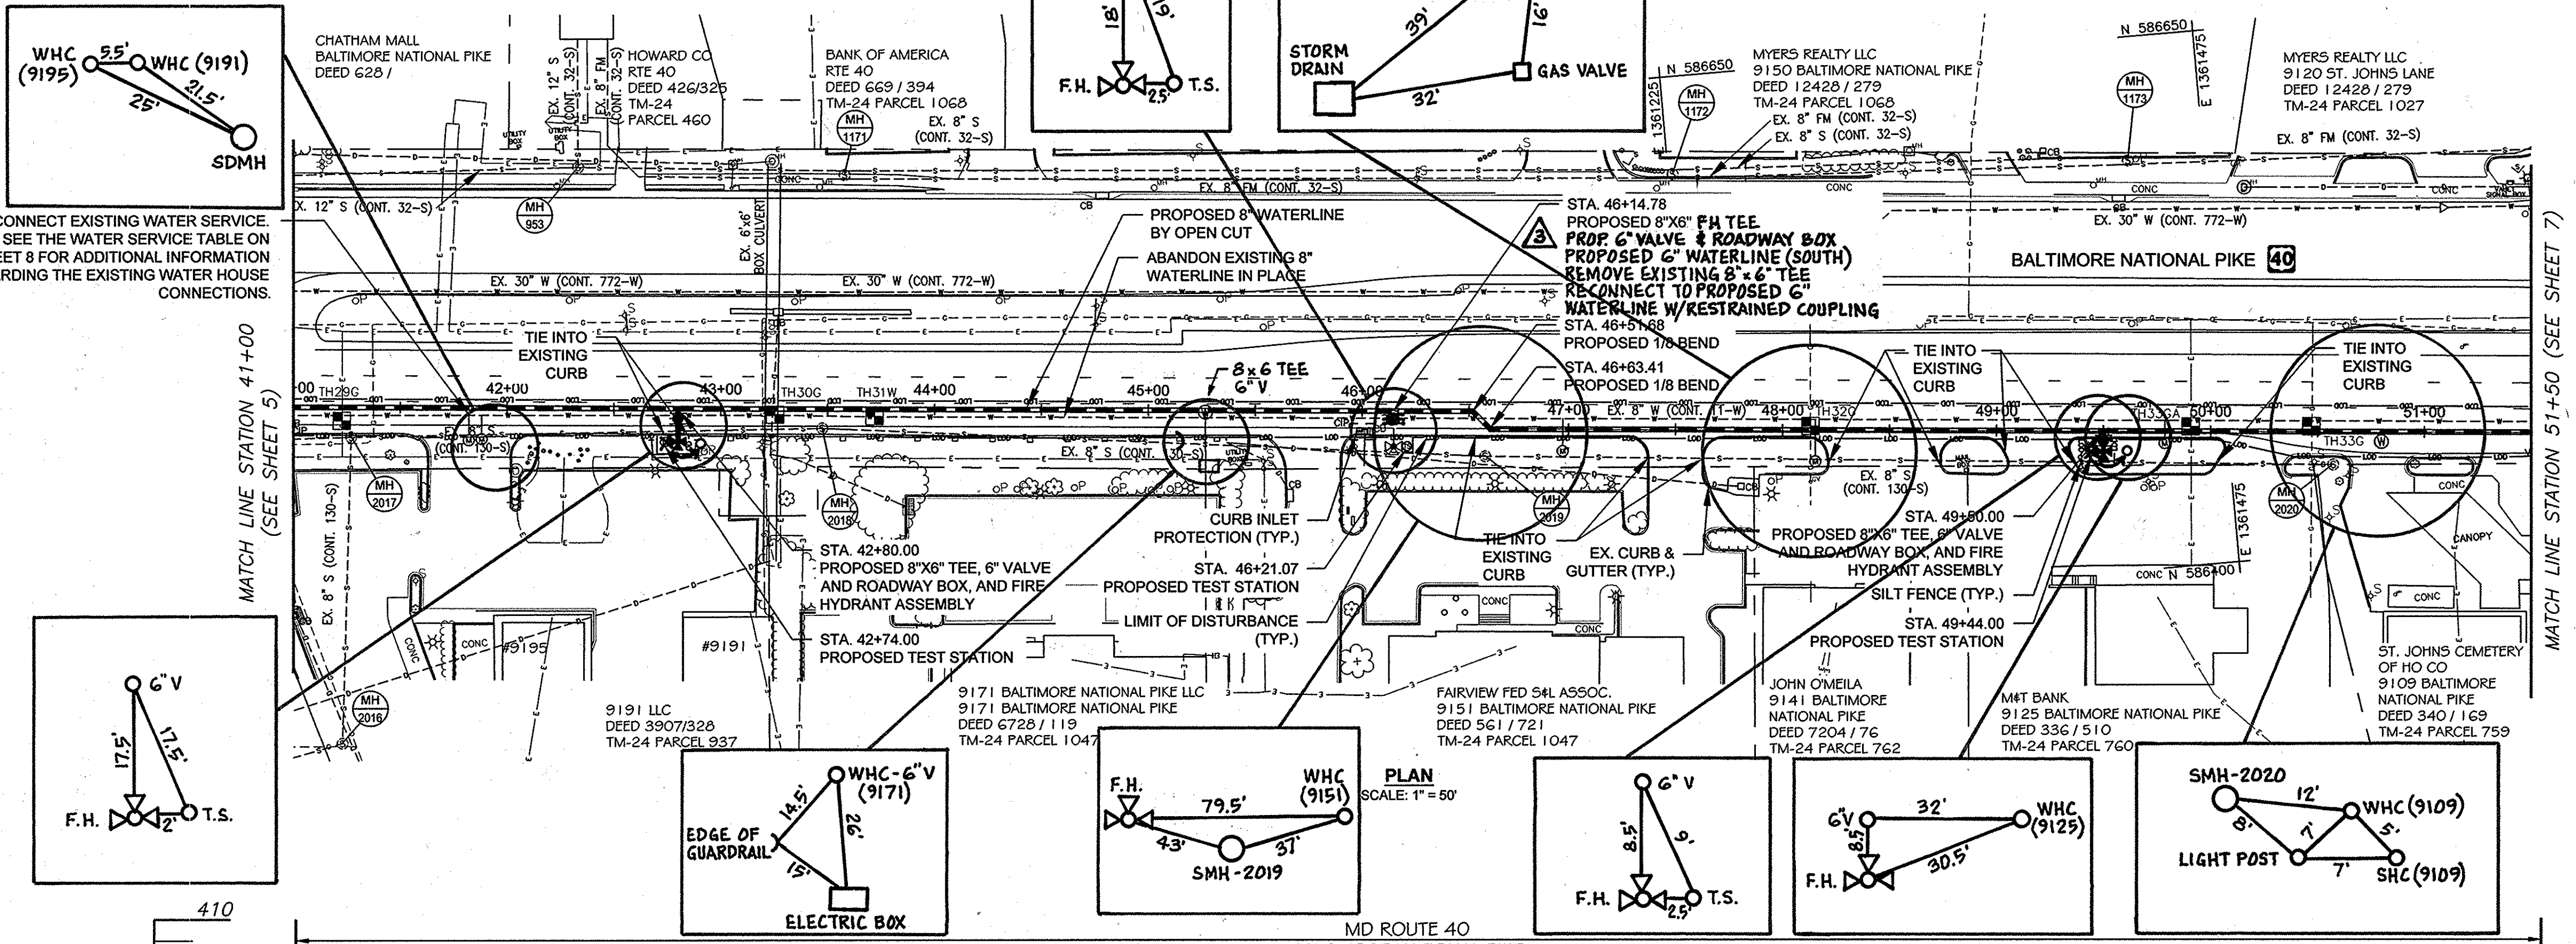

DEPARTMENT OF PUBLIC WORKS
HOWARD COUNTY, MARYLAND

Jan P. Van 3/13/13
DIRECTOR OF PUBLIC WORKS DATE

Thomas S. Buttle 3/13/13
CHIEF, BUREAU OF ENGINEERING DATE

William C. Lewis 3/13/13
CHIEF, BUREAU OF UTILITIES DATE

Op. Design 3/12/13
CHIEF, UTILITY DESIGN DIVISION DATE

URS
MONTGOMERY PARK BUSINESS CENTER
1800 WASHINGTON BOULEVARD, SUITE 410
BALTIMORE, MARYLAND 21230
(410) 468-0875

Professional Certification
I hereby certify that these documents were prepared or approved by me, and that I am a duly licensed professional engineer under the laws of the State of Maryland, License No. 22817, Expiration Date: 08/01/13

NATHAN C. ATKINSON

DESIGN: NCA	ADD PROP. 6" AND 8" VALVE AND ROADWAY BOX	11/15/2013	URS
DRAWN: BJW			
CHK: EMT			
DATE: 3/7/13			
NO.	REVISION	DATE	BY

8" WATER MAIN
PLAN AND PROFILE
STATION 41+00 - 51+50

600' SCALE MAP NO. 24 BLOCK NO. 12




U.S. 40 WATER SERVICE MAIN REPLACEMENT
CAPITAL PROJECT NO. W-8311
CONTRACT NO. 44-4731
6TH ELECTION DISTRICT
HOWARD COUNTY, MARYLAND

SCALE:
AS SHOWN
SHEET
6 OF 13

AS-BUILT 1/2015



WATER MAIN STAKE-OUT SCHEDULE				
Station	Fitting	Northing	Easting	Invert
51+66.88	8"x6" TEE	586,447.07	1,361,633.32	393.73
51+67.06	6" VALVE AND ROADWAY BOX	586,441.34	1,361,632.88	393.73
51+74.47	TEST STATION	586,431.25	1,361,639.40	-
51+75.87	1/16 BEND (VERT.)	586,446.27	1,361,642.17	393.92
51+78.61	1/16 BEND (VERT.)	586,446.02	1,361,644.90	395.10
51+81.61	1/8 BEND (HOR.)	586,445.75	1,361,647.89	395.15
51+88.68	1/8 BEND (HOR.)	586,450.27	1,361,653.32	395.27
51+92.68	CONNECT TO EXISTING	586,449.91	1,361,657.30	395.39
52+12.85	CONNECT TO EXISTING	586,448.02	1,361,677.38	395.62
52+16.85	1/8 BEND (HOR.)	586,447.64	1,361,681.36	395.73
52+23.86	1/8 BEND (HOR.)	586,442.24	1,361,685.84	395.85
52+55.88	2.25" HD COUPLING (HOR.)	586,439.25	1,361,717.72	396.23
53+00.00	0.50" HD COUPLING (VERT.)	586,436.86	1,361,761.77	396.76
53+95.86	0.50" HD COUPLING (HOR.)	586,431.66	1,361,857.49	397.07
54+20.00	0.50" HD COUPLING (VERT.)	586,430.58	1,361,881.61	397.15
54+40.86	METER CONNECTION	586,429.61	1,361,902.45	397.04
54+54.29	TEST STATION	586,420.54	1,361,915.48	-
54+55.86	2.00" HD COUPLING (HOR.)	586,428.92	1,361,917.43	396.96
54+60.00	8"x6" TEE	586,428.88	1,361,921.57	396.94
54+60.00	6" VALVE AND ROADWAY BOX	586,424.25	1,361,921.52	396.94
54+60.00	FIRE HYDRANT (5'-5" BURY)	586,420.47	1,361,921.48	396.94
55+00.00	1.00" HD COUPLING (VERT.)	586,428.45	1,361,961.57	396.72
55+15.86	0.50" HD COUPLING (HOR.)	586,428.29	1,361,977.43	396.35
55+75.86	1.00" HD COUPLING (HOR.)	586,428.17	1,362,037.43	394.88
56+23.55	METER CONNECTION	586,428.91	1,362,085.11	393.89
56+35.86	1.00" HD COUPLING (HOR.)	586,429.10	1,362,097.42	393.61
56+40.00	2.00" HD COUPLING (VERT.)	586,429.24	1,362,101.56	393.51
56+62.37	METER CONNECTION	586,429.98	1,362,123.92	392.22
56+90.00	2.25" HD COUPLING (VERT.)	586,430.89	1,362,151.53	390.62
57+05.57	8"x6" TEE	586,431.40	1,362,167.09	390.33
57+05.57	6" VALVE & ROADWAY BOX	586,430.23	1,362,167.10	390.33
57+11.89	TEST STATION	586,417.91	1,362,174.16	-
57+40.00	1.25" HD COUPLING (VERT.)	586,433.29	1,362,201.47	389.69
57+57.97	METER CONNECTION	586,434.27	1,362,219.41	388.97
57+65.57	1.25" HD COUPLING (HOR.)	586,434.69	1,362,227.01	388.66
58+25.57	1.00" HD COUPLING (HOR.)	586,439.28	1,362,286.83	386.24
58+40.00	0.75" HD COUPLING (VERT.)	586,440.64	1,362,301.19	385.65
58+85.57	0.75" HD COUPLING (HOR.)	586,444.92	1,362,346.56	383.22
59+45.57	1.25" HD COUPLING (HOR.)	586,451.33	1,362,406.22	380.01
60+00.00	0.50" HD COUPLING (VERT.)	586,458.34	1,362,460.19	377.09
60+05.57	1.00" HD COUPLING (HOR.)	586,459.05	1,362,465.72	376.75
60+24+00	TEST STATION	586,450.69	1,362,485.58	-
60+30.00	8"x6" TEE	586,462.62	1,362,489.89	375.23
60+30.00	6" VALVE AND ROADWAY BOX	586,458.04	1,362,490.56	375.23
60+30.00	FIRE HYDRANT (5'-5" BURY)	586,451.57	1,362,491.52	375.23
60+41.23	1/8 BEND (HOR.)	586,464.25	1,362,501.00	374.53
60+46.74	1/8 BEND (HOR.)	586,468.68	1,362,504.28	374.18
60+50.69	CONNECT TO EXISTING	586,469.23	1,362,508.19	373.94

TEST PIT DATA		
TEST PIT NUMBER	TYPE OF UTILITY	TOP DEPTH
TH 34E	4" STEEL ELECTRIC CONDUIT	2.70
TH 35T	(4) 4" PLASTIC TELEPHONE CONDUITS	5.04
TH 36G	6" WRAPPED STEEL GAS PIPE	4.68
TH 37W	8" DUCTILE IRON WATER PIPE	5.18
TH 38G	1" WRAPPED STEEL GAS PIPE	2.44
TH 38G A	4" PLASTIC ELECTRIC CONDUIT	1.74
TH 38G B	1" STEEL GAS PIPE	3.62
TH 39G	1" PLASTIC GAS PIPE	2.30
TH 40G	NO USE UTILITY MARKS OR ELECTRICAL SIGNALS OR RECORDS OR LINES UNLESS SHOWN OTHERWISE FROM THE 20' AND FORWARD TO UTILITY.	N/A
TH 41W	8" DUCTILE IRON WATER PIPE	3.96

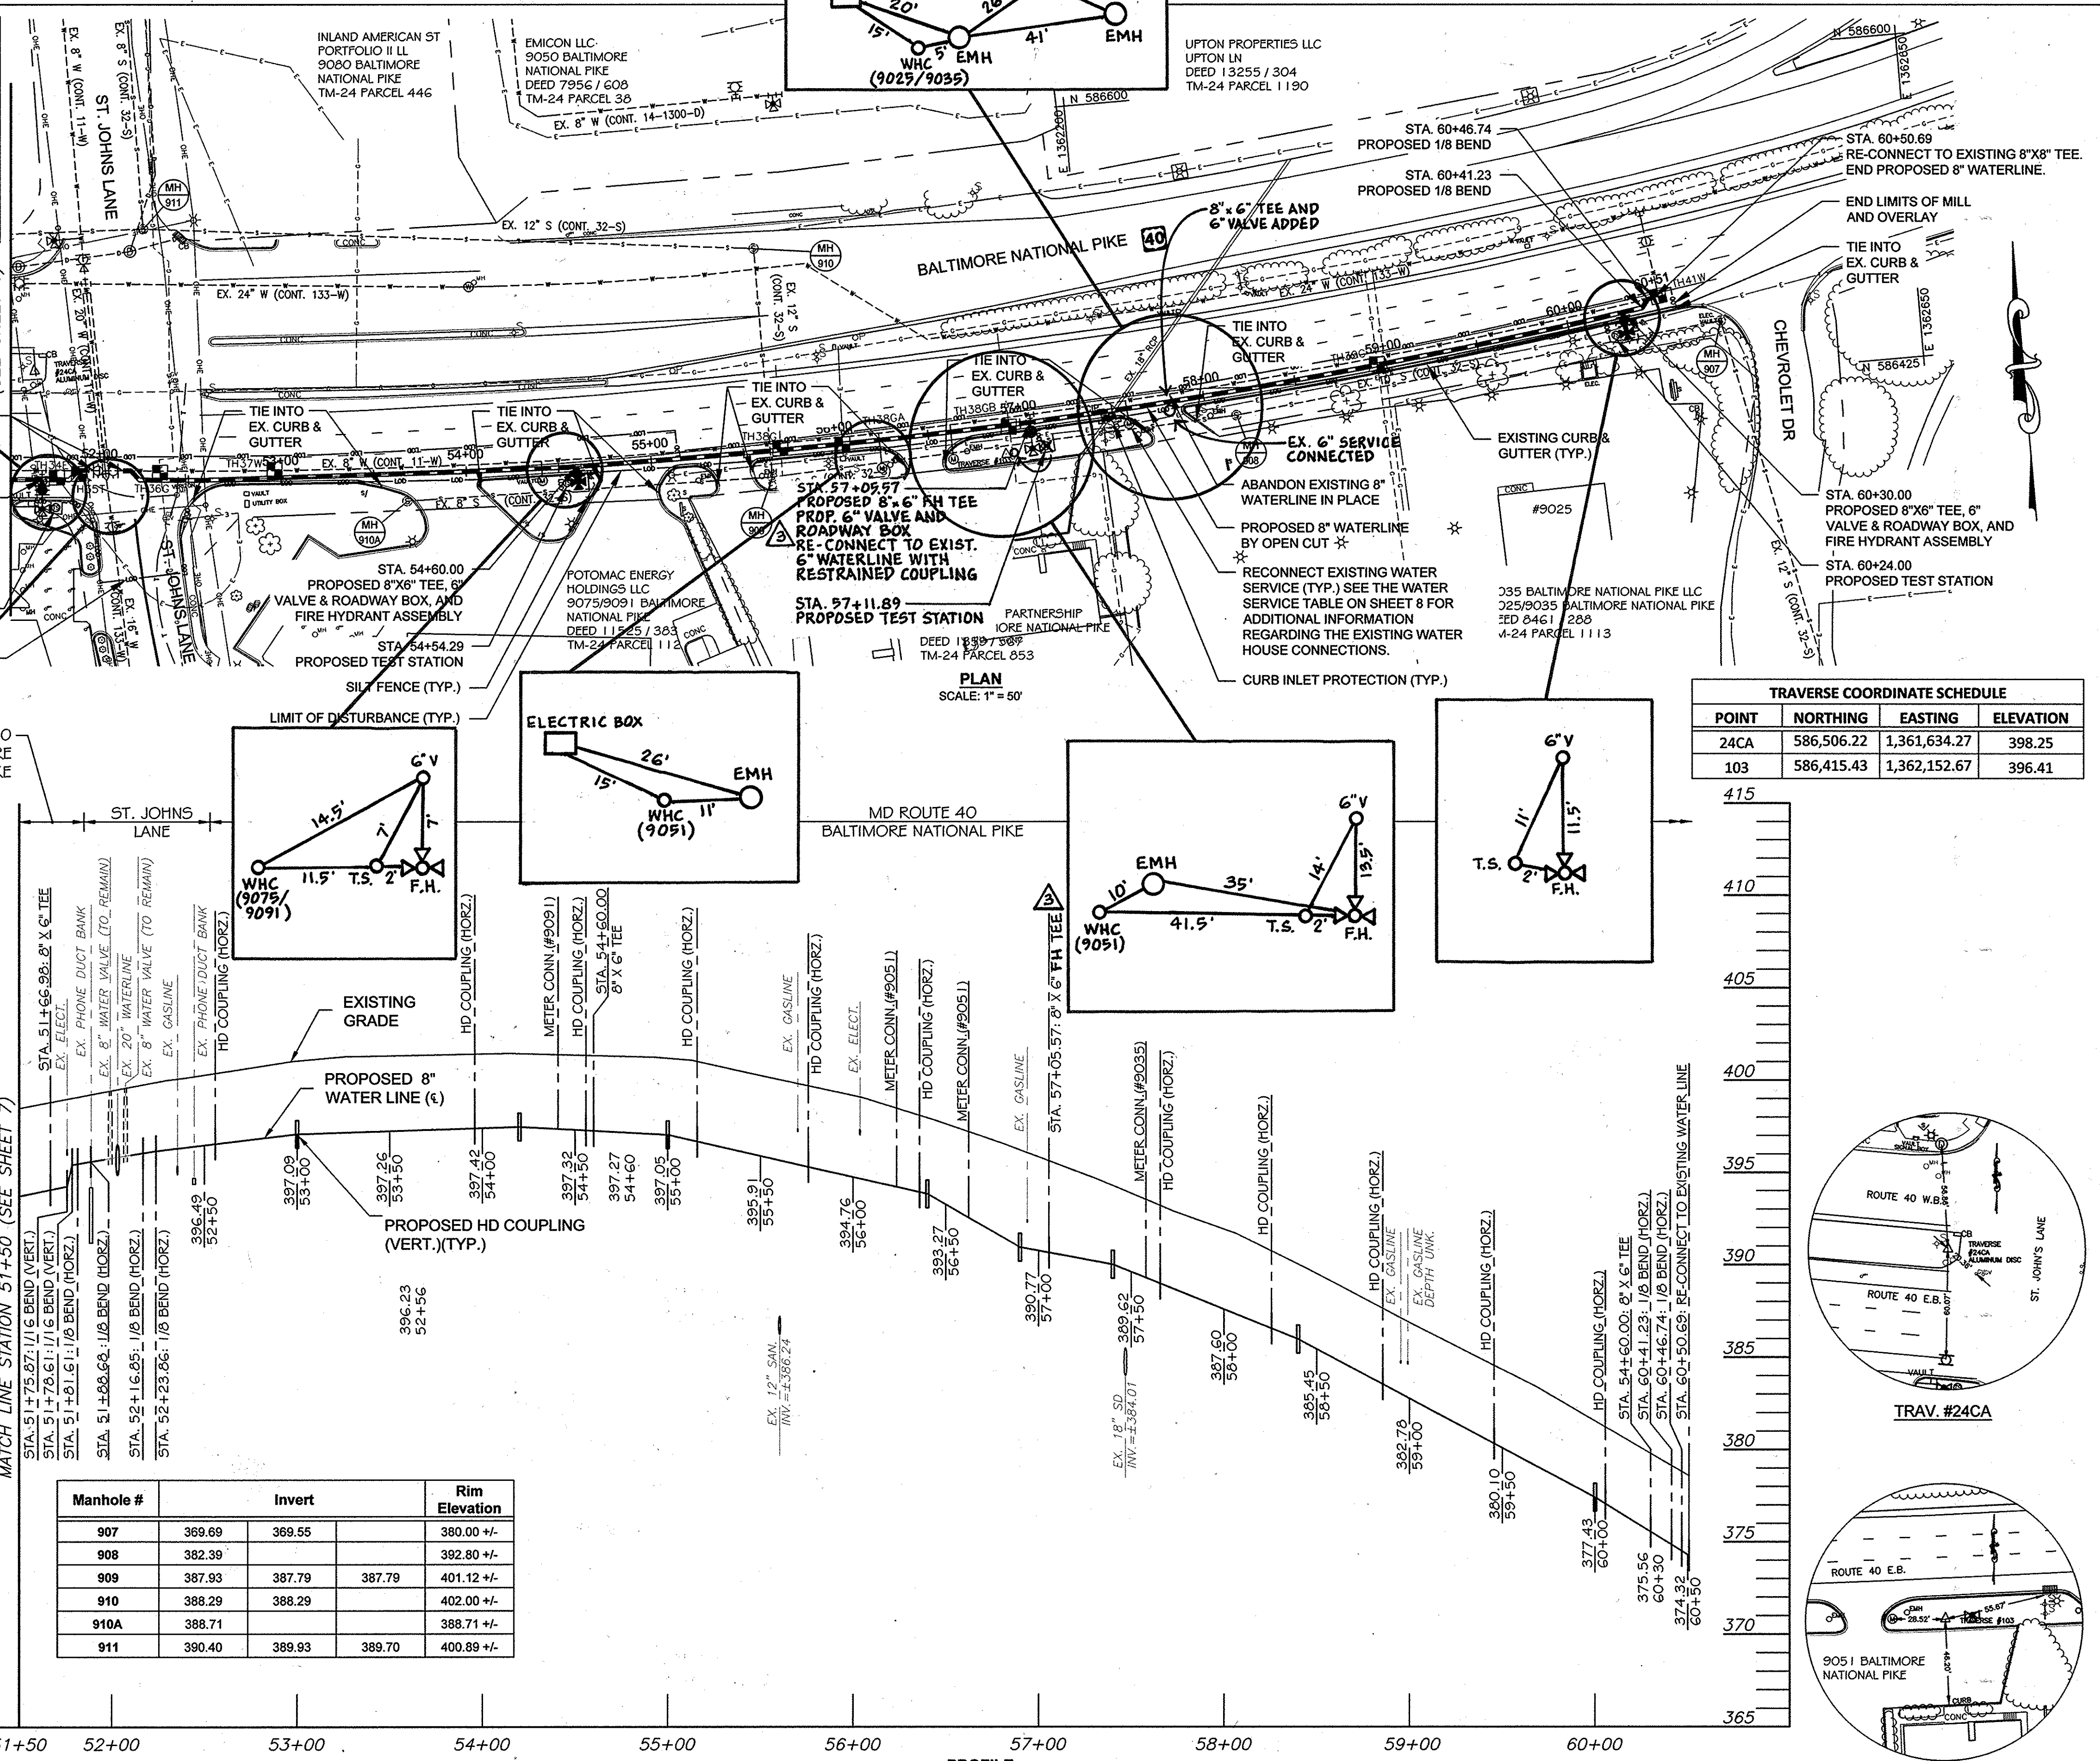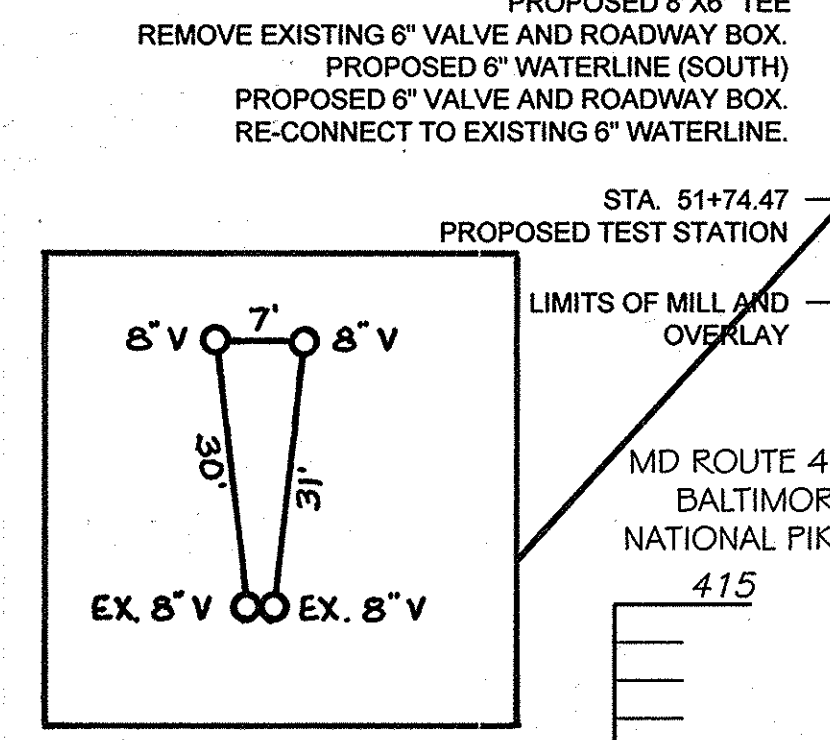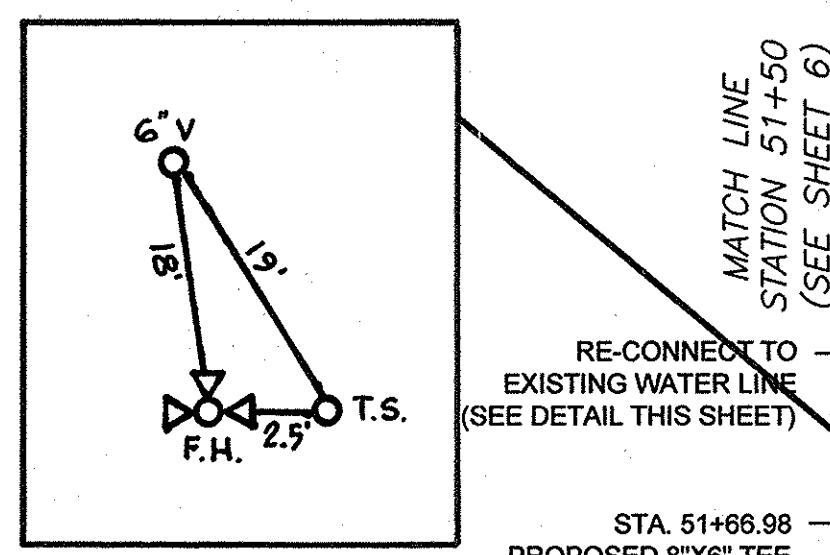

Manhole #	Invert	Rim Elevation
907	369.69	369.55
908	382.39	382.80
909	387.93	387.79
910	388.29	388.29
910A	388.71	388.71
911	390.40	389.70

TRAVERSE COORDINATE SCHEDULE			
POINT	NORTHING	EASTING	ELEVATION
24CA	586,506.22	1,361,634.27	398.25
103	586,415.43	1,362,152.67	396.41

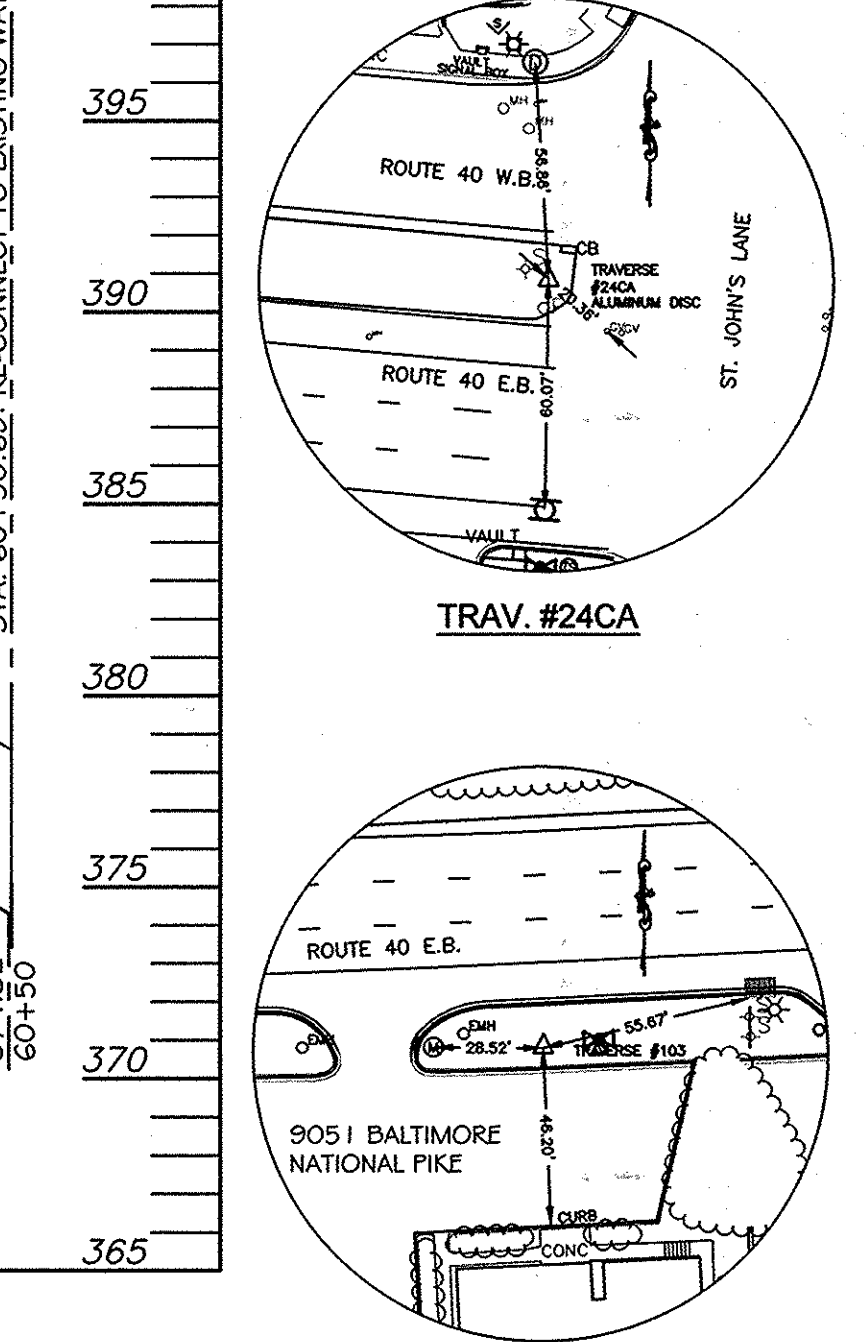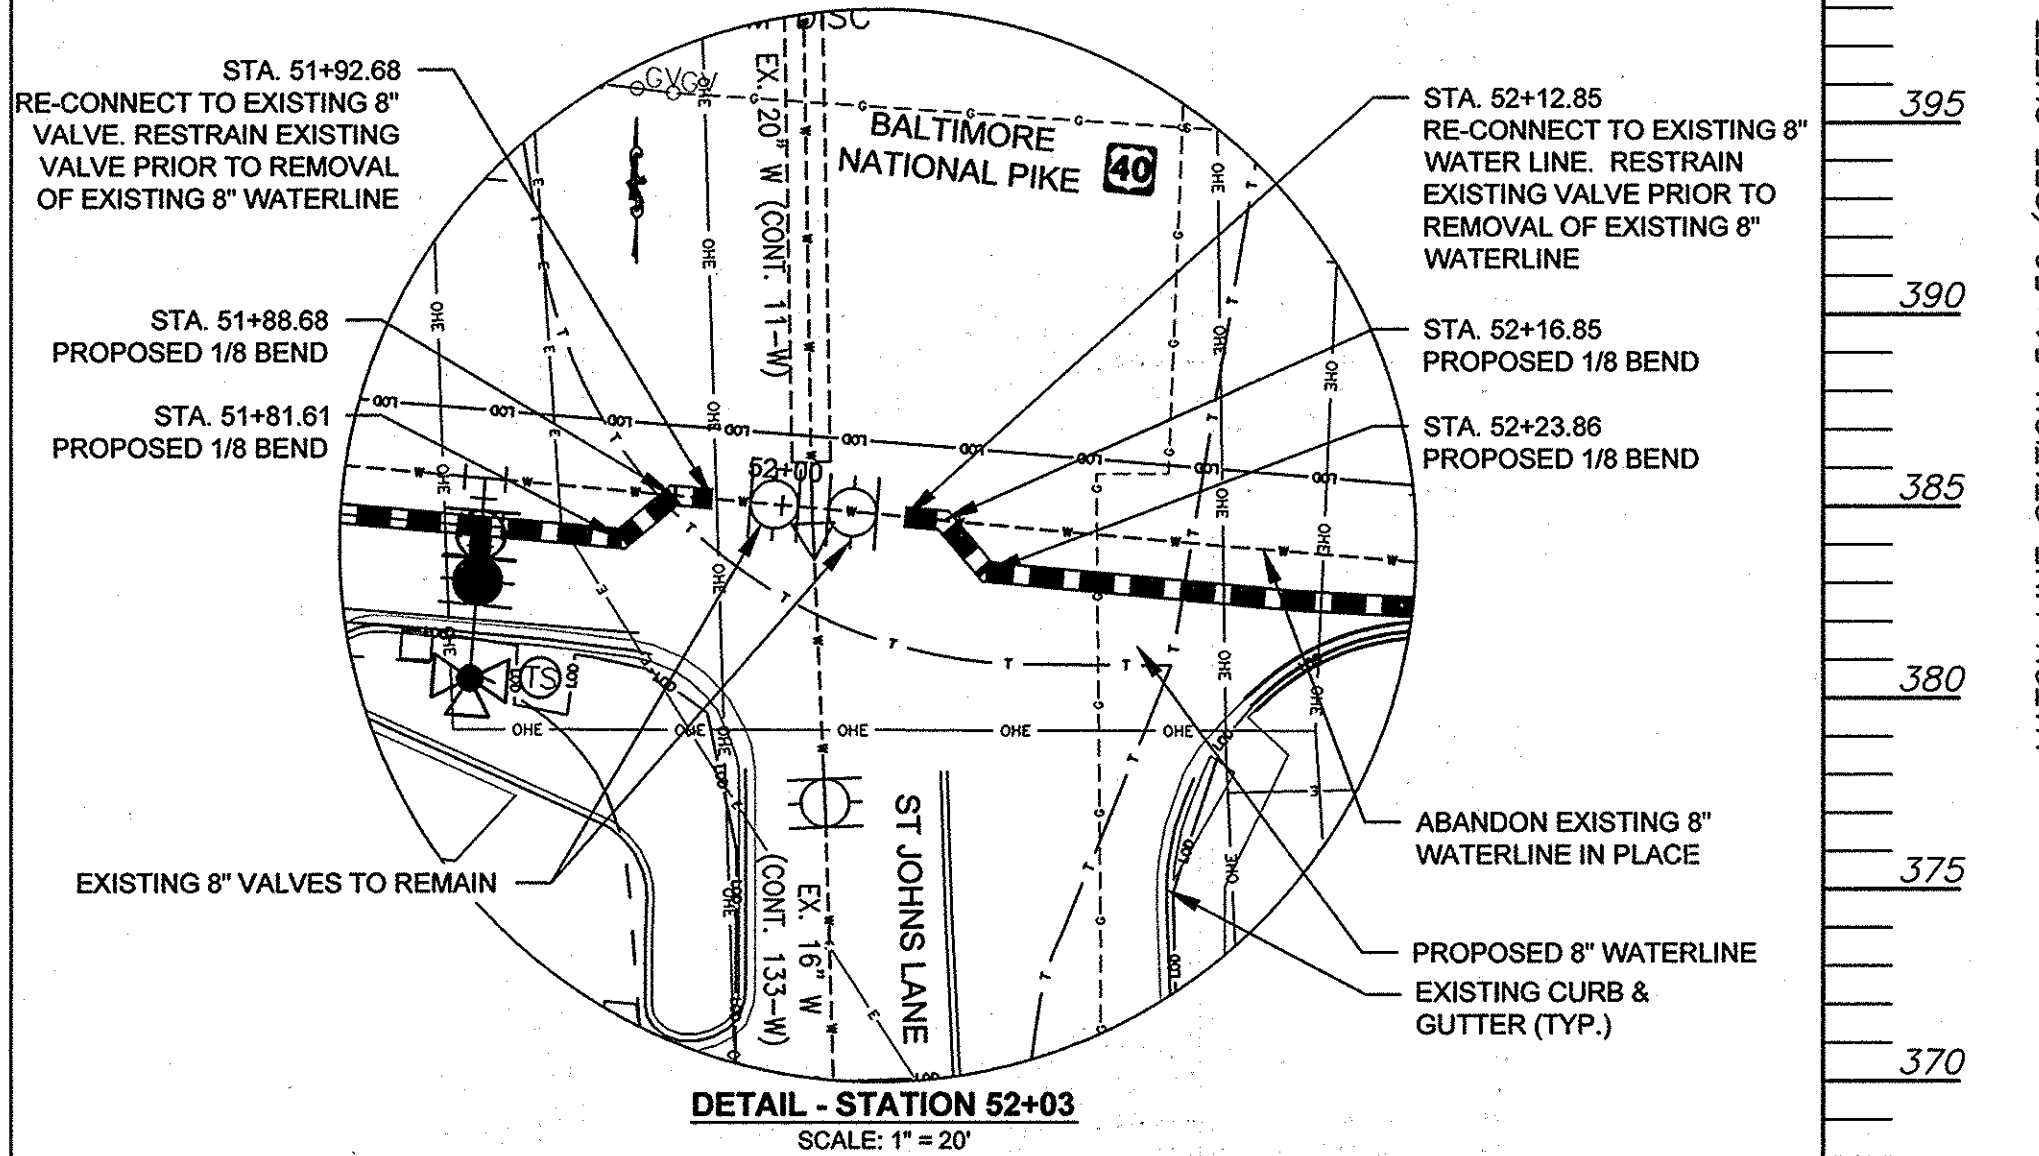

DEPARTMENT OF PUBLIC WORKS
 HOWARD COUNTY, MARYLAND
 Director of Public Works: *John G. ...* 3/13/13
 Chief, Bureau of Engineering: *Thomas J. Butler* 3/13/13
 Chief, Bureau of Utilities: *Silvia ...* 3/13/13
 Chief, Utility Design Division: *O. ...* 3/12/13

URS
 MONTGOMERY PARK BUSINESS CENTER
 1800 WASHINGTON BOULEVARD, SUITE 410
 BALTIMORE, MARYLAND 21230
 (410) 468-0875
 Professional Certification: I hereby certify that these documents were prepared or approved by me, and that I am a duly licensed professional engineer under the laws of the State of Maryland, License No. 22817, Expiration Date: 08/01/13
 NATHAN C. ATKINSON



DESIGN:	DATE:	BY:	REVISION:	DATE:	BY:
NCA	11/19/2013	URS	PROP. 6" VALVE AND ROADWAY BOX	11/19/2013	URS
BJW					
EMT					
NO.					

U.S. 40 WATER SERVICE MAIN REPLACEMENT
 CAPITAL PROJECT NO. W-8311
 CONTRACT NO. 44-4731
 6TH ELECTION DISTRICT
 HOWARD COUNTY, MARYLAND
 SCALE: AS SHOWN
 SHEET 7 OF 13

AS-BUILT 1/2015

US ROUTE 40 WATER MAIN REPLACEMENT - WATER SERVICE TABLE										
Address #	Road Name	WHC Size	As-Built WHC Size	Domestic Meter Size	As-Built WM Vault used based on Domestic Meter Size (if outside)	Fire Meter Size	Assumed Service length in public R/W	As-Built length in public R/W (if)	Remarks	As-Built Remarks
9025	Baltimore National Pike	6" (shared)		1" (inside)			25		2 buildings on this parcel, it appears one 6" line from main may serve both buildings	
9035	Baltimore National Pike			5/8" (inside)		6" (inside)				
9051	Baltimore National Pike	3/4"		5/8"			25		2 services to this parcel, multiple bldgs	
9075	Baltimore National Pike	2"		2" (inside)			25			
9109	Baltimore National Pike	1"		3/4"			25			
9125	Baltimore National Pike	1"		3/4"			25			
9141	Baltimore National Pike	1 1/2"		1 1/2"			25			
9151	Baltimore National Pike	2"		2"			25			
9171	Baltimore National Pike	6" (shared)		1 1/2" (inside)		6" (inside)	25		2 services to this parcel, 2 bldgs	
9191	Baltimore National Pike	1 1/2"		1 1/2" (inside)			25			
9195	Baltimore National Pike	1 1/2"		1 1/2" (inside)			25		2 services to this parcel, 2 bldgs	
9235	Baltimore National Pike	1 1/2"		1" (inside)			25			
9245	Baltimore National Pike	1"		3/4" (inside)			25			
9251	Baltimore National Pike	1 1/2"		1 1/2" (outside)			25			
9267	Baltimore National Pike	2"		2" (inside)			25		possibly one tee, then split into 2 separate services on-site - curb stops not shown on plans	
9275	Baltimore National Pike	6" (shared)		1 1/2" (inside)		4" (inside)	25			
9291	Baltimore National Pike				n/a				water served from Chatham Road WM	
9309	Baltimore National Pike	1 1/2"		1 1/2" (outside)			25			
9319	Baltimore National Pike	1"		1" (outside)			25			
9335	Baltimore National Pike	3/4"		5/8" (inside)			25			
9337	Baltimore National Pike	3/4"		5/8" (inside)			25			
9339	Baltimore National Pike	2"		1 1/2" (inside)			25			
3410	Plumtree Drive				n/a				water served from Plumtree Drive WM	
9395	Baltimore National Pike	1"		3/4"			25			
9435	Baltimore National Pike	1"		3/4" (outside)			25			
9441	Baltimore National Pike	1 1/2"		1" (outside)			25			
9445	Baltimore National Pike	1"		3/4" (outside)			25			
9449	Baltimore National Pike	1"		3/4" (outside)			60		or 9461? (served thru R/W on 9455 parcel)	
9455	Baltimore National Pike	2"		2" (inside)			25			
9469	Baltimore National Pike	6"		2" (inside)		6" (inside)	25			

- Notes:
- Meter & WHC size information from meter cards obtained from Bureau of Utilities 2/25/2011.
 - If inside/outside meter not clarified, meter location unknown/ All meter locations must be field verified.
 - Outside Meter Note: Contractor shall reconnect all existing water services encountered to proposed 8" waterline. Provide new materials from water main to property owner side of water meter, including new piping, fittings, tapping saddle, corporation cock assembly, water meter vault, frame & cover, valves, meter setter assembly & couplings. Transfer existing water meter from existing meter vault to new meter vault. See Howard County Standard Details W3.27, W3.28, W3.29 & W3.34. Please note that only concrete meter vaults will be accepted (no polyethylene meter vaults).
 - Inside Meter Note: Contractor shall reconnect all existing water services encountered to proposed 8" waterline. Provide new materials from water main to property owner side of curb stop, including new piping, fittings, tapping saddle, corporation cock assembly, couplings, valves, and valve roadway box. See Howard County Standard Details W3.21.

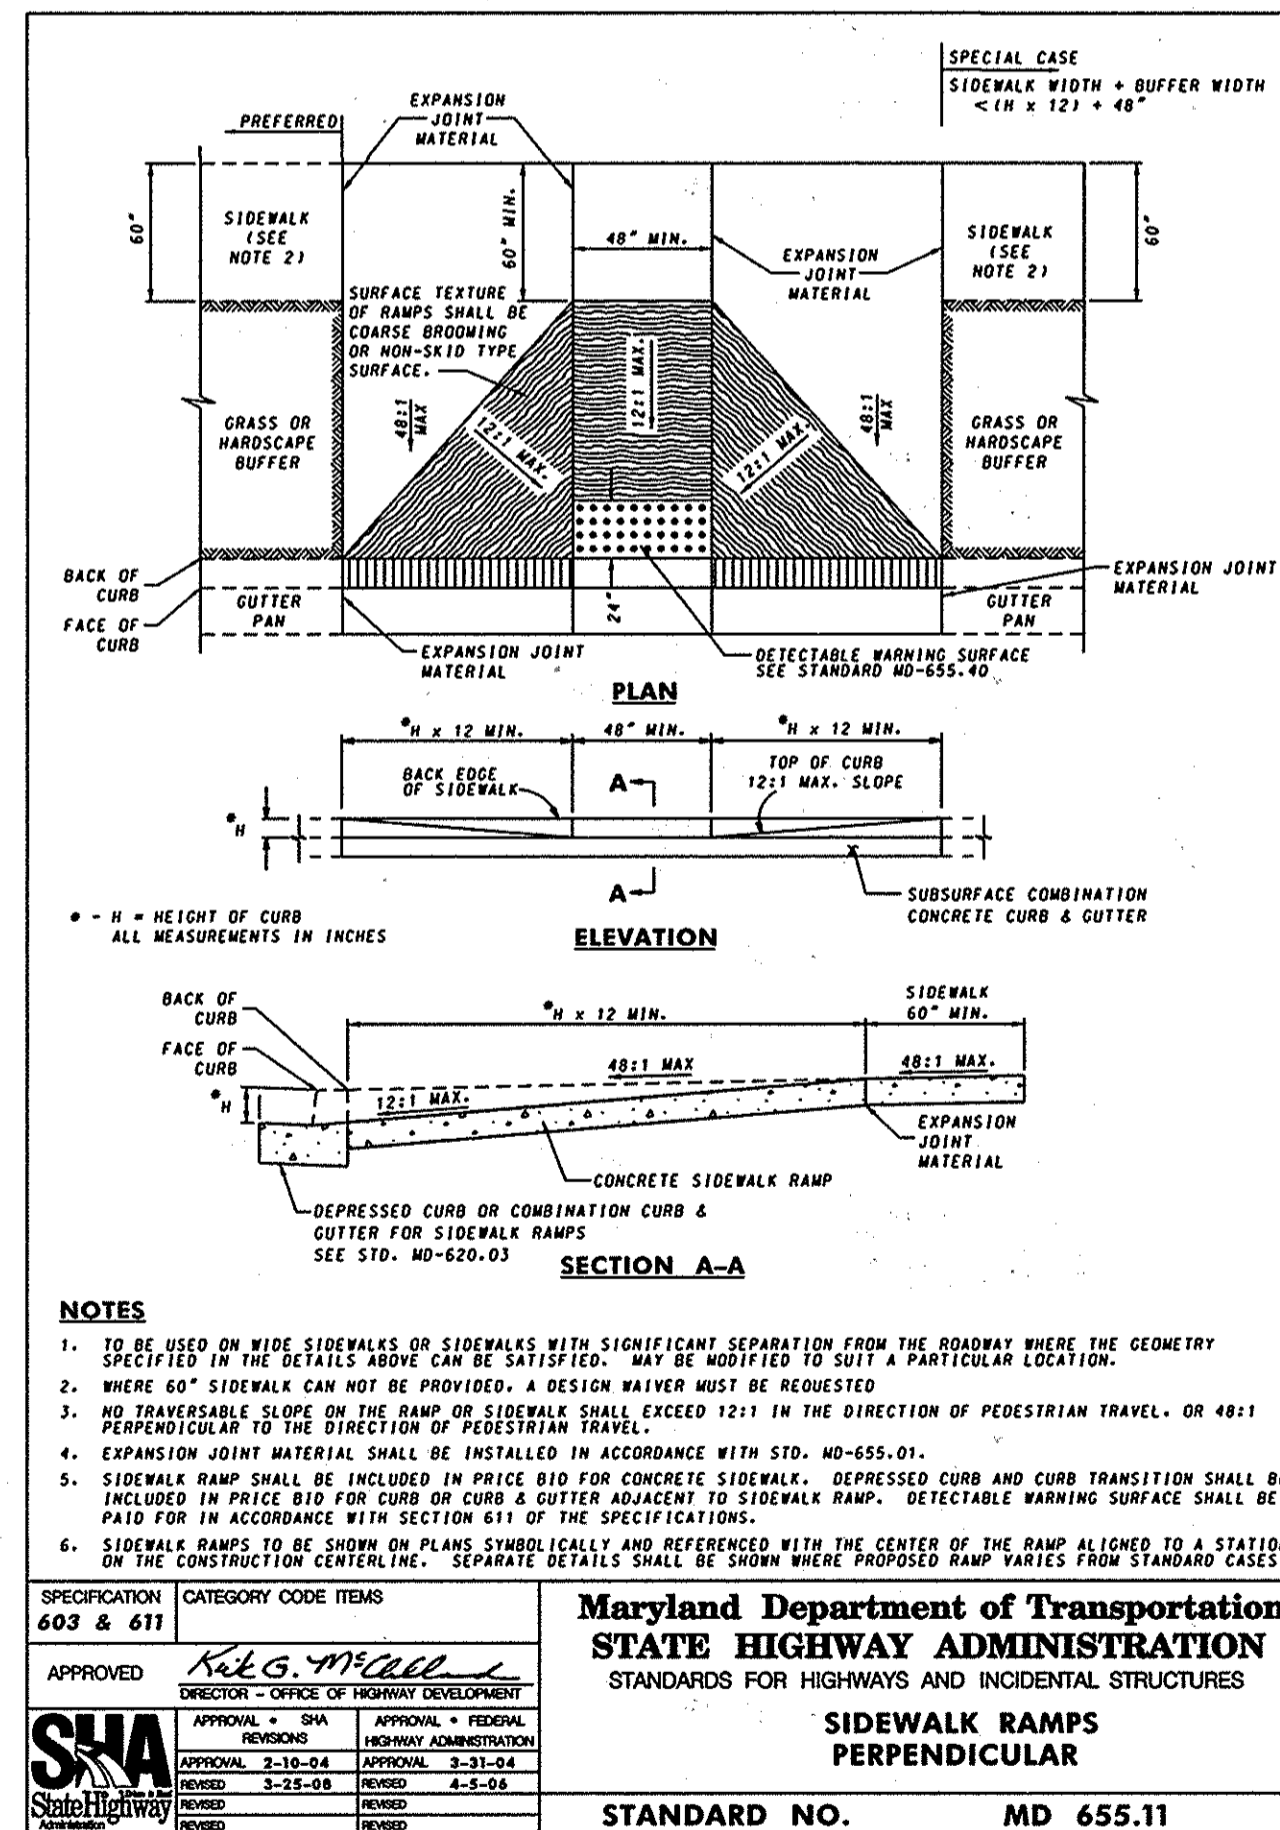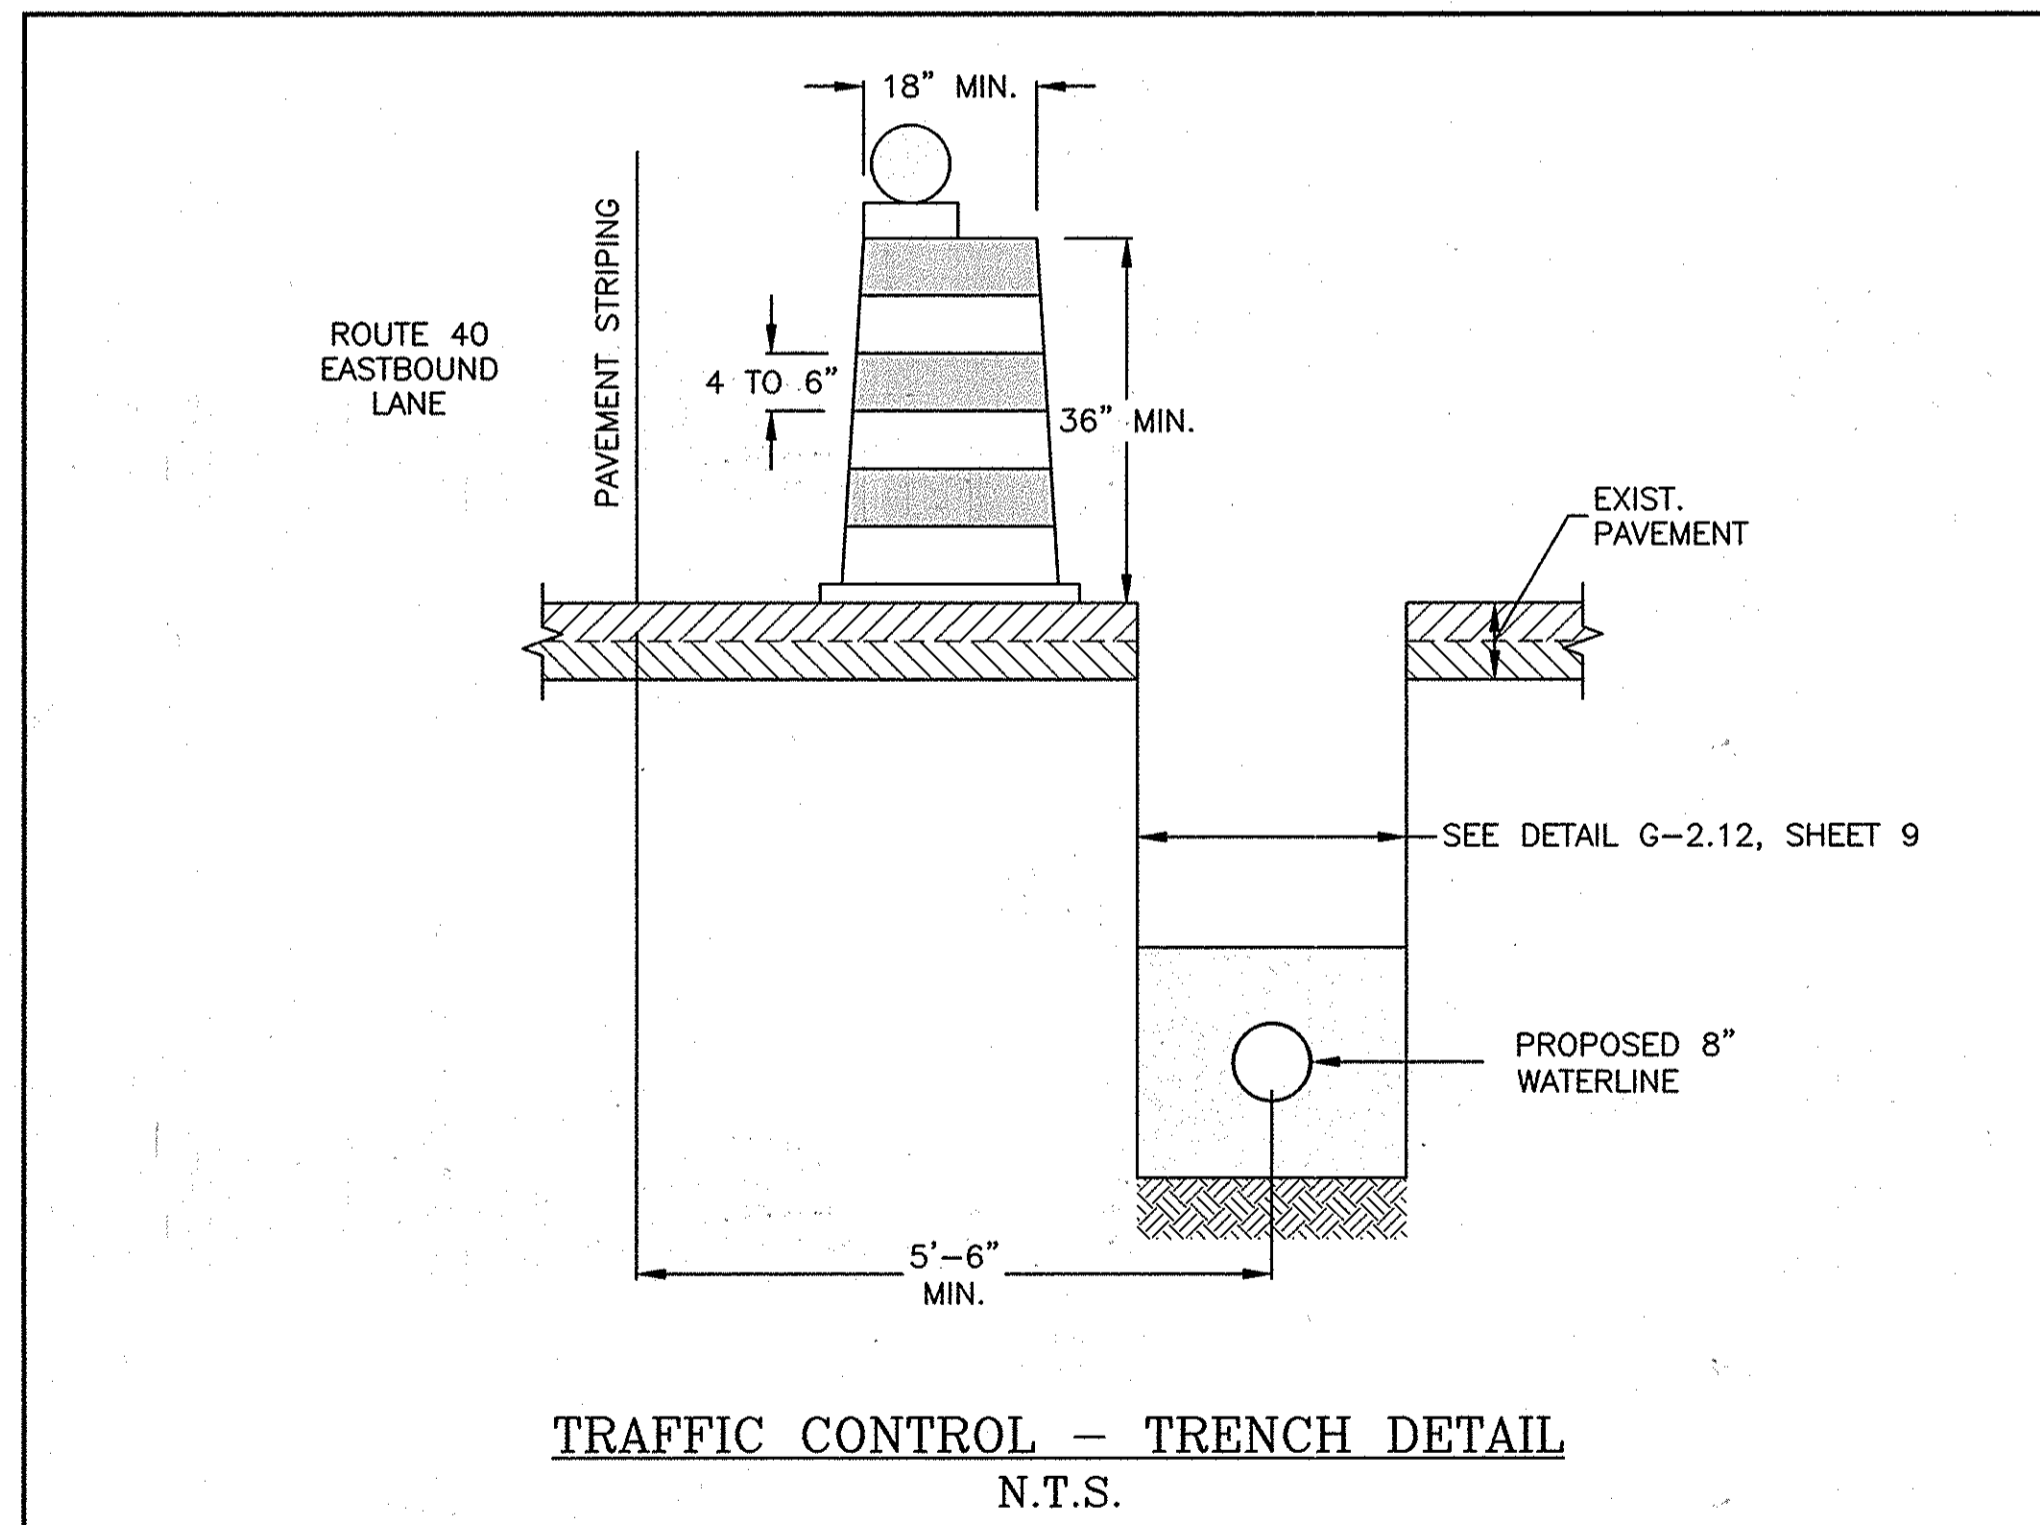

SEQUENCE OF CONSTRUCTION

- ENGINEER TO COORDINATE PRE-CONSTRUCTION MEETING.
- PROVIDE VIDEO TAPE TO ENGINEER DOCUMENTING EXISTING CONDITIONS.
- OBTAIN ALL REQUIRED PERMITS AND APPROVALS FROM APPROPRIATE AGENCIES. OBTAIN GRADING PERMIT PRIOR TO STARTING CONSTRUCTION.
- NOTIFY HOWARD COUNTY CONSTRUCTION INSPECTION DIVISION - SEDIMENT CONTROL (410)313-1855 SEVEN DAYS PRIOR TO STARTING CONSTRUCTION.
- NOTIFY MDE INSPECTION AND COMPLIANCE (410) 537-3510 7 DAYS PRIOR TO STARTING CONSTRUCTION.
- CONSTRUCT WATER SYSTEM IMPROVEMENTS FROM STATION 0+00 - 14+95.
 - INSTALL TRAFFIC CONTROLS.
 - INSTALL SEDIMENT CONTROLS.
 - PROVIDE TEMPORARY WATER SERVICE CONNECTIONS IF SERVICES ENCOUNTERED.
 - INSTALL NEW THRUST COLLARS ON EXISTING WATER MAIN AS REQUIRED.
 - ISOLATE EXISTING WATERLINE AND REMOVE FROM SERVICE. CONTACT HOWARD COUNTY BUREAU OF UTILITIES (410) 313-4900 TO COORDINATE CLOSING OF VALVE UPSTREAM OF CONNECTION POINT. CONTRACTOR MUST COORDINATE CLOSING OF VALVE A MINIMUM OF 72 HOURS IN ADVANCE.
 - REMOVE AND REPLACE EXISTING WATERLINE IN-KIND. INSTALL PROPOSED WATER MAIN AND WATER HOUSE CONNECTIONS. CONTRACTOR TO COORDINATE WATER METER LOCATION WITH HOME OWNER. LOCATION OF WATER METER AND WATER HOUSE CONNECTION IS SUBJECT TO APPROVAL BY THE COUNTY.
 - PERFORM HYDROSTATIC PRESSURE AND LEAK TEST ON INSTALLED WATER MAIN AS PER THE LATEST EDITION OF THE HOWARD COUNTY VOLUME IV DESIGN MANUAL.
 - DISINFECT AND BACTERIA TEST THE INSTALLED WATER MAIN. SEE HOWARD COUNTY VOLUME IV DESIGN MANUAL SECTIONS 1007 AND 1008.
 - FLUSH NEW WATER MAIN IN PREPARATION FOR CONNECTION.
 - CONNECT TO EXISTING WATER SYSTEM AND PLACE NEW WATERLINE INTO SERVICE.
 - CHECK CONNECTIONS FOR LEAKS.
 - RECONNECT EXISTING WATER SERVICES.
 - RESTORE AREA TO ORIGINAL CONDITIONS AND REMOVE SEDIMENT & TRAFFIC CONTROLS, UPON APPROVAL FROM THE COUNTY.
- CONSTRUCT WATER SYSTEM IMPROVEMENTS FROM STATION 14+95 - 33+15.
 - INSTALL TRAFFIC CONTROLS.
 - INSTALL SEDIMENT CONTROLS.
 - INSTALL PROPOSED WATER MAIN AND WATER HOUSE CONNECTIONS. CONTRACTOR TO COORDINATE WATER METER LOCATION WITH HOME OWNER. LOCATION OF WATER METER AND WATER HOUSE CONNECTION IS SUBJECT TO APPROVAL BY THE COUNTY.
 - PERFORM HYDROSTATIC PRESSURE AND LEAK TEST ON INSTALLED WATER MAIN AS PER THE LATEST EDITION OF THE HOWARD COUNTY VOLUME IV DESIGN MANUAL.
 - DISINFECT AND BACTERIA TEST THE INSTALLED WATER MAIN. SEE HOWARD COUNTY VOLUME IV DESIGN MANUAL SECTIONS 1007 AND 1008.
 - FLUSH NEW WATER MAIN IN PREPARATION FOR CONNECTION.
 - CONNECT TO EXISTING WATER SYSTEM AND PLACE NEW WATERLINE INTO SERVICE.
 - CHECK CONNECTIONS FOR LEAKS.
 - RECONNECT EXISTING WATER SERVICES.
 - RESTORE AREA TO ORIGINAL CONDITIONS AND REMOVE SEDIMENT & TRAFFIC CONTROLS, UPON APPROVAL FROM THE COUNTY.
- CONSTRUCT WATER SYSTEM IMPROVEMENTS FROM STATION 33+15 - 46+57.
 - INSTALL TRAFFIC CONTROLS.
 - INSTALL SEDIMENT CONTROLS.
 - INSTALL PROPOSED WATER MAIN AND WATER HOUSE CONNECTIONS. CONTRACTOR TO COORDINATE WATER METER LOCATION WITH HOME OWNER. LOCATION OF WATER METER AND WATER HOUSE CONNECTION IS SUBJECT TO APPROVAL BY THE COUNTY.
 - PERFORM HYDROSTATIC PRESSURE AND LEAK TEST ON INSTALLED WATER MAIN AS PER THE LATEST EDITION OF THE HOWARD COUNTY VOLUME IV DESIGN MANUAL.
 - DISINFECT AND BACTERIA TEST THE INSTALLED WATER MAIN. SEE HOWARD COUNTY VOLUME IV DESIGN MANUAL SECTIONS 1007 AND 1008.
 - FLUSH NEW WATER MAIN IN PREPARATION FOR CONNECTION.
 - CONNECT TO EXISTING WATER SYSTEM AND PLACE NEW WATERLINE INTO SERVICE.
 - CHECK CONNECTIONS FOR LEAKS.
 - RECONNECT EXISTING WATER SERVICES.
 - RESTORE AREA TO ORIGINAL CONDITIONS AND REMOVE SEDIMENT & TRAFFIC CONTROLS, UPON APPROVAL FROM THE COUNTY.
- CONSTRUCT WATER SYSTEM IMPROVEMENTS FROM STATION 46+57 - 51+97.
 - INSTALL TRAFFIC CONTROLS.
 - INSTALL SEDIMENT CONTROLS.
 - INSTALL PROPOSED WATER MAIN AND WATER HOUSE CONNECTIONS. CONTRACTOR TO COORDINATE WATER METER LOCATION WITH HOME OWNER. LOCATION OF WATER METER AND WATER HOUSE CONNECTION IS SUBJECT TO APPROVAL BY THE COUNTY.
 - TEMPORARILY RELOCATE EXISTING SERVICES ENCOUNTERED AND RECONNECT TO EXISTING WATERLINE.
 - PERFORM HYDROSTATIC PRESSURE AND LEAK TEST ON INSTALLED WATER MAIN AS PER THE LATEST EDITION OF THE HOWARD COUNTY VOLUME IV DESIGN MANUAL.
 - DISINFECT AND BACTERIA TEST THE INSTALLED WATER MAIN. SEE HOWARD COUNTY VOLUME IV DESIGN MANUAL SECTIONS 1007 AND 1008.
 - FLUSH NEW WATER MAIN IN PREPARATION FOR CONNECTION.
 - CONNECT TO EXISTING WATER SYSTEM AND PLACE NEW WATERLINE INTO SERVICE.
 - CHECK CONNECTIONS FOR LEAKS.
 - RECONNECT EXISTING WATER SERVICES.
 - RESTORE AREA TO ORIGINAL CONDITIONS AND REMOVE SEDIMENT & TRAFFIC CONTROLS, UPON APPROVAL FROM THE COUNTY.
- CONSTRUCT WATER SYSTEM IMPROVEMENTS FROM STATION 51+97 - 60+51.
 - INSTALL TRAFFIC CONTROLS.
 - INSTALL SEDIMENT CONTROLS.
 - INSTALL PROPOSED WATER MAIN AND WATER HOUSE CONNECTIONS. CONTRACTOR TO COORDINATE WATER METER LOCATION WITH HOME OWNER. LOCATION OF WATER METER AND WATER HOUSE CONNECTION IS SUBJECT TO APPROVAL BY THE COUNTY.
 - TEMPORARILY RELOCATE EXISTING SERVICES ENCOUNTERED AND RECONNECT TO EXISTING WATERLINE.
 - PERFORM HYDROSTATIC PRESSURE AND LEAK TEST ON INSTALLED WATER MAIN AS PER THE LATEST EDITION OF THE HOWARD COUNTY VOLUME IV DESIGN MANUAL.
 - DISINFECT AND BACTERIA TEST THE INSTALLED WATER MAIN. SEE HOWARD COUNTY VOLUME IV DESIGN MANUAL SECTIONS 1007 AND 1008.
 - FLUSH NEW WATER MAIN IN PREPARATION FOR CONNECTION.
 - INSTALL NEW THRUST COLLARS ON EXISTING WATER MAIN AS REQUIRED.
 - CONNECT TO EXISTING WATER SYSTEM AND PLACE NEW WATERLINE INTO SERVICE.
 - CHECK CONNECTIONS FOR LEAKS.
 - RECONNECT EXISTING WATER SERVICES.
 - RESTORE AREA TO ORIGINAL CONDITIONS AND REMOVE SEDIMENT & TRAFFIC CONTROLS, UPON APPROVAL FROM THE COUNTY.
- MILL AND OVERLAY ASPHALT AND INSTALL PERMANENT PAVEMENT MARKINGS.
- FINAL CLEANUP AND RESTORATION.
- PROVIDE AS-BUILT RECORDS TO ENGINEER.

DEPARTMENT OF PUBLIC WORKS
 HOWARD COUNTY, MARYLAND
 Director of Public Works: *[Signature]* 3/13/13
 Chief, Bureau of Engineering: *[Signature]* 3/13/13
 Chief, Bureau of Utilities: *[Signature]* 3/13/13
 Chief, Utility Design Division: *[Signature]* 3/13/13

URS
 MONTGOMERY PARK BUSINESS CENTER
 1800 WASHINGTON BOULEVARD, SUITE 410
 BALTIMORE, MARYLAND 21230
 (410) 468-0875

Professional Certification
 I hereby certify that these documents were prepared or approved by me, and that I am a duly licensed professional engineer under the laws of the State of Maryland, License No. 22817, Expiration Date: 08/01/13
 NATHAN C. ATKINSON

DESIGN: NCA
 DRAWN: BLW
 CHK: EMT
 DATE: 3/7/13

MISCELLANEOUS DETAILS AND SEQUENCE OF CONSTRUCTION
 600' SCALE MAP NO. 24
 BLOCK NO. 12

U.S. 40 WATER SERVICE MAIN REPLACEMENT
 CAPITAL PROJECT NO. W-8311
 CONTRACT NO. 44-4731
 6TH ELECTION DISTRICT
 HOWARD COUNTY, MARYLAND
 SCALE: AS SHOWN
 SHEET 8 OF 13

AS-BUILT 1/2015

PLASTIC		
PIPE DIA. "D"	"W"	TRENCH WIDTH
4	12	28
6	11	28
8	10	28
10	9	28
12	8	28

ALL DIMENSIONS IN INCHES

NOTES:

- THE "W" DIMENSION SHALL BE USED TO CALCULATE MAXIMUM TRENCH PAY WIDTH.
- FOR TRENCHES WHERE TRENCH BOX OR TRENCH SHEETING IS NOT REQUIRED, MEASUREMENT FOR CONTINGENT BORROW MATERIALS WILL BE BASED ON THE TRENCH WIDTH SHOWN.
- FOR TRENCHES WHERE TRENCH BOX OR TRENCH SHEETING IS REQUIRED, MEASUREMENT FOR CONTINGENT BORROW MATERIALS WILL BE BASED ON THE TRENCH WIDTH SHOWN PLUS 24 INCHES.
- FOR COPPER, PVC AND HDPE PIPE, 3 INCHES OR SMALLER: PIPE EMBEDMENT ZONE MATERIAL IS FINE AGGREGATE (SAND) "W" DIMENSION IS 6 INCHES MINIMUM AND BEDDING THICKNESS UNDER PIPE IS 4" MINIMUM. FOR TRENCHES IN ROCK, MINIMUM BEDDING THICKNESS IS 6 INCHES.
- SPECIAL DESIGN IS REQUIRED AND SHALL BE SPECIFIED OR DETAILED IN THE CONTRACT DOCUMENTS FOR THE FOLLOWING PIPES:
PVC ANMA C-905 LARGER THAN 12 INCHES
PVC GRAVITY SANITARY SEWERS LARGER THAN 12 INCHES
HDPE CORRUGATED DRAIN PIPE
STREAM CROSSINGS SEE DETAILS S-3.11 AND S-3.12

Howard County, Maryland Department of Public Works	Pipe Trench Plastic & Copper	Detail G-2.12
---	---------------------------------	------------------

NOTES:

- TEST STATIONS SHALL BE USED FOR ALL NON-METALLIC PIPE EXCEPT GRAVITY SEWER MAINS UNLESS REQUIRED BY THE DWP.
- FOR SPlicing BETWEEN TEST STATIONS, SEE NOTE 4 ON DETAIL W-1.15.
- TEST STATION SPACING SHALL BE A MAXIMUM OF 400 FEET, OR IMMEDIATELY ADJACENT TO FIRE HYDRANTS, WHICHEVER IS LESS. FOR RECLAIMED WATER OR PRESSURE SEWER, TEST STATION SPACING SHALL BE A MAXIMUM OF 400 FEET, AND PLACED ADJACENT TO EXISTING AT-GRADE STRUCTURES SUCH AS VALVES OR MANHOLES WHERE POSSIBLE.
- TEST STATION SHALL BE INSTALLED IN NON-TRAFFIC BEARING AREAS. DO NOT INSTALL IN ROADWAY.
- SEE DETAIL G-2.11 & G-2.12 FOR TRENCH BEDDING INFORMATION.
- REFER TO APPLICABLE SPECIFICATION SECTIONS 905.1002, 1011.1017, AND 1018 FOR ADDITIONAL REQUIREMENTS.

Howard County, Maryland Department of Public Works	Continuity Test Station	Detail G-8.21
---	-------------------------	------------------

NOTES:

- TEST STATION MUST BE PLACED TO THE RIGHT OR LEFT SIDE OF THE FIRE HYDRANT.
- VALVE VAULT FRAME AND COVER TO BE SET FLUSH WITH FINAL GRADE.
- BUTTRESSES AND STRAPPING NOT SHOWN FOR CLARITY.
- NO SPICES BETWEEN TEST STATIONS, UNLESS APPROVED BY HOWARD COUNTY. LATERAL SPICES APPROVED BY THE COUNTY SHALL CONSIST OF A BRASS COMPRESSION NUT, WATERPROOF BINDER, AND UNDERGROUND ELECTRICAL TAPE. EXTENSION SPICES SHALL BE MADE USING A CRIMP CONNECTOR AND SHRINK TUBING.


Howard County, Maryland Department of Public Works	FIRE HYDRANT Continuity Test Station	Detail W-1.15
---	---	------------------

PIPE DIA. INCH	THRUST BLOCK DIMENSIONS			THRUST BLOCK REINFORCEMENT
	T	H	L	
8	1'-3"	3'-0"	4'-4"	5# 12" #4 EW-4#5 ADDITIONAL REINF.

NOTES:

- ALL CONCRETE SHALL BE $f'_c=4000$ PSI @ 28 DAYS. PIPELINE SHALL NOT BE PRESSURIZED UNTIL CONCRETE STRENGTH REACHES 4000 PSI AND TRENCH HAS BEEN BACKFILLED.
- ALL REBARS SHALL BE ASTM A615 GRADE 60.
- STEEL PLATES SHALL BE ASTM A36.
- MAINTAIN 2" CLEAR BETWEEN ALL REBARS AND PIPE.
- COAT ALL EXPOSED STEEL WITH FIELD APPLIED COATING.
- BOLT CIRCLE FOR 3/4" THE RODS @ THRUST COLLAR EQUAL BOLT CIRCLE @ THE BOLTS.
- THE RODS SHALL BE PARALLEL TO AXIS OF PIPE.
- THE COUPLING, IF NECESSARY, SHALL BE STAR NATIONAL PRODUCTS SUPER STAR TIE COUPLING NO. SS10.
- DEPTH OF FINISHED GRADE TO TOP OF PIPE ASSUMED TO EQUAL 4'-0". IF SHALLOWER, SPECIAL BLOCK DESIGN IS REQUIRED.
- SOFT OR ORGANIC SOIL CONDITIONS REQUIRE SPECIAL BLOCK DESIGN.
- REPLACE ALL DISTURBED SOIL BETWEEN NEW FITTING AND CONCRETE COLLAR WITH CRUSHED STONE COMPACTED AS STRUCTURAL FILL.
- ALL COLLAR DIMENSIONS ARE BASED ON A STATIC WATER PRESSURE OF 150 PSI AND A MINIMUM SOIL BEARING PRESSURE OF 3,000 PSF. WHERE ACTUAL FIELD CONDITIONS ARE DIFFERENT, THE AREA OF BEARING SHALL BE INCREASED AS DETERMINED BY THE ENGINEER.


Howard County, Maryland Department of Public Works	THRUST RESTRAINT COLLAR DETAIL	Detail W-1.15
---	--------------------------------	------------------

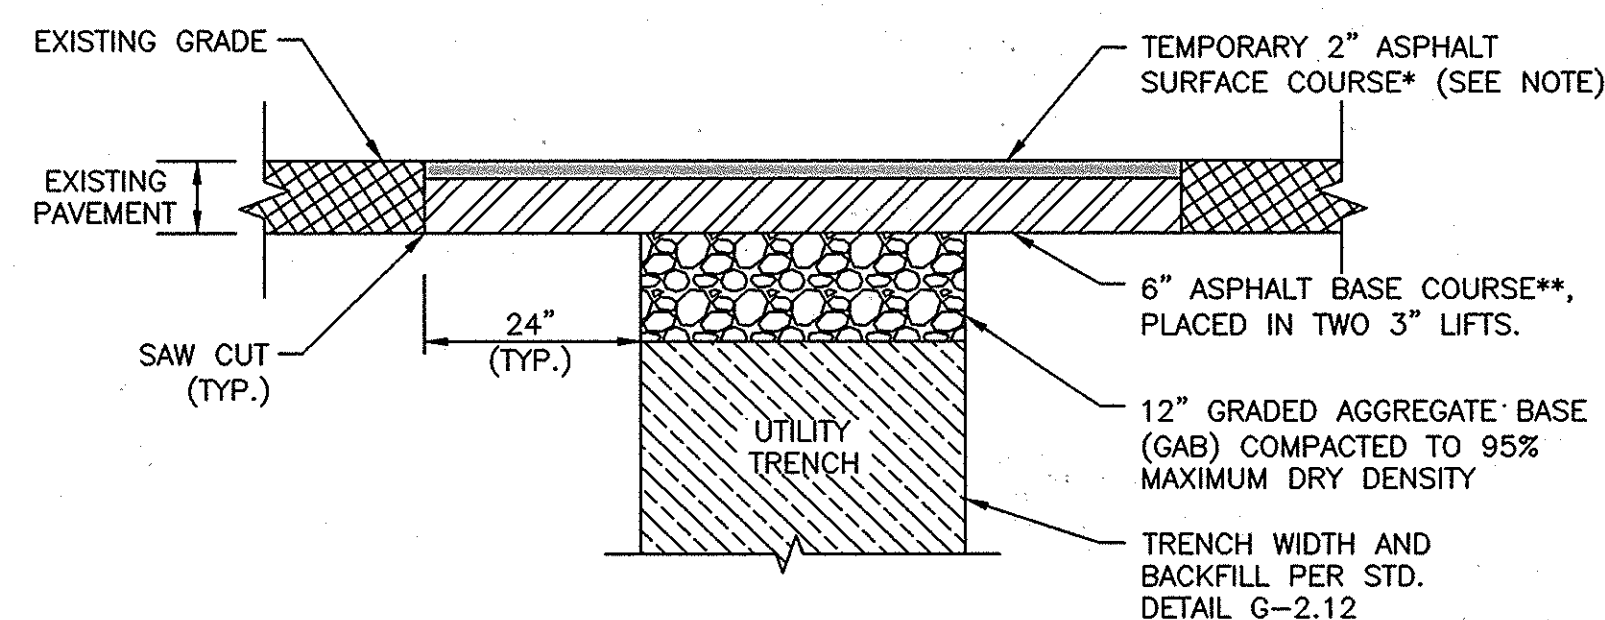

- * = HOT MIX SUPERPAVE SURFACE COURSE
9.5 MM PG 64-22 LEVEL 2 OR
12.5 MM PG 76-22 LEVEL 2
- ** = HOT MIX SUPERPAVE BASE COURSE
19.0 MM PG 64-22 LEVEL 2

NOTE: CONTRACTOR SHALL REPAIR TRENCH AND PAVEMENT TO MATCH EXISTING ROAD GRADE. FOLLOWING COMPLETION OF WATER SYSTEM IMPROVEMENTS, CONTRACTOR SHALL MILL AND OVERLAY EXISTING ROADWAY TO LIMITS INDICATED ON THE DRAWINGS, INCLUDING TRENCH PAVEMENT REPAIR AREAS. NO SEPARATE PAVEMENT WILL BE MADE FOR TEMPORARY 2" SURFACE COURSE.

TRENCH PAVEMENT REPAIR DETAIL
NOT TO SCALE

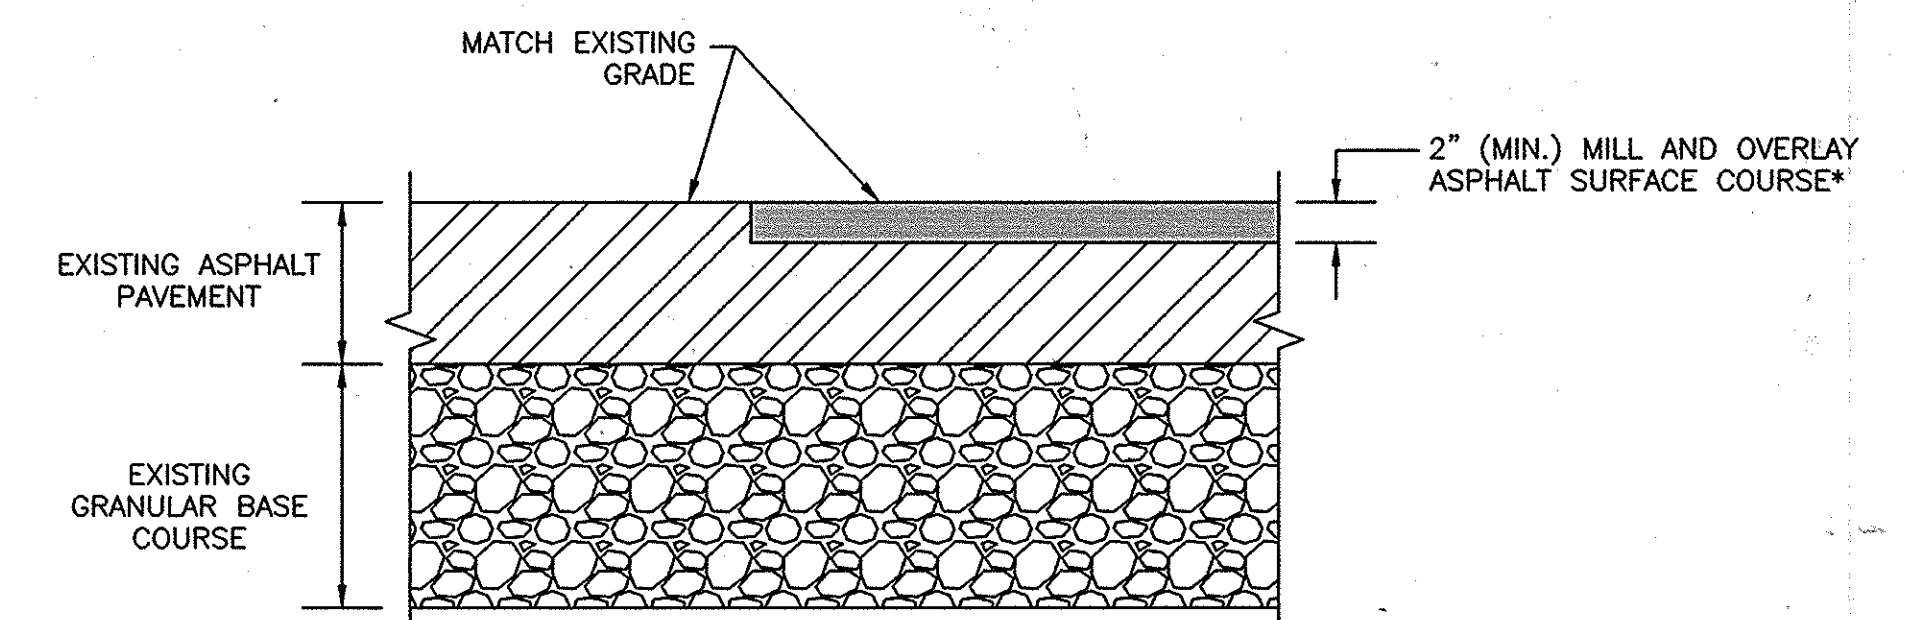

- * = HOT MIX SUPERPAVE
9.5 MM PG 64-22 LEVEL 2 OR
12.5 MM PG 76-22 LEVEL 2

MILL AND OVERLAY DETAIL
NOT TO SCALE

DEPARTMENT OF PUBLIC WORKS HOWARD COUNTY, MARYLAND			
<i>J. G. Lee</i> DIRECTOR OF PUBLIC WORKS	3/13/13	<i>M. S. Butler</i> CHIEF, BUREAU OF ENGINEERING	3/13/13
<i>S. C. Lee</i> CHIEF, BUREAU OF UTILITIES	3/13/13	<i>O. DeLeon</i> CHIEF, UTILITY DESIGN DIVISION	3/12/13

URS
MONTGOMERY PARK BUSINESS CENTER
1800 WASHINGTON BOULEVARD, SUITE 410
BALTIMORE, MARYLAND 21230
(410) 468-0875

Professional Certification
I hereby certify that these documents were prepared or approved by me, and that I am a duly licensed professional engineer under the laws of the State of Maryland, License No. 28517, Expiration Date: 06/01/13
NATHAN C. ATKINSON






DESIGN: NCA					
DRAWN: BLW					
CHK: EMT					
DATE: 3/7/13	NO.	REVISION	DATE	BY	

MISCELLANEOUS DETAILS	600' SCALE MAP NO. 24	BLOCK NO. 12
-----------------------	-----------------------	--------------

U.S. 40 WATER SERVICE MAIN REPLACEMENT
CONTRACT PROJECT NO. W-8311
CONTRACT NO. 44-4731
6TH ELECTION DISTRICT
HOWARD COUNTY, MARYLAND

SCALE: AS SHOWN
SHEET 9 OF 13

AS-BUILT 1/2015

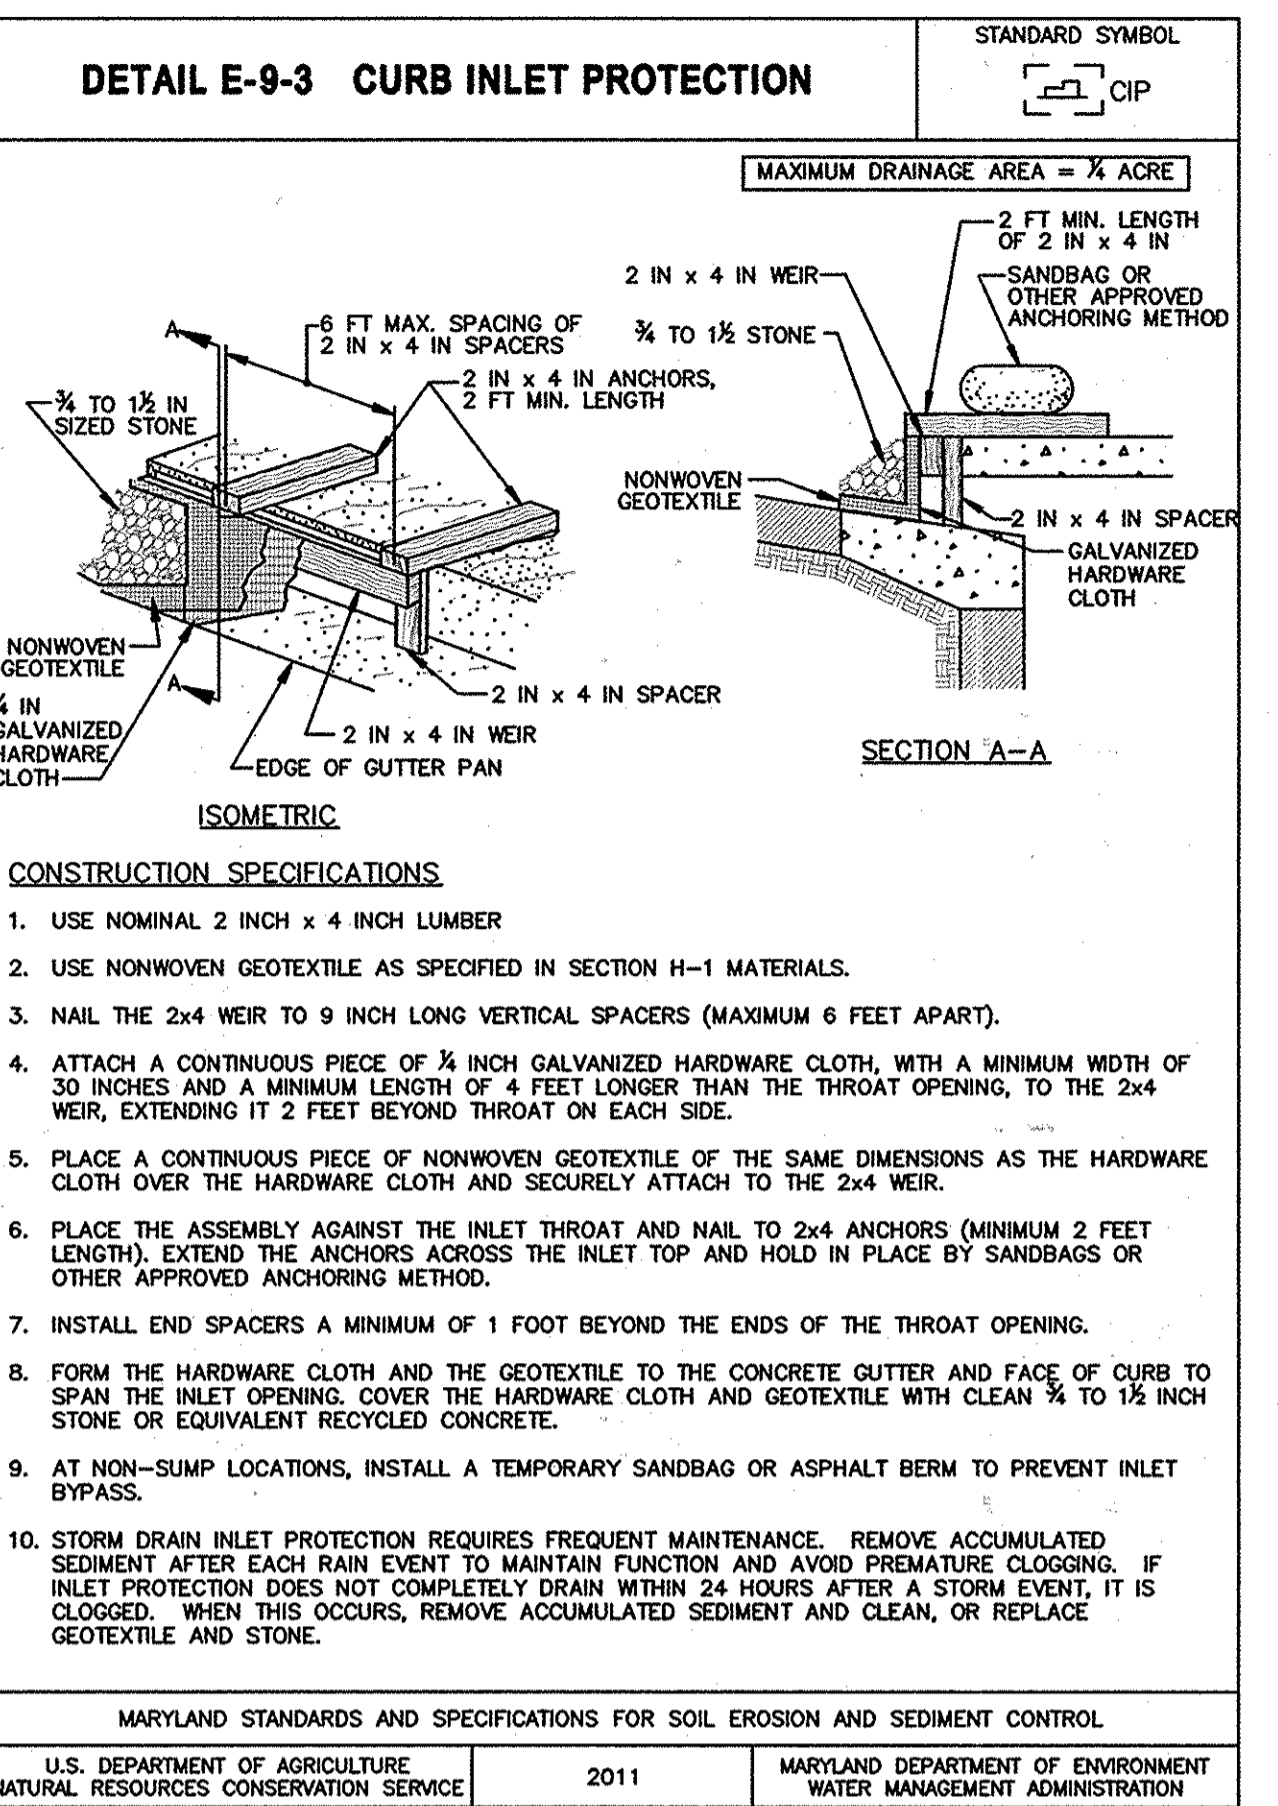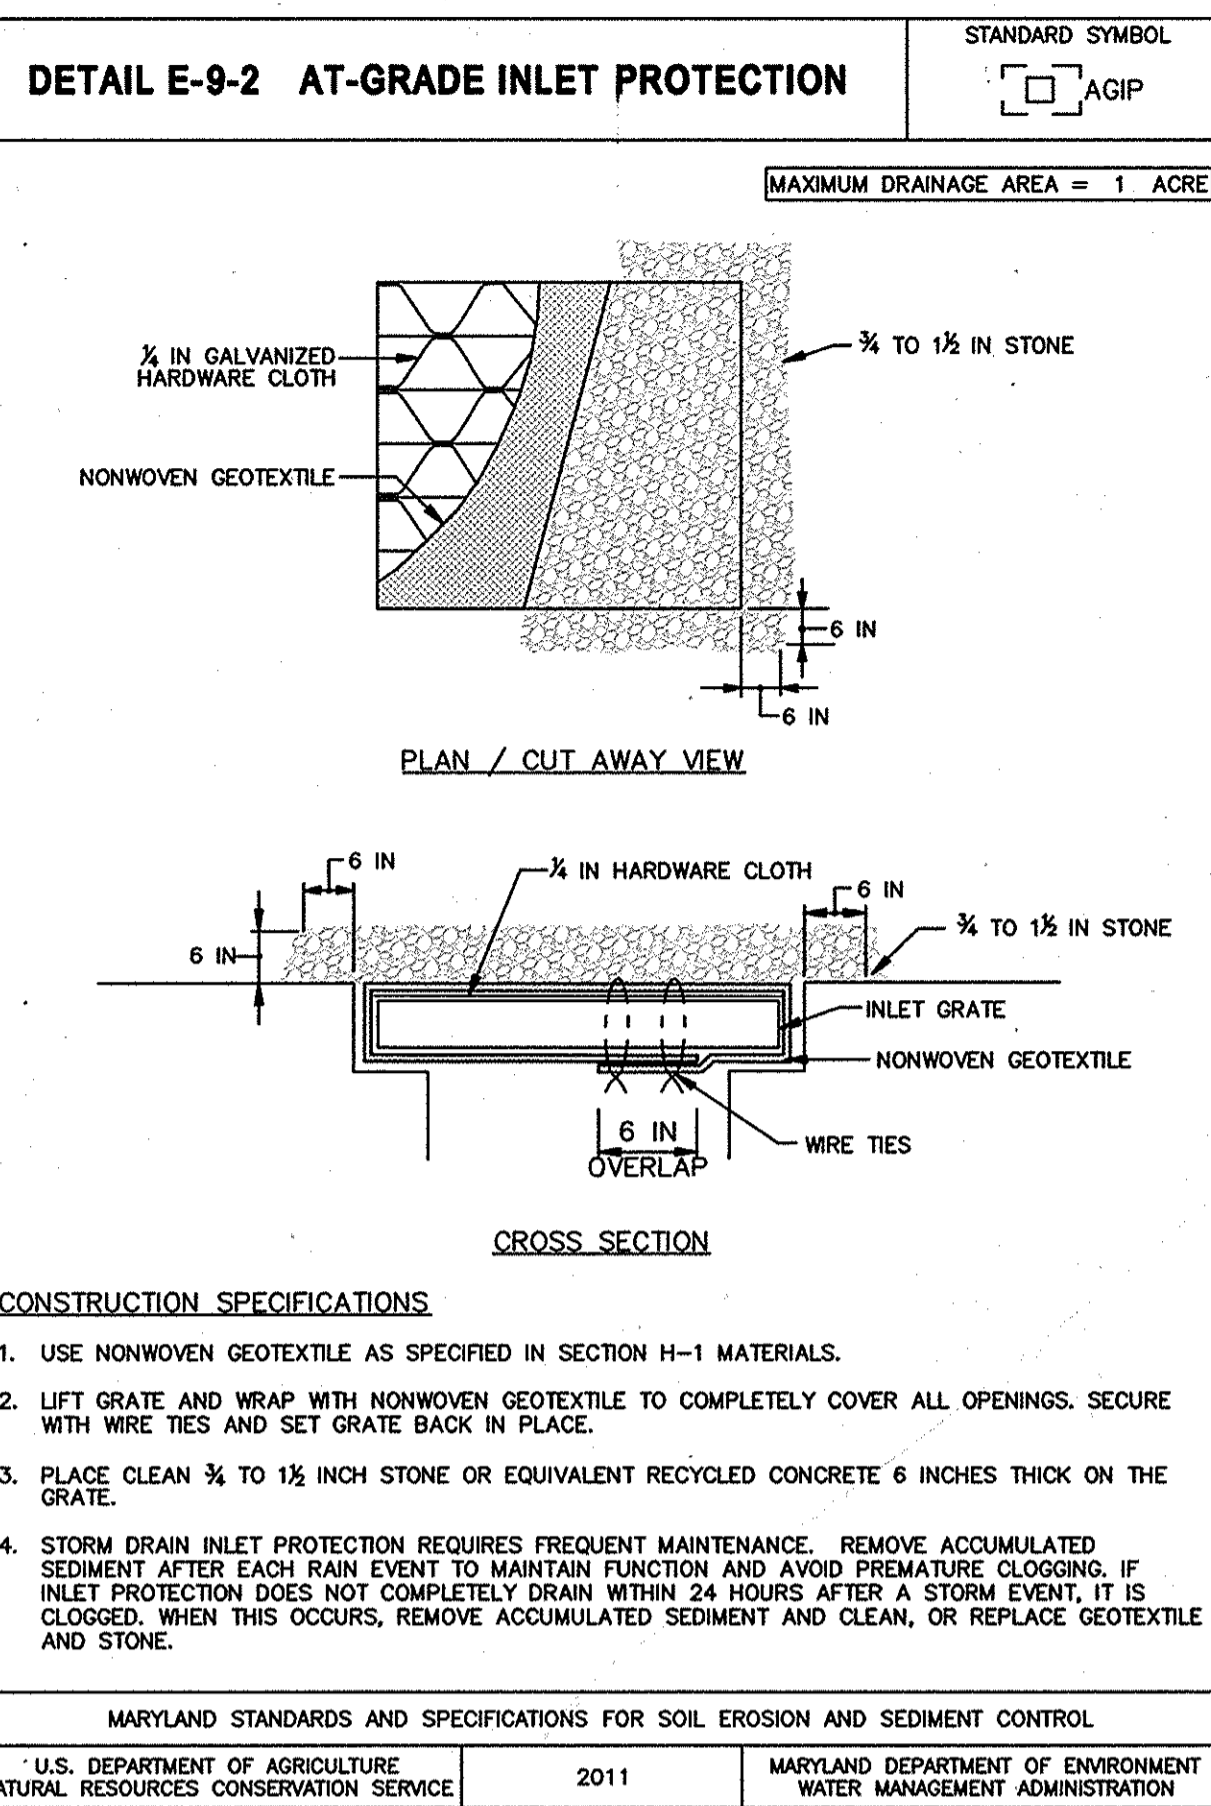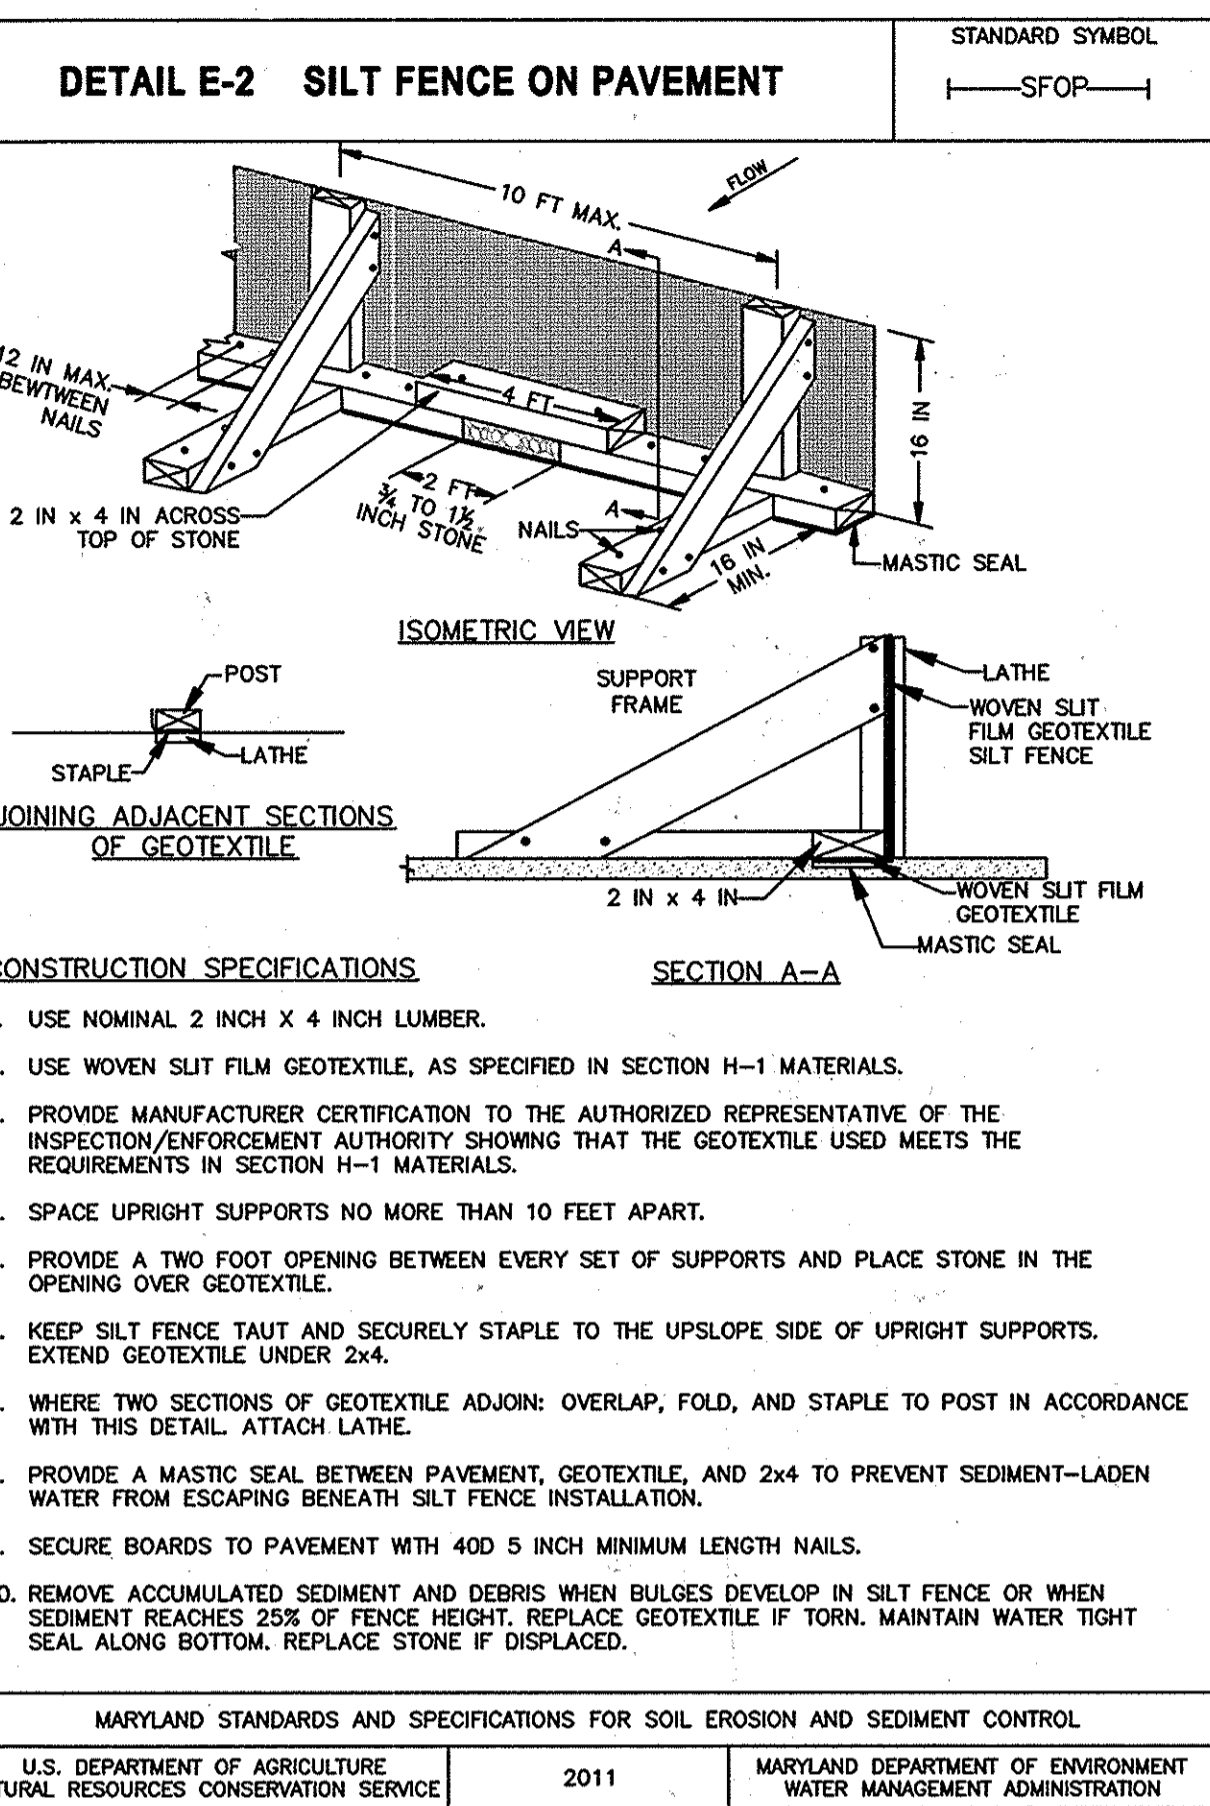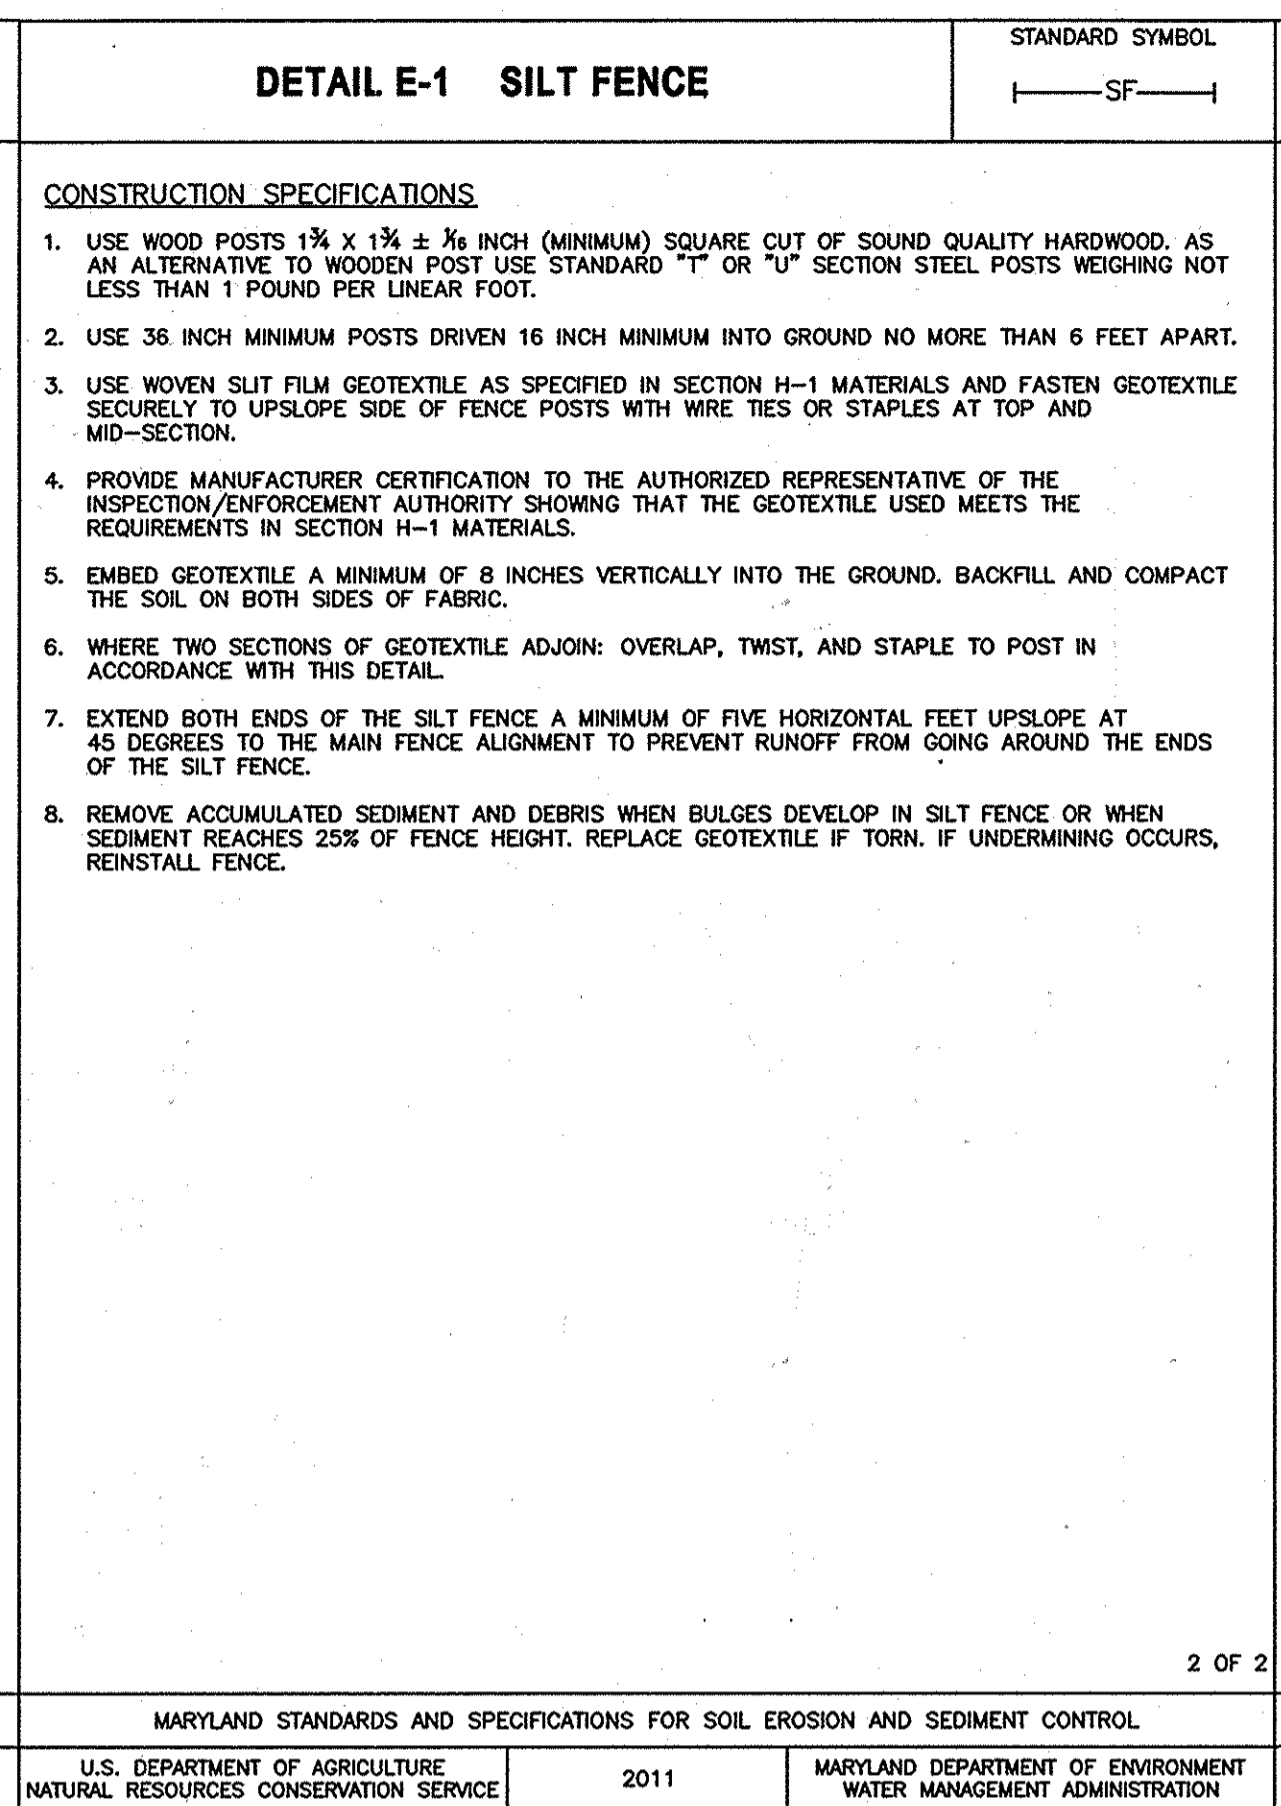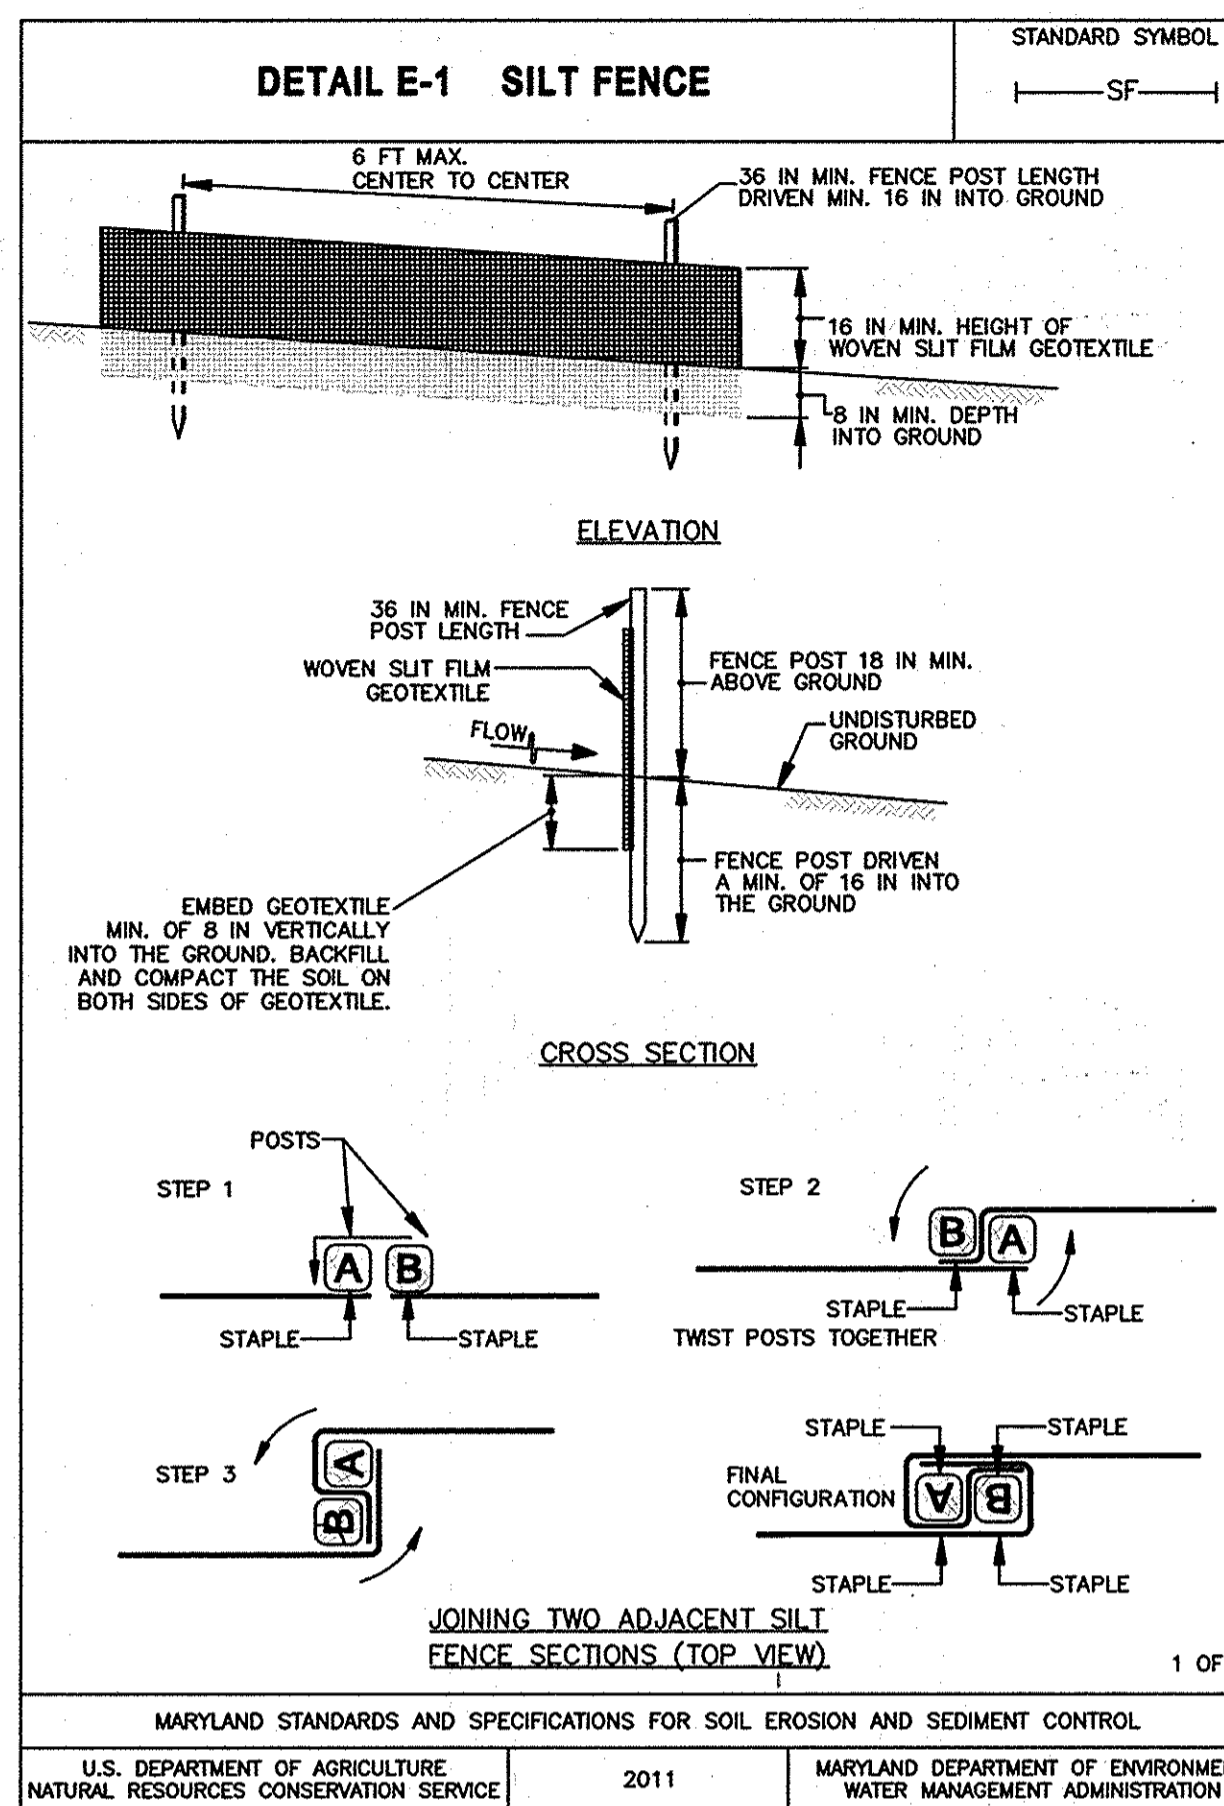

MARYLAND STANDARDS AND SPECIFICATIONS FOR SOIL EROSION AND SEDIMENT CONTROL
 U.S. DEPARTMENT OF AGRICULTURE NATURAL RESOURCES CONSERVATION SERVICE 2011
 MARYLAND DEPARTMENT OF ENVIRONMENT WATER MANAGEMENT ADMINISTRATION


PERMANENT SEEDING NOTES
 1. Apply to graded or cleared areas not subject to immediate further disturbance where a permanent long-lived vegetative cover is needed.
 2. Seedbed Preparation: Loosen upper three inches of soil by raking, disking or other acceptable means before seeding, if not previously loosened.
 3. Soil Amendments: In lieu of soil test recommendations, use one of the following schedules:
 4. Preferred - Apply 2 tons/acre dolomitic limestone (92 lbs/1000 sq. ft.) and 600 lbs/acre 10-10-10 fertilizer (14 lbs/1000 sq. ft.) before seeding. Harrow or disk into upper three inches of soil. At time of seeding, apply 400 lbs/acre 30-0-0 ureaform fertilizer (9 lbs/1000 sq. ft.)
 5. Acceptable - Apply 2 tons/acre dolomitic limestone (92 lbs/1000 sq. ft.) and 1000 lbs/acre 10-10-10 fertilizer (23 lbs/1000 sq. ft.) before seeding. Harrow or disk into upper three inches of soil.
 6. Seeding:
 A. For the periods March 1 - April 30, and August 1 - October 15, seed with 60 lbs/acre (1.4 lbs/1000 sq. ft.) of Kentucky 31 Tall Fescue.
 B. For the period May 1 - July 31, seed with 60 lbs Kentucky 31 Tall Fescue per acre and 2 lbs/acre (.05 lbs/1000 sq. ft.) of weeping lovegrass.
 C. During the period of October 16 - February 28, protect site by:
 Option 1 - Two tons per acre of well anchored straw mulch and seed as soon as possible in the spring.
 Option 2 - Use sod.
 Option 3 - Seed: with 60 lbs/acre Kentucky 30 Tall Fescue and mulch with 2 tons/acre well anchored straw.
 7. Mulching - Apply 1-1/2 to 2 tons per acre (70 to 90 lbs/1000 sq. ft.) of unrotted small grain straw immediately after seeding. Anchor mulch immediately after application using mulch anchoring tool or 218 gal. per acre (5 gal/1000 sq. ft.) of emulsified asphalt on flat areas. On slope 8 feet or higher, use 348 gallons per acre (8 gal/1000 sq. ft.) for anchoring.
 8. Maintenance - Inspect all seeding areas and make needed repairs, replacements and reseedings.

MARYLAND STANDARDS AND SPECIFICATIONS FOR SOIL EROSION AND SEDIMENT CONTROL
 U.S. DEPARTMENT OF AGRICULTURE NATURAL RESOURCES CONSERVATION SERVICE 2011
 MARYLAND DEPARTMENT OF ENVIRONMENT WATER MANAGEMENT ADMINISTRATION

TEMPORARY SEEDING NOTES
 1. Apply to graded or cleared areas likely to be re-disturbed where a short-term vegetative cover is needed.
 2. Seedbed preparation: - Loosen upper three inches of soil by raking, disking or other acceptable means before seeding, if not previously loosened.
 3. Soil Amendments: - Apply 600 lbs/acre 10-10-10 fertilizer (14 lbs/1000 sq. ft.)
 4. Seeding: - For periods March 1 - April 30 and from August 15 - October 15, seed with 2-1/2 bushel per acre of annual rye (3.2 lbs/1000 sq. ft.). For the period May 1 - August 14, seed with 3 lbs/acre of weeping lovegrass (.07 lbs/1000 sq. ft.). For the period November 16 - February 28, protect site by applying 2 tons/acre of well anchored straw mulch and seed as soon as possible in the spring, or use sod.
 5. Mulching: - Apply 1-1/2 to 2 tons/acre (70 to 90 lbs/1000 sq. ft.) of unrotted weed-free, small grain straw immediately after seeding. Anchor mulch immediately after application using mulch anchoring tool or 218 gal. per acre (5 gal/1000 sq. ft.) of emulsified asphalt on flat areas. On slope 8 ft. or higher, use 348 gal. per acre (8 gal/1000 sq. ft.) for anchoring.
 6. Refer to the 2011 MD STANDARD AND SPECIFICATIONS FOR SOIL EROSION AND SEDIMENT CONTROL for additional rates and methods not covered.

MARYLAND STANDARDS AND SPECIFICATIONS FOR SOIL EROSION AND SEDIMENT CONTROL
 U.S. DEPARTMENT OF AGRICULTURE NATURAL RESOURCES CONSERVATION SERVICE 2011
 MARYLAND DEPARTMENT OF ENVIRONMENT WATER MANAGEMENT ADMINISTRATION

STANDARD SEDIMENT CONTROL NOTES
 1. A MINIMUM OF 48 HOURS NOTICE MUST BE GIVEN TO THE HOWARD COUNTY DEPARTMENT OF INSPECTIONS, LICENSES AND PERMITS, SEDIMENT CONTROL DIVISION PRIOR TO THE START OF ANY CONSTRUCTION (410) 313-1855.
 2. ALL VEGETATIVE AND STRUCTURAL PRACTICES ARE TO BE INSTALLED ACCORDING TO THE PROVISIONS OF THIS PLAN AND ARE TO BE IN CONFORMANCE WITH THE MOST CURRENT MARYLAND STANDARDS AND SPECIFICATIONS FOR SOIL EROSION AND SEDIMENT CONTROL AND REVISIONS THERETO.
 3. FOLLOWING INITIAL SOIL DISTURBANCE OR RE-DISTURBANCE, PERMANENT OR TEMPORARY STABILIZATION SHALL BE COMPLETED WITHIN: A) 7 CALENDAR DAYS FOR ALL PERIMETER SEDIMENT CONTROL STRUCTURES, DIKES, PERIMETER SLOPES AND ALL SLOPES GREATER THAN 3:1, B) 14 DAYS AS TO ALL OTHER DISTURBED OR GRADED AREAS ON THE PROJECT SITE.
 4. STOCKPILING OF THE EXCAVATED MATERIAL IS TO BE PLACED ON THE UPSLOPE SIDE OF THE TRENCH.
 5. ALL DISTURBED AREAS MUST BE STABILIZED WITHIN THE TIME PERIOD SPECIFIED ABOVE IN ACCORDANCE WITH THE 1994 MARYLAND STANDARDS AND SPECIFICATIONS FOR SOIL EROSION AND SEDIMENT CONTROL FOR PERMANENT SEEDING (SEC. 51), SOD (SEC. 54), TEMPORARY SEEDING (SEC. 50) AND MULCHING (SEC. 52). TEMPORARY STABILIZATION WITH MULCH ALONE CAN ONLY BE DONE WHEN RECOMMENDED SEEDING DATES DO NOT ALLOW FOR PROPER GERMINATION AND ESTABLISHMENT OF GRASSES.
 6. ALL SEDIMENT CONTROL STRUCTURES ARE TO REMAIN IN PLACE AND ARE TO BE MAINTAINED IN OPERATIVE CONDITION UNTIL PERMISSION FOR THEIR REMOVAL HAS BEEN OBTAINED FROM THE HOWARD COUNTY SEDIMENT CONTROL INSPECTOR.
 7. SITE ANALYSIS / RESTORATION SCHEDULE:
 A. TOTAL AREA OF SITE 2.3 ACRES
 B. AREA DISTURBED 2.3 ACRES
 C. AREA TO BE ROOFED OR PAVED 1.9 ACRES
 D. AREA TO BE VEGETATIVELY STABILIZED 0.4 ACRES
 E. TOTAL CUT N/A CU. YDS.
 F. TOTAL FILL N/A CU. YDS.
 G. OFF-SITE WASTE/BORROW AREA LOCATION: TO BE DETERMINED BY CONTRACTOR
 8. ANY SEDIMENT CONTROL PRACTICE WHICH IS DISTURBED BY GRADING ACTIVITY FOR PLACEMENT OF UTILITIES MUST BE REPAIRED ON THE SAME DAY OF DISTURBANCE.
 9. ADDITIONAL SEDIMENT CONTROL MUST BE PROVIDED, IF DEEMED NECESSARY BY THE HOWARD COUNTY SEDIMENT CONTROL INSPECTOR.
 10. ON ALL SITES WITH DISTURBED AREAS IN EXCESS OF 2 ACRES, APPROVAL OF THE INSPECTION AGENCY SHALL BE REQUESTED UPON COMPLETION OF INSTALLATION OF PERIMETER EROSION AND SEDIMENT CONTROLS, BUT BEFORE PROCEEDING WITH ANY OTHER EARTH DISTURBANCE OR GRADING. OTHER BUILDING OR GRADING INSPECTION APPROVALS MAY NOT BE AUTHORIZED UNTIL THIS INITIAL APPROVAL BY THE INSPECTION AGENCY IS MADE.
 11. TRENCHES FOR THE CONSTRUCTION OF UTILITIES IS LIMITED TO THREE PIPE LENGTHS OR THAT WHICH SHALL BE BACK-FILLED AND STABILIZED BY THE END OF EACH WORK DAY, WHICHEVER IS SHORTER.
 12. CONTRACTOR SHALL PROVIDE A STABILIZED CONSTRUCTION ENTRANCE AT THE DIRECTION OF THE SEDIMENT CONTROL INSPECTOR.

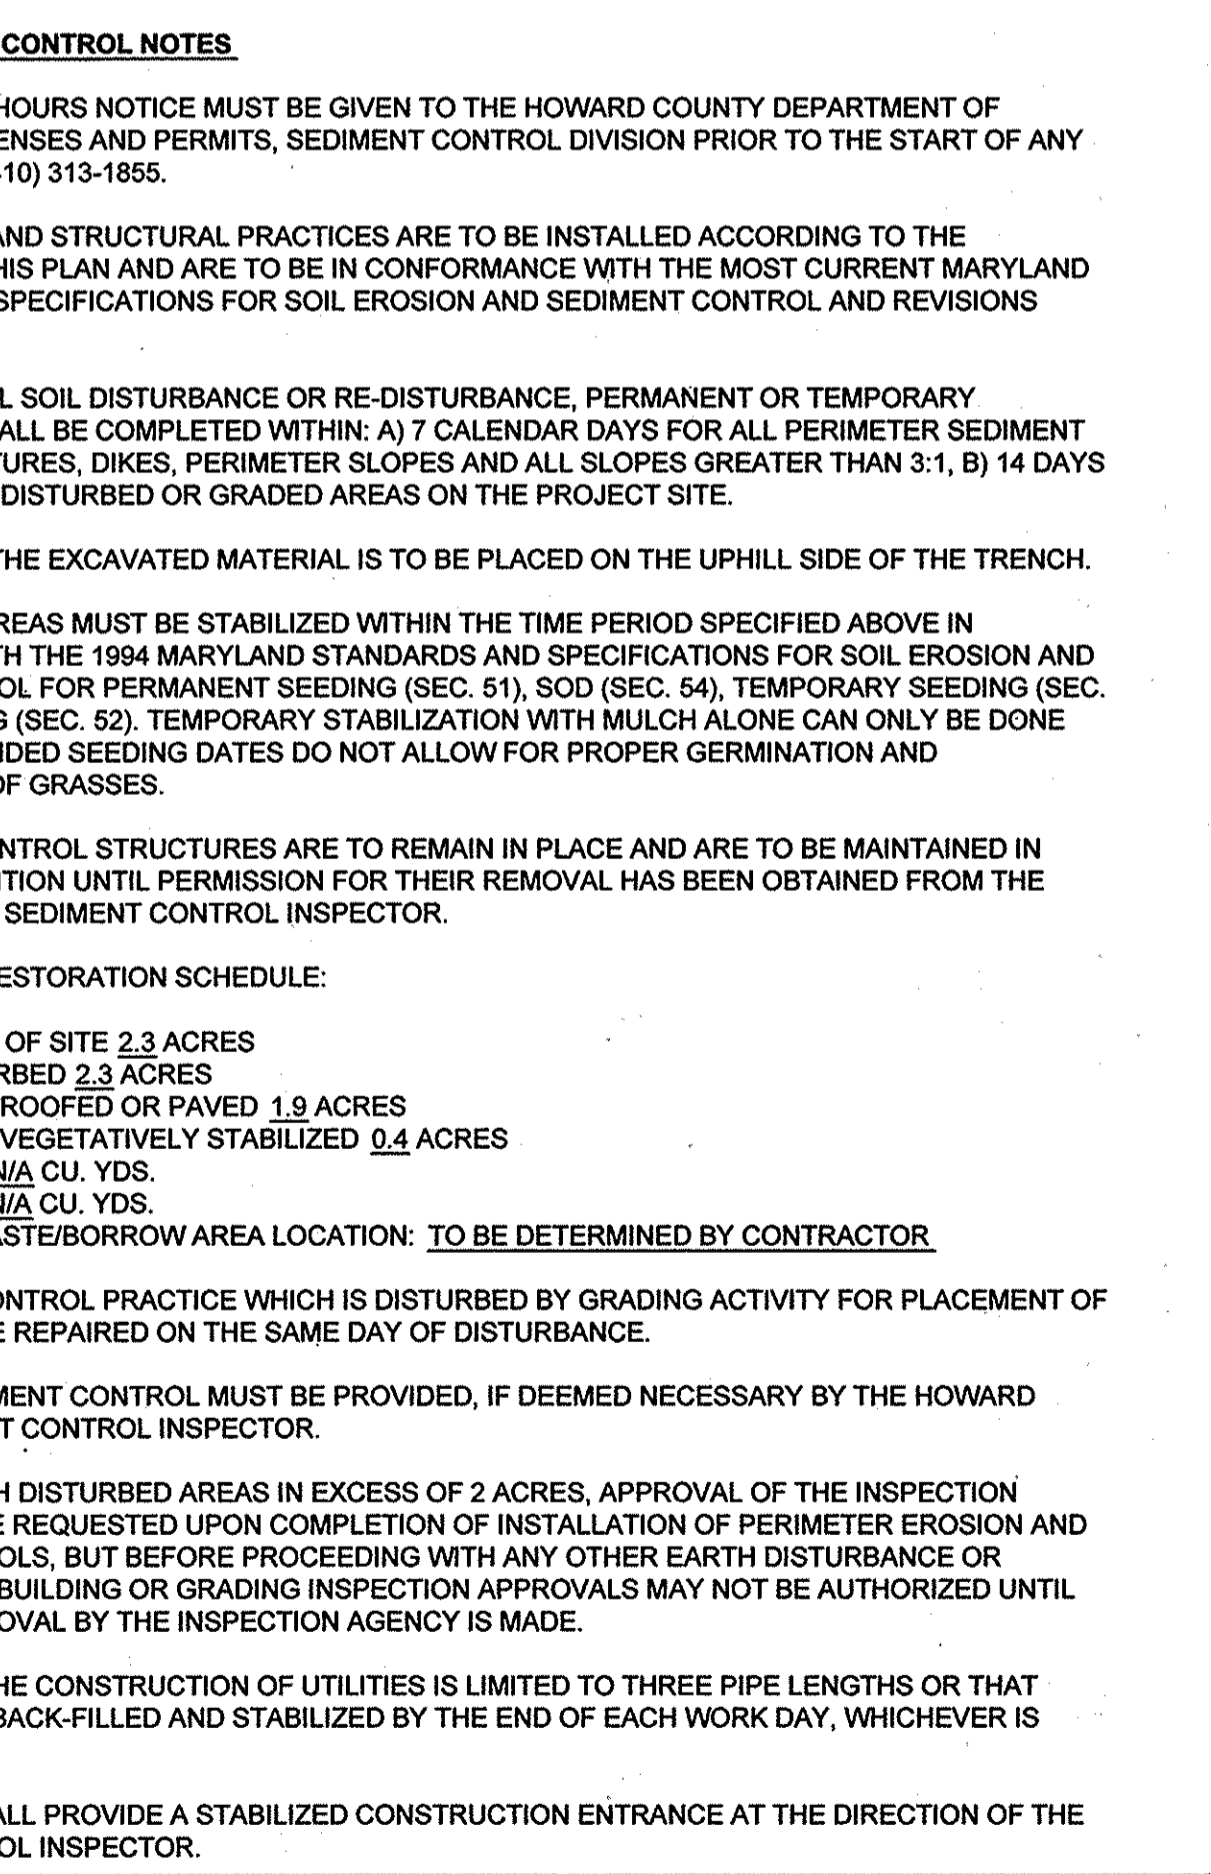

DEPARTMENT OF PUBLIC WORKS
 HOWARD COUNTY, MARYLAND
 Director of Public Works: [Signature] 5/15/13
 Chief, Bureau of Engineering: [Signature] 3/13/13
 Chief, Bureau of Utilities: [Signature] 3/12/13
 Chief, Utility Design Division: [Signature] 3/12/13

URS
 MONTGOMERY PARK BUSINESS CENTER
 1800 WASHINGTON BOULEVARD, SUITE 410
 BALTIMORE, MARYLAND 21230
 (410) 468-0875




Professional Certification
 I hereby certify that these documents were prepared or approved by me, and that I am a duly licensed professional engineer under the laws of the State of Maryland, License No. 22817, Expiration Date: 08/01/13
 NATHAN C. ATKINSON

DESIGN: NCA					
DRAWN: BJW					
CHK: EMT					
DATE: 3/7/13	NO.	REVISION	DATE	BY	

EROSION & SEDIMENT CONTROL DETAILS
 600' SCALE MAP NO. 24
 BLOCK NO. 12

U.S. 40 WATER SERVICE MAIN REPLACEMENT
 CAPITAL PROJECT NO. W-8311
 CONTRACT NO. 44-4731
 6TH ELECTION DISTRICT
 HOWARD COUNTY, MARYLAND
 SCALE: AS SHOWN
 SHEET 10 OF 13




AS-BUILT 4/2015

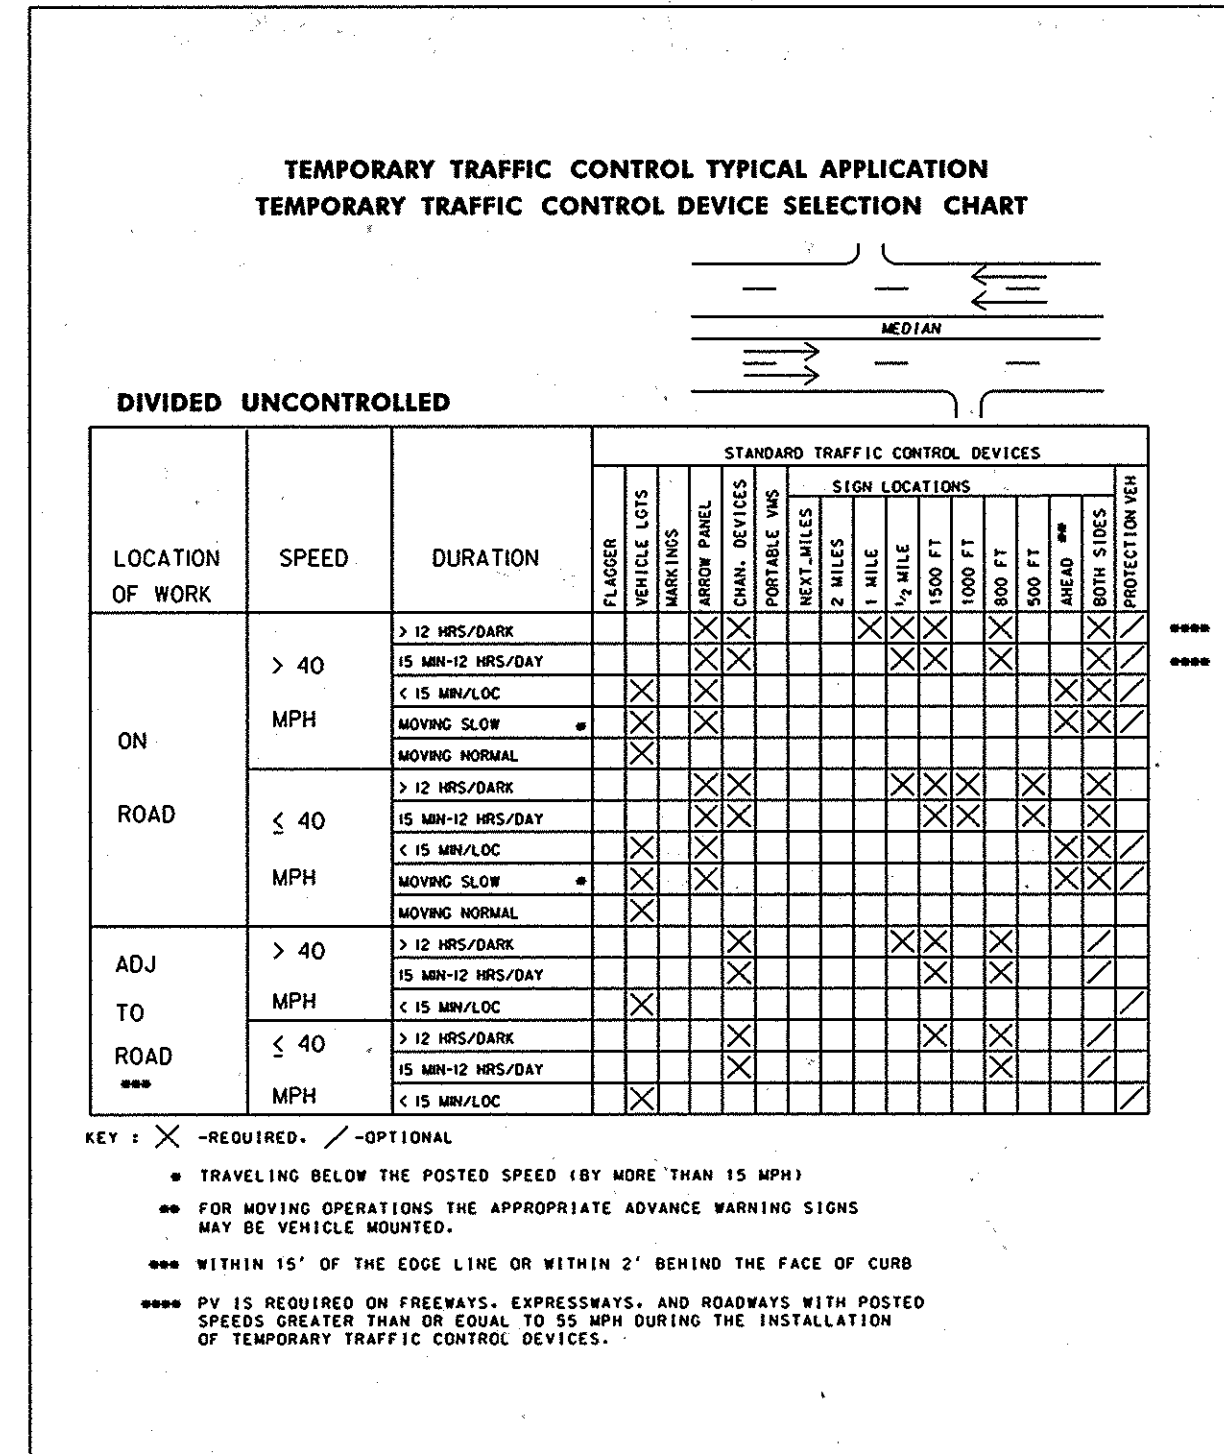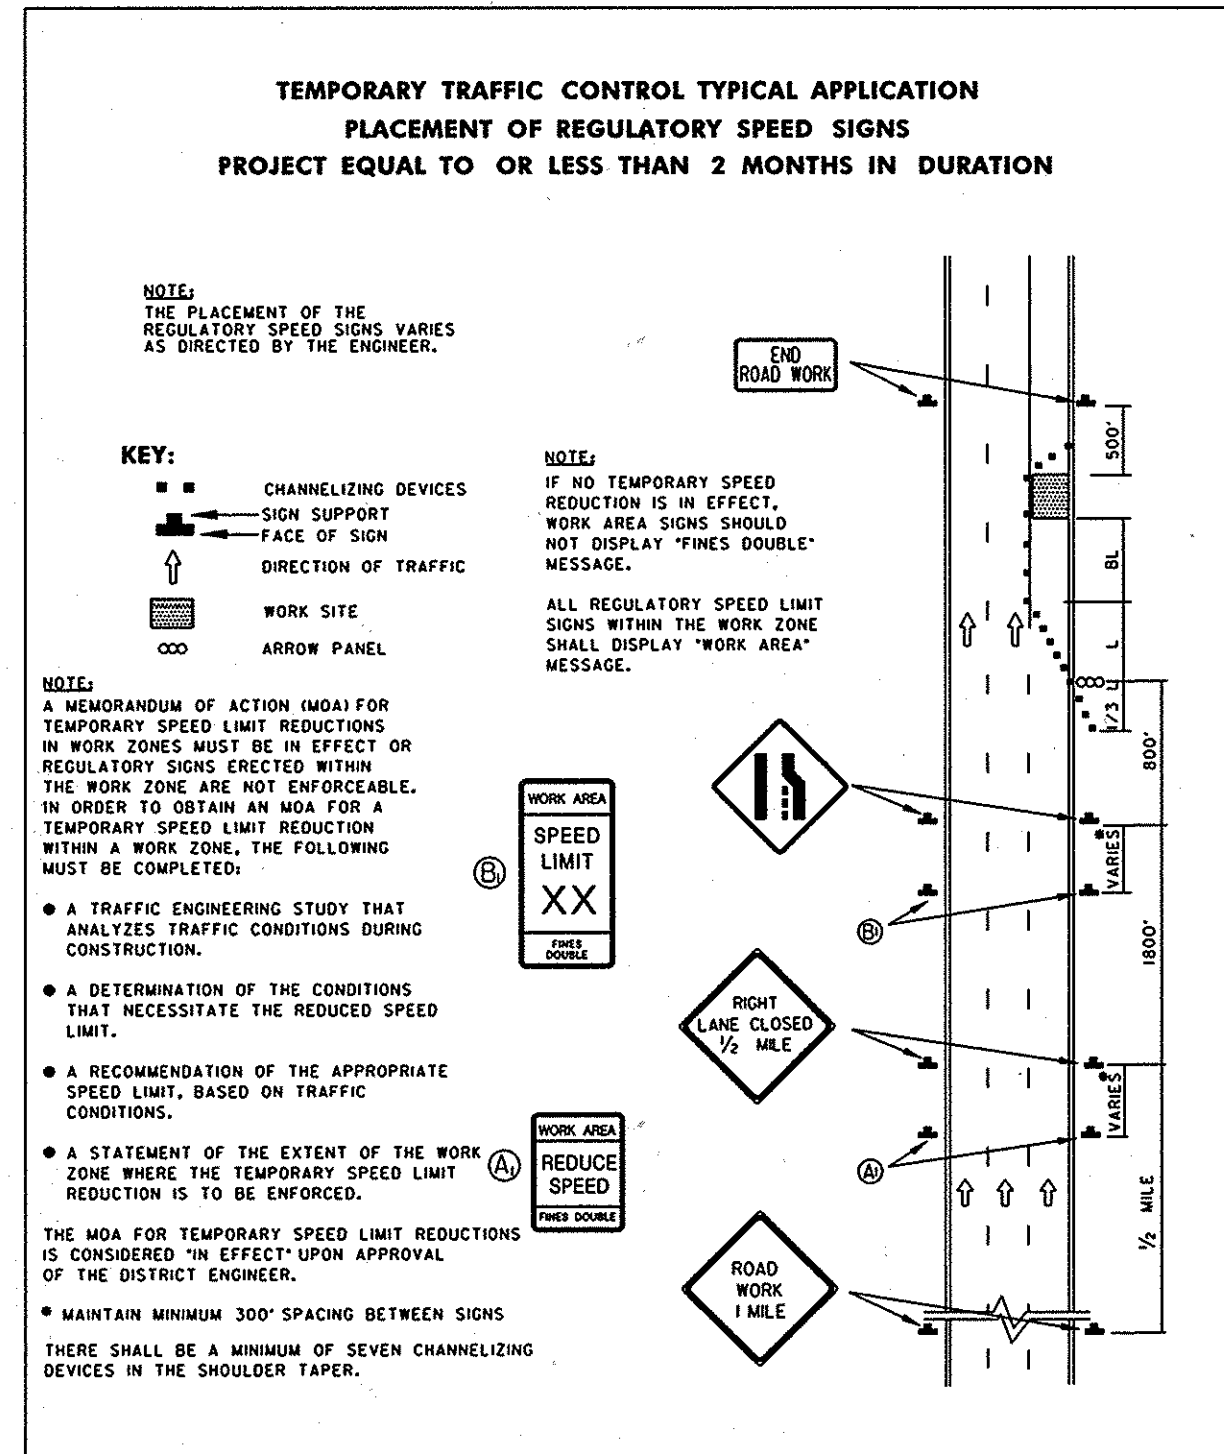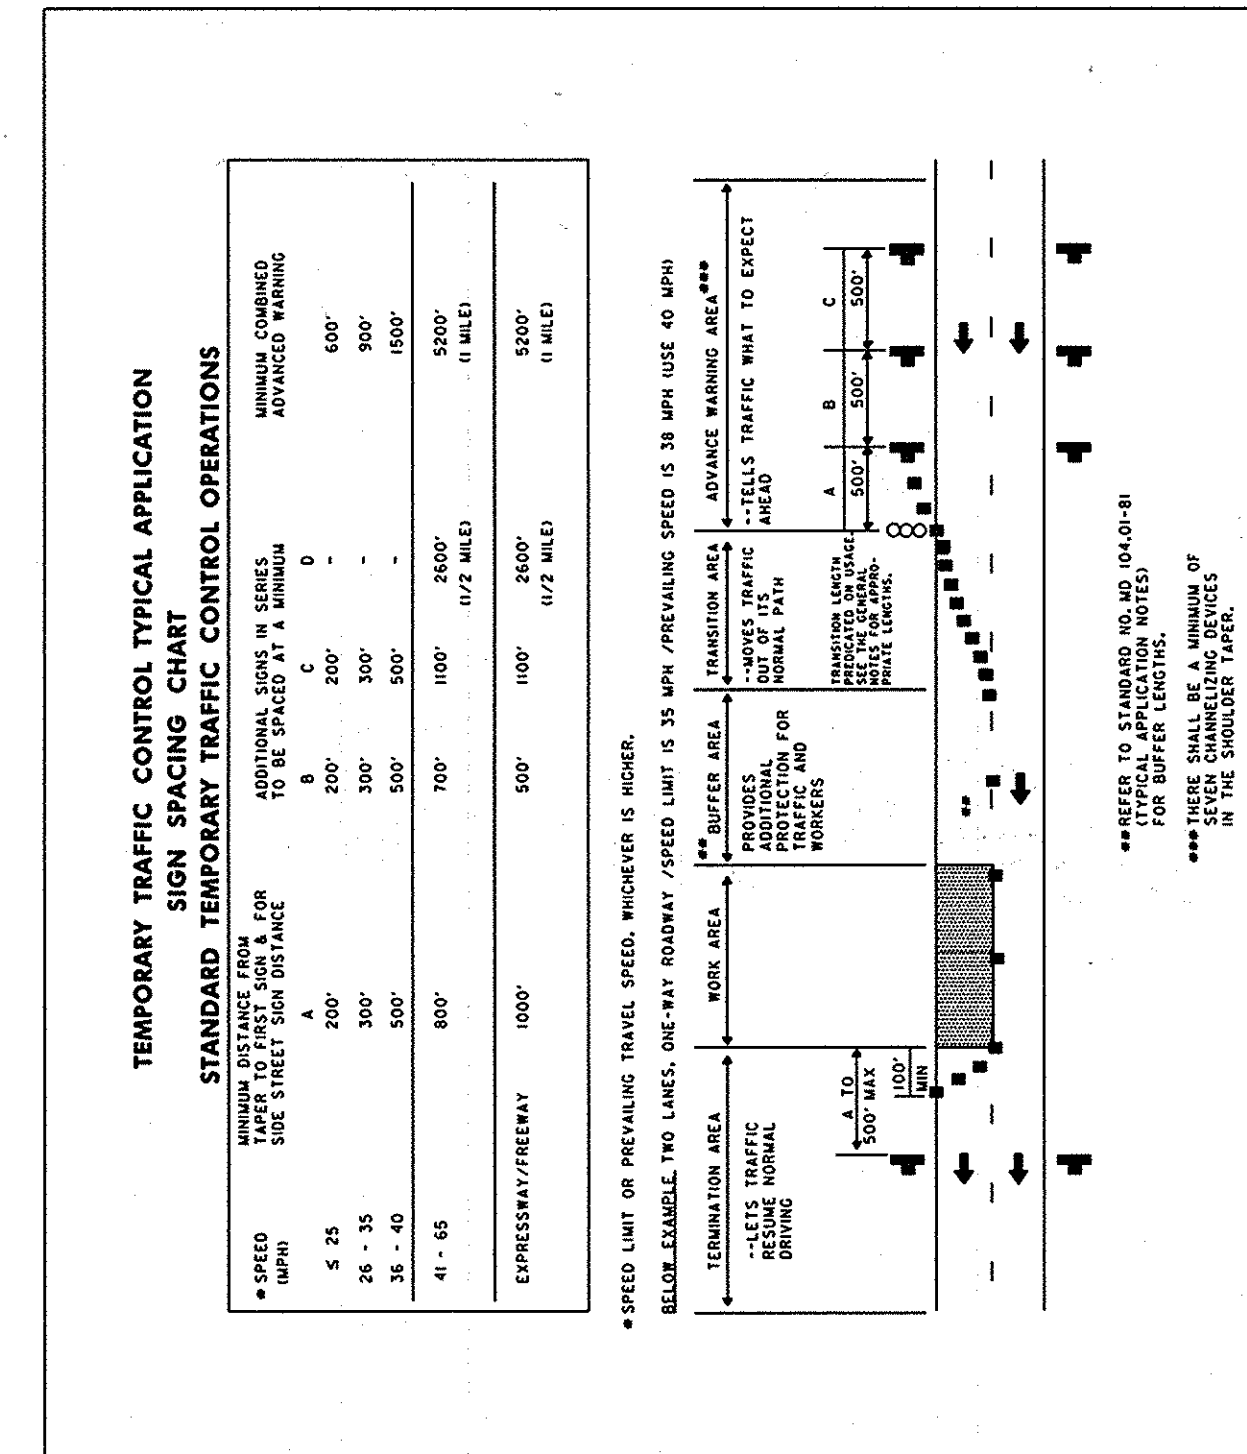

MINIMUM DISTANCE FROM SIGN TO FACE OF SIGN	MINIMUM ADVANCED WARNING
15 MPH	1500'
20 - 25 MPH	2000'
30 - 35 MPH	3000'
40 - 45 MPH	4000'
50 MPH	5000'
60 MPH	6000'
70 MPH	7000'
80 MPH	8000'
90 MPH	9000'
100 MPH	10000'
110 MPH	11000'
120 MPH	12000'
130 MPH	13000'
140 MPH	14000'
150 MPH	15000'

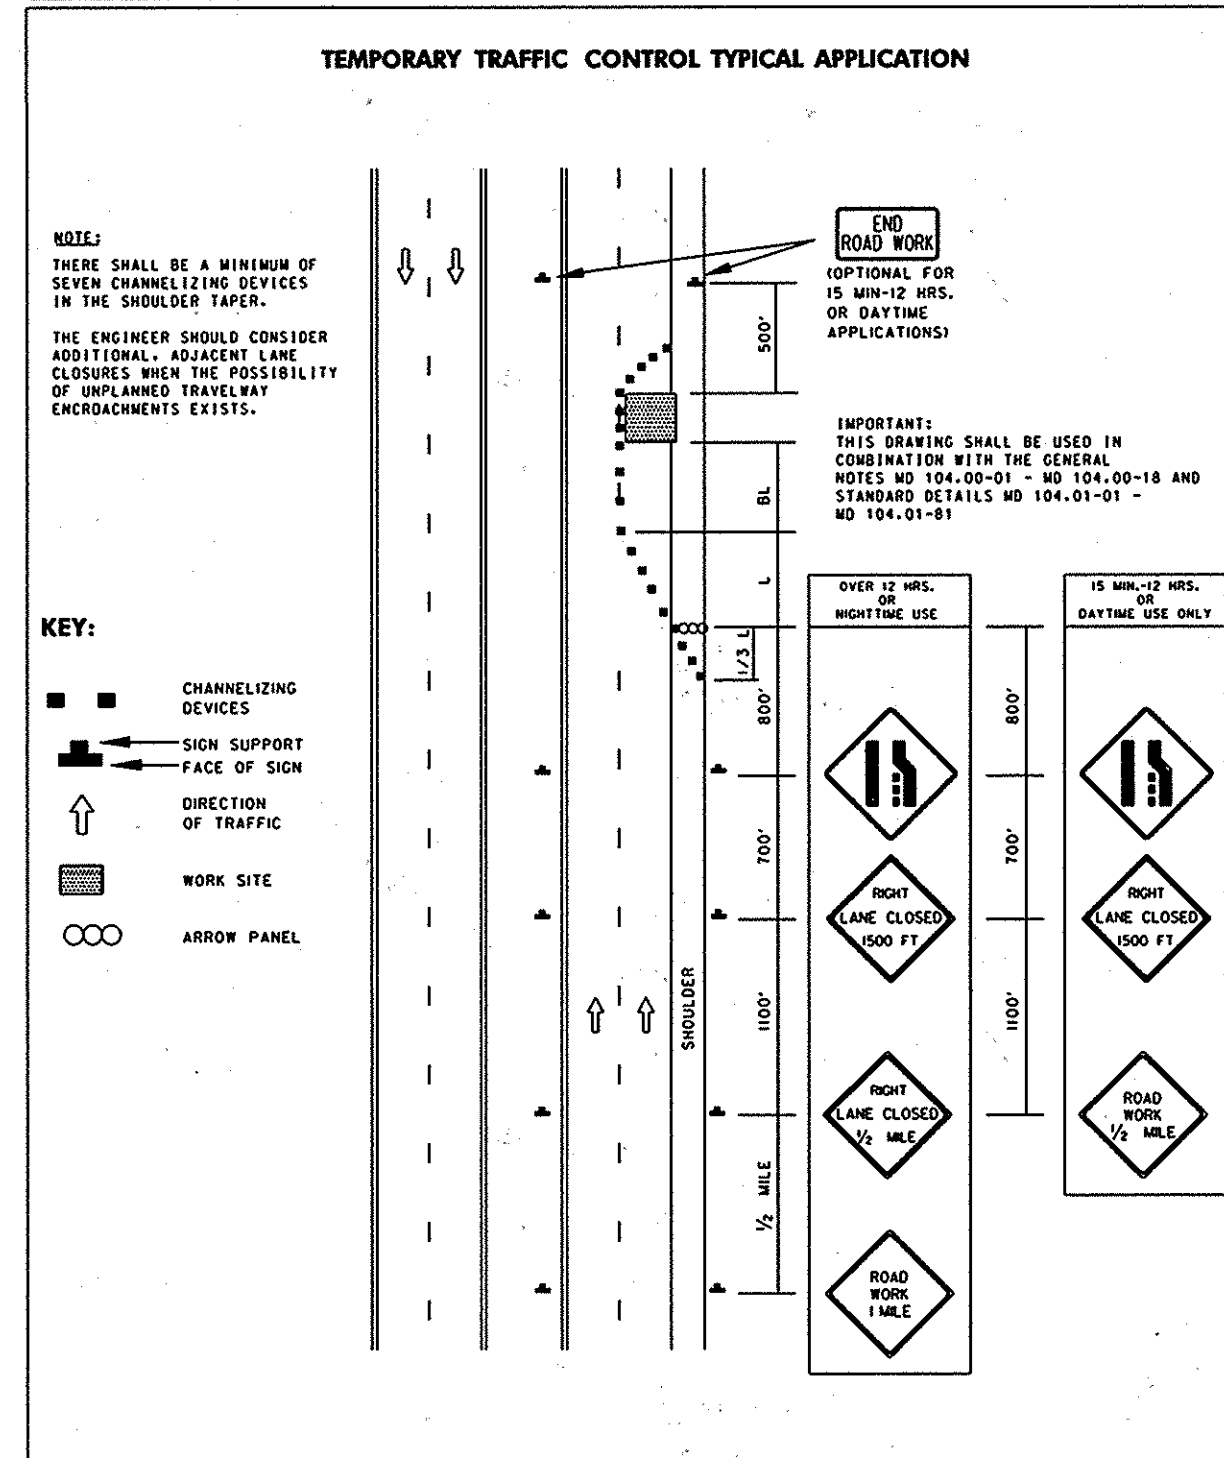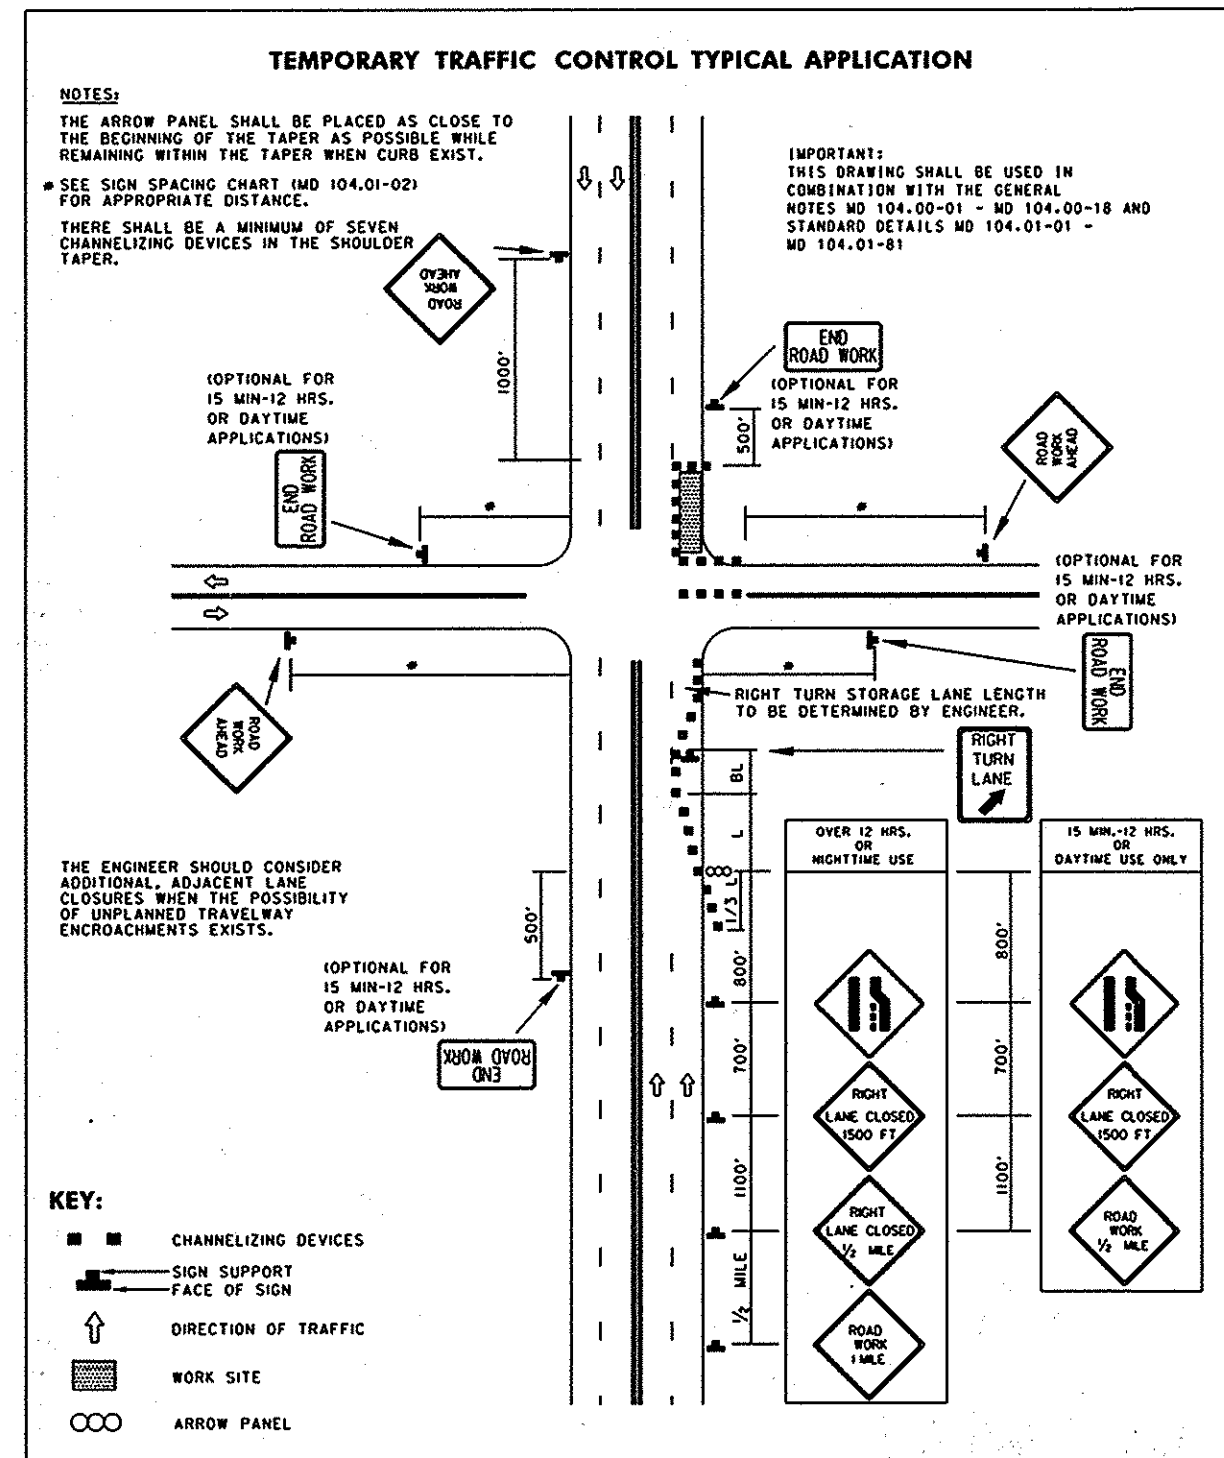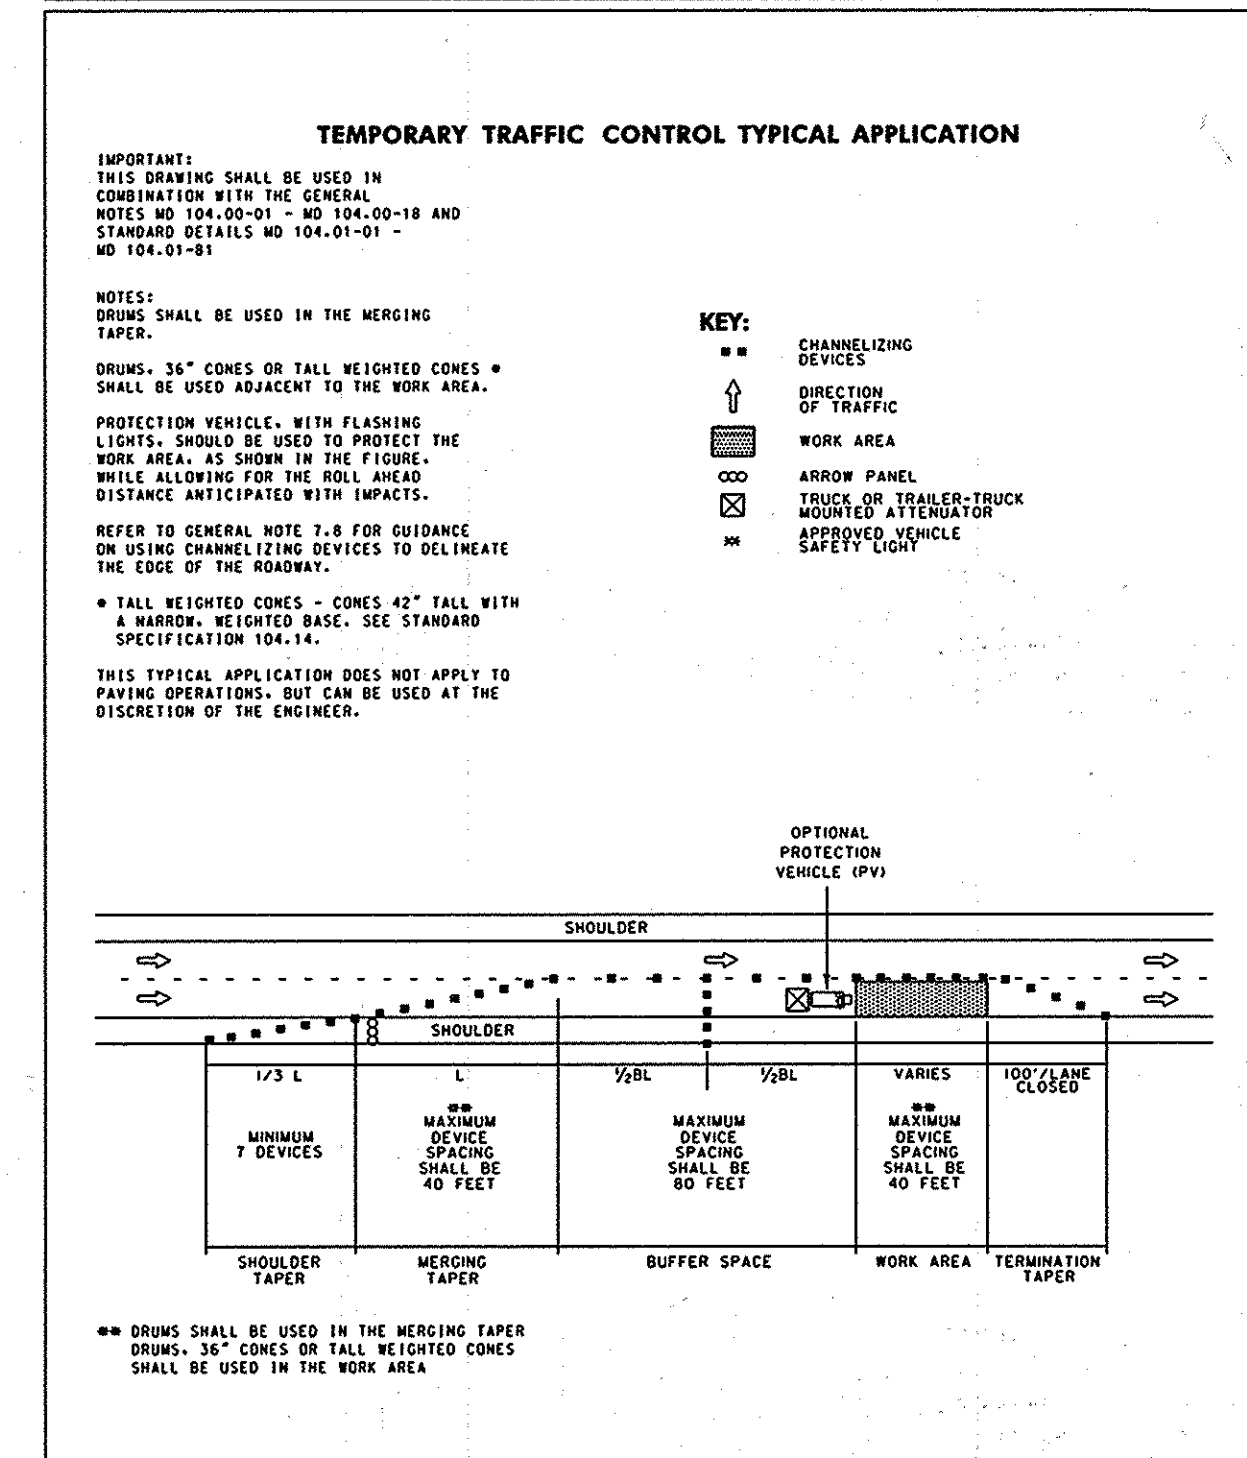

MINIMUM DISTANCE FROM SIGN TO FACE OF SIGN	MINIMUM ADVANCED WARNING
15 MPH	1500'
20 - 25 MPH	2000'
30 - 35 MPH	3000'
40 - 45 MPH	4000'
50 MPH	5000'
60 MPH	6000'
70 MPH	7000'
80 MPH	8000'
90 MPH	9000'
100 MPH	10000'
110 MPH	11000'
120 MPH	12000'
130 MPH	13000'
140 MPH	14000'
150 MPH	15000'

TEMPORARY TRAFFIC CONTROL GENERAL NOTES

1. AT THE COMPLETION OF THE WORK ACTIVITY, CONDITIONS WITHIN THE PROJECT SITE SHALL BE FULLY RESTORED TO THOSE WHICH EXISTED PRIOR TO THE WORK ACTIVITY.
2. ALL WARNING SIGNS SHALL BE FULLY REFLECTORIZED WITH HIGH INTENSITY, REFLECTIVE SHEETING AS PER THE CURRENT EDITION AND REVISIONS OF THE FEDERAL HIGHWAY MANUAL ON UNIFORM TRAFFIC CONTROL DEVICES FOR STREETS AND HIGHWAYS (M.U.T.C.D.).
3. ALL TRAFFIC CONTROLS MUST BE IN ACCORDANCE WITH THE CURRENT EDITION AND REVISIONS OF THE MARYLAND MANUAL FOR UNIFORM TRAFFIC CONTROL DEVICES (MdMUTCD).
4. AT THE DIRECTION OF THE ENGINEER, THE SPACING OF TEMPORARY SIGNING MAY BE ADJUSTED SLIGHTLY TO IMPROVE VISIBILITY OF THE SIGN.
5. CONTRACTOR SHALL MAINTAIN ACCESS TO ALL LOCAL BUSINESSES AND BUILDINGS DURING CONSTRUCTION AND COORDINATE WITH LOCAL BUSINESSES ABOUT THE RESTRICTIONS ON INGRESS AND EGRESS TRAFFIC CONTROL.
6. THE CONTRACTOR IS RESPONSIBLE FOR THE REPLACEMENT OF ANY PAVEMENT MARKINGS REMOVED OR DESTROYED DURING CONSTRUCTION. ALL PAVEMENT MARKINGS REMOVED OR DESTROYED DURING CONSTRUCTION WILL BE REPLACED WITH EITHER LATEX PAINT OR THERMOPLASTIC TO MATCH EXISTING MARKINGS.
7. PROPERLY EQUIPPED FLAGGERS SHALL BE USED TO DIRECT TRAFFIC FOR A LANE CLOSURE OF A TWO-LANE STREET AND WHEN CONSTRUCTION VEHICLES ARE ENTERING AND EXITING THE WORK AREA OR AT OTHER LOCATIONS. FLAGGERS' CLOTHING AND EQUIPMENT SHALL CONFORM TO THE LATEST EDITION OF THE M.U.T.C.D.
8. MUD AND CONSTRUCTION DEBRIS ON STREETS OR SIDEWALKS SHALL BE CLEANED OFF IMMEDIATELY.
9. TRAFFIC CONTROL DEVICES WHEN NOT IN USE SHALL BE COMPLETELY COVERED OR REMOVED FROM THE CONSTRUCTION SITE.
10. THE CONTRACTOR SHALL BE RESPONSIBLE FOR MAINTAINING ALL TRAFFIC CONTROL DEVICES ON AN AROUND THE CLOCK BASIS, WHETHER OR NOT WORK IS ACTIVELY BEING PURSUED AND ANY DEFICIENCIES NOTED SHALL BE CORRECTED IMMEDIATELY.
11. THE TRAFFIC CONTROL REQUIREMENTS SHOWN ON THESE PLANS ARE MINIMUM REQUIREMENTS ONLY AND DO NOT ATTEMPT TO ADDRESS IN DEPTH THE VARIETY OF SITUATIONS THAT MAY OCCUR ONCE CONSTRUCTION HAS STARTED. IN NO WAY DO THE REQUIREMENTS SHOWN ON THESE PLANS RELIEVE THE CONTRACTOR OF HIS RESPONSIBILITY FOR SELECTING THE PROPER TRAFFIC CONTROL DEVICES AND IMPLEMENTATION PROCEDURES THAT WILL ASSURE THE SAFETY OF MOTORIST, PEDESTRIANS, AND WORKERS AT ALL TIMES.

12. SHOULD THE CONTRACTOR FAIL TO ENFORCE THE TRAFFIC CONTROL PLAN OR FAIL TO CLEAN, REPAIR, REPLACE OR OTHERWISE MAINTAIN THE TRAFFIC CONTROL DEVICES WHEN DIRECTED TO DO SO BY THE ENGINEER OR HIS REPRESENTATIVE, HOWARD COUNTY MAY STOP THE WORK UNTIL DEFICIENCIES ARE CORRECTED.
13. ANY PERMANENT SIGN CONFLICTING WITH THIS TRAFFIC CONTROL PLAN SHALL BE COVERED OR REMOVED AS DIRECTED BY THE ENGINEER.
14. ACCESS SHALL BE MAINTAINED TO ALL DRIVES AND SIDE STREETS.
15. CONSTRUCTION VEHICLES SHALL BE PARKED ALONG STREETS SO AS NOT TO RESTRICT SIGHT DISTANCE FOR VEHICLES EXITING AT STREETS OR ANY DRIVES.
16. DURING ALL CONSTRUCTION PERIODS, THE CONTRACTOR SHALL HAVE AT THE JOBSITE ALL NECESSARY TRAFFIC CONTROL DEVICES (APPROPRIATE SIGNS, LIGHTED ARROW DISPLAY, CHANNELIZING DEVICES, ETC.) TO PROPERLY CLOSE AT LEAST ONE LANE OF TRAFFIC.
17. CONSTRUCTION SHALL BE SEQUENCED TO PROVIDE THE LEAST POSSIBLE ADVERSE EFFECT TO RESIDENCES.
18. THE CONTRACTOR IS RESPONSIBLE FOR AVOIDING ANY AND ALL UTILITIES WHEN SETTING SIGN POSTS AND WILL BE REQUIRED TO COORDINATE HIS ACTIVITIES WITH ANY AND ALL UTILITY COMPANIES WHETHER THEIR FACILITY IS INDICATED ON THE PLANS OR NOT.
19. TRENCH MUST BE BACKFILLED AND TEMPORARILY PATCHED DAILY OR STEEL PLATED PER SHA UTILITY PERMIT. STEEL PLATES, IF USED SHALL BE A36 CERTIFIED STEEL AT LEAST 1" THICK WITH LIFT HOOKS AND MUST BE PINNED AND COLD PATCHED DAILY. WHEN MORE THAN 1 STEEL PLATE IS USED AT A TIME THEY MUST BE TACK WELDED BY A CERTIFIED WELDER.
20. THE CONTRACTOR IS RESPONSIBLE FOR INSTALLING TEMPORARY PAVEMENT MARKINGS FOR ANY DOUBLE YELLOW OR EDGE LINES REMOVED OR DESTROYED DURING CONSTRUCTION.
21. THE CONTRACTOR SHALL COORDINATE ANY DISRUPTION OF TRAFFIC SIGNALS, SENSORS AND WIRING WITH MARYLAND STATE HIGHWAY ADMINISTRATION, OFFICE OF TRAFFIC AND SAFETY.

Formula for Determining Taper Length

Speed (S) in mph	Taper Length (L) in feet
40 mph or less	$L = \frac{WS^2}{60}$
45 mph or more	$L = WS$

Where: L = taper length in feet
W = width of offset in feet
S = posted speed limit

Guidelines for Length of Longitudinal Buffer Space	
Speed* (mph)	Length (feet)
20	35
25	55
30	85
35	120
40	170
45	220
50	280

DEPARTMENT OF PUBLIC WORKS
HOWARD COUNTY, MARYLAND
3/13/13
3/13/13
3/13/13
3/12/13

URS
MONTGOMERY PARK BUSINESS CENTER
1800 WASHINGTON BOULEVARD, SUITE 410
BALTIMORE, MARYLAND 21230
(410) 468-0875

Professional Certification
I hereby certify that these documents were prepared or approved by me, and that I am a duly licensed professional engineer under the laws of the State of Maryland, License No. 22817, Expiration Date: 08/01/13
NATHAN C. ATKINSON

DESIGN: NCA					
DRAWN: BJW					
CHK: EMT					
DATE: 3/7/13	NO.	REVISION	DATE	BY	

TRAFFIC CONTROL DETAILS
U.S. 40 WATER SERVICE MAIN REPLACEMENT
CAPITAL PROJECT NO. W-8311
CONTRACT NO. 44-4731
6TH ELECTION DISTRICT
HOWARD COUNTY, MARYLAND
SCALE: AS SHOWN
SHEET 11 OF 13
AS-BUILT 1/2015