


32. DEVELOPER RESERVES UNTO ITSELF, ITS SUCCESSORS AND ASSIGNS, ALL EASEMENTS SHOWN ON THIS PLAT FOR WATER, SEWER, STORM DRAINAGE, AND OTHER PUBLIC UTILITIES AND FOREST CONSERVATION (DESIGNATED AS "FOREST CONSERVATION EASEMENT"), LOCATED IN, ON, OVER AND THROUGH OPEN SPACE LOTS 25 THRU 28, ANY CONVEYANCE OF AFORESAID PARCEL SHALL BE SUBJECT TO THE EASEMENTS HEREIN RESERVED, WHETHER OR NOT EXPRESSLY STATED IN THE DEED(S) CONVEYING SAID PARCEL. DEVELOPER SHALL EXECUTE AND DELIVER DEEDS FOR THE EASEMENTS HEREIN RESERVED TO HOWARD COUNTY WITH A METES AND BOUNDS DESCRIPTION OF THE FOREST CONSERVATION EASEMENT. UPON COMPLETION OF THE PUBLIC UTILITIES AND THEIR ACCEPTANCE BY HOWARD COUNTY, AND IN THE CASE OF THE FOREST CONSERVATION EASEMENT, UPON COMPLETION OF THE DEVELOPER'S OBLIGATIONS UNDER THE FOREST CONSERVATION INSTALLATION AND MAINTENANCE AGREEMENT EXECUTED BY THE DEVELOPER AND THE COUNTY, AND THE RELEASE OF THE DEVELOPER'S SURETY POSTED WITH SAID AGREEMENT, THE COUNTY SHALL ACCEPT THE EASEMENTS AND RECORD THE DEED(S) OF THE EASEMENT IN THE LAND RECORDS OF HOWARD COUNTY.
33. THE FOREST CONSERVATION REQUIREMENTS PER SECTION 16.120 OF THE HOWARD COUNTY CODE FOR FOREST CONSERVATION HAVE BEEN MET BY ON-SITE RETENTION OF 1.97 ACRES AND REFORESTATION OF 0.26 ACRES. FINANCIAL SURETY FOR THE 1.97 ACRES (85,813.2 SQ. FT.) OF RETENTION IN THE AMOUNT OF \$17,162.64 AND 0.26 ACRES (11,325.6 SQ. FT.) OF REFORESTATION IN THE AMOUNT OF \$5,662.80 HAS BEEN POSTED AS PART OF THE DPW DEVELOPERS AGREEMENT IN THE AMOUNT OF \$22,825.44.
34. THE PURPOSE OF NON-BUILDABLE PARCEL A IS FOR INGRESS/EGRESS FOR PARCELS 706, 708, 711, 709, 710, 699 AND LOT 10A. PARCEL A WILL BE TRANSFERRED AS A FEE-SIMPLE TRANSACTION TO LOT 10A AT NO CHARGE TO LOT 10A SINCE THE LAND TRANSFER IS A REQUIREMENT OF THE SUBDIVISION PROCESS.
35. THIS PROJECT IS A SUBJECT TO A WP-03-63 TO WAIVE SECTIONS: 16.120(b)(4)(iv), 16.120(c)(2)(ii), 16.121(e)(1) AND 16.121(e)(2). APPROVED ON JANUARY 14, 2003 SUBJECT TO FOLLOWING CONDITIONS:
1. PROVIDE A MINIMUM 20' ACCESS EASEMENT TO THE OPEN SPACE 26 WITHOUT OBLIGATION TO DEPARTMENT OF RECREATION AND PARKS TO SHARE IN DRIVEWAY MAINTENANCE.
 2. PROVIDE MINIMUM 24' SHARED ACCESS EASEMENT FOR LOTS 2 & 3, EXTENDED TO THE SOUTHERN BOUNDARY OF LOT 3.
 3. PROVIDE A PEDESTRIAN CROSSING BRIDGE ACROSS THE WETLANDS AND STREAM ON OPEN SPACE LOT 26, OVER THE PROPOSED WATER, SEWER AND UTILITY EASEMENT.
36. APPLICATION WAS APPROVED ON MAY 5, 2004, BY THE MDE NON-TIDAL WETLANDS & WATERWAYS DIVISION FOR THE DRIVEWAY CROSSING OF THE WETLANDS, STREAM, AND THEIR BUFFERS FOR THE INSTALLATION OF A WATER & SEWER MAIN UNDER TRACKING # 03-NT-0509/200460595.
37. ARTICLES OF INCORPORATION FOR "ILCHESTER OAKS HOMEOWNER'S ASSOCIATION, INC", IDENTIFICATION # D10013811. THIS PROPERTY WAS FORMERLY REFERRED TO AS "DOBSON PROPERTY."
38. A WAIVER PETITION WAS FILED ON DECEMBER 18, 2003 REQUESTING TO WAIVE SECTION 16.120(b)(4)(iii)(b) TO ALLOW WETLANDS AND WETLAND BUFFER ON A RESIDENTIAL LOT LESS THAN 10 ACRES IN SIZE IF THE BUILDING ENVELOPE IS NO CLOSER THAN 35 FEET FROM THE ENVIRONMENTAL FEATURES. THE WAIVER, WP-04-85, WAS APPROVED ON FEBRUARY 5, 2004 SUBJECT TO THE FOLLOWING CONDITIONS:
- ON F-03-36 AND THE SUBSEQUENT SITE DEVELOPMENT PLANS, PROVIDE THE FOLLOWING:
1. PROVIDE THE LOT CONFIGURATION AND NUMBER OF LOTS AS SHOWN ON THE AMENDED EXHIBIT FOR wp-04-85 SUBMITTED TO THE COUNTY ON JANUARY 21, 2004.
 2. SHOW THE 35 FOOT ENVIRONMENTAL SETBACK FROM THE WETLAND BUFFER ON LOT 4.
 3. PROVIDE DOCUMENTATION FROM SCD CONCERNING THE RELOCATION OF THE SEWER EASEMENT ON OPEN SPACE LOT 25 TO THE ADJACENT SITE.
39. THIS PLAT IS SUBJECT TO THE FIFTH EDITION OF THE SUBDIVISION AND LAND DEVELOPMENT REGULATIONS AND ZONING REGULATIONS AS AMENDED BY CB 50-2001. DEVELOPMENT OR CONSTRUCTION ON THESE LOTS MUST COMPLY WITH SETBACK AND BUFFER REGULATIONS IN EFFECT AT THE TIME OF SUBMISSION OF THE SITE DEVELOPMENT PLAN, WAIVER PETITION APPLICATION, OR BUILDING/GRADING PERMIT.

23. THE PROPERTY IS RECORDED AS HO-390, TALBOT'S LAST SHIFT IN THE HOWARD COUNTY HISTORIC SITES INVENTORY. THE ORIGINAL INVENTORY FORM ON THE PROPERTY DATES THE STONE HOUSE TO THE 18TH CENTURY AND THE FRAME ADDITIONS TO THE LATE 19TH CENTURY. THE TWO STORY STONE HOUSE, STONE SPRING HOUSE, AND LOG SMOKEHOUSE ARE TO REMAIN. ALL OTHER STRUCTURES ARE TO BE REMOVED. THE EXISTING STONE HOUSE LOCATED ON LOT 3 HAS AN ADDRESS OF 5231 TALBOTS LANDING ELLICOTT CITY, MARYLAND 21043, AND WILL HAVE A CHANGE OF ADDRESS. NO NEW BUILDINGS, EXTENSIONS OR ADDITIONS TO THE EXISTING DWELLING ARE TO BE CONSTRUCTED AT A DISTANCE LESS THAN THE CURRENT ZONING REGULATIONS REQUIRE.
24. OPEN SPACE LOT 26 IS DEDICATED TO HOWARD COUNTY, MARYLAND, AND OPEN SPACE LOTS 23,24,&25 ARE DEDICATED TO THE HOMEOWNERS ASSOCIATION FOR THE RESIDENTS OF THE SUBDIVISION AND RECORDING REFERENCES OF THE ARTICLES OF INCORPORATION AND RESTRICTIONS ARE SHOWN HEREON.
25. LANDSCAPING FOR LOTS 1 THRU 22 IS PROVIDED IN ACCORDANCE WITH A CERTIFIED LANDSCAPE PLAN AS PART OF CONSTRUCTION DRAWINGS IN ACCORDANCE WITH SECTION 16.124 OF THE HOWARD COUNTY CODE AND THE LANDSCAPE PLAN.
26. FINANCIAL SURETY FOR THE REQUIRED LANDSCAPING (38 SHADE TREES, 22 SMALL DECIDUOUS/ORNAMENTAL TREES, 20 EVERGREENS, 18 PRIVATE STREET TREES) HAS BEEN POSTED AS PART OF THE DPW DEVELOPERS AGREEMENT IN THE AMOUNT OF \$23,100.00.
27. THIS SUBDIVISION IS SUBJECT TO SECTION 18.122B OF THE HOWARD COUNTY CODE. PUBLIC WATER AND SEWER SERVICE TO THESE LOTS HAS BEEN GRANTED UNDER THE TERMS AND PROVISIONS, THEREOF, EFFECTIVE ~~Sept. 3, 2004~~ ON WHICH DATE DEVELOPER AGREEMENT # 14-4098-D WAS FILED AND ACCEPTED.
28. WETLAND DELINEATION PREPARED BY ECO-SCIENCE PROFESSIONAL, INC. DATED APRIL 2000.
29. THIS PROJECT IS SUBJECT TO THE 5TH EDITION SUBDIVISION AND LAND DEVELOPMENT REGULATIONS AND TO THE COUNTY COUNCIL BILL 50-2001 ZONING REGULATIONS AMENDMENT.
30. STORMWATER MANAGEMENT CONTROL WILL BE PROVIDED IN ACCORDANCE WITH THE 2000 MARYLAND DESIGN MANUAL. SWM WILL BE PRIVATE.
31. A WAIVER PETITION WAS FILED ON MAY 19, 2004 REQUESTING TO WAIVE SECTION 16.123(a)(2) TO ALLOW ISSUANCE OF A GRADING PERMIT FOR MASS GRADING FOR INFRASTRUCTURE IMPROVEMENTS PRIOR TO SIGNATURE APPROVAL OF CONSTRUCTION DRAWINGS; AND SECTION 16.147(e) TO ALLOW ISSUANCE OF A GRADING PERMIT PRIOR TO SIGNATURE APPROVAL OF THE ROAD CONSTRUCTION DRAWINGS AND EXECUTION OF A DEVELOPER'S AGREEMENT COVERING FINANCIAL OBLIGATIONS WITH APPROPRIATE SECURITY GUARANTEES. THE WAIVER, WP-04-142, WAS APPROVED ON JUNE 16, 2004 SUBJECT TO THE FOLLOWING CONDITIONS:
1. PROVIDE A GRADING PLAN WITH ALL UTILITIES, PAVEMENT AND STRUCTURES REMOVED TO HOWARD SOIL CONSERVATION DISTRICT.
 2. PRIOR TO COMMENCEMENT OF ANY ACTIVITY ON THE SITE, OBTAIN A GRADING PERMIT TO MASS GRADE THE SITE IN ACCORDANCE WITH THE GRADING SHOWN ON THE WAIVER PETITION EXHIBIT (SHOWING A LIMIT OF DISTURBANCE GENERALLY ALONG THE SITE BOUNDARY AND TO PROTECT THE ENVIRONMENTAL FEATURES ON OPEN SPACE LOT 26).
 3. INSTALL, INSPECT AND MAINTAIN ALL SEDIMENT AND EROSION CONTROLS IN COMPLIANCE WITH THE SOIL CONSERVATION DISTRICT REQUIREMENTS.
 4. COORDINATE THE SITE INSPECTIONS WITH THE CID OF THE DPW. HAVE A QUALIFIED PRIVATE CONSTRUCTION INSPECTOR ON SITE AT ALL TIMES DURING GRADING AND CONSTRUCTION OF ALL INFRASTRUCTURE IMPROVEMENTS.
 5. OBTAIN SIGNED ROAD CONSTRUCTION DRAWINGS AND SIGNED WATER AND SEWER DRAWINGS AND DEVELOPER'S AGREEMENTS AS SOON AS POSSIBLE AND PRIOR TO SUBMISSION OF THE PLAT ORIGINALS.

GENERAL NOTES

1. PROJECT BACKGROUND:
LOCATION: FIRST ELECTION DISTRICT - TAX MAP 31, GRID 16
PARCEL 641 & 841
DEED REFERENCE : 996/245 AND 5889/315, 5091/702.
ZONING: R-20
TOTAL TRACT AREA: 13.80 ACRES ±
AREA OF BG&E UTILITY EASEMENT: 1.08 ACRES ±
NET AREA: 12.72 ACRES ±
NUMBER OF PROPOSED LOTS: 26 (22 BUILDABLE & 4 OPEN SPACE)
ACREAGE OF PROPOSED BUILDABLE LOTS : 6.88 ACRES ±
ACREAGE OF NON-BUILDABLE PARCEL "A" : 0.21 ACRES ±
OPEN SPACE REQUIRED : 5.09 ACRES ± (40% OF NET AREA)
OPEN SPACE PROVIDED : 5.83 ACRES ±
OPEN SPACE CREDITED : 5.14 ACRES ±
OPEN SPACE NON-CREDITED : 0.71 ACRES ±
RECREATIONAL OPEN SPACE REQUIRED (24 UNITSX200 SQ.FT.) : 4,800SQ.FT.
RECREATIONAL OPEN SPACE PROVIDED : 5,192 SQ. FT.
PROPOSED ROAD DEDICATION : 0.78 ACRES ±
AREA OF STEEP SLOPES : N/A
AREA OF 100 YEAR FLOODPLAIN : N/A
DPZ REFERENCE # : SP-02-07, WP-03-63
2. THIS PLAT IS BASED ON A FIELD RUN MONUMENTED BOUNDARY SURVEY PERFORMED FEBRUARY 2002 BY MILDENBERG, BOENDER & ASSOC., INC.
3. COORDINATES BASED ON NAD '83 MARYLAND COORDINATE SYSTEM AS PROJECTED BY HOWARD COUNTY GEODETIC CONTROL STATIONS NO. 31EA & 31 EB.
STA. No. 31EA N 569,641.124 ELEV. 469.604
E 1,374,815.936
STA. No. 31EB N 568,730.984 ELEV. 453.398
E 1,376,273.491
4. ● DENOTES AN IRON PIN OR IRON PIPE FOUND.
○ DENOTES ANGULAR CHANGE IN BEARING OF BOUNDARY OR RIGHT-OF-WAY.
BRL DENOTES A BUILDING RESTRICTION LINE.
5. SURVEY WORK AND DOCUMENTS ARE TO BE PERFORMED IN CONFORMANCE WITH SUBTITLE 13, BOARD OF PROFESSIONAL LAND SURVEYORS, 09.13.06 STATE OF MARYLAND MINIMUM STANDARDS OF PROFESSIONAL PRACTICE.
6. ALL AREAS ARE MORE OR LESS.
7. THIS SUBDIVISION IS IN THE METROPOLITAN DISTRICT.
8. NO BURIAL GROUNDS OR CEMETERIES EXIST ON-SITE.
9. NO STEEP SLOPES, STREAMS, OR FLOODPLAIN EXIST ON-SITE.
10. STORMWATER MANAGEMENT REQUIREMENTS WILL BE BY ON-SITE SAND FILTER AND NATURAL AREA CONSERVATION EASEMENT CREDITS. SWM FACILITY WILL BE PRIVATELY OWNED AND MAINTAINED.
11. THE PROPERTY IS RECORDED AS HO-390, TALBOT'S LAST SHIFT IN THE HOWARD COUNTY HISTORIC SITES INVENTORY. THE ORIGINAL INVENTORY FORM ON THE PROPERTY DATES THE STONE HOUSE TO THE 18TH CENTURY AND THE FRAME ADDITIONS TO THE LATE 19TH CENTURY. THE TWO STORY STONE HOUSE, STONE SPRING HOUSE AND LOG SMOKEHOUSE ARE TO REMAIN. ALL OTHER STRUCTURES ARE TO BE REMOVED. THE HOUSE AND SMOKEHOUSE ARE LOCATED ON LOT 3.
12. [Symbol] DENOTES PRIVATE STORMWATER MANAGEMENT & UTILITY EASEMENT
13. [Symbol] DENOTES PRIVATE USE IN COMMON ACCESS PLACE EASEMENT.
14. [Symbol] DENOTES PUBLIC SEWER, WATER, DRAINAGE & UTILITY EASEMENT
- 14A. [Symbol] DENOTES PRIVATE DRAINAGE & UTILITY EASEMENT
15. [Symbol] DENOTES FOREST CONSERVATION (RETENTION) CREDIT EASEMENT
16. [Symbol] DENOTES FOREST CONSERVATION (REFORESTATION CREDIT EASEMENT)
17. [Symbol] DENOTES WETLANDS
18. [Symbol] DENOTES NON-CREDITED OPEN SPACE
19. [Symbol] DENOTES PUBLIC TREE MAINTENANCE EASEMENT
20. DRIVEWAYS SHALL BE PROVIDED PRIOR TO RESIDENTIAL OCCUPANCY TO ENSURE SAFE ACCESS FOR FIRE AND EMERGENCY VEHICLES PER THE FOLLOWING MINIMUM REQUIREMENTS:
A) WIDTH - 12 FEET (14 FEET SERVING MORE THAN ONE RESIDENT).
B) SURFACE - 6 INCHES OF COMPACTED CRUSHER RUN BASE WITH TAR AND CHIP COATING.
C) GEOMETRY - MAXIMUM 15% GRADE, MAXIMUM 10% GRADE CHANGE AND MINIMUM OF 45-FOOT TURNING RADIUS.
D) STRUCTURES (CULVERT/BRIDGES) - CAPABLE OF SUPPORTING 25 GROSS TONS (H25 LOADING).
E) DRAINAGE ELEMENTS - CAPABLE OF SAFELY PASSING 100-YEAR FLOOD WITH NO MORE THAN 1 FOOT DEPTH OVER DRIVEWAY SURFACE.
F) STRUCTURE CLEARANCES - MINIMUM 12 FEET
G) MAINTENANCE - SUFFICIENT TO ENSURE ALL WEATHER USE.
21. FOR FLAG OR PIPESTEM LOTS, REFUSE COLLECTION, SNOW REMOVAL AND ROAD MAINTENANCE ARE PROVIDED TO THE JUNCTION OF THE FLAG OR PIPESTEM AND ROAD RIGHT-OF-WAY LINE AND NOT ONTO THE PIPESTEM LOT DRIVEWAY.
22. THE 4'X10' CONCRETE REFUSE AND RECYCLE COLLECTION PLAD (6 INCHES IN DEPTH) WITHIN THE PUBLIC RIGHT-OF-WAY WILL BE MAINTAINED BY THE OWNERS OF LOTS 4-10 PURSUANT TO THE DECLARATION OF RIGHT OF ACCESS AND MAINTENANCE OBLIGATIONS RECORDED AMONG THE LAND RECORDS OF HOWARD COUNTY, MARYLAND.

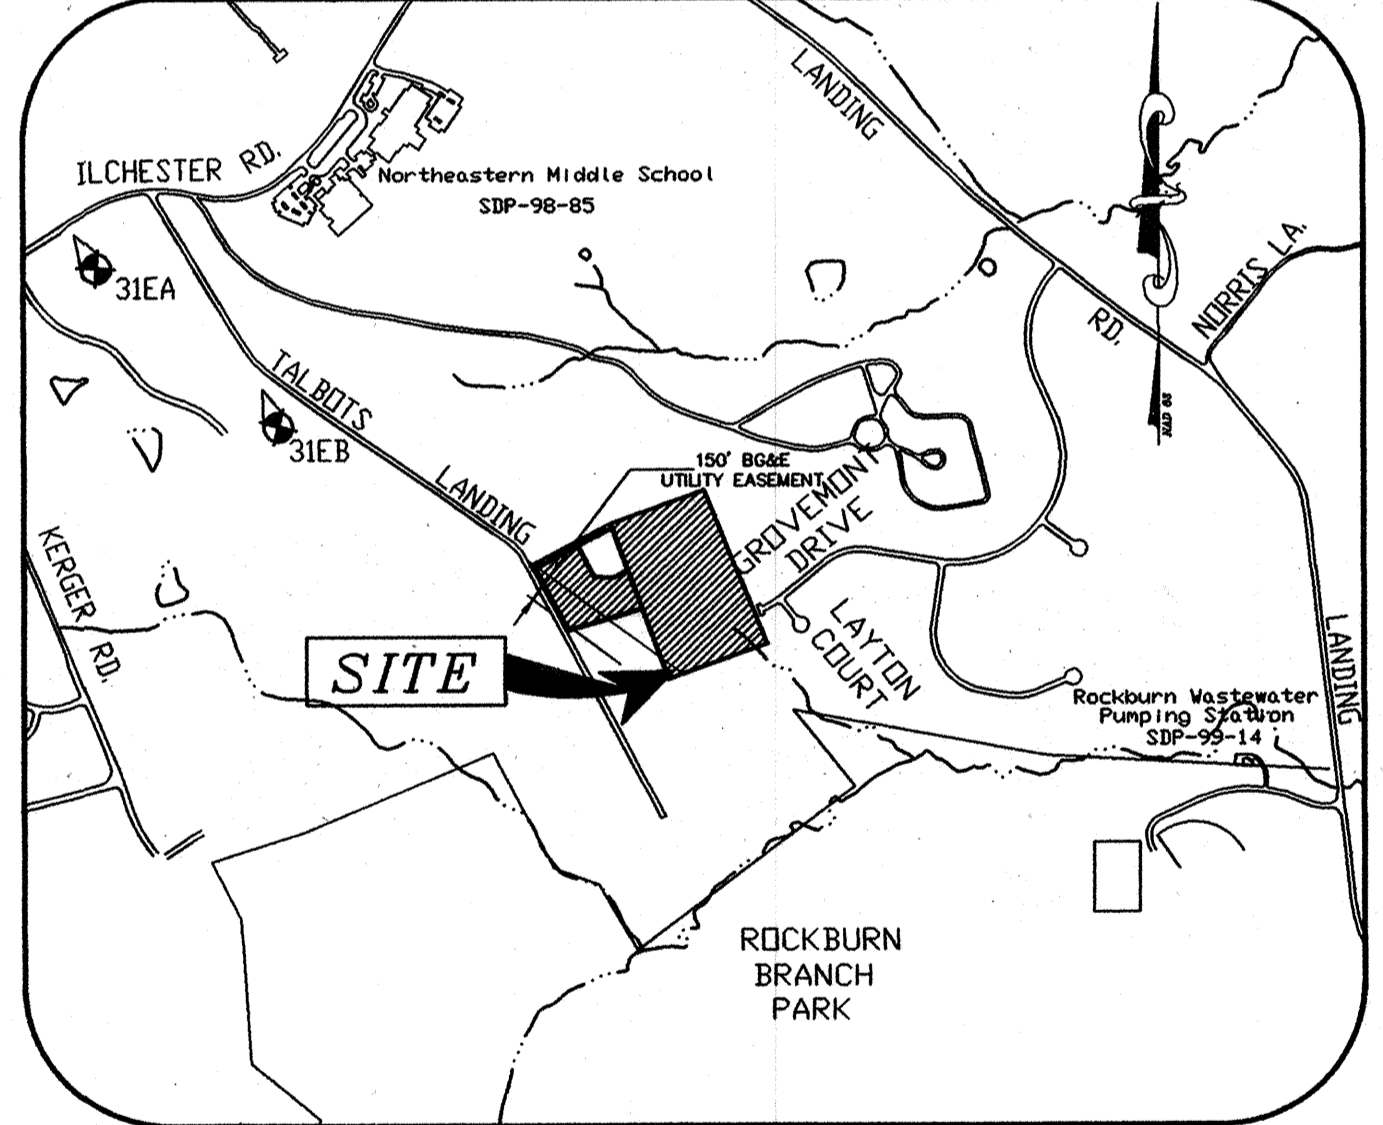

VICINITY MAP
SCALE: 1"=1000'

THE REQUIREMENTS OF §§3-108, THE REAL PROPERTY ARTICLE, ANNOTATED CODE OF MARYLAND, 1988 REPLACEMENT VOLUME (AS SUPPLEMENTED) AS FAR AS THEY RELATE TO THE MAKING OF THIS PLAT AND THE SETTING OF MARKERS HAVE BEEN COMPLIED WITH.

[Signature] 9/16/04
DONALD REUWER, PRESIDENT DATE

FOREST CONSERVATION EASEMENTS

ID	ACREAGE	TYPE
FCE A	1.11 ACRES	RETENTION
FCE B	0.08 ACRES	REFORESTATION
FCE C	0.18 ACRES	REFORESTATION
FCE D	0.86 ACRES	RETENTION

OWNER AND DEVELOPER
ELLCOTT CITY LAND HOLDING, INC.
c/o DONALD REUWER
8000 MAIN STREET
ELLCOTT CITY, MARYLAND 21043
410-480-9105

AREA TABULATION

NUMBER OF BUILDABLE LOTS	22
NUMBER OF OPEN SPACE LOTS	4
NUMBER OF LOTS OR PARCELS	26
AREA OF BUILDABLE LOTS	3.57
AREA OF OPEN SPACE LOTS	5.99 ±
PUBLIC ROAD RIGHT-OF-WAY	0.78 ±
TOTAL AREA (THIS SHEET)	13.80 ±

APPROVED: FOR PUBLIC WATER AND PUBLIC SEWERAGE SYSTEMS
HOWARD COUNTY HEALTH DEPARTMENT

[Signature] 10/15/04
HOWARD COUNTY HEALTH OFFICER DATE

APPROVED: HOWARD COUNTY DEPARTMENT OF PLANNING AND ZONING

[Signature] 10/5/04
CHIEF, DEVELOPMENT ENGINEERING DIVISION DATE

[Signature] 10/21/04
DIRECTOR DATE

OWNER'S CERTIFICATE

WE, ELLCOTT CITY LAND HOLDING, INC., OWNER OF THE PROPERTY SHOWN AND DESCRIBED HEREON, HEREBY ADOPT THIS PLAN OF SUBDIVISION AND IN CONSIDERATION OF THE APPROVAL OF THIS FINAL PLAT BY THE DEPARTMENT OF PLANNING AND ZONING, ESTABLISH THE MINIMUM BUILDING RESTRICTION LINES AND GRANT UNTO HOWARD COUNTY, MARYLAND, ITS SUCCESSORS AND ASSIGNS, 1) THE RIGHT TO LAY, CONSTRUCT AND MAINTAIN SEWERS, DRAINS, WATER PIPES AND OTHER MUNICIPAL UTILITIES AND SERVICES IN AND UNDER ALL ROADS AND STREET RIGHT-OF-WAYS AND THE SPECIFIC EASEMENTS SHOWN HEREON, 2) THE RIGHT TO REQUIRE DEDICATION FOR PUBLIC USE, THE BEDS OF THE STREETS AND/OR ROADS AND FLOODPLAINS AND OPEN SPACE WHERE APPLICABLE, AND FOR GOOD AND OTHER VALUABLE CONSIDERATION, HEREBY GRANT THE RIGHT AND OPTION TO HOWARD COUNTY TO ACQUIRE THE FEE SIMPLE TITLE TO THE BEDS OF THE STREETS AND/OR ROADS AND FLOODPLAINS, STORM DRAINAGE FACILITIES AND OPEN SPACE WHERE APPLICABLE, 3) THE RIGHT TO REQUIRE DEDICATION OF WATERWAY AND DRAINAGE EASEMENTS FOR THE SPECIFIC PURPOSE OF THEIR CONSTRUCTION, REPAIR AND MAINTENANCE, AND 4) THAT NO BUILDING OR SIMILAR STRUCTURE OF ANY KIND SHALL BE ERRECTED ON OR OVER THE SAID EASEMENT AND RIGHTS-OF-WAY.

WITNESS MY HAND THIS 8th DAY OF Sept 2004

[Signature] DONALD REUWER, PRESIDENT

[Signature] WITNESS

SURVEYOR'S CERTIFICATE

I HEREBY CERTIFY THAT THE FINAL PLAT SHOWN HEREON IS CORRECT; THAT IT IS A SUBDIVISION OF LAND CONVEYED BY DEBORAH ELLGARD & ROBERT HARTZELL TO ELLCOTT CITY LAND HOLDING, INC., BY DEED DATED SEPTEMBER 29, 2003 AND RECORDED AMONG THE LAND RECORDS FOR HOWARD COUNTY IN LIBER 7702 AT FOLIO 558 AND THE ESTATE OF KENWARD S. & CHARLOTTE DOBSON TO ELLCOTT CITY LAND HOLDING, INC., BY DEED DATED SEPTEMBER 29, 2003 AND RECORDED AMONG THE LAND RECORDS FOR HOWARD COUNTY IN LIBER 7702 AND FOLIO 553 AND THAT ALL MONUMENTS ARE IN PLACE OR WILL BE IN PLACE PRIOR TO THE ACCEPTANCE OF THE STREETS IN THE SUBDIVISION BY HOWARD COUNTY AS SHOWN IN ACCORDANCE WITH THE ANNOTATED CODE OF MARYLAND AS AMENDED, AND THE BOUNDARY SURVEY IS IN ACCORDANCE WITH THE HOWARD COUNTY SUBDIVISION REGULATIONS.

[Signature] 9/16/04
DATE

RECORDED AS PLAT 17005 ON 10/28/04 AMONG THE LAND RECORDS OF HOWARD COUNTY, MD.

ILCHESTER OAKS
LOTS 1 THRU 22 AND
OPEN SPACE LOTS 23 THRU 26
& NON-BUILDABLE PARCEL "A"

SHEET 1 OF 4

TAX MAP 31 1st ELECTION DISTRICT SCALE: 1"=50'
PARCEL NO. 641 & 841 HOWARD COUNTY, MARYLAND DATE: SEPTEMBER 2004
GRID 16 EX. ZONING R-20 DPZ FILE NOS. SP-02-07
WP-03-63
WP-04-85

MILDENBERG, BOENDER & ASSOC., INC.
Engineers Planners Surveyors
5072 Dorsey Hall Drive, Suite 202, Ellicott City, Maryland 21042
(410) 997-0296 Buit. (301) 621-5521 Wash. (410) 997-0298 Fax


H:\02-007\dwg\final\007-final.plt.dwg

COORDINATE LIST		
NO.	NORTH	EAST
1	567,932.346	1,377,360.073
2	568,051.433	1,377,583.067
3	567,888.043	1,377,669.083
4	567,887.508	1,377,770.850
5	567,929.086	1,377,843.395
6	568,150.125	1,377,762.558
7	567,934.554	1,377,358.893
8	567,952.021	1,377,349.560
9	568,168.908	1,377,755.688
13	567,722.805	1,377,918.834
14	567,608.673	1,377,533.022
15	567,791.238	1,377,435.472
16	567,816.382	1,377,470.383
17	567,806.886	1,377,486.933
18	567,717.252	1,377,607.217
19	567,698.402	1,377,712.961
23	567,819.572	1,377,996.182
24	567,810.530	1,377,973.829
25	567,805.709	1,377,934.692
26	567,736.789	1,377,701.614
27	567,749.325	1,377,631.118
28	567,838.960	1,377,510.834
29	567,861.908	1,377,425.038
30	567,878.452	1,377,388.870

CURVE TABLE					
CURVE	RADIUS	LENGTH	TANGENT	DELTA	CHORD BEARING & DISTANCE
C7	25.00'	23.55'	12.73'	53°57'56"	N66°13'21"E 22.69'
C10	80.00'	19.13'	9.61'	13°41'52"	N60°09'20"W 19.08'

NOTE: COORDINATES AND GRID TICKS SHOWN HEREON ARE BASED ON NAD'83 AND ARE IN FEET. TO CONVERT TO METERS DIVIDE BY 3.2808333.

MINIMUM LOT SIZE CHART			
LOT NO.	GROSS AREA	PIPESTEM AREA	MINIMUM LOT SIZE
13	12,618 SQ. FT.	606 SQ. FT.	12,012 SQ. FT.
14	13,103 SQ. FT.	1,058 SQ. FT.	12,045 SQ. FT.
15	13,511 SQ. FT.	1,509 SQ. FT.	12,002 SQ. FT.
16	13,970 SQ. FT.	1,966 SQ. FT.	12,004 SQ. FT.
21	13,432 SQ. FT.	1,432 SQ. FT.	12,000 SQ. FT.

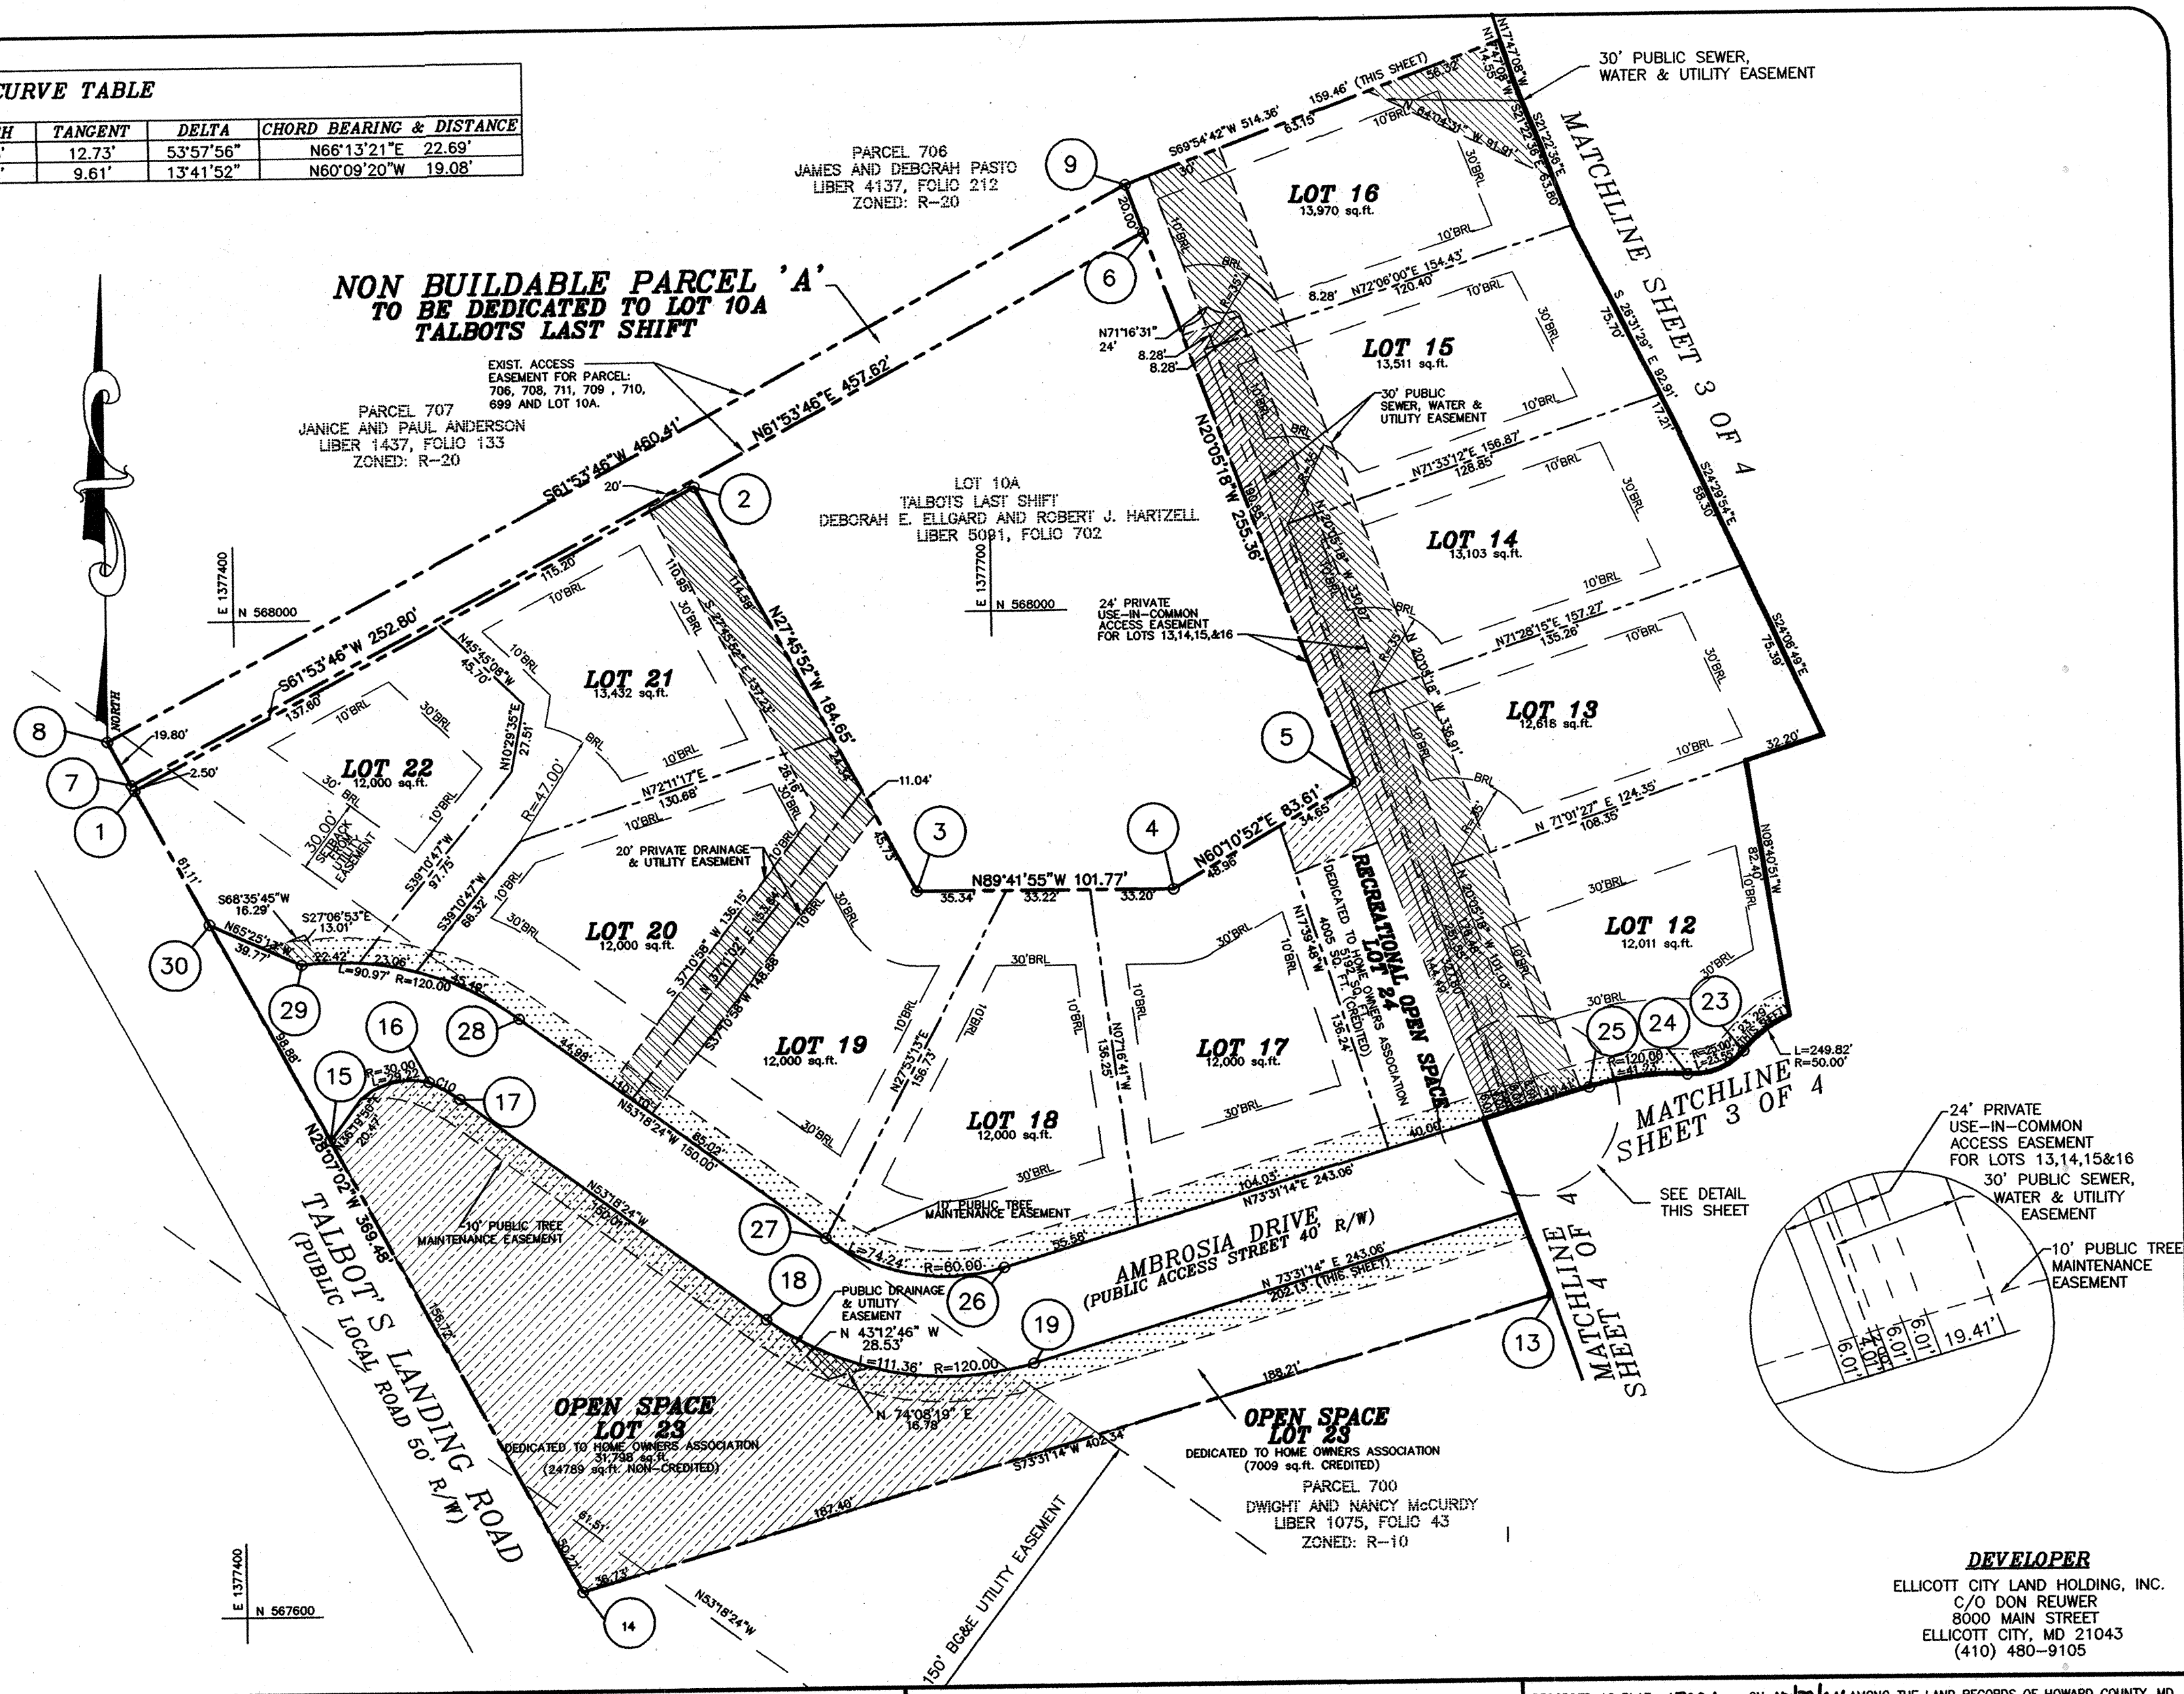

THE REQUIREMENTS OF §§3-108, THE REAL PROPERTY ARTICLE, ANNOTATED CODE OF MARYLAND, 1986 REPLACEMENT VOLUME (AS SUPPLEMENTED) AS FAR AS THEY RELATE TO THE MAKING OF THIS PLAT AND THE SETTING OF MARKERS HAVE BEEN COMPLIED WITH.

John W. Miltenberg
 JOHN W. MILTENBERG, SURVEYOR
 DATE: 9/2/04

Donald Reuwer
 DONALD REUWER, PRESIDENT
 DATE: 9/14/04

AREA TABULATION	
NUMBER OF BUILDABLE LOTS (THIS SHEET)	11
NUMBER OF OPEN SPACE LOTS (THIS SHEET)	2
NUMBER OF LOTS OR PARCELS (THIS SHEET)	13
AREA OF BUILDABLE LOTS (THIS SHEET)	3.18 ±
AREA OF OPEN SPACE LOTS (THIS SHEET)	0.85 ±
PUBLIC ROAD RIGHT-OF-WAY (THIS SHEET)	0.00 ±
TOTAL AREA (THIS SHEET)	4.03 ±

APPROVED: FOR PUBLIC WATER AND PUBLIC SEWERAGE SYSTEMS
 HOWARD COUNTY HEALTH DEPARTMENT

Lynda...
 HOWARD COUNTY HEALTH OFFICER
 DATE: 10/18/04

APPROVED: HOWARD COUNTY DEPARTMENT OF PLANNING AND ZONING

...
 CHIEF, DEVELOPMENT ENGINEERING DIVISION
 DATE: 10/5/04

...
 DIRECTOR
 DATE: 10/24/04

OWNER'S CERTIFICATE

WE, ELLICOTT CITY LAND HOLDING, INC., OWNER OF THE PROPERTY SHOWN AND DESCRIBED HEREON, HEREBY ADOPT THIS PLAN OF SUBDIVISION, AND IN CONSIDERATION OF THE APPROVAL OF THIS FINAL PLAT BY THE DEPARTMENT OF PLANNING AND ZONING, ESTABLISH THE MINIMUM BUILDING RESTRICTION LINES AND GRANT UNTO HOWARD COUNTY, MARYLAND, ITS SUCCESSORS AND ASSIGNS, 1) THE RIGHT TO LAY, CONSTRUCT AND MAINTAIN SEWERS, DRAINS, WATER PIPES AND OTHER MUNICIPAL UTILITIES AND SERVICES IN AND UNDER ALL ROADS AND STREET RIGHT-OF-WAYS AND THE SPECIFIC EASEMENTS SHOWN HEREON, 2) THE RIGHT TO REQUIRE DEDICATION FOR PUBLIC USE, THE BEDS OF THE STREETS AND/OR ROADS AND FLOODPLAINS, STORM DRAINAGE FACILITIES AND OPEN SPACE WHERE APPLICABLE, AND FOR GOOD AND OTHER VALUABLE CONSIDERATION, HEREBY GRANT THE RIGHT AND OPTION TO HOWARD COUNTY TO ACQUIRE THE FEE SIMPLE TITLE TO THE BEDS OF THE STREETS AND/OR ROADS AND FLOODPLAINS, STORM DRAINAGE FACILITIES AND OPEN SPACE WHERE APPLICABLE, 3) THE RIGHT TO REQUIRE DEDICATION OF WATERWAY AND DRAINAGE EASEMENTS FOR THE SPECIFIC PURPOSE OF THEIR CONSTRUCTION, REPAIR AND MAINTENANCE, AND 4) THAT NO BUILDING OR SIMILAR STRUCTURE OF ANY KIND SHALL BE ERRECTED ON OR OVER THE SAID EASEMENT AND RIGHTS-OF-WAY.

WITNESS MY HAND THIS 8th DAY OF Sept 2004

Donald Reuwer
 DONALD REUWER, PRESIDENT

John W. Miltenberg
 WITNESS

SURVEYOR'S CERTIFICATE

I HEREBY CERTIFY THAT THE FINAL PLAT SHOWN HEREON IS CORRECT, THAT IT IS A SUBDIVISION OF LAND CONVEYED BY DEBORAH ELLGARD & ROBERT HARTZELL TO ELLICOTT CITY LAND HOLDING, INC. BY DEED DATED SEPTEMBER 29, 2003 AND RECORDED AMONG THE LAND RECORDS FOR HOWARD COUNTY IN LIBER 7702 AT FOLIO 558 AND THE ESTATE OF KENNARD S. & CHARLOTTE DOBSON TO ELLICOTT CITY LAND HOLDING, INC., BY DEED DATED SEPTEMBER 29, 2003 AND RECORDED AMONG THE LAND RECORDS FOR HOWARD COUNTY IN LIBER 7702 AND FOLIO 553 AND THAT ALL MONUMENTS ARE IN PLACE OR WILL BE IN PLACE PRIOR TO THE ACCEPTANCE OF THE STREETS IN THE SUBDIVISION BY HOWARD COUNTY AS SHOWN IN ACCORDANCE WITH THE ANNOTATED CODE OF MARYLAND AS AMENDED, AND THE BOUNDARY SURVEY IS IN ACCORDANCE WITH THE HOWARD COUNTY SUBDIVISION REGULATIONS.

John W. Miltenberg
 JOHN W. MILTENBERG, SURVEYOR
 DATE: 9/2/04

RECORDED AS PLAT 17006 ON 10/29/04 AMONG THE LAND RECORDS OF HOWARD COUNTY, MD.

ILCHESTER OAKS
 LOTS 1 THRU 22 AND
 OPEN SPACE LOTS 23 THRU 26
 & NON-BUILDABLE PARCEL "A"

SHEET 2 OF 4

TAX MAP 31 1st ELECTION DISTRICT SCALE: 1"=50'
 PARCEL NO. 641 & 841 HOWARD COUNTY, MARYLAND DATE: SEPTEMBER 2004
 GRID 16 EX. ZONING R-20 DPZ FILE NOS. SP-02-07
 WP-03-63
 WP-04-85

MILDENBERG, BOENDER & ASSOC., INC.
 Engineers Planners Surveyors
 5072 Dorsey Hall Drive, Suite 202, Ellicott City, Maryland 21042
 (410) 997-0298 Balt. (301) 621-5521 Wash. (410) 997-0298 Fax.


COORDINATE LIST		
NO.	NORTH	EAST
10	568,345.572	1,378,238.754
20	567,767.352	1,377,946.039
21	567,770.566	1,377,972.130
22	567,759.642	1,377,993.647
23	567,819.572	1,377,996.182
24	567,810.530	1,377,973.829
25	567,805.709	1,377,934.692

NOTE: COORDINATES AND GRID TICKS SHOWN HEREON ARE BASED ON NAD'83 AND ARE IN FEET. TO CONVERT TO METERS DIVIDE BY 3.2808333.

MINIMUM LOT SIZE CHART			
LOT NO.	GROSS AREA	PIPESTEM AREA	MINIMUM LOT SIZE
5	12,179 SQ. FT.	179 SQ. FT.	12,000 SQ. FT.
6	12,527 SQ. FT.	527 SQ. FT.	12,000 SQ. FT.
7	12,718 SQ. FT.	718 SQ. FT.	12,000 SQ. FT.
8	13,086 SQ. FT.	1,079 SQ. FT.	12,007 SQ. FT.
9	13,226 SQ. FT.	1,198 SQ. FT.	12,028 SQ. FT.
10	12,669 SQ. FT.	663 SQ. FT.	12,006 SQ. FT.

CURVE TABLE					
CURVE	RADIUS	LENGTH	TANGENT	DELTA	CHORD BEARING & DISTANCE
C6	120.00'	39.61'	19.99'	18°54'49"	S82°58'39"W 39.43'
C7	25.30'	25.15'	13.73'	56°58'32"	N67°57'07"E 24.13'
C8	25.29'	25.15'	13.73'	56°58'57"	N63°05'00"W 24.13'
C9	80.00'	26.41'	13.33'	18°54'49"	S82°58'39"W 26.29'
C11	38.00'	26.58'	13.86'	40°04'47"	N29°59'12"E 26.04'
C12	62.00'	43.37'	22.62'	40°04'47"	N29°59'12"E 42.49'
C13	88.00'	42.35'	21.60'	27°34'33"	N03°50'27"W 41.95'
C14	112.00'	53.90'	27.48'	27°34'33"	N03°50'27"W 53.39'

LINE TABLE		
LINE	LENGTH	BEARING
W34	25.03	N38°21'55"W
W35	4.53	N31°21'28"E
W36	30.67	N44°07'44"W
W37	44.05	S55°39'26"W
W38	29.42	N36°19'19"W
W39	14.75	N23°55'56"W
W40	30.65	N05°43'28"W
W41	13.52	N39°10'14"E
W42	23.21	N72°16'16"E
W43	17.47	N07°48'15"E
W44	29.02	N41°10'55"W
W45	28.43	N14°37'01"W
W46	37.49	N02°24'49"W
W47	45.40	N35°10'49"W
W48	16.48	N68°40'57"W
W49	54.61	N41°34'27"W
W50	37.05	N10°45'15"W
W51	24.90	N70°08'45"W
W52	32.89	N77°24'36"W
W53	32.96	N45°01'41"W
W54	37.86	N87°46'57"W
W55	44.23	S73°53'30"W
W56	26.64	S87°29'06"W
W57	94.52	N83°23'04"W
W58	15.58	N62°27'15"W
W59	11.33	N06°45'49"E
W60	27.80	S53°10'31"E
W70	6.40	S76°06'37"E
W71	28.01	S35°15'47"E
W72	23.83	S04°25'42"W
W73	12.59	S47°37'12"E
W74	47.51	S22°46'34"W
W75	35.36	S16°04'12"E
W76	44.71	S24°01'23"E
W77	38.92	S52°21'27"E
W78	36.23	S12°40'51"E
W79	72.18	S37°06'34"E
W80	26.56	S75°45'37"E
W81	16.52	S28°32'28"E
W82	30.08	S00°23'25"E
W83	32.64	S30°43'02"E
W84	26.86	S43°46'19"E
W85	33.87	S11°48'28"E
W86	34.71	S36°37'57"E

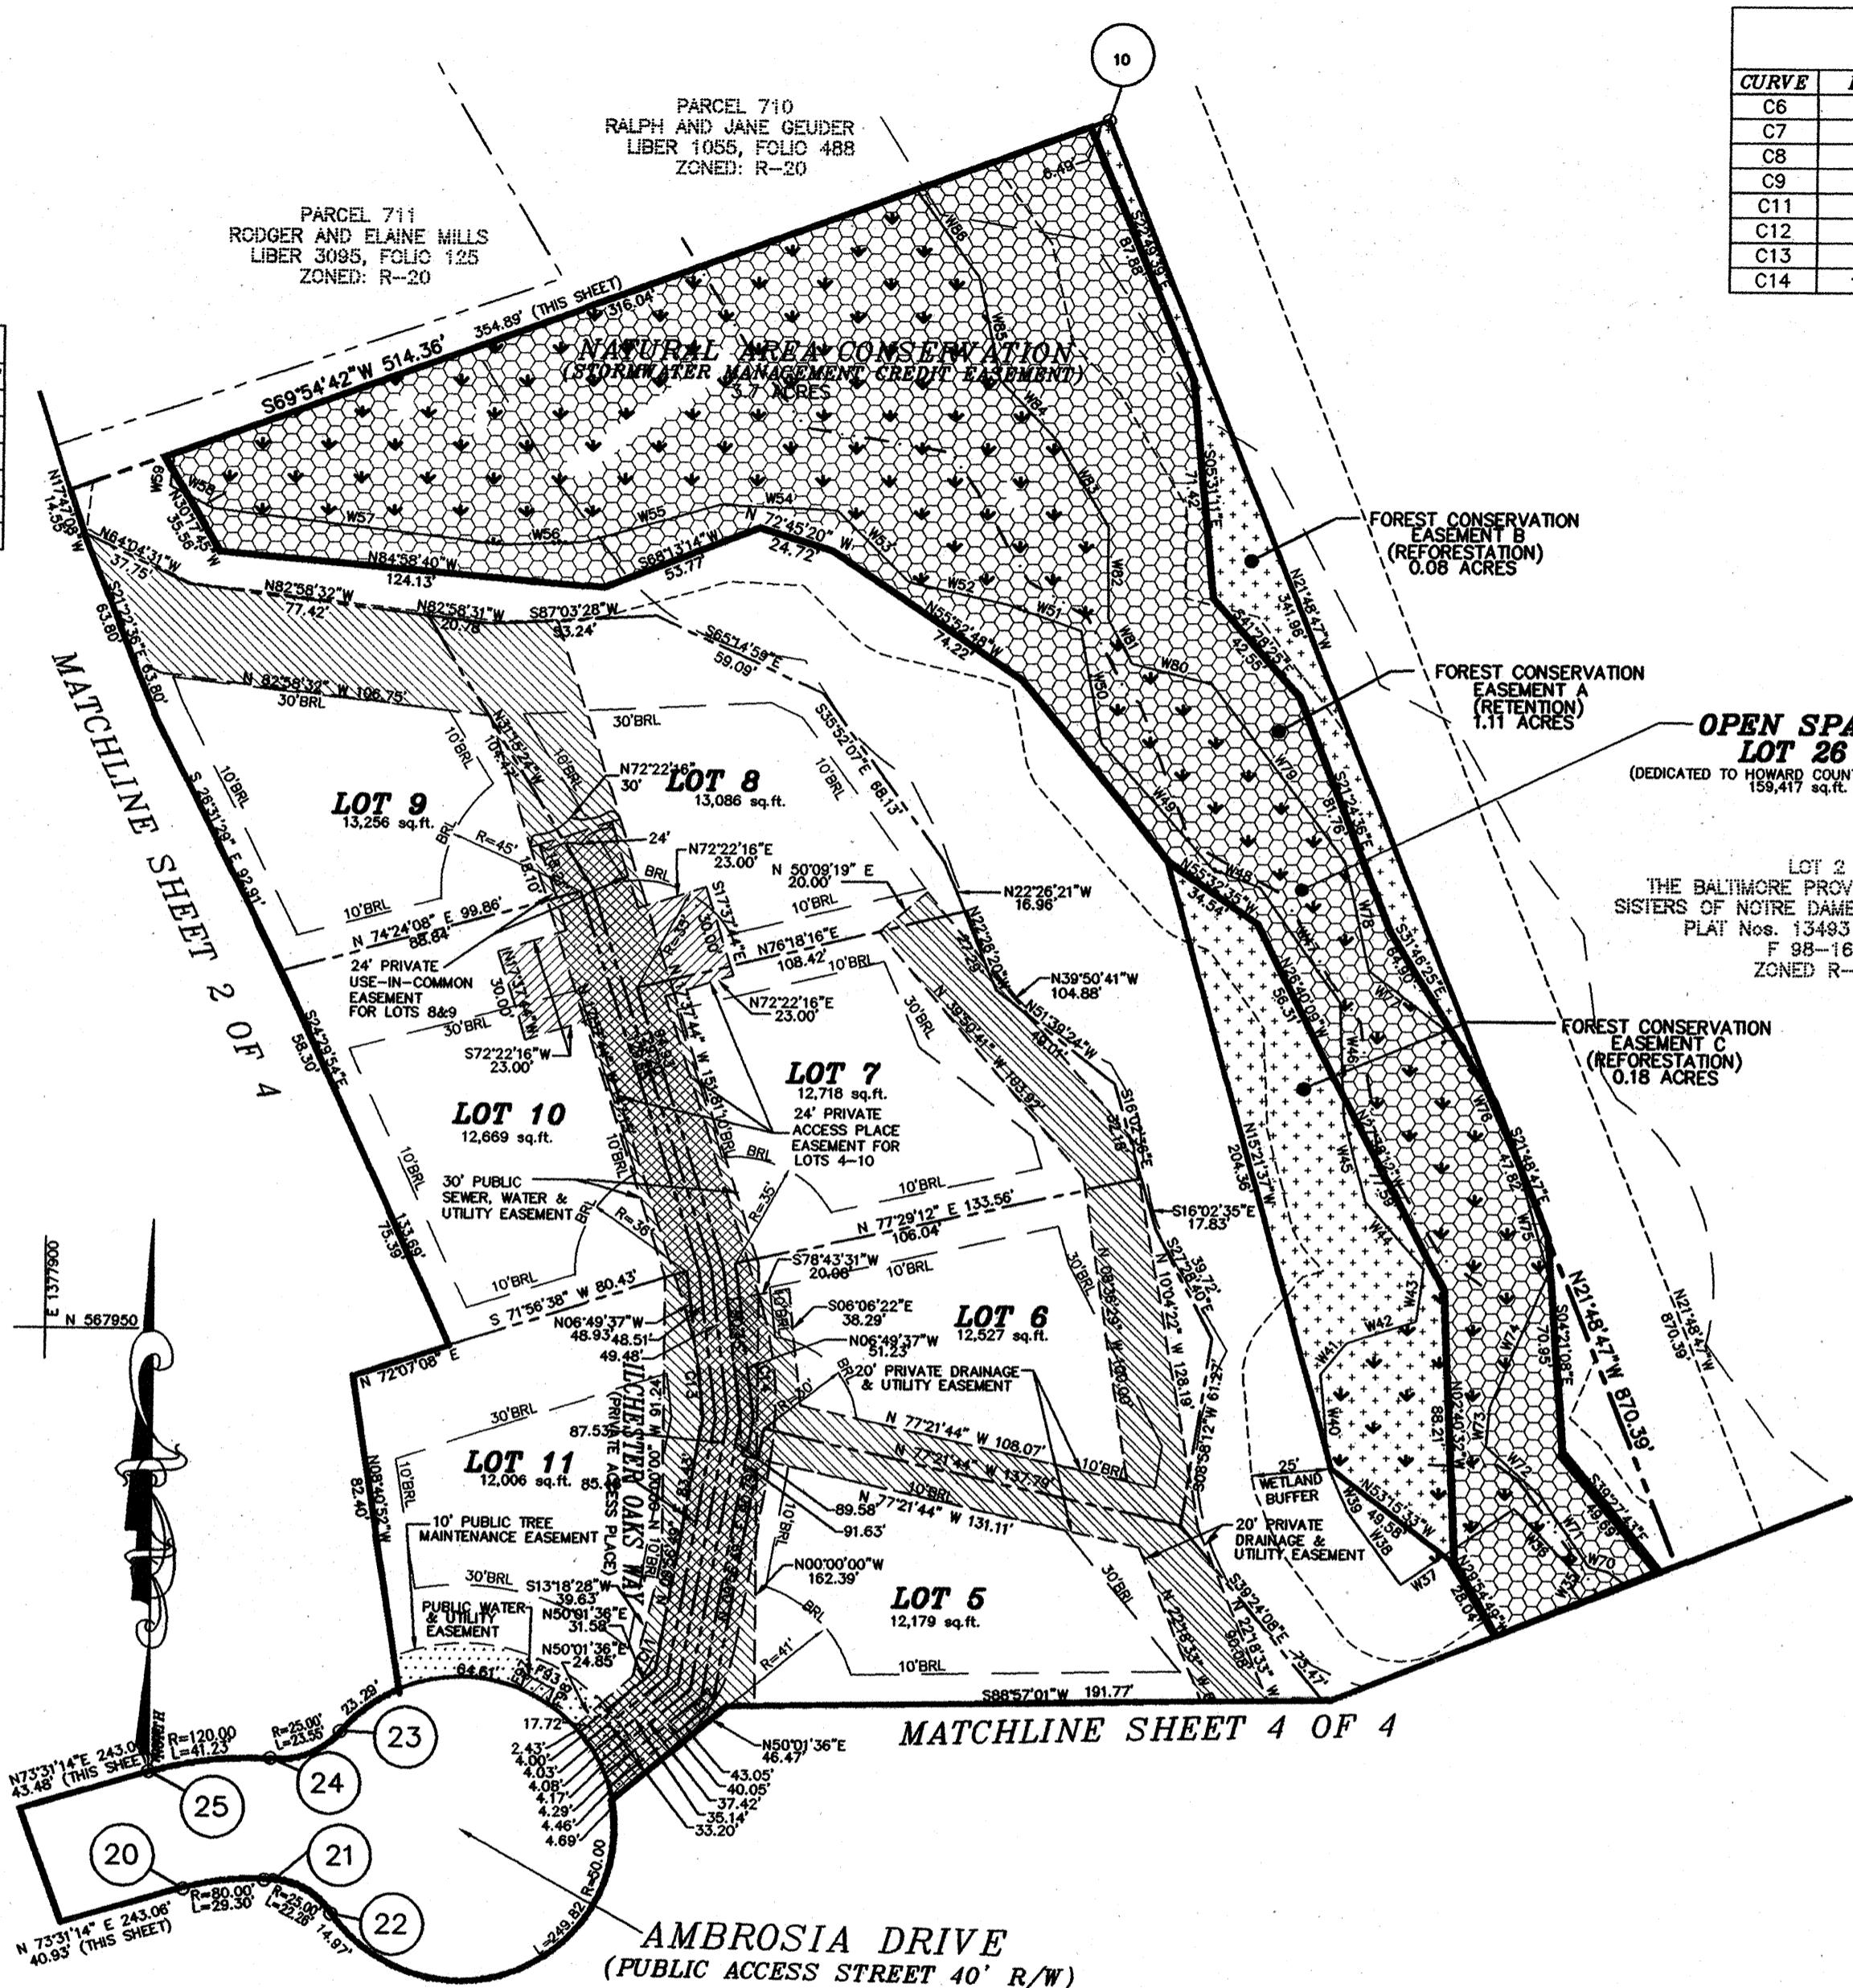

THE REQUIREMENTS OF §§3-108, THE REAL PROPERTY ARTICLE, ANNOTATED CODE OF MARYLAND, 1988 REPLACEMENT VOLUME (AS SUPPLEMENTED) AS FAR AS THEY RELATE TO THE MAKING OF THIS PLAT AND THE SETTING OF MARKERS HAVE BEEN COMPLIED WITH.

[Signature] 9/2/04
 DONALD REUMER, SURVEYOR
 DONALD REUMER, PRESIDENT
 DATE

AREA TABULATION	
NUMBER OF BUILDABLE LOTS	7
NUMBER OF OPEN SPACE LOTS	1
NUMBER OF LOTS OR PARCELS	8
AREA OF BUILDABLE LOTS	2.03 ±
AREA OF OPEN SPACE LOTS	1.95 ±
PUBLIC ROAD RIGHT-OF-WAY	0.0 ±
TOTAL AREA (THIS SHEET)	3.98 ±

APPROVED: FOR PUBLIC WATER AND PUBLIC SEWERAGE SYSTEMS
 HOWARD COUNTY HEALTH DEPARTMENT

[Signature] 10/18/04
 HOWARD COUNTY HEALTH OFFICER
 DATE

APPROVED: HOWARD COUNTY DEPARTMENT OF PLANNING AND ZONING

[Signature] 10/5/04
 CHIEF, DEVELOPMENT ENGINEERING DIVISION
 DATE

[Signature] 10/21/04
 DIRECTOR
 DATE

OWNER'S CERTIFICATE

WE, ELLICOTT CITY LAND HOLDING, INC., OWNER OF THE PROPERTY SHOWN AND DESCRIBED HEREON, HEREBY ADOPT THIS PLAN OF SUBDIVISION, AND IN CONSIDERATION OF THE APPROVAL OF THIS FINAL PLAT BY THE DEPARTMENT OF PLANNING AND ZONING, ESTABLISH THE MINIMUM BUILDING RESTRICTION LINES AND GRANT UNTO HOWARD COUNTY, MARYLAND, ITS SUCCESSORS AND ASSIGNS, 1) THE RIGHT TO LAY, CONSTRUCT AND MAINTAIN SEWERS, DRAINS, WATER PIPES AND OTHER MUNICIPAL UTILITIES AND SERVICES IN AND UNDER ALL ROADS AND STREET RIGHT-OF-WAYS AND THE SPECIFIC EASEMENTS SHOWN HEREON, 2) THE RIGHT TO REQUIRE DEDICATION FOR PUBLIC USE, THE BEDS OF THE STREETS AND/OR ROADS AND FLOODPLAINS AND OPEN SPACE WHERE APPLICABLE, AND FOR GOOD AND OTHER VALUABLE CONSIDERATION, HEREBY GRANT THE RIGHT AND OPTION TO HOWARD COUNTY TO ACQUIRE THE FEE SIMPLE TITLE TO THE BEDS OF THE STREETS AND/OR ROADS AND FLOODPLAINS, STORM DRAINAGE FACILITIES AND OPEN SPACE WHERE APPLICABLE, 3) THE RIGHT TO REQUIRE DEDICATION OF WATERWAY AND DRAINAGE EASEMENTS FOR THE SPECIFIC PURPOSE OF THEIR CONSTRUCTION, REPAIR AND MAINTENANCE, AND 4) THAT NO BUILDING OR SIMILAR STRUCTURE OF ANY KIND SHALL BE ERECTED ON OR OVER THE SAID EASEMENT AND RIGHTS-OF-WAY.

WITNESS MY HAND THIS 8th DAY OF Sept 2004

[Signature]
 DONALD REUMER, PRESIDENT

[Signature]
 WITNESS

SURVEYOR'S CERTIFICATE

I HEREBY CERTIFY THAT THE FINAL PLAT SHOWN HEREON IS CORRECT; THAT IT IS A SUBDIVISION OF LAND CONVEYED BY DEBORAH ELLICOTT & ROBERT HARTZELL TO ELLICOTT CITY LAND HOLDING, INC., BY DEED DATED SEPTEMBER 29, 2003 AND RECORDED AMONG THE LAND RECORDS FOR HOWARD COUNTY IN LIBER 7702 AT FOLIO 558 AND THE ESTATE OF KENNARD S. & CHARLOTTE DOBSON TO ELLICOTT CITY LAND HOLDING, INC., BY DEED DATED SEPTEMBER 29, 2003 AND RECORDED AMONG THE LAND RECORDS FOR HOWARD COUNTY IN LIBER 7702 AND FOLIO 553 AND THAT ALL MONUMENTS ARE IN PLACE OR WILL BE IN PLACE PRIOR TO THE ACCEPTANCE OF THE STREETS IN THE SUBDIVISION BY HOWARD COUNTY AS SHOWN IN ACCORDANCE WITH THE ANNOTATED CODE OF MARYLAND AS AMENDED, AND THE BOUNDARY SURVEY IS IN ACCORDANCE WITH THE HOWARD COUNTY SUBDIVISION REGULATIONS.

[Signature]
 DONALD REUMER, SURVEYOR
 DATE

RECORDED AS PLAT 17007 ON 10/28/04 AMONG THE LAND RECORDS OF HOWARD COUNTY, MD.

ILCHESTER OAKS
 LOTS 1 THRU 22 AND
 OPEN SPACE LOTS 23 THRU 26
 & NON-BUILDABLE PARCEL "A"

SHEET 3 OF 4

TAX MAP 31
 PARCEL NO. 641 & 841
 GRID 16

1st ELECTION DISTRICT
 HOWARD COUNTY, MARYLAND
 EX. ZONING R-20

SCALE: 1"=50'
 DATE: SEPTEMBER 2004
 DPZ FILE NOS. SP-02-07
 WP-03-63
 WP-04-85

MILDENBERG, BOENDER & ASSOC., INC.
 Engineers Planners Surveyors

5072 Dorsey Hall Drive, Suite 202, Ellicott City, Maryland 21042
 (410) 997-0296 Balt. (301) 621-5521 Wash. (410) 997-0298 Fax.

H:\02-007.dwg from\007-rp-2.dwg

MATCHLINE SHEET 3 OF 4

COORDINATE LIST

NO.	NORTH	EAST
11	567,537.497	1,378,562.173
12	567,351.835	1,378,054.504
13	567,722.805	1,377,918.834
20	567,767.352	1,377,946.039
21	567,770.566	1,377,972.130
22	567,759.642	1,377,993.647



NOTE: COORDINATES AND GRID TICKS SHOWN HEREON ARE BASED ON NAD'83 AND ARE IN FEET. TO CONVERT TO METERS DIVIDE BY 3.2808333.

LINE TABLE

LINE	LENGTH	BEARING
W1	60.21	N40°09'06"W
W2	14.36	N71°04'28"W
W3	25.17	N47°30'41"W
W4	17.61	N77°17'37"W
W5	31.29	S40°47'40"W
W6	64.52	S76°10'07"W
W7	23.94	N85°04'20"W
W8	22.72	N29°47'40"W
W9	28.17	N58°21'04"E
W10	38.00	N77°25'47"E
W11	35.32	N58°23'11"E
W12	14.49	N46°39'15"E
W13	45.30	N59°03'51"W
W14	42.70	S74°46'53"W
W15	38.17	N47°10'19"W
W16	37.98	N36°56'14"E
W17	32.41	S88°01'06"E
W18	28.02	N35°29'21"W
W19	45.39	N16°25'20"W
W20	41.55	N56°44'31"E
W21	74.13	S46°33'49"E
W22	35.37	S17°19'35"E
W23	68.43	S25°18'43"E
W24	33.28	S13°14'24"E
W25	35.96	S58°03'38"E
W26	46.91	S35°03'49"E
W27	75.63	N20°41'08"W
W28	30.57	N49°53'17"W
W29	85.12	N21°27'06"W
W30	29.24	N01°16'46"E
W31	51.83	N16°00'37"W
W32	23.30	N15°21'42"W
W33	47.53	N07°45'56"W
W60	16.84	N71°42'57"W
W61	26.76	S35°46'44"E
W62	19.40	S56°36'15"E
W63	25.88	S31°21'17"E
W64	40.51	S37°03'18"E
W65	26.23	S19°42'21"E
W66	35.39	S14°42'54"E
W67	33.85	S02°56'57"E
W68	57.41	S22°14'02"E
W68	85.24	S15°04'23"E

MINIMUM LOT SIZE CHART

LOT NO.	GROSS AREA	PIPESTEM AREA	MINIMUM LOT SIZE
4	12,644 SQ. FT.	54 SQ. FT.	12,601 SQ. FT.

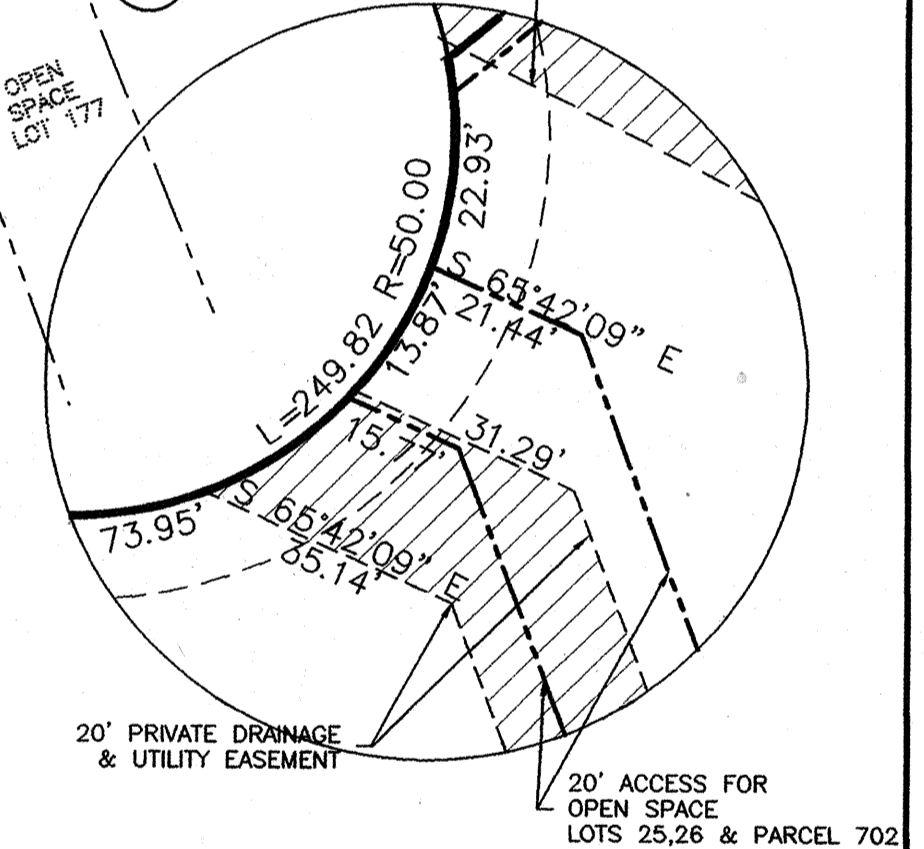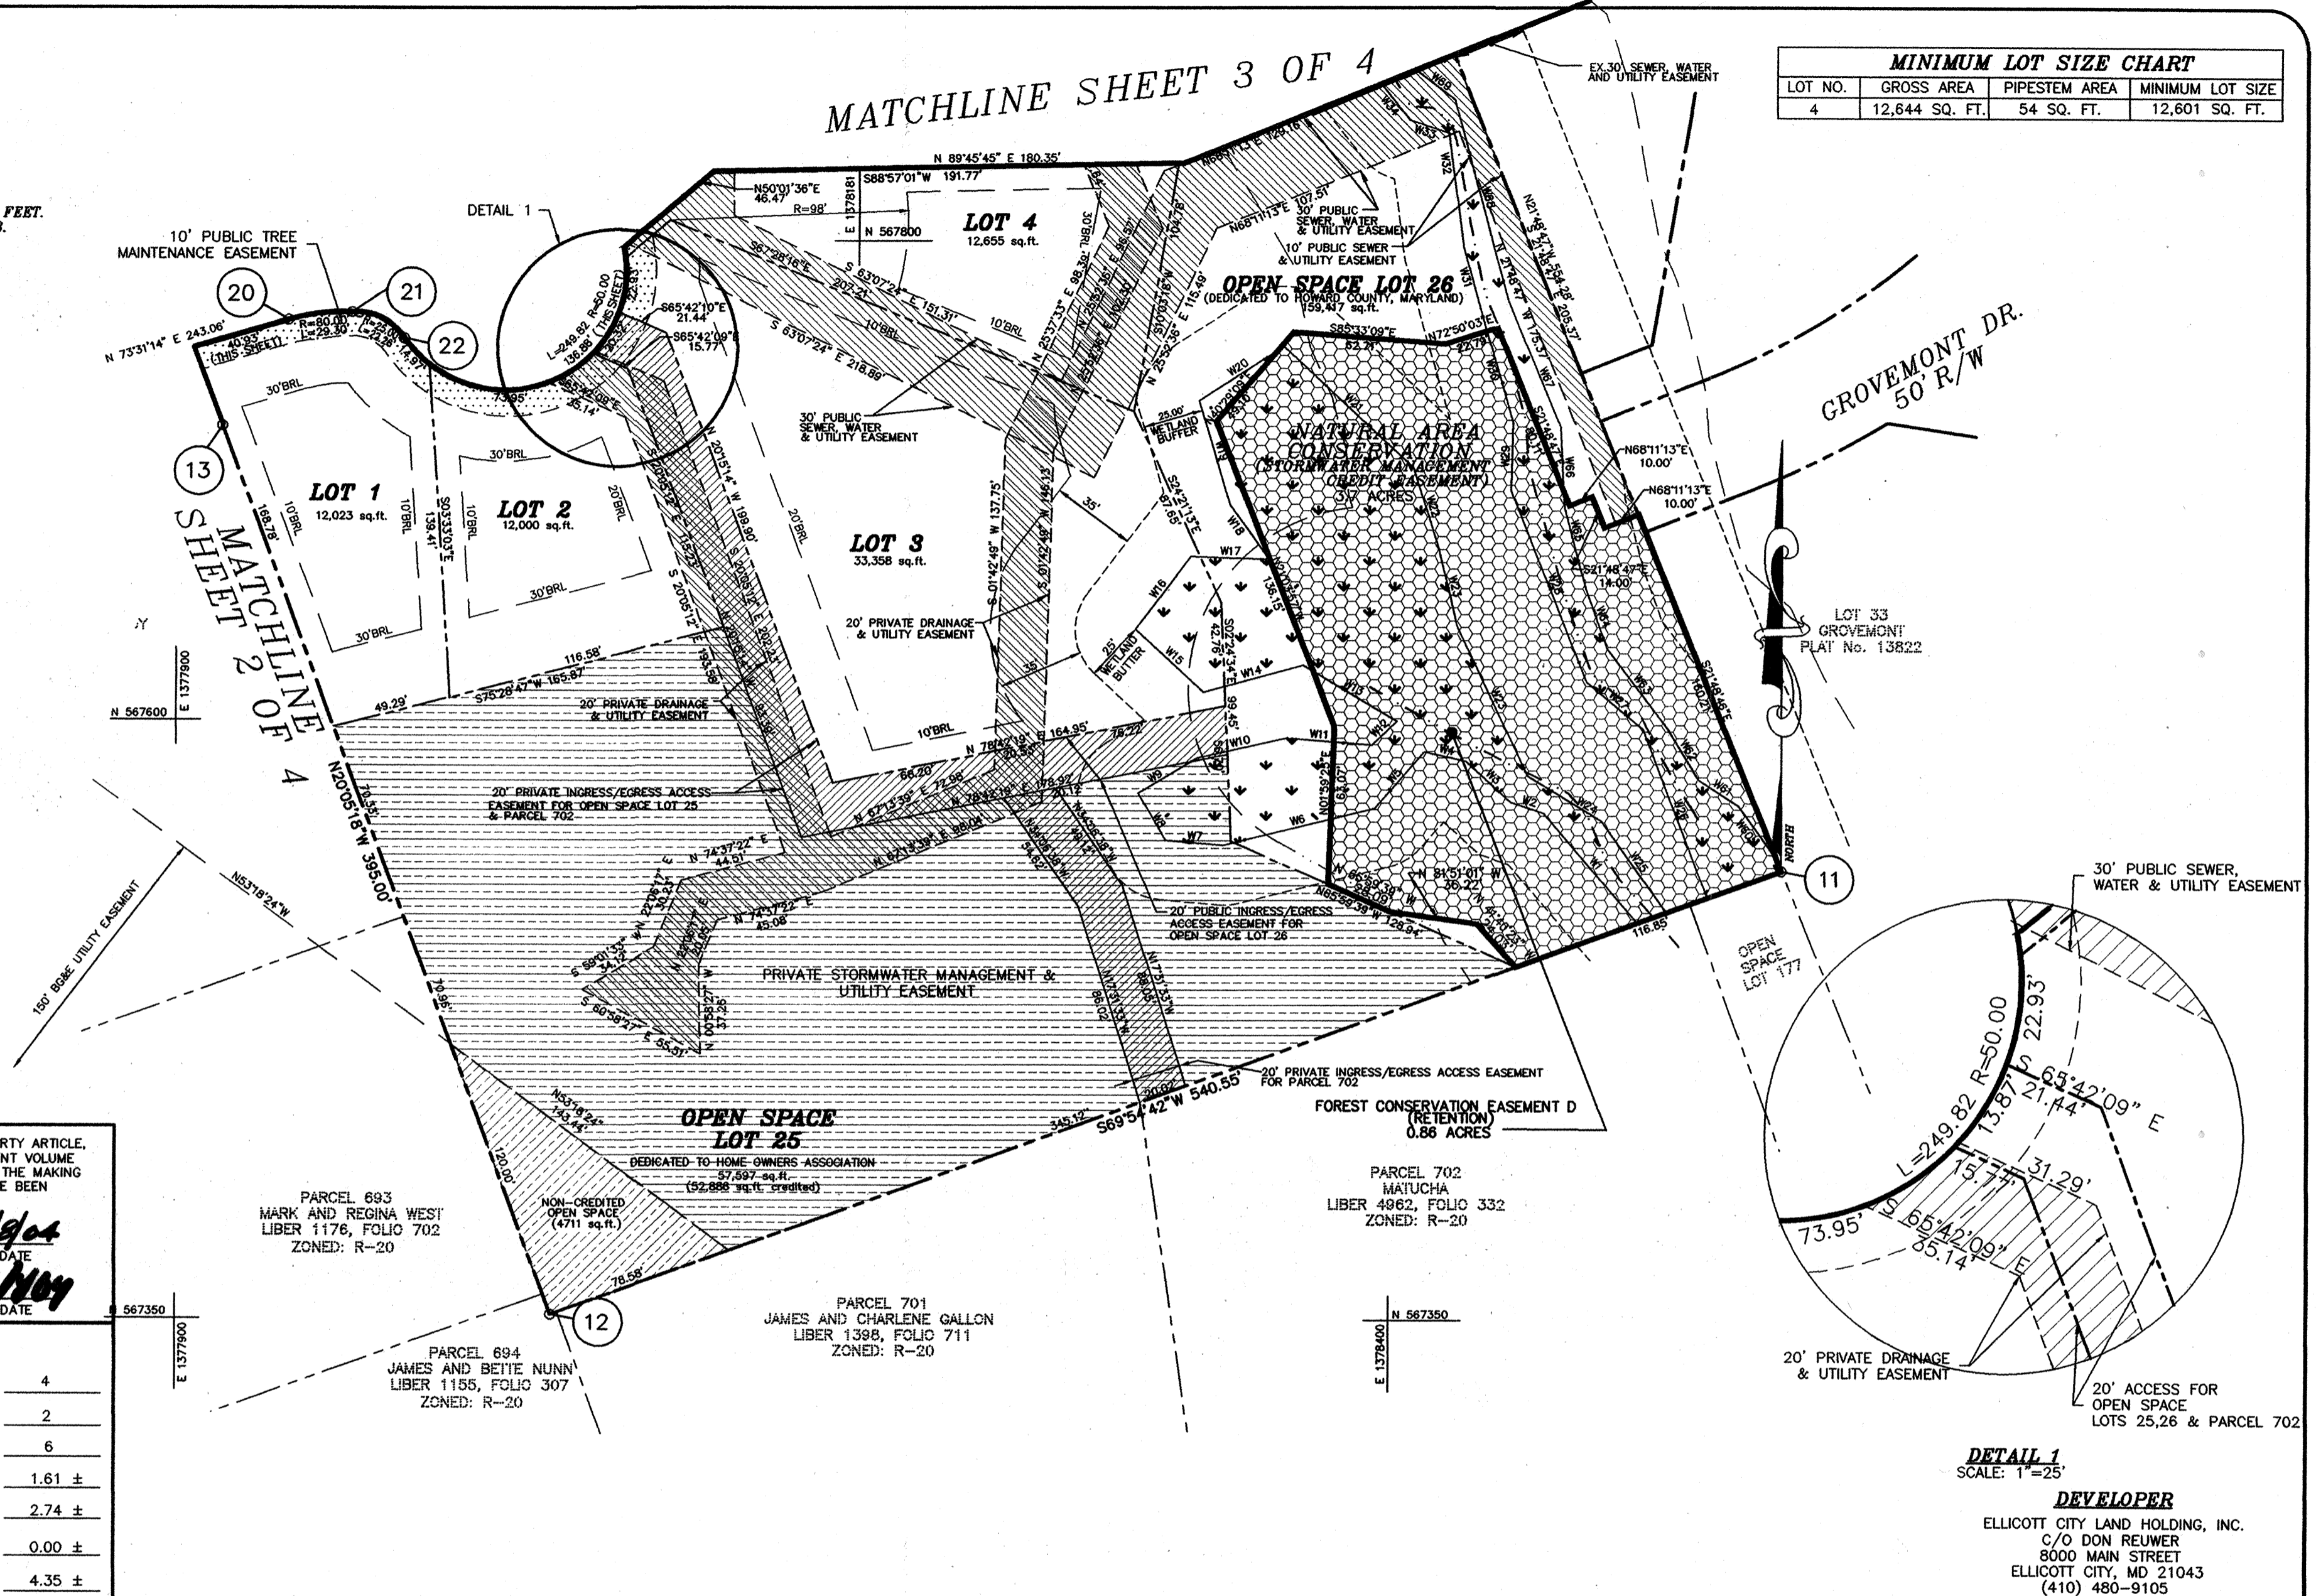

THE REQUIREMENTS OF §3-108, THE REAL PROPERTY ARTICLE, ANNOTATED CODE OF MARYLAND, 1988 REPLACEMENT VOLUME (AS SUPPLEMENTED) AS FAR AS THEY RELATE TO THE MAKING OF THIS PLAT AND THE SETTING OF MARKERS HAVE BEEN COMPLIED WITH.

John B. Mildenberg 9/9/04
 JOHN B. MILDENBERG, SURVEYOR
 DONALD REUWER, PRESIDENT

AREA TABULATION

NUMBER OF BUILDABLE LOTS	4
NUMBER OF OPEN SPACE LOTS	2
NUMBER OF LOTS OR PARCELS	6
AREA OF BUILDABLE LOTS	1.61 ±
AREA OF OPEN SPACE LOTS	2.74 ±
PUBLIC ROAD RIGHT-OF-WAY	0.00 ±
TOTAL AREA (THIS SHEET)	4.35 ±

OWNER'S CERTIFICATE

WE, ELLICOTT CITY LAND HOLDING, INC., OWNER OF THE PROPERTY SHOWN AND DESCRIBED HEREON, HEREBY ADOPT THIS PLAN OF SUBDIVISION, AND IN CONSIDERATION OF THE APPROVAL OF THIS FINAL PLAT BY THE DEPARTMENT OF PLANNING AND ZONING, ESTABLISH THE MINIMUM BUILDING RESTRICTION LINES AND GRANT UNTO HOWARD COUNTY, MARYLAND, ITS SUCCESSORS AND ASSIGNS, 1) THE RIGHT TO LAY, CONSTRUCT AND MAINTAIN SEWERS, DRAINS, WATER PIPES AND OTHER MUNICIPAL UTILITIES AND SERVICES IN AND UNDER ALL ROADS AND STREET RIGHT-OF-WAYS AND THE SPECIFIC EASEMENTS SHOWN HEREON, 2) THE RIGHT TO REQUIRE DEDICATION FOR PUBLIC USE, THE BEDS OF THE STREETS AND/OR ROADS AND FLOODPLAINS AND OPEN SPACE WHERE APPLICABLE, AND FOR GOOD AND OTHER VALUABLE CONSIDERATION, HEREBY GRANT THE RIGHT AND OPTION TO HOWARD COUNTY TO ACQUIRE THE FEE SIMPLE TITLE TO THE BEDS OF THE STREETS AND/OR ROADS AND FLOODPLAINS, STORM DRAINAGE FACILITIES AND OPEN SPACE WHERE APPLICABLE, 3) THE RIGHT TO REQUIRE DEDICATION OF WATERWAY AND DRAINAGE EASEMENTS FOR THE SPECIFIC PURPOSE OF THEIR CONSTRUCTION, REPAIR AND MAINTENANCE, AND 4) THAT NO BUILDING OR SIMILAR STRUCTURE OF ANY KIND SHALL BE ERECTED ON OR OVER THE SAID EASEMENT AND RIGHTS-OF-WAY.

WITNESS MY HAND THIS 31st DAY OF Sept 2004

Donald Reuwer
 DONALD REUWER, PRESIDENT

SURVEYOR'S CERTIFICATE

I HEREBY CERTIFY THAT THE FINAL PLAT SHOWN HEREON IS CORRECT; THAT IT IS A SUBDIVISION OF LAND CONVEYED BY DEBORAH ELLGARD & ROBERT HARTZELL TO ELLICOTT CITY LAND HOLDING, INC., BY DEED DATED SEPTEMBER 29, 2003 AND RECORDED AMONG THE LAND RECORDS FOR HOWARD COUNTY IN LIBER 7702 AT FOLIO 558 AND THE ESTATE OF KENNARD S. & CHARLOTTE OOBSON TO ELLICOTT CITY LAND HOLDING, INC., BY DEED DATED SEPTEMBER 29, 2003 AND RECORDED AMONG THE LAND RECORDS FOR HOWARD COUNTY IN LIBER 7702 AND FOLIO 553 AND THAT ALL MONUMENTS ARE IN PLACE OR WILL BE IN PLACE PRIOR TO THE ACCEPTANCE OF THE STREETS IN THE SUBDIVISION BY HOWARD COUNTY AS SHOWN IN ACCORDANCE WITH THE ANNOTATED CODE OF MARYLAND AS AMENDED, AND THE BOUNDARY SURVEY IS IN ACCORDANCE WITH THE HOWARD COUNTY SUBDIVISION REGULATIONS.

John B. Mildenberg
 JOHN B. MILDENBERG, SURVEYOR

RECORDED AS PLAT 17008 ON 10/28/04 AMONG THE LAND RECORDS OF HOWARD COUNTY, MD.

ILCHESTER OAKS
 LOTS 1 THRU 22 AND
 OPEN SPACE LOTS 23 THRU 26
 & NON-BUILDABLE PARCEL "A"
 SHEET 4 OF 4

TAX MAP 31
 PARCEL NO. 641 & 841
 GRID 16

1st ELECTION DISTRICT
 HOWARD COUNTY, MARYLAND
 EX. ZONING R-20

SCALE: 1"=50'
 DATE: SEPTEMBER 2004
 DPZ FILE NOS. SP-02-07
 WP-03-63
 WP-04-85

MILDENBERG, BOENDER & ASSOC., INC.
 Engineers Planners Surveyors
 5072 Dorsey Hall Drive, Suite 202, Ellicott City, Maryland 21042
 (410) 997-0296 Balt. (301) 621-5521 Wash. (410) 997-0298 Fax.


H:\02-007\dwg\final\007-PP-3.dwg

NOTE: THIS DRAWING IS TO BE USED FOR FOREST CONSERVATION PLAN PURPOSES ONLY.

NOTES:
 1. THE FOREST CONSERVATION REQUIREMENTS PER SECTION 16.1200 OF THE HOWARD COUNTY CODE FOR FOREST CONSERVATION HAVE BEEN MET BY ON-SITE RETENTION OF 1.97 ACRES AND REFORESTATION OF 0.26 ACRES. FINANCIAL SURETY FOR THE 1.97 ACRES (\$5,813.25 SQ. FT.) OF RETENTION IN THE AMOUNT OF \$17,162.64 AND 0.26 ACRES (11,326.50 SQ. FT.) OF REFORESTATION IN THE AMOUNT OF \$5,662.80 HAS BEEN POSTED AS PART OF THE DPW DEVELOPERS AGREEMENT IN THE AMOUNT OF \$22,825.44.

FOREST CONSERVATION DATA

I. BASIC SITE DATA		ACRES
GROSS SITE AREA		13.80
AREA WITHIN 100 YEAR FLOODPLAIN		0.00
AREA WITHIN AGRICULTURAL USE OR PRESERVATION PARCEL		0.00
NET TRACT AREA		13.80
LAND USE CATEGORY	RESIDENTIAL-SUBURBAN	
II. FOREST CONSERVATION WORKSHEET DATA SUMMARY		
B. REFORESTATION THRESHOLD (20%)		2.76
C. AFFORESTATION MINIMUM (10%)		2.07
D. EXISTING FOREST ON NET TRACT AREA		2.10
E. FOREST AREAS TO BE CLEARED		0.13
F. FOREST AREAS TO BE RETAINED		1.97
III. REFORESTATION CALCULATIONS		
G. FOREST AREAS CLEARED ABOVE REFORESTATION THRESHOLD		0.00
H. FOREST AREAS CLEARED BELOW REFORESTATION THRESHOLD		0.13
I. FOREST AREAS RETAINED ABOVE REFORESTATION THRESHOLD		0.00
J. REFORESTATION FOR CLEARING ABOVE THRESHOLD		0.00
K. REFORESTATION FOR CLEARING BELOW THRESHOLD		0.26
L. TOTAL REFORESTATION REQUIRED		0.26
M. TOTAL REFORESTATION PROVIDED		0.26

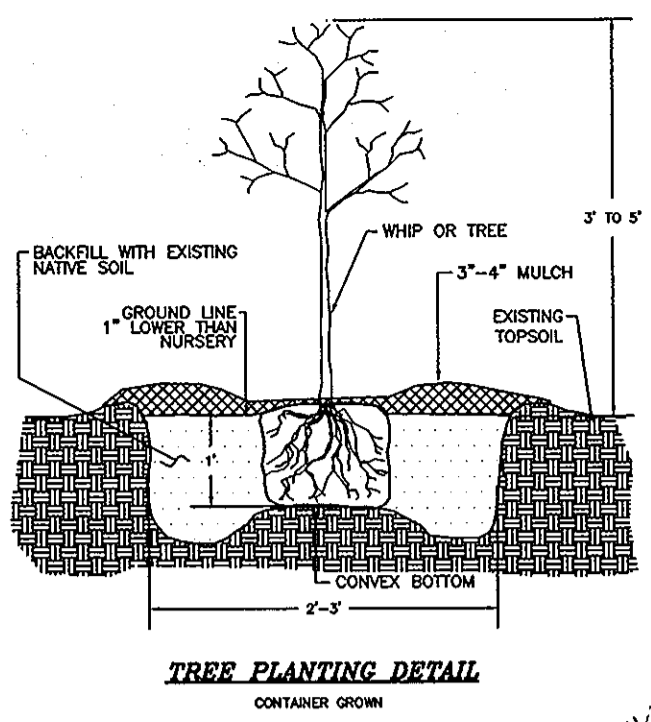

FOREST CONSERVATION EASEMENTS

EASEMENT	ACREAGE
FCE A	1.11 ACRES (RETENTION)
FCE B	0.08 ACRES (REFORESTATION)
FCE C	0.18 ACRES (REFORESTATION)
FCE D	0.86 ACRES (RETENTION)

GENERAL NOTES

FOREST PROTECTION

- ALL FOREST RETENTION AREAS SHALL BE TEMPORARILY PROTECTED BY WELL ANCHORED BLAZE ORANGE PLASTIC MESH FENCING AND SIGNAGE AS INDICATED ON THE PLANS. THE DEVICES SHALL BE INSTALLED ALONG THE FOREST RETENTION BOUNDARY PRIOR TO ANY LAND CLEARING, GRUBBING, OR GRADING ACTIVITIES.
- THE FOREST PROTECTION DEVICES SHALL BE INSTALLED SUCH THAT THE CRITICAL ROOT ZONES OF ALL TREES WITHIN THE RETENTION AREA NOT OTHERWISE PROTECTED WILL BE WITHIN FOREST PROTECTION DEVICES.
- ALL PROTECTION DEVICES SHALL BE MAINTAINED THROUGHOUT CONSTRUCTION, INCLUDING SILT FENCE BEING USED AS PROTECTIVE FENCING. ALL DEVICES SHALL REMAIN IN PLACE UNTIL ALL CONSTRUCTION HAS CEASED IN THE IMMEDIATE VICINITY.
- ATTACHMENT OF SIGNS, OR ANY OTHER OBJECTS TO TREES IS PROHIBITED. NO EQUIPMENT, MACHINERY, VEHICLES, MATERIAL OR EXCESSIVE PEDESTRIAN TRAFFIC SHALL BE ALLOWED WITHIN THESE PROTECTED AREAS.
- INSTALLATION AND MAINTENANCE OF PROTECTIVE FENCING AND SIGNAGE SHALL BE THE RESPONSIBILITY OF THE GENERAL CONTRACTOR. THE GENERAL CONTRACTOR SHALL TAKE THE UTMOST CARE TO PROTECT TREE ROOT SYSTEMS DURING ALL CONSTRUCTION ACTIVITIES. TREE ROOT SYSTEMS SHALL BE PROTECTED FROM SMOTHERING, FLOODING, EXCESSIVE WEETING FROM DE-WATERING OPERATIONS, OFF-SITE RUN OFF, SPILLAGE AND DRAINING OF MATERIALS THAT MAY BE HARMFUL TO TREES.
- THE GENERAL CONTRACTOR SHALL PREVENT PARKING OF CONSTRUCTION VEHICLES AND EQUIPMENT, AND THE STORING OF BUILDING SUPPLIES OR STOCKPILING OF EARTH WITHIN FOREST CONSERVATION EASEMENTS.
- REMOVAL OF TOPSOIL OR ROOT MAT WITHIN THE TREE PRESERVATION AREA SHALL BE PROHIBITED.
- THE GENERAL CONTRACTOR SHALL BE HELD RESPONSIBLE FOR ANY TREES DAMAGED OR DESTROYED WITHIN THE FOREST CONSERVATION EASEMENTS. TREE PRUNING SHALL BE USED AT THE LIMIT OF DISTURBANCE OR LIMIT OF GRADING WITHIN AND ADJACENT TO ALL PRESERVATION AREAS, AS NECESSARY.

PRE-CONSTRUCTION MEETING

- AFTER THE BOUNDARIES OF THE FOREST RETENTION AREAS HAVE BEEN FIELD LOCATED AND MARKED, AND AFTER THE FOREST PROTECTION DEVICES HAVE BEEN INSTALLED, BUT BEFORE ANY OTHER DISTURBANCE HAS TAKEN PLACE ON SITE, A PRE-CONSTRUCTION MEETING SHALL TAKE PLACE ON SITE. THE DEVELOPER, CONTRACTOR OR PROJECT MANAGER AND HOWARD COUNTY INSPECTORS SHALL ATTEND. THE PURPOSE OF THIS MEETING WILL BE:
 - IDENTIFY THE LOCATIONS OF THE FOREST RETENTION AREAS, SPECIFY TREES WITHIN 50 FEET OF THE LIMIT OF DISTURBANCE, LIMITS OF CONSTRUCTION, EMPLOYEE PARKING AREAS AND EQUIPMENT STAGING AREAS.
 - INSPECT ALL FLAGGED BOUNDARIES AND PROTECTION DEVICES.
 - MAKE ALL NECESSARY ADJUSTMENTS.
 - ASSIGN RESPONSIBILITIES AS APPROPRIATE AND DISCUSS PENALTIES.

CONSTRUCTION MONITORING

- THE SITE SHALL BE INSPECTED PERIODICALLY DURING THE CONSTRUCTION PHASE OF THE PROJECT. A QUALIFIED PROFESSIONAL SHALL BE RESPONSIBLE FOR IDENTIFYING DAMAGED OR PROTECTED FOREST AREAS OR INDIVIDUAL TREES WHICH MAY HAVE BEEN CAUSED BY CONSTRUCTION ACTIVITIES, SUCH AS SOIL COMPACTION, ROOT INJURY, TRUNK WOUNDS, LIMB INJURY OR STRESS CAUSED BY FLOODING OR DROUGHT CONDITIONS.
- ANY SUCH DAMAGE THAT MAY OCCUR SHALL BE REMEDIATED IMMEDIATELY USING APPROPRIATE MEASURES. SOVEREIGN PROBLEMS MAY REQUIRE CONSULTATION WITH A PROFESSIONAL ARBORIST.
- THE CONSTRUCTION PROCEDURE SHALL NOT DAMAGE AREAS OUTSIDE OF THE LIMITS OF DISTURBANCE AS DESIGNATED ON THE PLANS. ANY DAMAGE SHALL BE RESTORED BY THE CONTRACTOR AT HIS EXPENSE AND TO THE SATISFACTION OF THE DESIGN TEAM OR ENGINEER.

PLANTING SPECIFICATIONS AND NOTES

- PROTECTION FENCING IS TO BE INSTALLED AS A FIRST ORDER OF BUSINESS. SEE PLAN FOR LOCATIONS.
- DISTURBANCE OF SOILS SHOULD BE LIMITED TO THE PLANTING FIELD FOR EACH PLANT. AS SHOWN ON THE DETAIL VIEW, A PLANTING FIELD OF RADIUS = 5 X DIAMETER OF THE ROOT BALLS OF CONTAINER IS RECOMMENDED.
- SOIL MIX FOR ALL PLANTS EXCEPT ERICACEOUS MATERIAL: SOIL MIX SHALL CONSIST OF EXISTING NATIVE TOPSOIL MIXTURE AT EACH PLANTING FIELD LOCATION INTO WHICH THE CONTRACTOR SHALL THOROUGHLY INCORPORATE 25% BY VOLUME OF COMPOSTED SLUDGE.
- SOIL MIX FOR ERICACEOUS MATERIAL: SOIL MIX SHALL CONSIST OF EXISTING NATIVE TOPSOIL MIXTURE AT EACH PLANTING FIELD LOCATION INTO WHICH THE CONTRACTOR SHALL THOROUGHLY INCORPORATE 25% BY VOLUME PEAT MOSS.
- ALL MIXING IN PARAGRAPHS 3 AND 4 SHALL BE LIMITED TO CONTAINER GROWN OR BALL AND BURLAP STOCK ONLY AND CONFINED TO THE PLANTING FIELD AND IMMEDIATE ADJACENT SURFACE AREA AND SHALL BE DONE TO THE SATISFACTION OF THE DESIGN TEAM OR ENGINEER.

PLANT STORAGE AND INSPECTION

- FOR CONTAINER GROWN NURSERY STOCK, PLANTING SHOULD OCCUR WITHIN 2 WEEKS AFTER DELIVERY TO THE SITE.
- FOR BALL AND BURLAP NURSERY STOCK, PLANTING SHOULD OCCUR WITHIN 30 DAYS AFTER DELIVERY TO THE SITE.
- PLANTING STOCK SHOULD BE INSPECTED PRIOR TO PLANTING. PLANTS NOT CONFORMING TO STANDARD NURSERYMAN SPECIFICATIONS FOR SIZE, ROOT BALL, TRUNK WOUNDS, INSECTS AND DISEASE SHOULD BE REPLACED.
- UNTIL PLANTED, ALL PLANT STOCK SHALL BE KEPT IN A SHADED, COOL, AND MOISTENED ENVIRONMENT.

PLANT INSTALLATION

- THE PLANTING FIELD SHOULD BE PREPARED AS SPECIFIED (SEE DETAIL). NATIVE STOCKPILED SOILS SHOULD BE USED FOR SOIL MIX AND BACKFILL FOR PLANTING FIELD. AFTER PLANT INSTALLATION, BACKFILL SHOULD BE PLACED OVER THE PLANTING FIELD AND COVER WITH AT LEAST 4 INCHES OF MULCH. WATER, GENEROUSLY, TO SETTLE SOIL.
- PLANTING FIELD DIAMETERS SHOULD BE REDUCED OR PLANTING FIELD MOVED IF IT APPEARS THAT EXCESSIVE EXISTING ROOT DAMAGE MAY OCCUR DURING DIGGING OPERATION NEAR EXISTING TREES.
- CARE SHALL BE TAKEN WHEN DIGGING PLANTING FIELDS NOT TO CHOP THROUGH LARGER EXISTING ROOTS FROM EXISTING TREES. IF ROOTS GREATER THAN 1/2 INCH ARE ENCOUNTERED PLEASE TRY TO DIG AROUND THEM AS MUCH AS POSSIBLE TO MINIMIZE IMPACT TO EXISTING TREES. IF ROOTS ARE CUT, THEY SHOULD BE ENCLOSED IN THE ROOT BALL. SUBSTITUTION IS STRONGLY RECOMMENDED.
- CONTAINER GROWN STOCK SHOULD BE REMOVED FROM THE CONTAINER AND ROOTS GENTLY LOOSENED FROM THE SOIL. IF THE ROOTS ENCLOSE THE ROOT BALL, SUBSTITUTION IS STRONGLY RECOMMENDED. ROOTS MAY NOT BE TRIMMED ON SITE, DUE TO THE INCREASED RISK OF SOIL BORNE DISEASES.
- FOR BALL AND BURLAP STOCK, PLACE TREE IN PREPARED PLANTING FIELD AND REMOVE WIRE AND/OR STRING FROM ROOT BALL. THEN PEEL BACK BURLAP TO BASE OF ROOT BALL AND COVER ENTIRE ROOT BALL WITH TOPSOIL MIXTURE INDICATED ABOVE AND COVER WITH MULCH.
- FOR TREES PLANTED IN THE AFFORESTATION AREA, CONTRACTOR SHALL EVENLY DISPERSE SPECIES IN GROUPS OF TWO (2) TO FIVE (5), PER MAINTAINING AN AVERAGE RANDOM SPACING OF INDIVIDUAL TREES AT PROPER SPACING INDICATED ON PLANT LIST.
- AVOID PLANTING IN A STRAIGHT GRID PATTERN. TREES SHALL BE PLANTED ON AN AVERAGE SPACING AS INDICATED ON PLANT LISTS TO OBTAIN A MORE NATURAL APPEARANCE.
- NEWLY PLANTED TREES WILL NEED WATERING AS MUCH AS ONCE A WEEK FOR THE ENTIRE GROWING SEASON, DUE TO THE VERY DEEP, WELL DRAINED NATURE OF THE NATIVE SOILS FOUND ON THIS SITE COMBINED WITH THE LOOSENESS OF THE BACKFILLED AREA WITHIN THE PLANTING FIELD. THE NEXT TWO YEARS MAY REQUIRE WATERING ONLY A FEW TIMES A YEAR DURING SUMMER AND DRY MONTHS. AFTER THAT PERIOD, TREES SHOULD ONLY NEED WATER IN SEVERE DROUGHTS. ANY WATERING PLAN SHOULD COMPENSATE FOR RECENT RAINFALL PATTERNS.

FERTILIZING

- DO NOT FERTILIZE NEWLY PLANTED TREES WITHIN THE FIRST GROWING SEASON AFTER PLANTING. DOING SO MAY CAUSE A SPURT OF CANOPY GROWTH WHICH THE ROOTS CANNOT SUPPORT AND ADD ADDITIONAL STRESS TO THE ALREADY DISTURBED PLANT.
- NOTHING SHOULD BE ADDED TO THE SOIL WITHOUT TESTING IT FIRST TO DETERMINE ITS NEEDS.
- IF AND WHEN IT IS TIME TO FERTILIZE, ORGANIC FERTILIZERS ARE PREFERRED TO SYNTHETIC FERTILIZERS. BONE MEAL OR SEAWED BASED PRODUCTS ARE AVAILABLE COMMERCIALY AND ARE RECOMMENDED. THEY HAVE THE ABILITY TO SUPPLY NUTRIENTS TO THE PLANT AS NEEDED WHILE MINIMIZING THE RISK OF EXCESS NUTRIENTS ENTERING THE FOREST SYSTEM AND WATER SUPPLY.


MAINTENANCE SCHEDULE

- ANNUAL MAINTENANCE DURING THE GROWING SEASON, FOR A THREE YEAR PERIOD.
- ASSESS TREE MORTALITY OF PLANTING STOCK, REMOVE AND REPLACE ANY DEAD OR DISEASED PLANTINGS.
- VOLUNTEER SEEDING OF NATIVE, LOCAL AND ENDEMIC VEGETATION IS TO BE DISCOURAGED. DO NOT DISCOURAGE THIS EFFORT UNLESS IT IS NEGATIVELY EFFECTING THE PLANTED STOCK.
- REMOVE THROUGH MANUAL MEANS (GRUBBING, PULLING, CUTTING) AGGRESSIVE, NOXIOUS, INVASIVE SPECIES AND ALL HERCACEOUS VEGETATION WITHIN A 3-FOOT RADIUS SURROUNDING THE PLANTED WOODY NURSERY STOCK.
- REMOVE AND DISPOSE OF MAN-MADE TRASH, INCLUDING ITEMS CONTAINED WITHIN ENTIRE PLANTING AREA. DO NOT REMOVE DOWN AND DEAD MATERIAL NATURALLY OCCURRING OR ACCUMULATING, UNLESS IT IS SMOTHERING PLANTING STOCK.
- A 75 PERCENT SURVIVAL OF PLANTED STOCK MUST BE ACHIEVED AT THE END OF THE 24 MONTH MANAGEMENT PERIOD. IF NOT, ADDITIONAL PLANTINGS MAY BE REQUIRED TO ACHIEVE THIS GOAL.

SUPERVISION

- ALL FOREST CONSERVATION ACTIVITIES SHALL BE DONE UNDER THE DIRECT SUPERVISION OF SOMEONE FROM THE DESIGN TEAM OR OTHER "QUALIFIED PROFESSIONAL" AS DETERMINED BY THE REQUIREMENTS OF COMAR 08.19.06.01 AND THE MARYLAND DEPARTMENT OF NATURAL RESOURCES, PUBLIC LANDS AND FORESTRY DIVISION.

LEGEND

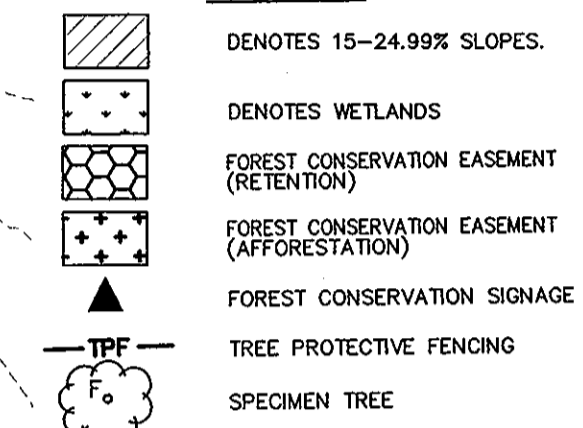

FOREST CONSERVATION EASEMENTS

ID	ACREAGE	TYPE
FCE A	1.11 ACRES	RETENTION
FCE B	0.08 ACRES	REFORESTATION
FCE C	0.18 ACRES	REFORESTATION
FCE D	0.86 ACRES	RETENTION

SPECIMEN TREES

KEY	SPECIES	CONDITION	STATUS
A	ACER RUBRUM	GOOD	TO BE REMOVED
B	ULMUS SP.	GOOD	TO BE REMOVED
C	ACER RUBRUM	GOOD	TO BE REMOVED
D	ACER RUBRUM	GOOD	TO BE REMOVED
E	ACER RUBRUM	GOOD	TO BE REMOVED
F	ACER PLATANOIDES	POOR (TRUNK ROT)	TO BE REMOVED

FOREST CONSERVATION REQUIREMENTS

	ALTERNATIVE 1	ALTERNATIVE 2
FCE A	16 TREES REQUIRED	28 TREES REQUIRED
FCE B	36 TREES REQUIRED	63 TREES REQUIRED

SOILS DESCRIPTION

SYMBOL DESCRIPTION
 C03 CHILLUM-FARRAX LOAMS, 5%-15% SLOPES, SEVERELY ERODED (C)
 N03 NESHAMINY SILT LOAM, LOCAL ALLUVIUM, 1%-15% SLOPES (C)
 N02 NESHAMINY SILT LOAM, 3%-8% SLOPES, MODERATELY ERODED (B)
 N02 NESHAMINY SILT LOAM, 8%-15% SLOPES, MODERATELY ERODED (B)
 S02 SASSAFRAS GRAVELY SANDY LOAM, 1%-5% SLOPES, MODERATELY ERODED (B)
 S02 SASSAFRAS GRAVELY SANDY LOAM, 10%-15% SLOPES, MODERATELY ERODED (B)
 S02 SASSAFRAS LOAM, MODERATELY ERODED, 15%-5% SLOPES, (B)
 S02 SASSAFRAS LOAM, 5%-10% SLOPES, MODERATELY ERODED (B)
 S02 SASSAFRAS SOILS, 15%-40% SLOPE (B)
 W02 WOODSTOWN SANDY LOAM, 1%-5% SLOPES, MODERATELY ERODED (C)

REFORESTATION PLANT LIST


ALTERNATIVE 1				ALTERNATIVE 2			
QTY.	SPECIES	SHADE TOL.	MOIST. REQ.	WET. STATUS	MIN.D.C.	SIZE & SPACING	REMARKS
20	Acer rubrum	VT	D-W	FAC	11'	SEEDLING/WHIP	CONT/B & B
5	Lindera benzoin	T	M	FAC-W	11'	SEEDLING/WHIP	CONT/B & B
6	Liquidambar styraciflua	I	M-W	FAC	11'	SEEDLING/WHIP	CONT/B & B
10	Liriodendron tulipifera	MT	D-M	FAC	11'	SEEDLING/WHIP	CONT/B & B
18	Nyssa sylvatica	T	M-W	FAC	11'	SEEDLING/WHIP	CONT/B & B
5	Prunus serotina	I	M	FACU	11'	SEEDLING/WHIP	CONT/B & B
5	Viburnum dentatum	T	M	FACW	11'	SEEDLING/WHIP	CONT/B & B
5	Vaccinium corymbosum	MT	M-W	FACW	11'	SEEDLING/WHIP	CONT/B & B
5	Highbush Blueberry	MT	M-W	FACW	11'	SEEDLING/WHIP	CONT/B & B
TOTAL	66 TREES & SHRUBS						52 TREES REQUIRED
ALTERNATIVE 1				ALTERNATIVE 2			
36	Acer rubrum	VT	D-W	FAC	11'	SEEDLING/WHIP	CONT/B & B
8	Lindera benzoin	T	M	FACW	11'	SEEDLING/WHIP	CONT/B & B
9	Liquidambar styraciflua	I	M-W	FAC	11'	SEEDLING/WHIP	CONT/B & B
18	Liriodendron tulipifera	MT	D-M	FAC	11'	SEEDLING/WHIP	CONT/B & B
18	Nyssa sylvatica	T	M-W	FAC	11'	SEEDLING/WHIP	CONT/B & B
8	Prunus serotina	I	M	FACU	11'	SEEDLING/WHIP	CONT/B & B
8	Viburnum dentatum	T	M	FACW	11'	SEEDLING/WHIP	CONT/B & B
8	Vaccinium corymbosum	MT	M-W	FACW	11'	SEEDLING/WHIP	CONT/B & B
8	Highbush Blueberry	MT	M-W	FACW	11'	SEEDLING/WHIP	CONT/B & B
TOTAL	113 WHIPS WITH TREE SHELTERS & SHRUBS						91 WHIPS REQUIRED

FOREST RETENTION AREA
 MACHINERY, DUMPING OR STORAGE OF ANY MATERIALS IS PROHIBITED.
 VIOLATORS ARE SUBJECT TO FINES AS IMPOSED BY THE MARYLAND FOREST AND CONSERVATION ACT OF 1991.

PROTECTIVE FENCE DETAIL
 BLAZE ORANGE PLASTIC MESH
 ANCHOR POSTS SHOULD BE 3/4" DIA. STEEL 1/2" DIA. LENGTH 36" MIN. HOLEY VIBRILE FLAGGED. USE 2" X 4" LAGBOLTS TO ANCHOR TO FACE BOTTOM.

REFORESTATION PROJECT
 TREES FOR YOUR FUTURE
 MD DNR QUALIFIED PROFESSIONAL
 Mark D. Piny 10/27/08

SIGNAGE DETAILS
 PURPOSE NOTE: SHOW AS-BUILT POND GRADING, REMOVE PIPE STEMS, ACCESS EASEMENT AROUND POND, REMOVE RETAINING WALL.
 APPROVED: DEPARTMENT OF PLANNING AND ZONING
 [Signature] 11/24/08
 [Signature] 11/20/08

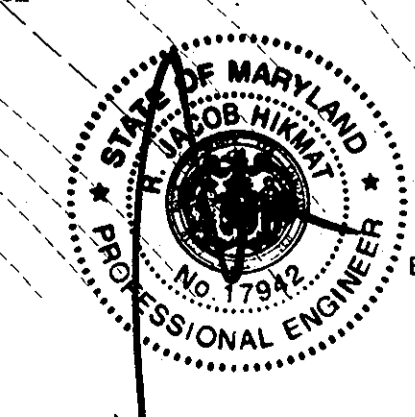

DEVELOPER
 ELLICOTT CITY LAND HOLDING, INC.
 C/O DON STREET
 8000 MAIN STREET
 ELLICOTT CITY, MD 21043
 (410) 480-9105

MILDENBERG, BOENDER & ASSOC., INC.
 Surveyors
 5072 Dorsey Hill Drive, Suite 202, Ellicott City, Maryland 21042
 (410) 997-0286 Fax: (301) 621-5621 Wash. (410) 997-0298 Fax.

REVISIONS

NO.	DATE	DESCRIPTION
1	11/05/08	REVISED PLAN TO REFLECT APPROVED F-06-08(ELICOTT OAKS 2)
2	10/27/08	SHOW AS-BUILT POND GRADING, REMOVE PIPE STEMS, ACCESS EASEMENT AROUND POND, REMOVE RETAINING WALL.

DATE: 11/24/08
 TIME: 11:50 AM
 PROJECT: ELICOTT OAKS
 DRAWING: HSP/SID
 SCALE: 1"=50'
 SHEET: 15 OF 15
 F-04-36

SCHEDULE D - STORMWATER MANAGEMENT AREA LANDSCAPING

LINEAR FEET OF PERIMETER	106 LF (PERIMETER A)	209 LF (PERIMETER B)	89 LF (PERIMETER C)	172 LF (PERIMETER D)	576 LF (TOTAL)
CREDIT FOR EXISTING VEGETATION (NO, YES AND LINEAR FEET)	NO	NO	NO	NO	NO
CREDIT FOR OTHER LANDSCAPING (NO, YES AND X)	N/A	N/A	N/A	N/A	N/A
NUMBER OF TREES REQUIRED	2 SHADE TREES 3 EVERGREEN TREES	4 SHADE TREES 5 EVERGREEN TREES	2 SHADE TREES 2 EVERGREEN TREES	3 SHADE TREES 4 EVERGREEN TREES	11 SHADE TREES 14 EVERGREEN TREES
NUMBER OF TREES PROVIDED	0 SHADE TREES 3 EVERGREEN TREES 4 SMALL TREES	4 SHADE TREES 5 EVERGREEN TREES 0 SMALL TREES	2 SHADE TREES 2 EVERGREEN TREES 0 SMALL TREES	3 SHADE TREES 4 EVERGREEN TREES 0 SMALL TREES	9 SHADE TREES 14 EVERGREEN TREES 4 SMALL TREES

NOTE: THIS DRAWING IS TO BE USED FOR LANDSCAPE PLAN PURPOSES ONLY.

NOTES:
 1. THIS PLAN HAS BEEN PREPARED IN ACCORDANCE WITH THE PROVISIONS OF SECTION 16.124 OF THE HOWARD COUNTY CODE AND THE LANDSCAPE MANUAL.
 2. FINANCIAL SURETY FOR THE REQUIRED LANDSCAPING (38 SHADE TREES, 22 SMALL DECIDUOUS/ORNAMENTAL TREES, 20 EVERGREENS, 18 PRIVATE STREET TREES) HAS BEEN POSTED AS PART OF THE DPW DEVELOPERS AGREEMENT IN THE AMOUNT OF \$23,100.00.

STREET TREE CALCULATIONS


TALBOT'S LANDING ROAD - 325 LF/30 = 11
 AMBROSIA DRIVE (PUBLIC ROAD) - 1492 LF/30 = 50
 AMBROSIA DRIVE (PRIVATE ACCESS PLACE) - 706 LF/40 = 18
TOTAL TREES REQUIRED = 61 SMALL STREET TREES
 18 LARGE STREET TREES
 61 SMALL STREET TREES
TOTAL TREES PROVIDED = 18 LARGE STREET TREES

STREET TREE PLANTING SCHEDULE


QUANTITY	SYMBOL	BOTANICAL NAME	COMMON NAME	SIZE
50	(Symbol)	ACER CAMPESTRE	HEDGE MAPLE	2 1/2" CAL.
11	(Symbol)	PRUNUS SERRULATA 'KWANZAN'	KWANZAN CHERRY	2 1/2" CAL.
TOTAL		61 PUBLIC STREET TREES (SMALL STREET TREES)		

PERIMETER LANDSCAPE PLANTING SCHEDULE

QUANTITY	SYMBOL	BOTANICAL NAME	COMMON NAME	SIZE
17	(Symbol)	ACER CAMPESTRE	HEDGE MAPLE	1 1/2" - 2" CAL.
56	(Symbol)	ACER SACCHARUM 'GREEN MOUNTAIN'	GREEN MOUNTAIN SUGAR MAPLE	2 1/2" - 3" CAL.
20	(Symbol)	PINUS THUNBERGIANA	JAPANESE BLACK PINE	6' - 8' HT.
5	(Symbol)	PRUNUS SERRULATA 'KWANZAN'	KWANZAN CHERRY	1 1/2" - 2" CAL.
TOTAL		98 TREES (38 SHADE TREES, 22 SMALL DECIDUOUS TREES, 20 EVERGREENS, 18 PRIVATE STREET TREES)		

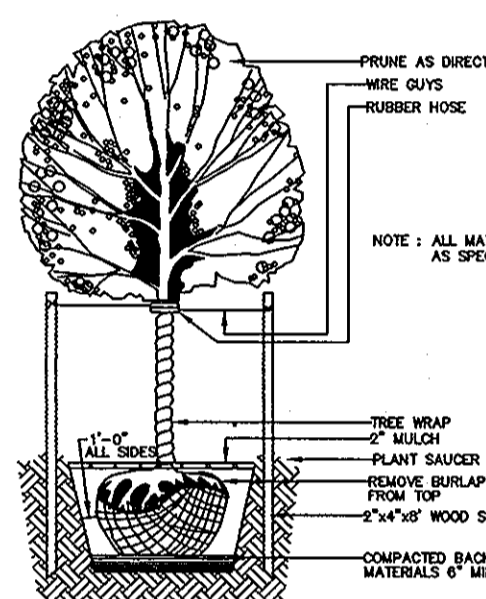

TYPICAL DECIDUOUS TREE PLANTING DETAIL (NOT TO SCALE)

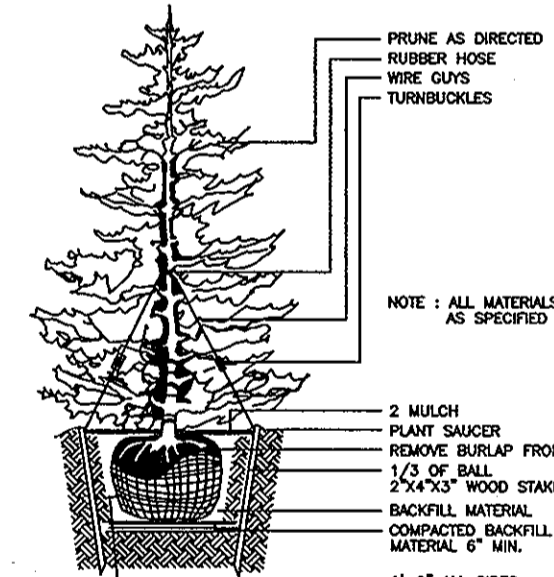

TYPICAL EVERGREEN TREE PLANTING DETAIL (NOT TO SCALE)

LEGEND

- (Symbol) DENOTES 15-24.99% SLOPES.
- (Symbol) DENOTES WETLANDS
- (Symbol) FOREST CONSERVATION EASEMENT (RETENTION)
- (Symbol) FOREST CONSERVATION EASEMENT (AFFRETTATION)
- (Symbol) FOREST CONSERVATION SIGNAGE
- (Symbol) TREE PROTECTIVE FENCING
- (Symbol) SPECIMEN TREE

DEVELOPER'S/OWNER'S CERTIFICATE

I/WE CERTIFY THAT THE LANDSCAPING SHOWN ON THIS PLAN WILL BE DONE IN ACCORDANCE WITH THE PLAN, SECTION 16.124 OF THE HOWARD COUNTY CODE, AND THE HOWARD COUNTY LANDSCAPE MANUAL. I/WE FURTHER CERTIFY THAT UPON COMPLETION A CERTIFICATION OF LANDSCAPE INSTALLATION, ACCOMPANIED BY AN EXERCISED ONE YEAR GUARANTEE OF PLANT MATERIALS, WILL BE SUBMITTED TO THE DEPARTMENT OF PLANNING AND ZONING.


[Signature] 10/27/08
 DATE

PURPOSE NOTE:
 SHOW AS-BUILT POND GRADING, REMOVE PIPE STEMS, ACCESS EASEMENT AROUND POND, REMOVE RETAINING WALL

APPROVED: DEPARTMENT OF PLANNING AND ZONING
[Signature] 11/24/08
 CHIEF, DIVISION OF LAND DEVELOPMENT DATE

[Signature] 11/20/08
 CHIEF, DEVELOPMENT/ENGINEERING DIVISION DATE

DEVELOPER
 ELLICOTT CITY LAND HOLDING, INC.
 C/O DON REUWER
 8000 MAIN STREET
 ELLICOTT CITY, MD 21043
 (410) 480-9105

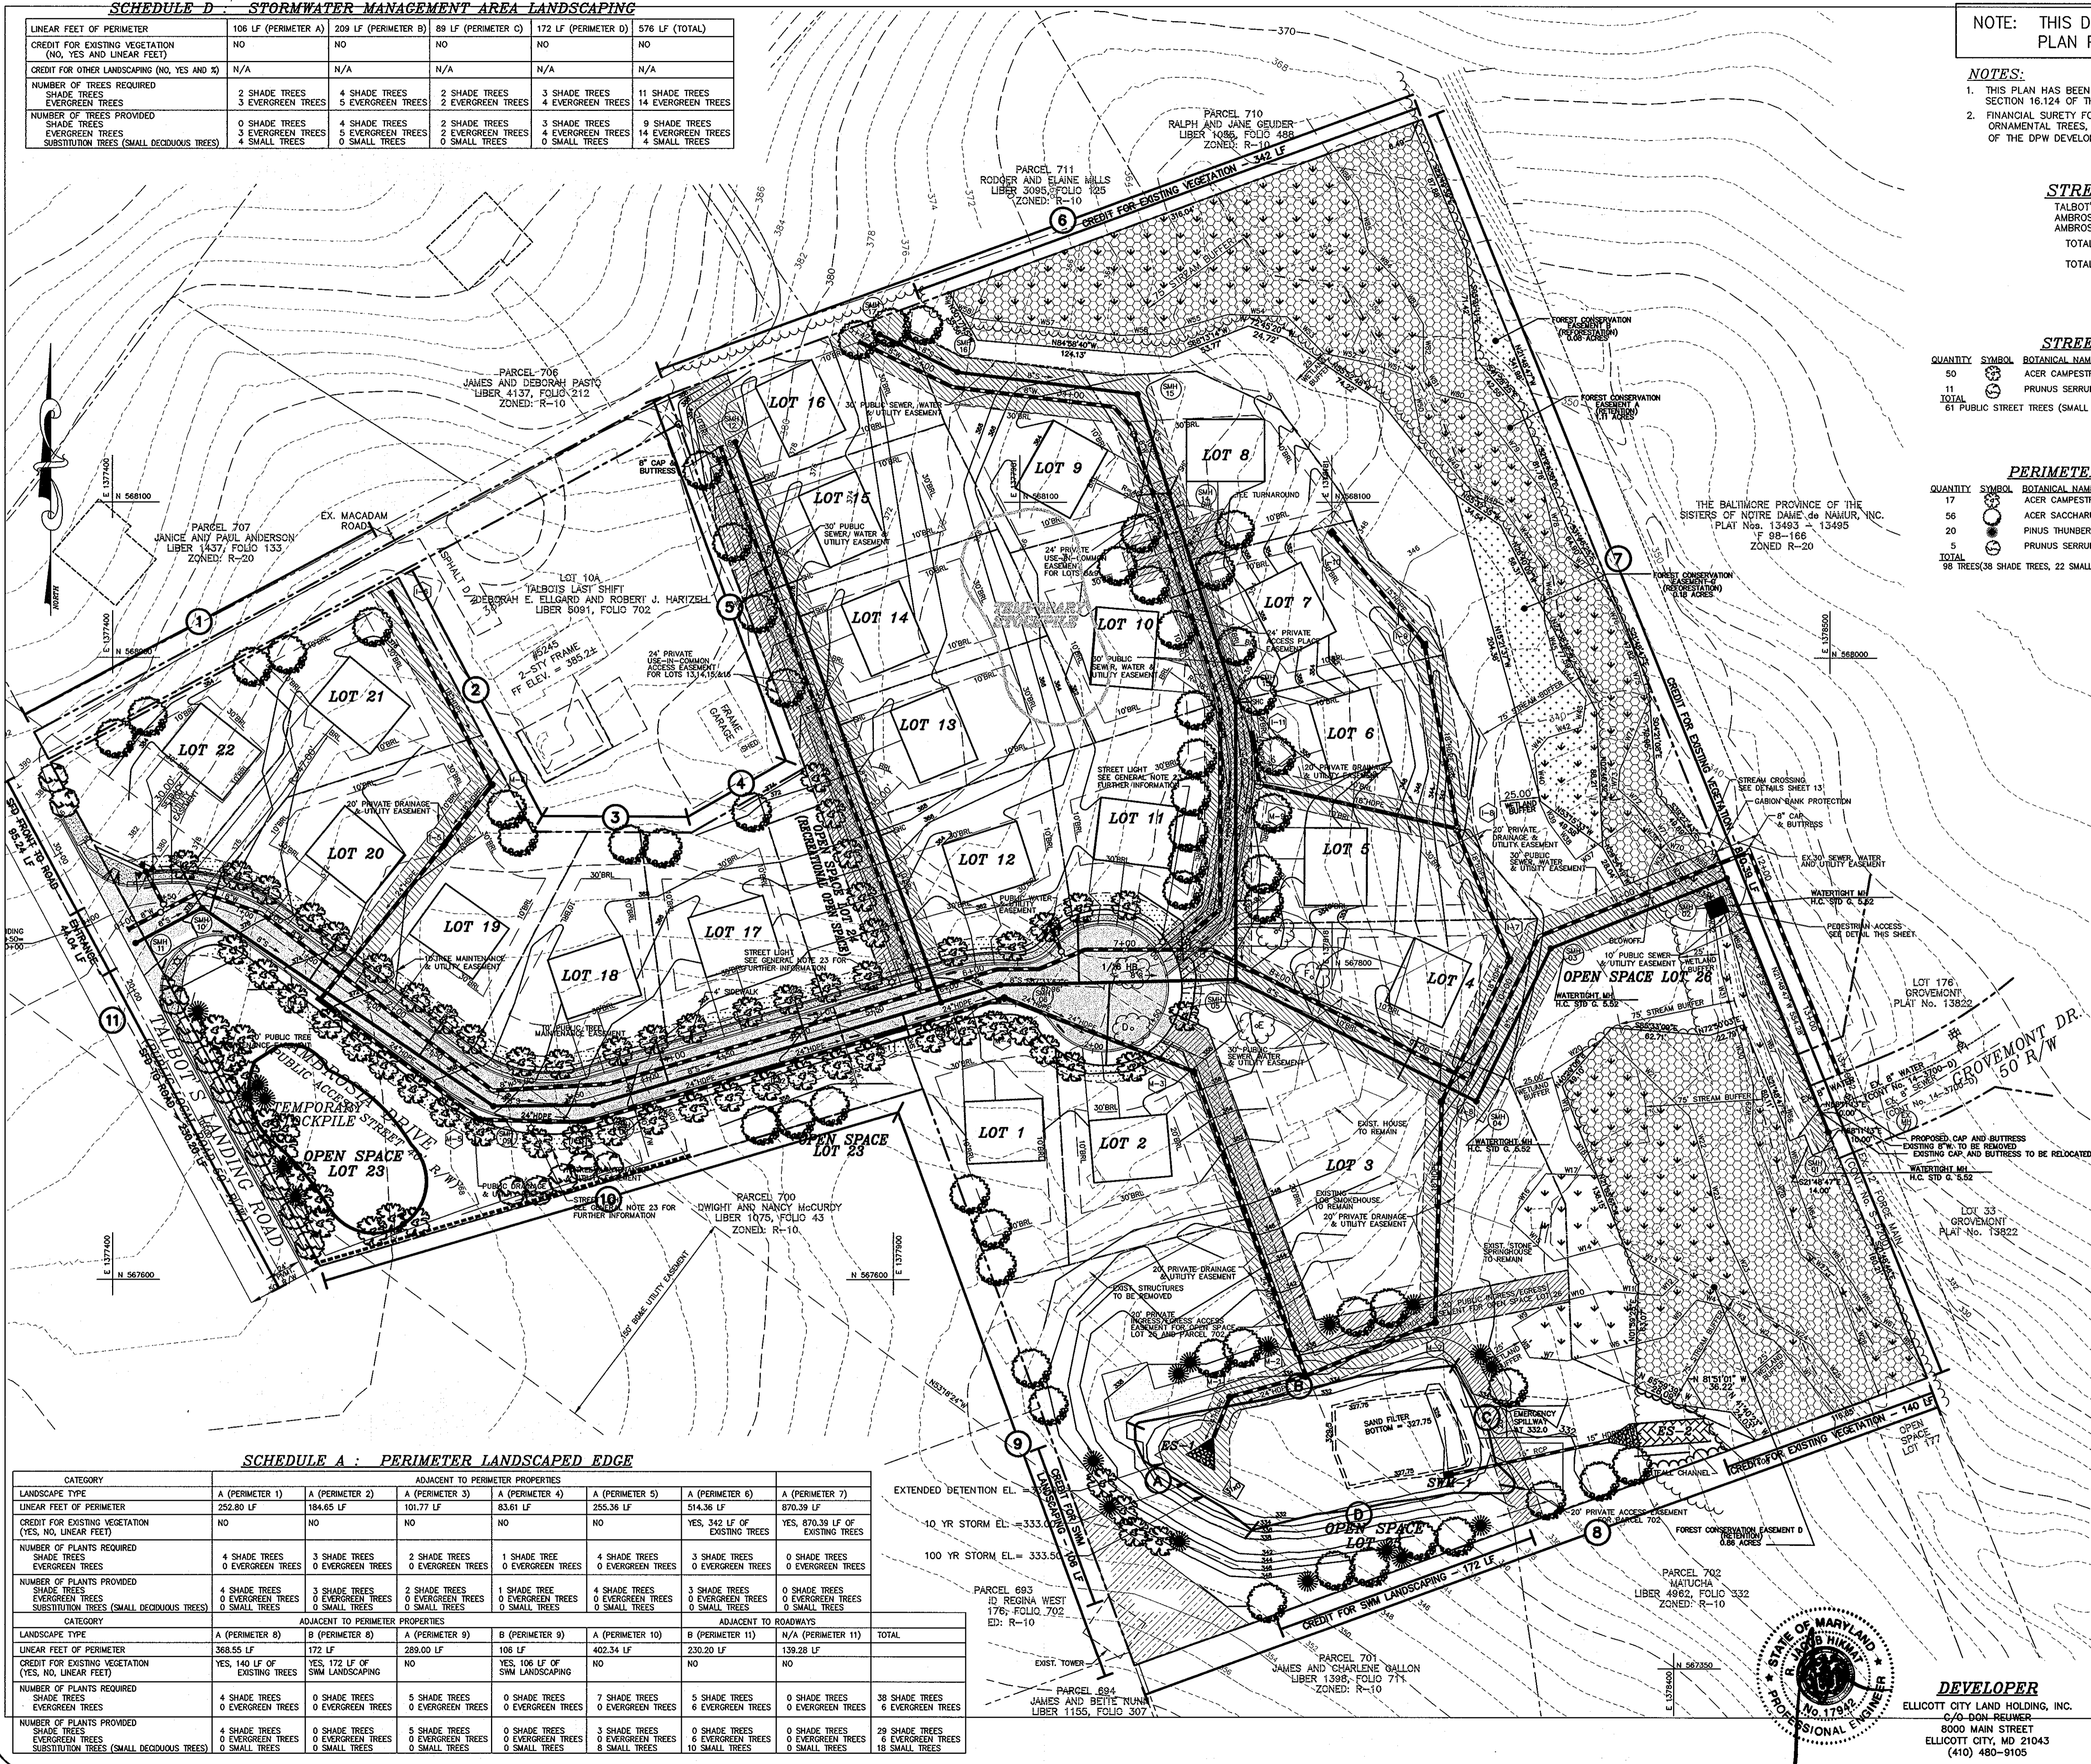

SCHEDULE A: PERIMETER LANDSCAPED EDGE

CATEGORY	ADJACENT TO PERIMETER PROPERTIES						
LANDSCAPE TYPE	A (PERIMETER 1)	A (PERIMETER 2)	A (PERIMETER 3)	A (PERIMETER 4)	A (PERIMETER 5)	A (PERIMETER 6)	A (PERIMETER 7)
LINEAR FEET OF PERIMETER	252.80 LF	184.65 LF	101.77 LF	83.61 LF	255.38 LF	514.36 LF	870.39 LF
CREDIT FOR EXISTING VEGETATION (YES, NO, LINEAR FEET)	NO	NO	NO	NO	NO	YES, 342 LF OF EXISTING TREES	YES, 870.39 LF OF EXISTING TREES
NUMBER OF PLANTS REQUIRED	4 SHADE TREES 0 EVERGREEN TREES	3 SHADE TREES 0 EVERGREEN TREES	2 SHADE TREES 0 EVERGREEN TREES	1 SHADE TREE 0 EVERGREEN TREES	4 SHADE TREES 0 EVERGREEN TREES	3 SHADE TREES 0 EVERGREEN TREES	0 SHADE TREES 0 EVERGREEN TREES
NUMBER OF PLANTS PROVIDED	4 SHADE TREES 0 EVERGREEN TREES 0 SMALL TREES	3 SHADE TREES 0 EVERGREEN TREES 0 SMALL TREES	2 SHADE TREES 0 EVERGREEN TREES 0 SMALL TREES	1 SHADE TREE 0 EVERGREEN TREES 0 SMALL TREES	4 SHADE TREES 0 EVERGREEN TREES 0 SMALL TREES	3 SHADE TREES 0 EVERGREEN TREES 0 SMALL TREES	0 SHADE TREES 0 EVERGREEN TREES 0 SMALL TREES
CATEGORY	ADJACENT TO PERIMETER PROPERTIES			ADJACENT TO ROADWAYS			
LANDSCAPE TYPE	A (PERIMETER 8)	B (PERIMETER 9)	A (PERIMETER 10)	B (PERIMETER 11)	A (PERIMETER 12)	B (PERIMETER 13)	TOTAL
LINEAR FEET OF PERIMETER	368.55 LF	172 LF	289.00 LF	106 LF	402.34 LF	230.20 LF	139.28 LF
CREDIT FOR EXISTING VEGETATION (YES, NO, LINEAR FEET)	YES, 140 LF OF EXISTING TREES	NO	NO	NO	NO	NO	NO
NUMBER OF PLANTS REQUIRED	4 SHADE TREES 0 EVERGREEN TREES	0 SHADE TREES 0 EVERGREEN TREES	5 SHADE TREES 0 EVERGREEN TREES	0 SHADE TREES 0 EVERGREEN TREES	7 SHADE TREES 0 EVERGREEN TREES	5 SHADE TREES 0 EVERGREEN TREES	0 SHADE TREES 0 EVERGREEN TREES
NUMBER OF PLANTS PROVIDED	4 SHADE TREES 0 EVERGREEN TREES 0 SMALL TREES	0 SHADE TREES 0 EVERGREEN TREES 0 SMALL TREES	5 SHADE TREES 0 EVERGREEN TREES 0 SMALL TREES	0 SHADE TREES 0 EVERGREEN TREES 0 SMALL TREES	3 SHADE TREES 0 EVERGREEN TREES 0 SMALL TREES	0 SHADE TREES 0 EVERGREEN TREES 0 SMALL TREES	29 SHADE TREES 6 EVERGREEN TREES 18 SMALL TREES

Project	2002-007	date	JUNE 2004
Illustration	HSP/SID	date	10/27/08
Scale	1" = 50'	date	11/15/07
approval	SID	description	REVISED PLAN TO REFLECT APPROVED F-04-08(ELICHTER OAKS 2)

2	SHOW AS-BUILT POND GRADING, REMOVE PIPE STEMS, ACCESS EASEMENT AROUND POND, REMOVE RETAINING WALL	10/27/08
1	REVISED PLAN TO REFLECT APPROVED F-04-08(ELICHTER OAKS 2)	11/15/07
1	REVISED PLAN TO REFLECT APPROVED F-04-08(ELICHTER OAKS 2)	11/15/07

ILCHESTER OAKS
 LOTS 1 THRU 22, OPEN SPACES 23 THRU 26 & NON-BUILDABLE PARCEL "A"
 TAX MAP 31 PARCEL 641 AND P/O PARCEL 699
 FIRST ELECTION DISTRICT
 HOWARD COUNTY, MARYLAND
 REVISED LANDSCAPE PLAN

MILDENBERG, BOENDER & ASSOC., INC.
 Engineers Planners Surveyors
 5072 Dorsey Hall Drive, Suite 202, Beltsville, MD 21054
 (410) 997-0296 Fax: (301) 621-5321 Wash. (410) 997-0298 Fax.

MD-378 POND SPECIFICATIONS (JANUARY 2000)

CONSTRUCTION SPECIFICATIONS
 THESE SPECIFICATIONS ARE APPROPRIATE TO ALL PONDS WITHIN THE SCOPE OF THE STANDARD FOR PRACTICE MD-378. ALL REFERENCES TO ASTM AND AASHTO SPECIFICATIONS APPLY TO THE MOST RECENT VERSION.

SITE PREPARATION
 AREAS DESIGNATED FOR BORROW AREAS, EMBANKMENT, AND STRUCTURAL WORKS SHALL BE CLEARED AND STRIPPED OF TOPSOIL. ALL TREES, VEGETATION, ROOTS AND OTHER OBSTRUCTABLE MATERIAL SHALL BE REMOVED. CHANNEL BANKS AND BREAKS SHALL BE SLOPED TO NO STEEPER THAN 1:1. ALL TREES SHALL BE CLEARED AND GRUBBED WITHIN 15 FEET OF THE TOE OF THE EMBANKMENT.

AREAS TO BE COVERED BY THE RESERVOIR WILL BE CLEARED OF ALL TREES, BRUSH, LOGS, FENCES, RUBBER AND OTHER OBSTRUCTABLE MATERIAL, UNLESS OTHERWISE DESIGNATED ON THE PLANS. TREES, BRUSH, AND STUMPS SHALL BE CUT APPROXIMATELY LEVEL WITH THE GROUND SURFACE. FOR DRY STREAM WATER MANAGEMENT POND, A MINIMUM OF A 25-FOOT RADIUS AROUND THE INLET STRUCTURE SHALL BE CLEARED.

ALL CLEARED AND GRUBBED MATERIAL SHALL BE DEPOSITED OUTSIDE AND BELOW THE LIMITS OF THE DRAIN AND RESERVOIR AS DIRECTED BY THE OWNER OR HIS REPRESENTATIVE. WHEN SPECIFIED, A SUFFICIENT QUANTITY OF TOPSOIL WILL BE STOCKPILED IN A SUITABLE LOCATION FOR USE ON THE EMBANKMENT AND OTHER DESIGNATED AREAS.

EARTH FILL
 MATERIAL - THE FILL MATERIAL SHALL BE TAKEN FROM APPROVED DESIGNATED BORROW AREAS. IT SHALL BE FREE OF ROOTS, STUMPS, WOOD, RUBBER, STONES GREATER THAN 6" PROZEN OR OTHER OBSTRUCTABLE MATERIAL. FILL MATERIAL FOR THE COVER OF THE EMBANKMENT AND CUT-OUT TRENCH SHALL CONFORM TO UNFINED SOIL CLASSIFICATION CC, SC, CH, OR CL AND MUST HAVE AT LEAST 30% PASSING THE #20 SIEVE. CONSTRUCTION SHALL BE IN ACCORDANCE WITH THE REQUIREMENTS OF THE EMBANKMENT DESIGNED BY A GEOTECHNICAL ENGINEER. SUCH SPECIAL DESIGNS MUST HAVE CONSTRUCTION SUPERVISED BY A GEOTECHNICAL ENGINEER. MATERIALS USED IN THE OUTER SHELL OF THE EMBANKMENT MUST HAVE THE CAPABILITY TO SUPPORT VEGETATION OF THE QUALITY REQUIRED TO PREVENT EROSION OF THE EMBANKMENT.

PLACEMENT - AREAS ON WHICH FILL IS TO BE PLACED SHALL BE SCARIFIED PRIOR TO PLACEMENT OF FILL. FILL MATERIALS SHALL BE PLACED IN MAXIMUM 8 INCH THICK (BEFORE COMPACTED) LAYERS WHICH ARE TO BE CONTINUOUS OVER THE ENTIRE LENGTH OF THE FILL. THE MOST PERMEABLE BORROW MATERIAL SHALL BE PLACED IN THE DOWNSTREAM PORTIONS OF THE EMBANKMENT. FILL PLACEMENT AND CUT-OUT TRENCH SHALL BE INSTALLED CONCURRENTLY WITH FILL PLACEMENT AND NOT EXCAVATED INTO THE EMBANKMENT.

COMPACTION - THE MOVEMENT OF THE HAULING AND SPREADING EQUIPMENT OVER THE FILL SHALL BE CONTROLLED SO THAT THE ENTIRE SURFACE OF EACH LIFT SHALL BE TRAVELLED BY NOT LESS THAN ONE TRACK OF HEAVY EQUIPMENT OR CONSTRUCTION SHALL BE CHECKED BY A NUMBER OF FOUR CORNER PASSAGES OF A SHEEPSFOOT RUBBER TRED OR VIBRATORY ROLLER. FILL MATERIAL SHALL CONTAIN SUFFICIENT MOISTURE SUCH THAT THE REQUIRED DEGREE OF COMPACTION WILL BE OBTAINED WITH THE EQUIPMENT USED. THE FILL MATERIAL SHALL CONTAIN SUFFICIENT MOISTURE SO THAT IT FORMED INTO A BALL IT WILL NOT CRUMBLE, YET NOT BE SO WET THAT WATER CAN BE SQUEEZED OUT. WHEN REQUIRED BY THE DESIGNING AGENCY THE MINIMUM REQUIRED DENSITY SHALL NOT BE LESS THAN 95% OF MAXIMUM DRY DENSITY WITH A MOISTURE CONTENT WITHIN 2% OF THE OPTIMUM. EACH LAYER OF FILL SHALL BE COMPACTED AS NECESSARY TO OBTAIN THAT DENSITY, AND IS TO BE CERTIFIED BY THE ENGINEER AT THE TIME OF CONSTRUCTION. ALL COMPACTION IS TO BE DETERMINED BY AASHTO METHOD T-99 (STANDARD PROCTOR).

CUT OFF TRENCH - THE CUT OFF TRENCH SHALL BE EXCAVATED INTO IMPERVIOUS MATERIAL ALONG OR PARALLEL TO THE CENTRELINE OF THE EMBANKMENT AS SHOWN ON THE PLANS. THE BOTTOM WIDTH OF THE TRENCH SHALL BE COVERED BY THE EQUIPMENT USED FOR EXCAVATION, WITH THE MINIMUM WIDTH BEING FOUR FEET. THE DEPTH SHALL BE AT LEAST FOUR FEET BELOW THE FLOW GRADE OR AS SHOWN ON THE PLANS. THE SIDE SLOPES OF THE TRENCH SHALL BE 1 TO 1 OR FLATTER. THE BACKFILL SHALL BE COMPACTED WITH CONSTRUCTION EQUIPMENT, ROLLERS, OR HAND TAMPERS TO ASSURE MAXIMUM DENSITY AND MINIMUM PERMEABILITY.

EMBANKMENT CORE - THE CORE SHALL BE PARALLEL TO THE CENTRELINE OF THE EMBANKMENT AS SHOWN ON THE PLANS. THE TOP WIDTH OF THE CORE SHALL BE A MINIMUM OF FOUR FEET. THE HEIGHT SHALL EXTEND UP TO AT LEAST THE 10 YEAR WATER ELEVATION OR AS SHOWN ON THE PLANS. THE SIDE SLOPES SHALL BE 1 TO 1 OR FLATTER. THE CORE SHALL BE COMPACTED WITH CONSTRUCTION EQUIPMENT, ROLLERS, OR HAND TAMPERS TO ASSURE MAXIMUM DENSITY AND MINIMUM PERMEABILITY. IN ADDITION, THE CORE SHALL BE PLACED CONCURRENTLY WITH THE OUTER SHELL OF THE EMBANKMENT.

STRUCTURAL BACKFILL
 BACKFILL ADJACENT TO PIPES OR STRUCTURES SHALL BE OF THE TYPE AND QUALITY CONFORMING TO THAT SPECIFIED FOR THE ADJACENT FILL MATERIAL. THE FILL SHALL BE PLACED IN HORIZONTAL LAYERS NOT TO EXCEED 12 INCH THICK. THE EQUIPMENT USED FOR EXCAVATION SHALL BE MANUALLY OPERATED EQUIPMENT. THE MATERIAL NEEDS TO FILL COMPLETELY ALL SPACES UNDER AND ADJACENT TO THE PIPE. AT NO TIME DURING THE BACKFILL OPERATION SHALL DRIVE EQUIPMENT BE ALLOWED TO OPERATE CLOSER THAN FOUR FEET MEASURED HORIZONTALLY TO ANY PART OF A STRUCTURE. UNDER NO CIRCUMSTANCES SHALL EQUIPMENT BE DRIVEN OVER ANY PART OF A STRUCTURE OR PIPE UNLESS THERE IS A COMPACTED FILL OF 24" OR GREATER OVER THE STRUCTURE OR PIPE. BACKFILL MATERIAL MUST BE FLOWABLE FILL MEETING THE REQUIREMENTS OF MARYLAND DEPARTMENT OF TRANSPORTATION, STATE HIGHWAY ADMINISTRATION STANDARD SPECIFICATIONS FOR CONSTRUCTION MATERIALS AND MATERIALS, SECTION 221.09, CLASS C.

OPERATION MAINTENANCE AND INSPECTION
 INSPECTION OF THE POND(S) SHOWN HEREON SHALL BE PERFORMED AT LEAST ANNUALLY, IN ACCORDANCE WITH THE CHECKLIST AND REQUIREMENTS CONTAINED WITHIN THESE SPECIFICATIONS AND SPECIFICATIONS FOR PONDS (MD-378), THE POND OWNER(S) AND THE HEIRS SUCCESSORS OR ASSIGNS SHALL BE RESPONSIBLE FOR THE SAFETY OF THE POND AND THE MAINTENANCE OF THE POND. THE POND OWNER(S) SHALL PROMPTLY NOTIFY THE SOIL CONSERVATION DISTRICT OF ANY UNUSUAL OBSERVATIONS THAT MAY BE INDICATORS OF DISTRESS SUCH AS EXCESSIVE SEEPAGE, TURBID SEEPAGE, SLUMP OR SLIDING.

OPERATION AND MAINTENANCE SCHEDULE FOR PRIVATELY OWNED AND MAINTAINED SURFACE STORMWATER FILTRATION SYSTEM

PIPE CONDUIT
 ALL PIPES SHALL BE CIRCULAR IN CROSS SECTION.

CORRUGATED METAL PIPE - ALL OF THE FOLLOWING CRITERIA SHALL APPLY FOR CORRUGATED METAL PIPE:
 1. MATERIALS - (POLYMER COATED STEEL PIPE) - STEEL PIPES WITH POLYMERIC COATINGS SHALL HAVE A MINIMUM COATING THICKNESS OF 0.01 INCH (10 MIL) ON BOTH SIDES OF THE PIPE. THIS PIPE AND ITS APPURTENANCES SHALL CONFORM TO THE REQUIREMENTS OF AASHTO SPECIFICATIONS M-245 & M-246 WITH WATER TIGHT COUPLING BANDS OR FLANGES.
 MATERIALS - (ALUMINUM COATED STEEL PIPE) - THIS PIPE AND ITS APPURTENANCES SHALL CONFORM TO THE REQUIREMENTS OF AASHTO SPECIFICATIONS M-189 OR M-211 WITH WATER TIGHT COUPLING BANDS OR FLANGES. ALUMINUM PIPE WHEN USED WITH FLOWABLE FILL WHEN SOIL AND/OR WATER CONDITIONS WARRANT FOR INCREASED DURABILITY, SHALL BE FULLY BRITANNIUM COATED PER REQUIREMENTS OF AASHTO SPECIFICATION M-189 TYPE A. ALUMINUM SURFACES THAT ARE TO BE IN CONTACT WITH CONCRETE SHALL BE PAINTED WITH TWO COATS OF ASPHALT. HOT DIP GALVANIZED BOLTS MAY BE USED FOR CONNECTIONS. THE PH OF THE SURROUNDING SOILS SHALL BE BETWEEN 4 AND 9.

2. COUPLING BANDS, ANTI-SEEP COLLARS, END SECTIONS, ETC. SHALL BE COMPOSED OF THE SAME MATERIAL AND COATINGS AS THE PIPE. METALS MUST BE INSULATED FROM DISSIMILAR MATERIALS WITH USE OF RUBBER OR PLASTIC INSULATING MATERIALS AT LEAST 24 MILS IN THICKNESS.
 3. CONNECTIONS - ALL CONNECTIONS WITH PIPES MUST BE COMPLETELY WATER TIGHT. THE DRAIN PIPE OR BARREL CONNECTION TO THE RISER SHALL BE WELDED ALL AROUND WHEN THE PIPE AND RISER ARE METAL. ANTI-SEEP COLLARS SHALL BE CONNECTED TO THE PIPE IN SUCH A MANNER AS TO BE COMPLETELY WATER TIGHT. SIMPLE BANDS ARE NOT CONSIDERED TO BE WATER TIGHT.
 ALL CONNECTIONS SHALL USE A RUBBER OR NEOPRENE GASKET WHEN JOINING PIPE SECTIONS. THE END OF EACH PIPE SHALL BE ROLLED TO ADEQUATE NUMBER OF CORRUGATIONS TO ACCOMMODATE THE BANDWIDTH. THE FOLLOWING TYPE CONNECTIONS ARE ACCEPTABLE FOR PIPES LESS THAN 24 INCHES IN DIAMETER: FLANGES ON BOTH ENDS OF THE PIPE WITH A CIRCULAR 3/8 INCH CLOSED CELL NEOPRENE GASKET, PRE-PANCHED TO THE FLANGE BOLT CIRCUMFERENCE BETWEEN ADJACENT FLANGES. A 12-INCH WIDE STAINLESS LAP TYPE BAND WITH 12-INCH WIDE BY 3/8-INCH THICK CLOSED CELL CIRCULAR NEOPRENE GASKET, AND A 12-INCH WIDE HUGGER TYPE BAND WITH 4-RING GASKETS HAVING A MINIMUM DIAMETER OF 1/8 INCH GREATER THAN THE CORROSION DEPTH. PIPES 24 INCHES IN DIAMETER AND LARGERS SHALL BE CONNECTED BY A 24-INCH LONG ANNUAL CORRUGATED BAND USING A MINIMUM OF 4 (FOUR) RODS AND WELDS. 2 ON EACH CONNECTING PIPE END, A 24-INCH WIDE BY 3/8-INCH THICK CLOSED CELL CIRCULAR NEOPRENE GASKET WILL BE INSTALLED WITH 4 INCHES ON THE END OF EACH PIPE. PLACED JOINTS WITH 3/8 INCH CLOSED CELL GASKETS THE FULL WIDTH OF THE FLANGE IS ALSO ACCEPTABLE.
 HELICALLY CORRUGATED PIPE SHALL HAVE EITHER CONTINUOUSLY WELDED SEAMS OR HAVE LOCK SEAMS WITH INTERNAL CAULKING OR A NEOPRENE BEAD.

4. BEDDING - THE PIPE SHALL BE FIRMLY AND UNIFORMLY BEDDED THROUGHOUT ITS ENTIRE LENGTH. WHERE ROCK OR SOFT, SPONGY OR OTHER UNSTABLE SOIL IS ENCOUNTERED, ALL SUCH MATERIAL SHALL BE REMOVED AND REPLACED WITH SUITABLE EARTH COMPACTED TO PROVIDE ADEQUATE SUPPORT.
 5. BACKFILLING SHALL CONFORM TO "STRUCTURE BACKFILL".
 6. OTHER DETAILS (ANTI-SEEP COLLARS, VALVES, ETC) SHALL BE AS SHOWN ON THE DRAWINGS.
REINFORCED CONCRETE PIPE - ALL OF THE FOLLOWING CRITERIA SHALL APPLY FOR REINFORCED CONCRETE PIPE:
 1. MATERIALS - REINFORCED CONCRETE PIPE SHALL HAVE BELL AND SPIGOT JOINTS WITH RUBBER GASKETS AND SHALL EQUAL OR EXCEED ASTM C-391.
 2. BEDDING - REINFORCED CONCRETE PIPE CONDUITS SHALL BE LAID IN A CONCRETE BEDDING/GRADE FOR THEIR ENTIRE LENGTH. THIS BEDDING/GRADE SHALL CONSIST OF HIGH SLUMP CONCRETE PLACED UNDER THE PIPE AND UP THE SIDES OF THE PIPE AT LEAST 50% OF ITS OUTSIDE DIAMETER WITH A MINIMUM THICKNESS OF 4 INCHES. WHERE A CONCRETE CRACK IS NOT NECESSARY FOR STRUCTURAL REASONS, FLOWABLE FILL MAY BE USED AS DESCRIBED IN THE "STRUCTURE BACKFILL" SECTION OF THIS STANDARD. GRAVEL BEDDING IS NOT PERMITTED.
 3. LAYING PIPE - BELL AND SPIGOT PIPE SHALL BE PLACED WITH THE BELL END UPSTREAM. JOINTS SHALL BE MADE IN ACCORDANCE WITH RECOMMENDATIONS OF THE MANUFACTURER OF THE MATERIAL. AFTER THE JOINTS ARE SEALED FOR THE ENTIRE LENGTH OF THE PIPE, THE BEDDING SHALL BE PLACED UNDER THE PIPE AS FOLLOWS. CARE SHALL BE EXERCISED TO PREVENT ANY DEVIATION FROM THE ORIGINAL LINE AND GRADE OF THE PIPE. THE FIRST JOINT MUST BE LOCATED WITHIN 4 FEET FROM THE RISER.

4. BACKFILLING SHALL CONFORM TO "STRUCTURE BACKFILL".
 5. OTHER DETAILS (ANTI-SEEP COLLARS, VALVES, ETC) SHALL BE AS SHOWN ON THE DRAWINGS.
PLASTIC PIPE - THE FOLLOWING CRITERIA SHALL APPLY FOR PLASTIC PIPE:
 1. MATERIALS - PVC PIPE SHALL BE PVC-1120 OR PVC-1220 CONFORMING TO ASTM D1785 OR ASTM D-2241. CORRUGATED HIGH DENSITY POLYETHYLENE (HDPE) PIPE, COUPLINGS AND FITTINGS SHALL CONFORM TO THE FOLLOWING: 4" - 10" INCH PIPE SHALL MEET THE REQUIREMENTS OF AASHTO M25 TYPE S, AND 12" THROUGH 24" INCH SHALL MEET THE REQUIREMENTS OF AASHTO M25 TYPE S.
 2. JOINTS AND CONNECTIONS TO ANTI-SEEP COLLARS SHALL BE COMPLETELY WATER TIGHT.
 3. BEDDING - THE PIPE SHALL BE FIRMLY AND UNIFORMLY BEDDED THROUGHOUT ITS ENTIRE LENGTH. WHERE ROCK OR SOFT, SPONGY OR OTHER UNSTABLE SOIL IS ENCOUNTERED, ALL SUCH MATERIAL SHALL BE REMOVED AND REPLACED WITH SUITABLE EARTH COMPACTED TO PROVIDE ADEQUATE SUPPORT.
 4. BACKFILL SHALL CONFORM TO "STRUCTURE BACKFILL".
 5. OTHER DETAILS (ANTI-SEEP COLLARS, VALVES, ETC) SHALL BE AS SHOWN ON THE DRAWINGS.
CONCRETE
 CONCRETE SHALL MEET THE REQUIREMENTS OF MARYLAND DEPARTMENT OF TRANSPORTATION, STATE HIGHWAY ADMINISTRATION STANDARD SPECIFICATIONS FOR CONSTRUCTION MATERIALS, SECTION 414, MIX NO. 3.
ROCK RIPRAP
 ROCK RIPRAP SHALL MEET THE REQUIREMENTS OF MARYLAND DEPARTMENT OF TRANSPORTATION, STATE HIGHWAY ADMINISTRATION STANDARD SPECIFICATIONS FOR CONSTRUCTION MATERIALS, SECTION 311.
GEOTEXTILE SHALL BE PLACED UNDER ALL RIPRAP AND SHALL MEET THE REQUIREMENTS OF MARYLAND DEPARTMENT OF TRANSPORTATION, STATE HIGHWAY ADMINISTRATION STANDARD SPECIFICATIONS FOR CONSTRUCTION MATERIALS, SECTION 321.09, CLASS C.
CARE OF WATER DURING CONSTRUCTION
 ALL WORK ON PERMANENT STRUCTURES SHALL BE CARRIED OUT IN AREAS FREE FROM WATER. THE CONTRACTOR SHALL CONSTRUCT AND MAINTAIN ALL TEMPORARY DICES, LEVESES, COFFERDAMS, DRAINAGE CHANNELS, AND STREAM DIVERSIONS NECESSARY TO PROTECT THE AREAS TO BE OCCUPIED BY THE PERMANENT WORKS. THE CONTRACTOR SHALL ALSO FURNISH, INSTALL, OPERATE, AND MAINTAIN ALL NECESSARY PUMPING AND OTHER EQUIPMENT REQUIRED FOR REMOVAL OF WATER FROM VARIOUS PARTS OF THE WORK AND FOR MAINTAINING THE EXCAVATIONS, FOUNDATION, AND OTHER PARTS OF THE WORK FREE FROM WATER AS REQUIRED OR DIRECTED BY THE ENGINEER FOR PROTECTION OF THE WORK. AFTER HAVING SERVED THEIR PURPOSE, ALL TEMPORARY STRUCTURES SHALL BE REMOVED OR LEVELED AND GRADED TO THE EXTENT REQUIRED TO PREVENT OBSTRUCTION IN ANY DEGREE WHATSOEVER OF THE FLOW OF WATER TO THE SPILLWAY OR OUTLET WORKS AND SO AS NOT TO INTERFERE IN ANY WAY WITH THE OPERATION OR MAINTENANCE OF THE STRUCTURE. STREAM DIVERSIONS SHALL BE MAINTAINED UNTIL THE FULL FLOW CAN BE PASSED THROUGH THE PERMANENT WORKS. THE REMOVAL OF WATER FROM THE REQUIRED EXCAVATION AND THE FOUNDATION SHALL BE ACCOMPANIED BY A MAINTENANCE AND TO THE EXTENT THAT WILL MAINTAIN STABILITY OF THE EXCAVATED SLOPES AND BOTTOM REQUIRED EXCAVATIONS. THE CONTRACTOR SHALL BE RESPONSIBLE FOR THE PROTECTION OF ALL EXISTING UTILITIES. THE PLACING AND COMPACTING OF MATERIAL IN REQUIRED EXCAVATIONS, THE WATER LEVEL AT THE LOCATIONS BEING REFILLED SHALL BE MAINTAINED BELOW THE BOTTOM OF THE EXCAVATION AT SUCH LOCATIONS WHICH MAY REQUIRE DRAINING THE WATER Sumps FROM WHICH THE WATER SHALL BE PUMPED.

STABILIZATION
 ALL BORROW AREAS SHALL BE GRADED TO PROVIDE PROPER DRAINAGE AND LEFT IN A SLIGHTLY CONDITON ALL EXPOSED SURFACES OF THE EMBANKMENT, SPILLWAY, SPILL AND BORROW AREAS, AND DEBRIS SHALL BE STABILIZED BY SEEDING, LIMING, FERTILIZING AND MULCHING IN ACCORDANCE WITH THE NATURAL RESOURCES CONSERVATION SERVICE STANDARDS AND SPECIFICATIONS FOR CRITICAL AREA PLANTING (MD-242) OR AS SHOWN ON THE ACCOMPANYING DRAWINGS.

EROSION AND SEDIMENT CONTROL
 CONSTRUCTION OPERATIONS WILL BE CARRIED OUT IN SUCH A MANNER THAT EROSION WILL BE CONTROLLED AND WATER AND AIR POLLUTION MINIMIZED. STATE AND LOCAL LAWS CONCERNING POLLUTION ABATEMENT WILL BE FOLLOWED. CONSTRUCTION PLANS SHALL DETAIL EROSION AND SEDIMENT CONTROL MEASURES.

OPERATION MAINTENANCE AND INSPECTION
 INSPECTION OF THE POND(S) SHOWN HEREON SHALL BE PERFORMED AT LEAST ANNUALLY, IN ACCORDANCE WITH THE CHECKLIST AND REQUIREMENTS CONTAINED WITHIN THESE SPECIFICATIONS AND SPECIFICATIONS FOR PONDS (MD-378), THE POND OWNER(S) AND THE HEIRS SUCCESSORS OR ASSIGNS SHALL BE RESPONSIBLE FOR THE SAFETY OF THE POND AND THE MAINTENANCE OF THE POND. THE POND OWNER(S) SHALL PROMPTLY NOTIFY THE SOIL CONSERVATION DISTRICT OF ANY UNUSUAL OBSERVATIONS THAT MAY BE INDICATORS OF DISTRESS SUCH AS EXCESSIVE SEEPAGE, TURBID SEEPAGE, SLUMP OR SLIDING.

OPERATION AND MAINTENANCE SCHEDULE FOR PRIVATELY OWNED AND MAINTAINED SURFACE STORMWATER FILTRATION SYSTEM

PIPE CONDUIT
 ALL PIPES SHALL BE CIRCULAR IN CROSS SECTION.

CORRUGATED METAL PIPE - ALL OF THE FOLLOWING CRITERIA SHALL APPLY FOR CORRUGATED METAL PIPE:
 1. MATERIALS - (POLYMER COATED STEEL PIPE) - STEEL PIPES WITH POLYMERIC COATINGS SHALL HAVE A MINIMUM COATING THICKNESS OF 0.01 INCH (10 MIL) ON BOTH SIDES OF THE PIPE. THIS PIPE AND ITS APPURTENANCES SHALL CONFORM TO THE REQUIREMENTS OF AASHTO SPECIFICATIONS M-245 & M-246 WITH WATER TIGHT COUPLING BANDS OR FLANGES.
 MATERIALS - (ALUMINUM COATED STEEL PIPE) - THIS PIPE AND ITS APPURTENANCES SHALL CONFORM TO THE REQUIREMENTS OF AASHTO SPECIFICATIONS M-189 OR M-211 WITH WATER TIGHT COUPLING BANDS OR FLANGES. ALUMINUM PIPE WHEN USED WITH FLOWABLE FILL WHEN SOIL AND/OR WATER CONDITIONS WARRANT FOR INCREASED DURABILITY, SHALL BE FULLY BRITANNIUM COATED PER REQUIREMENTS OF AASHTO SPECIFICATION M-189 TYPE A. ALUMINUM SURFACES THAT ARE TO BE IN CONTACT WITH CONCRETE SHALL BE PAINTED WITH TWO COATS OF ASPHALT. HOT DIP GALVANIZED BOLTS MAY BE USED FOR CONNECTIONS. THE PH OF THE SURROUNDING SOILS SHALL BE BETWEEN 4 AND 9.

2. COUPLING BANDS, ANTI-SEEP COLLARS, END SECTIONS, ETC. SHALL BE COMPOSED OF THE SAME MATERIAL AND COATINGS AS THE PIPE. METALS MUST BE INSULATED FROM DISSIMILAR MATERIALS WITH USE OF RUBBER OR PLASTIC INSULATING MATERIALS AT LEAST 24 MILS IN THICKNESS.
 3. CONNECTIONS - ALL CONNECTIONS WITH PIPES MUST BE COMPLETELY WATER TIGHT. THE DRAIN PIPE OR BARREL CONNECTION TO THE RISER SHALL BE WELDED ALL AROUND WHEN THE PIPE AND RISER ARE METAL. ANTI-SEEP COLLARS SHALL BE CONNECTED TO THE PIPE IN SUCH A MANNER AS TO BE COMPLETELY WATER TIGHT. SIMPLE BANDS ARE NOT CONSIDERED TO BE WATER TIGHT.
 ALL CONNECTIONS SHALL USE A RUBBER OR NEOPRENE GASKET WHEN JOINING PIPE SECTIONS. THE END OF EACH PIPE SHALL BE ROLLED TO ADEQUATE NUMBER OF CORRUGATIONS TO ACCOMMODATE THE BANDWIDTH. THE FOLLOWING TYPE CONNECTIONS ARE ACCEPTABLE FOR PIPES LESS THAN 24 INCHES IN DIAMETER: FLANGES ON BOTH ENDS OF THE PIPE WITH A CIRCULAR 3/8 INCH CLOSED CELL NEOPRENE GASKET, PRE-PANCHED TO THE FLANGE BOLT CIRCUMFERENCE BETWEEN ADJACENT FLANGES. A 12-INCH WIDE STAINLESS LAP TYPE BAND WITH 12-INCH WIDE BY 3/8-INCH THICK CLOSED CELL CIRCULAR NEOPRENE GASKET, AND A 12-INCH WIDE HUGGER TYPE BAND WITH 4-RING GASKETS HAVING A MINIMUM DIAMETER OF 1/8 INCH GREATER THAN THE CORROSION DEPTH. PIPES 24 INCHES IN DIAMETER AND LARGERS SHALL BE CONNECTED BY A 24-INCH LONG ANNUAL CORRUGATED BAND USING A MINIMUM OF 4 (FOUR) RODS AND WELDS. 2 ON EACH CONNECTING PIPE END, A 24-INCH WIDE BY 3/8-INCH THICK CLOSED CELL CIRCULAR NEOPRENE GASKET WILL BE INSTALLED WITH 4 INCHES ON THE END OF EACH PIPE. PLACED JOINTS WITH 3/8 INCH CLOSED CELL GASKETS THE FULL WIDTH OF THE FLANGE IS ALSO ACCEPTABLE.
 HELICALLY CORRUGATED PIPE SHALL HAVE EITHER CONTINUOUSLY WELDED SEAMS OR HAVE LOCK SEAMS WITH INTERNAL CAULKING OR A NEOPRENE BEAD.

4. BEDDING - THE PIPE SHALL BE FIRMLY AND UNIFORMLY BEDDED THROUGHOUT ITS ENTIRE LENGTH. WHERE ROCK OR SOFT, SPONGY OR OTHER UNSTABLE SOIL IS ENCOUNTERED, ALL SUCH MATERIAL SHALL BE REMOVED AND REPLACED WITH SUITABLE EARTH COMPACTED TO PROVIDE ADEQUATE SUPPORT.
 5. BACKFILLING SHALL CONFORM TO "STRUCTURE BACKFILL".
 6. OTHER DETAILS (ANTI-SEEP COLLARS, VALVES, ETC) SHALL BE AS SHOWN ON THE DRAWINGS.
REINFORCED CONCRETE PIPE - ALL OF THE FOLLOWING CRITERIA SHALL APPLY FOR REINFORCED CONCRETE PIPE:
 1. MATERIALS - REINFORCED CONCRETE PIPE SHALL HAVE BELL AND SPIGOT JOINTS WITH RUBBER GASKETS AND SHALL EQUAL OR EXCEED ASTM C-391.
 2. BEDDING - REINFORCED CONCRETE PIPE CONDUITS SHALL BE LAID IN A CONCRETE BEDDING/GRADE FOR THEIR ENTIRE LENGTH. THIS BEDDING/GRADE SHALL CONSIST OF HIGH SLUMP CONCRETE PLACED UNDER THE PIPE AND UP THE SIDES OF THE PIPE AT LEAST 50% OF ITS OUTSIDE DIAMETER WITH A MINIMUM THICKNESS OF 4 INCHES. WHERE A CONCRETE CRACK IS NOT NECESSARY FOR STRUCTURAL REASONS, FLOWABLE FILL MAY BE USED AS DESCRIBED IN THE "STRUCTURE BACKFILL" SECTION OF THIS STANDARD. GRAVEL BEDDING IS NOT PERMITTED.
 3. LAYING PIPE - BELL AND SPIGOT PIPE SHALL BE PLACED WITH THE BELL END UPSTREAM. JOINTS SHALL BE MADE IN ACCORDANCE WITH RECOMMENDATIONS OF THE MANUFACTURER OF THE MATERIAL. AFTER THE JOINTS ARE SEALED FOR THE ENTIRE LENGTH OF THE PIPE, THE BEDDING SHALL BE PLACED UNDER THE PIPE AS FOLLOWS. CARE SHALL BE EXERCISED TO PREVENT ANY DEVIATION FROM THE ORIGINAL LINE AND GRADE OF THE PIPE. THE FIRST JOINT MUST BE LOCATED WITHIN 4 FEET FROM THE RISER.




EROSION AND SEDIMENT CONTROL
 CONSTRUCTION OPERATIONS WILL BE CARRIED OUT IN SUCH A MANNER THAT EROSION WILL BE CONTROLLED AND WATER AND AIR POLLUTION MINIMIZED. STATE AND LOCAL LAWS CONCERNING POLLUTION ABATEMENT WILL BE FOLLOWED. CONSTRUCTION PLANS SHALL DETAIL EROSION AND SEDIMENT CONTROL MEASURES.

OPERATION MAINTENANCE AND INSPECTION
 INSPECTION OF THE POND(S) SHOWN HEREON SHALL BE PERFORMED AT LEAST ANNUALLY, IN ACCORDANCE WITH THE CHECKLIST AND REQUIREMENTS CONTAINED WITHIN THESE SPECIFICATIONS AND SPECIFICATIONS FOR PONDS (MD-378), THE POND OWNER(S) AND THE HEIRS SUCCESSORS OR ASSIGNS SHALL BE RESPONSIBLE FOR THE SAFETY OF THE POND AND THE MAINTENANCE OF THE POND. THE POND OWNER(S) SHALL PROMPTLY NOTIFY THE SOIL CONSERVATION DISTRICT OF ANY UNUSUAL OBSERVATIONS THAT MAY BE INDICATORS OF DISTRESS SUCH AS EXCESSIVE SEEPAGE, TURBID SEEPAGE, SLUMP OR SLIDING.

OPERATION AND MAINTENANCE SCHEDULE FOR PRIVATELY OWNED AND MAINTAINED SURFACE STORMWATER FILTRATION SYSTEM

PIPE CONDUIT
 ALL PIPES SHALL BE CIRCULAR IN CROSS SECTION.

CORRUGATED METAL PIPE - ALL OF THE FOLLOWING CRITERIA SHALL APPLY FOR CORRUGATED METAL PIPE:
 1. MATERIALS - (POLYMER COATED STEEL PIPE) - STEEL PIPES WITH POLYMERIC COATINGS SHALL HAVE A MINIMUM COATING THICKNESS OF 0.01 INCH (10 MIL) ON BOTH SIDES OF THE PIPE. THIS PIPE AND ITS APPURTENANCES SHALL CONFORM TO THE REQUIREMENTS OF AASHTO SPECIFICATIONS M-245 & M-246 WITH WATER TIGHT COUPLING BANDS OR FLANGES.
 MATERIALS - (ALUMINUM COATED STEEL PIPE) - THIS PIPE AND ITS APPURTENANCES SHALL CONFORM TO THE REQUIREMENTS OF AASHTO SPECIFICATIONS M-189 OR M-211 WITH WATER TIGHT COUPLING BANDS OR FLANGES. ALUMINUM PIPE WHEN USED WITH FLOWABLE FILL WHEN SOIL AND/OR WATER CONDITIONS WARRANT FOR INCREASED DURABILITY, SHALL BE FULLY BRITANNIUM COATED PER REQUIREMENTS OF AASHTO SPECIFICATION M-189 TYPE A. ALUMINUM SURFACES THAT ARE TO BE IN CONTACT WITH CONCRETE SHALL BE PAINTED WITH TWO COATS OF ASPHALT. HOT DIP GALVANIZED BOLTS MAY BE USED FOR CONNECTIONS. THE PH OF THE SURROUNDING SOILS SHALL BE BETWEEN 4 AND 9.

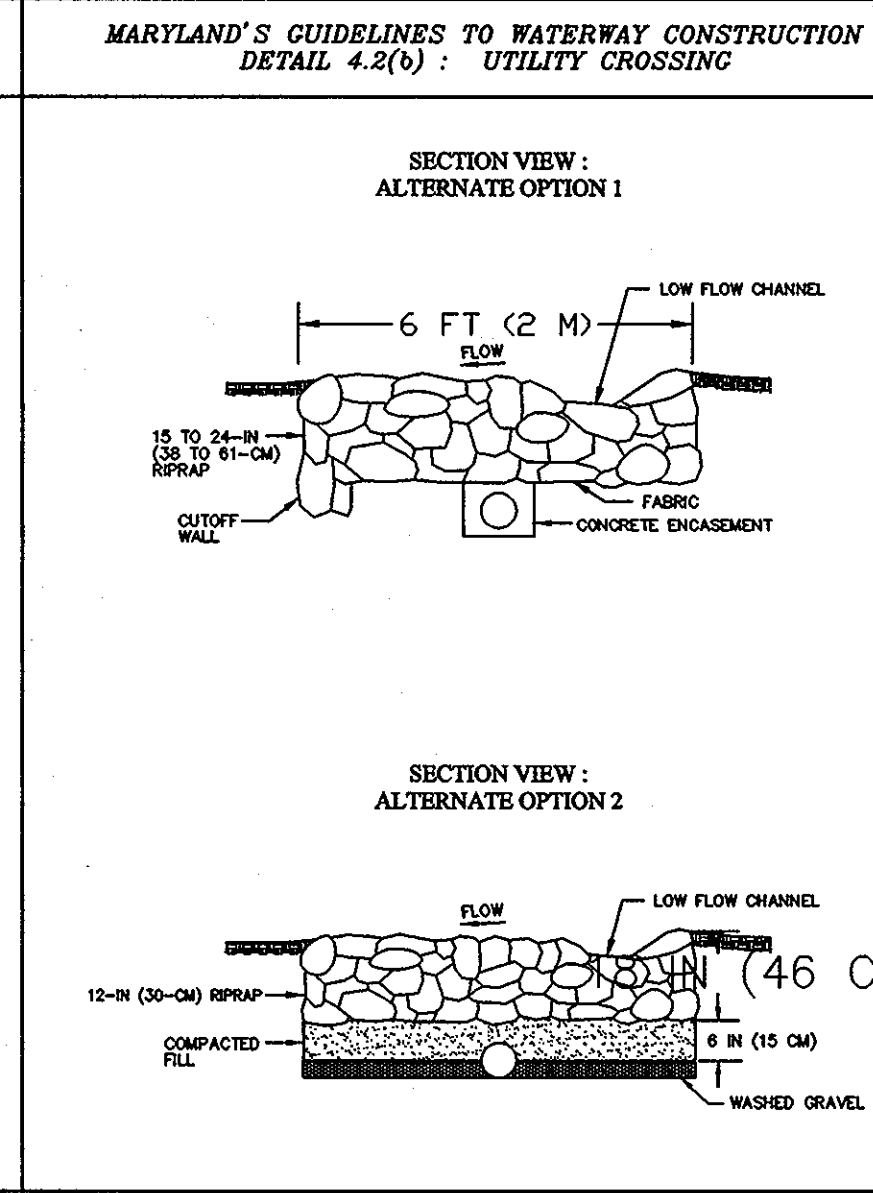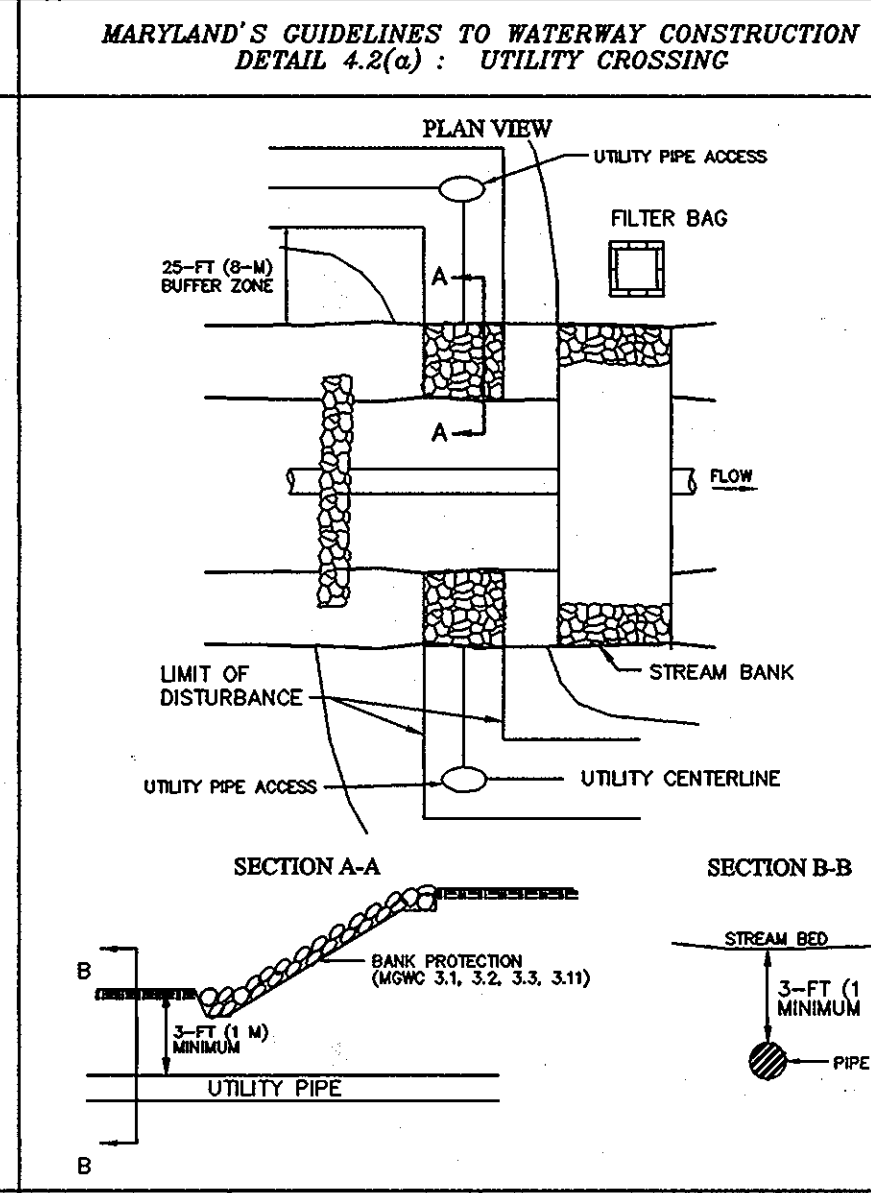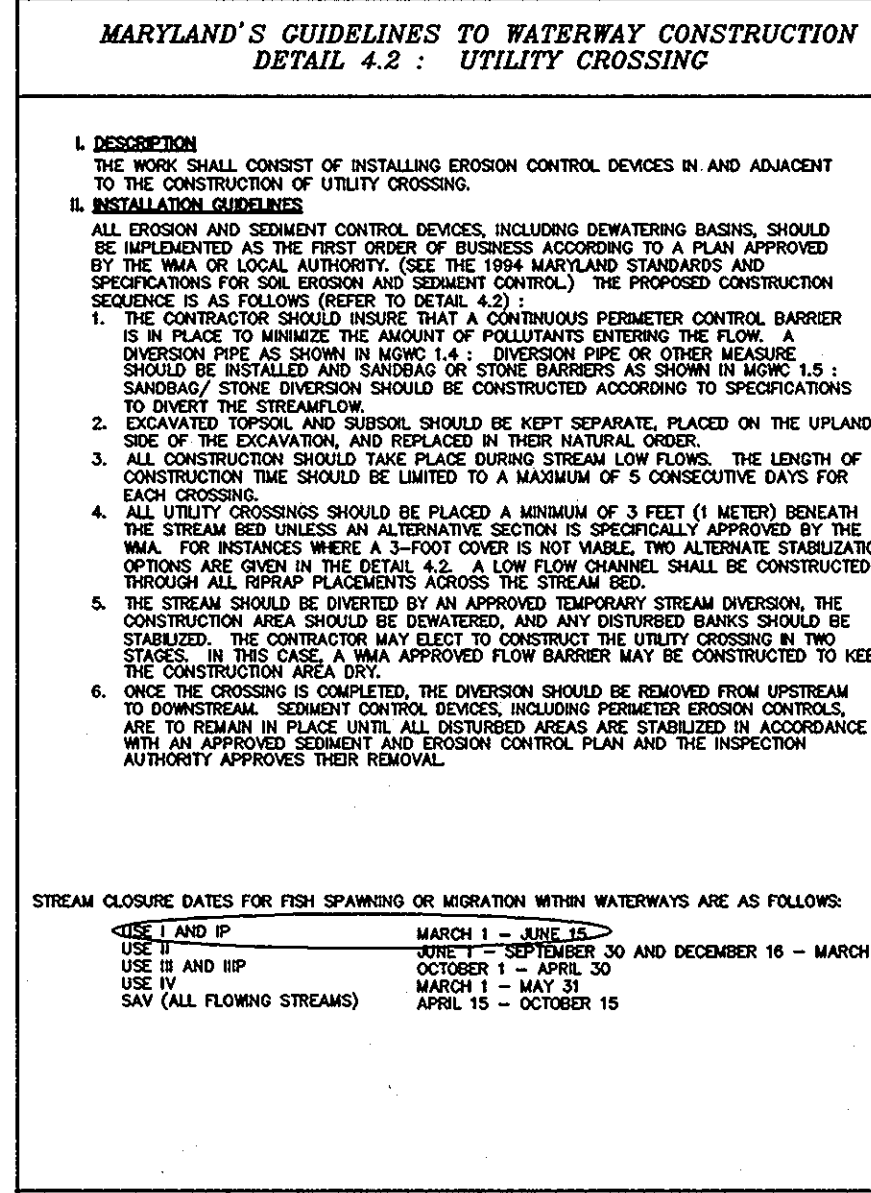

STREAM CLOSURE DATES FOR FISH SPawning OR MIGRATION WITH WATERWAYS ARE AS FOLLOWS:
 I AND II MARCH 1 - END 15
 USE III AND IV JUNE 1 - SEPTEMBER 30 AND DECEMBER 16 - MARCH 14
 USE V MAY 1 - MAY 31
 SAV (ALL FLOWING STREAMS) APRIL 15 - OCTOBER 15

REVISOR NOVEMBER 2000 PAGE 4.2-1 MARYLAND DEPARTMENT OF THE ENVIRONMENT WATER MANAGEMENT ADMINISTRATION

REVISOR NOVEMBER 2000 PAGE 4.2-2 MARYLAND DEPARTMENT OF THE ENVIRONMENT WATER MANAGEMENT ADMINISTRATION

REVISOR NOVEMBER 2000 PAGE 4.2-3 MARYLAND DEPARTMENT OF THE ENVIRONMENT WATER MANAGEMENT ADMINISTRATION

Project Name: **Ilchester Oaks** Parcel No: **23** Section: **23** Subsection: **23** Block: **23** Lot: **23**

ELEV.	SOIL DESCRIPTION	DEPTH	TEST	REMARKS & COMMENTS
115.0	Clayey silt loam to silty clay	0-12"	100	Topsoil
110.0	Clayey silt loam to silty clay	12-24"	100	Discontinuity at 12"
105.0	Clayey silt loam to silty clay	24-36"	100	Discontinuity at 24"
100.0	Clayey silt loam to silty clay	36-48"	100	Discontinuity at 36"
95.0	Clayey silt loam to silty clay	48-60"	100	Discontinuity at 48"
90.0	Clayey silt loam to silty clay	60-72"	100	Discontinuity at 60"
85.0	Clayey silt loam to silty clay	72-84"	100	Discontinuity at 72"
80.0	Clayey silt loam to silty clay	84-96"	100	Discontinuity at 84"
75.0	Clayey silt loam to silty clay	96-108"	100	Discontinuity at 96"
70.0	Clayey silt loam to silty clay	108-120"	100	Discontinuity at 108"

BEST MANAGEMENT PRACTICES FOR WORKING IN NONTIDAL WETLANDS, WETLAND BUFFERS, WATERWAYS, AND 100-YEAR FLOODPLAINS


- NO EXCESS FILL, CONSTRUCTION MATERIAL, OR DEBRIS SHALL BE STOCKPILED OR STORED IN NONTIDAL W

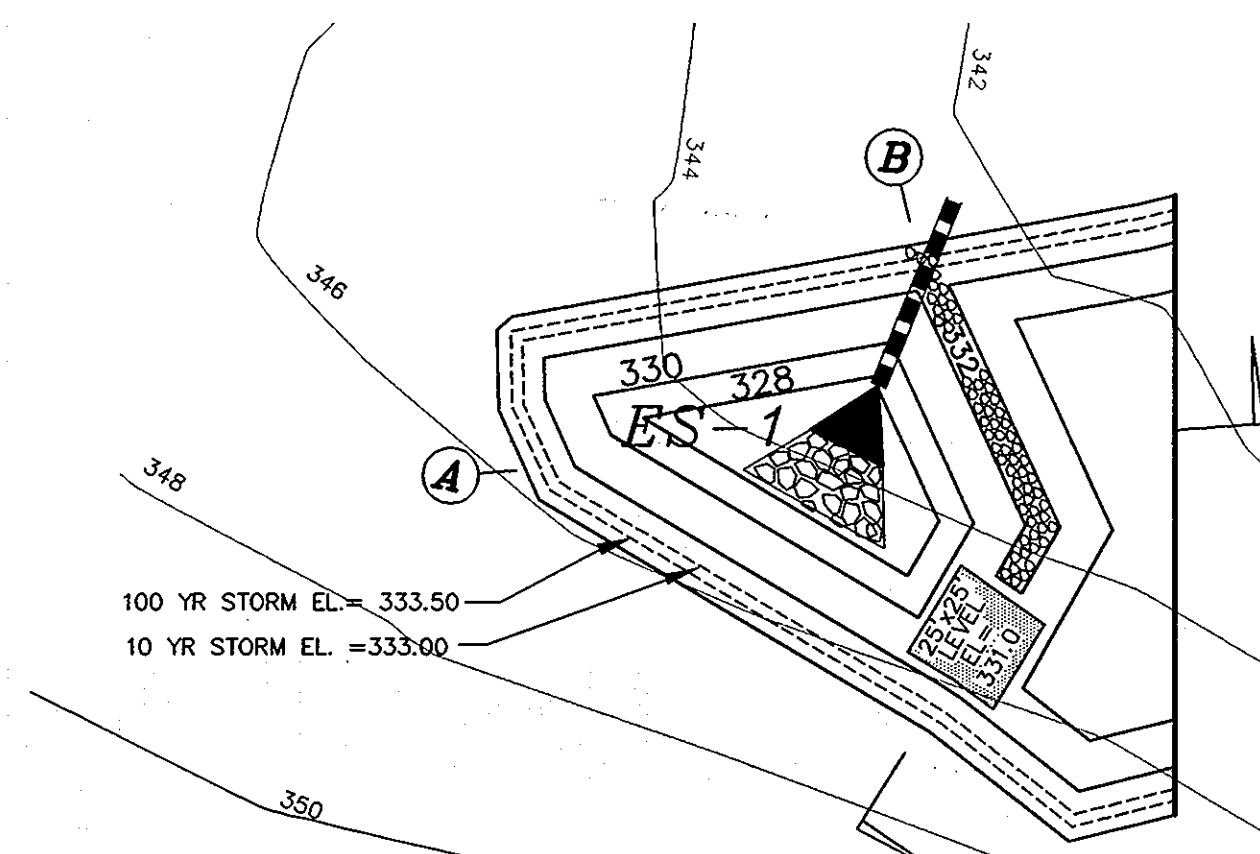


PLAN VIEW-FOREBAY
SCALE: 1"=50'

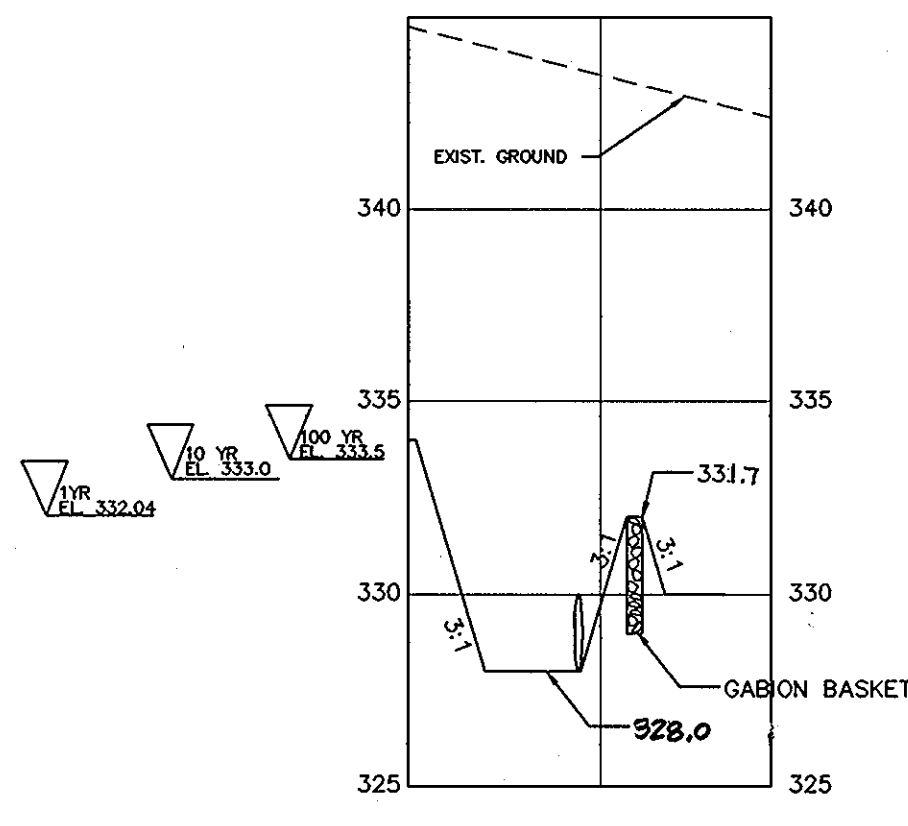

SECTION A - FOREBAY
SCALE: HOR. 1"=50'
VER. 1"=5'

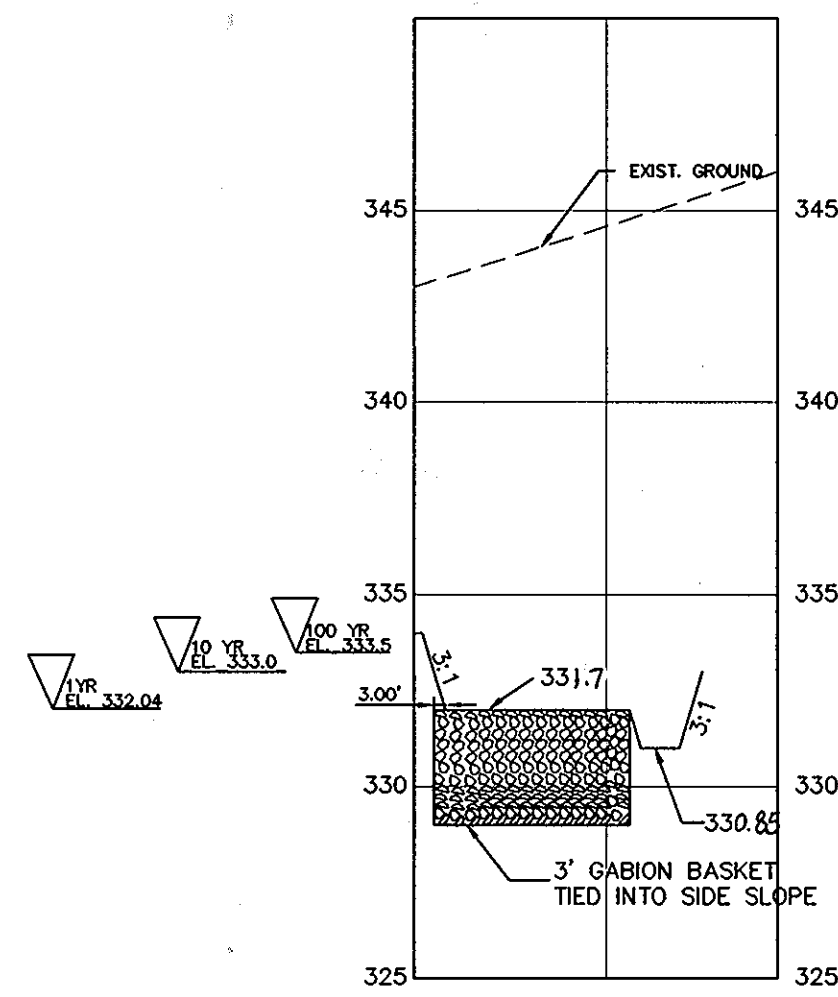


SECTION B - FOREBAY
SCALE: HOR. 1"=50'
VER. 1"=5'

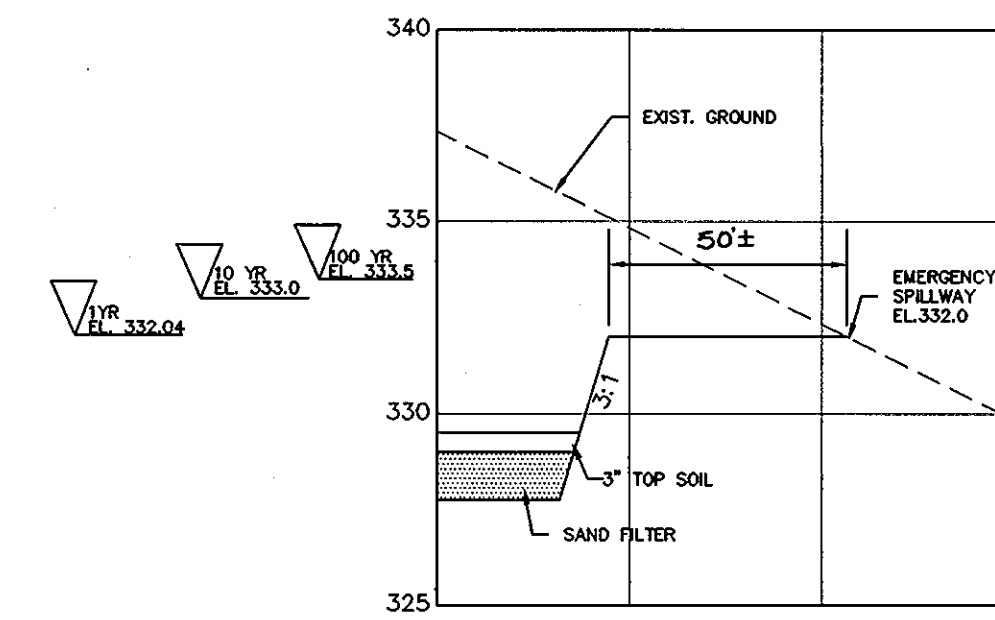


PROFILE - EMERGENCY SPILLWAY
SCALE: HOR. 1"=50'
VER. 1"=5'


Q1 = 0.16 CFS, VP = 0.11 FPS
Q10 = 11.3 CFS, VP = 2.16 FPS
Q100 = 12.0 CFS, VP = 2.19 FPS

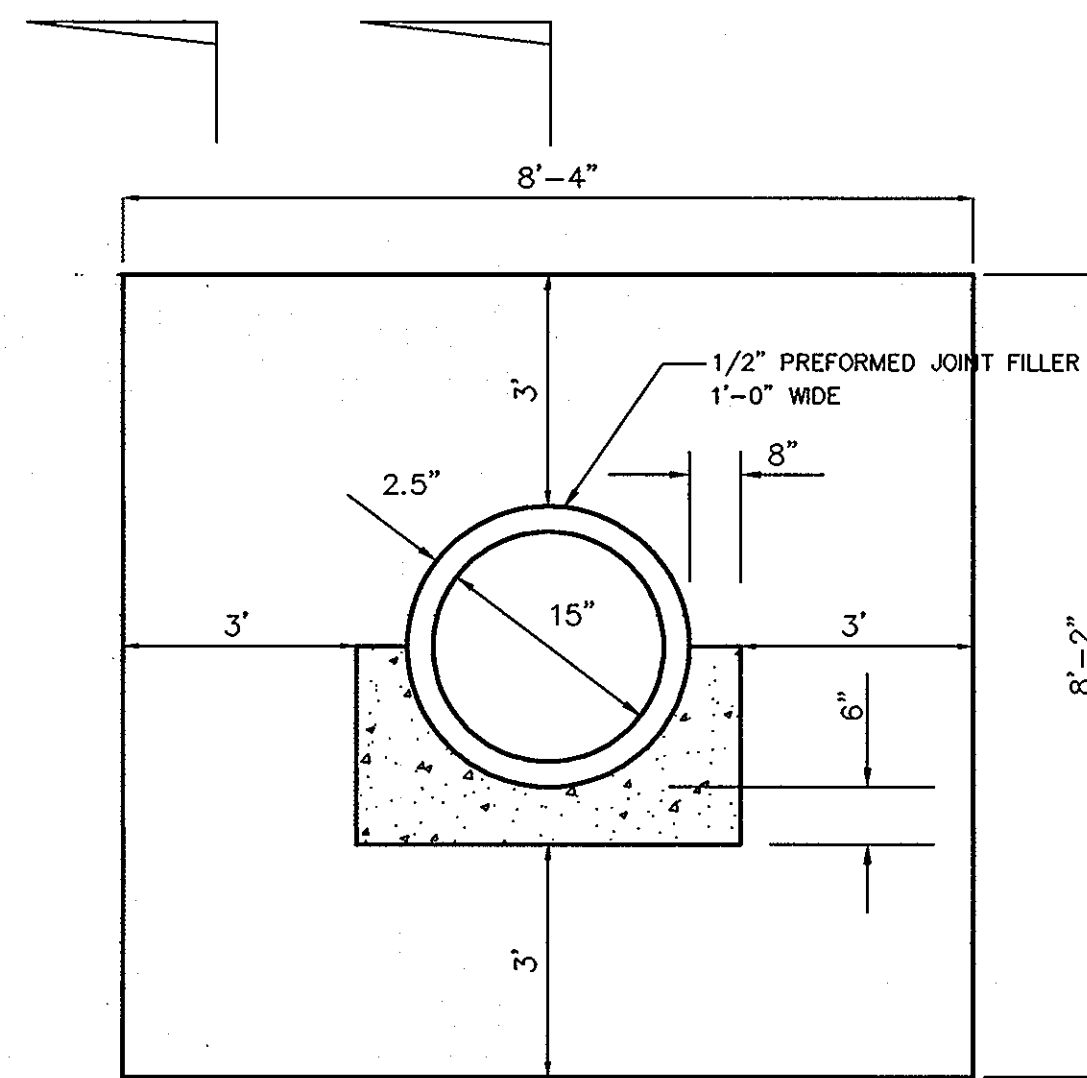


ANTI-SEEP COLLAR DETAIL
N.T.S.

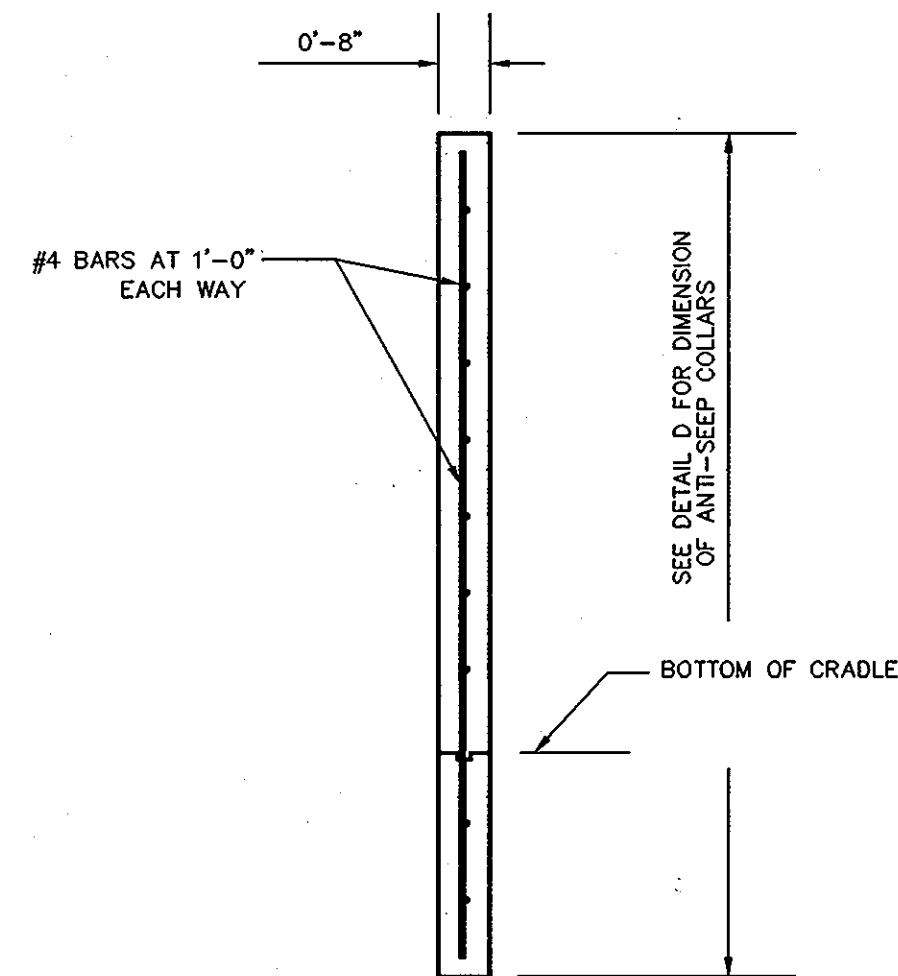


SECTION 4
N.T.S.

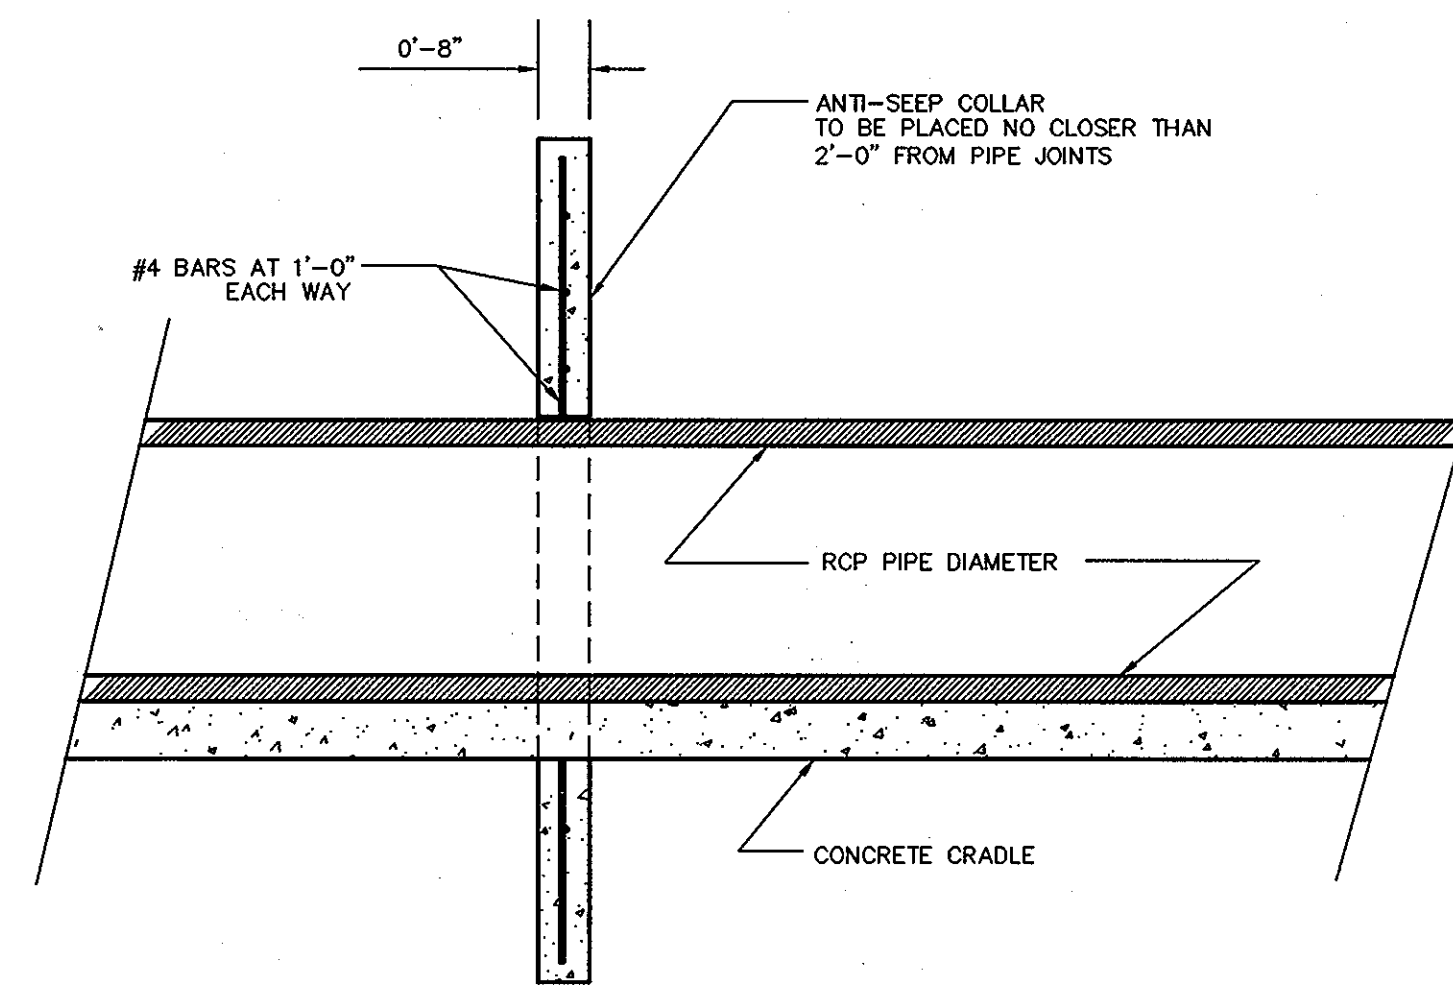


SECTION 5
N.T.S.

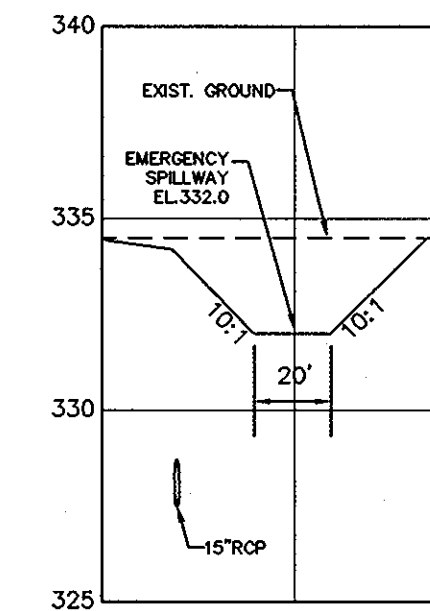

SECTION - EMERGENCY SPILLWAY
SCALE: HOR. 1"=50'
VER. 1"=5'

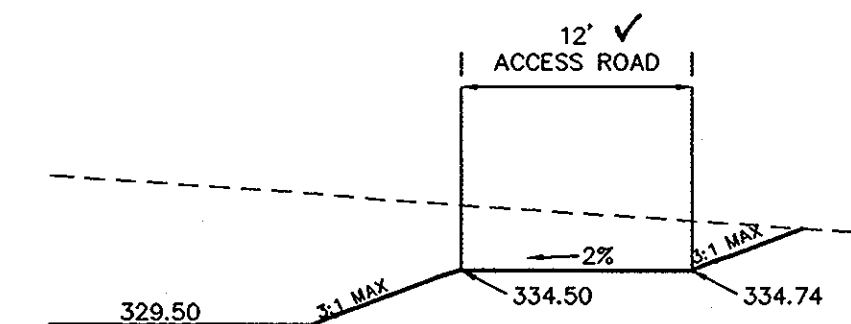

SECTION-ACCESS ROAD
N.T.S.

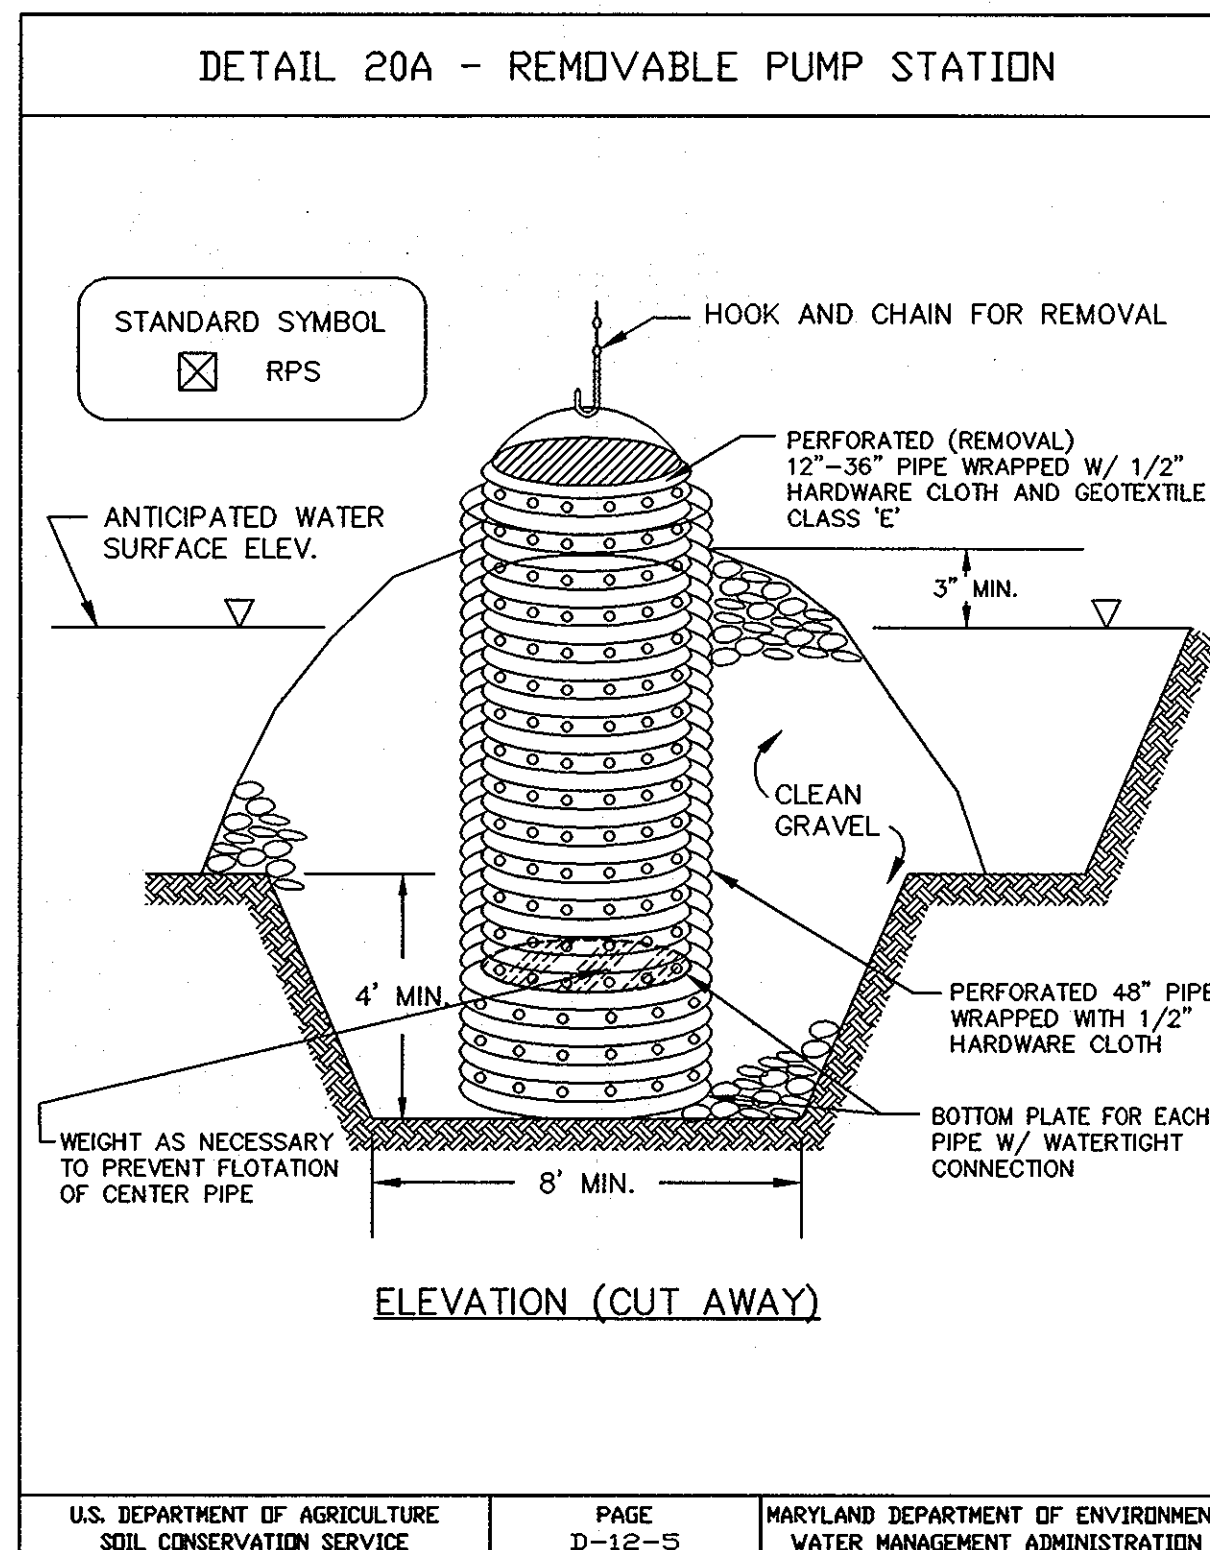


U.S. DEPARTMENT OF AGRICULTURE SOIL CONSERVATION SERVICE PAGE D-12-5 MARYLAND DEPARTMENT OF ENVIRONMENT WATER MANAGEMENT ADMINISTRATION

SPECIFICATIONS FOR REMOVABLE PUMP STATION

12.0 DEWATERING SPECIFICATIONS FOR REMOVABLE PUMPING STATION
Description of Practice
Purpose
Conditions Where Practice Applies
Design Criteria
Construction Specifications

- The inner pipe shall be constructed by perforating a 12" to 36" diameter pipe with a watertight cap on the bottom end and wrapping it with 1/2" hardware cloth and Geotextile Class E. The perforations shall be 1/2"x6" slits or 1" diameter holes 6" on center.
- The outer pipe shall be at least 4" larger in diameter than the inside pipe. Both the inner and outer pipes should extend 12" to 18" above the riser crest elevation, or anticipated high water elevation.
- Filter material ranging from clean gravel (minimum fines) to #57 stone (1 1/2" maximum diameter) should be backfilled around the outer pipe.
- The suction hose from the pump shall be placed inside the inner pipe to begin dewatering. The discharge hose shall be placed in a stabilized area down slope of unstabilized area to prevent erosion. Meadow or wooded areas are preferred discharge locations, but storm drains and paved areas are acceptable.

U.S. DEPARTMENT OF AGRICULTURE SOIL CONSERVATION SERVICE PAGE D-12-5 MARYLAND DEPARTMENT OF ENVIRONMENT WATER MANAGEMENT ADMINISTRATION

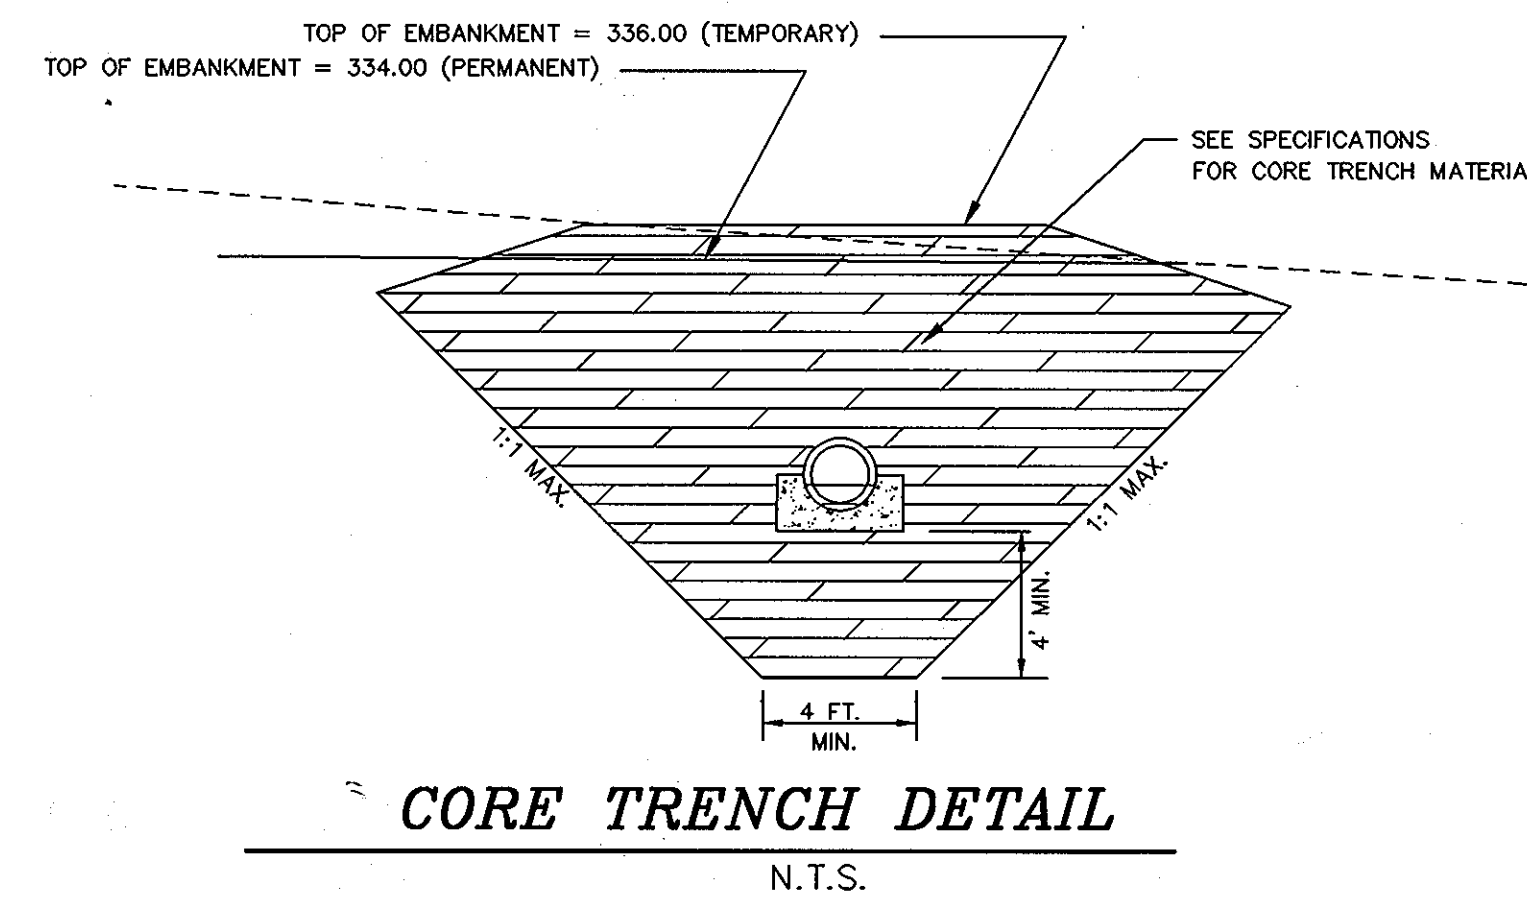


CORE TRENCH DETAIL
N.T.S.



I HEREBY CERTIFY THAT THE FACILITY SHOWN ON THIS PLAN WAS CONSTRUCTED AS SHOWN ON THE "AS-BUILT" PLANS AND IN ACCORDANCE WITH THE APPROVED PLANS AND SPECIFICATIONS.

DEVELOPER
ELLCOTT CITY LAND HOLDING, INC.
C/O DONALD REUWER
8000 MAIN STREET
ELLCOTT CITY, MD 21043
(410) 480-9105

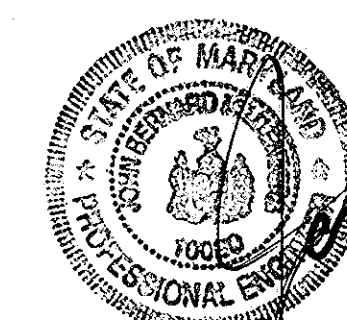


APPROVED: DEPARTMENT OF PLANNING AND ZONING
Linda Hamilton, 5/14/04
Chief, Division of Land Development
M. J. ... 7/30/04
Chief, Development Engineering Division

date	JUNE 2004	engineering	HSP	approval	JBM
project	2002-007	illustration	HSP	scale	NTS


date	9/08	description	AS-BUILT INFORMATION ADDED, AS-BUILT CHANGES
no.	2	revisions	

ILCHESTER OAKS
LOTS 1 THRU 22 & OPEN SPACES 23 THRU 26 & BULK PARCEL "A"
TAX MAP 31 PARCEL 841 AND P/O PARCEL 689
FIRST ELECTION DISTRICT HOWARD COUNTY, MARYLAND
STORMWATER MANAGEMENT DETAILS


MILDENBERG, BOENDER & ASSOC., INC.
Engineers Planners Surveyors
5072 Dorsey Hall Drive, Suite 202, Ellicott City, Maryland 21042
(410) 397-0286 Fax: (301) 621-5521 Wash. (410) 397-0298 Fax.

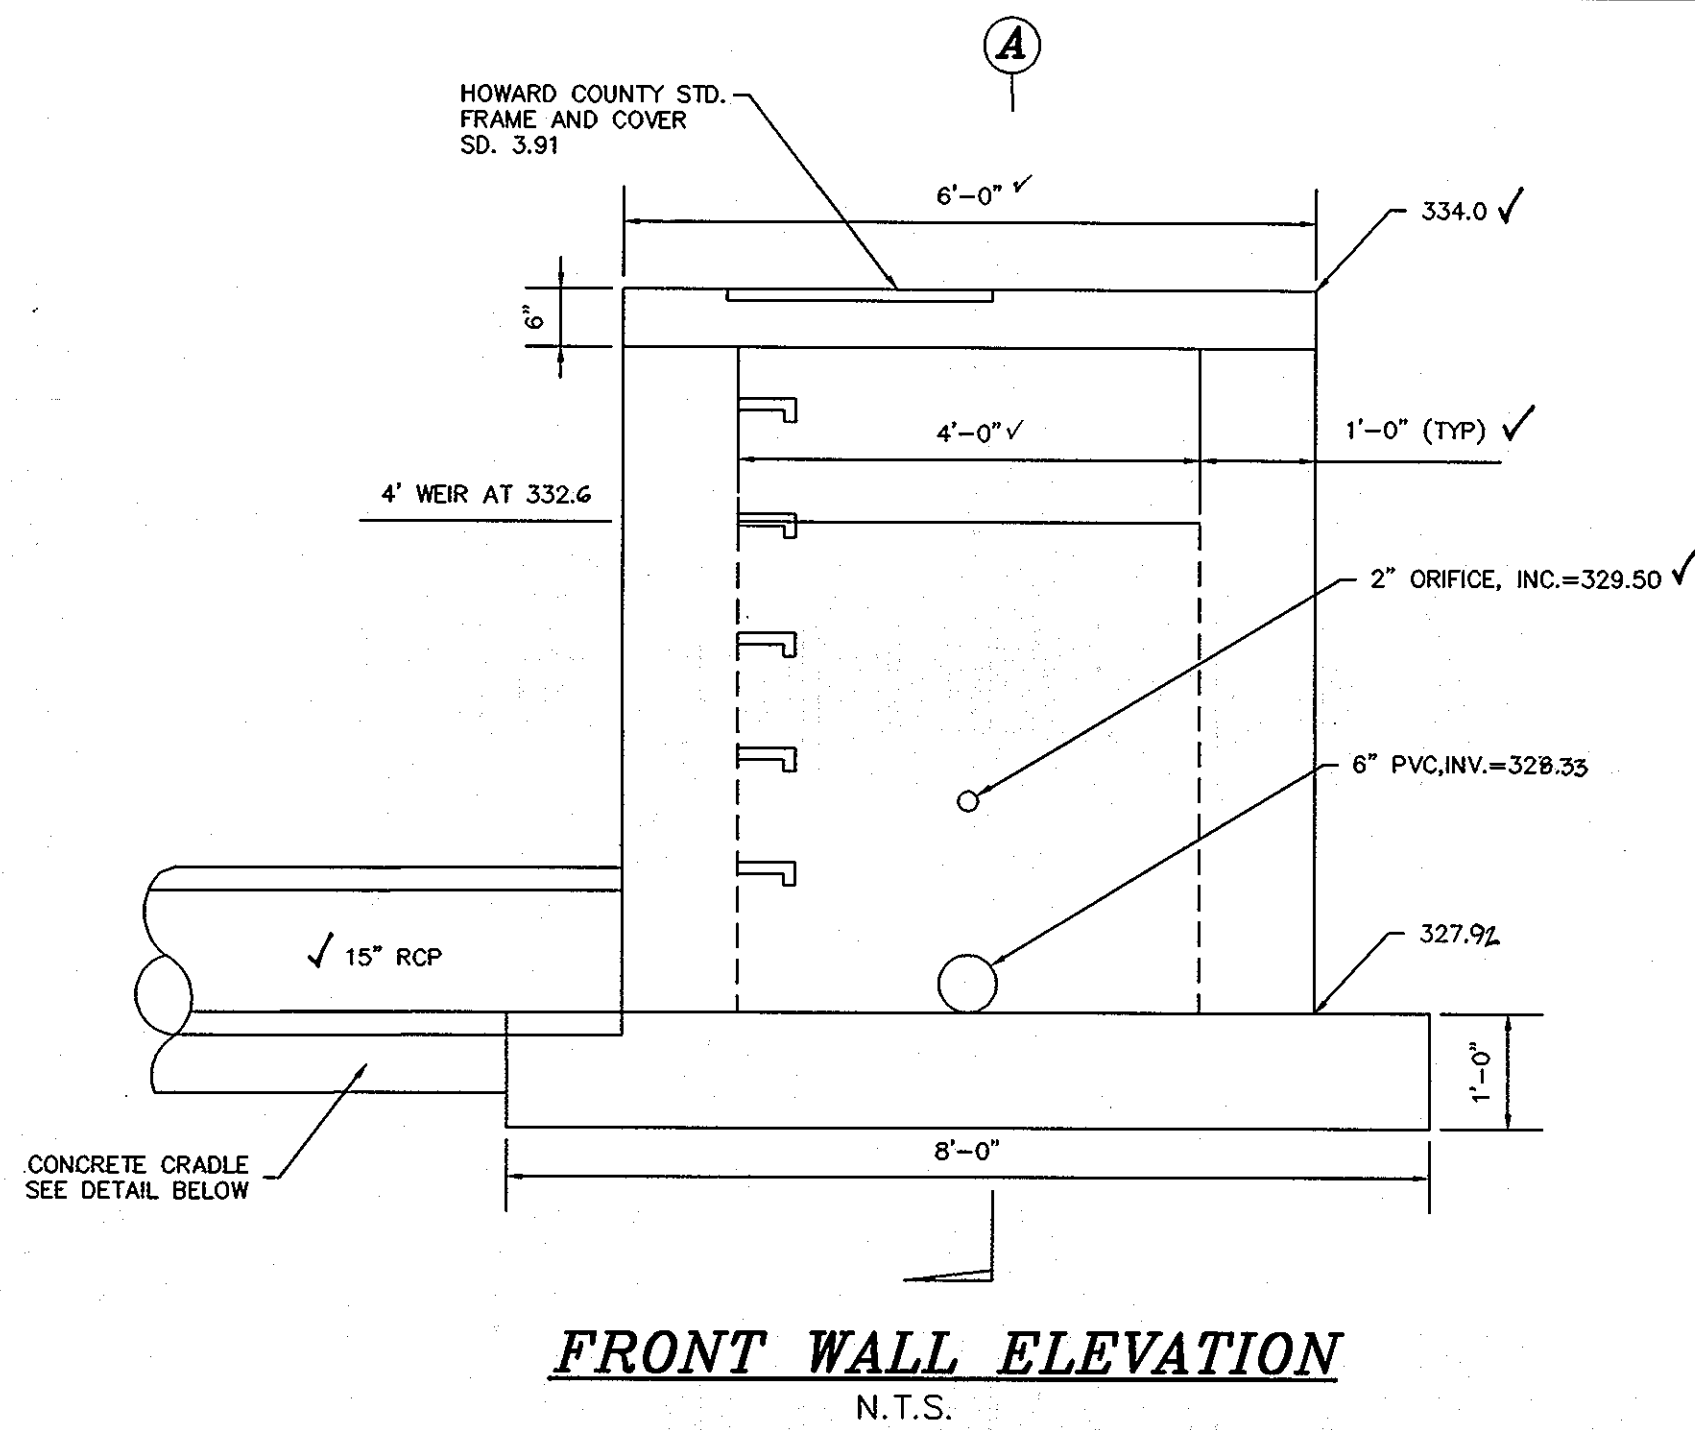


FRONT WALL ELEVATION
N.T.S.

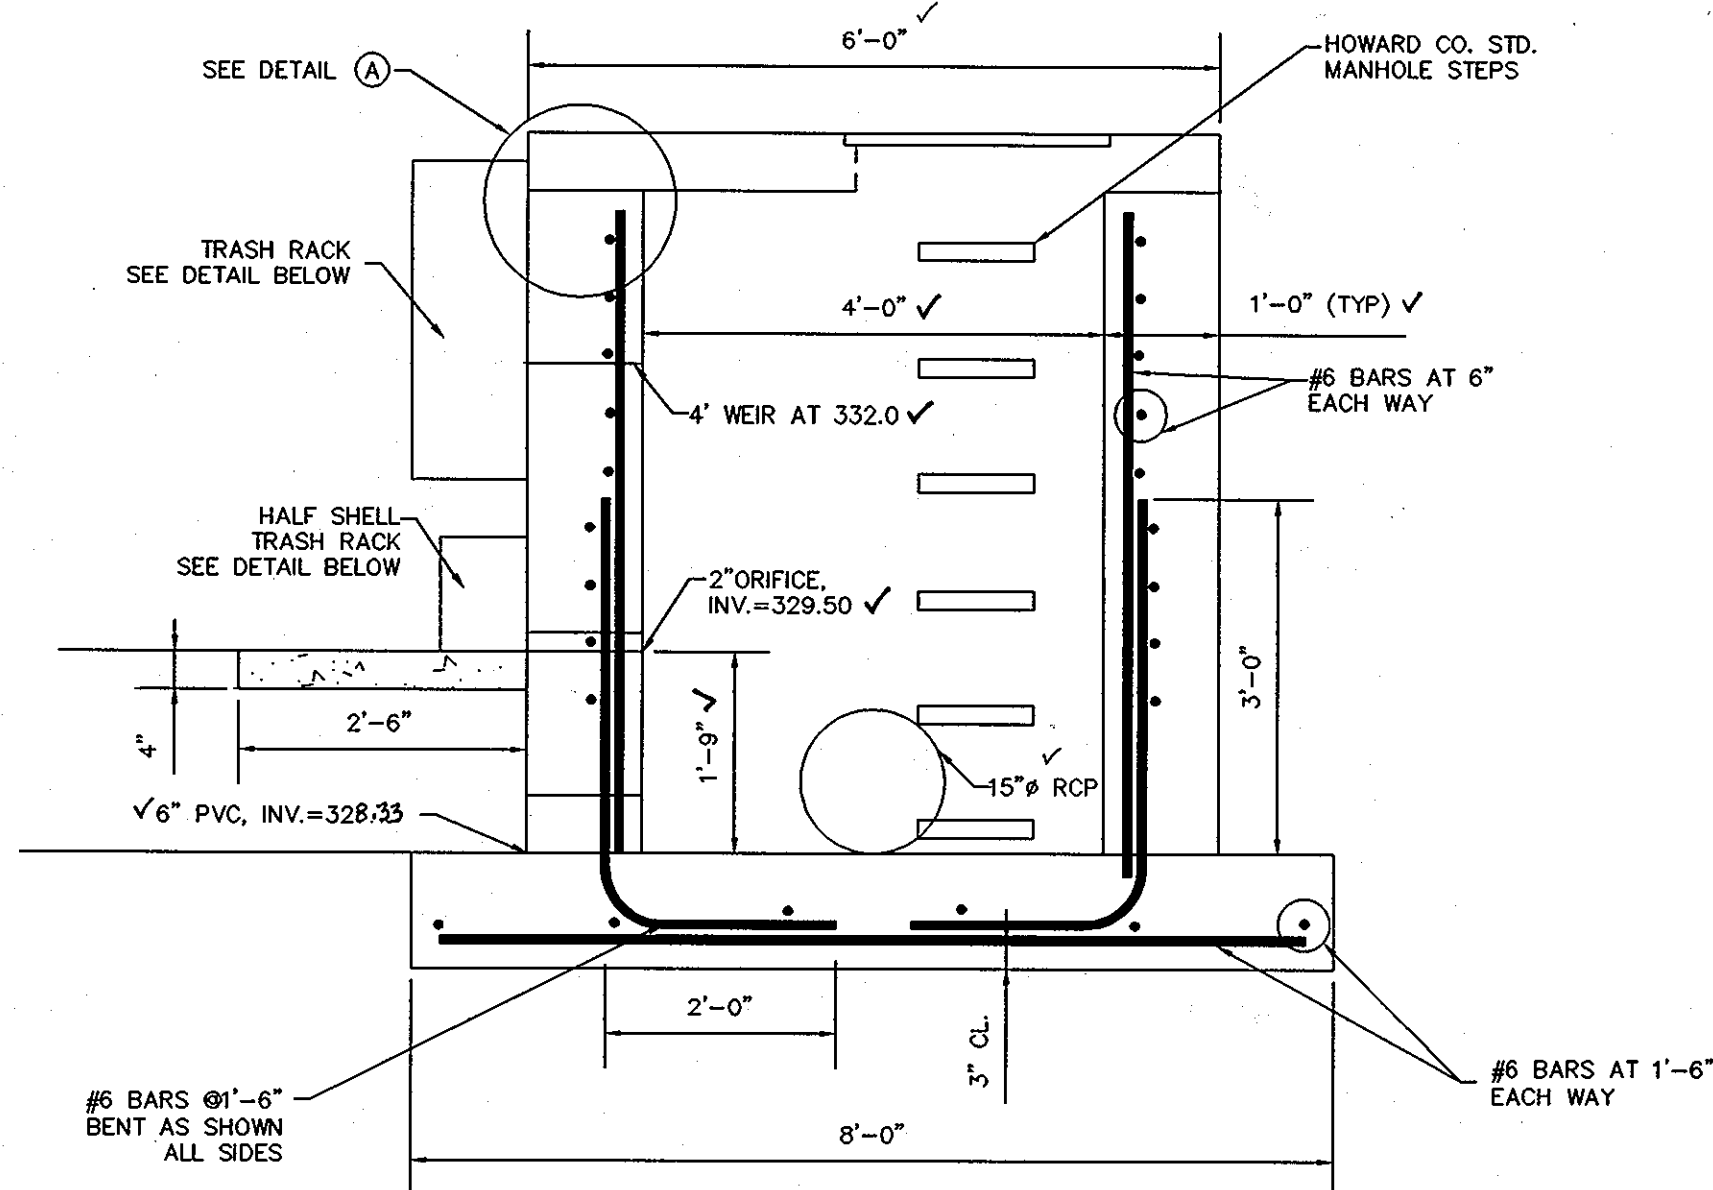


SECTION 1
N.T.S.

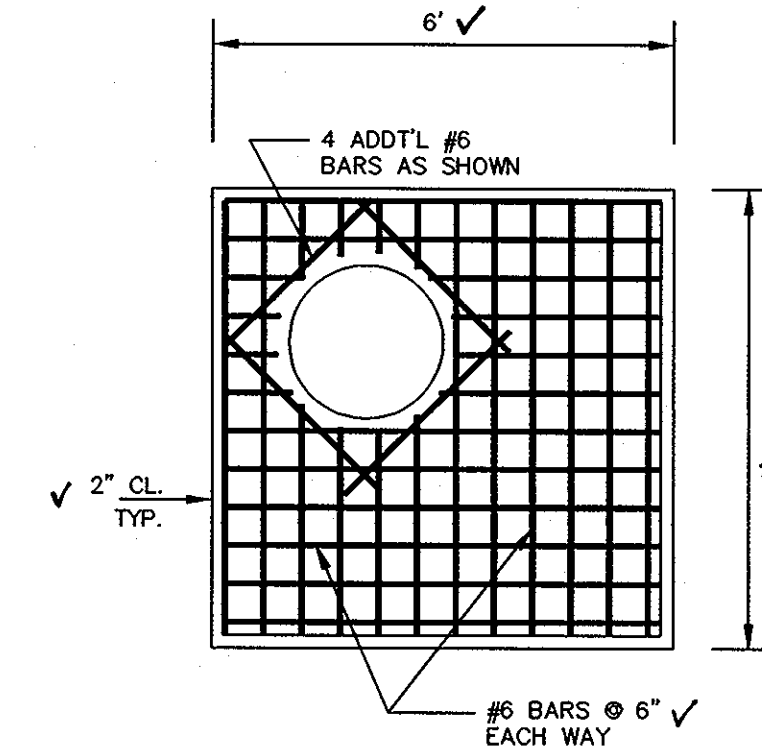


TOP SLAB DETAIL
N.T.S.

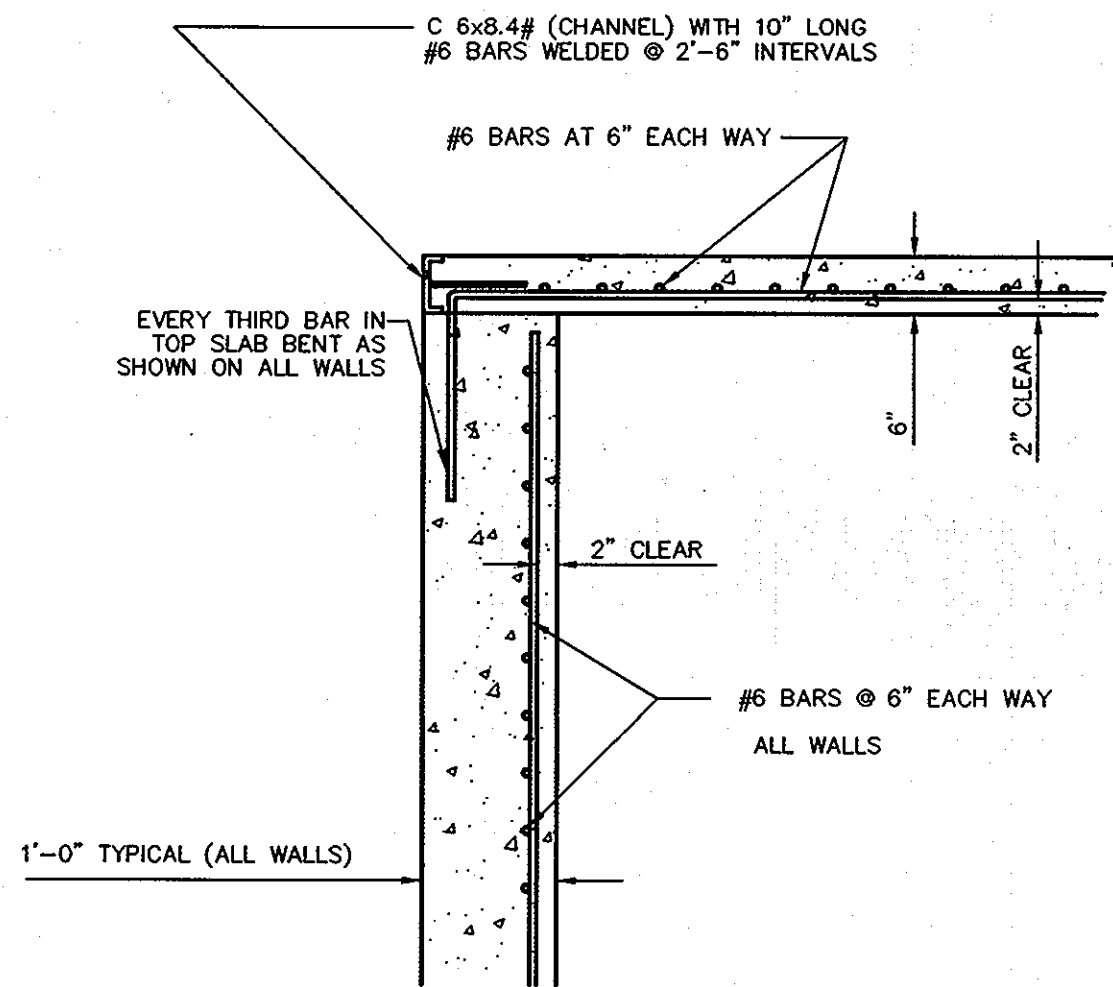


DETAIL A
N.T.S.

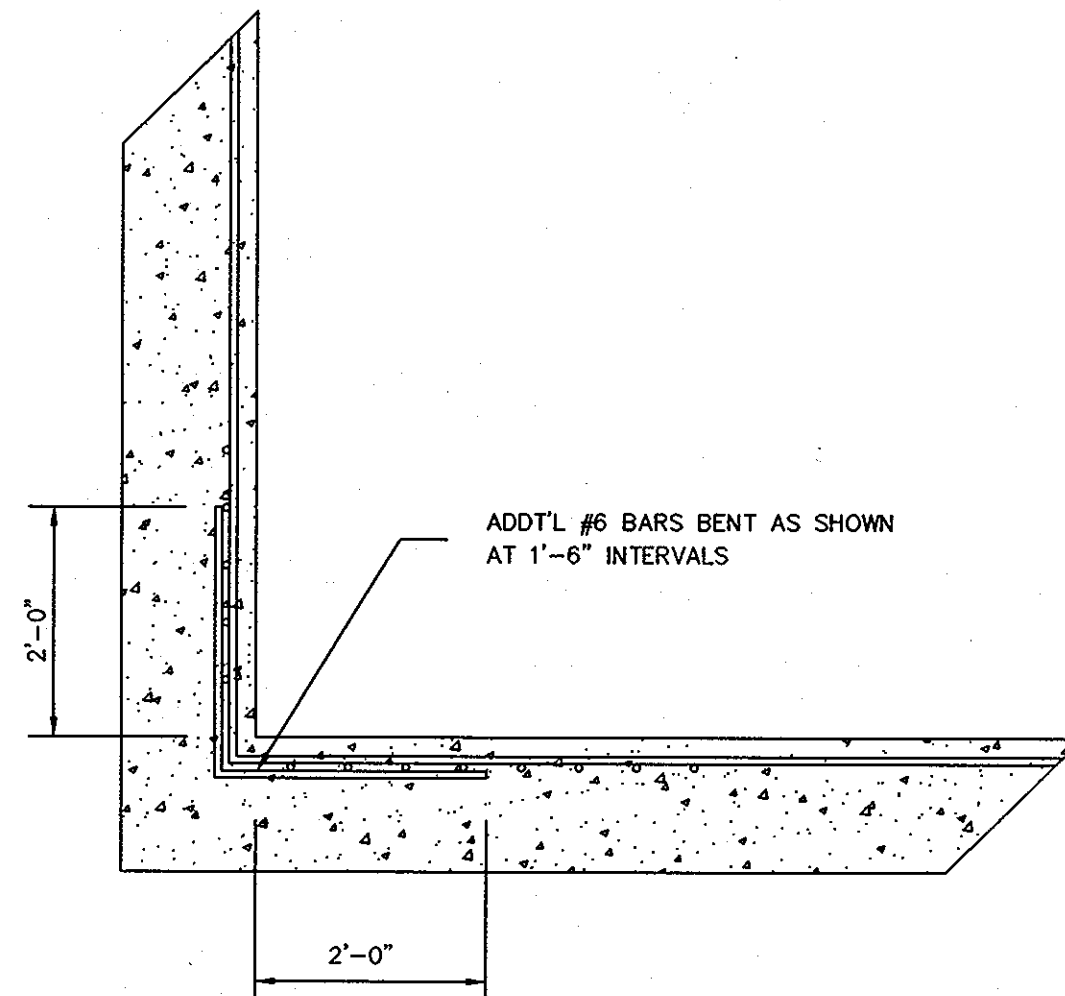


CORNER TREATMENT DETAIL
N.T.S.

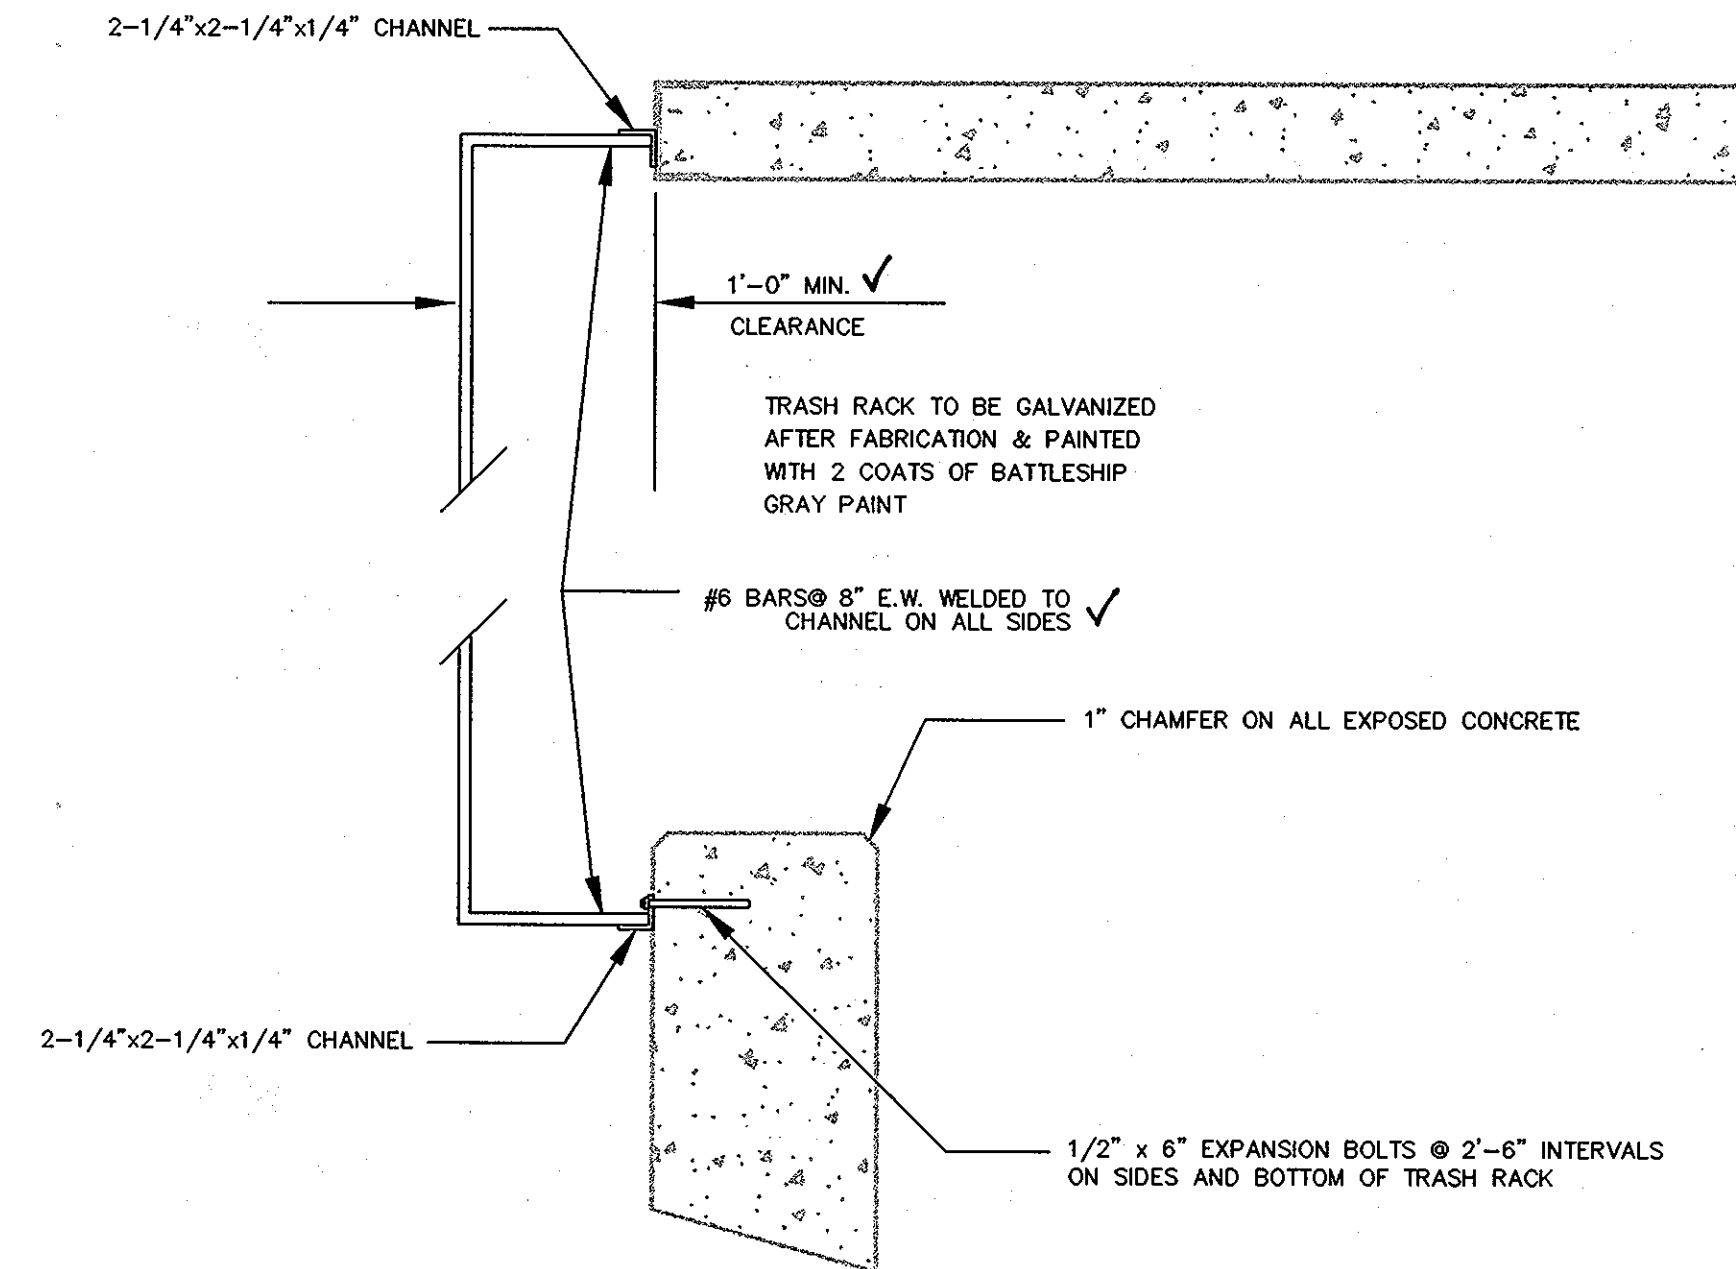


SECTION 2
N.T.S.

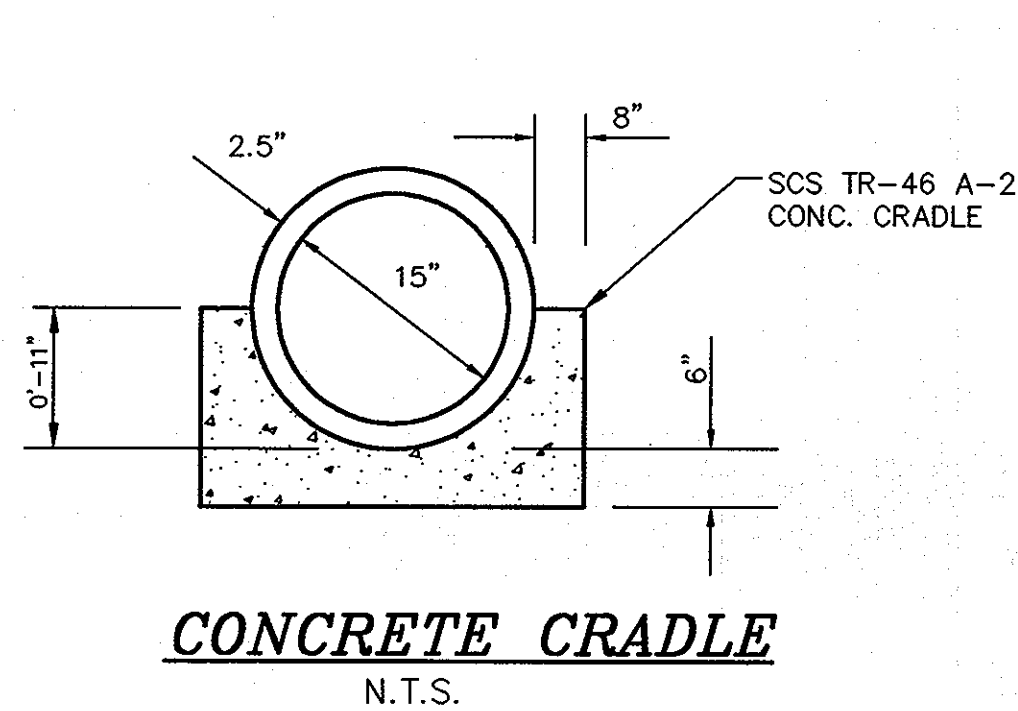

CONCRETE CRADLE
N.T.S.

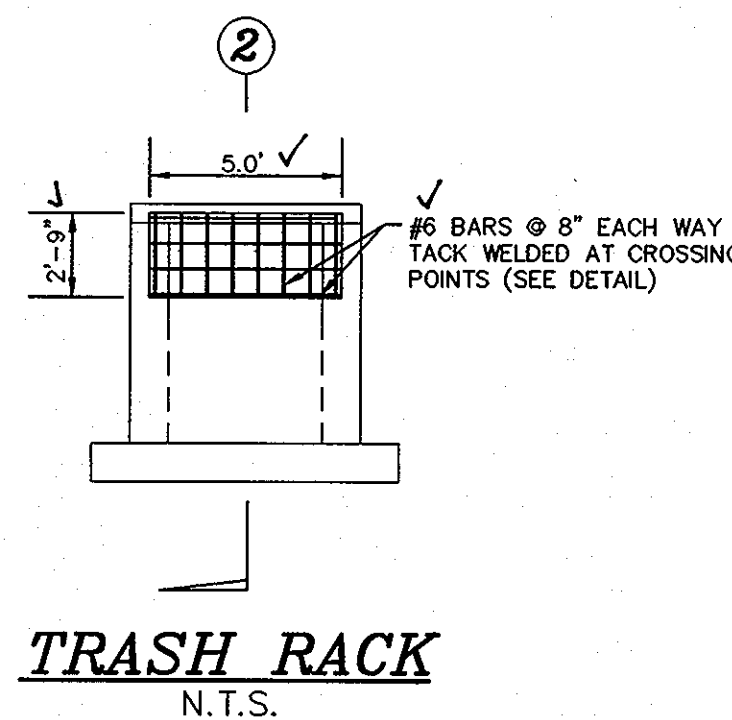

TRASH RACK
N.T.S.

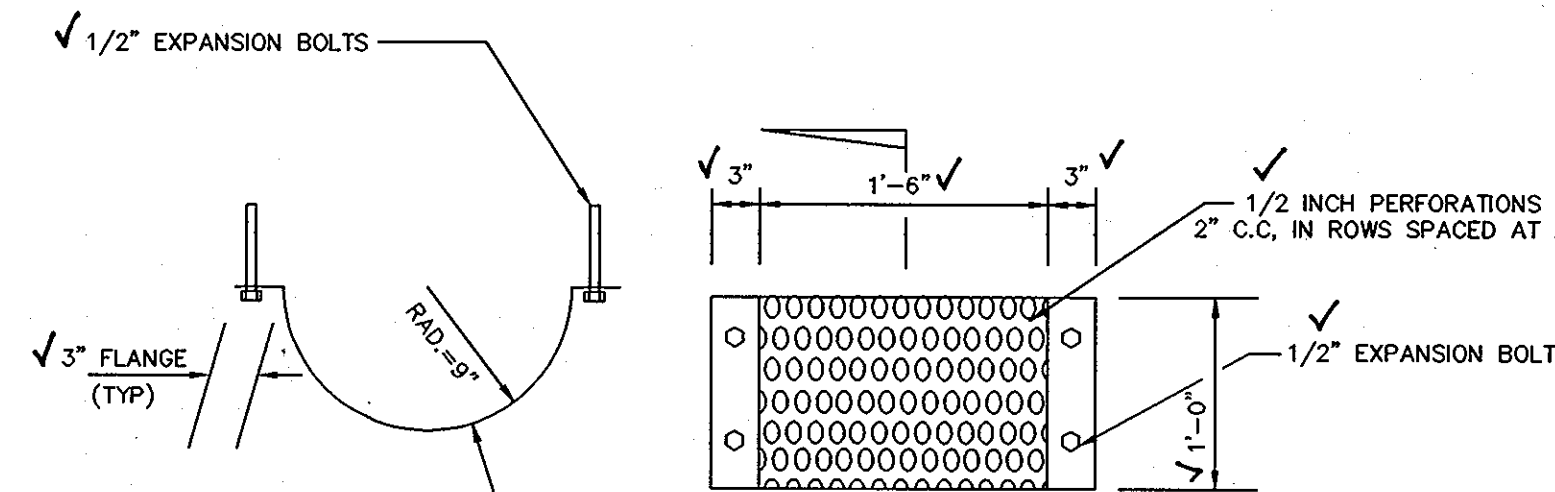

SECTION 3
N.T.S.

NOTE: HALF SHELL TRASH RACK TO BE HOT DIPPED GALVANIZED AND PAINTED BATTLESHIP GRAY.



I HEREBY CERTIFY THAT THE FACILITY SHOWN ON THIS PLAN WAS CONSTRUCTED AS SHOWN ON THE MAP, BUILT PLAN AND ASSETS WITH THE APPROVED PLANS AND SPECIFICATIONS.

DEVELOPER
ELLICOTT CITY LAND HOLDING, INC.
C/O DONALD REUWER
8000 MAIN STREET
ELLICOTT CITY, MD 21043
(410) 480-9105




APPROVED: DEPARTMENT OF PLANNING AND ZONING
Chief, Development Engineering Division
DATE: 8/10/04

Project	2002-007	date	JUNE 2004
Illustration	HSP	scale	NTS
approval	HSP	date	JBM


no.	description	date
1	AS-BUILT INFORMATION	9/28
2	AS-BUILT CHANGES	9/28

ILCHESTER OAKS
LOTS 1 THRU 22 & OPEN SPACES 23 THRU 26 & BULK PARCEL "A"
TAX MAP 31 PARCEL 641 AND P/O PARCEL 699
FIRST ELECTION DISTRICT
HOWARD COUNTY, MARYLAND
STORMWATER MANAGEMENT DETAILS

MILDENBERG, BOENDER & ASSOC., INC.
Engineers Planners Surveyors
5092 Dorsey Hill Drive, Suite 202, Ellicott City, Maryland 21042
(410) 997-0296 Fax: (301) 621-6521 Wash. (410) 397-0296 Fax

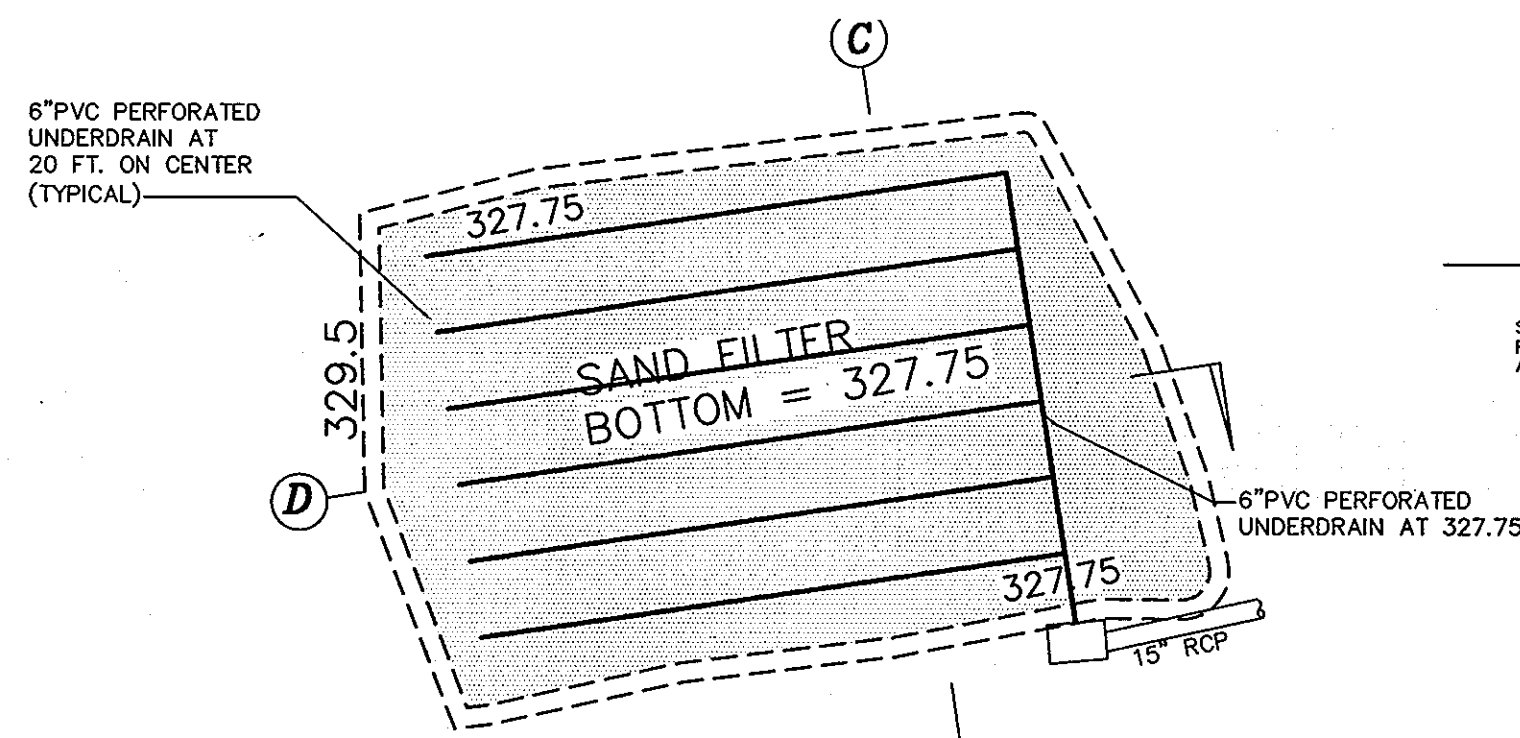


PLAN - SAND FILTER

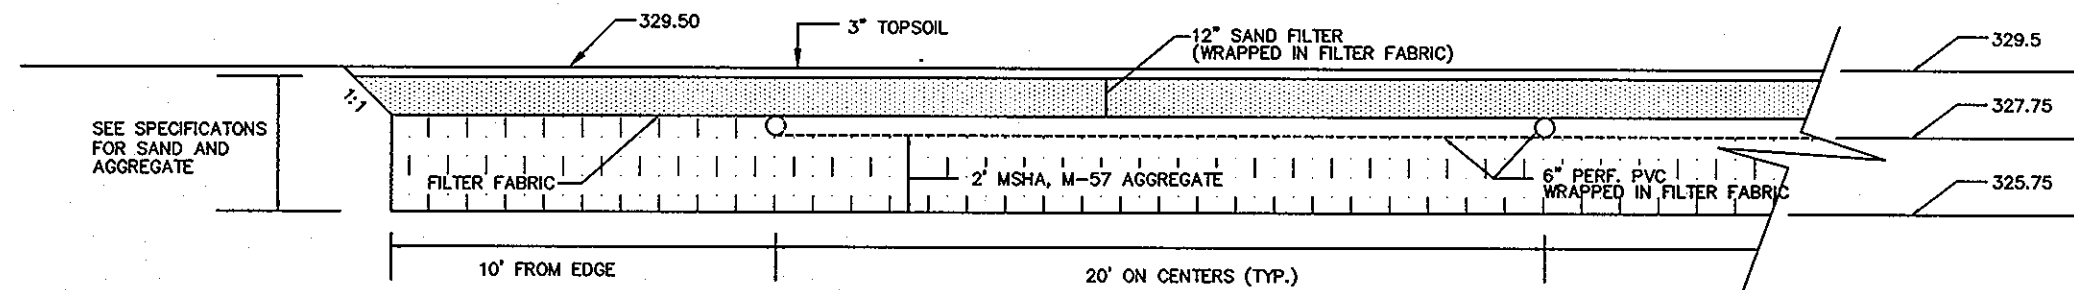


SECTION C
SCALE: 1"=5'

SWM POND DATA:

HAZARD CLASSIFICATION:	"A"
DRAINAGE AREA:	= 25.4 AC
PROPOSED RCN:	= 72
PROPOSED Tc:	= 0.33 HRS.
SAND FILTER AREA (Wq):	3,896 SQ. FT.
EXTENDED DETENTION WSEL:	331.6
10 YR. WSEL:	333.0
100 YR. WSEL:	333.6
Wqv REQUIRED:	= 10,122 Cu. Ft.
Wqv PROVIDED:	= 59,245 Cu. Ft.
Rev REQUIRED:	= 3,031 Cu. Ft.
Rev PROVIDED:	= 3,117 Cu. Ft.
Cov Peak (OUT OF SWMF):	= 0.16 CFS @ EL. = 331.5
10 YR. Q (OUT OF SWMF):	= 57.7 CFS @ EL. = 333.0
100 YR. Q (OUT OF SWMF):	= 105.2 CFS @ EL. = 333.5
OWNERSHIP:	PRIVATE
MAINTENANCE:	PRIVATE

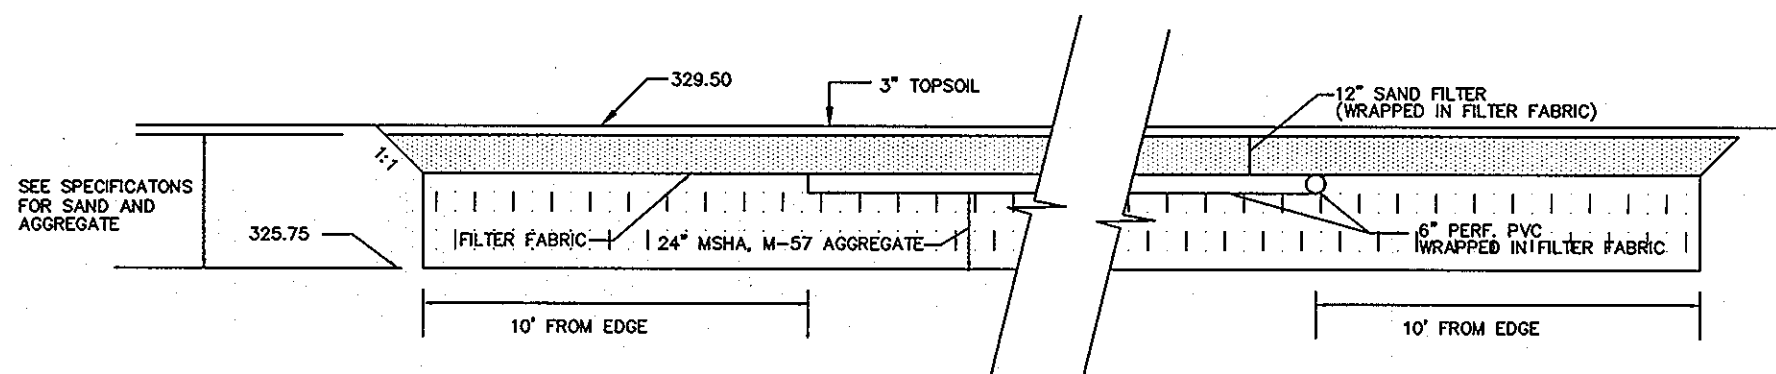


SECTION D
SCALE: 1"=5'

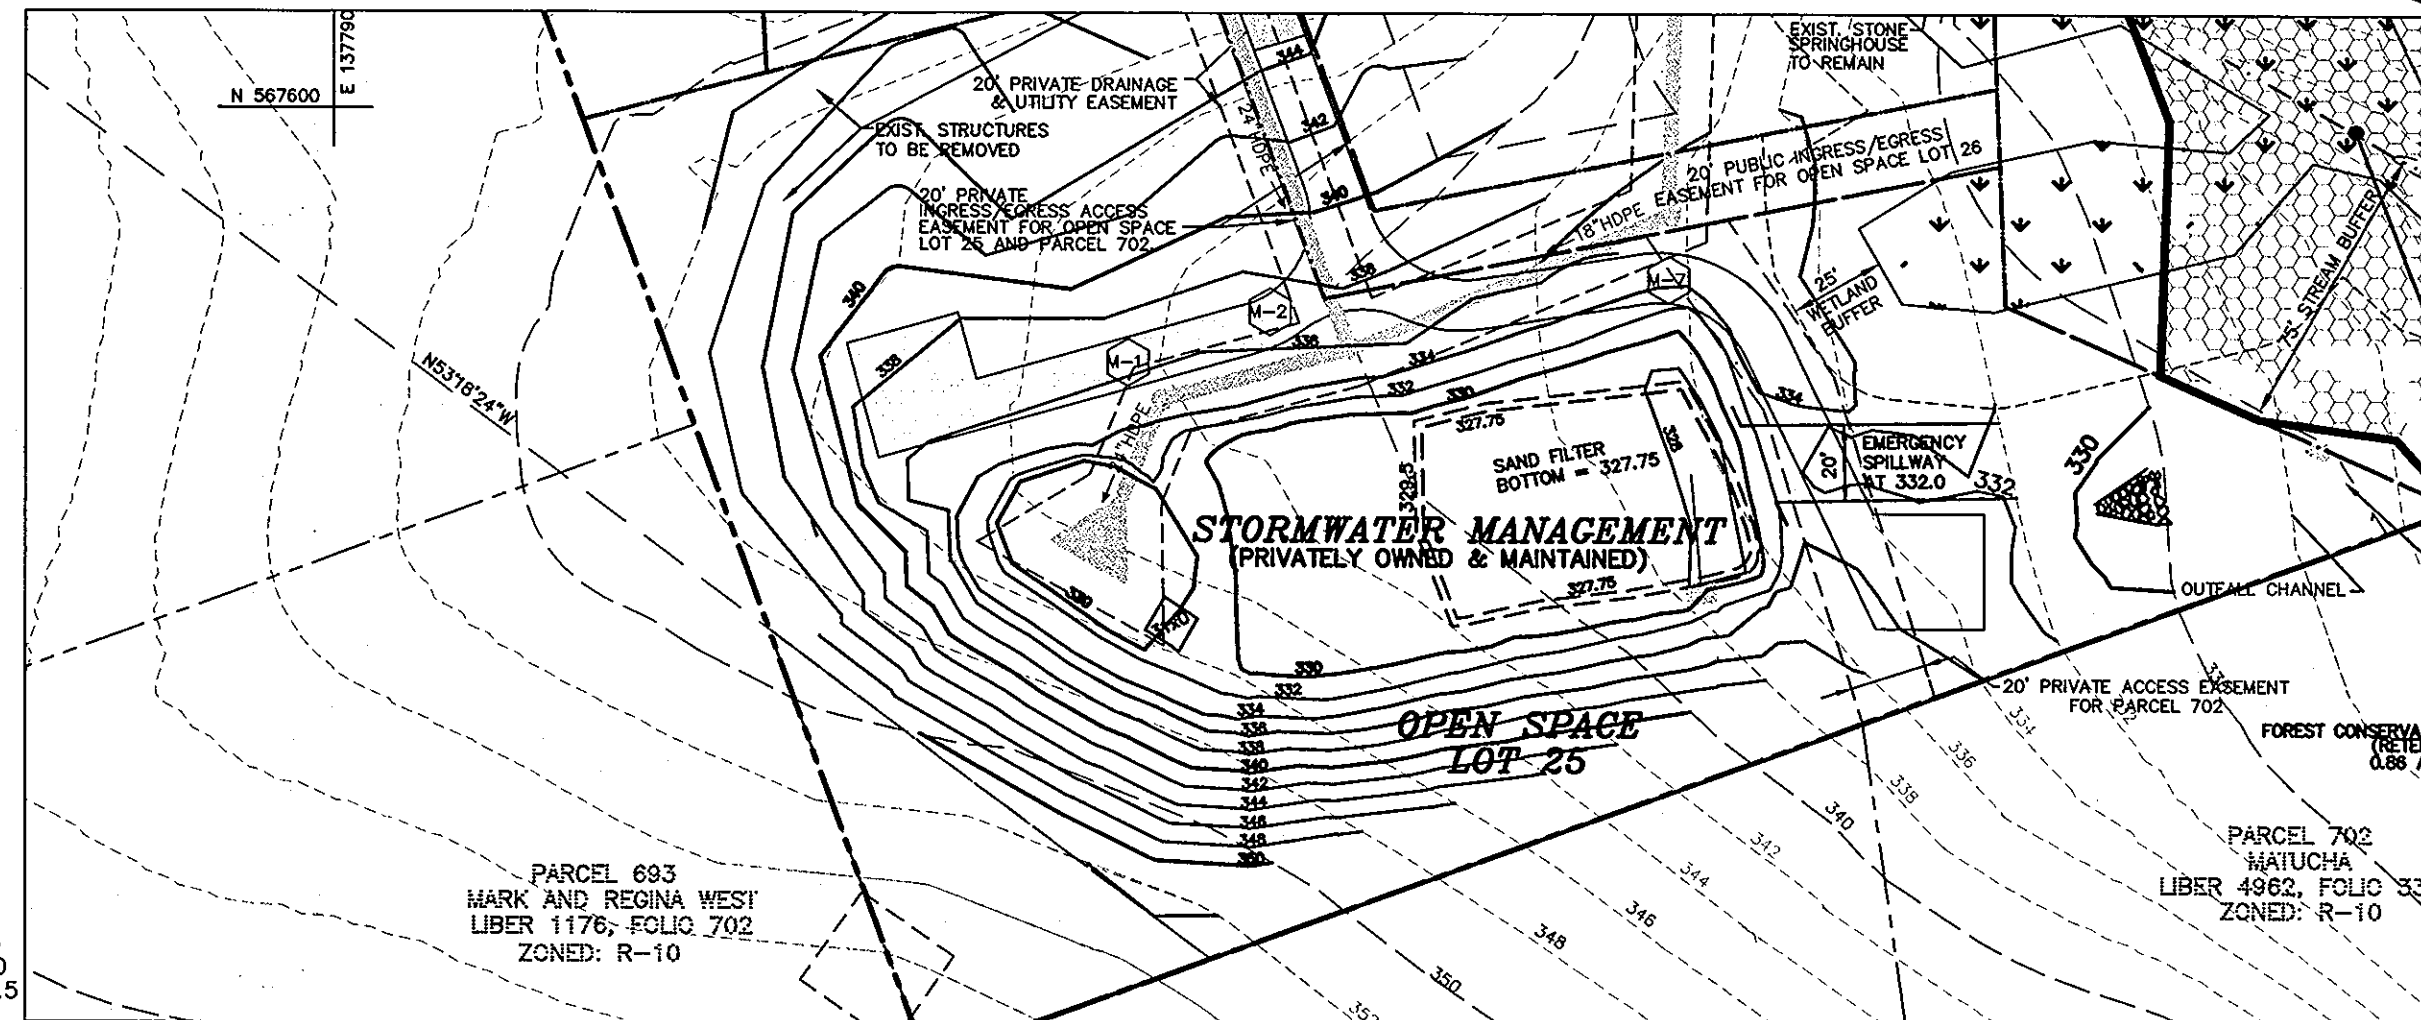


PLAN - STORMWATER MANAGEMENT


SCALE: 1"=50'

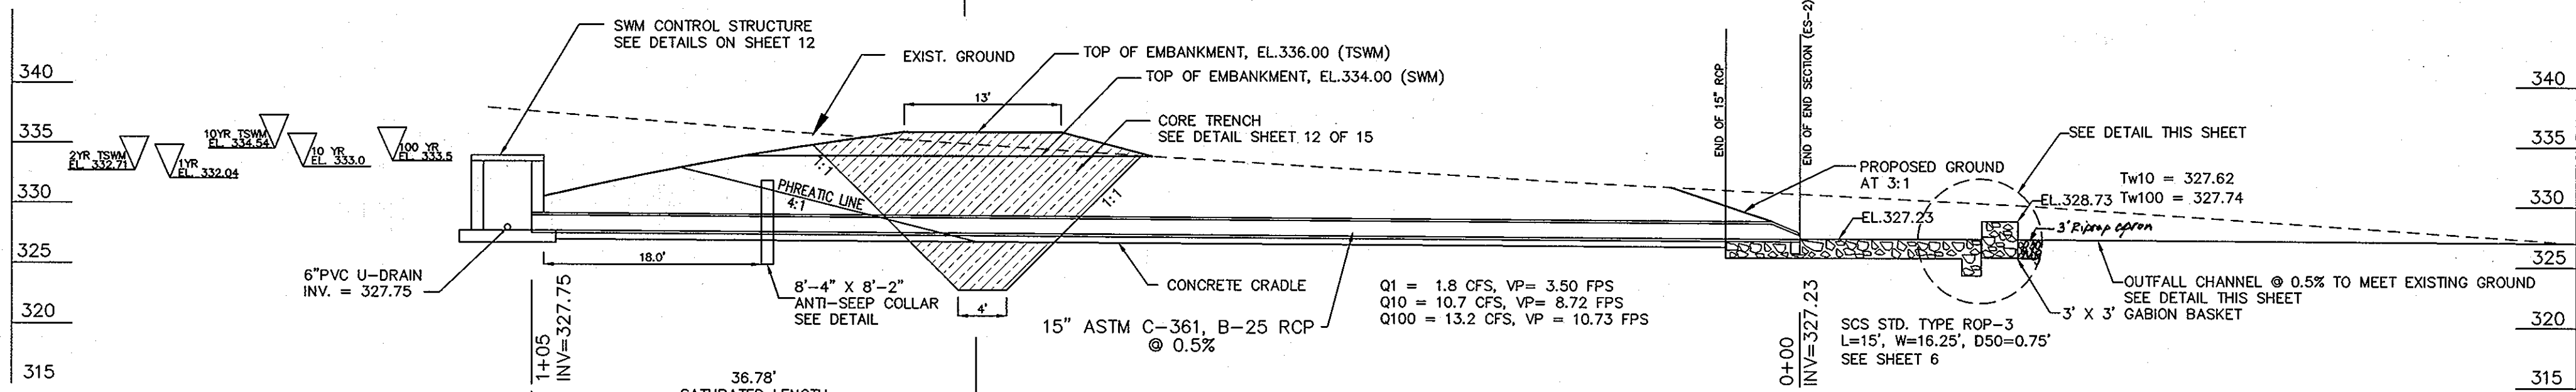

PROFILE - PRINCIPLE SPILLWAY
SCALE: 1"=10'

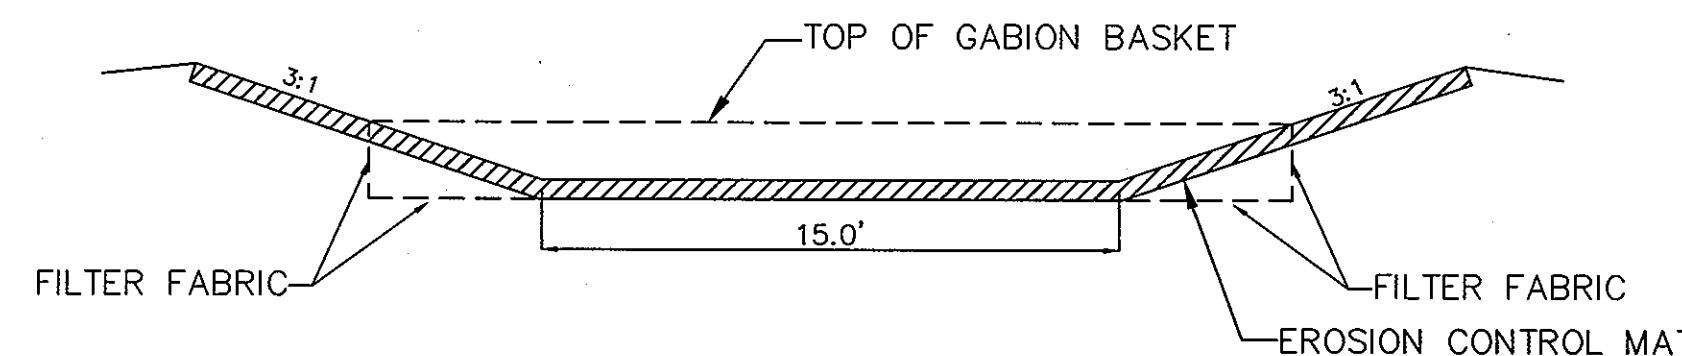


DETAIL - OUTFALL CHANNEL
NTS

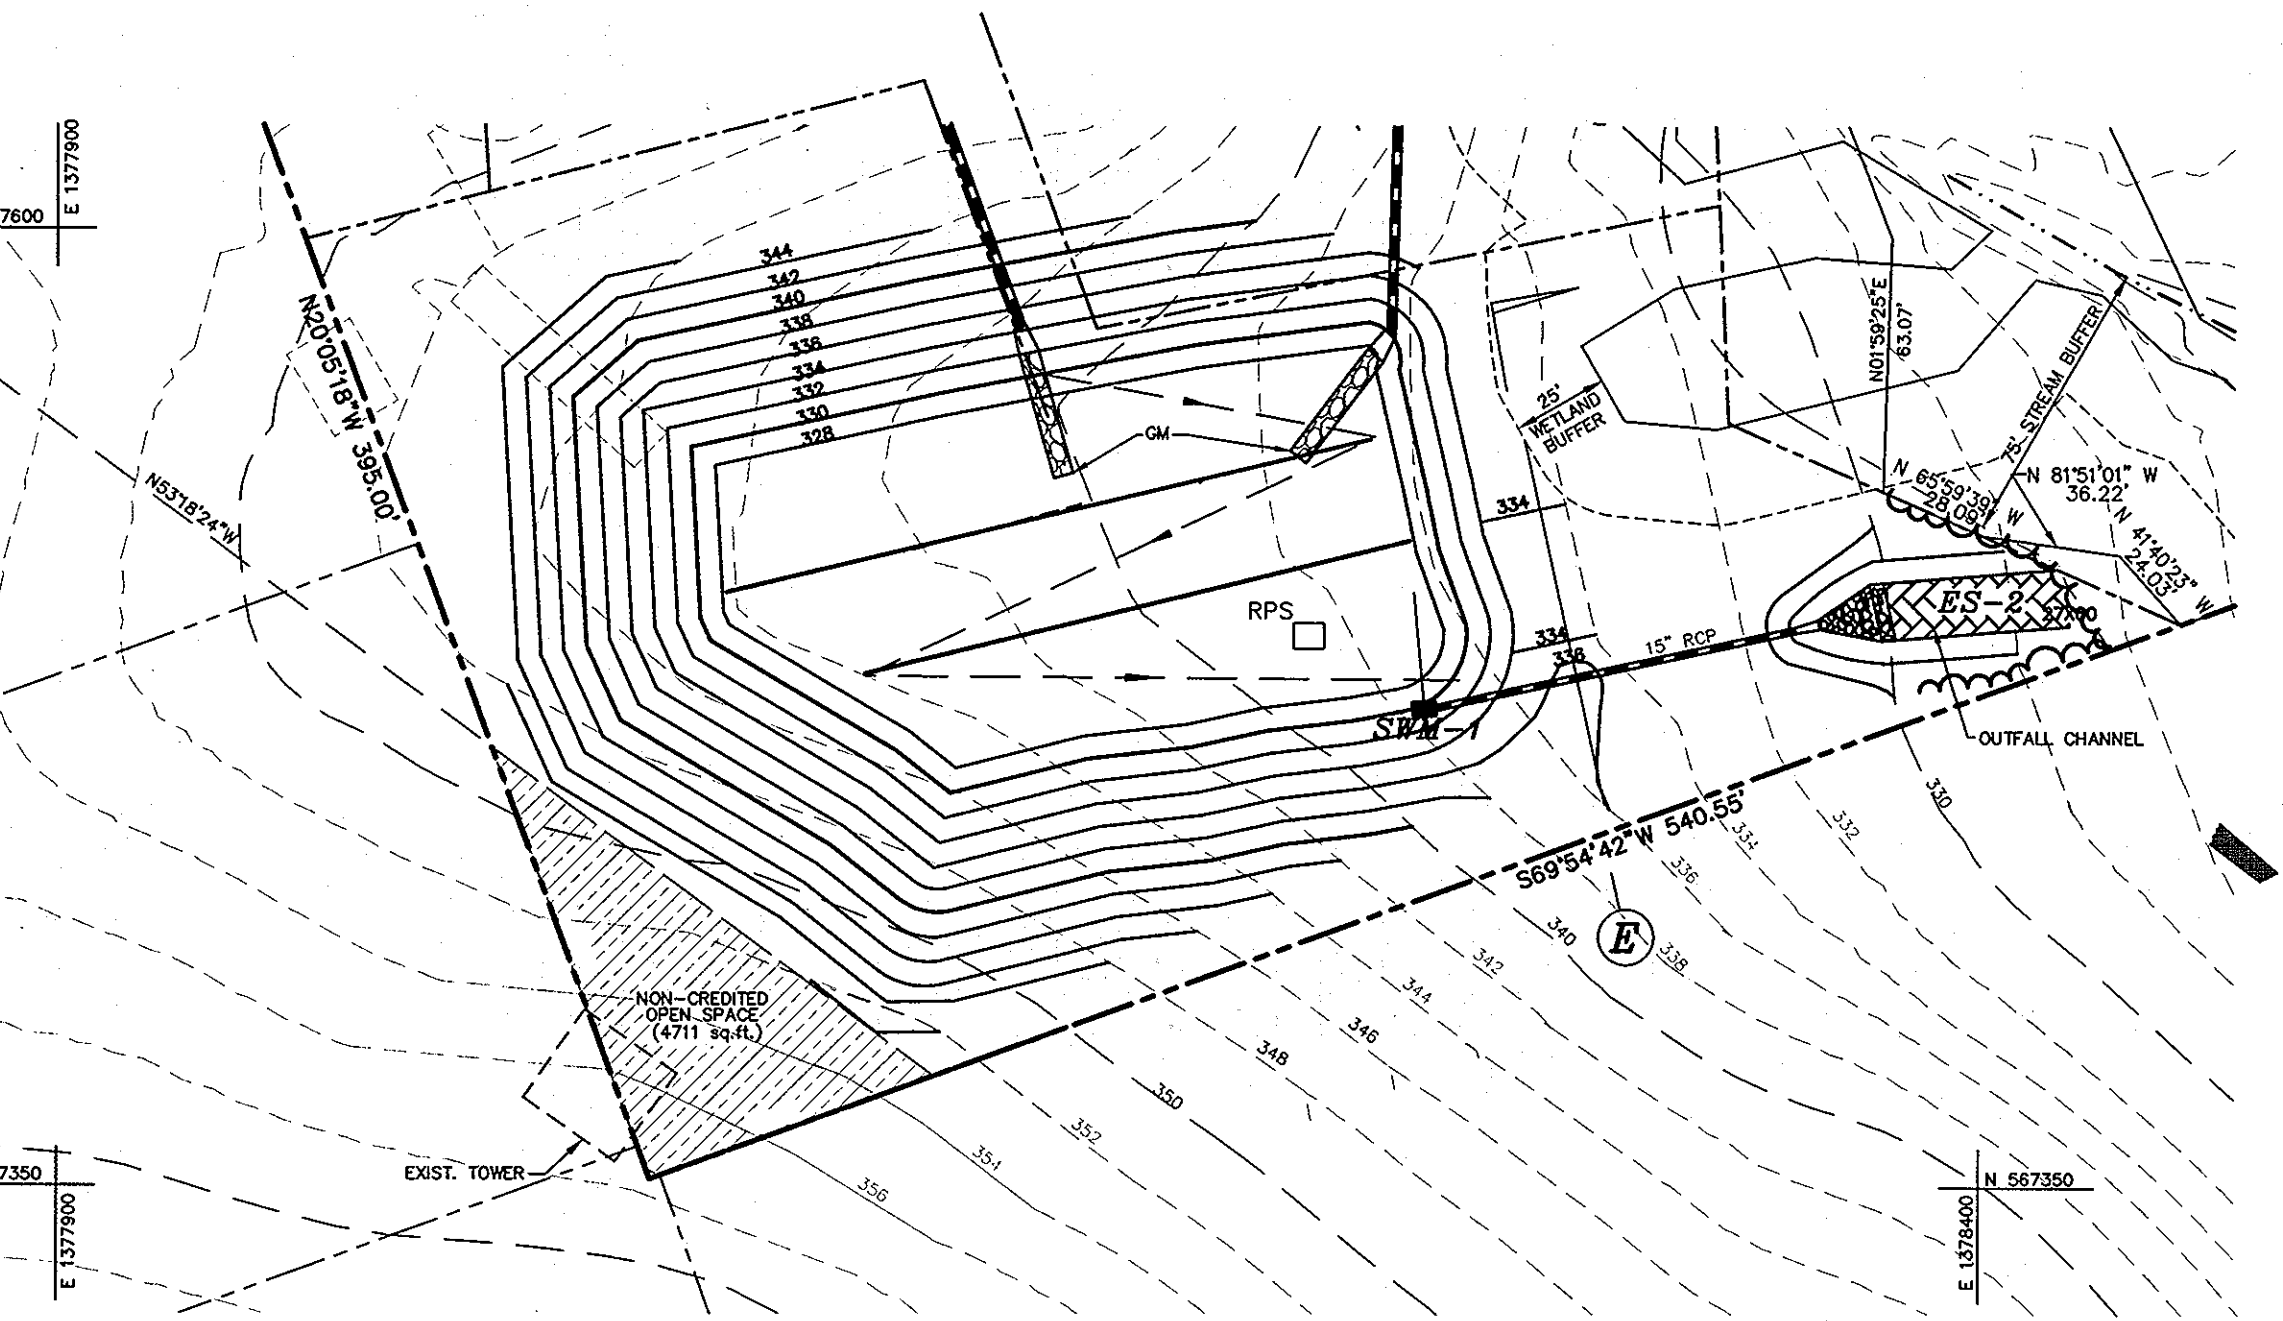


PLAN - TEMPORARY SEDIMENT BASIN


SCALE: 1"=50'

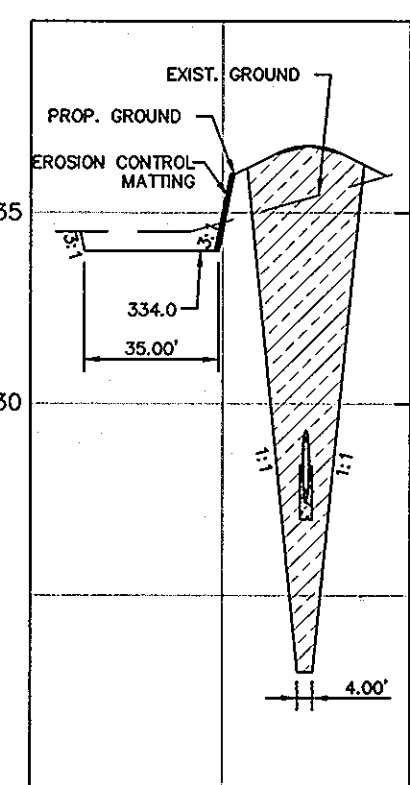


SECTION E - TSM
SCALE: HOR. 1"=50'
VER. 1"=5'

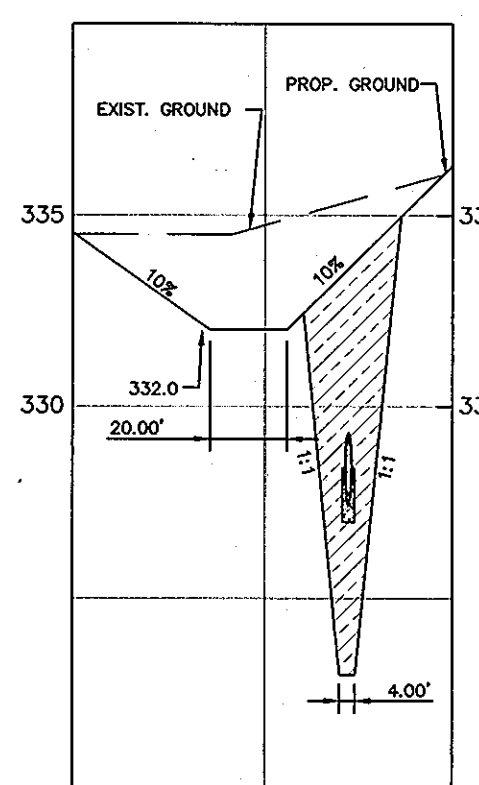


SECTION E - SWM (PERMANENT)
SCALE: HOR. 1"=50'
VER. 1"=5'

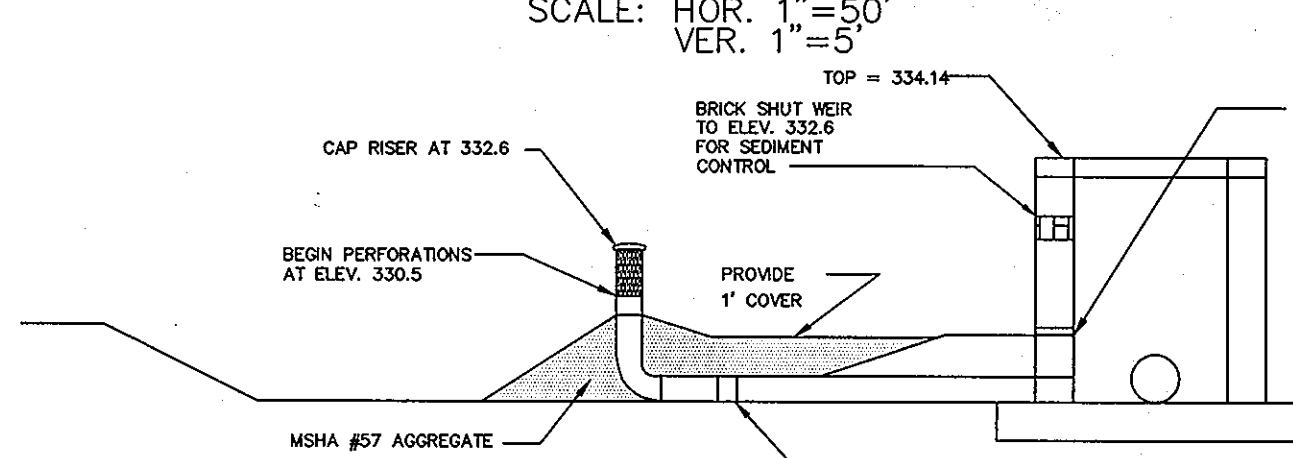

DETAIL - TEMPORARY RISER
NTS

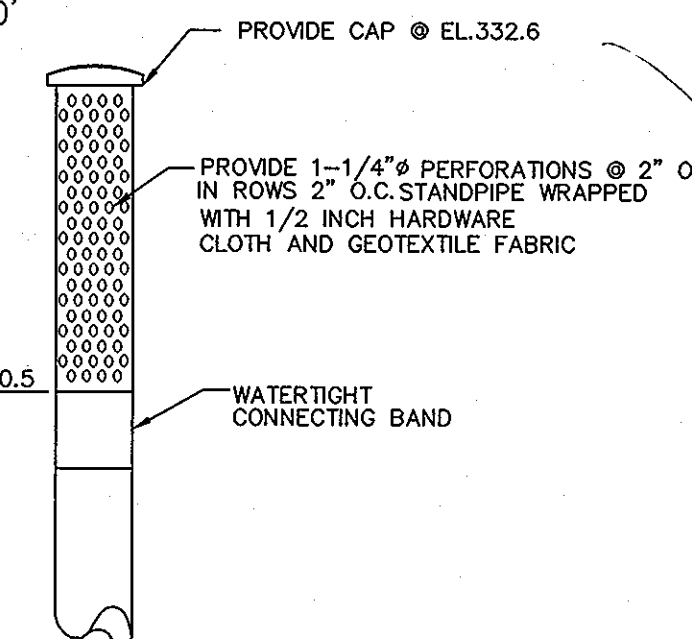

TEMPORARY STANDPIPE DETAIL
NTS

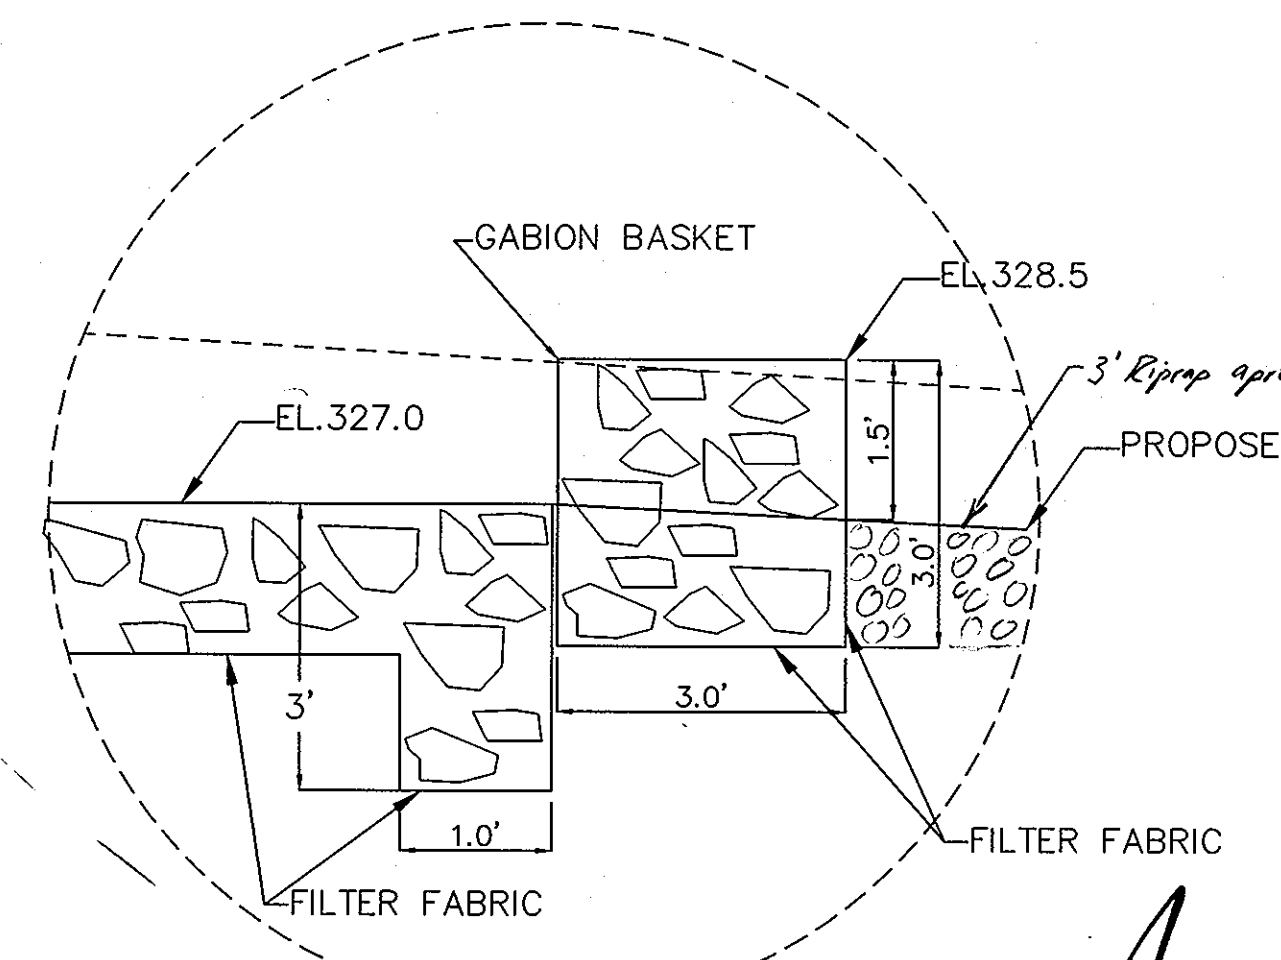

DETAIL
NTS

EXIST. DRAINAGE AREA	22.96 AC.
PROP. DRAINAGE AREA	25.4 AC.
REQ'D STORAGE	91,440 CU. FT.
STORAGE PROV'D @ 332.6	91,440 CU. FT.
WET STORAGE REQ'D	45,720 CU. FT.
WET STORAGE PROV'D @ 330.5	46,537 CU. FT.
DRY STORAGE REQ'D	45,720 CU. FT.
DRY STORAGE PROV'D @ 332.6	45,720 CU. FT.
CLEANOUT ELEV.	329.2
BOTTOM ELEV.	327.75
Q2 EXIST.	5.5 CFS
Q2 PROP. (TEMP)	2.3 CFS
Q10 (TEMP)	46.2 CFS
10 YR. WSEL	334.54
EMBANKMENT ELEV.	336.00


1. THE TOTAL AREA OF THE PERFORATIONS MUST BE GREATER THAN 4 TIMES THE AREA OF THE INTERNAL ORIFICE.
2. THE PERFORATED PORTION OF THE DRAW-DOWN DEVICE SHALL BE WRAPPED WITH 1/2\"/>

DEVELOPER

ELLICOTT CITY LAND HOLDING, INC.
C/O DONALD REUWER
8000 MAIN STREET
ELLICOTT CITY, MD 21043
(410) 480-9105

PURPOSE NOTE:
SHOW AS-BUILT POND GRADING, REMOVE PIPE STEMS,
ACCESS EASEMENT AROUND POND, REMOVE RETAINING WALL.

APPROVED: DEPARTMENT OF PLANNING AND ZONING
DATE: 11/24/08
DATE: 11/20/08

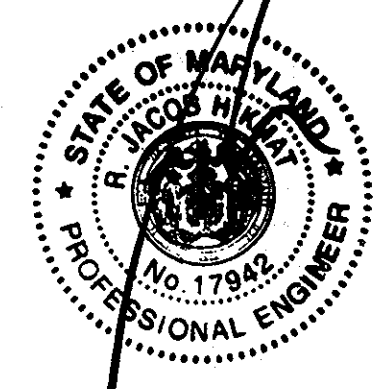


date	JUNE 2004
project	2002-007
illustration	HSP
scale	HSP
approval	NTS
description	JBM

date	10/27/08
description	SHOW AS-BUILT POND GRADING, REMOVE PIPE STEMS, ACCESS EASEMENT AROUND POND, REMOVE RETAINING WALL, REVISED PLAN TO REFLECT APPROVED F-04-08(LOCHESTER OAKS 2)
date	11/19/07
description	
revisions	

ILCHESTER OAKS
LOTS 1 THRU 22 & OPEN SPACES 23 THRU 26 & BULK PARCEL "A"
TAX MAP 31 PARCEL 641 AND P/O PARCEL 699
FIRST ELECTION DISTRICT
HOWARD COUNTY, MARYLAND
REVISED STORMWATER MANAGEMENT DETAILS

MILDENBERG, BOENDER & ASSOC., INC.
Engineers Planners Surveyors
5072 Dorsey Hall Drive, Suite 202, Ellicott City, Maryland, 21042
(410) 987-0286 Ext. (301) 821-6521 Wash. (410) 987-0288 Fax

02-007-DWG\FINAL\007-FINAL SD - DRAINAGE

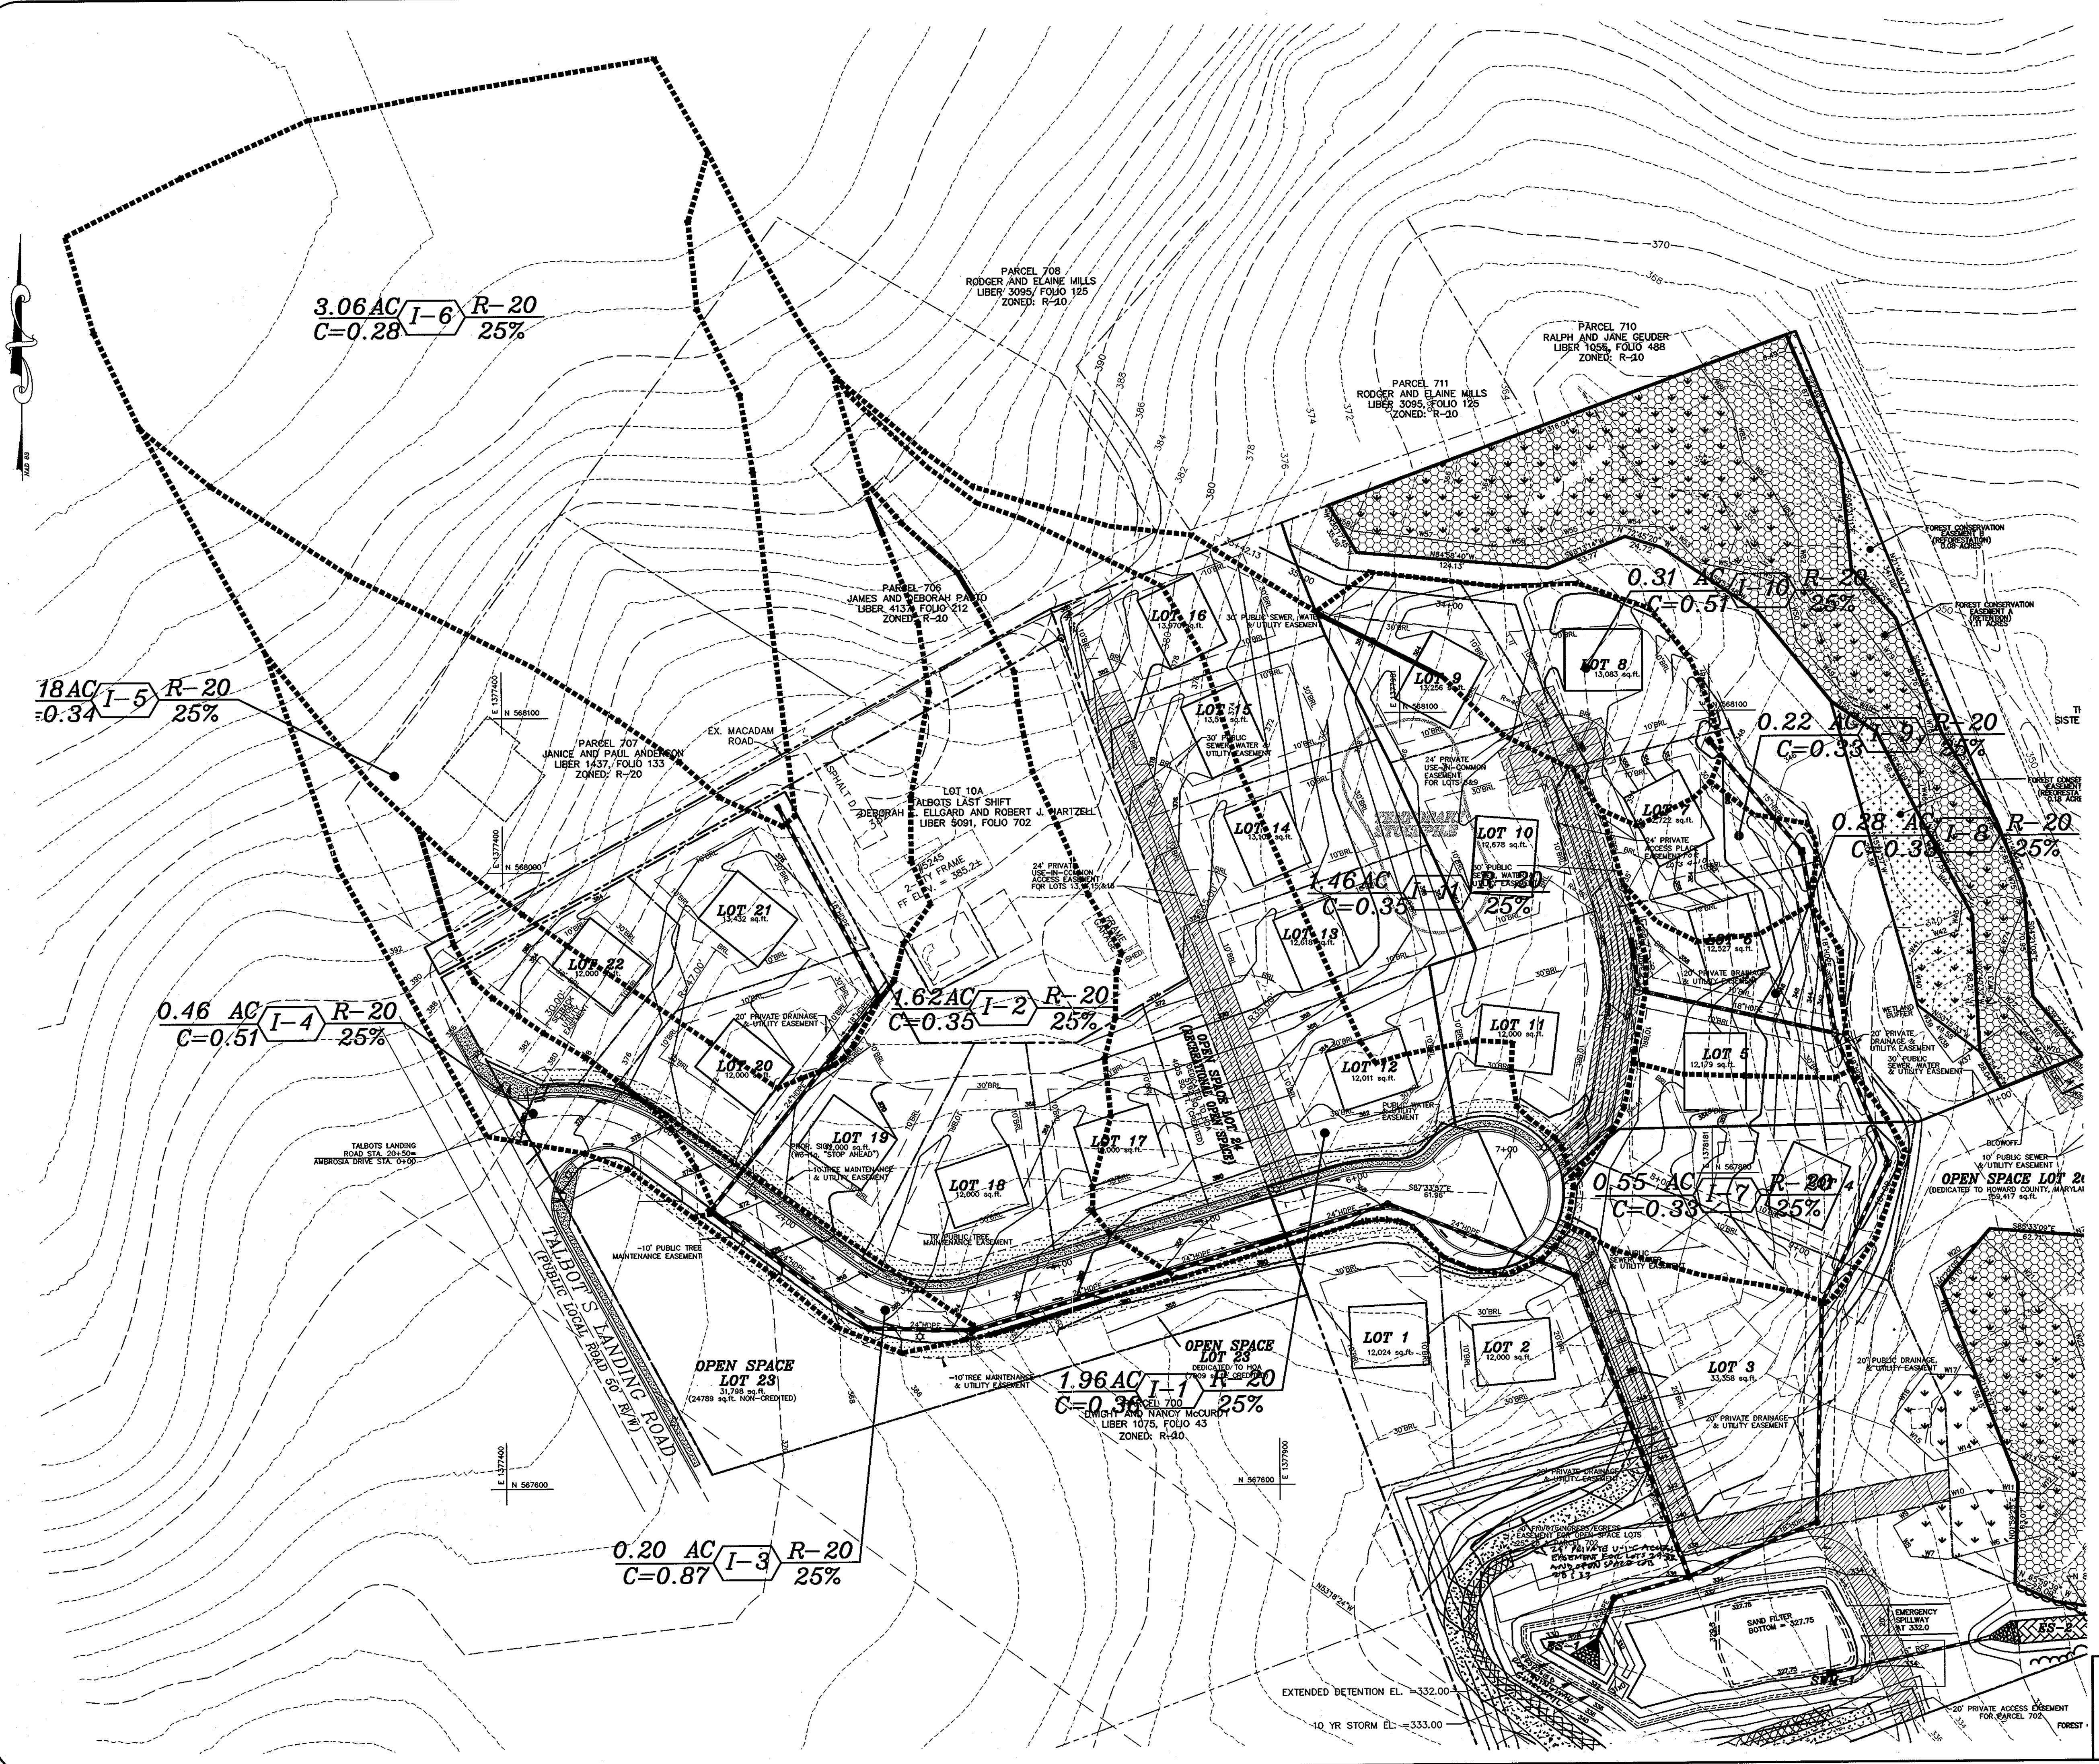

DEVELOPER
 ELLICOTT CITY LAND HOLDING, INC.
 C/O DON REUWER
 8000 MAIN STREET
 ELLICOTT CITY, MD 21043
 (410) 480-9105

[Signature]
 PROFESSIONAL SURVEYOR
 STATE OF MARYLAND


APPROVED: DEPARTMENT OF PLANNING AND ZONING
[Signature] 7/10/04
 CHIEF, DIVISION OF LAND DEVELOPMENT
[Signature] 7/3/04
 CHIEF, DEVELOPMENT ENGINEERING DIVISION

project	2002-007	date	JUNE 2004
illustration	HSP	engineering	HSP
scale	NTS	approval	HSP
revisions		description	


no.	1	date	4/15/04
description	REVISED PLANS TO CORRECT APPROVED P.C. & T.B. (LSE) DRAWING		

ILCHESTER OAKS
 LOTS 1 THRU 22, OPEN SPACES 23 THRU 26 & NON-BUILDABLE PARCEL "A"
 TAX MAP 31 PARCEL 641 AND P/O PARCEL 699
 HOWARD COUNTY, MARYLAND
 FIRST ELECTION DISTRICT
 DRAINAGE AREA MAP


MILLENBERG, BOENDER & ASSOC., INC.
 Engineers Planners Surveyors
 5072 Dorsey Hall Drive, Suite 202, Ellicott City, Maryland 21042
 (410) 997-0266 Balt. (301) 621-5521 Wash. (410) 997-0298 Fax

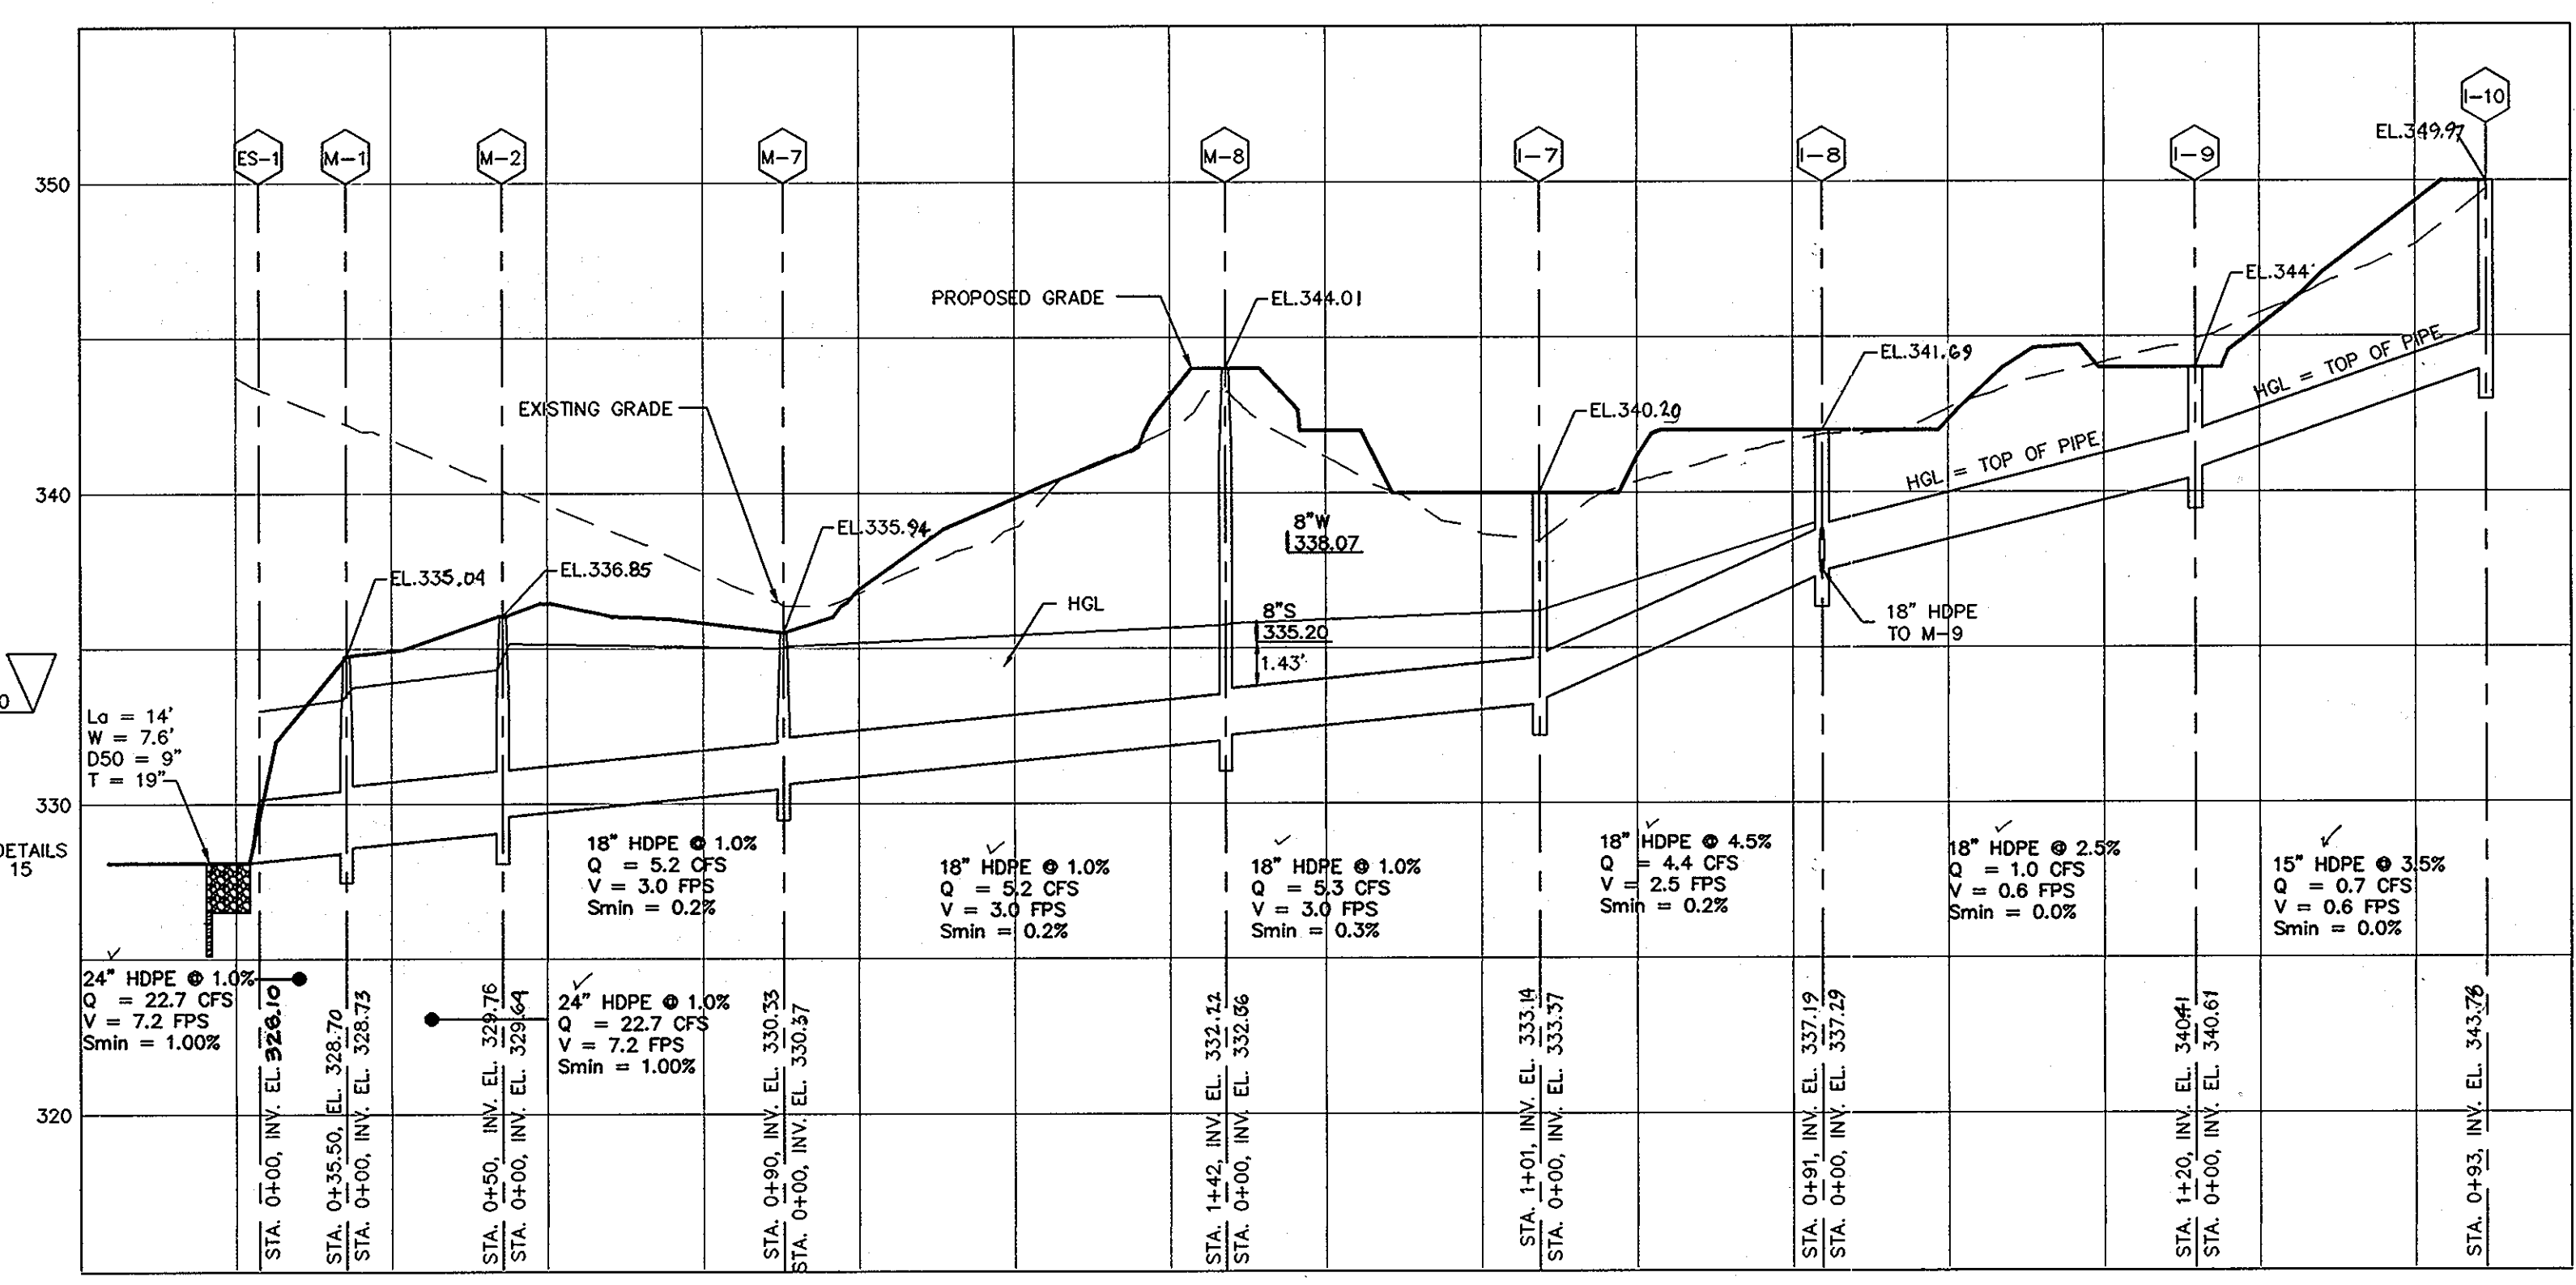

STORM DRAIN PROFILE FROM ES-1 TO I-10
 HORIZONTAL SCALE: 1" = 50'
 VERTICAL SCALE: 1" = 5'

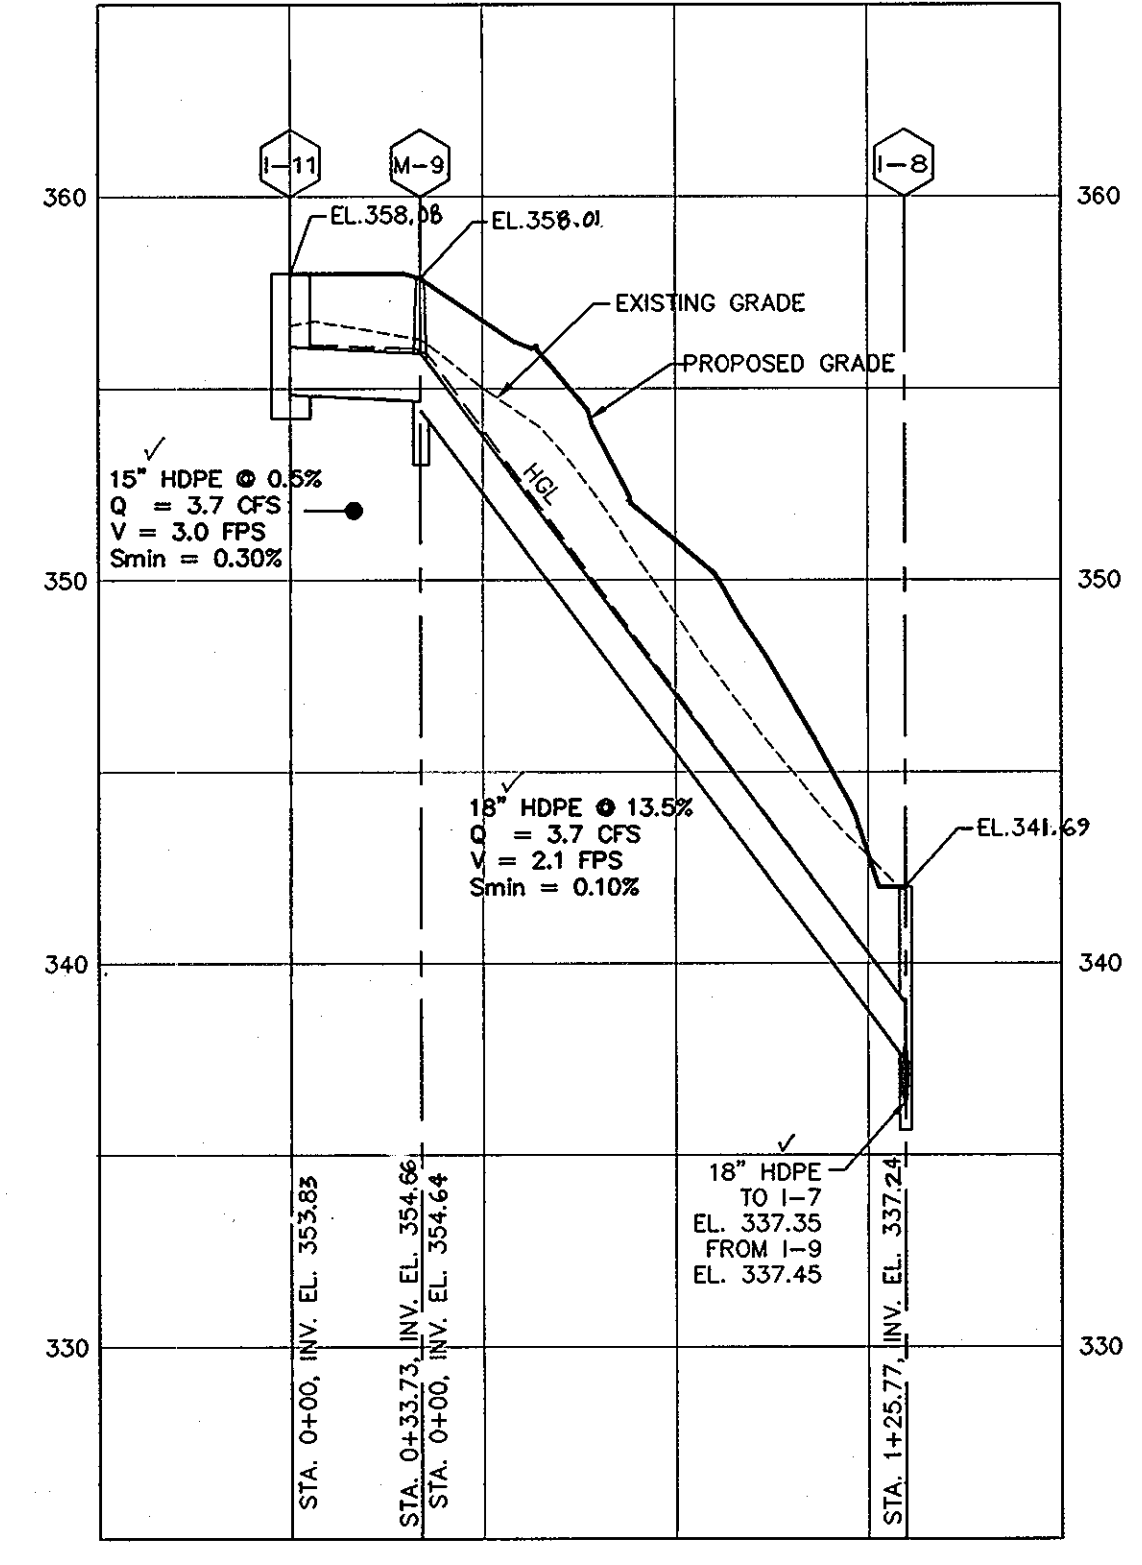

STORM DRAIN PROFILE FROM I-11 TO I-8
 HORIZONTAL SCALE: 1" = 50'
 VERTICAL SCALE: 1" = 5'

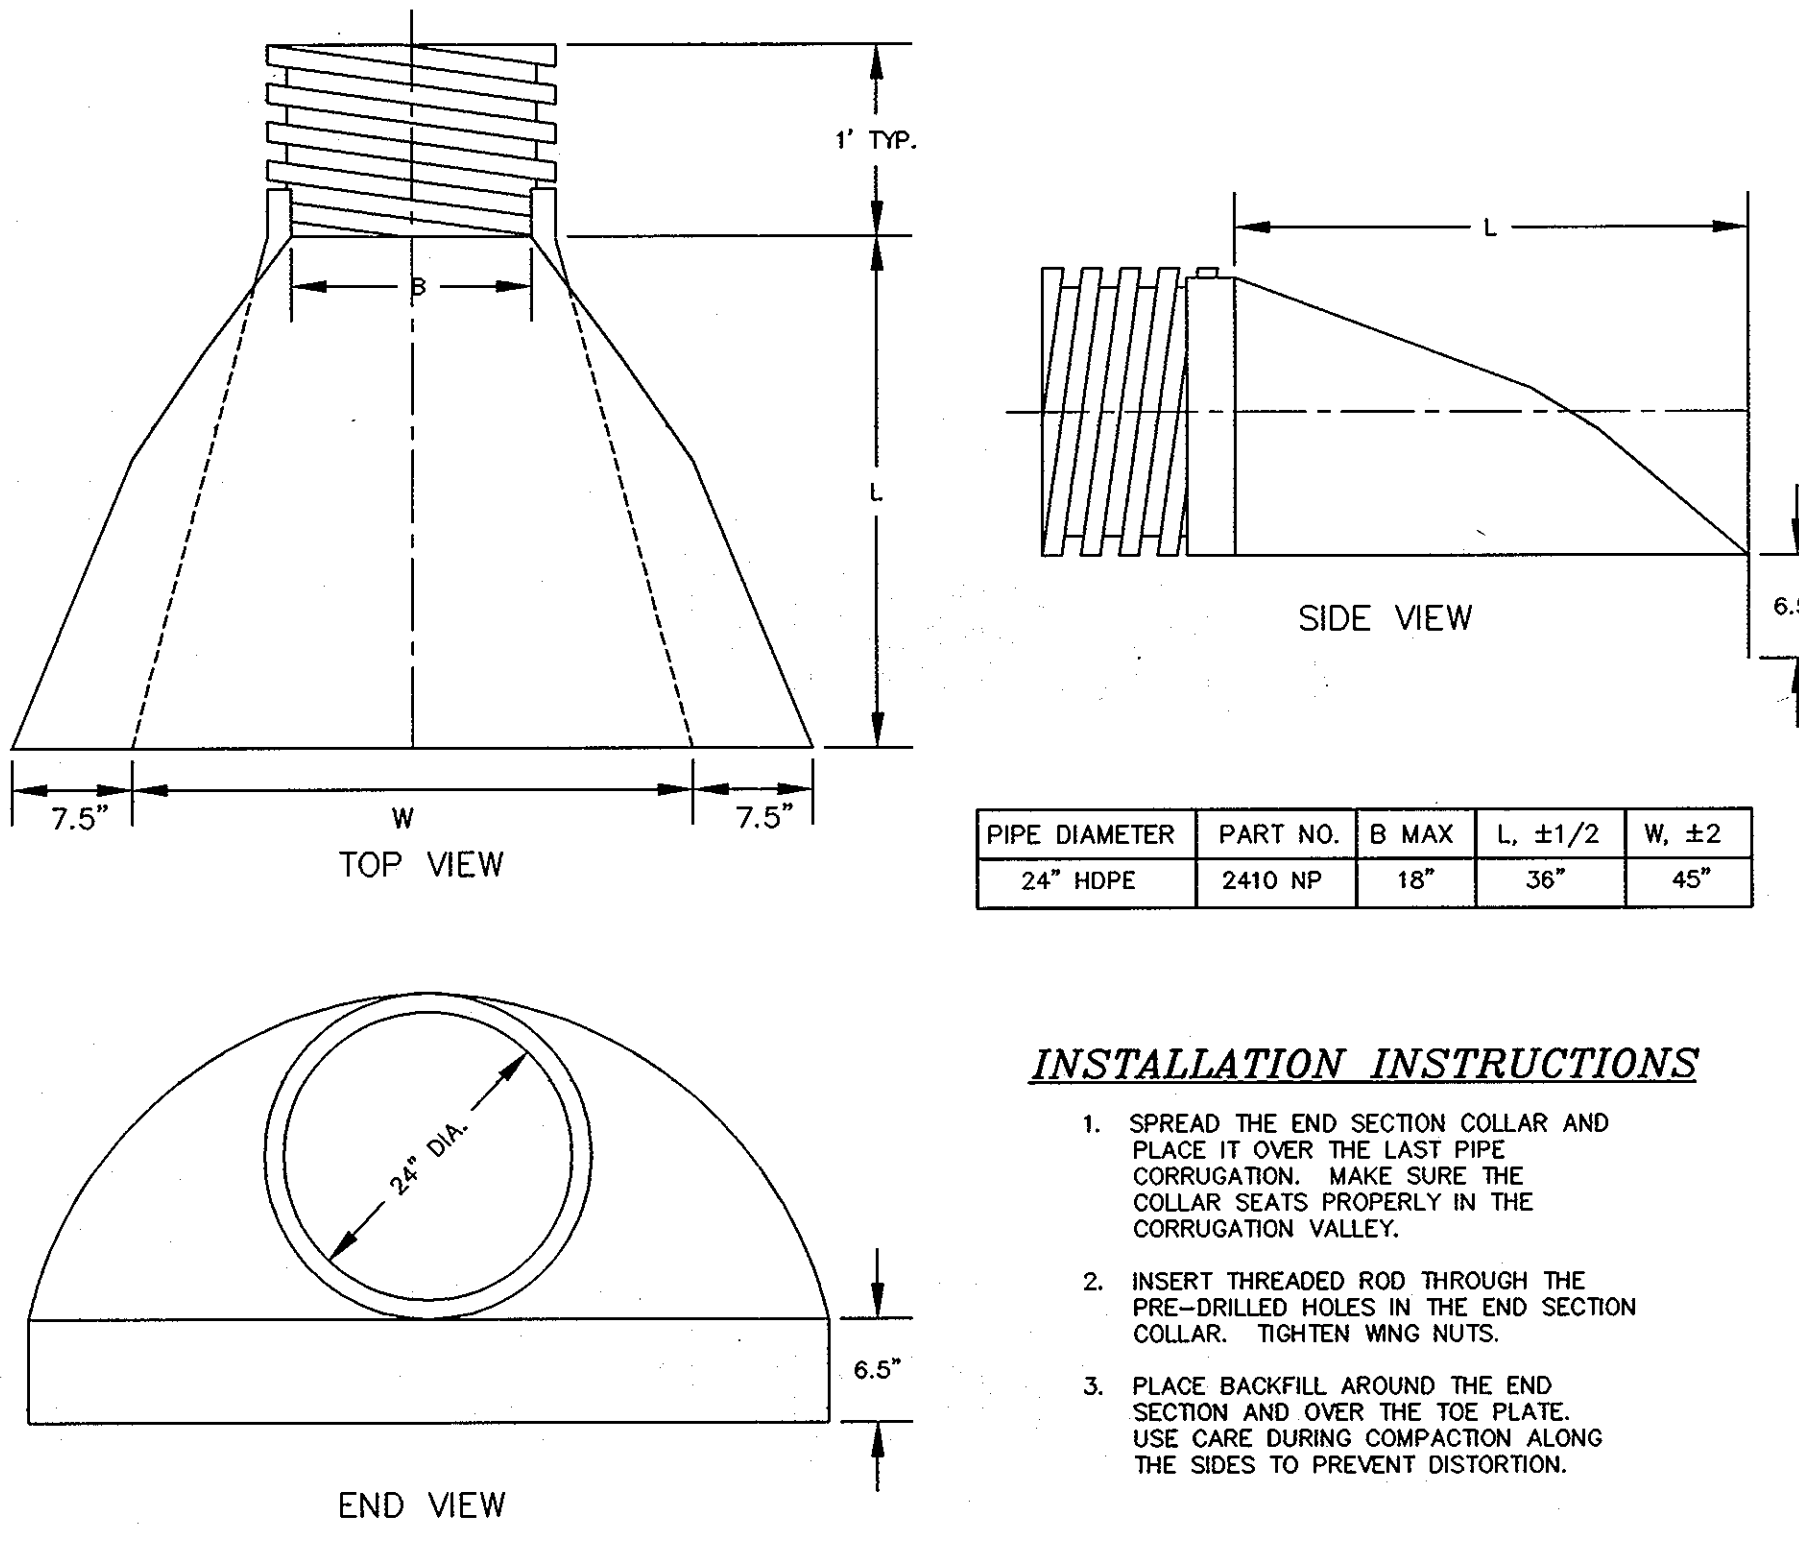

PIPE DIAMETER	PART NO.	B MAX	L, ±1/2	W, ±2
24" HDPE	2410 NP	18"	36"	45"

INSTALLATION INSTRUCTIONS

- SPREAD THE END SECTION COLLAR AND PLACE IT OVER THE LAST PIPE CORRUGATION. MAKE SURE THE COLLAR SEATS PROPERLY IN THE CORRUGATION VALLEY.
- INSERT THREADED ROD THROUGH THE PRE-DRILLED HOLES IN THE END SECTION COLLAR. TIGHTEN WING NUTS.
- PLACE BACKFILL AROUND THE END SECTION AND OVER THE TOE PLATE. USE CARE DURING COMPACTION ALONG THE SIDES TO PREVENT DISTORTION.

HDPE END SECTIONS
 (PART NO. 2410 NP)
 NOT TO SCALE

MGWC 2.5: LIVE FASCINES

Woody vegetative system for bank stabilization

DESCRIPTION
 Establishment of live fascines, also known as wattles, consists of the following:
 • preparation of sausage-shaped bundles of live, woody plant cuttings,
 • anchoring of these bundles in shallow ditches in a slope or streambank with live and/or inert stout stakes, and
 • partial burial of the fascines to promote growth.

EFFECTIVE USES & LIMITATIONS
 As with other bioengineering measures, live fascines are an economical method when materials are locally available. Additionally, wattling is often an effective measure when employed to:
 • reduce runoff energy, and hence surface erosion, by breaking a slope into a series of shorter slopes,
 • protect other bioengineering measures from washout and undermining,
 • replace brush layers on suitable cut slopes (since they are easier to install),
 • protect streambanks from washout and seepage, particularly at toes where water levels fluctuate only moderately, and
 • stabilize or protect streambanks for the following Rouseff stream types: D1, B5, B6, C1, C2, C3, C4, C5, C6, D1A, E3, E4, E5, and E6.

Supplementary or alternative mitigating measures may be required for the following situations:
 • streambanks with heavy surface drainage,
 • areas of flthy flows,
 • slopes subject to shallow mass movements (since fascines have a modest rooting depth), and
 • the outside of meander bends (high velocity areas of the channel).

MATERIAL SPECIFICATIONS
 Willow, alder, and dogwood cuttings are well suited for use in live fascines. Fascine bundles can range from 5 to 30 feet (1.5 to 9 meters) in length, depending upon handling and transportation limitations, with diameters ranging from 4 to 16 inches (10 to 40 cm). Unrooted live or wire-soled stakes should be at least 2 millimeters thick. If inert (dead) stakes are employed to secure the bundles, they should be made from 2 by 4-inch (5 by 10-cm) lumber cut on the diagonal with lengths of 2.5 feet (0.8 meters) for cut slopes and 3 feet (0.9 meters) for fill slopes.

Approximate Cost (\$1999)
 \$5.50-\$22 per linear ft.

INSTALLATION GUIDELINES
 Live fascine construction should occur during the dormancy period, usually late fall to early spring, with bundle preparation proceeding as follows (refer to Detail 2.5):
 • the growing tips of all branches should be oriented downstream in the same direction, and

SLIPE PROTECTION AND STABILIZATION TECHNIQUES MARYLAND DEPARTMENT OF THE ENVIRONMENT WATERWAY CONSTRUCTION GUIDELINES REVISED NOVEMBER 2000

MGWC 2.5: LIVE FASCINES

• bundles should be tied every 12 to 18 inches (30 to 45 cm) along their lengths.
 The initial row of bundles should be positioned at the height of the normal summer water level such that one-half to two-thirds of the bundle is submerged. These toe bundles should be protected from washout by positioning them on brush layers extending 20 to 31 inches (50 to 80 cm) into the stream. Project planners may need to study an upply chosen vegetated reference reach for further guidance when installing live fascines.

All bundles should be anchored in trenches dug to a depth of at least one-half the bundle diameter. Inert stakes should be driven every 12 to 39 inches (30 to 100 cm) through and below the lengths of the fascines with extra stakes used at bundle overlaps. The length of overlap should be approximately 1 to 2 feet (0.3 to 0.6 meters). Live stakes can be employed on the down slope side of the fascine rows or through the bundles with the tops of the stakes extending 2 to 3 inches (5 to 8 cm) above the bundle tops. Soil should be tamped into and along the sides of the bundles, leaving the top 2 inches (5 cm) exposed to promote growth.

Additional fascine rows should be installed up the slope at predetermined intervals. If the slope is dry a majority of the time, bundles should be arranged parallel to the contour according to Table 2.5a.

Table 2.5a: Fascine Spacing on Dry Slope

Slope Steepness	Contour Distance
1:1 to 1.5:1	3-4 ft (0.9-1.2 m)
1.5:1 to 2:1	4-5 ft (1.2-1.5 m)
2:1 to 2.5:1	5-6 ft (1.5-1.8 m)
2.5:1 to 3:1	6-8 ft (1.8-2.4 m)
3.5:1 to 4:1	8-9 ft (2.4-2.7 m)
4.5:1 to 5:1	9-10 ft (2.7-3.0 m)

Conversely, if the slope is excessively wet, bundles should be installed at an angle to the contour to expedite slope drainage as dictated in Table 2.5b.

Table 2.5b: Fascine Spacing on Wet Slope

Slope Steepness	Contour Distance
1:1 to 1.5:1	2-3 ft (0.6-0.9 m)
1.5:1 to 2:1	3-5 ft (0.9-1.5 m)
2:1 to 2.5:1	3-5 ft (0.9-1.5 m)
2.5:1 to 3:1	4-5 ft (1.2-1.5 m)
3.5:1 to 4:1	5-7 ft (1.5-2.1 m)
4.5:1 to 5:1	6-8 ft (1.8-2.4 m)

Straw or mulching material should be spread between fascine rows on slopes flatter than 1.5:1, and pins or coir tubes should be used on slopes greater than 1.5:1 in central erosion until the live trees and supporting vegetation become established.


SLIPE PROTECTION AND STABILIZATION TECHNIQUES MARYLAND DEPARTMENT OF THE ENVIRONMENT WATERWAY CONSTRUCTION GUIDELINES REVISED NOVEMBER 2000

Maryland's Guidelines To Waterway Construction
 DETAIL 2.5: LIVE FASCINES




Preliminary Step - prepare fascine bundles as follows: cigar-shaped bundles of live, rotatable brush and branches with burs alternating, 4 to 10-inch (10 to 25-cm) diameters, tied 12 to 18 inches (30 to 45 cm) on center

Construction Note: installation begins at the bottom of the slope and proceeds from Step 1 through Step 5 Adapted from Leiser (1983)

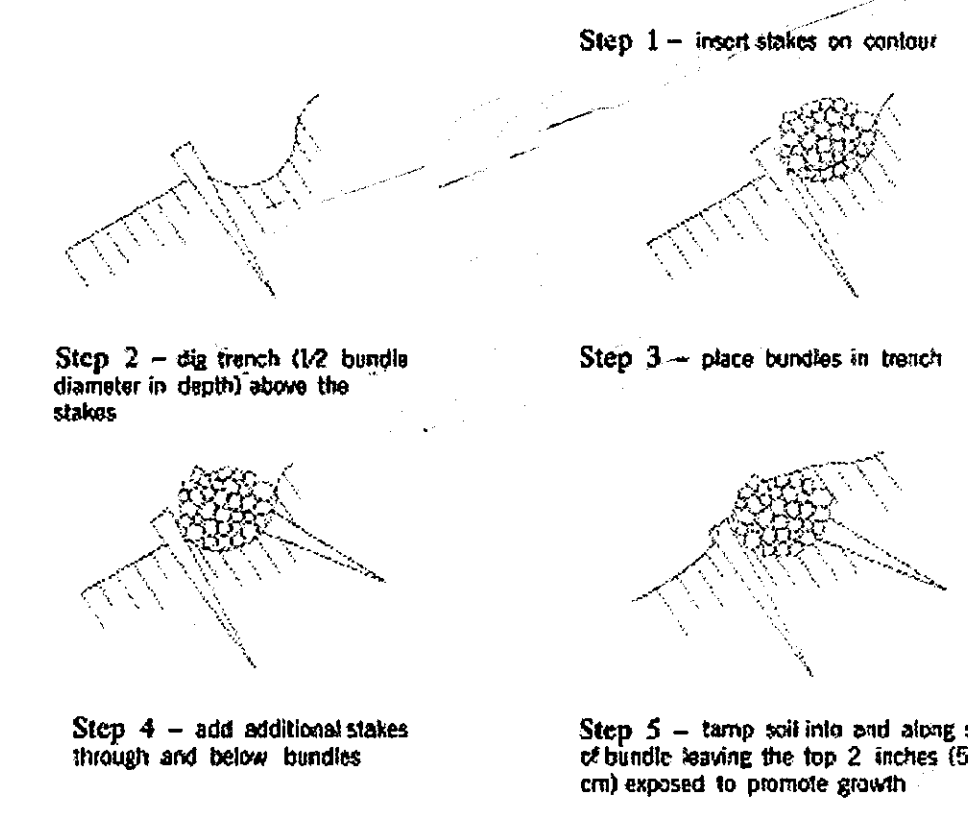

SLIPE PROTECTION AND STABILIZATION TECHNIQUES MARYLAND DEPARTMENT OF THE ENVIRONMENT WATERWAY CONSTRUCTION GUIDELINES REVISED NOVEMBER 2000

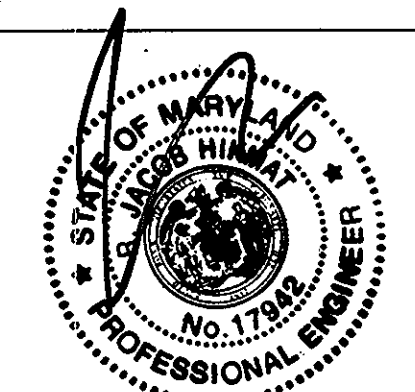


I HEREBY CERTIFY THAT THE FACILITY SHOWN ON THIS PLAN WAS CONSTRUCTED AS SHOWN IN THE "AS-BUILT" PLANS AND AGREES WITH THE ORIGINAL PLANS AND SPECIFICATIONS.

DEVELOPER
 ELLICOTT CITY LAND HOLDING, INC.
 C/O DON REUWER
 8000 MAIN STREET
 ELLICOTT CITY, MD 21043
 (410) 480-9105

APPROVED: DEPARTMENT OF PUBLIC WORKS
 [Signature] 7-27-04
 CHIEF BUREAU OF HIGHWAYS
 APPROVED: DEPARTMENT OF PLANNING AND ZONING
 [Signature] 8/10/04
 CHIEF, DIVISION OF LAND DEVELOPMENT
 APPROVED: [Signature] 7/20/04
 CHIEF, DEVELOPMENT ENGINEERING DIVISION

MILDENBERG & ASSOC., INC.
 Surveyors
 Planners
 Engineers
 5072 Dorsey Hill Drive, Suite 202, Ellicott City, Maryland, 21042
 (410) 987-0296 Balt. (301) 621-5521 Wash. (410) 987-0298 Fax.

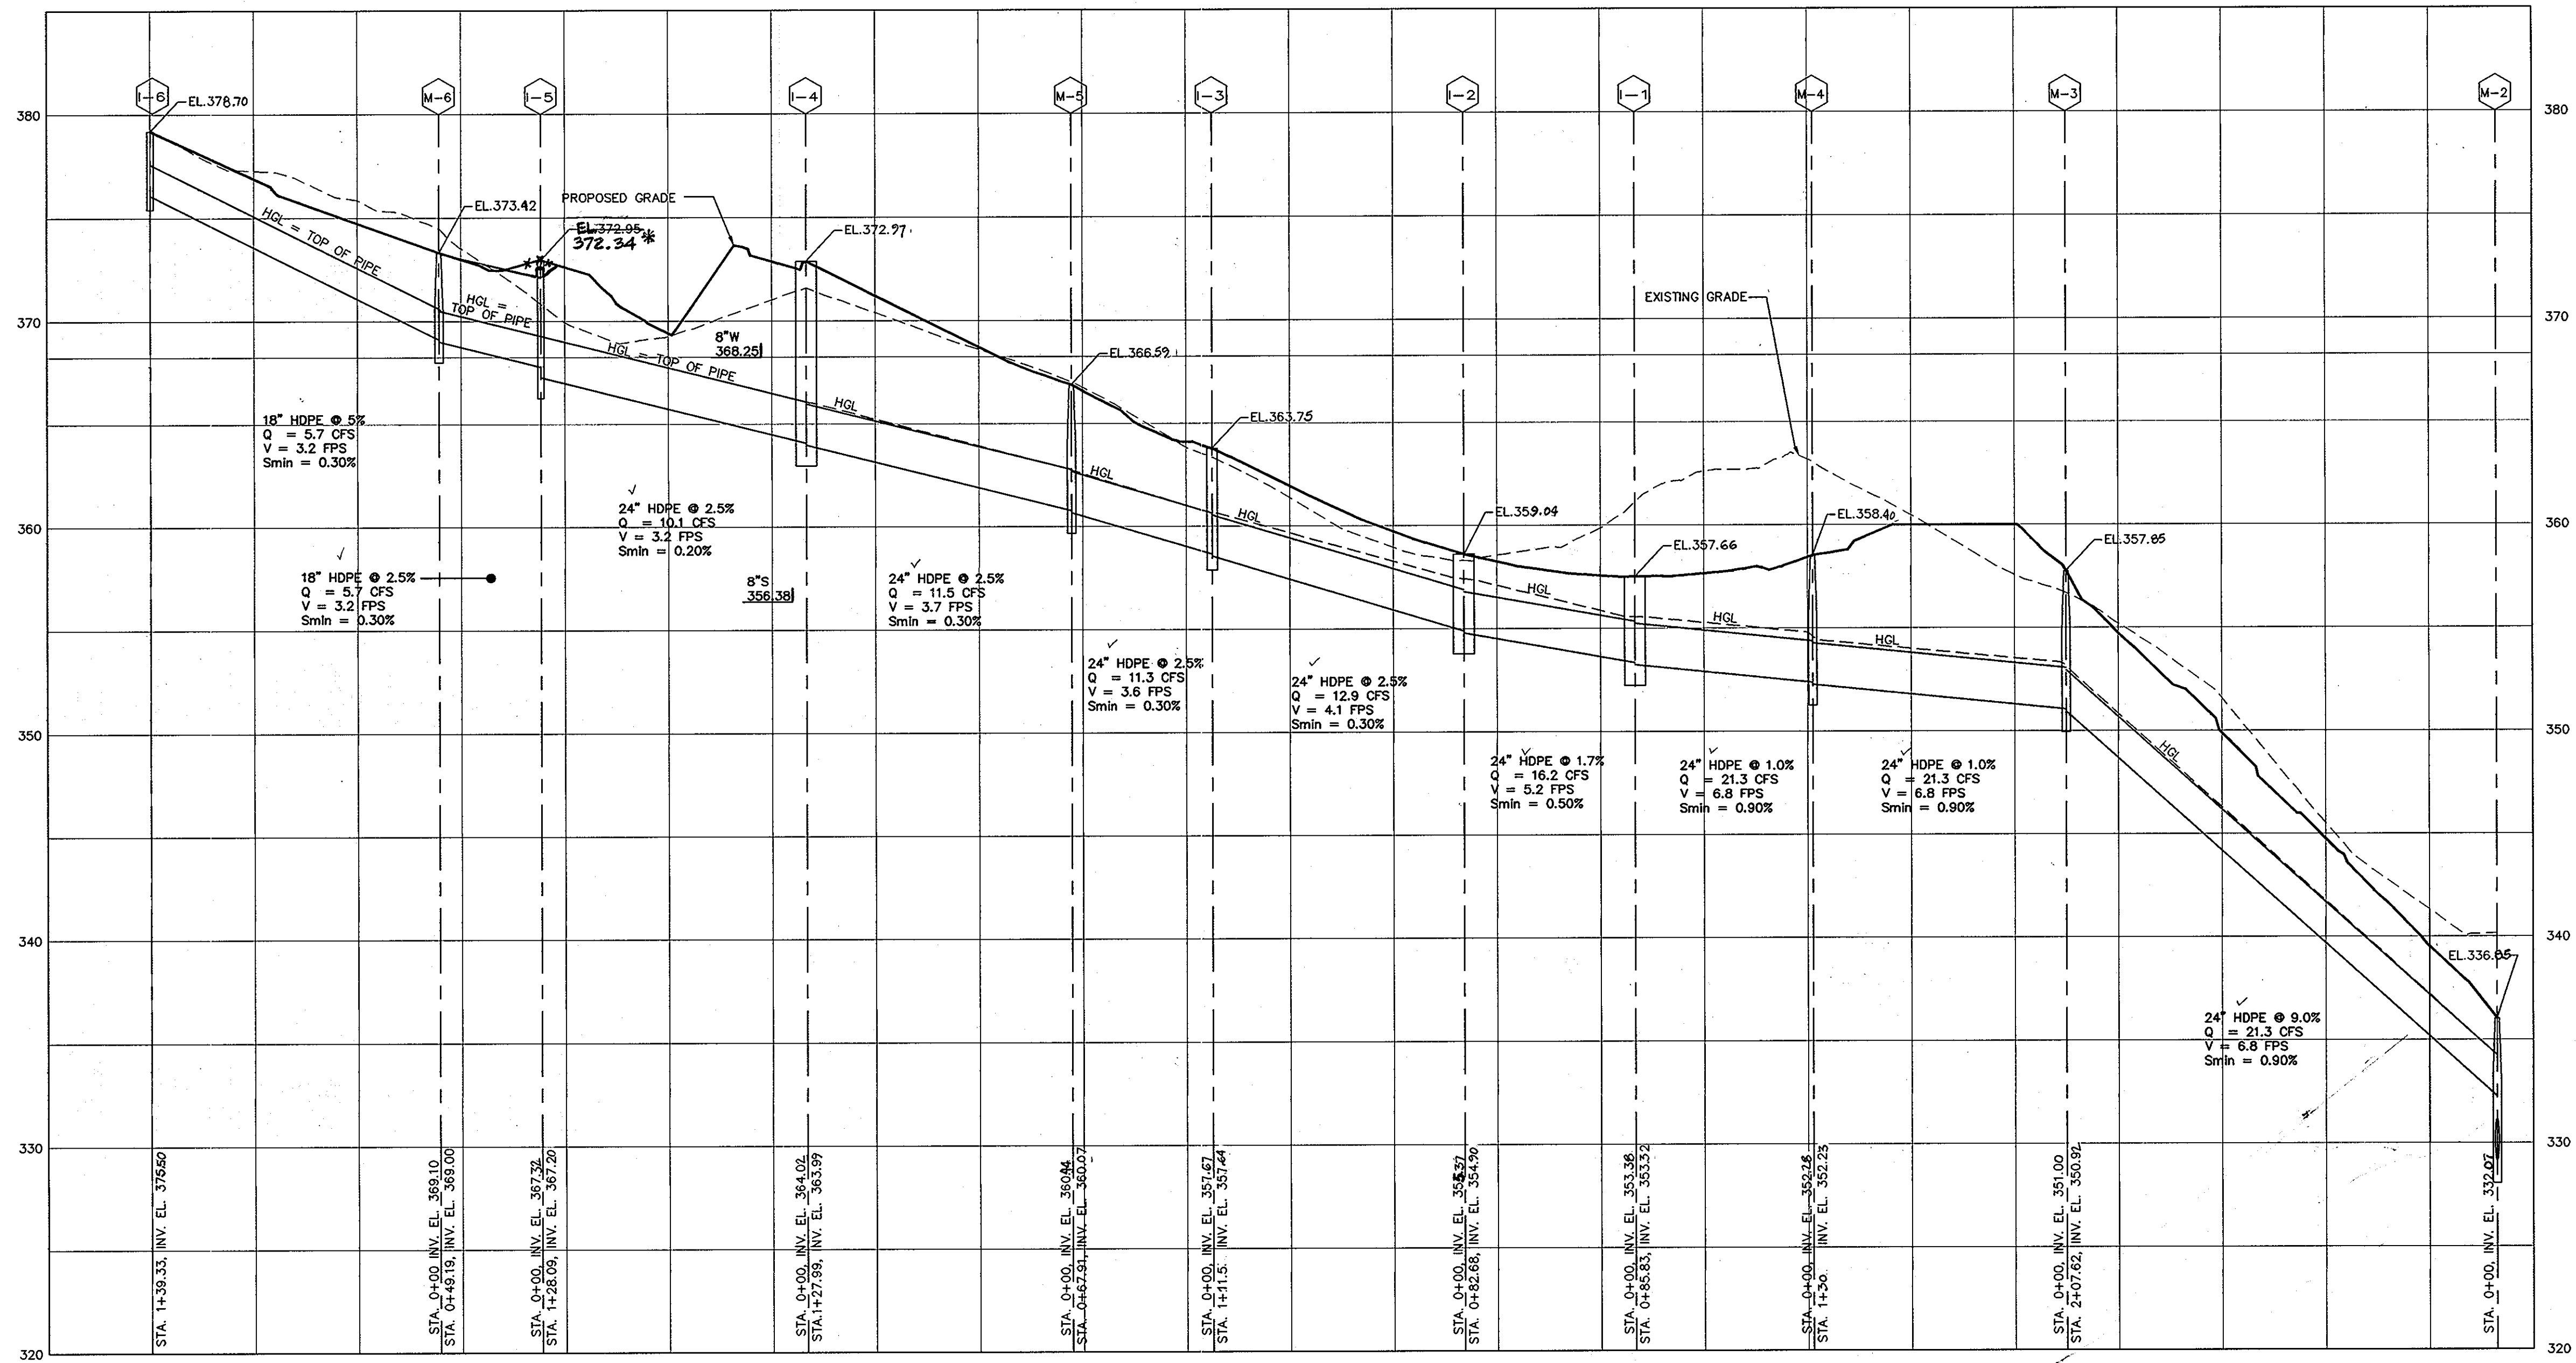

* For Revision #1 Only
 5-10-06

STORM DRAIN PROFILE FROM I-6 TO M-2
 HORIZONTAL SCALE: 1" = 50'
 VERTICAL SCALE: 1" = 5'



STRUCTURE SCHEDULE

NO.	LOCATION*	TOP**	INV. IN	INV. OUT	COMMENTS
ES-1	N567491.778 E1378102.110	----	328.13	----	24" Ø HDPE END SECTION
I-1	AMBROSIA DRIVE, STA. 5+56.71 14.85' RT.	357.66	353.38	353.32	INLET TYPE A-10 (HO. CO. STD SD 4.41) - SUMP
I-2	AMBROSIA DRIVE, STA. 4+74.03 14.84' RT.	359.04	355.57	354.90	INLET TYPE A-10 (HO. CO. STD SD 4.41)
I-3	AMBROSIA DRIVE, STA. 3+53.63 14.82' RT.	363.75	357.57	357.64	INLET TYPE A-10 (HO. CO. STD SD 4.40)
I-4	AMBROSIA DRIVE, STA. 14-71.41 14.85' RT.	372.97	364.02	363.99	INLET TYPE A-10 (HO. CO. STD SD 4.41)
I-5	N567877.377 E1377612.620	*372.34	367.32	367.20	INLET TYPE K WITH GRATE (HO. CO. STD SD-4.12 & SD-4.13) - SUMP
I-6	N568041.620 E1377578.343	378.70	375.50	375.50	INLET TYPE K WITH GRATE (HO. CO. STD SD-4.12 & SD-4.13) - SUMP
I-7	N567805.937 E1378294.823	340.20	333.37	333.14	INLET TYPE K WITH GRATE (HO. CO. STD SD-4.12 & SD-4.13) - SUMP
I-8	N567890.083 E1378260.983	342.0	337.29	337.19	INLET TYPE K WITH GRATE (HO. CO. STD SD-4.12 & SD-4.13) - SUMP
I-9	N568008.270 E1378240.259	344.55	340.61	340.41	INLET TYPE K WITH GRATE (HO. CO. STD SD-4.12 & SD-4.13) - SUMP
I-10	N568080.418 E1378180.973	349.97	----	343.78	INLET TYPE A-10 (HO. CO. STD SD 4.41) - SUMP
I-11	N567947.885 E1378130.947	358.08	----	353.85	INLET TYPE A-10 (HO. CO. STD SD 4.41) - SUMP
M-1	N567524.661 E1378115.465	335.04	328.73	328.70	MH (HO. CO. STD G 5.01)
M-2	N567539.155 E1378163.545	336.86	329.84	329.76	MH (HO. CO. STD G 5.01)
M-3	N567734.141 E1378092.241	357.85	351.00	350.92	MH (HO. CO. STD G 5.01)
M-4	AMBROSIA DRIVE, STA. 6+45.44 5.75' RT.	358.40	352.28	352.23	MH (HO. CO. STD G 5.01)
M-5	AMBROSIA DRIVE, STA. 2+94.79 18.94' RT.	366.59	360.44	360.07	MH (HO. CO. STD G 5.01)
M-6	N567918.114 E1377642.828	373.42	369.10	369.00	MH (HO. CO. STD G 5.01)
M-7	N567573.010 E1378246.960	335.94	330.37	330.35	MH (HO. CO. STD G 5.01)
M-8	N567646.949 E1378259.890	344.01	332.36	332.32	MH (HO. CO. STD G 5.01)
M-9	N567715.012 E1378251.208	358.01	354.66	354.64	MH (HO. CO. STD G 5.01)

* STATIONS GIVEN TO CENTERLINE FACE OF INLET AT TOP OF CURB FOR INLETS LOCATED WITHIN THE ROAD RIGHT-OF-WAY. STATIONS FOR "K" INLETS TO CL OF INLET. LOCATION OF MANHOLES IS TO CL OF MANHOLE COVER. END SECTION GIVEN TO THE CENTERLINE OF PIPE AT THE CONNECTION OF THE STORM DRAIN PIPE TO THE END SECTION.
 ** ELEVATIONS MEASURED TO CENTER OF ALL INLETS.

PIPE SCHEDULE

QUANTITY	PIPE SIZE
128	15" HDPE
876	18" HDPE
1030	24" HDPE

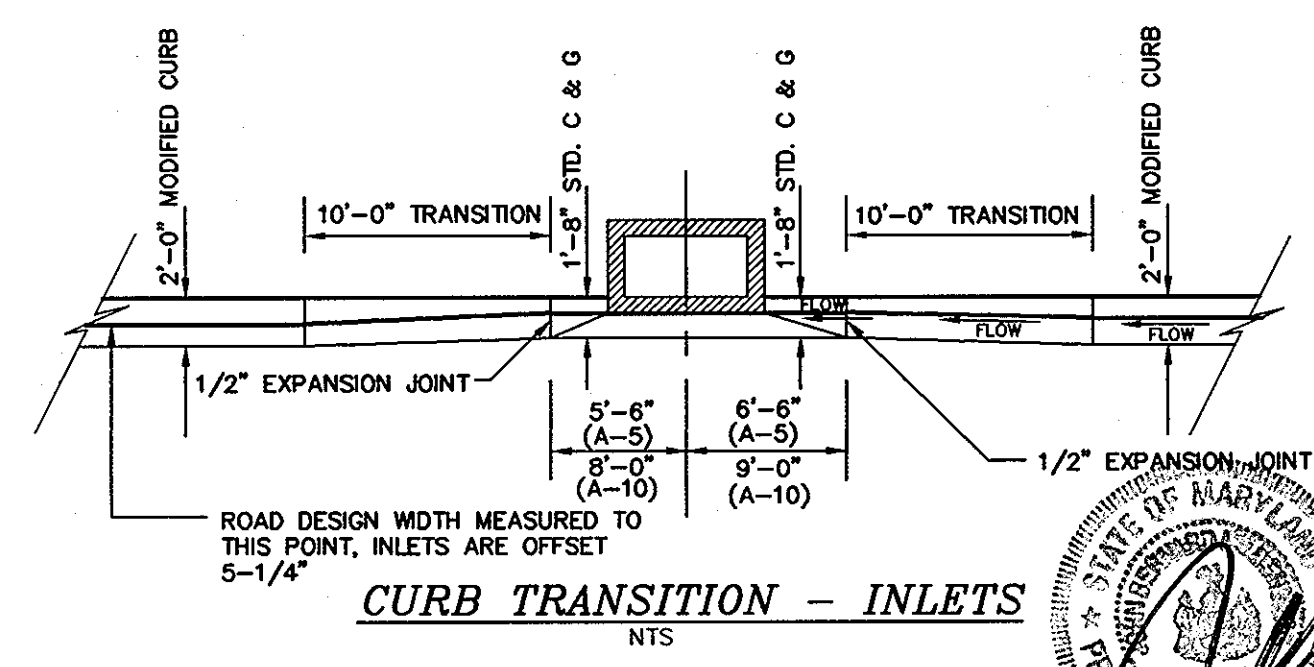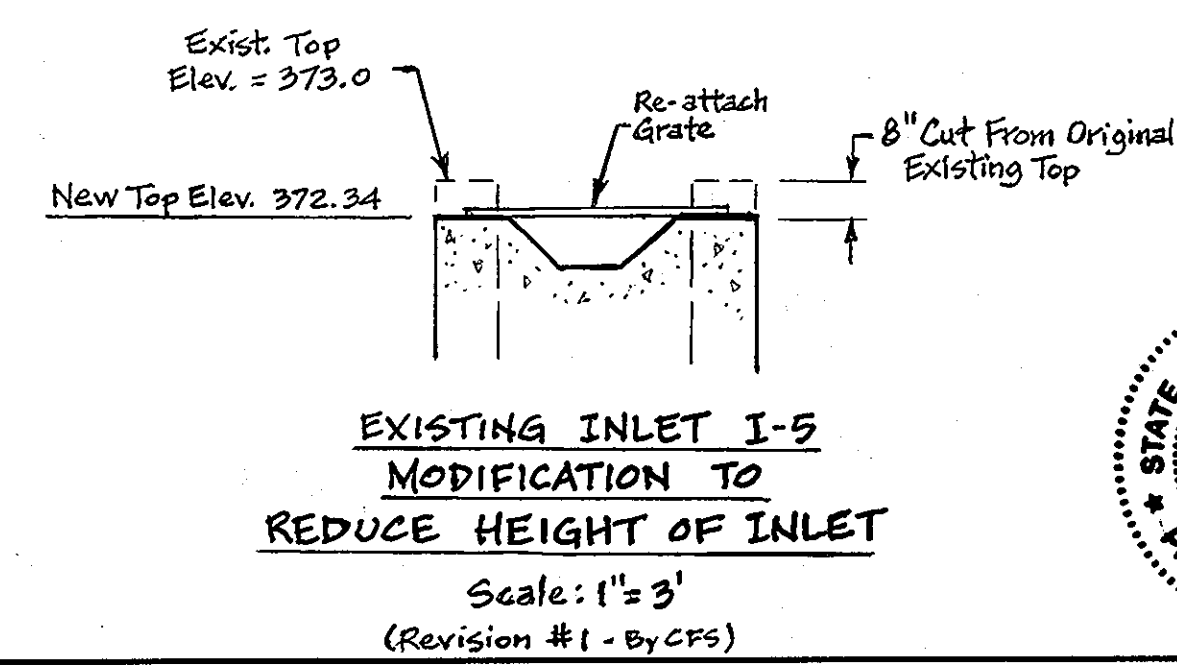

DEVELOPER
 ELLICOTT CITY LAND HOLDING, INC.
 C/O DON REUWER
 8000 MAIN STREET
 ELLICOTT CITY, MD 21043
 (410) 480-9105

APPROVED DEPARTMENT OF PUBLIC WORKS
 CHIEF BUREAU OF HIGHWAYS
 APPROVED DEPARTMENT OF PLANNING AND ZONING
 CHIEF DIVISION OF LAND DEVELOPMENT


date	JUNE 2004
project	2002-007
illustration	HSP
scale	HSP
approval	HSP
AS SHOWN	JBM

date	9/08
description	AS BUILT CHANGES
no.	1
revisions	AS-BUILT INFORMATION ADDED Modified Str. I-5: Height of Slot (By-Crds)
date	15/10/06

ILCHESTER OAKS
 LOTS 1 THRU 22-OPEN SPACES 23 THRU 26 & NON-BUILDABLE PARCEL "A"
 TAX MAP 31 PARCEL 641 AND P/O PARCEL 699
 HOWARD COUNTY, MARYLAND
 FIRST ELECTION DISTRICT
 STORM DRAIN PROFILES

MILDENBERG, BOENDER & ASSOC., INC.
 Engineers Planners Surveyors
 5072 Dorsy Hill Drive, Suite 202, Ellicott City, Maryland, 21042
 (410) 997-0296 Fax: (301) 621-5521 Wash. (410) 997-0298 Fax.


NOTE: SEE GRADING PLAN FOR CONTINUATION OF THE STORM DRAIN.

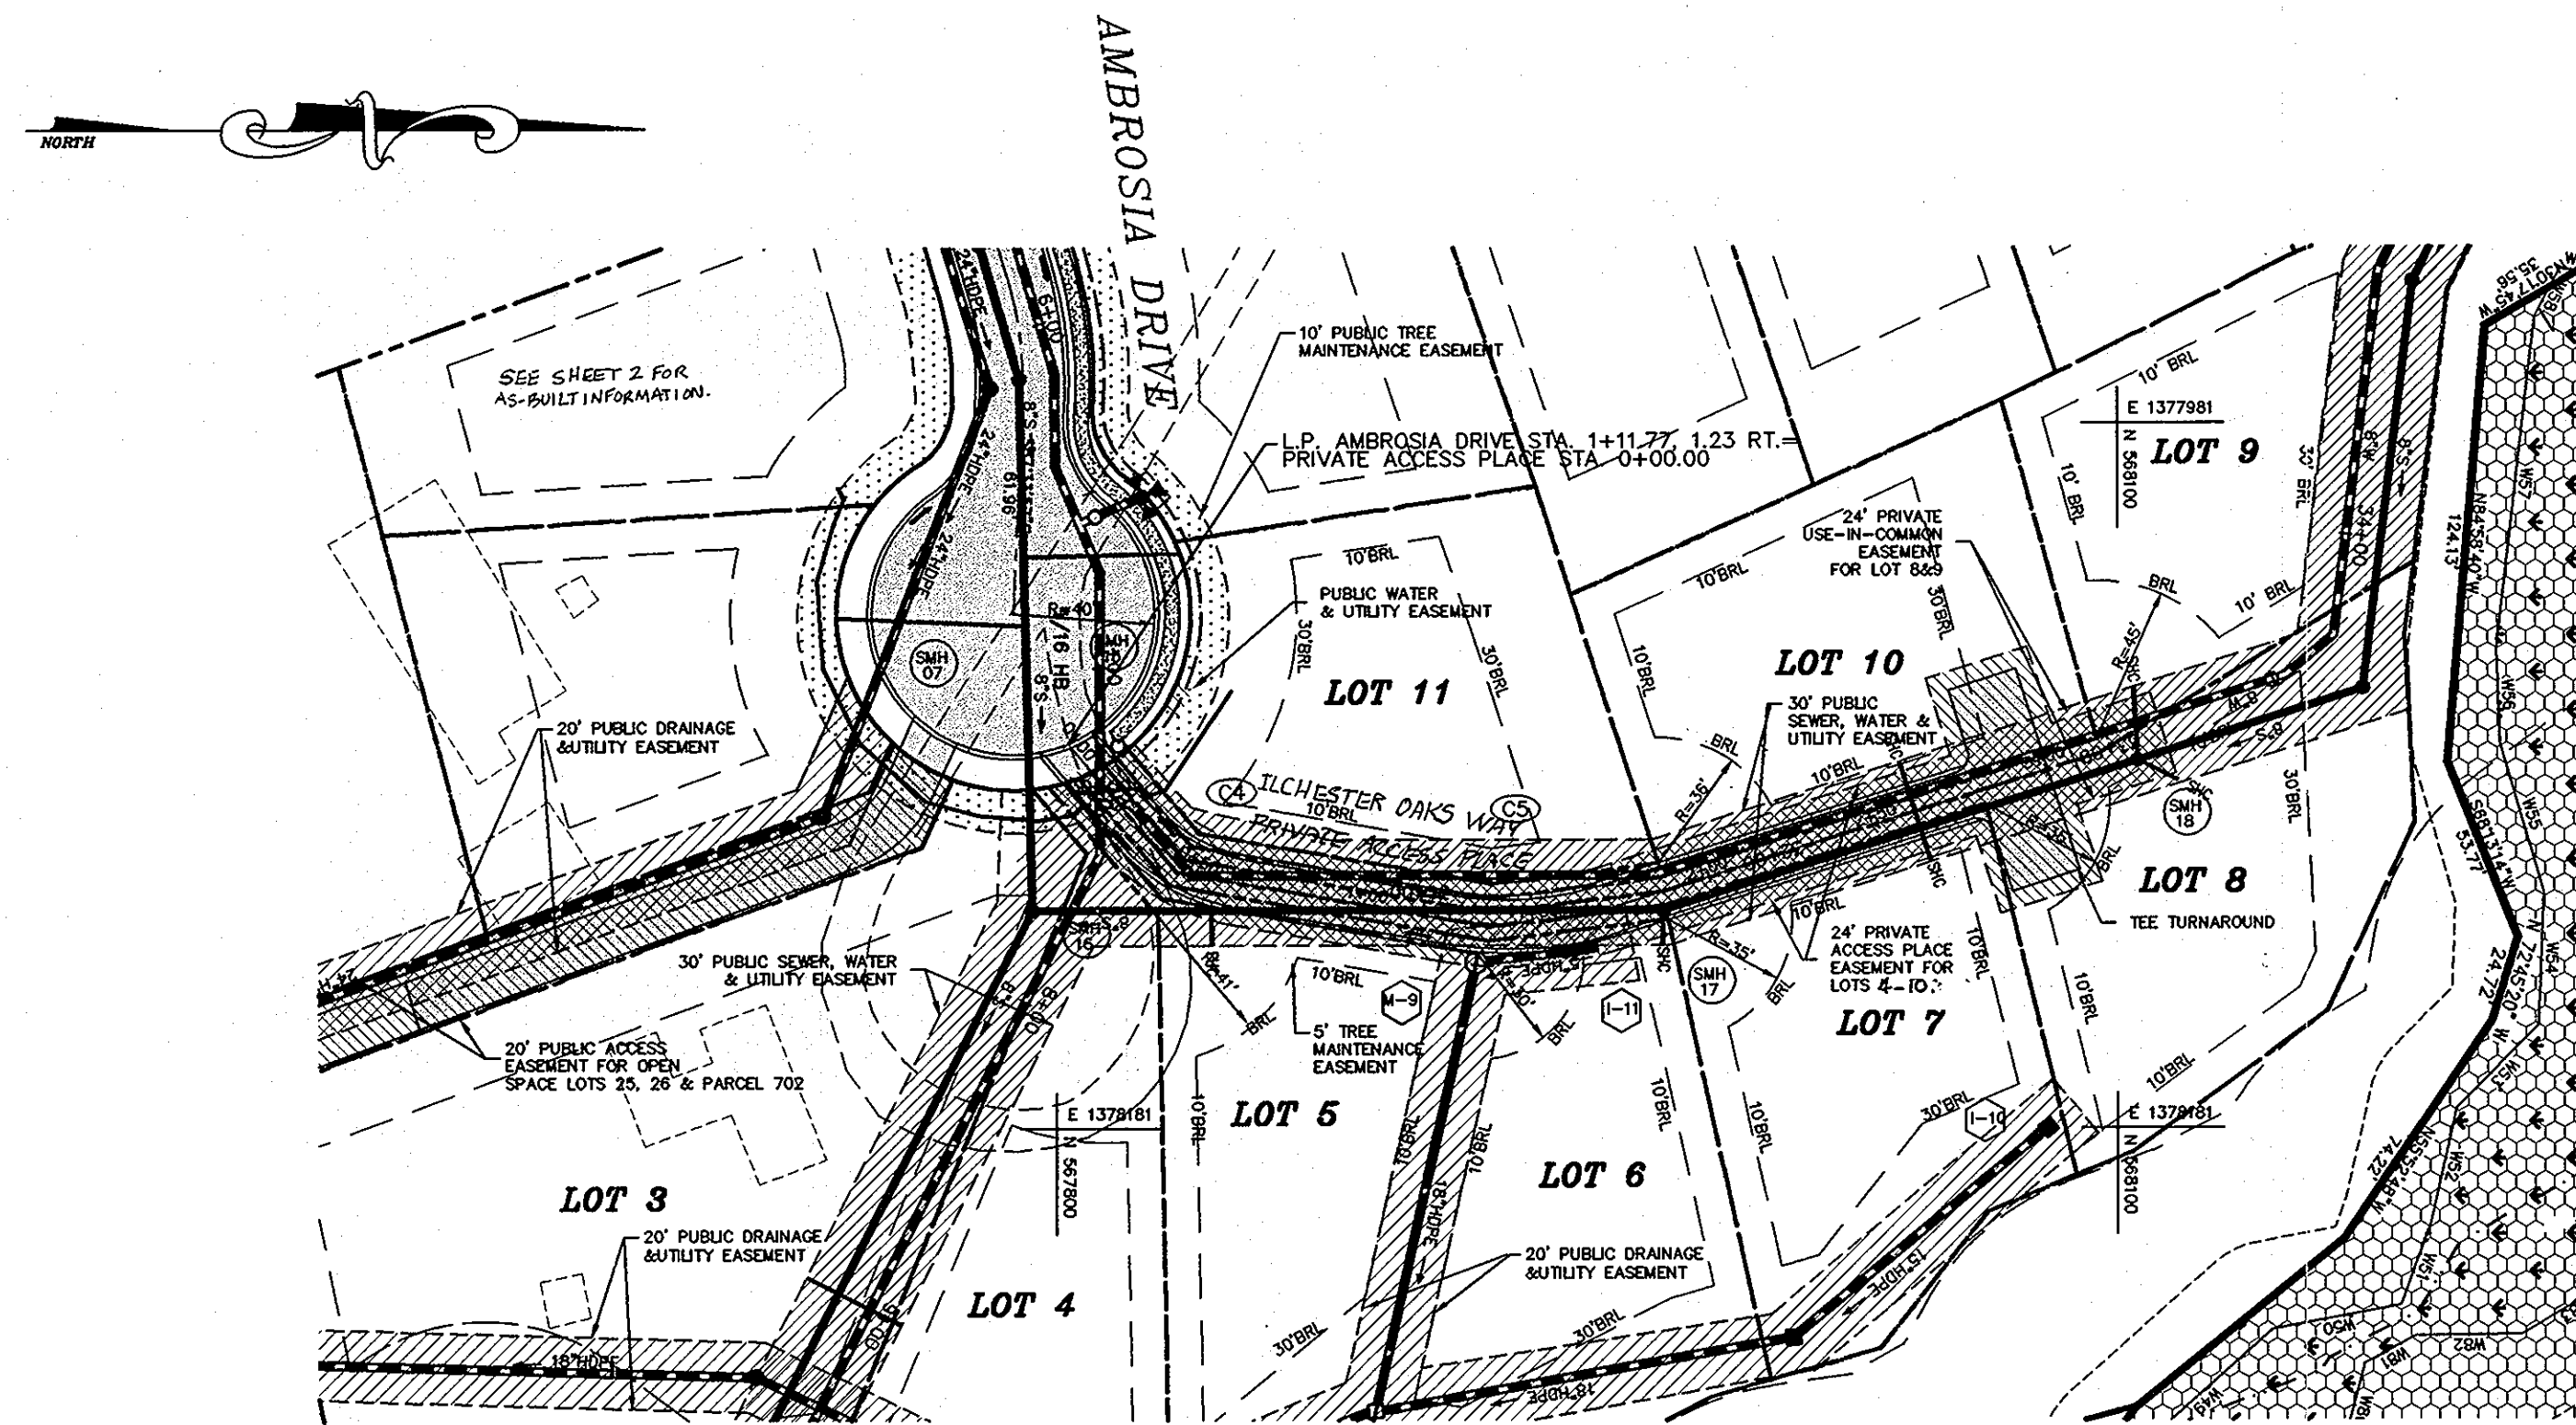


ILCHESTER OAKS WAY PLAN

SCALE: 1"=50'


CURVE TABLE					
CURVE	RADIUS	LENGTH	TANGENT	DELTA	CHORD
C4	50.00'	34.98'	18.24'	40°04'47"	N29°59'12"W 34.27'
C5	100.00'	48.13'	24.54'	27°54'32"	N03°50'27"E 47.67'

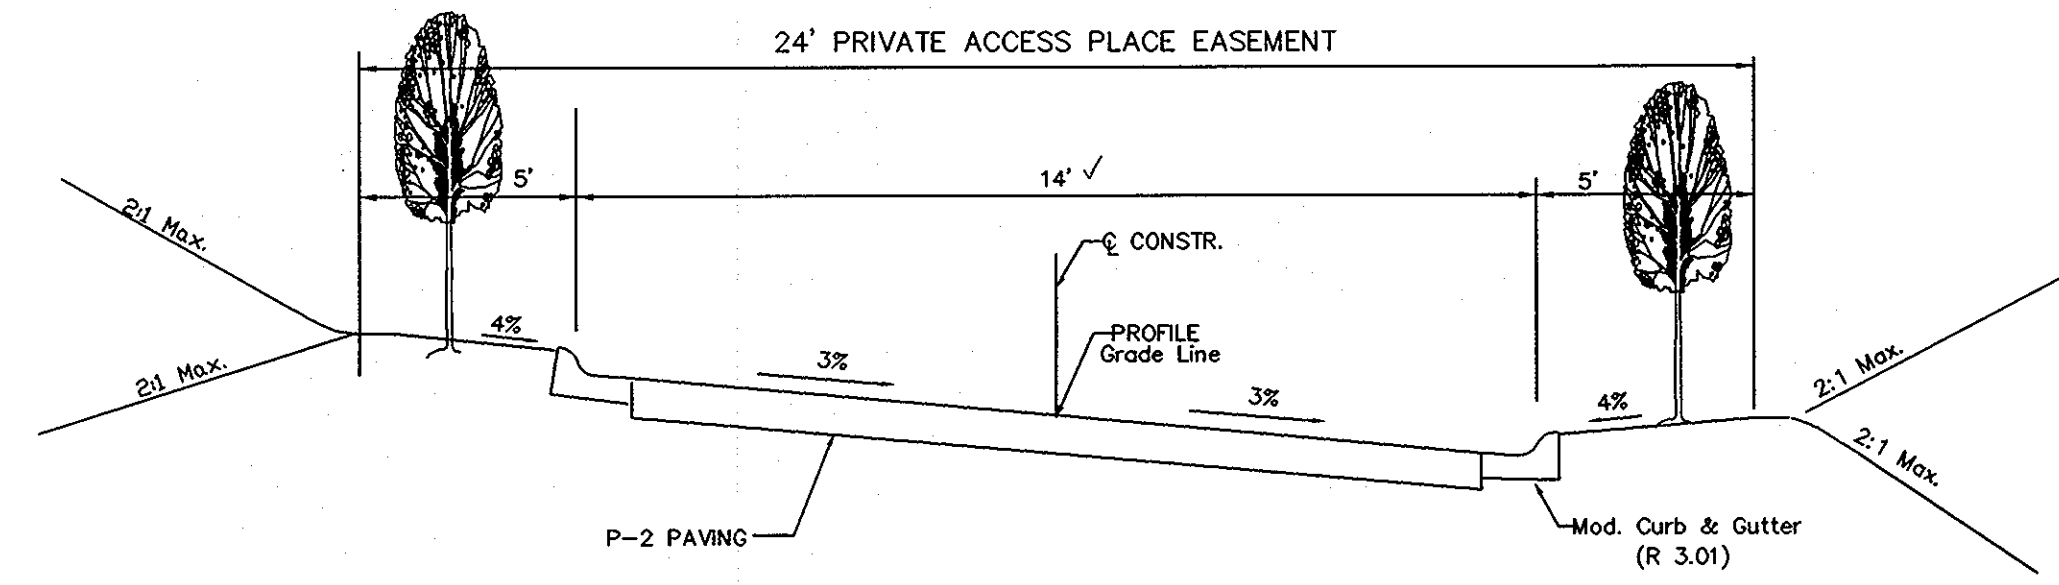

TYPICAL ROADWAY SECTION
 CLASSIFICATION: PRIVATE ACCESS PLACE
 DESIGN SPEED: 25 MPH
 STA. 0+00 TO STA. 3+10.92
 SECTION NOT TO SCALE

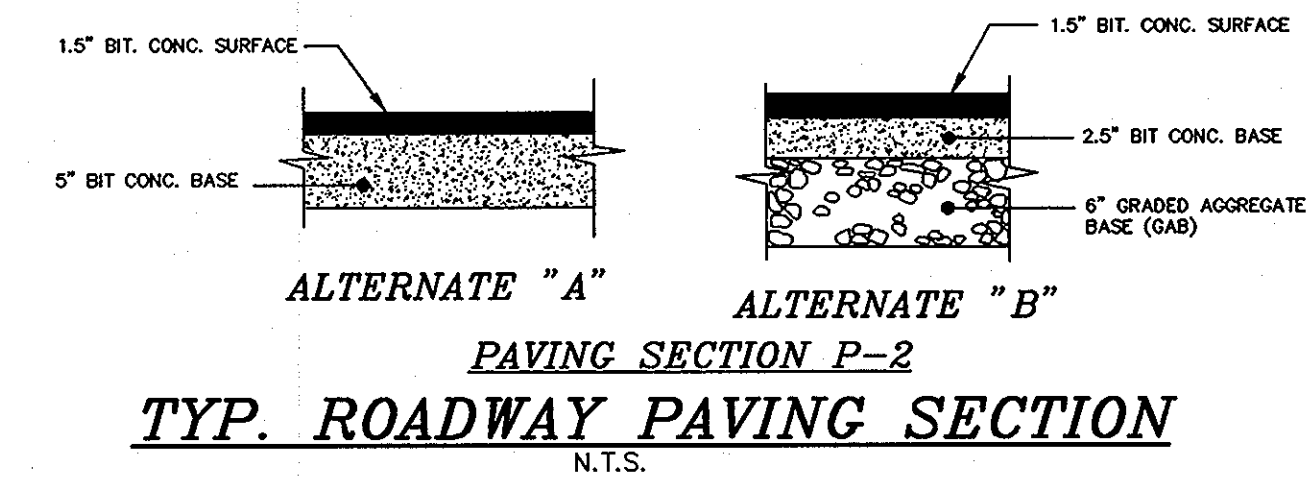


TYP. ROADWAY PAVING SECTION
 N.T.S.

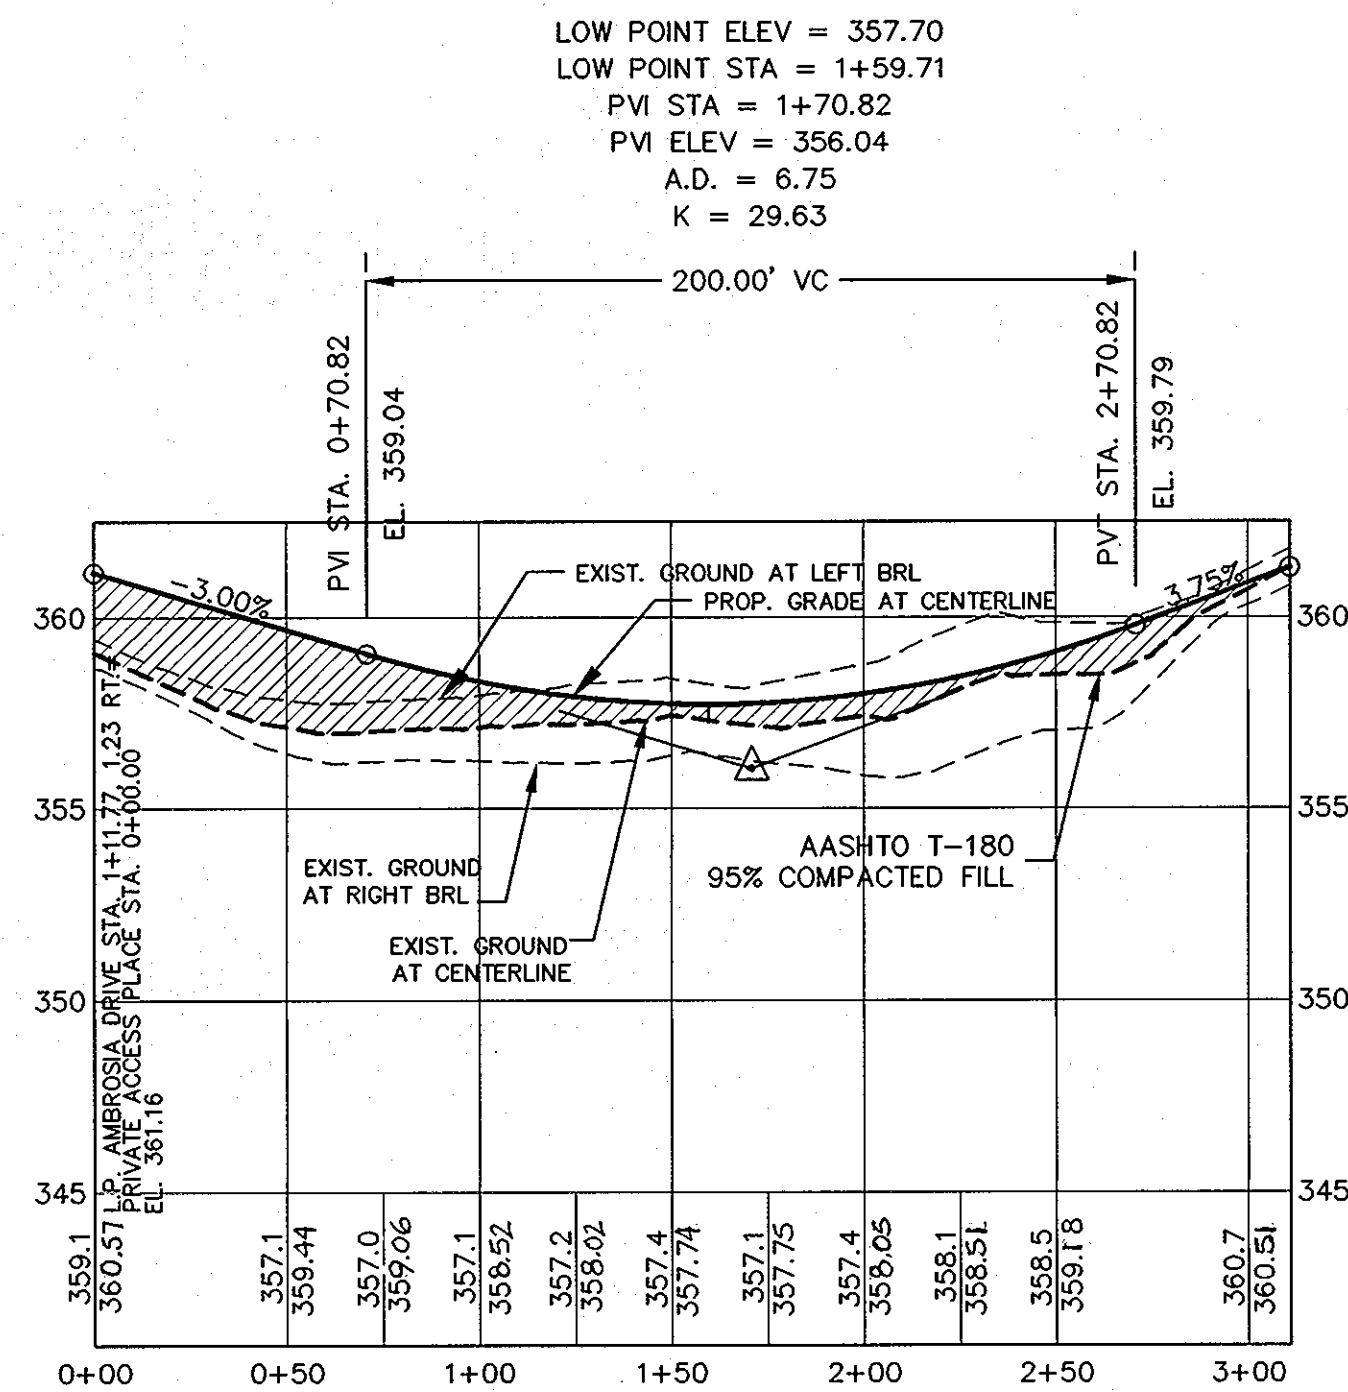

PRIVATE ACCESS PLACE PROFILE

SCALE: HOR. 1"=50'
 VER. 1"=5'

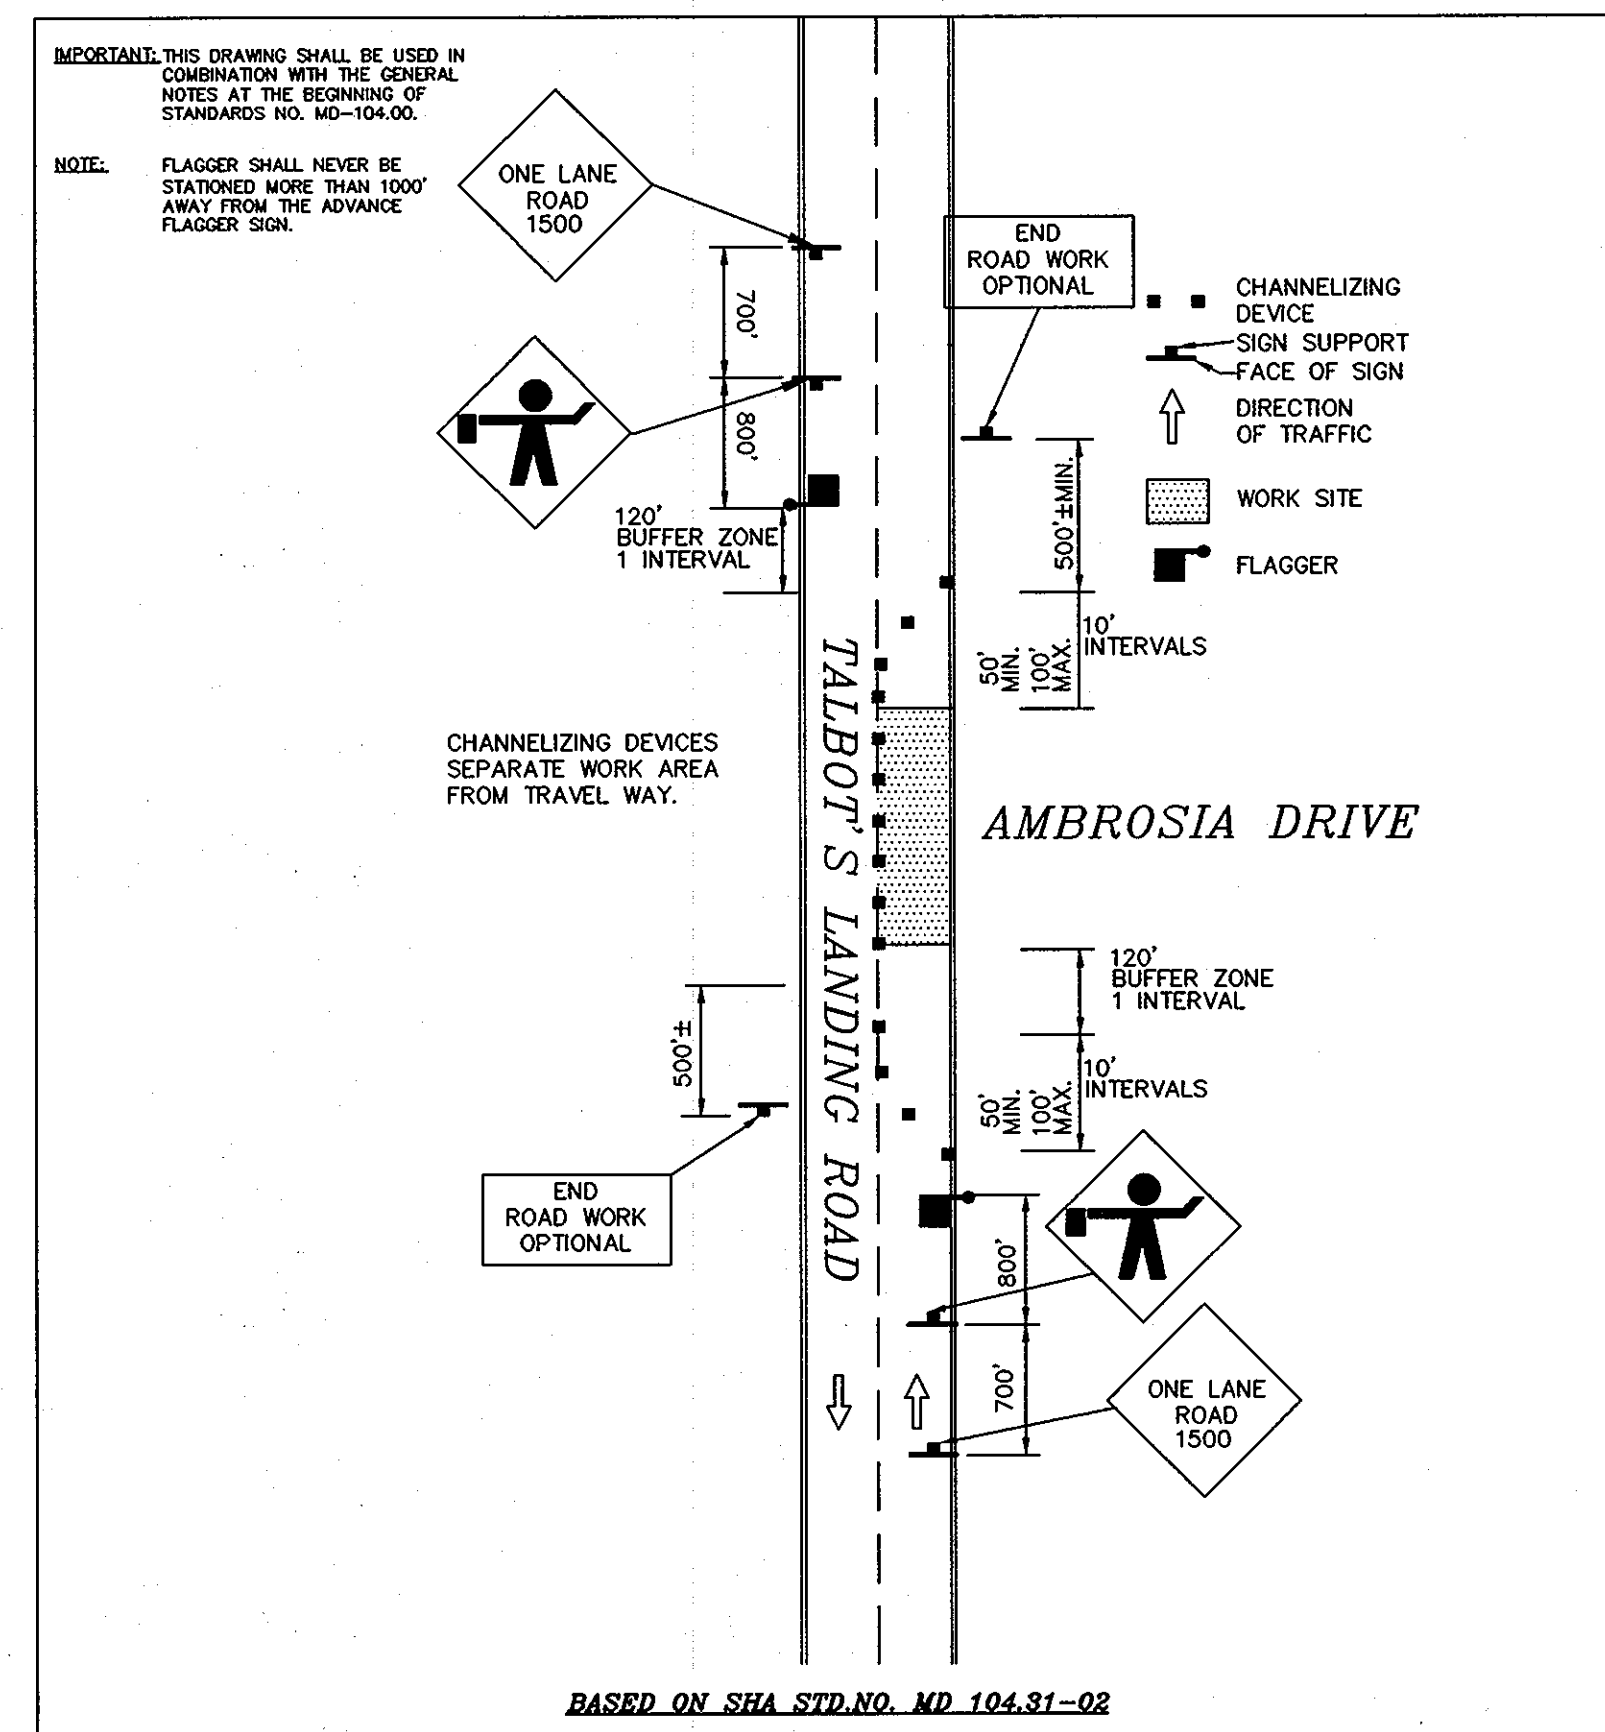

TEMPORARY TRAFFIC CONTROL PLAN



I HEREBY CERTIFY THAT THE FACILITY SHOWN ON THIS PLAN WAS CONSTRUCTED AS SHOWN ON THE AS-BUILT PLAN, AND MEETS WITH THE APPROVED PLANS AND SPECIFICATIONS.

DEVELOPER
 ELLICOTT CITY LAND HOLDING, INC.
 C/O DON REUER
 8000 MAIN STREET
 ELLICOTT CITY, MD 21043
 (410) 480-9105

APPROVED: DEPARTMENT OF PUBLIC WORKS
 [Signature] 7-27-04
 CHIEF BUREAU OF HIGHWAYS DATE

APPROVED: DEPARTMENT OF PLANNING AND ZONING
 [Signature] 8/10/04
 CHIEF, DIVISION OF LAND DEVELOPMENT DATE


[Signature] 7/20/04
 CHIEF, DEVELOPMENT ENGINEERING DIVISION DATE

project	2002-007	date	JUNE 2004
illustration	HSP	engineering	HSP
scale	HSP	approval	HSP
no.	1	AS SHOWN	JBM

no.	1	description	AS-BUILT INFORMATION ADDED	date	9/08
no.	2	description	AS-BUILT CHANGES	date	9/08
no.	3	description	REVISIONS	date	

ILCHESTER OAKS
 LOTS 1 THRU 22, OPEN SPACES 23 THRU 26 & NON-BUILDABLE PARCEL "A"
 TAX MAP 31 PARCEL 641 AND P/O PARCEL 699
 HOWARD COUNTY, MARYLAND
 FIRST ELECTION DISTRICT
ILCHESTER OAKS WAY PLAN AND PROFILE


MILDENBERG, BOENDER & ASSOC., INC.
 Engineers Planners Surveyors
 5072 Dorsey Hall Drive, Suite 202, Ellicott City, Maryland 21042
 (410) 997-0296 Fax. (301) 621-5521 Wash. (410) 997-0298 Fax.

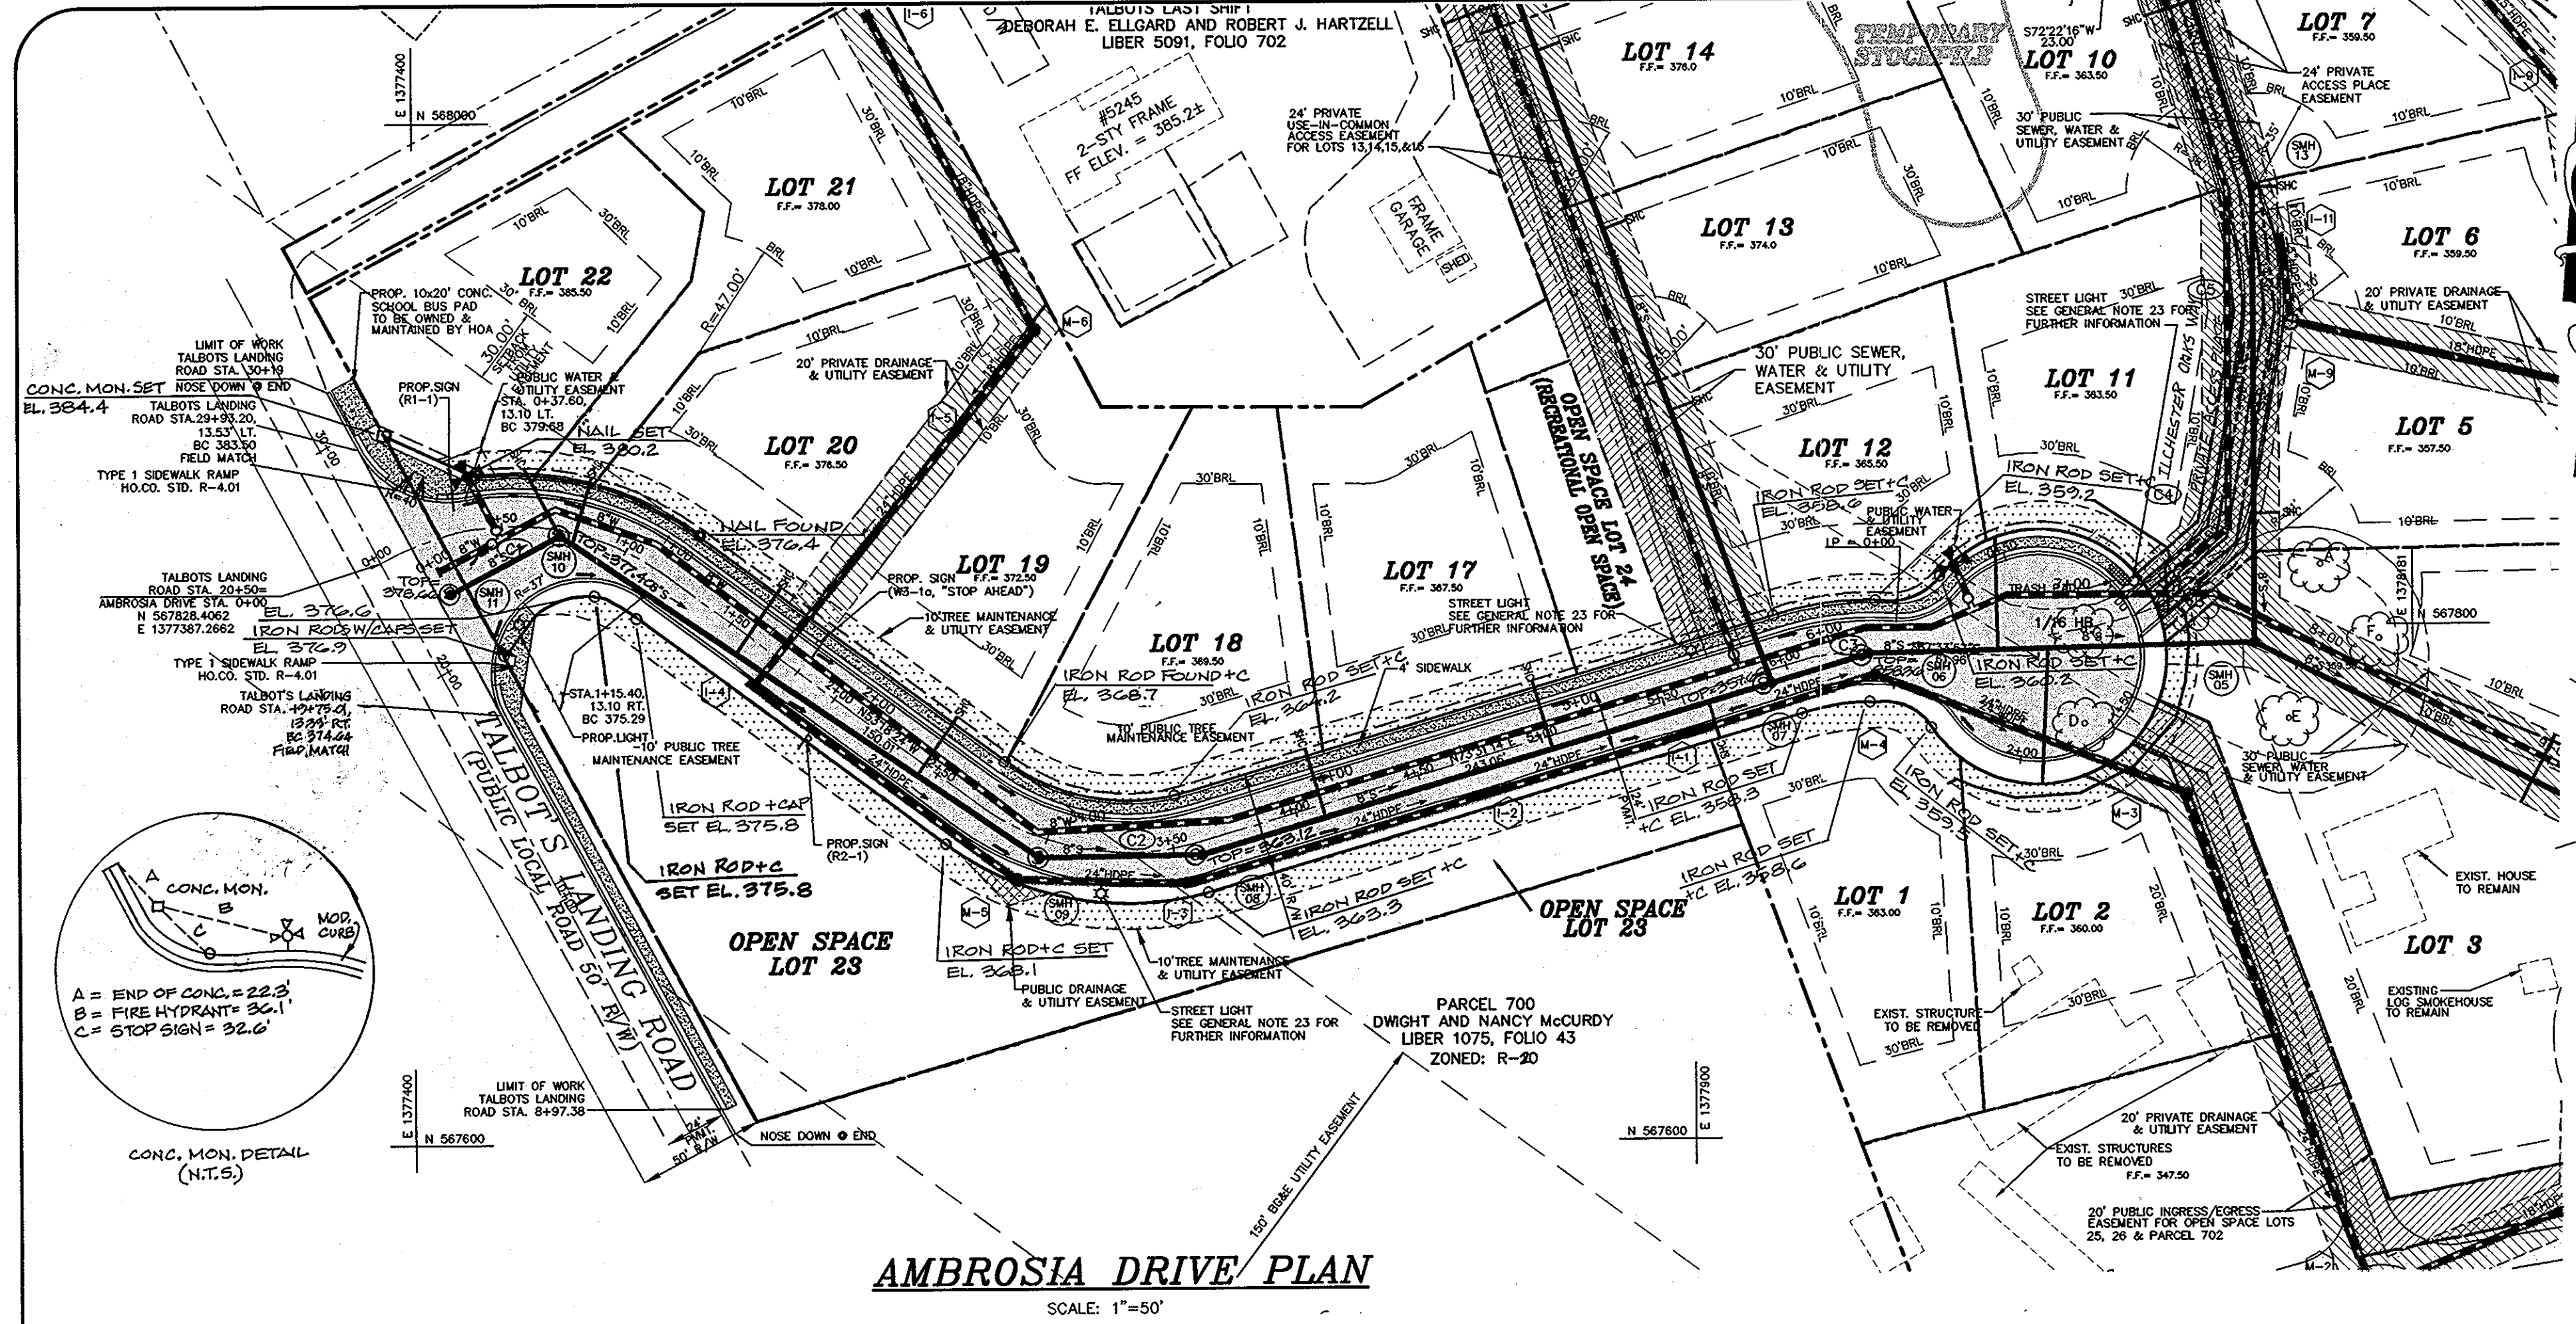


AMBROSIA DRIVE PLAN
SCALE: 1"=50'

NOTE: SEE GRADING PLAN FOR CONTINUATION OF THE STORM DRAIN.

CURVE TABLE					
CURVE	RADIUS	LENGTH	TANGENT	DELTA	CHORD
C1	100.00'	113.12'	63.47'	64°48'38"	N85°42'43"W 107.18'
C2	100.00'	92.80'	50.05'	53°10'22"	S79°53'35"E 89.51'
C3	100.00'	33.01'	16.66'	18°54'49"	S82°58'39"W 32.86'

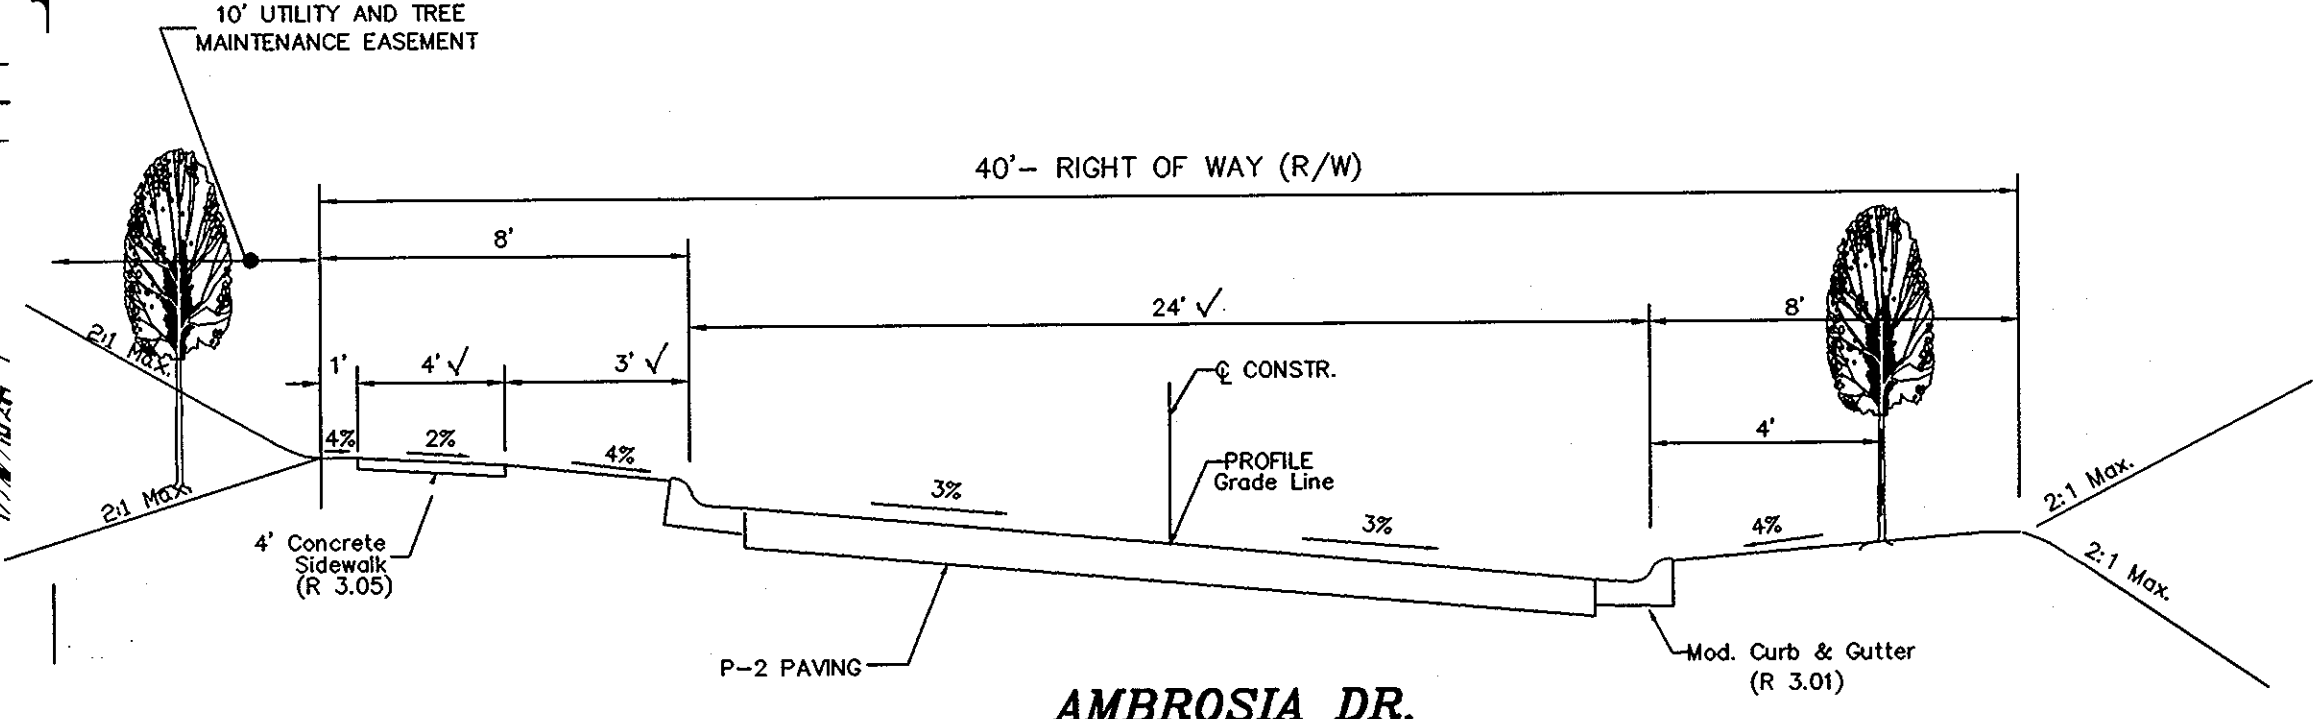


AMBROSIA DR.
TYPICAL ROADWAY SECTION
CLASSIFICATION: ACCESS STREET
DESIGN SPEED: 25 MPH
STA. 0+00 TO STA. 6+39.73
SECTION NOT TO SCALE

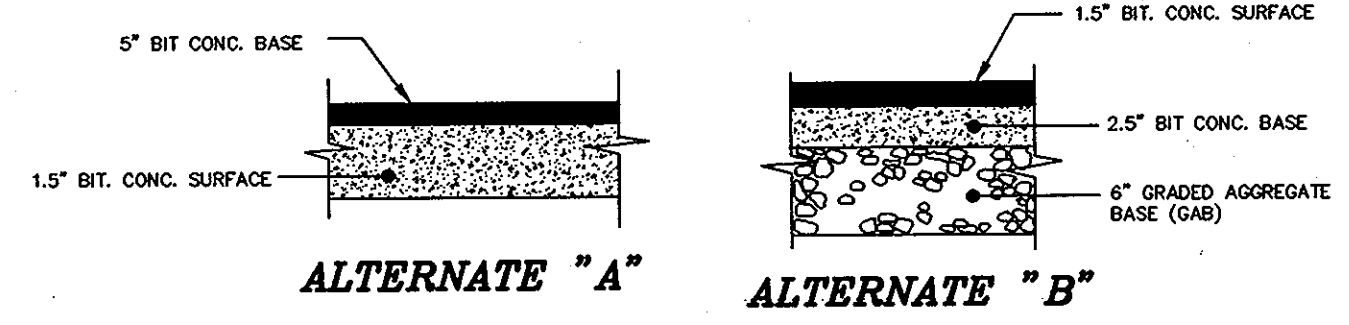

PAVING SECTION P-2
N.T.S.


TYP. PAVING SECTION FOR AMBROSIA DR.

HIGH POINT ELEV = 360.99
HIGH POINT STA = 1+09.74
PVI STA = 1+09.74
PVI ELEV = 361.17
A.D. = -4.00
K = 25.00

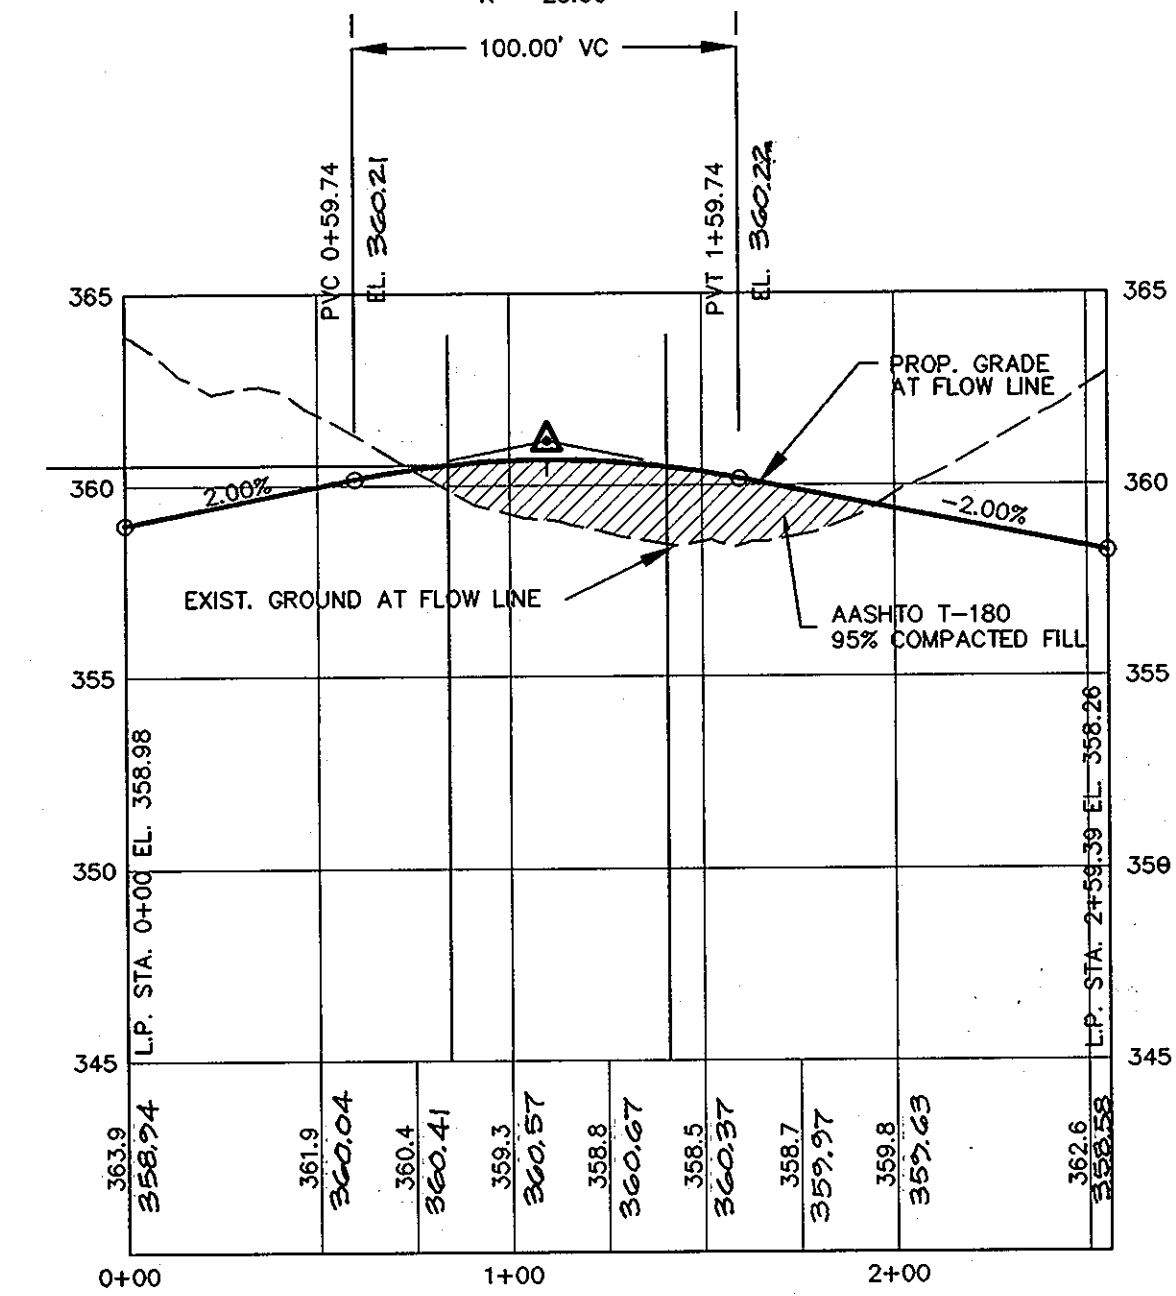


AMBROSIA DRIVE LINEAR PROFILE
SCALE: HOR. 1"=50'
VER. 1"=5'

NOTE: EXISTING PAVEMENT ON TALBOT'S LANDING ROAD IS TO BE SAW CUT AS REQUIRED FOR CONSTRUCTION OF CURB & GUTTER. NEW PAVEMENT OF TALBOT'S LANDING ROAD SHALL CONFORM TO HOWARD COUNTY STD-P-2 PAVING SECTION IF REQUIRED.

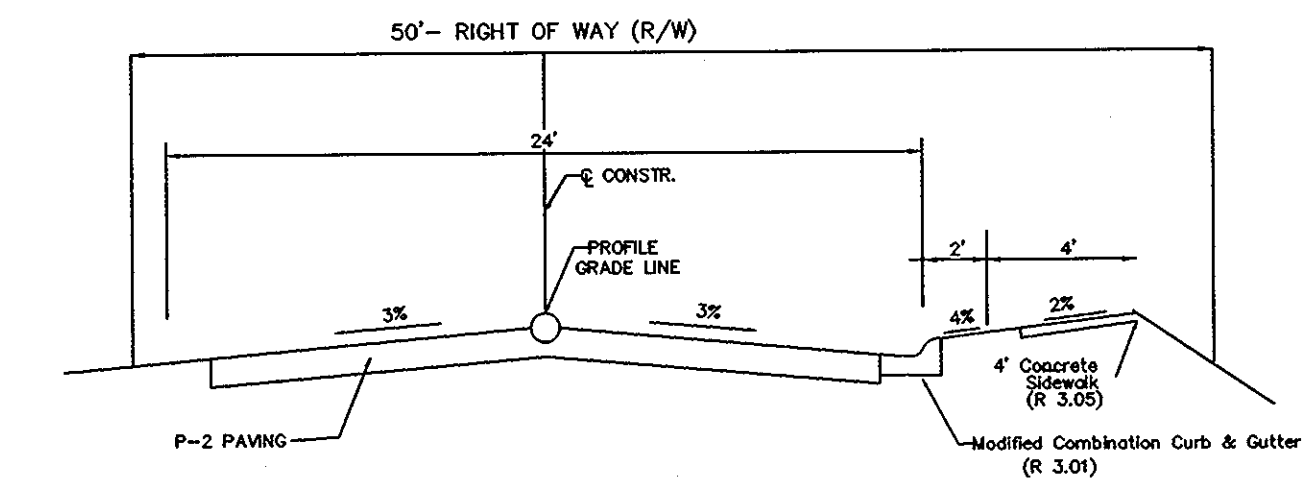

TYPICAL ROADWAY SECTION TALBOT'S LANDING ROAD
SECTION NOT TO SCALE

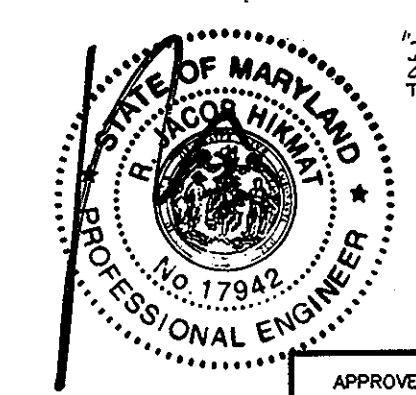


APPROVED: DEPARTMENT OF PUBLIC WORKS
William J. Mullen 7-27-04
CHIEF BUREAU OF HIGHWAYS MS DATE

APPROVED: DEPARTMENT OF PLANNING AND ZONING
Wanda Hamilton 8/10/04
CHIEF, DIVISION OF LAND DEVELOPMENT DATE

Chris Pannunzio 7/30/04
CHIEF, DEVELOPMENT ENGINEERING DIVISION DATE

DEVELOPER
ELLCOTT CITY LAND HOLDING, INC.
C/O DON REUWER
8000 MAIN STREET
ELLCOTT CITY, MD 21043
(410) 480-9105

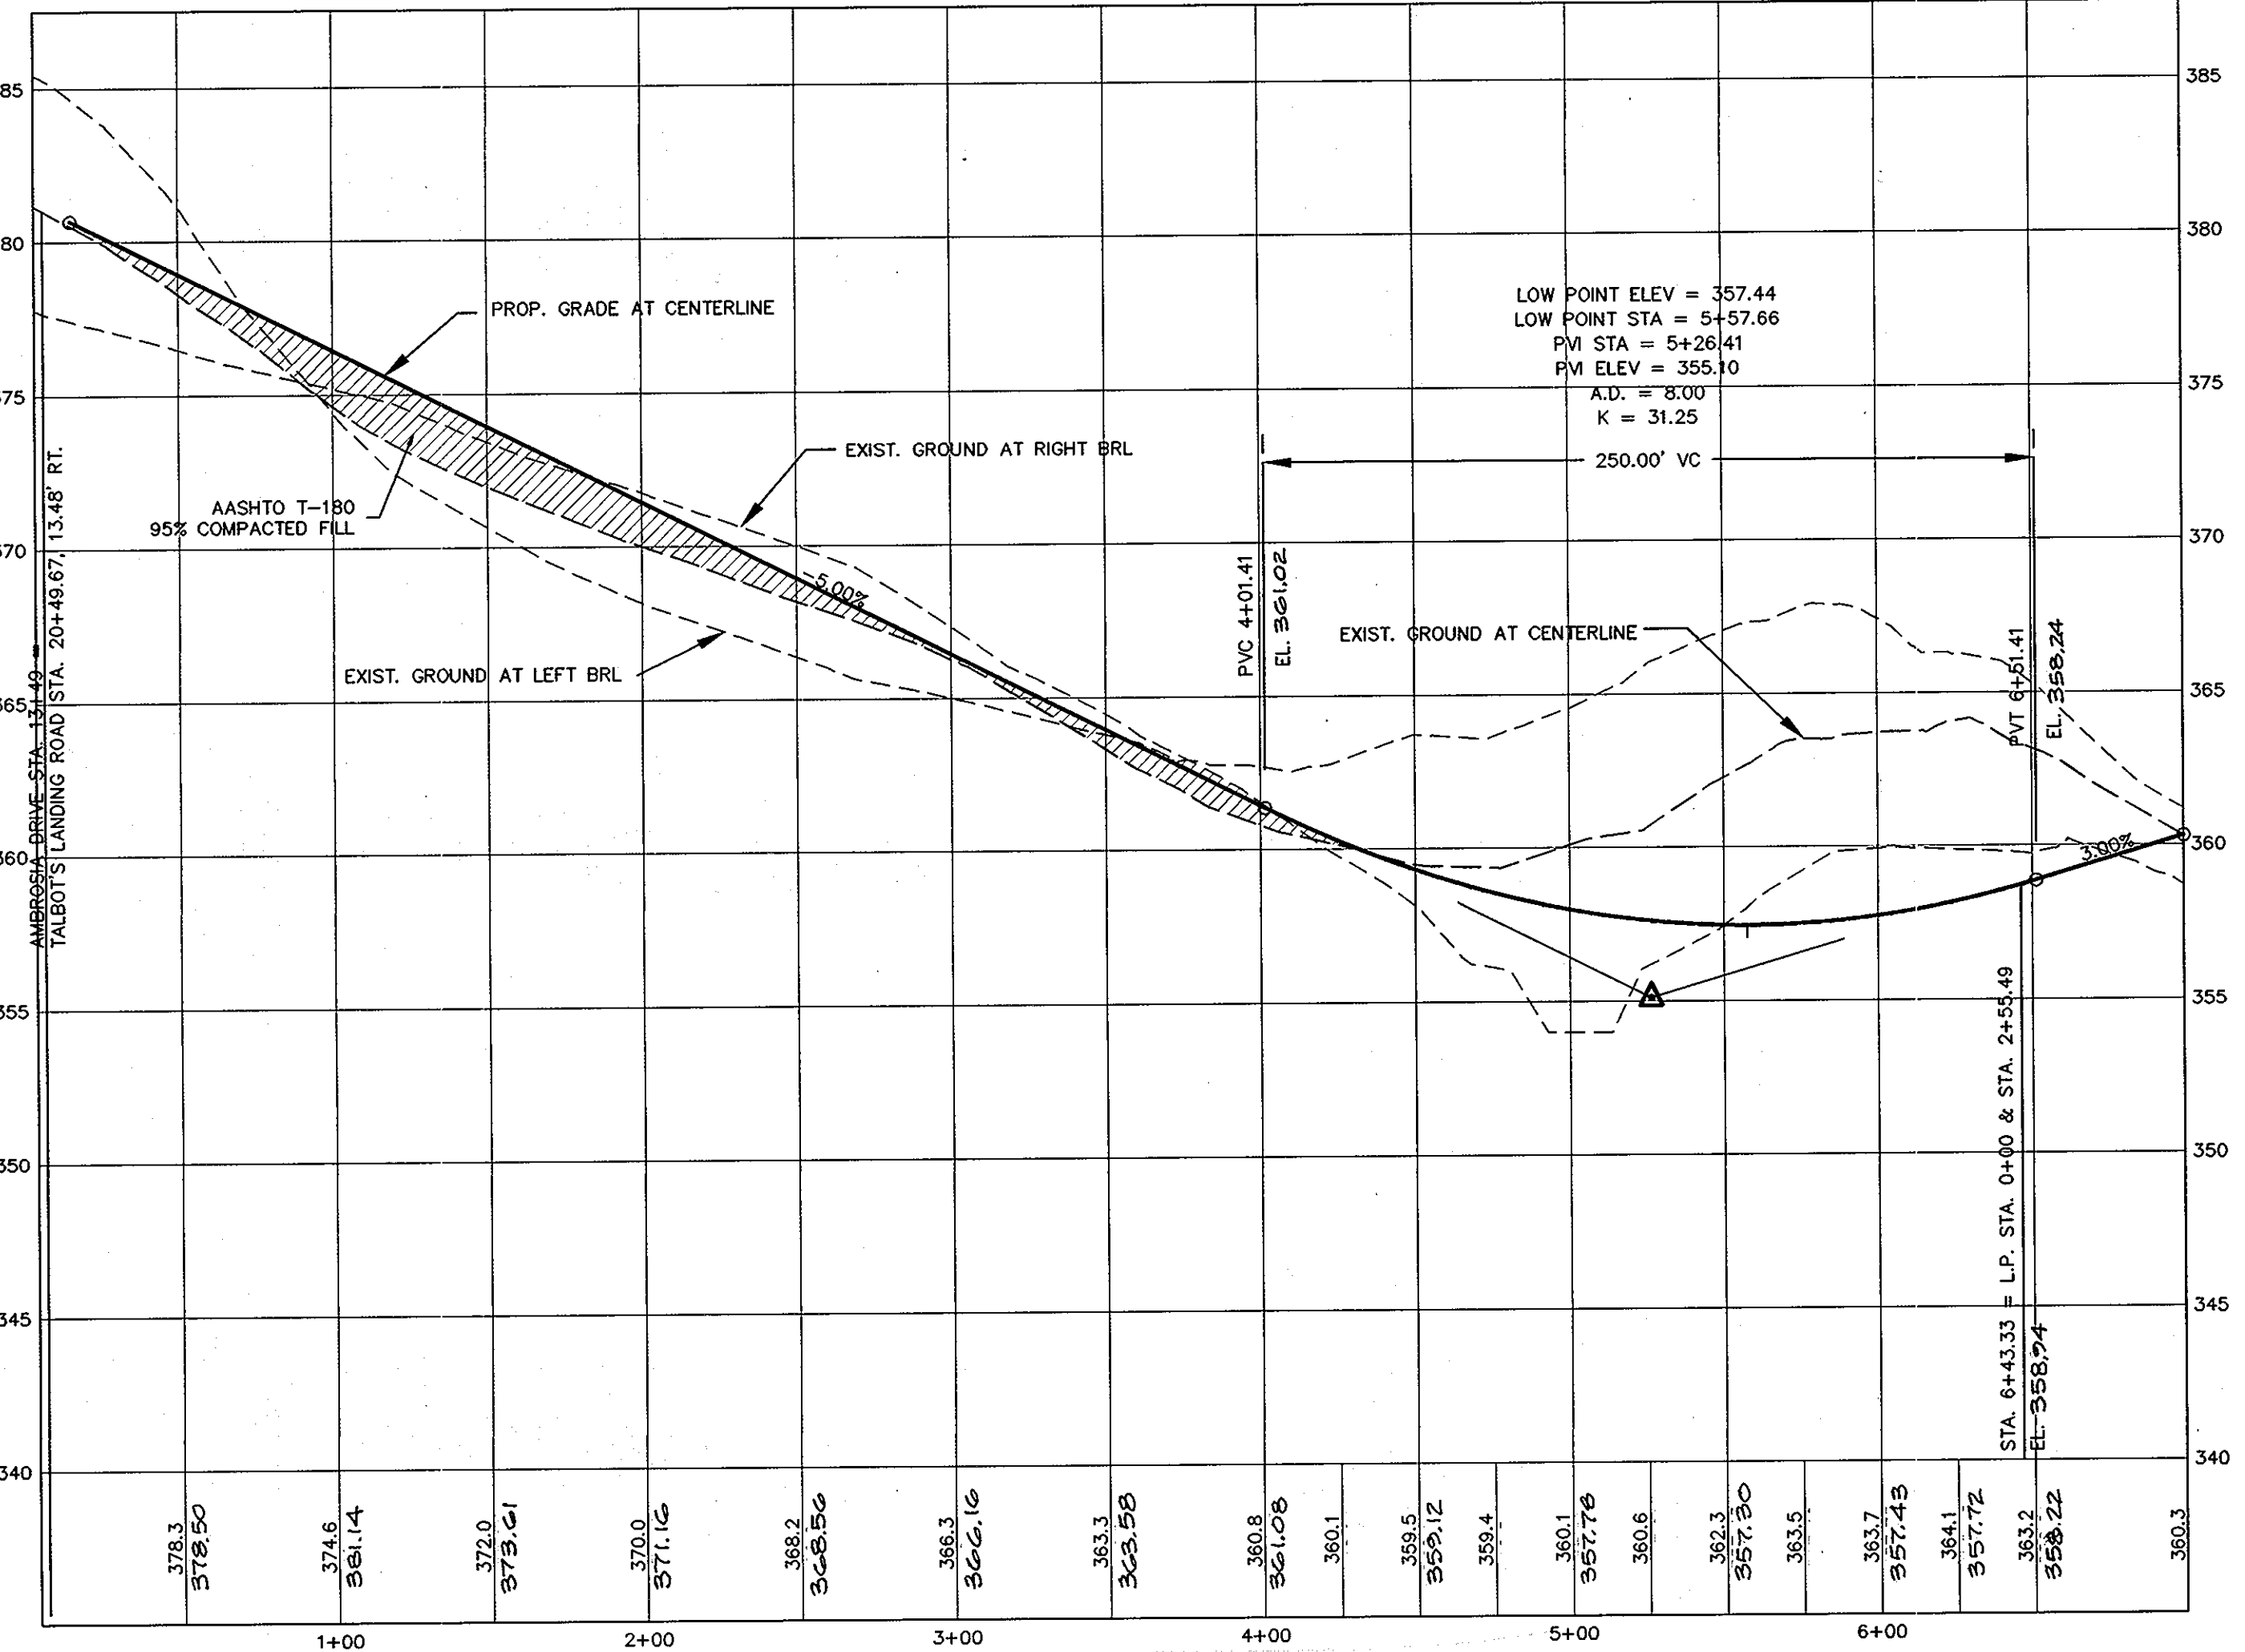

AMBROSIA DRIVE PROFILE
SCALE: HOR. 1"=50'
VER. 1"=5'

date	JUNE 2004	approval	JBM
project	2002-007	scale	NTS
illustration	HSP	description	AS-BUILT INFORMATION ADDED
revision	1	date	9/08
revision	2	date	OCT 06

LOT 1 THRU 22, OPEN SPACES 23 THRU 26 & NON-BUILDABLE PARCEL "A"
TAX MAP 31 PARCEL 641 AND P/O PARCEL 699
HOWARD COUNTY, MARYLAND
FIRST ELECTION DISTRICT

ILCHESTER OAKS
AMBROSIA DRIVE ROAD PLAN AND PROFILE

MILDENBERG & ASSOC., INC.
Engineers Planners Surveyors
5072 Dorsey Hall Drive, Suite 202, Ellicott City, Maryland 21042
(410) 997-0296 Balt. (301) 621-5521 Wash. (410) 997-0298 Fax.