


SCHEDULE A : PERIMETER LANDSCAPED EDGE

CATEGORY	ADJ. TO PERIMETER PROPERTIES ADJ. TO PERIMETER PROPERTIES ADJ. TO PERIMETER PROPERTIES	ADJ. TO PERIMETER PROPERTIES	TOTAL	
LANDSCAPE TYPE	PERIMETER 1- TYPE A	PERIMETER 2- TYPE A	PERIMETER 3- TYPE A	
LINEAR FEET OF PERIMETER	703.11 LF	448.35 LF	736.81 LF	
CREDIT FOR EXISTING VEGETATION (YES, NO, LINEAR FEET)	NO	NO	NO	
CREDIT FOR WALL, FENCE, OR BERM (YES, NO, LINEAR FEET)	NO	NO	NO	
NUMBER OF PLANTS REQUIRED	12 SHADE TREES 0 EVERGREEN TREES 0 SHRUBS	7 SHADE TREES 0 EVERGREEN TREES 0 SHRUBS	12 SHADE TREES 0 EVERGREEN TREES 0 SHRUBS	31 SHADE TREES 0 EVERGREEN TREES 0 SHRUBS
NUMBER OF PLANTS PROVIDED	12 SHADE TREES 0 EVERGREEN TREES 0 SUBSTITUTION TREES 0 SHRUBS (10:1 SUBSTITUTION)	7 SHADE TREES 0 EVERGREEN TREES 0 SUBSTITUTION TREES 0 SHRUBS	12 SHADE TREES 0 EVERGREEN TREES 0 SUBSTITUTION TREES 0 SHRUBS	31 SHADE TREES 0 EVERGREEN TREES 0 SUBSTITUTION TREES 0 SHRUBS

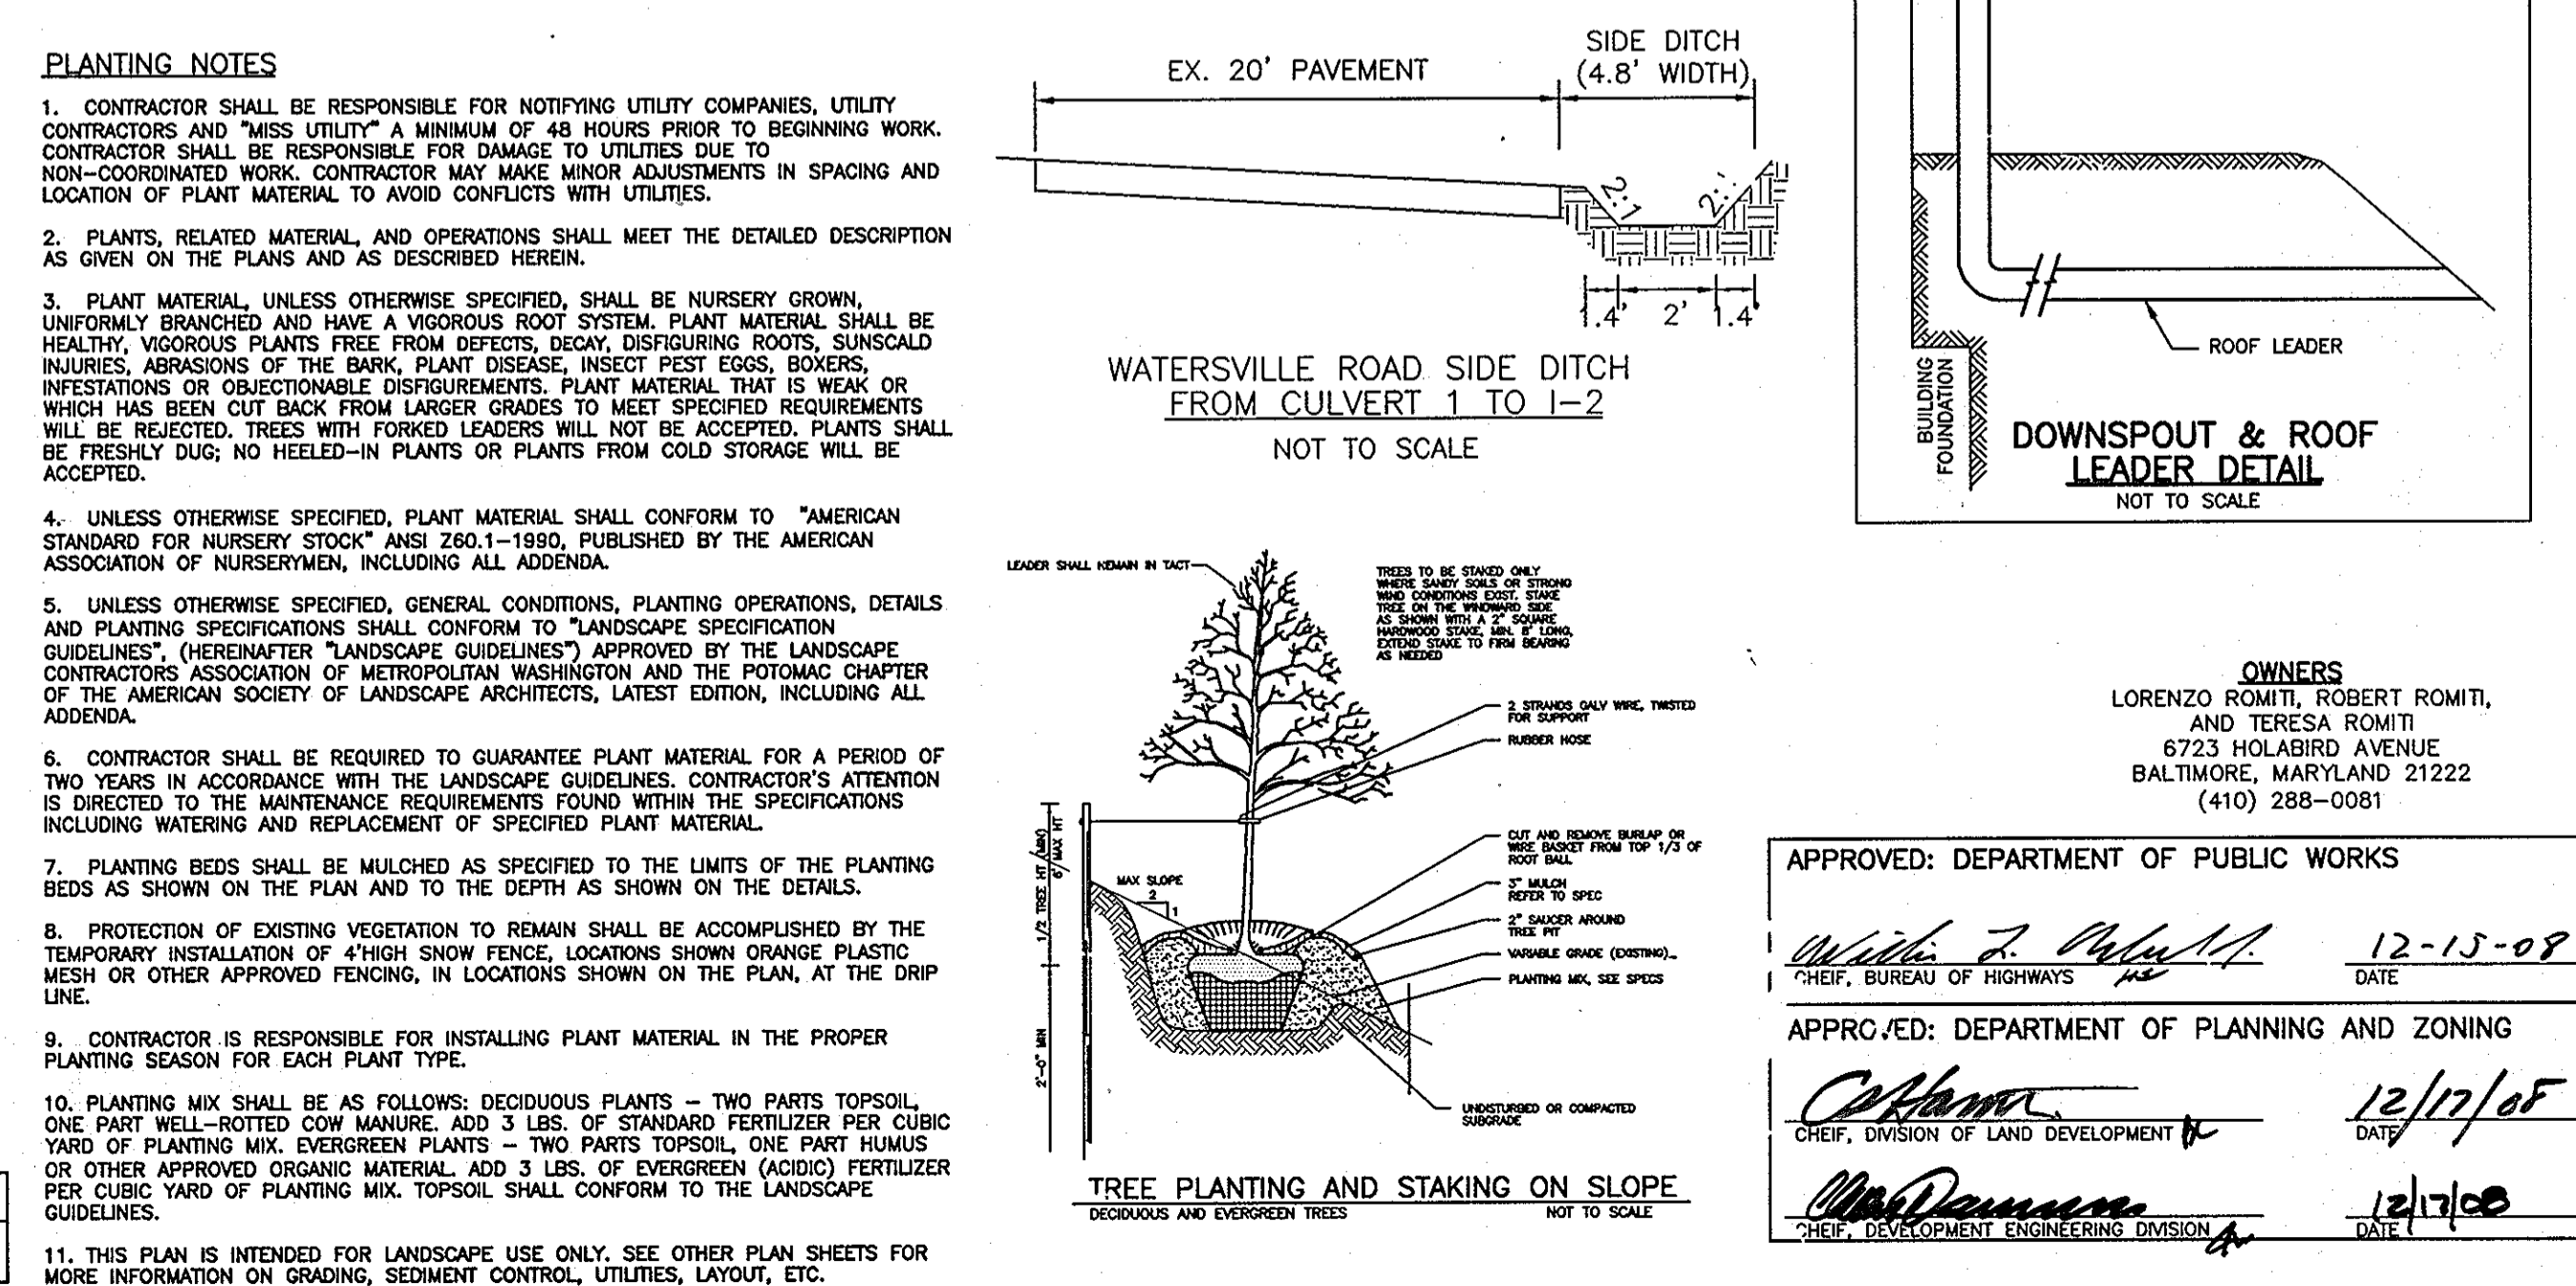

PERIMETER PLANT LIST

KEY	BOTANICAL NAME	COMMON NAME	SPACING	SIZE	REMARKS	QUANTITY
ARU	ACER RUBRUM RED SUNSET	RED SUNSET RED MAPLE	AS SHOWN	2.5"-3" CAL.	B&B	31

HARMS
ENGINEERS • PLANNERS • SURVEYORS
1209 N. EAST STREET, FREDERICK, MARYLAND, 21701
Office: 301/631-2027 Fax: 301/631-2028

NO.	REVISION	BY	DATE
1	AS-BUILT DATA	MA	7/9/12

SUPPLEMENTAL PLAN
ROMITI PROPERTY, LOTS 1 THRU 4 & PRESERVATION PARCELS D THRU F
A RESUBDIVISION OF ROMITI PROPERTY, PARCELS A THRU C
Tax Map 2, Parcel 61 (Parcel B), Grids 15, 16, & 17
Election District No. 6
Scale: AS SHOWN
Howard County, Maryland

APPROVED: DEPARTMENT OF PUBLIC WORKS
APPROVED: DEPARTMENT OF PLANNING AND ZONING

DESIGNED BY: SJD
DRAWN BY: SIN
CHECKED BY: SJD
DATE: DECEMBER 2008
W.O. NO. 08-07-017A

2 OF 2

Date: 12/10/2008 User: sdemchik Drawing Path: \\p0260\projects\romiti\Property\08-07-017A\Drawings\Final Plans\romiti-supplemental-plan.dwg XREF File(s): PR-BISE-ROMITI.dwg EX-BISE-ROMITI.dwg