

SHEET INDEX	
SHEET No.	SHEET
1	TITLE SHEET
2	ICE CRYSTAL DRIVE PLAN AND PROFILE
3	ICE CRYSTAL DRIVE PLAN AND PROFILE
4	BIRCHTREE LANE PLAN AND PROFILE
5	STREET TREE, GRADING AND SEDIMENT CONTROL PLAN
6	STREET TREE, GRADING AND SEDIMENT CONTROL PLAN
7	STREET TREE, GRADING AND SEDIMENT CONTROL PLAN
8	STORM DRAIN DRAINAGE AREA MAP & LANDSCAPE PLAN
9	TYPICAL ROADWAY SECTION AND DETAILS
10	STORM DRAIN PROFILES
11	STORM DRAIN PROFILES
12	SEDIMENT AND EROSION CONTROL NOTES & DETAILS
13	SEDIMENT AND EROSION CONTROL NOTES & DETAILS
14	S.W.M. NOTES & DETAILS
15	S.W.M. FACILITY NO. 1 PROFILES, NOTES & DETAILS
16	S.W.M. FACILITY NO. 2 PROFILES, NOTES & DETAILS
17	S.W.M. FACILITY NO. 2 PROFILES, NOTES & DETAILS
18	FOREST CONSERVATION PLAN
19	SEDIMENT AND EROSION CONTROL NOTES AND DETAILS
20	OFF-SITE FOREST CONSERVATION PLAN
21	FOREST CONSERVATION NOTES AND DETAILS

FINAL ROAD CONSTRUCTION, GRADING, STORMDRAINS AND STORMWATER MANAGEMENT PLANS

CHERRYTREE PARK

LOTS 1 THRU 10, OPEN SPACE LOTS 11 THRU 13 AND BULK PARCELS 'A' THRU 'H'

(PHASES I AND II)


ZONED MXD-6

TAX MAP No. 46 PARCEL No. 156 GRID NO. 4

APPROVED: DEPARTMENT OF PUBLIC WORKS <i>Andrew M. D'Amico</i> CHIEF, BUREAU OF HIGHWAYS	1-16-02 DATE
APPROVED: DEPARTMENT OF PLANNING AND ZONING <i>Cathy Kamata</i> CHIEF, DIVISION OF LAND DEVELOPMENT	2/4/02 DATE
<i>Mark D'Amico</i> CHIEF, DEVELOPMENT ENGINEERING DIVISION	2/4/02 DATE

ROAD CLASSIFICATION CHART		
ROAD NAME	CLASSIFICATION	R/W WIDTH
ICE CRYSTAL DRIVE	PUBLIC LOCAL STREET	60'
BIRCHTREE LANE	PUBLIC ACCESS STREET	40'

TRAFFIC CONTROL SIGNS				
STREET NAME	C.L. STATION	OFFSET	POSTED SIGN	SIGN CODE
ICE CRYSTAL DRIVE	0+47	2'L	KEEP RIGHT	R4-7
ICE CRYSTAL DRIVE	1+92	2'R	KEEP RIGHT	R4-7
ICE CRYSTAL DRIVE	0+63	24'R	YIELD	R1-2
ICE CRYSTAL DRIVE	1+78	24'L	YIELD	R1-2
ICE CRYSTAL DRIVE	4+00	21'R	SPEED LIMIT 25	R2-1
ICE CRYSTAL DRIVE	11+00	21'R	SPEED LIMIT 25	R2-1
BIRCHTREE LANE	0+80	2'R	KEEP RIGHT	R4-7
BIRCHTREE LANE	0+55	22'L	YIELD	R1-2
BIRCHTREE LANE	2+40	14'R	SPEED LIMIT 25	R2-1
BIRCHTREE LANE	1+30	14'R	ONE LANE ROAD AHEAD	
BIRCHTREE LANE	3+13	14'L	ONE LANE ROAD AHEAD	
BIRCHTREE LANE	5+51	14'R	ONE LANE ROAD AHEAD	
BIRCHTREE LANE	6+51	14'L	ONE LANE ROAD AHEAD	

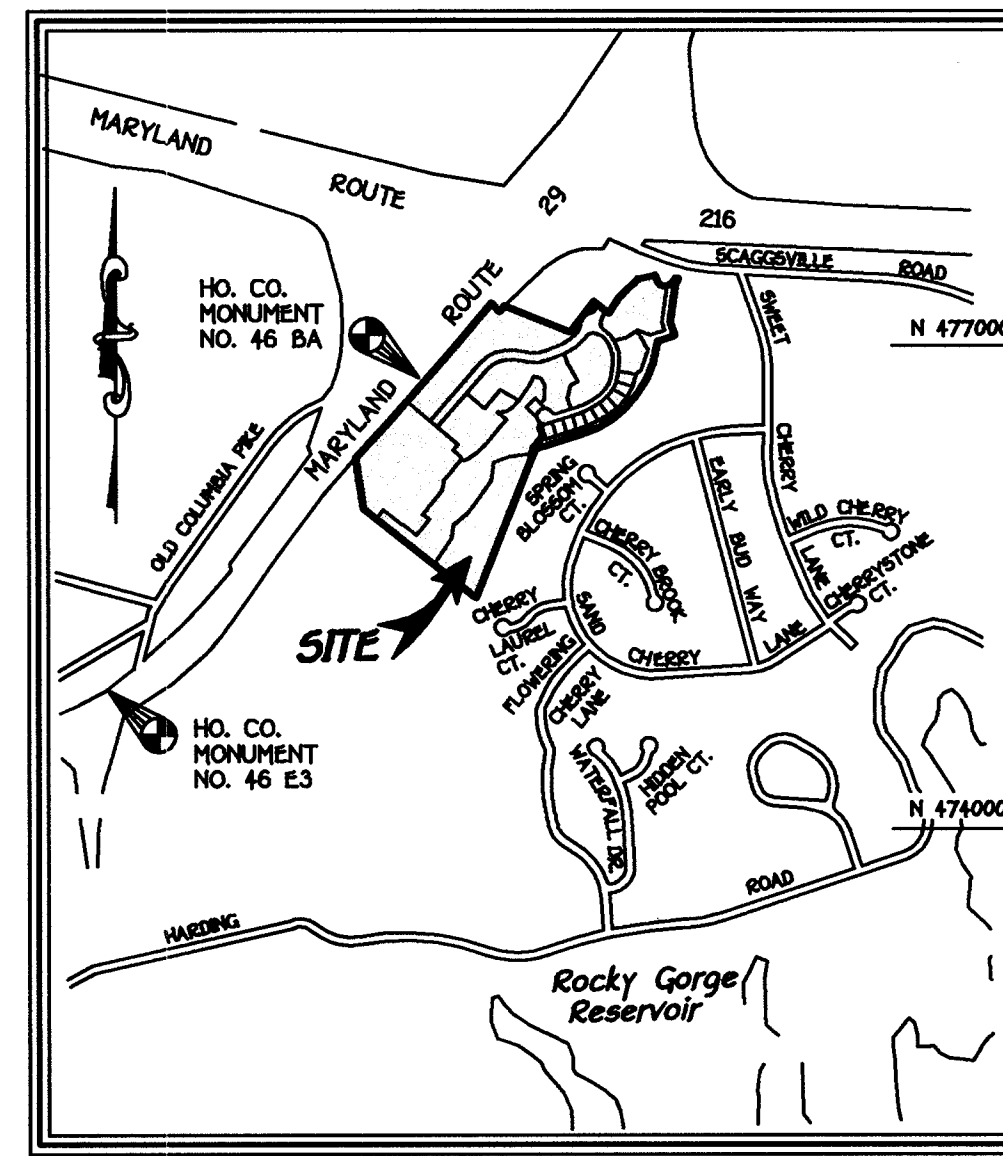

VICINITY MAP

SCALE: 1" = 1200'

SIXTH ELECTION DISTRICT HOWARD COUNTY, MARYLAND

STREET LIGHT CHART			
STREET NAME	STATION	OFFSET	FIXTURE/POLE TYPE
ICE CRYSTAL DRIVE	* C.L. STA. 0+66	25'R	150-WATT H.P.S. VAPOR PENDANT (CUT-OFF) MOUNTED AT 30° ON A BRONZE FIBERGLASS POLE USING A 12' ARM
	* C.L. STA. 1+62	40'R	
	* C.L. STA. 1+72	20'L	
	C.L. STA. 4+90	23'L	
	C.L. STA. 7+65	23'R	
BIRCHTREE LANE	* C.L. STA. 10+78	23'R	150-WATT H.P.S. VAPOR PENDANT (CUT-OFF) MOUNTED AT 30° ON A BRONZE FIBERGLASS POLE USING A 12' ARM
	* C.L. STA. 13+59	20'L	
BIRCHTREE LANE	* C.L. STA. 0+52	25'L	150-WATT H.P.S. VAPOR PENDANT (CUT-OFF) MOUNTED AT 30° ON A BRONZE FIBERGLASS POLE USING A 12' ARM
BIRCHTREE LANE	C.L. STA. 2+67	10'L	100-WATT "TRADITIONAIRE" H.P.S. VAPOR FIXTURE, POST TOP FIXTURE MOUNTED ON A 14-FOOT BLACK FIBERGLASS POLE.
	C.L. STA. 6+00	10'L	
BIRCHTREE LANE	L.P. STA. 1+30	3' BEHIND CURB	100-WATT "TRADITIONAIRE" H.P.S. VAPOR FIXTURE, POST TOP FIXTURE MOUNTED ON A 14-FOOT BLACK FIBERGLASS POLE.

* - ANGLE ARM AS SHOWN ON PLAN


AT&T EASEMENT NOTE:
NO CONSTRUCTION ACTIVITIES ARE ALLOWED WITHIN THE AT&T CABLE EASEMENT WITHOUT DIRECT SUPERVISION BY AT&T PERSONNEL. NOTICE TO ENTER, CROSS & INSTALL THE PROPOSED STORM DRAINS WITHIN THE AT&T EASEMENT MUST BE GIVEN TO AT&T A MINIMUM OF FORTY-EIGHT (48) HOURS PRIOR TO ANY CONSTRUCTION ACTIVITY.

GENERAL NOTES:

- ALL CONSTRUCTION SHALL BE IN ACCORDANCE WITH THE LATEST STANDARDS AND SPECIFICATIONS OF HOWARD COUNTY PLUS MSHA STANDARDS AND SPECIFICATIONS IF APPLICABLE.
- THE CONTRACTOR SHALL NOTIFY THE DEPARTMENT OF PUBLIC WORKS / BUREAU OF ENGINEERING / CONSTRUCTION INSPECTION DIVISION AT (410) 313-1800 AT LEAST (5) WORKING DAYS PRIOR TO THE START OF WORK.
- THE CONTRACTOR SHALL NOTIFY "MISS UTILITY" AT 1-800-257-7777 AT LEAST 48 HOURS PRIOR TO ANY EXCAVATION WORK BEING DONE.
- TRAFFIC CONTROL DEVICES, MARKINGS AND SIGNING SHALL BE IN ACCORDANCE WITH THE LATEST EDITION OF THE MANUAL OF UNIFORM TRAFFIC CONTROL DEVICES (MUTCD). ALL STREET AND REGULATORY SIGNS SHALL BE IN PLACE PRIOR TO THE PLACEMENT OF ANY ASPHALT.
- 2 FOOT CONTOUR TOPOGRAPHY AND EXISTING CONDITIONS BASED ON FIELD RUN SURVEY PREPARED BY FISHER, COLLINS & CARTER, INC. ON OR ABOUT AUGUST 1998.
- COORDINATES BASED ON NAD '83, MARYLAND COORDINATE SYSTEM AS PROJECTED BY HOWARD COUNTY GEODETIC CONTROL STATIONS NO. 46 BA AND NO. 46 E3
46 BA N 537,545.640
E 1,339,849.050
46 E3 N 535,610.715
E 1,337,927.533
- PUBLIC WATER AND SEWER WILL BE USED WITHIN THE PROJECT, CONTRACT NO. 24-4000-D LOCATED IN THE PATUXENT RIVER DRAINAGE AREA, WATERSHED CODE 02-13-11.
- THE TRAFFIC STUDY WAS PREPARED BY THE TRAFFIC GROUP, INC. DATED JULY, 2000.
- BACKGROUND INFORMATION:
A. SUBDIVISION NAME: CHERRYTREE PARK
B. TAX MAP NO.: 46
C. PARCEL NO.: 156
D. ZONING: MXD-6
E. ELECTION DISTRICT: SIXTH
F. TOTAL TRACT AREA: 41.078 AC
G. TOTAL AREA OF PHASE I: 25.672 AC
H. NO. OF BUILDABLE LOTS: 10
I. NO. OF BULK PARCELS: 8
J. NO. OF OPEN SPACE LOTS: 3
K. PRELIMINARY EQUIVALENT SKETCH PLAN APPROVAL DATE: 12-20-00
L. PREVIOUS FILE NO.: 78 973M SP 00-06
M. TOTAL AREA OF OPEN SPACE REQUIRED: 8.985 AC.
N. TOTAL AREA OF OPEN SPACE PROVIDED: 12.636 AC.
- NO CEMETERIES EXIST ON THE PROPERTY.
- ALL FILL AREAS WITHIN ROADWAYS AND UNDER STRUCTURES SHALL BE COMPACTED TO A MINIMUM OF 95% COMPACTION OF AASHTO T-99.
- THE FOREST DELINEATION AND WETLAND ANALYSIS WERE DELINEATED BY MCCARTHY AND ASSOCIATES, INC. DATED JULY, 2000.
- THE FOREST CONSERVATION EASEMENT(S) HAS BEEN ESTABLISHED TO FULFILL THE REQUIREMENTS OF SECTION 16.1200 OF THE HOWARD COUNTY FOREST CONSERVATION ACT. NO CLEARING, GRADING OR CONSTRUCTION IS PERMITTED WITHIN THE FOREST CONSERVATION EASEMENT, EXCEPT AS SHOWN ON AN APPROVED ROAD CONSTRUCTION DRAWING OR SITE DEVELOPMENT PLAN. HOWEVER, FOREST MANAGEMENT PRACTICES AS DEFINED IN THE DEED OF FOREST CONSERVATION EASEMENT ARE ALLOWED. THE FOREST CONSERVATION REQUIREMENTS FOR THIS SITE WILL BE MET BY PROVIDING 4.82 ACRES OF ON-SITE RETENTION AND 5.29 ACRES OF OFF-SITE AFFORESTATION PLANTING ON OPEN SPACE LOTS 6 AND 129 OF THE ASHLIEGH KNOLLS SUBDIVISION KNOWN AS F 93-16 AND F 96-22. THE SURETY AMOUNT FOR THIS PROJECT WILL BE \$188,833.40.
- STORMWATER MANAGEMENT FACILITY:
TYPE - POND No 1 IS WET POOL DESIGN, POND No. 2 IS EXTENDED DETENTION
OWNER - HOMEOWNERS ASSOCIATION
MAINTENANCE - PRIVATELY MAINTAINED.
- STREET LIGHTS WILL BE REQUIRED IN THE DEVELOPMENT IN ACCORDANCE WITH THE DESIGN MANUAL STREET LIGHT PLACEMENT AND THE TYPE OF FIXTURE AND POLE SELECTED SHALL BE IN ACCORDANCE WITH THE LATEST HOWARD COUNTY DESIGN MANUAL, VOLUME III (1993) AND AS MODIFIED BY "GUIDELINES FOR STREET LIGHTS IN RESIDENTIAL DEVELOPMENTS (JUNE 1993)". THE JUNE 1993 POLICY INCLUDES GUIDELINES FOR LATERAL AND LONGITUDINAL PLACEMENT. A MINIMUM OF 20' SHALL BE MAINTAINED BETWEEN ANY STREET LIGHT AND ANY TREE.
- THE NOISE STUDY WAS PREPARED BY STAIANO ENGINEERING, INC. DATED JULY, 2000, AND APPROVED UNDER SP-00-09.
- THE PROPOSED 4' WIDE MACADAM PATHWAY SYSTEM UNDER SP-00-08 IS TO BE CONSTRUCTED WITH THE FUTURE SITE DEVELOPMENT PLAN SUBMISSIONS.
- EXISTING UTILITIES SHOWN HEREON ARE TAKEN FROM CURRENT HOWARD COUNTY CONTRACT DRAWINGS.
A. EXISTING WATER CONTRACT No. 24-3741
B. EXISTING SEWER CONTRACT Nos. 24-3741 AND 24-1906-D

COLUMBIA PIKE US ROUTE 29

REVISIONS		
No.	DESCRIPTION	DATE
1	REVISE STORM DRAIN FOR AT&T CROSSING AND REMOVE TRAFFIC CALMING ON BIRCHTREE LANE	10-10-02

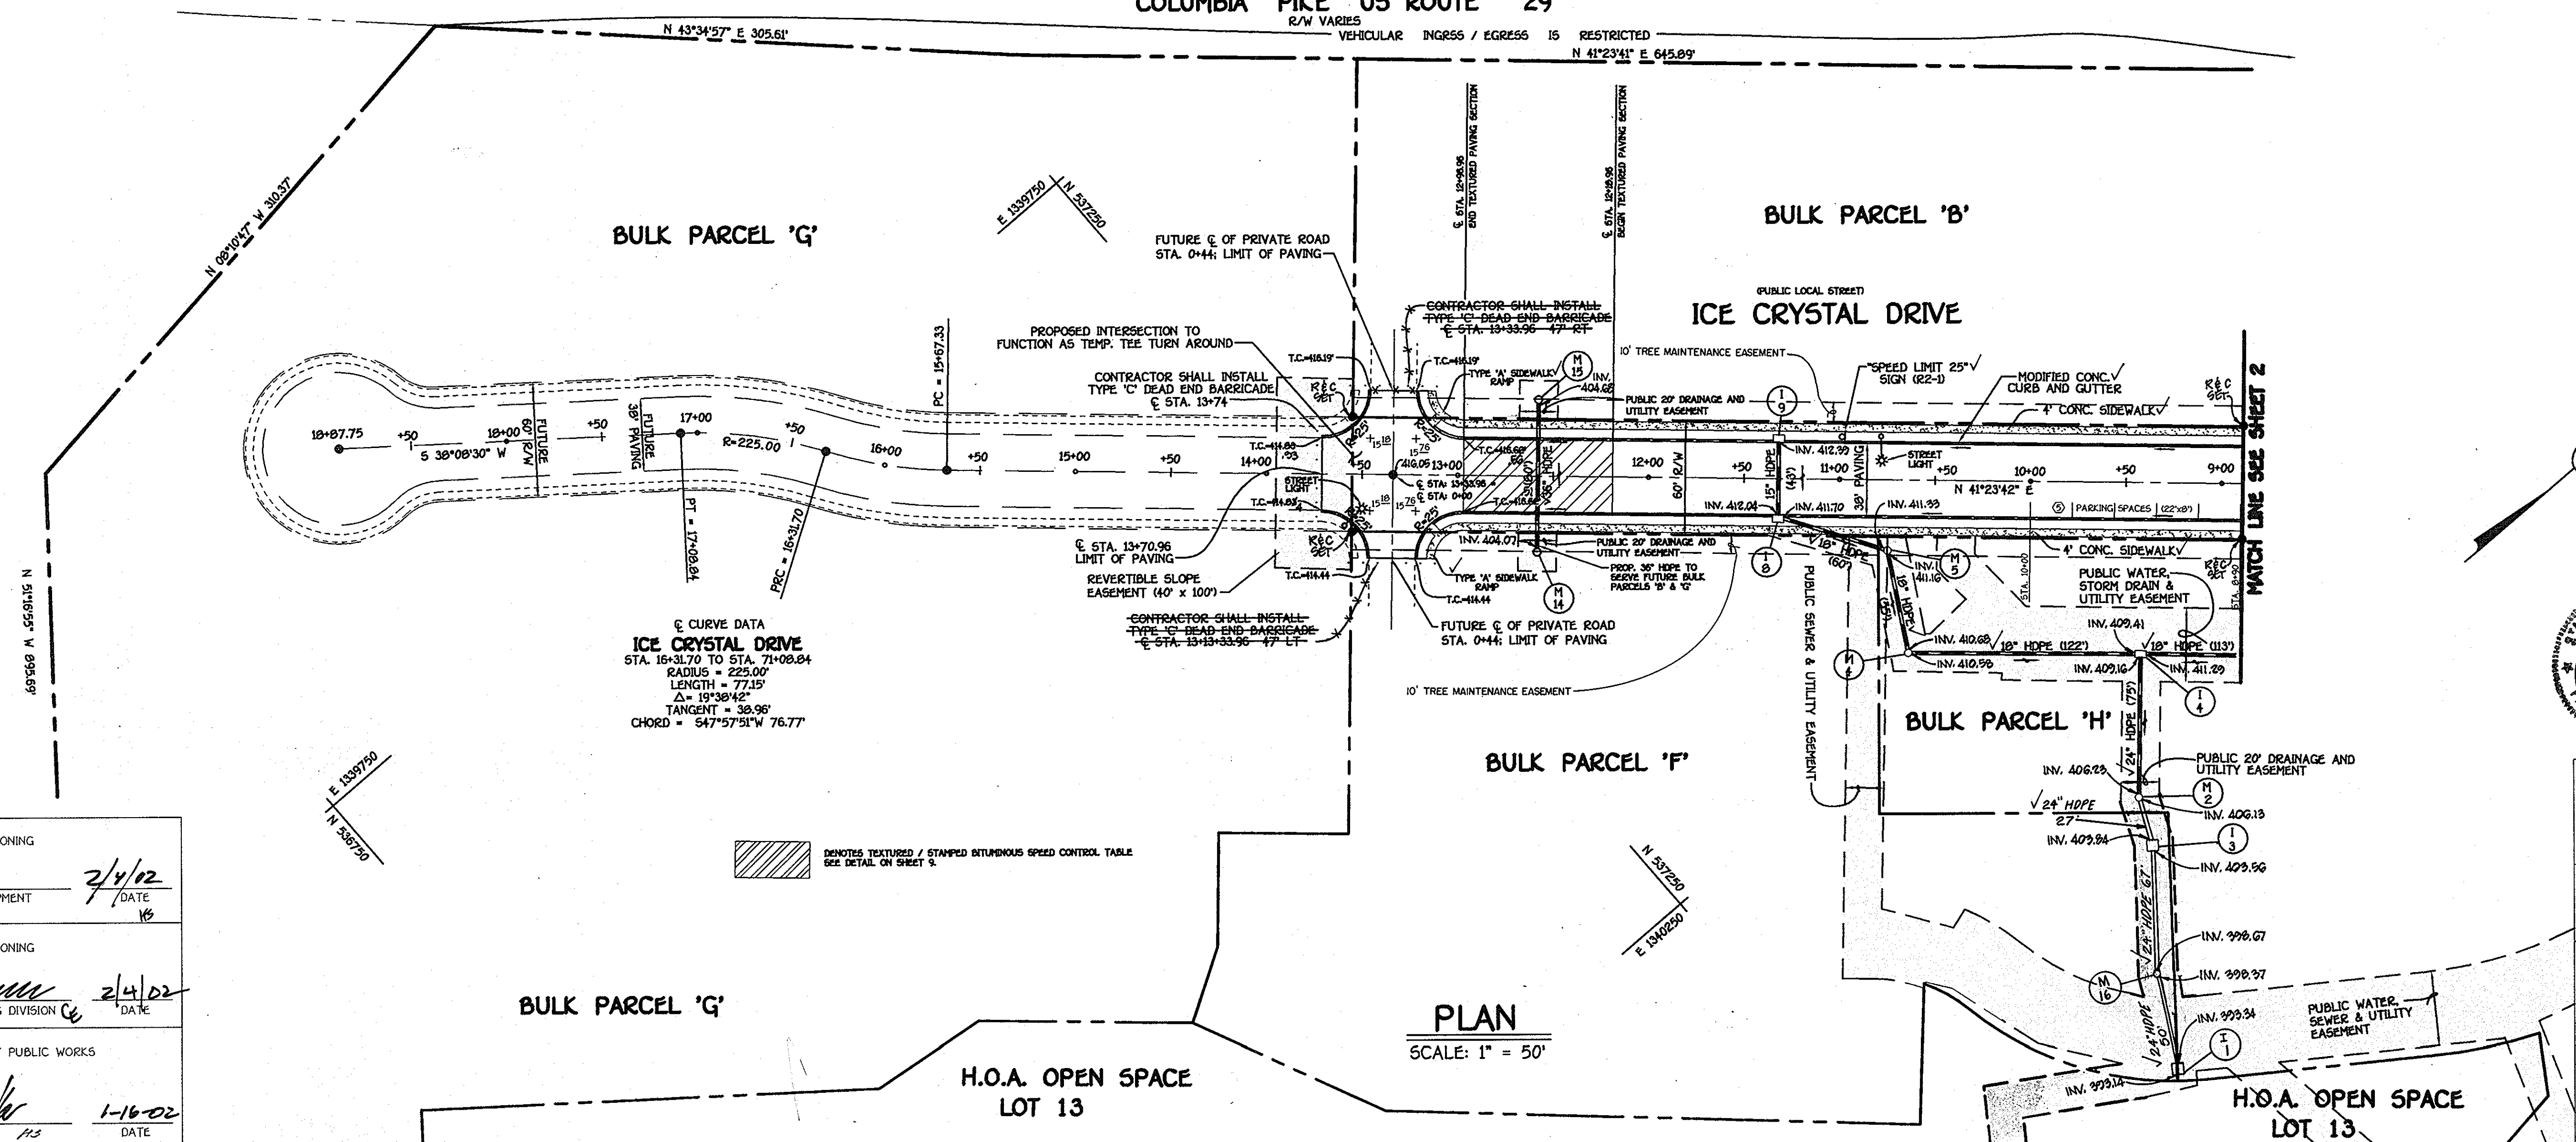

ICE CURVE DATA
 STA. 15+31.70 TO STA. 71+08.84
 RADIUS = 225.00'
 LENGTH = 77.15'
 $\Delta = 19^{\circ}38'42''$
 TANGENT = 38.96'
 CHORD = 547'57" W 76.77'


DIAGONALS TEXTURED / STAMPED INDICIOUS SPEED CONTROL TABLE
 SEE DETAIL ON SHEET 5

PLAN
 SCALE: 1" = 50'

APPROVED
 DEPARTMENT OF PLANNING AND ZONING
Cindy Hamrick 2/4/02
 CHIEF, DIVISION OF LAND DEVELOPMENT

APPROVED
 DEPARTMENT OF PLANNING AND ZONING
Chris Deussen 2/4/02
 CHIEF, DEVELOPMENT ENGINEERING DIVISION

APPROVED
 HOWARD COUNTY DEPARTMENT OF PUBLIC WORKS
Richard M. Danks 1-16-02
 CHIEF, BUREAU OF HIGHWAYS

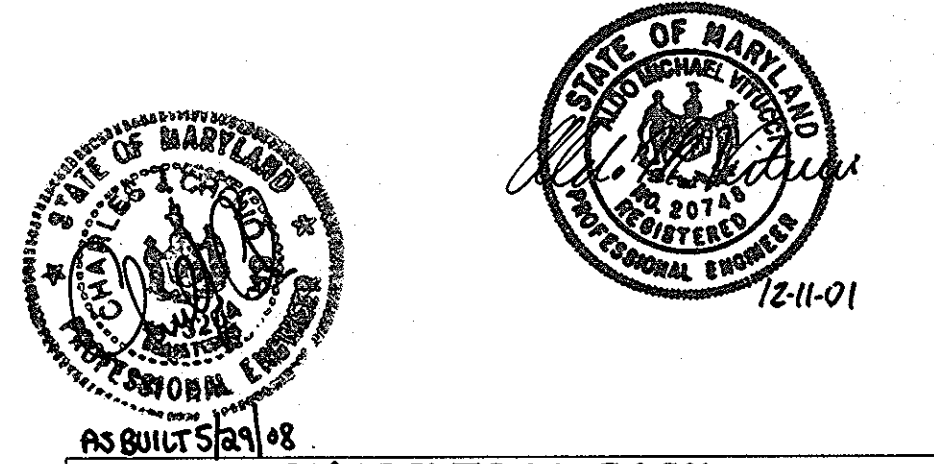


CHERRYTREE PARK
 LOTS 1 THRU 10, OPEN SPACE LOTS 11 THRU 13
 AND BULK PARCELS 'A' THRU 'H'

ICE CRYSTAL DRIVE
 PLAN AND PROFILE


OWNER/DEVELOPER
 CHERRYTREE I, L.L.C.
 7520 INDIAN PIPE COURT
 COLUMBIA, MARYLAND 21046

SCALE: 1" = 50' DATE: DEC. 7, 2001 DWG. NO. 3 OF 21
 DES. AMV. DRN. F.J.M. CHK. AMV.

FISHER, COLLINS & CARTER, INC.
 CIVIL ENGINEERING CONSULTANTS & LAND SURVEYORS
 CENTENNIAL SQUARE OFFICE PARK - 10272 BALTIMORE NATIONAL PIKE
 ELLSWORTH CITY, MARYLAND 21042
 (410) 461-2995

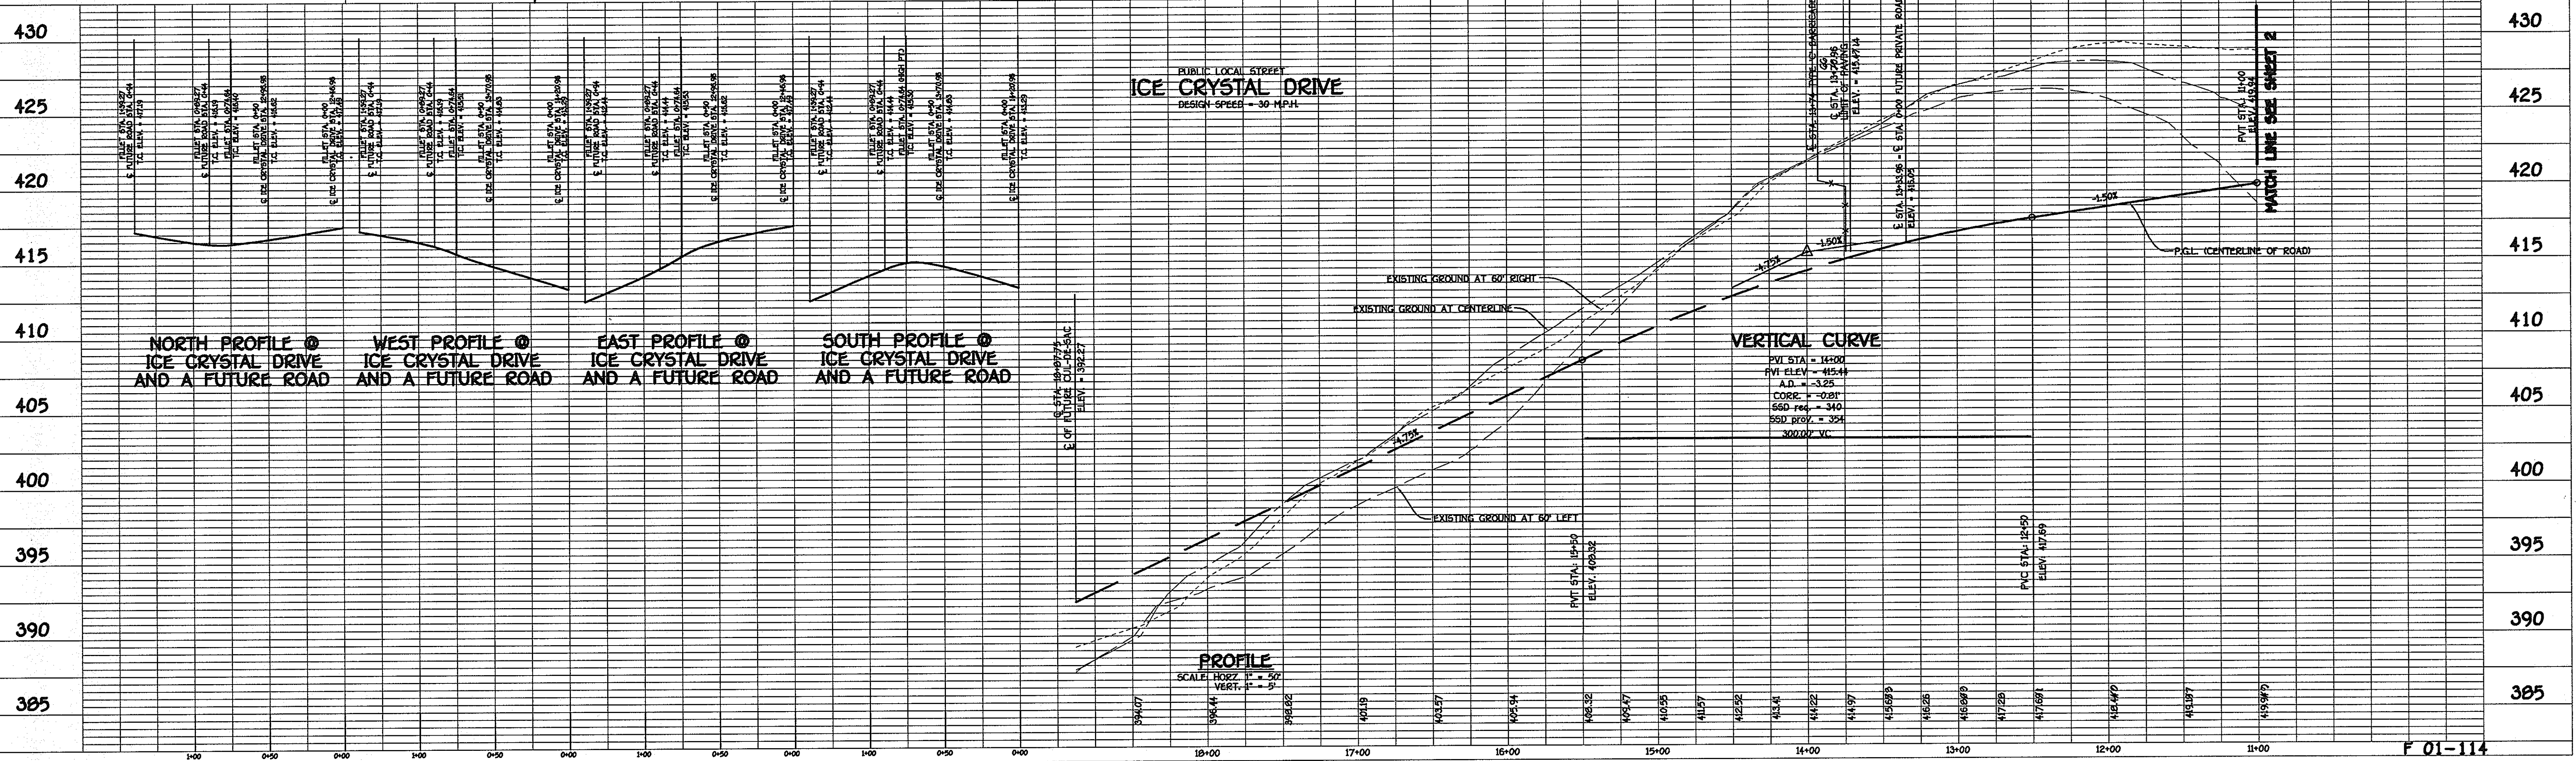


AS BUILT F-01-114

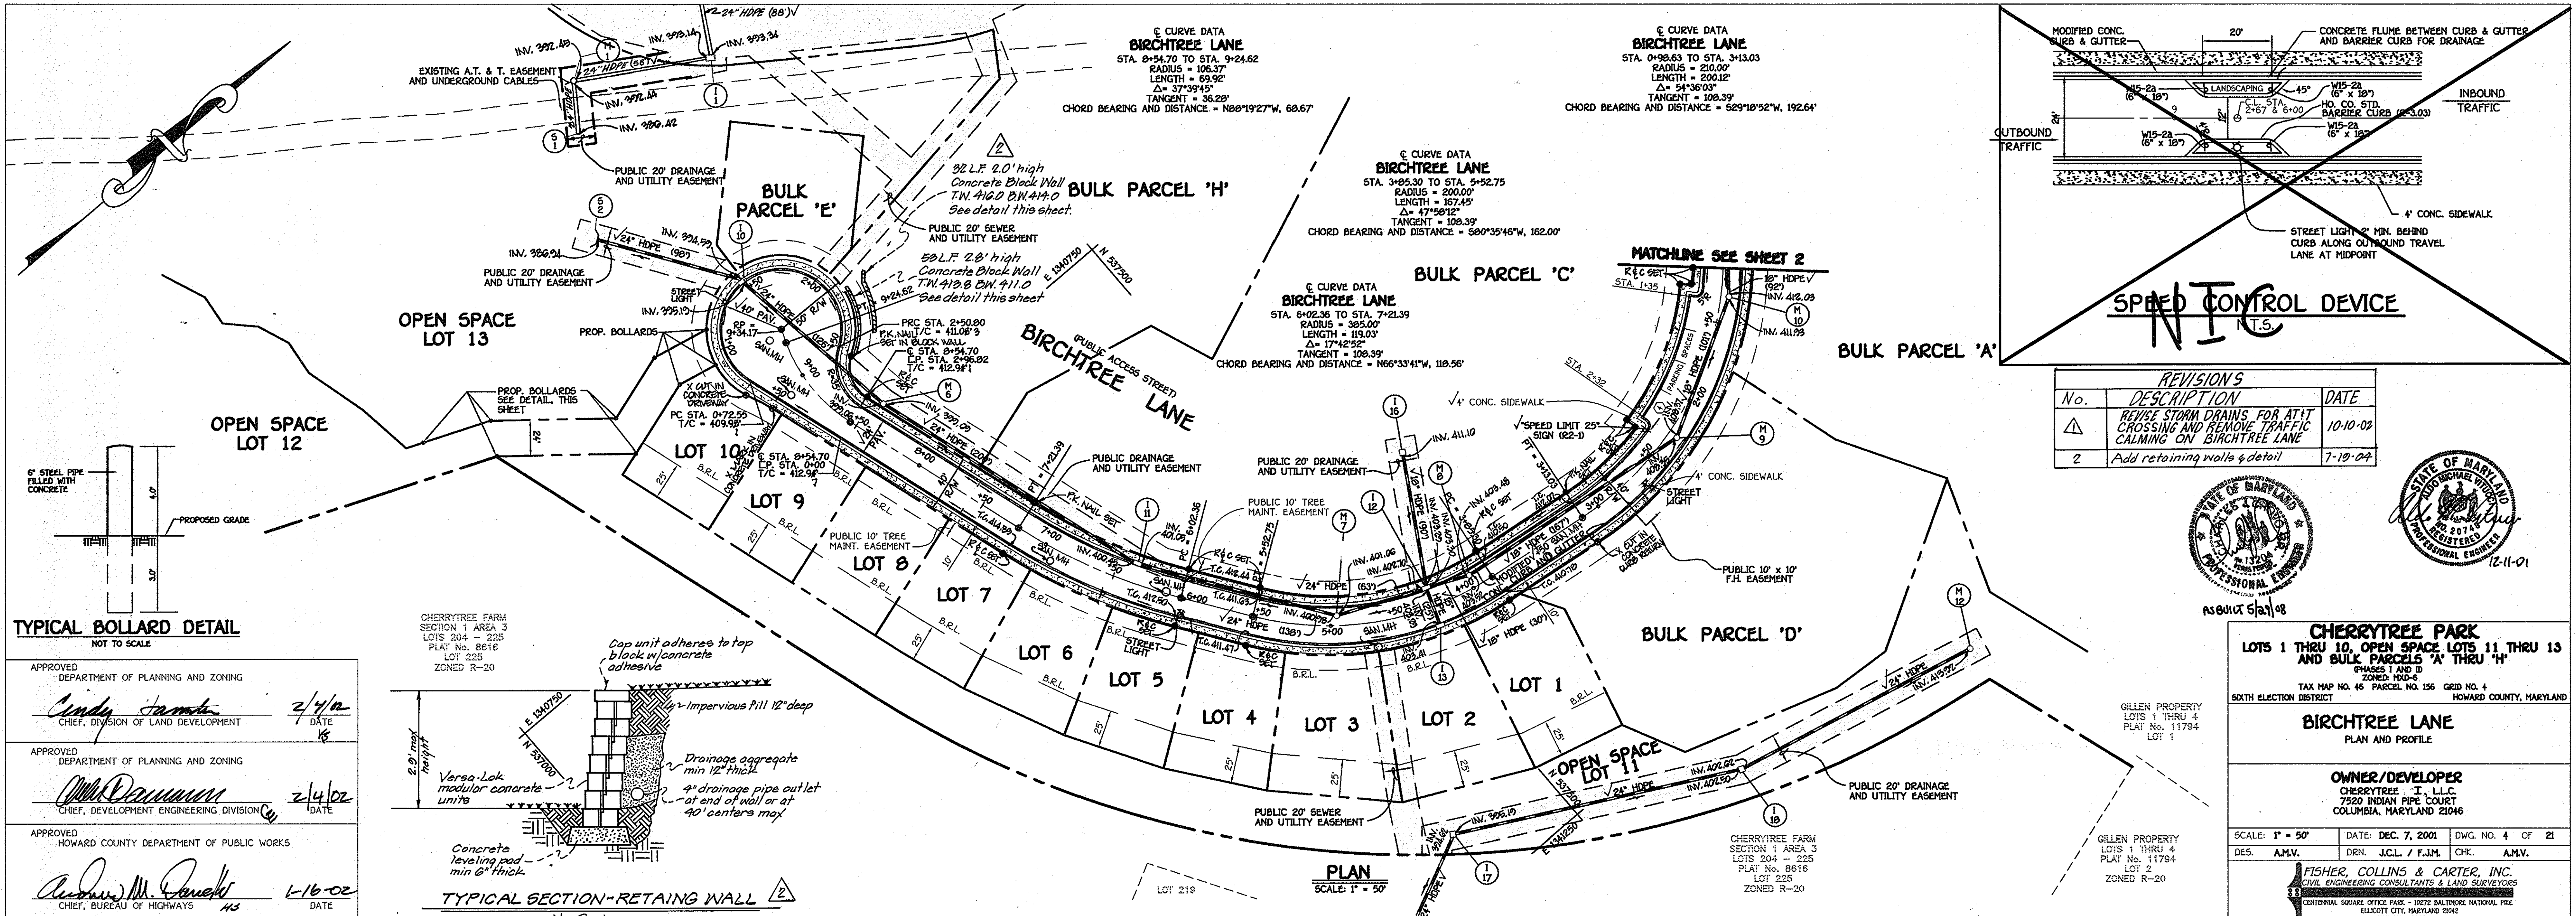

APPROVED
 DEPARTMENT OF PLANNING AND ZONING
 Chief, Division of Land Development
 2/4/02 DATE

APPROVED
 DEPARTMENT OF PLANNING AND ZONING
 Chief, Development Engineering Division
 2/4/02 DATE

APPROVED
 HOWARD COUNTY DEPARTMENT OF PUBLIC WORKS
 Chief, Bureau of Highways
 1-16-02 DATE

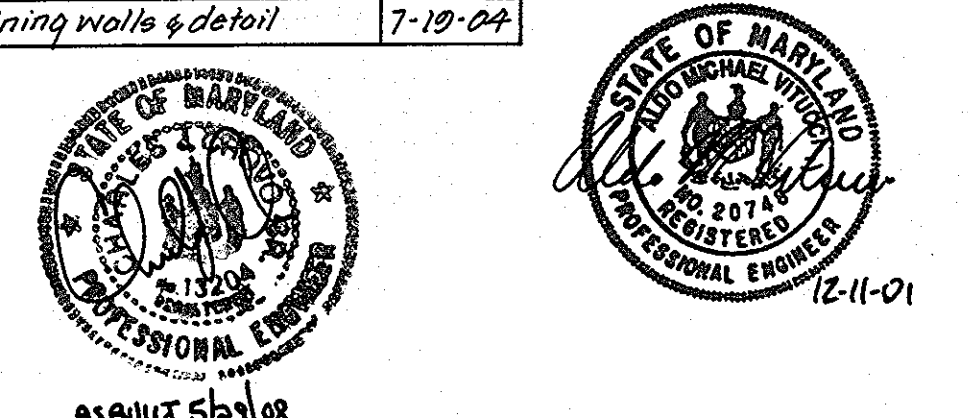

CHERRYTREE PARK
 LOTS 1 THRU 10, OPEN SPACE LOTS 11 THRU 13
 AND BULK PARCELS 'A' THRU 'H'


PHASES I AND II
 ZONED R-20
 TAX MAP No. 46 PARCEL No. 156 GRID No. 4
 SIXTH ELECTION DISTRICT HOWARD COUNTY, MARYLAND

BIRCHTREE LANE
 PLAN AND PROFILE

OWNER/DEVELOPER
 CHERRYTREE FARM, L.L.C.
 7520 INDIAN PIPE COURT
 COLUMBIA, MARYLAND 21046

SCALE: 1" = 50' DATE: DEC. 7, 2001 DWG. NO. 4 OF 21
 DES. AMV. DRN. J.C.L. / F.J.M. CHK. AMV.

FISHER, COLLINS & CARTER, INC.
 CIVIL ENGINEERING CONSULTANTS & LAND SURVEYORS
 CENTRAL SQUARE OFFICE PARK - 8077 BALTIMORE NATIONAL FREE
 ELKLOTT CITY, MARYLAND 21115
 (410) 661-2855

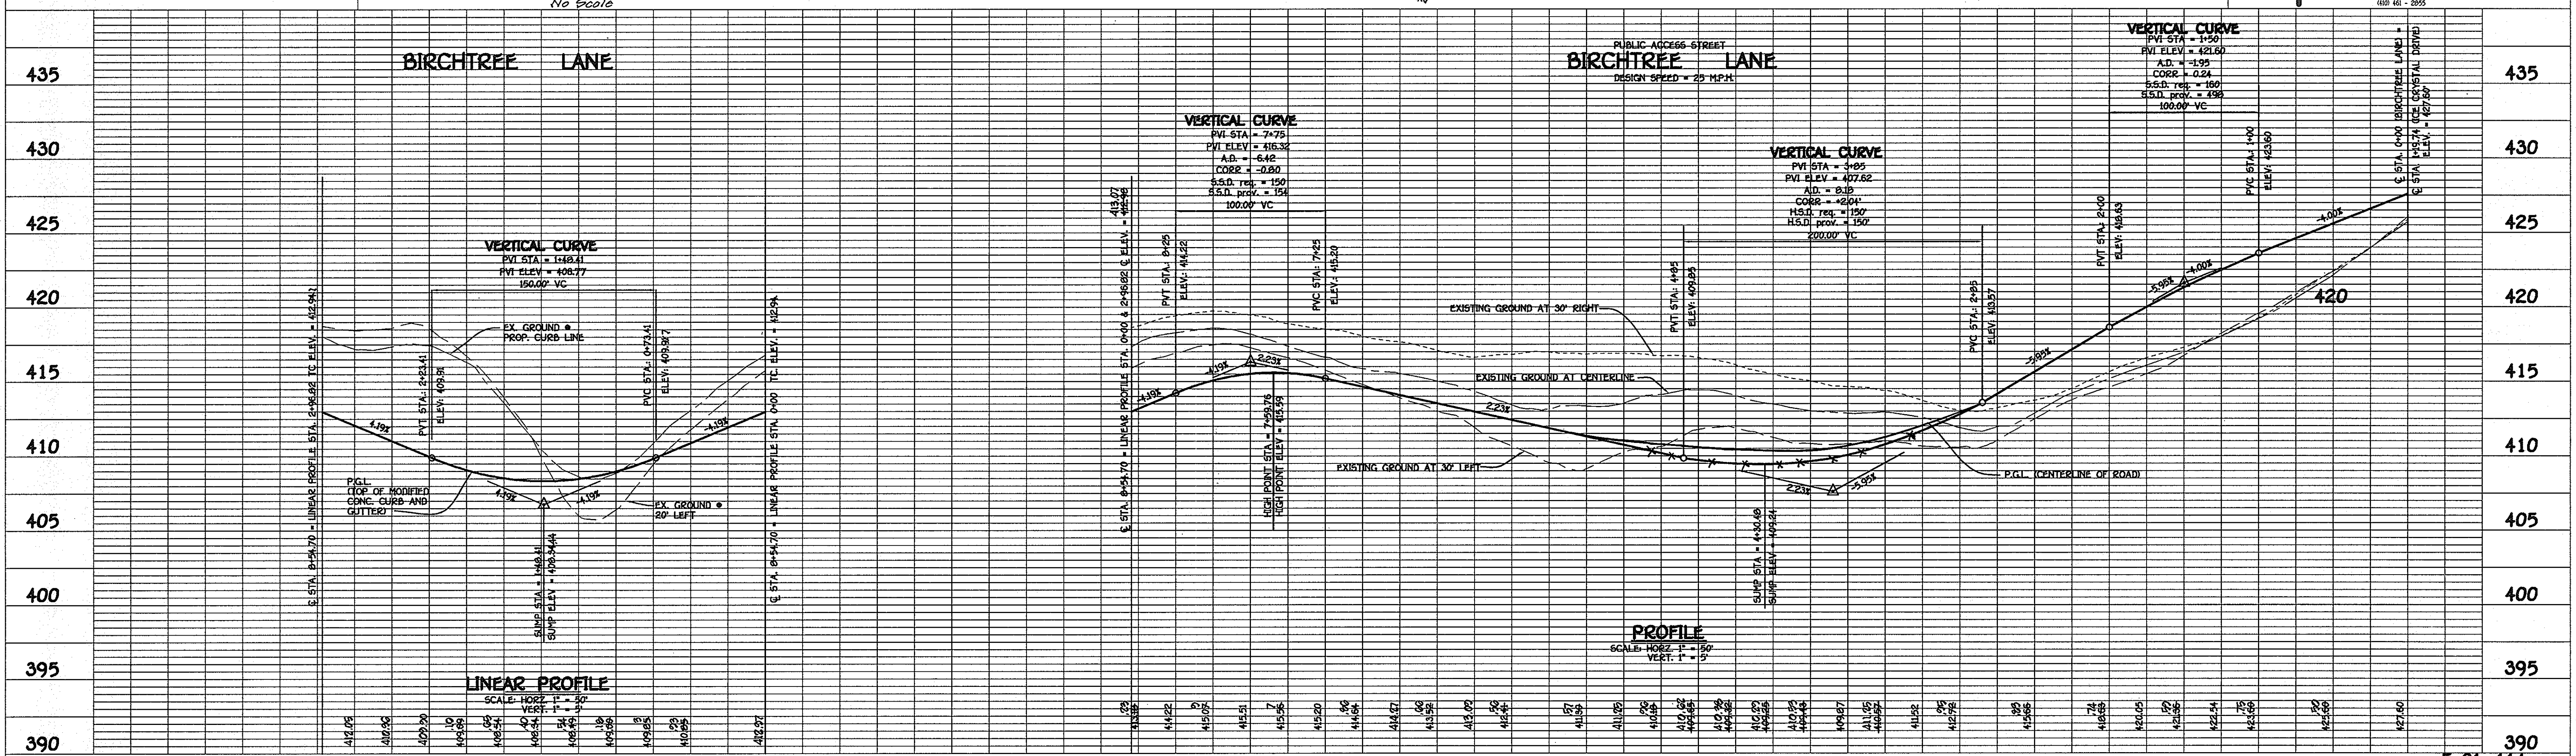


STREET TREE SCHEDULE

SYMBOL	BOTANICAL AND COMMON NAME	SIZE	COMMENTS
	ACER RUBRUM OCTOBER GLORY RED MAPLE	2 1/2"-3" CAL.	40' APART ON PUBLIC R/W
	PLATANUS OCCIDENTALIS "BLOODGOOD" LONDON PLANETREE	2 1/2"-3" CAL.	40' APART ON PUBLIC R/W

NOTE: FINANCIAL SURETY FOR THE 111 REQUIRED STREET TREES HAS BEEN POSTED AS PART OF THE DEVELOPER'S AGREEMENT.

- 59 TOTAL STREET TREES
- 52 TOTAL STREET TREES

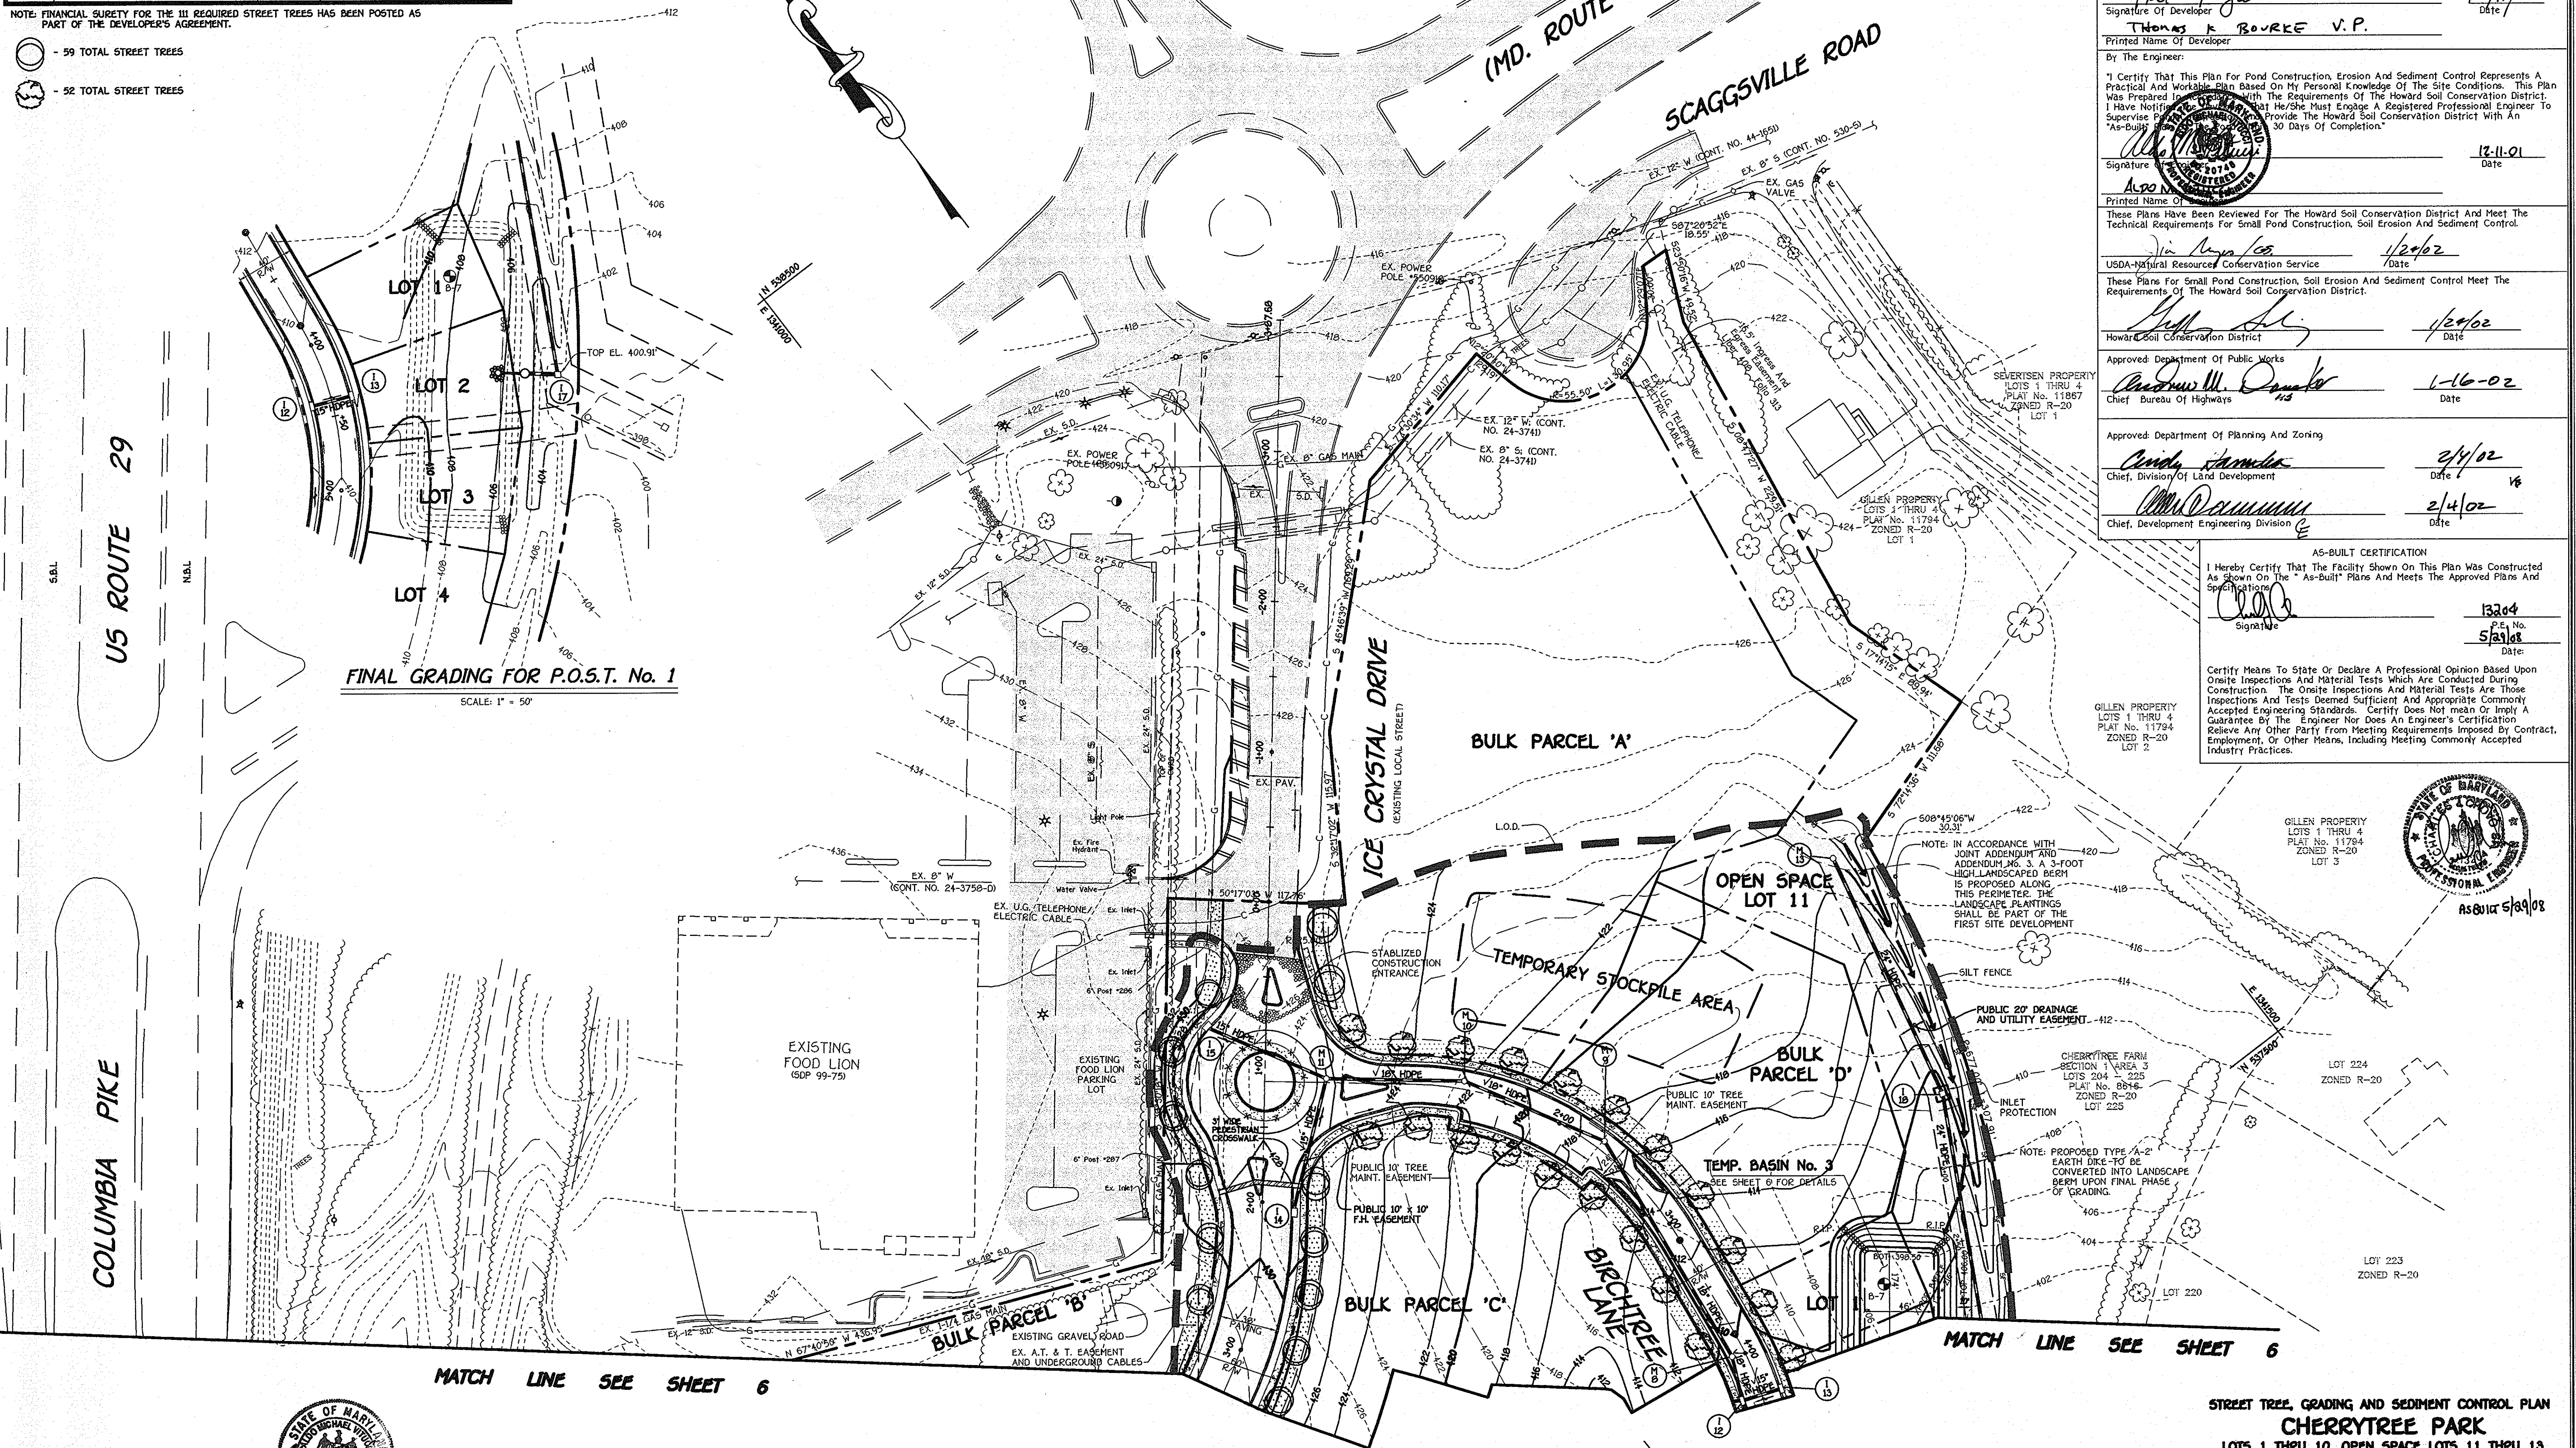

FINAL GRADING FOR P.O.S.T. No. 1
SCALE: 1" = 50'

PLAN
SCALE: 1" = 50'

OWNER/DEVELOPER
CHERRYTREE I, L.L.C.
7920 INDIAN PIPE COURT
COLUMBIA, MARYLAND 21046

By The Developer:
 "I/We Certify That All Development And/Or Construction Will Be Done According To These Plans. And That Any Responsible Personnel Involved In The Construction Project Will Have A Certificate Of Attendance At A Department Of The Environment Approved Training Program For The Control Of Sediment And Erosion Before Beginning The Project. I Shall Engage A Registered Professional Engineer To Supervise Pond Construction And Provide The Howard Soil Conservation District With An "As-Built" Plan Of The Pond Within 30 Days Of Completion. I Also Authorize Periodic On-Site Inspections By The Howard Soil Conservation District."
 Signature Of Developer: *Thomas K. Burke* Date: 12/11/01
 Printed Name Of Developer: **THOMAS K. BURKE V.P.**

By The Engineer:
 "I Certify That This Plan For Pond Construction, Erosion And Sediment Control Represents A Practical And Workable Plan Based On My Personal Knowledge Of The Site Conditions. This Plan Was Prepared In Accordance With The Requirements Of The Howard Soil Conservation District. I Have Notified The District That I/We Must Engage A Registered Professional Engineer To Supervise Pond Construction And Provide The Howard Soil Conservation District With An "As-Built" Plan Of The Pond Within 30 Days Of Completion."
 Signature: *[Signature]* Date: 12-11-01
 Printed Name Of Engineer: **ALAN M. [Name]**

These Plans Have Been Reviewed For The Howard Soil Conservation District And Meet The Technical Requirements For Small Pond Construction, Soil Erosion And Sediment Control.
 USDA-Natural Resources Conservation Service Date: 1/24/02
 These Plans For Small Pond Construction, Soil Erosion And Sediment Control Meet The Requirements Of The Howard Soil Conservation District.
 Approved Department Of Public Works: *[Signature]* Date: 1/24/02
 Chief, Bureau Of Highways: **ANDREW M. [Name]** Date: 1-16-02
 Approved Department Of Planning And Zoning: *[Signature]* Date: 2/1/02
 Chief, Division Of Land Development: **ANDREW M. [Name]** Date: 2/4/02
 Chief, Development Engineering Division: *[Signature]* Date: 2/4/02

AS-BUILT CERTIFICATION
 I Hereby Certify That The Facility Shown On This Plan Was Constructed As Shown On The "As-Built" Plans And Meets The Approved Plans And Specifications.
 Signature: *[Signature]* Date: 1/30/04
 P.E. No. 574108

Certify Means To State Or Declare A Professional Opinion Based Upon Onsite Inspections And Material Tests Which Are Conducted During Construction. The Onsite Inspections And Material Tests Are Those Inspections And Tests Deemed Sufficient And Appropriate Commonly Accepted Engineering Standards. Certify Does Not Mean Or Imply A Guarantee By The Engineer Nor Does An Engineer's Certification Relieve Any Other Party From Meeting Requirements Imposed By Contract, Employment, Or Other Means, Including Meeting Commonly Accepted Industry Practices.



FISHER COLLINS & CARTER, INC.
 CIVIL ENGINEERING CONSULTANTS & LAND SURVEYORS
 CENTENNIAL SQUARE OFFICE PARK - 10272 BALTIMORE NATIONAL PIKE
 GAITHERSBURG, MARYLAND 20878
 (410) 461-2855




STREET TREE, GRADING AND SEDIMENT CONTROL PLAN
CHERRYTREE PARK
 LOTS 1 THRU 10, OPEN SPACE LOTS 11 THRU 13
 AND BULK PARCELS 'A' THRU 'H'
 (PHASES I AND II)
 ZONED: MXD-6
 TAX MAP NO. 46 PARCEL NO. 156 GRID NO. 4
 SIXTH ELECTION DISTRICT - HOWARD COUNTY, MARYLAND
 DATE: DECEMBER 7, 2001
 SHEET 5 OF 21

F 01-114

REVISIONS		
No.	DESCRIPTION	DATE
1	REVISE STORM DRAINS FOR AT-T CROSSINGS AND REMOVE TRAFFIC CALMING ON BIRCHTREE LANE	10-10-02
2	Add 2 Concrete Block Retaining Walls	7-19-04

MATCH LINE SEE SHEET 5

NOTE: SEE SEQUENCE OF CONSTRUCTION NOTE NO. 3 FOR GRADING PHASING.

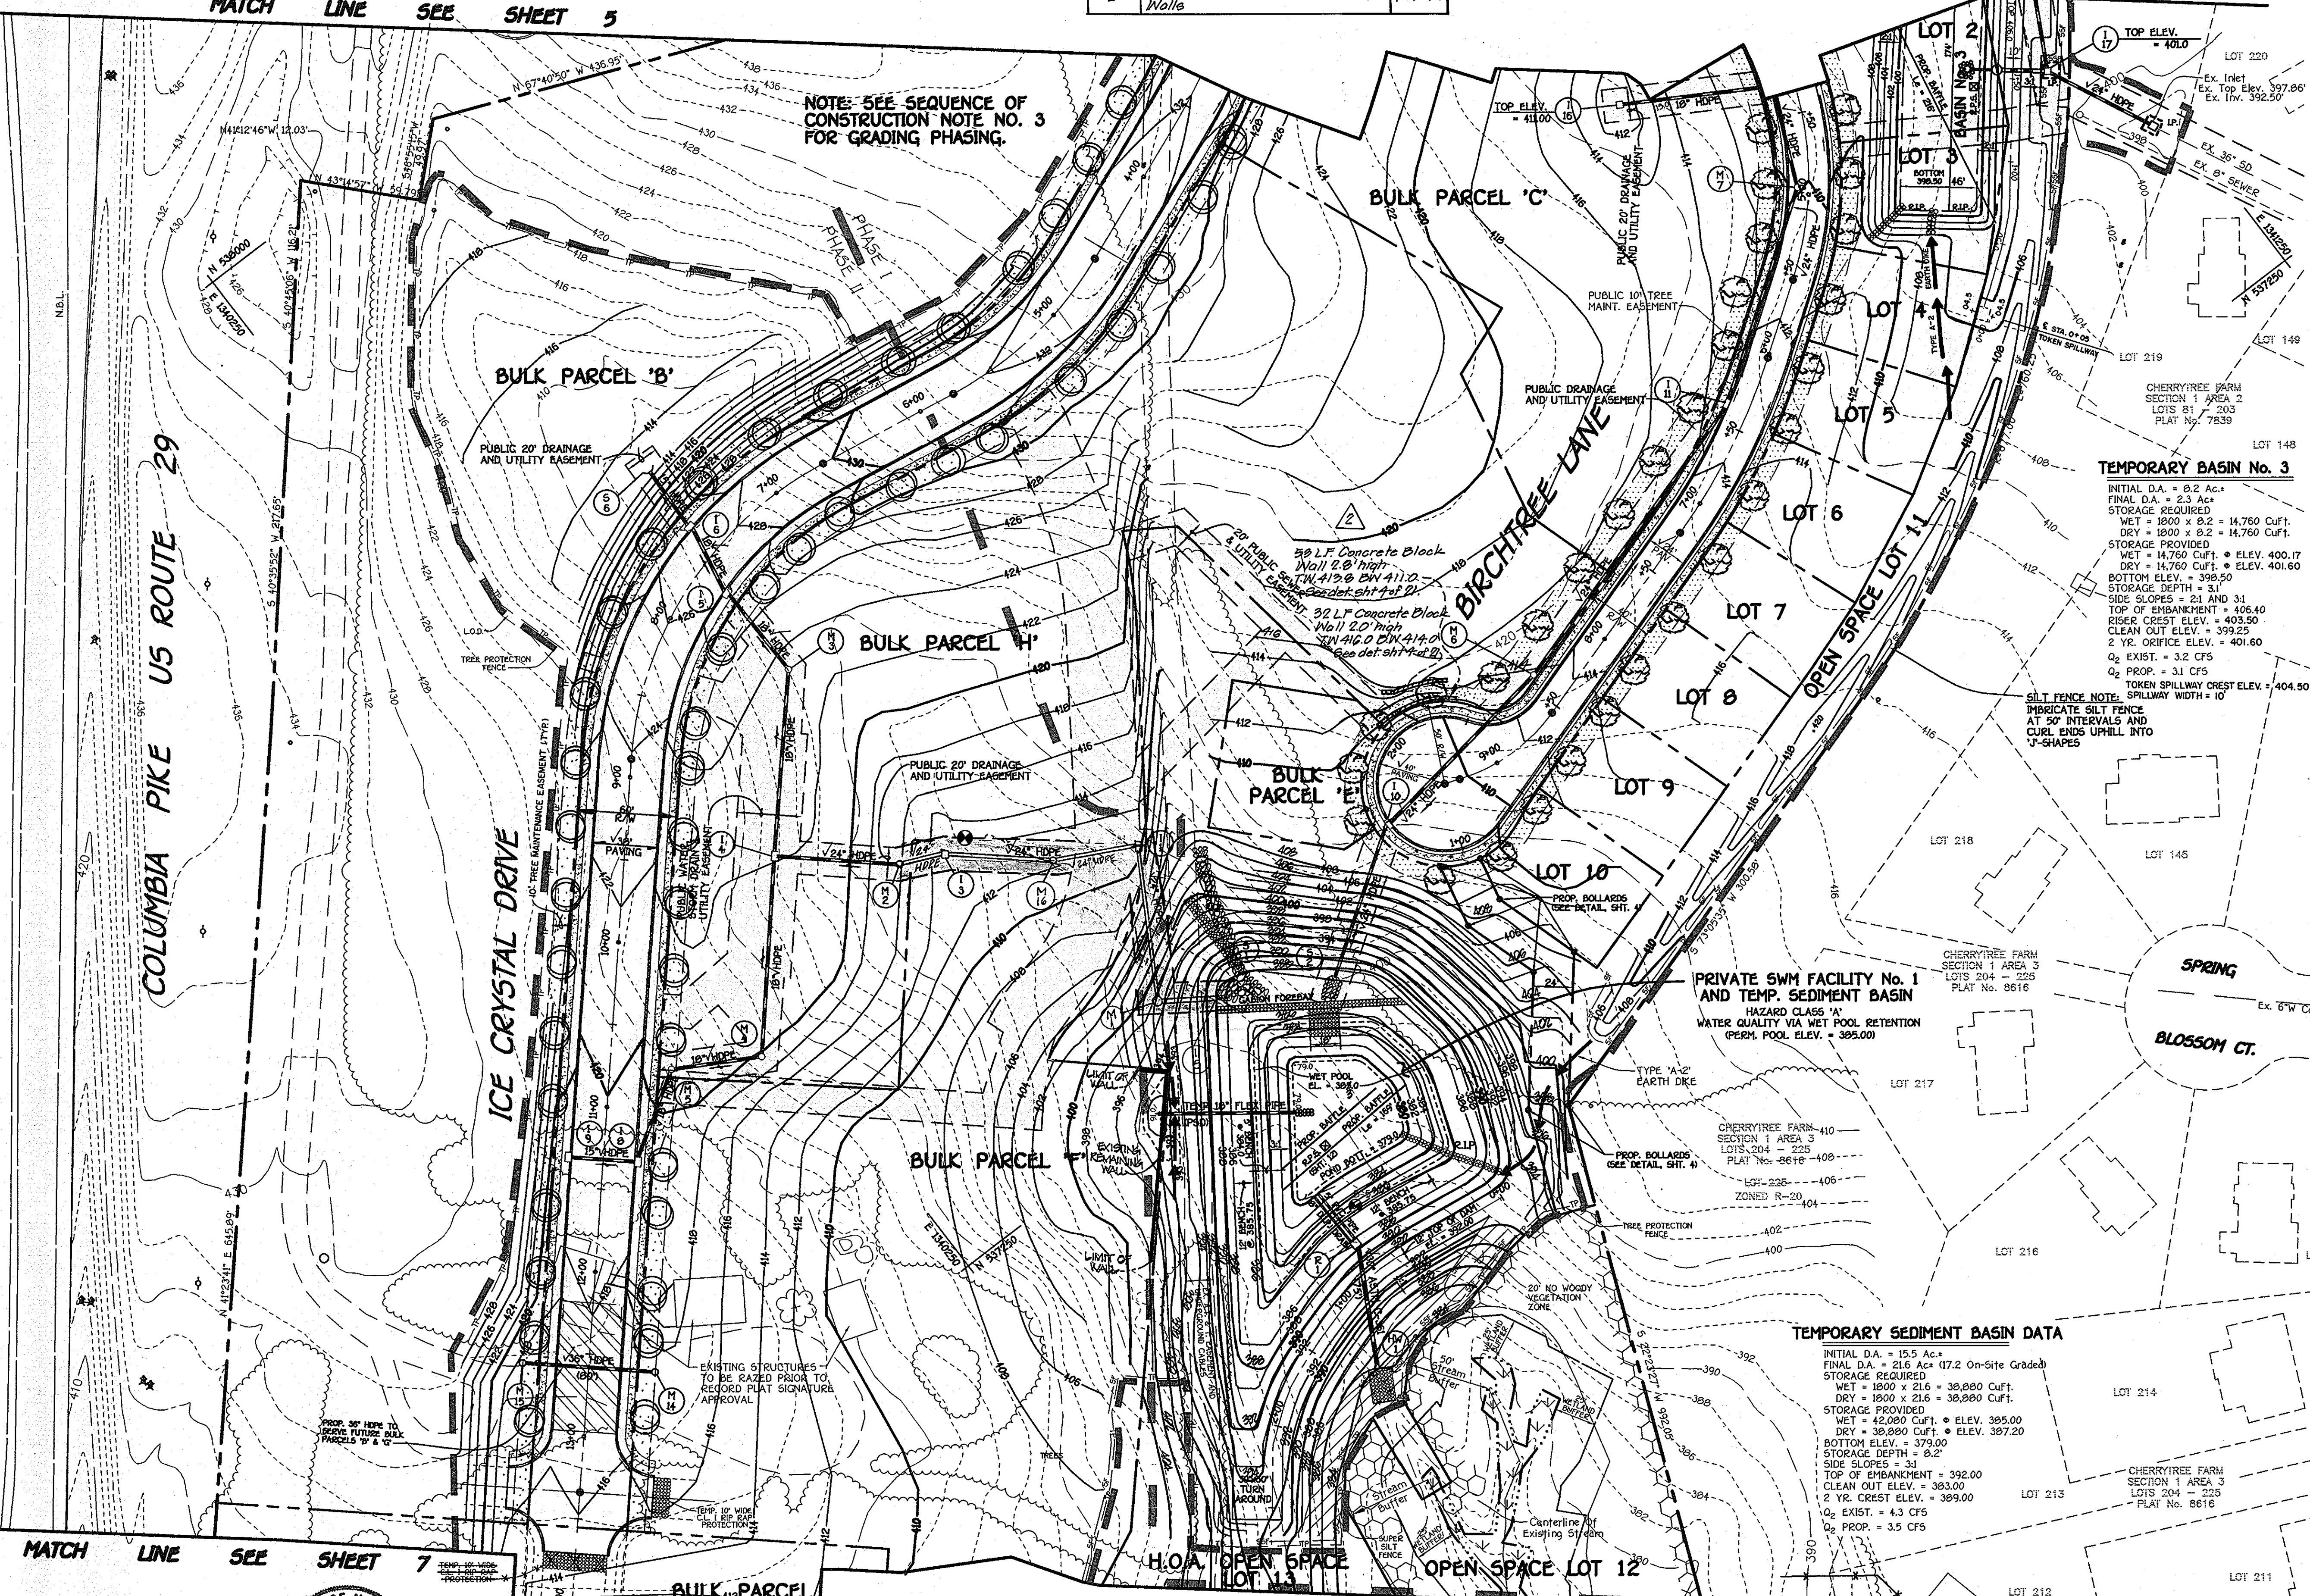

TEMPORARY BASIN No. 3
 INITIAL D.A. = 8.2 Ac.
 FINAL D.A. = 2.3 Ac.
 STORAGE REQUIRED
 WET = 1800 x 8.2 = 14,760 Cuft.
 DRY = 1800 x 8.2 = 14,760 Cuft.
 STORAGE PROVIDED
 WET = 14,760 Cuft. @ ELEV. 400.17
 DRY = 14,760 Cuft. @ ELEV. 401.60
 BOTTOM ELEV. = 395.50
 STORAGE DEPTH = 3'
 SIDE SLOPES = 2:1 AND 3:1
 TOP OF EMBANKMENT = 405.40
 RISER CREST ELEV. = 403.50
 CLEAN OUT ELEV. = 399.25
 2 YR. ORIFICE ELEV. = 401.60
 Q₂ EXIST. = 3.2 CFS
 Q₂ PROP. = 3.1 CFS
 TOKEN SPILLWAY CREST ELEV. = 404.80
 SPILLWAY WIDTH = 10'

SILT FENCE NOTE:
 IMBRICATE SILT FENCE AT 50' INTERVALS AND CURL ENDS UPHILL INTO 'J'-SHAPES

PRIVATE SWM FACILITY No. 1 AND TEMP. SEDIMENT BASIN
 HAZARD CLASS 'A'
 WATER QUALITY VIA WET POOL RETENTION (PERM. POOL ELEV. = 395.00)

TEMPORARY SEDIMENT BASIN DATA
 INITIAL D.A. = 15.5 Ac.
 FINAL D.A. = 21.6 Ac. (17.2 On-Site Graded)
 STORAGE REQUIRED
 WET = 1800 x 21.6 = 38,880 Cuft.
 DRY = 1800 x 21.6 = 38,880 Cuft.
 STORAGE PROVIDED
 WET = 42,000 Cuft. @ ELEV. 395.00
 DRY = 38,880 Cuft. @ ELEV. 397.20
 BOTTOM ELEV. = 379.00
 STORAGE DEPTH = 8.2'
 SIDE SLOPES = 3:1
 TOP OF EMBANKMENT = 392.00
 CLEAN OUT ELEV. = 393.00
 2 YR. CREST ELEV. = 399.00
 Q₂ EXIST. = 4.3 CFS
 Q₂ PROP. = 3.5 CFS

By The Developer:
 I/We Certify That All Development And/Or Construction Will Be Done According To These Plans, And That Any Responsible Personnel Involved In The Construction Project Will Have A Certificate Of Attendance At A Department Of The Environment Approved Training Program For The Control Of Sediment And Erosion Before Beginning The Project. I Shall Engage A Registered Professional Engineer To Supervise Pond Construction And Provide The Howard Soil Conservation District With An "As-Built" Plan Of The Pond Within 30 Days Of Completion. I Also Authorize Periodic On-Site Inspections By The Howard Soil Conservation District.

Signature Of Developer: *Thomas F. Bourke* 12-11-02
 Printed Name Of Developer: **THOMAS F. BOURKE VP**
 Date: 12-11-02

By The Engineer:
 I Certify That This Plan For Pond Construction, Erosion And Sediment Control Represents A Practical And Workable Plan Based On My Personal Knowledge Of The Site Conditions. This Plan Was Prepared In Accordance With The Requirements Of The Howard Soil Conservation District. I Have Notified The District That He/She Must Engage A Registered Professional Engineer To Supervise And Provide The Howard Soil Conservation District With An "As-Built" Plan Within 30 Days Of Completion.

Signature: *John M. Cas...* 12-11-02
 Printed Name Of Engineer: **John M. Cas...**
 Date: 12-11-02

These Plans Have Been Reviewed For The Howard Soil Conservation District And Meet The Technical Requirements For Small Pond Construction, Soil Erosion And Sediment Control.

USDA-Natural Resources Conservation Service 1/24/02
 Date: 1/24/02

These Plans For Small Pond Construction, Soil Erosion And Sediment Control Meet The Requirements Of The Howard Soil Conservation District.

Howard Soil Conservation District 1/24/02
 Date: 1/24/02

Approved: Department Of Public Works
Robert M. Conner 1-16-02
 Chief, Bureau Of Highways
 Date: 1-16-02

Approved: Department Of Planning And Zoning
Conny Hamilton 2/4/02
 Chief, Division Of Land Development
 Date: 2/4/02

John D. ... 2/4/02
 Chief, Development Engineering Division
 Date: 2/4/02

AS-BUILT CERTIFICATION
 I Herby Certify That The Facility Shown On This Plan Was Constructed As Shown On The "As-Built" Plans And Meets The Approved Plans And Specifications.

Signature: *John D. ...* 13204
 P.E. No. 51202
 Date: 1/24/02

Certify Means To State Or Declare A Professional Opinion Based Upon Onsite Inspections And Material Tests Which Are Conducted During Construction. The Onsite Inspections And Material Tests Are Those Inspections And Tests Deemed Sufficient And Appropriate Commonly Accepted Engineering Standards. Certify Does Not Mean Or Imply A Guarantee By The Engineer Nor Does An Engineer's Certification Relieve Any Other Party From Meeting Requirements Imposed By Contract, Employment, Or Other Means, Including Requirements Commonly Accepted Industry Practices.



- LEGEND**
- S—S—S— SUPER-SILT FENCE
 - SF—SF— SILT FENCE
 - TP—TP—TP— TREE PROTECTION FENCE
 - I.P. INLET PROTECTION
 - S.C.E. STABILIZED CONSTRUCTION ENTRANCE
 - EARTH DIKE
 - — — — — LIMIT OF DISTURBANCE
 - R.I.P. RIP-RAP INFLOW PROTECTION

STREET TREE GRADING AND SEDIMENT CONTROL PLAN
CHERRYTREE PARK
 LOTS 1 THRU 10, OPEN SPACE LOTS 11 THRU 13 AND BULK PARCELS 'A' THRU 'H' (PHASES I AND II)
 TAX MAP NO. 46 PARCEL NO. 156 GRID NO. 4
 SIXTH ELECTION DISTRICT HOWARD COUNTY, MARYLAND
 DATE: DECEMBER 7, 2001
 SHEET 6 OF 21
 F 01-114

MATCH LINE SEE SHEET 7

MATCH LINE SEE SHEET 7

FISHER, COLLINS & CARTER, INC.
 CIVIL ENGINEERING CONSULTANTS & LAND SURVEYORS
 CENTRAL SQUARE OFFICE PARK - 10272 BALTIMORE NATIONAL PIKE
 ELICOTT CITY, MARYLAND 21042
 (410) 461-2855


STATE OF MARYLAND
 PROFESSIONAL ENGINEER
 No. 80748
 12-11-02

PLAN
 SCALE: 1" = 50'

OWNER/DEVELOPER
 CHERRYTREE II, L.L.C.
 7520 INDIAN PIPE COURT
 COLUMBIA, MARYLAND 21046

ASBUILT F-01-114

COLUMBIA PIKE US ROUTE 29

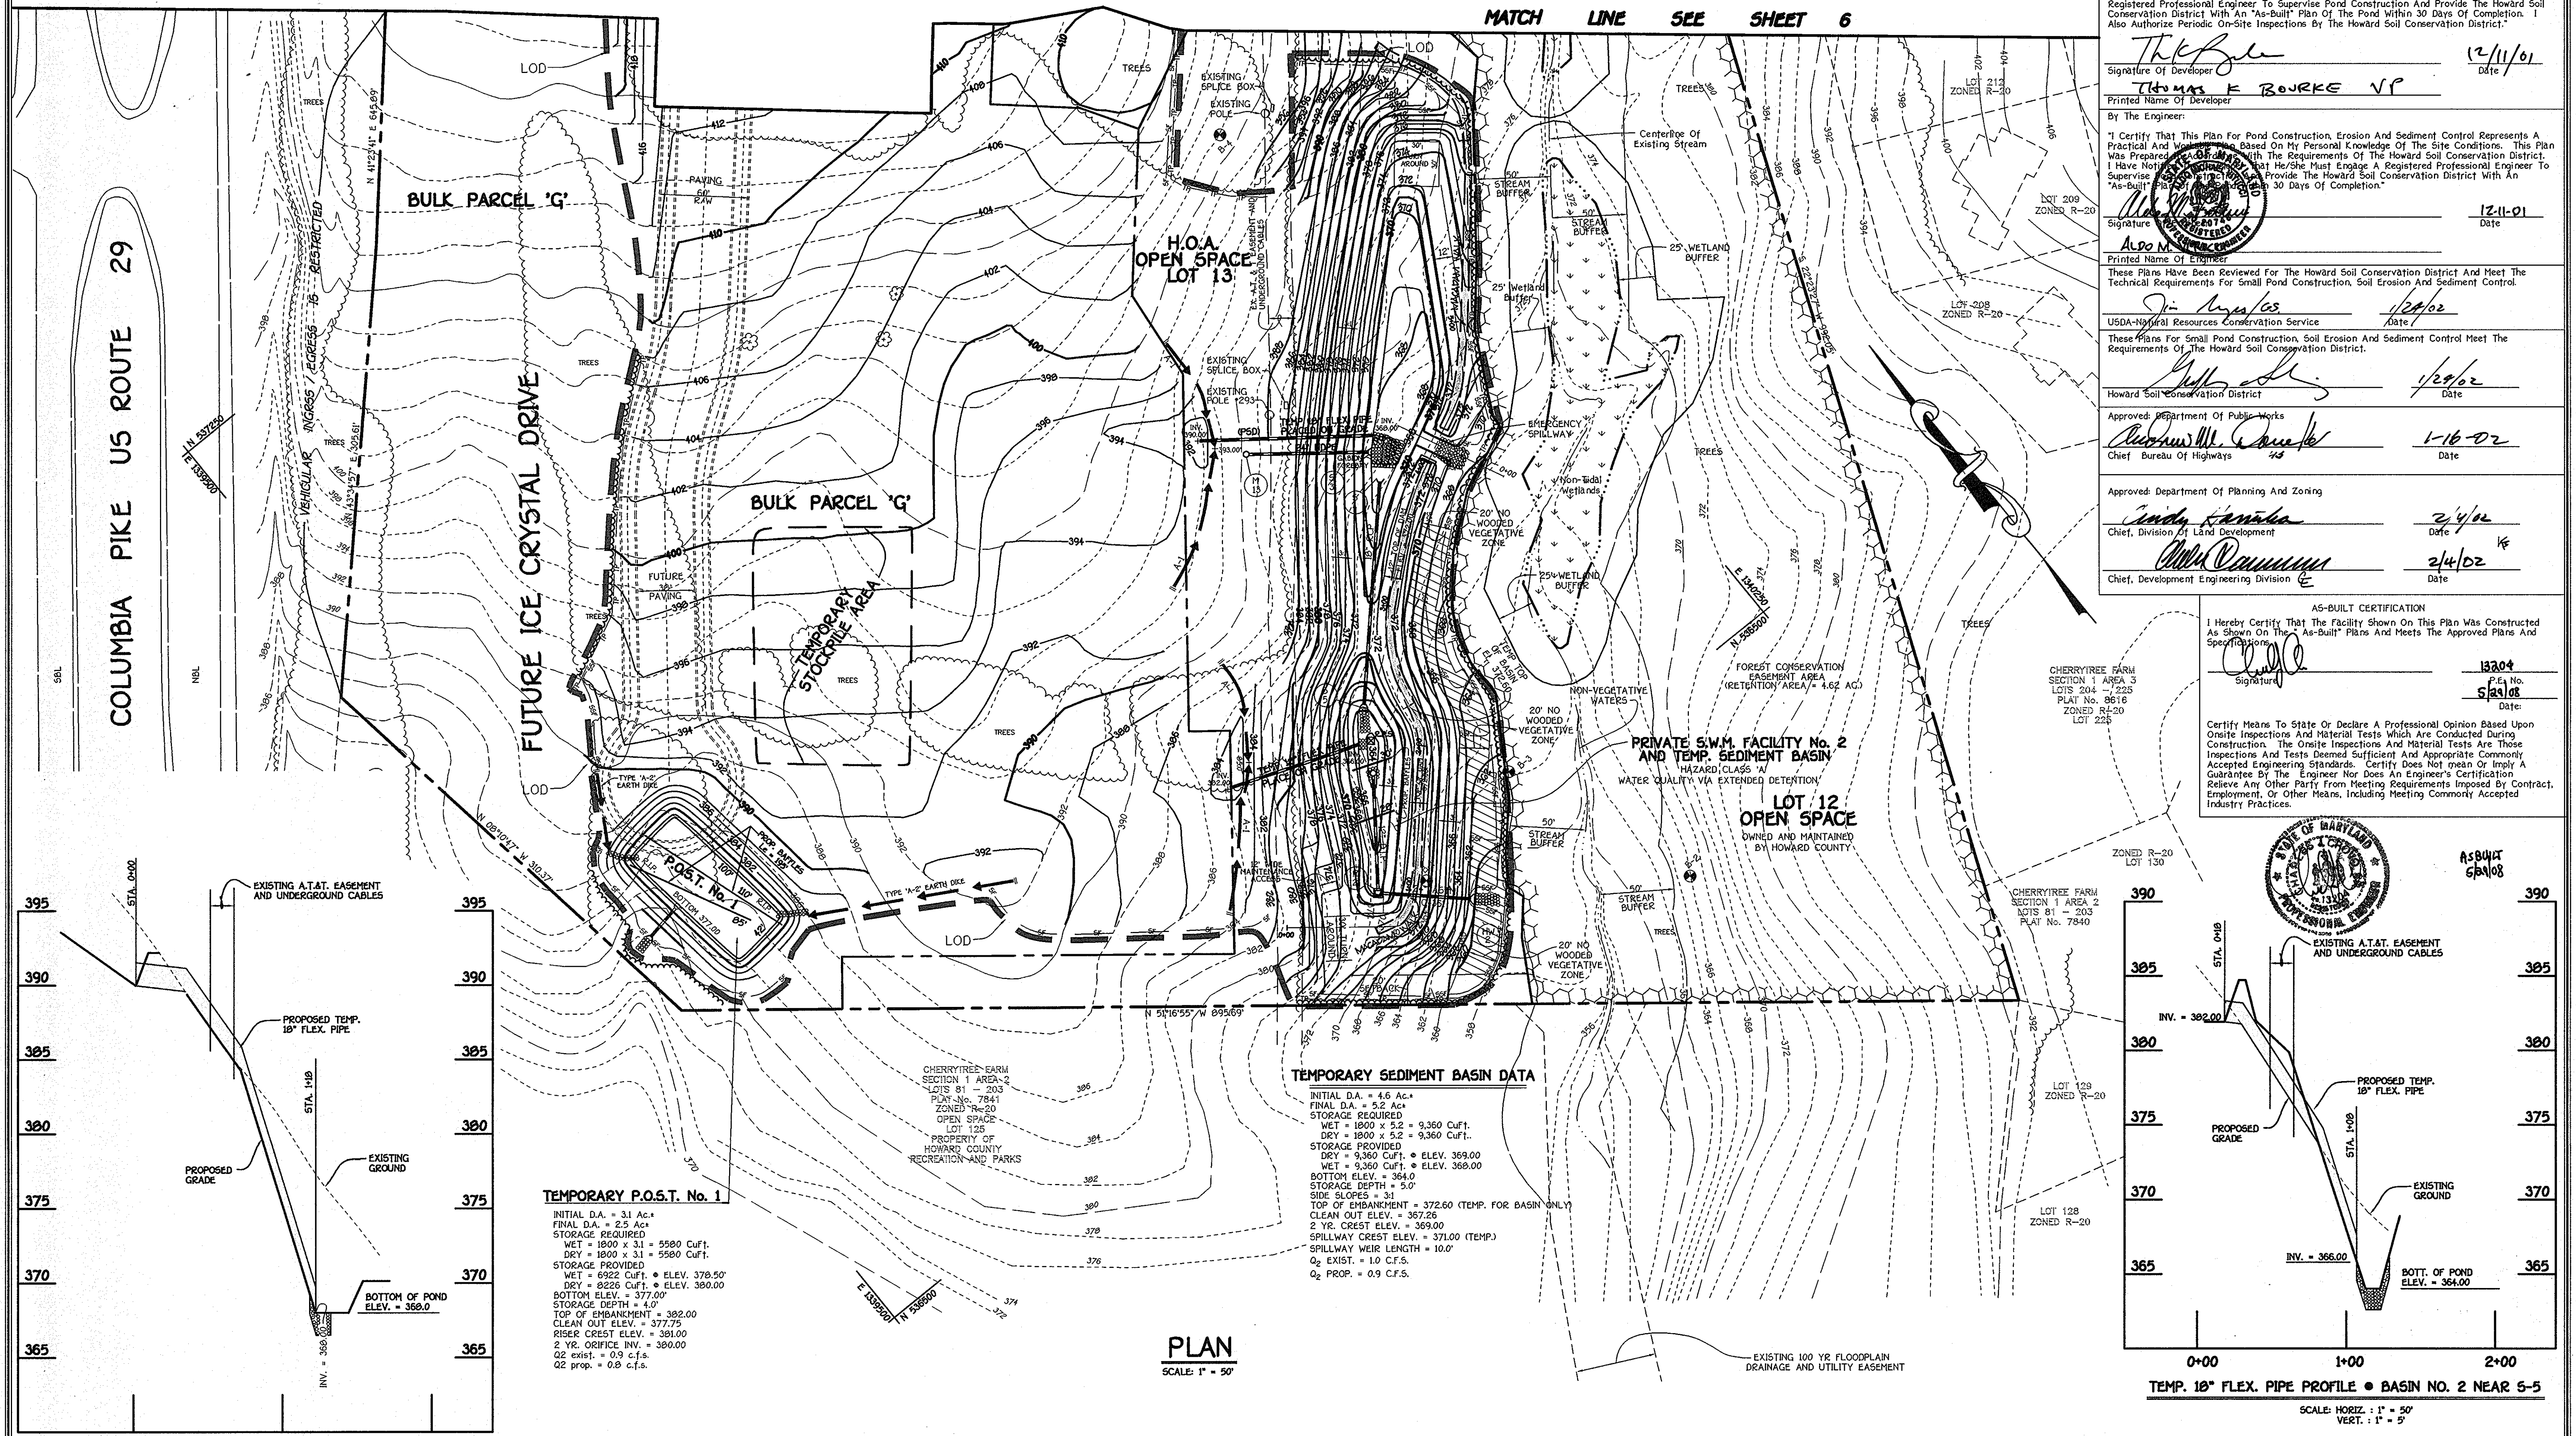

TEMPORARY P.O.S.T. No. 1
 INITIAL D.A. = 3.1 Ac.
 FINAL D.A. = 2.5 Ac.
 STORAGE REQUIRED
 WET = 1800 x 3.1 = 5580 Cuf.
 DRY = 1800 x 3.1 = 5580 Cuf.
 STORAGE PROVIDED
 WET = 6922 Cuf. @ ELEV. 378.50'
 DRY = 9226 Cuf. @ ELEV. 380.00'
 BOTTOM ELEV. = 377.00'
 STORAGE DEPTH = 4.0'
 TOP OF EMBANKMENT = 382.00'
 CLEAN OUT ELEV. = 377.75'
 RISER CREST ELEV. = 381.00'
 2 YR. ORIFICE INV. = 380.00'
 Q₂ EXIST. = 0.9 c.f.s.
 Q₂ PROP. = 0.8 c.f.s.

TEMPORARY SEDIMENT BASIN DATA
 INITIAL D.A. = 4.6 Ac.
 FINAL D.A. = 5.2 Ac.
 STORAGE REQUIRED
 WET = 1800 x 5.2 = 9,360 Cuf.
 DRY = 1800 x 5.2 = 9,360 Cuf.
 STORAGE PROVIDED
 WET = 9,360 Cuf. @ ELEV. 369.00'
 DRY = 9,360 Cuf. @ ELEV. 368.00'
 BOTTOM ELEV. = 364.00'
 STORAGE DEPTH = 5.0'
 SIDE SLOPES = 3:1
 TOP OF EMBANKMENT = 372.50 (TEMP. FOR BASIN ONLY)
 CLEAN OUT ELEV. = 367.25'
 2 YR. CREST ELEV. = 369.00'
 SPILLWAY CREST ELEV. = 371.00 (TEMP.)
 SPILLWAY WEIR LENGTH = 10.0'
 Q₂ EXIST. = 1.0 c.f.s.
 Q₂ PROP. = 0.9 c.f.s.

PLAN
 SCALE: 1" = 50'

By The Developer:
 "I/We Certify That All Development And/Or Construction Will Be Done According To These Plans, And That Any Responsible Personnel Involved In The Construction Project Will Have A Certificate Of Attendance At A Department Of The Environment Approved Training Program For The Control Of Sediment And Erosion Before Beginning The Project. I Shall Engage A Registered Professional Engineer To Supervise Pond Construction And Provide The Howard Soil Conservation District With An "As-Built" Plan Of The Pond Within 30 Days Of Completion. I Also Authorize Periodic On-Site Inspections By The Howard Soil Conservation District."

Signature Of Developer: *Thomas E. Bourke VP* Date: 12/11/01
 Printed Name Of Developer: **THOMAS E. BOURKE VP**

By The Engineer:
 "I Certify That This Plan For Pond Construction, Erosion And Sediment Control Represents A Practical And Workable Plan Based On My Personal Knowledge Of The Site Conditions. This Plan Was Prepared In Accordance With The Requirements Of The Howard Soil Conservation District. I Have Noted That He/She Must Engage A Registered Professional Engineer To Supervise Pond Construction And Provide The Howard Soil Conservation District With An "As-Built" Plan Of The Pond Within 30 Days Of Completion."

Signature: *Aldo N. ...* Date: 12-11-01
 Printed Name Of Engineer: **ALDO N. ...**

These Plans Have Been Reviewed For The Howard Soil Conservation District And Meet The Technical Requirements For Small Pond Construction, Soil Erosion And Sediment Control.

Signature: *Jim ...* Date: 1/24/02
 Printed Name Of Engineer: **JIM ...**

Signature: *John ...* Date: 1/29/02
 Printed Name Of Engineer: **JOHN ...**



Signature: *Richard M. ...* Date: 1-16-02
 Printed Name Of Engineer: **RICHARD M. ...**

Signature: *Judy ...* Date: 2/4/02
 Printed Name Of Engineer: **JUDY ...**


Signature: *John ...* Date: 2/4/02
 Printed Name Of Engineer: **JOHN ...**

AS-BUILT CERTIFICATION
 I Herby Certify That The Facility Shown On This Plan Was Constructed As Shown On The "As-Built" Plans And Meets The Approved Plans And Specifications.
 Signature: *...* Date: 12/04/02
 P.E. No. 524108

Certify Means To State Or Declare A Professional Opinion Based Upon Onsite Inspections And Material Tests Which Are Conducted During Construction. The Onsite Inspections And Material Tests Are Those Inspections And Tests Deemed Sufficient And Appropriate Commonly Accepted Engineering Standards. Certify Does Not Mean Or Imply A Guarantee By The Engineer Nor Does An Engineer's Certification Relieve Any Other Party From Meeting Requirements Imposed By Contract, Employment, Or Other Means, Including Meeting Commonly Accepted Industry Practices.

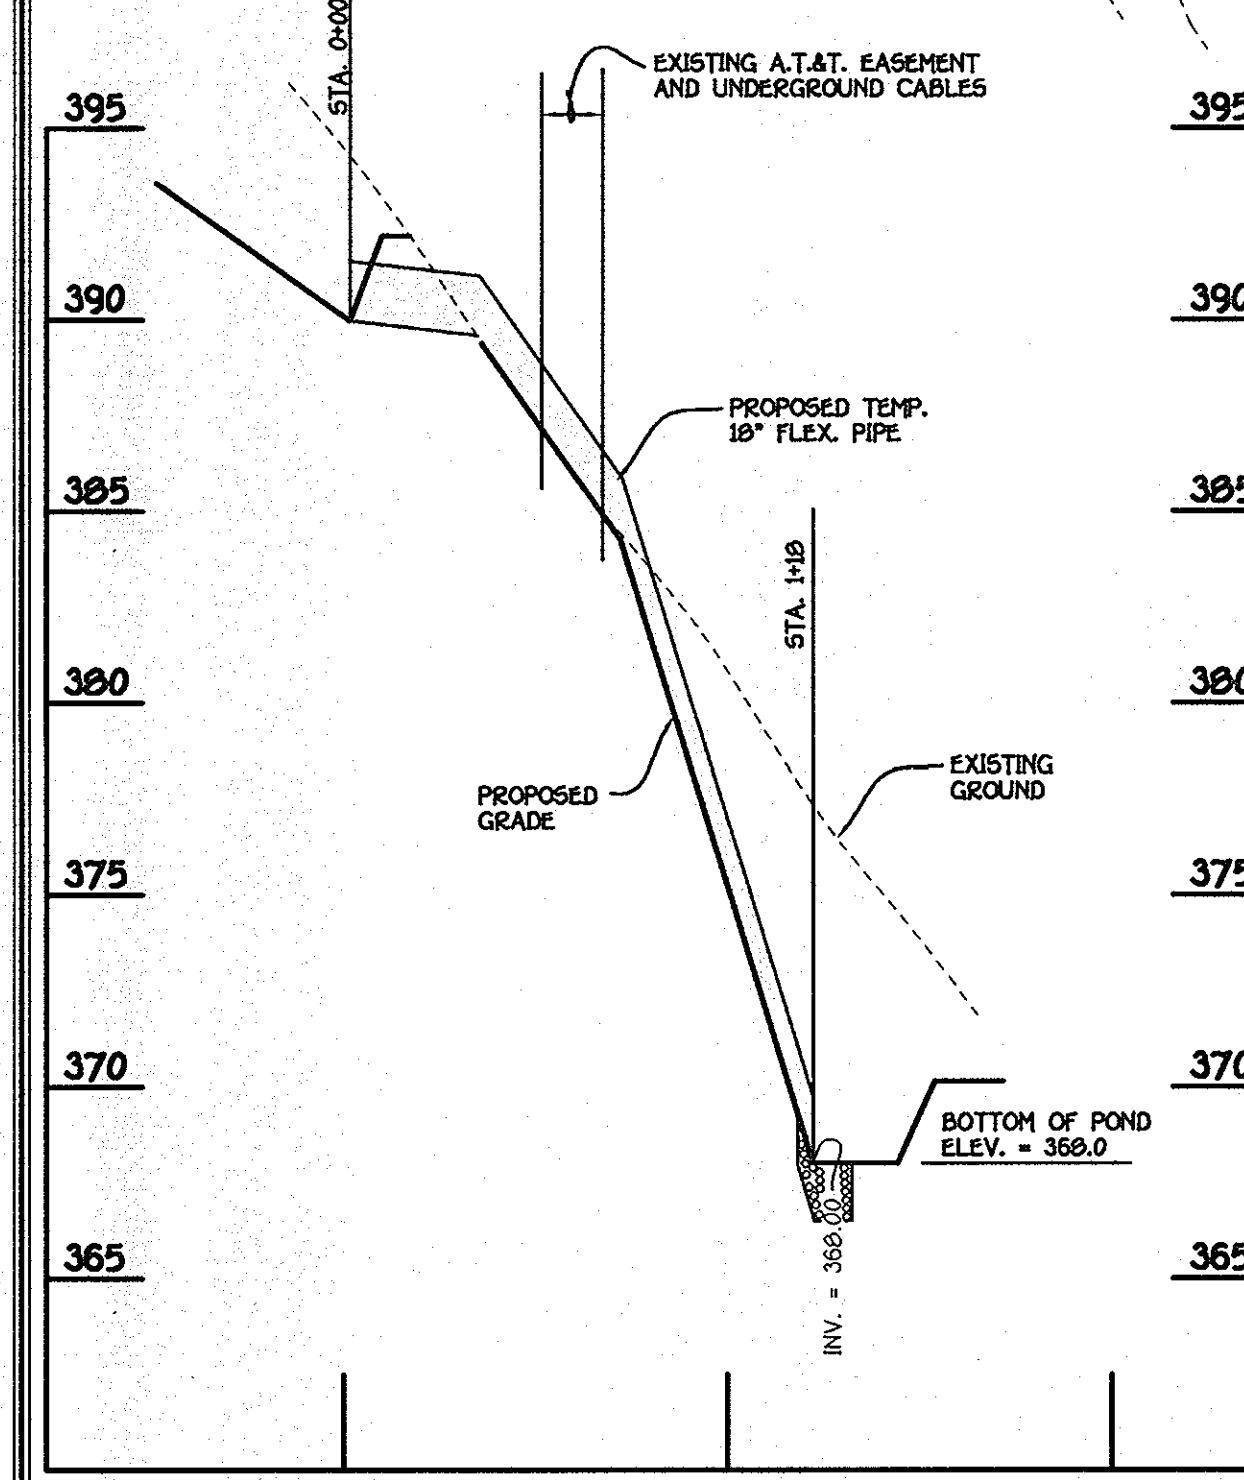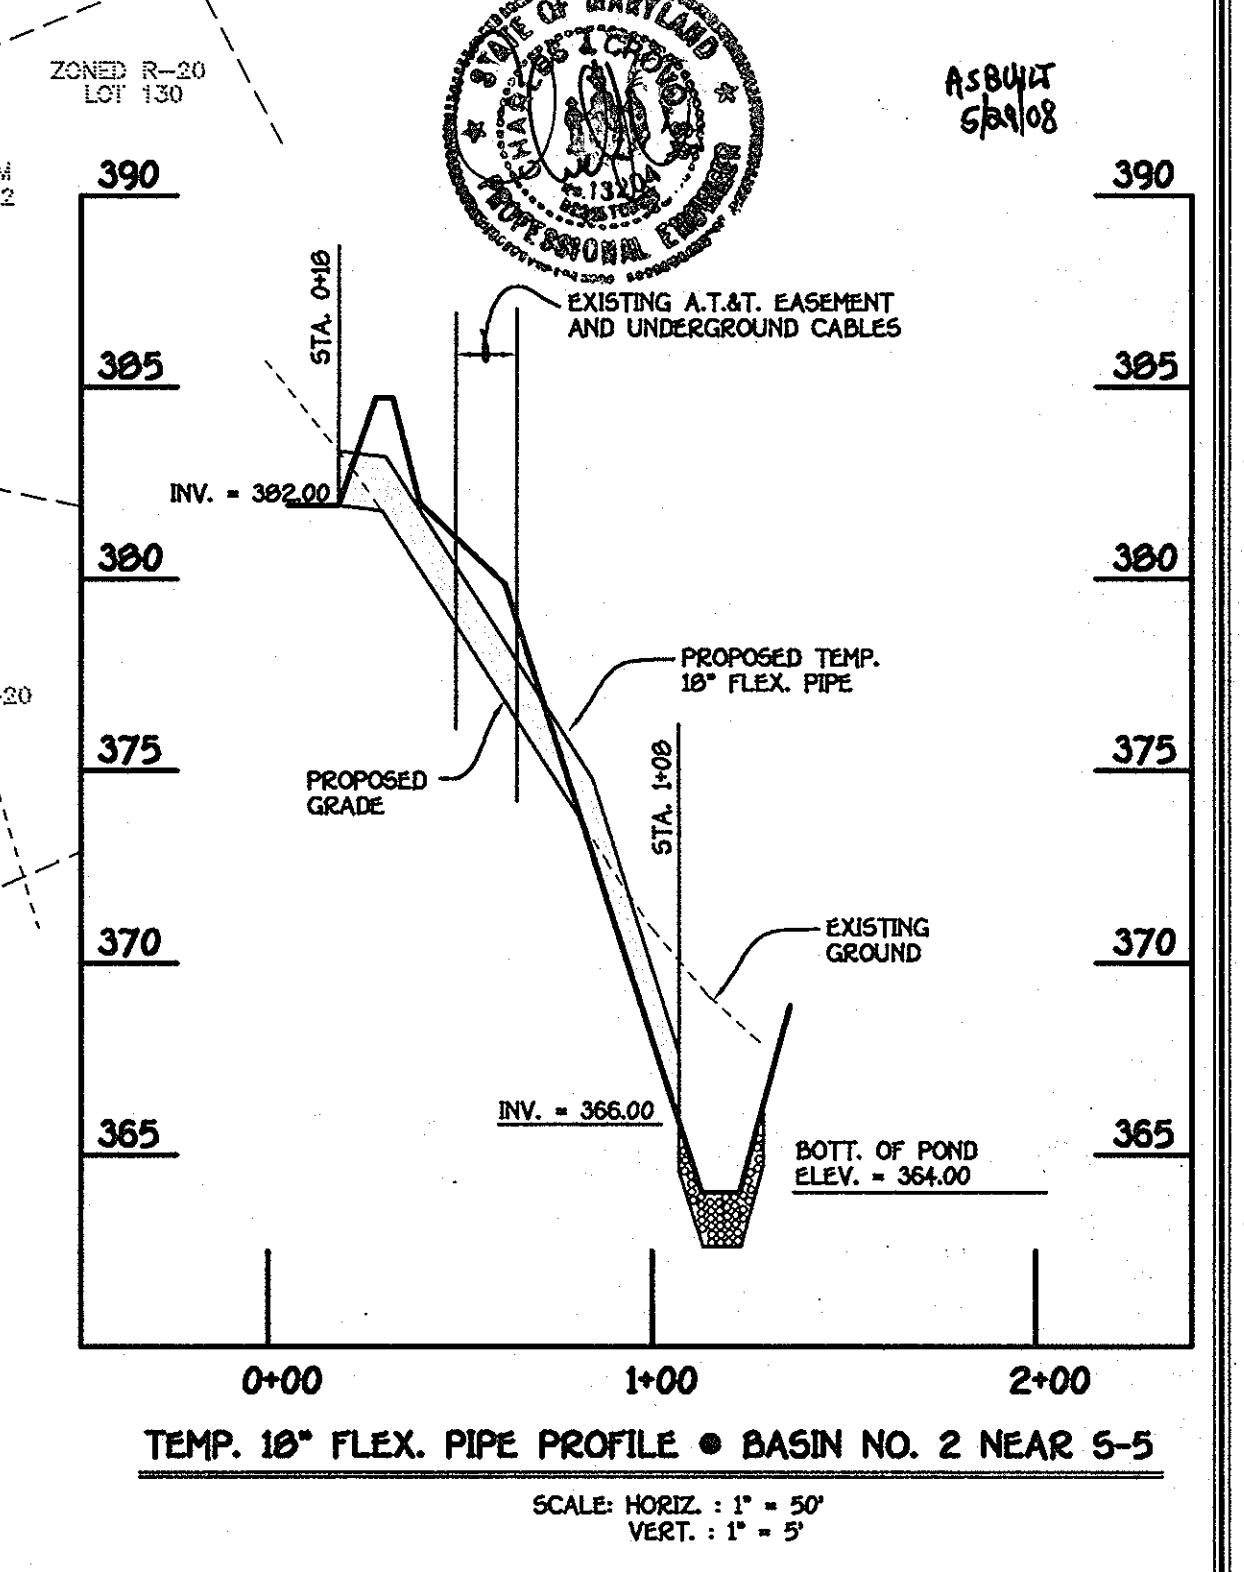

FISHER, COLLINS & CARTER, INC.
 CIVIL ENGINEERING CONSULTANTS & LAND SURVEYORS
 CENTENNIAL SQUARE OFFICE PARK • 10272 BALTIMORE NATIONAL PIKE
 ELICOTT CITY, MARYLAND 21117
 (410) 481-2855

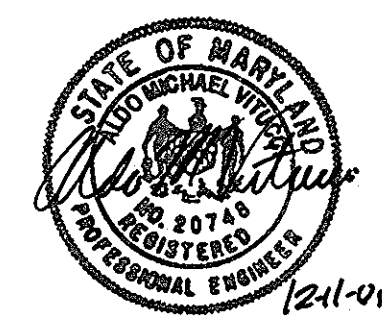

OWNER/DEVELOPER
 CHERRYTREE I, L.L.C.
 7920 INDIAN PIPE COURT
 COLUMBIA, MARYLAND 21046


STREET TREE, GRADING AND SEDIMENT CONTROL PLAN
CHERRYTREE PARK
 LOTS 1 THRU 10, OPEN SPACE LOTS 11 THRU 13
 AND BULK PARCELS 'A' THRU 'H'
 (PHASES I AND II)
 ZONED: MXD-6
 TAX MAP NO. 46 PARCEL NO. 156 GRID NO. 4
 SIXTH ELECTION DISTRICT HOWARD COUNTY, MARYLAND
 DATE: DECEMBER 7, 2001
 SHEET 7 OF 21

F-01-114 ASBUILT

APPROVED: DEPARTMENT OF PUBLIC WORKS
Richard M. Daniels 1-16-02
 CHIEF, BUREAU OF HIGHWAYS DATE

APPROVED: DEPARTMENT OF PLANNING AND ZONING
Carly Harris 2/4/02
 CHIEF, DIVISION OF LAND DEVELOPMENT DATE

Mike Dammann 2/4/02
 CHIEF, DEVELOPMENT ENGINEERING DIVISION DATE

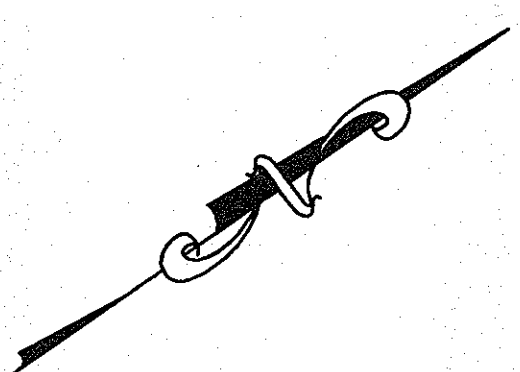


E 130720
 N 245720

CHERRYTREE PARK
 SECTION 1 AREA 2
 LOTS 11 - 203
 PLAT No. 7841
 OPEN SPACE
 LOT 15
 ZONED R-20

QTY.	KEY	NAME	SIZE
24		ACER RUBRUM "OCTOBER GLORY" OCTOBER RED MAPLE	3" - 3 1/2" CALIPER
36		FRAXINUS AMERICANA "AUTUMN PURPLE" AUTUMN PURPLE WHITE ASH	3" - 3 1/2" CALIPER
10		CEDRUS DEODORA DEODAR CEDAR	6' - 8' HT.
43		PINUS STROBUS EASTERN WHITE PINE	6' - 8' HT.

"THIS PLAN HAS BEEN PREPARED IN ACCORDANCE WITH THE PROVISIONS OF SECTION 16124 OF THE HOWARD COUNTY CODE AND THE LANDSCAPE MANUAL". FINANCIAL SURETY FOR THE PHASE I REQUIRED LANDSCAPE TREES HAS BEEN POSTED AS PART OF THE DEVELOPER'S AGREEMENT IN THE AMOUNT OF \$25,950.00 FOR 60 SHADE TREES AND 53 EVERGREEN TREES.

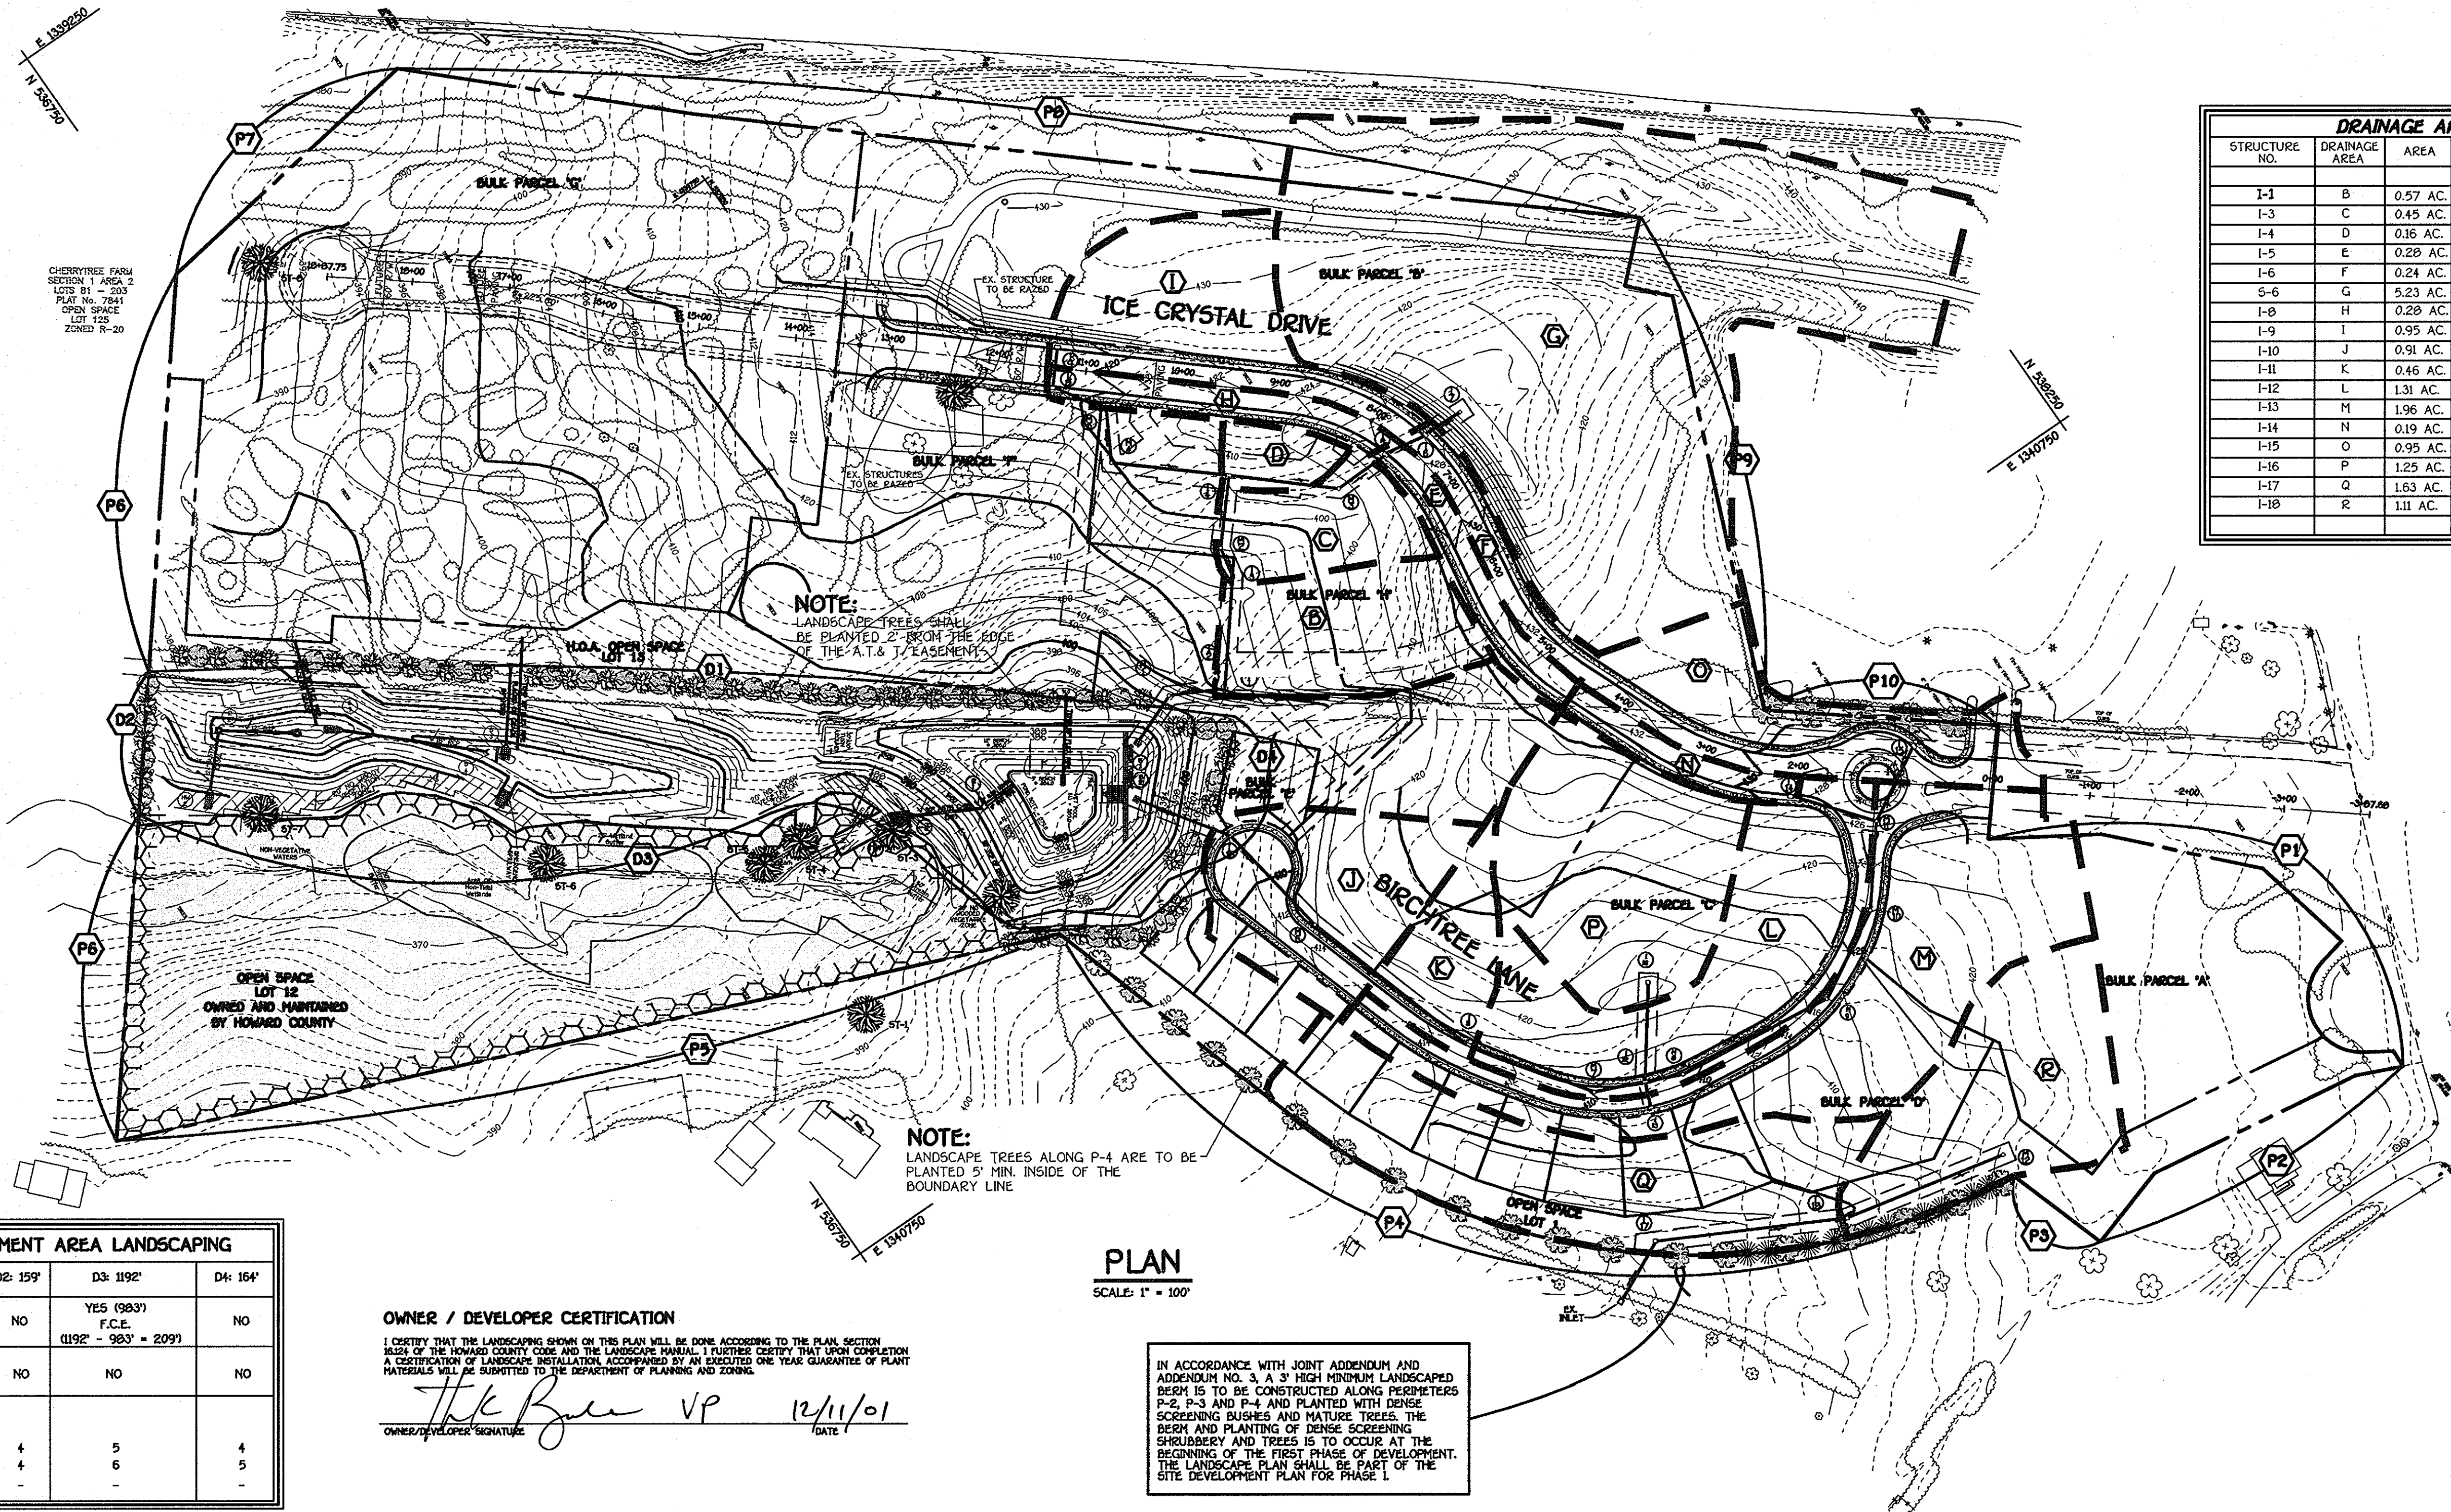

NOTE:
 LANDSCAPE TREES SHALL BE PLANTED 2'-8" FROM THE EDGE OF THE A.T.A. EASEMENT

NOTE:
 LANDSCAPE TREES ALONG P-4 ARE TO BE PLANTED 5' MIN. INSIDE OF THE BOUNDARY LINE

PLAN
 SCALE: 1" = 100'

OWNER / DEVELOPER CERTIFICATION
 I CERTIFY THAT THE LANDSCAPING SHOWN ON THIS PLAN WILL BE DONE ACCORDING TO THE PLAN SECTION 16124 OF THE HOWARD COUNTY CODE AND THE LANDSCAPE MANUAL. I FURTHER CERTIFY THAT UPON COMPLETION A CERTIFICATION OF LANDSCAPE INSTALLATION ACCOMPANIED BY AN EXECUTED ONE YEAR GUARANTEE OF PLANT MATERIALS WILL BE SUBMITTED TO THE DEPARTMENT OF PLANNING AND ZONING.
Thea Buler VP 12/11/01
 OWNER/DEVELOPER SIGNATURE DATE

IN ACCORDANCE WITH JOINT ADDENDUM AND ADDENDUM NO. 3, A 3' HIGH MINIMUM LANDSCAPED BESH IS TO BE CONSTRUCTED ALONG PERIMETERS P-2, P-3 AND P-4 AND PLANTED WITH DENSE SCREENING BUSHES AND MATURE TREES. THE BESH AND PLANTING OF DENSE SCREENING SHRUBBERY AND TREES IS TO OCCUR AT THE BEGINNING OF THE FIRST PHASE OF DEVELOPMENT. THE LANDSCAPE PLAN SHALL BE PART OF THE SITE DEVELOPMENT PLAN FOR PHASE I.

STRUCTURE NO.	DRAINAGE AREA	AREA	"C"	ZONED	% IMP.
I-1	B	0.57 AC.	0.38	MXD-6	65%
I-3	C	0.45 AC.	0.38	MXD-6	65%
I-4	D	0.16 AC.	0.35	MXD-6	65%
I-5	E	0.28 AC.	0.66	MXD-6	86%
I-6	F	0.24 AC.	0.72	MXD-6	90%
I-8	G	5.23 AC.	0.18	MXD-6	5%
I-8	H	0.28 AC.	0.67	MXD-6	86%
I-9	I	0.95 AC.	0.47	MXD-6	73%
I-10	J	0.91 AC.	0.48	MXD-6	74%
I-11	K	0.46 AC.	0.41	MXD-6	70%
I-12	L	1.31 AC.	0.45	MXD-6	72%
I-13	M	1.96 AC.	0.43	MXD-6	70%
I-14	N	0.19 AC.	0.71	MXD-6	89%
I-15	O	0.95 AC.	0.95	MXD-6	75%
I-16	P	1.25 AC.	0.35	MXD-6	65%
I-17	Q	1.63 AC.	1.63	MXD-6	45%
I-18	R	1.11 AC.	1.11	MXD-6	50%

LINEAR FEET OF PERIMETER	D1: 1117'	D2: 159'	D3: 1192'	D4: 164'
CREDIT FOR EXISTING VEGETATION (NO, YES AND %)	NO	NO	YES (98%) F.C.E. (1192' - 98% = 209')	NO
CREDIT FOR OTHER LANDSCAPING (NO, YES AND %)	NO	NO	NO	NO
NUMBER OF TREES REQUIRED & PROVIDED: (TYPE 'B' BUFFER)				
SHADE TREES (1:50 L.F.)	23	4	5	4
EVERGREEN TREES (1:40 L.F.)	28	4	6	5
OTHER TREES (2:1 SUBSTITUTION)	-	-	-	-

PERIMETER	* P-1	* P-2	* P-3	P-4	P-5	* P-6	* P-7	* P-8	* P-9	P-10
CATEGORY	Adjacent to Roadway	Adjacent to Perimeter Property	Adjacent to Perimeter Property	Adjacent to Perimeter Property	Adjacent to Perimeter Property	Adjacent to Perimeter Property	Adjacent to Perimeter Property	Adjacent to Roadway	Adjacent to Perimeter Property	Adjacent to Perimeter Property
LANDSCAPE TYPE	E	C	C	A C	C	C	C	C	A	A
LINEAR FEET OF PERIMETER	604'	389'	112'	861' 200'	992'	899'	311'	1229'	560'	241'
CREDIT FOR EXISTING VEGETATION (YES, NO, LINEAR FEET)	NO	NO	NO	NO	YES (99%) CREDIT EX. WOODS (F.C.E.)	YES (90%) CREDIT (899' - 90% = 399) EX. WOODS (F.C.E.)	NO	NO	NO	NO
CREDIT FOR WALL, FENCE OR BESH (YES, NO, LINEAR FEET)	NO	NO	NO	NO	NO	NO	NO	NO	NO	NO
NUMBER OF PLANTS REQUIRED & PROVIDED										
SHADE TREES	16	10	3	14	5	0	10	8	33	5
EVERGREEN TREES	151	20	6	0	10	0	16	15	-	0
SHRUBS	-	-	-	-	-	-	-	-	-	-

* NOTE: PERIMETERS P-6, P-7, P-8 & P-9 WILL BE SATISFIED IN PHASE III OF THIS DEVELOPMENT.
 PERIMETERS P-1, P-2 & P-3 WILL BE SATISFIED UPON COMPLETION OF THE COMMERCIAL SITE (BULK PARCEL 'A') AND ITS ASSOCIATED SITE DEVELOPMENT PLAN.

- DENOTES SPECIMEN TREE
 ST-1

No.	DESCRIPTION	DATE
1	REVISE STORM DRAINS FOR AT&T CROSSING AND REMOVE TRAFFIC CALMING ON BIRCHTREE LANE	10/10/02

FISHER, COLLINS & CARTER, INC.
 CIVIL ENGINEERING CONSULTANTS & LAND SURVEYORS
 CENTENNIAL SQUARE OFFICE PARK - 10272 BALTIMORE NATIONAL FREE
 COLUMBIA CITY, MARYLAND 21042
 (410) 621-2855




OWNER/DEVELOPER
 CHERRYTREE I, L.L.C.
 7520 INDIAN PIPE COURT
 COLUMBIA, MARYLAND 21046




STORM DRAIN DRAINAGE AREA MAP AND LANDSCAPE PLAN
CHERRYTREE PARK
 LOTS 1 THRU 10, OPEN SPACE LOTS 11 THRU 13 AND BULK PARCELS 'A' THRU 'H' (PHASES I AND II)
 TAX MAP NO. 46 PARCEL NO. 156 GRID NO. 4
 SIXTH ELECTION DISTRICT HOWARD COUNTY, MARYLAND
 DATE: DECEMBER 7, 2001
 SHEET 8 OF 21

ASBUILT F-01-114


APPROVED DEPARTMENT OF PLANNING AND ZONING
Ind. Hamilton 2/4/02 DATE
 CHIEF, DIVISION OF LAND DEVELOPMENT
Mike Dammann 2/4/02 DATE
 CHIEF, DEVELOPMENT ENGINEERING DIVISION
 APPROVED HOWARD COUNTY DEPARTMENT OF PUBLIC WORKS
Robert M. Danks 1-16-02 DATE
 CHIEF, BUREAU OF HIGHWAYS

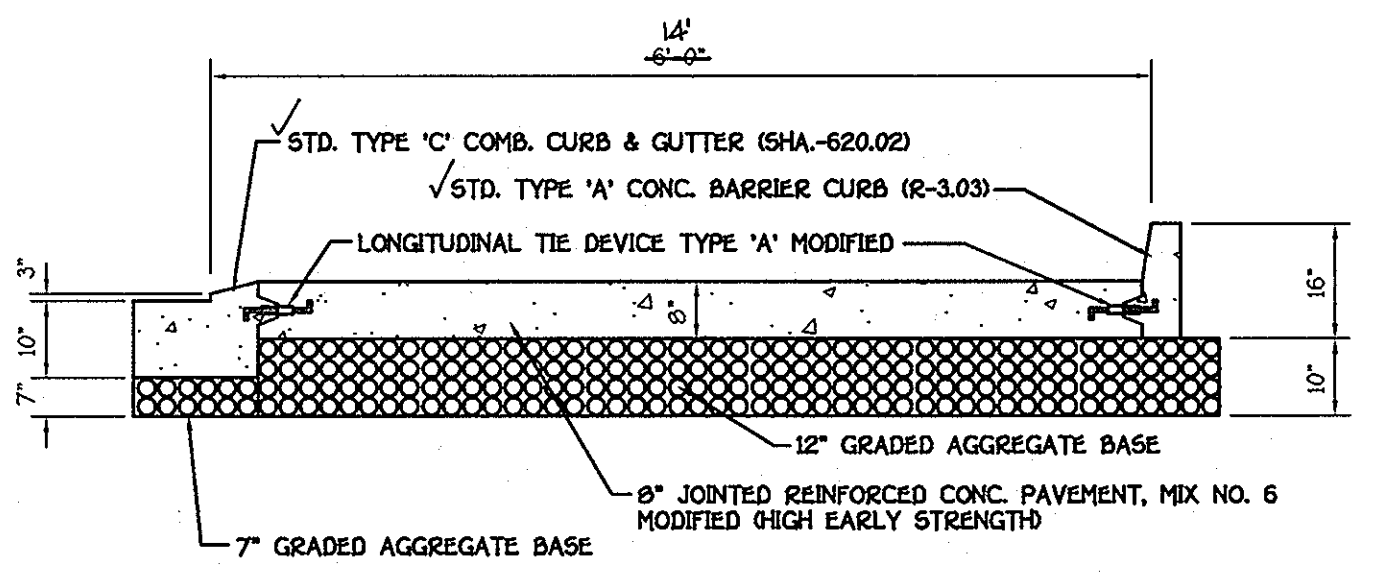


SECTION 'A-A'
NO SCALE

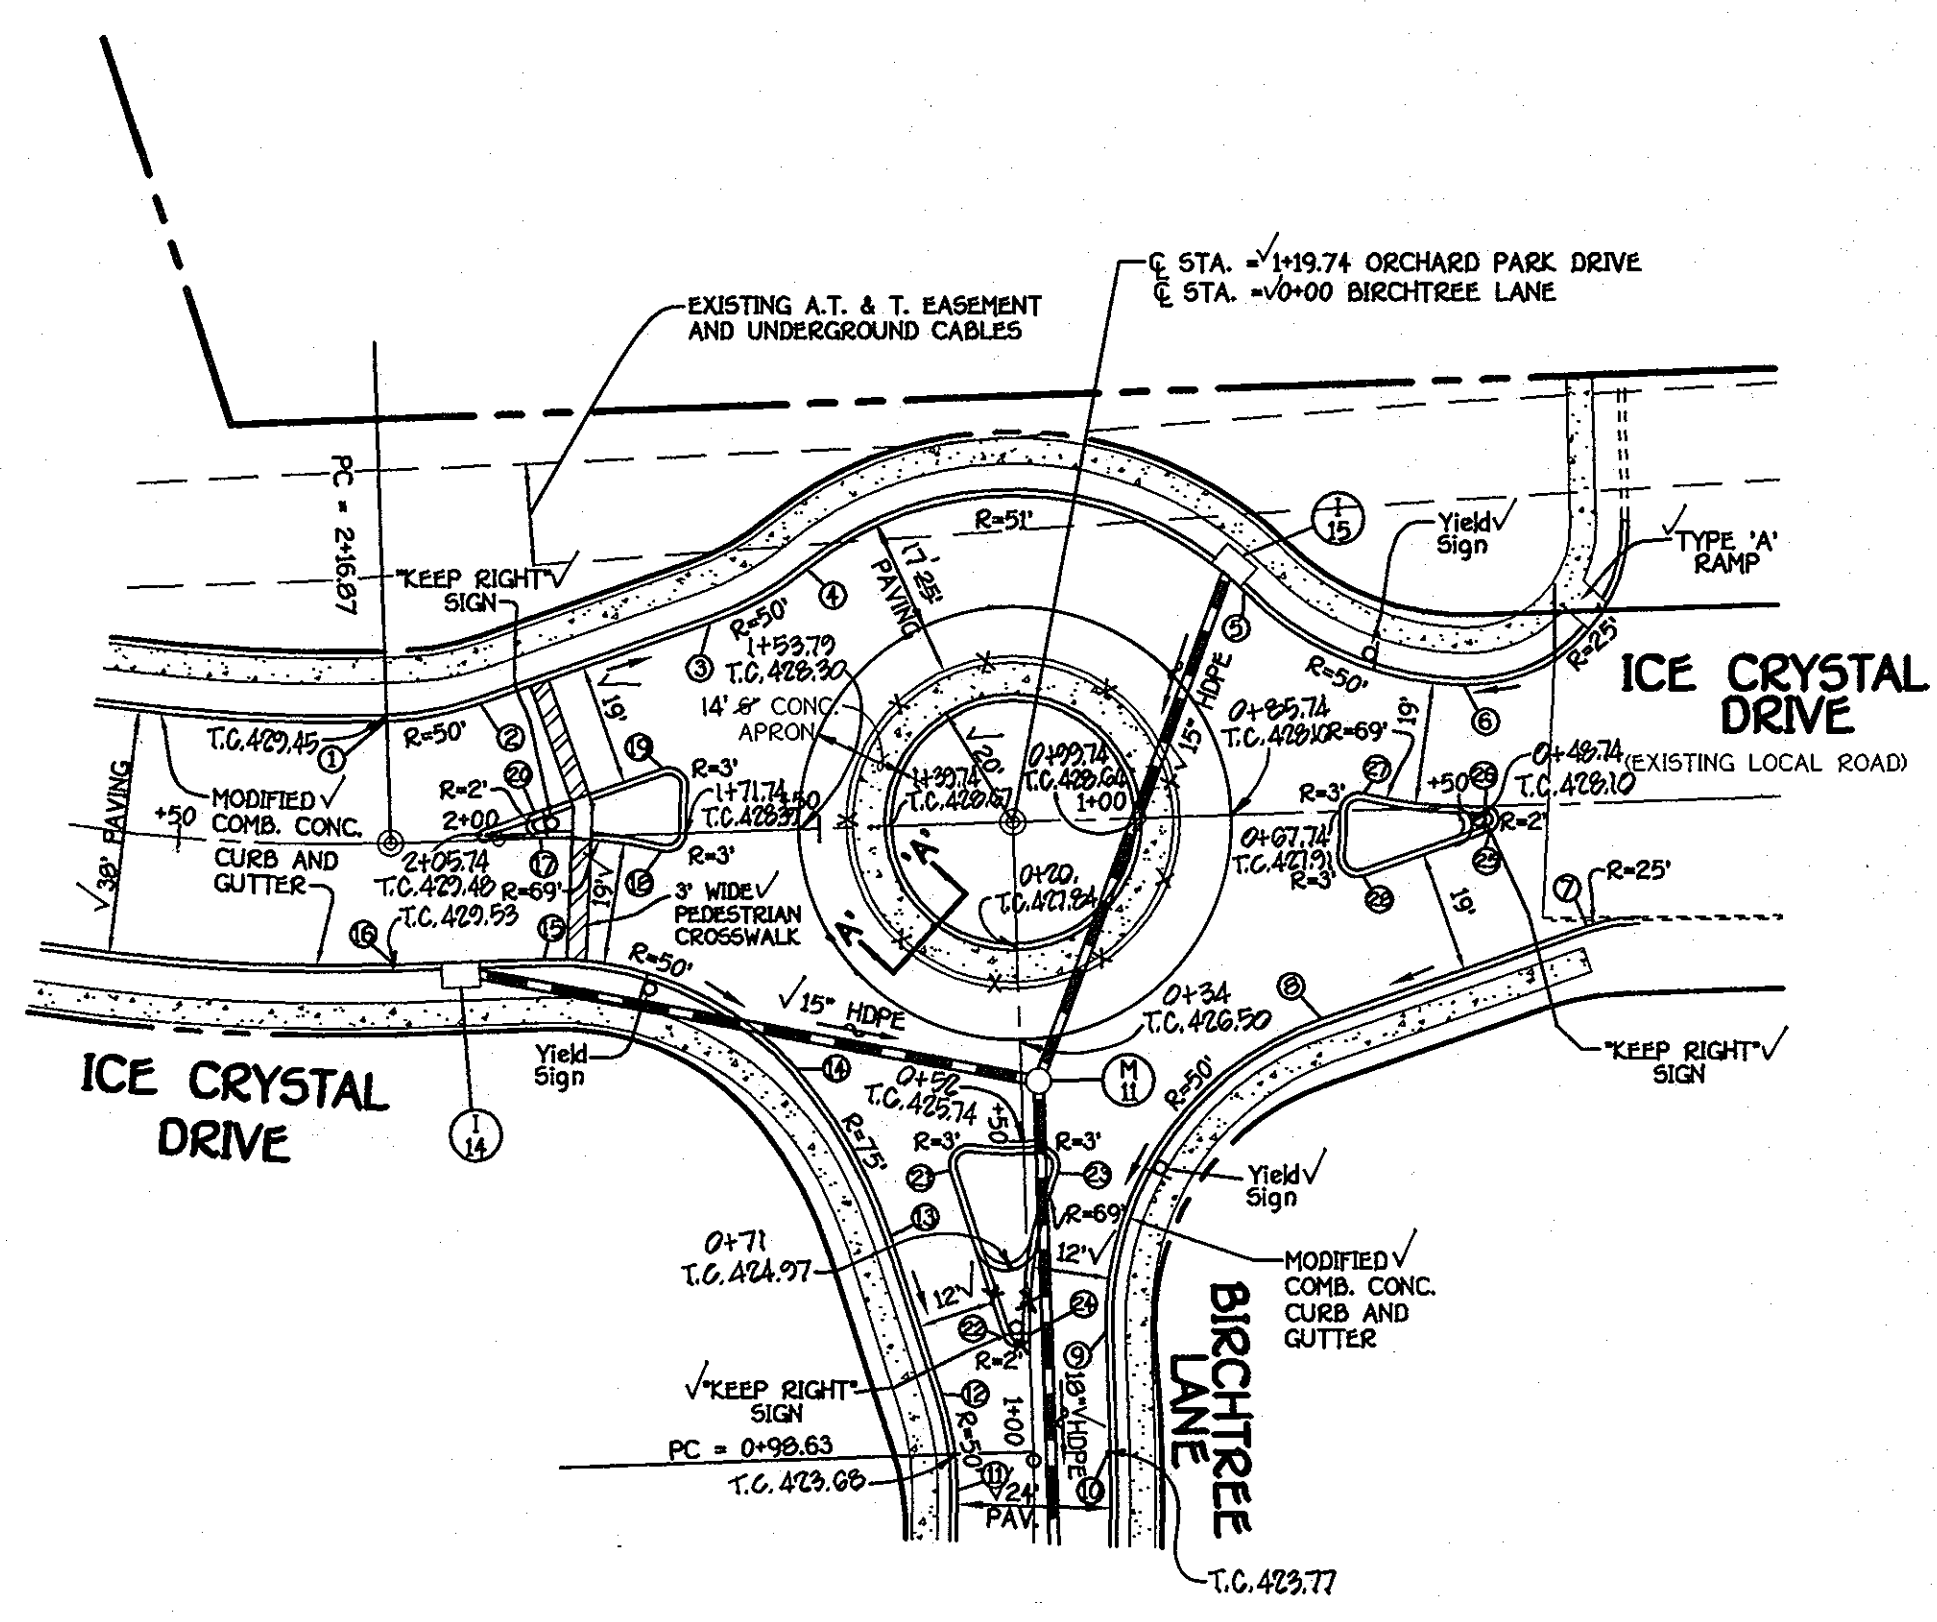

ROUNDBOUT DETAIL
SCALE: 1" = 30'

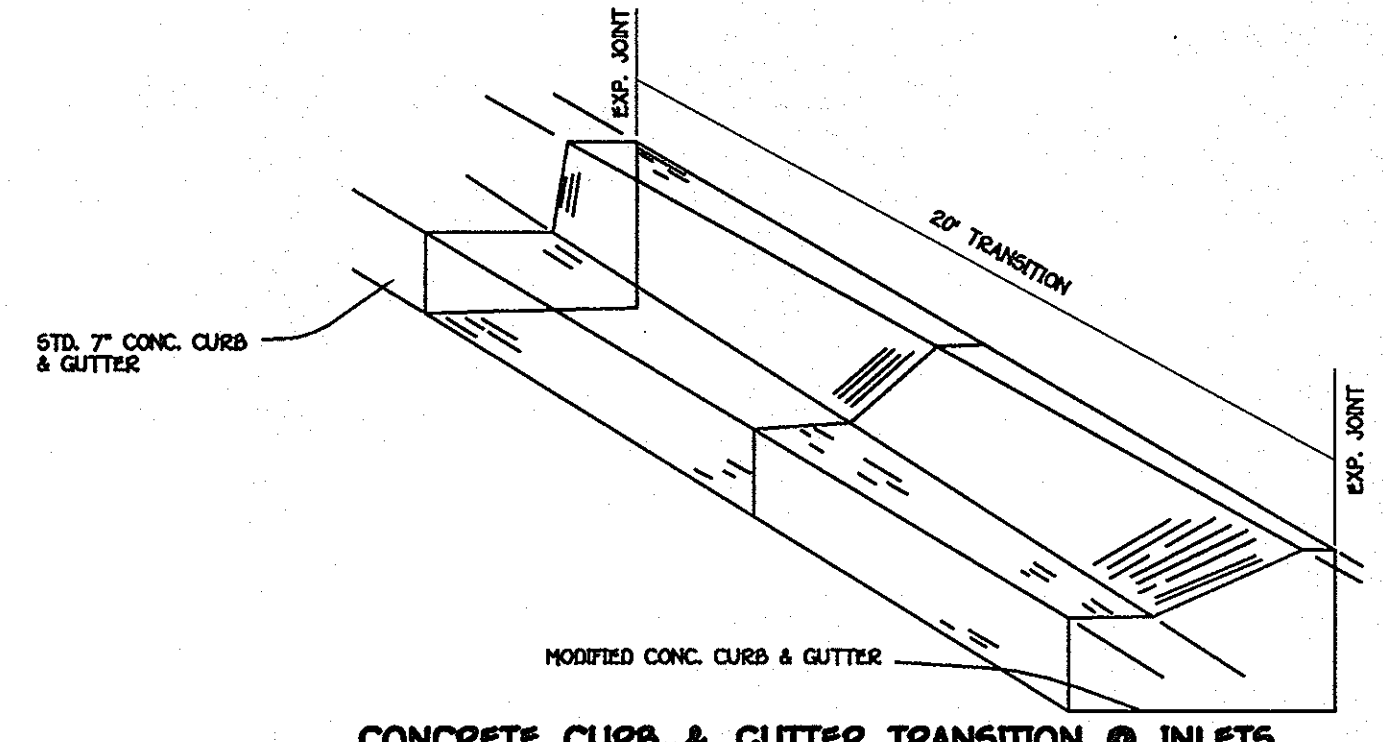


CONCRETE CURB & GUTTER TRANSITION @ INLETS
NO SCALE

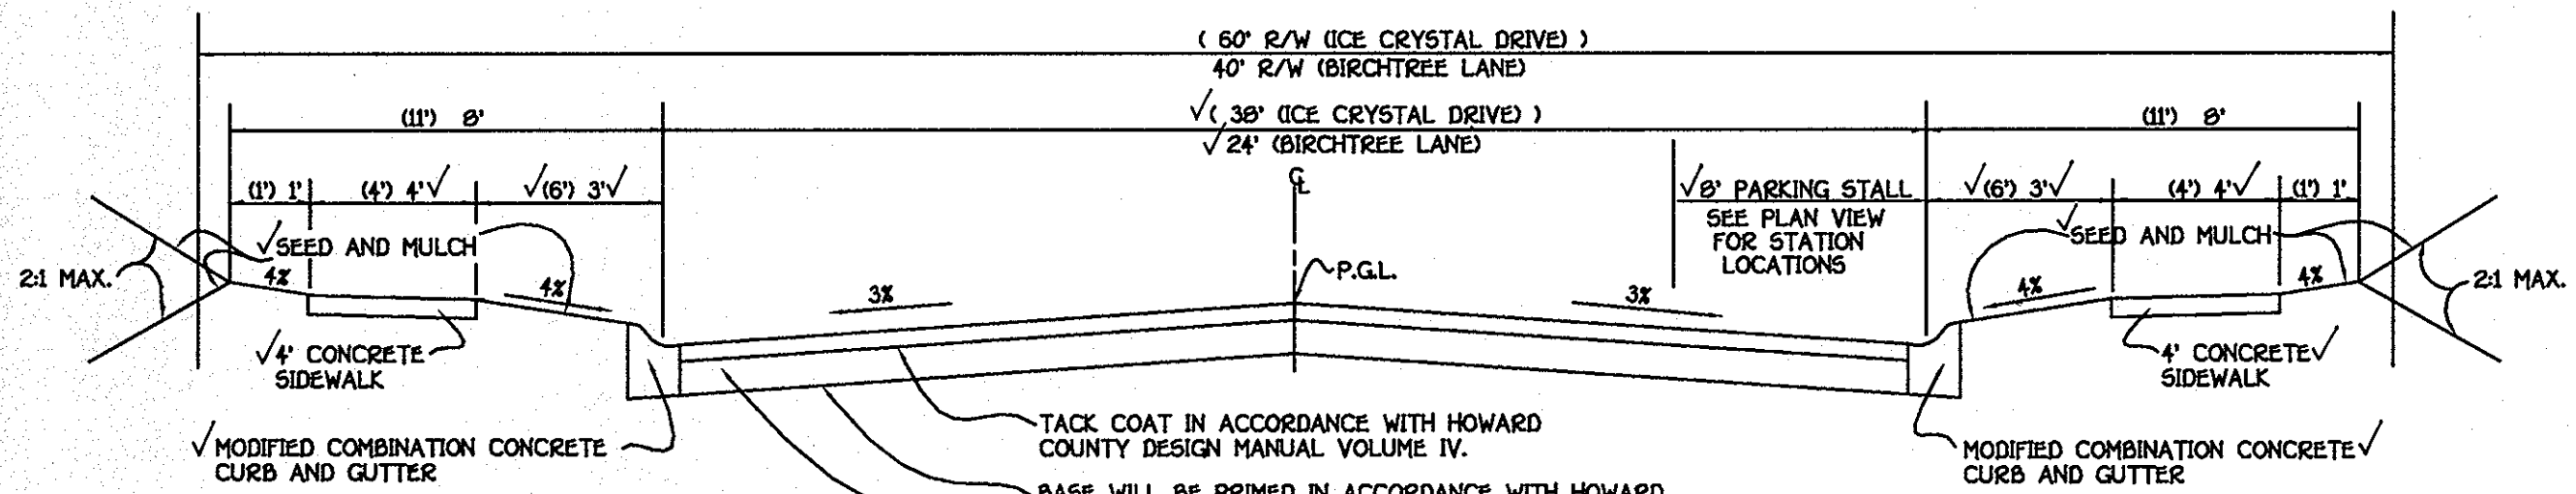

TYPICAL ROADWAY SECTION
NO SCALE


No.	ROAD NAME	STATION	OFFSET	TOP OF CURB ELEVATION
1	ICE CRYSTAL DRIVE	2+17.22	19.00 R	429.27
2	ICE CRYSTAL DRIVE	2+02.16	21.29 R	428.77
3	ICE CRYSTAL DRIVE	1+65.93	32.66 R	427.53
4	ICE CRYSTAL DRIVE	1+50.63	40.99 R	427.02
5	ICE CRYSTAL DRIVE	0+92.49	34.84 R	426.94
6	ICE CRYSTAL DRIVE	0+48.64	19.07 R	427.66
7	ICE CRYSTAL DRIVE	0+30.75	19.23 L	427.91
8	ICE CRYSTAL DRIVE	0+72.71	32.40 L	427.64
9	BIRCHTREE LANE	0+80.11	12.00 L	424.36
10	BIRCHTREE LANE	0+98.63	12.00 L	423.61
11	BIRCHTREE LANE	1+04.61	12.00 R	423.41
12	BIRCHTREE LANE	0+89.06	14.00 R	423.94
13	BIRCHTREE LANE	0+84.05	21.17 R	424.72
14	BIRCHTREE LANE	0+37.95	34.96 R	425.37
15	ICE CRYSTAL DRIVE	1+93.56	19.00 L	428.59
16	ICE CRYSTAL DRIVE	2+16.87	19.00 L	429.26
17	ICE CRYSTAL DRIVE	1+93.56	0	428.84
18	ICE CRYSTAL DRIVE	1+74.56	2.67 L	428.61
19	ICE CRYSTAL DRIVE	1+74.56	10.19 R	428.38
20	ICE CRYSTAL DRIVE	1+94.16	3.91 R	429.06
21	BIRCHTREE LANE	0+54.13	11.53 R	425.40
22	BIRCHTREE LANE	0+80.66	3.92 R	424.57
23	BIRCHTREE LANE	0+25.15	5.29 L	425.96
24	BIRCHTREE LANE	0+80.11	0	424.40
25	ICE CRYSTAL DRIVE	0+45.38	3.91 L	428.16
26	ICE CRYSTAL DRIVE	0+45.98	0	427.99
27	ICE CRYSTAL DRIVE	0+84.91	2.85 R	427.99
28	ICE CRYSTAL DRIVE	0+65.34	10.17 L	427.71

ROADWAY INFORMATION CHART					
ROAD NAME	CLASSIFICATION	DESIGN SPEED	ZONING	STATION LIMITS	PAVING SECTION
ICE CRYSTAL DRIVE	PUBLIC LOCAL STREET	30 M.P.H.	MXD-6	0+00 TO 19+64.20 ✓	P-3
BIRCHTREE LANE	PUBLIC ACCESS STREET	25 M.P.H.	MXD-6	0+00 TO 9+34.16 ✓	P-2

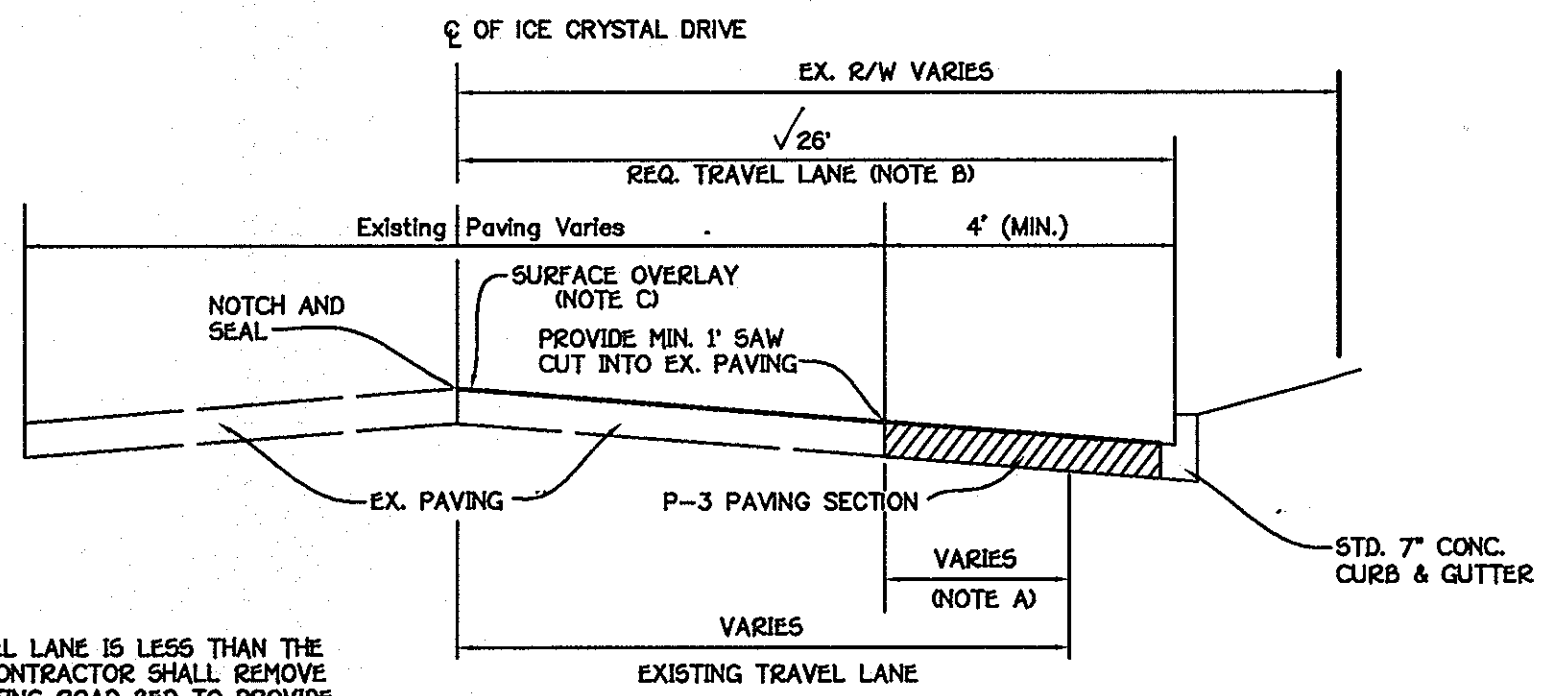


TYPICAL WIDENING SECTION (ICE CRYSTAL DRIVE)
NO SCALE

NOTE A - WHEN EXISTING TRAVEL LANE IS LESS THAN THE REQUIRED 12' LANE CONTRACTOR SHALL REMOVE ENOUGH OF THE EXISTING ROAD BED TO PROVIDE A MINIMUM BASE WIDENING OF 4'.
 NOTE B - THE SURFACE OVERLAY SHALL BE CARRIED TO THE C OF THE ROAD AND NOTCHED AND SEALED.
 NOTE C - SURFACE OVERLAY COURSE TO BE EQUAL TO SURFACE COURSE OF TYPICAL PAVING SECTION.
 NOTE D - C OF ROAD TO BE MILLED AT DEPTH OF 1 1/2" x 1' WIDE USING A MILLING MACHINE.

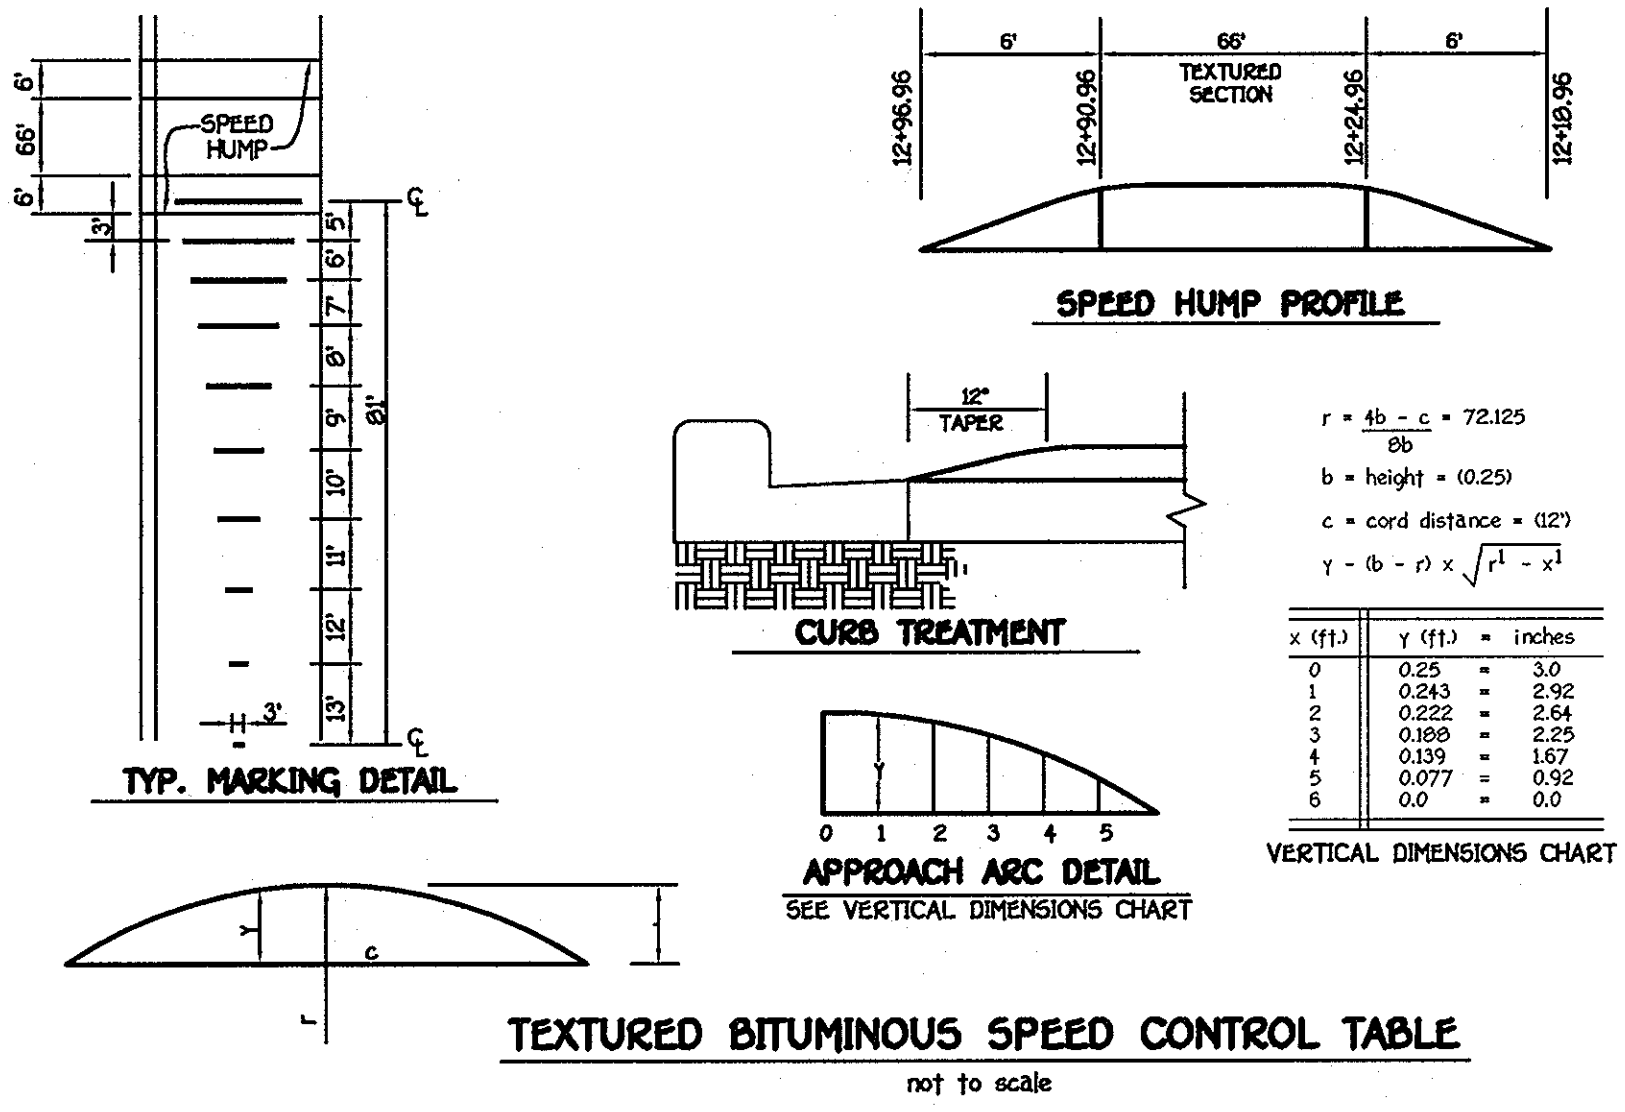


TEXTURED BITUMINOUS SPEED CONTROL TABLE
not to scale

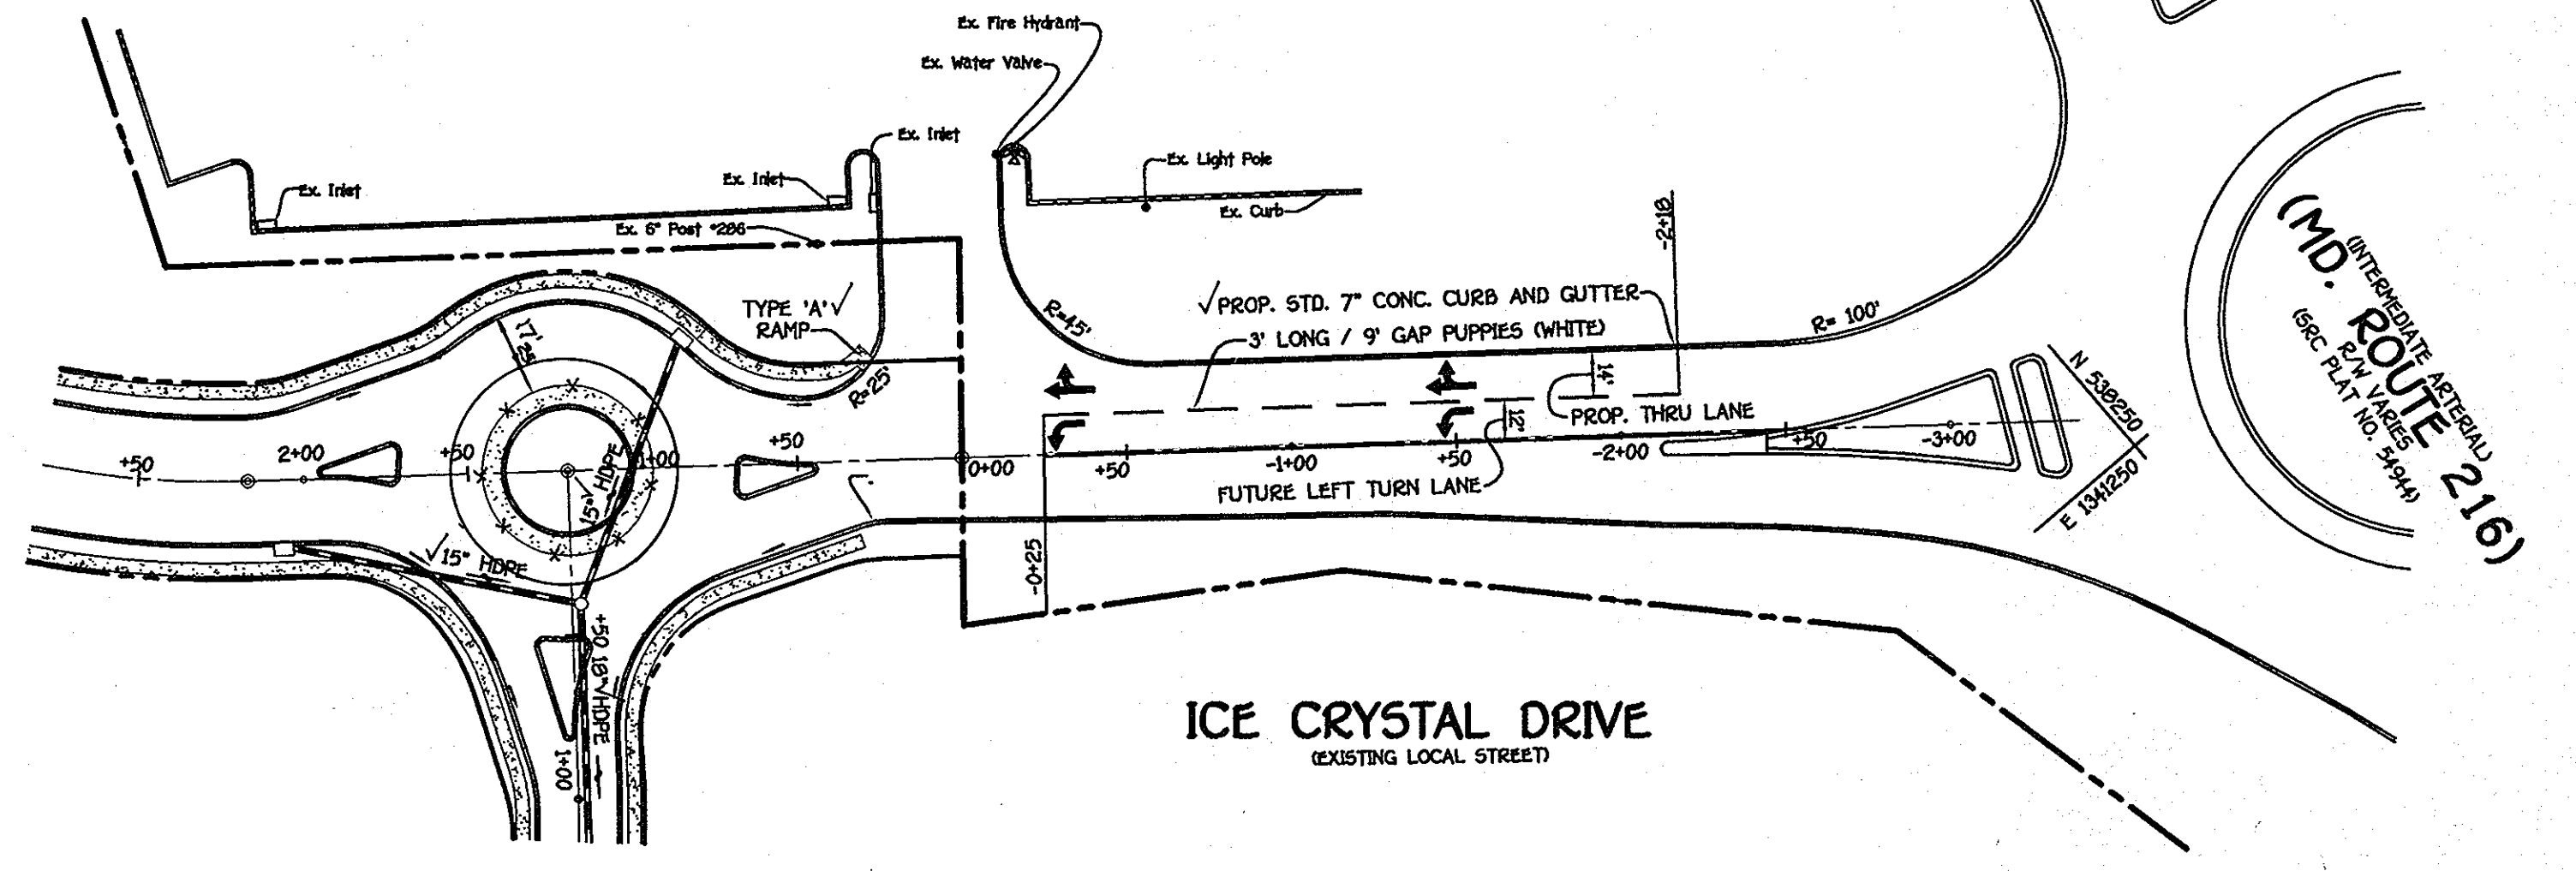


STRIPING PLAN
SCALE: 1" = 50'

TYPICAL ROADWAY SECTION AND DETAILS
CHERRYTREE PARK
 LOTS 1 THRU 10, OPEN SPACE LOTS 11 THRU 13
 AND BULK PARCELS 'A' THRU 'H'
 (PHASES I AND II)
 TAX MAP NO. 46 PARCEL NO. 156 GRID NO. 4
 SIXTH ELECTION DISTRICT HOWARD COUNTY, MARYLAND
 DATE: DECEMBER 7, 2001
 SHEET 9 OF 21

FISHER, COLLINS & CARTER, INC.
 CIVIL ENGINEERING CONSULTANTS & LAND SURVEYORS
 CENTENNIAL SQUARE OFFICE PARK - 10772 BALTIMORE NATIONAL PIKE
 ELICOTT CITY, MARYLAND 21032
 (410) 461-2355

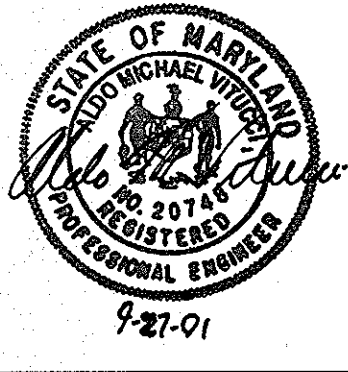

OWNER/DEVELOPER
 CHERRYTREE I, LLC
 7520 INDIAN PIPE COURT
 COLUMBIA, MARYLAND 21046

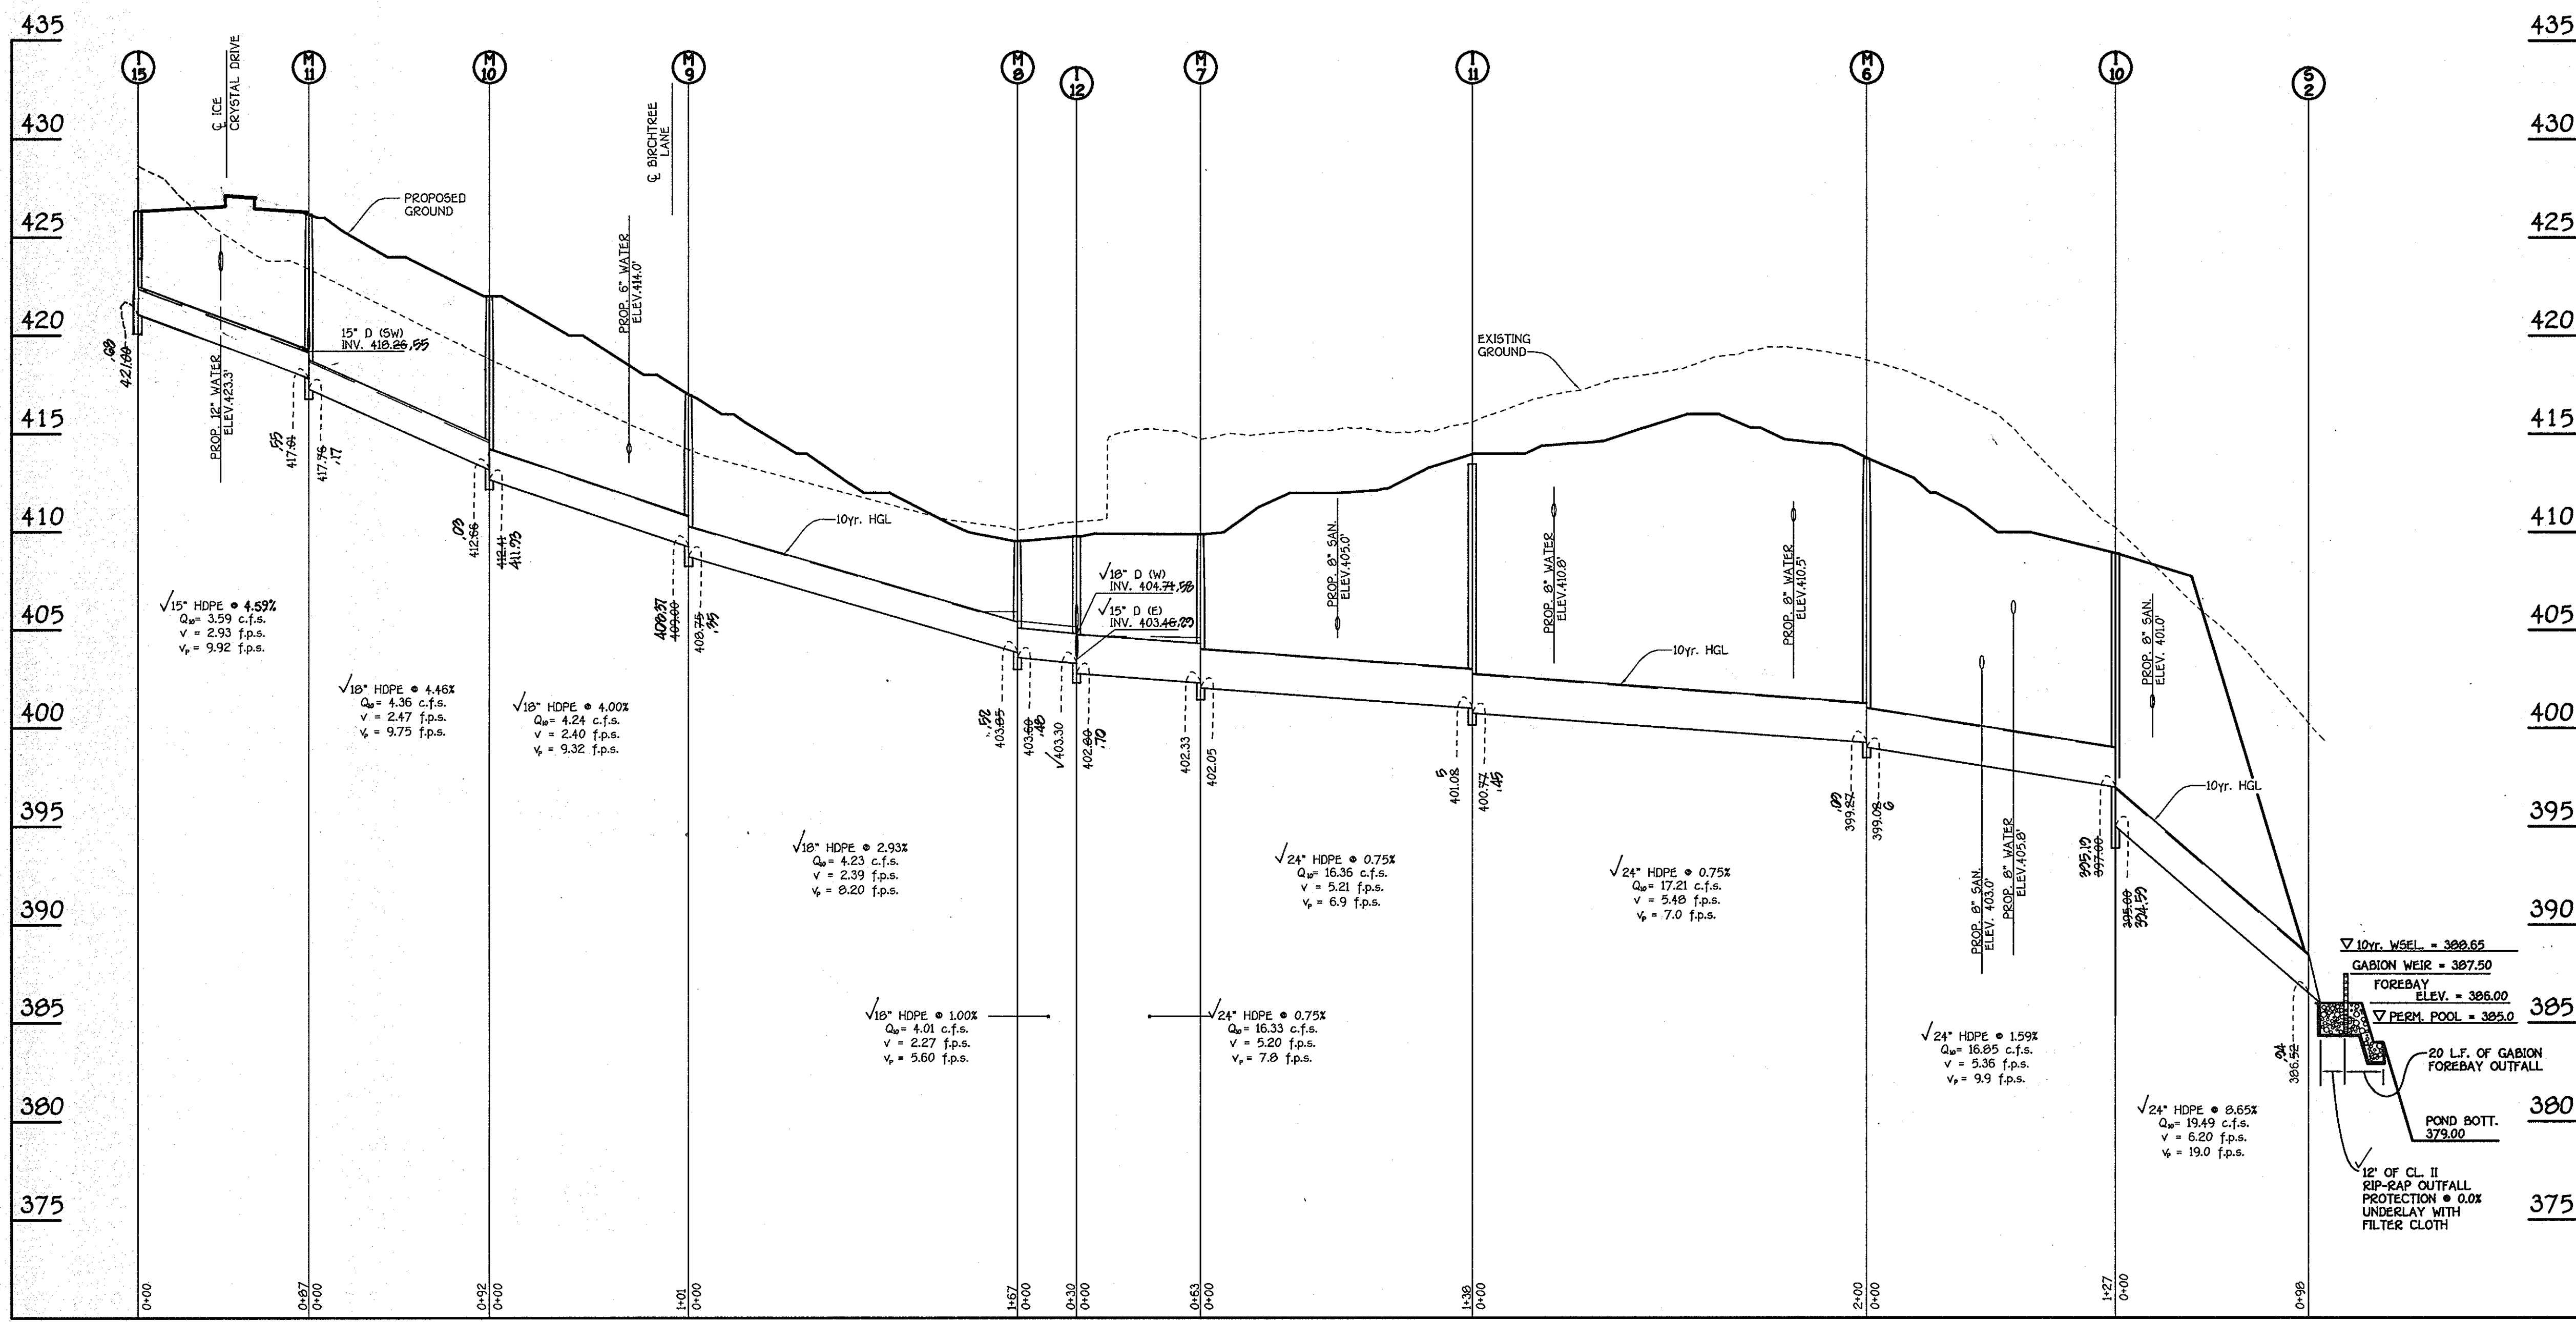


PROFILE
SCALE: HORIZ. : 1" = 50'
VERT. : 1" = 5'


APPROVED
DEPARTMENT OF PLANNING AND ZONING
Cindy Harvada 2/4/02
CHIEF, DIVISION OF LAND DEVELOPMENT DATE

APPROVED
DEPARTMENT OF PLANNING AND ZONING
Mike DeMunnis 2/4/02
CHIEF, DEVELOPMENT ENGINEERING DIVISION DATE


APPROVED
HOWARD COUNTY DEPARTMENT OF PUBLIC WORKS
Robert M. Parker 1-16-02
CHIEF, BUREAU OF HIGHWAYS DATE

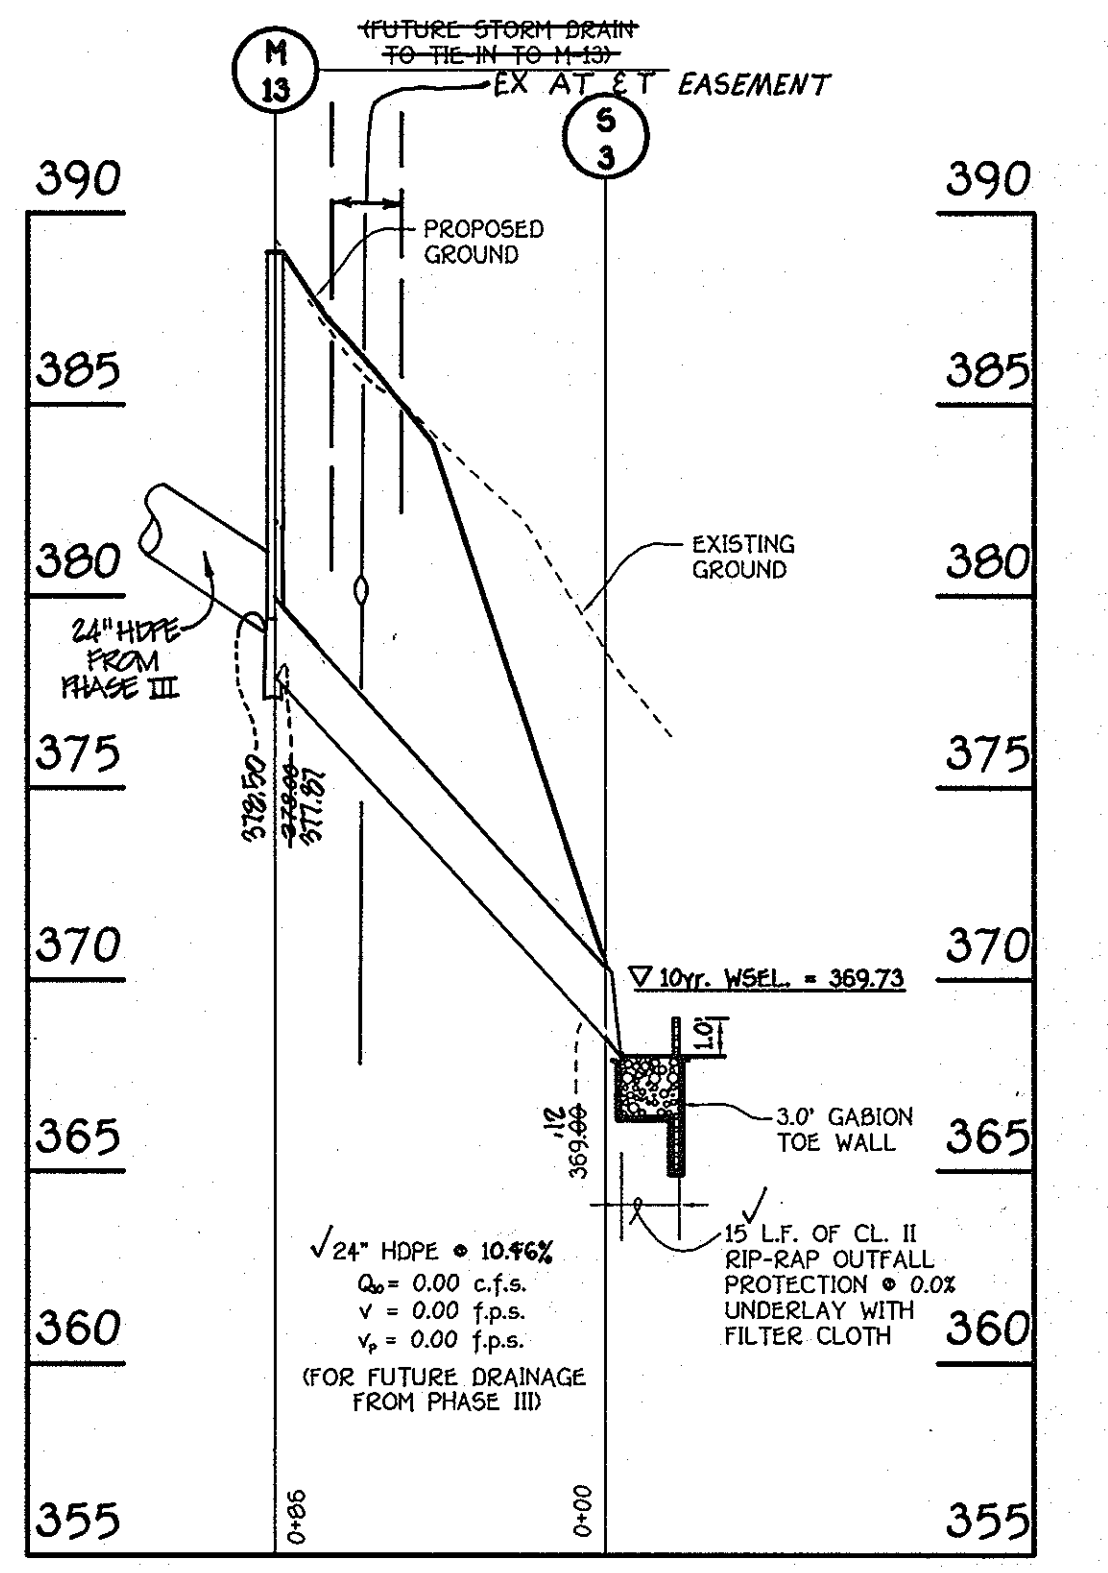


PROFILE
SCALE: HORIZ. : 1" = 50'
VERT. : 1" = 5'

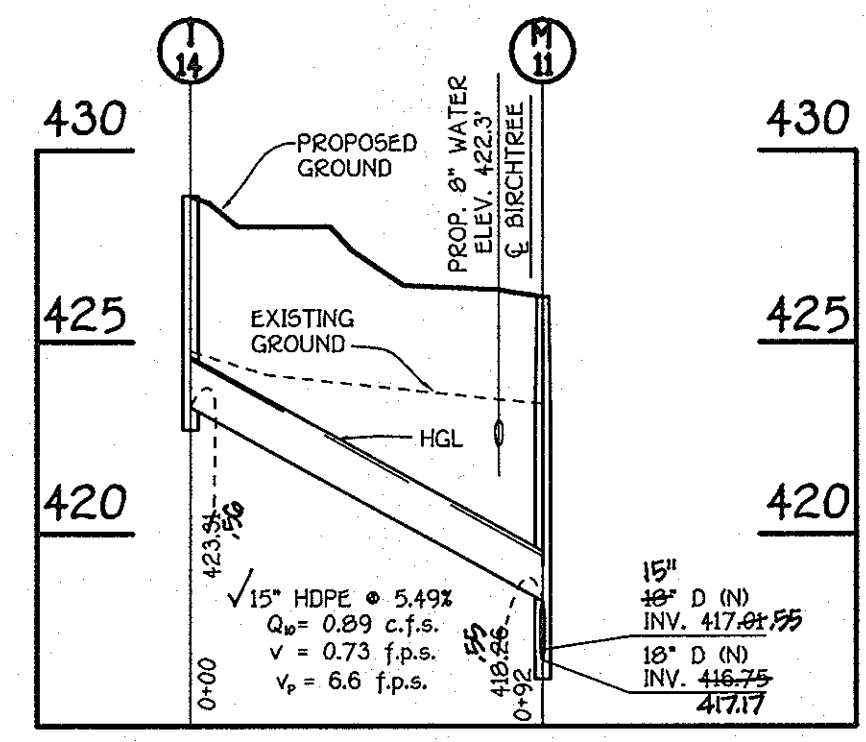

PROFILE
SCALE: HORIZ. : 1" = 50'
VERT. : 1" = 5'

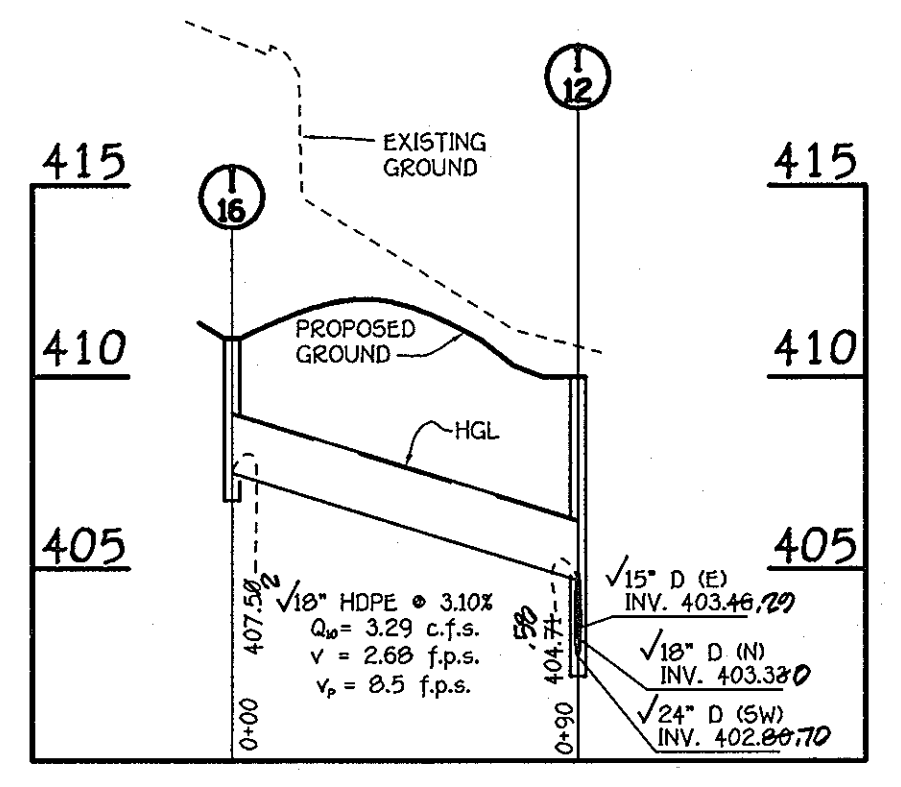

PROFILE
SCALE: HORIZ. : 1" = 50'
VERT. : 1" = 5'

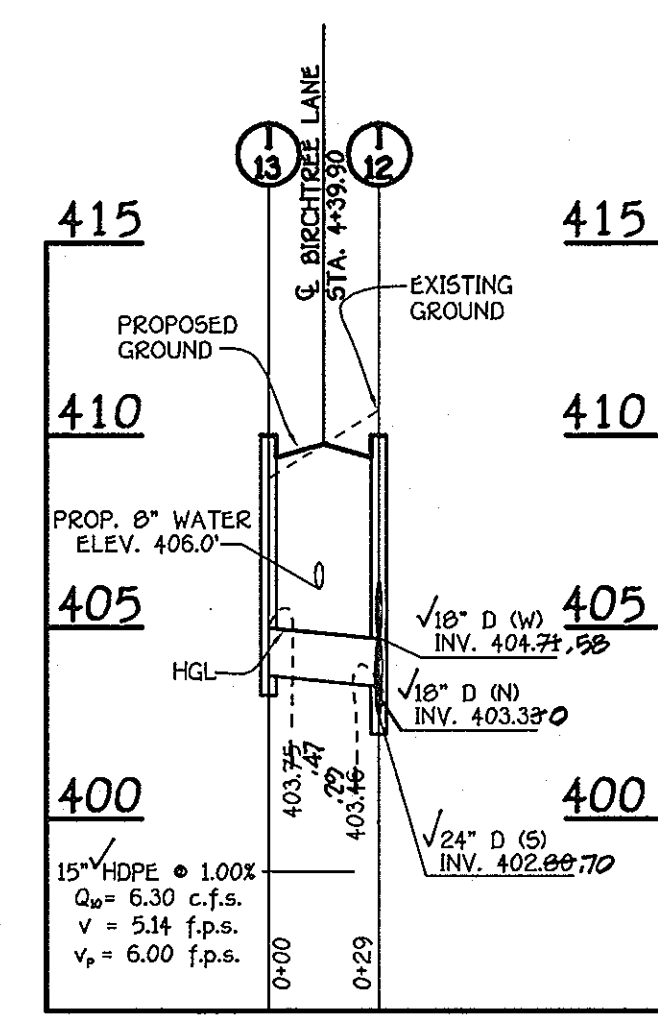

PROFILE
SCALE: HORIZ. : 1" = 50'
VERT. : 1" = 5'

REVISIONS		
No.	DESCRIPTION	DATE
1	REVISE STORM DRAINS FOR AT&T CROSSING AND REMOVE TRAFFIC CALMING ON BIRCHTREE LANE	10/10/02



FISHER, COLLINS & CARTER, INC.
CIVIL ENGINEERING CONSULTANTS & LAND SURVEYORS
CENTENNIAL SQUARE OFFICE PARK • 10272 BALTIMORE NATIONAL PIKE
ELLSWORTH CITY, MARYLAND 21042
4107 481 • 2875


OWNER/DEVELOPER
CHERRYTREE I, LLC
7520 INDIAN PIPE COURT
COLUMBIA, MARYLAND 21046

STORM DRAIN PROFILES
CHERRYTREE PARK
LOTS 1 THRU 10, OPEN SPACE LOTS 11 THRU 13
AND BULK PARCELS 'A' THRU 'H'
(PHASES I AND II)
ZONED: MHX-B
TAX MAP NO. 45, PARCEL NO. 156, GRID NO. 4
SIXTH ELECTION DISTRICT HOWARD COUNTY, MARYLAND
DATE: DECEMBER 7, 2001
SHEET 10 OF 21

AS BUILT FOI-114


STRUCTURE SCHEDULE								
STRUCTURE NO.	TOP ELEVATION	INV. IN	INV. OUT	ROAD NAME	ROAD STA.	OFFSET	TYPE	REMARKS
I-1	411.77	393.83	393.14	---	N 537309.33 401.10 E 340485.53 392.72	---	A-10 INLET	S.D. 4.41
I-3	402.77	409.50	404.25	409.24	---	---	YARD INLET	S.D. 4.14
I-4	421.77	422.97	411.94	410.09	409.59	1.6	ICE CRYSTAL DRIVE	S.D. 4.22
I-5	426.92	427.0	412.96	412.96	---	---	ICE CRYSTAL DRIVE	S.D. 4.41
I-6	427.58	427.60	413.79	412.96	---	---	ICE CRYSTAL DRIVE	S.D. 4.41
I-8	419.47	412.57	412.57	412.04	---	---	ICE CRYSTAL DRIVE	S.D. 4.41
I-9	419.47	412.57	412.57	412.04	---	---	ICE CRYSTAL DRIVE	S.D. 4.41
I-10	408.66	397.00	395.17	395.17	---	---	BIRCHTREE LANE	S.D. 4.41
I-11	413.47	401.02	400.77	401.02	---	---	BIRCHTREE LANE	S.D. 4.41
I-12	410.33	409.42	404.30	403.40	---	---	BIRCHTREE LANE	S.D. 4.41
I-13	410.26	409.16	404.72	403.79	---	---	BIRCHTREE LANE	S.D. 4.41
I-14	426.84	426.84	412.88	412.88	---	---	ICE CRYSTAL DRIVE	S.D. 4.41
I-15	426.84	426.84	412.88	412.88	---	---	ICE CRYSTAL DRIVE	S.D. 4.41
I-16	411.89	407.50	407.50	407.50	---	---	BIRCHTREE LANE	S.D. 4.14
I-17	400.77	400.00	395.69	394.92	---	---	YARD INLET	S.D. 4.14
I-18	410.48	408.62	402.66	402.66	---	---	YARD INLET	S.D. 4.14
M-1	377.24	392.37	392.37	44	---	---	STD. MANHOLE	G - 5.12
M-2	415.30	411.02	406.35	129	---	---	STD. MANHOLE	G - 5.12
M-3	424.54	423.44	412.78	129	---	---	STD. MANHOLE	G - 5.12
M-4	420.76	419.59	411.28	129	---	---	STD. MANHOLE	G - 5.12
M-5	420.00	418.77	411.67	129	---	---	ICE CRYSTAL DRIVE	G - 5.12
M-6	414.09	413.75	399.07	129	---	---	BIRCHTREE LANE	G - 5.12
M-7	409.89	408.53	401.06	129	---	---	BIRCHTREE LANE	G - 5.12
M-9	416.60	414.44	409.00	129	---	---	BIRCHTREE LANE	G - 5.12
M-10	422.16	420.00	412.60	129	---	---	BIRCHTREE LANE	G - 5.12
M-11	425.89	417.05	410.59	129	---	---	BIRCHTREE LANE	G - 5.12
M-8	410.10	409.19	403.89	129	---	---	BIRCHTREE LANE	G - 5.12
M-12	420.51	417.50	389.00	129	---	---	STD. MANHOLE	G - 5.12
M-13	389.00	377.37	380.00	129	---	---	FUTURE INV.	G - 5.12
M-14	417.50	404.00	365.00	129	---	---	FUTURE INV.	G - 5.11
M-15	418.00	398.00	398.00	129	---	---	FUTURE INV.	G - 5.11
M-16	419.32	412.50	398.75	129	---	---	FUTURE INV.	G - 5.12
S-1	388.40	388.40	388.40	42	---	---	HDPE END SECTION	** A.D.S. FLARED END SECT.
S-2	388.40	388.40	388.40	42	---	---	HDPE END SECTION	** A.D.S. FLARED END SECT.
S-3	371.12	371.00	369.00	12	---	---	HDPE END SECTION	** A.D.S. FLARED END SECT.
S-4	367.44	367.44	365.94	12	---	---	HDPE END SECTION	** A.D.S. FLARED END SECT.
S-5	365.94	365.94	364.44	12	---	---	HDPE END SECTION	** A.D.S. FLARED END SECT.
S-6	415.42	414.00	413.50	12	---	---	HDPE END SECTION	** A.D.S. FLARED END SECT.
HW-1	383.50	---	381.00	2	---	---	TYPE 'A' HEADWALL	S.D. 5.11
HW-2	381.47	---	381.47	47	---	---	TYPE 'A' HEADWALL	S.D. 5.11
R-1	371.50	382.00	381.75	20	---	---	CONC. RISER	---
R-2	371.50	362.00	361.75	20	---	---	CONC. RISER	---

** - A.D.S. - ADVANCED DRAINAGE SYSTEMS
LONDON, OHIO
1-800-733-9554

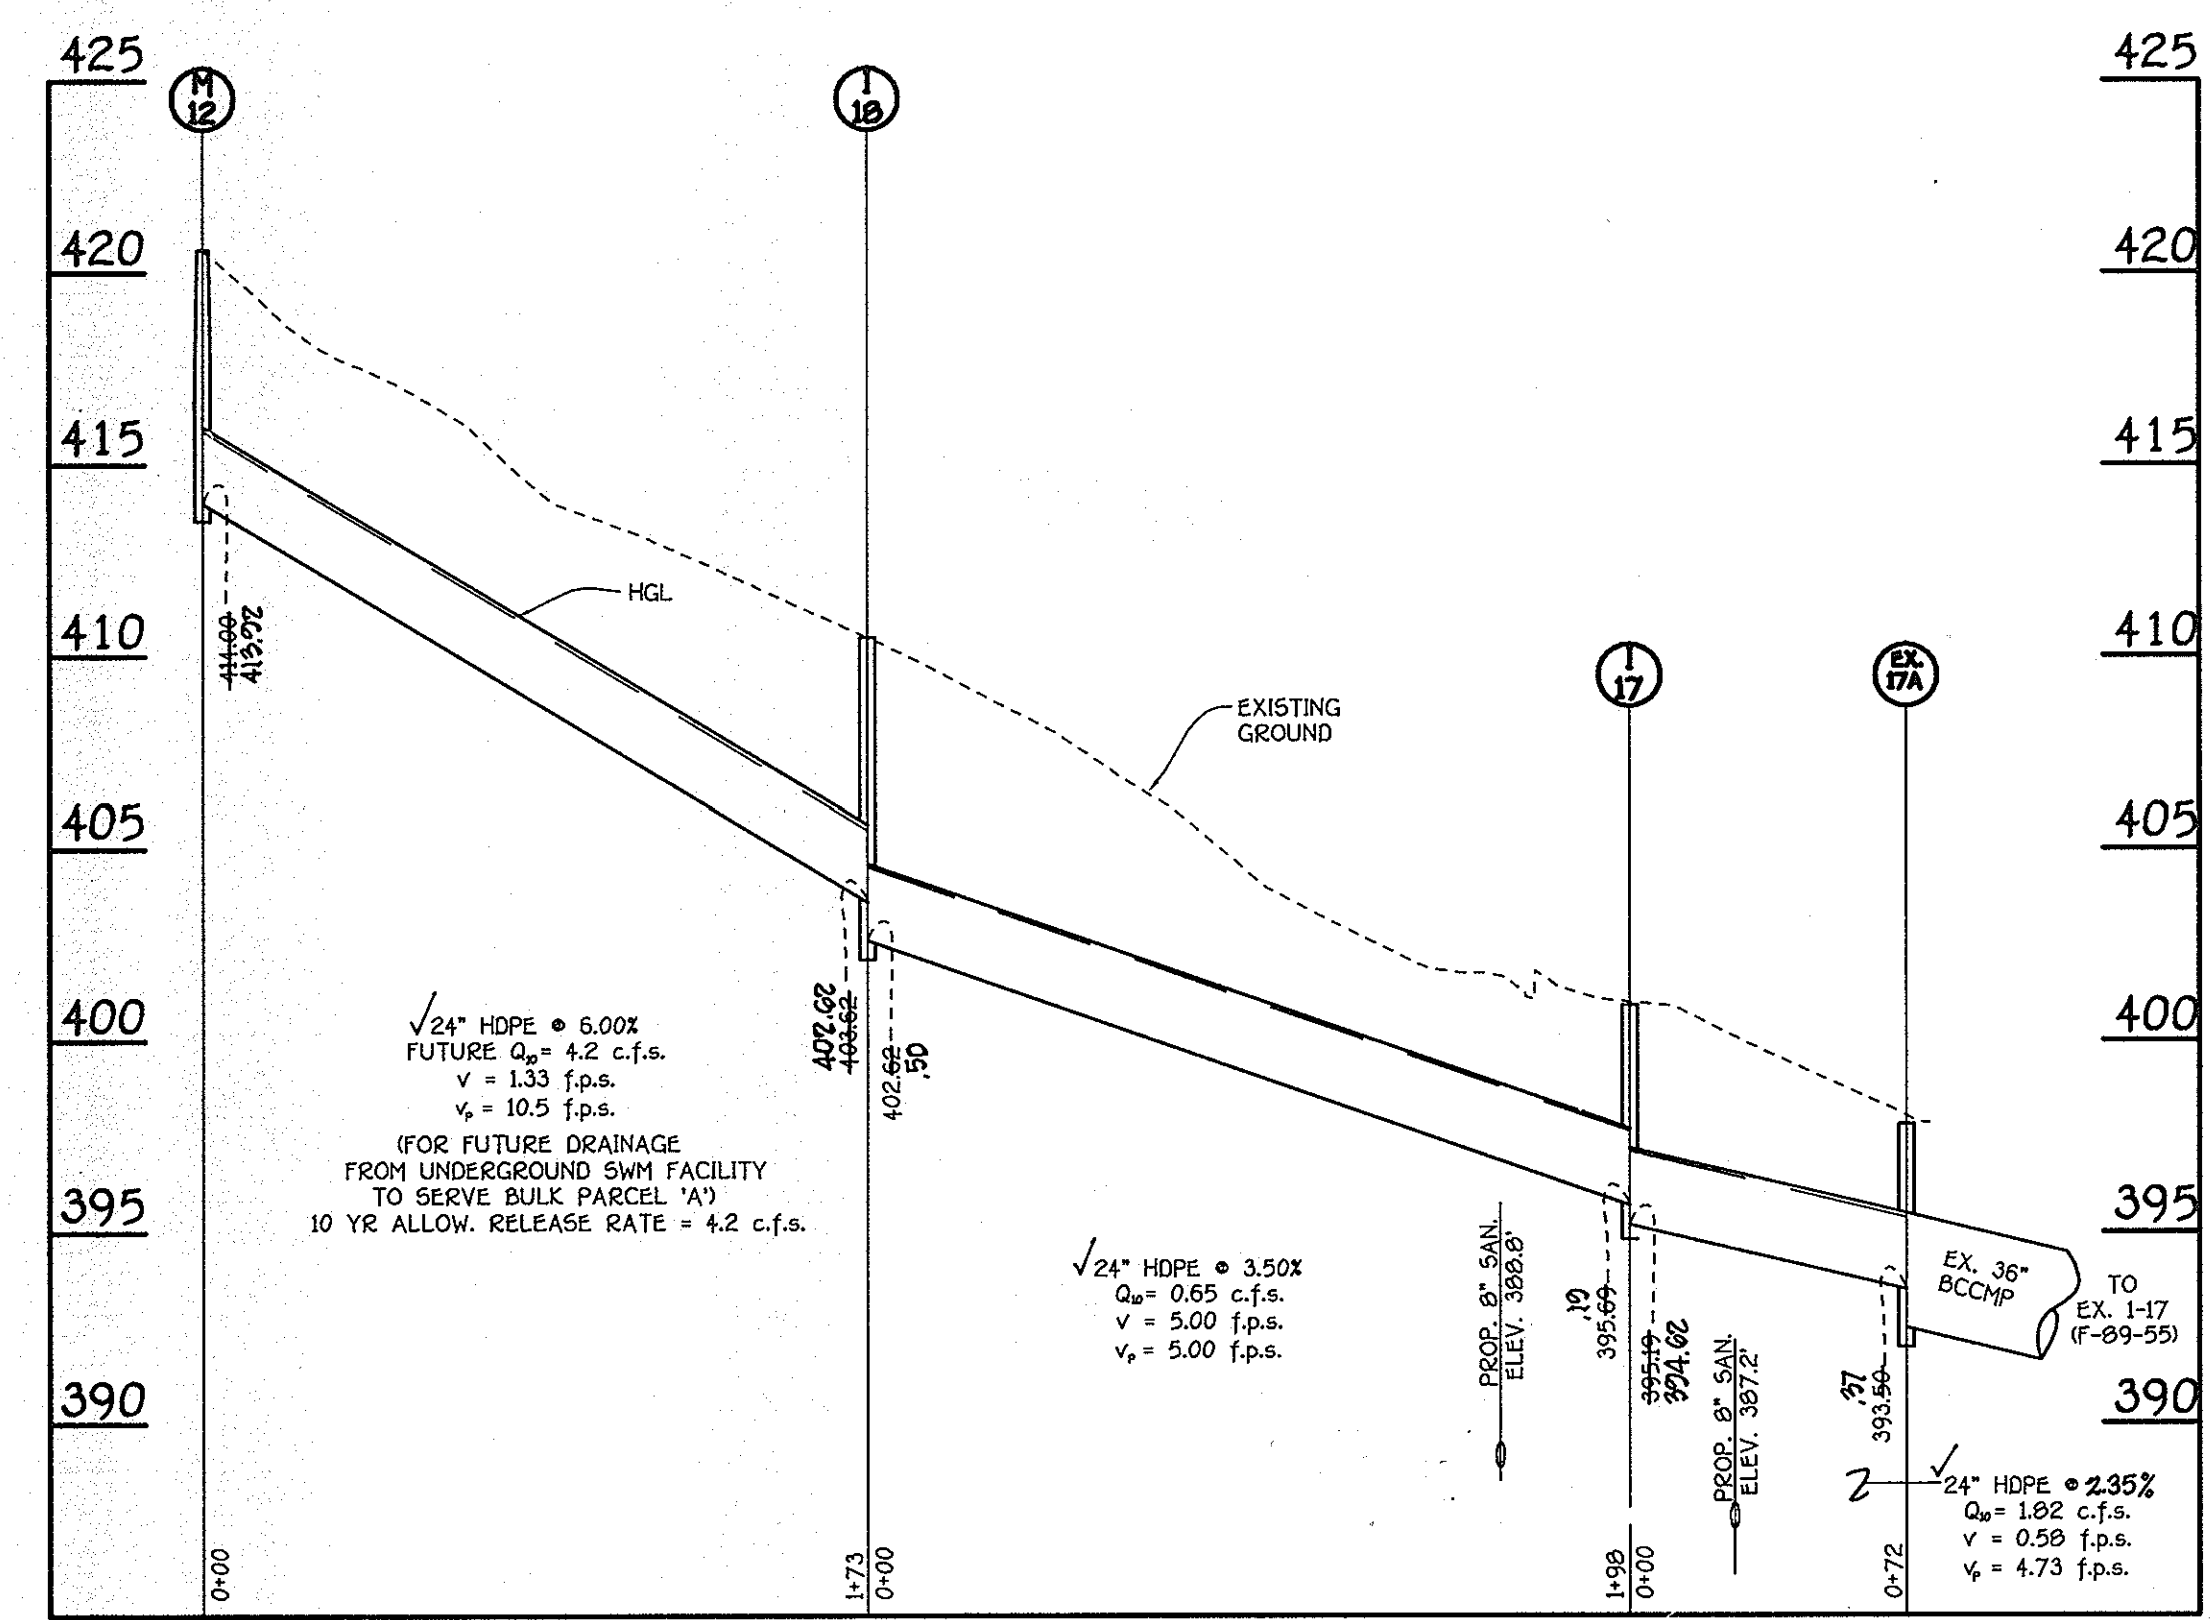


PROFILE
SCALE: HORIZ. : 1" = 50'
VERT. : 1" = 5'

FISHER, COLLINS & CARTER, INC.
CIVIL ENGINEERING CONSULTANTS & LAND SURVEYORS
CENTRAL SQUARE OFFICE PARK - 10272 BALTIMORE NATIONAL PIKE
ELICOTT CITY, MARYLAND 21117
(410) 461-2825


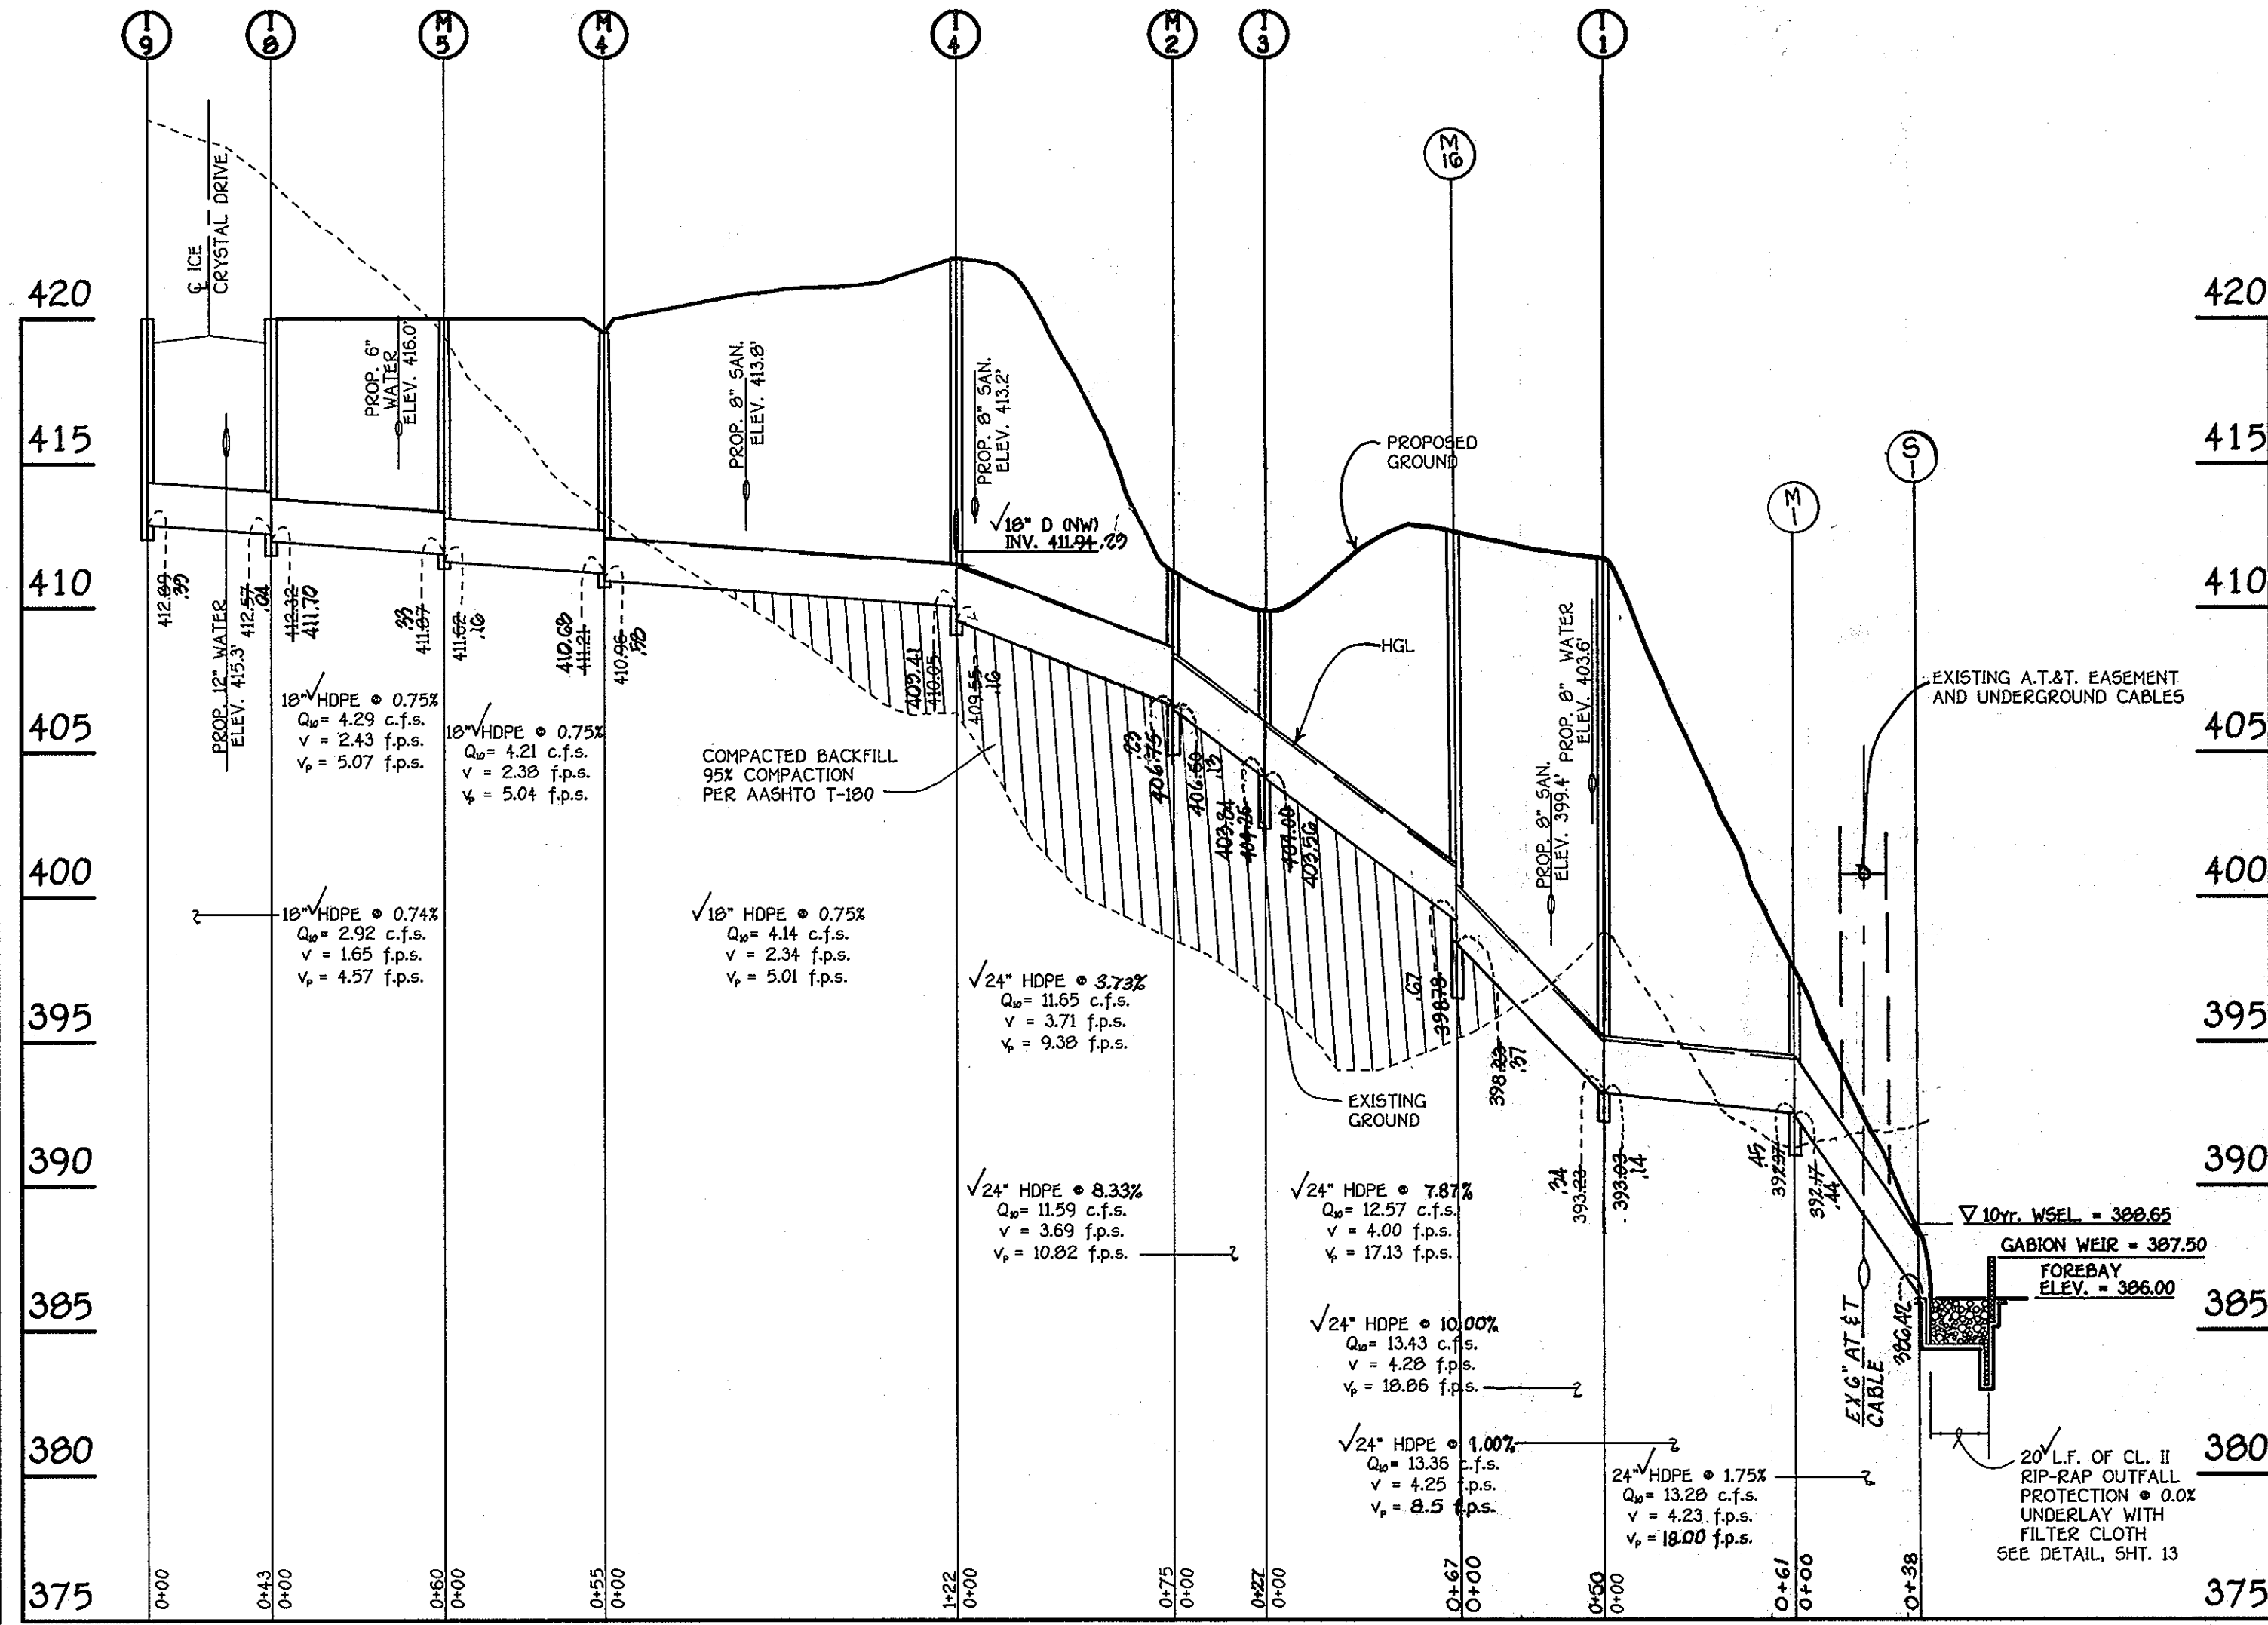


PROFILE
SCALE: HORIZ. : 1" = 50'
VERT. : 1" = 5'

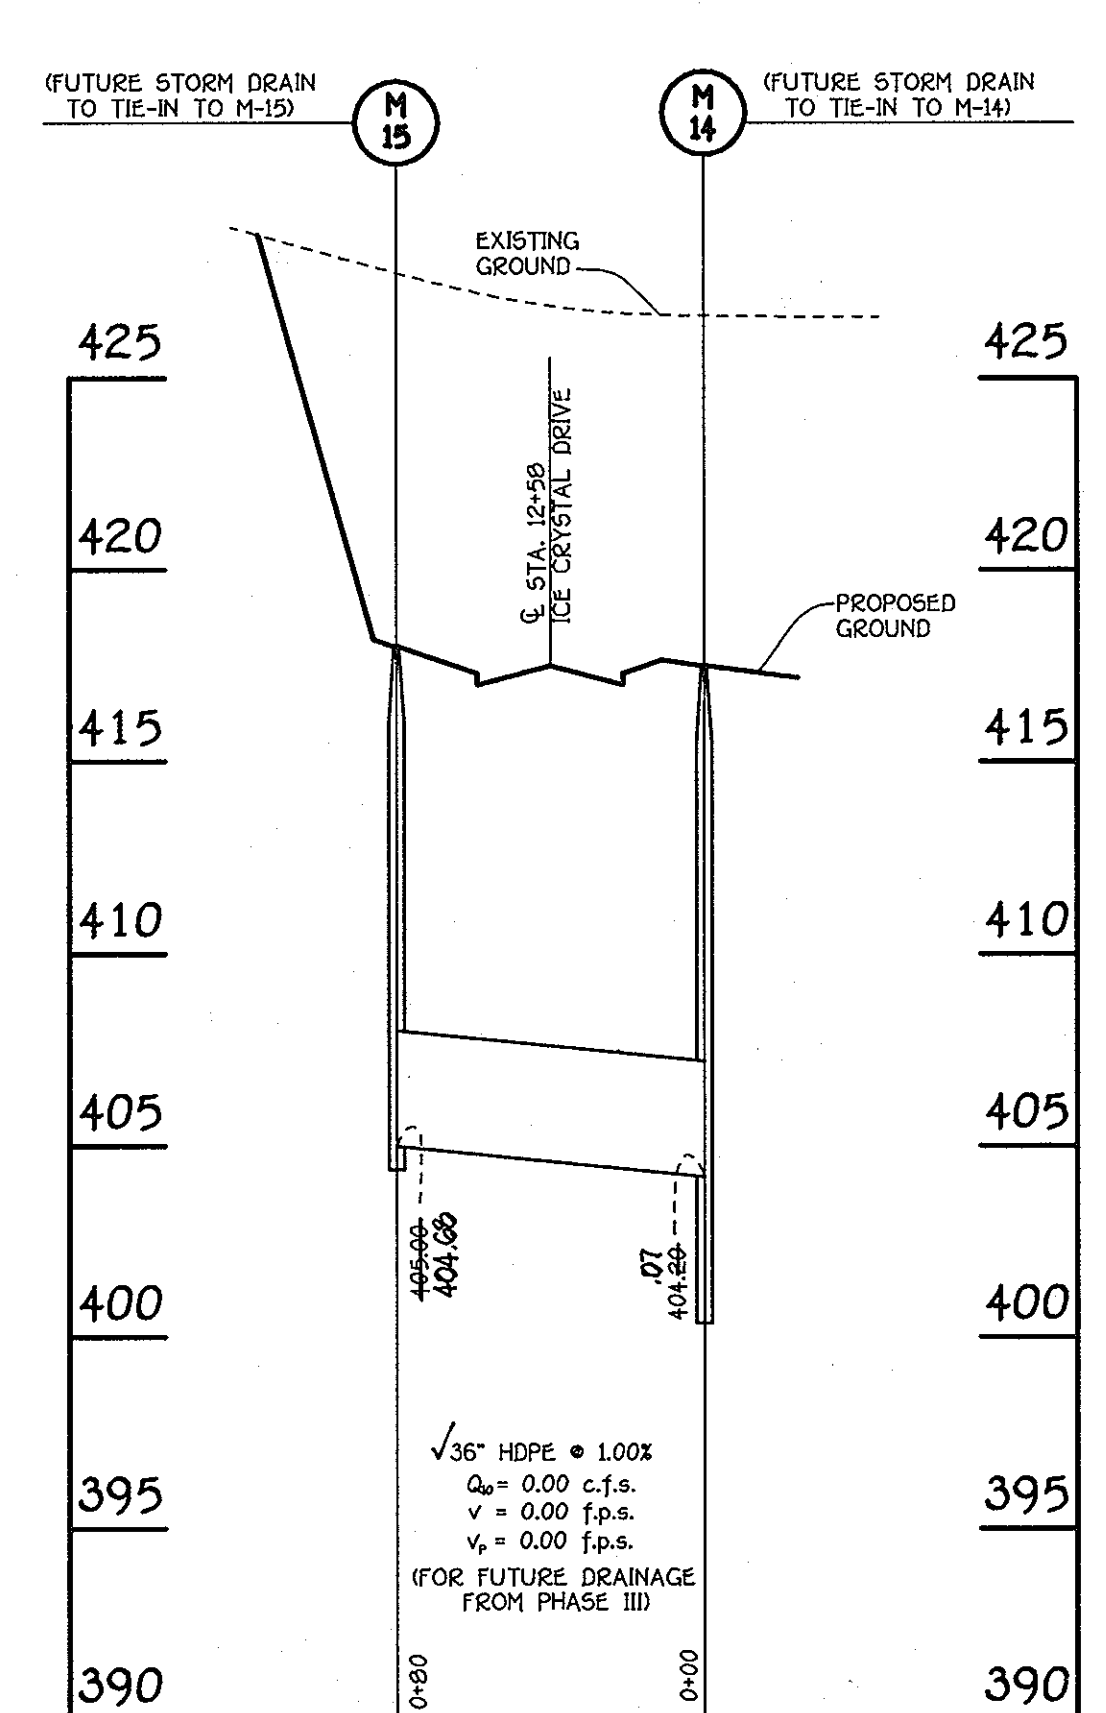


PROFILE
SCALE: HORIZ. : 1" = 50'
VERT. : 1" = 5'

OWNER/DEVELOPER
CHERRYTREE I, LLC
7520 INDIAN PIPE COURT
COLUMBIA, MARYLAND 21046

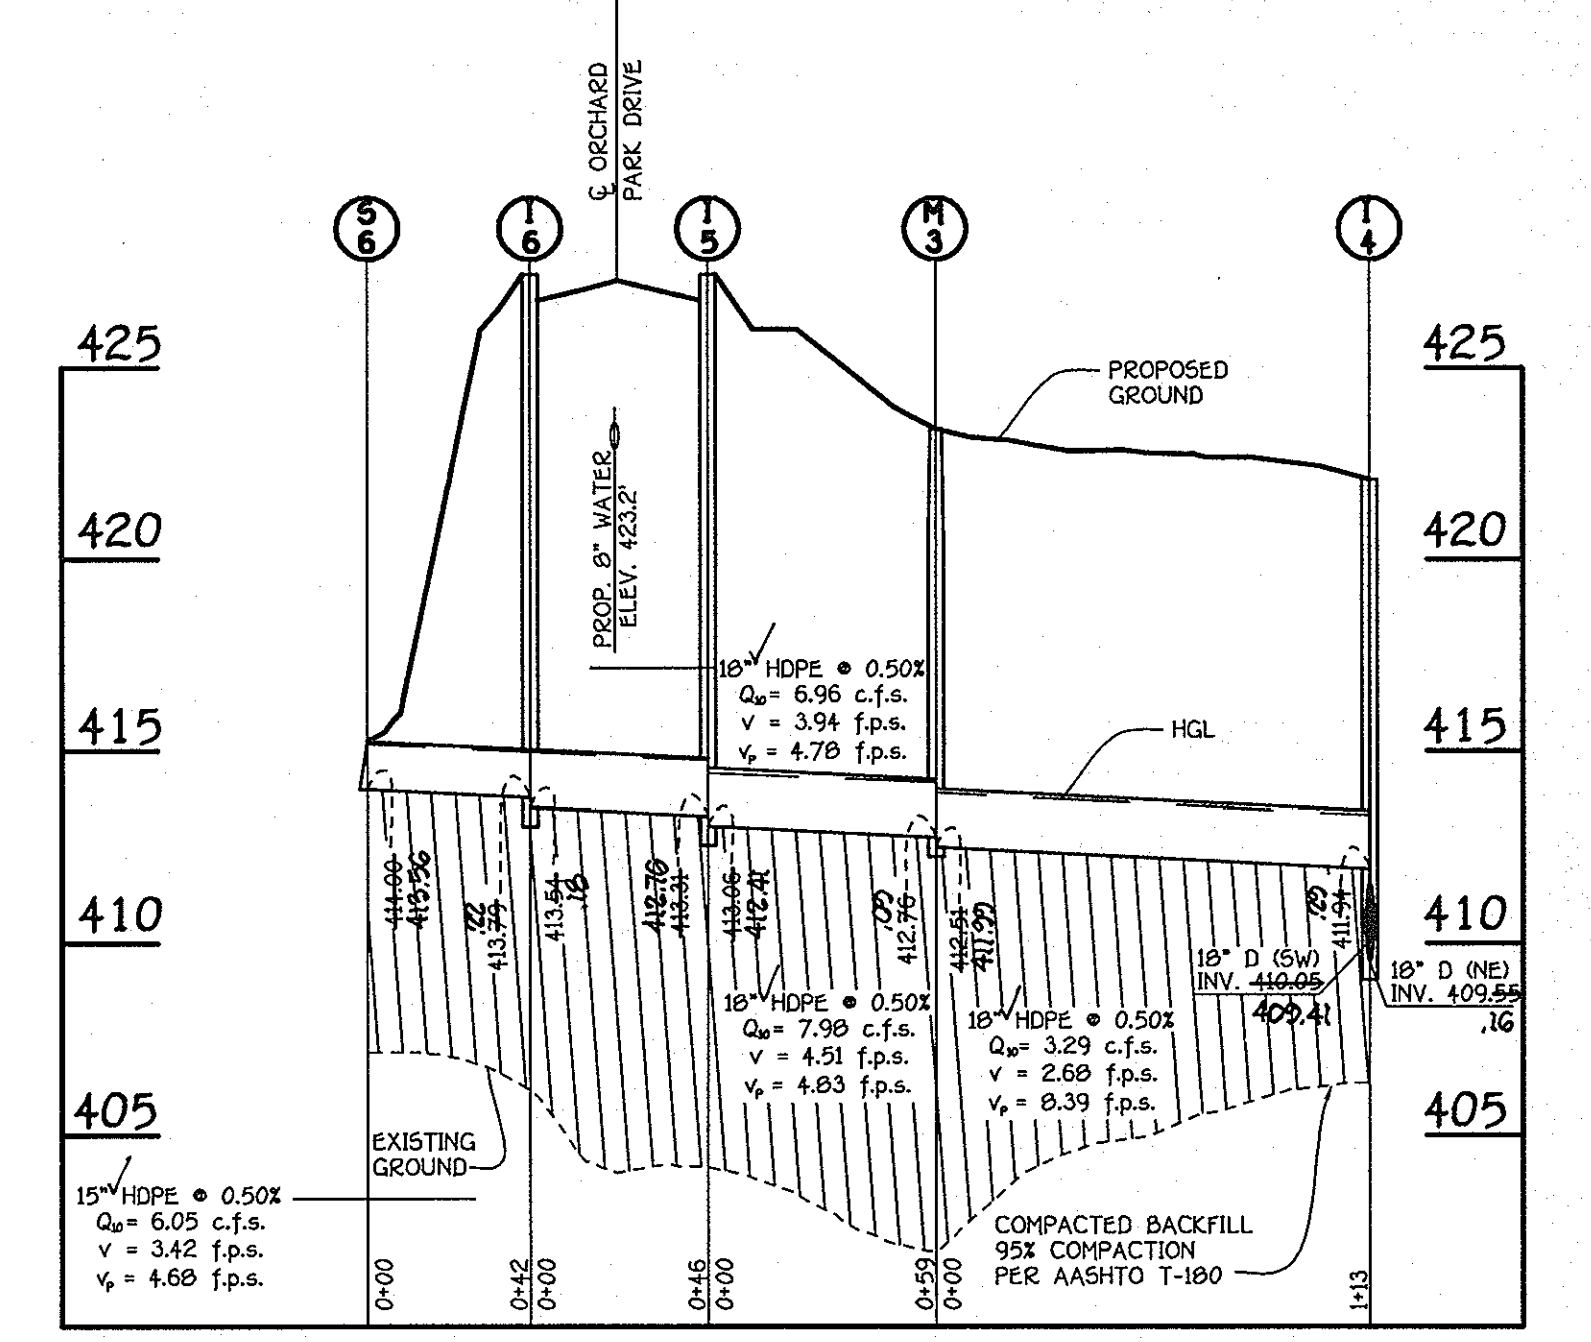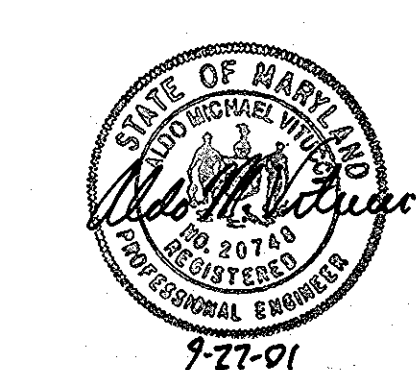

PROFILE
SCALE: HORIZ. : 1" = 50'
VERT. : 1" = 5'

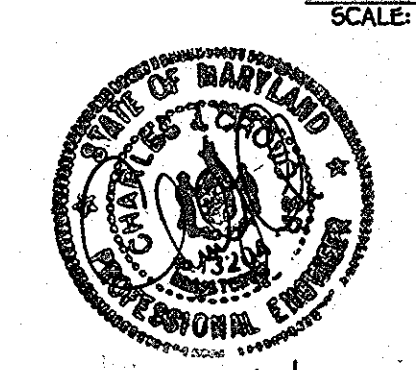

STORM DRAIN PROFILES
CHERRYTREE PARK
LOTS 1 THRU 10, OPEN SPACE LOTS 11 THRU 13
AND BULK PARCELS 'A' THRU 'H'
(PHASES I AND II)
ZONED MD-6
TAX MAP NO. 45 PARCEL NO. 156 GRID NO. 4
SIXTH ELECTION DISTRICT HOWARD COUNTY, MARYLAND
DATE: DECEMBER 7, 2001
SHEET 11 OF 21

APPROVED
DEPARTMENT OF PLANNING AND ZONING
Cindy Harston 2/4/02
CHIEF, DIVISION OF LAND DEVELOPMENT DATE

APPROVED
DEPARTMENT OF PLANNING AND ZONING
Mr. D... 2/4/02
CHIEF, DEVELOPMENT ENGINEERING DIVISION DATE

APPROVED
HOWARD COUNTY DEPARTMENT OF PUBLIC WORKS
Richard M. D... 1-10-02
CHIEF, BUREAU OF HIGHWAYS DATE

PIPE SCHEDULE		
SIZE	MATERIAL	LENGTH
15"	HDPE	250'
18"	HDPE	978'
24"	HDPE	1778'
36"	HDPE	80'

REVISIONS		
No.	DESCRIPTION	DATE
1	REVISE STORM DRAINS FOR AT&T CROSSINGS AND REMOVE TRAFFIC CALMING ON BIRCHTREE LANE	10-10-02

AS BUILT FOI-114

STANDARDS AND SPECIFICATIONS FOR TOPSOIL

Definition
Placement of topsoil over a prepared subsoil prior to establishment of permanent vegetation.

Purpose
To provide a suitable soil medium for vegetative growth. Soils of concern have low moisture content, low nutrient levels, low pH, materials toxic to plants, and/or unacceptable soil gradation.

Conditions Where Practice Applies

- This practice is limited to areas having 2:1 or flatter slopes where:
 - The texture of the exposed subsoil/parent material is not adequate to produce vegetative growth.
 - The soil material is so shallow that the rooting zone is not deep enough to support plants or furnish continuing supplies of moisture and plant nutrients.
 - The original soil to be vegetated contains materials toxic to plant growth.
 - The soil is so acidic that treatment with limestone is not feasible.
- For the purpose of these Standards and Specifications, areas having slopes steeper than 2:1 require special consideration and design for adequate stabilization. Areas having slopes flatter than 2:1 shall have the appropriate stabilization shown on the plans.

Construction and Material Specifications

- Topsoil salvaged from the existing site may be used provided that it meets the standards as set forth in these specifications. Typically, the depth of topsoil to be salvaged for a given soil type can be found in the representative soil profile section in the Soil Survey published by USDA-SCS in cooperation with Maryland Agricultural Experiment Station.
- Topsoil Specifications - Soil to be used as topsoil must meet the following:
 - Topsoil shall be a loam, sandy loam, clay loam, silty loam, sandy clay loam, loamy sand. Other soils may be used if recommended by an agronomist or soil scientist and approved by the appropriate approval authority. Specifications for topsoil shall be a mixture of contrasting textured subsoils and shall contain less than 5% by volume of cinders, stones, slag, coarse fragments, gravel, sticks, roots, trash, or other materials larger than 1 1/2" in diameter.
 - Topsoil must be free of plants or plant parts such as bermuda grass, quackgrass, Johnson grass, nutcracker, poison ivy, thistle, or other noxious weeds.
 - Where the subsoil is either highly acidic or composed of heavy clays, ground limestone shall be spread at the rate of 4-8 tons/acre (2000-4000 pounds per 1,000 square feet) prior to the placement of topsoil. Lime shall be distributed uniformly over designated areas and worked into the soil in conjunction with tillage operations as described in the following procedures.
 - For sites having disturbed areas under 5 acres:
- Place topsoil (if required) and apply soil amendments as specified in 22.0 Vegetative Stabilization - Section 1 - Vegetative Stabilization Methods and Materials.
- For sites having disturbed areas over 5 acres:
 - On soil meeting Topsoil specifications, obtain test results regarding fertilizer and lime amendments and approved by the appropriate approval authority, may be used in lieu of natural topsoil.
 - For sites having disturbed areas under 5 acres:
 - pH for topsoil shall be between 6.0 and 7.5. If the tested soil demonstrates a pH of less than 6.0, sufficient lime shall be prescribed to raise the pH to 6.5 or higher.
 - Organic content of topsoil shall be not less than 1.5 percent by weight.
 - Topsoil having soluble salt content greater than 500 parts per million shall not be used.
 - No seed or seed shall be placed on soil which has been treated with soil sterilants or chemicals used for weed control until sufficient time has elapsed (14 days min) to permit desorption of phytotoxic materials.

Notes: Topsoil substitutes or amendments, as recommended by a qualified agronomist or soil scientist and approved by the appropriate approval authority, may be used in lieu of natural topsoil.

22.0 Vegetative Stabilization - Section 1 - Vegetative Stabilization Methods and Materials

- Topsoil Application
 - When topsoiling, maintain needed erosion and sediment control practices such as diversions, grade stabilization structures, earth dikes, slope sill fence and sediment traps and basins.
 - Grades on the areas to be topsoiled, which have been previously established, shall be maintained, altered 4" - 8" layer in elevation.
 - Topsoil shall be uniformly distributed in a 4" - 8" layer and lightly compacted to a minimum thickness of 4". Spreading shall be performed in such a manner that seeding or sodding can proceed with a minimum of additional soil preparation and tillage. Any irregularities in the surface resulting from topsoiling operations shall be corrected in order to prevent the formation of depressions or water pockets.

- Topsoil shall not be placed while the topsoil or subsoil is in a frozen or muddy condition, when the subsoil is excessively wet or in a condition that may otherwise be detrimental to proper grading and seeded preparation.

- Alternative for Permanent Seeding - Instead of applying the full amounts of lime and commercial fertilizer, composted sludge and amendments may be applied as specified below:
 - Composted Sludge Material for use as a soil conditioner for areas having disturbed areas over 5 acres shall be tested to prescribe amendments and for sites having disturbed areas under 5 acres shall conform to the following requirements:
 - Composted sludge shall be supplied by, or originate from, a person or persons that are permitted (in the time of acquisition of the compost) by the Maryland Department of the Environment under COMAR 26.04.06.
 - Composted sludge shall contain at least 1 percent nitrogen, 1.5 percent phosphorus, and 0.2 percent potassium and a pH of 7.0 to 9.0. If compost does not meet these requirements, the appropriate constituents must be added to meet the requirements prior to use.
 - Composted sludge shall be applied at a rate of 1 ton/1,000 square feet.
 - Composted sludge shall be amended with a potassium fertilizer applied at the rate of 4 lb/1,000 square feet, and 1/3 the normal lime application rate.

References: Guideline Specifications, Soil Preparation and Seeding, MD-VIA, Pub. # Cooperative Extension Service, University of Maryland and Virginia Polytechnic Institute, Revised 1975.

22.0 STANDARDS AND SPECIFICATIONS FOR VEGETATIVE STABILIZATION

DEFINITION

Using vegetation as cover for barren soil to protect it from forces that cause erosion.

PURPOSE

Vegetative stabilization specifications are used to promote the establishment of vegetation on exposed soil. When soil is stabilized with vegetation, the soil is less likely to erode and more likely to allow infiltration of rainfall, thereby reducing sediment loads and runoff to downstream areas, and improve wildlife habitat and visual resources.

CONDITIONS WHERE PRACTICE APPLIES

This practice shall be used on denuded areas as specified on the plans and may be used on highly erodible or critically eroding areas. This specification is divided into Temporary Seeding, to quickly establish vegetative cover for short duration (up to one year), and Permanent Seeding for long term vegetative cover.

EFFECTS ON WATER QUALITY AND QUANTITY

Planting vegetation in disturbed areas will have an effect on the water budget, especially on volumes and rates of runoff, infiltration, evaporation, transpiration, percolation, and groundwater recharge. Vegetation over time, will increase organic matter content and improve the water holding capacity of the soil and subsequent plant growth. Vegetation will help reduce the movement of sediment, nutrients, and other chemicals carried by runoff to receiving waters. Plants will also help protect groundwater supplies from substances present within the root zone. Sediment control devices must remain in place during grading, seeded preparation, seeding, mulching and vegetative establishment to prevent large quantities of sediment and associated chemicals and nutrients from washing into surface waters.

SECTION 1 - VEGETATIVE STABILIZATION METHODS AND MATERIALS

- Site Preparation
 - Initial erosion and sediment control structures (temporary of permanent) such as diversions, grade stabilization structures, berms, waterways, or sediment control basins.
 - Perform all grading operations at right angles to the slope. Final grading and shaping is not usually necessary for temporary seeding.
 - Schedule required soil tests to determine soil amendment composition and application rates for sites having disturbed areas over 5 acres.

- Soil Amendments (Fertilizer and Lime Specifications)
 - Soil tests must be performed to determine the exact ratios and application rates for both lime and fertilizer on sites having disturbed areas over 5 acres. Soil analysis may be performed by the University of Maryland or a recognized commercial laboratory. Soil samples taken for engineering purposes may also be used for chemical analyses.
 - Fertilizers shall be uniform in composition, free flowing and suitable for accurate application by broadcast equipment. Fertilizer may be substituted for fertilizer with prior approval from the appropriate approval authority. Fertilizers shall not be delivered to the site fully labeled according to the applicable state fertilizer laws and shall bear the name, trade name or trademark and warranty of the producer.
 - Lime materials shall be ground limestone hydrated or burnt lime may be substituted which contains at least 90% total calcium oxide plus magnesium oxide. Limestone shall be ground to a fineness that at least 50% will pass through a #100 mesh sieve and 90-100% will pass through a #20 mesh sieve.

- Seeded Preparation
 - Seeded preparation shall consist of loosening soil to a depth of 3" to 5" by means of suitable agricultural or construction equipment, such as disc harrows or chisel plows or rippers mounted on construction equipment. After the soil is loosened, it shall not be rolled or displaced, but left in the roughened condition. Seeded areas (greater than 50) should be tracked leaving the surface in an irregular condition with ridges running parallel to the contour of the slope.
 - Apply fertilizer and lime as prescribed on the plans.
 - Compost the lime and fertilizer into the top 3-5" of soil by disking or other suitable means.

- Permanent Seeding
 - Minimum soil conditions required for permanent vegetative establishment:
 - Soil pH shall be between 6.0 and 7.0.
 - Soluble salts shall be less than 500 parts per million (ppm).
 - The soil shall contain less than 40% clay, but enough fine grained material (30% silt plus clay) to provide the capacity to hold a moderate amount of moisture. An exception is in wetlands or seepage seeps where it is to be planted, then a sandy soil (30% silt plus clay) would be acceptable.
 - Soil shall contain 1.5% minimum organic matter by weight.
 - Soil must contain sufficient pore space to permit adequate root penetration.
 - If these conditions cannot be met by soils on site, sodding is required in accordance with Section 22.0 Seeding Methods and Materials.
 - Areas previously graded in conformity with the drawings shall be maintained in a true and even grade. Then, scarified or otherwise loosened to a depth of 3-5" to permit bedding of the topsoil to the surface area and to create horizontal erosion check slots to prevent topsoil from being washed away.
 - Apply soil amendments as per soil test or as included on the plans.
 - Soil amendments into the top 3-5" of topsoil by disking or other suitable means. Lawn areas should be raked to smooth the surface, remove large objects like stones and branches, and ready the area for seed and application. Where site conditions will not permit normal seeded preparation, loosen surface soil by disking with a heavy chain or other equipment to roughen the surface. Steep slopes (steeper than 3:1) should be tracked by a dozer leaving a wide and an irregular condition with ridges running parallel to the contour of the slope. The top 1-3" of soil should be loose and friable. Seeded basins may not be necessary on steeply disturbed areas.

- Seed Specifications
 - All seed must meet the requirements of the Maryland State Seed Law. All seed shall be subject to a germination test by a recognized authority. All seed of the same species shall be tested within the 6 months immediately preceding the date of sowing such material on the job.
 - Seeds shall be made available to verify the quantity and rate of seed used.
 - Inoculant - The inoculant for treating legume seed in the seed mixture shall be a pure culture of the appropriate rhizobium species and shall be applied to the seed in accordance with the directions on the container. Add fresh inoculant as directed on packages. Use four lines the equal length of the seed. Temperatures above 75-80° F. can weaken bacteria and make the inoculant less effective.

- Methods
 - Hydroseeding - Apply seed uniformly with hydroseeder (slurry includes seed and fertilizer), broadcast or drop seeds.
 - If fertilizer is being applied at the time of seeding, the application rates amounts will not exceed the following: nitrogen maximum of 100 lbs per acre total of soluble nitrogen; P2O5 maximum of 50 lbs per acre; and K2O maximum of 50 lbs per acre.
 - Lime - Use only ground agricultural limestone. Up to 1 ton per acre may be applied by hydroseeding. Normally, not more than 2 tons are applied by hydroseeding at 8% of one line. Do not use burnt or hydrated lime when hydroseeding.
 - Seed and fertilizer shall be mixed on the site and seeding shall be done immediately and without interruption.

- Dry Seeding
 - Seed shall be incorporated into the subsoil at the rates prescribed on the plans.
 - When straw mulch is used, it shall be spread over all seeded areas at the rate of 2 tons/acre. Mulch shall be applied to a uniform loose depth of between 1" and 2". Mulch applied shall achieve a uniform distribution and depth so that the soil surface is not exposed. If a mulch anchoring tool is to be used, the rate should be increased to 2.5 tons/acre.
 - Wood cellulose fiber used as a mulch shall be applied at a net dry weight of 1500 lbs. per acre. The wood cellulose fiber shall be mixed with water and the mixture shall contain 50 lbs. of wood cellulose fiber per 100 gallons of water.
 - Securing straw mulch (anchoring): Mulch anchoring shall be performed immediately following mulch application to minimize loss by wind or water. This may be done by one of the following methods listed by preference, depending upon size of area and erosion hazard:
 - A mulch anchoring tool is a tractor driven implement designed to punch and anchor mulch into the soil surface a minimum of two 120 inches. This practice is most effective on large slopes and is not applicable in flatter areas where equipment will operate safely.
 - This practice should be used on the contour if possible.
 - Wood cellulose fiber should be used for anchoring. The fiber binder shall be applied at a net dry weight of 750 pounds/acre. The wood cellulose fiber shall be mixed with water and the mixture shall contain a maximum of 50 pounds of wood cellulose fiber per 100 gallons of water.

- Application of liquid binders should be heavier at the edges where wind catches much, such as in valleys and crest of banks. The remainder of area should be applied uniform after binder application. Synthetic binders such as acrylic glue (Super-Bond) shall be used in accordance with the manufacturer's instructions. Other approved equal may be used at rates recommended by the manufacturer to anchor mulch.

- Lightweight plastic netting may be applied over the mulch according to manufacturer's recommendations. Netting is usually available in lengths 4' to 17' wide and 200' to 3,000' feet long.

Incremental Stabilization - Cut Slopes

- All cut slopes shall be dressed, prepared, seeded and mulched as the work progresses. Slopes shall be excavated and stabilized in equal increments not to exceed 15'.
- Construction sequence (Refer to Figure 3 below):
 - Excavate and stabilize all temporary swales, side ditches, or berms that will be used to convey runoff from the excavation.
 - Perform Phase 2 excavation, dress, and stabilize. Overseed Phase 1 areas as necessary.
 - Perform Phase 3 excavation, dress and stabilize. Overseed previously seeded areas as necessary.

Note: Once excavation has begun the operation should be continuous from grubbing through the completion of grading and placement of topsoil of required and permanent seed and mulch. Any interruptions in the operation of completing the operation out of the seeding season will necessitate the application of temporary stabilization.

- Incremental Stabilization of Embankments - Fill Slopes
 - Embankments shall be constructed in lifts as prescribed on the plans.
 - Slopes shall be stabilized immediately when the vertical height of the multiple lifts reaches 15' or when the grading operation ceases as prescribed on the plans.
 - The top of embankment shall be finished to the required grade and slope ditches should be constructed along the top edge of the embankment to intercept surface runoff and cover it down the slope in a non-erosive manner to the side.

- Construction sequence (Refer to Figure 4 below):
 - Excavate and stabilize all temporary swales, side ditches, or berms that will be used to divert runoff around the fill. Construct slope sill fence on low side of fill as shown on the plans.
 - Place Phase 1 embankment, dress and stabilize.
 - Place Phase 2 embankment, dress and stabilize.
 - Place final phase embankment, dress and stabilize. Overseed previously seeded areas as necessary.

Note: Once the placement of fill has begun the operation should be continuous from grubbing through the completion of grading and placement of topsoil of required and permanent seed and mulch. Any interruptions in the operation or completing the operation out of the seeding season will necessitate the application of temporary stabilization.

SECTION 2 - TEMPORARY SEEDING

Vegetation - annual grass or grain used to provide cover on disturbed areas for up to 12 months. For longer duration of vegetative cover, Permanent Seeding is required.

A. Seed Mixtures - Temporary Seeding

- Select one or more of the species or mixtures listed in Table 25 for the appropriate Plant Hardness Zone (from Figure 5) and enter them in the Temporary Seeding summary below, along with application rates and seeding dates and seeding depths. If this summary is not put on the plans and completed, then Table 25 must be put on the plans.

- For sites having disturbed areas over 5 acres, the rates shown on this table shall be deleted and the rates recommended by the testing agency shall be written in. Soil tests are not required for Temporary Seeding.

Seed Mixture (Hardness Zone ...)	Fertilizer Rate (lb/10-10)	Lime Rate
1. BARKLEY 122	600 lb/ac	2 tons/ac
2. OATLEY 96	600 lb/ac	2 tons/ac
3. RYE 140	600 lb/ac	2 tons/ac

SECTION 3 - PERMANENT SEEDING

Seeding grass and legumes to establish ground cover for a minimum of one year on disturbed areas generally receiving low maintenance.

A. Seed Mixtures - Permanent Seeding


- Select one or more of the species or mixtures listed in Table 25 for the appropriate Plant Hardness Zone (from Figure 5) and enter them in the Permanent Seeding summary below, along with application rates and seeding dates and seeding depths. If this summary is not put on the plans and completed, then Table 25 must be put on the plans. Additional planting specifications for exceptional sites such as streambanks, streambanks, or dunes or for special purposes such as wildlife or aesthetic treatment may be found in MD-04-025, Technical Road Criteria Guide, Section 342 - Critical Area Disturbed. For special low maintenance areas, see sections IV and V Turfgrass.

- For sites having disturbed areas over 5 acres, the rates shown on this table shall be deleted and the rates recommended by the soil testing agency shall be written in.

- For areas receiving low maintenance, apply uniform fertilizer 160-0-0 at 3 1/2 lbs/1000 sq. ft. (50 lb/acre) in addition to the above soil amendments shown in the table below, to be performed at the time of seeding.

Seed Mixture (Hardness Zone ...)	Fertilizer Rate (lb/10-10)	Lime Rate
1. TALL FESCUE (050)	150	3/1 - 5/15
2. PERENNIAL RYEGRASS (020)	150	0/15 - 10/15
3. KENTUCKY BLUEGRASS (03)	150	1" - 2"
4. TALL FESCUE (020)	150	0/15 - 10/15
5. WOOD FESCUE (020)	30	0/15 - 10/15

REMOVABLE PUMPING STATION (FOR BASINS 1, 2 & 3)

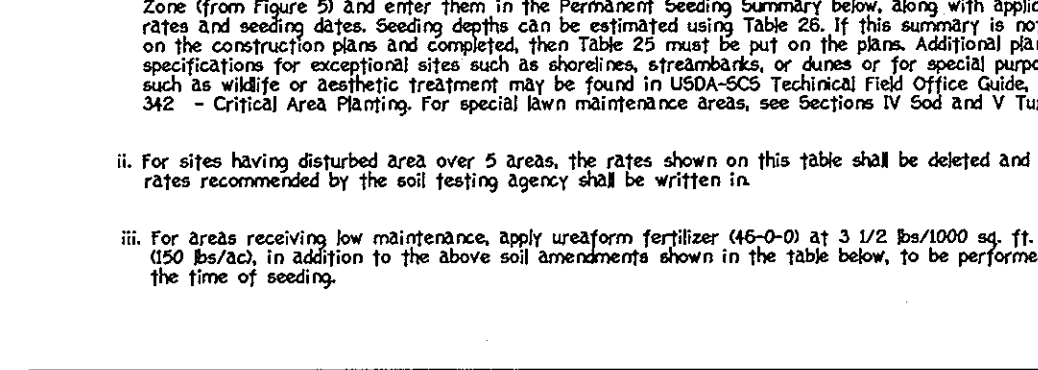


Construction Specifications

- The outer pipe should be 48" dia. or shall, in any case, be at least 4' greater in diameter than the center pipe. The outer pipe shall be wrapped with 1/2" hardware cloth to prevent backfill material from entering the perforations.
- After installing the outer pipe, backfill around outer pipe with 2" aggregate or clean gravel.
- The inside stand pipe (center pipe) should be constructed by perforating a corrugated PVC pipe (minimum 12" dia. diameter). The perforations shall be 1/2" x 6" slots or 1" diameter holes 6" on center. The center pipe shall be wrapped with 1/2" hardware cloth first, then wrapped with geotextile class C.
- The center pipe should extend 12" to 18" above the anticipated water surface elevation or riser crest elevation when dewatering a basin.

PIPE SLOPE DRAIN

NOT TO SCALE

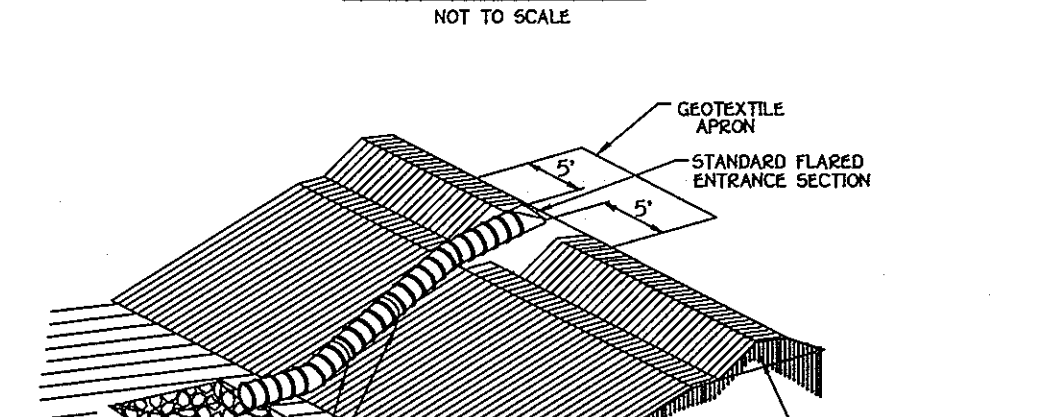


Construction Specifications for Pipe Slope Drain

- The Pipe Slope Drain (PSD) shall have a slope of 3 percent or steeper.
- The top of the earth dike over the inlet pipe shall be at least 2 times the pipe diameter measured at the invert of the pipe.
- Flexible tubing is preferred. However, corrugated metal pipe or equivalent PVC pipe can be used. All connections shall be watertight.
- A filter and section shall be attached to the inlet end of the pipe by using at the grooves provided. Spacing for anchors shall be as provided by manufacturer's specification. In no case shall less than two (2) anchors be provided, equally spaced along the length of pipe. These details should be provided by pipe supplier.
- The Pipe Slope Drain shall be securely anchored to the slope by using at the grooves provided. Spacing for anchors shall be as provided by manufacturer's specification. In no case shall less than two (2) anchors be provided, equally spaced along the length of pipe. These details should be provided by pipe supplier.
- The soil around and under the pipe and end section shall be hand tamped to a 1 inch lift in the top of the earth dike.
- All pipe connections shall be watertight.
- Whenever possible a PSD draining an unestablished area, it shall outlet into a sediment trap or basin. If this is not possible then the slope drain will discharge into a stable conveyance that leads to a sediment trap or basin. When discharging into a trap or basin the PSD shall discharge at the same elevation as the wet pool elevation. The discharge from the PSD must be as far away from the sediment control outlet as possible.
- When the drainage area is established, the PSD shall discharge onto a stabilized area at a non-erosive velocity.
- Inspection and any required maintenance shall be performed periodically and after each rain event.
- The inlet must be kept open at all times.

Table 6 Design Criteria for Pipe Slope Drain

Size	Pipe/Tubing Diameter (ID) in	Maximum Drainage Area (Acres)
PSD-12	12	0.5
PSD-18	18	1.5
PSD-24	24	2.5
PSD-24 (2)	24	3.0

NOTE: PIPE SIZE DESIGNATION IS: PSD 12 = PIPE SLOPE DRAIN WITH A 12" DIAMETER PIPE.

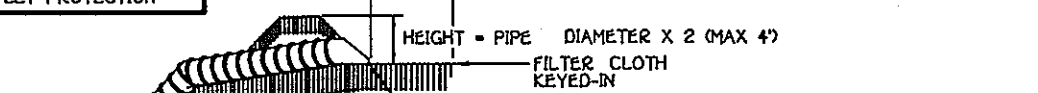


Construction Specifications

- The substrate for the filter, rip-rap, or gabion shall be prepared to the required lines and grades. Any fill required in the substrate shall be compacted to a density of approximately that of the surrounding undisturbed material.
- The rock or gravel surrounding the specified grading limits when installed respectively in the rip-rap or filter.
- Geotextile shall be protected from puncturing, cutting, or tearing. Any damage other than an occasional small hole shall be repaired by placing another piece of geotextile over the damaged part or by completely replacing the geotextile. All overlaps whether for repairs or for joining two pieces of geotextile shall be a minimum of one foot.
- Stones for the rip-rap or gabion outlets may be placed by equipment. They shall be constructed to the full course thickness in one operation and in such a manner as to avoid displacement of underlying materials. The stone for rip-rap or gabion outlets shall be delivered and placed in a manner that will ensure that it is reasonably homogeneous with the smaller stones and spalls filling the voids between the larger stones. Rip-rap shall be placed in a manner to prevent damage to the filter blanket or geotextile. Hand placement will be required to the extent necessary to prevent damage to the permanent works.
- The stone shall be placed so that it blends in with the existing ground. If the stone is placed too high then the flow will be forced out of the channel and scour adjacent to the stone will occur.

SEQUENCE OF CONSTRUCTION

- OBTAIN GRADING PERMITS. (2 weeks)
- NOTIFY "WES UTILITY" AT LEAST 48 HOURS BEFORE BEGINNING ANY WORK AT 1-800-257-7777. NOTIFY HOWARD COUNTY DEPARTMENT OF CONSTRUCTION/INSPECTION OFFICE AT LEAST 24 HOURS BEFORE STARTING ANY WORK. IN ADDITION, NOTIFY AT/AT PRIORITY TO ANY ACTIVITY WITHIN THEIR JURISDICTION.
- GRADING OPERATIONS WILL BE PHASED FOR THIS PROJECT IN ORDER TO ALLOW HOUSING CONSTRUCTION TO BEGIN ALONG BIRCHTREE LANE SUCH THAT MASS GRADING OF PARCELS F & G WITH SWM FACILITY #2 CAN PROCEED ALONG A SEPARATE TIME SCHEDULE. PHASE 1 INCLUDES F & G WITH INCLUDE CRISTALL DRIVE UP TO STA. 6+00, AND 40' OF BIRCHTREE LANE AND SWM FACILITY #1. PHASE 2 WILL INCLUDE THE REMAINDER OF SWM FACILITY #2 AND THE MASS GRADING OF THE REMAINDER OF THE SITE. GRADING OPERATIONS FOR BOTH PHASES CAN OCCUR SIMULTANEOUSLY BUT INDEPENDENTLY OF EACH OTHER AS PER EACH TIME SCHEDULE.
- INSTALL PERIMETER SEDIMENT CONTROL MEASURES FOR PHASE 1 WHICH INCLUDE STABILIZED CONSTRUCTION ENTRANCE, SILT FENCE, BASIN #3, SWM/BASIN #1 W/ TEMP. FLEX PIPE AND ASSOCIATED EARTH DICES. PHASE II MEASURES WILL INCLUDE P.O.S.T.M., SWM/TEMP. #2 W/ TEMP. FLEX PIPE, EARTH DICES AND SILT FENCE. (3 weeks)
- AFTER PERMISSION IS GRANTED BY THE SEDIMENT CONTROL INSPECTOR GRAB SITE TO SUBGRADE AND STABILIZE USING TEMPORARY SEEDING NOTES. INSTALL STORM DRAINS, WATER MAINS AND SEWER MAINS WITHIN THE LIMITS OF EACH PHASE OF THE SITE GRADING. THE PHASE 1 STORM DRAIN SHALL INCLUDE THE RUN FROM 0+2 UP TO 1+15. UTILITY DUST CONTROL SPECIFICATIONS SHOWN ON SHEET 19. (6 weeks)
- THE CONTRACTOR SHALL INSPECT AND PROVIDE NECESSARY MAINTENANCE ON ALL SEDIMENT AND EROSION CONTROL STRUCTURES SHOWN HEREON AFTER EACH RAINFALL AND ON A DAILY BASIS. REMOVE SEDIMENTS FROM ALL TRAPS WHEN CLEANOUT ELEVATIONS ARE REACHED. ALL SEDIMENTS MUST BE PLACED UPSTREAM OF AN APPROVED TRAP DEVICE.
- INSTALL ROADWAY BASE COURSE PAVING IN ACCORDANCE WITH EACH OF THE PHASED PAVING LIMITS. (1 week)
- STABILIZE ALL DISTURBED AREAS PHASE 1 ROAD CONSTRUCTION AND OBTAIN PERMISSION FROM THE SEDIMENT CONTROL INSPECTOR TO PROCEED TO PHASE 2 OF THE SITE. (6 weeks)
- APPLY TACK COAT TO BASE COURSE PAVING AND LAY SURFACE COURSE. (1 week)
- WHEN ALL CONTRIBUTING AREAS TO THE SEDIMENT CONTROL DEVICES (SILT FENCE, BASIN #3, DRESK & P.O.S.T. #1) HAVE BEEN STABILIZED AND WITH THE PERMISSION OF THE SEDIMENT CONTROL INSPECTOR, THE DEVICE MAY BE REMOVED AND/OR BACKFILLED AND THE REMAINING AREAS BROUGHT TO FINAL GRADE. (4 weeks)
- SWM/BASIN #1 AND #2 CAN REMAIN IN PLACE AS BASINS FOR A PERIOD OF 3 YEARS, SO THEY CAN BE UTILIZED FOR FUTURE PHASES OF THIS DEVELOPMENT.
- NOTIFY HOWARD COUNTY OFFICE OF INSPECTIONS AND PERMITS FOR A FINAL INSPECTION OF THE COMPLETED PROJECT OR COMPLETION OF EACH PHASE OF THE SITE GRADING.

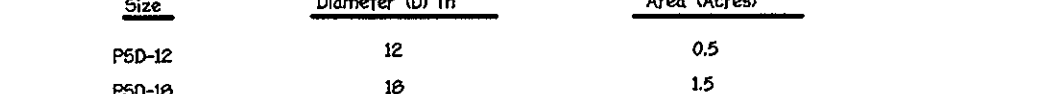

Construction Specifications

- Silt Fence to be heeled into the soil.
- Wire, snap fence, etc. for tree protection only.
- Boundaries of Retention Area will be established as part of the Forest conservation plan review process.
- Boundaries of Retention Area should be staked and flagged prior to installing device.
- Avoid root damage when placing anchor posts.
- Device should be properly maintained throughout construction.
- Protection signs are also required, using Figure D-4.
- Locate Fence outside the Critical Root Zone.

TREE PROTECTION FENCE

NOT TO SCALE

SEDIMENT CONTROL NOTES

1. A MINIMUM OF 48 HOURS NOTICE MUST BE GIVEN TO THE HOWARD COUNTY DEPARTMENT OF INSPECTIONS, LICENSES AND PERMITS, SEDIMENT CONTROL DIVISION PRIOR TO THE START OF ANY CONSTRUCTION (13-1659).

2. ALL NEGATIVE AND POSITIVE PRACTICES TO BE INSTALLED IN ACCORDANCE WITH THE MOST CURRENT MARYLAND STANDARDS AND SPECIFICATIONS FOR SOIL EROSION AND SEDIMENT CONTROL, AND REVISIONS THEREOF.

3. FOLLOWING INITIAL SOIL DISTURBANCE OR RE-DISTURBANCE, PERMANENT OR TEMPORARY SEDIMENT CONTROL STRUCTURES SHALL BE INSTALLED WITHIN CALENDAR DAYS FOR ALL PERIMETER SEDIMENT CONTROL STRUCTURES, DICES, PERIMETER SLOPES AND ALL SLOPES STEEPER THAN 3:1, 10' IS 10 DAYS AS TO ALL OTHER DISTURBED OR GRADED AREAS ON THE PROJECT SITE.

4. ALL SEDIMENT TRAPS/BASINS SHOWN MUST BE FENCED AND WARNING SIGNS POSTED AROUND THEIR PERIMETER IN ACCORDANCE WITH CHAPTER 12 OF THE HOWARD COUNTY DESIGN MANUAL, STORM DRAINAGE.

5. ALL DISTURBED AREAS MUST BE STABILIZED WITHIN THE TIME PERIOD SPECIFIED ABOVE IN ACCORDANCE WITH THE 1994 MARYLAND STANDARDS AND SPECIFICATIONS FOR SOIL EROSION AND SEDIMENT CONTROL, FOR PERMANENT SEEDING (SEC. 30), SOIL SEC. 34, TEMPORARY SEEDING (SEC. 30), AND MULCHING (SEC. 30). TEMPORARY STABILIZATION WITH MULCH ALONE CAN ONLY BE DONE WHEN RECOMMENDED SEEDING DATES DO NOT ALLOW FOR PROPER GERMINATION AND ESTABLISHMENT OF GRASSES.

6. ALL SEDIMENT CONTROL STRUCTURES ARE TO REMAIN IN PLACE AND ARE TO BE MAINTAINED IN OPERATIVE CONDITION UNTIL PERMISSION FOR THEIR REMOVAL HAS BEEN OBTAINED FROM THE HOWARD COUNTY SEDIMENT CONTROL INSPECTOR.

7. SITE ANALYSIS:

TOTAL AREA OF SITE	4,079 ACRES
AREA DISTURBED	27.0 ACRES
AREA TO BE ROOFED OR PAVED	2.70 ACRES
AREA TO BE VEGETATIVELY STABILIZED	24.60 ACRES
TOTAL CUT	20,395 CU. YDS.
TOTAL FILL	10,252 CU. YDS.

8. WASTE/WASTE/BORROW AREA LOCATION: N/A

9. ANY SEDIMENT CONTROL PRACTICE WHICH IS DISTURBED BY GRADING ACTIVITY FOR PLACEMENT OF UTILITIES MUST BE REPAIRED ON THE SAME DAY OF DISTURBANCE.

10. ADDITIONAL SEDIMENT CONTROLS MUST BE PROVIDED, IF DEEMED NECESSARY BY THE HOWARD COUNTY SEDIMENT CONTROL INSPECTOR.

11. ON ALL SITES WITH DISTURBED AREAS IN EXCESS OF 2 ACRES, APPROVAL OF THE INSPECTION AGENCY SHALL BE REQUESTED UPON COMPLETION OF INSTALLATION OF PERIMETER EROSION AND SEDIMENT CONTROLS, BUT BEFORE PROCEEDING WITH ANY OTHER GRADING, DISTURBANCE OR GRADING. OTHER BUILDING OR GRADING INSPECTION APPROVALS MAY NOT BE AUTHORIZED UNTIL THIS INITIAL APPROVAL BY THE INSPECTION AGENCY IS MADE.

12. TRENCES FOR THE CONSTRUCTION OF UTILITIES IS LIMITED TO THREE PILE LENGTHS OR THAT WHICH SHALL BE BACK-FILLED AND STABILIZED WITHIN ONE WORKING DAY, WHICHEVER IS SHORTER.




13. APPROVED: Department of Public Works, Chief Bureau of Highways, 1-16-02, Date.

14. APPROVED: Department of Planning and Zoning, Chief, Division of Land Development, 2/4/02, Date.


15. APPROVED: Chief, Development Engineering Division, 2/4/02, Date.




16. APPROVED: Department of Planning and Zoning, Chief

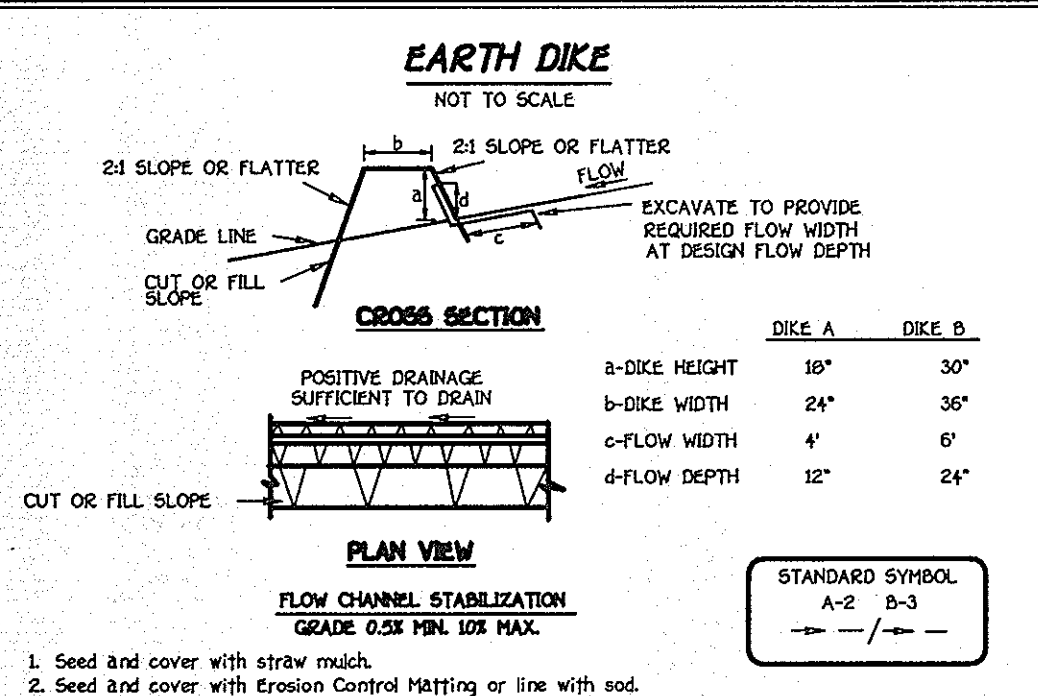


- CONSTRUCTION SPECIFICATIONS**
- Seed and cover with straw mulch.
 - Seed and cover with erosion control matting or line with sod.
 - 4" x 7" stone or recycled concrete equivalent pressed into the soil 7" minimum.
- Construction Specifications
- All temporary earth dikes shall have uninterrupted positive grade to an outlet. Spot elevations may be necessary for grades less than 1%.
 - Runoff diverted from a disturbed area shall be conveyed to a sediment trapping device.
 - Runoff diverted from an undisturbed area shall outlet directly into an undisturbed, stabilized area at a conservative velocity.
 - All trees, brush, stumps, obstructions, and other objectionable material shall be removed and disposed of so as not to interfere with the proper functioning of the dike.
 - The dike shall be excavated or shaped to line, grade and cross section as required to meet the critical specified location and be free of bark projections or other irregularities which will impede normal flow.
 - Fill shall be compacted by earth moving equipment.
 - All earth removed and not needed for construction shall be placed so that it will not interfere with the functioning of the dike.
 - Inspection and maintenance must be provided periodically and after each rain event.

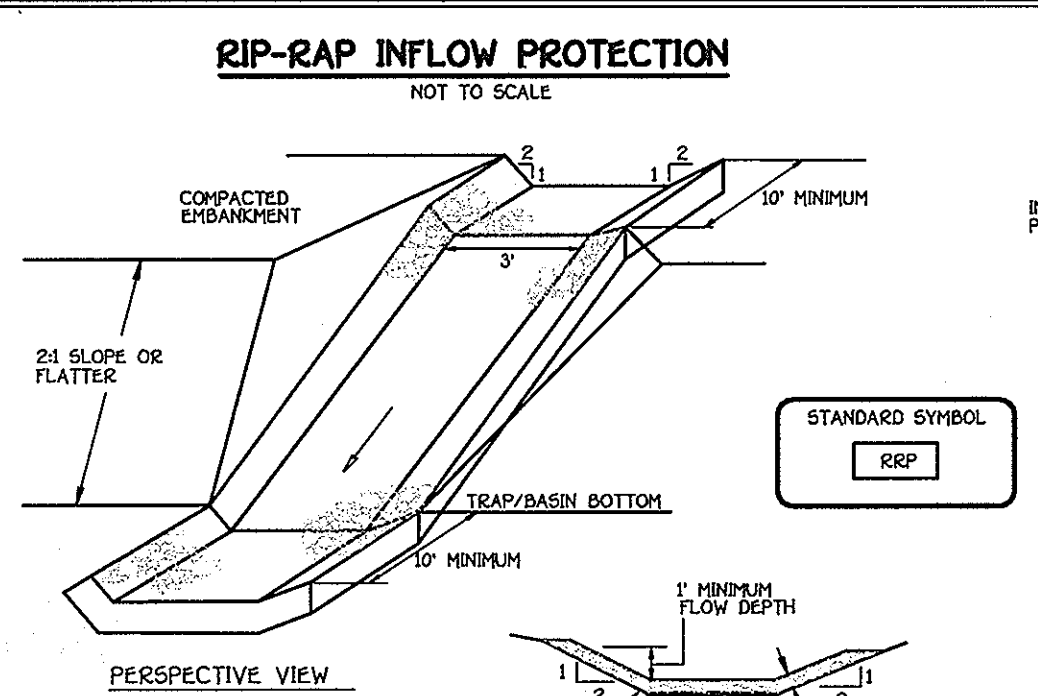


- CONSTRUCTION SPECIFICATIONS**
- Rip-rap lined inflow channels shall be 1' in depth, have a trapezoidal cross section with 2:1 or flatter side slopes and 3" (min) bottom width. The channel shall be lined with 4" to 12" rip-rap to a depth of 18".
 - Filter cloth shall be installed under all rip-rap. Filter cloth shall be Geotextile Class C.
 - Entrance and exit sections shall be installed as shown on the detail section.
 - Rip-rap used for the lining may be recycled for permanent outlet protection if the basin is to be converted to a stormwater management facility.
 - Gabion Inflow Protection may be used in lieu of Rip-rap Inflow Protection.
 - Rip-rap should blend into existing ground.
 - Rip-rap Inflow Protection shall be used where the slope is between 4:1 and 10:1, for slopes flatter than 10:1 use Earth Dike or Temporary Swale Lining criteria.

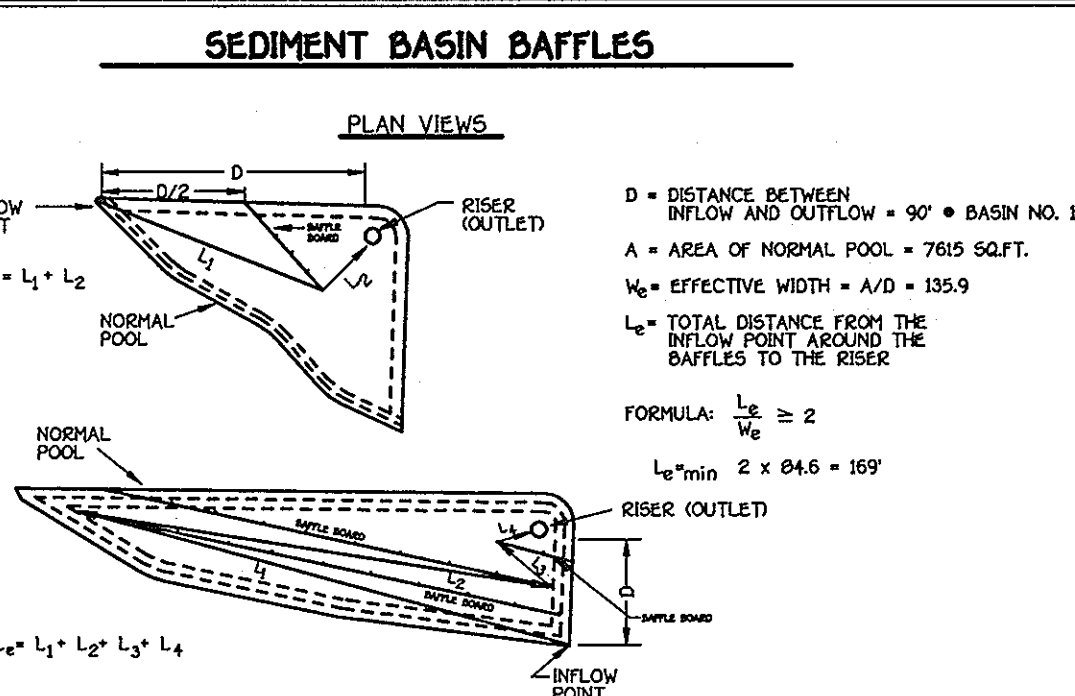


- CONSTRUCTION SPECIFICATIONS**
- Where ends of geotextile fabric come together, they shall be overlapped, folded and stapled to prevent sediment bypass.
 - Silt fence shall be inspected after each rainfall event and maintained when bulges occur or when sediment accumulation reduced 50% of the fabric height.

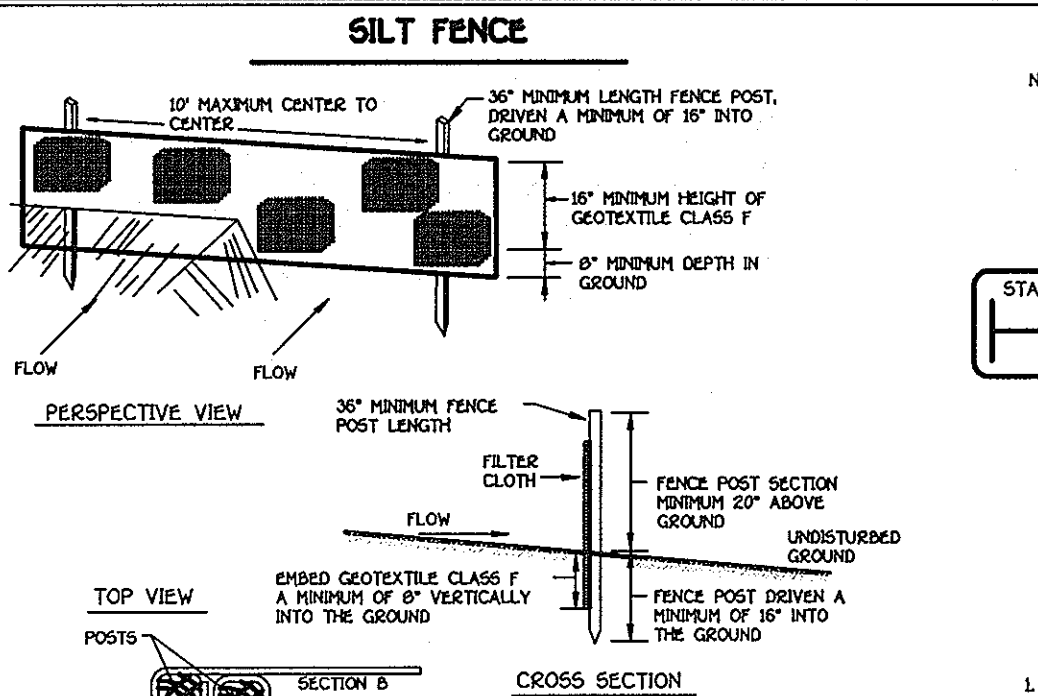


- CONSTRUCTION SPECIFICATIONS**
- Fence posts shall be a minimum of 36" long driven 10" minimum into the ground. Wood posts shall be 1 1/2" x 1 1/2" square (minimum) or 1 1/2" diameter (minimum) round and shall be of sound quality hardwood. Steel posts will be standard T or U section weighing not less than 100 ppc per linear foot.
 - Geotextile shall be fastened to each fence post with wire ties or staples at top and mid-section and shall meet the following requirements for Geotextile Class F:
 - Where ends of geotextile fabric come together, they shall be overlapped, folded and stapled to prevent sediment bypass.
 - Silt fence shall be inspected after each rainfall event and maintained when bulges occur or when sediment accumulation reduced 50% of the fabric height.

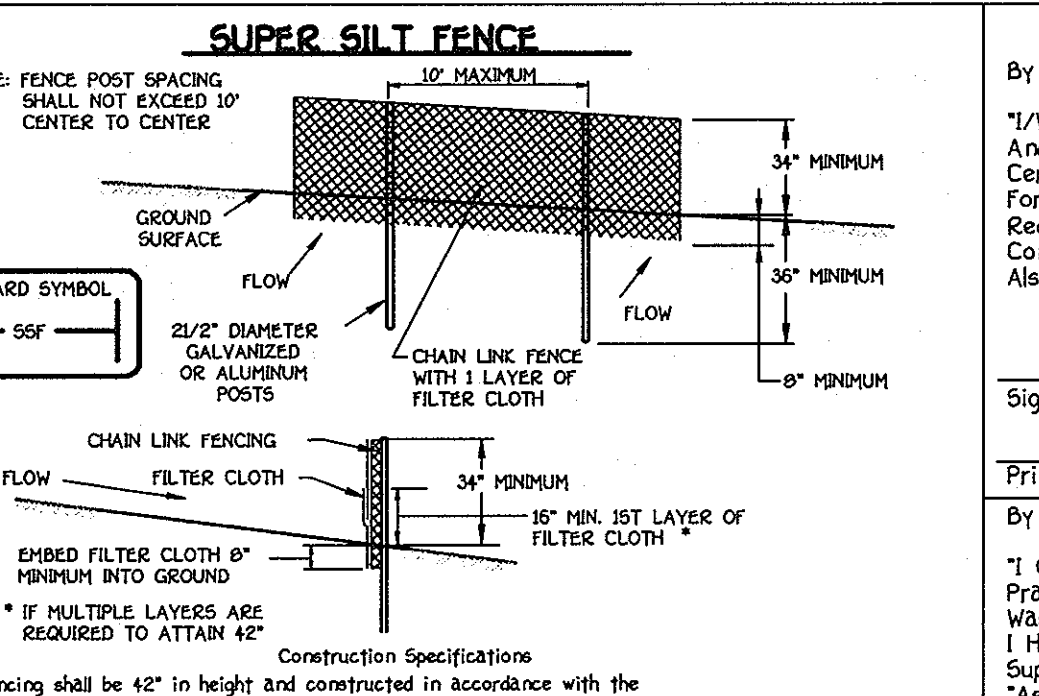


- CONSTRUCTION SPECIFICATIONS**
- Fencing shall be 42" in height and constructed in accordance with the latest Maryland State Highway Design for Chain Link Fencing. The specification for a 6' fence shall be used substituting 42" fabric and 6' length posts.
 - Chain link fence shall be fastened securely to the fence posts with wire ties. The lower tension wire, brace and cross rods, drive anchors and post caps are not required except on the ends of the fence.
 - Filter cloth shall be fastened to the chain link fence with ties spaced every 24" at the top and mid section.
 - Filter cloth shall be overlapped a minimum of 6" into the ground.
 - When two sections of filter cloth adjoin each other, they shall be overlapped by 6" and folded.
 - Maintenance shall be performed as needed and silt buildup removed when 'bulges' develop in the silt fence, or when silt reaches 50% of fence height.
 - Filter cloth shall be fastened to each fence post with wire ties or staples at top and mid section and shall meet the following requirements for Geotextile Class F:

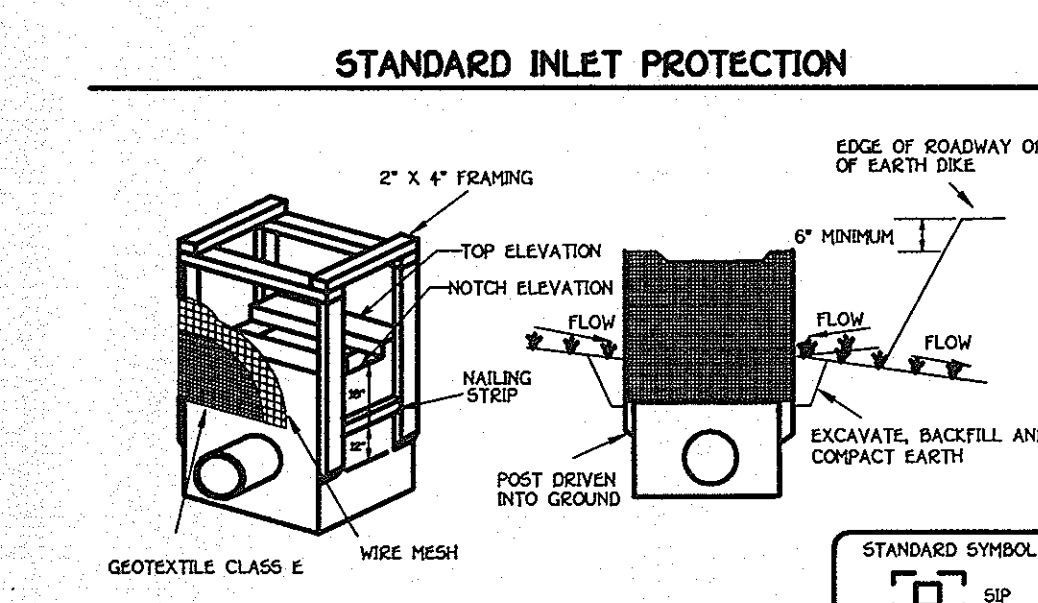


- CONSTRUCTION SPECIFICATIONS**
- Excavate completely around the inlet to a depth of 18" below the notch elevation.
 - Drive the 2' x 4" construction grade lumber posts 1" into the ground at each corner of the inlet. Place nail strips between the posts on the ends of the inlet. Assemble the top portion of the 2' x 4" frame using the overlap joint shown on Detail 23A. The top of the frame (weir) must be 6" below adjacent roadways where flooding and safety issues may arise.
 - Stretch the 1/2" x 1/2" wire mesh tightly around the frame and fasten securely. The ends must meet and overlap at a post.
 - Stretch the Geotextile Class E tightly over the wire mesh with the geotextile extending from the top of the frame to 18" below the inlet notch elevation. Flatten the geotextile firmly to the frame. The ends of the geotextile must meet at a post, be overlapped and folded, then fastened down.
 - Backfill around the inlet in compacted 6" layers until the three of earth is level with the notch elevation on the ends and top elevation on the sides.
 - If the inlet is not in a ramp, construct a compacted earth dike around the ditch line directly below it. The top of the earth dike should be at least 6" higher than the top of the frame.
 - The structure must be inspected periodically and after each rain and the geotextile replaced when it becomes clogged.

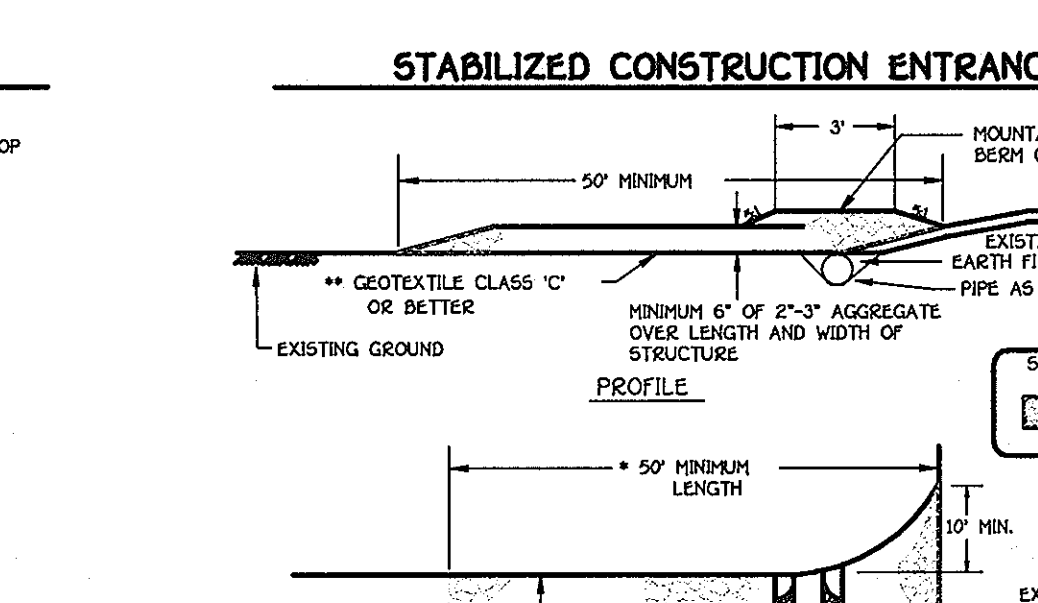


- CONSTRUCTION SPECIFICATIONS**
- Length - minimum of 50' (x30' for single residence lot).
 - Width - 10' minimum, should be flared at the existing road to provide a turning radius.
 - Geotextile fabric (filter cloth) shall be placed over the existing ground prior to placing stone. **The plan approval authority may not require single family residences to use geotextile.
 - Stone - crushed aggregate 1/2" to 3/4" or reclaimed or recycled concrete equivalent shall be placed at least 6" deep over the length and width of the entrance.
 - Surface Water - All surface water flowing to or diverted toward construction entrances shall be piped through the entrance, maintaining positive drainage. Pipe installed through the stabilized construction entrance shall be protected with a mountable berm with 5:1 slopes and a minimum of 6" of stone over the pipe. Pipe has to be sized according to the drainage. When the SCE is located at a high spot and has no drainage to convey a pipe will not be necessary. Pipe should be sized according to the amount of runoff to be conveyed. A 6" minimum will be required.
 - Location - A stabilized construction entrance shall be located at every point where construction traffic enters or leaves a construction site. Vehicles leaving the site must travel over the entire length of the stabilized construction entrance.

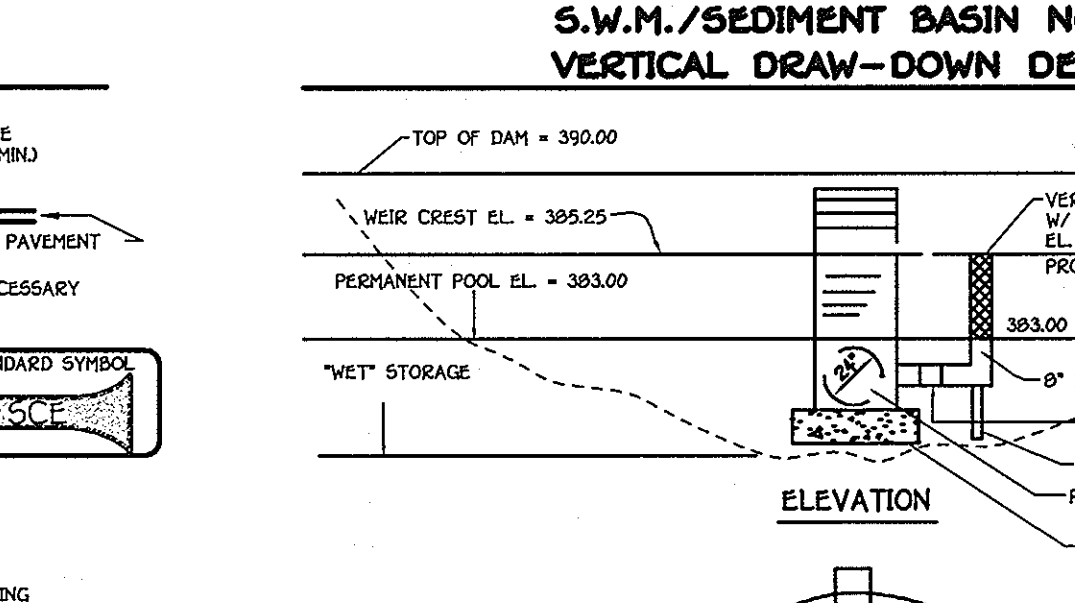

- CONSTRUCTION SPECIFICATIONS**
- PERFORATIONS IN THE DRAW-DOWN DEVICE MAY NOT EXTEND INTO THE WET STORAGE.
 - THE TOTAL AREA OF THE PERFORATIONS MUST BE GREATER THAN 2 TIMES THE AREA OF THE INTERNAL ORIFICE.
 - THE PERFORATED PORTION OF THE DRAW-DOWN DEVICE SHALL BE WRAPPED WITH 1/2" HARDWARE CLOTH AND GEOTEXTILE FABRIC. THE GEOTEXTILE FABRIC SHALL MEET THE SPECIFICATIONS FOR GEOTEXTILE CLASS E.
 - PROVIDE SUPPORT OF DRAW-DOWN DEVICE TO PREVENT SAGGING AND FLOATION. AN ACCEPTABLE PREVENTATIVE MEASURE IS TO STAKE BOTH SIDES OF DRAW-DOWN DEVICE WITH 1" STEEL ANGLE, OR 1" BY 4" SQUARE OR 2" ROUND WOODEN POSTS SET 3' MINIMUM INTO THE GROUND THEN JOINING THEM TO THE DEVICE BY WRAPPING WITH 12 GAUGE MINIMUM WIRE.

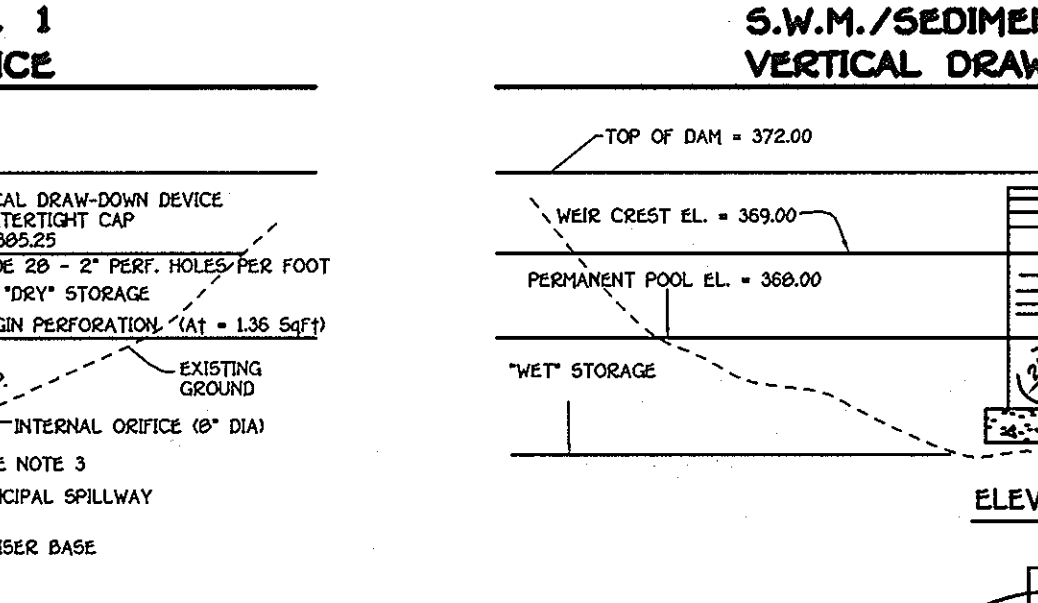


- CONSTRUCTION SPECIFICATIONS**
- PERFORATIONS IN THE DRAW-DOWN DEVICE MAY NOT EXTEND INTO THE WET STORAGE.
 - THE TOTAL AREA OF THE PERFORATIONS MUST BE GREATER THAN 2 TIMES THE AREA OF THE INTERNAL ORIFICE.
 - THE PERFORATED PORTION OF THE DRAW-DOWN DEVICE SHALL BE WRAPPED WITH 1/2" HARDWARE CLOTH AND GEOTEXTILE FABRIC. THE GEOTEXTILE FABRIC SHALL MEET THE SPECIFICATIONS FOR GEOTEXTILE CLASS E.
 - PROVIDE SUPPORT OF DRAW-DOWN DEVICE TO PREVENT SAGGING AND FLOATION. AN ACCEPTABLE PREVENTATIVE MEASURE IS TO STAKE BOTH SIDES OF DRAW-DOWN DEVICE WITH 1" STEEL ANGLE, OR 1" BY 4" SQUARE OR 2" ROUND WOODEN POSTS SET 3' MINIMUM INTO THE GROUND THEN JOINING THEM TO THE DEVICE BY WRAPPING WITH 12 GAUGE MINIMUM WIRE.

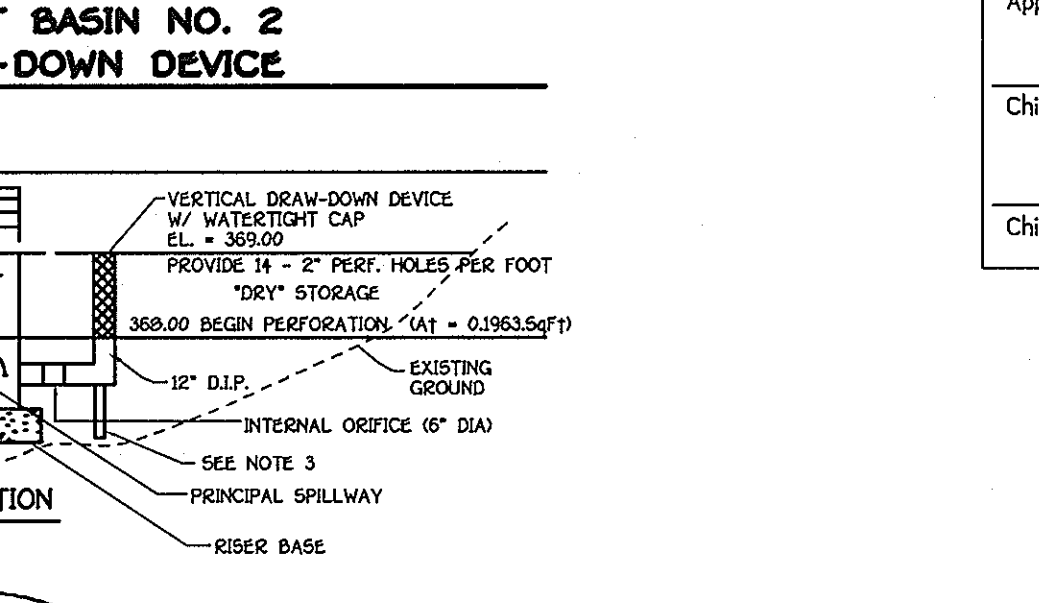

RIP-RAP CHANNEL DESIGN DATA

STRUCTURE	AREA	WETTED PERIMETER	R	R ^{2/3}	S	S ^{1/2}	W	d	N	V (C.F.S.)	Q	RIP-RAP SIZE	BLANKET THICKNESS	DIA.
S-1	8.12 SF	8.16'	0.7500'	0.8255	0.0050	0.0707	3.00'	1.10'	0.04	2.17	13.28	9.5"	15"	19"
S-2	8.01 SF	9.20'	0.8707'	0.9118	0.0050	0.0707	3.00'	1.39'	0.04	2.39	19.18	16"	24"	32"
S-3														


FUTURE PHASE III OF PROJECT

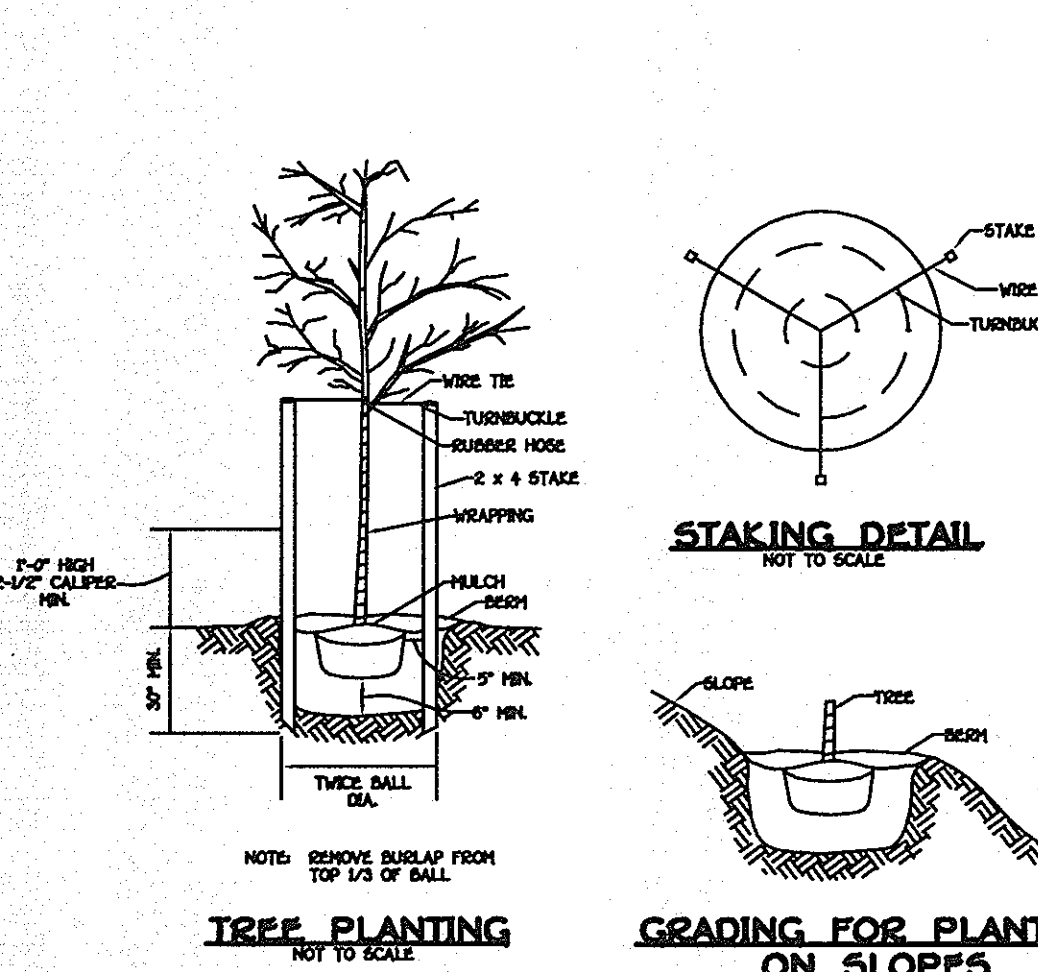


STATE OF MARYLAND PROFESSIONAL ENGINEER

FISHER, COLLINS & CARTER, INC.
CIVIL, ENGINEERING, CONSULTANTS & LAND SURVEYORS
CENTRAL SQUARE OFFICE PARK - 10272 BALTIMORE NATIONAL PIKE
ELLSWORTH CITY, MARYLAND 21032
(410) 461 - 2855


12-11-01

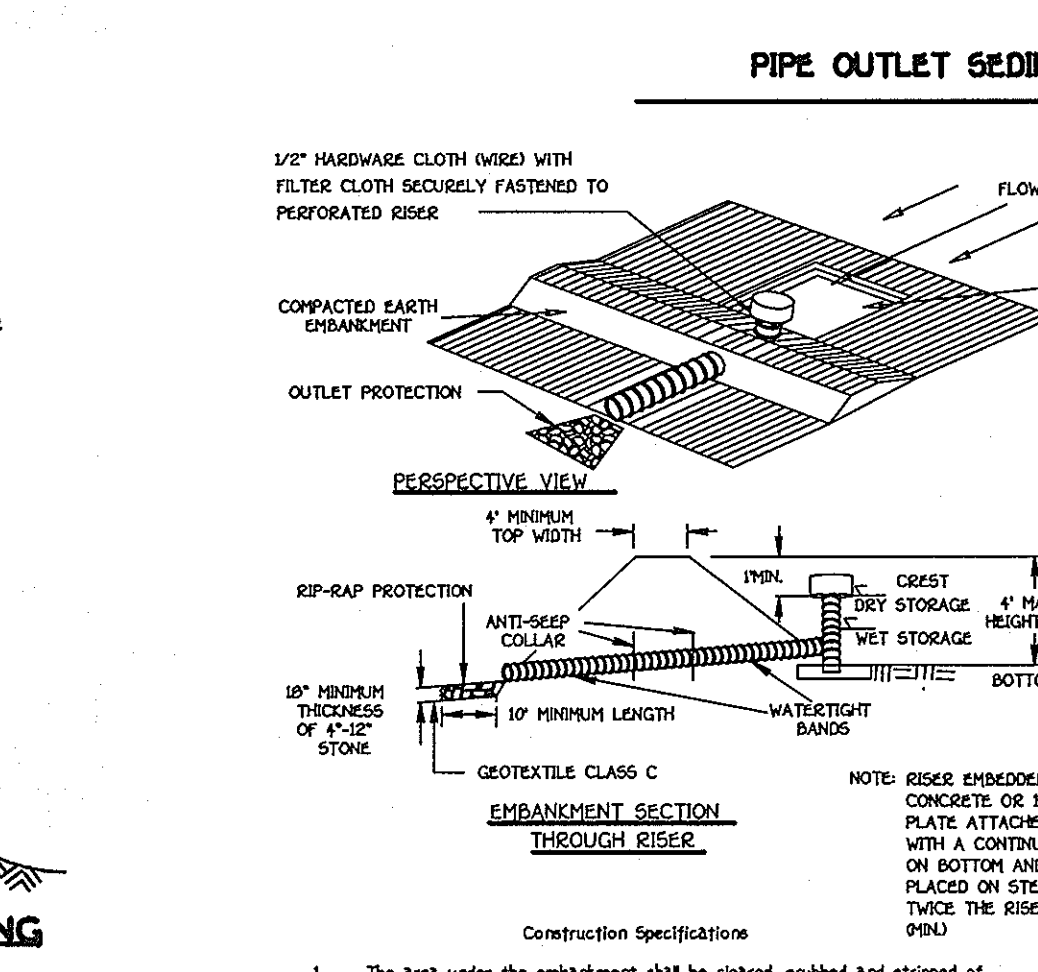

- CONSTRUCTION SPECIFICATIONS**
- The area under the embankment shall be cleared, grubbed and stripped of any vegetation and root mat. The pool area shall be cleared.
 - The fill material for the embankment shall be free of roots or other woody vegetation as well as oversized stones, rocks, organic material or other objectionable material. The embankment shall be compacted by traveling with equipment while it is being constructed.
 - The total trap volume as measured from the bottom to riser crest elevation shall be 3000 cubic feet per acre of catchment area (see Table 9). The top of embankment must be at least 7" above the riser crest elevation.
 - Sediment shall be removed and the trap returned to its original dimensions when the sediment has accumulated to one half of the wet storage depth of the trap (9000/2). The sediment shall be deposited in a suitable area and in such a manner that it will not erode.
 - The structure shall be inspected periodically and after each rain and repair made as necessary.

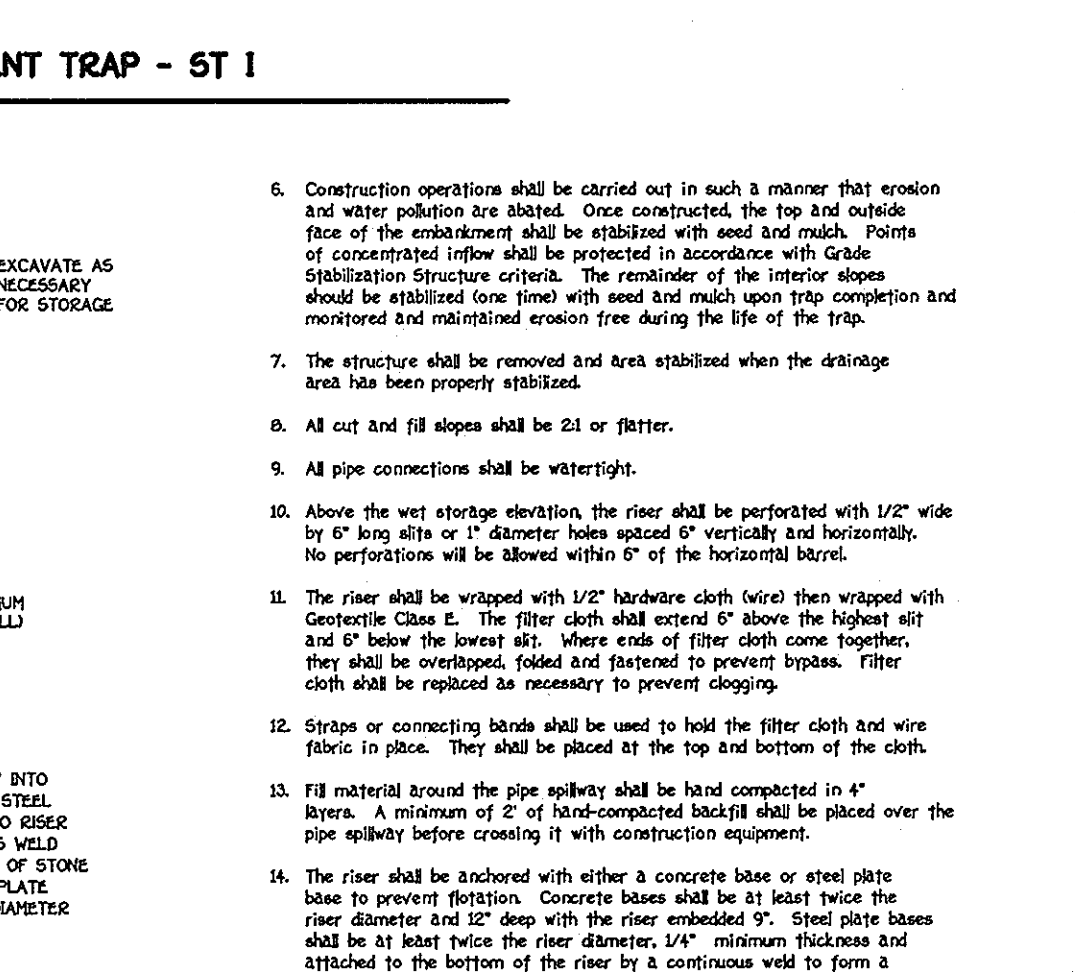

- CONSTRUCTION SPECIFICATIONS**
- Key-in the matting by placing the top ends of the matting in a narrow trench, 6" in depth. Backfill the trench and tamp firmly to conform to the channel cross-section. Secure with a row of staples about 4" down slope from the trench. Spacing between staples is 6".
 - Staple the 4" overlap in the channel center using an 18" spacing between staples.
 - Before stapling the outer edges of the matting, make sure the matting is smooth and in firm contact with the soil.
 - Staples shall be placed 2' apart with 4 rows for each strip, 2 outer rows, and 2 alternating rows down the center.
 - Where one roll of matting ends and another begins, the end of the top strip shall overlap the upper end of the lower strip by 4", slightly fashion. Reinforce the overlap with a double row of staples spaced 6" apart in a staggered pattern on either side.
 - The discharge end of the matting line should be similarly secured with 2 double rows of staples.
- Note: If flow will enter from the edge of the matting then the area effected by the flow must be key-in.

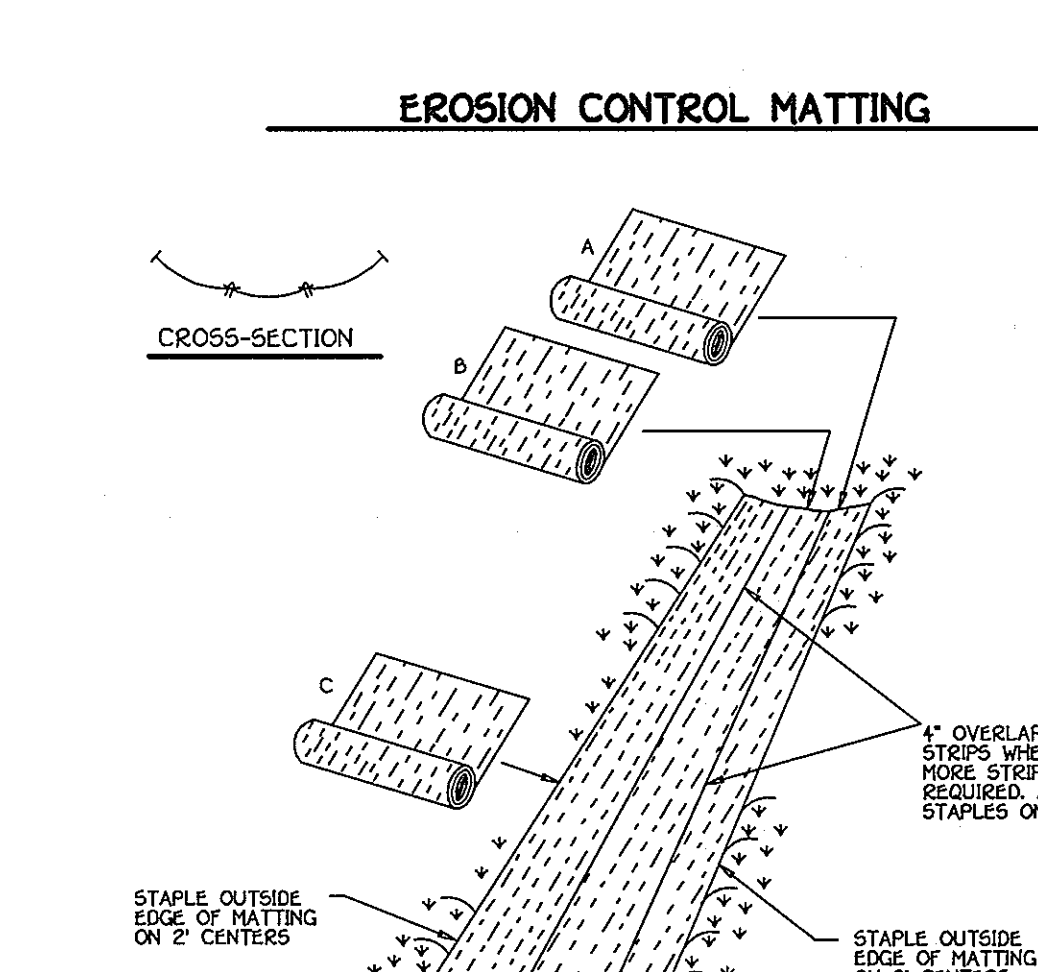

- CONSTRUCTION SPECIFICATIONS**
- Construction operations shall be carried out in such a manner that erosion and water pollution are abated. Once constructed, the top and outside face of the embankment shall be stabilized with seed and mulch. Points of concentrated inflow shall be protected in accordance with Storm Stabilization Structure criteria. The remainder of the interior slopes should be stabilized from time to time with seed and mulch upon trap completion and monitored and maintained erosion free during the life of the trap.
 - The structure shall be removed and area stabilized when the drainage area has been properly stabilized.
 - All cut and fill slopes shall be 2:1 or flatter.
 - All pipe connections shall be watertight.
 - Above the wet storage elevation, the riser shall be performed with 1/2" wide by 6" long slits or 1" diameter holes spaced 6" vertically and horizontally. No perforations will be allowed within 6" of the horizontal batter.
 - The riser shall be wrapped with 1/2" hardware cloth (weir) then wrapped with Geotextile Class E. The filter cloth shall extend 6" above the highest sill and 6" below the lowest sill. Where ends of filter cloth come together, they shall be overlapped, folded and fastened to prevent bypass. Filter cloth shall be replaced as necessary to prevent clogging.
 - Staples or connecting bands shall be used to hold the filter cloth and wire fabric in place. They shall be placed at the top and bottom of the cloth.
 - Fill material around the pipe spillway shall be hand compacted in 4" layers. A minimum of 2" of hand-compacted backfill shall be placed over the pipe spillway before creating it with construction equipment.
 - The riser shall be anchored with either a concrete base or steel pipe base to prevent flotation. Concrete bases shall be at least twice the riser diameter and 12" deep with the riser embedded 9". Steel pipe bases shall be at least twice the riser diameter, 1/4" minimum thickness and attached to the bottom of the riser with a continuous weld to form a watertight connection. Then place 2" of stone, gravel or topped earth on the pipe.
 - Anti-seep collars shall be constructed in accordance with plans (ref. Table 15 and Details 13 and 14).
 - Concentric trash rack and anti-vortex device design details are on Detail 15.
 - Refer to Section D for dewatering requirements of sediment traps.
 - Outlet - An outlet shall be provided, which includes a means of conveying the discharge in an erosion free manner to an existing stable channel.
 - Where discharge occurs at the property line, local ordinances and drainage placement requirements shall be met.

- CONSTRUCTION SPECIFICATIONS**
- PERFORATIONS IN THE DRAW-DOWN DEVICE MAY NOT EXTEND INTO THE WET STORAGE.
 - THE TOTAL AREA OF THE PERFORATIONS MUST BE GREATER THAN 2 TIMES THE AREA OF THE INTERNAL ORIFICE.
 - THE PERFORATED PORTION OF THE DRAW-DOWN DEVICE SHALL BE WRAPPED WITH 1/2" HARDWARE CLOTH AND GEOTEXTILE FABRIC. THE GEOTEXTILE FABRIC SHALL MEET THE SPECIFICATIONS FOR GEOTEXTILE CLASS E.
 - PROVIDE SUPPORT OF DRAW-DOWN DEVICE TO PREVENT SAGGING AND FLOATION. AN ACCEPTABLE PREVENTATIVE MEASURE IS TO STAKE BOTH SIDES OF DRAW-DOWN DEVICE WITH 1" STEEL ANGLE, OR 1" BY 4" SQUARE OR 2" ROUND WOODEN POSTS SET 3' MINIMUM INTO THE GROUND THEN JOINING THEM TO THE DEVICE BY WRAPPING WITH 12 GAUGE MINIMUM WIRE.

OWNER/DEVELOPER

CHERRYTREE P, L.L.C.
7520 INDIAN PIKE COURT
COLUMBIA, MARYLAND 21046

AS BUILT 5/23/08

By The Developer:

I/We Certify That All Development And/Or Construction Will Be Done According To These Plans, And That Any Responsible Personnel Involved In The Construction Project Will Have A Certificate Of Attendance At A Department Of The Environment Approved Training Program For The Control Of Sediment And Erosion Before Beginning The Project. I Shall Engage A Registered Professional Engineer To Supervise Pond Construction And Provide The Howard Soil Conservation District With An "As-Built" Plan Of The Pond Within 30 Days Of Completion. I Also Authorize Periodic On-Site Inspections By The Howard Soil Conservation District.


Signature Of Developer: *Thomas K Bourke* 12/11/01
Printed Name Of Developer: **THOMAS K BOURKE VP**
By The Engineer:

I Certify That This Plan For Pond Construction Erosion And Sediment Control Represents A Practical And Workable Plan Based On My Personal Knowledge Of The Site Conditions. This Plan Was Prepared In Accordance With The Requirements Of The Howard Soil Conservation District. I Have Notified The District That I/We Must Engage A Registered Professional Engineer To Supervise Pond Construction And Provide The Howard Soil Conservation District With An "As-Built" Plan Of The Pond Within 30 Days Of Completion.

Signature Of Engineer: *Thomas K Bourke* 12-11-01
Printed Name Of Engineer: **THOMAS K BOURKE**
These Plans Have Been Reviewed For The Howard Soil Conservation District And Meet The Technical Requirements For Small Pond Construction, Soil Erosion And Sediment Control.

Signature: *Jim Hays* 1/26/02
USDA-Natural Resources Conservation Service Date: 1-16-02
These Plans For Small Pond Construction, Soil Erosion And Sediment Control Meet The Requirements Of The Howard Soil Conservation District.

Signature: *John W. Dwyer* 1/26/02
Howard Soil Conservation District Date: 1-16-02
Approved: Department Of Public Works
Signature: *John W. Dwyer* 1-16-02
Chief, Bureau Of Highways Date: 1-16-02
Approved: Department Of Planning And Zoning
Signature: *Cindy Hamer* 2/4/02
Chief, Division Of Land Development Date: 2/4/02
Signature: *John W. Dwyer* 2/4/02
Chief, Development Engineering Division Date: 2/4/02

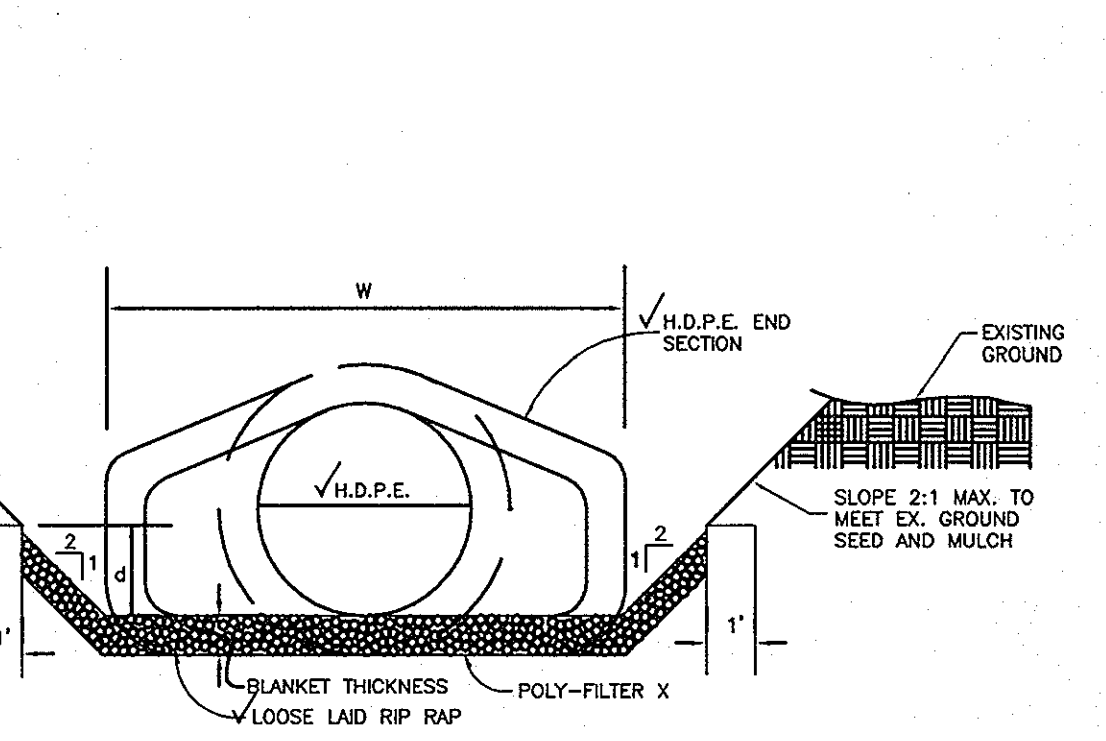

RIP-RAP CHANNEL DESIGN DATA

STRUCTURE	AREA	WETTED PERIMETER	R	R ^{2/3}	S	S ^{1/2}	W	d	N	V (C.F.S.)	Q	RIP-RAP SIZE	BLANKET THICKNESS	DIA.
S-1	8.12 SF	8.16'	0.7500'	0.8255	0.0050	0.0707	3.00'	1.10'	0.04	2.17	13.28	9.5"	15"	19"
S-2	8.01 SF	9.20'	0.8707'	0.9118	0.0050	0.0707	3.00'	1.39'	0.04	2.39	19.18	16"	24"	32"
S-3														

FUTURE PHASE III OF PROJECT

SEDIMENT AND EROSION CONTROL NOTES & DETAILS

CHERRYTREE PARK

LOTS 1 THRU 10, OPEN SPACE LOTS 11 THRU 13 AND BULK PARCELS 'A' THRU 'H' (PHASES I AND II)

ZONED: MXD-6
TAX MAP NO. 46 PARCEL NO. 156 GRID NO. 4
SIXTH ELECTION DISTRICT HOWARD COUNTY, MARYLAND
DATE: DECEMBER 7, 2001
SHEET 13 OF 21

AS BUILT

STORM WATER MANAGEMENT POND CONSTRUCTION SPECIFICATIONS

These specifications are appropriate to all ponds within the scope of the Standard for practice MD-37B. All references to ASTM and AASHTO specifications apply to the most recent version.

Site Preparation

Areas designated for borrow areas, embankment, and structural works shall be cleared, grubbed and stripped of topsoil. All trees, vegetation roots and other objectionable material shall be removed. Channel banks and grub breaks shall be sloped to no steeper than 1:1. All trees shall be cleared and grubbed within 15 feet of the toe of the embankment.

Areas to be covered by the reservoir will be cleared of all trees, brush, logs, fences, rubbish and other objectionable material unless otherwise designated on the plans. Trees, brush, and stumps shall be cut approximately level with the ground surface. For dry stormwater management ponds, a minimum of a 25-foot radius around the inlet structure shall be cleared.

All cleared and grubbed material shall be disposed of outside and below the limits of the dam and reservoir as directed by the owner or his representative. When specified, a sufficient quantity of topsoil will be stockpiled in a suitable location for use on the embankment and other designated areas.

Earth Fill

Material - The fill material shall be taken from approved designated borrow areas. It shall be free of roots, stumps, wood, rubbish, stones, gravel, cinders, or other objectionable materials. Fill material for the center of the embankment, and cut off trench shall conform to Unified Soil Classification GC, SC, CH or CL and must have at least 30% passing the #200 sieve. Consideration may be given to the use of other materials in the embankment if designed by a geotechnical engineer. Such special designs must be constructed supervised by a geotechnical engineer. Materials used in the outer shell of the embankment must have the capability to support vegetation of the quality required to prevent erosion of the embankment.

Placement - Areas on which fill is to be placed shall be scarified prior to placement of fill. Fill material shall be placed in maximum 8-inch thick before compaction layers which are to be continuous over the entire length of the fill. The most permeable borrow material shall be placed in the downstream portions of the embankment. The principal spillway must be installed concurrently with fill placement and not excavated into the embankment.

Compaction - The movement of the hauling and spreading equipment over the fill shall be controlled so that the entire surface of each lift shall be traversed by not less than one tread track of heavy equipment or compaction shall be achieved by a minimum of four complete passes of a sheepsfoot, rubber tired or vibratory roller. Fill material shall contain sufficient moisture such that the required degree of compaction will be obtained with the equipment used. The fill material shall contain sufficient moisture so that if formed into a ball it will not crumble, yet not be so wet that water can be squeezed out.

When required by the reviewing agency the minimum required density shall not be less than 95% of maximum dry density with a moisture content within ±2% of the optimum. Each layer of fill shall be compacted as necessary to obtain that density, and is to be certified by the engineer at the time of construction. All compaction is to be determined by AASHTO Method T-99 (Standard Proctor).

Cut Off Trench - The cutoff trench shall be excavated into impervious material along or parallel to the centerline of the embankment as shown on the plans. The bottom width of the trench shall be governed by the equipment used for excavation, with the minimum width being four feet. The depth shall be at least four feet below existing grade or as shown on the plans. The side slopes of the trench shall be 1 to 1 or flatter. The backfill shall be compacted with construction equipment, rollers, or hand tampers to assure maximum density and minimum permeability.

Embankment Core - The core shall be parallel to the centerline of the embankment as shown on the plans. The top width of the core shall be a minimum of four feet. The height shall extend up to at least the 10 percent elevation or as shown on the plans. The side slopes shall be 1 to 1 or flatter. The core shall be compacted with construction equipment, rollers, or hand tampers to assure maximum density and minimum permeability. In addition the core shall be placed concurrently with the outer shell of the embankment.

Structure Backfill

Backfill adjacent to pipes or structures shall be of the type and quality conforming to that specified for the adjoining fill material. The fill shall be placed in horizontal layers not to exceed four feet in thickness and compacted by hand tampers or other suitable compaction equipment. The material needs to fill completely all spaces under and adjacent to the pipe. At no time during the backfilling operation shall driven equipment be allowed to operate closer than four feet, measured horizontally, to any part of a structure. Under no circumstances shall equipment be driven over any part of a concrete structure or pipe, unless there is a compacted fill of 24" or greater over the structure or pipe.

Structure backfill may be flowable fill meeting the requirements of Maryland Department of Transportation, State Highway Administration Standard Specifications for Construction and Materials, Section 303 as modified. The mixture shall have a 100-200 psi 28 day unconfined compressive strength. The flowable fill shall have a minimum pH of 4.0 and a minimum resistivity of 2,000 ohm-cm. Material shall be placed such that a minimum of 6" (measured perpendicular to the outside of the pipe of flowable fill shall be under bedding), over and on the sides of the pipe. Cut off needs to extend up to the existing line for rigid conduits. Average slump of the fill shall be 7" to assure flowability of the material. Adequate measures shall be taken (using bags, etc.) to prevent floating the pipe. When using flowable fill all material shall be bituminous coated. Any adjoining soil fill shall be placed in horizontal layers not to exceed four inches in thickness and compacted by hand tampers or other manually directed compaction equipment. The material shall completely fill all voids adjacent to the flowable fill and shall be placed in horizontal layers not to exceed four feet, measured horizontally, to any part of a structure. Under no circumstances shall equipment be driven over any part of a structure or pipe unless there is a compacted fill of 24" or greater over the structure or pipe. Backfill material under the structural backfill (flowable fill zone shall be of the type and quality conforming to the specified for the core of the embankment or other embankment materials.

Pipe Conduits

All pipes shall be circular in cross section.

Corrugated Metal Pipe - All of the following criteria shall apply for corrugated metal pipe:

1. Materials - (Polymer Coated steel pipe) - Steel pipes with polymeric coatings shall have a minimum coating thickness of 0.01 inch (0 mil) on both sides of the pipe. This pipe and its appurtenances shall conform to the requirements of AASHTO Specifications M-245 & M-246 with watertight coupling bands or flanges.

Materials - (Aluminum Coated Steel Pipe) - This pipe and its appurtenances shall conform to the requirements of AASHTO Specification M-274 with watertight coupling bands or flanges. Aluminum Coated Steel Pipe, when used with flowable fill or when soil and/or water conditions warrant the need for increased durability, shall be fully bituminous coated per requirements of AASHTO Specification M-190 Type A. Any aluminum coating damaged or otherwise removed shall be replaced with cold applied bituminous coating compound. Aluminum surfaces that are to be in contact with concrete shall be painted with one coat of zinc chromate primer or two coats of asphalt.

Materials - (Aluminum Pipe) - This pipe and its appurtenances shall conform to the requirements of AASHTO Specification M-190 or M-221 with watertight coupling bands or flanges. Aluminum Pipe, when used with flowable fill or when soil and/or water conditions warrant for increased durability, shall be fully bituminous coated per requirements of AASHTO Specification M-190 Type A. Aluminum surfaces that are to be in contact with concrete shall be painted with one coat of zinc chromate primer or two coats of asphalt. Hot dip galvanized bolts may be used for connections. The pH of the surrounding soils shall be between 4 and 9.

2. Coupling bands, anti-seep collars, end sections, etc., must be composed of the same material and coatings as the pipe. Metals must be insulated from dissimilar materials with use of rubber or plastic insulating materials at least 24 mils in thickness.

3. Connections - All connections with pipes must be completely watertight. The drain pipe or barrel connection to the riser shall be welded all around when the pipe and riser are metal. Anti-seep collars shall be connected to the pipe in such a manner as to be completely watertight. Dimple bands are not considered to be watertight.

All connections shall use a rubber or neoprene gasket when joining pipe sections. The end of each pipe shall be re-rolled an adequate number of corrugations to accommodate the bandwidth. The following pipe connections are acceptable for pipes less than 24-inches in diameter: flanges on both ends of the pipe with a circular 3/8 inch closed cell neoprene gasket, prepared to the flange bolt circle, sandwiched between adjacent flanges; a 12-inch wide standard lip type band with 12-inch wide by 3/8-inch thick closed cell circular neoprene gasket; and a 12-inch wide hugger type band with o-ring gaskets having a minimum diameter of 1/2-inch greater than the corrugation depth. Pipes 24-inches in diameter and larger shall be connected by a 24-inch long annular corrugated band using a minimum of 4 (four) rods and nuts, 2 on each connecting pipe end. A 24-inch wide by 3/8-inch thick closed cell circular neoprene gasket will be installed with 12-inches on the end of each pipe. Flanged joints with 3/8-inch closed cell gaskets the full width of the flange is also acceptable. Helically corrugated pipe shall have either continuously welded seams or have lock seams with internal caulking or a neoprene bead.

4. Bedding - The pipe shall be firmly and uniformly bedded throughout its entire length. Where rock or soft, spongy or other unstable soil is encountered, all such material shall be removed and replaced with suitable earth compacted to provide adequate support.

5. Backfilling shall conform to "Structure Backfill".

6. Other details (anti-seep collars, valves, etc.) shall be as shown on the drawings.

Reinforced Concrete Pipe - All of the following criteria shall apply for reinforced concrete pipe:

1. Materials - Reinforced concrete pipe shall have bell and spigot joints with rubber gaskets and shall equal or exceed ASTM C-301.

2. Bedding - Reinforced concrete pipe conduits shall be laid in a concrete bedding/grade for their entire length. This bedding/grade shall consist of high slump concrete placed under the pipe and up the sides of the pipe at least 2" of its outside diameter with a minimum thickness of 6 inches. Where a concrete grade is not needed for structural reasons, flowable fill may be used as described in the "Structure Backfill" section of this standard. Gravel bedding is not permitted.

3. Laying pipe - Bell and spigot pipe shall be placed with the bell end upstream. Joints shall be made in accordance with recommendations of the manufacturer of the material. After the joints are sealed for the entire line, the bedding shall be placed so that all spaces under the pipe are filled. Care shall be taken to prevent any deviation from the original line and grade of the pipe. The first joint must be located within 4 feet from the riser.

4. Backfilling shall conform to "Structure Backfill".

5. Other details (anti-seep collars, valves, etc.) shall be as shown on the drawings.

Plastic Pipe

The following criteria shall apply for plastic pipe:

1. Materials - PVC pipe shall be PVC-1220 conforming to ASTM D-1785 or ASTM D-2241. Corrugated High Density Polyethylene (HDPE) pipe, couplings and fittings shall conform to the following: 4" - 10" inch pipe shall meet the requirement of AASHTO M232 Type 5, and 12" through 24" inch shall meet the requirement of AASHTO M234 Type 5.

2. Joints and connections to anti-seep collars shall be completely watertight.

3. Bedding - The pipe shall be firmly and uniformly bedded throughout its entire length. Where rock or soft, spongy or other unstable soil is encountered, all such material shall be removed and replaced with suitable earth compacted to provide adequate support.

4. Backfilling shall conform to "Structure Backfill".

5. Other details (anti-seep collars, valves, etc.) shall be as shown on the drawings.

Drainage Diaphragms - When a drainage diaphragm is used, a registered professional engineer will supervise the design and construction inspection.

Concrete

Concrete shall meet the requirements of Maryland Department of Transportation, State Highway Administration Standard Specifications for Construction and Materials, Section 414, Mix No. 3.

Rock Riprap

Rock riprap shall meet the requirements of Maryland Department of Transportation, State Highway Administration Standard Specifications for Construction and Materials, Section 311.

Geotextile shall be placed under all riprap and shall meet the requirements of Maryland Department of Transportation, State Highway Administration Standard Specifications for Construction and Materials, Section 921.05, Class C.

Care of Water during Construction

All work on permanent structures shall be carried out in areas free from water. The Contractor shall construct and maintain all temporary dikes, levees, cofferdams, drainage channels, and stream diversions necessary to protect the areas to be occupied by the permanent works. The contractor shall furnish, install, operate, and maintain all necessary pumping and other equipment required for removal of water from various parts of the work and for maintaining the excavations, foundation and other parts of the work free from water as required or directed by the engineer for constructing each part of the work. After having served their purpose, all temporary protective works shall be removed or leveled and graded to the extent required to prevent obstruction in any degree whatsoever of the flow of water to the spillway or outlet works and so as not to interfere in any way with the operation or maintenance of the structure. Stream diversions shall be maintained until the full flow can be passed through the permanent works. The removal of water from the required excavation and the foundation shall be accomplished in a manner and to the extent that will maintain stability of the excavated slopes and bottom required excavations and will allow satisfactory performance of all construction operations. During the placing and compacting of material in required excavations, the water level at the locations being refilled shall be maintained below the bottom of the excavation at all locations which may require draining the water sumps from which the water shall be pumped.

Stabilization

All borrow areas shall be graded to provide proper drainage and left in a slightly condition. All exposed surfaces of the embankment, spillway, pool and borrow areas, and berms shall be stabilized by seeding, liming, fertilizing and mulching in accordance with the Natural Resources Conservation Service Standards and Specifications for Critical Area Planting MD-342D or as shown on the accompanying drawings.

Erosion and Sediment Control

Construction operations will be carried out in such a manner that erosion will be controlled and water and air pollution minimized. State and local laws concerning pollution abatement will be followed. Construction plans shall detail erosion and sediment control measures.

OPERATION AND MAINTENANCE

An operation and maintenance plan in accordance with Local or State Regulations will be prepared for all ponds. As a minimum, the dam inspection checklist located in Appendix A shall be included as part of the operation and maintenance plan and performed at least annually. Written records of maintenance and major repairs needs to be retained in a file. The issuance of a Maintenance and Repair Permit for any repairs or original design that involves the modification of the dam or spillway from its original design and specifications is required. A permit is also required for any repairs or reconstruction that involve a substantial portion of the structure. All indicated repairs are to be made as soon as practical.


BORING B-1			
ELEVATION	DESCRIPTION OF MATERIALS	DEPTH SURFACE	REMARKS
364.5	TOPSOIL	5'	BAG SAMPLE: 10 - 50 FT. WATER NOT ENCOUNTERED WHILE DRILLING
349.5	BROWN TO RED-BROWN MOIST, LOOSE TO MEDIUM DENSE, MICACEOUS, MEDIUM TO FINE SAND AND SILT. (S9) AASHTO A-4	15.0'	WATER LEVEL AT COMPLETION DRY WATER LEVEL AFTER 24 HRS: 9.9' HOLE CAVED AT COMPLETION 13.5' HOLE CAVED AFTER 24 HRS: 12.5'
360.0	BOTTOM OF HOLE AT 15'-0"		
BORING B-2			
ELEVATION	DESCRIPTION OF MATERIALS	DEPTH SURFACE	REMARKS
366.0	TOPSOIL	12"	12" TOPSOIL
351.0	BROWN, MOIST, MICACEOUS, LOOSE TO MEDIUM DENSE, MEDIUM TO FINE SAND AND SILT. (S9) AASHTO A-4	15.0'	WATER LEVEL AT COMPLETION 5.2' WATER LEVEL AFTER 24 HRS: 6.9' HOLE CAVED AT COMPLETION 5.9' HOLE CAVED AFTER 24 HRS: 9.3'
351.0	BOTTOM OF HOLE AT 15.0'		
BORING B-3			
ELEVATION	DESCRIPTION OF MATERIALS	DEPTH SURFACE	REMARKS
362.2	TOPSOIL	4"	4" TOPSOIL
359.7	BROWN TO GRAY-BROWN MOIST, VERY LOOSE, MICACEOUS SAND AND SILT. (S9) AASHTO A-4	2.5'	WATER ENCOUNTERED AT 6.5'
356.7	BROWN, MOIST, VERY LOOSE, CLAYEY SILT AND FINE SAND. (S9) AASHTO A-4	5.5'	WATER LEVEL AT COMPLETION 6.0' WATER LEVEL AFTER 24 HRS: 4.2' HOLE CAVED AT COMPLETION 10.0' HOLE CAVED AFTER 24 HRS: 6.0'
347.2	BOTTOM OF HOLE AT 15.0'		

DESIGN SUMMARY (S.W.M. NO. 1)					
DESIGN STORM	ALLOWABLE RELEASE RATE	FACILITY INFLOW	FACILITY DISCHARGE	WATER SURFACE ELEVATION	STORAGE VOLUME (ACFT)
2 YEAR	1.0 cfs	29.0	1.0	367.39	0.9871
10 YEAR	10.0 cfs	63.1	8.9	368.65	1.7645
100 YEAR	N/A	103.0	47.8	369.85	2.5556

STRUCTURE CLASSIFICATION, LOW HAZARD, CLASS 'A' POND
STORAGE - HEIGHT PRODUCT 1.75 Ac. ft. x 19' = 26.3
WATERSHED AREA TO FACILITY (ACRES): ULTIMATE 15.01 ACRES
LEVEL OF MANAGEMENT PROVIDED BY FACILITY: TWO AND TEN YEAR STORMS

DESIGN SUMMARY (S.W.M. NO. 2)					
DESIGN STORM	ALLOWABLE RELEASE RATE	FACILITY INFLOW	FACILITY DISCHARGE	WATER SURFACE ELEVATION	STORAGE VOLUME (ACFT)
2 YEAR	1.0 cfs	10.7	0.6	368.47	0.3196
10 YEAR	7.7 cfs	26.4	7.3	369.73	0.5982
100 YEAR	N/A	51.4	26.8	370.71	1.3056

STRUCTURE CLASSIFICATION, LOW HAZARD, CLASS 'A' POND
STORAGE - HEIGHT PRODUCT 0.59 Ac. ft. x 12' = 7.1
WATERSHED AREA TO FACILITY (ACRES): ULTIMATE 6.06 ACRES
LEVEL OF MANAGEMENT PROVIDED BY FACILITY: TWO AND TEN YEAR STORMS

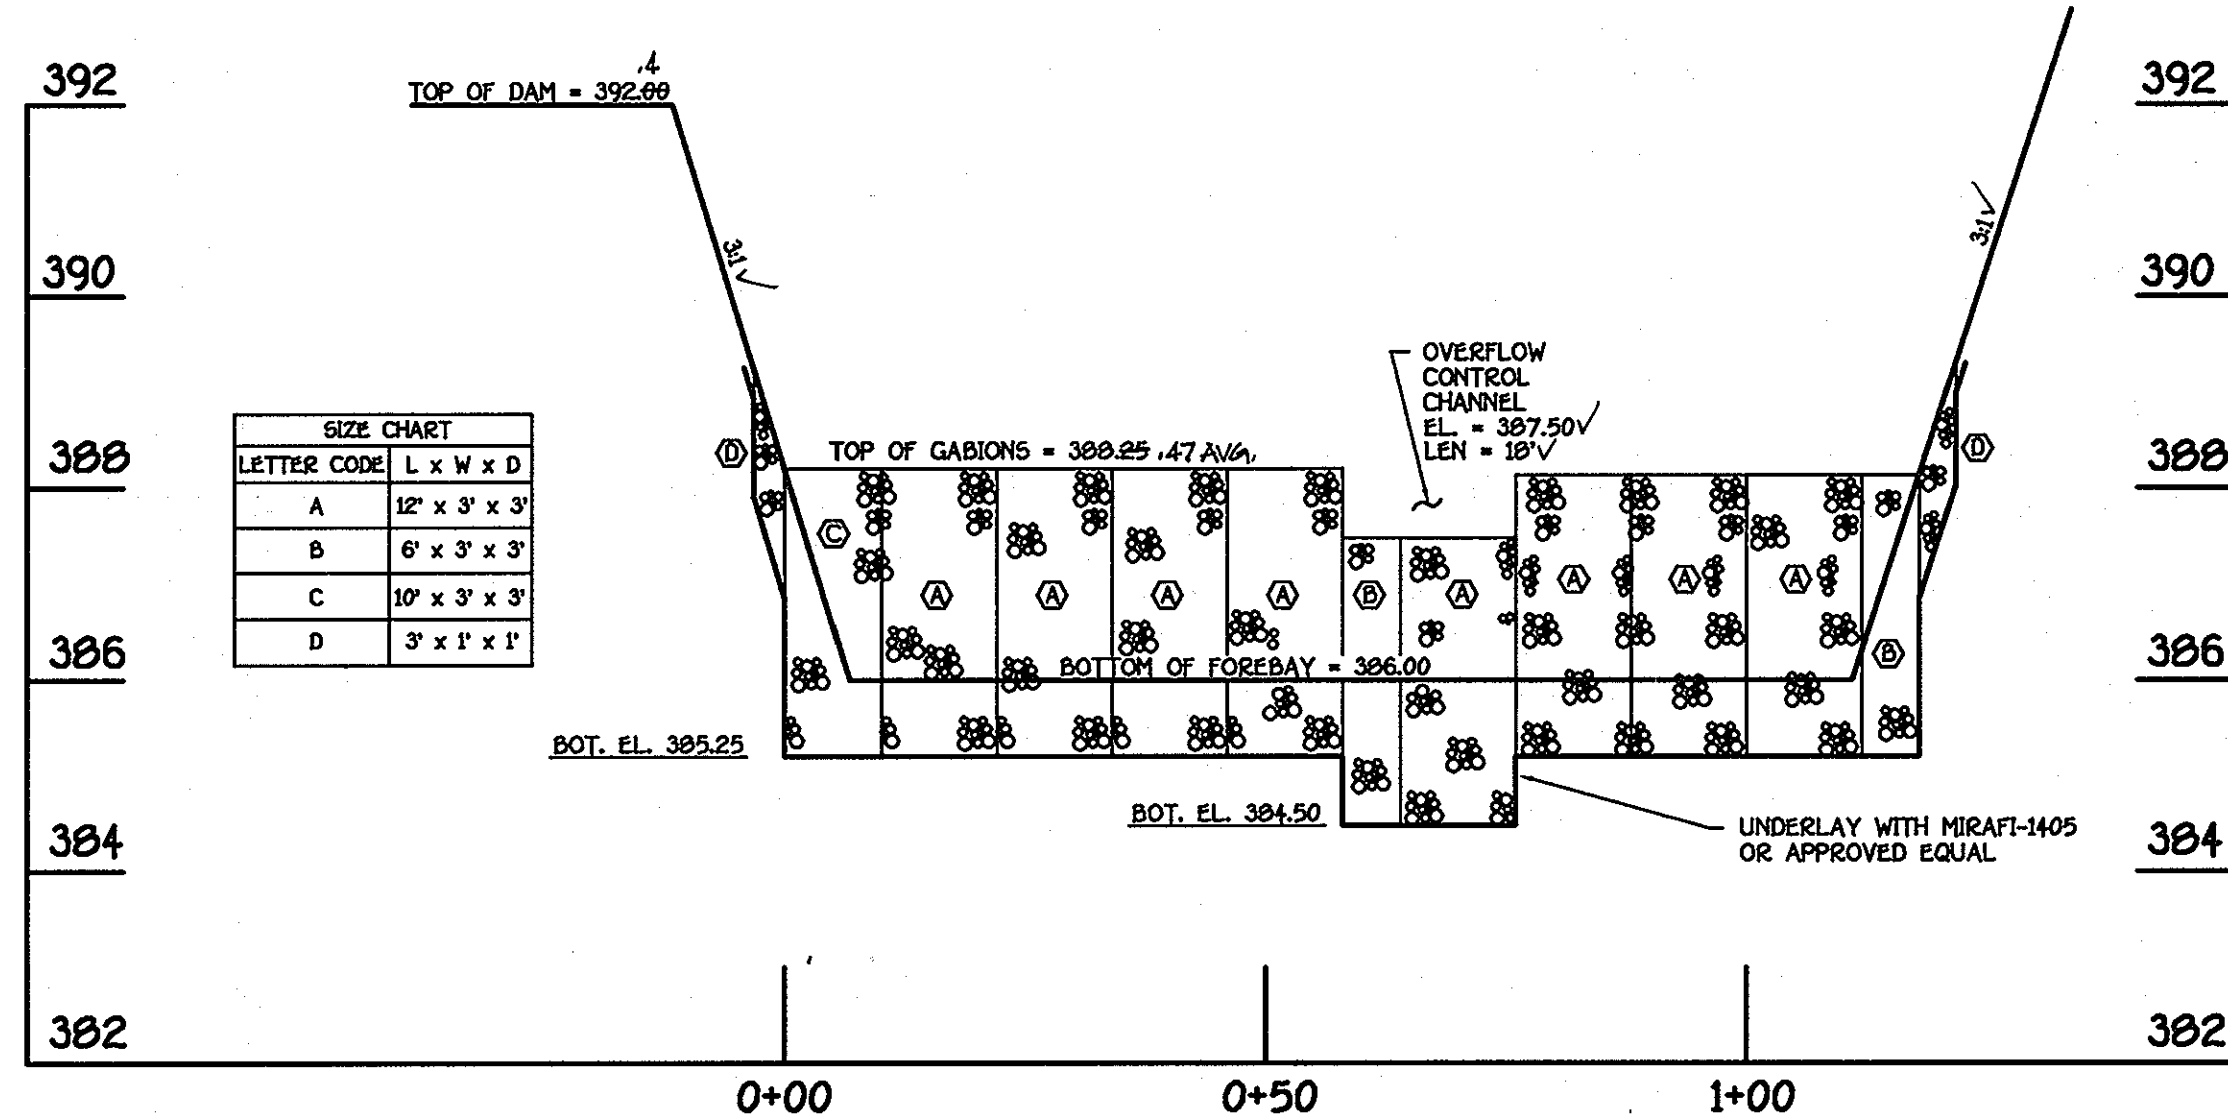

S.W.M. FACILITY NO. 1 (GABION FOREBAY PROFILE)

SCALE: HORIZ. 1" = 20'
VERT. 1" = 2'

BORING B-4			
ELEVATION	DESCRIPTION OF MATERIALS	DEPTH SURFACE	REMARKS
40.9	TOPSOIL	5'	BAG SAMPLE: 10 - 50 FT. WATER NOT ENCOUNTERED WHILE DRILLING
396.9	BROWN, MOIST, LOOSE, MICACEOUS SILT AND FINE SAND. (S9) AASHTO A-4	5.0'	WATER LEVEL AT COMPLETION DRY WATER LEVEL AFTER 24 HRS: 9.9' HOLE CAVED AT COMPLETION 12.9' HOLE CAVED AFTER 24 HRS: 12.0'
386.9	BOTTOM OF HOLE AT 15.0'		
BORING B-5			
ELEVATION	DESCRIPTION OF MATERIALS	DEPTH SURFACE	REMARKS
387.3	TOPSOIL	3"	3" TOPSOIL
380.3	BROWN TO GRAY, DRY TO MOIST, LOOSE, MICACEOUS SILT AND FINE SAND. (S1) AASHTO A-4	7.0'	WATER ENCOUNTERED AT 12.0' WATER LEVEL AT COMPLETION 9.9' WATER LEVEL AFTER 24 HRS: 9.9' HOLE CAVED AT COMPLETION 12.6' HOLE CAVED AFTER 24 HRS: 12.6'
372.3	BOTTOM OF HOLE AT 15.0'		
BORING B-6			
ELEVATION	DESCRIPTION OF MATERIALS	DEPTH SURFACE	REMARKS
395.4	TOPSOIL	2"	2" TOPSOIL
388.4	BROWN TO GRAY, DRY TO MOIST, VERY LOOSE, MICACEOUS SILT AND FINE SAND. (S1) AASHTO A-4	7.0'	WATER NOT ENCOUNTERED WHILE DRILLING WATER LEVEL AT COMPLETION DRY WATER LEVEL AFTER 24 HRS: 7.0' HOLE CAVED AT COMPLETION 12.2' HOLE CAVED AFTER 24 HRS: 12.5'
380.4	BOTTOM OF HOLE AT 15.0'		
BORING B-7			
ELEVATION	DESCRIPTION OF MATERIALS	DEPTH SURFACE	REMARKS
404.9	TOPSOIL	4"	4" TOPSOIL
402.4	BROWN, MOIST, MEDIUM DENSE, MEDIUM TO FINE SAND AND CLAYEY SILT. (S9) AASHTO A-4	2.5'	BAG SAMPLE: 10 - 50 FT. WATER ENCOUNTERED AT 15.0' WATER LEVEL AT COMPLETION 8.9' WATER LEVEL AFTER 24 HRS: 7.0' HOLE CAVED AT COMPLETION 11.9' HOLE CAVED AFTER 24 HRS: 9.4'
389.9	BOTTOM OF HOLE AT 15.0'		



AS-BUILT 5/21/08

I hereby certify that the Facility Shown On This Plan Was Constructed As Shown On The "As-Built" Plans And Meets The Approved Plans And Specifications.

Signature: *Thomas K. Bourke*
Date: 1/31/08
P.E. No. 589108

Embankment and Cut-off Trench Construction

THE AREA OF THE PROPOSED SWM POND SHOULD BE STRIPPED OF TOPSOIL AND ANY OTHER UNSUITABLE MATERIALS FROM THE EMBANKMENT OR STRUCTURE AREA IN ACCORDANCE WITH SOIL CONSERVATION GUIDELINES. AFTER STRIPPING OPERATIONS HAVE BEEN COMPLETED, THE EXPOSED SUBGRADE MATERIALS SHOULD BE PROTECTED WITH A LOADED DUMP TRUCK OR SIMILAR EQUIPMENT IN THE PRESENCE OF A GEOTECHNICAL ENGINEER OR HIS REPRESENTATIVE UTILIZING A DYNAMIC CONE PENETROMETER. ANY EXCESSIVELY SOFT OR LOOSE MATERIALS IDENTIFIED BY PROFFULLING OR PENETROMETER TESTING SHOULD BE EXCAVATED TO SUITABLE FIRM SOIL, AND THEN GRADES RE-ESTABLISHED BY BACKFILLING WITH SUITABLE SOIL. A REPRESENTATIVE OF THE GEOTECHNICAL ENGINEER SHOULD BE PRESENT TO MONITOR PLACEMENT AND COMPACTION OF FILL FOR THE EMBANKMENT AND CUT-OFF TRENCH. IN ACCORDANCE WITH MARYLAND SOIL CONSERVATION SPECIFICATION 37B SOILS CONSIDERED SUITABLE FOR THE CENTER OF EMBANKMENT AND CUT-OFF TRENCH SHALL CONFORM TO UNIFIED SOIL CLASSIFICATION GC, SC, CH OR CL. IT IS OUR PROFESSIONAL OPINION THAT IN ADDITION TO THE SOIL MATERIALS DESCRIBED ABOVE A FINE GRAINED SOIL, INCLUDING SILT (ML) WITH A PLASTICITY INDEX OF 10 OR MORE CAN BE UTILIZED FOR THE CENTER OF THE EMBANKMENT AND CORE TRENCH. BASED ON OUR VISUAL CLASSIFICATIONS IT APPEARS THAT SOME OF THE ON-SITE SOILS, ESPECIALLY THE NEAR SURFACE SOILS, WILL BE SUITABLE FOR USE AS CORE TRENCH MATERIAL. IT IS RECOMMENDED THAT ADDITIONAL EXPLORATION AND LABORATORY TESTING BE PERFORMED PRIOR TO POND CONSTRUCTION TO IDENTIFY AND QUANTIFY POTENTIAL BORROW AREAS FOR CORE TRENCH MATERIAL. ALL FILL MATERIALS MUST BE PLACED AND COMPACTED WITH MD SCS 37B SPECIFICATIONS.

S.W.M. NOTES AND DETAILS
CHERRYTREE PARK
LOTS 1 THRU 10, OPEN SPACE LOTS 11 THRU 13
AND BULK PARCELS 'A' THRU 'H'
(PHASES I AND II)


OWNER/DEVELOPER
CHERRYTREE I, L.L.C.
7520 INDIAN PIPE COURT
COLUMBIA, MARYLAND 21046

TAX MAP NO. 46 PARCEL NO. 156 GRID NO. 4
SIXTH ELECTION DISTRICT HOWARD COUNTY, MARYLAND
DATE: DECEMBER 2001
SHEET 14 OF 21


AS BUILT F01-114




9-77-01

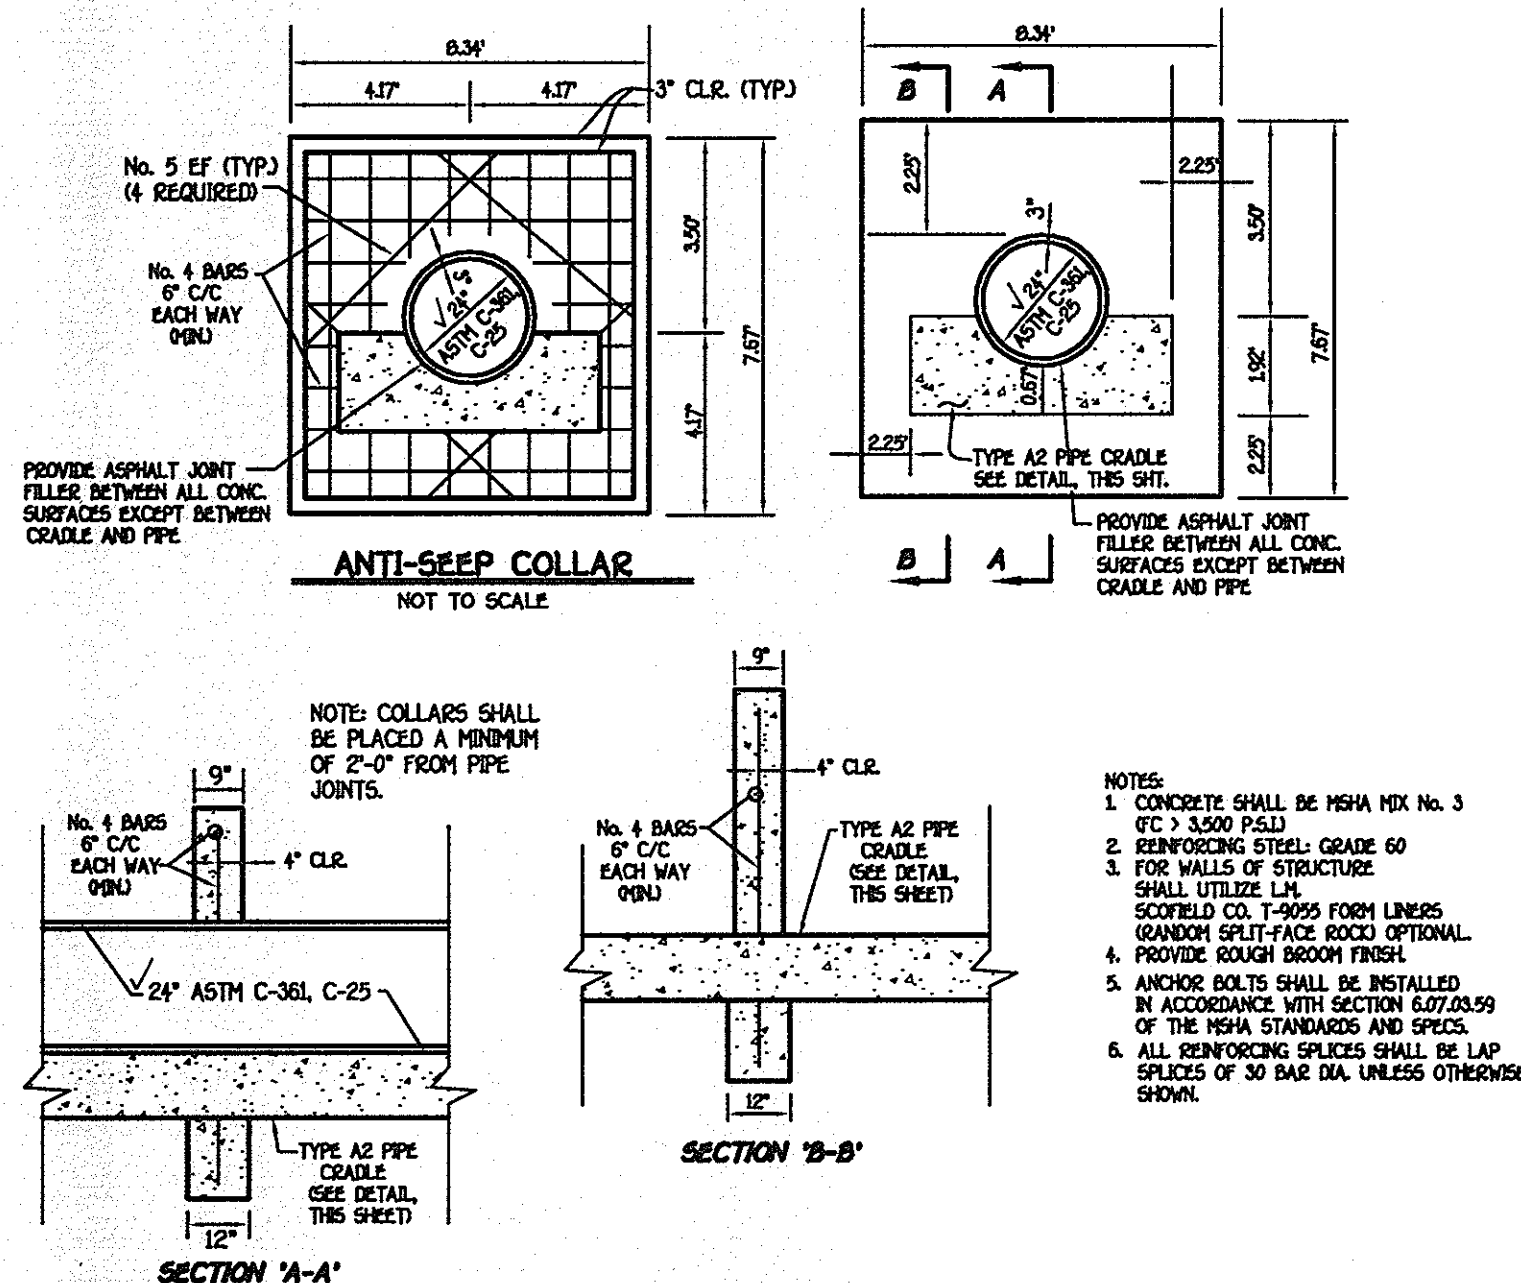



TYPICAL SECTION THROUGH BARREL, CRADLE AND ANTI-SEEP COLLAR
NO SCALE

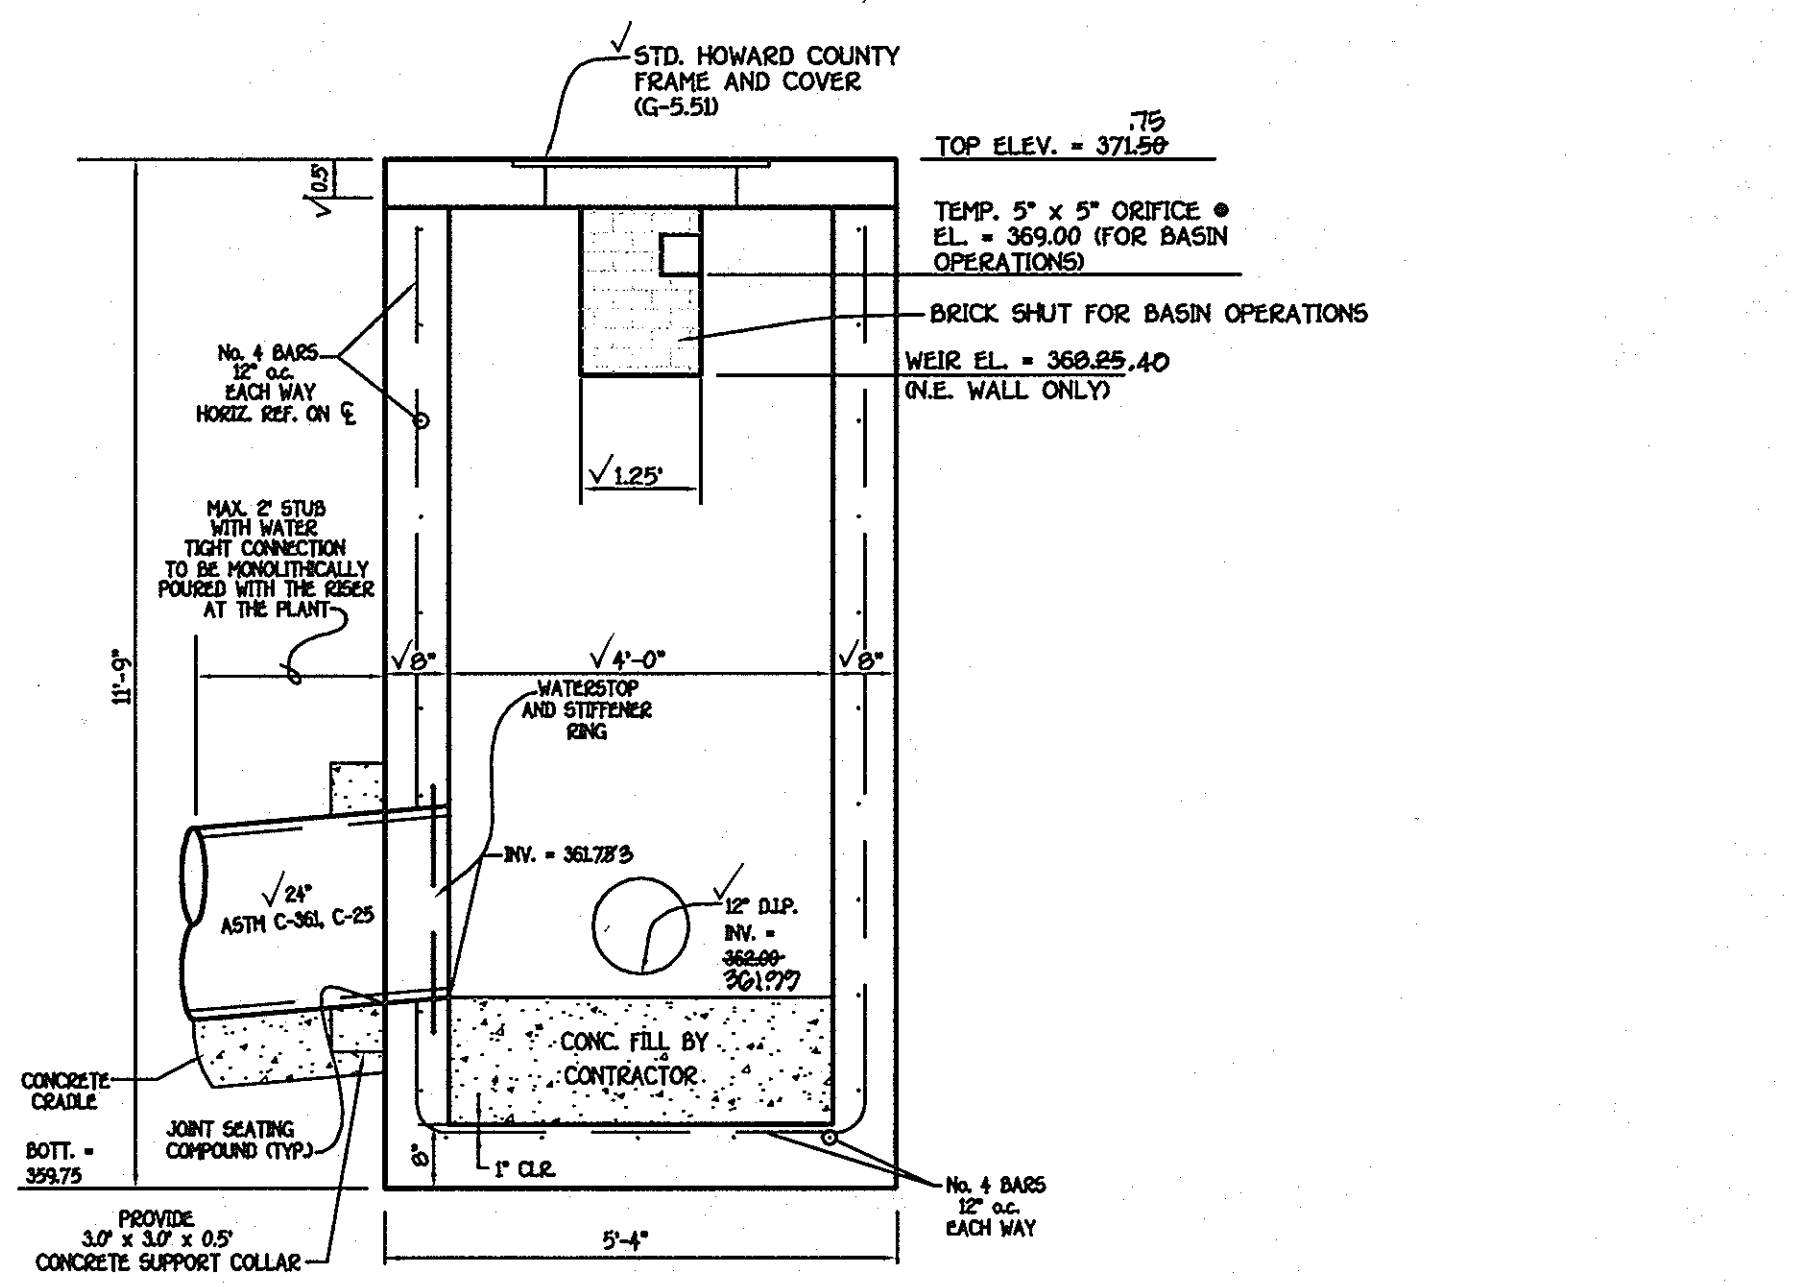



PROFILE VIEW A CONCRETE RISER DETAIL
SCALE: 1" = 2"

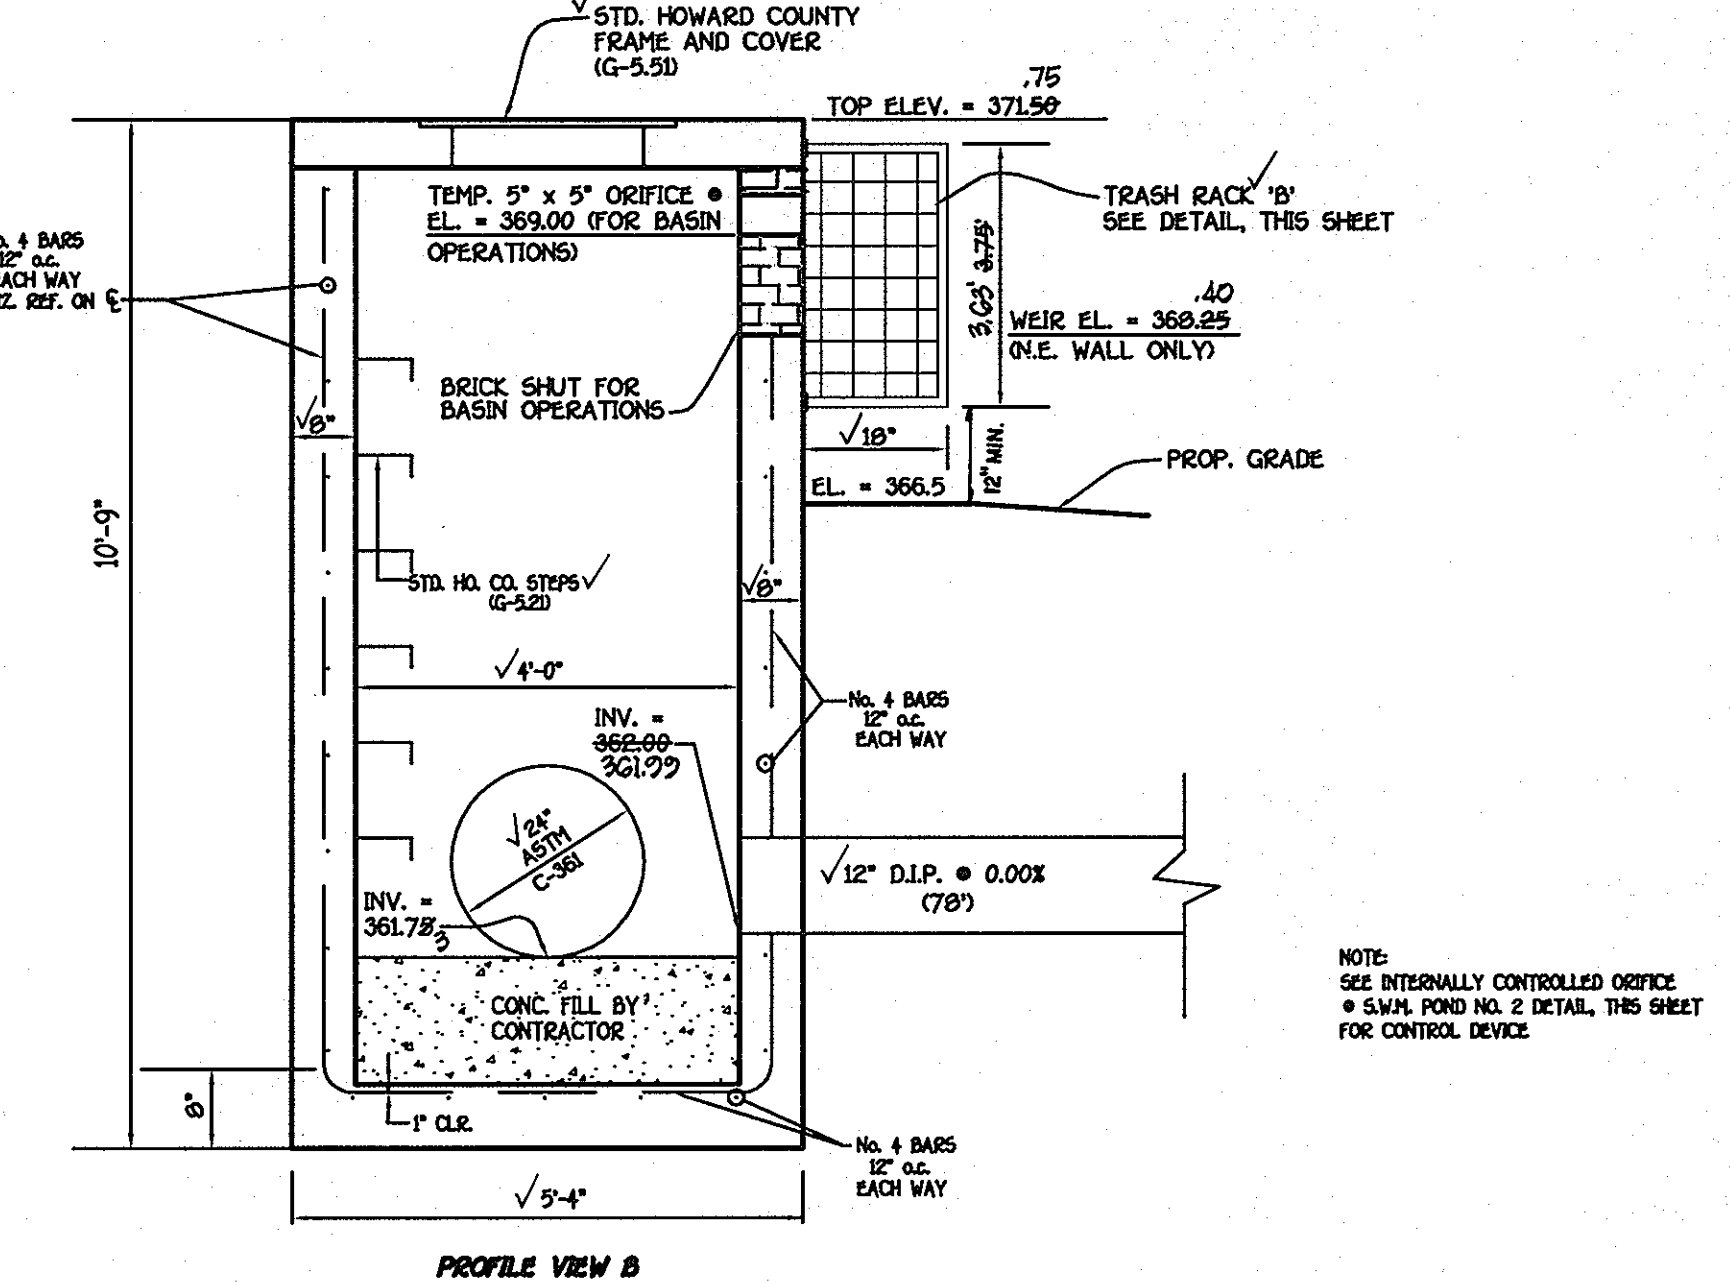


PROFILE VIEW B CONCRETE RISER DETAIL
SCALE: 1" = 2"

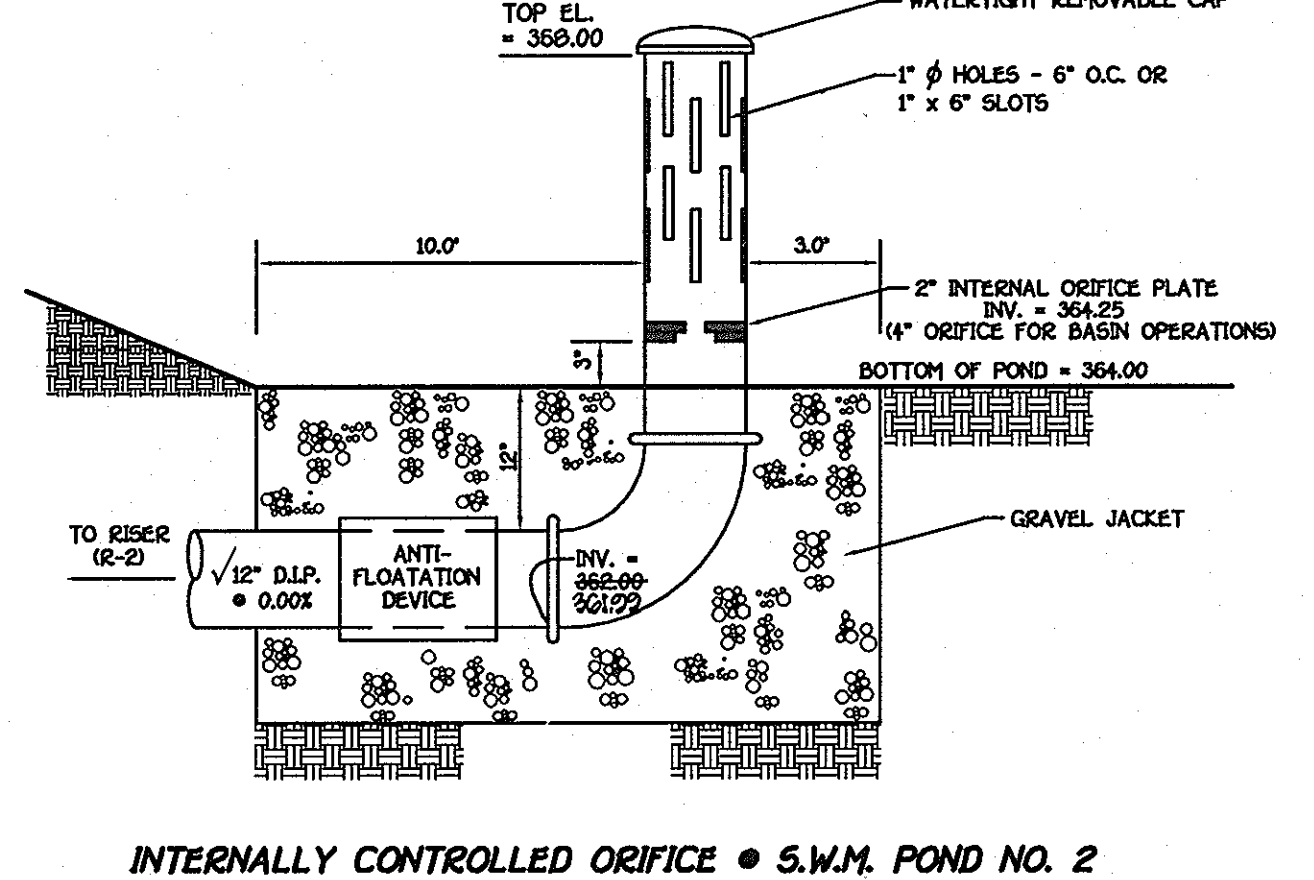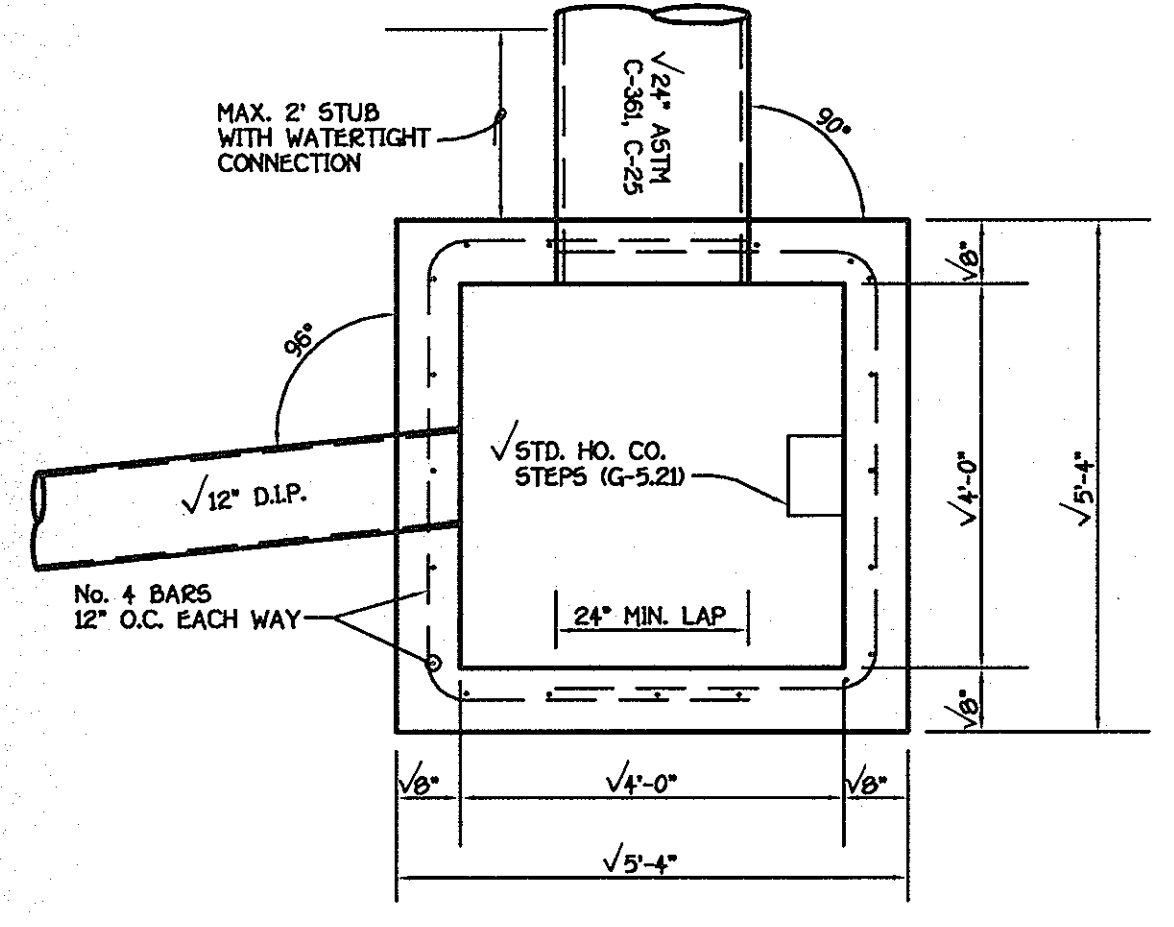

INTERNALLY CONTROLLED ORIFICE • S.W.M. POND NO. 2
NO SCALE

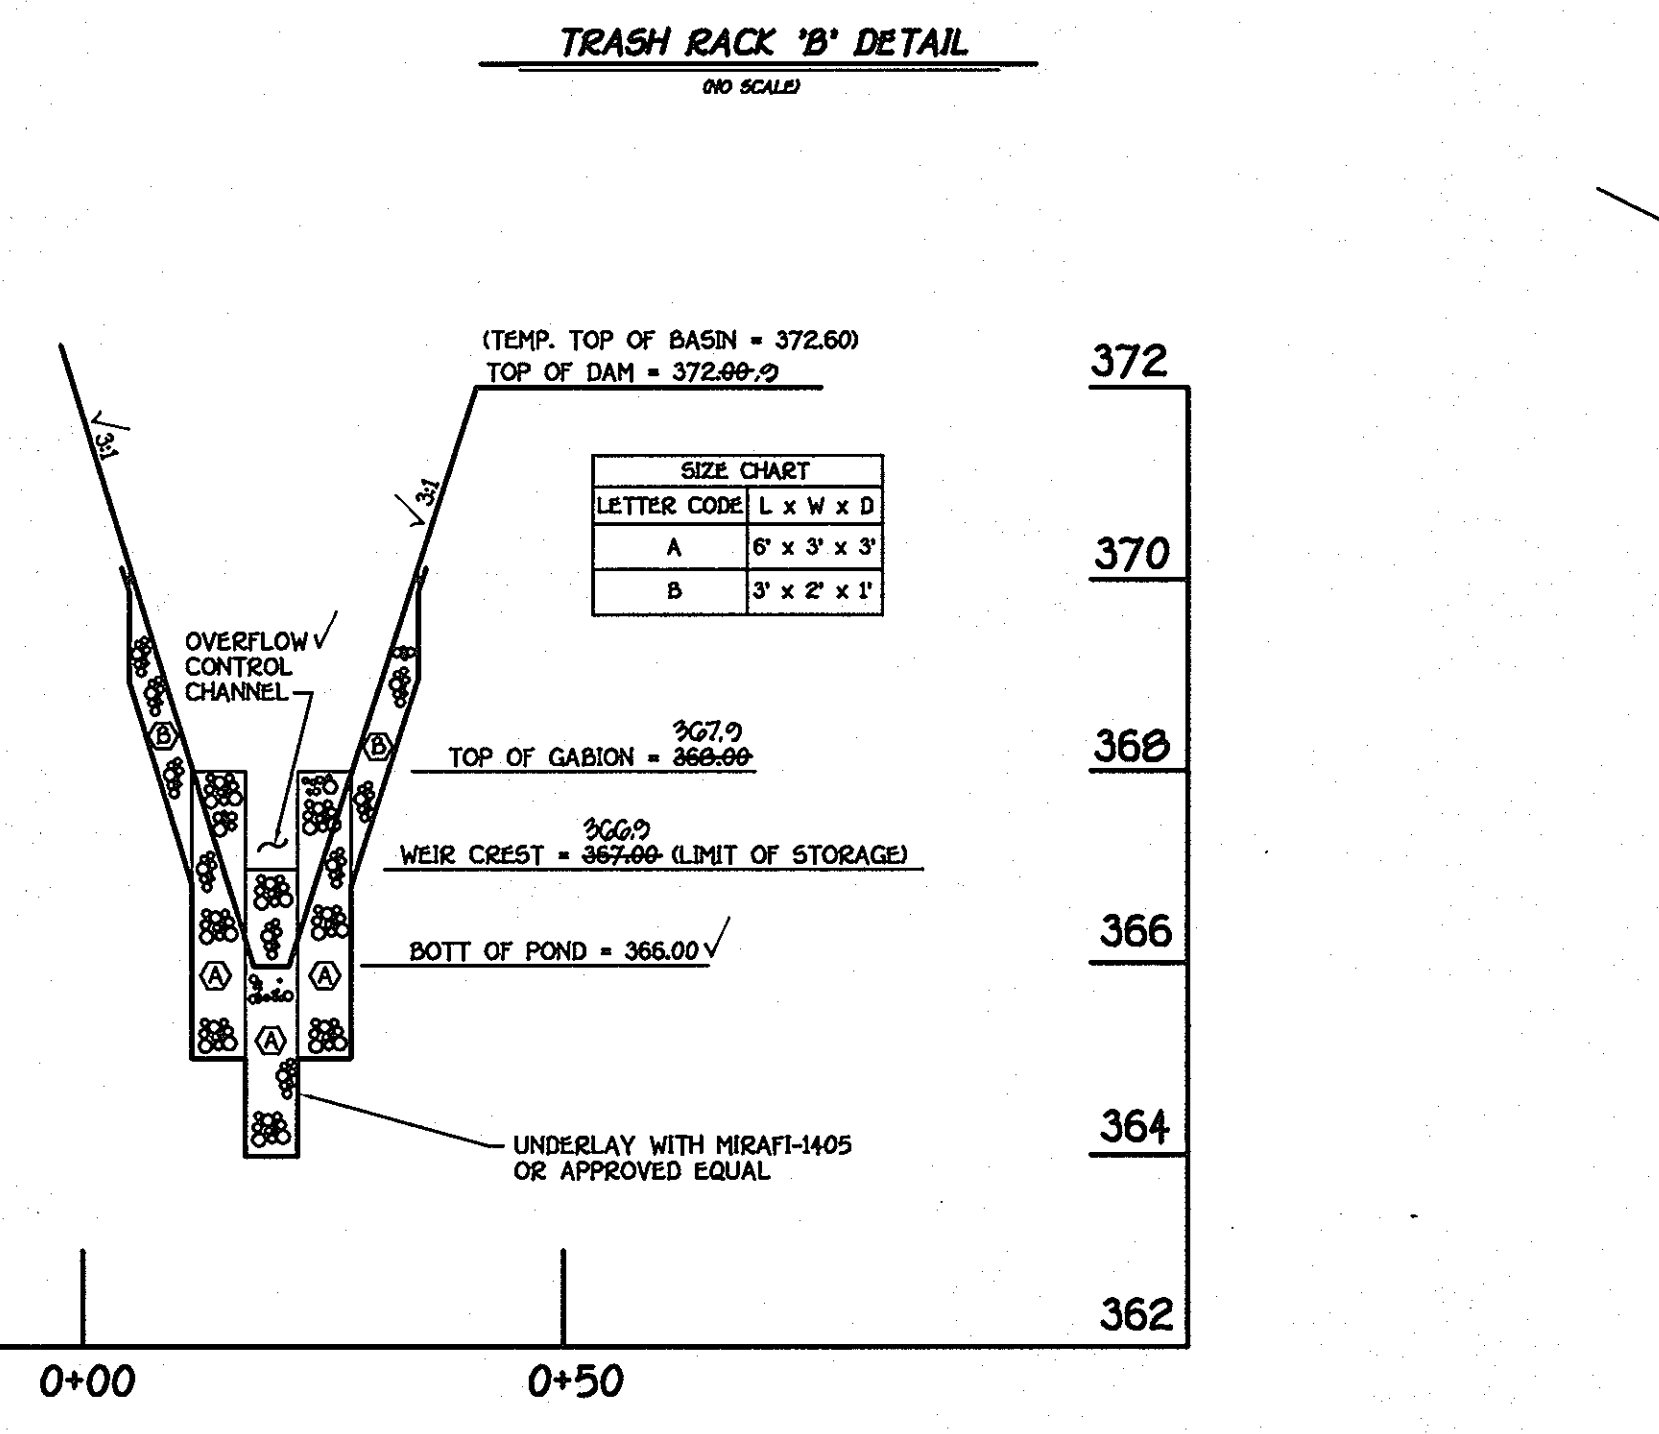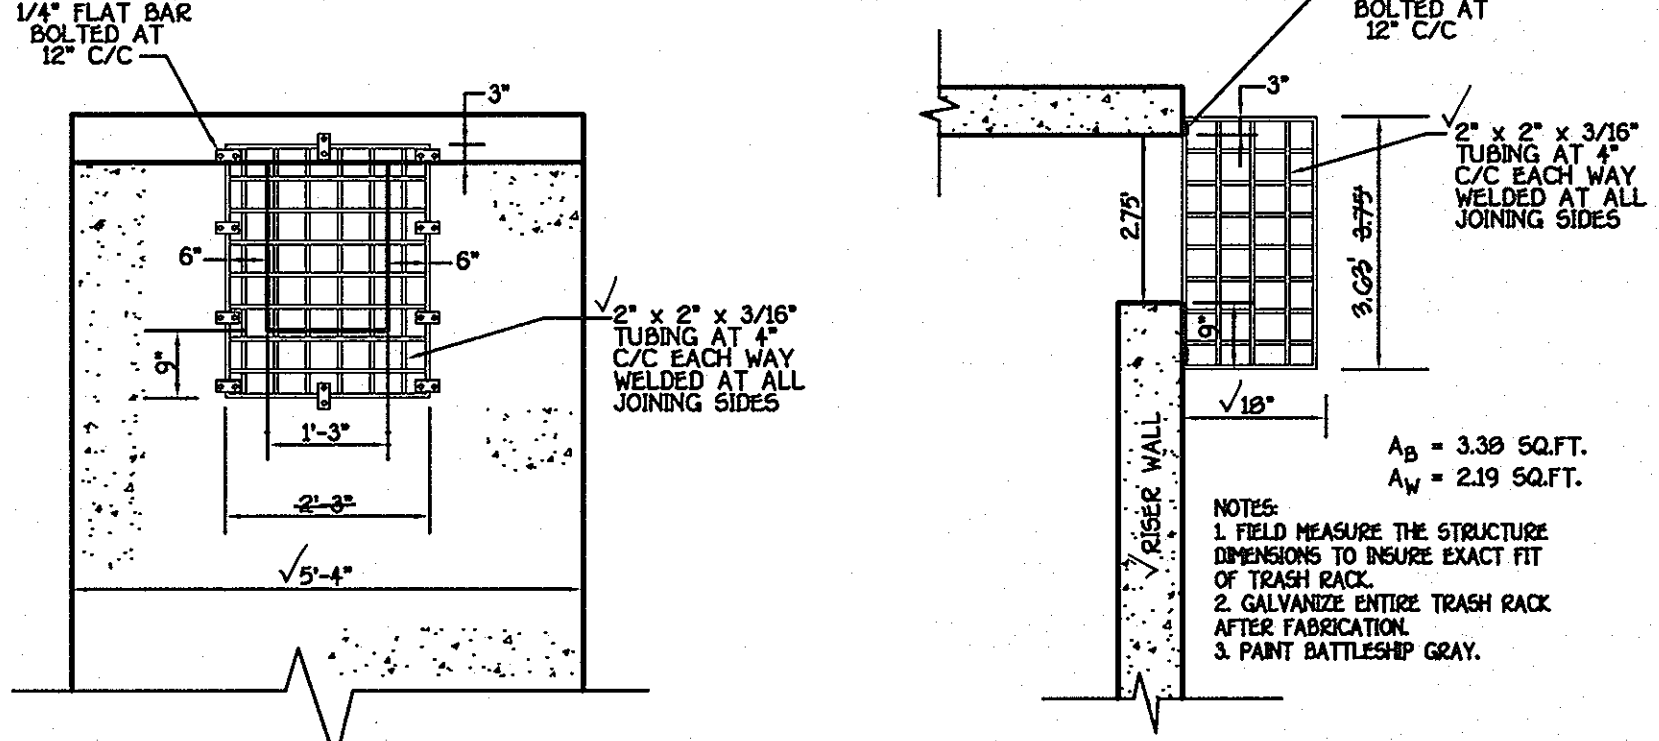

S.W.M. FACILITY NO. 2 (GABION FOREBAY PROFILE)
SCALE: HORIZ. 1" = 20'
VERT. 1" = 2"

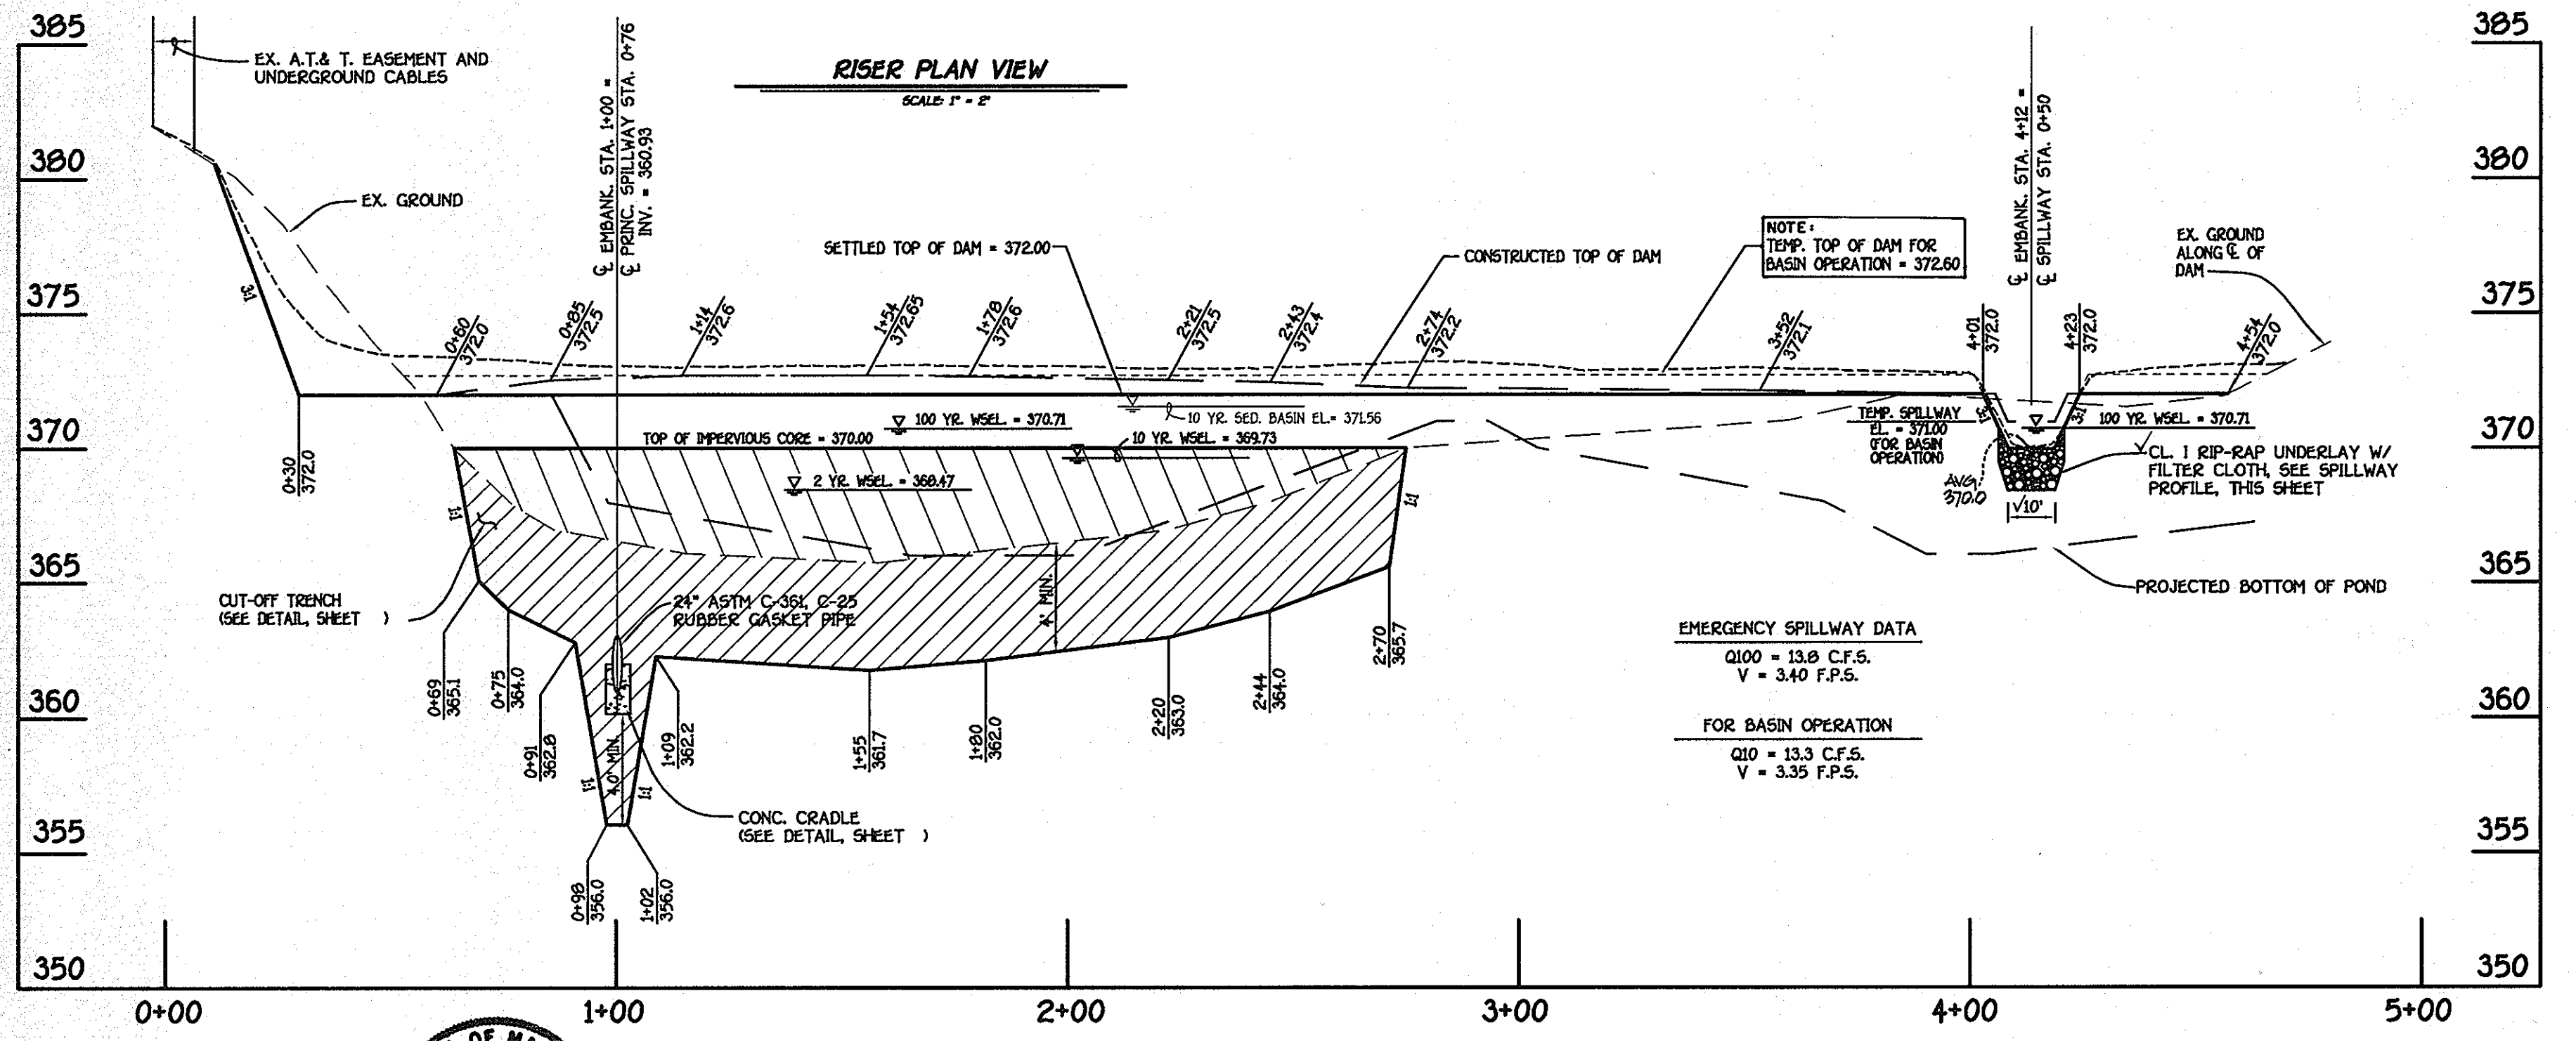

S.W.M. FACILITY NO. 2 PROFILE ALONG EMBANKMENT
SCALE: HORIZ. 1" = 30'
VERT. 1" = 5'

By The Developer:
I/We Certify That All Development And/Or Construction Will Be Done According To These Plans, And That Any Responsible Personnel Involved In The Construction Project Will Have A Certificate Of Attendance At A Department Of The Environment Approved Training Program For The Control Of Sediment And Erosion Before Beginning The Project. I Shall Engage A Registered Professional Engineer To Supervise Pond Construction And Provide The Howard Soil Conservation District With An "As-Built" Plan Of The Pond Within 30 Days Of Completion. I Also Authorize Periodic On-Site Inspections By The Howard Soil Conservation District.

Signature of Developer: *Thomas E. Bourke* VP
Date: 12/11/01

Printed Name of Developer: **THOMAS E. BOURKE VP**

By The Engineer:
I Certify That This Plan For Pond Construction, Erosion And Sediment Control Represents A Practical And Workable Plan Based On My Knowledge Of The Site Conditions. This Plan Was Prepared In Accordance With The Howard Soil Conservation District. I Have Notified The Developer That I Am A Registered Professional Engineer To Supervise Pond Construction And Provide The Howard Soil Conservation District With An "As-Built" Plan Of The Pond Within 30 Days Of Completion.

Signature of Engineer: *Alfred M. Vitucci*
Date: 9-27-01

Printed Name of Engineer: **ALFRED M. VITUCCI**

These Plans Have Been Reviewed For The Howard Soil Conservation District And Meet The Technical Requirements For Small Pond Construction Soil Erosion And Sediment Control.

USDA-Natural Resources Conservation Service
Signature: *Jim Reynolds*
Date: 1/24/02

These Plans For Small Pond Construction Soil Erosion And Sediment Control Meet The Requirements Of The Howard Soil Conservation District.

Signature: *John S. ...*
Date: 1/24/02

Howard Soil Conservation District
Approved Department of Public Works
Signature: *Robert W. ...*
Date: 1-10-02

Chief, Bureau Of Highways

Approved Department of Planning And Zoning
Signature: *Andy ...*
Date: 2/4/02

Chief, Division Of Land Development


Signature: *Michael ...*
Date: 2/4/02

Chief, Development Engineering Division

AS-BUILT CERTIFICATION
I Herby Certify That The Facility Shown On This Plan Was Constructed As Shown On The "As-Built" Plans And Meets The Approved Plans And Specifications.

Signature: *...*
Date: 12/04/02
P.E. No. 578108

NOTE: Certify Means To State Or Declare A Professional Opinion Based Upon On-site Inspections And Material Tests Which Are Conducted During Construction. The On-site Inspections And Material Tests Are Those Inspections And Tests Deemed Sufficient And Appropriate Commonly Accepted Engineering Standards. Certify Does Not Mean Or Imply A Guarantee By The Engineer Nor Does An Engineer's Certification Relieve Any Other Party From Meeting Requirements Imposed By Contract, Employment, Or Other Means, Including Meeting Commonly Accepted Industry Practices.

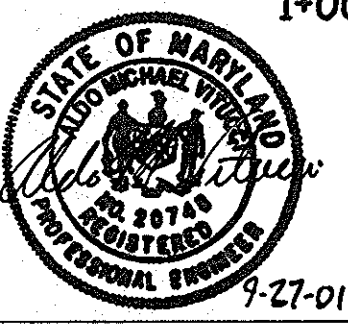

FOREST CONSERVATION NOTES:

1. FOREST CONSERVATION REQUIREMENTS PER SECTION 16.1202 OF THE HOWARD COUNTY CODE AND THE FOREST CONSERVATION MANUAL FOR THIS PROJECT HAS BEEN FULFILLED BY THE RETENTION OF EXISTING FOREST IN THE AMOUNT OF 4.62 ACRES. THE REMAINING OBLIGATION OF 5.56 ACRES OF REFORESTATION REQUIREMENT WILL BE PROVIDED BY 5.89 ACRES OF REFORESTATION IN THE ASHLEIGH KNOLLS SUBDIVISION. SEE SHEETS 20 AND 21 FOR PLAN AND DETAILS.
2. THE FOREST CONSERVATION EASEMENT HAS BEEN ESTABLISHED TO FULFILL THE REQUIREMENTS OF SECTION 16.1202 OF THE HOWARD COUNTY CODE, FOREST CONSERVATION ACT. NO CLEARING, GRADING OR CONSTRUCTION IS PERMITTED WITHIN THE FOREST CONSERVATION EASEMENT; HOWEVER, FOREST MANAGEMENT PRACTICES AS DEFINED IN THE DEED OF FOREST CONSERVATION EASEMENT ARE ALLOWED.

APPROVED: DEPARTMENT OF PUBLIC WORKS
[Signature] 1-16-02
 CHIEF, BUREAU OF HIGHWAYS DATE

APPROVED: DEPARTMENT OF PLANNING AND ZONING
[Signature] 2/4/02
 CHIEF, DIVISION OF LAND DEVELOPMENT DATE

[Signature] 2/4/02
 CHIEF, DEVELOPMENT ENGINEERING DIVISION DATE

**FOREST CONSERVATION WORKSHEET
 VERSION 1.0**

NET TRACT AREA:

A. TOTAL TRACT AREA.....	41.10
B. AREA WITHIN 100 YEAR FLOODPLAIN.....	2.0
C. AREA TO REMAIN IN AGRICULTURAL PRODUCTION.....	0.0
D. NET TRACT AREA.....	41.10

LAND USE CATEGORY: (from table 3.2.1, page 40, manual)

INPUT THE NUMBER "1" UNDER THE APPROPRIATE LAND USE ZONING, AND LIMIT TO ONLY ONE ENTRY.

ARA	MDR	IDA	ARA	MPD	CIA
0	0	0	0	1	0

E. AFFORESTATION THRESHOLD..... 15% x D = 6.17

F. CONSERVATION THRESHOLD..... 15% x D = 6.17

EXISTING FOREST COVER:

G. EXISTING FOREST COVER (EXCLUDING FLOODPLAIN).....	16.03
H. AREA OF FOREST ABOVE AFFORESTATION THRESHOLD.....	9.87
I. AREA OF FOREST ABOVE CONSERVATION THRESHOLD.....	

BREAK EVEN POINT:


J. FOREST RETENTION ABOVE THRESHOLD WITH NO MITIGATION.....	8.14
K. CLEARING PERMITTED WITHOUT MITIGATION.....	7.89

PROPOSED FOREST CLEARING:

L. TOTAL AREA OF FOREST TO BE CLEARED.....	11.41
M. TOTAL AREA OF FOREST TO BE RETAINED.....	4.62


PLANTING REQUIREMENTS:

N. REFORESTATION FOR CLEARING ABOVE CONSERVATION THRESHOLD.....	2.47
P. REFORESTATION FOR CLEARING BELOW CONSERVATION THRESHOLD.....	3.09
Q. CREDIT FOR RETENTION ABOVE CONSERVATION THRESHOLD.....	0.0
R. TOTAL REFORESTATION REQUIRED.....	5.56
S. TOTAL AFFORESTATION REQUIRED.....	0.0
T. TOTAL REFORESTATION AND AFFORESTATION REQUIRED.....	5.56

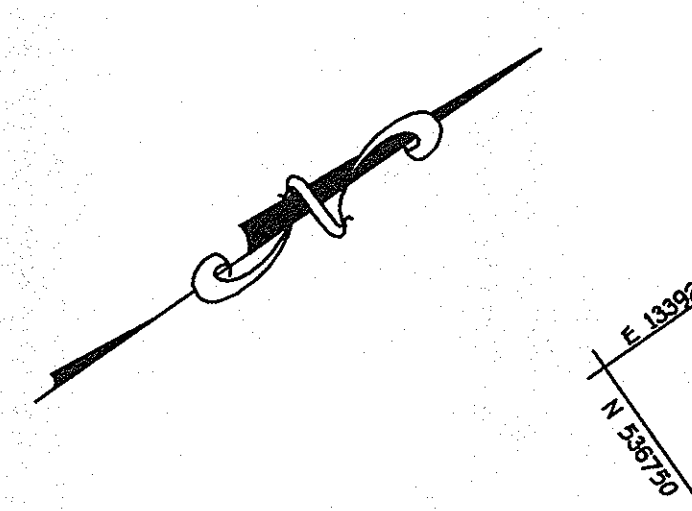

E 1349220
 N 348720

CHERRYTREE PARK
 SECTION 1 AREA 2
 LOTS 11 - 203
 PLAT No. 7841
 OPEN SPACE
 LOT 125
 ZONED R-20

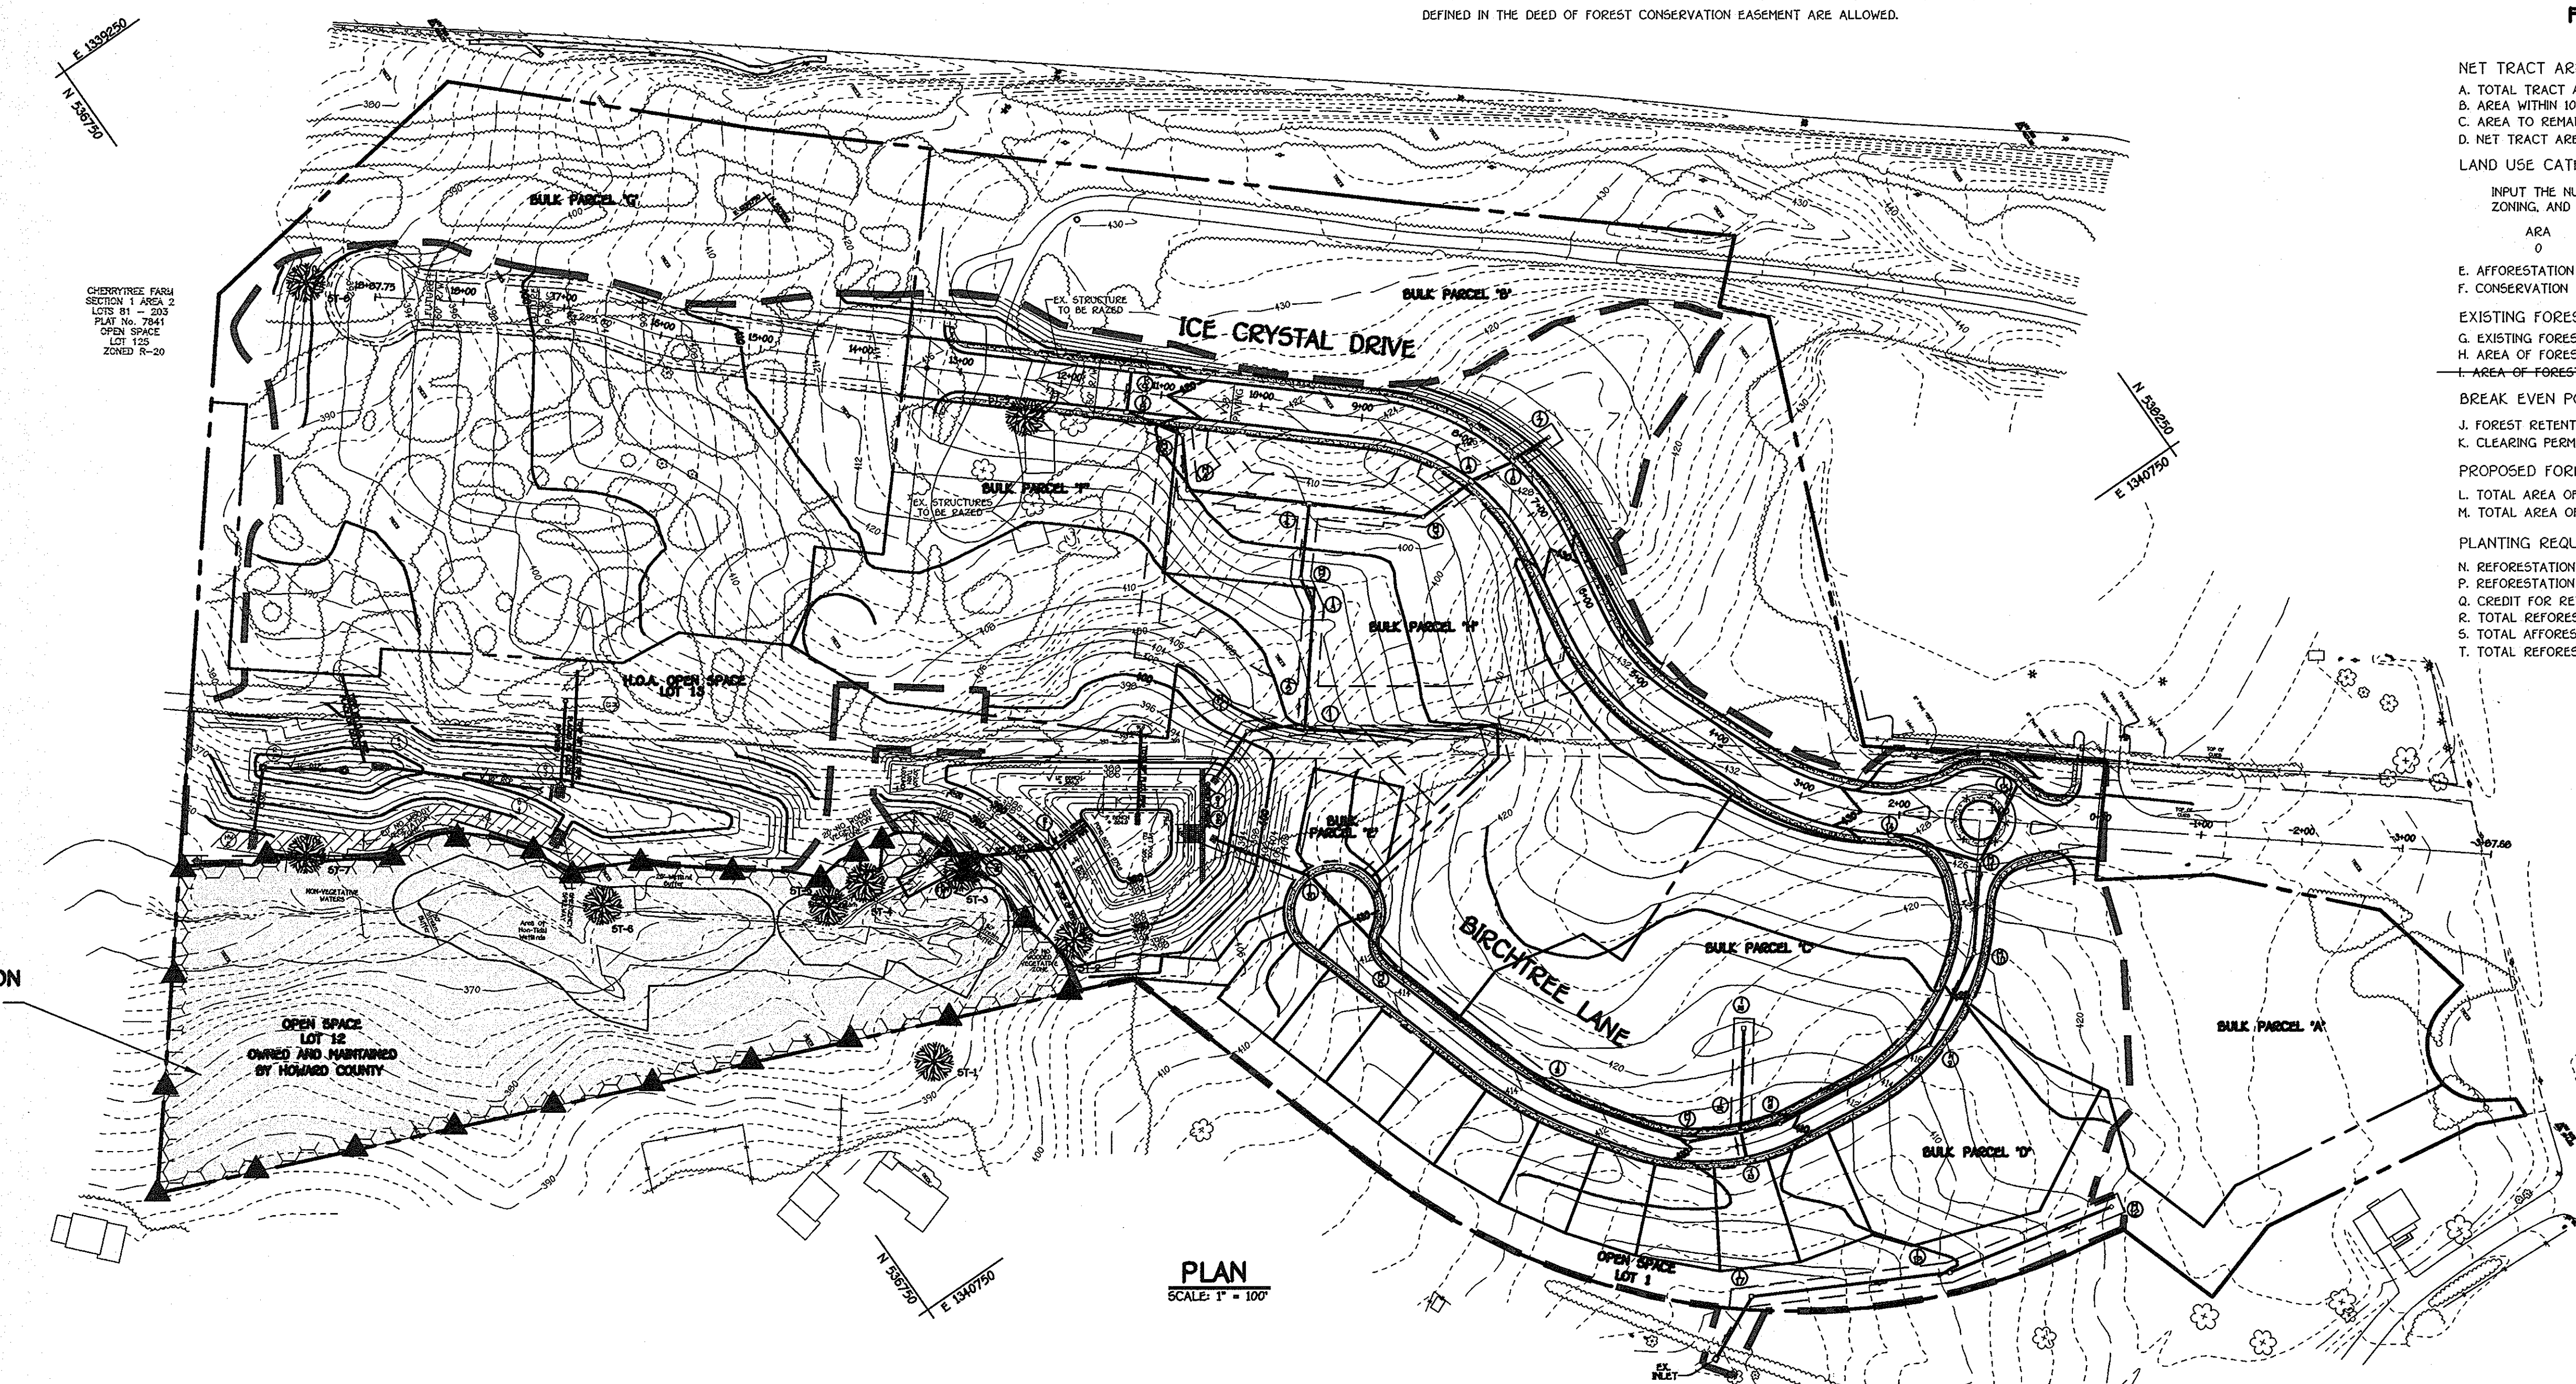

**FOREST CONSERVATION
 EASEMENT NO. 1**
 4.62 AC.±
 (RETENTION)

PLAN
 SCALE: 1" = 100'

11" MIN


**FOREST
 CONSERVATION
 AREA**

DO NOT DISTURB

MACHINERY, DUMPING
 OR STORAGE OF
 AND MATERIALS
PROHIBITED

VIOLATORS ARE SUBJECT TO
 FINES IMPOSED BY THE
 MARYLAND FOREST
 CONSERVATION ACT OF
 1991

1/4" MIN. ±

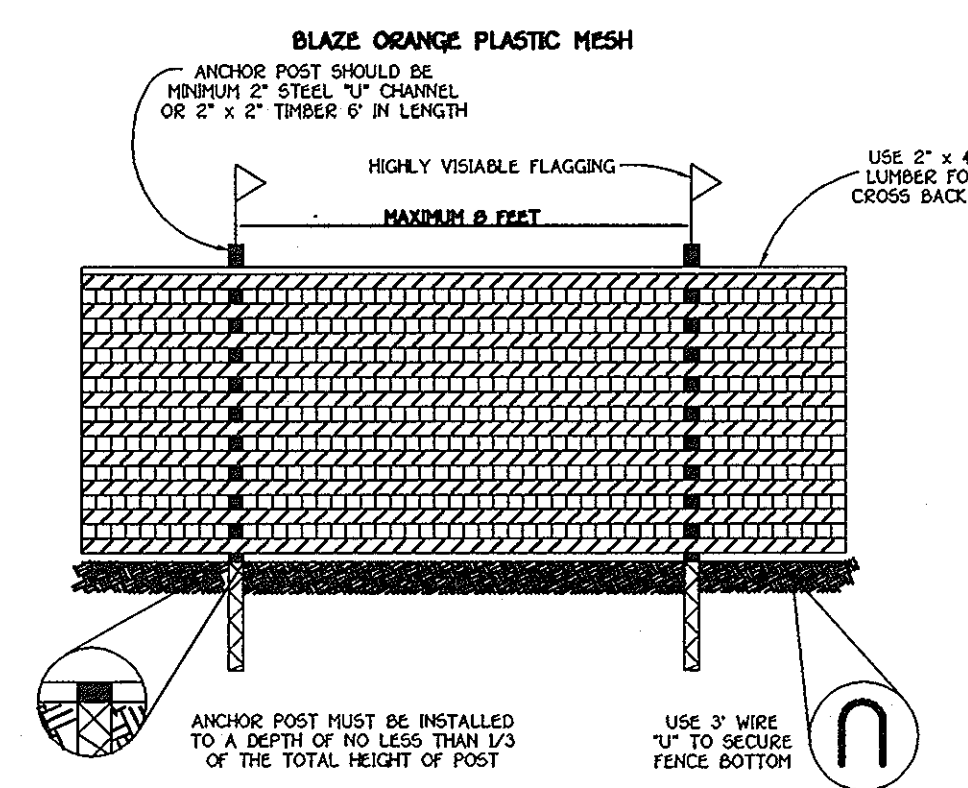

- NOTES:**
1. FOREST PROTECTION DEVICE ONLY.
 2. RESTRICTION AREA WILL BE SET AS PART OF THE REVIEW PROCESS.
 3. BOUNDARIES OF RESTRICTION AREA SHOULD BE STAKED AND FLAGGED PRIOR TO INSTALLING DEVICE.
 4. SOOT DAMAGE SHOULD BE AVOIDED.
 5. PROTECTIVE SIGNAGE MAY ALSO BE USED.
 6. DEVICE SHOULD BE MAINTAINED THROUGHOUT CONSTRUCTION.

TREE PROTECTION DETAIL
 NOT TO SCALE

LEGEND

- DENOTES LIMIT OF DISTURBANCE
- DENOTES EXISTING TREE LINE
- DENOTES FOREST CONSERVATION SIGNAGE
- DENOTES TREE PROTECTION FENCE
- DENOTES FOREST CONSERVATION EASEMENT
- DENOTES SPECIMEN TREE



**FOREST CONSERVATION PLAN
 CHERRYTREE PARK**
 LOTS 1 THRU 10, OPEN SPACE LOTS 11 THRU 13
 AND BULK PARCELS 'A' THRU 'H'
 (PHASES I AND II)

ZONED: MXD-6
 TAX MAP NO. 45 PARCEL NO. 156 GRID NO. 4
 SIXTH ELECTION DISTRICT HOWARD COUNTY, MARYLAND
 DATE: DECEMBER 7, 2001
 SHEET 19 OF 21


FISHER, COLLINS & CARTER, INC.
 CIVIL, ENGINEERING, CONSULTANTS & LAND SURVEYORS
 CENTENNIAL SQUARE OFFICE PARK - 10272 BALTHAZORE NATIONAL PIKE
 ELLSWORTH CITY, MARYLAND 21114
 (410) 481 - 2855

**Eco-Science
 Professionals, Inc.**
 CONSULTING ECOLOGISTS


MD DNR Qualified Professional
 USACOE Wildlife Director
 Certificate No. 440CP93MD06100418
[Signature]
 JOHN P. CANOLES

OWNER/DEVELOPER
 CHERRYTREE I, LLC
 7520 INDIAN PIPE COURT
 COLUMBIA, MARYLAND 21046

**BASIN #3
TYPICAL ANTI-SEEP COLLARS**

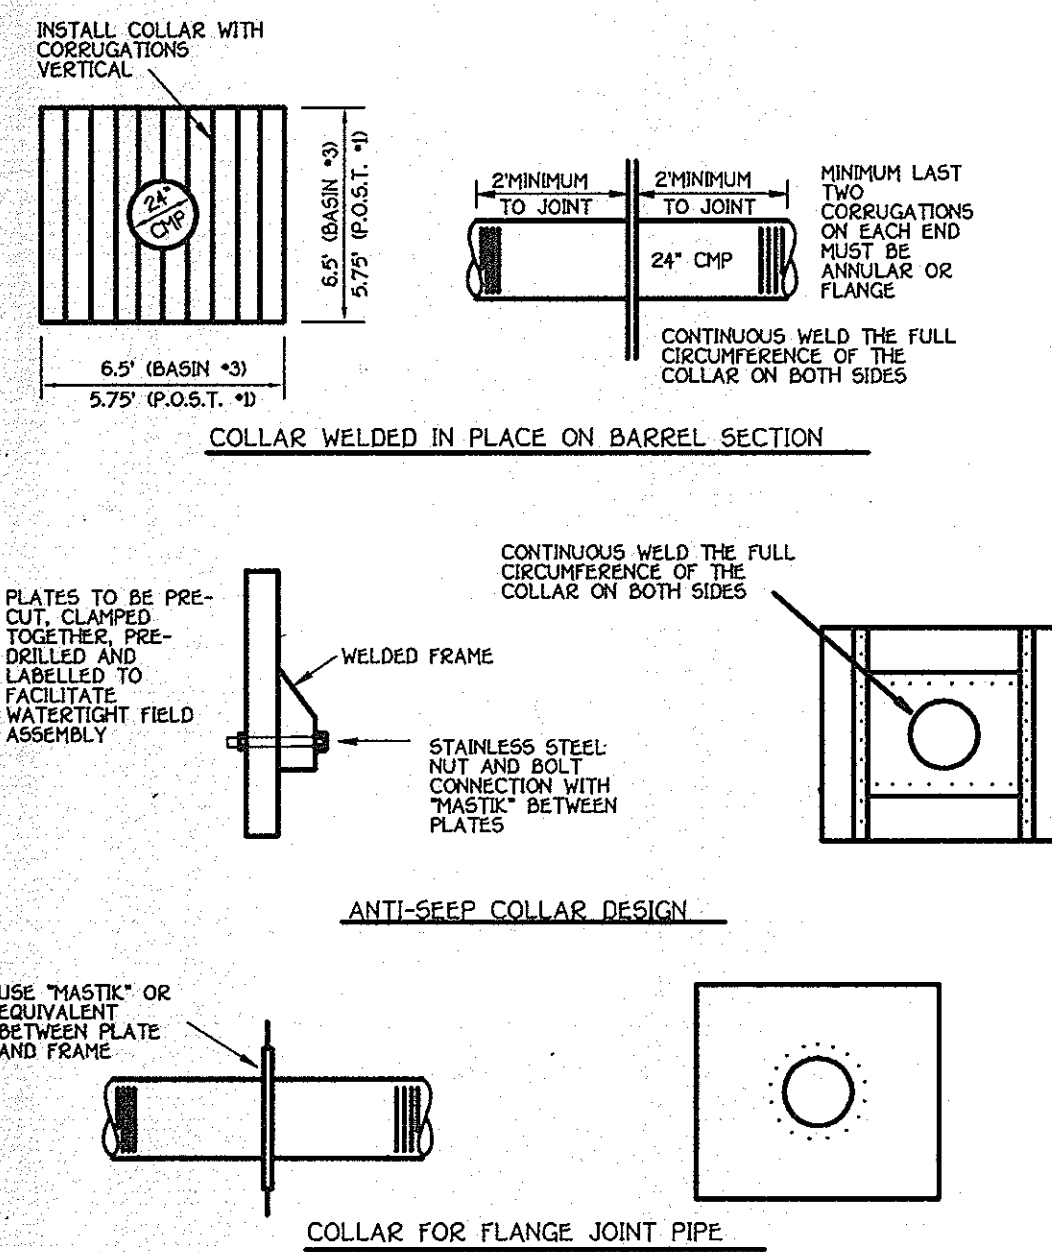

**BASIN #3
RISER BASE DETAIL**

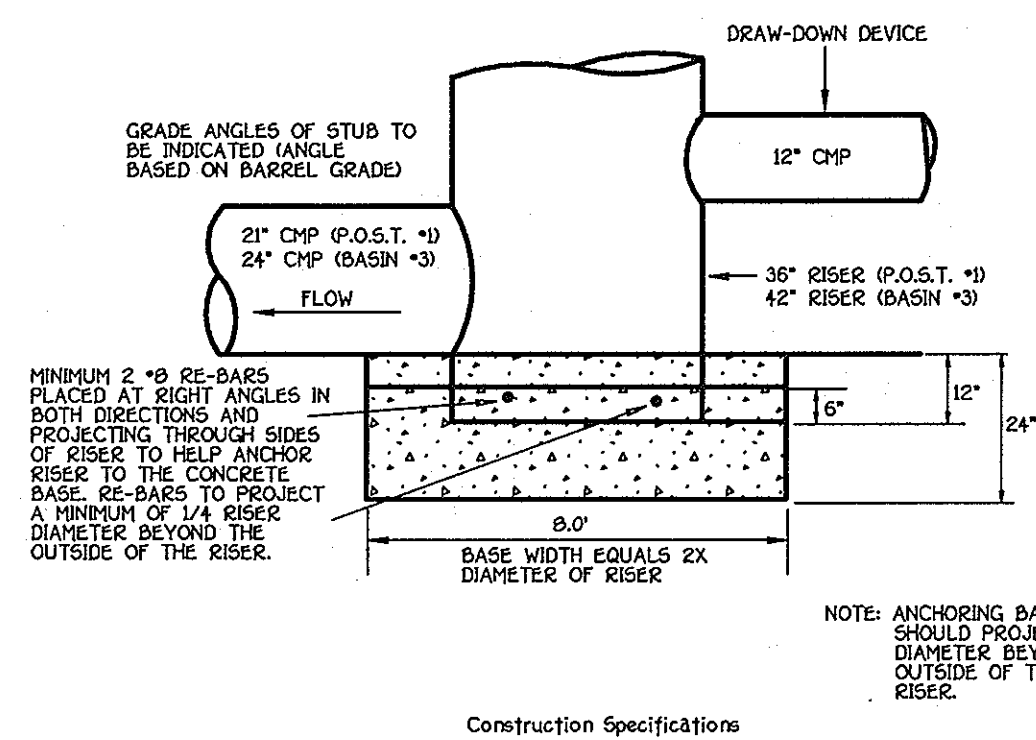

Construction Specifications

The riser shall have a base attached with a watertight connection and shall have sufficient weight to prevent flotation of the riser. Two approved bases for risers 10" or less in height are:

1. A concrete base 18" thick with the riser embedded 9" in the base.
2. A 1/4" minimum thickness steel plate attached to the riser by a continuous weld around the circumference of the riser to form a watertight connection. The plate shall have 2" of stone, gravel, or compacted earth placed on it to prevent flotation. In either case, each side of the square base shall be twice the riser diameter.

Note: For risers greater than ten feet high computations shall be made to design a base which will prevent flotation. The minimum factor of safety shall be 1.20 downward forces = 1.20 x upward forces.

DUST CONTROL NOTES

DEFINITION
CONTROLLING DUST BLOWING AND MOVEMENT ON CONSTRUCTION SITES AND ROADS.

PURPOSE
TO PREVENT BLOWING AND MOVEMENT OF DUST FROM EXPOSED SOIL SURFACES, REDUCE ON AND OFF-SITE DAMAGE, HEALTH HAZARDS, AND IMPROVE TRAFFIC SAFETY.

CONDITIONS WHERE PRACTICE APPLIES
THIS PRACTICE IS APPLICABLE TO AREAS SUBJECT TO DUST BLOWING AND MOVEMENT WHERE ON AND OFF-SITE DAMAGE IS LIKELY WITHOUT TREATMENT.

SPECIFICATIONS


TEMPORARY METHODS

1. MULCHES - SEE STANDARDS FOR VEGETATIVE STABILIZATION WITH MULCHES ONLY. MULCH SHOULD BE CRIMPED OR TACKED TO PREVENT BLOWING.
2. VEGETATIVE COVER - SEE STANDARDS FOR TEMPORARY VEGETATIVE COVER.
3. TILLAGE - TO ROUGHEN SURFACE AND BRING CLODS TO THE SURFACE. THIS IS AN EMERGENCY MEASURE WHICH SHOULD BE USED BEFORE SOIL BLOWING STARTS. BEGIN FLOWING ON WINDWARD SIDE OF SITE. CHISL-TYPE FLOWS SPACED ABOUT 12" APART, SPRING-TOOTHED HARROWS, AND SIMILAR FLOWS ARE EXAMPLES OF EQUIPMENT WHICH MAY PRODUCE THE DESIRED EFFECT.
4. IRRIGATION - THIS IS GENERALLY DONE AS AN EMERGENCY TREATMENT. SITE IS SPRINKLED WITH WATER UNTIL THE SURFACE IS MOIST. REPEAT AS NEEDED. AT NO TIME SHOULD THE SITE BE IRRIGATED TO THE POINT THAT RUNOFF BEGINS TO FLOW.
5. BARRIERS - SOLID BOARD FENCES, SILT FENCES, SNOW FENCES, BURLAP FENCES, STRAW BALE DIKES, AND SIMILAR MATERIAL CAN BE USED TO CONTROL AIR CURRENTS AND SOIL BLOWING. BARRIERS PLACED AT RIGHT ANGLES TO PREVAILING CURRENTS AT INTERVALS OF ABOUT 10 TIMES THEIR HEIGHT ARE EFFECTIVE IN CONTROLLING SOIL BLOWING.
6. CALCIUM CHLORIDE - APPLY AT RATES THAT WILL KEEP SURFACE MOIST. MAY NEED RETREATMENT.

PERMANENT METHODS

1. PERMANENT VEGETATION - SEE STANDARDS FOR PERMANENT VEGETATIVE COVER, AND PERMANENT STABILIZATION WITH SOIL EXISTING TREES OR LARGE SHRUBS MAY AFFORD VALUABLE PROTECTION IF LEFT IN PLACE.
2. TOPSOILING - COVERING WITH LESS EROSION SOIL MATERIALS. SEE STANDARDS FOR TOPSOILING.
3. STONE - COVER SURFACE WITH CRUSHED STONE OR COARSE GRAVEL.

CONCENTRIC TRASH RACK AND ANTI-VORTEX DEVICE

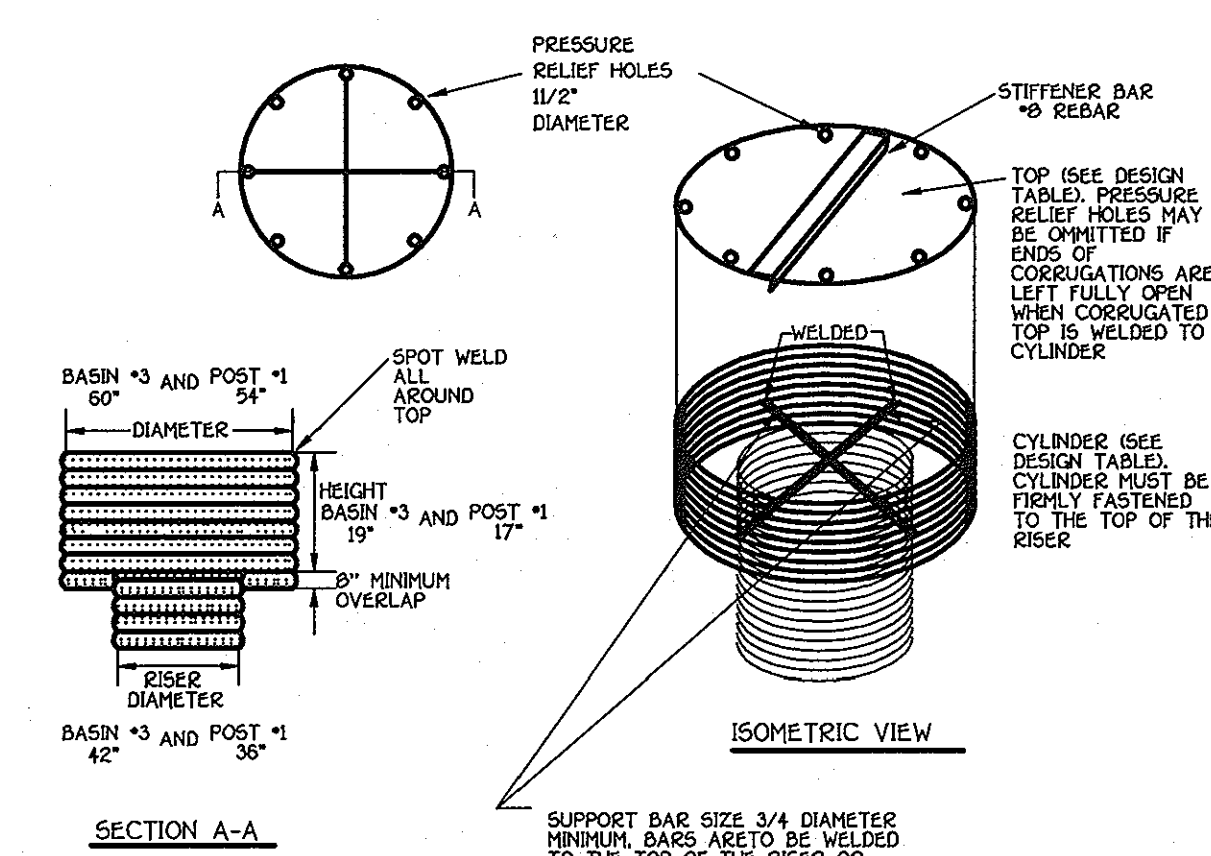

**Sediment Basin
Construction Specifications**

1. Site Preparation: Perimeter sediment control devices must be installed prior to clearing and grubbing. Areas where the embankment is to be placed shall be cleared, grubbed, and stripped of topsoil to remove trees, vegetation, roots or other objectionable material. The pool area shall not be cleared until completion of the dam embankment unless the pool area is to be used for borrow. In order to facilitate clean-out and restoration, the pool area (measured at the top of the pipe spillway) shall be cleared of all brush, trees, and other objectionable materials.
2. Cut-off Trench: A cut-off trench shall be excavated along the centerline of earth fill embankments. The minimum depth shall be four feet. The cut-off trench shall extend up both abutments to the riser crest elevation. The minimum bottom width shall be two feet, but wide enough to permit operation of excavation and compaction equipment. The side slopes shall be no steeper than 1:1. Compaction requirements shall be the same as those for the embankment. The trench shall be dewatered during the backfilling-compaction operations. For dewatering see Section D.
3. Embankment: The fill material shall be taken from approved areas shown on the plans. It shall be clean mineral soil free of roots, woody vegetation, oversized stones, rocks, or other objectionable material. Reductive previous materials such as sand or gravel (Unified Soil Classes O₁, O₂, O₃ or A₁) or organic materials (Unified Soil Classes O₄ and O₅) shall not be placed in the embankment. Areas on which fill is to be placed shall be scarified prior to placement of fill. The fill material shall contain sufficient moisture so that it can be properly compacted. Fill material shall be placed in six-inch to eight-inch thick continuous lifts over the entire length of the fill. Compaction shall be obtained by routing and hauling the construction equipment over the fill so that the entire surface of each layer of the fill is traversed by at least one wheel or tread track of the equipment or by the use of a compactor. The embankment shall be constructed to an elevation 10 percent higher than the design height to allow for settlement.
4. Principal Spillway: Steel risers shall be securely attached to the barrel or barrel stub by welding the full circumference making a watertight structural connection. Concrete risers shall be poured with the principal spillway in place or precast with voids around the principal spillway filled with concrete or sink proof grout for watertight connection. The barrel stub must be attached to the riser at the same percent (angle) of grade as the outlet conduit. The connection between the riser and the riser base shall be watertight. All connections between barrel sections must be achieved by approved watertight band assemblies. The barrel and riser shall be placed on a firm, smooth foundation of impervious soil as the embankment is constructed. Breaching the embankment to install the barrel is unacceptable. Previous materials such as sand, gravel, or crushed stone shall not be used as backfill around the pipe or anti-seep collars. The fill material around the pipe spillway shall be placed in four inch lifts and hand compacted under and around the pipe to at least the same density as the adjacent embankment. A depth of 1.5 times of pipe diameter (min) shall be backfilled over the principal spillway and hand compacted before proceeding with construction equipment.
5. Emergency Spillway: The emergency spillway shall be installed in undisturbed ground. The achievement of planned elevations, grades, design width, entrance and exit channel slopes are critical to the successful operation of the emergency spillway and must be constructed within a tolerance of + 0.2 feet.
6. Vegetative Treatment: Stabilize the embankment in accordance with the appropriate vegetative standards and specifications immediately following construction. In no case shall the embankment remain unvegetated for more than seven (7) days. Once constructed, the top and outside face of the embankment shall be stabilized with seed and mulch. The remainder of the interior slopes should be stabilized one time with seed and mulch upon basin completion and monitored and maintained erosion free during the life of the basin.
7. Safety: Local requirements concerning fencing and signs shall be met, warning the public of hazards of soft sediment and floodwater.
8. Maintenance: Repair all damage caused by soil erosion and construction equipment at or before the end of each working day. Sediment shall be removed from the basin when it reaches the specified distance below the top of the riser as shown on the plan. This sediment shall be placed in such a manner that it will not erode from the site. The sediment shall be placed in a manner that it will not erode from the site. The sediment shall be placed in a manner that it will not erode from the site. The sediment shall be placed in a manner that it will not erode from the site.
9. Final Disposal: When temporary structures have served their intended purpose and the contributing drainage area has been properly stabilized, the embankment and resulting sediment deposits are to be leveled or otherwise disposed of in accordance with the approved sediment control plan. The proposed use of a sediment basin site will often dictate final disposition of the basin and any sediment contained therein. If the site is scheduled for future construction, then the basin material and trapped sediments must be removed and safely disposed of and the basin shall be backfilled with a structural fill. When the basin area is to remain open space, the pond may be pumped dry using methods in Section D - Dewatering, graded, and back filled.
10. Conversion to Stormwater Management Structure: After permanent stabilization of all disturbed contributory drainage areas, temporary sediment basins, if initially built and certified to meet permanent standards, may be converted to permanent stormwater management structures. To convert the basin from temporary to permanent use, the outlet structure must be modified in accordance with approved stormwater management design plans. Additional grading may also be necessary to provide the required storage volume in the basin. Conversion can only take place after all disturbed areas have been permanently stabilized to the satisfaction of the inspection authority and storm drains have been flushed.

ENGINEER'S CERTIFICATE

I hereby certify that this plan and specification for Sediment Control Devices was prepared by me or under my direct supervision and that I am a duly Licensed Professional Engineer in the State of Maryland.

Signature of Engineer: *W. M. ...* Date: 12/11/01

DEVELOPER'S CERTIFICATE

I/we certify that all development and construction will be done according to this plan of development and plan for erosion and sediment control and that all responsible personnel involved in the construction project will have a certificate of attendance at a Department of Natural Resources Approved Training Program for the Control of Sediment and Erosion before beginning the project. I also authorize periodic on-site inspection by the Howard Soil Conservation District or their authorized agents, as are deemed necessary.

Signature of Developer: *Th. K. Bile* VP Date: 12/11/01

Reviewed for Howard County Soil Conservation District and Meets Technical Requirements.

Signature: *J. ...* Date: 1/2/02

U.S.D.A. Natural Resources Conservation Service

Approved: This Development is Approved For Erosion And Sediment Control By The Howard Soil Conservation District.

Signature: *...* Date: 1/2/02

District: Howard Soil Conservation Dist.

Approved: Department Of Planning And Zoning

Signature: *...* Date: 2/4/02

Chief, Division Of Land Development





Signature: *...* Date: 2/4/02

Chief, Development Engineering Division

Approved: Howard County Department Of Public Works

Signature: *...* Date: 1-16-02

Chief, Bureau Of Highways

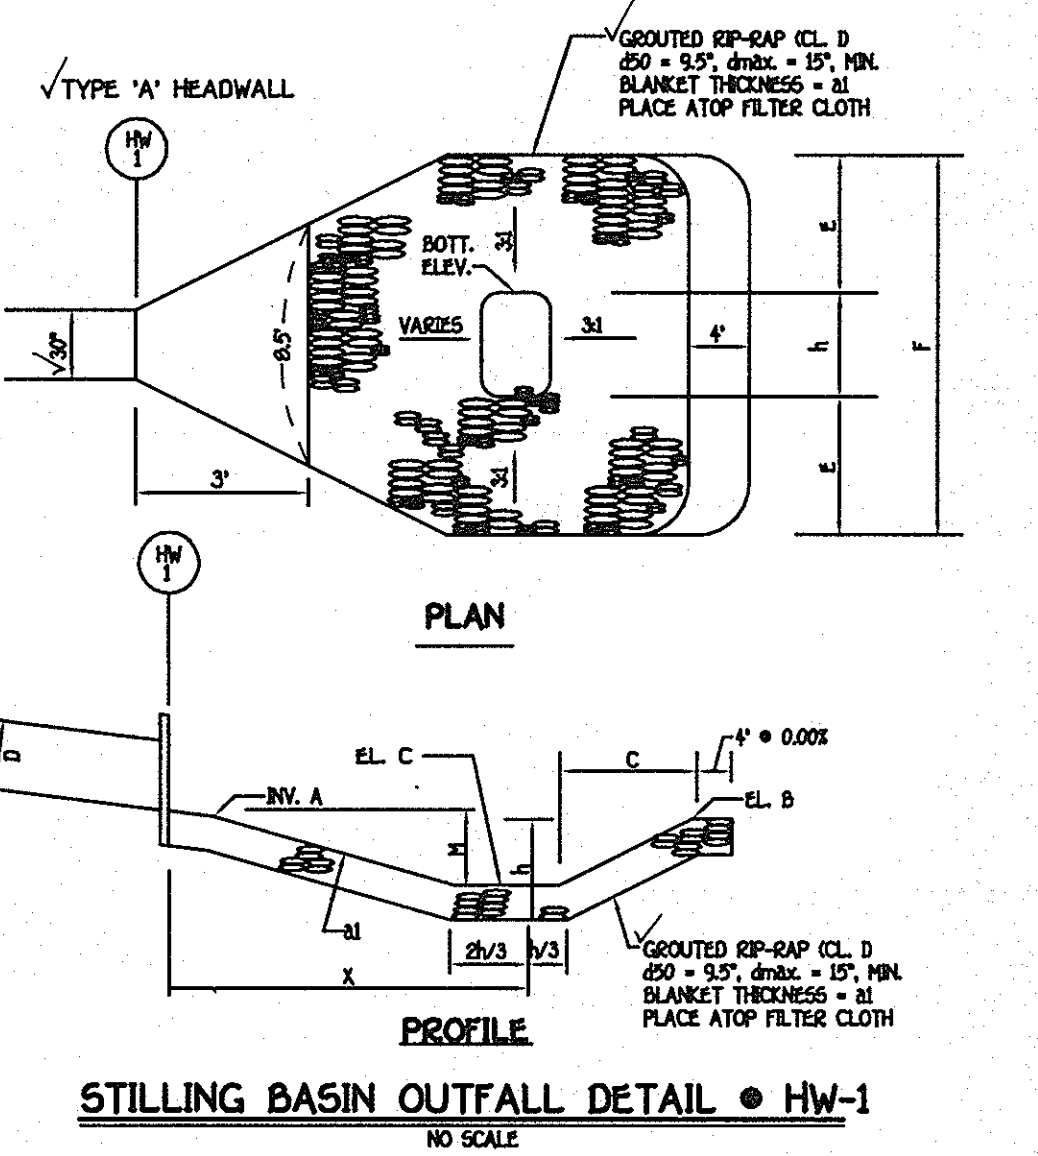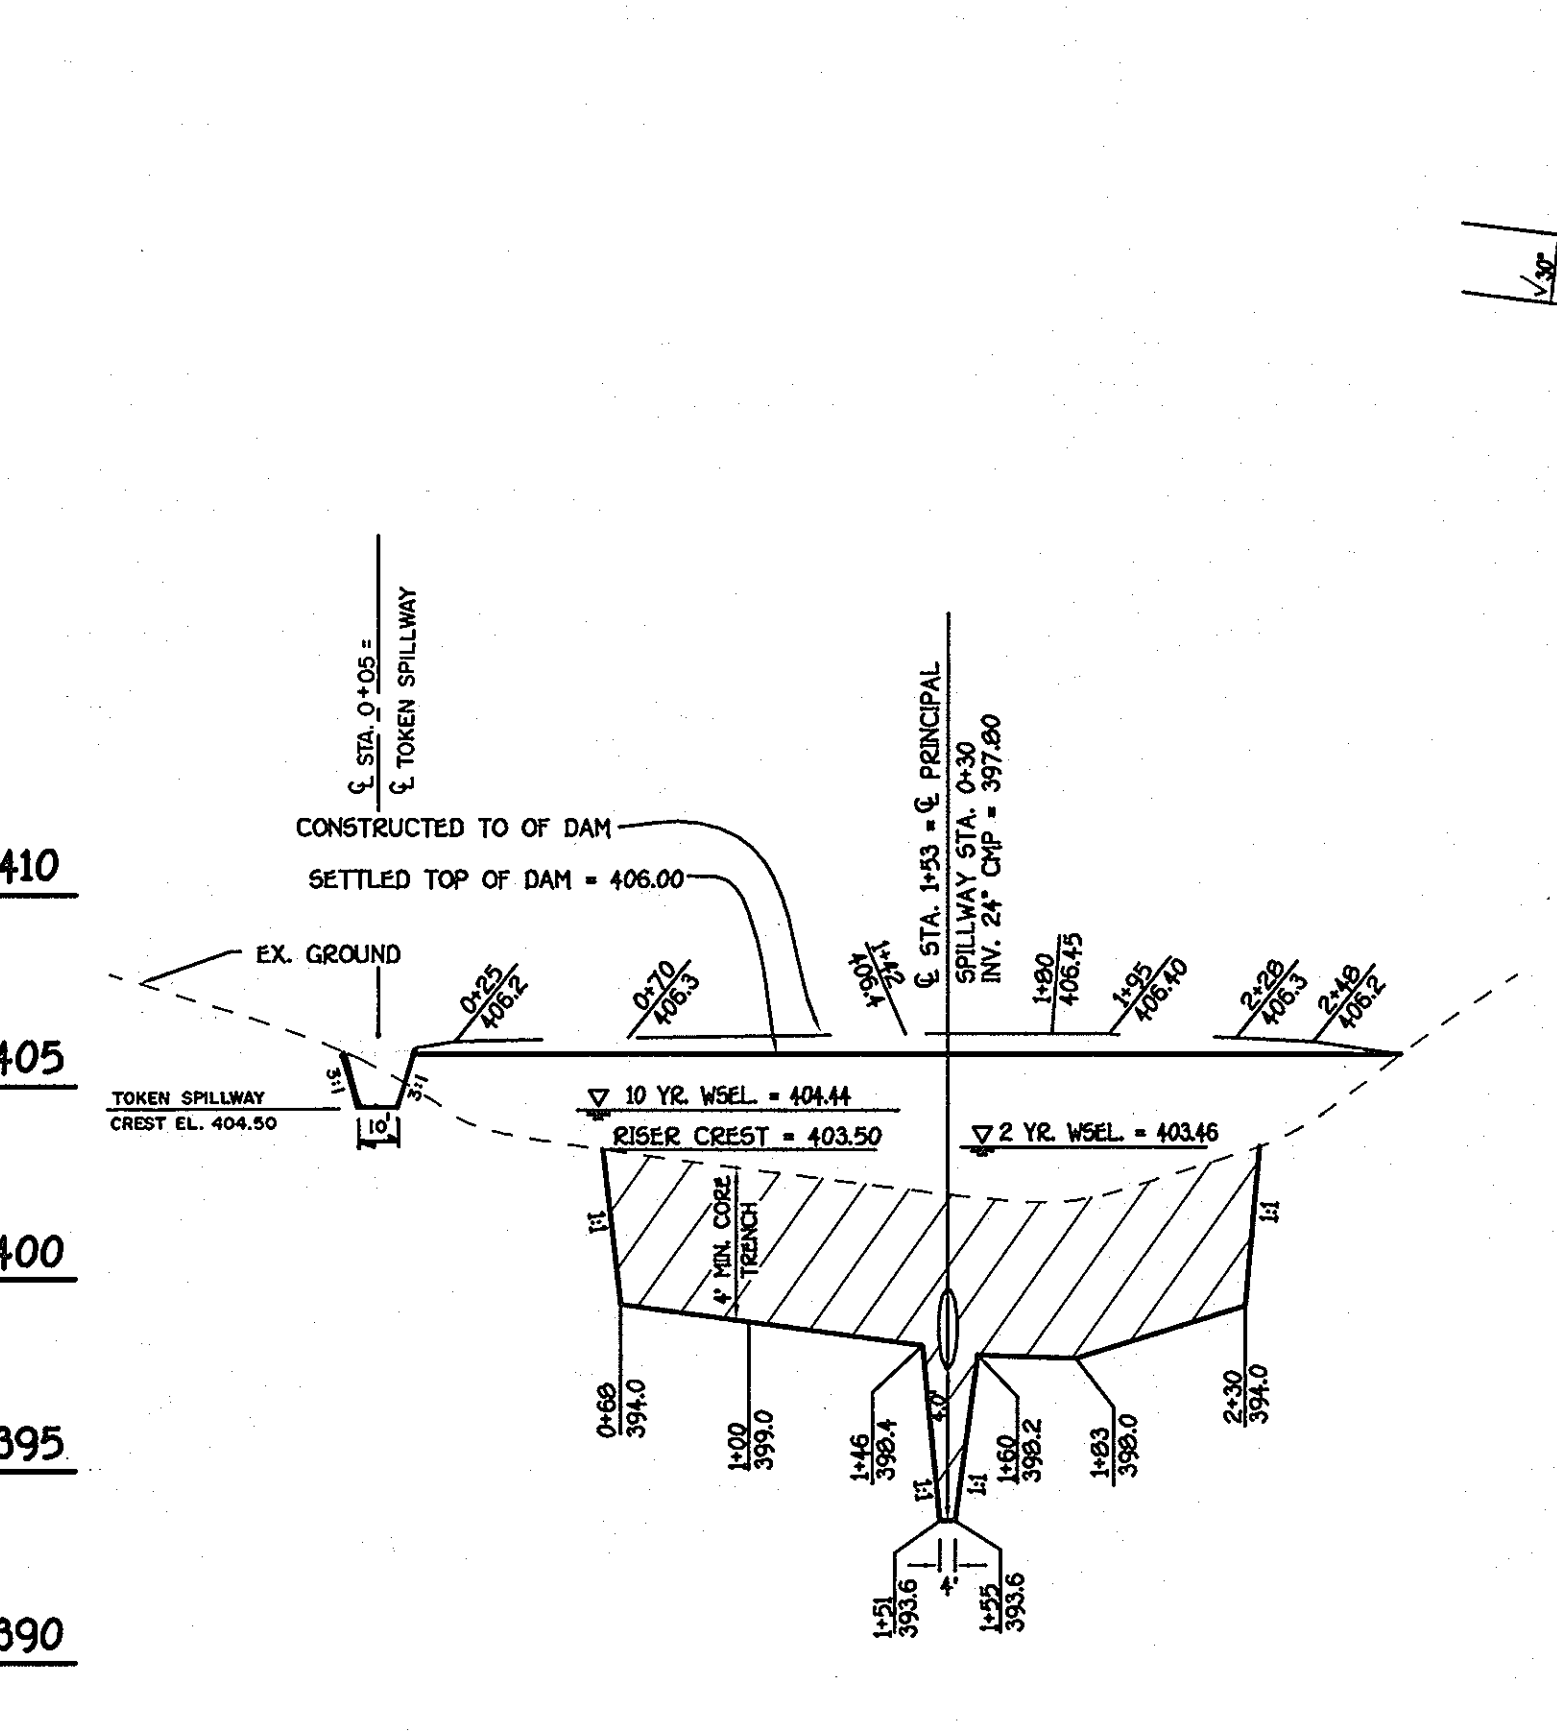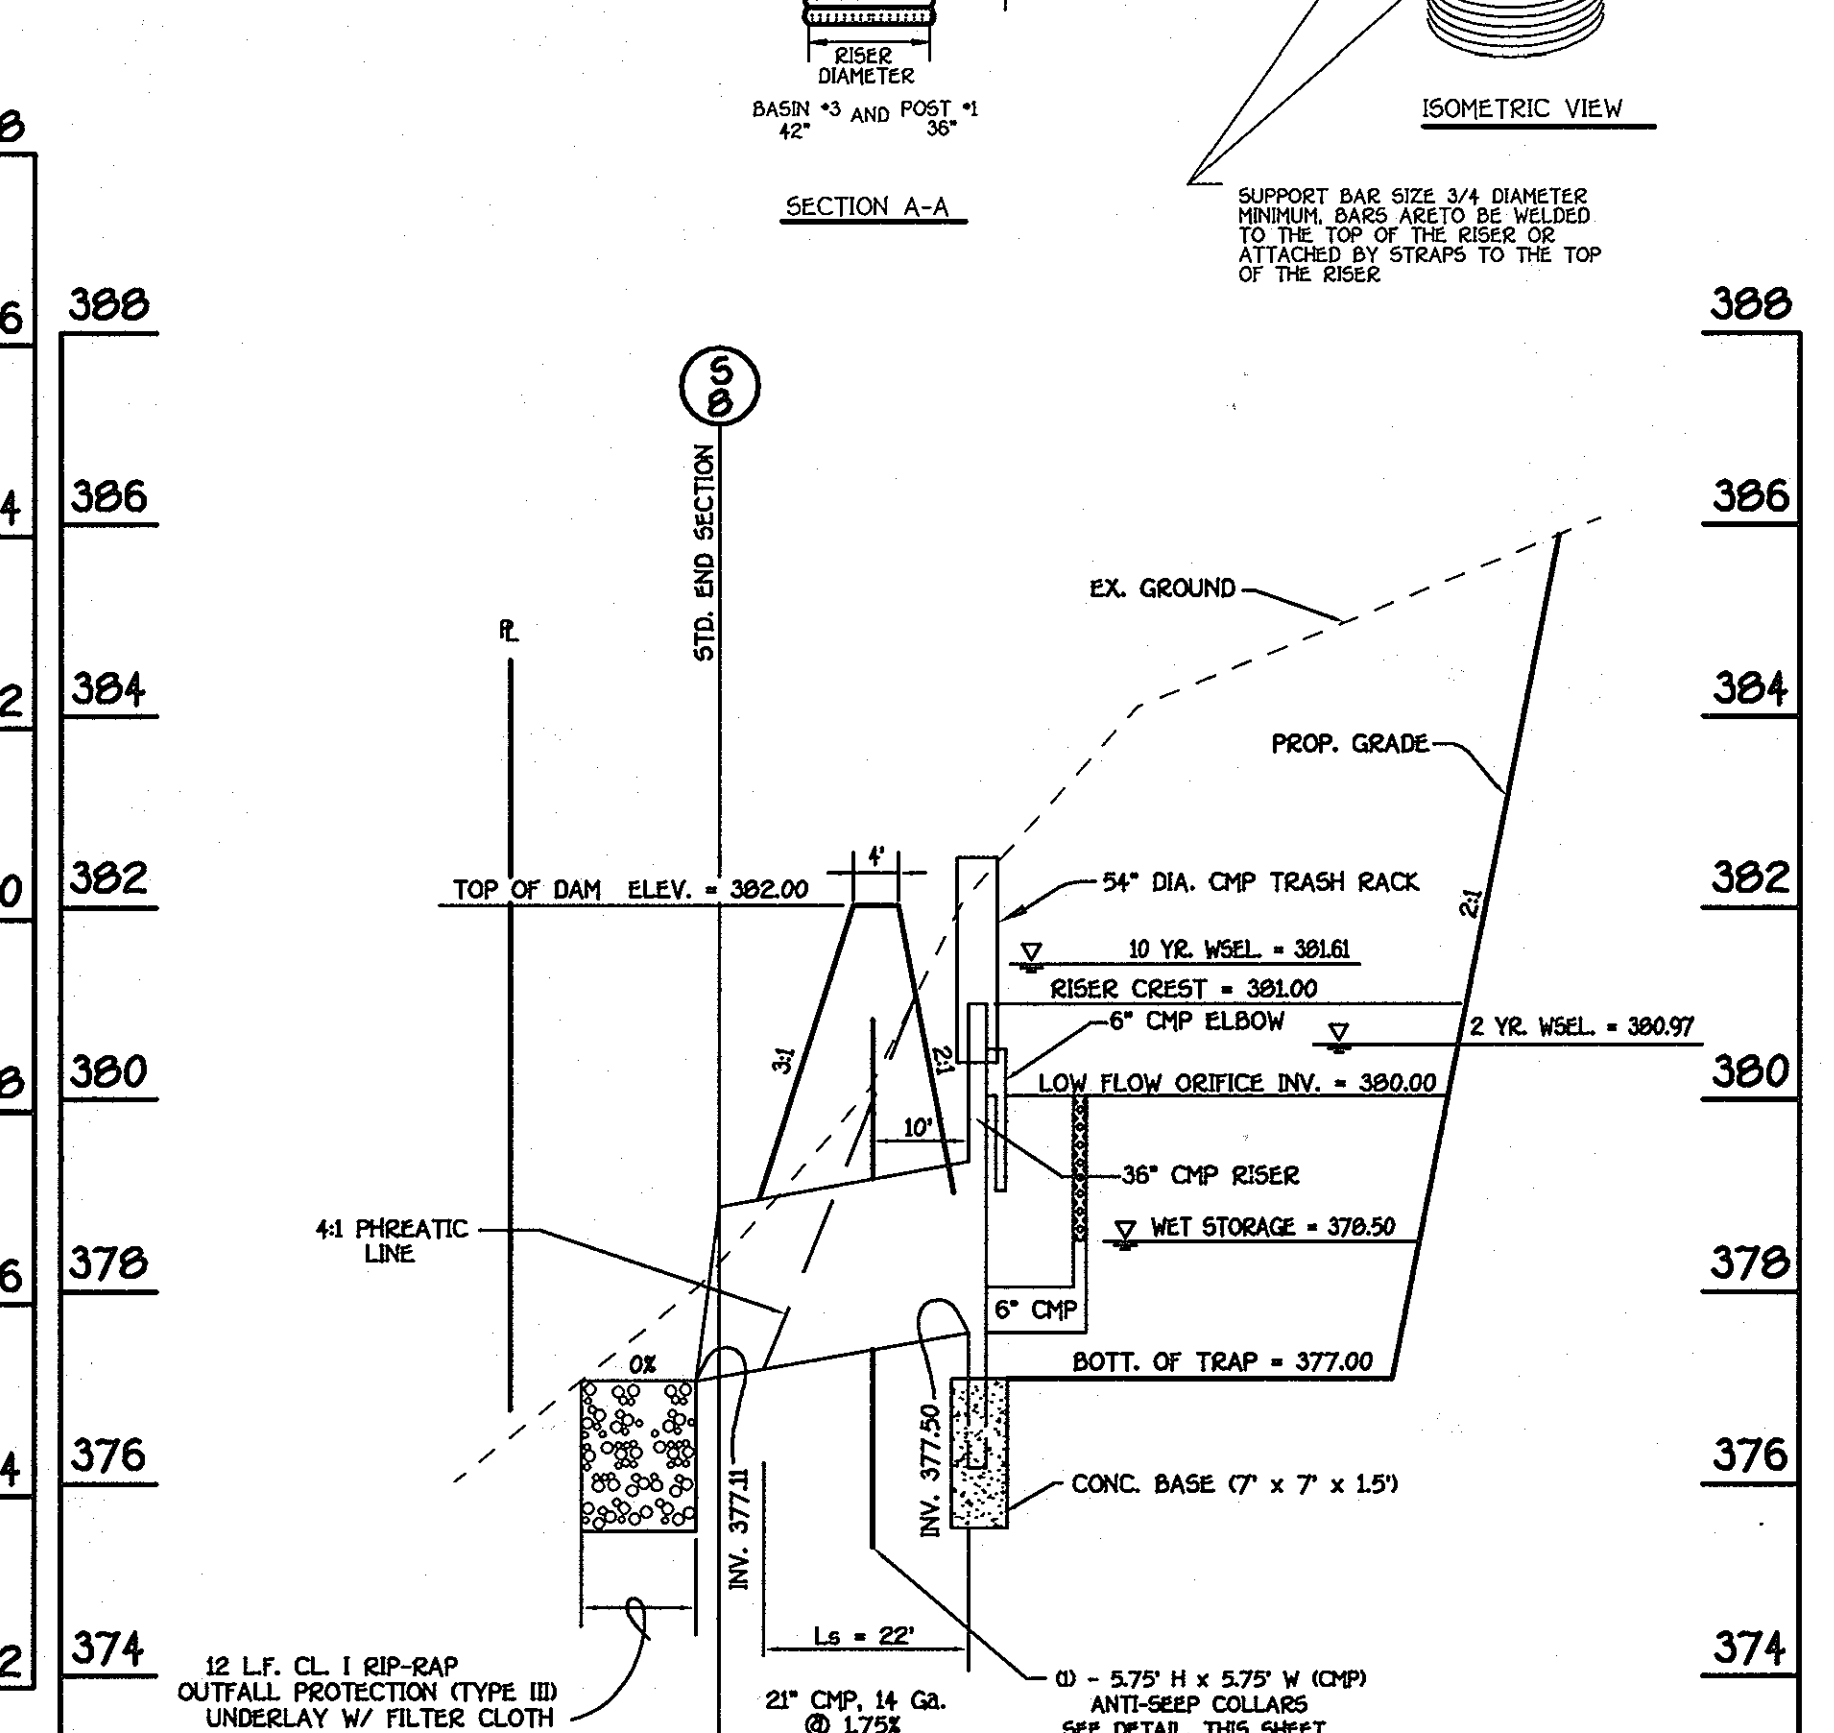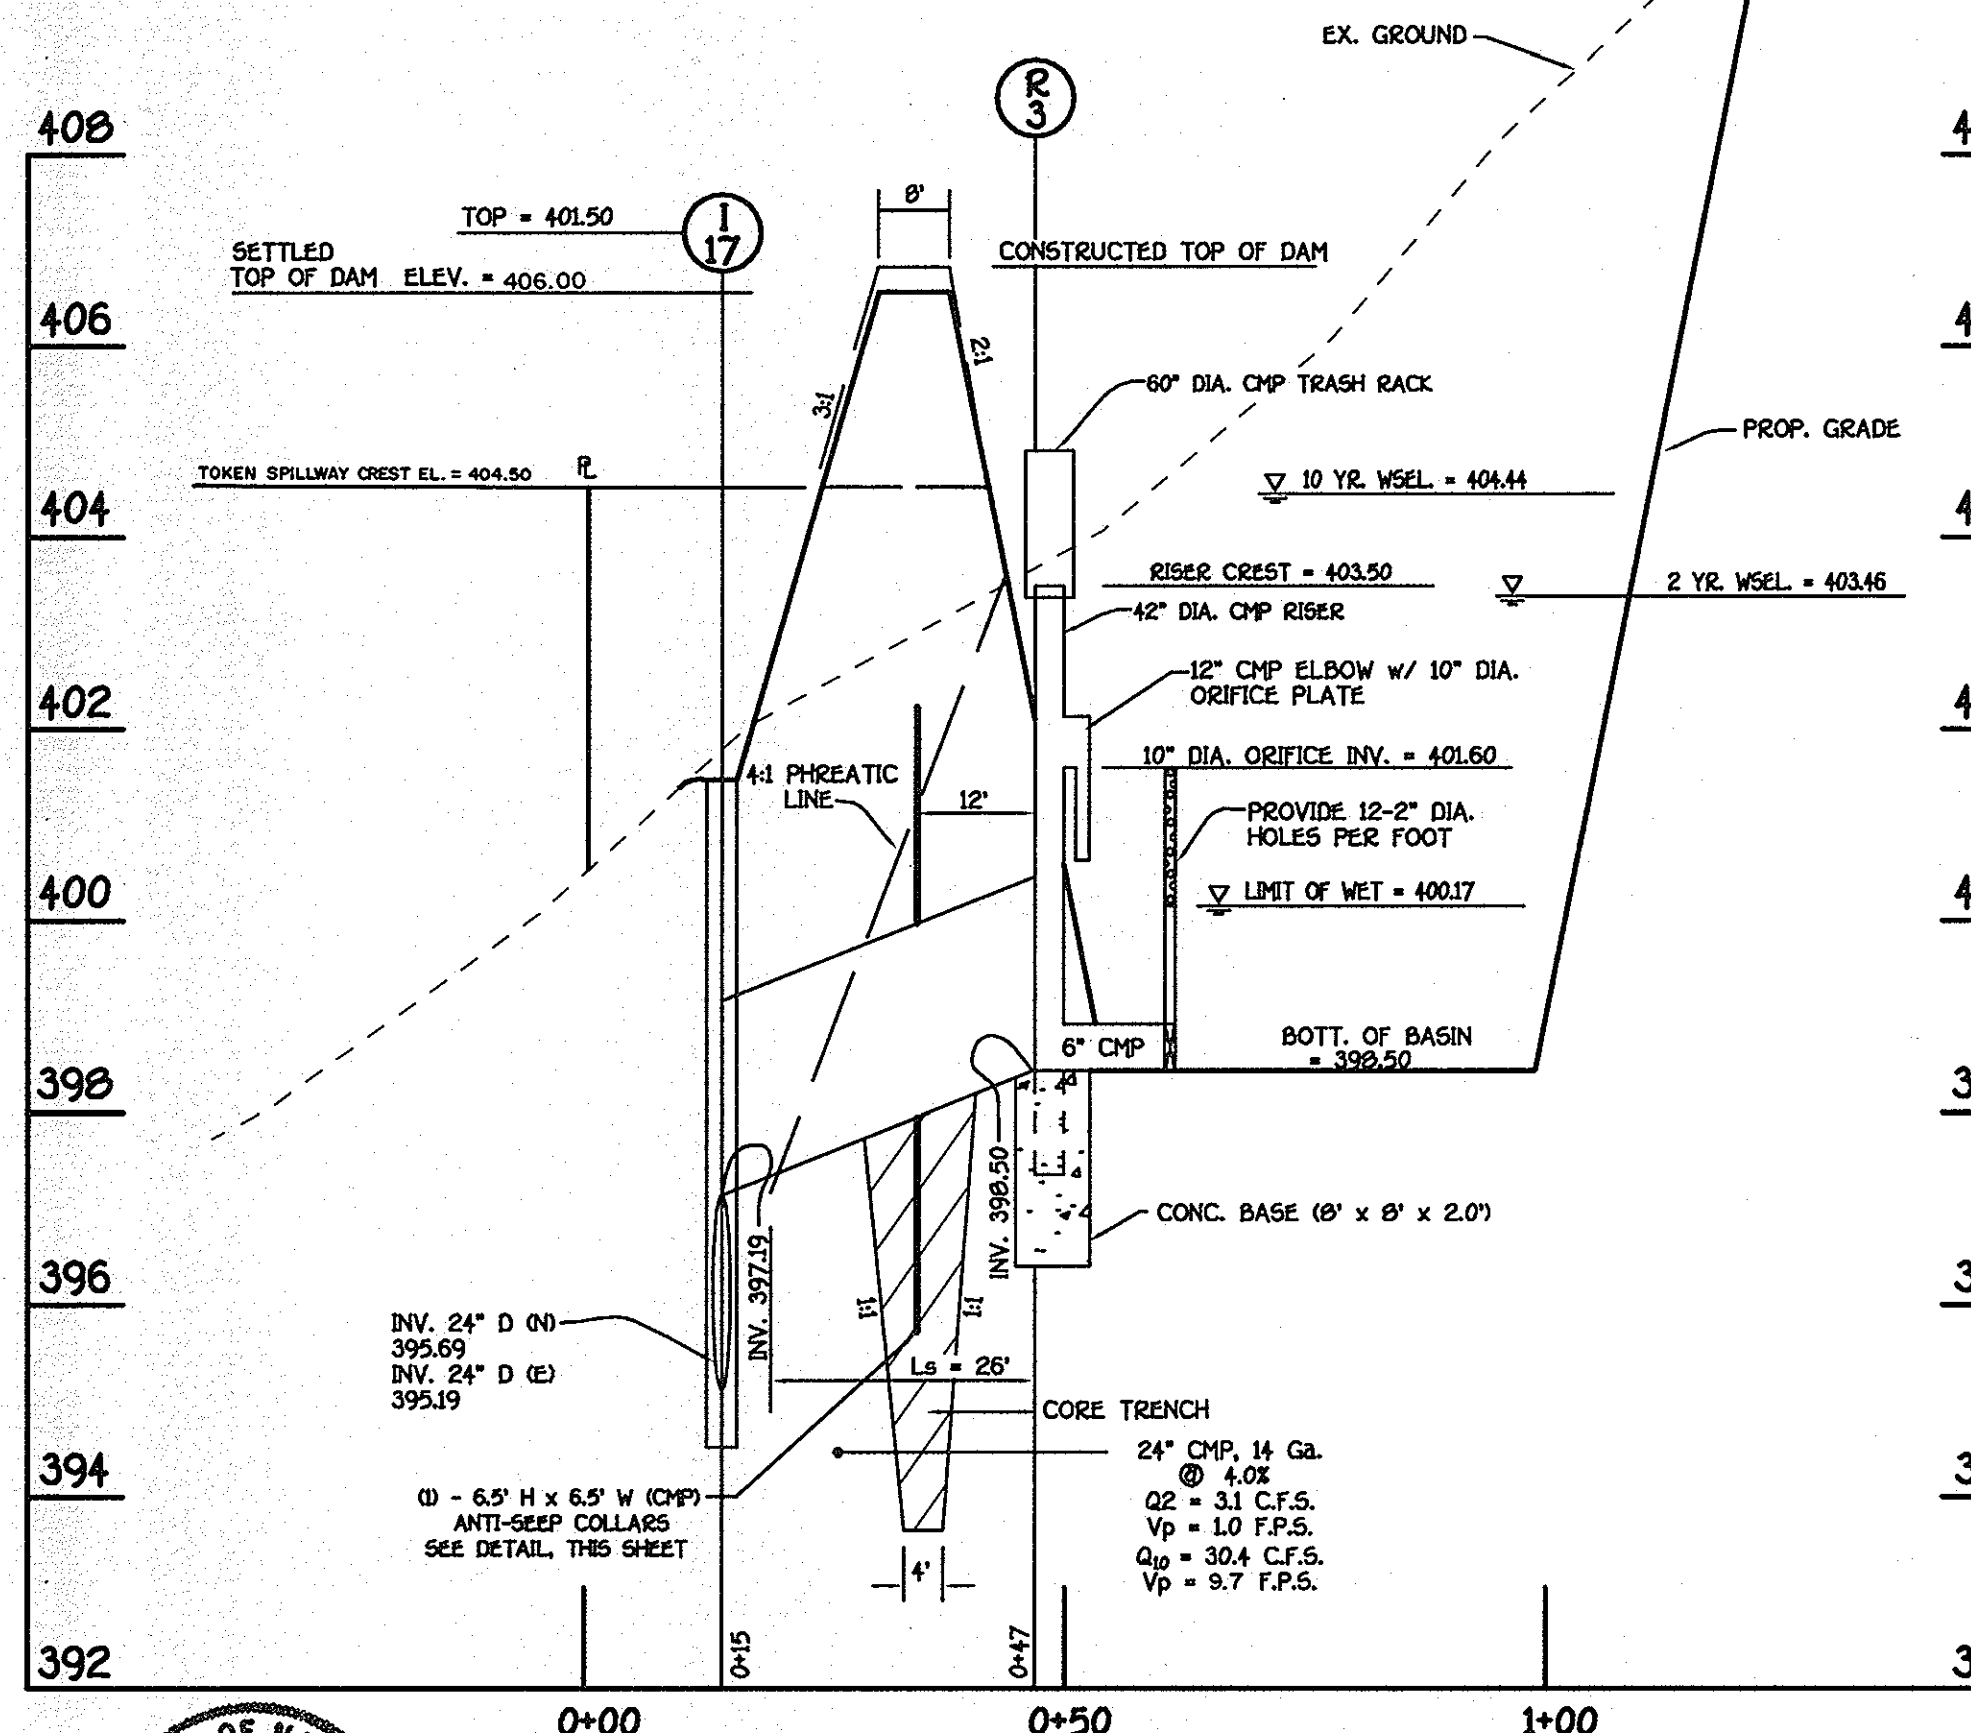

STILLAGE BASIN DATA

STRUCTURE NO.	INV. A	EL. B	EL. C	D	E	F	h	M	ai	X
HW-1	380.0	380.50	378.00	5.0'	2.5'	5.0'	12.50'	2.50'	142'	19'



**TEMP. SEDIMENT BASIN No. 3
PRINCIPAL SPILLWAY PROFILE**

SCALE: HOR. : 1" = 20'
VER. : 1" = 2'

**P.O.S.T. NO. 1
PRINCIPAL SPILLWAY PROFILE**

SCALE: HOR. : 1" = 20'
VER. : 1" = 2'

**TEMP. SEDIMENT BASIN NO. 3
PROFILE ALONG EMBANKMENT**

SCALE: HOR. : 1" = 20'
VER. : 1" = 5'

FISHER, COLLINS & CARTER, INC.
CIVIL ENGINEERING CONSULTANTS & LAND SURVEYORS
CENTRAL SQUARE OFFICE PARK - 10272 BALTIMORE NATIONAL PIKE
ELLSWORTH CITY, MARYLAND 21042
(410) 461-2255

OWNER/DEVELOPER
CHERRYTREE I, L.L.C.
7520 INDIAN PIPE COURT
COLUMBIA, MARYLAND 21046


SEDIMENT AND EROSION CONTROL NOTES & DETAILS
CHERRYTREE PARK
LOTS 1 THRU 10, OPEN SPACE LOTS 11 THRU 13
AND BULK PARCELS 'A' THRU 'H'
(PHASES 1 AND 2)
ZONED: M-XD-6
TAX MAP NO. 46 PARCEL NO. 156 GRID NO. 4
SIXTH ELECTION DISTRICT HOWARD COUNTY, MARYLAND
DATE: DECEMBER 7, 2001
SHEET 19 OF 21

ASBUILT F-01-114


APPROVED: DEPARTMENT OF PUBLIC WORKS
Robert M. Dando 1-16-02
 CHIEF, BUREAU OF HIGHWAYS DATE

APPROVED: DEPARTMENT OF PLANNING AND ZONING
Craig Stanek 2/4/02
 CHIEF, DIVISION OF LAND DEVELOPMENT DATE

Mike Dammann 2/4/02
 CHIEF, DEVELOPMENT ENGINEERING DIVISION DATE

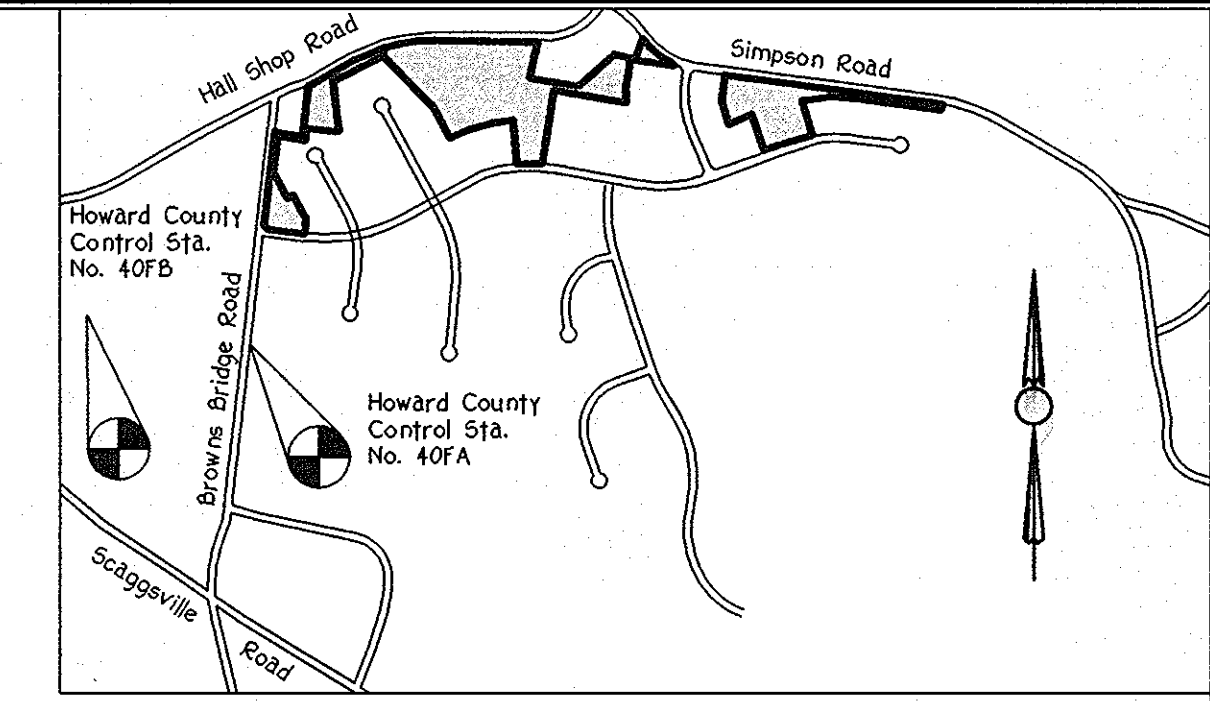

Vicinity Map
 Scale: 1"=1200'

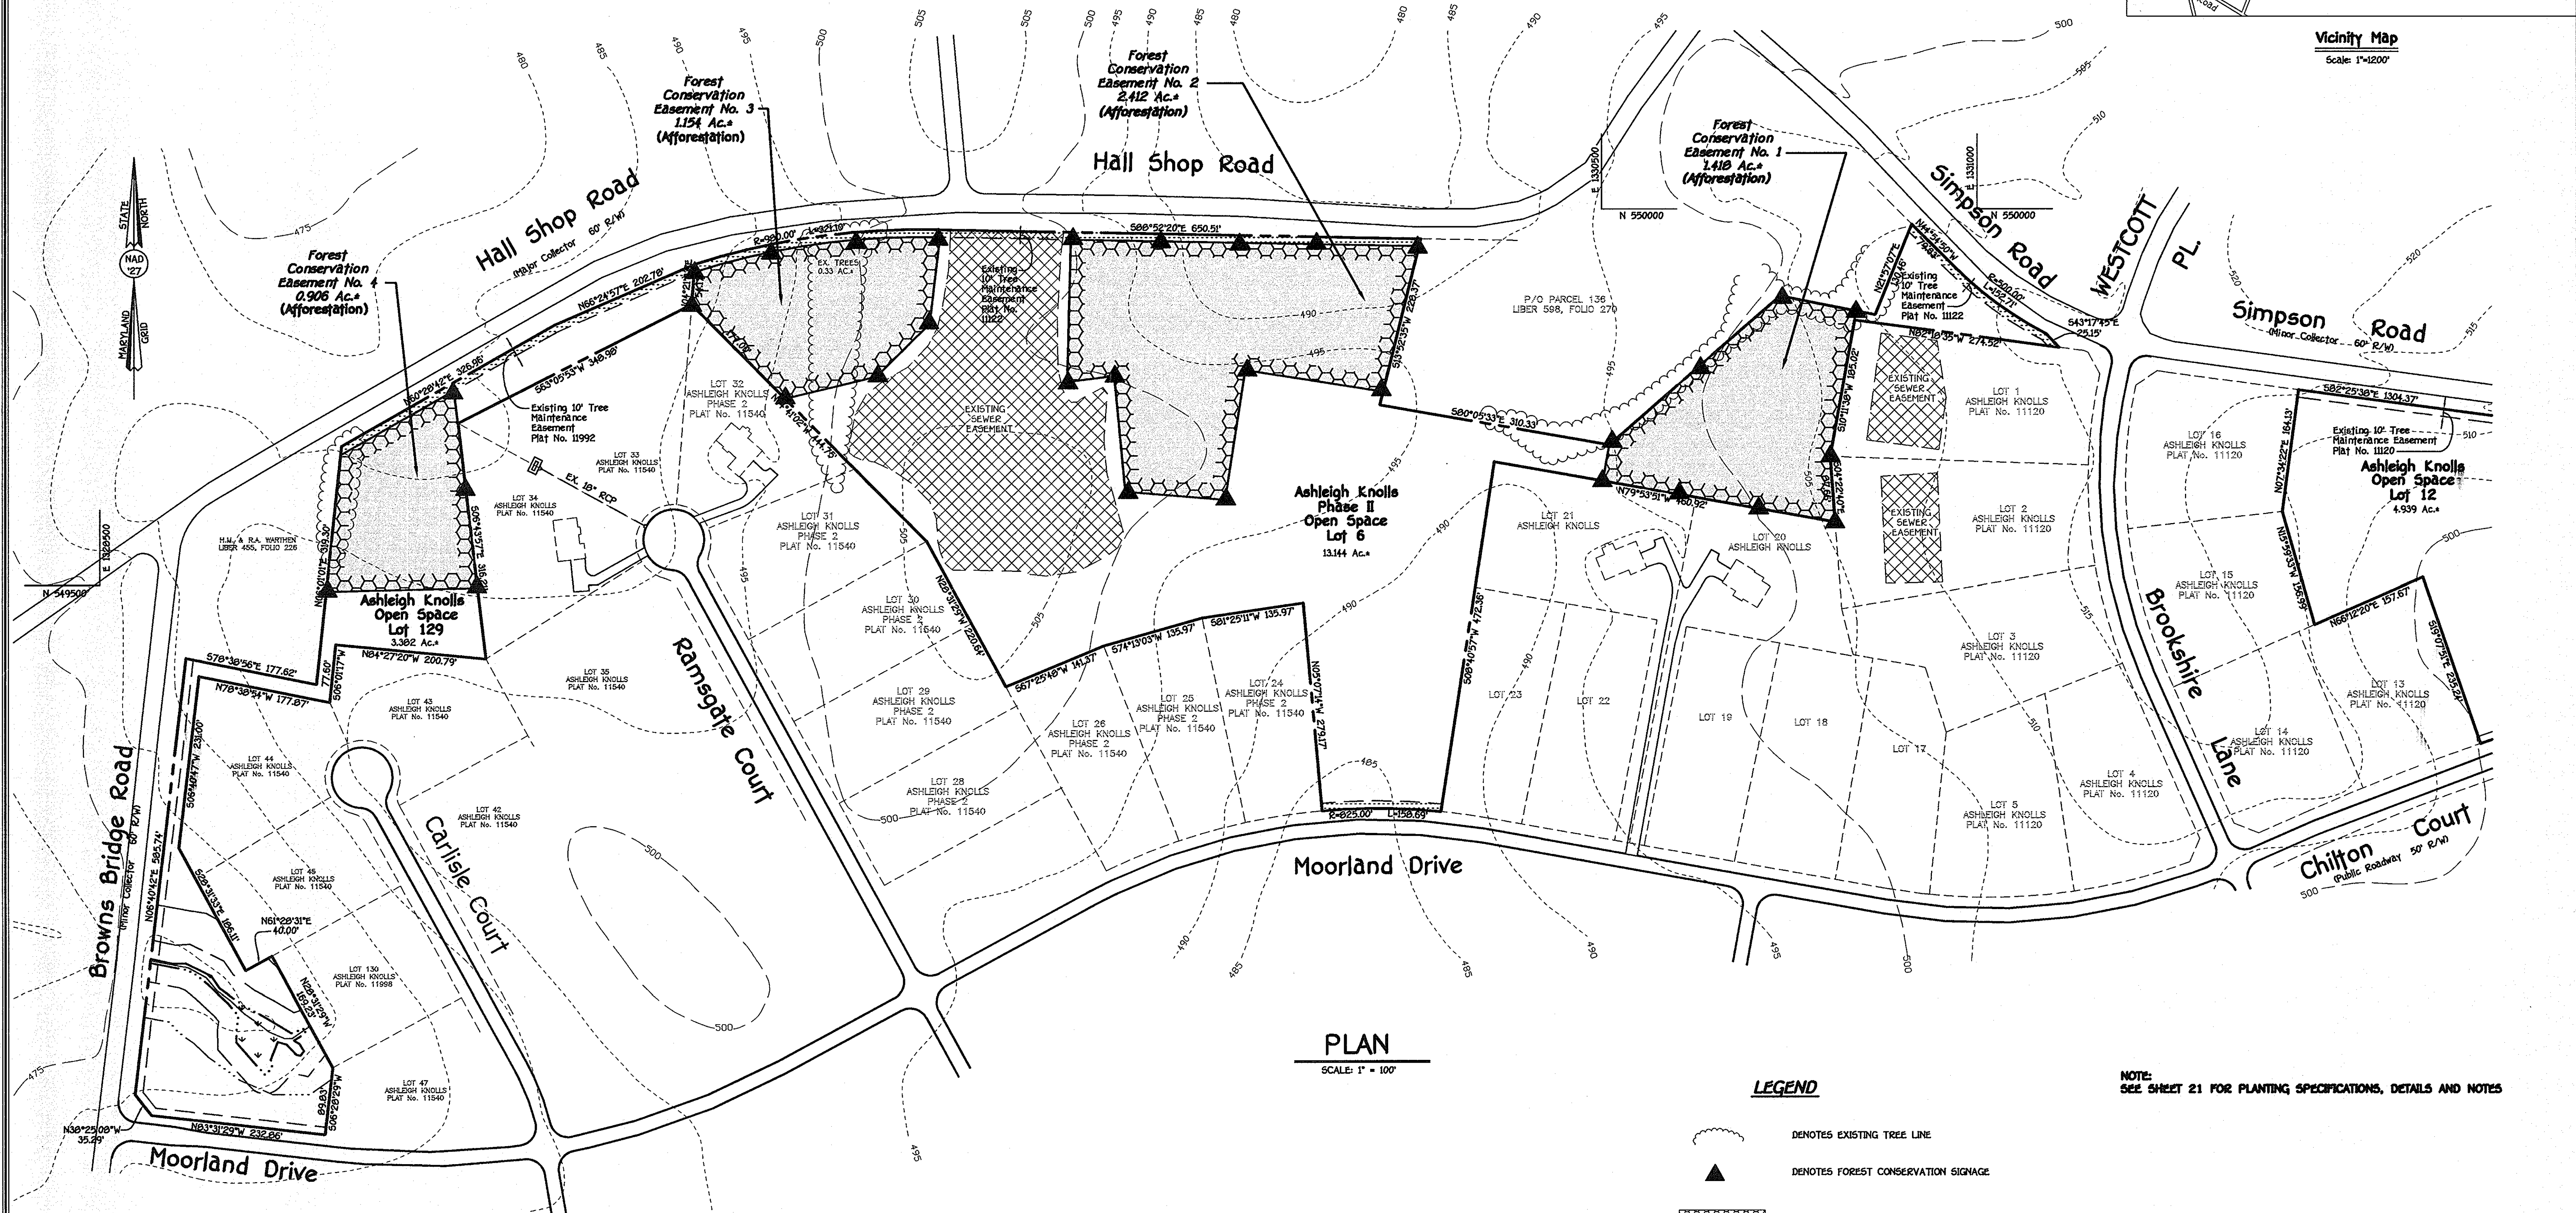

PLAN
 SCALE: 1" = 100'

LEGEND

- DENOTES EXISTING TREE LINE
- DENOTES FOREST CONSERVATION SIGNAGE
- DENOTES FOREST CONSERVATION EASEMENT

NOTE:
 SEE SHEET 21 FOR PLANTING SPECIFICATIONS, DETAILS AND NOTES

OFF-SITE FOREST CONSERVATION PLAN
CHERRYTREE PARK
 LOTS 1 THRU 10, OPEN SPACE LOTS 11 THRU 13
 AND BULK PARCELS 'A' THRU 'H'
 (PHASES I AND II)
 ZONED: M40-6
 TAX MAP NO. 46 PARCEL NO. 156 GRID NO. 4
 SIXTH ELECTION DISTRICT HOWARD COUNTY, MARYLAND
 SCALE: 1" = 100'
 DATE: DECEMBER 7, 2001
 SHEET 20 OF 21



FISHER, COLLINS & CARTER, INC.
 CIVIL ENGINEERING CONSULTANTS & LAND SURVEYORS
 CENTRAL SQUARE OFFICE PARK - 10222 BALTIMORE NATIONAL PIKE
 ELLSWORTH CITY, MARYLAND 21042
 (410) 461-2855

Eco-Science Professionals, Inc.
 CONSULTING ECOLOGISTS

MD DNE Qualified Professional
 USACE Wetland Designer
 Certification No. WDCP9310R100418
John P. Canoles
 JOHN P. CANOLES

OWNER/DEVELOPER
 CHERRYTREE I, LLC
 7950 INDIAN PIPE COURT
 COLUMBIA, MARYLAND 21046

ASBUILT

F 01-114

ASBUILT FILE-114

FCE PLANTING AREA 1 (1.418 acres)

QTY.	SPECIES	SIZE	SPACING
20	ACER RUBRUM - RED MAPLE	1" CAL.	15' O.C.
10	CERCIS CANADENSIS - RED BUD	1" CAL.	15' O.C.
12	CORNUS FLORIDA - FLOWERING DOGWOOD	1" CAL.	15' O.C.
15	FRAXINUS AMERICANA - WHITE ASH	1" CAL.	15' O.C.
20	QUERCUS ALBA - WHITE OAK	1" CAL.	15' O.C.
60	ACER RUBRUM - RED MAPLE	2 - 3' WHIP	**
25	CERCIS CANADENSIS - RED BUD	2 - 3' WHIP	**
70	FRAXINUS AMERICANA - WHITE ASH	2 - 3' WHIP	**
10	LIRIODENDRON TULIPIFERA - POPLAR	2 - 3' WHIP	**
35	NYSSA SYLVATICA - BLACK GUM	2 - 3' WHIP	**
30	PRUNUS SEROTINA - BLACK CHERRY	2 - 3' WHIP	**
25	QUERCUS RUBRA - RED OAK	2 - 3' WHIP	**
25	VIBURNUM DENTATUM - ARROWWOOD	2 - 3' B.T.	**
25	VIBURNUM PRUNIFOLIUM - BLACKHAW	2 - 3' B.T.	**

FCE PLANTING AREA 3 (1.154 acres - 0.33 acres existing hedgerow)

QTY.	SPECIES	SIZE	SPACING
10	ACER RUBRUM - RED MAPLE	1" CAL.	15' O.C.
5	CERCIS CANADENSIS - RED BUD	1" CAL.	15' O.C.
5	CORNUS FLORIDA - FLOWERING DOGWOOD	1" CAL.	15' O.C.
23	FRAXINUS AMERICANA - WHITE ASH	1" CAL.	15' O.C.
15	QUERCUS ALBA - WHITE OAK	1" CAL.	15' O.C.
40	ACER RUBRUM - RED MAPLE	2 - 3' WHIP	**
30	CERCIS CANADENSIS - RED BUD	2 - 3' WHIP	**
55	FRAXINUS AMERICANA - WHITE ASH	2 - 3' WHIP	**
50	LIRIODENDRON TULIPIFERA - POPLAR	2 - 3' WHIP	**
30	NYSSA SYLVATICA - BLACK GUM	2 - 3' WHIP	**
30	PRUNUS SEROTINA - BLACK CHERRY	2 - 3' WHIP	**
30	QUERCUS RUBRA - RED OAK	2 - 3' WHIP	**
20	VIBURNUM DENTATUM - ARROWWOOD	2 - 3' B.T.	**
20	VIBURNUM PRUNIFOLIUM - BLACKHAW	2 - 3' B.T.	**

KEY:
 ** - PLANTINGS TO BE SPREAD ON 11 FOOT CENTERS - PLANTINGS SHOULD BE INSTALLED IN ROWS TO FACILITATE FUTURE MAINTENANCE. WHERE POSSIBLE ROWS SHOULD BE MADE ALONG CONTOUR.
 B.T. - BRANCHED TRANSPLANT

KEY:
 ** - PLANTINGS TO BE SPREAD ON 11 FOOT CENTERS - PLANTINGS SHOULD BE INSTALLED IN ROWS TO FACILITATE FUTURE MAINTENANCE. WHERE POSSIBLE ROWS SHOULD BE MADE ALONG CONTOUR.
 B.T. - BRANCHED TRANSPLANT

FCE PLANTING AREA 2 (2.412 acres)

QTY.	SPECIES	SIZE	SPACING
15	ACER RUBRUM - RED MAPLE	2" CAL.	20' O.C.
15	FRAXINUS AMERICANA - WHITE ASH	2" CAL.	20' O.C.
14	QUERCUS ALBA - WHITE OAK	2" CAL.	20' O.C.
30	ACER RUBRUM - RED MAPLE	1" CAL.	15' O.C.
20	CERCIS CANADENSIS - RED BUD	1" CAL.	15' O.C.
25	CORNUS FLORIDA - FLOWERING DOGWOOD	1" CAL.	15' O.C.
30	FRAXINUS AMERICANA - WHITE ASH	1" CAL.	15' O.C.
30	QUERCUS ALBA - WHITE OAK	1" CAL.	15' O.C.
70	ACER RUBRUM - RED MAPLE	2 - 3' WHIP	**
35	CERCIS CANADENSIS - RED BUD	2 - 3' WHIP	**
80	FRAXINUS AMERICANA - WHITE ASH	2 - 3' WHIP	**
10	LIRIODENDRON TULIPIFERA - POPLAR	2 - 3' WHIP	**
55	NYSSA SYLVATICA - BLACK GUM	2 - 3' WHIP	**
50	PRUNUS SEROTINA - BLACK CHERRY	2 - 3' WHIP	**
35	QUERCUS RUBRA - RED OAK	2 - 3' WHIP	**
30	VIBURNUM DENTATUM - ARROWWOOD	2 - 3' B.T.	**
35	VIBURNUM PRUNIFOLIUM - BLACKHAW	2 - 3' B.T.	**

FCE PLANTING AREA 4 (0.906 acres)

QTY.	SPECIES	SIZE	SPACING
15	ACER RUBRUM - RED MAPLE	1" CAL.	15' O.C.
10	CERCIS CANADENSIS - RED BUD	1" CAL.	15' O.C.
10	CORNUS FLORIDA - FLOWERING DOGWOOD	1" CAL.	15' O.C.
20	FRAXINUS AMERICANA - WHITE ASH	1" CAL.	15' O.C.
15	QUERCUS ALBA - WHITE OAK	1" CAL.	15' O.C.
30	ACER RUBRUM - RED MAPLE	2 - 3' WHIP	**
15	CERCIS CANADENSIS - RED BUD	2 - 3' WHIP	**
35	FRAXINUS AMERICANA - WHITE ASH	2 - 3' WHIP	**
35	LIRIODENDRON TULIPIFERA - POPLAR	2 - 3' WHIP	**
20	PRUNUS SEROTINA - BLACK CHERRY	2 - 3' WHIP	**
25	QUERCUS RUBRA - RED OAK	2 - 3' WHIP	**
15	VIBURNUM DENTATUM - ARROWWOOD	2 - 3' B.T.	**
20	VIBURNUM PRUNIFOLIUM - BLACKHAW	2 - 3' B.T.	**

KEY:
 ** - PLANTINGS TO BE SPREAD ON 11 FOOT CENTERS - PLANTINGS SHOULD BE INSTALLED IN ROWS TO FACILITATE FUTURE MAINTENANCE. WHERE POSSIBLE ROWS SHOULD BE MADE ALONG CONTOUR.
 B.T. - BRANCHED TRANSPLANT

KEY:
 ** - PLANTINGS TO BE SPREAD ON 11 FOOT CENTERS - PLANTINGS SHOULD BE INSTALLED IN ROWS TO FACILITATE FUTURE MAINTENANCE. WHERE POSSIBLE ROWS SHOULD BE MADE ALONG CONTOUR.
 B.T. - BRANCHED TRANSPLANT

NOTE:
 A DETAILED PLANTING PLAN WILL BE PROVIDED TO THE PLANTING CONTRACTOR.

Planting/Soil Specifications

- Planting of nursery stock shall take place between March 15th and April 30th or September 15th - November 15th.
- A twelve (12) inch layer of topsoil shall be spread over all forestation areas impacted by site grading to assure a suitable planting area. Disturbed areas shall be seeded and stabilized as per general construction plan for project. Planting areas not impacted by site grading shall have no additional topsoil installed.
- All bare-root planting stock shall have their root systems dipped into an anti-desiccant gel prior to planting.
- Plants shall be installed so that the top of root mass is level with the top of existing grade. Backfill in the planting pits shall consist of 3 parts existing soil to 1 part pine fines or equivalent.
- Fertilizer shall consist of Agriform 22-9-2, or equivalent, applied as per manufacturer's specifications.
- A two (2) inch layer of hardwood mulch shall be placed over the root area of all plantings.
- Plant material shall be transported to the site in a tarped or covered truck. Plants shall be kept moist prior to planting.
- All non-organic debris associated with the planting operation shall be removed from the site by the contractor.

Sequence of Construction

- Sediment control and tree protection devices shall be installed in accordance with general construction plan for site. Site shall be graded in accordance with general construction plans.
- Proposed forestation areas impacted by site grading shall be topsoiled and stabilized as per *2 of Planting/Soil Specifications for project.
- Plants shall be installed as per Plant Schedule and the Planting/Soil Specifications for the project.
- Upon completion of the planting, signage shall be installed as per the Forest Protection Devices shown on the Forest Conservation Plan.
- Plantings shall be maintained and guaranteed in accordance with the Maintenance and Guarantee requirements for project.

Maintenance of Plantings

- Maintenance of plantings shall last for a period of 24 months.
- All plant material shall be watered twice a month during the 1st growing season. Watering may be more or less frequent depending on weather conditions. During second growing season, once a month during May-September, if needed.
- Invasive exotics and noxious weeds will be removed from forestation areas. Old field successional species will be retained.
- Plants will be examined a minimum two times during the growing season for serious plant pests and diseases. Serious problems will be treated with the appropriate agent.
- Dead branches will be pruned from plantings.

Guarantee Requirements

- A 75 percent survival rate of forestation plantings will be required at the end of the 24 month maintenance period. All plant material below the 75 percent threshold will be replaced at the beginning of the next growing season.

Surety for Forestation

- The developer shall post a surety bond, letter of credit to ensure that forestation plantings are completed. Upon acceptance of the plantings by the County, the bond shall be released.

Cost of Forestation Project

- The estimated cost of installation of the proposed planting plan is \$30,000.

FCP NOTES

- The reforestation plans shown hereon have been prepared to meet the reforestation obligation of the proposed Cherrytree Park subdivision.
- Any Forest Conservation Easement (FCE) Area shown hereon is subject to protective covenants which may be found in the Land Records of Howard County which restrict the disturbance and use of these areas.
- The Forest Conservation Easements have been established to fulfill the requirements of Section 16.1200 of the Howard County Code, Forest Conservation Act. No clearing, grading, or construction is permitted within the Forest Conservation Easements; however, forest management practices as defined in the Deed of Forest Conservation Easement are allowed.
- There shall be no clearing, grading, construction or disturbance of vegetation in the Forest Conservation Easement, except as permitted by Howard County DPZ.
- No stockpiles, parking areas, equipment cleaning areas, etc. shall occur within areas designated as Forest Conservation Easements.
- Permanent signage shall be placed 50-100' apart along the boundaries of all areas included in Forest Conservation Easements.




APPROVED: DEPARTMENT OF PUBLIC WORKS
 [Signature] 1-16-02
 CHIEF, BUREAU OF HIGHWAYS DATE

APPROVED: DEPARTMENT OF PLANNING AND ZONING
 [Signature] 2/4/02
 CHIEF, DIVISION OF LAND DEVELOPMENT DATE

[Signature] 2/4/02
 CHIEF, DEVELOPMENT ENGINEERING DIVISION DATE

Cherrytree Park Site Data

	Acres
Gross Area:	41.1
Net Tract Area:	41.1
Existing Forest:	16.03
Conservation Threshold:	6.17
Afforestation Threshold:	6.17
Forest To be Retained in FCE:	4.62
Reforestation Obligation:	5.56
Offsite Afforestation Proposed:	5.89

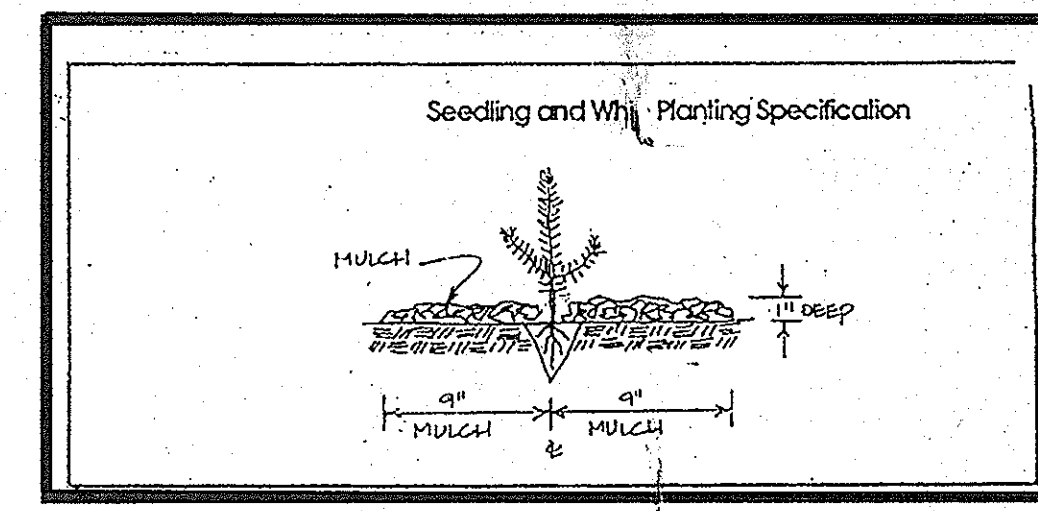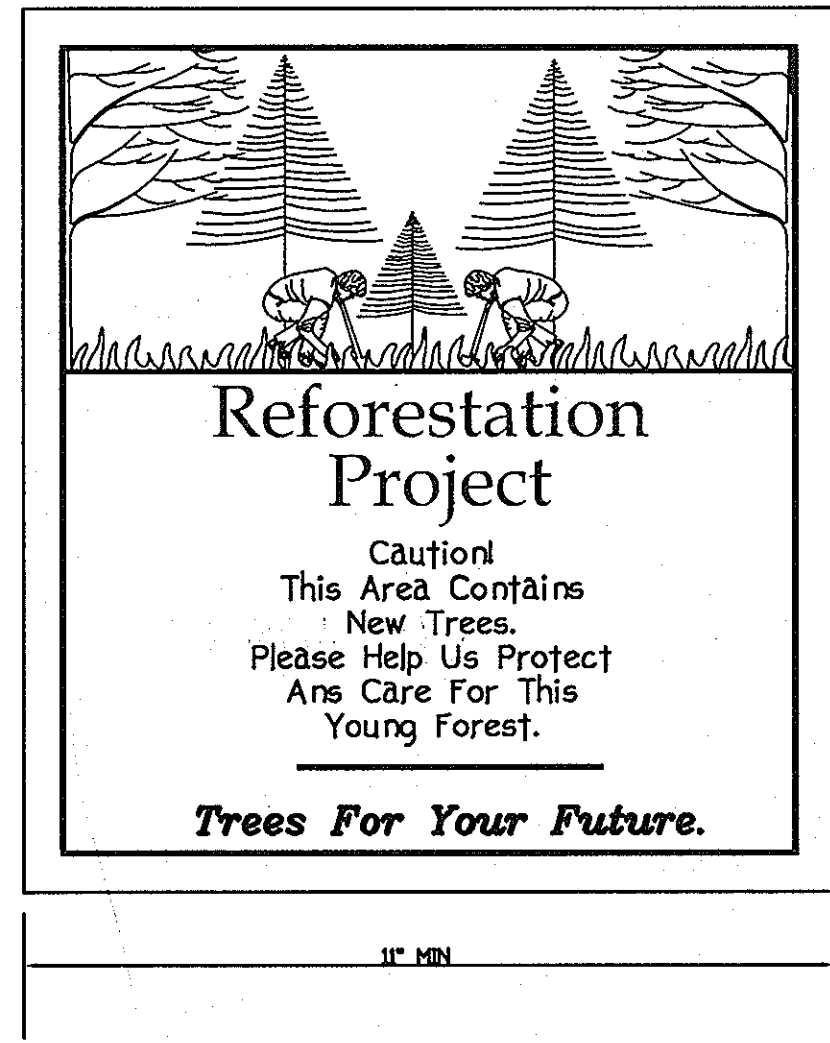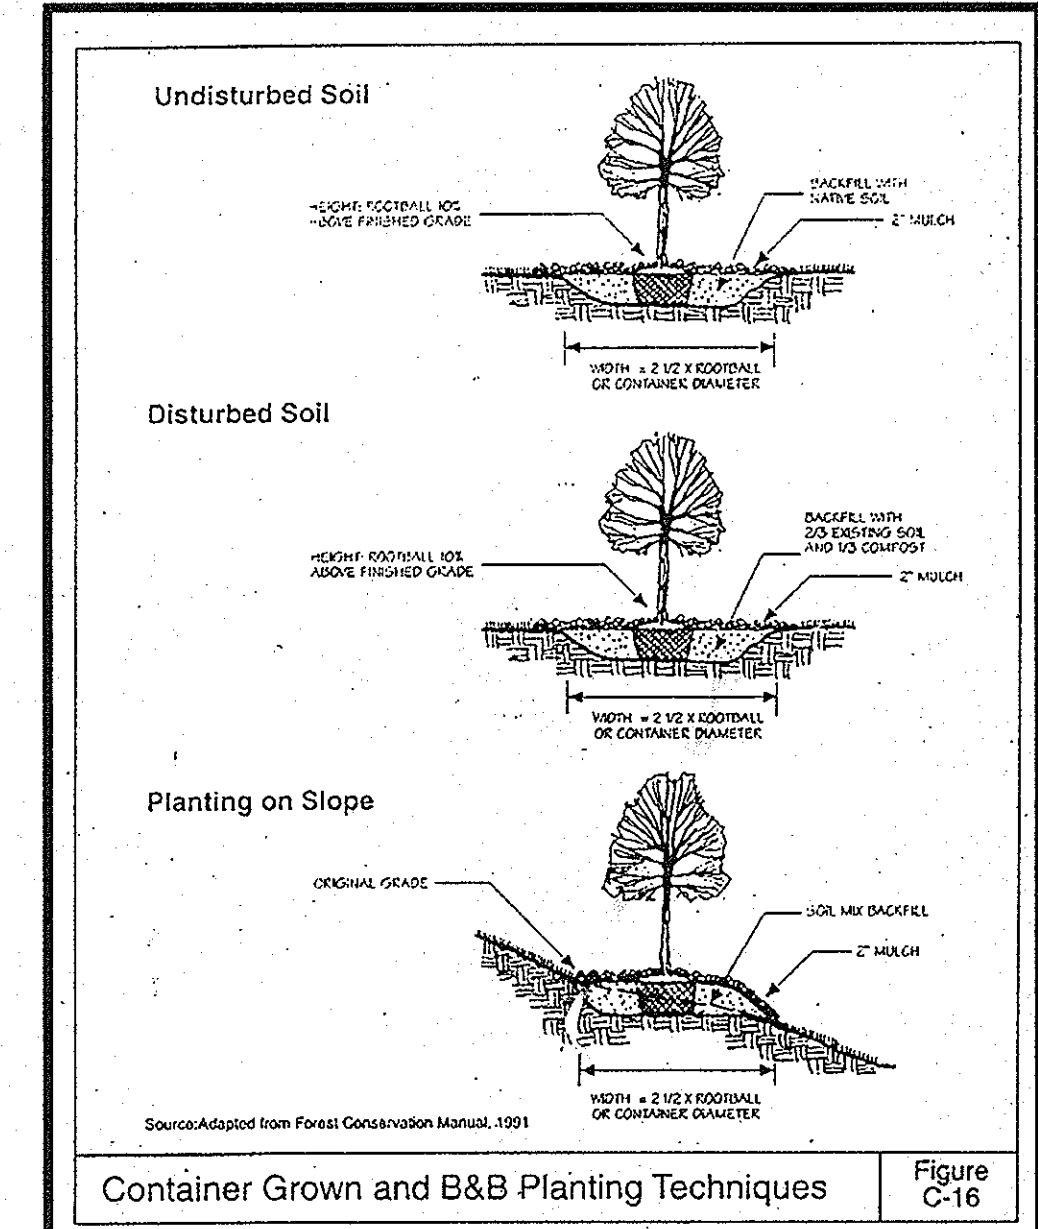

FISHER, COLLINS & CARTER, INC.
 CIVIL ENGINEERING CONSULTANTS & LAND SURVEYORS
 CENTRAL SQUARE OFFICE PARK #1072 BALTIMORE NATIONAL FREE
 ELICOTT CITY, MARYLAND 21042
 410.461.2922

Eco-Science Professionals, Inc.
 CONSULTING ECOLOGISTS

MD DNR Qualified Professional
 USACE Wetland Designer
 Certified Professional DC093340200448
 [Signature] JAMES T. CANNON

OWNER/DEVELOPER
 CHERRYTREE I, L.L.C.
 7520 INDIAN PIPE COURT
 COLUMBIA, MARYLAND 21046



OFF-SITE FOREST CONSERVATION NOTES AND DETAILS
CHERRYTREE PARK
 LOTS 1 THRU 10, OPEN SPACE LOTS 11 THRU 13
 AND BULK PARCELS 'A' THRU 'H'
 (PHASES I AND II)
 ZONED: MXD-6
 TAX MAP NO. 46 PARCEL NO. 156 GRID NO. 4
 SIXTH ELECTION DISTRICT HOWARD COUNTY, MARYLAND
 SCALE: 1" = 100'
 DATE: DECEMBER 7, 2001
 SHEET 21 OF 21

F-01-114 ASBULL