

FINAL PLAN EMERSON SECTION 2, PHASE 1-A

6th ELECTION DISTRICT HOWARD COUNTY, MARYLAND

BENCHMARK

DESCRIPTION


COORDINATES IN MARYLAND NAD83(91) (HORIZONTAL)
AND NGVD29 (VERTICAL) DATUMS.

47E4 NORTHING: 163326.2295
EASTING: 413136.2350
ELEVATION: 338.909ft.

47G2 NORTHING: 162440.1212
EASTING: 418539.2719
ELEVATION: 364.210ft.


GENERAL NOTES

1. All construction shall be in accordance with the latest standards and specifications of Howard County plus MSHA standards and specifications if applicable.
2. The contractor shall notify the Department of Public Works/Bureau of Engineering/Construction Inspection Division at 410-313-1960 at least five (5) working days prior to the start of work.
3. The contractor shall notify "Miss Utility" at 1-800-257-7777 at least 48 hours prior to any excavation work being done.
4. Traffic control devices, markings and signing shall be in accordance with the latest edition of the Manual of Uniform Traffic Control Devices (MUTCD). All street and regulatory signs be in place prior to the placement of any asphalt.
5. Street light placement and the type of fixture and pole shall be in accordance with the Howard County Design Manual, Volume III (1993) and as modified by "Guidelines for Street Lights in Residential Developments (June 1993)". A minimum spacing of 20' shall be light and any trees.
6. The existing topography is taken from aerial survey with 2' contour intervals prepared by Air Survey Corporation dated 4-3-98.
7. The coordinates shown herein are based upon the Howard County Geodetic Control which is based upon the Maryland State Plane Coordinate System, Howard County Monument Nos. 29G4 and 29G5 were used for this project.
8. Existing utilities are based on Existing Construction Plans (contract no. 30-3294-D), Field verified Manholes and proposed plans provided by MKA Engineers and GLW Engineers.
9. The traffic study for this project was prepared by Wells and Associates, and was approved on September 29, 2000.
10. Sidewalk ramps shall meet current ADA requirements.
11. Project background information:
 Subdivision Name: Emerson, Section 2
 Tax Map: 47
 Section/Area: Section 2, Phase 1-A
 Lot/Parcel: F/O: P. 837, P. 3, P. 462
 Zoning: M2D
 Election District: 6th
 Total Tract Area: 8.20 acres
 Section 2, Phase 1-A
 Preliminary Plan Approval Date: 11-21-00
 Open Space Lots: 4
 File Numbers: ZB-979M, PB-339, S-99-12, and P00-15
12. All sidewalks at intersections to have handicaps ramps. See detail on sheet 7 of 24.
13. Street trees shall be planted at least 5' from any Inlet structure.
14. All Forest Conservation obligations for the Development of Emerson Section 2, Phase 1A will be satisfied in Section 2, Phase 1B (F-01-137).
15. Stormwater Management for this project will be addressed with the installation of three Stormwater Management Facilities which will control the runoff per the latest approved Design Standards.
16. THE STORMWATER MANAGEMENT PONDS WILL BE OWNED BY THE H.O.A.
17. MAINTENANCE RESPONSIBILITY, ROUTINE AND NON-ROUTINE SCHEDULE IS SHOWN ON SHEET 24, NOTE 1T.

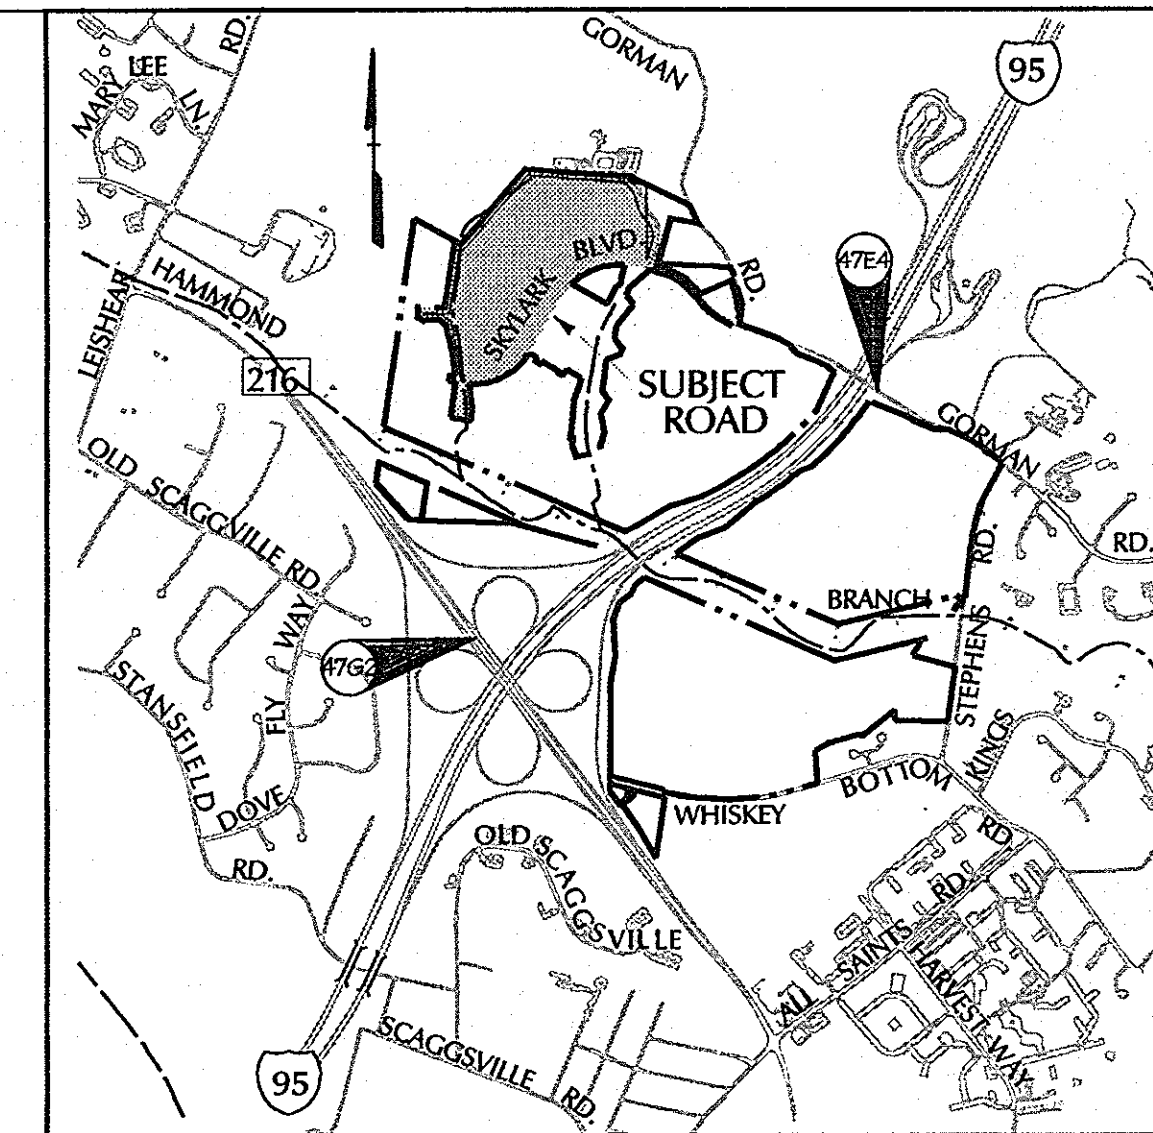

LOCATION MAP

SCALE: 1"=2000'

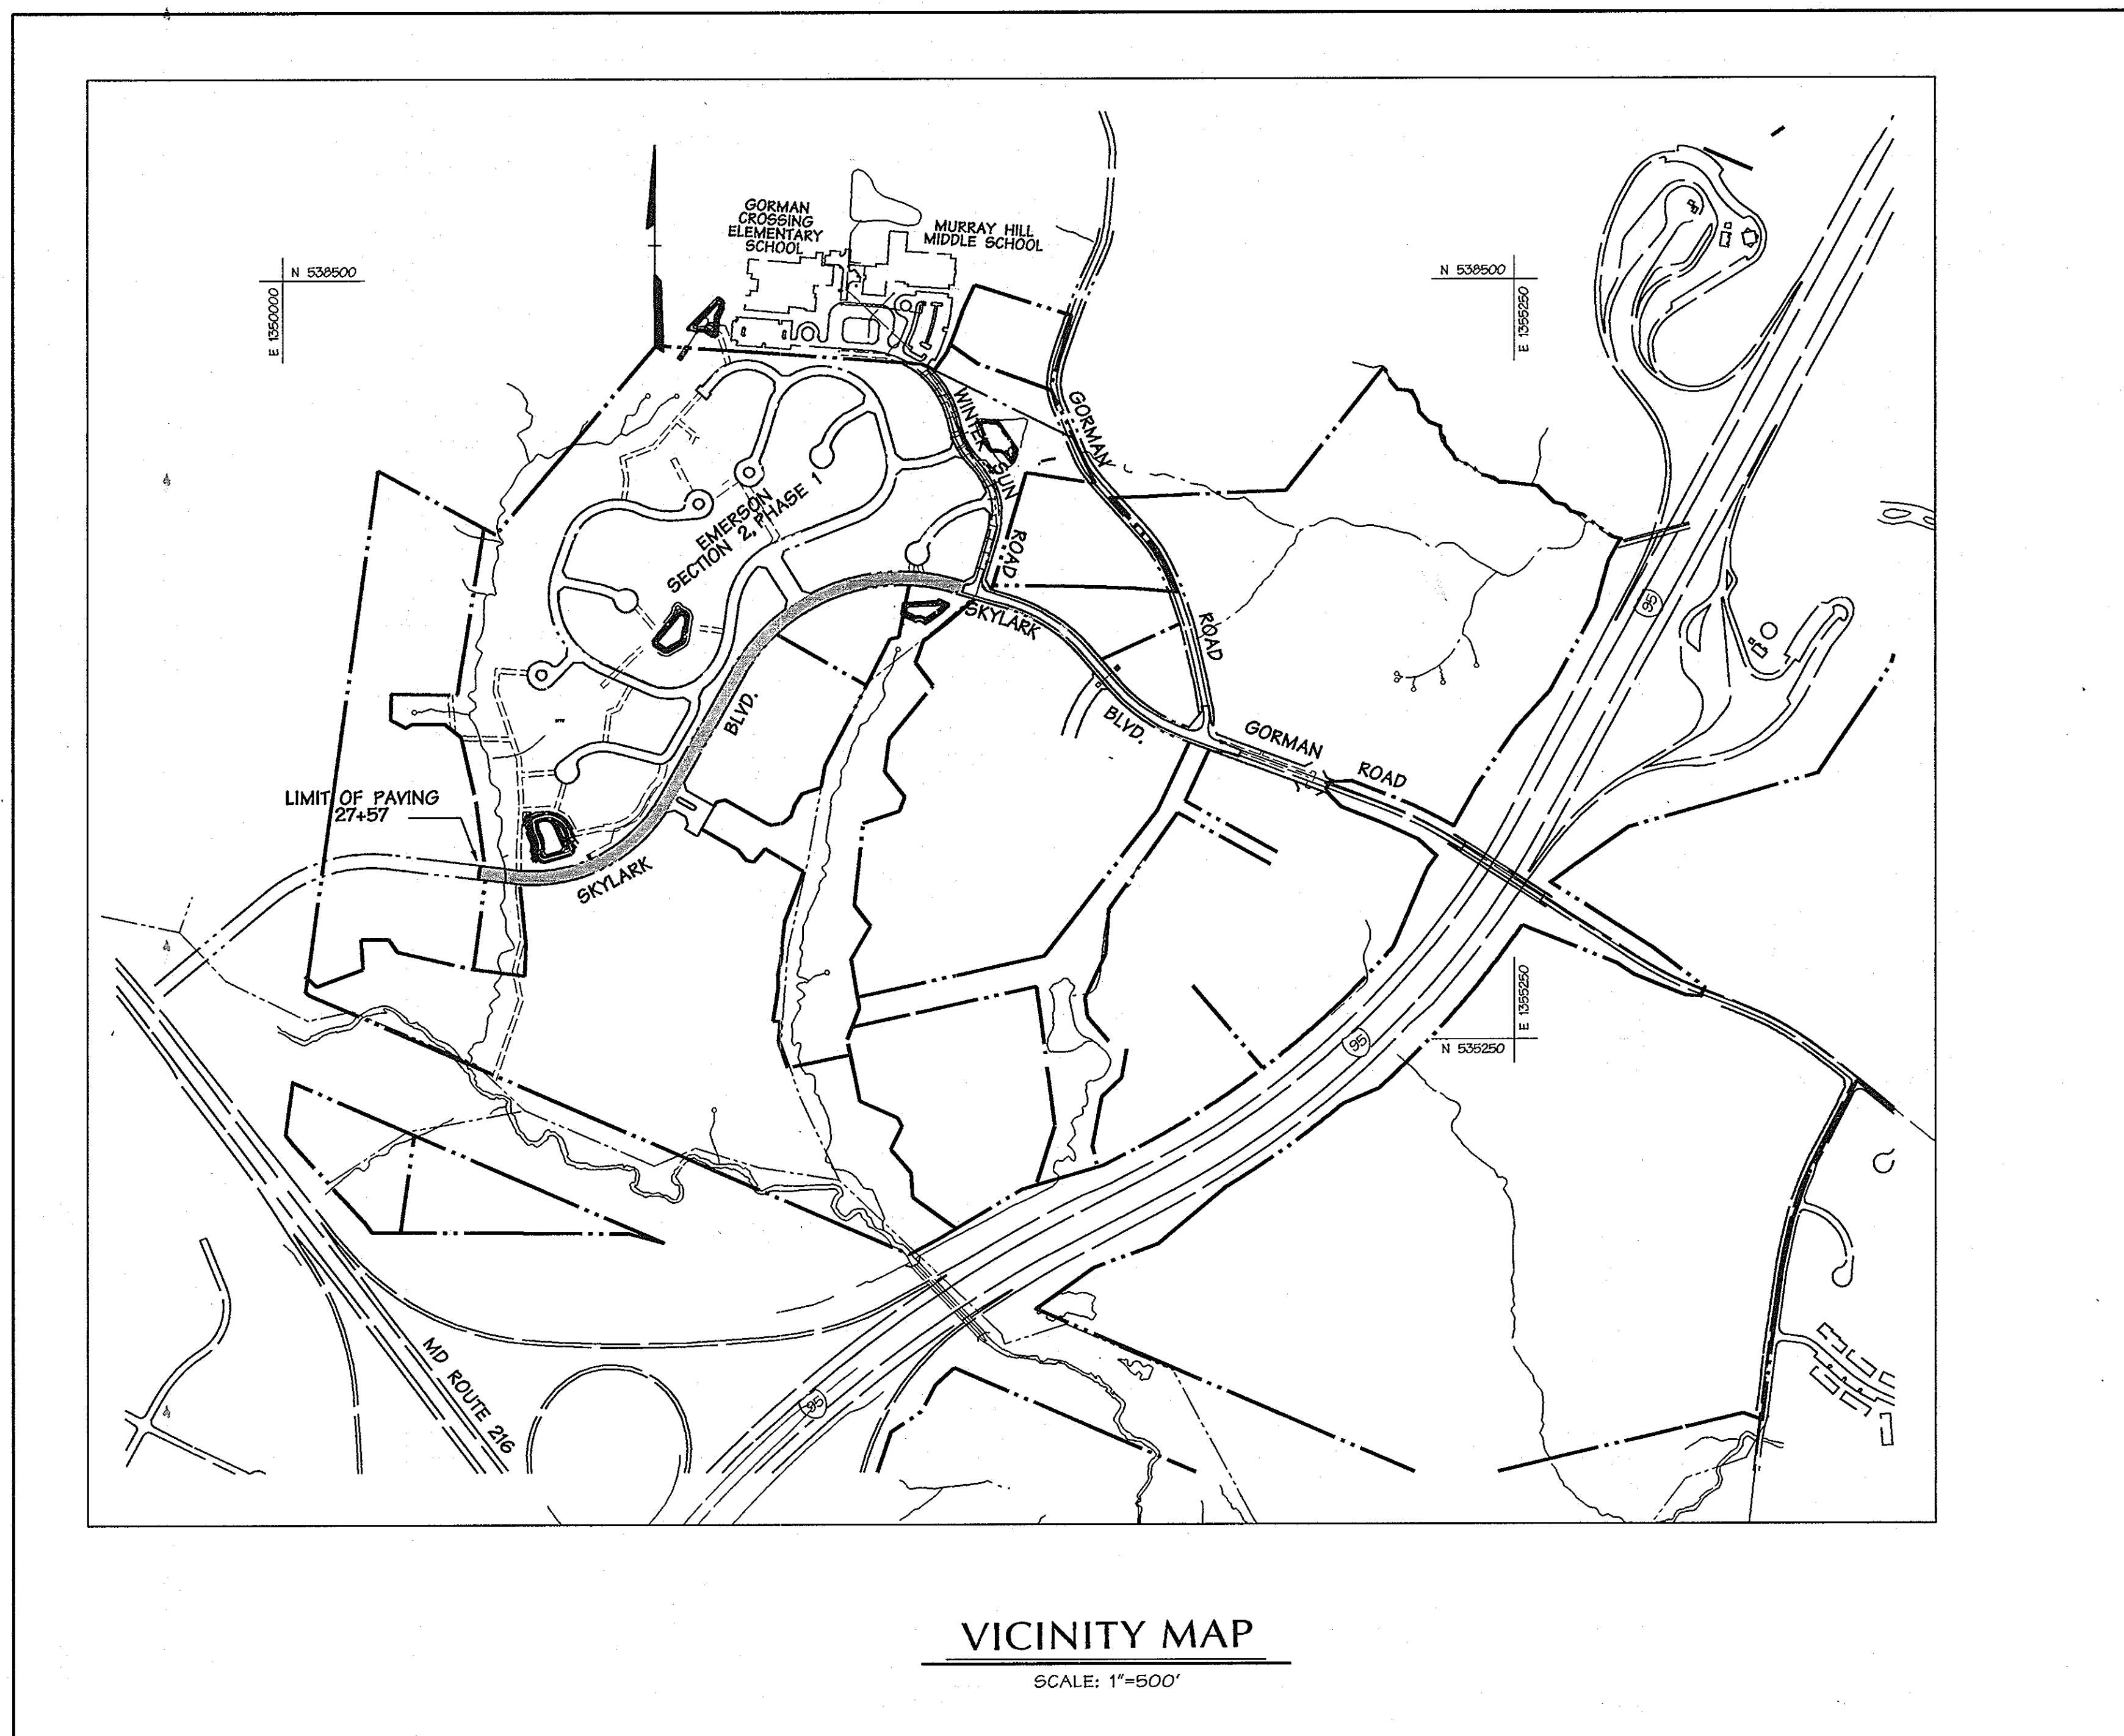

VICINITY MAP

SCALE: 1"=500'

SHEET INDEX	
NO.	DESCRIPTION
1	TITLE SHEET
2	ROAD CONSTRUCTION PLAN SKYLARK BOULEVARD (EAST)
3	ROAD CONSTRUCTION PLAN SKYLARK BLVD & STA 44+50 (EAST) - 1'+00' (WEST)
4	ROAD CONSTRUCTION PLAN SKYLARK BOULEVARD & STA 10+00 - 20+00
5	ROAD CONSTRUCTION PLAN SKYLARK BOULEVARD & STA 20+00 - 27+57
6	PROPOSED CULVERT PLAN & PROFILE
7	DRAINAGE AREA MAP
8	STORM DRAIN PROFILES
9	ROAD CONSTRUCTION DETAILS
10	EROSION & SEDIMENT CONTROL DRAINAGE AREA MAP
11	EROSION & SEDIMENT CONTROL PLAN
12	EROSION & SEDIMENT CONTROL PLAN
13	EROSION & SEDIMENT CONTROL PLAN
14	EROSION & SEDIMENT CONTROL DETAILS
15	EROSION & SEDIMENT CONTROL DETAILS
16	EROSION & SEDIMENT CONTROL DETAILS
17	STORM WATER MANAGEMENT DRAINAGE AREA MAP
18	Basin I / SWM I GRADING PLAN
19	Basin I / SWM I DETAILS
20	Basin II / SWM II GRADING PLAN
21	Basin II / SWM II DETAILS
22	Basin VI / SWM VI GRADING PLAN
23	Basin VI / SWM VI DETAILS
24	SWM GENERAL DETAILS & SPECIFICATIONS
25	SOIL BORINGS
26	LANDSCAPE PLAN
27	LANDSCAPE DETAILS

APPROVED: HOWARD COUNTY DEPARTMENT OF PUBLIC WORKS

Andrew M. Daniels 10-29-01
CHIEF, BUREAU OF HIGHWAYS MS DATE

APPROVED: HOWARD COUNTY DEPT. OF PLANNING & ZONING
John P. ... 10/31/01
CHIEF, DEVELOPMENT ENGINEERING DIVISION MK DATE

John P. ... 11/6/01
CHIEF, DIVISION OF LAND DEVELOPMENT HB DATE

DATE NO. REVISION DESCRIPTION

EMERSON

FORMERLY KEY PROPERTY
SECTION 2, PHASE 1A

OWNER/DEVELOPER:
THE HOWARD RESEARCH & DEVELOPMENT CORPORATION
10275 Little Patuxent Parkway
Columbia, Maryland 21044


DMW
Darr-McCune-Walker, Inc.
200 East Pennsylvania Avenue
Towson, Maryland 21286
(410) 296-3833
Fax 296-4708
A Team of Land Planners,
Landscape Architects,
Engineers, Surveyors &
Environmental Professionals

SUBDIVISION NAME: EMERSON SECTION 2 SECTION AREA: PHASE 1A LOT/PARCEL # P. 837, P. 3, P. 462
PLAT OF: 10/27/01 ZONE: M2D TAXING MAP: 6 TH CROSS TRACT: F-01-137
WATER CODE: LA 30.00.00 SEWER CODE: 6 TH

TITLE SHEET

Des By: MAT/JDC Scale: AS SHOWN Proj. No.: 95054.F
Dm By: KMF/WHJ Date: 9-26-01
Chk By: Approved

1 of 27

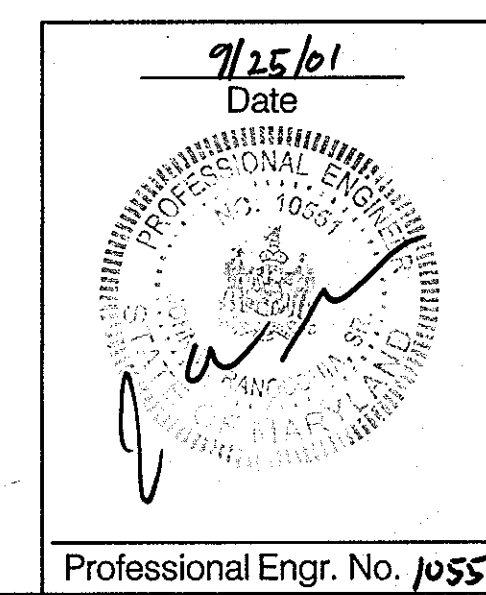

Professional Engr. No. 10551

F-01-136
Tue Sep 25 11:20:26 2001\95054.F\95054.F



ROAD & STORM DRAIN AS-BUILT
Shanaberger & Lane 9/26/01

SHANABERGER & LANE
8726 TOWN & COUNTRY BLVD.
SUITE 201
ELLCOTT CITY, MARYLAND 21043

CURVE DATA					
NAME	DELTA	RADIUS	LENGTH	TANGENT	CHORD
①	32°25'48"	700.00'	396.21'	203.57'	
②	28°56'29"	700.00'	348.51'	178.48'	

APPROVED: HOWARD COUNTY DEPARTMENT OF PUBLIC WORKS
Andrew M. Danziger 10/29/01
 CHIEF, BUREAU OF HIGHWAYS

APPROVED: HOWARD COUNTY DEPT. OF PLANNING & ZONING
William D. ... 10/31/01
 CHIEF, DEVELOPMENT ENGINEERING DIVISION MKK

Colman ... 11/6/01
 CHIEF, DIVISION OF LAND DEVELOPMENT

STREET LIGHT LEGEND


* 250 WATT HIGH PRESSURE SODIUM (HPS) VAPOR PENDANT (P&C) MOUNTED AT 30' ON A BRONZE FIBERGLASS POLE USING 1" DIA. 2" DIA.

STREET LIGHT TABLE


DWG. NO.	STREET NAME	STATION	OFF-SET	FIXTURE / POLE TYPE	COMMENTS
	SKYLARK BLVD.	54+80	24' LT	*	Angle to center of intersection
	SKYLARK BLVD.	52+50	23' LT	*	
	SKYLARK BLVD.	50+00	28' RT	*	
	SKYLARK BLVD.	48+50	23' LT	*	
	SKYLARK BLVD.	46+00	23' LT	*	

STREET SIGN LEGEND

- 24" X 30" RECTANGLE, R2-1, SPEED LIMIT 25
- 30" X 30" OCTAGON, R1-1, STOP SIGN

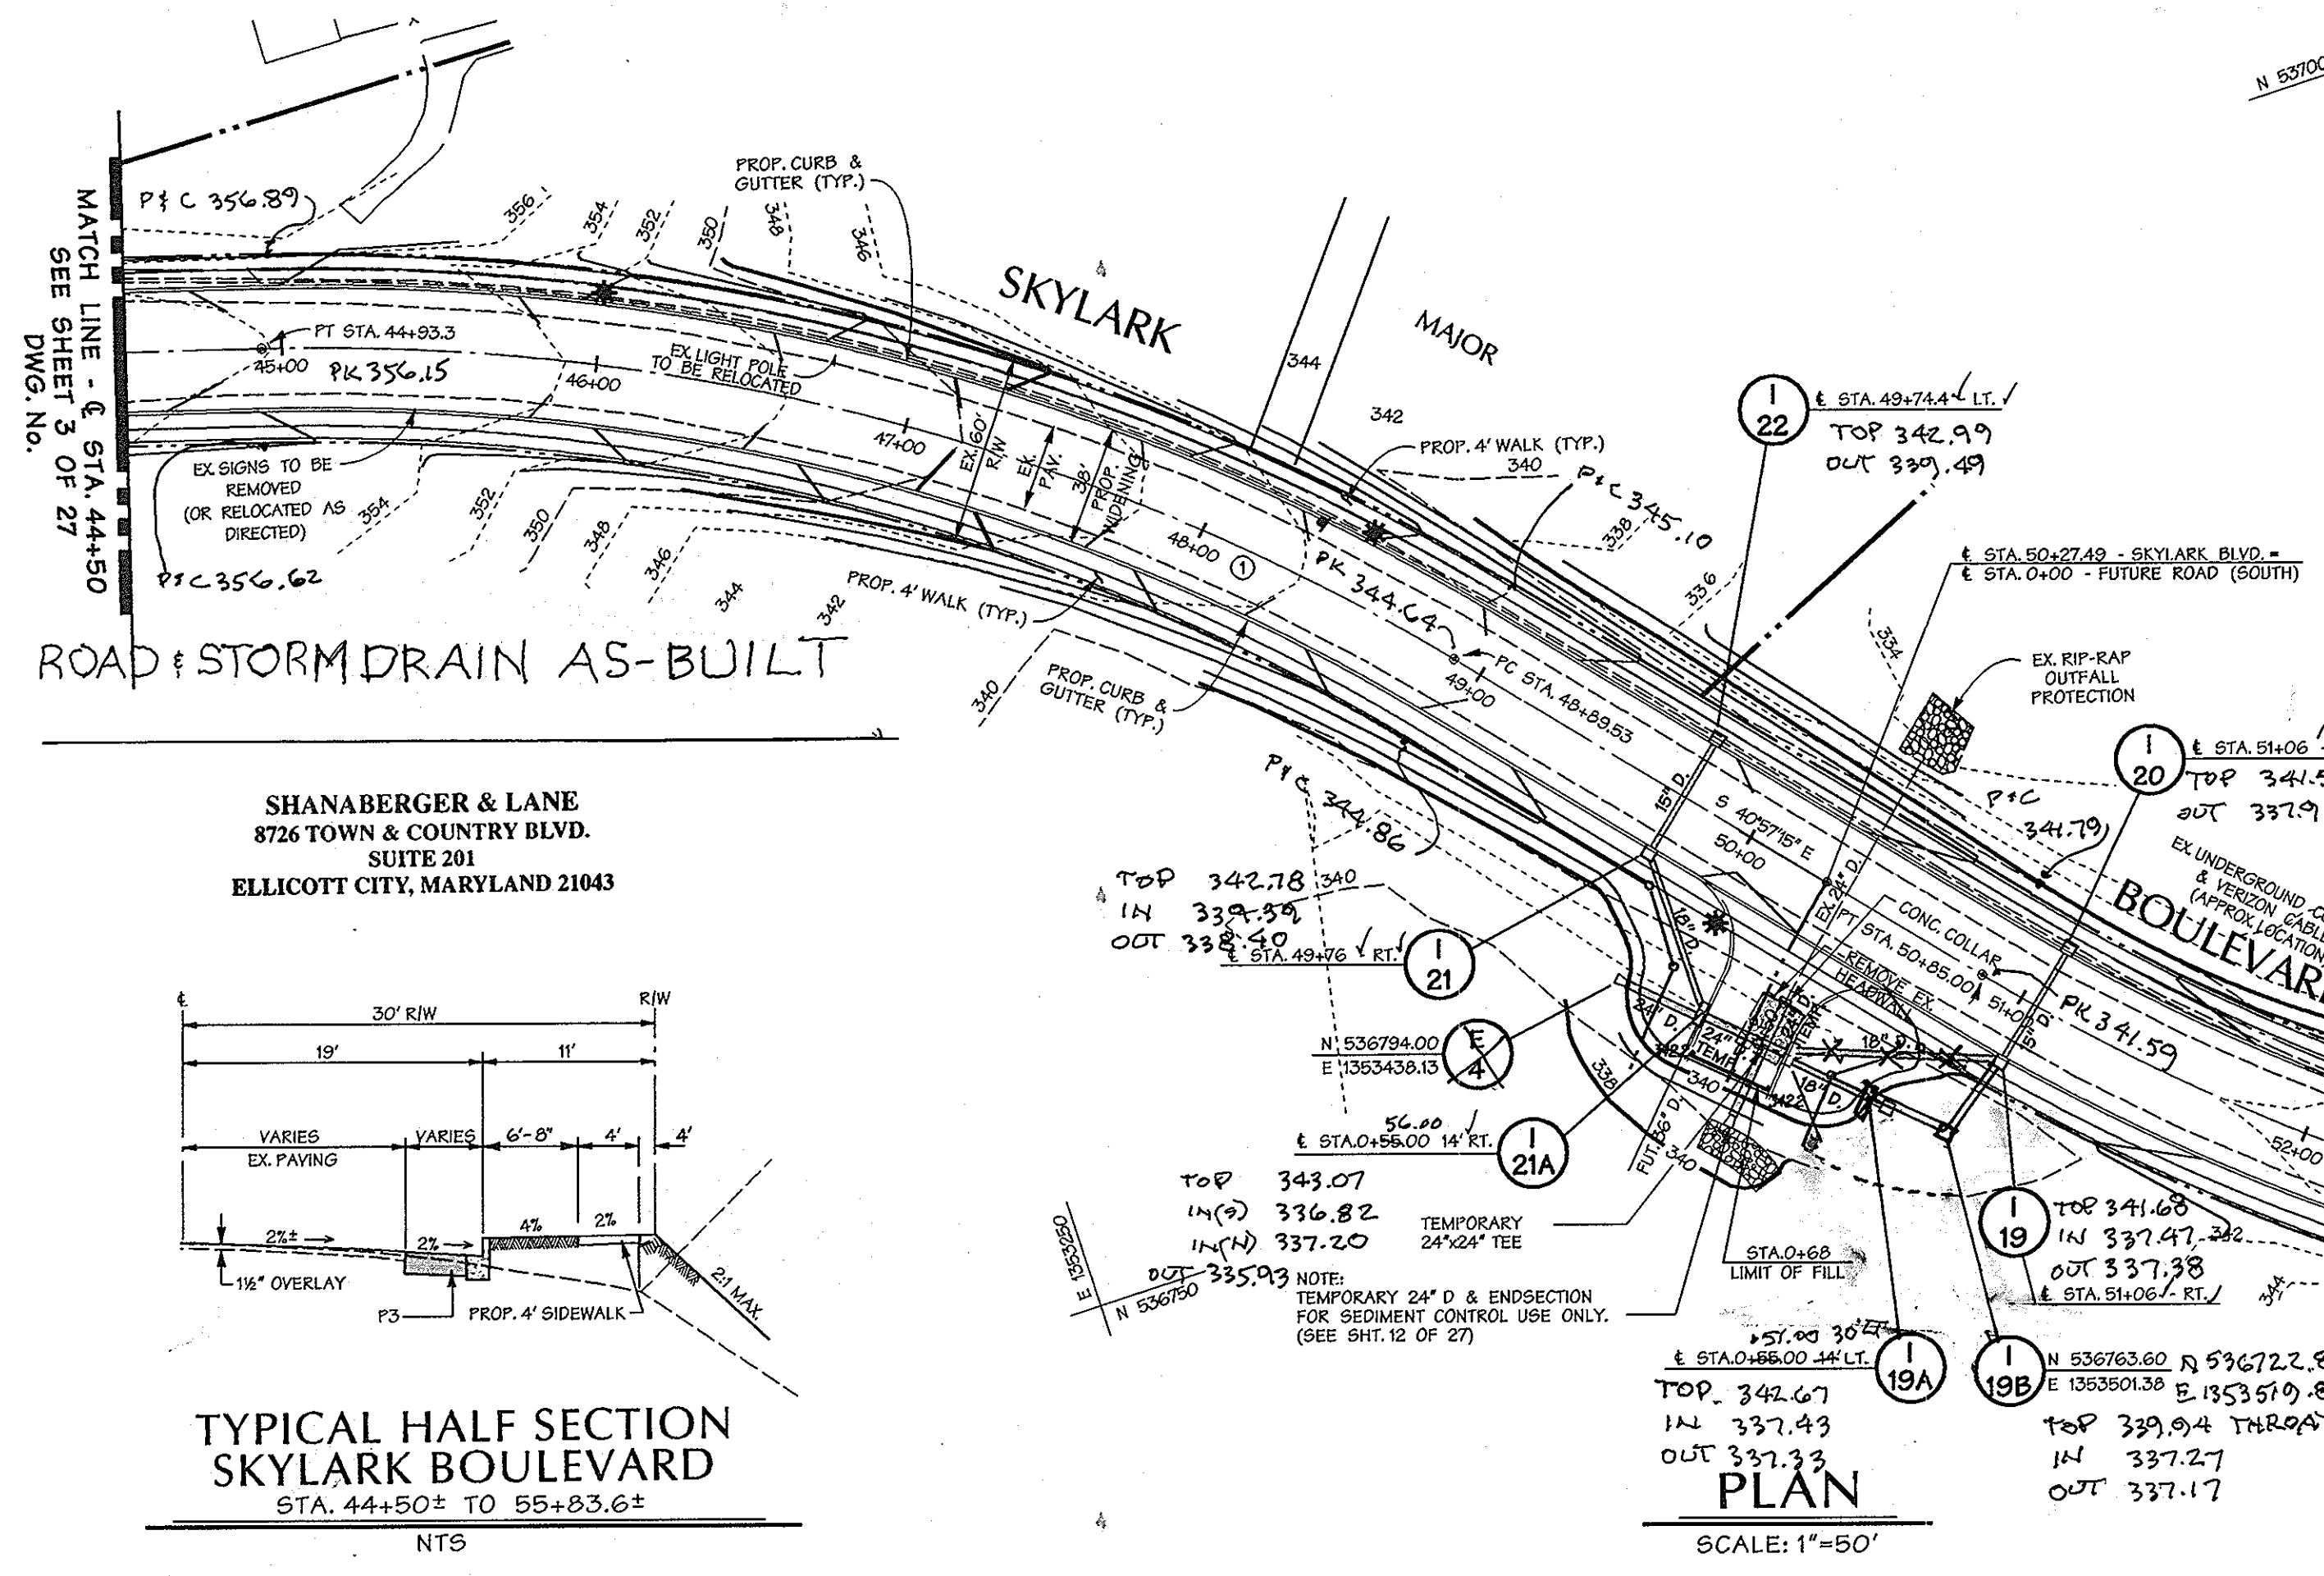

SHANABERGER & LANE
 8726 TOWN & COUNTRY BLVD.
 SUITE 201
 ELLICOTT CITY, MARYLAND 21043

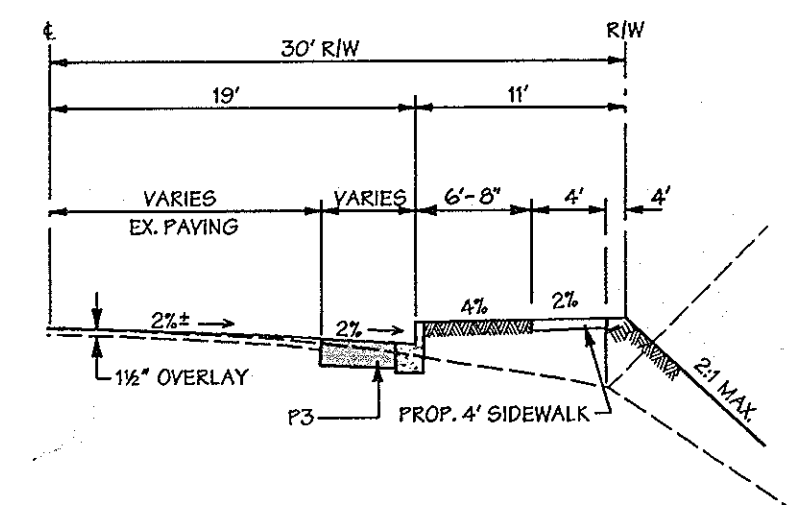

TYPICAL HALF SECTION SKYLARK BOULEVARD
 STA. 44+50± TO 55+83.6±
 NTS

- NOTE:
 1. FOR ADDITIONAL INFO, SEE DETAIL R10.01
 2. PROVIDE A ONE FOOT FULL DEPTH SAWCUT AT THE ROAD MIDDLINE

9/25/01
 Date

Professional Engr. No. 10551

EMERSON
 FORMERLY KEY PROPERTY
 SECTION 2, PHASE 1A

OWNER/DEVELOPER:
 THE HOWARD RESEARCH & DEVELOPMENT CORPORATION
 10275 Little Patuxent Parkway
 Columbia, Maryland 21044


DMW
 Draft: McCune-Walker, Inc.
 200 East Pennsylvania Avenue
 Timonium, Maryland 21088
 (410) 296-5533
 Fax: 296-4706

A Team of Land Planners, Landscape Architects, Engineers, Surveyors & Environmental Professionals

SUBMISSION NAME	SECTION/AREA	LOT/PARCEL #
EMERSON SECTION 2	PHASE 1A	P10, P. 637, P. 3, P. 462
DATE FOR PLAN	TRACED	DATE FOR PLAN
DATE FOR PLAN	DATE FOR PLAN	DATE FOR PLAN
DATE FOR PLAN	DATE FOR PLAN	DATE FOR PLAN

TITLE ROAD CONSTRUCTION PLAN SKYLARK BOULEVARD (EAST)

Des By	Scale	Proj. No.
MAT/JDC	1"=50'	95054.F
Dm By	Date	
KMF/WJH	9-26-01	
Chk By	Approved	
		2 of 27

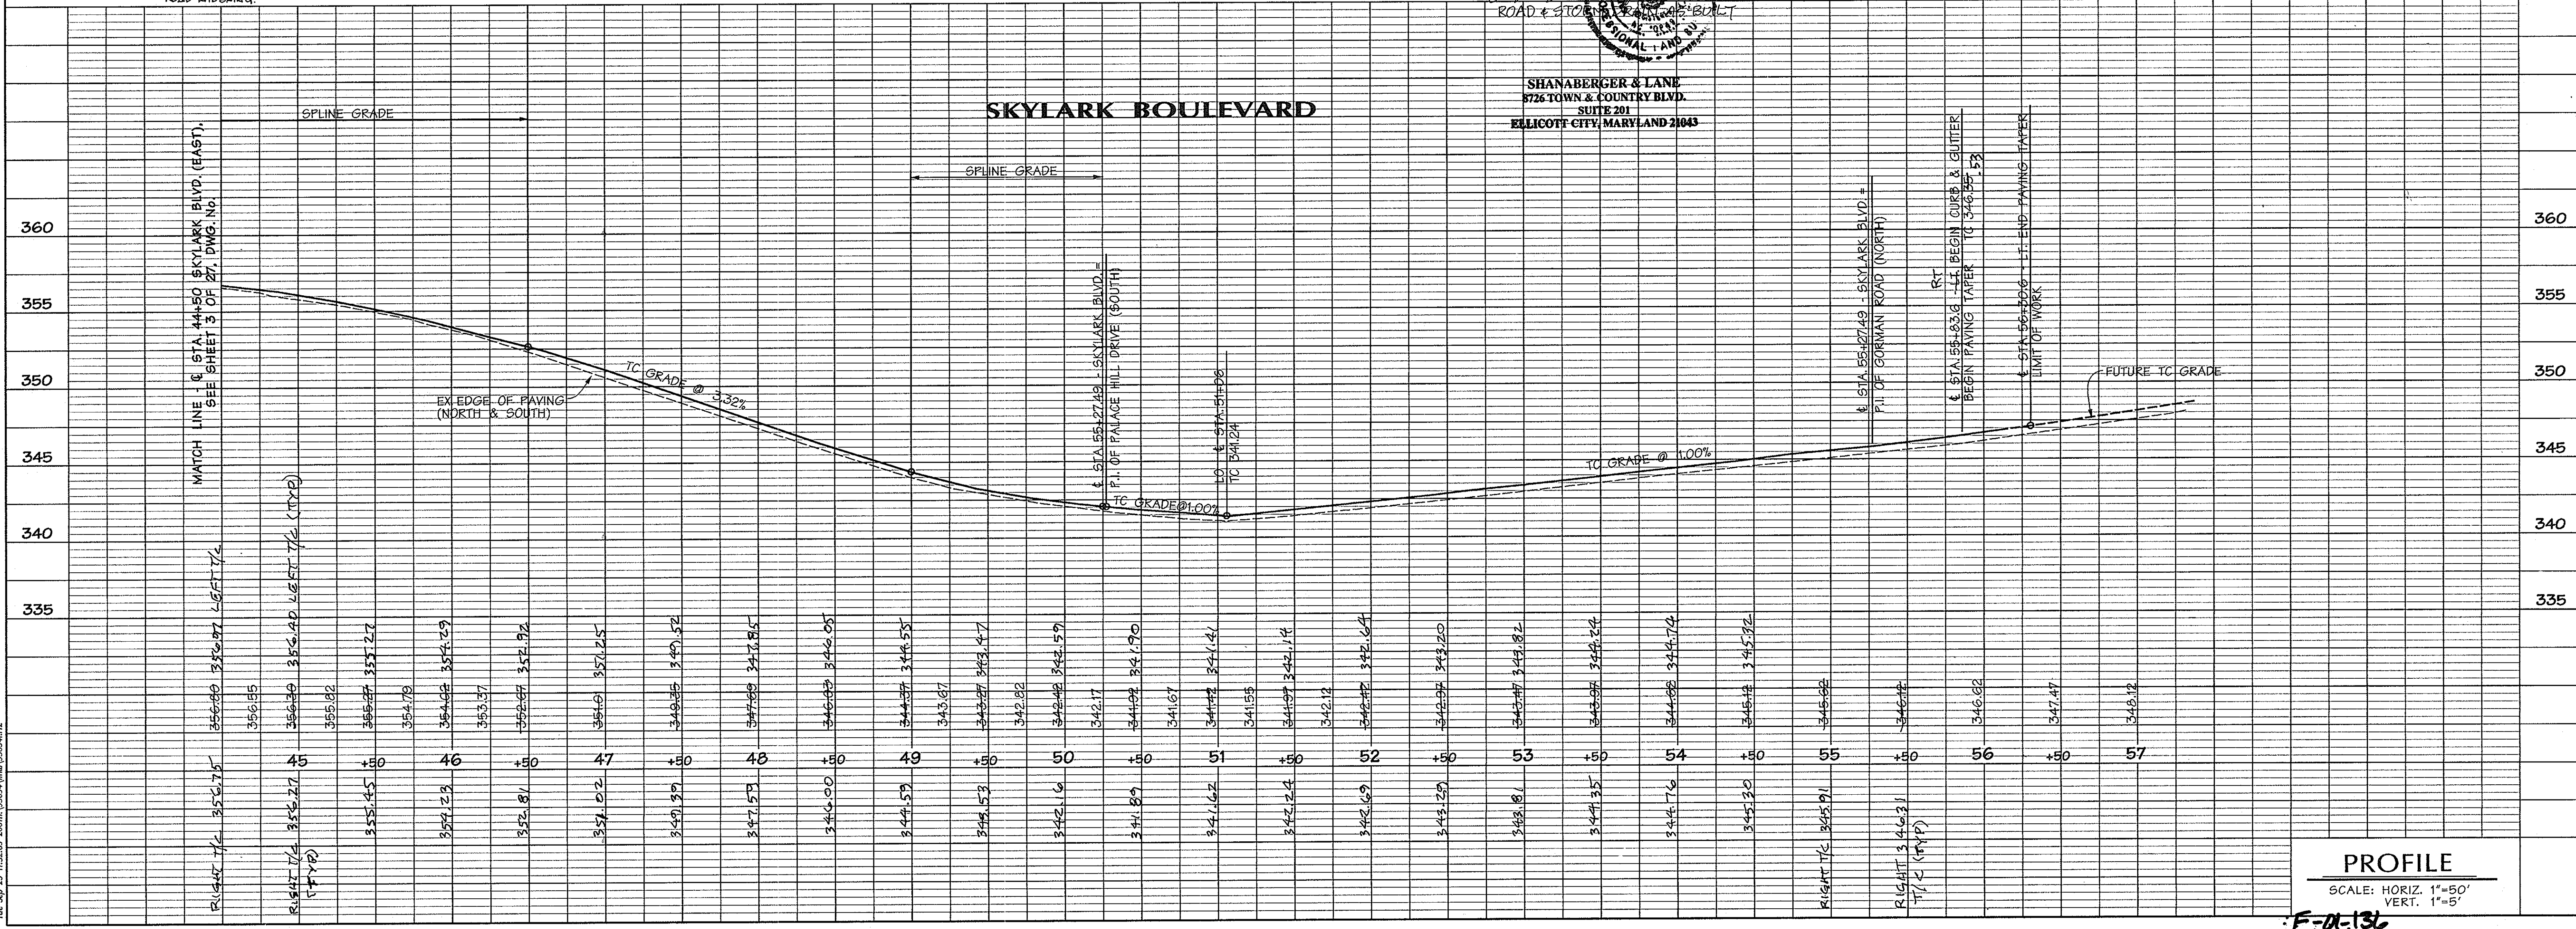

PROFILE

SCALE: HORIZ. 1"=50'
 VERT. 1"=5'

F-01-136

CURVE DATA					
NAME	DELTA	RADIUS	LENGTH	TANGENT	CHORD
①	77°12'	800.00'	1075.0'	636.56'	568°06'22"W 996.24'

APPROVED: HOWARD COUNTY DEPARTMENT OF PUBLIC WORKS
Richard M. Dumble 10-20-01
 CHIEF, BUREAU OF HIGHWAYS

APPROVED: HOWARD COUNTY DEPT. OF PLANNING & ZONING
John P. ... 10/31/01
 CHIEF, DEVELOPMENT ENGINEERING DIVISION MK

John P. ... 11/6/01
 CHIEF, DIVISION OF LAND DEVELOPMENT HP

1/22/02 **STORM DRAIN OUTFALL**
 Date No. Revision Description

EMERSON

FORMERLY KEY PROPERTY
SECTION 2, PHASE 1A

OWNER/DEVELOPER:
 THE HOWARD RESEARCH & DEVELOPMENT CORPORATION
 10275 Little Patuxent Parkway
 Columbia, Maryland 21044

DMW
 David M. Case-Walker, Inc.
 200 East Pennsylvania Avenue
 Towson, Maryland 21286
 (410) 286-5383
 Fax 286-4705

A Team of Land Planners,
Landscape Architects,
Engineers, Surveyors &
Environmental Professionals

SUBMISSION NAME	EMERSON SECTION 2	SECTION AREA	PHASE 1	LOI/PARCEL #	PI 0.837, P. 3, P. 462
DATE	1-22-02	ZONE	TAKING MAP	ELECT DISTRICT	CESUS TRACT
WATER CODE	1a, 8, 20, 8, 21	MOD	47	6 TH	

TITLE			
ROAD CONSTRUCTION PLAN			
SKYLARK BOULEVARD			
CL STA. 44+50 (East) - 10+00 (West)			
Des By	MAT/JDC	Scale	1"=50'
Drn By	WHJ/MGS	Date	9-26-01
Chk By		Approved	
			Proj. No. 95054.F 3 of 27

STREET LIGHT LEGEND

* 250 WATT HIGH PRESSURE SODIUM (HPS) VAPOR PENDANT (SAC) MOUNTED AT 30' ON A BRONZE FIBERGLASS POLE USING A 12 ARM


DWG. NO.	STREET NAME	STATION	OFF-SET	FIXTURE / POLE TYPE	COMMENTS
	SKYLARK BLVD.	1+00	23' RT	*	Angle to center of intersection
	SKYLARK BLVD.	3+00	23' RT	*	
	SKYLARK BLVD.	5+50	23' RT	*	
	SKYLARK BLVD.	8+50	23' RT	*	
	SKYLARK BLVD.	43+75	34' LT	*	

STREET SIGN LEGEND

24" X 30" RECTANGLE, R2-1, SPEED LIMIT 25
 30" X 30" OCTAGON, R1-1, STOP SIGN

9/23/01
 Date

Professional Engr. No. 10551

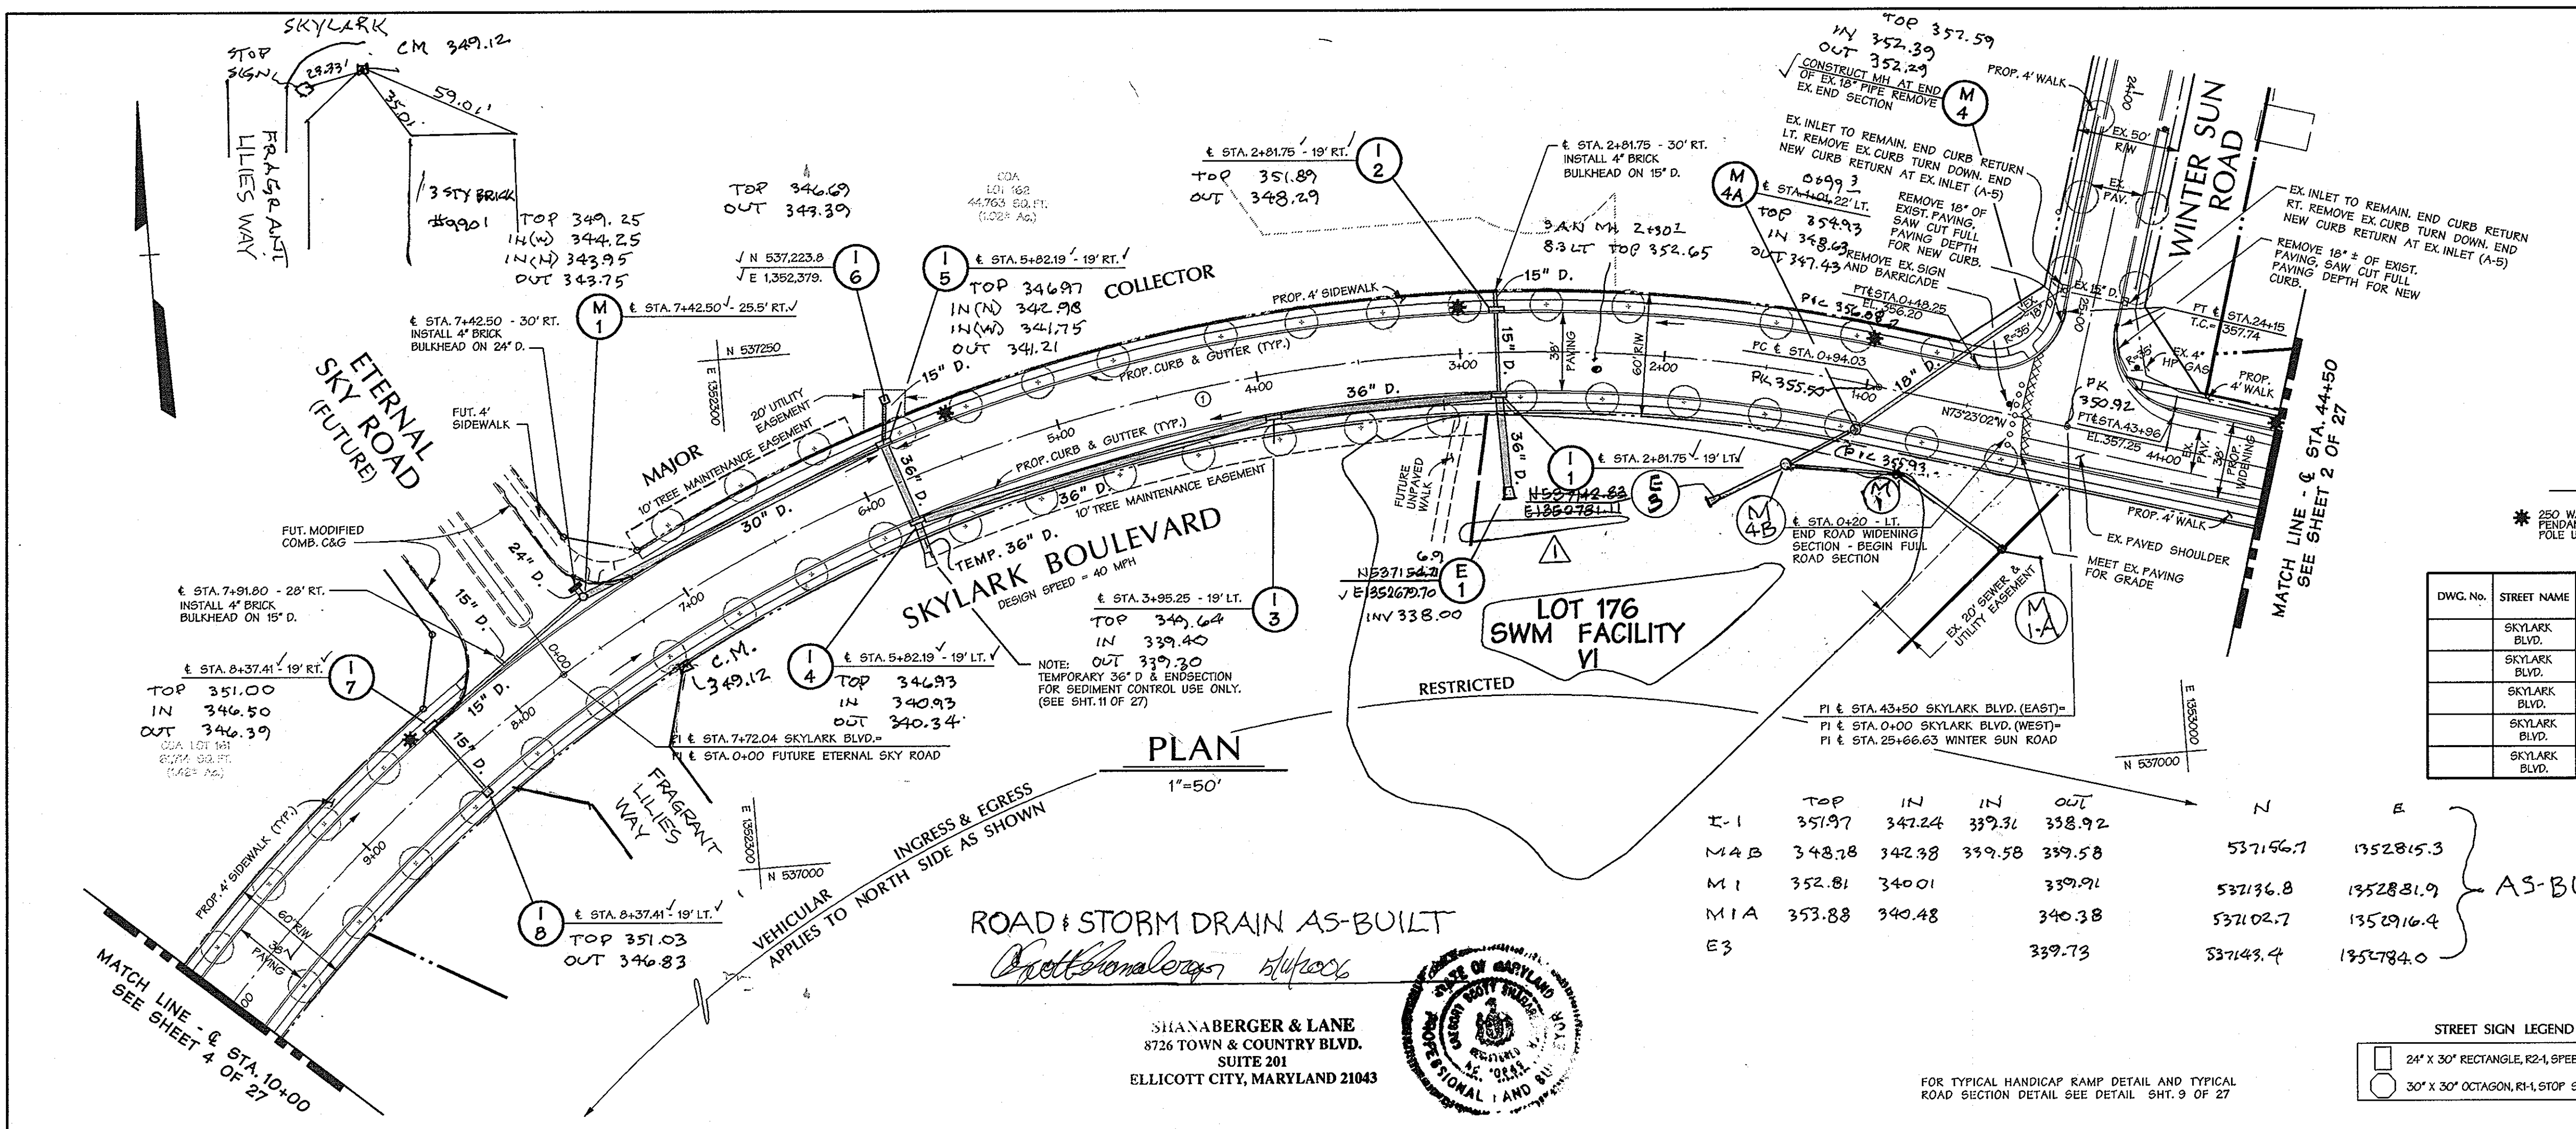


ROAD & STORM DRAIN AS-BUILT

	TOP	IN	IN	OUT	N	E
I-1	351.97	342.24	339.31	338.92	537196.7	1352815.3
M A B	348.78	342.38	339.58	339.58		
M 1	352.81	340.01		339.91	537196.8	1352815.9
M 1 A	353.88	340.48		340.38	537102.7	1352916.4
E 3				339.73	537149.4	1352784.0

AS-BUILT

SHANABERGER & LANE
 8726 TOWN & COUNTRY BLVD.
 SUITE 201
 ELLICOTT CITY, MARYLAND 21043

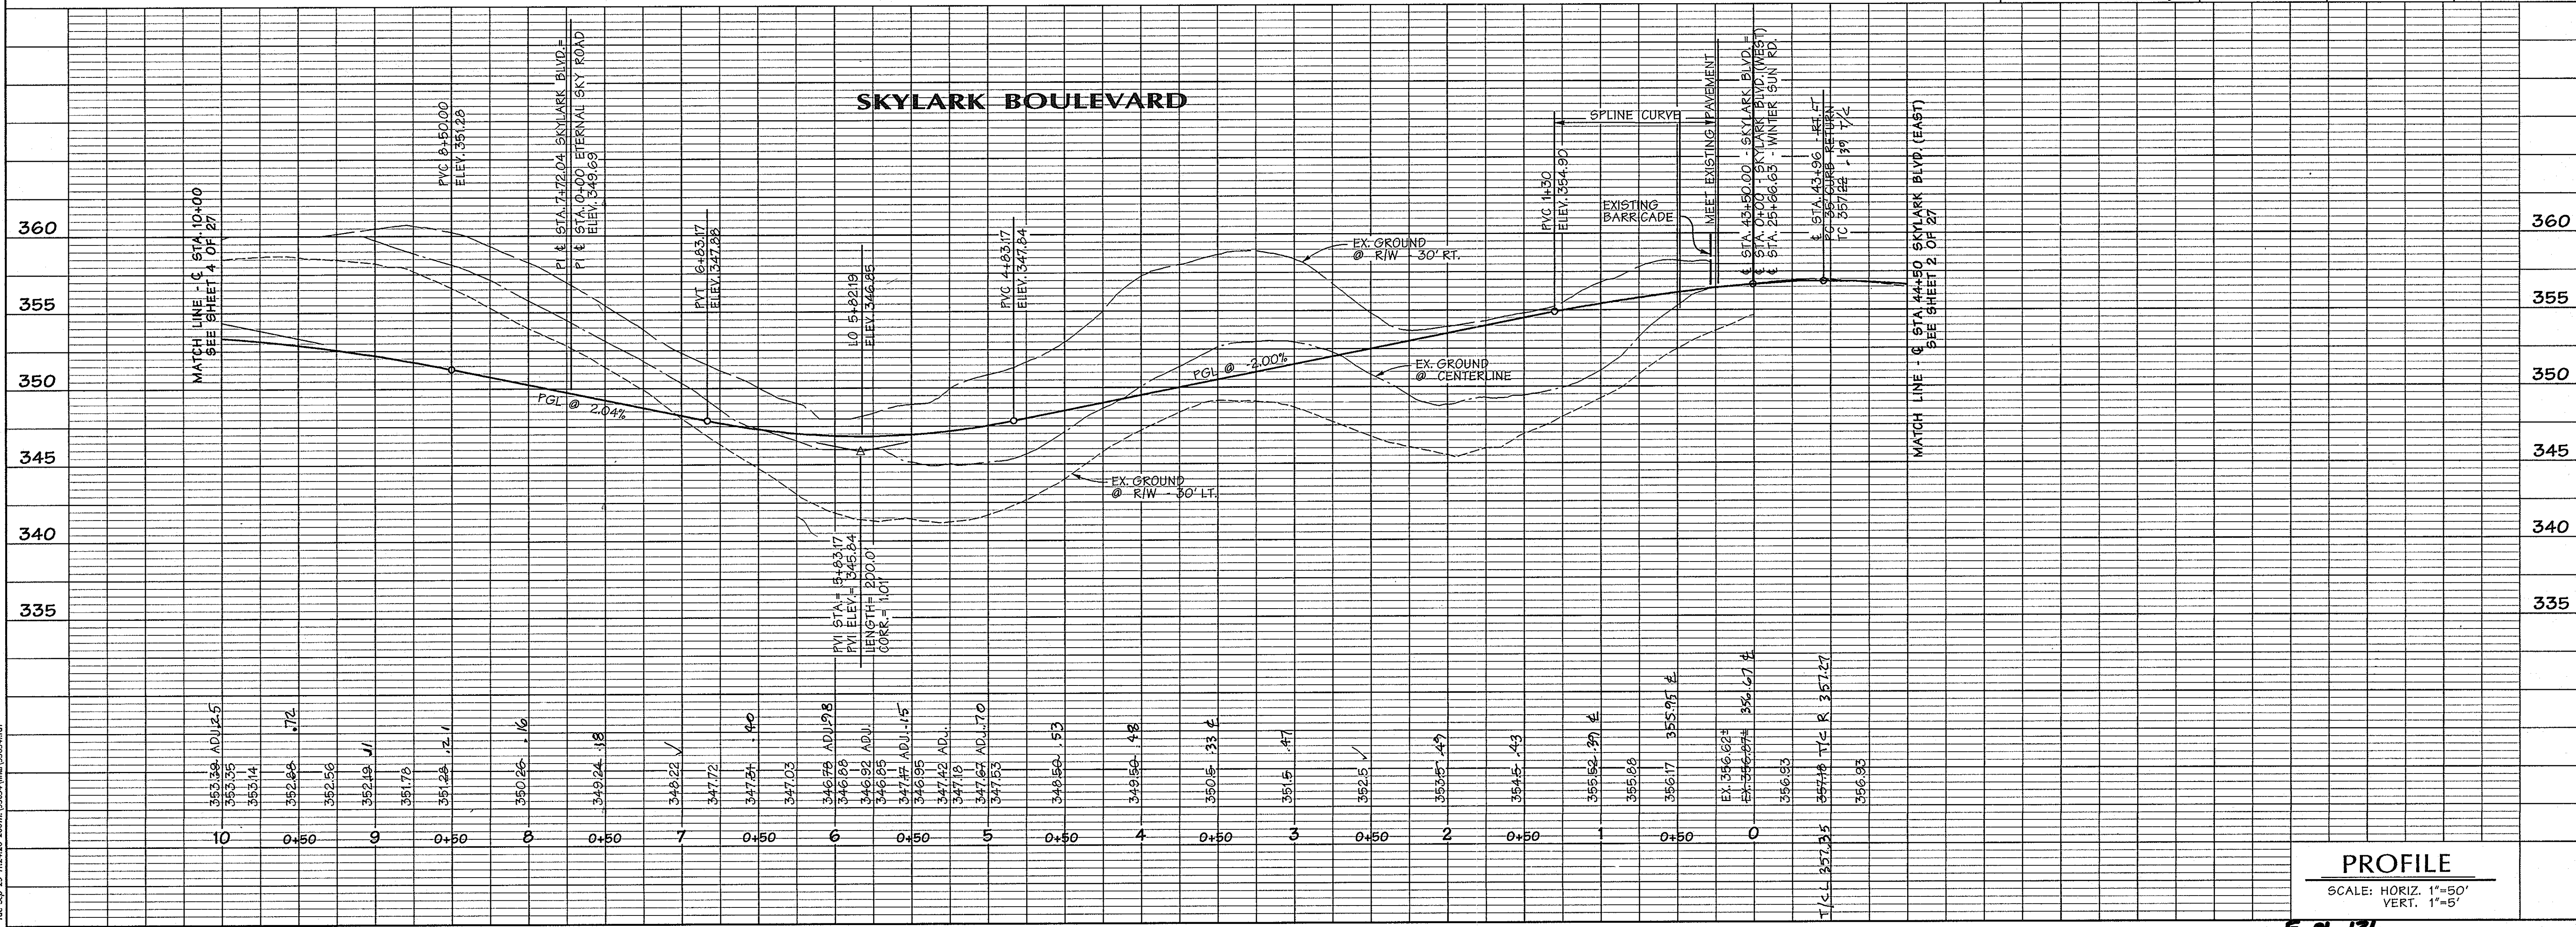

PROFILE
 SCALE: HORIZ. 1"=50'
 VERT. 1"=5'

F-01-136

Tue Sep 25 11:24:26 2001: \\s05c1\man\95054.fpl

SKYLARK BLVD.

CURVE DATA						
NAME	DELTA	RADIUS	LENGTH	TANGENT	CHORD	
①	77°01'22"	800.00'	1075.0'	636.58'	568°06'22"W	986.24'
②	67°20'25"	650.00'	763.39'	433.01'	563°15'59"W	720.73'

APPROVED: HOWARD COUNTY DEPARTMENT OF PUBLIC WORKS.
Andrew M. Dancy 10-21-01
 CHIEF, BUREAU OF HIGHWAYS
 APPROVED: HOWARD COUNTY DEPT. OF PLANNING & ZONING
John D. ... 10/31/01
 CHIEF, DEVELOPMENT ENGINEERING DIVISION MK
John D. ... 11/6/01
 CHIEF, DIVISION OF LAND DEVELOPMENT

4/14/01 **ADDED THREE MOONS WAY**
 Date No. Revision Description

EMERSON
 FORMERLY KEY PROPERTY
 SECTION 2, PHASE 1A

OWNER/DEVELOPER:
 THE HOWARD RESEARCH & DEVELOPMENT CORPORATION
 10275 Little Patuxent Parkway
 Columbia, Maryland 21044

DMW
 Darr McCune-Walker, Inc.
 200 East Pennsylvania Avenue
 Towson, Maryland 21286
 (410) 286-3838
 Fax 296-4705
 A Team of Land Planners, Landscape Architects, Engineers, Surveyors & Environmental Professionals

9-25-01
 Date

 Professional Engr. No. 10551

STREET LIGHT LEGEND
 250 WATT HIGH PRESSURE SODIUM (HPS) VAPOR PENDANT (SAG) MOUNTED AT 30' ON A BRONZE FIBERGLASS POLE USING A 12' ARM



DWG. No.	STREET NAME	STATION	OFF-SET	FIXTURE / POLE TYPE	COMMENTS
	SKYLARK BLVD.	11+00	23' RT.	*	
	SKYLARK BLVD.	13+50	23' LT.	*	
	SKYLARK BLVD.	16+00	23' RT.	*	
	SKYLARK BLVD.	18+50	23' LT.	*	

STREET SIGN LEGEND

	24' X 30' RECTANGLE, R2-L, SPEED LIMIT 25
	30' X 30' OCTAGON, R1-L, STOP SIGN

ROAD CONSTRUCTION PLAN
 SKYLARK BOULEVARD
 STA. 10+00 - 20+00


Des By	MAT/JDC	Scale	1"=50'	Proj. No.	95054-F
Dm By	WHJ/MGS	Date	9-26-01	Approved	4 of 27

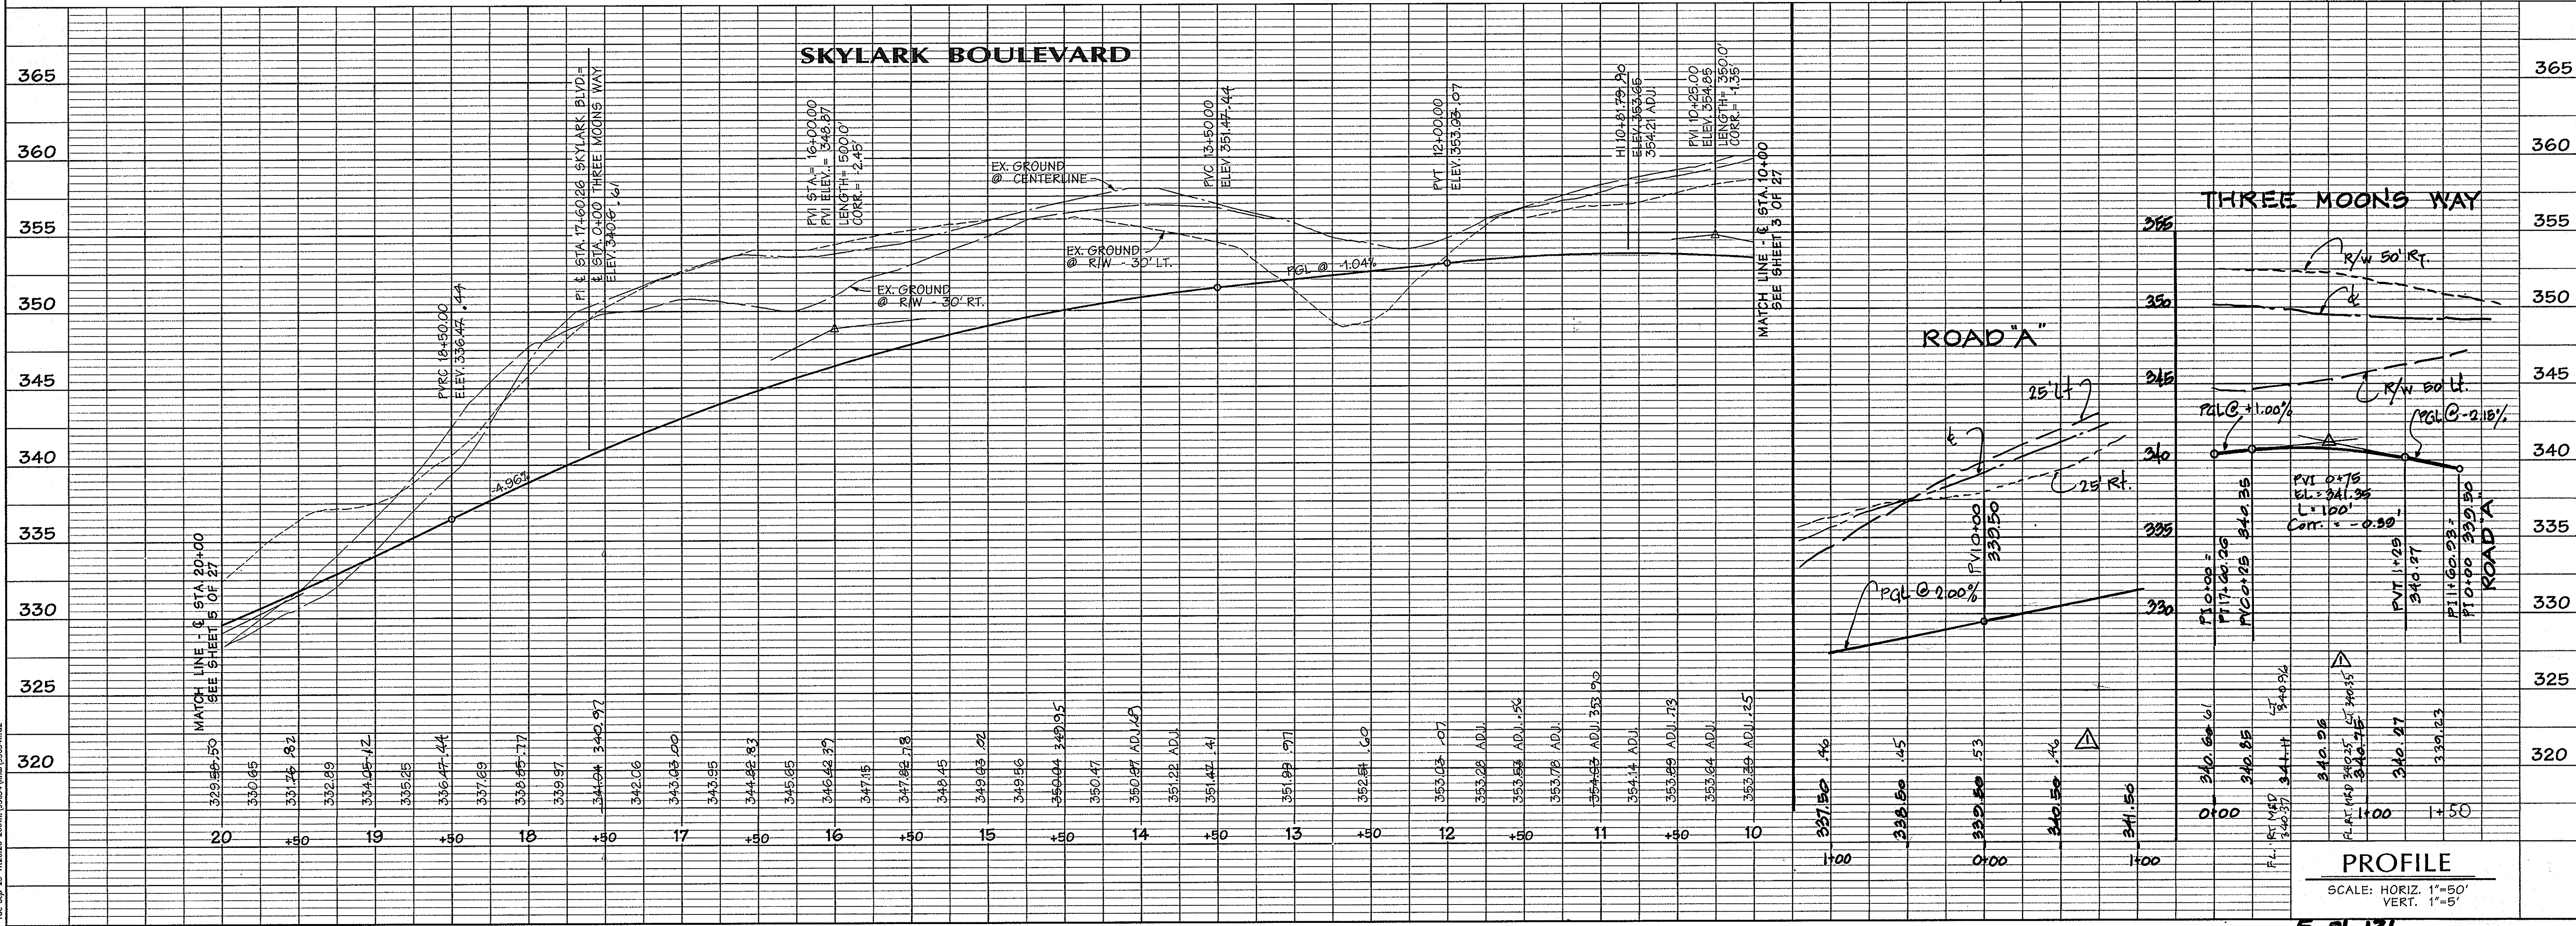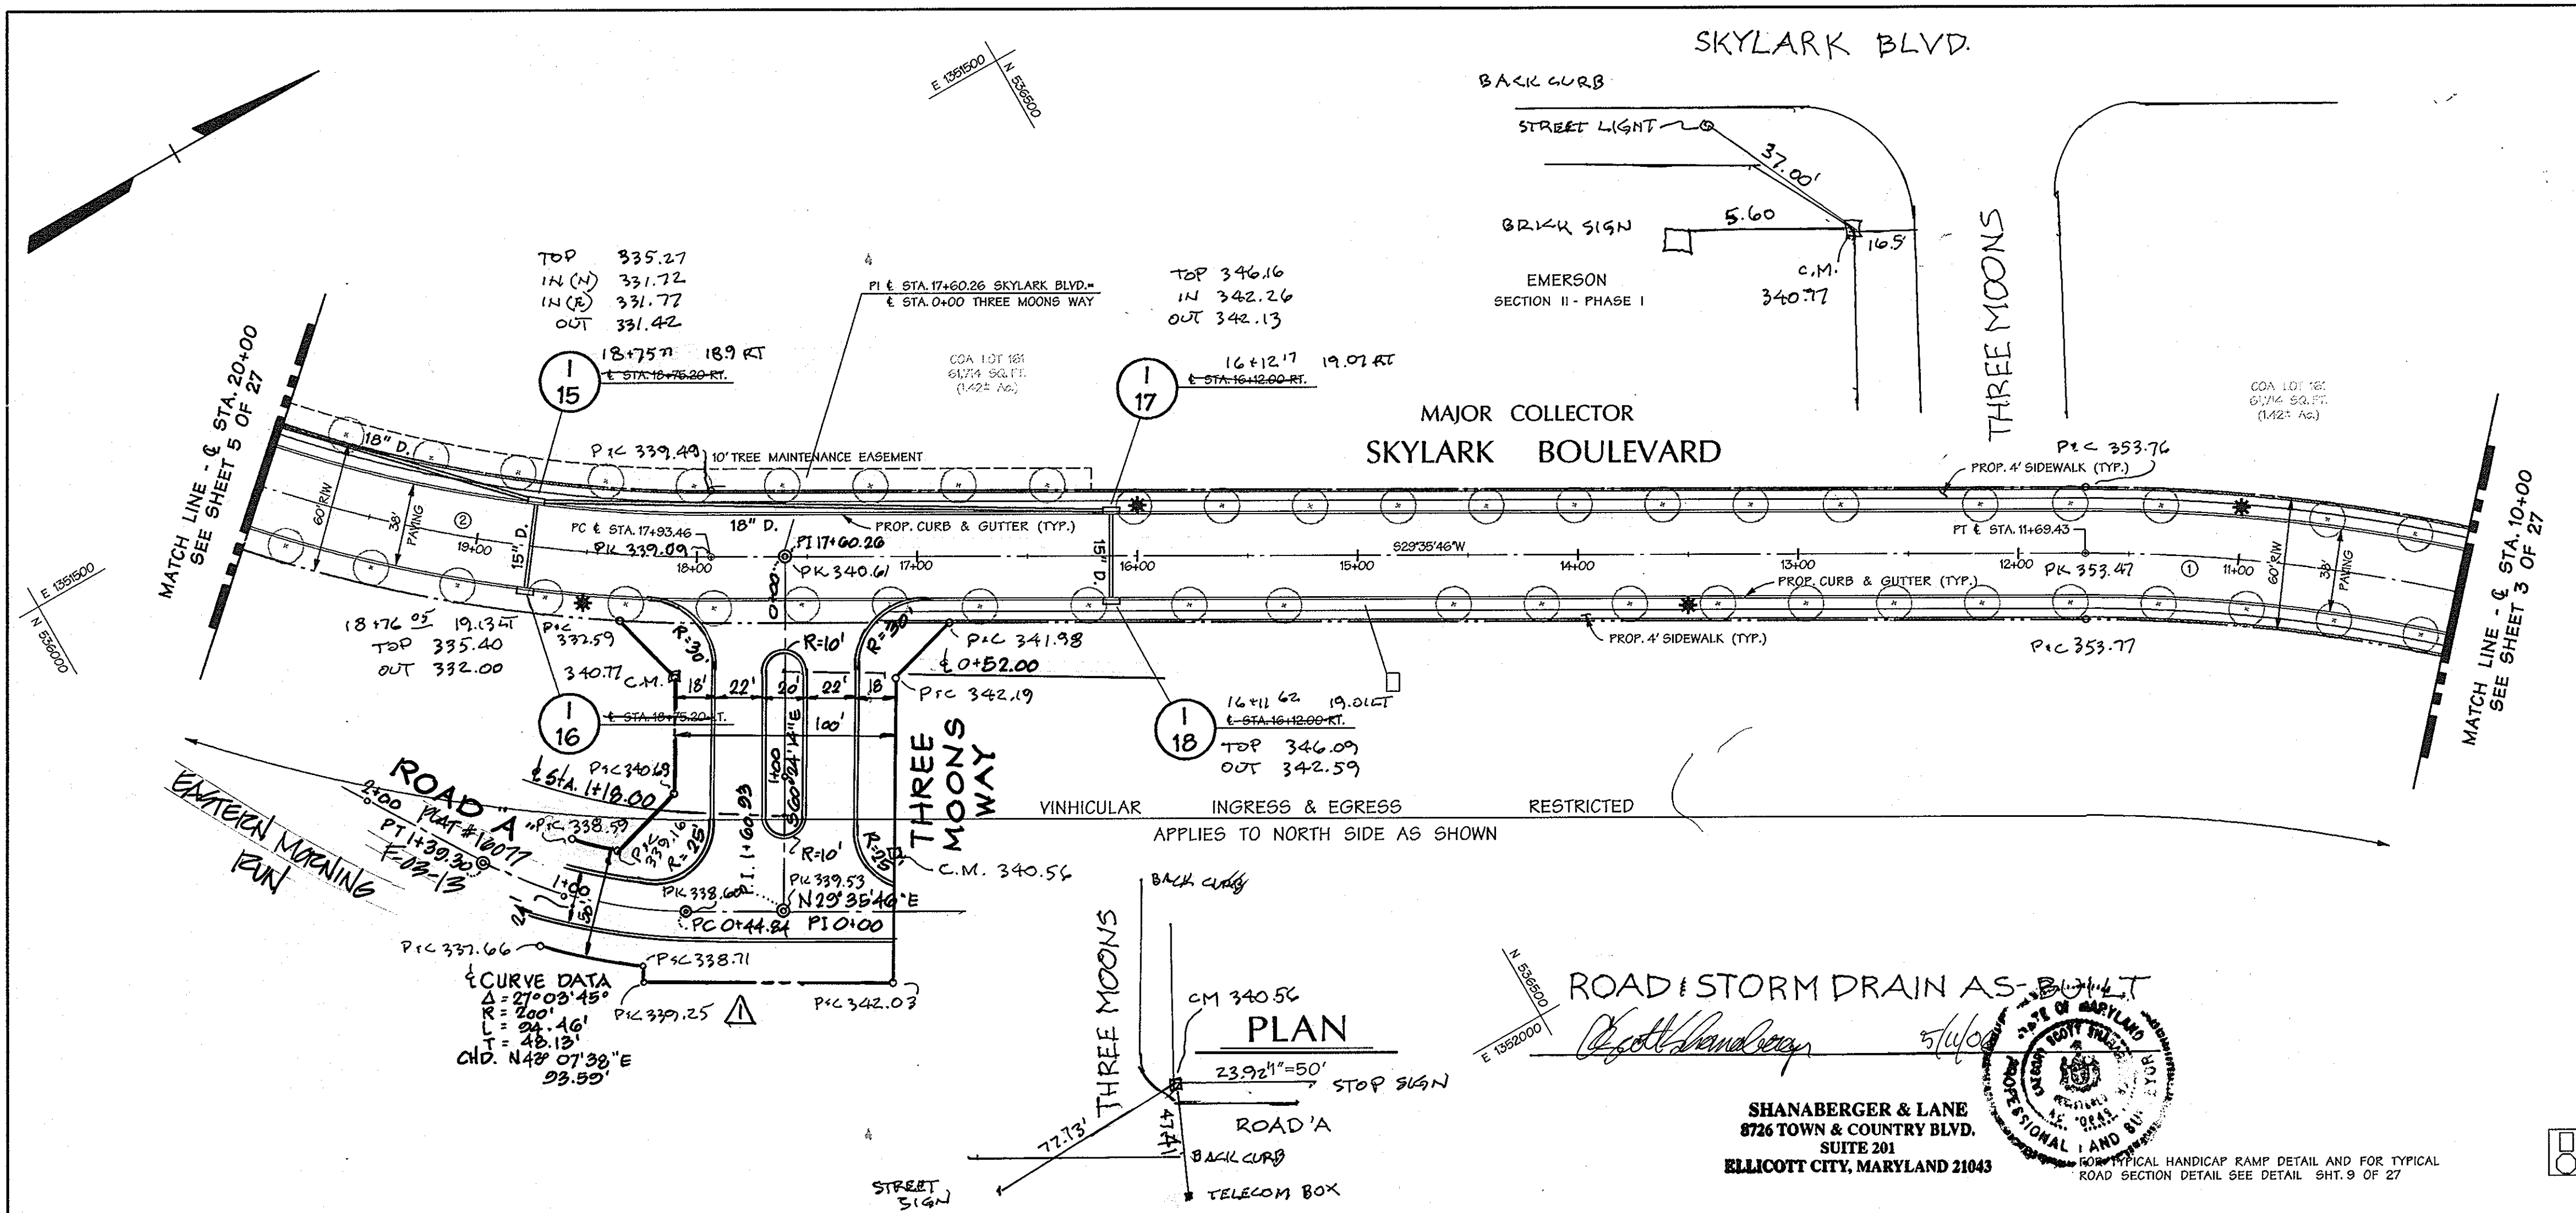

PROFILE
 SCALE: HORIZ. 1"=50'
 VERT. 1"=5'

Top Sep 25 11:26:26 2001m:gsocx\lmal\95054-f.dwg

CURVE DATA					
NAME	DELTA	RADIUS	LENGTH	TANGENT	CHORD
②	67°20'25"	650.00'	763.95'	433.01'	563°19'59"W 720.73'

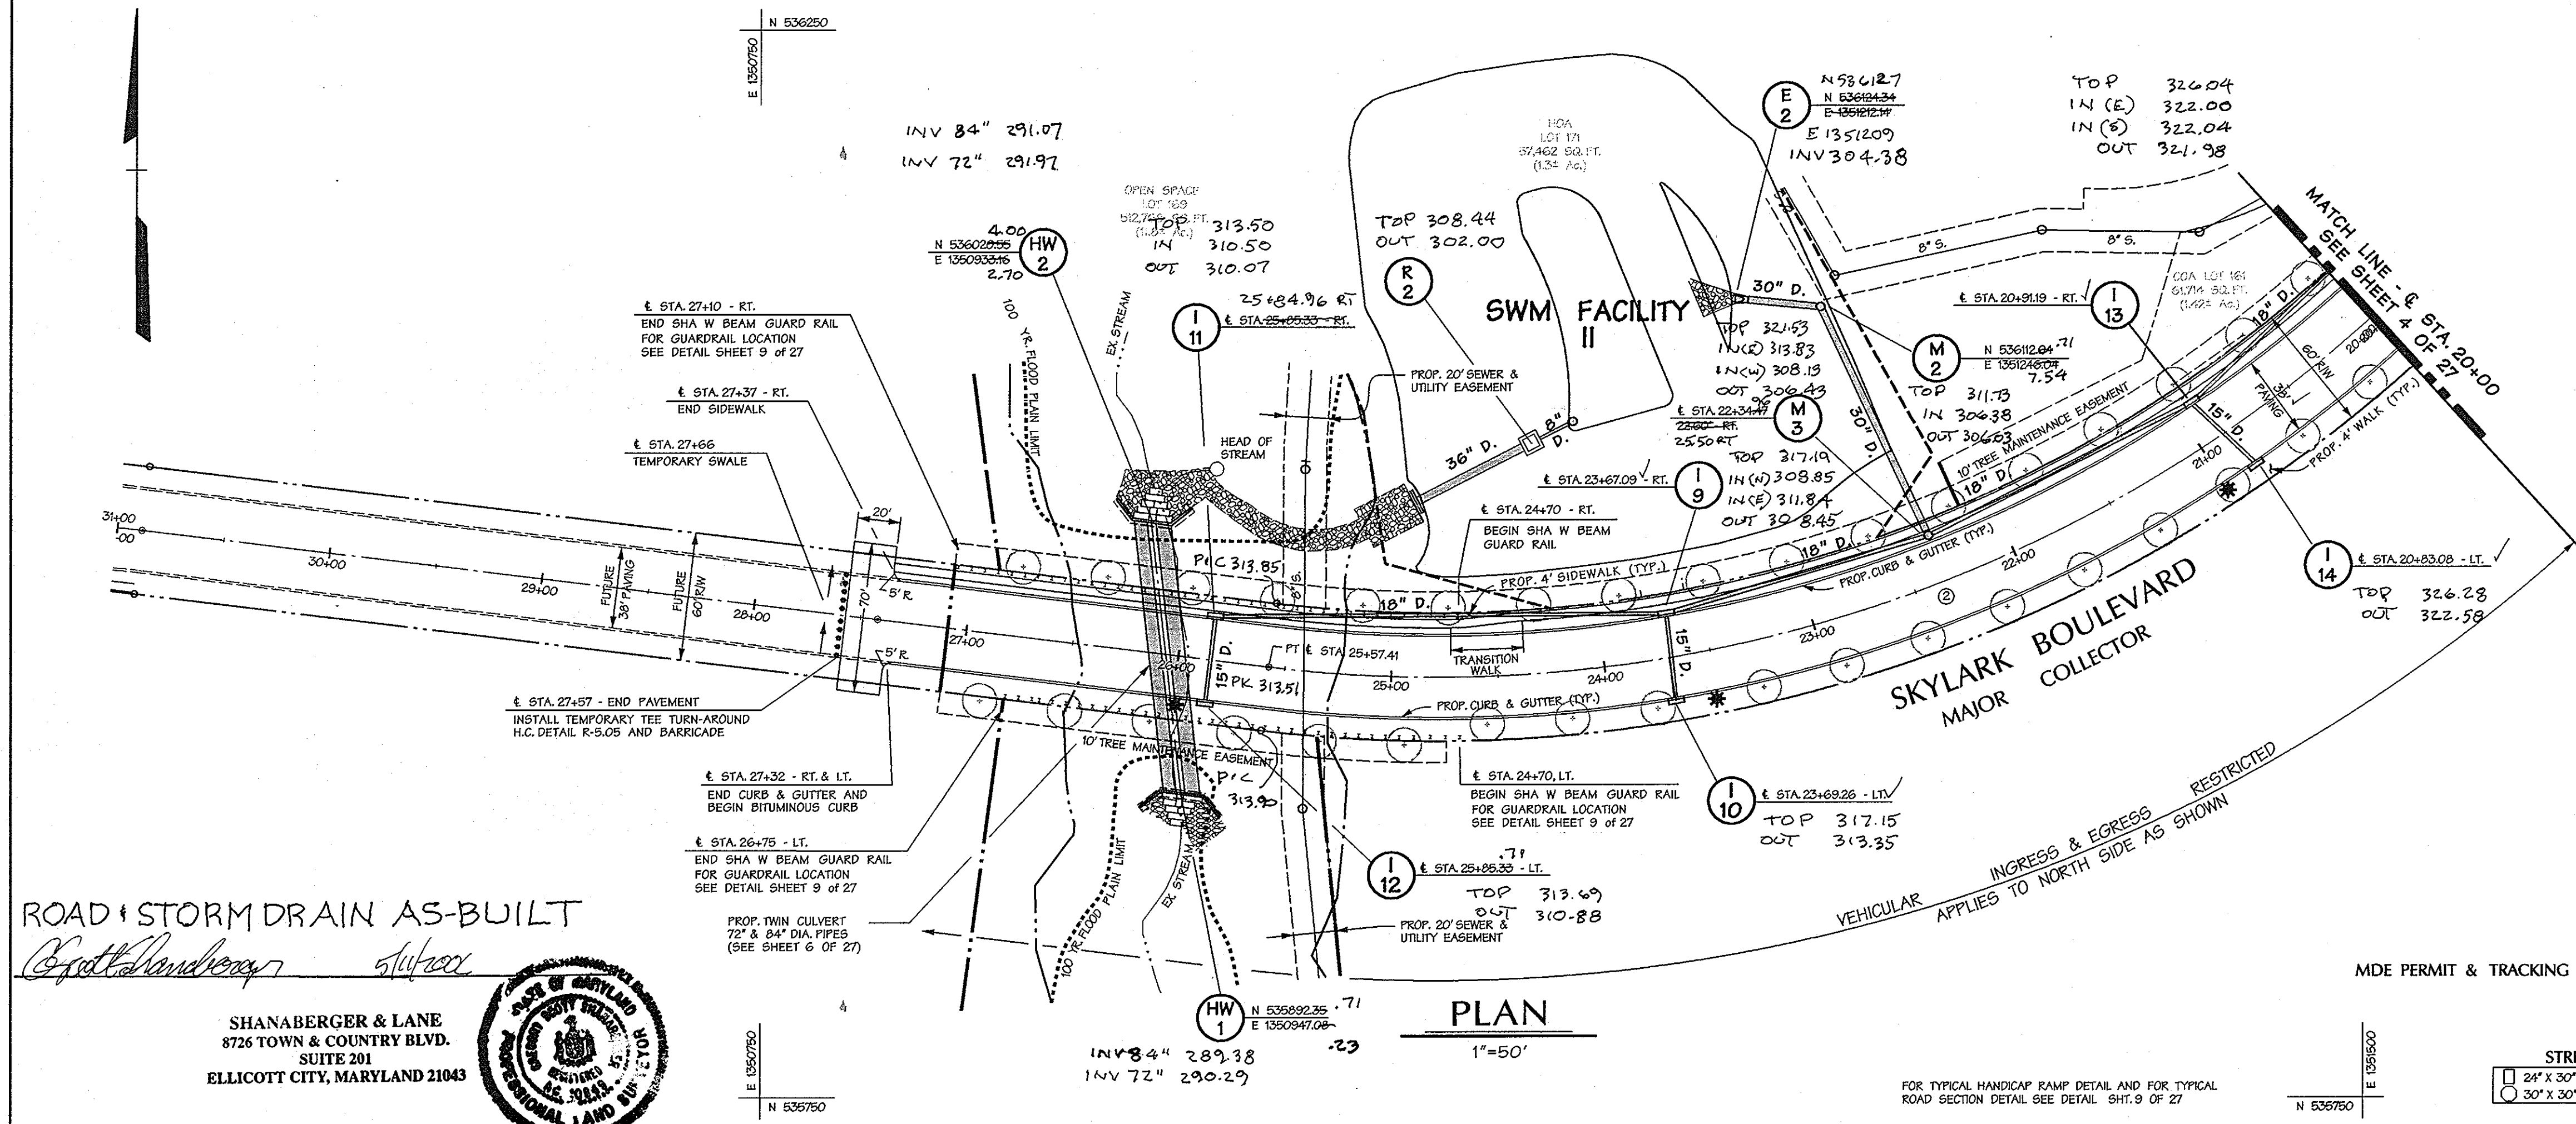

STREET LIGHT LEGEND

250 WATT HIGH PRESSURE SODIUM (HPS) VAPOR PENDANT (645) MOUNTED AT 30' ON A BRONZE FIBERGLASS POLE USING A 12' ARM

DWG. NO.	STREET NAME	STATION	OFF-SET	FIXTURE / POLE TYPE	COMMENTS
	SKYLARK BLVD.	21+00	23' LT.	●	
	SKYLARK BLVD.	23+50	23' LT.	●	
	SKYLARK BLVD.	26+00	23' LT.	●	

9/25/01
Date

Professional Engr. No. 10551

APPROVED: HOWARD COUNTY DEPARTMENT OF PUBLIC WORKS.
Richard M. Shuster 10/28/01
CHIEF, BUREAU OF HIGHWAYS. DATE

APPROVED: HOWARD COUNTY DEPT. OF PLANNING & ZONING
John J. ... 10/31/01
CHIEF, DEVELOPMENT ENGINEERING DIVISION [MJK] DATE

Ed ... 11/6/01
CHIEF, DIVISION OF LAND DEVELOPMENT DATE

Date No. Revision Description

EMERSON
FORMERLY KEY PROPERTY
SECTION 2, PHASE 1A

OWNER/DEVELOPER:
THE HOWARD RESEARCH & DEVELOPMENT CORPORATION
10275 Little Patuxent Parkway
Columbia, Maryland 21044

DMW
Dart-McCune-Walker, Inc.
200 East Pennsylvania Avenue
Towson, Maryland 21286
(410) 296-3333
Fax 296-4705

A Team of Land Planners,
Landscape Architects,
Engineers, Surveyors &
Environmental Professionals


SUBMISSION NAME: EMERSON SECTION 2
SECTION/PART: PHASE 1A
LOT/PARCEL #: P10 P. 637, P. 3, P. 462


DATE OF PLAN: 9/25/01
SCALE: 1"=50'
M.D.: 47
ELECT. DISTRICT: 6 TH
SEWER CODE: 47

TITLE: ROAD CONSTRUCTION PLAN
SKYLARK BOULEVARD
@ STA. 20+00 - 27+57

Des By: MAT/JDC Scale: 1"=50' Proj. No.: 95054.F
Dwn By: WH/JMS Date: 9-26-01
Chk By: Approved


5 of 27

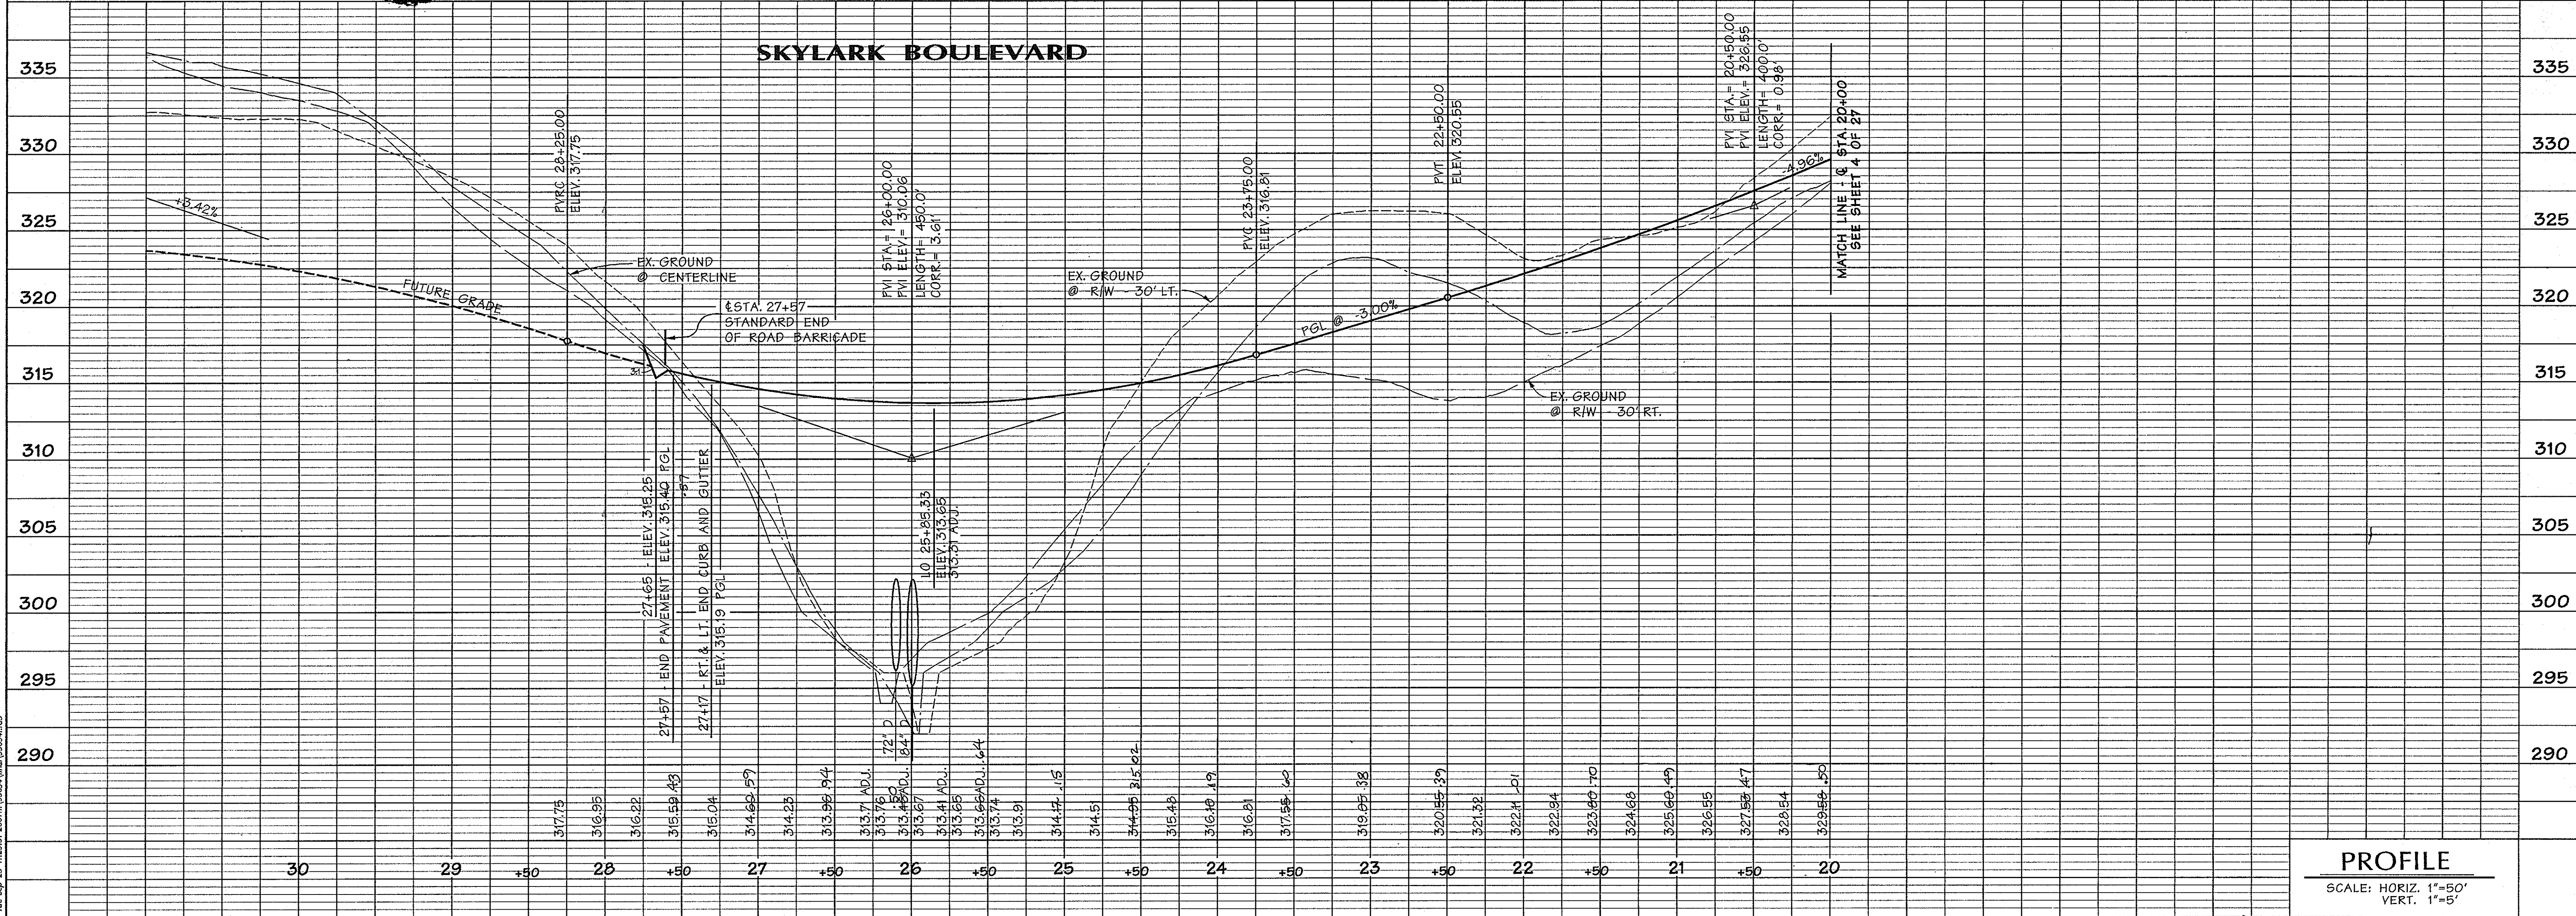

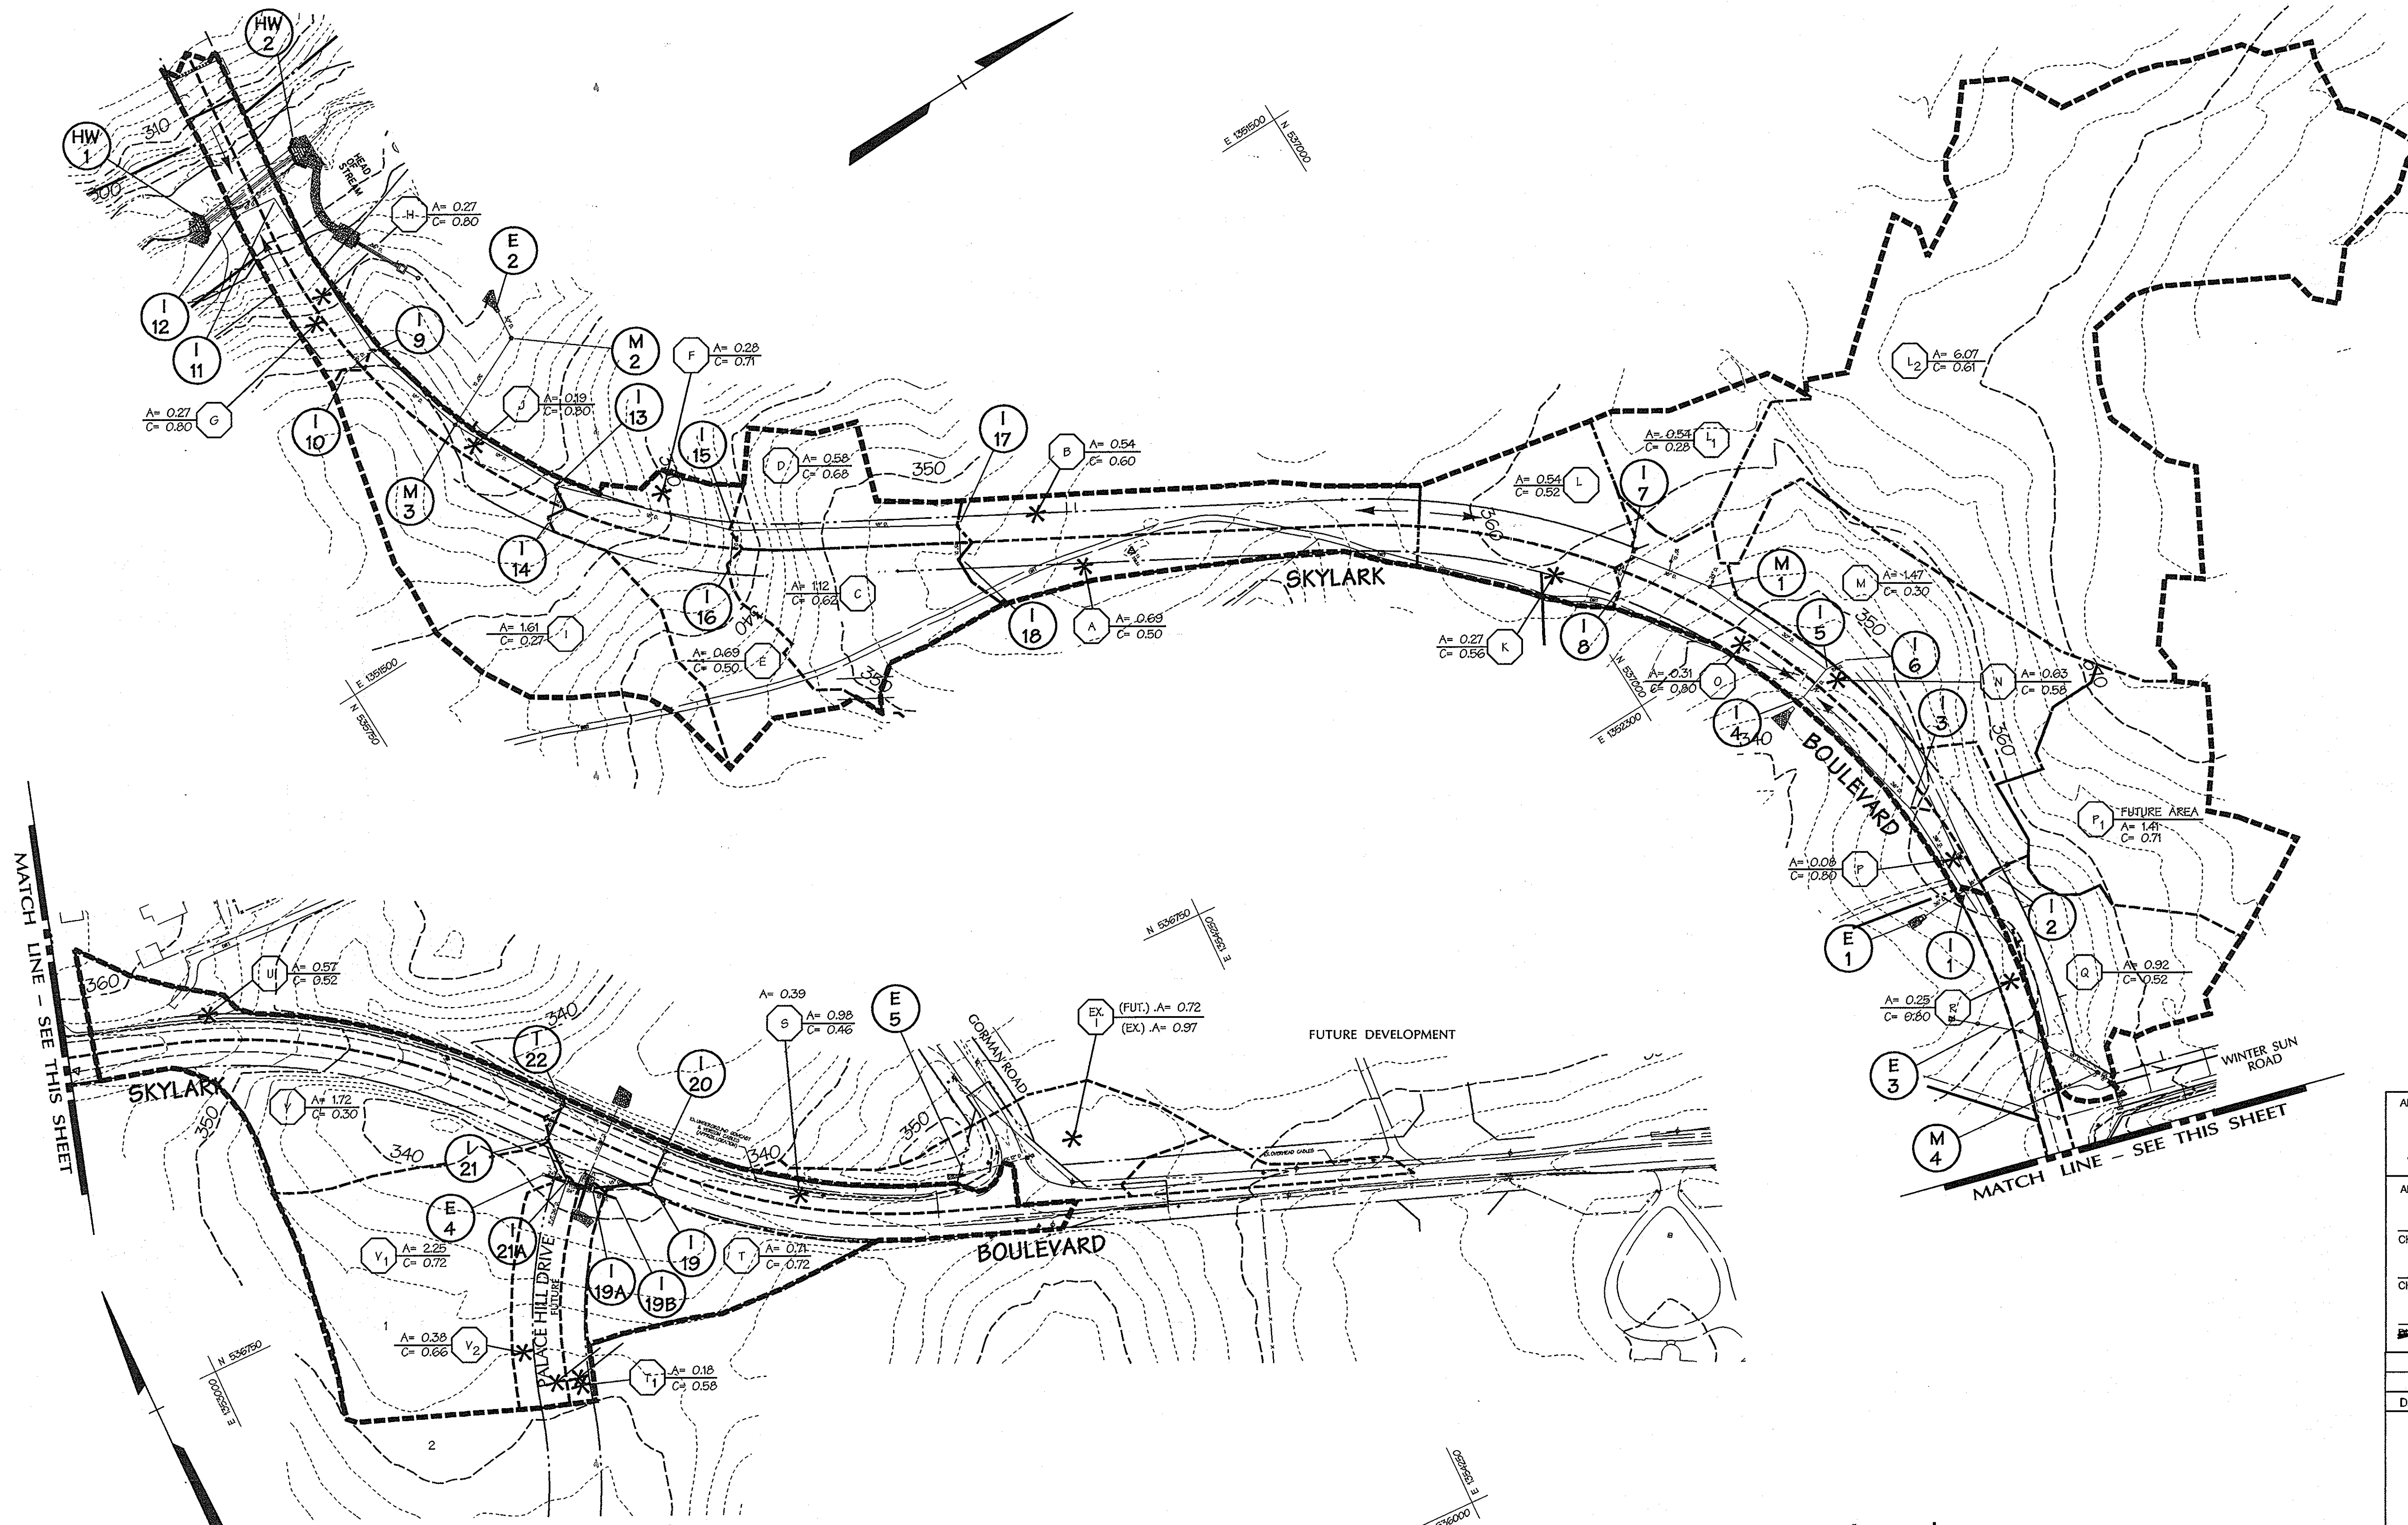

DRAINAGE AREA MAP
SCALE: 1"=100'

- Legend**
- 340 EXISTING CONTOUR
 - 340 PROPOSED CONTOUR
 - 15" D PROPOSED STORMDRAIN
 - PROPOSED DRAINAGE AREA LIMIT
 - A= 1.47
C= 0.30 PROPOSED DRAINAGE AREA LABEL

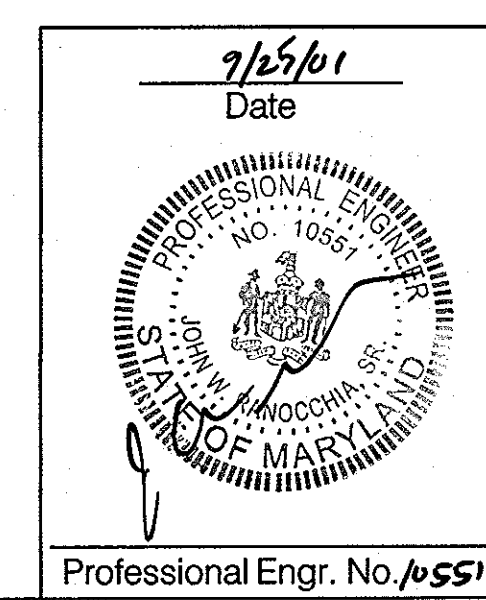

APPROVED: HOWARD COUNTY DEPARTMENT OF PUBLIC WORKS.
Richard M. Walker 10-29-01
 CHIEF, BUREAU OF HIGHWAYS, MS DATE

APPROVED: HOWARD COUNTY DEPT. OF PLANNING & ZONING
Mark Dammann 10/31/01
 CHIEF, DEVELOPMENT ENGINEERING DIVISION MK DATE

C. Hananiah 11/6/01
 CHIEF, DIVISION OF LAND DEVELOPMENT MS DATE

Date	No.	Revision Description

EMERSON
FORMERLY KEY PROPERTY
SECTION 2, PHASE 1A

OWNER/DEVELOPER:
 THE HOWARD RESEARCH & DEVELOPMENT CORPORATION
 10275 Little Patuxent Parkway
 Columbia, Maryland 21044

DMW
 Datt-McCune-Walker, Inc.
 200 East Pennsylvania Avenue
 Towson, Maryland 21286
 (410) 296-3333
 Fax 296-4705
 A Team of Land Planners,
 Landscape Architects,
 Engineers, Surveyors &
 Environmental Professionals


SUBDIVISION NAME	EMERSON SECTION 2	SECTION/AREA	PHASE 1A	LOT/PARCEL #	P10 P. 037, P. 3, P. 462
PLAN OR "AS BUILT" SURVEY	1/2"=1" & 1"=1"	ZONE	1	PLANNING MAP	NO. 27, 28 & 29
WATER CODE	1A, 2A, 3A, 3B	MOD	47	ELECT. DISTRICT	6 TH
		SEWER CODE		CENSUS TRACT	

TITLE
DRAINAGE AREA MAP

Des By	RLH/JDC	Scale	1"=100'	Proj. No.	95054.F
Dm By	WHJ	Date	9-26-01		
Chk By		Approved			7 of 27

Professional Engr. No. 10551

F-01-136

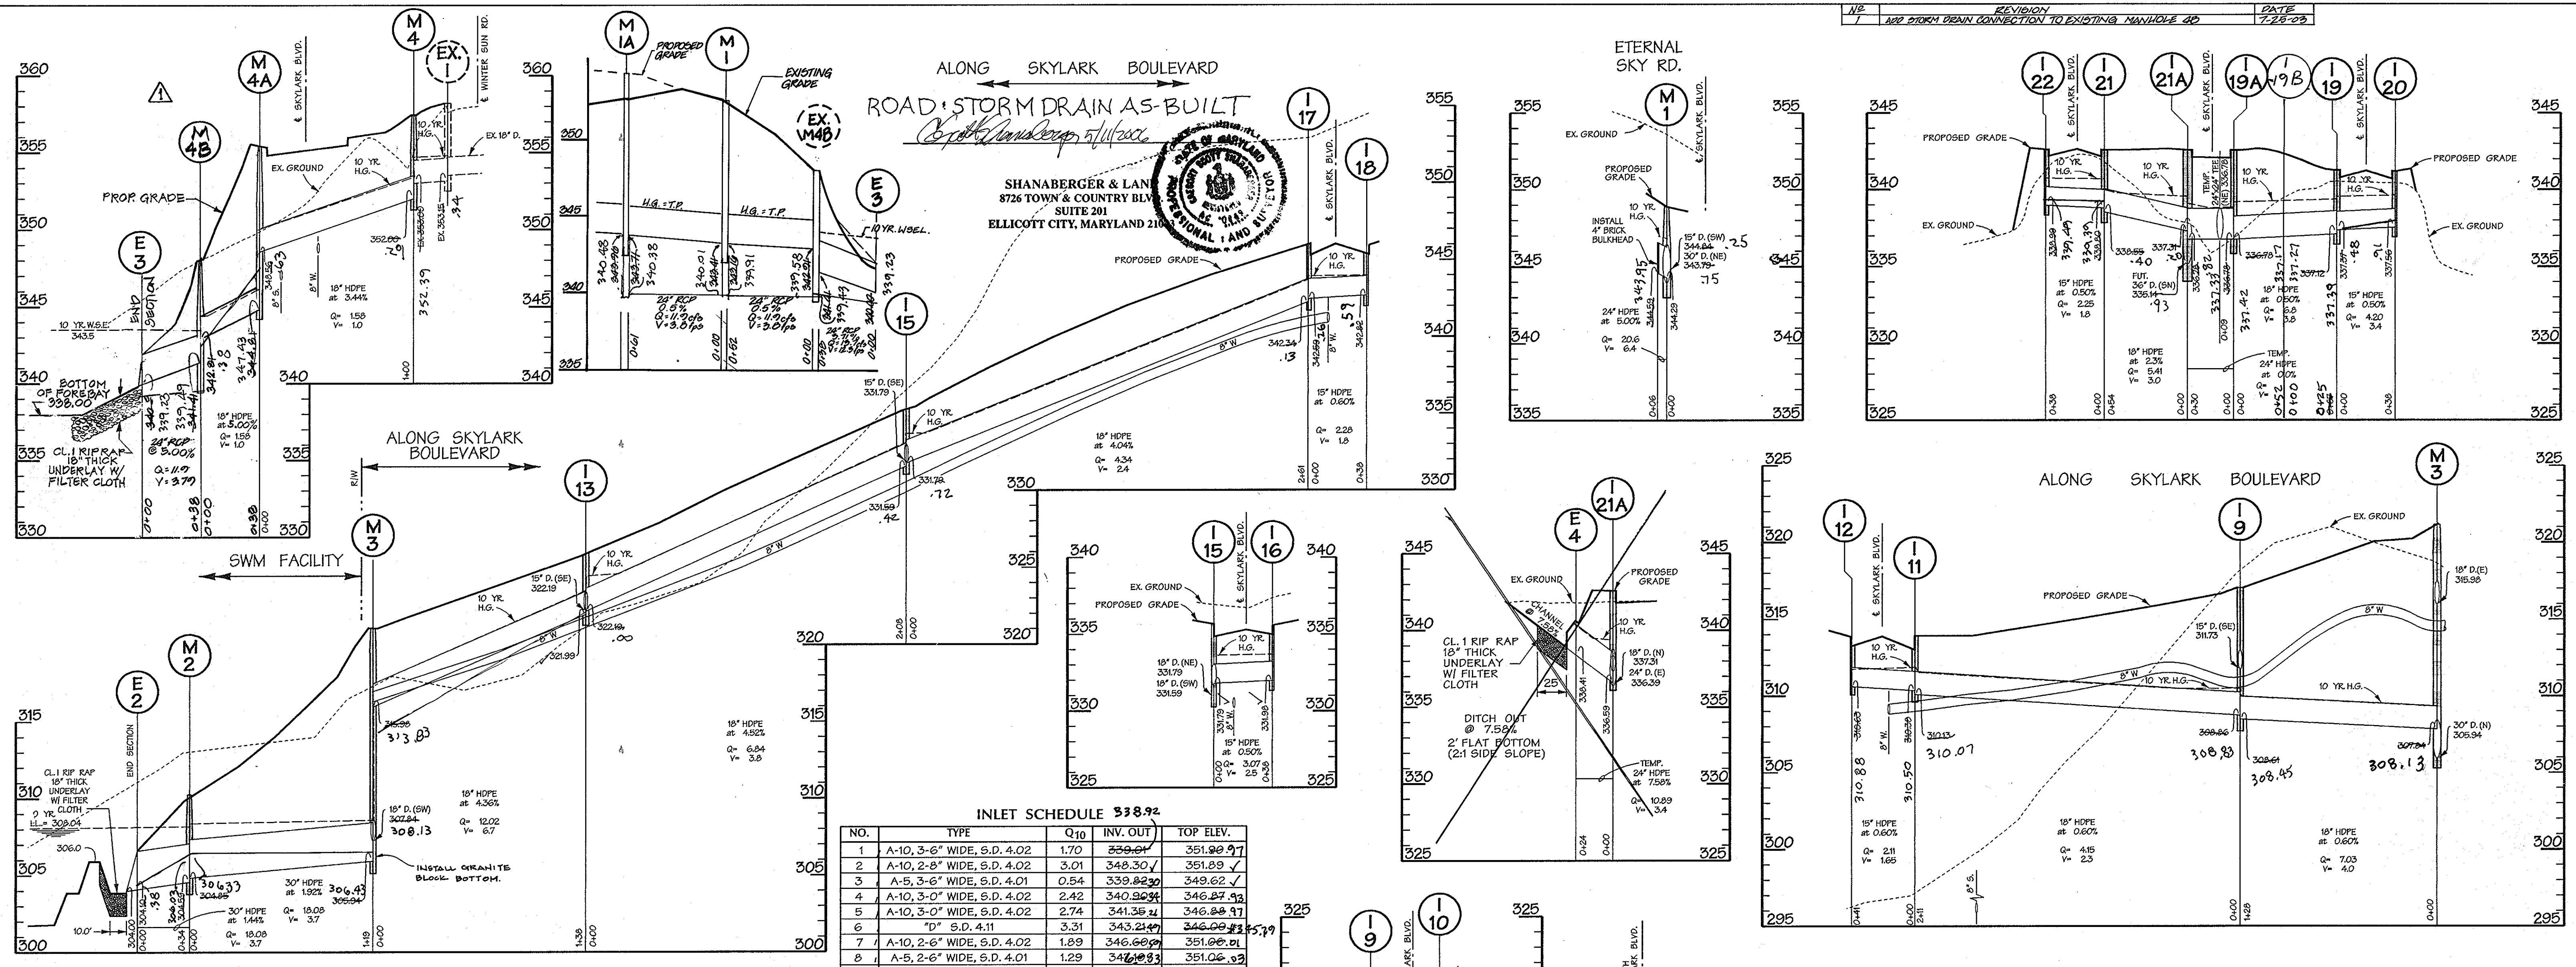

INLET SCHEDULE 338.92

NO.	TYPE	Q10	INV. OUT	TOP ELEV.
1	A-10, 3-6" WIDE, S.D. 4.02	1.70	339.01	351.99 97
2	A-10, 2-8" WIDE, S.D. 4.02	3.01	348.30	351.89 ✓
3	A-5, 3-6" WIDE, S.D. 4.01	0.54	339.82	349.62 ✓
4	A-10, 3-0" WIDE, S.D. 4.02	2.42	340.96	346.27 93
5	A-10, 3-0" WIDE, S.D. 4.02	2.74	341.36	346.88 97
6	"D" S.D. 4.11	3.31	343.24	346.00 83
7	A-10, 2-6" WIDE, S.D. 4.02	1.89	346.60	351.00 01
8	A-5, 2-6" WIDE, S.D. 4.01	1.29	347.83	351.06 07
9	A-5, 2-6" WIDE, S.D. 4.01	1.29	308.64	317.05 19
10	A-10, 2-6" WIDE, S.D. 4.02	2.87	313.25	317.00 15
11	A-10, 2-6" WIDE, S.D. 4.02	2.11	310.43	313.35 50
12	A-10, 2-6" WIDE, S.D. 4.02	2.11	310.63	313.35 49
13	A-10, 2-6" WIDE, S.D. 4.02	1.31	321.99	325.94 82 0.04
14	A-10, 2-6" WIDE, S.D. 4.02	2.28	322.51	326.26 ✓
15	A-10, 2-6" WIDE, S.D. 4.02	2.28	342.82	346.87 09
16	A-15, 2-6" WIDE, S.D. 4.02	3.07	331.98	338.23 27
17	A-10, 2-6" WIDE, S.D. 4.02	2.75	342.34	346.07 16
18	A-10, 2-6" WIDE, S.D. 4.02	2.28	342.82	346.87 09
19	A-15, 2-6" WIDE, S.D. 4.02	3.32	337.00	341.27 68
20	A-15, 2-6" WIDE, S.D. 4.02	4.20	337.00	341.27 68
21	A-10, 2-6" WIDE, S.D. 4.02	3.41	338.66	342.74 79
22	A-10, 2-6" WIDE, S.D. 4.02	2.25	338.92	342.74 79
19A	A-5, 2-6" WIDE, S.D. 4.01	0.78	338.53	342.58 67
19B	"D" S.D. 4.11	3.89	337.17	340.25 8
21A	A-10, 4-0" WIDE, S.D. 4.02	2.13	336.39	342.58

* INDICATES THROAT ELEVATION


MANHOLE SCHEDULE 306.03

NO.	TYPE	SIZE	INV. OUT	TOP ELEV.
1	SHALLOW MH, G 5.05	48"	343.79	349.12
2	SHALLOW MH, G 5.05	48"	340.68	346.29
3	STANDARD MH, G 5.01	48"	346.94	352.16
4	SHALLOW MH, G 5.05	48"	352.09	357.00
4A	STD. MANHOLE G.S.12	48"	344.41	355.64
4B	STD. MANHOLE G.S.12	48"	341.44	348.00

END SECTION SCHEDULE

NO.	TYPE	SIZE	INV. OUT	TOP ELEV.
E-1	HDPE END SEC.	36"	338.00	341.11
E-2	HDPE END SEC.	30"	304.00	308.38
E-3	HDPE END SEC.	18"	229.00	230.20
E-4	HDPE END SEC.	24"	338.41	-

ALL STORM FLOWS (Q) SHOWN AND VELOCITIES (V), ARE BASED ON A 10 YEAR STORM EVENT.

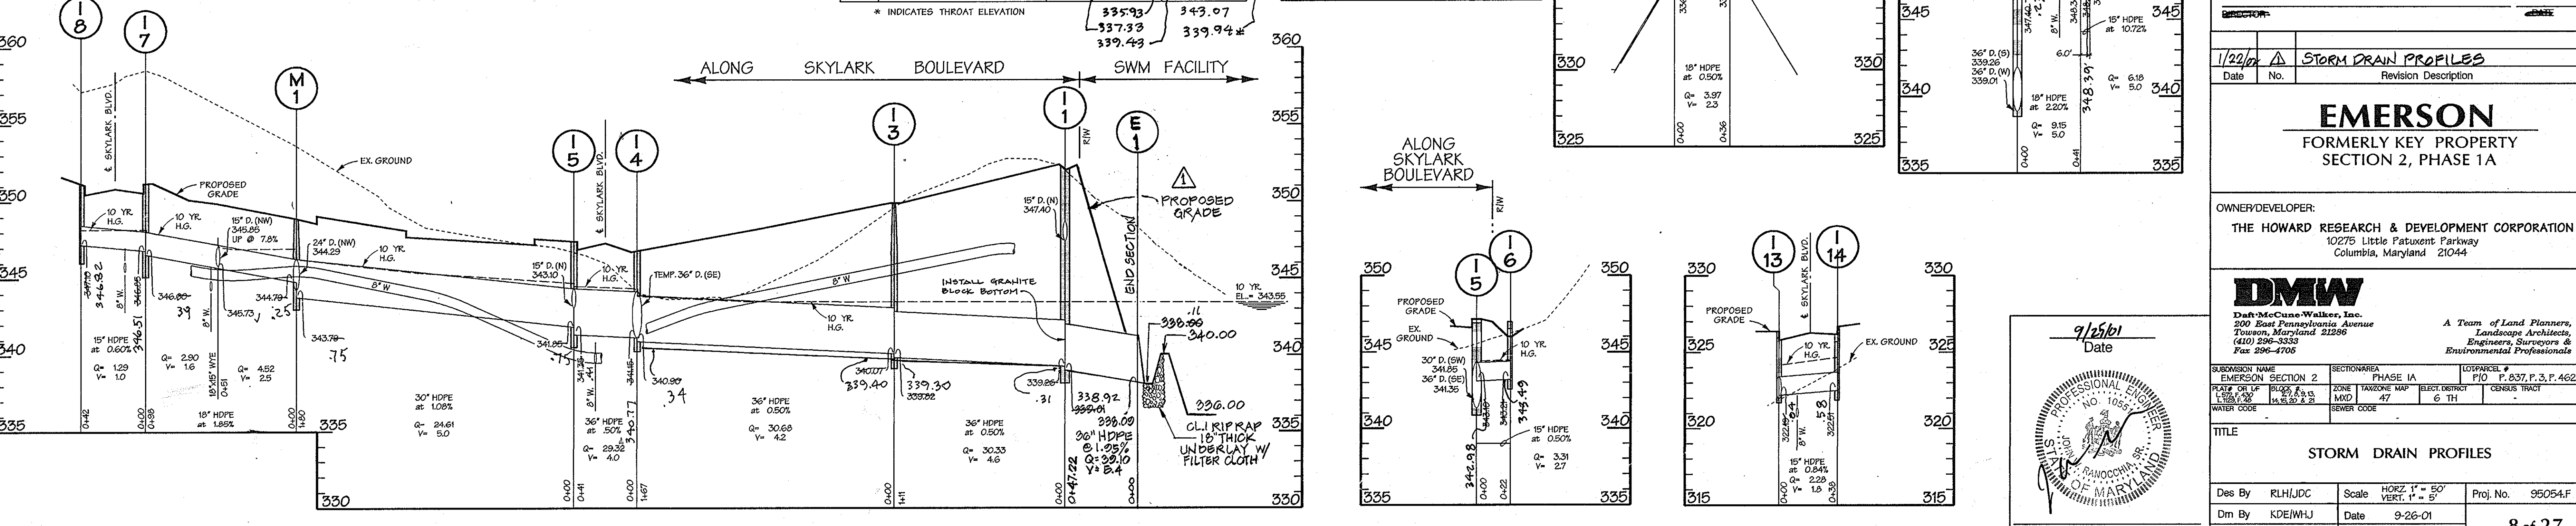

APPROVED: HOWARD COUNTY DEPARTMENT OF PUBLIC WORKS
 APPROVED: HOWARD COUNTY DEPT. OF PLANNING & ZONING
 CHIEF DEVELOPMENT ENGINEERING DIVISION MKK
 CHIEF DIVISION OF LAND DEVELOPMENT

STORM DRAIN PROFILES

Date	1/22/05
Revision	1
Description	STORM DRAIN PROFILES

EMERSON
 FORMERLY KEY PROPERTY
 SECTION 2, PHASE 1A


OWNER/DEVELOPER:
 THE HOWARD RESEARCH & DEVELOPMENT CORPORATION
 10275 Little Patuxent Parkway
 Columbia, Maryland 21044



DMW
 Dan McCune-Walker, Inc.
 200 East Pennsylvania Avenue
 Towson, Maryland 21286
 (410) 296-3333
 Fax 296-4705

SUBMISSION NAME	EMERSON SECTION 2	SECTION AREA	PHASE 1A	LOT/PARCEL #
PLAN	DATE	SCALE	VERT. 1" = 5'	PROJ. NO.
WATER CODE	SEWER CODE	SEWER CODE	SEWER CODE	SEWER CODE



TITLE: **STORM DRAIN PROFILES**

Des By	RLH/JDC	Scale	HORIZ 1" = 50'	Proj. No.	95054.F
Dim By	KDE/MJH	Date	9-26-01	8 of 27	
Chk By	Approved				

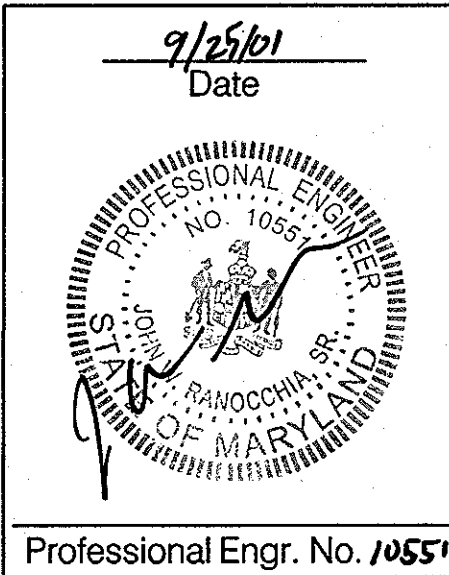


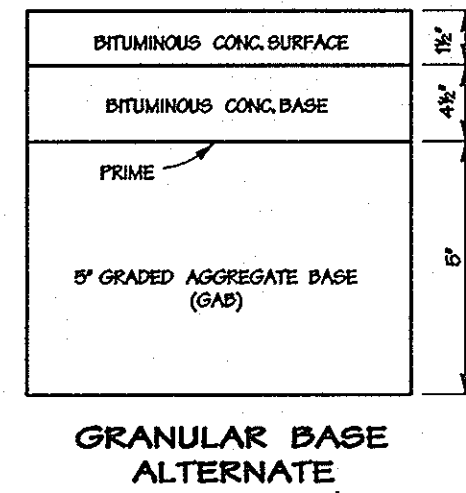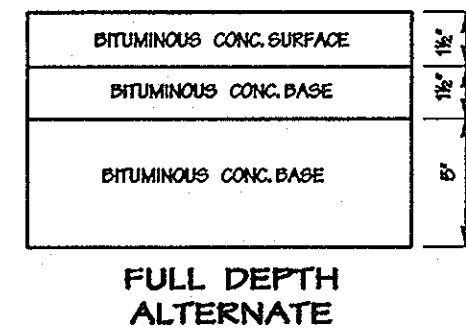


**PAVING SECTION P-3
MINOR & MAJOR COLLECTORS**
NO SCALE

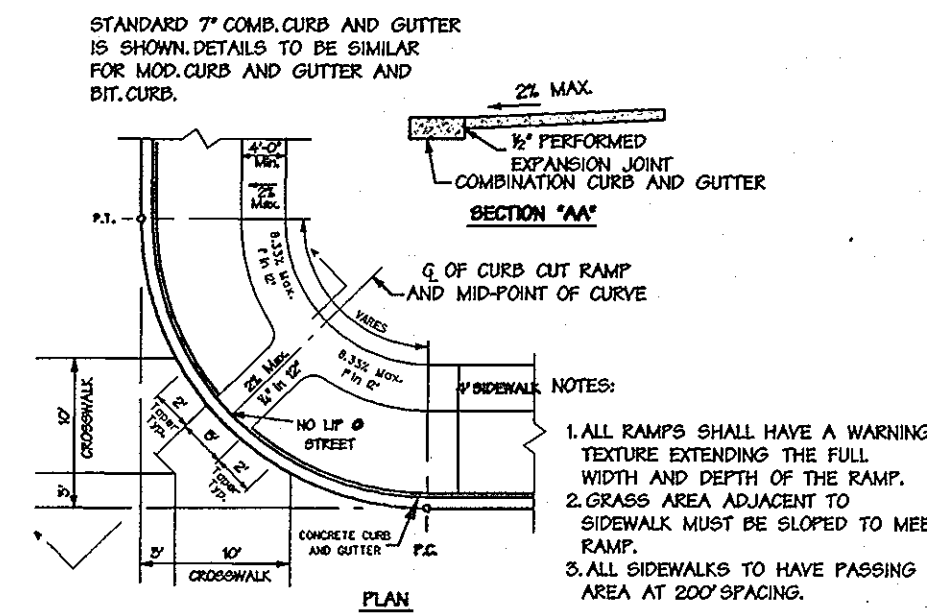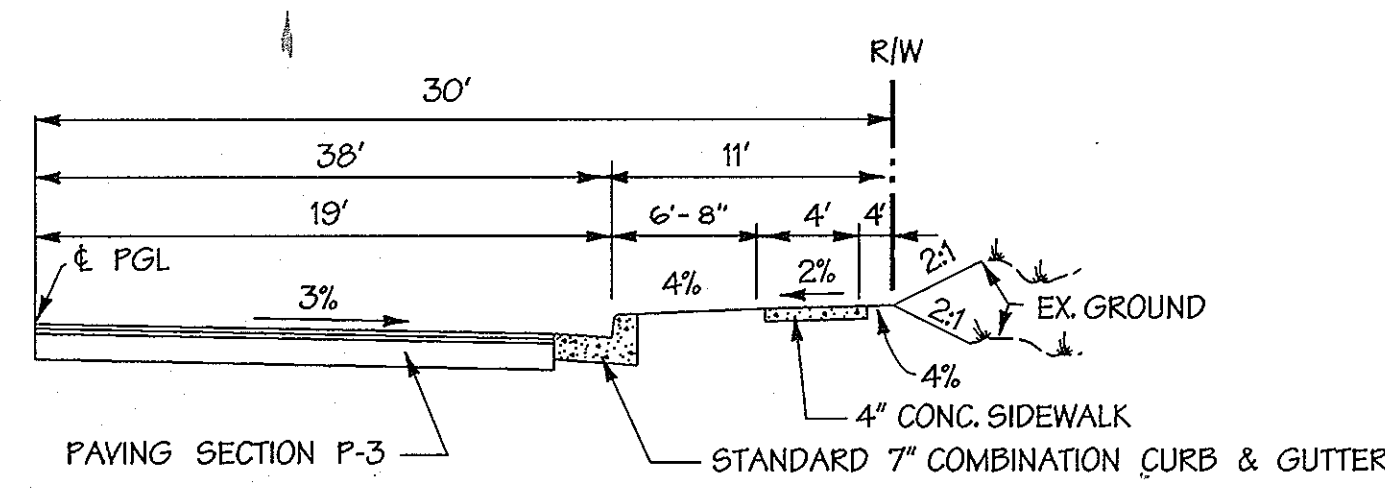


**SIDEWALK RAMP
TYPE 'A'**

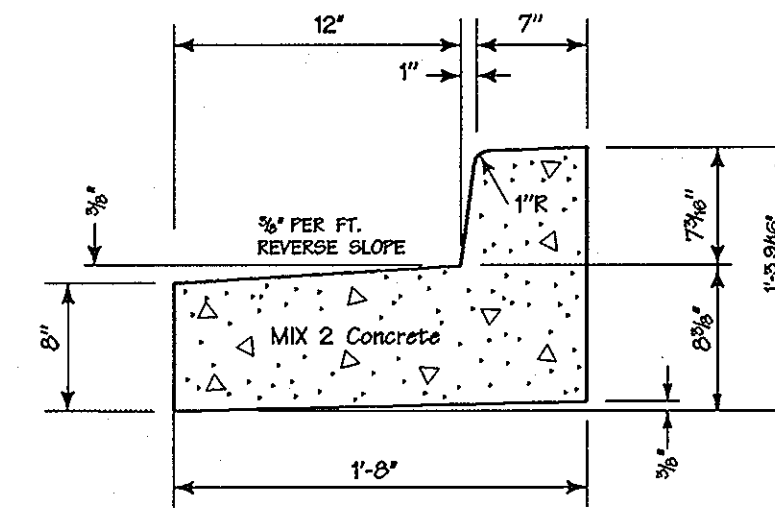


**REVERSE 7" COMBINATION
CURB & GUTTER**
NO SCALE

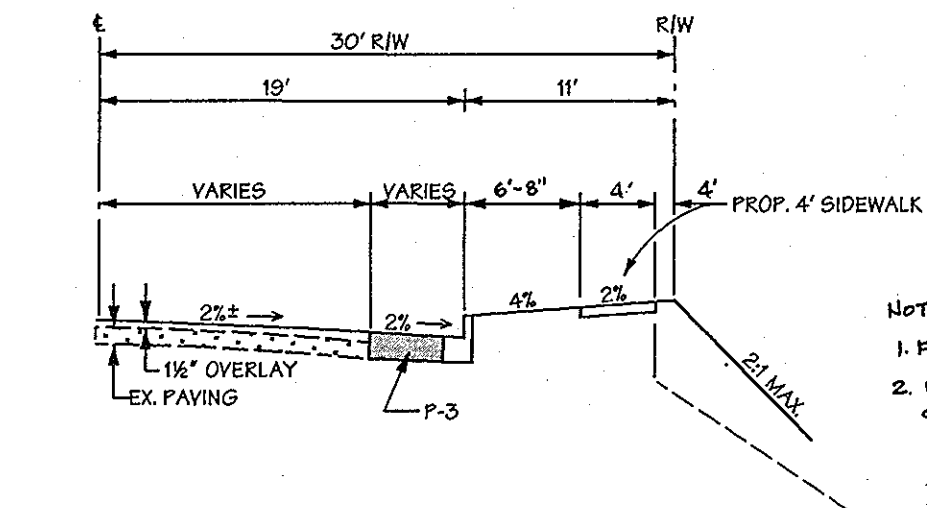


**TYPICAL HALF SECTION
SKYLARK BOULEVARD**
STA. 43+50± TO 44+50±
NTS

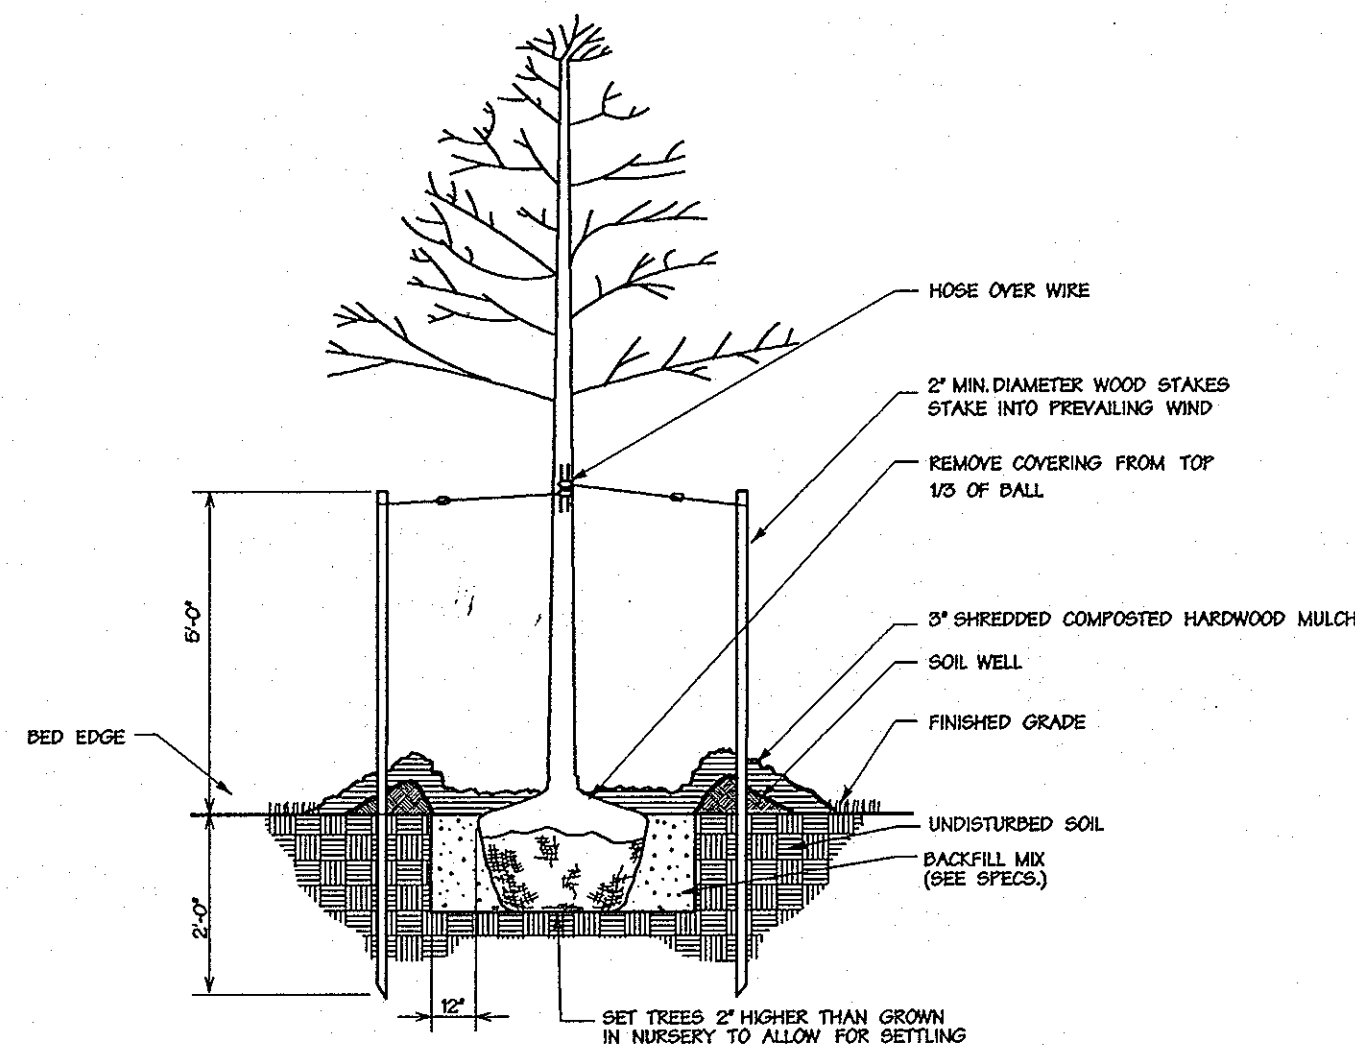


**DECIDUOUS TREE DETAIL
(TO 3" CALIFER)**

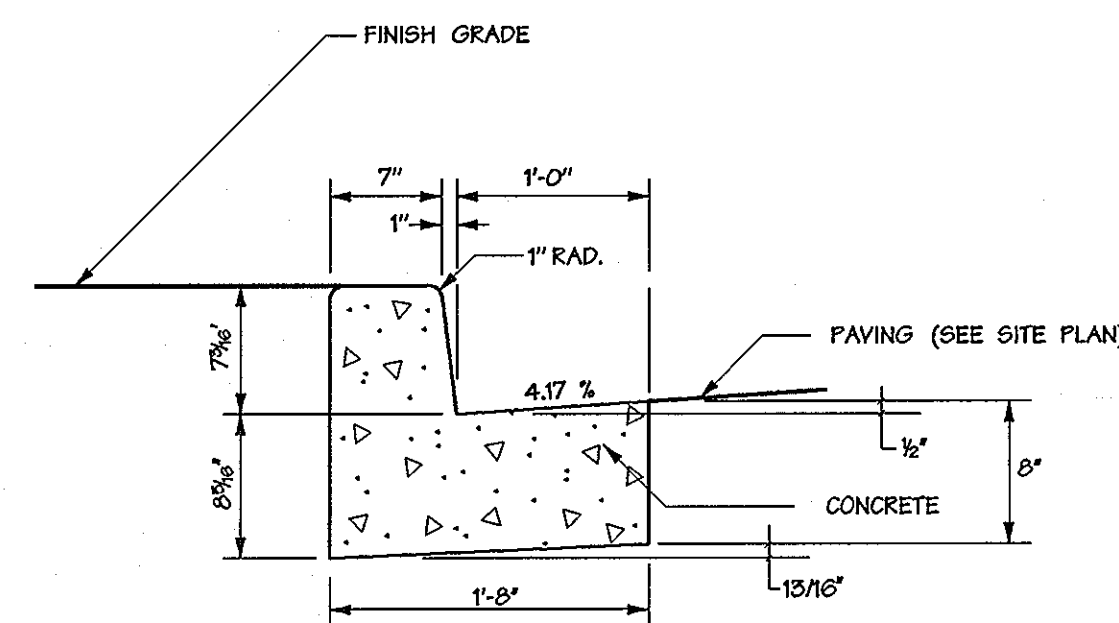

**SECTION
TYPE 'A' CURB AND GUTTER**
NO SCALE

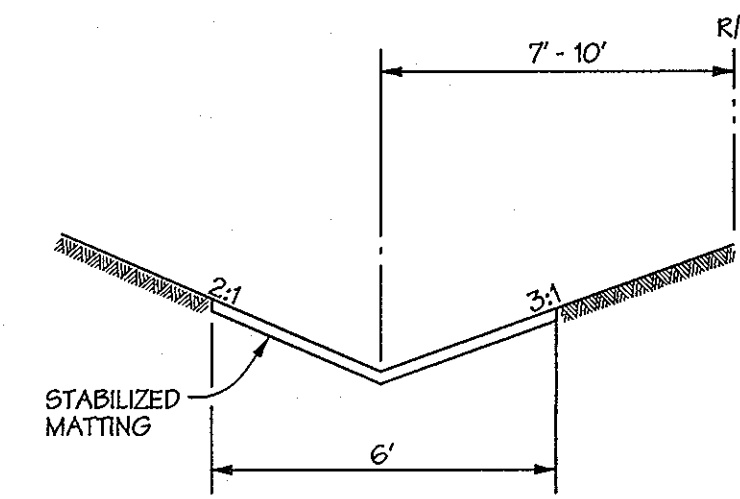

**EX. 12" D OUTFALL
TYPICAL SWALE DETAIL**
NO SCALE

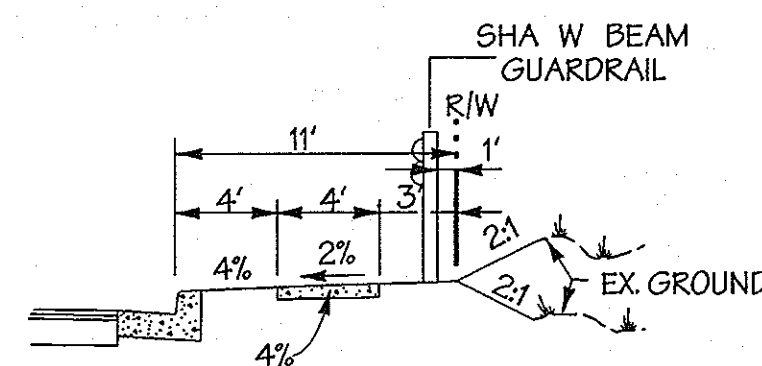

**LOCATON PLAN
W BEAM GUARDRAIL**

APPROVED: HOWARD COUNTY DEPARTMENT OF PUBLIC WORKS.	
<i>Richard M. Danks</i>	10-29-01
CHIEF, BUREAU OF HIGHWAYS.	DATE
APPROVED: HOWARD COUNTY DEPT. OF PLANNING & ZONING	
<i>Paul Dammers</i>	10/29/01
CHIEF, DEVELOPMENT ENGINEERING DIVISION MJK	DATE
<i>C. H. ...</i>	11/6/01
CHIEF, DIVISION OF LAND DEVELOPMENT	DATE
APPROVED:	DATE

Date	No.	Revision Description

EMERSON
FORMERLY KEY PROPERTY
SECTION 2, PHASE 1A

OWNER/DEVELOPER:
THE HOWARD RESEARCH & DEVELOPMENT CORPORATION
10275 Little Patuxent Parkway
Columbia, Maryland 21044

DMW
Duff-McCune-Walker, Inc.
200 East Pennsylvania Avenue
Towson, Maryland 21286
(410) 296-3333
Fax 296-4705


A Team of Land Planners,
Landscape Architects,
Engineers, Surveyors &
Environmental Professionals

SUBDIVISION NAME	EMERSON SECTION 2	SECTION/PARCEL	PHASE 1	LOT/PARCEL #	P10 P. 037, P. 3, P. 462
PLAT OF	27.5 & 13	ZONE	MDX	WATER CODE	6 TH
DATE	11.6.01	SEWER CODE			

TITLE		
ROAD CONSTRUCTION DETAILS		
Des By	Scale AS SHOWN	Proj. No. 95054.F
Drn By	Date 9-26-01	9 of 27
Chk By	Approved	

9/27/01
Date

Professional Engr. No. /0551

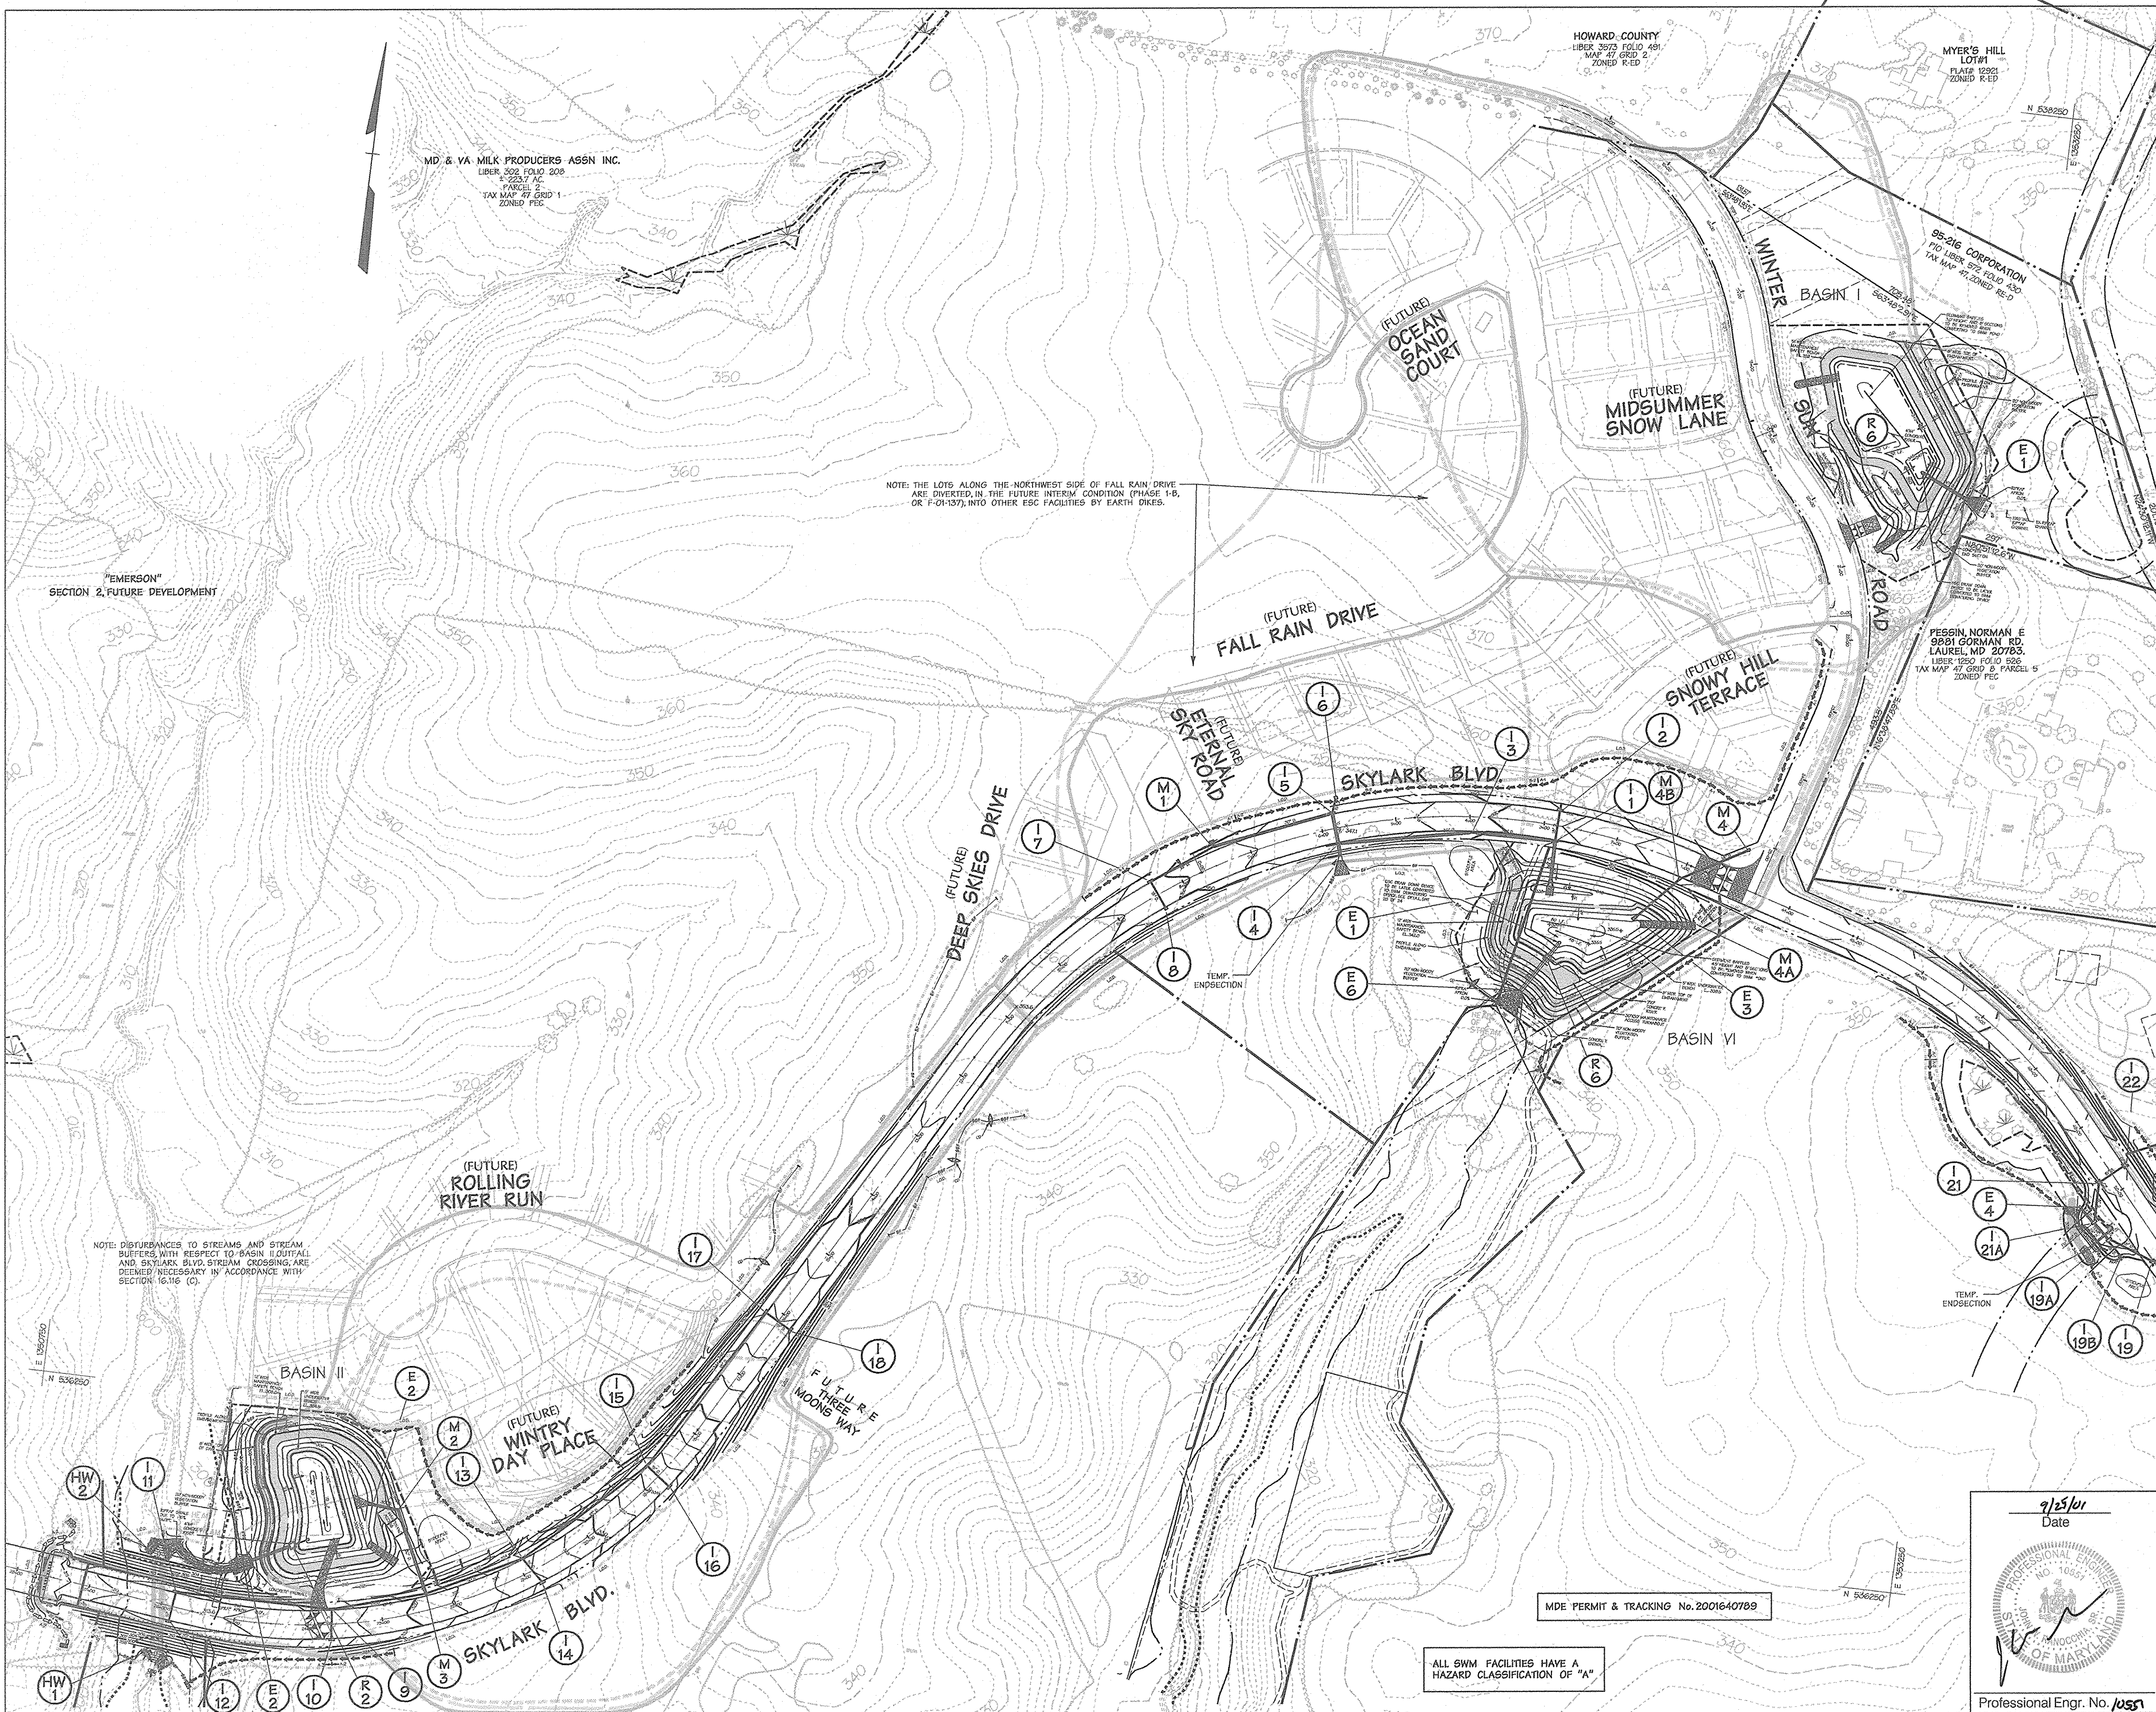

Legend

- PROPERTY LINE
- - - 20' SWM EASEMENT
- - - 360 EXISTING CONTOUR
- - - 362 PROPOSED CONTOUR
- CLEAN WATER DIVERSION PIPE
- ▲ MOUNTABLE BERM
- L.O.D. LIMIT OF DISTURBANCE
- SF - SF SILT FENCE
- SSF - SSF SUPER SILT FENCE
- EARTH DIKE
- EXISTING DRAINAGE AREA (DA) TO BASIN (ASSUMES BASIN IS BUILT, ROAD CONSTRUCTION HAS NOT BEGUN)
- INTERIM DRAINAGE AREA TO BASIN (ASSUMES OPEN CUT CONDITION, SKYLARK BOULEVARD, ONLY)
- FUTURE INTERIM DRAINAGE AREA TO BASIN (ASSUMES COMPLETION OF SKYLARK BOULEVARD, OPEN CUT CONDITION AND ESC IN PLACE FOR FUTURE SUBDIVISION ROADS)

INTERIM CONDITION HYDROLOGY TABLE (USING "FUTURE INTERIM" DRAINAGE AREAS SEE LEGEND THIS SHEET)

BASIN/ TRAP	DRAINAGE AREA	RCN	TIME OF CONC. (MIN.)
BASIN I	9.89	77	0.15
BASIN II	10.12	81	0.11
BASIN VI	12.60	81	0.10

APPROVED: HOWARD COUNTY DEPARTMENT OF PUBLIC WORKS
Andrew M. Powell 10-20-01
 CHIEF, BUREAU OF HIGHWAYS
 APPROVED: HOWARD COUNTY DEPT. OF PLANNING & ZONING
Mr. [Signature] 10/31/01
 CHIEF, DEVELOPMENT ENGINEERING DIVISION MKK
Mr. [Signature] 11/6/01
 CHIEF, DIVISION OF LAND DEVELOPMENT HB

Date	No.	Revision Description

EMERSON

FORMERLY KEY PROPERTY
SECTION 2, PHASE 1A

OWNER/DEVELOPER:
 THE HOWARD RESEARCH & DEVELOPMENT CORPORATION
 10275 Little Patuxent Parkway
 Columbia, Maryland 21044

DMW
 Date-McCune-Walker, Inc.
 200 East Pennsylvania Avenue
 Towson, Maryland 21286
 (410) 286-3322
 Fax 286-4705

A Team of Land Planners,
 Landscape Architects,
 Engineers, Surveyors &
 Environmental Professionals

9/25/01
 Date

Professional Engr. No. 10551

SUBDIVISION NAME EMERSON SECTION 2	SECTION/AREA PHASE 1A	LOT/PARCEL # P/O P. 037, P. 3, P. 462
FILE # OF "A" BLOCK 1-102-1-02	PARCEL # MDX 47	BLK/SHEET E TH
WATER CODE 	SEWER CODE 	CONTR. TRACT
TITLE EROSION & SEDIMENT CONTROL DRAINAGE AREA MAP		
Des By MRT	Scale 1"=100'	Proj. No. 95054.F
Drn By WHJ	Date 9-26-01	10 of 27
Chk By 	Approved 	


MDE PERMIT & TRACKING No. 2001640789

ALL SWM FACILITIES HAVE A HAZARD CLASSIFICATION OF "A"

SUB-SEQUENCE "B"
CONSTRUCTION OF EXISTING 24" DRAIN - TEMPORARY EXTENSION
(UNDER MAIN SEQUENCE, SEQ. #3 - SEE SHEET-14)

- | SEQUENCE | NO. OF DAYS |
|--|-------------|
| 1. CLEAR FOR AND INSTALL S.S.F. AT INFLOW AREA | 1 |
| 2. ROUGH GRADE INFLOW AREA AND STABILIZE WITH EROSION CONTROL MATTING. INSTALL RIP-RAP INFLOW PROTECTION. | 1 |
| 3. INSTALL TEMPORARY 24" D EXTENSION AND ENDSECTION. | 1 |
| 4. ROUGH GRADE SITE AREA TO MAINTAIN 4' COVER OVER TEMPORARY PIPE. | 2 |
| 5. REMOVE TEMPORARY 24" D DURING MAIN SEQUENCE # 6 (SEE SHEET 14), AND WITH THE SEDIMENT CONTROL INSPECTOR'S APPROVAL COMPLETE STORM DRAIN CONNECTION. | 1 |
| 6. FINE GRADE DISTURBED AREAS AND STABILIZE. | 1 |

NOTE: CONTRACTOR SHALL ESTABLISH AND MAINTAIN EROSION/SEDIMENT CONTROL MEASURES AT THE END OF EACH DAY. ALL DISTURBED AREAS OUTSIDE OF THE LOD SHALL BE PROTECTED WITH OTHER MEANS OF ESC MEASURES OR STABILIZED WITH TEMPORARY SEEDING AT THE END OF EACH DAY, AS APPROVED BY SEDIMENT CONTROL INSPECTOR.

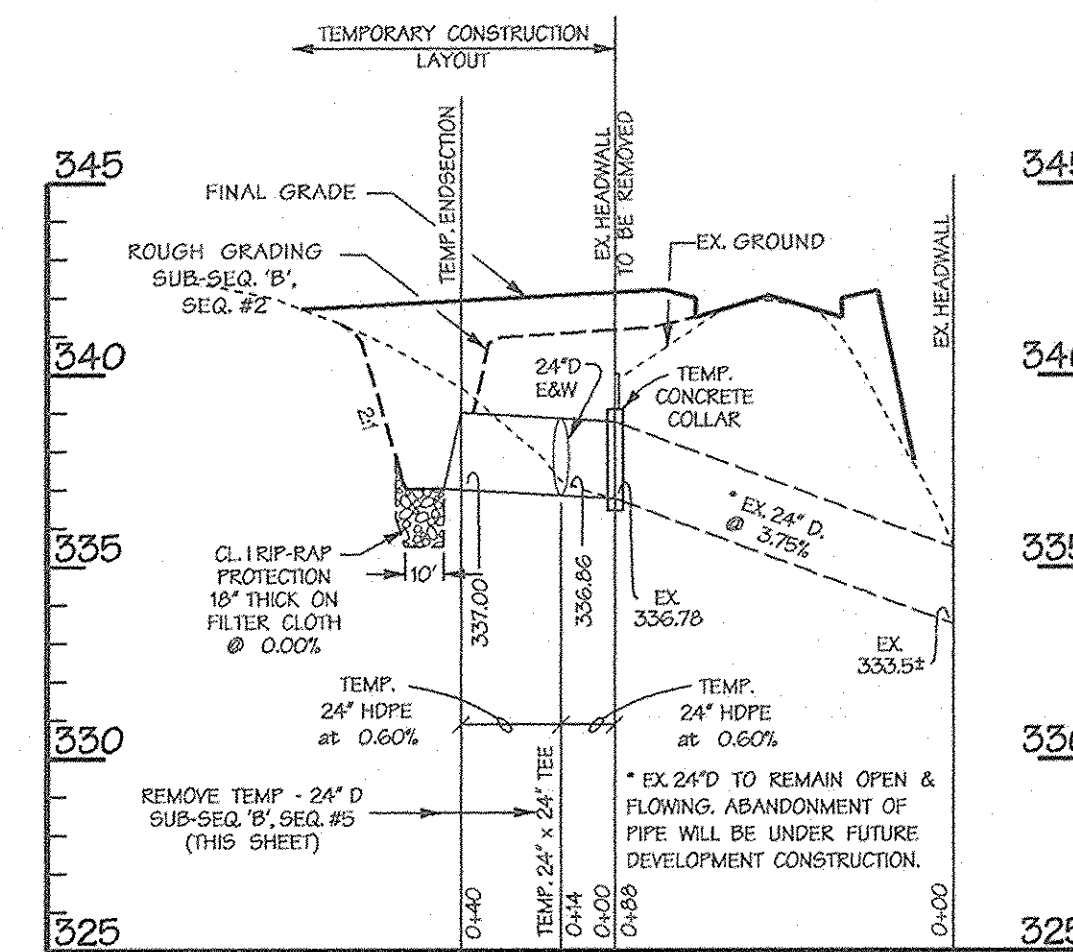

SUB-SEQ. "B" - SEQ. #3
TEMPORARY EX. 24" D. EXTENSION

Scale: Horiz. 1"=50'
Vert. 1"=5'

LEGEND

- PROPERTY LINE
- - - - - EXISTING CONTOUR
- - - - - PROPOSED CONTOUR
- LOD --- LIMIT OF DISTURBANCE
- LOS --- LIMIT OF SEEDING
- SF --- SILT FENCE - SEE DETAIL, SHT. 15 OF 27
- SSF --- SUPER SILT FENCE - SEE DETAIL, SHT. 15 OF 27
- RPS --- REMOVABLE PUMPING STATION
- CIP --- CURB INLET PROTECTION
- A5P --- AT GRADE INLET PROTECTION
- S.O.S. --- STONE OUTLET STRUCTURE
- EROSION CONTROL MATTING/SEEDING

SUB-SEQUENCE "A"
CONSTRUCTION OF SWALE & ADJUSTMENT TO EX. 12" D SEQUENCE
(UNDER MAIN SEQUENCE, SEQ. #5 - SEE SHEET-14)

- 1) CLEAR FOR AND INSTALL SILT FENCE AT OUTFALL END.
- 2) CLEAR AND GRADE SWALE, STABILIZE SWALE AREA IMMEDIATELY WITH EROSION CONTROL MATTING/SEEDING.
- 3) REMOVE 65" OF EX. 12" D, INSTALL ENDSECTION AND OUTFALL PROTECTION.
- 4) INSTALL SILT FENCE ALONG R/W AND ADJUST SILT FENCE AT SWALE OUTFALL FOR ROAD WIDENING CONSTRUCTION.

MATCH LINE - STA. 44+40 - SEE SHEET 12 OF 27

SKYLARK BLVD (EXISTING)

HALL DRIVE (FUTURE)


GORMAN ROAD (EXISTING)

NOTE: EXTREME CAUTION SHALL BE USED BY THE CONTRACTOR WHEN INSTALLING SILT FENCE AND EARTH DIKE ALONG EXISTING WETLAND AREA. MINIMAL DISTURBANCE TO BE MAINTAINED.

STABILIZED BOTTOM WITH EROSION CONTROL MATTING & NETLOW W/ G. RIP-RAP (SUB-SEQ. "B", SEQ. 2)

N 537000
E 1563750

N 536500
E 1563750

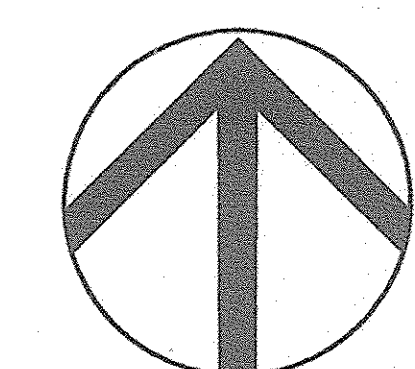

THESE PLANS HAVE BEEN REVIEWED FOR THE HOWARD SOIL CONSERVATION DISTRICT AND MEET THE TECHNICAL REQUIREMENTS FOR SMALL POND CONSTRUCTION, SOIL EROSION AND SEDIMENT CONTROL.

John A. Jenkins 10/10/01
DATE

U.S.D.A. NATURAL RESOURCES CONSERVATION SERVICE

APPROVED: *John A. Jenkins* 10/10/01
DATE

HOWARD SOIL CONSERVATION DISTRICT

PLAN NUMBER

DEVELOPERS CERTIFICATE:

I/WE CERTIFY THAT ALL DEVELOPMENT AND/OR CONSTRUCTION WILL BE DONE ACCORDING TO THESE PLANS AND THAT ANY RESPONSIBLE PERSONNEL INVOLVED IN THE CONSTRUCTION PROJECT WILL HAVE A CERTIFICATE OF ATTENDANCE AT A DEPARTMENT OF ENVIRONMENT APPROVED TRAINING PROGRAM FOR THE CONTROL OF SEDIMENT AND EROSION BEFORE BEGINNING THE PROJECT. I SHALL ENGAGE A REGISTERED PROFESSIONAL ENGINEER TO SUPERVISE POND CONSTRUCTION AND PROVIDE THE HOWARD SOIL CONSERVATION DISTRICT WITH AN "AS-BUILT" PLAN OF THE POND WITHIN 30 DAYS OF COMPLETION. I ALSO AUTHORIZE PERIODIC ON-SITE INSPECTIONS BY THE HOWARD SOIL CONSERVATION DISTRICT.

Robert A. Jenkins 10/21/01
SIGNATURE OF DEVELOPER DATE

PRINT NAME: BELOW SIGNATURE

ENGINEERS CERTIFICATE:

I CERTIFY THAT THIS PLAN FOR POND CONSTRUCTION, EROSION AND SEDIMENT CONTROL REPRESENTS A PRACTICAL AND WORKABLE PLAN BASED ON MY PERSONAL KNOWLEDGE OF THE SITE CONDITIONS. THIS PLAN WAS PREPARED IN ACCORDANCE WITH THE REQUIREMENTS OF THE HOWARD SOIL CONSERVATION DISTRICT. I HAVE NOTIFIED THE DEVELOPER THAT HE/SHE MUST ENGAGE A REGISTERED PROFESSIONAL ENGINEER TO SUPERVISE POND CONSTRUCTION AND PROVIDE THE HOWARD SOIL CONSERVATION DISTRICT WITH AN "AS-BUILT" PLAN OF THE POND WITHIN 30 DAYS OF COMPLETION.

John W. Ranocchia, Sr. 9/25/01
SIGNATURE OF ENGINEER DATE

PRINT NAME: BELOW SIGNATURE

9/25/01
Date

Professional Engr. No. 10551

APPROVED: HOWARD COUNTY DEPARTMENT OF PUBLIC WORKS.
Richard M. Daniels 10-20-01
CHIEF, BUREAU OF HIGHWAYS. DATE

APPROVED: HOWARD COUNTY DEPT. OF PLANNING & ZONING
John A. Jenkins 10/21/01
CHIEF, DEVELOPMENT ENGINEERING DIVISION MK. DATE

Cathy Shindler 11/6/01
CHIEF, DIVISION OF LAND DEVELOPMENT HB. DATE

Date	No.	Revision Description

EMERSON
FORMERLY KEY PROPERTY
SECTION 2, PHASE 1A

OWNER/DEVELOPER:
THE HOWARD RESEARCH & DEVELOPMENT CORPORATION
10275 Little Patuxent Parkway
Columbia, Maryland 21044

DMW
Dart-McCune-Walker, Inc.
200 East Pennsylvania Avenue
Towson, Maryland 21286
(410) 296-3353
Fax 296-4706
A Team of Land Planners, Landscape Architects, Engineers, Surveyors & Environmental Professionals

SUBMISSION NAME	SECTION AREA	PHASE	LOT/FACILITY #
EMERSON SECTION 2	PHASE 1A		

PLATE NO. 14
BLOCK, E.O.D. MDD
14.5, 22.5 & 21

ZONE 47
TAXING MAP 6 TH
ELECT. DISTRICT

WATER CODE
SEWER CODE

TITLE
EROSION & SEDIMENT CONTROL PLAN

Des By	MRT	Scale	1"=50'	Proj. No.	95054.F
Drn By	WHJ	Date	9-26-01		
Chk By		Approved			11 of 27

F-01-136
Tue Sep 25 12:33:41 2002 55054.F (01) 95054.F (01) 11 of 27

BASIN TABLE	
BASIN NUMBER	II
EXISTING DRAINAGE AREA AC.	6.72
INTERIM DRAINAGE AREA AC.	8.00
PROPOSED DRAINAGE AREA AC.	14.72
STORAGE REQUIRED C.F.	WET 14,436
	DRY 14,436
	TOTAL 28,872
STORAGE PROVIDED C.F.	WET 14,810
	DRY 15,570
	TOTAL 30,380
EXISTING GROUND ELEV.	302.0
TOP EMBANKMENT ELEV.	310.7
EMERGENCY SPILLWAY CREST ELEV.	N/A
RISER CREST ELEV.	307.0
WET STORAGE ELEV.	304.0
CLEANOUT ELEV.	303.2
BOTTOM ELEV.	302.0
Q INTO BASIN (C.F.S.) 10 YR. CLOGGED	36.96
Q OUT BARREL (C.F.S.) 10 YR. CLOGGED	21.32
Q OUT EMERGENCY SPILLWAY	N/A
BASIN DEPTH	WET 2.00'
	DRY 1.20'
	TOTAL 3.20'
DESIGN HIGHWATER 10 YR. CLOGGED	307.56
FREEBOARD PROVIDED	2.94'
BARREL DIAMETER	36"
RISER DIMENSIONS	4' X 4'
EMERGENCY SPILLWAY WIDTH	N/A
WET STORAGE ZONE ELEV.	302.0-304.0
DRY STORAGE ZONE ELEV.	304.0-305.2
BOTTOM DIMENSIONS	40' X 110'
EXISTING 2 YR. Q	1.77 CFS
PROPOSED 2 YR. Q	0.47 CFS

* BASED ON WORST-CASE CONDITION WITH SKYLARK BLVD. PAVED, SUBDIVISION ROADS OPEN CUT.
 ** D.A. WILL EXPAND TO THIS SIZE AFTER ENTIRE AREA IS STABILIZED.

DEVELOPERS CERTIFICATE:
 I/WE CERTIFY THAT ALL DEVELOPMENT AND/OR CONSTRUCTION WILL BE DONE ACCORDING TO THESE PLANS AND THAT ANY RESPONSIBLE PERSONNEL INVOLVED IN THE CONSTRUCTION PROJECT WILL HAVE A CERTIFICATE OF ATTENDANCE AT A DEPARTMENT OF ENVIRONMENT APPROVED TRAINING PROGRAM FOR THE CONTROL OF SEDIMENT AND EROSION BEFORE BEGINNING THE PROJECT. I/SHALL ENGAGE A REGISTERED PROFESSIONAL ENGINEER TO SUPERVISE POND CONSTRUCTION AND PROVIDE THE HOWARD SOIL CONSERVATION DISTRICT WITH AN "AS-BUILT" PLAN OF THE POND WITHIN 30 DAYS OF COMPLETION. I ALSO AUTHORIZE PERIODIC ON-SITE INSPECTIONS BY THE HOWARD SOIL CONSERVATION DISTRICT.

Robert A. Jenkins 10/23/01
 SIGNATURE OF DEVELOPER DATE
 PRINT NAME BELOW SIGNATURE

THESE PLANS HAVE BEEN REVIEWED FOR THE HOWARD SOIL CONSERVATION DISTRICT AND MEET THE TECHNICAL REQUIREMENTS FOR SMALL POND CONSTRUCTION, SOIL EROSION AND SEDIMENT CONTROL.

John M. ... 10/16/01
 U.S.D.A. NATURAL RESOURCES CONSERVATION SERVICE DATE

THESE PLANS FOR SMALL POND CONSTRUCTION, SOIL EROSION AND SEDIMENT CONTROL MEET THE REQUIREMENTS OF HOWARD SOIL CONSERVATION DISTRICT.

John M. ... 10/10/01
 APPROVED: HOWARD SOIL CONSERVATION DISTRICT DATE

PLAN NUMBER


ENGINEERS CERTIFICATE:
 I CERTIFY THAT THIS PLAN FOR POND CONSTRUCTION, EROSION AND SEDIMENT CONTROL REPRESENTS A PRACTICAL AND WORKABLE PLAN BASED ON MY PERSONAL KNOWLEDGE OF THE SITE CONDITIONS. THIS PLAN WAS PREPARED IN ACCORDANCE WITH THE REQUIREMENTS OF THE HOWARD SOIL CONSERVATION DISTRICT. I HAVE NOTIFIED THE DEVELOPER THAT HE/SHE MUST ENGAGE A REGISTERED PROFESSIONAL ENGINEER TO SUPERVISE POND CONSTRUCTION AND PROVIDE THE HOWARD SOIL CONSERVATION DISTRICT WITH AN "AS-BUILT" PLAN OF THE POND WITHIN 30 DAYS OF COMPLETION.

John V. Ramachandra, P.E. 9/25/01
 SIGNATURE OF ENGINEER DATE
 PRINT NAME BELOW SIGNATURE

- NOTES:
- 1) A TEMPORARY STREAM BYPASS WILL BE CONSTRUCTED WHILE THE PROPOSED TWIN CULVERTS ARE INSTALLED. DETAILS OF BYPASS METHOD IS INDICATED ON ESC DETAIL SHEET 16 OF 27.
 - 2) SWM POND FOREBAY EMBANKMENT (BETWEEN STORMDRAIN OUTFALLS INTO BASIN AND SEDIMENT BAFFLES) WILL BE INSTALLED WHEN CONVERTING BASIN TO SWM POND.
 - 3) THE 2:1 SLOPES THAT EXTEND ALONG SKYLARK BLVD. STA. 24+00 TO STA. 27+50 TO EXISTING GRADE AT THE STREAM CHANNEL SHALL BE IMMEDIATELY STABILIZED AFTER THEY ARE CONSTRUCTED. THESE SLOPES SHALL BE STABILIZED WITH ECM AND PERMANENT SEED MIX.
 - 4) NO WORK SHALL BE CONDUCTED IN THE EXISTING STREAM DURING MARCH 1 - JUNE 15 INCLUSIVE, DURING ANY YEAR.

LEGEND

- 360 --- PROPERTY LINE
- - - 360 - - - EXISTING CONTOUR
- - - 362 - - - PROPOSED CONTOUR
- ▲▲▲▲▲ MOUNTABLE BERM
- L.O.D. --- LIMIT OF DISTURBANCE
- SF --- SF --- SILT FENCE - SEE DETAIL, SHT. 15 OF 27
- S6F --- S6F --- SUPPLY SILT FENCE - SEE DETAIL, SHT. 15 OF 27
- E.D. --- E.D. --- EARTH DIKE - SEE DETAIL, SHT. 15 OF 27
- ☐ RPS REMOVABLE PUMPING STATION
- ☐ CIP CURB INLET PROTECTION
- ☐ AGP AT GRADE INLET PROTECTION
- ☐ S.O.S. STONE OUTLET STRUCTURE

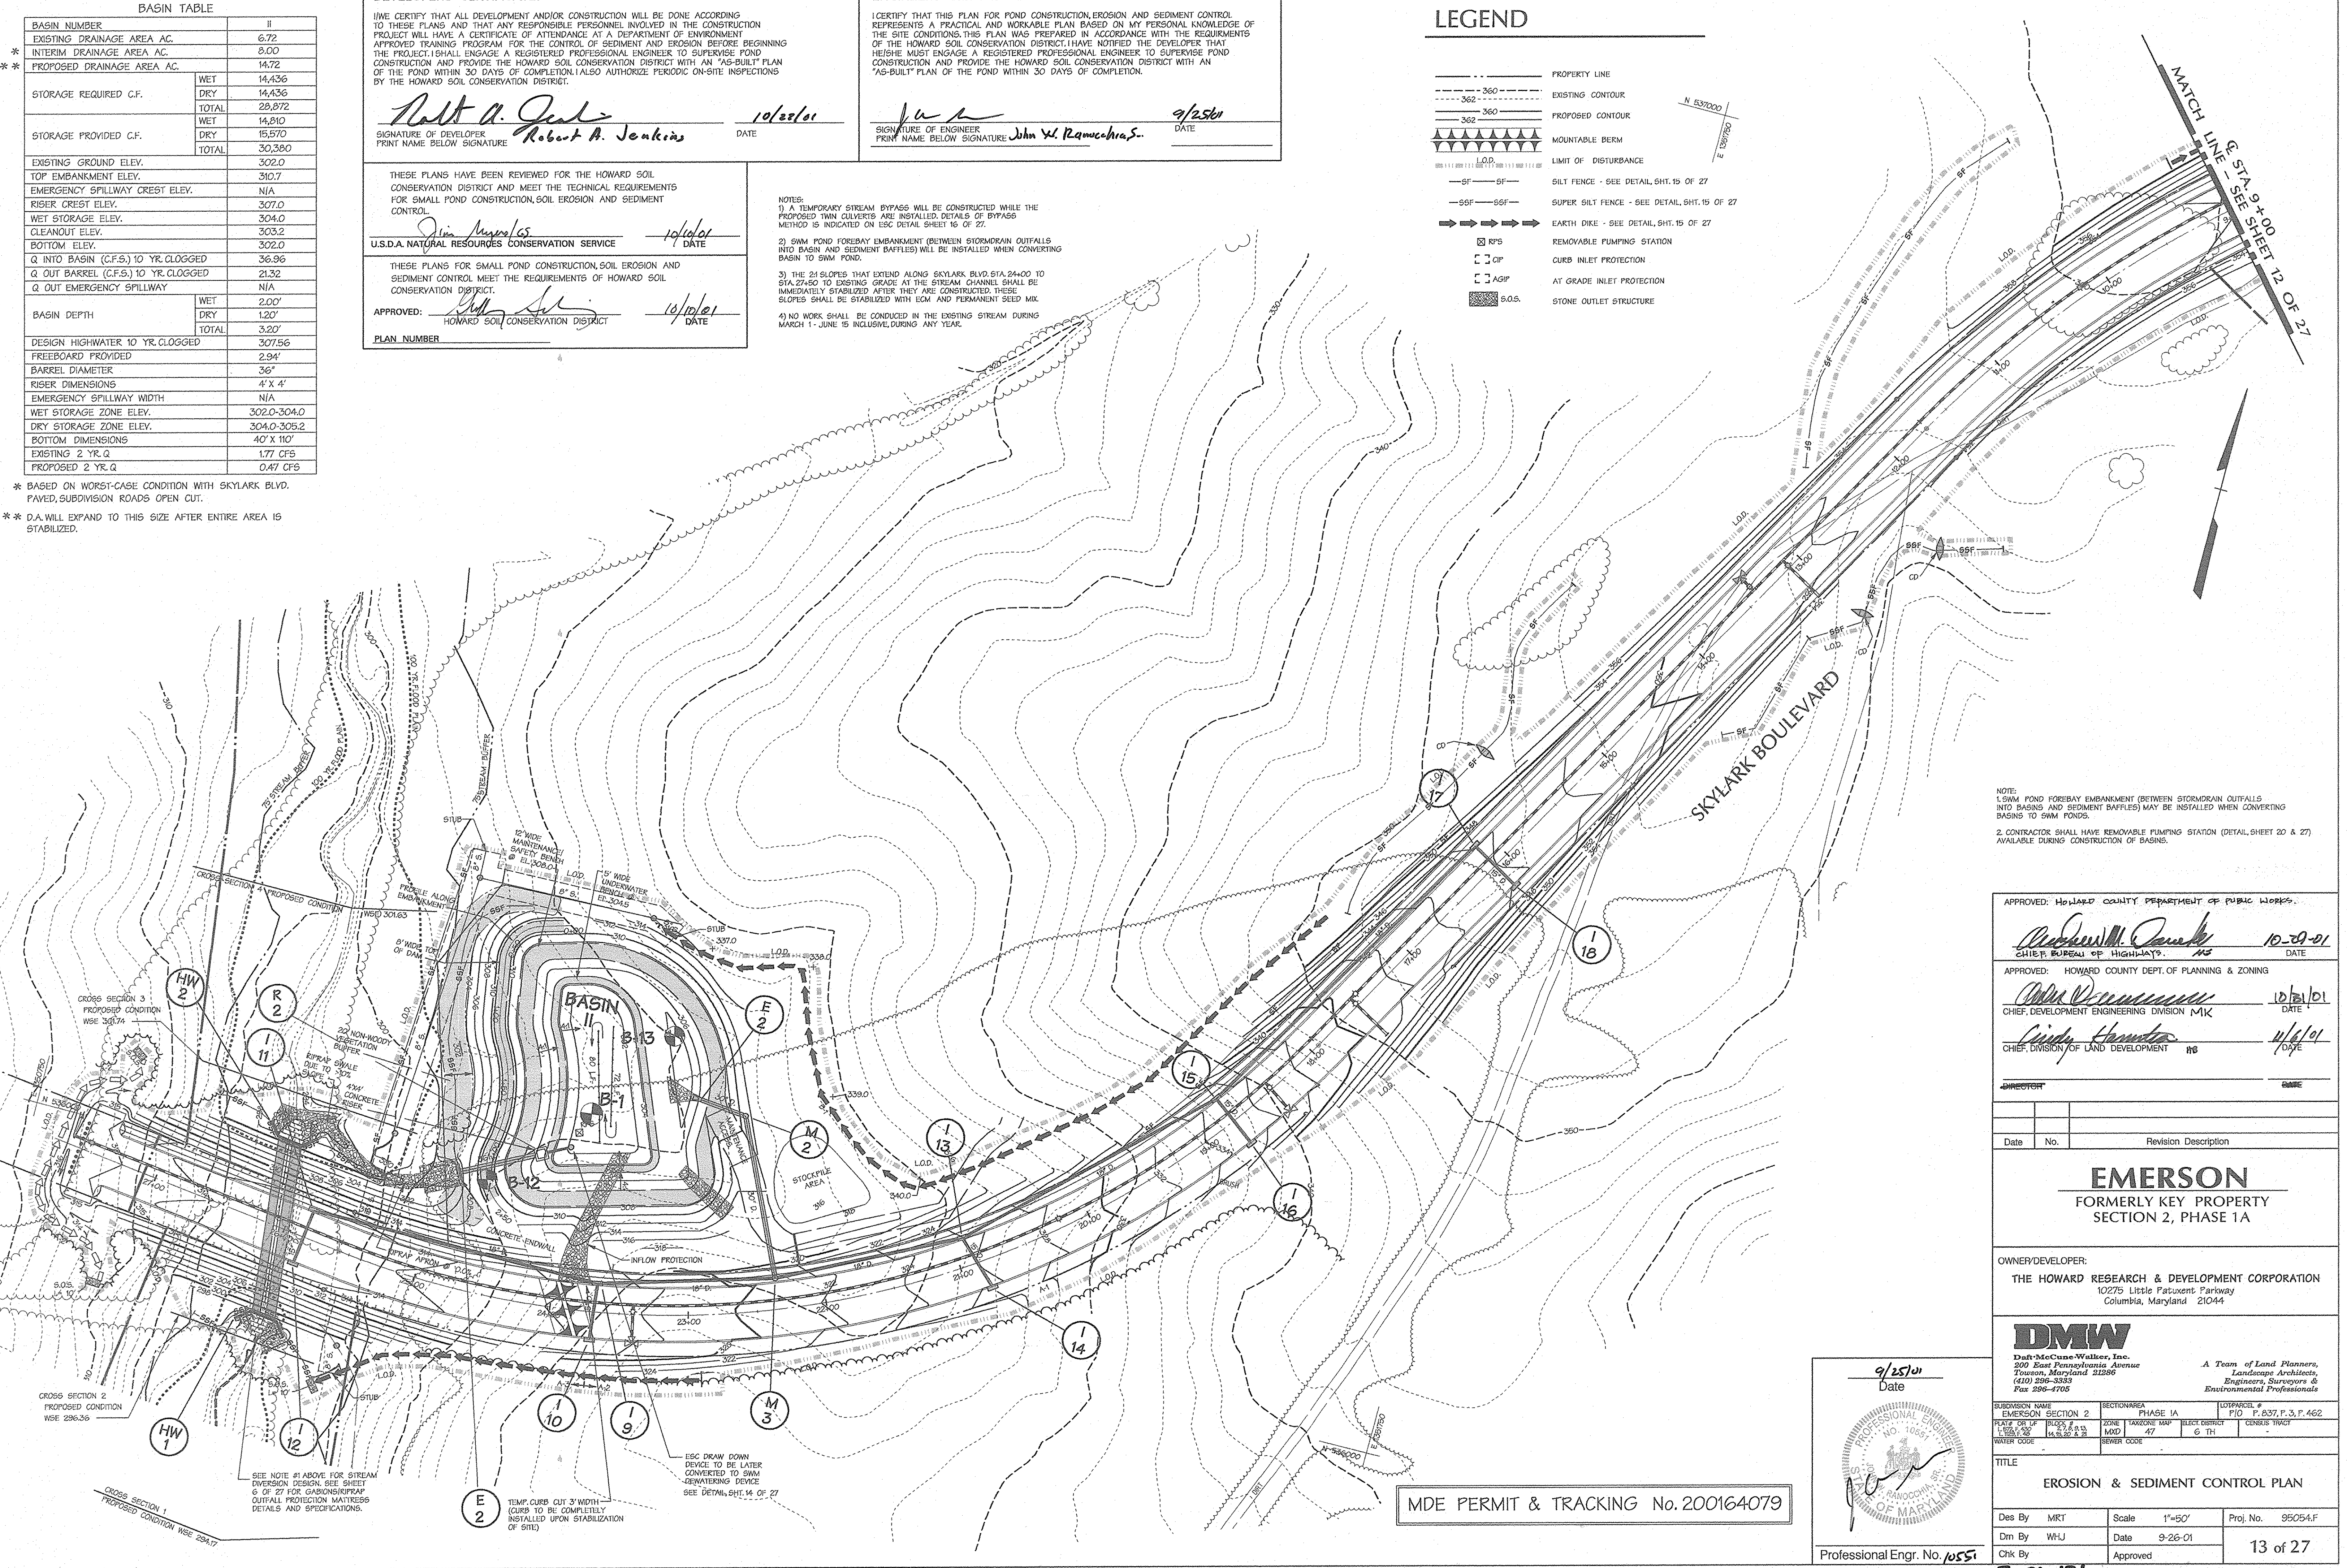

NOTE:
 1. SWM POND FOREBAY EMBANKMENT (BETWEEN STORMDRAIN OUTFALLS INTO BASIN AND SEDIMENT BAFFLES) MAY BE INSTALLED WHEN CONVERTING BASIN TO SWM POND.
 2. CONTRACTOR SHALL HAVE REMOVABLE PUMPING STATION (DETAIL, SHEET 20 & 27) AVAILABLE DURING CONSTRUCTION OF BASIN.

APPROVED: HOWARD COUNTY DEPARTMENT OF PUBLIC WORKS
Richard W. ... 10-29-01
 CHIEF, BUREAU OF HIGHWAYS. DATE

APPROVED: HOWARD COUNTY DEPT. OF PLANNING & ZONING
John ... 10/16/01
 CHIEF, DEVELOPMENT ENGINEERING DIVISION MKK DATE

Chris ... 11/6/01
 CHIEF, DIVISION OF LAND DEVELOPMENT H8 DATE

DATE No. Revision Description

EMERSON
 FORMERLY KEY PROPERTY
 SECTION 2, PHASE 1A

OWNER/DEVELOPER:
 THE HOWARD RESEARCH & DEVELOPMENT CORPORATION
 10275 Little Patuxent Parkway
 Columbia, Maryland 21044

DMW
 Daft-McCune-Walker, Inc.
 200 East Pennsylvania Avenue
 Towson, Maryland 21286
 (410) 296-3333
 Fax 296-4708

A Team of Land Planners, Landscape Architects, Engineers, Surveyors & Environmental Professionals

SUBMISSION NAME: EMERSON SECTION 2 PHASE 1A LOT/PROJECT # P10 P. 237, P. 3, P. 462
 DATE OF PLAN: 10/25/01
 ZONE: MD 47
 TAX/ZONE MAP: 6 TH
 CENSUS TRACT: 14-5, 22 & 23
 WATER CODE: SEWER CODE:

TITLE: EROSION & SEDIMENT CONTROL PLAN

Des By: MRT Scale: 1"=50' Proj. No.: 95054.F
 Dm By: W-LJ Date: 9-26-01
 Chk By: Approved 13 of 27





MDE PERMIT & TRACKING No. 200164079

9/25/01
 Date

Professional Engr. No. 10551

- A MINIMUM OF 48 HOURS NOTICE MUST BE GIVEN TO THE HOWARD COUNTY DEPARTMENT OF INSPECTIONS, AND PERMITS, SEDIMENT CONTROL DIVISION PRIOR TO THE START OF ANY CONSTRUCTION (03-0505).
- ALL VEGETATIVE AND STRUCTURAL PRACTICES ARE TO BE INSTALLED ACCORDING TO THE PROVISIONS OF THIS PLAN AND ARE TO BE IN CONFORMANCE WITH THE MOST CURRENT MARYLAND STANDARDS AND SPECIFICATIONS FOR SOIL EROSION AND SEDIMENT CONTROL AND REVISIONS THERETO.
- FOLLOWING INITIAL SOIL DISTURBANCE OR RE-DISTURBANCE, PERMANENT OR TEMPORARY STABILIZATION SHALL BE COMPLETED WITHIN:
 - SEVEN CALENDAR DAYS FOR ALL PERIMETER SEDIMENT CONTROL STRUCTURES, DIKES, PERIMETER SLOPES AND ALL SLOPES STEEPER THAN 3:1.
 - FOURTEEN DAYS AS TO ALL OTHER DISTURBED OR GRADED AREAS ON THE PROJECT SITE.
- ALL SEDIMENT TRAPPING SHOWS MUST BE FENCED AND WARNING SIGNS POSTED AROUND THEIR PERIMETER IN ACCORDANCE WITH VOL. 1, CHAPTER 12, OF THE "HOWARD COUNTY DESIGN MANUAL", STORM DRAINAGE.
- ALL DISTURBED AREAS MUST BE STABILIZED WITHIN THE TIME PERIOD SPECIFIED ABOVE IN ACCORDANCE WITH THE 1994 MARYLAND STANDARDS AND SPECIFICATIONS FOR SOIL EROSION AND SEDIMENT CONTROL FOR PERMANENT SEEDINGS (SEC. 51), SODS (SEC. 54), TEMPORARY SEEDINGS (SEC. 50), AND MULCHING (SEC. 52). TEMPORARY STABILIZATION WITH MULCH ALONE CAN ONLY BE DONE WHEN RECOMMENDED SEEDING DATES DO NOT ALLOW FOR PROPER GERMINATION AND ESTABLISHMENT OF GRASSES.
- ALL SEDIMENT CONTROL STRUCTURES ARE TO REMAIN IN PLACE AND ARE TO BE MAINTAINED IN OPERATIVE CONDITION UNTIL PERMITS FOR THEIR REMOVAL HAS BEEN OBTAINED FROM THE HOWARD COUNTY SEDIMENT CONTROL INSPECTOR.
- SITE ANALYSIS:

TOTAL AREA OF SITE (BOTH PHASES)	82.0 ACRES
AREA DISTURBED	29.0 ACRES
AREA TO BE ROOFED OR PAVED	15.5 ACRES
AREA TO BE VEGETATIVELY STABILIZED	115 ACRES
TOTAL CUT	106,000 CUBIC YARDS
TOTAL FILL	106,000 CUBIC YARDS
- OFF-SITE WASTE/BORROW AREA LOCATION WASTE:
 - APPLY TO GRADED OR CLEARED AREAS NOT SUBJECT TO IMMEDIATE FURTHER DISTURBANCE WHERE A PERMANENT LONG-LIVED VEGETATIVE COVER IS NEEDED.
 - SEEDBED PREPARATION LOOSEN UPPER THREE INCHES OF SOIL BY RAKING, DISKING OR OTHER ACCEPTABLE MEANS BEFORE SEEDING, IF NOT PREVIOUSLY LOOSENED.
 - SOIL AMENDMENTS - IN LIEU OF SOIL TEST RECOMMENDATIONS, USE ONE OF THE FOLLOWING SCHEDULES:
 - PREFERRED - APPLY 2 TONS PER ACRE DOLOMITIC LIMESTONE (92 LBS/1000 SQ.FT.) AND 1000 LBS. PER ACRE 10-10-10 FERTILIZER (14 LBS/1000 SQ.FT.) BEFORE SEEDING. HARROW OR DISK INTO UPPER THREE INCHES OF SOIL. AT TIME OF SEEDING, APPLY 400 LBS. PER ACRE 30-0-0 UREAFORM FERTILIZER (9 LBS/1000 SQ.FT.)
 - ACCEPTABLE - APPLY 2 TONS PER ACRE DOLOMITIC LIMESTONE (92 LBS/1000 SQ.FT.) AND 1000 LBS. PER ACRE 10-10-10 FERTILIZER (23 LBS/1000 SQ.FT.) BEFORE SEEDING. HARROW OR DISK INTO UPPER THREE INCHES OF SOIL.
 - SEEDING - FOR THE PERIODS MARCH 1 THRU APRIL 30, AND AUGUST 1 THRU OCTOBER 15, SEED WITH 60 LBS. PER ACRE (14 LBS/1000 SQ.FT.) OF KENTUCKY 31 TALL FESCUE. FOR THE PERIOD MAY 1 THRU JULY 31 SEED WITH 60 LBS. KENTUCKY 31 TALL FESCUE PER ACRE AND 2 LBS. PER ACRE (0.5 LBS/1000 SQ.FT.) OF KEEPING LONGGRASS. DURING THE PERIOD OF OCTOBER 16 THRU FEBRUARY 28, PROTECT SITE BY OPTION (1) - 2 TONS PER ACRE OF WELL ANCHORED STRAW MULCH AND SEED AS SOON AS POSSIBLE IN THE SPRING. OPTION (2) - USE SOD. OPTION (3) - SEED WITH 60 LBS. KENTUCKY 31 TALL FESCUE AND MULCH WITH 2 TONS. FACE WELL ANCHORED STRAW.
 - MULCHING - APPLY 1/2 TO 2 TONS PER ACRE (70 TO 90 LBS/1000 SQ.FT.) OF UNPROTIED SMALL GRAIN STRAW IMMEDIATELY AFTER SEEDING. ANCHOR MULCH IMMEDIATELY AFTER APPLICATION USING MULCH ANCHORING TOOL OR 200 GALLONS PER ACRE (5 GALLON/SQ.FT.) OF EMULSIFIED ASPHALT ON FLAT AREAS, ON SLOPES 8 FEET OR HIGHER, USE 340 GALLONS PER ACRE (8 GALLON/SQ.FT.) FOR ANCHORING.
 - MAINTENANCE - INSPECT ALL SEEDING AREAS AND MAKE NEEDED REPAIRS, REPLACEMENTS AND RESEEDING.
- TEMPORARY SEEDING NOTES:
 - APPLY TO GRADED OR CLEARED AREAS LIKELY TO BE REDISTURBED WHERE A SHORT-TERM VEGETATIVE COVER IS NEEDED.
 - SEEDBED PREPARATION - LOOSEN UPPER THREE INCHES OF SOIL BY RAKING, DISKING OR OTHER ACCEPTABLE MEANS BEFORE SEEDING, IF NOT PREVIOUSLY LOOSENED.
 - SOIL AMENDMENTS - APPLY 600 LBS. PER ACRE 10-10-10 FERTILIZER (14 LBS/1000 SQ.FT.)
 - SEEDING - FOR THE PERIODS MARCH 1 THRU APRIL 30, AND AUGUST 1 THRU OCTOBER 15, SEED WITH 2-1/2 BUSHEL PER ACRE OF ANNUAL RYE (32 LBS/1000 SQ.FT.). FOR THE PERIOD MAY 1 THRU AUGUST 14, SEED WITH 3 LBS. PER ACRE OF KEEPING LONGGRASS (0.7 LBS/1000 SQ.FT.). FOR THE PERIOD NOVEMBER 16 THRU FEBRUARY 28, PROTECT SITE BY APPLYING 2 TONS PER ACRE OF WELL ANCHORED STRAW MULCH AND SEED AS SOON AS POSSIBLE IN THE SPRING, OR USE SOD.
 - MULCHING - APPLY 1/2 TO 2 TONS PER ACRE (70 TO 90 LBS/1000 SQ.FT.) OF UNPROTIED SMALL GRAIN STRAW IMMEDIATELY AFTER SEEDING. ANCHOR MULCH IMMEDIATELY AFTER APPLICATION USING MULCH ANCHORING TOOL OR 210 GALLON PER ACRE (5 GALLON/SQ.FT.) OF EMULSIFIED ASPHALT ON FLAT AREAS, ON SLOPES 8 FT. OR HIGHER, USE 340 GALLON PER ACRE (8 GALLON/SQ.FT.) FOR ANCHORING.
 - REFER TO THE 1994 MARYLAND STANDARDS AND SPECIFICATIONS FOR SOIL EROSION AND SEDIMENT CONTROL FOR ADDITIONAL RATES AND METHODS NOT COVERED.

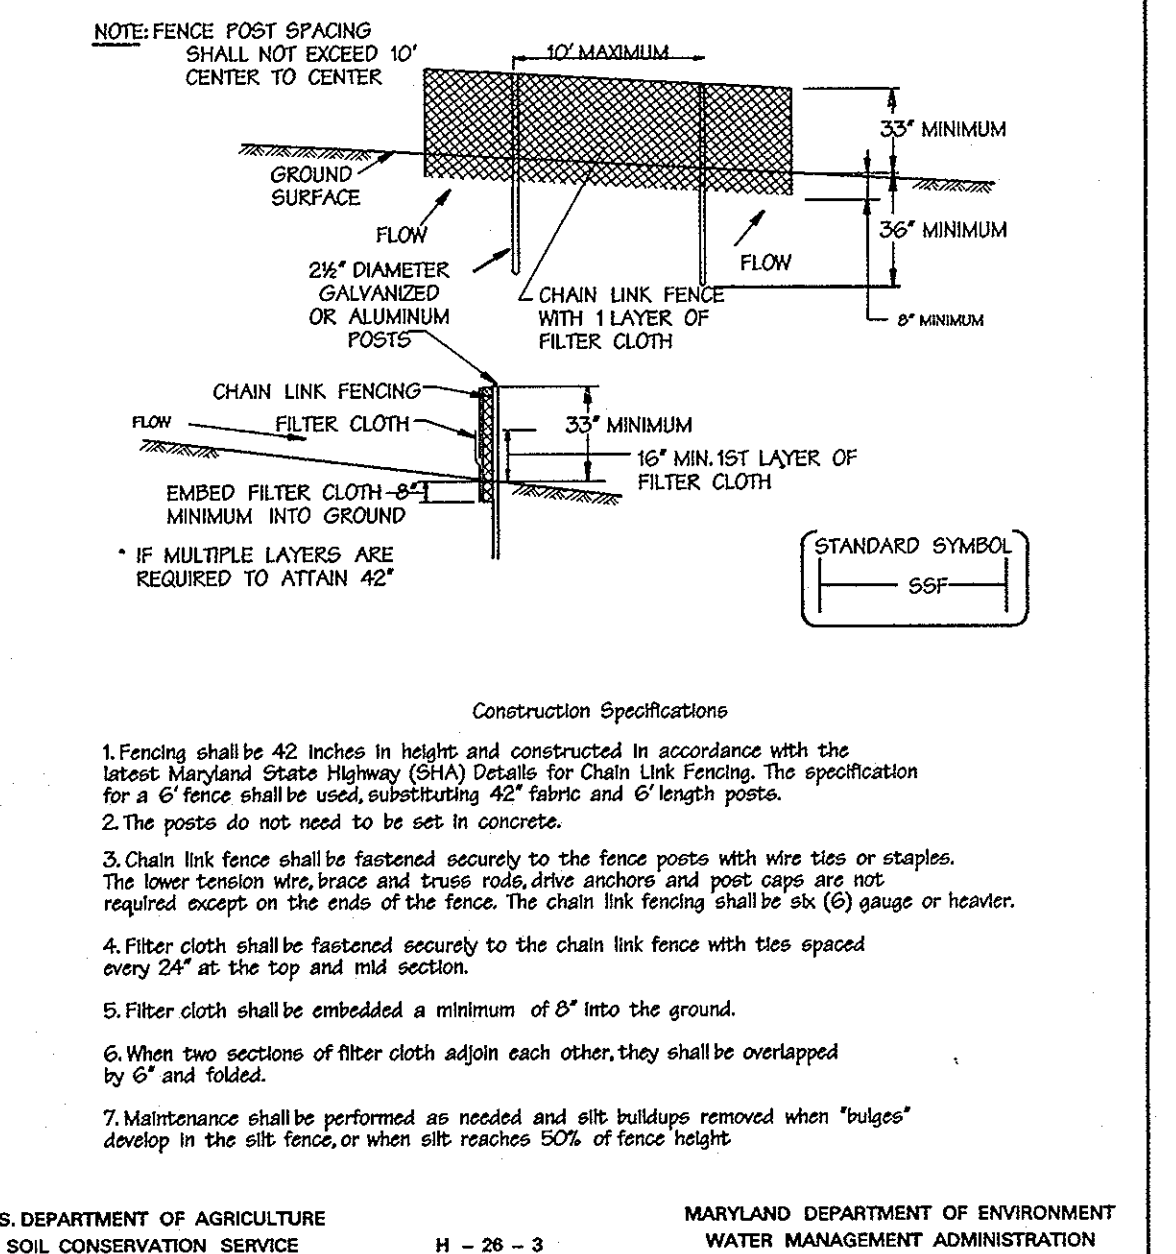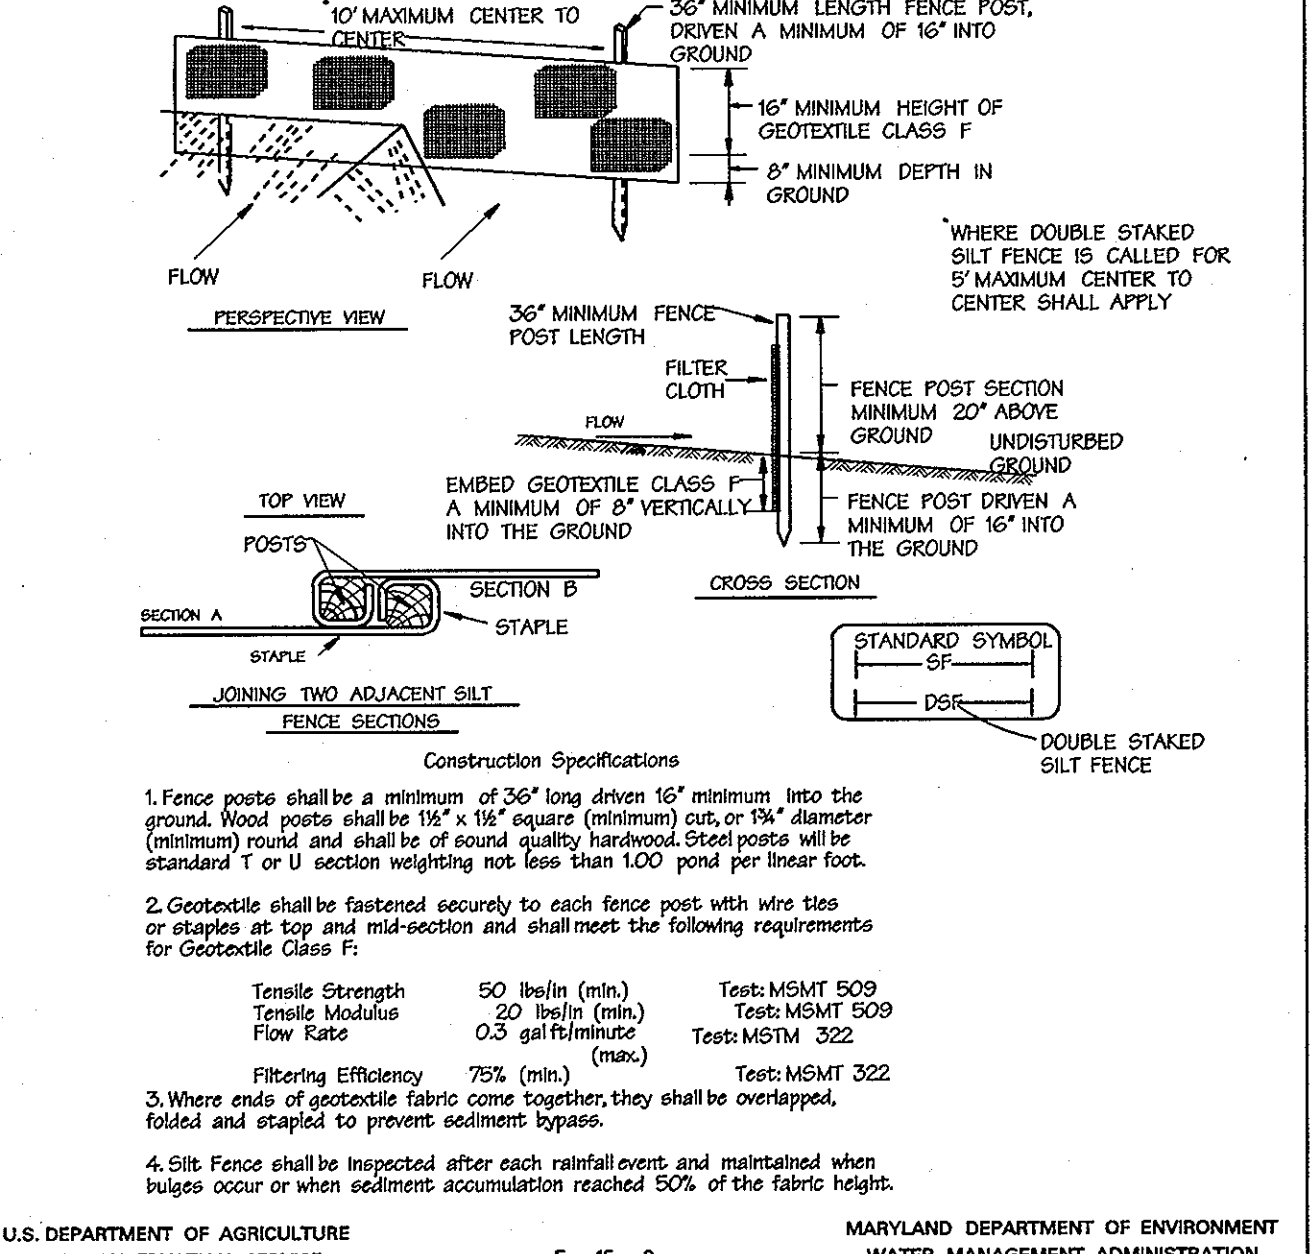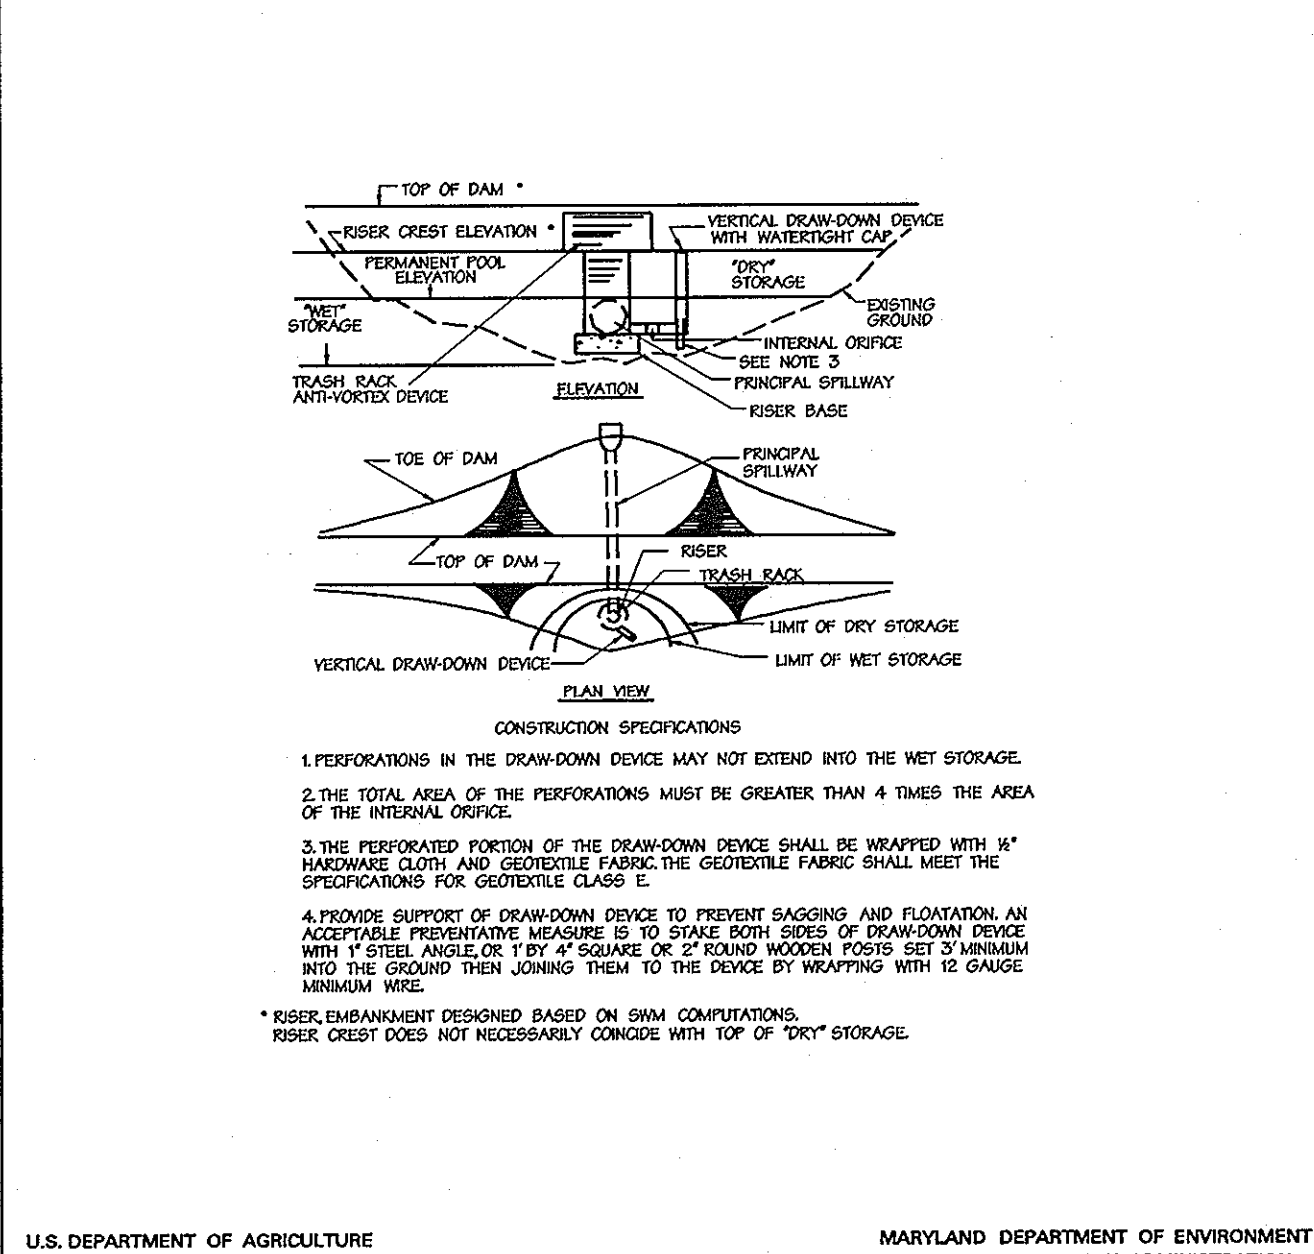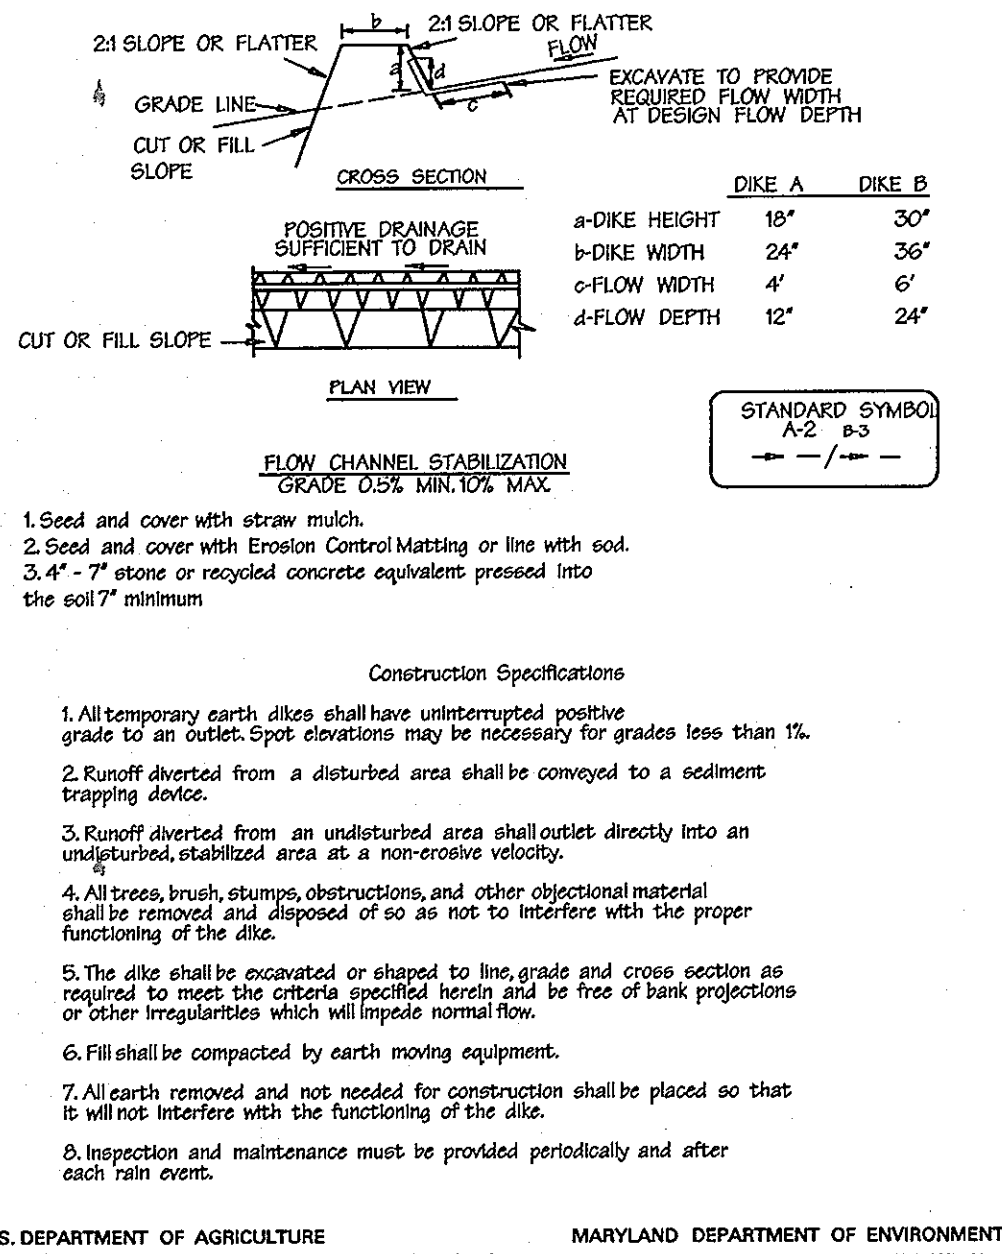

Ho. Co. Sediment Control General Notes

Earth Dike Not to Scale

Basin Schematic Vertical Draw-Down Device Not to Scale

Silt Fence Not to Scale

Super Silt Fence Not to Scale

PERMANENT SEEDING NOTES

APPLY TO GRADED OR CLEARED AREAS NOT SUBJECT TO IMMEDIATE FURTHER DISTURBANCE WHERE A PERMANENT LONG-LIVED VEGETATIVE COVER IS NEEDED.

SEEDBED PREPARATION LOOSEN UPPER THREE INCHES OF SOIL BY RAKING, DISKING OR OTHER ACCEPTABLE MEANS BEFORE SEEDING, IF NOT PREVIOUSLY LOOSENED.

SOIL AMENDMENTS - IN LIEU OF SOIL TEST RECOMMENDATIONS, USE ONE OF THE FOLLOWING SCHEDULES:

- PREFERRED - APPLY 2 TONS PER ACRE DOLOMITIC LIMESTONE (92 LBS/1000 SQ.FT.) AND 1000 LBS. PER ACRE 10-10-10 FERTILIZER (14 LBS/1000 SQ.FT.) BEFORE SEEDING. HARROW OR DISK INTO UPPER THREE INCHES OF SOIL. AT TIME OF SEEDING, APPLY 400 LBS. PER ACRE 30-0-0 UREAFORM FERTILIZER (9 LBS/1000 SQ.FT.)
- ACCEPTABLE - APPLY 2 TONS PER ACRE DOLOMITIC LIMESTONE (92 LBS/1000 SQ.FT.) AND 1000 LBS. PER ACRE 10-10-10 FERTILIZER (23 LBS/1000 SQ.FT.) BEFORE SEEDING. HARROW OR DISK INTO UPPER THREE INCHES OF SOIL.

SEEDING - FOR THE PERIODS MARCH 1 THRU APRIL 30, AND AUGUST 1 THRU OCTOBER 15, SEED WITH 60 LBS. PER ACRE (14 LBS/1000 SQ.FT.) OF KENTUCKY 31 TALL FESCUE. FOR THE PERIOD MAY 1 THRU JULY 31 SEED WITH 60 LBS. KENTUCKY 31 TALL FESCUE PER ACRE AND 2 LBS. PER ACRE (0.5 LBS/1000 SQ.FT.) OF KEEPING LONGGRASS. DURING THE PERIOD OF OCTOBER 16 THRU FEBRUARY 28, PROTECT SITE BY OPTION (1) - 2 TONS PER ACRE OF WELL ANCHORED STRAW MULCH AND SEED AS SOON AS POSSIBLE IN THE SPRING. OPTION (2) - USE SOD. OPTION (3) - SEED WITH 60 LBS. KENTUCKY 31 TALL FESCUE AND MULCH WITH 2 TONS. FACE WELL ANCHORED STRAW.

MULCHING - APPLY 1/2 TO 2 TONS PER ACRE (70 TO 90 LBS/1000 SQ.FT.) OF UNPROTIED SMALL GRAIN STRAW IMMEDIATELY AFTER SEEDING. ANCHOR MULCH IMMEDIATELY AFTER APPLICATION USING MULCH ANCHORING TOOL OR 200 GALLONS PER ACRE (5 GALLON/SQ.FT.) OF EMULSIFIED ASPHALT ON FLAT AREAS, ON SLOPES 8 FEET OR HIGHER, USE 340 GALLONS PER ACRE (8 GALLON/SQ.FT.) FOR ANCHORING.

MAINTENANCE - INSPECT ALL SEEDING AREAS AND MAKE NEEDED REPAIRS, REPLACEMENTS AND RESEEDING.

TEMPORARY SEEDING NOTES

APPLY TO GRADED OR CLEARED AREAS LIKELY TO BE REDISTURBED WHERE A SHORT-TERM VEGETATIVE COVER IS NEEDED.

SEEDBED PREPARATION - LOOSEN UPPER THREE INCHES OF SOIL BY RAKING, DISKING OR OTHER ACCEPTABLE MEANS BEFORE SEEDING, IF NOT PREVIOUSLY LOOSENED.

SOIL AMENDMENTS - APPLY 600 LBS. PER ACRE 10-10-10 FERTILIZER (14 LBS/1000 SQ.FT.)

SEEDING - FOR THE PERIODS MARCH 1 THRU APRIL 30, AND AUGUST 1 THRU OCTOBER 15, SEED WITH 2-1/2 BUSHEL PER ACRE OF ANNUAL RYE (32 LBS/1000 SQ.FT.). FOR THE PERIOD MAY 1 THRU AUGUST 14, SEED WITH 3 LBS. PER ACRE OF KEEPING LONGGRASS (0.7 LBS/1000 SQ.FT.). FOR THE PERIOD NOVEMBER 16 THRU FEBRUARY 28, PROTECT SITE BY APPLYING 2 TONS PER ACRE OF WELL ANCHORED STRAW MULCH AND SEED AS SOON AS POSSIBLE IN THE SPRING, OR USE SOD.

MULCHING - APPLY 1/2 TO 2 TONS PER ACRE (70 TO 90 LBS/1000 SQ.FT.) OF UNPROTIED SMALL GRAIN STRAW IMMEDIATELY AFTER SEEDING. ANCHOR MULCH IMMEDIATELY AFTER APPLICATION USING MULCH ANCHORING TOOL OR 210 GALLON PER ACRE (5 GALLON/SQ.FT.) OF EMULSIFIED ASPHALT ON FLAT AREAS, ON SLOPES 8 FT. OR HIGHER, USE 340 GALLON PER ACRE (8 GALLON/SQ.FT.) FOR ANCHORING.

REFER TO THE 1994 MARYLAND STANDARDS AND SPECIFICATIONS FOR SOIL EROSION AND SEDIMENT CONTROL FOR ADDITIONAL RATES AND METHODS NOT COVERED.

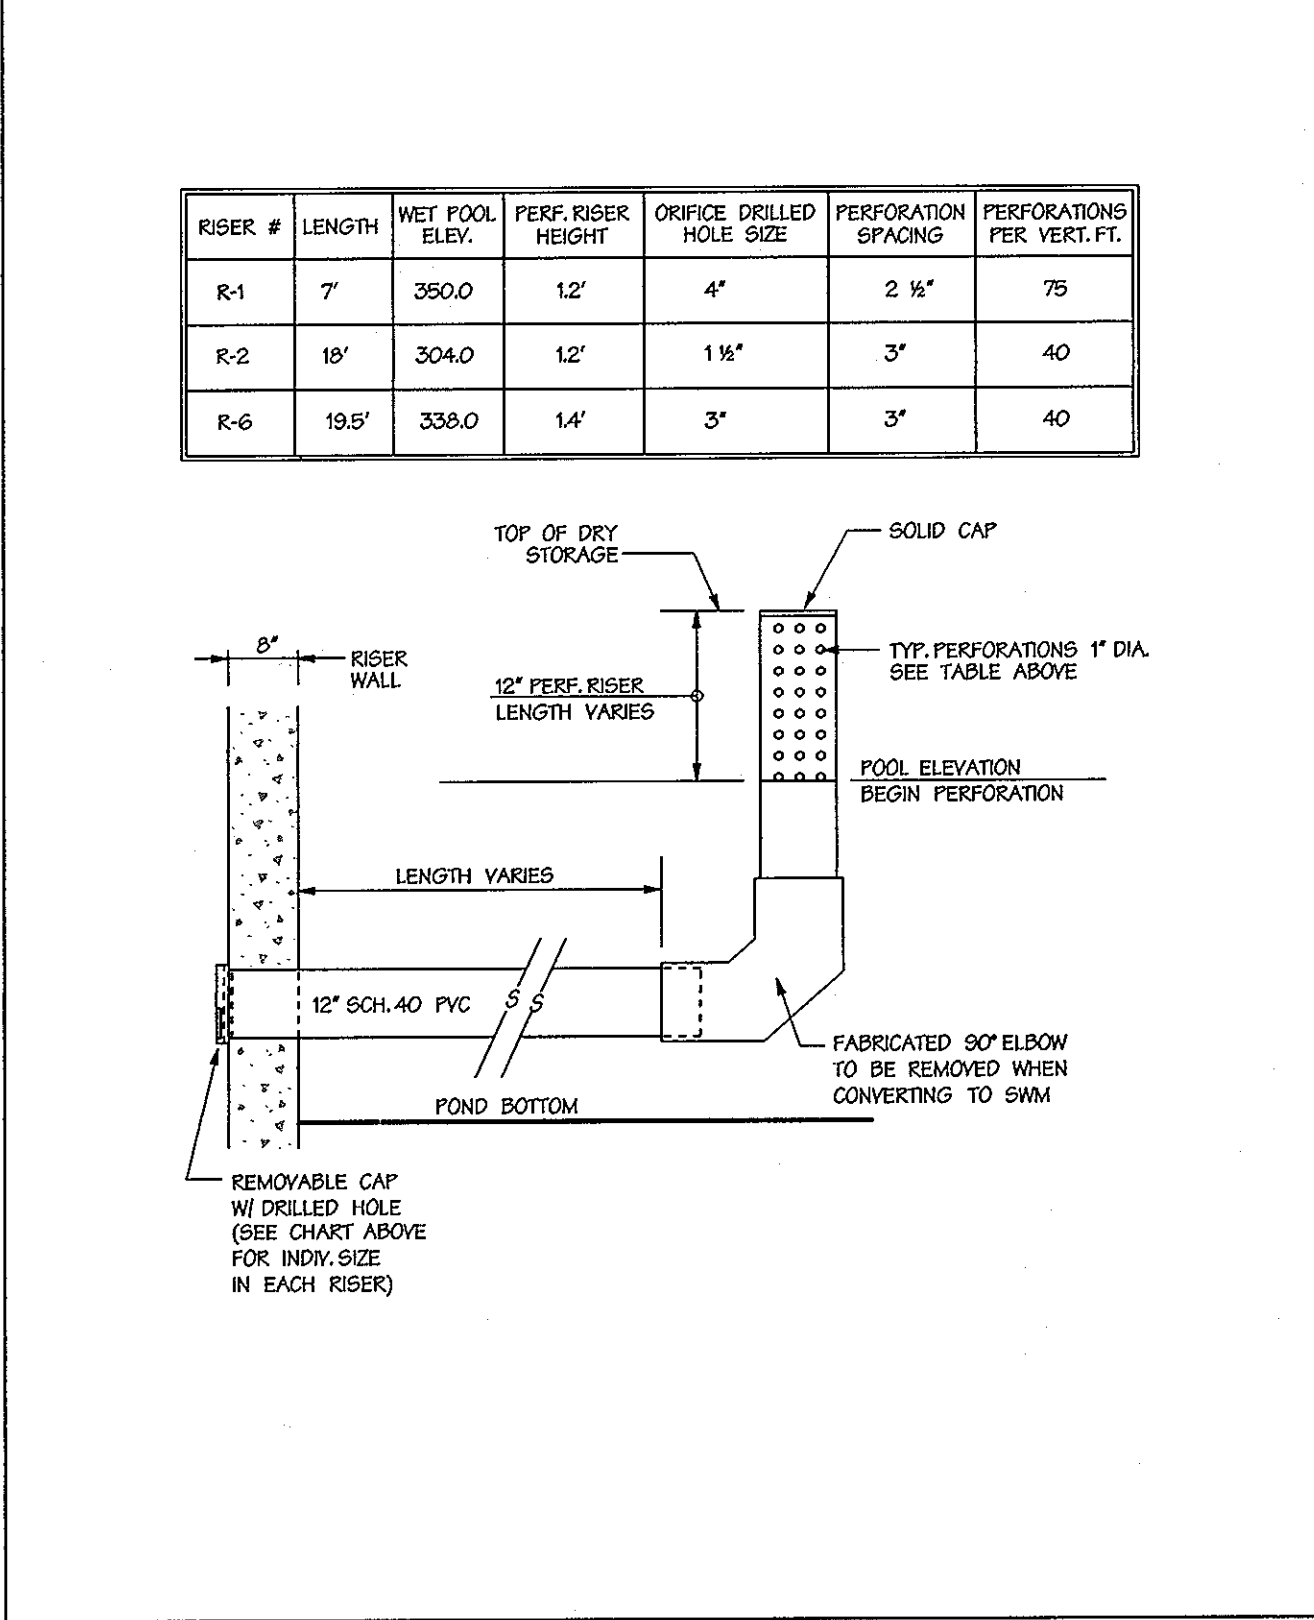
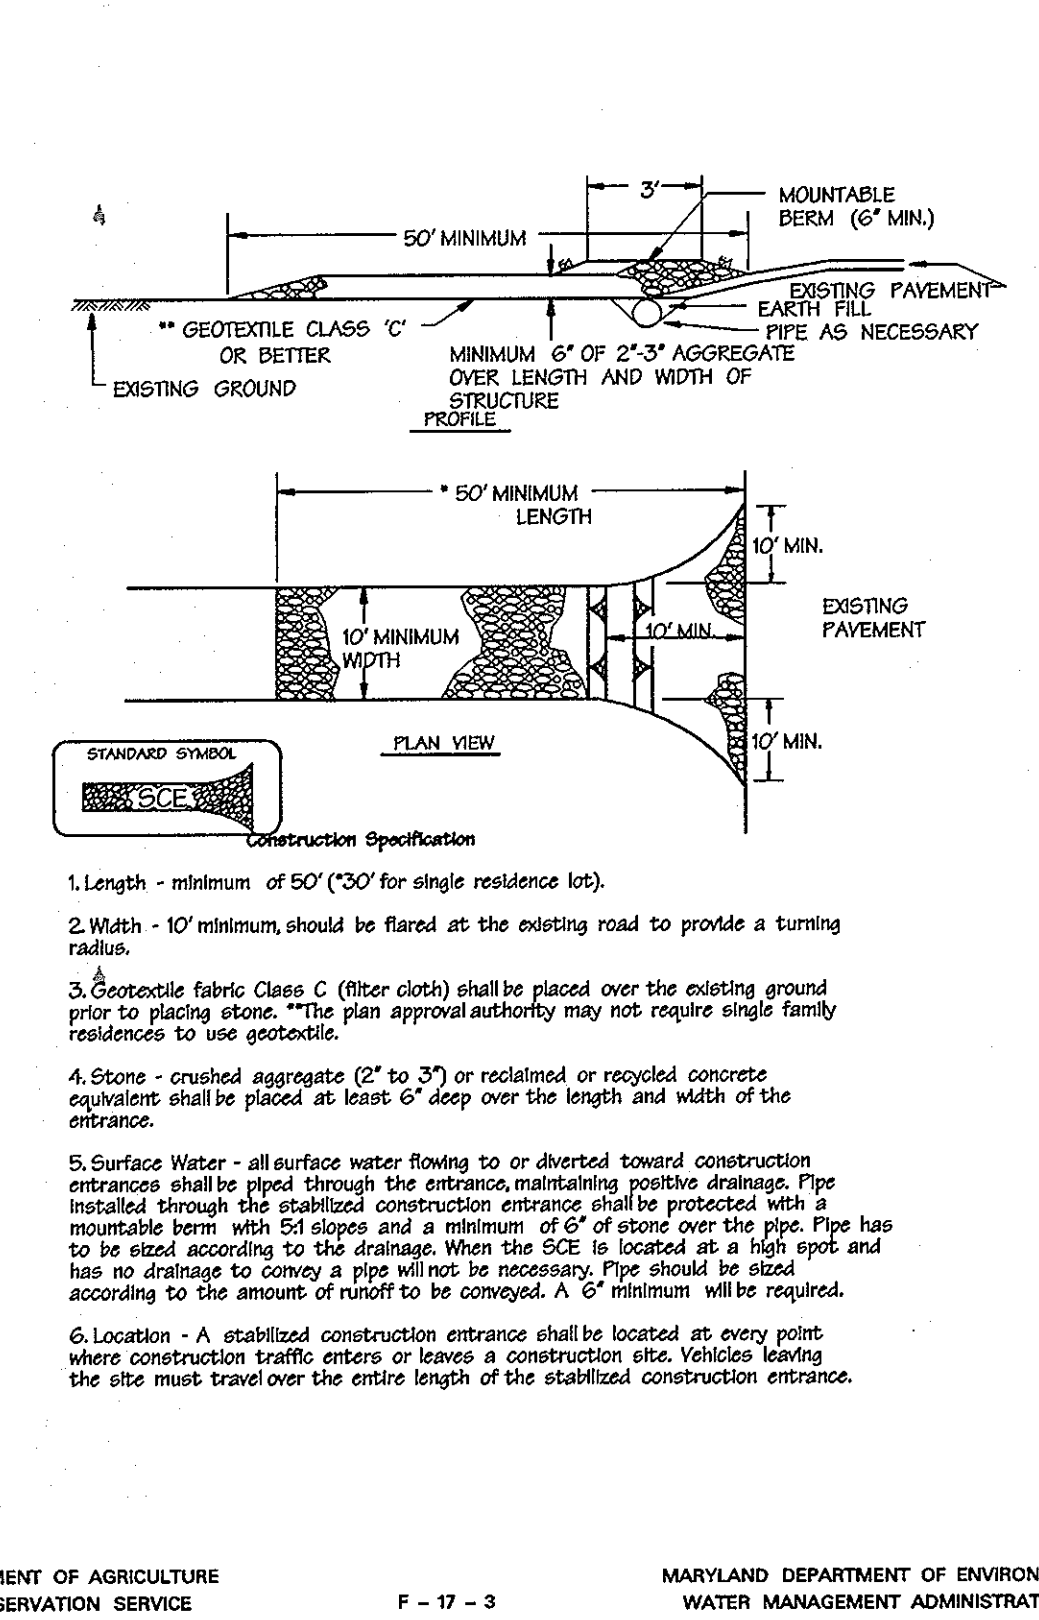


Table 26. Stone Size

NUMBER	SIZE RANGE	D ₈₀	D ₁₀₀	AASHTO	WEIGHT
NUMBER 57*	3/8" - 1/2"	1/2"	1/2"	M-43	N/A
NUMBER 1	2" - 3"	2 1/2"	3"	M-43	N/A
RIP-RAP**	4" - 7"	5 1/2"	7"	N/A	N/A
CLASS I	N/A	9.5"	15"	N/A	150lb max.
CLASS II	N/A	16"	24"	N/A	700lb max.
CLASS III	N/A	23"	34"	N/A	2000lb max.

Table 27. Geotextile Fabric

CLASS	APPARENT OPENING SIZE MM. MAX.	GRAB TENSILE STRENGTH LB. MIN.	BURST STRENGTH PSI. MIN.
A	0.30"	250	500
B	0.60	200	320
C	0.30	200	320
D	0.60	90	145
E	0.30	90	145
F (SILT FENCE)	0.40-0.80"	90	190

The properties shall be determined in accordance with the following procedures:

- Apparent opening size MSMT 303
- Grab tensile strength ASTM D 1682, 4x8" specimen, 1/2" clamps, 12" min. strain rate in both principal directions of geotextile fabric.
- Burst strength ASTM D 3786

The fabric shall be inert to commonly encountered chemicals and hydrocarbons, and will be rot and mildew resistant. It shall be manufactured from fibers consisting of long chain synthetic polymers, and composed of a minimum of 85% by weight of polyolefins, polyesters, or polyamides. The geotextile fabric shall resist deterioration from ultraviolet exposure.

In addition, Classes A through E shall have a 0.01 cm/sec. minimum permeability when tested in accordance with MSMT 507, and an apparent strength requirements listed above.

Silt Fence

Class F geotextile fabric for silt fence shall have a 50 lb./in. minimum tensile strength and a 20 lb./in. minimum tensile modulus when tested in accordance with MSMT 505. The material shall also have a 0.5 gal./ft. min. flow rate and severity-free percent (TF) minimum filtering efficiency when tested in accordance with MSMT 322. Geotextile fabrics used in the construction of silt fence shall resist deterioration from ultraviolet exposure. The fabric shall contain sufficient amounts of ultraviolet ray inhibitors and stabilizers to provide a minimum of 12 months of expected useful construction life at a temperature range of 0 to 120 degrees F.

APPROVED: HOWARD COUNTY DEPARTMENT OF PUBLIC WORKS.
 APPROVED: HOWARD COUNTY DEPT. OF PLANNING & ZONING
 APPROVED: CHIEF ENGINEERING DIVISION MK
 APPROVED: CHIEF DIVISION OF LAND DEVELOPMENT HB

Temporary And Permanent Seeding Notes

Stabilized Construction Entrance Not to Scale

Sediment Control Draw-Down Not To Scale

Geotextile Material Specifications

Revision Description

EMERSON
FORMERLY KEY PROPERTY
SECTION 2, PHASE 1A

OWNER/DEVELOPER:
THE HOWARD RESEARCH & DEVELOPMENT CORPORATION
10275 Little Patuxent Parkway
Columbia, Maryland 21044

DMW
Darr McCause-Walkers, Inc.
300 East Pennsylvania Avenue
Towson, Maryland 21286
(410) 286-3333
Fax: 286-4708

A Team of Land Planners, Landscape Architects, Engineers, Surveyors & Environmental Professionals

SUBMISSION NAME: EMERSON SECTION 2
 SECTION NUMBER: PHASE 1A
 PLAN OR LE: BLOSS # 1212
 TAX MAP: MD 47
 SUBJECT DISTRICT: 6 TH
 CENSUS TRACT: 15B, 22
 WATER CODE: 14B, 20, 5, 2
 SEWER CODE: 14B, 20, 5, 2

TITLE: EROSION & SEDIMENT CONTROL DETAILS

Des By: MRT
 Dm By: WHJ
 Chk By: Approved

Scale: AS SHOWN
 Date: 9-26-01
 Approved

Proj. No.: 95054-F
 15 of 27

Professional Engr. No. 10557

DEVELOPER'S CERTIFICATION:

I/WE CERTIFY THAT ALL DEVELOPMENT AND CONSTRUCTION WILL BE DONE ACCORDING TO THIS PLAN, AND THAT ANY RESPONSIBLE PERSONNEL INVOLVED IN THE CONSTRUCTION PROJECT WILL HAVE A CERTIFICATE OF ATTENDANCE AT A DEPARTMENT OF THE ENVIRONMENT APPROVED TRAINING PROGRAM FOR THE CONTROL OF SEDIMENT AND EROSION BEFORE BEGINNING THE PROJECT. I ALSO AUTHORIZE PERIODIC ON-SITE INSPECTION BY THE HOWARD SOIL CONSERVATION DISTRICT.

Signature: Robert A. Jenkins
 Date: 10/27/01

ENGINEER'S CERTIFICATION:

I CERTIFY THAT THIS PLAN FOR EROSION AND SEDIMENT CONTROL REPRESENTS A PRACTICAL AND WORKABLE PLAN BASED ON MY PERSONAL KNOWLEDGE OF THE SITE CONDITIONS AND THAT IT WAS PREPARED IN ACCORDANCE WITH THE REQUIREMENTS OF THE HOWARD SOIL CONSERVATION DISTRICT.


Signature: John W. Ramonchin, Sr.
 Date: 9/25/01


REVIEWED FOR HOWARD S.C.D. AND MEETS TECHNICAL REQUIREMENTS

Signature: [Blank]
 Date: 10/10/01

Signature: [Blank]
 Date: 10/10/01

Signature: [Blank]
 Date: 10/10/01

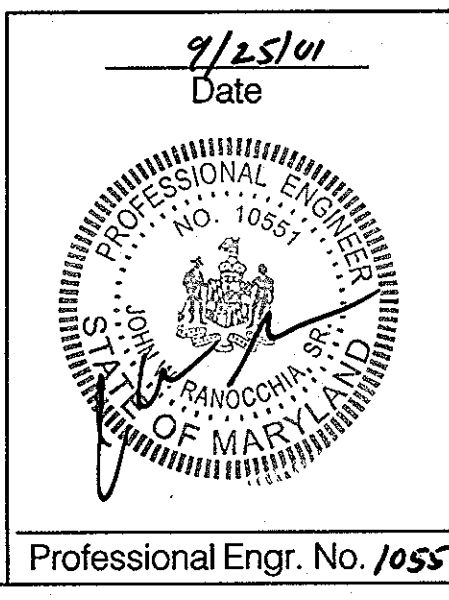

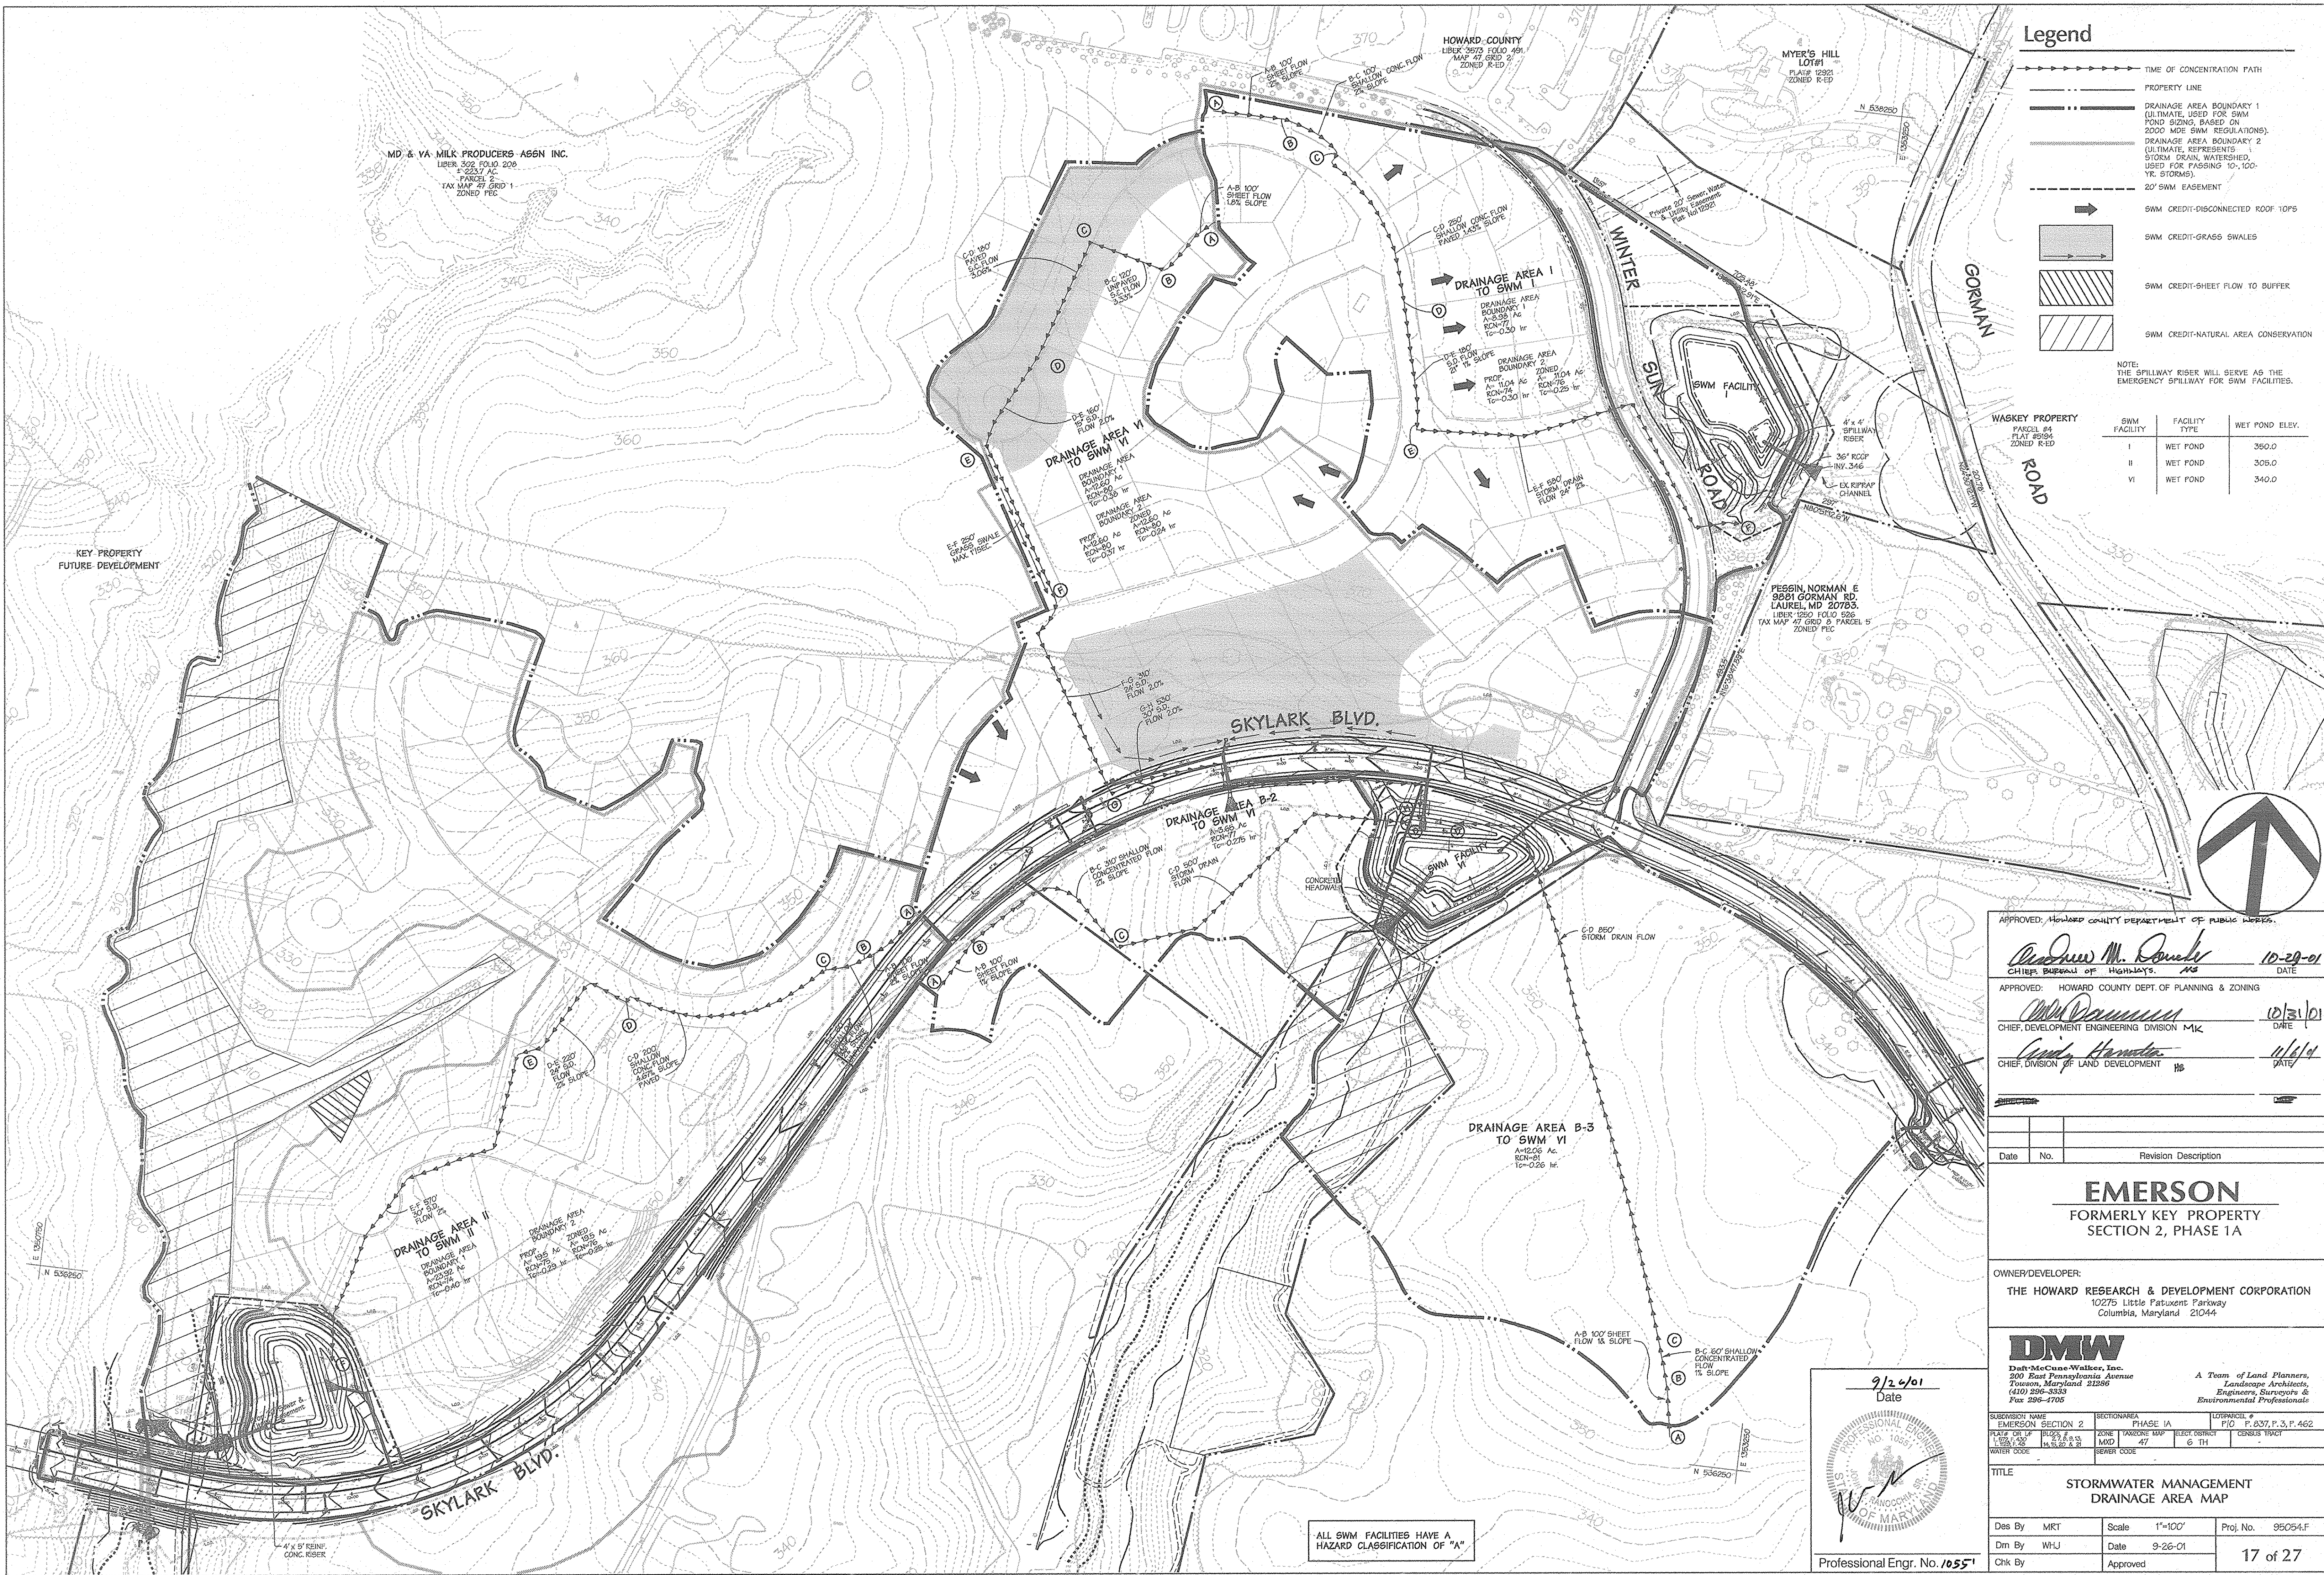

Legend

- TIME OF CONCENTRATION PATH
- PROPERTY LINE
- DRAINAGE AREA BOUNDARY 1 (ULTIMATE, USED FOR SWM POND SIZING, BASED ON 2000 MFD SWM REGULATIONS)
- DRAINAGE AREA BOUNDARY 2 (ULTIMATE, REPRESENTS STORM DRAIN WATERSHED, USED FOR PASSING 10-, 100-YR. STORMS)
- 20' SWM EASEMENT
- SWM CREDIT-DISCONNECTED ROOF TOPS
- SWM CREDIT-GRASS SWALES
- SWM CREDIT-SHEET FLOW TO BUFFER
- SWM CREDIT-NATURAL AREA CONSERVATION

NOTE: THE SPILLWAY RISER WILL SERVE AS THE EMERGENCY SPILLWAY FOR SWM FACILITIES.

SWM FACILITY	FACILITY TYPE	WET POND ELEV.
I	WET POND	350.0
II	WET POND	305.0
VI	WET POND	340.0

APPROVED: HOWARD COUNTY DEPARTMENT OF PUBLIC WORKS.
Andrew M. Roubicek 10-29-01
 CHIEF, BUREAU OF HIGHWAYS, HS DATE

APPROVED: HOWARD COUNTY DEPT. OF PLANNING & ZONING
John Drayton 10/31/01
 CHIEF, DEVELOPMENT ENGINEERING DIVISION MK, DATE

Gina Handra 11/14/01
 CHIEF, DIVISION OF LAND DEVELOPMENT HS DATE

Date	No.	Revision Description

EMERSON

FORMERLY KEY PROPERTY
SECTION 2, PHASE 1A

OWNER/DEVELOPER:
THE HOWARD RESEARCH & DEVELOPMENT CORPORATION
 10275 Little Patuxent Parkway
 Columbia, Maryland 21044

DMW
 Dan-McCune-Walker, Inc.
 200 East Pennsylvania Avenue
 Towson, Maryland 21286
 (410) 296-3833
 Fax 296-4705

A Team of Land Planners,
 Landscape Architects,
 Engineers, Surveyors &
 Environmental Professionals

9/26/01
Date


Professional Engr. No. 10551

SUBMISSION NAME	SECTION/AREA	LOT/PARCEL #
EMERSON SECTION 2	PHASE 1A	P10, P. 437, P. 3, P. 462
PLAN OR OF	ZONE	SECTION MAP
1/2" = 1'	MXD	47
WATER CODE	SEWER CODE	6 TH
TITLE		
STORMWATER MANAGEMENT DRAINAGE AREA MAP		
Des By	MRT	Scale 1"=100'
Proj. No.	95054.F	
Dm By	WHJ	Date 9-26-01
Chk By	Approved	17 of 27

ALL SWM FACILITIES HAVE A HAZARD CLASSIFICATION OF "A"

LEGEND


- PROPERTY LINE
- 20' SWM EASEMENT
- 360 EXISTING CONTOUR
- 360 PROPOSED CONTOUR
- 362
- L.O.D.
- LIMIT OF DISTURBANCE

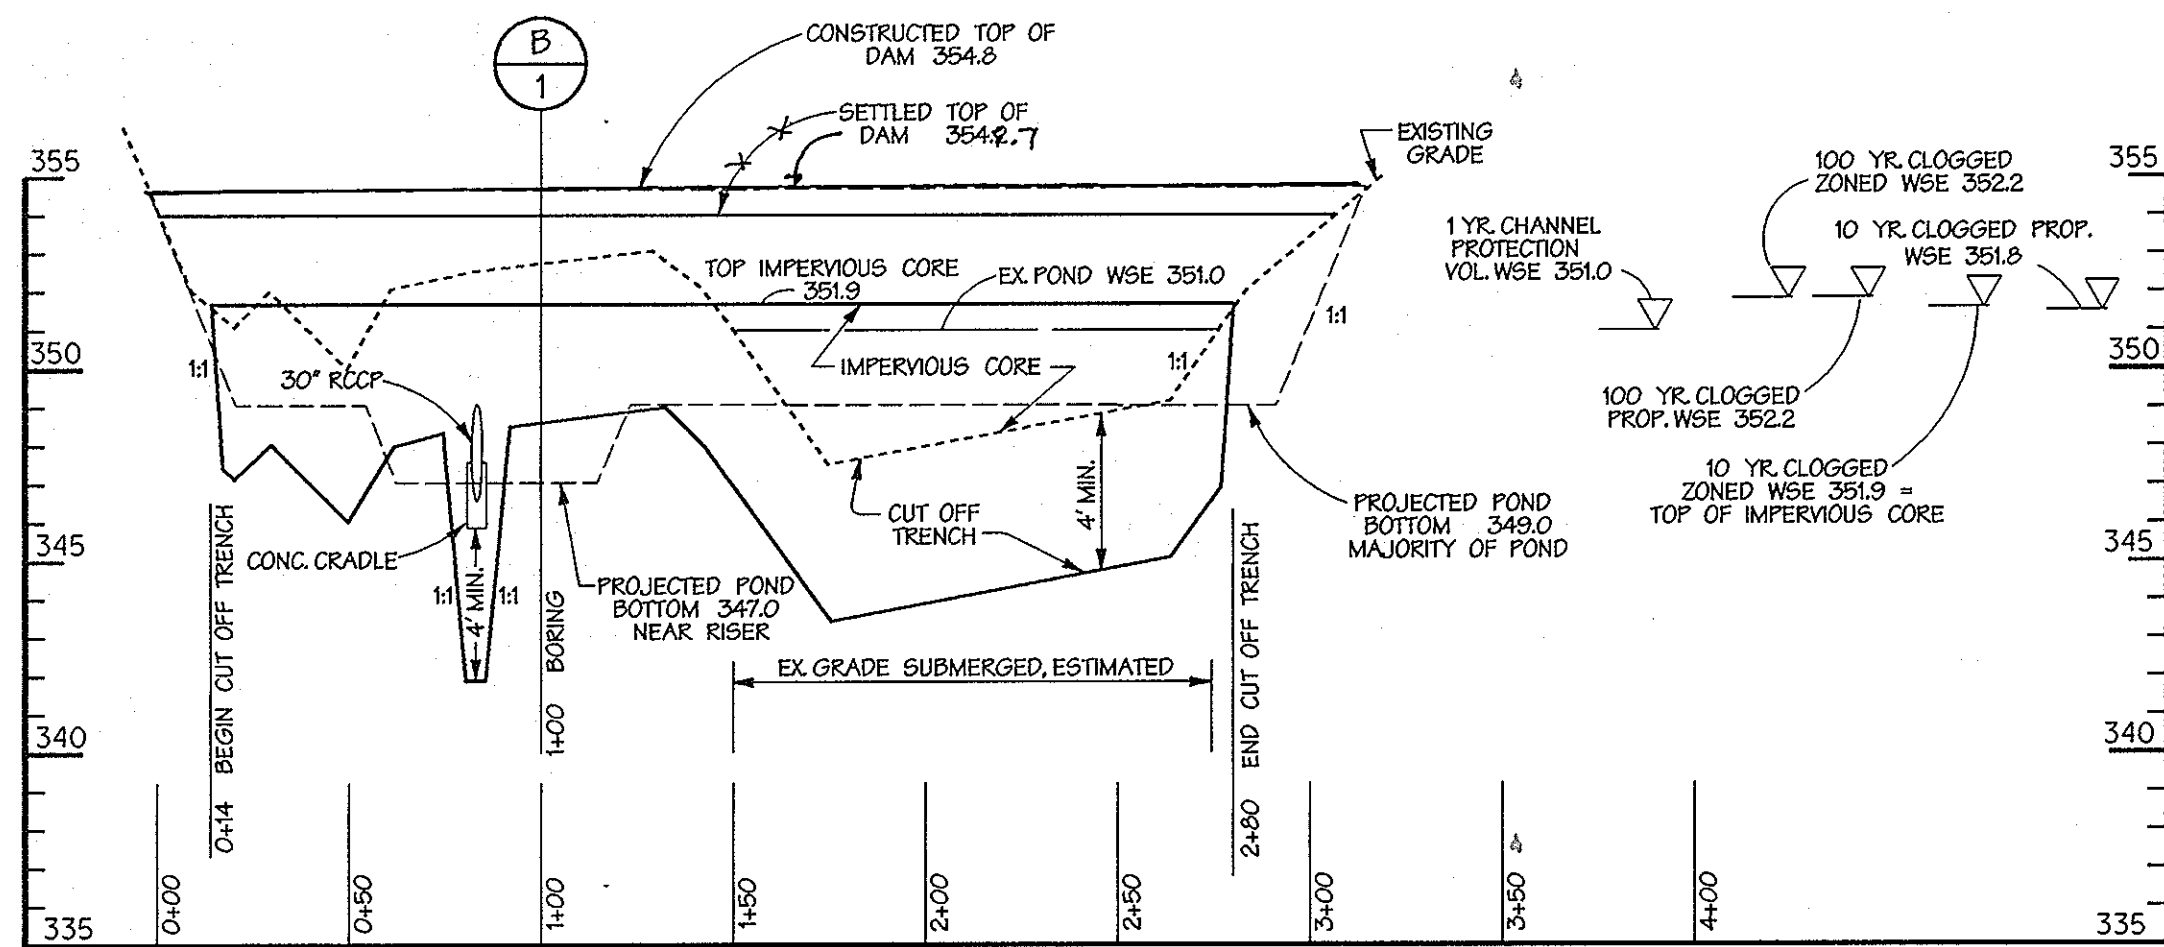

PROFILE ALONG CENTERLINE OF EMBANKMENT SWM 1

SCALE: HORIZ. - 1" = 50'
VERT. - 1" = 5'

NOTE:
BASIN 1 SHALL NOT BE CONVERTED TO SWM 1 UNTIL THE COMPLETION OF PHASE 1-B (P-01-157). AT THAT TIME, CONVERT TO SWM POND AS SHOWN ON THIS PLAN.

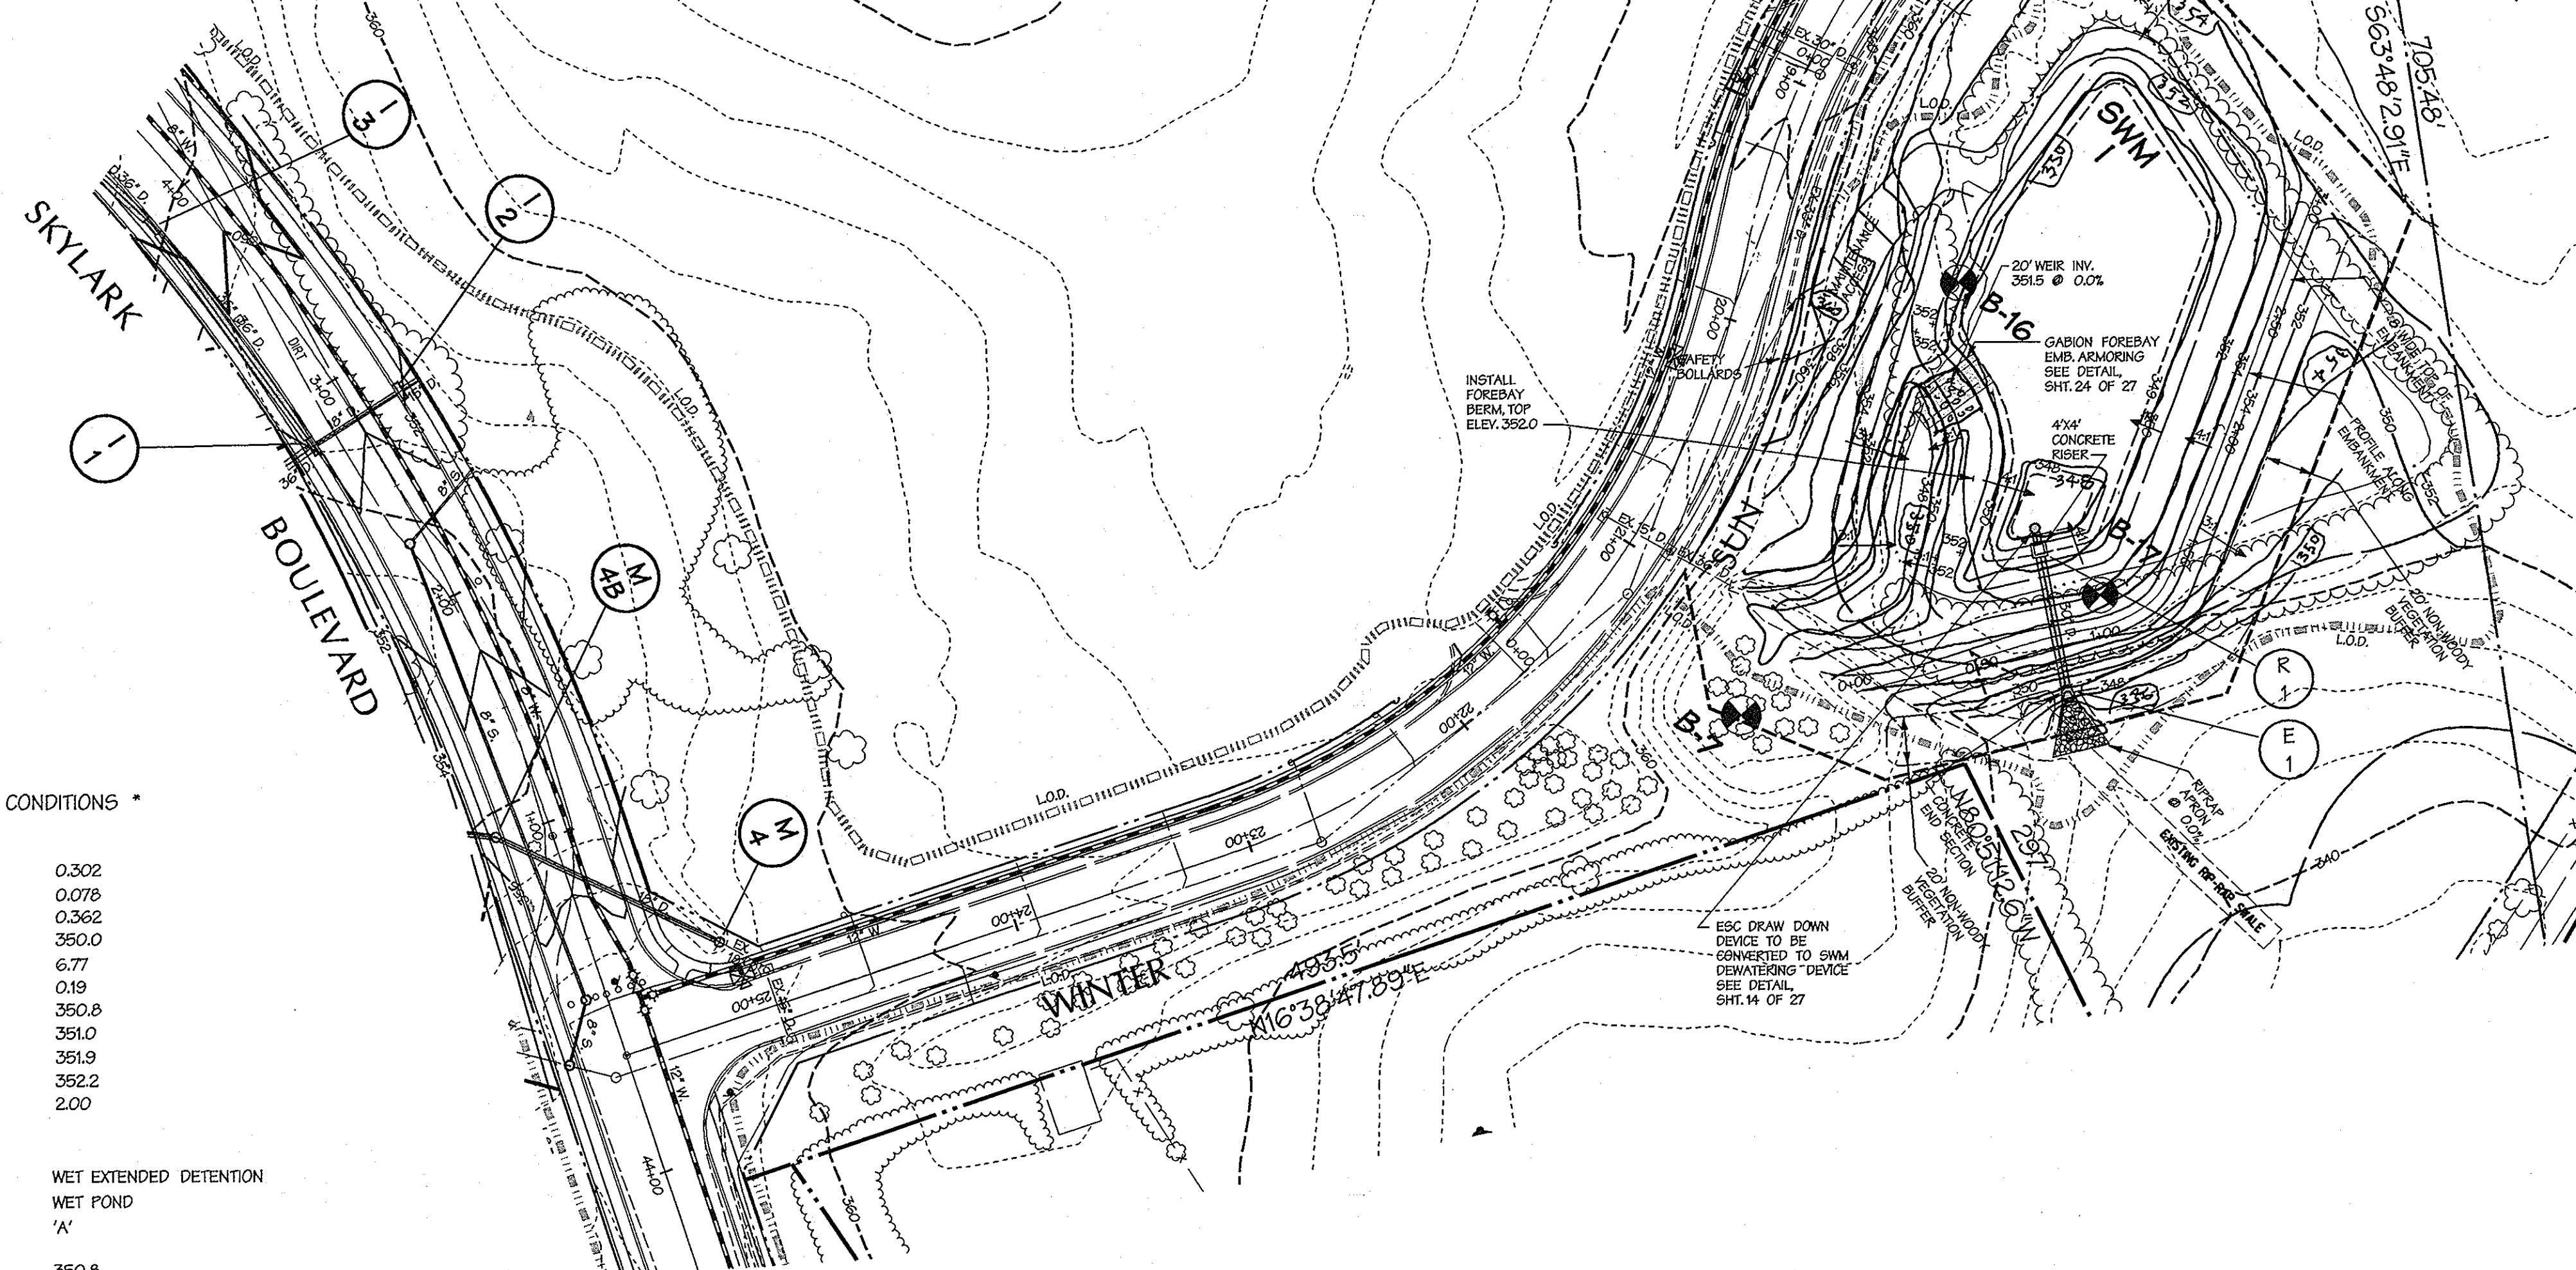

POND 1 DESIGN FLOW SUMMARY PROPOSED CONDITIONS *

Water Quality Vol. W _q (Ac-ft)	0.302
Recharge Vol. R _{re} (Ac-ft)	0.078
Channel Protection Vol. C _p (Ac-ft)	0.362
W _q Water Surface Elev. = Normal Pool	350.0
C _p Discharge, Proposed (cfs)	6.77
C _p Discharge, Managed (cfs)	0.19
C _p Water Surface Elev.	350.8
Riser Crest Elev.	351.0
10 Yr. Clogged Water Surface Elev.	351.9
100 Yr. Clogged Water Surface Elev.	352.2
Pond Volume Below 100 Yr. Clogged WSE	2.00

Structure Type	WET EXTENDED DETENTION
Water Quality Type	WET POND
Structure Classification	'A'
Storage Height Product 1 year	350.8
Storage Height Product 10 year	351.8
Storage Height Product 100 year	352.2
Watershed Area to Facility	0.017 SQ MI.
Level of Management Required	1YR.
Riser Crest Elev.	1YR.
Top Width Provided	8'
Maximum Height of Fill	7.0'
Freeboard Required	2.0'
Freeboard Provided	2.0'

* BASED ON 2000 MDE SWM REGULATIONS. ALL FIGURES REFLECT NON-STRUCTURAL CREDITS TAKEN PER THE AFOREMENTIONED REGULATIONS.

THESE PLANS HAVE BEEN REVIEWED FOR THE HOWARD SOIL CONSERVATION DISTRICT AND MEET THE TECHNICAL REQUIREMENTS FOR SMALL POND CONSTRUCTION, SOIL EROSION AND SEDIMENT CONTROL.

Jim Myers 10/10/01
U.S.D.A. NATURAL RESOURCES CONSERVATION SERVICE DATE

THESE PLANS FOR SMALL POND CONSTRUCTION, SOIL EROSION AND SEDIMENT CONTROL MEET THE REQUIREMENTS OF HOWARD SOIL CONSERVATION DISTRICT.

Robert A. Jenkins 10/10/01
APPROVED: HOWARD SOIL CONSERVATION DISTRICT DATE

PLAN NUMBER

DEVELOPERS CERTIFICATE:


I/WE CERTIFY THAT ALL DEVELOPMENT AND/OR CONSTRUCTION WILL BE DONE ACCORDING TO THESE PLANS AND THAT ANY RESPONSIBLE PERSONNEL INVOLVED IN THE CONSTRUCTION PROJECT WILL HAVE A CERTIFICATE OF ATTENDANCE AT A DEPARTMENT OF ENVIRONMENT APPROVED TRAINING PROGRAM FOR THE CONTROL OF SEDIMENT AND EROSION BEFORE BEGINNING THE PROJECT. I/SHALL ENGAGE A REGISTERED PROFESSIONAL ENGINEER TO SUPERVISE POND CONSTRUCTION AND PROVIDE THE HOWARD SOIL CONSERVATION DISTRICT WITH AN "AS-BUILT" PLAN OF THE POND WITHIN 30 DAYS OF COMPLETION. I ALSO AUTHORIZE PERIODIC ON-SITE INSPECTIONS BY THE HOWARD SOIL CONSERVATION DISTRICT.

Robert A. Jenkins 10/10/01
SIGNATURE OF DEVELOPER DATE
PRINT NAME BELOW SIGNATURE

ENGINEERS CERTIFICATE:

I CERTIFY THAT THIS PLAN FOR POND CONSTRUCTION, EROSION AND SEDIMENT CONTROL REPRESENTS A PRACTICAL AND WORKABLE PLAN BASED ON MY PERSONAL KNOWLEDGE OF THE SITE CONDITIONS. THIS PLAN WAS PREPARED IN ACCORDANCE WITH THE REQUIREMENTS OF THE HOWARD SOIL CONSERVATION DISTRICT. I HAVE NOTIFIED THE DEVELOPER THAT HE/SHE MUST ENGAGE A REGISTERED PROFESSIONAL ENGINEER TO SUPERVISE POND CONSTRUCTION AND PROVIDE THE HOWARD SOIL CONSERVATION DISTRICT WITH AN "AS-BUILT" PLAN OF THE POND WITHIN 30 DAYS OF COMPLETION.

John W. Ranocchia 9/25/01
SIGNATURE OF ENGINEER DATE
PRINT NAME BELOW SIGNATURE

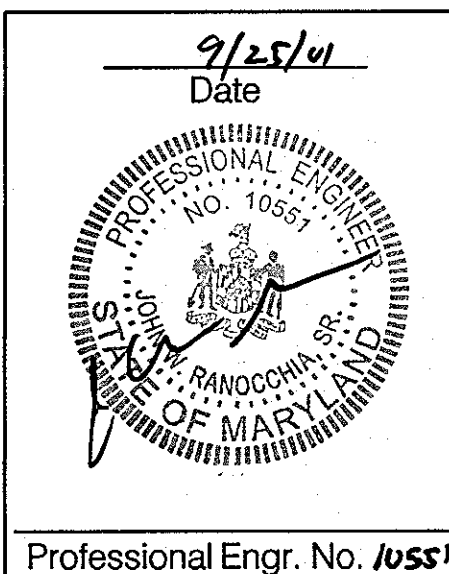

ROAD & STORM DRAIN AS-BUILT

Robert A. Jenkins
SHANABERGER & LAND
8726 TOWN & COUNTRY BLVD.
SUITE 201
ELLCOTT CITY, MARYLAND 21117

NOTES:
DAM HAZARD CLASSIFICATION:
SWM 1 HAS A DAM CLASSIFICATION OF 'A'.
THIS SWM FACILITY SHALL BE MAINTAINED AND OPERATED AS INDICATED IN ITEM #17 ON SHEET 24 OF 27.

APPROVED: HOWARD COUNTY DEPARTMENT OF PUBLIC WORKS.
Andrew M. Danks 10-29-01
CHIEF, BUREAU OF HIGHWAYS DATE

APPROVED: HOWARD COUNTY DEPT. OF PLANNING & ZONING
Chris Drummer 10/31/01
CHIEF, DEVELOPMENT ENGINEERING DIVISION MJK DATE

Andy Hamstra 11/6/01
CHIEF, DIVISION OF LAND DEVELOPMENT HB DATE

Date	No.	Revision Description

EMERSON
FORMERLY KEY PROPERTY
SECTION 2, PHASE 1A

OWNER/DEVELOPER:
THE HOWARD RESEARCH & DEVELOPMENT CORPORATION
10275 Little Patuxent Parkway
Columbia, Maryland 21044

DMW
Doh-MacCause-Walken, Inc.
200 East Pennsylvania Avenue
Towson, Maryland 21286
(410) 296-4339
Fax 296-4705


A Team of Land Planners,
Landscape Architects,
Engineers, Surveyors &
Environmental Professionals

SECTION NAME	EMERSON SECTION 2	SECTION AREA	PHASE 1A	LOT/FACIL. #	P10 P. 837, P. 3, P. 462
PLAT OF LOTS	1584, 22	TAXING MAP	47	ELECT. DISTRICT	6 TH
WATER CODE	14.5.02.8.2	SEWER CODE			

TITLE: STORMWATER MANAGEMENT PLAN SWM 1

Des By	MRT	Scale	1"=50'	Proj. No.	95054-F
Drn By	WHJ	Date	9-26-01		
Chk By		Approved			

Professional Engr. No. 10551

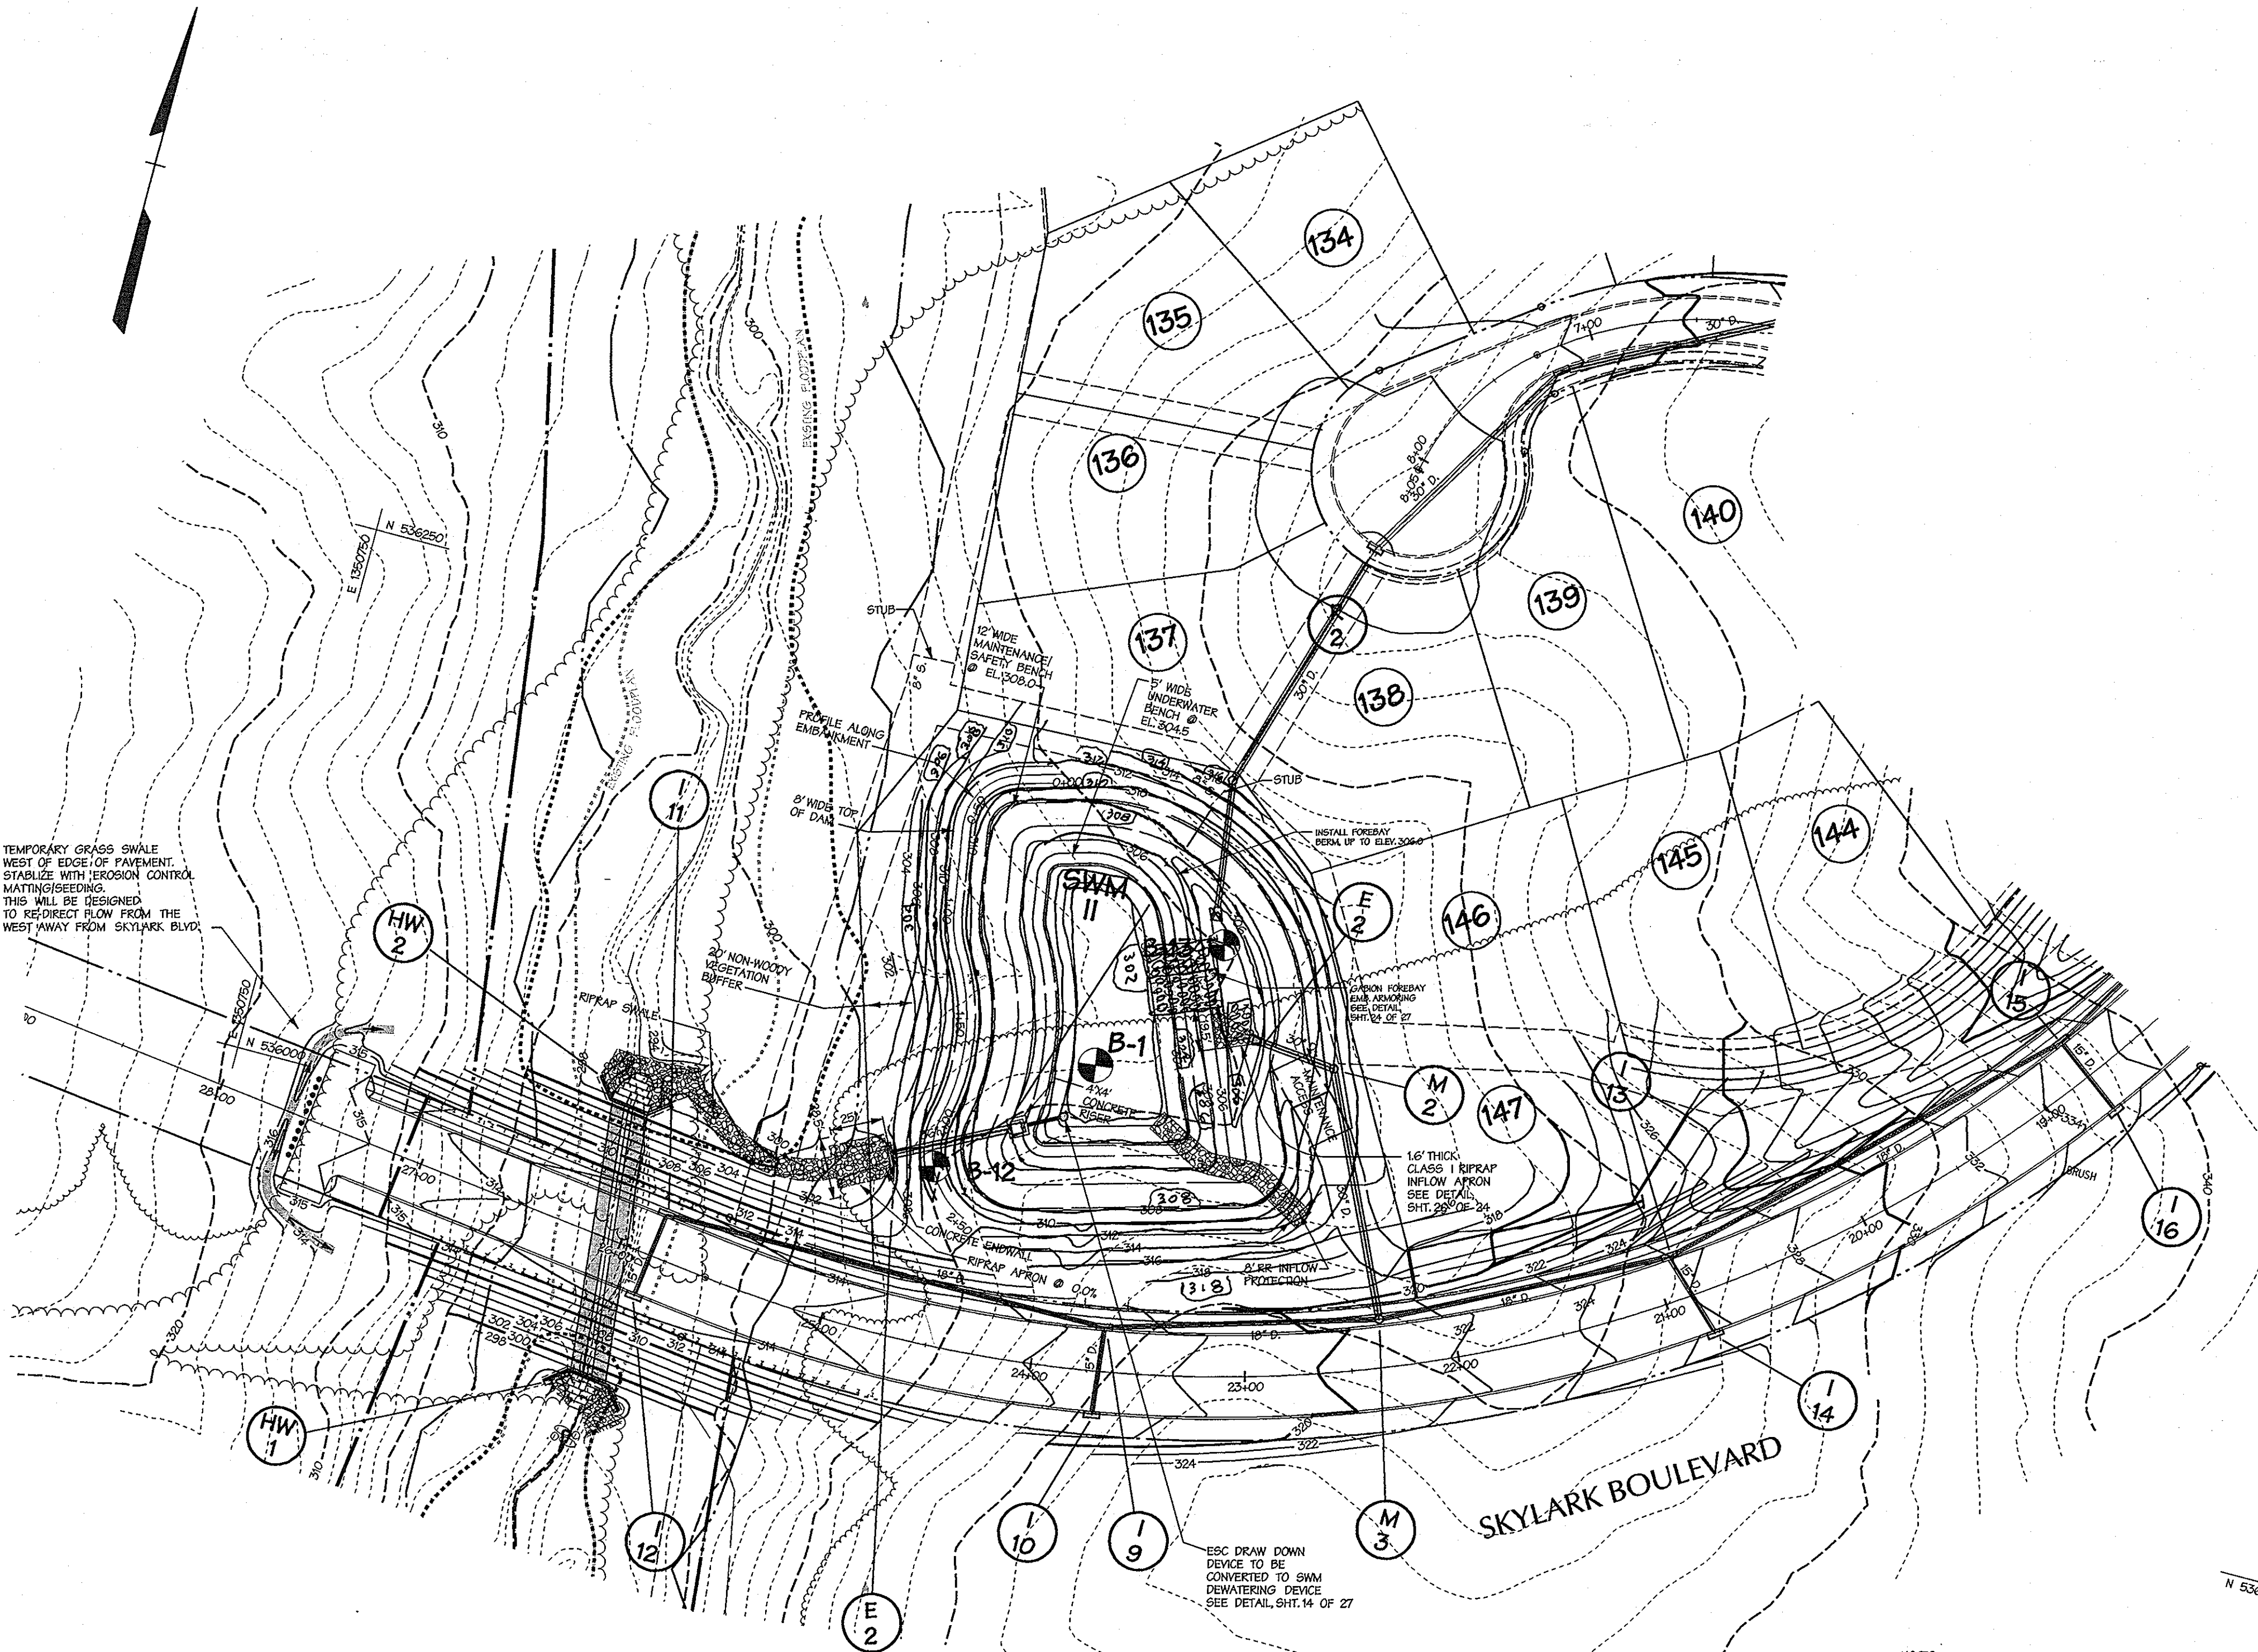

POND II DESIGN FLOW SUMMARY PROPOSED CONDITIONS *

Water Quality Vol. W _q (Ac-ft)	0.537
Recharge Vol. R _r (Ac-ft)	0.150
Channel Protection Vol. C _p (Ac-ft)	0.820
W _q Water Surface Elev. - Normal Pool	305.0
C _p Discharge Proposed (cfs)	1123
C _p Discharge Managed (cfs)	0.38
C _p Water Surface Elev.	306.9
Riser Crest Elev.	307.0
10 Yr. Clogged Water Surface Elev.	308.1
100 Yr. Clogged Water Surface Elev.	308.7
Pond Volume Below 100 Yr. Clogged WSE	2.00
Structure Type	WET EXT. DETENTION
Water Quality Type	WET POND
Structure Classification	'A'
Storage Height Product 1 year	306.9
Storage Height Product 10 year	308.0
Storage Height Product 100 year	308.6
Watershed Area to Facility	0.0309 SQ. MI.
Level of Management Required	1YR.
Level of Management Provided	1YR.
Minimum Top Width Provided	8'
Maximum Height of Fill	8.5'
Freeboard Required	2.0'
Freeboard Provided	2.0'

* BASED ON 2000 MDE SWM REGULATIONS. ALL FIGURES REFLECT NON-STRUCTURAL CREDITS TAKEN PER THE AFOREMENTIONED REGULATIONS.

ROAD & STORM DRAIN AS-BUILT

Robert A. Jenkins 10/27/01

SHANABERGER & LANE
8726 TOWN & COUNTRY BLVD.
SUITE 201
ELLICOTT CITY, MARYLAND 21043

APPROVED: HOWARD COUNTY DEPARTMENT OF PUBLIC WORKS

Richard M. Reubke 10-19-01
CHIEF, BUREAU OF HIGHWAYS MS DATE

APPROVED: HOWARD COUNTY DEPT. OF PLANNING & ZONING

John D. ... 10/24/01
CHIEF, DEVELOPMENT ENGINEERING DIVISION MK DATE

... Hamilton 11/6/01
CHIEF, DIVISION OF LAND DEVELOPMENT HB DATE

LEGEND

---	PROPERTY LINE
---	20' SWM EASEMENT
---	EXISTING CONTOUR
---	PROPOSED CONTOUR
---	LIMIT OF DISTURBANCE
---	EROSION CONTROL MATTING/SEEDING

EMERSON
FORMERLY KEY PROPERTY
SECTION 2, PHASE 1A

OWNER/DEVELOPER:
THE HOWARD RESEARCH & DEVELOPMENT CORPORATION
10275 Little Patuxent Parkway
Columbia, Maryland 21044

DMW
Duff-McCune-Walker, Inc.
200 East Pennsylvania Avenue
Towson, Maryland 21286
(410) 296-3333
Fax 296-4705

A Team of Land Planners, Landscape Architects, Engineers, Surveyors & Environmental Professionals

SUBMISSION NAME	SECTION 2	PHASE 1A	LOT/PARCEL #
EMERSON SECTION 2			P10 P. 037, P. 3, P. 462
FILE NO.	MD 47	6 TH	CERES TRACT
DATE	10/27/01		
WATER CODE			
SEWER CODE			

TITLE: STORM WATER MANAGEMENT PLAN AND SPECIFICATIONS

Des By	MRT	Scale	AS SHOWN	Proj. No.	95054.F
Dm By	WHJ	Date	9-26-01		
Chk By		Approved			20 of 27

THESE PLANS HAVE BEEN REVIEWED FOR THE HOWARD SOIL CONSERVATION DISTRICT AND MEET THE TECHNICAL REQUIREMENTS FOR SMALL POND CONSTRUCTION, SOIL EROSION AND SEDIMENT CONTROL.

Jim ... 10/10/01
U.S.D.A. NATURAL RESOURCES CONSERVATION SERVICE DATE

THESE PLANS FOR SMALL POND CONSTRUCTION, SOIL EROSION AND SEDIMENT CONTROL MEET THE REQUIREMENTS OF HOWARD SOIL CONSERVATION DISTRICT.

APPROVED: *...* 10/10/01
HOWARD SOIL CONSERVATION DISTRICT DATE

PLAN NUMBER

DEVELOPERS CERTIFICATE:


I/WE CERTIFY THAT ALL DEVELOPMENT AND/OR CONSTRUCTION WILL BE DONE ACCORDING TO THESE PLANS AND THAT ANY RESPONSIBLE PERSONNEL INVOLVED IN THE CONSTRUCTION PROJECT WILL HAVE A CERTIFICATE OF ATTENDANCE AT A DEPARTMENT OF ENVIRONMENT APPROVED TRAINING PROGRAM FOR THE CONTROL OF SEDIMENT AND EROSION BEFORE BEGINNING THE PROJECT. I/SHALL ENGAGE A REGISTERED PROFESSIONAL ENGINEER TO SUPERVISE POND CONSTRUCTION AND PROVIDE THE HOWARD SOIL CONSERVATION DISTRICT WITH AN "AS-BUILT" PLAN OF THE POND WITHIN 30 DAYS OF COMPLETION. I/ALSO AUTHORIZE PERIODIC ON-SITE INSPECTIONS BY THE HOWARD SOIL CONSERVATION DISTRICT.

Robert A. Jenkins 10/27/01
SIGNATURE OF DEVELOPER DATE
PRINT NAME BELOW SIGNATURE


ENGINEERS CERTIFICATE:

I CERTIFY THAT THIS PLAN FOR POND CONSTRUCTION, EROSION AND SEDIMENT CONTROL REPRESENTS A PRACTICAL AND WORKABLE PLAN BASED ON MY PERSONAL KNOWLEDGE OF THE SITE CONDITIONS. THIS PLAN WAS PREPARED IN ACCORDANCE WITH THE REQUIREMENTS OF THE HOWARD SOIL CONSERVATION DISTRICT. I HAVE NOTIFIED THE DEVELOPER THAT HE/SHE MUST ENGAGE A REGISTERED PROFESSIONAL ENGINEER TO SUPERVISE POND CONSTRUCTION AND PROVIDE THE HOWARD SOIL CONSERVATION DISTRICT WITH AN "AS-BUILT" PLAN OF THE POND WITHIN 30 DAYS OF COMPLETION.

John V. Ramoche, Jr. 7/25/01
SIGNATURE OF ENGINEER DATE
PRINT NAME BELOW SIGNATURE

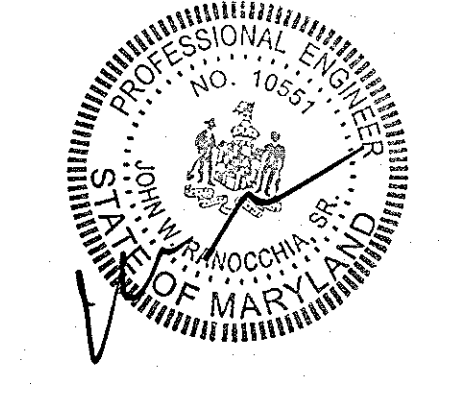


Professional Engr. No. 10157

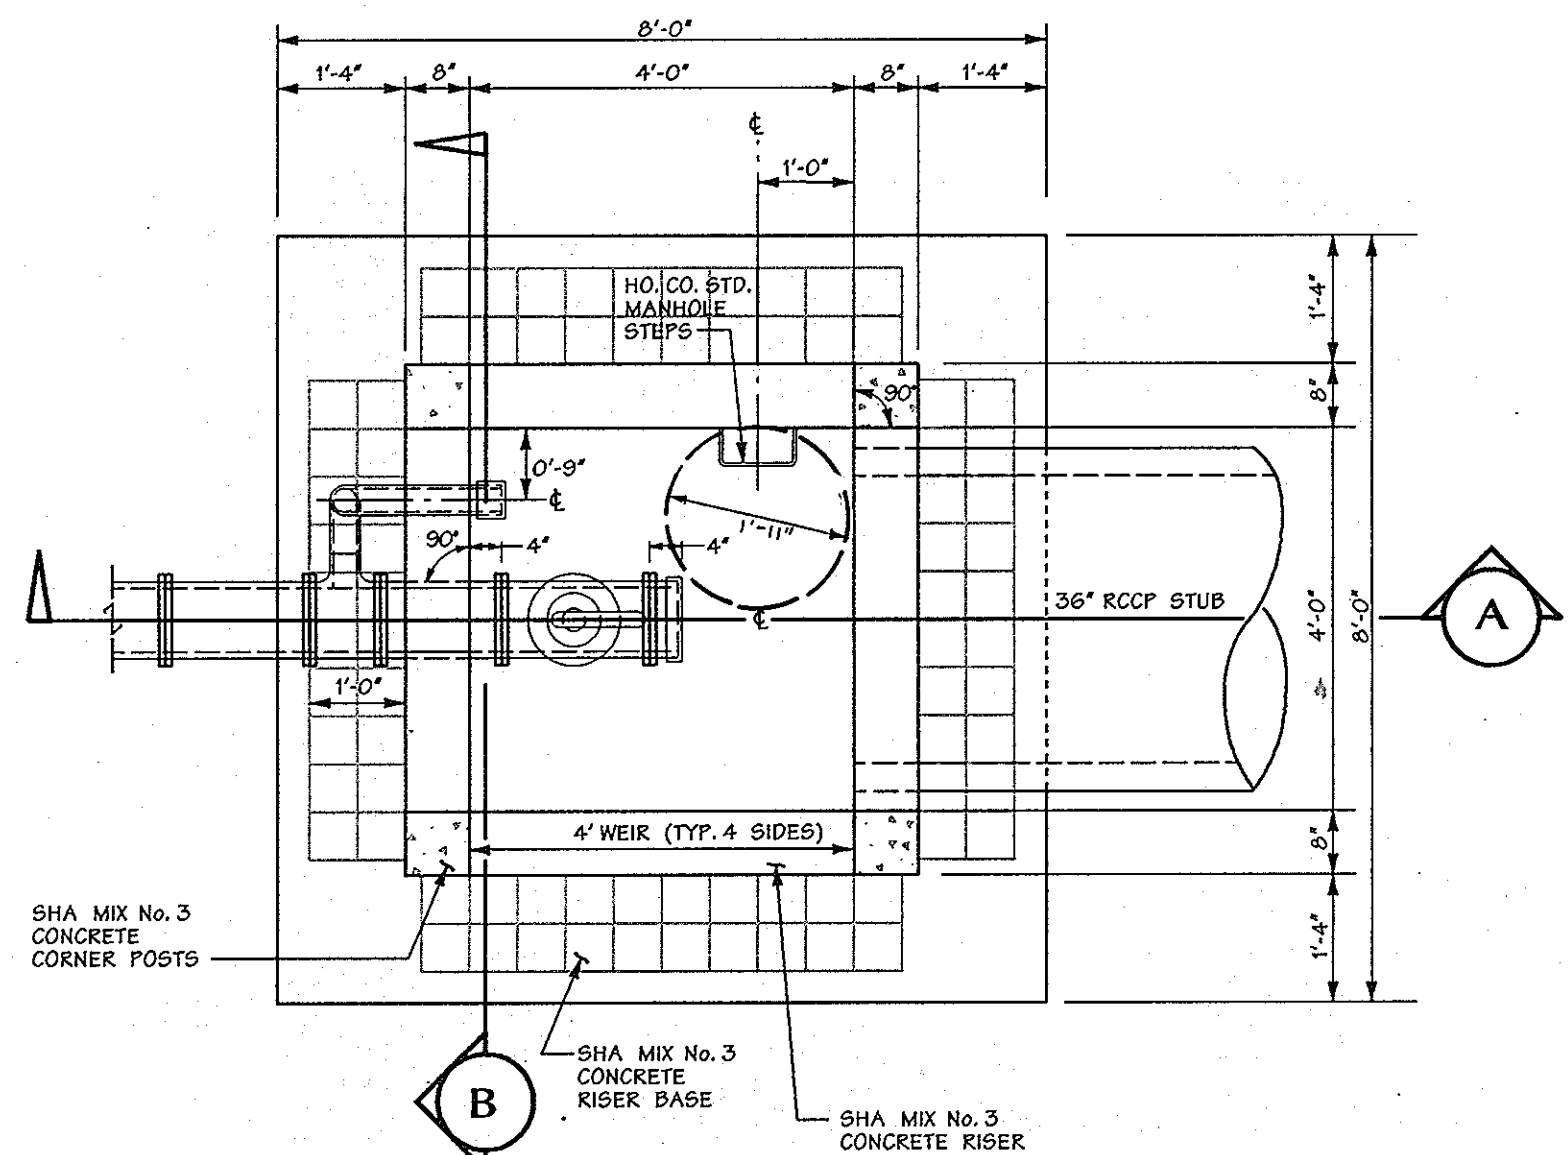


R-1 RISER PLAN (TOP SLAB REMOVED) - SWM II

Scale: 1/8" = 1'-0"
CAST IN PLACE

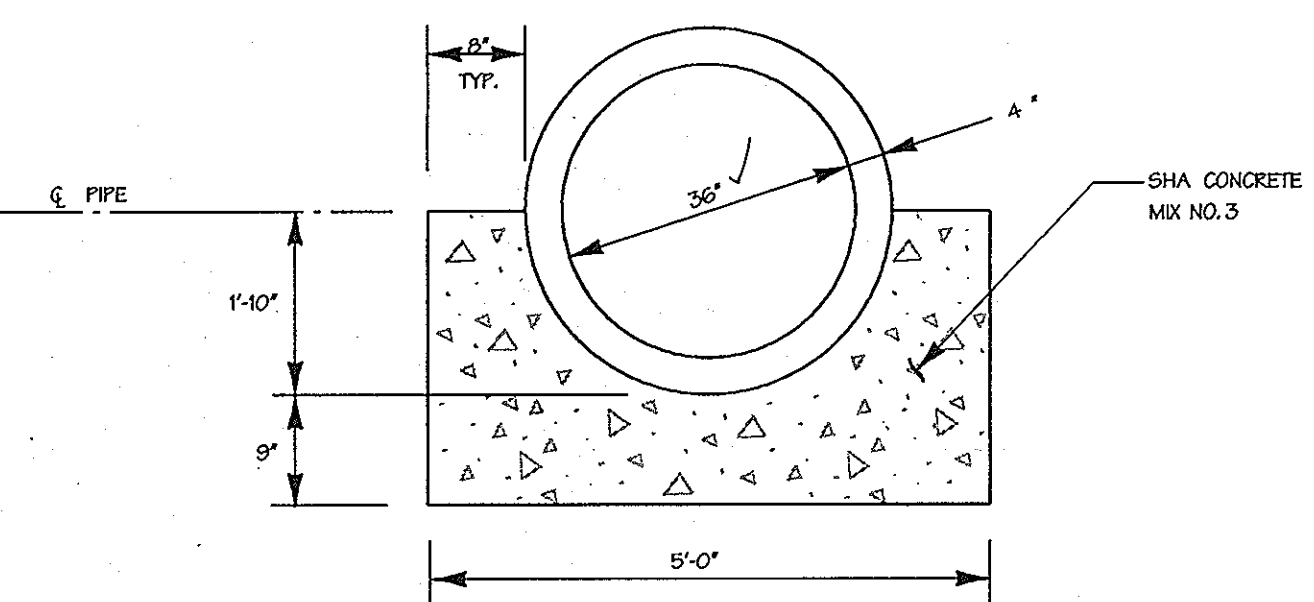


CONCRETE CRADLE DETAIL - SWM II

NTS

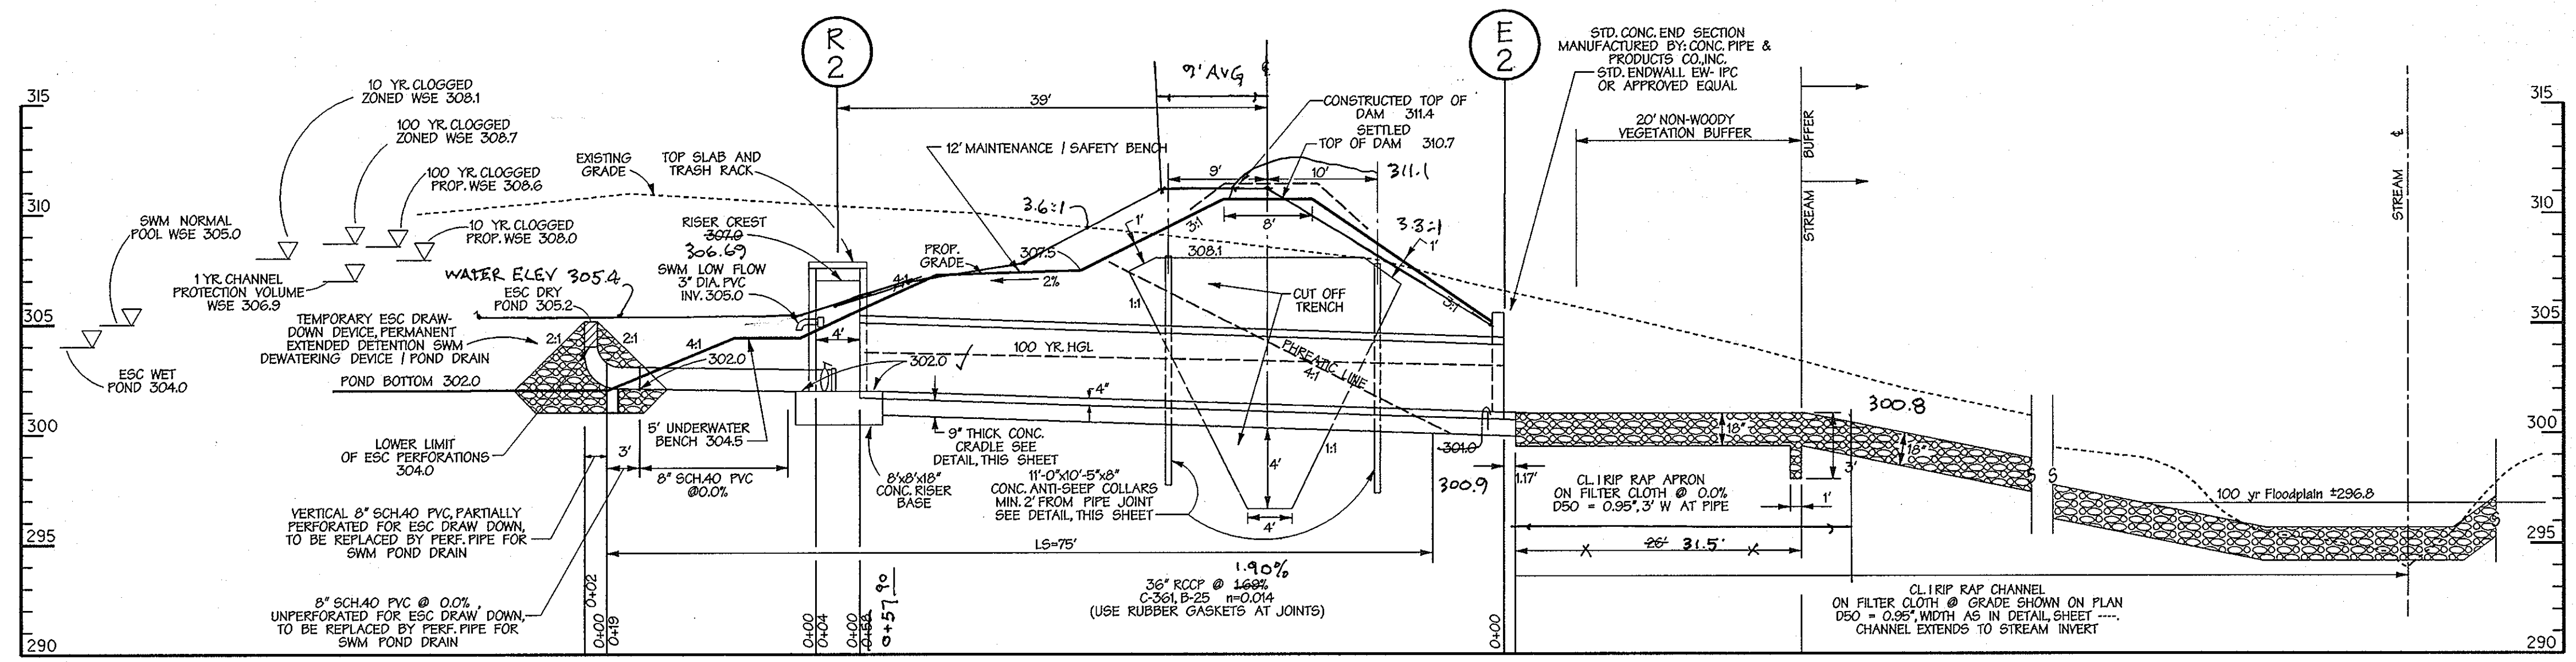


PROFILE ALONG PRINCIPAL SPILLWAY SWM POND II

SCALE: HORIZ. - 1" = 10'
VERT. - 1" = 5'

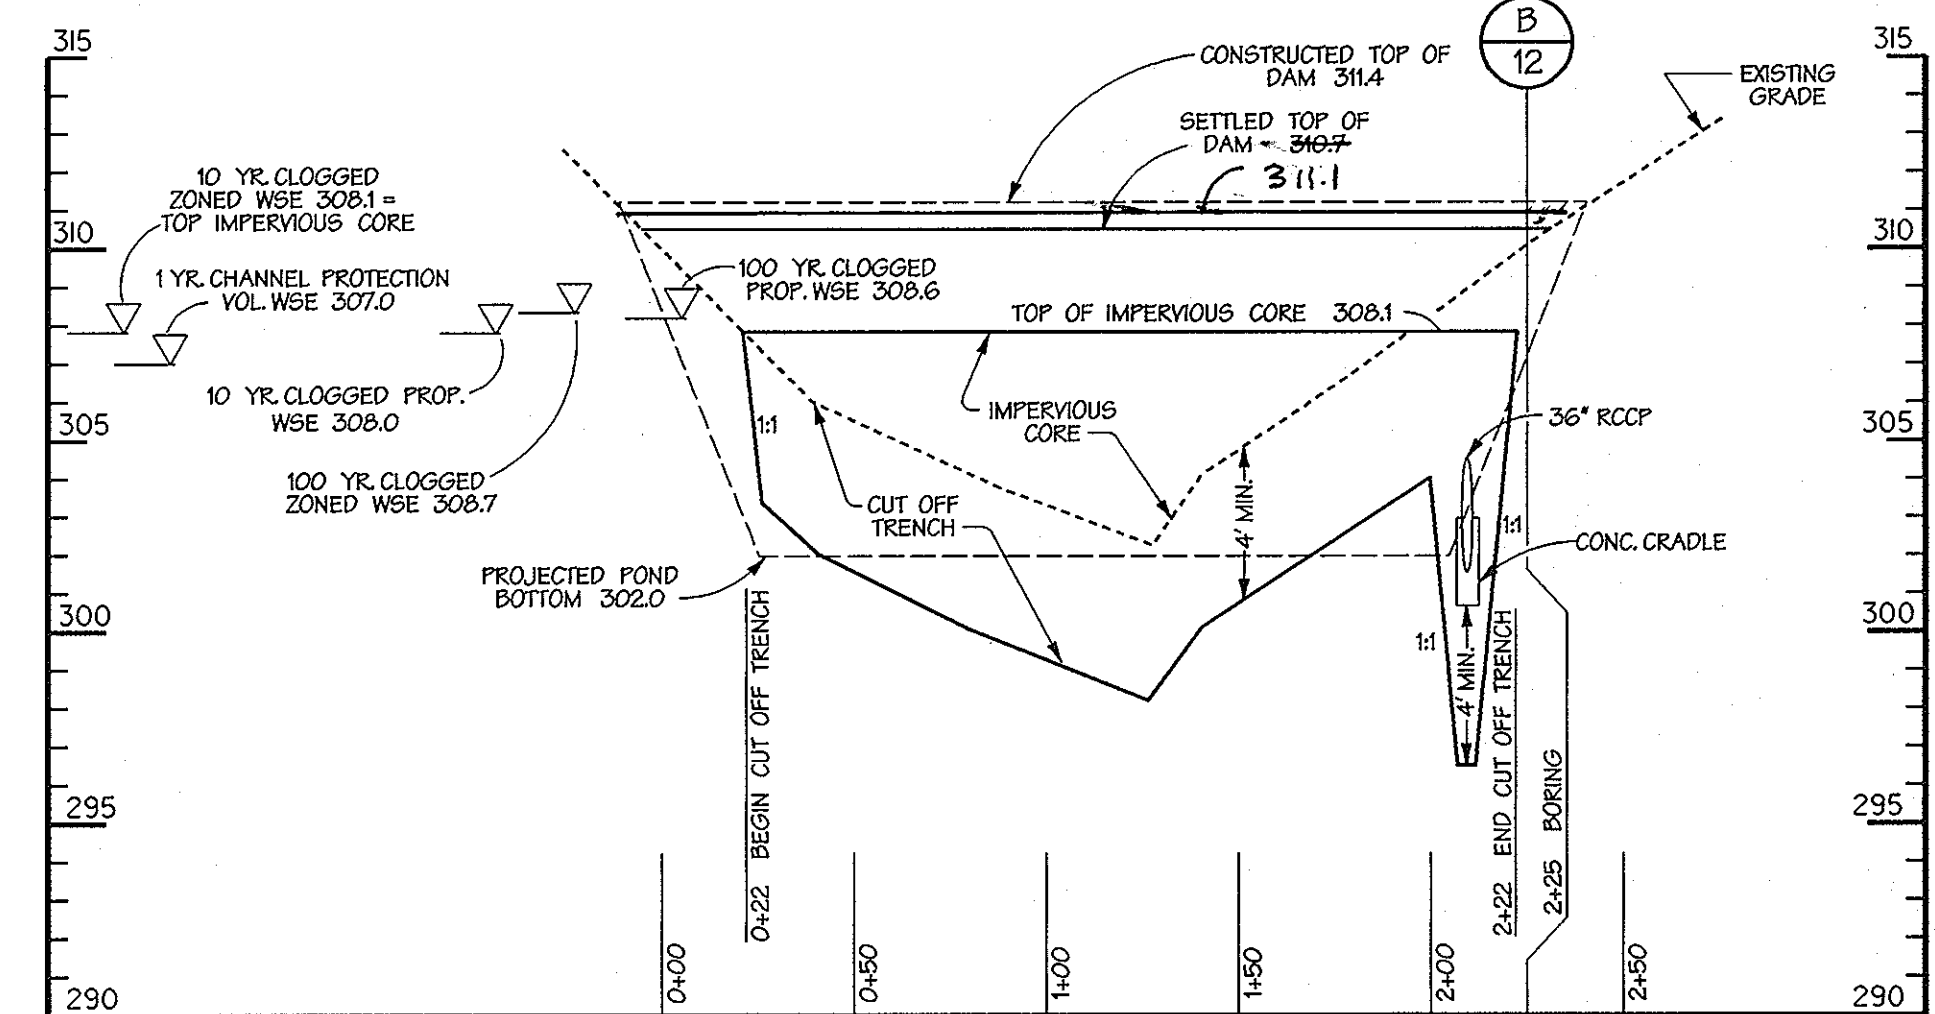


PROFILE ALONG CENTERLINE OF EMBANKMENT SWM II

SCALE: HORIZ. - 1" = 50'
VERT. - 1" = 5'

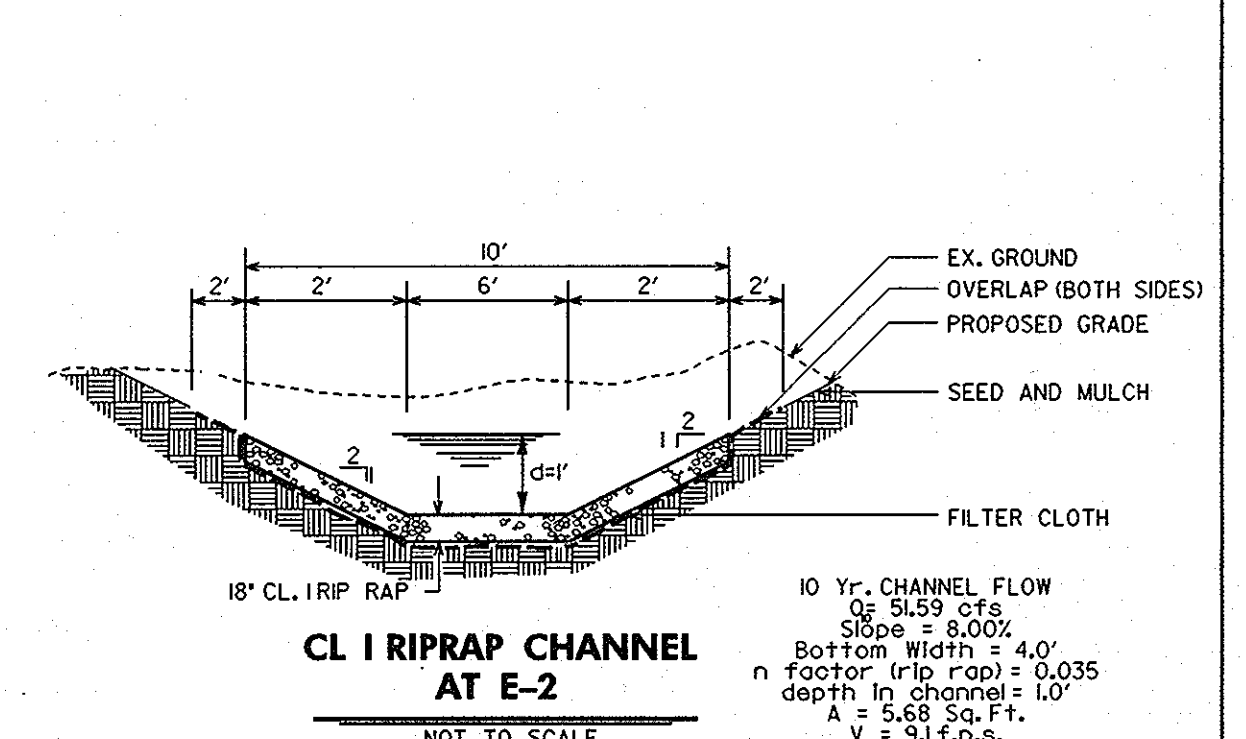


CL I RIPRAP CHANNEL AT E-2

NOT TO SCALE

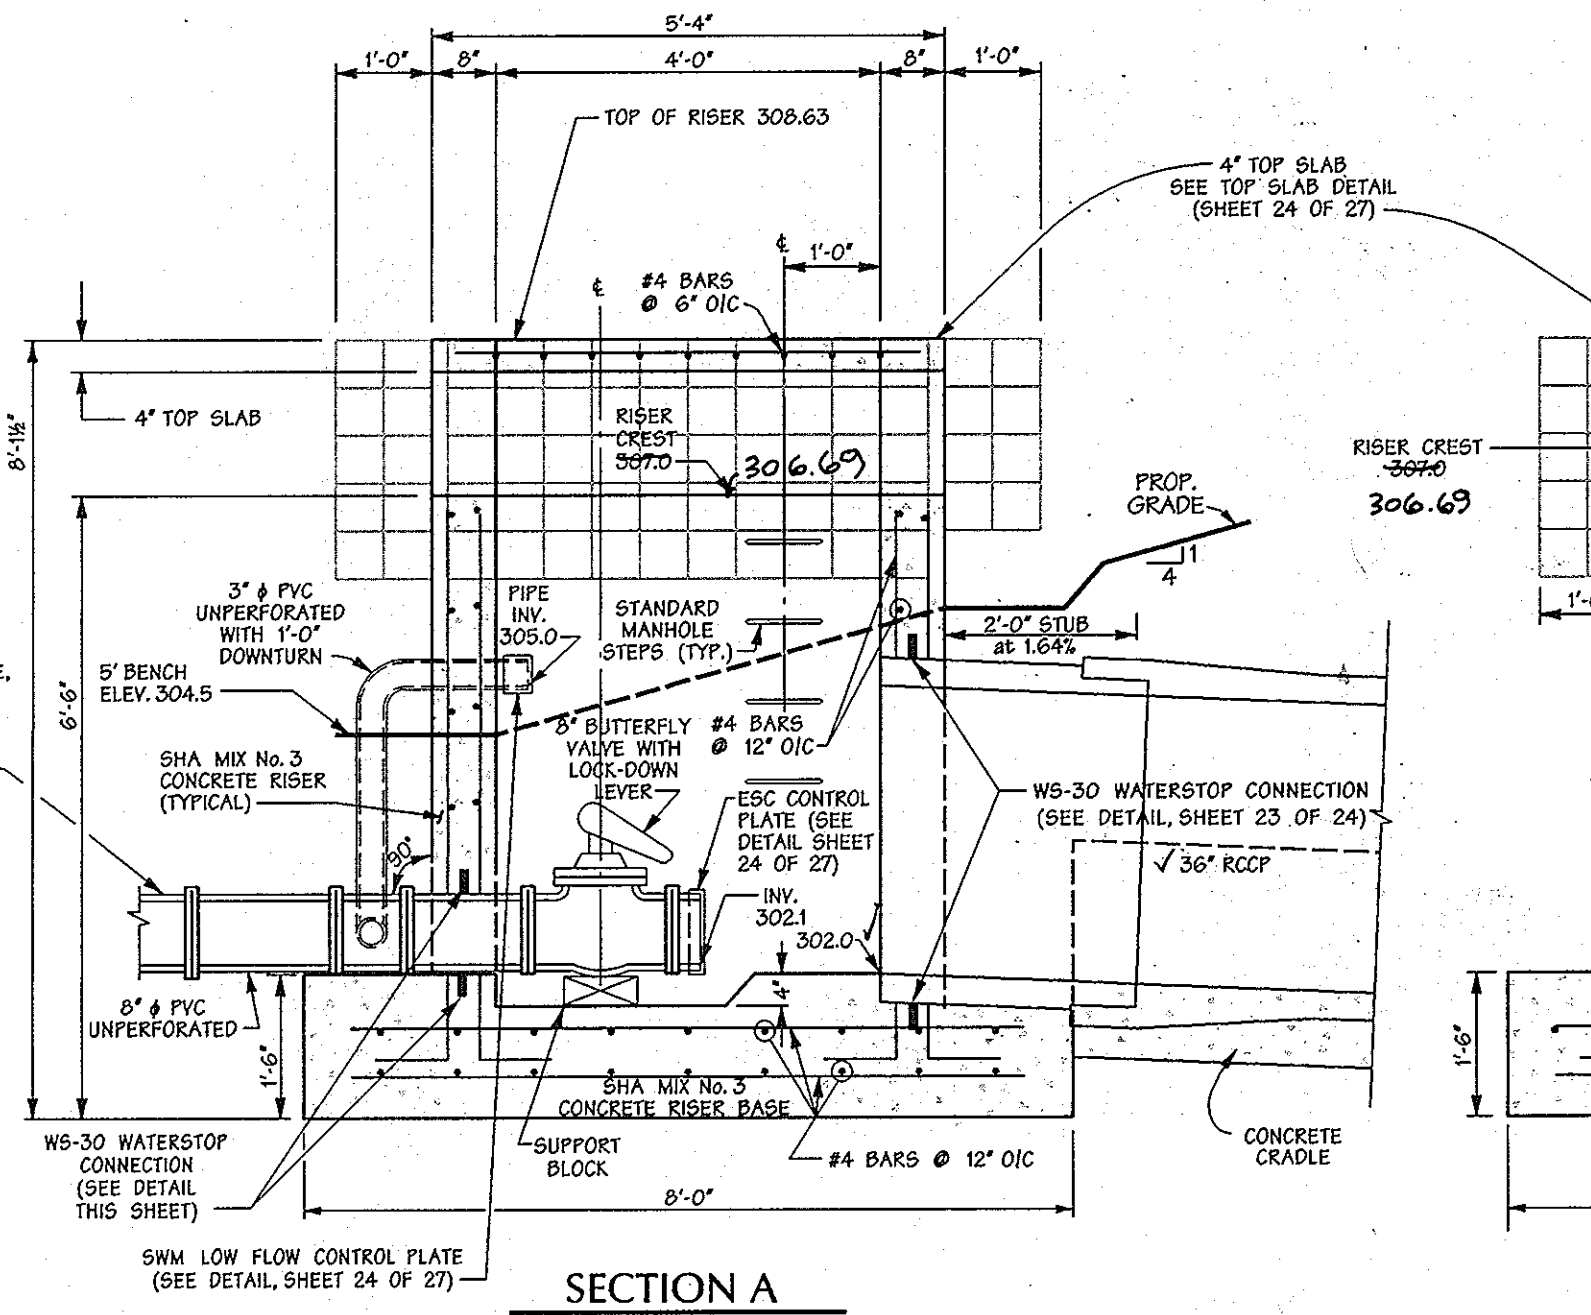

SECTION A

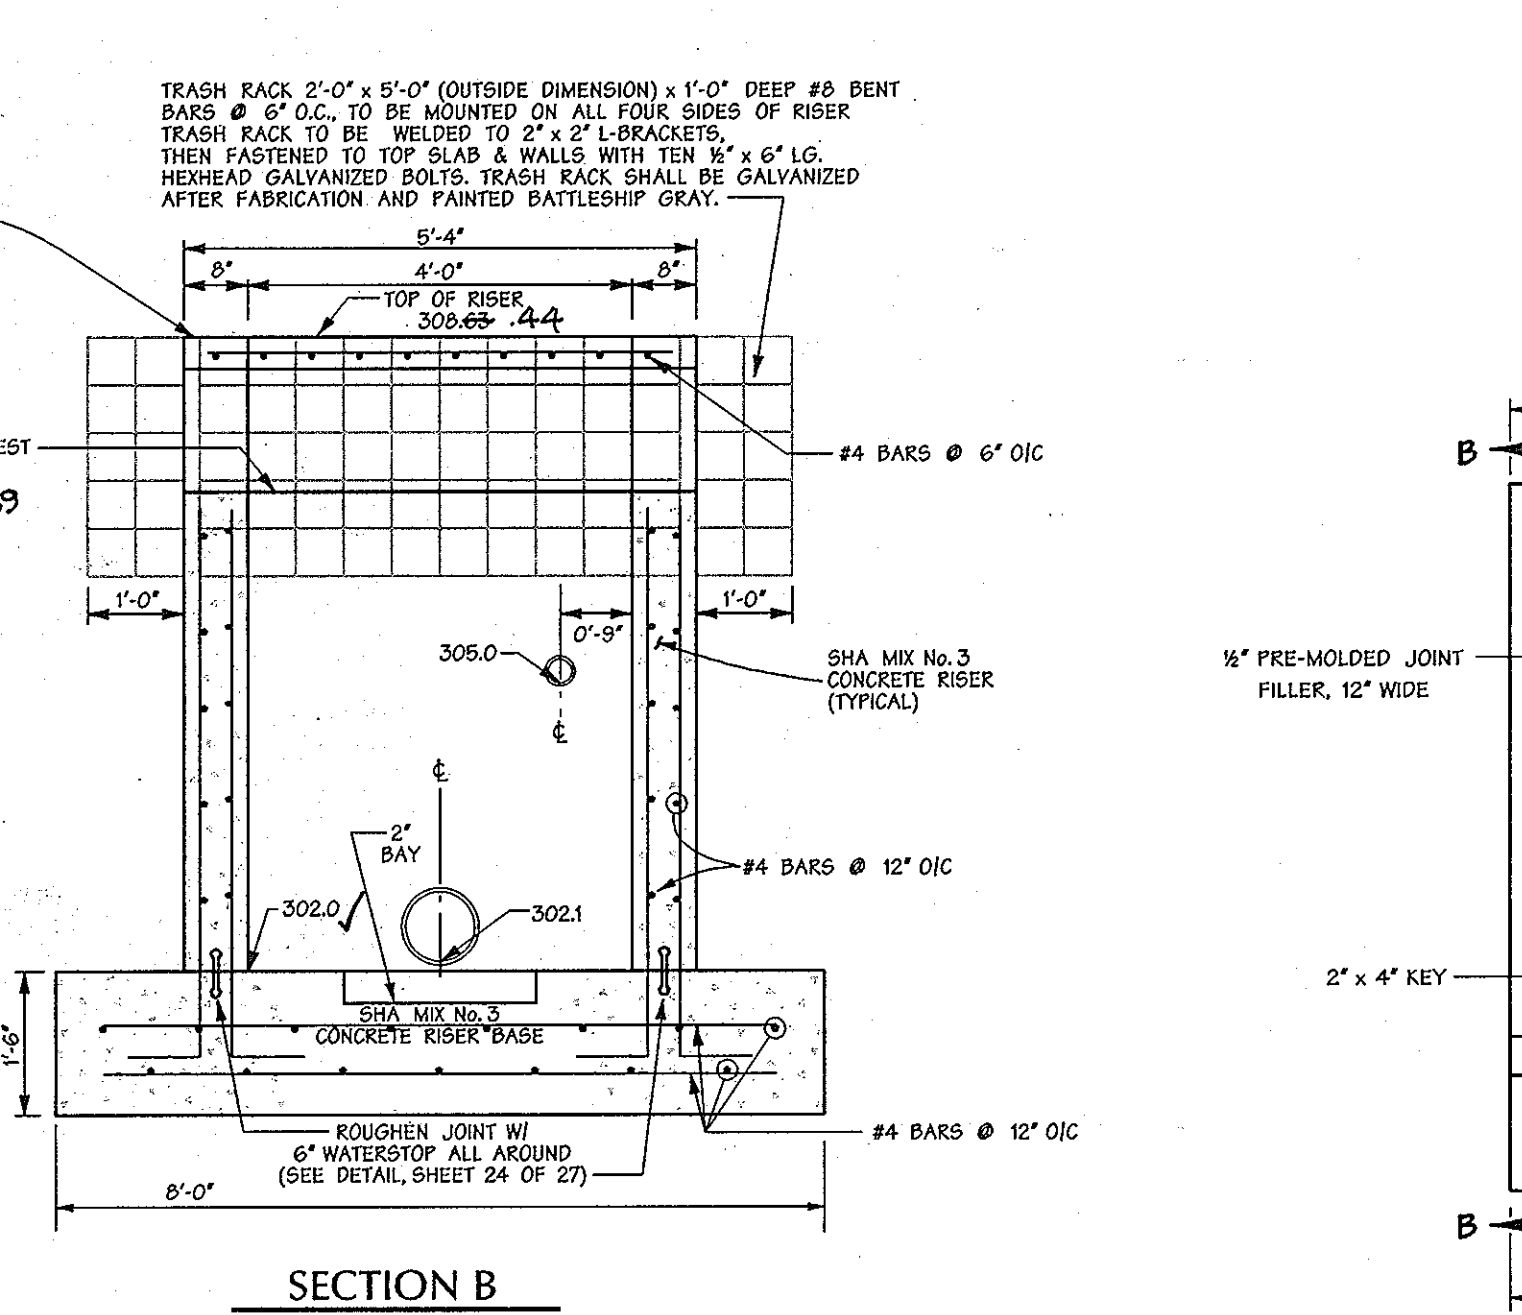


SECTION B

NOTE: MAINTENANCE STAFF WILL CARRY A PORTABLE VALVE STEM INTO THE FIELD FOR OPERATION OF 12" GATE VALVE FROM TOP SLAB.


R-2 RISER DETAIL FOR POND - SWM II

Scale: 1/2" = 1'-0"
CAST IN PLACE

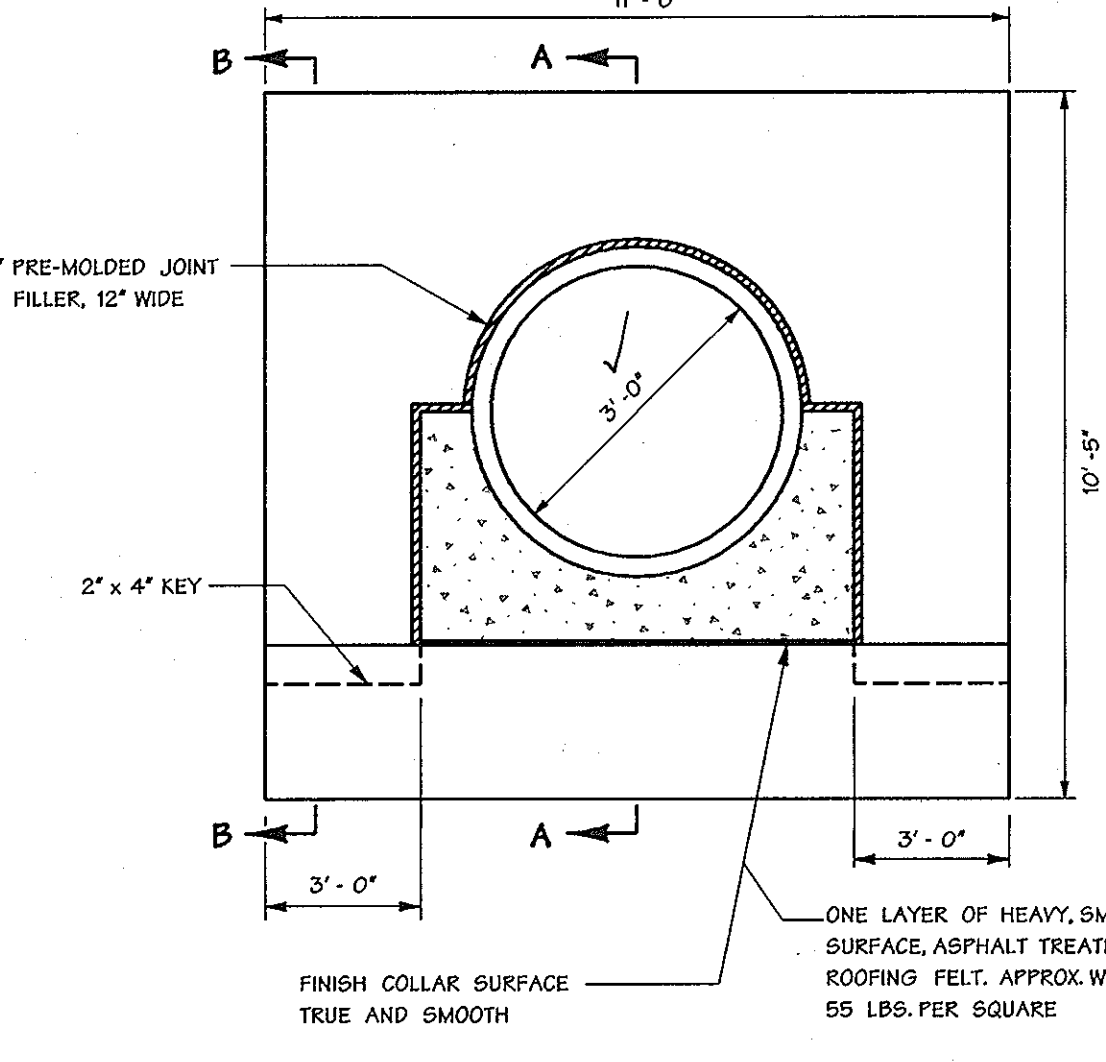

ANTI-SEEP COLLAR DETAIL - SWM II

CAST IN PLACE - NOT TO SCALE

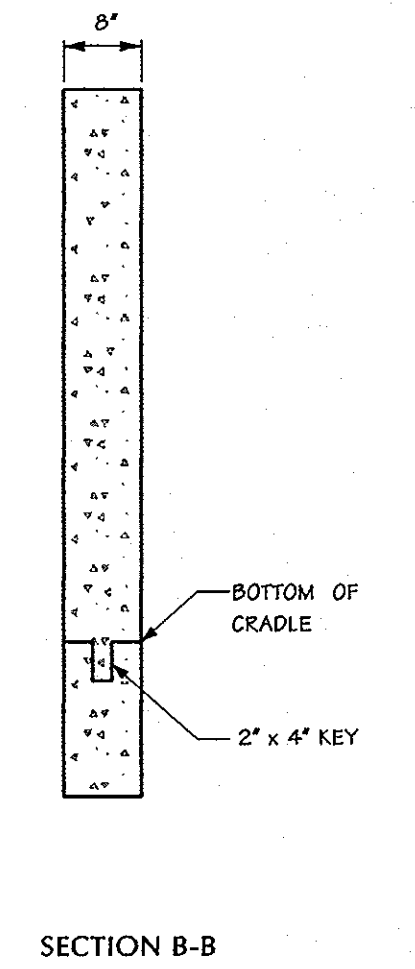

SECTION A-A

SECTION B-B

APPROVED: HOWARD COUNTY DEPARTMENT OF PUBLIC WORKS	
<i>Andrew M. Rowche</i>	10-29-01
CHIEF, BUREAU OF HIGHWAYS	NS
APPROVED: HOWARD COUNTY DEPT. OF PLANNING & ZONING	
<i>Chris Dammus</i>	10/31/01
CHIEF, DEVELOPMENT ENGINEERING DIVISION	MK
<i>Cindy Hernandez</i>	11/6/01
CHIEF, DIVISION OF LAND DEVELOPMENT	16

Date	No.	Revision Description
------	-----	----------------------

EMERSON
FORMERLY KEY PROPERTY
SECTION 2, PHASE 1A


OWNER/DEVELOPER:
THE HOWARD RESEARCH & DEVELOPMENT CORPORATION
10275 Little Patuxent Parkway
Columbia, Maryland 21044

DMW
Dale McCune-Walker, Inc.
200 East Pennsylvania Avenue
Towson, Maryland 21286
(410) 281-3333
Fax: 281-3365

SECTION NAME	EMERSON SECTION 2	SECTION/AREA	PHASE 1A	LOT/PARCEL #	P10 P. 037, P. 3, P. 462
SCALE	1" = 1'-0"	DATE	10/29/01	PROJECT DISTRICT	6 TH
WATER CODE	1A 5.2, 5.3, 5.4	SEWER CODE			

TITLE
**STORMWATER MANAGEMENT
DETAILS - SWM II**

Des By	MRT	Scale	1" = 50'	Proj. No.	95054.F
Drn By	WHJ	Date	9-26-01		
Chk By		Approved			21 of 27

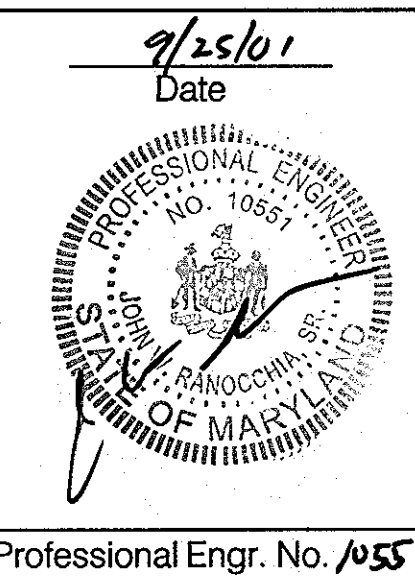


Professional Engr. No. 10551

ROAD & STORM DRAIN AS-BUILT

Erin Handberg

SHANABERGER & LANE
8726 TOWN & COUNTRY BLVD.
SUITE 201
ELLCOTT CITY, MARYLAND 21043

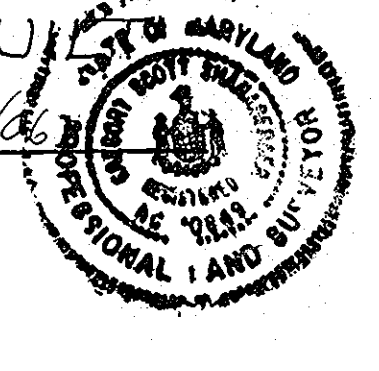

THESE PLANS HAVE BEEN REVIEWED FOR THE HOWARD SOIL CONSERVATION DISTRICT AND MEET THE TECHNICAL REQUIREMENTS FOR SMALL POND CONSTRUCTION, SOIL EROSION AND SEDIMENT CONTROL.

Jim Mays 10/10/01
U.S.D.A. NATURAL RESOURCES CONSERVATION SERVICE

THESE PLANS FOR SMALL POND CONSTRUCTION, SOIL EROSION AND SEDIMENT CONTROL MEET THE REQUIREMENTS OF HOWARD SOIL CONSERVATION DISTRICT.

Robert A. Jenkins 10/10/01
APPROVED: HOWARD SOIL CONSERVATION DISTRICT


PLAN NUMBER

DEVELOPERS CERTIFICATE:
I/WE CERTIFY THAT ALL DEVELOPMENT AND/OR CONSTRUCTION WILL BE DONE ACCORDING TO THESE PLANS AND THAT ANY RESPONSIBLE PERSONNEL INVOLVED IN THE CONSTRUCTION PROJECT WILL HAVE A CERTIFICATE OF ATTENDANCE AT A DEPARTMENT OF ENVIRONMENT APPROVED TRAINING PROGRAM FOR THE CONTROL OF SEDIMENT AND EROSION BEFORE BEGINNING THE PROJECT. I/SHALL ENGAGE A REGISTERED PROFESSIONAL ENGINEER TO SUPERVISE POND CONSTRUCTION AND PROVIDE THE HOWARD SOIL CONSERVATION DISTRICT WITH AN "AS-BUILT" PLAN OF THE POND WITHIN 30 DAYS OF COMPLETION. I/ALSO AUTHORIZE PERIODIC ON-SITE INSPECTIONS BY THE HOWARD SOIL CONSERVATION DISTRICT.

Robert A. Jenkins 10/27/01
SIGNATURE OF DEVELOPER
PRINT NAME BELOW SIGNATURE

ENGINEERS CERTIFICATE:
I CERTIFY THAT THIS PLAN FOR POND CONSTRUCTION, EROSION AND SEDIMENT CONTROL REPRESENTS A PRACTICAL AND WORKABLE PLAN BASED ON MY PERSONAL KNOWLEDGE OF THE SITE CONDITIONS. THIS PLAN WAS PREPARED IN ACCORDANCE WITH THE REQUIREMENTS OF THE HOWARD SOIL CONSERVATION DISTRICT. I HAVE NOTICED THE DEVELOPER THAT HE/SHE MUST ENGAGE A REGISTERED PROFESSIONAL ENGINEER TO SUPERVISE POND CONSTRUCTION AND PROVIDE THE HOWARD SOIL CONSERVATION DISTRICT WITH AN "AS-BUILT" PLAN OF THE POND WITHIN 30 DAYS OF COMPLETION.

John V. Rowche, Sr. 9/25/01
SIGNATURE OF ENGINEER
PRINT NAME BELOW SIGNATURE

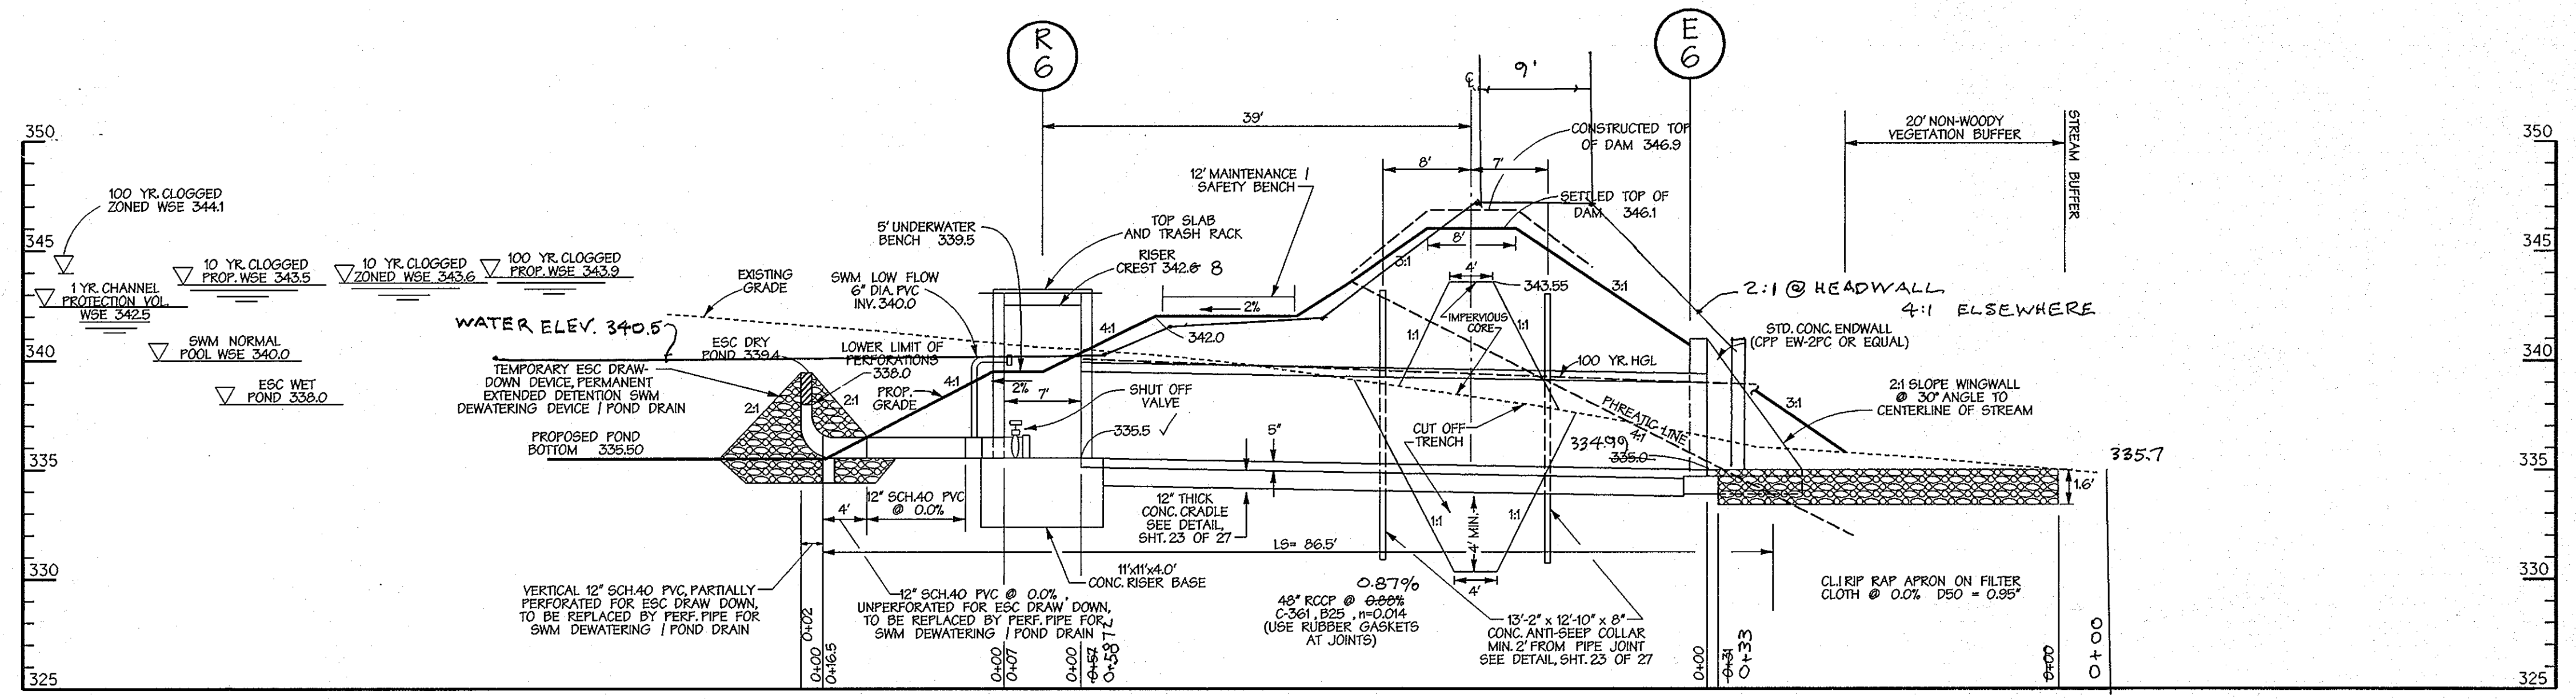

PROFILE ALONG PRINCIPAL SPILLWAY SWM POND VI

SCALE: HORIZ. 1" = 10'
VERT. 1" = 5'

NOTE: BASIN VI SHALL NOT BE CONVERTED TO SWM VI UNTIL THE COMPLETION OF PHASE I-B (P-01-137). AT THAT TIME, CONVERT TO SWM POND AS SHOWN ON THIS PLAN.


LEGEND

---	PROPERTY LINE
---	20' SWM EASEMENT
---	EXISTING CONTOUR
---	PROPOSED CONTOUR
---	LIMIT OF DISTURBANCE
---	6' CHAIN LINK FENCE - SEE DETAIL SHT. 23 OF 27

ROAD & STORM DRAIN AS-BUILT

John V. Remo

SHANBERGER PLANE AND SURVEY
7725 TOWN & COUNTRY BLVD., SUITE 201
BELLICOTT CITY, MARYLAND 21043

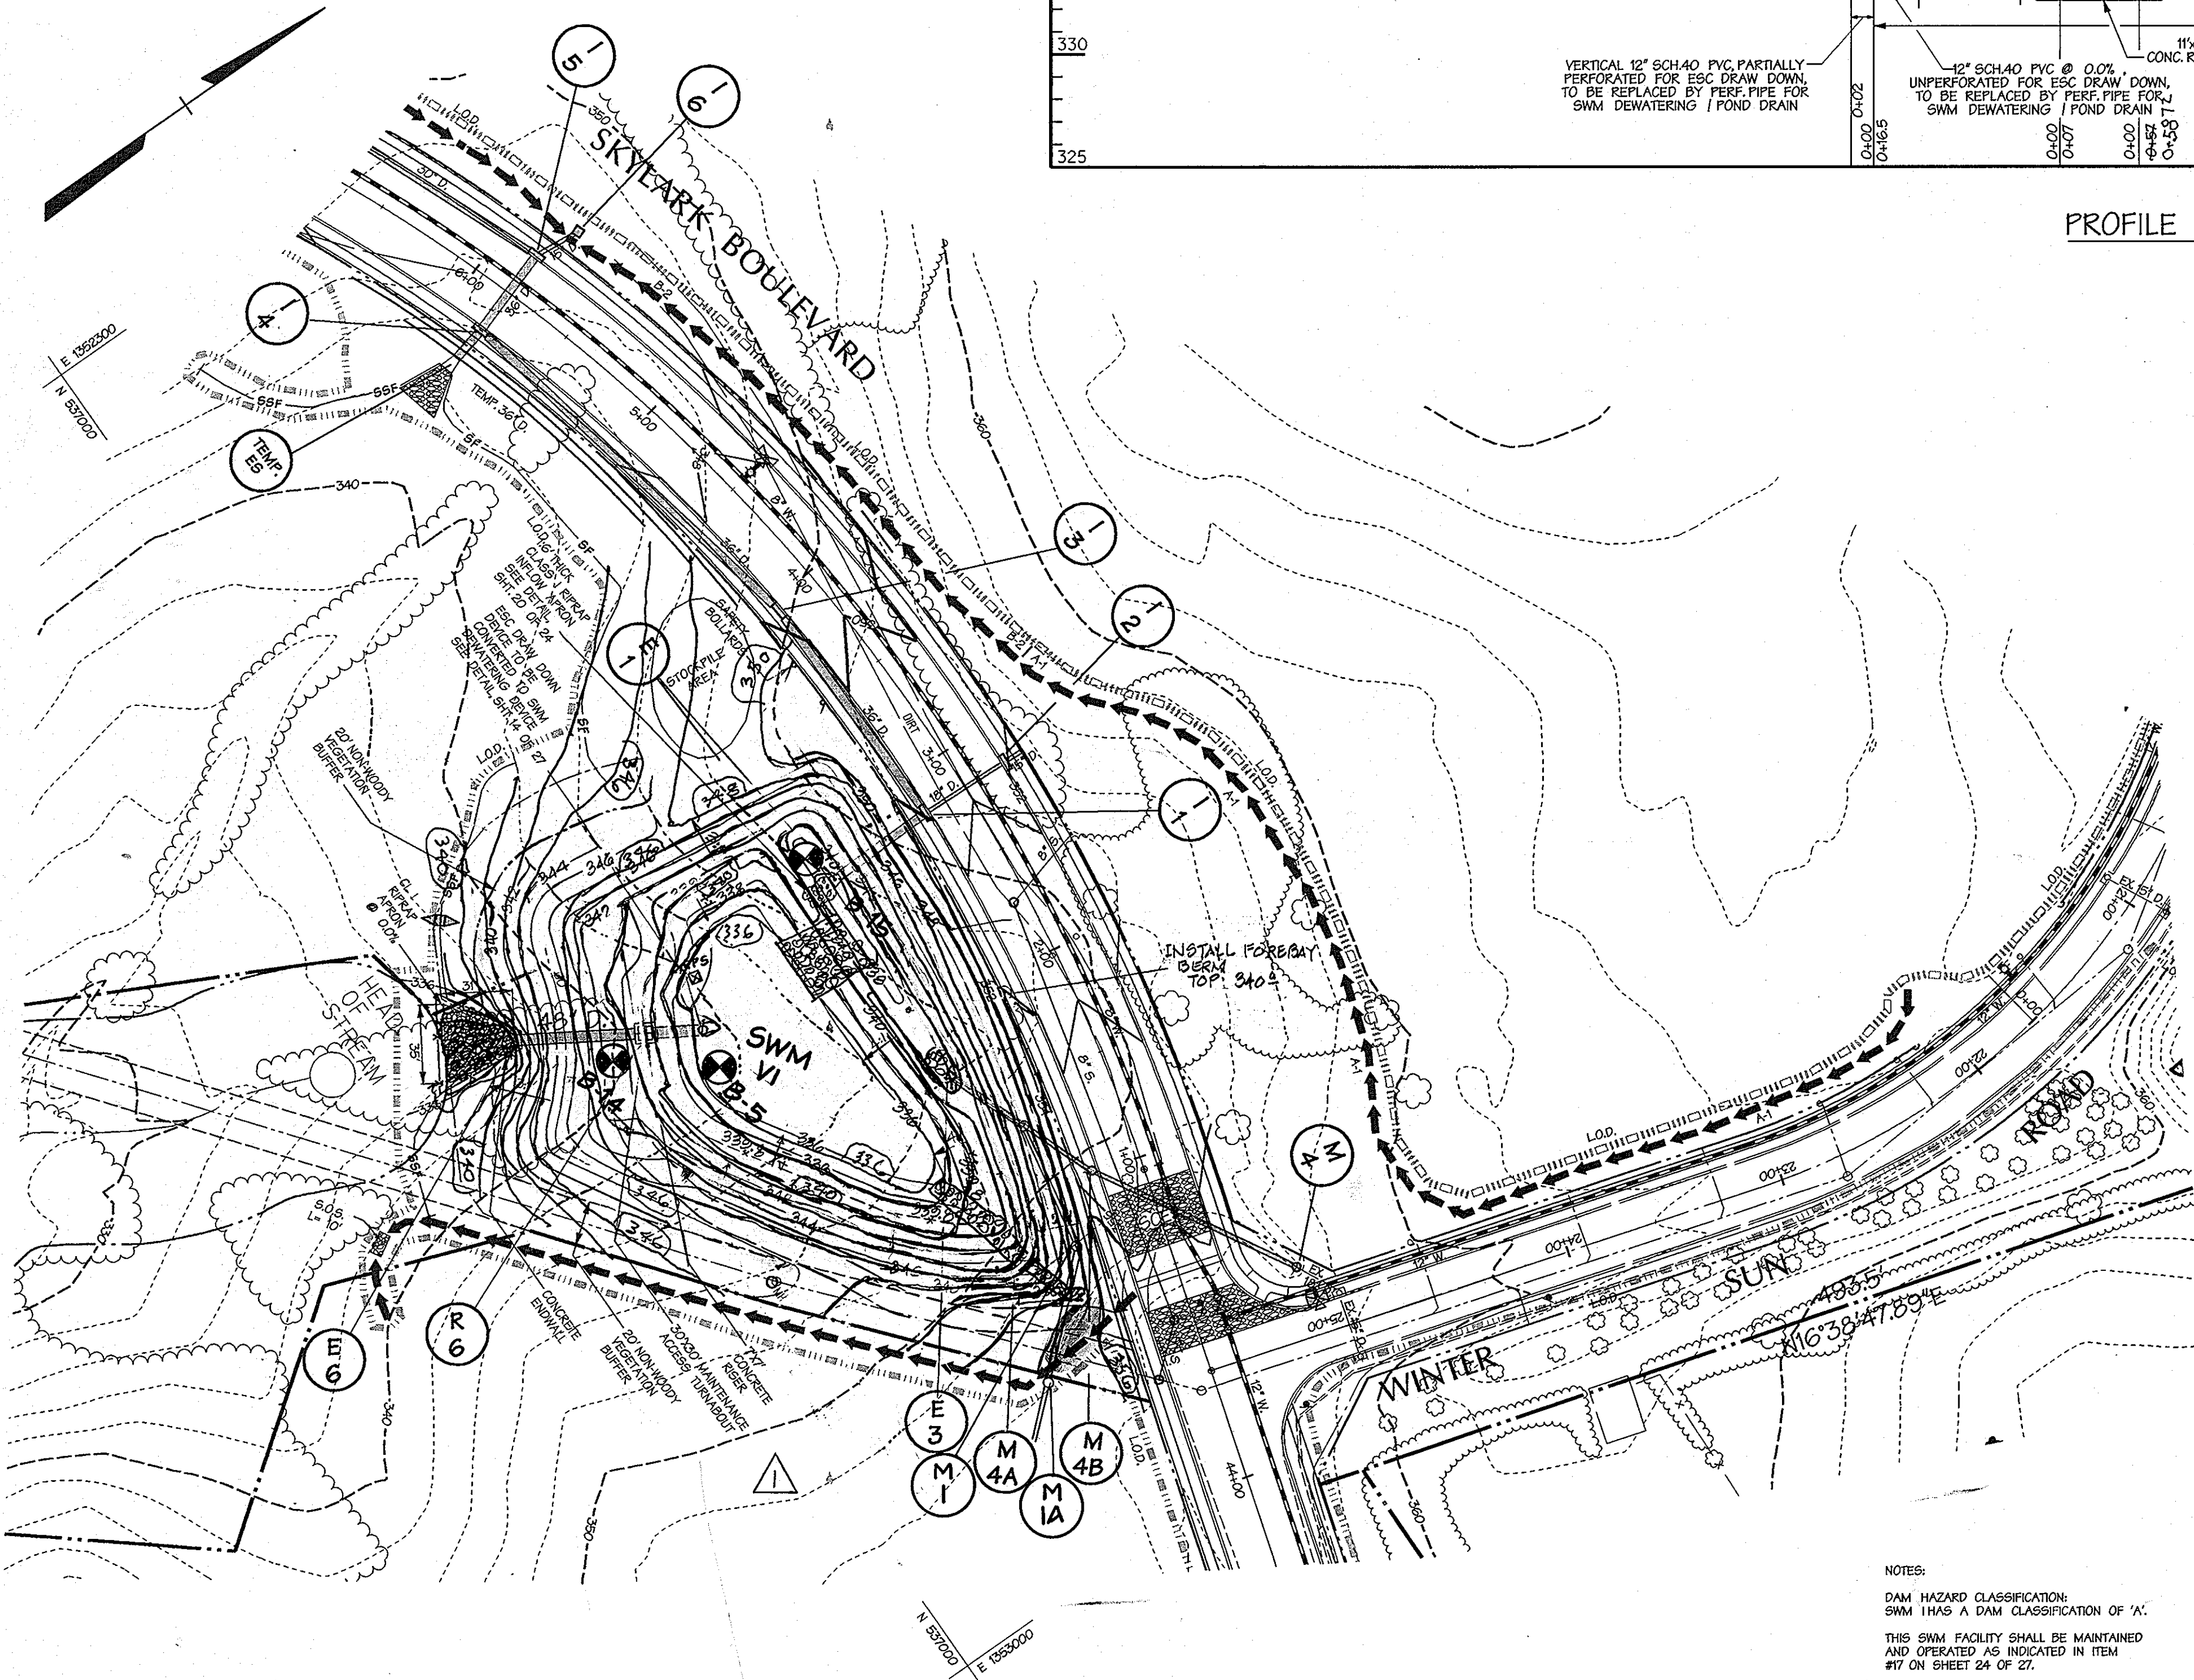

POND VI DESIGN FLOW SUMMARY PROPOSED CONDITIONS *

Water Quality Vol. WQ _v (Ac-ft)	0.803
Recharge Vol. R _v (Ac-ft)	0.216
Channel Protection Vol. C _p (Ac-ft)	1.361
WQ _v Water Surface Elev. - Normal Pool	340.0
C _p Discharge, Proposed (cfs)	25.24
C _p Discharge, Managed (cfs)	0.33
C _p Water Surface Elev.	342.6
Riser Crest Elev.	342.6
10 Yr. Clogged Water Surface Elev.	343.6
100 Yr. Clogged Water Surface Elev.	344.1
Pond Volume Below 100 Yr. Clogged WSE	3.68

Structure Type	WET EXTENDED DETENTION
Water Quality Type	WET POND
Structure Classification	'A'
Storage Height Product 1 year	342.5
Storage Height Product 10 year	343.5
Storage Height Product 100 year	343.9
Watershed Area to Facility	0.044 SQ. MI.
Level of Management Required	1YR.
Level of Management Provided	1YR.
Top Width Provided	8'
Maximum Height of Fill	8.1'
Freeboard Required	2.0'
Freeboard Provided	2.0'

* BASED ON 2000 MDE SWM REGULATIONS. ALL FIGURES REFLECT NON-STRUCTURAL CREDITS TAKEN PER THE AFOREMENTIONED REGULATIONS.

NOTES:
DAM HAZARD CLASSIFICATION: SWM VI HAS A DAM CLASSIFICATION OF 'A'.
THIS SWM FACILITY SHALL BE MAINTAINED AND OPERATED AS INDICATED IN ITEM #17 ON SHEET 24 OF 27.

THESE PLANS HAVE BEEN REVIEWED FOR THE HOWARD SOIL CONSERVATION DISTRICT AND MEET THE TECHNICAL REQUIREMENTS FOR SMALL POND CONSTRUCTION, SOIL EROSION AND SEDIMENT CONTROL.

Jim Moran 10/10/01
U.S.D.A. NATURAL RESOURCES CONSERVATION SERVICE

THESE PLANS FOR SMALL POND CONSTRUCTION, SOIL EROSION AND SEDIMENT CONTROL MEET THE REQUIREMENTS OF HOWARD SOIL CONSERVATION DISTRICT.

Robert A. Jenkins 10/10/01
APPROVED: HOWARD SOIL CONSERVATION DISTRICT

DEVELOPERS CERTIFICATE:

I/WE CERTIFY THAT ALL DEVELOPMENT AND/OR CONSTRUCTION WILL BE DONE ACCORDING TO THESE PLANS AND THAT ANY RESPONSIBLE PERSONNEL INVOLVED IN THE CONSTRUCTION PROJECT WILL HAVE A CERTIFICATE OF ATTENDANCE AT A DEPARTMENT OF ENVIRONMENT APPROVED TRAINING PROGRAM FOR THE CONTROL OF SEDIMENT AND EROSION BEFORE BEGINNING THE PROJECT. I SHALL ENGAGE A REGISTERED PROFESSIONAL ENGINEER TO SUPERVISE POND CONSTRUCTION AND PROVIDE THE HOWARD SOIL CONSERVATION DISTRICT WITH AN "AS-BUILT" PLAN OF THE POND WITHIN 30 DAYS OF COMPLETION. I ALSO AUTHORIZE PERIODIC ON-SITE INSPECTIONS BY THE HOWARD SOIL CONSERVATION DISTRICT.

Robert A. Jenkins 10/23/01
SIGNATURE OF DEVELOPER
PRINT NAME BELOW SIGNATURE

ENGINEERS CERTIFICATE:

I CERTIFY THAT THIS PLAN FOR POND CONSTRUCTION, EROSION AND SEDIMENT CONTROL REPRESENTS A PRACTICAL AND WORKABLE PLAN BASED ON MY PERSONAL KNOWLEDGE OF THE SITE CONDITIONS. THIS PLAN WAS PREPARED IN ACCORDANCE WITH THE REQUIREMENTS OF THE HOWARD SOIL CONSERVATION DISTRICT. I HAVE NOTIFIED THE DEVELOPER THAT HE/SHE MUST ENGAGE A REGISTERED PROFESSIONAL ENGINEER TO SUPERVISE POND CONSTRUCTION AND PROVIDE THE HOWARD SOIL CONSERVATION DISTRICT WITH AN "AS-BUILT" PLAN OF THE POND WITHIN 30 DAYS OF COMPLETION.

John V. Remo 9/25/01
SIGNATURE OF ENGINEER
PRINT NAME BELOW SIGNATURE

9/25/01
Date

PROFESSIONAL ENGINEER
JOHN V. REMO
STATE OF MARYLAND

Professional Engr. No. 10551

APPROVED: HOWARD COUNTY DEPARTMENT OF PUBLIC WORKS
Richard M. Daniels 10-29-01
CHIEF, BUREAU OF HIGHWAYS

APPROVED: HOWARD COUNTY DEPT. OF PLANNING & ZONING
Mike Deane 10/23/01
CHIEF, DEVELOPMENT ENGINEERING DIVISION

Cindy Hamada 11/6/01
CHIEF, DIVISION OF LAND DEVELOPMENT

1/22/02 POND GRADING
Date No. Revision Description

EMERSON
FORMERLY KEY PROPERTY
SECTION 2, PHASE 1A

OWNERS/DEVELOPER:
THE HOWARD RESEARCH & DEVELOPMENT CORPORATION
10275 Little Patuxent Parkway
Columbia, Maryland 21044


DMW
Darr McCreane-Walker, Inc.
200 East Pennsylvania Avenue
Towson, Maryland 21286
(410) 296-4705
Fax 296-4705
A Team of Land Planners, Landscape Architects, Engineers, Surveyors & Environmental Professionals

SUBDIVISION NAME EMERSON SECTION 2 PHASE 1A LOT/FACILITY # P10 P. 837, P. 3, P. 462
PLAT OR REFERENCE TO RECORD MAP 1A 5.32 & 2
DATE OF RECORD MAP 11/23/93
WATER CODE 47 6 TH
SEWER CODE

TITLE
STORMWATER MANAGEMENT PLAN
SWM VI


Des By MRT Scale 1"=50' Proj. No. 95054-F
Dm By WtJ Date 9-26-01
Chk By Approved 22 of 27

F-01-136
Tue Sep 25 14:19:05 2001

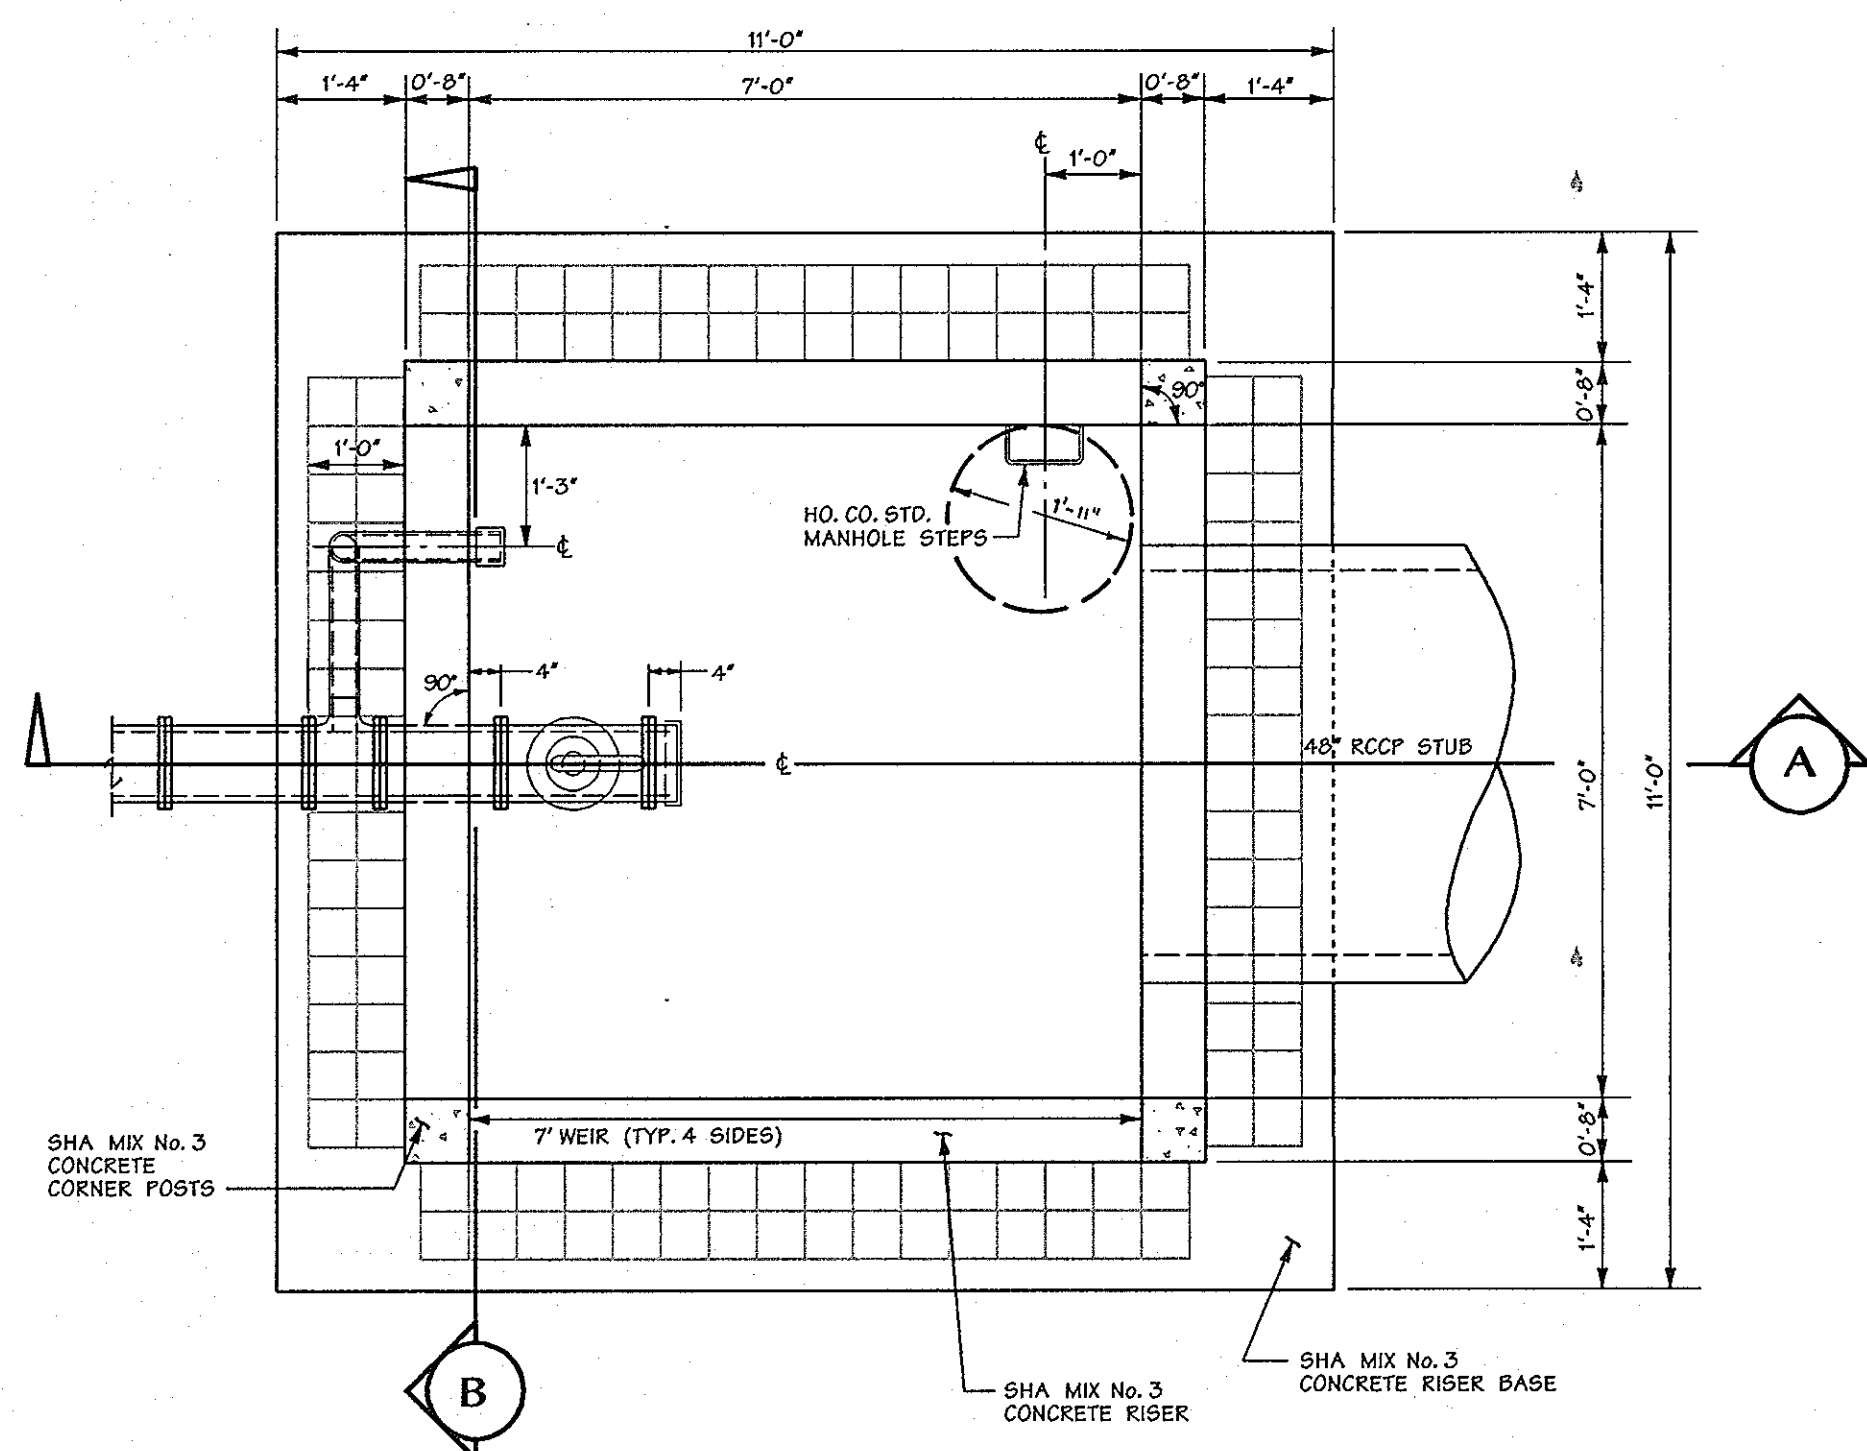


R-1 RISER PLAN (TOP SLAB AND TRASH RACK REMOVED) - SWM VI

Scale: 1/2" = 1'-0"
CAST IN PLACE

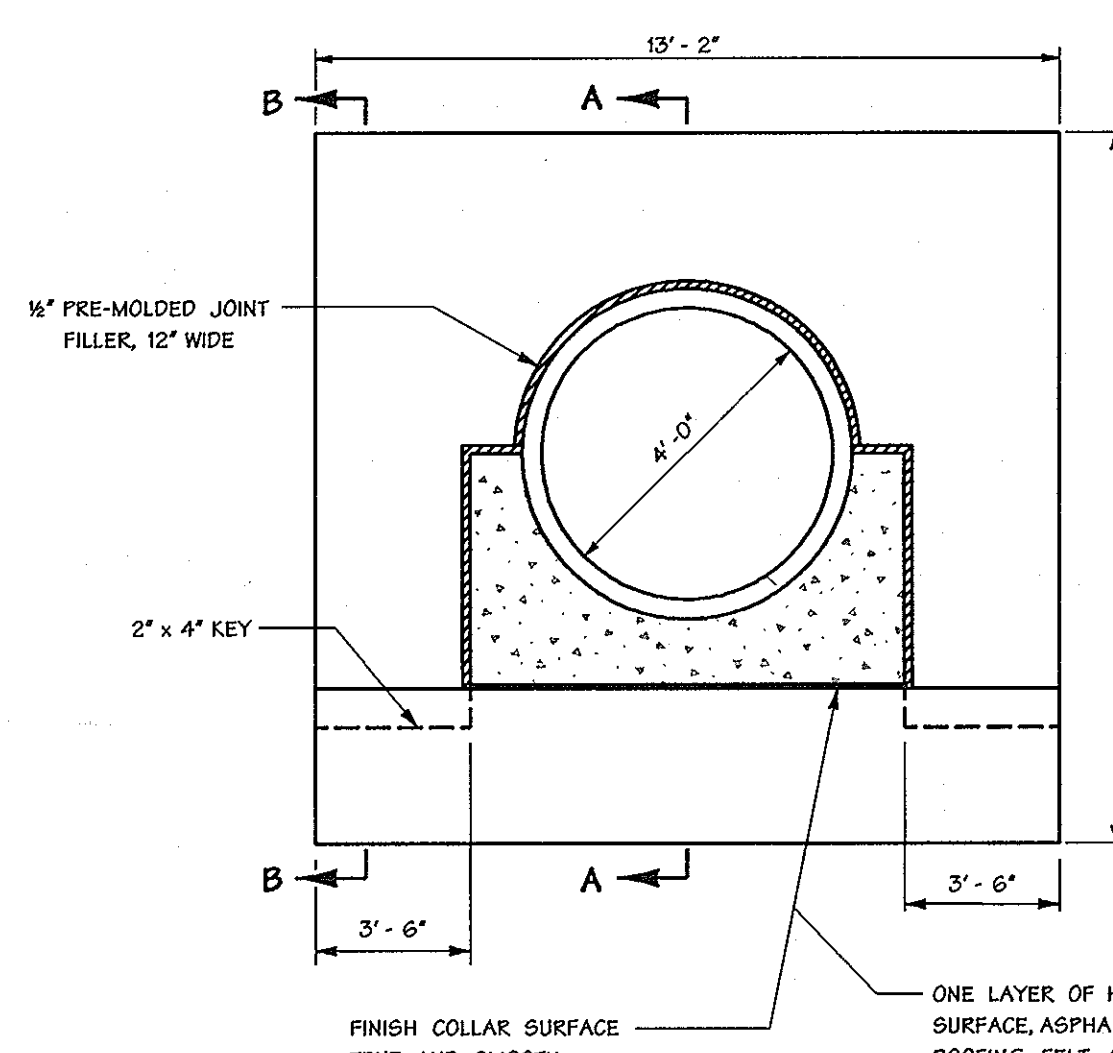


6' CHAIN LINK FENCE DETAIL

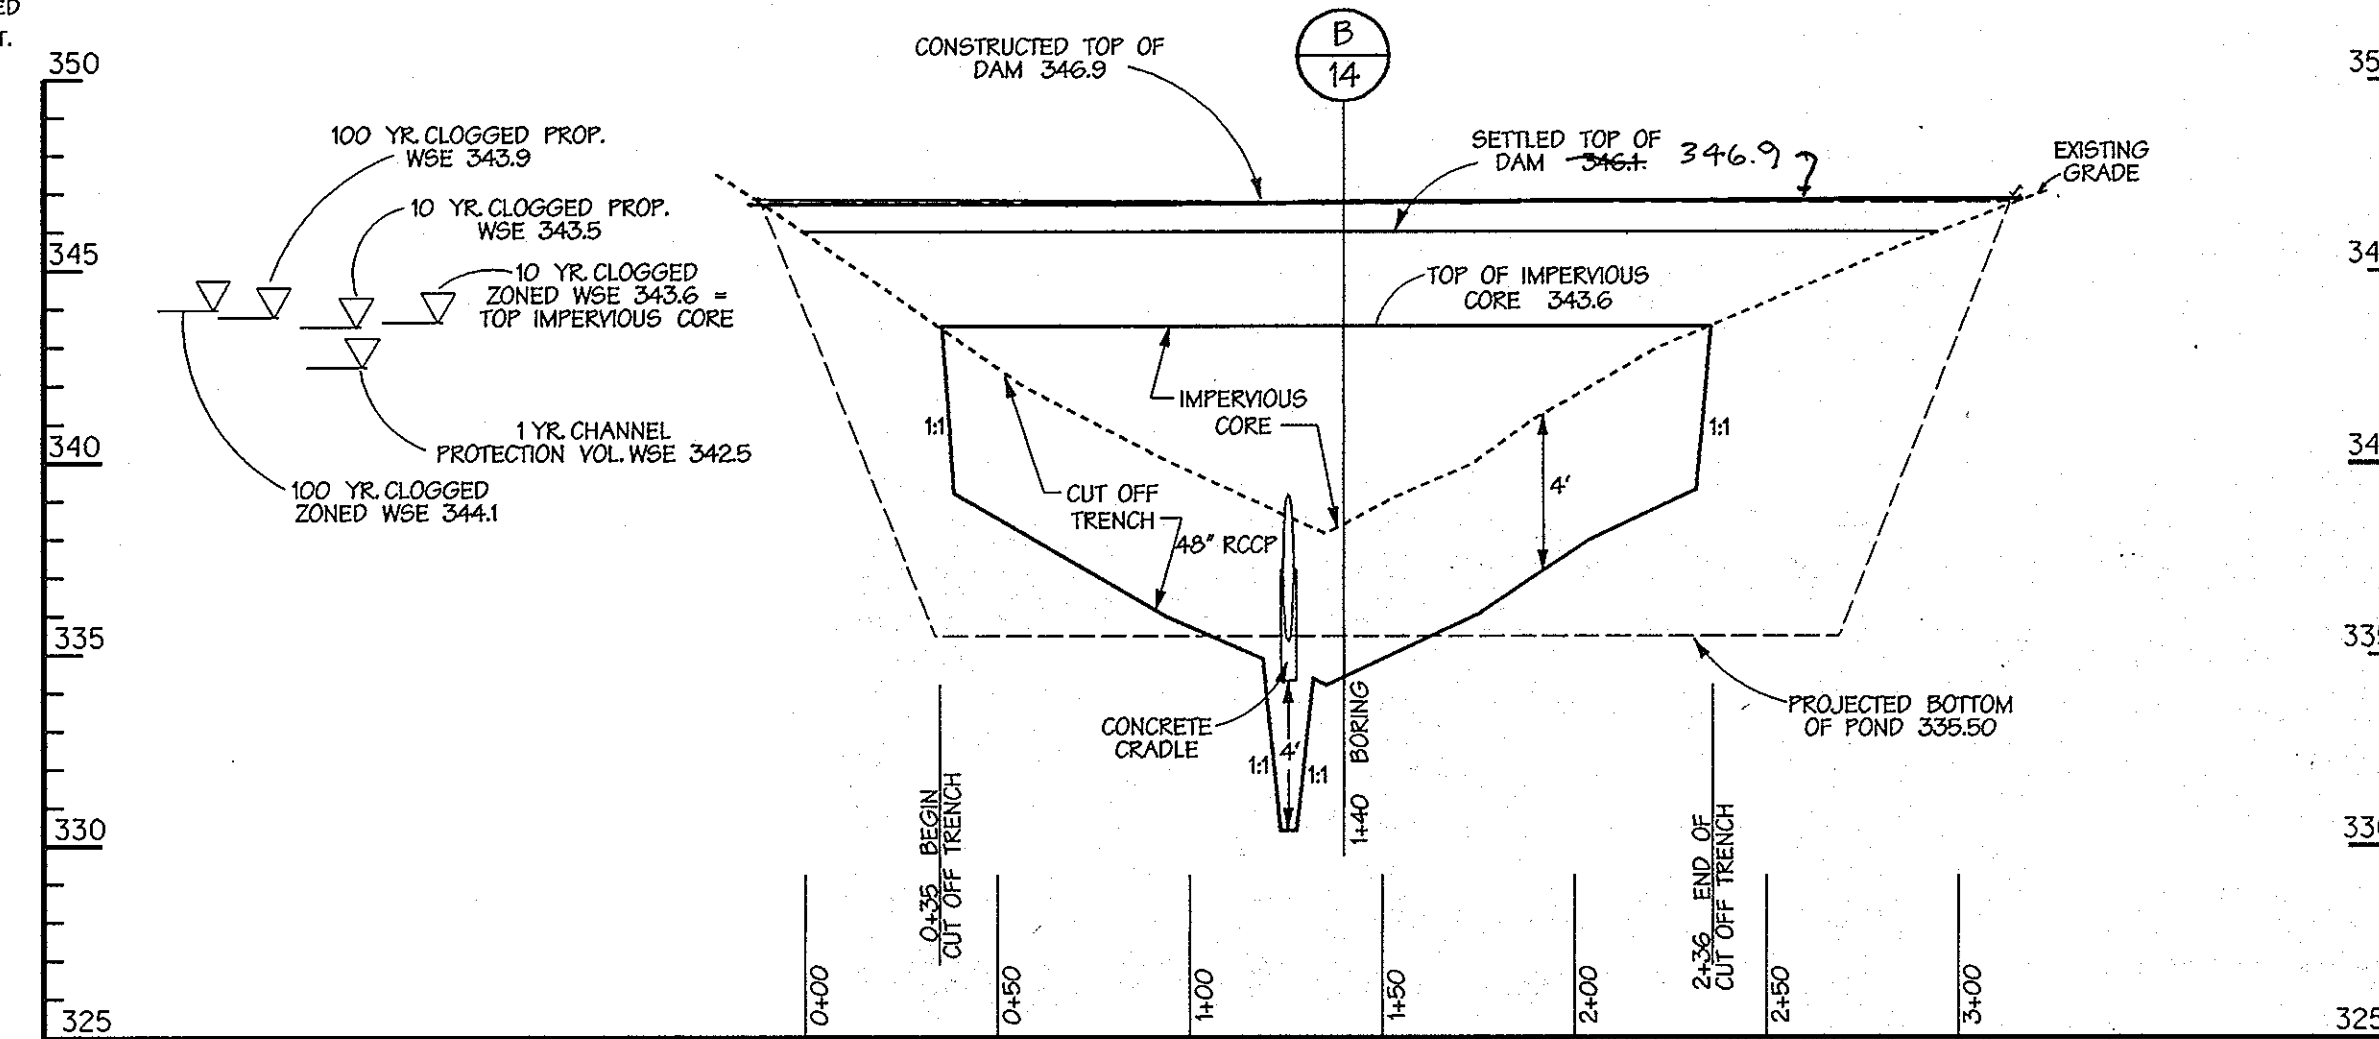

PROFILE ALONG CENTERLINE OF EMBANKMENT SWM VI


SCALE: HORIZ. 1" = 50'
VERT. 1" = 5'

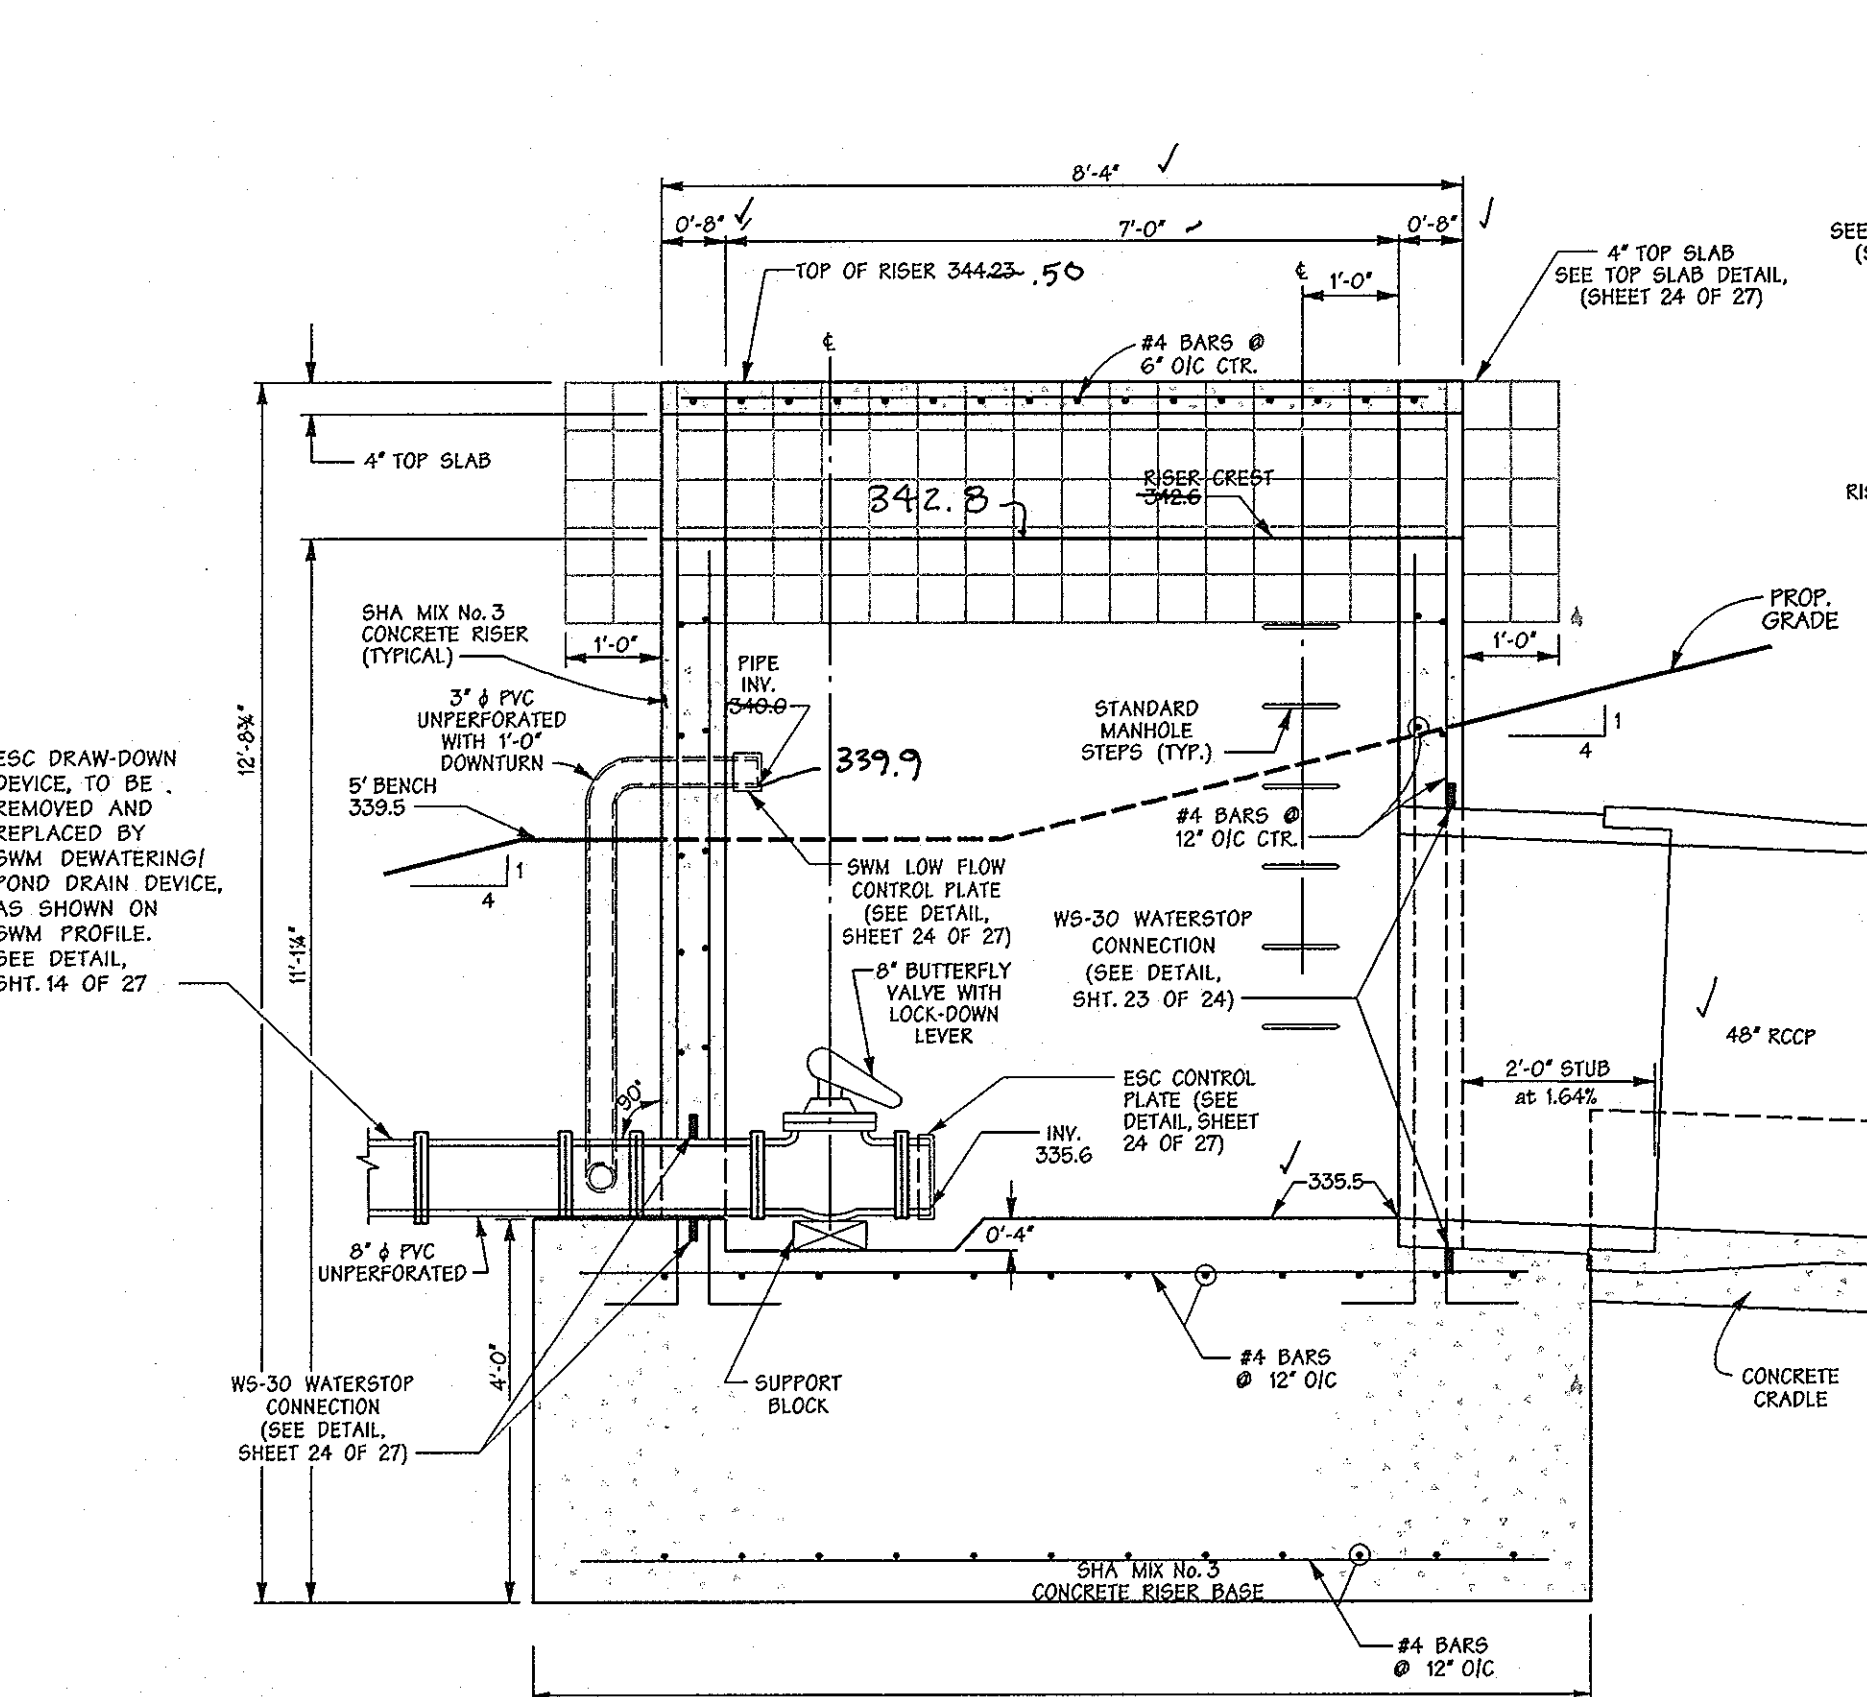

SECTION A

R-6 RISER DETAIL FOR POND - SWM VI

Scale: 1/2" = 1'-0"
CAST IN PLACE

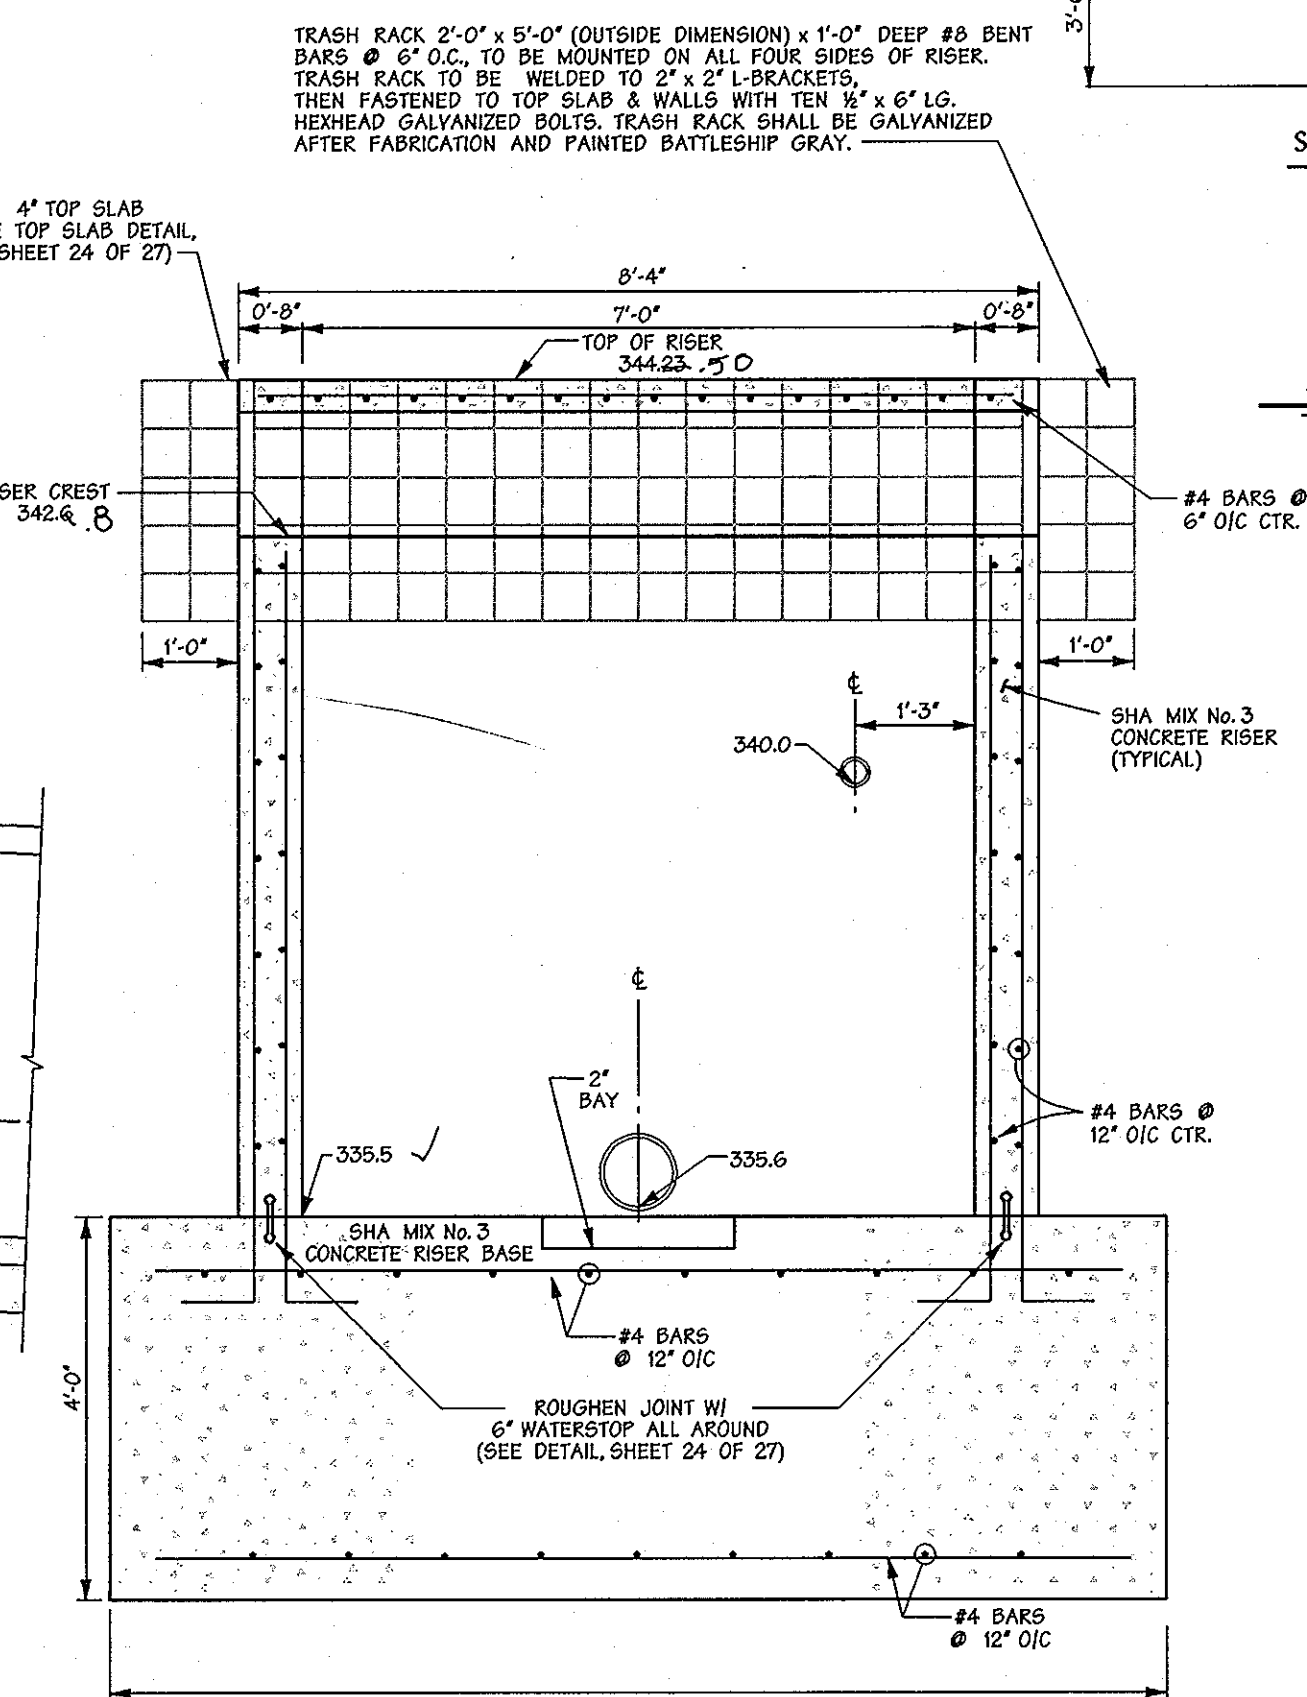

SECTION A-A

SECTION B-B

ANTI-SEEP COLLAR DETAIL - SWM VI

CAST IN PLACE - NOT TO SCALE

ROAD & STORM DRAIN AS-BUILT

John W. Ranocchia, Sr.

SHANABERGER & LANE
8726 TOWN & COUNTRY BLVD.
SUITE 201
ELLCOTT CITY, MARYLAND 21043



THESE PLANS HAVE BEEN REVIEWED FOR THE HOWARD SOIL CONSERVATION DISTRICT AND MEET THE TECHNICAL REQUIREMENTS FOR SMALL POND CONSTRUCTION, SOIL EROSION AND SEDIMENT CONTROL.

Jim Muesler 10/10/01
U.S.D.A. NATURAL RESOURCES CONSERVATION SERVICE DATE

THESE PLANS FOR SMALL POND CONSTRUCTION, SOIL EROSION AND SEDIMENT CONTROL MEET THE REQUIREMENTS OF HOWARD SOIL CONSERVATION DISTRICT.

APPROVED: *Robert A. Jenkins* 10/10/01
HOWARD SOIL CONSERVATION DISTRICT DATE

PLAN NUMBER

DEVELOPERS CERTIFICATE:


I/WE CERTIFY THAT ALL DEVELOPMENT AND/OR CONSTRUCTION WILL BE DONE ACCORDING TO THESE PLANS AND THAT ANY RESPONSIBLE PERSONNEL INVOLVED IN THE CONSTRUCTION PROJECT WILL HAVE A CERTIFICATE OF ATTENDANCE AT A DEPARTMENT OF ENVIRONMENT APPROVED TRAINING PROGRAM FOR THE CONTROL OF SEDIMENT AND EROSION BEFORE BEGINNING THE PROJECT. I/SHALL ENGAGE A REGISTERED PROFESSIONAL ENGINEER TO SUPERVISE POND CONSTRUCTION AND PROVIDE THE HOWARD SOIL CONSERVATION DISTRICT WITH AN "AS-BUILT" PLAN OF THE POND WITHIN 30 DAYS OF COMPLETION. I/ALSO AUTHORIZE PERIODIC ON-SITE INSPECTIONS BY THE HOWARD SOIL CONSERVATION DISTRICT.

Robert A. Jenkins 10/22/01
SIGNATURE OF DEVELOPER PRINT NAME BELOW SIGNATURE DATE

ENGINEERS CERTIFICATE:

I CERTIFY THAT THIS PLAN FOR POND CONSTRUCTION, EROSION AND SEDIMENT CONTROL REPRESENTS A PRACTICAL AND WORKABLE PLAN BASED ON MY PERSONAL KNOWLEDGE OF THE SITE CONDITIONS. THIS PLAN WAS PREPARED IN ACCORDANCE WITH THE REQUIREMENTS OF THE HOWARD SOIL CONSERVATION DISTRICT. I HAVE NOTIFIED THE DEVELOPER THAT HE/SHE MUST ENGAGE A REGISTERED PROFESSIONAL ENGINEER TO SUPERVISE POND CONSTRUCTION AND PROVIDE THE HOWARD SOIL CONSERVATION DISTRICT WITH AN "AS-BUILT" PLAN OF THE POND WITHIN 30 DAYS OF COMPLETION.

John W. Ranocchia, Sr. 9/26/01
SIGNATURE OF ENGINEER PRINT NAME BELOW SIGNATURE DATE

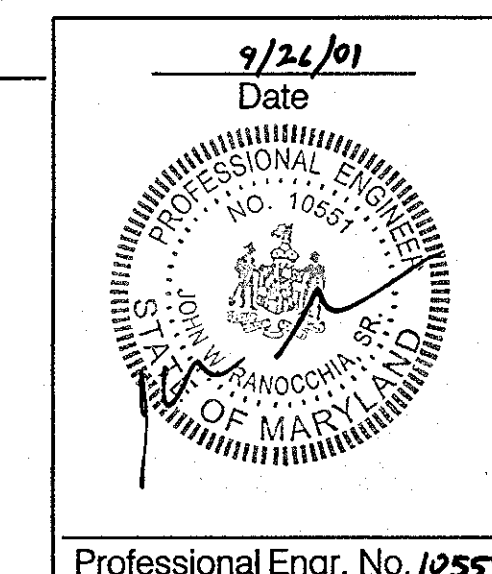

APPROVED: HOWARD COUNTY DEPARTMENT OF PUBLIC WORKS...
Richard M. Daniels 10-29-01
CHIEF, BUREAU OF HIGHWAYS DATE

APPROVED: HOWARD COUNTY DEPT. OF PLANNING & ZONING
John W. Ranocchia, Sr. 10/31/01
CHIEF, DEVELOPMENT ENGINEERING DIVISION MKK DATE

John W. Ranocchia, Sr. 11/6/01
CHIEF, DIVISION OF LAND DEVELOPMENT DATE

Date	No.	Revision Description

EMERSON
FORMERLY KEY PROPERTY
SECTION 2, PHASE 1A

OWNER/DEVELOPER:
THE HOWARD RESEARCH & DEVELOPMENT CORPORATION
10275 Little Patuxent Parkway
Columbia, Maryland 21044

DMW
Duff-McCune-Walker, Inc.
200 East Pennsylvania Avenue
Towson, Maryland 21286
(410) 390-3333
Fax 396-4705

A Team of Land Planners,
Landscape Architects,
Engineers, Surveyors &
Environmental Professionals

SUBMISSION NAME	SECTION/AREA	PHASE	LOPP/PANEL #
EMERSON SECTION 2	SECTION 2	PHASE 1A	PHD P. 037, P. 3, P. 462

TITLE: **STORMWATER MANAGEMENT DETAILS - SWM VI**

Des By	Scale	Proj. No.
MRT	AS SHOWN	95054.F

Chk By	Date	Approved
WHJ	9-26-01	23 of 27

Professional Engr. No. 10551

F-01-136

**STORMWATER MANAGEMENT POND
GENERAL CONSTRUCTION SPECIFICATIONS**

1. GENERAL
ALL STORMWATER MANAGEMENT FACILITIES SHALL BE CONSTRUCTED IN ACCORDANCE WITH BALTIMORE COUNTY'S "STANDARD SPECIFICATIONS AND DETAILS FOR CONSTRUCTION (1995)" AND THE N.C.C.S. MARYLAND "STANDARDS AND SPECIFICATIONS FOR PONDS" (MD-370, 2000). THESE SPECIFICATIONS ARE APPROPRIATE TO ALL PONDS WITHIN THE SCOPE OF THE STANDARD PRACTICE MD-370. ALL REFERENCES TO ASTM AND AASHTO SPECIFICATIONS APPLY TO THE MOST RECENT VERSION.

2. SITE PREPARATION
AREAS DESIGNATED FOR BORROW AREAS, EMBANKMENT, AND STRUCTURAL WORKS SHALL BE CLEARED, GRUBBED AND STRIPPED OF TOPSOIL. ALL TREES, VEGETATION, ROOTS AND OTHER OBJECTIONABLE MATERIAL SHALL BE REMOVED. CHANNEL BANKS AND SHARP BREAKS SHALL BE SLOPED TO NO STEEPER THAN 1:1. ALL TREES SHALL BE CLEARED AND GRUBBED WITHIN 15 FEET OF THE TOE OF THE EMBANKMENT. AREAS TO BE COVERED BY THE RESERVOIR WILL BE CLEARED OF ALL TREES, BRUSH, LOGS, FENCES, RUBBISH AND OTHER OBJECTIONABLE MATERIAL UNLESS OTHERWISE DESIGNATED ON THE PLANS. TREES, BRUSH AND STUMPS SHALL BE CUT APPROXIMATELY LEVEL WITH THE GROUND SURFACE. FOR DRY STORMWATER MANAGEMENT PONDS, A MINIMUM OF A 25-FOOT RADIUS AROUND THE INLET STRUCTURE SHALL BE CLEARED.

ALL CLEARED AND GRUBBED MATERIAL SHALL BE DISPOSED OF OUTSIDE AND BELOW THE LIMITS OF THE DAM AND RESERVOIR AS DIRECTED BY THE OWNER OR HIS REPRESENTATIVE. WHEN SPECIFIED, A SUFFICIENT QUANTITY OF TOPSOIL WILL BE STOCKPILED IN A SUITABLE LOCATION FOR USE ON THE EMBANKMENT AND OTHER DESIGNATED AREAS.

3. EARTH FILL
MATERIAL - THE FILL MATERIAL SHALL BE TAKEN FROM APPROVED DESIGNATED BORROW AREAS. IT SHALL BE FREE OF ROOTS, STUMPS, WOOD, RUBBISH, STONES GREATER THAN 6" FROZEN OR OTHER OBJECTIONABLE MATERIALS. THE FILL MATERIAL SHALL BE COMPACTED TO THE STANDARD PROCTOR MAXIMUM DRY DENSITY IN ACCORDANCE WITH ASTM T-99. THE FILL MATERIAL SHALL BE PLACED IN LIFT THICKNESSES OF APPROXIMATELY 6" TO 8" AND COMPACTED TO 95 PERCENT OF THE STANDARD PROCTOR MAXIMUM DRY DENSITY IN ACCORDANCE WITH ASTM T-99. THE STATIC WEIGHT OF EQUIPMENT USED ADJACENT TO WALLS SHALL NOT EXCEED 3,000 POUNDS. NO BACKFILL SHALL BE PLACED AGAINST THE CAST-IN-PLACE WALLS UNTIL THE CONCRETE HAS ATTAINED THE SPECIFIED 28 DAY STRENGTH.

MATERIALS USED IN THE OUTER SHELL OF THE EMBANKMENT MUST HAVE THE CAPABILITY TO SUPPORT VEGETATION OF THE QUALITY REQUIRED TO PREVENT EROSION OF THE EMBANKMENT.

PLACEMENT - AREAS ON WHICH FILL IS TO BE PLACED SHALL BE SCARIFIED PRIOR TO PLACEMENT OF FILL. FILL MATERIALS SHALL BE PLACED IN MAXIMUM 6" INCH THICK (BEFORE COMPACTION) LAYERS WHICH ARE TO BE CONTINUED OVER THE ENTIRE LENGTH OF THE MOST PERMISSIBLE BORROW MATERIAL SHALL BE PLACED IN THE DOWNSTREAM PORTIONS OF THE EMBANKMENT. THE PRINCIPAL SPILLWAY MUST BE INSTALLED CONCURRENTLY WITH FILL PLACEMENT AND NOT EXCAVATED INTO THE EMBANKMENT.

COMPACTION - THE MOVEMENT OF THE HAULING AND SPREADING EQUIPMENT OVER THE FILL SHALL BE CONTROLLED SO THAT THE ENTIRE SURFACE OF EACH LIFT SHALL BE TRAVERSED BY NOT LESS THAN ONE TREAD TRACK OF THE EQUIPMENT OR COMPACTION SHALL BE ACHIEVED BY A MINIMUM OF FOUR COMPLETE PASSES OF A SHEEPSFOOT, RUBBER TIRE OR VIBRATORY ROLLER. MATERIAL SHALL CONTAIN SUFFICIENT MOISTURE SUCH THAT THE REQUIRED DEGREE OF COMPACTION WILL BE OBTAINED WITH THE EQUIPMENT USED. THE FILL MATERIAL SHALL CONTAIN SUFFICIENT MOISTURE SO THAT IF FORMED INTO A BALL IT WILL NOT CRUMBLE, YET NOT BE SO WET THAT WATER CAN BE SQUEEZED OUT.

WHEN REQUIRED BY THE REVIEWING AGENCY THE MINIMUM REQUIRED DENSITY SHALL NOT BE LESS THAN 95% OF THE MAXIMUM DRY DENSITY WITH A MOISTURE CONTENT WITHIN +/- 2% OF THE OPTIMUM. EACH LAYER OF FILL SHALL BE COMPACTED AS NECESSARY TO OBTAIN THAT DENSITY, AND IS TO BE CERTIFIED BY THE ENGINEER AT THE TIME OF CONSTRUCTION. ALL COMPACTION IS TO BE DETERMINED BY AASHTO METHOD T-99 (STANDARD PROCTOR).

CUT OFF TRENCH - THE CUT OFF TRENCH SHALL BE EXCAVATED INTO IMPERVIOUS MATERIAL ALONG OR PARALLEL TO THE CENTERLINE OF THE EMBANKMENT AS SHOWN ON THE PLANS. THE EQUIPMENT USED FOR EXCAVATION WITH THE MINIMUM WIDTH BEING FOUR FEET SHALL GOVERN THE BOTTOM WIDTH OF THE TRENCH. THE DEPTH OF THE TRENCH SHALL BE AT LEAST 18" BELOW EXISTING GRADE OR AS SHOWN ON THE PLANS. THE SIDE SLOPES OF THE TRENCH SHALL BE 1 TO 1. FILL MATERIAL SHALL BE PLACED CONCURRENTLY WITH THE TRENCH. THE BACKFILL SHALL BE COMPACTED WITH CONSTRUCTION EQUIPMENT, ROLLERS, OR HAND TAMPERS TO ASSURE MAXIMUM DENSITY AND MINIMUM PERMEABILITY. IN ADDITION, THE CORE SHALL BE PLACED CONCURRENTLY WITH THE OUTER SHELL OF THE EMBANKMENT.

EMBANKMENT CORE - THE CORE SHALL BE PARALLEL TO THE CENTERLINE OF THE EMBANKMENT AS SHOWN ON THE PLANS. THE TOP WIDTH OF THE CORE SHALL BE A MINIMUM OF FOUR FEET. THE HEIGHT SHALL EXTEND UP TO AT LEAST THE 10 YEAR WATER ELEVATION OR AS SHOWN ON THE PLANS. THE SIDE SLOPES SHALL BE 1 TO 1 OR FLATTER. THE CORE SHALL BE COMPACTED WITH CONSTRUCTION EQUIPMENT, ROLLERS OR HAND TAMPERS TO ASSURE MAXIMUM DENSITY AND MINIMUM PERMEABILITY. IN ADDITION, THE CORE SHALL BE PLACED CONCURRENTLY WITH THE OUTER SHELL OF THE EMBANKMENT.

4. STRUCTURE BACKFILL
BACKFILL ADJACENT TO PIPES OR STRUCTURES SHALL BE OF THE TYPE AND QUALITY CONFORMING TO THAT SPECIFIED FOR THE ADJOINING FILL MATERIAL. THE FILL SHALL BE PLACED IN HORIZONTAL LAYERS NOT TO EXCEED 4 INCHES IN THICKNESS AND COMPACTED BY HAND TAMPERS OR OTHER MANUALLY DIRECTED COMPACTION EQUIPMENT. EQUIPMENT SHALL COMPLETELY ALL SPACES UNDER AND ADJACENT TO THE PIPE. AT NO TIME DURING THE BACKFILLING OPERATION SHALL DRIVEN EQUIPMENT BE ALLOWED TO OPERATE CLOSER THAN 4 FEET, MEASURED HORIZONTALLY, TO ANY PART OF A STRUCTURE. UNDER NO CIRCUMSTANCES SHALL EQUIPMENT BE DRIVEN OVER ANY PART OF A CONCRETE STRUCTURE OR PIPE, UNLESS THERE IS A COMPACTED FILL OF 24" OR GREATER OVER THE STRUCTURE OR PIPE.

STRUCTURE BACKFILL MAY BE FLOWABLE FILL MEETING THE REQUIREMENTS OF MARYLAND DEPARTMENT OF TRANSPORTATION, STATE HIGHWAY ADMINISTRATION STANDARD SPECIFICATIONS FOR CONSTRUCTION AND MATERIALS, SECTION 521.09, CLASS C. THE FLOWABLE FILL SHALL HAVE A MINIMUM PH OF 4.0 AND A MINIMUM RESISTIVITY OF 2,000 OHM-CM. MATERIAL SHALL BE PLACED SUCH THAT A MINIMUM OF 6" (MEASURED PERPENDICULAR TO THE SURFACE OF THE PIPE) OF FLOWABLE FILL SHALL BE UNDER (BEDDING), OVER AND ON THE SIDES OF THE PIPE. IT ONLY NEEDS TO EXTEND UP TO THE SPRING LINE FOR RIGID CONDUITS. AVERAGE SLUMP OF THE FILL SHALL BE 7" TO ASSURE FLOWABILITY OF THE MATERIAL. ADEQUATE MEASURES SHALL BE TAKEN (SAND BAGS, ETC.) TO PREVENT FLOATING THE PIPE. WHEN USING FLOWABLE FILL, ALL METAL PIPE SHALL BE BITUMINOUS COATED. ANY ADJOINING SOIL FILL SHALL BE PLACED IN HORIZONTAL LAYERS NOT TO EXCEED FOUR INCHES IN THICKNESS AND COMPACTED BY HAND TAMPERS OR OTHER MANUALLY DIRECTED COMPACTION EQUIPMENT. THE MATERIAL SHALL COMPLETELY ALL SPACES UNDER AND ADJACENT TO THE STRUCTURE. EQUIPMENT SHALL COMPLETELY ALL SPACES UNDER AND ADJACENT TO THE STRUCTURE. UNDER NO CIRCUMSTANCES SHALL EQUIPMENT BE DRIVEN OVER ANY PART OF A STRUCTURE OR PIPE, UNLESS THERE IS A COMPACTED FILL OF 24" OR GREATER OVER THE STRUCTURE OR PIPE. BACKFILL MATERIAL ADJACENT TO STRUCTURE BACKFILL (FLOWABLE FILL) SHALL BE OF THE TYPE AND QUALITY CONFORMING TO THAT SPECIFIED FOR THE CORE OF THE EMBANKMENT OR OTHER EMBANKMENT MATERIALS.

5. REMOVAL AND REPLACEMENT OF DEFECTIVE FILL
FILL PLACED AT DENSITIES LOWER THAN SPECIFIED MINIMUM DENSITY OR AT MOISTURE CONTENTS OUTSIDE THE SPECIFIED ACCEPTABLE RANGE OF MOISTURE CONTENT OR OTHERWISE NOT CONFORMING TO THE REQUIREMENTS OF THE SPECIFICATIONS SHALL BE REMOVED TO MEET THE REQUIREMENTS OR REMOVED AND REPLACED BY ACCEPTABLE FILL. THE BOTTOMS OF SUCH EXCAVATIONS SHALL BE FINISHED FLAT OR GENTLY CURVING AND AT THE SIDES OF SUCH EXCAVATIONS THE ADJACENT SOUND FILL SHALL BE TRIMMED TO A SLOPE NOT STEEPER THAN 3:1. FILL SHALL BE PLACED HORIZONTALLY TO 1 FOOT VERTICALLY EXTENDING FROM THE BOTTOM OF THE EXCAVATION TO THE FILL SURFACE.

6. PIPE CONDUITS
ALL PIPES SHALL BE CIRCULAR IN CROSS SECTION. ALL PERFORATED PIPES SHALL HAVE A MINIMUM OF 3.31 SQUARE INCHES OF OPENING PER SQUARE FOOT OF PIPE SURFACE (EX-30 3/8" HOLES PER SQUARE FOOT). PERFORATIONS ARE TO BE UNIFORMLY SPACED AROUND THE FULL PERIPHERY OF THE PIPE. ANY HOLES BLOCKED OR PARTIALLY BLOCKED BY BITUMINOUS COATINGS SHALL BE OPENED PRIOR TO INSTALLATION.

REINFORCED CONCRETE PIPE - ALL OF THE FOLLOWING CRITERIA SHALL APPLY FOR REINFORCED CONCRETE PIPE:

- MATERIALS - REINFORCED CONCRETE PIPE SHALL HAVE BELL AND SPIGOT JOINTS WITH RUBBER GASKETS AND SHALL EQUAL OR EXCEED ASTM C-361.
- BEDDING - REINFORCED CONCRETE PIPE CONDUITS SHALL BE LAID IN A CONCRETE BEDDING FOR THEIR ENTIRE LENGTH. THIS BEDDING (CRADLE) SHALL CONSIST OF HIGH SLUMP CONCRETE PLACED UNDER THE PIPE AND UP THE SIDES OF THE PIPE AT LEAST 50 PERCENT OF ITS OUTSIDE DIAMETER WITH A MINIMUM THICKNESS OF 6 INCHES, WHERE CONCRETE CRADLE IS NOT NEEDED FOR STRUCTURAL REASONS. FLOWABLE FILL MAY BE USED AS DESCRIBED IN THE "STRUCTURE BACKFILL" SECTION OF THIS STANDARD. GRAVEL BEDDING IS NOT PERMITTED.
- LAYING PIPE - BELL AND SPIGOT PIPE SHALL BE PLACED WITH THE BELL END UPSTREAM. JOINTS SHALL BE MADE IN ACCORDANCE WITH RECOMMENDATIONS OF THE MANUFACTURER OF THE MATERIAL. AFTER THE JOINTS ARE SEALED, THE ENTIRE LINE OF THE BEDDING SHALL BE PLACED SO THAT ALL SPACES UNDER THE PIPE ARE FILLED. CARE SHALL BE EXERCISED TO PREVENT ANY DEVIATION FROM THE ORIGINAL LINE AND GRADE OF THE PIPE. THE FIRST JOINT MUST BE LOCATED WITHIN 4 FEET FROM THE RISER.
- BACKFILLING SHALL CONFORM TO "STRUCTURE BACKFILL".
- CONNECTIONS - ALL CONNECTIONS (TO ANTI-SEEP COLLARS, RISER, ETC.) SHALL BE WATER TIGHT.
- OTHER DETAILS (ANTI-SEEP COLLARS, VALVES, ETC.) SHALL BE AS SHOWN ON THE DRAWINGS.

PLASTIC PIPE - ALL OF THE FOLLOWING CRITERIA SHALL APPLY FOR PLASTIC PIPE:

- MATERIALS - PVC PIPE SHALL BE PVC-1120 OR PVC-1220 CONFORMING TO ASTM D-1738 OR ASTM D-2241, CORRUGATED HIGH DENSITY POLYETHYLENE (HDPE), COUPLINGS AND FITTINGS SHALL CONFORM TO THE FOLLOWING: 4" - 12" INCH PIPE SHALL MEET THE REQUIREMENTS OF AASHTO M252 TYPE S, AND 12" THROUGH 24" SHALL MEET THE REQUIREMENTS OF AASHTO M254 TYPE S.
- JOINTS AND CONNECTIONS TO ANTI-SEEP COLLARS SHALL BE COMPLETELY WATER TIGHT.
- BEDDING - THE PIPE SHALL BE FIRMLY AND UNIFORMLY BEDDED THROUGHOUT ITS ENTIRE LENGTH. WHERE ROCK OR SOFT SPONGY OR OTHER UNSUITABLE SOIL IS ENCOUNTERED, ALL SUCH MATERIAL SHALL BE REMOVED AND REPLACED WITH SUITABLE EARTH COMPACTED TO PROVIDE ADEQUATE SUPPORT.
- BACKFILLING SHALL CONFORM TO "STRUCTURE BACKFILL".
- OTHER DETAILS (ANTI-SEEP COLLARS, VALVES, ETC.) SHALL BE AS SHOWN ON THE DRAWINGS.

7. CONCRETE
CONCRETE SHALL MEET THE REQUIREMENTS OF THE MARYLAND DEPARTMENT OF TRANSPORTATION, STATE HIGHWAY ADMINISTRATION STANDARD SPECIFICATIONS FOR CONSTRUCTION AND MATERIALS, SECTION 414, MIX NO. 3.

CAST-IN-PLACE CONCRETE STRUCTURES

- SPECIFICATIONS: MARYLAND DEPARTMENT OF TRANSPORTATION, STATE HIGHWAY ADMINISTRATION STANDARD SPECIFICATIONS FOR CONSTRUCTION AND MATERIALS, LATEST EDITION.
- CONCRETE SHALL MEET THE REQUIREMENTS OF THE MARYLAND DEPARTMENT OF TRANSPORTATION, STATE HIGHWAY ADMINISTRATION STANDARD SPECIFICATIONS FOR CONSTRUCTION AND MATERIALS, SECTION 414 AND 902, MIX NO. 3.
- CONTRACTOR MAY ADD COLOR MIX AT PLANT IN ACCORDANCE WITH MANUFACTURERS RECOMMENDATION "C-12 MESA BEIGE" AS MANUFACTURED BY L. M. SCORFIELD COMPANY (215) 723-9285.
- CONTRACTOR SHALL SUPPLY MIX DESIGN FOR APPROVAL PRIOR TO APPLICATION. LOAD AND MIX TICKETS SHALL BE SUPPLIED FOR EACH TRUCK DELIVERY. NO PARTIAL MIX BIKES SHALL BE ALLOWED.
- ALL CONCRETE SHALL ATTAIN A MINIMUM COMPRESSIVE STRENGTH OF 3,500 PSI AT 28 DAYS. DESIGN FC = 1,200 PSI.
- ALL EXPOSED EDGES SHALL BE CHAMFERED 3/4" X 3/4". ALL CONSTRUCTION KEYS ARE SHOWN NOMINAL SIZE.
- REINFORCING STEEL: REINFORCING STEEL SHALL CONFORM TO ASTM A-615, GRADE 60, WHERE NOT INDICATED. BAR LAY SPACING SHALL BE IN ACCORDANCE WITH AASHTO SPECIFICATIONS. THE MINIMUM CONCRETE COVER SHALL BE 2 INCHES UNLESS OTHERWISE NOTED. DESIGN FS = 24,000 PSI.
- FOUNDATION: PRESUMED SOIL BEARING CAPACITY = 2,500 PSF. THE ENGINEER MUST APPROVE ALL FOUNDATIONS PRIOR TO CONCRETE PLACEMENT. IF UNSUITABLE MATERIAL IS ENCOUNTERED, THE MATERIAL SHALL BE UNDERGUT AND BACKFILLED WITH STRUCTURAL BACKFILL.
- STRUCTURAL BACKFILL CAST-IN-PLACE CONCRETE STRUCTURES AND PIPE SHALL BE BACKFILLED WITH SELECT GRANULAR BACKFILL MEETING THE REQUIREMENTS OF SHA GRADED AGGREGATE-SUBBASE. STRUCTURAL FILL SHALL BE PLACED IN LOOSE LIFTS OF APPROXIMATELY 6 INCHES AND COMPACTED TO 95 PERCENT OF THE STANDARD PROCTOR MAXIMUM DRY DENSITY IN ACCORDANCE WITH AASHTO T-99. THE STATIC WEIGHT OF EQUIPMENT USED ADJACENT TO WALLS SHALL NOT EXCEED 3,000 POUNDS. NO BACKFILL SHALL BE PLACED AGAINST THE CAST-IN-PLACE WALLS UNTIL THE CONCRETE HAS ATTAINED THE SPECIFIED 28 DAY STRENGTH.

PRE-CAST CONCRETE STRUCTURES


SHOP DRAWINGS FOR PRE-CAST STRUCTURES WITH SUPPORTING STRUCTURAL COMPUTATIONS (SIGNED AND SEALED BY A MARYLAND REGISTERED PROFESSIONAL ENGINEER) MEETING ASTM REQUIREMENTS FOR PRE-CAST STRUCTURES MUST BE SUBMITTED TO THE ENGINEER, AND THE APPROVING AGENCY (BALTIMORE COUNTY DEPARTMENT OF ENVIRONMENT PROTECTION AND RESOURCE MANAGEMENT) FOR APPROVAL PRIOR TO FABRICATION.

ROCK RIP-RAP


ROCK RIP-RAP SHALL MEET THE REQUIREMENTS OF THE MARYLAND DEPARTMENT OF TRANSPORTATION, STATE HIGHWAY ADMINISTRATION STANDARD SPECIFICATIONS FOR CONSTRUCTION AND MATERIALS, SECTION 311.

GEOTEXTILE SHALL BE PLACED UNDER ALL RIP-RAP AND SHALL MEET THE REQUIREMENTS OF THE MARYLAND DEPARTMENT OF TRANSPORTATION, STATE HIGHWAY ADMINISTRATION STANDARD SPECIFICATIONS FOR CONSTRUCTION AND MATERIALS, SECTION 521.09, CLASS C.

THE RIP-RAP SHALL BE PLACED TO THE REQUIRED THICKNESS IN ONE OPERATION. THE ROCK SHALL BE DELIVERED AND PLACED IN A MANNER THAT WILL INSURE THE RIP-RAP IN PLACE SHALL BE REASONABLY HOMOGENEOUS WITH THE LARGER ROCKS UNIFORMLY DISTRIBUTED AND FIRMLY IN CONTACT ONE TO ANOTHER WITH THE SMALLER ROCKS FILLING THE VOIDS BETWEEN THE LARGER ROCKS.

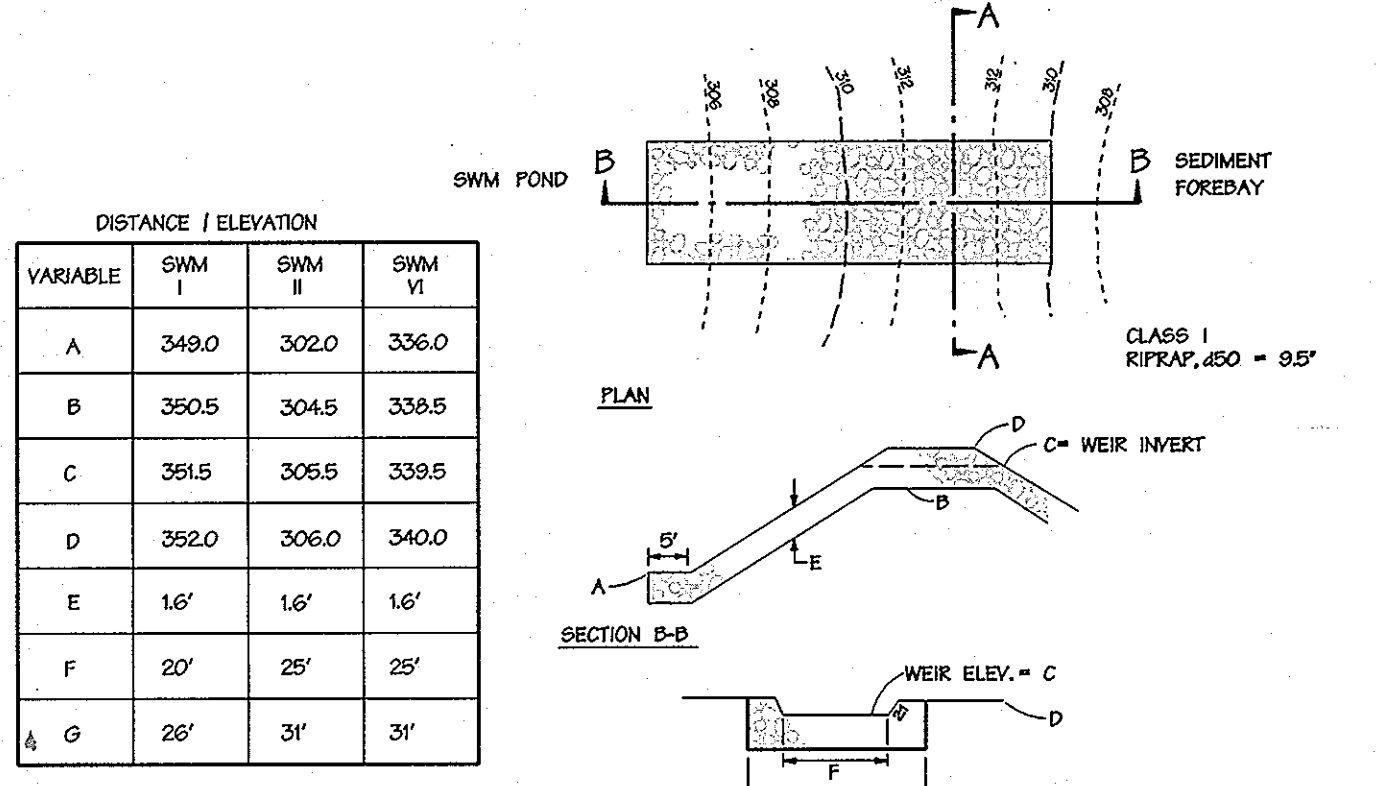

SWM FOREBAY EMBANKMENT ARMORING DETAIL
NOT TO SCALE

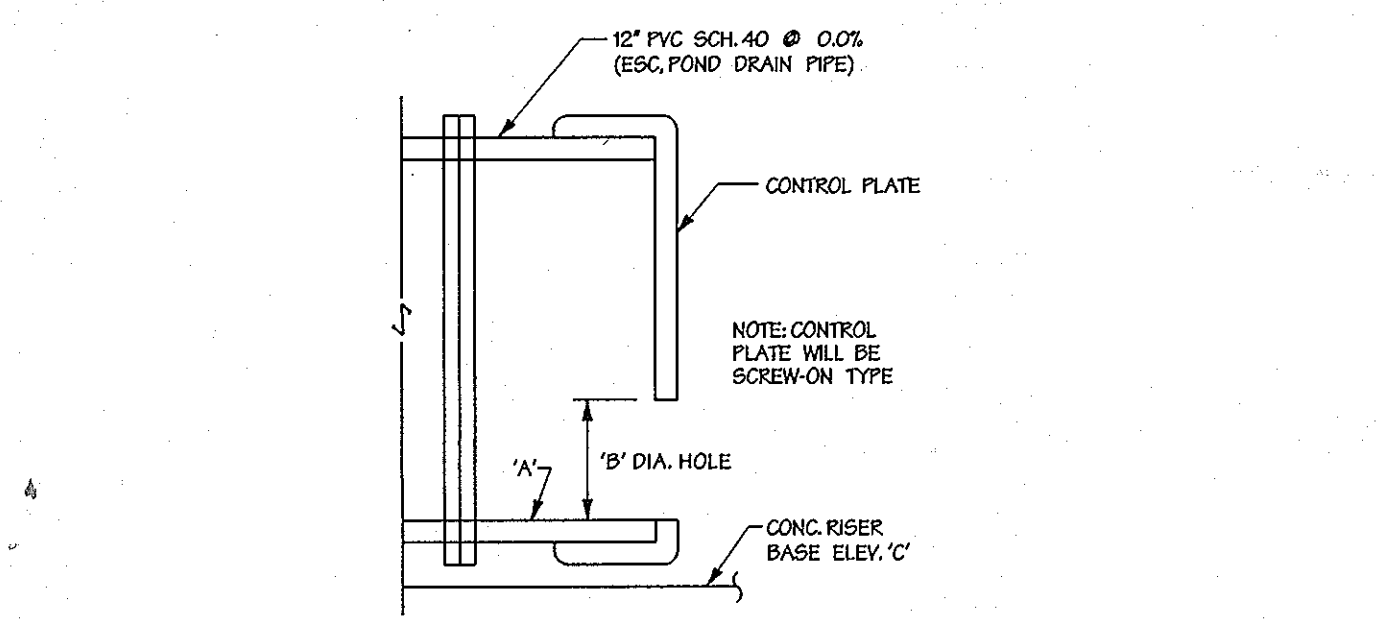

SWM POND	'A'	'B'	'C'
I	347.1	4.0'	347.0
II	302.1	3.0'	302.0
VI	336.6	3.0'	336.5

ESC CONTROL PLATE DETAIL
NTS

THESE PLANS HAVE BEEN REVIEWED FOR THE HOWARD SOIL CONSERVATION DISTRICT AND MEET THE TECHNICAL REQUIREMENTS FOR SMALL POND CONSTRUCTION, SOIL EROSION AND SEDIMENT CONTROL.

U.S.D.A. NATURAL RESOURCES CONSERVATION SERVICE
DATE: 10/10/01

THESE PLANS FOR SMALL POND CONSTRUCTION, SOIL EROSION AND SEDIMENT CONTROL MEET THE REQUIREMENTS OF HOWARD SOIL CONSERVATION DISTRICT.

APPROVED: [Signature] DATE: 10/10/01

PLAN NUMBER: _____

9. CARE OF WATER DURING CONSTRUCTION

ALL WORK ON PERMANENT STRUCTURES SHALL BE CARRIED OUT IN AREAS FREE FROM WATER. THE CONTRACTOR SHALL CONSTRUCT AND MAINTAIN ALL TEMPORARY DICES, LEVEES, COFFERDAMS, DRAINAGE CHANNELS, AND STREAM DIVERSIONS NECESSARY TO PROTECT THE AREAS TO BE OCCUPIED BY THE PERMANENT WORKS. THE CONTRACTOR SHALL ALSO FURNISH, INSTALL, OPERATE, AND MAINTAIN ALL NECESSARY PUMPING AND OTHER EQUIPMENT REQUIRED FOR REMOVAL OF WATER FROM THE VARIOUS PARTS OF THE WORK AND FOR MAINTAINING THE EXCAVATIONS, FOUNDATION, AND OTHER PARTS OF THE WORK FREE FROM WATER AS REQUIRED OR DIRECTED BY THE ENGINEER FOR CONSTRUCTING EACH PART OF THE WORK. AFTER HAVING SERVED THEIR PURPOSE, ALL TEMPORARY PROTECTIVE WORKS SHALL BE REMOVED OR LEVELED AND GRADED TO THE EXTENT REQUIRED TO PREVENT OBSTRUCTION IN ANY DEGREE WHATSOEVER OF THE FLOW OF WATER TO THE SPILLWAY OR OUTLET WORKS AND SO AS NOT TO INTERFERE IN ANY WAY WITH THE OPERATION OR MAINTENANCE OF THE STRUCTURE. STREAM DIVERSIONS SHALL BE MAINTAINED UNTIL THE FULL FLOW CAN BE PASSED THROUGH THE PERMANENT WORKS. THE REMOVAL OF WATER FROM THE EXCAVATION AND THE FOUNDATION SHALL BE ACCOMPLISHED IN A MANNER AND TO THE EXTENT THAT WILL MAINTAIN STABILITY OF THE EXCAVATED SLOPES AND BOTTOM OF REQUIRED EXCAVATIONS AND WILL ALSO SATISFACTORY PERFORMANCE OF ALL CONSTRUCTION OPERATIONS. DURING THE FLAGGING AND IMPACTING OF MATERIAL IN REQUIRED EXCAVATIONS, THE WATER LEVEL AT THE LOCATIONS BEING REFILLED SHALL BE MAINTAINED BELOW THE BOTTOM OF THE EXCAVATION AT SUCH LOCATIONS WHICH MAY REQUIRE DRAINING THE WATER TO SUMPS FROM WHICH THE WATER SHALL BE PUMPED.

10. STABILIZATION

ALL BORROW AREAS SHALL BE GRADED TO PROVIDE PROPER DRAINAGE AND LEFT IN A SLIGHTLY CONDITION. ALL EXPOSED SURFACES OF THE EMBANKMENT, SPILLWAY, AND BORROW AREAS, AND BERMS SHALL BE STABILIZED BY SEEDING, LIMING, FERTILIZING AND MULCHING IN ACCORDANCE WITH THE NATURAL RESOURCES CONSERVATION SERVICE STANDARDS AND SPECIFICATIONS FOR CRITICAL AREA PLANTING (MD-342) OR AS SHOWN ON THE ACCOMPANYING DRAWINGS.

11. EROSION AND SEDIMENT CONTROL

CONSTRUCTION OPERATIONS WILL BE CARRIED OUT IN SUCH A MANNER THAT EROSION WILL BE CONTROLLED AND WATER AND AIR POLLUTION MINIMIZED. STATE AND LOCAL LAWS CONCERNING POLLUTION ABATEMENT WILL BE FOLLOWED. CONSTRUCTION PLANS SHALL DETAIL EROSION AND SEDIMENT CONTROL MEASURES TO BE EMPLOYED DURING THE CONSTRUCTION PROCESS.

12. SEEDING


SEEDING, FERTILIZING AND MULCHING SHALL BE AS FOLLOWS:

SEED MIX: 50% KENBLUE KENTUCKY BLUEGRASS
30% PENNLAWN CREeping RED FESCUE
10% STREAKER REDTOP
APPLIED AT A RATE OF 150 LBS. PER ACRE.


REBEL ITALL FESCUE (125 LBS. PER ACRE)
PENNLAWN CREeping RED FESCUE (15 LBS. PER ACRE)
KENTUCKY BLUEGRASS (10 LBS. PER ACRE)
(OR)
PENNLAWN CREeping RED FESCUE (70 LBS. PER ACRE)
AUROKA HARD FESCUE (50 LBS. PER ACRE)
COMMON WHITE CLOVER (5 LBS. PER ACRE)
WINTER RYE (45 LBS. PER ACRE)
(OR)
70% FORAGER TALL FESCUE
30% CHEMUNG CROWN VETCH, INOCULATED
APPLIED AT A RATE OF 55 LBS. PER ACRE
OPTIMUM SEEDING DATES: MARCH 10 TO APRIL 30.

LIME: 2 TONS/ACRE DOLOMITIC LIMESTONE.

FERTILIZER: 600 LBS./ACRE 10-10-10 FERTILIZER BEFORE SEEDING.
400 LBS./ACRE 30-0-0 UREAFORM FERTILIZER AT TIME OF SEEDING.

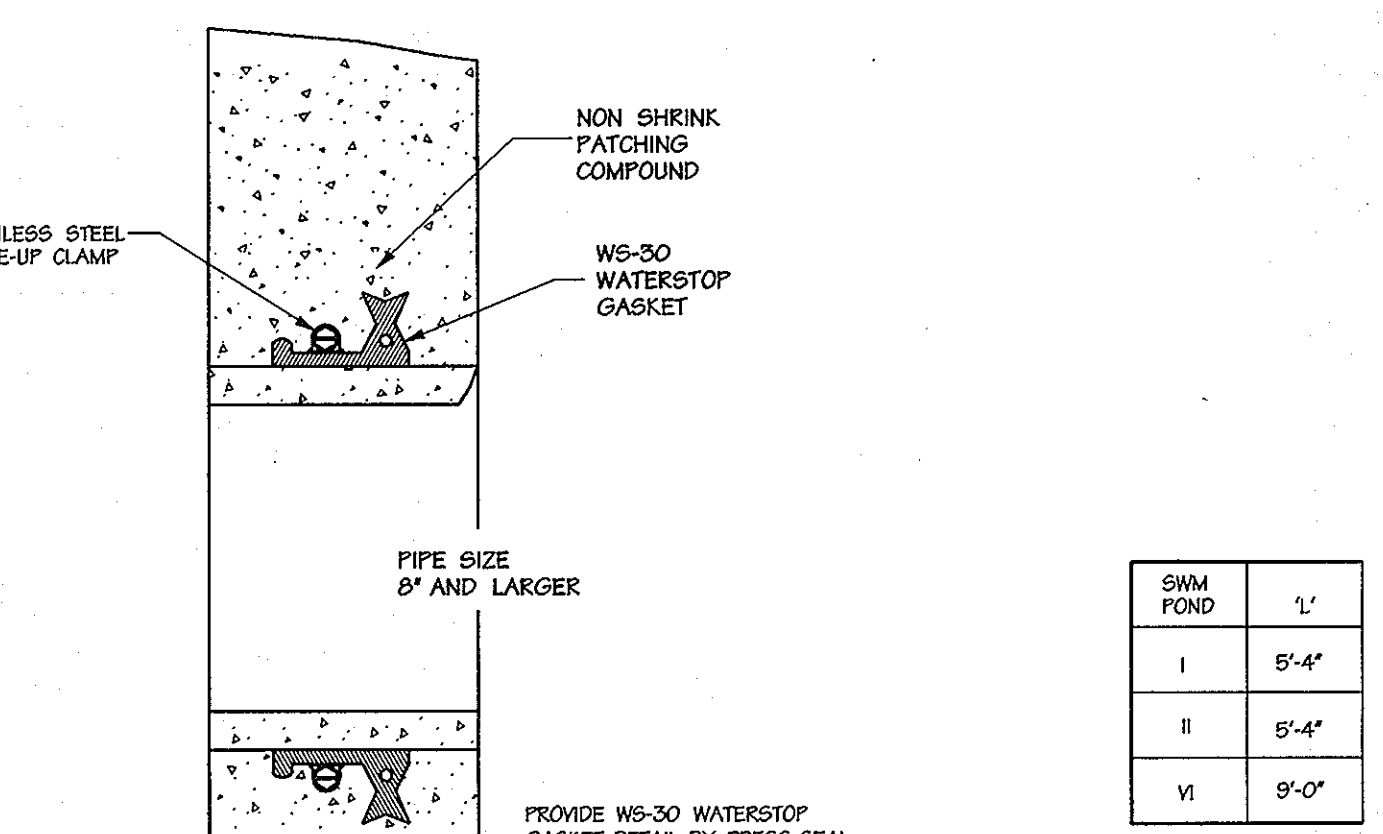

WS-30 WATER STOP DETAIL
NOT TO SCALE

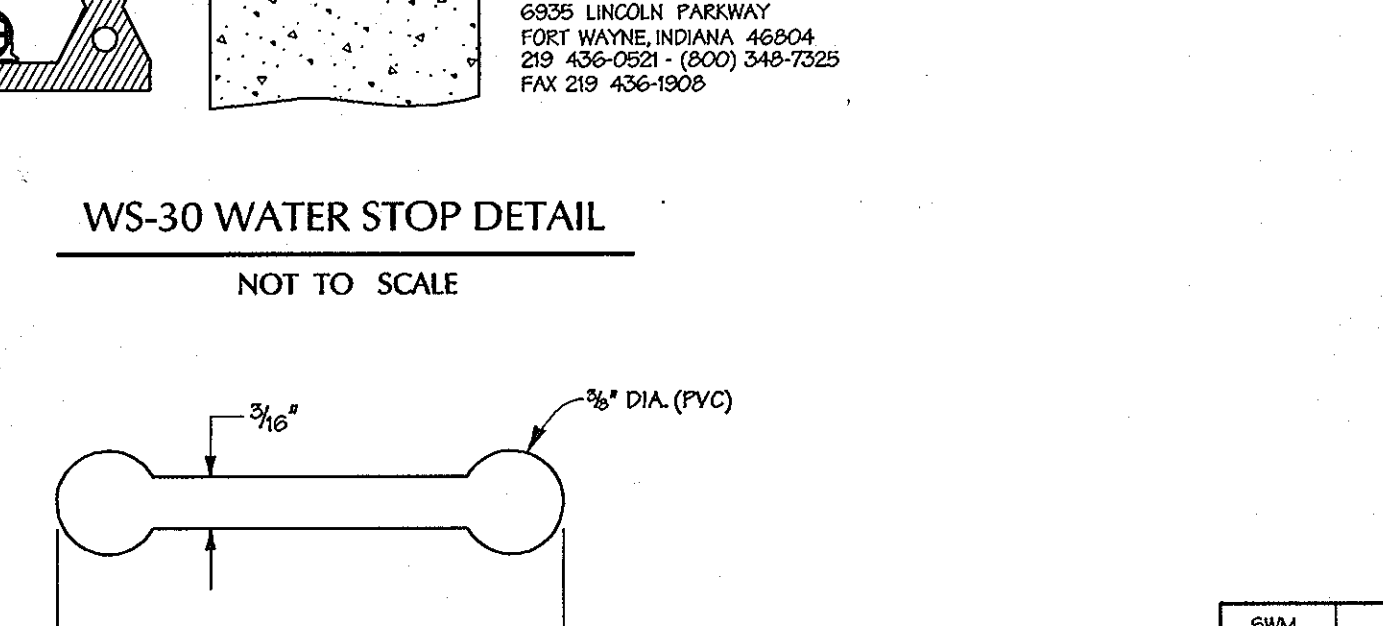

6\"/>

MULCH: STRAW AT 4,000 LBS. PER ACRE.

ANCHORING: MULCHING TOOL OR WOOD CELLULOSE FIBER BINDER AT A NET DRY BINDER RATE OF 750 POUNDS PER ACRE. THE WOOD CELLULOSE FIBER SHALL BE MIXED WITH WATER AND THE MIXTURE SHALL CONTAIN A MAXIMUM OF 50 POUNDS OF WOOD CELLULOSE FIBER PER 100 GALLONS OF WATER OR AS RECOMMENDED BY THE MANUFACTURER.

13. FILTER CLOTH

ALL FILTER CLOTH SHALL CONFORM TO THE 1994 MARYLAND STANDARDS AND SPECIFICATIONS FOR SOIL EROSION AND SEDIMENT CONTROL, OR THE LATEST EDITION.

14. GABIONS

ALL GABIONS SHALL BE PVC COATED WOVEN WIRE BASKETS. STONE SIZE SHALL BE 4 INCHES TO 7 INCHES. (CLASS IV GABIONS).

15. CONSTRUCTION INSPECTION BY DESIGNATED ENGINEERS


THE CONSTRUCTION OF THE POND AND EMBANKMENT AND CERTIFICATION THAT THE POND AND EMBANKMENT HAVE BEEN BUILT IN ACCORDANCE WITH THE PLANS SHALL BE UNDER THE SUPERVISION OF A REGISTERED PROFESSIONAL ENGINEER. THE ENGINEER SHALL BE NOTIFIED SUFFICIENTLY IN ADVANCE OF CONSTRUCTION IN ORDER THAT ARRANGEMENTS CAN BE MADE FOR (1) INSPECTION OF PIPE TRENCH AND BEDDING, (2) INSPECTION OF RISER AND ANTI-SEEP COLLARS AND (3) SUPERVISION OF EMBANKMENT CONSTRUCTION AND COMPACTION TESTING. THE ENGINEER SHALL DIRECT THE HANDLING OF WATER DURING CONSTRUCTION, MINOR CHANGES NOT AFFECTING THE INTEGRITY OF THE DAM IN ORDER TO COMPENSATE FOR UNUSUAL SOIL CONDITIONS, AND THE REMOVAL AND REPLACEMENT OF DEFECTIVE FILL.

16. INSPECTION SCHEDULE


1. PRIOR NOTIFICATION SHALL BE GIVEN TO THE ENGINEER SO THAT INSPECTIONS MAY BE MADE AT THE FOLLOWING STAGES:
 - (i) UPON COMPLETION OF EXCAVATION TO SUBFOUNDATION AND WHERE REQUIRED, INSTALLATION OF STRUCTURAL SUPPORTS OR REINFORCEMENT FOR STRUCTURES, INCLUDING BUT NOT LIMITED TO:
 - (i) CORE TRENCHES FOR STRUCTURAL EMBANKMENTS.
 - (ii) INLET-OUTLET STRUCTURES AND ANTI-SEEP STRUCTURES, WATER TIGHT CONNECTIONS ON PIPES AND
 - (iii) TRENCHES FOR ENCLOSED STORM DRAINAGE FACILITIES.
 - (ii) DURING PLACEMENT OF STRUCTURAL FILL, REINFORCING AND CONCRETE, AND INSTALLATION OF FIRING AND CATCH BASINS.
 - (iii) DURING BACKFILL OF FOUNDATIONS AND TRENCHES.
 - (iv) DURING EMBANKMENT CONSTRUCTION AND
 - (v) UPON COMPLETION OF FINAL GRADING AND ESTABLISHMENT OF PERMANENT STABILIZATION.
2. GEOTECHNICAL COMPACTION TESTING OF THE FACILITY EMBANKMENT IS REQUIRED. CERTIFICATION MUST BE PROVIDED TO THE DESIGNATED ENGINEER IN CHARGE OF THE BUILD.
3. A COPY OF ALL MATERIAL SUPPLY TICKETS MUST BE GIVEN TO THE DESIGNATED ENGINEER IN CHARGE OF THE AS-BUILT.

17. MAINTENANCE SCHEDULE

- ROUTINE MAINTENANCE**
 1. THE FACILITY SHALL BE INSPECTED TWICE ANNUALLY, MARCH AND SEPTEMBER, IN ACCORDANCE WITH THE CHECKLIST AND REQUIREMENTS CONTAINED WITHIN MD-370, SECTION 521.09 AND SPECIFICATIONS FOR POND (MD-370), THE POND OWNER(S) AND ANY HERBICIDE, SUCCESSORS, OR AGENTS SHALL BE RESPONSIBLE FOR THE SAFETY OF THE POND AND THE CONTINUED OPERATION, SURVEILLANCE, INSPECTION, AND MAINTENANCE THEREOF.
 2. VEGETATION COVER SHALL BE MAINTAINED AT ALL TIMES.
 3. TOP AND BOTTOM SURFACES OF THE EMBANKMENT SHALL BE MOWED A MINIMUM OF TWO (2) TIMES A YEAR, ONCE IN JUNE AND ONCE IN SEPTEMBER.
- WEIR MAINTENANCE**
 1. THE POND OWNER(S) SHALL PROMPTLY NOTIFY THE SOIL CONSERVATION DISTRICT OF ANY UNUSUAL OBSERVATIONS THAT MAY BE INDICATIONS OF DISTRESS SUCH AS EXCESSIVE SEEPAGE, TURBID SEEPAGE, SLUDGING OR SLUMPING.
 2. ALL OF THE SURFACES OF THE DAM AND SPILLWAY SHALL BE FILLED WITH SUITABLE MATERIAL AND THOROUGHLY COMPACTED. THESE AREAS SHALL BE RESEDED OR REEDDED, LIMED, AND FERTILIZED AS NEEDED.
 3. ALL APURTAINMENTS SHALL BE KEPT FREE OF TRASH.
 4. SEDIMENT SHALL BE REMOVED FROM FOREBAYS WITHIN THE DEPTH EXCEEDS ONE FOOT.
 5. TRASH AND DEBRIS SHALL BE REMOVED AS NECESSARY.
 6. VEGETATION AND BRANCHES SHALL NOT EXCEED 10" IN HEIGHT.
 7. INSURE SLOPE AND MAINTENANCE ACCESS SHALL BE MAINTAINED AS NEEDED. CARE SHALL BE TAKEN NOT TO MOVE ANY OF THE UPLAND PLANTINGS IN THE VICINITY OF THE FIVE FOOT SAFETY BENCH.
- MAINTENANCE OF UPLAND AREAS CONSERVATION DISTRICT AREAS**
 1. THESE AREAS SHALL NOT BE DISTURBED EITHER BY AFTER CONSTRUCTION WITH THE EXCEPTION OF ANY MITIGATION OR AFFORESTATION PROJECTS.
 2. BOUNDARIES FOR NATURAL AREAS SHALL BE CLEARLY MARKED AND MAINTAINED.

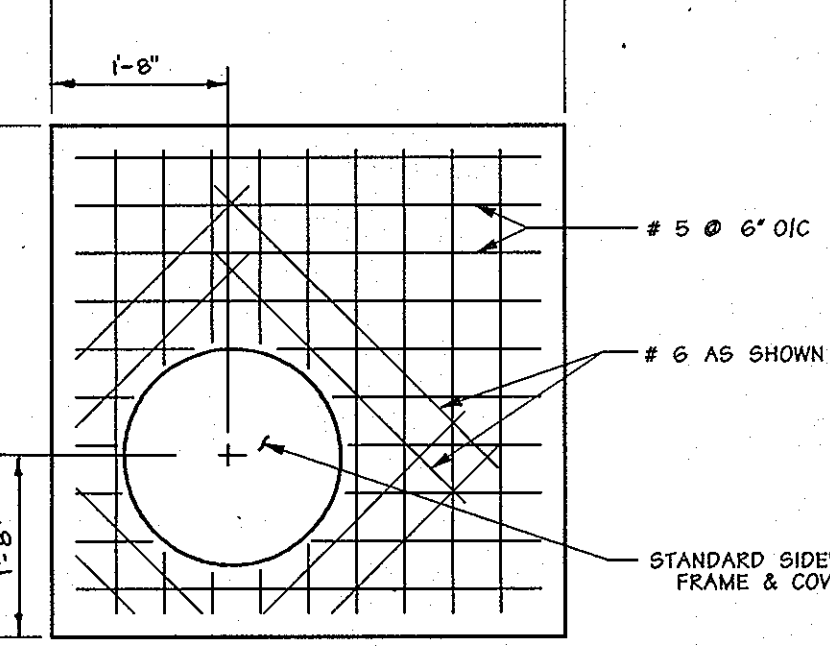

TOP SLAB
Scale: 1/2" = 1'-0"
CAST IN PLACE

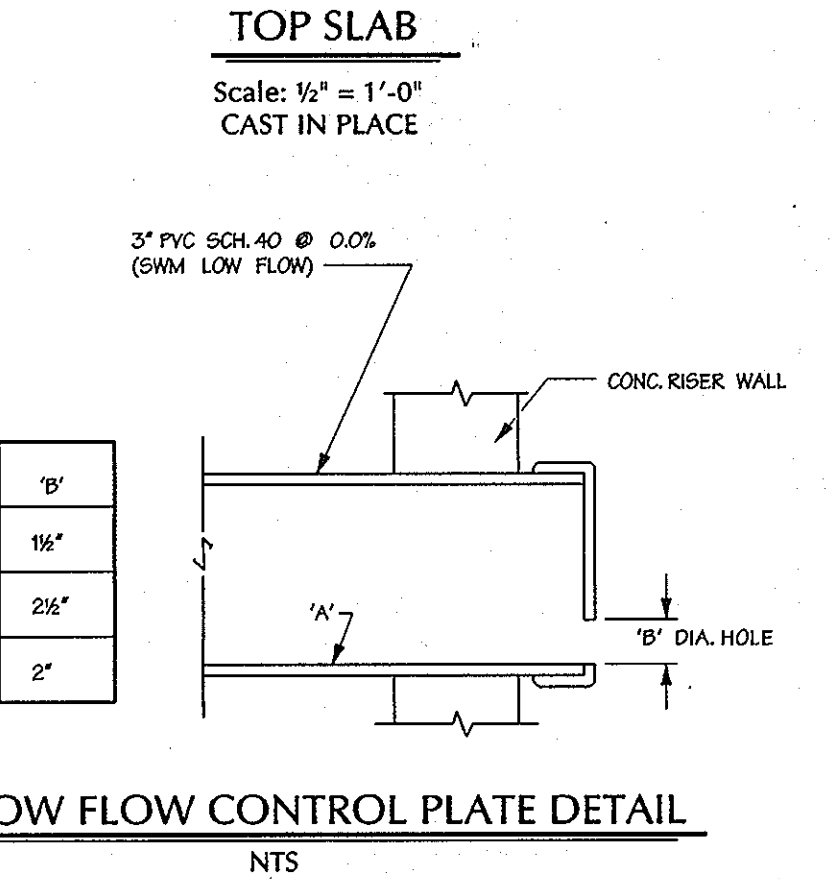

SWM LOW FLOW CONTROL PLATE DETAIL
NTS

APPROVED: HOWARD COUNTY DEPARTMENT OF PUBLIC WORKS
[Signature] DATE: 10-29-01
CHIEF, BUREAU OF HIGHWAYS

APPROVED: HOWARD COUNTY DEPT. OF PLANNING & ZONING
[Signature] DATE: 10/31/01
CHIEF, DEVELOPMENT ENGINEERING DIVISION M1K

APPROVED: [Signature] DATE: 11/6/01
CHIEF, DIVISION OF LAND DEVELOPMENT

DATE: 7/26/01

DATE: 7/25/01

DATE: 7/25/01

EMERSON
FORMERLY KEY PROPERTY
SECTION 2, PHASE 1A

OWNERS/DEVELOPER:
THE HOWARD RESEARCH & DEVELOPMENT CORPORATION
10275 Little Patuxent Parkway
Columbia, Maryland 21044

DMW
Duff-McCune-Walker, Inc.
200 East Pennsylvania Avenue
Towson, Maryland 21286
(410) 296-3333
Fax 396-4706

A Team of Land Planners,
Landscape Architects,
Engineers, Surveyors &
Environmental Professionals

SUBMISSION NAME: SECTION 2, PHASE 1A
PROJECT NO.: 95054.F
DATE: 7/25/01
WATER CODE: _____

TITLE: SWM GENERAL DETAILS AND SPECIFICATIONS


Des By: MRT Scale: AS SHOWN Proj. No.: 95054.F
Dm By: W-J Date: 9-26-01
Chk By: Approved 24 of 27

Professional Engr. No. 10651

F-01-130

ELEV.	DEPTH	Boring No.	CLASSIFICATION OF MATERIALS	SAMPLE NO.	BLOWS PER FT.	REMARKS	Begin	Completed
							3/23/00	3/23/00
306.75	0.25	B-1	Topsoil	1	8	Proposed pond bottom 301.0'		
			Brown moist micaceous mf SAND, little silt (SM) (Sandy loam) (Decomposed Rock)	2	21			
				3	50/3"			
				4	50/2"			
298.0	9.0		Brown wet micaceous of SAND, little silt, fr rock fragments (SM) (Sandy loam) (Decomposed Rock)	5	50/1"			
291.0	15.0		At completion of boring, water at 8.0' and caved at 15.0'	6	50/3"			

Under REMARKS mention kind of bit, loss of sample, loss of drilling water, caving, cavities, core recovery, unusual ground water conditions, etc., and depths at which these were encountered.

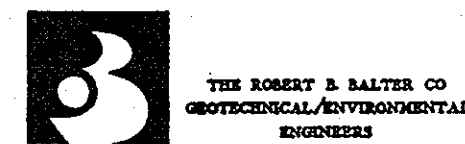

SCALE 1" = 5'

ELEV.	DEPTH	Boring No.	CLASSIFICATION OF MATERIALS	SAMPLE NO.	BLOWS PER FT.	REMARKS	Begin	Completed
							3/23/00	3/23/00
312.5	0.5	B-2	Topsoil	1	5	Proposed pond bottom 310.0'		
			Brown moist CLAY & SILT and mf SAND (CL) (Silty clay loam)	2	17			
311.0	2.0		Brown moist micaceous of SAND, some silt (SM) (Sandy loam) (Decomposed Rock)	3	21			
				4	51			
308.0	5.0		Brown moist micaceous of SAND, some silt (SM) (Sandy loam) (Decomposed Rock)	5	50/6"			
				6	50/4"			
302.0	11.0		Brown moist micaceous SILT and mf sand (ML) (Silty loam) (Decomposed Rock)	7	50/4"			
300.1	12.9		At completion of boring, water at 7.5' and caved at 9.6'. At 24 hours after completion, water at 4.0' and caved at 9.0'					

Under REMARKS mention kind of bit, loss of sample, loss of drilling water, caving, cavities, core recovery, unusual ground water conditions, etc., and depths at which these were encountered.



SCALE 1" = 5'

ELEV.	DEPTH	Boring No.	CLASSIFICATION OF MATERIALS	SAMPLE NO.	BLOWS PER FT.	REMARKS	Begin	Completed
							3/23/00	3/23/00
341.74	0.25	B-5	Topsoil	1	3	Proposed pond bottom 333.0'		
			Brown very moist CLAY & SILT, some mf SAND, fr rock frags (SM) (Sandy loam)	2	26			
342.0	2.0		Brown and gray moist of SAND, some silt & CLAY (SM) (Sandy loam)	3	20			
				4	24			
333.5	8.5		Multicolored moist micaceous SILT, some mf sand (ML) (Silty loam) (Decomposed Rock)	5	34			
				6	50			
323.0	19.0		At completion of boring, water at 5.0' and caved at 17.0'	7	50/5"			


Under REMARKS mention kind of bit, loss of sample, loss of drilling water, caving, cavities, core recovery, unusual ground water conditions, etc., and depths at which these were encountered.



SCALE 1" = 5'

ELEV.	DEPTH	Boring No.	CLASSIFICATION OF MATERIALS	SAMPLE NO.	BLOWS PER FT.	REMARKS	Begin	Completed
							3/24/00	3/24/00
384.0	2.0	B-7	Topsoil	1	2	Proposed pond bottom 382.0'		
			Brown very moist Silty CLAY, some of SAND, little organics (CL) (Silty clay loam)	2	10			
382.0	4.0		Reddish brown moist micaceous of SAND, little silt, fr rock fragments (SM) (Sandy loam) (Decomposed Rock)	3	21			
				4	56			
				5	26			
				6	52			
347.0	19.0		Gray moist micaceous of SAND, little silt, fr rock fragments (SM) (Sandy loam) (Decomposed Rock)	7	50/6"			
341.8	24.2		At completion of boring, water at 11.3' and caved at 21.3'	8	50/5"			


Under REMARKS mention kind of bit, loss of sample, loss of drilling water, caving, cavities, core recovery, unusual ground water conditions, etc., and depths at which these were encountered.

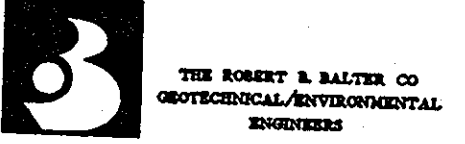

SCALE 1" = 5'

ELEV.	DEPTH	Boring No.	CLASSIFICATION OF MATERIALS	SAMPLE NO.	BLOWS PER FT.	REMARKS	Begin	Completed
							3/24/00	3/24/00
326.5	0.5	B-11	Topsoil	1	7	Proposed pond bottom 322.0'		
			Brown moist Clayey SILT and mf SAND, fr rock fragments (ML) (Sandy loam) (Decomposed Rock)	2	22			
324.0	3.0		Brown and gray moist micaceous clayey SILT and mf SAND (ML) (Silty loam) (Decomposed Rock)	3	34			
				4	40			
				5	48			
312.0	15.0		At completion of boring, water at 8.0' and caved at 13.2'. At 24 hours after completion of boring, water at 0.0' and caved at 6.3'	6	50/6"			

Under REMARKS mention kind of bit, loss of sample, loss of drilling water, caving, cavities, core recovery, unusual ground water conditions, etc., and depths at which these were encountered.

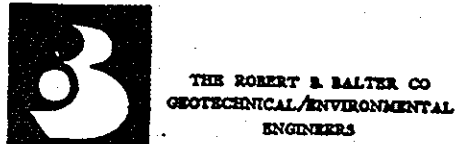

SCALE 1" = 5'

6. CONSTRUCTION CONSIDERATIONS

6.1. General Earthwork Requirements

Controlled compacted fill will be required for the embankments around the SWM ponds. The fill for these areas was assumed to be obtained from the SWM pond areas as well as other nearby regions. Most of the residual soils as described in Section 4.0 are not suitable for use as impermeable core trench materials based on their soil classification, unless proven otherwise with a more sophisticated analysis.

The maximum dry density (ASTM D-99) for the residual soil samples ranged from 108.4 to 117.2 pcf with optimum moisture contents ranging from 13.1% to 17.3%. The natural moisture content of the fill materials on site was generally 3% to 12% above the optimum moisture content. Based on these conditions, significant drying of the soil by discing and aeration or other means of manipulation can be anticipated during the earthwork process. Furthermore, the micaceous component of the on-site soils makes it susceptible to loss of strength upon exposure to free water. Therefore, it would be prudent to schedule clearing and grubbing, stripping, and earthwork operations for the warmer, dryer periods of the year (if possible) so that construction schedules will not be delayed due to inclement weather.

All fill placed for the embankment, utility backfill, or any other location requiring stable support or minimal settlement shall be constructed as controlled compacted fill. Controlled compacted fill and foundations excavations shall meet the following requirements:

- a) Within the described construction area, strip the vegetation, topsoil, and any organic, contaminated, or otherwise unsuitable materials to expose clean soils. The subject area shall encompass the SWM ponds and extend outward from the edges a minimum of 5 feet plus 1 additional foot horizontally for every foot of new fill to be placed, or cut to be excavated.
- b) Profile the stripped soil surface with a fully loaded, tandem-axle dump truck, or other approved equipment, under the observation of a geotechnical engineer or highly qualified senior level soils technician, to verify and establish a uniform, dense and stable condition. Any soft, yielding, organic, contaminated, or otherwise unacceptable spots detected shall be overexcavated and replaced with controlled compacted fill.
- c) Any material used for controlled fill shall be inspected and approved for use by a geotechnical engineer or qualified soils technician prior to use on the site. All fill shall be free from topsoil, boulders, cobbles, roots, organic matter, and debris. Preliminary approval of the borrow material shall not constitute general acceptance of all materials in the deposit or source of supply, and the acceptance shall be subject to field tests taken at the discretion of the geotechnical engineer or qualified soils technician.

- d) Compacted fill should be placed in horizontal, successive, uniform layers having a maximum uncompacted lift thickness of 8 inches. Each lift should be compacted uniformly to a minimum of 95 percent of the Standard Proctor maximum dry density as determined by ASTM D-99 (ASTM D-698). The moisture content of the materials shall be maintained within ± 3% of the optimum moisture content in order to attain the required degree of compaction. Each lift should be uniformly and evenly blade mixed during spreading to ensure uniformity of the material in each layer. If the work deteriorates prior to placement of the next lift, the layer shall be recompact and reshaped accordingly.
- e) Successive lifts of compacted fill shall not be placed until the layer under construction has been compacted to the required density as measured by a geotechnical engineer or qualified soils technician. Successive runs of equipment shall be staggered over the width of each layer.
- f) Where fills are to be placed on slopes, the original ground should be deeply scarified or where slopes are steeper than 5 horizontal to 1 vertical the slope should be stepped or benched, when considered necessary by the Engineer, in order that the placement of fill may be accomplished in horizontal lifts.

It is noted that this methodology is recommended both as preparation for areas to receive new fill, as well as locations where cut is required to establish the proposed grades such as foundation excavations. In cut areas, the profiling and selective undercutting shall be accomplished after excavation down to the proposed grades has been completed.

6.2. Dewatering

Groundwater measurements suggest that groundwater infiltration will be encountered in SWM facilities during construction. All excavations should be properly graded to avoid the accumulation of groundwater and surface water near foundation locations. Dewatering measures will most likely be required at these locations. Furthermore, contractors should provide suitable dewatering equipment to remove any water that has accumulated in excavations.

6.3. Excavation Issues

Conventional excavation methods should likely prove feasible for most of the excavations. However, it must be anticipated that dense to very dense decomposed rock or "floating" boulders may be encountered during earthwork, possibly requiring the use of specialized excavation equipment and methods. It is our experience that the degree of difficulty in excavation can, in a general sense, be correlated to the SPT values, the physical characteristics of the materials and the material's resistance to our drilling equipment. Typically, mass excavation of strata exhibiting SPT results of less than 50 blows per 6 inches could generally be accomplished using conventional earthwork techniques. However, limited ripping or jack hammering of harder materials may be required in narrow excavations or trenches. Materials

Mr. Joseph Necker
Howard Research & Development Corporation
Emerson SWM Facilities
December 13, 2000

Mr. Joseph Necker
Howard Research & Development Corporation
Emerson SWM Facilities
December 13, 2000

Mr. Joseph Necker
Howard Research & Development Corporation
Emerson SWM Facilities
December 13, 2000

Mr. Joseph Necker
Howard Research & Development Corporation
Emerson SWM Facilities
December 13, 2000

with SPT results of 50 blows per 3 inches to 6 inches, or which required very hard auger to penetrate with our drilling equipment, usually require ripping, jack hammering, or hoe ramming for removal, especially in trenches. Any excavations below the depths of auger refusal, or in materials with SPT results of 50 blows or less, will most likely require hard ripping, extensive jack hammering or blasting. The Table 2 presents depths of potential excavation problems at respective boring locations.




Table 2-Potential Excavation Problems

Boring	Existing Elevation	Proposed Bottom Elevation	Elevation to SPT resistances of:		
			50 blows/6 inches ⁽¹⁾	50 blows/3 to 6 inches ⁽²⁾	50 blows/3 inches or less ⁽³⁾
B-12	309.51	302	---	---	295.5
B-13	310.41	302	---	304.4	---
B-14	339.23	336	---	---	---
B-15	347.73	336	---	---	---
B-16	352.09	347	---	---	---
B-17	353.53	347	---	---	---
B-18	355.09	326	---	321.1	---
B-19	341.68	326	---	---	327.7
B-20	315.45	312	---	---	---
B-21	319.85	312	---	---	---
B-22	371.85	354	---	---	---
B-23	366.0	354	---	351.5	---

NOTES:

- (1) Excavation of materials exhibiting this range of blow counts are typically accomplished through mass excavation techniques, i.e. excavation by loader, pan, backhoe, etc. Some limited ripping or jack hammering of materials may be required, especially in trenches.
- (2) Excavation of materials exhibiting this range of blow counts will typically require ripping, jack hammering or hoe ramming for excavation, especially in trenches or other confined areas.
- (3) Excavation of materials exhibiting this range of blow counts will typically require hard ripping or extensive jack hammering. Blasting or other hard excavation techniques may be required, especially in trenches or other confined areas.

It must be noted that the physical characteristics of the rock materials (e.g., jointing, fracturing, and foliation), along with the type of equipment used, will greatly affect difficulty of excavation. It should also be noted that the data presented on the profiles represent the general subsurface conditions at the respective boring locations. Deviations in the excavation characteristics due to differing degrees of weathering, as well as the physical characteristics of

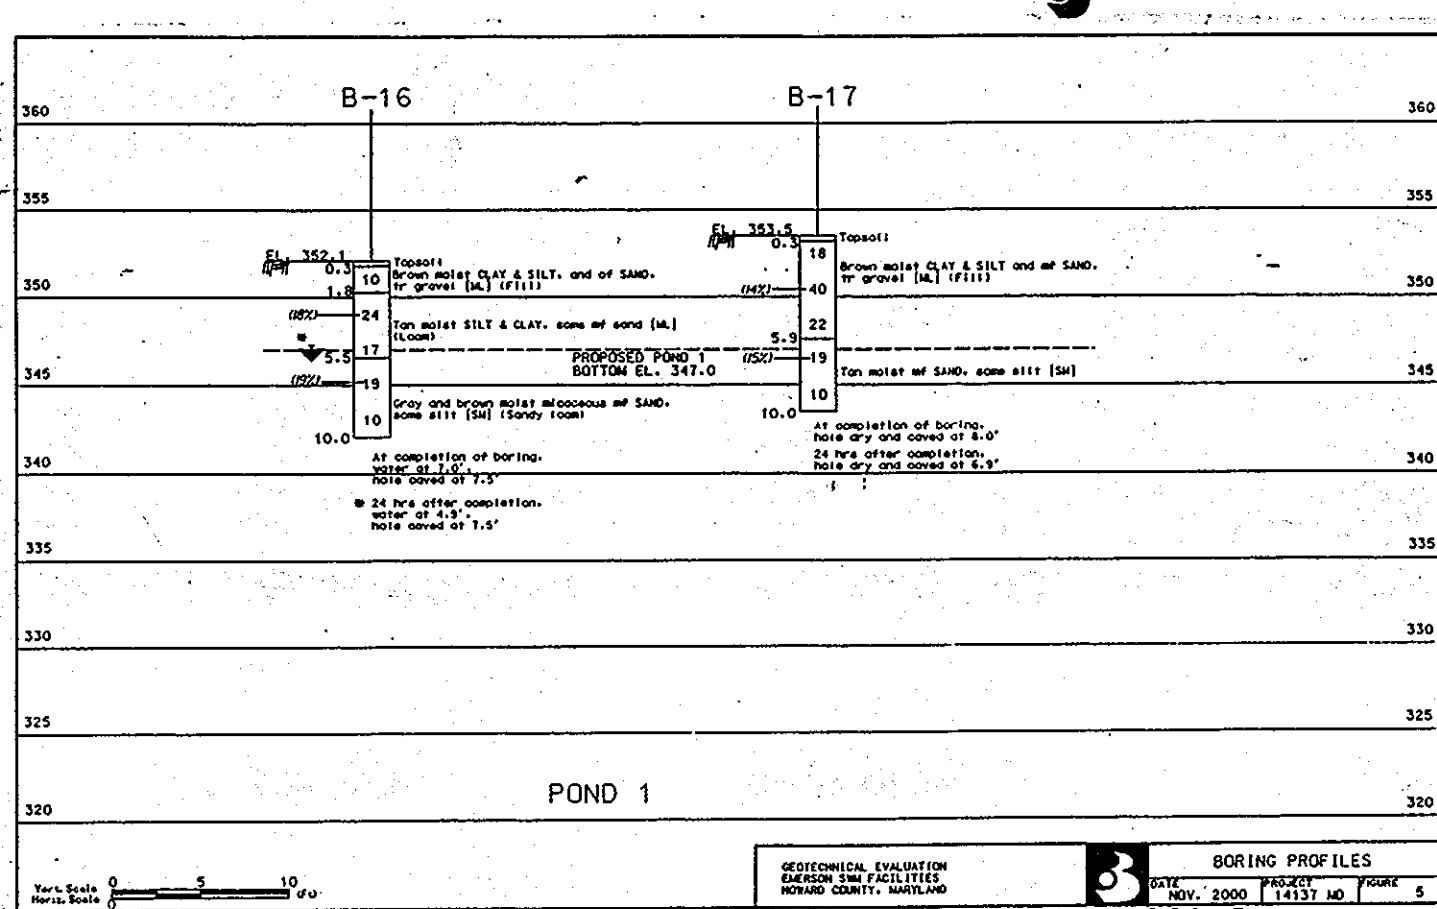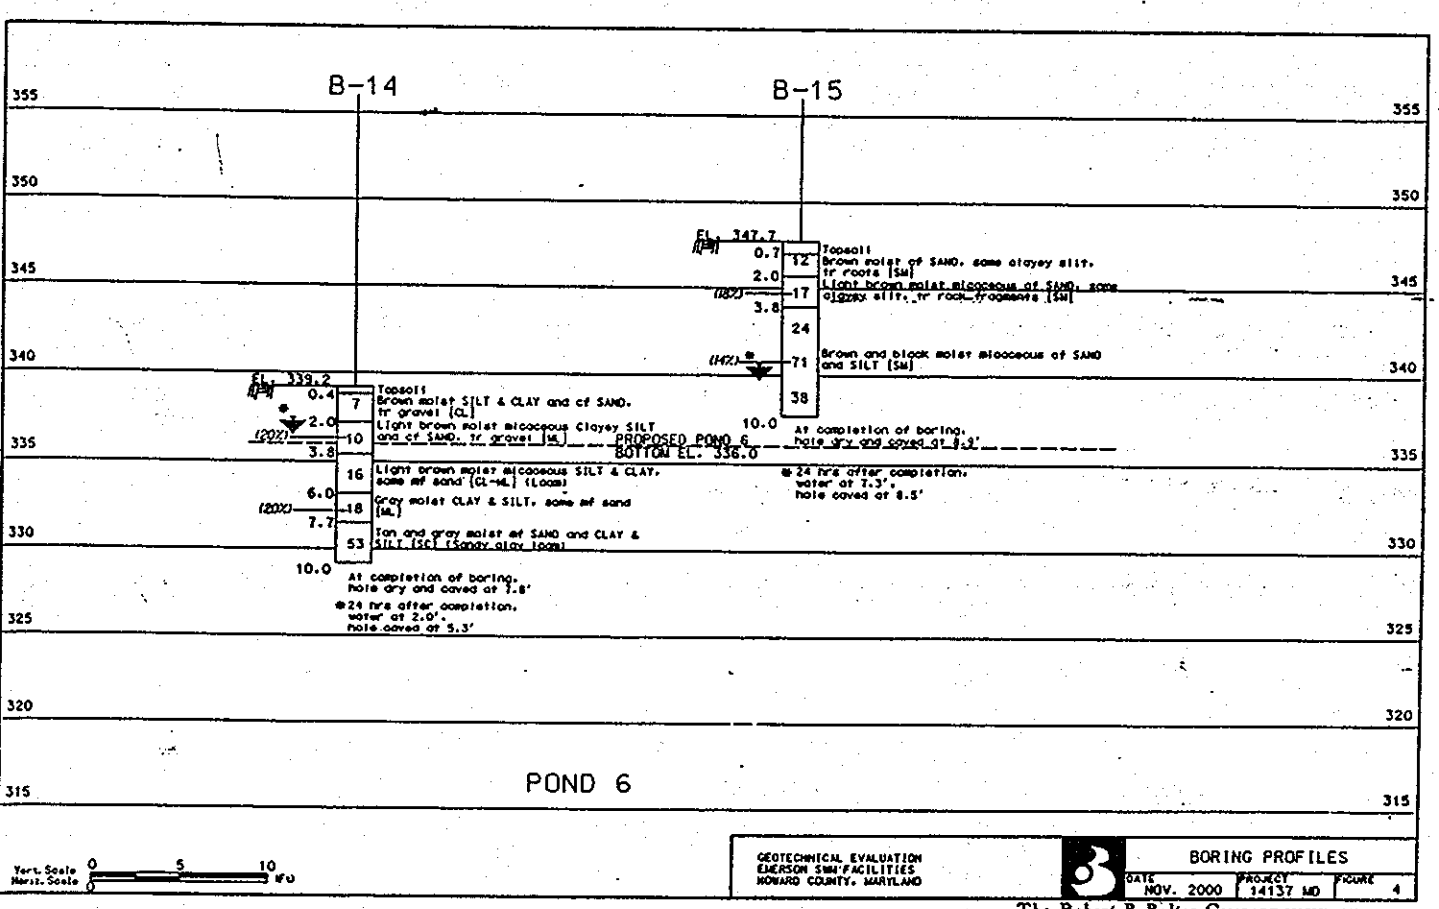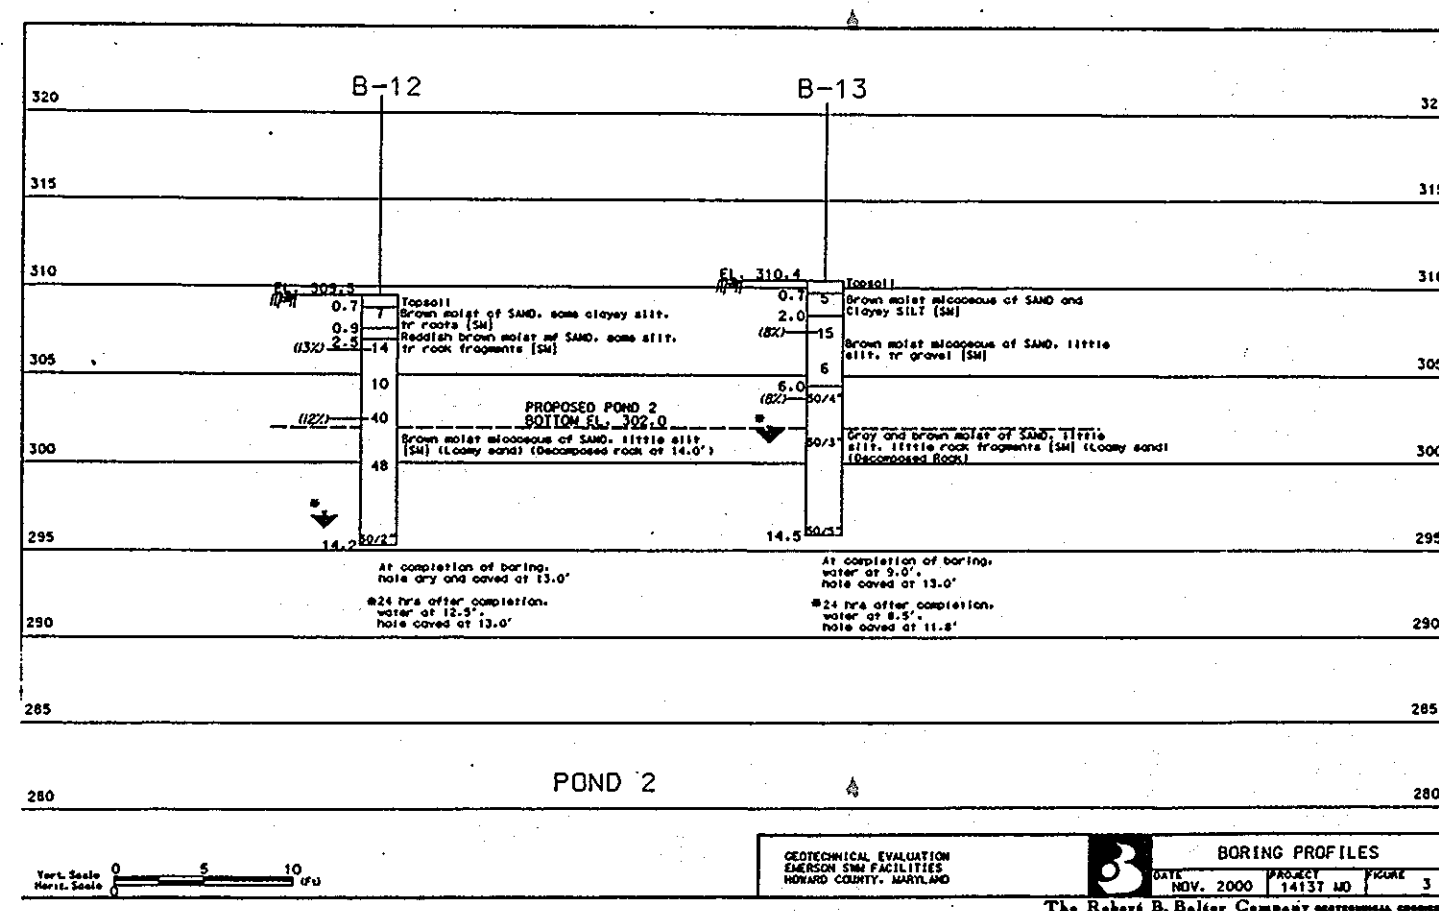

THESE PLANS HAVE BEEN REVIEWED FOR THE HOWARD SOIL CONSERVATION DISTRICT AND MEET THE TECHNICAL REQUIREMENTS FOR SMALL POND CONSTRUCTION, SOIL EROSION AND SEDIMENT CONTROL.

U.S.D.A. NATURAL RESOURCES CONSERVATION SERVICE
DATE: 10/10/01

APPROVED: HOWARD SOIL CONSERVATION DISTRICT
DATE: 10/10/01

DEVELOPERS CERTIFICATE:


I/WE CERTIFY THAT ALL DEVELOPMENT AND/OR CONSTRUCTION WILL BE DONE ACCORDING TO THESE PLANS AND THAT ANY RESPONSIBLE PERSONNEL INVOLVED IN THE CONSTRUCTION PROJECT WILL HAVE A CERTIFICATE OF ATTENDANCE AT A DEPARTMENT OF ENVIRONMENT APPROVED TRAINING PROGRAM FOR THE CONTROL OF SEDIMENT AND EROSION BEFORE BEGINNING THE PROJECT. I/SHALL ENGAGE A REGISTERED PROFESSIONAL ENGINEER TO SUPERVISE POND CONSTRUCTION AND PROVIDE THE HOWARD SOIL CONSERVATION DISTRICT WITH AN "AS-BUILT" PLAN OF THE POND WITHIN 30 DAYS OF COMPLETION. I/ALSO AUTHORIZE PERIODIC ON-SITE INSPECTIONS BY THE HOWARD SOIL CONSERVATION DISTRICT.

DATE: 10/25/01
SIGNATURE OF DEVELOPER: Robert A. Jenkins

ENGINEERS CERTIFICATE:

I CERTIFY THAT THIS PLAN FOR POND CONSTRUCTION EROSION AND SEDIMENT CONTROL REPRESENTS A PRACTICAL AND WORKABLE PLAN BASED ON MY PERSONAL KNOWLEDGE OF THE SITE CONDITIONS. THIS PLAN WAS PREPARED IN ACCORDANCE WITH THE REQUIREMENTS OF THE HOWARD SOIL CONSERVATION DISTRICT. I HAVE NOTIFIED THE DEVELOPER THAT HE/SHE MUST ENGAGE A REGISTERED PROFESSIONAL ENGINEER TO SUPERVISE POND CONSTRUCTION AND PROVIDE THE HOWARD SOIL CONSERVATION DISTRICT WITH AN "AS-BUILT" PLAN OF THE POND WITHIN 30 DAYS OF COMPLETION.

DATE: 9/25/01
SIGNATURE OF ENGINEER: John H. Rauscher, E

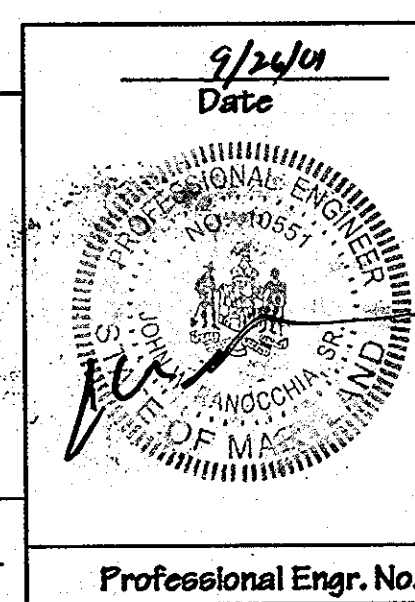

APPROVED: HOWARD COUNTY DEPARTMENT OF PUBLIC WORKS
DATE: 10-29-01

APPROVED: HOWARD COUNTY DEPT. OF PLANNING & ZONING
DATE: 10/31/01

APPROVED: CHIEF, DIVISION OF LAND DEVELOPMENT
DATE: 11/6/01

EMERSON FORMERLY KEY PROPERTY SECTION 2, PHASE 1A

OWNER/DEVELOPER: THE HOWARD RESEARCH & DEVELOPMENT CORPORATION
10275 Little Patuxent Parkway
Columbia, Maryland 21044

DMW
DATE: 9/24/01

EMERSON SECTION 2
PHASE 1A
DATE: 9/25/01

TITLE: BORING LOGS

Des By: Scale AS SHOWN
Dwn By: Date 9-26-01
Chk By: Approved

Proj. No. EES054.F
25 of 27

