

West Shenandoah Valley 8/9/07
 CHIEF, DIVISION OF LAND DEVELOPMENT DATE

[Signature] 8/15/07
 CHIEF, DEVELOPMENT ENGINEERING DIVISION DATE


SCHEDULE A PERIMETER LANDSCAPE EDGE		
CATEGORY	Adjacent to Internal Property	Adjacent to External Property
LANDSCAPE TYPE	A	B
LINEAR FEET OF PERIMETER	P1, 370.41 L.F.	P2, 306.13 L.F.
CREDIT FOR EXISTING VEGETATION (YES, NO, LINEAR FEET)	NO	NO
CREDIT FOR WALL, FENCE OR BEAM (YES, NO, LINEAR FEET)	NO	NO
CREDIT FOR EXISTING TREES (YES, NO, LINEAR FEET)	NO	NO
NUMBER OF PLANTS PROVIDED	370.41 ÷ 60 = 6.17	306.13 ÷ 60 = 5.10
SHADE TREES	1	1
EVERGREEN TREES	5	4
NUMBER OF TREES PROVIDED	6	5
SHADE TREES	1	1
EVERGREEN TREES	5	4
OTHER TREES (2:1 SUBSTITUTION)	1	1
SHRUBS (1:1 SUBSTITUTION)	1	1
OTHER SHRUBS (2:1 SUBSTITUTION)	1	1
DESCRIBE PLANT SUBSTITUTION CREDITS BELOW IF NEEDED	EVERGREEN FOR SHADE AT 2:1	

SCHEDULE D STORMWATER MANAGEMENT AREA LANDSCAPING		
LINEAR FEET OF PERIMETER	D1: 169.00'	D2: 144.24'
NUMBER OF TREES REQUIRED:		
SHADE TREES	4	3
EVERGREEN TREES	4	4
CREDIT FOR EXISTING VEGETATION (NO, YES AND X)	NO	NO
CREDIT FOR OTHER LANDSCAPING (NO, YES AND X)	NO	NO
NUMBER OF TREES PROVIDED:		
SHADE TREES	4	3
EVERGREEN TREES	4	4
OTHER TREES (2:1 SUBSTITUTION)	4	3

LANDSCAPING PLANT LIST			
QTY.	KEY	NAME	SIZE
12		ACER RUBRUM 'OCTOBER GLORY' (OCTOBER RED MAPLE)	2 1/2" x 3" CALIPER FULL CROWN, B&B
22		PINUS STROBUS EASTERN WHITE PINE	6' - 8' HT.
6		CUPRESSOCYPRIS LEYLANDI LEYLAND CYPRESS	5' - 6' HT.

DEVELOPER'S / BUILDER'S CERTIFICATE
 I/WE CERTIFY THAT THE LANDSCAPING SHOWN ON THIS PLAN WILL BE DONE ACCORDING TO THE PLAN, SECTION 16.24 OF THE HOWARD COUNTY CODE AND THE HOWARD COUNTY LANDSCAPE MANUAL. I/WE FURTHER CERTIFY THAT UPON COMPLETION, A CERTIFICATION OF LANDSCAPE INSTALLATION ACCOMPANIED BY AN EXECUTED ONE YEAR GUARANTEE OF PLANT MATERIALS WILL BE SUBMITTED TO THE DEPARTMENT OF PLANNING AND ZONING.



[Signature] 11/25/02
 NAME DATE

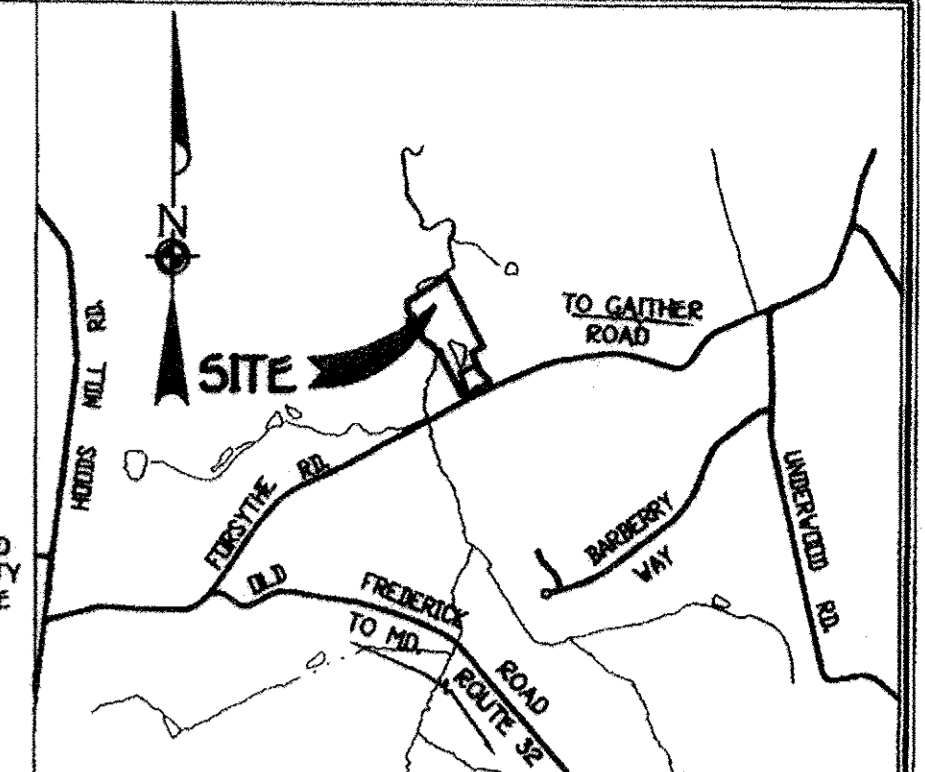

THIS PLAN HAS BEEN PREPARED IN ACCORDANCE WITH THE PROVISIONS OF SECTION 16.24 OF THE HOWARD COUNTY CODE AND THE LANDSCAPE MANUAL. FINANCIAL SURETY FOR THE 40 REQUIRED LANDSCAPE TREES WILL BE POSTED AS PART OF THE DEVELOPER'S AGREEMENT IN THE AMOUNT OF \$7,800.00. AT THE TIME OF INSTALLMENT, ALL SHRUBS AND OTHER PLANTINGS HEREWITH LISTED AND APPROVED FOR THIS SITE, SHALL BE OF THE PROPER HEIGHT REQUIREMENTS IN ACCORDANCE WITH THE HOWARD COUNTY LANDSCAPE MANUAL. IN ADDITION, NO SUBSTITUTIONS OR RELOCATION OF REQUIRED PLANTINGS MAY BE MADE WITHOUT PRIOR REVIEW AND APPROVAL FROM THE DEPARTMENT OF PLANNING AND ZONING. ANY DEVIATION FROM THIS APPROVED LANDSCAPE PLAN MAY RESULT IN DENIAL OR DELAY IN THE RELEASE OF LANDSCAPE SURETY UNTIL SUCH TIME AS ALL REQUIRED MATERIALS ARE PLANTED AND/OR REVISIONS ARE MADE TO APPLICABLE PLANS AND CERTIFICATES.

PLANTING NOTE:
 AT THE TIME OF INSTALLMENT, ALL SHRUBS AND OTHER PLANTINGS HEREWITH LISTED AND APPROVED FOR THIS SITE, SHALL BE OF THE PROPER HEIGHT REQUIREMENTS IN ACCORDANCE WITH THE HOWARD COUNTY LANDSCAPE MANUAL. IN ADDITION, NO SUBSTITUTIONS OR RELOCATION OF REQUIRED PLANTINGS MAY BE MADE WITHOUT PRIOR REVIEW AND APPROVAL FROM THE DEPARTMENT OF PLANNING AND ZONING. ANY DEVIATION FROM THIS APPROVED LANDSCAPE PLAN MAY RESULT IN DENIAL OR DELAY IN THE RELEASE OF LANDSCAPE SURETY UNTIL SUCH TIME AS ALL REQUIRED MATERIALS ARE PLANTED AND/OR REVISIONS ARE MADE TO APPLICABLE PLANS AND CERTIFICATES.

- GENERAL NOTES:**
- Subject Property Zoned RC-DEO.
 - Property Information:
 Tax Map No. = 9
 Tax Parcel No. = 69
 Grid No. = 1
 Gross Area = 13,354 Ac. +
 Recording Data = Liber 624, Folio 671.
 Election District = Second
 - Property Will Be Served by Private Water And Sewer.
 - Subdivision Data:
 Proposed No. Of Buildable Lots = 2
 Proposed No. Of Open Space Lots = 0
 Area Of Buildable Lots = 13,035 Ac. +
 Area Of Roadway Dedication = 0.319 Ac. +
 Total Area To Be Recorded = 13,354 Ac. +
 - Contour Information is Based On Electronic Howard County Aerial Topographic Sheets.
 - Indicates Existing Paving.
 - Indicates Existing Gravel Driveway.
 - Denotes Proposed Dwelling.
 - Denotes Private Sewerage Easement Of 10,000 Square Feet As Required By Maryland Department Of The Environment For Individual Sewerage Disposal.
 - Indicates Forest Conservation Easement.
 - The Establishment Of A Preservation Parcel To Support The Creation Of Lot 1 Will Be Deferred Until The Residue (Lot 2) Is Resubdivided.
 - The Existing Wet Pond On Lot 2 Is Spring Fed The Source Of Which Is At The Pond. There Are No Stream / Wetland And Areas Upstream Of This Pond.

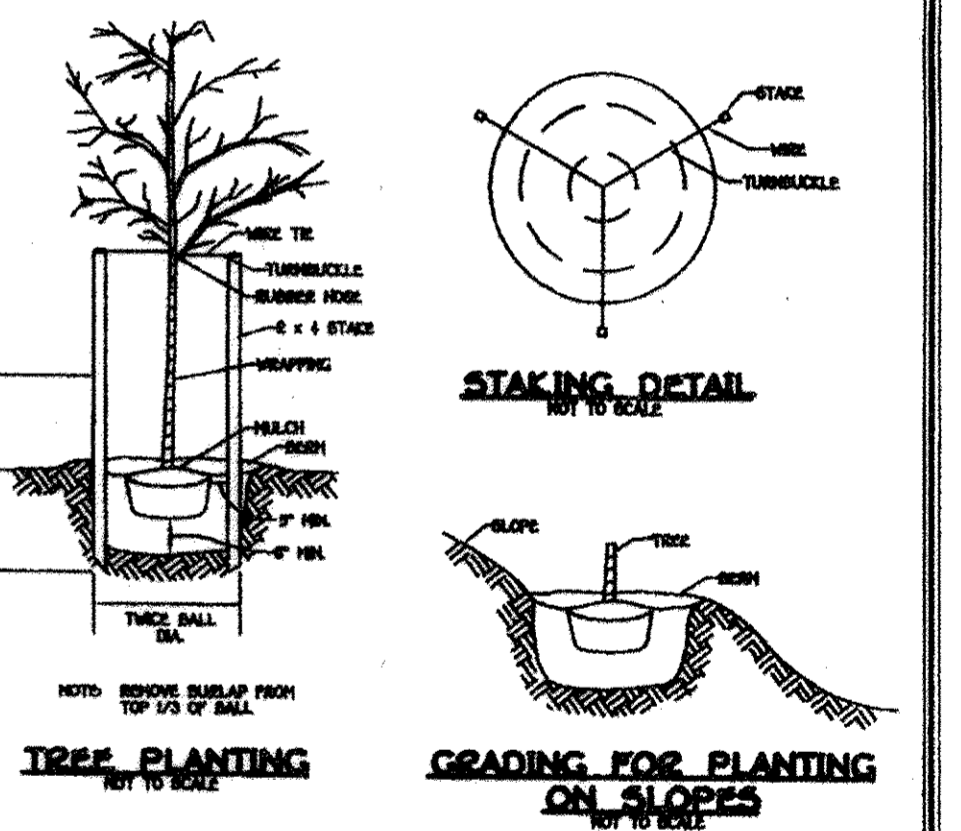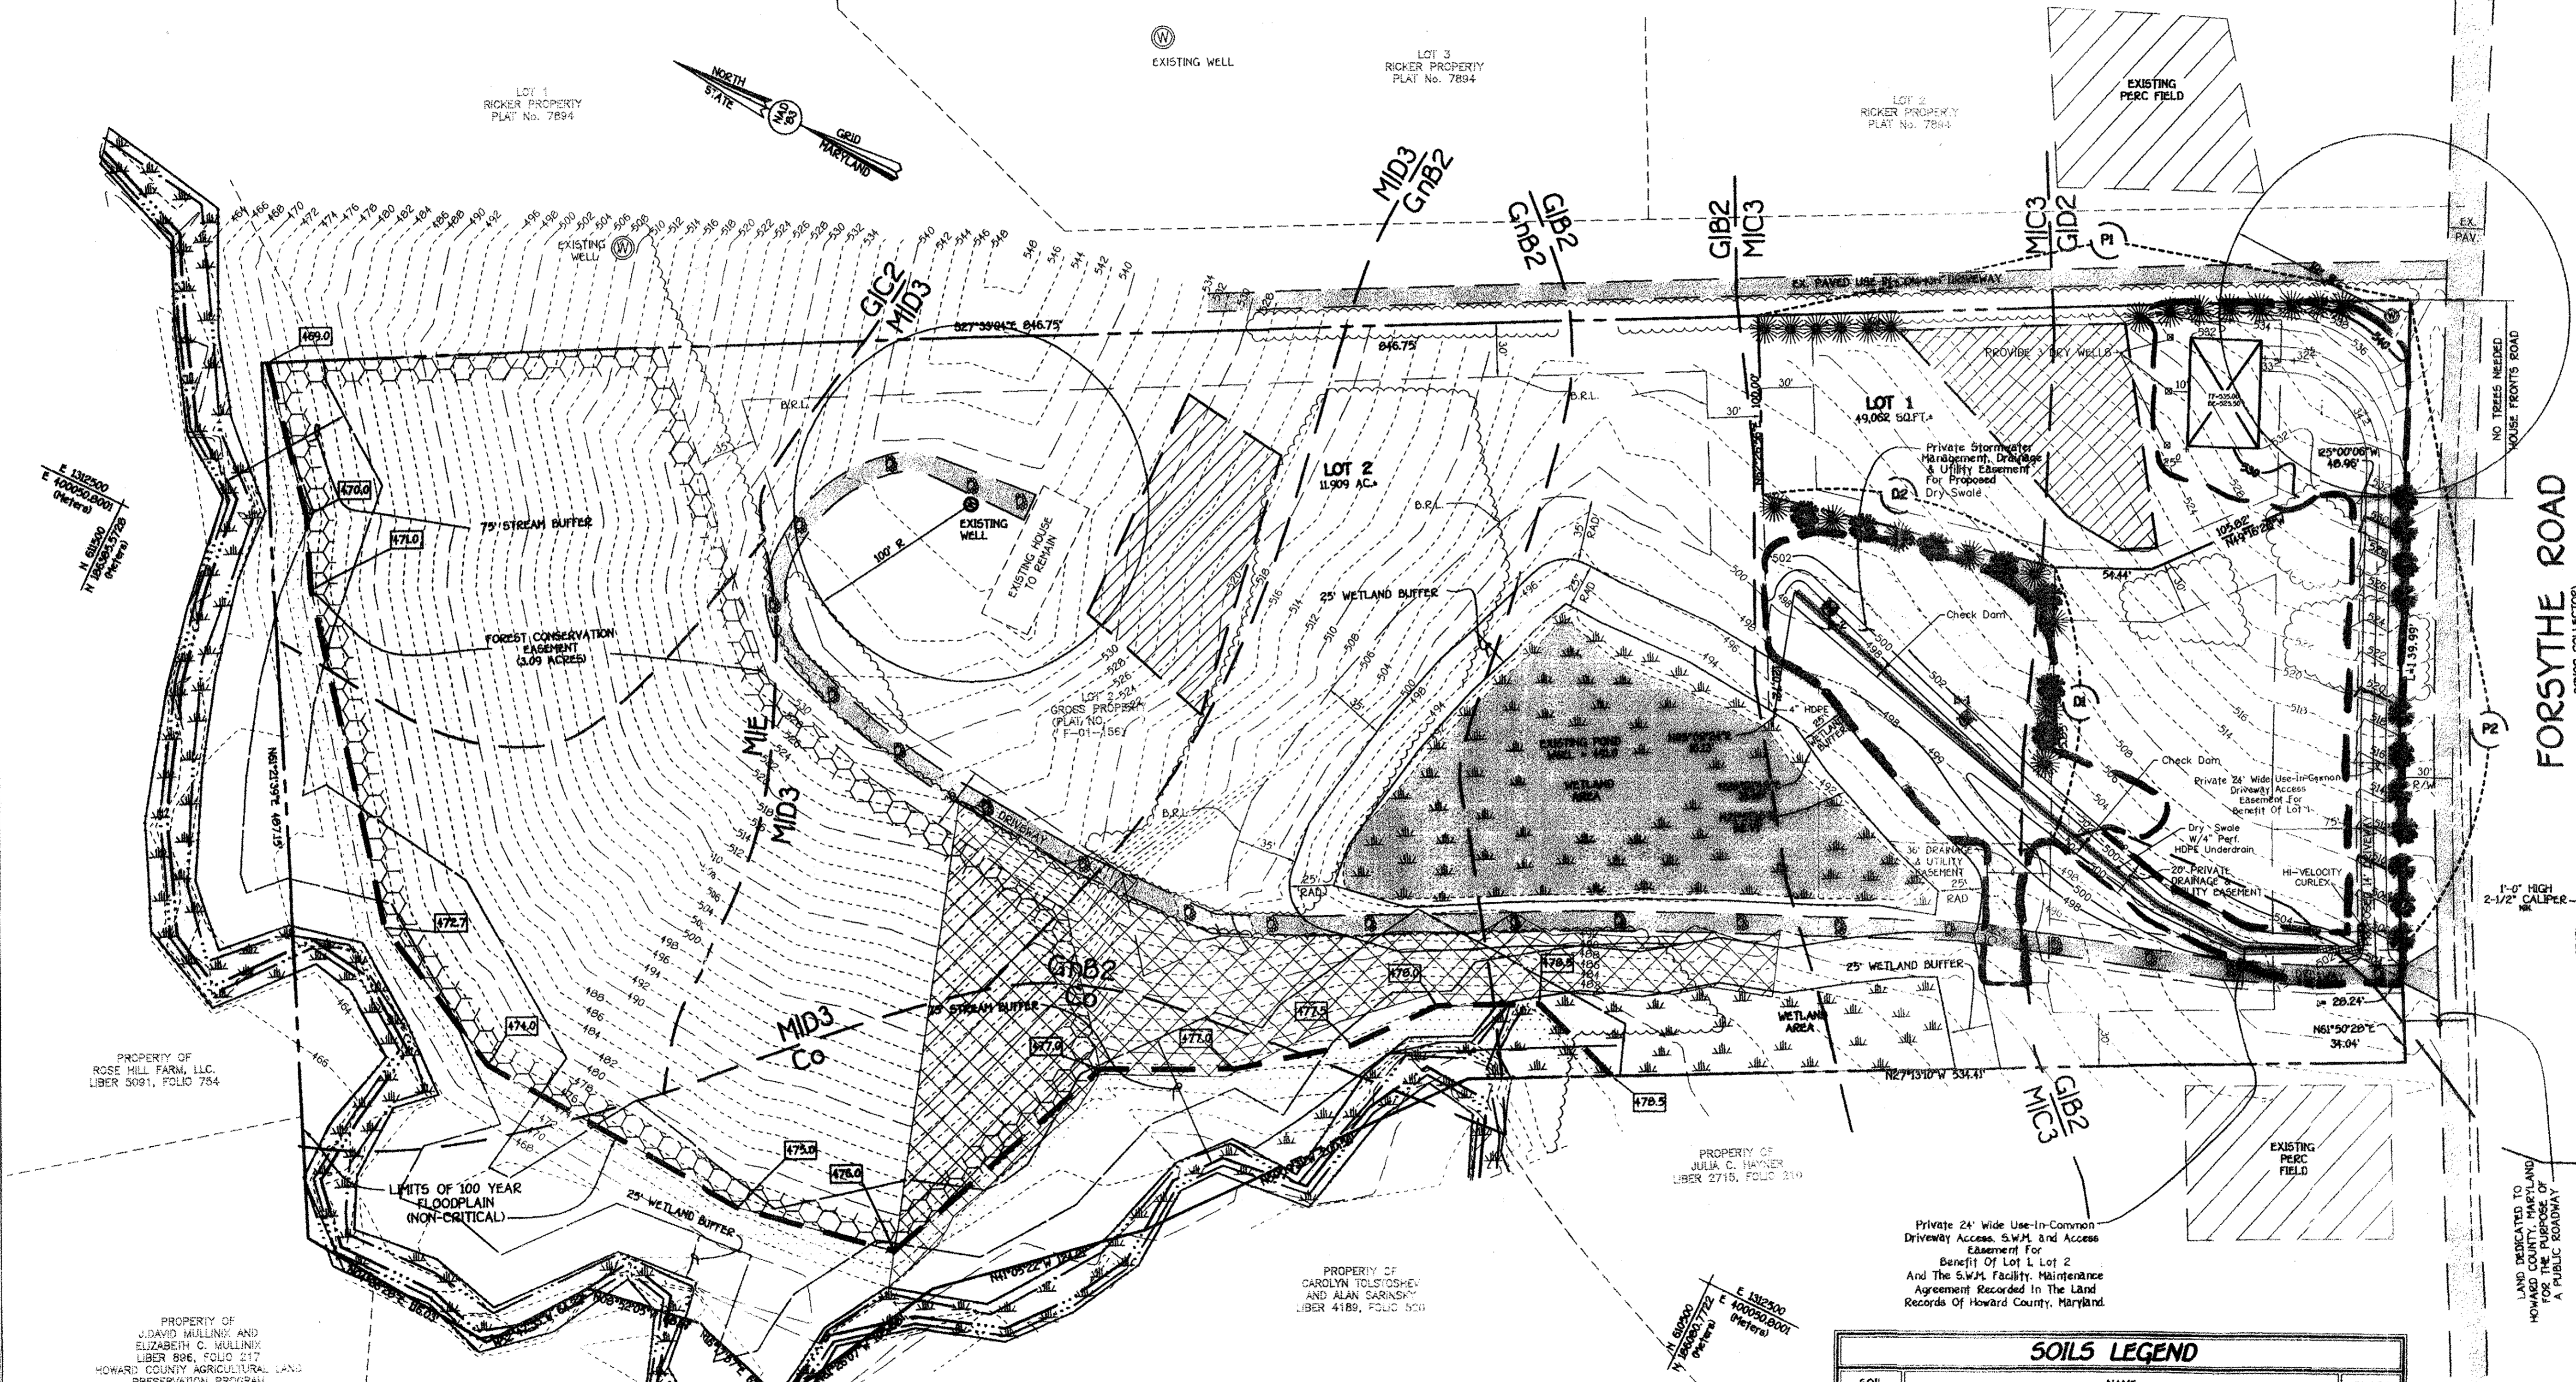

LEGEND

DENOTES SLOPES 25% OR GREATER

SOILS LEGEND

SOIL	NAME	CLASS
Co	Codorus silt loam	C
GIB2	Glenely loam, 3 to 8 percent slopes, moderately eroded	B
GIC2	Glenely loam, 8 to 15 percent slopes, moderately eroded	B
GIB2	Glenely silt loam, 3 to 8 percent slopes, moderately eroded	C
MIC3	Minor loam, 8 to 15 percent slopes, severely eroded	B
MID3	Minor loam, 15 to 25 percent slopes, severely eroded	B
GID2	Glenely loam, 15 to 25 percent slopes, moderately eroded	B

NOTES:

- Hydric soils and/or contains hydric inclusions
- May contain hydric inclusions
- Generally only within 100-year floodplain areas

REV. NO.	DATE	BY	REVISION
1	2006-09-06	DRS/smh	REMOVED PROPOSED BIO-RETENTION FACILITY AND ASSOCIATED GRADING AND NOTES. ADDED PROPOSED DRYSWALE AND CHECK DAMS AND UNDERDRAIN

PURPOSE: TO REPLACE THE PREVIOUSLY APPROVED BIO-RETENTION FACILITY WITH A DRYSWALE WITH CHECK DAMS AND UNDERDRAIN.

OWNER: ANGLUS ROY GROES AND ADRIENNE E. GROES
 15920 FORTSYTHE ROAD
 SYKESVILLE, MARYLAND 21794-5813

DEVELOPER: DAN RICKER
 13998 FORTSYTHE ROAD
 SYKESVILLE, MARYLAND 21794

D.R.S. & ASSOCIATES
 LAND DESIGN CONSULTANTS
 52 WINTERS STREET
 WESTMINSTER, MARYLAND 21157
 410-848-4060 410-876-6040
 FAX 410-876-7603

REVISED
 Supplemental Plan - Grading, Landscape, Topography, And Soils
GROSS PROPERTY
 LOTS 1 AND 2
 ZONED RC-DEO
 TAX MAP No. 9 GRID No. 1 PARCEL No. 69
 FOURTH ELECTION DISTRICT
 HOWARD COUNTY, MARYLAND

Scale: 1" = 50'
 DATE: NOVEMBER 18, 2002
 SHEET 1 OF 4

FISHER, COLLINS & CARTER, INC.
 CIVIL ENGINEERING CONSULTANTS & LAND SURVEYORS
 CENTRAL SQUARE OFFICE PARK - 10277 BALTIMORE NATIONAL FREE
 ELKLOTT CITY, MARYLAND 22842
 (410) 461-2955




SOILS LEGEND		
SOIL	NAME	CLASS
Co	Codorus silt loam	C
GIB2	Glenns loam, 3 to 8 percent slopes, moderately eroded	B
GIC2	Glenns loam, 8 to 15 percent slopes, moderately eroded	B
GIB2	Glenns silt loam, 3 to 8 percent slopes, moderately eroded	C
MIC3	Minor loam, 8 to 15 percent slopes, severely eroded	B
MID3	Minor loam, 15 to 25 percent slopes, severely eroded	B
GIB2	Glenns loam, 15 to 25 percent slopes, moderately eroded	B

NOTES:
 * Hydric soils and/or contains hydric inclusions
 ** May contain hydric inclusions
 † Generally only within 100-year floodplain areas

REV. NO.	DATE	BY	REVISION
1	2006-09-06	DRS/smh	REVISED STORMWATER MANAGEMENT AND DRAINAGE UTILITY EASEMENT NOTE.

PURPOSE: TO REPLACE THE PREVIOUSLY APPROVED BIO-RETENTION FACILITY WITH A DRYSWALE WITH CHECK DAMS AND UNDERDRAIN.

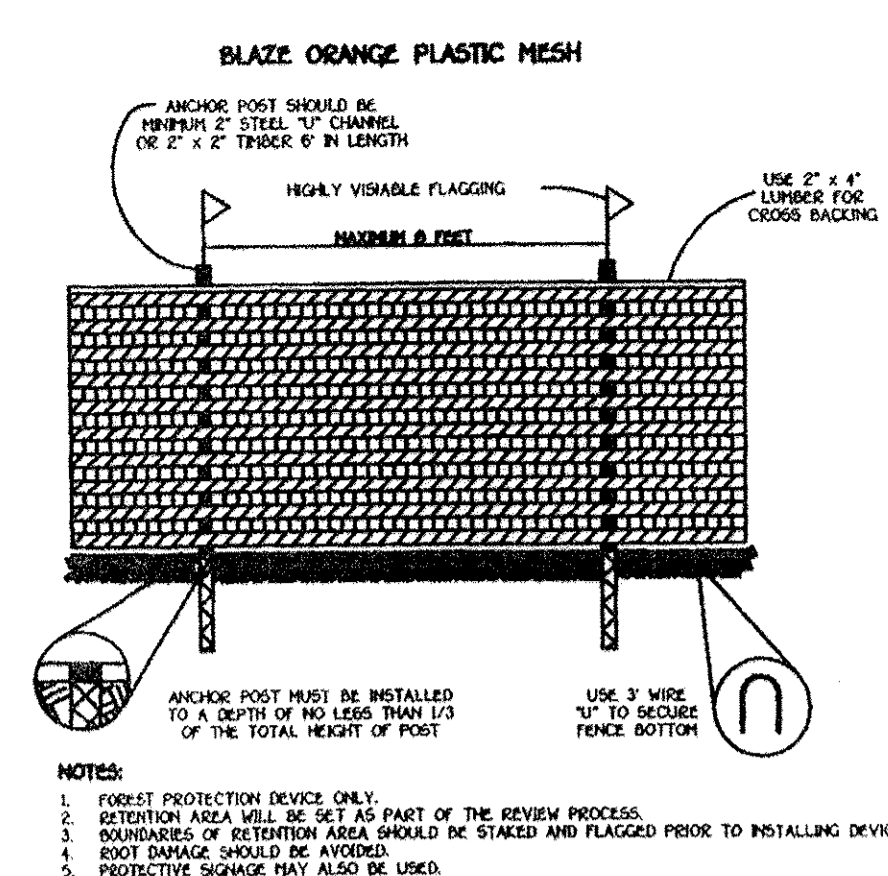


NOTES:
 1. FOREST PROTECTION DEVICE ONLY.
 2. RETENTION AREA WILL BE SET AS PART OF THE REVIEW PROCESS.
 3. BOUNDARIES OF RETENTION AREA SHOULD BE STAKED AND FLAGGED PRIOR TO INSTALLING DEVICE.
 4. ROOT DAMAGE SHOULD BE AVOIDED.
 5. PROTECTIVE SIGNAGE MAY ALSO BE USED.
 6. DEVICE SHOULD BE MAINTAINED THROUGHOUT CONSTRUCTION.

WETLAND DATA			
KEY	COMMUNITY TYPE	DOMINANT VEGETATION	PRIORITY ACREAGE
A	PUB3H	JUNCUS EFFUSUS, TYPHA LATIFOLIA, SCRIPUS CYPERINUS	1.0 +/-
	PEM1A	BOEHMERIA CYLINDRICA, LUDWIGIA ALTERNIFOLIA, SALIX NIGRA, SAMBUCA CANADENSIS, CYPERUS STYGOSUS,	
	ROL1M	JUNCUS EFFUSUS, FESTUCA PRATENSE, CORNUS AMOMUM	

FCP NOTES

- ANY FOREST CONSERVATION EASEMENT (FCE) AREA SHOWN HEREON IS SUBJECT TO PROTECTIVE COVENANTS WHICH MAY BE FOUND IN THE LAND RECORDS OF HOWARD COUNTY WHICH RESTRICT THE DISTURBANCE AND USE OF THESE AREAS.
- FORESTED AREAS OCCURRING OUTSIDE OF THE FCE SHALL NOT BE CONSIDERED PART OF THE FCE AND SHALL NOT BE SUBJECT TO PROTECTIVE LAND COVENANTS.
- LIMITS OF DISTURBANCE SHALL BE RESTRICTED TO AREAS OUTSIDE THE LIMIT OF TEMPORARY FENCING OR THE FCE BOUNDARY, WHICHEVER IS GREATER.
- THERE SHALL BE NO CLEARING, GRADING, CONSTRUCTION OR DISTURBANCE OF VEGETATION IN THE FOREST CONSERVATION EASEMENT, EXCEPT AS PERMITTED BY HOWARD COUNTY DPZ.
- NO STOCKPILES, PARKING AREAS, EQUIPMENT CLEANING AREAS, ETC. SHALL OCCUR WITHIN AREAS DESIGNATED AS FOREST CONSERVATION EASEMENTS.
- TEMPORARY FENCING SHALL BE USED TO PROTECT FOREST RESOURCES DURING CONSTRUCTION. THE FENCING SHALL BE PLACED ALONG ALL FCE BOUNDARIES WHICH OCCUR WITHIN 15 FEET OF THE PROPOSED LIMITS OF DISTURBANCE.
- PERMANENT SIGNAGE SHALL BE PLACED 50 - 100' APART ALONG THE BOUNDARIES OF ALL AREAS INCLUDED IN FOREST CONSERVATION EASEMENTS.
- FOREST CONSERVATION OBLIGATIONS IN ACCORDANCE WITH SECTION 16.102 OF THE HOWARD COUNTY CODE AND FOREST CONSERVATION MANUAL, HAVE BEEN MET BY THE PLACEMENT OF .309 ACRES OF FOREST RETENTION INTO AN EASEMENT AREA.

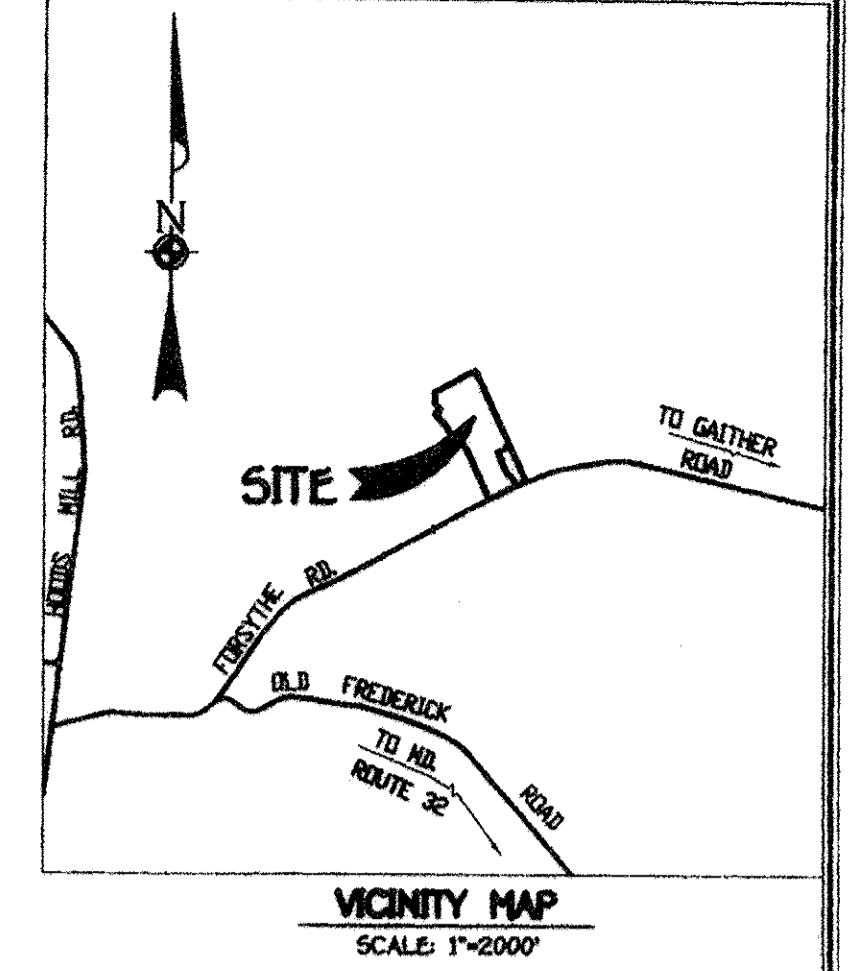

- GENERAL NOTES:**
- Subject Property Zoned RC-DEO.
 - Property Information:
 Tax Map No. = 9
 Tax Parcel No. = 69
 Grid No. = 1
 Gross Area = 13.354 Ac.
 Recording Data = Liber 624, Folio 671.
 Election District = Fourth
 - Property Will Be Served By Private Water And Sewer.
 - Existing Dwelling On Lot 2 Is To Remain.
 - Denotes Proposed Dwelling.
 - Non-Critical 100 Year Floodplain Report Was Prepared By Fisher, Collins & Carter, Inc. February, 2001

- F50 NOTES:**
- NO RARE, THREATENED OR ENDANGERED SPECIES WERE OBSERVED ON THE PROPERTY.
 - SURROUNDING LAND USE IS LOW DENSITY RESIDENTIAL DEVELOPMENT.


FOREST CONSERVATION WORKSHEET

PROJECT NAME: GROSS PROPERTY Lots 1 & 2 DATE: 3/29/07

BASIC SITE DATA	
GROSS SITE AREA:	13.35 ACRES
AREA WITHIN 100 YEAR FLOODPLAIN:	1.89
AREA WITHIN AGRICULTURAL USE OR PRESERVATION PARCEL:	---
AREA WITHIN OVERHEAD TRANSMISSION LINES:	---
NET TRACT AREA INTA:	11.46
LAND USE CATEGORY:	RC-DEO
INFORMATION FOR CALCULATIONS	
NET TRACT AREA INTA:	11.46
FOREST CONSERVATION THRESHOLD (25% x INTA):	2.87
AFFORESTATION THRESHOLD (25% x INTA):	2.87
EXISTING FOREST ON INTA:	3.5
EXISTING FOREST ABOVE CONSERVATION THRESHOLD:	0.0
BREAK-EVEN POINT OF APPLICATION:	3.0
FOREST TO BE CLEARED:	0
FOREST TO BE RETAINED:	3.09

IF YOU ARE RETAINING FOREST AT OR ABOVE THE BREAK EVEN POINT, NO PLANTING IS REQUIRED.

SITE DATA	
GROSS AREA:	13.4 ACRES
100 YR. FLOODPLAIN:	1.9 ACRES
NET TRACT AREA:	11.5 ACRES
EXISTING FOREST:	3.5 ACRES
AFFORESTATION THRESHOLD:	2.9 ACRES
CONSERVATION THRESHOLD:	2.9 ACRES
BREAK-EVEN POINT:	3.0 ACRES
PROPOSED FCE:	3.09 ACRES

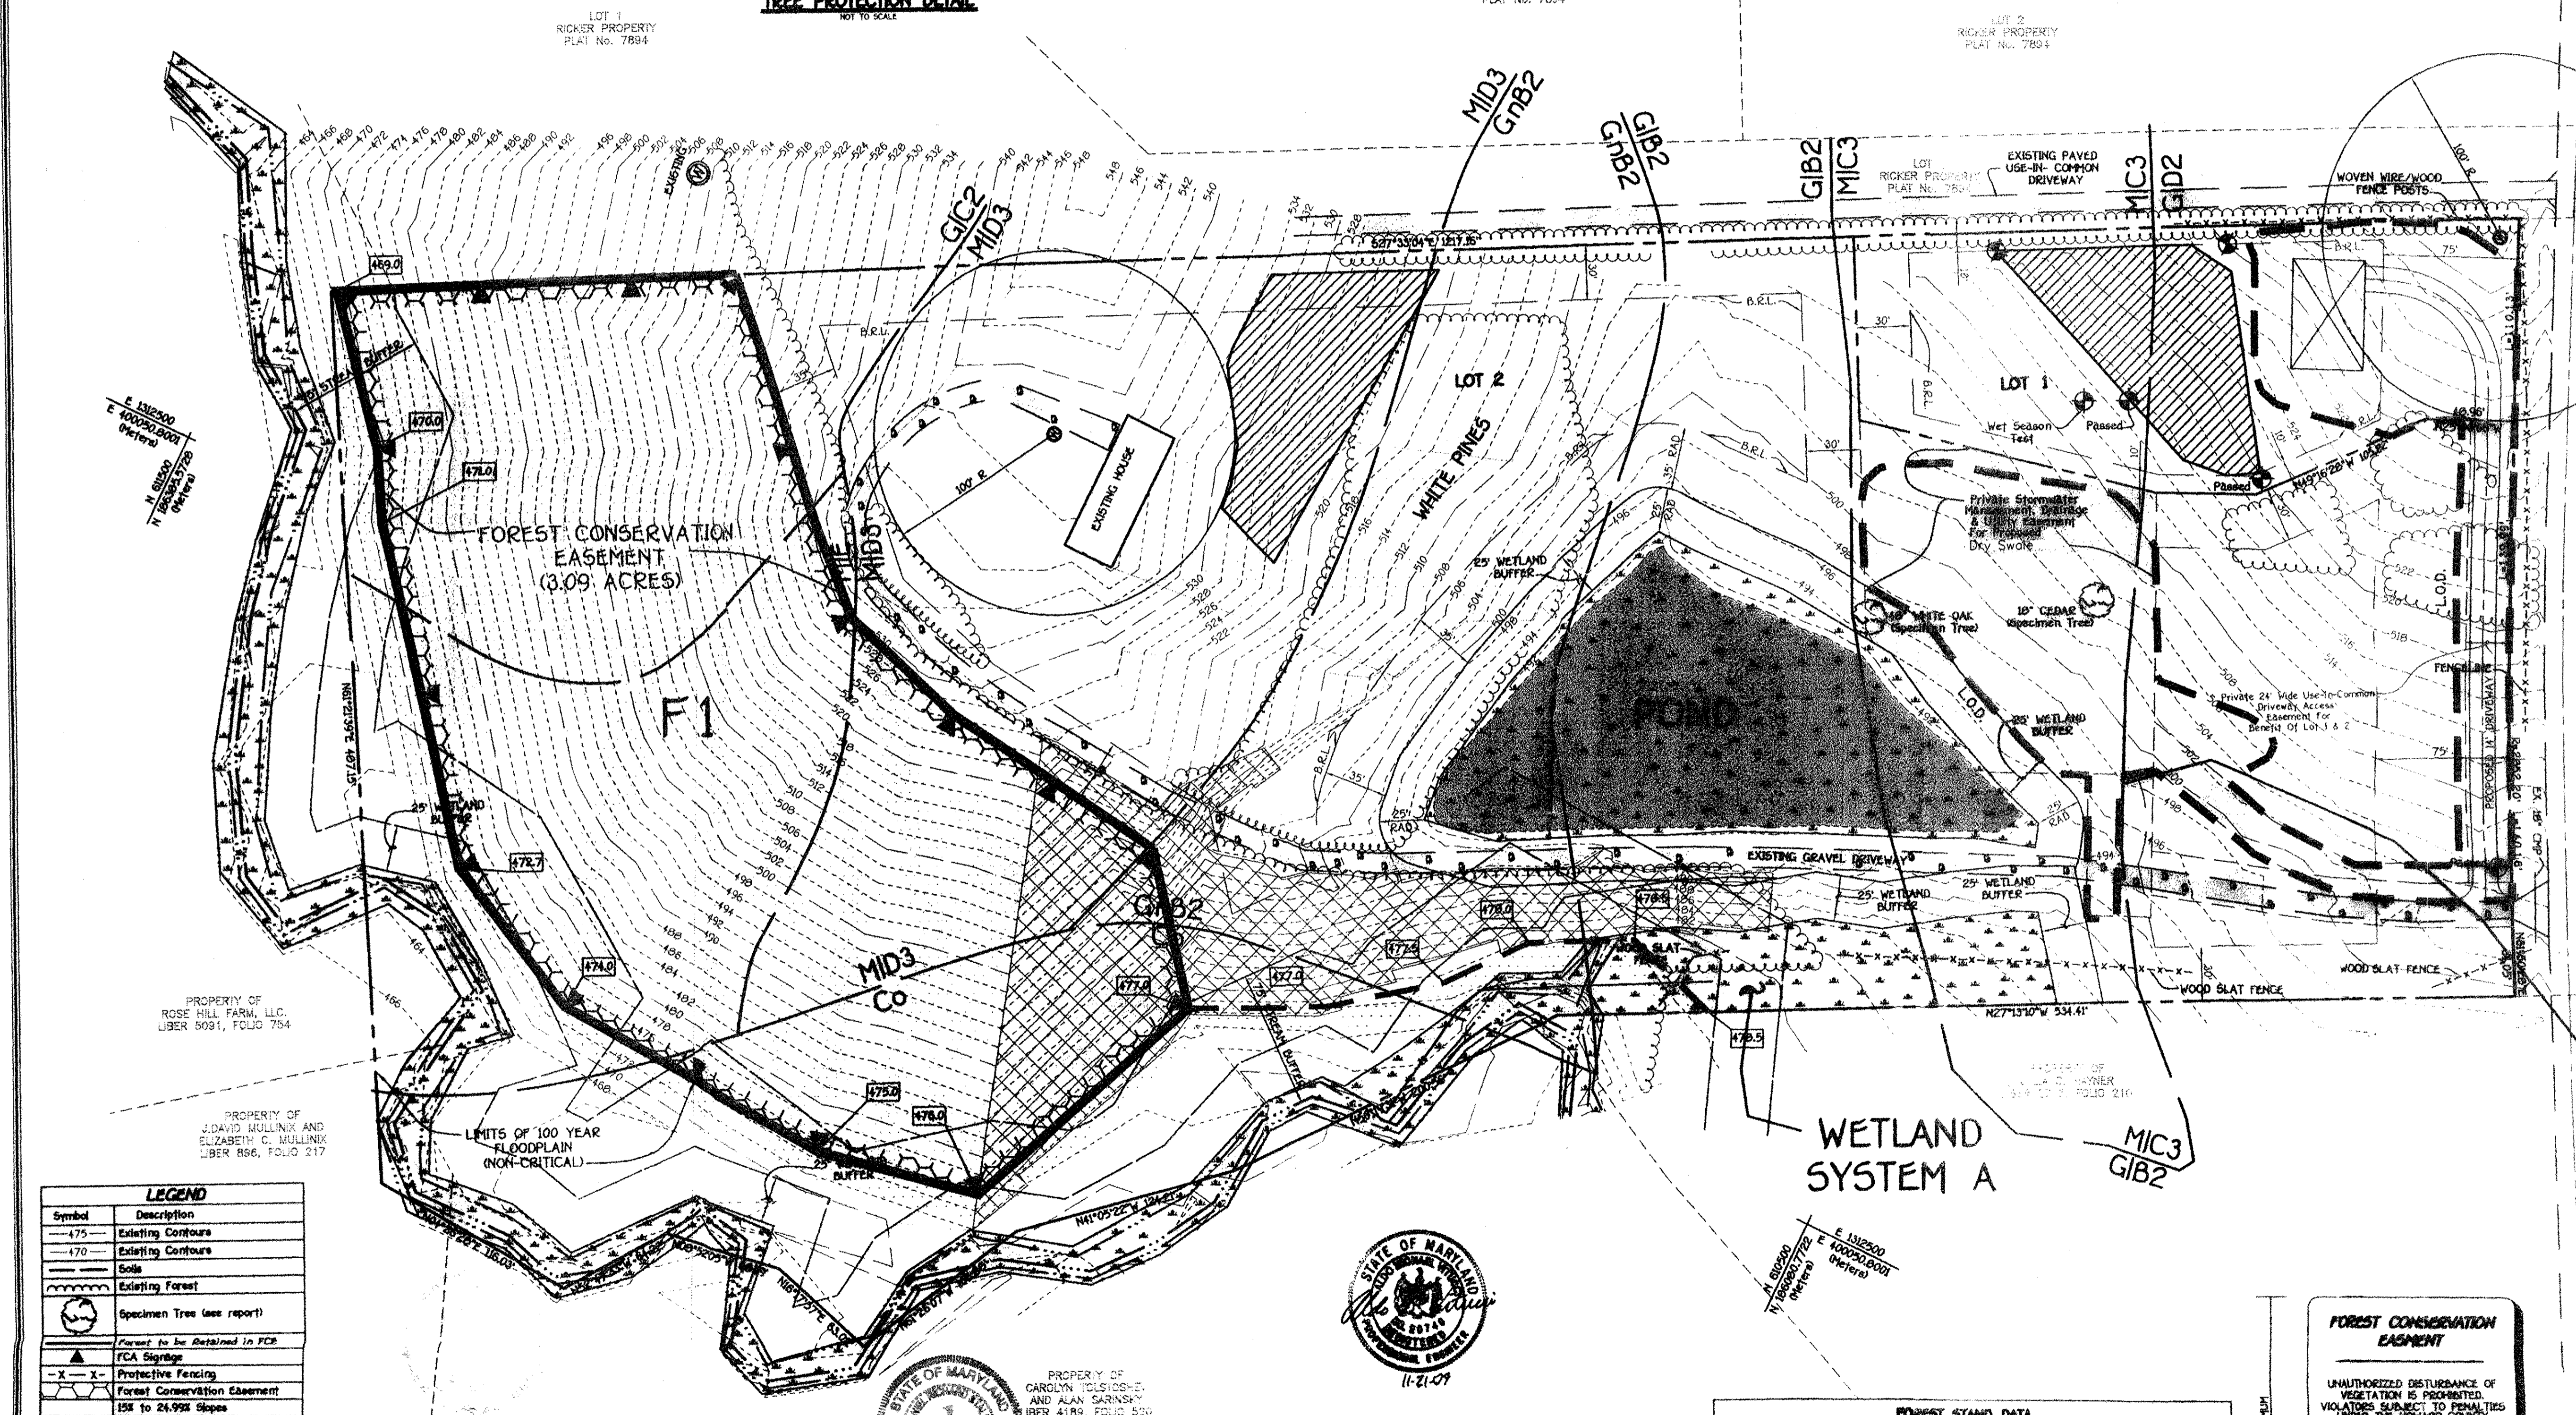

Symbol	Description
-475-	Existing Contours
-470-	Existing Contours
Soils	Soils
Existing Forest	Existing Forest
Specimen Tree (see report)	Specimen Tree (see report)
Forest to be Retained in FCP	Forest to be Retained in FCP
FCA Signage	FCA Signage
-X-X-	Protective Fencing
Forest Conservation Easement	Forest Conservation Easement
15% to 24.9% Slopes	15% to 24.9% Slopes
25% or Greater Slopes	25% or Greater Slopes

FISHER, COLLINS & CARTER, INC.
 CIVIL ENGINEERING CONSULTANTS & LAND SURVEYORS
 30715 Base Planning

Eco-Science Professionals, Inc.
 MD ENR Qualified Professional
 USACE Wetland Designer
 Certification # MD03900000448

D.R.S. & ASSOCIATES
 LAND DESIGN CONSULTANTS
 22 WINTERS STREET
 WESTMINSTER, MARYLAND 21157
 410-848-4060 410-876-8040
 FAX 410-876-7603

APPROVED DEPARTMENT OF PLANNING AND ZONING
 Kat Sheehan, Director
 CHIEF, DIVISION OF LAND DEVELOPMENT DATE: 3/9/07
 [Signature]
 CHIEF, DEVELOPMENT ENGINEERING DIVISION DATE: 3/16/07

FOREST STAND DATA					
KEY	COMMUNITY TYPE	ACREAGE	DOMINANT VEGETATION	GENERAL CONDITION	PRIORITY ACREAGE
F1	POPLAR	3.09	LINDODENDRUM TULIPIFERA, PENNSYLVANICA, ACER RUBRUM, QUERUS ALBA, LINERA BAZON	GOOD	3.09

SEE ACCOMPANYING REPORT FOR COMPLETE STAND DESCRIPTIONS

FOREST CONSERVATION EASEMENT
 UNAUTHORIZED DISTURBANCE OF VEGETATION IS PROHIBITED. VIOLATORS SUBJECT TO PENALTIES UNDER THE HOWARD COUNTY FOREST CONSERVATION ACT OF 1992.
 TREES FOR YOUR FUTURE



REVISED
 Wetland Delineation,
 Forest Stand Delineation &
 Forest Conservation Plan
GROSS PROPERTY
 LOTS 1 And 2
 TAX MAP No. 9 GRID 1 PARCEL No. 69
 FOURTH ELECTION DISTRICT
 HOWARD COUNTY, MARYLAND
 DATE: NOVEMBER 10, 2002
 SHEET 2 OF 4

APPROVED DEPARTMENT OF PLANNING AND ZONING

CHIEF, DIVISION OF LAND DEVELOPMENT DATE


CHIEF, DEVELOPMENT ENGINEERING DIVISION DATE

XXXXXX DENOTES SLOPES 25% OR GREATER

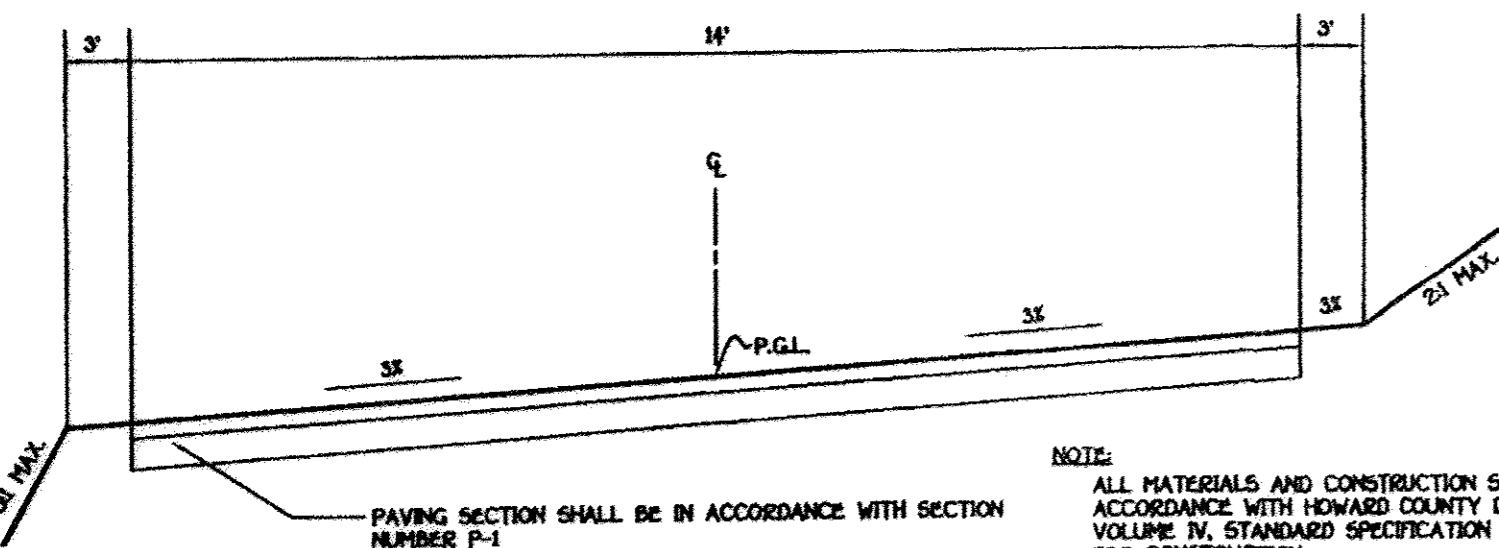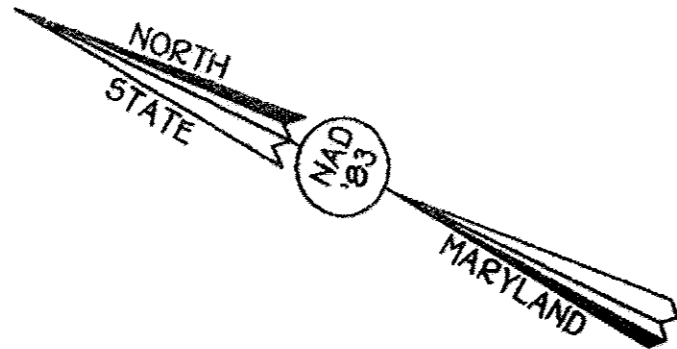

TYPICAL RESIDENTIAL DRIVEWAY
NO SCALE

ROAD NAME	CLASSIFICATION	DESIGN SPEED	ZONING	STATION LIMITS	PAVING SECTION
DRIVEWAY	PRIVATE DRIVEWAY	15 MPH	RC-DEO	0+00 TO 3+95.10	P-1

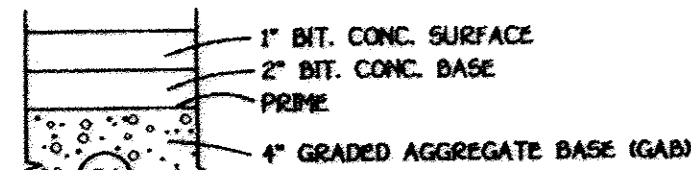

P-1 PAVING SECTION FOR DRIVEWAY
NO SCALE



REV. NO.	DATE	BY	REVISION
1	2006-09-06	DRS/smh	REMOVED PROPOSED BIO-RETENTION FACILITY AND ASSOCIATED GRADING, NOTES AND DETAILS. ADDED DRYSWALE, CHECK DAMS, UNDERDRAIN, PROFILE AND CROSS SECTION.
2	2010-03-16	DRS/jfs	UPDATE WITH AS-BUILT INFORMATION
3	2010-06-23	DRS/smh	UPDATED AS-BUILT INFORMATION PER FIELD REVISIONS
4	2010-08-30	DRS/smh	UPDATED AS-BUILT INFORMATION PER FIELD REVISIONS
5	2013-04-11	DRS/jfs	UPDATED AS-BUILT INFORMATION PER FIELD REVISIONS

PURPOSE: TO REPLACE THE PREVIOUSLY APPROVED BIO-RETENTION FACILITY WITH A DRYSWALE WITH CHECK DAMS AND UNDERDRAIN.


D.R.S. & ASSOCIATES
LAND DESIGN CONSULTANTS
52 WINTERS STREET
WESTMINSTER, MARYLAND 21157
410-848-4060 410-876-6040
FAX 410-876-7603




FISHER, COLLINS & CARTER, INC.
CIVIL ENGINEERING CONSULTANTS & LAND SURVEYORS
CENTRAL SQUARE OFFICE PARK - 10222 BALTIMORE NATIONAL FREE
BLIHOFF CITY, MARYLAND 21042
410 461 - 2255

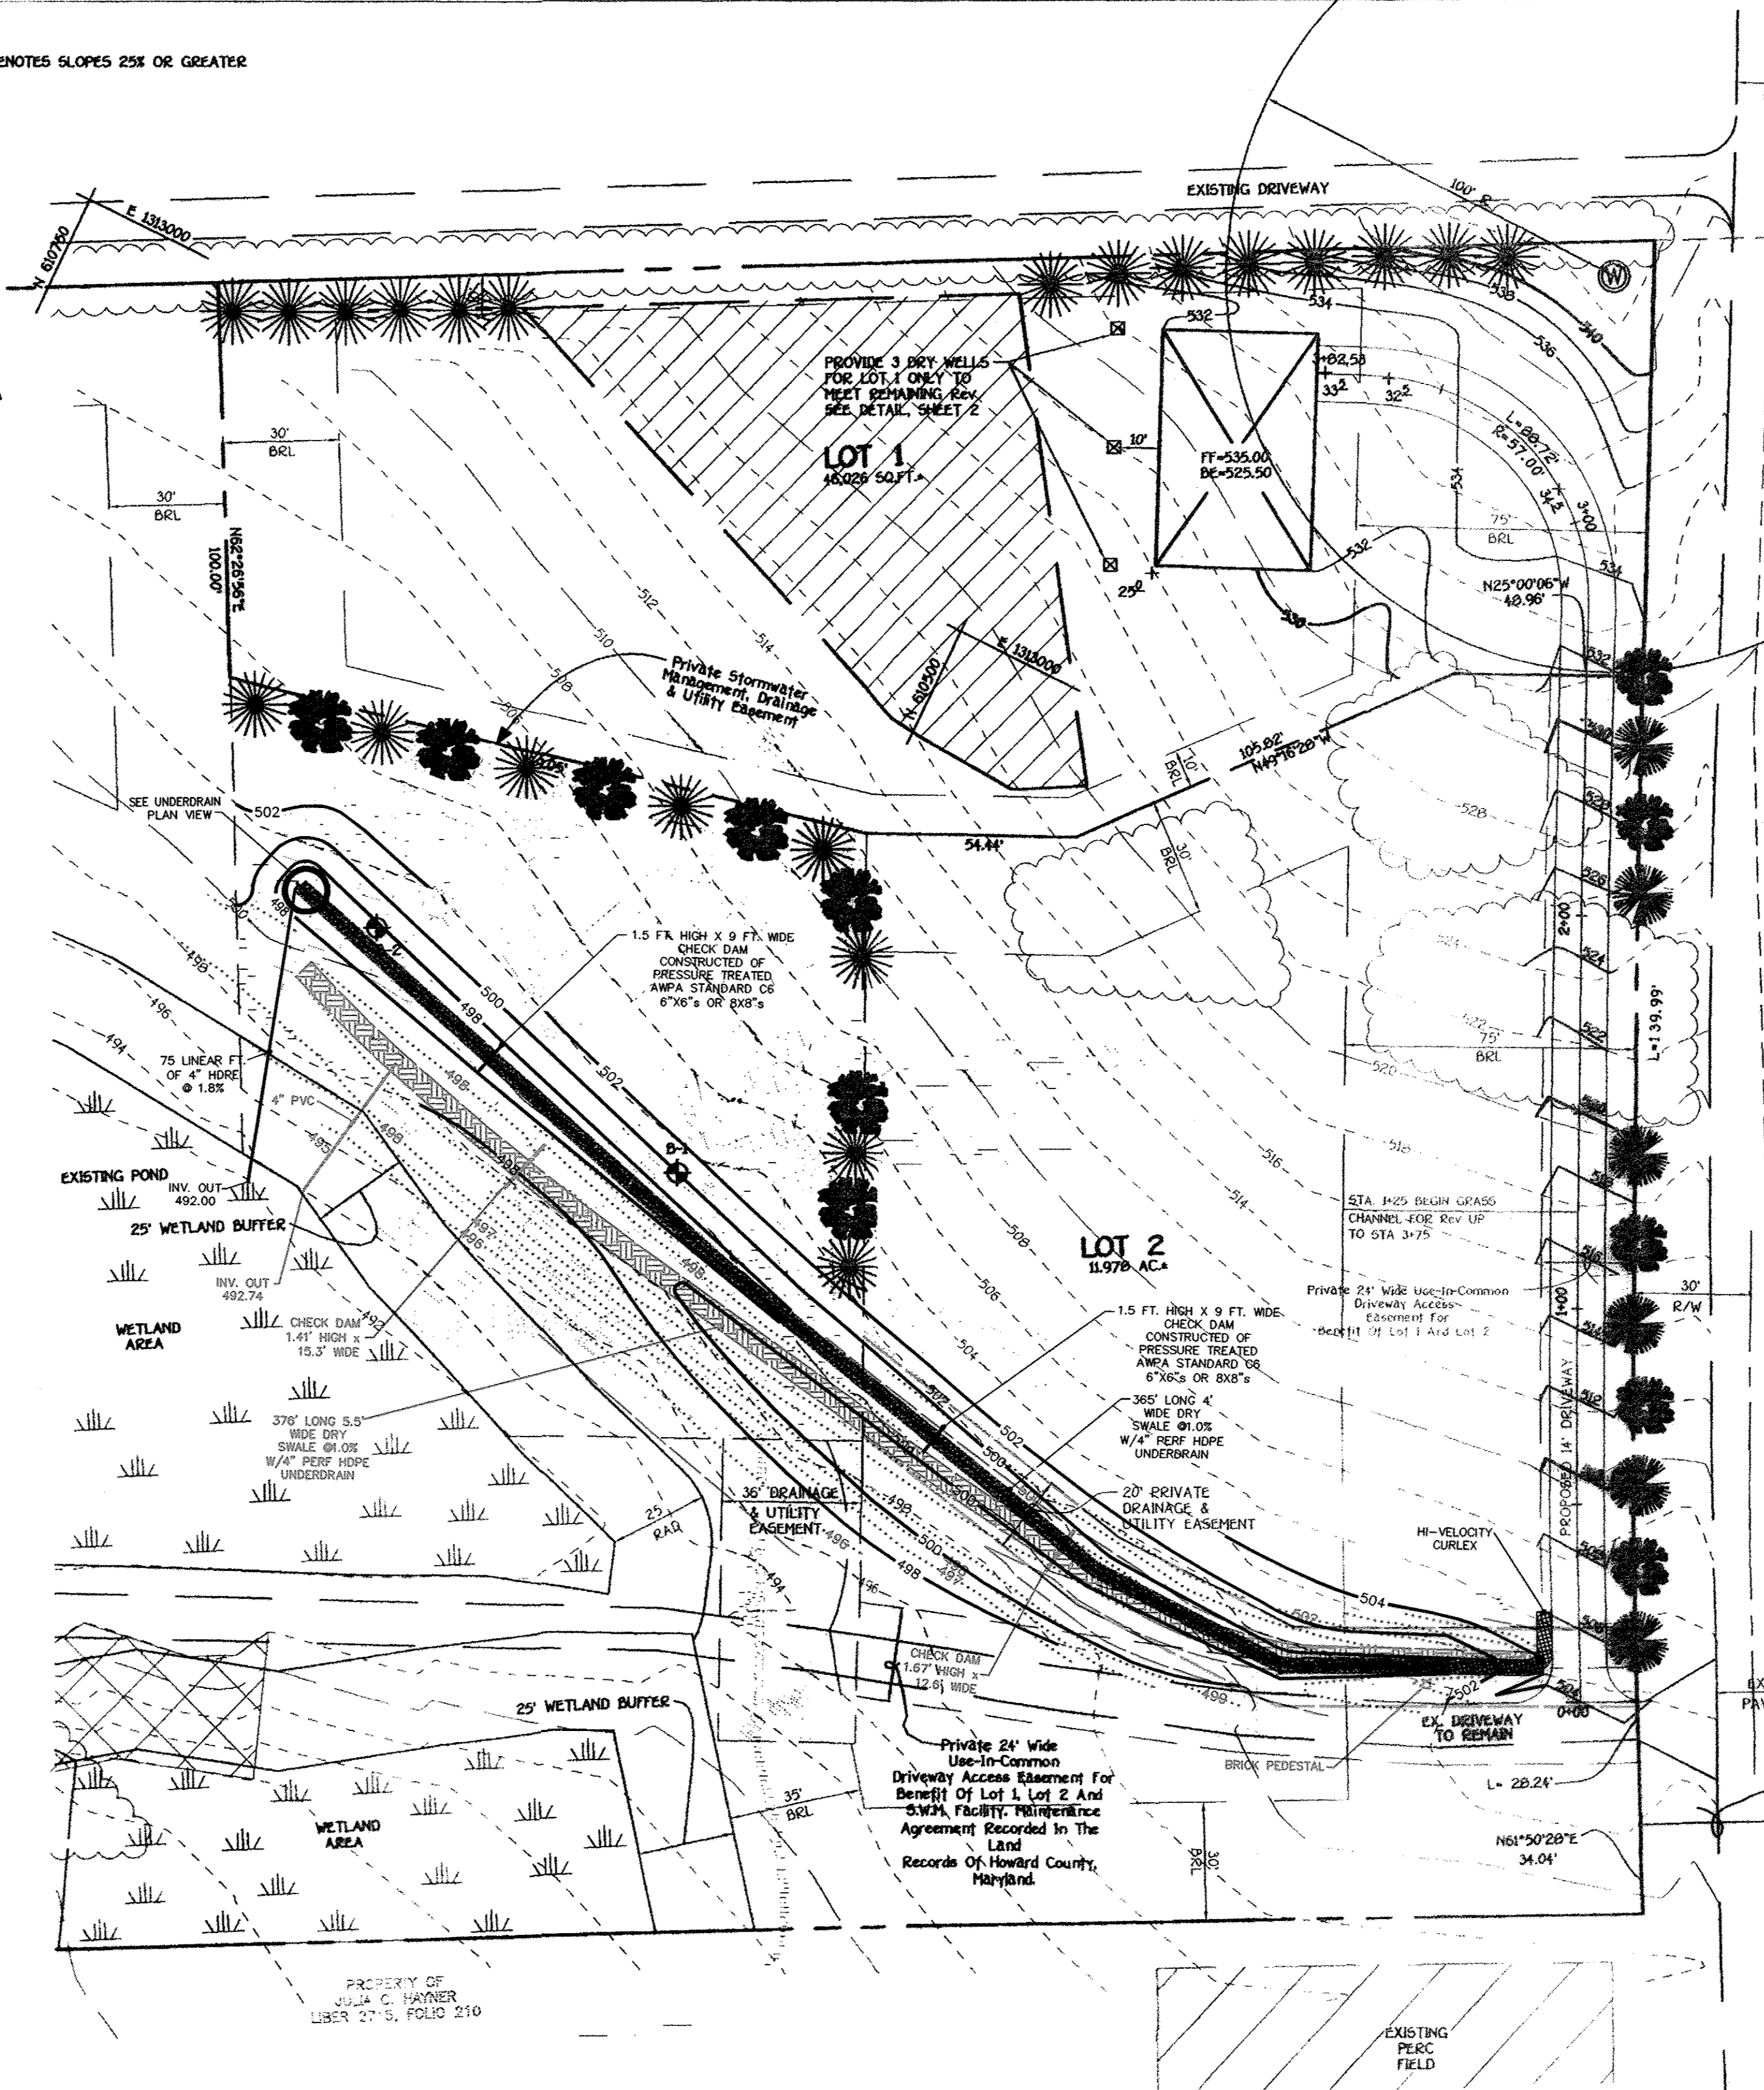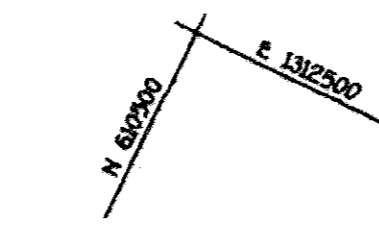


FORSYTHE ROAD
60' R/W

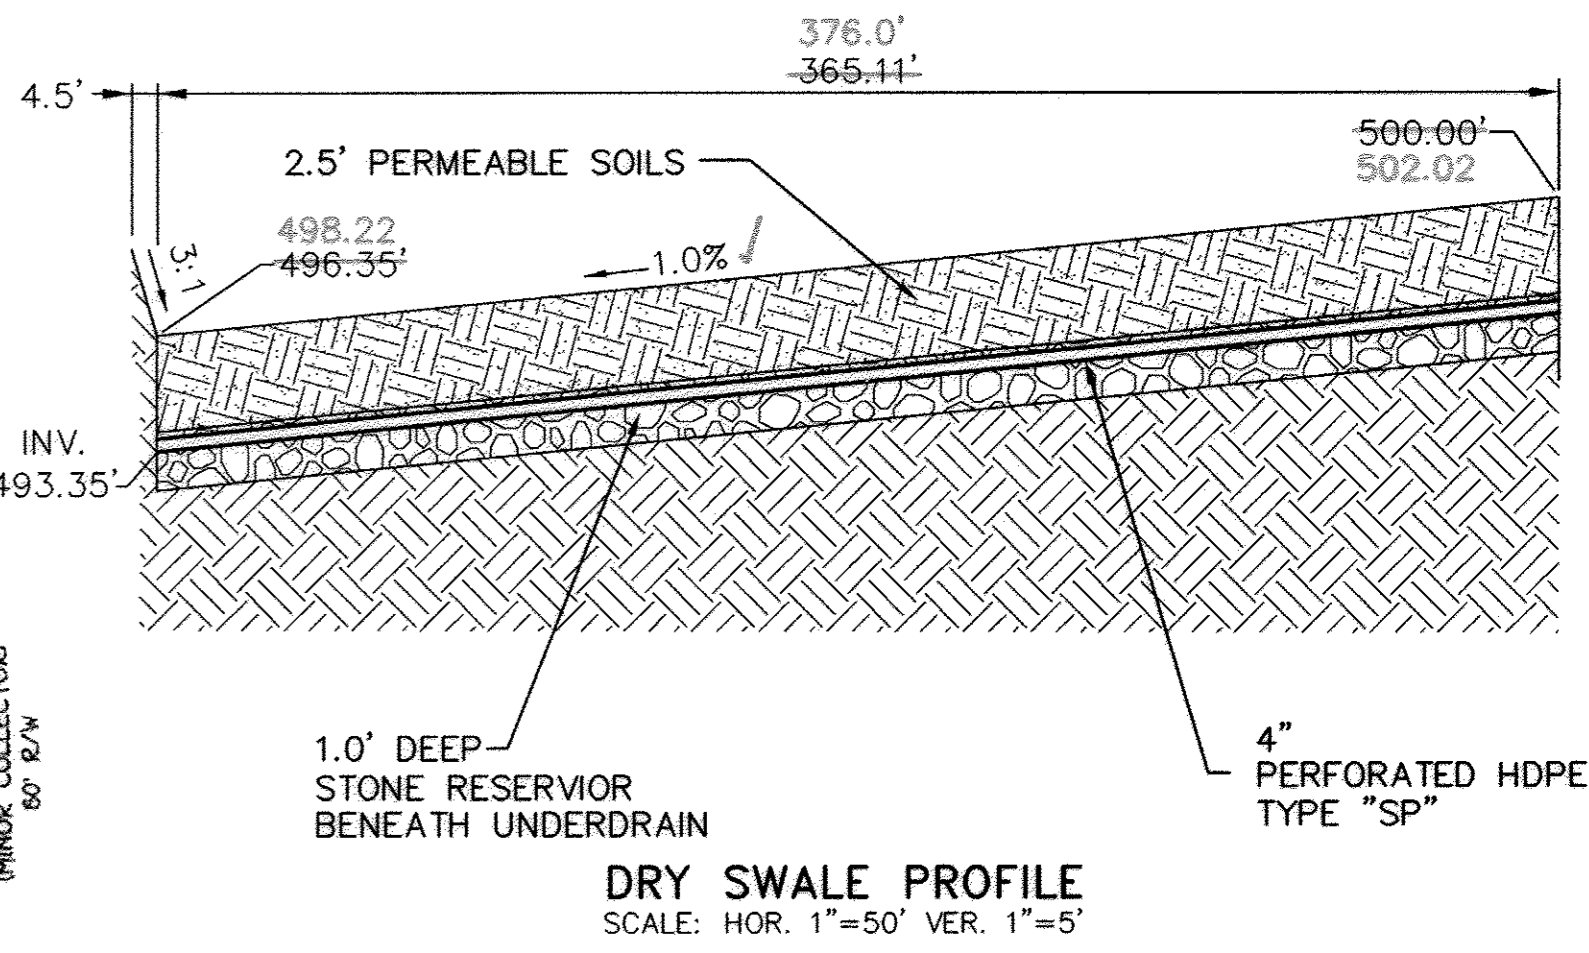

DRY SWALE PROFILE
SCALE: HOR. 1"=50' VER. 1"=5'

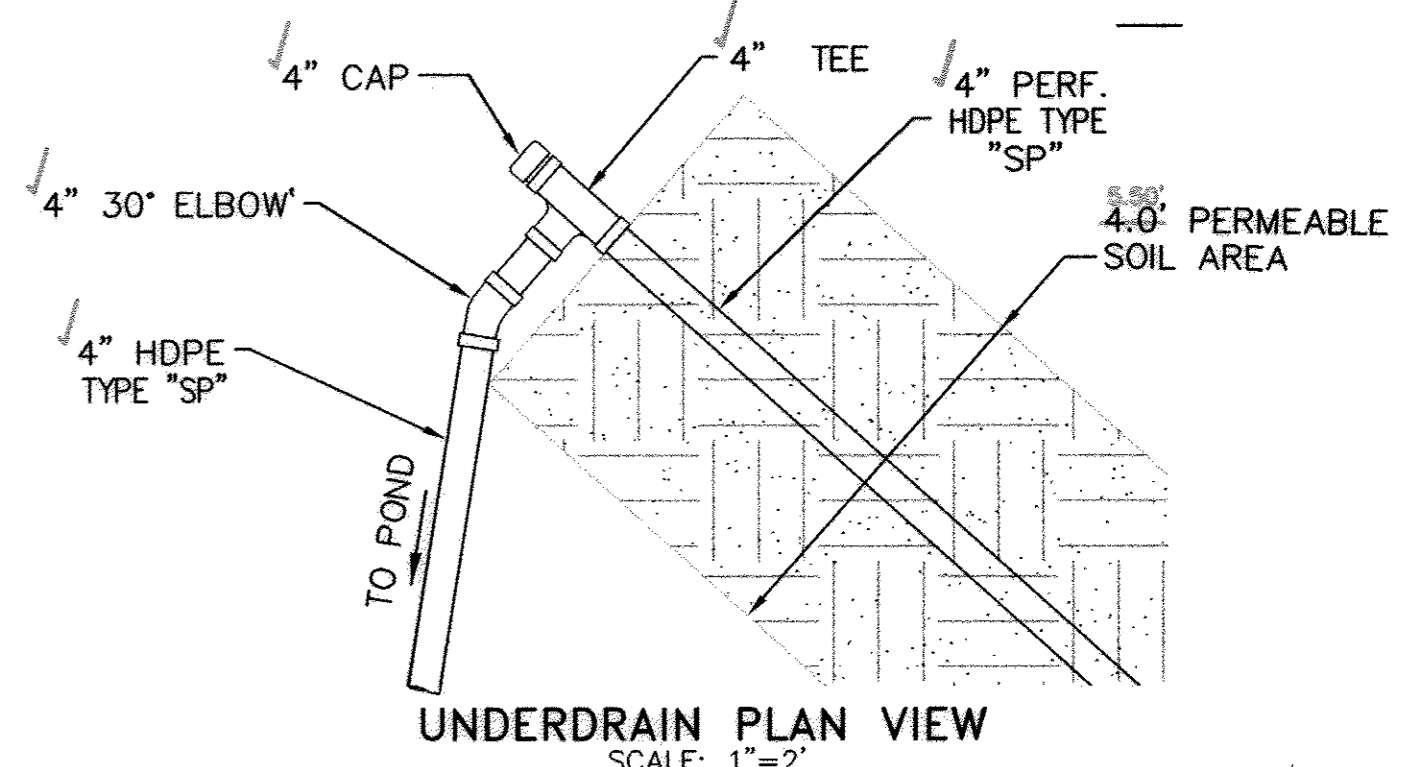

UNDERDRAIN PLAN VIEW
SCALE: 1"=2'

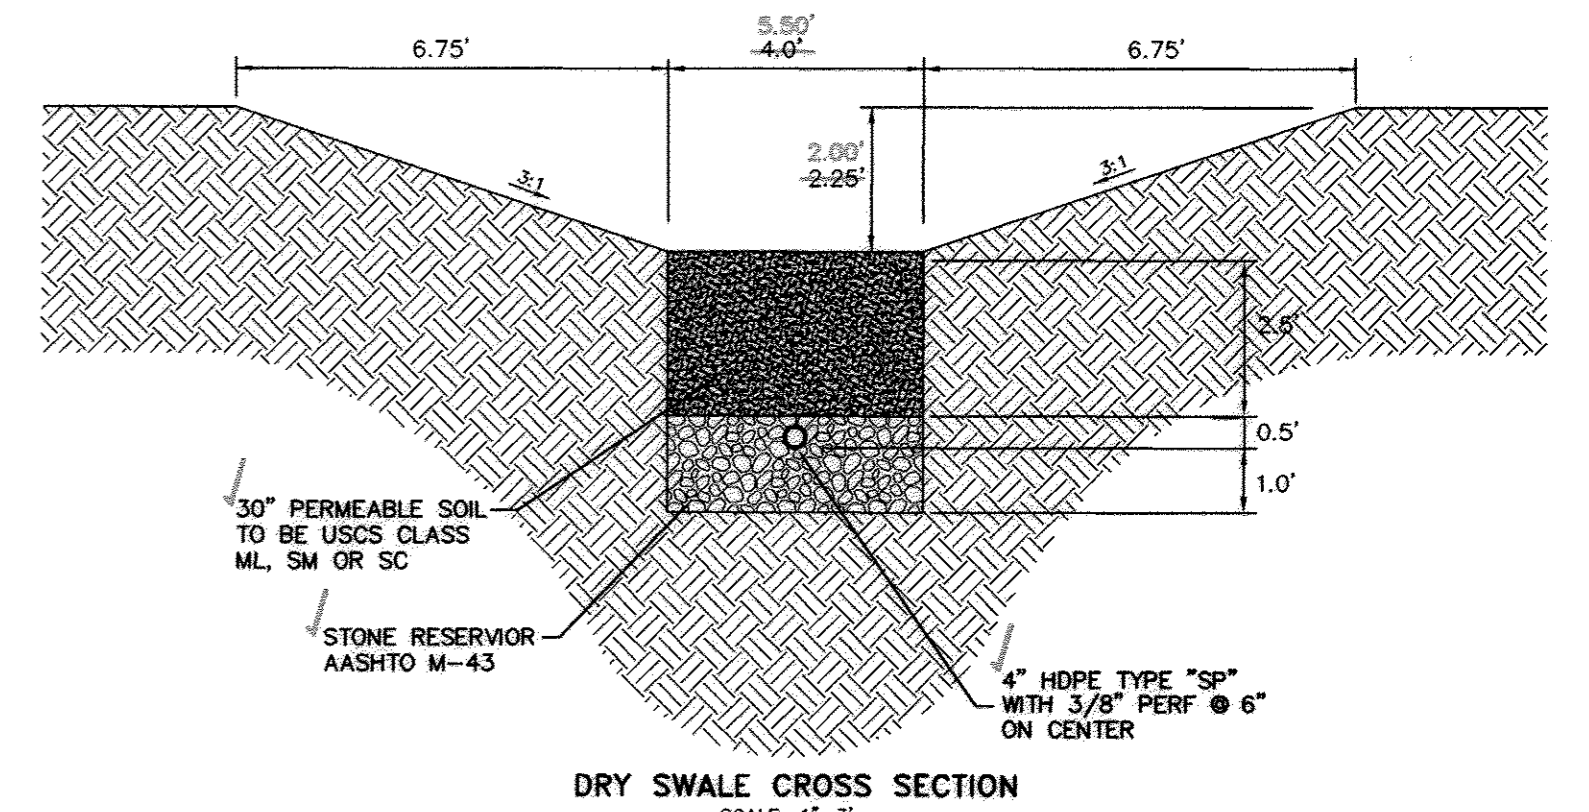


DRY SWALE CROSS SECTION
SCALE: 1"=3'

As Built Certification

I hereby certify that in accordance with Section 5.4.2.B.3, Volume I and Section 1100.03, Volume IV of the Design Manual, the facility shown on Revised Final S.W.M./Driveway Construction Plan Gross Property was constructed to the lines shown in red marked as built.

Signed: *Daniel R. Selby* 2013-05-27 Date

License No.: 10735 Expiration Date: 2014-01-18

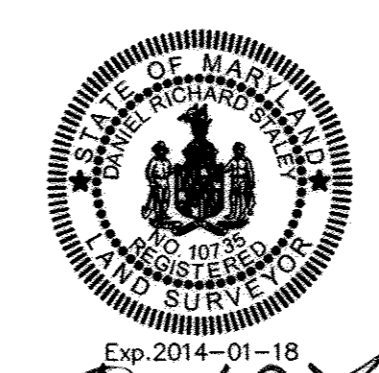

Daniel R. Selby

OWNER
ANGUS ROY GROSS AND ADRIENNE R. GROSS
13920 FORSYTHE ROAD
SYKESVILLE, MARYLAND 21784-5613

DEVELOPER
DAN RICKER
13920 FORSYTHE ROAD
SYKESVILLE, MARYLAND 21784


**As-Built
REVISED
FINAL S.W.M. / DRIVEWAY
CONSTRUCTION PLAN
GROSS PROPERTY**

LOTS 1 AND 2
ZONED RC-DEO
TAX MAP No. 9 GRID No. 1 PARCEL No. 69
FOURTH ELECTION DISTRICT
HOWARD COUNTY, MARYLAND

Scale: 1" = 30'
DATE: NOVEMBER 18, 2002
SHEET 1 OF 1

Let Skelton/1/14 *8/10/07*
 CHIEF, DIVISION OF LAND DEVELOPMENT DATE

John Quinn *8/10/07*
 CHIEF, DEVELOPMENT ENGINEERING DIVISION DATE

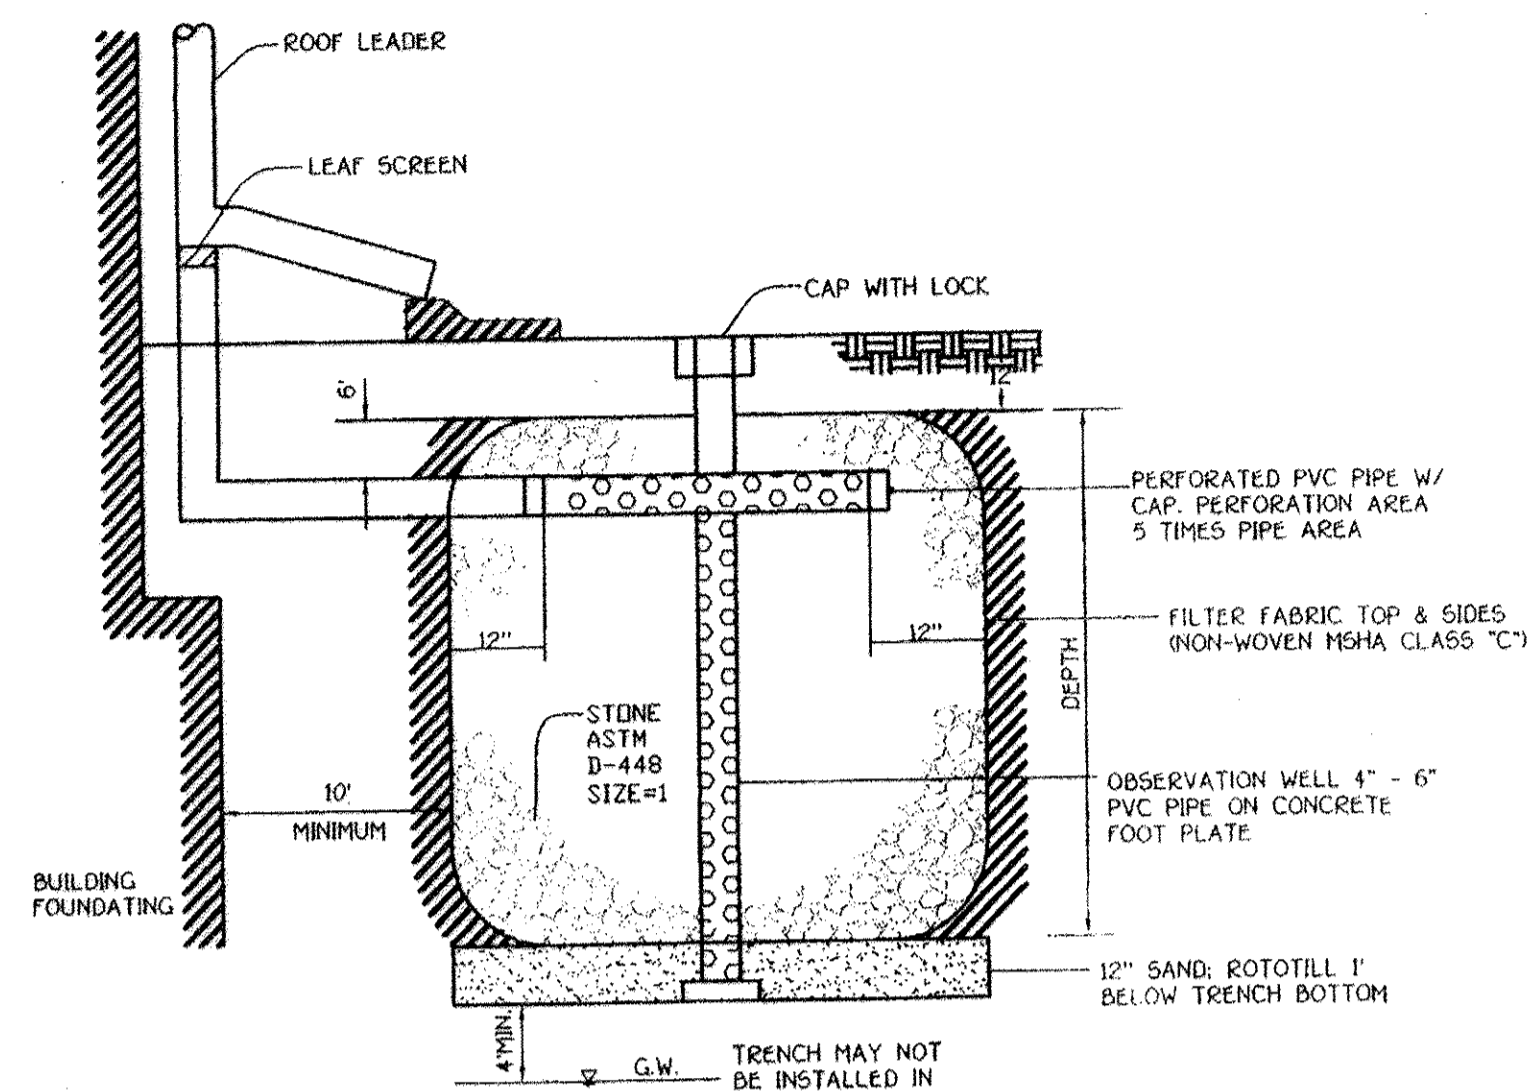


DETAIL - DRY WELL
 NOT TO SCALE

DRY WELL	DEPTH (FT)	" B " LENGTH (FT)	" A " WIDTH (FT)
1	4'	4'	4'
2	4'	4'	4'
3	4'	4'	4'

REV. NO.	DATE	BY	REVISION
1	2006-09-06	DRS/smh	REMOVED BIO-RETENTION CROSS SECTION DETAIL, STORM DRAIN PROFILE AND BIO-RETENTION DRAIN PIPE PROFILE.

PURPOSE: TO REPLACE THE PREVIOUSLY APPROVED BIO-RETENTION FACILITY WITH A DRYSWALE WITH CHECK DAMS AND UNDERDRAIN.

D.R.S. & ASSOCIATES
 LAND DESIGN CONSULTANTS
 52 WINTERS STREET
 WESTMINSTER, MARYLAND 21157
 410-848-4060 410-876-6040
 FAX 410-876-7603

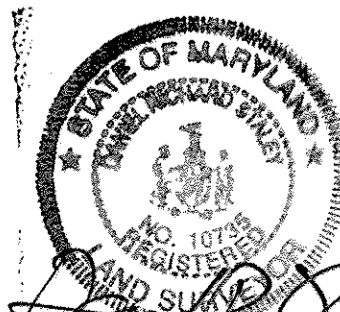


FISHER, COLLINS & CARTER, INC.
 CIVIL ENGINEERING CONSULTANTS & LAND SURVEYORS
 1200 NATIONAL SQUARE OFFICE PARK - 10272 BALTIMORE NATIONAL PIKE
 ELKLOFT CITY, MARYLAND 21042
 1938 06 - 2005

OWNER
 ANGUS ROY GROSS AND ADRIENNE R. GROSS
 13920 FORSYTHE ROAD
 SYKESVILLE, MARYLAND 21784-5613

DEVELOPER
 DAN RICKER
 13930 FORSYTHE ROAD
 SYKESVILLE, MARYLAND 21784

REVISED
 FINAL S.W.M. DETAIL SHEET
GROSS PROPERTY
 LOTS 1 AND 2
 ZONED RC-DEO
 TAX MAP No. 9 GRID No. 1 PARCEL No. 69
 FOURTH ELECTION DISTRICT
 HOWARD COUNTY, MARYLAND

Scale 1" = 30'
 DATE: NOVEMBER 18, 2002
 SHEET 4 OF 4

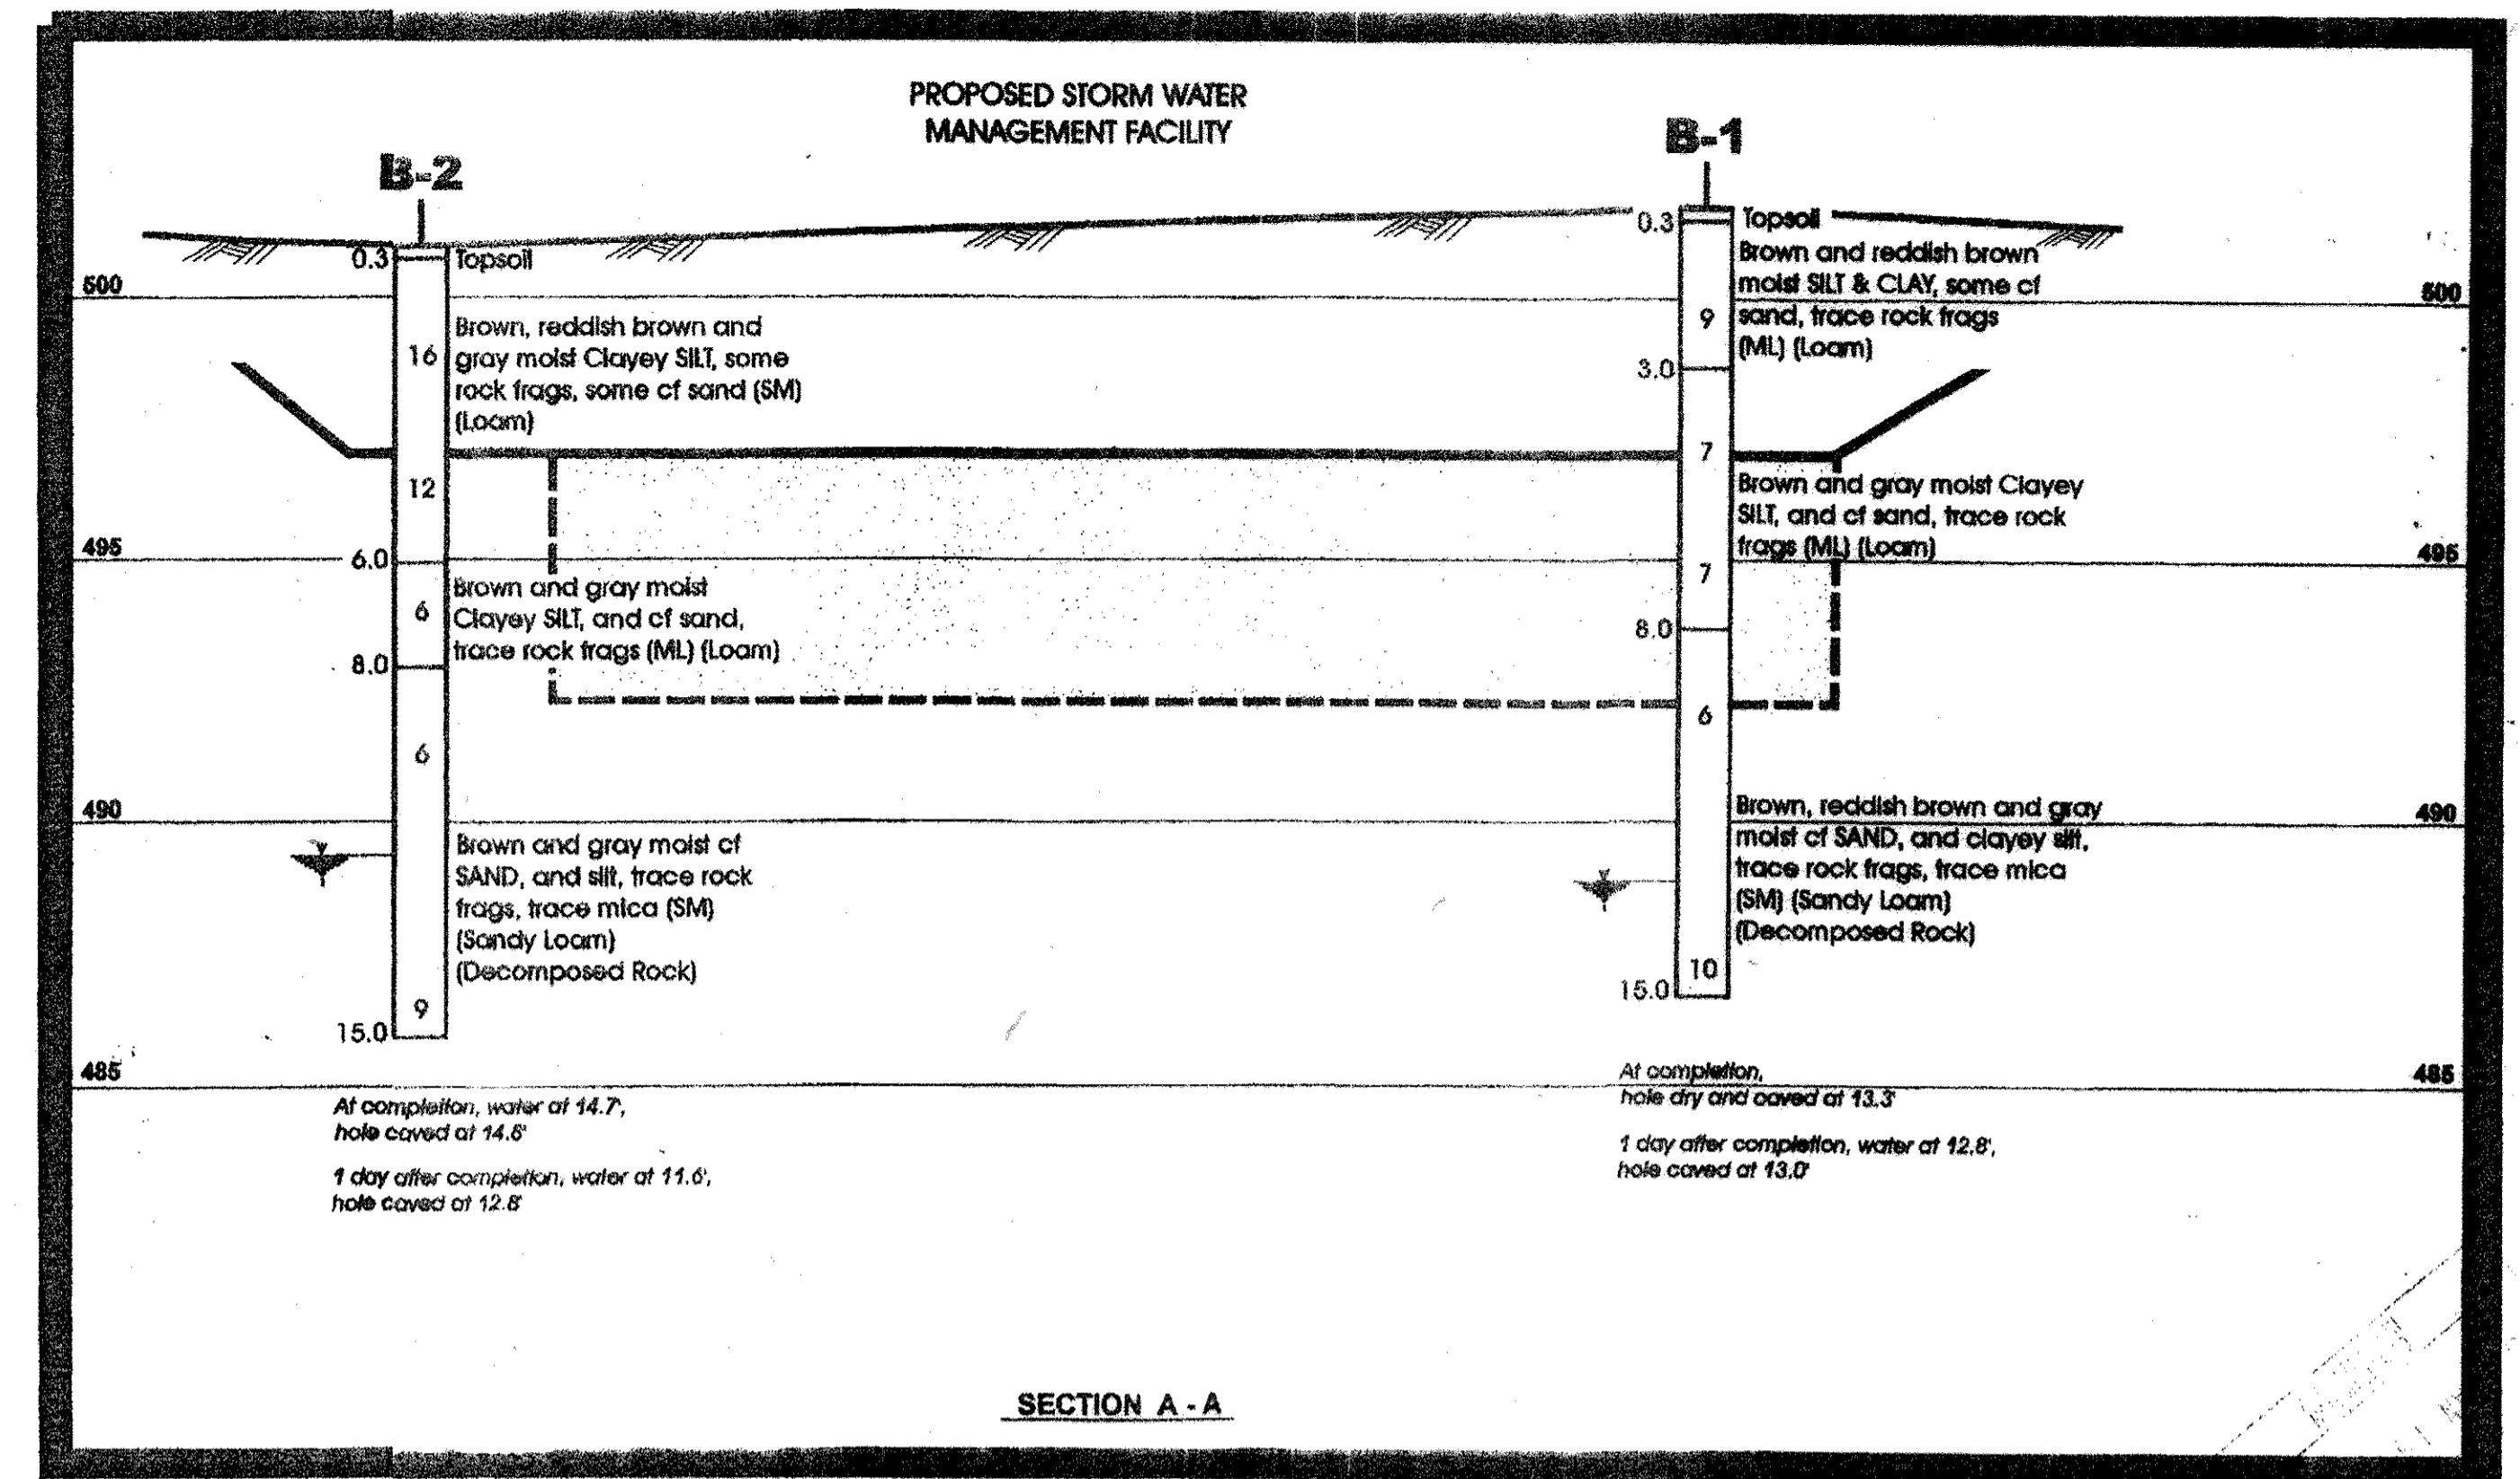

SECTION A - A

SOIL BORING DETAIL

NO SCALE