


**GENERAL NOTES**

- THE PROJECT IS IN CONFORMANCE WITH THE LATEST HOWARD COUNTY STANDARDS UNLESS WAIVERS HAVE BEEN APPROVED.
- PROJECT BACKGROUND:  
LOCATION: GORMAN ROAD @ STEPHENS ROAD  
TAX MAP: 36-18, 37-13  
ZONING: R-ED, R-SC-MXD-3, AND PEC-MXD-3  
ELECTION DISTRICT: 6  
AREA OF ROAD R/W TO BE DEDICATED: 1.53 Ac.  
LIMIT OF SUBMISSION: 6.24 Ac. (DISTURBED AREA)
- SEE DEPARTMENT OF PLANNING & ZONING FILE NUMBERS:  
S 00-13, WP 00-88, WP 00-126, WP 01-60, PB 345, WP 01-94, F 01-177, AND ZB-979.
- THE TOPOGRAPHY SHOWN HAS A 2' CONTOUR INTERVAL AND WAS DETERMINED BY: AERIAL PHOTOGRAPHY BY DAFT, McCUNE & WALKER, SUMMER 1998.
- PUBLIC WATER AND SEWER TO BE UTILIZED.  
SITE IS IN METROPOLITAN DISTRICT.
- HORIZONTAL AND VERTICAL CONTROL BASED ON HOWARD COUNTY CONTROL STATIONS 21941003 & 21941004.
- INFORMATION CONCERNING UNDERGROUND UTILITIES WAS OBTAINED FROM BEST AVAILABLE RECORDS. THE CONTRACTOR MUST DETERMINE THE EXACT LOCATION AND ELEVATION OF THE MAINS BY DIGGING TEST PITS BY HAND AT ALL CROSSINGS WELL IN ADVANCE OF CONSTRUCTION. ANY DISCREPANCIES MUST BE COMMUNICATED TO THE ENGINEER AT ONCE.
- ALL CONSTRUCTION SHALL BE IN ACCORDANCE WITH THE LATEST STANDARDS AND SPECIFICATIONS OF HOWARD COUNTY AND MSHA STANDARDS AND SPECIFICATIONS, IF APPLICABLE.
- THE CONTRACTOR SHALL NOTIFY THE DEPARTMENT OF PUBLIC WORKS /DIVISION OF CONSTRUCTION INSPECTION AT 1 (410) 313 - 1880 AT LEAST FIVE (5) DAYS PRIOR TO THE START OF WORK.
- THE CONTRACTOR SHALL NOTIFY THE FOLLOWING UTILITIES OR AGENCIES AT LEAST FIVE (5) WORKING DAYS BEFORE STARTING WORK SHOWN ON THE PLANS.  
MISS UTILITY 1-800-257-7777  
VERIZON 1-800-446-5266  
HOWARD COUNTY BUREAU OF UTILITIES 410-313-4900  
AT&T CABLE LOCATION DIVISION 393-3553  
BALTIMORE GAS & ELECTRIC CO. 410-850-4620 & 410-787-9068

# CONSTRUCTION PLAN FOR ROAD IMPROVEMENTS TO GORMAN ROAD STA. 97+99.27 TO 118+00 AND STEPHENS ROAD STA. 0+00 TO 2+55

**LEGEND**

- EXISTING STREET LIGHT
- PROPOSED STREET LIGHT
- PROP. TOP OF CURB ELEVATION
- EX. 12" W EXISTING WATER MAIN
- EX. 18" SD EXISTING STORM DRAIN
- EXIST. CURB/CURB & GUTTER
- PROP. CURB & GUTTER
- EXISTING PAVING
- EXISTING CONTOUR
- PROPOSED CONTOUR
- PROPOSED STREET TREES
- STEEP SLOPES (25% OR GREATER)
- STREAM BUFFER
- WETLAND BUFFER
- EXISTING CONTOUR
- PROPOSED CONTOUR
- EXISTING TREE LINE
- LIMIT OF DISTURBANCE

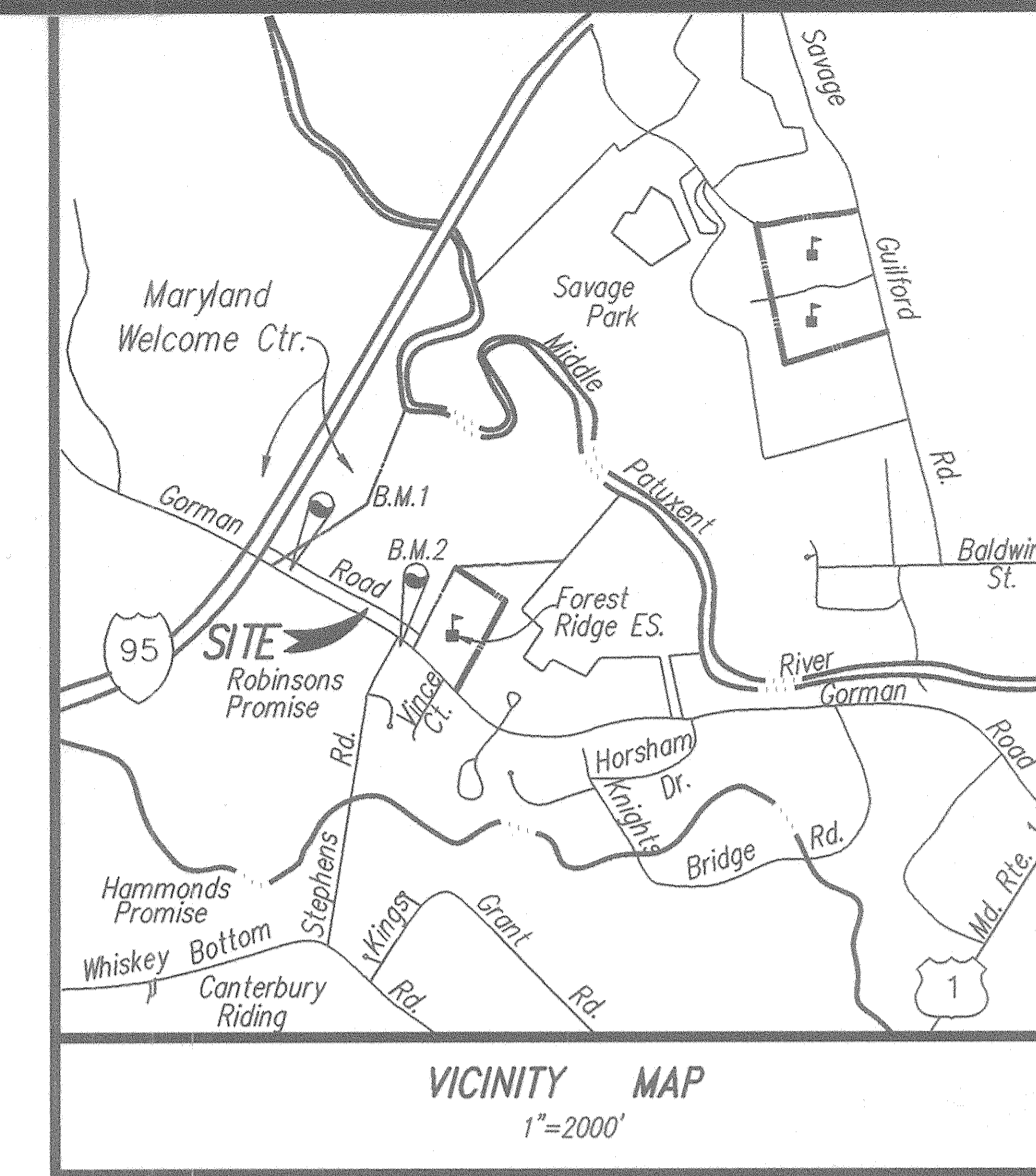


VICINITY MAP  
1"=2000'

**BENCHMARKS**

B.M. 1 HOWARD COUNTY CONTROL STATION 47E4  
B.M. 2 HOWARD COUNTY CONTROL STATION 1941003

- TYPES OF STORM DRAINS REFER TO THE STANDARD DETAILS OF HOWARD COUNTY AND MSHA.
- TRENCH COMPACTION FOR STORM DRAINS WITHIN ROADS AND STREET RIGHT - OF - WAYS LIMITS SHALL BE IN ACCORDANCE WITH "HOWARD COUNTY DESIGN MANUAL", VOL. IV, STANDARD G-2.01.
- SEDIMENT CONTROL SHALL BE PROVIDED IN ACCORDANCE WITH "1994 MARYLAND STANDARDS AND SPECIFICATION FOR SOILS EROSION AND SEDIMENT CONTROL".
- TRAFFIC CONTROL DEVICES, MARKINGS, AND SIGNING SHALL BE IN ACCORDANCE WITH THE LATEST EDITION OF THE MANUAL ON UNIFORM TRAFFIC CONTROL DEVICES (MUTCD).
- STREET TREES SHALL BE PLANTED A MINIMUM OF FIVE (5) FEET FROM STORM DRAIN, WATERLINE OR SEWER PIPE MANHOLES; ALSO A MINIMUM OF TWENTY (20) FEET FROM STREET LIGHTS.
- COMPACTION IN FILL AREAS SHALL BE IN ACCORDANCE WITH AASHTO T-180 OR AS APPROVED IN THE DESIGN MANUAL VOLUME IV.
- WETLAND STREAM DELINEATION BY DAFT, McCUNE AND WALKER.
- TRAFFIC STUDY WAS PREPARED AND SUBMITTED AS PART OF THE SKETCH PLAN FOR THE STONE LAKE SUBDIVISION, FILE NUMBER S 00-13.
- ALL ROADS IN THIS SUBDIVISION ARE PUBLIC.
- STREET TREE LOCATIONS SHOWN ARE TENTATIVE AND ARE TO BE USED FOR BOND PURPOSES ONLY. THE FINAL LOCATION AND VARIETY OF TREES MAY VARY TO ACCOMMODATE FIELD CONDITIONS AND BUILDERS LANDSCAPE PROGRAM.
- FOREST CONSERVATION OBLIGATIONS FOR THE ACREAGE SHOWN ON THIS PLAT HAS BEEN OR WILL BE ADDRESSED WITH THE SUBDIVISION PLANS FOR STONE LAKE (F 01-177) AND EMERSON, SECTION 2.
- STORM WATER MANAGEMENT FOR THIS SITE HAS BEEN SUBMITTED AND APPROVED UNDER F-01-177. THE FACILITY IS PRIVATELY OWNED AND MAINTAINED. THE TYPE OF FACILITY IS A WET POND WITH DETENTION.
- ON AUGUST 11, 2000, WP 00-88; WAIVER SECTION 16.116 b(1) AND (2) WAS GRANTED WHICH PROHIBITS GRADING OR CLEARING ON STEEP SLOPES OVER 25% IF THE CONTIGUOUS AREA IS MORE THAN 20,000 SQUARE FEET; AND SECTION 16.116(C), WAS GRANTED, WHICH PROHIBITS GRADING OR CLEARING IN WETLANDS, WETLAND BUFFERS, STREAMS, STREAM BUFFERS AND FLOODPLAINS, SUBJECT TO FIVE CONDITIONS IN THE APPROVAL LETTER.
- ON AUGUST 11, 2000, WP 00-126; WAIVER OF SECTION 16.144 (C)(2) AND 16.114q(3) WAS GRANTED WHICH REQUIRES THAT A DEVELOPER SUBMIT ADDITIONAL INFORMATION TO THE SRC WITHIN 45 DAYS OF RECEIVING NOTICES TO DO SO OR THE PLAN WILL BE DENIED, SUBJECT TO ONE CONDITION IN THE APPROVAL LETTER.
- ON JANUARY 16, 2000, WP 01-60; WAIVER OF SECTION 16.120 c (2) WAS GRANTED WHICH REQUIRES ALL LOTS TO HAVE FRONTAGE ON A PUBLIC ROAD; AND SECTION 16.120 c (4) WHICH LIMITS THE LENGTH OF A PRIVATE ROAD FOR SFA UNITS TO 200, SUBJECT TO ONE CONDITION IN THE APPROVAL LETTER.
- ON, APRIL 3, 2001, WP 01-94, WAIVER OF SECTIONS 16.116 b (1) AND (2) WAS GRANTED WHICH CLEARING ON STEEP SLOPES OVER 25% AND GREATER THAN 20,000 SQUARE FEET IN CONTIGUOUS AREA, SUBJECT TO THREE CONDITIONS.

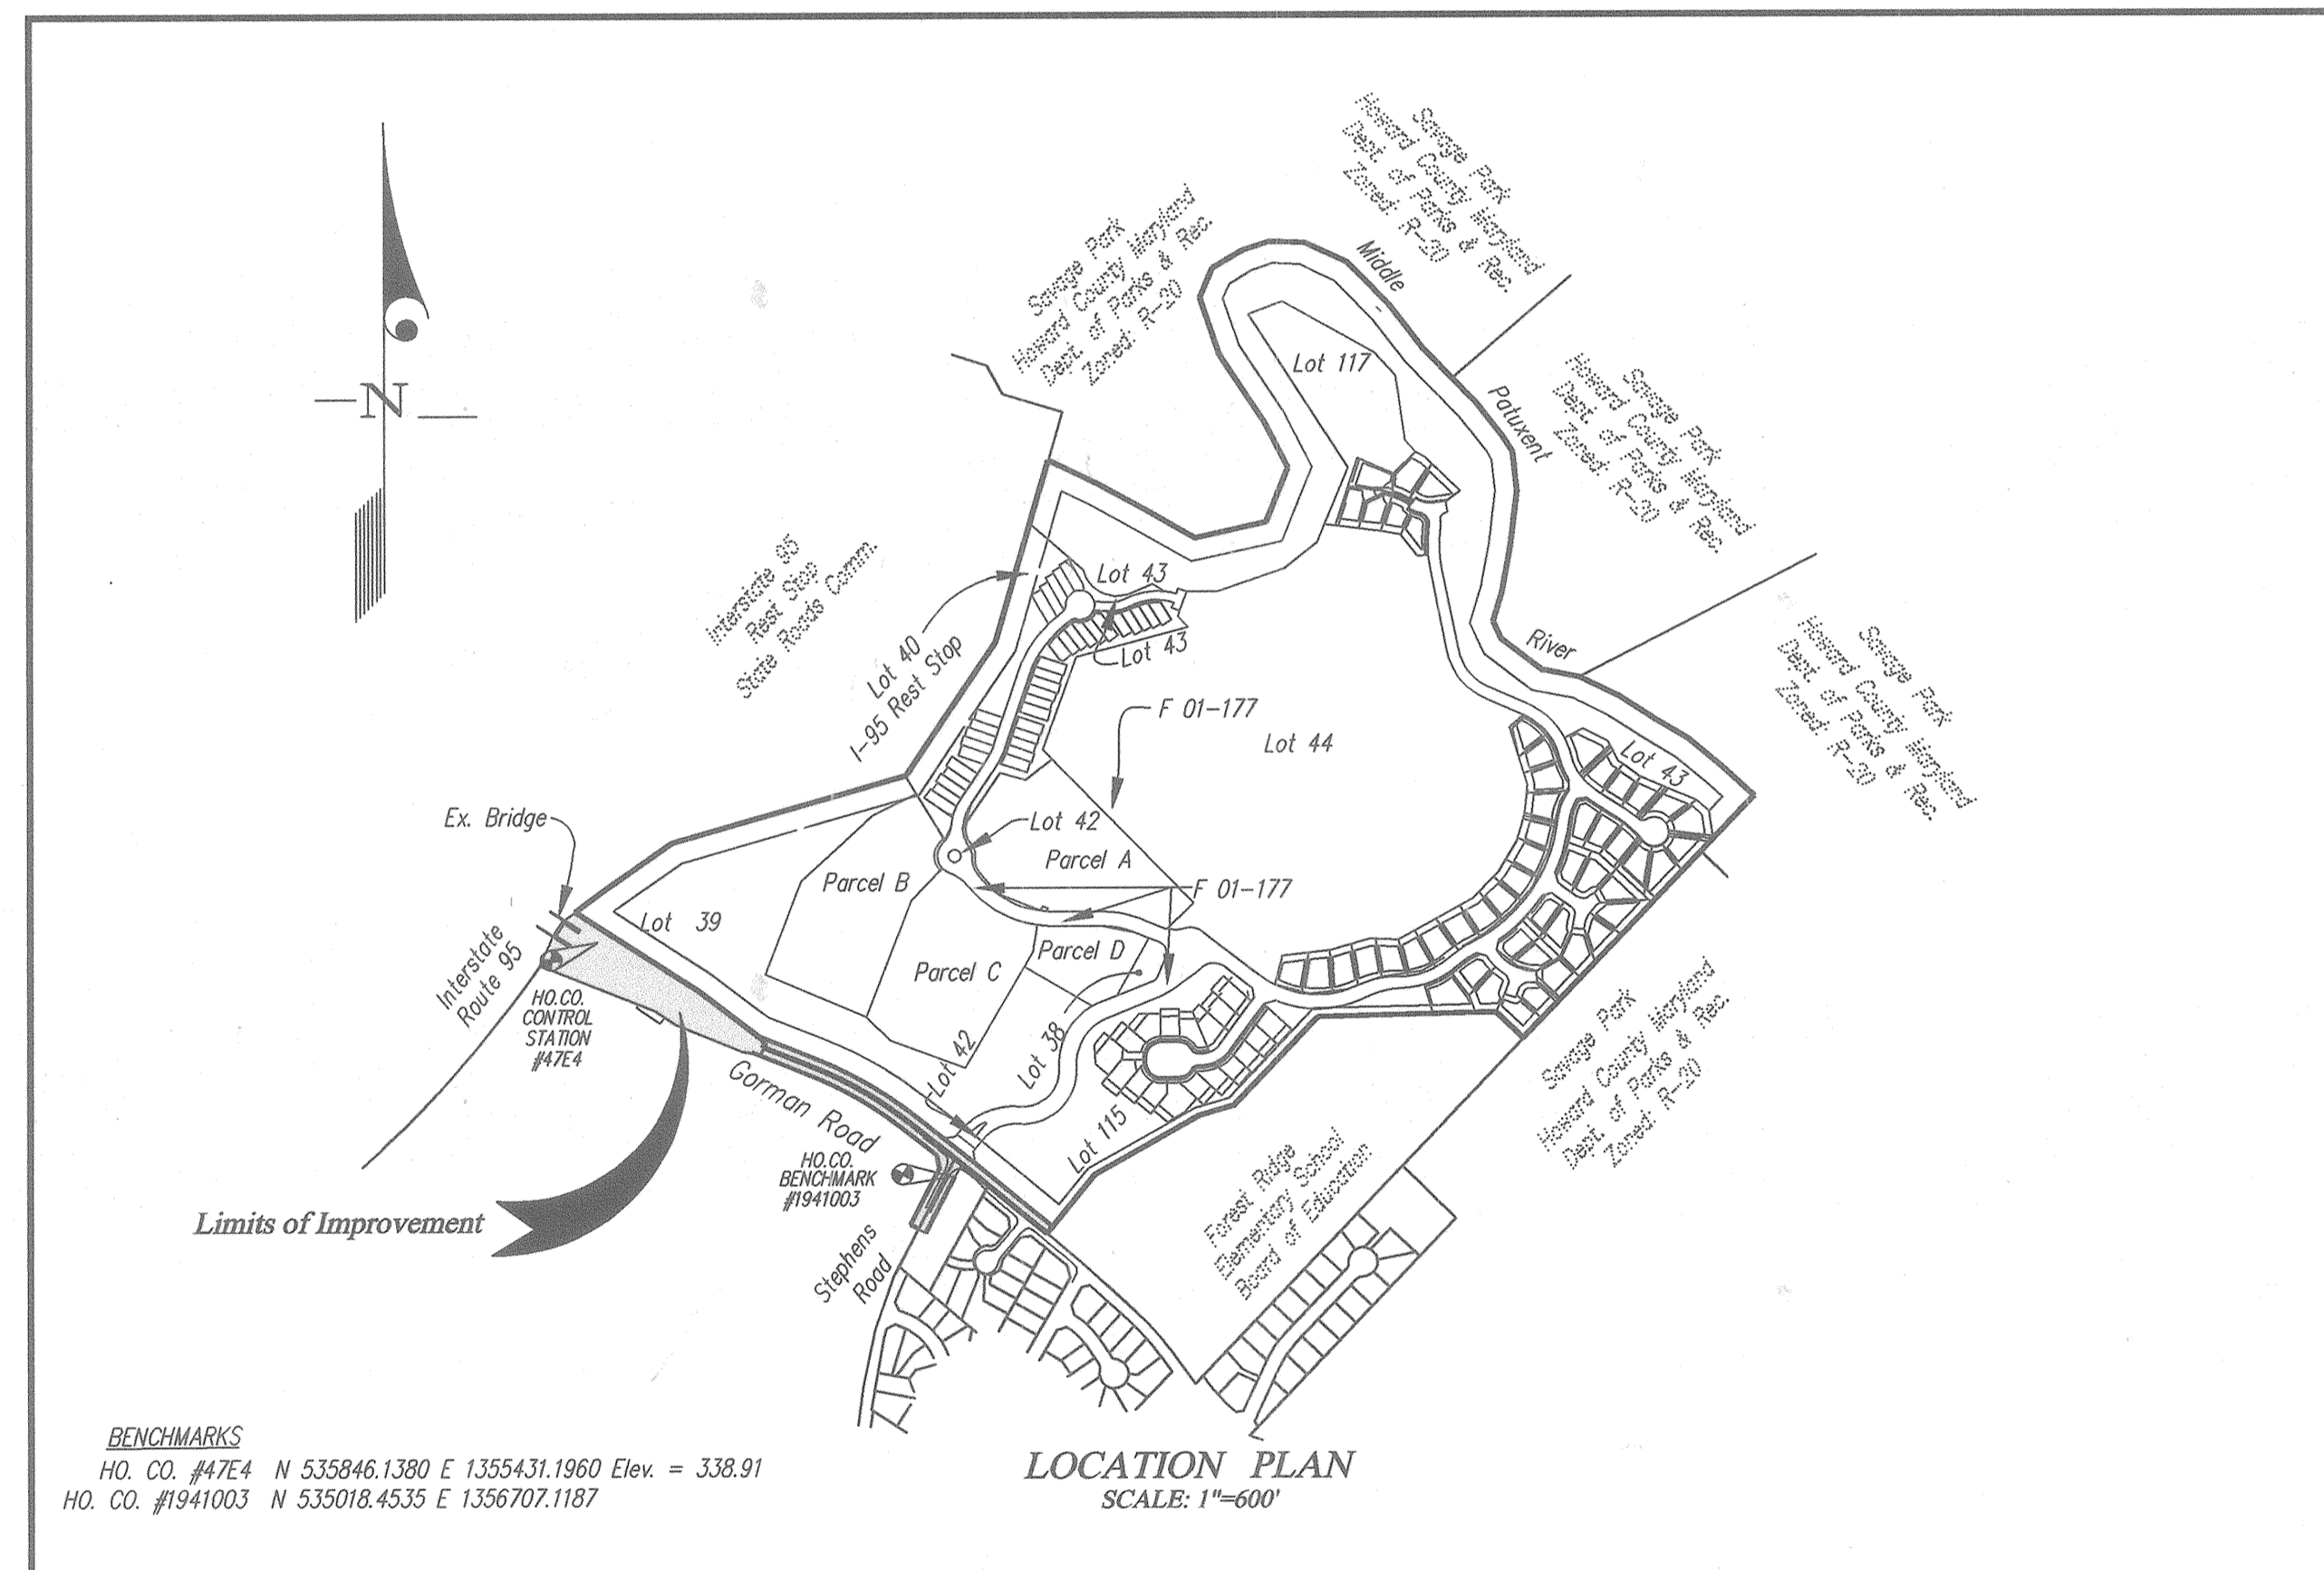

**SHEET INDEX**

- Cover Sheet
- Gorman Road Plan and Profile
- Stephens Road Plan and Profile
- Grading Plan/Sediment Control Plan
- Grading Plan/Sediment Control Plan
- Drainage Area Map
- Drainage Area Map
- Striping Plan
- Storm Drain Profiles and Schedules
- Road Construction Details and Notes
- Sediment Control Details/Notes
- Sediment Control Details/Notes

APPROVED: HOWARD COUNTY DEPARTMENT OF PUBLIC WORKS  
*Andrew M. Daniels* 1-16-02  
Chief, Bureau of Highways Date

APPROVED: HOWARD COUNTY DEPARTMENT OF PLANNING & ZONING  
*Chris Hamilton* 1/29/02  
Chief, Division of Land Development Date


Chief, Development Engineering Division Date

**GLW GUTSCHICK LITTLE & WEBER, P.A.**

CIVIL ENGINEERS, LAND SURVEYORS, LAND PLANNERS, LANDSCAPE ARCHITECTS  
3909 NATIONAL DRIVE - SUITE 250 - BURTONSVILLE OFFICE PARK  
BURTONSVILLE, MARYLAND 20866  
TEL: 301-421-4024 BAL: 410-880-1820 DC/VA: 301-999-2524 FAX: 301-421-4186

99140\gorman\99140CSP1.DWG DES. DRN. DCF. CHK. DATE REVISION BY APPR.

OWNER:  
THE HOWARD RESEARCH AND DEVELOPMENT CORPORATION  
10275 LITTLE PATIENT PARKWAY  
COLUMBIA, MD 21044  
PH: 410-992-6089  
ATTN: MR. BOB JENKINS

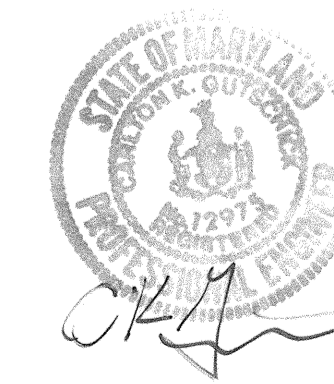

COVER SHEET  
ROAD CONSTRUCTION PLANS  
IMPROVEMENTS TO GORMAN ROAD  
AND STEPHENS ROAD  
GORMAN ROAD FROM 97+99.27 TO 118+00  
STEPHENS ROAD FROM 0+00 TO 2+55

AS-BUILT  
*G. Scott Shanaberger*  
G. SCOTT SHANABERGER DATE  
PROF. LS. # 10849


SHANBERGER & LANE  
8726 TOWN & COUNTRY BLVD.  
SUITE 201  
ELLSWORTH CITY, MARYLAND 21043

SCALE	ZONING	G. L. W. FILE No.
AS SHOWN	R-ED R-SC-MXD-3 PEC-MXD-3	99140
DATE	TAX MAP - GRID	SHEET
OCT., 2001	47 - 9/10	1 OF 12

HOWARD COUNTY, MARYLAND



Location	Lamp Type	Fixture Type	Pole Type
Sta. 101+05 Gorman Road, 3rd Right	150 Watt H.P. medium vapor	Color Head on a 12' arm	2 1/2" Bronze Aluminum
Sta. 101+07 Gorman Road, 4th Left	"	"	"
Sta. 101+05 Gorman Road, 2nd Right	"	"	"

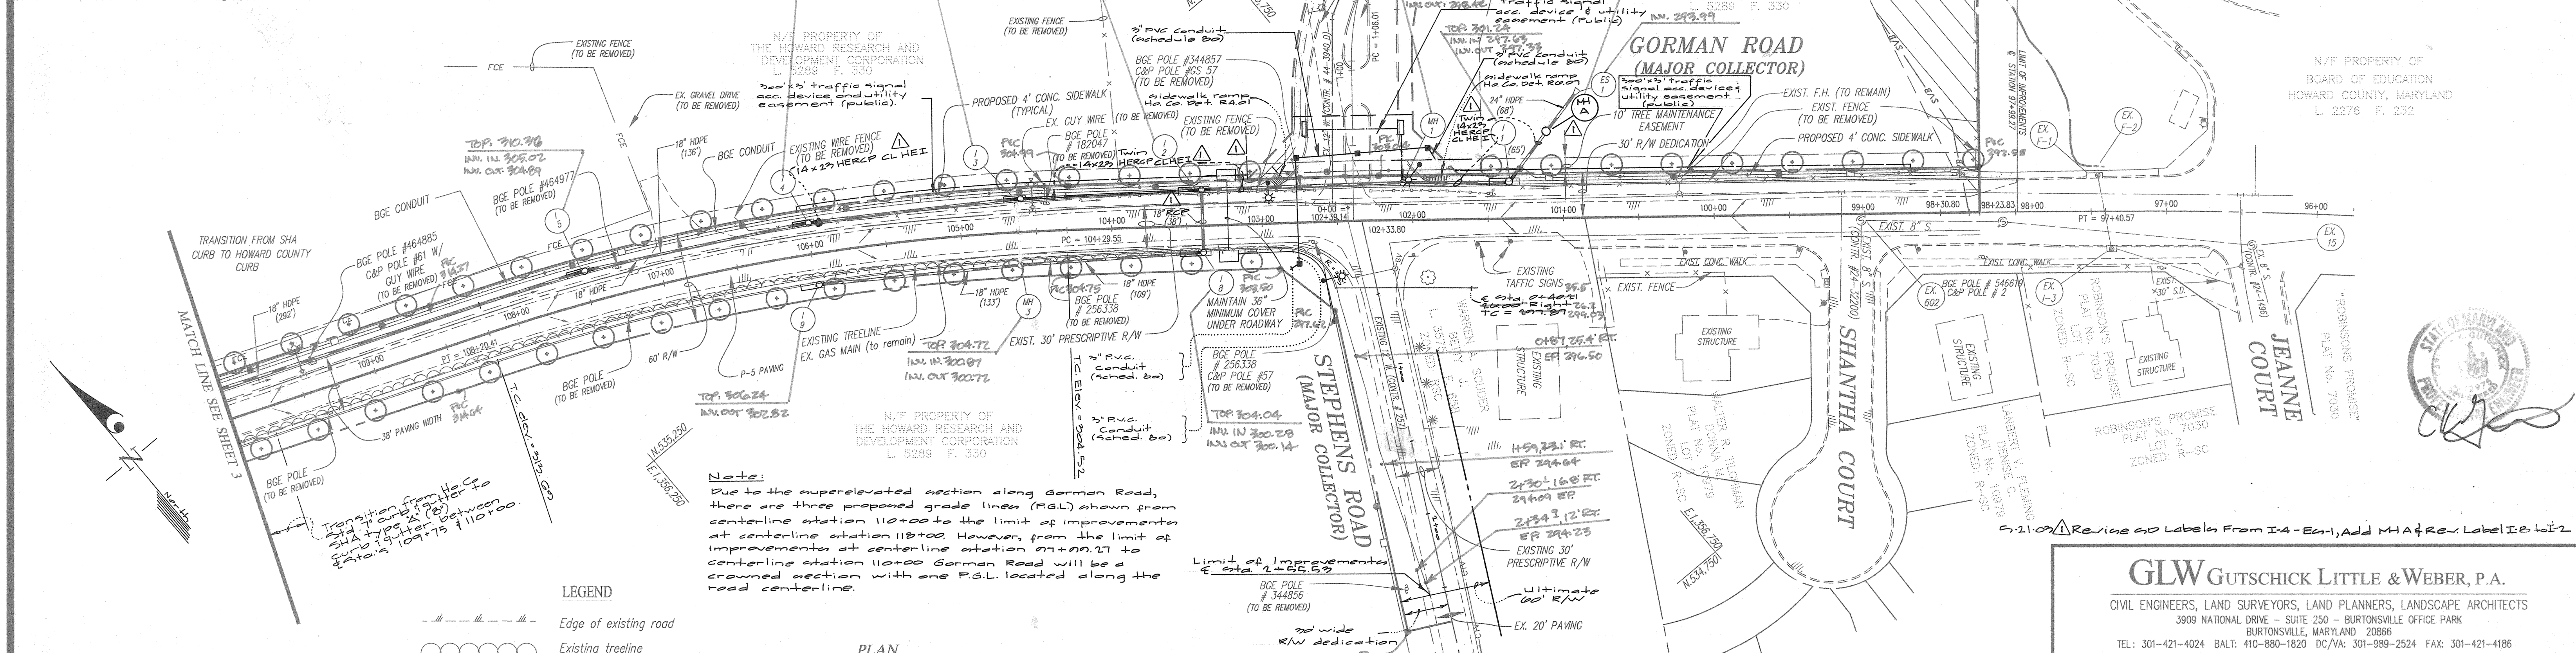

APPROVED: HOWARD COUNTY DEPARTMENT OF PUBLIC WORKS  
*Sandra M. Daniels* 1/16/02  
 Chief, Bureau of Highways

APPROVED: HOWARD COUNTY DEPARTMENT OF PLANNING & ZONING  
*Cindy Hamata* 1/29/02  
 Chief, Division of Land Development

Chief, Development Engineering Division

- LEGEND**
- Edge of existing road
  - Existing treeline
  - BGE Conduit
  - BGE Conduit Manhole
  - Traffic Signal Handbox
  - BGE Pull Box

**PLAN**  
SCALE: 1"=50'

**Widening along Stephens Road**

Station	Pavement width
0+00 - 0+51	26'
0+51 - 1+10	transition from 26' to 22'
1+10 - 1+50	22'
1+50 - 2+55	transition from 22' to 13'


Note: Existing pavement width = 105'±

**CURVE DATA**

STREET NAME	P.C. STA.	P.R.C. STA.	P.T. STA.	RADIUS	ARC	TANGENT	CHORD	BEARING	DELTA
GORMAN ROAD	102+10.55		102+12.41	1952.00'	202.80'	102.81'	220.40'	S 100° 01' 30" E	10° 35' 10"
GORMAN ROAD	110+84.17		112+03.43	1145.02'	220.20'	115.21'	228.88'	S 02° 59' 40" E	11° 27' 47"

**STREET TREE SCHEDULE**

SYMBOL	NAME (BOTANICAL/COMMON)	SIZE	QUANTITY	REMARKS
⊙	Acer Saccharum / Green Mountain Sugar Maple	2"-2 1/2" cal.	48	B & B Full Heads

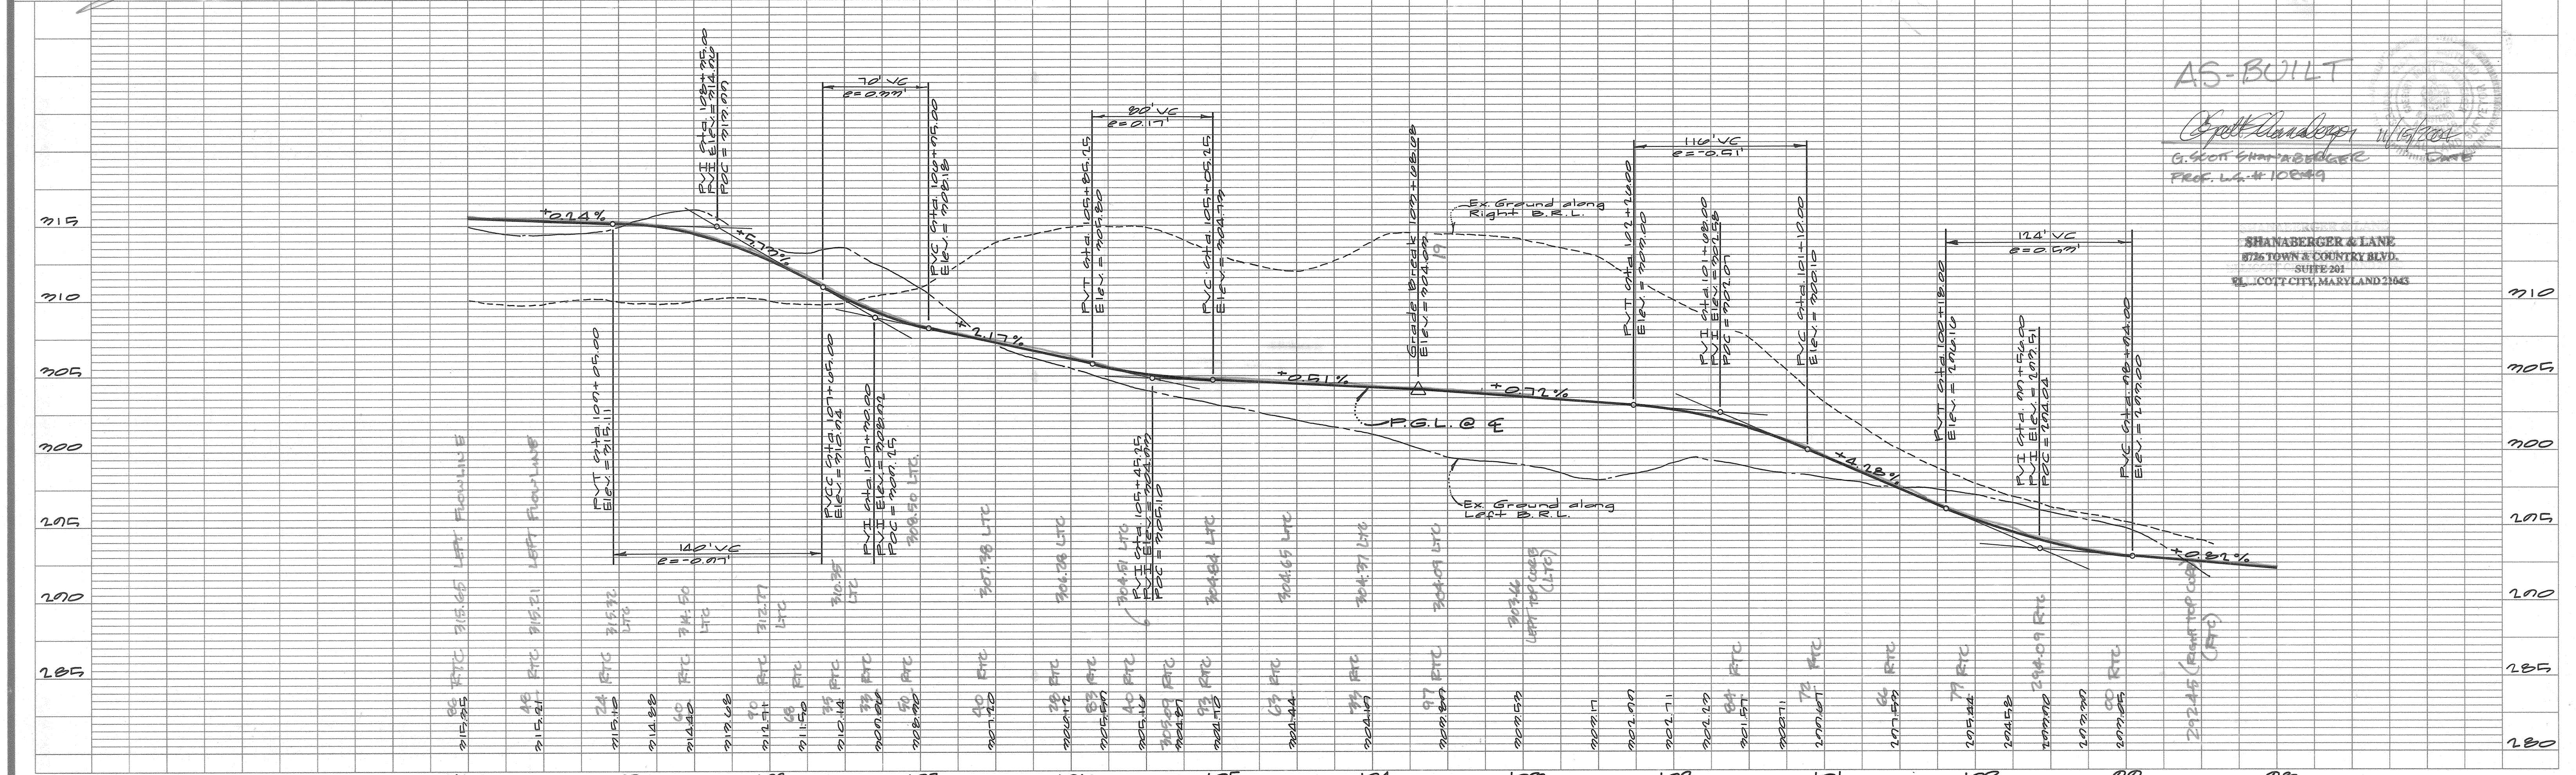

**AS-BUILT**

*G. Scott Shambaugh*  
 G. Scott Shambaugh  
 Prof. L.G.# 100589

**SHANABERGER & LANE**  
 8726 TOWN & COUNTRY BLVD.  
 SUITE 201  
 COLUMBIA, MARYLAND 21046

**GLW GUTSCHICK LITTLE & WEBER, P.A.**  
 CIVIL ENGINEERS, LAND SURVEYORS, LAND PLANNERS, LANDSCAPE ARCHITECTS  
 3909 NATIONAL DRIVE - SUITE 250 - BURTONSVILLE OFFICE PARK  
 BURTONSVILLE, MARYLAND 20866  
 TEL: 301-421-4024 BAL: 410-880-1820 DC/VA: 301-999-2524 FAX: 301-421-4186

**ROAD CONSTRUCTION PLANS**  
**IMPROVEMENTS TO GORMAN ROAD**  
**AND STEPHENS ROAD**  
 GORMAN ROAD FROM 97+99.27 TO 118+00  
 STEPHENS ROAD FROM 0+00 TO 2+55



DESIGNED DEV: [Signature] 1/16/02  
 DRAWN JAU/CAD  
 CHECKED DEV/  
 DATE: Oct., 2001

SCALE AS SHOWN  
 DRAWING 2 OF 12  
 ZONING R-5B, REC-MSP-3, R-6C-MSP-2  
 JOB No. 99140

PREPARED FOR:  
 THE HOWARD RESEARCH AND DEVELOPMENT CORPORATION  
 10275 LITTLE PATUXENT PARKWAY  
 COLUMBIA, MARYLAND 21044  
 ATTN: MR. BOB JENKINS  
 PH: (410) 992-6089



Note:  
Due to the super-elevated section along Gorman Road, there are three proposed grade lines (P.G.L.) shown from centerline station 110+00 to the limit of improvements at centerline station 118+00. However, from the limit of improvements at centerline station 118+00 to the centerline station 110+00 Gorman Road will be a crowned section with one P.G.L. located along the road centerline.

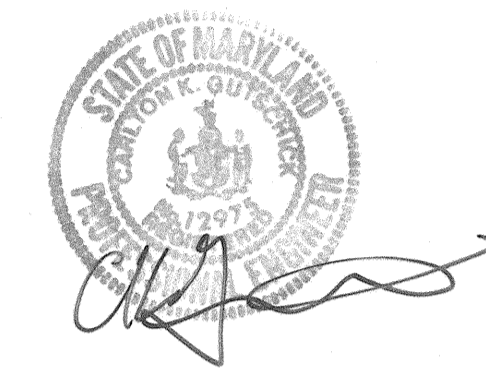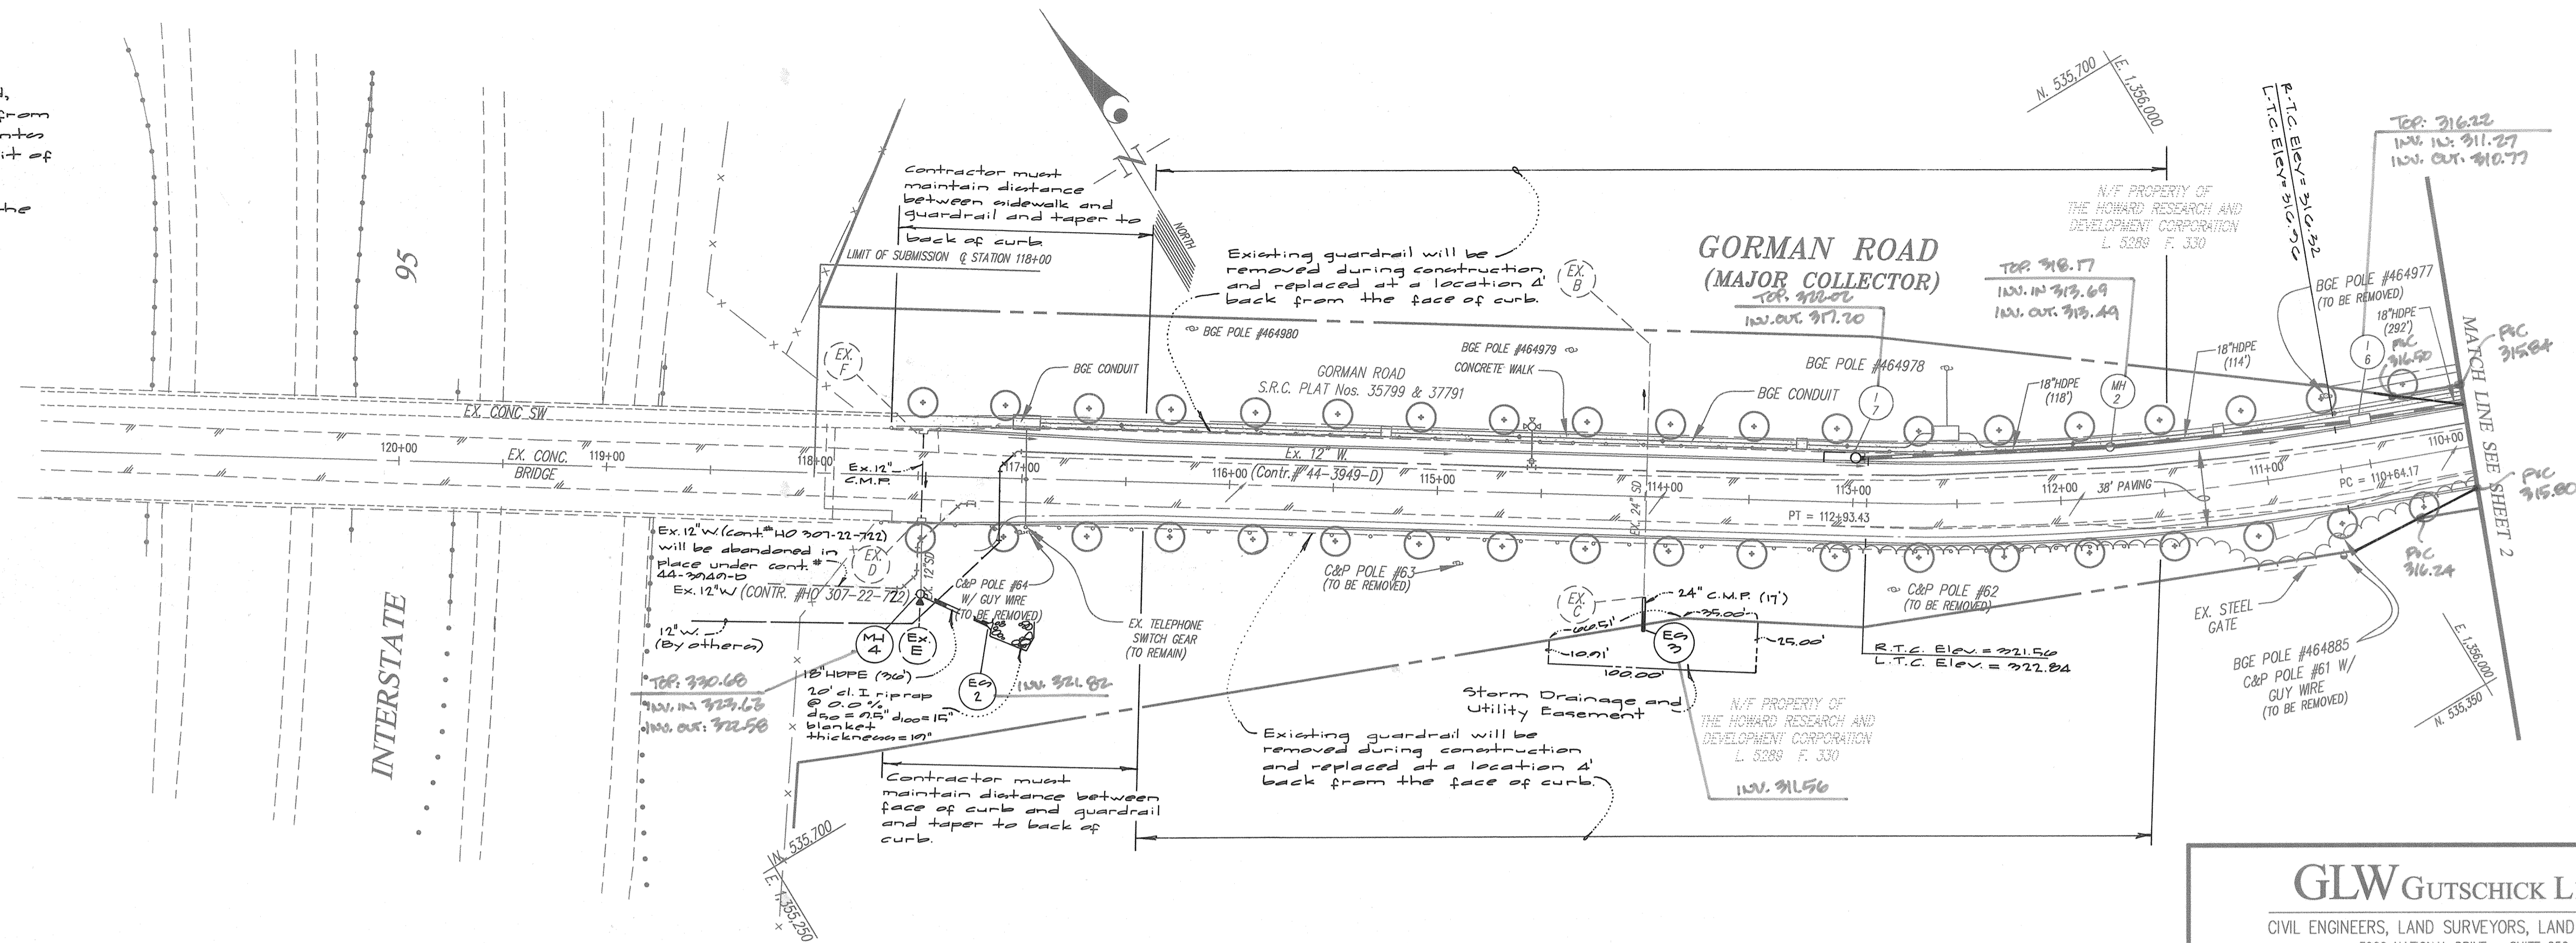

- LEGEND
- - - - - Edge of existing road
  - ~ ~ ~ ~ ~ Existing treeline
  - BGE Conduit
  - BGE Conduit Manhole
  - BGE Pull Box

Note: Since the improvements are limited to overlaying the existing pavement and providing road widening, an existing ground line along the centerline of the road has not been shown.

PLAN  
SCALE: 1"=50'

¢ CURVE DATA

STREET NAME	P.C. STA.	P.R.C. STA.	P.T. STA.	RADIUS	ARC	TANGENT	CHORD	BEARING	DELTA
GORMAN ROAD	104+20.55		108+20.41	1252.00'	220.80'	100.81'	280.40'	0°02'00"E	10°29'10"
GORMAN ROAD	110+24.17		112+22.43	1145.02'	220.20'	115.01'	228.88'	0°02'01"E	11°27'47"

STREET TREE SCHEDULE


SYMBOL	NAME (BOTANICAL/COMMON)	SIZE	QUANTITY	REMARKS
○	Acer Saccharum / Green Mountain Sugar Maple	2"-2 1/2" cal.	38	B & B Full Heads

APPROVED: HOWARD COUNTY DEPARTMENT OF PUBLIC WORKS  
*Richard M. Decker* 1-16-02  
 Chief, Bureau of Highways Date

APPROVED: HOWARD COUNTY DEPARTMENT OF PLANNING & ZONING  
*C. Hamilton* 1/29/02  
 Chief, Division of Land Development Date

APPROVED: *[Signature]* 1/23/02  
 Chief, Development Engineering Division Date

PROFILE  
HORIZ. 1"=50'  
VERT. 1"=3'

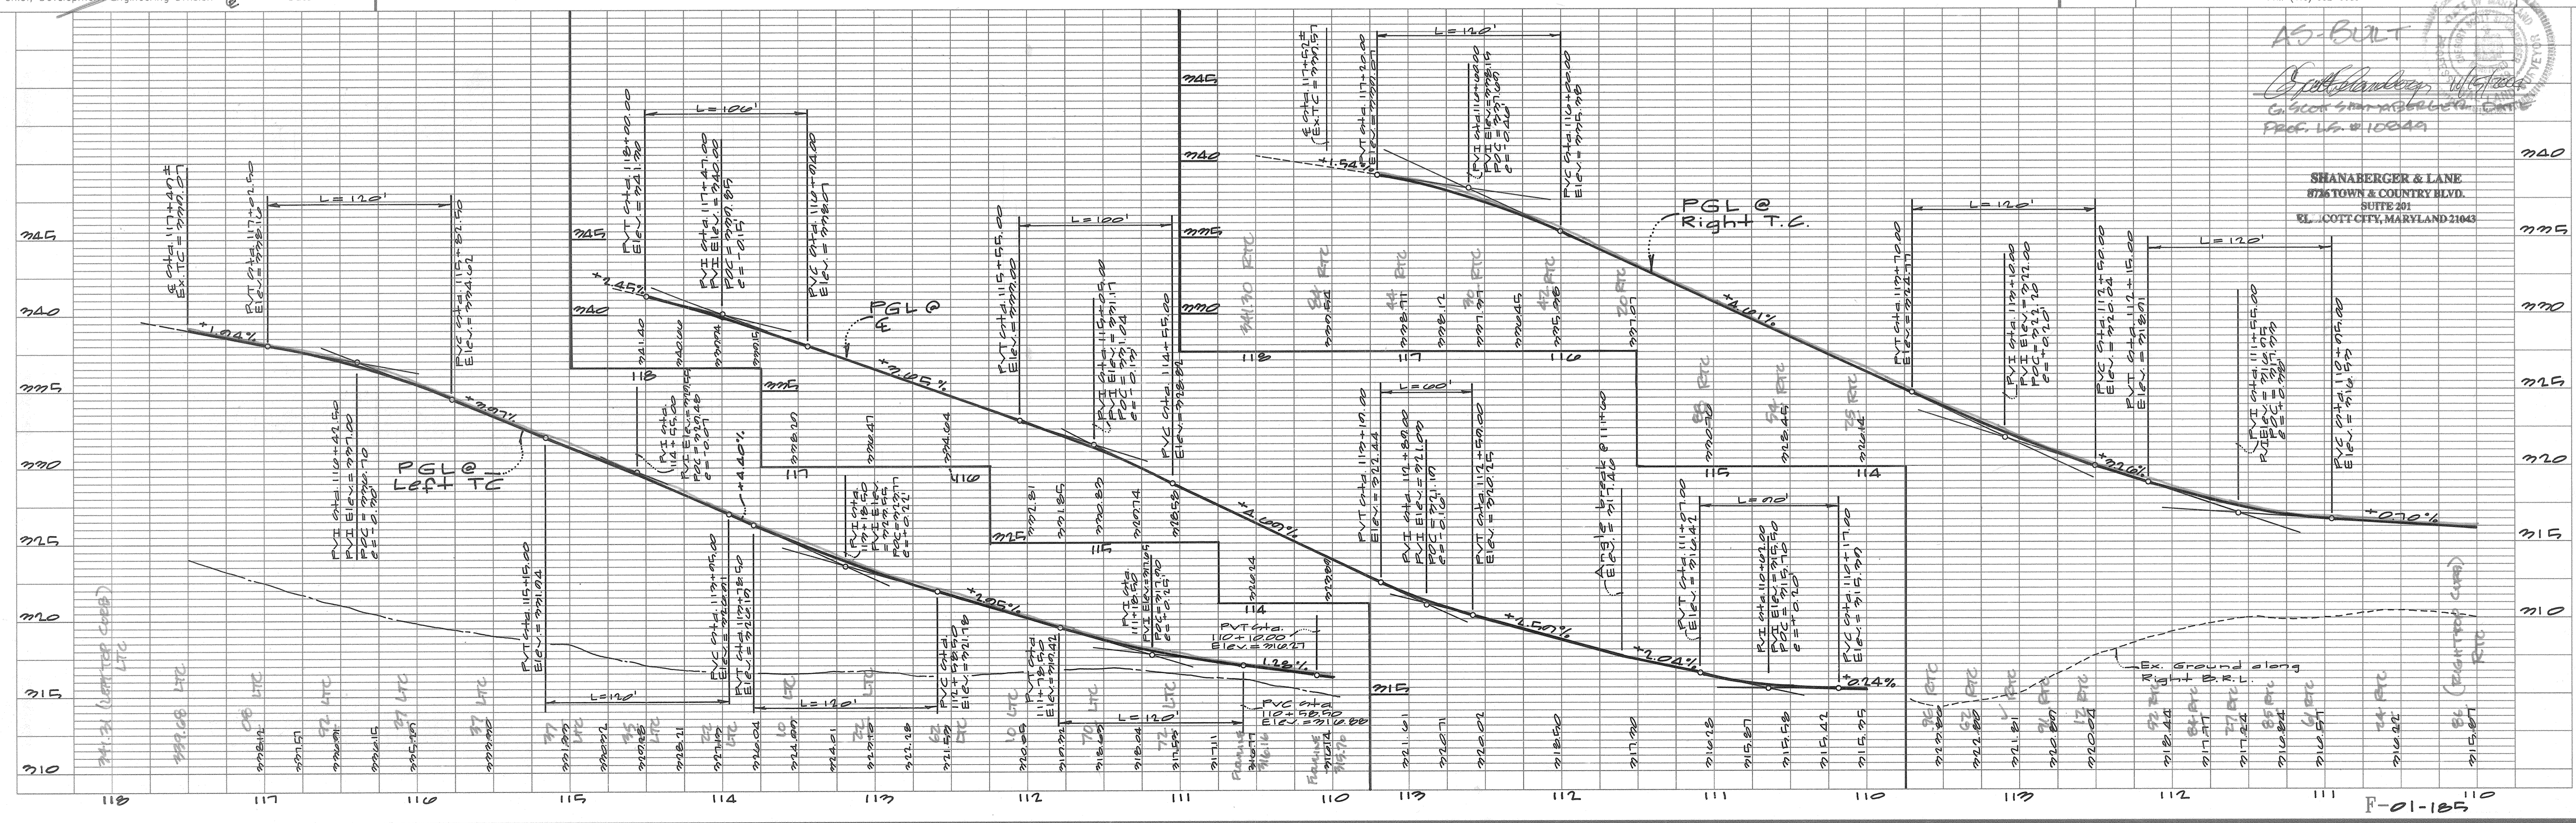

**GLW GUTSCHICK LITTLE & WEBER, P.A.**  
 CIVIL ENGINEERS, LAND SURVEYORS, LAND PLANNERS, LANDSCAPE ARCHITECTS  
 3909 NATIONAL DRIVE - SUITE 250 - BURTONSVILLE OFFICE PARK  
 BURTONSVILLE, MARYLAND 20886  
 TEL: 301-421-4024 BAL: 410-880-1820 DC/VA: 301-999-2524 FAX: 301-421-4186



**ROAD CONSTRUCTION PLANS  
 IMPROVEMENTS TO GORMAN ROAD  
 AND STEPHENS ROAD**  
 GORMAN ROAD FROM 97+99.27 TO 118+00  
 STEPHENS ROAD FROM 0+00 TO 2+55

ELECTION DISTRICT No. 6  
 HOWARD COUNTY, MARYLAND

PREPARED FOR:  
 THE HOWARD RESEARCH AND DEVELOPMENT CORPORATION  
 10275 LITTLE PATUXENT PARKWAY  
 COLUMBIA, MARYLAND 21044  
 ATTN: MR. BOB JENKINS  
 PH: (410) 992-6089

SCALE AS SHOWN  
 DRAWING 3 OF 12  
 ZONING R-2C-MAP-3  
 JOB No. 99140



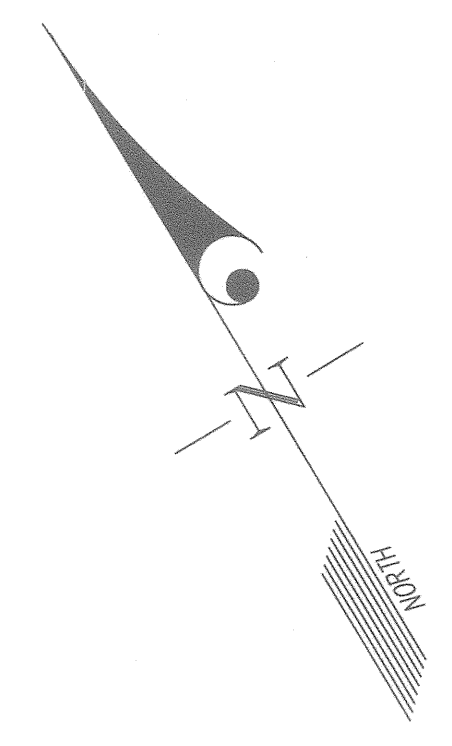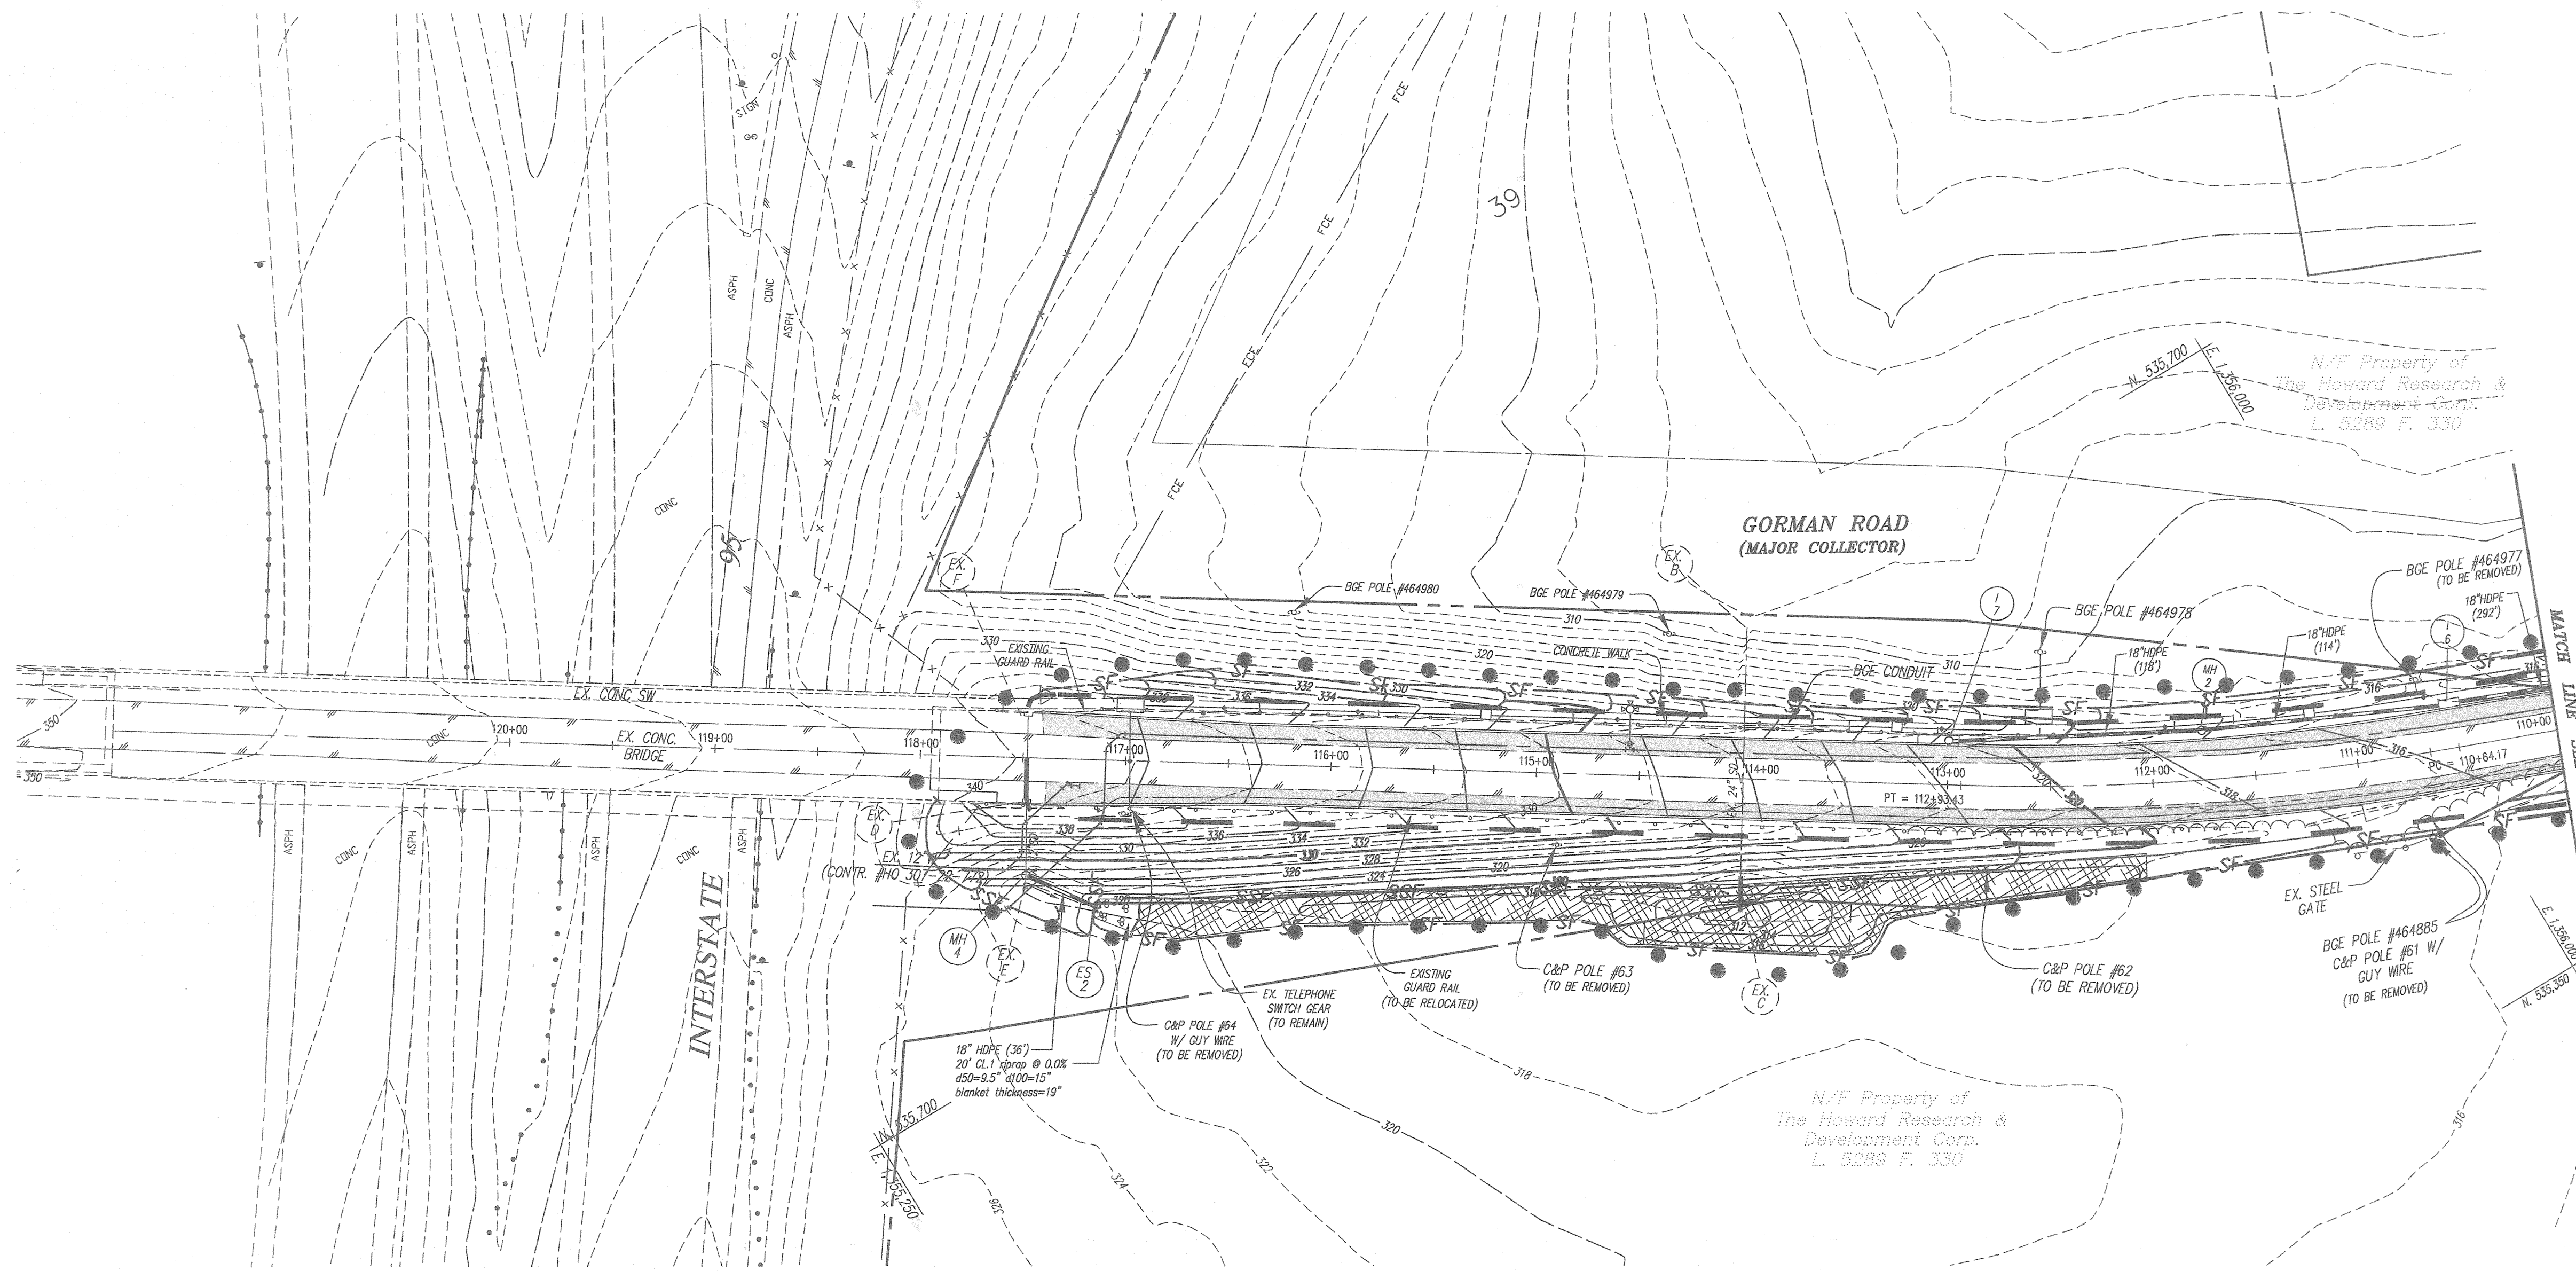

**LEGEND**

- SF — SILT FENCE
- SSF — SUPER SILT FENCE
- ● ● ● LIMIT OF DISTURBANCE
- [Cross-hatched box] EROSION CONTROL MATTING
- - - DRAINAGE AREA DIVIDE TO TRAP #1



**ENGINEER'S CERTIFICATE**

"I certify that this plan for erosion and sediment control represents a practical and workable plan based on my personal knowledge of the site conditions and that it was prepared in accordance with the requirements of the Howard Soil Conservation District."

*CKJ* 12/20/01  
 Date

**DEVELOPER'S/BUILDER'S CERTIFICATE**

"I/We certify that all development and/or construction will be done according to this plan, and that any responsible personnel involved in the construction project will have a Certificate of Attendance at a Maryland Department of the Environment Approved Training Program for the Control of Sediment and Erosion before beginning the project. I also authorize periodic on-site inspection by the HSCD."

*Paul A. Paul* 12/20/01  
 Signature of Developer/Builder Date

These plans have been reviewed for the Howard Soil Conservation District and meet the technical requirements.

*Jim Ryan / GCS* 1/24/02  
 Natural Resources Conservation Service Date

This Development Plan is approved for Soil Erosion and Sediment Control by the Howard Soil Conservation District.

*John Selig* 1/24/02  
 Howard S.C.D. Date

Approved: Howard County Department of Public Works  
*Andrew M. Daulton* 1/16/02  
 Chief, Bureau of Highways AS Date

APPROVED: HOWARD COUNTY DEPARTMENT OF PLANNING & ZONING

*Cindy Hamada* 1/24/02  
 Chief, Division of Land Development HB Date

*[Signature]* 1/24/02  
 Chief, Development Engineering Division e Date

**GLW GUTSCHICK LITTLE & WEBER, P.A.**  
 CIVIL ENGINEERS, LAND SURVEYORS, LAND PLANNERS, LANDSCAPE ARCHITECTS  
 3909 NATIONAL DRIVE - SUITE 250 - BURTONSVILLE OFFICE PARK  
 BURTONSVILLE, MARYLAND, 20886  
 TEL: 301-421-4024 BALT: 410-880-1820 DC/VA: 301-989-2524 FAX: 301-421-4188

DATE	REVISION	BY	APP'R.

PREPARED FOR:  
 THE HOWARD RESEARCH AND DEVELOPMENT CORPORATION  
 10275 LITTLE PATRIOT PARKWAY  
 COLUMBIA, MARYLAND 21044  
 ATTN: MR. BOB JENKINS  
 P.O. (410) 992-6088

**ROAD GRADING/SEDIMENT CONTROL PLAN**  
**ROAD CONSTRUCTION PLANS**  
**IMPROVEMENTS TO GORMAN ROAD**  
**AND STEPHENS ROAD**  
 GORMAN ROAD FROM 97+99.27 TO 118+00  
 STEPHENS ROAD FROM 0+00 TO 2+55

ELECTION DISTRICT No. 6


HOWARD COUNTY, MARYLAND

SCALE	ZONING	G. L. W. FILE No.
1"=50'	R-ED R-SC-MXD-3 PEG-MXD-3	99140
DATE	TAX MAP - GRID	SHEET
OCT., 2001	47-9/10	4 of 12

99140GPI.dwg 11-1-01 3:17:49 pm EST




NOTE:  
The disturbance to the buffer associated with the road improvements for Gorman Road was approved as part of WP-00-88.

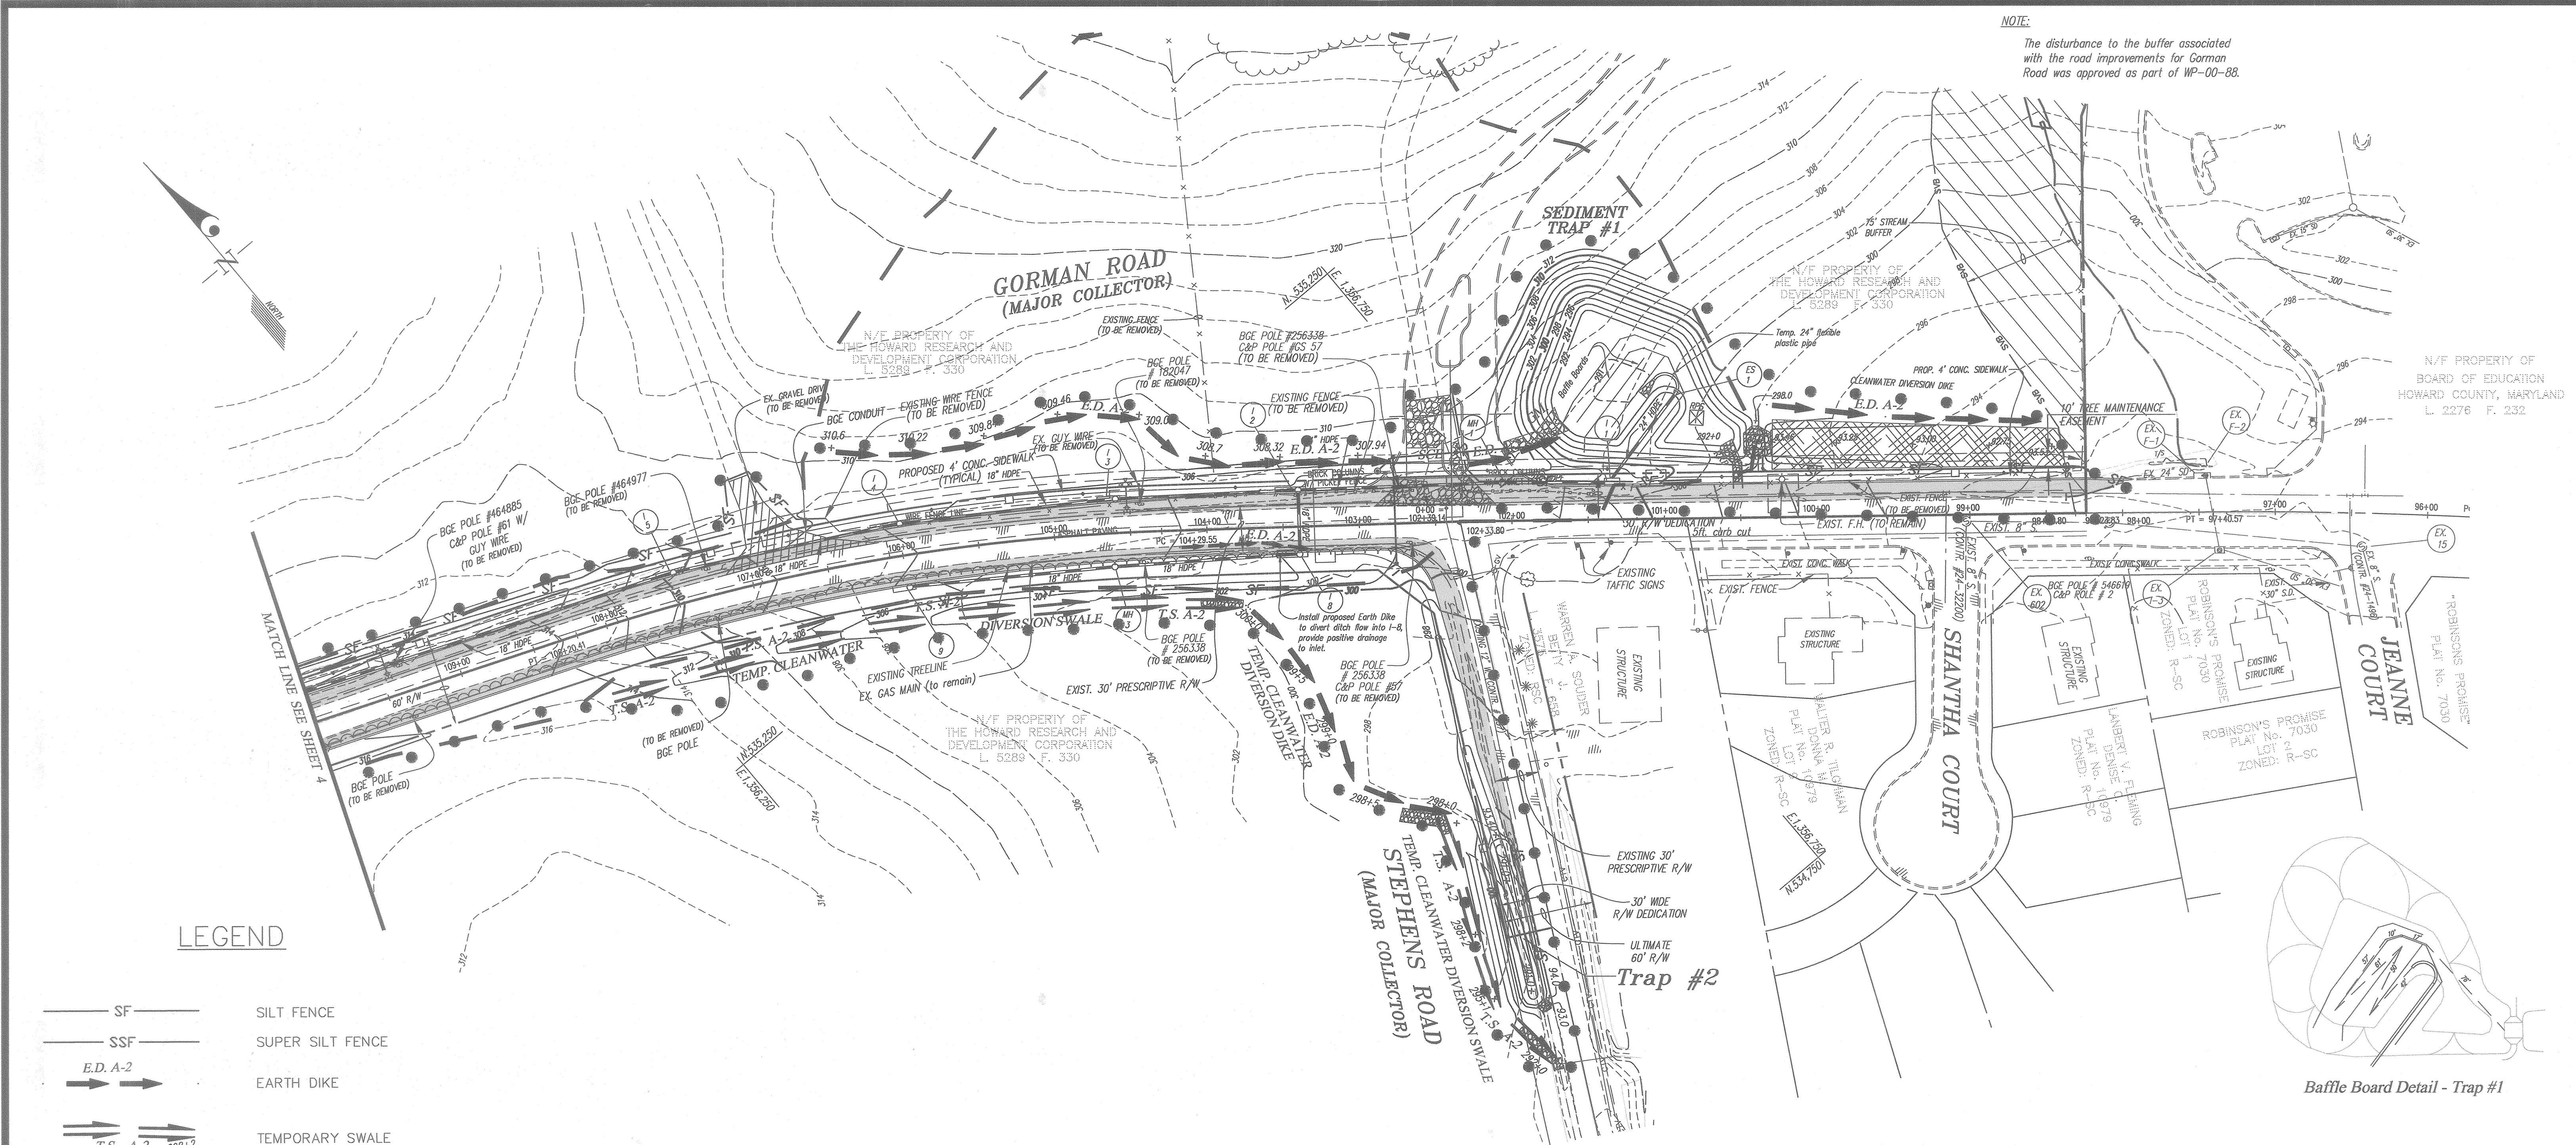

LEGEND

- SF SILT FENCE
- SSF SUPER SILT FENCE
- E.D. A-2 EARTH DIKE
- T.S. A-2 TEMPORARY SWALE
- S.C.E. STABILIZED CONSTRUCTION ENTRANCE
- LIMIT OF DISTURBANCE
- EROSION CONTROL MATTING
- DRAINAGE AREA DIVIDE TO TRAP #1

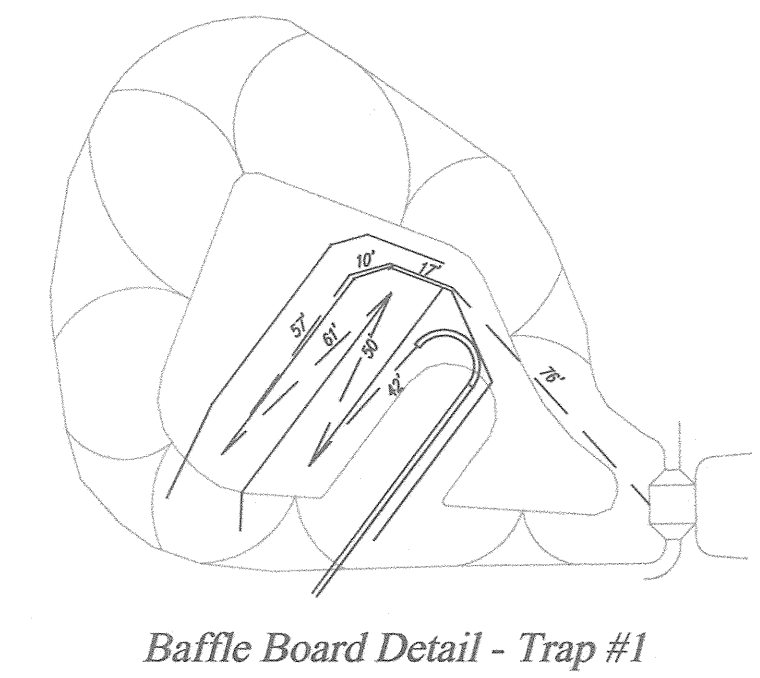

**STONE/RIP RAP OUTLET SEDIMENT TRAP #1 (ST-IV)**  
 Before Dev. Drainage Area = 6.59 Acres  
 After Dev. Drainage Area = 8.10 Acres

**STORAGE REQUIREMENTS**

Temp. SWM = 21,275 Cu. Ft.  
 Sediment Control = 14,580 Cu. Ft.  
 Storage Provided = 35,855 Cu. Ft.

Top of Dam Elev. = 298.00  
 Bottom = 291.00  
 Cleanout Elev. = 292.49  
 Wet Volume Elev. = 293.46  
 Wet Volume = 14,580 cf  
 Dry Volume Elev. = 295.17  
 Dry Volume = 14,580 cf  
 Temp. SWM Elev. = 295.93  
 Weir Crest Elev. = 296.00

Before Dev. Q2 = 4.51 CFS  
 After Dev. Q2 = 18.17 CFS  
 Managed Q2 = 2.34 CFS

**STONE/RIP RAP OUTLET SEDIMENT TRAP #2 (ST-IV)**  
 Before Dev. Drainage Area = 0.5 Acres  
 After Dev. Drainage Area = 0.5 Acres

**STORAGE REQUIREMENTS**

Sediment Control = 1,800 Cu. Ft.  
 Storage Provided = 1,800 Cu. Ft.

Top of Dam Elev. = 294.00  
 Bottom = 291.00  
 Cleanout Elev. = 292.49  
 Wet Volume Elev. = 292.00  
 Wet Volume = 900 cf  
 Dry Volume Elev. = 293.00  
 Dry Volume = 900 cf  
 Weir Crest Elev. = 293.00

NOTE: TURN ALL ENDS ON SILT FENCE/ SUPER SILT FENCE UPHILL BY 2 FEET.



Engineer's Certificate  
 I certify that this plan for erosion and sediment control represents a practical and workable plan based on my personal knowledge of the site conditions and that it was prepared in accordance with the requirements of the Howard Soil Conservation District.

*CKJ* 12/20/01

DEVELOPER'S/BUILDER'S CERTIFICATE

"I/we certify that all development and/or construction will be done according to this plan, and that any responsible personnel involved in the construction project will have a Certificate of Attendance at a Maryland Department of the Environment Approved Training Program for the Control of Sediment and Erosion before beginning the project. I also authorize periodic on-site inspection by the HSCD."

This Development Plan is approved for Soil Erosion and Sediment Control by the Howard Soil Conservation District.

*Howard S.C.D.* 1/20/02  
 Date

*Jin Nguyen/05* 1/20/02  
 Natural Resources Conservation Service Date

*Robert A. Gault* 12/20/01  
 Signature of Developer/Builder Date

Approved: Howard County Department of Public Works  
*Andrew M. Smith* 1/16/02  
 Chief, Bureau of Highways Date

APPROVED: HOWARD COUNTY DEPARTMENT OF PLANNING & ZONING  
*Vivian Bennett* 1/29/02  
 Chief, Division of Land Development Date

*Ce* 1/23/02  
 Chief, Development Engineering Division Date

**GLW GUTSCHICK LITTLE & WEBER, P.A.**  
 CIVIL ENGINEERS, LAND SURVEYORS, LAND PLANNERS, LANDSCAPE ARCHITECTS  
 3909 NATIONAL DRIVE - SUITE 250 - BURTONSVILLE OFFICE PARK  
 BURTONSVILLE, MARYLAND, 20886  
 TEL: 301-421-4024 BAL: 410-880-1820 DC/WA: 301-989-2524 FAX: 301-421-4186

DES.	DRN.	CHK.	DATE	REVISION	BY	APP'R.

PREPARED FOR:  
 THE HOWARD RESEARCH AND DEVELOPMENT CORPORATION  
 10275 LITTLE PATRIENT PARKWAY  
 COLUMBIA, MARYLAND 21044  
 ATTN: MR. BOB JENKINS  
 PH: (410) 992-6089


**ROAD GRADING/SEDIMENT CONTROL PLAN**  
**ROAD CONSTRUCTION PLANS**  
**IMPROVEMENTS TO GORMAN ROAD**  
**AND STEPHENS ROAD**  
 GORMAN ROAD FROM 97+99.27 TO 118+00  
 STEPHENS ROAD FROM 0+00 TO 2+55  
 ELECTION DISTRICT No. 6  
 HOWARD COUNTY, MARYLAND

SCALE	ZONING	G. L. W. FILE No.
1"=50'	R-ED R-SC-MXD-3 PEC-MXD-3	99140
DATE	TAX MAP - GRID	SHEET
OCT., 2001	47-9/10	5 of 12

99140GP2.dwg 11-1-01 3:20:59 pm EST



DRAINAGE AREA INFORMATION			
INLET	AREA	'C' VALUE	% IMP.
I-6	0.39	0.70	65%
I-7	0.63	0.90	94%

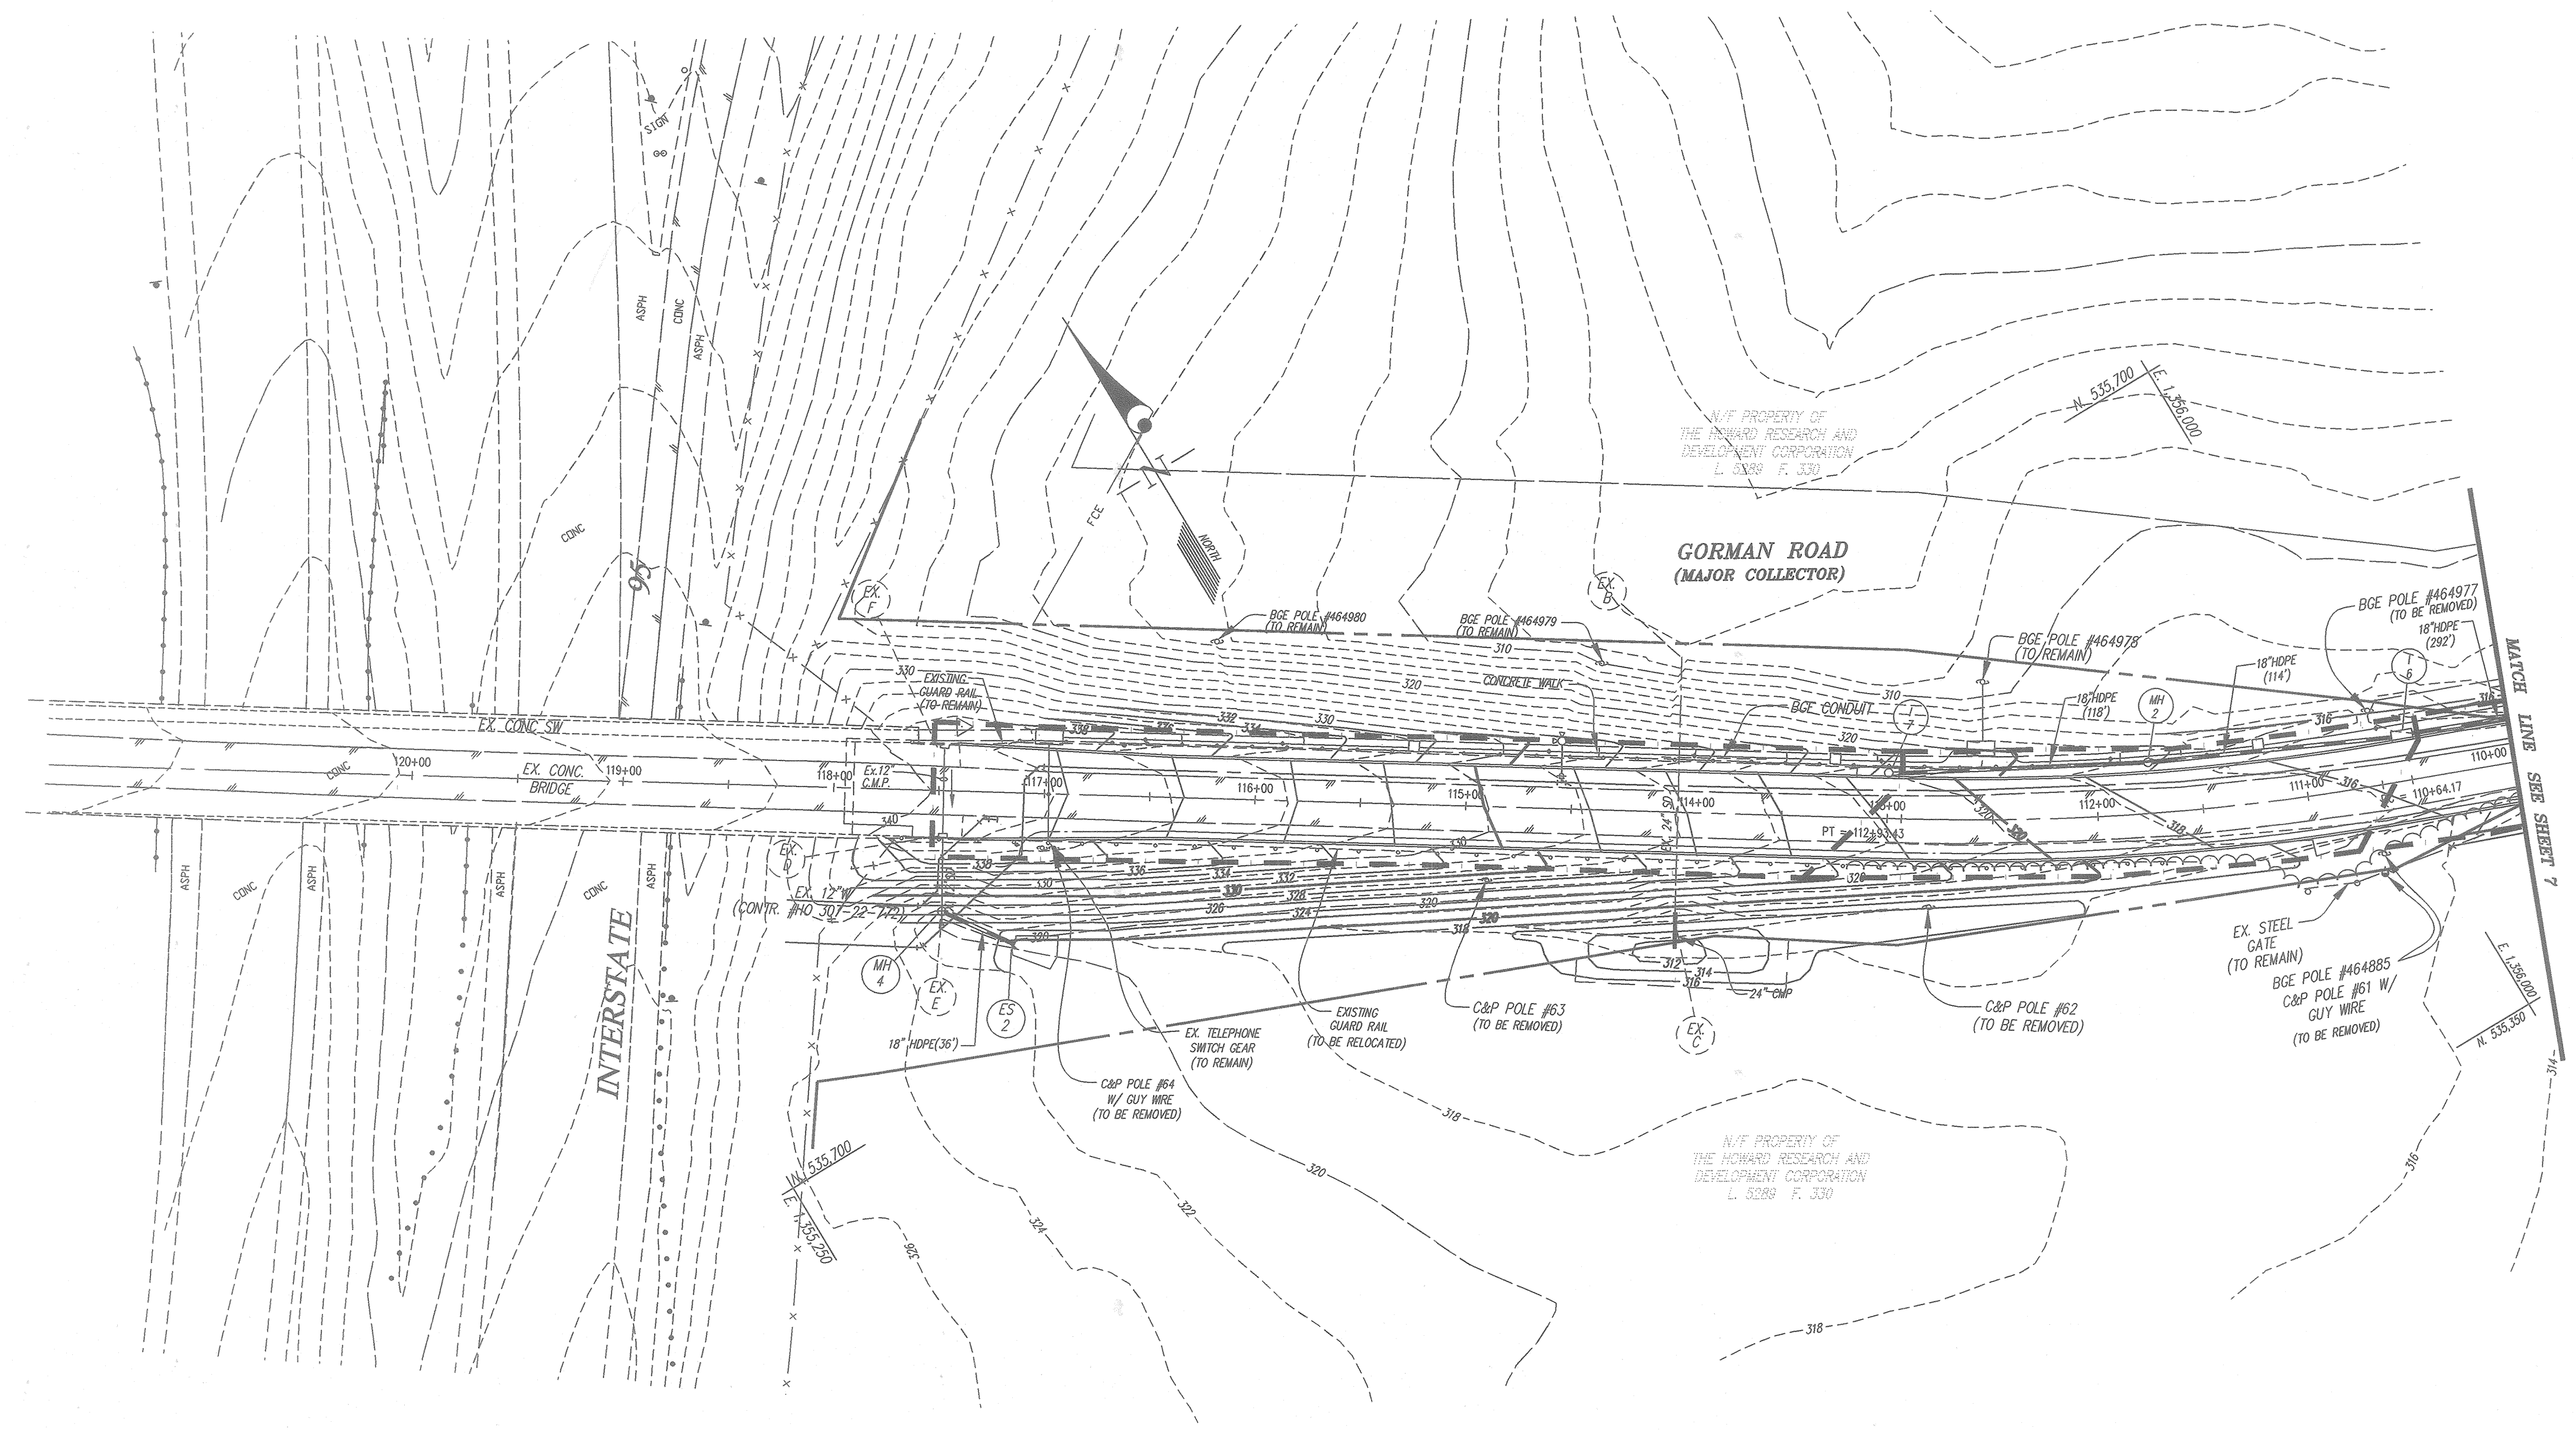

Approved: Howard County Department of Public Works  
*Richard M. Daniels* 1-16-02  
 Chief, Bureau of Highways  
 APPROVED: HOWARD COUNTY DEPARTMENT OF PLANNING & ZONING  
*Cindy Klammer* 1/29/02  
 Chief, Division of Land Development  
*[Signature]* 1/29/02  
 Chief, Development-Engineering Division



**GLW GUTSCHICK LITTLE & WEBER, P.A.**  
 CIVIL ENGINEERS, LAND SURVEYORS, LAND PLANNERS, LANDSCAPE ARCHITECTS  
 3909 NATIONAL DRIVE - SUITE 250 - BURTONSVILLE OFFICE PARK  
 BURTONSVILLE, MARYLAND 20866  
 TEL: 301-421-4024 BALT: 410-880-1820 DC/VA: 301-989-2524 FAX: 301-421-4186

DATE	REVISION	BY	APP'R

PREPARED FOR:  
 THE HOWARD RESEARCH AND DEVELOPMENT CORPORATION  
 10275 LITTLE PATENT PARKWAY  
 COLUMBIA, MARYLAND 21044  
 ATTN: MR. BOB JENKINS  
 PH: (410) 892-6089

**DRAINAGE AREA MAP**  
**ROAD CONSTRUCTION PLANS**  
**IMPROVEMENTS TO GORMAN ROAD**  
**AND STEPHENS ROAD**  
 GORMAN ROAD FROM 97+99.27 TO 118+00  
 STEPHENS ROAD FROM 0+00 TO 2+55  
 HOWARD COUNTY, MARYLAND


SCALE	ZONING	G. L. W. FILE No.
1"=50'	R-ED R-SC-MXD-3 PEC-MXD-3	99140
DATE	TAX MAP - GRID	SHEET
OCT., 2001	47-9/10	6 of 12

99140DA1.dwg 12-20-01 3:00:25 pm EST



**DRAINAGE AREA INFORMATION**

INLET	AREA	'C' VALUE	% IMP.
I-1			
I-2	0.83	0.50	36%
I-3	1.00	0.50	36%
I-4	0.76	0.50	36%
I-5	0.45	0.70	65%
I-8	0.30	0.90	94%
I-9	0.39	0.90	94%

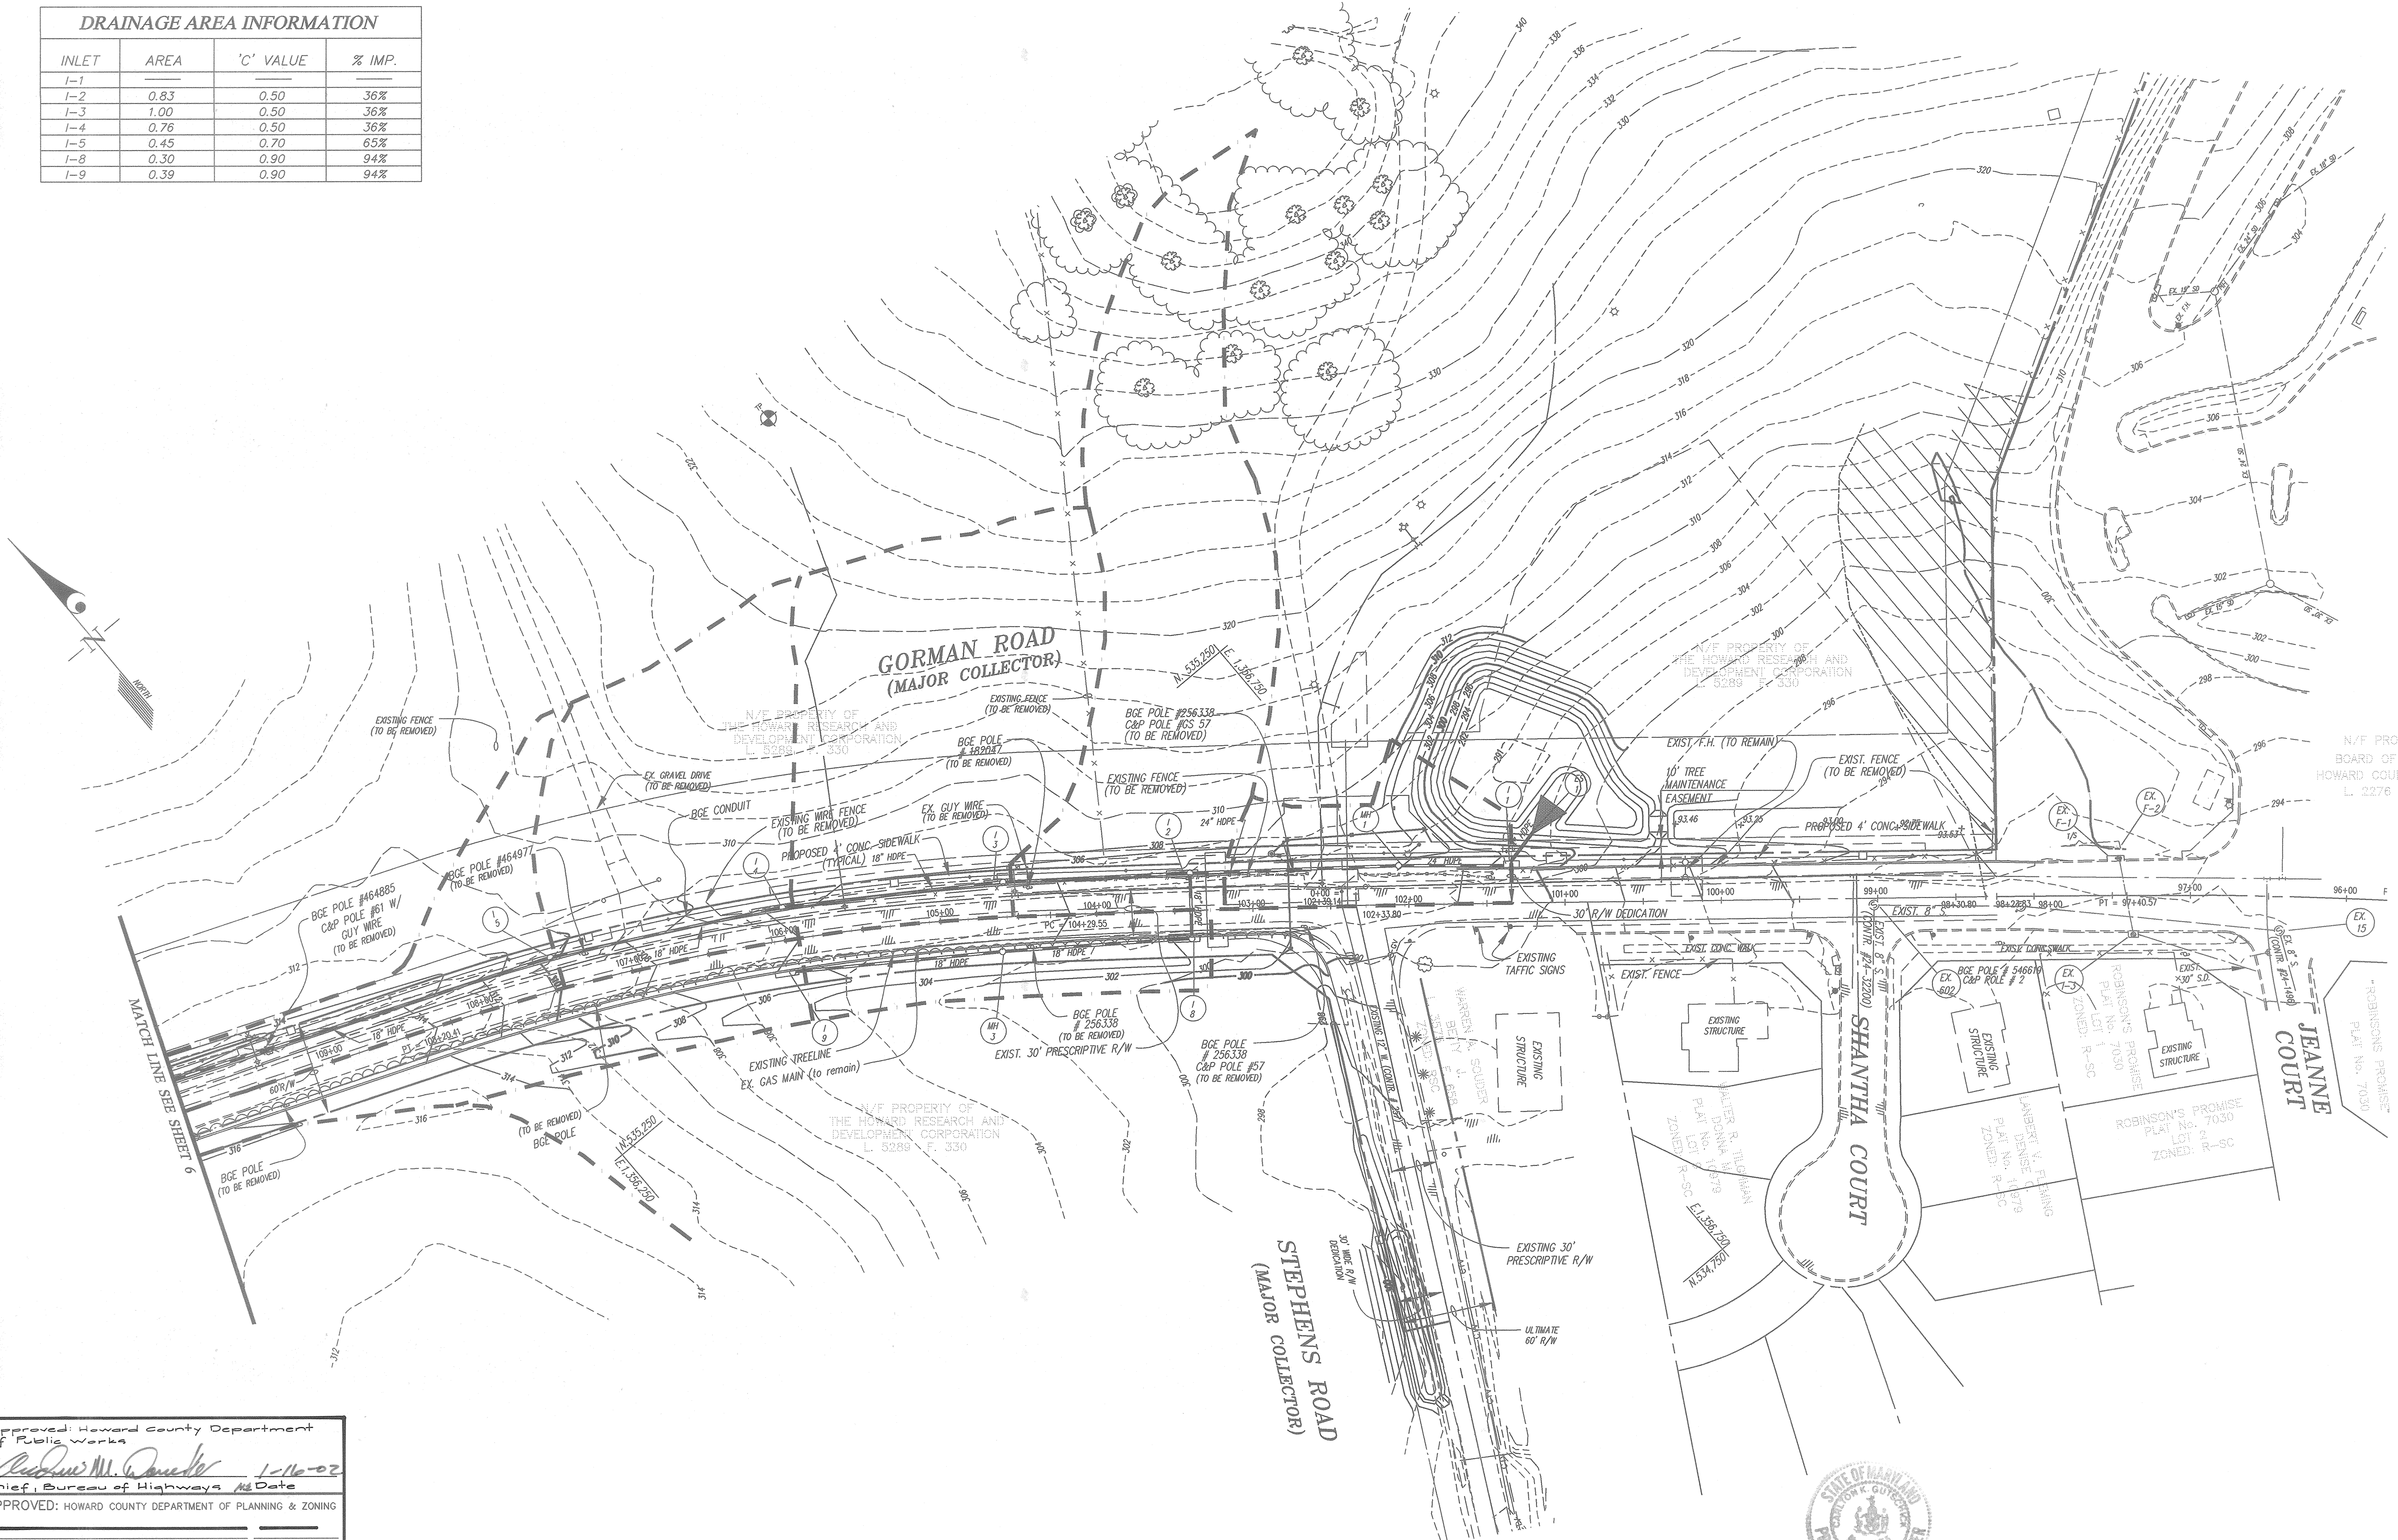

Approved: Howard County Department of Public Works  
 Chief, Bureau of Highways  
 APPROVED: HOWARD COUNTY DEPARTMENT OF PLANNING & ZONING  
 Chief, Division of Land Development  
 Chief, Development Engineering Division

**GLW GUTSCHICK LITTLE & WEBER, P.A.**  
 CIVIL ENGINEERS, LAND SURVEYORS, LAND PLANNERS, LANDSCAPE ARCHITECTS  
 3809 NATIONAL DRIVE - SUITE 250 - BURTONSVILLE OFFICE PARK  
 BURTONSVILLE, MARYLAND 20866  
 TEL: 301-421-4024 BAL: 410-880-1820 DC/VA: 301-989-2524 FAX: 301-421-4186

NO.	REVISION	DATE	BY	APP'R.

PREPARED FOR:  
 THE HOWARD RESEARCH AND DEVELOPMENT CORPORATION  
 10275 LITTLE PATENT PARKWAY  
 COLUMBIA, MARYLAND 21044  
 ATTN: MR. BOB ENKENS  
 PH: (410) 892-6089







**DRAINAGE AREA MAP**  
**ROAD CONSTRUCTION PLANS**  
**IMPROVEMENTS TO GORMAN ROAD**  
**AND STEPHENS ROAD**  
 GORMAN ROAD FROM 97+99.27 TO 118+00  
 STEPHENS ROAD FROM 0+00 TO 2+55  
 HOWARD COUNTY, MARYLAND

SCALE	ZONING	G. L. W. FILE No.
1"=50'	R-ED R-SC-MXD-3 PEC-MXD-3	99140
DATE	TAX MAP - GRID	SHEET
OCT, 2001	47-9/10	7 of 12

99140DA2.dwg 12-20-01 3:01:52 pm EST



MATCH LINE SEE THIS SHEET

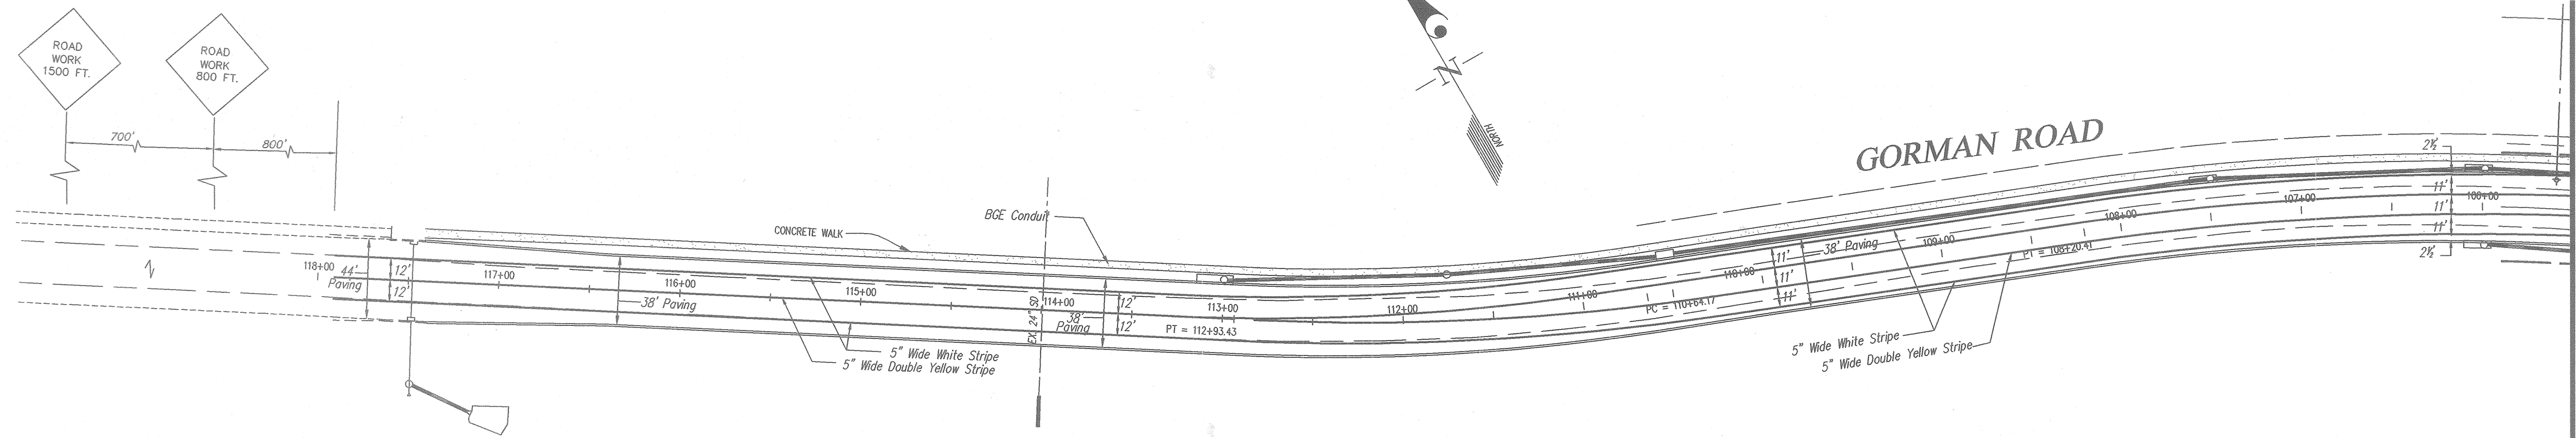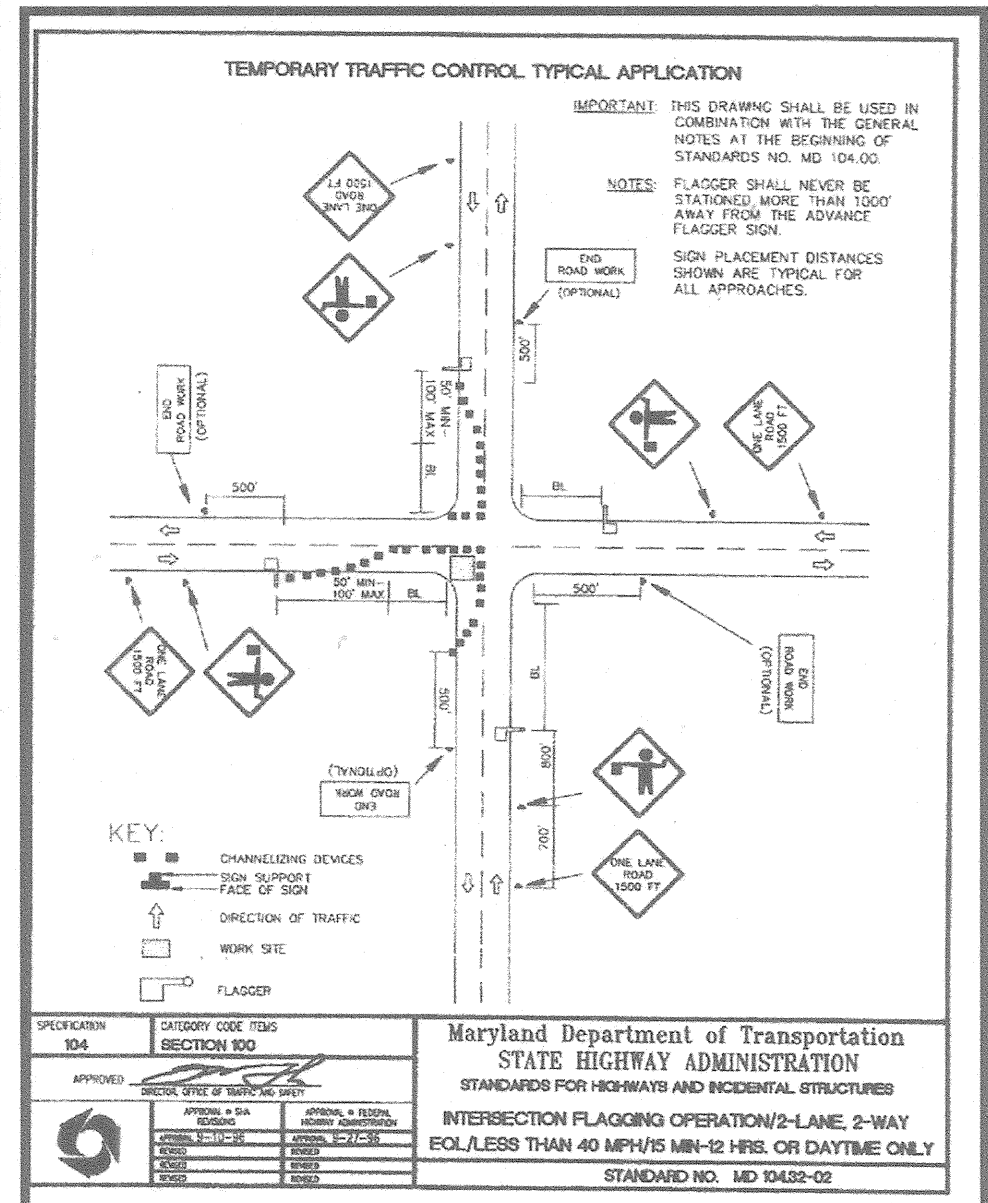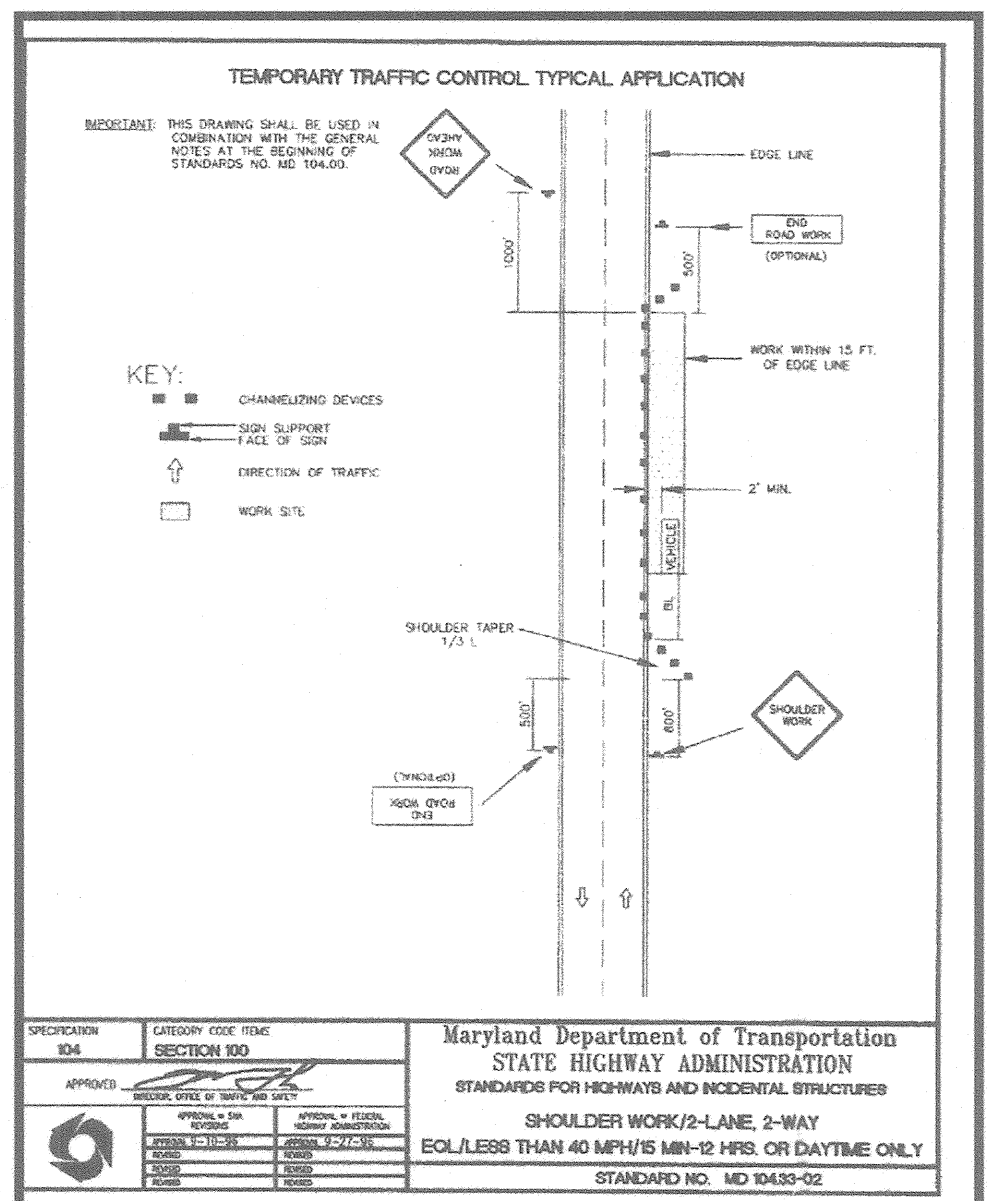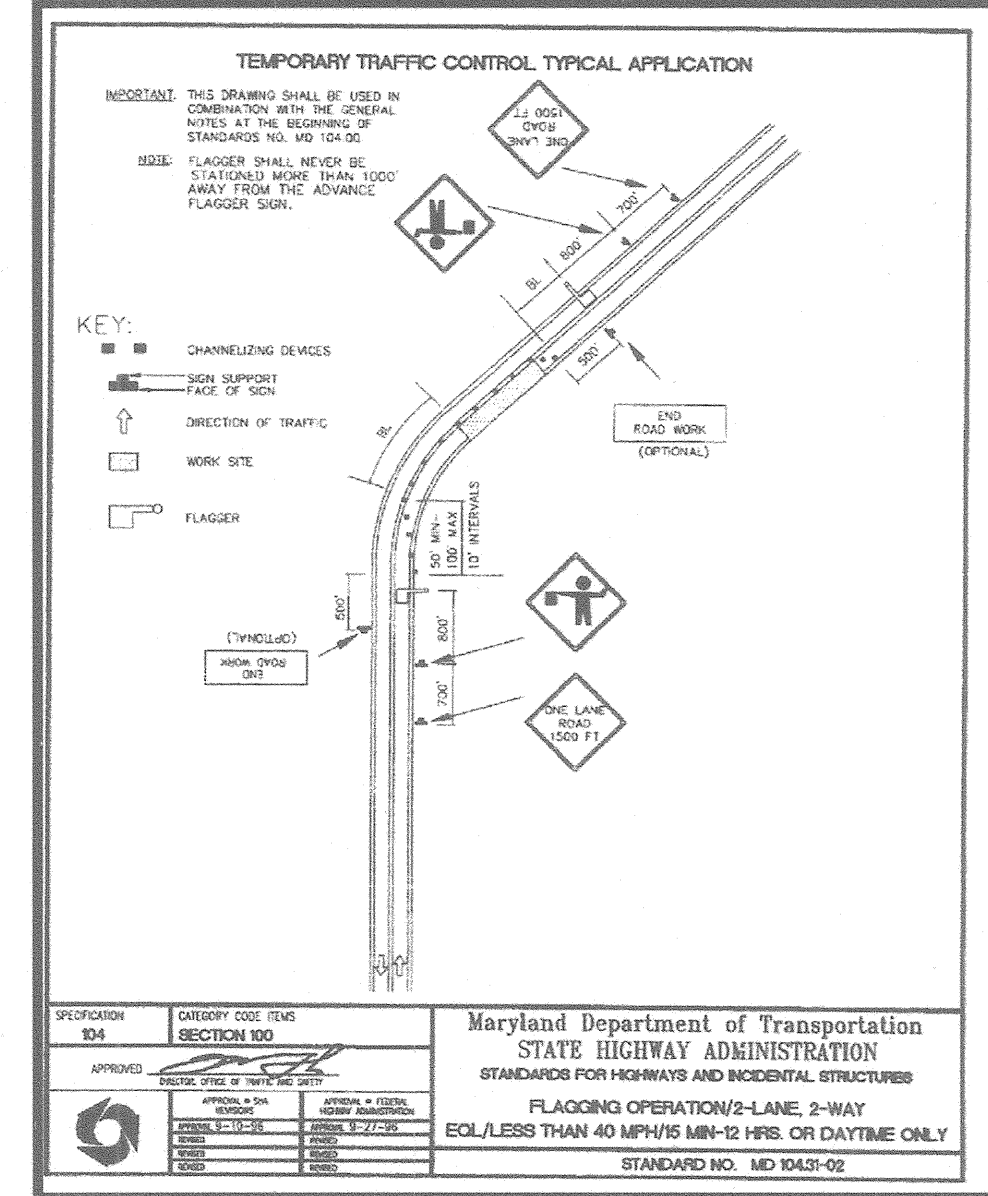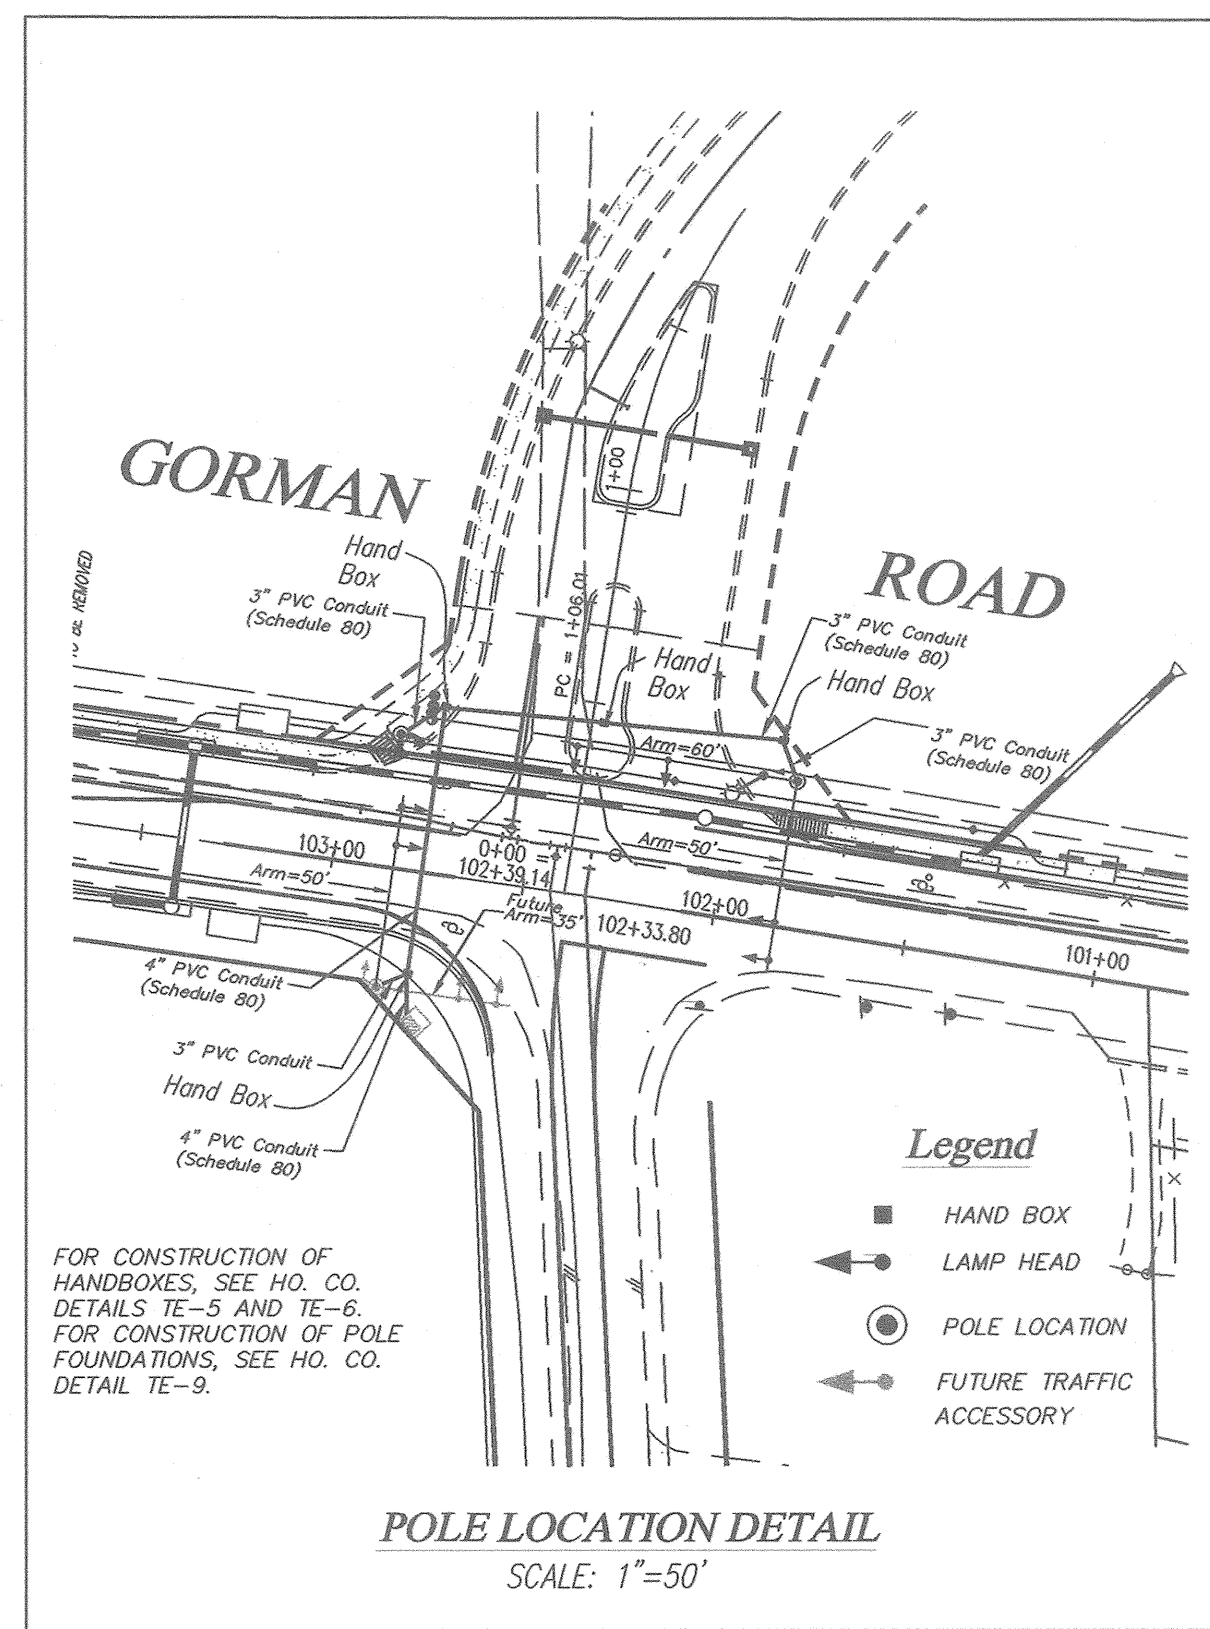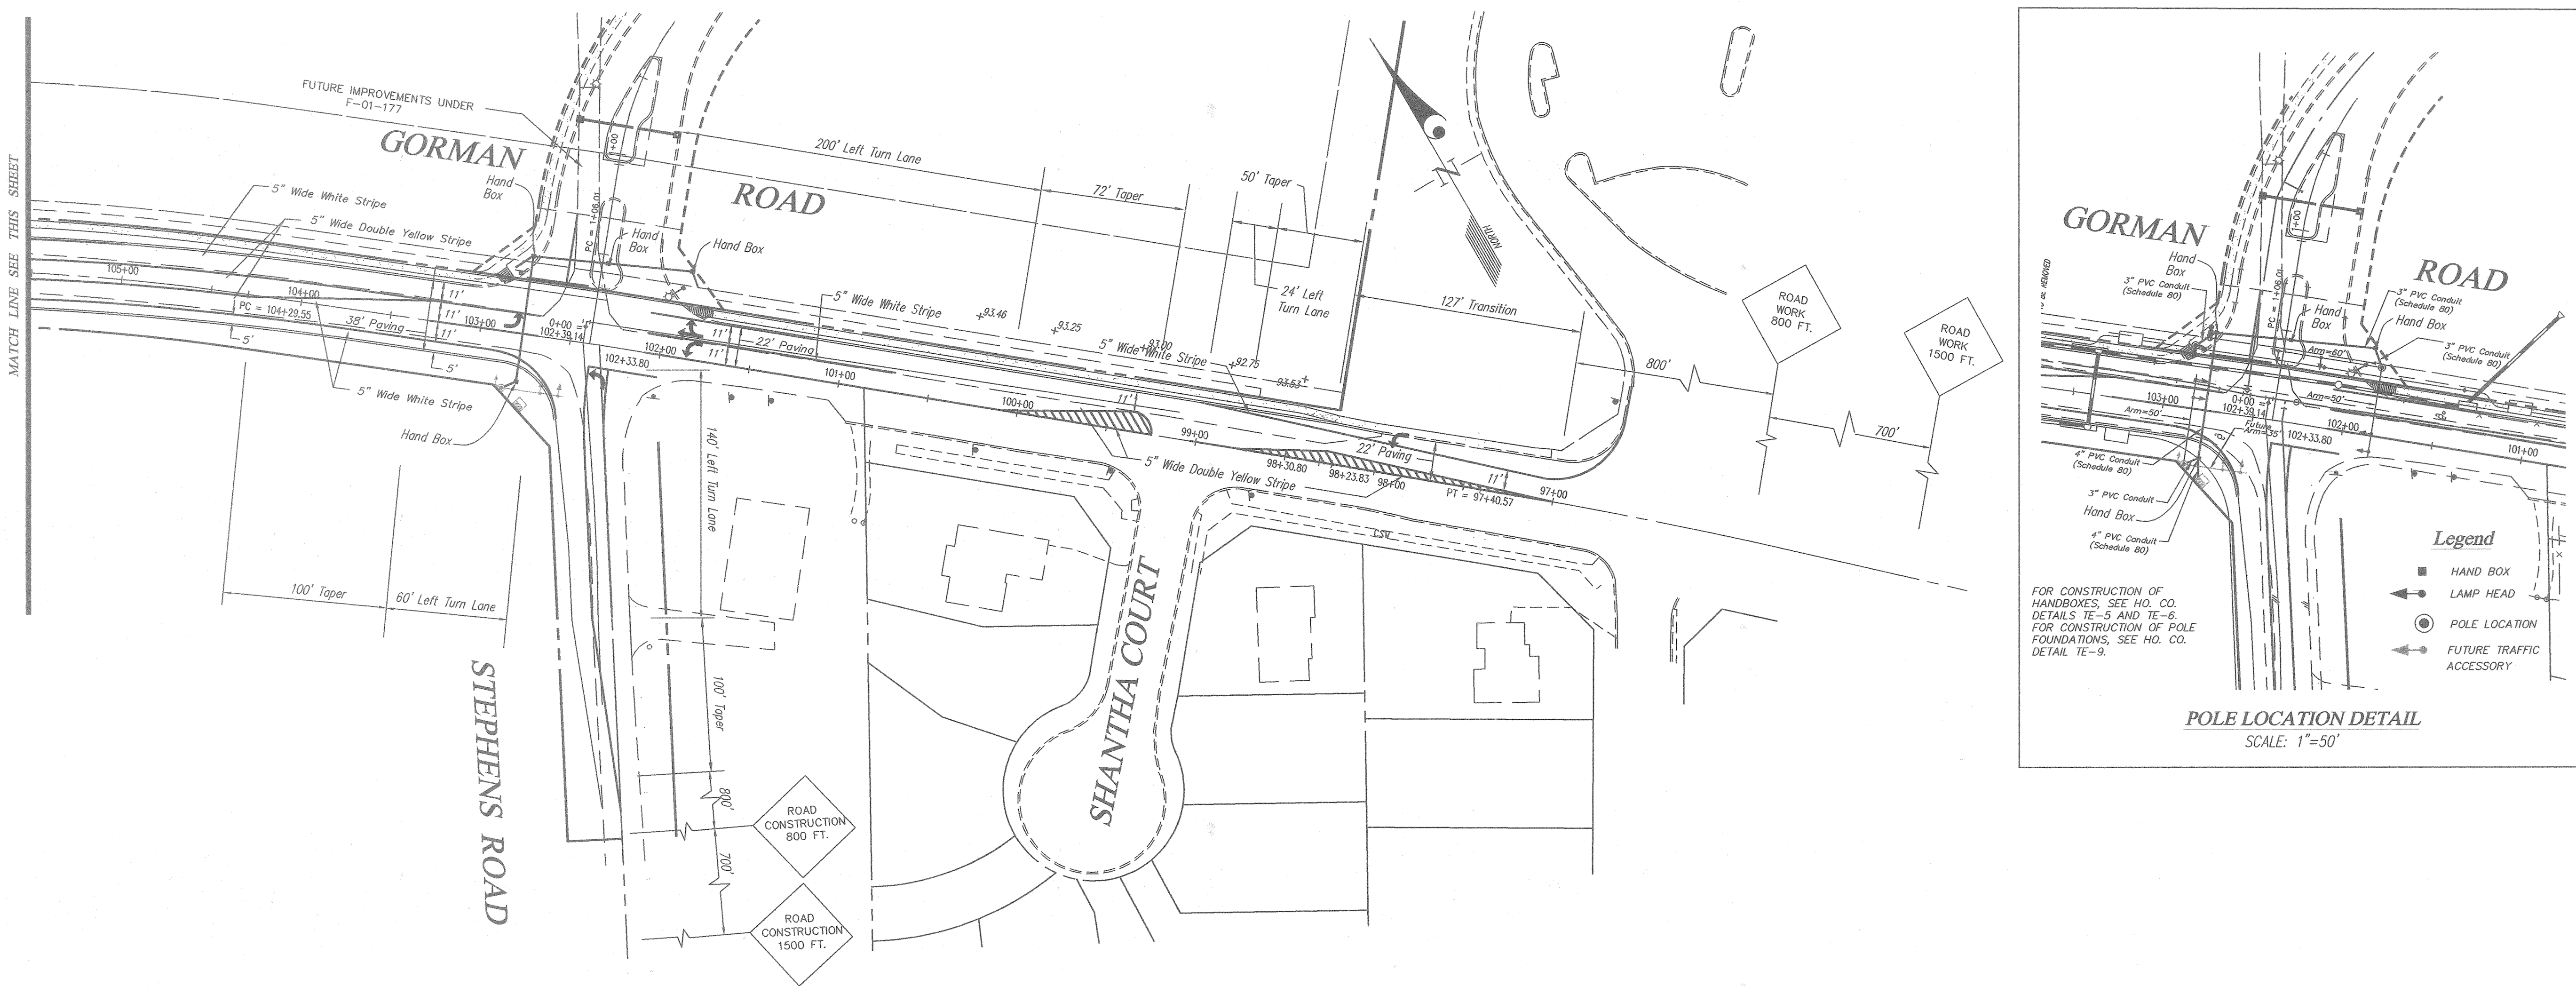

- PAVEMENT MARKING NOTES**
- ALL PAVEMENT MARKINGS TO BE APPLIED USING "SETFAST PREMIUM ALKYD TRAFFIC PAINT" BY SHERWIN WILLIAMS OR APPROVED EQUAL.
  - EXISTING PAVEMENT MARKINGS THAT ARE IN CONFLICT WITH THE PROPOSED PAVEMENT MARKINGS FOR THIS CONTRACT WILL BE REMOVED BY GRINDING.
  - EXACT LOCATION OF STOP LINES IS TO BE ESTABLISHED IN THE FIELD BY THE HOWARD COUNTY TRAFFIC DIVISION. CALL DIANE SCHWARZMAN AT 313-2430.

- SIGNING NOTES**
- SIGN ERECTED AT THE SIDE OF THE ROAD SHALL BE MOUNTED AT A HEIGHT OF AT LEAST 7 FEET MEASURED FROM THE BOTTOM OF THE SIGN TO THE NEAR EDGE OF THE PAVEMENT.
  - ALL SIGNS TO BE MOUNTED ON 4"x12" WOLMANIZED, (PRESSURE TREATED), WOODEN POSTS.
  - SIGNS SHALL BE 12" TO 18" FROM EDGE OF SIGN TO CURB LINE. STOP SIGNS SHALL BE LOCATED 15' BACK FROM INTERSECTING STREET CURB LINE OR AS DIRECTED BY HOWARD COUNTY TRAFFIC DIVISION.

Approved: Howard County Department of Public Works  
*Robert M. Smith* 1-16-02  
 Chief, Bureau of Highways No Date

Approved: Howard County Department of Planning and Zoning  
*Andy Harmon* 1/29/02  
 Chief, Div. of Land Development Date

Approved: Chief, Development Engineering Division  
*[Signature]* 1/29/02  
 Date



**GLW GUTSCHICK LITTLE & WEBER, P.A.**  
 CIVIL ENGINEERS, LAND SURVEYORS, LAND PLANNERS, LANDSCAPE ARCHITECTS  
 3909 NATIONAL DRIVE - SUITE 250 - BURTONSVILLE OFFICE PARK  
 BURTONSVILLE, MARYLAND 20866  
 TEL: 301-421-4024 BALT: 410-880-1820 DC/VA: 301-989-2524 FAX: 301-421-4186

NO.	DATE	REVISION	BY	APP'R.

PREPARED FOR:  
 THE HOWARD RESEARCH AND DEVELOPMENT CORPORATION  
 10275 LITTLE PATUXENT PARKWAY  
 COLUMBIA, MD. 21044  
 PH: 410-992-6089  
 ATTN: BOB JENKINS

**STRIPING PLAN**  
**ROAD CONSTRUCTION PLANS**  
**IMPROVEMENTS TO GORMAN ROAD**  
**AND STEPHENS ROAD**  
 GORMAN ROAD FROM 97+99.27 TO 118+00  
 STEPHENS ROAD FROM 0+00 TO 2+55  
 ELECTION DISTRICT No. 6  
 HOWARD COUNTY, MARYLAND

SCALE	ZONING	G. L. W. FILE No.
1"=50'	R-ED R-SC-MXD-3 PEC-MXD-3	99140
DATE	TAX MAP - GRID	SHEET
OCT, 2001	47 - 9/10	8 OF 12

99140RST.dwg 12-20-01 3:09:12 pm EST







ROAD INFORMATION CHART & NOTES

ROAD NAME & STATION	ROAD CLASSIFICATION	ZONING	DESIGN SPEED	PAVING SECTION	CROSS SECTION
Gorman Road 98+00 to 101+00	Major Collector	Note 1	40 MPH	P-5	5
Gorman Road 101+00 to 102+67	Major Collector	Note 1	40 MPH	P-5	4
Gorman Road 102+67 to 105+62	Major Collector	Note 1	40 MPH	P-5	3
Gorman Road 105+62 to 109+32	Major Collector	Note 1	40 MPH	P-5	2
Gorman Road 109+32 to 109+85	Major Collector	Note 1	40 MPH	P-5	* Note 3 & 9
Gorman Road 109+85 to 113+68	Major Collector	Note 1	40 MPH	P-5	* Note 4 & 9
Gorman Road 113+68 to 115+79	Major Collector	Note 1	40 MPH	P-5	* Note 5 & 9
Gorman Road 115+79 to 117+00	Major Collector	Note 1	40 MPH	P-5	* Note 6 & 9
Gorman Road 117+00 to 117+50	Major Collector	Note 1	40 MPH	P-5	* Note 7 & 9
Gorman Road 117+50 to 118+00	Major Collector	Note 1	40 MPH	P-5	* Note 8 & 9
Stephens Road 0+12 to 2+55	Local Road	R-SC-MXD-3	40 MPH	P-5	6 Note 9

NOTES:


- Zoning classifications for subject property are: R-ED, R-SC-MXD-3, and PEC-MXD-3.
- Stations shown for limits of cross sections and transitions described below are approximate and can be modified with engineer's approval to better suit field conditions.
- The Eastbound Lane will transition from a normal crowned section (2% cross slope) at 109+32 to 0% cross slope at 109+85 and the superelevation will begin. The cross slope for the Westbound Lane will remain 2%.
- The Eastbound and Westbound Lanes are both superelevated and the cross slope varies. See sheet 3 of these drawings for the top of curb elevations and centerline grades in order to calculate the cross slope at any given point.
- The Westbound Lane begins transitions from superelevated cross slope at 113+75 to the existing cross slope station 114+75. The remainder of the operation from 114+75 to 117+50 in the Westbound is mill and overlay of the existing pavement and widening to the full road width. The Eastbound Lane continues to transition through the superelevated section and obtains a cross slope of 0% at station 115+79.
- The Eastbound Lane transitions from the 0% cross slope at station 115+79 to the existing cross slope of Gorman Road at station 117+00.
- From station 117+00 to 117+50 the work in both the East and West Bound lanes will consist of the removal and replacement of the existing pavement and widening to the full road width.
- From station 117+50 to 118+00 the work in both the East and West Bound Lanes will consist of the removal and replacement of the existing pavement.
- The contractor shall provide at least 1 (one) foot sawcut into existing pavement and place a minimum of 1 1/2" surface course pavement to meet the required grade and conform to the standard P-5 section in accordance with H.C. Det. & local Prior to pavement overlay.
- Due to transition of the road section in this area, it does not conform to any of the sections shown. Survey/construction coordination must be used for proper elevations.

- Superelevated- see detail provided on this sheet.
- Crowned section (centerline of paving at the centerline of the right of way).
- Crowned section (centerline of paving is shifted from centerline of the right of way).
- Crowned section (improvements to westbound lane only, centerline of paving is shifted) from centerline R/W
- Crowned section (improvements to westbound lane only, centerline of paving is at centerline right of way).
- Crowned section (improvements to southbound lane only).

APPROVED: HOWARD COUNTY DEPARTMENT OF PUBLIC WORKS  
*Richard M. Donato* 1-16-02  
 Chief, Bureau of Highways  
 Date











APPROVED: HOWARD COUNTY DEPARTMENT OF PLANNING & ZONING  
*Cindy K. Rasmussen* 1/29/02  
 Chief, Division of Land Development  
 Date

*[Signature]*  
 Chief, Development Engineering Division  
 Date


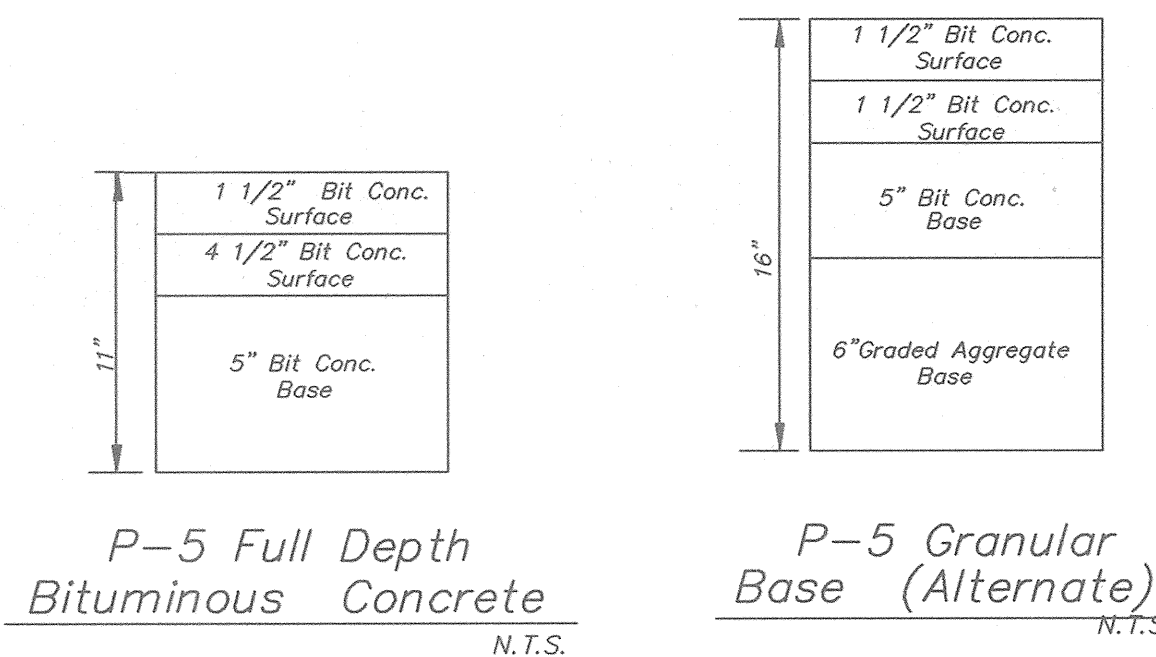


Paving Sections

Note: Other equivalent paving sections may be used where approved by a Geotechnical.

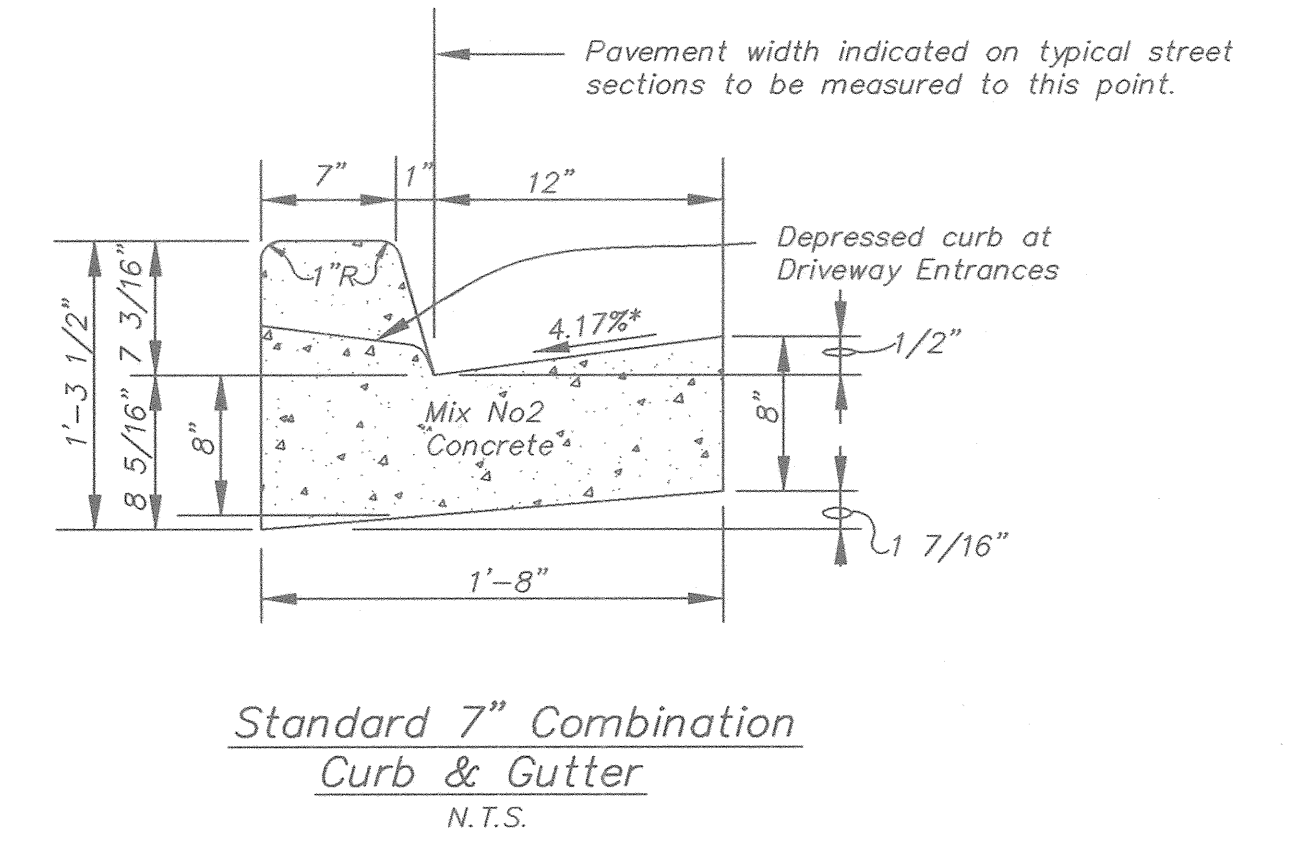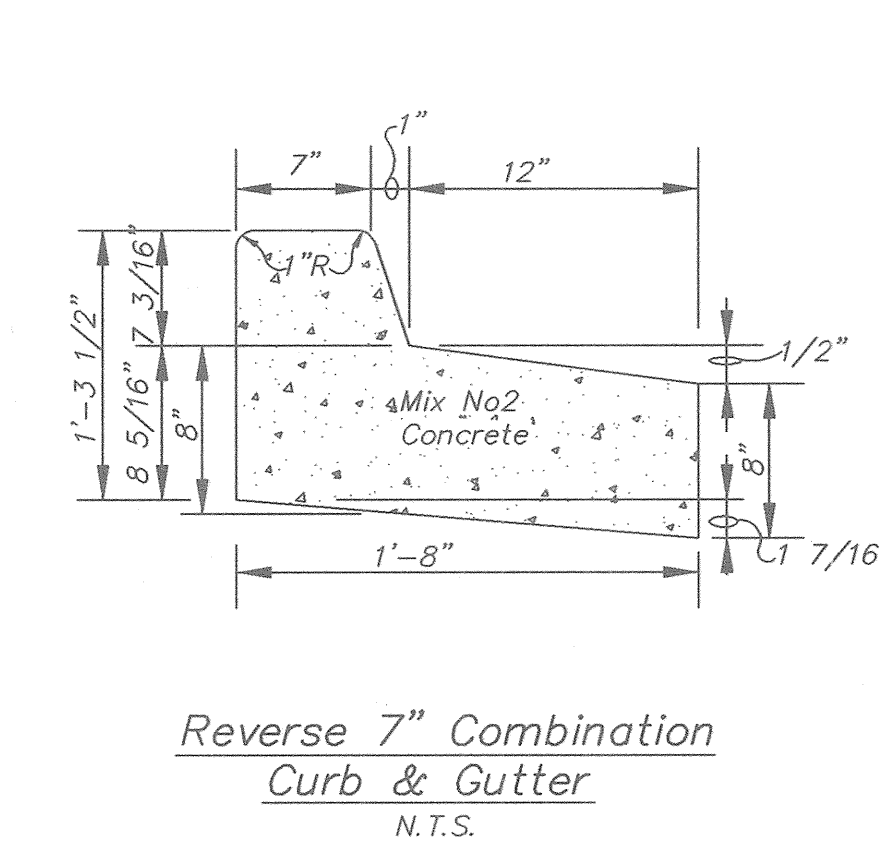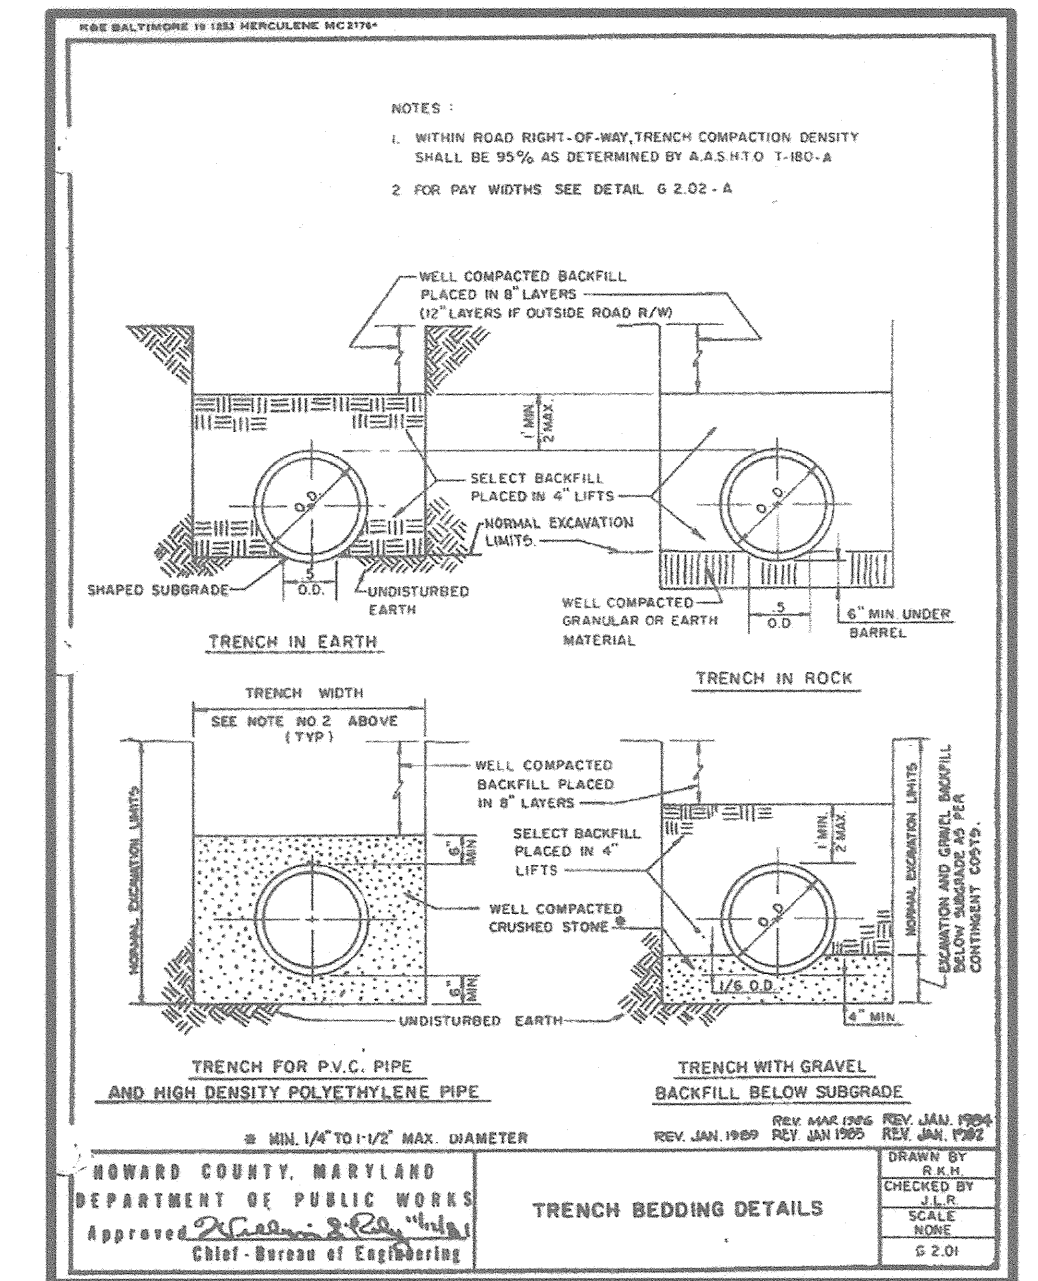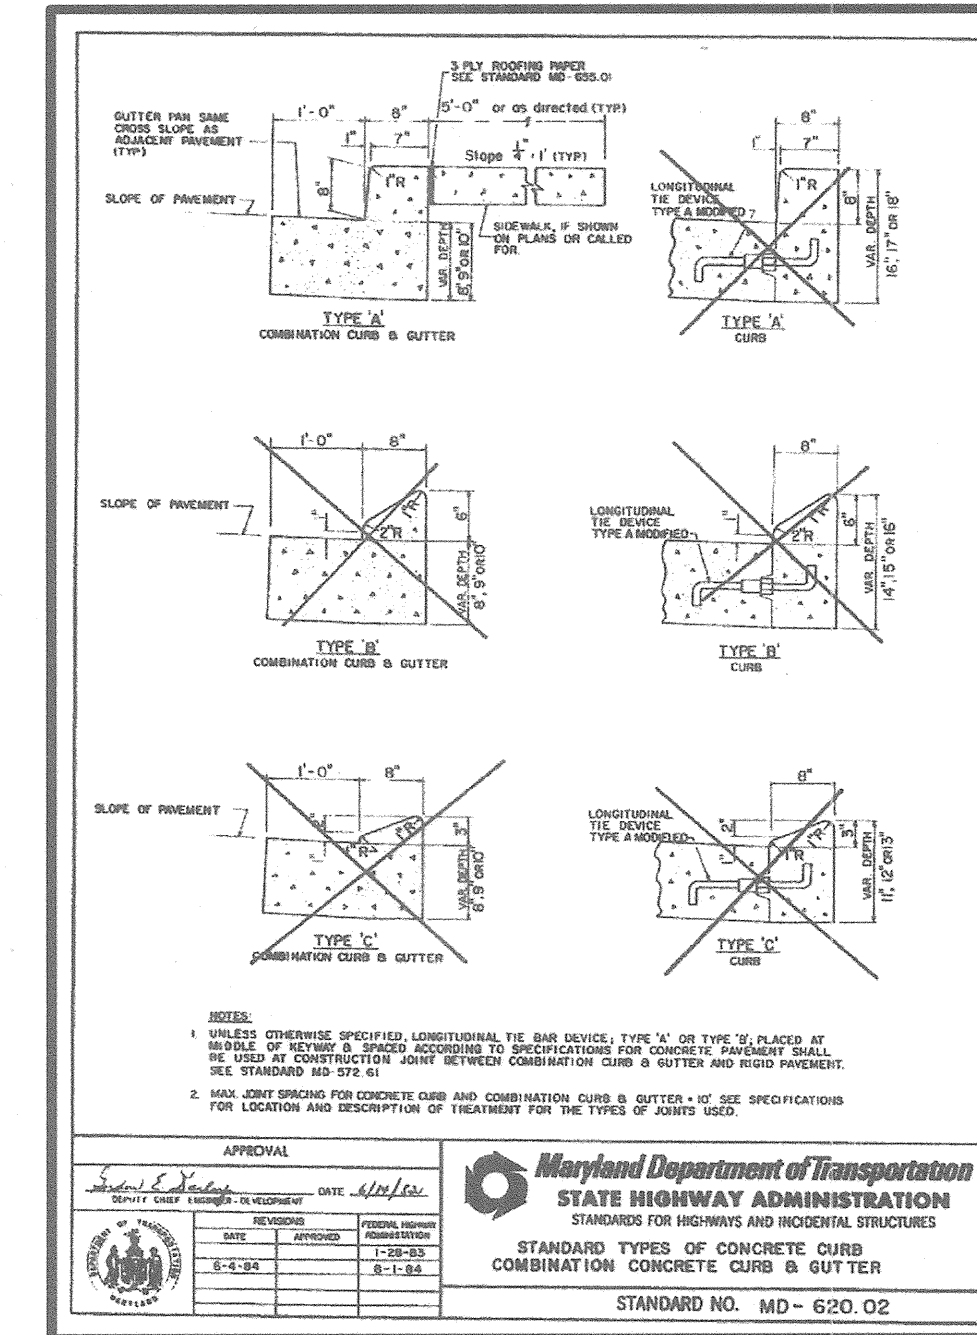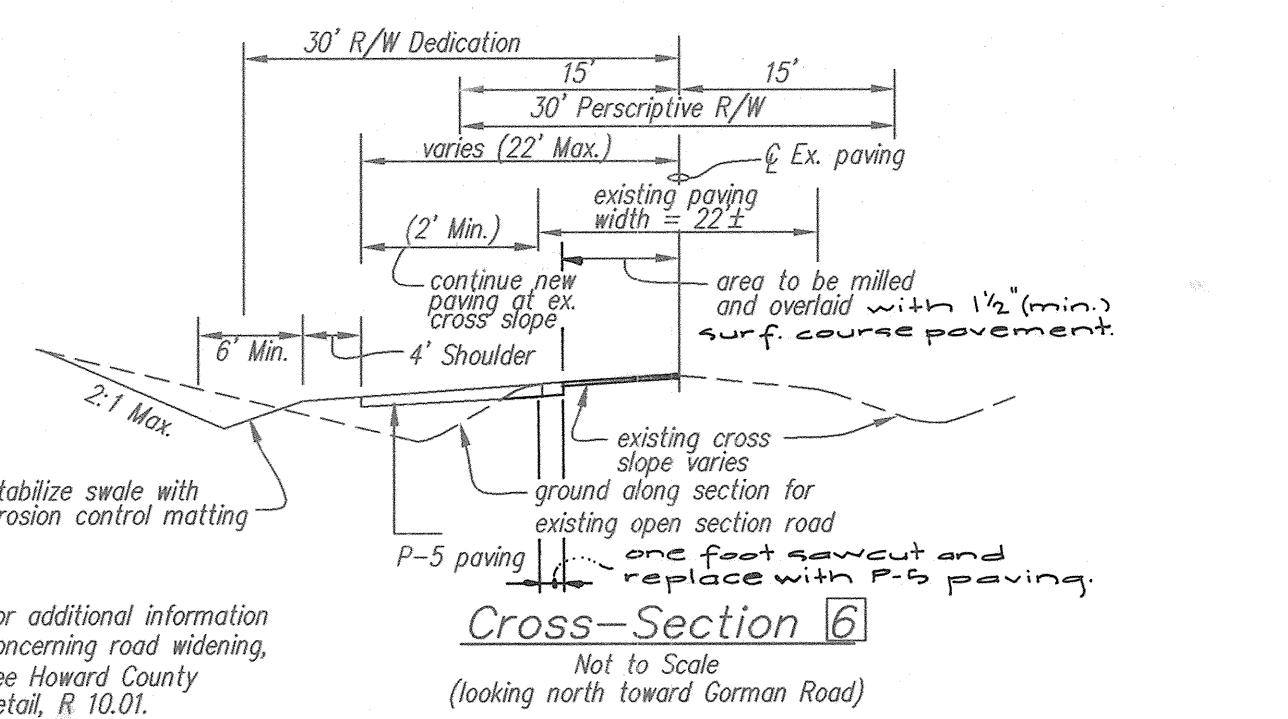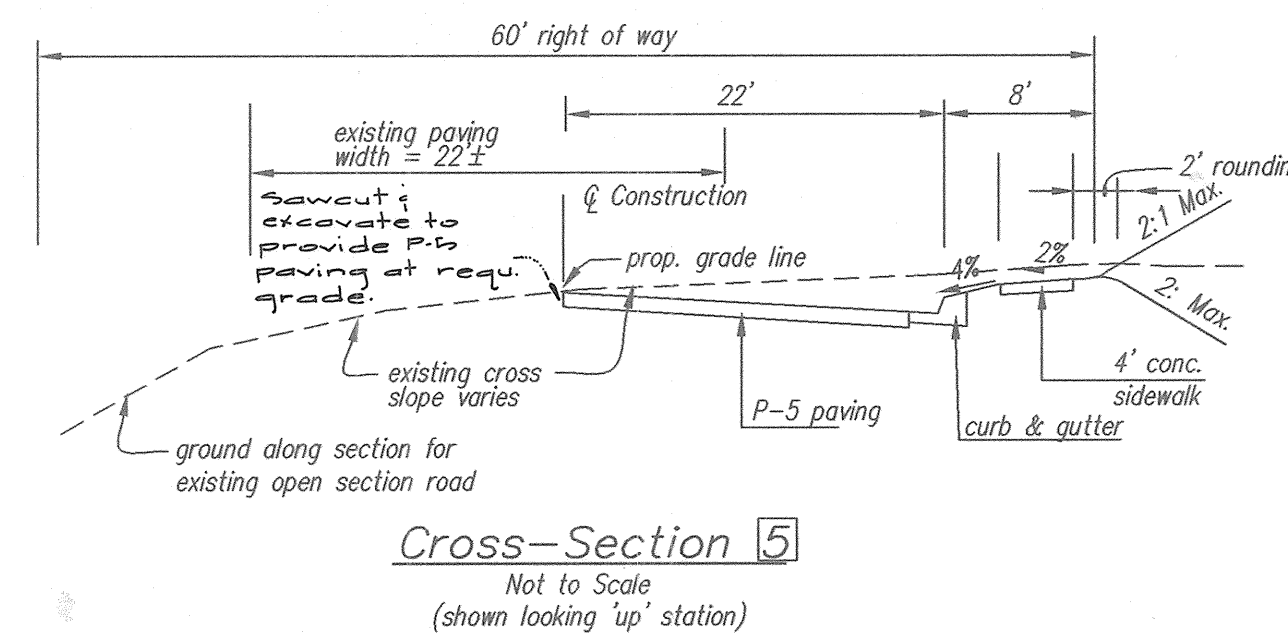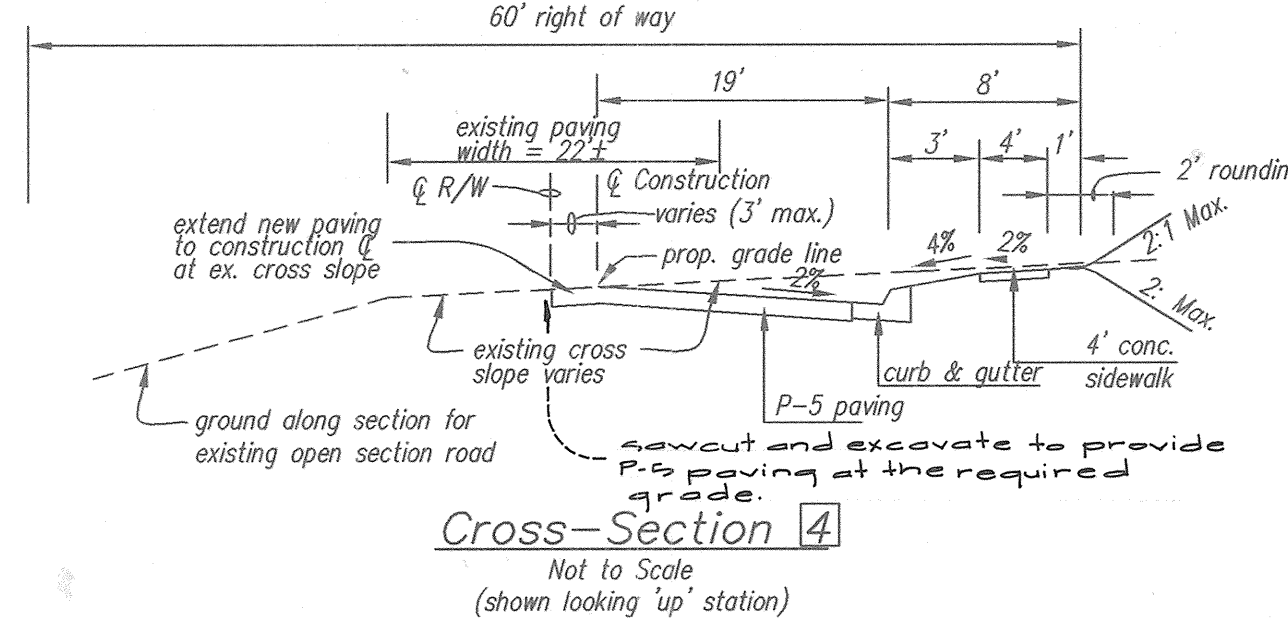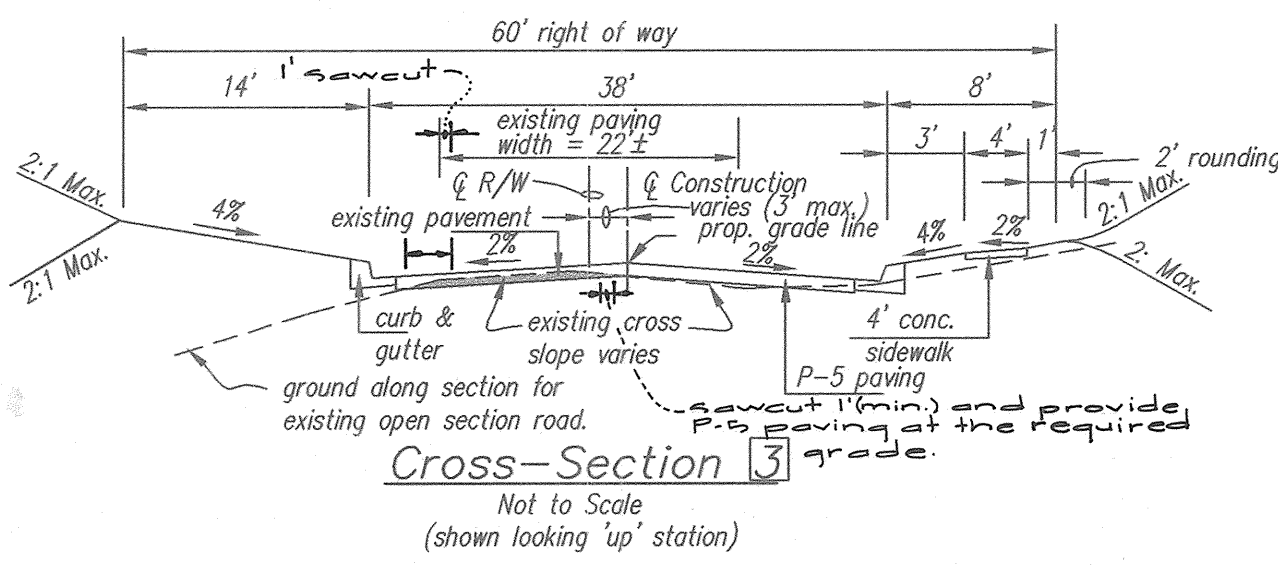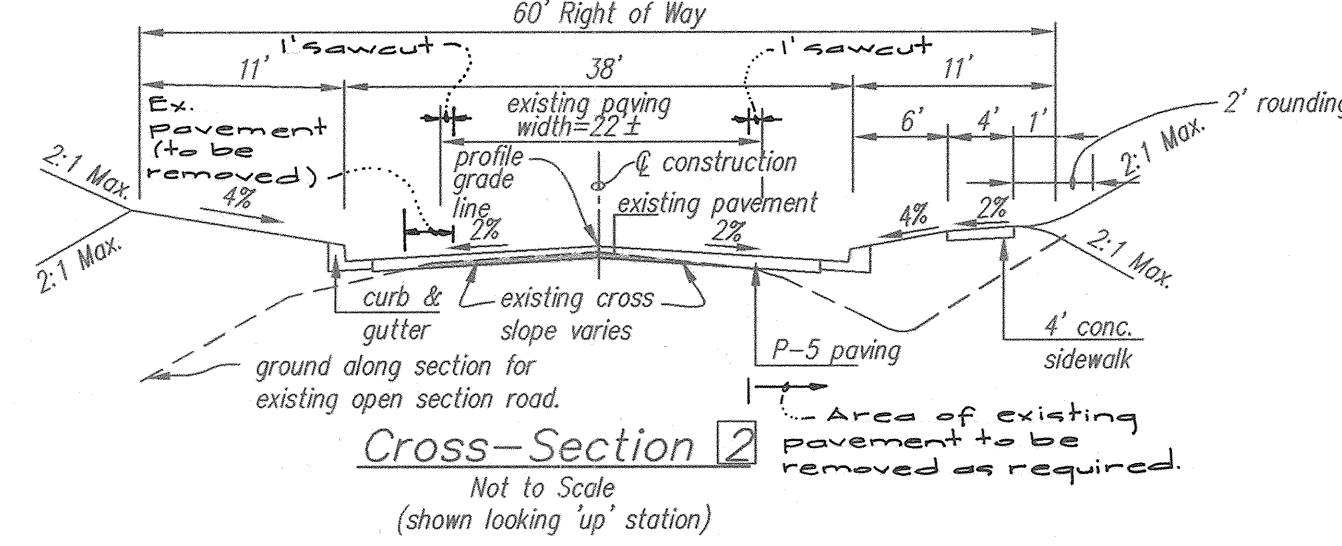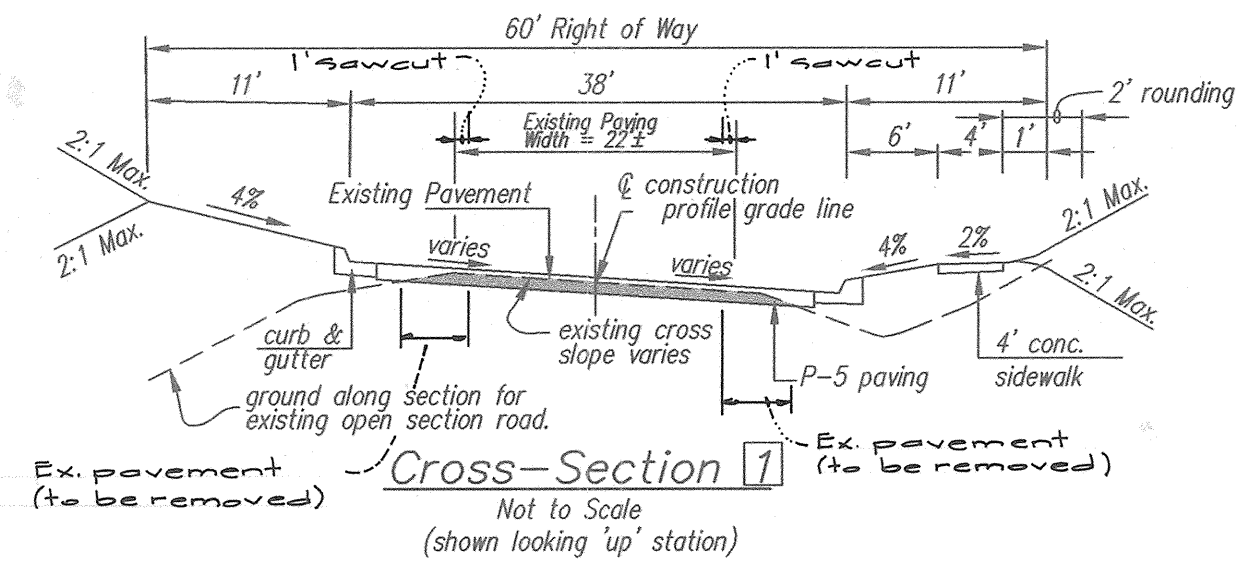

\* Gutter pan at median edge of intermediate arterials or the high side of superelevated sections shall be sloped at the same rate and in the same direction as the pavement. Match pavement cross slope when curb is located on the low side of superelevated section and the rate of superelevation is greater than 3% for modified curb and gutter.

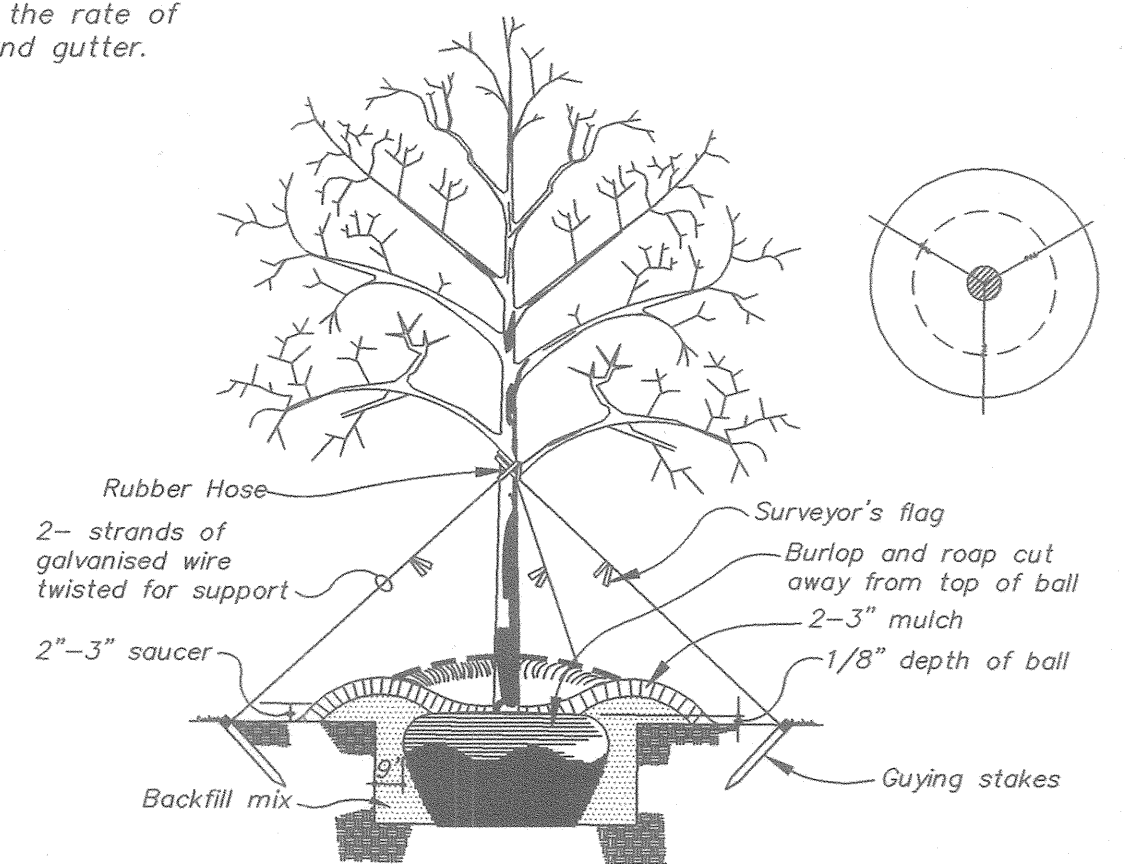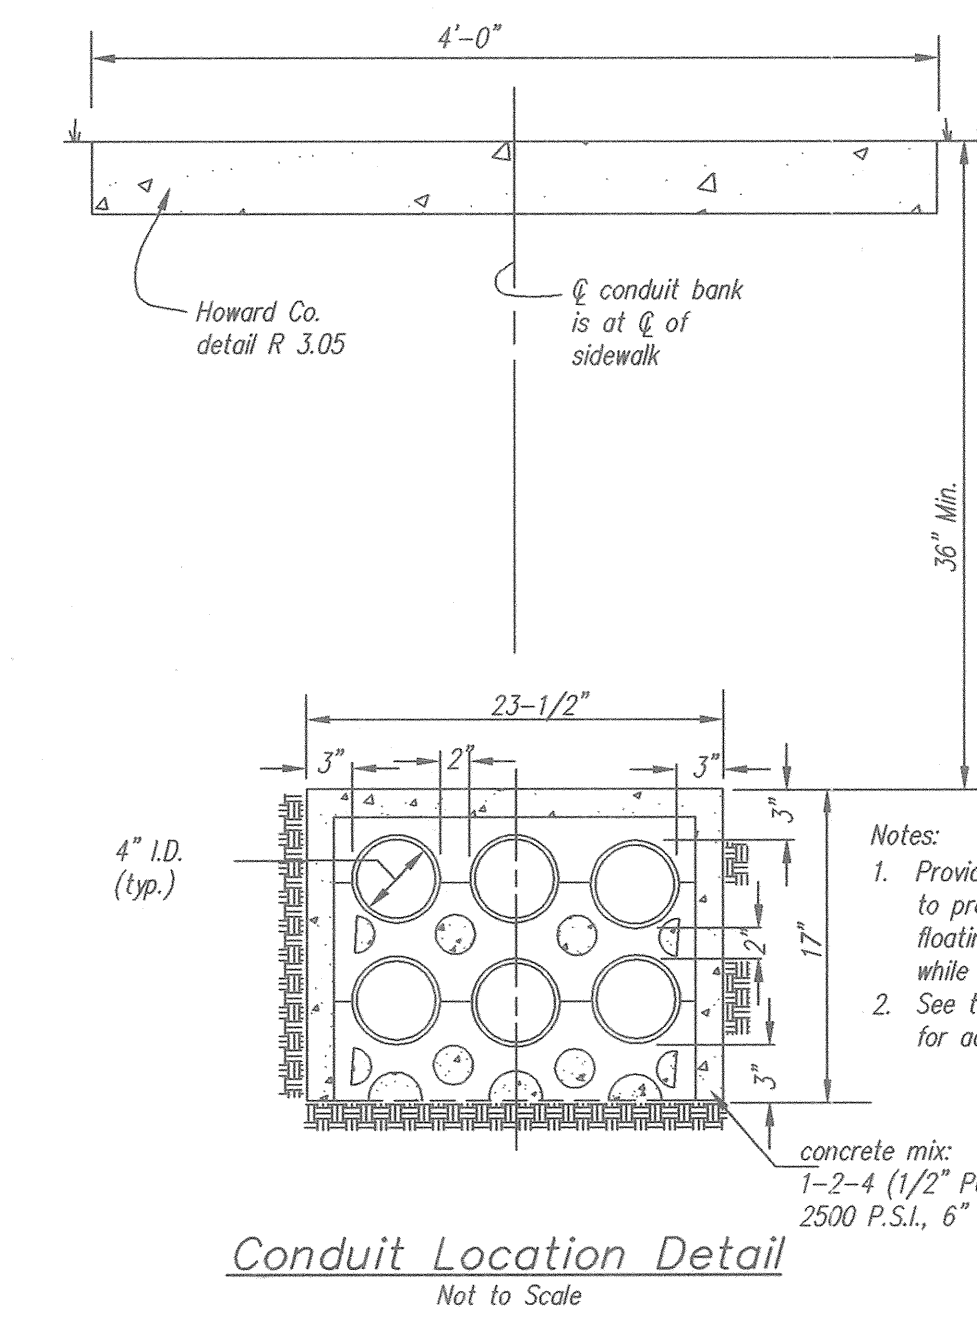

**GLW GUTSCHICK LITTLE & WEBER, P.A.**  
 CIVIL ENGINEERS, LAND SURVEYORS, LAND PLANNERS, LANDSCAPE ARCHITECTS  
 3909 NATIONAL DRIVE - SUITE 250 - BURTONSVILLE OFFICE PARK  
 BURTONSVILLE, MARYLAND 20866  
 TEL: 301-421-4024 BAL: 410-880-1820 DC/VA: 301-989-2524 FAX: 301-421-4186



PREPARED FOR:  
**THE HOWARD RESEARCH AND DEVELOPMENT CORPORATION**  
 10275 LITTLE PATUXENT PKWY.  
 COLUMBIA, MD 21044  
 ATTN: BOB JENKINS  
 (410) 992-6089

**ROAD CONSTRUCTION NOTES & DETAILS**  
 ROAD CONSTRUCTION PLANS  
 IMPROVEMENTS TO GORMAN ROAD  
 AND STEPHENS ROAD  
 GORMAN ROAD FROM 97+93.27 TO 118+00  
 STEPHENS ROAD FROM 0+00 TO 2+55  
 ELECTION DISTRICT No. 6  
 HOWARD COUNTY, MARYLAND

SCALE	ZONING	G. L. W. FILE NO.
AS SHOWN	R-ED R-SC-MXD-3 PEC-MXD-3	99140
OCT., 2001	47-9/10	10 OF 12



DETAIL 2 - TEMPORARY SWALE

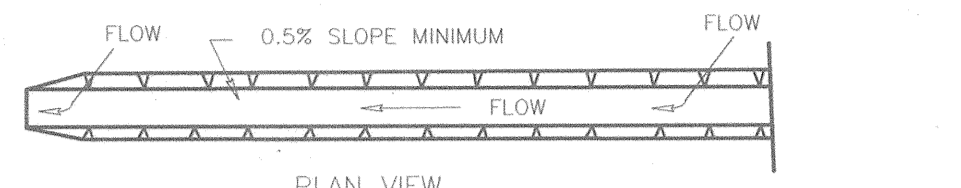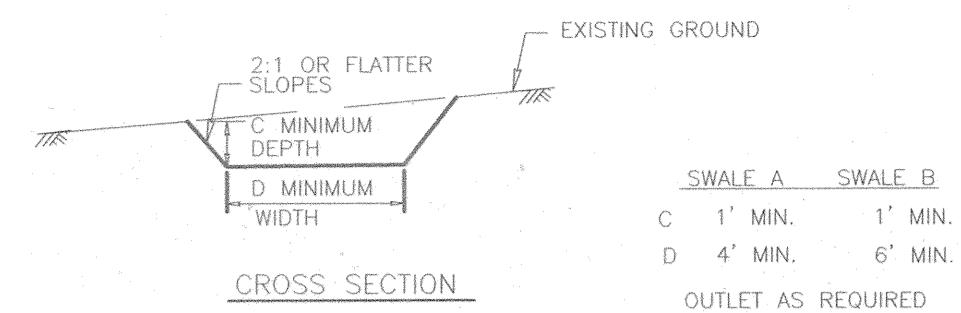

DRAINAGE AREA = 10 ac (MAX)  
SLOPE = 10% (MAX)

FLOW CHANNEL STABILIZATION  
GRADE 0.5% MIN. 10% MAX.

STANDARD SYMBOL  
A - 2 / B - 3




1. Seed and cover with straw mulch.
2. Seed and cover with Erosion Control Matting or line with sod.
3. 4" - 7" stone or recycled concrete equivalent pressed into soil in a minimum 7" layer.

Construction Specifications

1. All temporary swales shall have uninterrupted positive grade to an outlet. Spot elevations may be necessary for grades less than 1%.
2. Runoff diverted from a disturbed area shall be conveyed to a sediment trapping device.
3. Runoff diverted from an undisturbed area shall outlet directly into an undisturbed stabilized area at a non-erosive velocity.
4. All trees, brush, stumps, obstructions, and other objectionable material shall be removed and disposed of so as not to interfere with the proper functioning of the swale.
5. The swale shall be excavated or shaped to line, grade and cross section as required to meet the criteria specified herein and be free of bank projections or other irregularities which will impede normal flow.
6. Fill, if necessary, shall be compacted by earth moving equipment.
7. All earth removed and not needed for construction shall be placed so that it will not interfere with the functioning of the swale.
8. Inspection and maintenance must be provided periodically and after each rain event.

U.S. DEPARTMENT OF AGRICULTURE SOIL CONSERVATION SERVICE	PAGE A - 2 - 4	MARYLAND DEPARTMENT OF ENVIRONMENT WATER MANAGEMENT ADMINISTRATION
---	-------------------	---

DETAIL 10A - STONE / RIP-RAP OUTLET SEDIMENT TRAP - ST IV

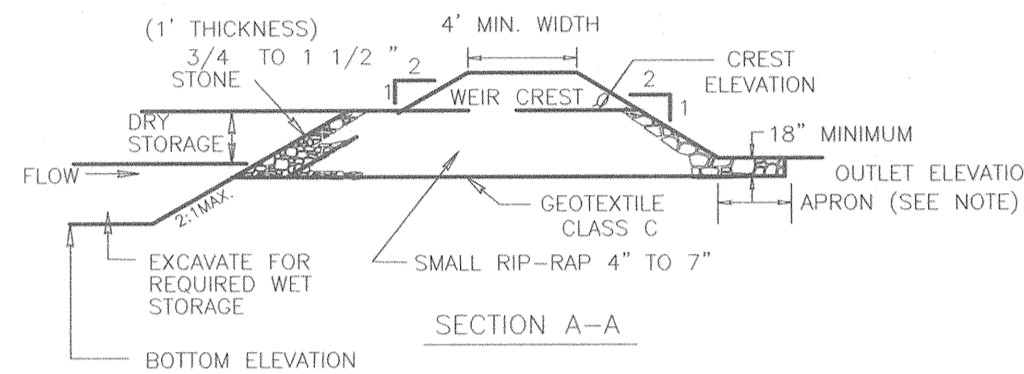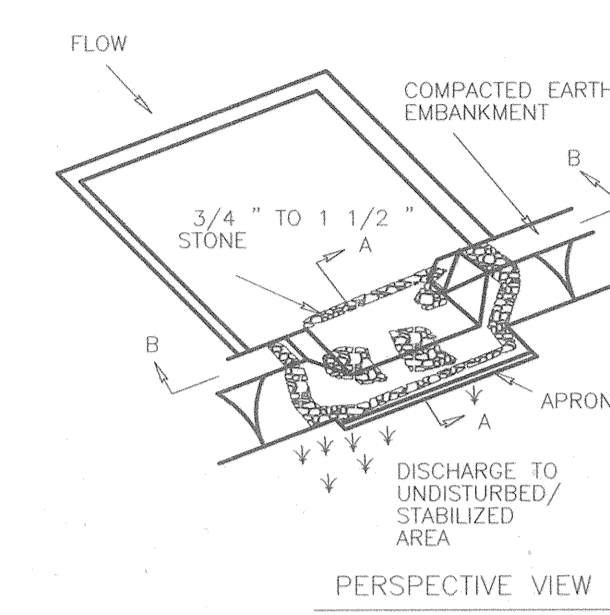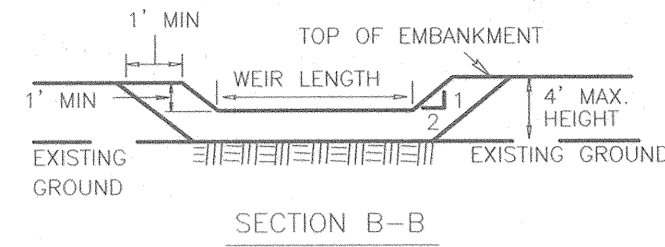

U.S. DEPARTMENT OF AGRICULTURE SOIL CONSERVATION SERVICE	PAGE C - 9 - 16	MARYLAND DEPARTMENT OF ENVIRONMENT WATER MANAGEMENT ADMINISTRATION
---	--------------------	---



STONE RIP-RAP OUTLET SEDIMENT TRAP - ST IV

Construction Specifications

1. The area under embankment shall be cleared, grubbed and stripped of any vegetation and root mat. The pool area shall be cleared.
2. The fill material for the embankment shall be free of roots or other woody vegetation as well as over-sized stones, rocks, organic material or other objectionable material. The embankment shall be compacted by traversing with equipment while it is being constructed. Maximum height of embankment shall be 4', measured at centerline of embankment.
3. All cut and fill slopes shall be 2:1 or flatter.
4. Elevation of the top of any dike directing water into trap must equal or exceed the height of trap embankment.
5. Storage area provided shall be figured by computing the volume measured from top of excavation. (For storage requirements see Table 9.)
6. Geotextile Class C shall be placed over the bottom and sides of the outlet channel prior to placement of stone. Section of fabric must overlap at least 1' with section nearest the entrance placed on top. Fabric shall be embedded at least 6" into existing ground at entrance of outlet channel.
7. 4" - 7" stone shall be used to construct the weir and 4" - 12" or Class 1 rip-rap shall be used to construct the outlet channel.
8. Outlet - An outlet shall include a means of conveying the discharge in an erosion free manner to an existing stable channel. Protection against scour at the discharge point shall be provided as necessary.
9. Outlet channel must have positive drainage from the trap.
10. Sediment shall be removed and trap restored to its original dimensions when the sediment has accumulated to 1/2' of the wet storage depth of the trap (900 cf/ac). Removed sediment shall be deposited in a suitable area and in such a manner that it will not erode.
11. The structure shall be inspected periodically after each rain and repaired as needed.
12. Construction of traps shall be carried out in such a manner that sediment pollution is abated. Once constructed, the top and outside face of the embankment shall be stabilized with seed and mulch. Pockets of concentrated runoff shall be protected in accordance with Grade Stabilization Structure criteria. The remainder of the interior slopes should be stabilized (one time) with seed and mulch upon trap completion and monitored and maintained erosion free during the life of the trap.
13. The structure shall be dewatered by approved methods, removed and the area stabilized when the drainage area has been properly stabilized.

U.S. DEPARTMENT OF AGRICULTURE SOIL CONSERVATION SERVICE	PAGE C - 9 - 16A	MARYLAND DEPARTMENT OF ENVIRONMENT WATER MANAGEMENT ADMINISTRATION
---	---------------------	---

DETAIL 1 - EARTH DIKE

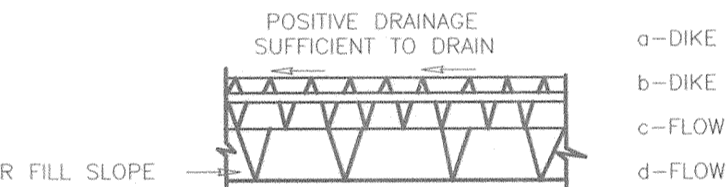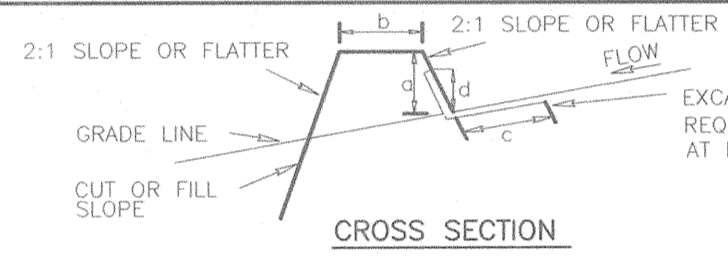

STANDARD SYMBOL  
A - 2 / B - 3

1. Seed and cover with straw mulch.
2. Seed and cover with Erosion Control Matting or line with sod.
3. 4" - 7" stone or recycled concrete equivalent pressed into the soil 7" minimum.

Construction Specifications

1. All temporary earth dikes shall have uninterrupted positive grade to an outlet. Spot elevations may be necessary for grades less than 1%.
2. Runoff diverted from a disturbed area shall be conveyed to a sediment trapping device.
3. Runoff diverted from an undisturbed area shall outlet directly into an undisturbed, stabilized area at a non-erosive velocity.
4. All trees, brush, stumps, obstructions, and other objectionable material shall be removed and disposed of so as not to interfere with the proper functioning of the dike.
5. The dike shall be excavated or shaped to line, grade and cross section as required to meet the criteria specified herein and be free of bank projections or other irregularities which will impede normal flow.
6. Fill shall be compacted by earth moving equipment.
7. All earth removed and not needed for construction shall be placed so that it will not interfere with the functioning of the dike.
8. Inspection and maintenance must be provided periodically and after each rain event.

U.S. DEPARTMENT OF AGRICULTURE SOIL CONSERVATION SERVICE	PAGE A - 1 - 6	MARYLAND DEPARTMENT OF ENVIRONMENT WATER MANAGEMENT ADMINISTRATION
---	-------------------	---

I. General

1. This Subsection prescribes trenching requirements for the installation of gas and/or electric distribution facilities. Regulations governing trenching safety, boring, shoring, tunneling, etc. and the details are contained in Distribution Work Practices.
1. This standard sets forth trenching requirements for the installation of gas pipe and electric cable. Adhering to the dimensions in this standard, the designer, in cooperation with construction, will determine the most economical trenching method.
2. Any deviations from this standard shall be promptly referred to the Construction Standards and Practices Unit of the Electric System Operations and Planning Department.
3. If field conditions do not allow the specified separations, contact the Construction Standards and Practices Unit.

4. The state and county enforcement divisions must be contacted twenty-four to forty-eight hours prior to construction. At each construction site requiring erosion and sediment control, at least one person responsible for the construction shall hold a certificate of training (green card) for sediment and erosion control issued by the State Department of Natural Resources. Contractors from out-of-state must be certified. A copy of the Grading Permit and approved plan shall be available on-site to the grading inspector at all times.

B. Miss Utility

1. Contact "Miss Utility" before any excavating or trenching begins. 48 hours advanced notice shall be given to "Miss Utility" except in emergency situations.
2. The location of water, sewer, and other utilities shown on the drawings are for informational purposes and are not guaranteed to be correct.

C. Erosion and Sediment Control

1. All Erosion and Sediment Control Requirements must be applied as needed. See the Environmental Work Practices manual for detailed requirements.
1. All shoring must comply with OSHA specifications.

II. Requirements

- A. Trench width and depth (minimum cover) are determined by a number of factors, such as: cable operating voltage, number and size of cables, gas pipe and operating pressure, separation required between facilities being installed and from existing facilities, right-of-way width, storage of excavated material, and trenching equipment capability and availability.

1. A minimum cover, the distance from the top of the electric cable and/or gas pipe to the final grade of the surface under which the electric cable or gas pipe is being installed, is required as a protection for the electric cable and/or gas pipe.
2. Gas pipe and electric cable installations shall take place following the installations of water and sewer mains and services.
3. Before excavating in new developments or to new homes, a crew shall not begin trenching until the Service Planner in New Business Construction Department (SP) has established, with documentation, that grading is within 6" of final grade. The SP shall have the grading stamp or documented statement signed by the building superintendent or the person responsible for the construction site.
4. In certain instances, such as in advance of street improvement, profiles may be furnished. The trench shall be excavated to the indicated depths.
5. A road crossing requires special considerations. Open cutting is preferred, but boring or providing a sleeve may be required or be economically more feasible.

III. Trenching General

- A. The trench for all gas and electric lines shall be excavated in as straight a line as practical.
- B. Earth and paving material removed from a trench shall be piled in such a manner as to avoid unnecessary public inconvenience and complaints and to avoid siltling of adjacent areas, storm sewers, streams, etc. in the event of inclement weather. Earth removed from a trench, suitable for use as a backfill, shall be reasonably protected to prevent excessive drying or wetting. Soil stabilizer (Mat'l No. 42-955) shall be used on wet backfill to reduce the possibility of sunken trenches.

1. Excavated material shall never be placed closer than 24" from the side of the trench or excavation.
2. Earth and paving materials shall be piled separately to ensure that only earth is used in the backfilling of the trench. All paving materials removed from a trench shall be hauled away.

- C. The trench bottom shall be excavated in a manner to provide a firm continuous bearing surface. The bottom and sides of the trench shall be reasonably smooth and free of rocks, stones and sharp projections that could damage plastic pipes, steel pipe coatings, or electric cables.

1. Solid rock or significantly rocky soil shall be removed to a depth of 2" below the standard trench depth and the trench so excavated shall be padded with clean earth or sand to a minimum depth of 2" so the pipe or electric cables will be protected from any hard points of rock which might project above the bottom of the trench.

2. The bottom of all trenches shall be carefully graded so voids or depressions will not exist under the pipe or cable to be installed.
3. The condition of the trench bottom shall be inspected before the gas pipe or electric cable is installed to ensure that it is free of projections that may cause damage.

- D. If blasting is required, necessary permits are required and adequate protection against personal injury or property damage shall be provided. For details, refer to the Gas Distribution Standards C-709-1.

1. The use of electric detonating or firing devices for blasting is prohibited on or in the vicinity of Electric Transmission Lines. Blasting charges may also be restricted to protect Company or other property, as deemed advisable.
- E. Where common trenching is permitted, the installations shall be made as described and shown in these standards.

IV. Service Trenching Requirements

- A. The service trench shall be laid out in a perpendicular straight line from the main to the house where practical. If the trench is to a lawn, care must be exercised to disturb a minimal amount of sod. The excavated earth is to be placed on ground covers to protect the grass and when the service is completed, the lawn shall be restored by replacing the sod.
- B. The trench for all gas and electric services shall be excavated to provide at least 24" of cover over the assembled pipe and/or cable from the finished grade.
- C. The trench width for services shall facilitate the installation of the service and permit compacting of the backfill.

STANDARD AND SPECIFICATIONS FOR TOPSOIL DEFINITION

Placement of topsoil over a prepared subsoil prior to establishment of permanent vegetation.

PURPOSE

To provide a suitable soil medium for vegetative growth. Soils of concern have low moisture content, low nutrient levels, low pH, materials toxic to plants, and/or unacceptable soil gradation.

CONDITIONS WHERE PRACTICE APPLIES

- I. This practice is limited to areas having 2:1 or flatter slopes where:
  - a. The texture of the exposed subsoil/parent material is not adequate to produce vegetative growth.
  - b. The soil material is so shallow that the rooting zone is not deep enough to support plants or furnish continuing supplies of moisture and plant nutrients.
  - c. The original soil to be vegetated contains material toxic to plant growth.
  - d. The soil is so acidic that treatment with limestone is not feasible.
- II. For the purpose of these Standards and Specifications, areas having slopes steeper than 2:1 require special consideration and design for adequate stabilization. Areas having slopes steeper than 2:1 shall have the appropriate stabilization shown on the plans.

CONSTRUCTION AND MATERIAL SPECIFICATIONS

- I. Topsoil salvaged from the existing site may be used provided that it meets the standards as set forth in these specifications. Typically, the depth of topsoil to be salvaged for a given soil type can be found in the respective soil profile section in the Soil Survey published by USDA-SSS in cooperation with Maryland Agricultural Experimental Station.

- i. Topsoil shall be a loam, sandy loam, clay loam, silt loam, sandy clay loam, loamy sand. Other soils may be used if recommended by an agronomist or soil scientist and approved by the appropriate approval authority.

Regardless, topsoil shall not be a mixture of contrasting textured subsoils and shall contain less than 5% by volume of cinders, stones, slag, coarse fragments, gravel, sticks, roots, trash, or other materials larger than 1 1/2" in diameter.

- ii. Topsoil must be free of plant parts such as bermuda grass, quackgrass, Johnsongrass, nutgrass, poison ivy, thistle, or others as specified.
- iii. Where the subsoil is either highly acidic or composed of heavy clays, ground limestone shall be spread at the rate of 4-8 tons/acre (200-400 pounds per 1,000 square feet) prior to the placement of topsoil. Lime shall be distributed uniformly over designated areas and worked into the soil in conjunction with tillage operations as described in the following procedures.

II. For sites having disturbed areas under 5 acres:

- i. Place topsoil (if required) and apply soil amendments as specified in 20.0 Vegetative Stabilization - Section 1 - Vegetative Stabilization Methods and Materials.

- III. For sites having disturbed areas over 5 acres:
  - i. On soil meeting Topsoil specifications, obtain test results dictating fertilizer and lime amendments required to bring the soil into compliance with the following:
    - a. pH for topsoil shall be between 6.0 and 7.5. If

SEQUENCE OF CONSTRUCTION

1. Obtain grading permit and arrange for an on-site pre-construction meeting with the sediment control inspector (SCI) 1 day
2. Install stabilized construction entrance in the area of the existing driveway to serve as a staging area. Construct Trap #1 and clearewater diversion dikes/swales, and the stabilized ECM channel below trap #1. Install the clearewater diversion dikes and swales along the south side of Gorman road and construct Trap #2. Install storm drain run from ES-1 through I-9 and divert ditch flow along Gorman Road into opening of I-8 with an Earth Dike. (provide positive drainage from ditch into opening) Construct the storm drain extension at Ex. "C" and storm drain run from ES-2 to MH-4, then construct and stabilize proposed swale from ES-2 to Ex. "C". Wrap swale with silt fence to prevent unnecessary disturbance to the stabilized channel. 3 weeks
- NOTE: No other construction activity is permitted until the construction items in S.O.C. #2 have been completed.
3. With permission from the SCI to proceed, fine grade the site and install utilities (BOE conduit, water and storm drains). Also remove or relocate any existing utilities as directed on these plans. 1 month
4. Install the concrete sidewalk and curb and gutter. 2 weeks
5. Install the base paving in the areas being widened, perform milling of the existing pavement as determined by these plans and then put down the surface course (1-1/2" min) over the base paved and milled areas. (2 months)
6. With permission from the SCI to proceed, remove sediment control devices and stabilize any remaining disturbed areas. Note: Trap 1 and the earth dike draining to it are to remain in place until F-01-177 is completed and stabilized. (1 week)

This Development Plan is approved for Soil Erosion and Sediment Control by the Howard Soil Conservation District.

Signature: [Signature]  
Date: 1/20/02

These plans have been reviewed for the Howard Soil Conservation District and meet the technical requirements.

Signature: [Signature]  
Date: 1/20/02

SEDIMENT CONTROL NOTES

1. A minimum of 24 hours notice must be given to the Howard County Office of Inspection and Permits prior to the start of any construction. (410) 131-1800
2. All vegetative and structural practices are to be installed according to the provisions of this plan and are to be in conformance with the 1994 MARYLAND STANDARDS AND SPECIFICATIONS FOR SOIL EROSION AND SEDIMENT CONTROL.
3. Following initial soil disturbance or redistribution, permanent or temporary stabilization shall be completed within:
  - a) 7 calendar days for all perimeter sediment control structures, dikes and perimeter slopes and all slopes greater than 3:1, b) 14 days as to all other disturbed or graded areas on the project site.
4. All sediment traps/basins shown must be fenced and warning signs posted around their perimeter in accordance with Vol. 1, Chapter 12, of the HOWARD COUNTY DESIGN MANUAL, Storm Drainage.
5. All disturbed areas must be stabilized within the time period specified above in accordance with the 1983 MARYLAND STANDARDS AND SPECIFICATIONS FOR SOIL EROSION AND SEDIMENT CONTROL for permanent seedings (Sec. 51), sod (Sec. 54), temporary seedings (Sec. 50) and mulching (Sec. 52). Temporary stabilization, with mulch alone, can only be done when recommended seeding dates do not allow for proper germination and establishment of grasses.
6. All sediment control structures are to remain in place and are to be maintained in operative condition until permission for their removal has been obtained from the Howard County Sediment Control Inspector.
7. Site Analysis:
 

Total Area of Site	: 1.53	Acres
Area to be roofed or paved	: 6.24	Acres
Area to be vegetatively stabilized	: 4.71	Acres
Total Cut	: 100	Cu. Yds.
Total Fill	: 3000	Cu. Yds.

 Off-site waste/borrow area location: F-01-177
8. Any sediment control practice which is disturbed by grading activity for placement of utilities must be repaired on the same day of disturbance.
9. Additional sediment control must be provided, if deemed necessary by the Howard County DPW Sediment Control Inspector.
10. On all sites with disturbed areas in excess of 2 acres, approval of the inspection agency shall be requested upon completion of installation of perimeter erosion and sediment controls, but before proceeding with any other earth disturbance or grading. Other building or grading inspection approvals may not be authorized until this initial approval by the inspection agency is made.
11. Trenches for the construction of utilities is limited to 3 pipe lengths or that which shall be backfilled and stabilized within one working day whichever is shorter.

PERMANENT SEEDING NOTES

- Apply to graded or cleared area not subject to immediate further disturbance where a permanent long-lived vegetative cover is needed.
- Seeded Preparation: Loosen upper three inches of soil by raking, discing or other acceptable means before seeding (unless previously loosened).
- Soil Amendments: In lieu of soil test recommendations, use one of the following schedules
- 1) Preferred - Apply 2 tons per acre dolomitic limestone (92 lbs/1000 square feet) and 600 lbs per acre 10-10-10 fertilizer (14 lbs/1000 sq ft) before seeding. Harrow or disc into upper three inches of soil. At time of seeding, apply 400 lbs per acre 30-0-0 ureamform fertilizer (9 lbs/1000 sq ft).
  - 2) Acceptable - Apply 2 tons per acre dolomitic limestone (92 lbs/1000 sq ft) and 1000 lbs per acre 10-10-10 fertilizer (23 lbs/1000 sq ft) before seeding. Harrow or disc into upper three inches of soil.
- Seeding: For the periods March 1 thru April 30, and August 1 thru October 15, seed with 60 lbs per acre (14 lbs/1000 sq ft) of Kentucky 31 Tall Fescue. For the period May 1 thru July 31, seed with 60 lbs Kentucky 31 Tall Fescue per acre and 2 lbs per acre (.05 lbs/1000 sq ft) of weeping lovegrass. During the period of October 16 thru February 28, protect site by Option (1) 2 tons per acre of well anchored straw mulch and seed as soon as possible in the spring. Option (2) Use sod. Option (3) Seed with 60 lbs/acre Kentucky 31 Tall Fescue and mulch with 2 tons/acre well anchored straw.
- Mulching: Apply 1-1/2 to 2 tons per acre (70 to 90 lbs/1000 sq ft) of unrotted small grain straw immediately after seeding. Anchor mulch immediately after application using mulch anchoring tool or 218 gallons per acre (5 gal/1000 sq ft) of emulsified asphalt on flat areas. On slopes 8 feet or higher, use 348 gallons per acre (8 gal/1000 sq ft) for anchoring.
- Maintenance: Inspect all seeded areas and make needed repairs, replacements and reseedings.

TEMPORARY SEEDING NOTES

- Apply to graded or cleared areas likely to be redistributed where a short-term vegetative cover is needed.
- Seeded Preparation: Loosen upper three inches of soil by raking, discing or other acceptable means before seeding (unless previously loosened).
- Soil Amendments: Apply 600 lbs per acre 10-10-10 fertilizer (14 lbs/1000 sq ft).
- Seeding: For periods March 1 thru April 30 and from August 15 thru November 15, seed with 2-1/2 bushel per acre of annual ryegrass (3.2 lbs./1000 sq ft). For the period May 1 thru August 14, seed with 3 lbs per acre of weeping lovegrass (.07 lbs/1000 sq ft). For the period November 16 thru February 28, protect site by applying 2 tons per acre of well anchored straw mulch and seed as soon as possible in the spring, or use sod.
- Mulching: Apply 1-1/2 to 2 tons per acre (70 to 90 lbs/1000 sq ft) of unrotted small grain straw immediately after seeding. Anchor mulch immediately after application using mulch anchoring tool or 218 gal per acre (5 gal/1000 sq ft) of emulsified asphalt on flat areas. On slopes, 8 ft or higher, use 348 gal per acre (8 gal/1000 sq ft) for anchoring.

Refer to the 1994 MARYLAND STANDARDS AND SPECIFICATIONS FOR SOIL EROSION AND SEDIMENT CONTROL for rate and methods not covered.

ENGINEER'S CERTIFICATE

"I certify that this plan for erosion and sediment control represents a practical and workable plan based on my personal knowledge of the site conditions and that it was prepared in accordance with the requirements of the Howard Soil Conservation District."

Signature: [Signature]  
Date: 12/20/01

DEVELOPER'S/BUILDER'S CERTIFICATE

"I/we certify that all development and/or construction will be done according to this plan, and that any responsible personnel involved in the construction project will have a Certificate of Attendance at a Maryland Department of the Environment Approved Training Program for the Control of Sediment and Erosion before beginning the project. I also authorize periodic on-site inspection by the HSCD."

Signature: [Signature]  
Date: 12/20/01

APPROVED: HOWARD COUNTY DEPARTMENT OF PUBLIC WORKS  
Signature: [Signature]  
Date: 1-16-02

APPROVED: HOWARD COUNTY DEPARTMENT OF PLANNING & ZONING  
Signature: [Signature]  
Date: 1/29/02

Signature: [Signature]  
Date: 1/20/02

GLW GUTSCHICK LITTLE & WEBER, P.A.  
CIVIL ENGINEERS, LAND SURVEYORS, LAND PLANNERS, LANDSCAPE ARCHITECTS  
3909 NATIONAL DRIVE - SUITE 250 - BURTONSVILLE OFFICE PARK  
BURTONSVILLE, MARYLAND 20866  
TEL: 301-421-4024 BAL: 410-860-1820 DC/VA: 301-998-2524 FAX: 301-421-4186

99140\GORMAN\99140SCD.dwg	DES.	DRN.	CHK.	DATE	REVISION	BY	APP'R.
---------------------------	------	------	------	------	----------	----	--------

PREPARED FOR:  
THE HOWARD RESEARCH AND DEVELOPMENT CORPORATION  
10275 LITTLE PATUXENT PKWY.  
COLUMBIA, MD 21044  
ATTN: BOB JENKINS  
(410) 992-6089

SEDIMENT CONTROL DETAILS  
ROAD CONSTRUCTION PLANS  
IMPROVEMENTS TO GORMAN ROAD  
AND STEPHENS ROAD  
GORMAN ROAD FROM 97+99.27 TO 118+00  
STEPHENS ROAD FROM 0+00 TO 2+55




SCALE	ZONING	G. L. W. FILE NO.
AS SHOWN	R-ED R-SC-MDD-3 PEC-MDD-3	99140
OCT., 2001	47-9/10	11 OF 12

HOWARD COUNTY, MARYLAND

F-01-185

99140SCD.dwg 11-1-01 3:28:52 pm EST



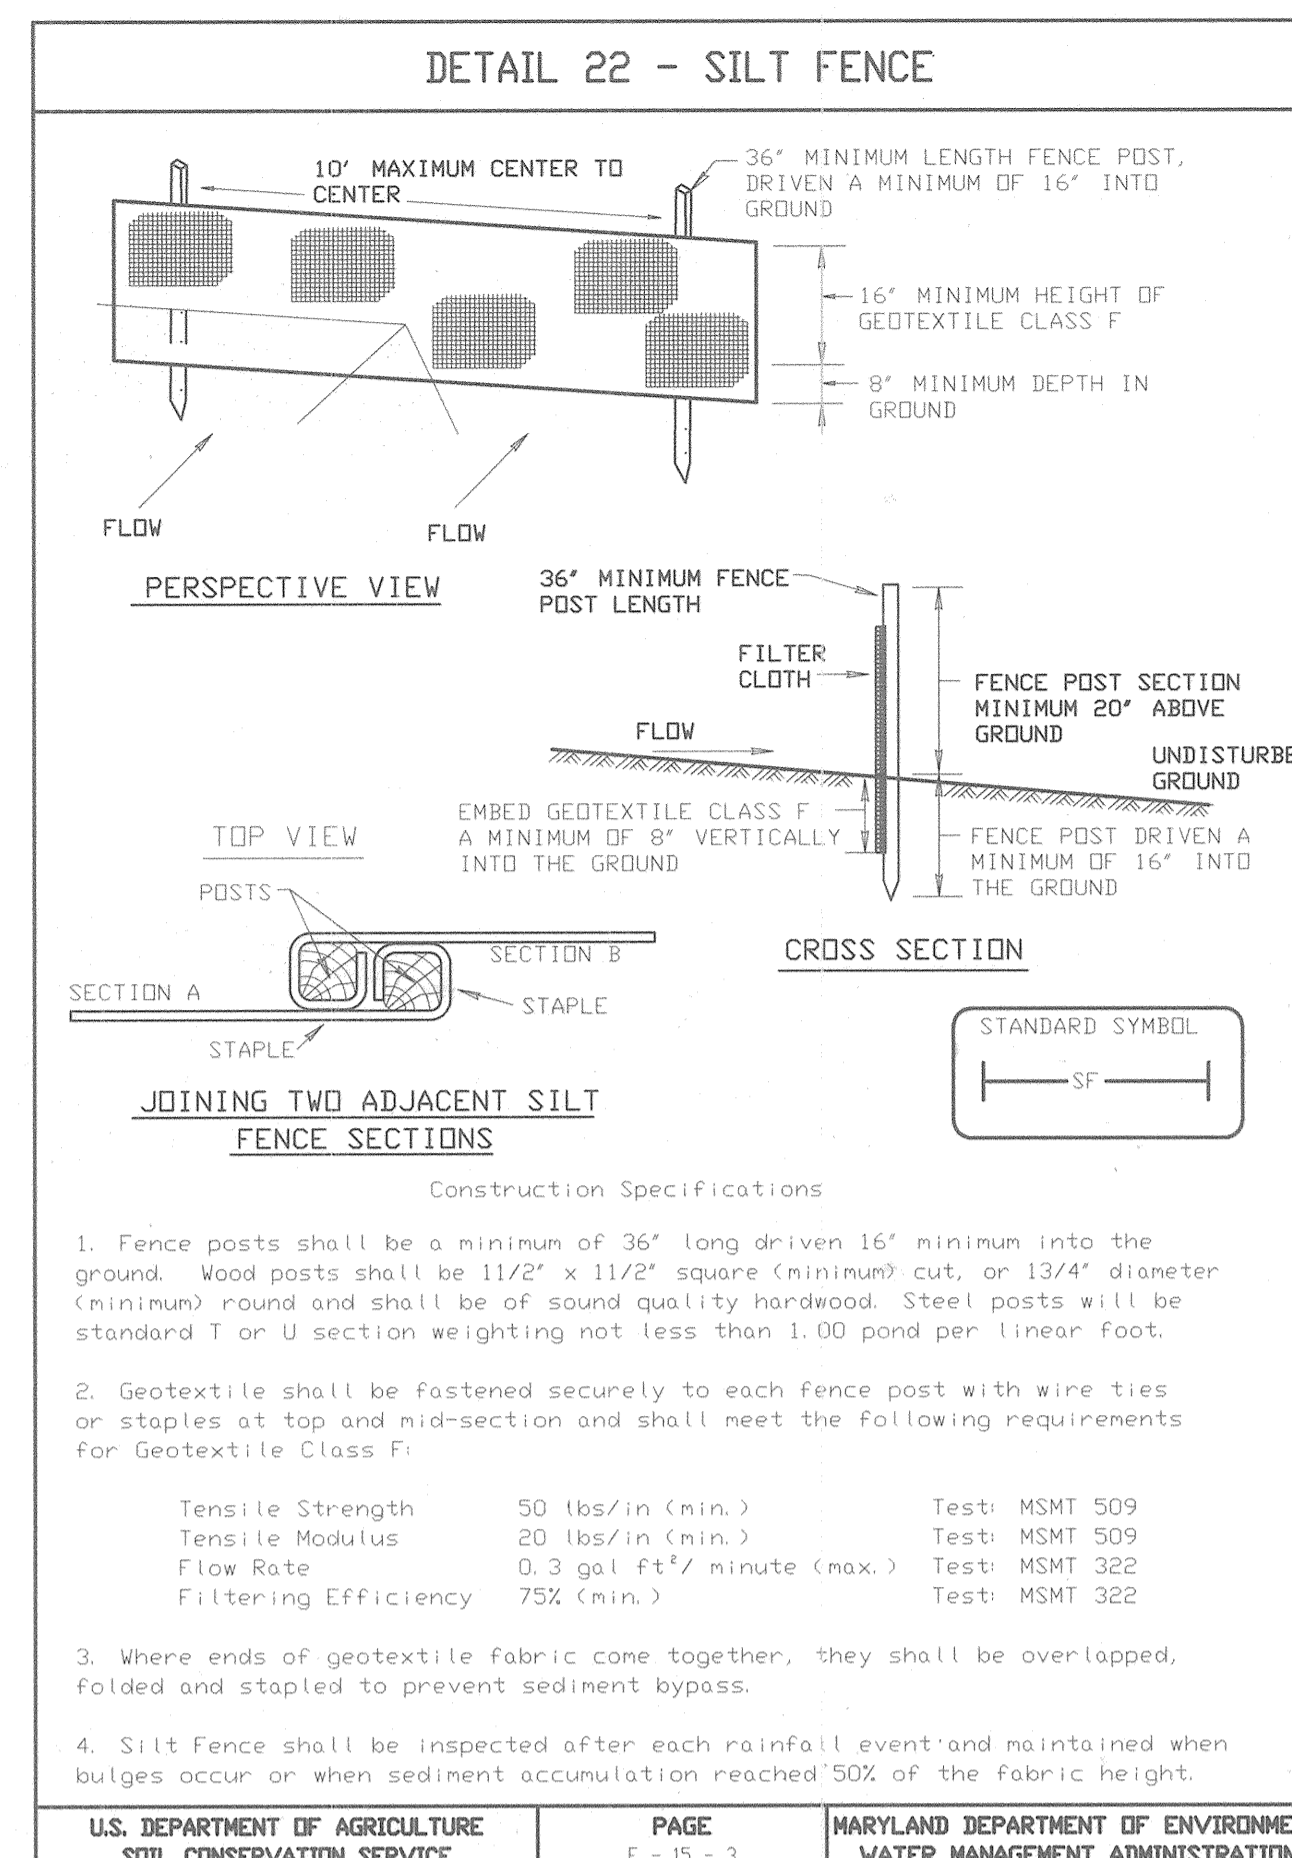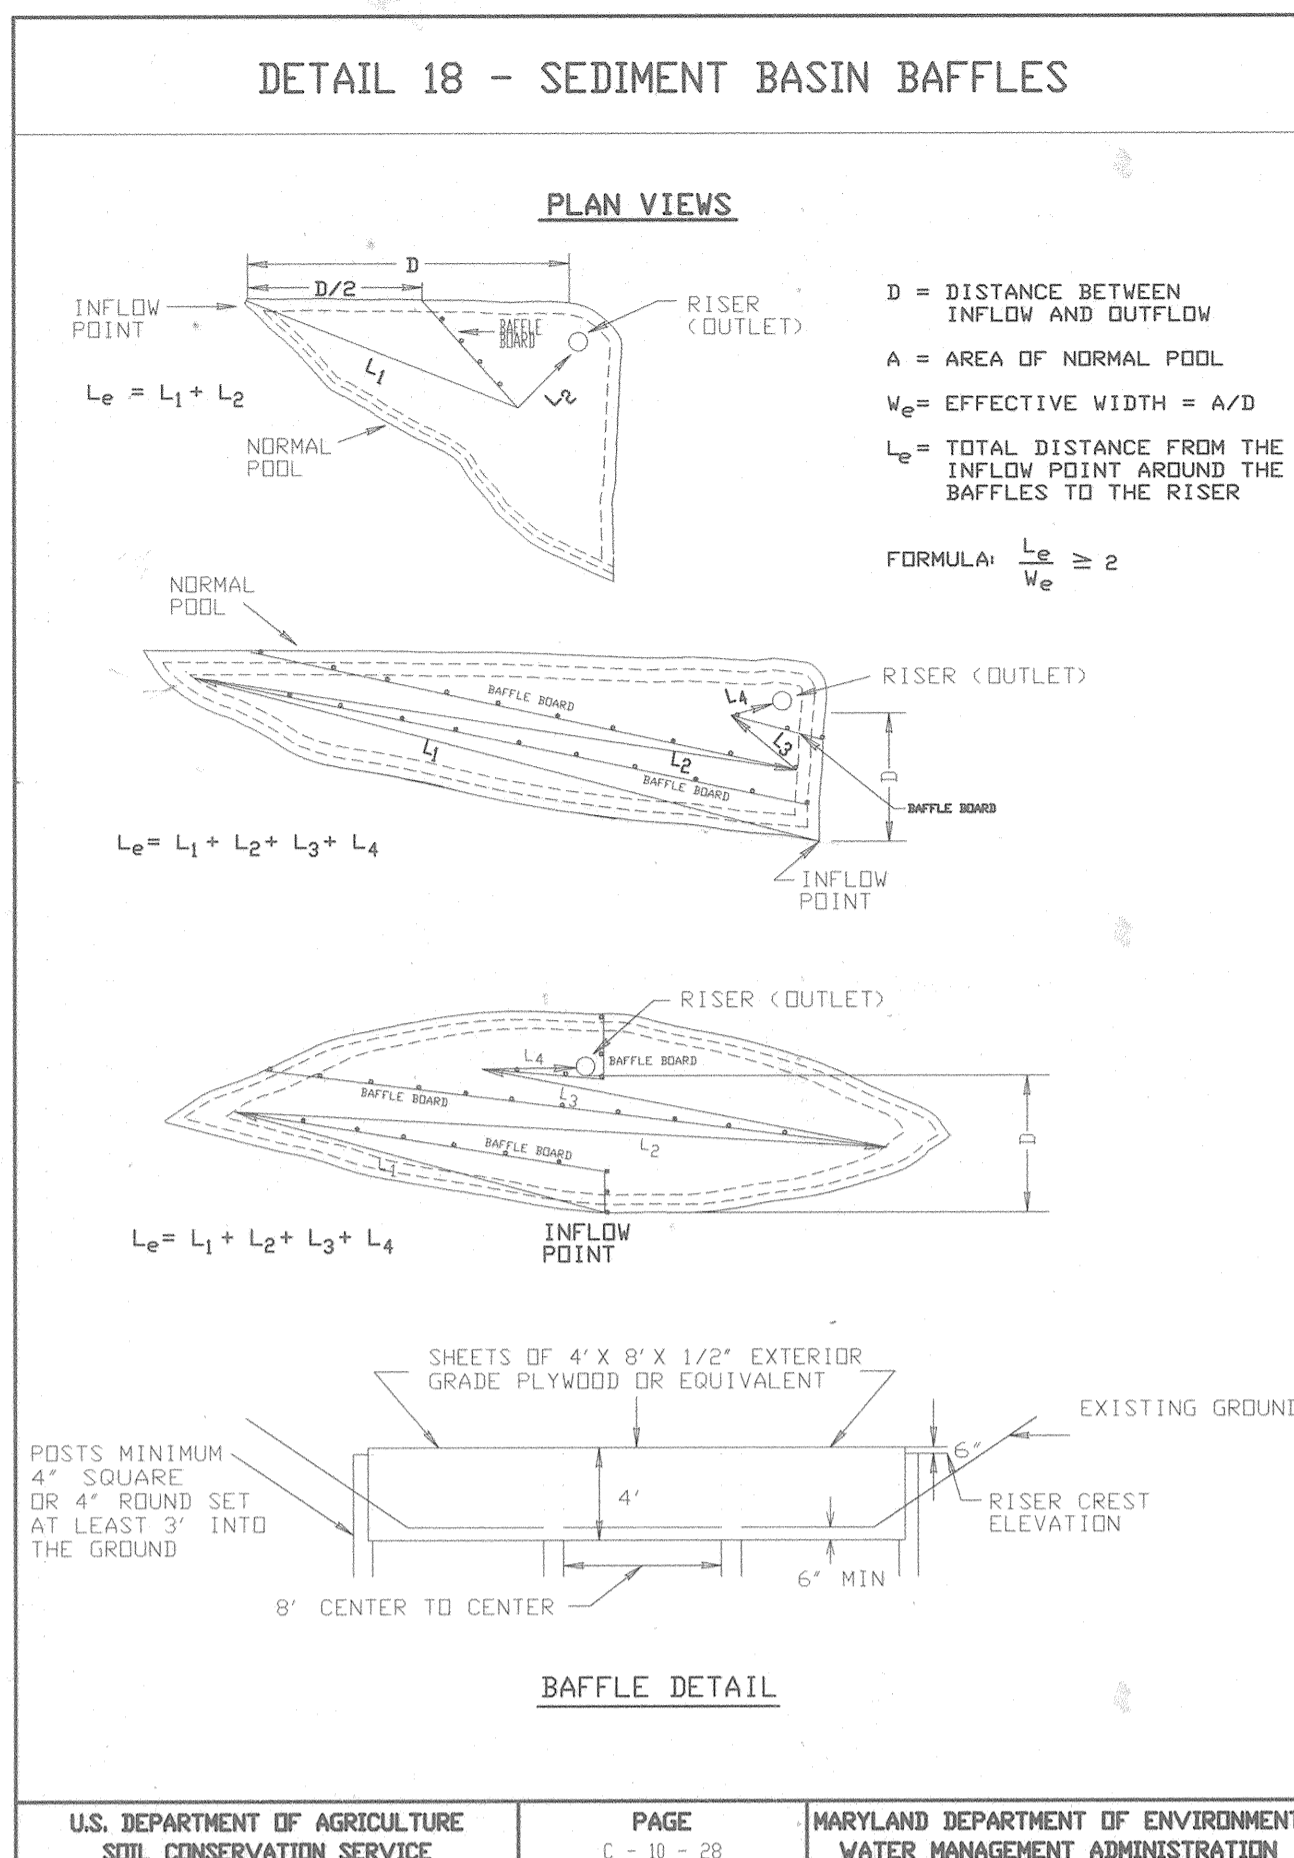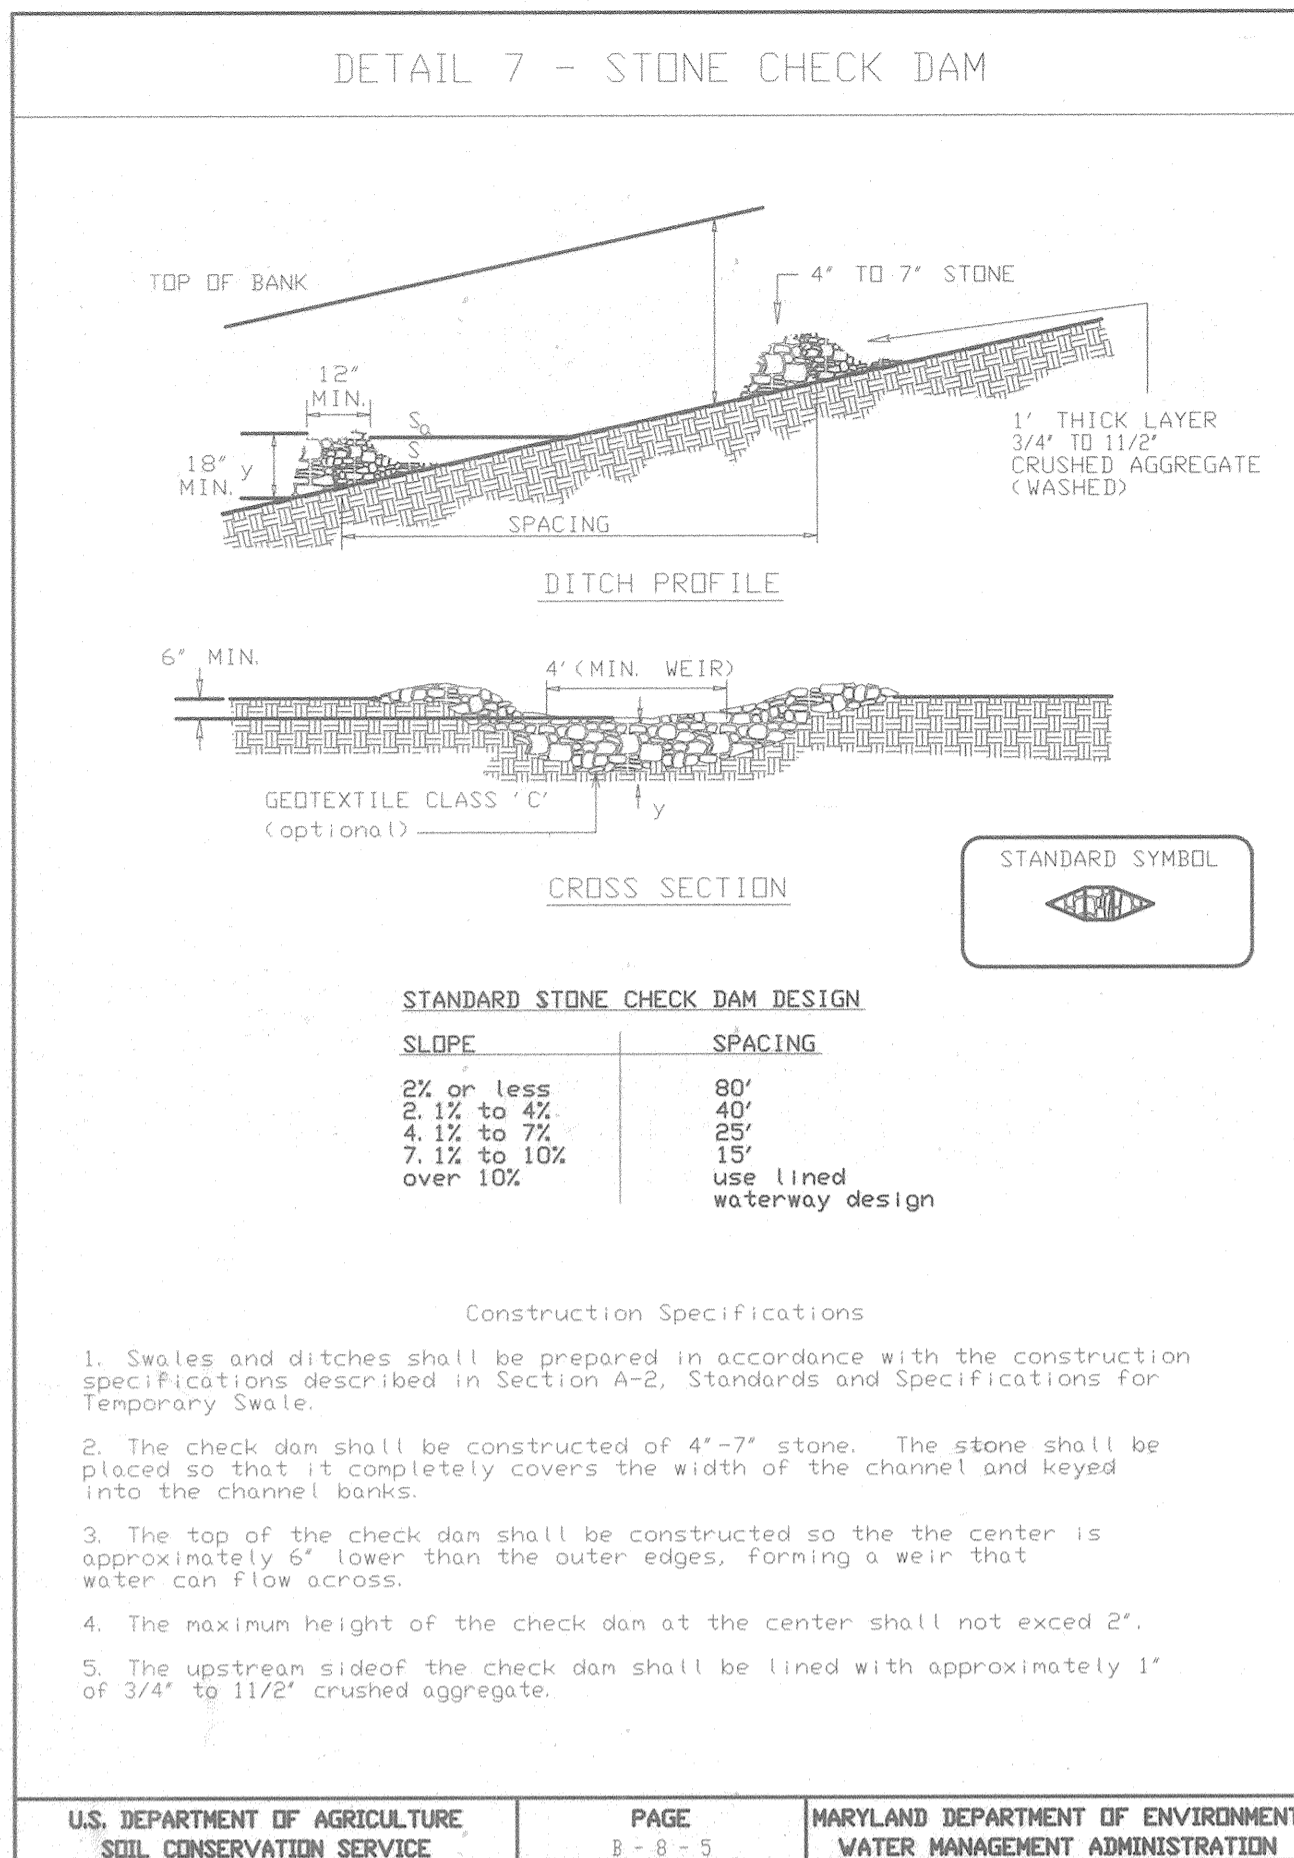


### SILT FENCE

Silt Fence Design Criteria

Slope Steepness	(Maximum)	
	Slope Length	Silt Fence Length
Flatter than 50:1	unlimited	unlimited
50:1 to 10:1	125 feet	unlimited
10:1 to 5:1	100 feet	1,000 feet
5:1 to 3:1	60 feet	750 feet
3:1 to 2:1	40 feet	500 feet
2:1 and steeper	20 feet	250 feet

Note: In areas of less than 2% slope and sandy soils (USDA general classification system, soil Class A) maximum slope length and silt fence length will be unlimited. In these areas a silt fence may be the only perimeter control required.

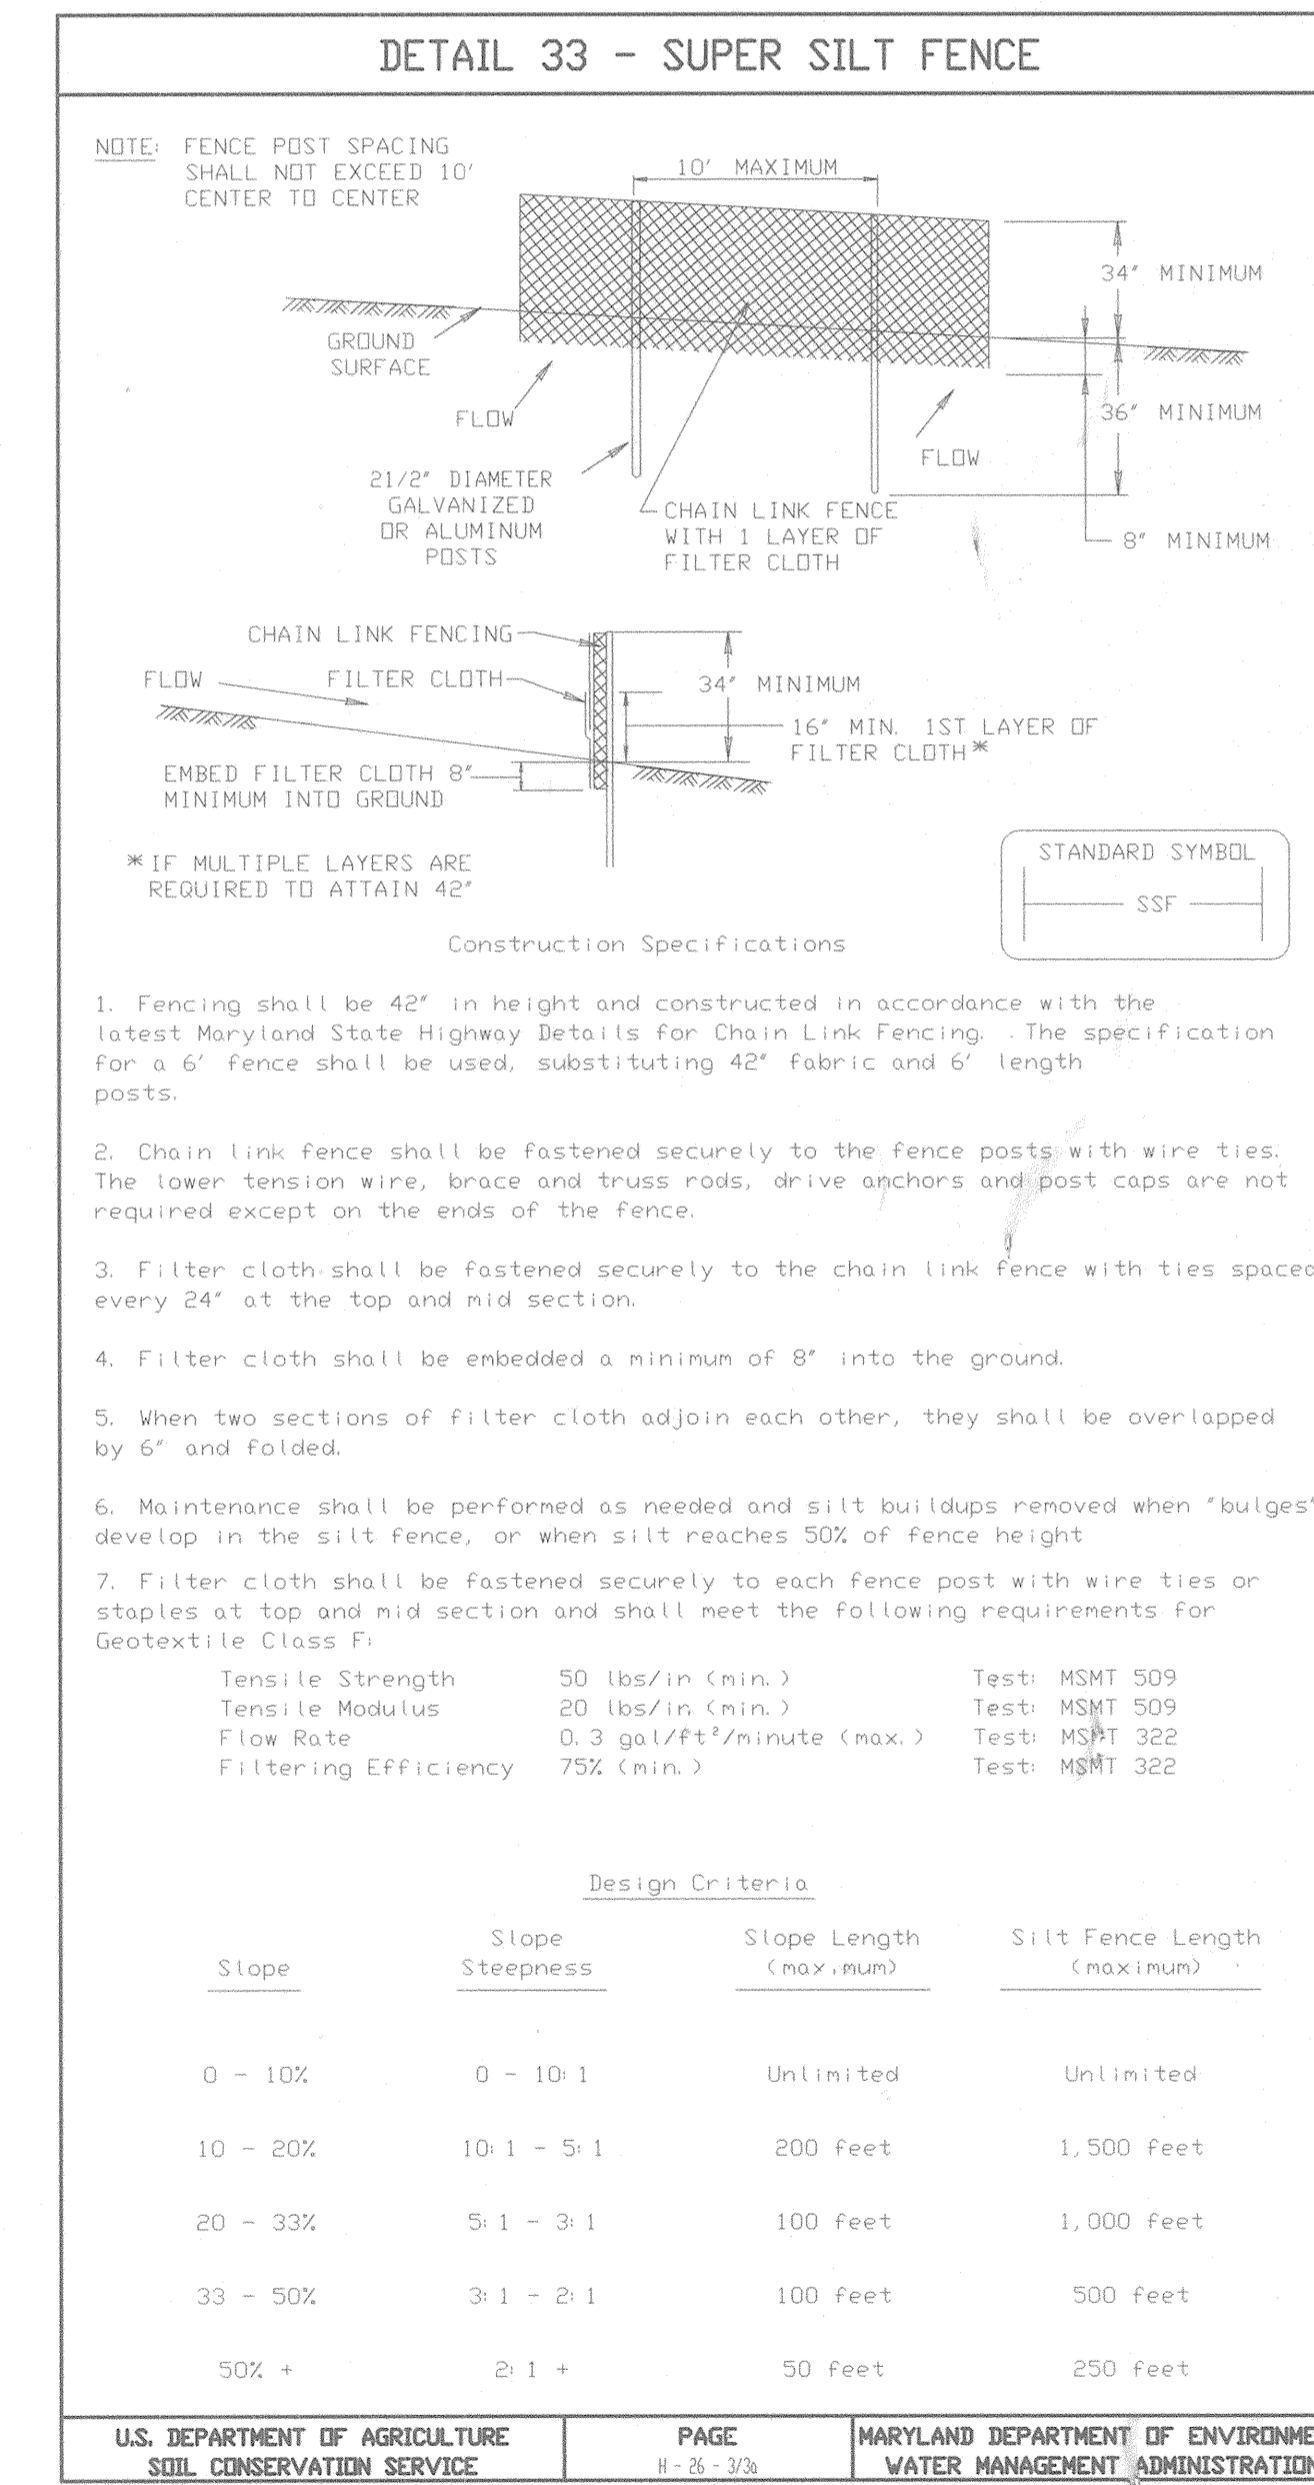

**DEVELOPER'S/BUILDER'S CERTIFICATE**

"I/we certify that all development and/or construction will be done according to this plan, and that any responsible personnel involved in the construction project will have a Certificate of Attendance at a Maryland Department of the Environment Approved Training Program for the Control of Sediment and Erosion before beginning the project. I also authorize periodic on-site inspection by the HSCD."

*Robert A. Jenkin* 12/20/01  
 Signature of Developer/Builder Date

**ENGINEER'S CERTIFICATE**

"I certify that this plan for erosion and sediment control represents a practical and workable plan based on my personal knowledge of the site conditions and that it was prepared in accordance with the requirements of the Howard Soil Conservation District."




*Jim Myers/CS* 12/20/01  
 Signature Date

These plans have been reviewed for the Howard Soil Conservation District and meet the technical requirements.

APPROVED: HOWARD COUNTY DEPARTMENT OF PUBLIC WORKS  
*Richard M. Jenkin* 1-16-02  
 Chief, Bureau of Highways Date

APPROVED: HOWARD COUNTY DEPARTMENT OF PLANNING & ZONING  
*Cindy Harvath* 1/29/02  
 Chief, Division of Land Development Date

*John* 1/29/02  
 Chief, Development Engineering Division Date

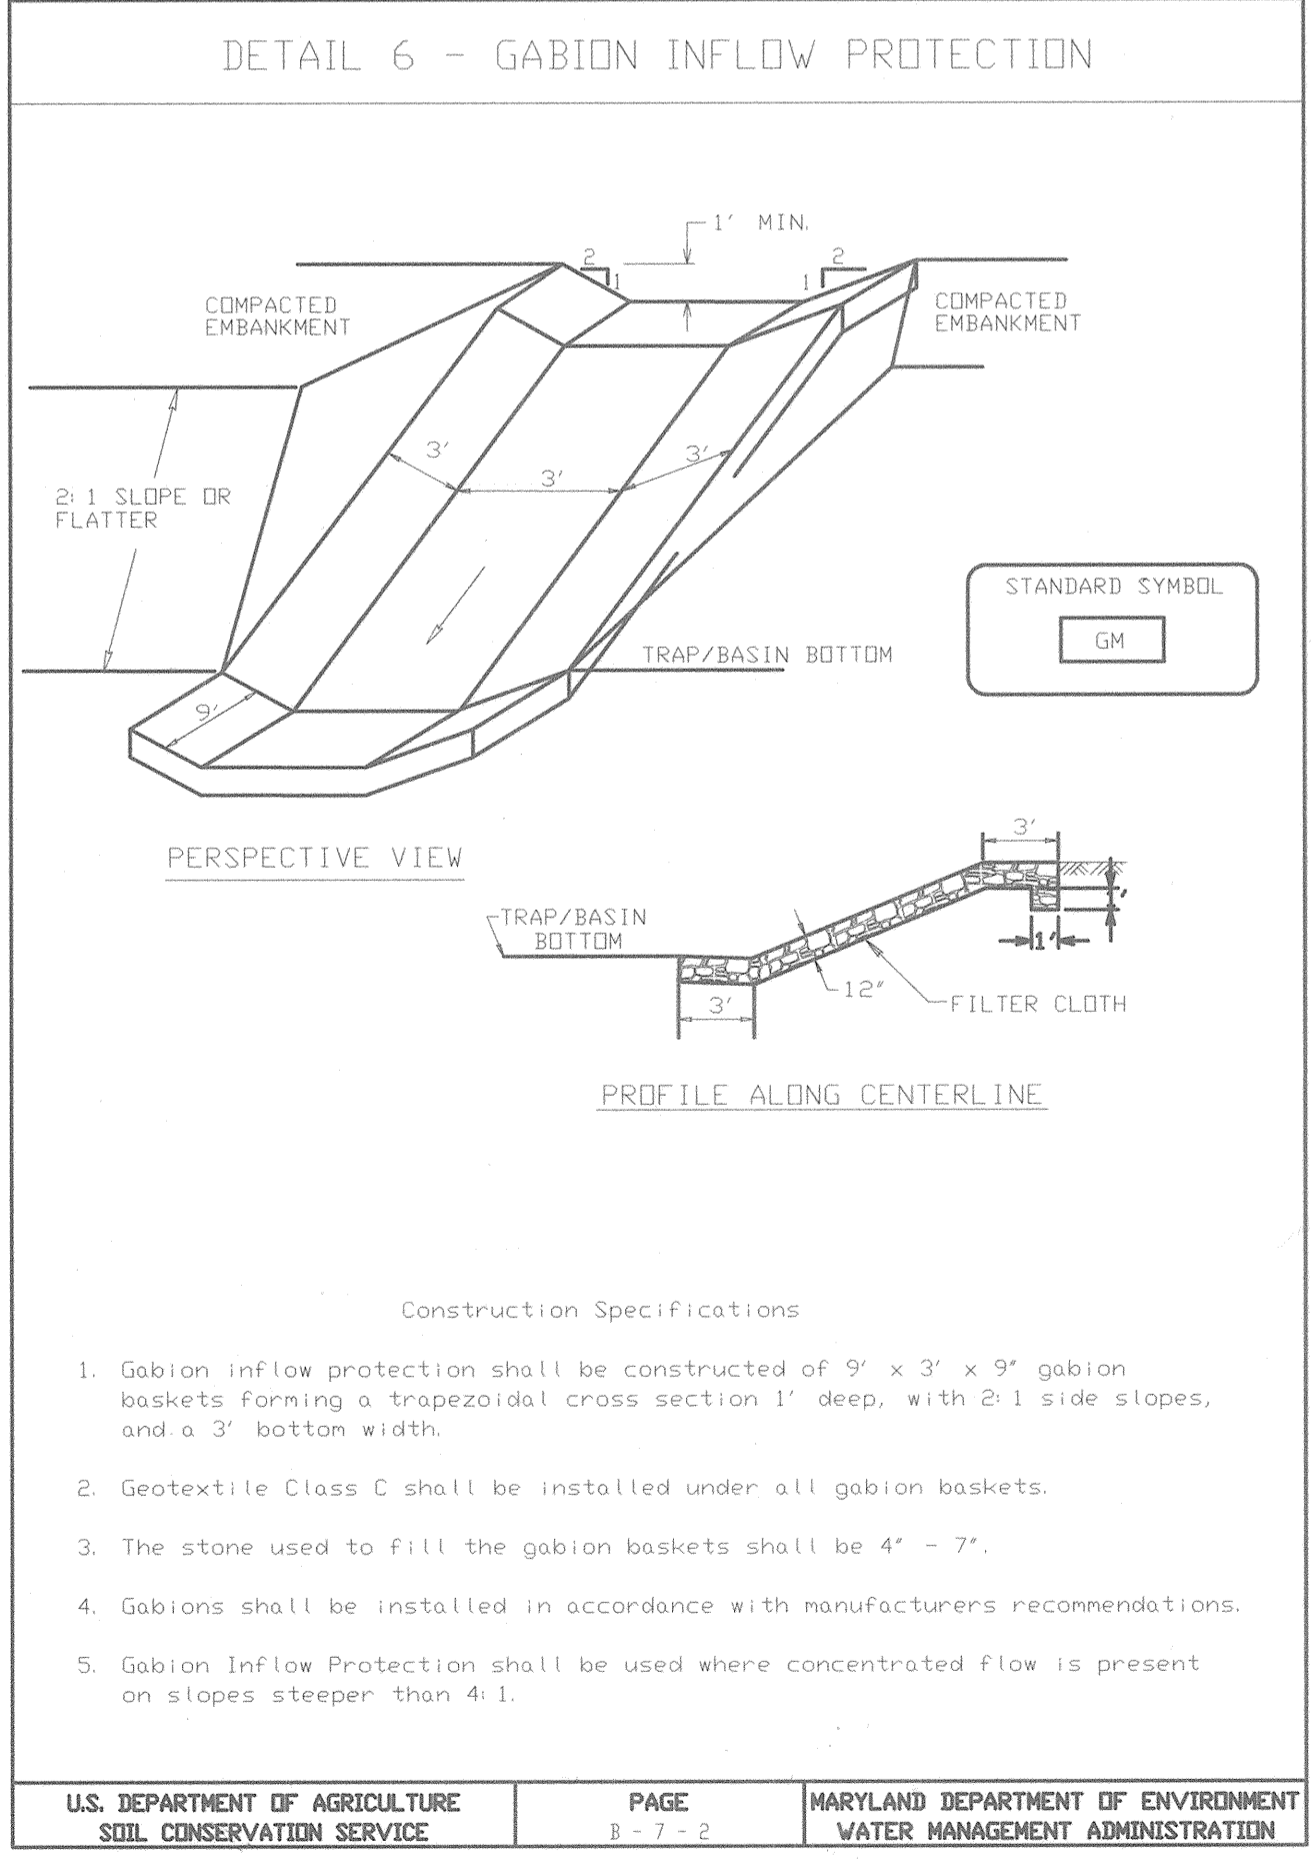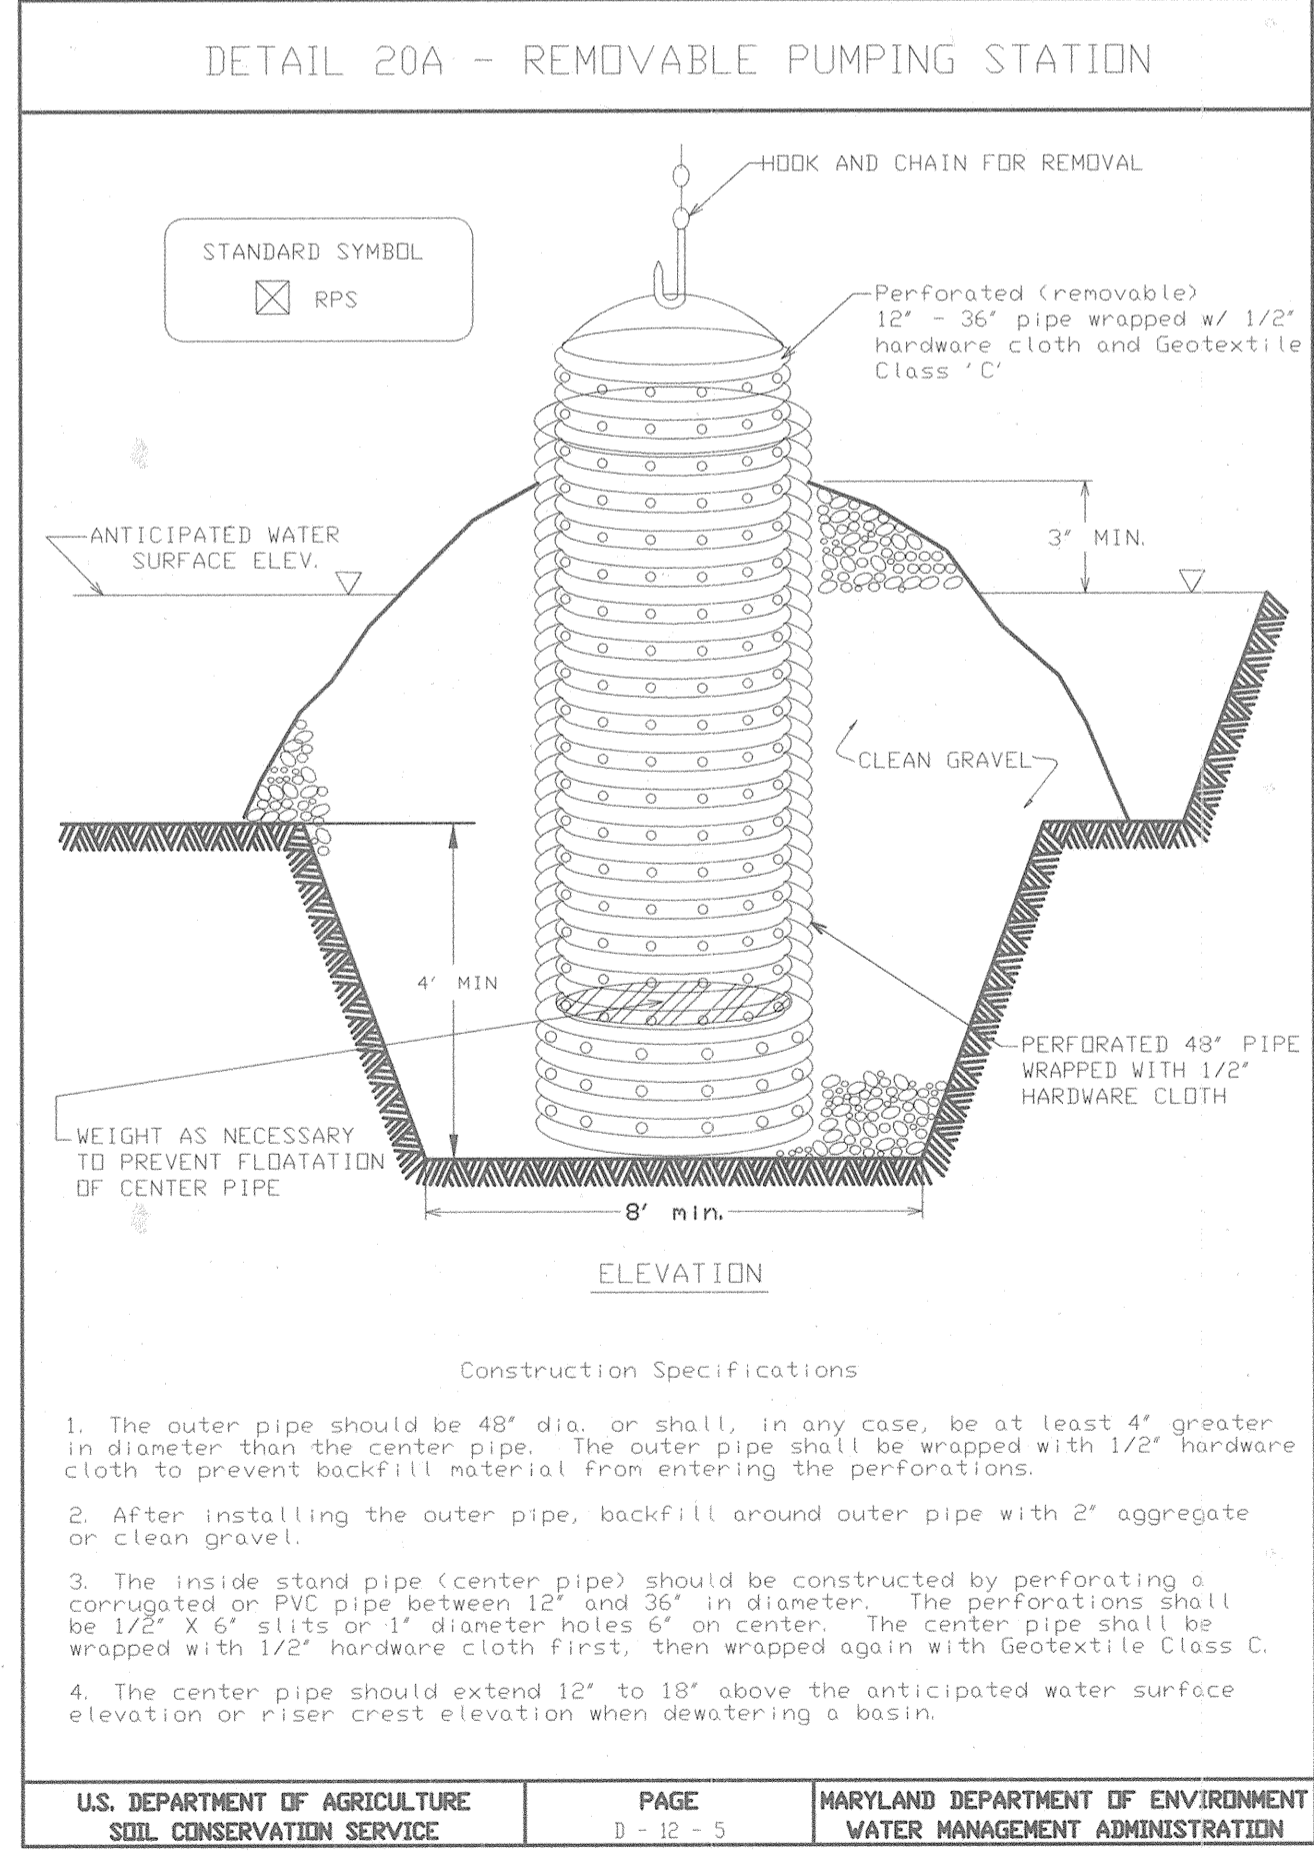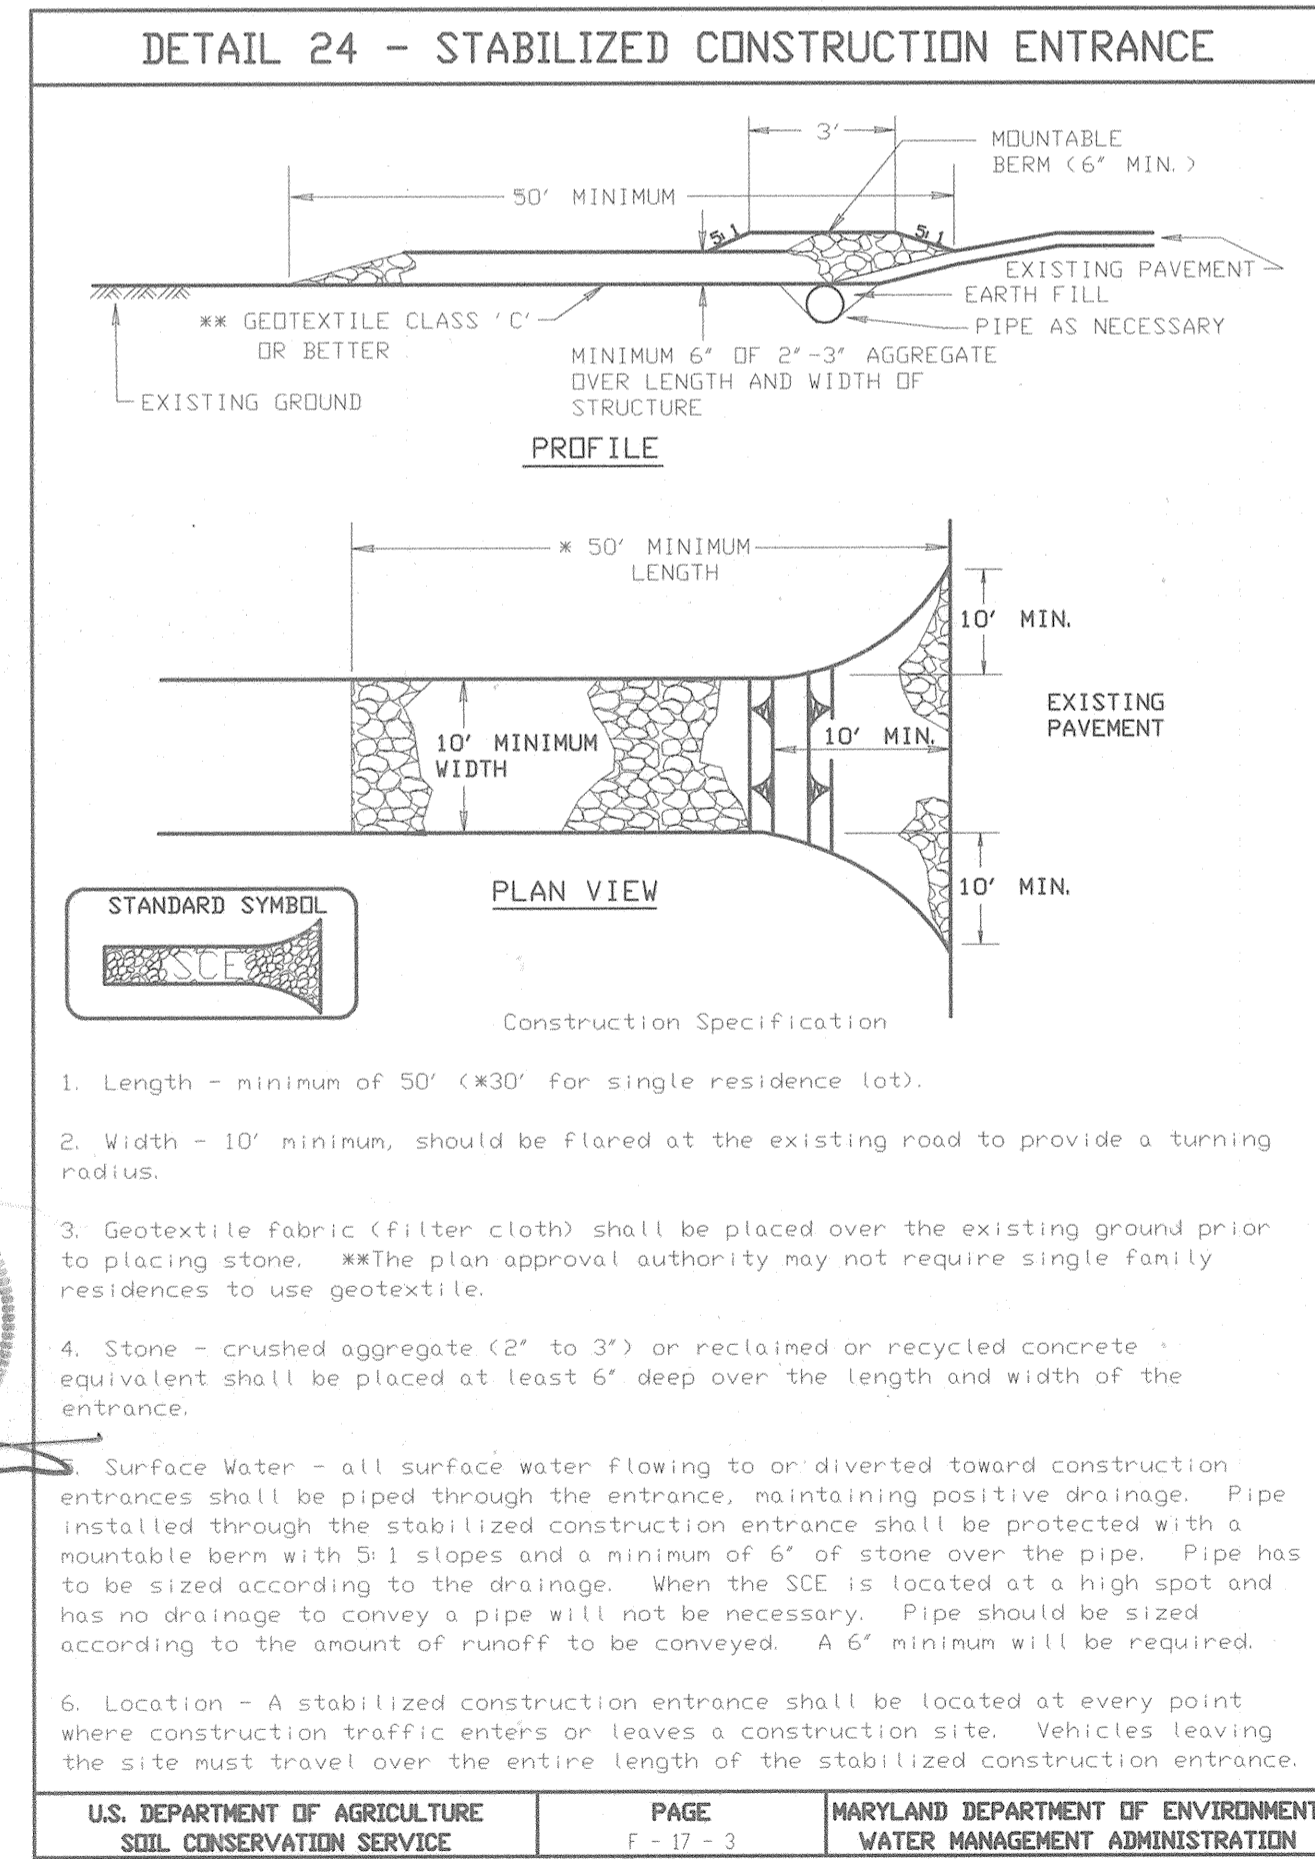

99140SCD2.dwg 11-1-01 3:27:52 pm EST

**GLW GUTSCHICK LITTLE & WEBER, P.A.**  
 CIVIL ENGINEERS, LAND SURVEYORS, LAND PLANNERS, LANDSCAPE ARCHITECTS  
 3909 NATIONAL DRIVE - SUITE 250 - BURTONSVILLE OFFICE PARK  
 BURTONSVILLE, MARYLAND 20866  
 TEL: 301-421-4024 BAL: 410-880-1820 DC/VA: 301-989-2524 FAX: 301-421-4188

DATE	REVISION	BY	APP'R.

PREPARED FOR:  
 THE HOWARD RESEARCH AND DEVELOPMENT CORPORATION  
 10275 LITTLE PATUXENT PKWY.  
 COLUMBIA, MD 21044  
 ATTN: BOB JENKINS  
 (410) 992-6089

SEDIMENT CONTROL DETAILS  
 ROAD CONSTRUCTION PLANS  
 IMPROVEMENTS TO GORMAN ROAD  
 AND STEPHENS ROAD  
 GORMAN ROAD FROM 97+99.27 TO 118+00  
 STEPHENS ROAD FROM 0+00 TO 2+55  
 ELECTION DISTRICT No. 6

SCALE	ZONING	G. L. W. FILE No.
AS SHOWN	R-ED R-30-MXD-3 PEC-MXD-3	99140
OCT., 2001	47-9/10	12 OF 12