

SHEET INDEX	
SHEET No.	SHEET
1	TITLE SHEET
2	FRAGRANT LILIES WAY AND LOVE SONG COURT PLAN AND PROFILES
3	FILLET PROFILE AND DETAILS
4	GRADING AND SEDIMENT CONTROL PLAN
5	SEDIMENT CONTROL NOTES AND DETAILS
6	SEDIMENT CONTROL NOTES AND DETAILS
7	STREET TREE AND LANDSCAPE PLAN
8	STORM DRAIN DRAINAGE AREA MAP
9	STORM DRAIN PROFILES

FINAL ROAD CONSTRUCTION, GRADING AND SEDIMENT CONTROL PLANS EMERSON

SECTION 2, PHASE 2

LOTS 1 THRU 63 AND OPEN SPACE LOT 64

(A RESUBDIVISION OF PARCEL B-1, EMERSON, SECTION 2, AREA 2, PLAT No. 15455)

ZONED: PEC-MXD-3 AND R-SC-MXD-3

TAX MAP: 47 P/O PARCELS: 3 AND 837 GRID: 8

SIXTH ELECTION DISTRICT


HOWARD COUNTY, MARYLAND

APPROVED: DEPARTMENT OF PUBLIC WORKS	
<i>[Signature]</i>	4/24/03
CHIEF, BUREAU OF HIGHWAYS	DATE
APPROVED: DEPARTMENT OF PLANNING AND ZONING	
<i>[Signature]</i>	4/25/03
CHIEF, DIVISION OF LAND DEVELOPMENT	DATE
<i>[Signature]</i>	4/24/03
CHIEF, DEVELOPMENT ENGINEERING DIVISION	DATE

ROAD CLASSIFICATION CHART		
ROAD NAME	CLASSIFICATION	R/W WIDTH
FRAGRANT LILIES WAY	PUBLIC ACCESS PLACE	40'
LOVE SONG COURT	PUBLIC ACCESS PLACE	40'

STREET LIGHT CHART			
STREET NAME	STATION	OFF-SET	FIXTURE/POLE TYPE
FRAGRANT LILIES WAY	0+33	20' R	100-WATT "TRADITIONAISE" HPS VAPOR FIXTURE POST TOP FIXTURE MOUNTED ON A 14-FOOT BLACK FIBERGLASS POLE
FRAGRANT LILIES WAY	2+65.84	20' L	100-WATT "TRADITIONAISE" HPS VAPOR FIXTURE POST TOP FIXTURE MOUNTED ON A 14-FOOT BLACK FIBERGLASS POLE
FRAGRANT LILIES WAY	4+10	15' L	100-WATT "TRADITIONAISE" HPS VAPOR FIXTURE POST TOP FIXTURE MOUNTED ON A 14-FOOT BLACK FIBERGLASS POLE
FRAGRANT LILIES WAY	5+65	15' L	100-WATT "TRADITIONAISE" HPS VAPOR FIXTURE POST TOP FIXTURE MOUNTED ON A 14-FOOT BLACK FIBERGLASS POLE
FRAGRANT LILIES WAY	4+10	15' L	100-WATT "TRADITIONAISE" HPS VAPOR FIXTURE POST TOP FIXTURE MOUNTED ON A 14-FOOT BLACK FIBERGLASS POLE
FRAGRANT LILIES WAY	L.P. STA. 1+30	3' L	100-WATT "TRADITIONAISE" HPS VAPOR FIXTURE POST TOP FIXTURE MOUNTED ON A 14-FOOT BLACK FIBERGLASS POLE

TRAFFIC CONTROL SIGNS				
STREET NAME	CL. STATION	OFFSET	POSTED SIGN	SIGN CODE
FRAGRANT LILIES WAY	0+43	20'L	STOP	R1-1
FRAGRANT LILIES WAY	2+04	19'R	SPEED LIMIT 25	R2-1
LOVE SONG COURT	0+25	20'L	STOP	R1-1

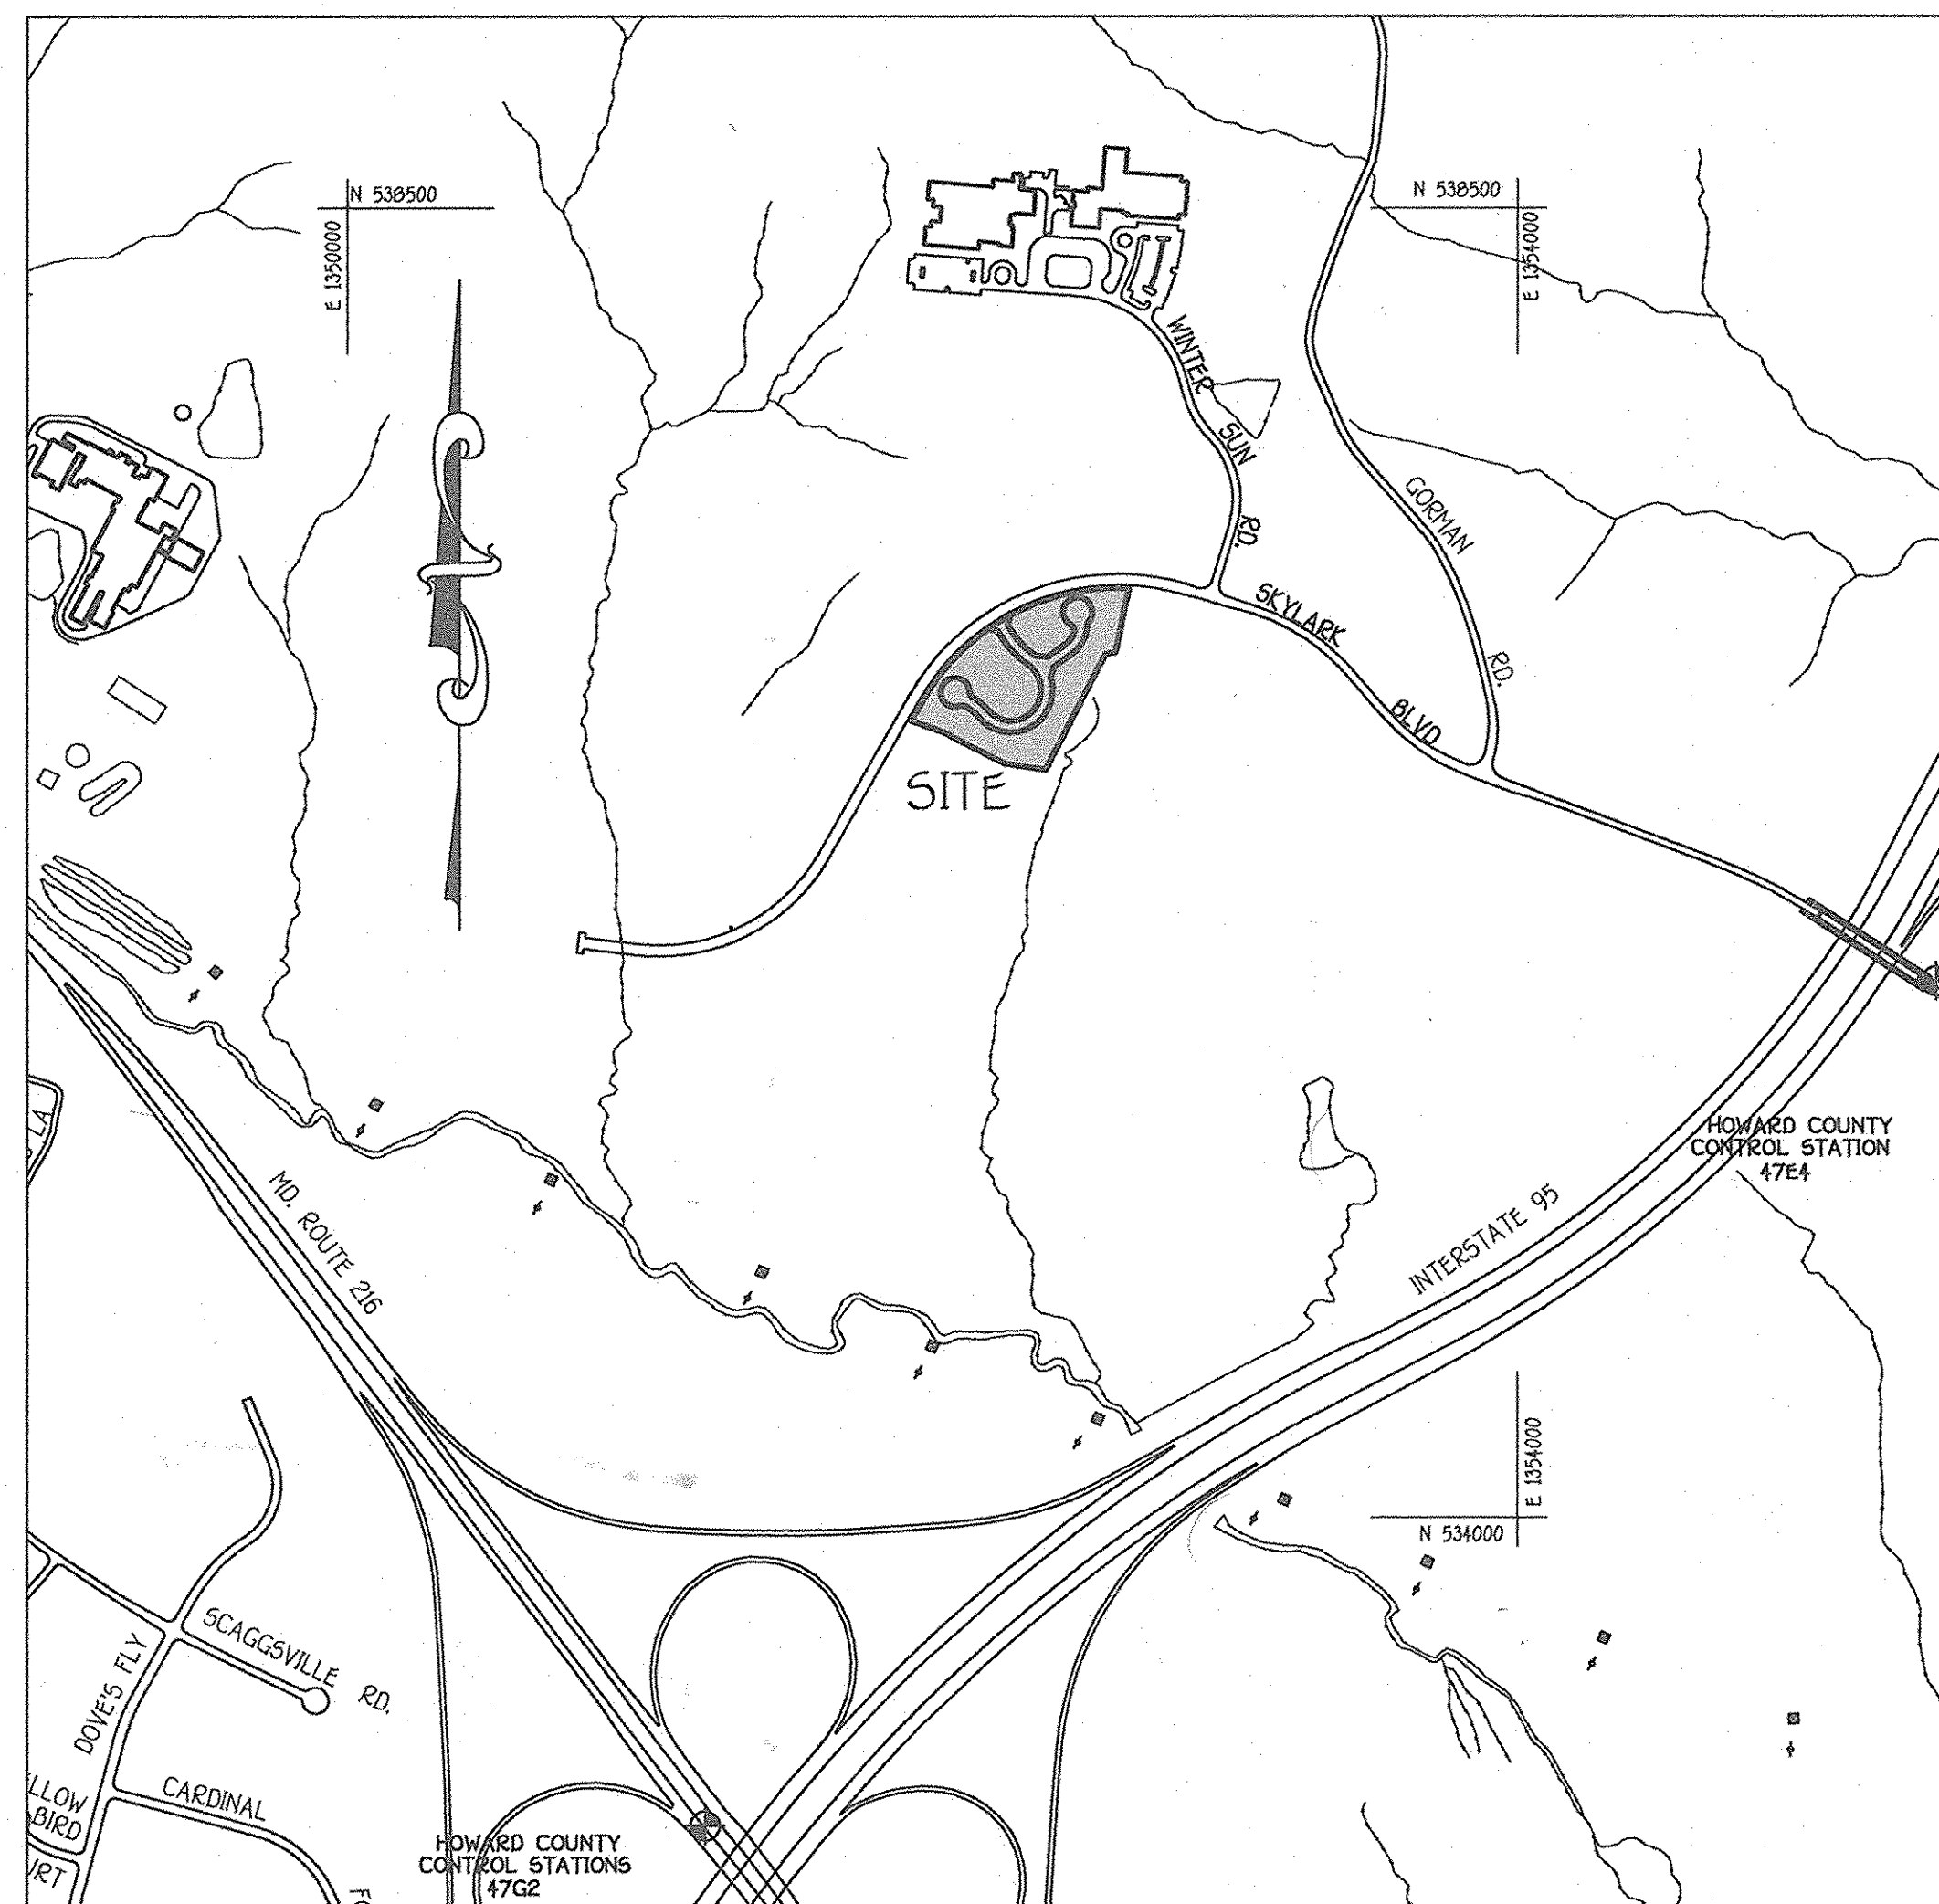


VICINITY MAP
SCALE: 1" = 1200'

GENERAL NOTES

- ALL ASPECTS OF THE PROJECT ARE IN CONFORMANCE WITH THE LATEST HOWARD COUNTY STANDARDS UNLESS, WAIVERS ARE APPROVED.
- THE CONTRACTOR SHALL NOTIFY THE DEPARTMENT OF PUBLIC WORKS, DIVISION OF CONSTRUCTION INSPECTION AT 410-315-1800 AT LEAST (5) WORKING DAYS PRIOR TO THE START OF CONSTRUCTION.
- THE CONTRACTOR SHALL NOTIFY "MISS UTILITY" AT 1-800-257-7777 AT LEAST 48 HOURS PRIOR TO ANY EXCAVATION.
- THE EXISTING TOPOGRAPHY IS TAKEN FROM AERIAL SURVEY WITH 2' CONTOUR INTERVALS PREPARED BY AIR SURVEY CORPORATION DATED 4/3/98.
- PROPERTY IS LOCATED WITHIN METROPOLITAN DISTRICT.
- WATER QUALITY AND STORMWATER MANAGEMENT HAS BEEN PROVIDED IN SECTION 2 PHASE 1A AND PHASE 1B BY F-01-136 AND F-01-137.
- UTILITIES SHOWN HEREON ARE TAKEN FROM CURRENT HOWARD COUNTY CONTRACT DRAWINGS, CONTRACT No. 34-4051-D.
- HOWARD COUNTY CONTROL STATIONS:
 - 47E4 N 535946.153
E 1355431.224
ELEV. 338.909'
 - 47G2 N 532938.9842
E 1351224.0950
ELEV. 364.210'
- AREA TABULATION (THE DIVISION OF LAND DEVELOPMENT WILL MONITOR THE RESUBDIVISION PLANS FOR "OR" PARCELS. OPEN SPACE WILL BE TABULATED AS "OR" LAND USE.)
 - A. TOTAL NUMBER OF BUILDABLE LOTS TO BE RECORDED 63
 - B. TOTAL NUMBER OF OPEN SPACE LOTS TO BE RECORDED 1
 - C. TOTAL NUMBER OF LOTS TO BE RECORDED 64
 - D. TOTAL AREA OF BUILDABLE LOTS TO BE RECORDED 312 AC±
 - E. TOTAL AREA OF OPEN SPACE LOTS TO BE RECORDED 172 AC±
 - F. TOTAL AREA OF ROADWAY TO BE RECORDED 119 AC±
 - G. TOTAL AREA TO BE RECORDED 603 AC.
- NOISE STUDY PROVIDED UNDER 5-99-12.
- FOREST CONSERVATION OBLIGATIONS FOR THIS AREA OF THE EMERSON MXD PROJECT WERE ADDRESSED UNDER F-01-137.
- THERE IS NO 100 YEAR FLOODPLAIN WITHIN THIS SITE.
- THERE ARE NO WETLANDS WITHIN THIS SITE.
- NO CEMETERIES EXIST ON THE PROPERTY.
- THE APPROXIMATE STUDY PROVIDED UNDER 5-99-12 AND AS RE-APPROVED UNDER PB-359.
- THIS PLAN SUBJECT TO HOWARD COUNTY FILES: ZB-9794, PB-359, 5-99-12, 5P-02-12, F-01-136, F-01-137, F-01-145, F-02-167.
- OPEN SPACE LOT 64 IS TO BE DEDICATED TO HOMEOWNERS' ASSOCIATION.
- THE REQUIRED REAR TO REAR DISTANCE BETWEEN TOWNHOUSES DOES NOT INCLUDE DECKS, BUT IS MEASURED FROM REAR FACE OF BUILDING TO REAR FACE OF BUILDING.
- PER SECTION 12B.11(G) OF THE ZONING REGULATIONS, THE FRONT STAIRS OF ANY TOWNHOUSE MAY NOT EXTEND MORE THAN 10 FEET INTO THE FRONT SETBACK.
- STREET LIGHTS WILL BE SELECTED IN THIS DEVELOPMENT IN ACCORDANCE WITH THE DESIGN MANUAL. STREET LIGHT PLACEMENT AND TYPE OF FIXTURE AND POLE SELECTED SHALL BE IN ACCORDANCE WITH THE LATEST HOWARD COUNTY DESIGN MANUAL, VOLUME III (8993) AND AS MODIFIED BY "GUIDELINES FOR STREET LIGHTS IN RESIDENTIAL DEVELOPMENTS (JUNE 1993)". THE JUNE 1993 POLICY INCLUDES GUIDELINES FOR LATERAL AND LONGITUDINAL PLACEMENT. A MINIMUM SPACING OF 20' SHALL BE MAINTAINED BETWEEN AND STREET LIGHT AND ANY TREE.


SHANBERGER & LANE
8726 TOWN & COUNTRY BLVD.
SUITE 201
ELLICOTT CITY, MARYLAND 21043

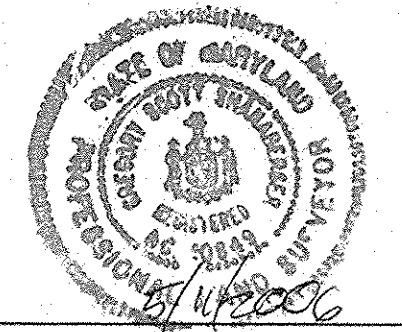

ROAD & STORM DRAIN AS-BUILT

TITLE SHEET
EMERSON
SECTION 2, PHASE 2
LOTS 1 THRU 63 AND OPEN SPACE LOT 64
(A RESUBDIVISION OF PARCEL B-1, EMERSON, SECTION 2, AREA 2, PLAT No. 15455)

ZONED: PEC-MXD-3 AND R-SC-MXD-3
TAX MAP: 47 P/O PARCELS: 3 AND 837 GRID: 8
SIXTH ELECTION DISTRICT HOWARD COUNTY, MARYLAND
DATE: APRIL 9, 2003
SHEET 1 OF 9

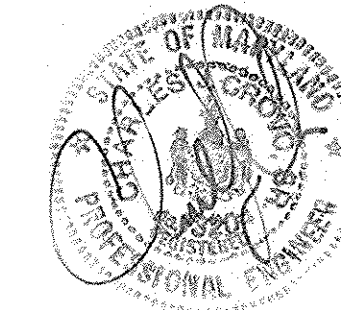

Owner and Developer
Ryland Homes
7250 Parkway Drive, Suite 520
Hanover, MD 21076
410-712-7012

FISHER, COLLINS & CARTER, INC.
CIVIL ENGINEERING CONSULTANTS & LAND SURVEYORS
CENTENNIAL SQUARE OFFICE PARK - 12072 BALTIMORE NATIONAL PIKE
ELLICOTT CITY, MARYLAND 21042
(410) 461-2295



CURVE DATA CHART

NUMBER	ROAD NAME	STA. TO STA.	RADIUS	LENGTH	DELTA	TANGENT	CHORD
1	FRAGRANT LILIES WAY	0+81.19 TO 2+01.80	295'	120.61	23°25'30"	61.16	543°39'17"E 119.77'
2	FRAGRANT LILIES WAY	2+01.80 TO 3+81.91	125'	180.12	82°33'35"	109.74	514°05'14"E 154.93'
3	FRAGRANT LILIES WAY	3+81.91 TO 6+28.56	120'	240.64	114°53'56"	188.00	N84°38'31"E 202.30'
4	FRAGRANT LILIES WAY	6+28.56 TO 6+42.89	112'	54.33	17°53'47"	17.30	N48°42'21"E 34.20'
5	LOVE SONG COURT	1+41.14 TO 2+05.35	110'	92.21	168°01'44"	49.01	N51°07'07"E 89.53'
6	LOVE SONG COURT	2+05.35 TO 2+46.11	75'	39.75	30°22'13"	20.35	N08°04'52"E 39.29'

REVISIONS		
NO.	DESCRIPTION	DATE
1	REVISED HDPE TO RCCP CL IV	10-20-03

APPROVED: DEPARTMENT OF PLANNING AND ZONING

Cindy Hamits 4/25/03
 CHIEF, DIVISION OF LAND DEVELOPMENT DATE

MK 4/23/03
 CHIEF, DEVELOPMENT ENGINEERING DIVISION DATE

APPROVED: HOWARD COUNTY DEPARTMENT OF PUBLIC WORKS

Samuel Slicker 4/20/03
 CHIEF, BUREAU OF HIGHWAYS DATE

ROAD STORM DRAIN AS-BUILT


EMERSON
 SECTION 2, PHASE 2
 LOTS 1 THRU 63 AND OPEN SPACE LOT 64
 (A RESUBDIVISION OF PARCEL B-1, EMERSON, SECTION 2, AREA 2,
 PLAT No. 15458)
 ZONED: REC-HKD-3 AND R-SC-HKD-3
 TAX MAP: 47 P/O PARCELS: 3 AND 837 GRID: B
 SIXTH ELECTION DISTRICT HOWARD COUNTY, MARYLAND

FRAGRANT LILIES WAY AND LOVE SONG COURT
 PLAN AND PROFILES



Owner and Developer
 Ryland Homes
 7250 Parkway Drive, Suite 920
 Hanover, MD 21076
 410-712-7012

SCALE: AS SHOWN DATE: APRIL 9, 2003 DWG. NO. 2 OF 9
 DES. F.M. DRN. F.M. CHK. K.R.P.

FISHER, COLLINS & CARTER, INC.
 CIVIL ENGINEERING CONSULTANTS & LAND SURVEYORS
 CENTENIAL SQUARE OFFICE PARK - 1972 BALTIMORE NATIONAL PKWY
 ELICOTT CITY, MARYLAND 21042
 (410) 481-2829

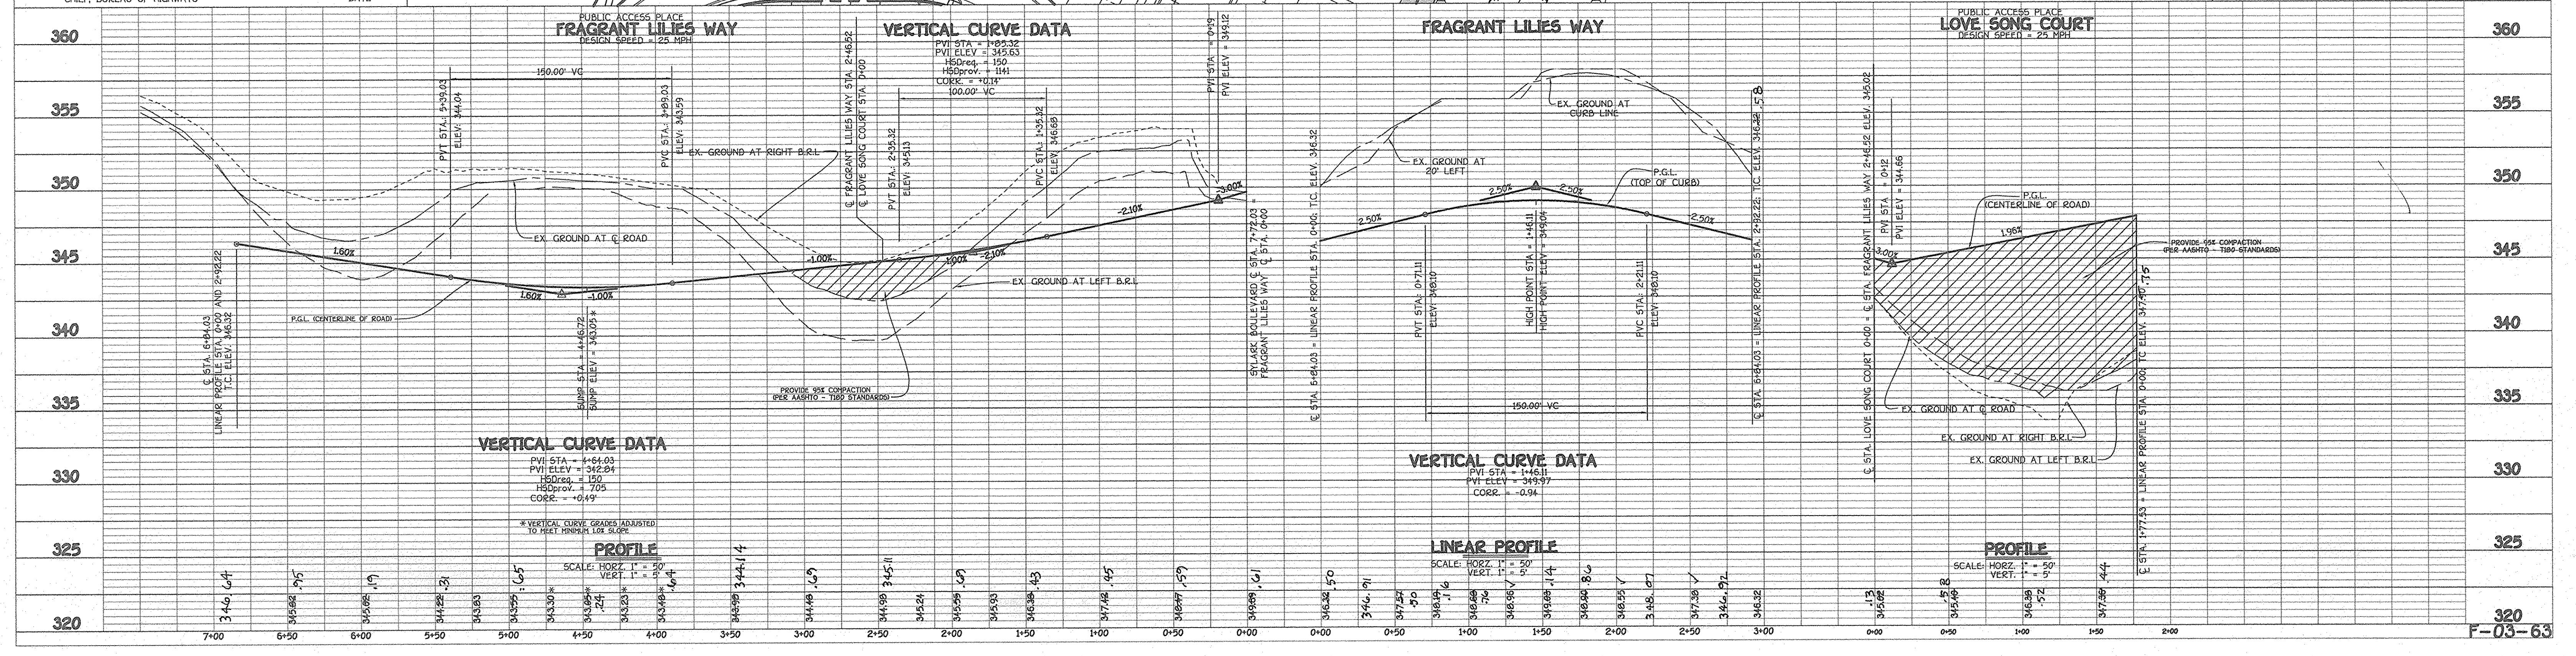

J:\03001 Emerson Property\wg\Sec2\Phase2\03097-R\plan\FINAL\03097 FINAL PLAN BASE.dwg, 4/10/2003 8:33:28 AM

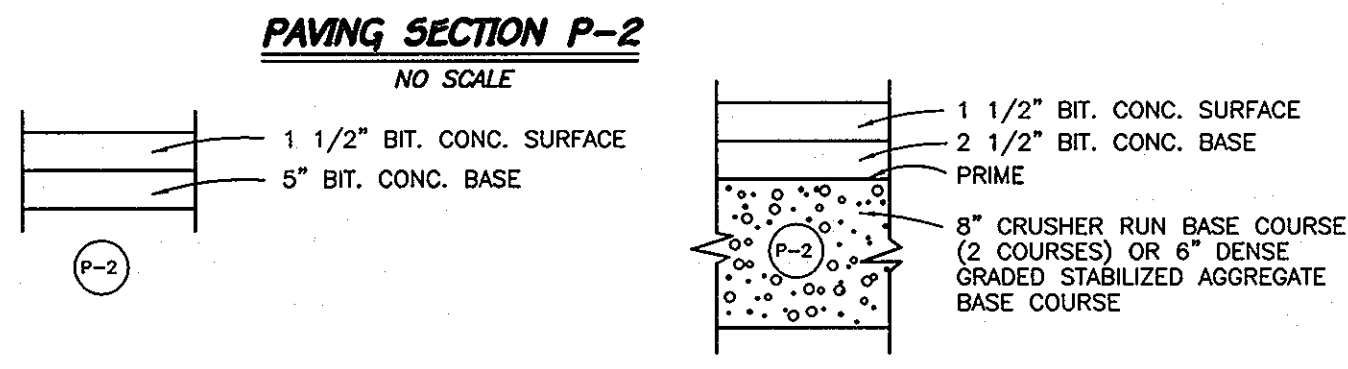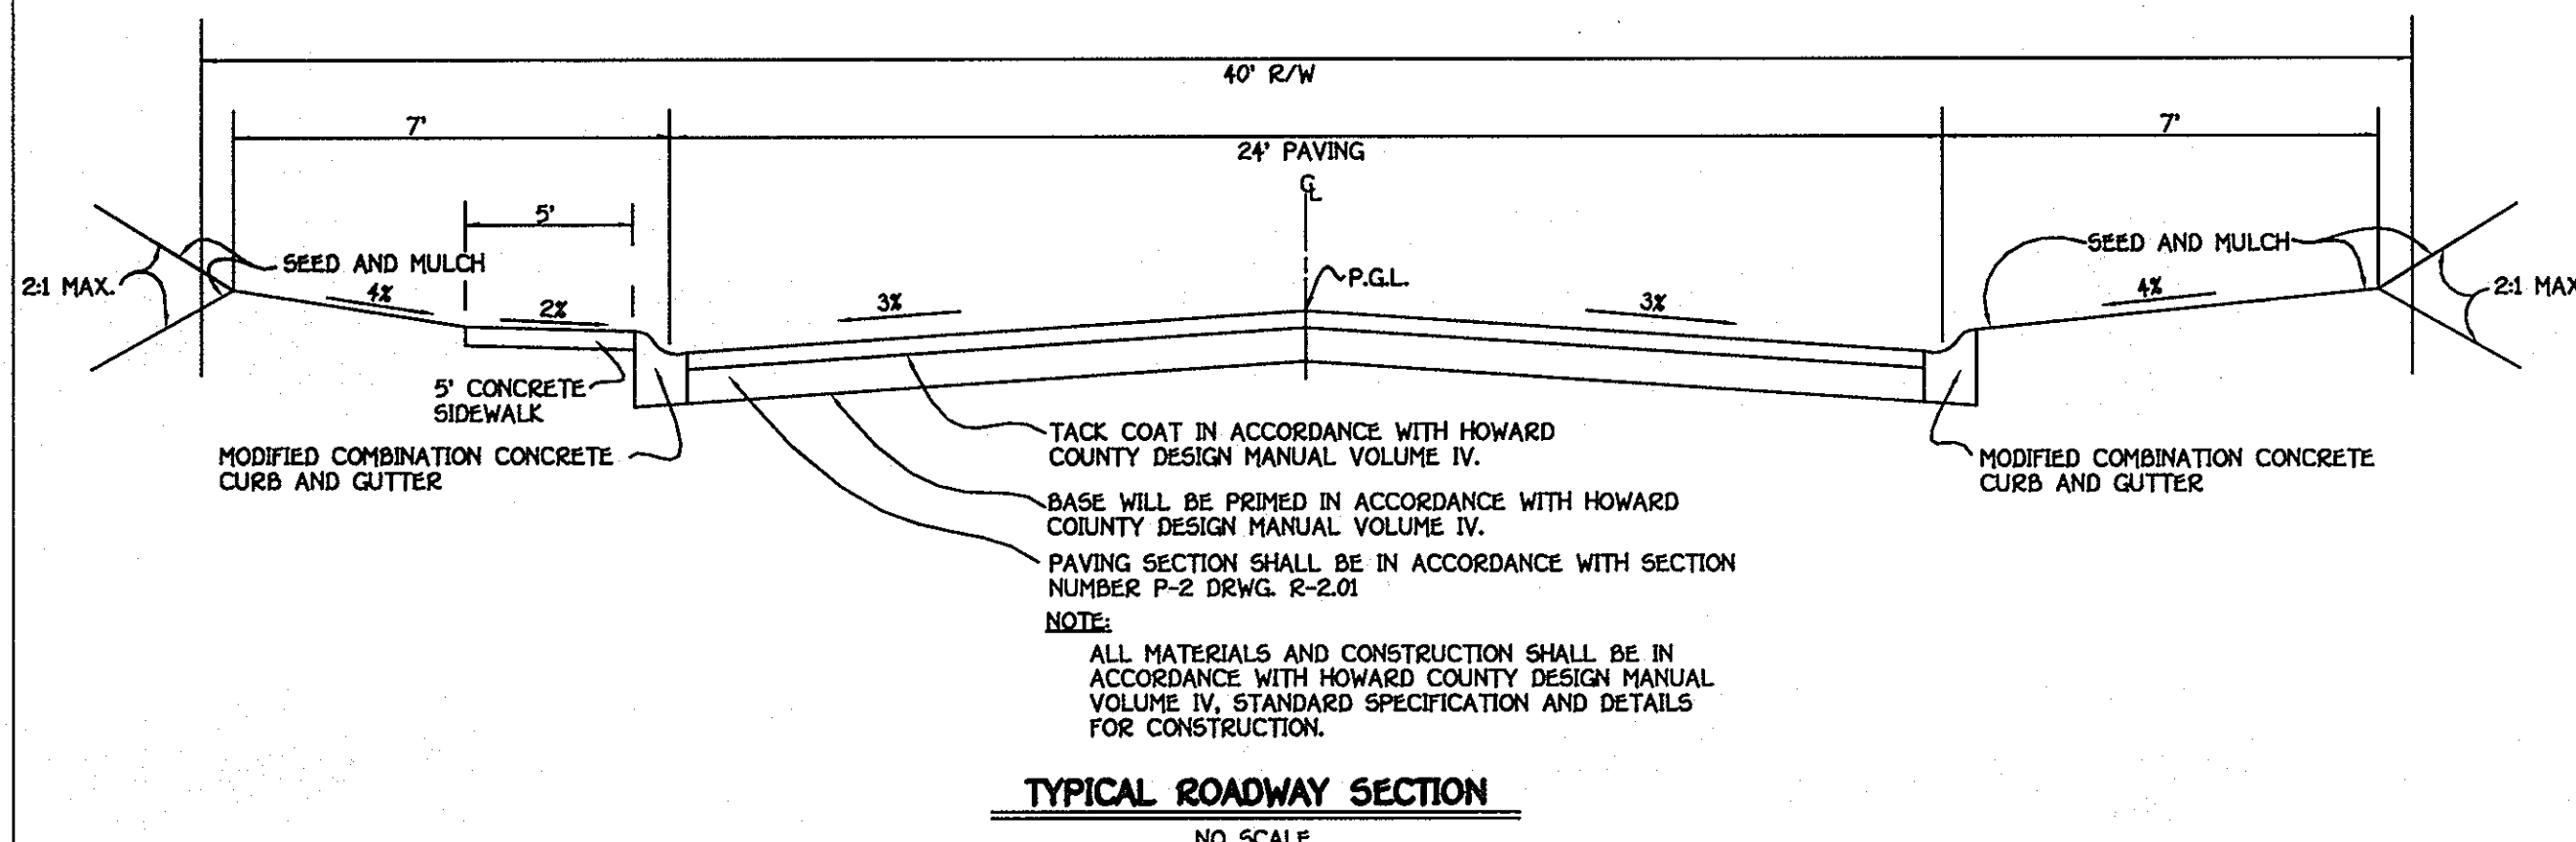

SHANABERGER & LANE
8726 TOWN & COUNTRY BLVD.
SUITE 201
ELLCOTT CITY, MARYLAND 21043






Copied/Handwritten
ROAD & STORM DRAIN AS-BUILT

ROADWAY INFORMATION CHART					
ROAD NAME	CLASSIFICATION	DESIGN SPEED	ZONING	Q. STATION LIMITS	PAVING SECTION
FRAGRANT LILIES WAY	PUBLIC ACCESS PLACE	25 M.P.H.	PEC-MXD-3	0+00 TO 6+64.03	P-2
LOVE SONG COURT	PUBLIC ACCESS PLACE	25 M.P.H.	PEC-MXD-3	0+00 TO 1+77.53	P-2

REVISIONS		
NO.	DESCRIPTION	DATE

APPROVED: DEPARTMENT OF PLANNING AND ZONING
Cindy Hamrick
CHIEF, DIVISION OF LAND DEVELOPMENT
4/25/03
DATE

APPROVED: HOWARD COUNTY DEPARTMENT OF PUBLIC WORKS
Howard S. Clark Jr.
CHIEF, BUREAU OF HIGHWAYS
4/23/03
DATE

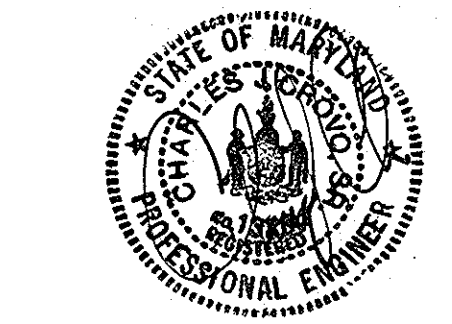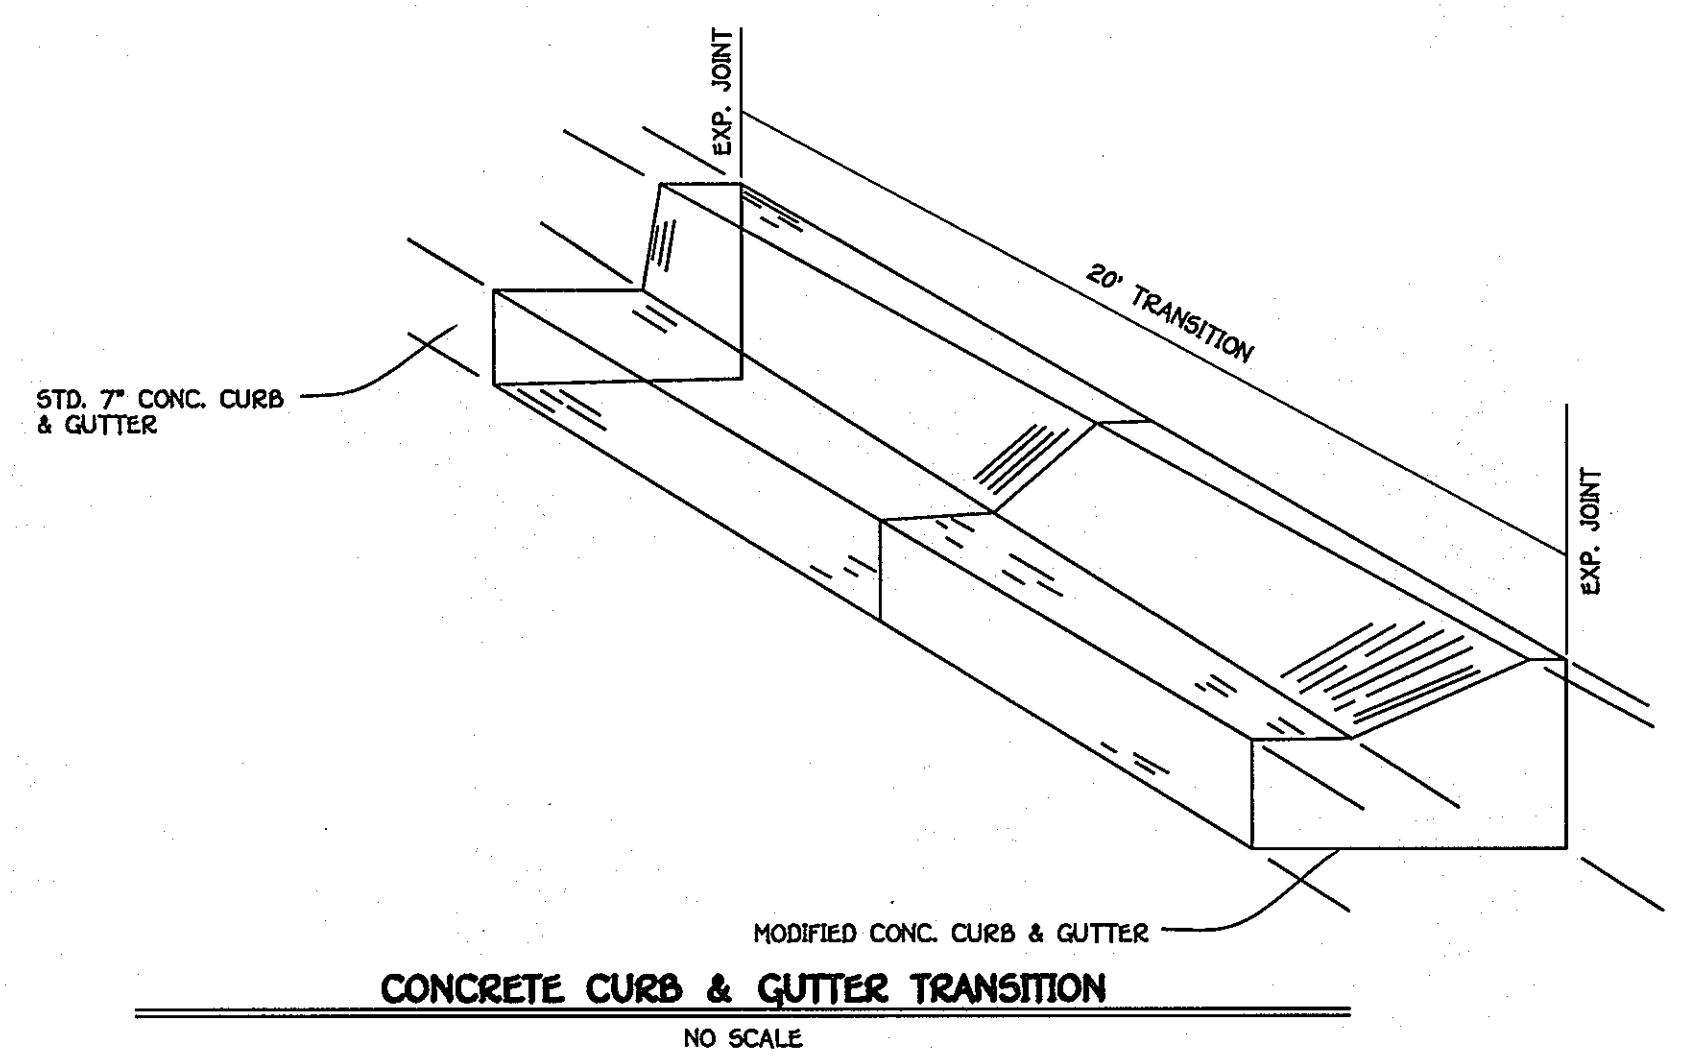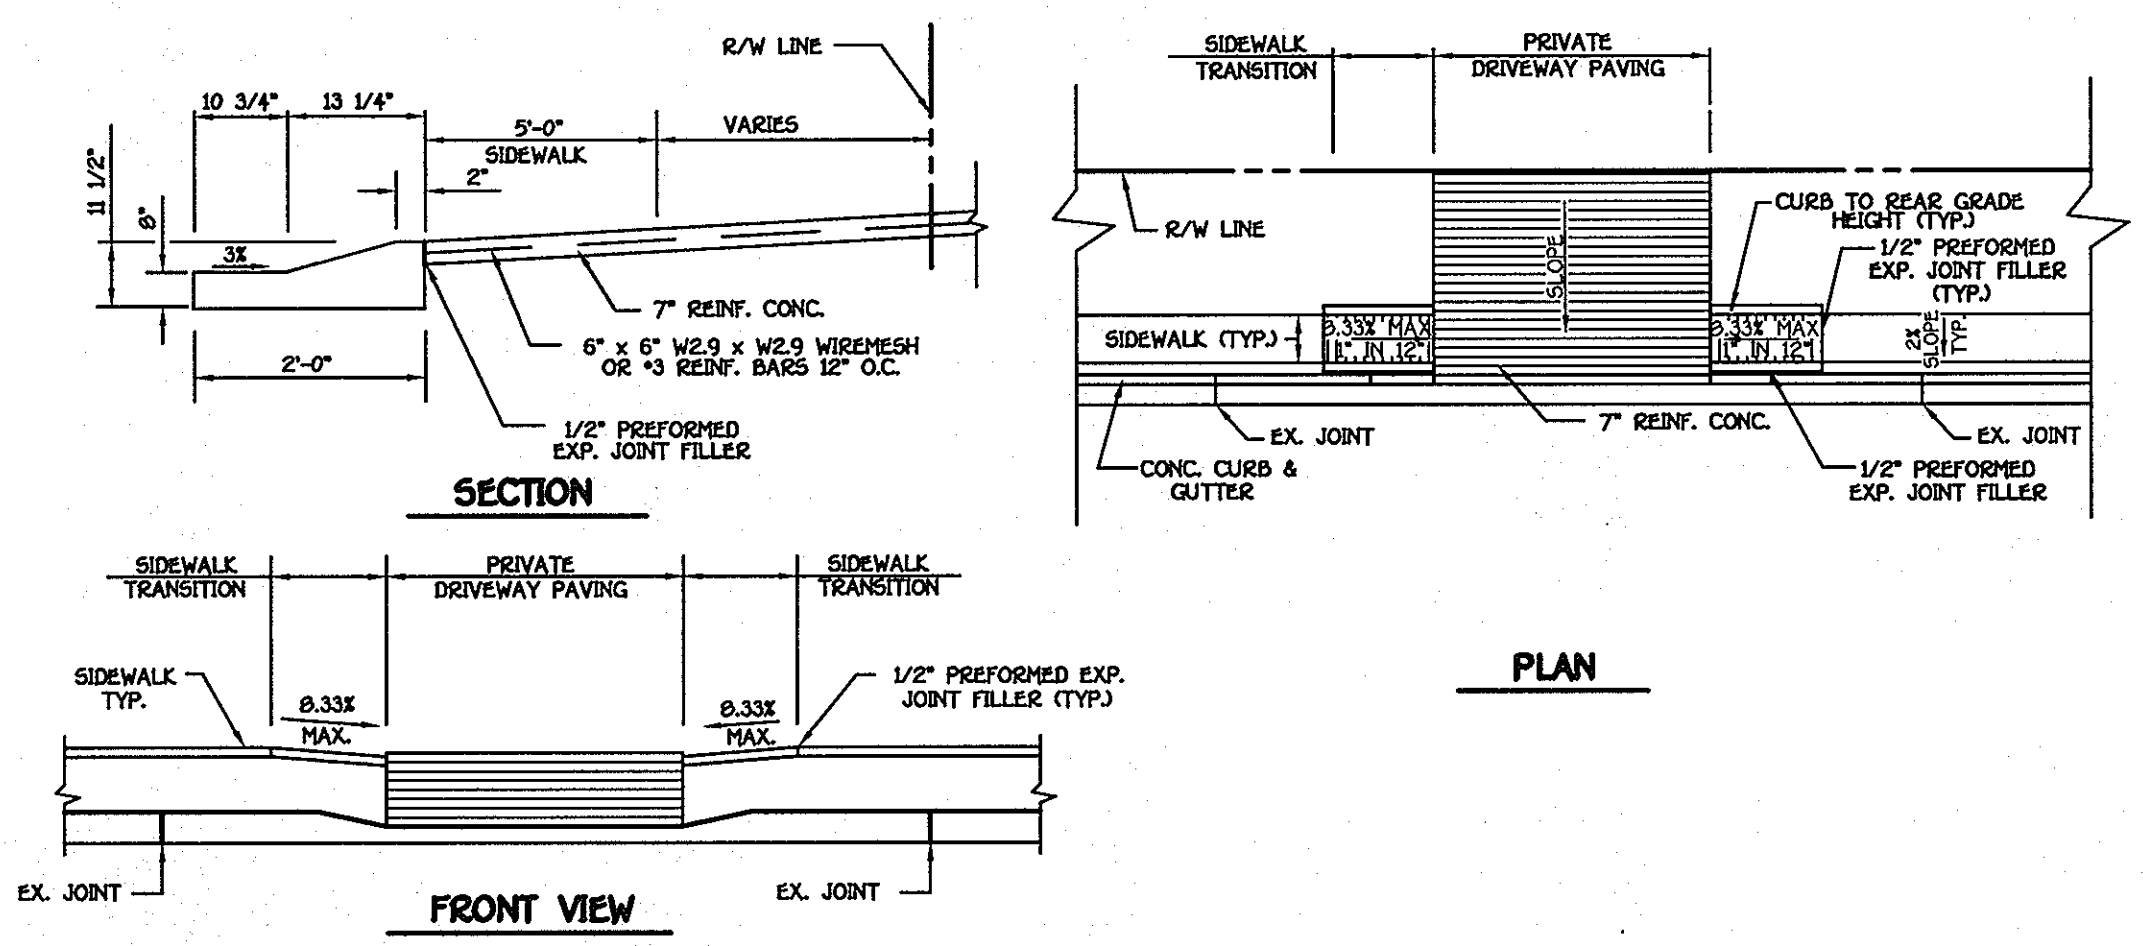


EMERSON SECTION 2 PHASE 2
LOTS 1 THRU 63 AND OPEN SPACE LOT 64
(A RESUBDIVISION OF PARCEL B-1, EMERSON, SECTION 2, AREA 2, PLAT No. 15455)
ZONED: PEC-MXD-3 AND R-5C-MXD-3
TAX MAP 47 PVD PARCELS 3 AND 637 GRID: B
SIXTH ELECTION DISTRICT HOWARD COUNTY, MARYLAND

FILLET PROFILES AND DETAILS

Owner and Developer
Ryland Homes
7250 Parkway Drive, Suite 520
Hanover, MD 21076
410-712-7012

SCALE: AS SHOWN DATE: APRIL 9, 2003 DWG. NO. 3 OF 9
DES. DRN. CHK.

FISHER, COLLINS & CARTER, INC.
CIVIL ENGINEERING CONSULTANTS & LAND SURVEYORS
CENTENNIAL SQUARE OFFICE PARK - 10722 BALTIMORE NATIONAL PIKE
ELLCOTT CITY, MARYLAND 21042
(410) 461-2995

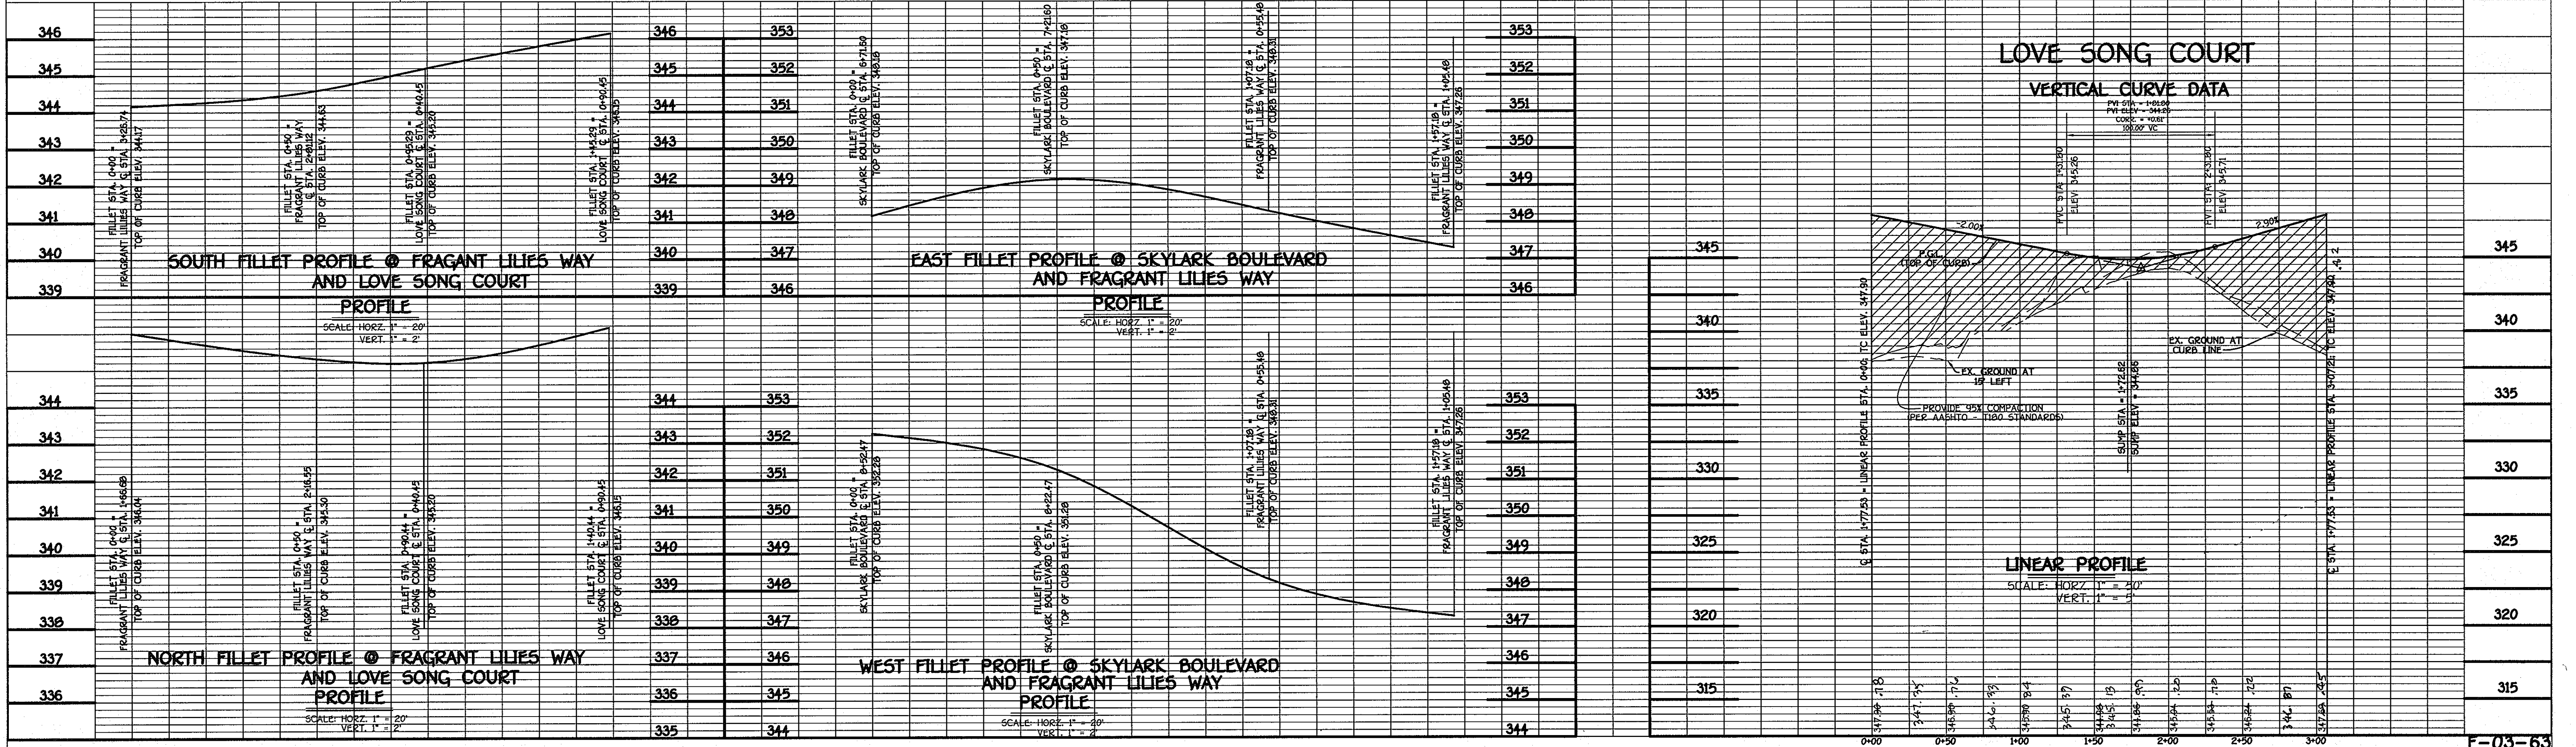

ENGINEER'S CERTIFICATE

I hereby certify that this plan for erosion and sediment control represents a practical and workable plan based on my personal knowledge of the site condition and that it was prepared in accordance with the requirements of the Howard Soil Conservation District.

Signature of Engineer: *[Signature]* Date: 4/10/03

DEVELOPER'S CERTIFICATE

"I/we certify that all development and construction will be done according to this plan of development and plan for erosion and sediment control and that all responsible personnel involved in the construction project will have a certificate of attendance at a department of natural resources approved training program for the control of sediment and erosion before beginning the project. I also authorize periodic on-site inspection by the Howard Soil Conservation District or their authorized agents, as are deemed necessary."

Signature of Developer: *[Signature]* Date: 4/10/03

Reviewed For Howard County Soil Conservation District And Meets Technical Requirements: *[Signature]* Date: 4/22/03

U.S.D.A. - Natural Resources Conservation Service: *[Signature]* Date: 4/22/03

Approved: This Development Is Approved For Erosion And Sediment Control By The Howard Soil Conservation District. District Howard Soil Conservation Dist. Date: 4/22/03

Approved: Department Of Planning And Zoning: *[Signature]* Date: 4/25/03


Chief, Division Of Land Development: *[Signature]* Date: 4/25/03

Approved: Howard County Department Of Public Works: *[Signature]* Date: 4/25/03

Chief, Bureau Of Highways: *[Signature]* Date: 4/25/03

TEMPORARY S.W.M. P.O.S.T. NO. 1

INITIAL DRAINAGE AREA = 3.14 AC.
FINAL DRAINAGE AREA = 3.14 AC.
STORAGE REQUIRED:
WET = 1800 x 3.14 = 5,652 CU. FT.
DRY = 11749 x 3.14 = 36,992 CU. FT.
STORAGE PROVIDED:
WET = 6,352 CU. FT. @ ELEV. 330.75
DRY = 11,749 CU. FT. @ ELEV. 332.67
BOTTOM ELEV. = 329.50
STORAGE DEPTH = 3.17'
SIDE SLOPES = 2:1
TOP OF EMBANKMENT = 334.00
CLEANOUT ELEV. = 330.20
8" LOW FLOW ORIFICE = 330.75
RISER CREST ELEV. = 332.67
Q2 EXISTING = 2.1 c.f.s.
Q2 PROPOSED = 2.1 c.f.s.

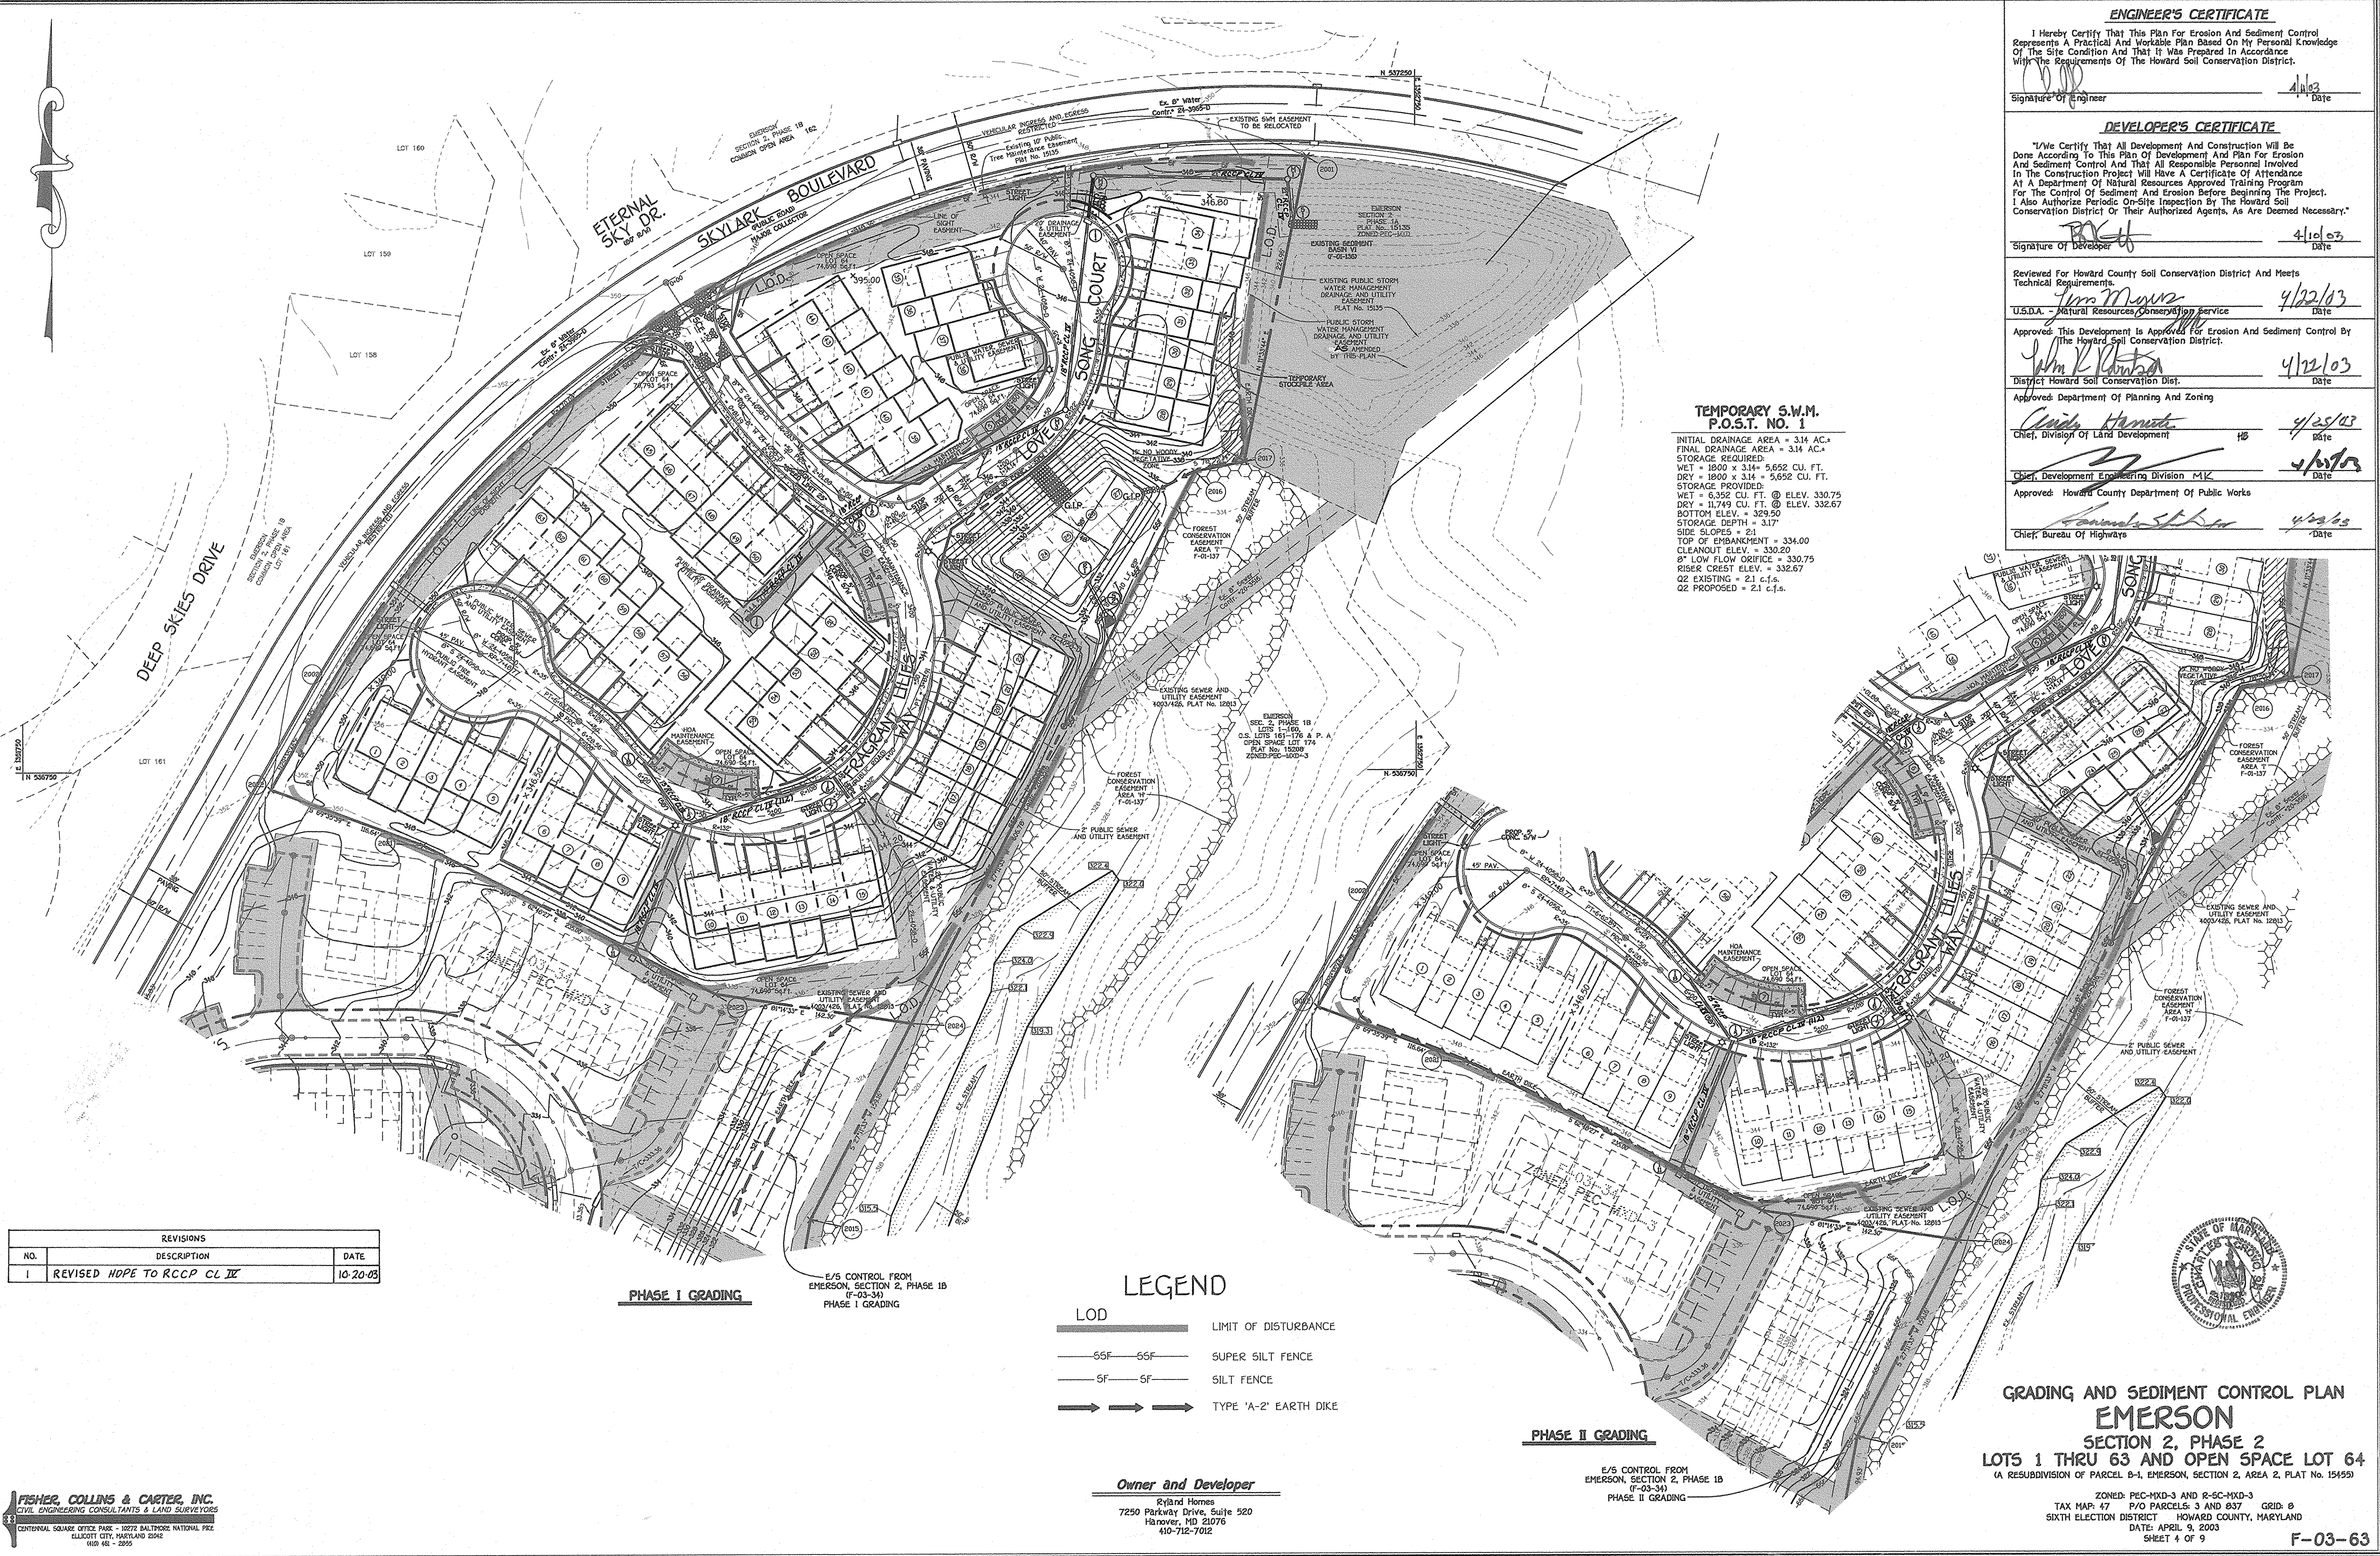

REVISIONS		
NO.	DESCRIPTION	DATE
I	REVISED HDPE TO RCCP CL III	10-20-03

LEGEND

LOD ————— LIMIT OF DISTURBANCE

—SSF—SSF— SUPER SILT FENCE

—SF—SF— SILT FENCE

—>>>>> TYPE 'A-2' EARTH DIKE

Owner and Developer

Ryland Homes
7250 Parkway Drive, Suite 520
Hanover, MD 21076
410-712-7012

GRADING AND SEDIMENT CONTROL PLAN

EMERSON

SECTION 2, PHASE 2

LOTS 1 THRU 63 AND OPEN SPACE LOT 64

(A RESUBDIVISION OF PARCEL B-1, EMERSON, SECTION 2, AREA 2, PLAT NO. 15455)

ZONED: PEC-MXD-3 AND R-SC-MXD-3
P/O PARCELS: 3 AND 837 GRID: 6
SIXTH ELECTION DISTRICT HOWARD COUNTY, MARYLAND
DATE: APRIL 9, 2003
SHEET 4 OF 9

FISHER, COLLINS & CARTER, INC.
CIVIL ENGINEERING CONSULTANTS & LAND SURVEYORS
CENTENNIAL SQUARE OFFICE PARK - 10272 BALTIMORE NATIONAL PKWY
ELLCOTT CITY, MARYLAND 21117
410-461-2895



STANDARDS AND SPECIFICATIONS FOR TOPSOIL

Definition: Placement of topsoil over a prepared subsoil prior to establishment of permanent vegetation.

Purpose: To provide a suitable soil medium for vegetative growth. Soils of concern have low moisture content, low nutrient levels, low pH, materials toxic to plants, and/or unacceptable soil gradation.

Conditions Where Practice Applies: This practice is limited to areas having 2:1 or flatter slopes where the texture of the exposed subsoil material is not adequate to produce vegetative growth, the soil material is so shallow that the rooting zone is not deep enough to support plants or furnish continuing supplies of moisture and plant nutrients, the original soil to be vegetated contains material toxic to plant growth, and the soil is so acidic that treatment with limestone is not feasible.

Construction and Material Specifications: Topsoil salvaged from the existing site may be used provided that it meets the standards as set forth in these specifications. Typically, the depth of topsoil to be salvaged for a given soil type can be found in the representative soil profile section in the Soil Survey published by USDA-NCSS in cooperation with Maryland Agricultural Experimental Station.

2.0.0 STANDARDS AND SPECIFICATIONS FOR VEGETATIVE STABILIZATION
DEFINITION: Using vegetation as cover for barren soil to protect it from forces that cause erosion.

PURPOSE: Vegetative stabilization specifications are used to promote the establishment of vegetation on exposed soil. When soil is stabilized with vegetation, the soil is less likely to erode and more likely to allow infiltration of rainfall, thereby reducing sediment loads and runoff to downstream areas, and improving wildlife habitat and visual resources.

CONDITIONS WHERE PRACTICE APPLIES: This practice shall be used on denuded areas as specified on the plans and may be used on highly erodible or critically eroding areas. This specification is divided into Temporary Seeding, to quickly establish vegetative cover for short duration (up to one year), and Permanent Seeding, for long term vegetative cover. Estimates of applicable areas for Temporary Seeding are shown on temporary SOI Stipules, cleared areas being left between construction phases, earth dikes, etc., and for Permanent Seeding are shown on SOI Stipules, cleared areas being left between construction phases, earth dikes, etc.

EFFECTS ON WATER QUALITY AND QUANTITY: Planting vegetation in disturbed areas will have an effect on the water budget, especially on volumes and rates of runoff, infiltration, evaporation, transpiration, percolation, and groundwater recharge. Vegetation, over time, will increase organic matter content and improve water holding capacity of the soil. This, in turn, will increase infiltration of rainfall and reduce runoff. Vegetation will reduce the movement of sediment, nutrients, and other chemicals carried by runoff to receiving waters. Plants will also help protect groundwaters by stabilizing those substances present within the root zone. Sediment control devices must remain in place during grading, seeded preparation, seeding, mulching and vegetative establishment to prevent large quantities of sediment and associated chemicals and nutrients from washing into surface waters.

SECTION 1 - VEGETATIVE STABILIZATION METHODS AND MATERIALS

A. Site Preparation: Initial erosion and sediment control structures (either temporary or permanent) such as diversions, grade stabilization structures, berms, waterways, or sediment control basins.

B. Soil Amendments: Fertilizer and Liming Specification. Soil tests must be performed to determine the exact ratios and application rates for both lime and fertilizer on sites having disturbed areas over 5 acres. Soil analysis may be performed by the University of Maryland or a recognized commercial laboratory. Soil samples taken for engineering purposes may also be used for chemical analysis.

C. Seeded Preparation: Seeding preparation shall consist of loosening soil to a depth of 3" to 5" by means of suitable agricultural or construction equipment, such as disc harrows or chisel plows or other suitable equipment. After the soil is loosened it should not be rolled or dragged around, but left in the roughened condition. Sloped areas greater than 3:1 should be tracked leaving the surface in an irregular condition with ridges running parallel to the contour of the slope.

SECTION 2 - TEMPORARY SEEDING

Vegetation - annual grass or grain used to provide cover on disturbed areas for up to 12 months. For longer duration of vegetative cover, Permanent Seeding is required.

A. Seed mixtures - Temporary Seeding: Select one or more of the species or mixtures listed in Table 25 for the appropriate Plant Hardiness Zone (from Figure 5) and enter them in the Temporary Seeding summary below, along with application rates, seeding dates and seeding depths. If the summary is not put on the plans and completed, then Table 25 must be put on the plans.

Seed Mixture (Hardiness Zone - 6a)	No.	Species	Application Rate (lb/ac)	Seeding Dates	Seeding Depth (in)	Fertilizer Rate (0-10-10)	Lime Rate
From Table 25	1	BARLEY	122	3/1 - 5/15	1" - 2"	600 B/ac	2 tons/ac
	2	OATS	96	8/15 - 10/15	1" - 2"	05 B/1000sqft	000 B/1000sqft
	3	RYE	140		1" - 2"		

B. Permanent Seeding: Select one or more of the species or mixtures listed in Table 25 for the appropriate Plant Hardiness Zone (from Figure 5) and enter them in the Permanent Seeding summary below, along with application rates, seeding dates and seeding depths. If the summary is not put on the plans and completed, then Table 25 must be put on the plans.

Seed Mixture (Hardiness Zone - 6a)	No.	Species	Application Rate (lb/ac)	Seeding Dates	Seeding Depth (in)	N P205 K20	Lime Rate
From Table 25	1	TALL FESCUE (B&D)	165	3/1 - 5/15	1" - 2"	175 B/ac (4 B/1000sqft)	2 tons/ac (200 B/1000sqft)
	2	PERENNIAL RYEGRASS (B&D)	15	8/15 - 10/15	1" - 2"	15 B/ac (1 B/1000sqft)	000 B/1000sqft
	3	TALL FESCUE (B&D)	30	3/1 - 5/15	1" - 2"	175 B/ac (4 B/1000sqft)	2 tons/ac (200 B/1000sqft)

SECTION 3 - PERMANENT SEEDING

A. Seed mixtures - Permanent Seeding: Select one or more of the species or mixtures listed in Table 25 for the appropriate Plant Hardiness Zone (from Figure 5) and enter them in the Permanent Seeding summary below, along with application rates, seeding dates and seeding depths. If the summary is not put on the plans and completed, then Table 25 must be put on the plans. Additional planting specifications for exceptional sites such as shoreline, streambanks, or dunes or for special purposes such as wildlife or aesthetic treatment may be found in USDA-NCSS Technical Field Office, Section 342 - Critical Area Planning For special lawn maintenance areas, see Sections IV and V. Turfgrass.

Slope	Slope Steepness	Slope Length (maximum)	Silt Fence Length (maximum)
0% - 15%	0:1 - 3:1	Unlimited	Unlimited
15% - 25%	3:1 - 4:1	200 feet	1500 feet
25% - 35%	4:1 - 5:1	100 feet	1000 feet
35% - 45%	5:1 - 6:1	50 feet	500 feet
45% - 50%	5:1 - 6:1	50 feet	250 feet

SEEDING METHODS AND MATERIALS


A. Seeding: Seeding shall be performed by broadcast or other methods. Seeding shall be performed in a uniform manner. Seeding shall be performed in a uniform manner. Seeding shall be performed in a uniform manner.

EARTH DIKE

NOT TO SCALE

2:1 SLOPE OR FLATTER


EXCAVATE TO PROVIDE REQUIRED FLOW WIDTH AT DESIGN FLOW DEPTH

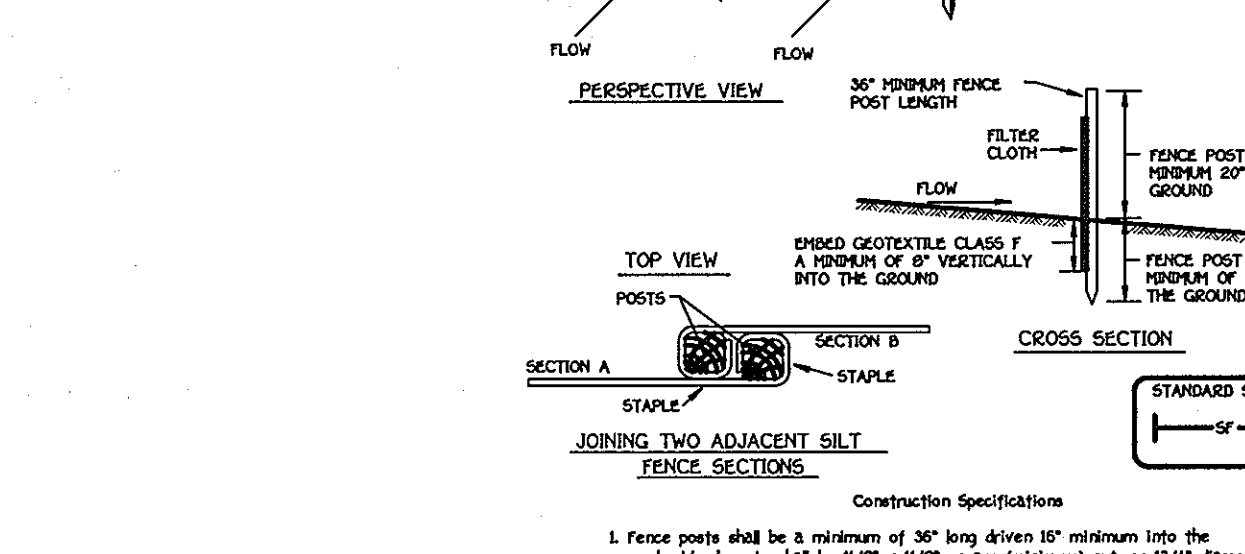

DIKE A	DIKE B
a-DIKE HEIGHT	18' 30'
b-DIKE WIDTH	24' 36'
c-FLOW WIDTH	4' 6'
d-FLOW DEPTH	12' 24'

PLAN VIEW: FLOW CHANNEL STABILIZATION GRADE: 0.5% MIN. 10% MAX.

SILT FENCE

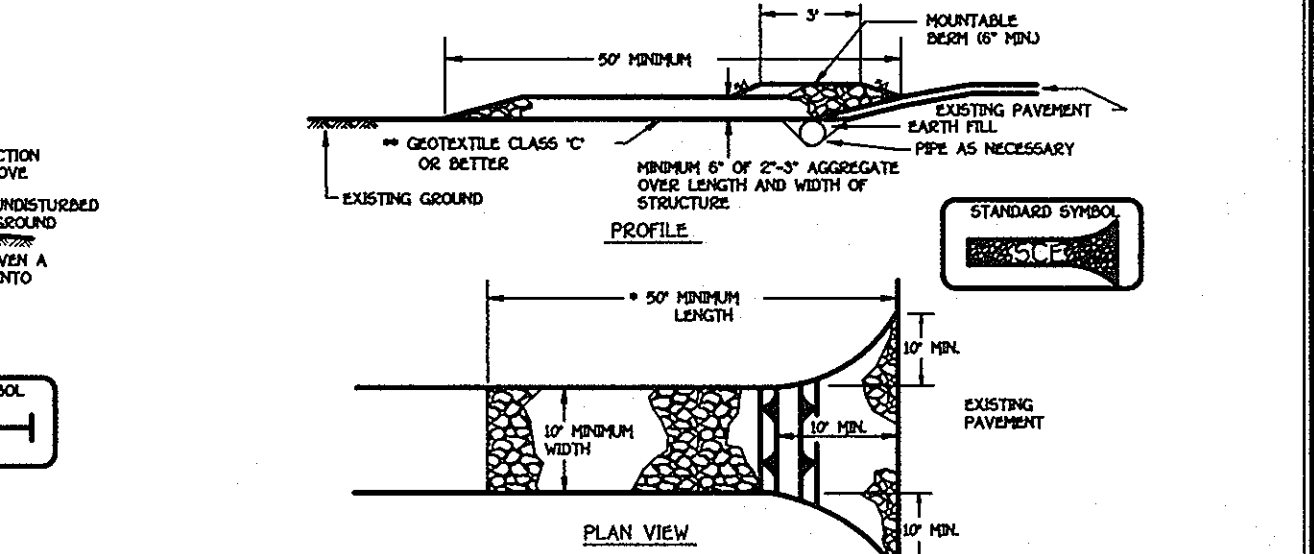

Slope Steepness	90%min Slope Length	90%min Silt Fence Length
Filter (Bank Soil)	unlimited	unlimited
50:1 to 100:1	125 feet	1000 feet
100:1 to 50:1	100 feet	750 feet
50:1 to 31:1	60 feet	500 feet
31:1 to 20:1	40 feet	250 feet
20:1 and steeper	20 feet	125 feet

SEDIMENT CONTROL NOTES

1. A MINIMUM OF 48 HOURS NOTICE MUST BE GIVEN TO THE HOWARD COUNTY DEPARTMENT OF INSPECTIONS, LICENSES AND PERMITS, SEDIMENT CONTROL DIVISION PRIOR TO THE START OF ANY CONSTRUCTION (0313-1055).

2. ALL VEGETATIVE AND STRUCTURAL PRACTICES ARE TO BE INSTALLED ACCORDING TO THE PROVISIONS OF THIS PLAN AND ARE TO BE IN CONFORMANCE WITH THE MOST CURRENT MARYLAND STANDARDS AND SPECIFICATIONS FOR SOIL EROSION AND SEDIMENT CONTROL AND REVISIONS THERETO.

3. FOLLOWING INITIAL SOIL DISTURBANCE OR RE-DISTURBANCE, PERMANENT OR TEMPORARY STABILIZATION SHALL BE COMPLETED WITHIN 7 CALENDAR DAYS FOR ALL PERIMETER SEDIMENT CONTROL STRUCTURES, DIKES, PERMETEE SLOPES AND ALL SLOPES STEEPER THAN 3:1, BY 14 DAYS AS TO ALL OTHER DISTURBED OR GRADED AREAS ON THE PROJECT SITE.

4. ALL SEDIMENT TRAPPING DEVICES SHALL BE FENCED AND WARNING SIGNS POSTED AROUND THEIR PERIMETER IN ACCORDANCE WITH VOL. 1, CHAPTER 12, OF THE HOWARD COUNTY DESIGN MANUAL, STORM DRAINAGE.

5. ALL DISTURBED AREAS MUST BE STABILIZED WITHIN THE TIME PERIOD SPECIFIED ABOVE IN ACCORDANCE WITH THE 1994 MARYLAND STANDARDS AND SPECIFICATIONS FOR SOIL EROSION AND SEDIMENT CONTROL FOR PERMANENT SEEDING (SEC. 5), SOIL (SEC. 54), TEMPORARY SEEDING (SEC. 50), AND MULCHING (SEC. 52). TEMPORARY STABILIZATION WITH MULCH ALONE CAN ONLY BE DONE WHEN RECOMMENDED SEEDING DATES DO NOT ALLOW FOR PROPER GERMINATION AND ESTABLISHMENT OF GRASES.

6. ALL SEDIMENT CONTROL STRUCTURES ARE TO REMAIN IN PLACE AND ARE TO BE MAINTAINED IN OPERATIVE CONDITION UNTIL PERMITS FOR THEIR REMOVAL HAS BEEN OBTAINED FROM THE HOWARD COUNTY SEDIMENT CONTROL INSPECTOR.

7. SITE ANALYSIS:

TOTAL AREA OF SITE	6.03	ACRES
AREA TO BE ROOFED OR PAVED	2.84	ACRES
AREA TO BE VEGETATIVELY STABILIZED	3.03	ACRES
TOTAL CUT	15,000	CU. YDS.
TOTAL FILL	15,000	CU. YDS.

8. OFFSITE WASTE/BORROW AREA LOCATION: N/A

9. ANY SEDIMENT CONTROL PRACTICE WHICH IS DISTURBED BY GRADING ACTIVITY FOR PLACEMENT OF UTILITIES MUST BE REPAIRED ON THE SAME DAY OF DISTURBANCE.

10. ADDITIONAL SEDIMENT CONTROLS MUST BE PROVIDED, IF DEEMED NECESSARY BY THE HOWARD COUNTY SEDIMENT CONTROL INSPECTOR.

11. ON ALL SITES WITH DISTURBED AREAS IN EXCESS OF 2 ACRES, APPROVAL OF THE INSPECTION AGENCY MUST BE REQUESTED UPON COMPLETION OF INSTALLATION OF PERMETEE EROSION AND SEDIMENT CONTROLS, BUT BEFORE PROCEEDING WITH ANY OTHER EARTH DISTURBANCE OR GRADING. OTHER BUILDING OR GRADING CONSTRUCTION APPROVALS MAY NOT BE AUTHORIZED UNTIL THIS INITIAL APPROVAL BY THE INSPECTION AGENCY IS MADE.

12. TECHNIQUES FOR THE CONSTRUCTION OF UTILITIES IS LIMITED TO THREE PIPE LENGTHS OR THAT WHICH SHALL BE BACK-FILLED AND STABILIZED WITHIN ONE WORKING DAY, WHICHEVER IS SHORTER.


SEEDING METHODS AND MATERIALS

A. Seeding: Seeding shall be performed by broadcast or other methods. Seeding shall be performed in a uniform manner. Seeding shall be performed in a uniform manner.

SEEDING METHODS AND MATERIALS

A. Seeding: Seeding shall be performed by broadcast or other methods. Seeding shall be performed in a uniform manner. Seeding shall be performed in a uniform manner.

STABILIZED CONSTRUCTION ENTRANCE

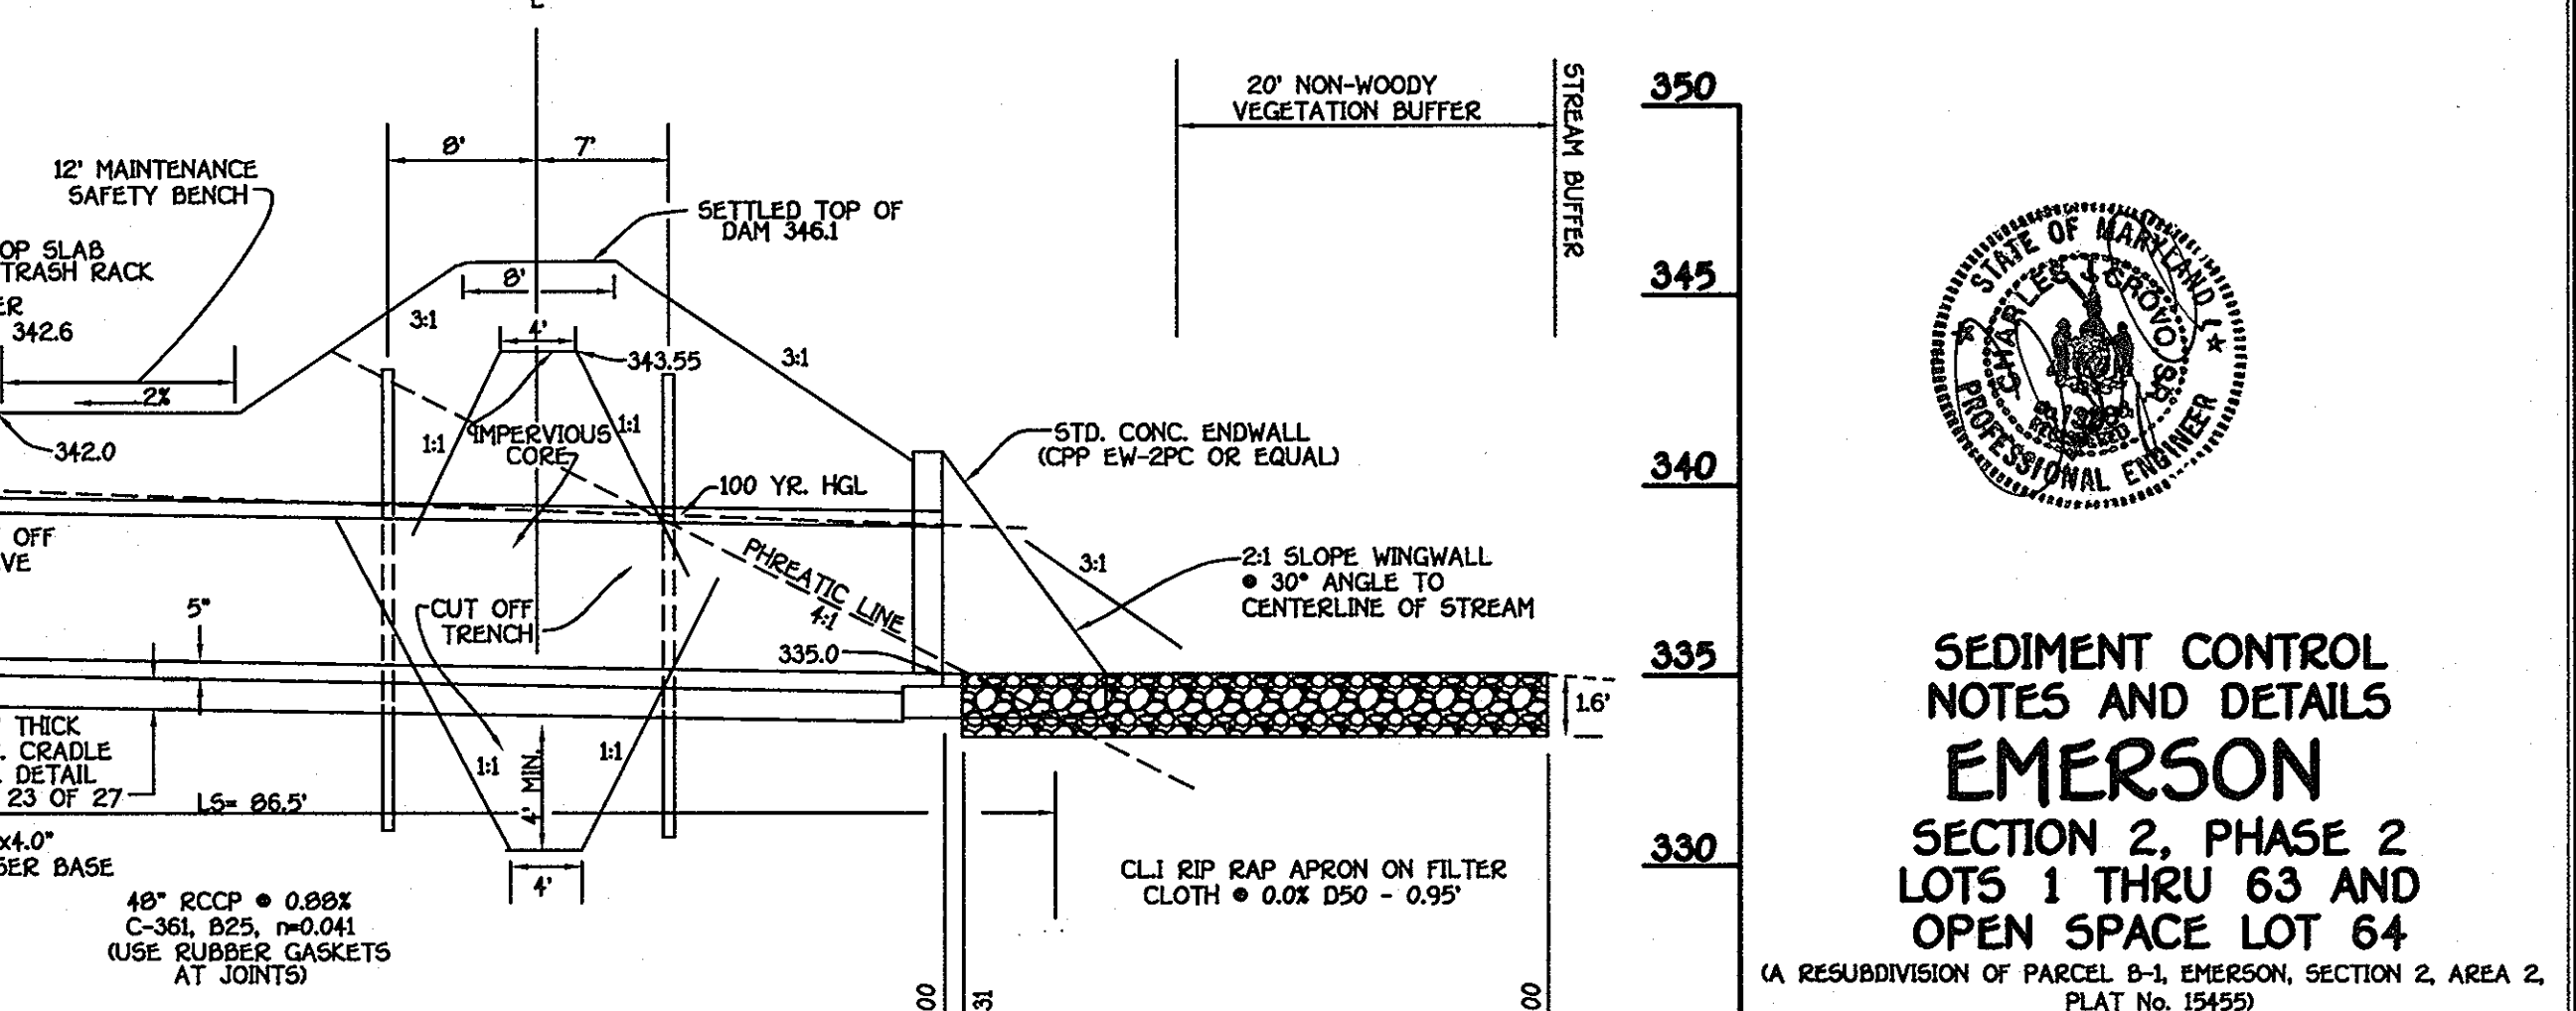

OWNER AND DEVELOPER:
 Ryland Homes
 7250 Parkway Drive, Suite 520
 Hanover, MD 21076
 410-712-7012

SEDIMENT CONTROL NOTES AND DETAILS
EMERSON
 SECTION 2, PHASE 2
 LOTS 1 THRU 63 AND
 OPEN SPACE LOT 64
 (A RESUBDIVISION OF PARCEL D-1, EMERSON, SECTION 2, AREA 2,
 PLAT NO. 15455)

ZONED: PFC-MXD-3 AND E-SC-HYD-3
 TAX MAP: 47
 P/O PARCELS: 3 AND B37
 SIXTH ELECTION DISTRICT HOWARD COUNTY, MARYLAND
 DATE: APRIL 9, 2003
 SHEET 5 OF 9

ENGINEER'S CERTIFICATE
 I hereby Certify That This Plan For Erosion And Sediment Control Represents A Practical And Workable Plan Based On My Personal Knowledge Of The Site Condition And That It Was Prepared In Accordance With The Requirements Of The Howard Soil Conservation District.

Signature Of Engineer: *[Signature]* Date: 4/10/03

DEVELOPER'S CERTIFICATE
 We Certify That All Development And Construction Will Be Done According To This Plan Of Development And Plan For Erosion And Sediment Control And That All Responsible Personnel Involved In The Construction Project Will Have A Certificate Of Attendance At A Department Of Natural Resources Approved Training Program For The Control Of Sediment And Erosion Before Beginning The Project. I Also Authorize Periodic On-Site Inspection By The Howard Soil Conservation District Or Their Authorized Agents, As Are Deemed Necessary.

Signature Of Developer: *[Signature]* Date: 4/10/03

Reviewed For Howard County Soil Conservation District And Meets Technical Requirements: *[Signature]* Date: 4/10/03

U.S.D.A. - Natural Resources Conservation Service: *[Signature]* Date: 4/10/03

Approved: Department of Planning And Zoning: *[Signature]* Date: 4/25/03

Chief, Division Of Land Development: *[Signature]* Date: 4/25/03


Approved: Howard County Department Of Public Works: *[Signature]* Date: 4/25/03

Chief, Bureau Of Highways: *[Signature]* Date: 4/25/03

FISHER, COLLINS & CARTER, INC.
 CIVIL ENGINEERING CONSULTANTS & LAND SURVEYORS
 CENTRAL SQUARE OFFICE PARK - 18277 BALTIMORE NATIONAL PIKE
 ELKTON, MD 21828
 (410) 461-2855

PIPE OUTLET SEDIMENT TRAP - ST 1


PIPE OUTLET SEDIMENT TRAP - ST 1

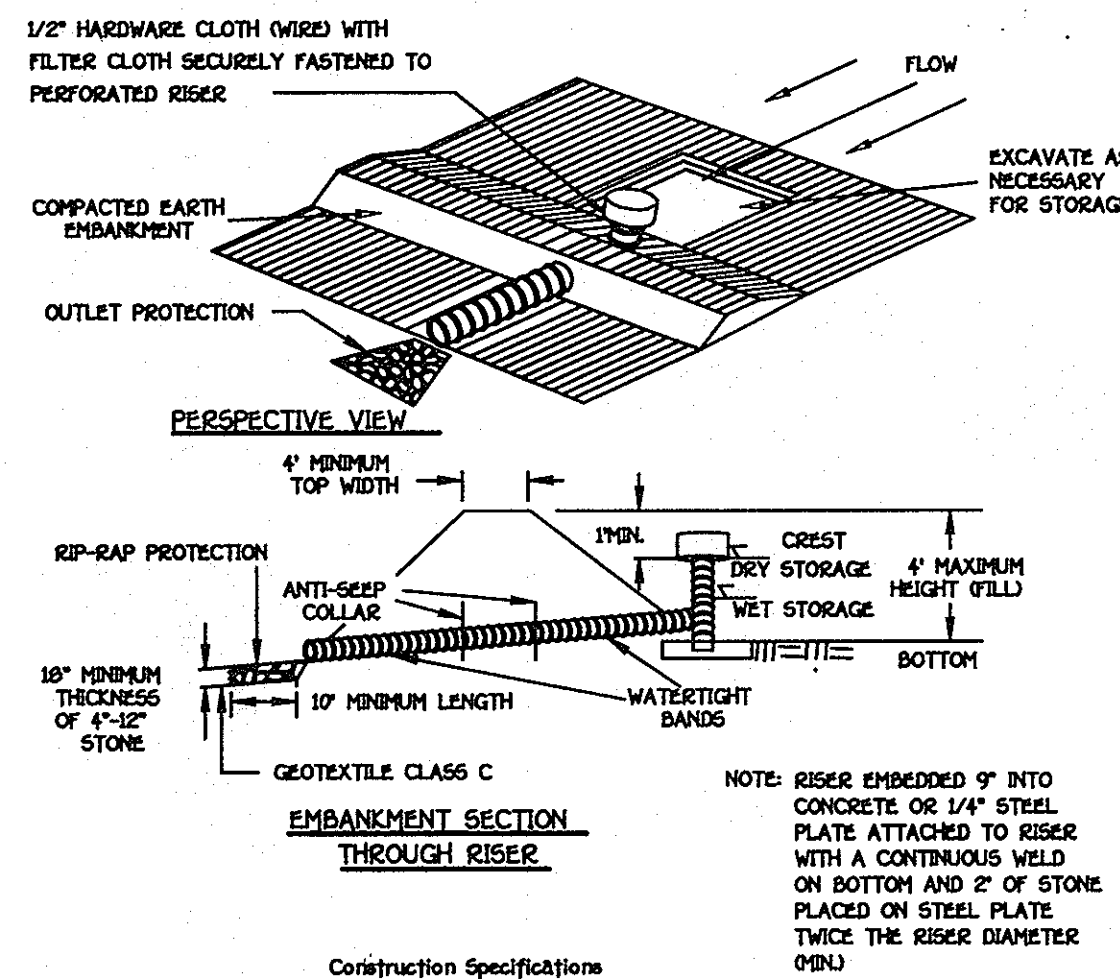

- Construction Specifications**
- The area under the embankment shall be cleared, grubbed and stripped of any vegetation and root mat. The pool area shall be cleared.
 - The fill material for the embankment shall be free of roots or other woody vegetation as well as oversized stones, rocks, organic material, or other objectionable material. The embankment shall be compacted by traversing with equipment while it is being constructed.
 - The total trap volume as measured from the bottom to riser crest elevation shall be 3000 cubic feet per acre of drainage area (see Table 5). The top of embankment must be $\geq 1'$ above the riser crest elevation.
 - Sediment shall be removed and the trap restored to its original dimensions when the sediment has accumulated to one half of the wet storage depth of the trap (5000/2). The sediment shall be deposited in a suitable area and in such a manner that it will not erode.
 - The structure shall be inspected periodically and after each rain and repairs made as necessary.


- Construction operations shall be carried out in such a manner that erosion and water pollution are abated. Once constructed, the top and outside face of the embankment shall be stabilized with seed and mulch. Points of concentrated inflow shall be protected in accordance with Grade Stabilization Structure criteria. The remainder of the interior slopes should be stabilized (one time) with seed and mulch upon trap completion and monitored and maintained erosion free during the life of the trap.
- The structure shall be removed and area stabilized when the drainage area has been properly established.
- All cut and fill slopes shall be 2:1 or flatter.
- All pipe connections shall be watertight.
- Above the wet storage elevation the riser shall be perforated with 1/2" wide by 6" long slots or 1" diameter holes spaced 6" vertically and horizontally. No perforations will be allowed within 6" of the horizontal bars.
- The riser shall be wrapped with 1/2" hardware cloth (wire) then wrapped with Geotextile Class E. The filter cloth shall extend 6" above the highest silt and 6" below the lowest slot. Where ends of filter cloth come together, they shall be overlapped, folded and fastened to prevent bypass. Filter cloth shall be replaced as necessary to prevent clogging.
- Straps or connecting bands shall be used to hold the filter cloth and wire fabric in place. They shall be placed at the top and bottom of the cloth.
- Fill material around the pipe spigot shall be hand compacted in 4" layers. A minimum of 2" of hand-compacted backfill shall be placed over the pipe spigot before crossing it with construction equipment.
- The riser shall be anchored with either a concrete base or steel plate base to prevent flotation. Concrete bases shall be at least twice the riser diameter and 12" deep with the riser embedded 9". Steel plate bases shall be at least twice the riser diameter, 1/4" minimum thickness and attached to the bottom of the riser by a continuous weld to form a watertight connection. Then place 2" of stone, gravel or tamped earth on the plate.
- Anti seep collars shall be constructed in accordance with plans (ref. table 16 and Details 13 and 14).
- Refer to Section D for dewatering requirements of sediment traps.
- Outlet - An outlet shall be provided, which includes a means of conveying the discharge in an erosion free manner to an existing stable channel.
- Where discharge occurs at the property line, local ordinances and drainage easement requirements shall be met.

TYPICAL ANTI-SEEP COLLARS

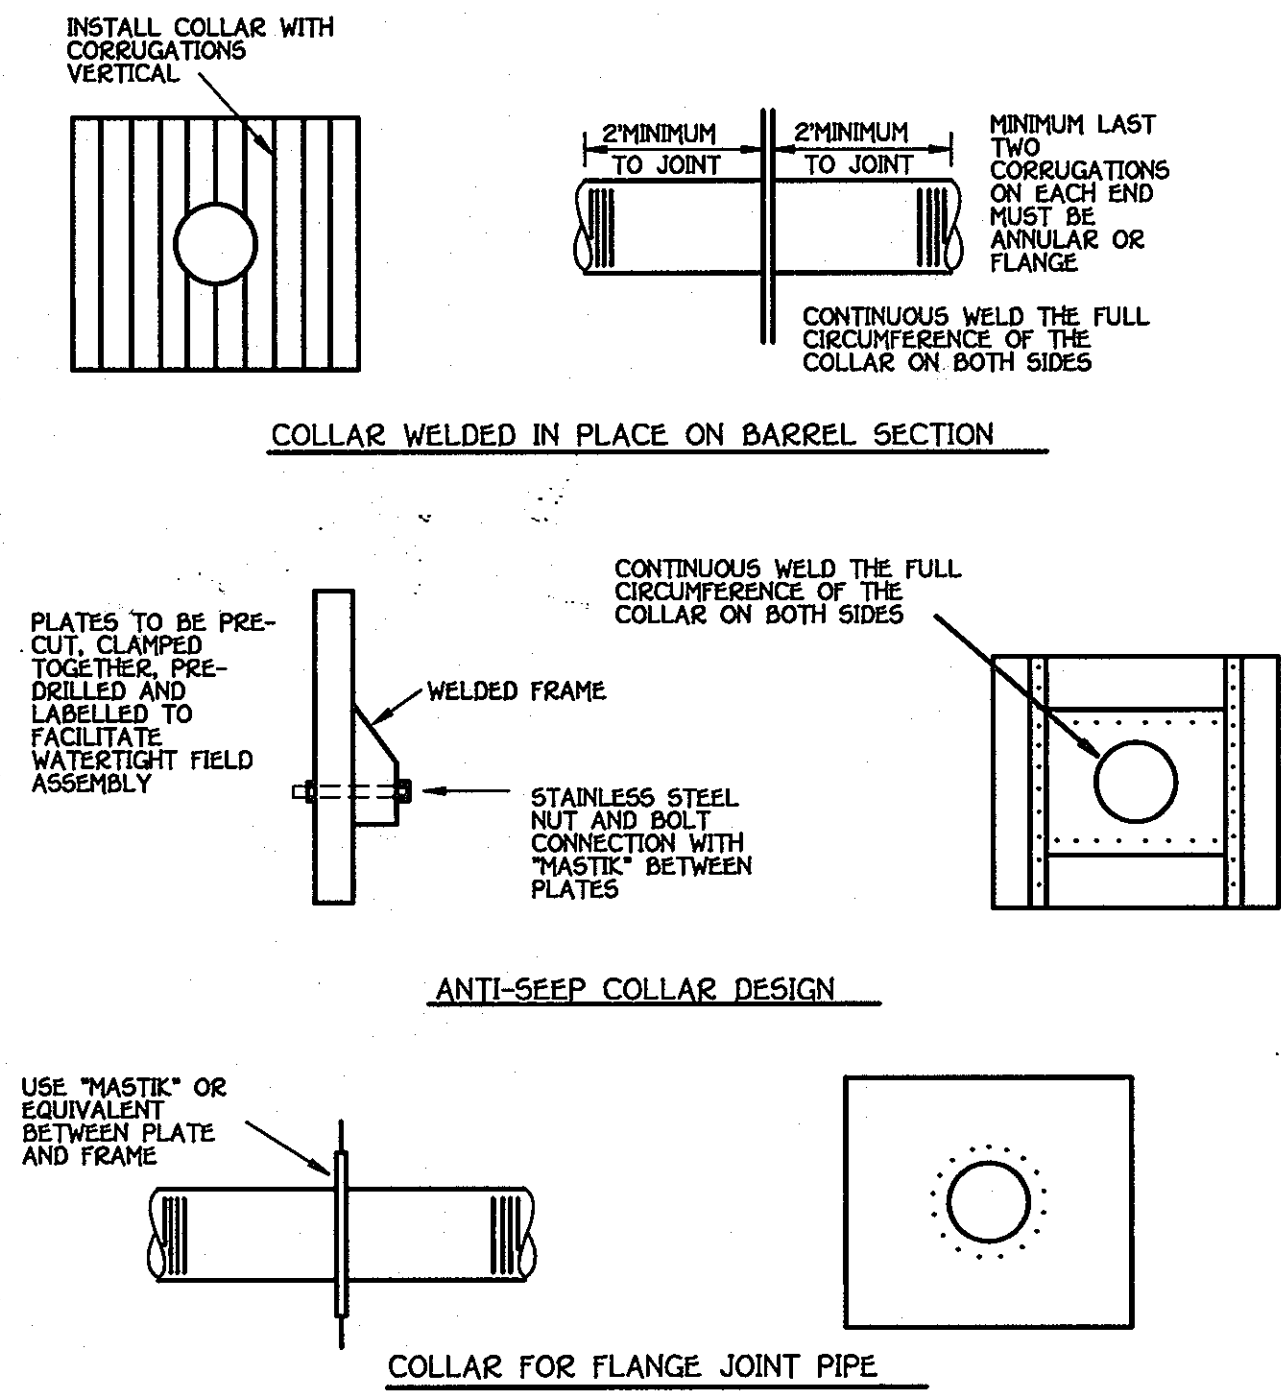


CONCENTRIC TRASH RACK AND ANTI-VORTEX DEVICE

Basin Drawdown Schematic Horizontal Draw-down Device

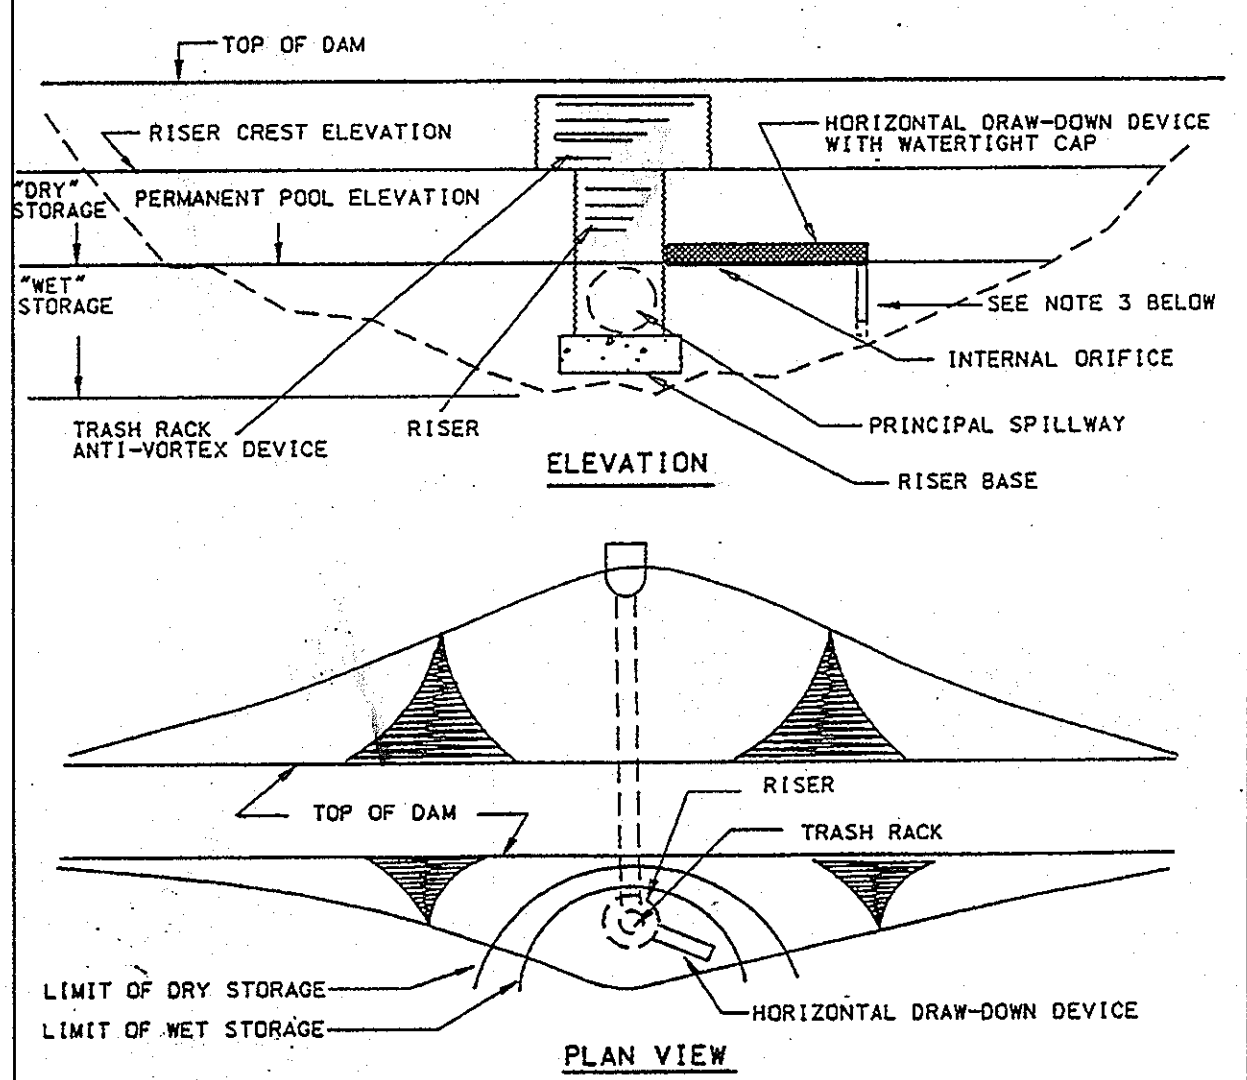


- Construction Specifications**
- The total area of the perforations must be greater than 2 times the area of the internal orifice.
 - The perforated portion of the draw-down device shall be wrapped with 1/2" hardware cloth and geotextile fabric. The geotextile fabric shall meet the specifications for Geotextile Class E.
 - Provide support of draw-down device to prevent sagging and flotation. An acceptable preventative measure is to stake both sides of draw-down device with 1" steel angle, or 1" by 4" square or 2" round wooden posts set 3" minimum into the ground then joining them to the device by wrapping with 12 gauge minimum wire.

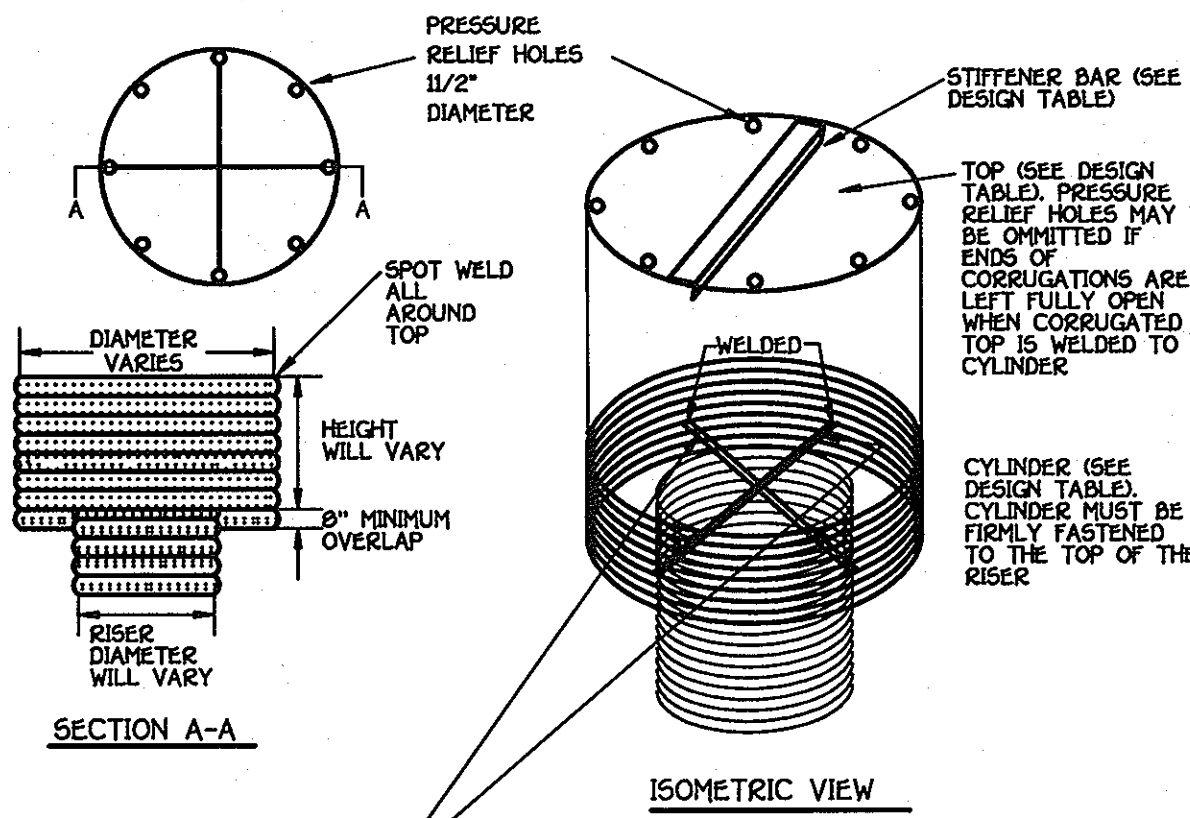

Riser Diam. in.	Trash Rack Diam. in.	Trash Rack Thick. in.	Trash Rack H. in.	Minimum Size Support Bar	Minimum Top Thickness	Stiffener
12	10	16	6	#6 rebar	16 ga.	-
15	21	16	7	#6 rebar	16 ga.	-
18	27	16	8	#6 rebar	16 ga.	-
21	30	16	11	#6 rebar	16 ga.	-
24	36	16	13	#6 rebar	14 ga.	-
27	42	16	15	#6 rebar	14 ga.	-
36	54	14	17	#6 rebar	12 ga.	-
42	60	14	19	#6 rebar	12 ga.	-
48	72	12	21	1-1/4" pipe or 1-1/4x1-1/4x4 angle	10 ga.	-
54	78	12	25	-	10 ga.	-
60	90	12	29	1-1/2" pipe or 1-1/2x1-1/2x4 angle	8 ga.	-
66	96	10	33	2" pipe or 2x2x3/16 angle	8 ga. w/stiffener	2x2x1/4 angle
72	102	10	36	-	8 ga. w/stiffener	2-1/2x2-1/2x 1/4 angle
78	114	10	39	2-1/2" pipe or 2x2x1/4 angle	8 ga. w/stiffener	2-1/2x2-1/2x 1/4 angle
84	120	10	42	2-1/2" pipe or 2-1/2x2-1/2x4 angle	8 ga. w/stiffener	2-1/2x2-1/2x 5/16 angle

Note: The above trash rack and anti-vortex device information is only for corrugated metal pipe. Concrete risers must meet the requirements of MD 37B.


RISER BASE DETAIL

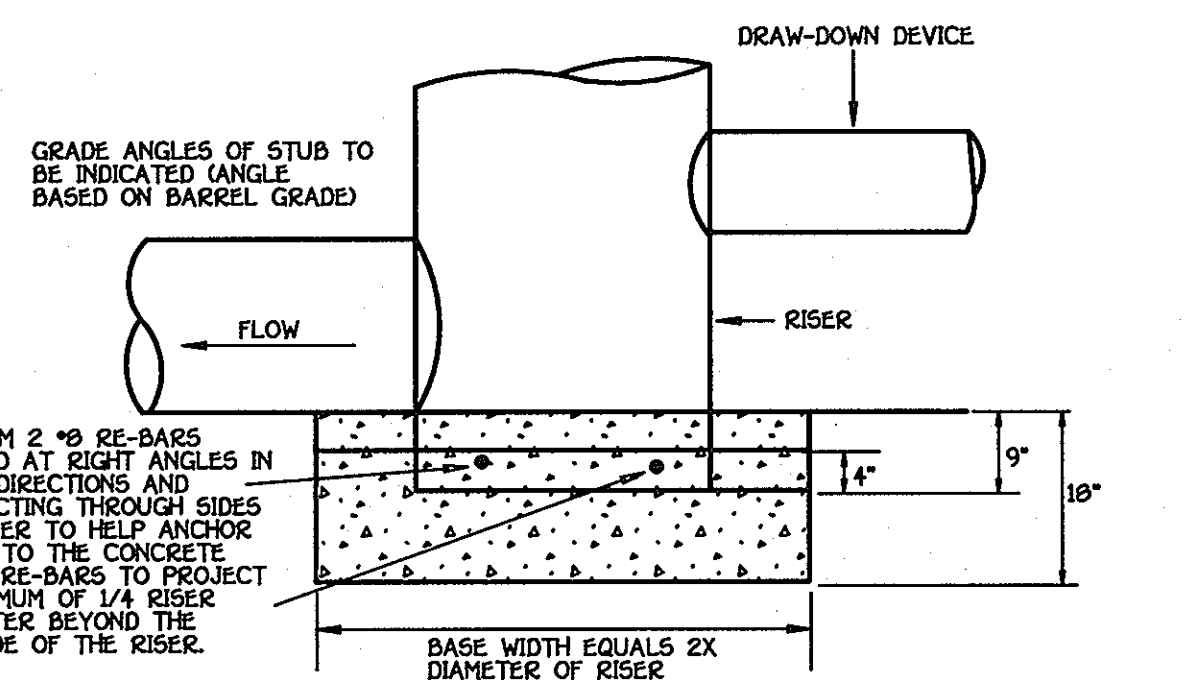


- Construction Specifications**
- The riser shall have a base attached with a watertight connection and shall have sufficient weight to prevent flotation of the riser. Two approved bases for risers 10" or less in height are:
- A concrete base 18" thick with the riser embedded 9" in the base.
 - A 1/4" minimum thickness steel plate attached to the riser by a continuous weld around the circumference of the riser to form a watertight connection. The plate shall have 2" of stone, gravel, or compacted earth placed on it to prevent flotation. In either case, each side of the square base shall be twice the riser diameter.

Note: For risers greater than ten feet high computations shall be made to design a base which will prevent flotation. The minimum factor of safety shall be 1.20 (downward forces = 1.20 x upward forces).

GABION INFLOW PROTECTION

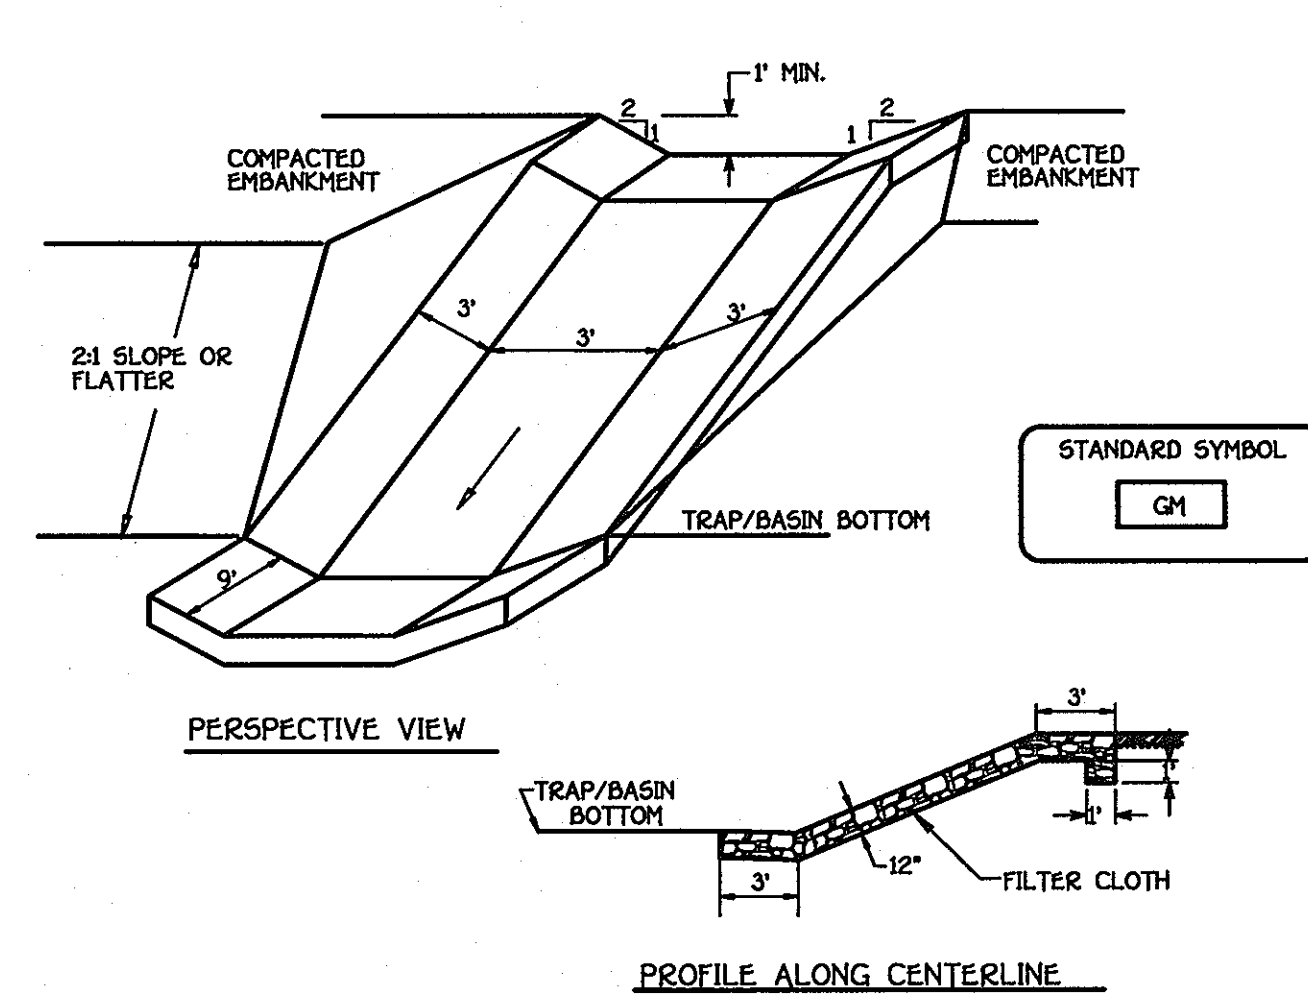

- Construction Specifications**
- Gabion inflow protection shall be constructed of 9' x 3' x 9' gabion baskets forming a trapezoidal cross section 1' deep, with 2:1 side slopes, and a 3' bottom width.
 - Geotextile Class C shall be installed under all gabion baskets.
 - The stone used to fill the gabion baskets shall be 4" - 7".
 - Gabions shall be installed in accordance with manufacturers recommendations.
 - Gabion Inflow Protection shall be used where concentrated flow is present on slopes steeper than 4:1.

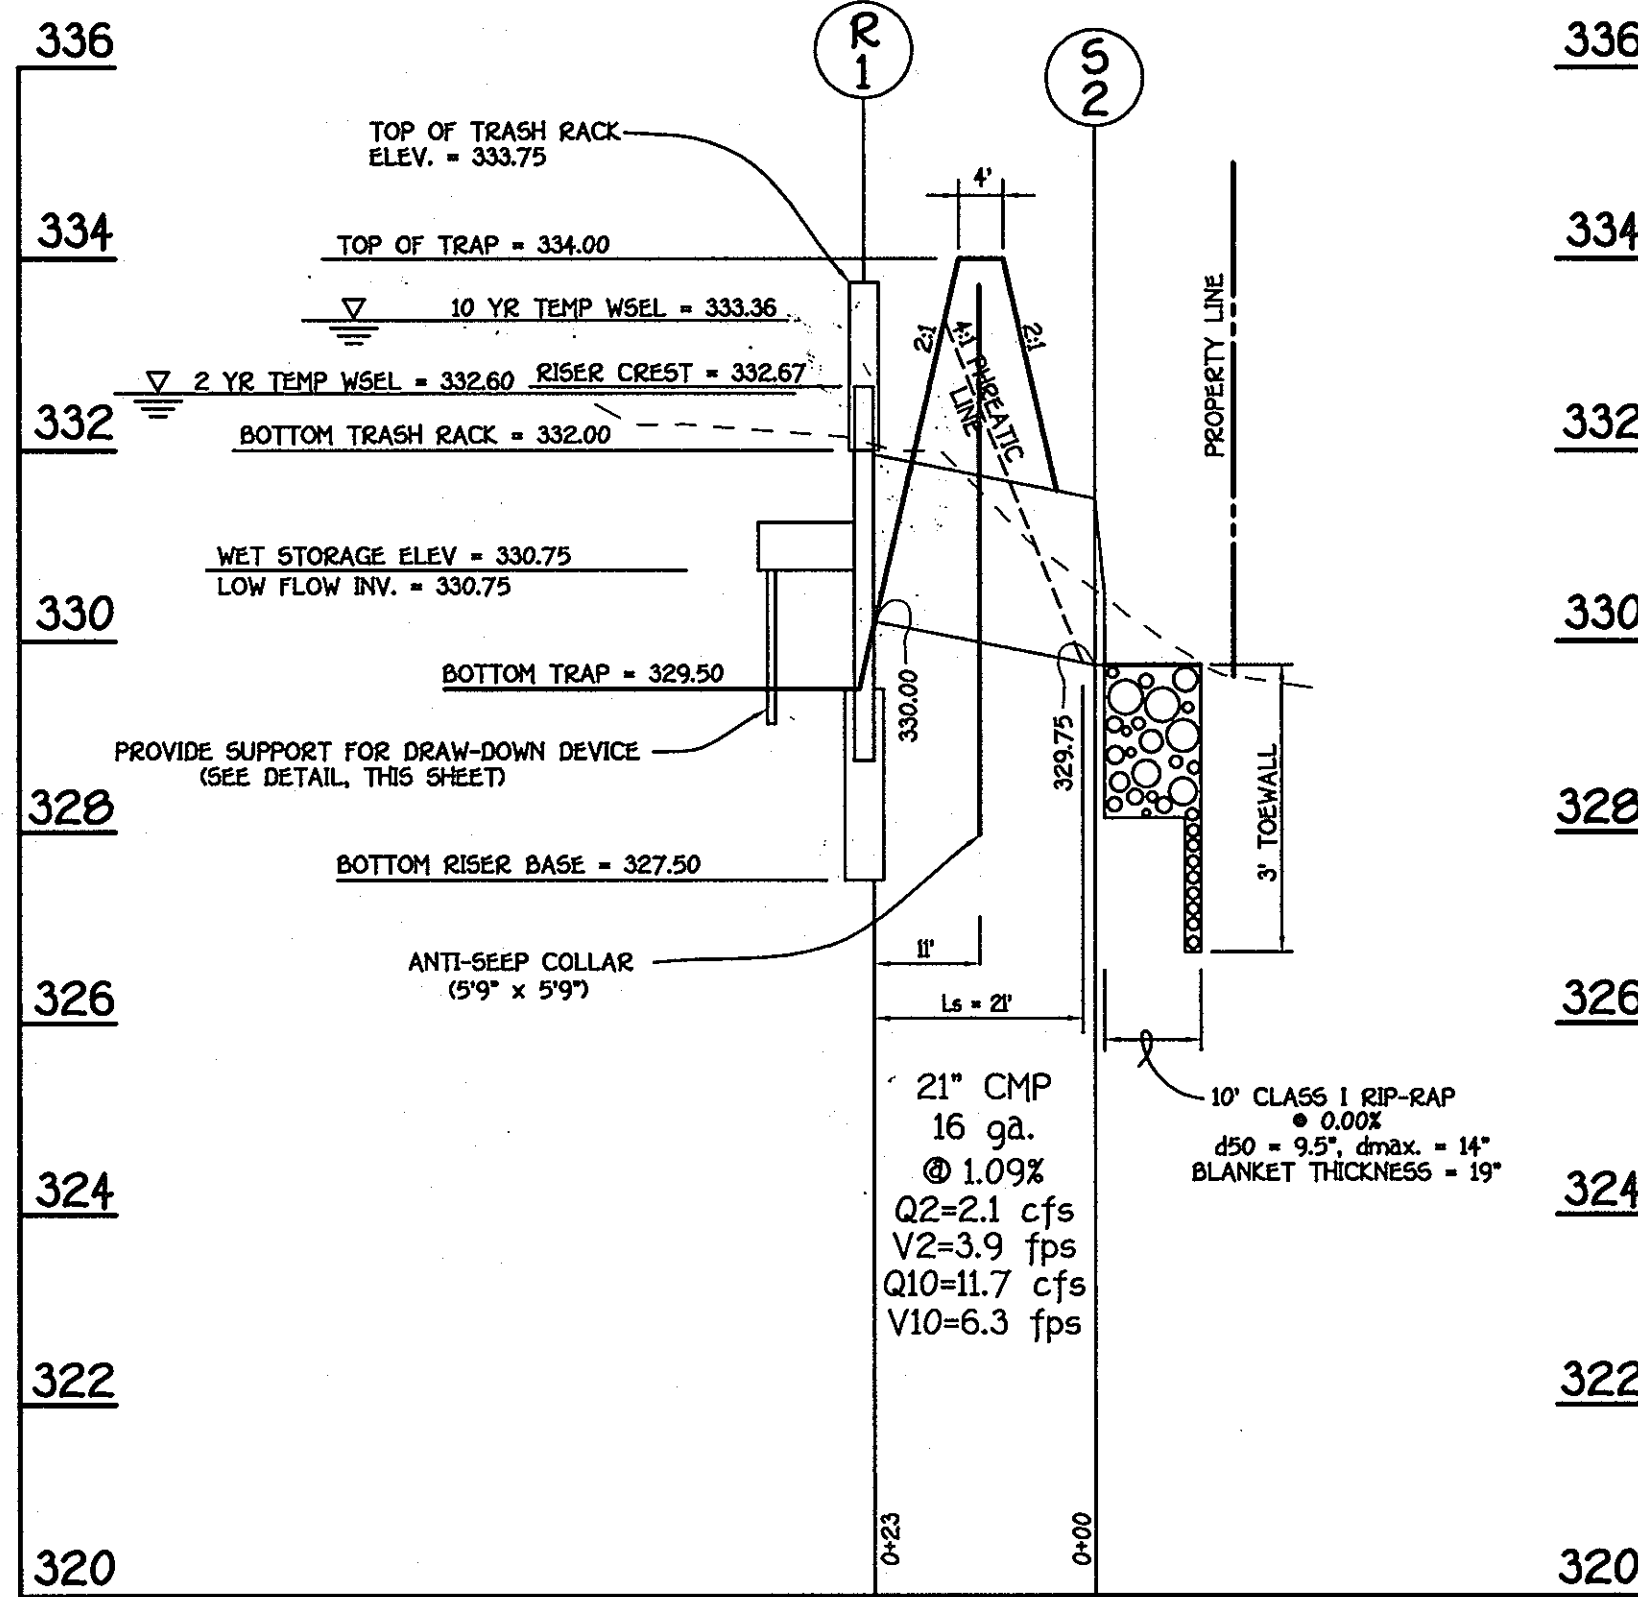

PROFILE THRU PRINCIPAL SPILLWAY

SCALE: HORIZ. 1" = 20'
VERT. 1" = 2'

ENGINEER'S CERTIFICATE

I hereby Certify That This Plan For Erosion And Sediment Control Represents A Practical And Workable Plan Based On My Personal Knowledge Of The Site Condition And That It Was Prepared In Accordance With The Requirements Of The Howard Soil Conservation District.

Signature Of Engineer: *[Signature]* Date: 4/16/03

DEVELOPER'S CERTIFICATE

"I/We Certify That All Development And Construction Will Be Done According To This Plan Of Development And Plan For Erosion And Sediment Control And That All Responsible Personnel Involved In The Construction Project Will Have A Certificate Of Attendance At A Department Of Natural Resources Approved Training Program For The Control Of Sediment And Erosion Before Beginning The Project. I Also Authorize Periodic On-Site Inspection By The Howard Soil Conservation District Or Their Authorized Agents, As Are Deemed Necessary."

Signature Of Developer: *[Signature]* Date: 4/16/03

Reviewed For Howard County Soil Conservation District And Meets Technical Requirements: *[Signature]* Date: 4/22/03

U.S.D.A. Natural Resources Conservation Service Approved: This Development Is Approved For Erosion And Sediment Control By The Howard Soil Conservation District. Date: 4/22/03

District Howard Soil Conservation Dist. Approved: Department Of Planning And Zoning Date: 4/25/03

Chief, Division Of Land Development Date: 4/25/03

Chief, Development Engineering Division Date: 4/25/03

Approved: Howard County Department Of Public Works Date: 4/29/03

Chief, Bureau Of Highways Date: 4/29/03


SEQUENCE OF CONSTRUCTION

- OBTAIN GRADING PERMITS. (2 WEEKS)
- NOTIFY "MISS UTILITY" AT LEAST 48 HOURS BEFORE BEGINNING ANY WORK AT 1-800-257-7777. NOTIFY HOWARD COUNTY OFFICE OF CONSTRUCTION/INSPECTION DIVISION AT 410-313-1874 AT LEAST 24 HOURS BEFORE STARTING ANY WORK. IN ADDITION, NOTIFY AT&T PRIOR TO ANY ACTIVITY WITHIN THEIR EASEMENT.
- GRADING OPERATIONS WILL BE PHASED FOR THIS PROJECT IN SUCH THAT THE CONSTRUCTION OF TOWNHOUSE LOTS 23-27 CANNOT TAKE PLACE UNTIL SUCH TIME AS THE PROPOSED ROADS ARE CONSTRUCTED TO SUBGRADE AND THE STORM DRAIN SYSTEM IS FUNCTIONING. GRADING OPERATIONS AND SEDIMENT CONTROL MEASURES FOR THIS PROJECT WILL BE SYNCHRONIZED WITH THE GRADING OPERATIONS AND SEDIMENT CONTROL MEASURES OF EMERSON, SECTION 2, PHASE 1B (F-03-34).
- INSTALL PHASE I SEDIMENT CONTROL MEASURES FOR THIS PROJECT WHICH INCLUDE STABILIZED CONSTRUCTION ENTRANCE, A SEDIMENT TRAP, AND SILT FENCE IN CONJUNCTION WITH THE SEDIMENT CONTROL MEASURES OF EMERSON, SECTION 2, PHASE 1B (F-03-34). THE CONTRACTOR SHALL INSPECT EXISTING SEDIMENT BASIN VI AND COMPLETELY REFURBISH THIS BASIN ACCORDING TO THE SPECIFICATIONS OF F-01-136. (1 WEEK)
- AFTER PERMISSION TO PROCEED IS GRANTED BY THE SEDIMENT CONTROL INSPECTOR GRADE SITE TO SUBGRADE AND STABILIZE ALL AREAS USING TEMPORARY SEEDING NOTES. THEN INSTALL STORM DRAINS, WATER MAINS, AND SEWER MAINS WITHIN THE LIMITS OF THE GRADING. UTILIZE DUST CONTROL MEASURES DURING THIS OPERATION. (8 WEEKS)
- THE CONTRACTOR SHALL INSPECT AND PROVIDE NECESSARY MAINTENANCE ON ALL SEDIMENT AND EROSION CONTROL STRUCTURES SHOWN HEREON AFTER EACH RAINFALL AND ON A DAILY BASIS. REMOVE SEDIMENTS FROM EXISTING BASIN VI (F-01-136) AND P.O.S.T. #1 WHEN CLEANOUT ELEVATIONS ARE REACHED. ALL SEDIMENTS MUST BE PLACED UPSTREAM OF AN APPROVED TRAP DEVICE.
- INSTALL ROADWAY BASE COURSE PAVING. (1 WEEK)
- STABILIZE ALL DISTURBED AREAS FOR PHASE I GRADING AND OBTAIN PERMISSION FROM THE SEDIMENT CONTROL INSPECTOR TO PROCEED TO PHASE 2 OF THE SITE WORK. (1 WEEK)
- APPLY TACK COAT TO BASE COURSE PAVING AND LAY SURFACE COURSE. (1 WEEK)
- INSTALL PHASE II SEDIMENT CONTROL MEASURES WHICH INCLUDE EARTH DIKE AND SILT FENCE. CONFIRM THAT THE ENTIRE STORM DRAIN SYSTEM FOR EMERSON, SECTION 2, PHASE 1B (F-03-34) HAS BEEN CONSTRUCTED PRIOR TO INSTALLATION OF PHASE II SEDIMENT CONTROL MEASURES. WHEN ALL CONTRIBUTING AREAS TO P.O.S.T. #1 HAVE BEEN STABILIZED AND WITH THE PERMISSION OF THE SEDIMENT CONTROL INSPECTOR, THE DEVICE MAY BE REMOVED AND/OR BACKFILLED AND THE REMAINING AREAS BROUGHT TO FINAL GRADE. (2 WEEKS)
- WHEN ALL CONTRIBUTING AREAS TO THE PHASE II SEDIMENT CONTROL DEVICES (EARTH DIKES AND SILT FENCE) HAVE BEEN STABILIZED AND WITH THE PERMISSION OF THE SEDIMENT CONTROL INSPECTOR, THE DEVICES MAY BE REMOVED AND THE REMAINING AREAS BROUGHT TO FINAL GRADE. THE EXISTING SWAMP/BASIN CAN REMAIN IN PLACE AS A BASIN FOR A PERIOD OF 3 YEARS SO THEY CAN BE UTILIZED FOR FUTURE PHASES OF THIS EMERSON DEVELOPMENT. (4 WEEKS)
- NOTIFY HOWARD COUNTY OFFICE OF INSPECTIONS AND PERMITS FOR A FINAL INSPECTION OF THE COMPLETED PROJECT OR COMPLETION OF EACH PHASE OF THE SITE GRADING.

SEDIMENT CONTROL NOTES AND DETAILS EMERSON

SECTION 2, PHASE 2
LOTS 1 THRU 63 AND OPEN SPACE LOT 64
(A RESUBDIVISION OF PARCEL B-1, EMERSON, SECTION 2, PLAT No. 15455)

ZONED: PEC-MXD-3 AND R-SC-MXD-3
TAX MAP: 47 P/O PARCELS: 3 AND 837 GRID: 8
SIXTH ELECTION DISTRICT HOWARD COUNTY, MARYLAND
DATE: APRIL 9, 2003
SHEET 6 OF 9

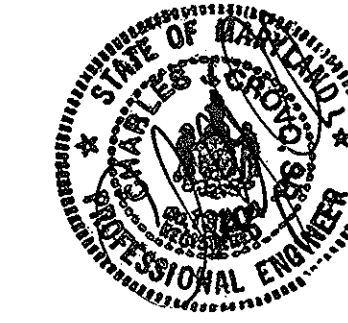

Owner and Developer

Ryland Homes
7250 Parkway Drive, Suite 520
Hanover, MD 21076
410-712-7012

PERIMETER PLANT SCHEDULE

KEY	QUANT	BOTANICAL NAME	COMMON NAME	SIZE
MAJOR SHADE TREES				
AO	5	Acer rubrum October glory	October Glory Maple	2.5-3' cal.
ZO	7	Zelkova Green Vase	Green Vase Zelkova	2.5-3' cal.
FLOWERING / INTERMEDIATE TREES				
AC	7	Amandorla canadensis	Shadblow Clump	3-5 stem
CC	6	Cercis canadensis Forest Pansy	Forest Pansy Redbud	2-2.5' cal.
FN	2	Prunus cerasifera Newport	Newport Flowering Plum	2-2.5' cal.
PK	10	Prunus subhirtella Rosy Cloud	Rosy Cloud Cherry	2-2.5' cal.
EVERGREEN TREES				
IF	18	Ilex alternata Fosterii	Fosterii Holly	7-8 ft.
PO	34	Picea canadensis	White Pine	7-8 ft.
PS	8	Pinus strobus	Eastern White Pine	7-8 ft.
SJ	16	Ilex aspreyana Dan Jost	Dan Jost Holly	5-6 ft.
SHRUBS				
BT	46	Berberis L. a. n. Craymon Pigny	Craymon Pigny Barberry	10-24" sp.

Approved: Department Of Planning And Zoning
Chief, Division of Land Development 4/25/13
Chief, Development Engineering Division MK
 Approved: Howard County Department Of Public Works
Chief, Bureau Of Highways 4/25/13

STREET TREE PLANT SCHEDULE

KEY	QUANT	BOTANICAL NAME	COMMON NAME	SIZE
TC	40	Tilia cordata Greenspire	Greenspire Linden	2.5-3' cal.
FN	12	Prunus cerasifera Newport	Newport Flowering Plum	2-2.5' cal.
52	TOTAL STREET TREES			




SCHEDULE D STORMWATER MANAGEMENT AREA LANDSCAPING

LINEAR FEET OF PERIMETER	P-7 : 225'
NUMBER OF TREES REQUIRED:	
SHADE TREES	5
EVERGREEN TREES	6
NUMBER OF TREES PROVIDED:	
SHADE TREES	5
EVERGREEN TREES	6
CREDIT FOR EXISTING VEGETATION (NO, YES AND S)	NO
CREDIT FOR OTHER LANDSCAPING (NO, YES AND S)	NO



SCHEDULE A PERIMETER LANDSCAPE EDGE

CATEGORY	PERIMETER EDGE							
	P-1	P-2	P-3	P-4	P-5	P-6	P-8	P-9
LANDSCAPE TYPE	C	E	C	C	E	C	N/A	B
LINEAR FEET OF ROADWAY FRONTAGE/PERIMETER	117	102	198	199	80	143	643	493
CREDIT FOR EXISTING VEGETATION (YES, NO LINEAR FEET) (DESCRIBE BELOW IF NEEDED)	-	-	-	-	-	-	YES	-
CREDIT FOR WALL, FENCE OR BERM (YES, NO LINEAR FEET) (DESCRIBE BELOW IF NEEDED)	-	-	-	-	-	-	-	-
NUMBER OF PLANTS REQUIRED	3	3	10	10	2	4	-	10
SHADE TREES	6	-	-	-	-	7	-	12
EVERGREEN TREES	-	26	-	-	-	-	-	-
NUMBER OF PLANTS PROVIDED	3	3	10	10	2	4	-	10
SHADE TREES	6	-	-	-	-	7	-	12
EVERGREEN TREES	-	26	-	-	-	-	-	-
OTHER TREES (2:1 SUBSTITUTION)	-	-	-	-	-	-	-	-
SHRUBS (10:1 SUBSTITUTION) (DESCRIBE PLANT SUBSTITUTION CREDITS BELOW IF NEEDED)	-	26	-	-	-	20	-	-

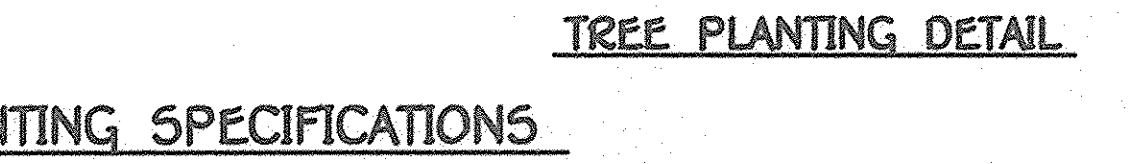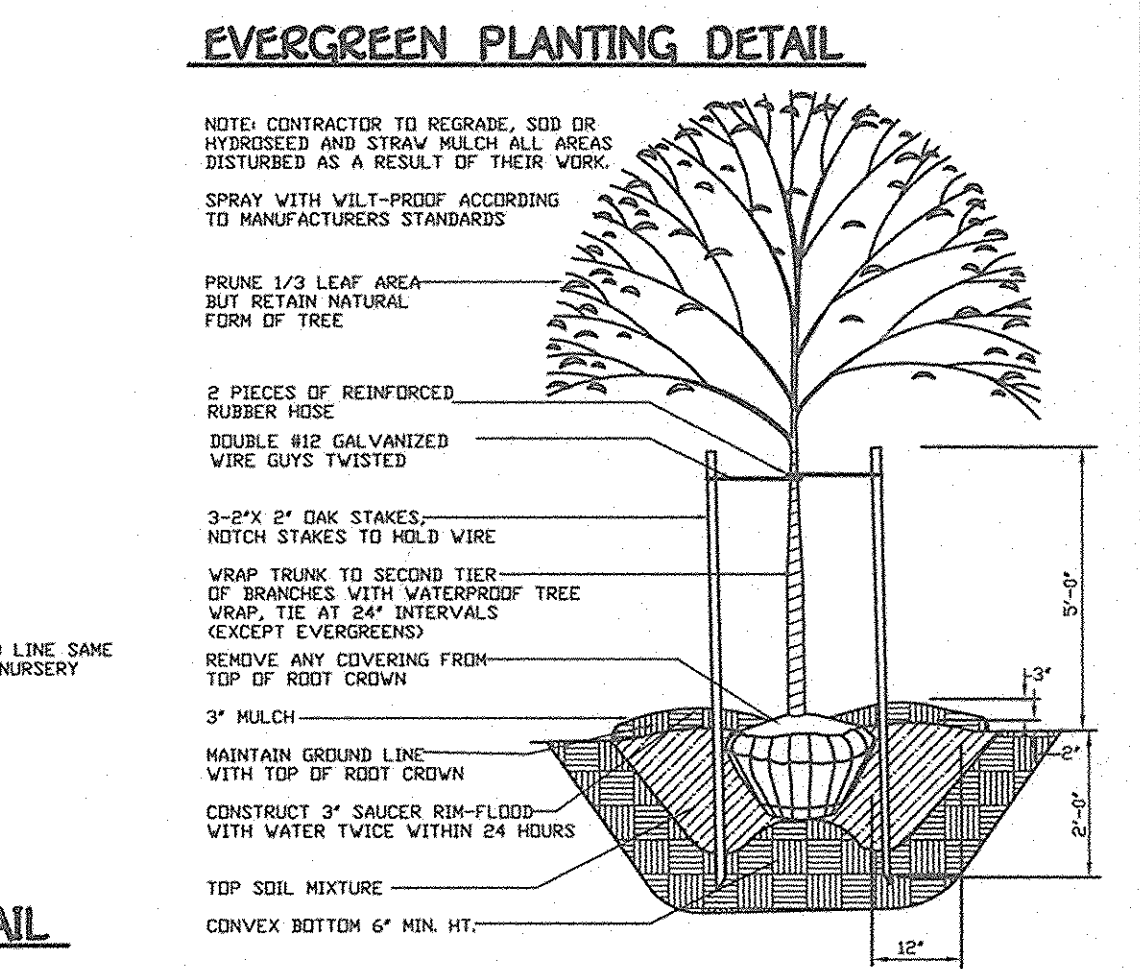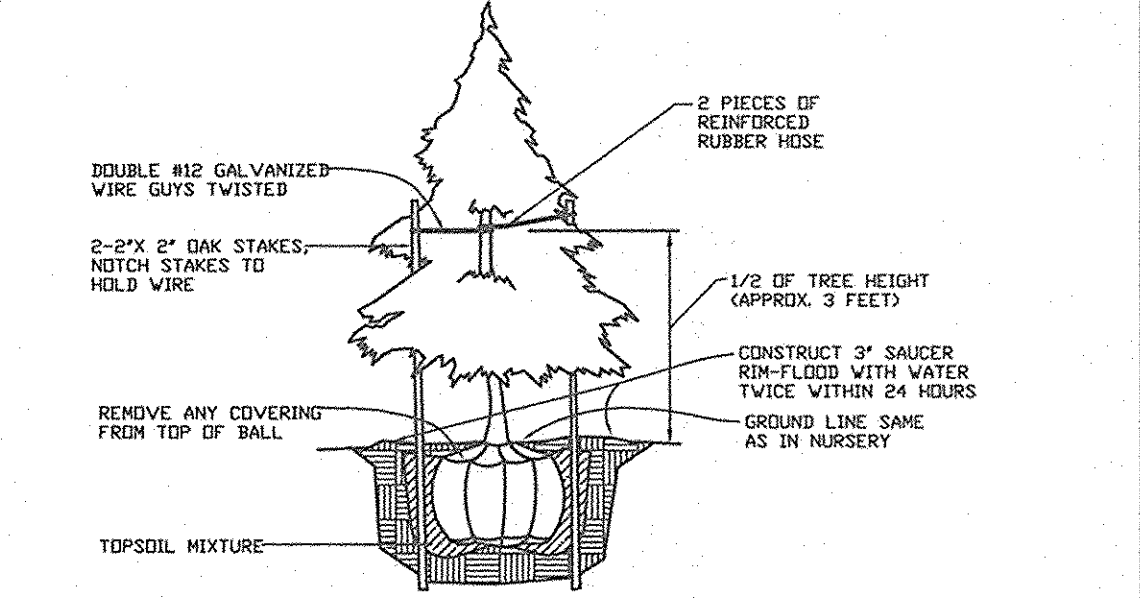

PLANTING SPECIFICATIONS

Plants, related material, and operations shall meet the detailed description as given on the plans and as described herein.

All plant material, unless otherwise specified, shall be nursery grown, uniformly branched, have a vigorous root system, and shall conform to the species, size, root and shape shown on the plant list and the American Association of Nurseries (AAN) Standards. Plant material shall be healthy, vigorous, free from defects, decay, disfiguring roots, sun scald, injuries, abrasions of the bark, plant disease, insect pest eggs, borers and all forms of insect infestations or objectionable disfigurements. Plant material that is weak or which has been cut back from larger grades to meet specified requirements will be rejected. Trees with forked leaders will not be accepted. All plants shall be freshly dug; no heeled-in plants from cold storage will be accepted.

Unless otherwise specified, all general conditions, planting operations, details and planting specification shall conform to "Landscape Specification Guidelines for Baltimore-Washington Metropolitan Areas" (hereinafter "Landscape Guidelines") approved by the Landscape Contractors' Association of Metropolitan Washington and the National Chapter of the American Society of Landscape Architects, latest edition, including all amendments.

Contractor shall be required to guarantee all plant material for a period of one year after date of acceptance in accordance with the appropriate section of the Landscape Guidelines. Contractor's attention is directed to the maintenance requirements found within the one-year specifications including watering and replacement of specified plant material.

Contractor shall be responsible for notifying utility companies, utility contractors and "Miss Utility" a minimum of 48 hours prior to beginning any work. Contractor may make minor adjustments in spacing and location of plant material to avoid conflicts with utilities. Damage to existing structure and utilities shall be repaired at the expense of the Contractor.

Protection of existing vegetation to remain shall be accomplished by the temporary installation of 4 foot high snow fence or blaze orange safety fence at the drip line.

Contractor is responsible for installing all material in the proper planting season for each plant type. All planting is to be completed within the growing season of completion of site construction.

Bid shall be based on actual site conditions. No extra payment shall be made for work arising from site conditions differing from those indicated on drawings and specifications.

Plant quantities are provided for the convenience of the contractor only. If discrepancies exist between quantities shown on plan and those shown on the plant list, the quantities on the plan take precedence.

All shrubs shall be planted in continuous trenches or prepared planting beds and mulched with composted hardwood mulch as details and specified except where noted on plans.

Positive drainage shall be maintained in planting beds 2 percent slope.

Planting mix shall be as follows: Deciduous Plants - Two parts topsoil, one part well-rotted cow or horse manure. Add 3 lbs. of standard fertilizer per cubic yard of planting mix. Evergreen Plants - two parts topsoil, one part humus or other approved organic material. Add 3 lbs. of evergreen (acidic) fertilizer per cubic yard of planting mix. Topsoil shall conform to the Landscape Guidelines.

Weed Control: Incorporate a pre-emergent herbicide into the planting bed following recommended rates on the label. Caution: Be sure to carefully check the chemical used to assure its adaptability to the specific ground cover to be treated.


All areas within contract limits disturbed during or prior to construction not designated to receive plants and mulch shall be fine graded and seeded.

This plan is intended for landscape use only. See other plan sheets for more information on grading, sediment control, layout, etc.

DEVELOPER'S/OWNER'S CERTIFICATE

I/WE CERTIFY THAT THE LANDSCAPING SHOWN ON THIS PLAN WILL BE DONE ACCORDING TO THE PLAN, SECTION 16.124 OF THE HOWARD COUNTY CODE AND THE LANDSCAPE MANUAL. I/WE FURTHER CERTIFY THAT UPON COMPLETION A LIST OF LANDSCAPE INSTALLATION, ACCOMPANIED BY AN EXECUTED ONE YEAR GUARANTEE OF PLANT MATERIALS, WILL BE SUBMITTED TO THE DEPARTMENT OF PLANNING AND ZONING.

Signature 4/16/13
 DEVELOPER'S/OWNER'S NAME DATE

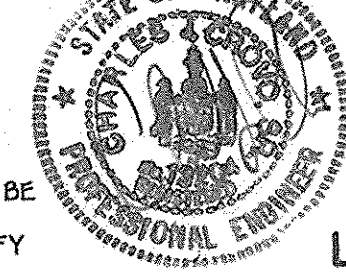

STREET TREE AND LANDSCAPE PLAN
EMERSON
 SECTION 2, PHASE 2
 LOTS 1 THRU 63 AND OPEN SPACE LOT 64
 (A RESUBDIVISION OF PARCEL B-1, EMERSON, SECTION 2, AREA 2, PLAT NO. 15455)

ZONED: P-C-HXD-3 AND R-SC-HXD-3
 TAX MAP: 47 PVO PARCELS 3 AND 837 GRID: 8
 SIXTH ELECTION DISTRICT HOWARD COUNTY, MARYLAND
 DATE: APRIL 9, 2013
 SHEET 7 OF 9

Approved: Department Of Planning And Zoning
 Chief, Division Of Land Development *Cindy Harvath* 4/28/03
 Date
 Approved: Howard County Department Of Public Works
 Chief, Development Engineering Division *MK* 4/28/03
 Date
 Approved: Howard County Department Of Public Works
 Chief, Bureau Of Highways *W. S. ...* 4/28/03
 Date

DRAINAGE AREA	AREA	'C' FACTOR	STRUCTURE No.	% IMP
A	0.66 Ac.	0.55	1-1	56.9
B	0.73 Ac.	0.63	1-2	60.9
C	0.26 Ac.	0.82	1-3	95.6
D	0.70 Ac.	0.39	1-4	32.2
E	0.49 Ac.	0.67	1-5	72.7
F	0.45 Ac.	0.73	1-6	81.1
G	0.61 Ac.	0.75	1-7	83.3
H	0.43 Ac.	0.66	1-8	72.5

REVISIONS		
NO.	DESCRIPTION	DATE
1	REVISED HDPE TO RCCP CL III	10-20-03


FISHER, COLLINS & CARTER, INC.
 CIVIL ENGINEERING CONSULTANTS & LAND SURVEYORS
 CENTENNIAL SQUARE OFFICE PARK - 18272 BALTIMORE NATIONAL PIKE
 ELICOTT CITY, MARYLAND 21042
 410-461-2202

Owner and Developer
 Ryland Homes
 7250 Parkway Drive, Suite 520
 Hanover, MD 21076
 410-712-7012




STORM DRAIN DRAINAGE AREA MAP
EMERSON
 SECTION 2, PHASE 2
 LOTS 1 THRU 63 AND OPEN SPACE LOT 64
 (A RESUBDIVISION OF PARCEL B-1, EMERSON, SECTION 2, AREA 2, PLAT No. 15455)
 ZONED: PEC-MXD-3 AND R-SC-MXD-3
 TAX MAP: 47 P/O PARCELS: 3 AND 837 GRID: 8
 SIXTH ELECTION DISTRICT HOWARD COUNTY, MARYLAND
 DATE: APRIL 9, 2003
 SHEET 8 OF 9 **F-03-63**

Approved: Department of Planning and Zoning
 Chief, Division of Land Development
 Date: 4/25/03
 Approved: Engineering Division MKK
 Chief, Howard County Department of Public Works
 Date: 4/28/03
 Approved: [Signature]
 Chief, Bureau of Highways
 Date: 4/28/03

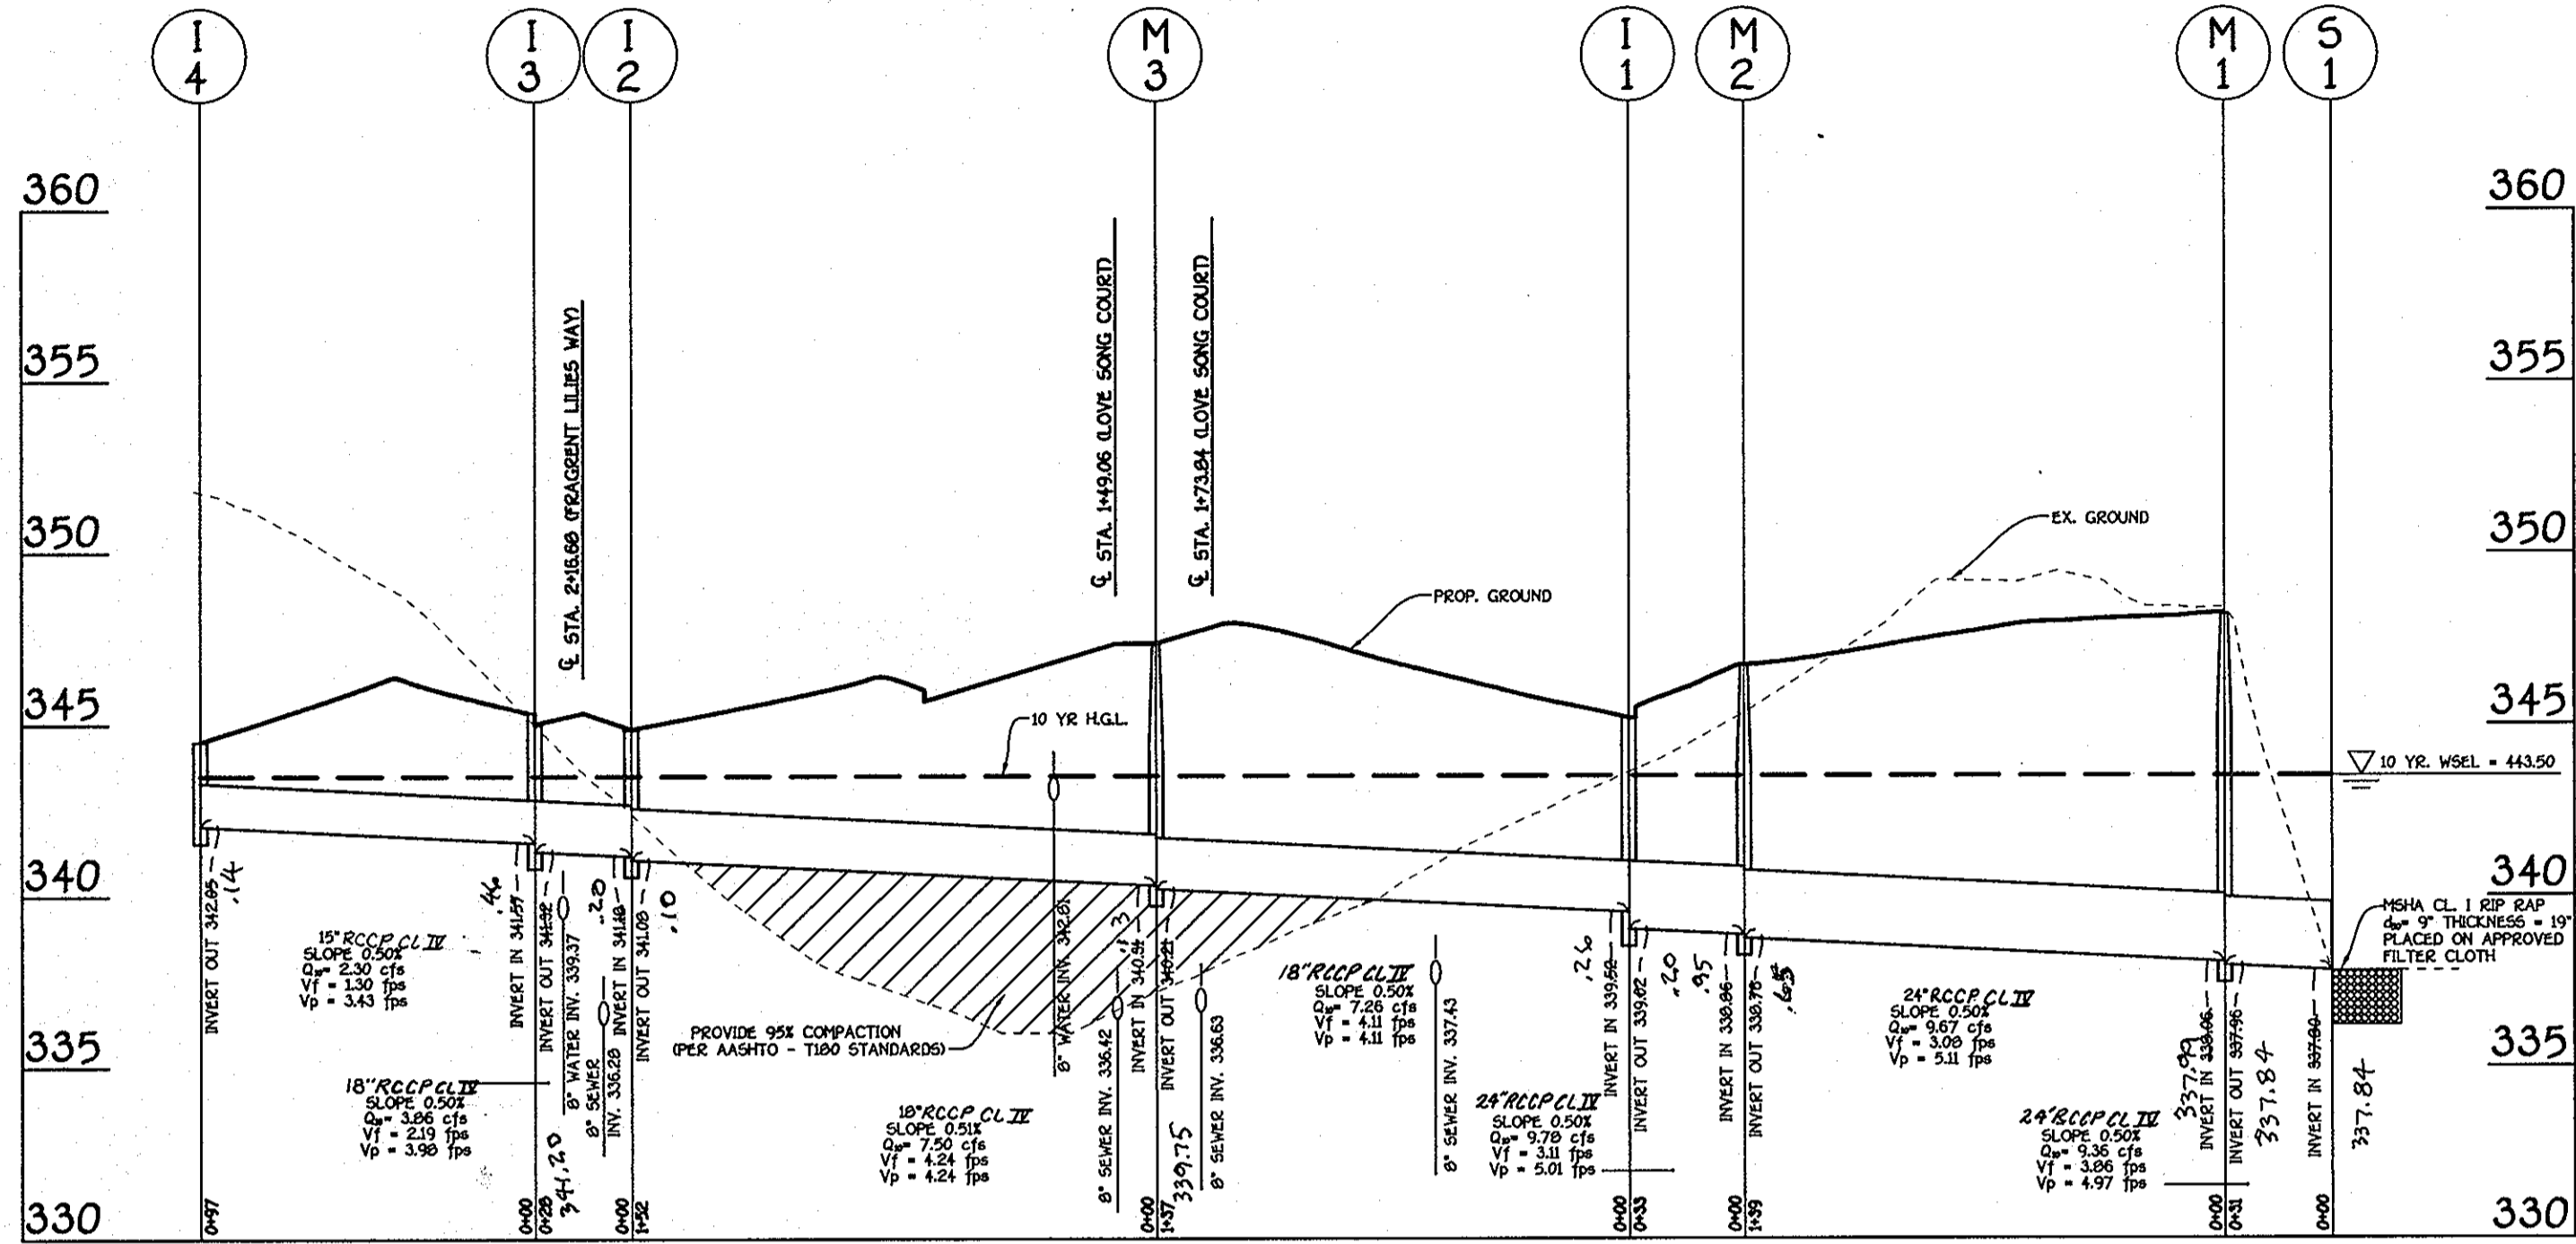


PROFILE
 SCALE: HORIZ. 1" = 50'
 VERT. 1" = 5'

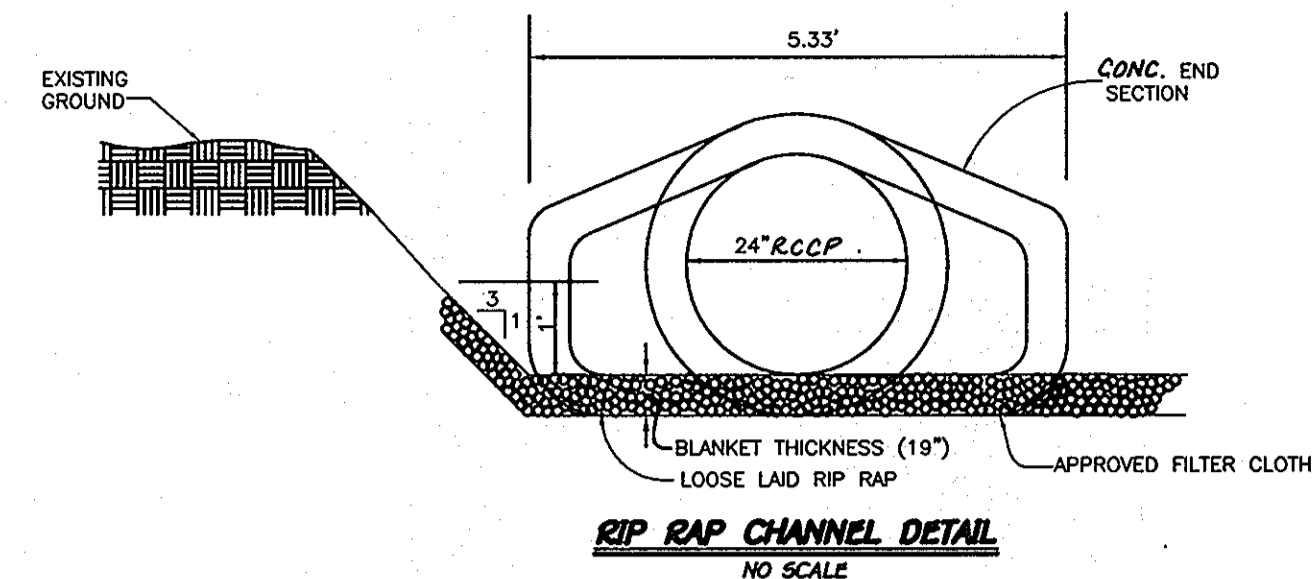


CONSTRUCTION SPECIFICATIONS FOR RIP-RAP OUTFALLS


- The subgrade for the filter, riprap or gabion shall be prepared to the required lines and grades. Any fill required in the subgrade shall be compacted to a density of approximately that of the surrounding undisturbed material.
- The rock or gravel shall conform to the specified grading limits when installed respectively in the riprap or filter.
- Filter cloth shall be protected from punching, cutting or tearing. Any damage other than on occasional small hole shall be repaired by placing another piece of cloth over the damaged part or by completely replacing the cloth. All overlaps whether for repairs or for joining two pieces of cloth shall be a minimum of one foot.
- Stone for the riprap or gabion outlets may be placed by equipment. Both shall each be constructed to the full course thickness in one operation and in such a manner as to avoid displacement of underlying materials. The stone for riprap or gabion outlets shall be delivered and placed in a manner that will insure that it is reasonably homogenous with the smaller stones and spalls filling the voids between the larger stones. Riprap shall be placed in a manner to prevent damage to the filter blanket or filter cloth. Hand placement will be required to the extent necessary to prevent damage to the permanent works.

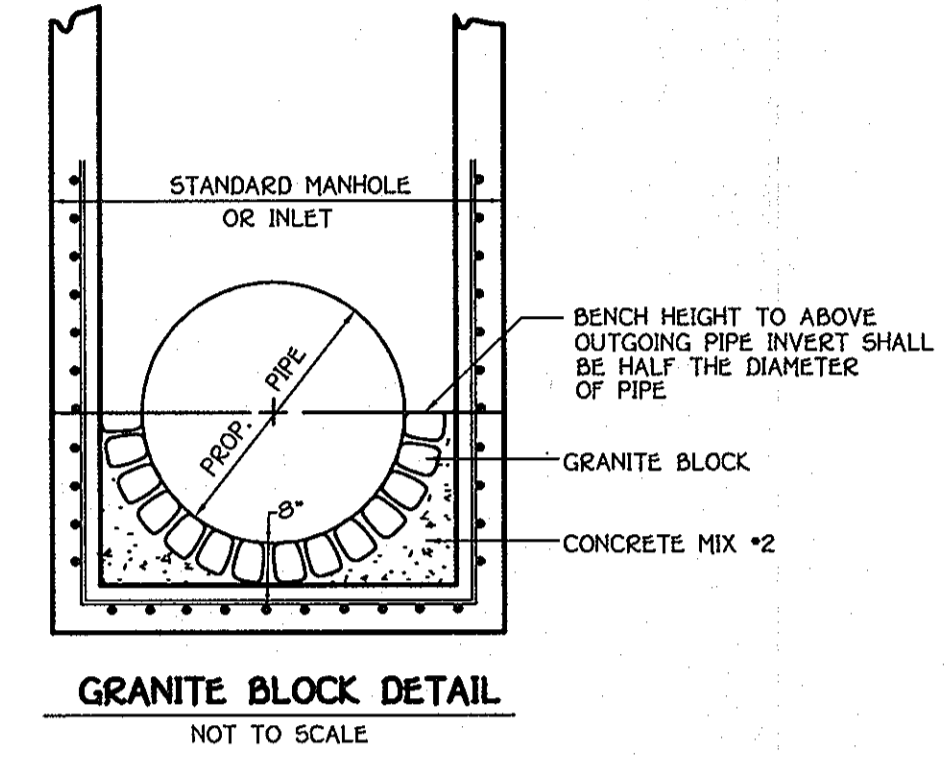

STRUCTURE SCHEDULE									
STRUCTURE NO.	TOP ELEVATION	INV. IN	INV. OUT	ROAD NAME	ROAD STA.	OFFSET	TYPE	REMARKS	
H-1	345.00	339.68	339.02	LOVE SONG COURT	L.P. STA. 1+72.68	7.5	DOUBLE 'S'		SD 4.23
H-2	344.87	341.18	341.08	FRAGRANT LILIES WAY	2+49.41	21.0	SINGLE 'S'		SD 4.22
H-3	345.38	341.57	341.82	FRAGRANT LILIES WAY	2+48.88	17.0	A-5		SD 4.01
H-4	344.50	342.23	342.05		N 336.25		12\"/>		

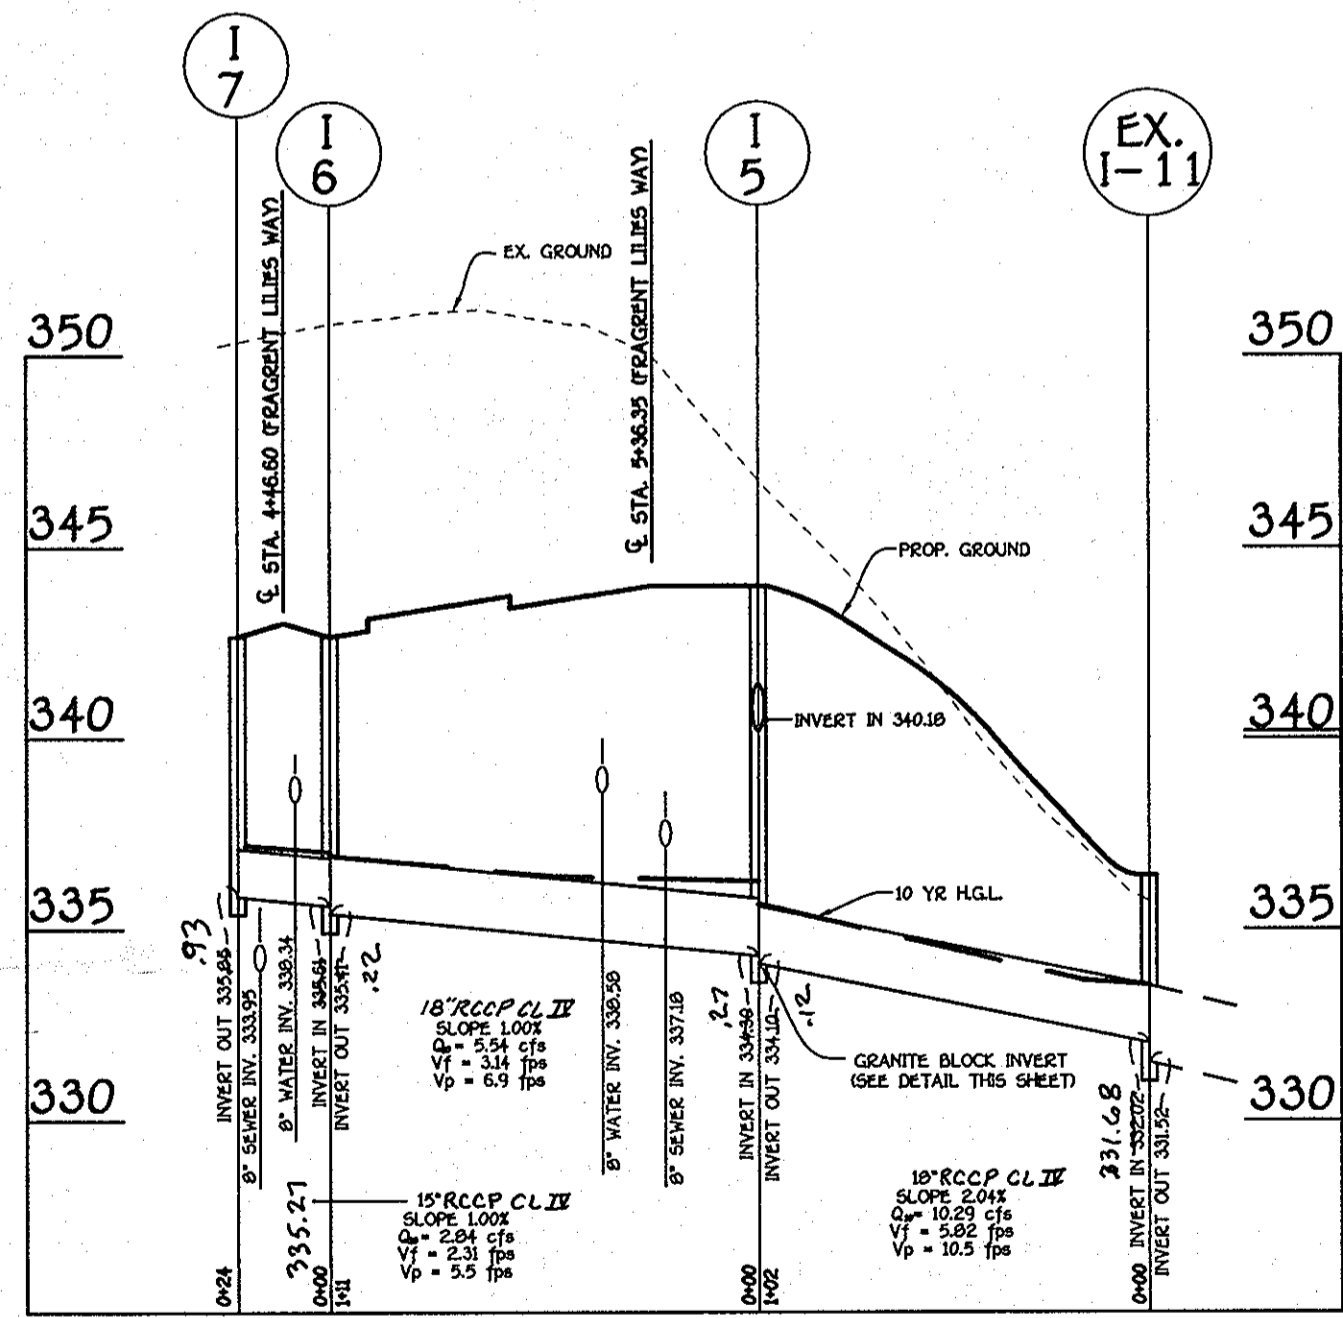

PROFILE
 SCALE: HORIZ. 1" = 50'
 VERT. 1" = 5'

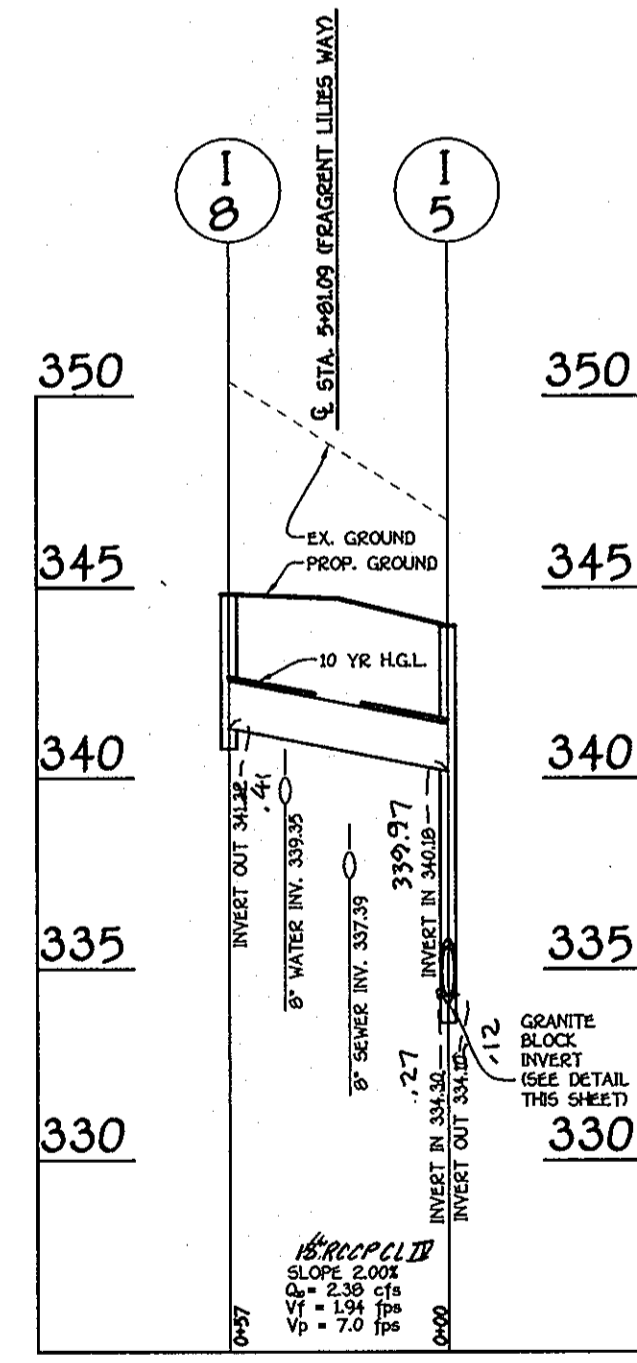

PROFILE
 SCALE: HORIZ. 1" = 50'
 VERT. 1" = 5'

NOTE:
 FOR CONTINUATION SEE
 CONSTRUCTION PLANS FOR
 EMERSON SECTION 2, PHASE 1-B

PIPE SCHEDULE		
SIZE	CLASS	LENGTH
18"	RCCP	178'
18"	RCCP	530'
24"	RCCP	203'
24"	CHP	23'

REVISIONS		
NO.	DESCRIPTION	DATE
1	REVISED HOPE TO RCCP CL II	10-20-03

FISHER, COLLINS & CARTER, INC.
 CIVIL ENGINEERING CONSULTANTS & LAND SURVEYORS
 CENTRAL SQUARE OFFICE PARK - 10772 BALTIMORE NATIONAL PIKE
 ELLICOTT CITY, MARYLAND 21114
 410-461-2895

Owner and Developer
 Ryland Homes
 7250 Parkway Drive, Suite 520
 Hanover, MD 21076
 410-712-7012



SHANABERGER & LANE
 8726 TOWN & COUNTRY BLVD.
 SUITE 201
 ELLICOTT CITY, MARYLAND 21103

ROAD STORM DRAIN AS-BUILT
 [Signature]

STORM DRAIN PROFILES
EMERSON
 SECTION 2, PHASE 2
 LOTS 1 THRU 63 AND OPEN SPACE LOT 64
 (A RESUBDIVISION OF PARCEL B-1, EMERSON, SECTION 2, AREA 2, PLAT NO. 15455)

ZONED: PEC-MXD-3 AND R-SC-MXD-3
 TAX MAP: 47 P/O PARCELS: 3 AND 837 GRID: 8
 SIXTH ELECTION DISTRICT HOWARD COUNTY, MARYLAND
 DATE: APRIL 9, 2003
 SHEET 9 OF 9