

**GENERAL NOTES  
FINAL PLAN**

- ALL CONSTRUCTION SHALL BE IN ACCORDANCE WITH THE LATEST STANDARDS AND SPECIFICATIONS OF HOWARD COUNTY PLUS SHA STANDARDS AND SPECIFICATIONS IF APPLICABLE.
- THE CONTRACTOR SHALL NOTIFY THE DEPARTMENT OF PUBLIC WORKS/BUREAU OF ENGINEERING/CONSTRUCTION INSPECTION DIVISION AT (410) 313-1880 AT LEAST FIVE (5) WORKING DAYS PRIOR TO THE START OF WORK.
- THE CONTRACTOR SHALL NOTIFY "MISS UTILITY" AT 1-800-257-7777 AT LEAST 48 HOURS PRIOR TO ANY EXCAVATION WORK BEING DONE.
- TRAFFIC CONTROL DEVICES, MARKINGS AND SIGNING SHALL BE IN ACCORDANCE WITH THE LATEST EDITION OF THE MANUAL OF UNIFORM TRAFFIC CONTROL DEVICES (MUTCD). ALL STREET AND REGULATORY SIGNS SHALL BE IN PLACE PRIOR TO THE PLACEMENT OF ANY ASPHALT.
- STREET LIGHT PLACEMENT AND THE TYPE OF FIXTURE AND POLE SHALL BE IN ACCORDANCE WITH THE HOWARD COUNTY DESIGN MANUAL, VOLUME III (1993) AND AS MODIFIED BY "GUIDELINES FOR STREET LIGHTS IN RESIDENTIAL DEVELOPMENTS (JUNE 1993)".
- THE EXISTING TOPOGRAPHY IS TAKEN FROM AERIAL SURVEY (SUPPLEMENTED BY FIELD SURVEY) WITH TWO FOOT CONTOUR INTERVALS PREPARED BY RODGERS CONSULTING, INC. DATED OCTOBER 2001.
- THE COORDINATES SHOWN HEREON ARE BASED UPON THE HOWARD COUNTY GEODETIC CONTROL, WHICH IS BASED UPON THE MARYLAND STATE PLANE COORDINATE SYSTEM. HOWARD COUNTY MONUMENT NOS. 30FA AND 30CA WERE USED FOR THIS PROJECT.
- WATER IS PUBLIC. HOWARD COUNTY CONTRACT #24-4055-D.
- SEWER IS PUBLIC. HOWARD COUNTY CONTRACT #24-4055-D.
- STORMWATER MANAGEMENT WILL BE PROVIDED ON SITE WITH 4 PUBLIC SWM PONDS. POND #1 IS A MICRO-POOL (P1) & POND #4 IS A VET POND (P-2) BOTH PROVIDING WATER QUALITY AND QUANTITY CONTROL (TO BE BUILT UNDER F-03-87). POND #2 IS A SAND FILTER (F-1) PROVIDING WATER QUALITY ONLY TO BE BUILT UNDER F-03-87. POND #3 IS A SAND FILTER (F-1) PROVIDING WATER QUALITY ONLY (TO BE BUILT UNDER THIS PLAN). FACILITIES WILL BE OWNED BY THE HOA WITH JOINT MAINTENANCE BETWEEN THE HOA AND HOWARD COUNTY.
- EXISTING UTILITIES ARE BASED ON HOWARD COUNTY CONTRACT DRAWINGS AND SOME SUPPLEMENTAL FIELD SURVEY INFORMATION. THE CONTRACTOR SHALL BE RESPONSIBLE TO CONFIRM THE EXISTING UTILITIES WITHIN THE LIMITS OF CONSTRUCTION.
- THE FLOODPLAIN STUDY FOR THIS PROJECT WAS PREPARED BY RODGERS CONSULTING, INC. NOVEMBER 2001 AND REVISED ON DECEMBER 2002 AND APPROVED ON 5/12/03.
- THE WETLANDS DELINEATION STUDY FOR THIS PROJECT WAS PREPARED BY MCCARTHY & ASSOCIATES, INC. DATED NOVEMBER 2000 AND WAS APPROVED PER SKETCH PLAN S-01-20.
- THE TRAFFIC STUDY FOR THIS PROJECT WAS PREPARED BY THE TRAFFIC GROUP DATED JANUARY 24, 2002.

**PROJECT BACKGROUND INFORMATION:**

SUBDIVISION NAME: MONTJOY  
 ZONING: R-20 (THIS PLAN ONLY)  
 TAX MAP: 30  
 GRID: 12  
 PARCEL: 260  
 ELECTION DISTRICT: 2nd  
 GROSS TRACT AREA: 30.06 ACRES (TOTAL SITE - 76.43 ACRES)  
 NUMBER OF LOTS: 62 BUILDABLE LOTS  
 5 OPEN SPACE LOTS

**PRELIMINARY PLANS**  
 PHASE I & II P02-10 APPROVED 9/27/02 (FINAL PLAN NEEDED TO BE SUBMITTED BY JULY 3, 2003)  
 PHASE III - P03-03 APPROVED 10/02/02 (FINAL PLAN NEEDED TO BE SUBMITTED BY MARCH 2, 2003)  
 SINGLE FAMILY - P02-17 APPROVED 9/26/02 (FINAL PLAN NEEDED TO BE SUBMITTED BY APRIL 1, 2003)

- THE FOREST CONSERVATION EASEMENT HAS BEEN ESTABLISHED TO FULFILL THE REQUIREMENTS OF SECTION 16.1200 OF THE HOWARD COUNTY FOREST CONSERVATION ACT. FOREST CONSERVATION REQUIREMENTS FOR THIS PLAN HAS BEEN PROVIDED UNDER F-03-87. NO CLEARING, GRADING OR CONSTRUCTION IS PERMITTED WITHIN THE FOREST CONSERVATION EASEMENT, EXCEPT AS SHOWN ON AN APPROVED ROAD CONSTRUCTION DRAWING OR SITE DEVELOPMENT PLAN.
- FINAL HOUSE LOCATIONS TO BE ESTABLISHED UNDER THE S.D.P. SHALL BE A MINIMUM OF 2' FROM ANY EASEMENTS.
- THE WAIVER PETITION, WP-01-117, WAS APPROVED ON AUGUST 1, 2001 TO WAIVE SECTION 16.115 AND 16.116(A) TO ALLOW WORK IN THE FLOODPLAIN AND IN THE STREAM BUFFER FOR THE CONSTRUCTION OF A PUBLIC ACCESS PLACE CROSSING TO SERVE 15 PROPOSED RESIDENTIAL R-20 ZONED LOTS, AND SECTION 15-120(C)(4) TO ALLOW SEPA LOTS TO FRONT ON A PRIVATE ROAD GREATER THAN 200 FEET IN LENGTH (APPLIES TO ROAD IN FRONT OF PROPOSED LOTS 89-103). APPROVAL IS SUBJECT TO THE FOLLOWING CONDITIONS: (1) CONSTRUCT THE CROSSING USING THE BOTTOMLESS CULVERT PROPOSED WITH THE WAIVER DOCUMENTATION. (2) LIMIT THE DISTURBANCE TO THE ENVIRONMENTAL AREAS TO THE MINIMUM EXTENT NECESSARY FOR CONSTRUCTION OF THE STREAM CROSSING. (3) IN PREPARATION OF THE FOREST CONSERVATION PLAN PROPOSAL, PROVIDE AFFORESTATION WITHIN THE UNWOODED AREA OF THE PRIORITY STREAM BUFFER SHOWN ON THE STREAM CROSSING EXHIBIT.
- A WAIVER OF DESIGN MANUAL, VOLUME I, SECTION 5.2.4.1 TO ALLOW POND TOP OF CUT TO BE LOCATED LESS THAN THE REQUIRED 25' MINIMUM DISTANCE FROM A RIGHT-OF-WAY WAS APPROVED ON AUGUST 7, 2002. APPROVAL IS SUBJECT TO THE FOLLOWING CONDITIONS: (1) INTERNAL POND LANDSCAPING IS REQUIRED FOR OPEN SPACE LOTS 189 AND 197 AS PER THE 2000 MARYLAND STORMWATER MANAGEMENT DESIGN MANUAL VOLUMES I AND II. EACH POND PERIMETER SHALL, AT A MINIMUM, MEET THE REQUIREMENTS OF THE HOWARD COUNTY LANDSCAPE MANUAL, TYPE B LANDSCAPE BUFFER. (2) STATE ON THE EXHIBIT THAT THE DESIGN MANUAL WAIVER REQUEST IS ON SHEETS 5, 6, AND 7 OF THE PRELIMINARY PLAN P-02-17 (3). THE PROPOSED ALIGNMENT OF THE WATER AND SEWER EASEMENT ACROSS LOTS 138-140 AND LOTS 162-163 COMBINED WITH THE PROPOSED STORM DRAIN EASEMENT RESULTS IN AN UNACCEPTABLE ENCUMBRANCE OF USABLE LOT SPACE FOR THESE LOTS. AN APPROVAL OF THIS DESIGN MANUAL WAIVER REQUEST CANNOT RESULT IN THE LOT LAYOUTS AS PROPOSED. ALTERNATIVE LOCATIONS OF THE STORM DRAIN SYSTEM AND ASSOCIATED EASEMENT MUST BE SHOWN ON THE PRELIMINARY PLANS P-02-17 TO REDUCE THE LOT ENCUMBRANCES OF LOTS 138-140 AND LOTS 162-163.
- THIS PLAN IS SUBJECT TO COMPLIANCE WITH THE FOURTH EDITION OF THE SUBDIVISION REGULATIONS. IN ADDITION, BECAUSE IT DID NOT HAVE PRELIMINARY PLAN APPROVED PRIOR TO NOVEMBER 1, 2001, IT IS SUBJECT TO COMPLIANCE WITH COUNTY COUNCIL BILL 20-2001 EFFECTIVE JANUARY 8, 2002 WHICH AMENDS PORTIONS OF THE ZONING REGULATIONS.
- SURETY FOR THE LANDSCAPE BUFFER AND STREET TREES HAVE BEEN POSTED AS A PART OF DEVELOPER'S AGREEMENT IN THE AMOUNT OF \$76,650.00 (\$37,350.00 FOR LANDSCAPE BUFFER, \$39,300.00 FOR STREET TREES). BONDING FOR THE LANDSCAPE MATERIAL IS SEPARATE FROM THE BONDING FOR STREET TREES.
- 95% COMPACTION REQUIRED IN FILL AREA PER AASHTO-T80 SPECIFICATIONS.
- A MINIMUM SPACING OF 20' SHALL BE MAINTAINED BETWEEN ANY STREET LIGHT AND ANY TREE.
- THE EXISTING DWELLING (MAIN DWELLING) LOCATED ON PROPOSED LOT 119 IS LISTED AS HO-145 ON THE HOWARD COUNTY HISTORIC SITE INVENTORY. THIS DWELLING WILL BE RETAINED AND RENOVATED. TWO OTHER EXISTING STRUCTURES LOCATED ON LOT 119 NORTHEAST OF THE MAIN DWELLING WILL BE RETAINED FOR THEIR HISTORICAL SIGNIFICANCE (SLAVE QUARTERS AND TOBACCO HOUSE). THESE TWO STRUCTURES ARE STRUCTURALLY UNSTABLE AND APPROPRIATE MEASURE WILL BE TAKEN TO EITHER STABILIZE THE STRUCTURES OR PRESERVE THE REMNANTS IN AN APPROPRIATE MANNER. ALL OTHER STRUCTURES LOCATED ON THE PROPERTY WILL BE DEMOLISHED EXCEPT FOR THE EXISTING BARNS LOCATED AT THE SOUTHERN PORTION OF THE SITE WHICH MAY BE SALVAGED FOR USE AT AN OFFSITE LOCATION.
- THE WAIVER PETITION, WP-03-78 WAS APPROVED ON JUNE 26, 2003 TO WAIVE SECTION 16.116(a) TO ALLOW GRADING AND DISTURBANCE WITHIN 75 FEET OF A PERENNIAL STREAM FOR THE PURPOSE OF RELOCATING THE ALIGNMENT OF 60 LF OF AN EXISTING AT&T EASEMENT.

APPROVED: HOWARD COUNTY DEPARTMENT OF PUBLIC WORKS

APPROVED: HOWARD COUNTY DEPARTMENT OF PLANNING & ZONING

APPROVED: HOWARD COUNTY DEPARTMENT OF PLANNING & ZONING

DATE	REVISION	DATE	BY	DATE
	BASE DATA		CADD	
	DESIGNED		PF, YSL	
	DRAWN		YSL	
	REVIEWED		PF, YSL	
	RELEASE FOR			
	FINAL AS-BUILT REVISIONS	OCT. 08		
	FINAL M/LAR SUBMITTAL FOR SIGNATURE	9/24/03		
	RE-SUBMITTED FOR REVIEW AND APPROVAL	07/11/03		
	RE-SUBMITTED FOR REVIEW AND APPROVAL	04/25/03		
	SUBMITTED FOR REVIEW	11-14-03		

# Montjoy SINGLE FAMILY DETACHED ELECTION DISTRICT NO.2 HOWARD COUNTY, MARYLAND

## FINAL ROAD CONSTRUCTION, STORM DRAIN, AND STORMWATER MANAGEMENT PLANS AS-BUILT PLANS




**LOCATION MAP**  
SCALE: 1"=200'

**AS-BUILT PLANS**

**AS-BUILT CERTIFICATION**  
I HEREBY CERTIFY THAT THE FACILITY SHOWN ON THIS PLAN WAS CONSTRUCTED AS SHOWN ON THE "AS-BUILT PLANS" AND MEETS THE APPROVED PLAN AND SPECIFICATIONS.  
SIGNATURE: Paul J. Rodgers, P.E. P.E. NO.: 20637 DATE: 11/12/2010

**PROFESSIONAL CERTIFICATION**  
I hereby certify that these documents were prepared or approved by me, and that I am a duly licensed professional engineer under the laws of the State of Maryland, License No. 20637, Expiration Date: 11/12/2010.

Developer/Owner: <b>Winchester Homes, Inc. &amp; Winchester Homes, Inc.</b> , as nominee for Stringtown Investments, LLC 6905 Rockledge Drive Suite 800 Bethesda, Maryland 20817 Stephen J. Nardella, Vice President (301) 803-4800	<b>CONSTRUCTION PLANS COVER SHEET</b>	<b>RODGERS CONSULTING</b> Enhancing the value of land assets Rodgers Consulting, Inc. 9260 Galther Road GaitHERSBURG, MD 20877 301.948.4700 301.948.6256 (fax) 301.253.6609 www.rodgers.com	<b>Montjoy - Single Family Detached</b> A RESUBDIVISION OF NON-BUILDABLE BULK PARCEL C (F-03-87) TO BUILDABLE LOTS 127-188 AND OPEN SPACE LOTS 189-193 ELECTION DISTRICT #2 HOWARD COUNTY, MARYLAND TAX MAP: 30, GRID: 12, PARCEL 260 DPZ FILES: S-01-20, WP-01-117, P-02-10, P-02-17, P-03-03, F-03-87
---	---	---	---

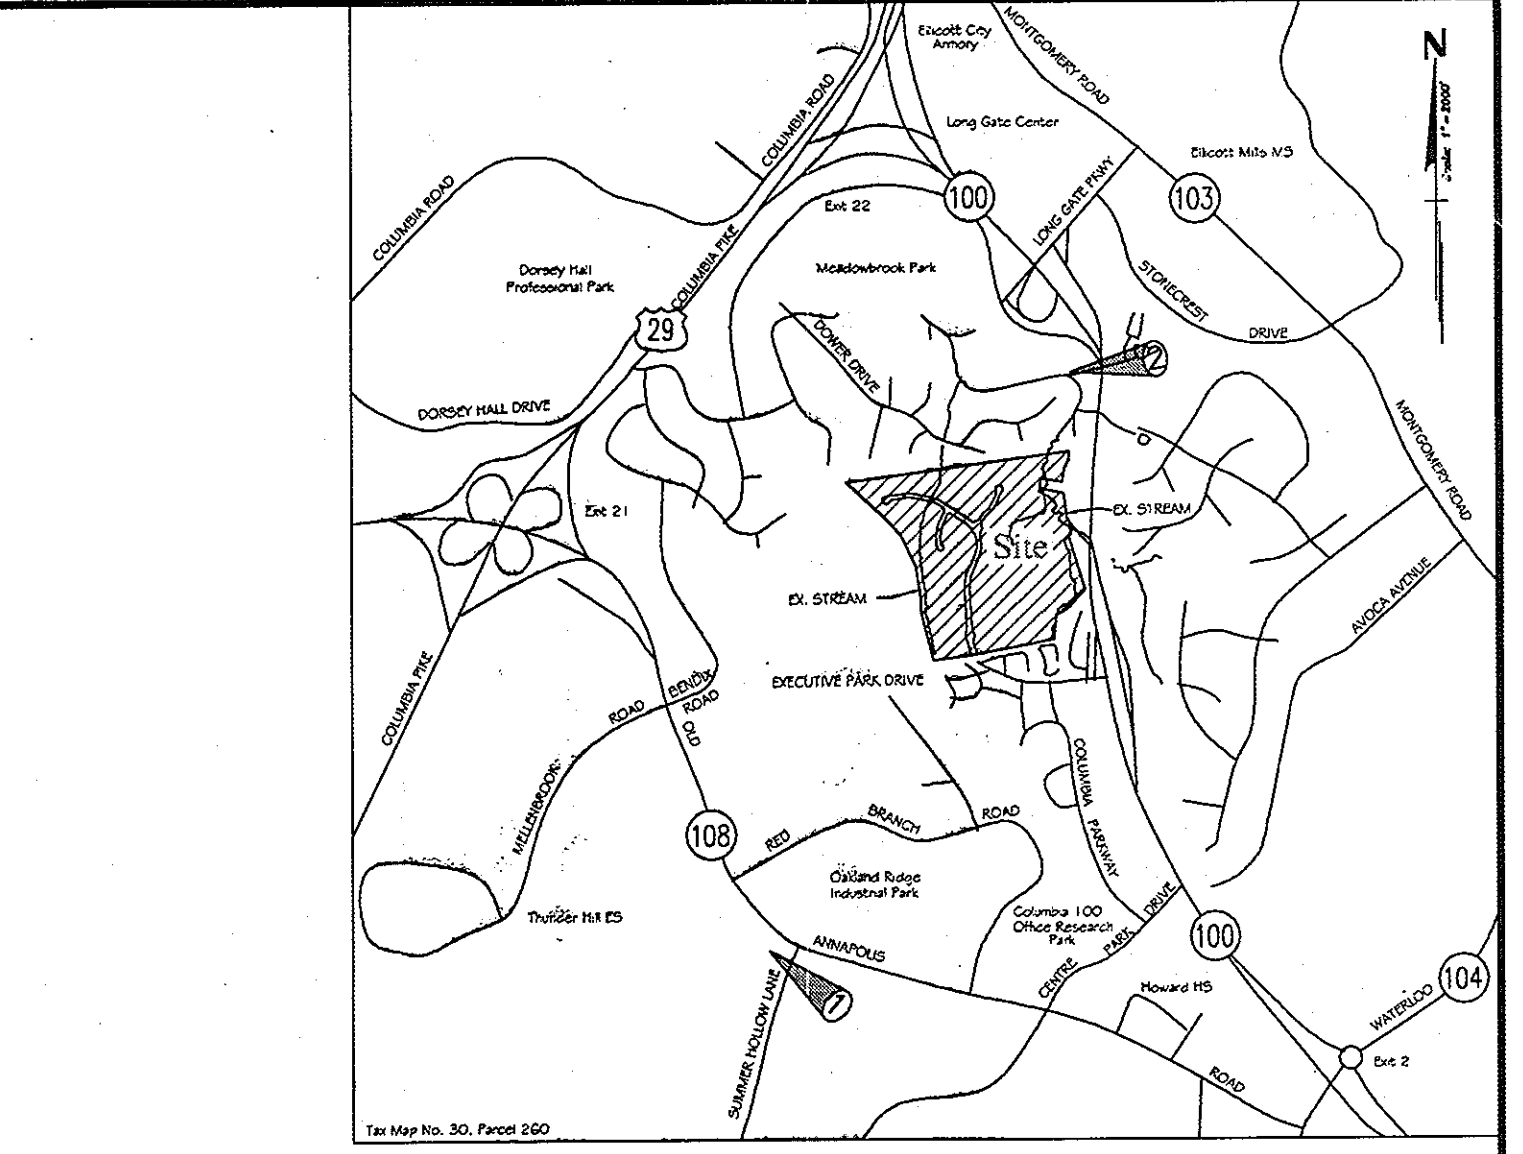


**Vicinity Map**  
Scale: 1"=2000'

**NOTES:**  
THIS SURVEY IS IN THE MARYLAND STATE PLANE COORDINATE SYSTEM BASED ON GPS OBSERVATIONS INCORPORATING THE FOLLOWING HOWARD COUNTY, MARYLAND CONTROL STATIONS:

STATION	30FA	N.568621.336'	E.1361563.983'
STATION 370B	N.553452.821'	E.1368503.167'	
STATION 30CA	N.575083.465'	E.1364481.801'	
STATION 30A	N.567750.958'	E.1364842.598'	

**BENCH MARKS (NAD83)**  
 BENCHMARK NO. 1---HO. CO. NO. 30FA  
 HOWARD CO. STD. STAMPED DISC LOCATED SW CORNER OF RT. 108 AND SUMMER HOLLOW LANE.  
 N 568621.336, E 1361563.983 ELEV. 441.619  
 BENCHMARK NO. 2---HO. CO. NO. 30CA  
 HOWARD CO. STD. STAMPED DISC LOCATED ON THE EAST SIDE OF THE N.B.L. OF RT. 100  
 N 575083.465, E 1364481.801 ELEV. 380.087

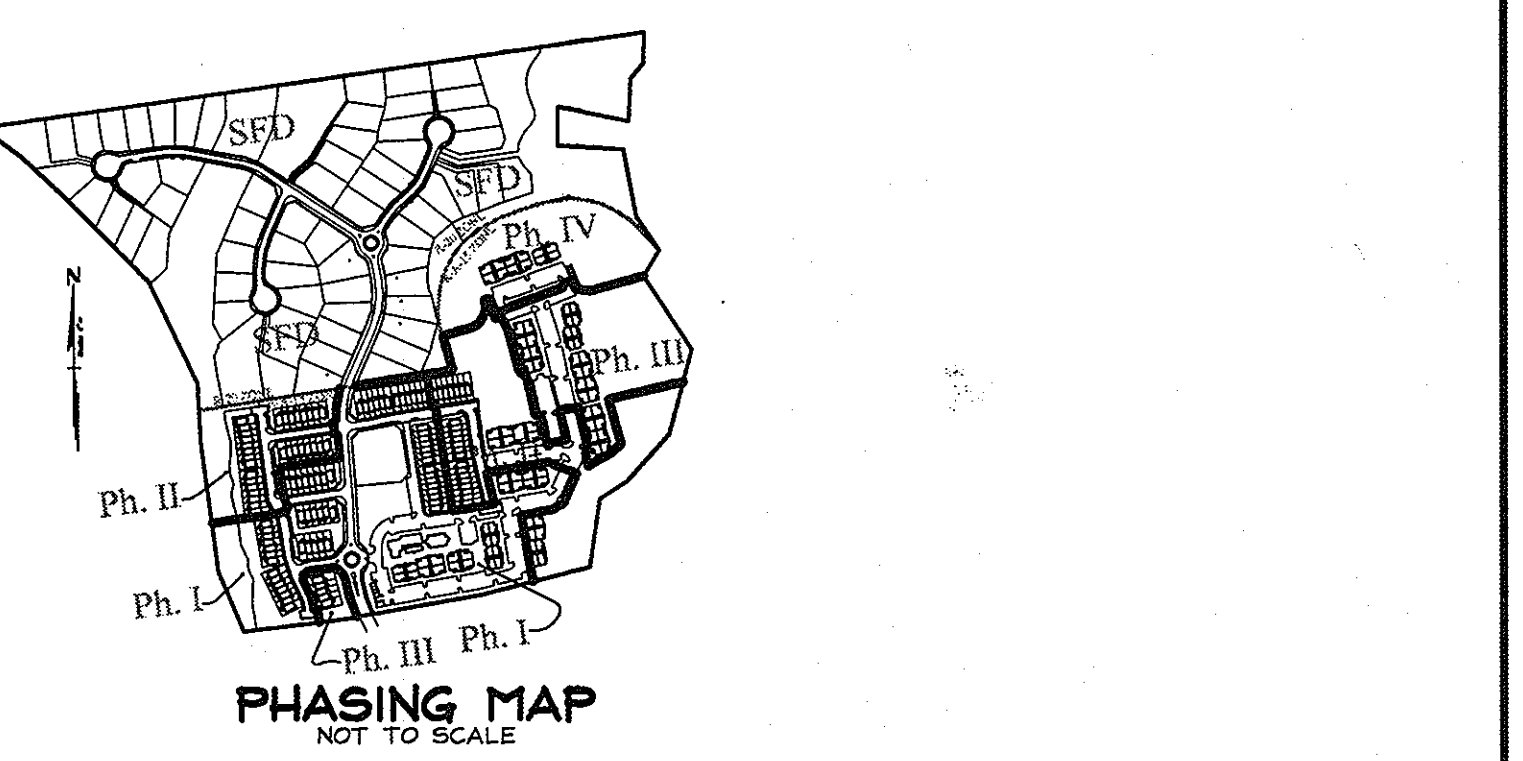

**SHEET INDEX**

SHEET	DESCRIPTION	CS
SHEET 1	COVER SHEET	CS-1
SHEET 2	PLAN & PROFILES- EXECUTIVE PARK DRIVE	RP-1
SHEET 3	PLAN & PROFILES- WETHERED DRIVE	RP-2
SHEET 4	PLAN & PROFILES- SANTS FE COURT	RP-3
SHEET 5	PLAN & PROFILES- CARSON COURT	RP-4
SHEET 6	ROUNDABOUT PLAN & DETAILS- EXECUTIVE PARK DR. STA. 13+74.49	RP-5
SHEET 7	CURB FILLET PROFILES	RP-6
SHEET 8	STREET LIGHT DATA & SIGNAGE PLAN	RP-7
SHEET 9	GRADING & STORM DRAIN PLANS/ DRAINAGE AREA MAP	GSD-1
SHEET 10	GRADING & STORM DRAIN PLANS/ DRAINAGE AREA MAP	GSD-2
SHEET 11	GRADING & STORM DRAIN PLANS/ DRAINAGE AREA MAP	GSD-3
SHEET 12	SEDIMENT & EROSION CONTROL PLAN	SC-1
SHEET 13	SEDIMENT & EROSION CONTROL PLAN	SC-2
SHEET 14	SEDIMENT & EROSION CONTROL PLAN	SC-3
SHEET 15	SEDIMENT & EROSION CONTROL NOTES & DETAILS	SC-4
SHEET 16	SEDIMENT & EROSION CONTROL PROFILES & DETAILS	SC-5
SHEET 17	STORM DRAIN PROFILES, NOTES & SCHEDULES	SD-1
SHEET 18	STORM DRAIN PROFILES	SD-2
SHEET 19	STORM DRAIN PROFILES	SD-3
SHEET 20	SWM PLAN, PROFILES & DETAILS- POND #3	SWM-1
SHEET 21	SWM SCHEDULES, GENERAL DETAILS	SWM-2
SHEET 22	SWM POND #3 STRUCTURAL PLANS & SECTIONS	SWM-3
SHEET 23	SWM SCHEDULES, SPECIFICATIONS & SOIL BORING LOGS	SWM-4
SHEET 24	SWM LANDSCAPE PLAN- POND #3	SWM-5
SHEET 25	LANDSCAPE PLAN	LS-1
SHEET 26	LANDSCAPE PLAN	LS-2
SHEET 27	LANDSCAPE PLAN	LS-3
SHEET 28	LANDSCAPE PLAN DETAILS	LS-4
SHEET 29	LOW PROFILE ARCH PLAN, PROFILE & LOGS	LPA-1
SHEET 30	LOW PROFILE ARCH DETAILS	LPA-2
SHEET 31	LOW PROFILE ARCH DETAILS	LPA-3
SHEET 32	LOW PROFILE ARCH SPECIFICATIONS	LPA-4
SHEET 33	LOW PROFILE ARCH SPECIFICATIONS	LPA-5
SHEET 34	LOW PROFILE ARCH SPECIFICATIONS	LPA-6

**CALL "MISS UTILITY" AT 1-800-257-7777 48 Hours Before Start Of Construction**

SCALE: AS SHOWN  
 JOB NO.: 506V3  
 DATE: 1-14-03  
 INDEX NO.: CS-1  
 SHEET NO.: 1 OF 34



R&C = REBAR & CAP

CURVE #	RAD.	ARC	TANG	DELTA	CHORD	CH. BEARING	PC STATION	PT STATION
21	295.00'	130.54'	66.35'	25°21'11"	129.47'	N10°55'25"E	7+25.98	8+56.52
22	300.00'	181.62'	93.69'	34°41'12"	178.86'	N06°15'24"E	10+62.90	12+44.52


DRIVEWAY LOCATION DATA

LOT #	LOCATION	STREET NAME
127	C.L. 8+45	EXECUTIVE PARK DRIVE
128	C.L. 8+87	EXECUTIVE PARK DRIVE
129	C.L. 9+70	EXECUTIVE PARK DRIVE
130	C.L. 10+48	EXECUTIVE PARK DRIVE
131	C.L. 11+81	EXECUTIVE PARK DRIVE
132	C.L. 12+83	EXECUTIVE PARK DRIVE
183	C.L. 12+67	EXECUTIVE PARK DRIVE
184	C.L. 12+04	EXECUTIVE PARK DRIVE
185	C.L. 11+36	EXECUTIVE PARK DRIVE
186	C.L. 10+76	EXECUTIVE PARK DRIVE
187	C.L. 10+08	EXECUTIVE PARK DRIVE
188	C.L. 9+26	EXECUTIVE PARK DRIVE

DRIVEWAY WIDTHS AT R/W SHALL BE 12' OR 18' WIDE AS REPRESENTED ON PLANS


NOTE: ALL CURB ELEVATIONS ARE TOP OF CURB FOR STD. 7" HOWARD CO. STD. COMB. CURB & GUTTER, UNLESS OTHERWISE NOTED ON THE PLAN. CONTRACTOR MUST ADJUST ELEVATION FOR DRIVEWAY APRON AND HANDICAP RAMP.

- ALL MATERIALS AND METHODS OF CONSTRUCTION SHALL BE IN ACCORDANCE WITH THE LATEST STANDARD AND SPECIFICATIONS OF HOWARD COUNTY PLUS SHA STANDARDS AND SPECIFICATIONS, IF APPLICABLE.
- ALL CONNECTIONS AT EXISTING IMPROVEMENTS SHALL BE WITH A CLEAN VERTICAL JOINT. SEE HOWARD COUNTY STANDARD DETAIL G4.01.
- ALL SPOT GRADES SHOWN ARE FLOW LINE ELEVATIONS (FL) UNLESS OTHERWISE NOTED.
- THE CONTRACTOR SHALL NOTIFY MISS UTILITY AT 1-800-257-7777 48 HOURS IN ADVANCE OF ANY EXCAVATION.
- THE CONTRACTOR SHALL NOTIFY THE DEPARTMENT PUBLIC WORK/ CONSTRUCTION INSPECTION DIVISION AT (410) 313-1880 AT LEAST FIVE (5) WORKING DAYS PRIOR TO THE START OF WORK.
- CURBS, GUTTERS, SIDEWALKS, AND ALL PAVING SHALL BE INSTALLED IN SUCH A MANNER AS TO PROVIDE POSITIVE DRAINAGE OF ALL AREAS SO THERE IS NO ACCUMULATION OF SURFACE WATER.
- WHERE PROPOSED CURB MEETS EX. CURB, THE CONTRACTOR SHALL MATCH EX. CURB & GUTTER IN LINE AND ON GRADE OR AS DIRECTED BY THE INSPECTOR.
- FOR SIDEWALK HANDICAP RAMP DETAIL & CONSTRUCTION SPECIFICATIONS, SEE HOWARD COUNTY STANDARD DETAIL R-4.02.
- ALL CURB AND GUTTERS SHOWN ON THE PLANS ARE HOWARD COUNTY STANDARDS AND DETAILS.
- ALL ROADWAY SUBGRADE SHALL MEET HOWARD COUNTY STANDARD AND SPECIFICATIONS.
- ALL DRIVEWAY APRON SHALL BE CONSTRUCTED PER HOWARD COUNTY STANDARD DETAIL R-6.01
- ALL CURB FILLET RADIUS SHALL BE 25' UNLESS NOTED OTHERWISE.
- CONTRACTOR SHALL PROVIDE SPILL GUTTER ON CURB FILLETS AS NEEDED TO CONVEY WATER ACROSS INTERSECTIONS.
- GRADE ALL DISTURBED AREAS TO PROVIDE POSITIVE DRAINAGE.
- INFORMATION CONCERNING UNDERGROUND UTILITIES WAS OBTAINED FROM AVAILABLE RECORDS, BUT THE CONTRACTOR MUST DETERMINE THE EXACT LOCATION AND ELEVATIONS OF THE MAINS BY DIGGING TEST PITS BY HAND AT ALL UTILITY CROSSINGS, WELL IN ADVANCE OF TRENCHING. IF CLEARANCES ARE LESS THAN SHOWN ON THIS PLAN, OR TWELVE (12) INCHES, WHICHEVER IS LESS, CONTACT THE HOWARD COUNTY DEPARTMENT OF PUBLIC WORK AND THE APPROPRIATE UTILITY OWNER BEFORE PROCEEDING WITH CONSTRUCTION.

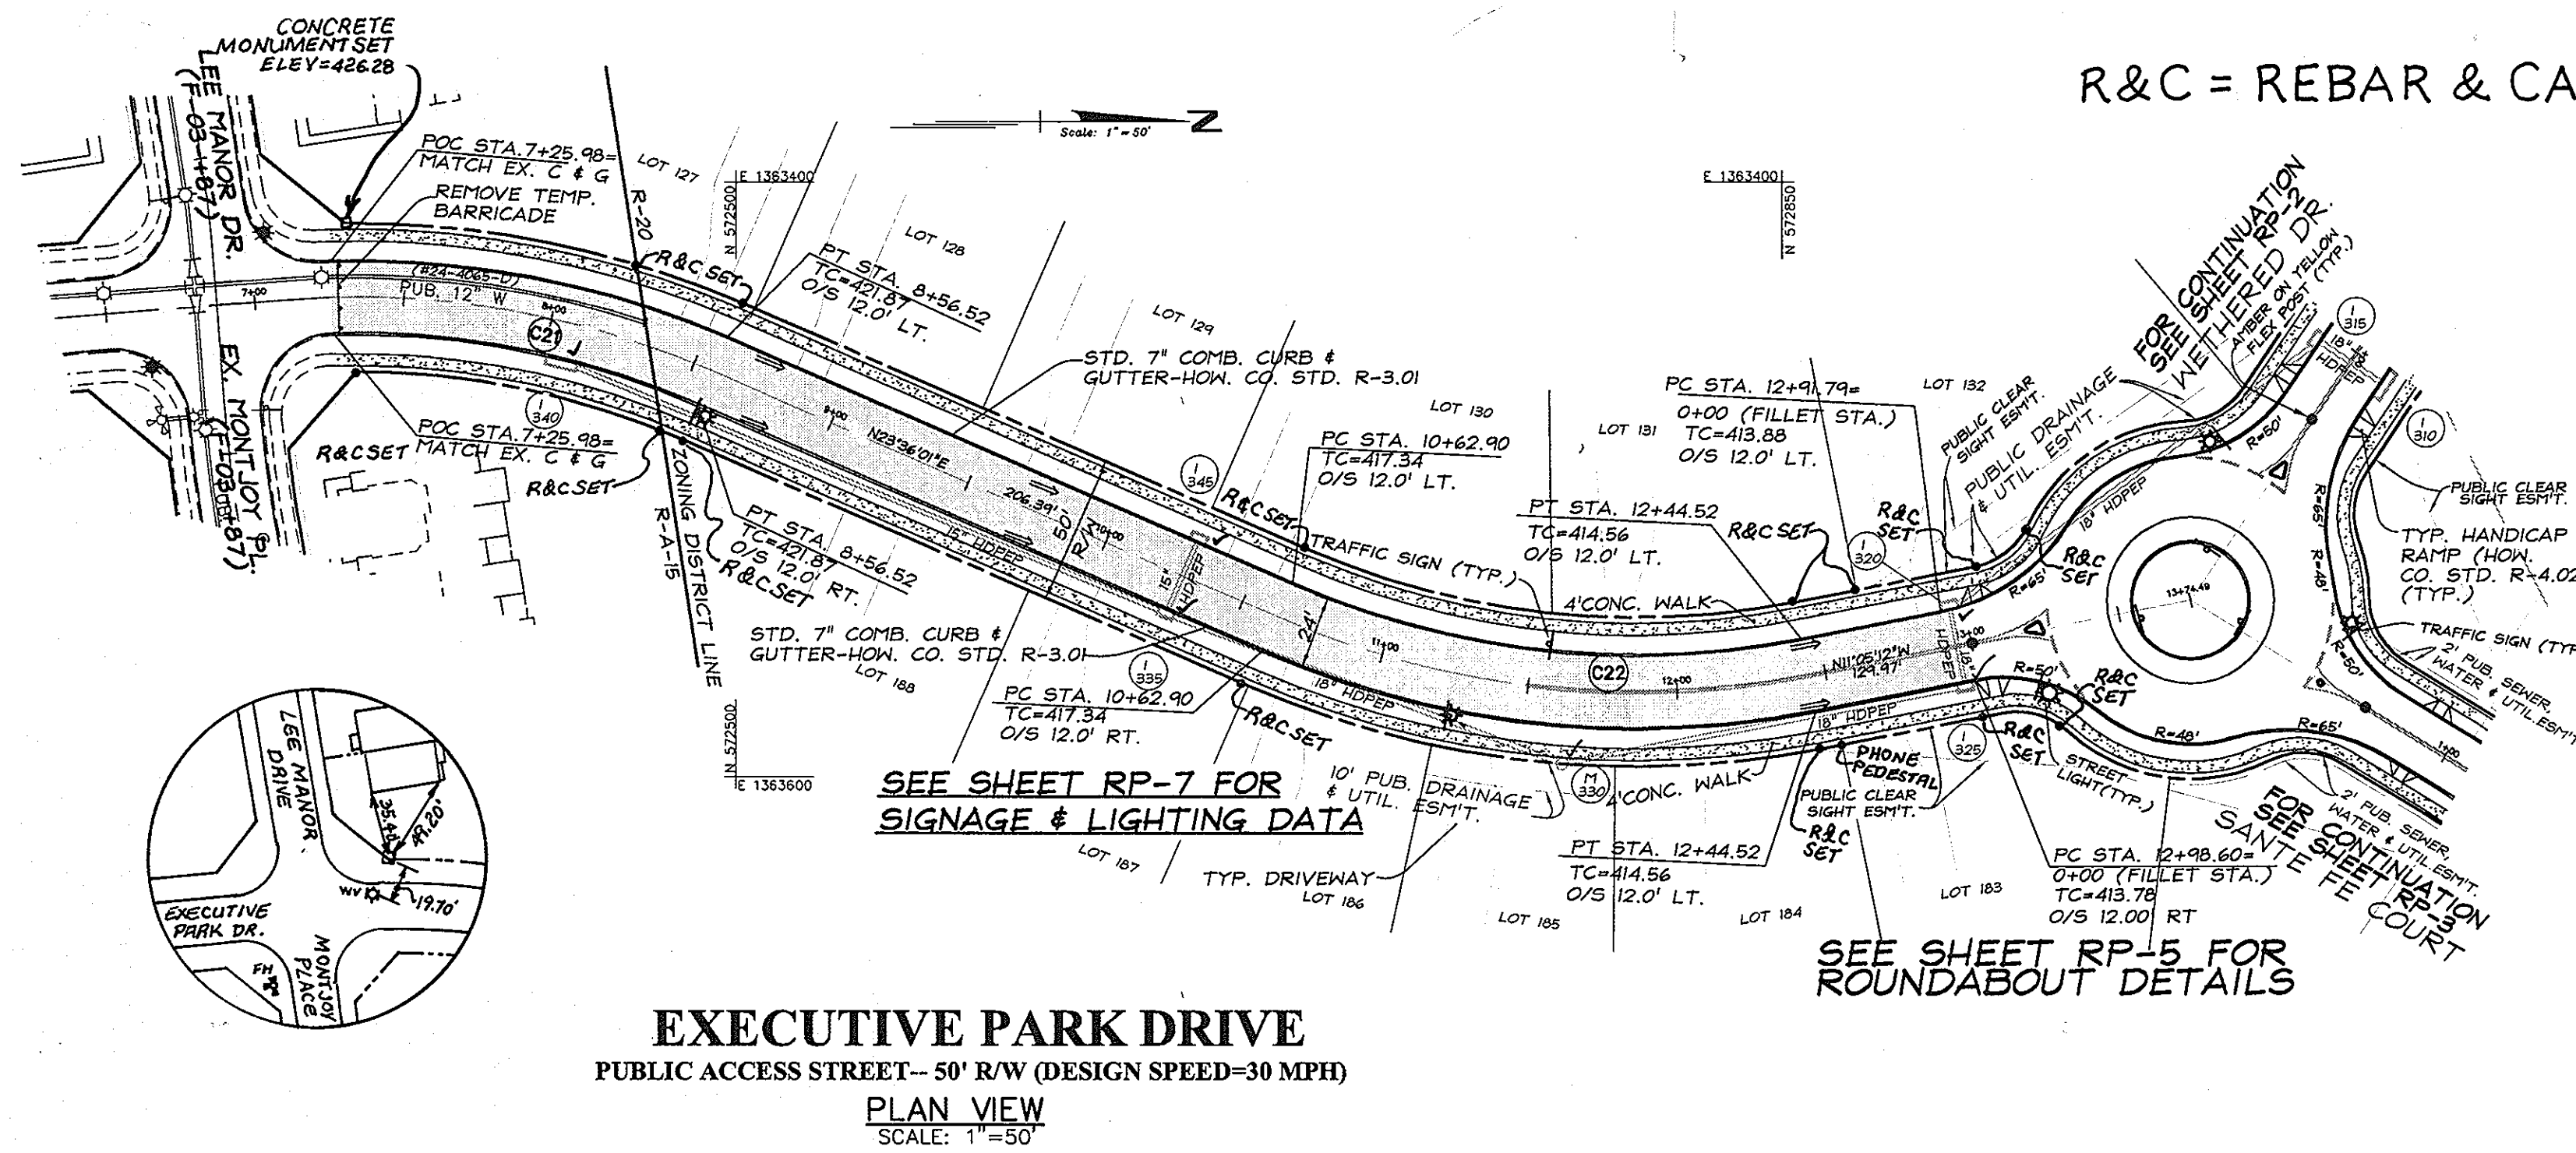


**EXECUTIVE PARK DRIVE**  
PUBLIC ACCESS STREET--50' R/W (DESIGN SPEED=30 MPH)  
PLAN VIEW  
SCALE: 1"=50'


CALL "MISS UTILITY" AT  
1-800-257-7777  
48 Hours Before Start Of Construction

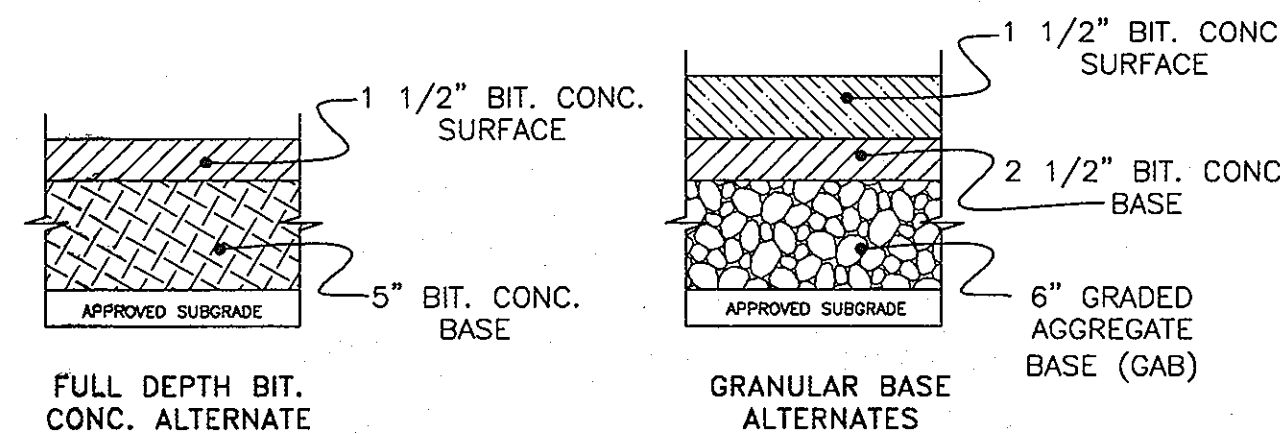


SECTION NUMBER	ROAD AND STREET CLASSIFICATION
P-2	RESIDENTIAL ZONES LOCAL, CUL-DE-SAC STS. ALLEYS AND PRIVATE ROADS SERVING INDIVIDUAL LOTS TRAVELWAYS APARTMENTS AND COMMERCIAL-INDUSTRIAL ZONES WITH NO MORE THAN 10 HEAVY TRUCKS PER DAY*

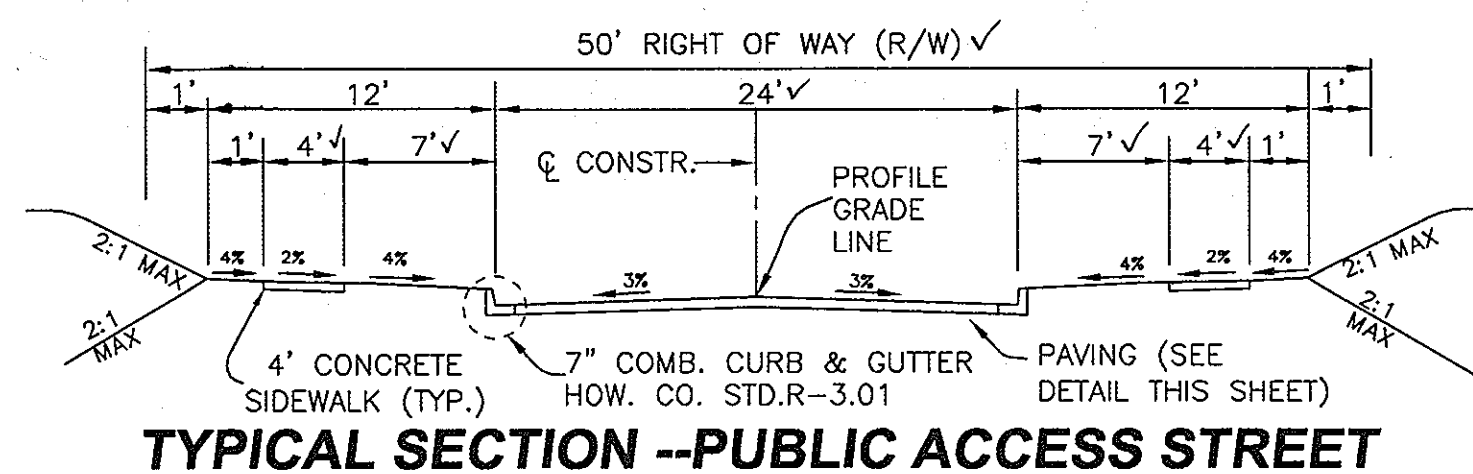

**TYPICAL SECTION --PUBLIC ACCESS STREET**  
(NOT TO SCALE)  
EXECUTIVE PARK DRIVE -- FROM STA. 7+25.98 TO STA. 12+98.60  
HOWARD COUNTY STANDARD FIGURE 2.09g  
MINIMUM DESIGN SPEED - 30 MPH

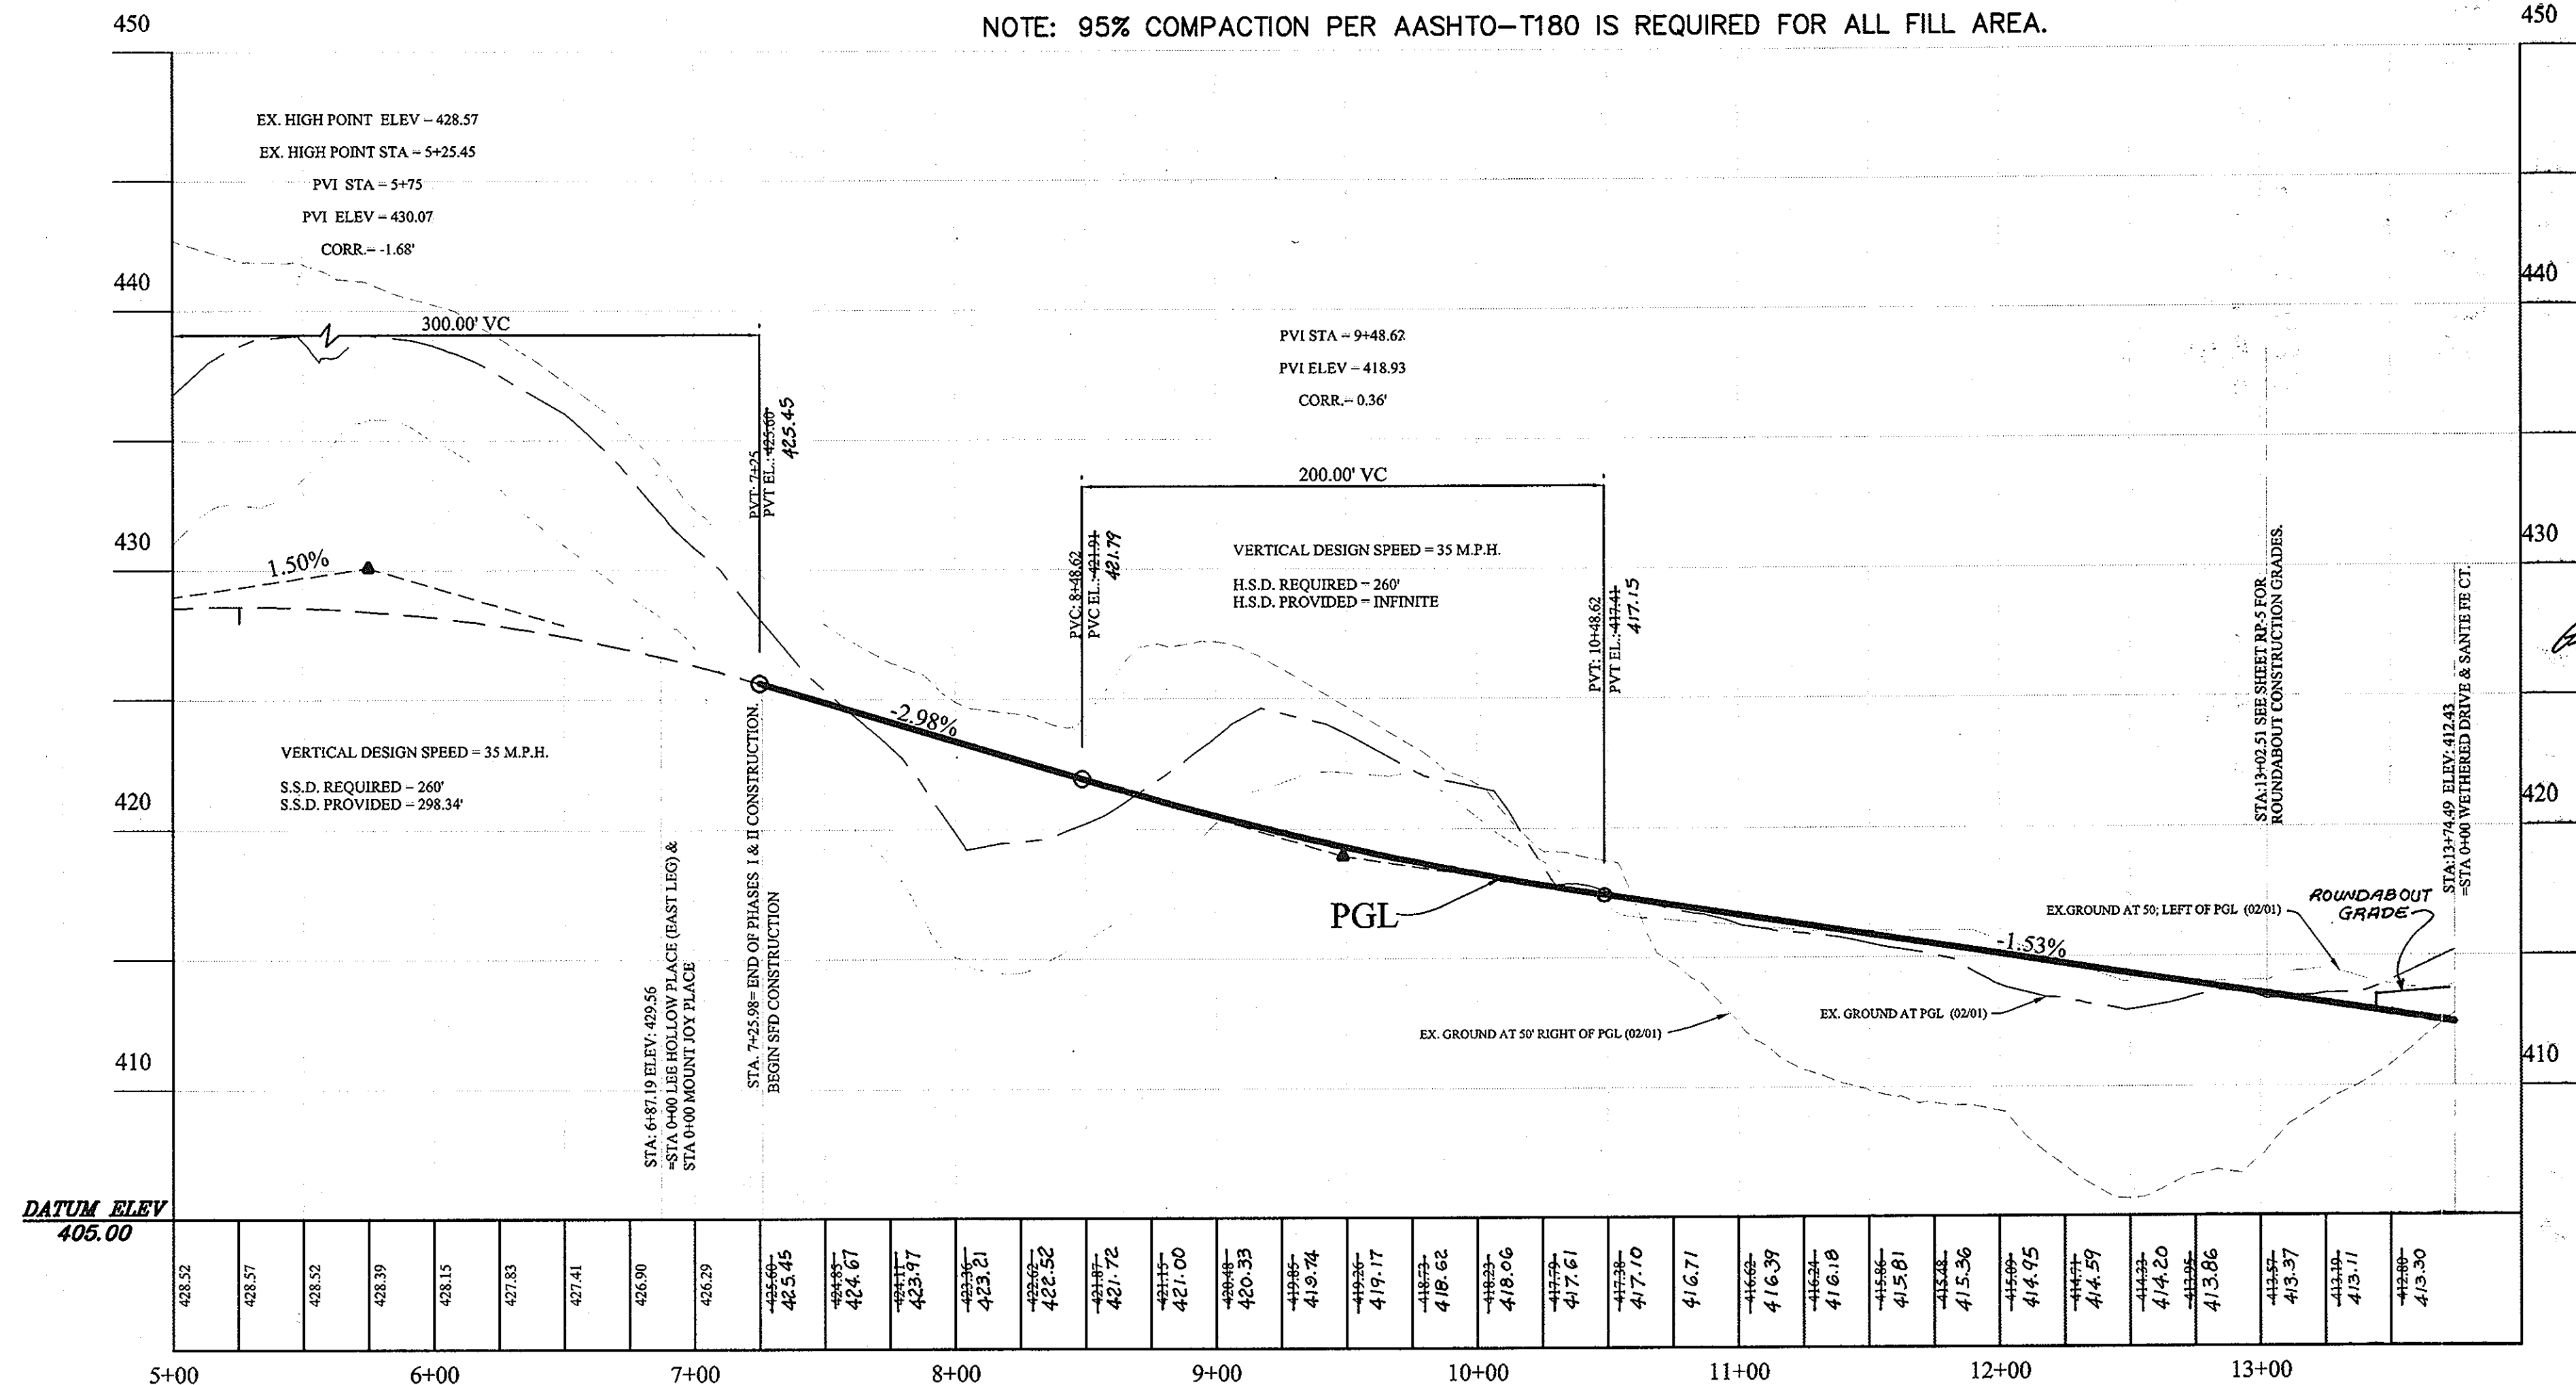

NOTE: 95% COMPACTION PER AASHTO-T180 IS REQUIRED FOR ALL FILL AREA.

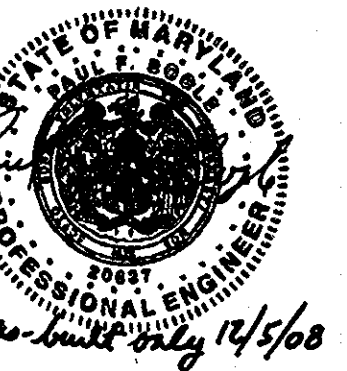

PROFILE SCALE:  
V: 1"=5'  
H: 1"=50'


APPROVED: HOWARD COUNTY DEPARTMENT OF PLANNING & ZONING  
*Cindy Hamilton* 10/26/03  
CHIEF, DIVISION OF LAND DEVELOPMENT  
*William Z. Mahler* 10/17/03  
CHIEF, DEVELOPMENT ENGINEERING DIVISION

APPROVED: HOWARD COUNTY DEPARTMENT OF PUBLIC WORKS  
*William Z. Mahler* 10-14-03  
CHIEF, BUREAU OF HIGHWAY

DATE	REVISION	DATE	BY	DATE
	BASE DATA		CADD	DATE
	DESIGNED		YSL/RC	DATE
	DRAWN		YSL	DATE
	REVIEWED		PF8	DATE
	RELEASE FOR			DATE

Developer/Owner:  
**Winchester Homes, Inc. & Winchester Homes, Inc.**, as nominee for Stringtown Investments, LLC  
6905 Rockledge Drive  
Suite 800  
Bethesda, Maryland 20817  
Stephen J. Nardella, Vice President  
(301) 803 - 4800

**AS-BUILT PLANS**  
(PUBLIC ACCESS STREET)  
**EXECUTIVE PARK DRIVE**  
PLAN & PROFILE

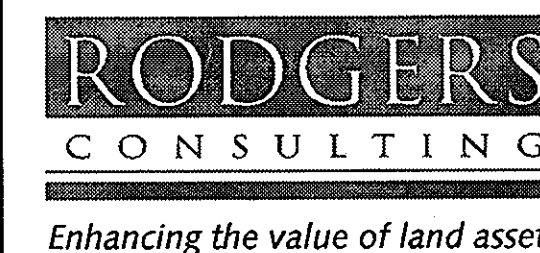

Rodgers Consulting, Inc.  
9260 Gaither Road  
Gaithersburg, MD 20877  
301.948.4700  
301.948.6256 (fax)  
301.253.6609  
www.rodgers.com

**Montjoy - Single Family Detached**  
A RESUBDIVISION OF NON-BUILDABLE BULK PARCEL C (F-03-B7)  
TO  
BUILDABLE LOTS 127- 188 AND OPEN SPACE LOTS 189-193  
ELECTION DISTRICT #2 HOWARD COUNTY, MARYLAND  
TAX MAP: 30, GRID: 12, PARCEL 260  
DPZ FILES: S-01-20, WP-01-117, P-02-10, P-02-10, P-03-03, P-03-08

SCALE	AS SHOWN
JOB No.	506V3
DATE:	1-14-03
INDEX No.	RP-1
SHEET No.	2 of 34








R&C = REBAR & CAP

CENTERLINE CURVE DATA								
CURVE #	RAD.	ARC	TANG	DELTA	CHORD	CH. BEARING	PC STATION	PT STATION
26	200.00'	53.11'	26.71'	15°12'51"	52.95'	N39°15'19"E	1+03.09	1+56.20
27	200.00'	85.46'	43.39'	24°28'57"	84.81'	N34°37'16"E	2+34.47	3+19.93
28	200.00'	60.37'	30.41'	17°17'36"	60.14'	N13°43'59"E	4+16.10	4+76.47


DRIVEWAY LOCATION DATA		
LOT #	LOCATION	STREET NAME
166	C.L. 1+10	SANTE FE COURT
167	C.L. 1+41	SANTE FE COURT
168	C.L. 2+75	SANTE FE COURT
169	C.L. 3+25	SANTE FE COURT
170	LP. 2+23	SANTE FE COURT
171 TO 174	LP. 1+61	SANTE FE COURT
175	LP. 0+55	SANTE FE COURT
177 TO 179	C.L. 3+76	SANTE FE COURT
180	C.L. 2+55	SANTE FE COURT
181	C.L. 1+90	SANTE FE COURT
182	C.L. 1+26	SANTE FE COURT
193	C.L. 4+16	SANTE FE COURT

DRIVEWAY WIDTHS AT R/W SHALL BE 12' OR 18' WIDE AS REPRESENTED ON PLANS

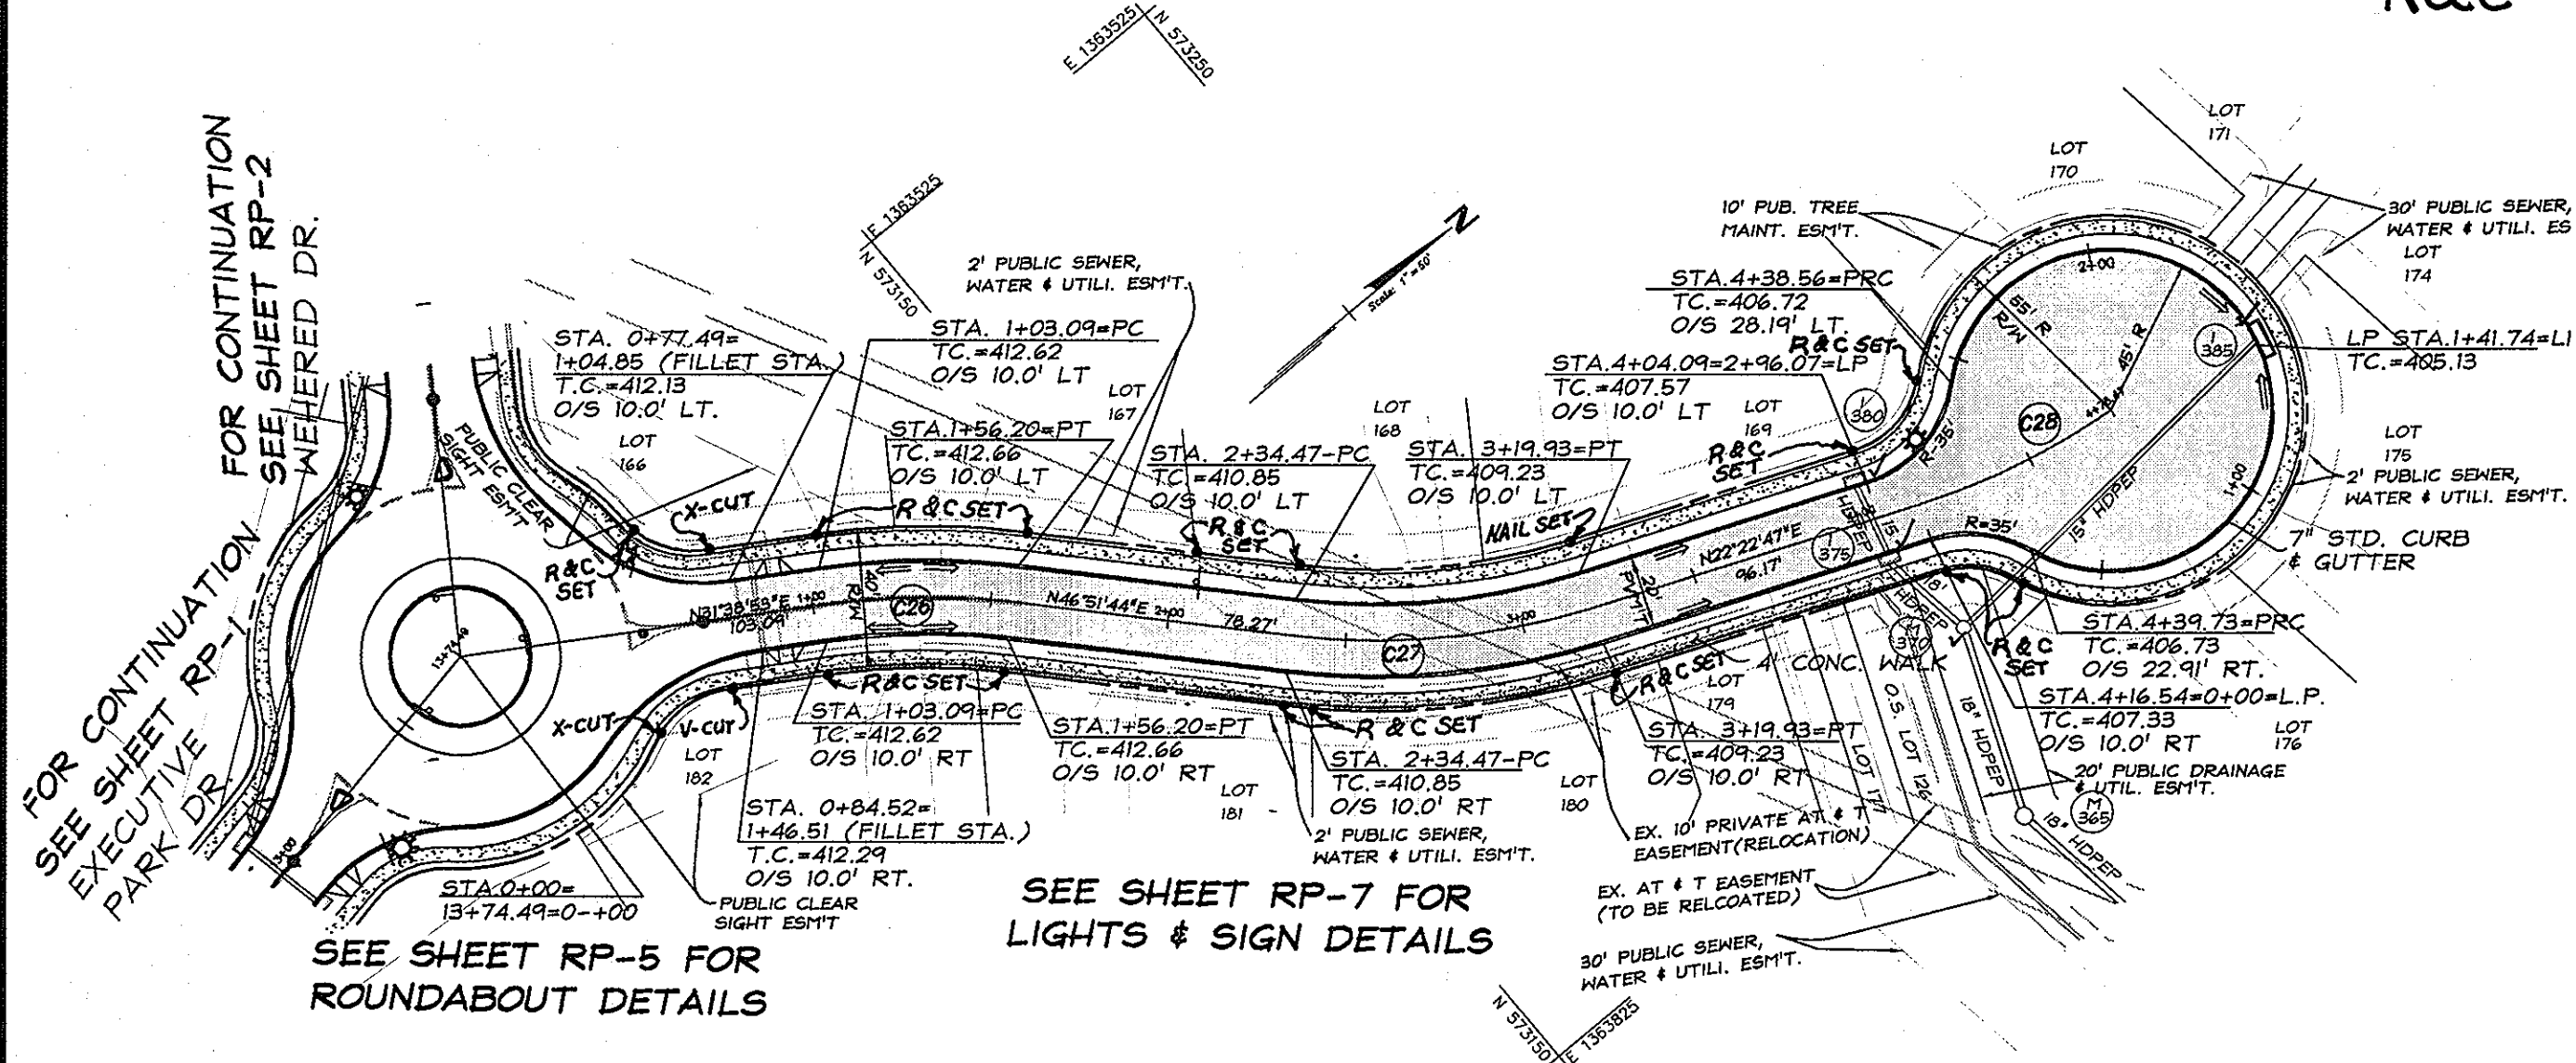


**SANTE FE COURT**  
PUBLIC ACCESS PLACE - 40' R/W (DESIGN SPEED=15 MPH)  
PLAN VIEW  
SCALE: 1"=50'

NOTE: ALL CURB ELEVATIONS ARE TOP OF CURB FOR STD. 7" HOWARD CO. STD. COMB. CURB & GUTTER, UNLESS OTHERWISE NOTED ON THE PLAN. CONTRACTOR MUST ADJUST ELEVATION FOR DRIVEWAY APRON AND HANDICAP RAMP.

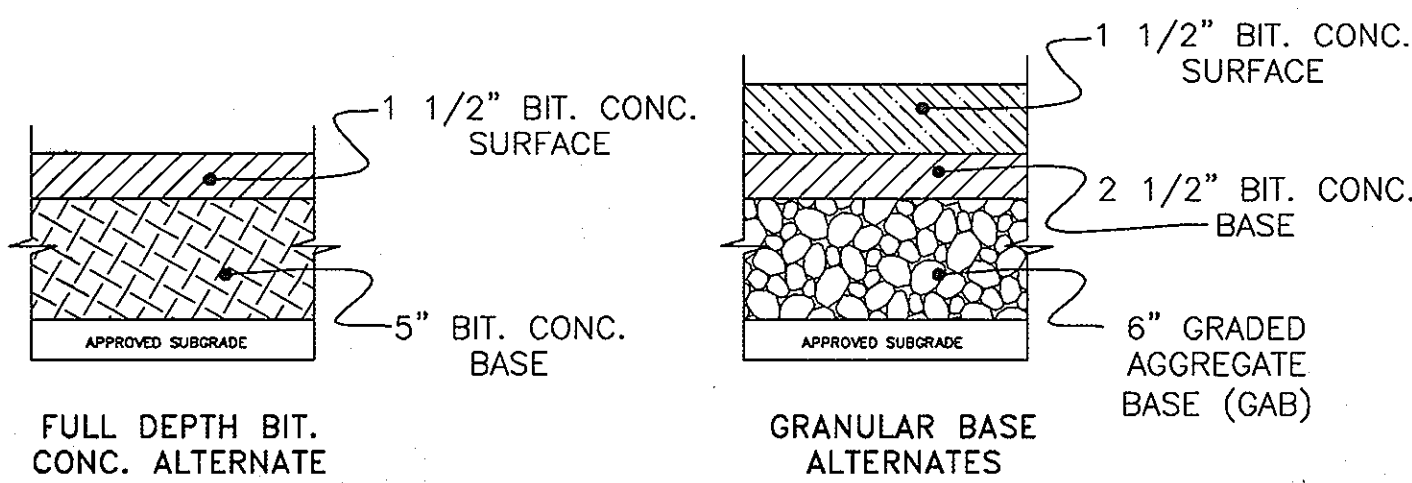


SECTION NUMBER	ROAD AND STREET CLASSIFICATION
P-2	RESIDENTIAL ZONES LOCAL, CUL-DE-SAC ST., ALLEYS AND PRIVATE ROADS SERVING INDIVIDUAL LOTS TRAVEL WAYS APARTMENTS AND COMMERCIAL ZONES WITH NO MORE THAN 10 HEAVY TRUCKS PER DAY

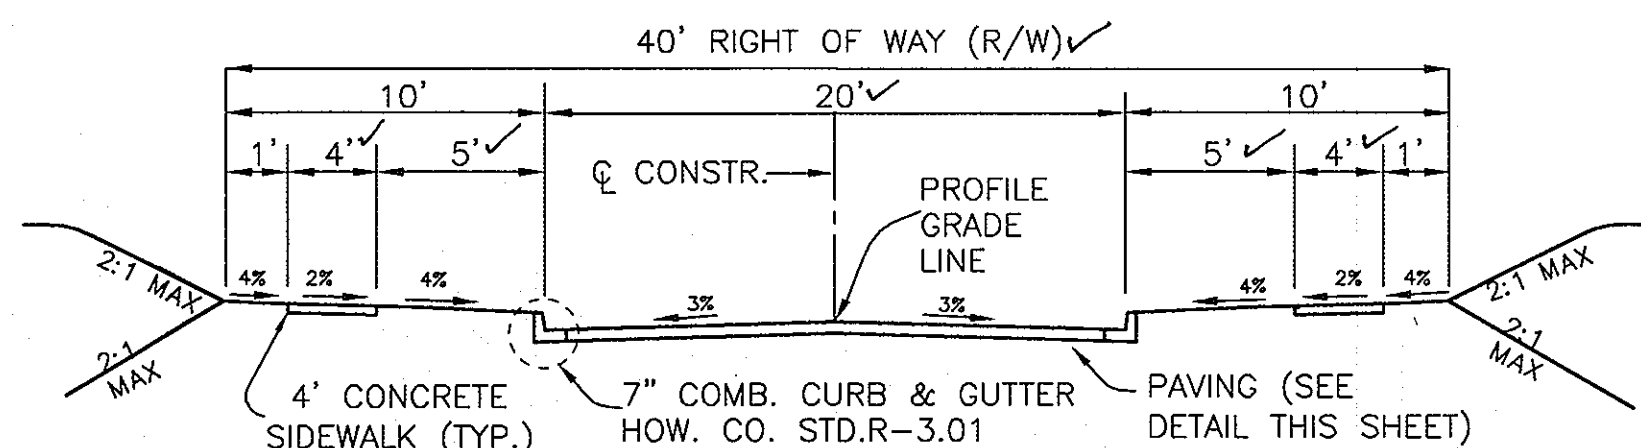


**TYPICAL SECTION --PUBLIC ACCESS PLACE**

(NOT TO SCALE)  
SANTE FE COURT - FROM STA. 0+84.52 TO 4+04.09  
HOWARD COUNTY STANDARD FIGURE 2.09a  
MINIMUM DESIGN SPEED - 15 MPH

NOTE: 95% COMPACTION PER AASHTO-T180 IS REQUIRED FOR ALL FILL AREA.

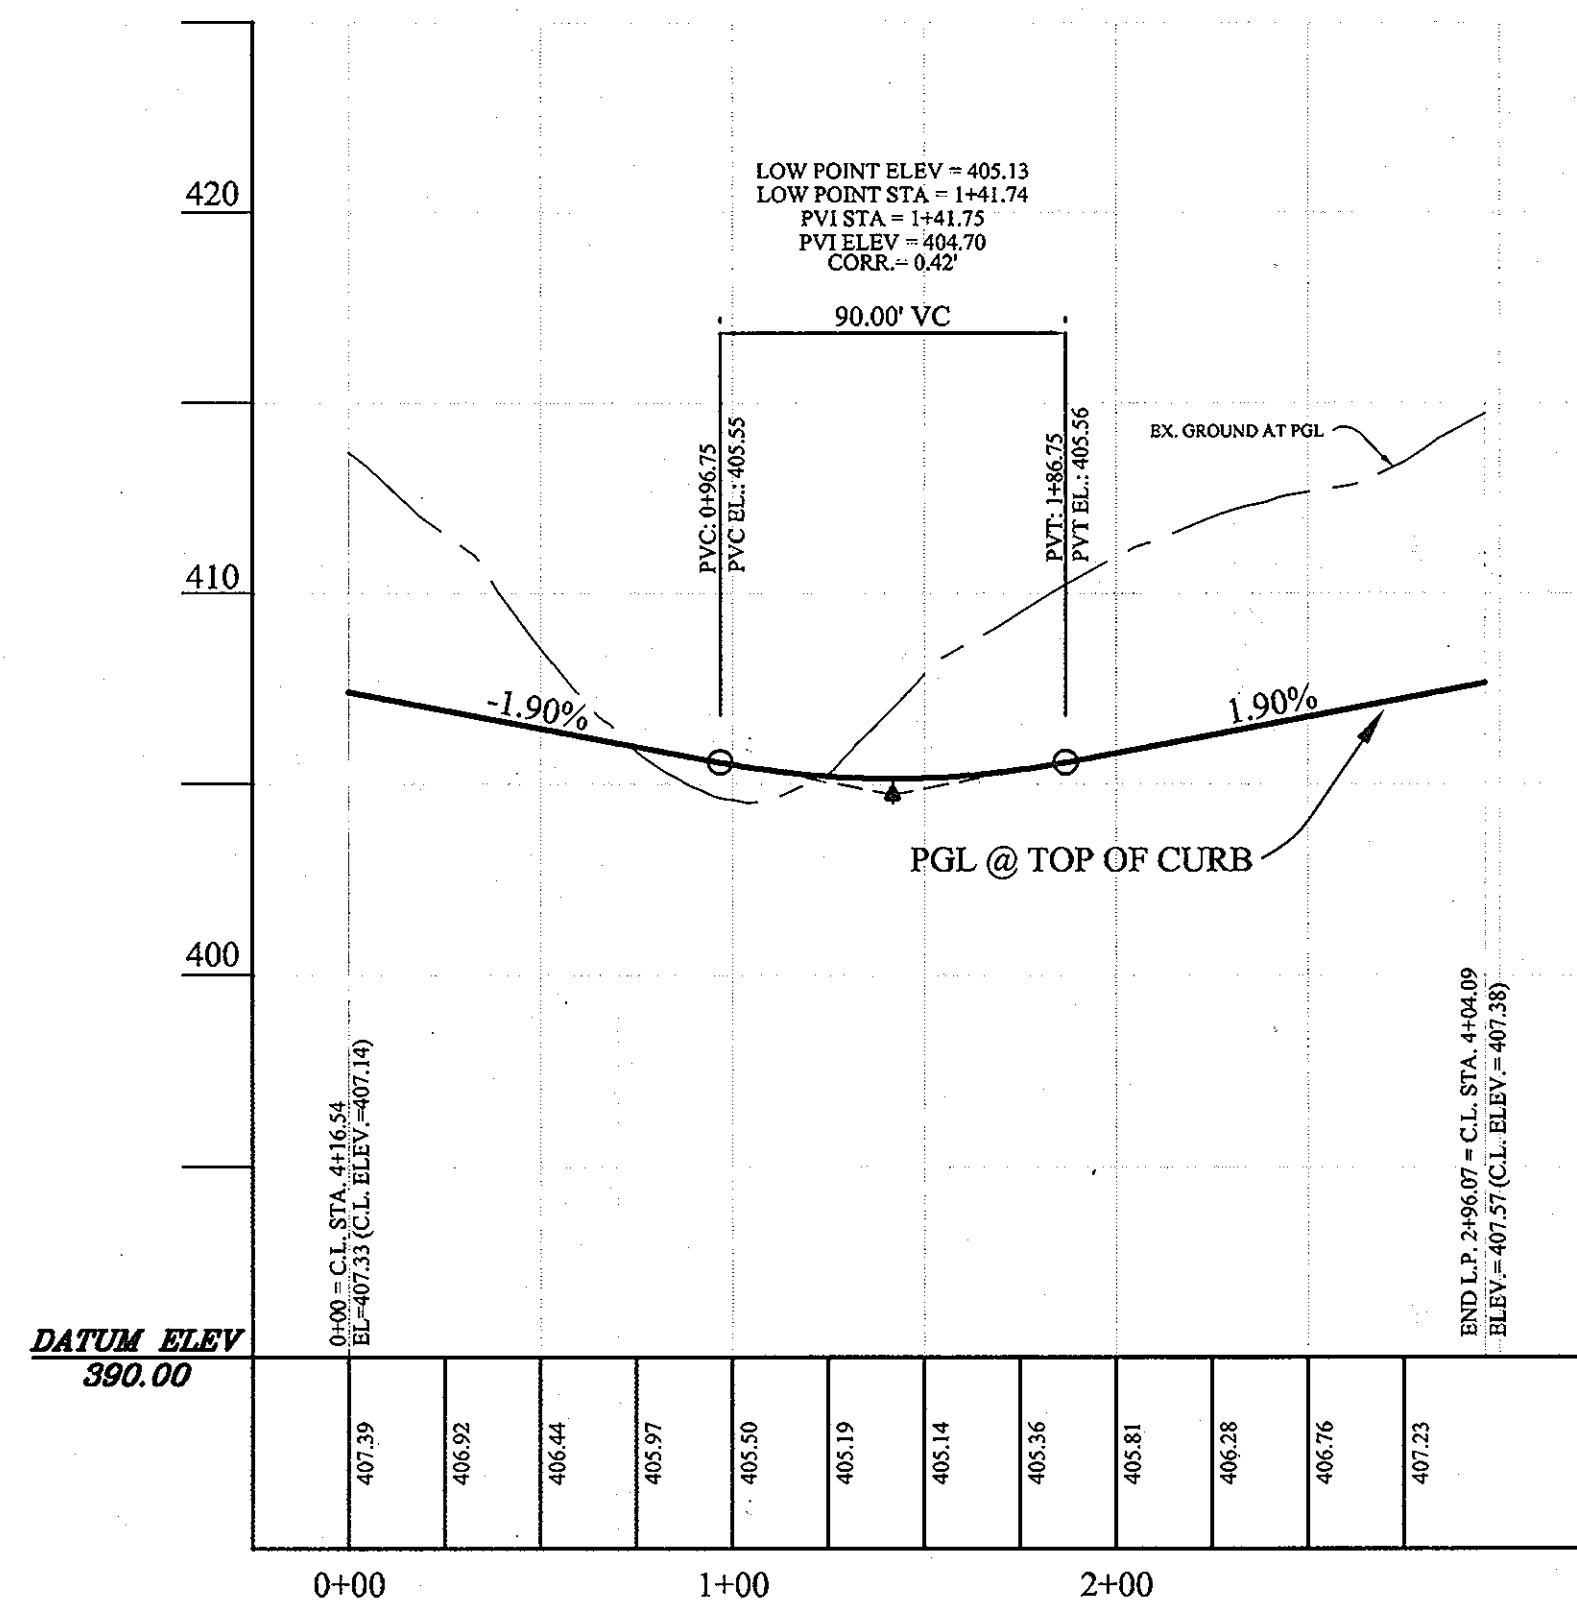

NOTE: 95% COMPACTION PER AASHTO-T180 IS REQUIRED FOR ALL FILL AREA.

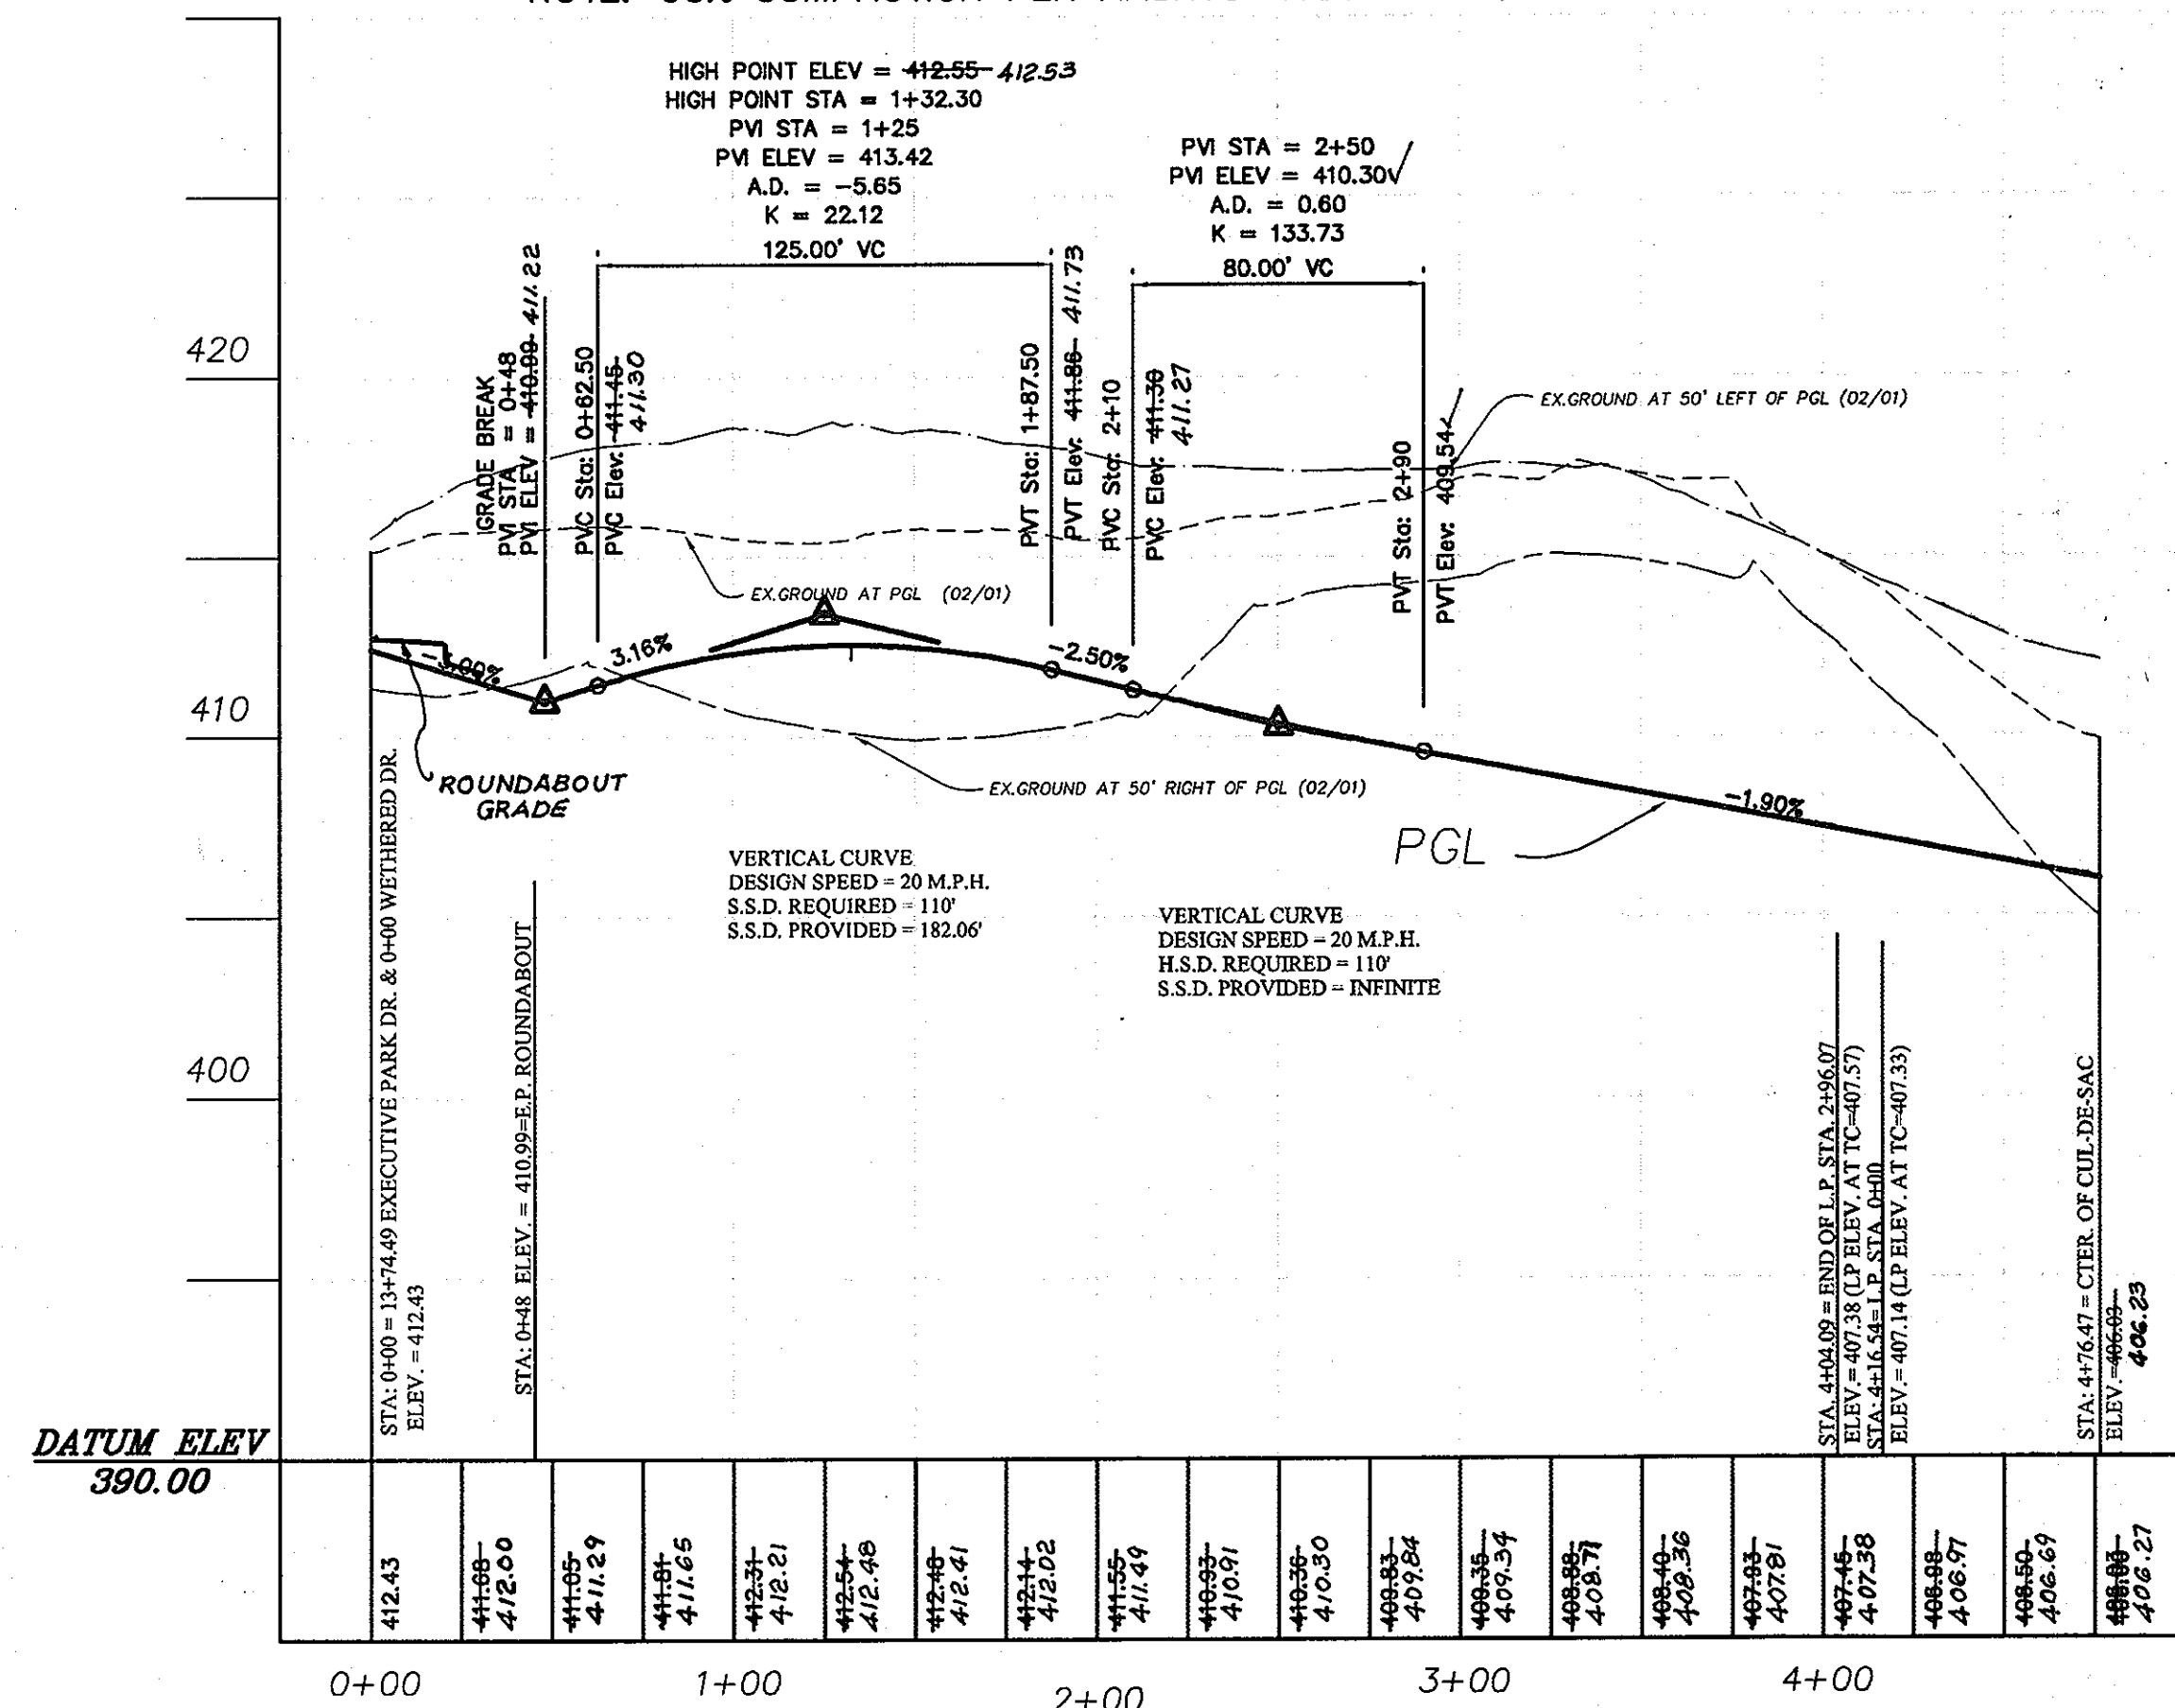

**SANTE FE COURT**  
PUBLIC ACCESS PLACE - DESIGN SPEED = 15 MPH

**LINEAR PROFILE: SANTE FE COURT**  
**AS-BUILT PLANS**


PROFILE SCALE:  
V: 1"=5'  
H: 1"=50'

APPROVED: HOWARD COUNTY DEPARTMENT OF PLANNING & ZONING  
*Cindy Hammit* 10/27/03  
CHIEF, DIVISION OF LAND DEVELOPMENT  
APPROVED: HOWARD COUNTY DEPARTMENT OF PUBLIC WORKS  
*William F. Mahan Jr.* 10-14-03  
CHIEF, BUREAU OF HIGHWAY

DATE	REVISION	DATE	BY	DATE
	BASE DATA		CADD	DATE
	DESIGNED		YSL/RC	DATE
	DRAWN		YSL	DATE
	REVIEWED		PFB/RF	DATE
	RELEASE FOR			DATE


Developer/Owner:  
**Winchester Homes, Inc. & Winchester Homes, Inc.**, as nominee for Stringtown Investments, LLC  
6905 Rockledge Drive  
Suite 800  
Bethesda, Maryland 20817  
Stephen J. Nardella, Vice President  
(301) 803 - 4800

**(PUBLIC ACCESS PLACE)**  
**SANTE FE COURT**  
**PLAN & PROFILE**

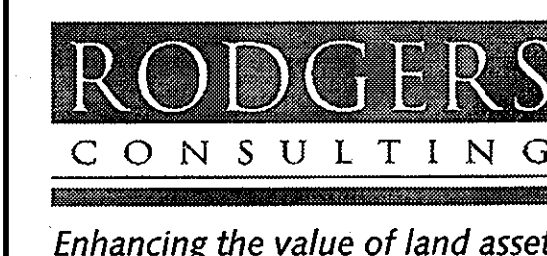

Rodgers Consulting, Inc.  
9260 Galther Road  
Gaithersburg, MD 20877  
301.948.4700  
301.948.6256 (fax)  
301.253.6609  
www.rodgers.com

**Montjoy - Single Family Detached**  
A RESUBDIVISION OF NON-BUILDABLE BULK PARCEL C (F-03-87)  
TO  
BUILDABLE LOTS 127 - 188 AND OPEN SPACE LOTS 189-193  
ELECTION DISTRICT #2 HOWARD COUNTY, MARYLAND  
TAX MAP: 30, GRID: 12, PARCEL 260  
DPZ FILES: S-01-20, WP-01-117, P-02-10, P-02-17, P-03-03, P-03-87

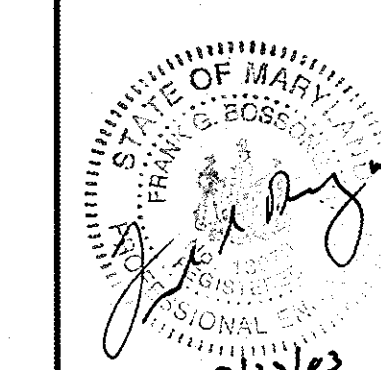


SCALE: AS SHOWN  
JOB No. 506V3  
DATE: 1-14-03  
INDEX No. RP-3  
SHEET No. 4 of 34



CALL "MISS UTILITY" AT  
1-800-257-7777  
48 Hours Before Start Of Construction

R&C = REBAR & CAP

CENTERLINE CURVE DATA								
CURVE #	RAD.	ARC	TANG	DELTA	CHORD	CH. BEARING	PC STATION	PT STATION
29	300.00'	126.98'	64.46'	24°15'06"	126.04'	S11°47'15"W	1+84.48	3+11.46
30	50.00'	27.63'	14.18'	31°39'37"	27.28'	S16°10'07"E	3+75.73	4+03.36

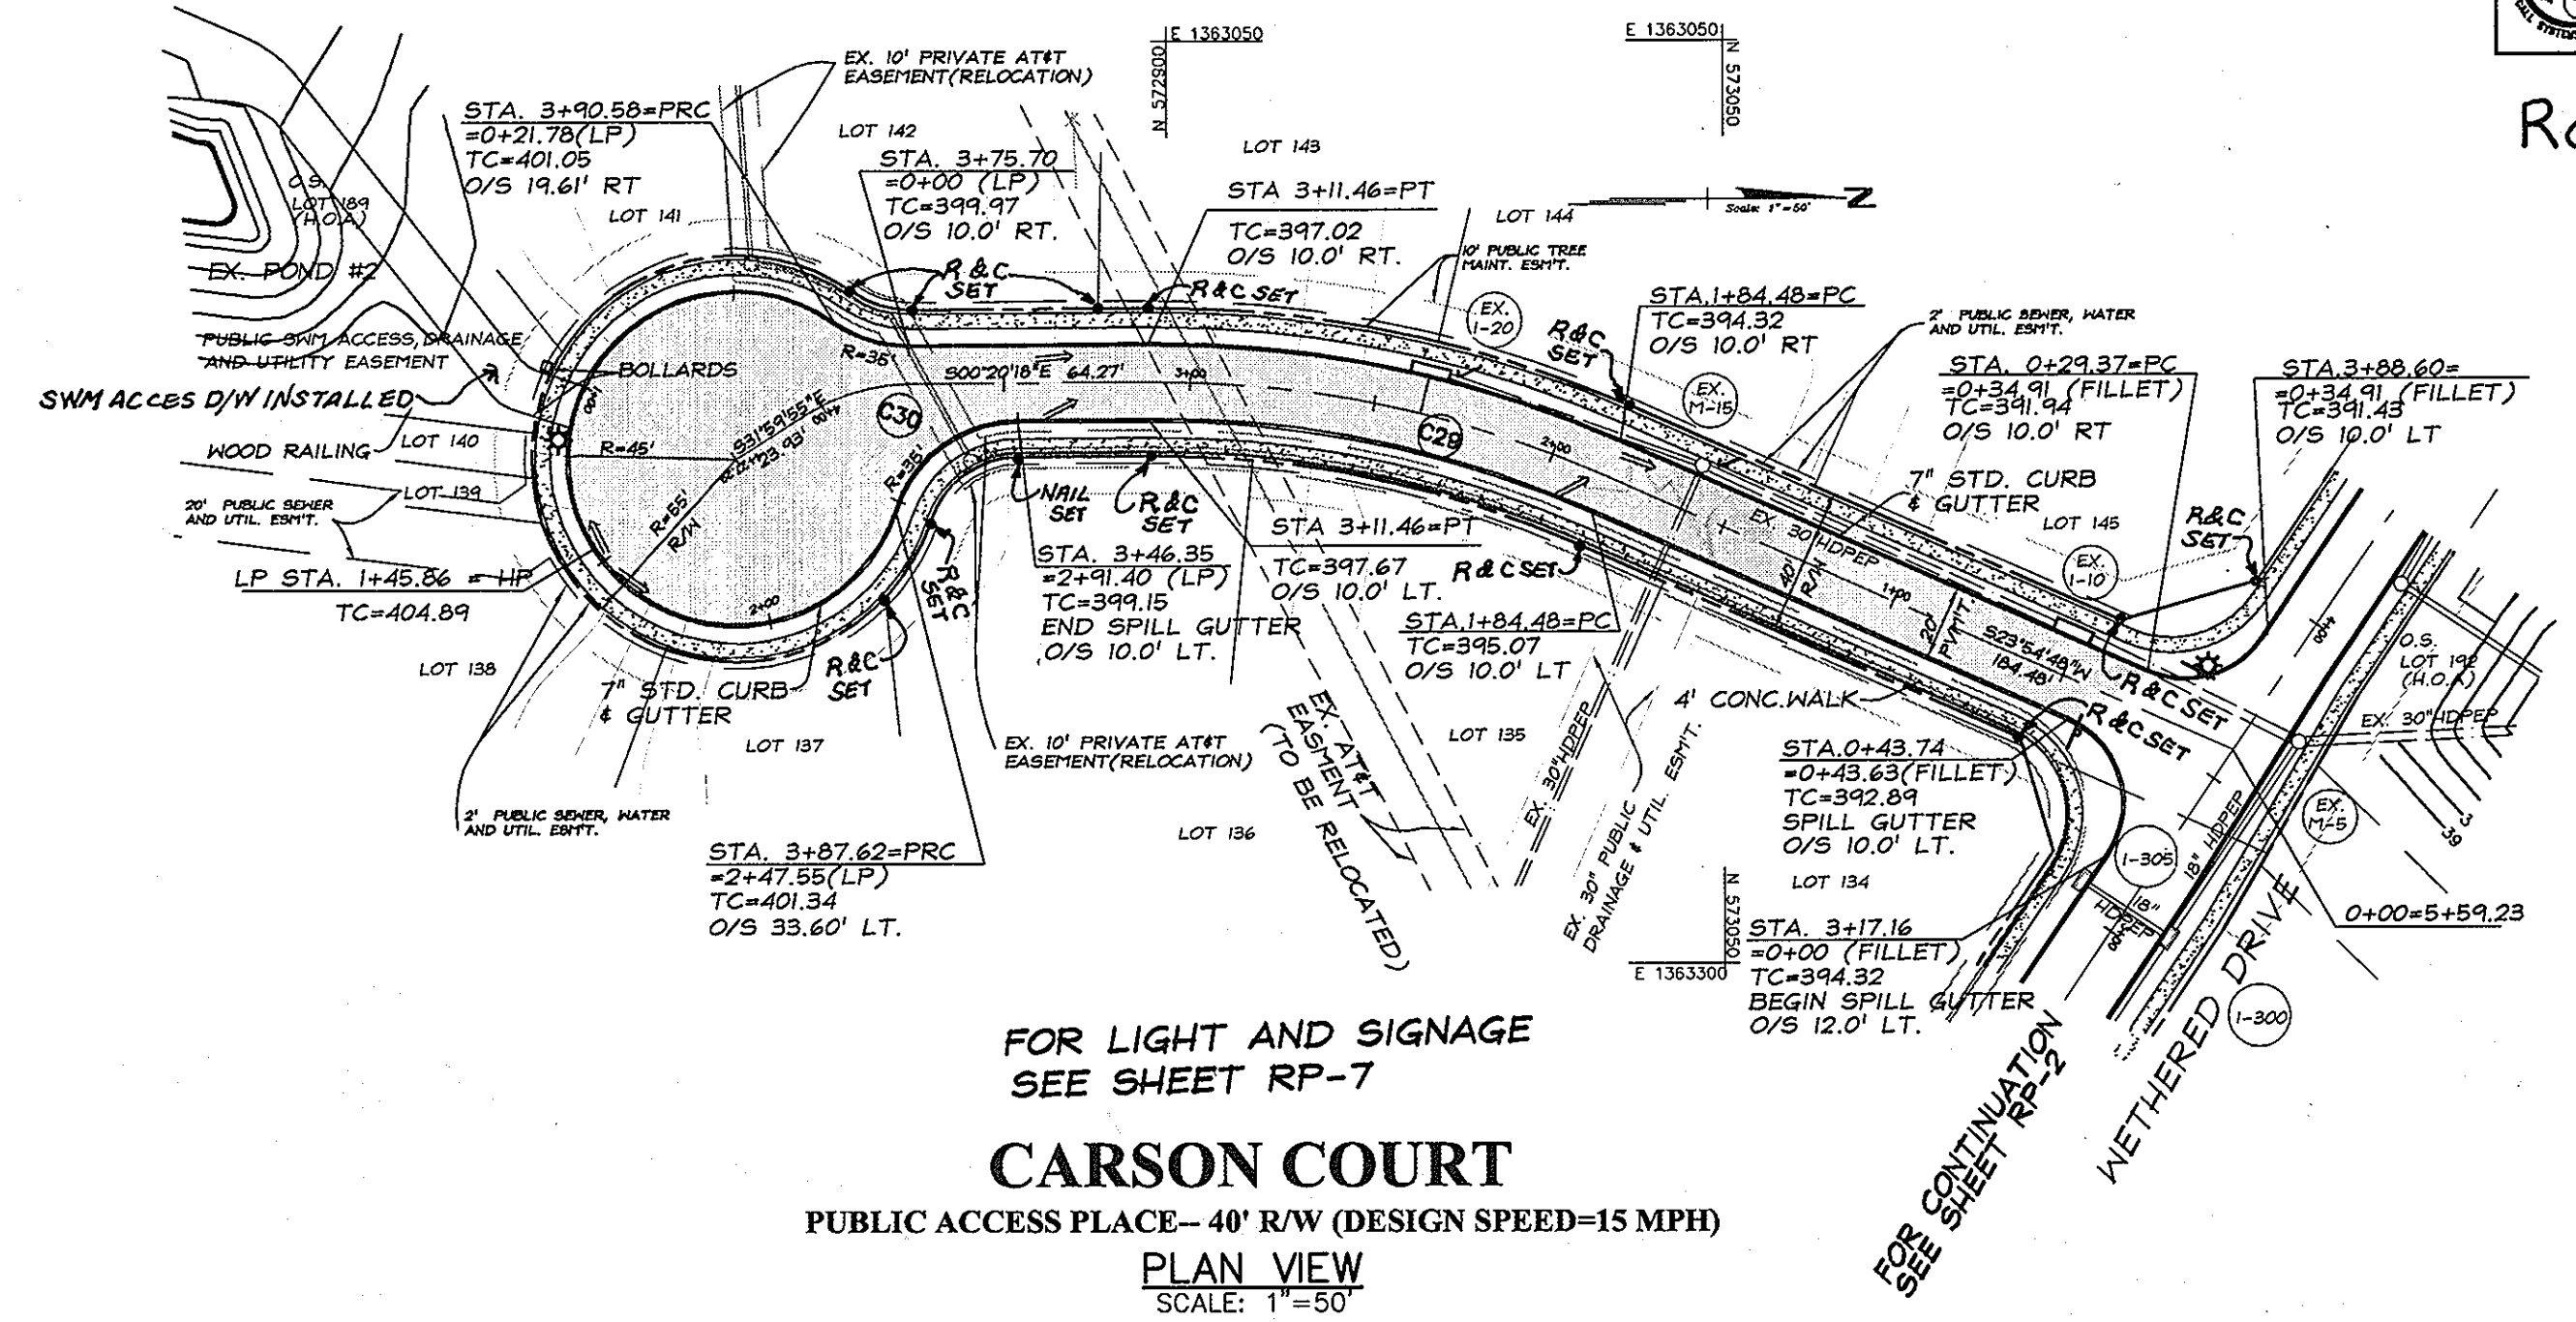

FOR LIGHT AND SIGNAGE  
SEE SHEET RP-7

**CARSON COURT**

PUBLIC ACCESS PLACE - 40' R/W (DESIGN SPEED=15 MPH)


PLAN VIEW  
SCALE: 1"=50'

**DRIVEWAY LOCATION DATA**


LOT #	LOCATION	STREET NAME
135	C.L. 2+60	CARSON COURT
136	C.L. 3+44	CARSON COURT
137	LP 1+82	CARSON COURT
138	LP 1+92	CARSON COURT
139/140	LP 1+27	CARSON COURT
141	LP 0+81	CARSON COURT
142	C.L. 3+45	CARSON COURT
143	C.L. 2+69	CARSON COURT
144	C.L. 1+59	CARSON COURT
145	C.L. 1+08	CARSON COURT
148	LP 1+08	CARSON COURT

DRIVEWAY WIDTHS AT R/W SHALL BE 12' OR 18' WIDE AS REPRESENTED ON PLANS

NOTE: ALL CURB ELEVATIONS ARE TOP OF CURB FOR STD. 7" HOWARD CO. STD. COMB. CURB & GUTTER, UNLESS OTHERWISE NOTED ON THE PLAN. CONTRACTOR MUST ADJUST ELEVATION FOR DRIVEWAY APRON AND HANDICAP RAMP.

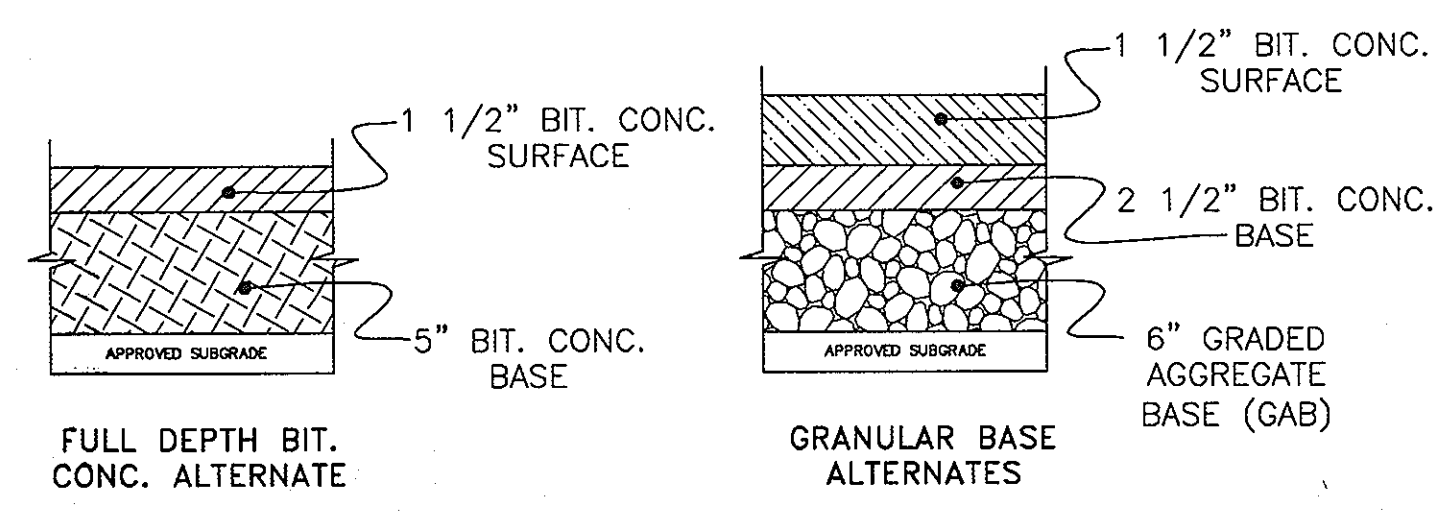


SECTION NUMBER	ROAD AND STREET CLASSIFICATION
P-2	RESIDENTIAL ZONES LOCAL, CUL-DE-SAC STS. ALLEYS AND PRIVATE ROADS SERVING INDIVIDUAL LOTS TRAVELWAYS APARTMENTS AND COMMERCIAL-INDUSTRIAL ZONES WITH NO MORE THAN 10 HEAVY TRUCKS PER DAY*

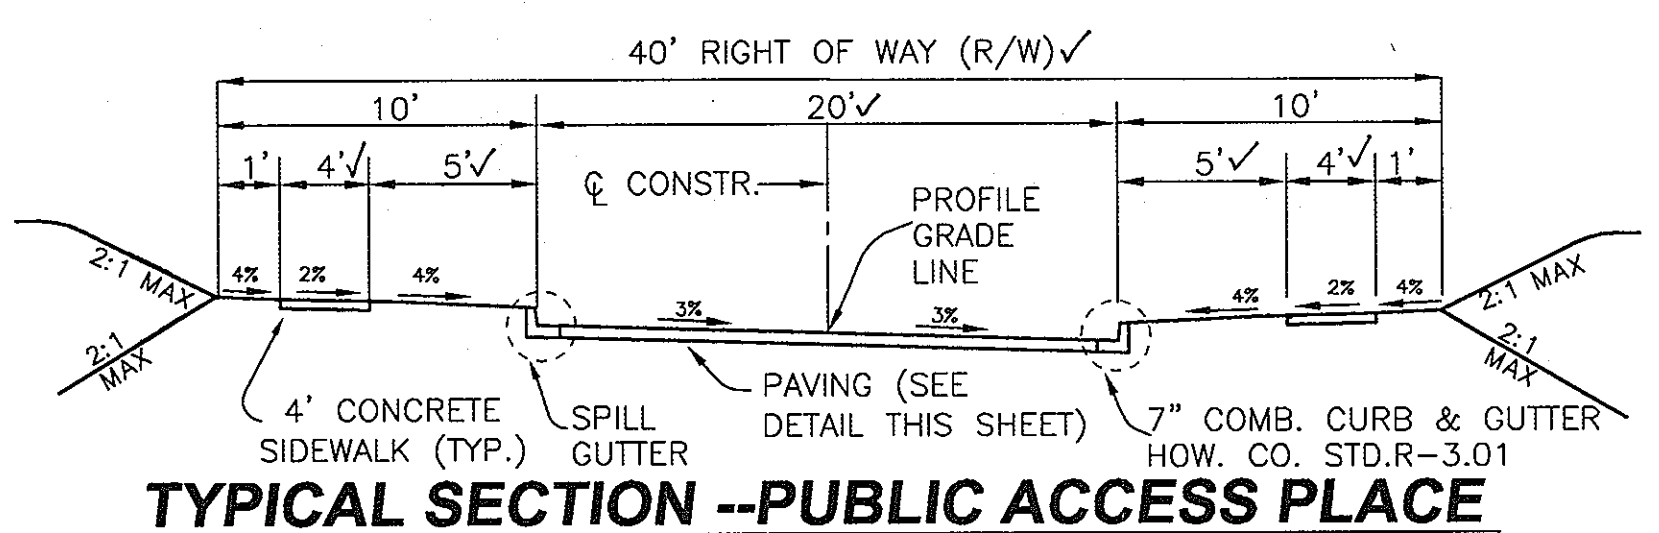


**TYPICAL SECTION --PUBLIC ACCESS PLACE**

(NOT TO SCALE)  
CARSON COURT - FROM STA. 0+43.74 TO STA. 3+46.35  
HOWARD COUNTY STANDARD FIGURE 2.09a (MODIFIED)  
MINIMUM DESIGN SPEED - 15 MPH

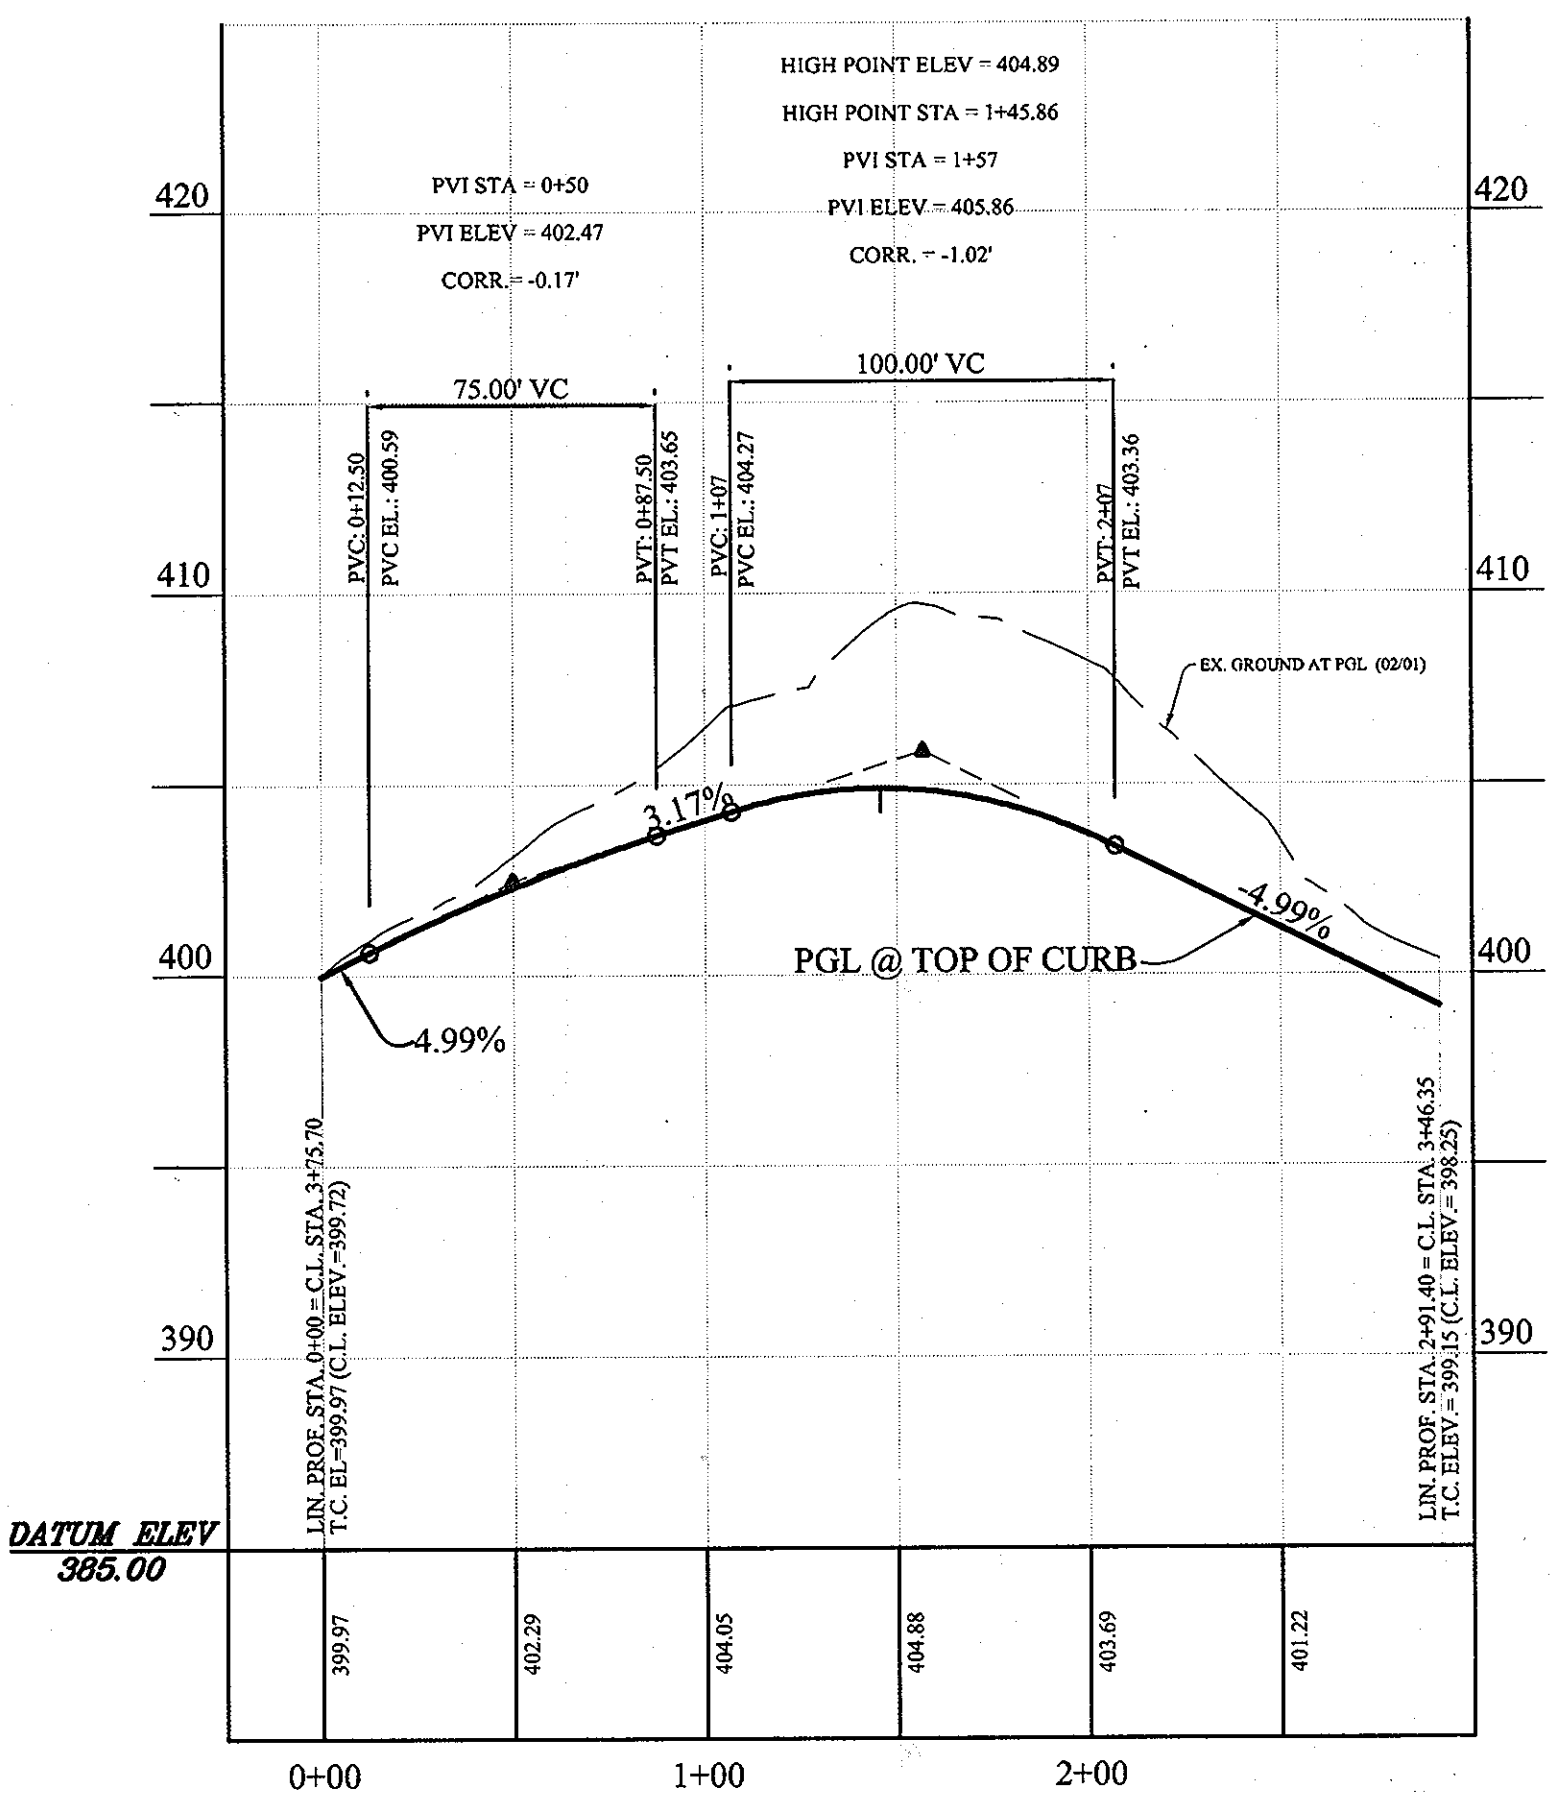

**LINEAR PROFILE: CARSON COURT**

NOTE: 95% COMPACTION PER AASHTO-T180 IS REQUIRED FOR ALL FILL AREA.

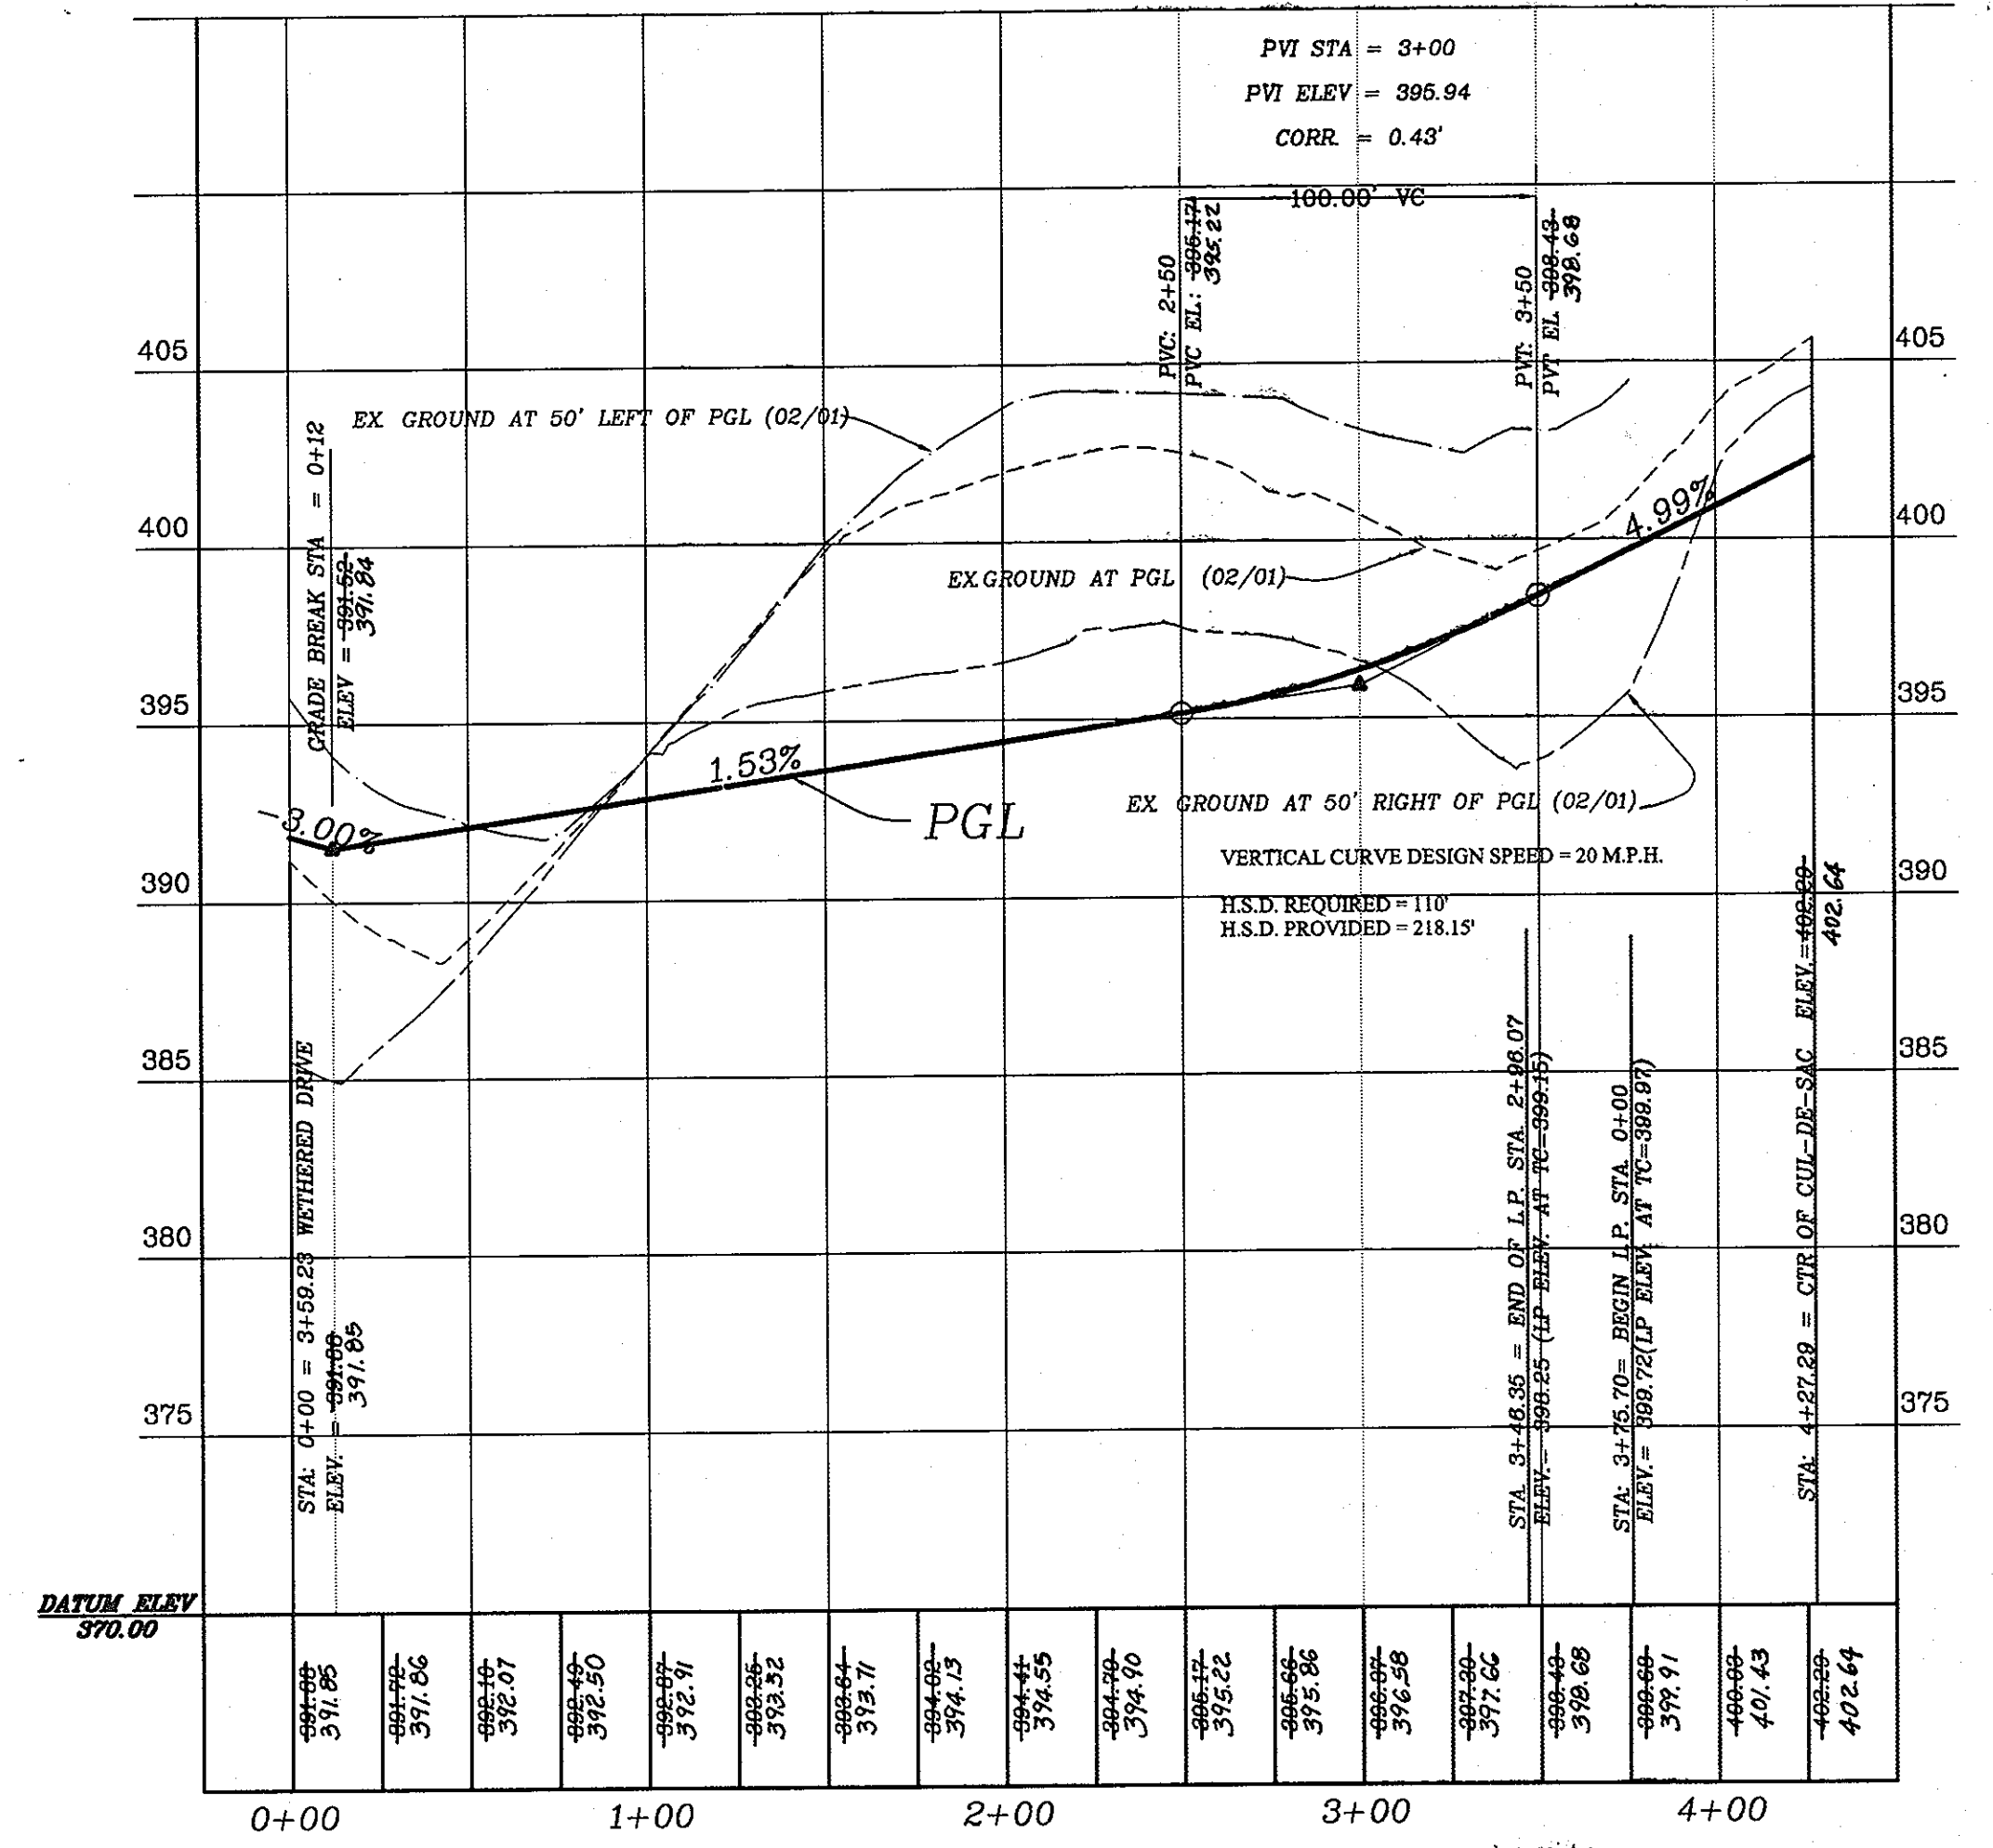

**CARSON COURT**  
PUBLIC ACCESS PLACE - DESIGN SPEED = 15 MPH

APPROVED: HOWARD COUNTY DEPARTMENT OF PLANNING & ZONING  
*Cindy Hamilton* 10/27/03  
CHIEF, DIVISION OF LAND DEVELOPMENT

APPROVED: HOWARD COUNTY DEPARTMENT OF PUBLIC WORKS  
*William J. Madala Jr.* 10-14-03  
CHIEF, BUREAU OF HIGHWAY

PROFILE SCALE:  
V: 1"=5'  
H: 1"=50'


**AS-BUILT PLANS**



DATE	REVISION	DATE	BY	DATE
	FINAL AS-BUILT REVISIONS	09/24/03		
	FINAL MFLAR SUBMITTAL FOR SIGNATURE	07/11/03		
	RE-SUBMITTED FOR REVIEW AND APPROVAL	04/25/03		
	RE-SUBMITTED FOR REVIEW AND APPROVAL	1-14-03		

Developer/Owner:  
**Winchester Homes, Inc. & Winchester Homes, Inc., as nominee for Stringtown Investments, LLC**  
6905 Rockledge Drive  
Suite 800  
Bethesda, Maryland 20817  
Stephen J. Nardella, Vice President  
(301) 803 - 4800

(PUBLIC ACCESS PLACE)  
**CARSON COURT**  
PLAN & PROFILE

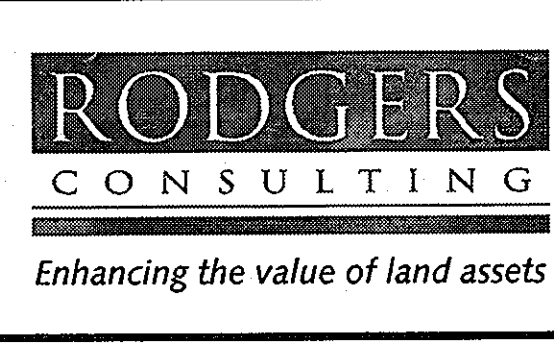

Rodgers Consulting, Inc.  
9250 Gaither Road  
Gaithersburg, MD 20877  
301.948.4700  
301.948.6256 (fax)  
301.253.6609  
www.rodgers.com


**Montjoy - Single Family Detached**  
A RESUBDIVISION OF NON-BUILDABLE BULK PARCEL C (F-03-87)  
TO  
BUILDABLE LOTS 127 - 188 AND OPEN SPACE LOTS 189-193  
ELECTION DISTRICT #2 HOWARD COUNTY, MARYLAND  
TAX MAP: 30, GRID: 12, PARCEL 260  
DPZ FILES: S-01-20, WP-01-117, P-02-10, P-02-17, P-03-08, F-03-87

SCALE: AS SHOWN  
JOB No. 506V3  
DATE: 1-14-03  
INDEX No. RP-4  
SHEET No. 5 OF 34








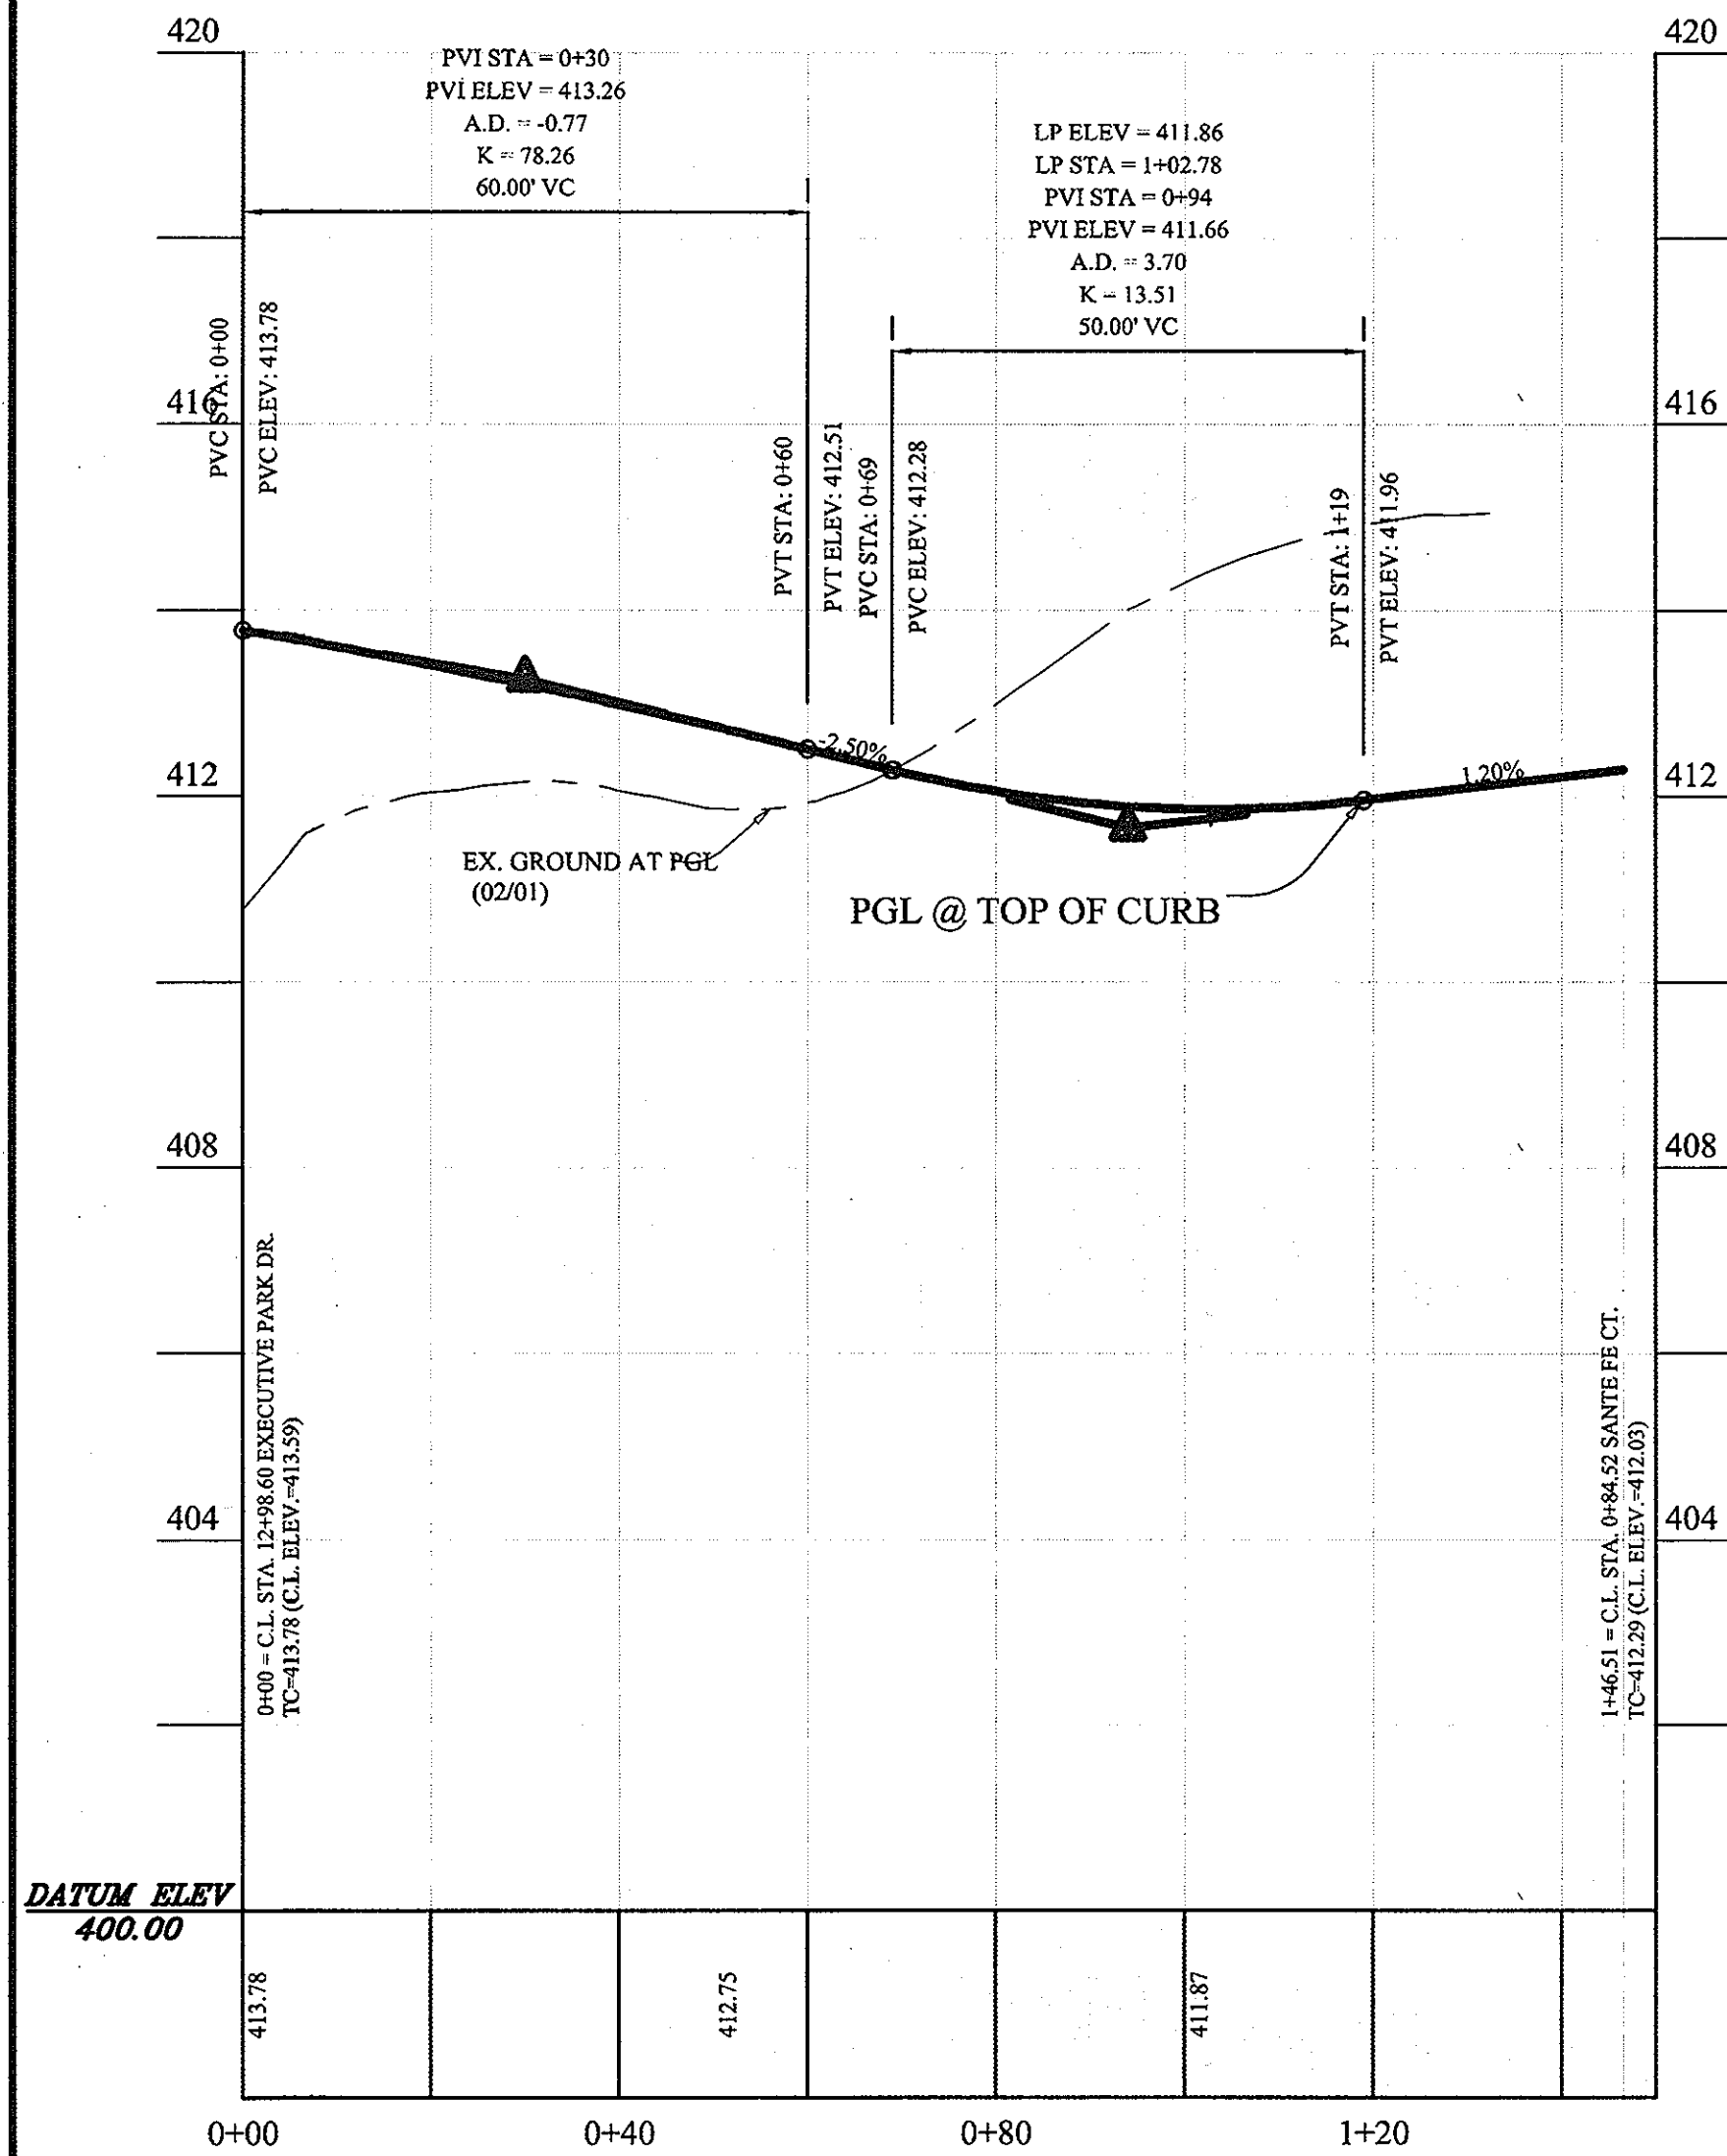


**CURB RETURN PROFILE:**  
RIGHT OF EXECUTIVE PARK DR. & SANTE FE CT.

PROFILE  
SCALE: H: 1"=20'  
V: 1"=2'

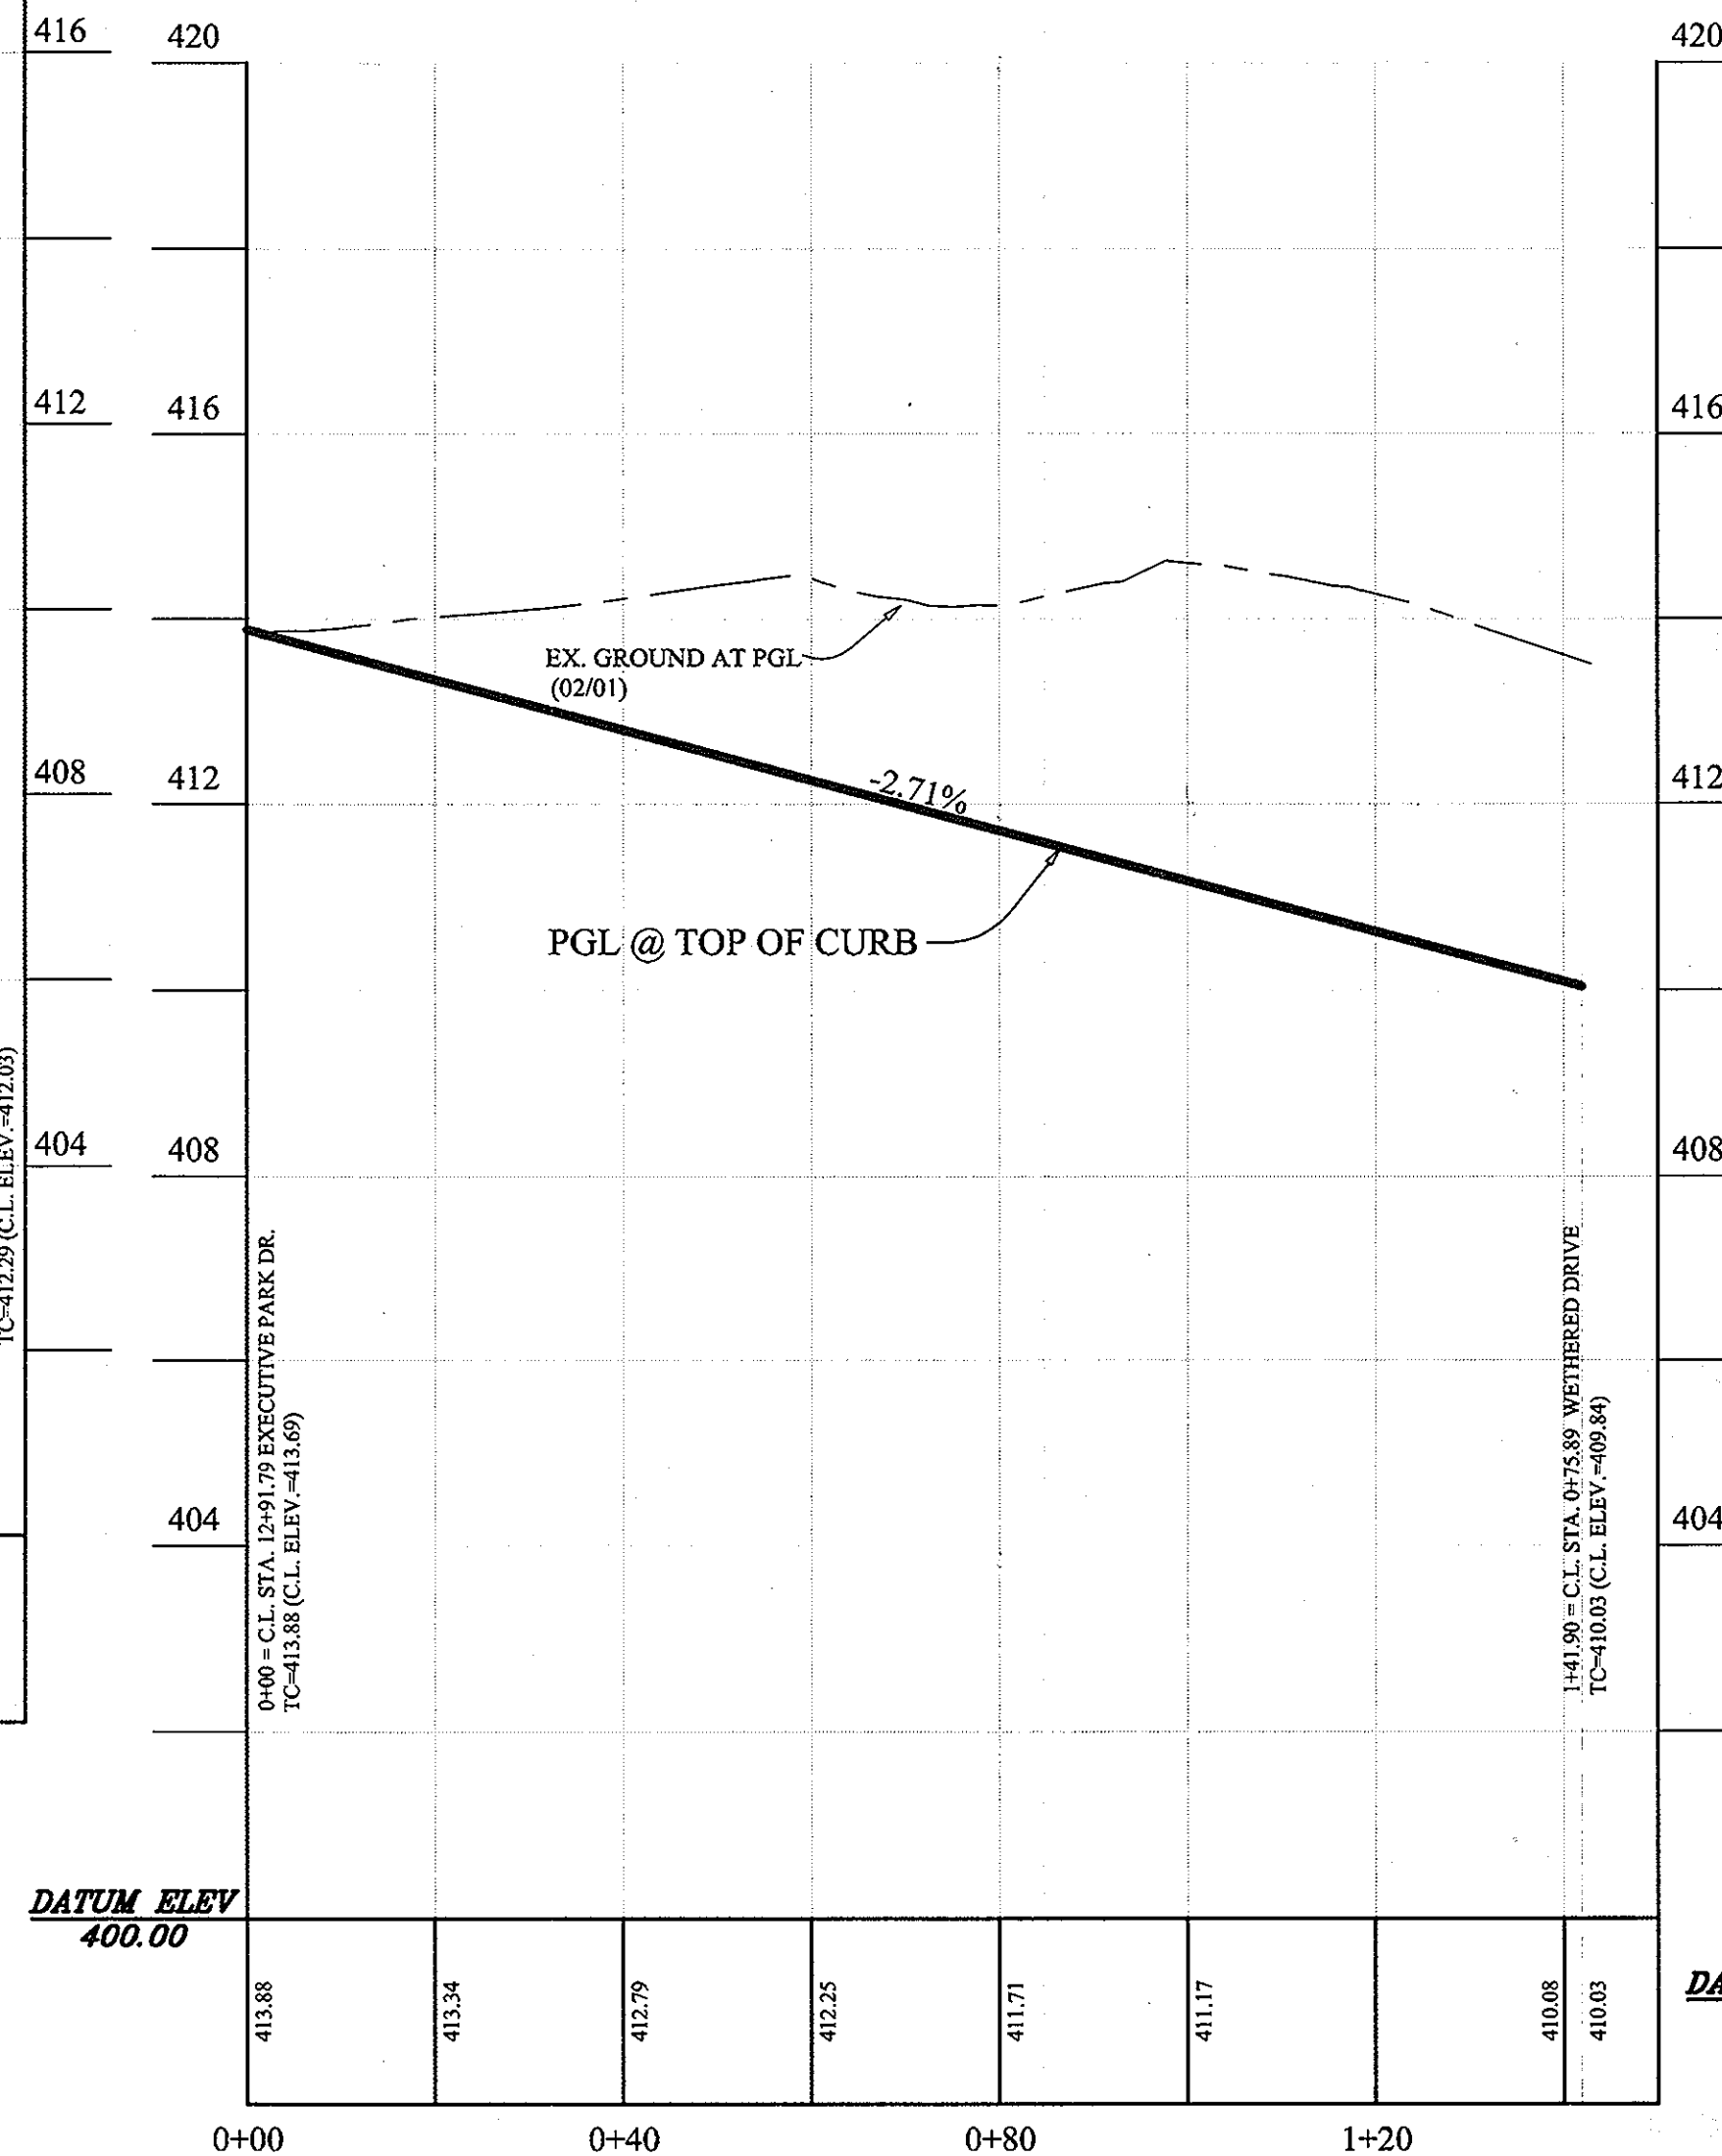


**CURB RETURN PROFILE:**  
LEFT OF EXECUTIVE PARK DR. & WETHERED DR.

PROFILE  
SCALE: H: 1"=20'  
V: 1"=2'

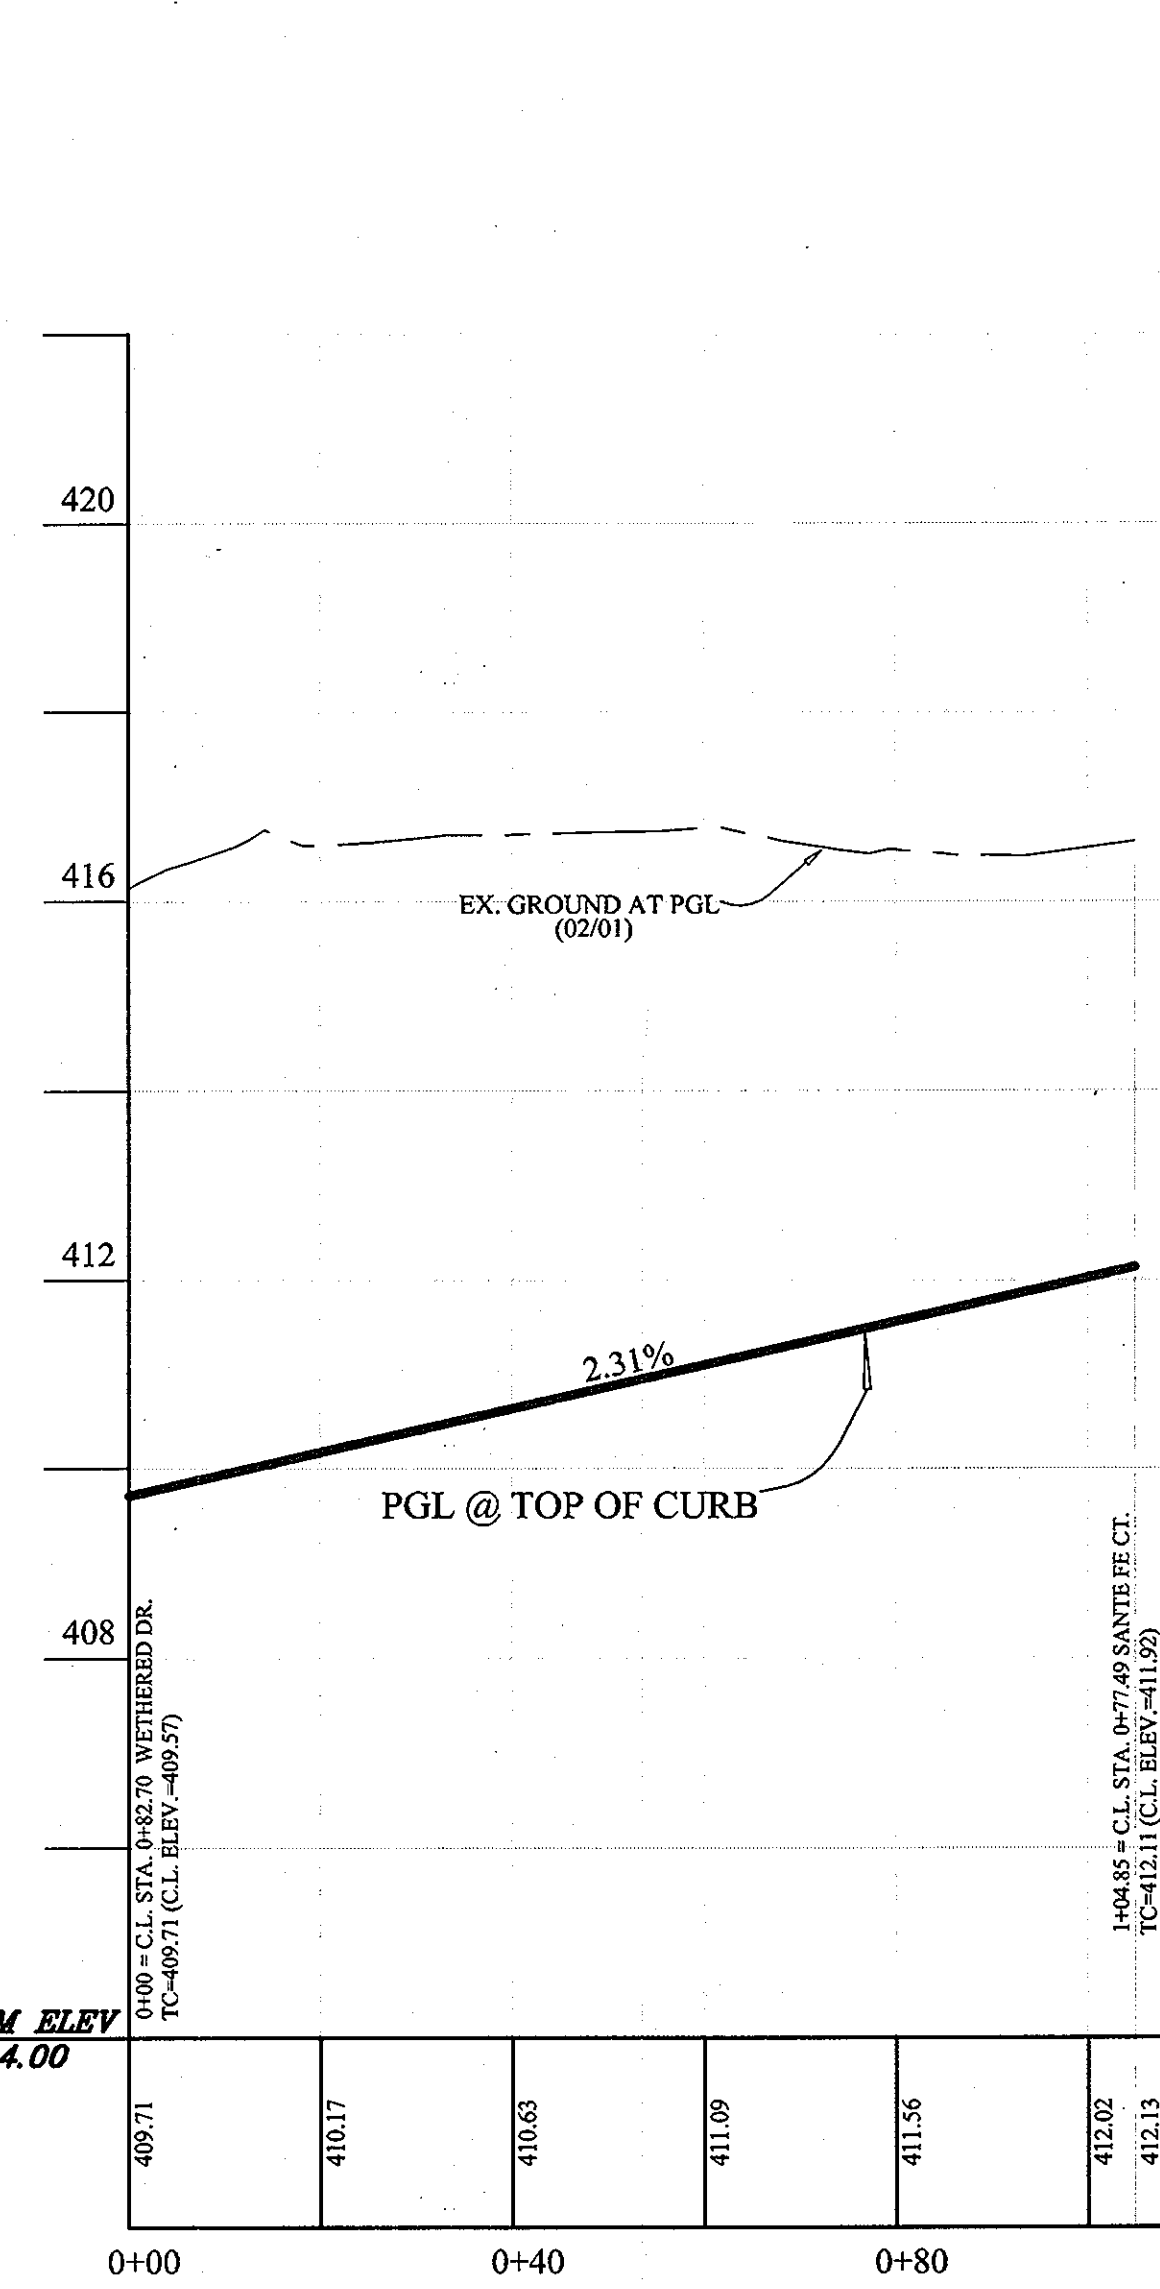


**CURB RETURN PROFILE:**  
RIGHT OF SANTE FE CT. & WETHERED DR.

PROFILE  
SCALE: H: 1"=20'  
V: 1"=2'

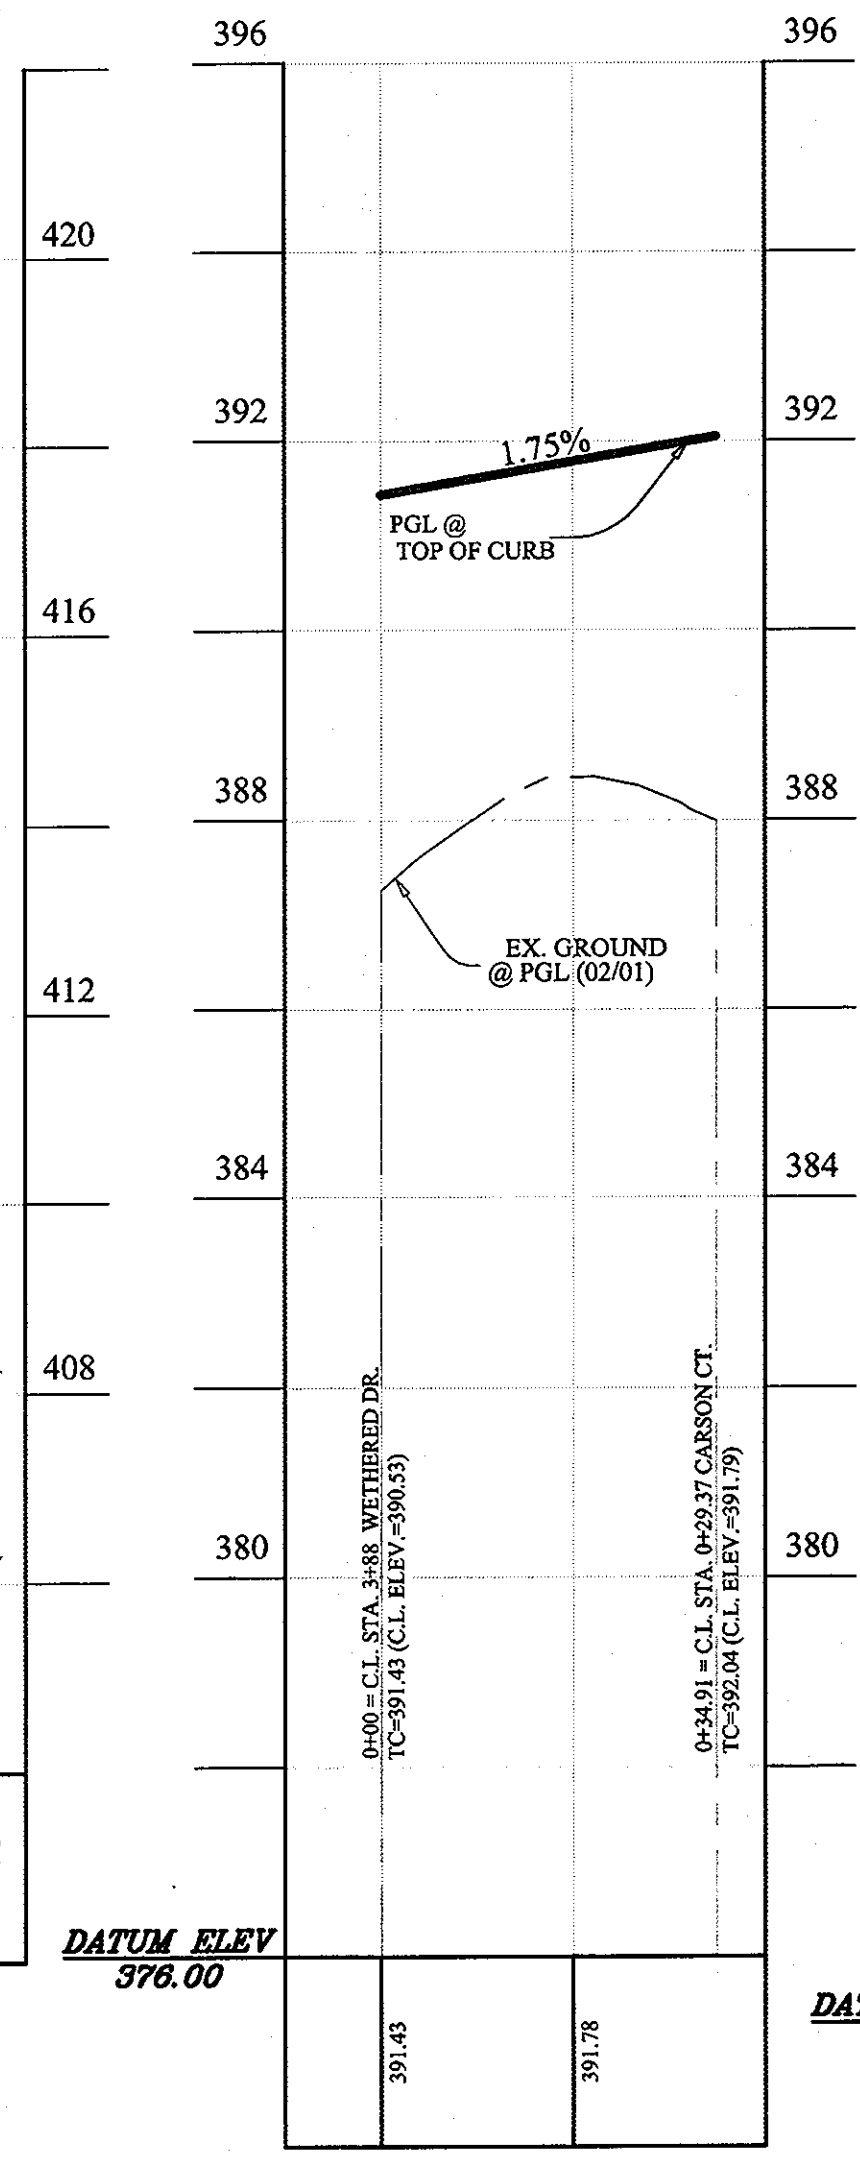

**CURB RETURN PROFILE:**  
RIGHT OF CARSON CT. & WETHERED DR.

PROFILE  
SCALE: H: 1"=20'  
V: 1"=2'

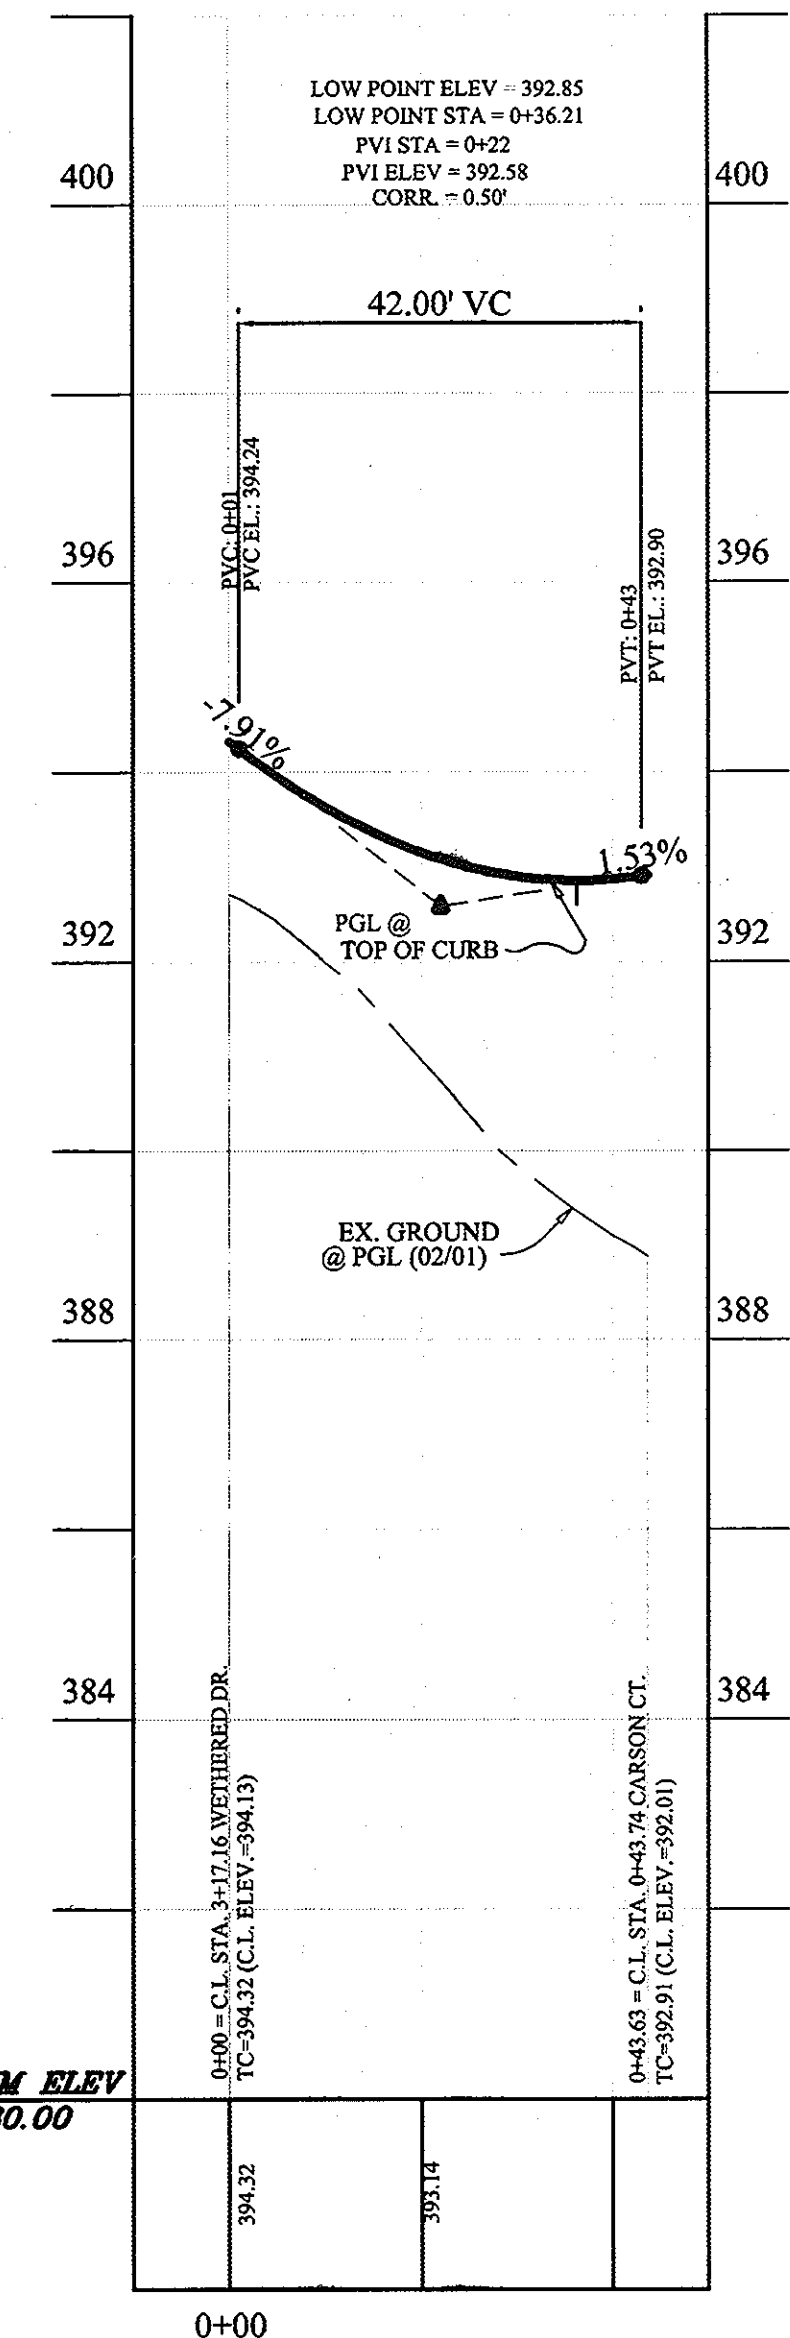

**CURB RETURN PROFILE:**  
LEFT OF WETHERED DR. & CARSON CT.

PROFILE  
SCALE: H: 1"=20'  
V: 1"=2'


APPROVED: HOWARD COUNTY DEPARTMENT OF PLANNING & ZONING

APPROVED: HOWARD COUNTY DEPARTMENT OF PUBLIC WORKS

*Cindy Hamilton* 10/27/02  
CHIEF, DIVISION OF LAND DEVELOPMENT  
*Chris Damman* 10/17/03  
CHIEF, DEVELOPMENT ENGINEERING DIVISION

*William J. Mahon Jr.* 10-14-03  
CHIEF, BUREAU OF HIGHWAY


**AS-BUILT PLANS**  
(No As-Built Data This Sheet)

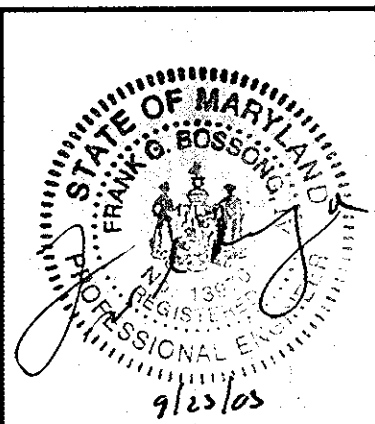

DATE	REVISION	DATE	BY	DATE
	BASE DATA		CADD	
	DESIGNED		YSL	
	DRAWN		YSL	
	REVIEWED		PFB/RF	
	RELEASE FOR			
	FINAL AS-BUILT REVISIONS	10/27/02		
	FINAL MYLAR SUBMITTAL FOR SIGNATURE	9/24/03		
	RE-SUBMITTED FOR REVIEW AND APPROVAL	07/11/03		
	RE-SUBMITTED FOR REVIEW AND APPROVAL	04/25/03		
	SUBMITTED FOR REVIEW	1-14-03		

Developer/Owner:  
**Winchester Homes, Inc. & Winchester Homes, Inc.**, as nominee for Stringtown Investments, LLC  
6905 Rockledge Drive  
Suite 800  
Bethesda, Maryland 20817  
Stephen J. Nardella, Vice President  
(301) 803 - 4800

**CURB RETURN PROFILES**

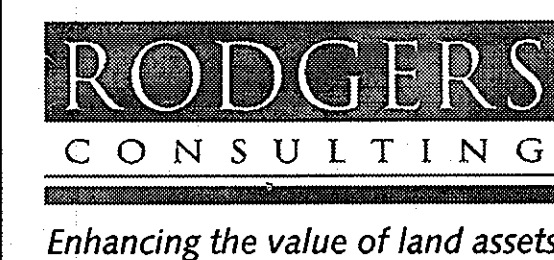

Rodgers Consulting, Inc.  
9250 Gaither Road  
Gaithersburg, MD 20877  
301.948.4700  
301.948.6256 (fax)  
301.253.6609  
www.rodgers.com

**Montjoy - Single Family Detached**

A RESUBDIVISION OF NON-BUILDABLE BULK PARCEL C (F-03-87)  
TO  
BUILDABLE LOTS 127- 188 AND OPEN SPACE LOTS 189-193  
ELECTION DISTRICT #2 HOWARD COUNTY, MARYLAND  
TAX MAP: 30, GRID: 12, PARCEL 260  
DPZ FILES: S-01-20, WP-01-117, P-02-10, P-02-17, P-03-03, P-03-87

AS SHOWN
JOB No. 506V3
DATE: 1-14-03
INDEX No. RP-6
SHEET No. 7 OF 34



CALL "MISS UTILITY" AT  
1-800-257-7777  
48 Hours Before Start of Construction

TRAFFIC SIGN LEGEND


SIGN	SYMBOL	SIGN	SYMBOL	SIGN	SYMBOL
(24x30) SPEED LIMIT 25 R2-1 (12x15) R4-7	(A)	(36x36) AHEAD OF WORK R2-1 R4-7	(E)*	STREET NAME (ON BACK OF R1-2) (CONTACT THE COUNTY)	(H)
(30x30) STOP R1-1	(C)	(36x36) W3-2a 15 MPH W3-2a (18x18)	(F)*	*36"x36" in inbound roadway 30"x30" in outbound roadway	
(36x12) ONE WAY (36x18) R6-1	(D)	(36x36x36) TO TRAFFIC IN CIRCLE (30x18) R1-2	(G)		

NOTE:  
Contact Howard County Traffic Division at 410-313-5752  
prior to ordering and installing any signs.

STREET LIGHT LOCATION DATA

STREET NAME	STATION	OFF-SET	FIXTURE/POLE TYPE	COMMENTS
Executive Park Dr.	8+60	15' o/s R	100 watt HPS vapor premier colonial post top fixture mounted on 14' black fiberglass pole.	
Executive Park Dr.	11+29	15' o/s R	"	
Executive Park Dr.	13+22	21.32' o/s R	"	Round-about
Wethered Drive	0+48	24' o/s L	"	Round-about
Wethered Drive	3+74	18' o/s L	"	
Wethered Drive	6+74	13' o/s L	"	
Wethered Drive	9+80	19' o/s L	"	
Carson Court	1+14(L.P.)	3'	"	Back of out-of-soc
Sante Fe Court	0+50	21.80' o/s L	"	
Sante Fe Court	4+21	17.70' o/s L	"	

NOTE: ALL SIGN LOCATIONS AND ALL PAVEMENT MARKINGS SHALL BE APPROVED BY HOWARD COUNTY DPW/HIGHWAY TRAFFIC DIVISION PRIOR TO THE INSTALLATION OF ANY OF THESE TRAFFIC CONTROL DEVICES.

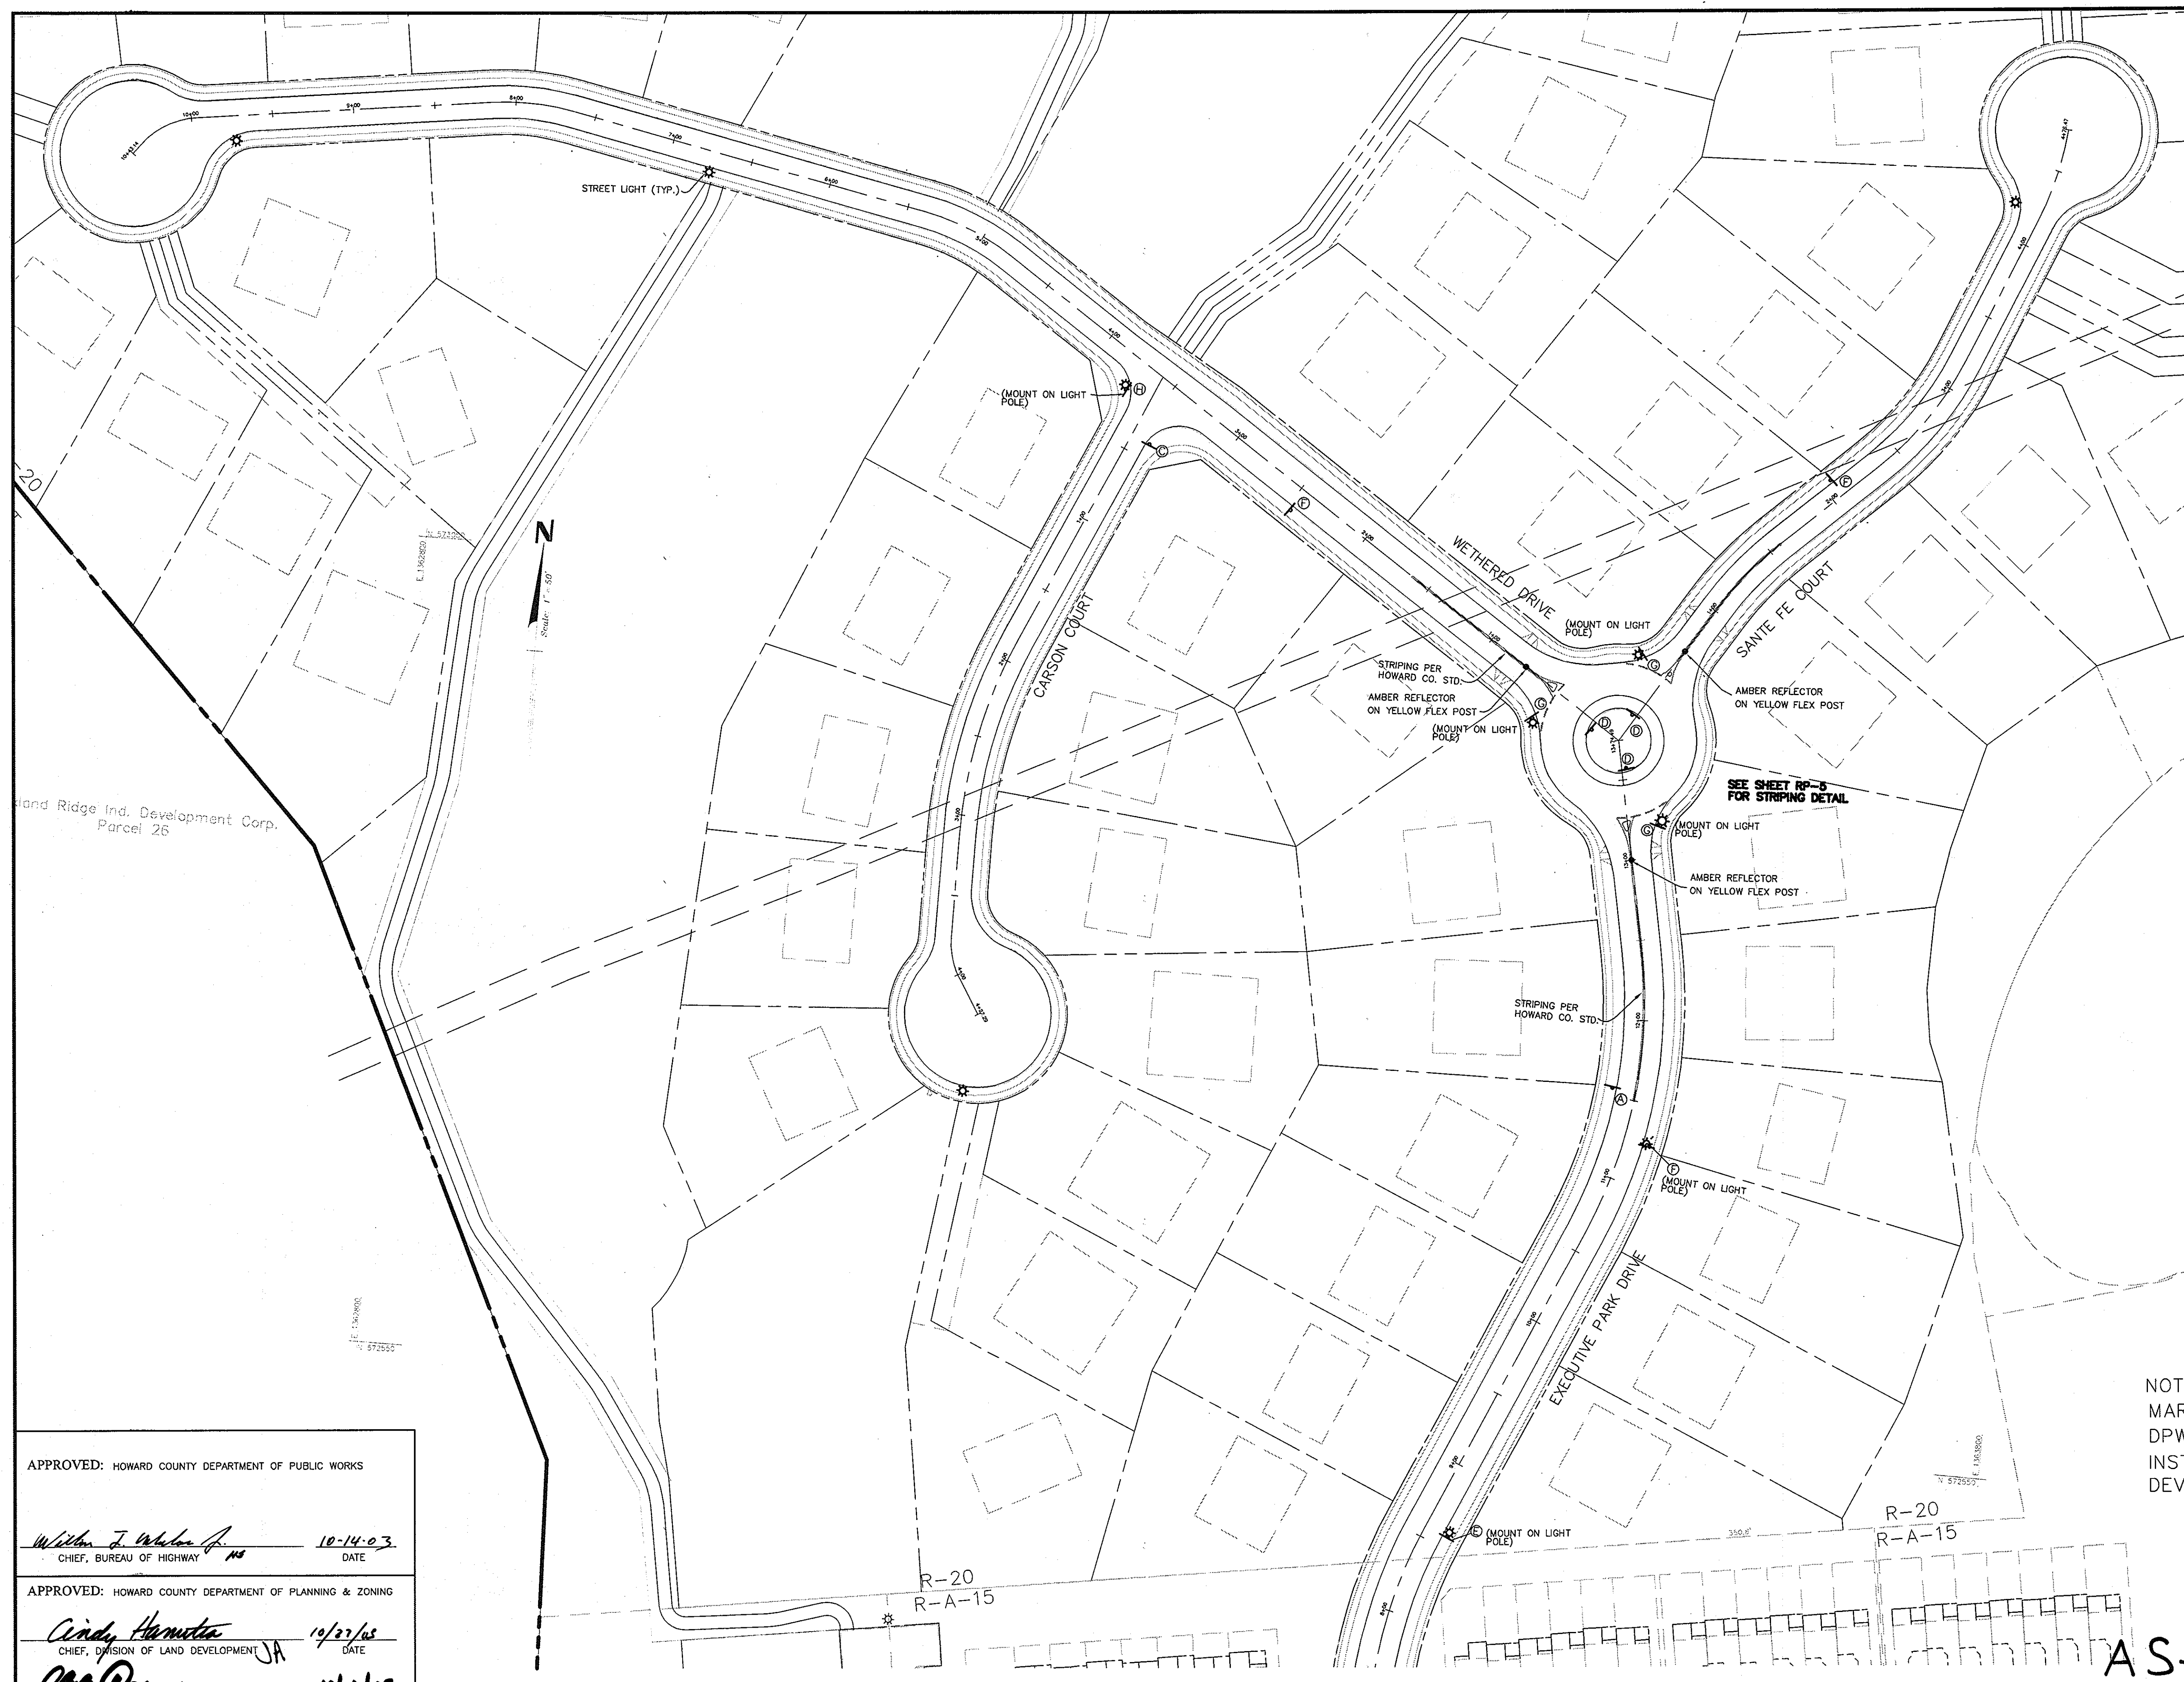

APPROVED: HOWARD COUNTY DEPARTMENT OF PUBLIC WORKS  
*William J. Wilson Jr.* 10-14-03  
CHIEF, BUREAU OF HIGHWAY

APPROVED: HOWARD COUNTY DEPARTMENT OF PLANNING & ZONING  
*Cindy Hamstra* 10/27/03  
CHIEF, DIVISION OF LAND DEVELOPMENT

*Chris Cummings* 10/17/03  
CHIEF, DEVELOPMENT ENGINEERING DIVISION

DATE	REVISION	DATE	BY	DATE
	BASE DATA		CADD	
	DESIGNED		PFB, YSL	
	DRAWN		YSL	
	REVIEWED		PFB/RF	
	RELEASE FOR			
9/24/03	FINAL MYLAR SUBMITTAL FOR SIGNATURE			
07/11/03	RE-SUBMITTED FOR REVIEW AND APPROVAL			
04/25/03	RE-SUBMITTED FOR REVIEW AND APPROVAL			
12/20/02	SUBMITTED FOR REVIEW			

Developer/Owner:  
**Winchester Homes, Inc. & Winchester Homes, Inc.**, as nominee for Stringtown Investments, LLC  
6905 Rockledge Drive  
Suite 800  
Bethesda, Maryland 20817  
Stephen J. Nardella, Vice President  
(301) 803-4800

STREET LIGHT DATA & SIGNAGE PLAN

**RODGERS CONSULTING**  
Enhancing the value of land assets

Rodgers Consulting, Inc.  
9250 Gaither Road  
Gaithersburg, MD 20877  
301.948.4700  
301.948.6256 (fax)  
301.253.6609  
www.rodgers.com

AS-BUILT PLANS  
(No As-Built Data This Sheet)

**Montjoy - Single Family Detached**  
A RESUBDIVISION OF NON-BUILDABLE BULK PARCEL C (F-03-87)  
TO  
BUILDABLE LOTS 127- 188 AND OPEN SPACE LOTS 189-193  
ELECTION DISTRICT #2 HOWARD COUNTY, MARYLAND  
TAX MAP: 30, GRID: 12, PARCEL 260  
DPZ FILES: S-01-20, WP-01-117, P-02-10, P-02-17, P-03-03, F-03-87



SCALE: 1"=50'  
JOB No.: 506V3  
DATE: 01/14/03  
INDEX No.: RP-7  
SHEET No.: 8 OF 34



CALL "MISS UTILITY" AT  
1-800-257-7777  
48 Hours Before Start of Construction

**Legend**

- (I-35) DRAINAGE AREA NUMBER
- (M) STRUCTURE NUMBER
- (I-35) DRAINAGE AREA NUMBER, EXISTING
- (M) STRUCTURE NUMBER, EXISTING
- DRAINAGE AREA LINE
- S.V.B. STORM DRAIN
- S.V.B. STREAM BUFFER
- 100 YR. FLOODPLAIN
- EXISTING TREELINE
- ZONING LINE
- MATCH LINE
- TP TEMP. TREE PROTECTION FENCE
- X-X EX. TREE PROTECTION FENCE (INST. UNDER F-03-87)
- X-SSX COMBINED SILT/TREE PROTECTION FENCE
- ▲ CONSERVATION SIGNAGE
- ..... L.O.D. LIMIT OF DISTURBANCE, SINGLE FAMILY PHASE
- ..... PREVIOUS LIMIT OF DISTURBANCE (PER F-03-87)
- EX. SWM CREDIT, UTILITY AND FOREST CONSERVATION EASEMENT (PER F-03-87)
- EX. SWM CREDIT EASEMENT (PER F-03-87)

NOTE: CONTRACTOR TO FIELD LOCATE THE EXISTING AT&T FIBER OPTIC LINES THROUGHOUT THIS SITE

**SWM CREDITS**

LOTS	CREDIT TYPE	CREDIT TAKEN	COMMENTS
124-122	SHEET FLOW TO BUFFER	WATER QUALITY, RECHARGE	USING LEVEL SPREADERS
136-140	GRASS SWALE	RECHARGE	
127-132	GRASS SWALE	RECHARGE	
181-186	SHEET FLOW TO BUFFER	WATER QUALITY, RECHARGE	USING LEVEL SPREADERS

NOTE: NATURAL CONSERVATION/BUFFER CREDIT AREAS INDICATED ON PLAN (SEE LEGEND ABOVE).




SEE SHEETS 17-19 FOR STORM DRAIN ELEVATIONS

**AS-BUILT CERTIFICATION**



I HEREBY CERTIFY THAT THE FACILITY SHOWN ON THIS PLAN WAS CONSTRUCTED AS SHOWN ON THE "AS-BUILT PLANS" AND MEETS THE APPROVED PLAN AND SPECIFICATIONS.

SIGNATURE: *James A. Rodgers* RE. NO.: 20637  
DATE: 12/5/06

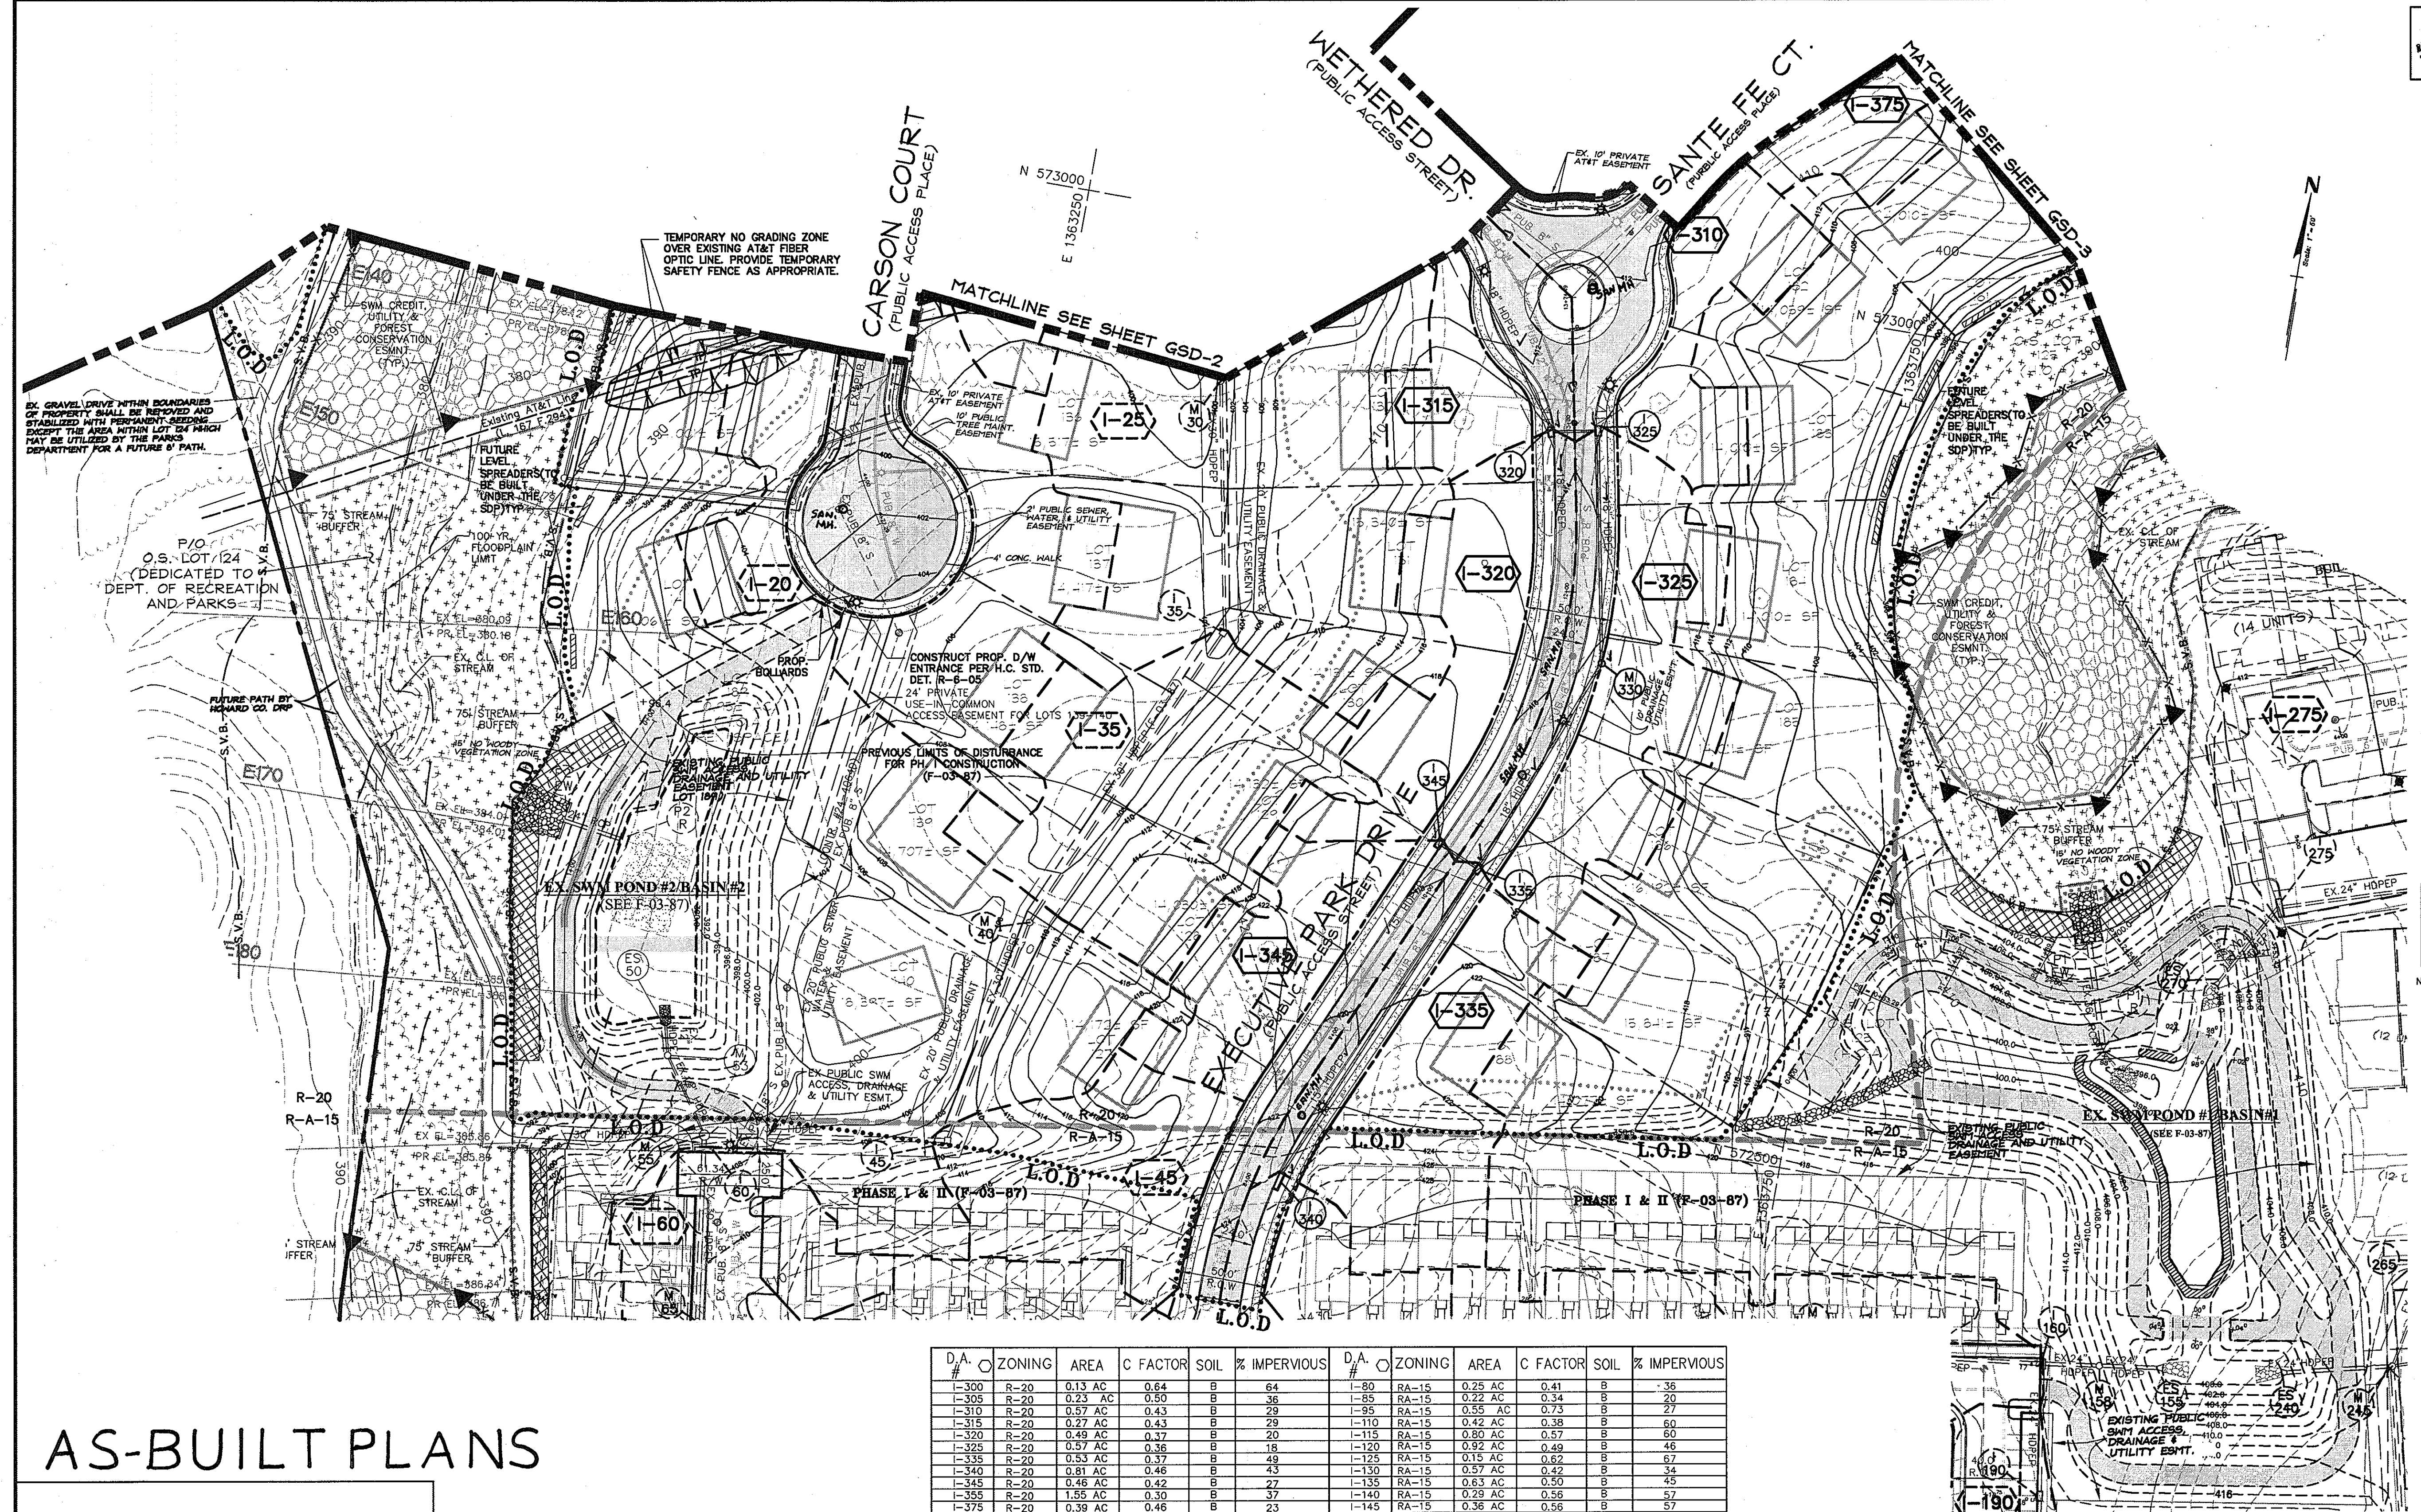



CALL "MISS UTILITY" AT  
1-800-257-7777  
48 Hours Before Start Of Construction

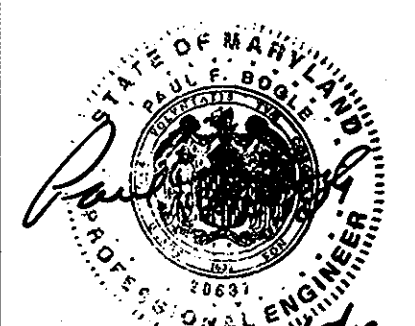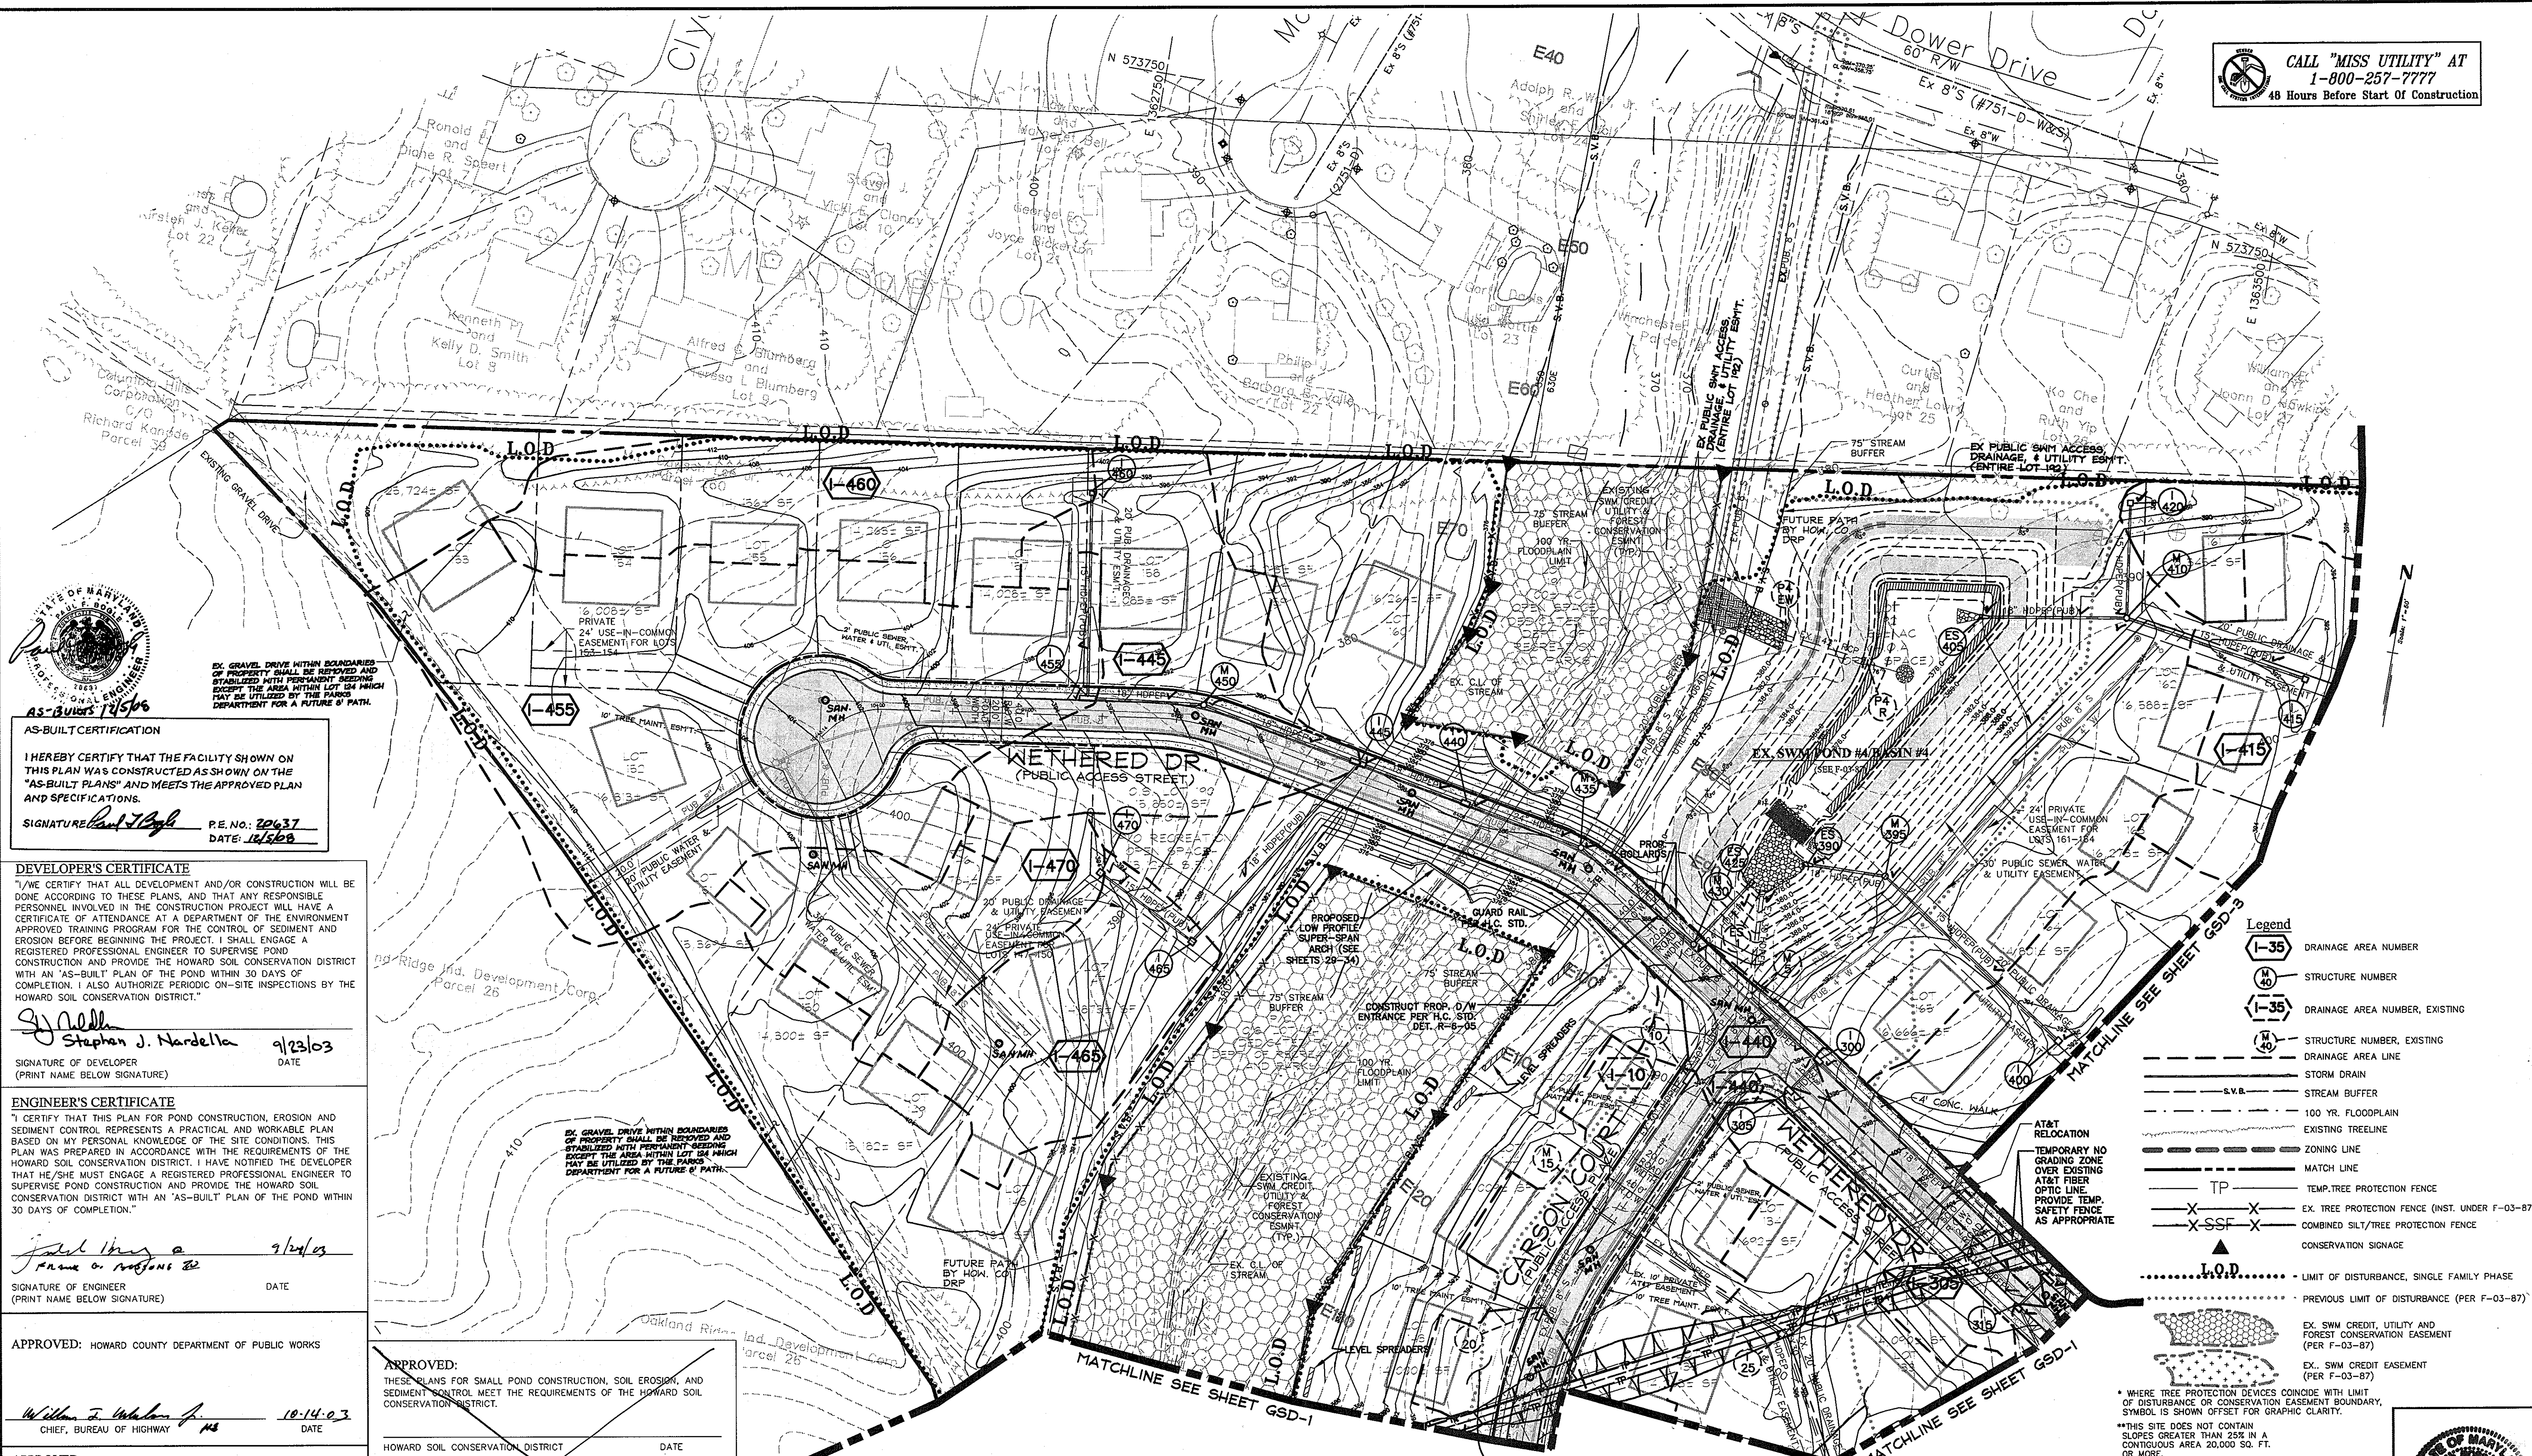

**AS-BUILT CERTIFICATION**  
I HEREBY CERTIFY THAT THE FACILITY SHOWN ON THIS PLAN WAS CONSTRUCTED AS SHOWN ON THE "AS-BUILT PLANS" AND MEETS THE APPROVED PLAN AND SPECIFICATIONS.  
SIGNATURE: *Stephan J. Nardella* P.E. No.: 14596 DATE: 10/17/03

**DEVELOPER'S CERTIFICATE**  
I/WE CERTIFY THAT ALL DEVELOPMENT AND/OR CONSTRUCTION WILL BE DONE ACCORDING TO THESE PLANS, AND THAT ANY RESPONSIBLE PERSONNEL INVOLVED IN THE CONSTRUCTION PROJECT WILL HAVE A CERTIFICATE OF ATTENDANCE AT A DEPARTMENT OF THE ENVIRONMENT APPROVED TRAINING PROGRAM FOR THE CONTROL OF SEDIMENT AND EROSION BEFORE BEGINNING THE PROJECT. I SHALL ENGAGE A REGISTERED PROFESSIONAL ENGINEER TO SUPERVISE POND CONSTRUCTION AND PROVIDE THE HOWARD SOIL CONSERVATION DISTRICT WITH AN "AS-BUILT" PLAN OF THE POND WITHIN 30 DAYS OF COMPLETION. I ALSO AUTHORIZE PERIODIC ON-SITE INSPECTIONS BY THE HOWARD SOIL CONSERVATION DISTRICT.  
SIGNATURE: *Stephan J. Nardella* DATE: 9/23/03

**ENGINEER'S CERTIFICATE**  
I CERTIFY THAT THIS PLAN FOR POND CONSTRUCTION, EROSION AND SEDIMENT CONTROL PRESENTS A PRACTICAL AND WORKABLE PLAN BASED ON MY PERSONAL KNOWLEDGE OF THE SITE CONDITIONS. THIS PLAN WAS PREPARED IN ACCORDANCE WITH THE REQUIREMENTS OF THE HOWARD SOIL CONSERVATION DISTRICT. I HAVE NOTIFIED THE DEVELOPER THAT HE/SHE MUST ENGAGE A REGISTERED PROFESSIONAL ENGINEER TO SUPERVISE POND CONSTRUCTION AND PROVIDE THE HOWARD SOIL CONSERVATION DISTRICT WITH AN "AS-BUILT" PLAN OF THE POND WITHIN 30 DAYS OF COMPLETION.  
SIGNATURE: *James A. Robinson* DATE: 9/24/03

**APPROVED: HOWARD COUNTY DEPARTMENT OF PUBLIC WORKS**  
WILLIAM J. WILSON, JR. DATE: 10-14-03  
CHIEF, BUREAU OF HIGHWAY

**APPROVED: HOWARD COUNTY DEPARTMENT OF PLANNING & ZONING**  
CINDY HAMILTON DATE: 10/17/03  
CHIEF, DIVISION OF LAND DEVELOPMENT

**APPROVED:** THESE PLANS FOR SMALL POND CONSTRUCTION, SOIL EROSION, AND SEDIMENT CONTROL MEET THE REQUIREMENTS OF THE HOWARD SOIL CONSERVATION DISTRICT.  
HOWARD SOIL CONSERVATION DISTRICT DATE: \_\_\_\_\_

**APPROVED:** THESE PLANS HAVE BEEN REVIEWED FOR THE HOWARD SOIL CONSERVATION DISTRICT AND MEET THE TECHNICAL REQUIREMENTS FOR SMALL POND CONSTRUCTION, SOIL EROSION, AND SEDIMENT CONTROL.  
DSSA-NATURAL RESOURCES CONSERVATION SERVICE DATE: \_\_\_\_\_

**SWM CREDITS**

LOTS	CREDIT TYPE	CREDIT TAKEN	COMMENTS
153-159, 160, 148-151	ROOFTOP DISCONNECTION	WATER QUALITY RECHARGE	
180	SHEET FLOW TO BUFFER	WATER QUALITY RECHARGE	NON-PERVIOUS AREA
161-165, 133-135	GRASS SWALE	RECHARGE	
143-145	SHEET FLOW TO BUFFER	WATER QUALITY RECHARGE	USING LEVEL SPREADERS

NOTE: NATURAL CONSERVATION/BUFFER CREDIT AREAS INDICATED ON PLAN (SEE LEGEND).

- Legend**
- (I-35) DRAINAGE AREA NUMBER
  - (M-40) STRUCTURE NUMBER
  - (I-35) DRAINAGE AREA NUMBER, EXISTING
  - (M-40) STRUCTURE NUMBER, EXISTING
  - DRAINAGE AREA LINE
  - STORM DRAIN
  - S.V.B. STREAM BUFFER
  - 100 YR. FLOODPLAIN
  - EXISTING TREELINE
  - ZONING LINE
  - MATCH LINE
  - TP TEMP. TREE PROTECTION FENCE
  - X EX. TREE PROTECTION FENCE (INST. UNDER F-03-87)
  - X-SSF COMBINED SILT/TREE PROTECTION FENCE
  - CONSERVATION SIGNAGE
  - L.O.D. LIMIT OF DISTURBANCE, SINGLE FAMILY PHASE
  - PREVIOUS LIMIT OF DISTURBANCE (PER F-03-87)
  - EX. SWM CREDIT, UTILITY AND FOREST CONSERVATION EASEMENT (PER F-03-87)
  - EX. SWM CREDIT EASEMENT (PER F-03-87)

**AS-BUILT PLANS**


SEE SHEETS 17-19 FOR STORM DRAIN ELEVATIONS

NOTE: CONTRACTOR TO FIELD LOCATE THE EXISTING AT&T FIBER OPTIC LINES THROUGHOUT THIS SITE

DATE	REVISION	DATE	BY	DATE
	BASE DATA		CADD	
	DESIGNED		PFB, YSL	
	DRAWN		YSL	
	REVIEWED		PFB	
	RELEASE FOR			

Developer/Owner:  
**Winchester Homes, Inc. & Winchester Homes, Inc., as nominee for Stringtown Investments, LLC**  
6905 Rockledge Drive, Suite 800  
Bethesda, Maryland 20817  
Stephen J. Nardella, Vice President  
(301) 803-4800

**GRADING & STORM DRAIN/ DRAINAGE AREA MAP**

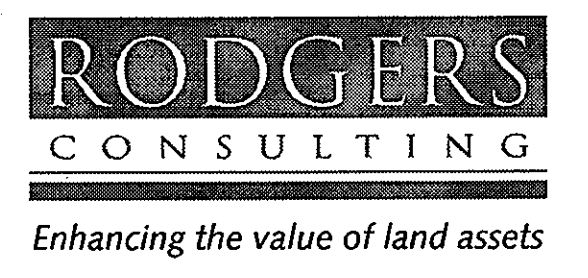

Rodgers Consulting, Inc.  
9260 Galther Road  
Gaithersburg, MD 20877  
301.948.4700  
301.948.6256 (fax)  
301.253.6609  
www.rodgers.com

**Montjoy - Single Family Detached**

A RESUBDIVISION OF NON-BUILDABLE BULK PARCEL C (F-03-87) TO BUILDABLE LOTS 127-188 AND OPEN SPACE LOTS 189-193  
ELECTION DISTRICT #2 HOWARD COUNTY, MARYLAND  
TAX MAP: 30, GRID: 12, PARCEL 260  
DP2 FILES: S-01-20, WP-01-117, P-02-10, P-02-17, P-03-03, P-03-87

SCALE: 1" = 50'  
JOB No.: 506V3  
DATE: 1-14-03  
INDEX No.: GSD-2  
SHEET No.: 10 OF 34




**SWM POND #3:**  
PUBLIC CLASS A SANDFILTER (F-1)  
(WATER QUALITY ONLY)

OWNER: HOA. JOINTLY MAINTAINED BY  
HOA & HOWARD COUNTY

SEE SHEET 20-22 FOR POND DETAILS NOT  
SHOWN-(SWM PLAN, PROFILE/DETAILS &  
RUNOFF SUMMARY TABLES)

SEE SHEET 24 FOR SWM LANDSCAPE PLAN

SEE SHEET 14 FOR TEMPORARY SEDIMENT  
BASIN GRADES

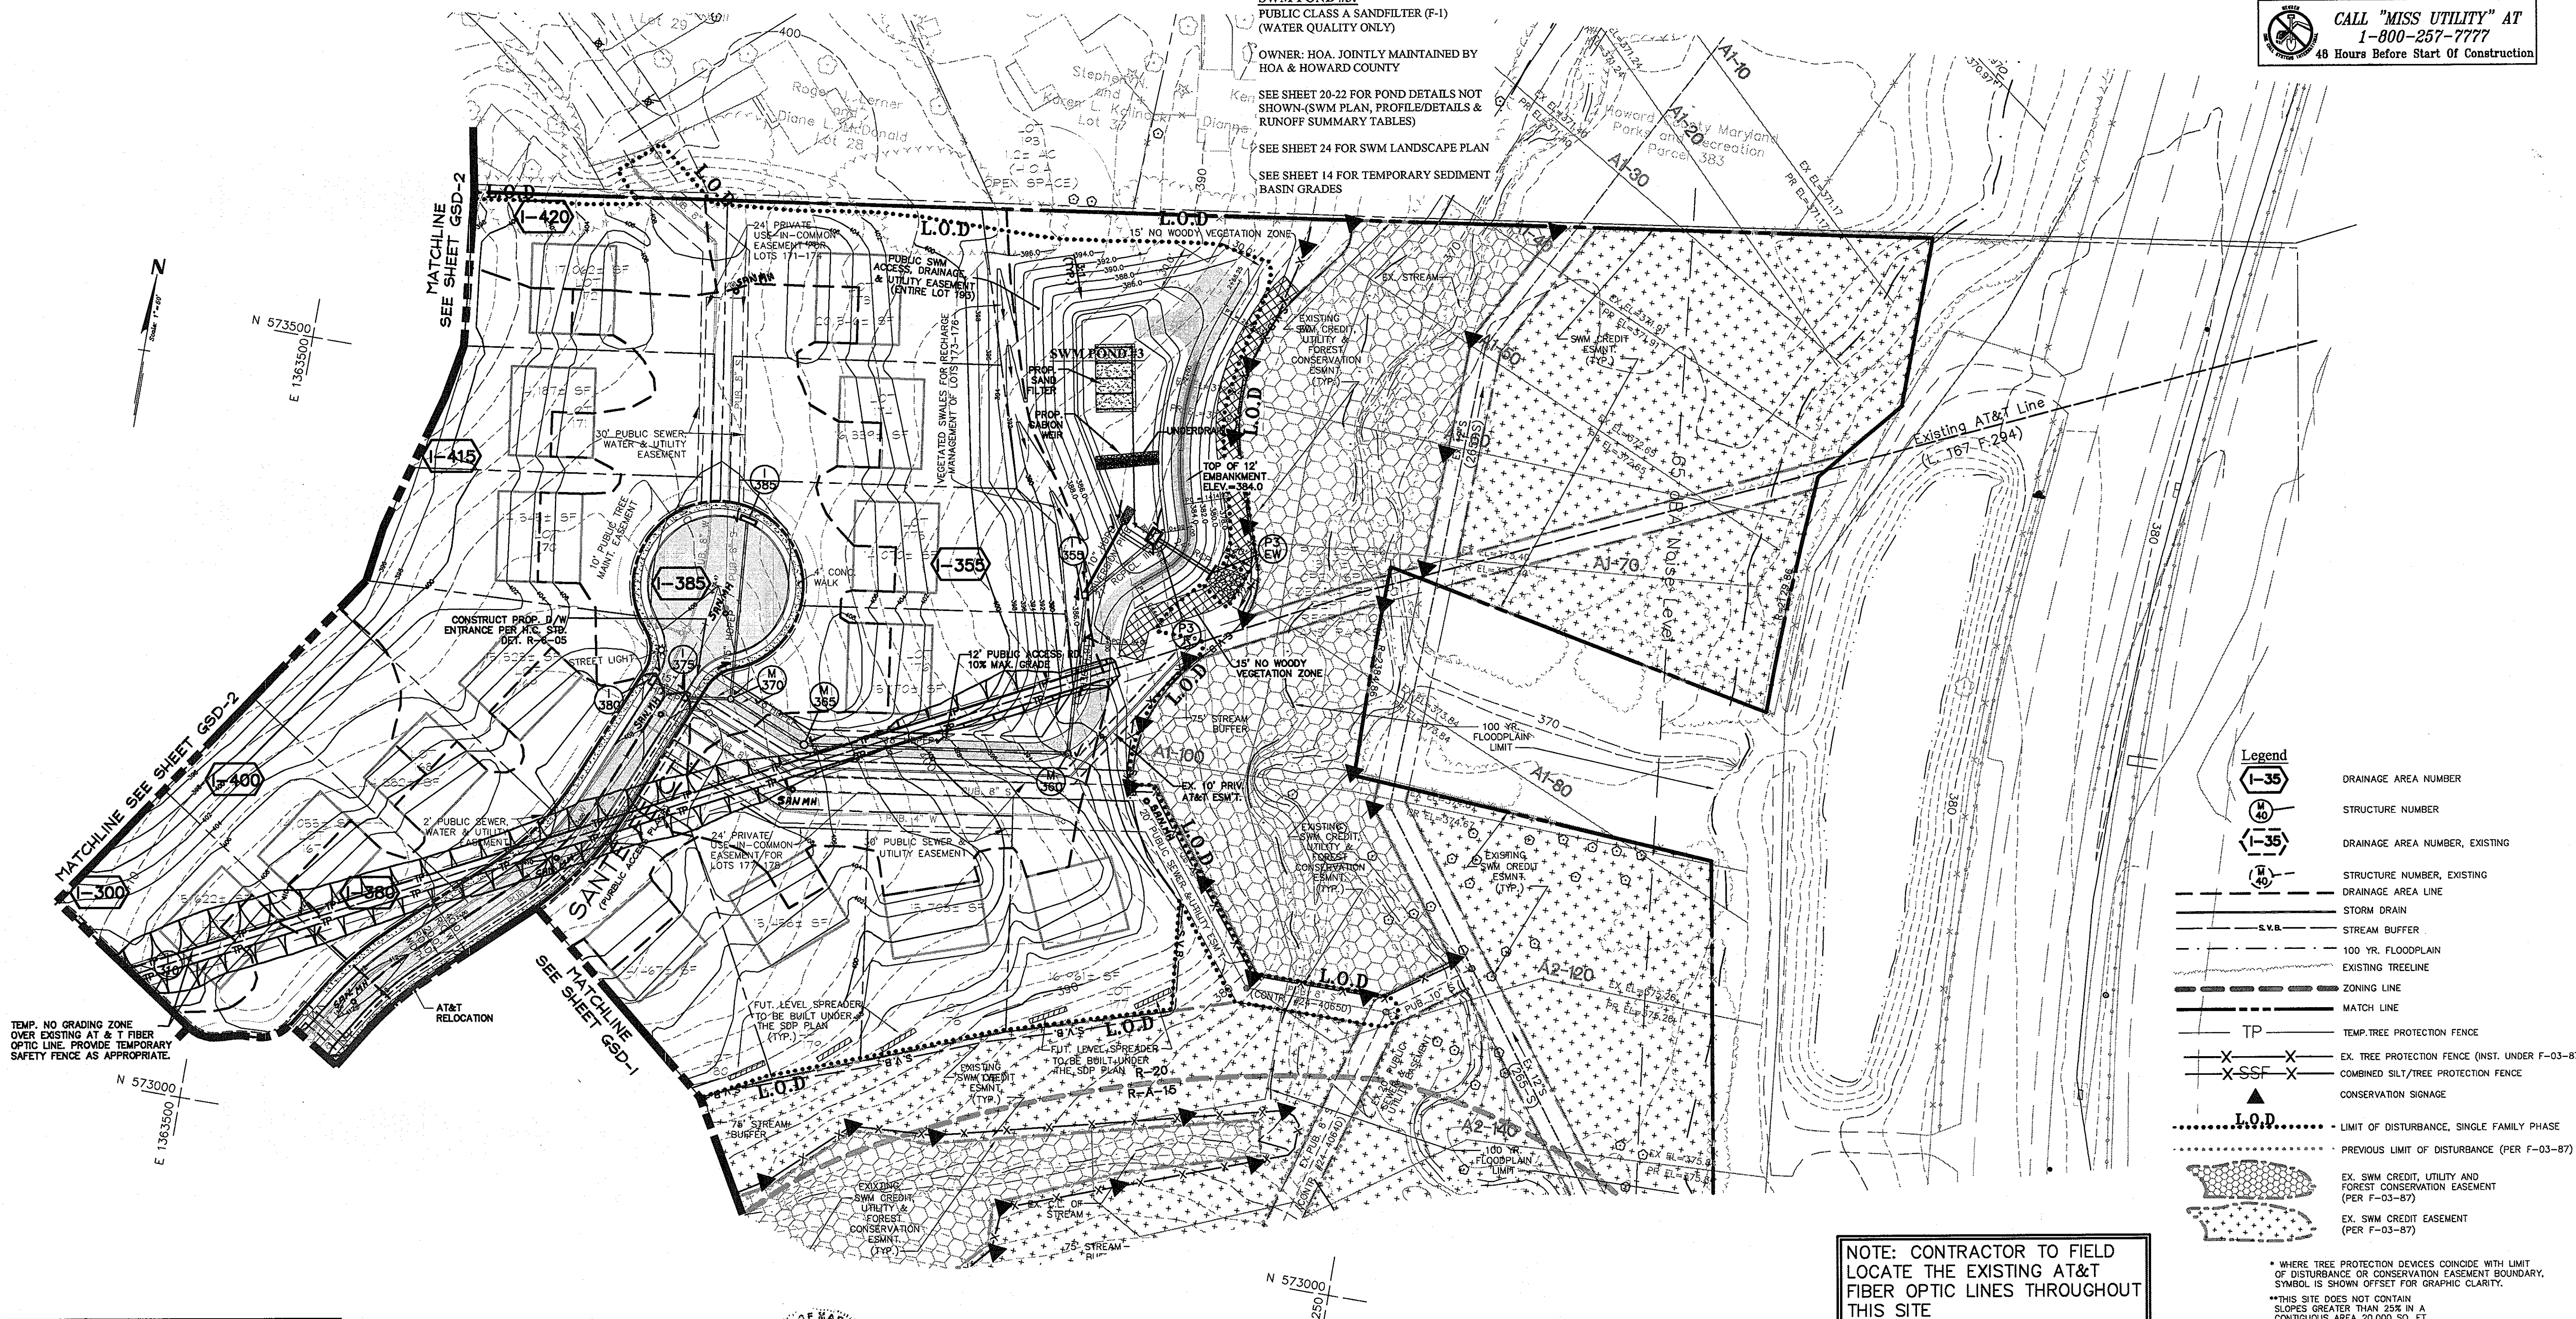

- Legend**
- DRAINAGE AREA NUMBER
  - STRUCTURE NUMBER
  - DRAINAGE AREA NUMBER, EXISTING
  - STRUCTURE NUMBER, EXISTING
  - DRAINAGE AREA LINE
  - STORM DRAIN
  - STREAM BUFFER
  - 100 YR FLOODPLAIN
  - EXISTING TREELINE
  - ZONING LINE
  - MATCH LINE
  - TEMP. TREE PROTECTION FENCE
  - EX. TREE PROTECTION FENCE (INST. UNDER F-03-87)
  - COMBINED SILT/TREE PROTECTION FENCE
  - CONSERVATION SIGNAGE
  - LIMIT OF DISTURBANCE, SINGLE FAMILY PHASE
  - PREVIOUS LIMIT OF DISTURBANCE (PER F-03-87)
  - EX. SWM CREDIT, UTILITY AND FOREST CONSERVATION EASEMENT BOUNDARY (PER F-03-87)
  - EX. SWM CREDIT EASEMENT (PER F-03-87)

**NOTE: CONTRACTOR TO FIELD  
LOCATE THE EXISTING AT&T  
FIBER OPTIC LINES THROUGHOUT  
THIS SITE**

\* WHERE TREE PROTECTION DEVICES COINCIDE WITH LIMIT OF DISTURBANCE OR CONSERVATION EASEMENT BOUNDARY, SYMBOL IS SHOWN OFFSET FOR GRAPHIC CLARITY.  
\*\* THIS SITE DOES NOT CONTAIN SLOPES GREATER THAN 25% IN A CONTIGUOUS AREA 20,000 SQ. FT. OR MORE.

APPROVED: HOWARD COUNTY DEPARTMENT OF PUBLIC WORKS  
*William J. Mahon Jr.* 10-14-03  
CHIEF, BUREAU OF HIGHWAY MS DATE

APPROVED: HOWARD COUNTY DEPARTMENT OF PLANNING & ZONING  
*Cindy Hendon* 10/27/03  
CHIEF, DIVISION OF LAND DEVELOPMENT JA DATE

*Chris Damman* 10/17/03  
CHIEF, DEVELOPMENT ENGINEERING DIVISION QP DATE

APPROVED:  
THESE PLANS FOR SMALL POND CONSTRUCTION, SOIL EROSION, AND SEDIMENT CONTROL MEET THE REQUIREMENTS OF THE HOWARD SOIL CONSERVATION DISTRICT.  
HOWARD SOIL CONSERVATION DISTRICT DATE

APPROVED:  
THESE PLANS HAVE BEEN REVIEWED FOR THE HOWARD SOIL CONSERVATION DISTRICT AND MEET THE TECHNICAL REQUIREMENTS FOR SMALL POND CONSTRUCTION, SOIL EROSION, AND SEDIMENT CONTROL.  
MSDA-NATURAL RESOURCES CONSERVATION SERVICE DATE

**AS-BUILT CERTIFICATION**  
I HEREBY CERTIFY THAT THE FACILITY SHOWN ON THIS PLAN WAS CONSTRUCTED AS SHOWN ON THE "AS-BUILT PLANS" AND MEETS THE APPROVED PLAN AND SPECIFICATIONS.  
SIGNATURE: *Stephen J. Nardella* P.E. No.: 20657 DATE: 12/5/05


SEE SHEETS 17-19 FOR STORM DRAIN ELEVATIONS  
**AS-BUILT PLANS**

LOTS	CREDIT TYPE	CREDIT TAKEN	COMMENTS
166-172, 173-176	GRASS SWALE	RECHARGE	
177-180	SHEET FLOW TO BUFFER	WATER QUALITY RECHARGE USING LEVEL SPREADERS	

NOTE: NATURAL CONSERVATION/BUFFER CREDIT AREAS INDICATED ON PLAN (SEE LEGEND).

**DEVELOPER'S CERTIFICATE**  
I/WE CERTIFY THAT ALL DEVELOPMENT AND/OR CONSTRUCTION WILL BE DONE ACCORDING TO THESE PLANS, AND THAT ANY RESPONSIBLE PERSONNEL INVOLVED IN THE CONSTRUCTION PROJECT WILL HAVE A CERTIFICATE OF ATTENDANCE AT A DEPARTMENT OF THE ENVIRONMENT APPROVED TRAINING PROGRAM FOR THE CONTROL OF SEDIMENT AND EROSION BEFORE BEGINNING THE PROJECT. I SHALL ENGAGE A REGISTERED PROFESSIONAL ENGINEER TO SUPERVISE POND CONSTRUCTION AND PROVIDE THE HOWARD SOIL CONSERVATION DISTRICT WITH AN "AS-BUILT" PLAN OF THE POND WITHIN 30 DAYS OF COMPLETION. I ALSO AUTHORIZE PERIODIC ON-SITE INSPECTIONS BY THE HOWARD SOIL CONSERVATION DISTRICT.  
*Stephen J. Nardella* 9/23/03  
SIGNATURE OF DEVELOPER DATE  
(PRINT NAME BELOW SIGNATURE)

**ENGINEER'S CERTIFICATE**  
I CERTIFY THAT THIS PLAN FOR POND CONSTRUCTION, EROSION AND SEDIMENT CONTROL REPRESENTS A PRACTICAL AND WORKABLE PLAN BASED ON MY PERSONAL KNOWLEDGE OF THE SITE CONDITIONS. THIS PLAN WAS PREPARED IN ACCORDANCE WITH THE REQUIREMENTS OF THE HOWARD SOIL CONSERVATION DISTRICT. I HAVE NOTIFIED THE DEVELOPER THAT HE/SHE MUST ENGAGE A REGISTERED PROFESSIONAL ENGINEER TO SUPERVISE POND CONSTRUCTION AND PROVIDE THE HOWARD SOIL CONSERVATION DISTRICT WITH AN "AS-BUILT" PLAN OF THE POND WITHIN 30 DAYS OF COMPLETION.  
*James A. Montjoy* 9/23/03  
SIGNATURE OF ENGINEER DATE  
(PRINT NAME BELOW SIGNATURE)

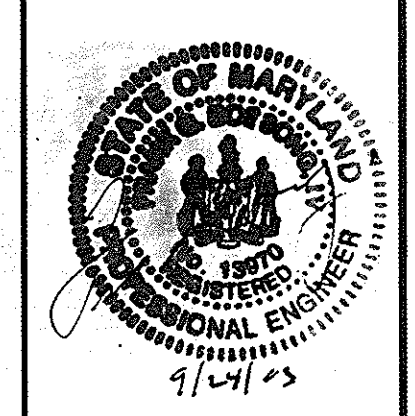


DATE	REVISION	DATE	BY	DATE
	BASE DATA		CADD	
	DESIGNED		PFB, YSL	
	DRAWN		YSL	
	REVIEWED		PFB/RF	
	RELEASE FOR			

FINAL AS-BUILT REVISIONS  
FINAL MYLAR SUBMITTAL FOR SIGNATURE 9/24/03  
RE-SUBMITTED FOR REVIEW AND APPROVAL 07/11/03  
RE-SUBMITTED FOR REVIEW AND APPROVAL 04/25/03  
SUBMITTED FOR REVIEW 1-14-03

Developer/Owner:  
**Winchester Homes, Inc. & Winchester Homes, Inc., as nominee for Stringtown Investments, LLC**  
6905 Rockledge Drive  
Suite 800  
Bethesda, Maryland 20817  
Stephen J. Nardella, Vice President  
(301) 803-4800

**GRADING & STORM DRAIN/  
DRAINAGE AREA MAP**

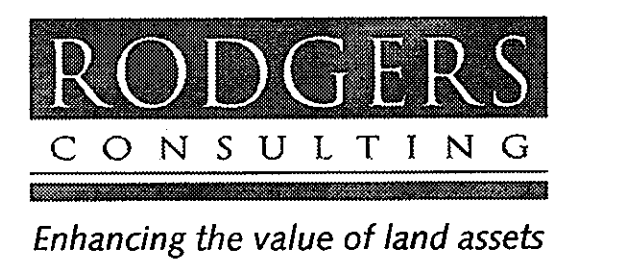

Rodgers Consulting, Inc.  
9260 Galthier Road  
Gaithersburg, MD 20877  
301.948.4700  
301.948.6256 (fax)  
301.253.6609  
www.rodgers.com

**Montjoy - Single Family Detached**  
A RESUBDIVISION OF NON-BUILDABLE BULK PARCEL C (F-03-87)  
TO  
BUILDABLE LOTS 127- 188 AND OPEN SPACE LOTS 189-193  
ELECTION DISTRICT #2 HOWARD COUNTY, MARYLAND  
TAX MAP: 30, GRID: 12, PARCEL 260  
DP2 FILES: 8-01-20, WP-01-117, P-02-10, P-02-17, P-03-03, P-03-87  
SCALE: 1" = 50'  
JOB No. 506V3  
DATE: 1-14-03  
INDEX No. GSD-3  
SHEET No. 11 of 34



CALL "MISS UTILITY" AT  
1-800-257-7777  
48 Hours Before Start of Construction

- Legend**
- PROPOSED EARTH DIKE
  - EXISTING EARTH DIKE (PER F-03-87)
  - STABILIZED CONSTRUCTION ENTRANCE
  - SILT FENCE
  - SUPER SILT FENCE
  - SAFETY FENCE
  - INLET PROTECTION
  - DRAINAGE AREA LINE
  - STORM DRAIN
  - STREAM BUFFER
  - 100 YR. FLOODPLAIN
  - LIMIT OF DISTURBANCE
  - PREVIOUS LIMIT OF DISTURBANCE (PER F-03-87)
  - EXISTING TREELINE
  - ZONING LINE
  - MATCH LINE
  - \*TREE PROTECTION FENCE
  - COMBINED SILT/TREE PROTECTION FENCE
  - CONSERVATION SIGNAGE
  - EX. SWM CREDIT, UTILITY AND FOREST CONSERVATION EASEMENT (PER F-03-87)
  - EX. SWM CREDIT EASEMENT (PER F-03-87)

\* WHERE TREE PROTECTION DEVICES COINCIDE WITH LIMIT OF DISTURBANCE OR CONSERVATION EASEMENT BOUNDARY SYMBOL IS SHOWN OFFSET FOR GRAPHIC CLARITY.

\*\* THIS SITE DOES NOT CONTAIN SLOPES GREATER THAN 25% IN A CONTIGUOUS AREA 20,000 SQ. FT. OR MORE.


NOTE: THIS PLAN TO BE USED FOR SEDIMENT CONTROL ONLY. ALL OTHER INFORMATION SHOWN FOR REFERENCE PURPOSE ONLY. SEE APPROPRIATE CONSTRUCTION DRAWING FOR ALL OTHER INFORMATION.

NOTE: CONTRACTOR TO FIELD LOCATE THE EXISTING AT&T FIBER OPTIC LINES THROUGHOUT THIS SITE

**TRAP/BASIN SCHEDULE**

BASIN/TRAP NO.	TRAP A
TRAP TYPE	ST-1
EXISTING DA (AC)	4.03
PROPOSED DA (AC)	1.54
TOTAL STORAGE VOLUME REQ'D (CF)	14,724
WET STORAGE REQ'D (CF)	7362
WET STORAGE PROVIDED (CF)	7362 @ ELEV = 394.76
DRY STORAGE REQ'D (CF)	7362
DRY STORAGE PROVIDED (CF)	7362 @ ELEV = 395.46
WEIR LENGTH (FT) OR RISER DIA (IN)	36" Ø
DEPTH BELOW OUTLET (FT)	N/A
CHANNEL DEPTH (FT)	N/A
OUTLET LENGTH (FT)	N/A
EMBANKMENT ELEV	390.00
RISER CREST ELEV	396.35
DRAWING DRIFGE ELEV	394.76
OVERFLOW ELEV	394.99
BOTTOM ELEV	394.00
BOTTOM DIMENSIONS (FT X FT)	SEE PLAN
Q <sub>max</sub> / Q <sub>min</sub> (CF/CF)	0.29 / 0.29

REFER TO SHEET 1-G FOR PROFILES, RISER AND BARREL DATA, AND DEWATERING DEVICE DETAILS.

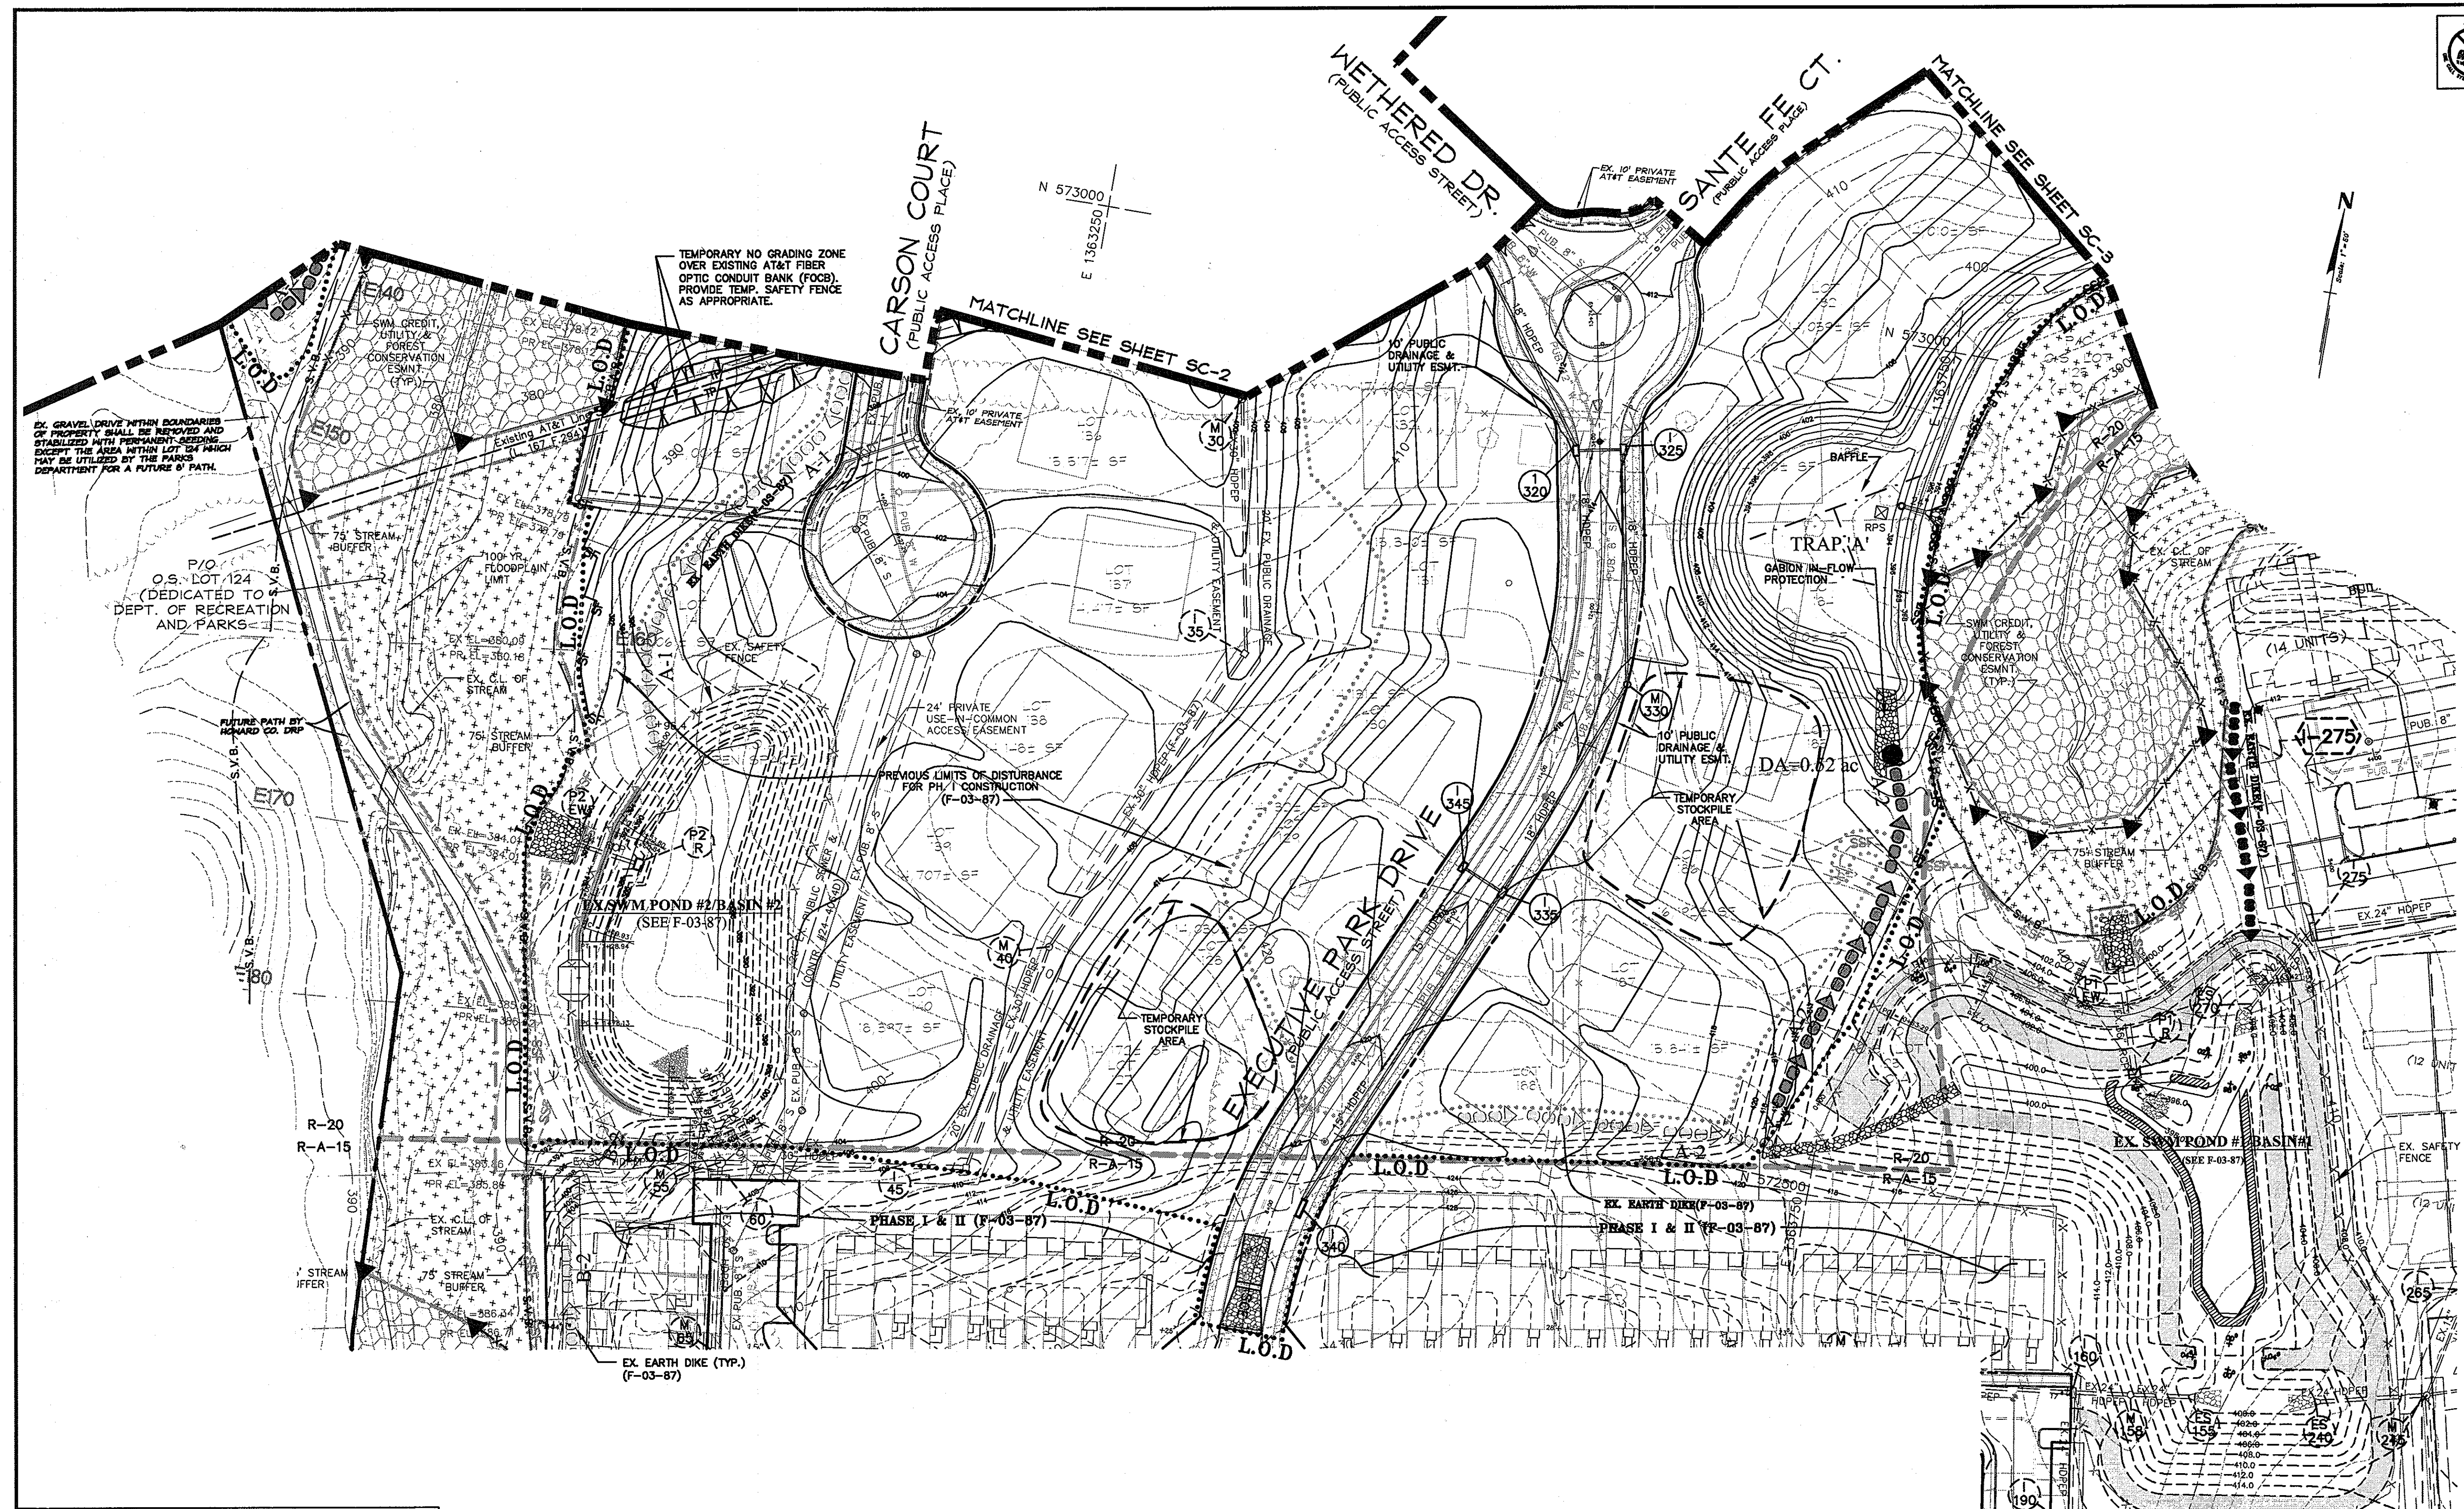

APPROVED: HOWARD COUNTY DEPARTMENT OF PUBLIC WORKS

*William J. Mahan Jr.* 10/14/03  
CHIEF, BUREAU OF HIGHWAY

APPROVED: HOWARD COUNTY DEPARTMENT OF PLANNING & ZONING

*Cindy Hamilton* 10/27/03  
CHIEF, DIVISION OF LAND DEVELOPMENT

*Chris Demmon* 10/17/03  
CHIEF, DEVELOPMENT ENGINEERING DIVISION

APPROVED: THESE PLANS FOR SMALL POND CONSTRUCTION, SOIL EROSION, AND SEDIMENT CONTROL MEET THE REQUIREMENTS OF THE HOWARD SOIL CONSERVATION DISTRICT.

*John Salis* 10/5/03  
HOWARD SOIL CONSERVATION DISTRICT

APPROVED: THESE PLANS HAVE BEEN REVIEWED FOR THE HOWARD SOIL CONSERVATION DISTRICT AND MEET THE TECHNICAL REQUIREMENTS FOR SMALL POND CONSTRUCTION, SOIL EROSION, AND SEDIMENT CONTROL.

*Jim Myers/US* 10/5/03  
USDA-NATURAL RESOURCES CONSERVATION SERVICE


DATE	REVISION	BY	DATE
	BASE DATA	CADD	
	DESIGNED	PFB, YSL	
	DRAWN	YSL	
	REVIEWED	PFB	
	RELEASE FOR		

Developer/Owner:  
Winchester Homes, Inc. &  
Winchester Homes, Inc., as nominee for Stringtown Investments, LLC  
6905 Rockledge Drive  
Suite 800  
Bethesda, Maryland 20817  
Stephen J. Nardella, Vice President  
(301) 803-4800

# AS-BUILT PLANS

(No As-Built Data This Sheet)


## SEDIMENT & EROSION CONTROL PLAN

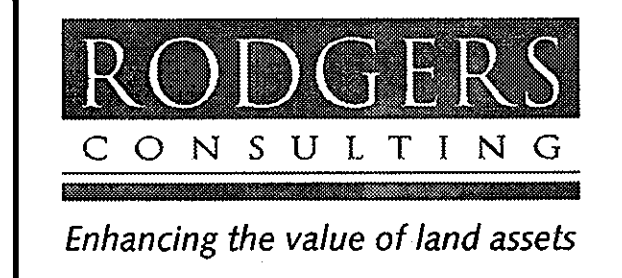

Rodgers Consulting, Inc.  
9260 Galthier Road  
Gathersburg, MD 20877  
301.948.4700  
301.948.6256 (fax)  
301.253.6609  
www.rodgers.com

### Montjoy - Single Family Detached

A RESUBDIVISION OF NON-BUILDABLE BULK PARCEL C (F-03-87)  
TO  
BUILDABLE LOTS 127- 188 AND OPEN SPACE LOTS 189-193  
ELECTION DISTRICT #2 HOWARD COUNTY, MARYLAND  
TAX MAP: 30, GRID: 12, PARCEL 260  
DP2 FILES: S-01-20, WP-01-117, P-02-10, P-02-17, P-03-03, F-03-87

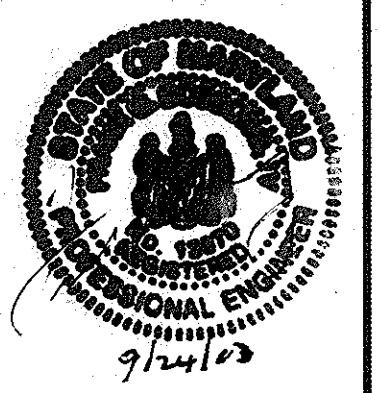

**DEVELOPER'S CERTIFICATE**

"I/WE CERTIFY THAT ALL DEVELOPMENT AND/OR CONSTRUCTION WILL BE DONE ACCORDING TO THESE PLANS, AND THAT ANY RESPONSIBLE PERSONNEL INVOLVED IN THE CONSTRUCTION PROJECT WILL HAVE A CERTIFICATE OF ATTENDANCE AT A DEPARTMENT OF THE ENVIRONMENT APPROVED TRAINING PROGRAM FOR THE CONTROL OF SEDIMENT AND EROSION BEFORE BEGINNING THE PROJECT. I SHALL ENGAGE A REGISTERED PROFESSIONAL ENGINEER TO SUPERVISE POND CONSTRUCTION AND PROVIDE THE HOWARD SOIL CONSERVATION DISTRICT WITH AN "AS-BUILT" PLAN OF THE POND WITHIN 30 DAYS OF COMPLETION. I ALSO AUTHORIZE PERIODIC ON-SITE INSPECTIONS BY THE HOWARD SOIL CONSERVATION DISTRICT."

*Stephen J. Nardella* 9/23/03  
SIGNATURE OF DEVELOPER (PRINT NAME BELOW SIGNATURE) DATE

**ENGINEER'S CERTIFICATE**

"I CERTIFY THAT THIS PLAN FOR POND CONSTRUCTION, EROSION AND SEDIMENT CONTROL REPRESENTS A PRACTICAL AND WORKABLE PLAN BASED ON MY PERSONAL KNOWLEDGE OF THE SITE CONDITIONS. THIS PLAN WAS PREPARED IN ACCORDANCE WITH THE REQUIREMENTS OF THE HOWARD SOIL CONSERVATION DISTRICT. I HAVE NOTIFIED THE DEVELOPER THAT HE/SHE MUST ENGAGE A REGISTERED PROFESSIONAL ENGINEER TO SUPERVISE POND CONSTRUCTION AND PROVIDE THE HOWARD SOIL CONSERVATION DISTRICT WITH AN "AS-BUILT" PLAN OF THE POND WITHIN 30 DAYS OF COMPLETION."



*James A. Bossone* 9/26/03  
SIGNATURE OF ENGINEER (PRINT NAME BELOW SIGNATURE) DATE

SCALE: 1"=50'  
JOB No. 506V3  
DATE: 1-14-03  
INDEX No. SC-1  
SHEET No. 12 of 34







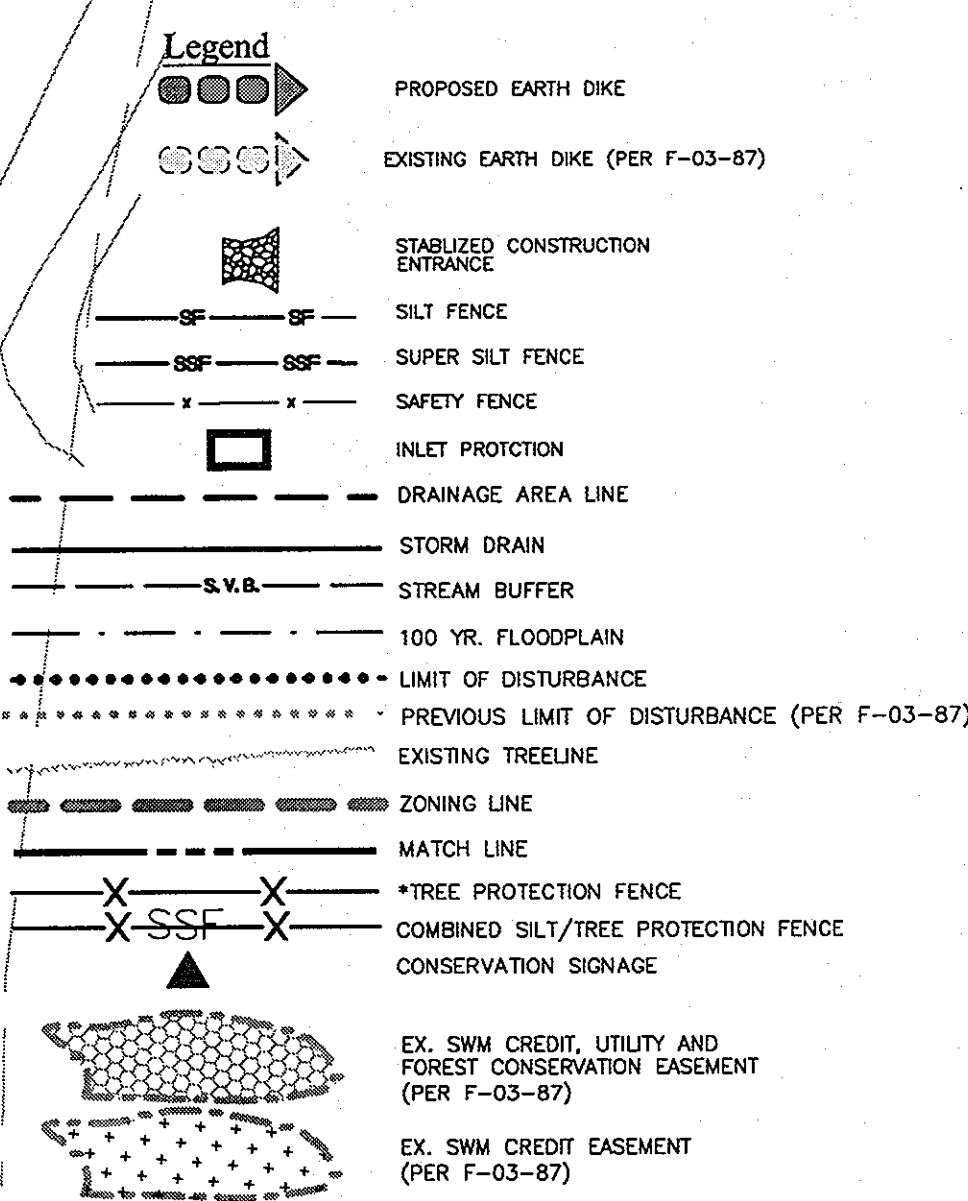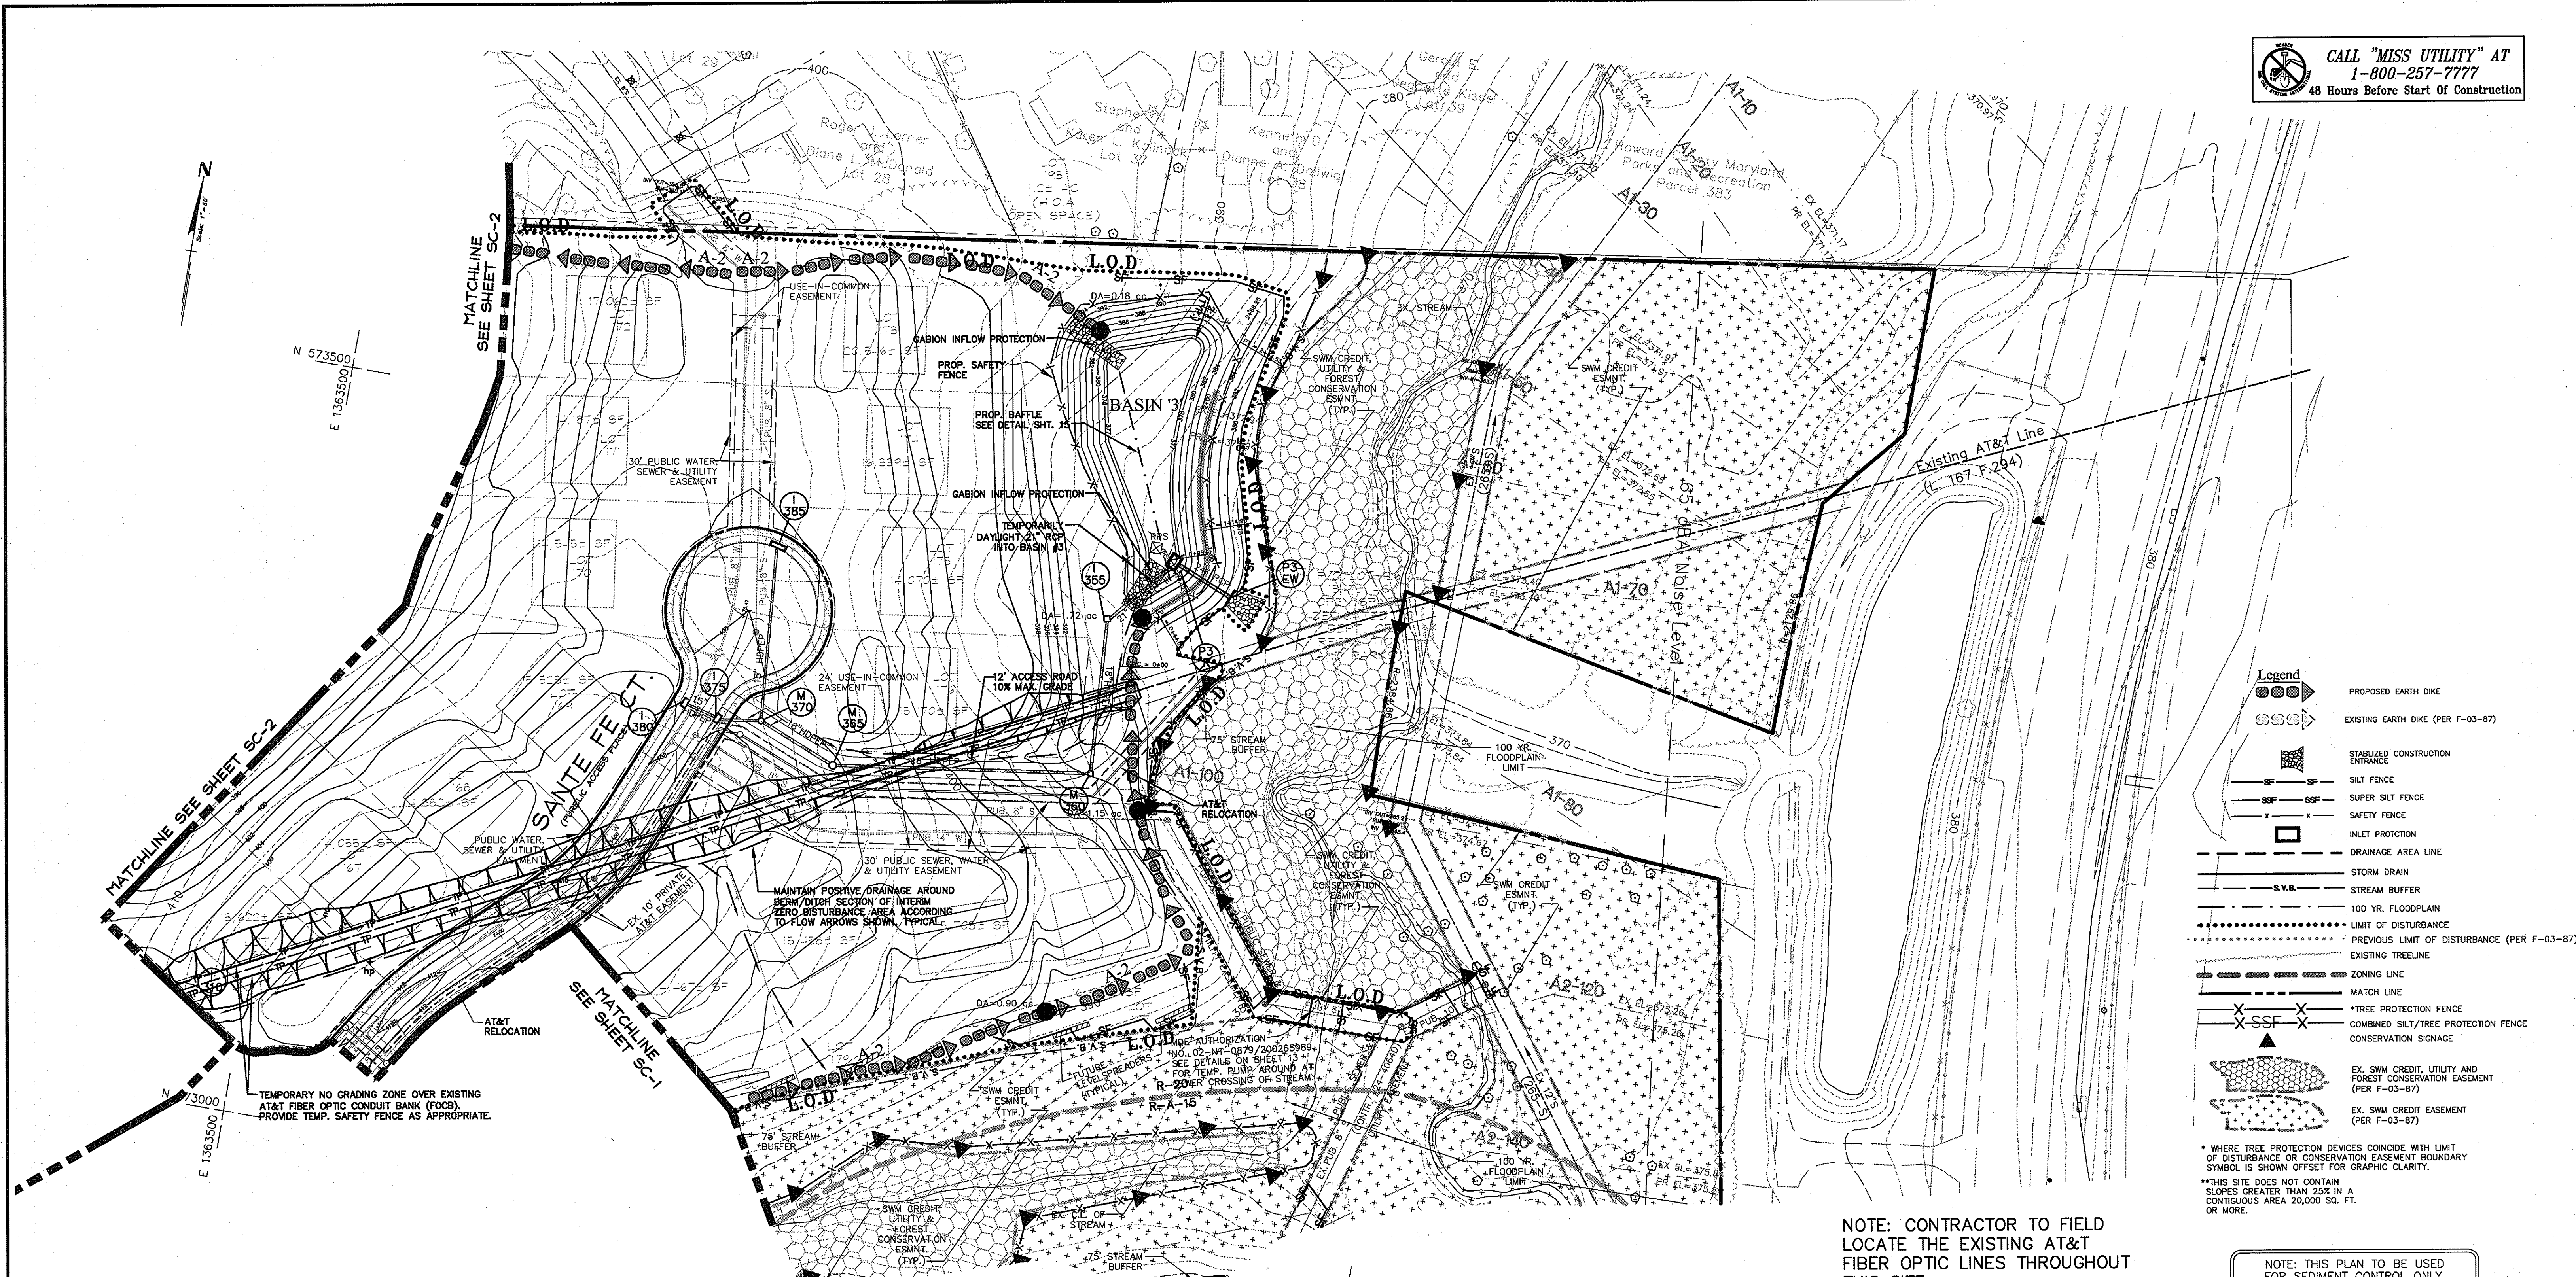

NOTE: CONTRACTOR TO FIELD LOCATE THE EXISTING AT&T FIBER OPTIC LINES THROUGHOUT THIS SITE

NOTE: THIS PLAN TO BE USED FOR SEDIMENT CONTROL ONLY. ALL OTHER INFORMATION SHOWN FOR REFERENCE PURPOSE ONLY. SEE APPROPRIATE CONSTRUCTION DRAWING FOR ALL OTHER INFORMATION.

# AS-BUILT PLANS

(No As-Built Data This Sheet)

TRAP/BASIN SCHEDULE	
BASIN/TRAP NO.	BASIN 3
TRAP TYPE	BASIN
EXISTING DA (AC)	4.03
PROPOSED DA (AC)	4.77
TOTAL STORAGE VOLUME REQ'D (CF)	17,172
WET STORAGE REQ'D (CF)	8586
WET STORAGE PROVIDED (CF)	9151 @ ELEV = 378.50
DRY STORAGE REQ'D (CF)	8586
DRY STORAGE PROVIDED (CF)	17172 @ ELEV = 379.70
WEIR LENGTH (FT) OR RISER DIA (IN)	N/A
DEPTH BELOW OUTLET (FT)	N/A
CHANNEL DEPTH (FT)	N/A
OUTFALL LENGTH (FT)	N/A
EMBANKMENT ELEV	384.00 @ 2' WIDE
WEIR CREST ELEV	381.25
DEWATERING ORIFICE ELEV	2 @ 377.25
CLIP-OUT ELEV	377.25
WEIR LENGTH (FT)	377.00
BOTTOM DIMENSIONS (FT X FT)	SEE PLAN
Quantity / Quantity (CFs/CFs)	0.21 / 0.21

REFER TO SHEETS 20-22 FOR SWM DETAILS & PROFILES  
REFER TO SHEET 16 FOR TEMPORARY DEWATERING DEVICE DETAILS.

**DEVELOPER'S CERTIFICATE**  
I/WE CERTIFY THAT ALL DEVELOPMENT AND/OR CONSTRUCTION WILL BE DONE ACCORDING TO THESE PLANS, AND THAT ANY RESPONSIBLE PERSONNEL INVOLVED IN THE CONSTRUCTION PROJECT WILL HAVE A CERTIFICATE OF ATTENDANCE AT A DEPARTMENT OF THE ENVIRONMENT APPROVED TRAINING PROGRAM FOR THE CONTROL OF SEDIMENT AND EROSION BEFORE BEGINNING THE PROJECT. I SHALL ENGAGE A REGISTERED PROFESSIONAL ENGINEER TO SUPERVISE POND CONSTRUCTION AND PROVIDE THE HOWARD SOIL CONSERVATION DISTRICT WITH AN 'AS-BUILT' PLAN OF THE POND WITHIN 30 DAYS OF COMPLETION. I ALSO AUTHORIZE PERIODIC ON-SITE INSPECTIONS BY THE HOWARD SOIL CONSERVATION DISTRICT.

*Stephen J. Nardella* 1/23/03  
SIGNATURE OF DEVELOPER (PRINT NAME BELOW SIGNATURE) DATE

**ENGINEER'S CERTIFICATE**  
I CERTIFY THAT THIS PLAN FOR POND CONSTRUCTION, EROSION AND SEDIMENT CONTROL REPRESENTS A PRACTICAL AND WORKABLE PLAN BASED ON MY PERSONAL KNOWLEDGE OF THE SITE CONDITIONS. THIS PLAN WAS PREPARED IN ACCORDANCE WITH THE REQUIREMENTS OF THE HOWARD SOIL CONSERVATION DISTRICT. I HAVE NOTIFIED THE DEVELOPER THAT HE/SHE MUST ENGAGE A REGISTERED PROFESSIONAL ENGINEER TO SUPERVISE POND CONSTRUCTION AND PROVIDE THE HOWARD SOIL CONSERVATION DISTRICT WITH AN 'AS-BUILT' PLAN OF THE POND WITHIN 30 DAYS OF COMPLETION.

*James H. Rossiter* 1/23/03  
SIGNATURE OF ENGINEER (PRINT NAME BELOW SIGNATURE) DATE



APPROVED: HOWARD COUNTY DEPARTMENT OF PUBLIC WORKS  
*William T. Madson Jr.* 10-14-03  
CHIEF, BUREAU OF HIGHWAY DATE

APPROVED: HOWARD COUNTY DEPARTMENT OF PLANNING & ZONING  
*Cindy Hamilton* 10/27/03  
CHIEF, DIVISION OF LAND DEVELOPMENT DATE


APPROVED: HOWARD SOIL CONSERVATION DISTRICT  
*John A. ...* 10/3/03  
DATE

APPROVED: USDA-NATURAL RESOURCES CONSERVATION SERVICE  
*Jim ...* 10/17/03  
DATE

DATE	REVISION	DATE	BY	DATE
	BASE DATA		CADD	
	DESIGNED		PFB, YSL	
	DRAWN		YSL	
	REVIEWED		PFB	
	RELEASE FOR			

Developer/Owner:  
**Winchester Homes, Inc. & Winchester Homes, Inc., as nominee for Stringtown Investments, LLC**  
6905 Rockledge Drive  
Suite 800  
Bethesda, Maryland 20817  
Stephen J. Nardella, Vice President  
(301) 803-4800

## SEDIMENT & EROSION CONTROL PLAN

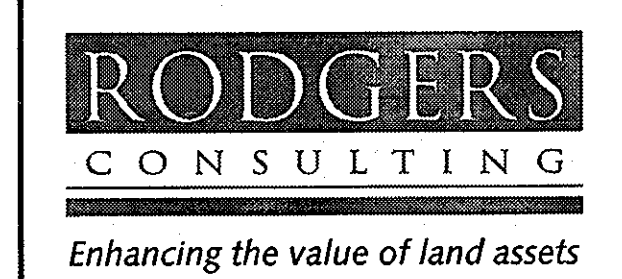





Rodgers Consulting, Inc.  
9260 Gaither Road  
Gaithersburg, MD 20877  
301.948.4700  
301.948.6256 (fax)  
301.253.6699  
www.rodgers.com

### Montjoy - Single Family Detached

A RESUBDIVISION OF NON-BUILDABLE BULK PARCEL C (F-03-87)  
BUILDABLE LOTS 127 - 188 AND OPEN SPACE LOTS 189-193  
ELECTION DISTRICT #2 HOWARD COUNTY, MARYLAND  
TAX MAP: #0, GRID: 12, PARCEL 260  
DPZ FILES: S-01-80, WP-01-117, P-02-10, P-02-17, P-03-03, F-03-87

SCALE: 1" = 50'  
JOB No. 506V3  
DATE: 1-14-03  
INDEX No. SC-3  
SHEET No. 14 OF 33



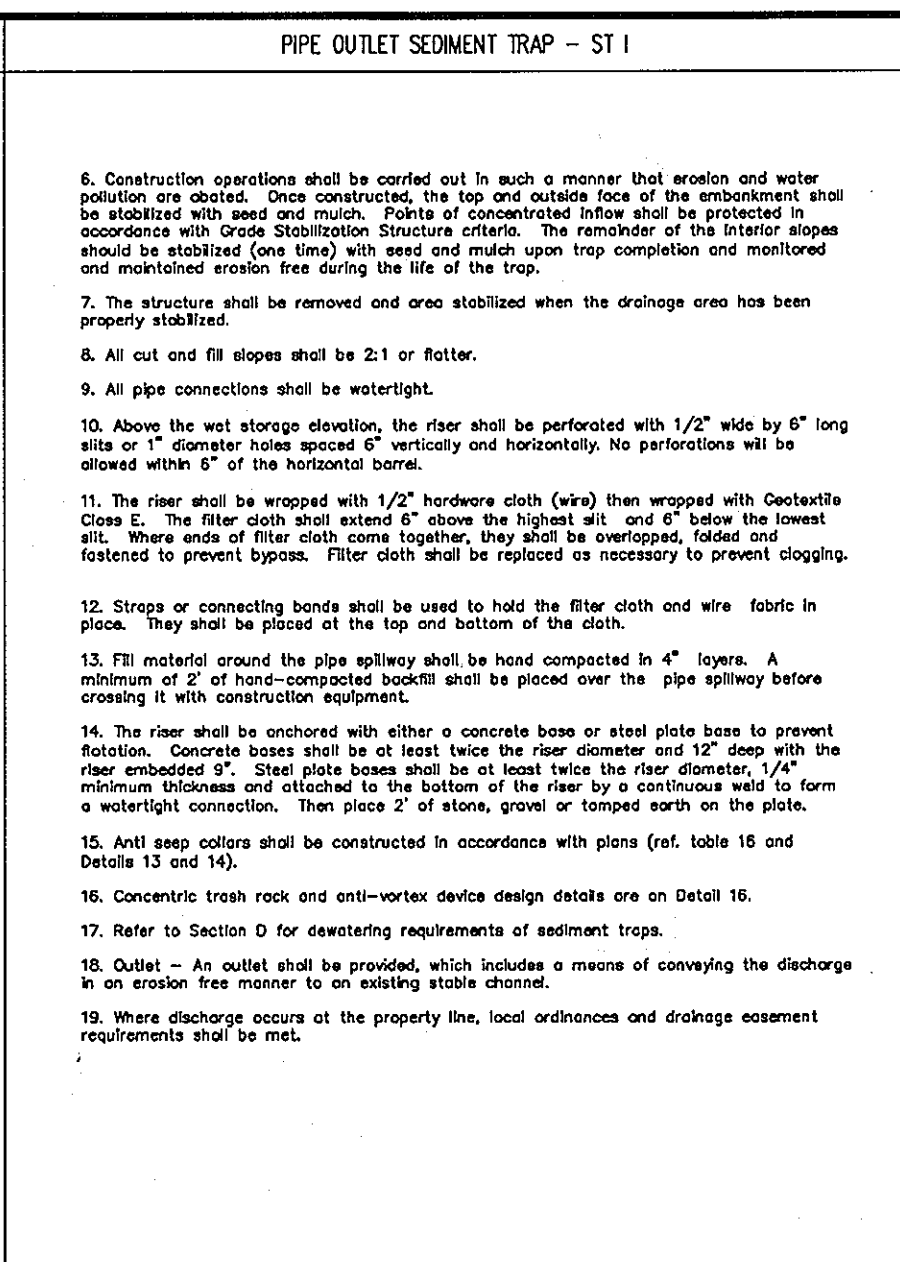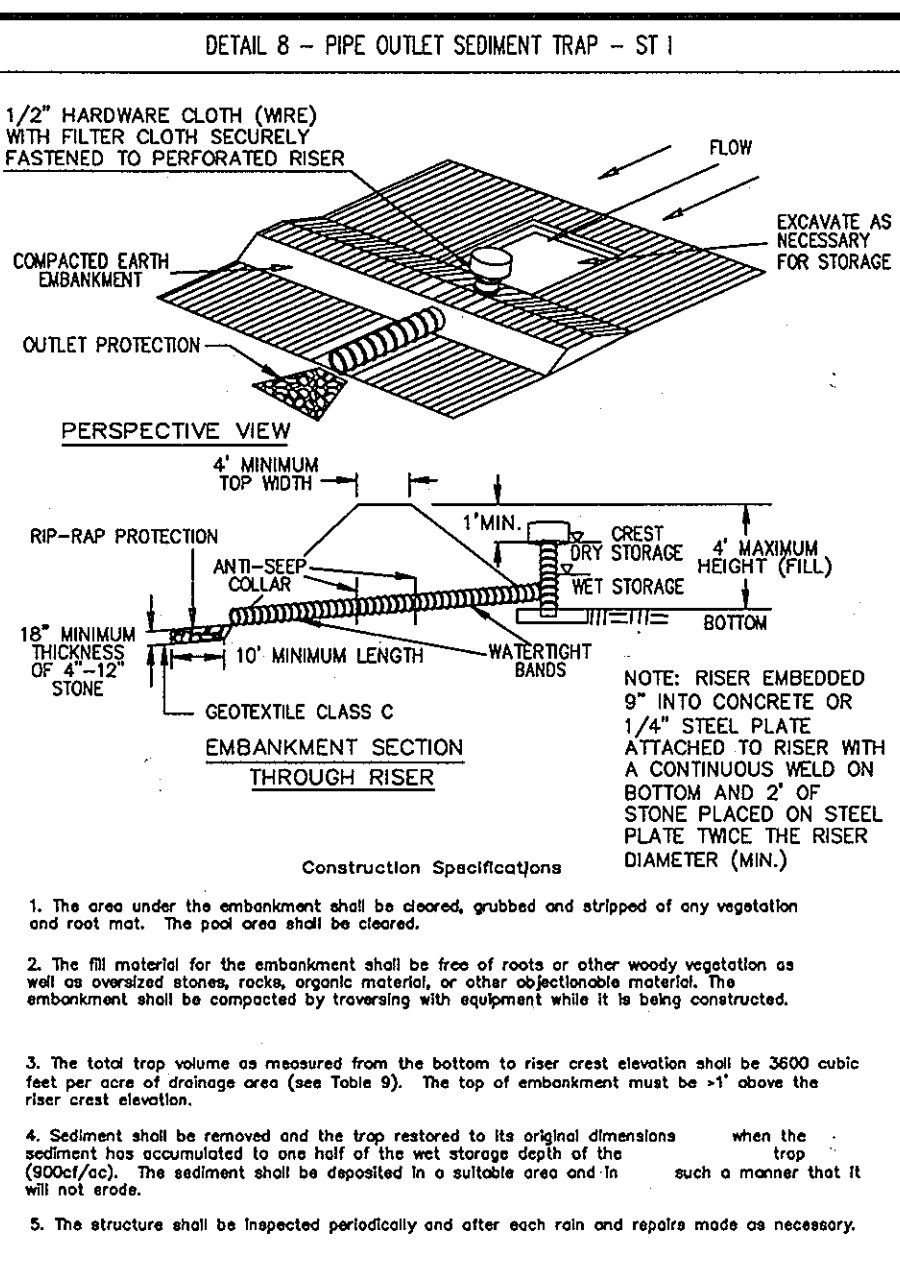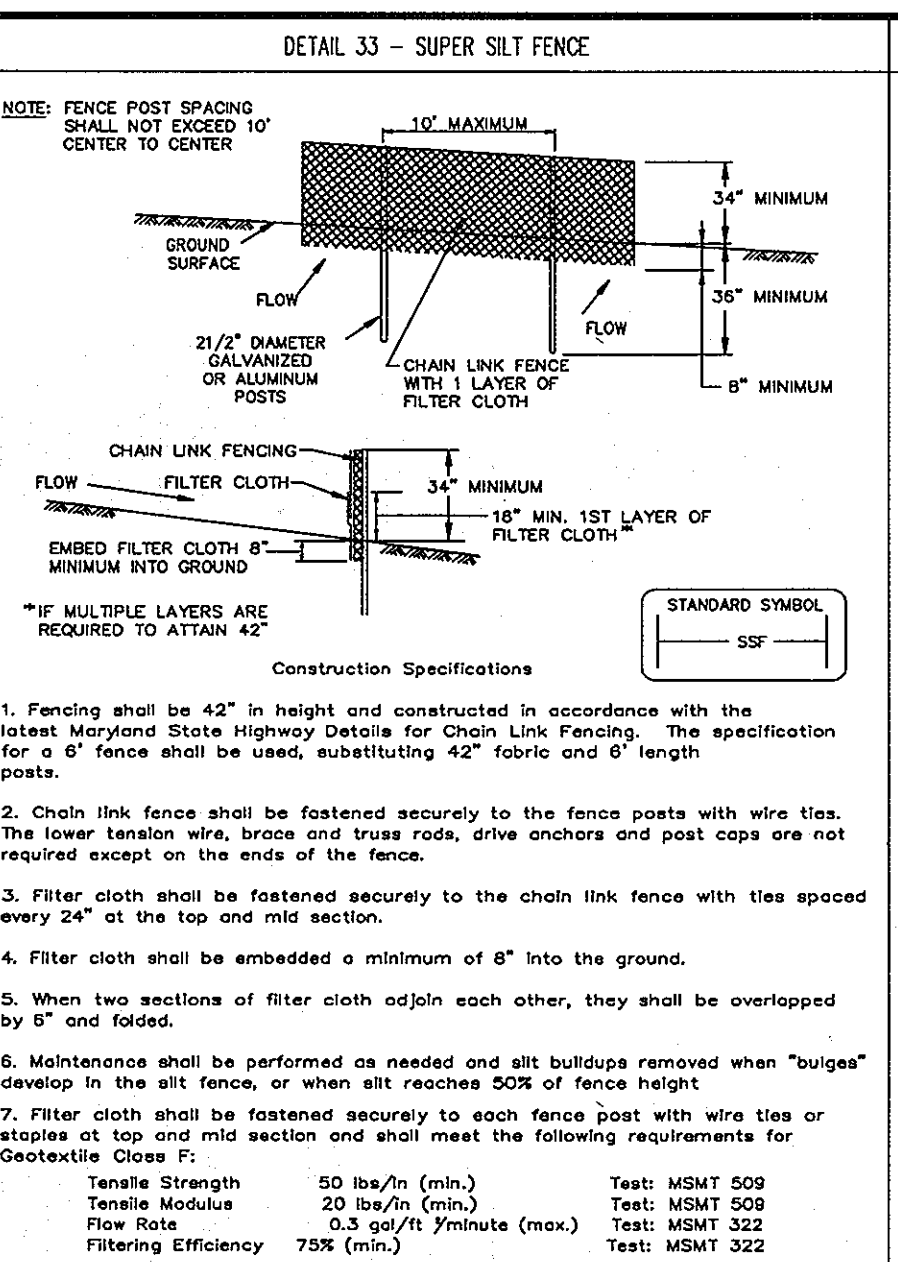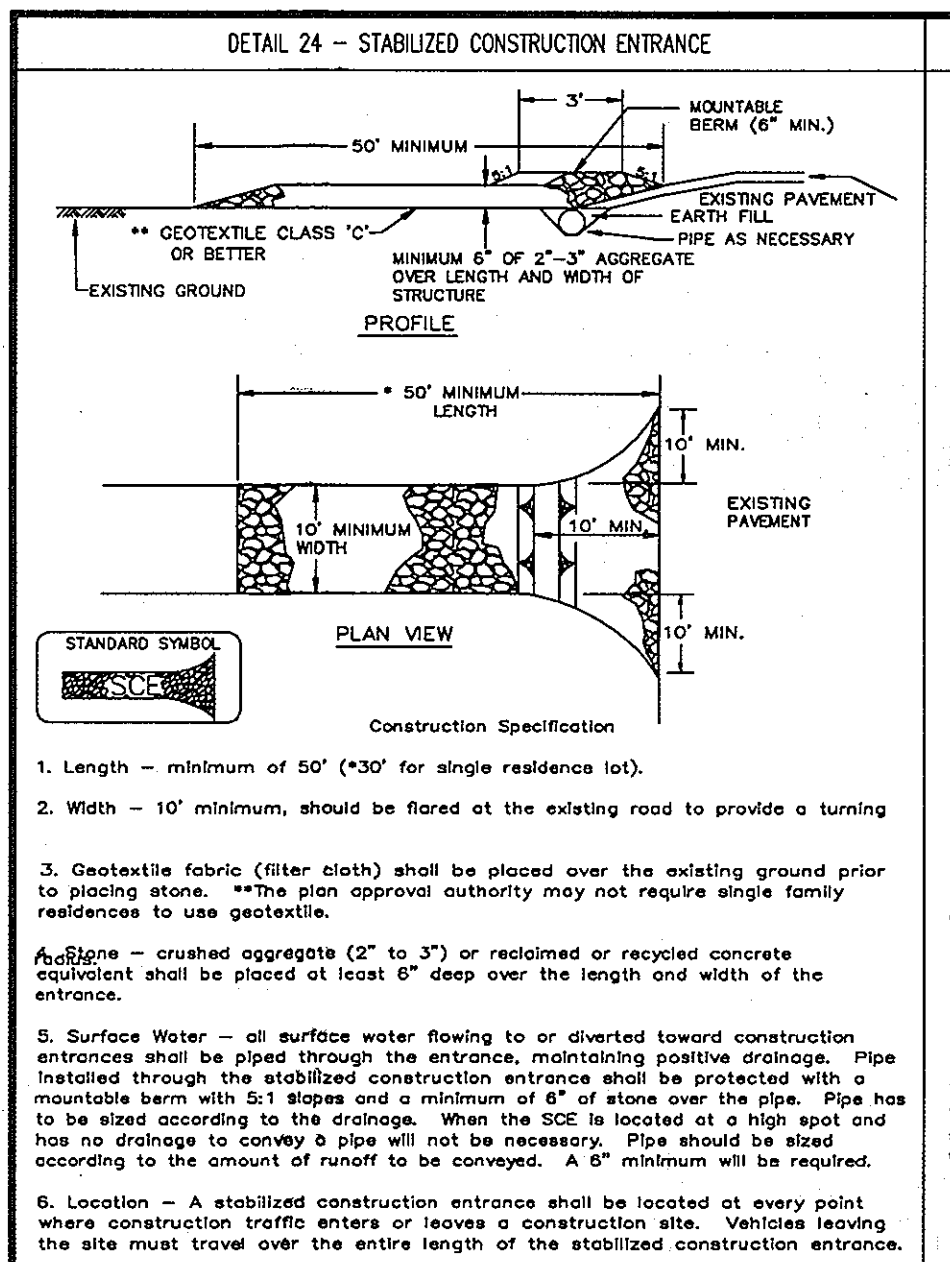

**21.0 STANDARD & SPECIFICATIONS FOR TOPSOIL**

**DEFINITION**  
 PLACEMENT OF TOPSOIL OVER A PREPARED SUBSTRATE PRIOR TO ESTABLISHMENT OF PERMANENT VEGETATION.

**PURPOSE**  
 TO PROVIDE A SUITABLE SOIL MEDIUM FOR VEGETATIVE GROWTH OF SPECIFIC CROPS OR PLANTS OF LOW MOISTURE CONTENT, LOW NUTRIENT LEVELS, LOW pH, MATERIALS TOXIC TO PLANTS, & NON UNACCEPTABLE SOIL GRAIN.

**CONDITIONS WHERE PRACTICE APPLIES**  
 THIS PRACTICE IS APPLICABLE TO AREAS HAVING 21.0 AS SEEN ON THE PLANS.

**A. THE TEXTURE OF THE EXISTING SUBSTRATE MATERIAL SHALL BE SUITABLE TO PRODUCE VEGETATION.**

**B. THE SOIL MATERIAL IS SO SHALLOW THAT THE ROOTING ZONE OF THE PLANT IS NOT PENETRATED BY THE ORIGINAL SOIL TO BE TREATED CONTAINS MATERIAL TOXIC TO PLANT GROWTH.**

**C. THE ORIGINAL SOIL TO BE TREATED CONTAINS MATERIAL TOXIC TO PLANT GROWTH.**

**D. THE SOIL IS SO ACIDIC THAT VEGETATION WITH MATERIAL IS NOT FEASIBLE.**

**E. FOR THE PURPOSE OF THESE STANDARDS AND SPECIFICATIONS, AREAS HAVING SLOPES STEEPER THAN 1:1 REQUIRE SPECIAL CONSIDERATION & DESIGN FOR APPROPRIATE STABILIZATION SHOWN ON THE PLANS.**

**CONSTRUCTION MATERIAL SPECIFICATIONS**

**I. TOPSOIL SALVAGED FROM THE EXISTING SITE MAY BE USED, PROVIDED THAT IT MEETS THE STANDARDS AS SET FORTH IN THESE SPECIFICATIONS. TYPICALLY, THIS TOPSOIL IS TO BE SALVAGED FROM A GIVEN SOIL TYPE CANE FOUND ON THE REPRESENTATIVE SOIL PROFILE SECTION OF THE SOIL SURVEY PUBLISHED BY USDA IN COOPERATION WITH MARYLAND AGRICULTURAL EXPERIMENTAL STATION.**

**II. TOPSOIL SPECIFICATIONS - SOIL TO BE USED AS TOPSOIL MUST MEET THE FOLLOWING:**

**1. TOPSOIL SHALL BE A LOAM (SANDY LOAM, CLAY LOAM, SILT LOAM, SANDY CLAY LOAM, LOAM SAND, OTHER SOILS MAY BE USED) RECOMMENDED BY AN AGRICULTURIST OR SOIL SCIENTIST AND APPROVED BY THE APPROPRIATE AGRICULTURAL AUTHORITY. REGRADING, TOPSOIL SHALL NOT BE A MIXTURE OF CONTRASTING TEXTURED SUBSTRATES AND SHALL CONTAIN LESS THAN 5% BY VOLUME OF SANDS, STONES, SLAG, COARSE FRAGMENTS, GRAVEL, STICKS, ROCKS, TRASH, OR OTHER MATERIALS LARGER THAN 1/4\"/>**

**SEDIMENT CONTROL NOTES**

1. A MINIMUM OF 48 HOURS NOTICE MUST BE GIVEN TO THE HOWARD COUNTY DEPARTMENT OF INSPECTIONS & PERMITS, SEDIMENT CONTROL DIVISION PRIOR TO THE START OF ANY CONSTRUCTION (H-13-1665).

2. ALL VEGETATIVE & STRUCTURAL PRACTICES ARE TO BE INSTALLED ACCORDING TO THE PROVISIONS OF THIS PLAN & ARE TO BE CONFORMATIVE WITH THE MOST CURRENT "MARYLAND STANDARDS & SPECIFICATIONS FOR SOIL EROSION & SEDIMENT CONTROL" & REVISIONS THERETO.

3. FOLLOWING INITIAL SOIL DISTURBANCES OR RESTORATION, PERMANENT OR TEMPORARY STABILIZATION SHALL BE COMPLETED WITHIN:

A) CALCULATED DAYS FOR ALL PERMITS SEDIMENT CONTROL. STRUCTURES, Dikes, PERIMETER SLOPES & SLOPES GREATER THAN 1:1.

B) ALL SEDIMENT BASINS TO ALL OTHER DISTURBED OR GRADED AREAS ON THE PROJECT SITE.

4. ALL SEDIMENT TRAP BASINS SHOWN ON THE PLAN SHALL BE FENCED A WARNING SIGN POSTED AS NEAR THE PROXIMITY AS POSSIBLE WITHIN THE PERIMETER OF THE BASIN. THE SIGN SHALL BE CONFORMATIVE WITH VOLUME 1, CHAPTER 12 OF THE "MOUNTAIN COUNTY DESIGN MANUAL, STORM DRAINAGE".

5. ALL DISTURBED AREAS MUST BE STABILIZED WITHIN THE PERIOD SPECIFIED ABOVE IN ACCORDANCE WITH THE MOST CURRENT "MARYLAND STANDARDS & SPECIFICATIONS FOR SOIL EROSION & SEDIMENT CONTROL" & REVISIONS THERETO. TEMPORARY STABILIZATION WITH WHICH ALONE CAN ONLY BE MAINTAINED FOR A LIMITED PERIOD OF TIME SHALL NOT BE CONSIDERED A PERMANENT ESTABLISHMENT OF GRASSES.

6. ALL SEDIMENT CONTROL STRUCTURES ARE TO REMAIN IN PLACE & TO BE MAINTAINED IN OPERATIVE CONDITION UNTIL PERMITS FOR THEIR REMOVAL HAS BEEN OBTAINED FROM THE HOWARD COUNTY SEDIMENT CONTROL INSPECTOR.

7. SITE ANALYSIS:

TOTAL SITE AREA:	38.8 ACRES (8,400 SQ. FT.)
DISTURBED AREA:	28.8 ACRES
UNDISTURBED AREA:	10.0 ACRES
AREA TO BE STABILIZED:	14.000 ACRES
TOTAL FILL:	14.000 CU. YD.
% OF SITE WATERBORN AREA:	100%





8. ALL EXCESS MATERIAL SHALL BE TRANSPORTED TO A SUITABLE SPILL SPILL APPROVED BY THE SEDIMENT CONTROL INSPECTOR. NO MATERIAL SHALL BE APPLIED TO THE SITE UNLESS IT IS APPROVED BY THE SEDIMENT CONTROL INSPECTOR. ALL OTHER ASSOCIATED SEDIMENT CONTROL MEASURES AS REQUIRED BY THE INSPECTOR SHALL BE INSTALLED.

9. ALL DISTURBED AREAS SHALL BE STABILIZED WITHIN THE PERIOD SPECIFIED ABOVE IN ACCORDANCE WITH THE MOST CURRENT "MARYLAND STANDARDS & SPECIFICATIONS FOR SOIL EROSION & SEDIMENT CONTROL" & REVISIONS THERETO. TEMPORARY STABILIZATION WITH WHICH ALONE CAN ONLY BE MAINTAINED FOR A LIMITED PERIOD OF TIME SHALL NOT BE CONSIDERED A PERMANENT ESTABLISHMENT OF GRASSES.

10. ON ALL SITES WITH DISTURBED AREAS IN EXCESS OF 4 ACRES, APPROVAL OF THE INSPECTION AGENCY AND A REGISTERED PROFESSIONAL ENGINEER (R.P.E.) SHALL BE OBTAINED PRIOR TO THE START OF ANY CONSTRUCTION. THE R.P.E. SHALL BE A MEMBER OF THE PROFESSIONAL ENGINEERS OF MARYLAND (P.E.M.) AND SHALL BE LICENSED IN THE STATE OF MARYLAND. THE R.P.E. SHALL BE A MEMBER OF THE PROFESSIONAL ENGINEERS OF MARYLAND (P.E.M.) AND SHALL BE LICENSED IN THE STATE OF MARYLAND. THE R.P.E. SHALL BE A MEMBER OF THE PROFESSIONAL ENGINEERS OF MARYLAND (P.E.M.) AND SHALL BE LICENSED IN THE STATE OF MARYLAND.

11. TRENCHES FOR THE CONSTRUCTION OF UTILITIES SHALL BE COVERED WITHIN ONE WORKING DAY. UNLESS OTHERWISE SPECIFIED, TRENCHES SHALL BE COVERED WITHIN ONE WORKING DAY. UNLESS OTHERWISE SPECIFIED, TRENCHES SHALL BE COVERED WITHIN ONE WORKING DAY. UNLESS OTHERWISE SPECIFIED, TRENCHES SHALL BE COVERED WITHIN ONE WORKING DAY.

12. QUANTITIES & ESTIMATES SHOWN ARE FOR SEDIMENT CONTROL PURPOSES ONLY. CONTRACTOR SHALL PROVIDE HIS OWN QUANTITY ESTIMATES TO HIS BEST SATISFACTION.

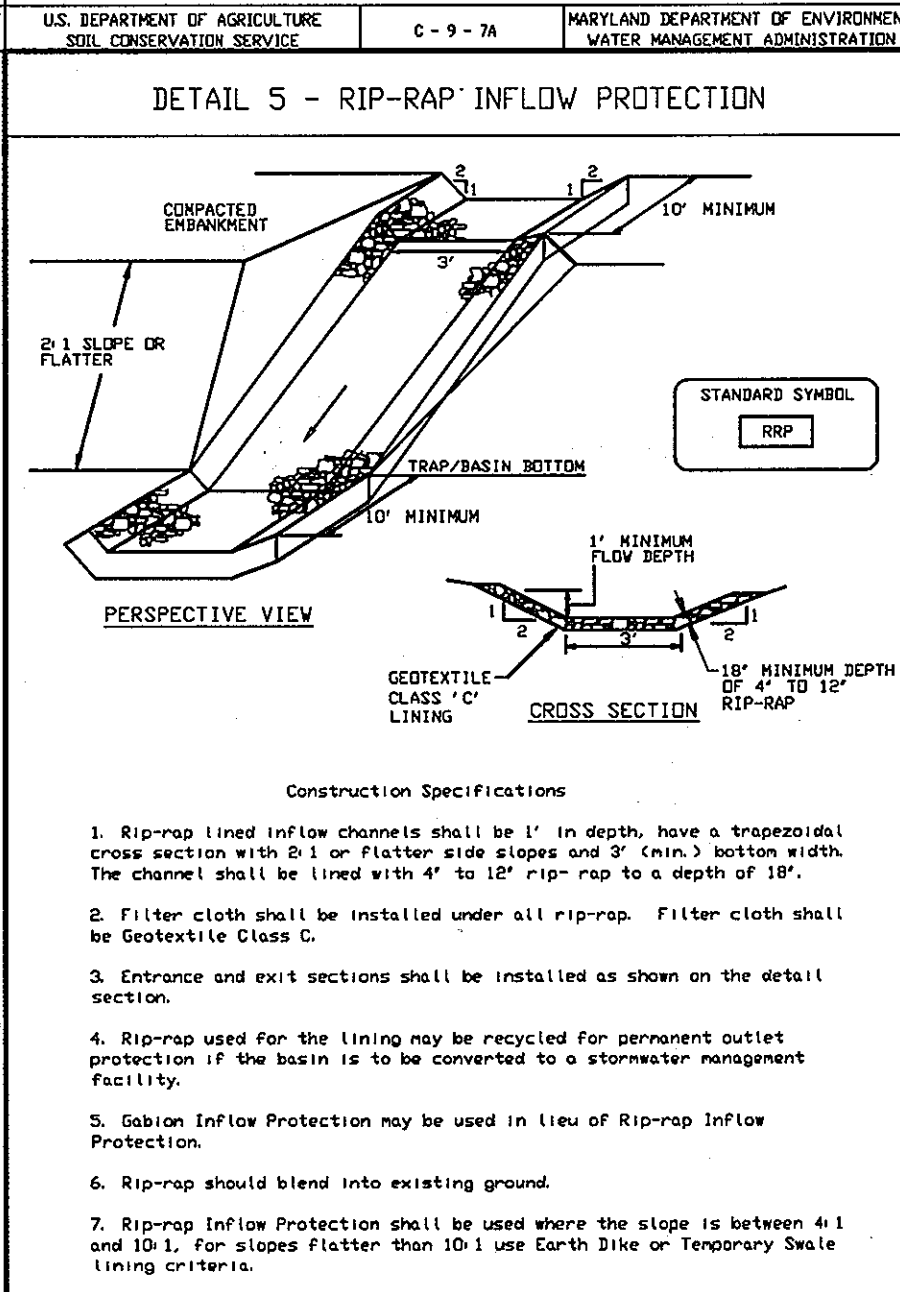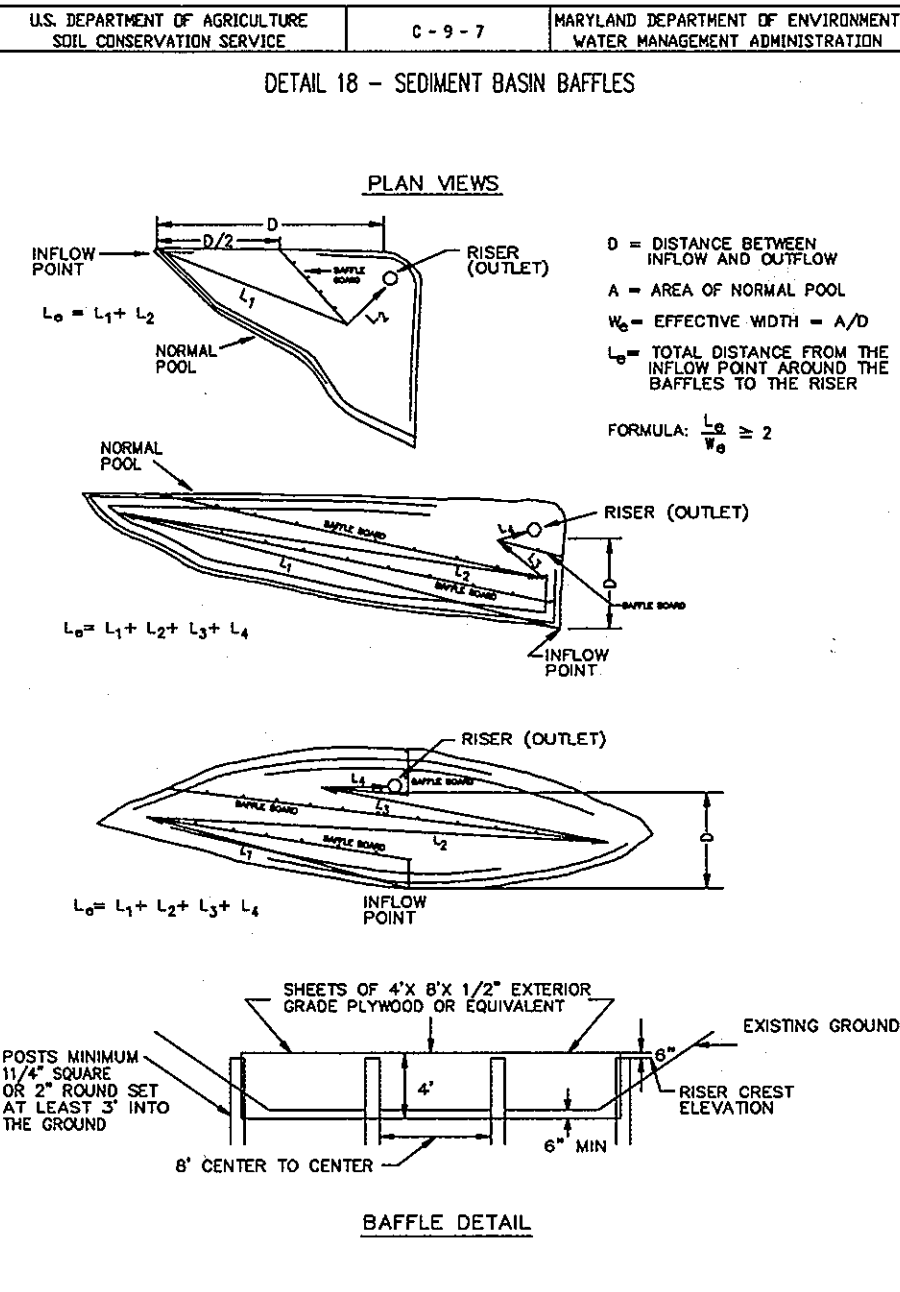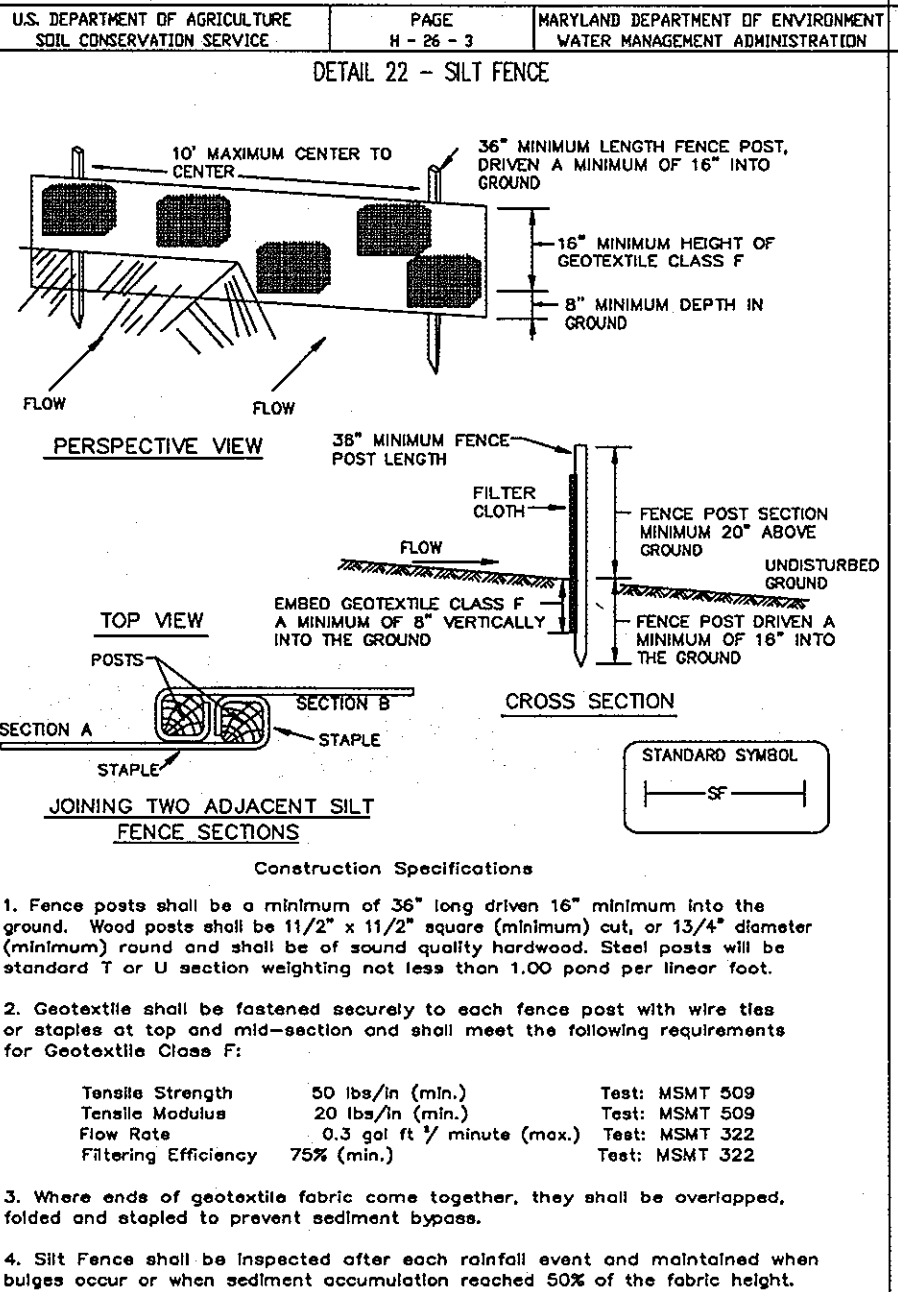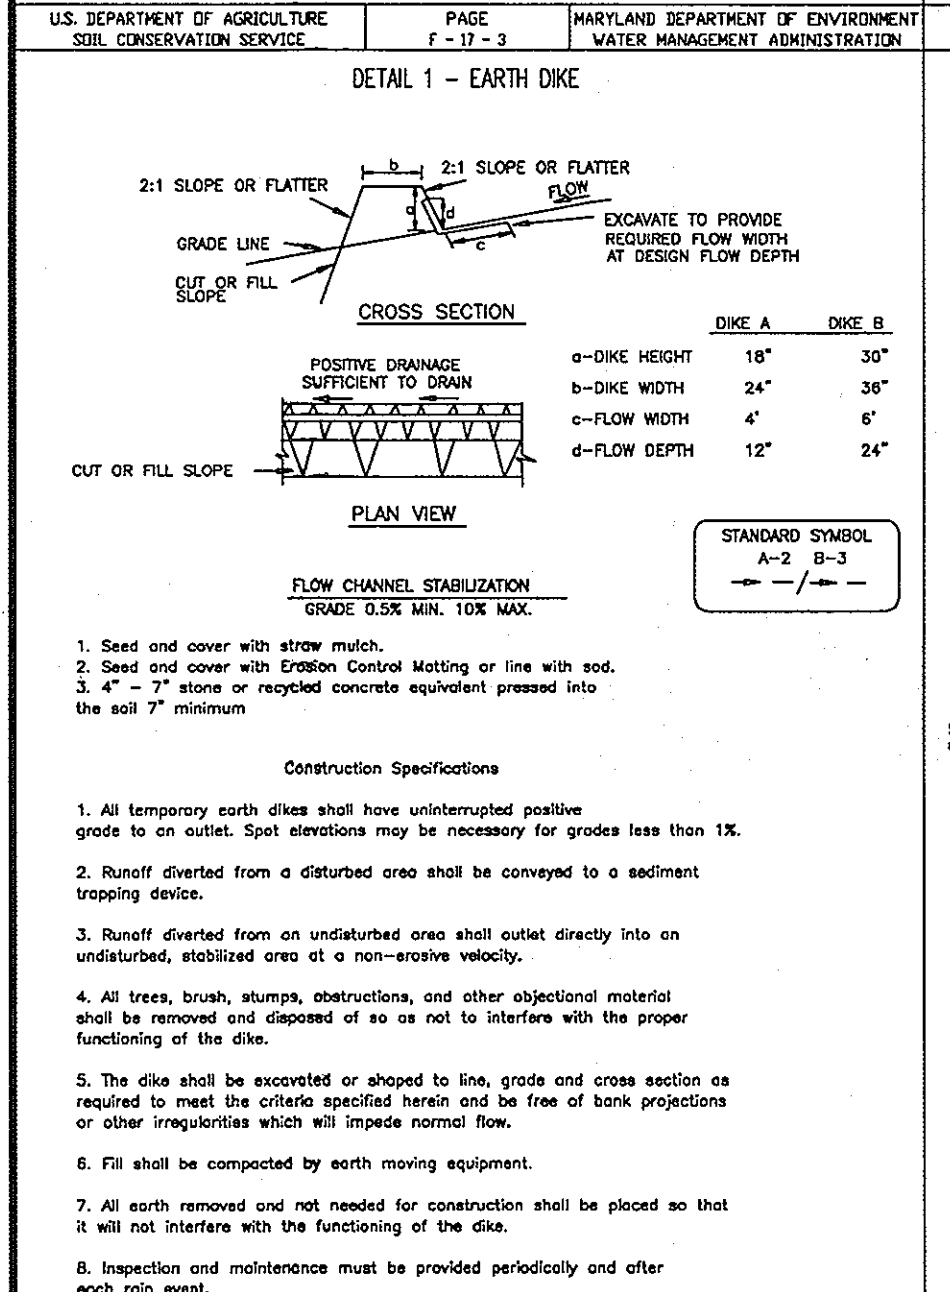

**CONSTRUCTION MATERIAL SPECIFICATIONS**

**I. TOPSOIL SALVAGED FROM THE EXISTING SITE MAY BE USED, PROVIDED THAT IT MEETS THE STANDARDS AS SET FORTH IN THESE SPECIFICATIONS. TYPICALLY, THIS TOPSOIL IS TO BE SALVAGED FROM A GIVEN SOIL TYPE CANE FOUND ON THE REPRESENTATIVE SOIL PROFILE SECTION OF THE SOIL SURVEY PUBLISHED BY USDA IN COOPERATION WITH MARYLAND AGRICULTURAL EXPERIMENTAL STATION.**

**II. TOPSOIL SPECIFICATIONS - SOIL TO BE USED AS TOPSOIL MUST MEET THE FOLLOWING:**

**1. TOPSOIL SHALL BE A LOAM (SANDY LOAM, CLAY LOAM, SILT LOAM, SANDY CLAY LOAM, LOAM SAND, OTHER SOILS MAY BE USED) RECOMMENDED BY AN AGRICULTURIST OR SOIL SCIENTIST AND APPROVED BY THE APPROPRIATE AGRICULTURAL AUTHORITY. REGRADING, TOPSOIL SHALL NOT BE A MIXTURE OF CONTRASTING TEXTURED SUBSTRATES AND SHALL CONTAIN LESS THAN 5% BY VOLUME OF SANDS, STONES, SLAG, COARSE FRAGMENTS, GRAVEL, STICKS, ROCKS, TRASH, OR OTHER MATERIALS LARGER THAN 1/4\"/>**

**SEDIMENT CONTROL NOTES**

1. A MINIMUM OF 48 HOURS NOTICE MUST BE GIVEN TO THE HOWARD COUNTY DEPARTMENT OF INSPECTIONS & PERMITS, SEDIMENT CONTROL DIVISION PRIOR TO THE START OF ANY CONSTRUCTION (H-13-1665).

2. ALL VEGETATIVE & STRUCTURAL PRACTICES ARE TO BE INSTALLED ACCORDING TO THE PROVISIONS OF THIS PLAN & ARE TO BE CONFORMATIVE WITH THE MOST CURRENT "MARYLAND STANDARDS & SPECIFICATIONS FOR SOIL EROSION & SEDIMENT CONTROL" & REVISIONS THERETO.

3. FOLLOWING INITIAL SOIL DISTURBANCES OR RESTORATION, PERMANENT OR TEMPORARY STABILIZATION SHALL BE COMPLETED WITHIN:

A) CALCULATED DAYS FOR ALL PERMITS SEDIMENT CONTROL. STRUCTURES, Dikes, PERIMETER SLOPES & SLOPES GREATER THAN 1:1.

B) ALL SEDIMENT BASINS TO ALL OTHER DISTURBED OR GRADED AREAS ON THE PROJECT SITE.

4. ALL SEDIMENT TRAP BASINS SHOWN ON THE PLAN SHALL BE FENCED A WARNING SIGN POSTED AS NEAR THE PROXIMITY AS POSSIBLE WITHIN THE PERIMETER OF THE BASIN. THE SIGN SHALL BE CONFORMATIVE WITH VOLUME 1, CHAPTER 12 OF THE "MOUNTAIN COUNTY DESIGN MANUAL, STORM DRAINAGE".

5. ALL DISTURBED AREAS MUST BE STABILIZED WITHIN THE PERIOD SPECIFIED ABOVE IN ACCORDANCE WITH THE MOST CURRENT "MARYLAND STANDARDS & SPECIFICATIONS FOR SOIL EROSION & SEDIMENT CONTROL" & REVISIONS THERETO. TEMPORARY STABILIZATION WITH WHICH ALONE CAN ONLY BE MAINTAINED FOR A LIMITED PERIOD OF TIME SHALL NOT BE CONSIDERED A PERMANENT ESTABLISHMENT OF GRASSES.

6. ALL SEDIMENT CONTROL STRUCTURES ARE TO REMAIN IN PLACE & TO BE MAINTAINED IN OPERATIVE CONDITION UNTIL PERMITS FOR THEIR REMOVAL HAS BEEN OBTAINED FROM THE HOWARD COUNTY SEDIMENT CONTROL INSPECTOR.

7. SITE ANALYSIS:

TOTAL SITE AREA:	38.8 ACRES (8,400 SQ. FT.)
DISTURBED AREA:	28.8 ACRES
UNDISTURBED AREA:	10.0 ACRES
AREA TO BE STABILIZED:	14.000 ACRES
TOTAL FILL:	14.000 CU. YD.
% OF SITE WATERBORN AREA:	100%

8. ALL EXCESS MATERIAL SHALL BE TRANSPORTED TO A SUITABLE SPILL SPILL APPROVED BY THE SEDIMENT CONTROL INSPECTOR. NO MATERIAL SHALL BE APPLIED TO THE SITE UNLESS IT IS APPROVED BY THE SEDIMENT CONTROL INSPECTOR. ALL OTHER ASSOCIATED SEDIMENT CONTROL MEASURES AS REQUIRED BY THE INSPECTOR SHALL BE INSTALLED.

9. ALL DISTURBED AREAS SHALL BE STABILIZED WITHIN THE PERIOD SPECIFIED ABOVE IN ACCORDANCE WITH THE MOST CURRENT "MARYLAND STANDARDS & SPECIFICATIONS FOR SOIL EROSION & SEDIMENT CONTROL" & REVISIONS THERETO. TEMPORARY STABILIZATION WITH WHICH ALONE CAN ONLY BE MAINTAINED FOR A LIMITED PERIOD OF TIME SHALL NOT BE CONSIDERED A PERMANENT ESTABLISHMENT OF GRASSES.

10. ON ALL SITES WITH DISTURBED AREAS IN EXCESS OF 4 ACRES, APPROVAL OF THE INSPECTION AGENCY AND A REGISTERED PROFESSIONAL ENGINEER (R.P.E.) SHALL BE OBTAINED PRIOR TO THE START OF ANY CONSTRUCTION. THE R.P.E. SHALL BE A MEMBER OF THE PROFESSIONAL ENGINEERS OF MARYLAND (P.E.M.) AND SHALL BE LICENSED IN THE STATE OF MARYLAND. THE R.P.E. SHALL BE A MEMBER OF THE PROFESSIONAL ENGINEERS OF MARYLAND (P.E.M.) AND SHALL BE LICENSED IN THE STATE OF MARYLAND. THE R.P.E. SHALL BE A MEMBER OF THE PROFESSIONAL ENGINEERS OF MARYLAND (P.E.M.) AND SHALL BE LICENSED IN THE STATE OF MARYLAND.

11. TRENCHES FOR THE CONSTRUCTION OF UTILITIES SHALL BE COVERED WITHIN ONE WORKING DAY. UNLESS OTHERWISE SPECIFIED, TRENCHES SHALL BE COVERED WITHIN ONE WORKING DAY. UNLESS OTHERWISE SPECIFIED, TRENCHES SHALL BE COVERED WITHIN ONE WORKING DAY.

12. QUANTITIES & ESTIMATES SHOWN ARE FOR SEDIMENT CONTROL PURPOSES ONLY. CONTRACTOR SHALL PROVIDE HIS OWN QUANTITY ESTIMATES TO HIS BEST SATISFACTION.

**APPROVED:**  
 THESE PLANS FOR SMALL POND CONSTRUCTION, SOIL EROSION, AND SEDIMENT CONTROL MEET THE REQUIREMENTS OF THE HOWARD SOIL CONSERVATION DISTRICT.

*[Signature]* 10/16/03  
 HOWARD SOIL CONSERVATION DISTRICT

**APPROVED:**  
 THESE PLANS HAVE BEEN REVIEWED FOR THE HOWARD SOIL CONSERVATION DISTRICT AND MEET THE TECHNICAL REQUIREMENTS FOR SMALL POND CONSTRUCTION, SOIL EROSION, AND SEDIMENT CONTROL.

*[Signature]* 10/21/03  
 USDA - NATURAL RESOURCES CONSERVATION SERVICE




**APPROVED:** HOWARD COUNTY DEPARTMENT OF PLANNING & ZONING

*[Signature]* 10/21/03  
 CHIEF, DIVISION OF LAND DEVELOPMENT

*[Signature]* 10/17/03  
 CHIEF, DEVELOPMENT ENGINEERING DIVISION

**APPROVED:** HOWARD COUNTY DEPARTMENT OF PUBLIC WORKS

*[Signature]* 10/14/03  
 CHIEF, BUREAU OF HIGHWAY

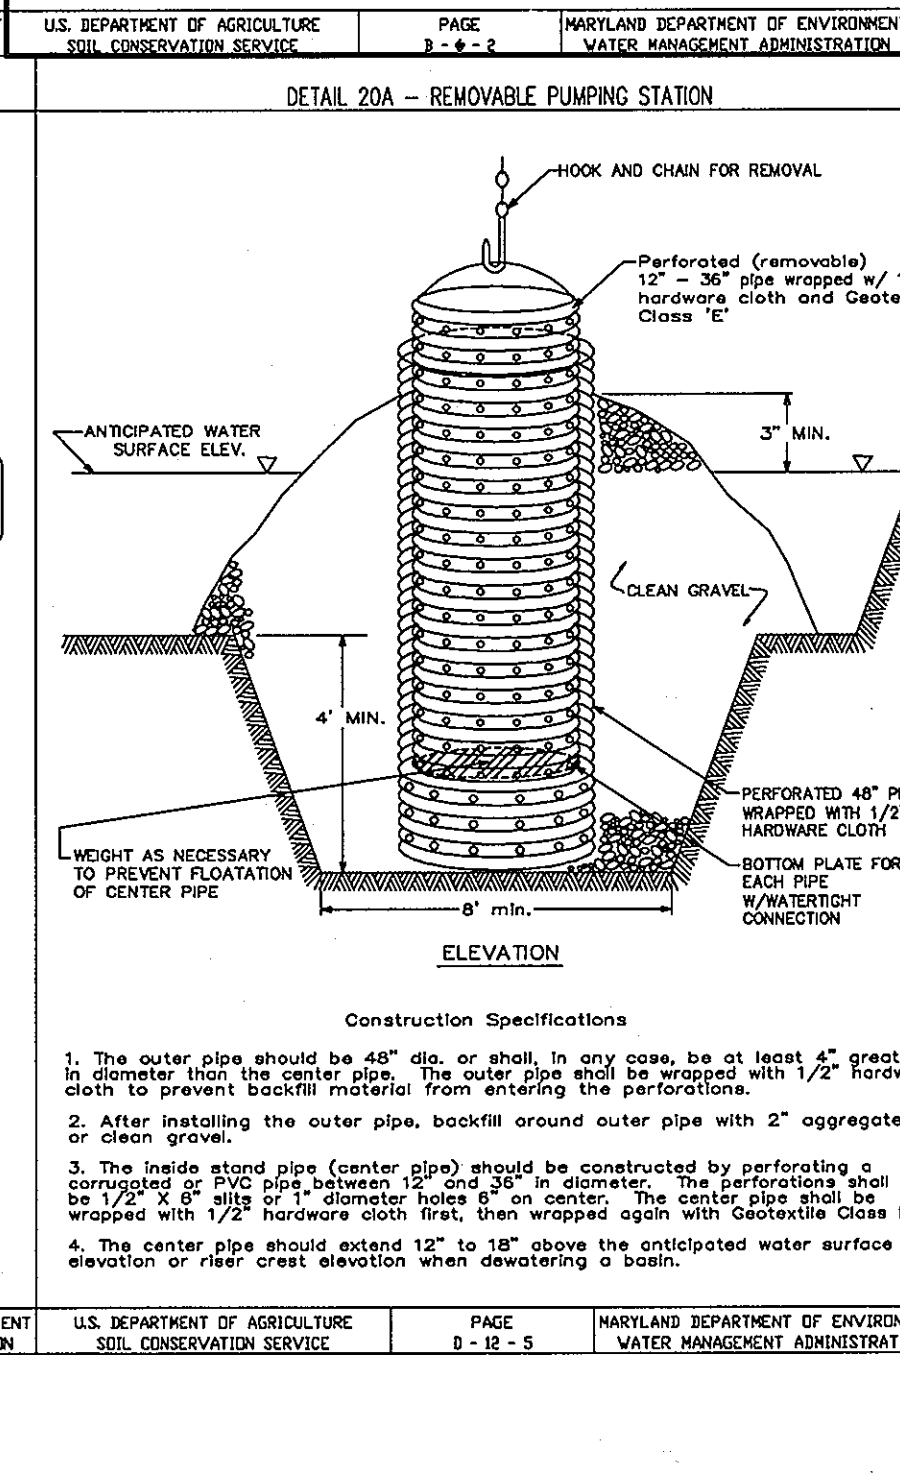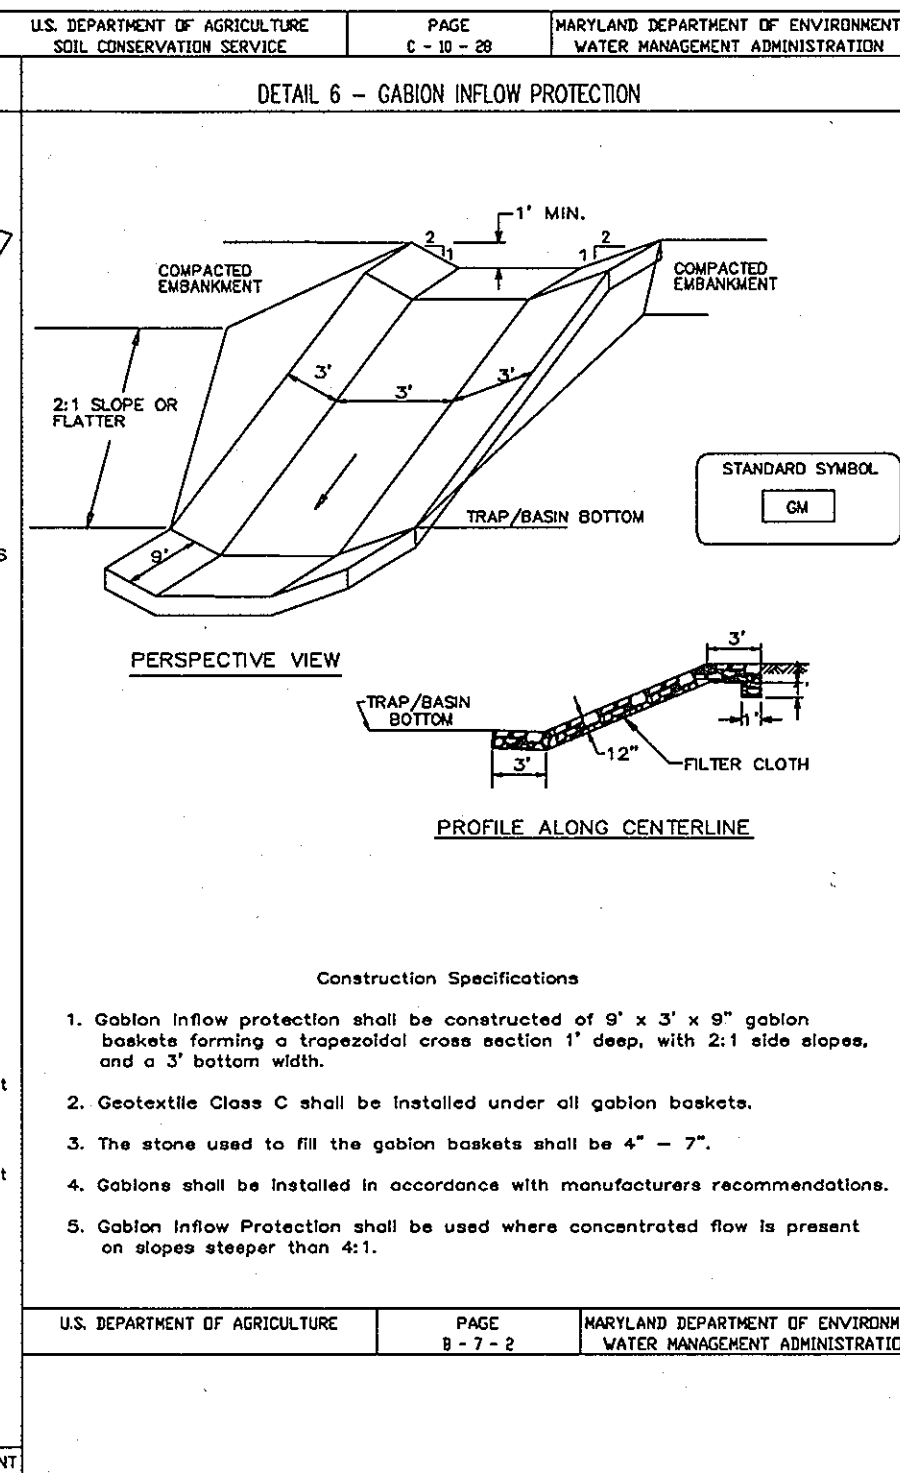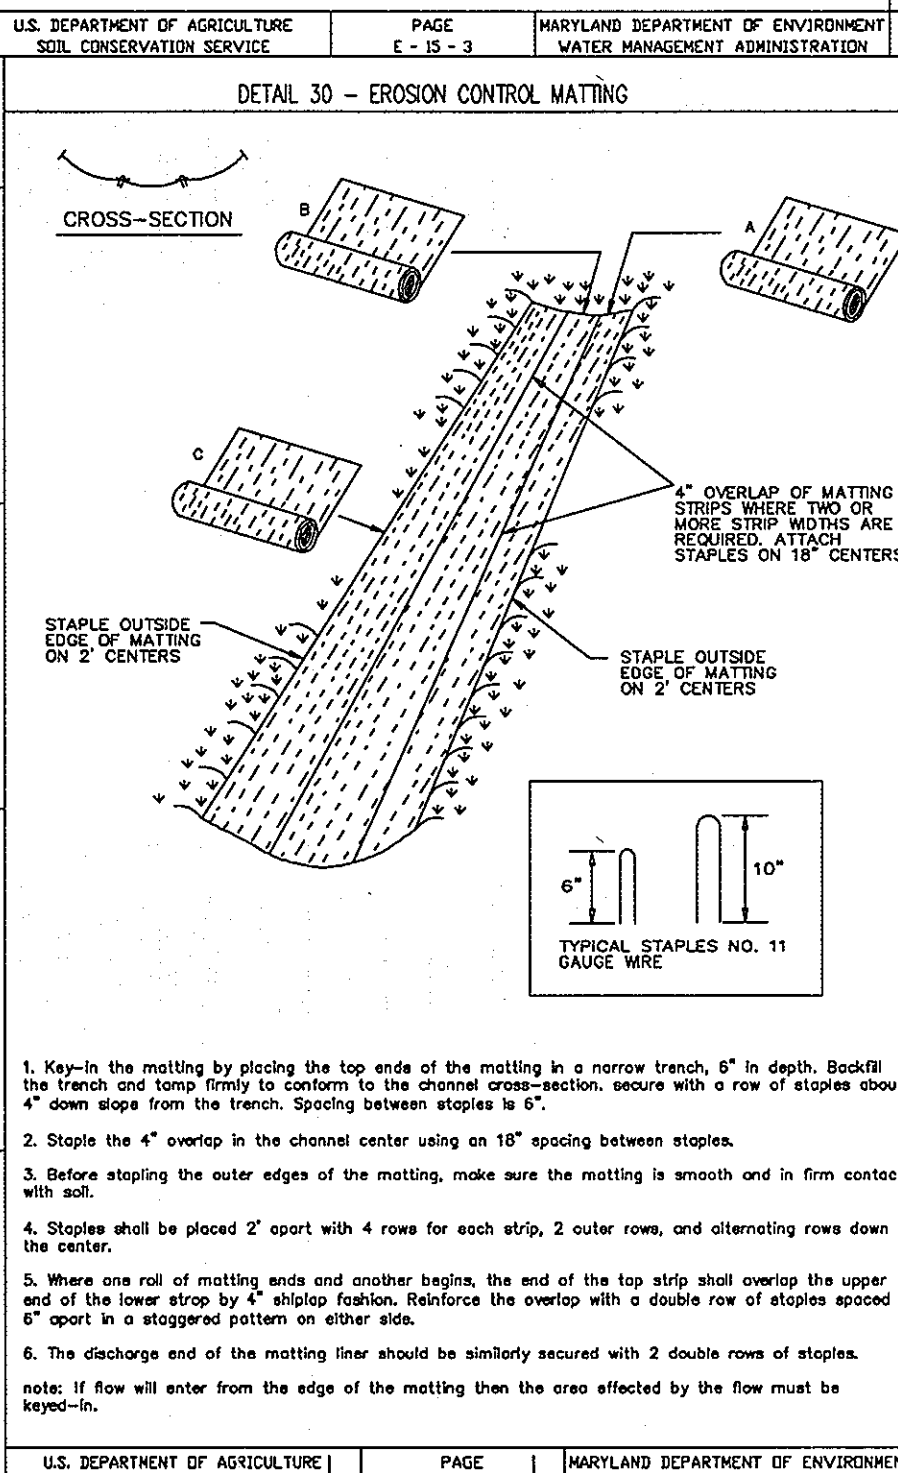

**CONSTRUCTION MATERIAL SPECIFICATIONS**

**I. TOPSOIL SALVAGED FROM THE EXISTING SITE MAY BE USED, PROVIDED THAT IT MEETS THE STANDARDS AS SET FORTH IN THESE SPECIFICATIONS. TYPICALLY, THIS TOPSOIL IS TO BE SALVAGED FROM A GIVEN SOIL TYPE CANE FOUND ON THE REPRESENTATIVE SOIL PROFILE SECTION OF THE SOIL SURVEY PUBLISHED BY USDA IN COOPERATION WITH MARYLAND AGRICULTURAL EXPERIMENTAL STATION.**

**II. TOPSOIL SPECIFICATIONS - SOIL TO BE USED AS TOPSOIL MUST MEET THE FOLLOWING:**

**1. TOPSOIL SHALL BE A LOAM (SANDY LOAM, CLAY LOAM, SILT LOAM, SANDY CLAY LOAM, LOAM SAND, OTHER SOILS MAY BE USED) RECOMMENDED BY AN AGRICULTURIST OR SOIL SCIENTIST AND APPROVED BY THE APPROPRIATE AGRICULTURAL AUTHORITY. REGRADING, TOPSOIL SHALL NOT BE A MIXTURE OF CONTRASTING TEXTURED SUBSTRATES AND SHALL CONTAIN LESS THAN 5% BY VOLUME OF SANDS, STONES, SLAG, COARSE FRAGMENTS, GRAVEL, STICKS, ROCKS, TRASH, OR OTHER MATERIALS LARGER THAN 1/4\"/>**

**SEDIMENT CONTROL NOTES**

1. A MINIMUM OF 48 HOURS NOTICE MUST BE GIVEN TO THE HOWARD COUNTY DEPARTMENT OF INSPECTIONS & PERMITS, SEDIMENT CONTROL DIVISION PRIOR TO THE START OF ANY CONSTRUCTION (H-13-1665).

2. ALL VEGETATIVE & STRUCTURAL PRACTICES ARE TO BE INSTALLED ACCORDING TO THE PROVISIONS OF THIS PLAN & ARE TO BE CONFORMATIVE WITH THE MOST CURRENT "MARYLAND STANDARDS & SPECIFICATIONS FOR SOIL EROSION & SEDIMENT CONTROL" & REVISIONS THERETO.

3. FOLLOWING INITIAL SOIL DISTURBANCES OR RESTORATION, PERMANENT OR TEMPORARY STABILIZATION SHALL BE COMPLETED WITHIN:

A) CALCULATED DAYS FOR ALL PERMITS SEDIMENT CONTROL. STRUCTURES, Dikes, PERIMETER SLOPES & SLOPES GREATER THAN 1:1.

B) ALL SEDIMENT BASINS TO ALL OTHER DISTURBED OR GRADED AREAS ON THE PROJECT SITE.

4. ALL SEDIMENT TRAP BASINS SHOWN ON THE PLAN SHALL BE FENCED A WARNING SIGN POSTED AS NEAR THE PROXIMITY AS POSSIBLE WITHIN THE PERIMETER OF THE BASIN. THE SIGN SHALL BE CONFORMATIVE WITH VOLUME 1, CHAPTER 12 OF THE "MOUNTAIN COUNTY DESIGN MANUAL, STORM DRAINAGE".

5. ALL DISTURBED AREAS MUST BE STABILIZED WITHIN THE PERIOD SPECIFIED ABOVE IN ACCORDANCE WITH THE MOST CURRENT "MARYLAND STANDARDS & SPECIFICATIONS FOR SOIL EROSION & SEDIMENT CONTROL" & REVISIONS THERETO. TEMPORARY STABILIZATION WITH WHICH ALONE CAN ONLY BE MAINTAINED FOR A LIMITED PERIOD OF TIME SHALL NOT BE CONSIDERED A PERMANENT ESTABLISHMENT OF GRASSES.

6. ALL SEDIMENT CONTROL STRUCTURES ARE TO REMAIN IN PLACE & TO BE MAINTAINED IN OPERATIVE CONDITION UNTIL PERMITS FOR THEIR REMOVAL HAS BEEN OBTAINED FROM THE HOWARD COUNTY SEDIMENT CONTROL INSPECTOR.

7. SITE ANALYSIS:

TOTAL SITE AREA:	38.8 ACRES (8,400 SQ. FT.)
DISTURBED AREA:	28.8 ACRES
UNDISTURBED AREA:	10.0 ACRES
AREA TO BE STABILIZED:	14.000 ACRES
TOTAL FILL:	14.000 CU. YD.
% OF SITE WATERBORN AREA:	100%

8. ALL EXCESS MATERIAL SHALL BE TRANSPORTED TO A SUITABLE SPILL SPILL APPROVED BY THE SEDIMENT CONTROL INSPECTOR. NO MATERIAL SHALL BE APPLIED TO THE SITE UNLESS IT IS APPROVED BY THE SEDIMENT CONTROL INSPECTOR. ALL OTHER ASSOCIATED SEDIMENT CONTROL MEASURES AS REQUIRED BY THE INSPECTOR SHALL BE INSTALLED.

9. ALL DISTURBED AREAS SHALL BE STABILIZED WITHIN THE PERIOD SPECIFIED ABOVE IN ACCORDANCE WITH THE MOST CURRENT "MARYLAND STANDARDS & SPECIFICATIONS FOR SOIL EROSION & SEDIMENT CONTROL" & REVISIONS THERETO. TEMPORARY STABILIZATION WITH WHICH ALONE CAN ONLY BE MAINTAINED FOR A LIMITED PERIOD OF TIME SHALL NOT BE CONSIDERED A PERMANENT ESTABLISHMENT OF GRASSES.

10. ON ALL SITES WITH DISTURBED AREAS IN EXCESS OF 4 ACRES, APPROVAL OF THE INSPECTION AGENCY AND A REGISTERED PROFESSIONAL ENGINEER (R.P.E.) SHALL BE OBTAINED PRIOR TO THE START OF ANY CONSTRUCTION. THE R.P.E. SHALL BE A MEMBER OF THE PROFESSIONAL ENGINEERS OF MARYLAND (P.E.M.) AND SHALL BE LICENSED IN THE STATE OF MARYLAND. THE R.P.E. SHALL BE A MEMBER OF THE PROFESSIONAL ENGINEERS OF MARYLAND (P.E.M.) AND SHALL BE LICENSED IN THE STATE OF MARYLAND. THE R.P.E. SHALL BE A MEMBER OF THE PROFESSIONAL ENGINEERS OF MARYLAND (P.E.M.) AND SHALL BE LICENSED IN THE STATE OF MARYLAND.

11. TRENCHES FOR THE CONSTRUCTION OF UTILITIES SHALL BE COVERED WITHIN ONE WORKING DAY. UNLESS OTHERWISE SPECIFIED, TRENCHES SHALL BE COVERED WITHIN ONE WORKING DAY. UNLESS OTHERWISE SPECIFIED, TRENCHES SHALL BE COVERED WITHIN ONE WORKING DAY.

12. QUANTITIES & ESTIMATES SHOWN ARE FOR SEDIMENT CONTROL PURPOSES ONLY. CONTRACTOR SHALL PROVIDE HIS OWN QUANTITY ESTIMATES TO HIS BEST SATISFACTION.

DATE	REVISION	BY	DATE
10/14/03 <td>1 <td>W. J. ... <td>10/14/03</td> </td></td>	1 <td>W. J. ... <td>10/14/03</td> </td>	W. J. ... <td>10/14/03</td>	10/14/03
10/21/03 <td>2 <td>C. ... <td>10/21/03</td> </td></td>	2 <td>C. ... <td>10/21/03</td> </td>	C. ... <td>10/21/03</td>	10/21/03
10/17/03 <td>3 <td>C. ... <td>10/17/03</td> </td></td>	3 <td>C. ... <td>10/17/03</td> </td>	C. ... <td>10/17/03</td>	10/17/03
10/21/03 <td>4 <td>H. ... <td>10/21/03</td> </td></td>	4 <td>H. ... <td>10/21/03</td> </td>	H. ... <td>10/21/03</td>	10/21/03
10/16/03 <td>5 <td>H. ... <td>10/16/03</td> </td></td>	5 <td>H. ... <td>10/16/03</td> </td>	H. ... <td>10/16/03</td>	10/16/03

DATE	REVISION	BY	DATE
10/14/03 <td>1 <td>W. J. ... <td>10/14/03</td> </td></td>	1 <td>W. J. ... <td>10/14/03</td> </td>	W. J. ... <td>10/14/03</td>	10/14/03
10/21/03 <td>2 <td>C. ... <td>10/21/03</td> </td></td>	2 <td>C. ... <td>10/21/03</td> </td>	C. ... <td>10/21/03</td>	10/21/03
10/17/03 <td>3 <td>C. ... <td>10/17/03</td> </td></td>	3 <td>C. ... <td>10/17/03</td> </td>	C. ... <td>10/17/03</td>	10/17/03
10/21/03 <td>4 <td>H. ... <td>10/21/03</td> </td></td>	4 <td>H. ... <td>10/21/03</td> </td>	H. ... <td>10/21/03</td>	10/21/03
10/16/03 <td>5 <td>H. ... <td>10/16/03</td> </td></td>	5 <td>H. ... <td>10/16/03</td> </td>	H. ... <td>10/16/03</td>	10/16/03

**AS-BUILT PLANS**  
 (No As-Built Data This Sheet)

**RODGER CONSULTING**  
 Enhancing the value of land assets

Rodgers Consulting, Inc.  
 3260 Gaither Road  
 Gaithersburg, MD 20877  
 301.948.4700  
 301.948.6256 (fax)  
 301.253.6609  
 www.rodgers.com

**DEVELOPER'S CERTIFICATE**

I/WE CERTIFY THAT ALL DEVELOPMENT AND/OR CONSTRUCTION WILL BE DONE ACCORDING TO THESE PLANS, AND THAT ANY RESPONSIBLE PERSONNEL INVOLVED IN THE CONSTRUCTION PROJECT WILL HAVE A CERTIFICATE OF ATTENDANCE AT A DEPARTMENT OF THE ENVIRONMENT APPROVED TRAINING PROGRAM FOR THE CONTROL OF SEDIMENT AND EROSION BEFORE BEGINNING THE PROJECT. I SHALL ENGAGE A REGISTERED PROFESSIONAL ENGINEER TO SUPERVISE POND CONSTRUCTION AND PROVIDE THE HOWARD SOIL CONSERVATION DISTRICT WITH AN "AS-BUILT" PLAN OF THE POND WITHIN 30 DAYS OF COMPLETION. I ALSO AUTHORIZE PERIODIC ON-SITE INSPECTIONS BY THE HOWARD SOIL CONSERVATION DISTRICT.

*[Signature]* 9/23/03  
 SIGNATURE OF DEVELOPER (PRINT NAME BELOW SIGNATURE)

**ENGINEER'S CERTIFICATE**


I CERTIFY THAT THIS PLAN FOR POND CONSTRUCTION, EROSION AND SEDIMENT CONTROL REPRESENTS A PRACTICAL AND WORKABLE PLAN BASED ON MY PERSONAL KNOWLEDGE OF THE SITE CONDITIONS. THIS PLAN WAS PREPARED IN ACCORDANCE WITH THE REQUIREMENTS OF THE HOWARD SOIL CONSERVATION DISTRICT. I HAVE NOTIFIED THE DEVELOPER THAT HE/SHE MUST ENGAGE A REGISTERED PROFESSIONAL ENGINEER TO SUPERVISE POND CONSTRUCTION AND PROVIDE THE HOWARD SOIL CONSERVATION DISTRICT WITH AN "AS-BUILT" PLAN OF THE POND WITHIN 30 DAYS OF COMPLETION.

*[Signature]* 9/24/03  
 SIGNATURE OF ENGINEER (PRINT NAME BELOW SIGNATURE)

**Montjoy - Single Family Detached**  
 A RESUBDIVISION OF NON-BUILDABLE BULK PARCEL C (F-03-87)  
 TO  
 BUILDABLE LOTS 127-188 AND OPEN SPACE LOTS 189-193  
 ELECTION DISTRICT #2 HOWARD COUNTY, MARYLAND  
 TAX MAP: 30, GRID: 12, PARCEL 260  
 DP2 FILES: 8-01-20, WP-01-117, P-02-110, P-02-117, P-03-03, P-03-87






SCALE: AS SHOWN  
 JOB No.: 506V3  
 DATE: 1-14-03  
 INDEX No.: SC-4  
 SHEET No.: 15 of 33  
 F-03-100



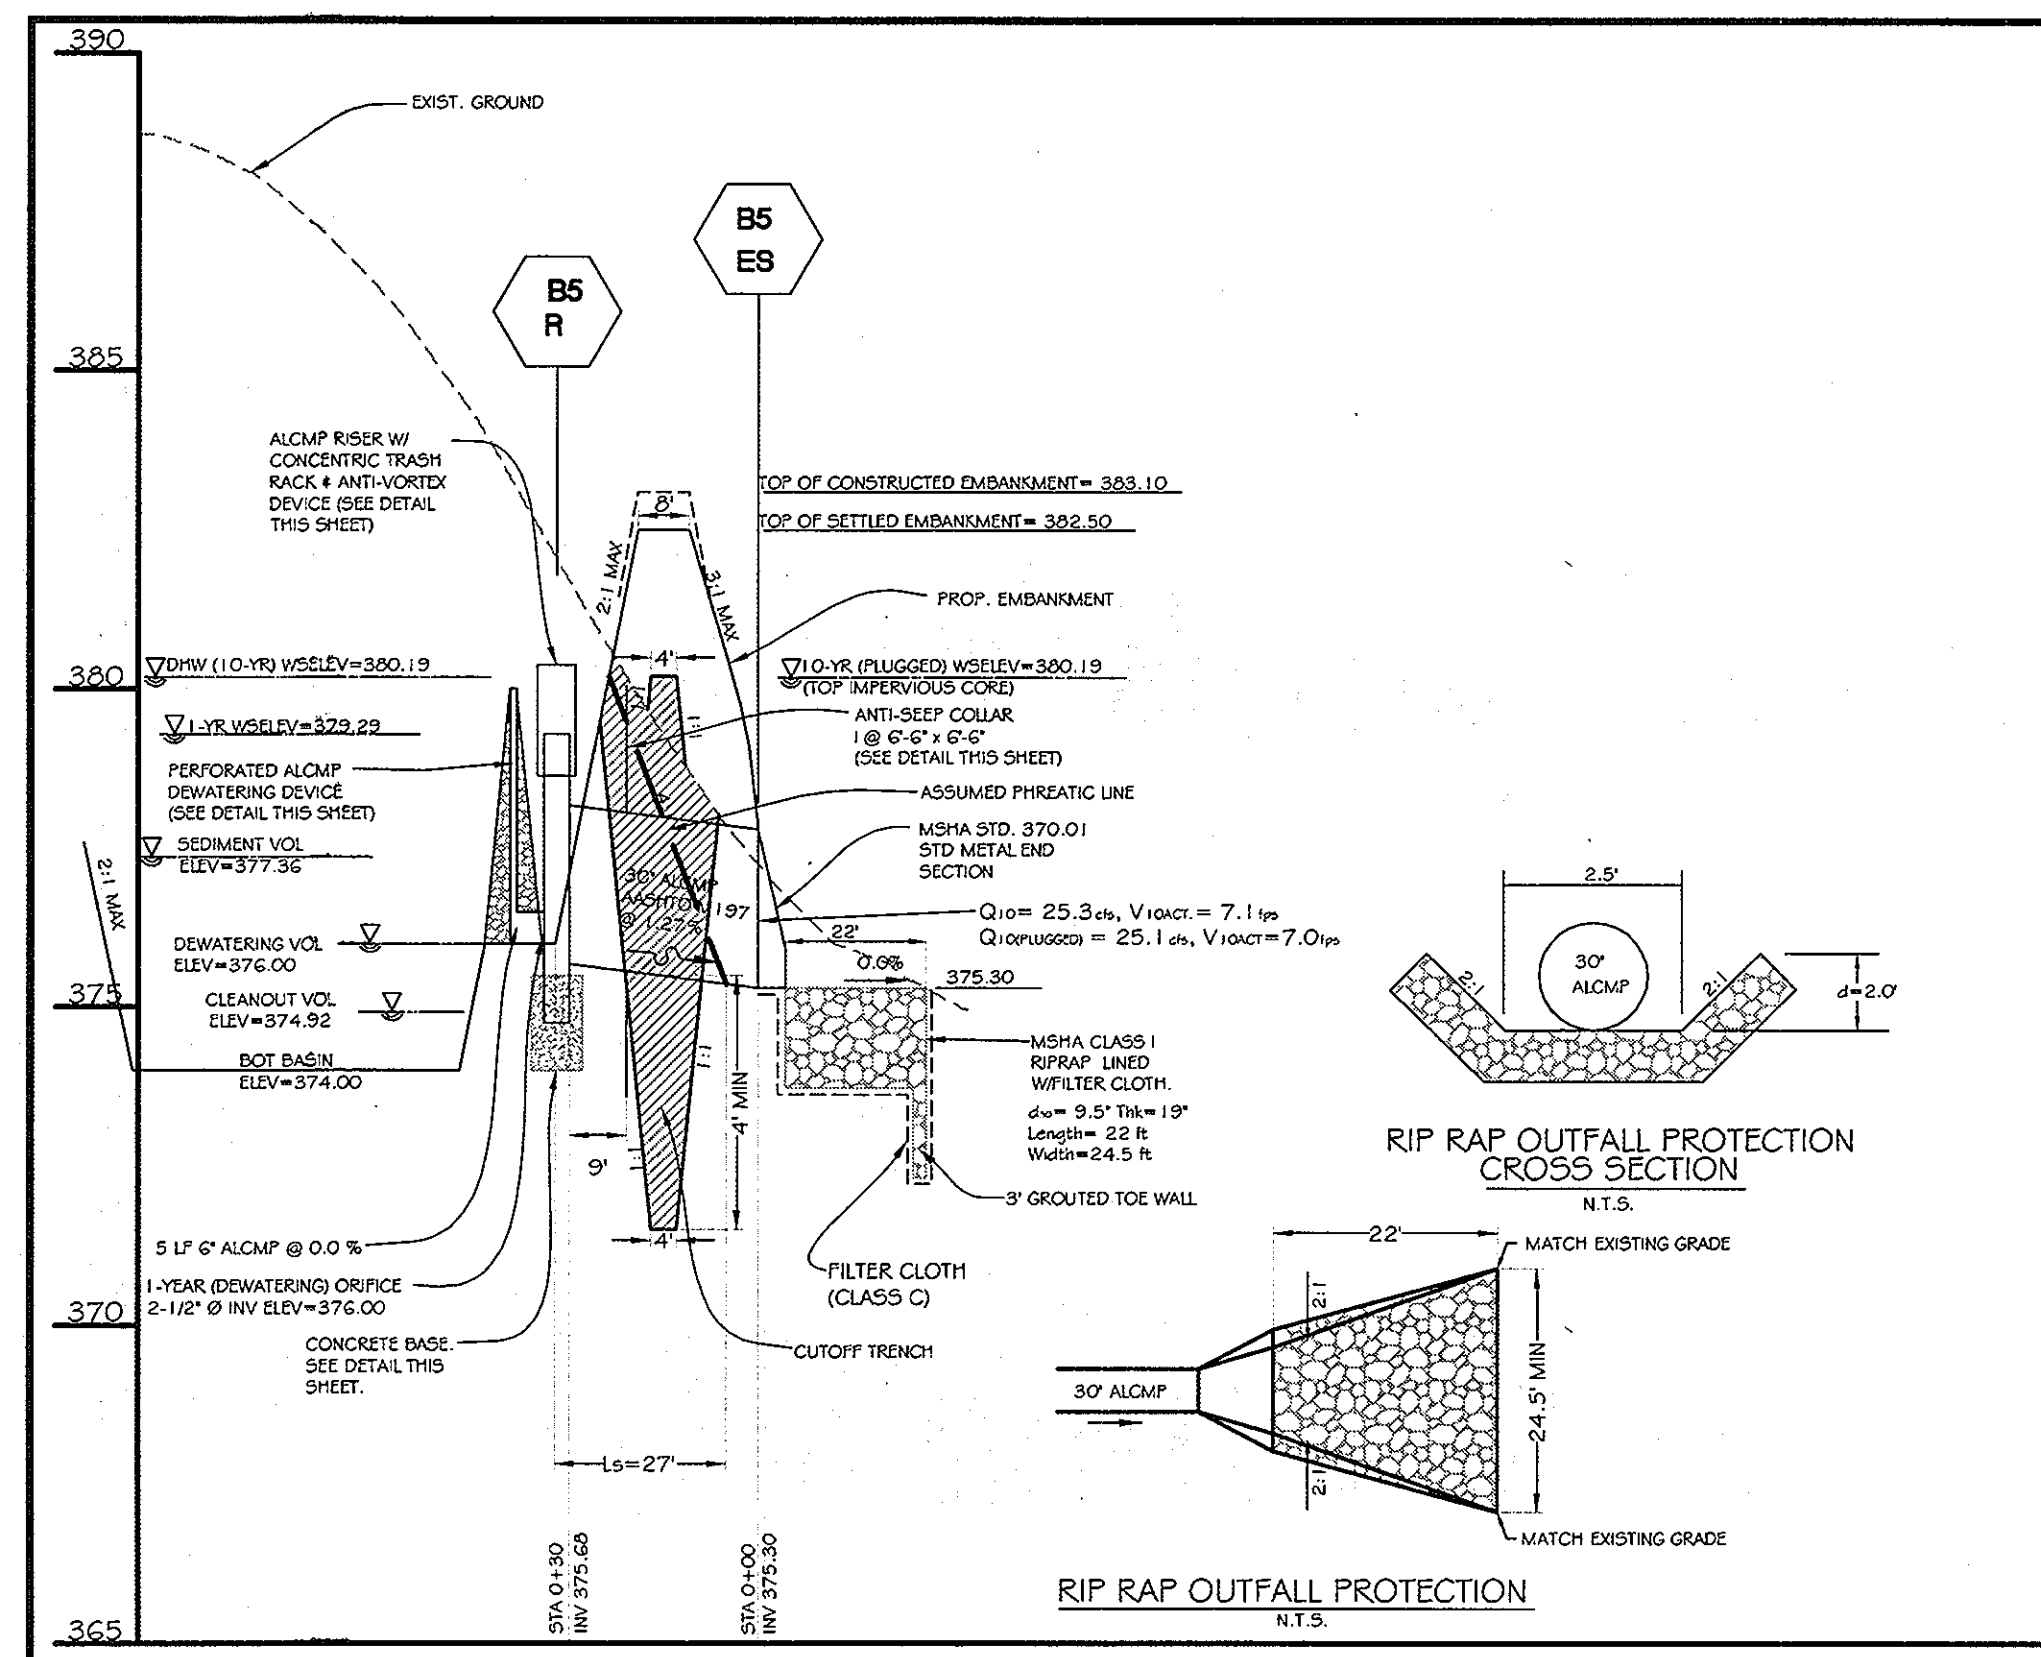

**STRUCTURE SCHEDULE** (SEE DIMENSIONS ON RISER, RISER BASE, TRASH RACK, AND DEWATERING DEVICE DETAILS THIS SHEET)

STRUCTURE	STRUCTURE DIMENSIONS										ELEVATION DATA									
	A (ft)	B (ft)	C (ft)	D (ft)	E (ft)	F (ft)	G (ft)	H (ft)	K (ft)	BASIN BOT. C/O ELEV.	SEDIMENT C/O ELEV.	WET VOL. ELEV.	DRY VOL. ELEV.	INV 1	INV 2	WEIR CREST / TOP DEWATERING DEVICE	1-YEAR WS ELEV.	10-YEAR WS ELEV.		
TRAP A	24	36	54	3	12	72	72	72	24	394.00	394.39	394.78	395.48	393.60	394.78	396.35	396.34	396.96		
BASIN 5	30	48	72	2.5	12	78	78	96	24	374.00	374.92	376.00	377.36	375.60	376.00	379.30	379.29	380.19		

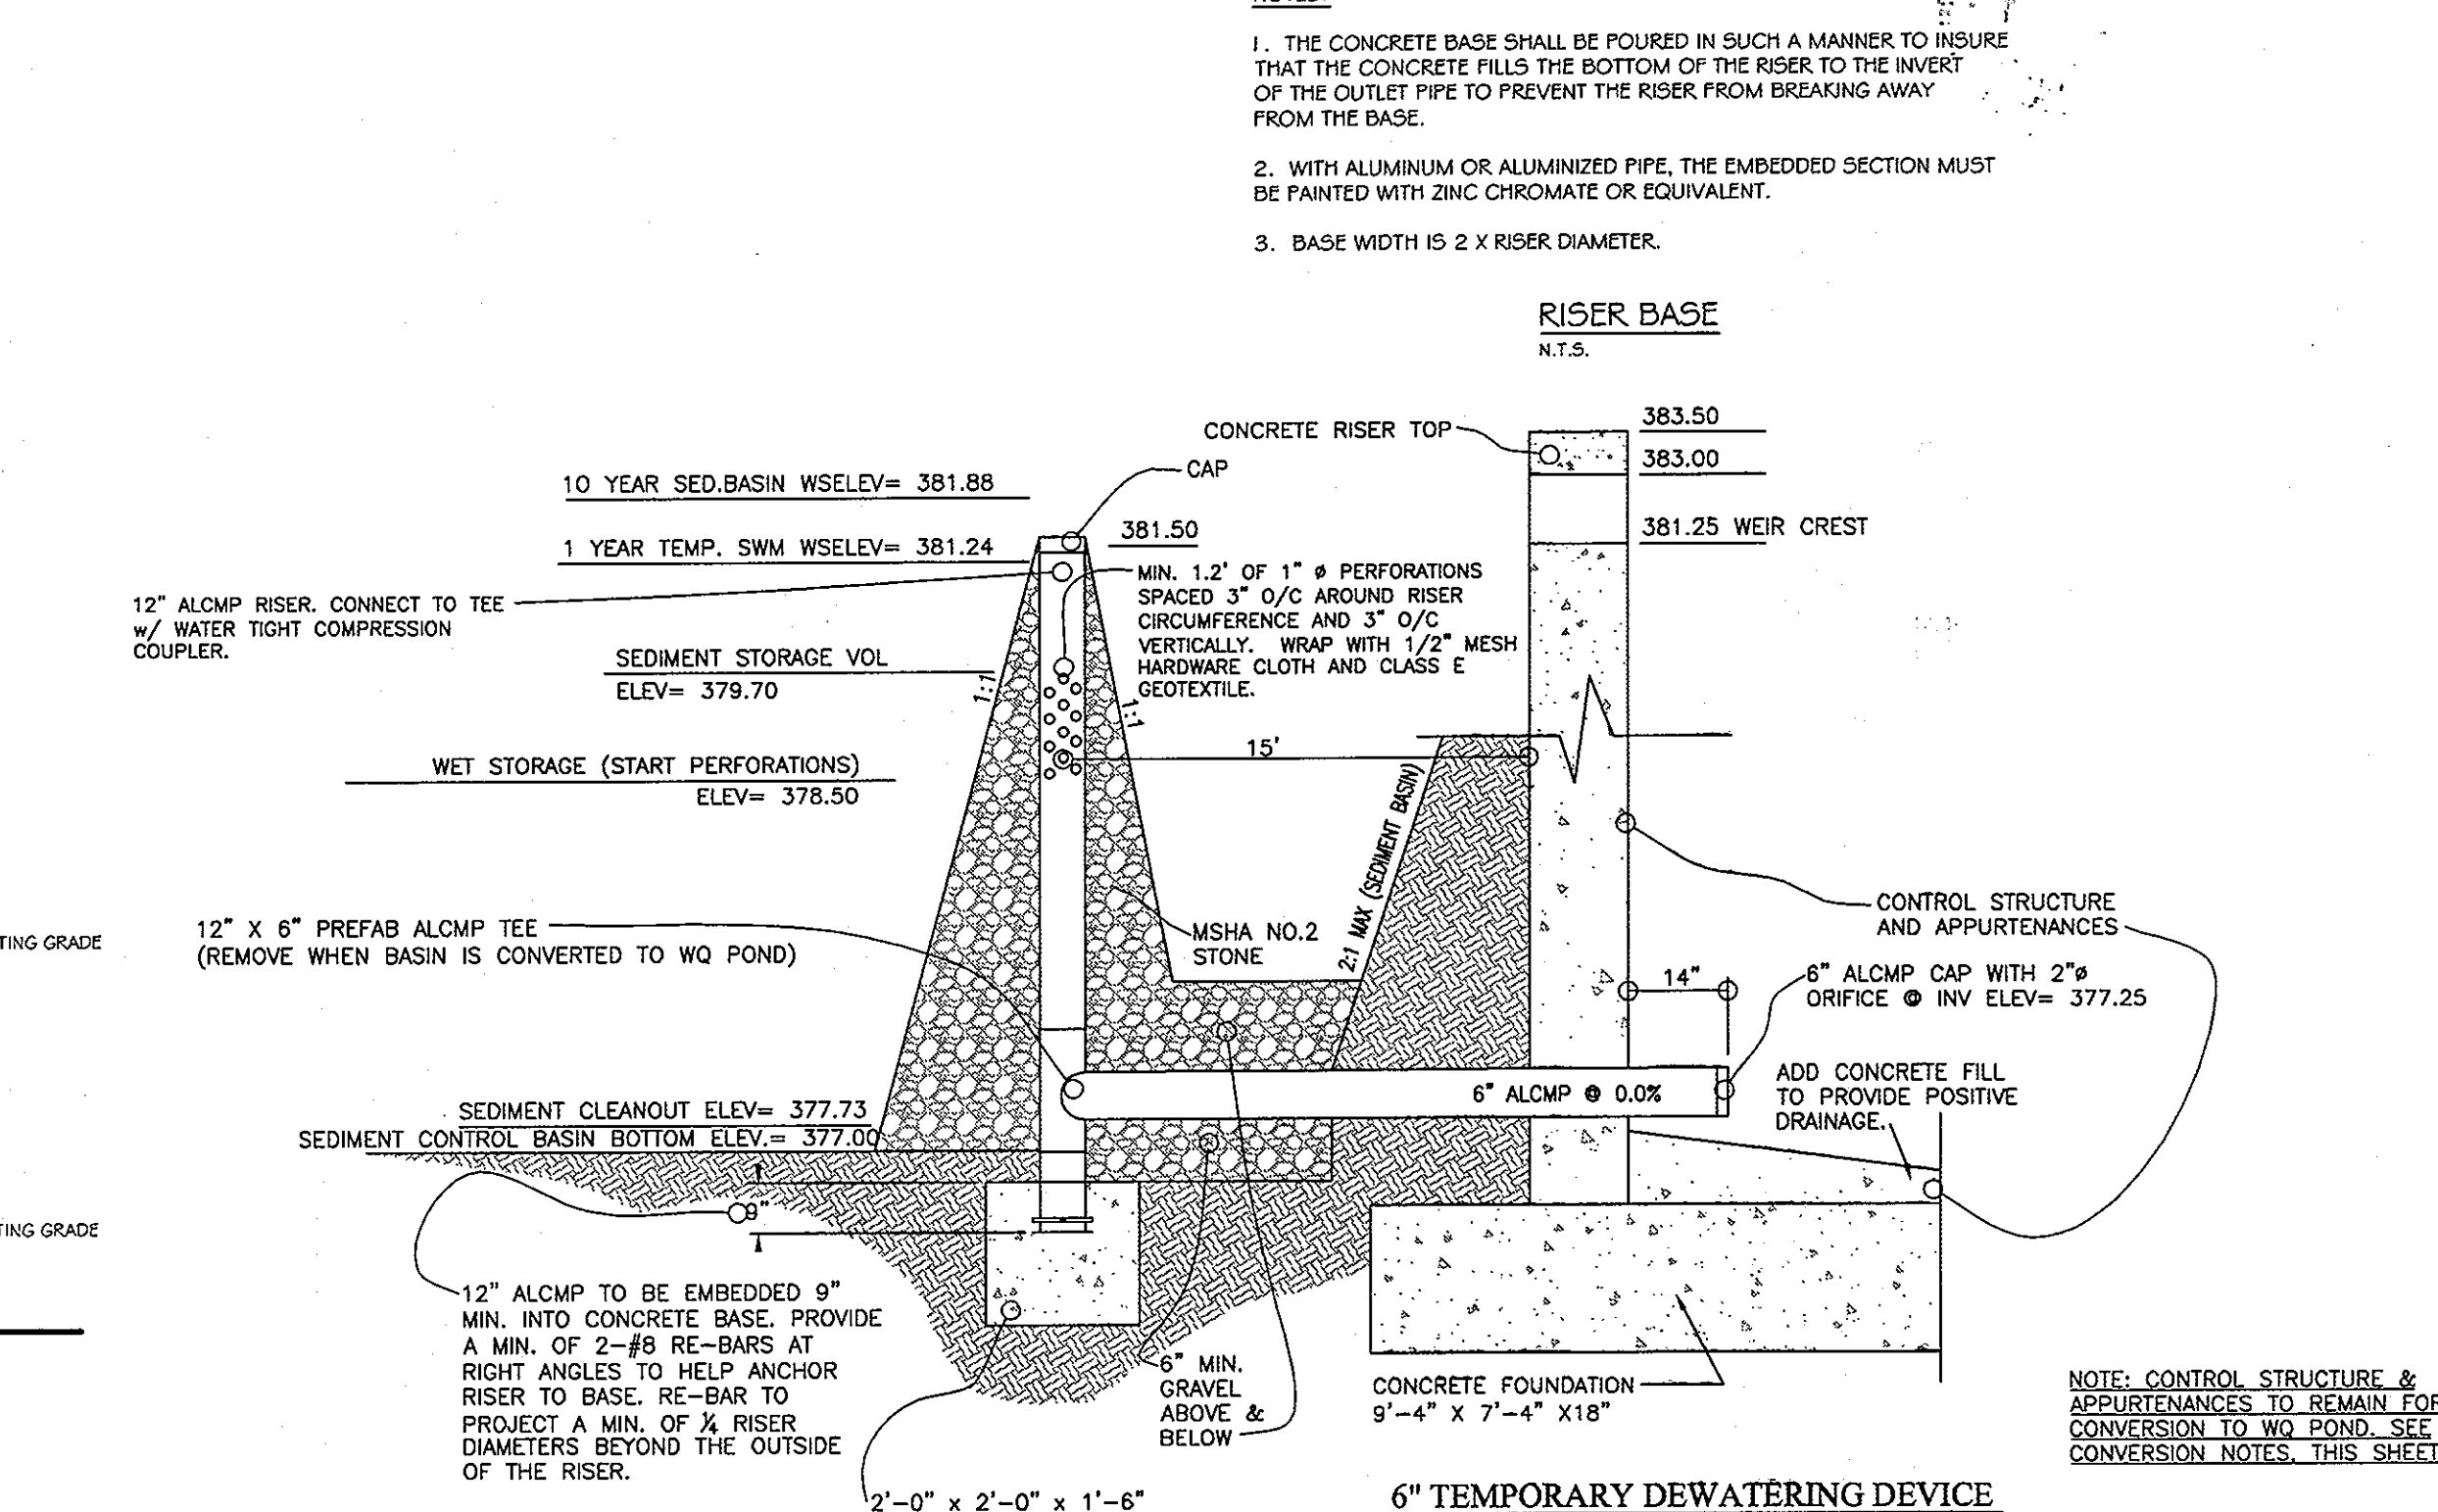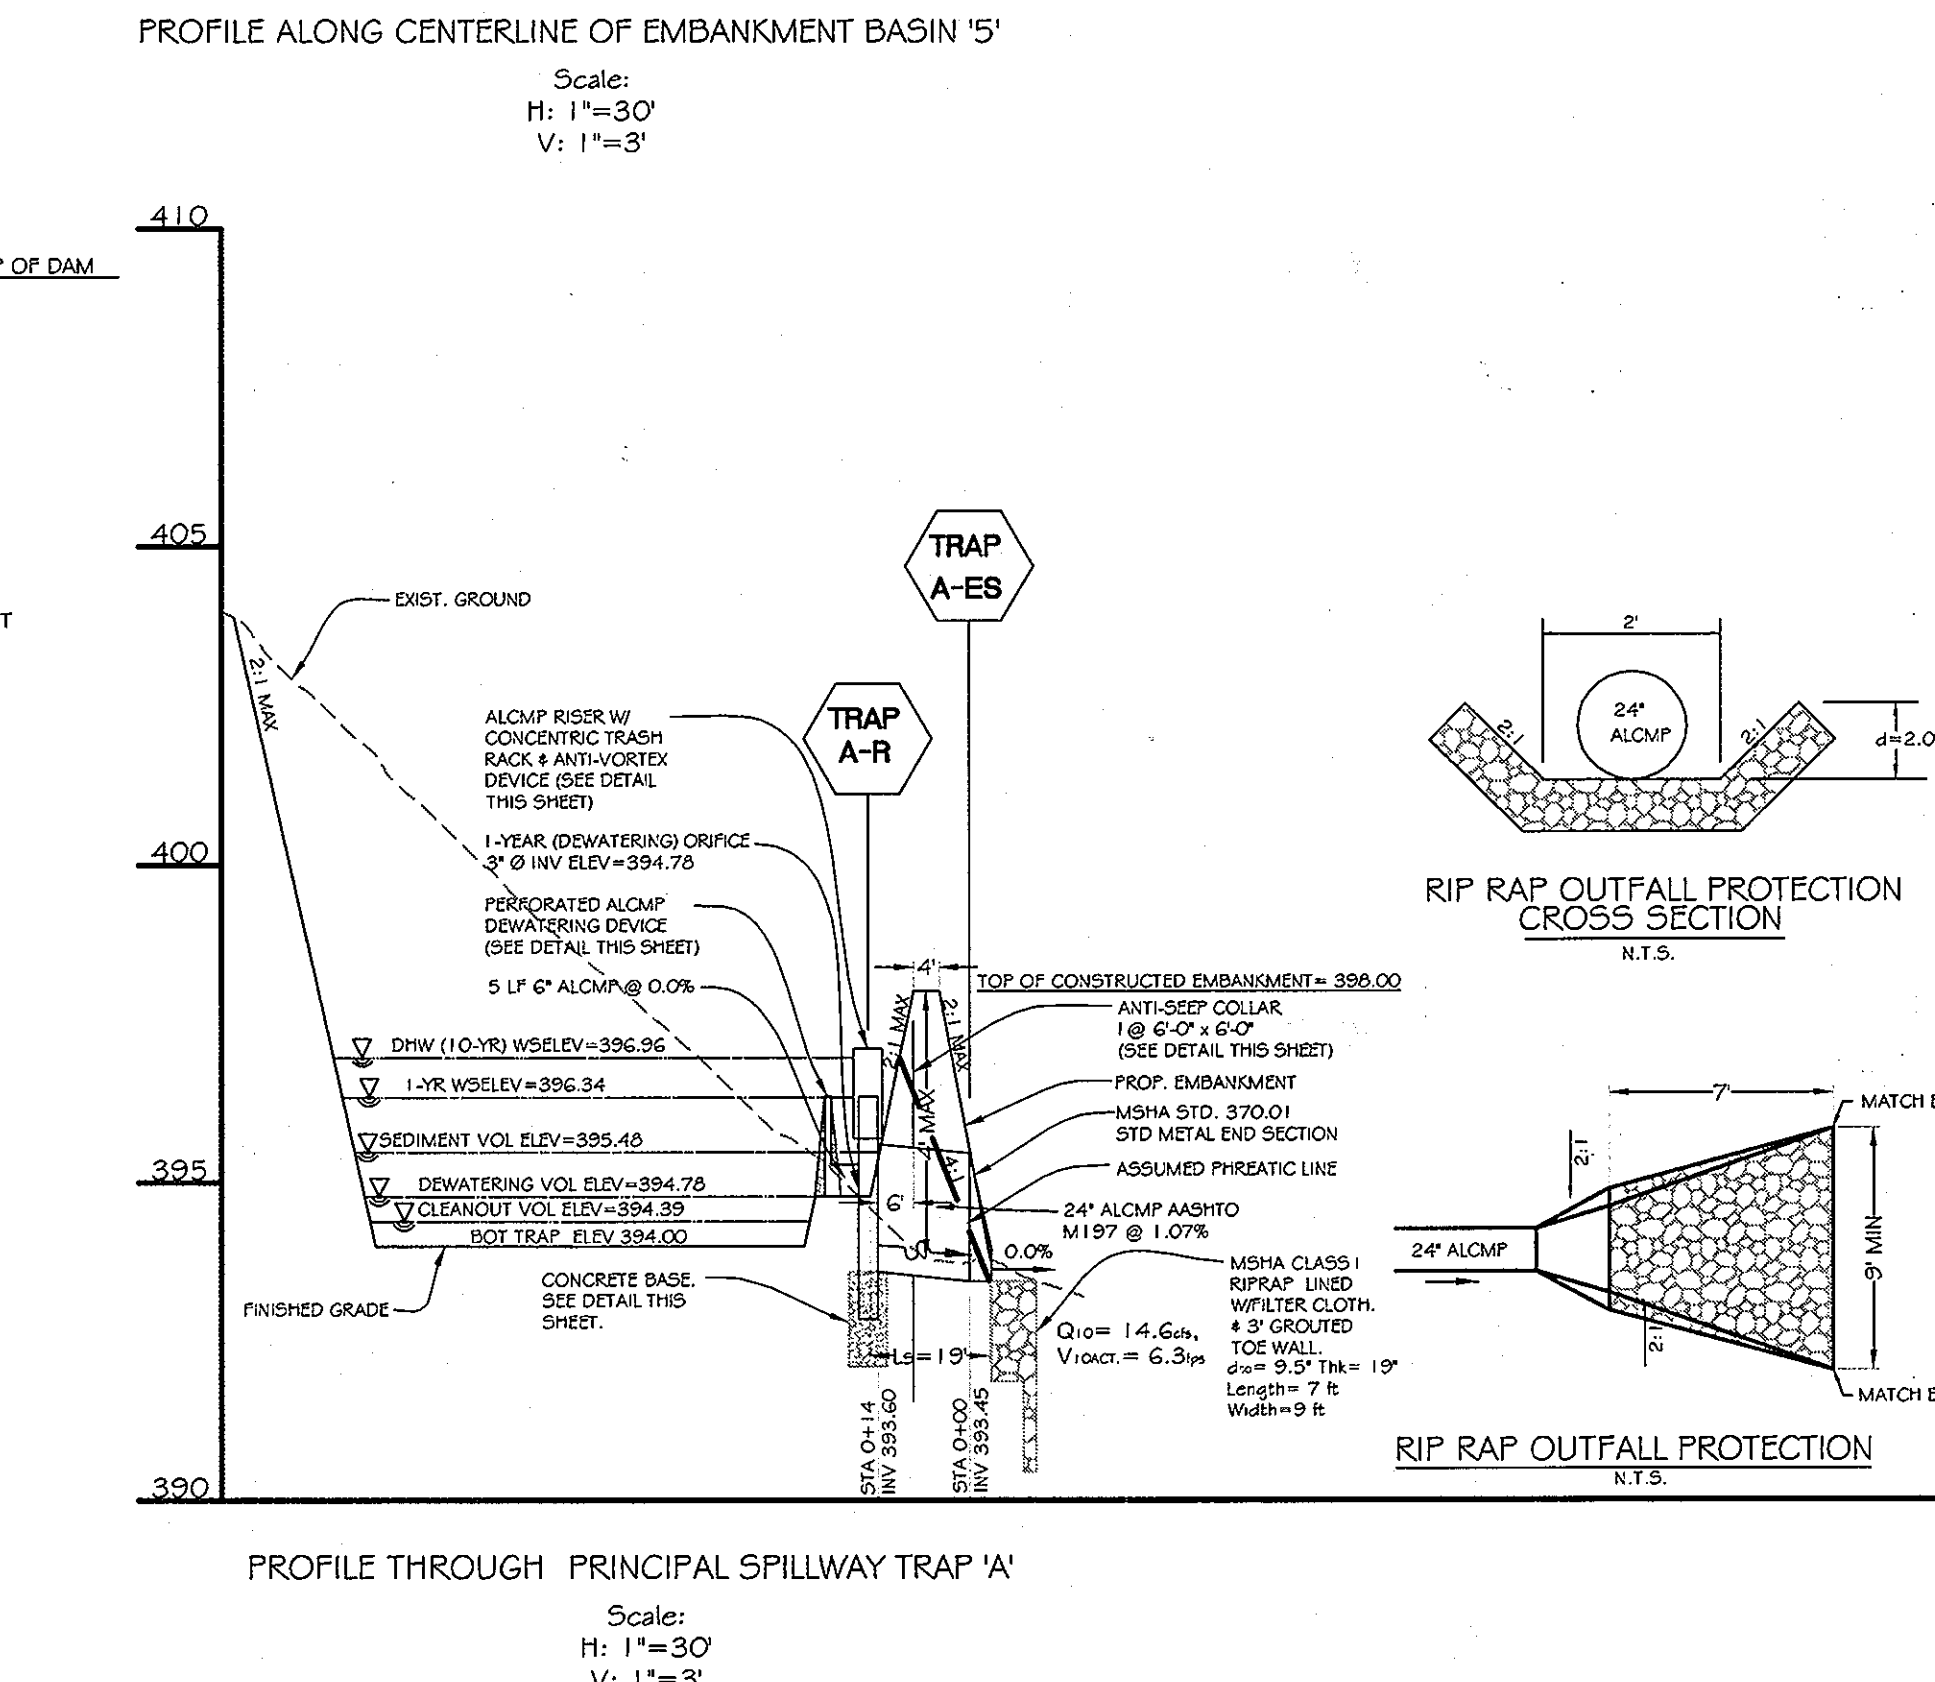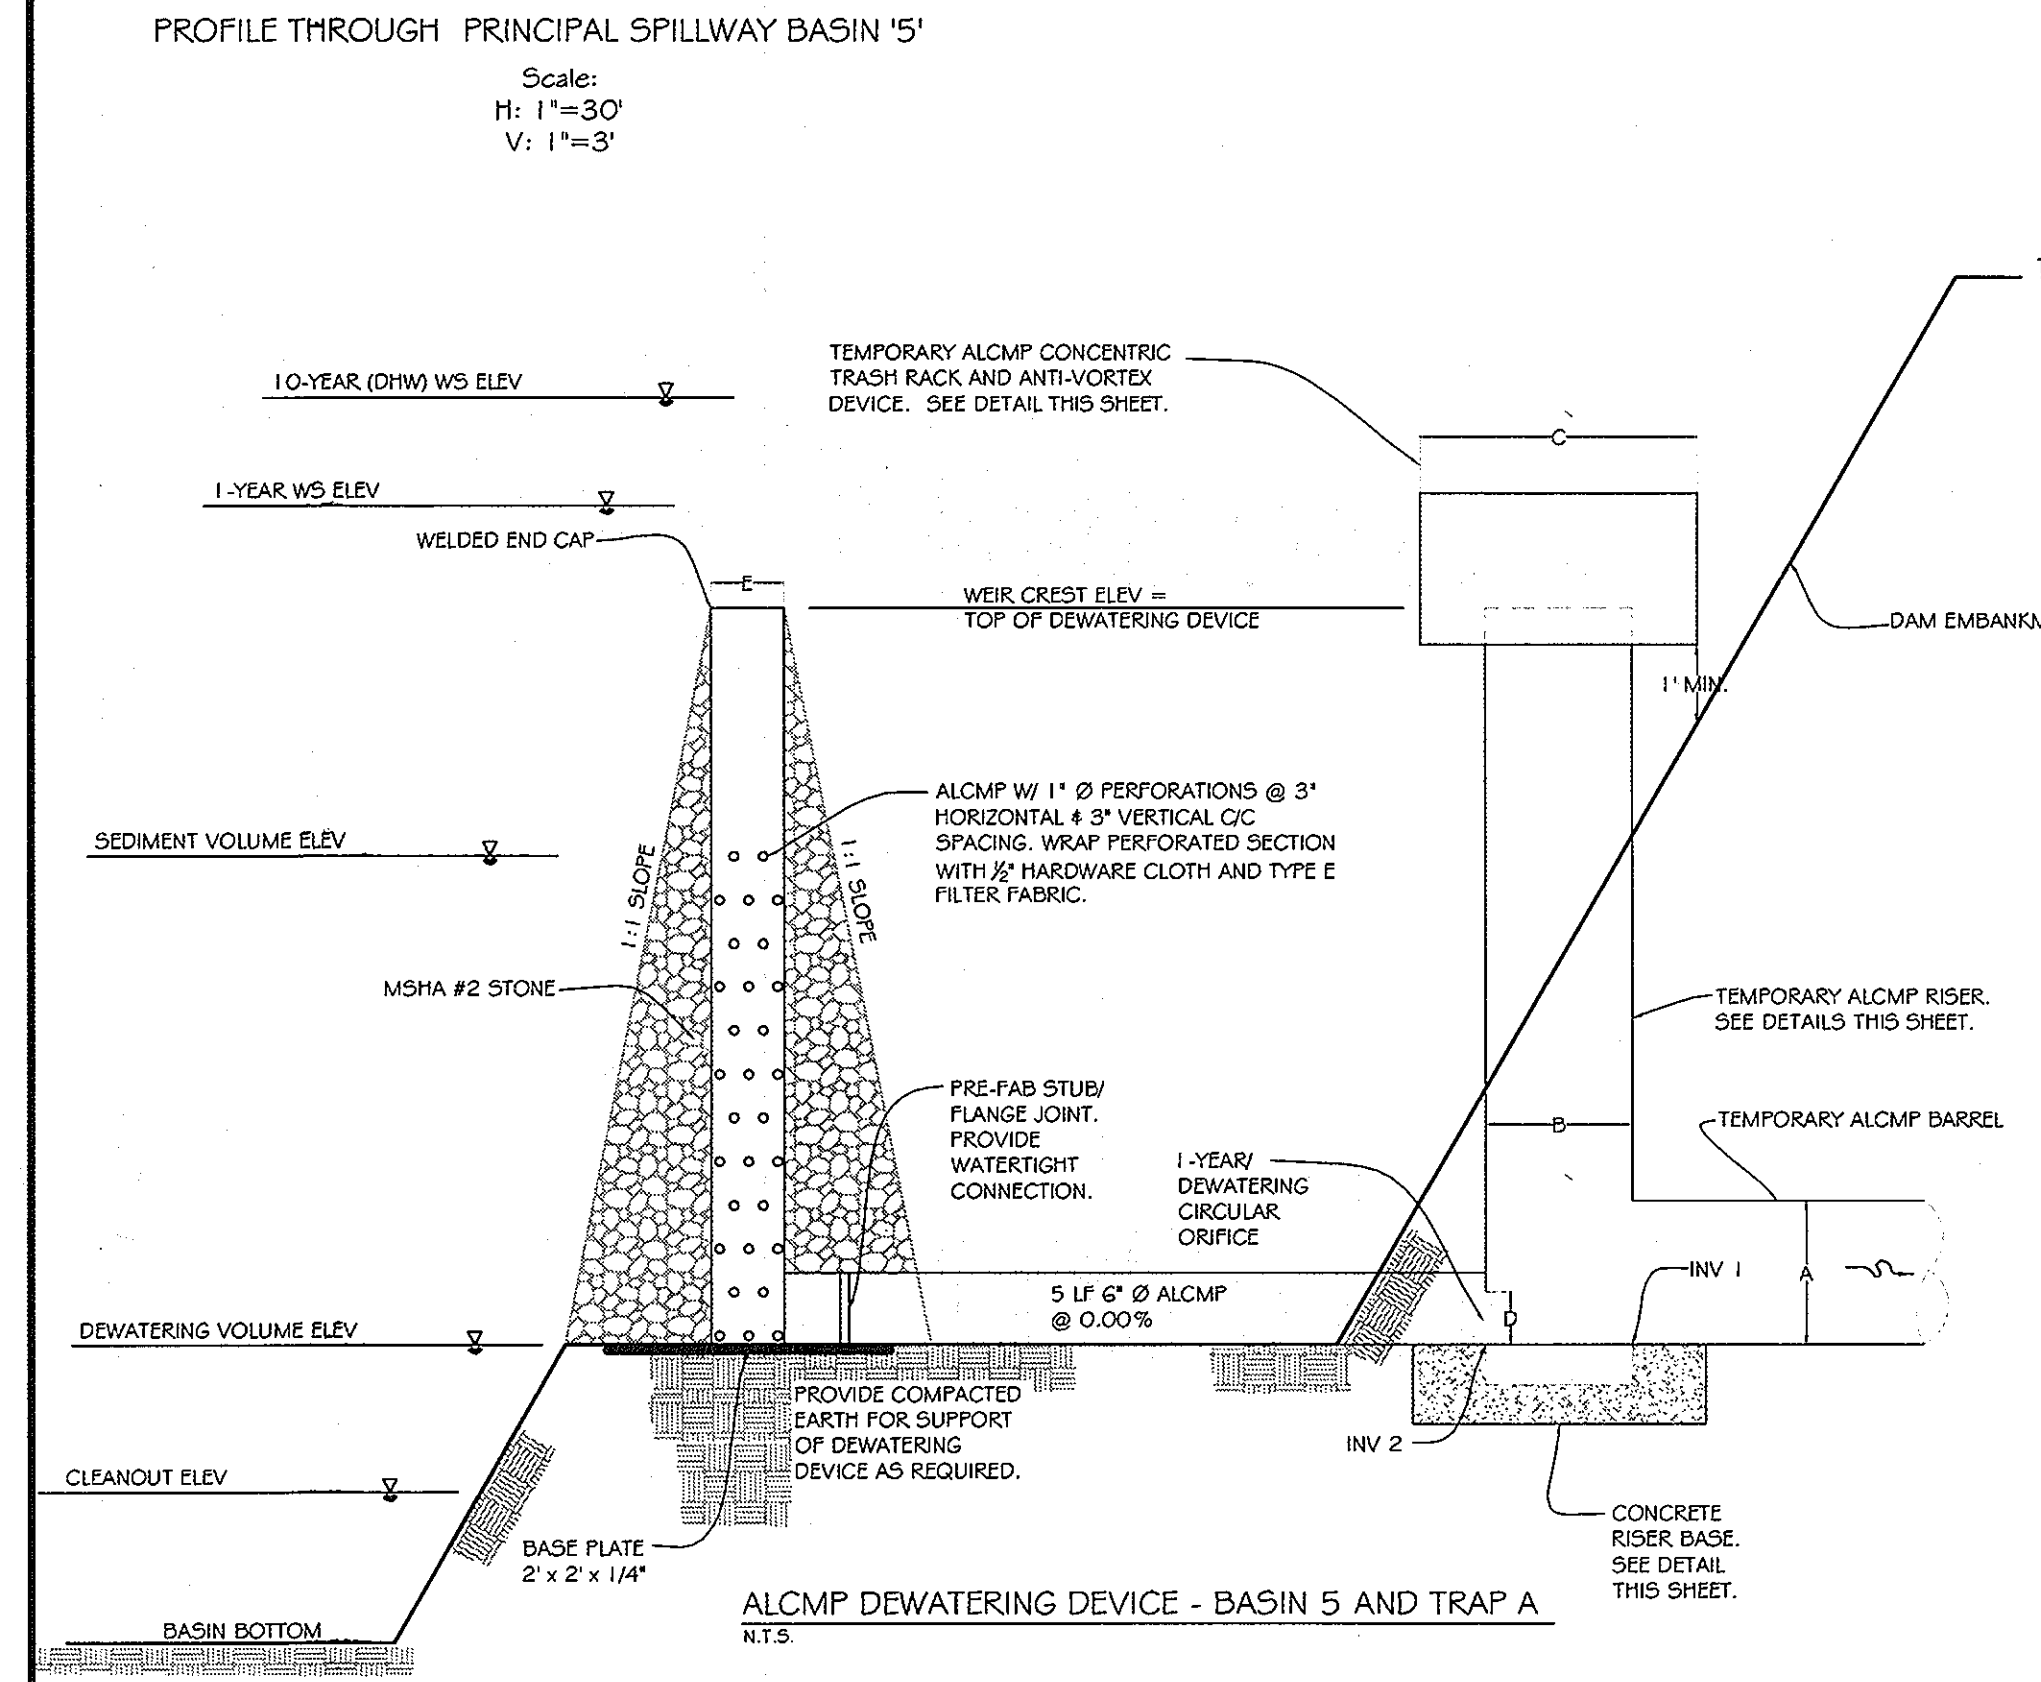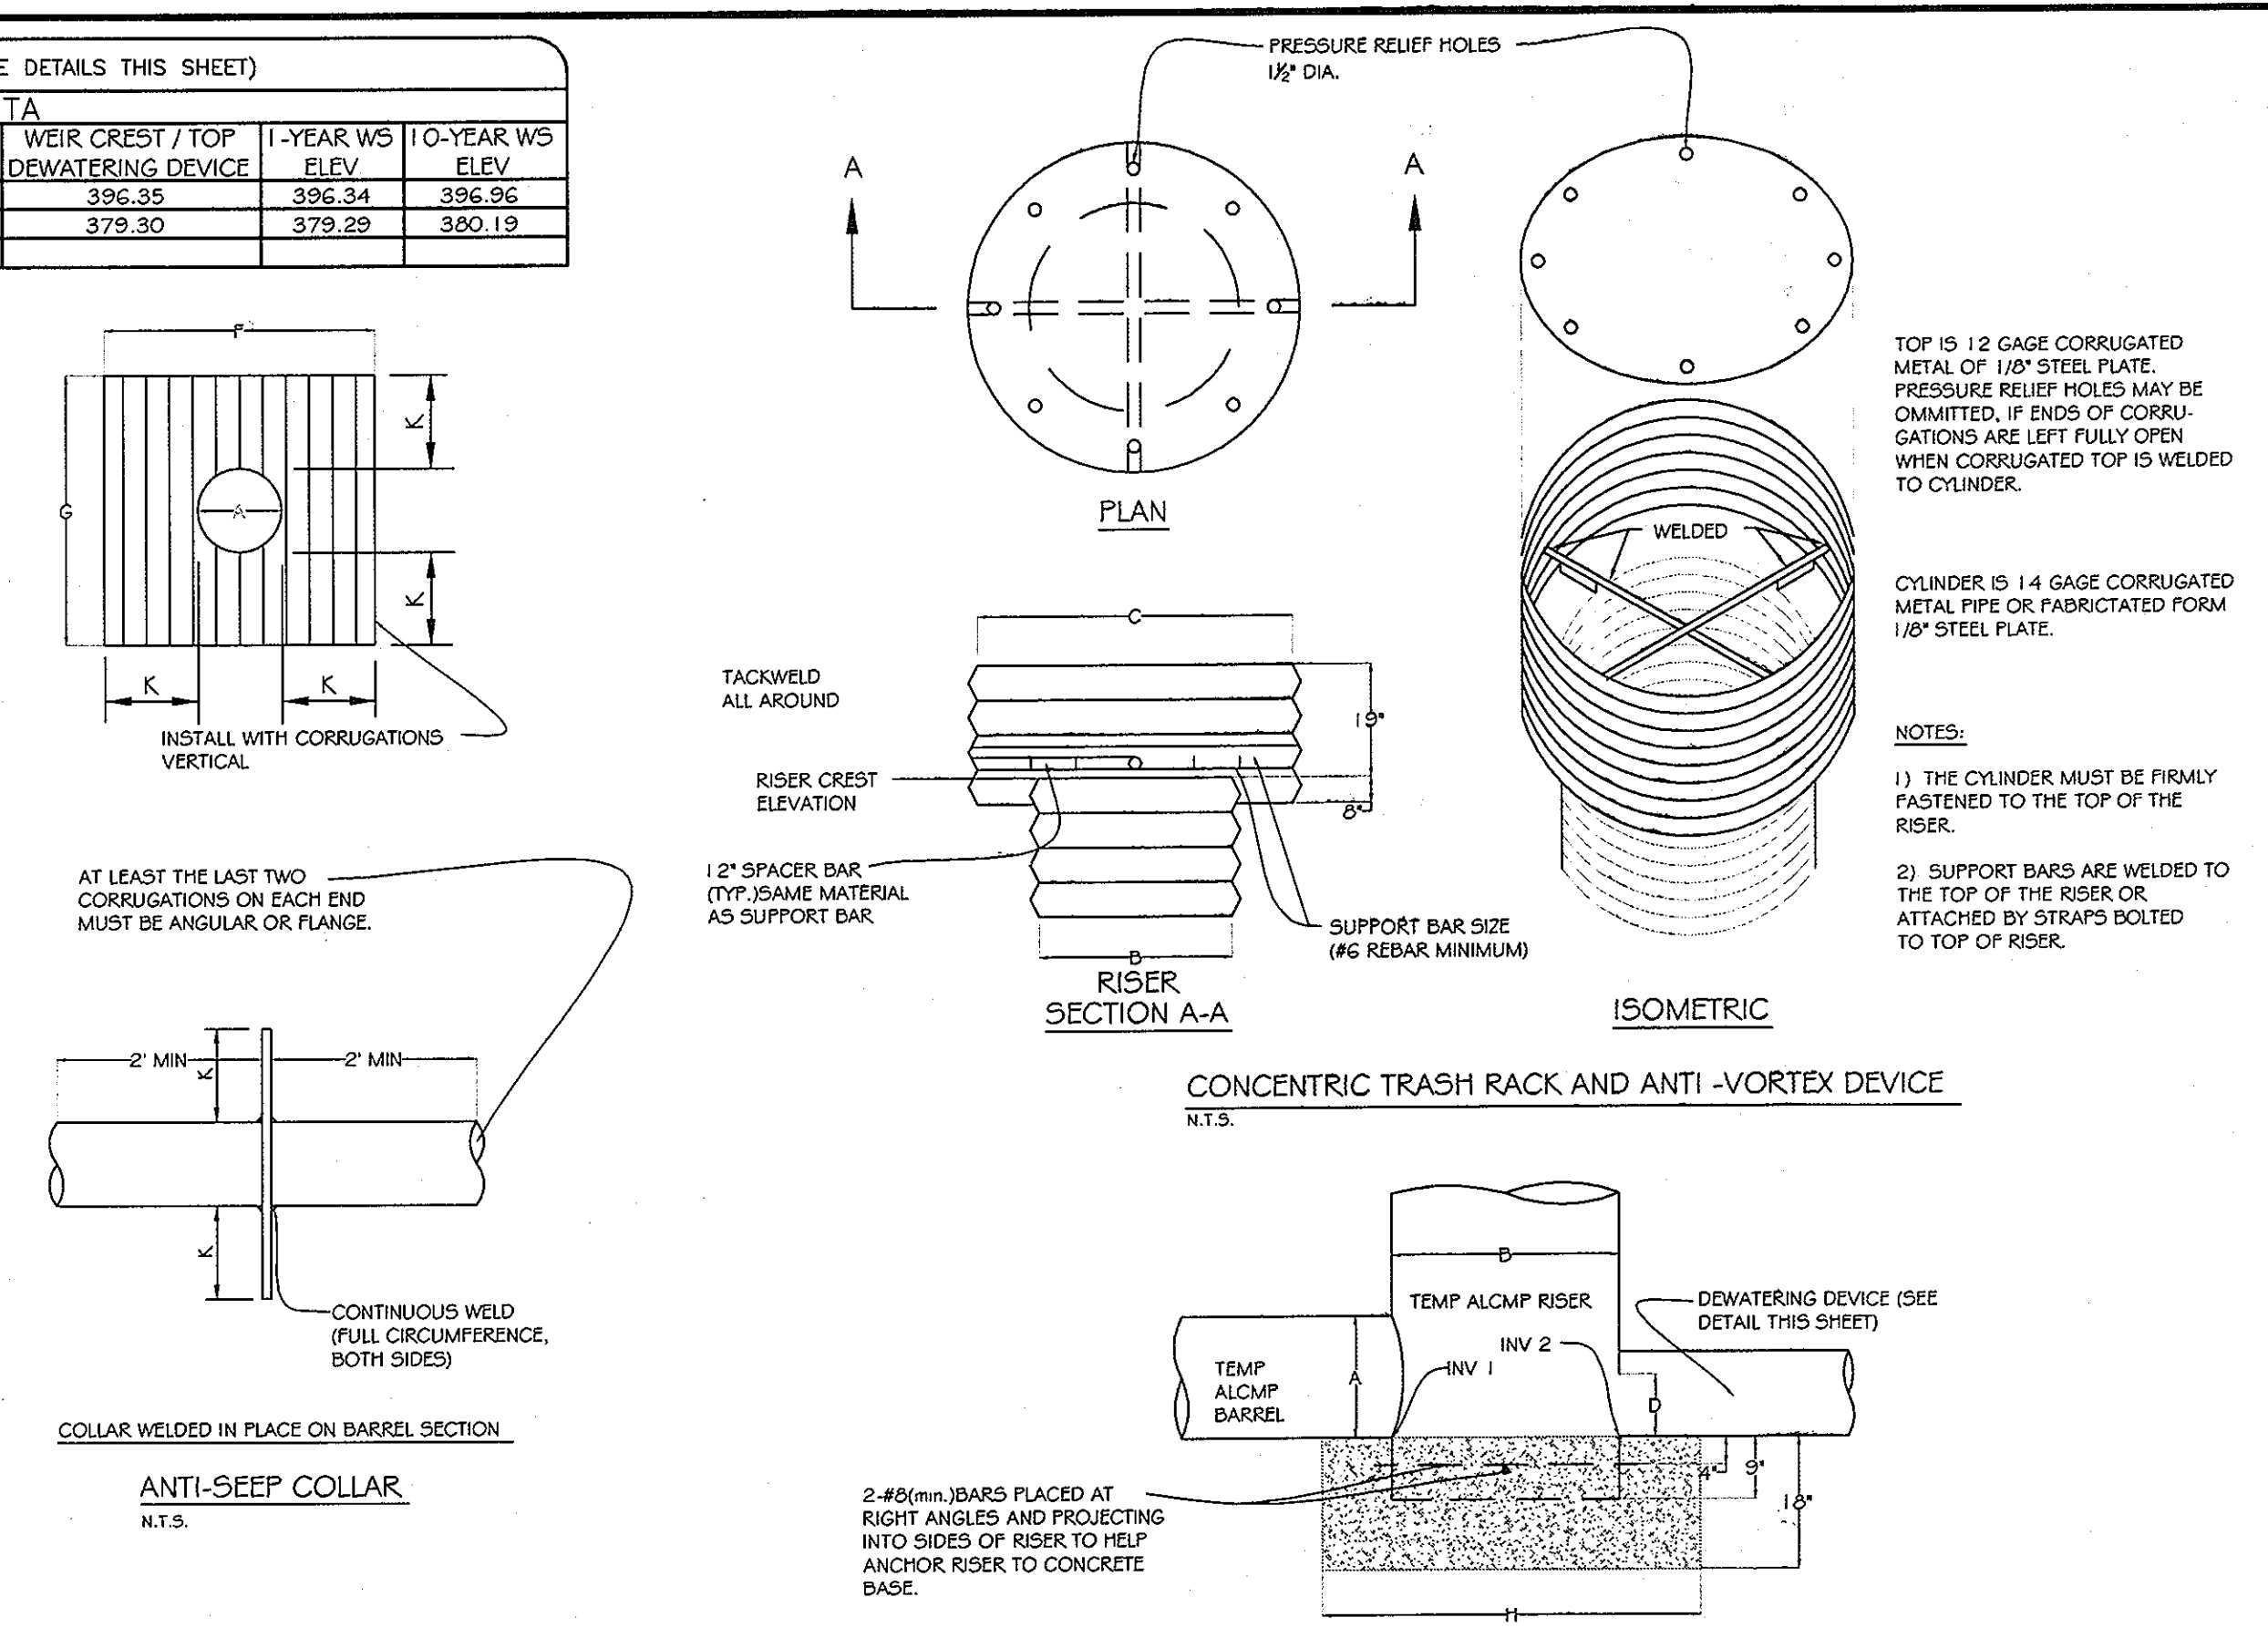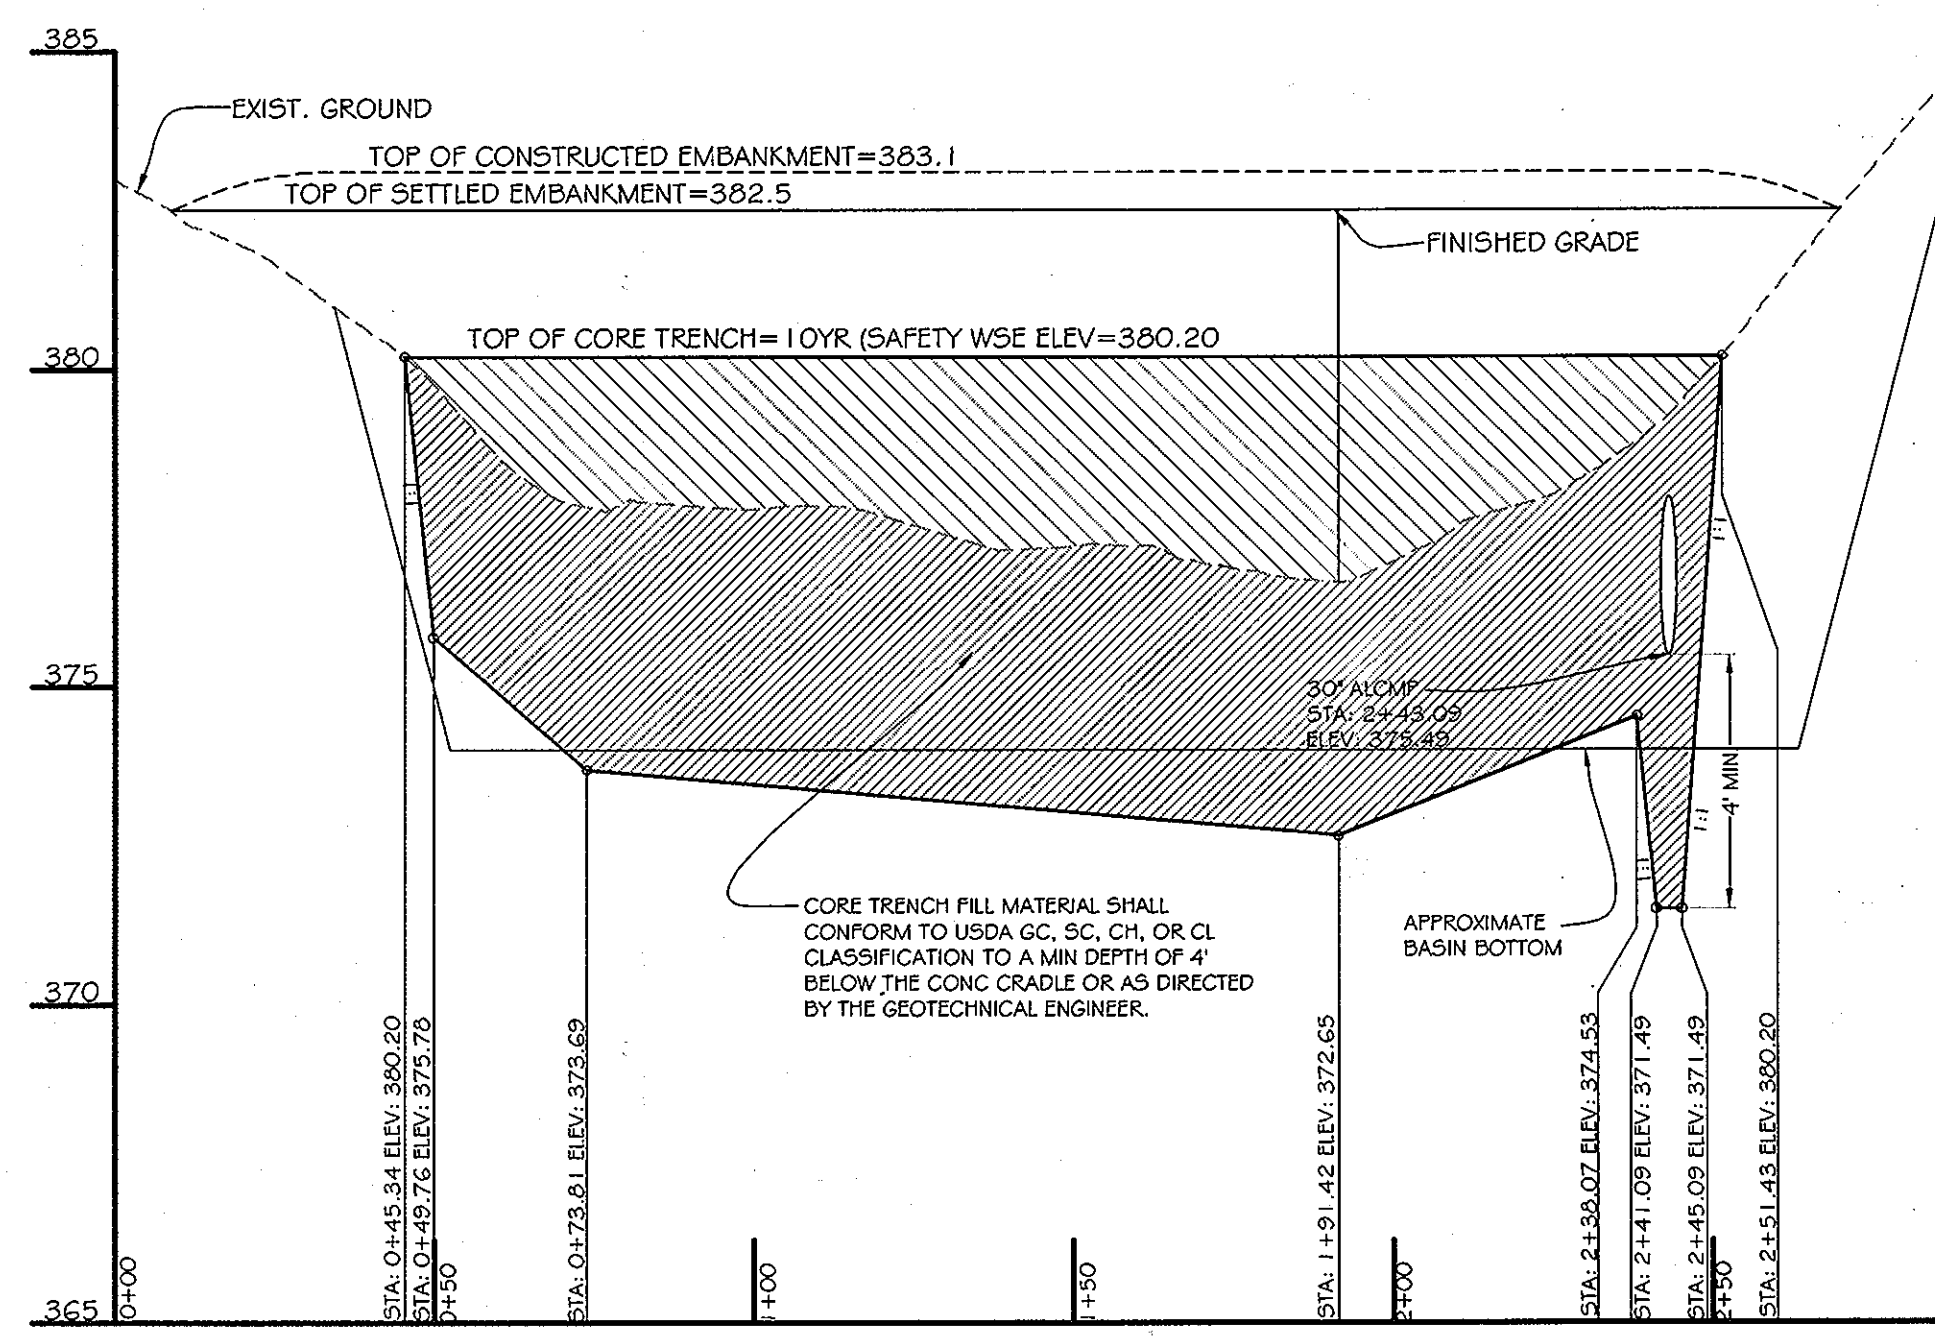

APPROVED: HOWARD COUNTY DEPARTMENT OF PLANNING & ZONING  
*Cindy Hamilton* 1/27/03  
CHIEF, DIVISION OF LAND DEVELOPMENT  
*Chris Demme* 10/17/03  
CHIEF, DEVELOPMENT ENGINEERING DIVISION  
APPROVED: HOWARD COUNTY DEPARTMENT OF PUBLIC WORKS  
*William T. Mahan* 10-14-03  
CHIEF, BUREAU OF HIGHWAY


APPROVED: THESE PLANS FOR SMALL POND CONSTRUCTION, SOIL EROSION, AND SEDIMENT CONTROL MEET THE REQUIREMENTS OF THE HOWARD SOIL CONSERVATION DISTRICT.  
*Stephen J. Nardella* 10/2/03  
HOWARD SOIL CONSERVATION DISTRICT  
APPROVED: THESE PLANS HAVE BEEN REVIEWED FOR THE HOWARD SOIL CONSERVATION DISTRICT AND MEET THE TECHNICAL REQUIREMENTS FOR SMALL POND CONSTRUCTION, SOIL EROSION, AND SEDIMENT CONTROL.  
*Jim Nye* 10/2/03  
USDA-NATURAL RESOURCES CONSERVATION SERVICE

DEVELOPER'S CERTIFICATE  
I/WE CERTIFY THAT ALL DEVELOPMENT AND/OR CONSTRUCTION WILL BE DONE ACCORDING TO THESE PLANS, AND THAT ANY RESPONSIBLE PERSONNEL INVOLVED IN THE CONSTRUCTION PROJECT WILL HAVE A CERTIFICATE OF ATTENDANCE AT A DEPARTMENT OF THE ENVIRONMENT APPROVED TRAINING PROGRAM FOR THE CONTROL OF SEDIMENT AND EROSION BEFORE BEGINNING THE PROJECT. I SHALL ENGAGE A REGISTERED PROFESSIONAL ENGINEER TO SUPERVISE POND CONSTRUCTION AND PROVIDE THE HOWARD SOIL CONSERVATION DISTRICT WITH AN 'AS-BUILT' PLAN OF THE POND WITHIN 30 DAYS OF COMPLETION. I ALSO AUTHORIZE PERIODIC ON-SITE INSPECTIONS BY THE HOWARD SOIL CONSERVATION DISTRICT.  
*Stephen J. Nardella* 9/23/03  
SIGNATURE OF DEVELOPER (PRINT NAME BELOW SIGNATURE)

ENGINEER'S CERTIFICATE  
I CERTIFY THAT THIS PLAN FOR POND CONSTRUCTION, EROSION AND SEDIMENT CONTROL REPRESENTS A PRACTICAL AND WORKABLE PLAN BASED ON MY PERSONAL KNOWLEDGE OF THE SITE CONDITIONS. THIS PLAN WAS PREPARED IN ACCORDANCE WITH THE REQUIREMENTS OF THE HOWARD SOIL CONSERVATION DISTRICT. I HAVE NOTIFIED THE DEVELOPER THAT HE/SHE MUST ENGAGE A REGISTERED PROFESSIONAL ENGINEER TO SUPERVISE POND CONSTRUCTION AND PROVIDE THE HOWARD SOIL CONSERVATION DISTRICT WITH AN 'AS-BUILT' PLAN OF THE POND WITHIN 30 DAYS OF COMPLETION.  
*James C. Robinson* 9/24/03  
SIGNATURE OF ENGINEER (PRINT NAME BELOW SIGNATURE)

CONVERSION NOTES: TEMPORARY DEWATERING DEVICE TO POND DRAIN (SEE TEMPORARY DEWATERING DEVICE & RISER MODIFICATION DETAILS THIS SHEET, & SAND FILTER DETAIL ON SWM POND 3 - SWM PLAN, & PROFILE & DETAILS, SHEET 20)  
1. OBTAIN PERMISSION FROM EROSION & SEDIMENT CONTROL INSPECTOR. REMOVE MSHA NO. 2 STONE, 12" ALCMP RISER, 12" x 6" ALCMP TEE, CONCRETE BASE FOR 12" ALCMP RISER, & HORIZONTAL 6" ALCMP PIPE FROM THE RISER TO THE CONTROL STRUCTURE. REPLACE OR REPAIR ANY DAMAGE TO CONTROL STRUCTURE RESULTING FROM THE REMOVAL OF THE DEWATERING DEVICE & APPURTENANCES.  
2. BRING BASIN TO PROPOSED GRADES AS SHOWN ON THE SWM PLAN (SHEET 20).  
3. INSTALL WATER QUALITY SAND FILTER & APPURTENANCES AS PER PLAN, ONLY AFTER THE CONTRIBUTORY DRAINAGE AREA HAS BEEN VEGETATIVELY STABILIZED.  
4. INSTALL 6" SCH 40 PVC FROM SAND FILTER THROUGH CONTROL STRUCTURE AS PER PLAN. PROVIDE WATER-TIGHT SEAL AROUND PIPE THROUGH THE CONTROL STRUCTURE WALL.  
5. DRESS UP & STABILIZE DISTURBED AREA AS REQUIRED.

**AS-BUILT PLANS**  
(No As-Built Data This Sheet)

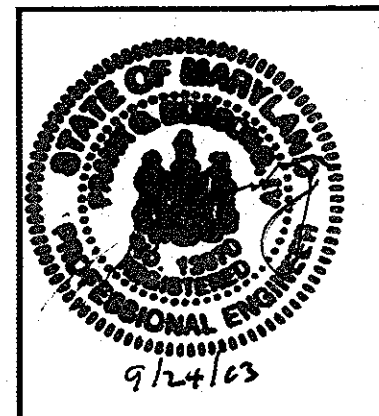

DATE	REVISION	DATE	BY	DATE
	BASE DATA		CADD	
	DESIGNED			
	DRAWN			
	REVIEWED		PFB	
	RELEASE FOR			
	BY			

Developer/Owner:  
**Winchester Homes, Inc. & Winchester Homes, Inc., as nominee for Stringtown Investments, LLC**  
6905 Rockledge Drive  
Suite 800  
Bethesda, Maryland 20817  
Stephen J. Nardella, Vice President  
(301) 803-4800

**SEDIMENT CONTROL PROFILES & DETAILS**

**RODGERS CONSULTING**  
Enhancing the value of land assets

Rodgers Consulting, Inc.  
9260 Gaither Road  
Gaithersburg, MD 20877  
301.948.4700  
301.948.6256 (fax)  
301.253.6669  
www.rodgers.com

**Montjoy - Single Family Detached**  
A RESUBDIVISION OF NON-BUILDABLE BULK PARCEL C (F-03-87)  
TO  
BUILDABLE LOTS 127- 188 AND OPEN SPACE LOTS 189-193  
ELECTION DISTRICT #2 HOWARD COUNTY, MARYLAND  
TAX MAP: 30, GRID: 12, PARCEL 260  
DPZ FILES: S-01-20, WP-01-117, P-02-10, P-02-17, P-03-03, F-03-87


SCALE: AS SHOWN  
JOB No.: 506V3  
DATE: 1-14-03  
INDEX No.: SC-5  
SHEET No.: 16 of 33



STRUCTURE SCHEDULE															
STR. No.	STRUCTURE TYPE	STRUCTURE LOCATION	STRUCTURE ELEVATION	INVERT (IN)	INVERT (IN)	INVERT (OUT)	REMARKS	STR. No.	STRUCTURE TYPE	STRUCTURE LOCATION	STRUCTURE TC ELEVATION	INVERT (IN)	INVERT (IN)	INVERT (OUT)	REMARKS
I-300	STD. A-5 INLET (WIDTH=2.5') HOWARD CO. STD. SD 4.40	WETHERED DRIVE STA. 3+07.16 O/S 12.0' RT.	392.07 / 394.72	392.07 (18")	394.72 (18")	392.07 (18")		ES-390	18" METAL END SECTION HOWARD CO. STD. SD-5.61	N 573297.9226 E 1363267.3591	378.60 / 377.17	377.17 (18")			
I-305	STD. A-5 INLET (WIDTH=2.5') HOWARD CO. STD. SD 4.40	WETHERED DRIVE STA. 3+07.16 O/S 12.0' LT.	392.07 / 394.70	392.07 (18")	394.70 (18")	392.07 (18")		M-395	MANHOLE HOWARD CO. STD. GS.11	N 573298.9173 E 1363316.3491	391.61 / 389.99	389.99 (15")			
I-310	STD. A-5 INLET (WIDTH=2.5') HOWARD CO. STD. SD 4.41	WETHERED DRIVE STA. 0+96.20 O/S 12.00' RT.	401.50 / 403.03	401.50 (18")	403.03 (18")	401.50 (18")		I-400	PRECAST STD. TYPE "D" INLET HOWARD CO. STD. S.D. 4.39	N 573209.4524 E 1363449.4198	397.86 / 394.85				
I-315	STD. A-5 INLET (WIDTH=2.5') HOWARD CO. STD. SD 4.40	WETHERED DRIVE STA. 0+96.20 O/S 12.00' LT.	401.26 / 403.02	401.26 (18")	403.02 (18")	401.26 (18")		ES-405	18" METAL END SECTION HOWARD CO. STD. SD-5.61	N 573482.4277 E 1363354.9018	372.82 / 371.32	371.32 (18")			
I-320	STD. A-5 INLET (WIDTH=2.5') HOWARD CO. STD. SD 4.40	EXECUTIVE PARK DRIVE STA. 12+95.08 O/S 12.00' LT.	412.75 / 413.72	412.75 (18")	413.72 (18")	412.75 (18")		M-410	MANHOLE HOWARD CO. STD. GS.11	N 573497.2042 E 1363445.7073	393.97 / 393.94	393.94 (15")			
I-325	STD. A-5 INLET (WIDTH=2.5') HOWARD CO. STD. SD 4.40	EXECUTIVE PARK DRIVE STA. 12+95.07 O/S 12.00' RT.	412.91 / 413.86	412.91 (18")	413.86 (18")	412.91 (18")		I-415	PRECAST STD. TYPE "D" INLET HOWARD CO. STD. S.D. 4.39	N 573476.8246 E 1363570.7525	397.74 / 394.85				
M-330	MANHOLE HOWARD CO. STD. GS.11	EXECUTIVE PARK DRIVE STA. 11+63.33 O/S 25.00 RT.	411.21 / 411.70	411.21 (18")	411.70 (18")	411.21 (18")		I-420	PRECAST STD. TYPE "D" INLET HOWARD CO. STD. S.D. 4.39	N 573574.2252 E 1363534.9123	398.85 / 398.85				
I-335	STD. A-5 INLET (WIDTH=2.5') HOWARD CO. STD. SD 4.40	EXECUTIVE PARK DRIVE STA. 10+28.08 O/S 12.00 RT.	412.28 / 413.87	412.28 (18")	413.87 (18")	412.28 (18")		ES-425	24" METAL END SECTION HOWARD CO. STD. SD-5.61	N 573275.9288 E 1363226.7434	379.10 / 379.08	379.08 (24")			
I-340	STD. A-5 INLET (WIDTH=2.5') HOWARD CO. STD. SD 4.41	EXECUTIVE PARK DRIVE STA. 8+06.81 O/S 12.00 RT.	423.38 / 423.76	423.38 (18")	423.76 (18")	423.38 (18")		M-430	MANHOLE HOWARD CO. STD. GS.11	WETHERED DRIVE STA. 4+21.64 O/S 12.85' RT.	389.58 / 377.17	377.17 (18")			
I-345	STD. A-5 INLET (WIDTH=2.5') HOWARD CO. STD. SD 4.40	EXECUTIVE PARK DRIVE STA. 10+28.08 O/S 12.00 LT.	412.81 / 413.72	412.81 (18")	413.72 (18")	412.81 (18")		M-435	MANHOLE HOWARD CO. STD. GS.11	WETHERED DRIVE STA. 5+17.91 O/S 12.98' RT.	386.82 / 386.82	386.82 (24")			
ES-354	10" END SECTION MODIFIED-SEE REMARKS	E 1364034.0941	381.01 / 380.83	380.83 (10")			MIRE END OF PIPE OR PROVIDE 12" X 10" REDUCER W/ 12" HDPEP END SECTION	I-440	STD. A-5 INLET (WIDTH=3.0') HOWARD CO. STD. SD 4.40	WETHERED DRIVE STA. 5+99.03 O/S 10.00' RT.	384.14 / 384.26	384.26 (18")			
I-355	PRECAST STD. TYPE "D" INLET HOWARD CO. STD. S.D. 4.39	N 573420.4380 E 1364018.2485	385.63 / 386.63	385.63 (18")	386.63 (18")	385.63 (18")	DIVERSION STRUCTURE 21" IS RCP PIPE	I-445	STD. A-5 INLET (WIDTH=3.0') HOWARD CO. STD. SD 4.41	WETHERED DRIVE STA. 6+75.92 O/S 10.00' RT.	386.96 / 386.96	386.96 (18")			
M-360	MANHOLE HOWARD CO. STD. GS.11	N 573317.2345 E 1364029.0421	387.93 / 387.80	387.93 (18")	387.80 (18")	387.93 (18")		M-450	MANHOLE HOWARD CO. STD. GS.11	WETHERED DRIVE STA. 7+84.64 O/S 13.04' RT.	390.10 / 389.99	389.99 (18")			
M-365	MANHOLE HOWARD CO. STD. GS.11	N 573293.6494 E 1363858.7637	406.32 / 406.80	406.32 (18")	406.80 (18")	406.32 (18")		I-455	STD. A-5 INLET (WIDTH=2.5') HOWARD CO. STD. SD 4.41	WETHERED DRIVE STA. 8+60.01 O/S 10.00' RT.	397.51 / 396.99	396.99 (15")			
M-370	MANHOLE HOWARD CO. STD. GS.11	N 573314.9447 E 1363805.0454	407.18 / 407.17	407.18 (18")	407.17 (18")	407.18 (18")		I-460	PRECAST STD. TYPE "D" INLET HOWARD CO. STD. S.D. 4.39	N 573463.0149 E 1362749.5924	395.82 / 395.82	395.82 (15")			
I-375	STD. A-5 INLET (WIDTH=2.5') HOWARD CO. STD. SD 4.40	SANTE FE COURT STA. 4+06.70 O/S 10.00' RT.	407.54 / 407.54	407.54 (15")	407.54 (15")	407.54 (15")		I-465	PRECAST STD. TYPE "D" INLET HOWARD CO. STD. S.D. 4.39	N 573177.1138 E 1362867.2711	387.88 / 387.88	387.88 (15")			
I-380	STD. A-5 INLET (WIDTH=2.5') HOWARD CO. STD. SD 4.40	SANTE FE COURT STA. 4+04.09 O/S 10.00' LT.	407.88 / 407.88	407.88 (15")	407.88 (15")	407.88 (15")		I-470	PRECAST STD. TYPE "D" INLET HOWARD CO. STD. S.D. 4.39	N 573212.0189 E 1362799.0359	387.25 / 387.25	387.25 (15")			
I-385	STD. A-5 INLET (WIDTH=2.5') HOWARD CO. STD. SD 4.41	L.P. STA. 1+43.31 O/S 0.0'	405.13 / 405.13	405.13 (15")	405.13 (15")	405.13 (15")	LOCATED IN SUMP								





PIPE SCHEDULE		
SIZE	TYPE	LENGTH
10"	HDPEP	50 L.F.
15"	HDPEP	999 L.F.
18"	HDPEP	1702 L.F.
24"	HDPEP	234 L.F.
24"	RCP CLASS III	57 L.F.

- ### STORM DRAIN NOTES
- ALL STORM DRAINS SHALL BE CONSTRUCTED IN ACCORDANCE WITH LATEST STANDARD AND SPECIFICATION OF HOWARD COUNTY PLUS SHA STANDARDS AND SPECIFICATIONS, IF APPLICABLE.
  - FOR TYPES OF STRUCTURES, REFER TO THE STANDARD STORM DRAINAGE DETAILS OF HOWARD COUNTY.
  - WHERE THE DROP ON THE MAIN LINE THROUGH A STRUCTURE CAN BE ACCOMMODATED BY AN INVERT SLOPE OF 1/12 OR FLATTER, A ROUNDED CHANNEL SHALL BE BUILT TO THE CROWN OF THE PIPES.
  - INFORMATION CONCERNING UNDERGROUND UTILITIES WAS OBTAINED FROM AVAILABLE RECORDS, BUT THE CONTRACTOR MUST DETERMINE THE EXACT LOCATION AND ELEVATIONS OF THE MAINS BY DIGGING TEST PITS BY HAND AT ALL UTILITY CROSSINGS, WELL IN ADVANCE OF TRENCHING. IF CLEARANCES ARE LESS THAN SHOWN ON THIS PLAN OR TWELVE (12) INCHES, WHICHEVER IS LESS, CONTACT THE INSPECTOR AND THE APPROPRIATE UTILITY OWNER BEFORE PROCEEDING WITH CONSTRUCTION.
  - CONTRACTOR MAKING ADJUSTMENTS TO EXISTING UTILITIES MUST BE APPROVED AND WORK UNDER THE SUPERVISION OF THE UTILITY COMPANY AND/OR HOWARD CO. DEPT. OF PUBLIC WORKS. REQUIRED MATERIALS MUST BE APPROVED BY THE APPROPRIATE UTILITY OWNER OR/AND THE HOWARD COUNTY DEPARTMENT IF PUBLIC WORKS.
  - ALL INLETS SHALL BE PROVIDED WITH WEEP HOLES AND FOUNDATION DRAINAGE MATERIALS PER HOWARD CO. STANDARDS.
  - WHERE ANY PART OF THE STORM DRAIN SYSTEM IS LOCATED IN FILL SECTION, PROVIDE SELECT FILL MATERIAL COMPACTED TO 95% AASHTO T-180 DENSITY FROM ORIGINAL UNDISTURBED GROUND UP TO STRUCTURE BOTTOM SLABS AND PIPE BEDDING. PROVIDE BEDDING PER HOWARD COUNTY STD. DETAIL #62.01
  - ELEVATIONS SHOWN ON PROFILES ARE AT PIPE INVERTS, UNLESS OTHERWISE NOTED.
  - GRADE ALL DISTURBED AREAS TO PROVIDE POSITIVE DRAINAGE.
  - ALL STANDARD STORM DRAINAGE STRUCTURES ARE SUBJECT TO MODIFICATION BY THE FIELD INSPECTOR TO MEET FIELD REQUIREMENTS.
  - CONTRACTOR SHALL NOTIFY MISS UTILITY (1-800-257-7777), 48 HOURS IN ADVANCE OF ANY EXCAVATION.

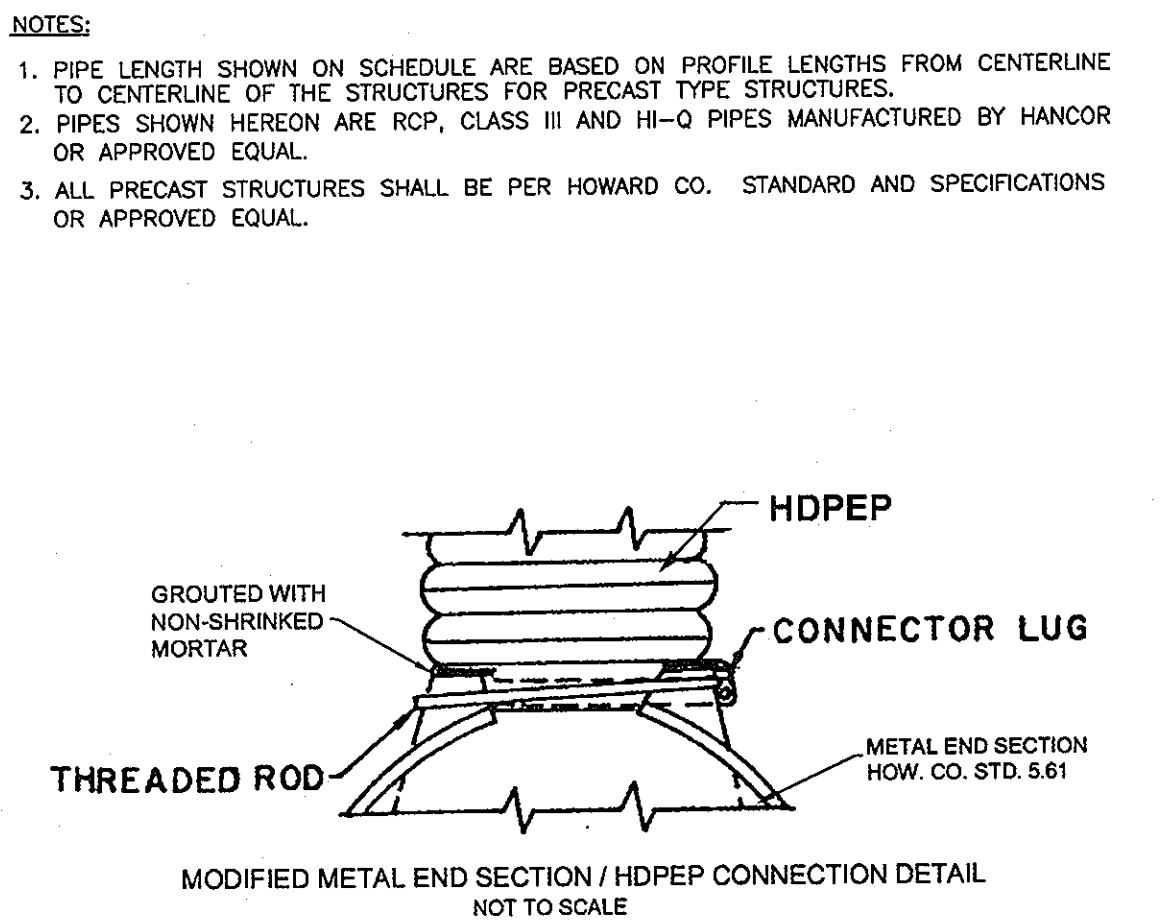

- ### NOTES:
- ALL CURB INLETS SHALL BE CAST FOR STANDARD 7" COMBINATION CURB & GUTTER (HOWARD CO. STD. R-30.1). OFFSET FOR INLETS IS TO FACE OF CURB, AND FOR MANHOLES IS TO CENTER OF STRUCTURE.
  - STATION INDICATES THE CENTER OF THE OUTSIDE WALL OF THE THROAT SECTION FOR INLETS AND THE CENTER OF THE STRUCTURE FOR MANHOLES.
  - TC. ELEV. / TC. ELEV. DENOTES THE UPSTREAM AND DOWNSTREAM EDGE OF THE OUTSIDE WALL OF THE THROAT SECTION FOR INLETS AND CENTER OF THE STRUCTURE FOR MANHOLES.

CALL "MISS UTILITY" AT 1-800-257-7777 48 Hours Before Start Of Construction

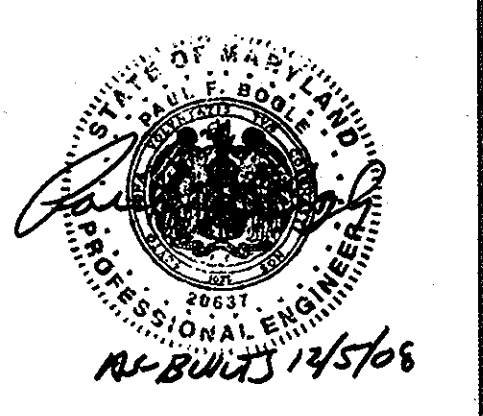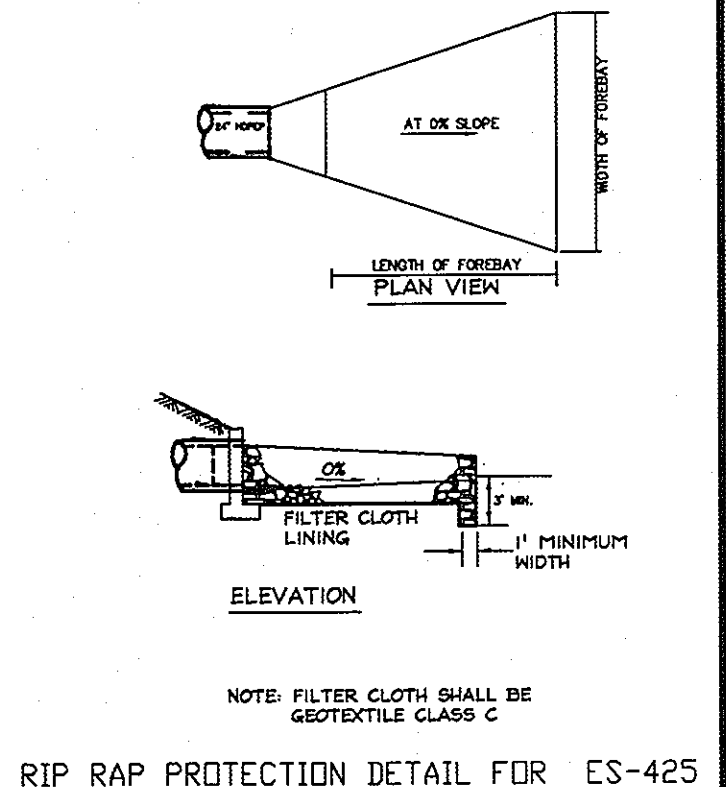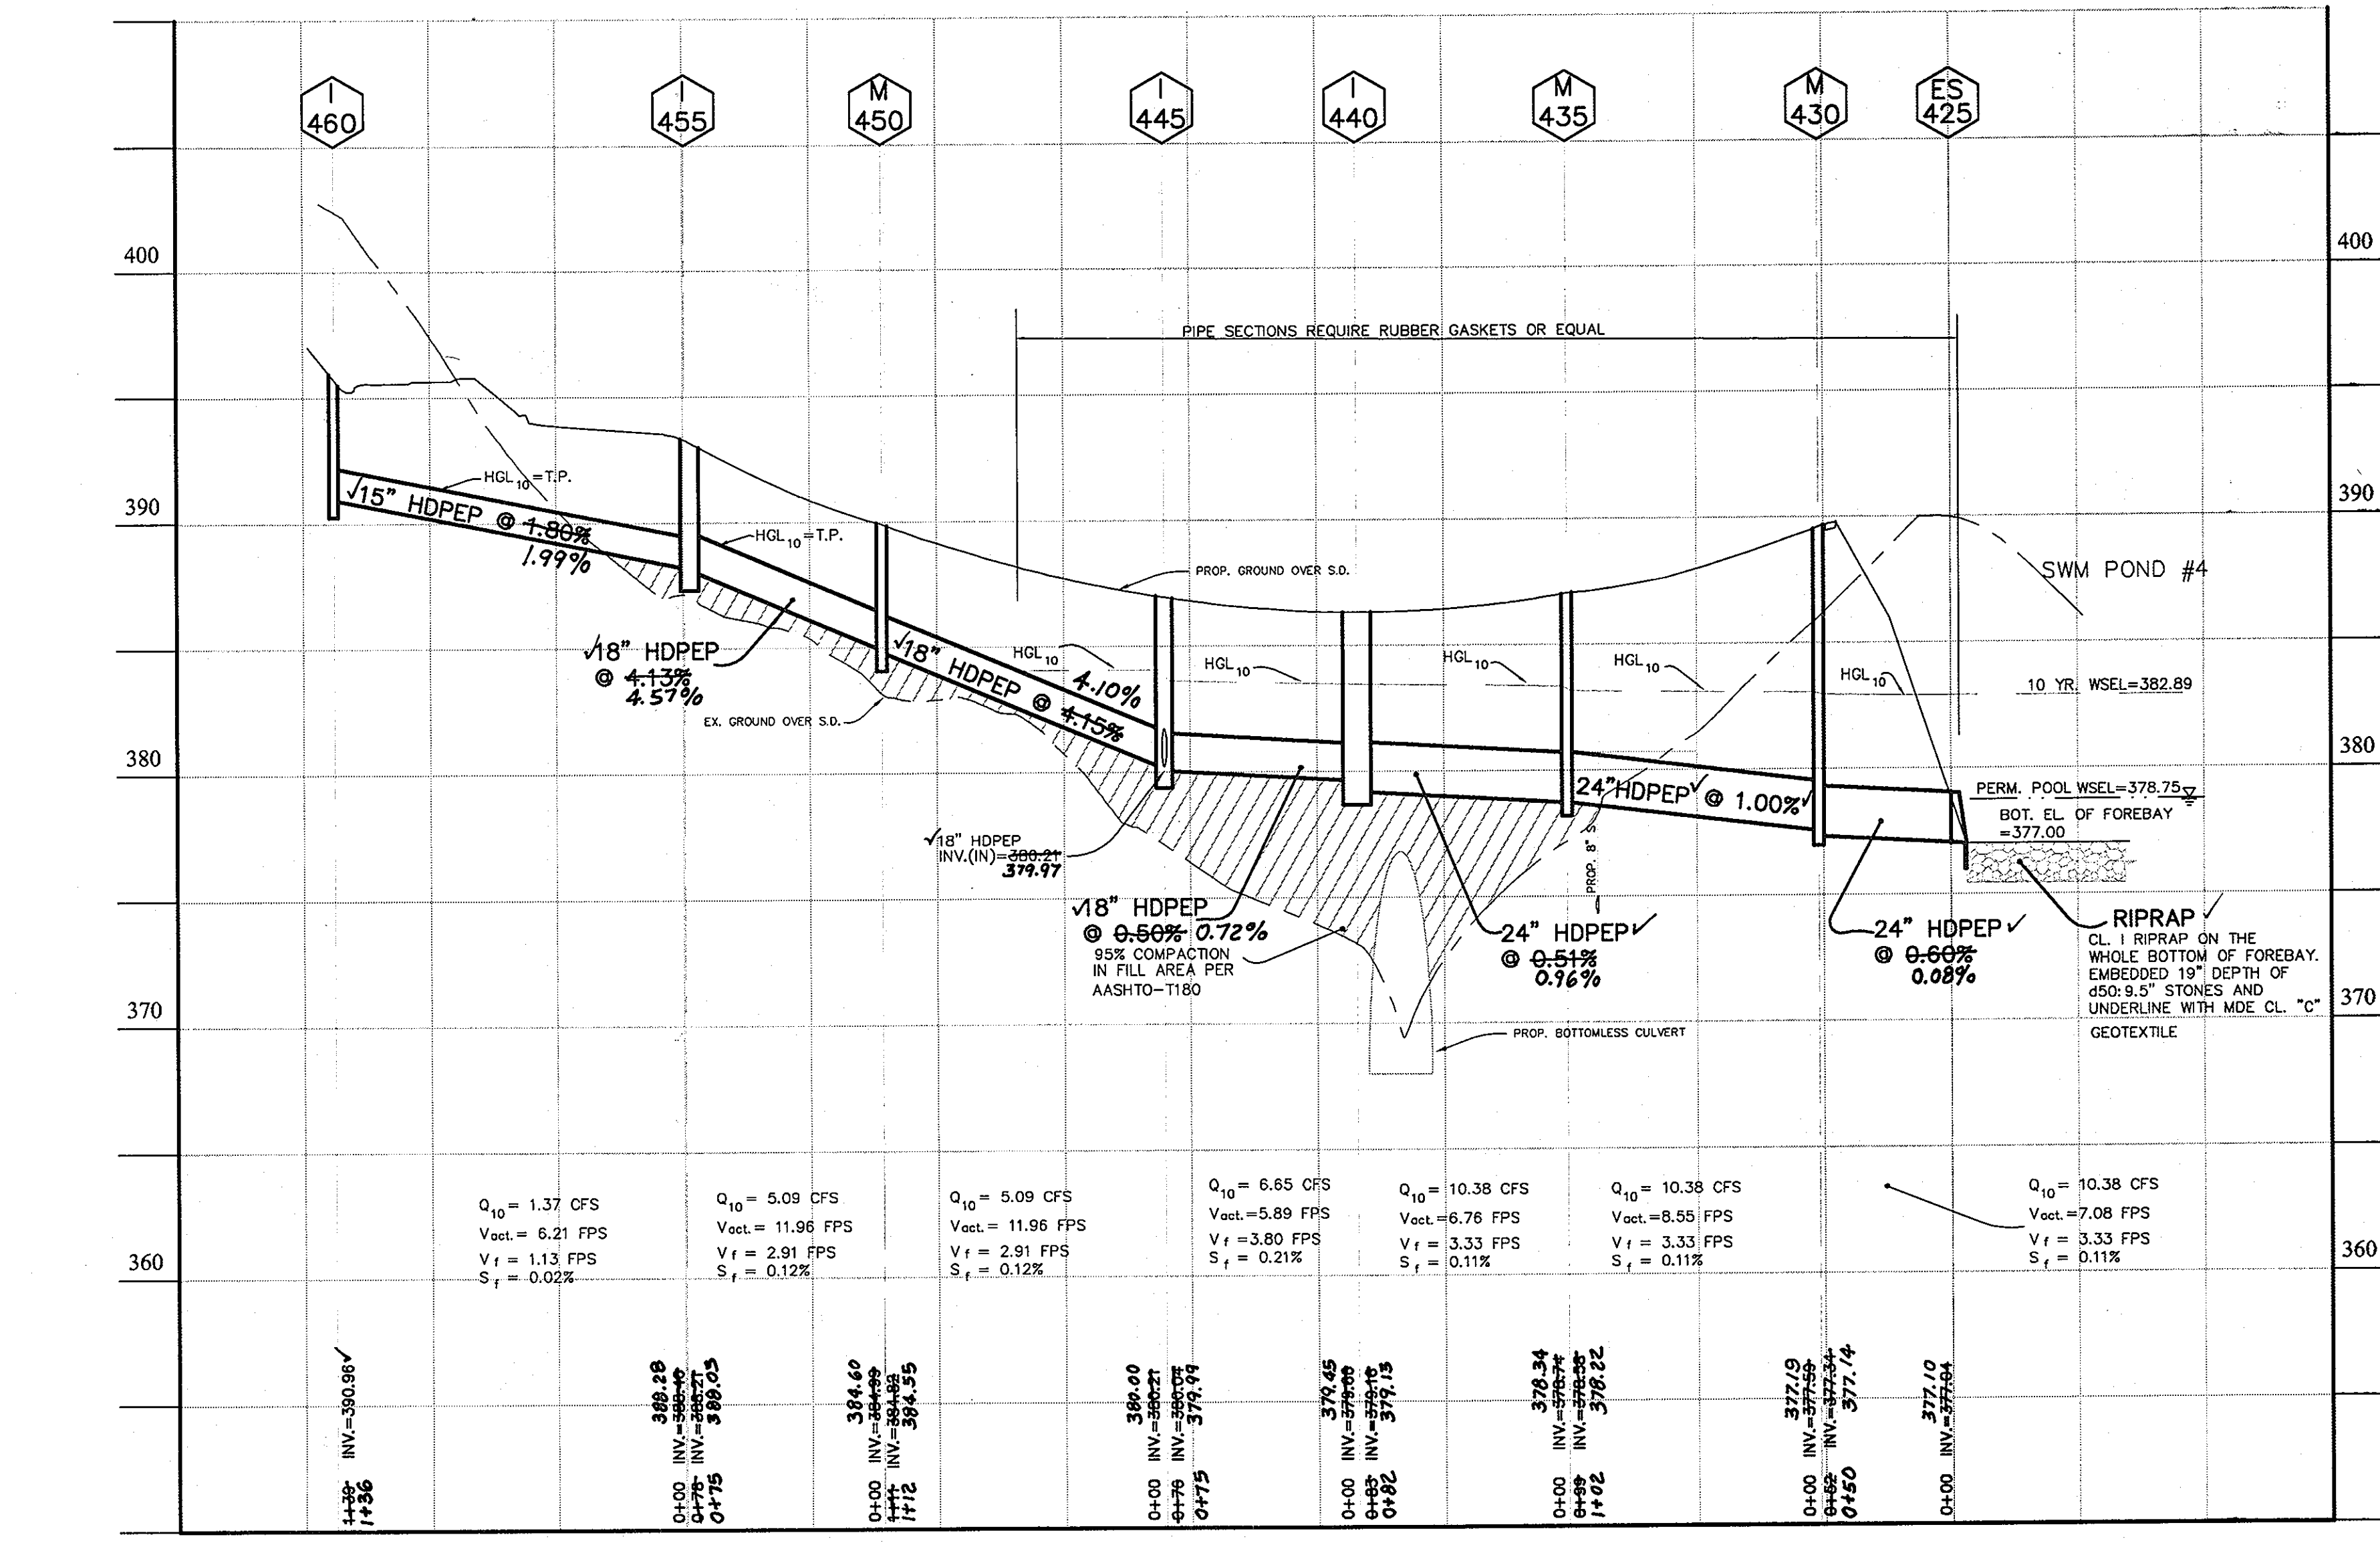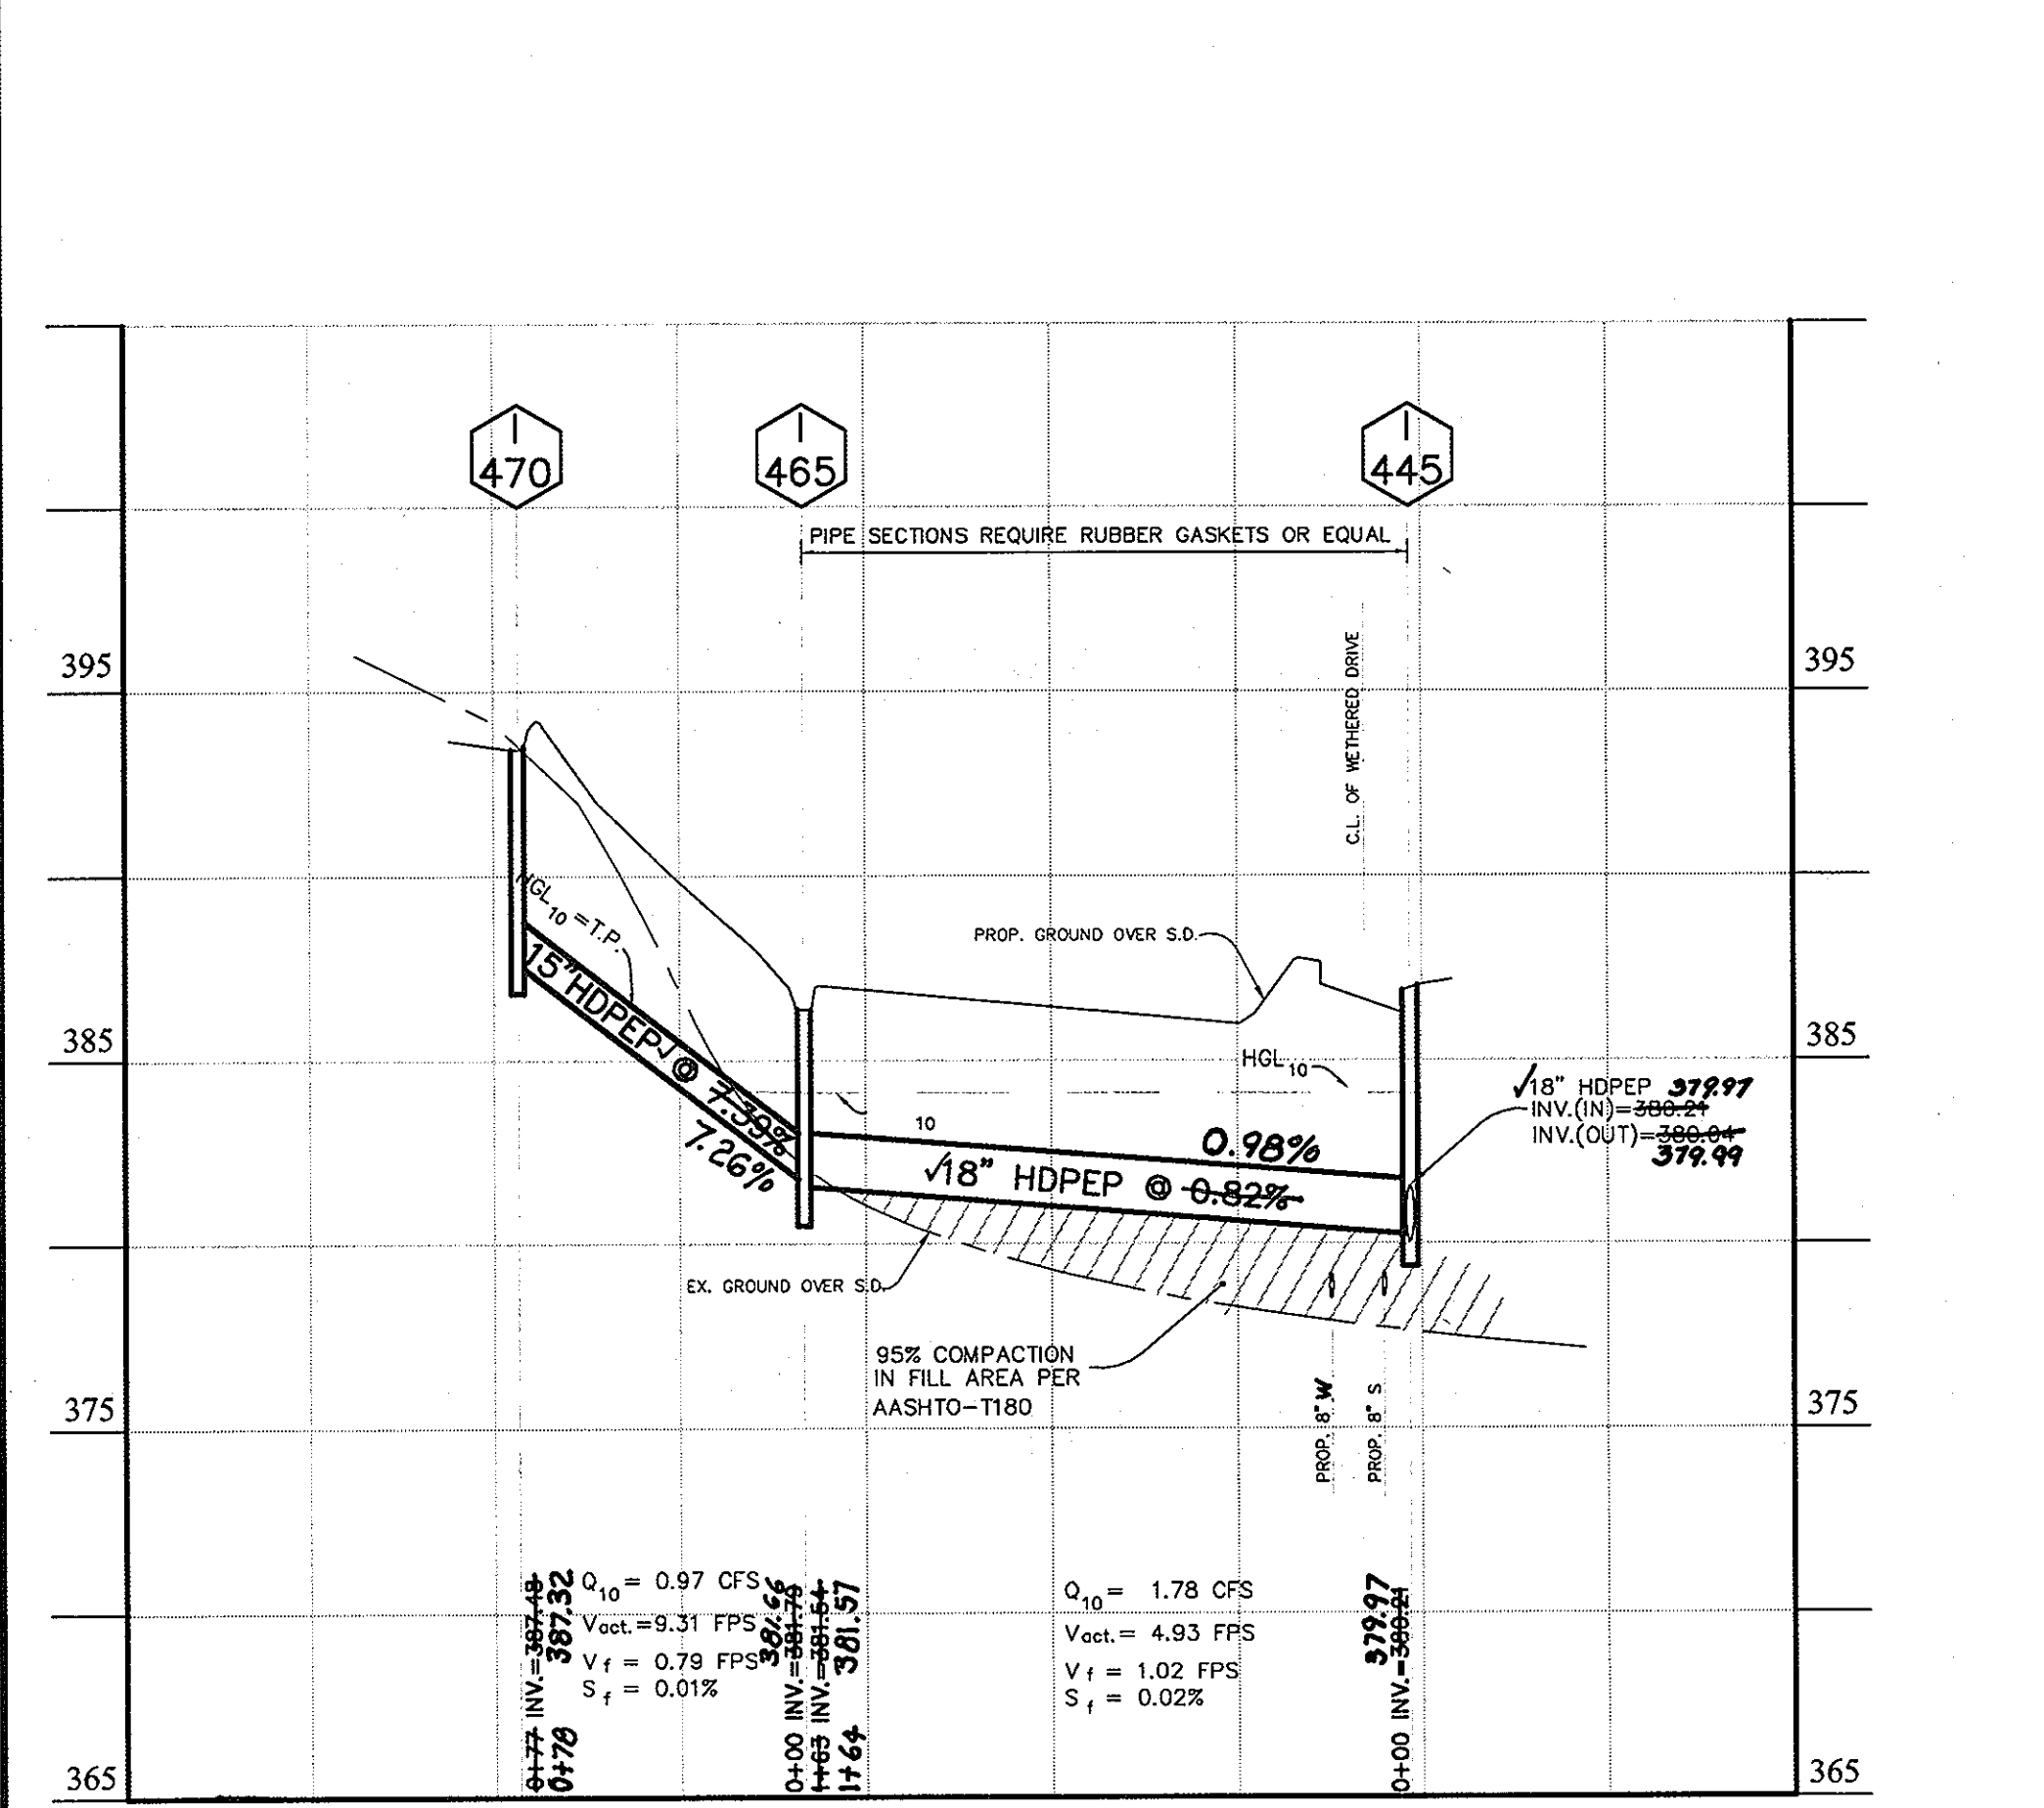

SCALE:  
V: 1"=5'  
H: 1"=50'

APPROVED: HOWARD COUNTY DEPARTMENT OF PLANNING & ZONING  
*Cindy Hamilton* 11/27/03  
 CHIEF, DIVISION OF LAND DEVELOPMENT  
 APPROVED: HOWARD COUNTY DEPARTMENT OF PUBLIC WORKS  
*William T. ...* 10/17/03  
 CHIEF, BUREAU OF HIGHWAY

## AS-BUILT PLANS


STORM DRAIN PROFILE: FROM ES-425 TO I-460 (PUBLIC SYSTEM)

DATE	REVISION	DATE	BY	DATE
	BASE DATA		CADD	
	DESIGNED		PFB, YSL	
	DRAWN		YSL	
	REVIEWED		PFB/RF	
	RELEASE FOR			

Developer/Owner:  
**Winchester Homes, Inc. & Winchester Homes, Inc., as nominee for Stringtown Investments, LLC**  
 6905 Rockledge Drive Suite 800  
 Bethesda, Maryland 20817  
 Stephen J. Nardella, Vice President  
 (301) 803 - 4800

## CONSTRUCTION PLANS

### STORM DRAIN PROFILES

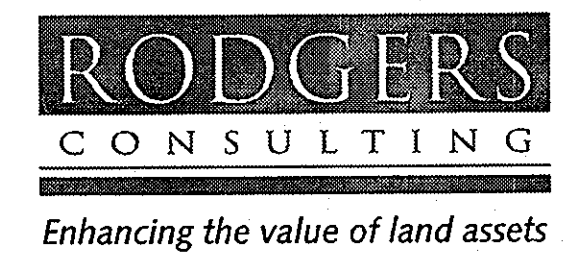


Rodgers Consulting, Inc.  
 9260 Gaither Road  
 Gaithersburg, MD 20877  
 301.948.4700  
 301.948.6256 (fax)  
 301.253.6609  
 www.rodgers.com


**Montjoy - Single Family Detached**  
 A RESUBDIVISION OF NON-BUILDABLE BULK PARCEL C (F-03-87)  
 TO BUILDABLE LOTS 127- 188 AND OPEN SPACE LOTS 189-193  
 ELECTION DISTRICT #2 HOWARD COUNTY, MARYLAND  
 TAX MAP: 30, GRID: 12, PARCEL 260  
 DP2 FILES: S-01-20, WP-01-117, P-02-10, P-02-17, P-03-03, P-03-07  
 SCALE: AS SHOWN  
 JOB No: 506v3  
 DATE: 01/14/03  
 INDEX No: SD-1  
 SHEET No: 17 OF 34




CALL "MISS UTILITY" AT  
1-800-257-7777  
48 Hours Before Start Of Construction

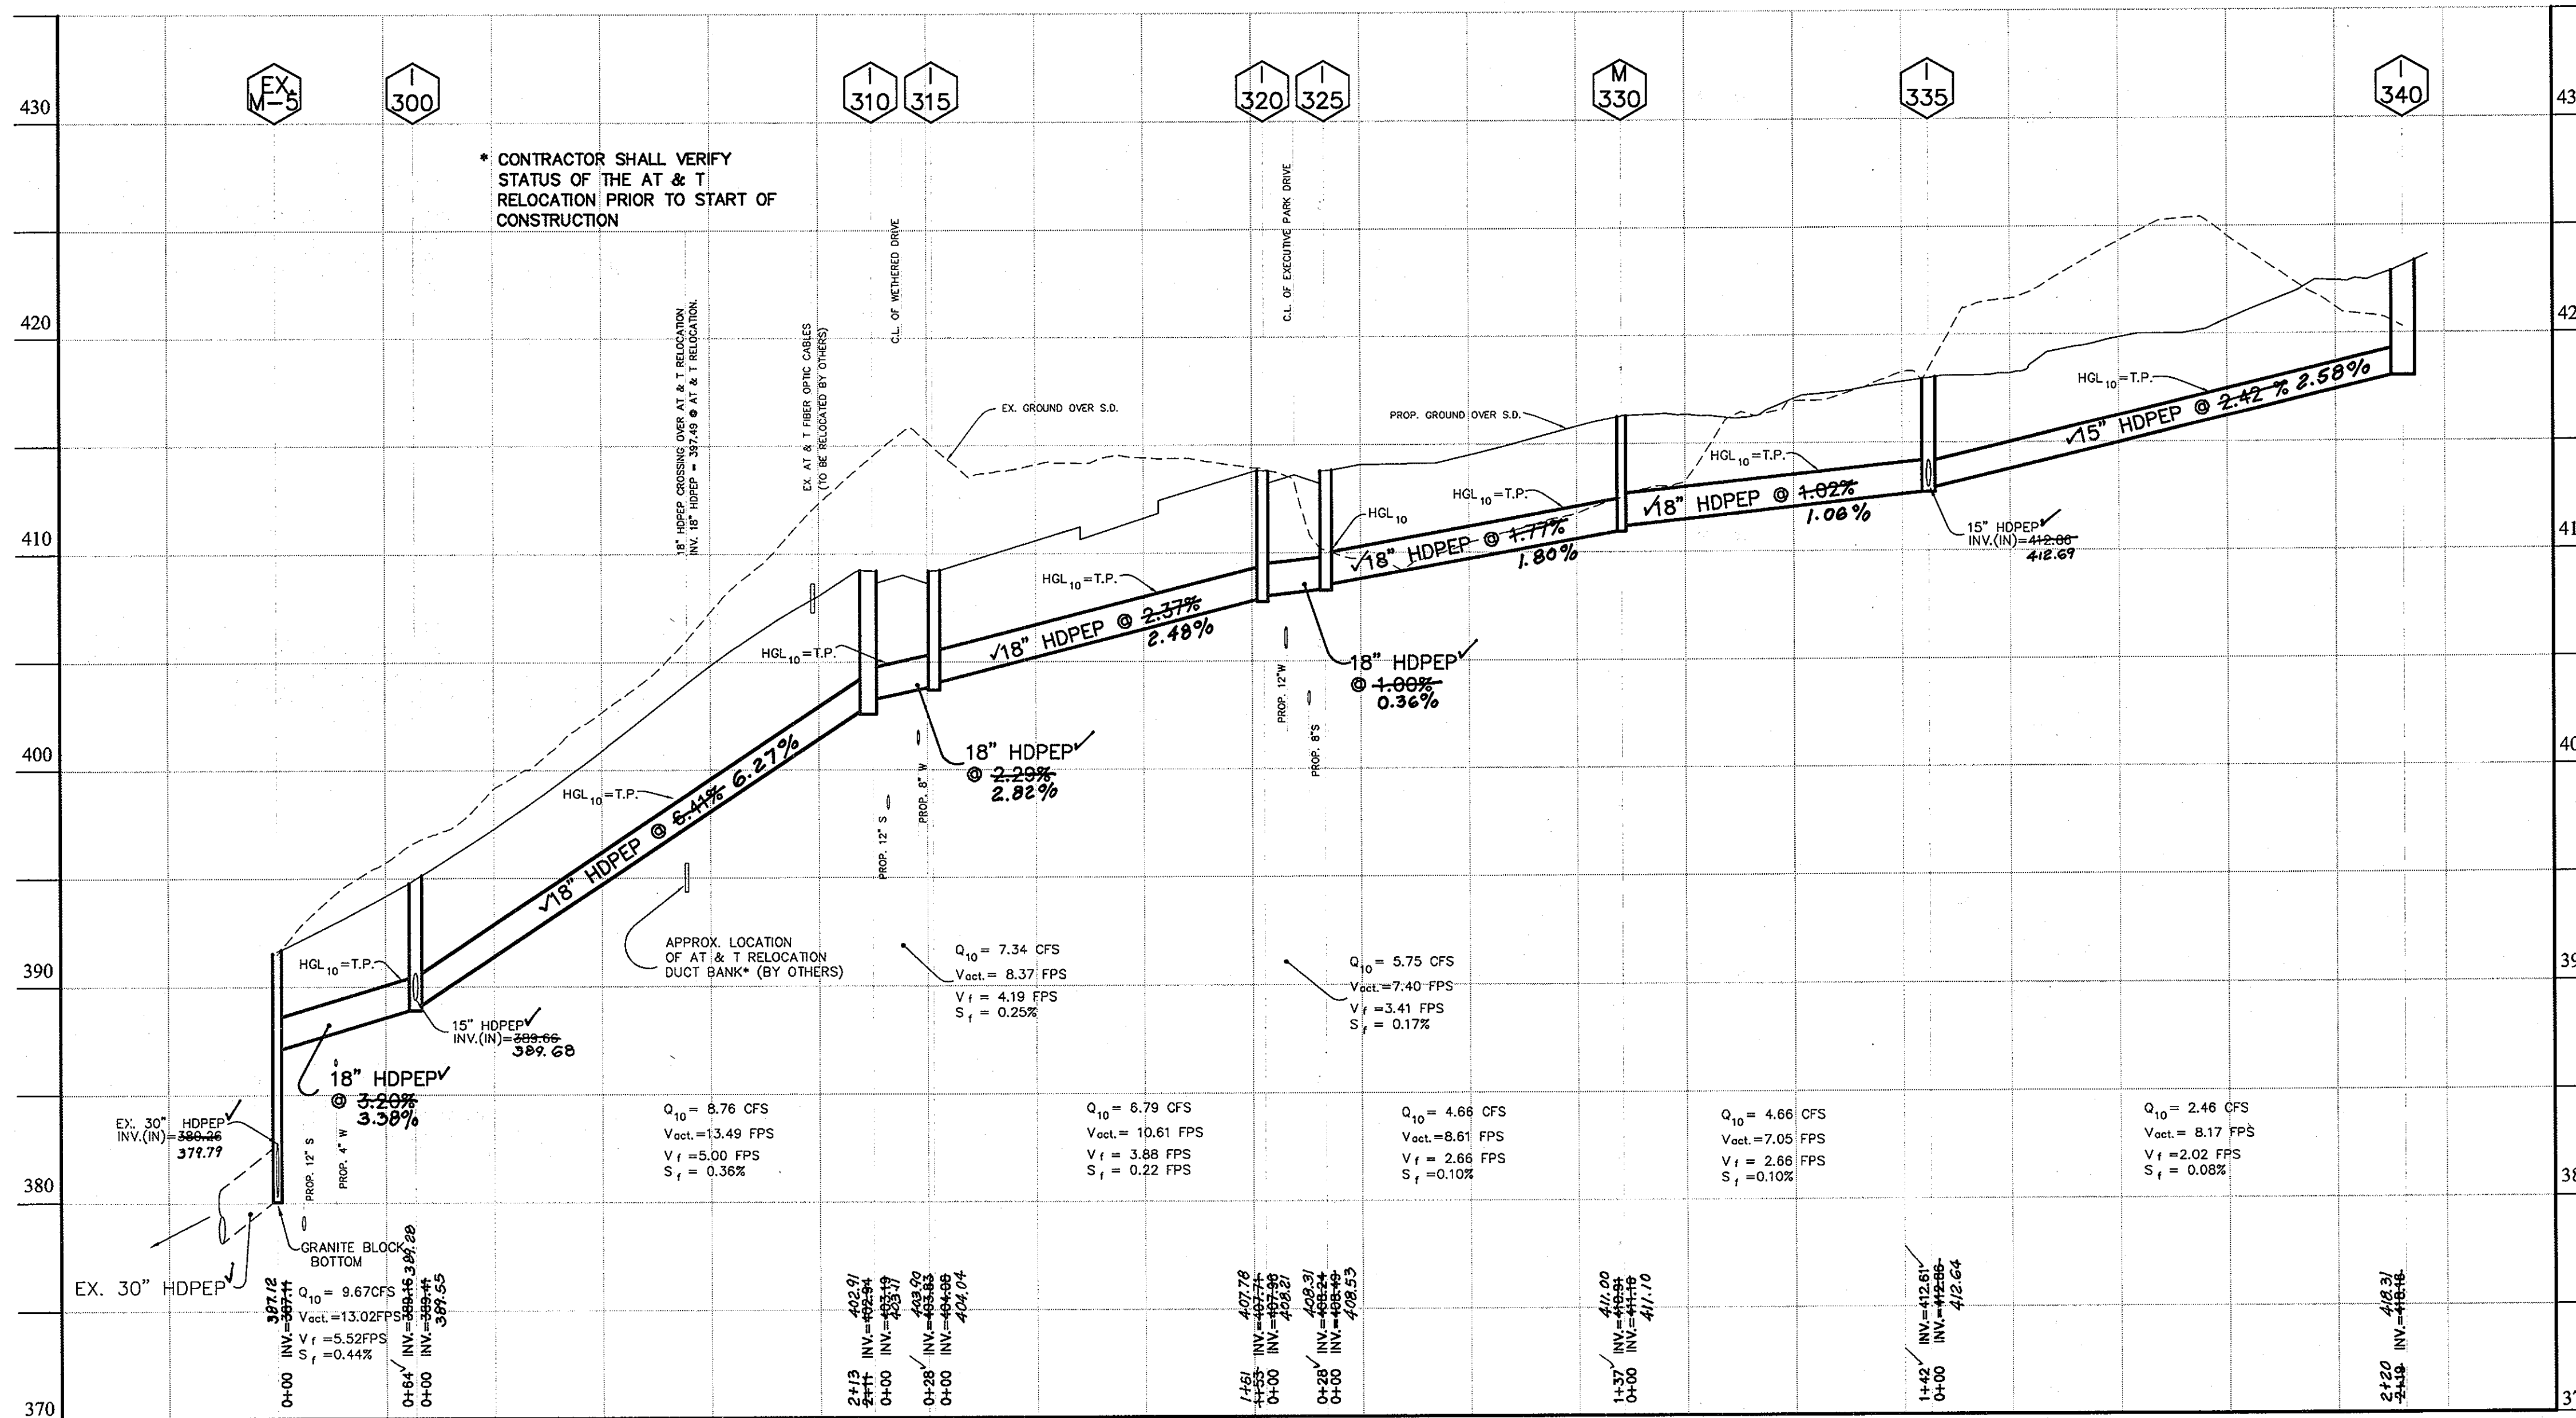


STORM DRAIN PROFILE: FROM EX. M-5 TO I-340  
(PUBLIC SYSTEM)

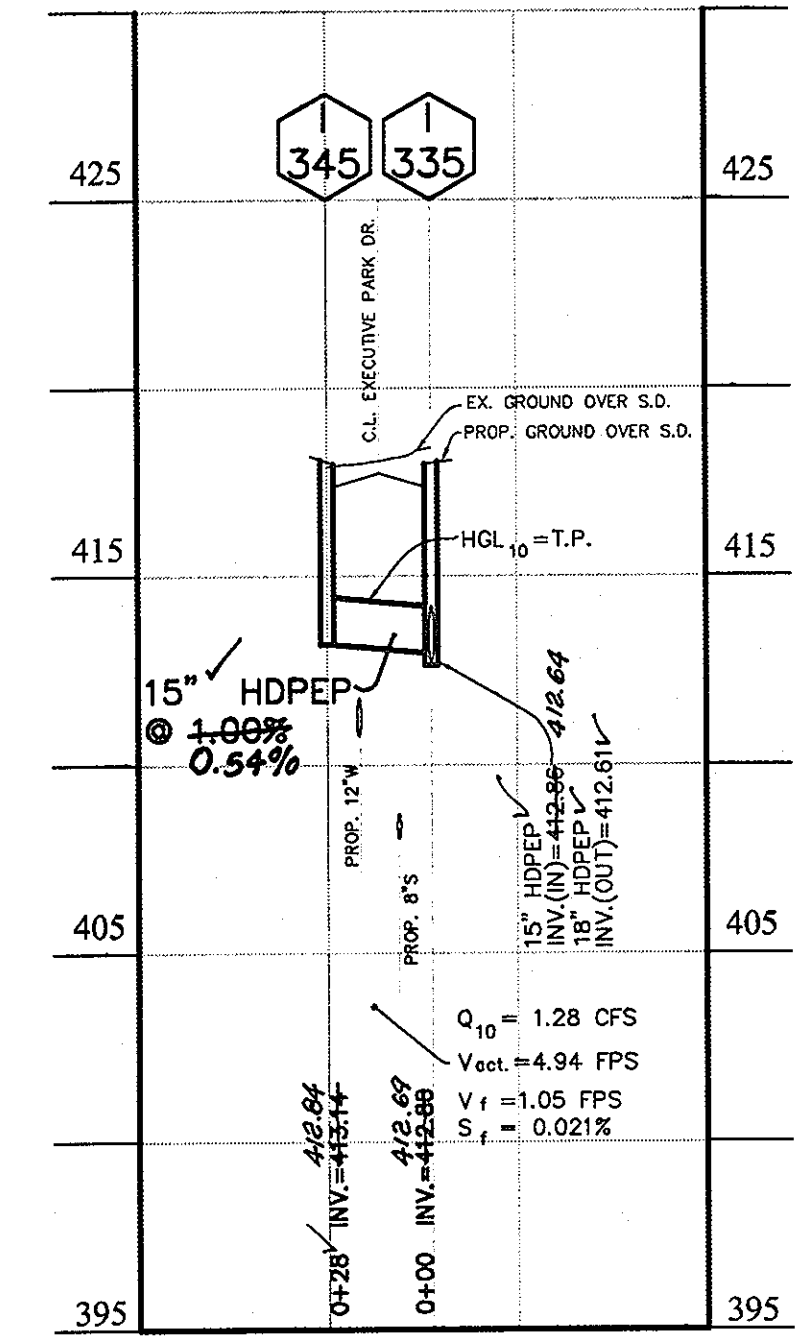

STORM DRAIN PROFILE:  
FROM I-345 TO I-335  
(PUBLIC SYSTEM)

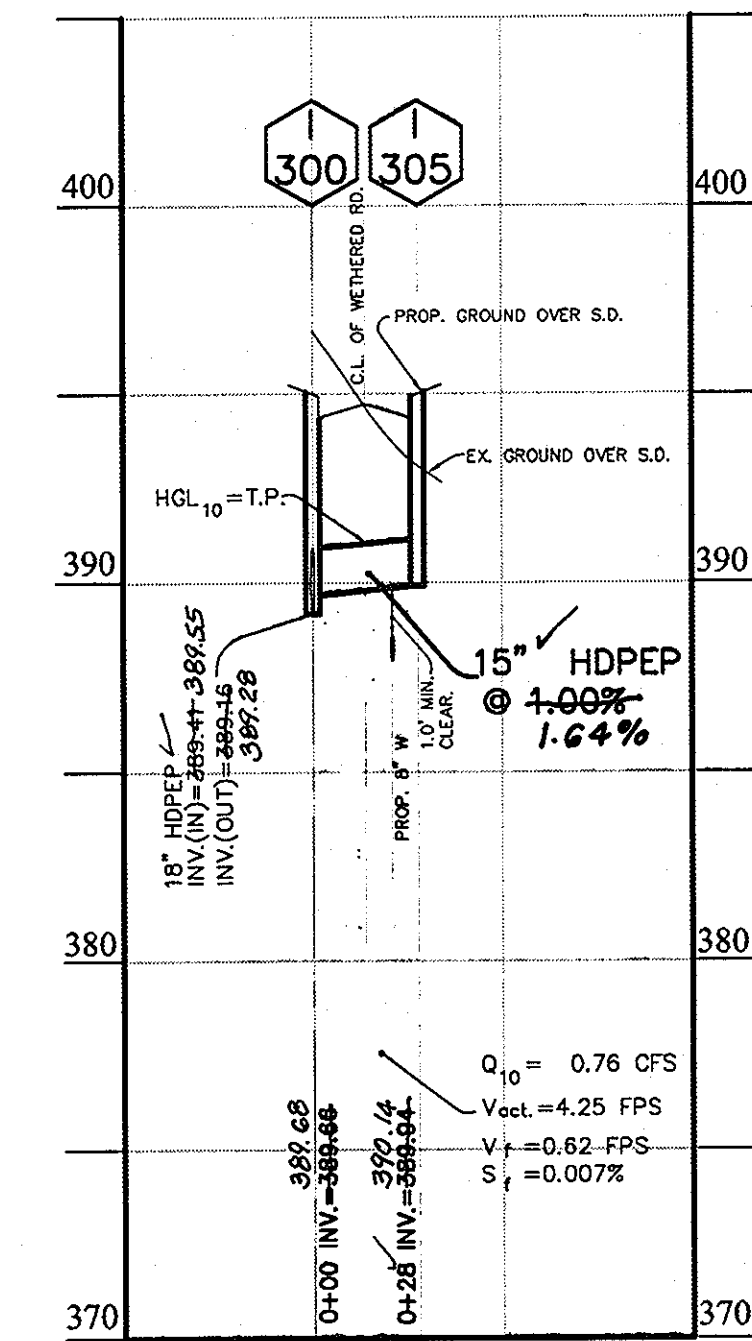

STORM DRAIN PROFILE:  
FROM I-300 TO I-305  
(PUBLIC SYSTEM)

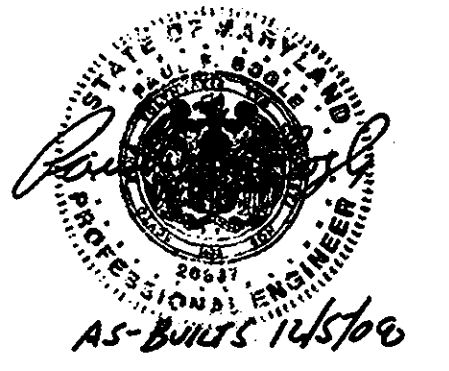

SCALE:  
V: 1"=5'  
H: 1"=50'

APPROVED: HOWARD COUNTY DEPARTMENT OF PLANNING & ZONING

APPROVED: HOWARD COUNTY DEPARTMENT OF PUBLIC WORKS

*Cindy Hamaker*  
CHIEF, DIVISION OF LAND DEVELOPMENT  
DATE: 10/27/03


*William Z. Wilson*  
CHIEF, BUREAU OF HIGHWAY  
DATE: 10-14-03

# AS-BUILT PLANS

DATE	REVISION	DATE	BY	DATE
	BASE DATA		CADD	
	DESIGNED		PFY, YSL	
	DRAWN		YSL	
	REVIEWED		PFY	
	RELEASE FOR			
	1. SUBMITTED FOR APPROVAL			

Developer/Owner:  
**Winchester Homes, Inc. & Winchester Homes, Inc.**, as nominee for Stringtown Investments, LLC  
6905 Rockledge Drive  
Suite 800  
Bethesda, Maryland 20817  
Stephen J. Nardella, Vice President  
(301) 803-4800

## CONSTRUCTION PLANS STORM DRAIN PROFILES

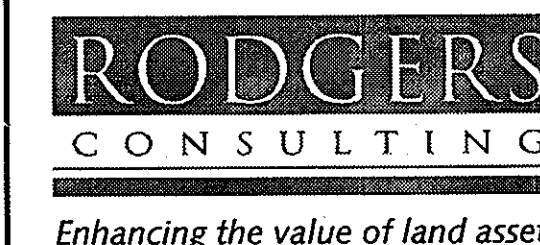








Rodgers Consulting, Inc.  
9260 Galloway Road  
Cathetersburg, MD 20877  
301.948.4700  
301.948.6256 (fax)  
301.253.6609  
www.rodgers.com

### Montjoy - Single Family Detached

A RESUBDIVISION OF NON-BUILDABLE BULK PARCEL C (F-03-87)  
TO  
BUILDABLE LOTS 127- 188 AND OPEN SPACE LOTS 189-193  
ELECTION DISTRICT #2 HOWARD COUNTY, MARYLAND  
TAX MAP: 30, GRID: 12, PARCEL 260  
DPZ FILES: S-01-20, WP-01-117, P-02-10, P-02-17, P-03-03, F-03-87

SCALE:	AS SHOWN
JOB No.	506v3
DATE:	11/02/02
INDEX No.	SD-2
SHEET No.	18 OF 34




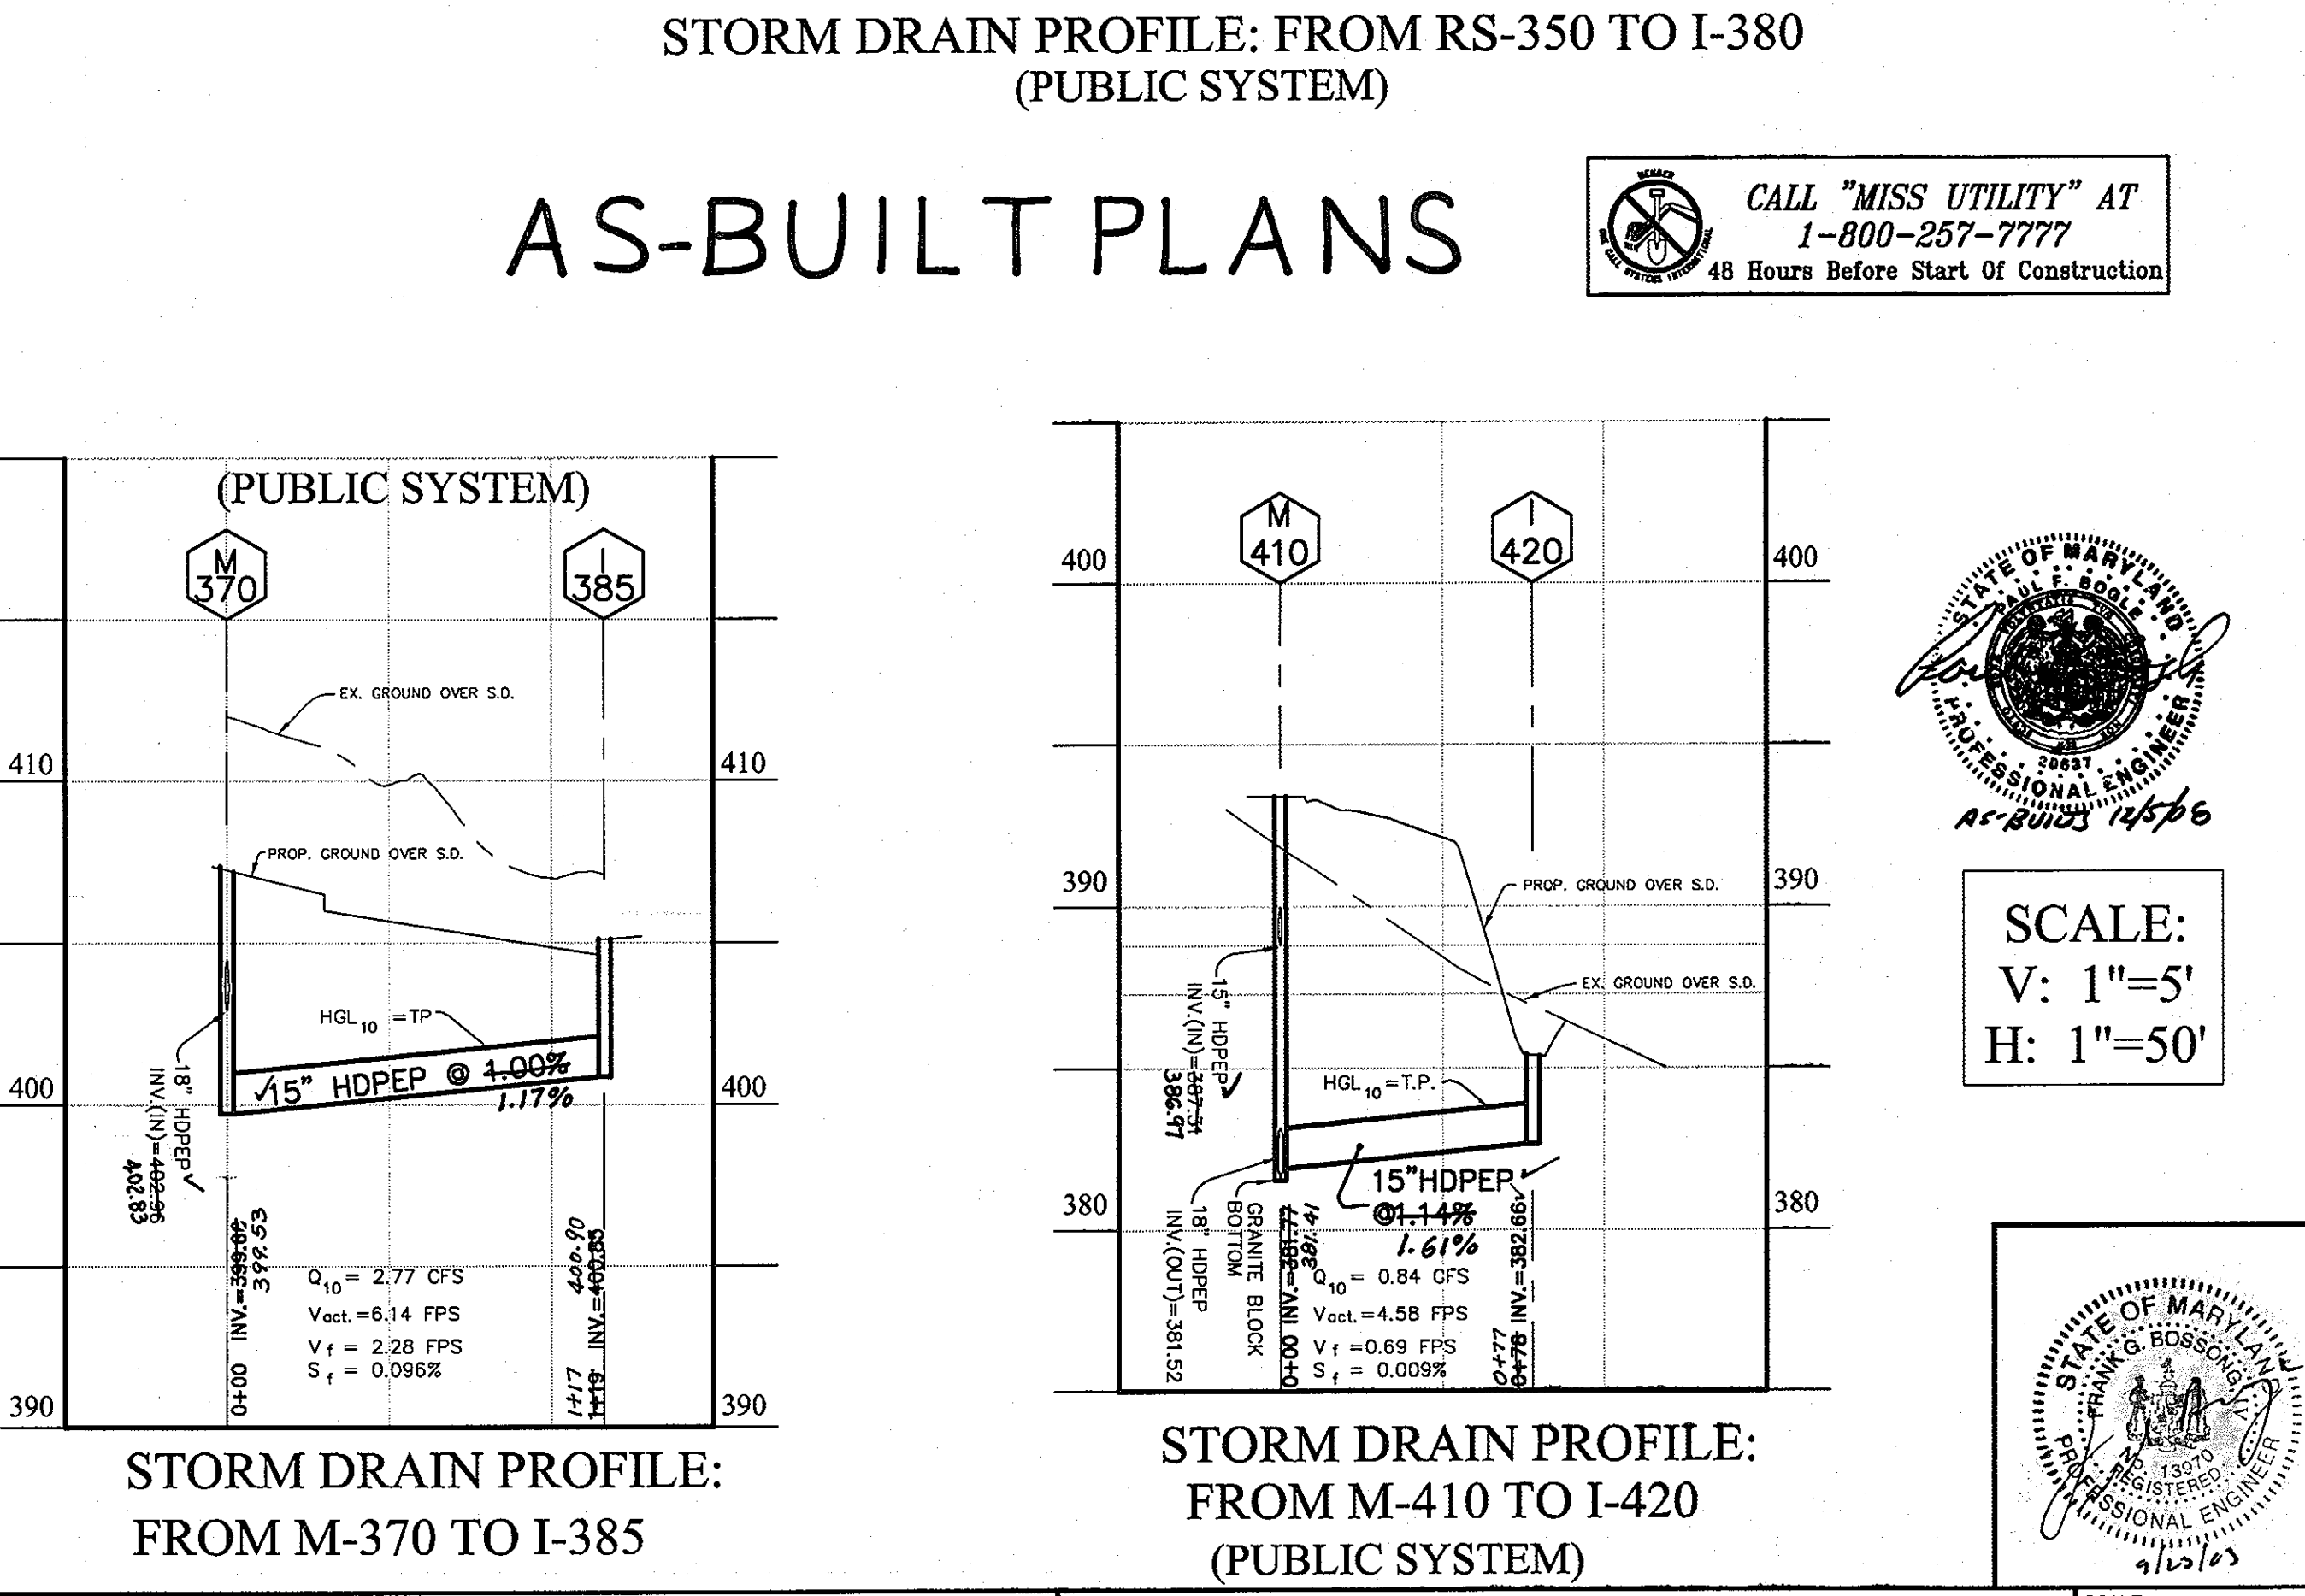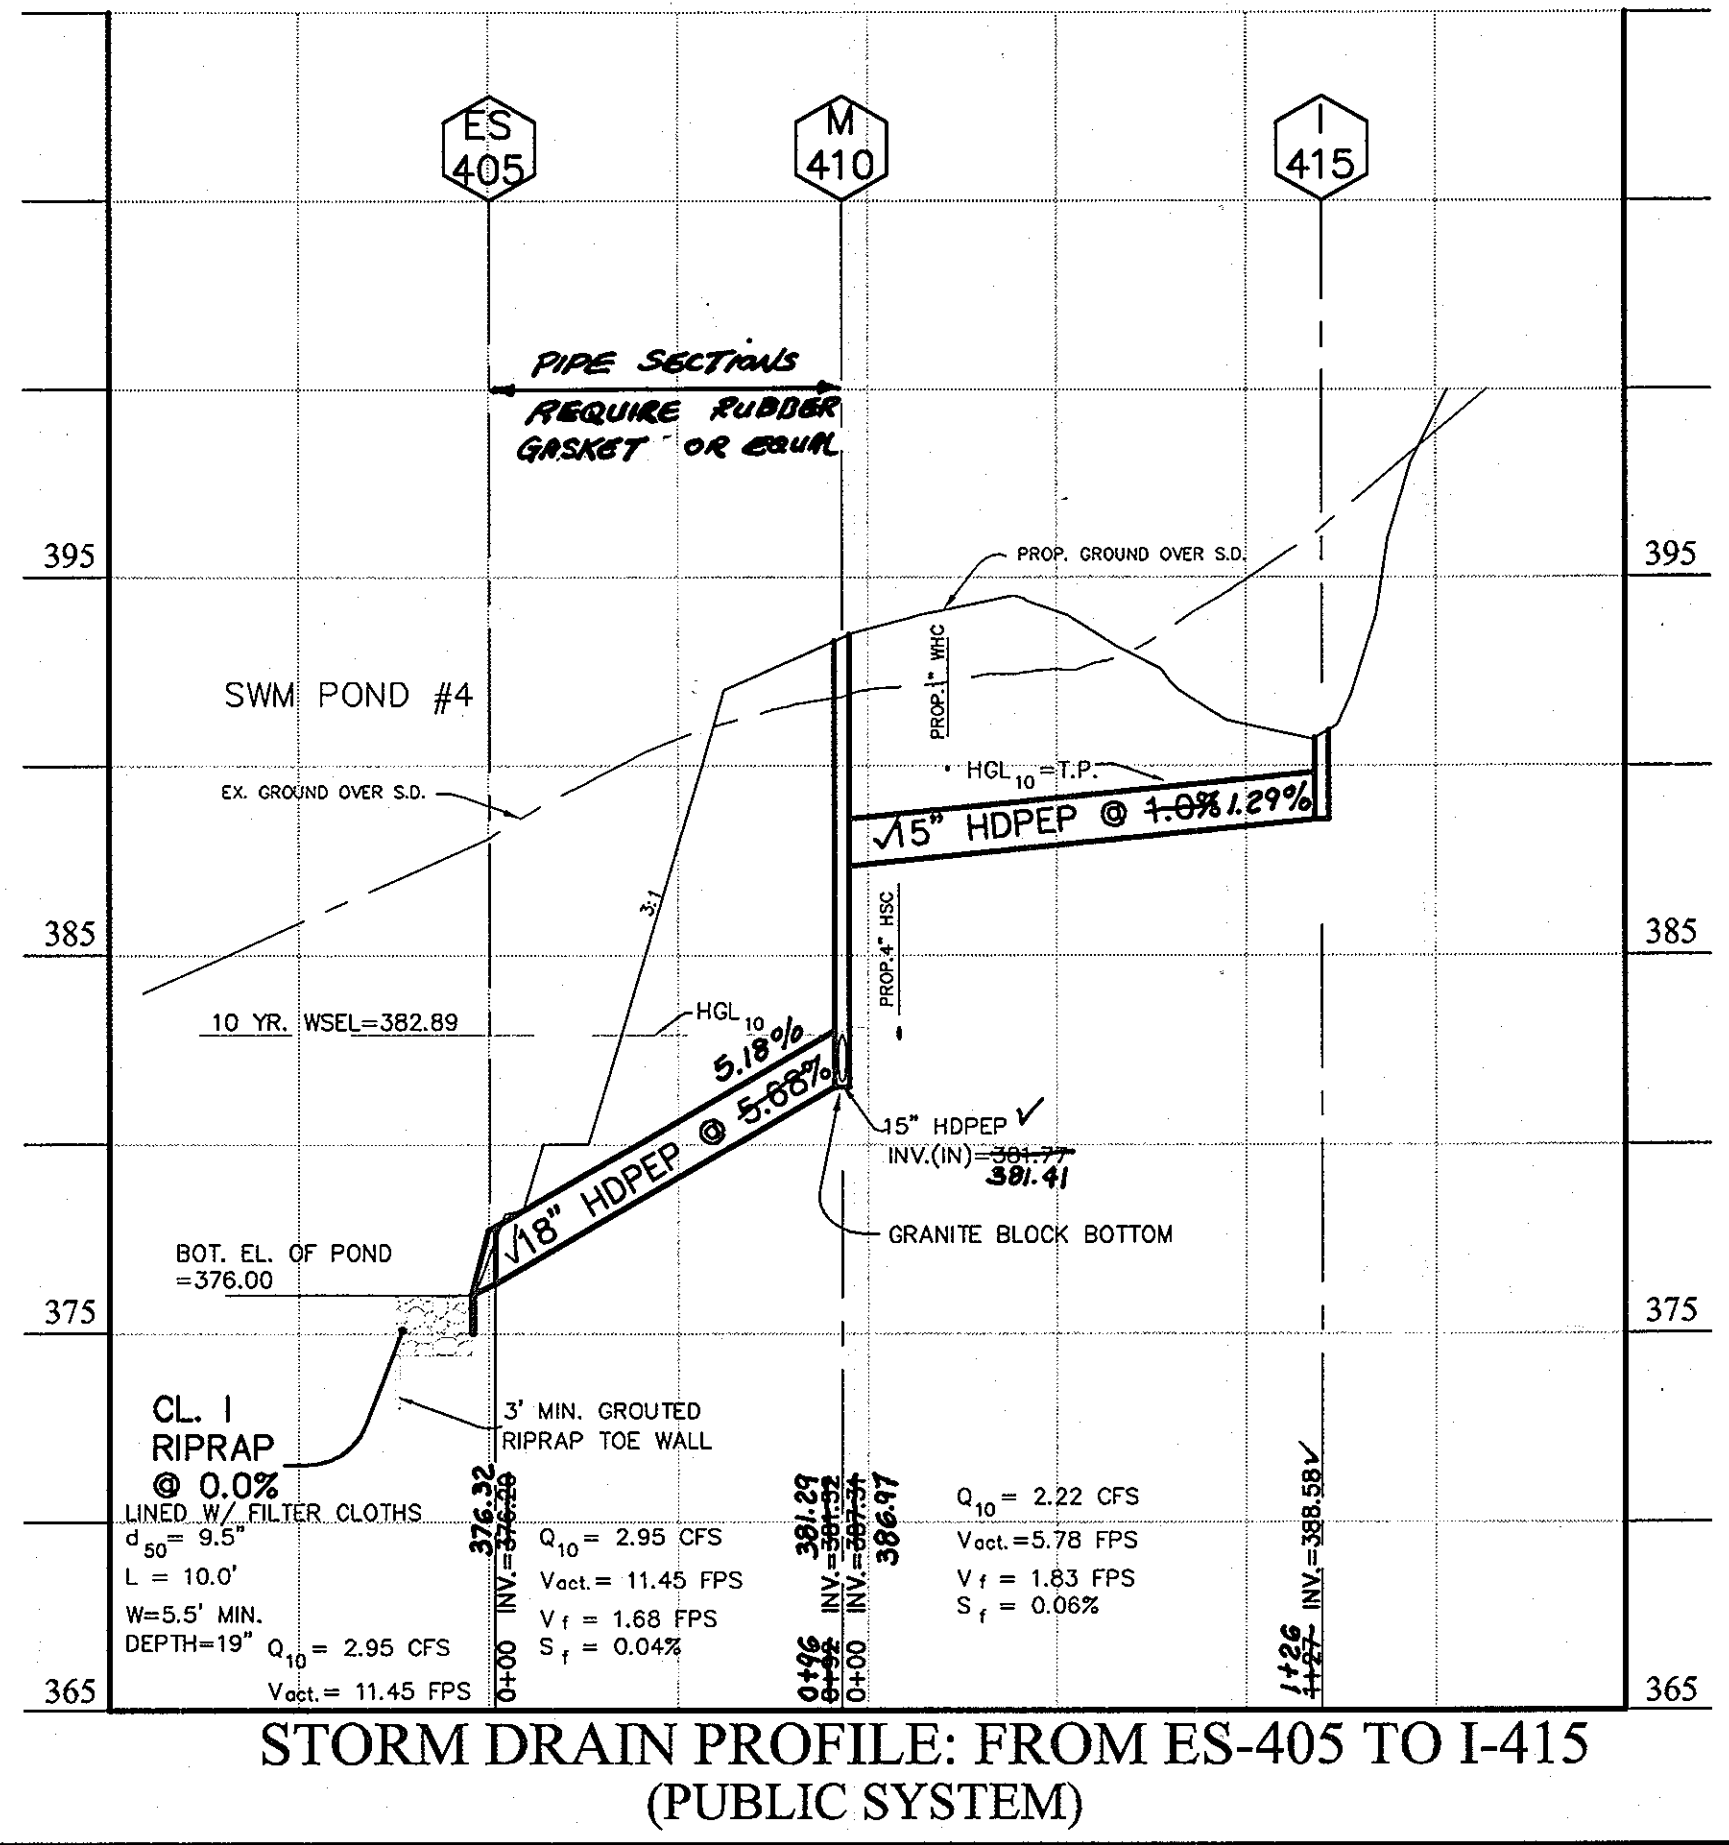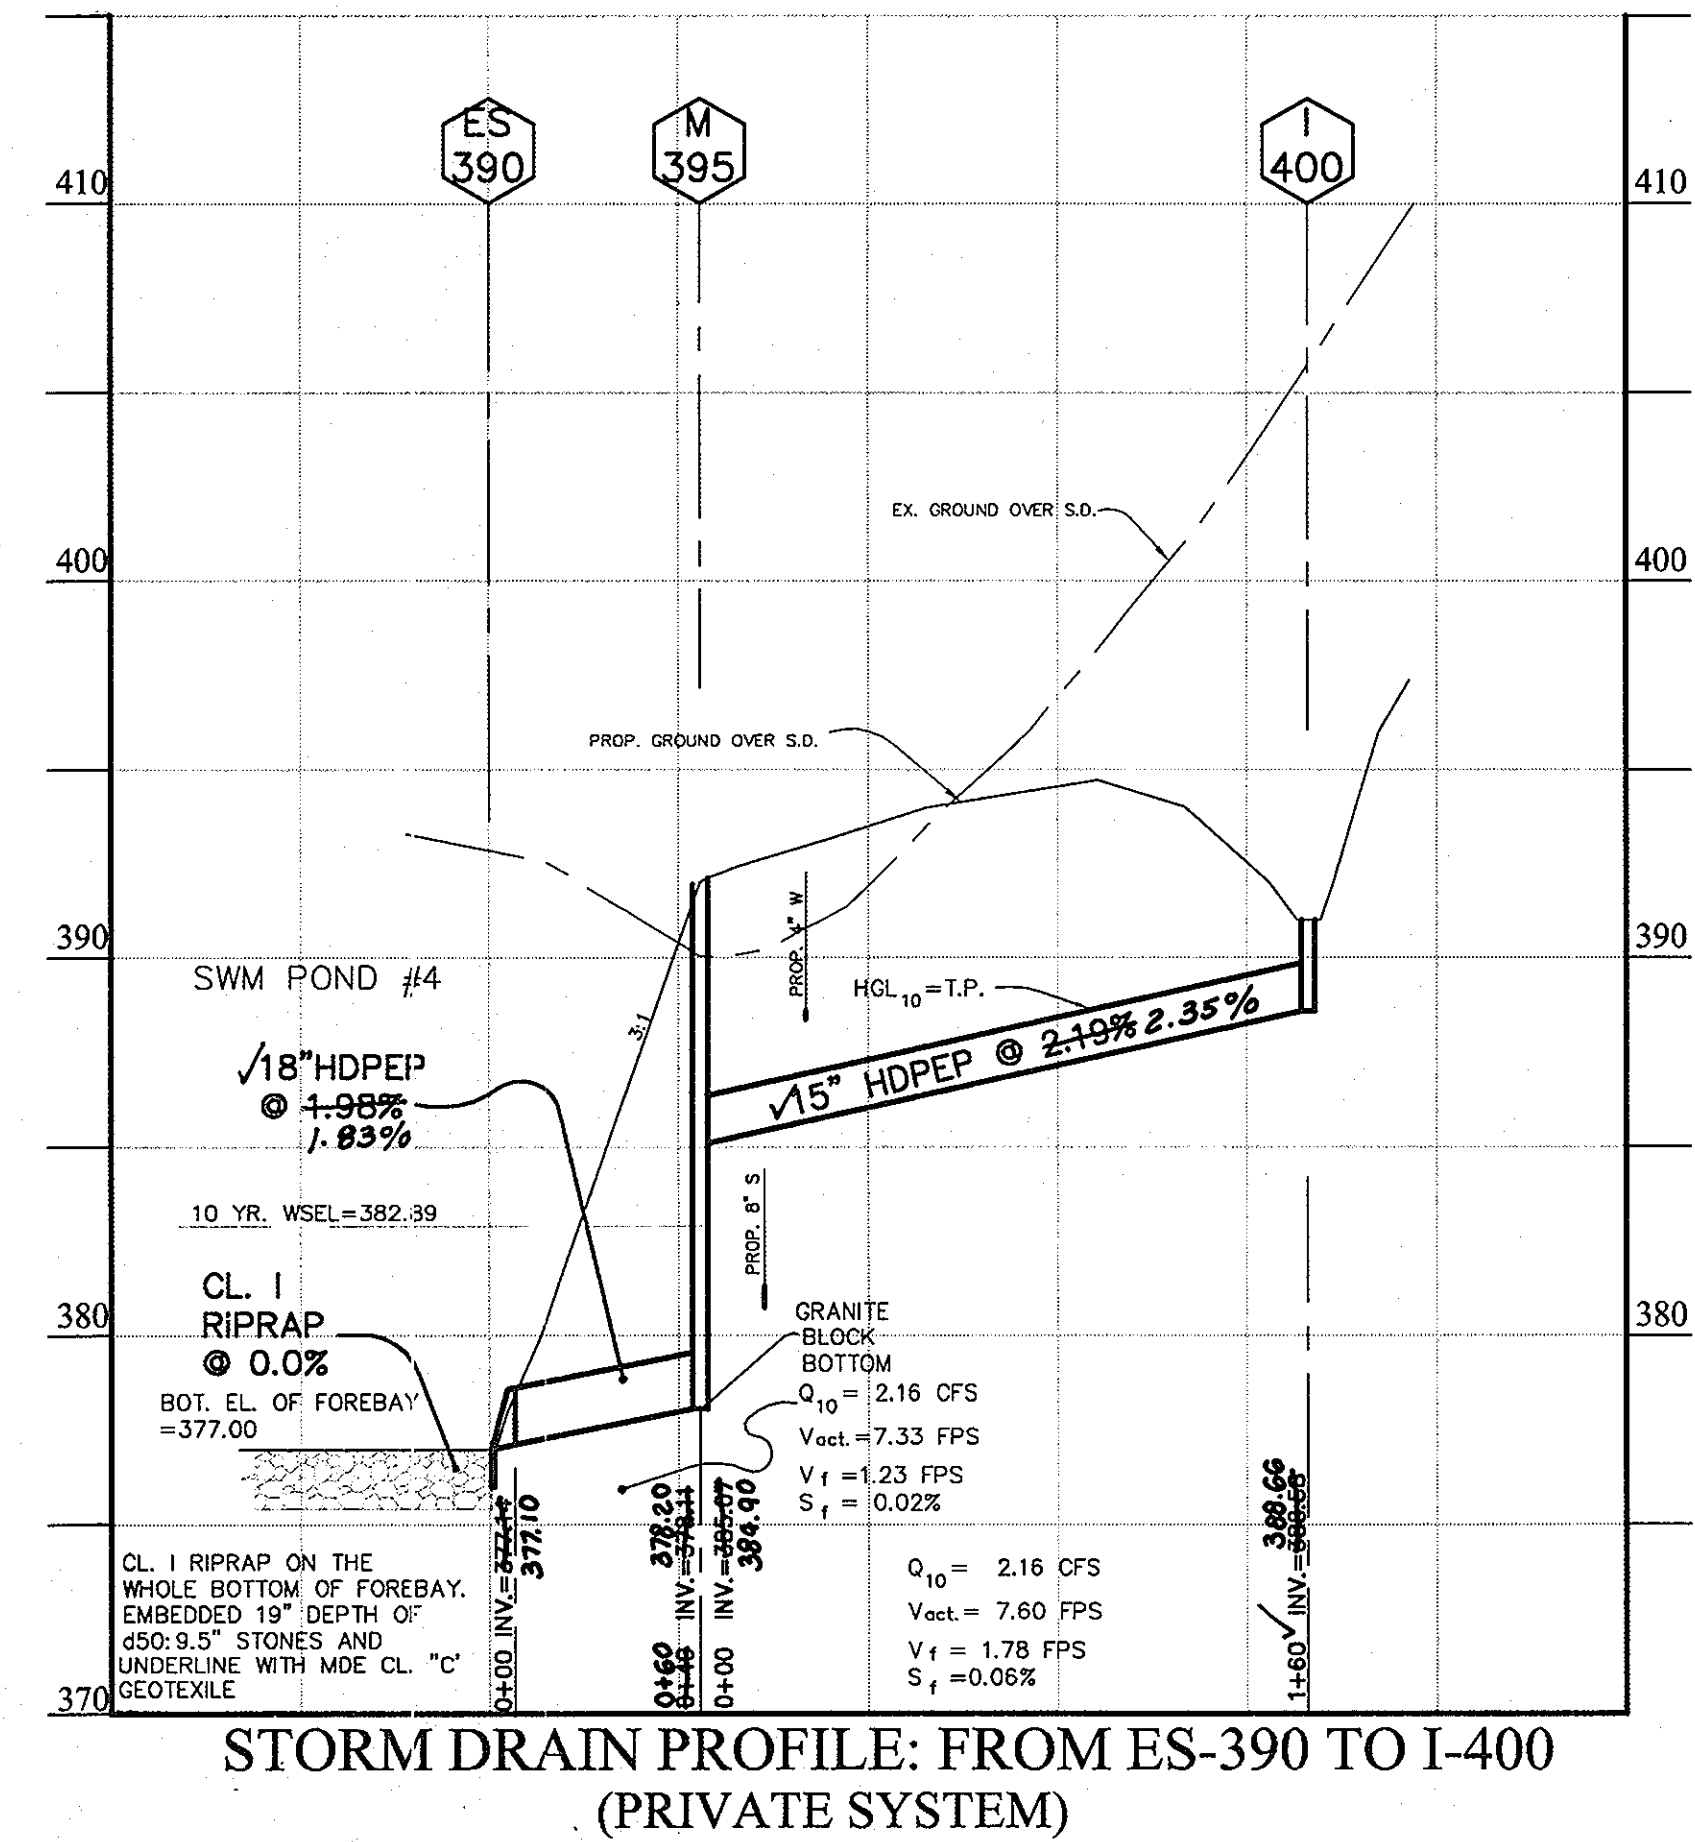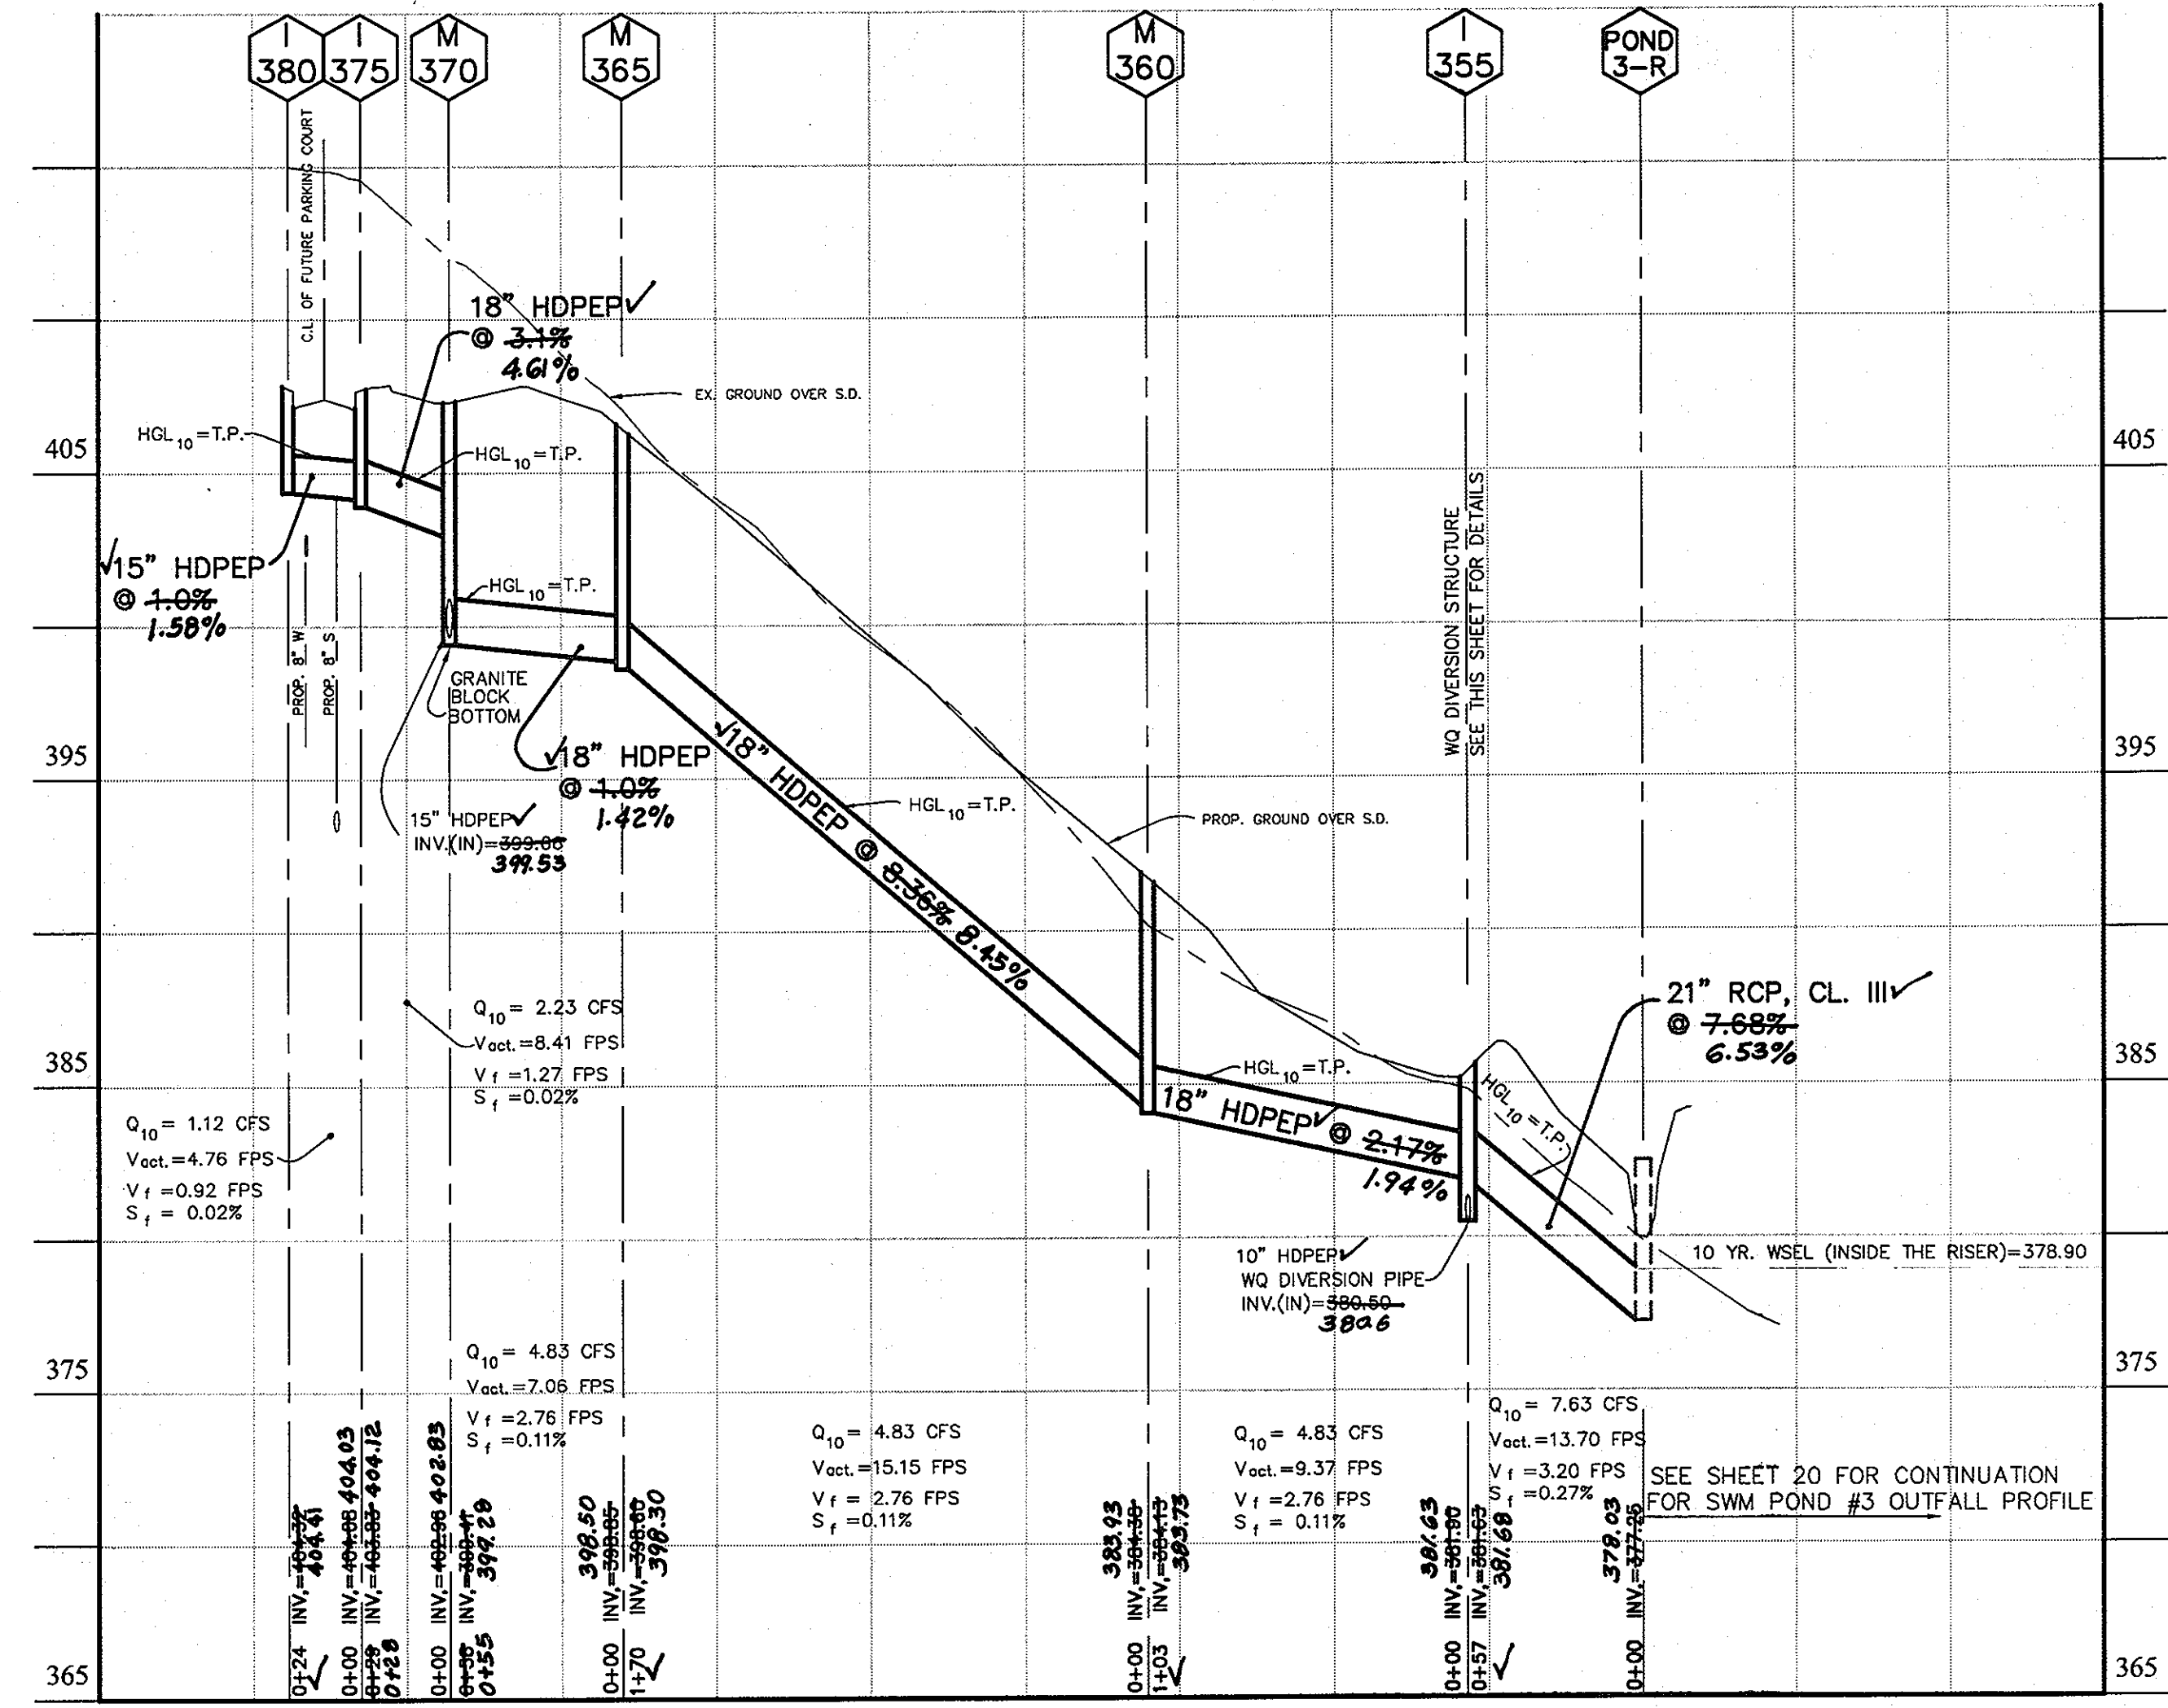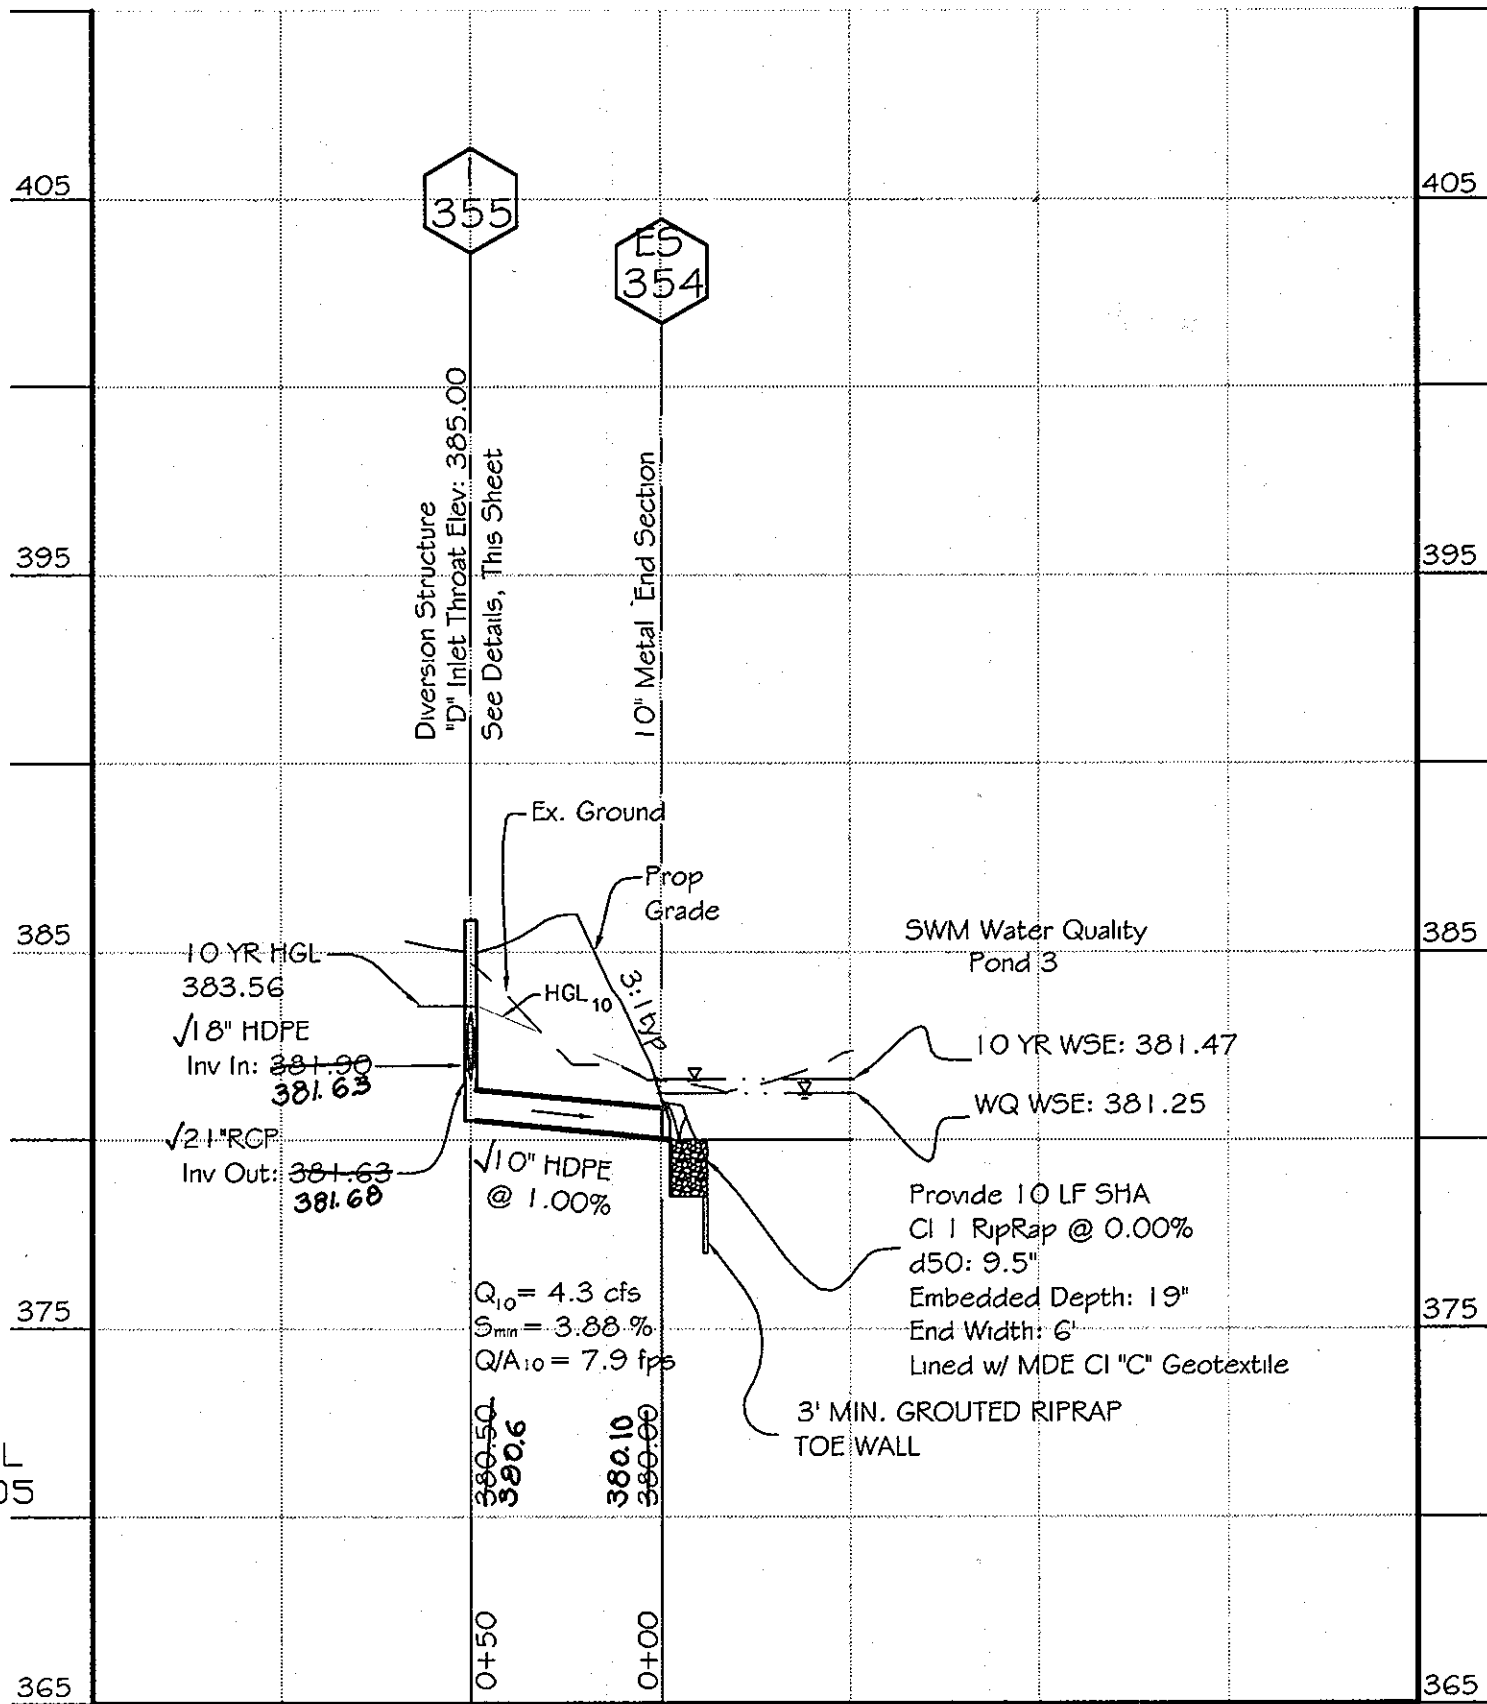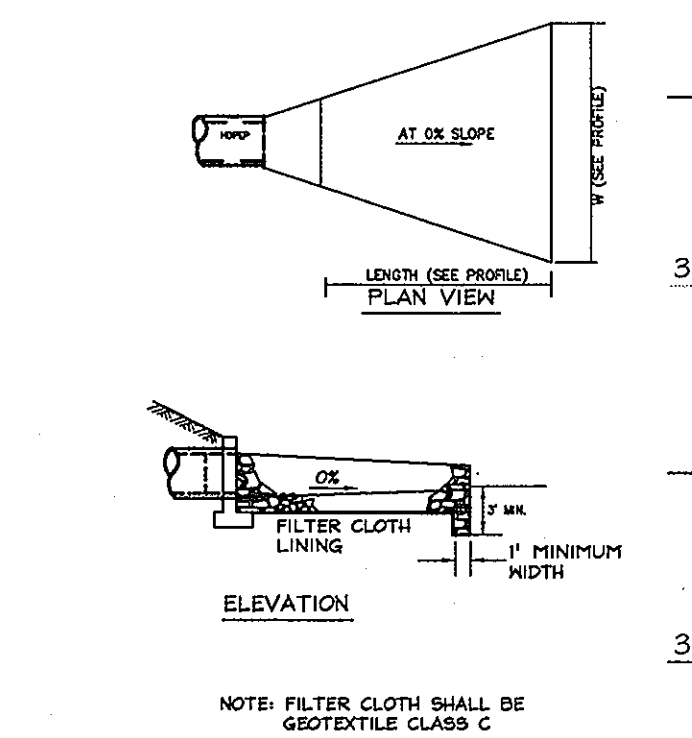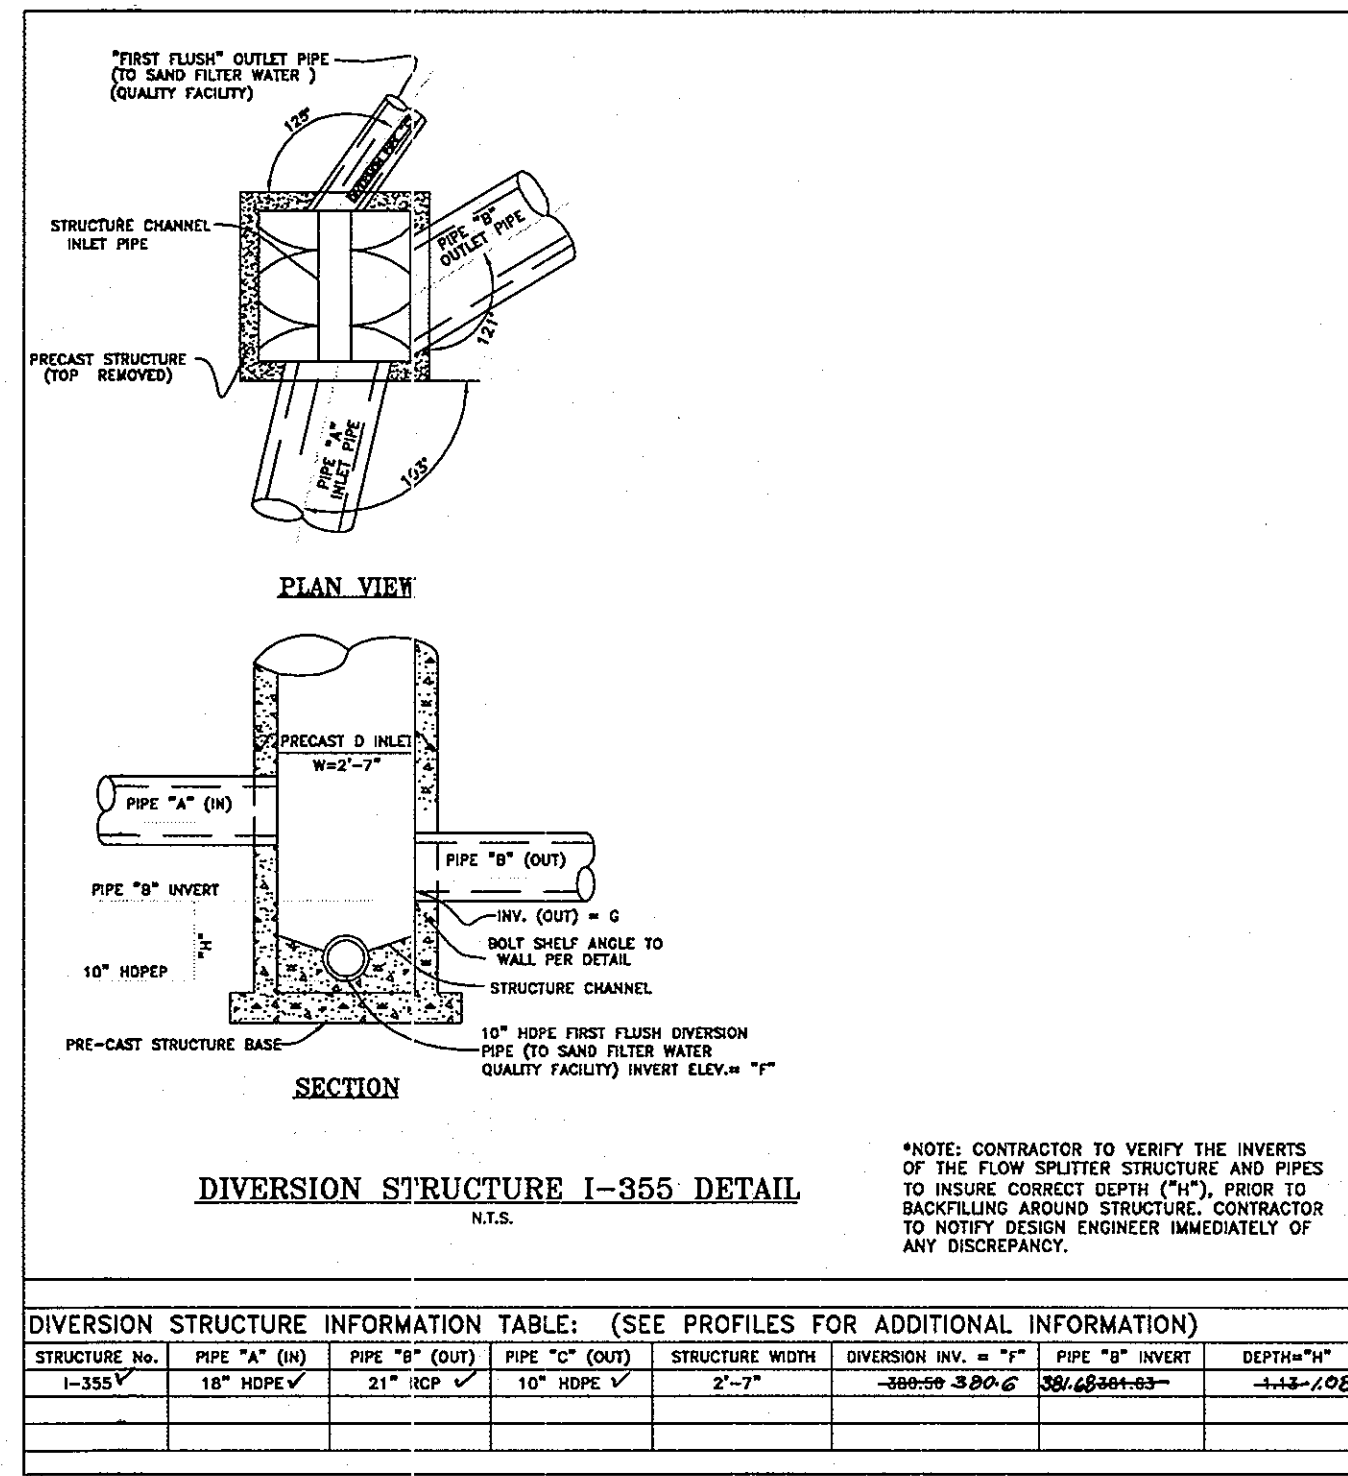

APPROVED: HOWARD COUNTY DEPARTMENT OF PLANNING & ZONING <i>Cinda Hamilton</i> 10/27/03 CHIEF, DIVISION OF LAND DEVELOPMENT	APPROVED: HOWARD COUNTY DEPARTMENT OF PUBLIC WORKS <i>William F. Wilson</i> 10-14-03 CHIEF, BUREAU OF HIGHWAY			
DATE	REVISION	DATE	BY	DATE
	BASE DATA		CADD	
	DESIGNED		PFB/YSL	
	DRAWN		YSL	
	REVIEWED		PFB/RF	
	RELEASE FOR			
	FINAL AS-BUILT REVISIONS			
	FINAL MTLR SUBMITTAL FOR SIGNATURE	9/24/03		
	RE-SUBMITTED FOR REVIEW AND APPROVAL	07/11/03		
	RE-SUBMITTED FOR REVIEW AND APPROVAL	04/25/03		
	1. SUBMITTED FOR APPROVAL	12/02		

Developer/Owner:  
**Winchester Homes, Inc. & Winchester Homes, Inc., as nominee for Stringtown Investments, LLC**  
 6905 Rockledge Drive  
 Suite 800  
 Bethesda, Maryland 20817  
 Stephen J. Nardella, Vice President  
 (301) 803-4800

**CONSTRUCTION PLANS**  
**STORM DRAIN PROFILES**

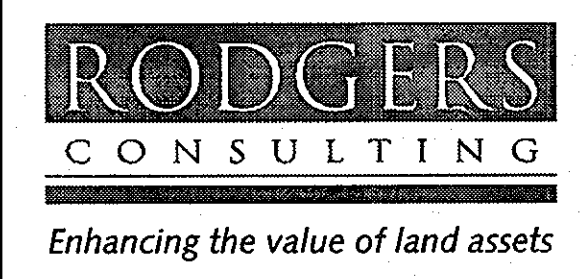

Rodgers Consulting, Inc.  
 9260 Gaither Road  
 Gaithersburg, MD 20877  
 301.948.4700  
 301.948.6256 (fax)  
 301.253.6609  
 www.rodgers.com

**Montjoy - Single Family Detached**  
 A RESUBDIVISION OF NON-BUILDABLE BULK PARCEL C (F-03-87)  
 TO  
 BUILDABLE LOTS 127-188 AND OPEN SPACE LOTS 189-193  
 ELECTION DISTRICT #2 HOWARD COUNTY, MARYLAND  
 TAX MAP: 30, GRID: 12, PARCEL 260  
 DP2 FILES: S-01-20, WP-01-117, P-02-10, P-02-17, P-03-03, P-03-87

SCALE: AS SHOWN  
 JOB No. 506v3  
 DATE: 01/14/03  
 INDEX No. SD-3  
 SHEET No. 19 OF 34






**DEVELOPER'S CERTIFICATE**  
 I/WE CERTIFY THAT ALL DEVELOPMENT AND/OR CONSTRUCTION WILL BE DONE ACCORDING TO THESE PLANS, AND THAT ANY RESPONSIBLE PERSONNEL INVOLVED IN THE CONSTRUCTION PROJECT WILL HAVE A CERTIFICATE OF ATTENDANCE AT A DEPARTMENT OF THE ENVIRONMENT APPROVED TRAINING PROGRAM FOR THE CONTROL OF SEDIMENT AND EROSION BEFORE BEGINNING THE PROJECT. I SHALL ENGAGE A REGISTERED PROFESSIONAL ENGINEER TO SUPERVISE POND CONSTRUCTION AND PROVIDE THE HOWARD SOIL CONSERVATION DISTRICT WITH AN "AS-BUILT" PLAN OF THE POND WITHIN 30 DAYS OF COMPLETION. I ALSO AUTHORIZE PERIODIC ON-SITE INSPECTIONS BY THE HOWARD SOIL CONSERVATION DISTRICT.

*Stephen J. Nardella* 9/23/03  
 SIGNATURE OF DEVELOPER DATE  
 (PRINT NAME BELOW SIGNATURE)

**ENGINEER'S CERTIFICATE**  
 I CERTIFY THAT THIS PLAN FOR POND CONSTRUCTION, EROSION AND SEDIMENT CONTROL REPRESENTS A PRACTICAL AND WORKABLE PLAN BASED ON MY PERSONAL KNOWLEDGE OF THE SITE CONDITIONS. THIS PLAN WAS PREPARED IN ACCORDANCE WITH THE REQUIREMENTS OF THE HOWARD SOIL CONSERVATION DISTRICT. I HAVE NOTIFIED THE DEVELOPER THAT HE/SHE MUST ENGAGE A REGISTERED PROFESSIONAL ENGINEER TO SUPERVISE POND CONSTRUCTION AND PROVIDE THE HOWARD SOIL CONSERVATION DISTRICT WITH AN "AS-BUILT" PLAN OF THE POND WITHIN 30 DAYS OF COMPLETION.

*Paul L. Bottom* 9/24/03  
 SIGNATURE OF ENGINEER DATE  
 (PRINT NAME BELOW SIGNATURE)

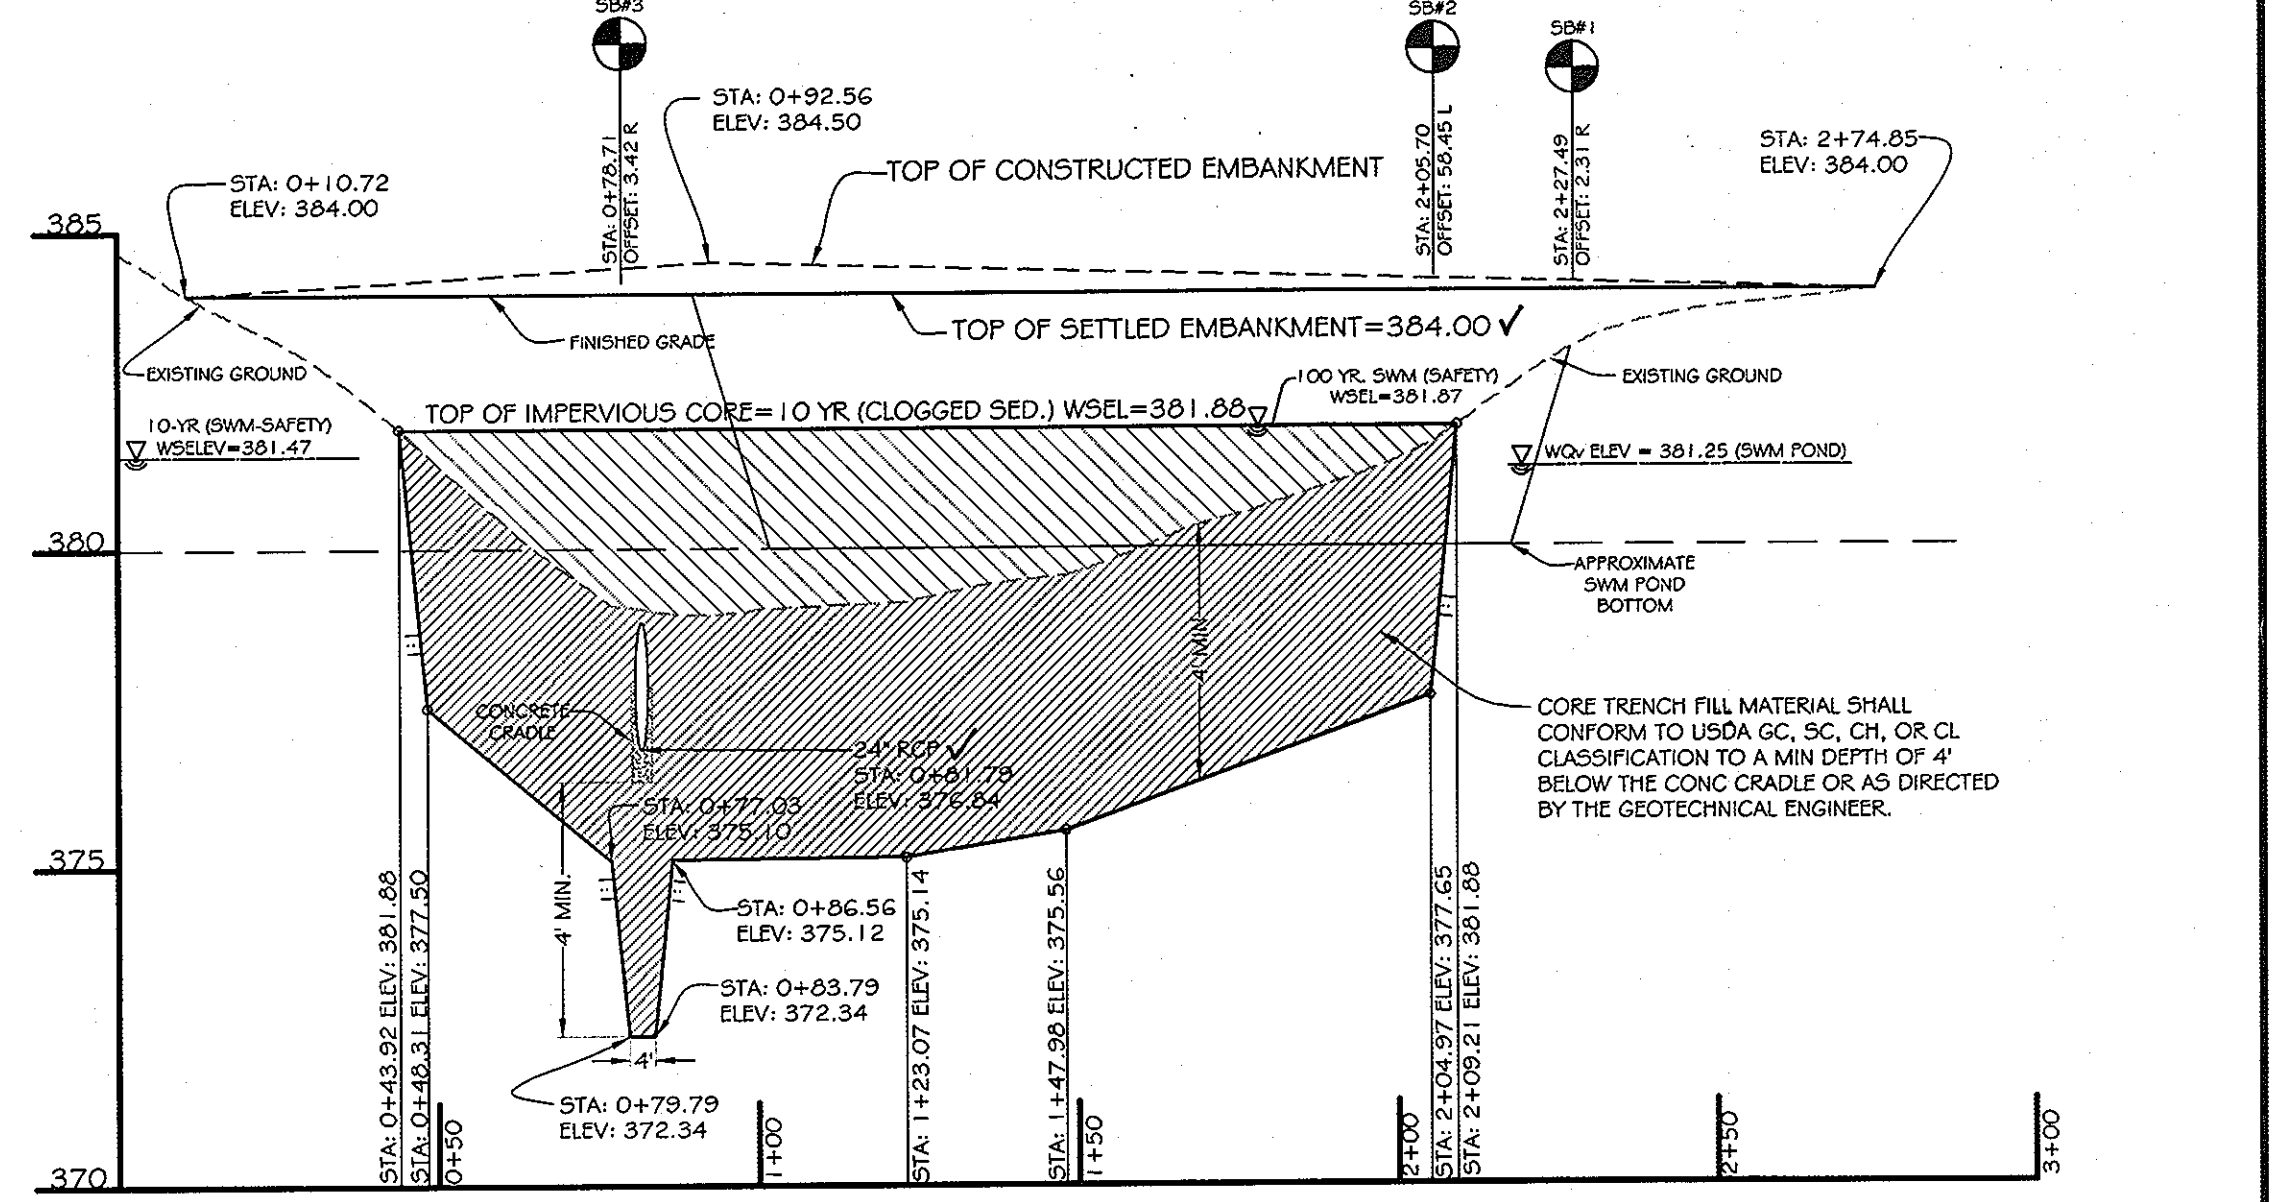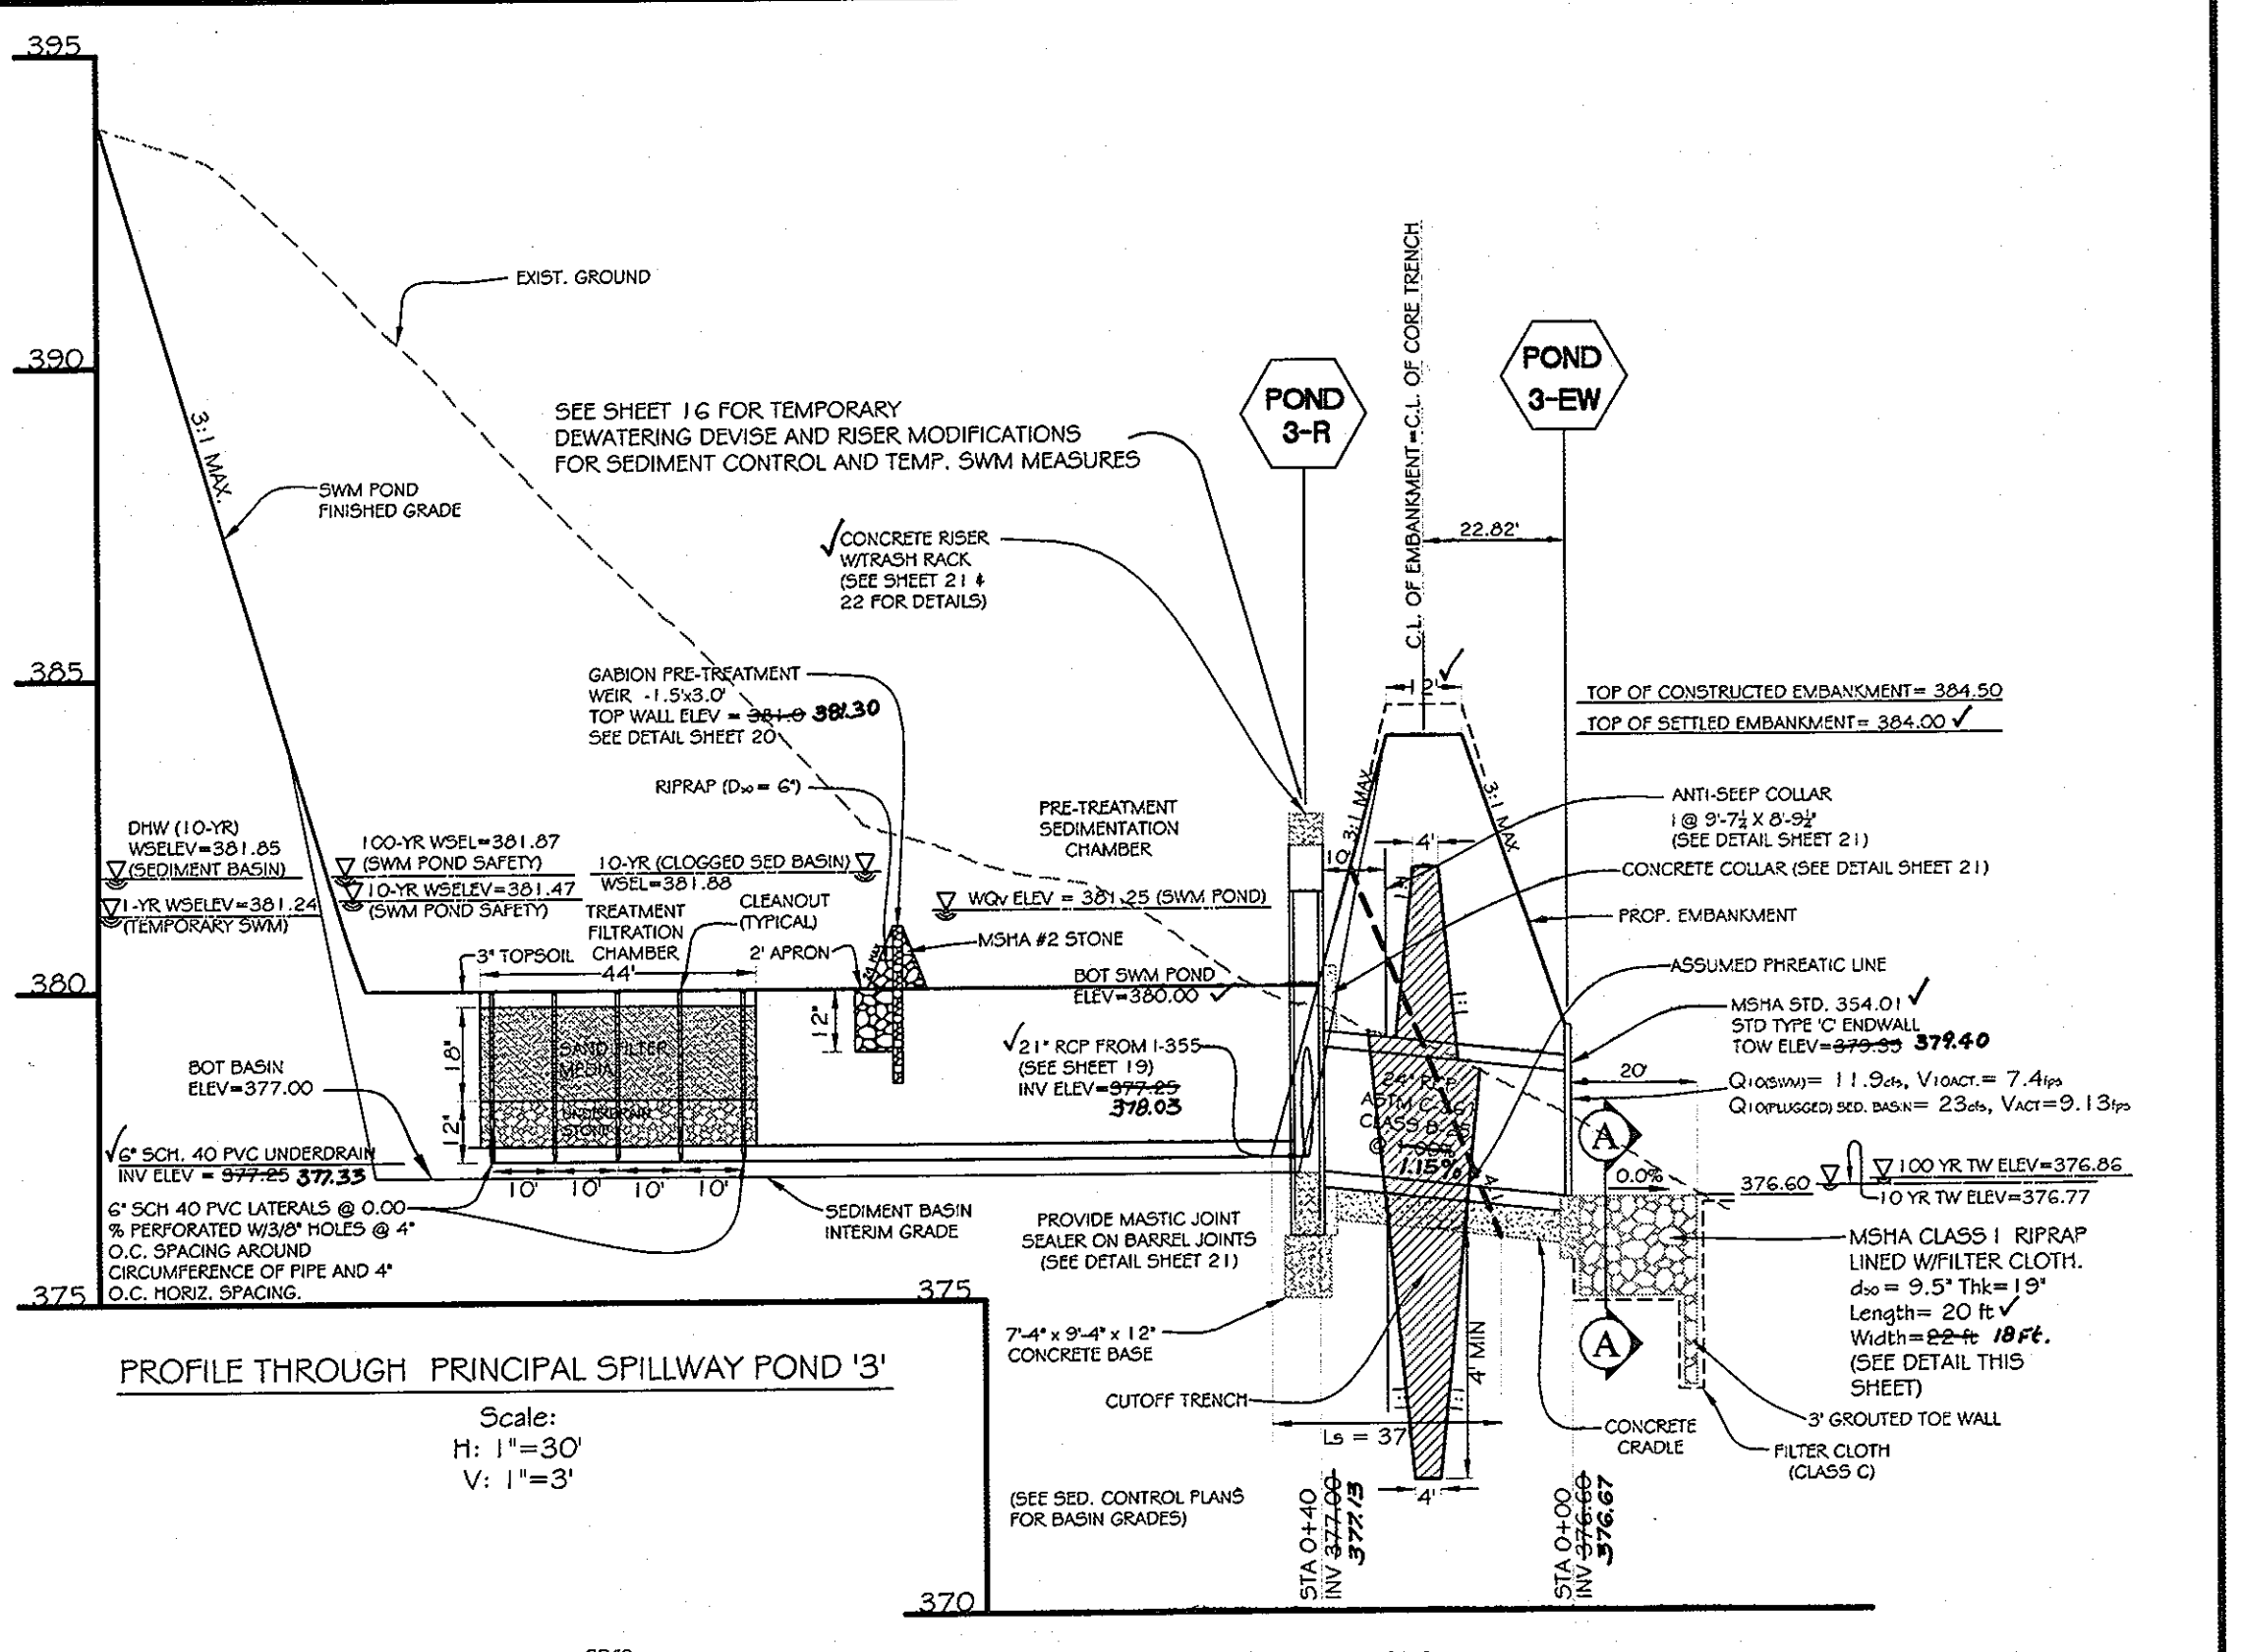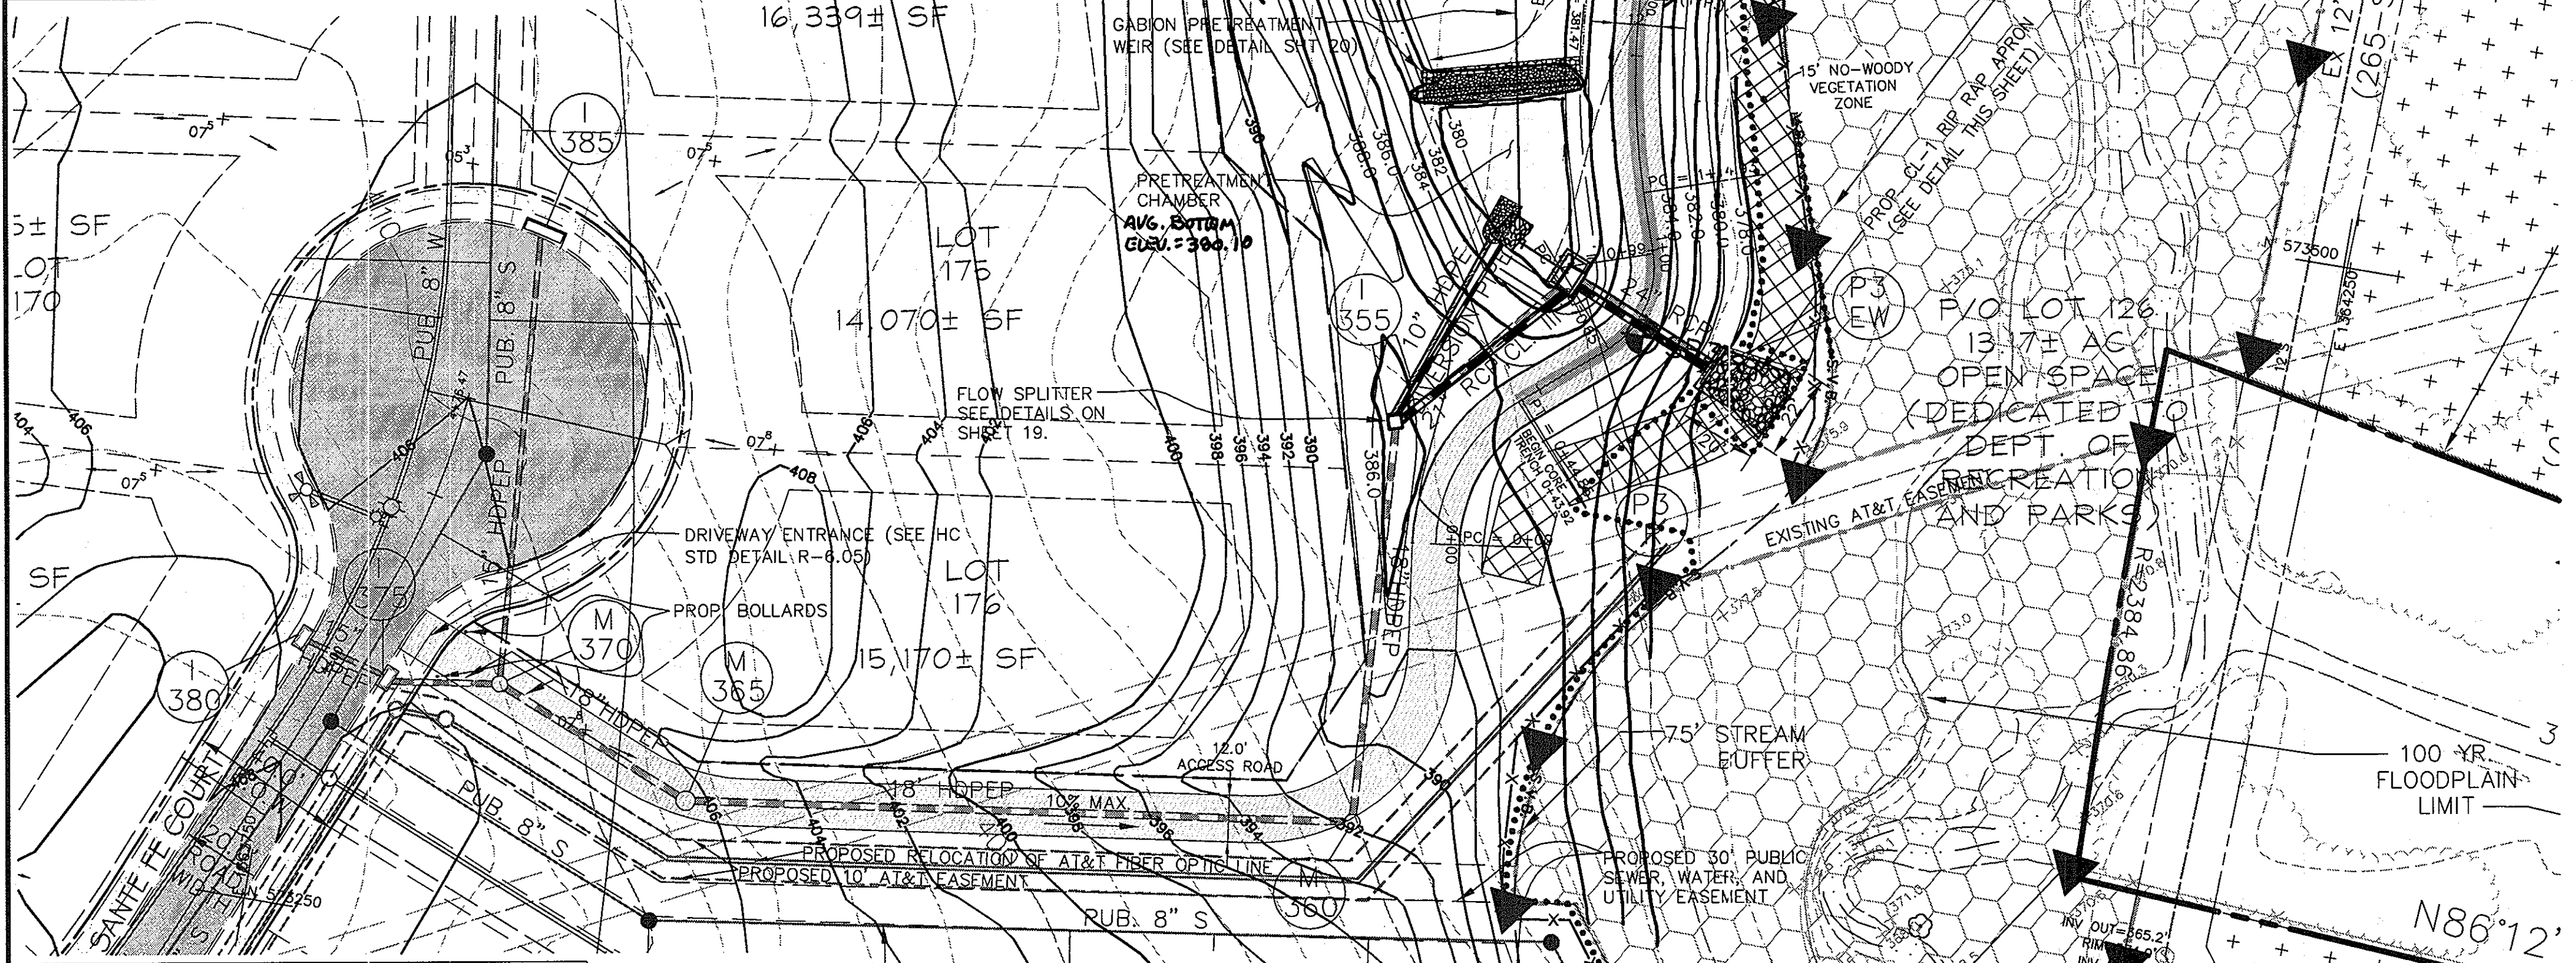

**APPROVED:**  
 THESE PLANS FOR SMALL POND CONSTRUCTION, SOIL EROSION, AND SEDIMENT CONTROL MEET THE REQUIREMENTS OF THE HOWARD SOIL CONSERVATION DISTRICT.

*Shells Slig* 10/2/03  
 HOWARD SOIL CONSERVATION DISTRICT DATE

**APPROVED:**  
 THESE PLANS HAVE BEEN REVIEWED FOR THE HOWARD SOIL CONSERVATION DISTRICT AND MEET THE TECHNICAL REQUIREMENTS FOR SMALL POND CONSTRUCTION, SOIL EROSION, AND SEDIMENT CONTROL.

*Jim Moya* 10/2/03  
 USDA-NATURAL RESOURCES CONSERVATION SERVICE DATE

**APPROVED:** HOWARD COUNTY DEPARTMENT OF PUBLIC WORKS

*William T. White* 10-14-03  
 CHIEF, BUREAU OF HIGHWAY DATE


**APPROVED:** HOWARD COUNTY DEPARTMENT OF PLANNING & ZONING

*Cindy Hammit* 11/22/03  
 CHIEF, DIVISION OF LAND DEVELOPMENT DATE

*Chris Danner* 10/17/03  
 CHIEF, DEVELOPMENT ENGINEERING DIVISION DATE




**SWM POND #3 NOTES:**

PUBLIC CLASS A POND.  
 SANDFILTER (F-1) WATER QUALITY ONLY  
 OWNER: HOA  
 JOINTLY MAINTAINED BY HOA & HOWARD COUNTY  
 SEE SHEET 23 FOR RUNOFF SUMMARY TABLES  
 SEE SHEET 24 FOR POND LANDSCAPING  
 SEE SHEET 14 FOR TEMPORARY SEDIMENT BASIN GRADES

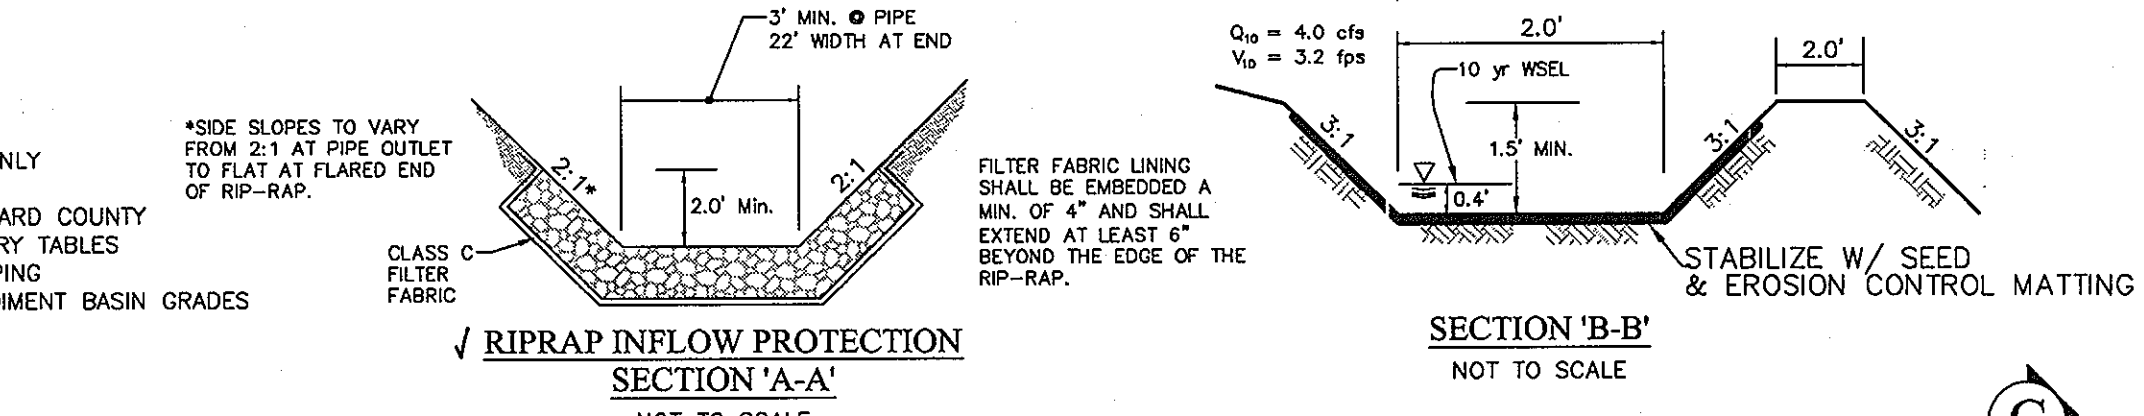

**AS-BUILT CERTIFICATION**  
 I HEREBY CERTIFY THAT THE FACILITY SHOWN ON THIS PLAN WAS CONSTRUCTED AS SHOWN ON THE "AS-BUILT PLANS" AND MEETS THE APPROVED PLAN AND SPECIFICATIONS.

*Paul L. Bottom* P.E. NO. 20637  
 DATE: 12/5/08

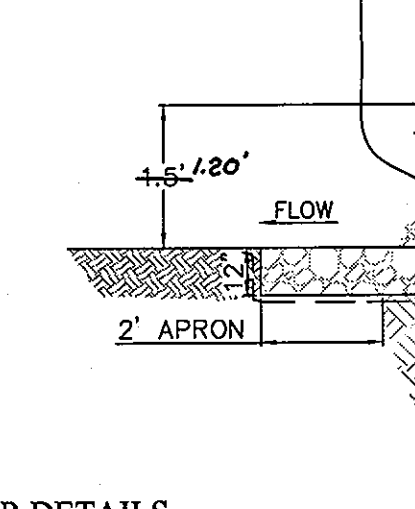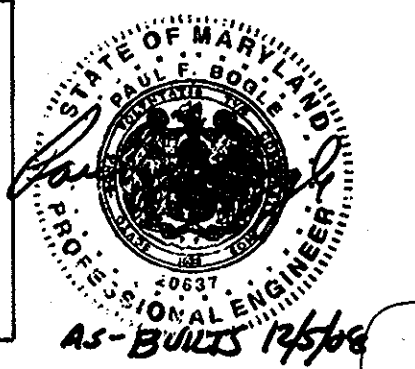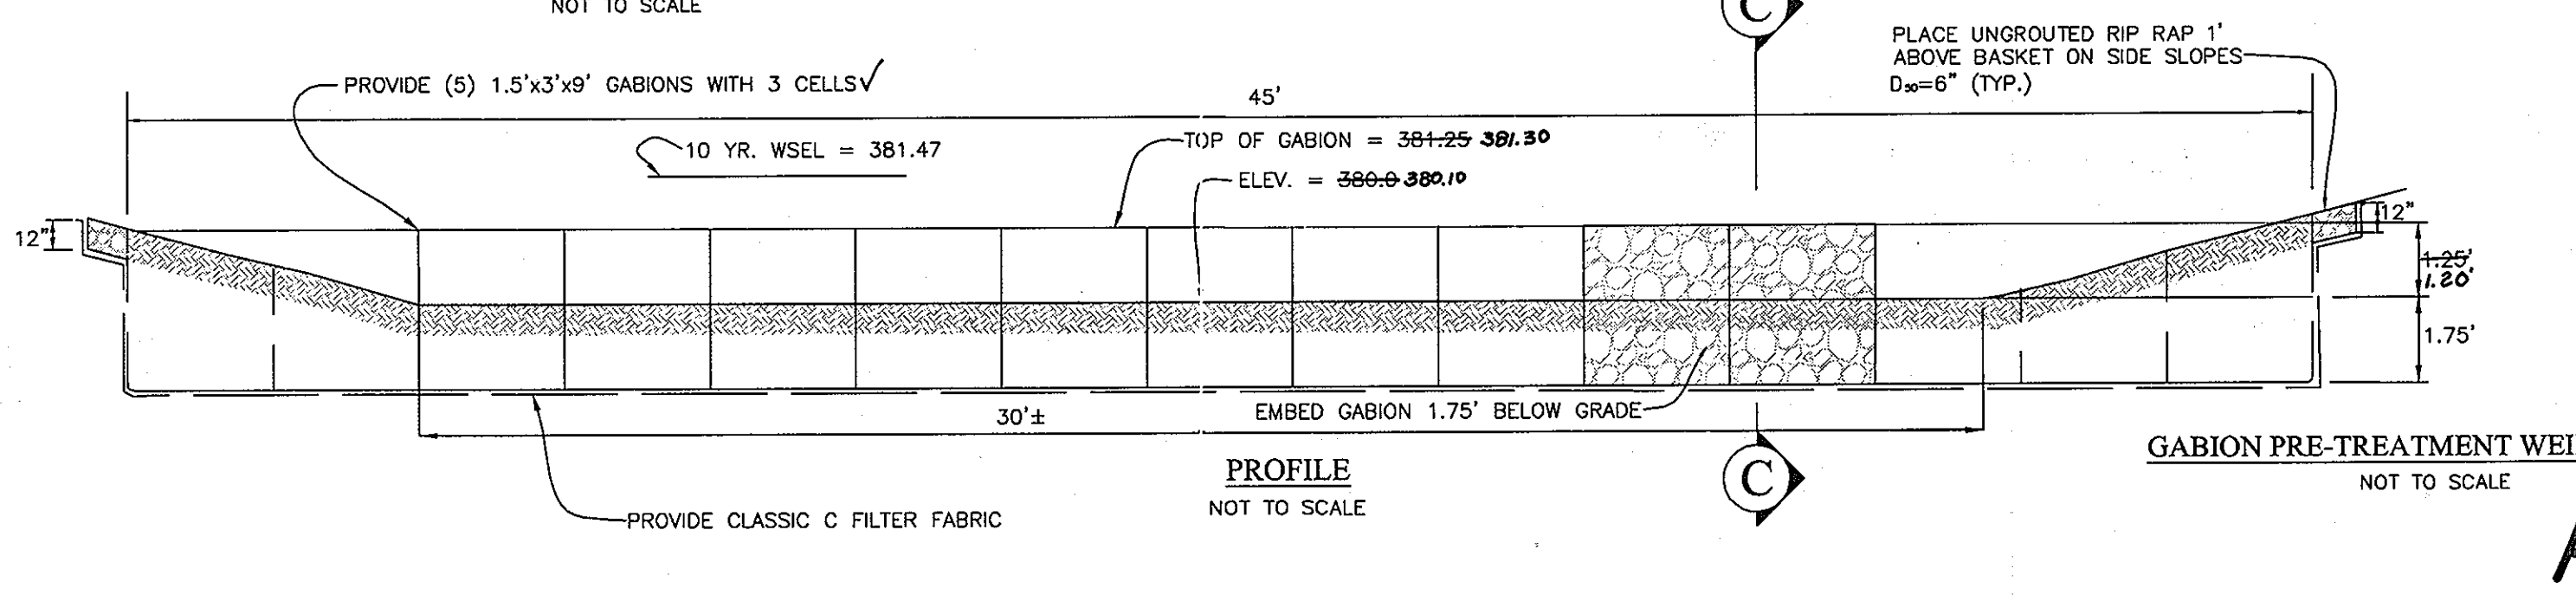

- GABION STRUCTURE NOTES**
- ALL WIRE USED IN GABION CONSTRUCTION SHALL BE GALVANIZED AND PLASTIC COATED. ALL PLIERS AND TOOLS SHALL BE PLASTIC COATED.
  - FILTER CLOTH SHALL BE PLACED WHENEVER GABION COMES IN CONTACT WITH SOIL.
  - STONE FILL SHALL CONSIST OF HARD, DURABLE CLEAN STONE, 4"-8" IN SIZE OR APPROVED BY THE ENGINEER.
  - CONSTRUCTION MATERIALS AND METHODS SHALL BE IN ACCORDANCE WITH MACCAFFERRI GABIONS INC., SPECS OR EQUAL.

NOTE: THIS PLAN TO BE USED FOR STORMWATER MANAGEMENT ONLY. ALL OTHER INFORMATION SHOWN FOR REFERENCE PURPOSE ONLY. SEE APPROPRIATE CONSTRUCTION DRAWING FOR ALL OTHER INFORMATION.

CALL "MISS UTILITY" AT 1-800-257-7777 48 Hours Before Start of Construction

DATE	REVISION	DATE	BY	DATE
	BASE DATA		CADD	
	DESIGNED		PFB, YSL	
	DRAWN		YSL	
	REVIEWED		PFB	
	RELEASE FOR			

Developer/Owner:  
**Winchester Homes, Inc. & Winchester Homes, Inc., as nominee for Stringtown Investments, LLC**  
 6905 Rockledge Drive  
 Suite 800  
 Bethesda, Maryland 20817  
 Stephen J. Nardella, Vice President  
 (301) 803-4800

**SWM POND 3**  
 SWM PLAN, PROFILES & DETAILS

**RODGERS CONSULTING**  
 Enhancing the value of land assets

Rodgers Consulting, Inc.  
 9260 Galthier Road  
 Gaithersburg, MD 20877  
 301.948.4700  
 301.948.6256 (fax)  
 301.253.6609  
 www.rodgers.com

**Montjoy - Single Family Detached**




A RESUBDIVISION OF NON-BUILDABLE BULK PARCEL C (F-03-87)  
 BUILDABLE LOTS 127-188 AND OPEN SPACE LOTS 189-193

ELECTION DISTRICT #2 HOWARD COUNTY, MARYLAND  
 TAX MAP: 30, GRID: 12, PARCEL 280

DP2 FILES: S-01-20, WP-01-17, P-02-10, P-02-17, P-03-03, P-03-08








SCALE: 1"=30'  
 JOB No. 506V3  
 DATE: 1-14-03  
 INDEX No. SWM-1  
 SHEET No. 20 of 33



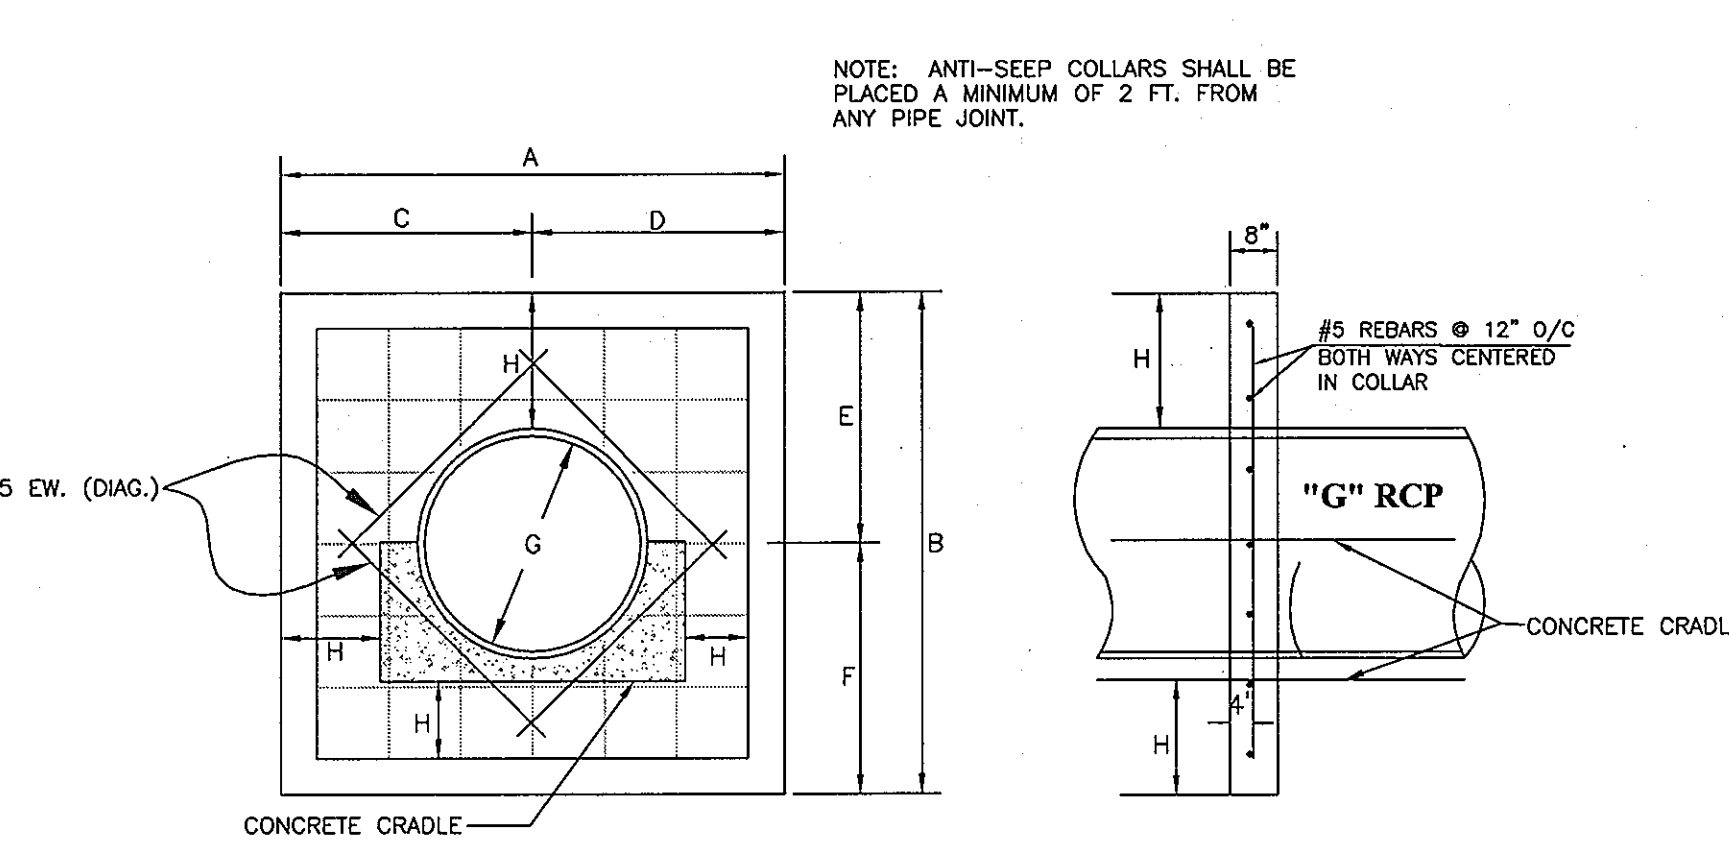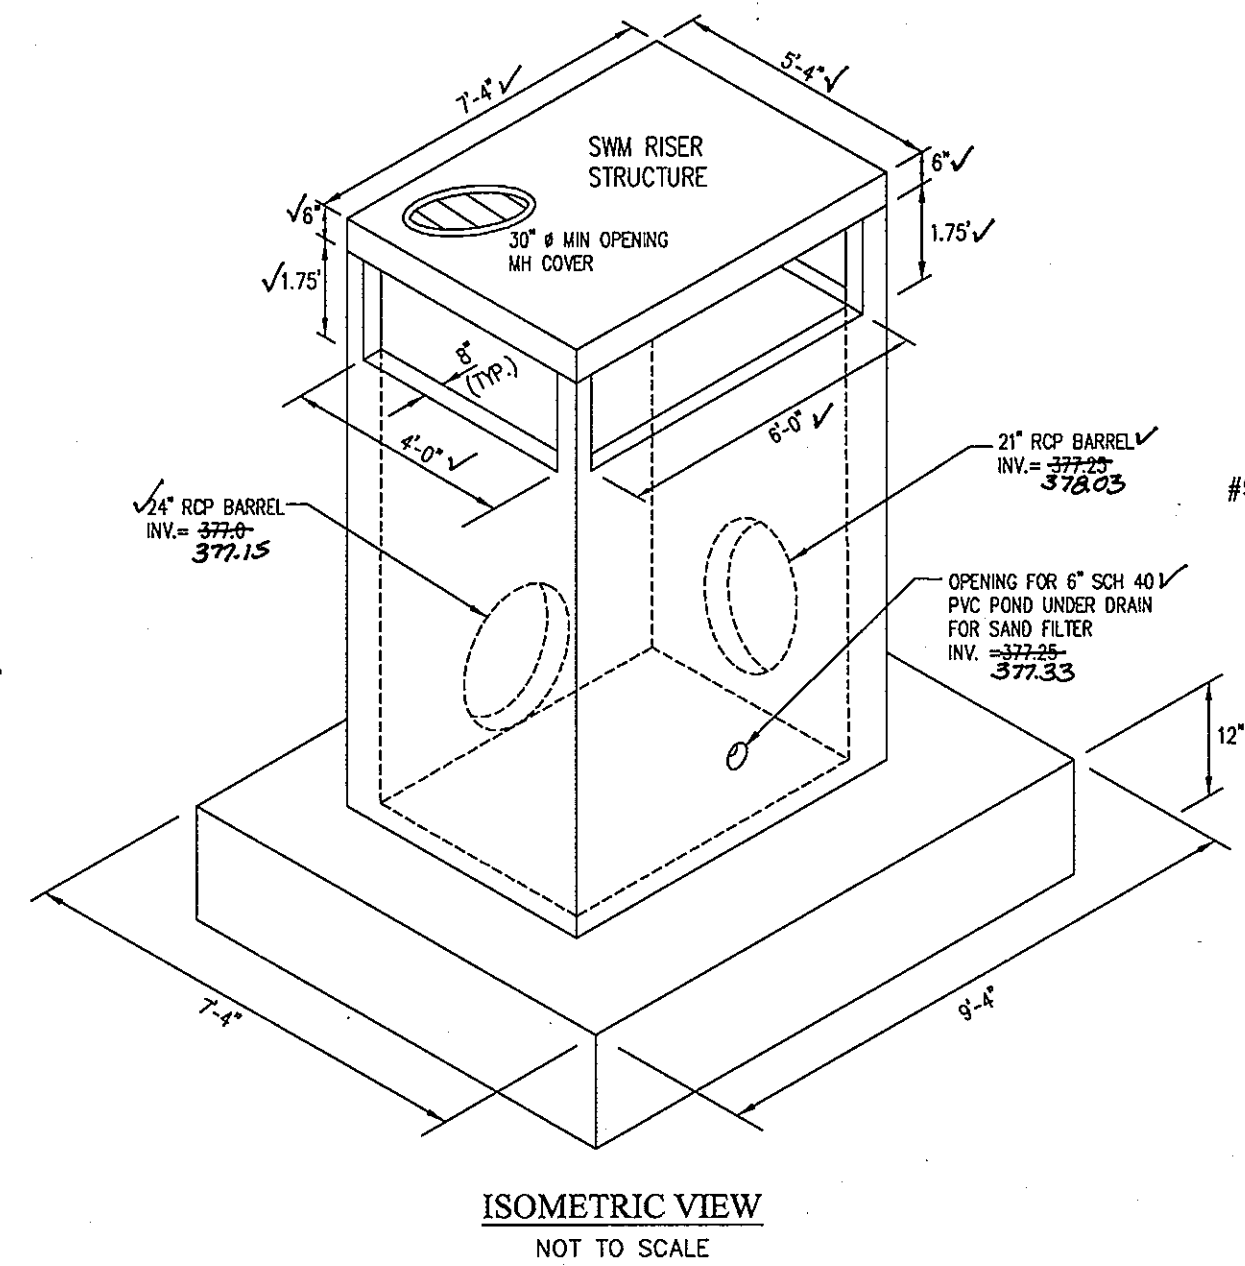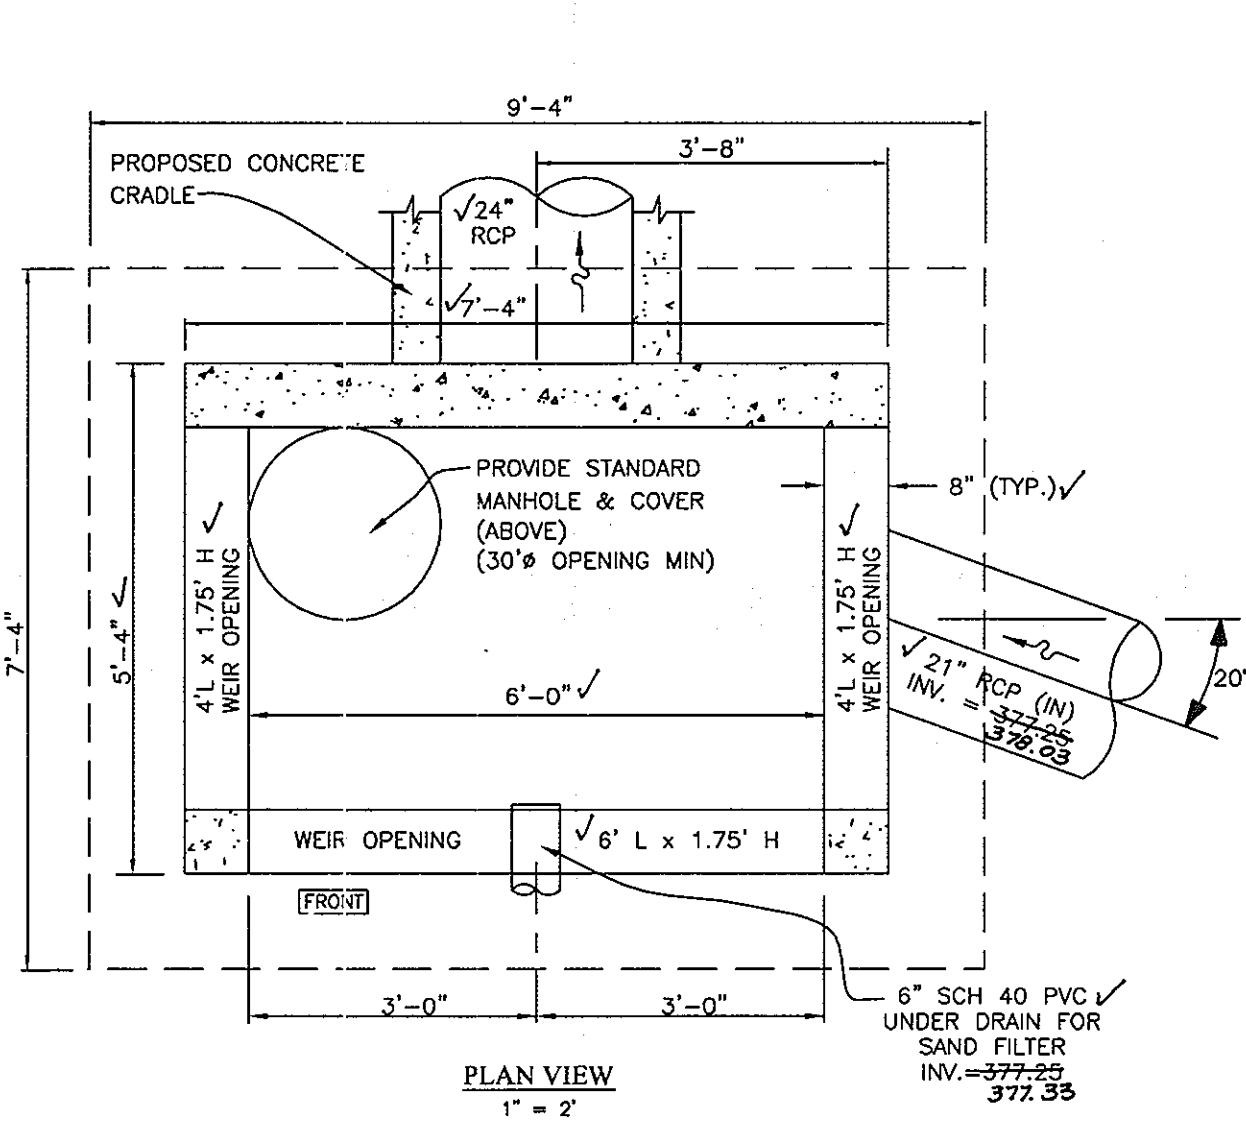



ANTI-SEEP COLLAR DETAIL DIMENSION TABLE

	"A"	"B"	"C"	"D"	"E"	"F"	"G"	"H"
POND 3	9'-7 1/2"	8'-9 1/2"	4'-9 3/4"	4'-9 3/4"	4'-1 1/2"	4'-7 3/4"	24"	2'-10"

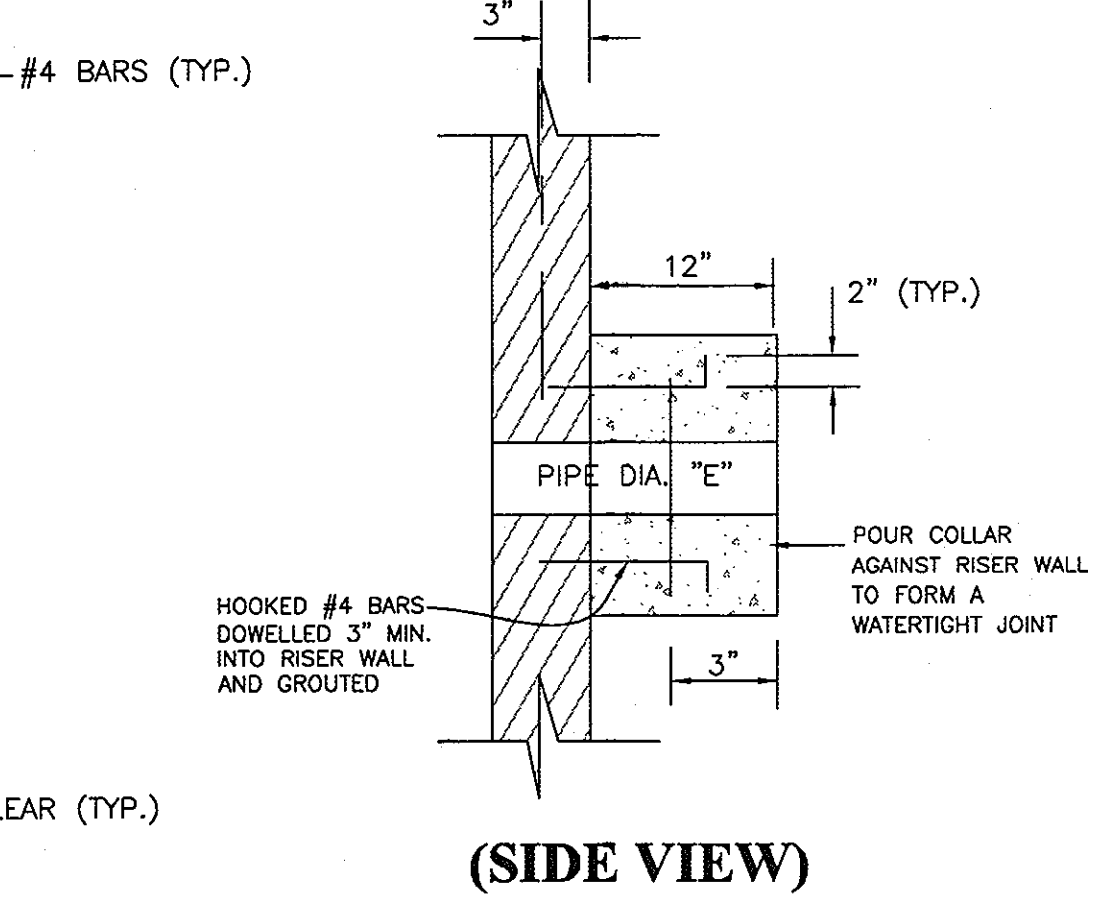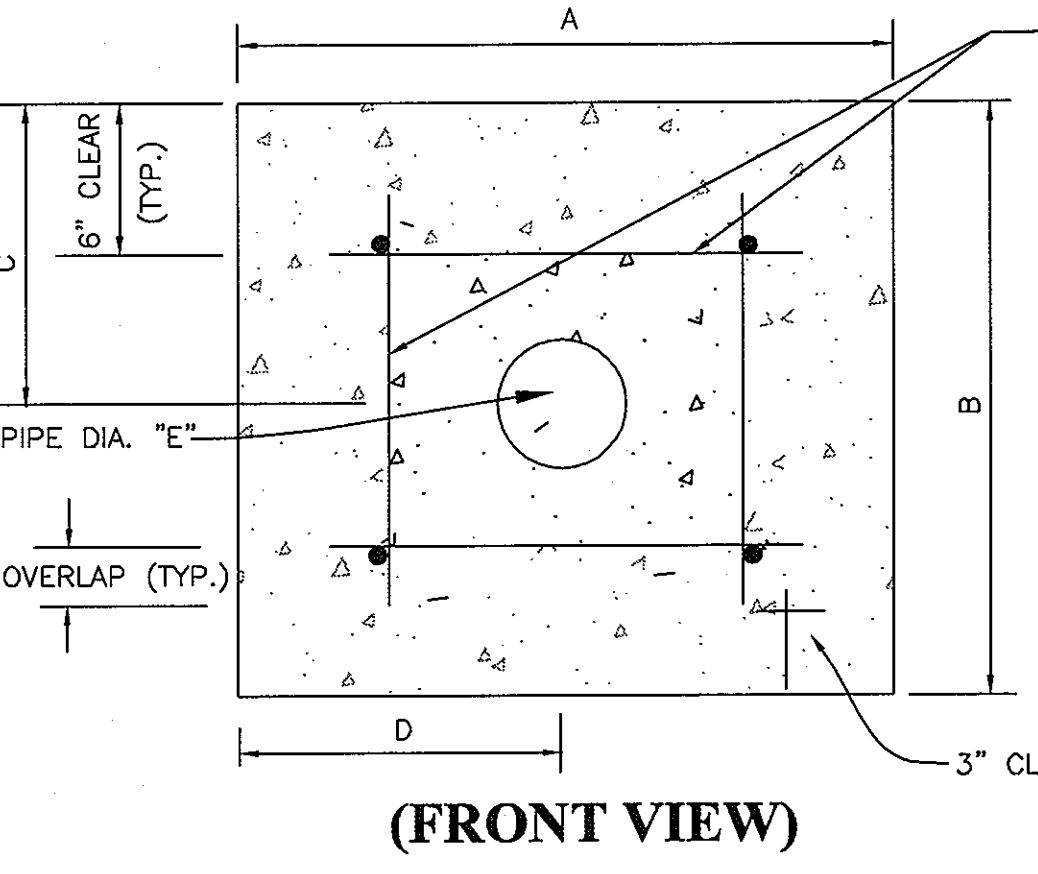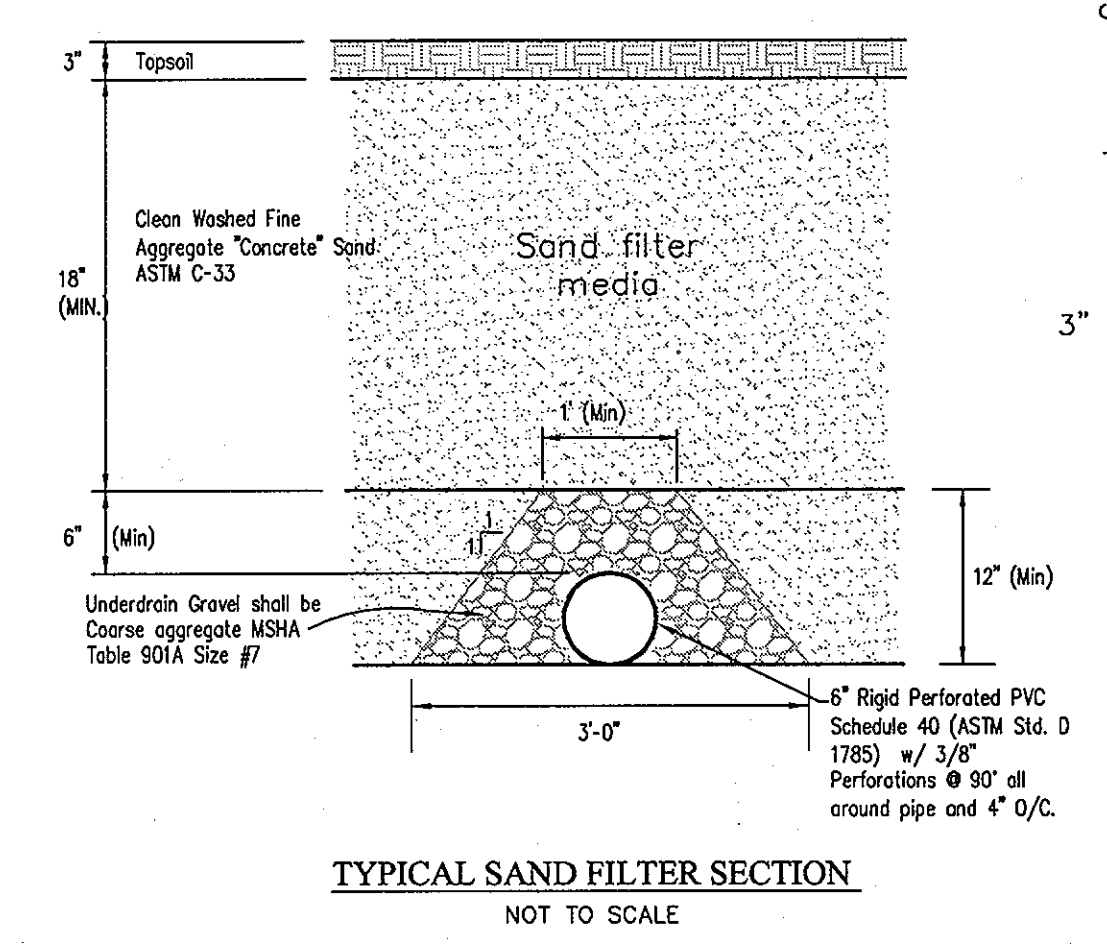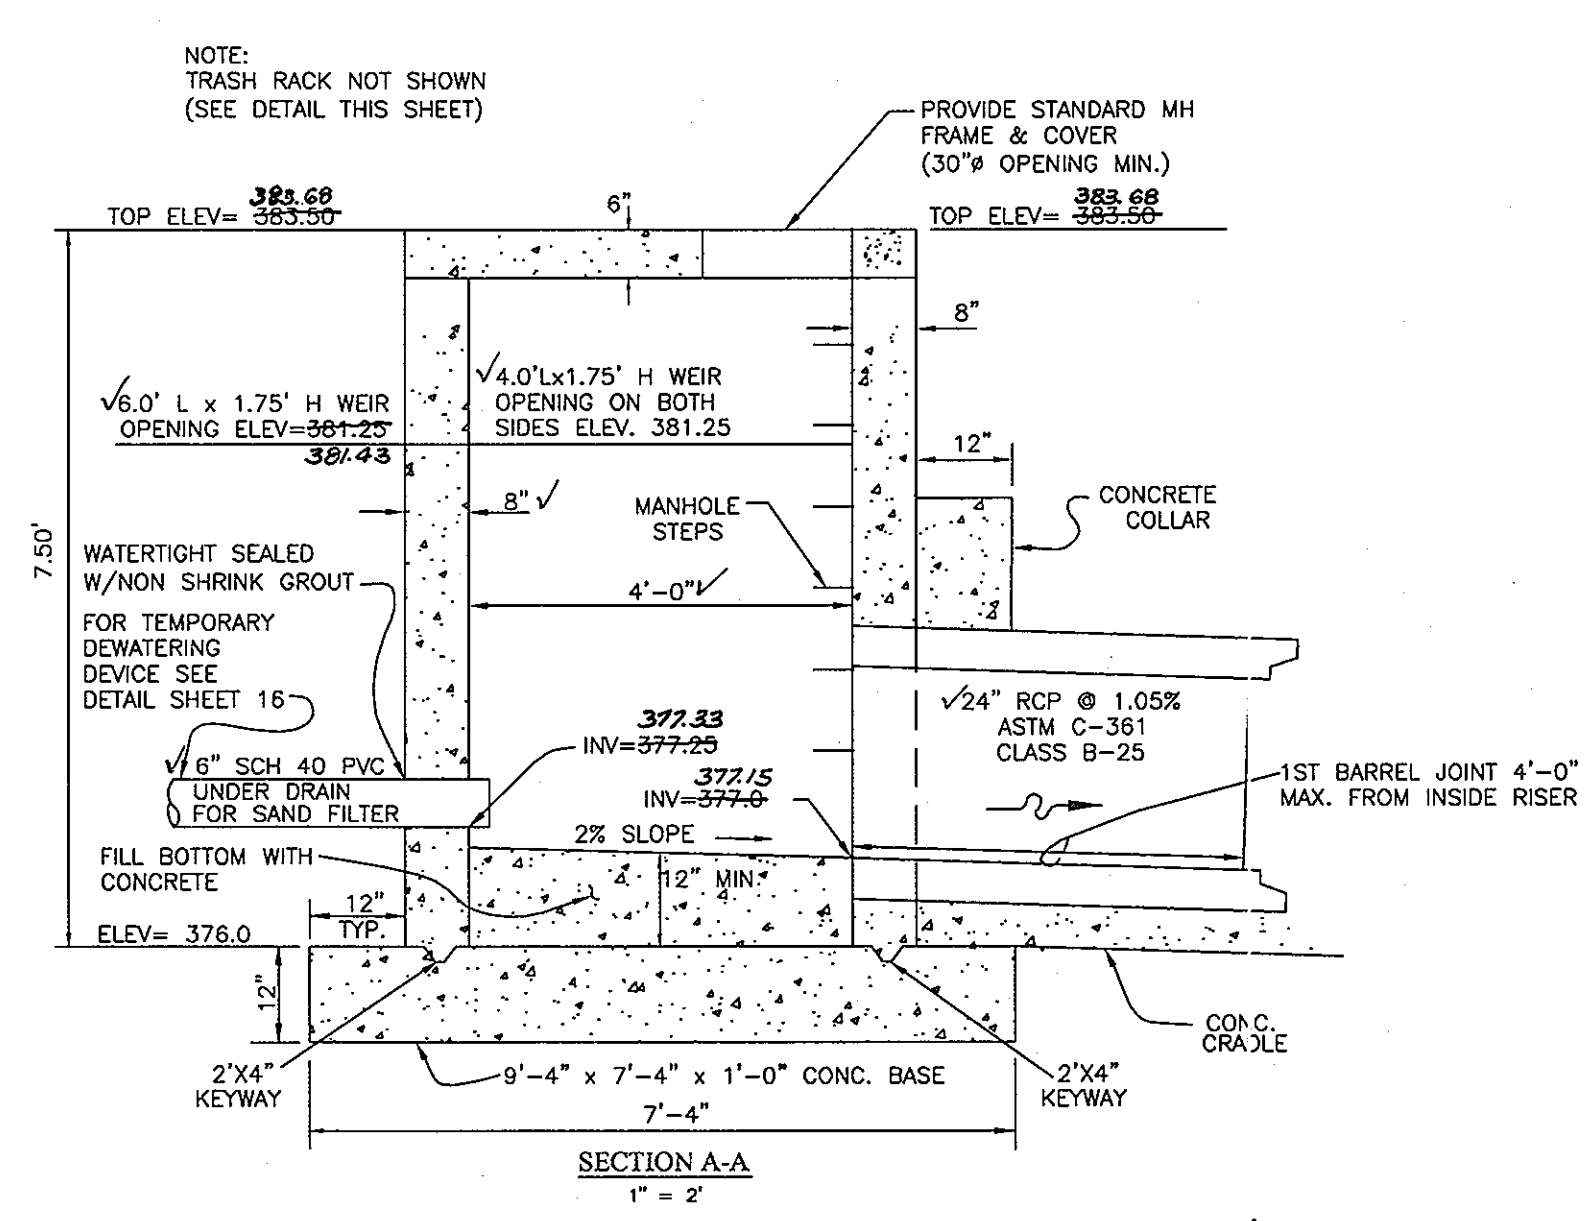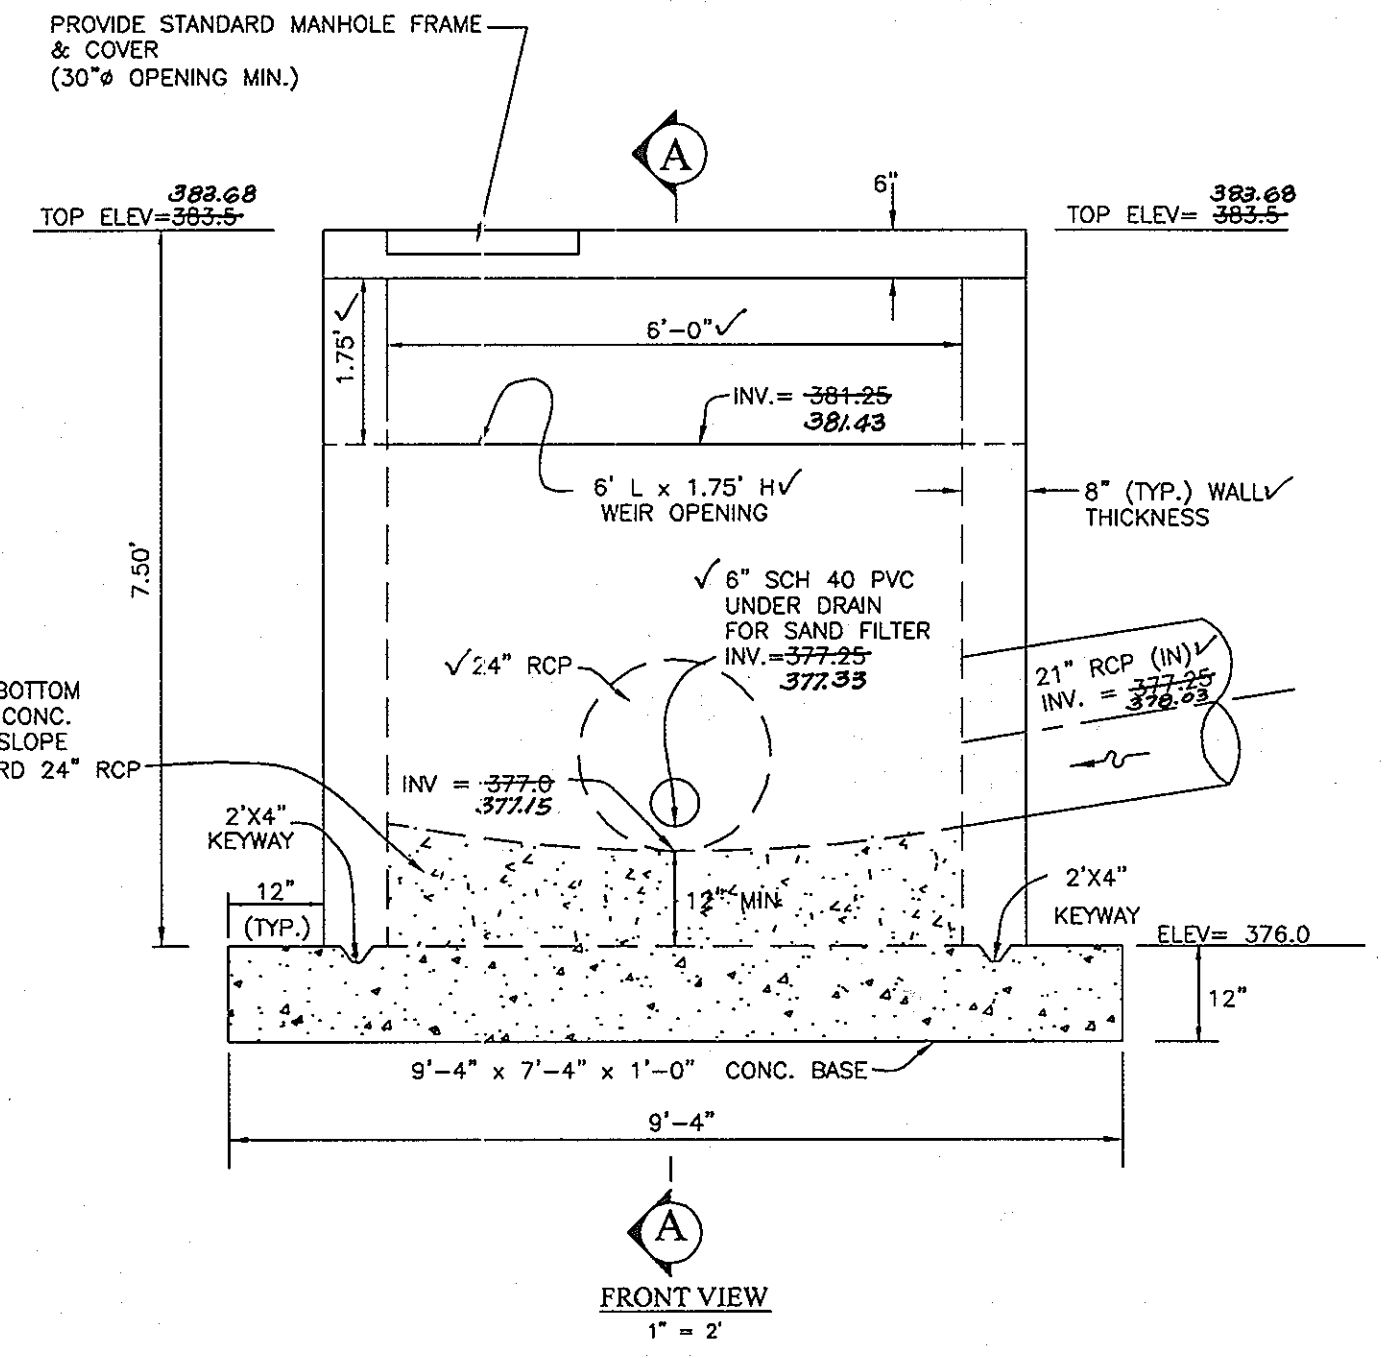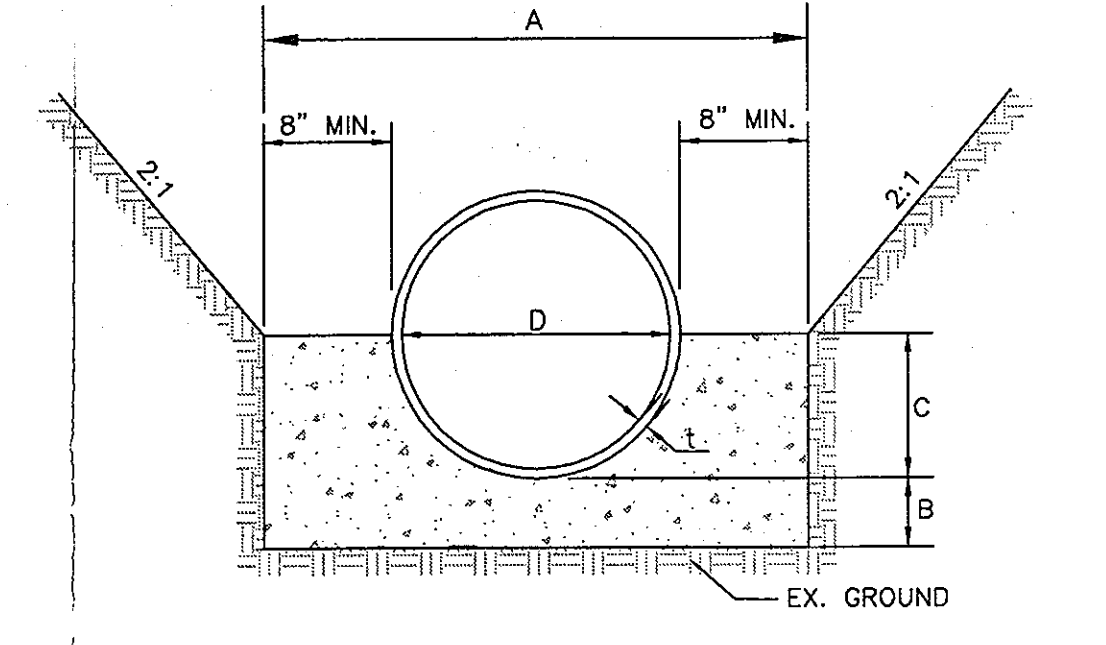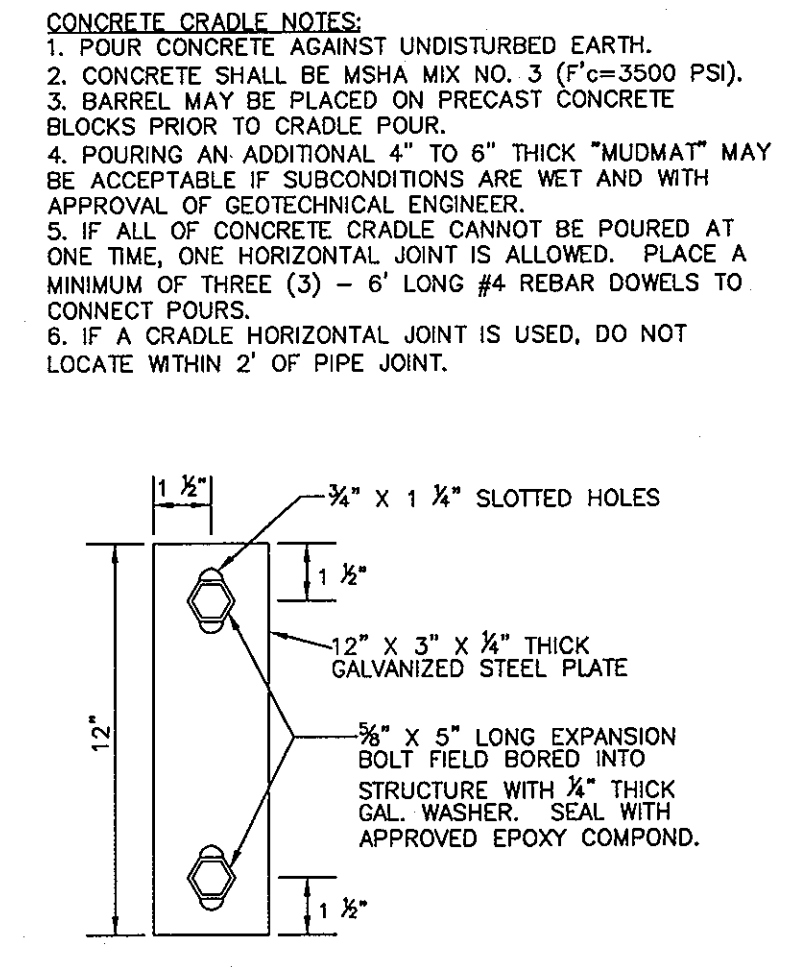

RISER STRUCTURE GENERAL NOTES FOR PRECAST OPTION:



- PRECAST RISER AND TOP SLAB TO BE MANUFACTURED AND SUPPLIED BY FREDERICK PRECAST CONCRETE, INC. OR APPROVED EQUIVALENT.
- SHOP DRAWINGS FOR RISER AND TOP SLAB MUST BE REVIEWED BY THE ENGINEER OF RECORD.
- IF ANY DIMENSIONS ARE CHANGED OR REDUCED, REVISED ANTI-FLOTATION COMPUTATION MUST BE SUBMITTED WITH THE SHOP DRAWINGS TO HOWARD COUNTY FOR APPROVAL.
- TRASH RACKS ARE NOT SHOWN FOR CLARITY.
- PRECASTER SHALL ENSURE THAT RISER STRUCTURE JOINTS ARE WATERTIGHT (JOINTS SHALL INCLUDE RUBBER GASKET). RISER JOINTS THAT WILL BE BURIED SHALL BE WRAPPED IN CLASS "C" FILTER FABRIC 1" ON EACH SIDE OF JOINTS, OVERLAP 1" MIN.
- ALL JOINTS SHALL BE FASTENED TOGETHER PER DETAIL ON THIS SHEET OR AN APPROVED EQUIV.

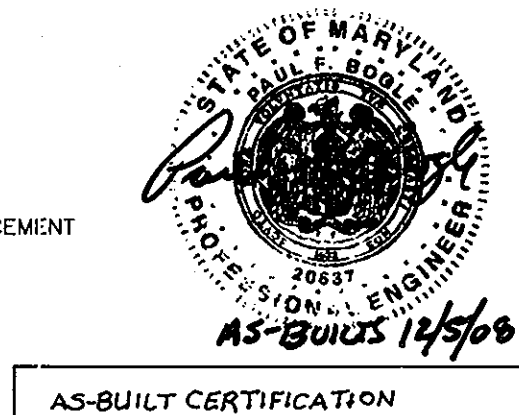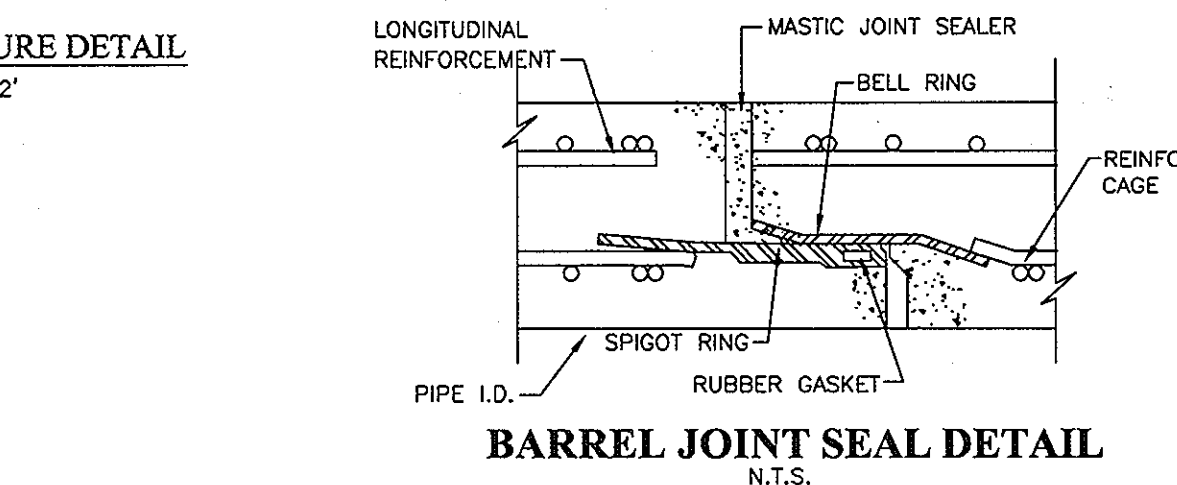

AS-BUILT CERTIFICATION

I HEREBY CERTIFY THAT THE FACILITY SHOWN ON THIS PLAN WAS CONSTRUCTED AS SHOWN ON THE "AS-BUILT PLANS" AND MEETS THE APPROVED PLAN AND SPECIFICATIONS

SIGNATURE: *Stephen J. Nardella* P.E. NO.: 20637 DATE: 12/5/08

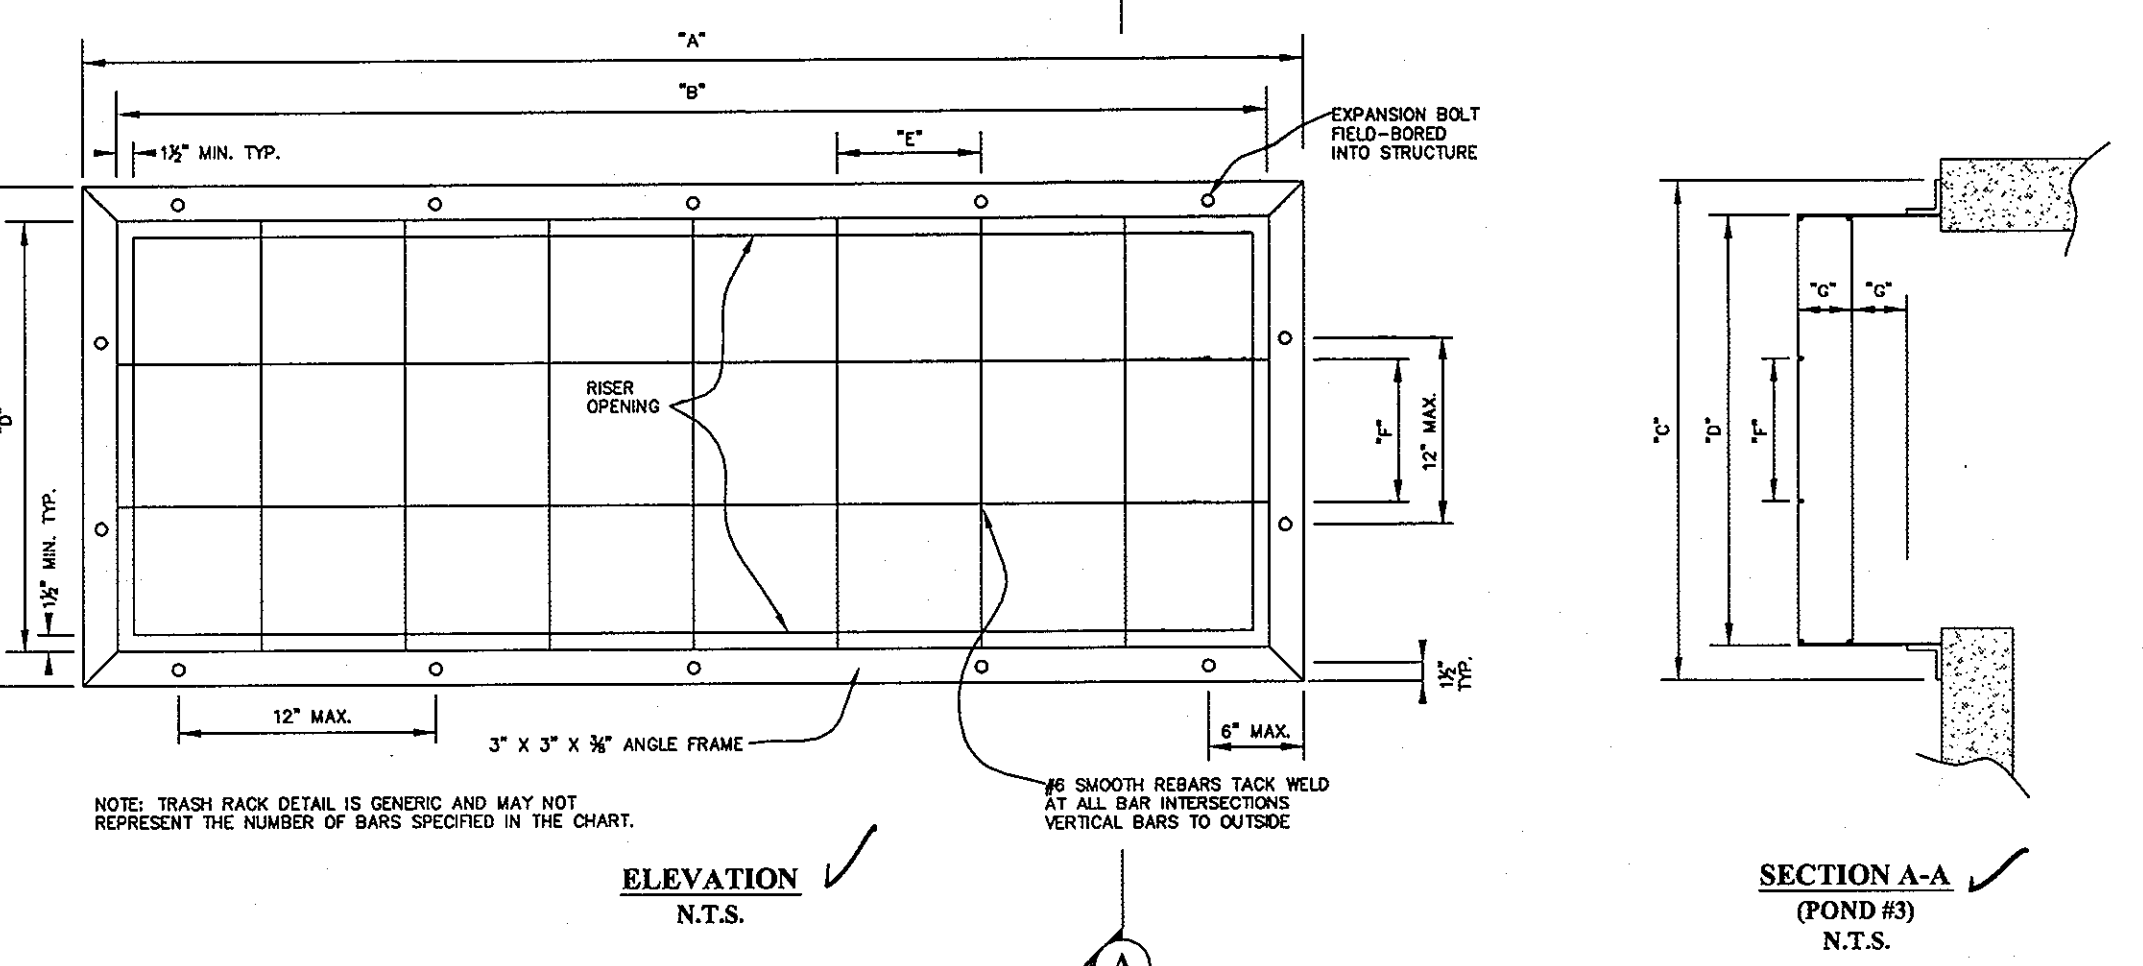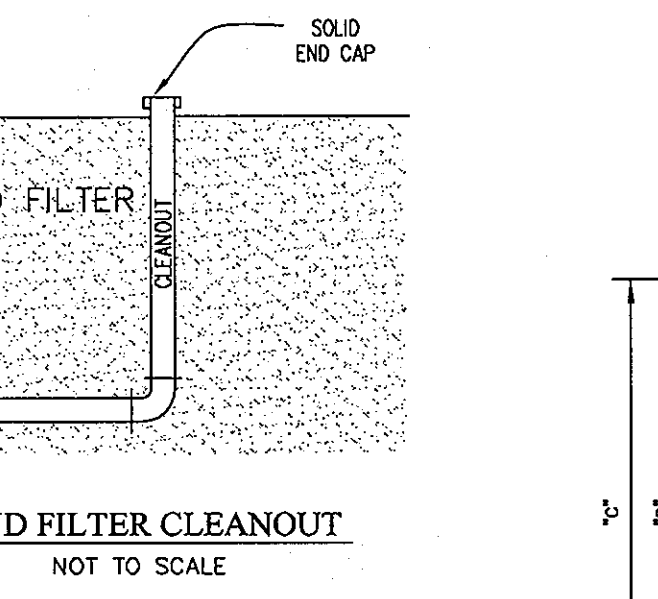



STRUCTURAL NOTES


- BUILDING CODES
  - ALL CONSTRUCTION SHALL CONFORM WITH THE 2000 INTERNATIONAL BUILDING CODE AND ALL SUBSEQUENT SUPPLEMENTS.
  - IN ADDITION, ALL CONSTRUCTION SHALL CONFORM WITH THE GOVERNING LOCAL BUILDING CODE.
- DESIGN LOADS
  - THE MINIMUM DESIGN DEAD LOADINGS FOR ALL FRAMINGS IS BASED ON THE CONSTRUCTION MATERIALS SHOWN ON THE DRAWINGS AND INDICATED IN THE SPECIFICATIONS.
  - THE CONTRACTOR SHALL NOT STORE ANY CONSTRUCTION MATERIALS OR UNDERTAKE ANY CONSTRUCTION OPERATION WHICH WILL EXCEED THE DESIGN LIVE LOADINGS NOTED.
- MISCELLANEOUS
  - THE CONTRACTOR SHALL REVIEW CIVIL DRAWINGS PREPARED BY RODGERS CONSULTING, INC. DATED 12/20/02 FOR LOCATION AND DIMENSION OF CHASES, INSERTS, OPENINGS, SLEEVES, DEPRESSIONS AND OTHER PROJECT REQUIREMENTS WHICH IMPACT THE STRUCTURAL COMPONENTS.
  - THE CONTRACTOR SHALL CHECK AND VERIFY ALL DIMENSIONS SHOWN ON THE CONTRACT DRAWINGS BEFORE PROCEEDING WITH CONSTRUCTION. ALL DISCREPANCIES AND OMISSIONS SHALL BE BROUGHT TO THE ATTENTION OF THE ARCHITECT.
  - THE CONTRACTOR SHALL NOT SUBMIT REPRODUCTIONS OF THE STRUCTURAL CONTRACT DOCUMENTS AS SHOP DRAWINGS.
  - SCALES SHOWN ON THE STRUCTURAL CONTRACT DRAWINGS ARE FOR GENERAL INFORMATION ONLY. DIMENSIONAL INFORMATION SHALL NOT BE OBTAINED BY SCALING THE DRAWINGS.
- FOUNDATIONS
  - ALL FOUNDATIONS HAVE BEEN DESIGNED FOR AN ASSUMED NET ALLOWABLE SOIL BEARING PRESSURE OF 2000 PSF. THE ALLOWABLE SOIL BEARING PRESSURE SHALL BE FIELD VERIFIED BY A REGISTERED GEOTECHNICAL ENGINEER AND APPROVED PRIOR TO PLACING FOUNDATIONS. SHOULD THE ACTUAL SOIL BEARING PRESSURE BE LESS THAN 2000 PSF, THE CONTRACTOR SHALL IMMEDIATELY NOTIFY THE ENGINEER.
  - ALL FILL PLACED UNDER FOUNDATIONS SHALL BE COMPACTED TO A DRY DENSITY OF AT LEAST 95 PERCENT OF MAXIMUM DRY DENSITY AS DETERMINED BY ASTM D 698.
  - ALL EXCAVATION AND BACKFILLING OPERATIONS WITHIN THE BUILDING FOOTPRINT, INCLUDING ALL COMPACTION TESTS AND INSPECTIONS, SHALL BE DONE UNDER THE DIRECTION AND SUPERVISION OF A REGISTERED GEOTECHNICAL ENGINEER. CONTRACTOR SHALL BACKFILL AROUND PERIMETER OF RISER AT AN EVEN RATE SO AS NOT TO CAUSE AN OVERTURNING MOMENT.
  - THE CONTRACTOR SHALL NOTIFY THE ENGINEER OF ALL FOUNDATION AND SOIL CONDITIONS WHICH DIFFER FROM THOSE ANTICIPATED OR INDICATED IN THE CONTRACT DOCUMENTS.
  - ALL EXISTING SOIL CONTAINING GRAVEL, CONSTRUCTION OR DEMOLITION DEBRIS, ORGANIC SUBSTANCES, OR OTHER FOREIGN OBJECTS SHALL BE REMOVED FROM THE REGION WITHIN THE FOOTPRINT OF THE STRUCTURE.
- CAST IN PLACE CONCRETE
  - ALL CONCRETE CONSTRUCTION SHALL CONFORM TO THE "SPECIFICATIONS FOR ENVIRONMENTAL ENGINEERING CONCRETE STRUCTURES 9501" AND TO THE BUILDING CODE REQUIREMENTS FOR REINFORCED CONCRETE (ACI 318).
  - IN ADDITION TO THE ABOVE, ALL CONCRETE WORK SHALL CONFORM TO THE FOLLOWING:
    - RECOMMENDED PRACTICE FOR HOT WEATHER CONCRETING (ACI 305).
    - RECOMMENDED PRACTICE FOR COLD WEATHER CONCRETING (ACI 306).
    - RECOMMENDED PRACTICE FOR CONCRETE FORMWORK (ACI 347).
    - ALL CONCRETE, UNLESS NOTED OTHERWISE, SHALL BE STONE AGGREGATE CONCRETE HAVING A MINIMUM 28 DAY COMPRESSIVE STRENGTH OF 4500 PSF. ALL CONCRETE EXPOSED TO WEATHER SHALL HAVE AN AIR ENTRAINMENT OF 6% ± 1%. NO ADMIXTURES CONTAINING CALCIUM CHLORIDE SHALL BE PERMITTED. MAXIMUM AGGREGATE SIZE SHALL BE 3/4". WATER/CEMENT RATIO SHALL BE 0.45. MAXIMUM SLUMP SHALL BE 4". 3" FOR SLABS ON GRADE. ALL CONCRETE EXCEPT FOOTINGS, SHALL CONTAIN A WATER REDUCING ADMIXTURE. PORTLAND CEMENT SHALL CONFORM TO ASTM C 150 AND NORMAL WEIGHT AGGREGATES SHALL CONFORM TO ASTM C 93.
    - ALL REINFORCING BARS SHALL BE NEW BILLET STEEL CONFORMING TO ASTM A 615 GRADE 60. ALL WELDED WIRE FABRIC (W/WF) SHALL CONFORM TO ASTM A 185. LAP ALL REINFORCING BARS A MINIMUM OF 48 BAR DIAMETERS AND ALL W/WF A MINIMUM OF TWO FULL GRIDS, UNLESS OTHERWISE INDICATED.
    - ALL REINFORCING SHALL BE DETAILED, FABRICATED AND PLACED IN ACCORDANCE WITH THE CRSI "MANUAL OF STANDARD PRACTICE", ACI 318' DETAILS AND DETAILING OF CONCRETE REINFORCEMENT", ACI SP 66 "DETAILING MANUAL".
    - ALL CONCRETE MIX DESIGNS, INCLUDING CEMENT CONTENT, WATER CEMENT RATIO, FINE AND COARSE AGGREGATE CONTENT AND ALL ADMIXTURES, SHALL BE REVIEWED BY ENGINEER PRIOR TO PLACING FIRST CONCRETE.
    - ALL CONCRETE SHALL BE SAMPLED AND TESTED BY THE TESTING AGENCY. THE CONTRACTOR SHALL NOTIFY THE TESTING AGENCY 48 HOURS PRIOR TO THE PLACING OF ANY CONCRETE.
    - GROUND BLAST FURNACE SLAG MAY BE USED TO REPLACE UP TO 50 PERCENT OF THE PORTLAND CEMENT IN A CONCRETE MIX, AND FLY ASH OR POZZOLAN MAY BE USED TO REPLACE UP TO 25 PERCENT OF PORTLAND CEMENT, SUBJECT TO THE APPROVAL OF THE STRUCTURAL ENGINEER AND SHALL CONFORM TO ASTM C 984.
    - MINIMUM COVER FOR ALL REINFORCING SHALL BE AS FOLLOWS UNLESS OTHERWISE INDICATED:
 

FOUNDATIONS	3 INCHES
WALLS	2 INCHES
    - THE GENERAL CONTRACTOR SHALL SUBMIT PLANS SHOWING ALL PENETRATIONS THROUGH THE FRAMED CONCRETE SLABS. THE OPENINGS SHALL BE ACCURATELY LOCATED AND DIMENSIONED.
- RETAINING WALLS
  - RISER WALLS HAVE BEEN DESIGNED WITH BACKFILL MATERIAL HAVING THE FOLLOWING CHARACTERISTICS:
 


γ <sub>soil</sub>	= 125.0 PCF
φ <sub>soil</sub>	= 33.0
EQUIVALENT FLUID	= 50H

 IT SHALL BE THE CONTRACTOR'S RESPONSIBILITY TO INSURE THE BACK FILL MATERIAL MEETS THESE CHARACTERISTICS.
  - RISER HAS BEEN DESIGNED FOR THE FOLLOWING MINIMUM FACTORS OF SAFETY:
 


OVERTURNING	2.0
-------------	-----
  - ALL RISER WALLS SHALL BE BRACED AND SHORED AS REQUIRED DURING BACKFILLING. BOTH SUPPORTING ELEMENTS SHALL BE IN PLACE AND DEVELOPING FULL REQUIRED STRENGTH PRIOR TO BACK FILLING OF WALLS SUPPORTED AT TOP AND BOTTOM.

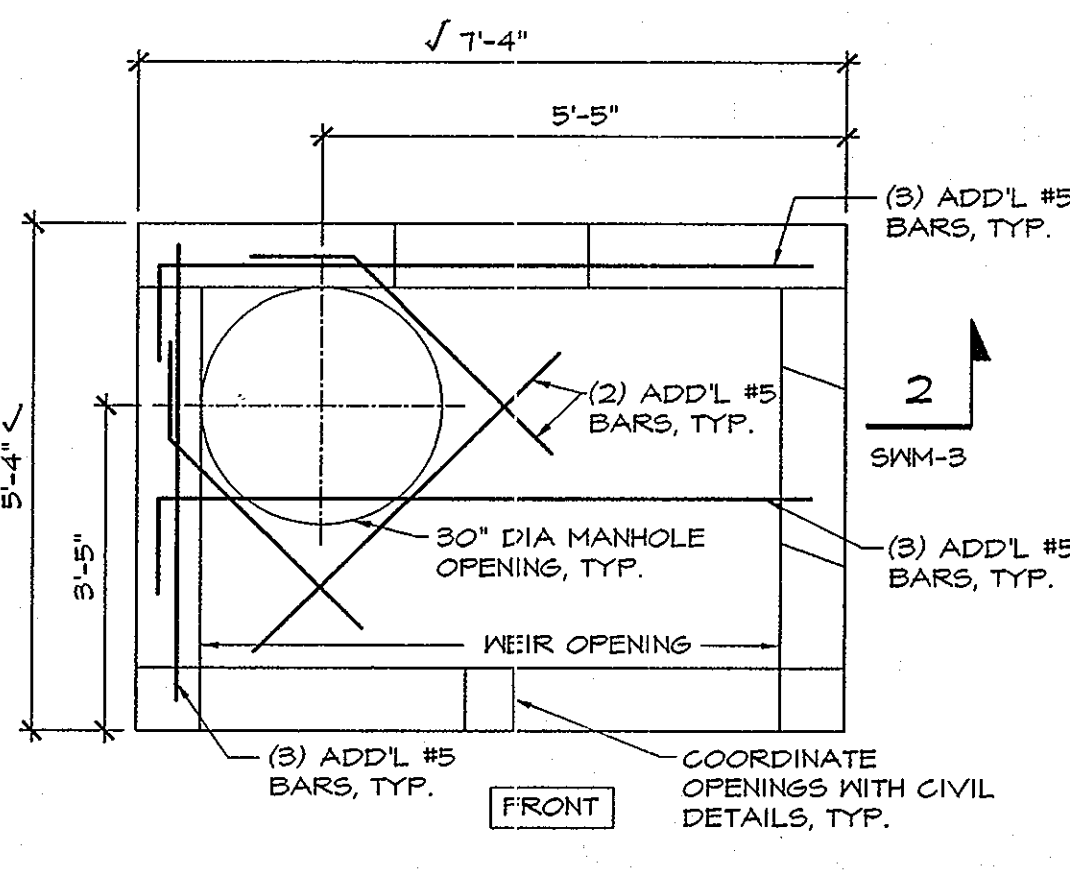


STRUCTURAL PLAN VIEW  
SECTION 1/SWM-3  
SCALE: 1/2" = 1'-0"

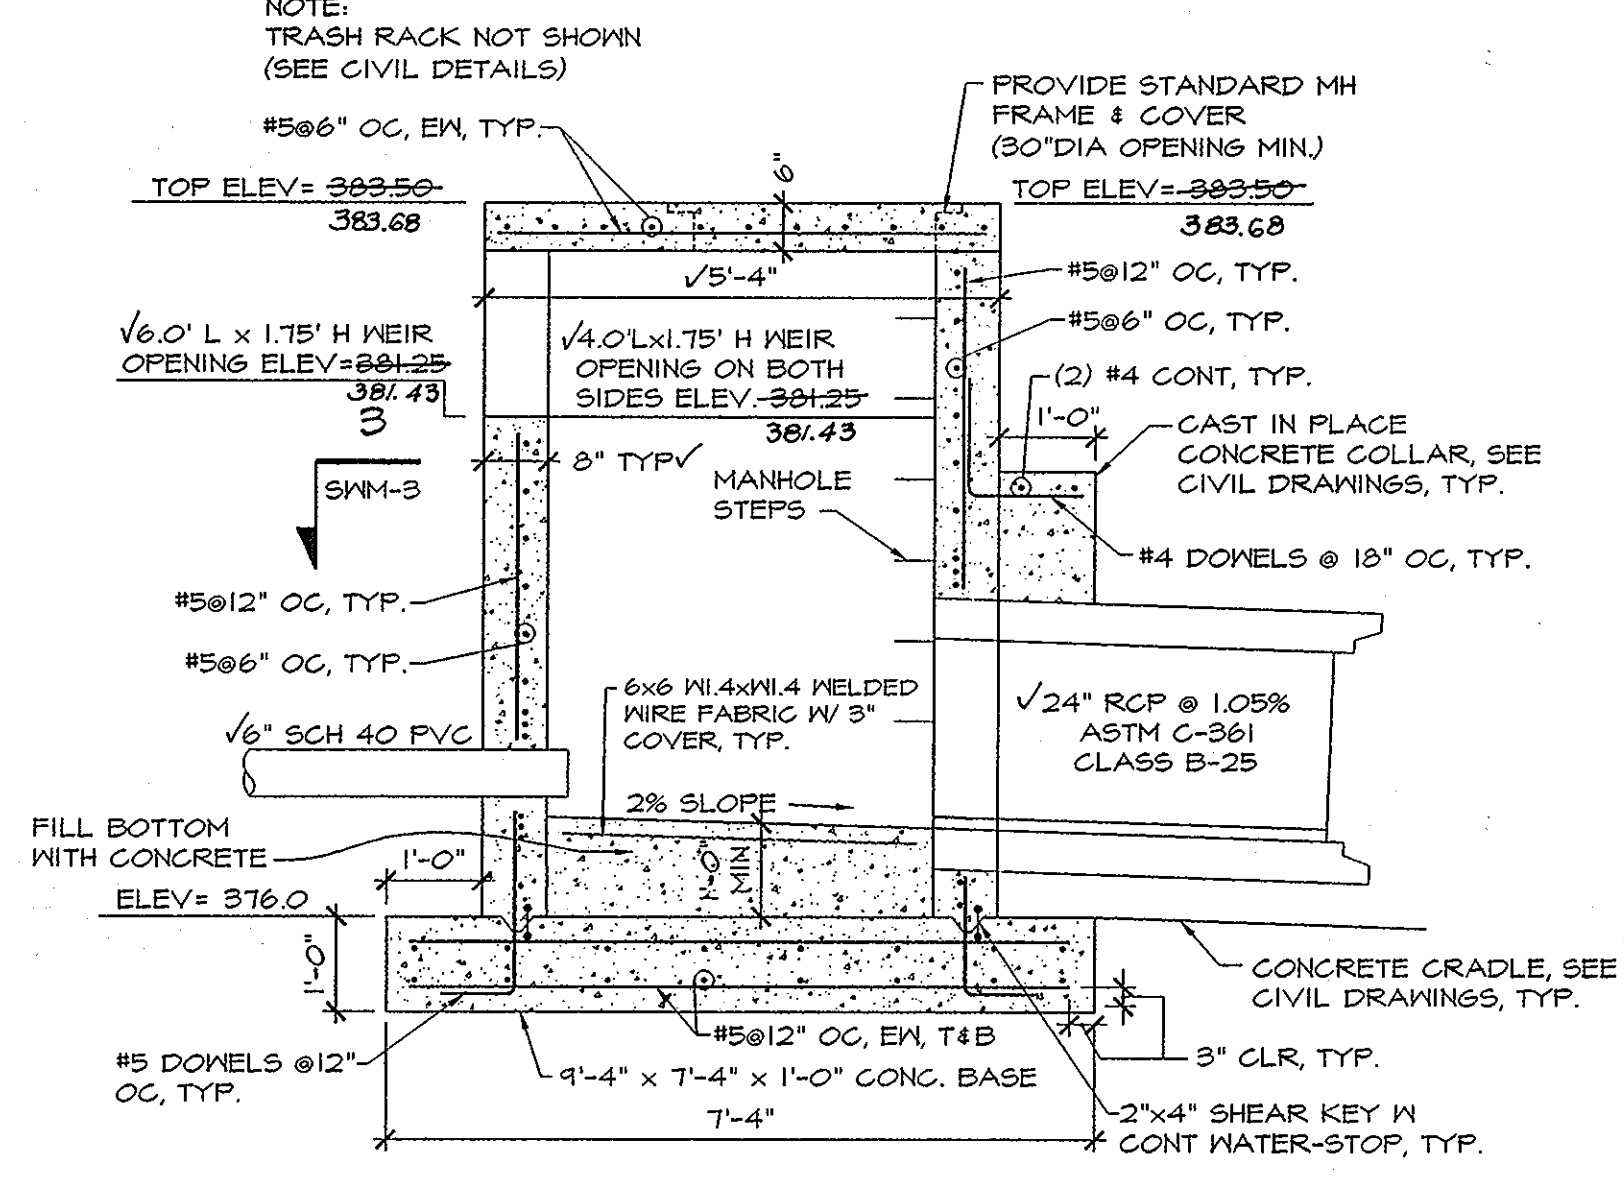


SECTION 2/SWM-3  
SCALE: 1/2" = 1'-0"

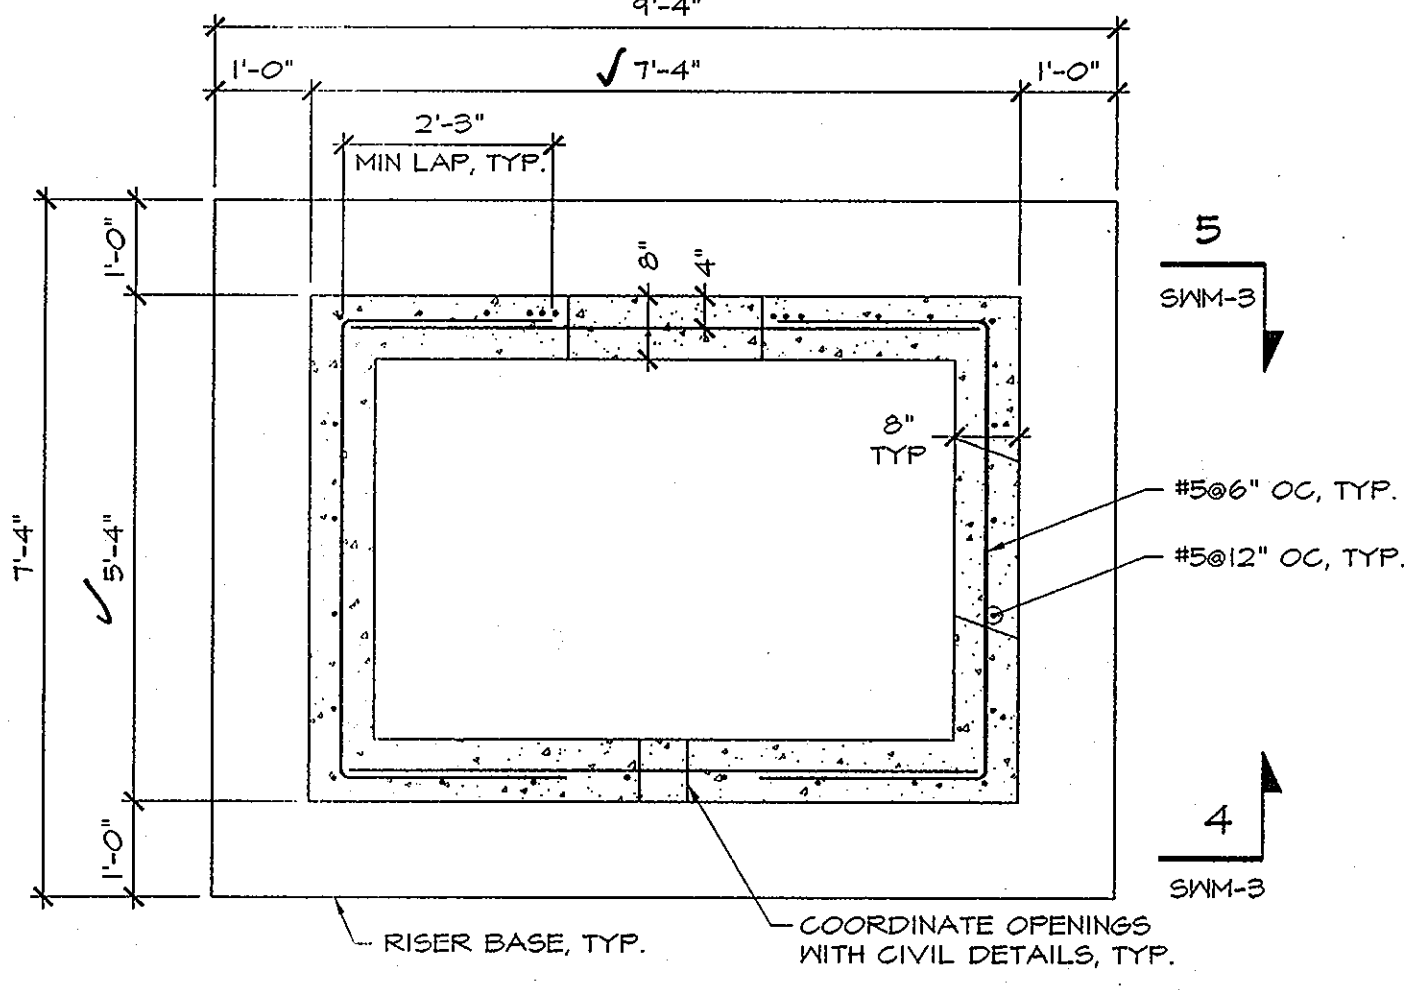


TYPICAL RISER SECTION  
SECTION 3/SWM-3  
SCALE: 1/2" = 1'-0"

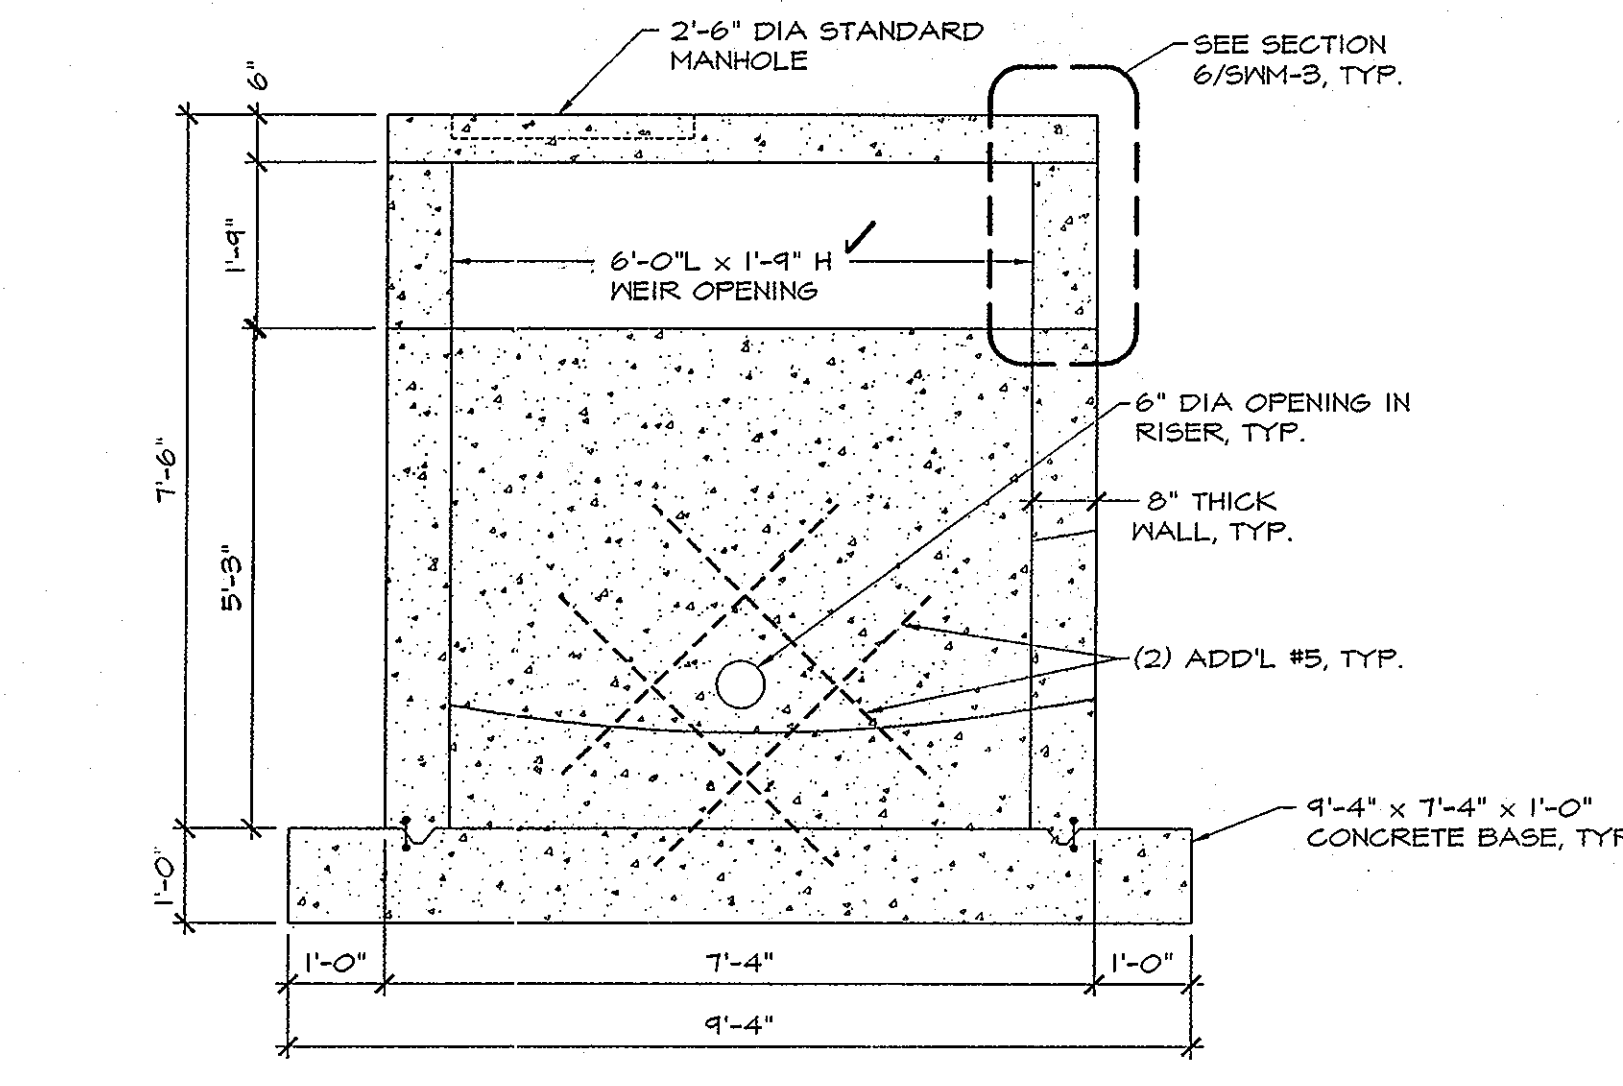


RISER ELEVATION (REINFORCING TYP @ OPENINGS < 1'-0" DIA)  
SECTION 4/SWM-3  
SCALE: 1/2" = 1'-0"

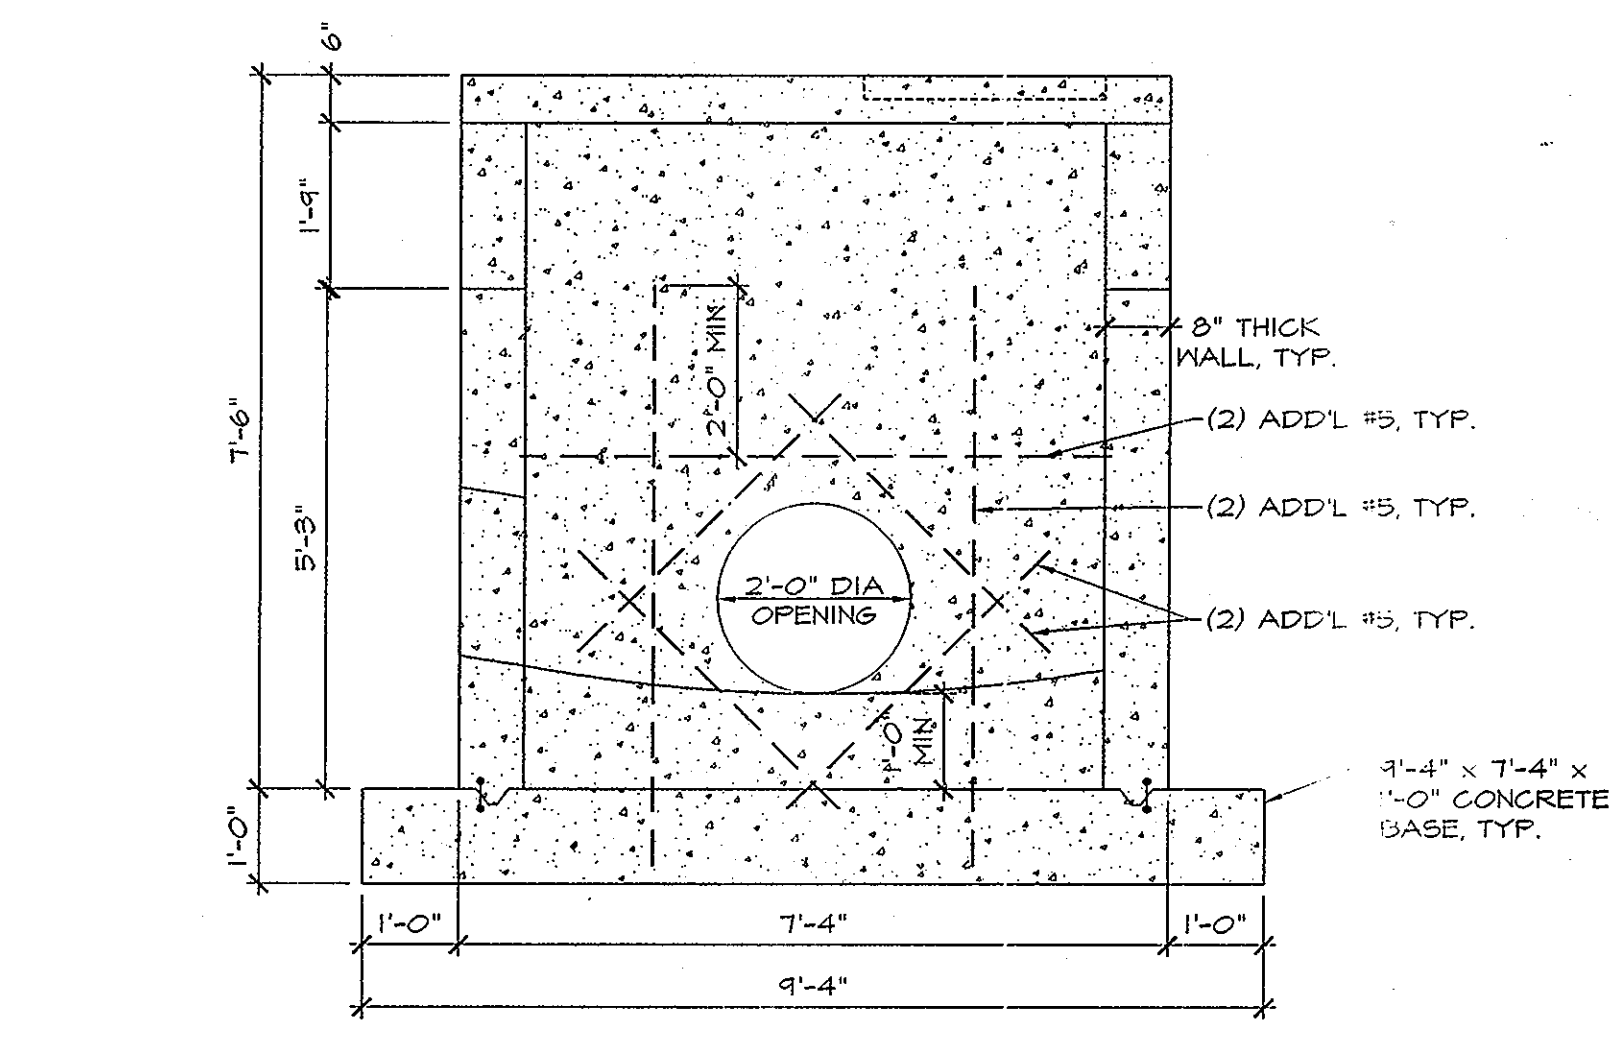

RISER ELEVATION (REINFORCING TYP @ OPENINGS > 1'-0" DIA)  
SECTION 5/SWM-3  
SCALE: 1/2" = 1'-0"

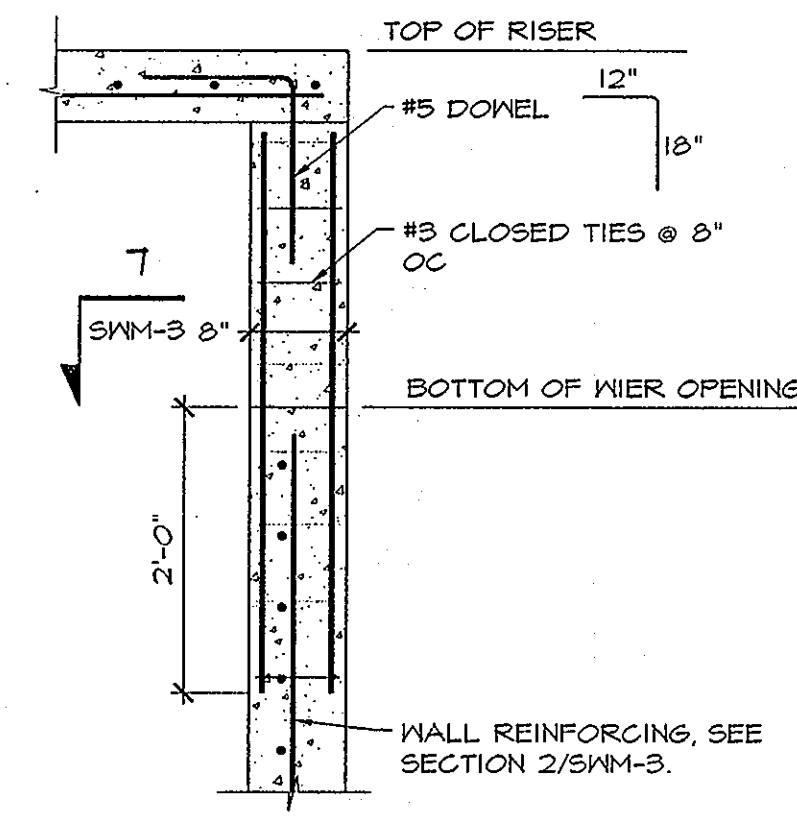

SECTION 6/SWM-3  
SCALE: 3/8" = 1'-0"

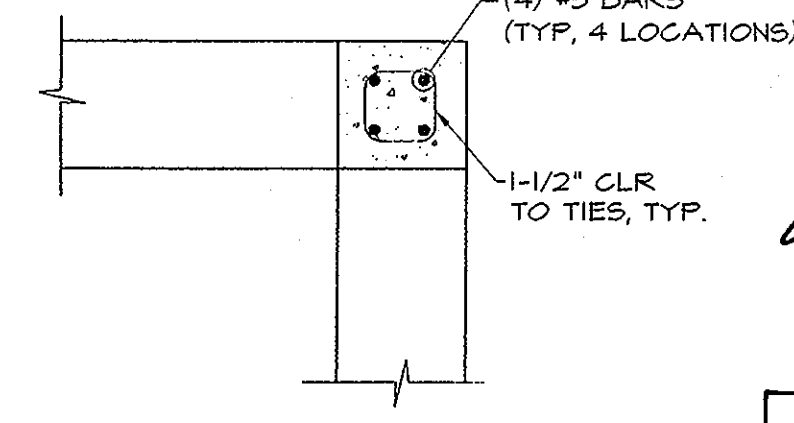

SECTION 7/SWM-3  
SCALE: 1" = 1'-0"

STRUCTURAL REINFORCING DETAILS FOR RISER P3-R (CAST-IN-PLACE OPTION)

APPROVED: HOWARD COUNTY DEPARTMENT OF PUBLIC WORKS  
 WILLIAM F. WILSON, JR.  
 CHIEF, BUREAU OF HIGHWAY  
 10/14/03

APPROVED: HOWARD COUNTY DEPARTMENT OF PLANNING & ZONING  
 CINDY HAMILTON  
 CHIEF, DIVISION OF LAND DEVELOPMENT  
 10/23/03

APPROVED: HOWARD SOIL CONSERVATION DISTRICT  
 STEPHEN J. NARDELLA  
 REGISTERED PROFESSIONAL ENGINEER  
 10/23/03

APPROVED: THESE PLANS HAVE BEEN REVIEWED FOR THE HOWARD SOIL CONSERVATION DISTRICT AND MEET THE TECHNICAL REQUIREMENTS FOR SMALL POND CONSTRUCTION, SOIL EROSION, AND SEDIMENT CONTROL.  
 JIM MYERS  
 USDA-NATURAL RESOURCES CONSERVATION SERVICE  
 10/23/03

ENGINEER'S CERTIFICATE  
 I CERTIFY THAT THIS PLAN FOR POND CONSTRUCTION, EROSION AND SEDIMENT CONTROL REPRESENTS A PRACTICAL AND WORKABLE PLAN BASED ON MY PERSONAL KNOWLEDGE OF THE SITE CONDITIONS. THIS PLAN WAS PREPARED IN ACCORDANCE WITH THE REQUIREMENTS OF THE HOWARD SOIL CONSERVATION DISTRICT. I HAVE NOTIFIED THE DEVELOPER THAT HE/SHE MUST ENGAGE A REGISTERED PROFESSIONAL ENGINEER TO SUPERVISE POND CONSTRUCTION AND PROVIDE THE HOWARD SOIL CONSERVATION DISTRICT WITH AN "AS-BUILT" PLAN OF THE POND WITHIN 30 DAYS OF COMPLETION.  
 JUD RAY  
 9/24/03

DEVELOPER'S CERTIFICATE  
 I/WE CERTIFY THAT ALL DEVELOPMENT AND/OR CONSTRUCTION WILL BE DONE ACCORDING TO THESE PLANS, AND THAT ANY RESPONSIBLE PERSONNEL INVOLVED IN THE CONSTRUCTION PROJECT WILL HAVE A CERTIFICATE OF ATTENDANCE AT A DEPARTMENT OF THE ENVIRONMENT APPROVED TRAINING PROGRAM FOR THE CONTROL OF SEDIMENT AND EROSION BEFORE BEGINNING THE PROJECT. I SHALL ENGAGE A REGISTERED PROFESSIONAL ENGINEER TO SUPERVISE POND CONSTRUCTION AND PROVIDE THE HOWARD SOIL CONSERVATION DISTRICT WITH AN "AS-BUILT" PLAN OF THE POND WITHIN 30 DAYS OF COMPLETION. I ALSO AUTHORIZE PERIODIC ON-SITE INSPECTIONS BY THE HOWARD SOIL CONSERVATION DISTRICT.  
 STEPHEN J. NARDELLA  
 9/23/03

**MRA**  
 MORRIS & RITCHIE ASSOCIATES, INC.  
 ENGINEERS, PLANNERS, SURVEYORS, AND LANDSCAPE ARCHITECTS  
 110 WEST ROAD, SUITE 245 TOWSON, MD 21284  
 9000 JUNCTION DRIVE, SUITE 9 ANNAPOLIS JUNCTION, MD 20701  
 PHONE: (410) 821-1690 PHONE: (410) 792-9792

STATE OF MARYLAND  
 PROFESSIONAL ENGINEER  
 12/5/06  
 AS-BUILT

AS-BUILT CERTIFICATION  
 I HEREBY CERTIFY THAT THE FACILITY SHOWN ON THIS PLAN WAS CONSTRUCTED AS SHOWN ON THE "AS-BUILT PLANS" AND MEETS THE APPROVED PLAN AND SPECIFICATIONS.  
 SIGNATURE: [Signature]  
 P.E. No.: 20637  
 DATE: 10/23/03

AS-BUILT PLANS  
 CALL "MISS UTILITY" AT 1-800-257-7777  
 48 Hours Before Start of Construction  
 NOTE: THIS PLAN TO BE USED FOR STORMWATER MANAGEMENT ONLY. ALL OTHER INFORMATION SHOWN FOR REFERENCE PURPOSE ONLY. SEE APPROPRIATE CONSTRUCTION DRAWING FOR ALL OTHER INFORMATION.

DATE	REVISION	DATE	BY	DATE
	DESIGNED		CADD	
	DRAWN		PFB	
	REVIEWED		PFB	
	RELEASE FOR			
	FINAL AS-BUILT REVISIONS	07/08		
	FINAL MYLAR SUBMITTAL FOR SIGNATURE	9/24/03		
	RE-SUBMITTED FOR REVIEW AND APPROVAL	04/25/03		
	SUBMITTED FOR REVIEW	1-14-03		

Developer/Owner:  
 Winchester Homes, Inc. & Winchester Homes, Inc., as nominee for Stringtown Investments, LLC  
 6905 Rockledge Drive Suite 800  
 Bethesda, Maryland 20817  
 Stephen J. Nardella, Vice President  
 (301) 803 - 4800

**SWM POND 3**  
 STRUCTURAL PLANS & SECTIONS

**RODGERS CONSULTING**  
 Enhancing the value of land assets  
 Rodgers Consulting, Inc.  
 9260 Galther Road  
 Gaithersburg, MD 20877  
 301.948.4700  
 301.948.6256 (fax)  
 301.253.6609  
 www.rodgers.com

Montjoy - Single Family Detached  
 A RESUBDIVISION OF NON-BUILDABLE BULK PARCEL C (P-13-87)  
 TO BUILDABLE LOTS 127 - 188 AND OPEN SPACE LOTS 189 - 193  
 ELECTION DISTRICT #2 HOWARD COUNTY, MARYLAND  
 TAX MAP: 30, GRID: 12, PARCEL 260  
 DPZ FILES: S-01-80, WP-01-117, P-02-10, P-02-17, P-03-03, F-03-87

SCALE:	AS SHOWN
JOB No.	12233.05
DATE:	1-14-03
INDEX No.	SWM-3
SHEET No.	22 of 34




LOG OF BORING NO. B-1

PROJECT: Mt. Joy Farm  
DATE: 11/02/03  
PROJECT LOCATION: Howard County, Maryland

GROUND SURFACE ELEVATION: 383.1  
DATE STARTED: November 8, 2001  
DATE COMPLETED: November 8, 2001  
DRILLING CONTRACTOR: Geo-Technology Associates, Inc.  
DRILLER: S. Cunningham  
LOGGED BY: S. Cunningham  
CHECKED BY: S. Rowe

DEPTH (ft)	DESCRIPTION	REMARKS
0.0	0.0 - 1.0	Topsoil 5 in.
1.0	1.0 - 2.0	ASHTO: A-4
2.0	2.0 - 3.0	Water Not Encountered While Drilling
3.0	3.0 - 4.0	ASHTO: A-2-4
4.0	4.0 - 5.0	ASHTO: A-2-4
5.0	5.0 - 6.0	ASHTO: A-2-4
244.0	244.0 - 245.0	ASHTO: A-2-4
2		



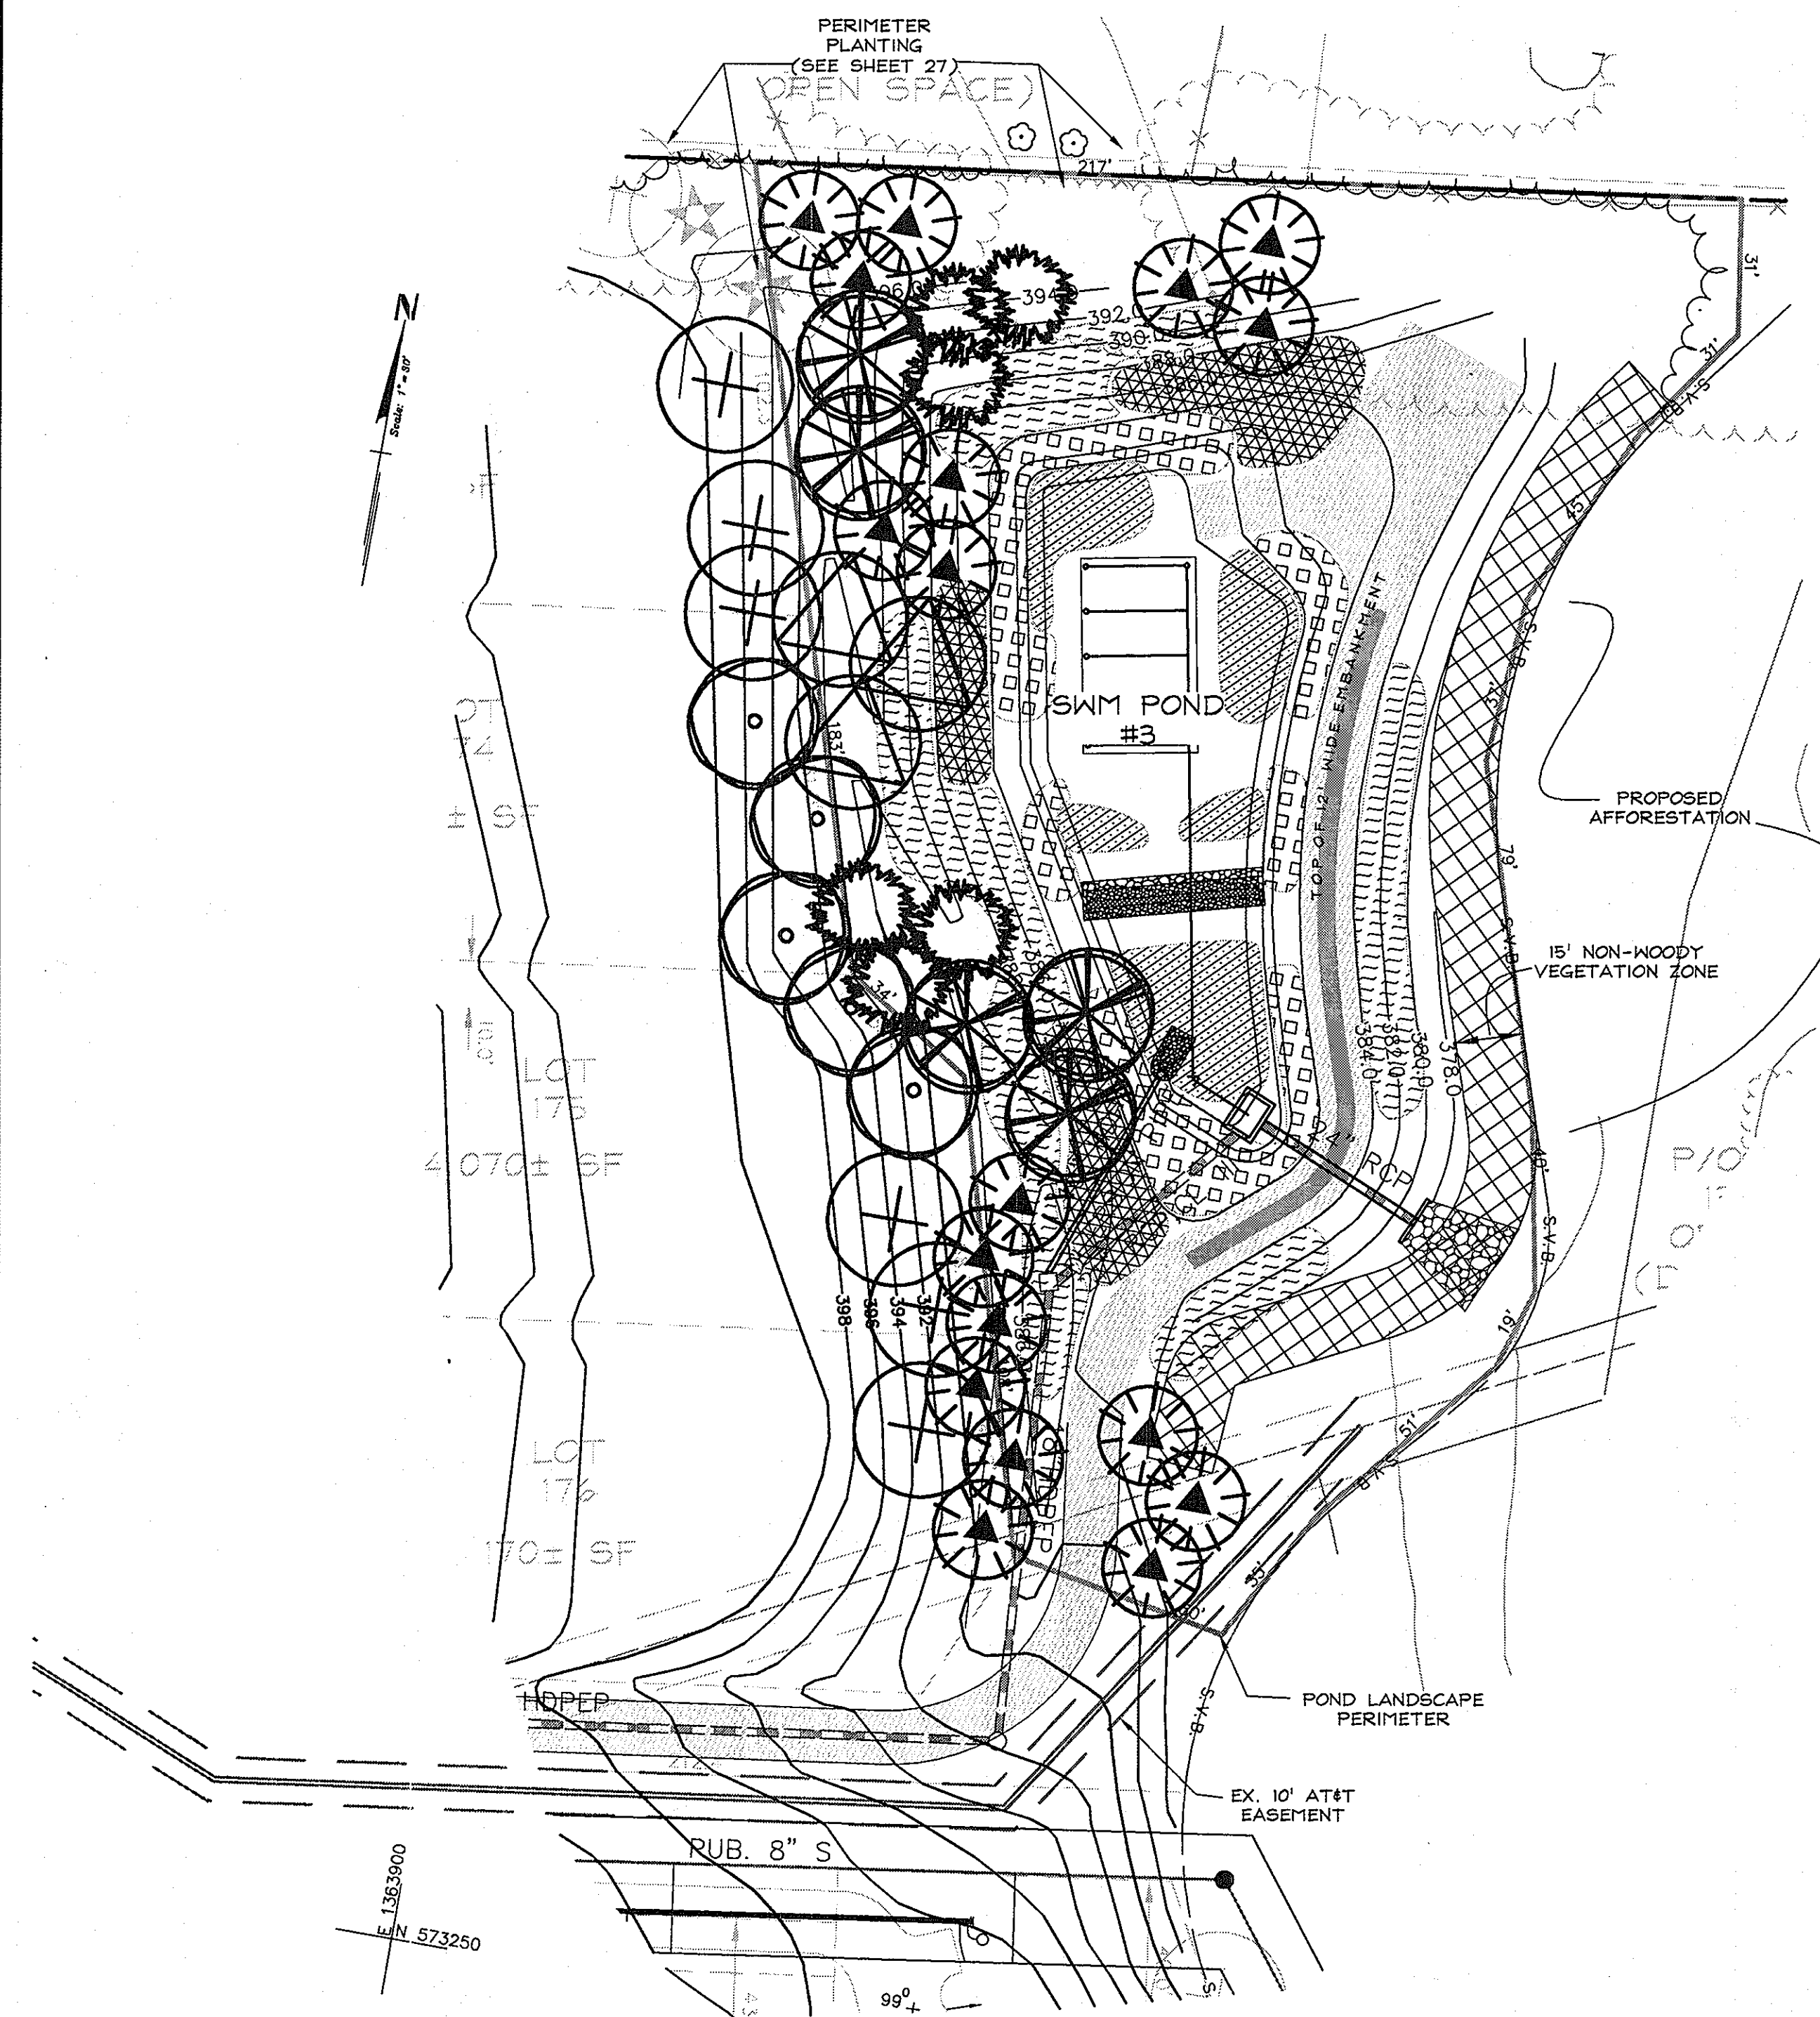

**THIS PLAN FOR LANDSCAPE USE ONLY (POND #3)**

SCALE: 1"=30'

APPROVED: HOWARD COUNTY DEPARTMENT OF PUBLIC WORKS  
 WILLIAM J. WILSON, CHIEF, BUREAU OF HIGHWAY, 10/14/03  
 APPROVED: HOWARD COUNTY DEPARTMENT OF PLANNING & ZONING  
 CINDY HAMMILL, CHIEF, DIVISION OF LAND DEVELOPMENT, 10/27/03  
 CHIEF, DEVELOPMENT ENGINEERING DIVISION, 10/17/03

TYPE	Lbs. per Acre (kg/ha)
<b>Wildflower Seed Mix:</b>	
Black-Eyed Susan ( <i>Rudbeckia hirta</i> )	2.0 lbs./Acre
Cori Poppy ( <i>Papaver rhoeas</i> )	1.25 lbs./Acre
Gold Yarrow ( <i>Achillea filipendula</i> )	0.2 lbs./Acre
Ox-Eyed Daisy ( <i>Chrysanthemum leucanthemum</i> )	1.0 lbs./Acre
Plains Coreopsis ( <i>Coreopsis tinctoria</i> )	1.0 lbs./Acre
White Yarrow ( <i>Achillea millefolium</i> )	0.2 lbs./Acre
Carrotflower ( <i>Centaurea cyanus</i> )	1.25 lbs./Acre
Cosmos ( <i>Cosmos bipinnatus</i> )	1.6 lbs./Acre
Dane's Rocket ( <i>Hesperis matronalis</i> )	1.5 lbs./Acre
Evening Primrose ( <i>Oenothera biennis</i> )	2.0 lbs./Acre
Lance-Leaved Coreopsis ( <i>Coreopsis lanceolata</i> )	2.0 lbs./Acre
Purple Coneflower ( <i>Echinacea purpurea</i> )	2.0 lbs./Acre
Rocket Larkspur ( <i>Delphinium ajacis</i> )	1.0 lbs./Acre
Gay Feather ( <i>Liatris spicata</i> ) with awns	2.0 lbs./Acre
Goldilocks ( <i>Collardia pulchella</i> )	1.0 lbs./Acre
<b>Meadow Grasses:</b>	
Hard or Sheep Fescue (Companion Seed)	10 lbs./Acre

**Pond #3 - Tree Schedule for Required Buffer**

POND PERIMETER=960' REQ'D PLANTING=19 SHADE TREES, 24 EVERGREEN					
SYMBOL	BOTANICAL NAME (COMMON NAME)	QTY	SIZE	ROOT	REMARKS
+	ACER RUBUM (RED MAPLE) ALTERNATE: PLATANUS OCCIDENTALIS (AMERICAN SYCAMORE)	6	2 1/2"-3" cal	B4B	
△	LIQUIDAMBAR STYRACIFLUA (SWEET GUM) ALTERNATE: LIRIODENDRON (TULIP TREE)	3	2 1/2"-3" cal	B4B	
○	QUERCUS RUBRA (RED OAK)	5	2 1/2"-3" cal	B4B	
⊗	NYSSA SYLVATICA (BLACK GUM) ALTERNATE: CRATAEGUS PHAENOPYRUM (WASHINGTON HAWTHORNE)	5	2 1/2"-3" cal	B4B	
⊙	CUPRESSOCYPARIS LEYLANDII (LEYLAND CYPRESS)	0	6'-8' ht	B4B	
⊙	PINUS STROBUS (WHITE PINE)	18	6'-8' ht	B4B	
⊙	ILEX OPACA (AMERICAN HOLLY)	6	6'-8' ht	B4B	

**\*General Landscaping Guidance for All Stormwater BMP's**

- Trees, shrubs, and/or any type of woody vegetation are not allowed on the embankment.
- Plant trees and shrubs at least 15ft away from the toe of slope of a dam.
- Plant trees and shrubs at least 25ft away from perforated pipes.
- Plant trees and shrubs at least 25ft away from a principal spillway structure.
- Provide 15ft clearance from a non-clogging, low flow orifice.
- Use erosion control mats and fabrics in channels to reduce the potential for erosion.
- Divert flows temporarily from seeded areas until stabilized.
- Do not block maintenance access to structures with trees or shrubs.
- To reduce thermal warming, shade inflow and outflow channels as well as southern exposures of ponds.
- For planting success, soils should be loosened to a depth of 3 - 5 inches.
- Soils should be loosened regardless of plant type.
- Whenever possible, topsoil should be spread to a depth of 4 - 8 inches and lightly compacted to a minimum thickness of 4 inches.
- Be sure to provide a source of water, especially in dry periods.
- Native plant species should be specified over exotic or foreign species.
- Species layout should generally be random and natural.
- A canopy should be established with an understory of shrubs and herbaceous material.
- Existing and proposed utilities must be identified and considered.

\*These guidelines were taken from the 2000 Maryland Stormwater Design Manual.

**Pond #3 - Herbaceous Plant Listing**

**Zone 1 - Deep Water Pool - 1 to 6 foot deep permanent pool**  
 Nuphar lutea - Spatterdock (Yellow water-lily)  
 Nymphaea odorata - White Water-lily  
 Sagittaria latifolia - Duck Potato  
 Potamogeton var. - Pondweed

**Zone 2 - Shallow Water Bench - 6 inches to 1 foot deep**  
 Aster spp.  
 Carex vulpinoidea - Fox Sedge  
 Iris versicolor - Blue Flag Iris  
 Sagittaria latifolia - Duck Potato (Arrowhead)  
 Scirpus spp. - Bulrush

**Zone 3 - Shoreline Fringe - Regularly Inundated**  
 Aster spp.  
 Carex vulpinoidea - Fox Sedge  
 Eupatorium purpurea - Joe Pye Weed  
 Iris versicolor - Blue Flag Iris  
 Typha latifolia - Broad Leaved Cattail

**Zone 4 - Riparian Fringe - Periodically Inundated**  
 Andropogon virginicus - Broomsedge  
 Lobelia cardinalis - Cardinal Flower  
 Panicum virgatum - Switch Grass  
 Spirea virginiana - Meadow Sweet Spirea  
 Viola papilionacea - Common Blue Violet

**Zone 5 - Floodplain Terrace - Infrequently Inundated**  
 Aster ericoides - White Heath Aster  
 Cyperus filicinus - Slender Flatsedge  
 Lolium perenne - Perennial Rye Grass  
 Panicum virgatum - Switch Grass  
 Phlox paniculata - Fall Phlox  
 Rudbeckia fulgida goldstrum - Blackeyed Susan  
 Wild Flower Mix

**Zone 6 - Upland Slopes - Seldom or Never Inundated**  
 Aster ericoides - White Heath Aster  
 Cyperus filicinus - Slender Flatsedge  
 Festuca pratensis - Meadow Fescue  
 Rudbeckia fulgida goldstrum - Blackeyed Susan  
 Viola papilionacea - Common Blue Violet  
 Wild Flower Mix

**Open Channel & Grass Seed Mixture**  
 15% - Agrostis palustris - Creeping Bentgrass  
 15% - Andropogon gerardii - Big Bluestem  
 20% - Festuca rubra - Red Fescue  
 5% - Lolium perenne - Perennial Rye Grass  
 15% - Panicum virgatum - Switch Grass  
 15% - Phalaris arundinacea - Red Canary Grass  
 15% - Poa pratensis - Kentucky Blue Grass

**Upland Slopes - Wildflower Seed Mix**  
 See Wildflower Chart

**Notes For Plant Selection**  
 - Within each hydrologic planting zone, there are several suggestions for herbaceous plantings. It is intended that 3 to 4 plants be selected within each planting zone from the above list. If a plant on the list is not readily available, it is the contractor's responsibility to either choose a replacement plant for that zone, with guidance from the Plant Nursery they are dealing with, or the contractor may eliminate the plant and simply redistribute the square footage among the available plants.  
 - The square footages provided are approximate areas for each planting zone.  
 - The plants, when planted from (plug, pot or root) are to be spaced at a rate of ONE (1) plant per TWO (2) square feet.  
 - Grass seed should be planted at a rate of 50 pounds per acre.  
 - Plants should be clustered by species within each zone. It is the responsibility of the contractor to locate the plants in the field.

SCHEDULE D STORMWATER MGMT AREA LANDSCAPING TYPE 'B' BUFFER	
	POND #3
LINEAR FEET OF PERIMETER	960'
NUMBER OF TREES REQ'D:	
SHADE TREES @ 1/50 LF	19
EVERGREEN TREES @ 1/40 LF	24
CREDIT FOR EX. VEGETATION	0


**Wildflower Mixtures:**

- Plant in spring or fall for best results. Spring seeding should be completed to take advantage of the spring rainfall.
- Fall planting should be late enough so germination does not occur until the following spring or seeding will be lost to winter freeze.
- Planting Rates: The seeding rate is about 16 to 20 lbs./acre. Minimum rate is 10 lbs./acre and maximum rates are 8 to 22 lbs./acre. Avoid using more than the recommended rates since poor perennial establishment may result.
- A wildflower planting requires the same weed control as traditional landscaping. Before planting, remove existing weeds by tilling or by using a nonselective herbicide such as Roundup Pro or a combination of these methods.
- Seed Application: For seeding large areas over one acre, use a drill seeder. Work to a depth of 1/4 inch and firm soil with a cultipacker. On small sites use a hand cyclone or drop seeder to apply the seed after the site has been tilled.
- Supplemental Water: Soak the planted areas thoroughly and maintain moisture for 4 to 6 weeks then gradually reduce waterings.
- Fertilizer: If the soil needs improvement, use a fertilizer with a 10-22-22 ratio at the rate of 450 lbs./acre immediately after seeding. Avoid over-fertilization.
- Management:**
- Mowing: Mow twice a year, once in early summer to remove spring flower seed heads and then again in the fall. Mow to a height of 6-8 inches; leave residue on ground.
- Weed control: After the flowers have germinated, weeds should be controlled as soon as they can be recognized either by pulling, spot spraying with a selective herbicide or by cutting with a string trimmer. Annual and some perennial grasses can be controlled with herbicides such as Ornamec and Fusilade.
- Reseeding: Sometimes it is necessary to reseed in the second and additional years if establishment of wildflowers is poor or spotty. The bare areas can be reseeded with original mixture either in the spring or fall.

**AS-BUILT PLANS  
(No As-Built Data This Sheet)**

NOTE: THIS PLAN TO BE USED FOR STORMWATER MANAGEMENT ONLY. ALL OTHER INFORMATION SHOWN FOR REFERENCE PURPOSE ONLY. SEE APPROPRIATE CONSTRUCTION DRAWING FOR ALL OTHER INFORMATION.


CALL "MISS UTILITY" AT 1-800-257-7777 48 Hours Before Start of Construction

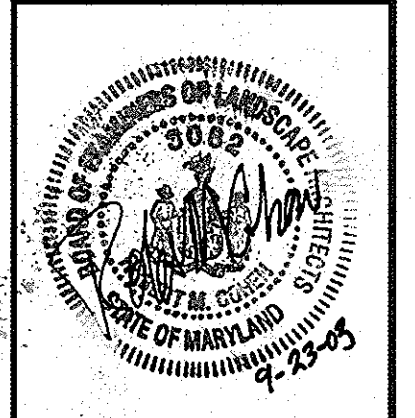

DATE	REVISION	DATE	BY	DATE
	BASE DATA		CADD	
	DESIGNED		PFB, YSL	
	DRAWN		YSL	
	REVIEWED		PFB	
	RELEASE FOR			

Developer/Owner:  
**Winchester Homes, Inc. & Winchester Homes, Inc.**, as nominee for Stringtown Investments, LLC  
 6905 Rockledge Drive  
 Suite 800  
 Bethesda, Maryland 20817  
 Stephen J. Nardella, Vice President  
 (301) 803-4800

**SWM POND 3  
LANDSCAPE PLAN**

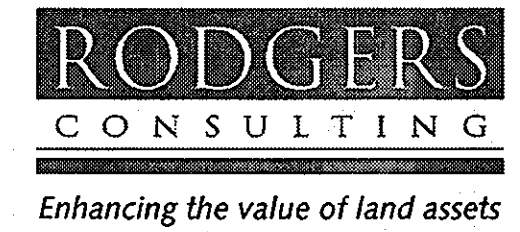

Rodgers Consulting, Inc.  
 9260 Gaither Road  
 Gaithersburg, MD 20877  
 301.948.4700  
 301.948.6256 (fax)  
 301.253.6609  
 www.rodgers.com

**Montjoy - Single Family Detached**

A RESUBDIVISION OF NON-BUILDABLE BULK PARCEL C (F-03-87)  
 BUILDABLE LOTS 127 - 188 AND OPEN SPACE LOTS 189 - 193  
 ELECTION DISTRICT #2 HOWARD COUNTY, MARYLAND  
 TAX MAP: 30, GRID: 12, PARCEL 260  
 DPZ FILES: S-01-20, WP-01-117, P-02-10, P-02-17, P-03-03, F-03-87


SCALE: 1"=30'
JOB No. 506V3
DATE: 1-14-03
INDEX No. SWM-5
SHEET No. 24 OF 34



CALL "MISS UTILITY" AT  
1-800-257-7777  
48 Hours Before Start Of Construction

- Legend**
- STORM DRAIN
  - S.V.B.- STREAM BUFFER
  - - - 100 YR. FLOODPLAIN
  - ..... LIMIT OF DISTURBANCE
  - EXISTING TREELINE
  - ZONING LINE
  - MATCH LINE
  - PHASING LINE
- WETLAND
  - FOREST CONSERVATION EASEMENT
  - PROPOSED UTILITY EASEMENTS
  - PROPOSED LIGHT POLE LOCATION (PUBLIC STREETS)
  - PROPOSED LANDSCAPE MAINTENANCE EASEMENT

\*THIS SITE DOES NOT CONTAIN SLOPES GREATER THAN 25% IN A CONTIGUOUS AREA 20,000 SQ. FT. OR MORE.

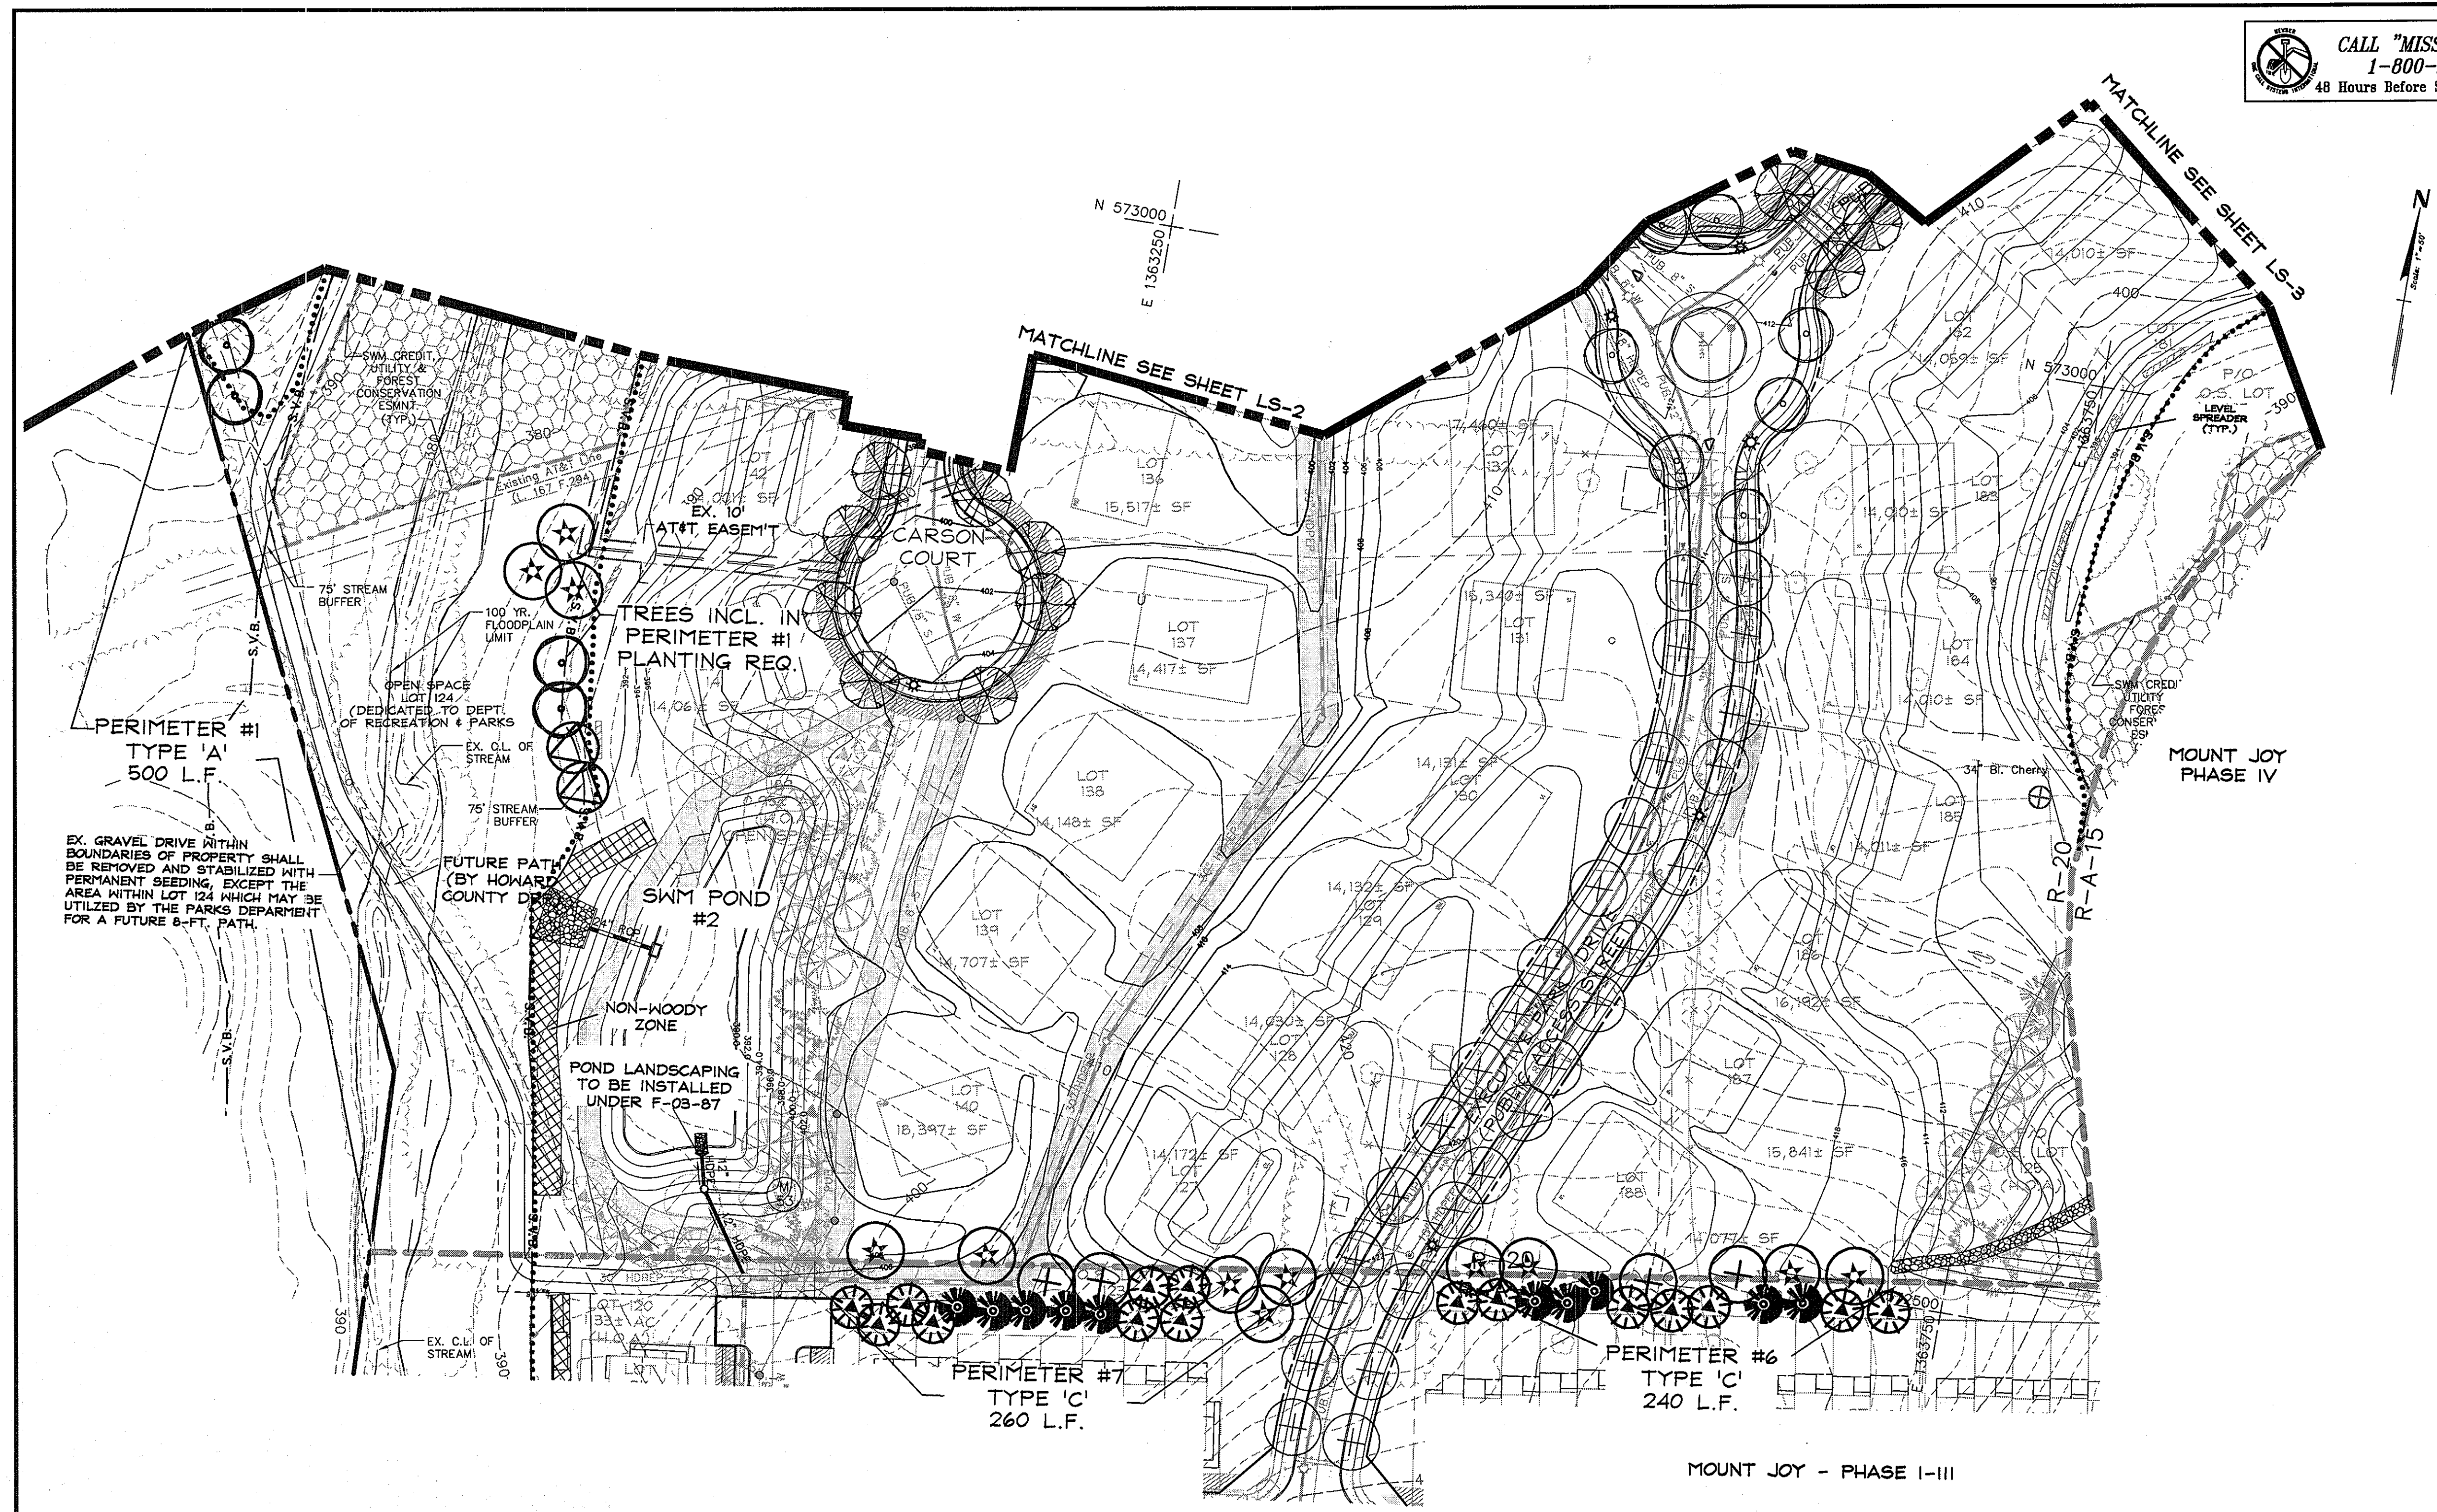

THIS PLAN FOR LANDSCAPE USE ONLY

NOTE: A MINIMUM SPACING OF 20 FEET SHALL BE MAINTAINED BETWEEN ANY STREET LIGHT AND ANY TREE.

- TREE SYMBOL KEY**  
SEE SHEET 26 FOR SCHEDULE & DETAILS
- LIQUIDAMBAR STYRACIFLUA (AMERICAN SWEETGUM)
  - ACER RUBUM (RED MAPLE)
  - TILIA CORDATA (LITTLELEAF LINDEN)
  - QUERCUS RUBRA (RED OAK)
  - FRAXINUS PENNSYLVANICA (MARSHALL'S SEEDLESS ASH)
  - CUPRESSOCYPARIS LEYLANDII (LEYLAND CYPRUS)
  - PINUS STROBUS (WHITE PINE)
  - TREES PROPOSED UNDER PHASE I-III LANDSCAPE PLAN NOT PART OF THIS PLAN. (SEE F-03-87)

APPROVED: HOWARD COUNTY DEPARTMENT OF PUBLIC WORKS

*William F. Mable Jr.* 10-14-03  
CHIEF, BUREAU OF HIGHWAY HS DATE

APPROVED: HOWARD COUNTY DEPARTMENT OF PLANNING & ZONING

*Cindy Hamrick* 10/29/03  
CHIEF, DIVISION OF LAND DEVELOPMENT JAK DATE

*Chris Daneman* 10/17/03  
CHIEF, DEVELOPMENT ENGINEERING DIVISION qas DATE


DATE	REVISION	DATE	BY	DATE
	BASE DATA		CADD	
	DESIGNED		PFB, YSL	
	DRAWN		YSL	
	REVIEWED		PFB	
	RELEASE FOR			
	BY			

Developer/Owner:  
**Winchester Homes, Inc. & Winchester Homes, Inc., as nominee for Stringtown Investments, LLC**  
6905 Rockledge Drive  
Suite 800  
Bethesda, Maryland 20817  
Stephen J. Nardella, Vice President  
(301) 803-4800

# AS-BUILT PLANS

(No As-Built Data This Sheet)


## LANDSCAPE PLAN & STREET TREE PLAN

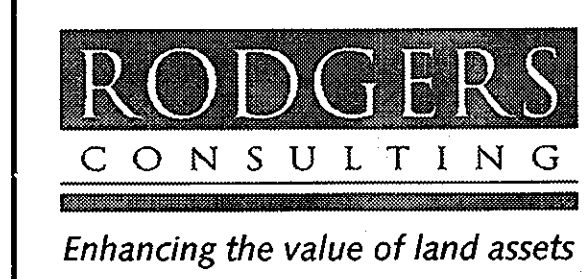

Rodgers Consulting, Inc.  
9260 Galther Road  
Gaitherburg, MD 20877  
301.948.4700  
301.948.6256 (fax)  
301.253.6609  
www.rodgers.com


### Montjoy - Single Family Detached

A RESUBDIVISION OF NON-BUILDABLE BULK PARCEL C (F-03-87)  
TO  
BUILDABLE LOTS 127-188 AND OPEN SPACE LOTS 189-193  
ELECTION DISTRICT #2 HOWARD COUNTY, MARYLAND  
TAX MAP: 30, GRID: 12, PARCEL 260  
DPZ FILES: S-01-20, WP-01-117, P-02-10, P-02-17, P-03-03, F-03-87

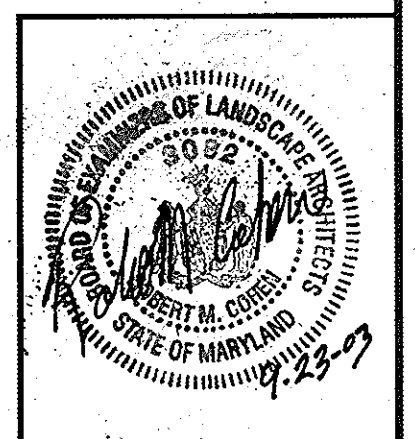

SCALE: 1"=50'  
JOB No. 506V3  
DATE: 1-14-03  
INDEX No. LS-1  
SHEET No. 25 of 34




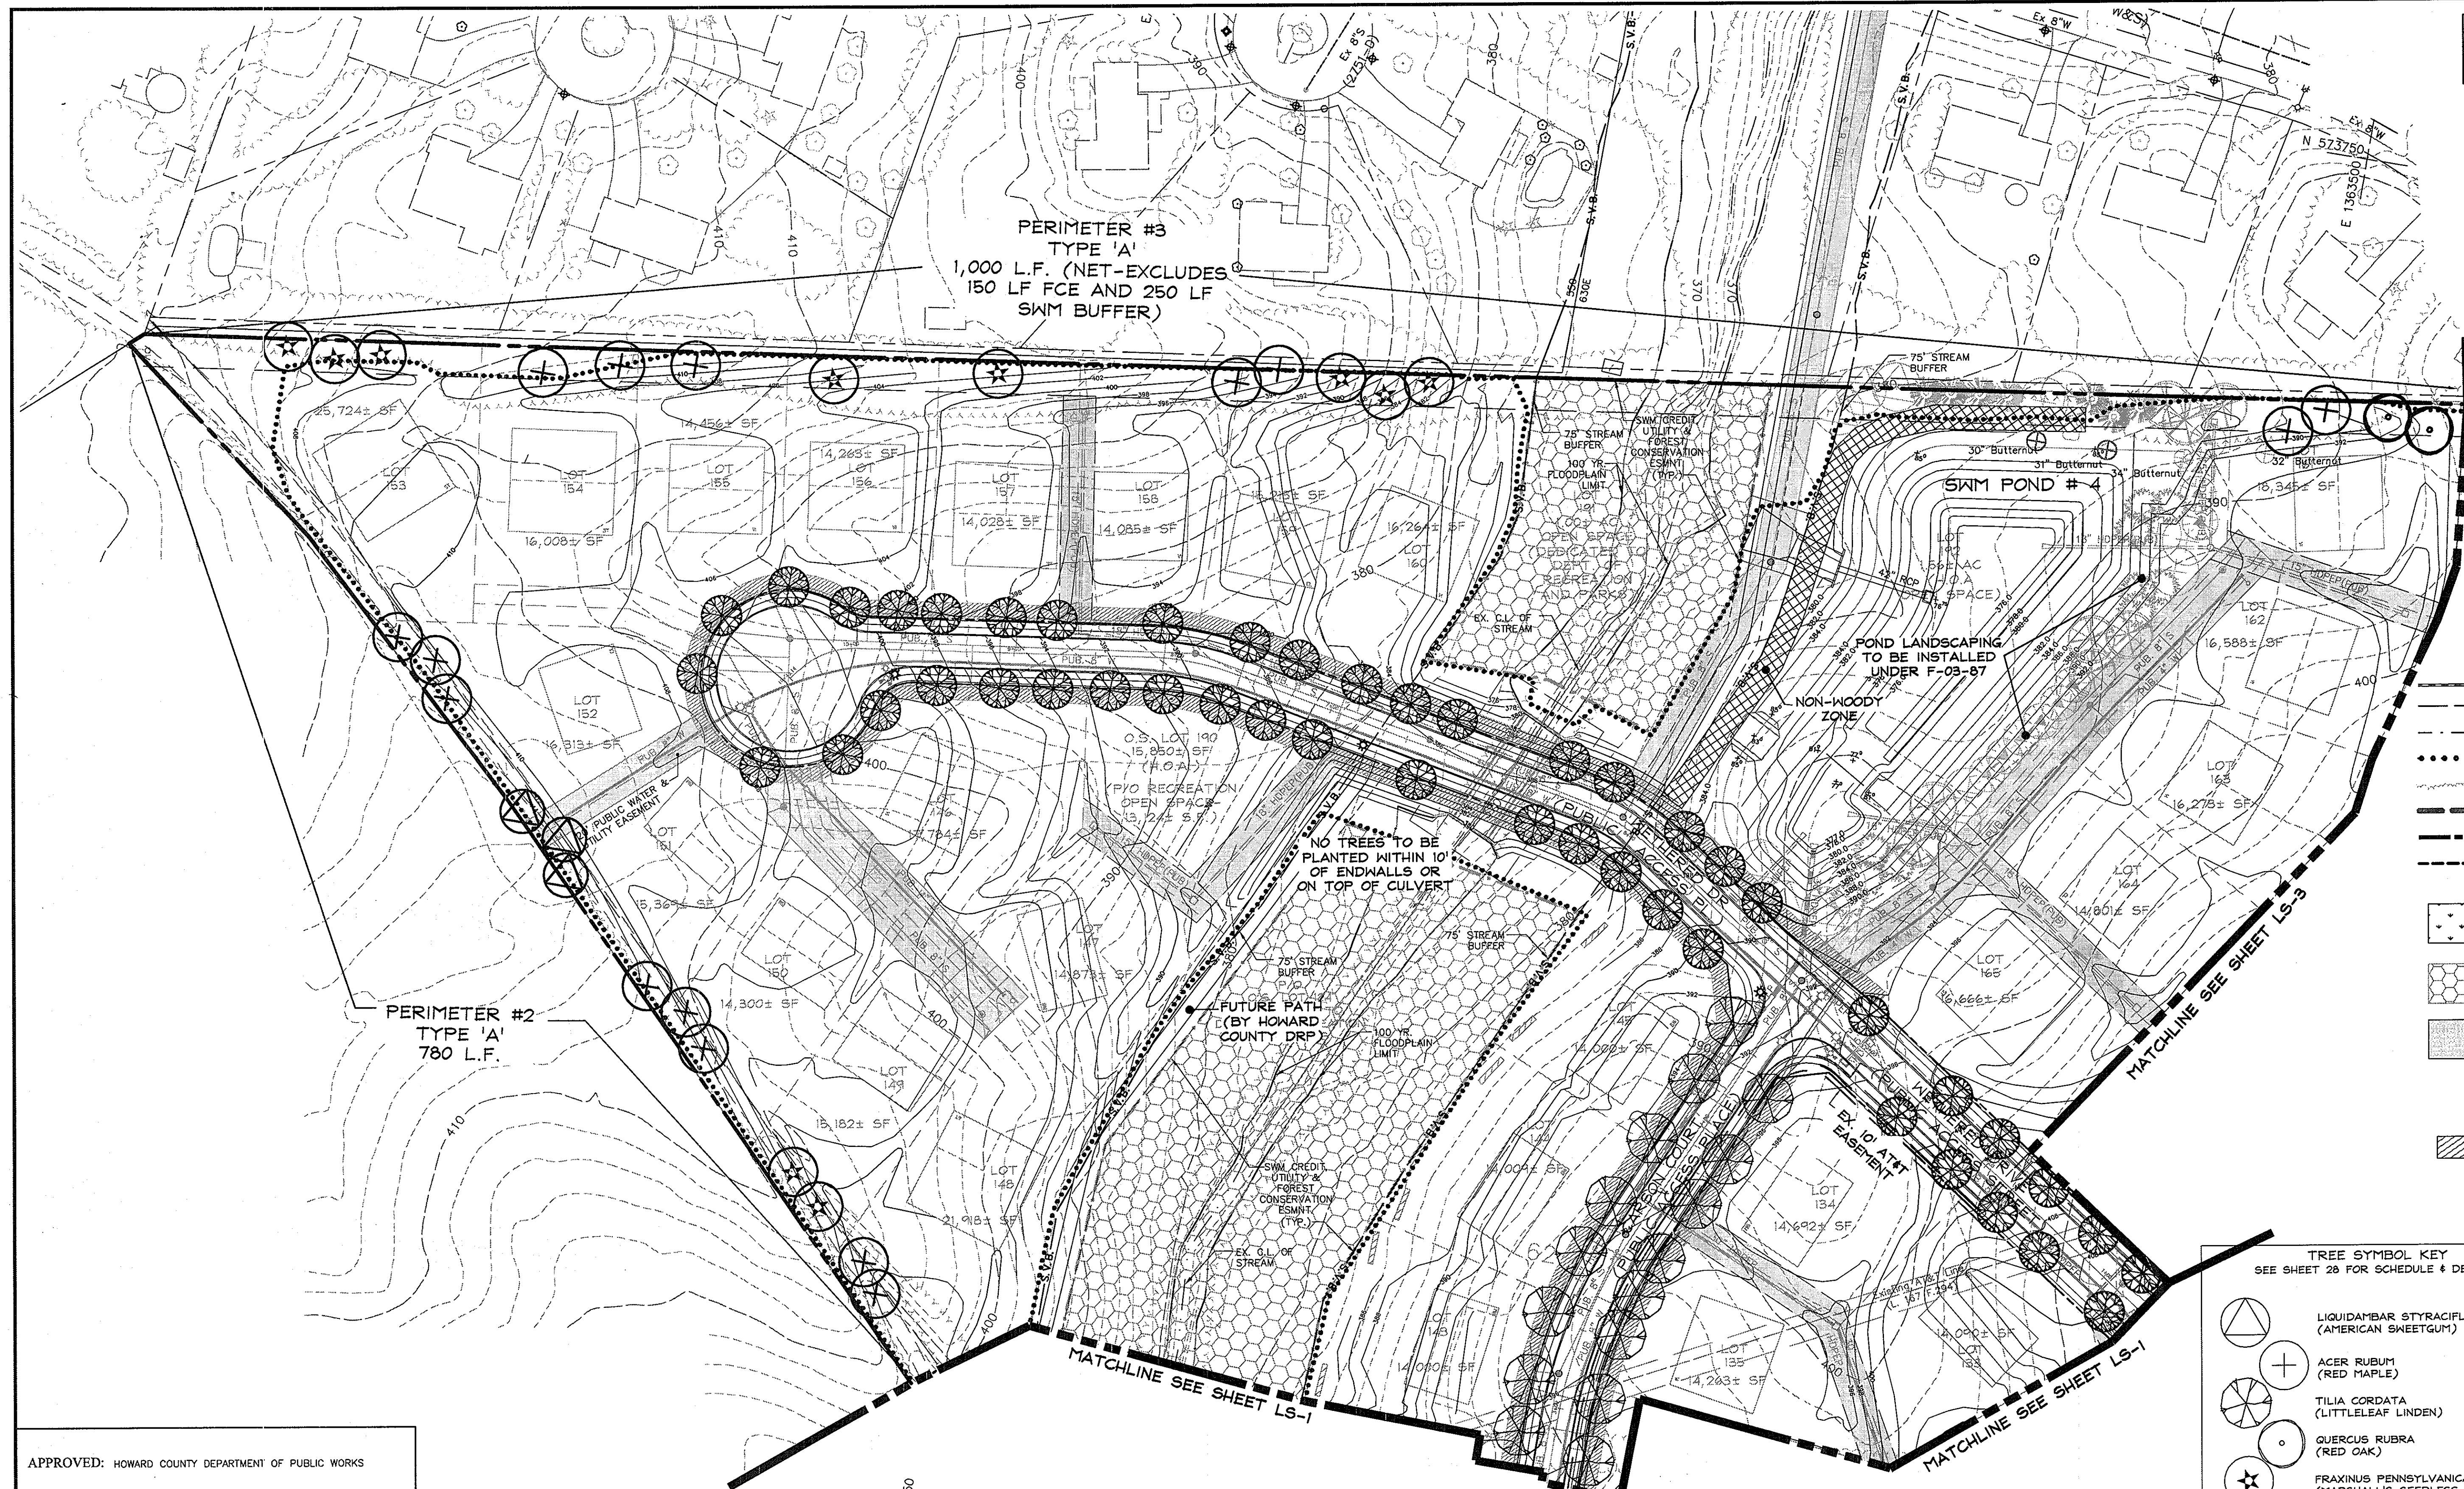

- Legend**
- S.V.B. --- STORM DRAIN
  - S.V.B. --- STREAM BUFFER
  - 100 YR. FLOODPLAIN
  - LIMIT OF DISTURBANCE
  - EXISTING TREELINE
  - ZONING LINE
  - MATCH LINE
  - PHASING LINE
  - [Pattern] WETLAND
  - [Pattern] FOREST CONSERVATION EASEMENT
  - [Pattern] PROPOSED UTILITY EASEMENTS
  - [Symbol] PROPOSED LIGHT POLE LOCATION (PUBLIC STREETS)
  - [Pattern] PROPOSED LANDSCAPE MAINTENANCE EASEMENT

\*THIS SITE DOES NOT CONTAIN SLOPES GREATER THAN 25% IN A CONTIGUOUS AREA 20,000 SQ. FT. OR MORE.

- TREE SYMBOL KEY**  
SEE SHEET 28 FOR SCHEDULE & DETAILS
- [Symbol] LIQUIDAMBAR STYRACIFLUA (AMERICAN SWEETGUM)
  - [Symbol] ACER RUBUM (RED MAPLE)
  - [Symbol] TILIA CORDATA (LITTLELEAF LINDEN)
  - [Symbol] QUERCUS RUBRA (RED OAK)
  - [Symbol] FRAXINUS PENNSYLVANICA (MARSHALL'S SEEDLESS ASH)
  - [Symbol] CUPRESSOCYPARIS LEYLANDII (LEYLAND CYPRUS)
  - [Symbol] PINUS STROBUS (WHITE PINE)
- TREES PROPOSED UNDER PHASE I-III LANDSCAPE PLAN NOT PART OF THIS PLAN. (SEE F-03-87)

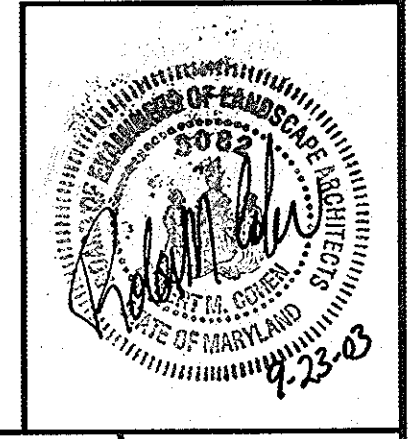

THIS PLAN FOR LANDSCAPE USE ONLY

NOTE: A MINIMUM SPACING OF 20 FEET SHALL BE MAINTAINED BETWEEN ANY STREET LIGHT AND ANY TREE.

**AS-BUILT PLANS**  
(No As-Built Data This Sheet)

APPROVED: HOWARD COUNTY DEPARTMENT OF PUBLIC WORKS  
*William T. ...* 10-14-03  
CHIEF, BUREAU OF HIGHWAY


APPROVED: HOWARD COUNTY DEPARTMENT OF PLANNING & ZONING  
*Cindy Hamilton* 10/27/03  
CHIEF, DIVISION OF LAND DEVELOPMENT

*Chris ...* 10/17/03  
CHIEF, DEVELOPMENT ENGINEERING DIVISION

DATE	REVISION	DATE	BY	DATE
	BASE DATA		CADD	
	DESIGNED		PFB, YSL	
	DRAWN		YSL	
	REVIEWED		PFB	
	RELEASE FOR			

Developer/Owner:  
**Winchester Homes, Inc. & Winchester Homes, Inc.**, as nominee for Stringtown Investments, LLC  
6905 Rockledge Drive  
Suite 800  
Bethesda, Maryland 20817  
Stephen J. Nardella, Vice President  
(301) 803 - 4800

**LANDSCAPE PLAN & STREET TREE PLAN**

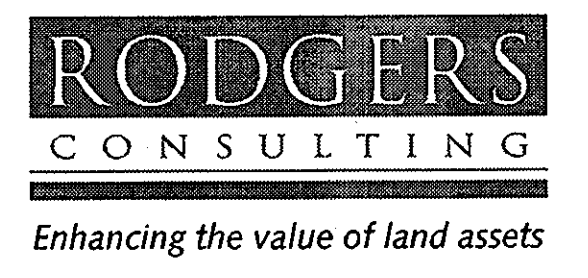


Rodgers Consulting, Inc.  
9260 Galther Road  
Gaithersburg, MD 20877  
301.948.4700  
301.948.6256 (fax)  
301.253.6609  
www.rodgers.com

**Montjoy - Single Family Detached**  
A RESUBDIVISION OF NON-BUILDABLE BULK PARCEL C (F-03-87)  
BUILDABLE LOTS 127- 188 AND OPEN SPACE LOTS 189-193  
ELECTION DISTRICT #2 HOWARD COUNTY, MARYLAND  
TAX MAP: 30, GRID: 12, PARCEL 260

SCALE: 1"=50'  
JOB No. 506V3  
DATE: 1-14-03  
INDEX No. LS-2  
SHEET No. 26 of 34



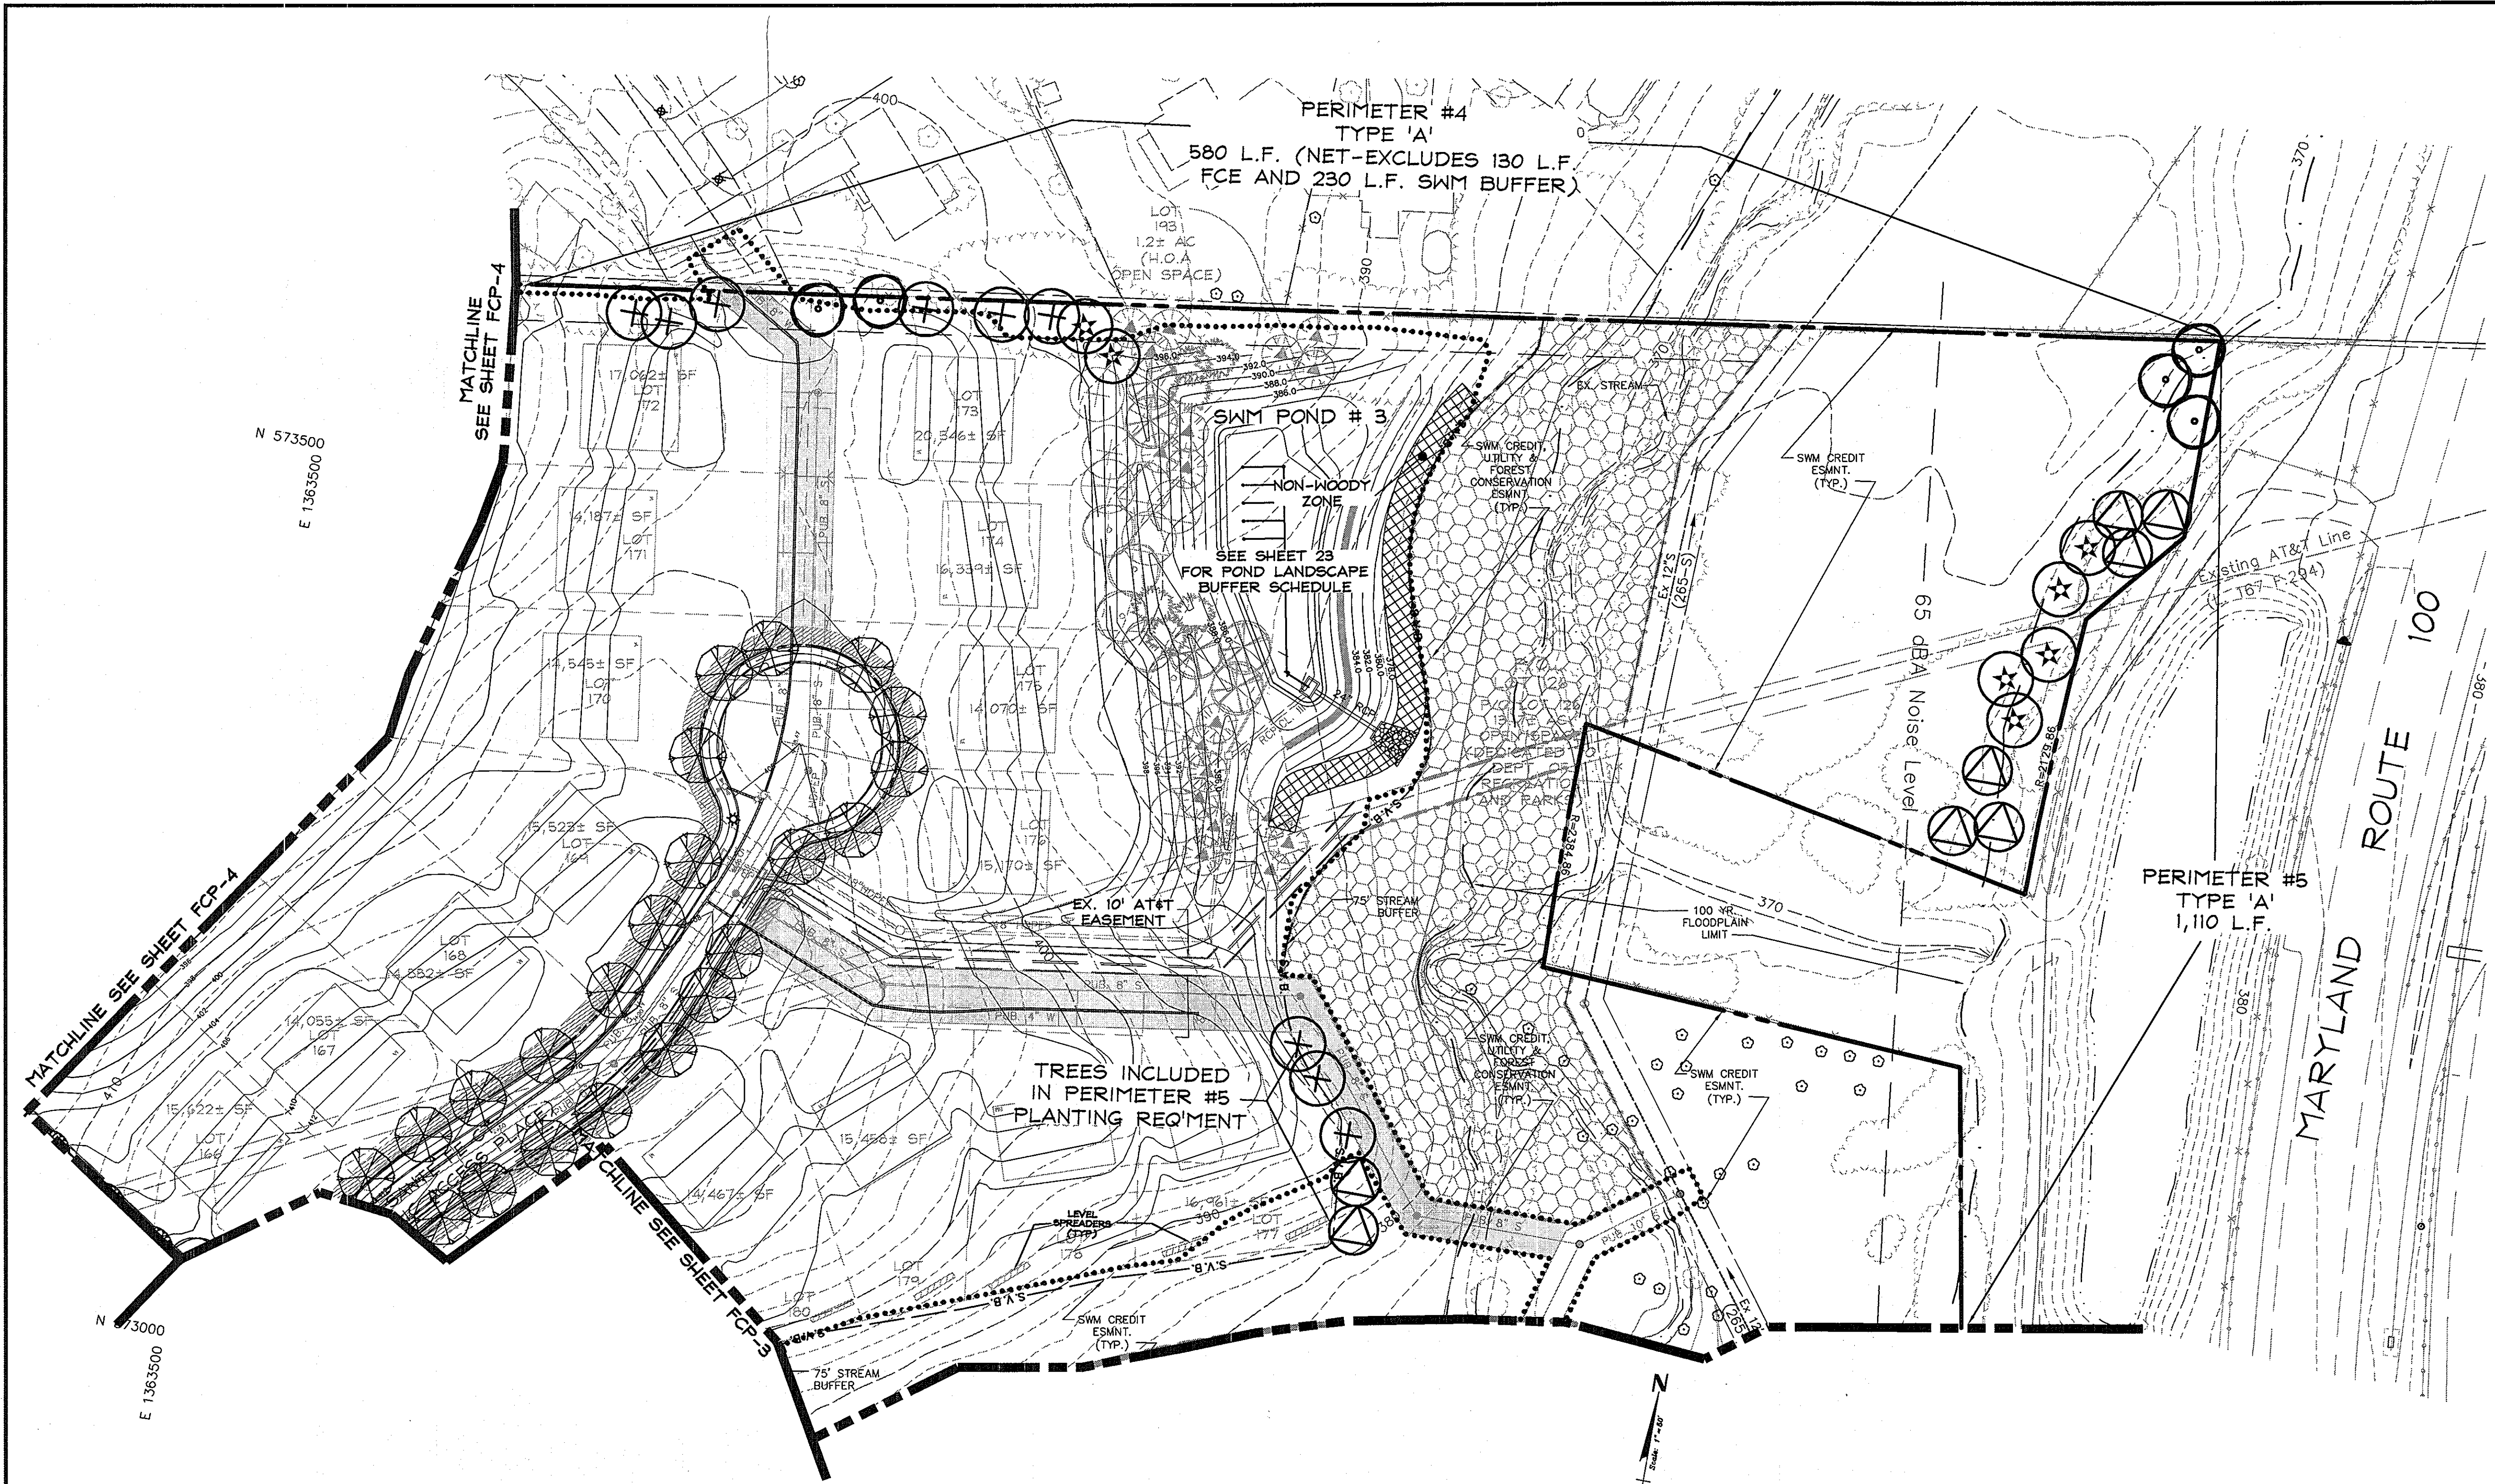

- Legend**
- S.V.B. --- STREAM BUFFER
  - 100 YR. FLOODPLAIN
  - ..... LIMIT OF DISTURBANCE
  - EXISTING TREELINE
  - ZONING LINE
  - MATCH LINE
  - PHASING LINE
  - [Pattern] WETLAND
  - [Pattern] FOREST CONSERVATION EASEMENT
  - [Pattern] PROPOSED UTILITY EASEMENTS
  - [Symbol] PROPOSED LIGHT POLE LOCATION (PUBLIC STREETS)
  - [Pattern] PROPOSED LANDSCAPE MAINTENANCE EASEMENT

\*THIS SITE DOES NOT CONTAIN SLOPES GREATER THAN 25% IN A CONTIGUOUS AREA 20,000 SQ. FT. OR MORE.

- TREE SYMBOL KEY**  
SEE SHEET 26 FOR SCHEDULE & DETAILS
- [Symbol] LIQUIDAMBAR STYRACIFLUA (AMERICAN SWEETGUM)
  - [Symbol] ACER RUBUM (RED MAPLE)
  - [Symbol] TILIA CORDATA (LITTLELEAF LINDEN)
  - [Symbol] QUERCUS RUBRA (RED OAK)
  - [Symbol] FRAXINUS PENNSYLVANICA (MARSHALL'S SEEDLESS ASH)
  - [Symbol] CUPRESSOCYPARIS LEYLANDII (LEYLAND CYPRUS)
  - [Symbol] PINUS STROBUS (WHITE PINE)
  - [Symbol] TREES PROPOSED UNDER PHASE I-III LANDSCAPE PLAN NOT PART OF THIS PLAN. (SEE F-03-87)

THIS PLAN FOR LANDSCAPE USE ONLY

NOTE: A MINIMUM SPACING OF 20 FEET SHALL BE MAINTAINED BETWEEN ANY STREET LIGHT AND ANY TREE.

APPROVED: HOWARD COUNTY DEPARTMENT OF PUBLIC WORKS

*William J. White* 10-14-03  
CHIEF, BUREAU OF HIGHWAY HS DATE


APPROVED: HOWARD COUNTY DEPARTMENT OF PLANNING & ZONING

*Cinda Hamata* 9/27/03  
CHIEF, DIVISION OF LAND DEVELOPMENT DATE

*Chad Damann* 10/17/03  
CHIEF, DEVELOPMENT ENGINEERING DIVISION Q10 DATE

**AS-BUILT PLANS**  
(No As-Built Data This Sheet)


**LANDSCAPE PLAN & STREET TREE PLAN**

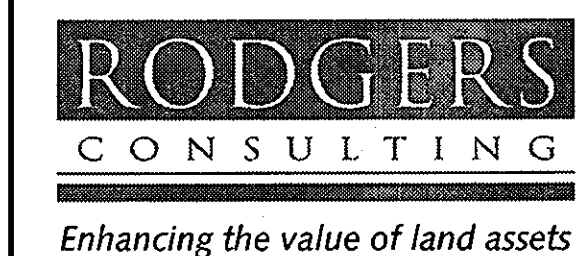

Rodgers Consulting, Inc.  
9260 Galther Road  
Gaithersburg, MD 20877  
301.948.4700  
301.948.6256 (fax)  
301.253.6609  
www.rodgers.com

**Montjoy - Single Family Detached**

A RESUBDIVISION OF NON-BUILDABLE BULK PARCEL C (F-03-87) TO BUILDABLE LOTS 127- 188 AND OPEN SPACE LOTS 189-193  
ELECTION DISTRICT #2 HOWARD COUNTY, MARYLAND  
TAX MAP: 30, GRID: 12, PARCEL 260  
DPZ FILES: S-01-20, WP-01-117, P-02-10, P-02-17, P-03-03, F-03-87

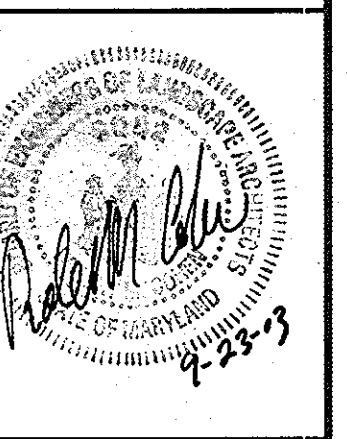

DATE	REVISION	DATE	BY	DATE
	BASE DATA		CADD	
	DESIGNED		PFB, YSL	
	DRAWN		YSL	
	REVIEWED		PFB	
	RELEASE FOR			
	BY			

Developer/Owner:  
**Winchester Homes, Inc. & Winchester Homes, Inc.**, as nominee for Stringtown Investments, LLC  
6905 Rockledge Drive  
Suite 800  
Bethesda, Maryland 20817  
Stephen J. Nardella, Vice President  
(301) 803-4800

SCALE: 1"=50'

JOB No.	506V3
DATE:	1-14-03
INDEX No.	LS-3
SHEET No.	27 of 34



SCHEDULE A  
PERIMETER LANDSCAPE EDGES

PERIMETER #	1	2	3	4	5	6	7
PROPOSED USE	SFD	SFD	SFD	SFD	SFD/OPEN	SFD	SFD
ADJACENT USE	NT-EMPLOYMT CENTER	NT-EMPLOYMT CENTER	SFD	SFD	HIGHWAY	SFA	SFA
LANDSCAPE TYPE	A	A	A	A	A	C	C
LINEAR FEET OF PERIMETER	500'	780'	1,000'	580'	1110'	240'	260'
CREDIT FOR EX. VEGETATION	0'	0'	0'	0'	0'	0'	0'
NET PERIMETER	500'	780'	1,000'	580'	1110'	240'	260'
NUMBER OF PLANTS REQ'D: <sup>1</sup>							
SHADE TREES	9 @ 1/60 LF	13 @ 1/60 LF	17 @ 1/60 LF	10 @ 1/60 LF	19 @ 1/60 LF	6 @ 1/40 LF	7 @ 1/40 LF
EVERGREEN TREES	0	0	0	0	0	12 @ 1/20 LF	0
SHRUBS	0	0	0	0	0	0	0
NUMBER OF PLANTS PROVIDED: <sup>2</sup>							
SHADE TREES	9	13	17	10	19	6	7
EVERGREEN TREES	0	0	0	0	0	12	13
SHRUBS	0	0	0	0	0	0	0

<sup>1</sup> BASED ON PERIMETER BEFORE CREDIT FOR EXISTING TREES.  
<sup>2</sup> TREES PROVIDED BASED ON NET PERIMETER AFTER CREDIT FOR EXISTING TREES. NO CREDIT TAKEN ON THIS PLAN.

SCHEDULE D  
STORMWATER MGMT AREA LANDSCAPING

TYPE 'B' BUFFER  
POND #3

LINEAR FEET OF PERIMETER	960'
NUMBER OF TREES REQ'D: <sup>1</sup>	
SHADE TREES @ 1/50 LF	19
EVERGREEN TREES @ 1/40 LF	24
CREDIT FOR EX. VEGETATION	0

SEE SHEET 24 FOR POND BUFFER PLANTING DETAILS AND PLANT SCHEDULE

PLANTING SCHEDULE - LANDSCAPE TREES

SYMBOL	BOTANICAL NAME (COMMON NAME)	Q'TY	SIZE	ROOT
(+)	ACER RUBUM (RED MAPLE)	28	2 1/2"-3" cal	B4B
(△)	LIQUIDAMBAR STYRACIFLUA (AMERICAN SWEETGUM)	13	2 1/2"-3" cal	B4B
(○)	QUERCUS RUBRA (RED OAK)	11	2 1/2"-3" cal	B4B
(☆)	FRAXINUS PENNSYLVANICA (MARSHALL'S SEEDLESS ASH)	29	2 1/2"-3" cal	B4B
(☼)	CUPRESSOCYPARIS LEYLANDII (LEYLAND CYPRESS)	10	6'-8' ht	B4B
(▲)	PINUS STROBUS (WHITE PINE)	15	6'-8' ht	B4B

PLANTING SCHEDULE - PUBLIC STREET TREES

SYMBOL	BOTANICAL NAME (COMMON NAME)	Q'TY	SIZE	ROOT
(+)	ACER RUBUM (RED MAPLE)	28	2 1/2"-3" cal	B4B
(△)	TILIA CORDATA (LITTLELEAF LINDEN)	49	2 1/2"-3" cal	B4B
(○)	QUERCUS RUBRA (RED OAK)	7	2 1/2"-3" cal	B4B
(☼)	PYRUS CALLERYANA 'CHANTICLEER' (CHANTICLEER PEAR)	47	2"-2 1/2" cal	B4B

Landscape Notes:


- ALL PLANTING SHALL BE DONE IN ACCORDANCE WITH THE HOWARD COUNTY LANDSCAPE MANUAL AS ADOPTED 1/4/83 AND AMENDED 3/2/98.
- Plants shall conform to current "American Standards for Nursery Stock" by American Association of Nurserymen (AAN), particularly with regards to site, growth, and size of ball and density of branch structure. Contractor to insure conformance to national and local building codes and ordinances.
  - All plants (B&B or container) shall be properly identified by weatherproof labels securely attached hereto before delivery to project site. Labels shall identify plants by name, species and size. Labels shall not be removed until the final inspection by the owners representative.
  - Any material and/or work may be rejected by the owners representative if it does not meet the requirements of the specifications. The contractor shall remove all rejected materials from the site.
  - The contractor shall furnish all plants in quantities and sizes to complete the work as specified in plant schedule. The landscape contractor shall be responsible to verify all plant quantities on the plans prior to commencement of work. Quantities in the plant schedule are for the contractors convenience only and do not constitute the final count.
  - Substitutions in plant species or size shall not be permitted except with the written approval of the owners representative.
  - Plants shall be located as shown on the drawings and by scaling or as designated in the field by the owners representative. All locations are to be approved by the owners representative before excavation.
  - Contractor shall locate and mark all underground utility lines and irrigation systems prior to excavating plant beds or pits. All utility easement areas where no planting shall take place shall also be marked on the site, prior to locating and digging the tree pits. If utility lines are encountered in excavation of tree pits, other locations for the trees shall be selected by the owners representative. Such changes shall be made by the contractor without additional compensation. No changes of location shall be made without the approval of the owners representative.
  - All equipment and tools shall be placed so as not to interfere or hinder the pedestrian and vehicular traffic flow.
  - During planting operations, excess and waste materials shall be promptly and frequently removed from the site.
  - All plant shrub beds are to be dug to a minimum of 24" deep and all existing soil, construction debris, roots and other foreign material are to be removed and discarded off site. All plant shrub beds are to be excavated to the width shown on the plans.
  - All tree pits are to be excavated to a minimum depth to allow the tree root ball to be a minimum of 4" higher than finish grade. The tree root ball is to rest on undisturbed soil, or a compacted bed must be prepared for the tree root ball to rest on and which will not subside causing the tree to sink below finish grade. All tree pits are to be a minimum of 12" larger on every side of the trees root ball.
  - The planter beds are to be entirely cleaned out to the undisturbed soil level. All existing soil, construction debris, roots and other foreign material are to be removed and discarded offsite.
  - The topsoil to be used to fill the tree pits, shrub beds and planters is to be plant specific. The topsoil for the trees, shrubs and planter shall consist of a maximum 2/3 existing topsoil from the site, which is cleaned and free of clay, a minimum of 1/3 peat moss, or other approved organic material or imported new loamy topsoil and 10% cow manure. All of these materials are to be mixed prior to placing in the planter or backfilling when planting.
  - The contractor is responsible to ensure that all tree pits, shrub beds and planter are well drained. No The landscape contractor without cost to the owner will replace all plant material, which is affected by poor drainage.
  - All lawn areas are to be seeded with grass seed appropriate for each of the sunlight conditions, which exist on the site.
  - All lawn areas are to be tilled to a depth of 6" and all foreign material removed which will inhibit the healthy growth of the lawn. All old grass and grass roots are to be removed from the site. New topsoil of a minimum 4" is to be placed over the areas to be sodded. The grass areas are to be fine graded to ensure that no undulations occur in the lawn. The lawns are to be graded in such a way as to appear perfectly well tilled and even. The lawn topsoil is to be rolled and lightly irrigated prior to placing of the seed. The seed is not to be laid on frozen or soaked soil.
  - The existing trees are to be protected during the preparation of the lawn areas. The roots of the trees are to be undisturbed during the cleaning of the topsoil.
  - The trees and shrubs are to be handled with the best care and attention to ensure that the plants are not bruised, broken, torn, damaged in any way which will affect the plants general appearance and well being.
  - The trees and shrubs are to be planted with the accepted standards of the American Association of Nurserymen. The plants are to be properly watered and backfilled during the planting. All care must be taken to ensure that the plants are upright, a plant's best side is exposed to the point of the plants greatest visibility.
  - The trees must be staked in accordance with acceptable nursery practice to ensure that they are secure in the ground and will grow straight and uniform. The trees are to be wrapped if the contractor deems it necessary to protect the trees from sun scald or insect attack.
  - The Landscape Contractor is to provide a 1-year guarantee for all plant material and other work done on site.
  - Large growing plants are not to be planted in front of windows, under building overhangs, or in drainage swales. Shrubs planted near H.V.A.C units to be located so that shrubs at maturity will maintain 1 foot airspace between unit and plant.
  - Contractor to slightly adjust plant locations in the field as necessary to be clear of drainage swales and utilities. Finished planting beds shall be graded so as not to impede drainage away from buildings.
  - Trees in public rights of way shall be located at least 3 feet from sidewalks. When the distance between the curb and the sidewalk is less than 6 feet, trees shall be planted 3 feet from sidewalk in the direction away from the road. (See road sections, below)
  - Quantities as shown on the plan shall govern over plant list quantities. Contractor to verify plant list totals with quantities shown on plan.
  - Groups of shrubs shall be placed in a continuous raised mulch bed with smooth continuous lines. All mulched bed edges shall be curvilinear in shape following the contour of the plant mass. Trees located within 4 feet of shrub beds shall share some mulch bed.

SEE SHEETS 24 FOR REQUIRED POND #3 PERIMETER LANDSCAPING AND SUPPLEMENTAL INTERIOR POND PLANTING


SURETY CALCULATION-LANDSCAPE TREES:  
(INCLUDES REQUIRED SWM BUFFER PLANTING-SEE SHEET 24 FOR PLANT SCHEDULE)  
SHADE TREES 100 @ \$300 ea = \$30,000  
ORNAMENTAL/EVERGREENS 49 @ \$150 ea = \$7,350  
TOTAL \$37,350

SURETY CALCULATION-PUBLIC STREET LANDSCAPE TREES:  
SHADE TREES 131 @ \$300 ea = \$39,300  
TOTAL \$39,300


SHRUB PLANTING

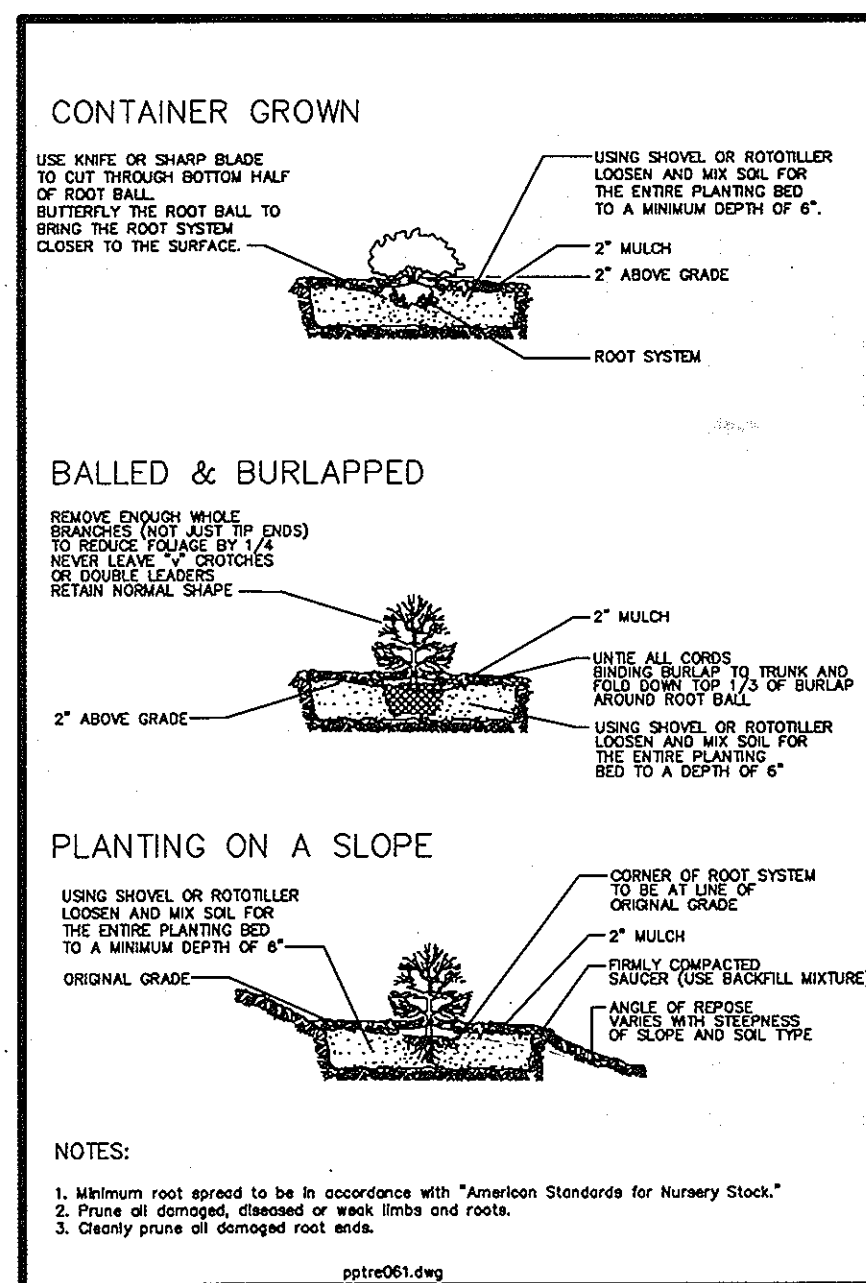



EVERGREEN TREE PLANTING

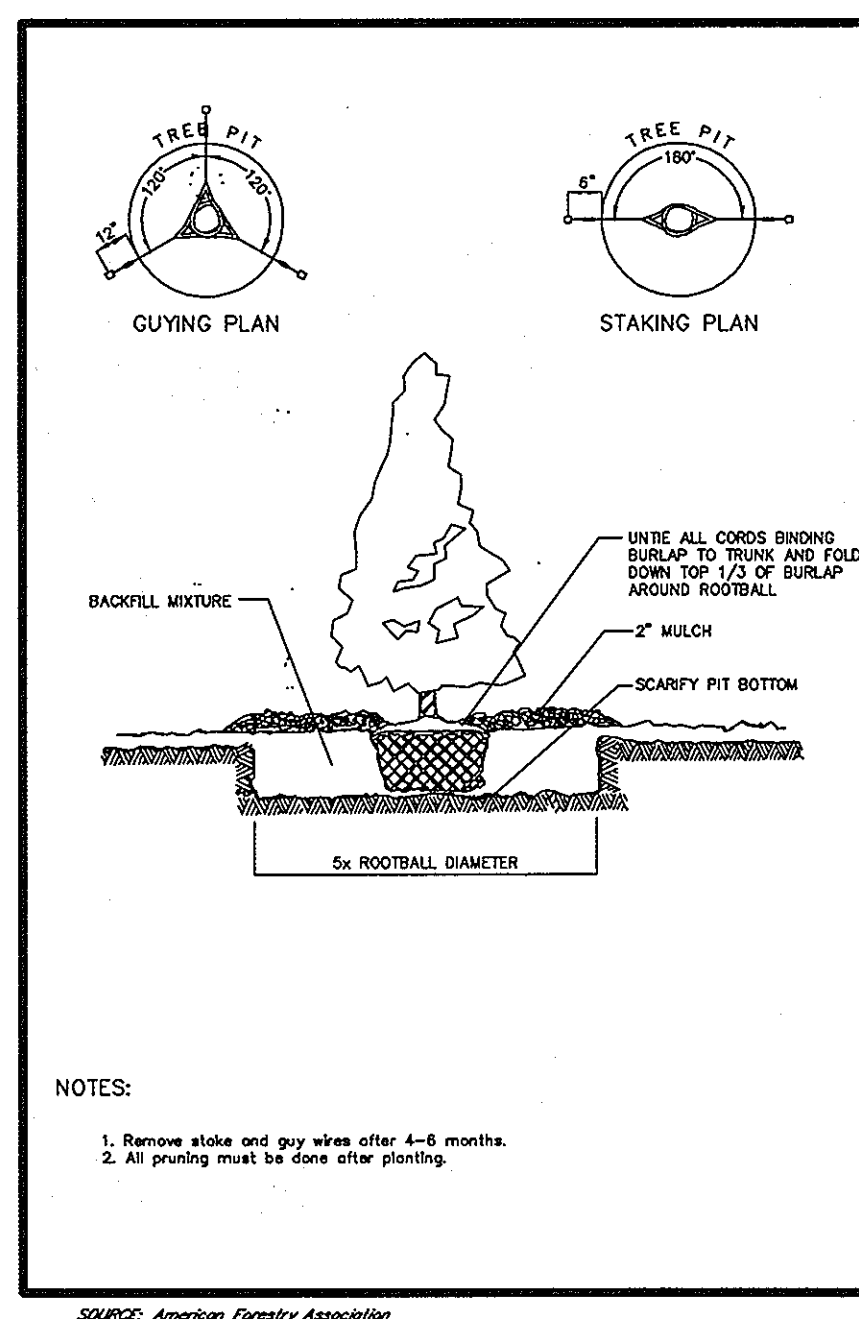

DECIDUOUS TREE PLANTING  
CONTAINER GROWN AND BALLED & BURLAPPED STOCK

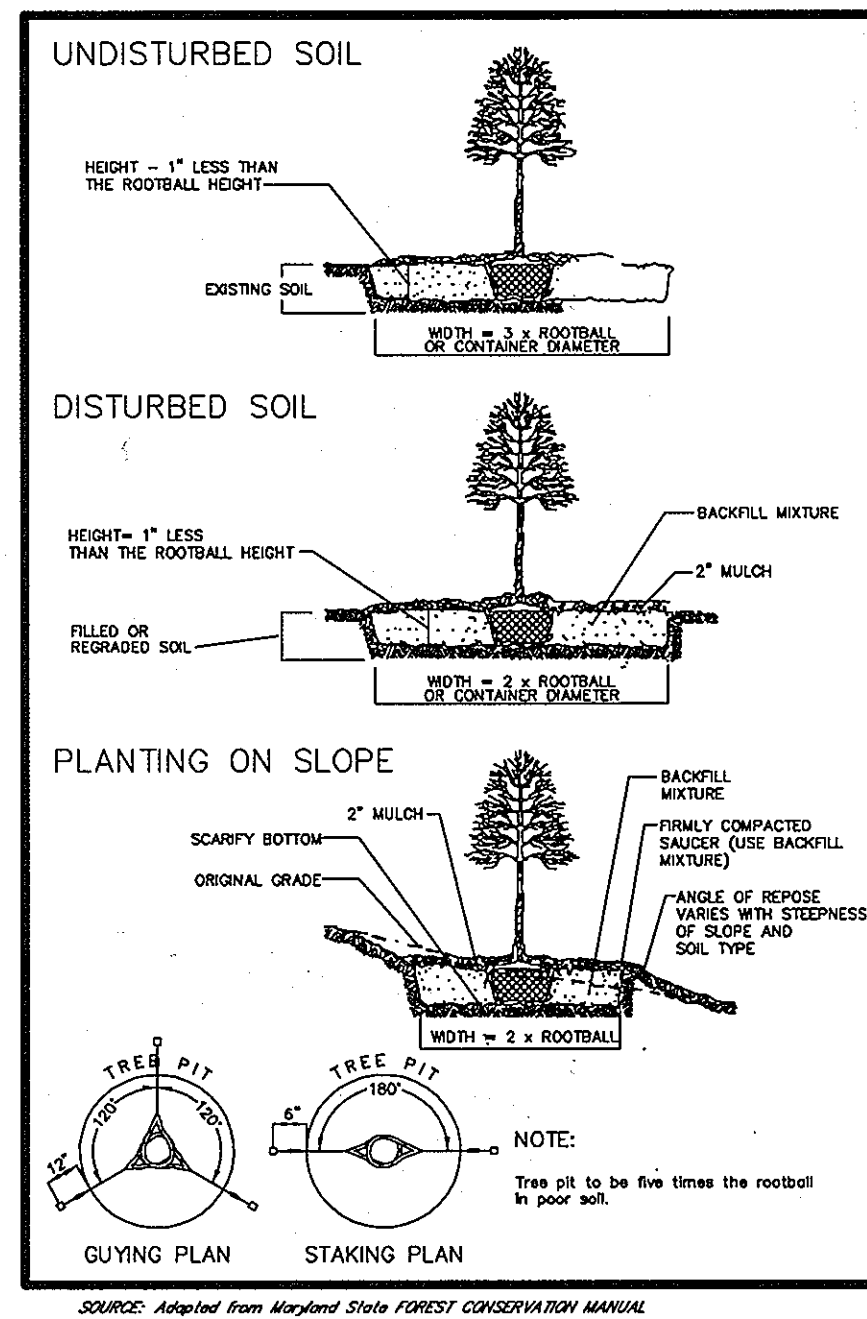

STAKED TREE SPECIFICATION (2)

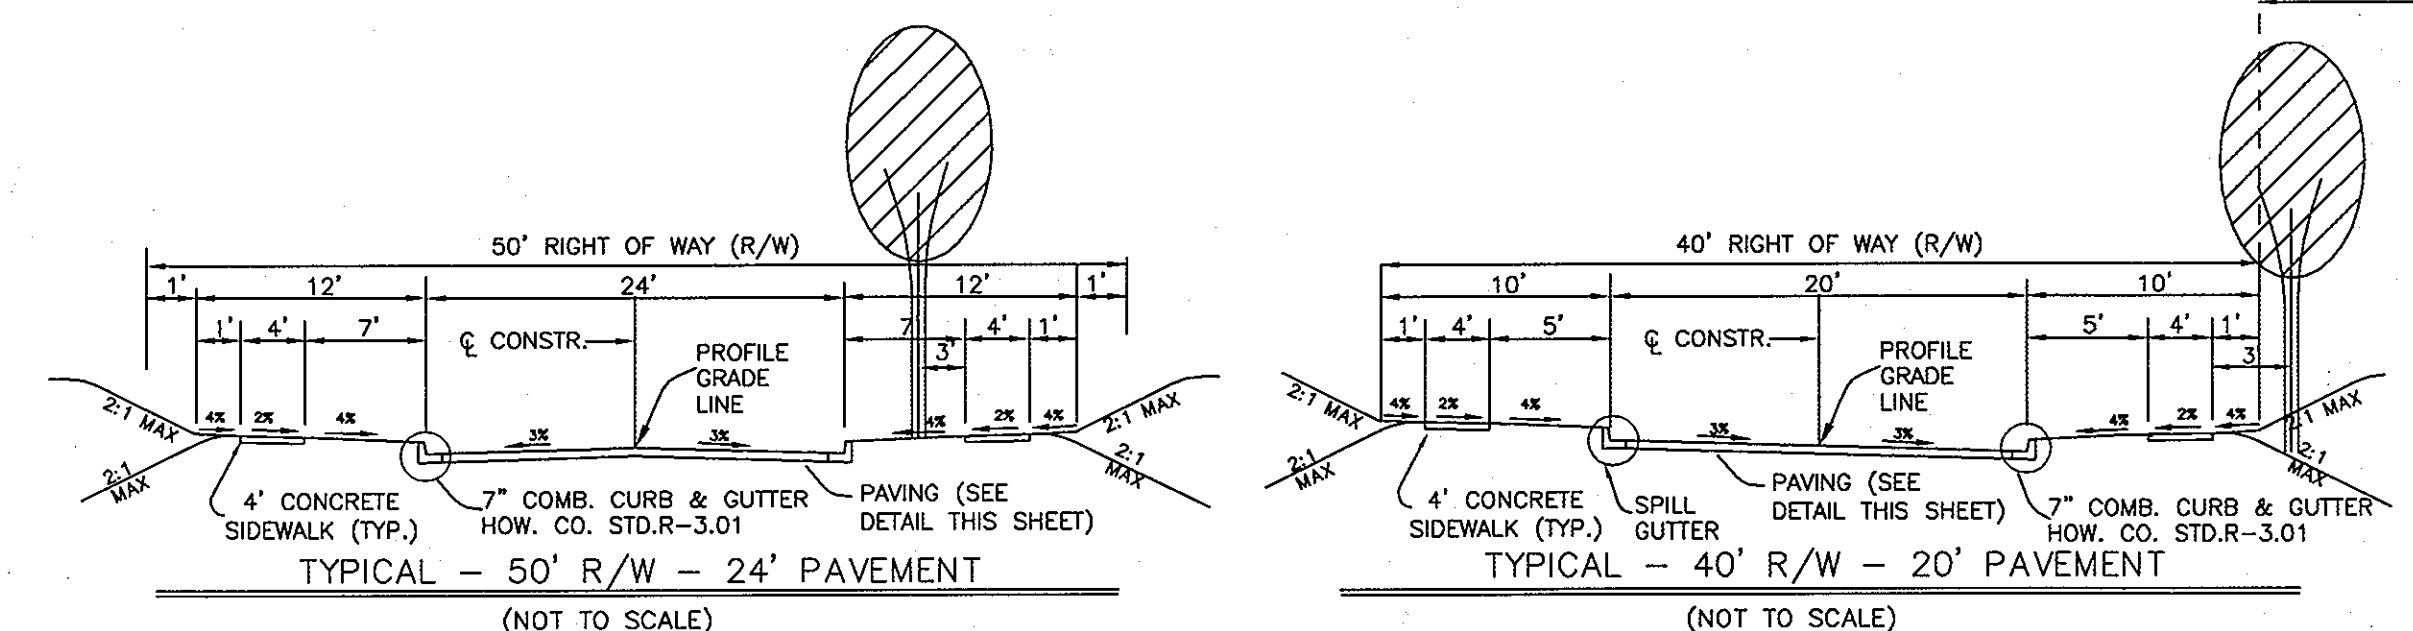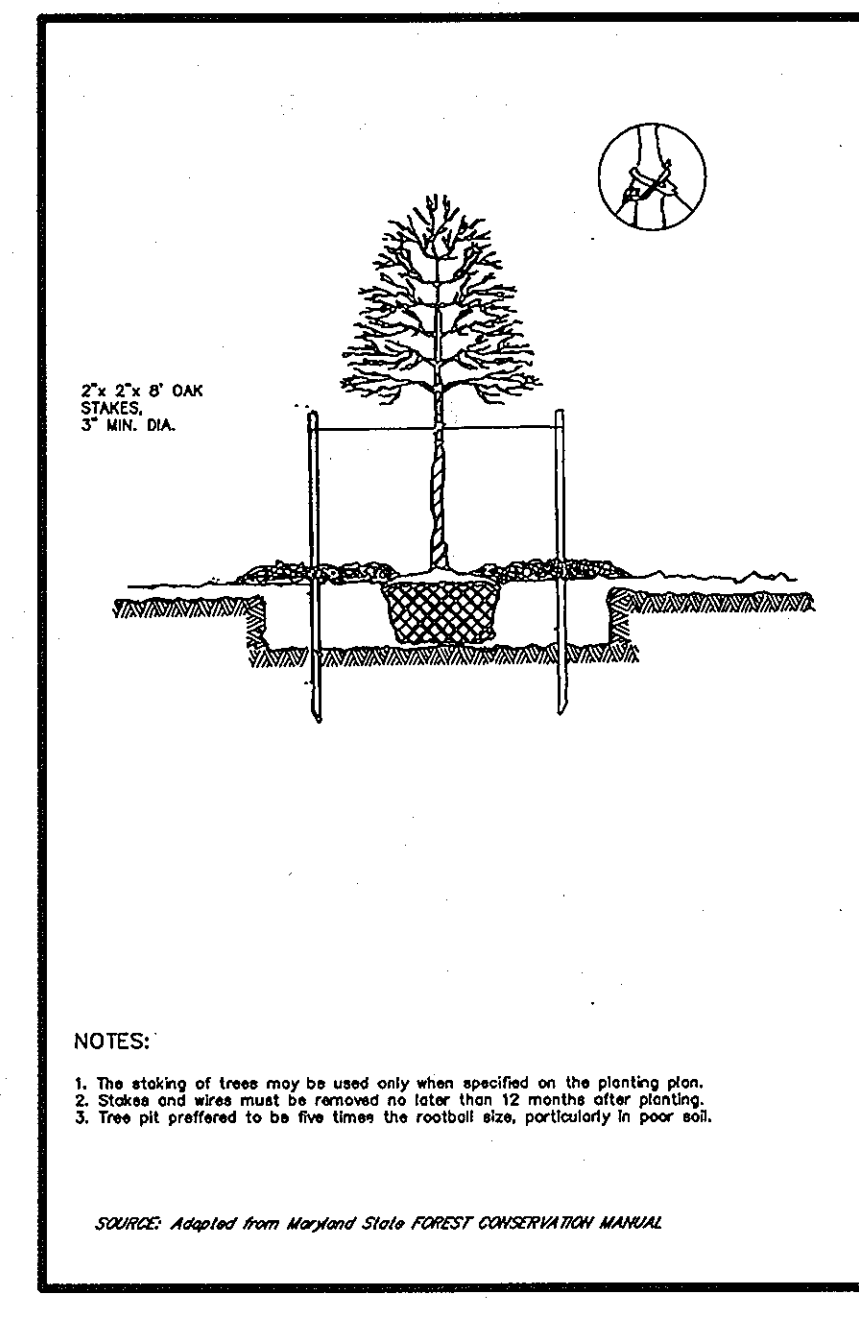

STREET TREE PLACEMENT

NOTE: A MINIMUM SPACING OF 20 FEET SHALL BE MAINTAINED BETWEEN ANY STREET LIGHT AND ANY TREE.

AS-BUILT PLANS  
(No As-Built Data This Sheet)

APPROVED: HOWARD COUNTY DEPARTMENT OF PUBLIC WORKS  
*William F. ...* 10/14/03  
CHIEF, BUREAU OF HIGHWAY

APPROVED: HOWARD COUNTY DEPARTMENT OF PLANNING & ZONING  
*Carla ...* 10/27/02  
CHIEF, DIVISION OF LAND DEVELOPMENT

*John ...* 10/17/03  
CHIEF, DEVELOPMENT ENGINEERING DIVISION

DATE	REVISION	DATE	BY	DATE
	BASE DATA		CADD	
	DESIGNED		PFB, YSL	
	DRAWN		YSL	
	REVIEWED		PFB	
	RELEASE FOR			
	BY			

Developer/Owner:  
Winchester Homes, Inc. &  
Winchester Homes, Inc., as nominee for Stringtown Investments, LLC  
6905 Rockledge Drive  
Suite 800  
Bethesda, Maryland 20817  
Stephen J. Nardella, Vice President  
(301) 803 - 4800

LANDSCAPE PLAN &  
STREET TREE PLAN  
Details

RODGERS  
CONSULTING  
Enhancing the value of land assets


Rodgers Consulting, Inc.  
9260 Gaither Road  
Gaithersburg, MD 20877  
301.948.4700  
301.948.6256 (fax)  
301.253.6609  
www.rodgers.com

Montjoy - Single Family Detached


A RESUBDIVISION OF NON-BUILDABLE BULK PARCEL C (F-03-87)  
TO  
RESUBDIVIDE LOTS 127- 188 AND OPEN SPACE LOTS 189-193  
ELECTION DISTRICT #2 HOWARD COUNTY, MARYLAND  
TAX MAP: 30, GRID: 12, PARCEL 260  
DPZ FILES: S-01-20, WP-01-117, P-02-10, P-02-17, P-03-03, F-03-87

SCALE: AS SHOWN  
JOB No. 506V3  
DATE: 1-14-03  
INDEX No. LS-4  
SHEET No. 28 OF 34  
F-03-100




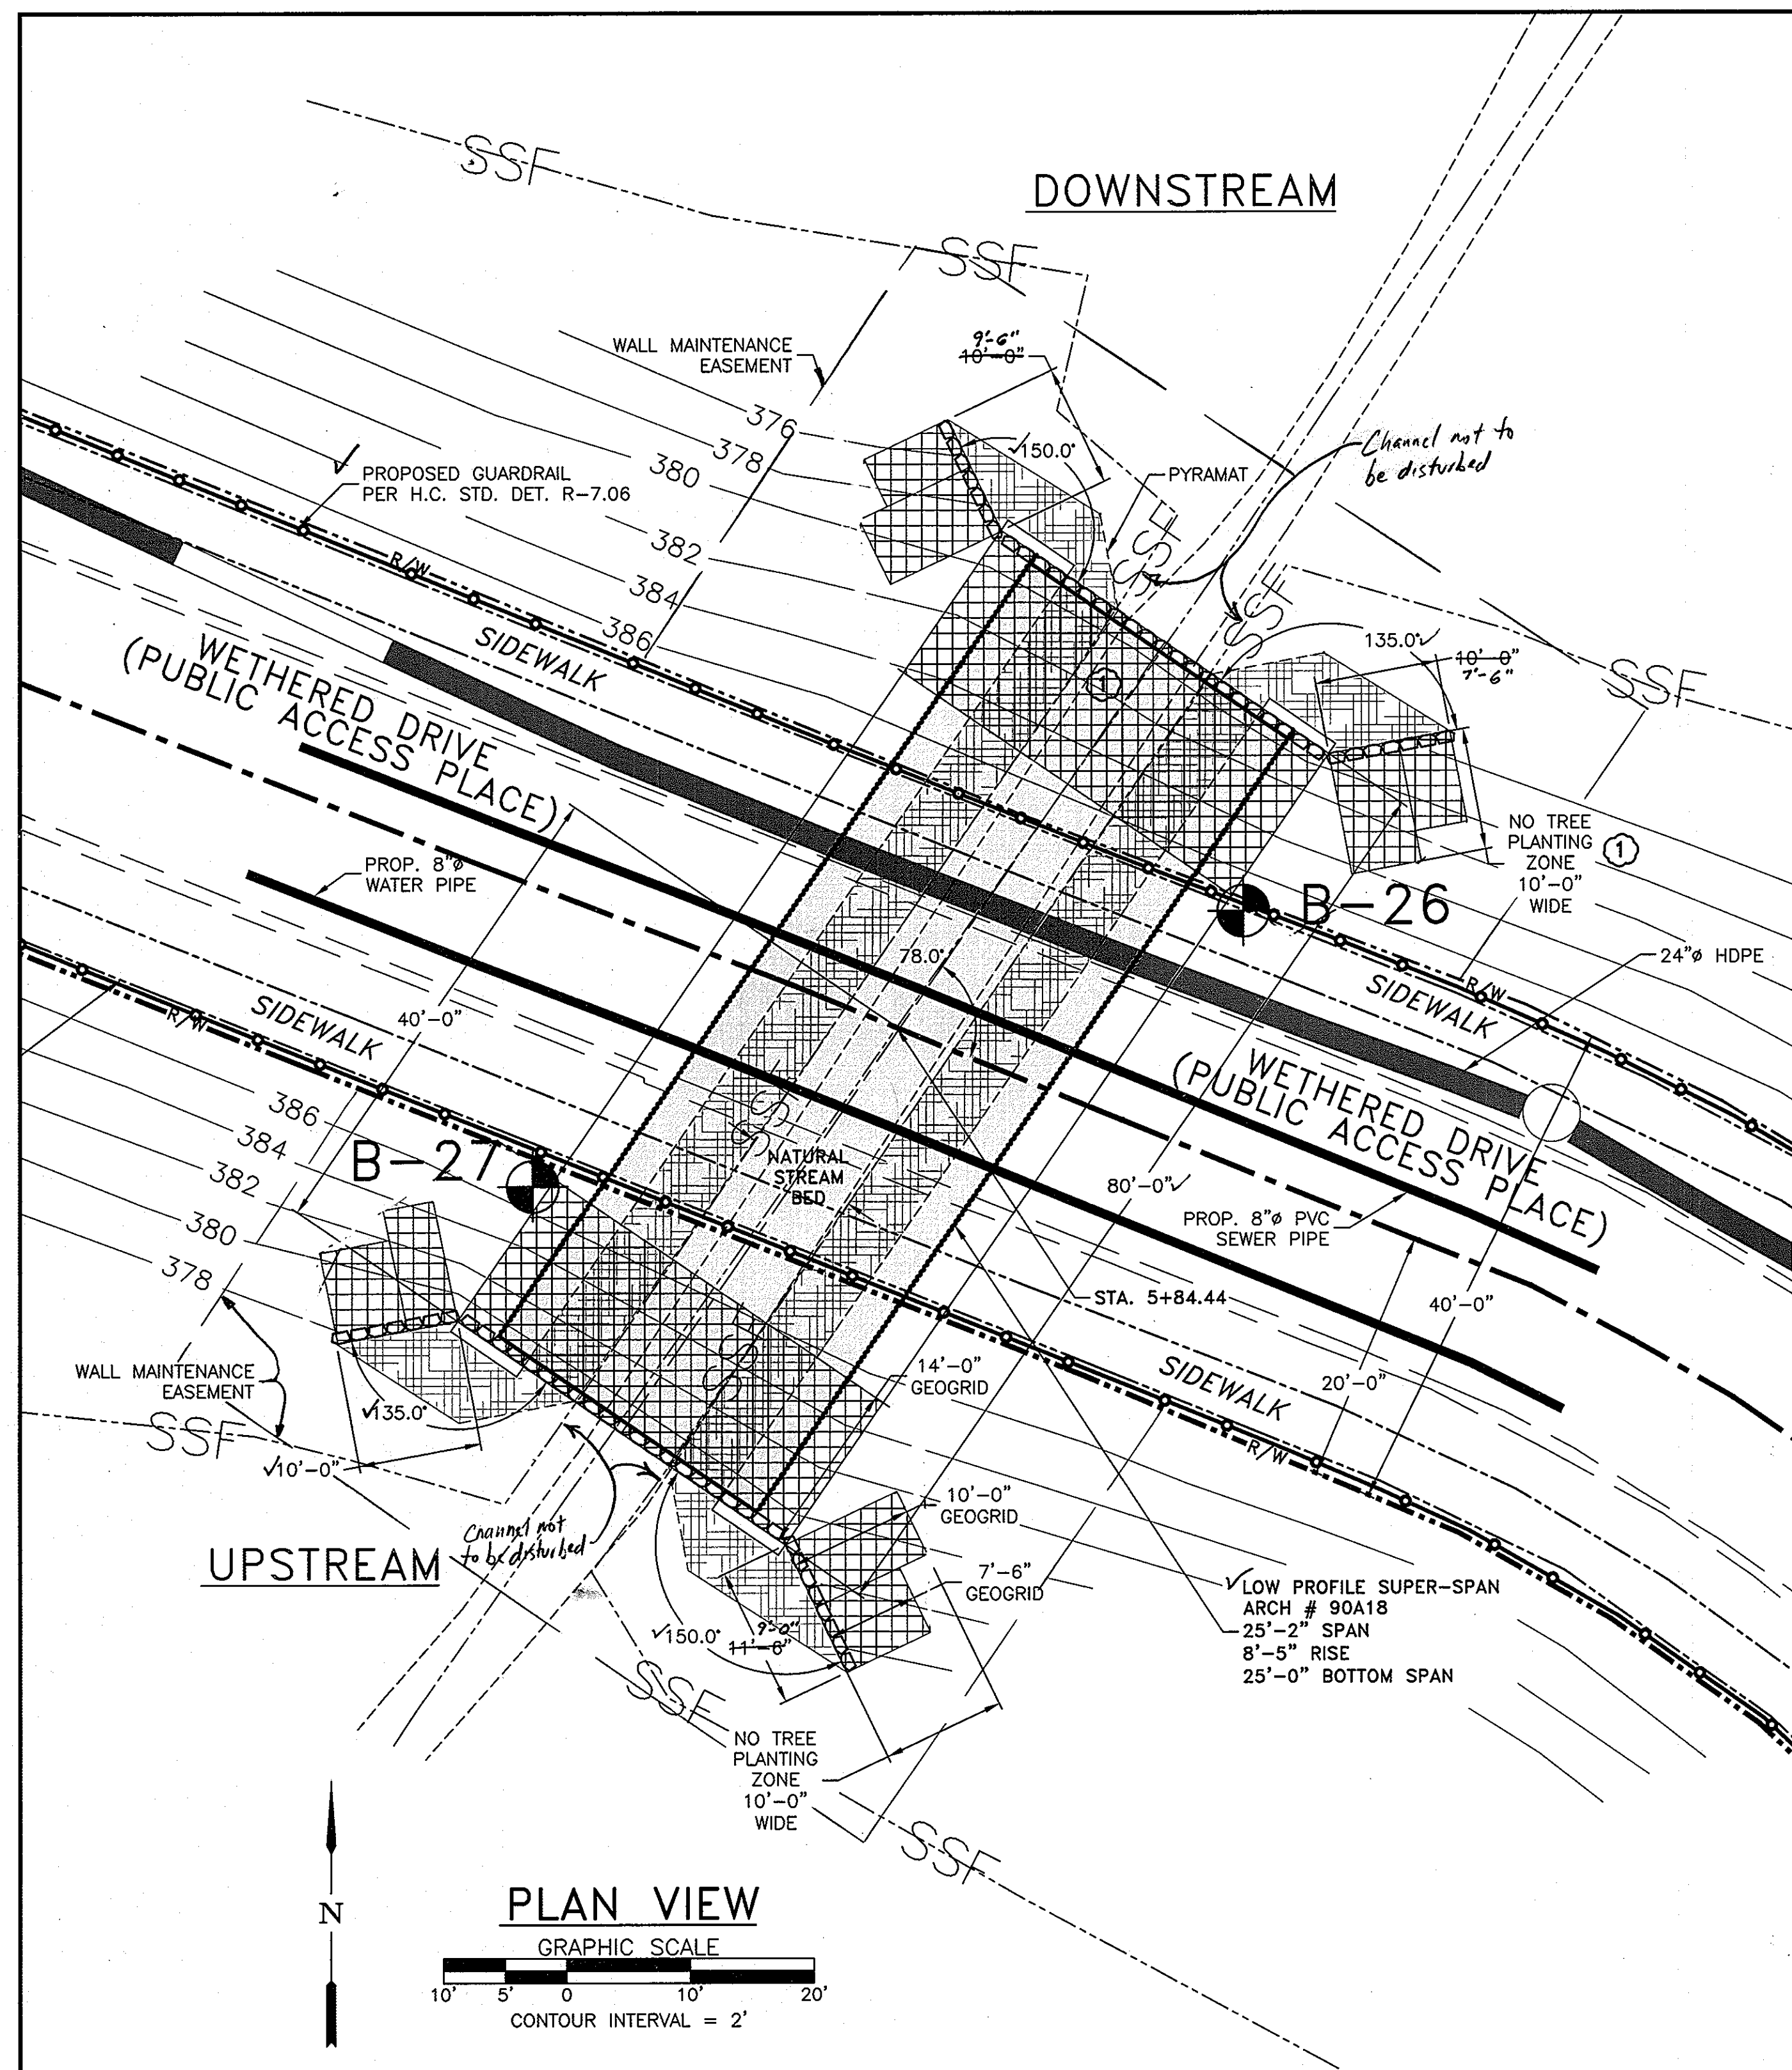

**PLAN VIEW**  
GRAPHIC SCALE  
CONTOUR INTERVAL = 2'

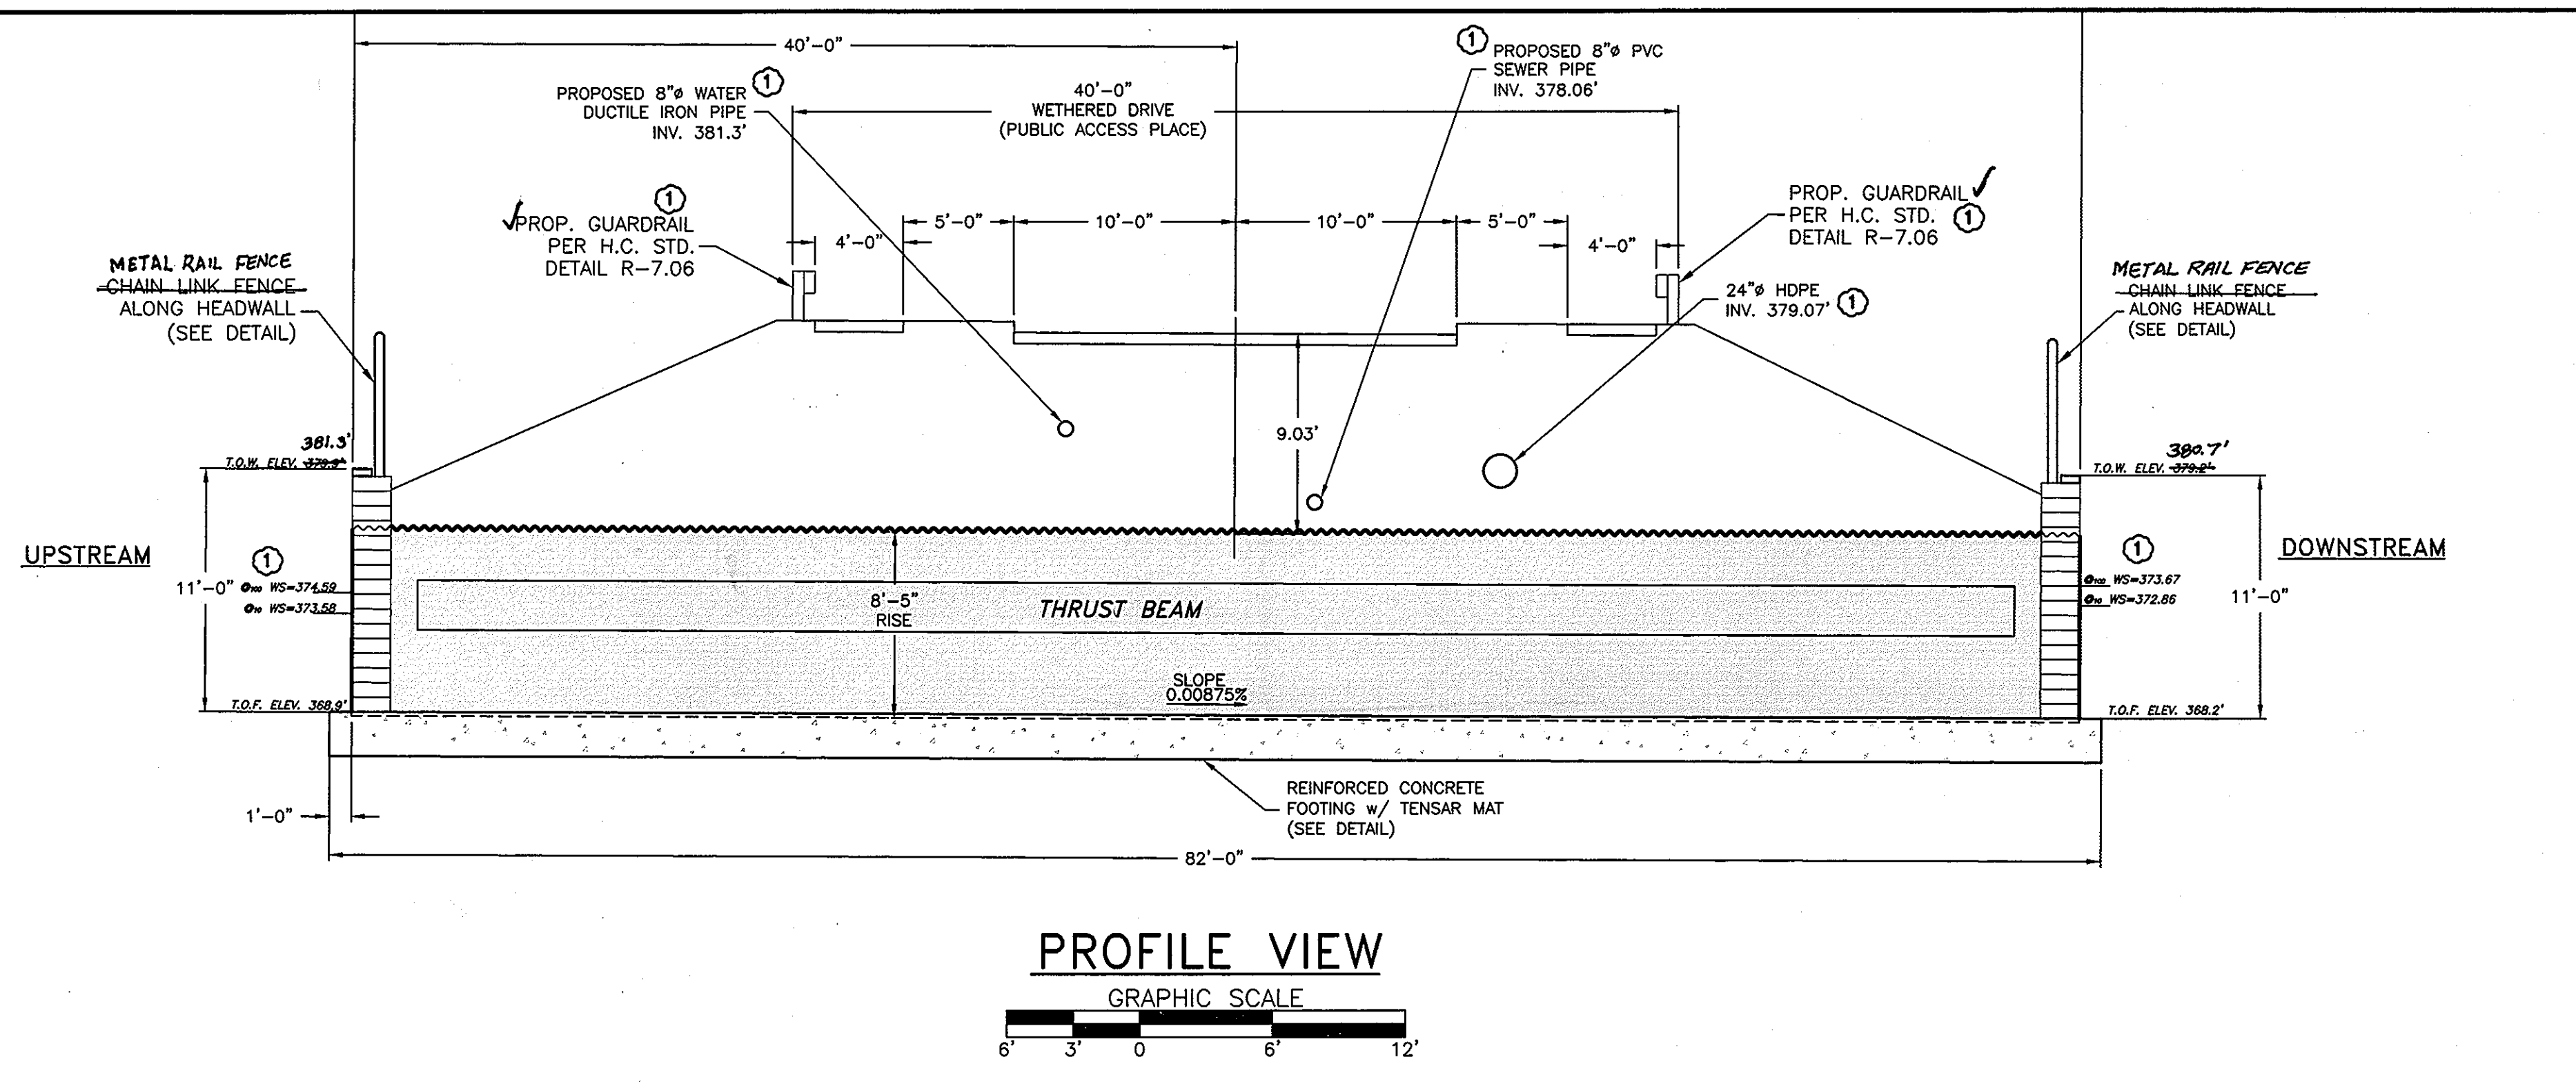

**PROFILE VIEW**  
GRAPHIC SCALE

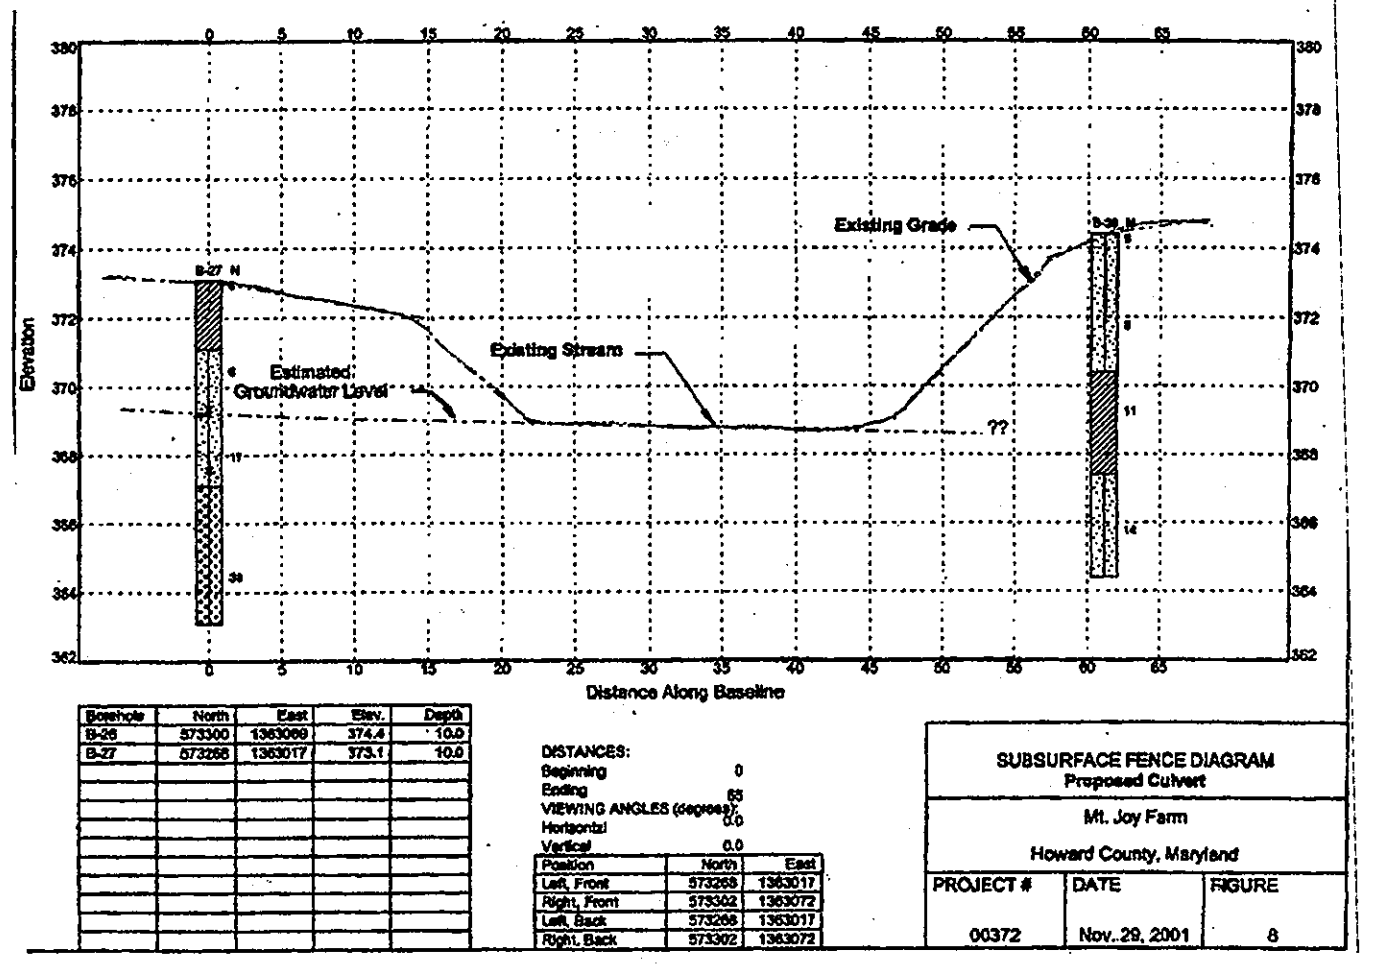

Friday, November 08, 2002 5:36 PM  
CONTECH CPI 410-838-7915  
11' - 1" = 2' 8.10PM 1 RODGERS CONSULTING+ 410 838 7915-11/8/21  
Sheet 1 of 1

**LOG OF BORING NO. B-26**

PROJECT: Mt. Joy Farm  
PROJECT NO: 00372  
PROJECT LOCATION: Howard County, Maryland  
DATE STARTED: November 8, 2001  
DATE COMPLETED: November 8, 2001  
DRILLING CONTRACTOR: Geo-Technology Associates, Inc.  
DRILLING METHOD: MSA  
SAMPLING METHOD: Split Spoon

WATER LEVEL: 3.0' Dry  
DATE: 11/08/01  
CAVED TO: 3.0'  
GROUND SURFACE ELEVATION: 373.6  
DATE: 11/08/01  
EQUIPMENT: CASE 45  
LOGGED BY: S. Greeningham  
CHECKED BY: S. Rowe

DEPTH (ft)	DIAMETER (in)	DESCRIPTION	REMARKS	
1.00	2.44	5.28	Brown, moist, loam, coarse to fine SAND, some SILT.	Topsoil 5 ft.
2.23	3.44	8	ASHIOT: A-2-4	
3.60	4.68	11	CL	Brown, moist, medium fine, silty CLAY, some coarse to fine SAND, trace fine gravel.
4.65	4.68	11	SN	Gray-brown, moist to wet, medium dense, coarse to fine SAND, trace SILT & CLAY.
		10	ASHIOT: A-2-4	
		10		Bottom of hole at 15.0 ft.

Notes:  
1. GEO-TECHNOLOGY ASSOCIATES, INC.  
2. 8000 Junction Drive, Suite 2  
Annapolis Junction, MD 20701

**LOG OF BORING NO. B-26**  
Sheet 1 of 1

Friday, November 08, 2002 5:36 PM  
CONTECH CPI 410-838-7915  
11' - 1" = 2' 8.10PM 1 RODGERS CONSULTING+ 410 838 7915-11/8/21  
Sheet 1 of 1

**LOG OF BORING NO. B-27**

PROJECT: Mt. Joy Farm  
PROJECT NO: 00372  
PROJECT LOCATION: Howard County, Maryland  
DATE STARTED: November 8, 2001  
DATE COMPLETED: November 8, 2001  
DRILLING CONTRACTOR: Geo-Technology Associates, Inc.  
DRILLING METHOD: MSA  
SAMPLING METHOD: Split Spoon

WATER LEVEL: 3.0' Dry  
DATE: 11/08/01  
CAVED TO: 3.0'  
GROUND SURFACE ELEVATION: 373.1  
DATE: 11/08/01  
EQUIPMENT: CASE 45  
LOGGED BY: S. Greeningham  
CHECKED BY: S. Rowe

DEPTH (ft)	DIAMETER (in)	DESCRIPTION	REMARKS	
1.00	3.44	8	CL	Brown, moist, medium fine, SILT & CLAY and fine SAND.
2.23	3.44	8	ASHIOT: A-2-4	
3.50	4.68	11	SN	Gray to brown, moist to dry, dense, coarse to fine SAND, trace SILT & CLAY.
4.65	4.68	11	ASHIOT: A-2-4	
		10		Bottom of hole at 15.0 ft.

Notes:  
1. GEO-TECHNOLOGY ASSOCIATES, INC.  
2. 8000 Junction Drive, Suite 2  
Annapolis Junction, MD 20701

**LOG OF BORING NO. B-27**  
Sheet 1 of 1

Developer/Owner:  
**Winchester Homes, Inc. & Winchester Homes, Inc.**, as nominee for Stringtown Investments, LLC  
6905 Rockledge Drive  
Bethesda, Maryland 20817  
Stephen J. Nardella, Vice President  
(301) 803 - 4800


HOWARD COUNTY DEPARTMENT OF PUBLIC WORKS  
*William F. Mahan* 10-14-03  
CHIEF, BUREAU OF HIGHWAY

HOWARD COUNTY DEPARTMENT OF PLANNING & ZONING  
*Chris Hamilton* 11/27/03  
CHIEF, DIVISION OF LAND DEVELOPMENT

*Chris Hamilton* 10/17/03  
CHIEF, DEVELOPMENT ENGINEERING DIVISION

# AS-BUILT PLANS

**AS-BUILT CERTIFICATION**  
I HEREBY CERTIFY THAT THE FACILITY SHOWN ON THIS PLAN WAS CONSTRUCTED AS SHOWN ON THE "AS-BUILT PLANS" AND MEETS THE APPROVED PLAN AND SPECIFICATIONS.  
SIGNATURE: *[Signature]* P.E. NO. 20637  
DATE: 12/5/08

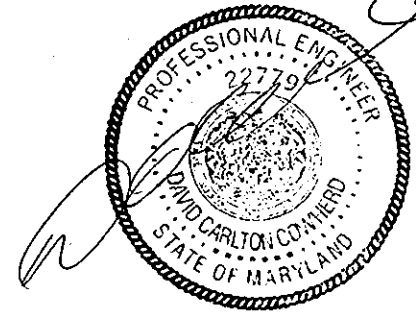

CONTECH CONSTRUCTION PRODUCTS, INC.  
DESIGN OF SUPER-SPAN  
LOW PROFILE ARCH #90A18

3	9/24/03	DWR	FINAL MYLAR SUBMITTAL FOR SIGNATURE
2	4/22/03	DWR	REVISION #2 - REVIEWER'S COMMENTS
1	4/11/03	DWR	REVISION #1 - REVIEWER'S COMMENTS


**CBC ENGINEERS**  
DAYTON, OHIO

**PLAN, PROFILE & LOGS**


Drawn By: DWR Date: 12/16/02  
Approved By: Date: 12/16/02

Scale: GRAPHIC Project No: CBC-4268 Rev: 3 Sheet: 29 OF 34




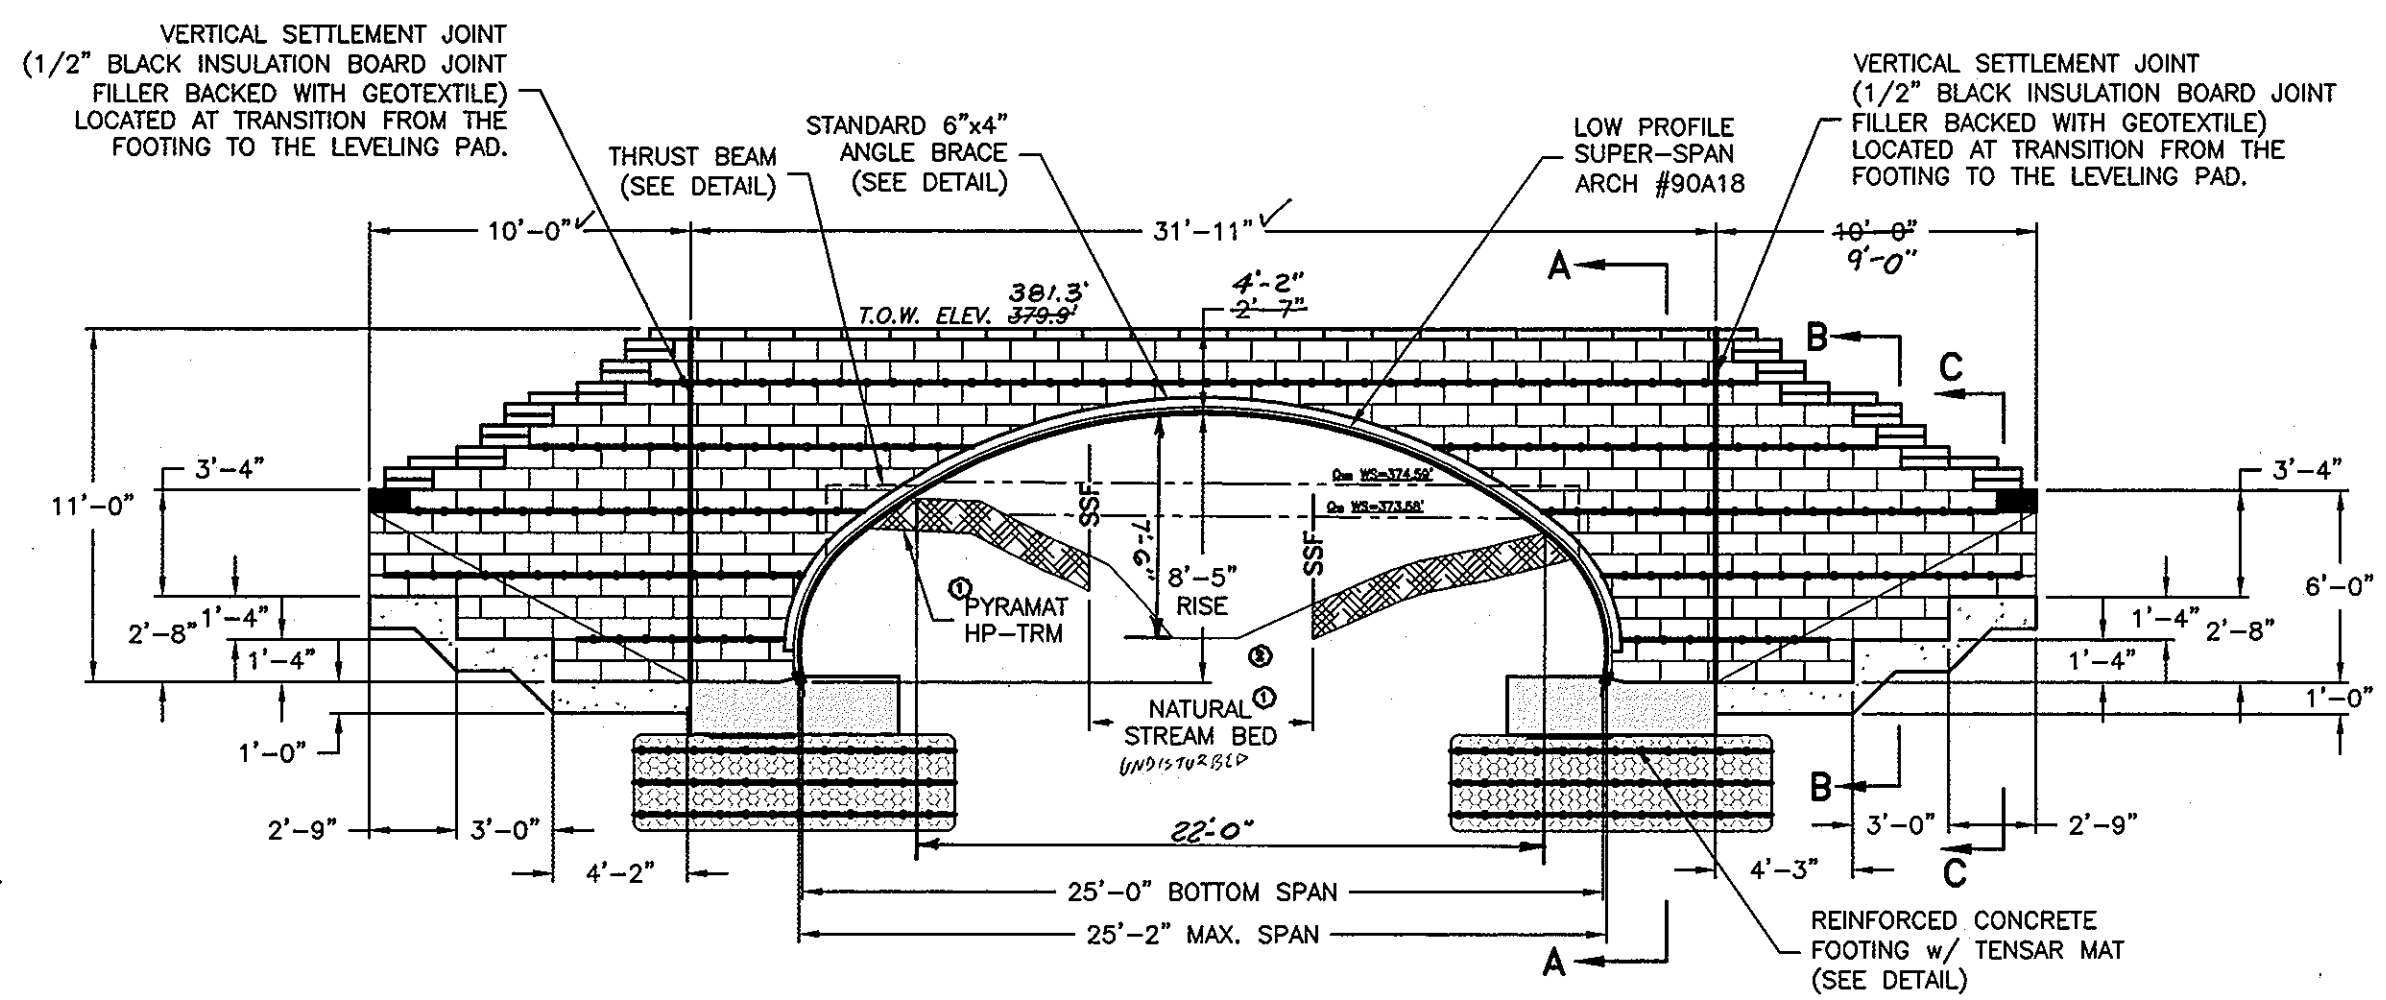


UPSTREAM ELEVATION VIEW

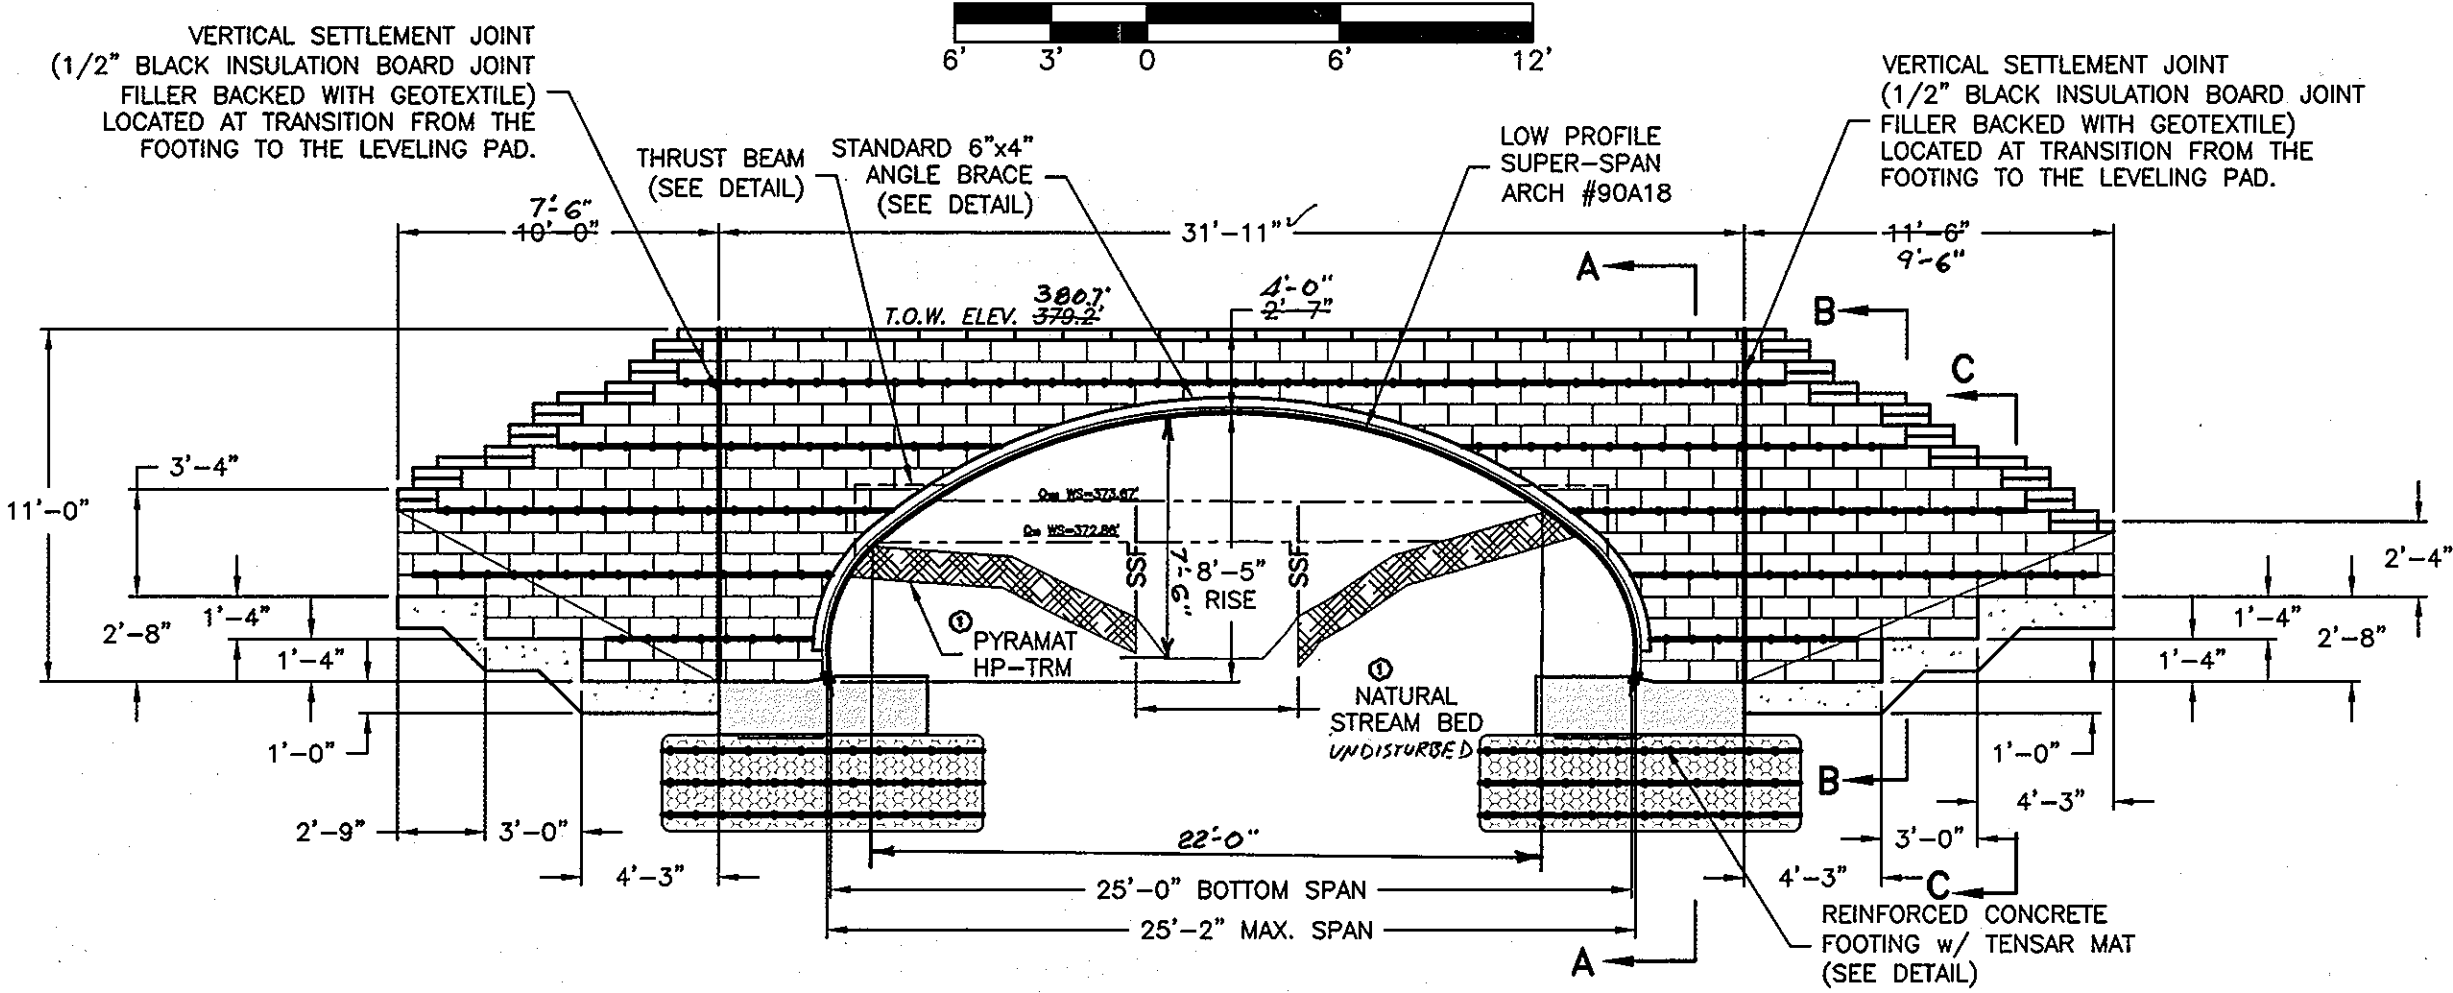


DOWNSTREAM ELEVATION VIEW

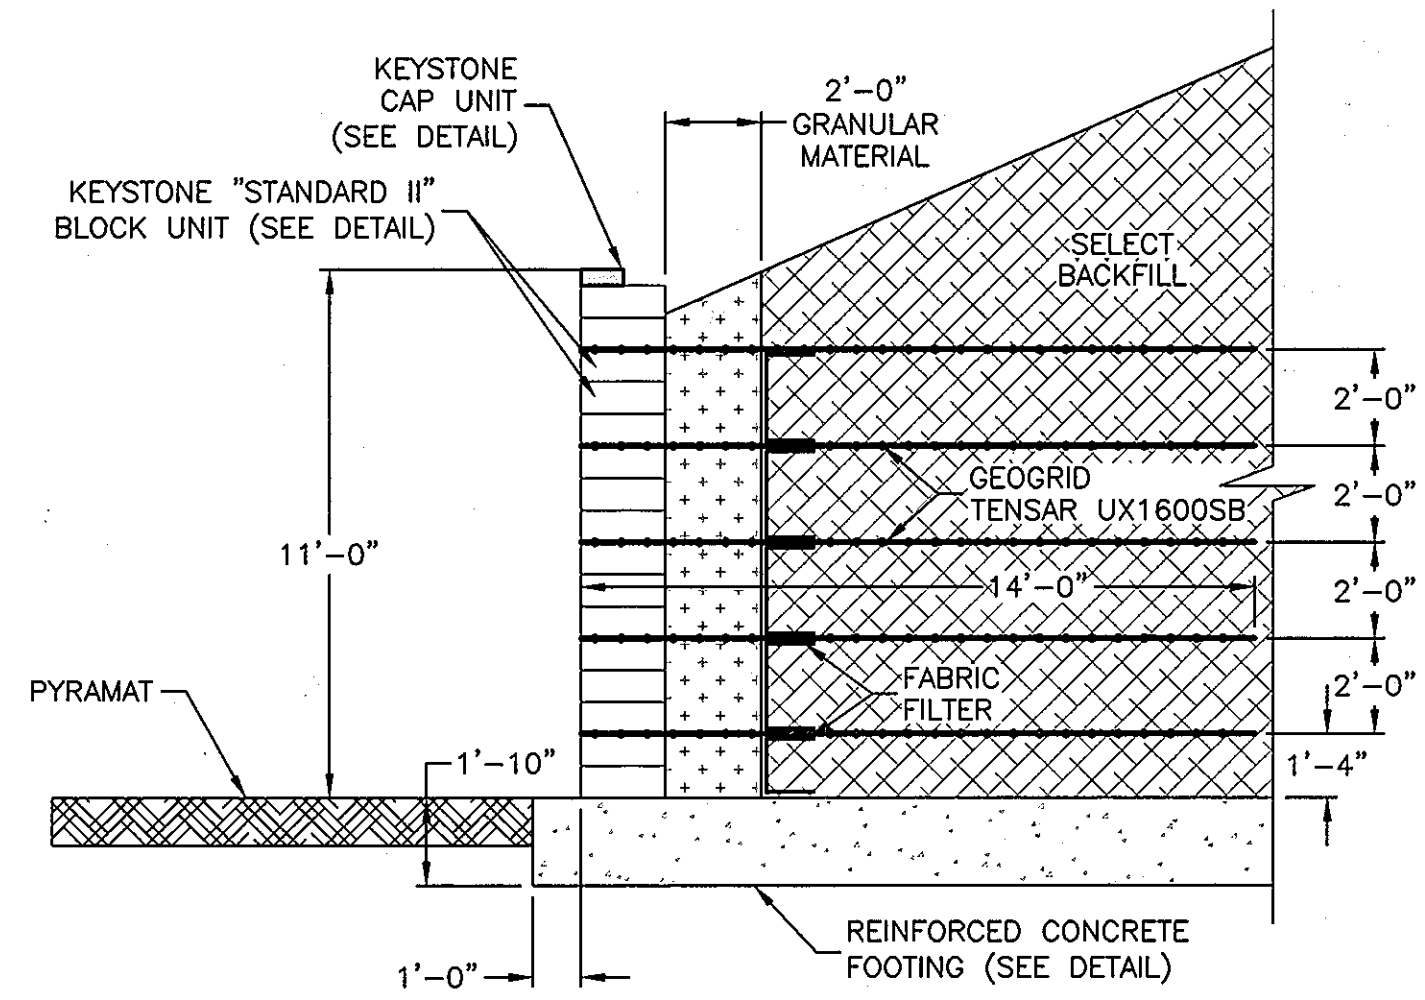

SECTION 'A-A'

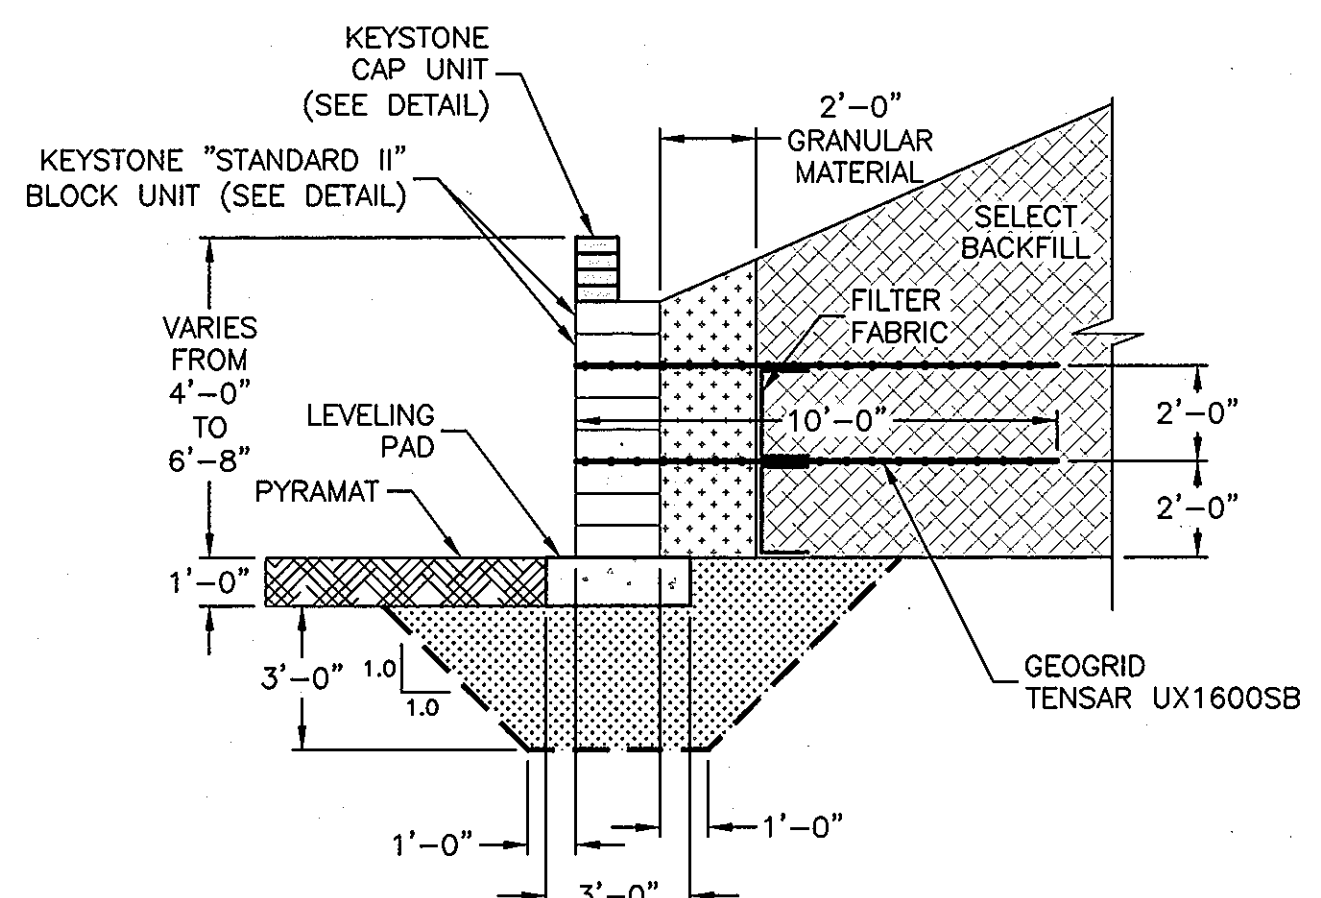

SECTION 'B-B' KEYSTONE WINGWALL

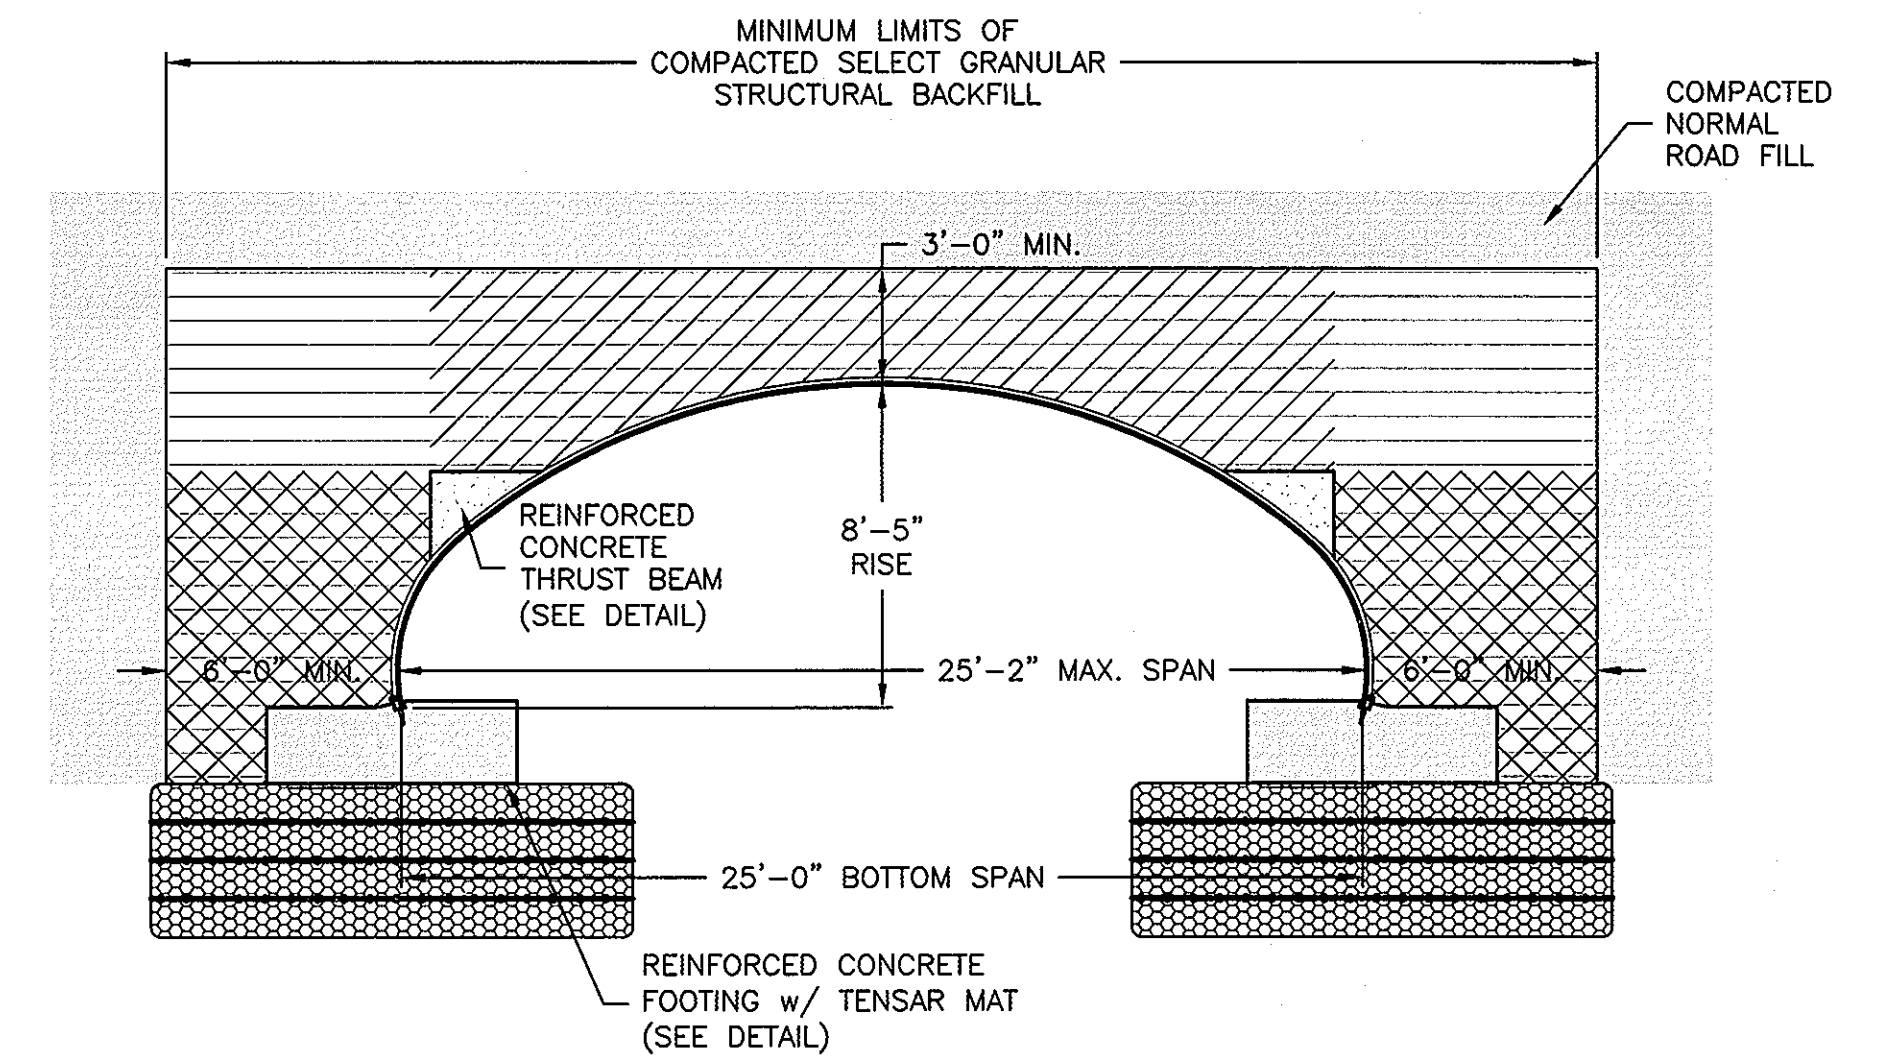


TYPICAL BACKFILL DETAIL


LEGEND:

- CRITICAL BACKFILL ZONE, PRESSURE ON SOIL GREATEST HERE.
- INITIAL LIFTS OVER CROWN OF STRUCTURE AS INDICATED BY SHADED AREA TO BE COMPACTED TO REQUIRED DENSITY WITH HAND OPERATED EQUIPMENT OR WITH SMALL TRACTOR (D-4 OR SMALLER) DRAWN EQUIPMENT.


- NOTES FOR BACKFILL REQUIREMENTS:
- ALL SELECT GRANULAR FILL TO BE COMPACTED TO 90% PER ASHTO T-180.
  - COMPLETE AND REGULAR MONITORING OF THE SUPER-SPAN SHAPE IS NECESSARY DURING ALL BACKFILLING OF THE STRUCTURE.
  - DO NOT OPERATE HEAVY OR MEDIUM COMPACTORS ON BACKFILL (USE WALK BEHIND EQUIPMENT) CLOSER THAN 2 FEET FROM THE SIDE PLATES.
  - PREVENT EXCESSIVE DISTORTION OF SHAPE AS NECESSARY BY VARYING COMPACTION METHODS AND EQUIPMENT.

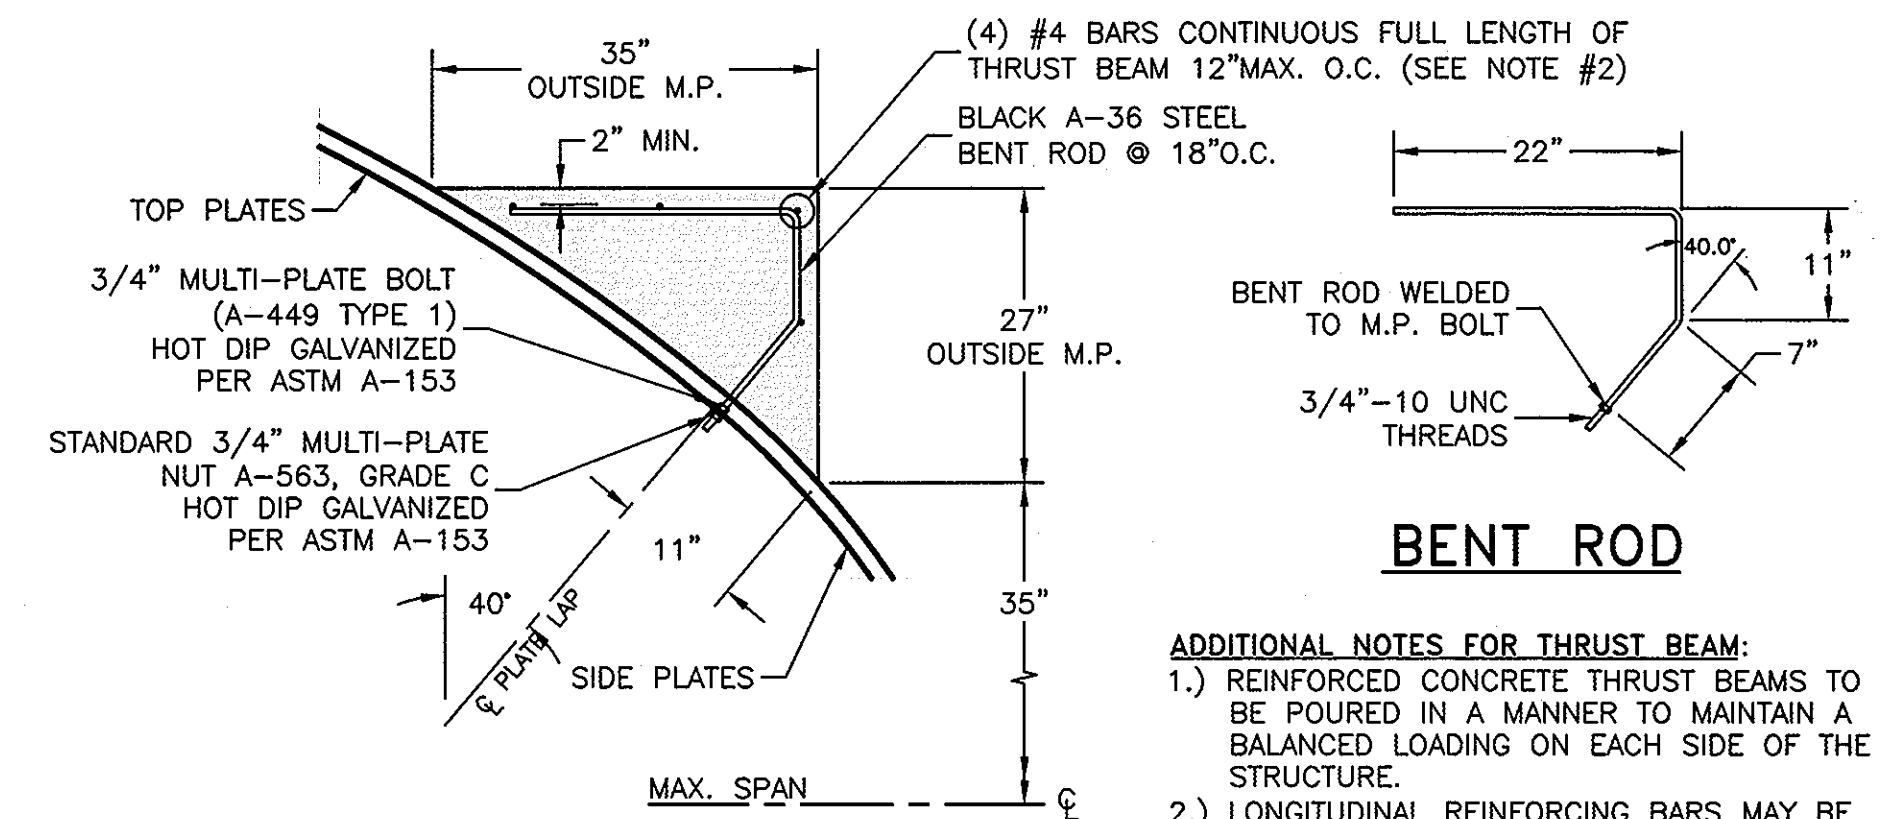

DETAIL OF THRUST BEAM  
NOT TO SCALE

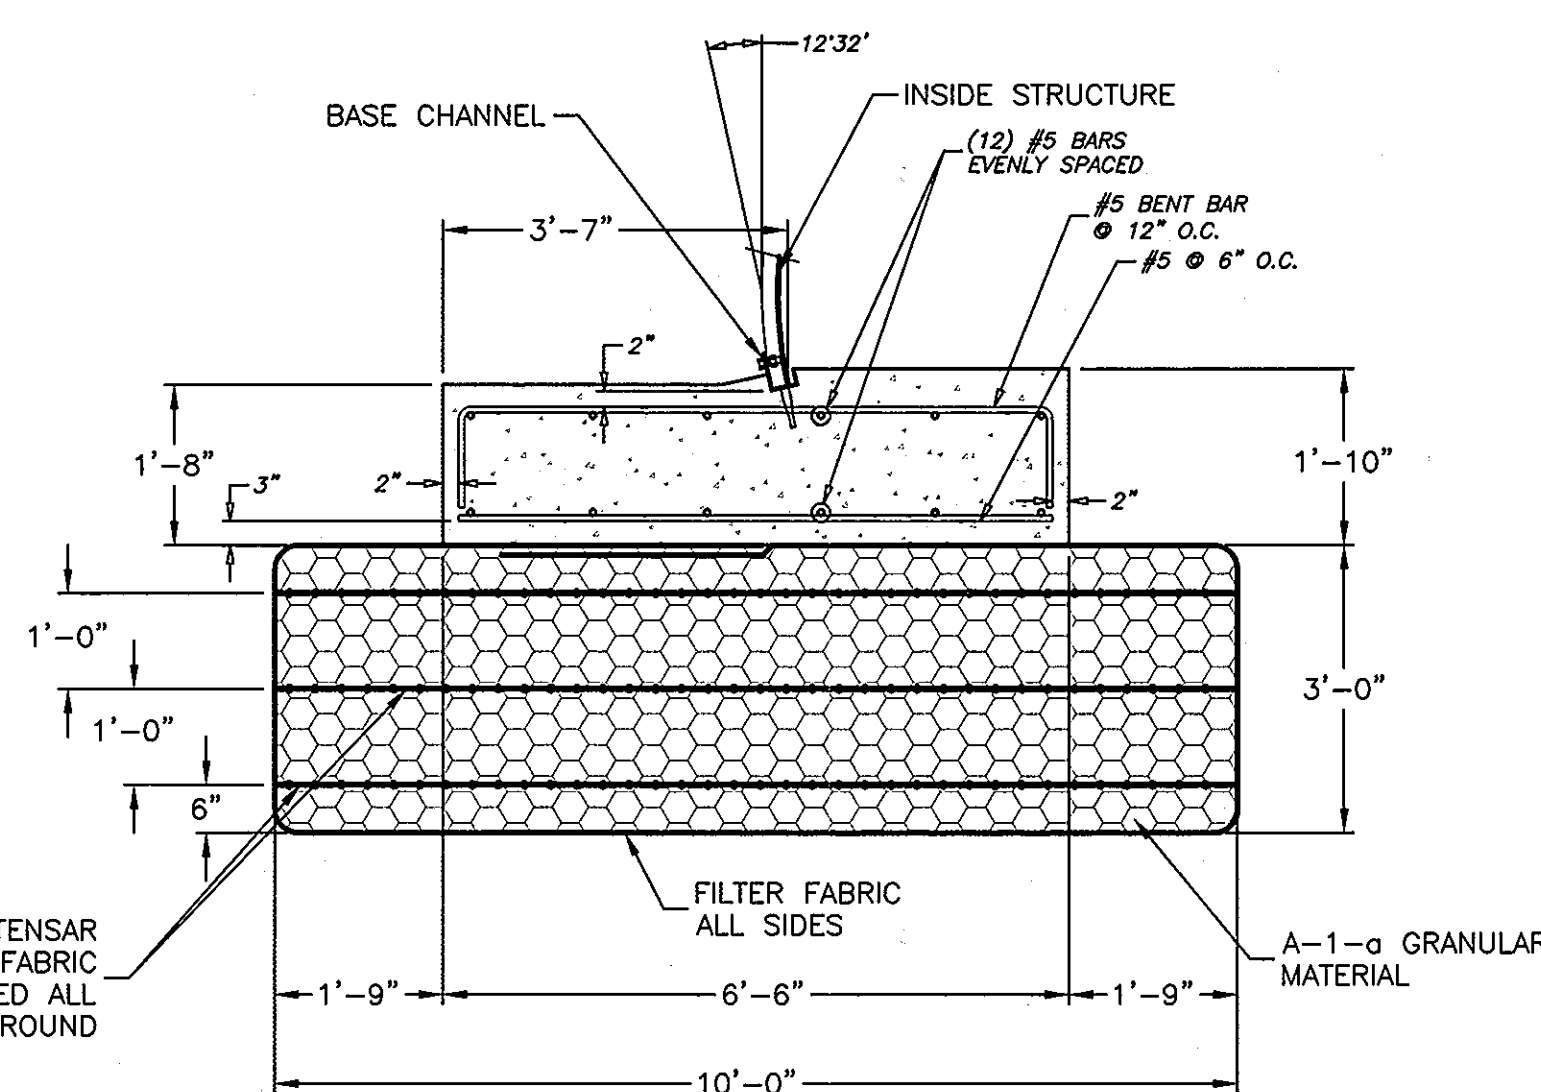

TYPICAL FOOTING SECTION

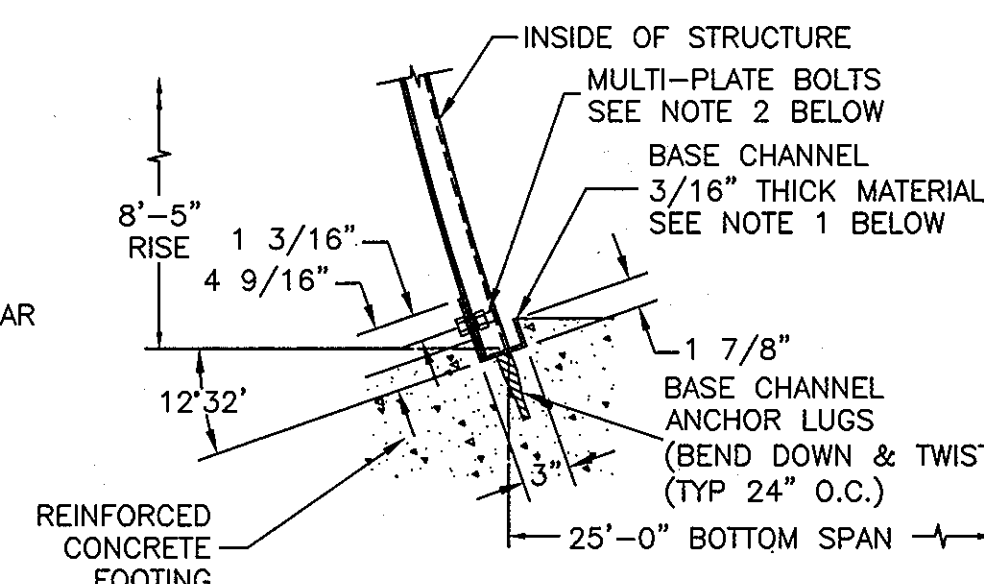

BASE CHANNEL DETAIL  
NOT TO SCALE

- NOTES FOR BASE CHANNEL
- REFERENCE CONTECH DWG. No. 1008964 FOR BASE CHANNEL DETAILS.
  - SHORT BOLT CONNECTION TO BASE CHANNEL SHOWN, OPPOSITE SIDE OF STRUCTURE REQUIRES 3" LONG BOLTS. REFERENCE CONTECH DWG. No. 103690 "MULTI-PLATE BASE CHANNEL INSTALLATION DETAILS."

- CONSTRUCTION NOTES:
- CONCRETE SHALL BE  $f'_c = 3,500$  psi
  - ALL REINFORCEMENT SHALL BE ASTM A-615, GRADE 60
  - RETAINING WALLS MAY ONLY BE CONSTRUCTED UNDER THE OBSERVATION OF A REGISTERED PROFESSIONAL ENGINEER AND A (NICET, WACEL, OR EQUIVALENT) CERTIFIED SOILS TECHNICIAN.
  - THE REQUIRED BEARING PRESSURE BENEATH THE FOOTING OF THE WALL SHALL BE VERIFIED IN THE FIELD BY A CERTIFIED SOILS TECHNICIAN. TESTING DOCUMENTATION MUST BE PROVIDED TO THE HOWARD COUNTY INSPECTOR PRIOR TO THE START OF CONSTRUCTION. THE REQUIRED TEST PROCEDURE SHALL BE THE DYNAMIC CONE PENETROMETER TEST ASTM STP-339.

- CONSTRUCTION NOTES (CONTINUED):
- THE SUITABILITY OF FILL MATERIAL SHALL BE CONFIRMED BY THE ON-SITE SOILS TECHNICIAN. EACH EIGHT INCH LIFT MUST BE COMPACTED TO A MINIMUM OF 95% STANDARD PROCTOR DENSITY AND THE TESTING REPORT SHALL BE MADE AVAILABLE TO HOWARD COUNTY INSPECTOR UPON COMPLETION OF CONSTRUCTION.
  - THE BEARING CAPACITY TO BE 2,500 psf BENEATH THE ARCH TENSAR MAT. THIS SHALL BE VERIFIED IN THE FIELD.

Developer/Owner:  
**Winchester Homes, Inc. & Winchester Homes, Inc.**, as nominee for Stringtown Investments, LLC  
6905 Rockledge Drive

Bethesda, Maryland 20817  
Stephen J. Nardella, Vice President  
(301) 803 - 4800


dev HOWARD COUNTY DEPARTMENT OF PUBLIC WORKS

*William F. ...* 10/14/03  
CHIEF, BUREAU OF HIGHWAY

dev HOWARD COUNTY DEPARTMENT OF PLANNING & ZONING

*Candis Hamate* 10/17/03  
CHIEF, DIVISION OF LAND DEVELOPMENT

*Chris ...* 10/17/03  
CHIEF, DEVELOPMENT ENGINEERING DIVISION

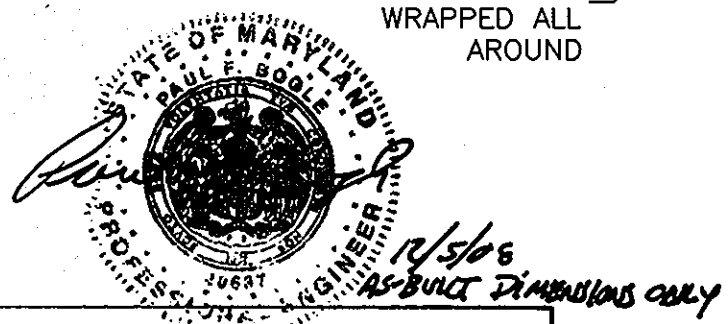

AS-BUILT CERTIFICATION  
I HEREBY CERTIFY THAT THE FACILITY SHOWN ON THIS PLAN WAS CONSTRUCTED AS SHOWN ON THE "AS-BUILT PLANS" AND MEETS THE APPROVED PLAN AND SPECIFICATIONS  
SIGNATURE: *Stephen J. Nardella* P.E. NO. 20637 DATE: 11/5/03

AS-BUILT PLANS

CONTECH CONSTRUCTION PRODUCTS, INC.  
DESIGN OF SUPER-SPAN  
LOW PROFILE ARCH #90A18


3	9/24/03	DWR	FINAL MYLAR SUBMITTAL FOR SIGNATURE
2	4/22/03	DWR	REVISION #2 - REVIEWER'S COMMENTS
1	4/11/03	DWR	REVISION #1 - REVIEWER'S COMMENTS

**CBC ENGINEERS**  
DAYTON, OHIO


DETAILS

Drawn By	Date	MONTJOY - SINGLE FAMILY DETACHED	
DWR	12/16/02	A RE-SUBDIVISION OF NON-BUILDABLE BULK PARCEL C/F-03-871	
Approved By	Date	TO	
		BUILDABLE LOTS 127-168 AND OPEN SPACE LOTS 169-193	
		ELECTION DISTRICT #2 HOWARD COUNTY, MARYLAND	
		TAX MAP: 30 GRID: 12 PARCEL 260	
Scale	Project No.	Rev.	Sheet
GRAPHIC	CBC-4268	3	30 OF 34





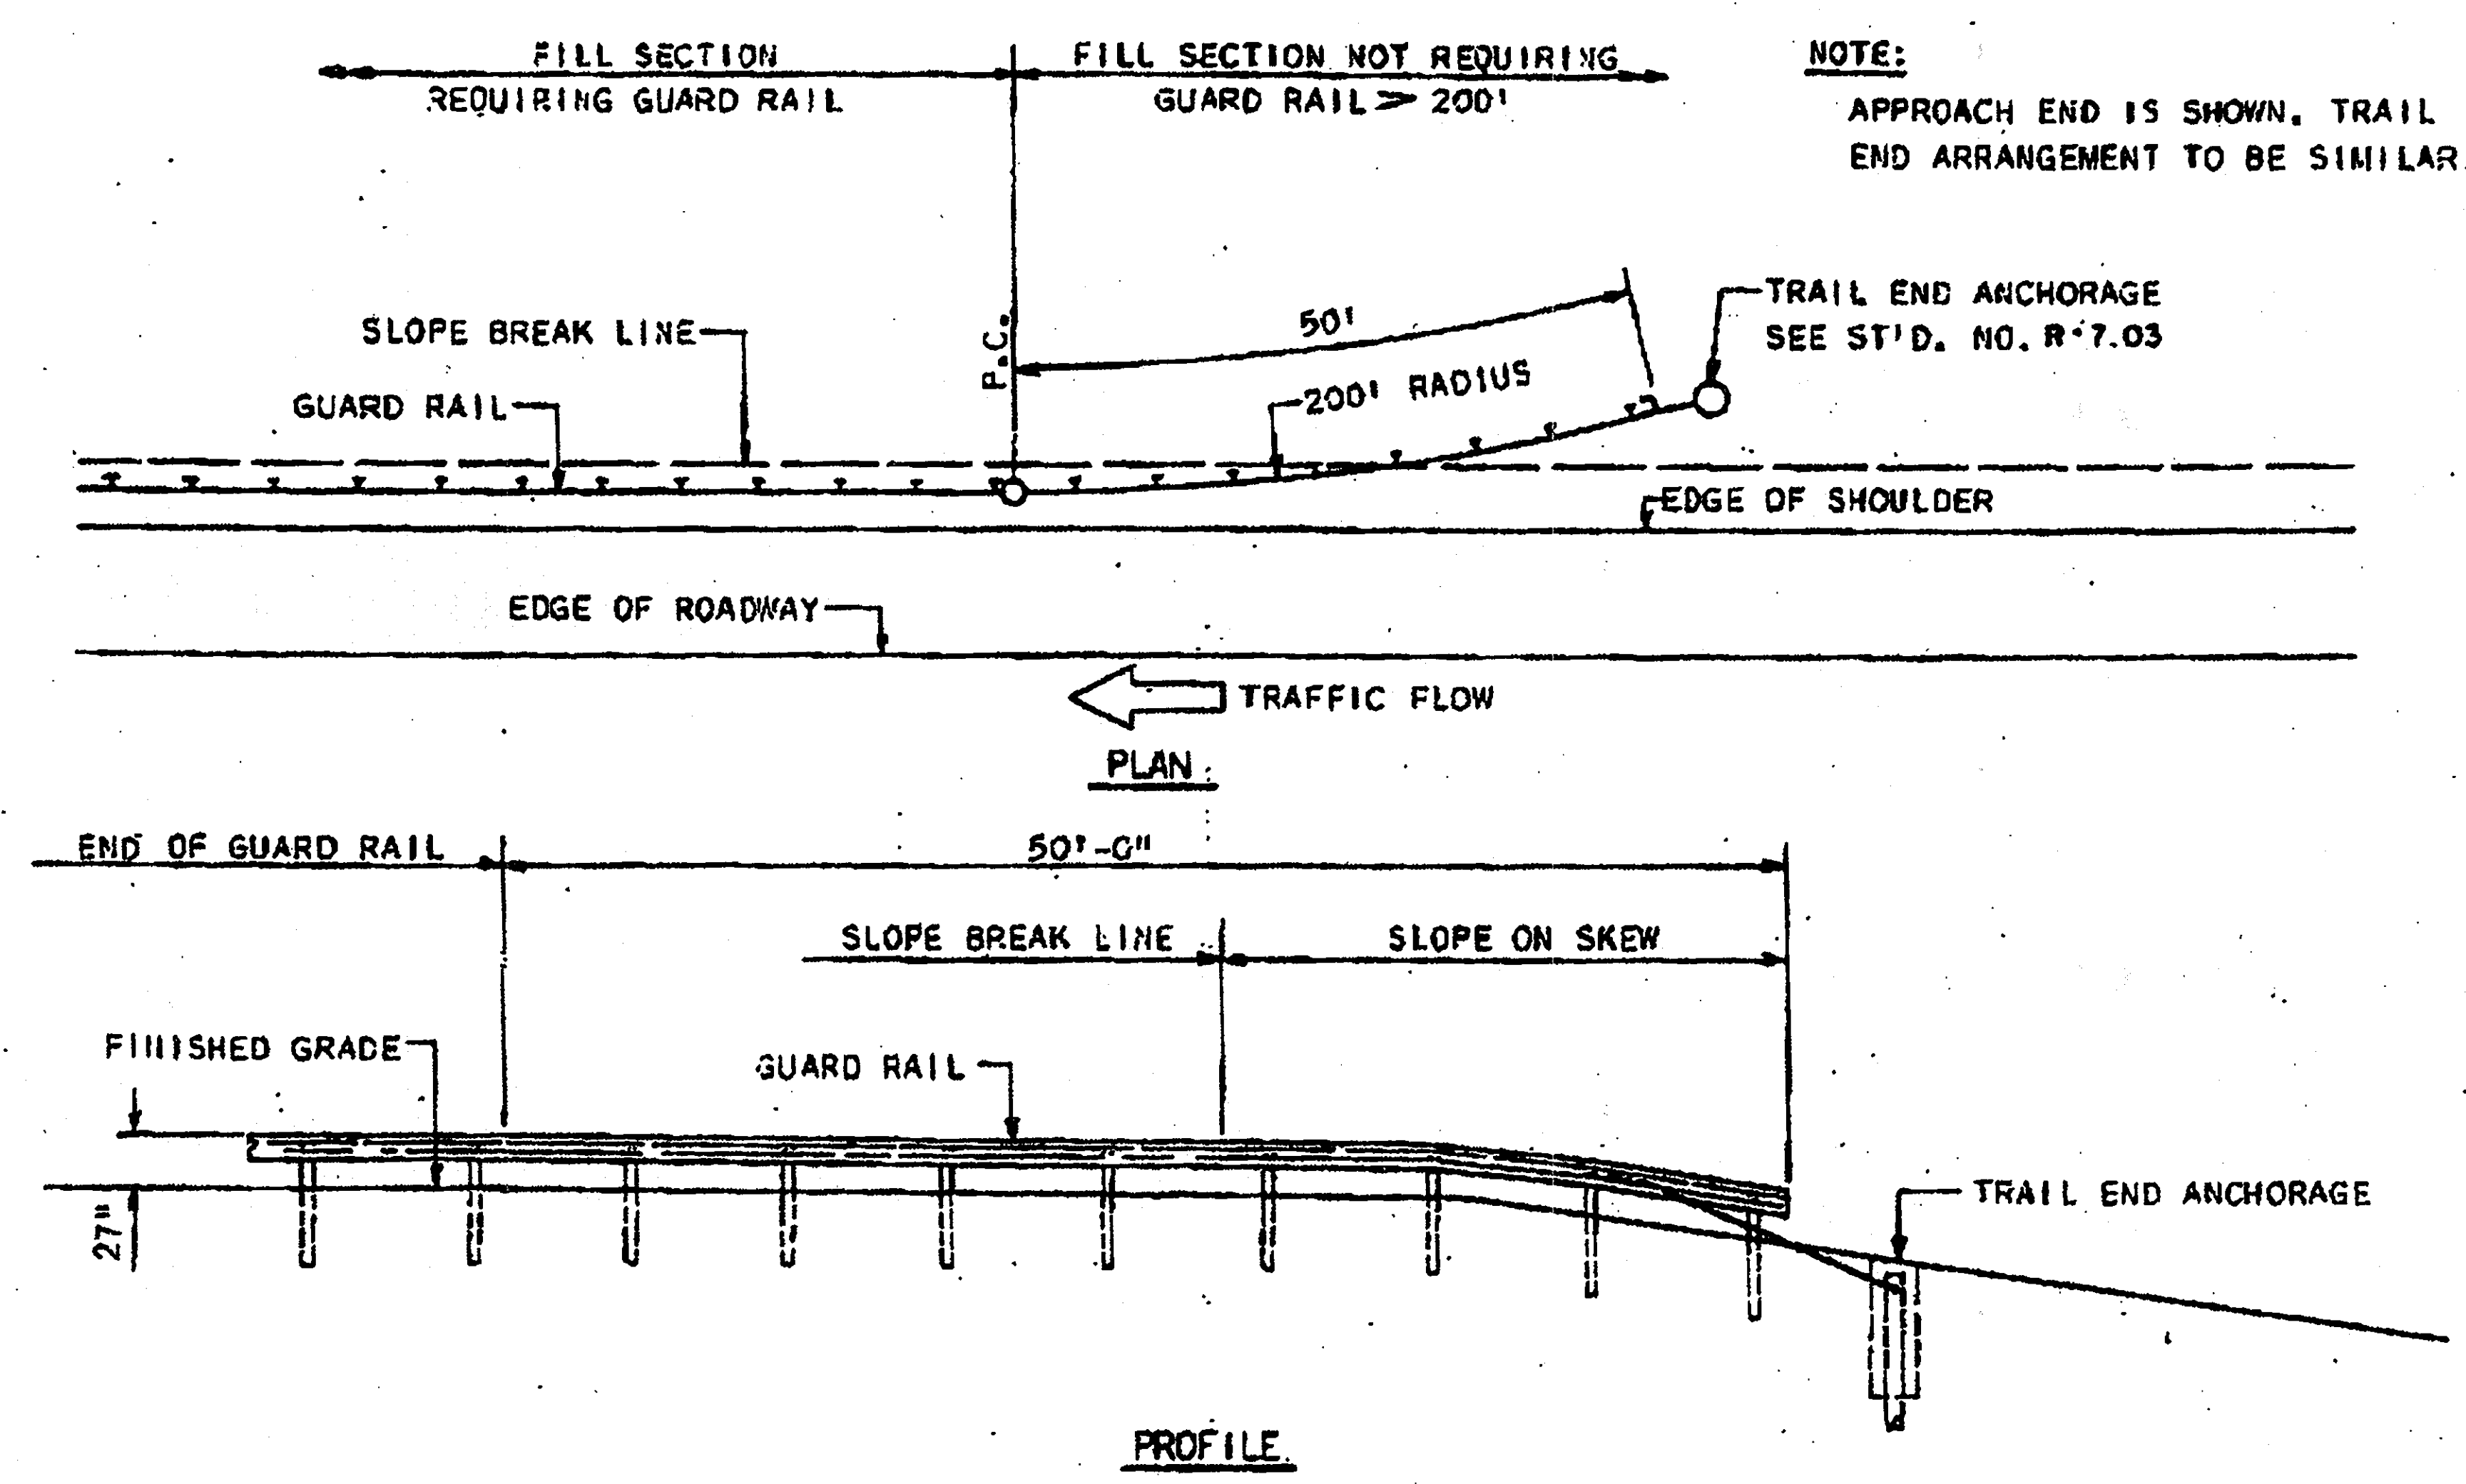


**GUARD RAIL W/ BEAM DETAIL ✓ INSTALLED**  
NOT TO SCALE

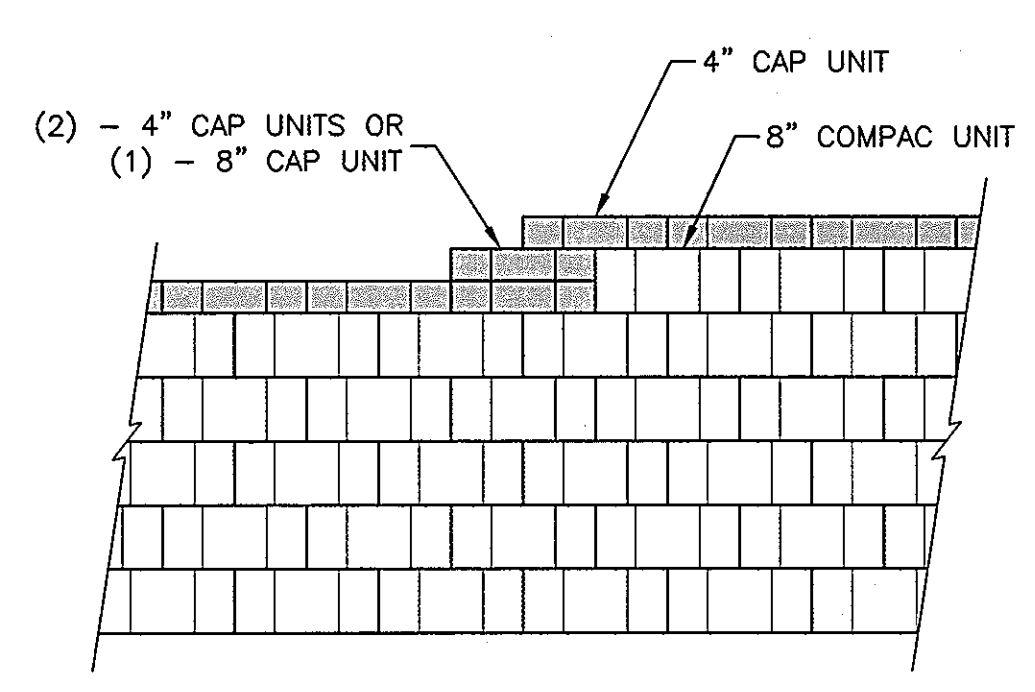


**TOP OF WALL STEPS DETAIL**

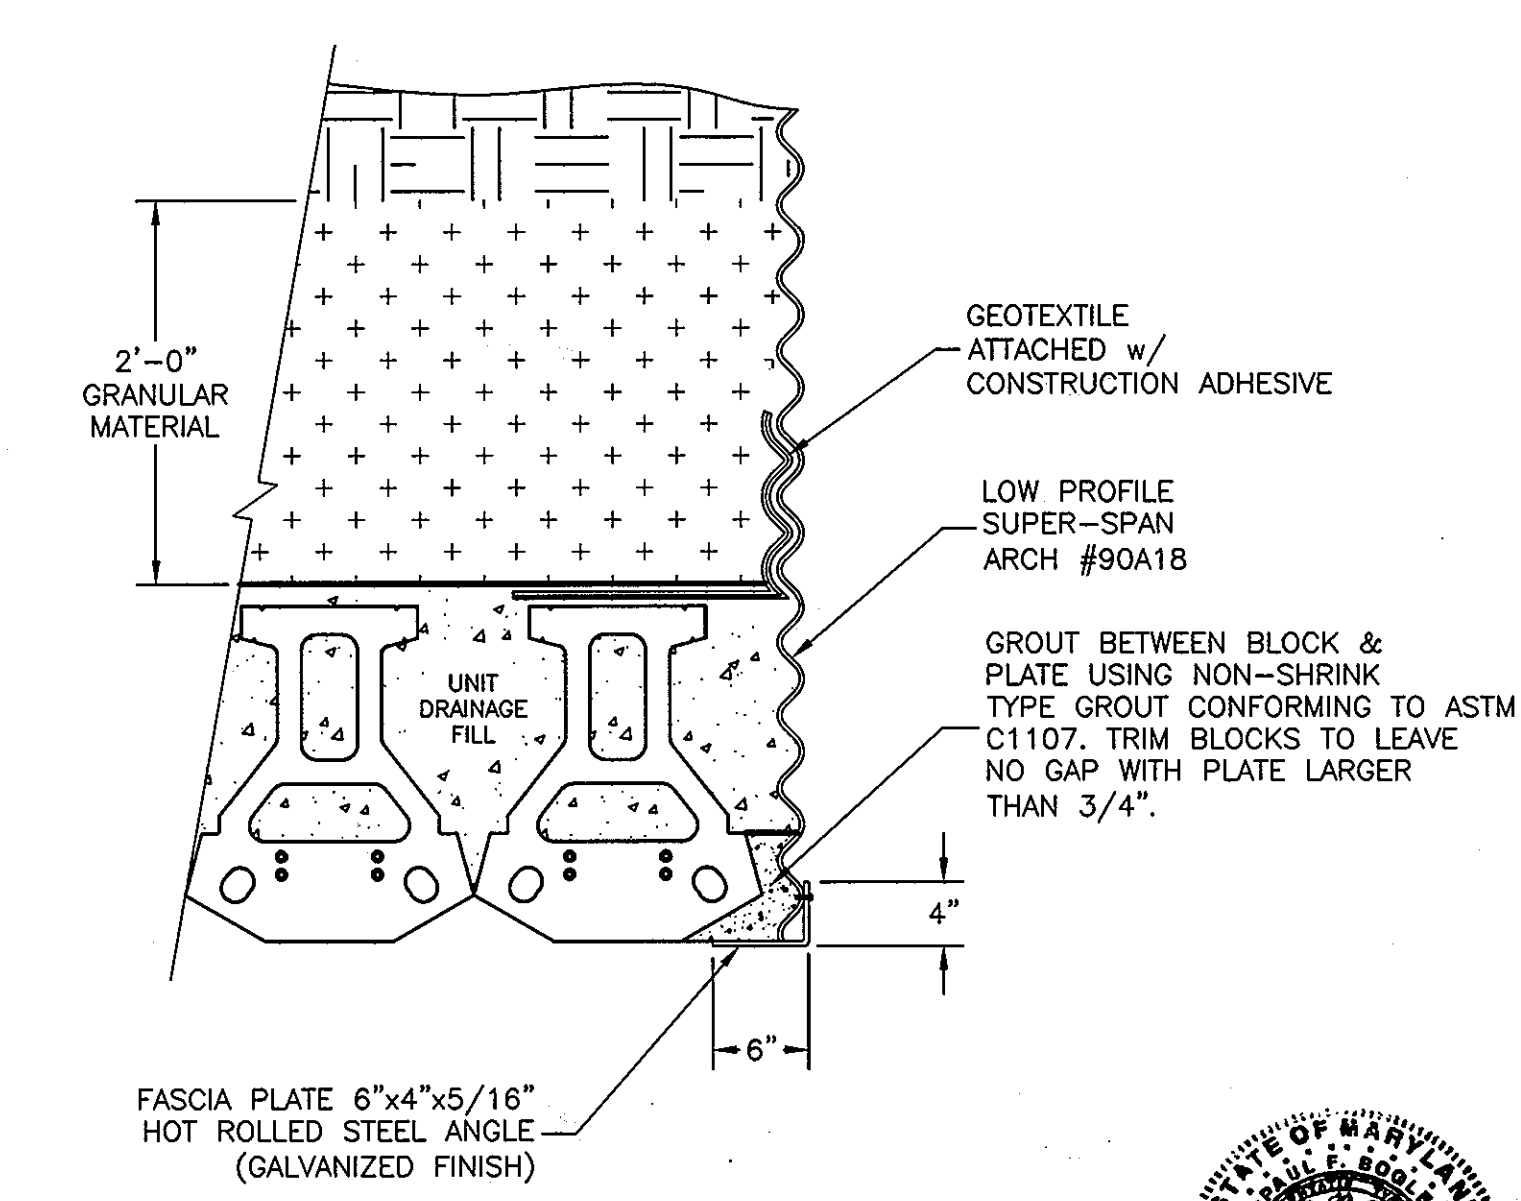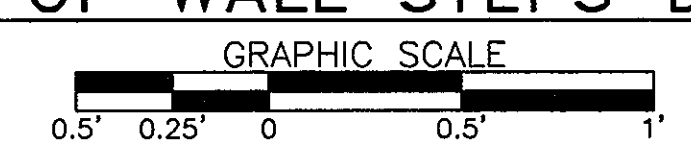


**DETAIL OF ANGLE BRACING**

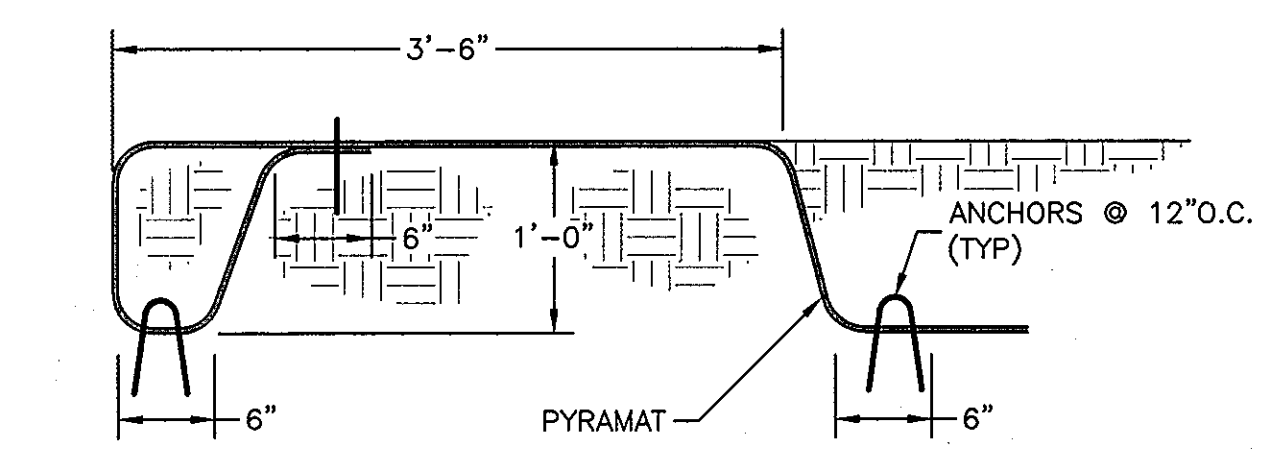


**PYRAMAT INSTALLATION DETAIL**

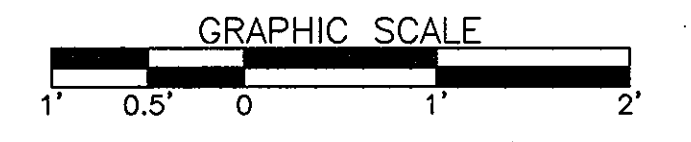

**AS-BUILT PLANS**

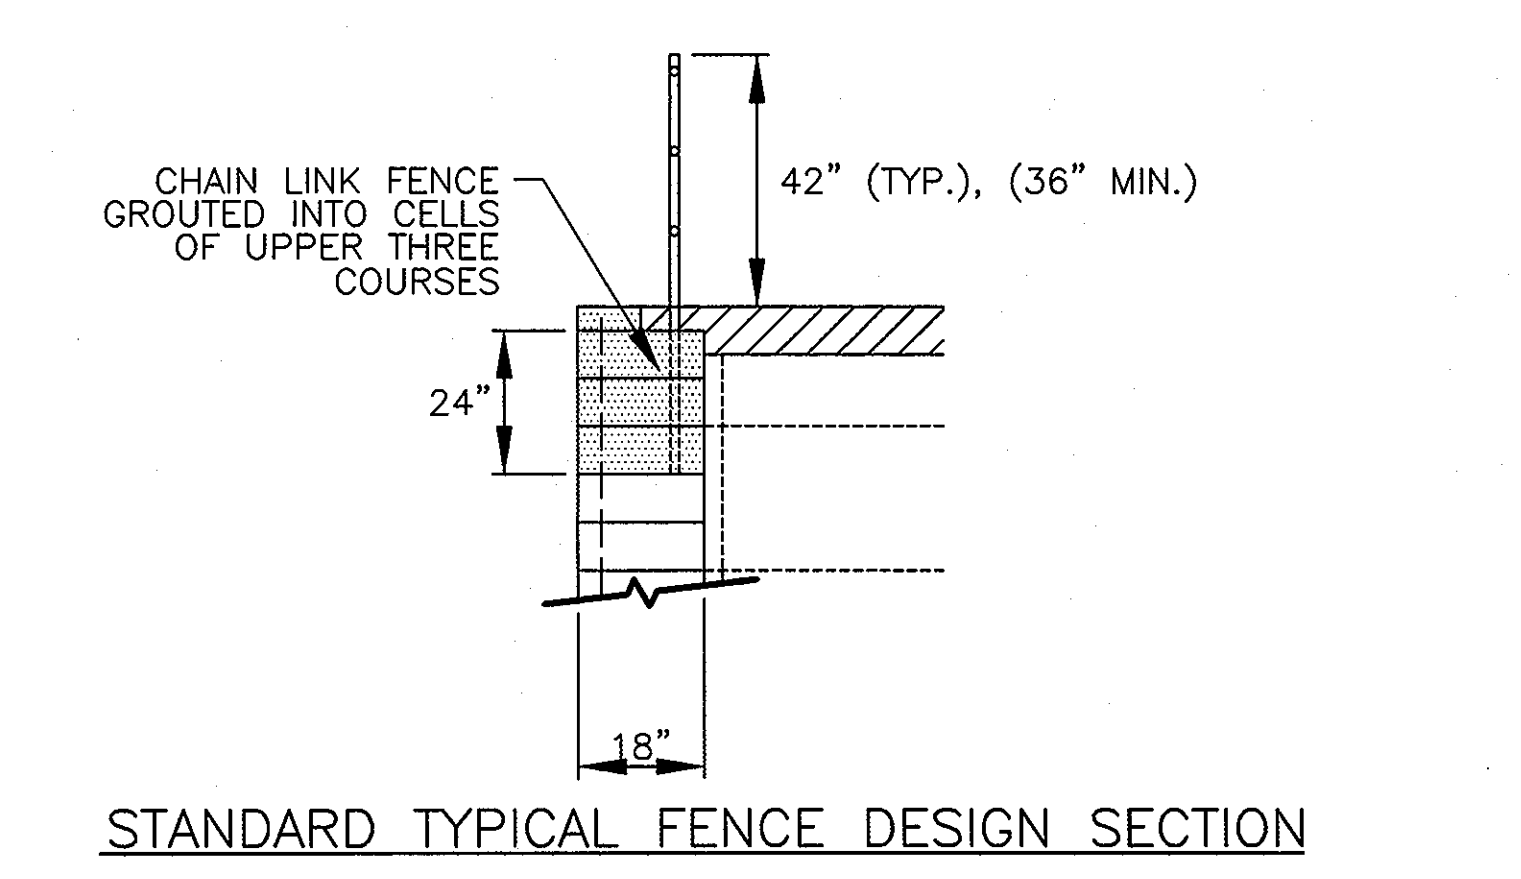


**METAL RAIL FENCE INSTALLED**

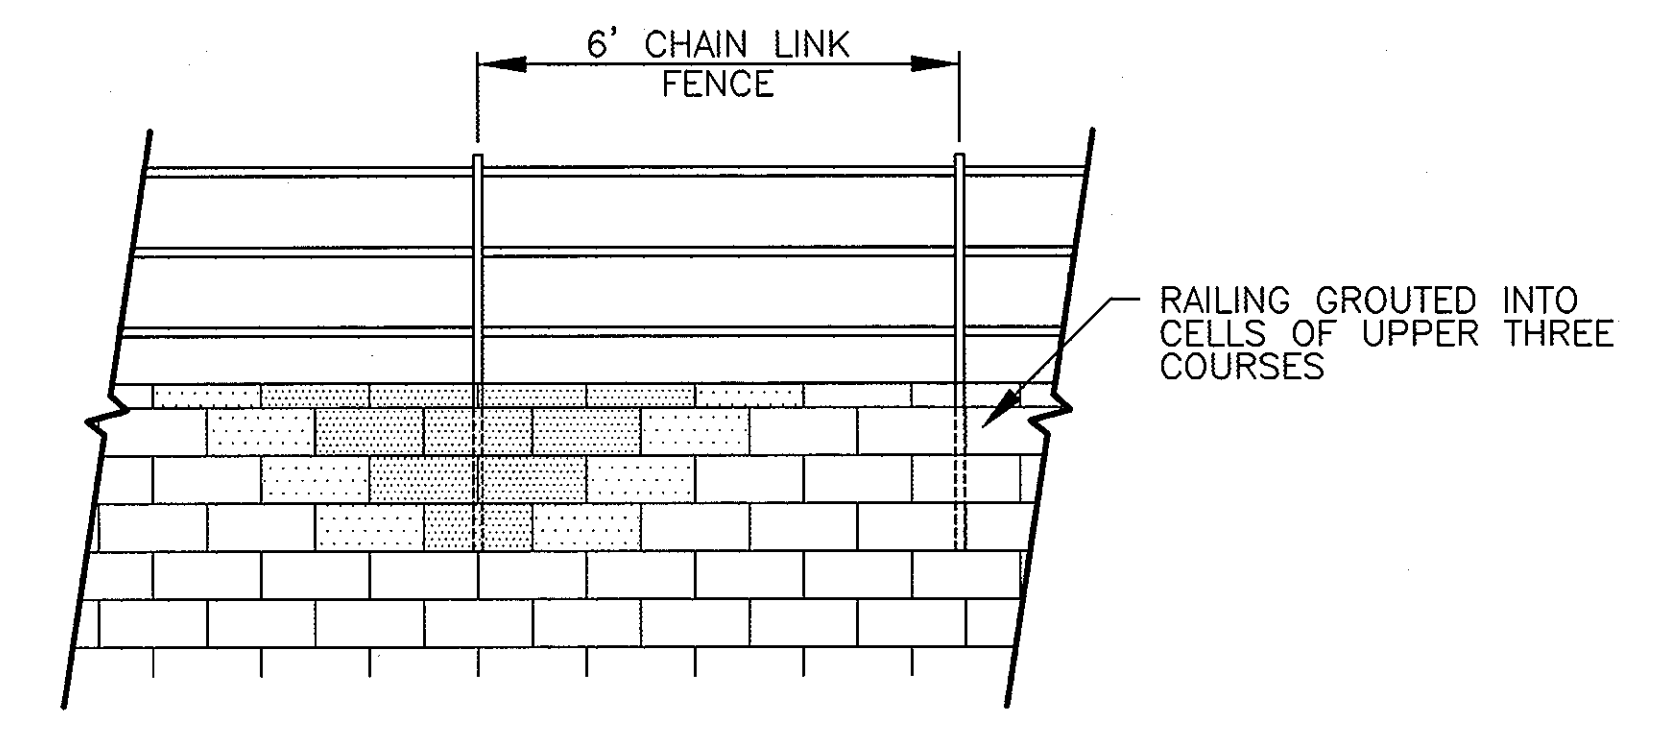

100% OF MASS AVAILABLE FOR OVERTURNING  
50% OF MASS AVAILABLE FOR OVERTURNING


**TYPICAL FENCE ELEVATION**

**TYPICAL FENCE DESIGN**  
DIRECT MOUNT - 20 PLF - STANDARD UNITS  
NO SCALE

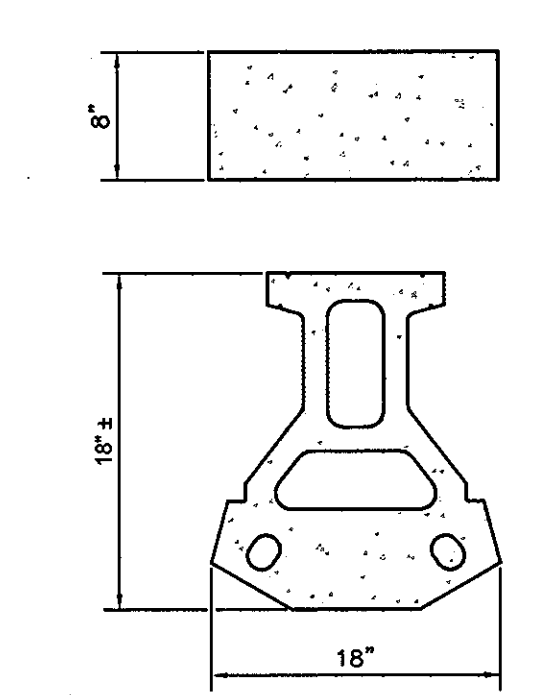

**"STANDARD II" BLOCK UNIT DETAIL**

NOT TO SCALE

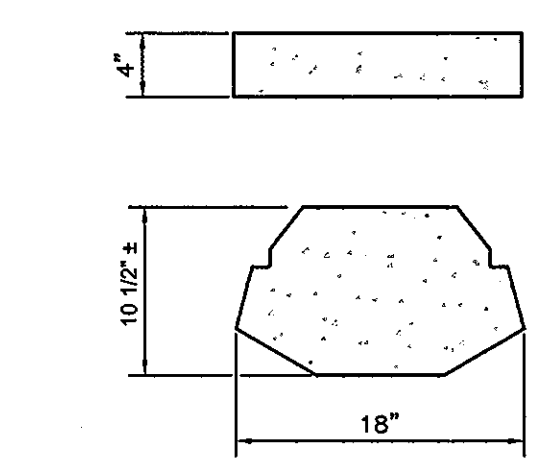

**"STANDARD II" CAP BLOCK DETAIL**


NOT TO SCALE

Developer/Owner:  
**Winchester Homes, Inc. & Winchester Homes, Inc.**, as nominee for Stringtown Investments, LLC  
6905 Rockledge Drive  
Bethesda, Maryland 20817  
Stephen J. Nardella, Vice President  
(301) 803 - 4800


dev HOWARD COUNTY DEPARTMENT OF PUBLIC WORKS  
*William F. Mahlon Jr.* 10/14/03  
CHIEF, BUREAU OF HIGHWAY

dev HOWARD COUNTY DEPARTMENT OF PLANNING & ZONING  
*Andy Hamilton* 11/27/03  
CHIEF, DIVISION OF LAND DEVELOPMENT

*Chad Cameron* 10/10/03  
CHIEF, DEVELOPMENT ENGINEERING DIVISION

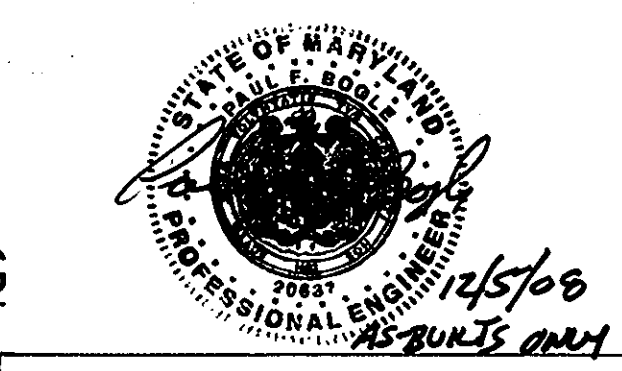

**AS-BUILT CERTIFICATION**  
I HEREBY CERTIFY THAT THE FACILITY SHOWN ON THIS PLAN WAS CONSTRUCTED AS SHOWN ON THE "AS-BUILT PLANS" AND MEETS THE APPROVED PLAN AND SPECIFICATIONS.  
SIGNATURE: *[Signature]* P.E. NO.: 20637  
DATE: 12/5/03

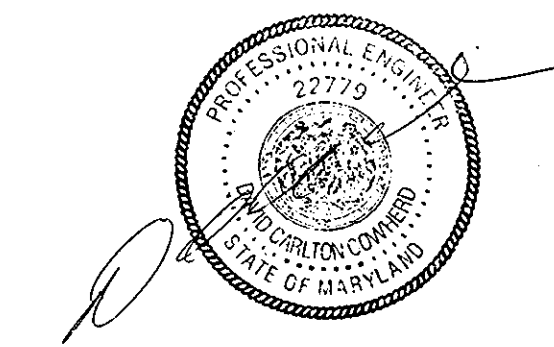

CONTECH CONSTRUCTION PRODUCTS, INC.  
DESIGN OF SUPER-SPAN  
LOW PROFILE ARCH #90A18

3	9/24/03	DWR	FINAL MYLAR SUBMITTAL FOR SIGNATURE
2	4/22/03	DWR	REVISION #2 - REVIEWER'S COMMENTS
1	4/11/03	DWR	REVISION #1 - REVIEWER'S COMMENTS

**CBC ENGINEERS**  
DAYTON, OHIO

**DETAILS (CONTINUED)**

Drawn By: DWR Date: 12/16/02  
Approved By: DWR Date: 12/16/02

Project No.: CBC-4268 Rev.: 3 Sheet: 31 OF 34



I - GENERAL

1.0 STANDARDS AND DEFINITIONS

1.1 STANDARDS - All standards refer to latest edition unless otherwise noted.

1.1.1 ASTM D-698-70 (Method C) "Standard Test Methods for Moisture, Density Relations of Soils and Soil Aggregate Mixtures Using 5.5-lb (2.5 kg.) Rammer and 12" (305-mm) Drop".

1.1.2 ASTM D-1557 "Test Method for Laboratory Compaction Characteristics of Soil Using Modified Effort (56,000 ft-lbf/ft<sup>3</sup> [2,700 kN·m/m<sup>3</sup>])".

1.1.3 ASTM D-2922 "Standard Test Method for Density of Soil and Soil Aggregate in Place by Nuclear Methods (Shallow Depth)".

1.1.4 ASTM D-1556 "Standard Test Method for Density of Soil in Place by the Sand-Cone Method".

1.1.5 All construction and materials shall be in accordance with the current AASHTO Specifications.

1.2 DEFINITIONS

1.2.1 Owner - In these specifications the word "Owner" shall mean Winchester Homes, Greenbelt, Maryland.

1.2.2 Engineer - In these specifications the word "Engineer" shall mean the Owner designated engineer.

1.2.3 Design Engineer - In these specifications the words "Design Engineer" shall mean CBC Engineers and Associates, Ltd.

1.2.4 Contractor - In these specifications the word "Contractor" shall mean the firm or corporation undertaking the execution of any work under the terms of these specifications.

1.2.5 Approved - In these specifications the word "approved" shall refer to the approval of the Engineer or his designated representative.

1.2.6 As Directed - In these specifications the words "as directed" shall refer to the directions to the Contractor from the Owner or his designated representative.

2.0 GENERAL CONDITIONS

2.1 The Contractor shall furnish all labor, material and equipment and perform all work and services except those set out and furnished by the Owner, necessary to complete in a satisfactory manner the site preparation, excavation, footings, culvert installation, head walls, wing walls, filling, compaction, and grading as shown on the plans and as described therein.

This work is to be accomplished under the observation of the Owner or his designated representative.

2.2 The Contractor shall examine, investigate and inspect the construction site as to the nature and location of the work, and the general and local conditions at the construction site, including, without limitation, the character of surface or subsurface conditions and obstacles to be encountered on and around the construction site; and shall make such additional investigation as he may deem necessary for the planning and proper execution of the work.

If conditions other than those indicated are discovered by the Contractor, the Owner should be notified immediately. The material which the Contractor believes to be a changed condition should not be disturbed so that the owner can investigate the condition.

2.3 The construction shall be performed under the direction of an experienced engineer who is familiar with the SUPER-SPAN structures.

2.4 Contech Construction Products, Inc. will provide a shape technician to monitor the shape of the structure during construction of the backfill until all select backfill has been placed.

II - FOUNDATION PREPARATION

1.0 UNDERCUTS

1.1 The area beneath footings for the structure shall be excavated to a depth of 3.0 feet below the bottom of footings and replaced with a Tensar reinforced mat.

1.2 The width of the Tensar reinforced mat shall extend to a minimum of 1.75 feet outside each edge of the footings.

1.3 The Tensar mat shall be placed in accordance with Section III of these specifications.

1.4 The geogrid to be placed in the mat must meet the requirements of Section III of these specifications.

2.0 DEWATERING

2.1 There may be a need to dewater before excavating. All foundation excavations shall be pumped free of water and all soft and loose material shall be removed before pour concrete.

3.0 INSPECTION

3.1 All foundation excavations should be examined by a geotechnical engineer or his representative to determine that they are bearing on proper materials.

4.0 PLACEMENT OF GRANULAR MATERIAL

4.1 The fill in the geogrid reinforced mat shall be an A1a gradation material compacted to 95% of the maximum modified Proctor dry unit weight.

III - GEOGRID REINFORCED MATS

1.0 GEOGRID REINFORCED MATS

1.1 The structure footings shall be supported on geogrid mats consisting of a compacted granular layer reinforced with Tensar geogrids.

1.2 The dimensions of the mats shall be as shown on the construction drawings.

1.3 The excavations shall be pumped free of water before any compacted backfill is placed.

1.4 A filter fabric meeting the requirements of Section V of these specifications shall be placed in the bottom of the excavation for the compacted mat.

1.5 The material for the compacted backfill in the mat shall conform to A1a gradation, and shall be compacted to 95% of the maximum modified Proctor dry unit weight.

1.6 Tensar structural geogrid BX6100 shall be placed at the locations shown on the construction drawings.

1.7 The structural geogrid shall be Tensar BX6100 and shall meet the requirements of Chapter III of these specifications.

2.0 GEOGRID SPECIFICATIONS

2.1 GENERAL

2.1.1 Geogrid meeting the requirements of this specification shall be placed at the locations shown on the construction drawings.

2.1.2 The geogrid shall extend to the lengths shown on the construction drawings.

2.2 DELIVERY, STORAGE AND HANDLING

2.2.1 The contractor shall check the geogrid upon delivery to assure that the proper material has been received.

2.2.2 Geogrids shall be stored above -20°F (-29°C) and be shaded from prolonged periods of direct exposure to sunlight.

2.2.3 The contractor shall prevent excessive mud, wet cement, epoxy, and like materials, which may affix themselves to the gridwork, from coming in contact with the geogrid material.

2.2.4 Rolled geogrid material may be laid flat or stood on end for storage.

2.3 DEFINITIONS

2.3.1 Geogrid: A polymer grid structure specifically fabricated for use as soil reinforcement.

2.3.2 Direction of Reinforcement: Refers to the orientation that the geogrid is used in for a particular project; along the roll for uniaxial geogrid and either along or across the roll for biaxial geogrid.

2.3.3 MD: Machine direction.

2.3.4 CMD: Cross machine direction.

2.4 MATERIALS

2.4.1 The geogrid reinforcement shall:  
• Be biaxially oriented polymer grid structure.  
• Be composed of high density polyethylene.

2.4.2 The manufacturer shall furnish test reports certifying that the product meets the requirements of this Specification upon request.

2.4.3 The geogrid shall be a regular grid structure formed by biaxially drawing a continuous sheet of select high density polyethylene material and shall have aperture geometry and rib and juncture cross-sections sufficient to permit significant mechanical interlock with the material being reinforced. The geogrid shall have high flexural rigidity and high tensile modulus in relation to the material being reinforced and shall also have high continuity of tensile strength through all ribs and junctions of the grid structure. The geogrid shall have high resistance to deformation under sustained long term design load while in service and shall also be resistant to ultraviolet degradation, to damage under normal construction practices and to all forms of biological or chemical degradation normally encountered in the material being reinforced.

The geogrid shall also conform in all respects to the property requirements of TENSAR BX6100 or equivalent listed below.

TABLE III-1  
PRODUCT PROPERTIES

PROPERTY	TEST METHOD	UNITS	BX6100
<b>Reinforcement Strength</b>			
Creep Limited Strength (TLT) • (100 Years)	GRI GG3 & GG4 <sup>1</sup>	lb./ft.	425
<b>Geometry</b>			
Apertures <sup>2</sup> • MD • CMD	I.D. Caliper <sup>3</sup>	in. (nom) in. (nom)	1.0 1.3
Open Area	COE Method <sup>4</sup>	% (nom)	70
Thickness • Ribs • Junction	ASTM D1777-64	in. (nom) in. (nom)	0.05 0.16
<b>Dimensional Stability</b>			
Flexural Rigidity	ASTM D1388-64 <sup>5</sup>	mg-cm (min)	1,000,000
Tensile Modulus • MD	GRI GGI-S7 <sup>6</sup>	lb./ft. (min)	30,000
Junctions • Strength • Efficiency	GRI GG2-S7 <sup>7</sup>	lb./ft. (min) % (min)	1,890 90
<b>Material</b>			
Polyethylene	ASTM D1248 Type III, Class A Grade 5	% (min)	pp8
Carbon Black	ASTM 4218	% (min)	0.5

- Notes:
- Long-Term strength measured by through-the-junction tensile creep testing to 10,000 hours as described in GRI Test Method GG3 "Tensile Creep Testing of Geogrids and GRI-GG4" Determination of the long-Term Design Strength of Geogrids"
  - MD dimensions is along the roll length. CMD dimension is across the roll width.
  - Maximum inside dimension in each principal direction measured by calipers.
  - Percent open area measured without magnification by Corps of Engineers method, as specified in CVI 02215 Civil Works Construction Guide, November 1977.
  - ASTM D1388-64 modified to account for wide specimen testing
  - Secant modulus at 2% elongation measured by Geosynthetic Research Institute Test Method GGI-S7 "Geogrid Tensile Strength" No offset allowances are made in calculating secant modulus.
  - Geogrid junction strength and junction efficiency measured by GRI Test Method GG2-S7 "Geogrid Junction Strength".
  - BX6100 is 99% (min) polypropylene.

2.5 GEOGRID INSTALLATION

2.5.1 Geogrid shall be laid at the proper elevation and orientation (i.e., the machine direction shall be perpendicular to the pipe structure axis) as shown on the construction drawings.

2.5.2 Correct orientation (roll direction) of the geogrid shall be verified by the Contractor. The correct roll direction shall be perpendicular to the structure axis.

2.5.3 Geogrid may be secured in-place with staples, pins, sand bags, or backfill as required by fill properties, fill placement procedures, or weather conditions, or as directed by the Engineer.

2.5.4 Geogrid Placement:  
• Geogrids should be laid horizontally on compacted fill. Care must be taken to prevent slack from becoming trapped within the geogrid as fill is placed.

2.6 BACKFILL PLACEMENT OVER GEOGRID

2.6.1 Backfill material shall be placed in lifts and compacted as directed in the text of this document.

2.6.2 Backfill shall be placed, spread, and compacted in such a manner that minimizes the development of wrinkles in and/or movement of the geogrid.

2.6.3 Tracked construction equipment shall not be operated directly upon the geogrid. A minimum fill thickness of six (6) inches (150mm) is required prior to operation of tracked vehicles over the geogrid. Turning of tracked vehicles should be kept to a minimum to prevent tracks from displacing the fill and damaging the geogrid.

2.6.4 Rubber tired equipment may pass over geogrid reinforcement at slow speeds, less than 10 MPH (16 KPH). Sudden braking and sharp turning shall be avoided.

3.0 CONCRETE FOOTING DIMENSIONS

3.1 The footings shall be reinforced in accordance with the construction drawings.

IV - SELECT BACKFILL SPECIFICATIONS

1.0 GENERAL CONDITIONS

1.1 The contractor shall furnish all labor, materials, and equipment, and perform all work and services necessary to complete in a satisfactory manner the site preparation, excavation, filling, compaction and grading as shown on the plans and as described therein.

1.2 This work shall consist of all clearing and grading, removal of existing structures unless otherwise stated, preparation of the land to be filled, spreading and compaction of the fill, and all subsidiary work necessary to complete the grading of the cut and fill areas to conform with the lines, grades, slopes, and specifications.

1.3 This work is to be accomplished under the constant and continuous supervision of the Owner or his designated representative.

2.0 SUBSURFACE CONDITIONS

2.1 The Contractor shall examine, investigate and inspect the construction site as to the nature and location of the work, and the general and local conditions at the construction site, including, without limitation, the character of surface or subsurface conditions and obstacles to be encountered on and around the construction site; and shall make such additional investigation as he may deem necessary for the planning and proper execution of the work.

2.2 If conditions other than those indicated are discovered by the Contractor, the Owner should be notified immediately. The material which the Contractor believes to be a changed condition should not be disturbed so that the Owner can investigate the condition.

3.0 SITE PREPARATION

3.1 Within the specified areas, all debris, existing stockpile material, and structures scheduled for demolition shall be removed and disposed of.

3.2 Any rubbish, organic and other objectionable soils, and other deleterious material, shall be disposed of off the site, or as directed by the Owner or his designated representative if on site disposal is provided. In no case shall such objectionable material be allowed in, or under the fill.

3.3 Prior to the addition of fill, the undercuts specified in Section II shall be made and the original ground shall be compacted to the project specifications as outlined below. Special attention shall be given to the proposed fill area at this time. If wet spots, spongy conditions, or ground water seepage is found, corrective measures must be taken before the placement of fill.

4.0 FORMATION OF FILL AREAS

4.1 SELECT BACKFILL

4.1.1 Select backfill shall be placed to a minimum distance of 6 feet horizontally, as measured from the springline of the structure, and to a distance of 3 feet above the crown of the structure as shown on the construction drawings.

5.0 MINIMUM BACKFILL REQUIREMENTS FOR SUPER-SPAN AND LONG SPAN STRUCTURES

5.1 MATERIAL

A granular type of material shall be used around and over the structure. This select structural backfill material shall conform to AASHTO Specification M-145, A-1, A2(4), or A2(5). Maximum particle size shall not exceed 3 inches. The gradation must conform to the following table:

TABLE IV-1  
BACKFILL REQUIREMENTS

GROUP CLASSIFICATION	AASHTO M-145 - TABLE 2 (MODIFIED)*			
	A-1		A-2 (Modified)	
	A-1-a	A-1-b	A-2-4	A-2-5
Sieve Analysis, Percent Passing				
No. 10 (2.00 mm)	50 max.	--	--	--
No. 40 (0.425 mm)	30 max.	50 max.	--	--
No. 100 (1.50 mm)	--	--	50 max.	50 max.
No. 200 (0.075 mm)	15 max.	25 max.	20 max.	20 max.
<b>CHARACTERISTICS OF FRACTION PASSING NO. 40 (0.425 mm)</b>				
Liquid Limit	--	--	40 max.	41 min.
Plasticity Index	6 max.		10 max.	10 max.
USUAL TYPES OF SIGNIFICANT CONSTITUENT MATERIALS	Stone Fragments, Gravel and Sand		Silty or Clayey Gravel and Sand	

\*Modified to be more select than M-145.

Additional Backfill Material Requirements:

- Backfill must be well-graded material. Open-graded or gap-graded materials are not allowed.
- Fine beach sands, windblown sands, stream deposited sands exhibiting fine, rounded particles and typically classified by AASHTO M-145 as A-3 materials are not allowed.
- On-site mixing or blending to achieve specified gradation is not allowed.
- The maximum particle size shall not exceed 3 inches.

Other backfill materials which provide equivalent long term structural properties in the environmental conditions expected (saturation, freeze-thaw, etc.) may be used. Such materials shall be approved only after thorough investigation and testing by a soils engineer familiar with the requirements for structural backfill of MULTI-PLATE and long span structures and approval by the Chief Engineer, Contech.

5.2 BACKFILL LIMITS

The required width of the structural backfill shall be 6 feet minimum outside the springline and to 3 feet over the top of the structure.

CONTECH CONSTRUCTION PRODUCTS, INC.  
DESIGN OF SUPER-SPAN  
LOW PROFILE ARCH #90A18

3	9/24/03	DWR	FINAL MYLAR SUBMITTAL FOR SIGNATURE
2	4/22/03	DWR	REVISION #2 - REVIEWER'S COMMENTS
1	4/11/03	DWR	REVISION #1 - REVIEWER'S COMMENTS


**CBC ENGINEERS**  
DAYTON, OHIO

**SPECIFICATIONS**

Drawn By: DWR Date: 12/16/02  
Approved By: Date: 10/17/03

Scale: GRAPHIC Project No.: CBC-4268 Rev.: 3 Sheet: 32 OF 34

MONTJOY - SINGLE FAMILY DETACHED  
A RE-SUBDIVISION OF NON-BUILDABLE BULK PARCEL C/F-03-87  
TO  
BUILDABLE LOTS 127-188 AND OPEN SPACE LOTS 189-193  
ELECTION DISTRICT #2 HOWARD COUNTY, MARYLAND  
TAX MAP: 30 GRID: 12 PARCEL 260  
DATE PUBLISHED: 08/01/01 (11) 02010 02010 02010 02010

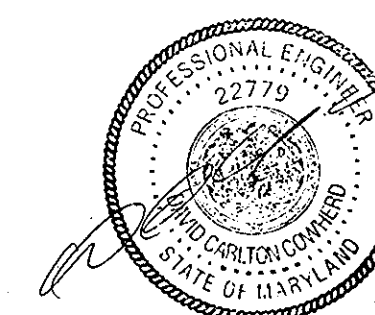

AS-BUILT PLANS  
(No As-Built Data This Sheet)

Developer/Owner:  
**Winchester Homes, Inc. & Winchester Homes, Inc., as nominee for Stringtown Investments, LLC**  
6905 Rockledge Drive

Bethesda, Maryland 20817  
Stephen J. Nardella, Vice President  
(301) 803 - 4800

HOWARD COUNTY DEPARTMENT OF PUBLIC WORKS

*William J. ...*  
CHIEF, BUREAU OF HIGHWAY 10/14/03 DATE

HOWARD COUNTY DEPARTMENT OF PLANNING & ZONING

*Cindy ...*  
CHIEF, DIVISION OF LAND DEVELOPMENT 10/27/03 DATE

*Cliff ...*  
CHIEF, DEVELOPMENT ENGINEERING DIVISION 10/17/03 DATE



5.3 BACKFILL PLACEMENT

Before backfilling, the erected structure shall meet the tolerance and symmetry requirements of AASHTO and Contech.

Approved backfill material shall be placed in horizontal, uniform layers not exceeding 8" in thickness, before compaction, and shall be brought up uniformly on both sides of the structure. Each layer of backfill shall be compacted to a relative density of not less than 90% of the modified Proctor per AASHTO Test Method No. T-180. Field density tests of compacted backfill shall be made at regular intervals during backfill.

SUPER-SPAN and long span structures, due to their size and shape, are sensitive to the types and weights of equipment used to place and compact the select backfill material. This is especially critical in the areas immediately adjacent to and above the structure. Therefore, equipment types will be restricted in those critical zones. Compaction equipment or methods that produce horizontal or vertical earth pressures which cause excessive distortion or damage to these structures shall not be used.

Contractors should plan to have a D4 (approximately 20,000 lbs.) or similar weight tracked dozer to place and grade backfill immediately alongside and above the structure until minimum cover level is reached. Lightweight vibratory plate or roller type compaction equipment must be used to compact the backfill in these zones. Use of heavier equipment and/or rubber tired equipment such as scrapers, graders and front end loaders are prohibited inside the select fill envelope zone until appropriate minimum cover height has been obtained.

5.5 CONSTRUCTION OBSERVATION

Contech shall provide a Shape Control Technician who is a qualified representative of a professional soils engineering firm, or other qualified organization, to monitor the installation and backfilling of the structure. The Shape Control Technician shall monitor the structure shape during the placement of structural backfill to the minimum cover height over the structure. The Shape Control Technician shall take initial measurements of the erected structure before backfilling, monitor all backfill materials, their placement and their compaction. He shall record all density readings and ensure they meet the requirements of the plans and specifications. However, in no case shall the relative densities be less than 90% per AASHTO T-180. No structural backfill shall be placed without the Contech Shape Control Technician on site. A competent geotechnical engineer registered in the state of Maryland shall be present on-site for the placement of any fill material.

The Contech Shape Control Technician shall;

- monitor the structure's shape throughout the backfilling operation and report shape change rates to the contractor.
• contact the Contech Regional Engineer immediately if there are problems in meeting the established tolerances.
• have full authority to stop backfill work if necessary.

It is the Project Engineer's responsibility to insure that the requirements of AASHTO and Contech have been met relative to the installation and backfilling of the structure. The Project Engineer shall also provide field density tests of the compacted backfill as directed by the Contech Shape Control Technician.

The Contech Shape Control Technician is not directly responsible for additional project control matters. However, the Shape Control inspector is expected to make observations and notify the Engineer of Record, Contractor, Project Engineer and Contech Region Engineer of any apparent problems or site condition changes which, in his judgment, may affect the quality or performance of the finished installation. Such conditions may include, but are not limited to:

- Observed soft or weak spots in the foundation, trench wall, embankment, or area within the controlled backfill zone.
• Apparent improper or changing backfill material quality. Specific details of the backfill material approved for the job will be provided by the Contech Region Engineer. Any changes in the backfill requirements must be approved in writing by the Contech Region Engineer.
• Use of improper compaction methods and/or lift thicknesses.
• Structural backfill limits that are less than those required by the plans and specifications.
• Adverse reaction of the SUPER-SPAN or long span to backfill placement or compaction methods.
• All items discussed and outlined in the Installation and Inspection Practices included in the Inspection Plan.

6.0 SLOPE RATIO AND STORM WATER RUN-OFF

Protected slopes shall not be greater than 2.0 (horizontal) to one (1) (vertical) in both cut and fill, and storm water shall not be drained over the slopes.

7.0 GRADING

The Contractor shall furnish, operate, and maintain such equipment as is necessary to construct uniform layers, and control smoothness of grade for maximum compaction and drainage.

8.0 COMPACTING

8.1 The compaction equipment shall be approved equipment of such design, weight, and quantity to obtain the required density in accordance with these specifications, without distorting the structure.

8.2 During backfill, only small tracked vehicles (D-4 or smaller) shall be near the structure as fill progresses above the crown and to finished grade. The contractor is cautioned that the minimum cover may need to be increased to handle temporary construction vehicle loads (larger than a D-4).

9.0 TOP LOADING

9.1 If the structure rises, and chord dimensions have become distorted by more than ±2% of plan, top loading or bracing may be necessary.

9.2 The structure can carry legal highway loads once the backfill is placed and compacted to a minimum cover of 3 feet. For heavier construction loads in the unpaved conditions the Contractor shall consult the Engineer.

10.0 TESTING AND INSPECTION SERVICES

10.1 Testing and inspection services will be provided by the Owner. No structural backfill shall be placed without the Contech Shape Control Technician on site.

10.2 Regular inspection during erection and backfilling is required to achieve a structure with proper shape and backfill compacted to the specified density. The structure's shape shall be monitored at all times during installation, and soil materials and compaction methods must be verified by testing.

11.0 SPECIFICS OF SHAPE MONITORING

11.1 The shape of the structure shall be monitored during construction.

11.2 Monitoring points other than the shape control hooks shall be identified with permanent paint. These points shall be monitored periodically throughout the placement of the backfill to determine if the shape of the structure has changed and to determine the rate of change. Typically the rise and chord dimensions should be maintained to less than ±2% of design values.

11.3 A set of measurements shall be made for each 12 to 16 inches of fill placed or one time each day, whichever is greater. The structure measurements should continue throughout the backfilling operation until all of the select material has been placed and compacted. After placement of soil over the select fill and completion of the final grade and roadway surfacing, the structure's shape should be documented by preparing an as-built shape of the structure.

11.4 Additional measurements shall be made to provide a record of the shape of the structure for comparison during future inspections. Corrugated metal structures can deflect and distort during erection and backfilling and also under subsequent loading. Although these distortions are not generally serious, the initial shape of the structure shall be documented for comparison with future inspections.

V - MODULAR BLOCK WALLS

1.0 GENERAL

1.1 DESCRIPTION

1.1.1 Work includes furnishing and installing modular block retaining wall units to the lines and grades shown on the construction drawings and as specified herein. The keystone blocks color and texture shall match other walls being constructed on site.

1.1.2 Work includes preparing foundation, furnishing and installing leveling pad, unit fill and backfill to the lines and grades shown on the construction drawings.

1.1.3 Work includes furnishing and installing all related materials required for construction of the retaining wall as shown on the construction drawings.

1.2 RELATED WORK

1.2.1 Section V - Geogrid soil reinforcement.

1.3 REFERENCE STANDARDS

1.3.1 ASTM C90 - Hollow load bearing masonry units.

1.3.2 ASTM C140 - Sampling and testing concrete masonry units.

1.3.3 ASTM C145 - Solid load bearing concrete masonry units.

1.3.4 UN-STD 1804.

1.3.5 ASTM 2339.

1.3.6 FHA UM-60.

1.4 DELIVERY, STORAGE AND HANDLING

1.4.1 Contractor shall check the materials upon delivery to assure that proper materials have been received.

1.4.2 Contractor shall prevent excessive mud, wet cement, epoxy and similar materials (which may affix themselves) from coming in contact with the materials.

1.4.3 Contractor shall protect the materials from damage. Damaged material shall not be incorporated into the retaining wall structure.

1.5 SUBMITTALS

1.5.1 Samples of all products used in the work of this section.

1.5.2 Latest edition of manufacturer's specifications for proposed materials, method of installation and list of material proposed for use.

1.6 QUALITY ASSURANCE

1.6.1 Owner will supply soil testing and inspection service for quality control testing during earth work operations.

2.0 PRODUCTS

2.1 CONCRETE UNITS

2.1.1 Masonry units shall be KEYSTONE Retaining Wall Standard Units manufactured in accordance with ASTM C-90 and ASTM C-140.

2.1.2 Exterior dimensions may vary in accordance with ASTM C90. Standard units shall have a minimum of 1 sq. ft. face area each.

2.1.3 KEYSTONE Standard units shall provide a minimum of 150 psf of wall face area. Fill which is contained within the dimensions of the units may be considered as 80% effective weight.

2.1.4 Units shall have angled sides capable of concave and convex alignment curves with a minimum radius of 3.5 feet (Where applicable, for straight walls, use non-angled straight side cap units).

2.1.5 Units shall be interlocked with non-corrosive fiberglass pins.

2.1.6 Units shall be interlocked and provide a vertical setback.

2.2 FIBERGLASS CONNECTING PINS

2.2.1 Connecting pins shall be 1/2" diameter thermoset isophthalic polyester resin-pultruded fiberglass reinforcement rods.

2.2.2 Pins shall have a minimum flexural strength of 128,000 psi and short beam shear of 64,000 psi.

2.3 KEYSTONE KAPSEAL CONSTRUCTION ADHESIVE

2.3.1 Material conforms to UN-STD 1804, ASTM 2339-70 and FHA UM-60.

2.4 BASE LEVELING PAD MATERIAL

2.4.1 Material shall consist of unreinforced concrete as shown on the construction drawing.

2.5 UNIT FILL

2.5.1 Fill for units shall be free draining crushed stone or coarse gravel. 3/8" to 1/2" with (no more than 5% passing the No. 200 sieve). Gradation of the fill shall be approved by the engineer.

2.5.2 Place recommended fill behind the retaining wall units. Peagravel shall not be used.

2.6 BACKFILL

2.6.1 Material shall be site excavated soils when approved by the engineer unless otherwise specified in the drawings. Unsuitable soils for backfill (heavy clays or organic soils) shall not be used in the backfill or in the reinforced soil mass.

2.6.2 Where borrow fill is required, contractor shall submit sample and specifications to the engineer for approval.

3.0 EXECUTION

3.1 EXCAVATION

3.1.1 Contract shall excavate to the lines and grades shown on the construction drawings. Contractor shall be careful not to disturb embankment materials beyond lines shown.

3.2 FOUNDATION SOIL PREPARATION

3.2.1 Foundation soil shall be excavated as required for leveling pad dimensions shown on the construction drawings, or as directed by the engineer.

3.2.2 Foundation soil shall be approved by the engineer to confirm that the actual foundation soil conditions meet or exceed the design strength. Soils not meeting required strength shall be removed and replaced with acceptable material.

3.2.3 Over-excavated areas shall be filled with approved compacted backfill material.

3.3 BASE LEVELING PAD

3.3.1 Leveling pad materials shall be placed as shown on the construction drawings.

3.3.2 Material shall be compacted so as to provide a level surface on which to place the first course of units. Compaction shall be to 95% of modified Proctor for sand or gravel type materials. For crushed rock, material shall be densely compacted.

3.3.3 Leveling pad shall be prepared to ensure complete contact of retaining wall unit with base.

3.3.4 Leveling pad materials shall be to the depth and widths shown. Concrete shall be unreinforced and a maximum of 6" thick.

3.4 UNIT INSTALLATION

3.4.1 Place first course of concrete wall units on the base leveling pad. The units shall be checked for level and alignment.

3.4.2 Ensure that units are in full contact with base.

3.4.3 Units are placed side by side for full length of wall alignment. Alignment may be done by means of a string line or offset from base line.

3.4.4 Install fiberglass connecting pins and fill all voids at units with unit fill material. Tamp fill.

3.4.5 Sweep all excess material from top of units and install next course. Ensure each course is completely unit filled, backfilled and compacted prior to proceeding to next course.

3.4.6 Lay up each course ensuring that pins protrude into adjoining courses above a minimum of 1". Two pins required per unit. Pull each unit forward, away from the embankment, against pins in the previous course, and backfill as the course is completed. Repeat procedure to the extent of wall height.

3.4.7 As appropriate where the wall changes elevation, units can be stepped with grade or turned into the embankment with a convex return end. Provide appropriate buried units on compacted leveling pad in area of convex return end.

3.5 CAP INSTALLATION

3.5.1 Place KEYSTONE Cap units over projecting pins from units below. Pull forward to setback position. Backfill and compact to finished grade.

3.5.2 As required, provide permanent mechanical connection to wall units with KEYSTONE KapSeal construction adhesive. Apply adhesive to top surface of unit below, and place cap unit into position.

3.6 GEOGRID INSTALLATION

3.6.1 Follow the requirements of Section VI, Geogrid Soil Reinforcement.

VI - KEYSTONE WALL GEOGRID SPECIFICATIONS

1.0 GENERAL

1.1 Geogrid meeting the requirements of this specification shall be placed at the locations shown on the construction drawings.

1.2 The geogrid shall extend to the lengths shown on the construction drawings.

1.3 The geogrid shall be secured to the modular block as recommended by the manufacturer.

2.0 DELIVERY, STORAGE AND HANDLING

2.1 The contractor shall check the geogrid upon delivery to assure that the proper material has been received.

2.2 Geogrids shall be stored above -20°F (-29°C) and be shaded from prolonged periods of direct exposure to sunlight.

2.3 The contractor shall prevent excessive mud, wet cement, epoxy, and like materials, which may affix themselves to the gridwork, from coming in contact with the geogrid material.

2.4 Rolled geogrid material may be laid flat or stood on end for storage.

3.0 DEFINITIONS

3.1 Geogrid: A polymer grid structure specifically fabricated for use as soil reinforcement.

3.2 Uniaxial Grid: A geogrid which has been manufactured with high junction strength and a high tensile strength and modulus in one direction only.

3.3 Direction of Reinforcement: Refers to the orientation that the geogrid is used in for a particular project; along the roll for uniaxial geogrid and either along or across the roll for biaxial geogrid.

3.4 MD: Machine direction.

3.5 CMD: Cross machine direction.

4.0 MATERIALS


4.1 The geogrid reinforcement shall:
• Be uniaxially oriented polymer grid structure.
• Be composed of high density polyethylene.

4.2 The manufacturer shall furnish test reports certifying that the product meets the requirements of this Specification upon request.

CONTECH CONSTRUCTION PRODUCTS, INC.
DESIGN OF SUPER-SPAN
LOW PROFILE ARCH #90A18

Table with 3 columns: No., Date, and Description. Row 1: 3, 9/24/03, DWR, FINAL MYLAR SUBMITTAL FOR SIGNATURE. Row 2: 2, 4/22/03, DWR, REVISION #2 - REVIEWER'S COMMENTS. Row 3: 1, 4/11/03, DWR, REVISION #1 - REVIEWER'S COMMENTS.

CBC ENGINEERS DAYTON, OHIO
SPECIFICATIONS (CONT'D.)
MONTJOY - SINGLE FAMILY DETACHED
A RE-SUBDIVISION OF NON-BUILDABLE BULK PARCEL C/F-03-87
TO
BUILDABLE LOTS 127-188 AND OPEN SPACE LOTS 188-193
ELECTION DISTRICT #2 HOWARD COUNTY, MARYLAND
TAX MAP: 30 GRID: 12 PARCEL 260
DATE PLOTTED: 8/10/03 11:11:11 AM

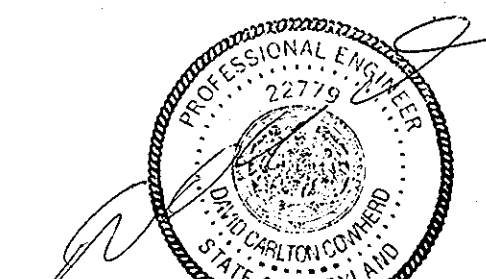

AS-BUILT PLANS
(No As-Built Data This Sheet)

Developer/Owner:
Winchester Homes, Inc. &
Winchester Homes, Inc., as nominee for Stringtown Investments, LLC
6905 Rockledge Drive

Bethesda, Maryland 20817
Stephen J. Nardella, Vice President
(301) 803 - 4800

HOWARD COUNTY DEPARTMENT OF PUBLIC WORKS
HOWARD COUNTY DEPARTMENT OF PLANNING & ZONING
Signatures and dates for Chief, Bureau of Highway (10/14/03), Chief, Division of Land Development (10/23/02), and Chief, Development Engineering Division (10/16/03).



4.3 The geogrid shall be a regular grid structure formed by uniaxially drawing a continuous sheet of select high density polyethylene material and shall have aperture geometry and rib and juncture cross-sections sufficient to permit significant mechanical interlock with the material being reinforced. The geogrid shall have high flexural rigidity and high tensile modulus in relation to the material being reinforced and shall also have high continuity of tensile strength through all ribs and junctions of the grid structure. The geogrid shall have high resistance to deformation under sustained long term design load while in service and shall also be resistant to ultraviolet degradation, to damage under normal construction practices and to all forms of biological or chemical degradation normally encountered in the material being reinforced.

The geogrid shall also conform in all respects to the property requirements of TENSAR UX1600SB or equivalent listed below.

PROPERTY	TEST METHOD	UNITS	VALUE
<b>INTERLOCK</b>			
• Apertures	LD Caliper <sup>d</sup>		
- MD		in	5.40 (nom)
- CMD		in	0.66 (nom)
• Open Area	COE Method <sup>d</sup>	%	60 (nom)
• Thickness	ASTM D1777-64		
- Ribs		in	0.070 (nom)
- Junctions		in	0.230 (nom)
<b>REINFORCEMENT</b>			
• Creep Limited Strength <sup>1</sup>	GRI GG4-87 <sup>d</sup>	lb/ft	3,000 (min)
• Flexural Rigidity	ASTM D1388-64 <sup>d</sup>	MG-CM	6,600,000 (min)
• Tensile Modulus - MD	GRI GG1-87 <sup>d</sup>	lb/ft	130,000 (min)
• Junctions	GRI GG2-87 <sup>d</sup>		
- Strength		lb/ft	7,000 (min)
- Efficiency		%	90 (min)
<b>MATERIAL</b>			
• High Density Polyethylene	ASTM D 1248	%	97.0 (min)
	Type III/Class A/Grade 5		
• Carbon	ASTM 4218	%	2.0 (min)
<b>DIMENSIONS</b>			
• Roll Length		ft	98
• Roll Width		ft	4.3

NOTES:

- MD dimensions is along roll length. CMD dimension is across roll width.
- Maximum inside dimension in each principal direction measured by caliper.
- Percent open area measured without magnification by Corps of Engineers method as specified in CW 02215 Civil Works Construction Guide, November 1977.
- Long term load capacity measured by through the junction tensile creep testing to 10,000 hours as described in Geosynthetic Research Institute test method GG3487 "Creep Behavior and Long Term Design Load of Geogrids".
- ASTM D 1388-64 modified to account for wide specimen testing as described in "Tensar test method TDM-5.0 "Stiffness of Geosynthetics".
- Seal modulus at 2% elongation measured by Geosynthetic Research Institute test method GG1-87 "Geogrid Tensile Strength". No offset allowances are made in calculating seal modulus.
- Geogrid junction strength and junction efficiency measured by Geosynthetic Research Institute test method GG2-87 "Geogrid Junction Strength".
- The long-term allowable design strength (LTADS) is determined using the method outlined in GRI-GG4 "Determination of the Long Term Design Strength to Stiff Geogrids". The GRI-GG4 method applies various partial factors of safety to account for construction damage, junction strength, connections, chemical and biological degradation.

5.0 GEOGRID INSTALLATION

- Geogrid shall be laid at the proper elevation and orientation (i.e., the machine direction shall be perpendicular to the pipe structure axis) as shown on the construction drawings.
- Correct orientation (roll direction) of the geogrid shall be verified by the Contractor. The correct roll direction shall be perpendicular to the structure axis.
- Geogrid may be secured in-place with staples, pins, sand bags, or backfill as required by fill properties, fill placement procedures, or weather conditions, or as directed by the Engineer.
- Geogrid Placement:
  - Geogrids should be laid horizontally on compacted fill and pulled taut from their connection to the concrete units before wall fill is placed over them. Care must be taken to prevent slack from becoming trapped within the geogrid as fill is placed.

6.0 BACKFILL PLACEMENT OVER GEOGRID

- Backfill material shall be placed in lifts and compacted as directed in the text of this document.
- Backfill shall be placed, spread, and compacted in such a manner that minimizes the development of wrinkles in and/or movement of the geogrid.
- Tracked construction equipment shall not be operated directly upon the geogrid. A minimum fill thickness of six (6) inches (150mm) is required prior to operation of tracked vehicles over the geogrid. Turning of tracked vehicles should be kept to a minimum to prevent tracks from displacing the fill and damaging the geogrid.
- Rubber tired equipment may pass over geogrid reinforcement at slow speeds, less than 10 MPH (16 KPH). Sudden braking and sharp turning shall be avoided.

Developer/Owner:  
**Winchester Homes, Inc. & Winchester Homes, Inc., as nominee for Stringtown Investments, LLC**  
 6905 Rockledge Drive

Bethesda, Maryland 20817  
 Stephen J. Nardella, Vice President  
 (301) 803 - 4800

HOWARD COUNTY DEPARTMENT OF PUBLIC WORKS

*William F. ...* 10-14-03  
 CHIEF, BUREAU OF HIGHWAY

HOWARD COUNTY DEPARTMENT OF PLANNING & ZONING

*Cinda ...* 10/27/03  
 CHIEF, DIVISION OF LAND DEVELOPMENT

*Charles ...* 10/17/03  
 CHIEF, DEVELOPMENT ENGINEERING DIVISION

VII - CONCRETE

1.0 CODES AND STANDARDS

1.1 Reinforced concrete shall conform to the requirements of AASHTO Standard Specifications for Highway Bridges, Division II - Construction, Section 8, "Concrete Structures" having a minimum compressive strength of 3,500 psi except for a minimum of 2400 psi for thrust beams.

2.0 STANDARDS FOR MATERIALS

- Portland Cement - Conforming to ASTM Specification C-150, Type I or II.
- Water - The water shall be drinkable, clean free from injurious amounts of oils, acids, alkalis, organic materials, or deleterious substances.
- Aggregates - Fine and coarse aggregates shall conform to current ASTM Specification C-33 "Specification for Concrete Aggregates" except that local aggregates which have been shown by tests and by actual service to produce satisfactory qualities may be used when approved by the Engineer.
- Submittals - Test data and/or certifications to the Owner shall be furnished upon request.

3.0 PROPORTIONING OF CONCRETE

- COMPOSITION
  - The concrete shall be composed of cement, fine aggregate, coarse aggregate and water.
  - The concrete shall be homogeneous, readily placeable and uniformly workable and shall be proportioned in accordance with ACI-211.1.
  - Proportions shall be established on the basis of field experience with the materials to be employed. The amount of water used shall not exceed the maximum 0.49 water/cement ratio, and shall be reduced as necessary to produce concrete of the specified consistency at the time of placement.
- Qualities Required - As indicated in the table below:

TABLE VII-1  
 QUALITIES REQUIRED

ITEM	QUALITY REQUIRED
Class	A
Type of Cement	I or II
Compressive Strength $f_c$ @ 28 days	3500 psi, 2400 psi for Thrust Beams
Slump, inches	2 - 4 in.

- Maximum Size of Coarse Aggregates - Maximum size of coarse aggregates shall not be larger than 38 mm (1 1/2 inches).
- Rate of Hardening of Concrete - Concrete mix shall be adjusted to produce the required rate of hardening for varied climatic conditions:  
 Under 40°F Ambient Temperature - Accelerate calcium chloride at 2% is acceptable when used within the recommendations of ACI-306R "Cold Weather Concreting." Admixtures containing chloride ion in excess of 1% by weight of admixture shall not be used in reinforced concrete.

4.0 MIXING AND PLACING

- Equipment - Ready Mix Concrete shall be used and shall conform to the "Specifications for Ready-Mix Concrete," ASTM C-94. Approval is required prior to using job mixed concrete.
- Preparation - All work shall be in accordance with ACI-304, "Recommended Practice for Measuring, Mixing, Transporting and Placing Concrete." All construction debris and extraneous matter shall be removed from within the forms. Concrete shall be placed on clean surfaces, free from water. Concrete that has to be dropped four (4) feet or more shall be placed through a tremie.
- All concrete shall be consolidated by internal mechanical vibration immediately after placement. Vibrators shall be of a size appropriate for the work, capable of transmitting vibration to concrete at frequencies of not less than 4,500 impulses per minute.

5.0 FORM WORK

- Forms shall be of wood, steel or other approved material and shall be set and held true to the dimensions, lines and grades of the concrete elements prior to and during the placement of concrete.
- Forms shall not be removed until the concrete has sufficient strength to prevent concrete drainage.

6.0 CURING

- Fresh concrete shall be protected from rains, flowing water and mechanical injury for a period of four (4) days.

7.0 REINFORCING STEEL

- MATERIAL
  - All reinforcing bars shall be deformed bars (ASTM-A615) Grade 60. The reinforcement bars can be Grade 40 for the thrust beams.
- BENDING AND SPLICING
  - Bar reinforcement shall be cut and bent to the shapes shown on the plans. Fabrication tolerances shall be in accordance with ACI 315. All bars shall be bent cold, unless otherwise permitted.

7.2.2 All reinforcement shall be furnished in the full lengths indicated on the plans unless otherwise permitted. Except for splices shown on the plans and splices for No. 5 or smaller bars, splicing of bars will not be permitted without written approval. Splices shall be staggered as far as possible.

7.2.3 In lapped splices, the bars shall be placed and wired in such a manner as to maintain the minimum distance to the surface of the concrete shown on the plans.

7.2.4 Substitution of different size bars will be permitted only when authorized by the engineer. The substituted bars shall have an area equivalent to the design area, or larger.

7.3 PLACING AND FASTENING

7.3.1 Steel reinforcement shall be accurately placed as shown on the plans and firmly held in position during the placing and setting of concrete. Bars shall be tied at all intersections around the perimeter of each mat and at not less than 2 foot centers or at every intersection, whichever is greater, elsewhere. Welding of cross bars (tack welding) will not be permitted for assembly of reinforcement.

7.3.2 Reinforcing steel shall be supported in its proper position by use of mortar blocks, wire bar supports, supplementary bars or other approved devices. Such devices shall be of such height and placed at sufficiently frequent intervals so as to maintain the distance between the reinforcing and the formed surface or the top surface within 1/4 inch of that indicated on the plans.

VIII - FILTER FABRIC

1.1 Filter fabric shall be placed around the granular material placed below the modular block walls, and below the riprap protection in accordance with MD S.H.A. specifications.

1.2 Filter fabric cloth shall conform to the following ASTM tests:

- Equivalent opening size equal to #70 - #100 U.S. Standard Sieve Size.
- ASTM D4632 (Grab Tensile Test) - Minimum Strength = 120 pounds.
- ASTM D4632 (Grab Elongation) - 30-70%.
- ASTM D4533 (Trapezoidal Tear) - Minimum Strength = 55 pounds.
- ASTM D4355 (Stabilized for Heat and Ultra-Violet Degradation) - 70% strength retained.

1.3 The minimum fabric coefficient of permeability shall be  $1 \times 10^{-2}$  cm/sec.

1.4 Gradient ratio shall be less than or equal to three.

1.5 Fabric shall not be placed over sharp or angular rocks that could tear or puncture it.

1.6 Care should be exercised to prevent any puncturing or rupture of the filter fabric. Should such rupture occur the damaged area should be covered with a patch of filter fabric using an overlap minimum of one (1) foot.

IX - PYRAMAT EROSION MATRIX

1.0 GENERAL

1.1 SCOPE OF WORK  
 The work covered by this section consists of furnishing all labor, equipment, and materials, and performing all operations in connection with the installation of Turf Reinforcement Mats (TRMs) in accordance with the lines, grades, design, and dimensions shown on the drawings and as specified herein.

2.0 MATERIAL

- The erosion matrix shall be Contech's turf reinforcement mat product TRC-61 or equivalent with the following minimum characteristics:
  - thickness: 0.50"
  - mass: 17 oz/sy
  - tensile strength: 350 x 250 lbs/ft
  - elongation: max 85%
  - standard roll width: 8.5 feet

3.0 INSTALLATION

- An anchor trench shall be excavated as shown on the construction drawings.
- The PYRAMAT roll shall be folded and secured using U-shaped wire staples (preferred), geotextile pins or wooden stakes.
- The anchor trench shall be backfilled with suitable soil compacted to a minimum of 90% of the standard Proctor dry unit weight.
- Wire staples shall be a minimum of 4.3 mm (8 gauge). Metal pins shall be at least 4.7 mm (3/16") diameter steel with a 38 mm (1 1/2") steel washer at the head of the pin. Wire staples and metal pins shall be driven flush to the soil surface. Wooden stakes shall be 75 x 38 mm (3" x 1 1/2") triangular wooden survey stakes. Approximately 50 mm (2") of wood staking shall remain above the soil surface. All anchors should be between 20-45 cm (8"-18") long and have sufficient ground penetration to resist pullout. Longer anchors may be required for loose soils.
- At the TRMs surface use 2 anchors/yard<sup>2</sup> as an anchor pattern guide.

CONTECH CONSTRUCTION PRODUCTS, INC.  
 DESIGN OF SUPER-SPAN  
 LOW PROFILE ARCH #90A18

3	9/24/03	DWR	FINAL MYLAR SUBMITTAL FOR SIGNATURE
2	4/22/03	DWR	REVISION #2 - REVIEWER'S COMMENTS
1	4/11/03	DWR	REVISION #1 - REVIEWER'S COMMENTS

**CBC ENGINEERS**  
 DAYTON, OHIO

**SPECIFICATIONS (CONT'D.)**

Drawn By: DWR Date: 12/16/02  
 Approved By: Date: 10/17/03

Project No. CBC-4268 Rev. 3 Sheet 34 OF 34

AS-BUILT PLANS  
 (No As-Built Data This Sheet)

