

GENERAL NOTES

- Subject property zoned "R-20" per 02/02/04 Comprehensive Zoning Plan.
- This site is located within the Metropolitan District.
- Public water and sewer to be utilized.
- Soils map no. 24.
- Gross area of site: 6.655 ac.±
- Area of proposed public R/W: 0.778 ac.±
- Number of proposed buildable lots: 12
- Area of proposed buildable lots: 4.421 ac.±
- Number of proposed open space lots: 4
- Area of proposed open space lots: 1.417 ac.± (Credited Area = 1.366 ac.±)
- Number of Bulk Parcels: 1
- Area of Bulk Parcel 'A': 0.039 ac.±
- Open Space requirements:
 - Open Space required (20%-16,000sf minimum lot size): 6.655 ac.± x 0.20 = 1.331 ac.±
 - Recreational Open Space required: 12 lots x 200 sf = 2,400 sf
 - Recreational Open Space provided: 6,434 sf in Open Space Lot II
- The coordinates shown hereon are based upon the Howard County Geodetic Control which is based on the Maryland State Plane Coordinate system. Howard County monument numbers 321A and 31B3 were used for this project.
- The lots shown hereon comply with the minimum ownership width and lot area as required by the Maryland State Department of the Environment.
- The contractor shall notify the following utility companies or agencies at least five(5) working days before starting work shown on these plans:

State Highway Administration	410.531.5533
BGE(Contractor services)	410.850.4620
BGE(underground damage control)	410.787.9068
Miss Utility	1.800.257.7777
Colonial Pipeline Company	410.795.1390
Howard County, Dept. of Public Works, Bureau of Utilities	410.313.4900
Howard County, Health Department	410.313.2640
- The contractor shall notify Miss Utility at 1-800-257-7777 at least 48 hours prior to any excavation work being done.
- The contractor shall notify the Department of Public Works/Bureau of Engineering Construction Inspection Division at (410) 313-1800 at least five (5) working days prior the start of work.
- All fills for public surfaces require 95% compaction (AASHTO-T-180).
- All construction shall be in accordance with the latest standards and specifications of Howard County plus MSHA standards and specifications if applicable.
- Traffic control devices, markings and signing shall be in accordance with the latest edition of the Manual of Uniform Traffic Control Devices (MUTCD). All street and regulatory signs shall be in place prior to the placement of any asphalt.
- Two foot contours, topography and boundary for Metzlers Garden is based on a field run survey prepared by C.B. Miller and Associates, Inc. in March 2004. Five foot contours and topography outside of the boundary is based on Howard County 1988 Aerial Topographic Surveys.
- Stormwater Management is provided in accordance with the 2000 Stormwater Management Manual Redevelopment guidelines. CPV, WQV, REV is achieved by reduction of existing impervious surfaces by more than 50% from 80% of existing impervious surfaces to approximately 35-40% of proposed impervious surfaces.
- A.P.F.O. Traffic Study prepared by Street Traffic Studies and approved under S-04-06.
- Wetlands Delineation and report prepared by Exploration research, Inc. and approved under S-04-06.
- Forest Stand Delineation and report prepared by Exploration Research, Inc. and approved under S-04-06.
- There are no historic structures or cemeteries on-site.
- There is no 100-Year Floodplain on the property.
- Previous county file numbers: SDP 82-19, SDP 85-107, SDP-75-54, SDP 87-14, BA-81-20, BA-84-22E, BA-86-07E, BA-87-14V, BA-95-11E, BA-96-34E, S-04-06, P-04-15.
- No clearing, grading or construction is permitted within wetlands, streams or their required buffers, unless approved by the Department of Planning and Zoning.
- All Existing Buildings, Structures, and Fencelines on site to be removed except the existing house shown on proposed lot 14.
- Overflow Parking Requirements:
 - Number of parking spaces required: 6 (0.5 per unit x 12 units)
 - Parking spaces provided along roadway and on private driveway pads
- This subdivision is subject to the Amended Fifth Edition of the Howard County Subdivision and Land Development Regulations. Development or construction on these lots/parcels must comply with setback and buffer regulations in effect at the time of submission of the site development plan, waiver petition, or building/grading permit application.
- All open space lots will be dedicated to the Homeowners Association.
- This subdivision complies with the forest conservation requirements of Section 16.1200 of the Howard County Code with a 100 acre deforestation obligation. Surety in the amount of \$18,433.50 was posted with the DPM, Developer's Agreement, based on afforestation planting of 44,876 sq. ft. less 8,000 sq. ft. for 20 trees bonded under landscape.
- See street lights and signs locations on the plan and street light tabulation on this sheet.
- The disturbance within the 50 foot stream buffer for the construction of the storm drain pipe and S-1 outfall was found to be essential by both Soil Conservation District in a letter dated 7/2/04, and the Division of Land Development. This determination is in accordance with section 16.116(c) of the subdivision and Land Development Regulations.
- Financial surety for the required landscaping must be posted as part of the Developer's Agreement in the amount of \$12,500.00 based on 41 shade trees @ \$300.00 each, 4 evergreen trees @ \$150.00 each.
- Contractor is responsible to construct all handicap ramps and handicap access in accordance with current ADA requirements. Handicap Ramps to conform to Howard County Standard Detail R-4.03 or Detail Sheet 2 (See plan for type).
- Any damage to public right-of-ways, paving or existing utilities will be corrected at the contractor's expense.
- All proposed spot elevations along curb and gutter are to the flowline unless otherwise noted.
- All construction shall be in accordance with the latest standards and specifications of Howard County in addition to MSHA standards and specifications if applicable.
- All reinforced concrete for storm drain structures shall have a minimum of twenty-eight (28) days strength at 3,500 psi. Any RCP Storm Drain pipe bedding shall be Class 'C'.
- All HDPE pipe specification and installation shall meet AASHTO M-252 Type S, M-294 Type S and ASTM D2321, respectively.
- All sign post uses for traffic control signs installed in the County Right-of-Way shall be mounted on a 2" galvanized steel, perforated, square tube post (14 gauge) inserted into a 2-1/2" galvanized steel, perforated, square tube sleeve (12 gauge) - 3' long. A galvanized steel pole cap shall be mounted on top of each post.
- Existing septic tanks to be properly abandoned during road construction phase.


FINAL ROAD CONSTRUCTION PLAN

METZLERS GARDEN

LOTS 1-6, 8-10, 12-14, OPEN SPACE LOTS 7, 11, 15, 16 AND BULK PARCEL 'A' HOWARD COUNTY, MARYLAND

LEGEND

- Existing contours - - - - - 552
- Existing Spot Elevation - - - - - 352.3
- Existing Trees to Remain
- 25' Wetlands Buffer - - - - - WB
- Stream Bank Buffer - - - - - SB
- Wetland - - - - - W
- Stream - - - - -
- Utility Pole
- Specimen Tree
- Proposed Dwelling

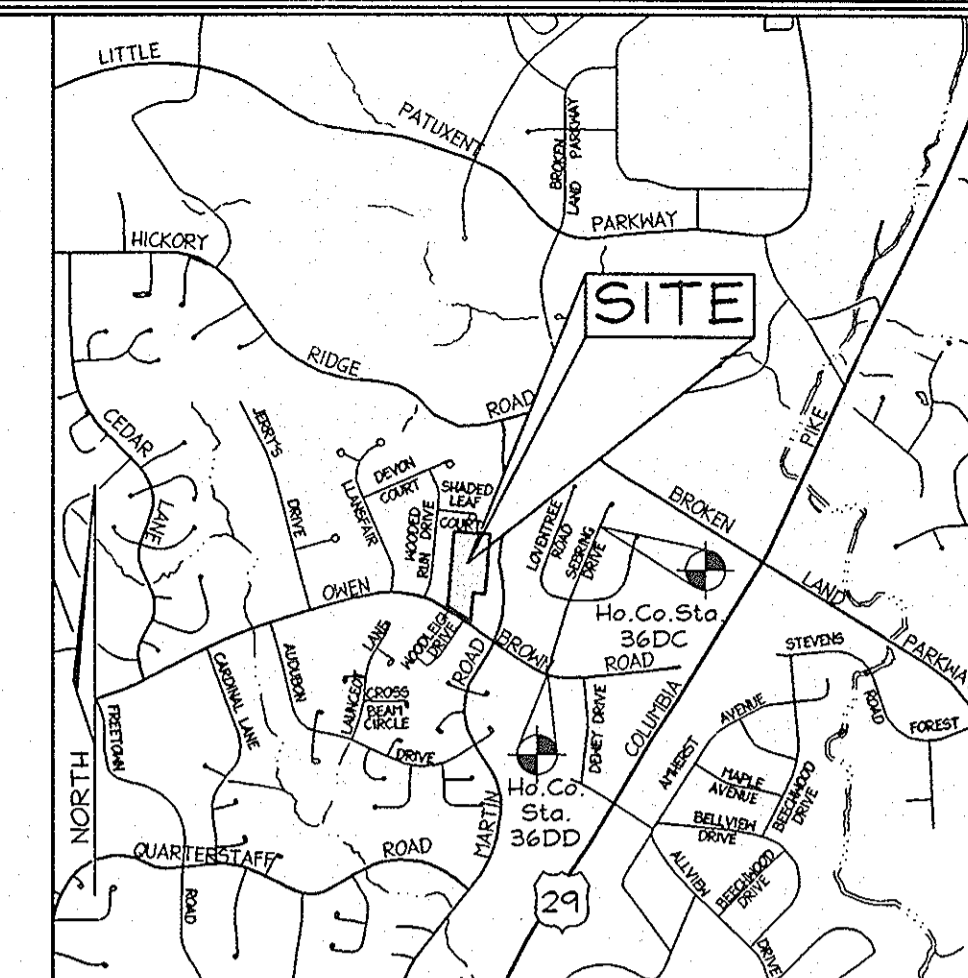

VICINITY MAP
SCALE: 1"=2000'

BENCHMARKS

Howard County monuments:
Sta. 36DC N 170,563.5470 E 411,615.1201 El.: 116.1813 (meters)
E 1,350,440.606 El.: 381.007 (feet)
(Concrete Monument on the west side of Sebring Drive 2' from the western edge of Sebring Drive, 10' south of existing driveway, 42' from a fire hydrant on the east side of Sebring Drive.)
Sta. 36DD N 170,095.9837 E 411,448.0004 El.: 119.8332 (meters)
E 1,349,842.314 El.: 393.153 (feet)
(Concrete Monument 2' from edge of eastbound lane of Owen Brown Road, 47.5' from a fire hydrant, 63' from GTE pole# 243772.)

SHEET INDEX

DESCRIPTION	SHEET No.
Cover Sheet	1 of 5
Road Plan and Profile	2 of 5
Sediment and Erosion Control and Grading Plan	3 of 5
Traffic Control Plan, Sediment and Erosion Control and Grading Notes and Details	4 of 5
Storm Drain Drainage Area Map	5 of 9
Storm Drain Profiles	6 of 9
Landscape Plan, Notes and Details	7 of 9
Forest Conservation Plan	8 of 9
Existing Conditions Plan	9 of 9

LINE TABLE


LINE	LENGTH	BEARING
L1	6.82	N34°21'18"E
L2	199.06	N20°27'21"E
L3	253.25	N04°42'25"E

CENTERLINE ROAD CURVE DATA

CURVE #	STATIONS	RADIUS	ARC LENGTH	DELTA	TANGENT	CHORD
C1	PC-0+06.82; PT-1+43.20	100.00'	136.39'	78°08'31"	81.18'	N04°42'58"W 126.00'
C2	PC-1+43.20; PT-2+66.54	110.00'	123.34'	64°14'34"	64.06'	N11°34'56"W 116.98'
C3	PC-4+65.94; PT-5+75.54	400.00'	104.95'	15°44'56"	55.32'	N12°34'53"E 104.60'


ROAD CLASSIFICATION

ROAD NAME	CLASSIFICATION	R/W
Dotts Way	Public Access Place	40'

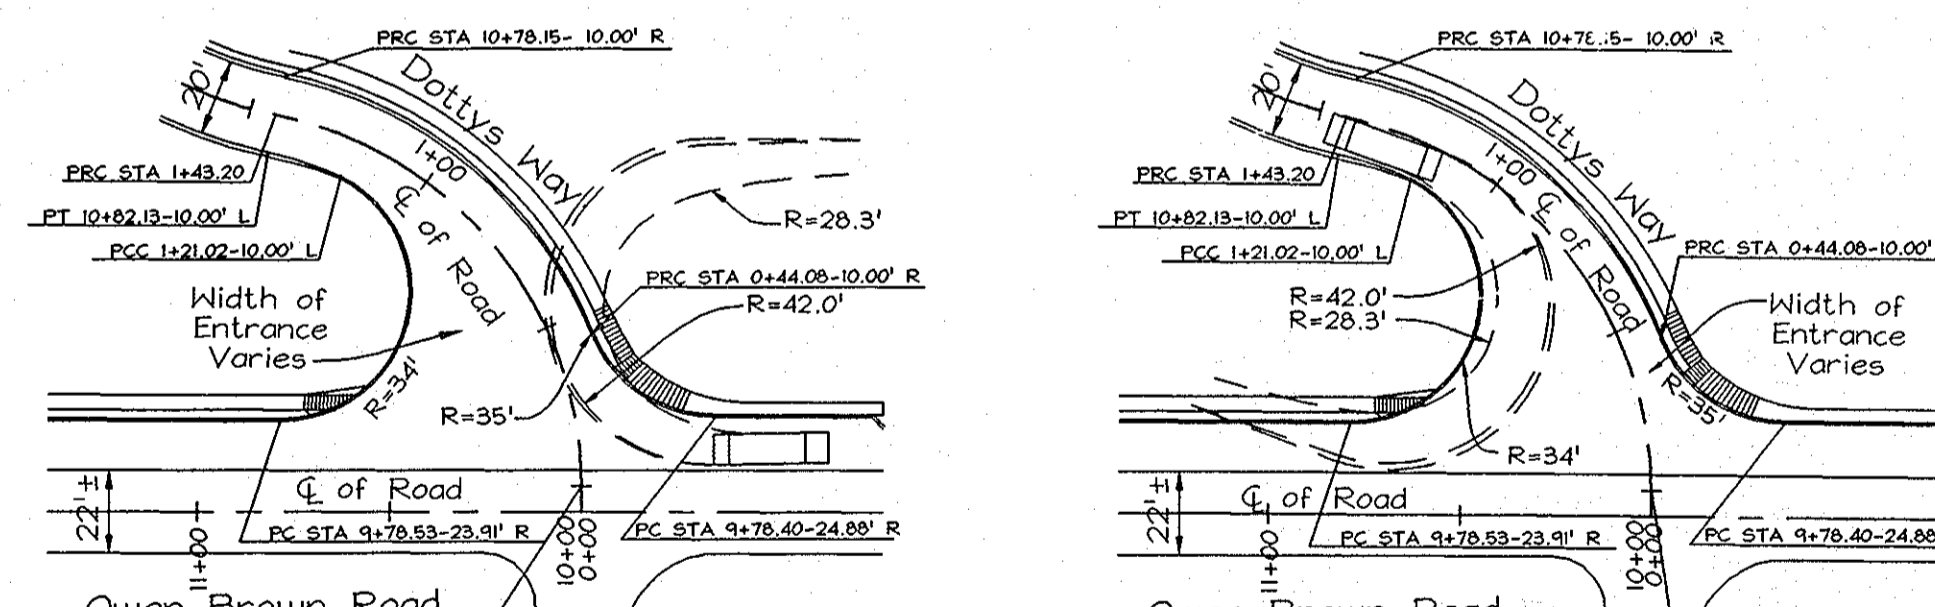

MINIMUM TURNING PATH FOR SU DESIGN VEHICLES
Scale: 1"=50'

AS-BUILT FOR ROADS, STORMDRAINS AND EROSION & SEDIMENT CONTROLS

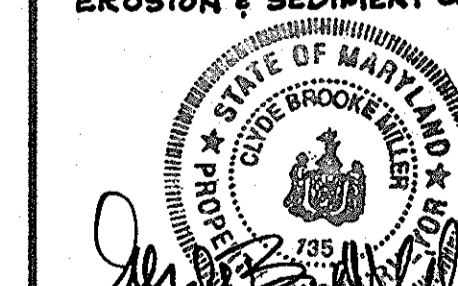

C. BROOKE MILLER
PROP. L.S. #135

6-8-2007

DATE

DEVELOPER

OWNER METZLER GROUP LLC
METZLER DOROTHY WF T/C
10358 OWEN BROWN ROAD
COLUMBIA, MARYLAND 21044-3834


CONTRACT PURCHASER WILLIAMSBURG GROUP LLC
5485 HARPERS FARM RD #200
COLUMBIA, MARYLAND 21044-3834
Telephone: (410) 997-8800
Fax: (410) 997-4358

COVER SHEET
METZLERS GARDEN

LOTS 1-6, 8-10, 12-14,
OPEN SPACE LOTS 7, 11, 15, 16 AND BULK PARCEL 'A'
TAX MAP 36 GRID 7 PARCEL 152
5TH ELECTION DISTRICT HOWARD COUNTY, MARYLAND

FSH Associates

Engineers Planners Surveyors
8318 Forrest Street - Ellicott City, MD 21043
Tel: 410-750-2251 Fax: 410-750-7350
E-mail: info@fsh.net

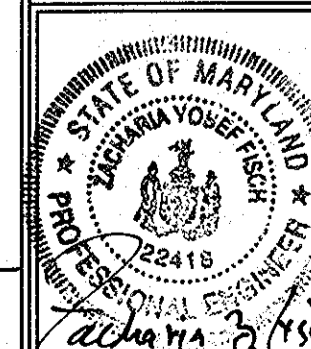


ZACHARIA Y. FISCH
PE # 22418

6/11/07

DATE

DESIGN BY: PS
DRAWN BY: MY
CHECKED BY: ZYP
SCALE: As Shown
DATE: May 24, 2005
H.O. No.: 3214
SHEET No.: 1 OF 9

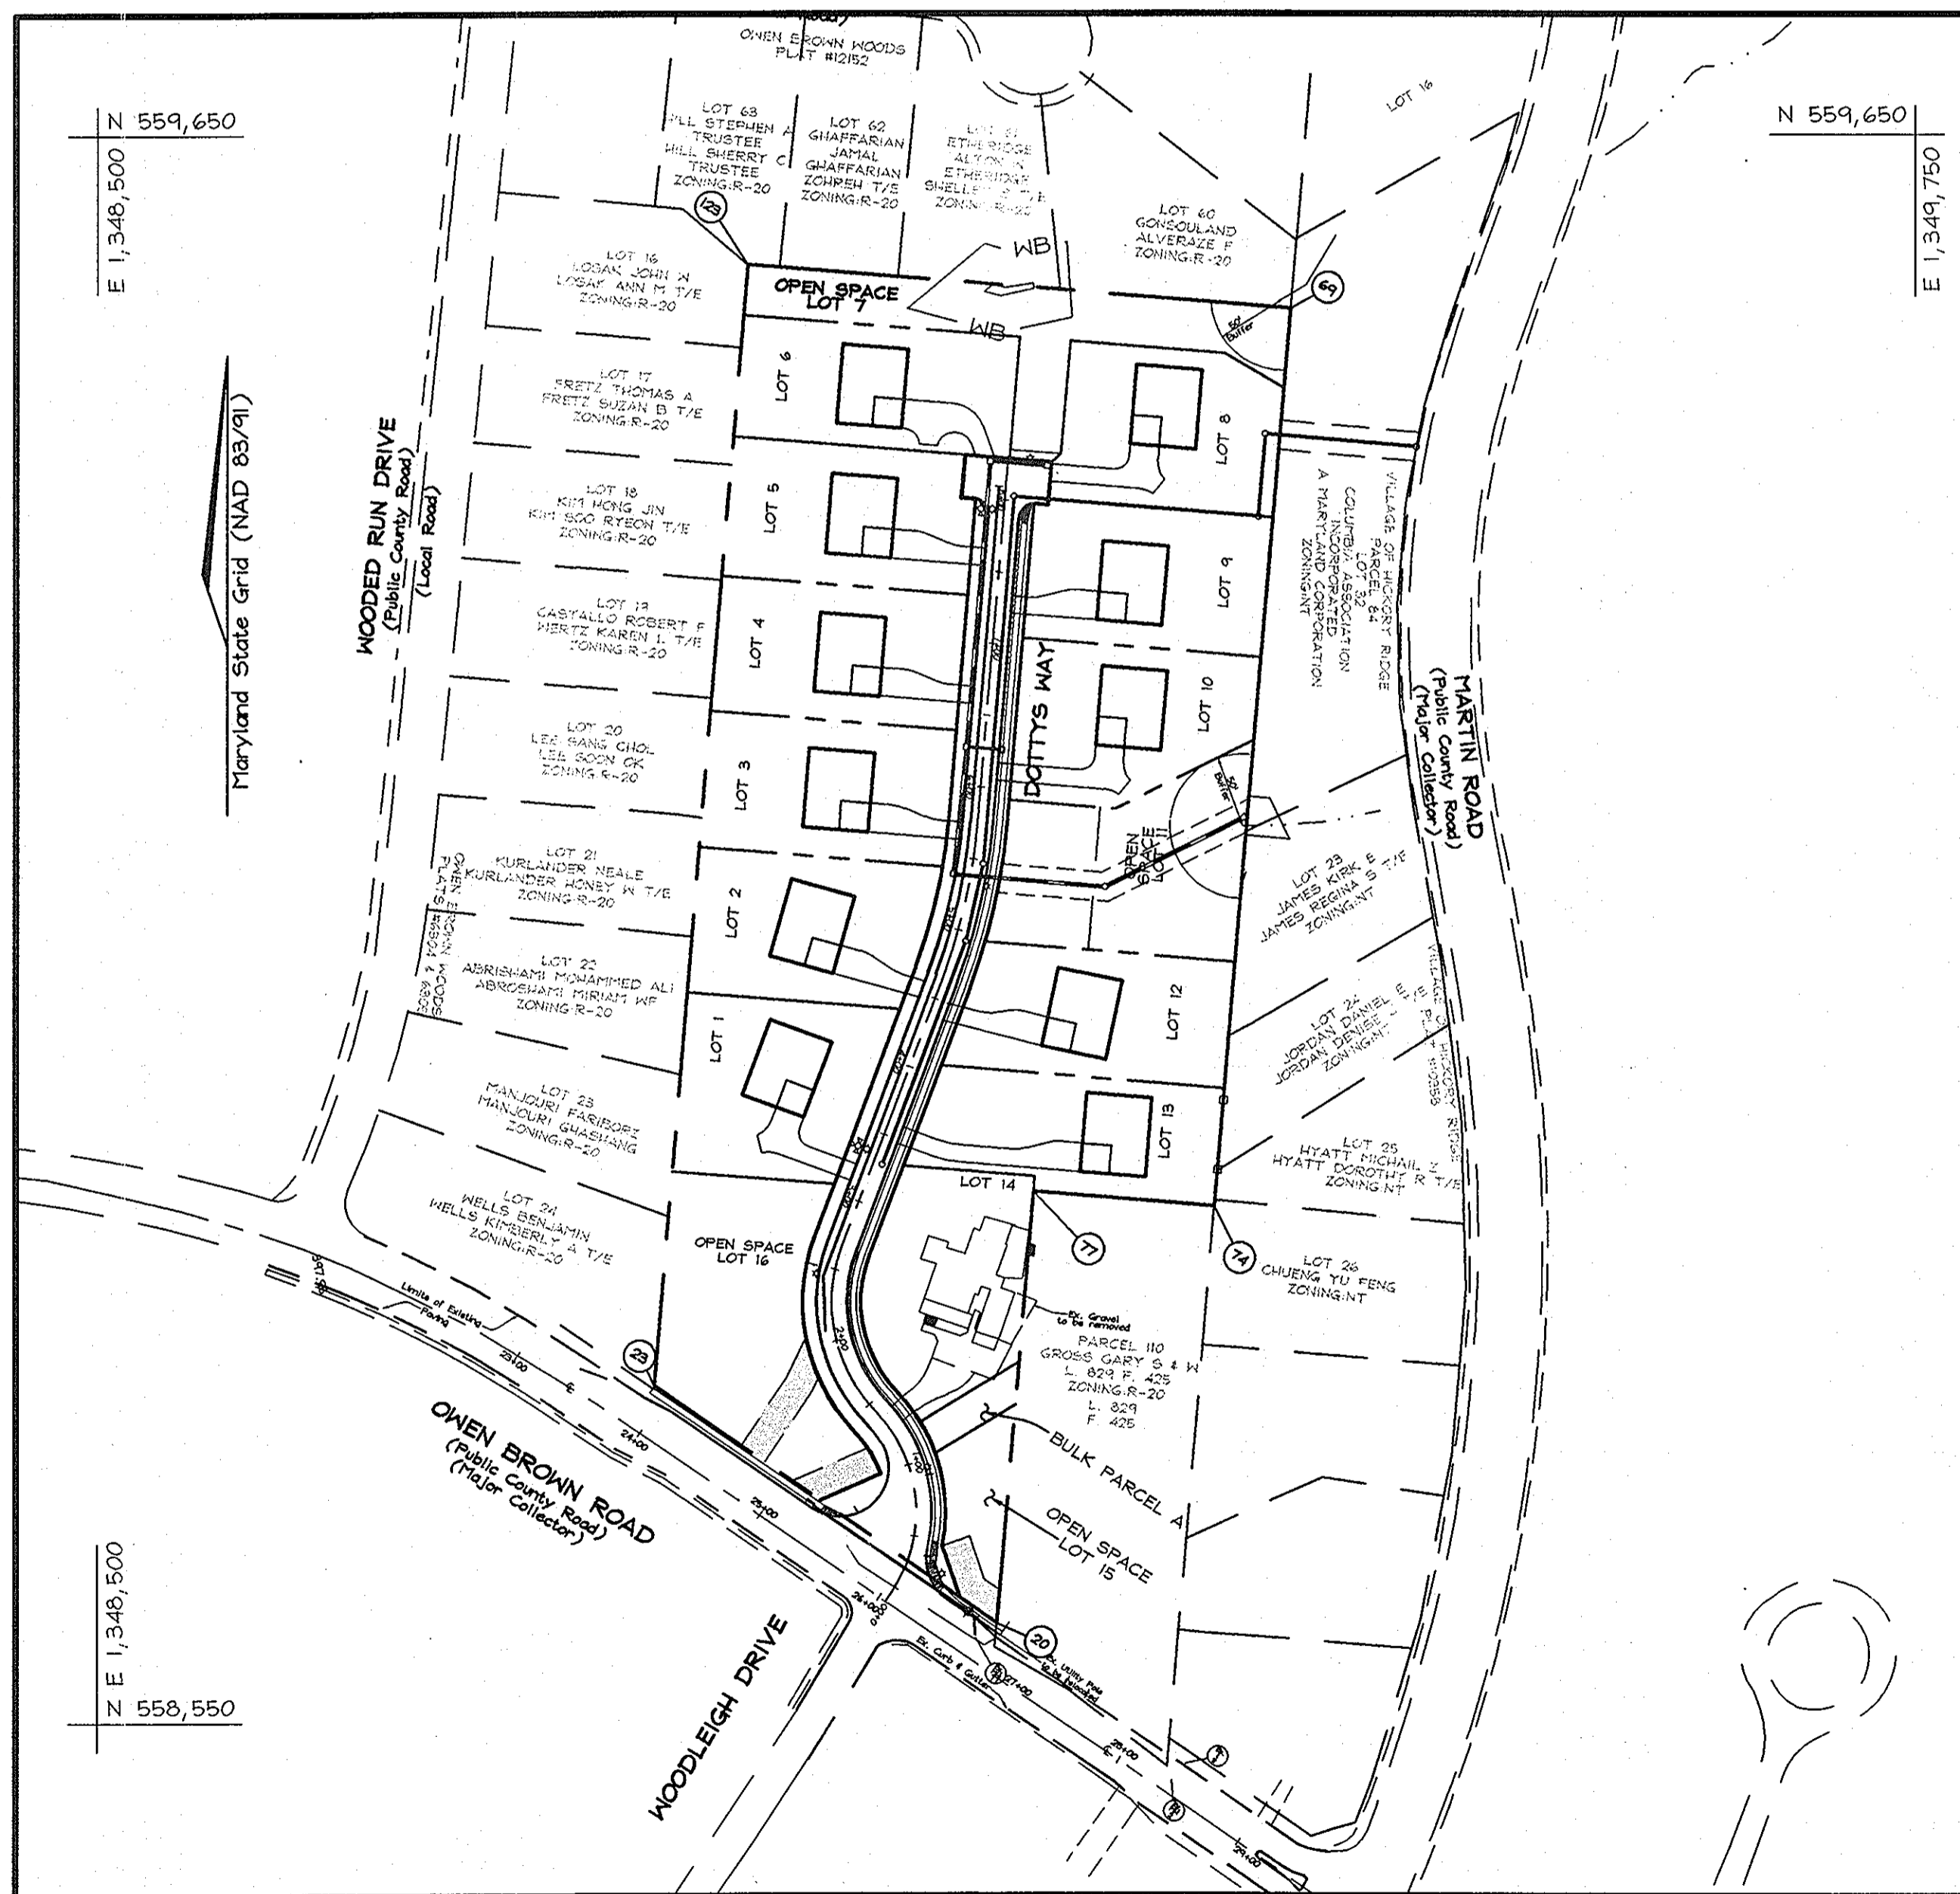

LOCATION MAP
SCALE: 1"=100'

STREET LIGHT TABLE

FIXTURE TYPE	POLE TYPE	LOCATION
150 watt premier post top	14' bronze fiberglass ornamental	Sta. 0+32.00 25.00' right
100 watt premier post top	14' bronze fiberglass ornamental	Sta. 0+95.00 12.00' right
100 watt premier post top	14' bronze fiberglass ornamental	Sta. 2+45.00 12.00' left
100 watt premier post top	14' bronze fiberglass ornamental	Sta. 5+33.00 12.00' right
100 watt premier post top	14' bronze fiberglass ornamental	Sta. 8+30.00 15.00' right



Note: Light pole location given at center of base

APPROVED: HOWARD COUNTY DEPARTMENT OF PLANNING AND ZONING

APPROVED: HOWARD COUNTY DEPARTMENT OF PUBLIC WORKS

Candy Hamilton 5/23/05
CHIEF, DIVISION OF LAND DEVELOPMENT
William E. Miller 5/26/05
CHIEF, DEVELOPMENT ENGINEERING DIVISION

William E. Miller 5-25-05
CHIEF, BUREAU OF HIGHWAYS

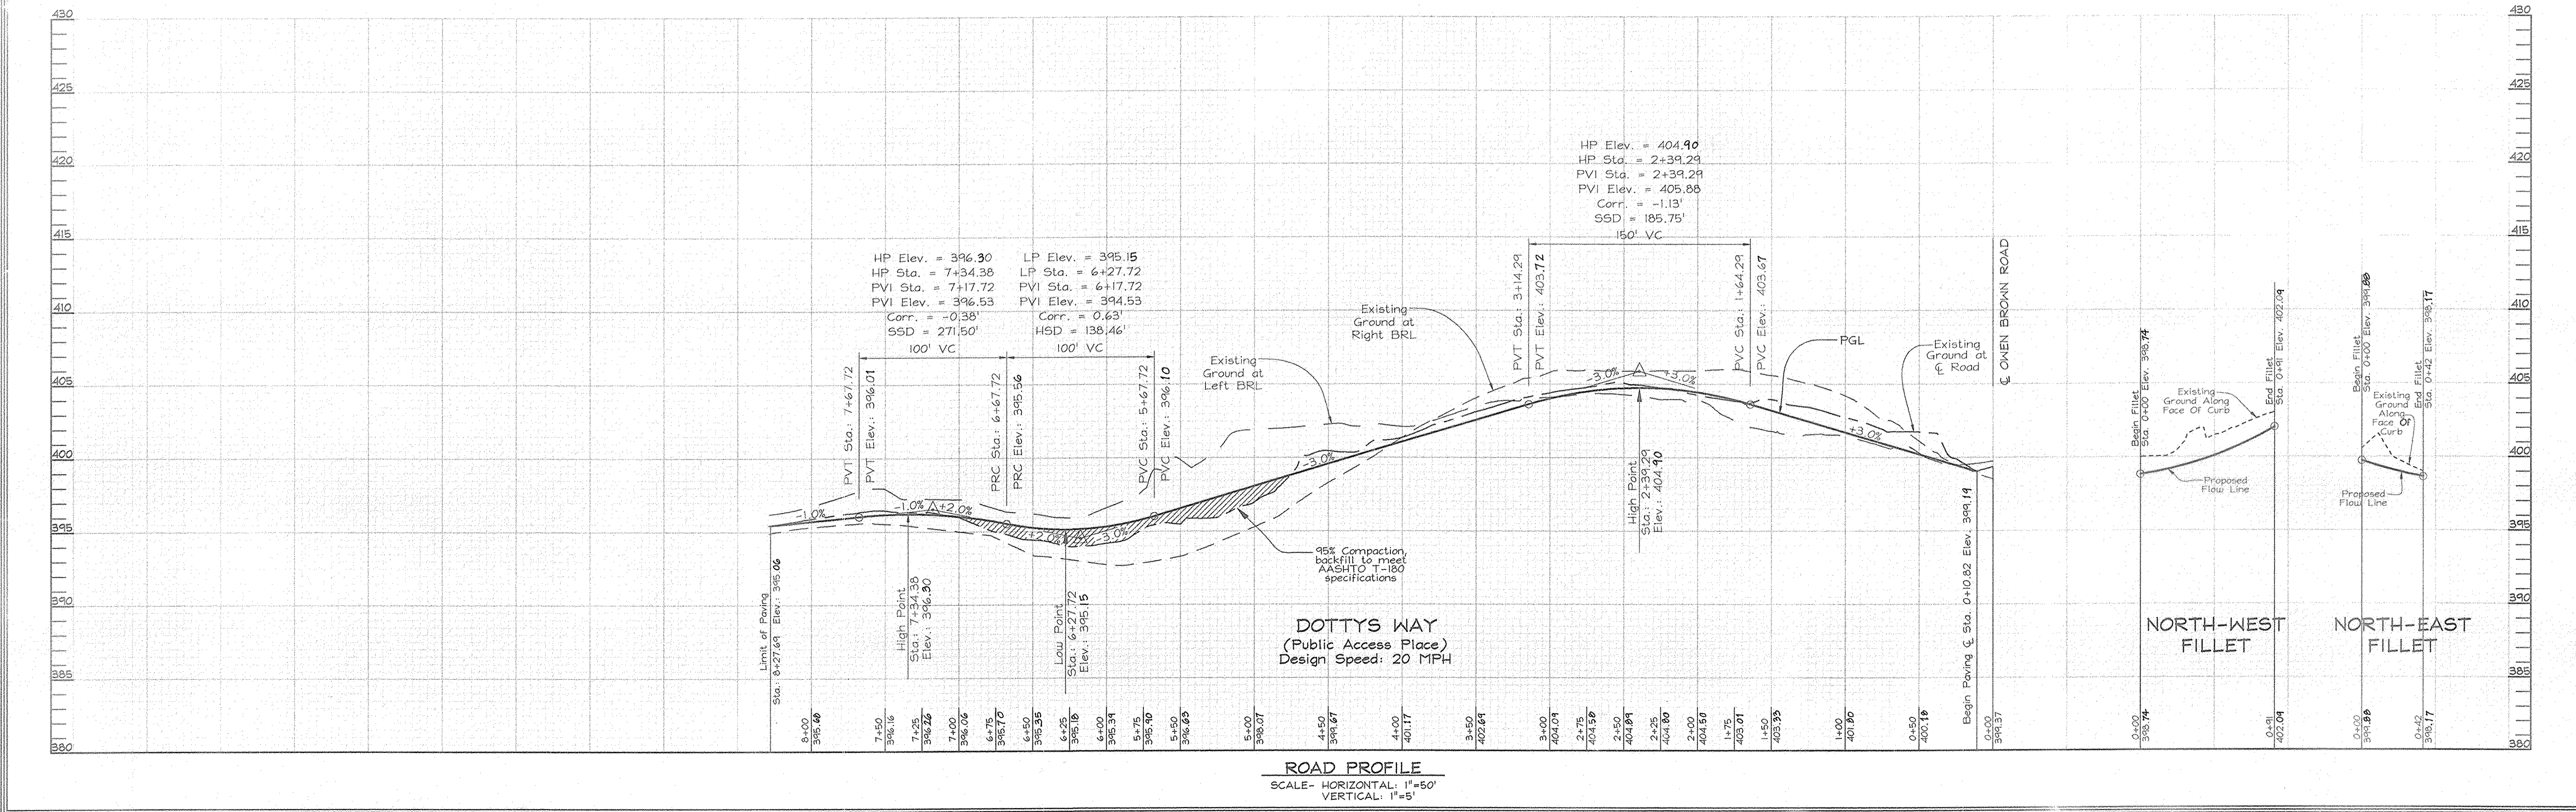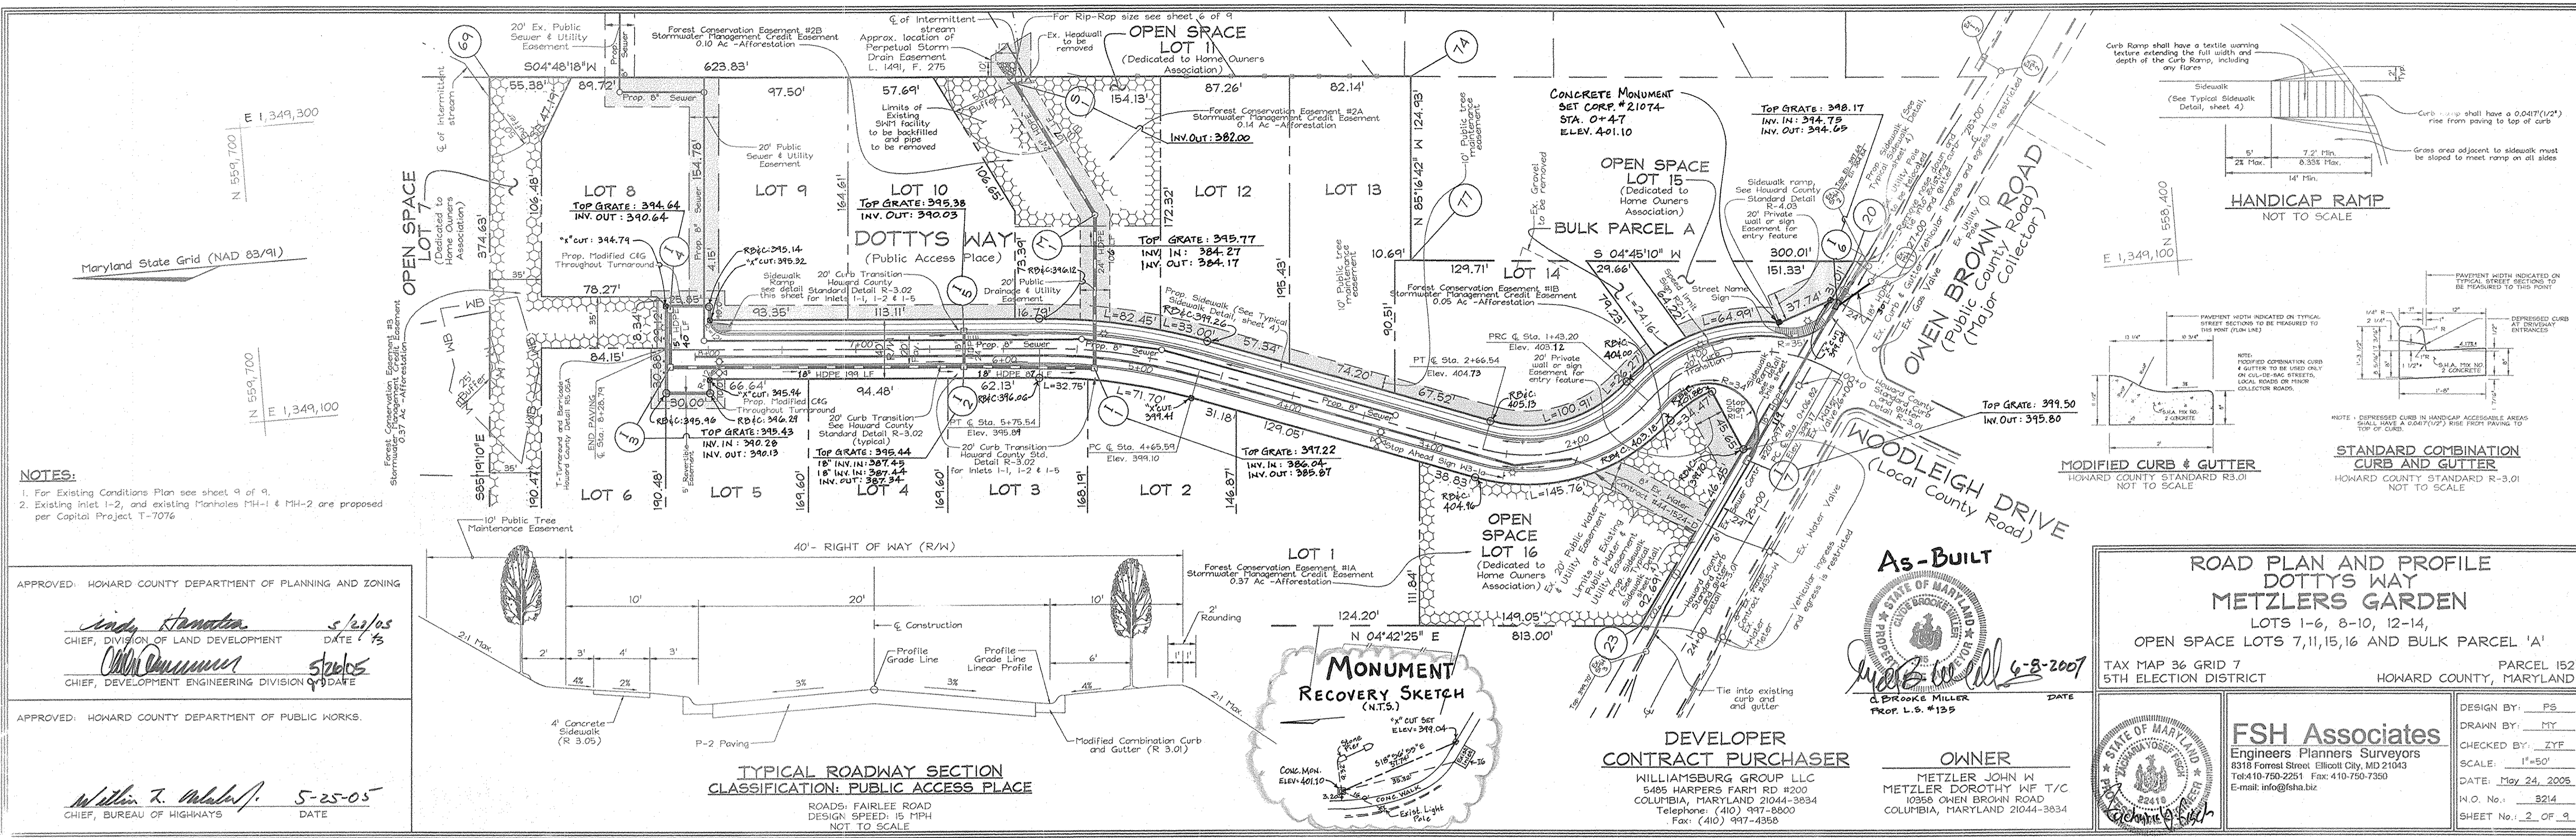

LEGEND	
Existing Contour	--- 382
Proposed Contour	--- +82.53
Spot Elevation	○
Direction of Flow	→
Stabilized Construction Entrance	▭ H H U
Silt Fence	— SF — SF —
Super Silt Fence	— SSF — SSF —
Earth Dike	— ED A-1 —
Limit of Disturbance	— LOD —
Erosion Control Matting	— EC1 —
Curb Inlet Protection	▭ CIP

SEDIMENT TRAP #1 (ST-II)

Existing Drainage Area: 3.19ac±
 Proposed Drainage Area: 3.1ac±
 Net Storage required: 9,000.0cf
 Net Storage provided: 9,000.0cf
 Dry Storage provided: 12,278.8cf
 Weir Length: 20.0'
 Storage Depth below outlet: 3.5'
 Cleanout Elevation: 384.29
 Embankment Height: 4.0'
 Trap Bottom: 383.50
 Trap Dimensions: 10'x50'
 Net Storage Elevation: 385.08
 Crest Elevation: 387.00

NOTE: See sheet 9 of 9 for existing structures and utilities on-site.

DEVELOPER'S CERTIFICATE

I/WE CERTIFY THAT ALL DEVELOPMENT AND CONSTRUCTION WILL BE DONE ACCORDING TO THIS PLAN FOR SEDIMENT AND EROSION CONTROL, AND THAT ALL RESPONSIBLE PERSONNEL INVOLVED IN THE CONSTRUCTION PROJECT WILL HAVE A CERTIFICATE OF ATTENDANCE AT A DEPARTMENT OF THE ENVIRONMENT APPROVED TRAINING PROGRAM FOR THE CONTROL OF SEDIMENT AND EROSION BEFORE BEGINNING THE PROJECT. I ALSO AUTHORIZE PERIODIC ON-SITE INSPECTION BY THE HOWARD SOIL CONSERVATION DISTRICT.

Signature of Developer: *[Signature]* DATE: 5/24/05
 WILLIAMSBURG GROUP LLC

ENGINEERS CERTIFICATE

I CERTIFY THAT THIS PLAN FOR SEDIMENT AND EROSION CONTROL REPRESENTS A PRACTICAL AND WORKABLE PLAN BASED ON MY PERSONAL KNOWLEDGE OF THE SITE CONDITIONS AND THAT IT WAS PREPARED IN ACCORDANCE WITH THE REQUIREMENTS OF THE HOWARD SOIL CONSERVATION DISTRICT.

Signature of Engineer: *[Signature]* DATE: 5/24/05
 ZACHARIA Y. FISCH


USDA NATURAL RESOURCES CONSERVATION SERVICE DATE: 5/24/05

HOWARD SOIL CONSERVATION DISTRICT DATE: 5/24/05

APPROVED: HOWARD COUNTY DEPARTMENT OF PUBLIC WORKS.
 Signature: *[Signature]* DATE: 5-23-05
 CHIEF, BUREAU OF HIGHWAYS

APPROVED: HOWARD COUNTY DEPARTMENT OF PLANNING AND ZONING
 Signature: *[Signature]* DATE: 5/23/05
 CHIEF, DIVISION OF LAND DEVELOPMENT

Signature: *[Signature]* DATE: 5/24/05
 CHIEF, DEVELOPMENT ENGINEERING DIVISION

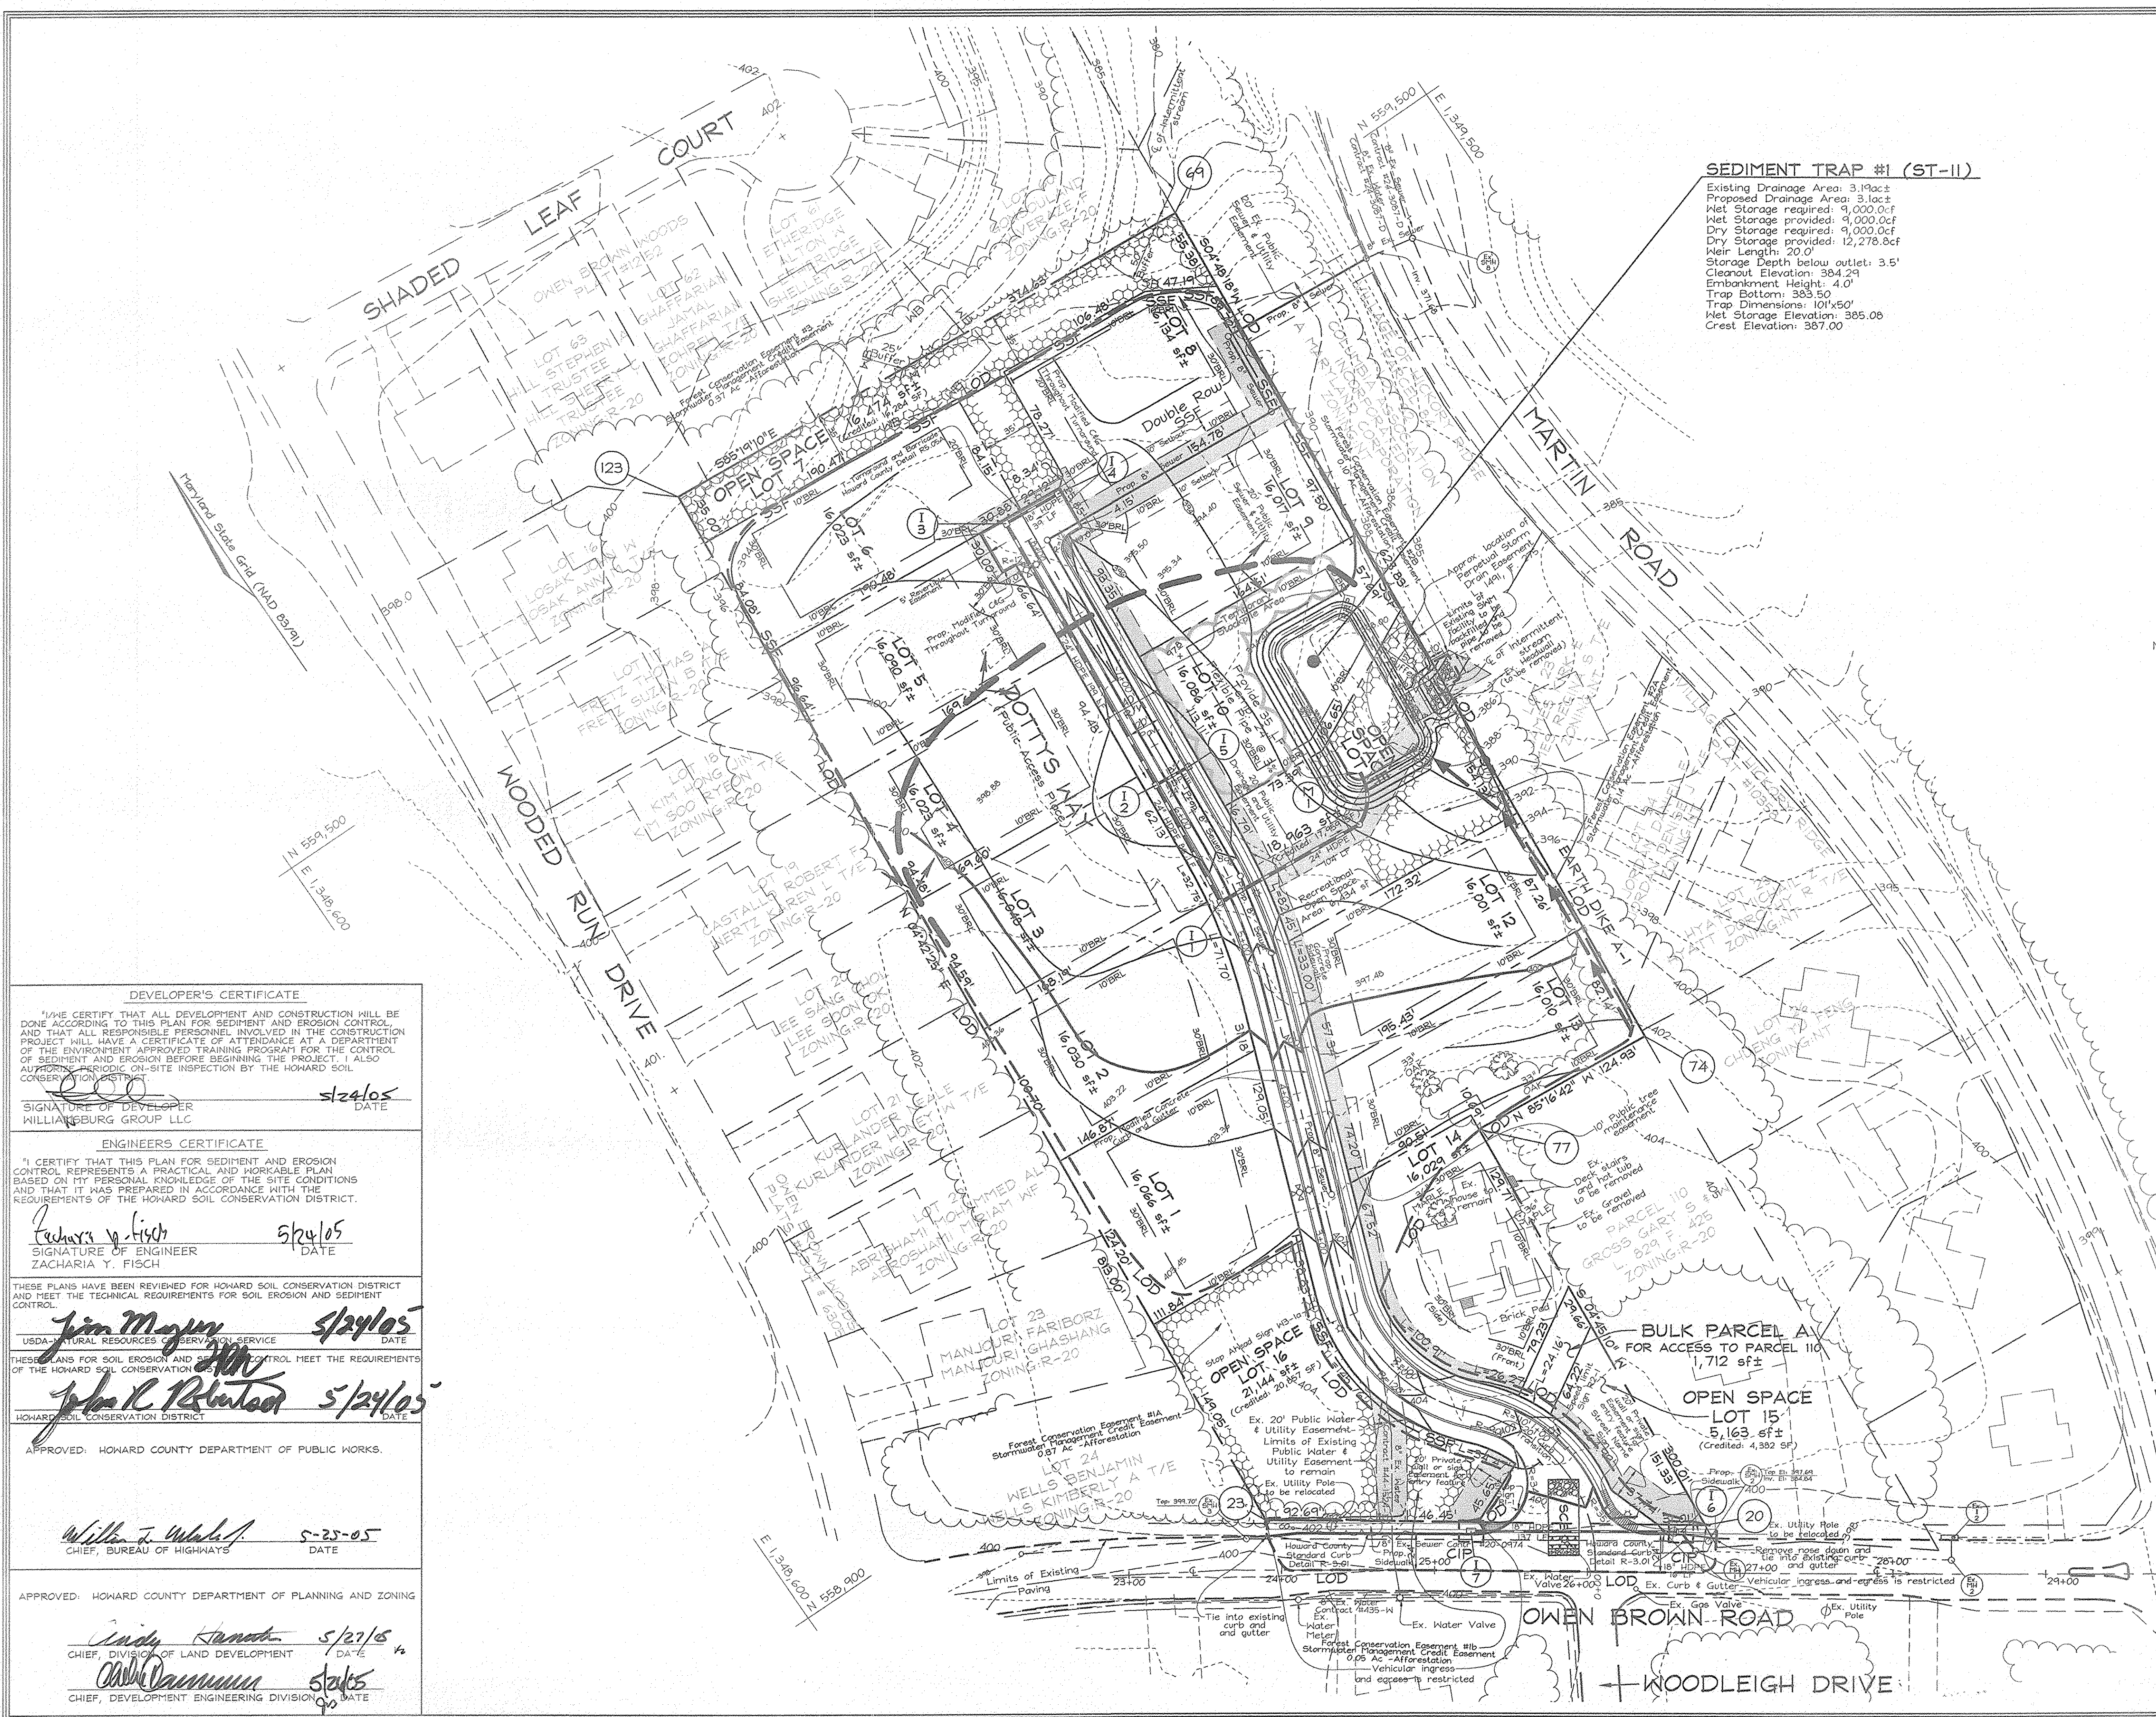

OWNER
 METZLER JOHN W
 METZLER DOROTHY WF T/C
 10358 OWEN BROWN ROAD
 COLUMBIA, MARYLAND 21044-3834

DEVELOPER
CONTRACT PURCHASER
 WILLIAMSBURG GROUP LLC
 5485 HARPERS FARM RD #200
 COLUMBIA, MARYLAND 21044-3834
 Telephone: (410) 997-8800
 Fax: (410) 997-4355

SEDIMENT AND EROSION CONTROL AND GRADING PLAN
METZLERS GARDEN
 LOTS 1-6, 8-10, 12-14,
 OPEN SPACE LOTS 7, 11, 15, 16 AND BULK PARCEL 'A'
 TAX MAP 36 GRID 7
 5TH ELECTION DISTRICT

PARCEL 152
 HOWARD COUNTY, MARYLAND

FSH Associates
 Engineers Planners Surveyors
 8318 Forrest Street, Ellicott City, MD 21043
 Tel: 410-750-2251 Fax: 410-750-7350
 E-mail: info@fsh.biz

DESIGN BY: FS
 DRAWN BY: MY
 CHECKED BY: ZYF
 SCALE: 1"=50'
 DATE: May 24, 2005
 P.O. No.: 3214
 SHEET No.: 3 OF 9

2.0 STANDARDS AND SPECIFICATIONS FOR TOPSOIL

Definition
Placement of topsoil over a prepared subgrade prior to establishment of permanent vegetation.

Purpose
To provide a suitable soil medium for vegetable growth, and to ensure low nutrient content, low nutrient levels, low pH, materials toxic to plants, and/or unacceptable soil gradation.

Conditions Where Practice Applies

- This practice is limited to areas having 2:1 or flatter slopes where:
 - The texture of the exposed subgrade/parent material is not adequate to produce vegetation growth.
 - The soil material is so shallow that the rooting zone is not deep enough to support plants or furnish continuing supplies of moisture and plant nutrients.
 - The original soil to be vegetated contains materials toxic to plant growth.
 - The soil is to acidify and treatment with lime is not feasible.
- For the purpose of these Standards and Specifications, areas having slopes steeper than 2:1 require special consideration and design for adequate stabilization. Areas having slopes steeper than 2:1 shall have the appropriate stabilization shown on the plans.

Construction and Material Specifications

- Topsoil salvaged from the existing site may be used provided that it meets the standards on soil tests in these specifications. Typically, the depth of topsoil to be salvaged for a given soil type can be found in the representative soil profile section in the Soil Survey published by USDA-NRCS in cooperation with Maryland Agricultural Experiment Station.
- Topsoil Specifications - Soil to be used as topsoil must meet the following:
 - Topsoil shall be a loam, sandy loam, clay loam, silt loam, sandy clay loam, loamy sand, or other soils as approved by the appropriate authority. Regardless, topsoil shall not be a mixture of contrasting textures and shall contain less than 5% by volume of cinders, slacks, slag, coarse fragments, gravel, sticks, roots, trash, or other materials larger than 1/2" in diameter.
 - Topsoil must be free of plants or plant parts such as Bermuda grass, quackgrass, Johnsongrass, nutgrass, poison ivy, thistle, or others as specified.
 - Where the subsoil is either highly acidic or composed of heavy clays, ground limestone shall be spread at the rate of 4-8 tons/acre (2000-4000 pounds per 1000 square feet) prior to the placement of topsoil. Lime shall be distributed uniformly over designated areas and worked into the soil in conjunction with tillage operations as described in the following procedures.
- For sites having disturbed areas under 5 acres:
 - Place topsoil (if required) and apply soil amendments as specified in 2.0.2 Vegetative Stabilization - Section 1 - Vegetative Stabilization Methods and Materials.
 - For sites having disturbed areas over 5 acres:
 - On soil meeting topsoil specifications, obtain test results detailing fertilizer and lime amendments required for the soil. Also complete the following:
 - Soil test shall be based on 0-10 and 10-20 cm increments and shall be presented to note the pH to 0.5 or higher.
 - Soil test shall be presented to note the cation exchange capacity (CEC) of the soil.
 - Soil test shall be presented to note the amount of soil which will contain greater than 500 parts per million shall not be used.
 - Soil test shall be presented to note the amount of soil which has been treated with soil sterilants or chemicals used for weed control until sufficient time has elapsed (14 days min.) to permit dissipation of phytotoxic materials.
 - NOTE: Topsoil substitutes or amendments, as recommended by a qualified agronomist or soil scientist and approved by the appropriate authority, may be used in lieu of natural topsoil.
 - Place topsoil (if required) and apply soil amendments specified in 2.0.2 Vegetative Stabilization-Section 1-Vegetative Stabilization Methods and Materials.

V. Topsoil Application

- When topsoiling, maintain needed erosion and sediment control practices such as diversions, Grade Stabilization Structures, Earth Dikes, Slope Silt Fence and Sediment Traps and Siltation Basins.
- Grades on the areas to be topsoiled, which have been previously established, shall be maintained, about 4" or higher in elevation.
- Topsoil shall be uniformly distributed in a 4" - 6" layer and lightly compacted to a minimum thickness of 4". Sedimentation and erosion control shall be maintained on the areas to be topsoiled, which have been previously established, shall be maintained, about 4" or higher in elevation.
- Topsoil shall not be placed while the topsoil or subsoil is in a frozen or muddy condition, when the subsoil is excessively wet or in a condition that may otherwise be detrimental to proper grading and seedbed preparation.

PERMANENT SEEDING NOTES

APPLY TO GRADED OR CLEARED AREAS NOT SUBJECT TO FURTHER DISTURBANCE WHERE A PERMANENT LONG-LIVED VEGETATIVE COVER IS NEEDED.

SEEDBED PREPARATION: Loosen upper three inches of soil by raking, discing or other acceptable means before seeding, if not previously loosened.

SOIL AMENDMENTS: In lieu of soil test recommendations, use one of the following schedules:

- Preferred: Apply 2 tons per acre dolomitic limestone (92 lb./100 sq.ft.) and 600 lbs. per acre 10-10-10 fertilizer (14 lb./100 sq.ft.) before seeding. Harrow or disc into upper three inches of soil. At the time of seeding, apply 200 lbs. per acre 30-0-0 granular fertilizer (14 lb./100 sq.ft.).
- Accepted: Apply 2 tons per acre dolomitic limestone (92 lb./100 sq.ft.) and apply 2000 lbs. per acre 10-10-10 fertilizer (23 lb./1000 sq.ft.) before seeding. Harrow or disc into upper three inches of soil.

SEEDING: For the periods March 1 thru April 30, and August 1 thru October 15, seed with 40 lbs. per acre (4 lb./1000 sq.ft.) of Tall Fescue. For the period May 1 thru July 31, seed with 40 lb./1000 sq.ft. of Tall Fescue per acre and 2 lbs. per acre of October 16 thru February 28, protect site by applying 2 tons per acre well-anchored straw mulch and seed on soon thereafter in the spring. Option (2) Use seed with 40 lbs/acre Kentucky 31 Tall Fescue and mulch with 2 tons/acre well anchored straw.

MULCHING: Apply 1 1/2 to 2 tons per acre (70 to 90 lbs./1000 sq.ft.) of unrotted small grain straw immediately after seeding. Anchor mulch immediately after application using mulch anchoring tool or 200 gallons per acre (5 gal/1000 sq.ft.) of emulsified asphalt on flat areas. On slopes 5 feet or higher, use 348 gallons per acre (8 gal/1000 sq.ft.) for anchoring.

MAINTENANCE: Inspect all seeded areas and make needed repairs, replacements and reseedings.

TEMPORARY SEEDING NOTES

SEEDBED PREPARATION: Loosen upper three inches of soil by raking, discing or other acceptable means before seeding, if not previously loosened.

SOIL AMENDMENTS: Apply 600 lbs. per acre 10-10-10 fertilizer (14 lb./1000 sq.ft.).

- SEEDING:** For periods March 1 thru April 30, and from August 15 thru November 15, seed with 2 1/2 bushel per acre of annual rye (3.2 lb./1000 sq.ft.). For the period May 1 thru August 14, seed with 3 lbs. per acre of wintering legumes (97 lb./1000 sq.ft.). For the period November 1 thru February 28, protect site by applying 2 tons per acre well-anchored straw mulch and seed on soon as possible thereafter in the spring.
- MULCHING:** Apply 1 1/2 to 2 tons per acre (70 to 90 lbs./1000 sq.ft.) of unrotted small grain straw immediately after seeding. Anchor mulch immediately after application using mulch anchoring tool or 200 gallons per acre (5 gal/1000 sq.ft.) of emulsified asphalt on flat areas. On slopes 5 feet or higher, use 348 gallons per acre (8 gal/1000 sq.ft.) for anchoring.

REFER TO THE HRA PARTLAND STANDARDS AND SPECIFICATIONS FOR SOIL EROSION AND SEDIMENT CONTROL, FOR RATE AND METHOD NOT COVERED.

SEDIMENT CONTROL NOTES

- A minimum of 48 hours notice must be given to the Howard County Department of Inspection, License and Permits Sediment Control Division prior to the start of any construction (316-105).
- All vegetation and structural practices are to be installed according to the provisions of this plan and are to be in accordance with the HRA PARTLAND STANDARDS AND SPECIFICATIONS FOR SOIL EROSION AND SEDIMENT CONTROL, and revisions thereof.
- Following initial soil disturbance or redisturbance, permanent or temporary stabilization shall be completed within (a) 7 calendar days for all perimeter sediment control structures, dikes, perimeter slopes, and all slopes greater than 3:1, (b) 14 days on all other disturbed or graded areas on the project site.
- All sediment traps/basins shown must be fenced and warning signs posted around perimeter in accordance with Vol. 1, Chapter 7, HOWARD COUNTY DESIGN MANUAL, Storm Drainage.
- All disturbed areas must be stabilized within the time period specified above in accordance with the HRA PARTLAND STANDARDS AND SPECIFICATIONS FOR SOIL EROSION AND SEDIMENT CONTROL, for permanent seeding, and temporary seeding, and mulching (Sec. 6). Temporary stabilization with mulch alone shall be done when recommended seeding does not allow for proper germination and establishment of grasses.
- All sediment control structures are to remain in place and are to be maintained in operative condition until permission for their removal has been obtained from the Howard County Sediment Control Inspector.
- Site Analysis:

Total Area	6.66 Acres
Area Disturbed	5.57 Acres
Area to be seeded or planted	5.57 Acres
Area to be vegetatively stabilized	5.57 Acres
Total Fertilizer	23.23 Tons
Total Lime	4,309.04 #
- On all sites with disturbed areas in excess of 2 acres, approval of the inspection agency shall be required upon completion of installation of perimeter erosion and sediment control practices as well as over-graded slopes, roads, concrete material or other objectionable material. The embankment shall be completed by installing with equipment while it is being constructed.
- Trenches for the collection of utilities is limited to three pipe lengths or that which shall be back-filled and stabilized within one working day, whichever is shorter.
- To be determined by contractor, with pre-approval of the Sediment Control Inspector with an approved and active grading permit.
- Refer to cut and fill quantities for permit purposes only. Contractor to verify earthwork quantities.

DUST CONTROL NOTES


Definition
Controlling dust blowing and movement on construction sites and roads.

Purpose
To prevent blowing of dust from exposed soil surfaces, reduce on and off-site damage, health hazards, and improve traffic safety.

Conditions Where Practice Applies
This practice is applicable to areas subject to dust blowing and movement where on- and off-site damage is likely without treatment.

Temporary Methods


- Mulches - See standards for vegetative stabilization with mulches only. Mulch shall be organized or banded to prevent blowing.
 - Vegetative cover - See standards for temporary vegetative cover.
 - Tillage - To roughen surface and bring clods to the surface. This is an emergency measure which should be used before soil blowing starts. Equipment used should be equipped with windrow side of site. Chisel-type plows spaced about 12' apart, spring-toothed harrows, and similar plows are examples of equipment which may produce the desired effect.
 - Irrigation - This is generally done on an emergency treatment. Site is irrigated with water until the surface is moist. Banded, as needed. At no time should the site be irrigated to the point that runoff begins to flow.
 - Barriers - Solid board fences, silt fences, area fences, burlap fences, straw bales, and similar material can be used to control air currents and soil blowing. Barriers placed at right angles to prevailing currents at intervals of about 10 times their height are effective in controlling soil blowing.
 - Calcium Chloride - Apply at rates that will keep surface moist. May need re-treatment.
- Permanent Methods**
- Permanent Vegetation - See standards for permanent vegetative cover, and permanent stabilization with seed. Existing trees or large shrubs may afford suitable protection if left in place.
 - Topsoiling - Covering with less erodible soil materials. See standards 3.1 Stone - Cover surface with crushed stone or coarse gravel.
- References**
- Agricultural Handbook 346. Wind Erosion Forces in the United States and Their Use in Predicting Soil Loss.
 - National Information Bulletin 354. How to Control Wind Erosion, USDA-ARS. (11-30-1)

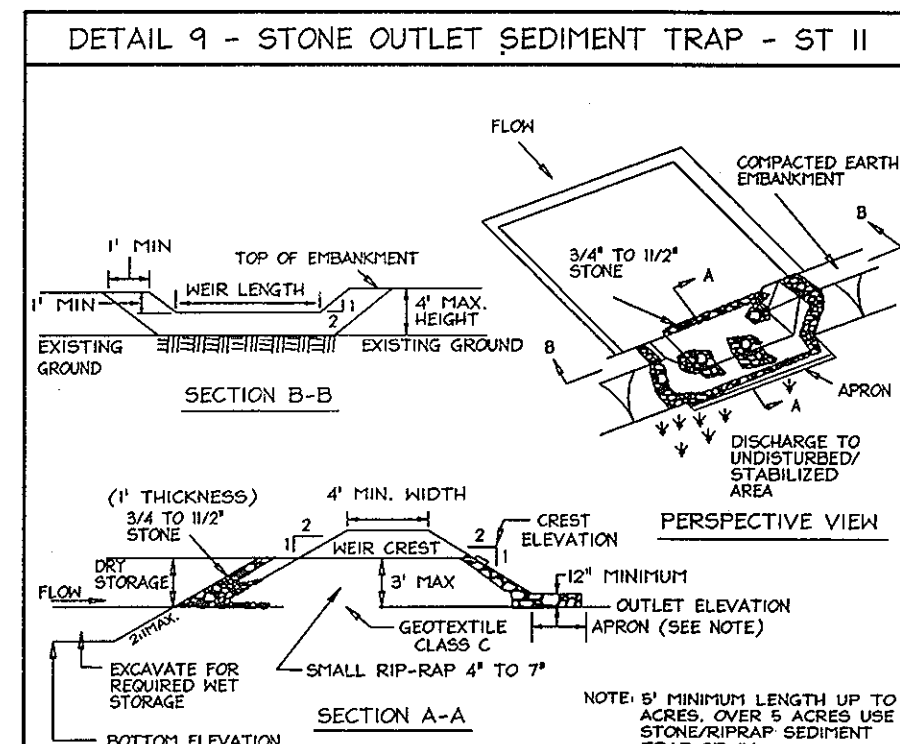


Construction Specifications

- Area under embankment shall be cleared, grubbed and stripped of any vegetation and root mat. The pool area shall be cleared.
- The fill material for the embankment shall be free of roots and other woody vegetation as well as over-sized rocks, organic material or other objectionable material. The embankment shall be completed by installing with equipment while it is being constructed.
- All cut and fill slopes shall be 2:1 or flatter.
- The stone used in the outlet shall be small ranging 4" to 7" in size with a 1/2" layer of 3/4" to 1 1/2" washed aggregate placed on the upstream face of the outlet. Stone larger than 4" is not necessary to prevent clogging. Geotextile Class C may be installed on the stone facing by placing it on the inside face of the stone outlet.
- Sediment shall be removed and trap returned to its original dimensions when the sediment has accumulated to one half of the wet storage depth of the trap. Removed sediment shall be deposited in a suitable area and in a manner that it will not erode.
- The structure shall be inspected periodically after each rain and repairs made as needed.
- Construction of traps shall carried out in such a manner that sediment pollution is avoided. Once constructed, the top and outside face of the embankment shall be stabilized with seed and mulch. Trunks of construction material shall be protected in accordance with the standards for erosion control. The erosion of the interior slopes shall be stabilized (one time) with seed and mulch upon trap completion and monitored and maintained during freeze during the life of the trap.
- The structure shall be dewatered by approved methods, removed and the area stabilized when the drainage area has been properly stabilized.
- Refer to section D for specifications concerning trap dewatering.
- Minimum trap depth shall be measured from water elevation.
- The elevation of the top of any dike directing water into the trap must equal or exceed the elevation of the trap embankment.
- Geotextile Class C shall be placed over the bottom and sides of the outlet channel prior to the installation of the stone. Geotextile Class C shall be installed at the bottom of the outlet channel and shall be extended at least 6" into existing ground at the entrance of the outlet channel.
- Outlet-Air outlet shall be provided, including a means of covering the discharge in an erosion free manner to an existing side channel.

U.S. DEPARTMENT OF AGRICULTURE SOIL CONSERVATION SERVICE PAGE C-2-B HOWARD COUNTY DEPARTMENT OF ENVIRONMENTAL WATER MANAGEMENT ADMINISTRATION

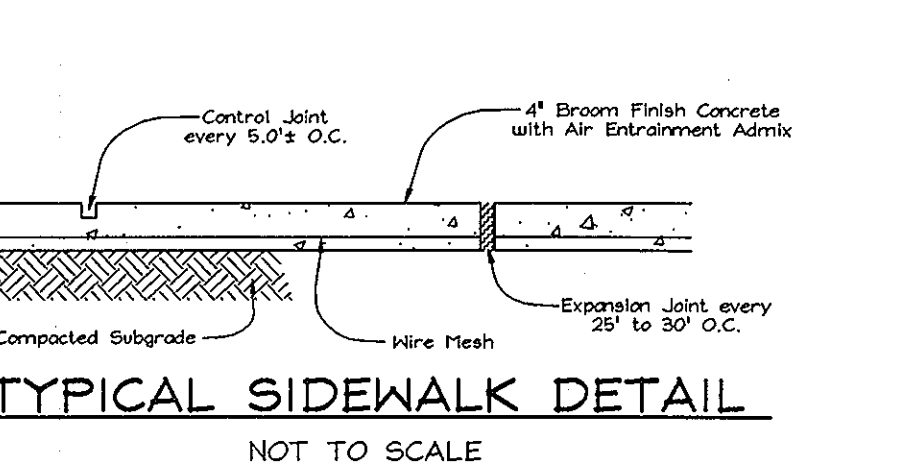


NOT TO SCALE

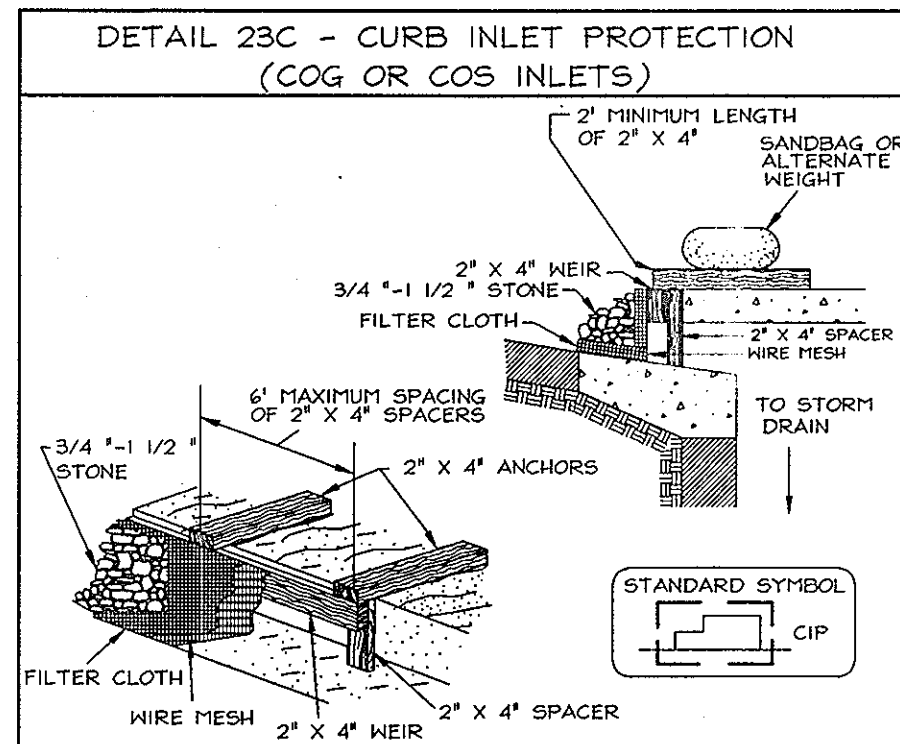


Construction Specifications

- Attach a continuous piece of wire mesh (30" minimum width by throat 4") to the 2" x 4" user (measuring throat length plus 2") as shown on the standard length plus drawing.
- Place a continuous piece of Geotextile Class E the same dimensions as the wire mesh over the wire mesh and securely attach it to the 2" x 4" user.
- Securely nail the 2" x 4" user to a 2" long vertical spacer to be located between the curb and the inlet face (max. 4" apart).
- Place the assembly against the inlet throat and nail (minimum 2" lengths of 2" x 4" to top of the curb at spacer locations). These 2" x 4" anchors shall extend across the inlet top and be held in place by sandbags or alternate weight.
- The assembly shall be placed so that the end spacers are a minimum 1" beyond both ends of the throat opening.
- Form the 1/2" x 1/2" wire mesh and the geotextile fabric to the concrete gutter and against the face of the curb on both sides of the inlet. Place chain 3/4" x 1 1/2" stone over the wire mesh and geotextile in such a manner to prevent water from entering the inlet under or around the geotextile.
- This type of protection must be inspected frequently and the filter cloth and stone replaced when clogged with sediment.
- Assure that storm flow does not bypass the inlet by installing a temporary earth or asphalt dike to direct the flow to the inlet.

U.S. DEPARTMENT OF AGRICULTURE SOIL CONSERVATION SERVICE PAGE E-16-50 HOWARD COUNTY DEPARTMENT OF ENVIRONMENTAL WATER MANAGEMENT ADMINISTRATION

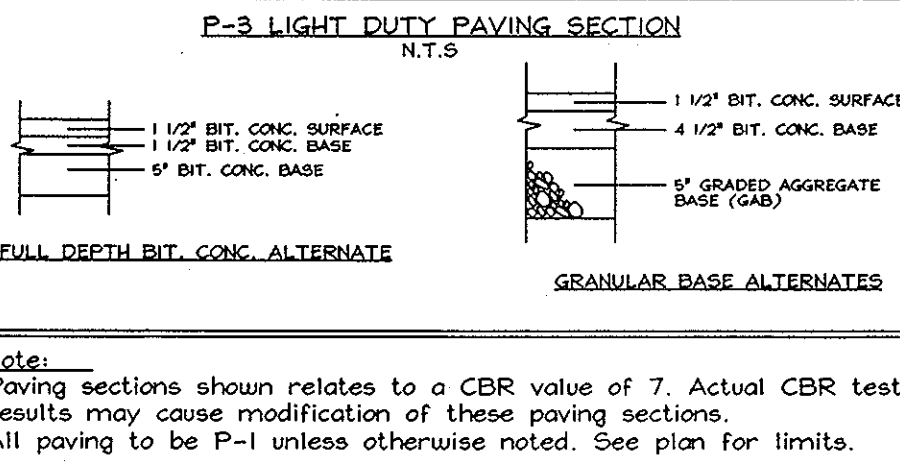

NOT TO SCALE

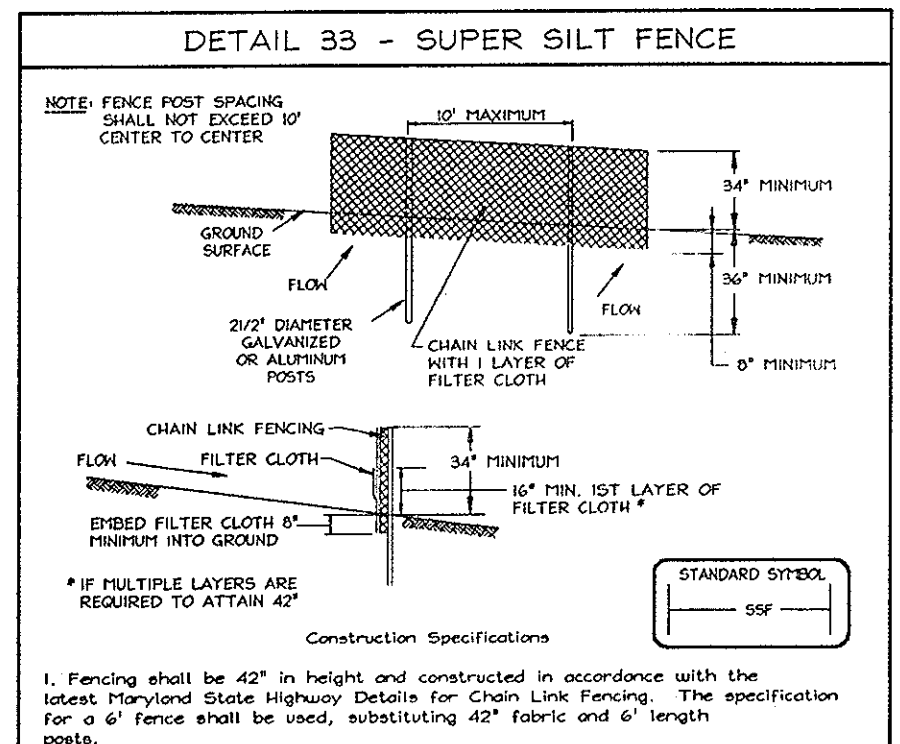


Construction Specifications

- Fencing shall be 42" in height and constructed in accordance with the latest Maryland State Highway Dept. for Chain Link Fencing. The specification for a 4" fence shall be used, substituting 42" fabric and 4" length posts.
- Chain link fence shall be fastened securely to the chain link fence with ties spaced every 24" at the top and mid section.
- Filter cloth shall be fastened to the chain link fence with ties spaced every 24" at the top and mid section.
- Filter cloth shall be embedded a minimum of 6" into the ground.
- When two sections of filter cloth adjoin each other, they shall be overlapped by 6" and folded.
- Maintenance shall be performed as needed and all bulging removed when "bulges" develop in the silt fence, or when silt reaches 50% of fence height.
- Filter cloth shall be fastened securely to each fence post with wire ties or staples at top and mid section and shall meet the following requirements for Geotextile Class F:

Tensile Strength	50 lbars (min.)	Test: FHST 508
Tensile Puncture	20 lbars (min.)	Test: FHST 508
Flow Rate	0.3 gal/ft. Minute (max.)	Test: FHST 322
Filtering Efficiency	75% (min.)	Test: FHST 322
- Filter cloth shall be fastened to each fence post with wire ties or staples at top and mid section and shall meet the following requirements for Geotextile Class F:

Tensile Strength	50 lbars (min.)	Test: FHST 508
Tensile Puncture	20 lbars (min.)	Test: FHST 508
Flow Rate	0.3 gal/ft. Minute (max.)	Test: FHST 322
Filtering Efficiency	75% (min.)	Test: FHST 322


U.S. DEPARTMENT OF AGRICULTURE SOIL CONSERVATION SERVICE PAGE H-26-3 HOWARD COUNTY DEPARTMENT OF ENVIRONMENTAL WATER MANAGEMENT ADMINISTRATION

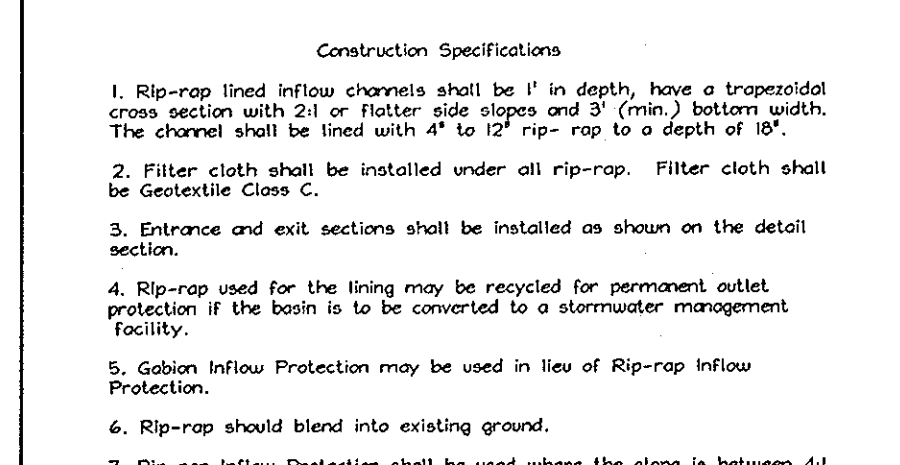

Construction Specifications

- Rip-rap lined inflow channels shall be 1' in depth, have a trapezoidal cross section with 2:1 or flatter side slopes and 2' (min.) bottom width. The channel shall be lined with 4" to 12" rip-rap to a depth of 10".
- Filter cloth shall be installed under all rip-rap. Filter cloth shall be Geotextile Class C.
- Entrance and exit sections shall be installed as shown on the detail section.
- Rip-rap used for the lining may be recycled for permanent outlet protection if the basin is to be converted to a stormwater management facility.
- Gabion Inflow Protection may be used in lieu of Rip-rap Inflow Protection.
- Rip-rap should blend into existing ground.
- Rip-rap Inflow Protection shall be used where the slope is between 4:1 and 10:1, for slopes flatter than 10:1 use Earth Dike or Temporary Swale lining criteria.


U.S. DEPARTMENT OF AGRICULTURE SOIL CONSERVATION SERVICE PAGE B-1-2 HOWARD COUNTY DEPARTMENT OF ENVIRONMENTAL WATER MANAGEMENT ADMINISTRATION

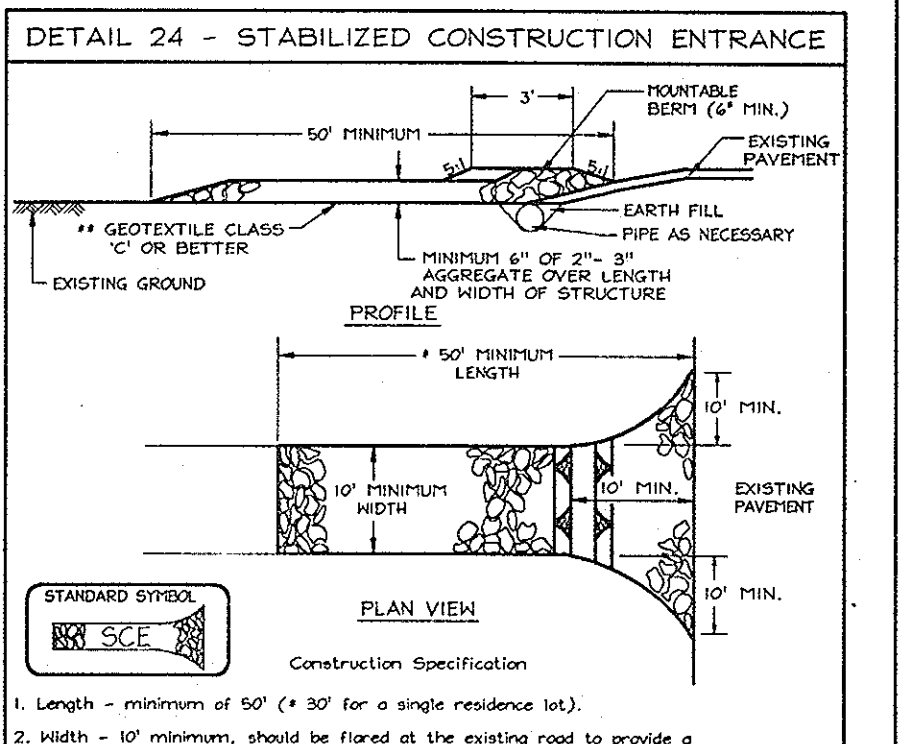

Construction Specifications

- Length - minimum of 50' (+30' for a single residence lot).
- Width - minimum of 60" shall be fixed at the existing road to provide a turning radius.
- Geotextile fabric (filter cloth) shall be placed over the existing ground prior to placing stone. The plan approval authority may not require single family residences to use geotextile.
- Stone - crushed aggregate (2" to 3") or reclaimed or recycled concrete equivalent shall be placed at 2" deep over the length and width of the entrance.
- Surface Water - all surface water flowing to or diverted toward construction entrances shall be directed through the entrance, maintaining positive drainage. Pipe installed through the stabilized construction entrance shall be protected with a flexible sleeve with 5:1 slopes and has no drainage to convey, a pipe will not be necessary. Pipe should be sized according to the amount of runoff to be conveyed. A 6" minimum will be required.
- Location - A stabilized construction entrance shall be located at every point where construction traffic enters or leaves a construction site. Manholes leaving the site must travel over the entire length of the stabilized construction entrance.

U.S. DEPARTMENT OF AGRICULTURE SOIL CONSERVATION SERVICE PAGE F-17-3 HOWARD COUNTY DEPARTMENT OF ENVIRONMENTAL WATER MANAGEMENT ADMINISTRATION

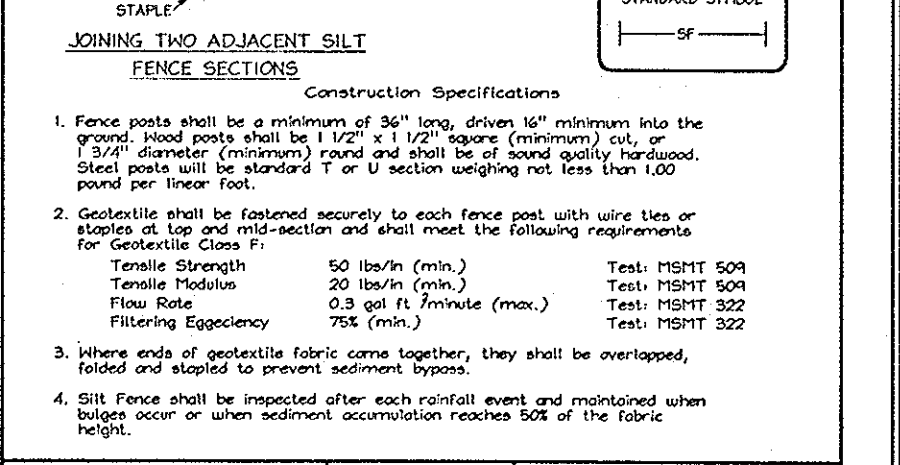

Construction Specifications

- Fence posts shall be a minimum of 30" long, driven 10" minimum into the ground. Wood posts shall be 1 1/2" x 1 1/2" (min. square) treated. Steel posts will be standard T or U section weighing not less than 100 lbs. per linear foot.
- Geotextile shall be fastened securely to each fence post with wire ties or staples at top and mid-section and shall meet the following requirements for Geotextile Class F:

Tensile Strength	50 lbars (min.)	Test: FHST 508
Tensile Puncture	20 lbars (min.)	Test: FHST 508
Flow Rate	0.3 gal/ft. Minute (max.)	Test: FHST 322
Filtering Efficiency	75% (min.)	Test: FHST 322
- Intersect ends of geotextile fabric come together, they shall be overlapped.
- Silt Fence shall be inspected after each rainfall event and maintained when bulging occur or when sediment accumulation reaches 50% of the fabric height.

U.S. DEPARTMENT OF AGRICULTURE SOIL CONSERVATION SERVICE PAGE F-8-3 HOWARD COUNTY DEPARTMENT OF ENVIRONMENTAL WATER MANAGEMENT ADMINISTRATION

SEQUENCE OF CONSTRUCTION


- Obtain grading permit.
- Notify Howard County Department of Inspections, License and Permits at (410) 313-1880 at least 24 hours before starting any work.
- Install Stabilized Construction Entrance, Earth dike, Sediment trap and Silt fence. (2 weeks)
- Rough grade site. (2 weeks)
- Construct storm drain system and road. Do not construct S-1 or storm drain pipe from M-1 to S-1. Construct temporary pipe from M-1 to sediment trap. Construct curb inlet protection for 1-6 and 1-7. (8 weeks)
- Fine grade site. (2 weeks)
- Flush storm drain system.
- Remove sediment trap and temporary pipe. Construct S-1 and storm drain pipe from S-1 to M-1. (2 weeks)
- During grading and after each rainfall, contractor will inspect and provide necessary maintenance to the sediment control measures on this plan.
- Following initial soil disturbance or any redisturbances, permanent or temporary stabilization shall be completed within:
 - 7 calendar days for all perimeter sediment control structures, dikes, swales and all slopes greater than 3:1.
 - 14 calendar days for all other disturbed areas.
- Upon stabilization of all disturbed areas and with the permission of the Sediment Control Inspector, remove all sediment control measures and stabilize any remaining disturbed area. (1 week)

DEVELOPER CONTRACT PURCHASER

OWNER
METZLER JOHN W
METZLER DOROTHY W/T/C
10355 OWEN BROWN ROAD
COLUMBIA, MARYLAND 21044-3834

CONTRACT PURCHASER
WILLIAMSBURG GROUP LLC
5485 HARPERS FARM RD #200
COLUMBIA, MARYLAND 21044-3834
Telephone: (410) 947-8800
Fax: (410) 947-4358

TRAFFIC CONTROL PLAN, SEDIMENT AND EROSION CONTROL NOTES AND DETAILS
METZLERS GARDEN
LOTS 1-6, 8-10, 12-14,
OPEN SPACE LOTS 7, 11, 15, 16 AND BULK PARCEL 'A'
TAX MAP 36 GRID 7 PARCEL 152
5TH ELECTION DISTRICT HOWARD COUNTY, MARYLAND

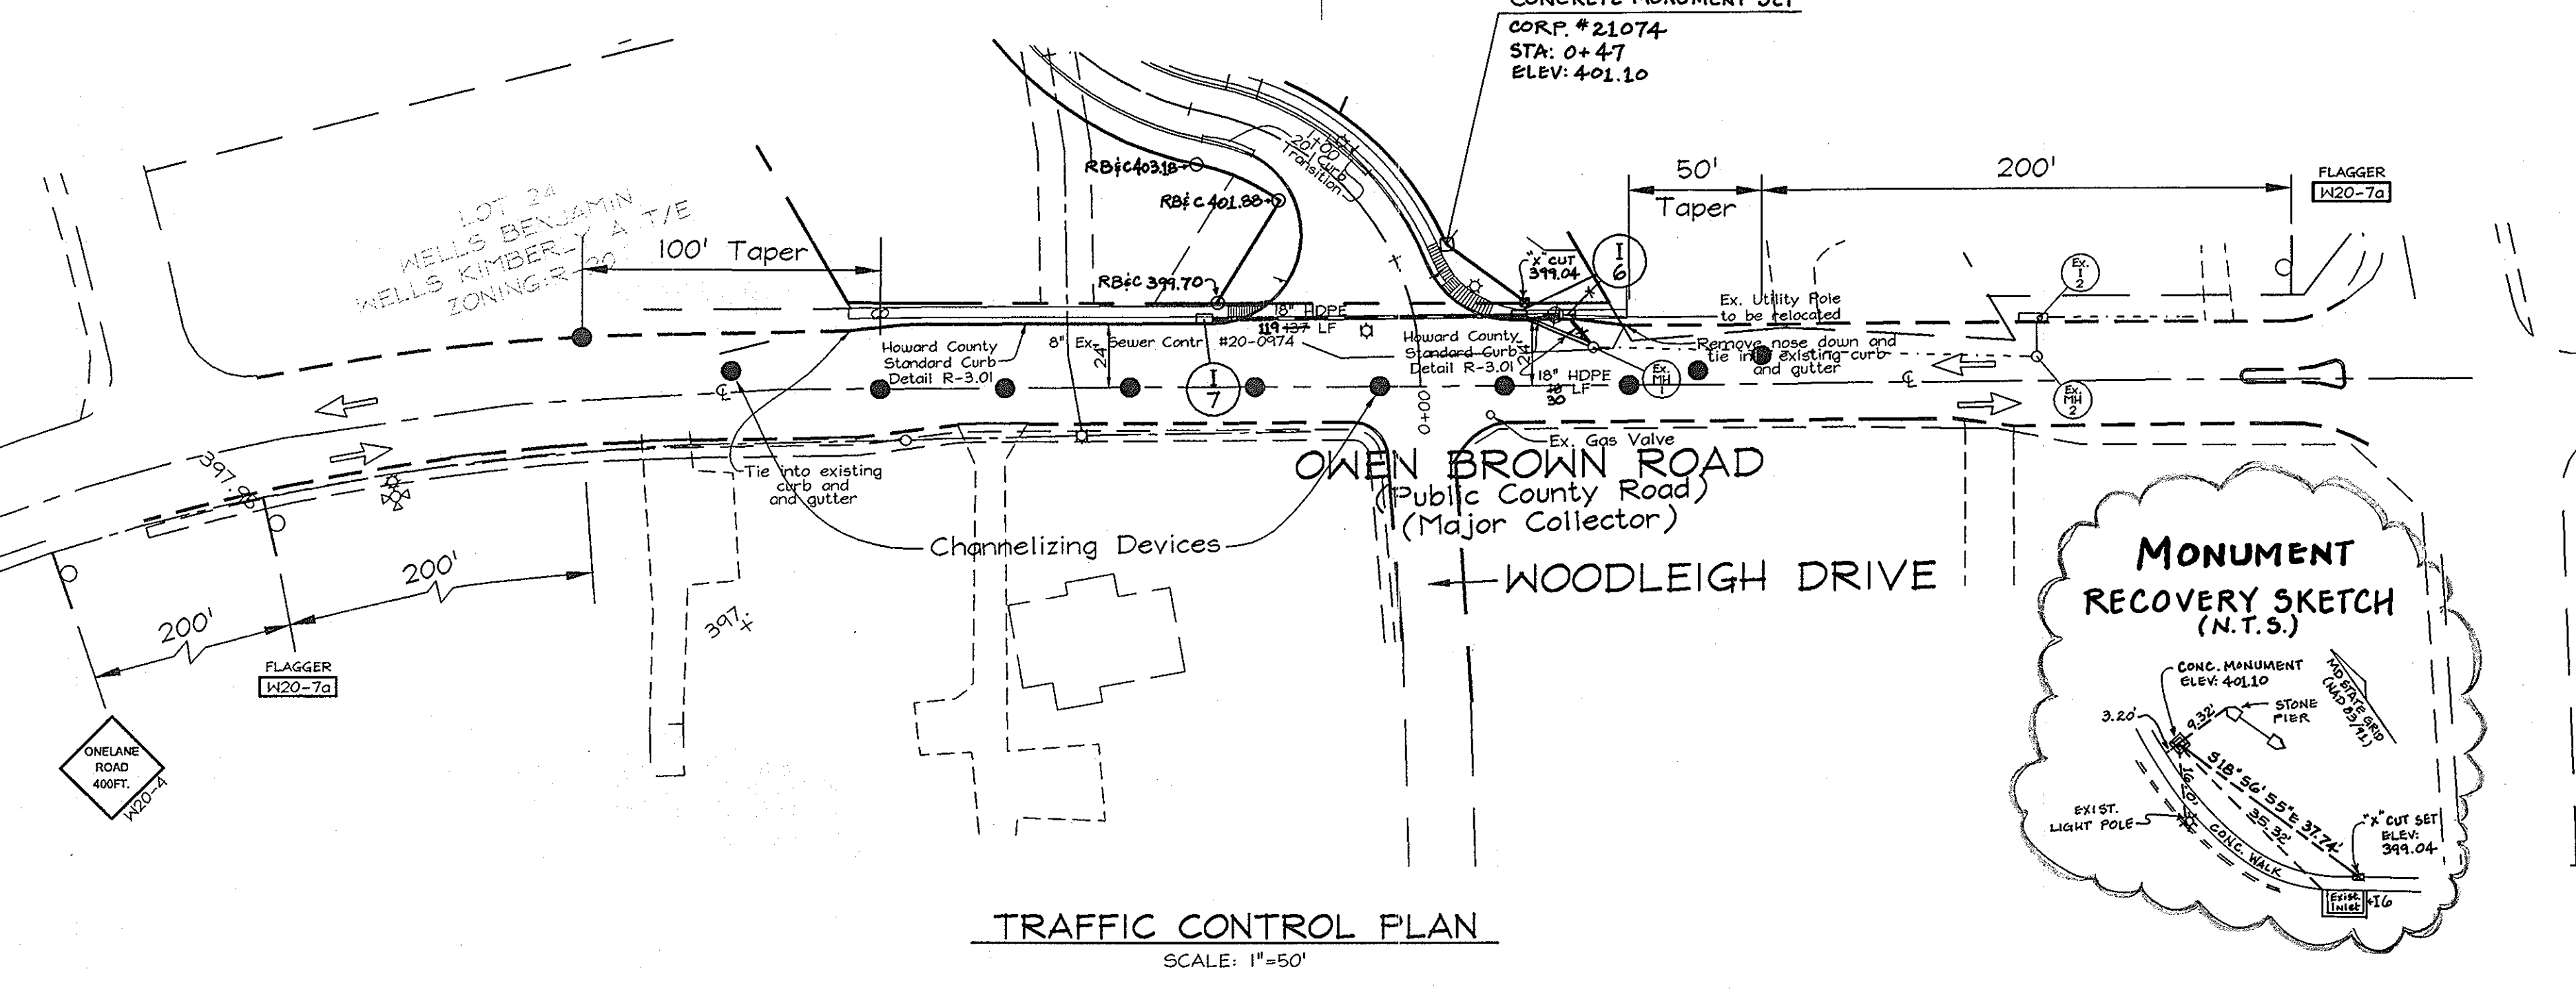

APPROVED: HOWARD COUNTY DEPARTMENT OF PLANNING AND ZONING

Cindy K. Thomas 5/24/05
CHIEF, DIVISION OF LAND DEVELOPMENT DATE

Chris P. ... 5/26/05
CHIEF, DEVELOPMENT ENGINEERING DIVISION DATE

APPROVED: HOWARD COUNTY DEPARTMENT OF PUBLIC WORKS.

William Z. ... 5-25-05
CHIEF, BUREAU OF HIGHWAYS DATE

DEVELOPER'S CERTIFICATE

"I/WE CERTIFY THAT ALL DEVELOPMENT AND CONSTRUCTION WILL BE DONE ACCORDING TO THIS PLAN FOR SEDIMENT AND EROSION CONTROL AND THAT ALL RESPONSIBLE PERSONNEL INVOLVED IN THE CONSTRUCTION PROJECT WILL HAVE A CERTIFICATE OF ATTENDANCE AT A DEPARTMENT OF THE ENVIRONMENT APPROVED TRAINING PROGRAM FOR THE CONTROL OF SEDIMENT AND EROSION BEFORE BEGINNING THE PROJECT. I ALSO AUTHORIZE PERIODIC ON-SITE INSPECTION BY THE HOWARD SOIL CONSERVATION DISTRICT."

John R. ... 5/24/05
SIGNATURE OF DEVELOPER DATE
WILLIAMSBURG GROUP LLC

ENGINEERS CERTIFICATE

"I CERTIFY THAT THIS PLAN FOR SEDIMENT AND EROSION CONTROL REPRESENTS A PRACTICAL AND WORKABLE PLAN BASED ON MY PERSONAL KNOWLEDGE OF THE SITE CONDITIONS AND THAT IT WAS PREPARED IN ACCORDANCE WITH THE REQUIREMENTS OF THE HOWARD SOIL CONSERVATION DISTRICT."

Zacharia Y. Fisch 5/24/05
SIGNATURE OF ENGINEER DATE
ZACHARIA Y. FISCH


THESE PLANS HAVE BEEN REVIEWED FOR HOWARD SOIL CONSERVATION DISTRICT AND MEET THE TECHNICAL REQUIREMENTS FOR SOIL EROSION AND SEDIMENT CONTROL.

John R. ... 5/24/05
SIGNATURE OF ENGINEER DATE
HOWARD SOIL CONSERVATION DISTRICT

FSH Associates
Engineers Planners Surveyors
8318 Forest Street, Ellicott City, MD 21043
Tel: 410-750-2251 Fax: 410-750-7350
E-mail: info@fsha.biz

DESIGN BY: PS
DRAWN BY: MYT
CHECKED BY: JTF
SCALE: As Shown
DATE: May 24, 2005
PROJECT NO.: 0214
SHEET No. 4 OF 9

SOILS LEGEND		
SYMBOL	NAME / DESCRIPTION	SOIL GROUP
BFB2	Brandywine loam, 3 to 8 percent slopes, moderately eroded	C
GIA	Glenela loam, 0 to 3 percent slopes	B
GIB2	Glenela loam, 3 to 8 percent slopes, moderately eroded	B
GnA	Glenville silt loam, 0 to 3 percent slopes	C

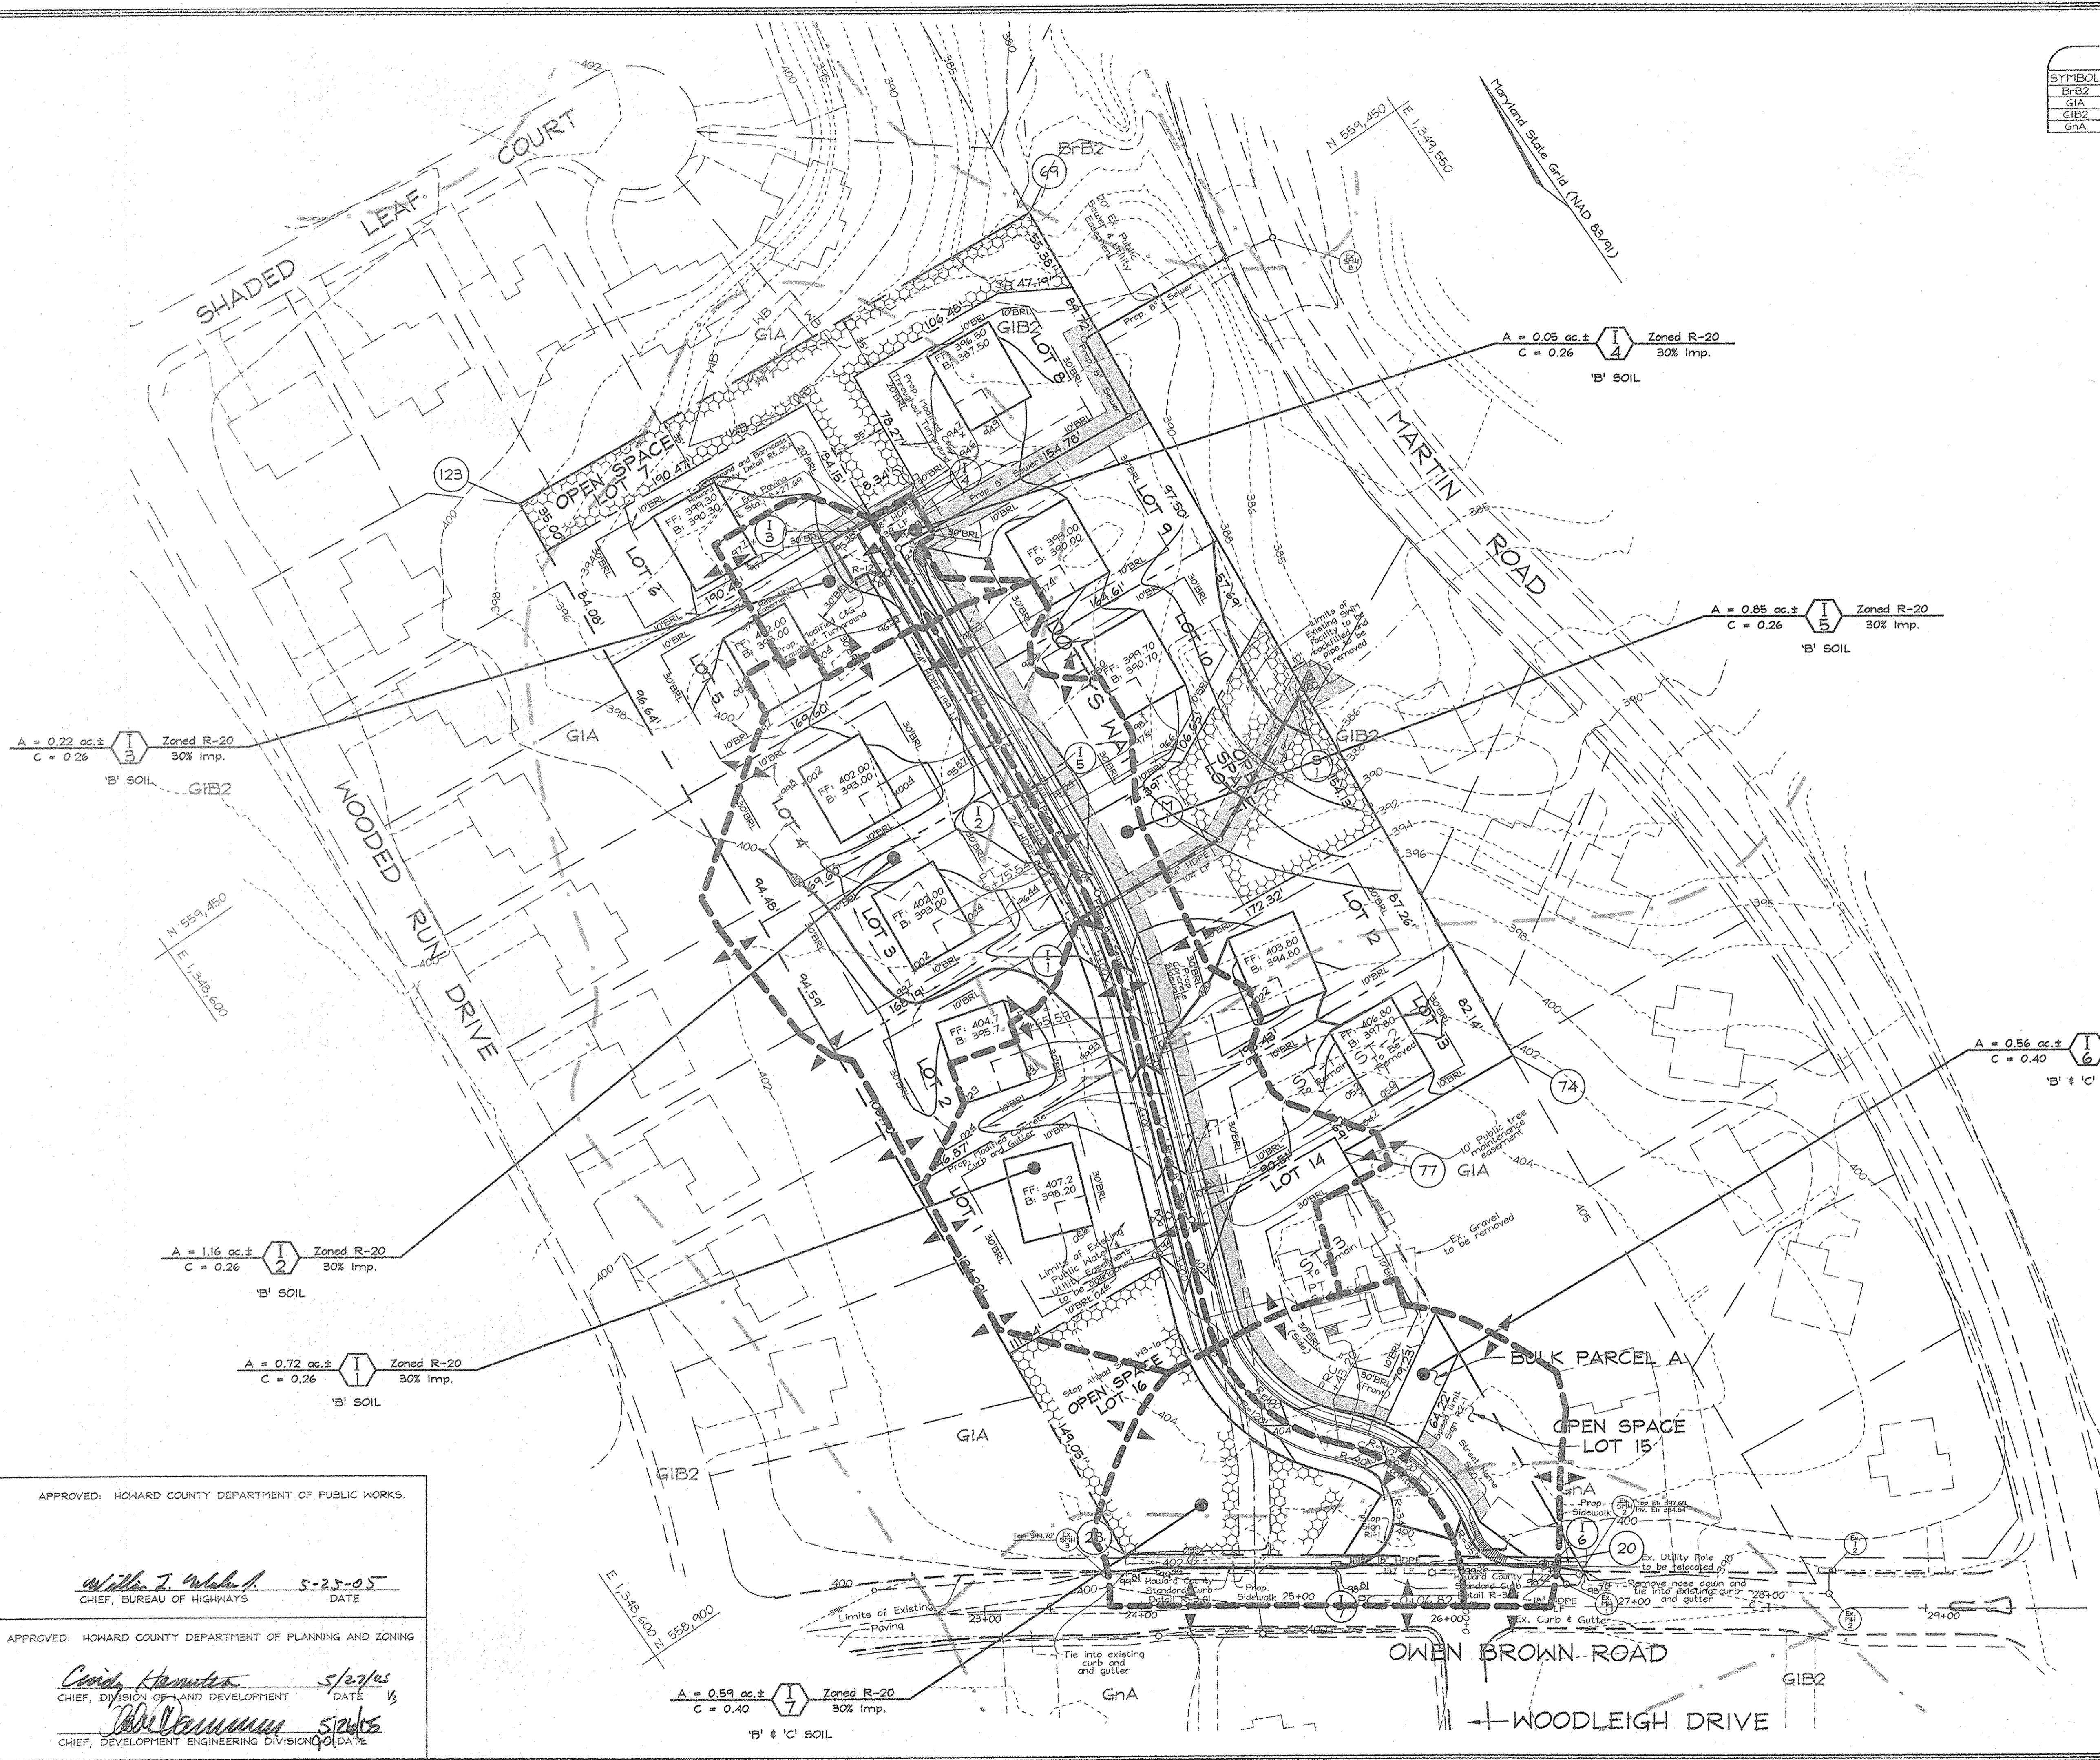

DEVELOPER
 CONTRACT PURCHASER
 OWNER
 METZLER JOHN W
 METZLER DOROTHY W F T/C
 10353 OWEN BROWN ROAD
 COLUMBIA, MARYLAND 21044-3834
 Telephone: (410) 997-8800
 Fax: (410) 997-4358
 WILLIAMSBURG GROUP LLC
 5485 HARPERS FARM RD #200
 COLUMBIA, MARYLAND 21044-3834
 Telephone: (410) 997-8800
 Fax: (410) 997-4358

STORMDRAIN DRAINAGE AREA MAP
METZLERS GARDEN
 LOTS 1-6, 8-10, 12-14,
 OPEN SPACE LOTS 7,11,15,16 AND BULK PARCEL 'A'
 TAX MAP 36 GRID 7 PARCEL 152
 5TH ELECTION DISTRICT HOWARD COUNTY, MARYLAND


Catherine J. Hise
 PROFESSIONAL ENGINEER

FSH Associates
 Engineers Planners Surveyors
 8318 Forrest Street, Elkton City, MD 21043
 Tel: 410-750-2251 Fax: 410-750-7350
 E-mail: info@fsha.biz

DESIGN BY: PS
 DRAWN BY: Ming
 CHECKED BY: ZYF
 SCALE: 1"=50'
 DATE: May 24, 2005
 P.O. No.: 3214
 SHEET No.: 5 OF 9


APPROVED: HOWARD COUNTY DEPARTMENT OF PUBLIC WORKS.
William J. Walsh 5-25-05
 CHIEF, BUREAU OF HIGHWAYS DATE

APPROVED: HOWARD COUNTY DEPARTMENT OF PLANNING AND ZONING
Cathy Hamilton 5/27/05
 CHIEF, DIVISION OF LAND DEVELOPMENT DATE
William J. Walsh 5/27/05
 CHIEF, DEVELOPMENT ENGINEERING DIVISION DATE

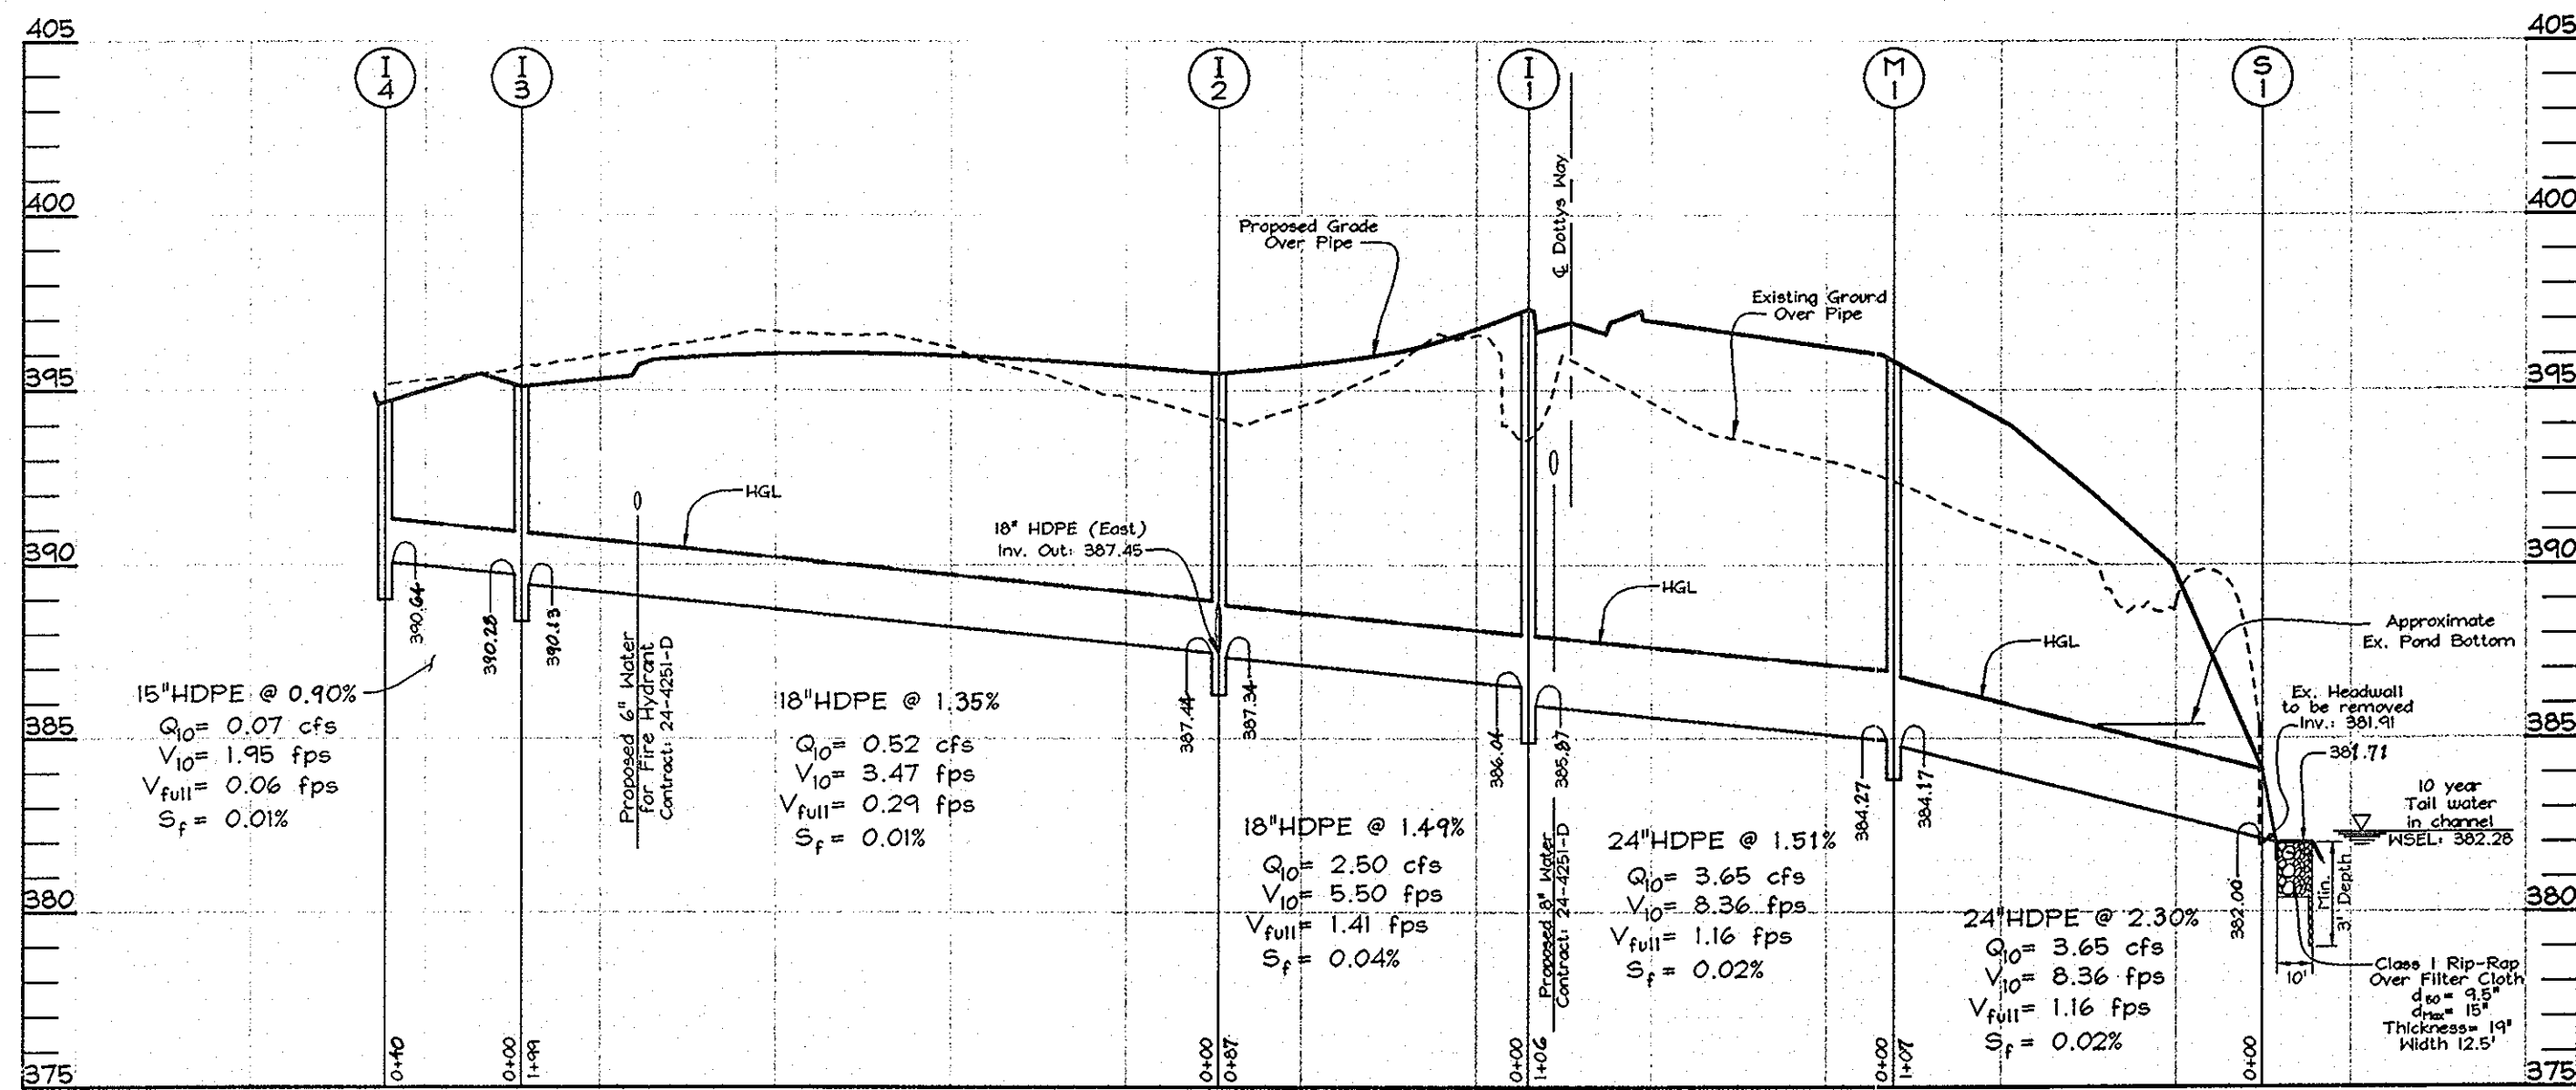


STORM DRAIN PROFILES

Scale: Horizontal-1"=50'
 Vertical-1"=5'

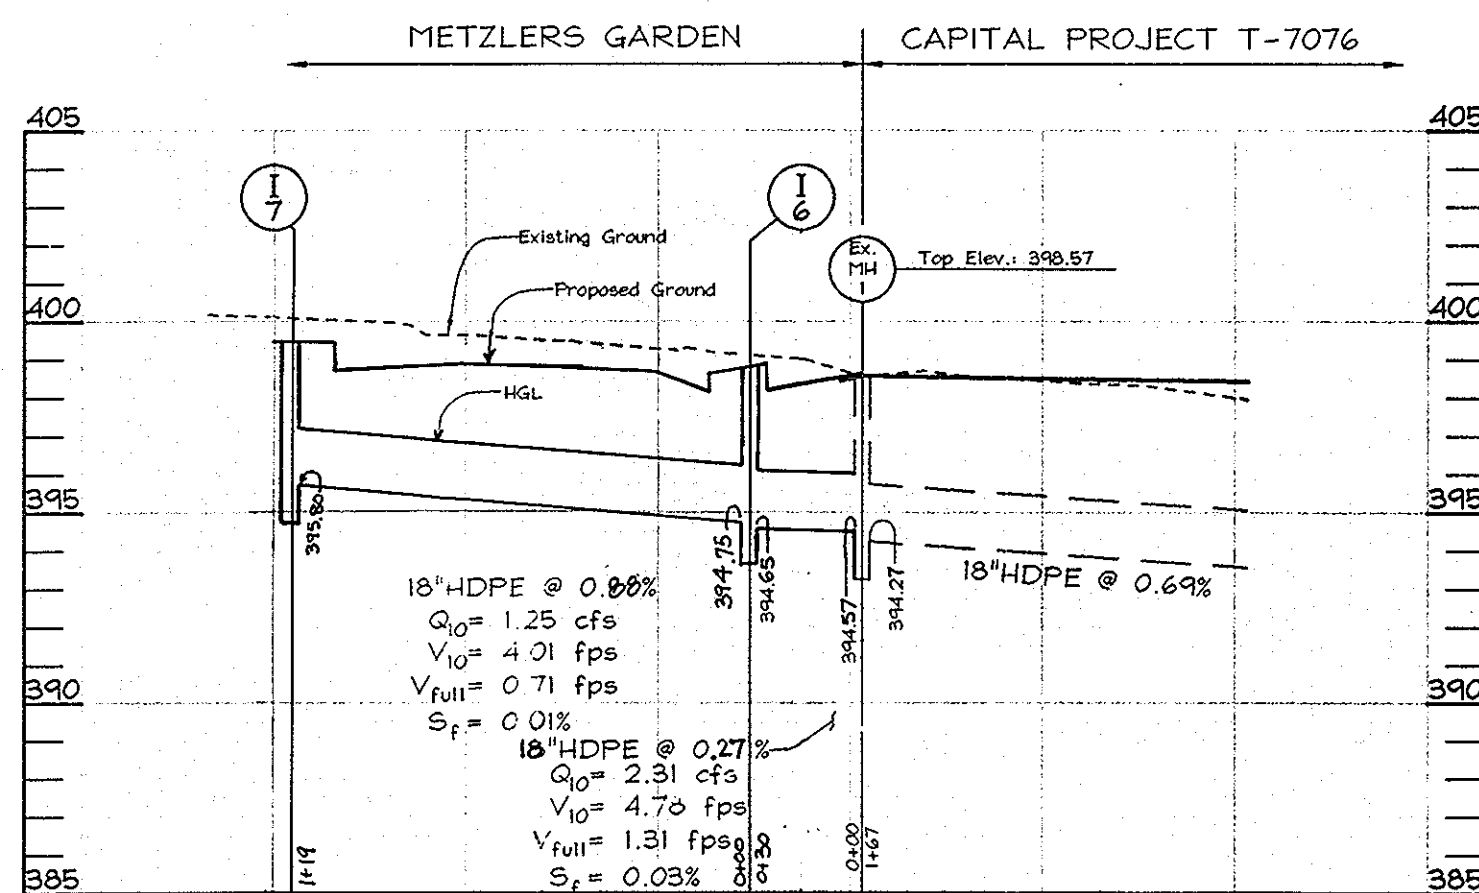

STORM DRAIN PROFILES

Scale: Horizontal-1"=50'
 Vertical-1"=5'

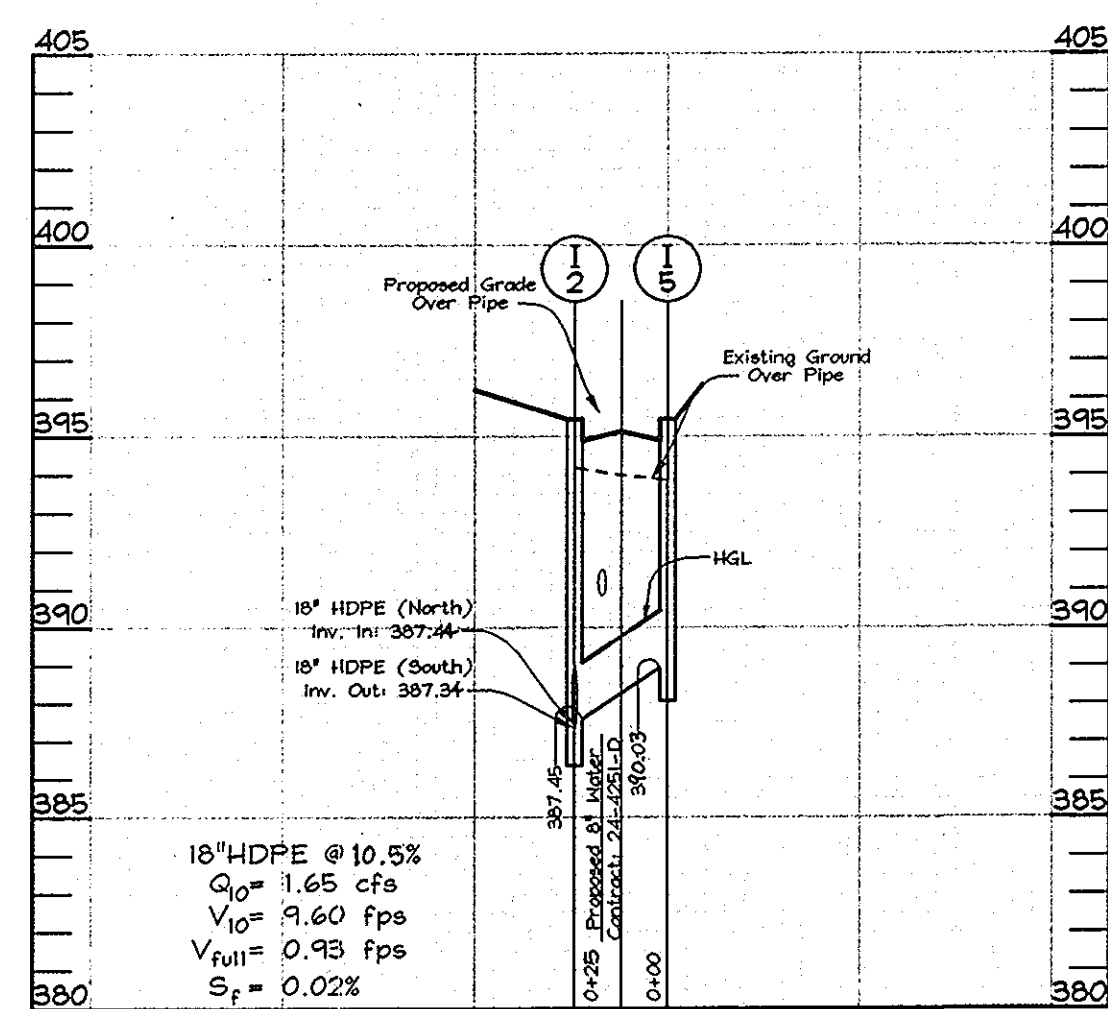


STORM DRAIN PROFILES

Scale: Horizontal-1"=50'
 Vertical-1"=5'

SIZE	TYPE	LENGTH
15"	HDPE	39 LF
18"	HDPE	464 LF
24"	HDPE	209 LF

STRUCTURE SCHEDULE						
NO.	TYPE	LOCATION	TOP ELEV.	INV. IN	INV. OUT	REMARKS
I-1	Type 'A-5' Inlet	Sta. 5+37.17-10' left	397.22	386.04	385.87	SD 4.01
I-2	Type 'A-5' Inlet	Sta. 6+26.80-10' left	395.44	387.42	387.34	SD 4.01
I-3	Type 'S' Inlet	Sta. 8+27.69-12' left	395.43	390.28	390.13	SD 4.22
I-4	Type 'S' Inlet	Sta. 8+27.69-27' right	394.64	-	390.64	SD 4.22
I-5	Type 'A-5' Inlet	Sta. 6+26.80-10' right	395.38	-	390.03	SD 4.01
I-6	Type 'A-5' Inlet	Sta. 26+61.06-24.90' left	398.17	394.75	394.65	SD 4.01
I-7	Type 'A-5' Inlet	Sta. 25+23.86-23.91' left	398.74	-	395.80	SD 4.01
M-1	Standard Precast Manhole (4')	N 559,127.9 E 1,349,192.8	395.77	384.27	384.17	G 5.12
S-1	24" HDPE End Section	N 559,175.0 E 1,349,286.5	-	382.00	381.71	Manhole or equivalent


- NOTES:
- Top elevations for Type 'S' Inlets along curb and gutter are to the center, edge of grate at the flow line.
 - Top elevations for A-5 inlets are to center of inlet, top of curb.
 - Top elevations for Precast Manholes are to the center top of manhole cover.
 - Top slope of structures to conform to slope of paving.

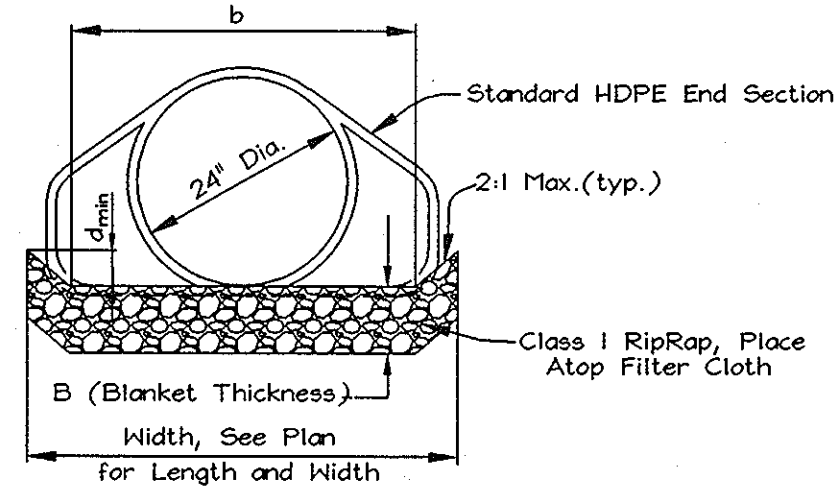

TYP. OUTFALL DETAIL
 Not to Scale

Structure	Q(c.f.s.)	S	n	b	d _{min}	d _{max}	d ₅₀	B (Blanket Thickness)
S-1	3.65	0%	0.06	4.9'	0.28'	15"	9.5"	19"

As-BUILT

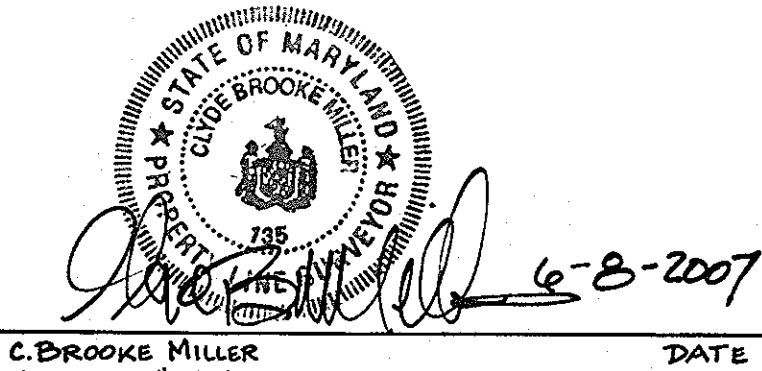

C. BROOKE MILLER
 PROP. L.S. #135
 DATE: 6-8-2007

OWNER METZLER JOHN W
 METZLER DOROTHY WF T/C
 10355 OWEN BROWN ROAD
 COLUMBIA, MARYLAND 21044-3834

DEVELOPER WILLIAMSBURG GROUP LLC
 5485 HARPERS FARM RD #200
 COLUMBIA, MARYLAND 21044-3834
 Telephone: (410) 997-8800
 Fax: (410) 997-4358

STORM DRAIN PROFILE
METZLERS GARDEN
 LOTS 1-6, 8-10, 12-14,
 OPEN SPACE LOTS 7,11,15,16 AND BULK PARCEL 'A'
 TAX MAP 36 GRID 7
 5TH ELECTION DISTRICT

PARCEL 152
 HOWARD COUNTY, MARYLAND




APPROVED: HOWARD COUNTY DEPARTMENT OF PLANNING AND ZONING
 Cindy Hamrick
 CHIEF, DIVISION OF LAND DEVELOPMENT
 DATE: 5/27/08

APPROVED: HOWARD COUNTY DEPARTMENT OF PUBLIC WORKS
 William J. ...
 CHIEF, BUREAU OF HIGHWAYS
 DATE: 5-25-08



FSH Associates
 Engineers Planners Surveyors
 8318 Forrest Street, Ellicott City, MD 21043
 Tel: 410-750-2251 Fax: 410-750-7350
 E-mail: info@fsha.biz

DESIGN BY: PS
 DRAWN BY: Ming
 CHECKED BY: ZYF
 SCALE: As Shown
 DATE: May 24, 2005
 P.L.O. No.: 3214
 SHEET No.: 6 OF 9

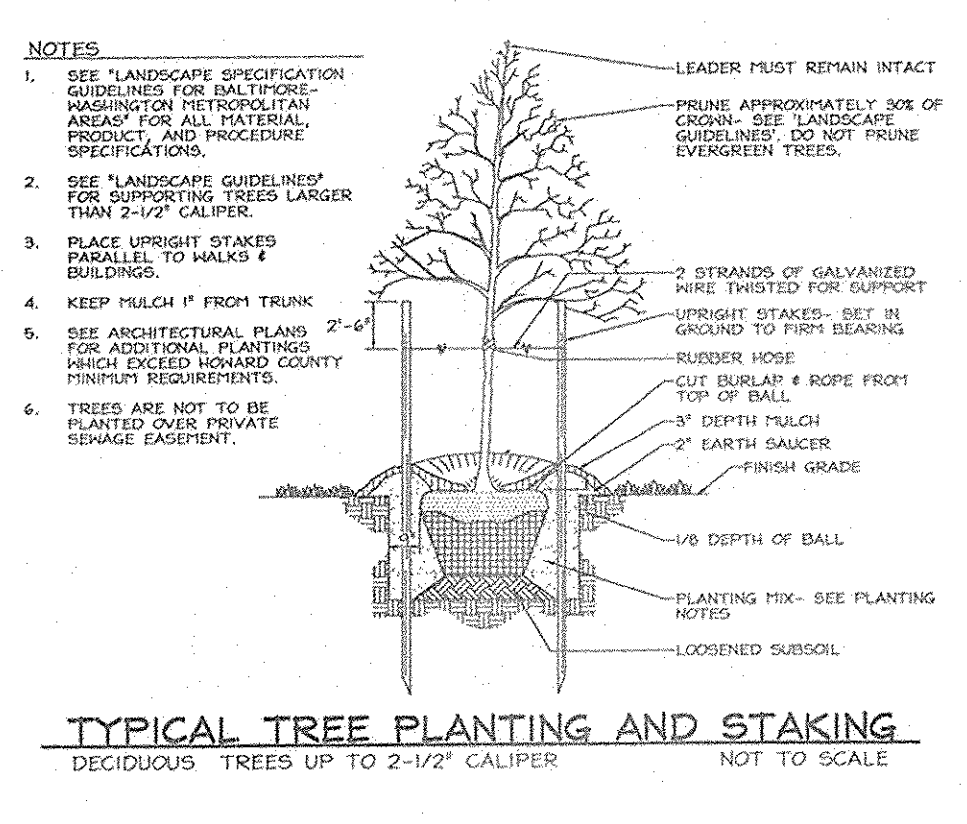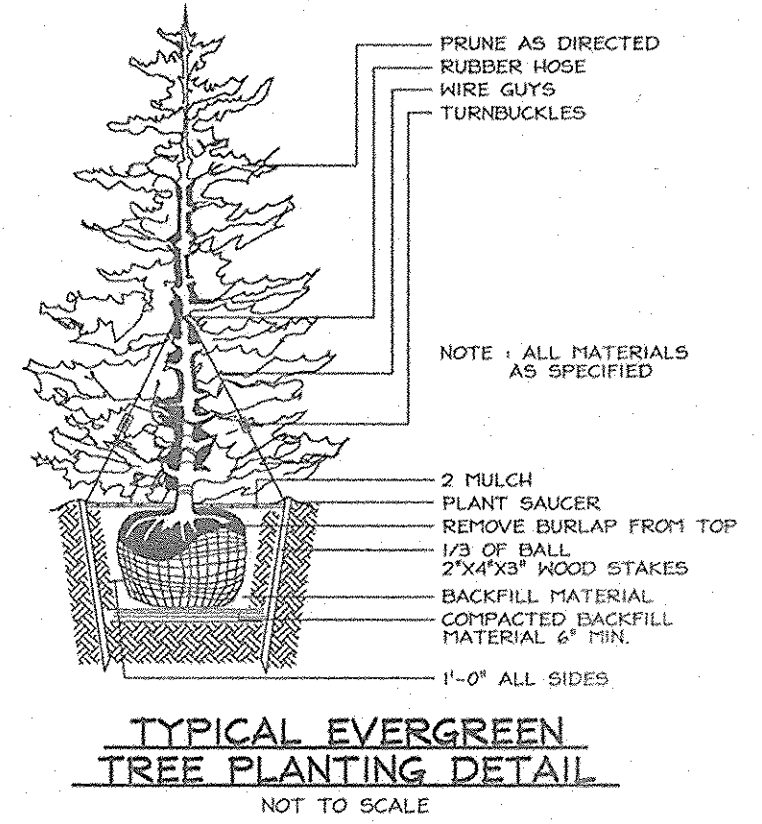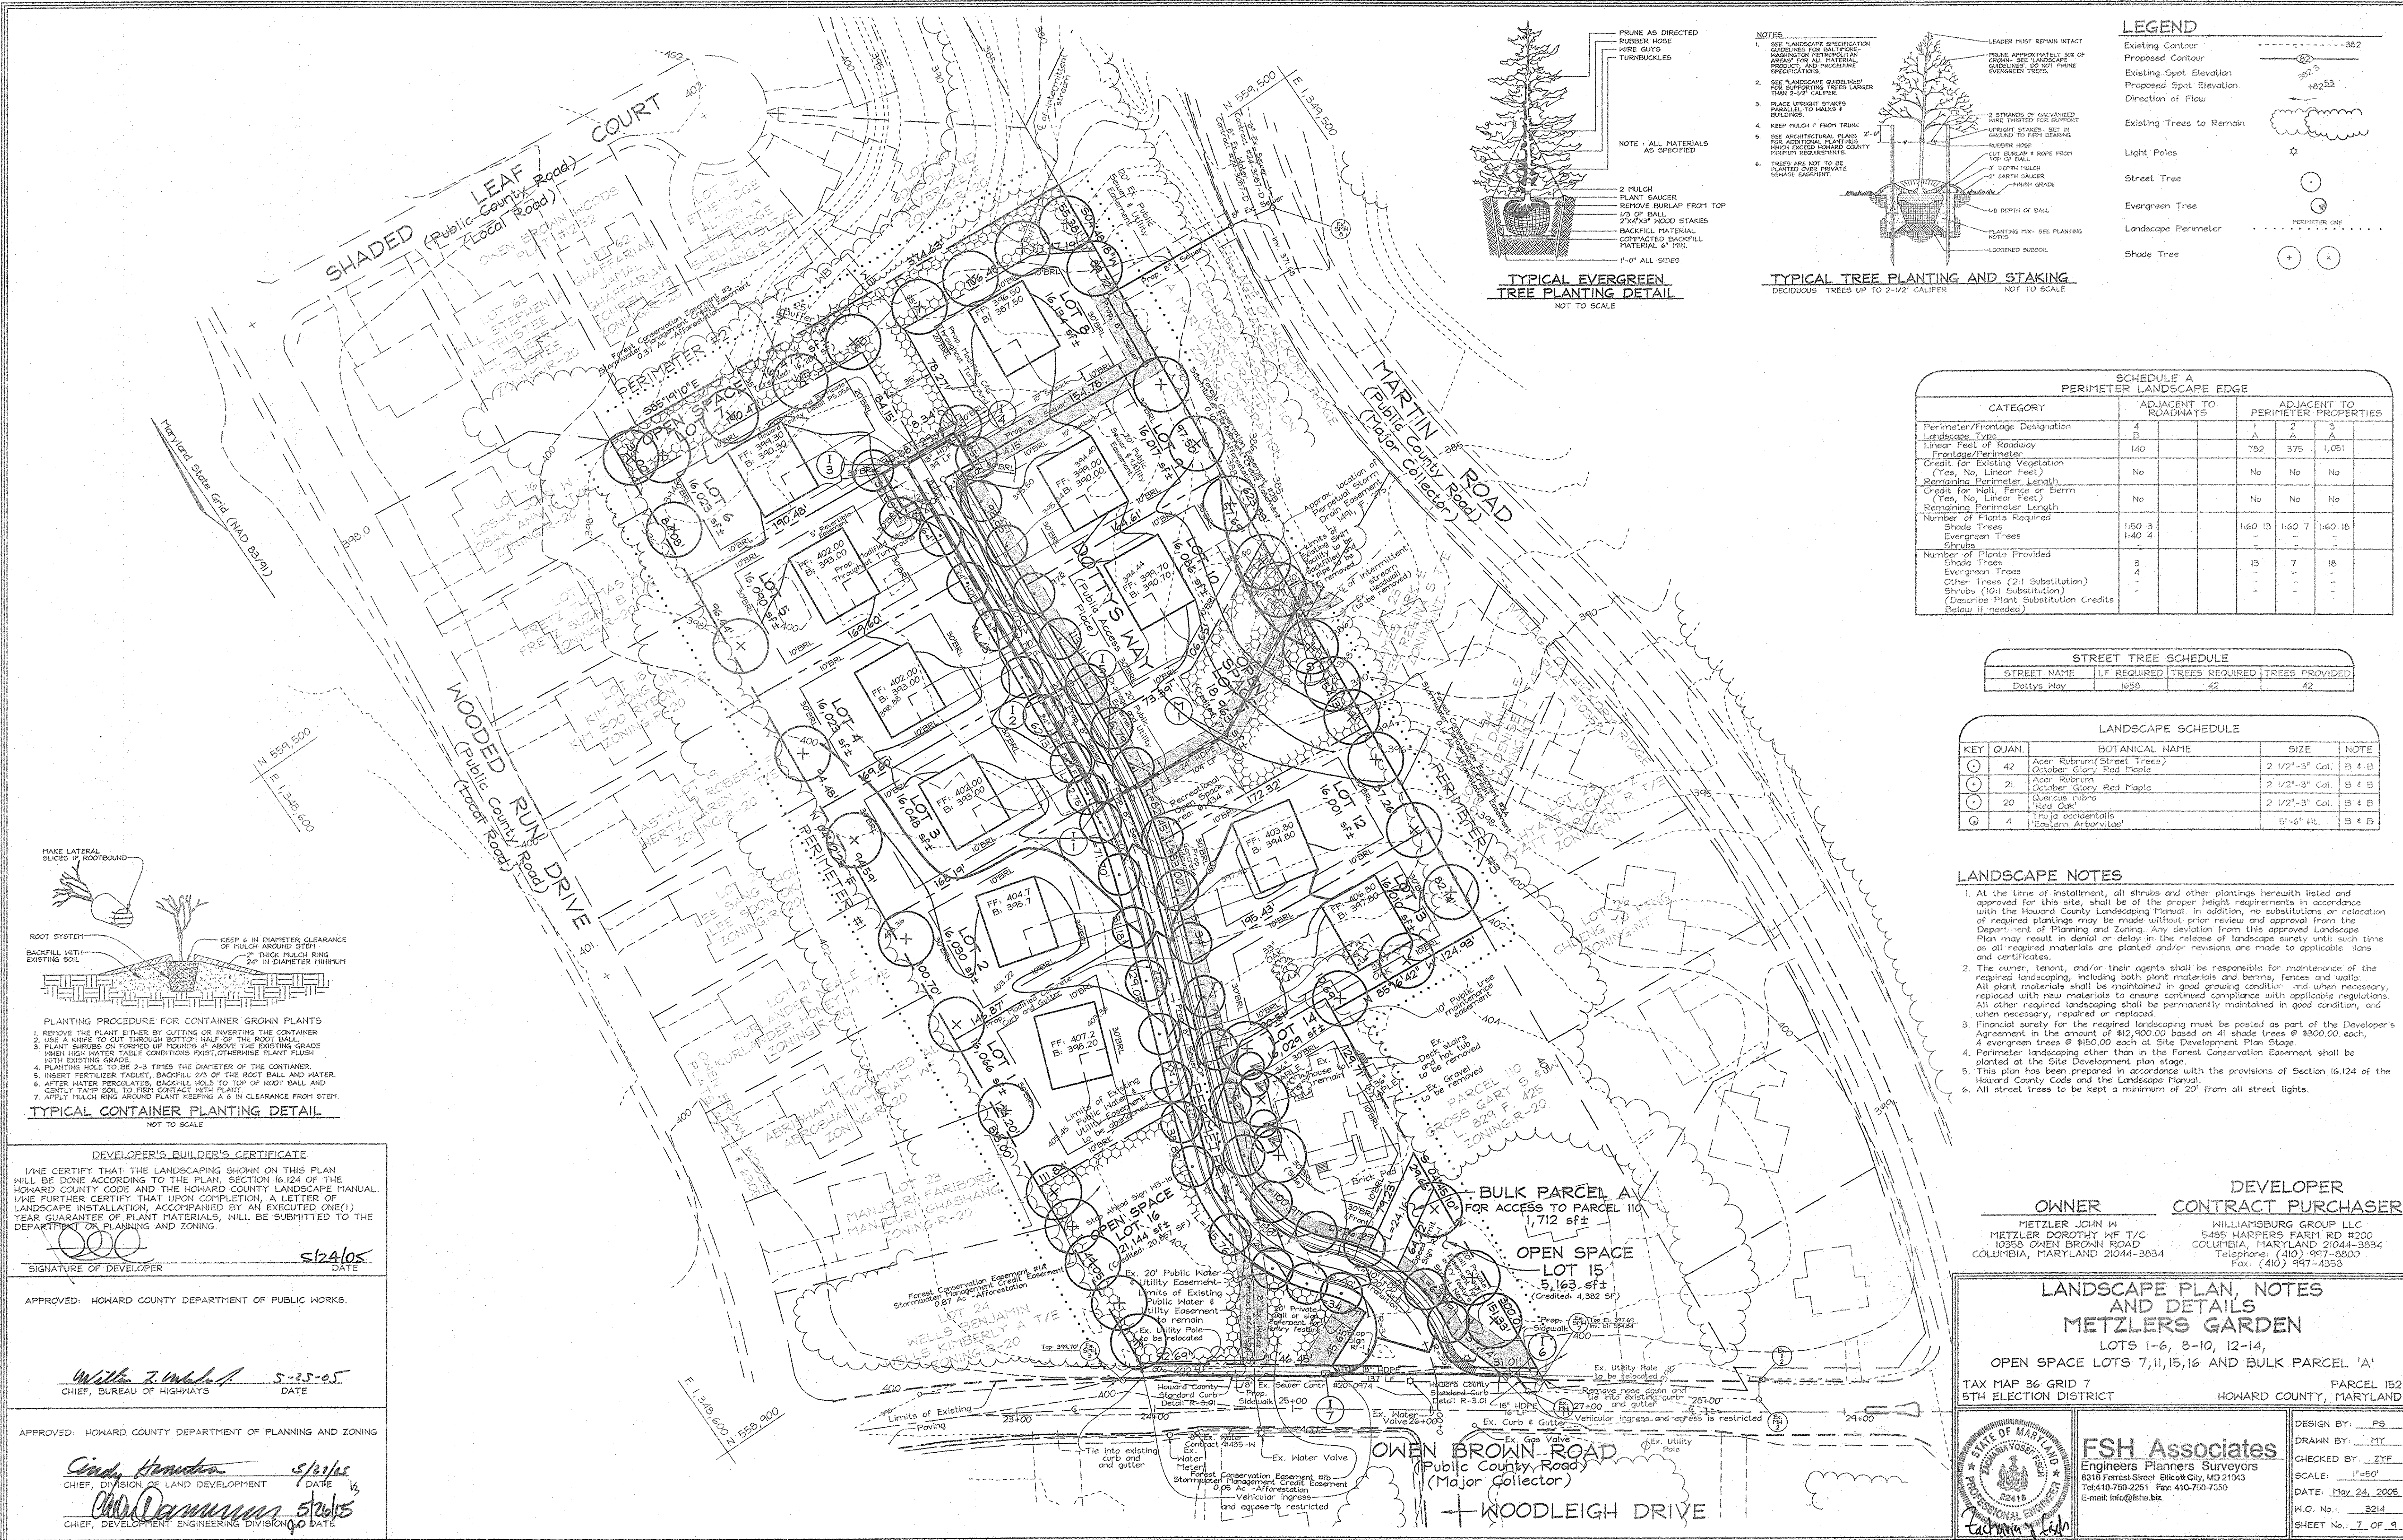

LEGEND

- Existing Contour
- Proposed Contour
- Existing Spot Elevation
- Proposed Spot Elevation
- Direction of Flow
- Existing Trees to Remain
- Light Poles
- Street Tree
- Evergreen Tree
- Landscape Perimeter
- Shade Tree

SCHEDULE A PERIMETER LANDSCAPE EDGE

CATEGORY	ADJACENT TO ROADWAYS			ADJACENT TO PERIMETER PROPERTIES		
	A	B	C	A	B	C
Perimeter/Frontage Designation	4	2	3	1	2	3
Landscape Type	140	782	375	1,051		
Linear Feet of Roadway Frontage/Perimeter						
Credit for Existing Vegetation (Yes, No, Linear Feet)	No	No	No	No	No	No
Remaining Perimeter Length						
Credit for Wall, Fence or Berm (Yes, No, Linear Feet)	No	No	No	No	No	No
Remaining Perimeter Length						
Number of Plants Required	150	3		160	13	160
Shade Trees	140	4				
Evergreen Trees						
Shrubs						
Number of Plants Provided						
Shade Trees	3			13	7	18
Evergreen Trees	4					
Other Trees (2:1 Substitution)						
Shrubs (10:1 Substitution)						
(Describe Plant Substitution Credits Below if needed)						

STREET TREE SCHEDULE

STREET NAME	LF REQUIRED	TREES REQUIRED	TREES PROVIDED
Dottys Way	1658	42	42

LANDSCAPE SCHEDULE

KEY	QUAN.	BOTANICAL NAME	SIZE	NOTE
○	42	Acer Rubrum (Street Trees)	2 1/2"-3" Cal.	B & B
○	21	October Glory Red Maple	2 1/2"-3" Cal.	B & B
○	21	Acer Rubrum	2 1/2"-3" Cal.	B & B
○	20	Quercus rubra Red Maple	2 1/2"-3" Cal.	B & B
○	20	Red Oak	2 1/2"-3" Cal.	B & B
○	4	Thuja occidentalis Eastern Arborvitae	5'-6" Ht.	B & B

LANDSCAPE NOTES

- At the time of installation, all shrubs and other plantings herewith listed and approved for this site, shall be of the proper height requirements in accordance with the Howard County Landscaping Manual. In addition, no substitutions or relocation of required plantings may be made without prior review and approval from the Department of Planning and Zoning. Any deviation from this approved Landscape Plan may result in denial or delay in the release of landscape surety until such time as all required materials are planted and/or revisions are made to applicable plans and certificates.
- The owner, tenant, and/or their agents shall be responsible for maintenance of the required landscaping, including both plant materials and berms, fences and walls. All plant materials shall be maintained in good growing condition and when necessary, replaced with new materials to ensure continued compliance with applicable regulations. All other required landscaping shall be permanently maintained in good condition, and when necessary, repaired or replaced.
- Financial surety for the required landscaping must be posted as part of the Developer's Agreement in the amount of \$12,500.00 based on 41 shade trees @ \$300.00 each, 4 evergreen trees @ \$150.00 each at Site Development Plan Stage.
- Perimeter landscaping other than in the Forest Conservation Easement shall be planted at the Site Development Plan Stage.
- This plan has been prepared in accordance with the provisions of Section 16.124 of the Howard County Code and the Landscape Manual.
- All street trees to be kept a minimum of 20' from all street lights.

OWNER
 METZLER JOHN W
 METZLER DOROTHY W F T/C
 10355 OWEN BROWN ROAD
 COLUMBIA, MARYLAND 21044-3834


DEVELOPER CONTRACT PURCHASER
 WILLIAMSBURG GROUP LLC
 5485 HARPERS FARM RD #200
 COLUMBIA, MARYLAND 21044-3834
 Telephone: (410) 997-5300
 Fax: (410) 997-4558

LANDSCAPE PLAN, NOTES AND DETAILS
METZLERS GARDEN
 LOTS 1-6, 8-10, 12-14,
 OPEN SPACE LOTS 7, 11, 15, 16 AND BULK PARCEL 'A'
 TAX MAP 36 GRID 7
 5TH ELECTION DISTRICT

PARCEL 152
 HOWARD COUNTY, MARYLAND

FSH Associates
 Engineers Planners Surveyors
 8318 Forest Street Ellicott City, MD 21043
 Tel: 410-750-2251 Fax: 410-750-7350
 E-mail: info@fsh.biz

DESIGN BY: PS
 DRAWN BY: MY
 CHECKED BY: ZYF
 SCALE: 1"=50'
 DATE: May 24, 2005
 N.O. No.: 3214
 SHEET No.: 7 OF 9

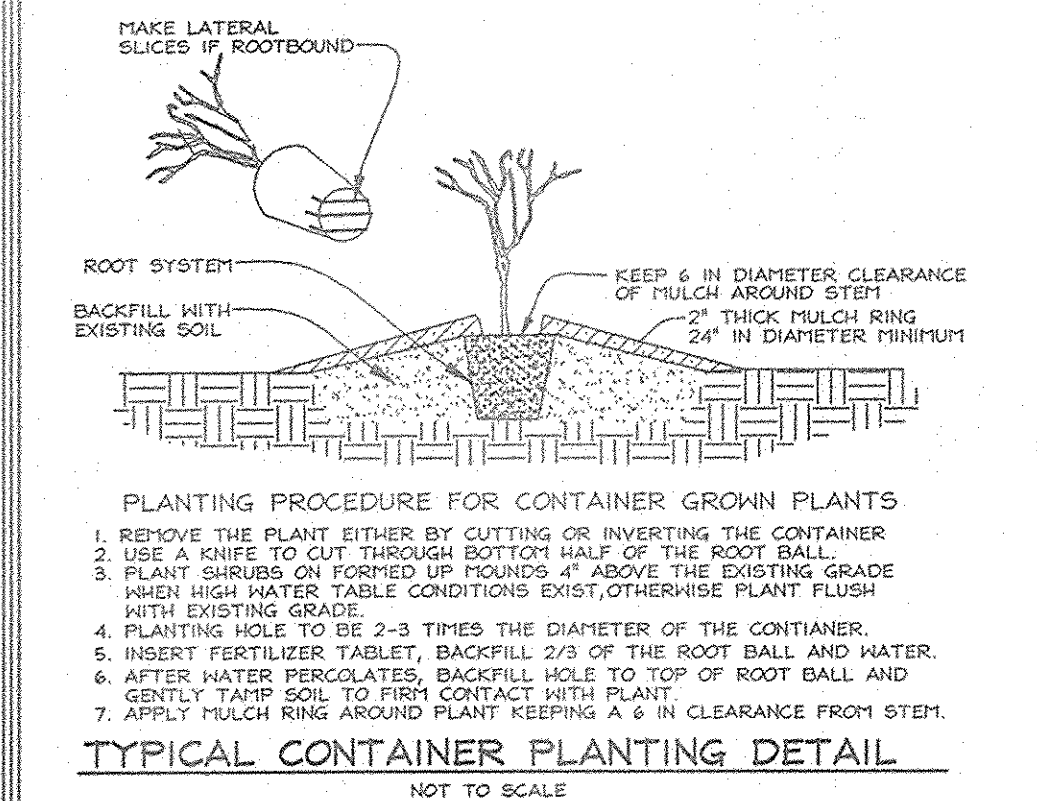

DEVELOPER'S BUILDER'S CERTIFICATE

I/WE CERTIFY THAT THE LANDSCAPING SHOWN ON THIS PLAN WILL BE DONE ACCORDING TO THE PLAN, SECTION 16.124 OF THE HOWARD COUNTY CODE AND THE HOWARD COUNTY LANDSCAPE MANUAL. I/WE FURTHER CERTIFY THAT UPON COMPLETION, A LETTER OF LANDSCAPE INSTALLATION, ACCOMPANIED BY AN EXECUTED ONE(1) YEAR GUARANTEE OF PLANT MATERIALS, WILL BE SUBMITTED TO THE DEPARTMENT OF PLANNING AND ZONING.

SIGNATURE OF DEVELOPER: *John Metzler* DATE: 5/24/05

APPROVED: HOWARD COUNTY DEPARTMENT OF PUBLIC WORKS.
William J. ... DATE: 5-25-05
 CHIEF, BUREAU OF HIGHWAYS


APPROVED: HOWARD COUNTY DEPARTMENT OF PLANNING AND ZONING
Cindy ... DATE: 5/24/05
 CHIEF, DIVISION OF LAND DEVELOPMENT

Chris ... DATE: 5/24/05
 CHIEF, DEVELOPMENT ENGINEERING DIVISION




Planting Area Monitoring Notes

1. Initial planting inspection and certification required. Planting contractor to notify ERI qualified professional 24 hours in advance of planting.
2. Monthly visits during the first growing season are to assess the success of the plantings and to determine if supplemental watering, pest control or other actions are necessary. Early spring visits will document winter kill and autumn visits will document summer kill.
3. The minimum survival rate shall be 75% of the total number of trees planted per acre at the end of the two year maintenance period. Wild tree seedlings from natural regeneration on the planting site may be counted up to 50% toward the total survival number if they are healthy native species at least 12 inches tall.
4. Survival will be determined by a stratified random sampling of the plantings. The species composition of the sample population should be proportionate to the amount of each species in the entire planting to be sampled.
5. Effective monitoring will assess plant survivability during the first growing season and make recommendations for reinforcement plantings if required at that time.
6. A final inspection and certification by the ERI qualified professional is required after the second growing season.

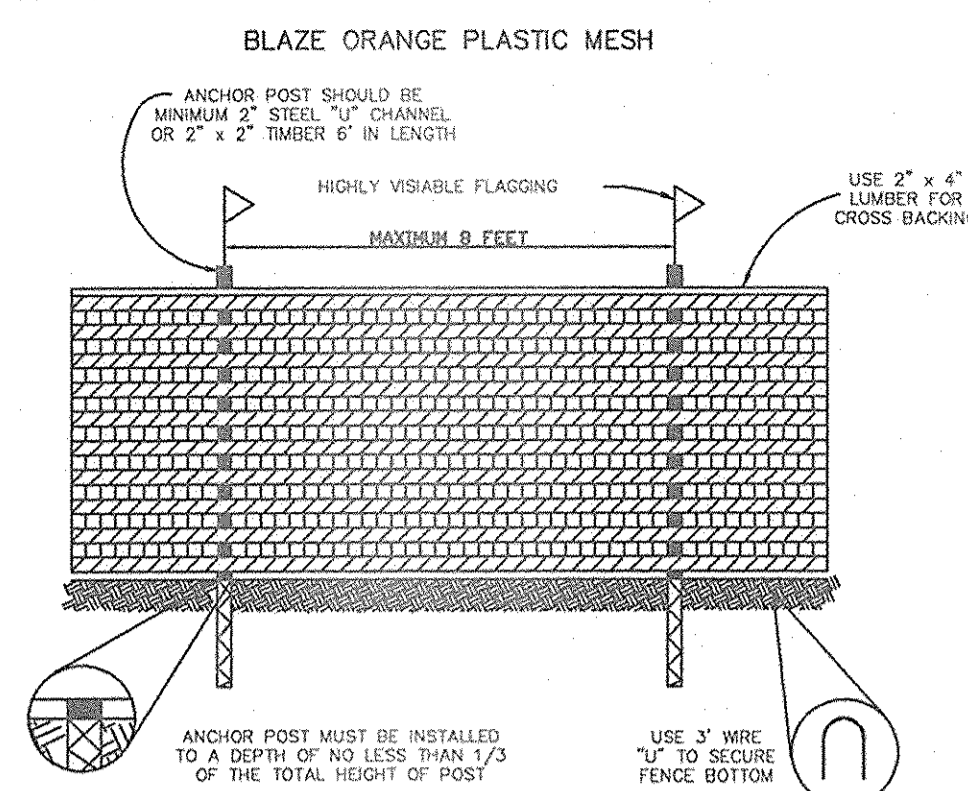

- NOTES:**
1. FOREST PROTECTION DEVICE ONLY.
 2. RETENTION AREA WILL BE SET AS PART OF THE REVIEW PROCESS.
 3. BOUNDARIES OF RETENTION AREA SHOULD BE STAKED AND FLAGGED PRIOR TO INSTALLING DEVICE.
 4. ROOT DAMAGE SHOULD BE AVOIDED.
 5. PROTECTIVE SOIL MAY ALSO BE USED.
 6. DEVICE SHOULD BE MAINTAINED THROUGHOUT CONSTRUCTION.

TREE PROTECTION DETAIL
NOT TO SCALE

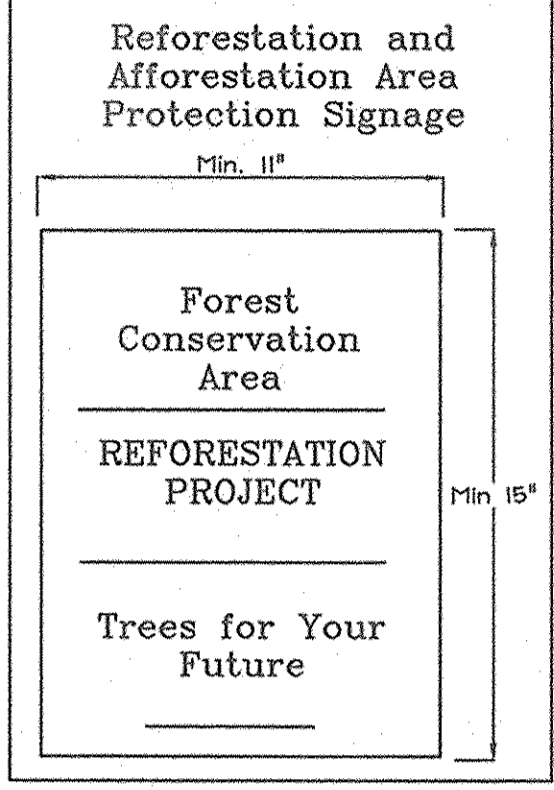

SIGN DETAIL: PERMANENT SIGN
SIGNAGE NOTE: ALL TREE PROTECTION SIGNS SHALL BE PLACED ON METAL 'T' POSTS OR PRESSURE TREATED WOOD POLES. NO ATTACHMENT OF SIGNS TO TREES IS PERMITTED.

Afforestation Area Planting Notes

1. Initial planting inspection and certification required. Planting contractor to notify ERI qualified professional 24 hours in advance of planting.
2. Afforestation areas may be planted as soon as reasonable to do so. Late winter- early spring plantings are preferred. Earliest planting dates will vary from year to year but planting may generally begin as soon as the ground is no longer frozen. Alternate planting dates may be considered as conditions warrant.
3. Soil amendments and fertilization recommendations will be made based upon the results of soil analysis for nitrogen, phosphorus, potassium, organic matter content and pH. If required, fertilizer will be provided using a slow release, soluble 16-8-16 analysis designed to last 5-8 years contained in polyethylene perforated bags such as manufactured by ADCO Works, P.O. Box 310 Hollins, N.Y. 11423 or approved equal.
4. Plant materials shall be planted in accordance with the planting diagram, planting details and planting schedule.
5. Plant stock must be protected from desiccation at all times prior to planting. Materials held for planting shall be moistened and placed in cool shaded areas until ready for placement.
6. Planting materials shall be inspected prior to planting. Plants not conforming to the American Standards for Nursery Stock specifications for size, form, vigor, or roots, or due to trunk wounds, breakage, desiccation, insect or disease must be replaced.
7. Newly planted trees may require watering at least once per week during the first growing season depending on rainfall in order to get established. The initial planting operation should allow for watering during installation to completely soak backfill materials.
8. Mulch shall be applied in accordance with the diagram provided and shall consist of composted, shredded hardwood bark mulch, free of wood alcohol.
9. Planting holes should be excavated to a minimum diameter of 2.5 to 3 times the diameter of the root ball or container. Mechanical angling is preferred with specification of the side of each hole.
10. All nursery stock to be sprayed with deer repellent containing Bitrex such as Repellex All nursery stock to be grown with deer repellent tablets in growing medium, such as Repellex Tablets.

LEGEND

- Existing contours
- Existing Spot Elevation
- Existing Trees to Remain
- 25' Wetlands Buffer
- Stream Bank Buffer
- Wetland
- Stream
- Gas Electric Utility Pole
- Specimen Tree
- Proposed 2 1/2" cal. tree
- Forest Conservation Easement Sign
- Tree Protection Fence

FOREST CONSERVATION EASEMENT TABLE

EASEMENT	TYPE	AREA (ACRES)
1a	Afforestation	0.37
1b	Afforestation	0.05
	Total	0.42
2a	Afforestation	0.14
2b	Afforestation	0.10
	Total	0.24
3	Afforestation	0.37
TOTAL		1.03

Easement 1: 0.42 Ac. (1A=7B-whips, 16-2.5" cal. / 1B=6-2.5" cal.)

Qty	Botanical Name	Common Name	Min. Size	Spacing	Notes	
18	Acer rubrum	Red Maple	WHIP 2-3'	11' o.c.	1-3 Gallon Container	
19	Quercus alba	White Oak	WHIP 2-3'	11' o.c.	Grown or Bare Root with 5' tree shelters	
19	Quercus rubra	Red oak	WHIP 2-3'	11' o.c.		
19	Amelanchier canadensis	Service berry	WHIP 2-3'	11' o.c.	Bare Root with 5' tree shelters	
19	Prunus serotina	Black Cherry	WHIP 2-3'	11' o.c.		
19	Juniperus virginiana	Redcedar	WHIP 2-3'	11' o.c.		
**	11	Acer rubrum	2.5" cal.	20' o.c.	B#B	
**	11	Quercus rubra	Red oak	2.5" cal.	20' o.c.	

Easement 2: 0.24 Ac. (2A=39-whips, 3-2.5" cal. / 2B=29-whips, 2-2.5" cal.)

Qty	Botanical Name	Common Name	Min. Size	Spacing	Notes	
12	Acer rubrum	Red Maple	WHIP 2-3'	11' o.c.	1-3 Gallon Container	
12	Quercus alba	White Oak	WHIP 2-3'	11' o.c.	Grown or Bare Root with 5' tree shelters	
11	Quercus rubra	Red oak	WHIP 2-3'	11' o.c.		
11	Amelanchier canadensis	Service berry	WHIP 2-3'	11' o.c.	Bare Root with 5' tree shelters	
11	Prunus serotina	Black Cherry	WHIP 2-3'	11' o.c.		
11	Juniperus virginiana	Redcedar	WHIP 2-3'	11' o.c.		
***	2	Acer rubrum	2.5" cal.	20' o.c.	B#B	
***	3	Quercus rubra	Red oak	2.5" cal.	20' o.c.	

Easement 3: 0.37 Ac. (9B-whips, 10-2.5" cal.)

Qty	Botanical Name	Common Name	Min. Size	Spacing	Notes	
16	Acer rubrum	Red Maple	WHIP 2-3'	11' o.c.	1-3 Gallon Container	
16	Quercus alba	White Oak	WHIP 2-3'	11' o.c.	Grown or Bare Root with 5' tree shelters	
16	Quercus rubra	Red oak	WHIP 2-3'	11' o.c.		
16	Amelanchier canadensis	Service berry	WHIP 2-3'	11' o.c.	Bare Root with 5' tree shelters	
16	Prunus serotina	Black Cherry	WHIP 2-3'	11' o.c.		
18	Juniperus virginiana	Redcedar	WHIP 2-3'	11' o.c.		
***	5	Acer rubrum	2.5" cal.	20' o.c.	B#B	
***	5	Quercus rubra	Red oak	2.5" cal.	20' o.c.	

* Two of the trees are being planted in conjunction with landscape buffer requirements
 ** Three of the trees are being planted in conjunction with landscape buffer requirements
 *** All of the trees are being planted in conjunction with landscape buffer requirements

NOTES: 1. See Sheet 7 of 9 for Planting Details
 2. See the record plat for F-05-90 for the bearing and distance information for the recorded forest conservation easement shown on this plan.

FOREST CONSERVATION WORKSHEET

Item	Description	Acres
A.	Total Tract Area	6.66
B.	Area Within 100 Year Floodplain	--
C.	Other deductions	--
D.	Net Tract Area	6.66
Zoning Use Category: RESIDENTIAL-SUBURBAN		
E.	Afforestation Minimum (15 % x D)	1.00
F.	Conservation Threshold (20 % x D)	1.33
Existing Forest Cover		
G.	Existing Forest on Net Tract Area	0
H.	Forest Area Above Conservation Threshold	0
Breakeven Point		
I.	Forest Retention Above Threshold with no Mitigation	N/A
J.	Clearing Permitted without Mitigation	N/A
Proposed Forest Clearing		
K.	Forest Areas to be Cleared	0
L.	Forest Areas to be Retained	0
Planting Requirements		
M.	Reforestation for Clearing Above Threshold	0
N.	Reforestation for Clearing Below the Threshold	0
P.	Credit for Retention Above Conservation Threshold	0
Q.	Total Reforestation Required	0
R.	Total Afforestation Required	1.00
S.	Total Reforestation and Afforestation Requirement	1.00

Forest Conservation Narrative

This Forest Conservation Plan was prepared in accordance with the Howard County Forest Conservation Manual. The subject property has a gross and net tract area of 6.66 Ac. There is no existing forest on site. There are several specimen trees around the existing home. Afforestation requirements will be met entirely on site in three easements. The three easements will enhance existing contiguous wooded and forest areas on surrounding properties to enhance forest diversity and wildlife habitat corridors. The 0.42 Ac. planting area will be planted with a mix of large and small stock due to its location. In conjunction with perimeter buffering requirements, 2.5" cal. stock shall be planted around the edges and container group stock shall in-fill at 350 trees/acre with tree shelters. The 0.24 Ac. and 0.37 Ac. planting areas will be planted primarily with small stock in conjunction with perimeter buffering requirements, 2.5" cal stock shall be planted at the property line and container group stock shall be used to in-fill at 350 trees/acre with tree shelters for the remainder of the area. The total forest conservation obligation met on this site is 1.00 acres, with a total forest conservation surety amount of \$18,433.50 (afforestation planting of 44,867 square feet less 8000 s.f. for 20 trees bonded under landscape = 36,867 s.f. X \$ 0.50). The forest conservation easements established on this plat fulfill the requirements of Section 16.1200 of the Howard County Code and the Forest Conservation Manual. No clearing, grading or construction is permitted within the forest conservation easements, however, forest management practices as defined in the Deed of Forest Conservation Easement are allowed.

APPROVED: HOWARD COUNTY DEPARTMENT OF PLANNING AND ZONING
 Chief, Development Engineering Division
 Chief, Division of Land Development

SPECIMEN TREES

NO.	DBH	COMMON NAME	SCIENTIFIC NAME	CONDITION
ST-1	33"	Black oak	Quercus velutina	Good
ST-2	31"	Black oak	Quercus velutina	Good
ST-3	31"	Red maple	Acer rubrum	Fair



OWNER
 METZLER JOHN W
 METZLER DOROTHY WF T/C
 10358 OWEN BROWN ROAD
 COLUMBIA, MARYLAND 21044-3834

DEVELOPER
 WILLIAMSBURG GROUP LLC
 5485 HARPERS FARM RD #200
 COLUMBIA, MARYLAND 21044-3834
 Telephone: (410) 997-8800
 Fax: (410) 997-4358

FOREST CONSERVATION PLAN
METZLERS GARDEN
 LOTS 1-6, 8-10, 12-14,
 OPEN SPACE LOTS 7, 11, 15, 16 AND BULK PARCEL 'A'
 TAX MAP 36 GRID 7
 5TH ELECTION DISTRICT

PARCEL 152
 HOWARD COUNTY, MARYLAND

EXPLORATION RESEARCH, INC.
 ENVIRONMENTAL CONSULTANTS
 LANDSCAPE ARCHITECTS
 6316 FOREST STREET
 ELICOTT CITY, MARYLAND 21043
 TEL: (410) 750-1100 FAX: (410) 750-7300
 EMAIL: EXPLORATION@RCRES.COM

FSH Associates
 Engineers Planners Surveyors
 8318 Forrest Street, Ellicott City, MD 21043
 Tel: 410-750-2251 Fax: 410-750-7350
 E-mail: info@fsha.biz

DESIGN BY: PS
 DRAWN BY: MY
 CHECKED BY: ZTF
 SCALE: 1"=50'
 DATE: May 24, 2005
 W.O. No.: 3214
 SHEET No.: 8 OF 9

LEGEND	
Existing contours	--- 552
Existing Spot Elevation	382.3
Existing Trees to Remain	
25' Wetlands Buffer	--- WB
Stream Bank Buffer	--- SB
Wetland	--- W
Stream	---
Gas Electric Utility Pole	⊗
Specimen Tree	⊗ ST-2



OWNER	DEVELOPER
METZLER JOHN W METZLER DOROTHY WF T/C 10358 OWEN BROWN ROAD COLUMBIA, MARYLAND 21044-3834	CONTRACT PURCHASER WILLIAMSBURG GROUP LLC 5485 HARPERS FARM RD #200 COLUMBIA, MARYLAND 21044-3834 Telephone: (410) 997-8800 Fax: (410) 997-4358

EXISTING CONDITIONS PLAN
METZLERS GARDEN
 LOTS 1-6, 8-10, 12-14,
 OPEN SPACE LOTS 7,11,15,16 AND BULK PARCEL 'A'
 TAX MAP 36 GRID 7 PARCEL 152
 5TH ELECTION DISTRICT HOWARD COUNTY, MARYLAND

	FSH Associates Engineers Planners Surveyors 8318 Forrest Street, Ellicott City, MD 21043 Tel: 410-750-2251 Fax: 410-750-7350 E-mail: info@fsha.biz	DESIGN BY: PS DRAWN BY: MY CHECKED BY: ZYF SCALE: 1"=50' DATE: May 24, 2005 P.L.O. No.: 3214 SHEET No.: 9 OF 9
--	---	--

APPROVED: HOWARD COUNTY DEPARTMENT OF PUBLIC WORKS.
Walter Z. White 5-23-05
 CHIEF, BUREAU OF HIGHWAYS DATE

APPROVED: HOWARD COUNTY DEPARTMENT OF PLANNING AND ZONING
Cindy Kramer 5/27/05
 CHIEF, DIVISION OF LAND DEVELOPMENT DATE

Chris Damman 5/24/05
 CHIEF, DEVELOPMENT ENGINEERING DIVISION DATE