
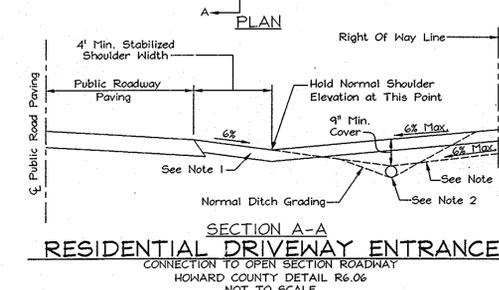


GENERAL NOTES

- This plan is subject to compliance with the 4th Edition of the Howard County Subdivision Regulations and the amended Howard County Zoning Regulations pursuant to Council Bill 75-2003.
- Subject property is zoned "RC-DEO" per the 02/02/04 Comprehensive Zoning Plan.
- Private water and sewer will be used within this site.
- The project is not within the metropolitan district.
- Gross area of site: 27.859 ac.±
- Area of proposed public R/W: 1.9561 ac.±
- Number of proposed buildable lots: 12
- Area of proposed buildable lots: 13,749 ac.±
- Number of Buildable Preservation Parcels: 1
- Area of Buildable Preservation Parcels: 1,634 ac.±
- Number of Non-Buildable Preservation Parcels: 5
- Area of Non-Buildable Preservation Parcels: 10,562 ac.±
- The project is in conformance with the latest Howard County Standards unless waivers have been approved.
- The contractor shall notify the following utility companies or agencies at least five(5) working days before starting work shown on these plans:
 - State Highway Administration 410.531.5533
 - BGE(Contractor Services) 410.850.4620
 - BGE(Underground Damage Control) 410.787.9068
 - Miss Utility 1.800.257.7777
 - Colonial Pipeline Company 410.795.1940
 - Howard County, Dept. of Public Works, Bureau of Utilities 410.313.4900
 - Howard County Health Department 410.313.2640
 - ATTI 1.800.252.1133
 - Verizon 1.800.745.0033/410.224.9210
- The contractor shall notify Miss Utility at 1-800-257-7777 at least 48 hours prior to any excavation work being done.
- The contractor shall notify the Department of Public Works/Bureau of Engineering Construction Inspection Division at (410) 313-4900 at least five (5) working days prior to the start of work. All fills for public road surfaces require 95% compaction (ASHTO-T-180).
- All construction shall be in accordance with the latest standards and specifications of Howard County plus MSHA standards and specifications if applicable.
- Traffic control devices, markings and signing shall be in accordance with the latest edition of the Manual of Uniform Traffic Control Devices (MUTCD). All street and regulatory signs shall be in place prior to the placement of any asphalt.
- The lots shown herein comply with the minimum ownership, width and lot area as required by the Maryland State Department of the Environment.
- ███ This area designates a private sewage easement, of at least 10,000 SF as required by the Maryland State Department of the Environment for individual sewage disposal (COMAR 26.04.03). Improvements of any nature in this area are restricted until public sewerage is available. These easements shall become null and void upon connection to a public sewerage system. The County Health Officer shall have the authority to grant adjustments to the private sewage easement. Recordation of a modified sewage easement shall not be necessary.
- All wells and septic fields within 100' of property's boundary have been shown.
- The septic fields are located on soil types BrC2, BrC3, MIB2, MIB3, MIB2, MIB3, MID2 and MIB2 as per the soil survey of Howard County, Maryland, Soils Map #3.
- On-site topography based on a Field Run Topographic Survey prepared by FSH Associates in February, 2002 with two foot contours. Off-site and non-critical topography based on Howard County 1999 Aerial Topographic Surveys with five foot contours.
- All wells to be drilled prior to submittal of record plat for signature. It is the developer's responsibility to schedule the well drilling prior to final plat submission. It will not be considered "government delay" if the well drilling holds up the Health Department signature of the record plat.
- Existing septic system on proposed lots 1, 3, 4 & 9 to be properly abandoned per Health Department requirements prior to submittal of record plat for signature.
- Existing structures on-site to be removed prior to submittal of record plat for signature.
- Proposed well on lot 9 to be drilled at furthest point from abandoned septic on lot 9.
- Ground water appropriation permit must be issued prior to record plat submission and/or prior to drilling wells.
- A.P.F.O. traffic study prepared by Street Traffic Studies, Ltd., October 9, 2002 and approved under SP-03-10.
- Wetlands delineation and report and Forest Stand Delineation prepared by Exploration Research Inc. approved under SP-03-10.
- The coordinates shown herein are based upon the Howard County Geodetic Control which is based on the Maryland State Plane Coordinate system. Howard County monument numbers 101A and 17AB were used for this project.
- Stormwater Management for Cpv is provided for in a Surface Sand Filter facility and Rev is provided for in grass swales. The Surface Sand Filter facility is privately owned and maintained by the Home Owners Association. INOV for lot 1 is provided by a dry swale. INOV for lots 6 & 11 is provided for by sheet flow to buffer, rooftop disconnects and non-rooftop disconnects. INOV for lots 2-5, 10 & 12 is provided for in a Surface Sand Filter facility.
- No grading, removal of vegetative cover or trees, or placement of new structures is permitted within the limits of wetlands, streams, or their buffers and forest conservation easement areas.
- The geotechnical report for this project was prepared by Geo-Technology Associates, Inc. dated September 17, 2002.
- For flag or pipeline lots, refuse collection, snow removal and road maintenance are provided to the junction of the flag or pipeline and road right-of-way line and not to the pipeline lot driveway.
- Non-Buildable Parcel 'E' is created to provide access to adjacent Parcel 18. Parcel 'E' will be transferred to the owners of Parcel 18 after recordation.
- This project is subject to waiver petition HP-03-148 in which on July 11, 2003 the Planning Director approved a waiver from Section 16.119.(e)(5) to allow the proposed Right of Way of Road 'A' to tie into existing Cavey Lane without the required 25 feet truncations on either side of the Right of Way.
- This project complies with the requirements of Section 16.1200 of the Howard County Code for Forest Conservation by retaining 0.35 acres of Forest Forest Conservation Easement 1, retaining 2.84 acres of forest and planting 0.14 acres within Forest Conservation Easement 2, and retaining 1.47 acres of forest and planting 1.03 acres within Forest Conservation Easement 3. Total retention = 4.71 acres. Total planting provided = 1.17 acres. \$66,516.12 surety to be posted with the Developer's Agreement.
- All sign posts used for traffic control signs installed in the County Right-of-Way shall be mounted on a 2" galvanized steel, perforated, square tube post (14 gauge) inserted into a 2-1/2" galvanized steel, perforated, square tube sleeve (12 gauge) - 3' long. A galvanized steel pole cap shall be mounted on top of each post.
- A total of six (6) CEU units are transferred to this site from Waterford Farm Parcel 7 Tax Map 20, Parcel 14, Grid 12 (2 units), Talley Property Parcel 3 Tax Map 6, Parcel 34, Grid 13 (4 units) by RE-05-006. Recorded in Plat Number 17921 and 17922.
- Level Spreaders located on Lots 6-9 & 11 and the dry swale located on Lot 1 and associated grading are to be constructed at the Plat filing stage.

landscape survey = \$29,700.00

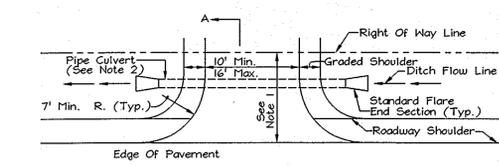

- NOTES:**
- Driveway must be paved from edge of public road to right of way line using standard paving section P-1 as shown on standard detail R.2.01 or alternate section equal to or better than P-1, as approved by D.P.M.
 - Drainage culvert shall be sized for a 10 year frequency storm and the minimum size shall be 12" dia. round or 14" x 9" arch pipe if larger pipe is required, ditch invert shall be lowered to provide min. ditch gradient of 0.5% and clearance shown.
 - Swale flow may be provided over driveway located at or near the crest of vertical curves on the public road where quantity of flow is small, as approved by D.P.M.
 - Tie-in grade of private driveway shall not exceed 14%.


- DRIVEWAY CULVERT REQUIREMENTS**
- Lot 1-5, 9-12 and Parcel 'F', 12" CMP or equivalent
 - Lot 6-8: 15" CMP or equivalent
- Denotes typical private driveway culvert see Grading Plans for location.

FINAL ROAD CONSTRUCTION PLANS

SADDLEBROOK FARM

LOTS 1-12, NON-BUILDABLE PRESERVATION PARCELS 'A'- 'D', NON-BUILDABLE PARCEL 'E' AND BUILDABLE PRESERVATION PARCEL 'F'


HOWARD COUNTY, MARYLAND

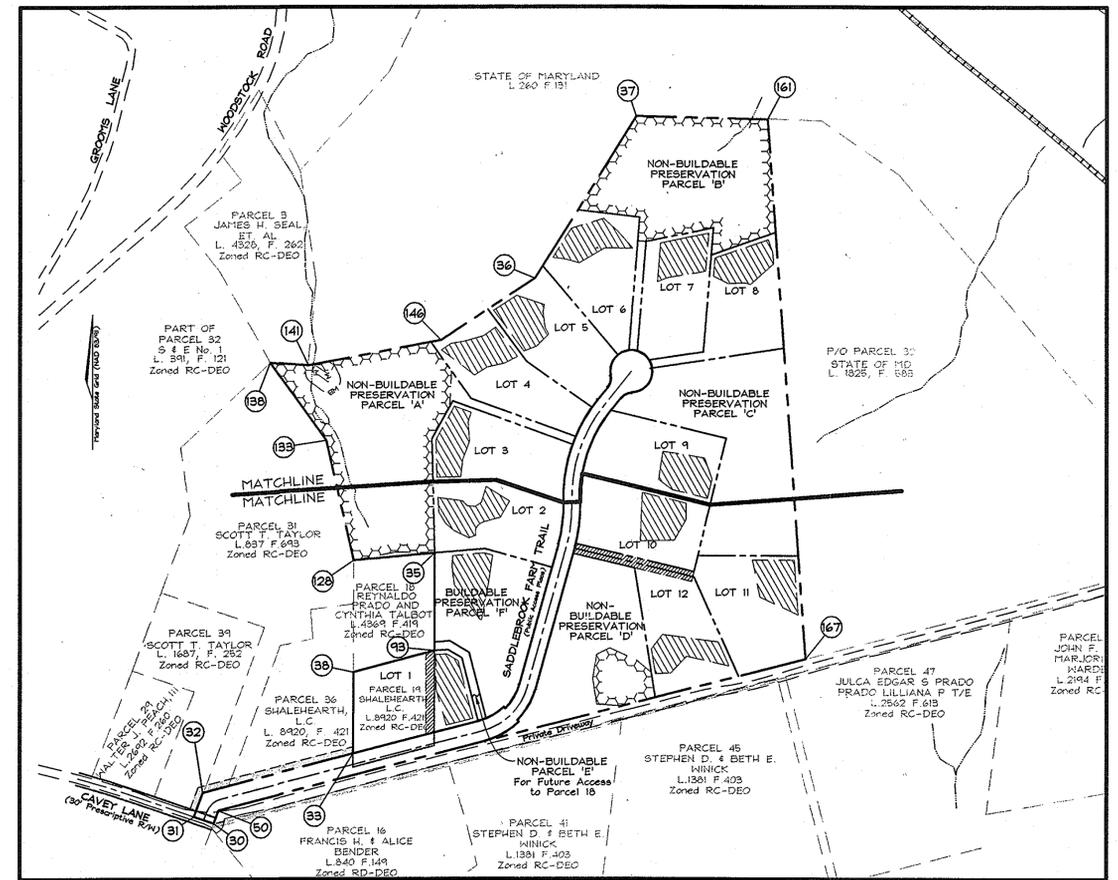

LOCATION MAP
SCALE: 1"=200'

LEGEND

- Existing Contour: Dashed line with elevation (e.g., 382)
- Proposed Contour: Solid line with elevation (e.g., 382)
- Direction of Flow: Arrow
- Existing Spot Elevation: Circle with elevation (e.g., 382.53)
- Proposed Spot Elevation: Square with elevation (e.g., 382.53)
- Existing Trees: Cloud-like symbol
- Proposed Septic Easement: Hatched pattern
- Existing Septic Easement: Dotted pattern
- 15-24.9% Slopes: Diagonal hatching
- 25-50% Slopes: Cross-hatching
- Wetlands: Wavy line pattern
- Use-In-Common Access Easement: Parallel lines
- Existing Dry Well: Circle with 'DW'
- Natural Conservation Stormwater Credit Easement: Stippled pattern
- Forest Conservation Easement: Grid pattern

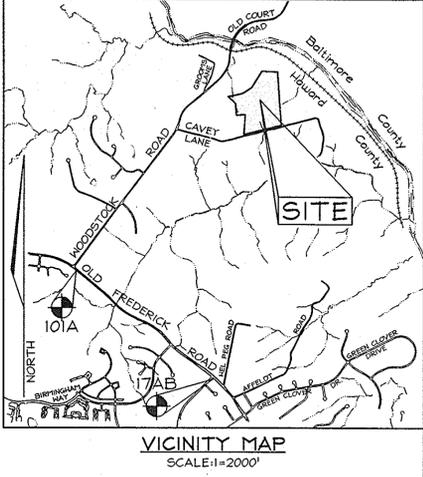

- BENCHMARKS**
- Sta. 101A: South side of Maryland Route 99, 31.5' north of well pipe, 36.4' east of CIP 142. Coordinates: N 183,183.6767 E 410,060.5747 El.: 134.9374 (meters) / N 600,995.112 E 1,345,340.402 El.: 442.707 (feet)
 - Sta. 17AB: Southeast of intersection of Maryland Route 99 and Ketherburn Road, 35' northeast of manhole, 18' northwest of brick well pier. Coordinates: N 182,403.4295 E 411,058.7508 El.: 155.1977 (meters) / N 598,435.251 E 1,348,615.251 El.: 509.178 (feet)

SHEET INDEX

DESCRIPTION	SHEET No.
Cover Sheet	1 of 16
Road Plan and Profile	2 of 16
Road Plan and Profile	3 of 16
Sediment & Erosion Control and Grading Plan	4 of 16
Sediment & Erosion Control and Grading Plan	5 of 16
Sediment & Erosion Control and Miscellaneous Notes & Details	6 of 16
Storm Drain Drainage Area Map	7 of 16
Storm Drain Profiles	8 of 16
Landscape Plan, Notes and Details	9 of 16
Landscape Plan, Notes and Details	10 of 16
Stormwater Management Notes, Details, and Structure Schedule	11 of 16
Stormwater Management Notes and Details	12 of 16
Forest Conservation Notes and Details	13 of 16
Forest Conservation Plan	14 of 16
Forest Conservation Notes and Details	15 of 16
Forest Conservation Notes and Details	16 of 16

CENTERLINE ROAD CURVE DATA

CURVE No.	RADIUS	LENGTH	DELTA	TANGENT	CHORD BEARING	CHORD LENGTH
C1	50.00'	47.78'	54.45/00°	25.84	S 48°12'47.10" W	45.98'
C2	150.00'	157.68'	62°02'00"	86.50	N 45°35'17.01" E	150.00'
C3	350.00'	106.27'	17°23.46"	53.55	N 06°53'24.26" E	106.86'
C4	350.00'	247.23'	40°28'20"	124.03	N 18°25'41.35" E	242.12'

ROAD CLASSIFICATION

ROAD NAME	CLASSIFICATION	R/W
Saddlebrook Farm Trail	Public Access Place	40' & 50'

OWNER/DEVELOPER
Shalehearth, L.C.
6820 Elm Street Suite 200
MC Leon, Virginia 22101
703.734.9730

COVER SHEET
SADDLEBROOK FARM
LOTS 1-12, NON-BUILDABLE PRESERVATION PARCELS 'A'- 'D', NON-BUILDABLE PARCEL 'E' AND BUILDABLE PRESERVATION PARCEL 'F'

Tax Map 11 Grid 13 3rd Election District
Parcels 19 & 32 Howard County, Maryland

APPROVED: HOWARD COUNTY DEPARTMENT OF PLANNING AND ZONING
Candy Hamilton 6/2/06
CHIEF, DIVISION OF LAND DEVELOPMENT DATE

APPROVED: HOWARD COUNTY DEPARTMENT OF PUBLIC WORKS.
William R. Whittall 6-6-06
CHIEF, BUREAU OF HIGHWAYS DATE



C. BROOKE MILLER DATE
PROP. L.S. # 135


ZACHARIY FISCH DATE
P.E. # 22418





FSH Associates
Engineers Planners Surveyors
8318 Forest Street Ellicott City, MD 21043
Tel: 410-750-2251 Fax: 410-750-7350
E-mail: info@fsha.biz

DESIGN BY: PS
DRAWN BY: MY
CHECKED BY: ZYF
SCALE: As Shown
DATE: May 17, 2006
W.O. No.: 3312
SHEET No.: 1 OF 16

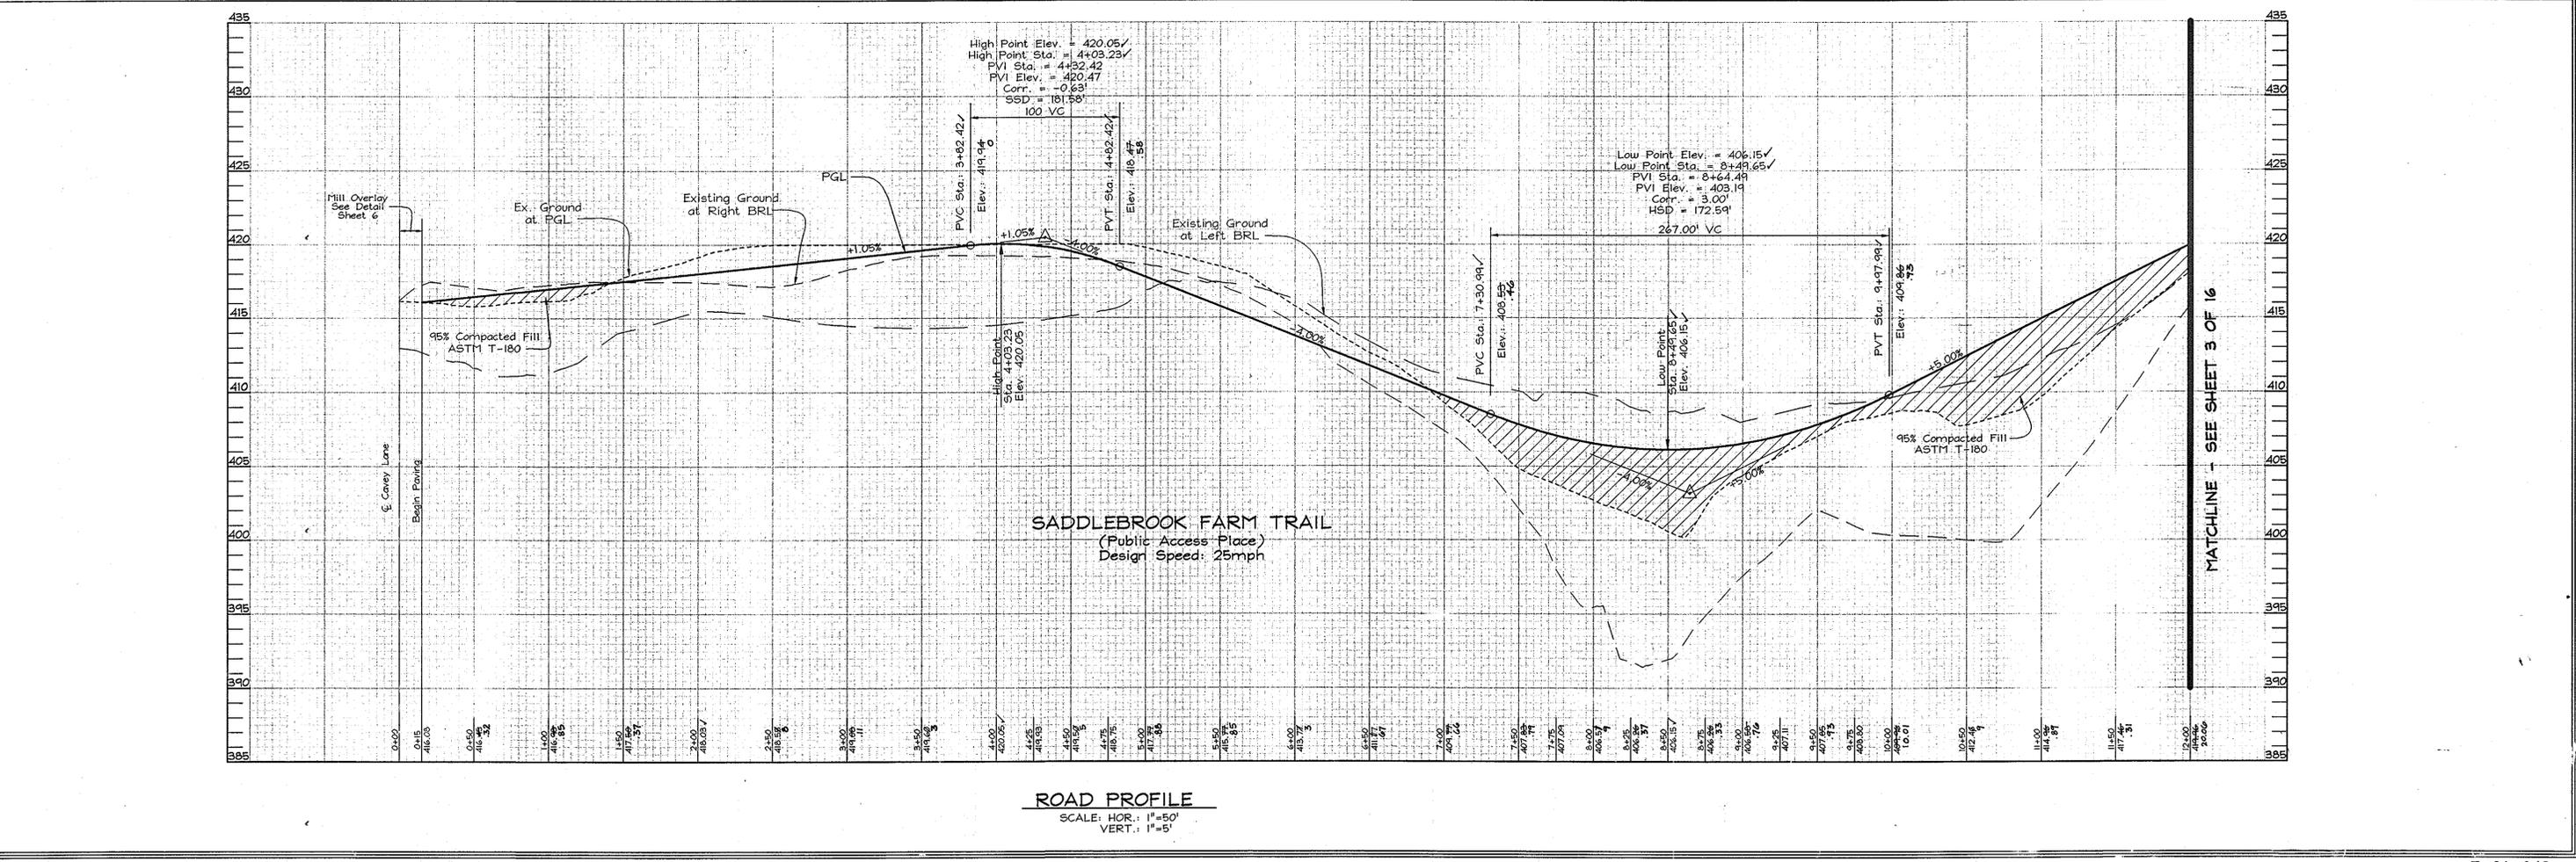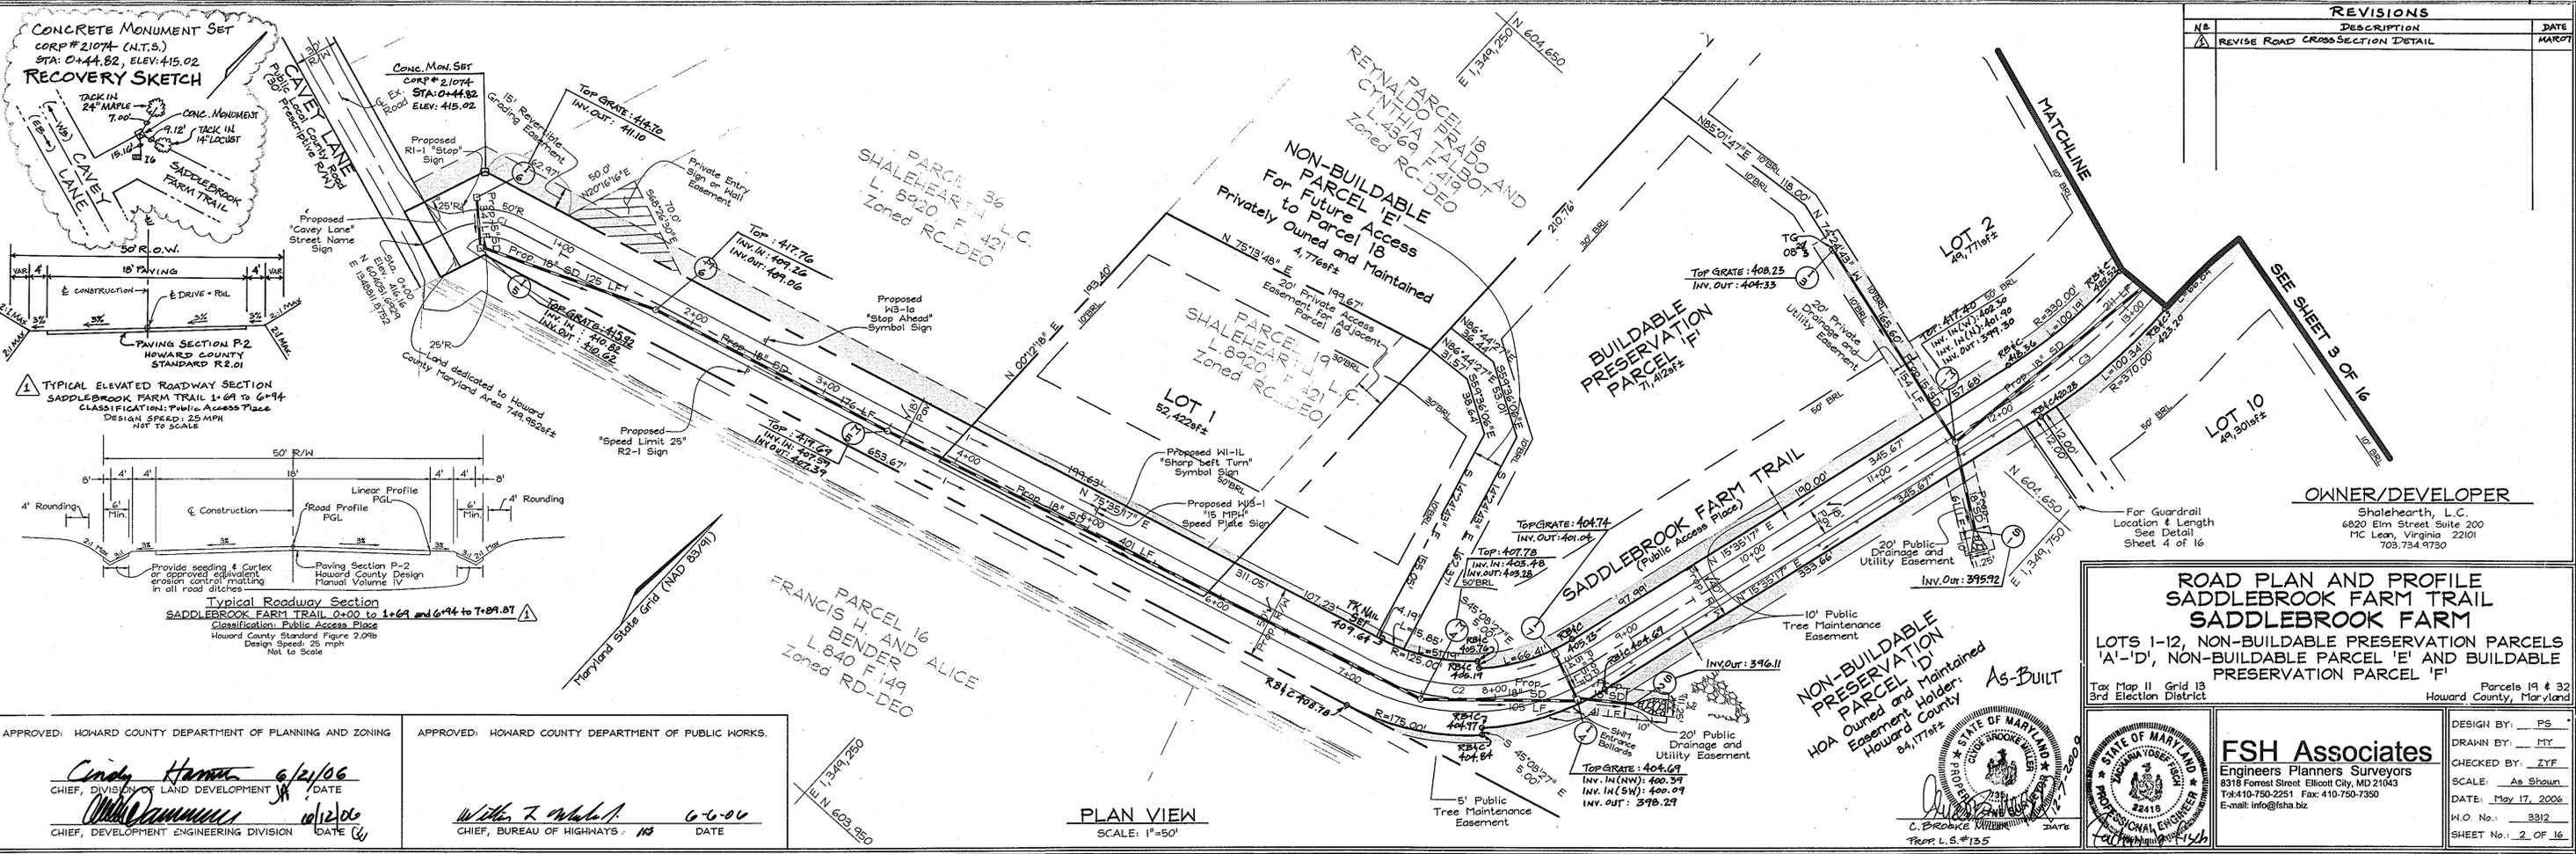

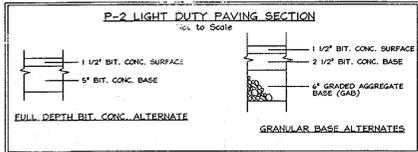

Note:
Paving sections shown relate to a CBR value of 7. Actual CBR test results may cause modification of these paving sections.

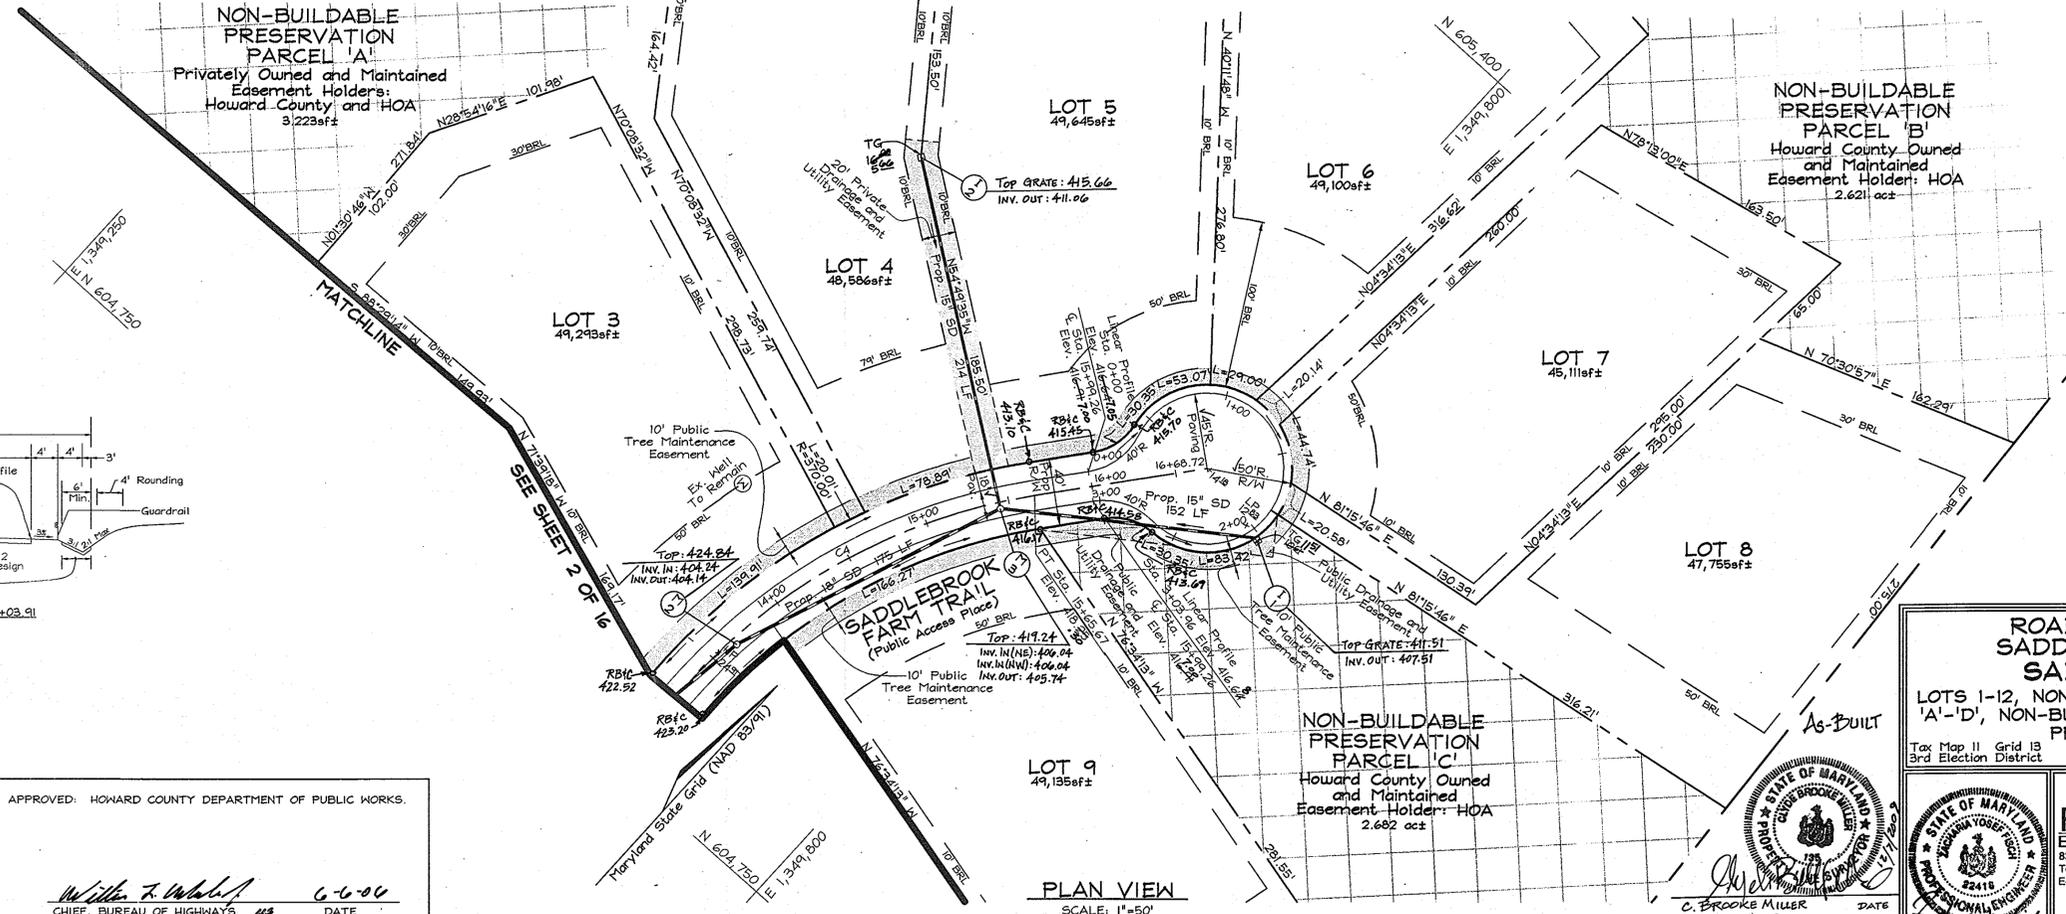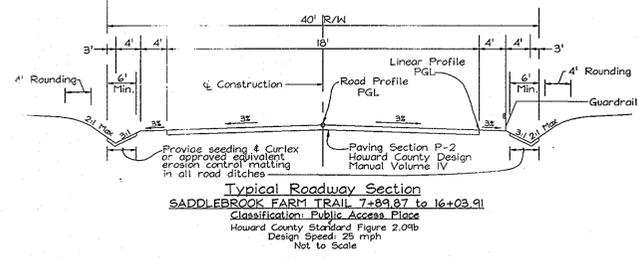

OWNER/DEVELOPER

Shalehearth, L.C.
6820 Elm Street Suite 200
MC Lean, Virginia 22101
703.734.9730

**ROAD PLAN AND PROFILE
SADDLEBROOK FARM TRAIL
SADDLEBROOK FARM**
LOTS 1-12, NON-BUILDABLE PRESERVATION PARCELS 'A'-'D', NON-BUILDABLE PARCEL 'E' AND BUILDABLE PRESERVATION PARCEL 'F'
Tax Map 11 Grid 13
3rd Election District
Parcels 19 & 32
Howard County, Maryland




FSH Associates
Engineers Planners Surveyors
8318 Forrest Street Elliott City, MD 21043
Tel: 410-750-2251 Fax: 410-750-7350
E-mail: info@fsha.biz

DESIGN BY: PS
DRAWN BY: MY
CHECKED BY: ZYF
SCALE: As Shown
DATE: May 17, 2006
W.O. No.: 3312
SHEET No.: 3 OF 16

APPROVED: HOWARD COUNTY DEPARTMENT OF PLANNING AND ZONING
Cindy Hammett 6/21/06
CHIEF, DIVISION OF LAND DEVELOPMENT
William J. ... 6/21/06
CHIEF, DEVELOPMENT ENGINEERING DIVISION


APPROVED: HOWARD COUNTY DEPARTMENT OF PUBLIC WORKS.
William F. ... 6-6-06
CHIEF, BUREAU OF HIGHWAYS

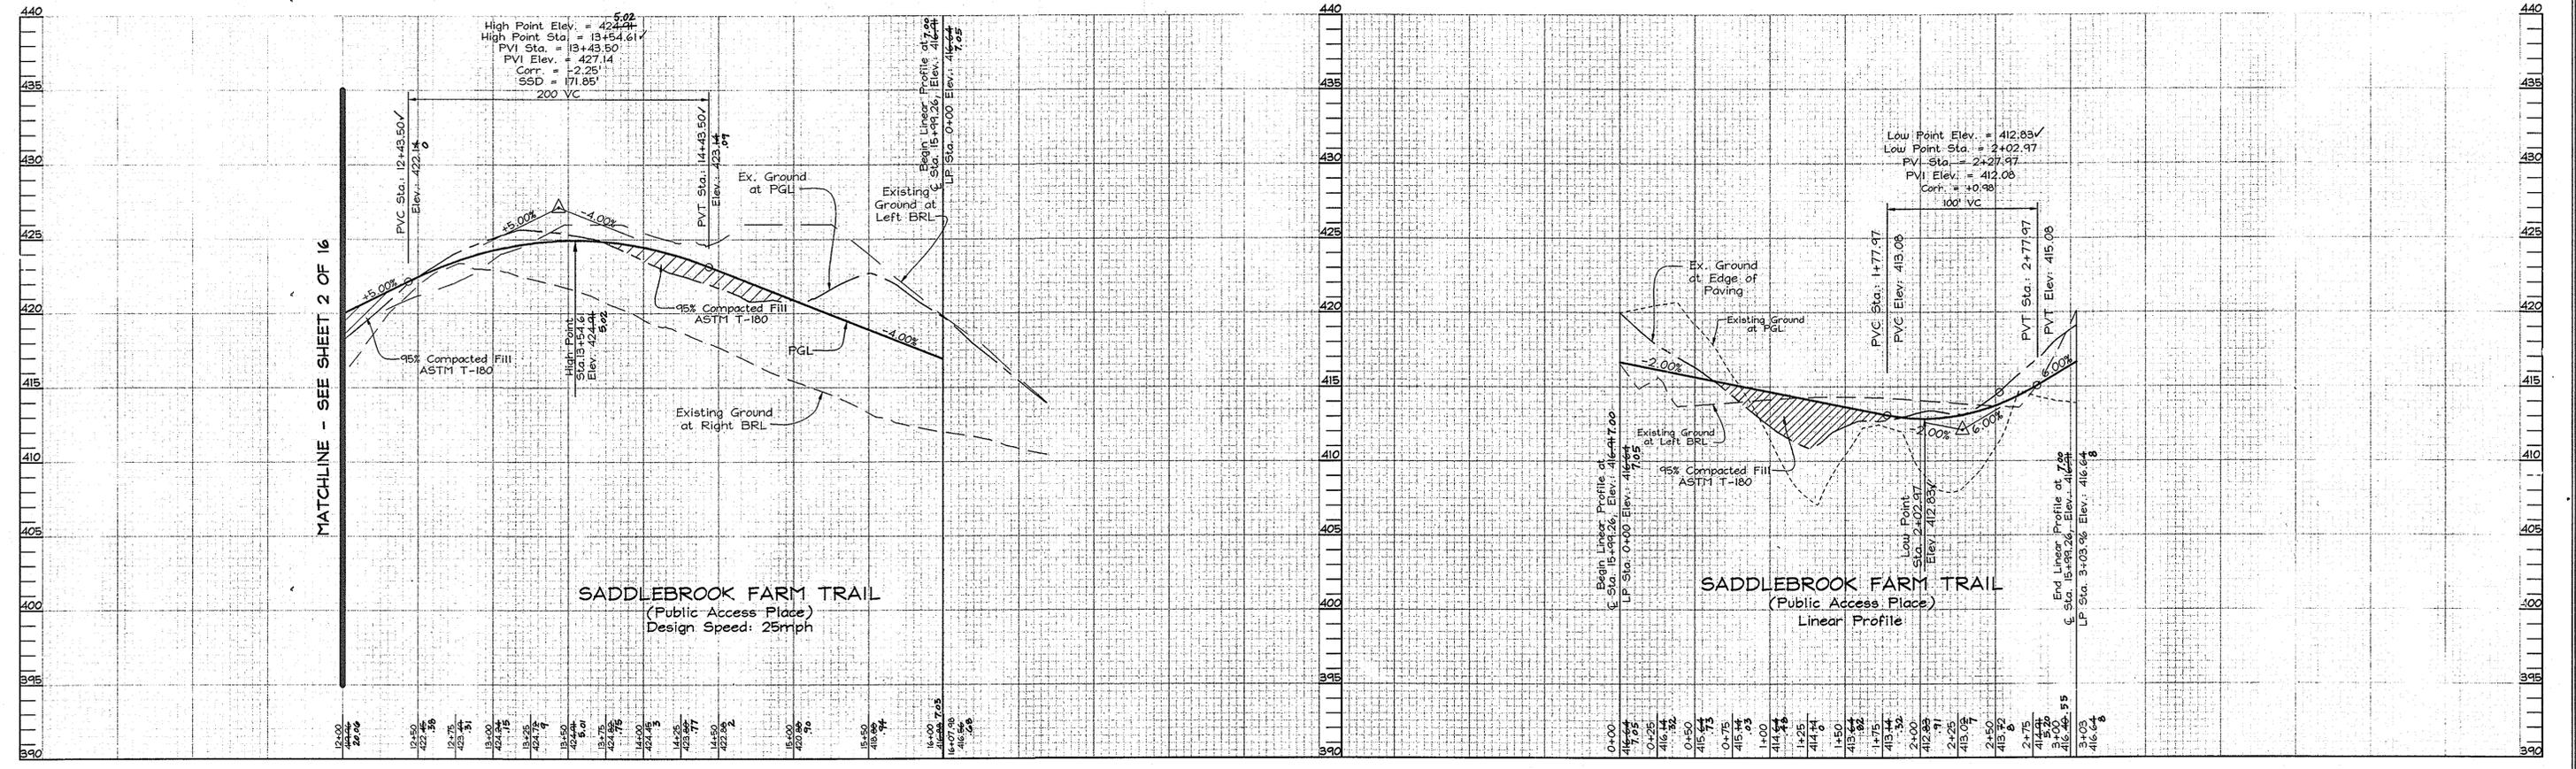


ROAD PROFILE
SCALE: HOR. 1"=50'
VERT. 1"=5'



GUARDRAIL DETAIL
Scale: 1"=50'

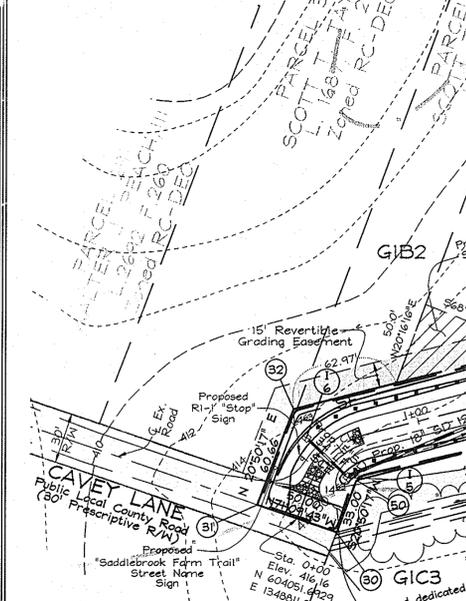

PLAN VIEW
Scale: 1"=50'

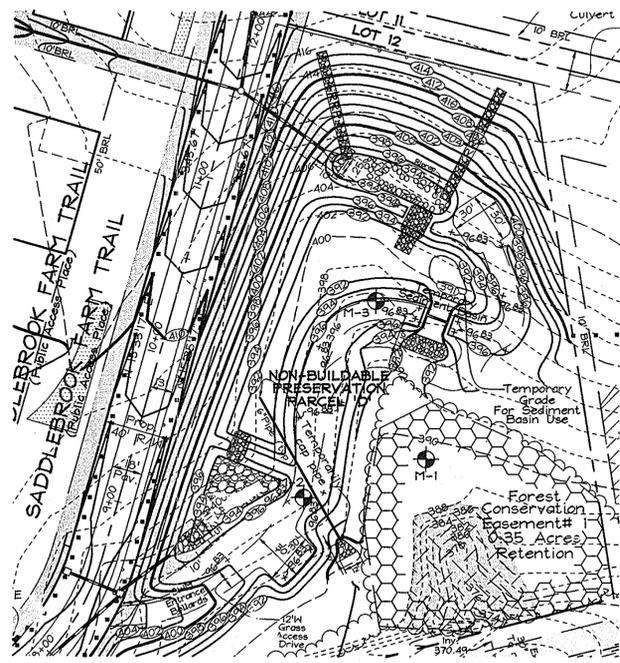

TEMPORARY SEDIMENT BASIN DETAIL
Scale: 1"=50'

LEGEND

- Existing Contour: ---
- Proposed Contour: - - -
- Spot Elevation: +52.52
- Direction of Flow: →
- Tree Protection Fence: [Symbol]
- Existing Trees to Remain: [Symbol]
- Stabilized Construction Entrance: [Symbol]
- Silt Fence: [Symbol]
- Super Silt Fence: [Symbol]
- Earth Dike: [Symbol]
- Limit of Disturbance: [Symbol]
- Erosion Control Matting: [Symbol]
- Rip-Rap Inflow Protection: [Symbol]
- Proposed Level Spreader: [Symbol]

As-BUILT FOR SWM ELEVATIONS
SEE SHEET 15 OF 16

ZACHARIA Y. FISCH
DATE: 12/1/09
P.E. # 22418

OWNER/DEVELOPER
Shalehearth, L.C.
6820 Elm Street Suite 200
MC Lean, Virginia 22101
703.734.9730

SEDIMENT AND EROSION CONTROL AND GRADING PLAN
SADDLEBROOK FARM
LOTS 1-12, NON-BUILDABLE PRESERVATION PARCELS 'A'-'D', NON-BUILDABLE PARCEL 'E' AND BUILDABLE PRESERVATION PARCEL 'F'

Parcel 19 & 32
Howard County, Maryland

FSH Associates
Engineers Planners Surveyors
8318 Forrest Street, Ellicott City, MD 21043
Tel: 410-750-2251 Fax: 410-750-7350
E-mail: info@fsha.biz

DESIGN BY: PS
DRAWN BY: MT
CHECKED BY: ZYF
SCALE: As shown
DATE: May 17, 2006
W.O. No.: 3312
SHEET No.: 4 OF 16

ENGINEERS CERTIFICATE

I, CERTIFY THAT THIS PLAN FOR SEDIMENT AND EROSION CONTROL REPRESENTS A PRACTICAL AND WORKABLE PLAN BASED ON MY PERSONAL KNOWLEDGE OF THE SITE CONDITIONS AND THAT IT WAS PREPARED IN ACCORDANCE WITH THE REQUIREMENTS OF THE HOWARD SOIL CONSERVATION DISTRICT.

Zacharia Y. Fisch 5/19/06
SIGNATURE OF ENGINEER DATE
ZACHARIA Y. FISCH

APPROVED: HOWARD COUNTY DEPARTMENT OF PLANNING AND ZONING
Cinda Hanick 6/2/06
CHIEF, DIVISION OF LAND DEVELOPMENT DATE

APPROVED: HOWARD COUNTY DEPARTMENT OF PUBLIC WORKS
William F. ... 6-6-06
CHIEF, BUREAU OF HIGHWAYS DATE

TEMPORARY SEDIMENT BASIN SCHEDULE

TRAP NUMBER	TYPE	Basin*
1	D.A.	2.8 Ac.
Storage Required	5040 cfd	5040 cfd
Storage Provided	16858 cfd	8091 cfd
Weir Length	12.0 ft.	
Top Embankment Elev.	396.33	
Bottom Trap Elev.	391.0	
Weir Crest Elev.	395.0	
Clean Out Elev.	390.0	
1 Yr. MS elev.	394.5	
1 Yr. Q out	0.11 cfs	
10 Yr. MS elev.	395.26	
10 Yr. Q out	9.64 cfs	

* Proposed SWM Facility is being utilized as a sediment basin for sediment control.

REVISIONS

NO.	REVISION	DATE
1	REVISE ROAD CROSSSECTION AND GRADING	MAR2007

DEVELOPER'S CERTIFICATE

I, WE CERTIFY THAT ALL DEVELOPMENT AND CONSTRUCTION WILL BE DONE ACCORDING TO THIS PLAN FOR SEDIMENT AND EROSION CONTROL AND THAT ALL RESPONSIBLE PERSONNEL INVOLVED IN THE CONSTRUCTION PROJECT WILL HAVE A CERTIFICATE OF ATTENDANCE AT A DEPARTMENT OF THE ENVIRONMENT APPROVED TRAINING PROGRAM FOR THE CONTROL OF SEDIMENT AND EROSION BEFORE BEGINNING THE PROJECT. I ALSO AUTHORIZE PERIODIC ON-SITE INSPECTION BY THE HOWARD SOIL CONSERVATION DISTRICT.

Zacharia Y. Fisch 5/18/06
SIGNATURE OF DEVELOPER DATE

Maryland State Grid (NAD 83/91)



Note:
Level Spreaders located on Lots 6-9 and associated grading are to be constructed at the Plot Plan stage.

OWNER/DEVELOPER
Shalehearth, L.C.
6820 Elm Street Suite 200
MC Lean, Virginia 22101
703.734.4730

SEDIMENT AND EROSION CONTROL AND GRADING PLAN
SADDLEBROOK FARM
LOTS 1-12, NON-BUILDABLE PRESERVATION PARCELS 'A'-D', NON-BUILDABLE PARCEL 'E' AND BUILDABLE PRESERVATION PARCEL 'F'
Tax Map II Grid 13 3rd Election District. Parcels 19 & 32 Howard County, Maryland

APPROVED: HOWARD COUNTY DEPARTMENT OF PLANNING AND ZONING
Cindy Hamilton 6/2/06
CHIEF, DIVISION OF LAND DEVELOPMENT JK DATE

APPROVED: HOWARD COUNTY DEPARTMENT OF PUBLIC WORKS
William R. White 6-6-06
CHIEF, BUREAU OF HIGHWAYS MS DATE

DEVELOPER'S CERTIFICATE
I/WE CERTIFY THAT ALL DEVELOPMENT AND CONSTRUCTION WILL BE DONE ACCORDING TO THIS PLAN FOR SEDIMENT AND EROSION CONTROL, AND THAT ALL RESPONSIBLE PERSONNEL INVOLVED IN THE CONSTRUCTION PROJECT WILL HAVE A CERTIFICATE OF ATTENDANCE AT A DEPARTMENT OF THE ENVIRONMENT APPROVED TRAINING PROGRAM FOR THE CONTROL OF SEDIMENT AND EROSION BEFORE BEGINNING THE PROJECT. I ALSO AUTHORIZE PERIODIC ON-SITE INSPECTION BY THE HOWARD SOIL CONSERVATION DISTRICT.
[Signature] 5/18/06
SIGNATURE OF DEVELOPER DATE

ENGINEER'S CERTIFICATE
I CERTIFY THAT THIS PLAN FOR SEDIMENT AND EROSION CONTROL REPRESENTS A PRACTICAL AND WORKABLE PLAN BASED ON MY PERSONAL KNOWLEDGE OF THE SITE CONDITIONS AND THAT IT WAS PREPARED IN ACCORDANCE WITH THE REQUIREMENTS OF THE HOWARD SOIL CONSERVATION DISTRICT.
Zacharia Y. Fisch 5/19/06
SIGNATURE OF ENGINEER DATE
ZACHARIA Y. FISCH

THESE PLANS HAVE BEEN REVIEWED FOR HOWARD SOIL CONSERVATION DISTRICT AND MEET THE TECHNICAL REQUIREMENTS FOR SOIL EROSION AND SEDIMENT CONTROL.
[Signature] 6/1/06
DATE
NATURAL RESOURCES CONSERVATION SERVICE
THESE PLANS FOR SOIL EROSION AND SEDIMENT CONTROL MEET THE REQUIREMENTS OF THE HOWARD SOIL CONSERVATION DISTRICT.
[Signature] 6/1/06
DATE
HOWARD SOIL CONSERVATION DISTRICT



FSH Associates
Engineers Planners Surveyors
8318 Forest Street Ellicott City, MD 21043
Tel: 410-750-2251 Fax: 410-750-7350
Email: info@fsh.biz

DESIGN BY: PS
DRAWN BY: MY
CHECKED BY: ZYF
SCALE: 1"=50'
DATE: May 17, 2006
W.O. No.: 3312
SHEET No.: 5 OF 16

21.0 STANDARDS AND SPECIFICATIONS FOR TOPSOIL

Definition
Placement of topsoil over a prepared subsoil prior to establishment of permanent vegetation.

PURPOSE
To provide a suitable soil medium for vegetation growth. Soils of concern have low moisture content, low nutrient levels, low pH, moderate to high salinity, and/or excessive soil erosion.

Conditions Where Practice Applies
1. This practice is limited to areas having 21 or flatter slopes where:
a. The texture of the exposed subsoil/parent material is not adequate to produce vegetative growth.
b. The soil material is so shallow that the rooting zone is not deep enough to support plants or furnish continuing supplies of moisture and plant nutrients.
c. The original soil to be vegetated contains material toxic to plant growth.
d. The soil is so acidic that treatment with limestone is not feasible.

2. For the purpose of these Standards on Specifications, areas having slopes steeper than 2:1 require special consideration and design for adequate stabilization. Areas having slopes steeper than 2:1 shall have the appropriate stabilization shown on the plans.

Construction and Material Specifications
I. Topsoil salvaged from the existing site may be used provided that it meets the standards as set forth in these specifications. Typically, the depth of topsoil to be salvaged for a given soil type can be found in the representative soil profile shown in the Soil Survey published by USDA-SCS in cooperation with Maryland Agricultural Experiment Station.
II. Topsoil Specifications - Soil to be used on topsoil must meet the following:
1. Topsoil shall be a loam, sandy loam, clay loam, or silty loam soil. Other soils may be used if recommended by an agronomist or a soil scientist and approved by the appropriate authority. Regardless, topsoil shall not be a mixture of contrasting textures and shall contain no clumps of weeds, stones, cinders, stones, slag, coarse fragments, gravel, sticky roots, twigs, or other materials larger than 1/2" in diameter.
2. Topsoil must be free of plants or plant parts such as Bermuda grass, quackgrass, nutgrass, johns, thistle, or others as specified.
3. Where the subsoil is either highly acidic or composed of heavy clay, ground limestone shall be spread at the rate of 4-6 tons/acre (200-600 pounds per 1,000 square feet) prior to the placement of topsoil. Limestone shall be distributed uniformly over designated areas and worked into the soil in conjunction with tillage operations as described in the following procedures.
II. For sites having disturbed areas under 5 acres:
1. Place topsoil (if required) and apply soil amendments as specified in 20.0 Vegetative Stabilization - Section 1 - Vegetative Stabilization Methods and Materials.

SEDIMENT CONTROL NOTES

- A minimum of 48 hours notice must be given to the Howard County Department of Inspection, Licenses and Permits Sediment Control Division prior to the start of any construction (519-855).
- All vegetation and structural practices are to be installed according to the provisions of this plan and are to be in conformance with the 1994 MARYLAND STANDARDS AND SPECIFICATIONS FOR SOIL EROSION AND SEDIMENT CONTROL, and revisions thereto.
- Following initial soil disturbance or redistribution, permanent or temporary stabilization shall be completed within: (a) 7 calendar days for all perimeter sediment control structures, dikes, perimeter slopes, and all slopes greater than 3:1, (b) 14 days to all other disturbed or graded areas on the project site.
- All sediment traps/basins shown must be fenced and warning signs posted around their perimeter in accordance with Vol. 1, Chapter 7, HOWARD COUNTY DESIGN MANUAL, Storm Drainage.
- All disturbed areas must be stabilized within the time period specified above in accordance with the 1994 MARYLAND STANDARDS AND SPECIFICATIONS FOR SOIL EROSION AND SEDIMENT CONTROL for permanent seeding, sod, temporary seeding, and mulching (Sec. G). Temporary stabilization with mulch alone shall be done when recommended seeding dates do not allow for proper germination and establishment of grasses.
- All sediment control structures are to remain in place and are to be maintained in operative condition until permission for their removal has been obtained from the Howard County Sediment Control Inspector.
- Site Analysis:
Total Area: 27,869 Acres.
Area Disturbed: 4,833 Acres.
Area to be roofed or paved: 1,856 Acres.
Area to be vegetatively stabilized: 3,043 Acres.
Total Fill: 5,000 CY.
Off-site waste/borrow area location: #2
- Any sediment control practice which is disturbed by grading activity for placement of utilities must be repaired on the same day of disturbance.
- Additional sediment controls must be provided, if deemed necessary by the Howard County Sediment Control Inspector.
- On all sites with disturbed areas in excess of 2 acres, approval of the inspection agency shall be requested upon completion of installation of perimeter erosion and sediment controls, but before proceeding with any other earth disturbance or grading. Other building or grading inspection approvals may not be authorized until this initial approval by the inspection agency is made.
- Trenches for the construction of utilities is limited to three pipe lengths or that which shall be back-filled and stabilized within one working day, whichever is shorter.
- Earthwork quantities are solely for the purpose of calculating fees. Contractor to verify all quantities prior to the start of construction.
- To be determined by contractor, with pre-approval of the Sediment Control Inspector with an approved and active grading permit.

SEQUENCE OF CONSTRUCTION

- Obtain grading permit and contact Howard County Sediment Control Inspector (SCI) to arrange a pre-construction meeting. (1 day)
- Install Stabilized Construction Entrance. (1 day)
- Clear and grub as necessary for installation of silt fence, super silt fence and sediment basin. (5 days)
- Install tree protection fence, silt fence/super silt fence, and install the stormwater management facility to be used as a sediment basin. Do not install the sand filter and drain pipes at this time. Install only the 6" PVC outflow pipe STA 0+14.67, 1+06 and cap both ends. Install forays and outlet structure with permanent trash rack to be covered with class #1 filter fabric. (3 weeks)
Note that all level spreaders and grass swales for lot no.1 to be installed under separate grading permit for lots.
- With permission of SCI, grade roads to subgrade. (3 weeks)
- Install storm drain system block 1-1, 1-2, and 1-3. (2 weeks)
- Final grade roads and complete paving and final vegetative stabilization. Storm drains to remain open to convey runoff to Sediment/Stormwater management basins, except inlets 1-1, 1-2, and 1-3 to be blocked. (1 week)
- With permission of SCI remove all sediment controls and apply permanent stabilization to those areas. (5 days)
- With permission of SCI, grade for and immediately stabilize all grass channels with ECM and permanent seeding. (3 days)
- Flush storm drains of sediment unblock 1-1, 1-2, and 1-3. Convert sediment/stormwater basin to permanent SWM by desilting, removing accumulated sediment, removing filter fabric on trash rack, grading bottom to permanent elevation shown and applying permanent seeding and mulching to disturbed areas. (1 week).

PERMANENT SEEDING NOTES

APPLY TO GRADED OR CLEARED AREAS NOT SUBJECT TO IMMEDIATE FURTHER DISTURBANCE WHERE A PERMANENT LONG-LIVED VEGETATIVE COVER IS NEEDED.

SEEDBED PREPARATION: Loosen upper three inches of soil by rolling, discing or other acceptable means before seeding, if not previously loosened.

SOIL AMENDMENTS: In lieu of soil test recommendations, use the following schedule: Apply 2 tons per acre of dolomitic limestone (85 lbs/1000 sq ft.) And 500 lbs./acre (20.7 lbs/1000 sq ft.) of 10-20-20 before seeding. Narrow or disc into upper 3 in. of soil.

SEEDING: Apply a mixture of Turf Type Tall Fescue (80%) and Hard Fescue (20%) in accordance with seeding dates and rates shown in the Temporary Seeding Summary shown on this sheet. For stabilization outside of the seeding dates, apply straw mulch at rates and methods specified below and apply permanent seeding within proper seeding dates.

MULCHING: Immediately following seeding, apply a uniform 1-2 in. Deep layer of untreated small grain straw at a rate of 2 tons/acre. (Apply 2.5 Tons/acre if a mulch anchoring tool is used).
Straw may be anchored with wood cellulose fiber at a rate of 50 lbs./acre mixed at a ratio of 50 lbs. Of wood fiber/100 gal. of water. Synthetic liquid binders such as Terra Tex II, Acrylic DLR (Agron. Tech), DCA-70, Petrosol and other approved equiva may be used at rates recommended by the manufacturers.

Seed Mixture (Hardiness Zone 7a and 6b)	Application Rate (lb/acre)	Seeding Dates	Seeding Depth	Fertilizer Rate (lb/1000 sq ft.)	Lime Rate (lb/1000 sq ft.)
Tall Fescue (80%)	120	3/1-5/15	0.5 in.	20 lbs/1000	750 lbs/1000
Hard Fescue (20%)	30	3/15-11/15	0.5 in.	12 lbs/1000	1000 lbs/1000

TEMPORARY SEEDING NOTES

SEEDBED PREPARATION: Loosen upper three inches of soil by rolling, discing or other acceptable means before seeding, if not previously loosened.


SOIL AMENDMENTS: In lieu of soil test recommendations, use the following schedule: Apply 2 tons per acre dolomitic limestone (85 lbs/1000 sq ft.) And 500 lbs./acre (lb/1000 sq ft.) of 10-20-20 before seeding. Narrow or disc into upper 3 in. of soil.

SEEDING: Apply the Maryland State Highway approved seed mixture of Barley or Rye plus Fertilizer Filled in accordance with seeding dates and rates shown in the Temporary Seeding Summary shown on this sheet. For stabilization outside of the seeding dates, apply straw mulch at rates and methods specified below.

MULCHING: Immediately following seeding, apply a uniform 1-2 in. Deep layer of untreated small grain straw at a rate of 2 tons/acre. (Apply 2.5 Tons/acre if a mulch anchoring tool is used).
Straw may be anchored with wood cellulose fiber at a rate of 50 lbs./acre mixed at a ratio of 50 lbs. Of wood fiber/100 gal. of water. Synthetic liquid binders such as Terra Tex II, Acrylic DLR (Agron. Tech), DCA-70, Petrosol and other approved equiva may be used at rates recommended by the manufacturers.

REFER TO THE 1994 MARYLAND STANDARDS AND SPECIFICATIONS FOR SOIL EROSION AND SEDIMENT CONTROL FOR RATE AND METHODS NOT COVERED.


Seed Mixture (Hardiness Zone 6a and 6b)	Application Rate (lb/acre)	Seeding Dates	Seeding Depth	Fertilizer Rate (lb/1000 sq ft.)	Lime Rate (lb/1000 sq ft.)
Barley or Rye plus Fertilizer Filled	150 lbs (3.5 tons/1000sq ft)	2/1-11/30 (7a)	1/2 in.	400 lb/acre	2 tons/acre
		3/15-10/31 (6a)	1/2 in.	750 lbs/1000sq ft	1000 lbs/1000sq ft

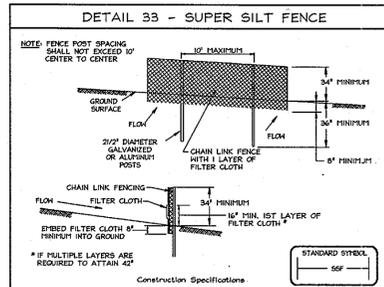

Construction Specifications

- Fencing shall be 42" in height and constructed in accordance with the latest Maryland State Highway Details for Chain Link Fencing. The specification for a 6' fence shall be used, substituting 42" fabric and 6' length posts.
- Chain link fence shall be fastened securely to the fence posts with wire ties. The lower tension wire, knox and truss rods, drive anchors and post caps are not required except on the ends of the fence.
- Filter cloth shall be fastened securely to the chain link fence with ties spaced every 24" at the top and mid section.
- Filter cloth shall be embedded a minimum of 6" into the ground.
- When two sections of filter cloth adjoin each other, they shall be overlapped by 6" and folded.
- Maintenance shall be performed as needed and all bulges removed when "bulges" develop in the silt fence, or when all reaches 50% of fence height.
- Filter cloth shall be fastened securely to each fence post with wire ties or staples at top and mid section and shall meet the following requirements for Geotextile Class F:
Tensile Strength: 50 lbs/in (min.) Test: FHST 504
Tensile Modulus: 20 lbs/in (min.) Test: FHST 504
Flow Rate: 0.3 gal/ft/minute (max.) Test: FHST 322
Filtering Efficiency: 70% (min.) Test: FHST 322


U.S. DEPARTMENT OF AGRICULTURE, SOIL CONSERVATION SERVICE, PAGE 1-8-3, MARYLAND DEPARTMENT OF ENVIRONMENT, WATER MANAGEMENT ADMINISTRATION

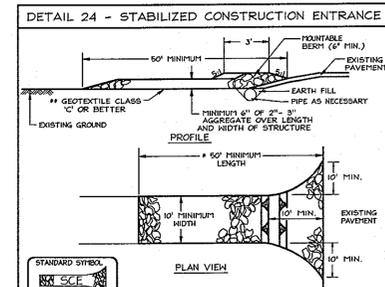

Construction Specifications

- Length - minimum of 50' (4' 30" for a single entrance width).
- Width - 10' minimum, shall be flared at the existing road to provide a turning radius.
- Geotextile fabric (filter cloth) shall be placed over the existing ground prior to placing stone. If the plan approval authority may not require stone, family residence to use geotextile.
- Stone - crushed aggregate (2" to 3") or rounded or recycled concrete equivalent shall be placed at least 6" deep over the length and width of the entrance.
- Surface Water - all surface water flowing to or diverted toward construction entrances shall be piped through the entrance, maintaining positive drainage. Pipe installed through the stabilized construction entrance shall be protected with a manhole with 5:1 slopes and a minimum of 6" of stone over the pipe. Pipe has to be sized according to the drainage. When the SCE is located at a high spot and has no drainage to convey, a pipe will not be necessary, pipe should be sized according to the amount of runoff to be conveyed. A 6" minimum will be required.
- Location - a stabilized construction entrance shall be located at every point where construction traffic enters or leaves a construction site. Vehicles leaving the site must travel over the entire length of the stabilized construction entrance.

U.S. DEPARTMENT OF AGRICULTURE, SOIL CONSERVATION SERVICE, PAGE 1-8-3, MARYLAND DEPARTMENT OF ENVIRONMENT, WATER MANAGEMENT ADMINISTRATION

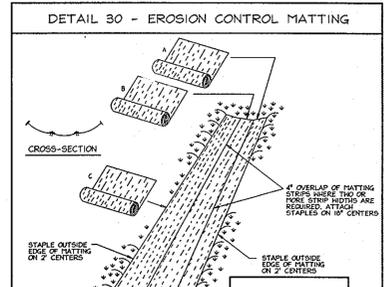


Construction Specifications

- Install in the matting by placing the top edge of the matting in a narrow trench, 6" in depth. Backfill the trench and tamp firmly to conform to the channel cross-section. Secure with a row of staples about 4" down slope from the trench. Spacing between staples is 6".
- Staple the 4" overlap in the channel center using an 18" spacing between staples.
- Before stapling the outer edges of the matting, make sure the matting is smooth and in firm contact with the soil.
- Staples shall be placed 2' apart with 4 rows for each strip, 2 outer rows, and 2 alternating rows down the center of the strip.
- Where one roll of matting ends and another begins, the end of the top strip shall overlap the upper end of the lower strip by 4", staple fashion. Reinforce the overlap with a double row of staples spaced 6" apart in a staggered pattern on either side.
- The discharge end of the matting liner should be similarly secured with 2 double rows of staples.

Note: If flow will enter from the edge of the matting then the area affected by the flow must be keyed-in.


U.S. DEPARTMENT OF AGRICULTURE, SOIL CONSERVATION SERVICE, PAGE 1-8-3, MARYLAND DEPARTMENT OF ENVIRONMENT, WATER MANAGEMENT ADMINISTRATION

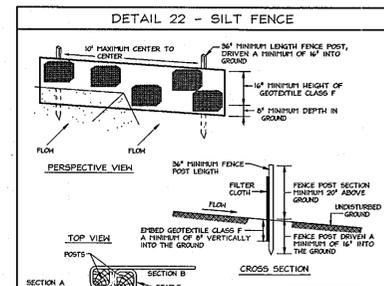

Construction Specifications

- Fence posts shall be a minimum of 36" long, driven 18" minimum into the ground. Posts shall be 1 1/2" x 1 1/2" square (minimum) and 1/2" diameter (maximum) round and shall be of wood quality hardwood. Steel posts will be permitted if 1/2" section welding not less than 100 pound per inch test.
- Geotextile shall be fastened securely to each fence post with wire ties or staples at top and mid-section and shall meet the following requirements for Geotextile Class F:
Tensile Strength: 50 lbs/in (min.) Test: FHST 504
Tensile Modulus: 20 lbs/in (min.) Test: FHST 504
Flow Rate: 0.3 gal/ft/minute (max.) Test: FHST 322
Filtering Efficiency: 70% (min.) Test: FHST 322
- Where ends of geotextile fabric come together, they shall be overlapped, folded and stapled to prevent sediment bypass.
- Silt fence shall be inspected after each rainfall event, and maintained when bulges occur or when sediment accumulation reaches 50% of the fabric height.

U.S. DEPARTMENT OF AGRICULTURE, SOIL CONSERVATION SERVICE, PAGE 1-8-3, MARYLAND DEPARTMENT OF ENVIRONMENT, WATER MANAGEMENT ADMINISTRATION

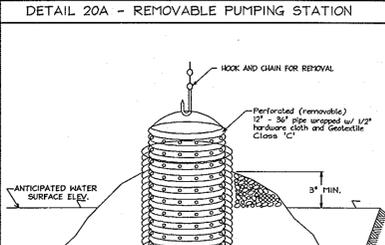

Construction Specifications

- The outer pipe should be 48" dia. or shall, in any case, be at least 4" greater in diameter than the center pipe. The outer pipe shall be wrapped with 12" hardware cloth to prevent backfill material from entering the perforations.
- After installing the outer pipes, backfill around outer pipe with 2" aggregate or clean gravel.
- The inside center pipe (center pipe) should be constructed by perforating a corrugated PVC pipe between 12" and 36" in diameter. The perforations shall be 1/2" x 6" slots or 1" diameter holes 6" on center. The center pipe shall be wrapped with 1/2" hardware cloth first, then wrapped again with Geotextile Class C.
- The center pipe should extend 12" to 18" above the anticipated water surface elevation or riser crest elevation when dewatering a basin.

U.S. DEPARTMENT OF AGRICULTURE, SOIL CONSERVATION SERVICE, PAGE 1-8-4, MARYLAND DEPARTMENT OF ENVIRONMENT, WATER MANAGEMENT ADMINISTRATION

OWNER/DEVELOPER

Shalehearth, L.C.
6820 Elm Street Suite 200
MC Lean, Virginia 22101
703.734.9730

SEDIMENT & EROSION CONTROL AND MISCELLANEOUS NOTES & DETAILS SADDLEBROOK FARM
LOTS 1-12, NON-BUILDABLE PRESERVATION PARCELS 'A'-D', NON-BUILDABLE PARCEL 'E' AND BUILDABLE PRESERVATION PARCEL 'F'

Tax Map II Grid 13 3rd Election District Parcel: 19 & 32 Howard County, Maryland



FSH Associates
Engineers Planners Surveyors
8318 Forrest Street Ellicott City, MD 21043
Tel: 410-750-2251 Fax: 410-750-7350
E-mail: info@fsha.biz

DESIGN BY: PS
DRAWN BY: ITY
CHECKED BY: ZYF
SCALE: As Shown
DATE: May 17, 2006
W.O. No.: 3312
SHEET No.: 6 OF 16

APPROVED: HOWARD COUNTY DEPARTMENT OF PLANNING AND ZONING
Cindy Hammit 6/14/06
CHIEF, DIVISION OF LAND DEVELOPMENT DATE

APPROVED: HOWARD COUNTY DEPARTMENT OF PLANNING AND ZONING
John R. Blanton 6/14/06
CHIEF, DEVELOPMENT ENGINEERING DIVISION DATE


APPROVED: HOWARD COUNTY DEPARTMENT OF PUBLIC WORKS.
William F. Mahan 6-6-06
CHIEF, BUREAU OF HIGHWAYS DATE

DEVELOPER'S CERTIFICATE
I/WE CERTIFY THAT ALL DEVELOPMENT AND CONSTRUCTION WILL BE DONE ACCORDING TO THIS PLAN FOR SEDIMENT AND EROSION CONTROL, AND THAT ALL RESPONSIBLE PERSONNEL INVOLVED IN THE CONSTRUCTION PROJECT WILL HAVE A CERTIFICATE OF ATTENDANCE AT A DEPARTMENT OF THE ENVIRONMENT APPROVED TRAINING PROGRAM FOR THE CONTROL OF SEDIMENT AND EROSION BEFORE BEGINNING THE PROJECT. I ALSO AUTHORIZE PERIODIC ON-SITE INSPECTION BY THE HOWARD SOIL CONSERVATION DISTRICT.
John R. Blanton 6/14/06
SIGNATURE OF DEVELOPER DATE

ENGINEERS CERTIFICATE
I CERTIFY THAT THIS PLAN FOR SEDIMENT AND EROSION CONTROL REPRESENTS A PRACTICAL AND WORKABLE PLAN BASED ON MY PERSONAL KNOWLEDGE OF THE SITE CONDITIONS AND THAT IT WAS PREPARED IN ACCORDANCE WITH THE REQUIREMENTS OF THE HOWARD SOIL CONSERVATION DISTRICT.
Zacharia Y. Fisch 6/14/06
SIGNATURE OF ENGINEER DATE
HOWARD SOIL CONSERVATION DISTRICT

THESE PLANS HAVE BEEN REVIEWED FOR HOWARD SOIL CONSERVATION DISTRICT AND MEET THE TECHNICAL REQUIREMENTS FOR SOIL EROSION AND SEDIMENT CONTROL.
John R. Blanton 6/14/06
DATE
HOWARD SOIL CONSERVATION DISTRICT

SYMBOL	NAME / DESCRIPTION	SOIL GROUP
Ba	Bale silt loam	D
BrC2	Brandywine loam, 8 to 15 percent slopes, moderately eroded	C
BrC3	Brandywine loam, 8 to 15 percent slopes, severely eroded	C
BrD2	Brandywine loam, 15 to 25 percent slopes, moderately eroded	C
BrF	Brandywine loam, 25 to 60 percent slopes	C
GIB2	Glennig loam, 3 to 8 percent slopes, moderately eroded	B
GIC2	Glennig loam, 8 to 15 percent slopes, moderately eroded	B
GIC3	Glennig loam, 8 to 15 percent slopes, severely eroded	B
GnB2	Glennville silt loam, 3 to 8 percent slopes, moderately eroded	B
MIc2	Manor gravelly loam, 8 to 15 percent slopes, moderately eroded	B
MIc3	Manor gravelly loam, 8 to 15 percent slopes, severely eroded	B
MIb2	Manor loam, 3 to 8 percent slopes, moderately eroded	B
MIc2	Manor loam, 8 to 15 percent slopes, moderately eroded	B
MIc3	Manor loam, 8 to 15 percent slopes, severely eroded	B
MIb2	Manor loam, 15 to 25 percent slopes, moderately eroded	B
MIb3	Manor loam, 15 to 25 percent slopes, severely eroded	B
MIe	Manor loam, 25 to 45 percent slopes	B

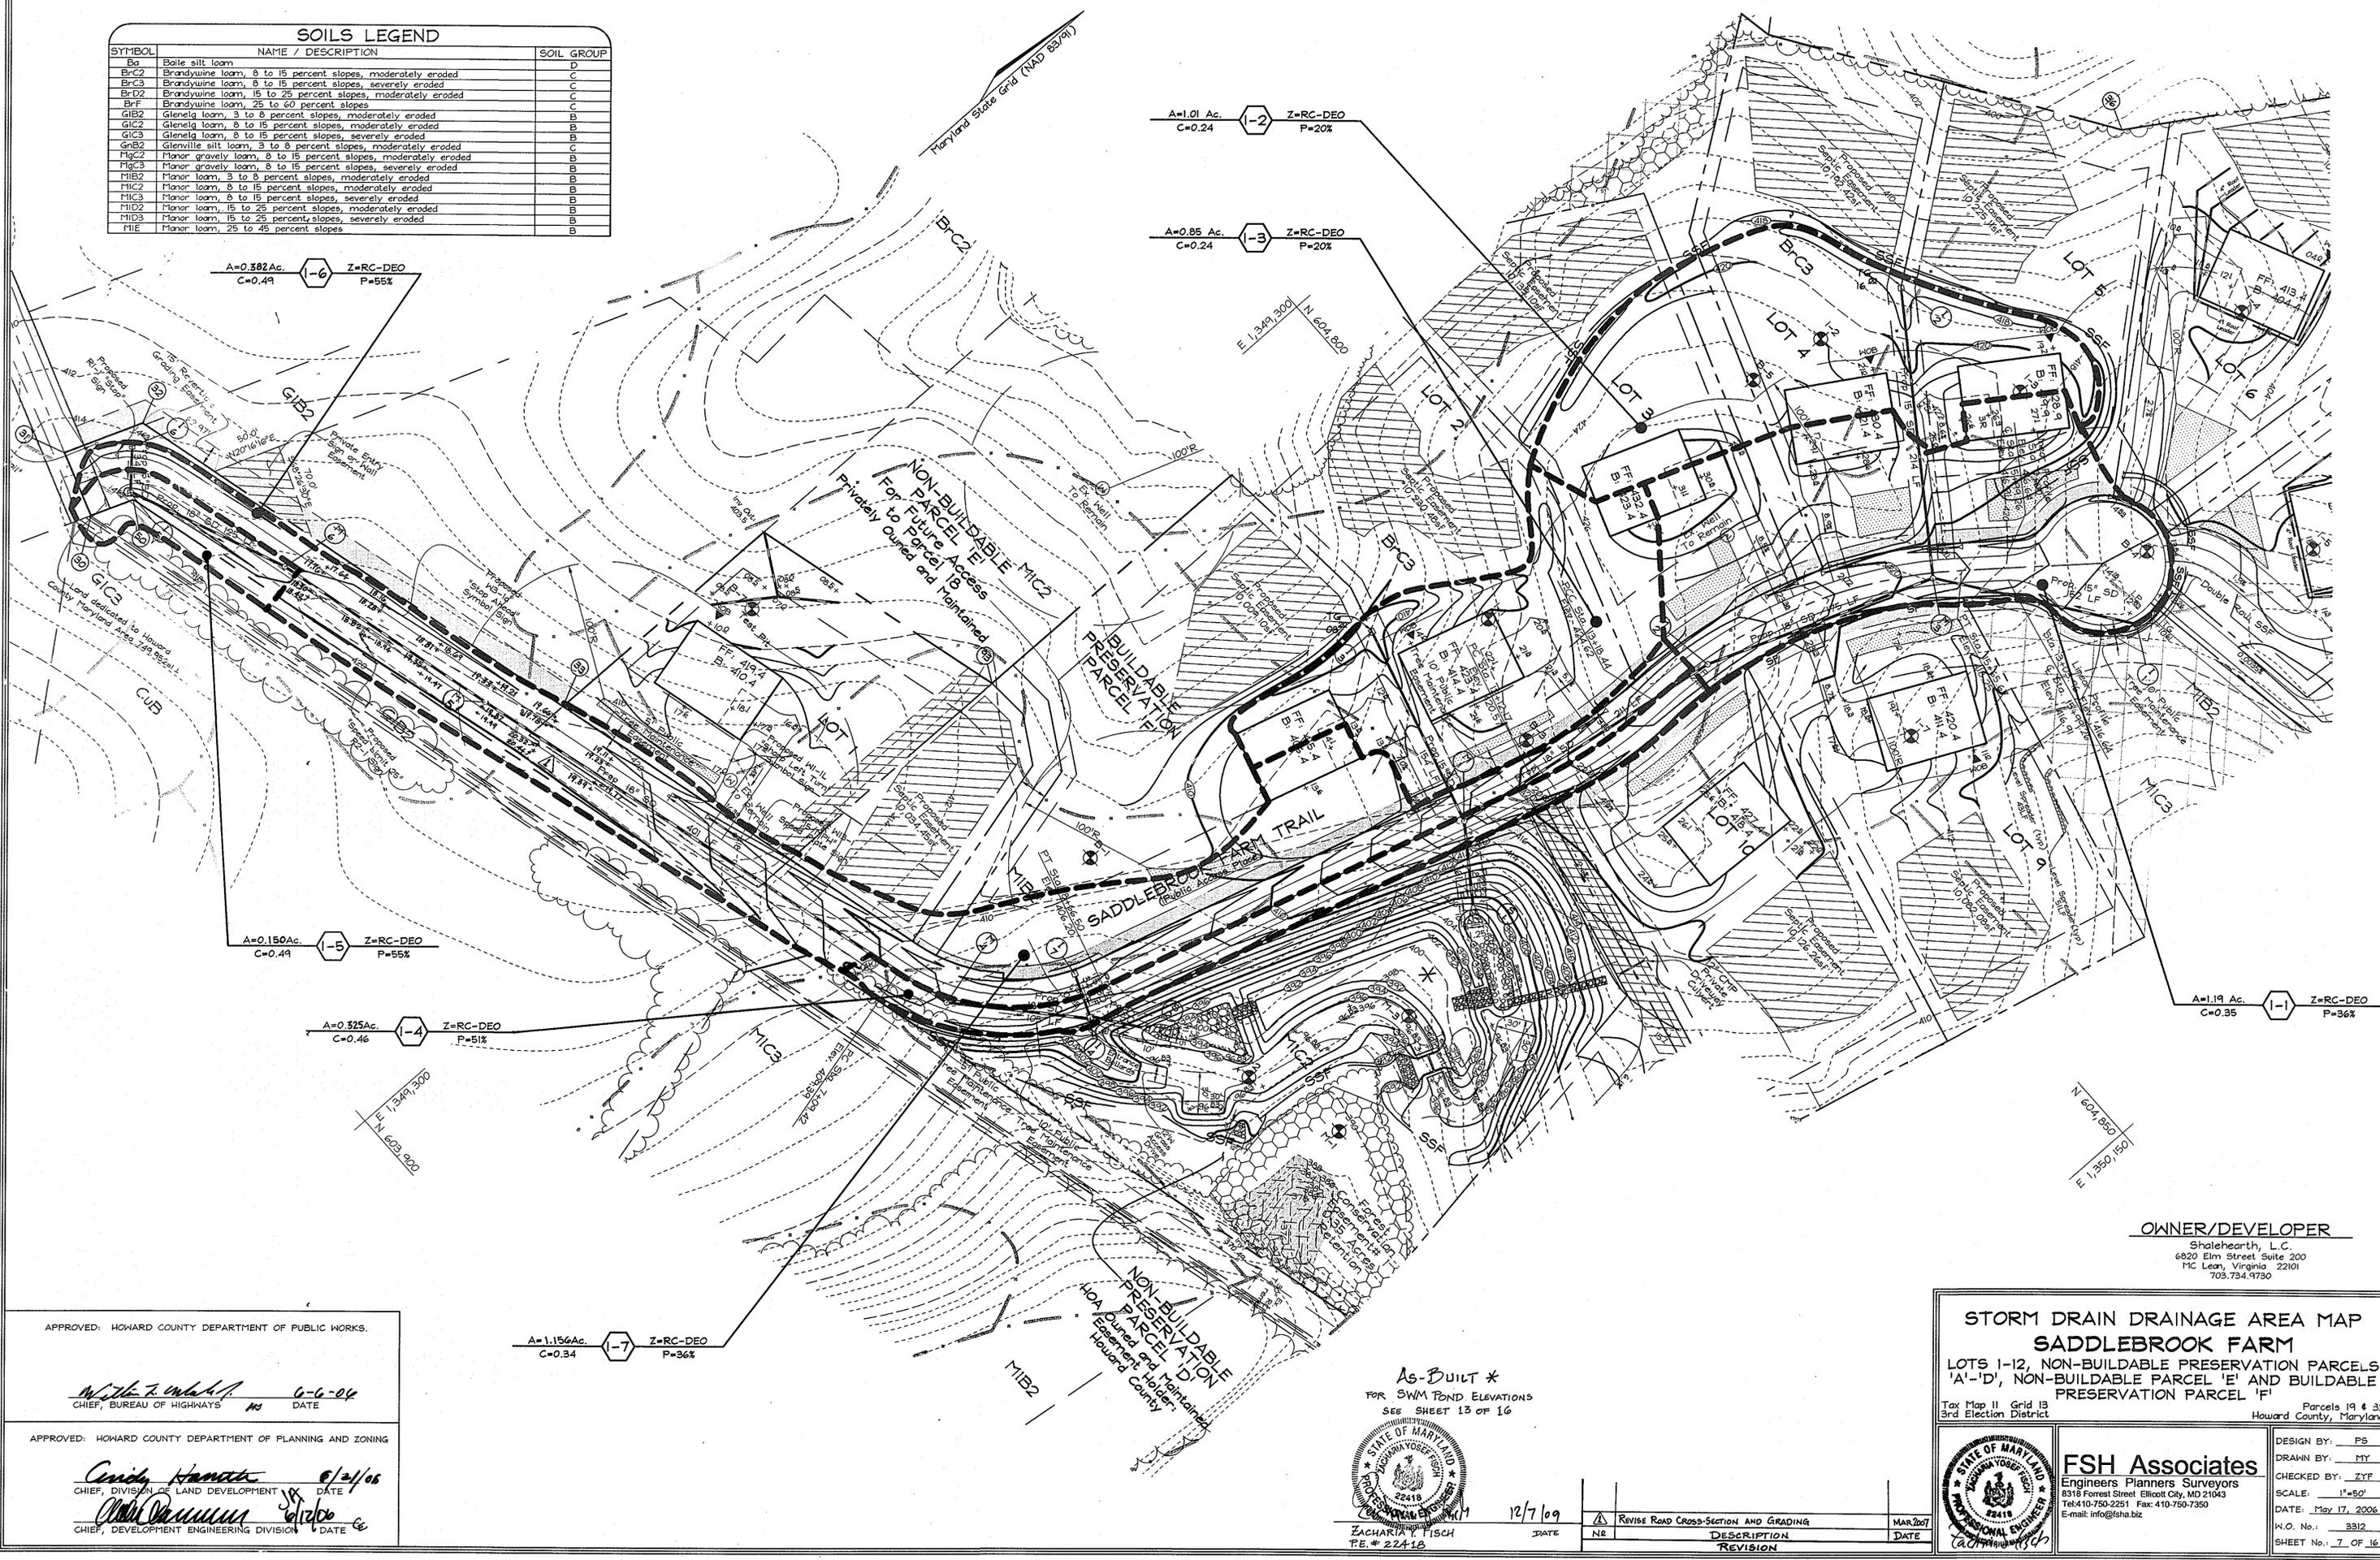

APPROVED: HOWARD COUNTY DEPARTMENT OF PUBLIC WORKS.

Walter Z. ... 6-6-04
CHIEF, BUREAU OF HIGHWAYS DATE

APPROVED: HOWARD COUNTY DEPARTMENT OF PLANNING AND ZONING

Cynthia ... 8/21/05
CHIEF, DIVISION OF LAND DEVELOPMENT DATE
Chris ... 8/21/05
CHIEF, DEVELOPMENT ENGINEERING DIVISION DATE

AS-BUILT *
FOR SWM POND ELEVATIONS
SEE SHEET 13 OF 16



ZACHARIA V. FISCH
PE # 22418

12/7/09 DATE

NO	REVISION	DATE
1	REVISE ROAD CROSS-SECTION AND GRADING	MAR 2007

OWNER/DEVELOPER


Shalehearth, L.C.
6920 Elm Street Suite 200
MC Lean, Virginia 22101
703.734.9730

STORM DRAIN DRAINAGE AREA MAP
SADDLEBROOK FARM
LOTS 1-12, NON-BUILDABLE PRESERVATION PARCELS 'A'-'D', NON-BUILDABLE PARCEL 'E' AND BUILDABLE PRESERVATION PARCEL 'F'
Tax Map II, Grid 13, 3rd Election District
Parcels 19 & 32
Howard County, Maryland




FSH Associates
Engineers Planners Surveyors
8318 Forrest Street, Elliott City, MD 21043
Tel: 410-750-2251 Fax: 410-750-7350
E-mail: info@fsha.biz


DESIGN BY: PS
DRAWN BY: MY
CHECKED BY: ZYF
SCALE: 1"=50'
DATE: May 17, 2006
M.O. No.: 3312
SHEET No.: 7 OF 16

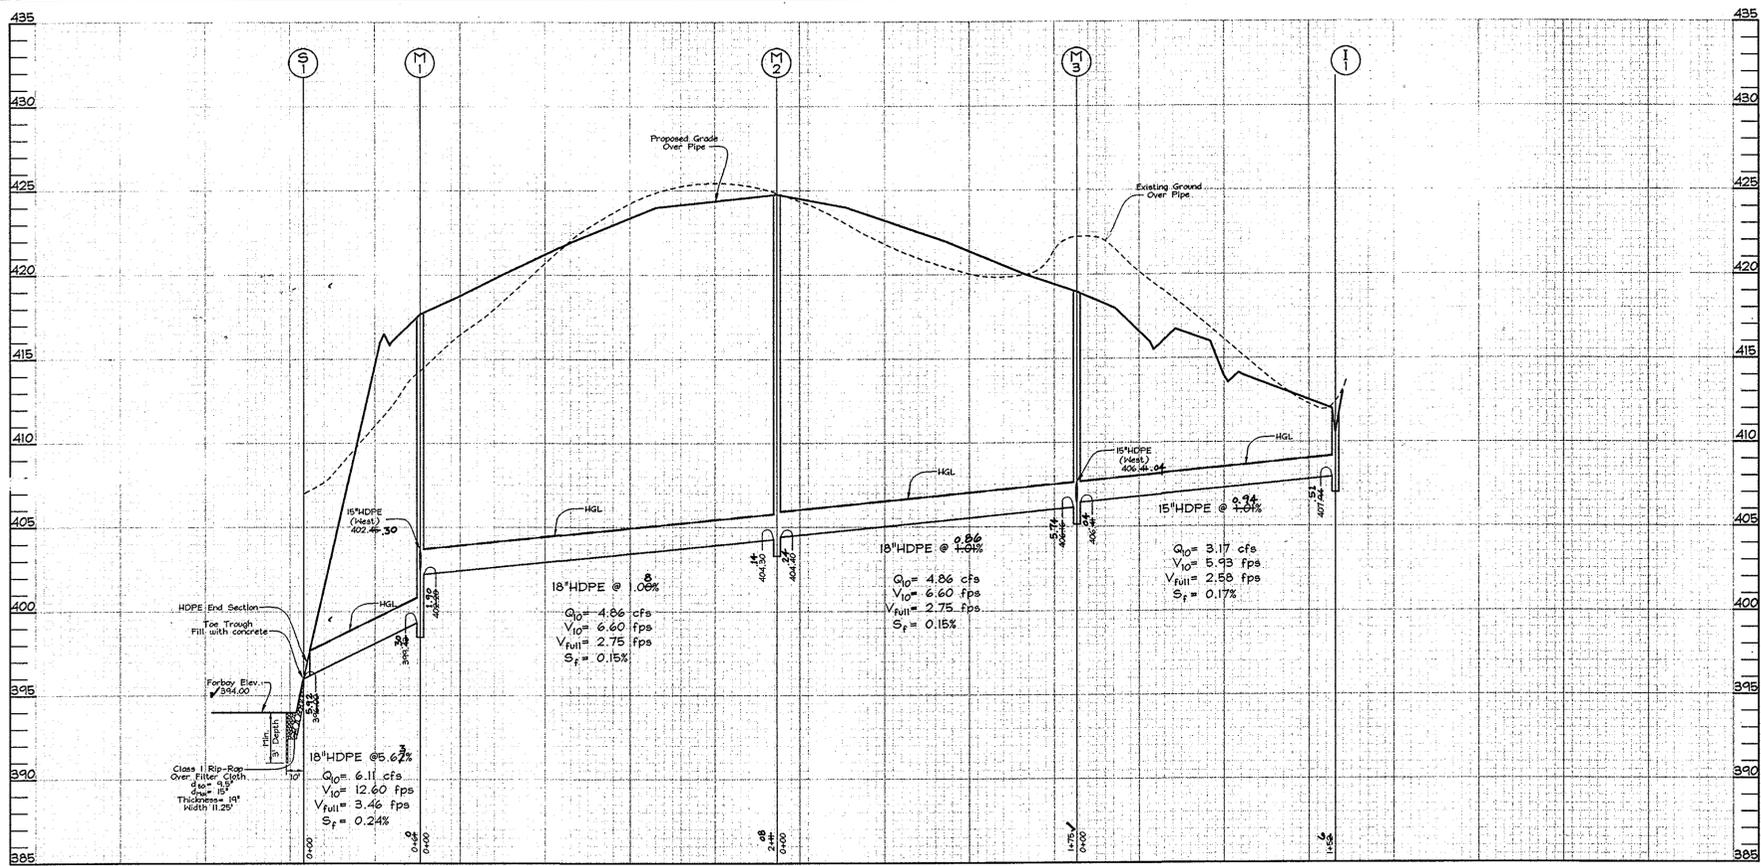


STORM DRAIN PROFILES
 Scale: Horizontal - 1"=50'
 Vertical - 1"=5'

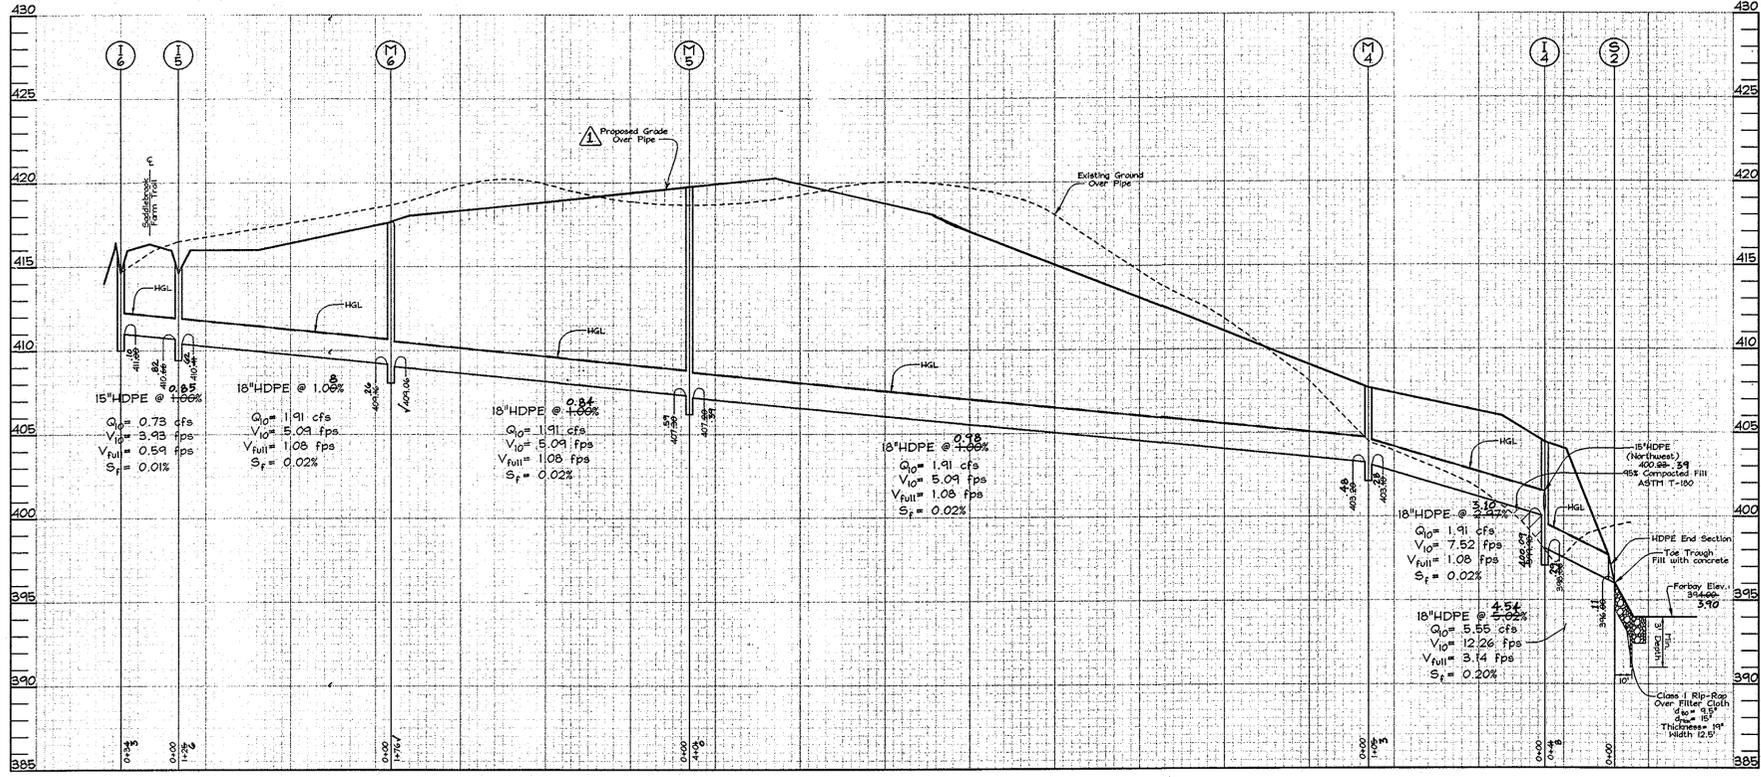


STORM DRAIN PROFILES
 Scale: Horizontal - 1"=50'
 Vertical - 1"=5'

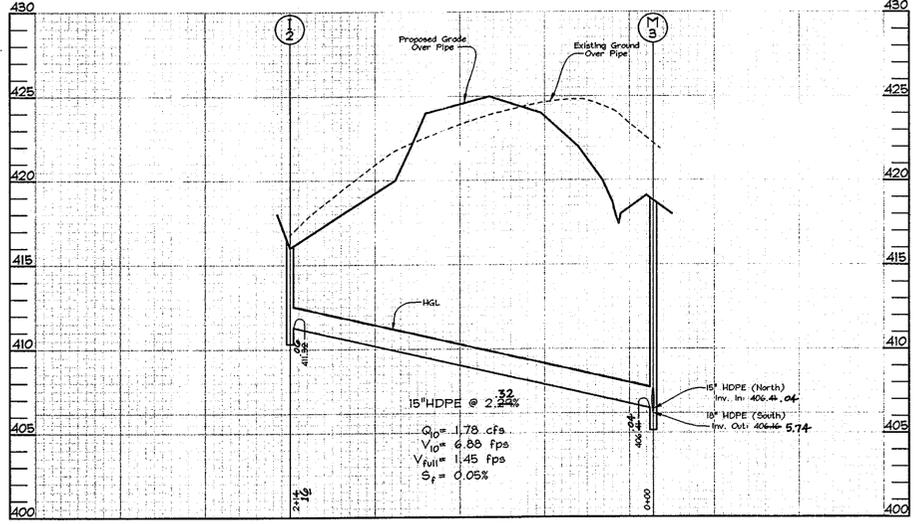

STORM DRAIN PROFILES
 Scale: Horizontal - 1"=50'
 Vertical - 1"=5'

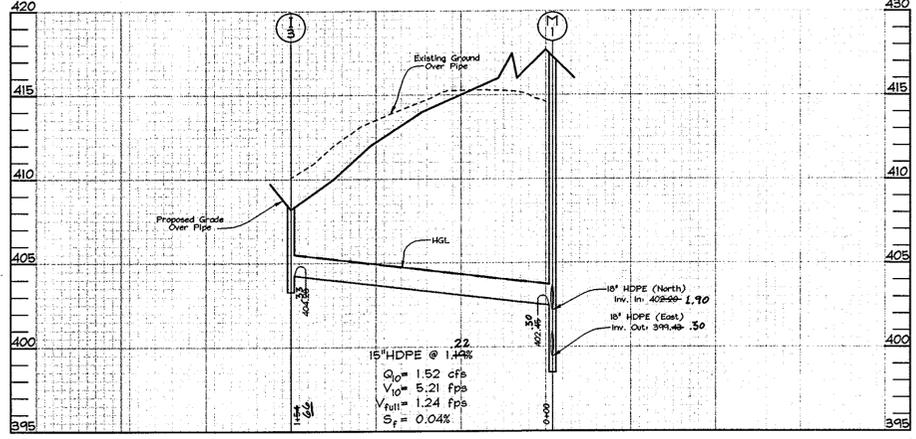

STORM DRAIN PROFILES
 Scale: Horizontal - 1"=50'
 Vertical - 1"=5'

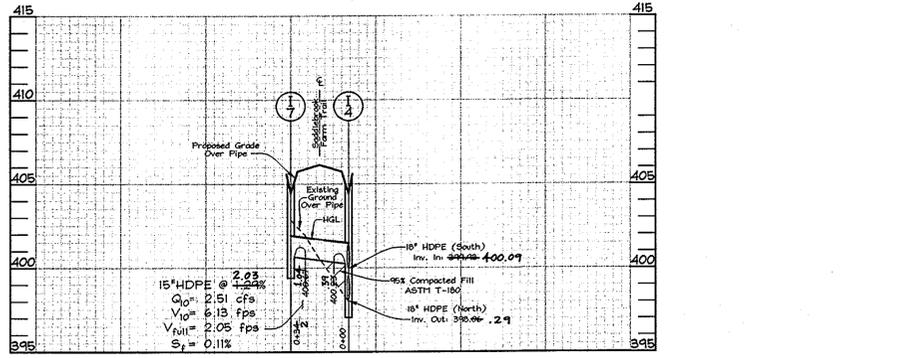

STORM DRAIN PROFILES
 Scale: Horizontal - 1"=50'
 Vertical - 1"=5'

OWNER/DEVELOPER
 Shalehearth, L.C.
 6820 Elm Street Suite 200
 MC Lean, Virginia 22101
 703.734.9730

STORM DRAIN PROFILES
SADDLEBROOK FARM
 LOTS 1-12, NON-BUILDABLE PRESERVATION PARCELS 'A'- 'D', NON-BUILDABLE PARCEL 'E' AND BUILDABLE PRESERVATION PARCEL 'F'

Parcel 19 & 32
 Howard County, Maryland

As-Built
 FOR ROADS, STORM DRAINS &
 EROSION AND SEDIMENT CONTROLS

C. BROOKE MILLER
 PROP. L.S. # 135

DATE: 12/7/2007



FSH Associates
 Engineers Planners Surveyors
 8318 Forest Street Ellicott City, MD 21043
 Tel: 410-750-2251 Fax: 410-750-7350
 E-mail: info@fsha.biz

DESIGN BY: PS
 DRAWN BY: MY
 CHECKED BY: ZYF
 SCALE: As Shown
 DATE: May 17, 2006
 W.O. No.: 3312
 SHEET No.: 8 OF 16

APPROVED: HOWARD COUNTY DEPARTMENT OF PLANNING AND ZONING


Cindy Hamlin 6/2/06
 CHIEF, DIVISION OF LAND DEVELOPMENT JK DATE

Chief, Development Engineering Division DATE: 6/16/06


APPROVED: HOWARD COUNTY DEPARTMENT OF PUBLIC WORKS

Walter T. ... 6-6-06
 CHIEF, BUREAU OF HIGHWAYS MS DATE


NO.	DESCRIPTION	DATE
1	REVISE PROPOSED GRADE OVER S.D. PIPE M6 TO M4	MAR07
2		
3		

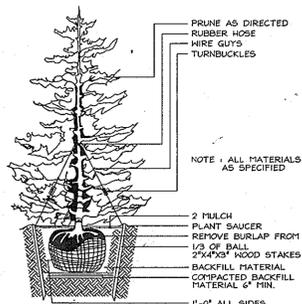

TYPICAL EVERGREEN TREE PLANTING DETAIL
NOT TO SCALE

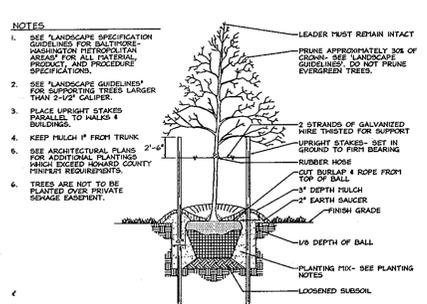

TYPICAL TREE PLANTING AND STAKING
DECIDUOUS TREES UP TO 2-1/2" CALIPER
NOT TO SCALE

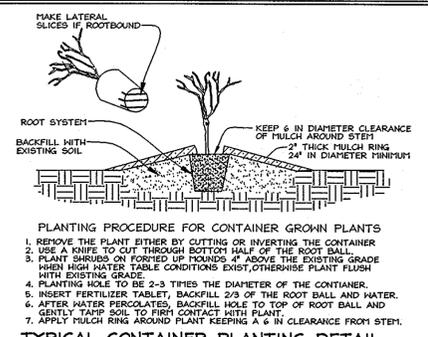

TYPICAL CONTAINER PLANTING DETAIL
NOT TO SCALE

**SCHEDULE D
STORMWATER MANAGEMENT AREA LANDSCAPING**


Linear Feet of Perimeter	10901F
Credit for Existing Vegetation (No, Yes and Linear Feet)	Yes, 2501F 8401F
Credit for other Landscaping (No, Yes and %)	N/A
Number of Trees Required	17 Shade Trees 27 Evergreen Trees

* Credit is for Shade Tree component only. Evergreen component will be provided for the entire perimeter length (10901F).

**SCHEDULE A
PERIMETER LANDSCAPE EDGE**

CATEGORY	ADJACENT TO ROADWAYS	ADJACENT TO PERIMETER PROPERTIES					
		1	2	3	4	5	6
Perimeter/Frontage Designation	B	A	A	A	A	A	A
Linear Feet of Roadway Frontage/Perimeter	369	961	1377	1242	1054	226	226
Credit for Existing Vegetation (Yes, No, Linear Feet)	No	Yes** 374	Yes** 647	Yes** 404	Yes** 60	No	No
Remaining Perimeter Length		587	730	838	994		
Credit for Wall, Fence or Berm (Yes, No, Linear Feet)	No	No	No	No	No	No	No
Remaining Perimeter Length							
Number of Plants Required							
Shade Trees	1:50 7	1:60 10	1:60 12	1:60 14	1:60 17	1:60 4	
Evergreen Trees	1:40 9						

* Existing woods to remain
** We are requesting alternative compliance credit for the noted 647' of Perimeter 2 that is coincident with the forest conservation area on Preservation Parcel 'A' and the adjacent property owned by the State of Maryland. The adjacent property is an undisturbed forest area in a State Park that will not face development or much if any active use. The preservation parcel will contain a forest conservation easement. Buffering with the addition of more trees would appear to be superfluous in this instance.

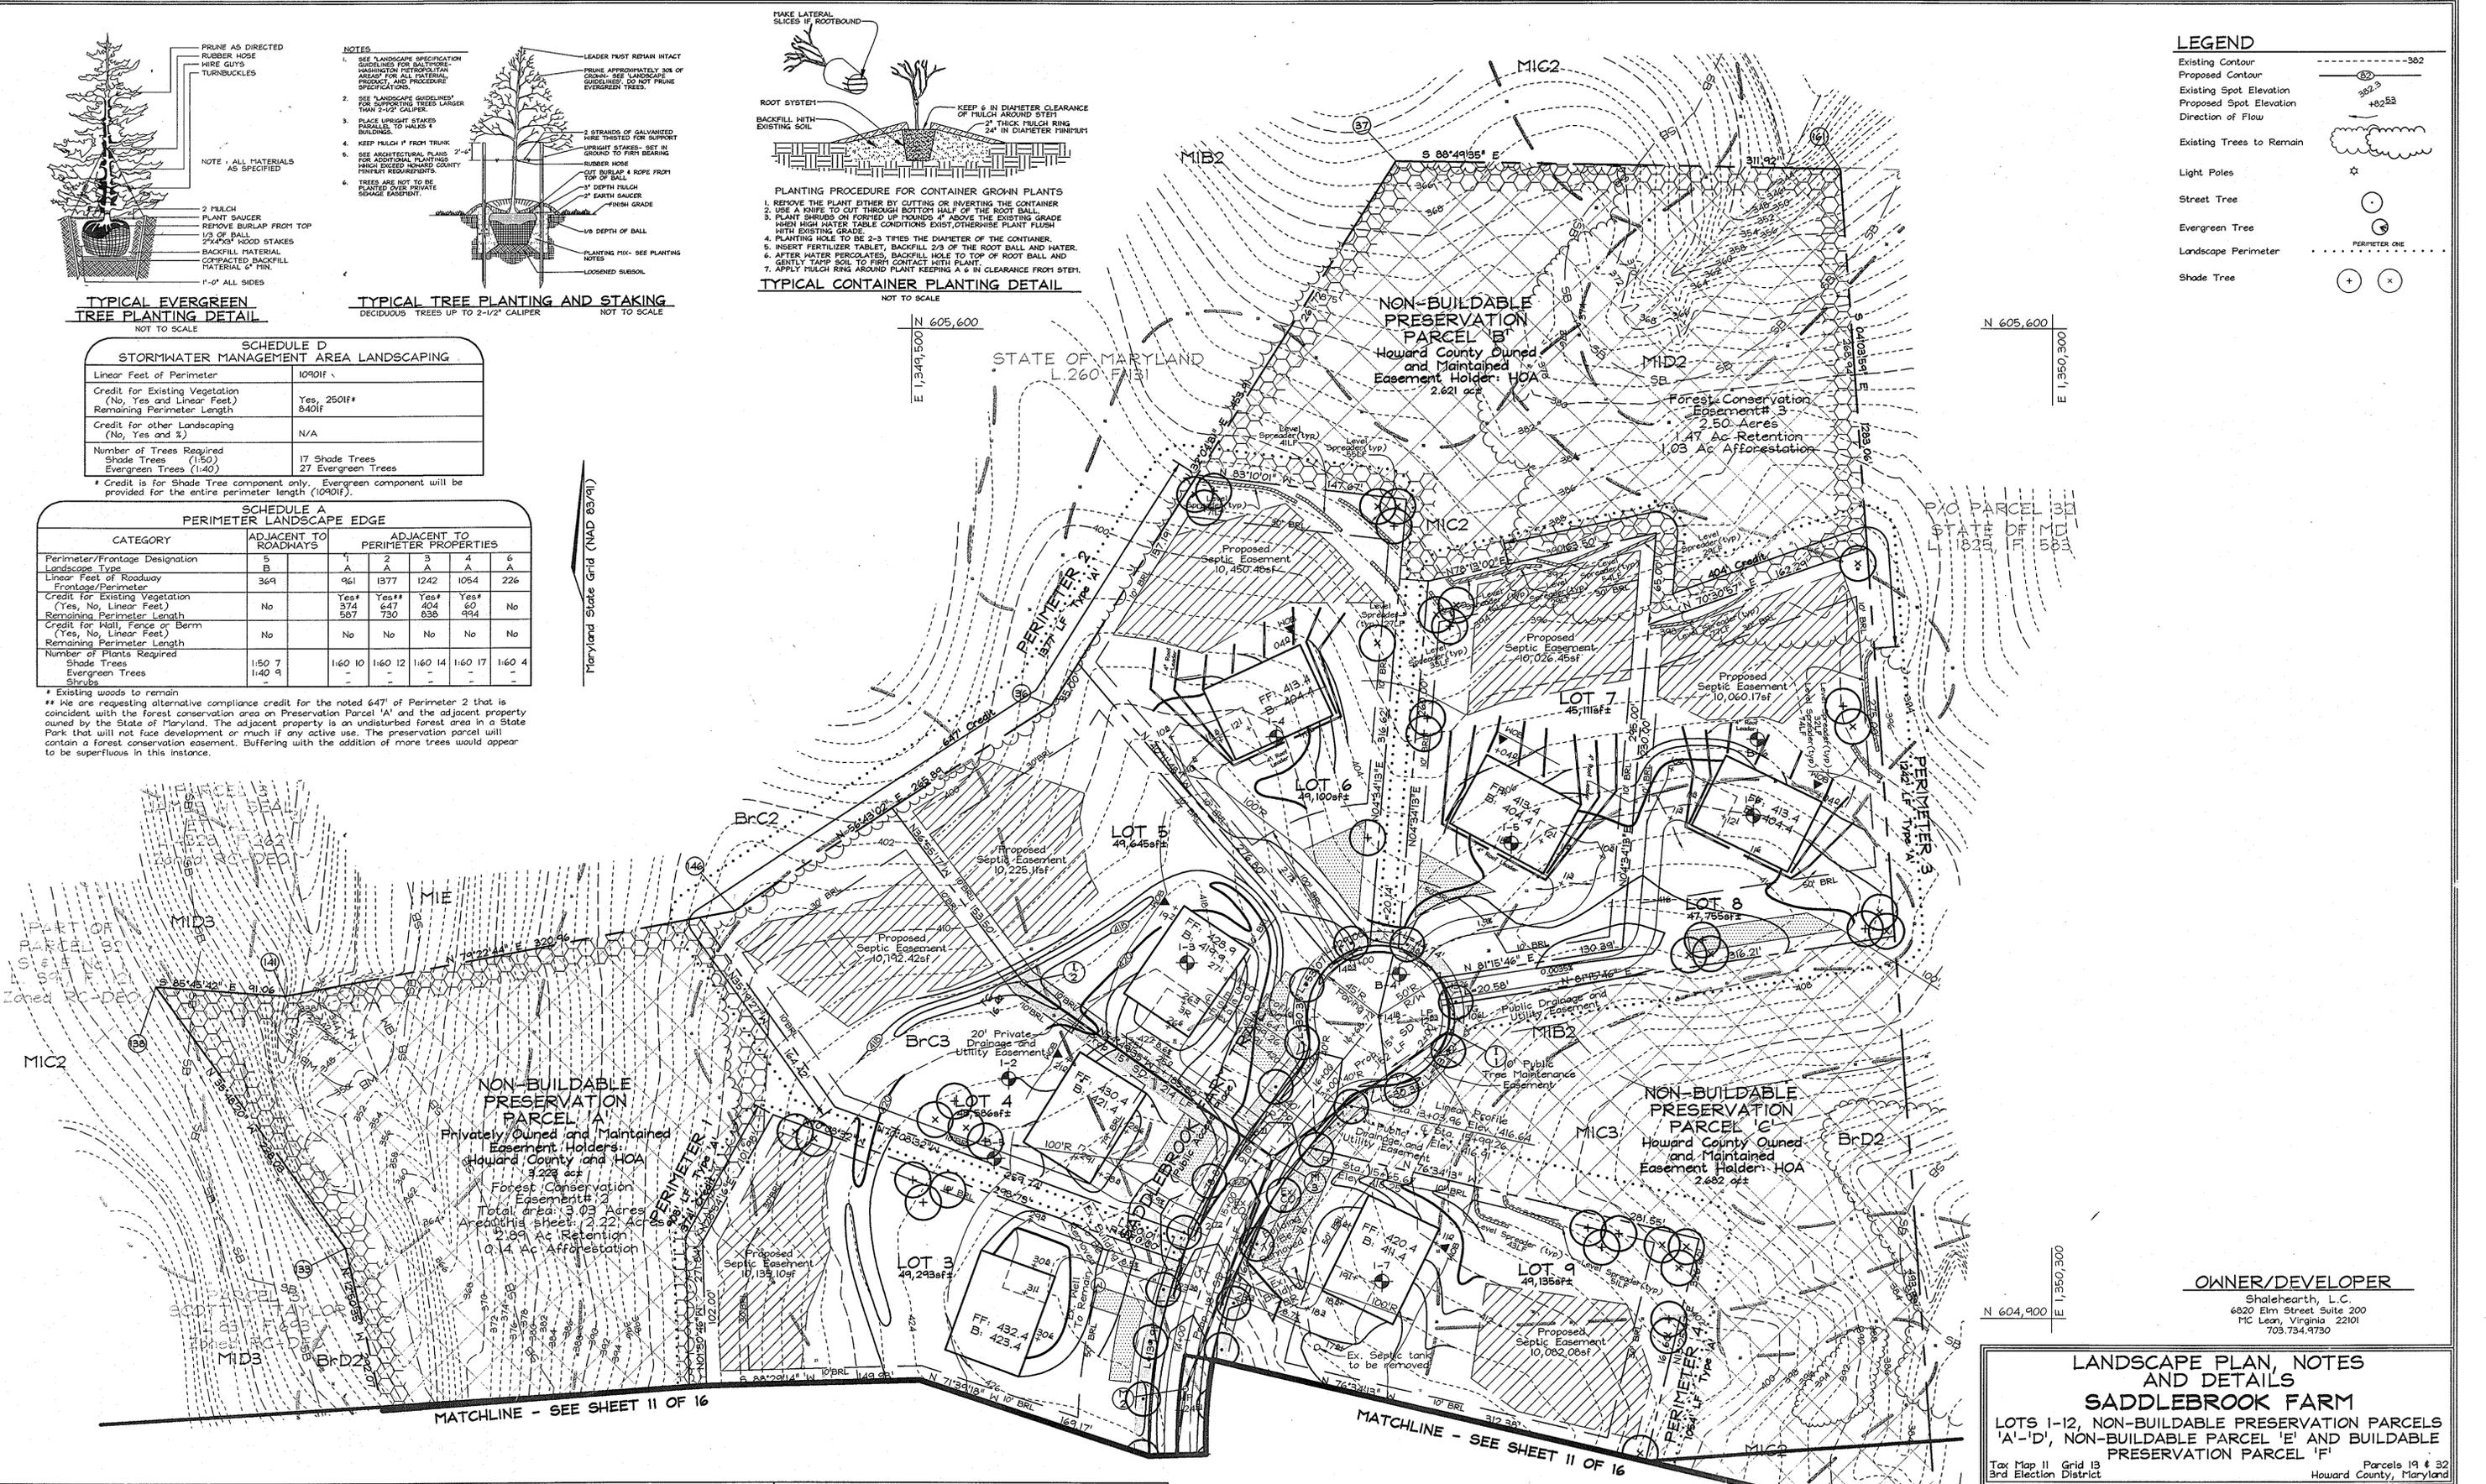

LEGEND

- Existing Contour: --- 362
- Proposed Contour: - - - 362
- Existing Spot Elevation: 362.3
- Proposed Spot Elevation: +32.5
- Direction of Flow: [Symbol]
- Existing Trees to Remain: [Symbol]
- Light Poles: [Symbol]
- Street Tree: [Symbol]
- Evergreen Tree: [Symbol]
- Landscape Perimeter: [Symbol]
- Shade Tree: [Symbol]

APPROVED: HOWARD COUNTY DEPARTMENT OF PLANNING AND ZONING
Cecilia Hamer 6/2/06
 CHIEF, DIVISION OF LAND DEVELOPMENT DATE

APPROVED: HOWARD COUNTY DEPARTMENT OF PUBLIC WORKS.
William A. Mahan 6-6-06
 CHIEF, BUREAU OF HIGHWAYS DATE

DEVELOPER'S/BUILDER'S CERTIFICATE
 I/WE CERTIFY THAT THE LANDSCAPING SHOWN ON THIS PLAN WILL BE DONE ACCORDING TO THE PLAN, SECTION 16.124 OF THE HOWARD COUNTY CODE AND THE HOWARD COUNTY LANDSCAPE MANUAL. I/WE FURTHER CERTIFY THAT UPON COMPLETION, A LETTER OF LANDSCAPE INSTALLATION, ACCOMPANIED BY AN EXECUTED ONE(1) YEAR GUARANTEE OF PLANT MATERIALS, WILL BE SUBMITTED TO THE DEPARTMENT OF PLANNING AND ZONING.
D. J. [Signature] 6/6/06
 SIGNATURE OF DEVELOPER DATE


NOTES:
 1. Erosion Control Matting will be provided in all ditches on property.

OWNER/DEVELOPER
 Shalehearth, L.C.
 6820 Elm Street Suite 200
 MC Lean, Virginia 22101
 703.734.9730


LANDSCAPE PLAN, NOTES AND DETAILS
SADDLEBROOK FARM
 LOTS 1-12, NON-BUILDABLE PRESERVATION PARCELS 'A'- 'D', NON-BUILDABLE PARCEL 'E' AND BUILDABLE PRESERVATION PARCEL 'F'
 Tax Map 11, Grid 13 3rd Election District
 Parcels 19 & 32
 Howard County, Maryland

FSH Associates
 Engineers Planners Surveyors
 8318 Forest Street, Ellicott City, MD 21042
 410-410-7500 Fax: 410-750-7350
 E-mail: info@fsha.biz


DESIGN BY: PS
 DRAWN BY: AT/MT
 CHECKED BY: ZYF
 SCALE: 1"=50'
 DATE: May 17, 2006
 I.C. No.: 3312
 SHEET No.: 3 OF 16

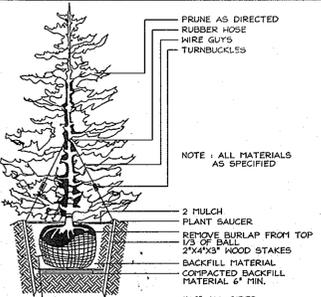

TYPICAL EVERGREEN TREE PLANTING DETAIL
NOT TO SCALE

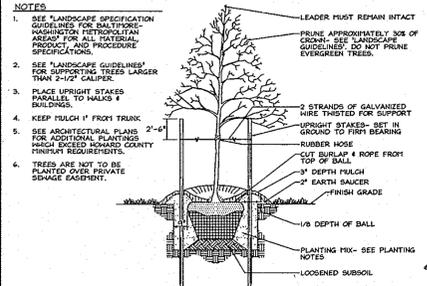

TYPICAL DECIDUOUS TREE PLANTING AND STAKING
NOT TO SCALE

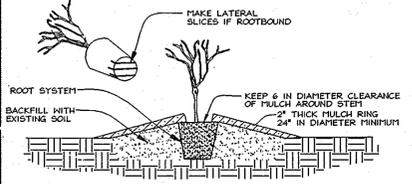



- PLANTING PROCEDURE FOR CONTAINER GROWN PLANTS**
- REMOVE THE PLANT EITHER BY CUTTING OR INVERTING THE CONTAINER
 - USE A KNIFE TO CUT THROUGH BOTTOM HALF OF THE ROOT BALL
 - PLANT SURFORS ON FORKED UP FOUNDS 4" ABOVE THE EXISTING GRADE WHEN HIGH WATER TABLE CONDITIONS EXIST, OTHERWISE PLANT FLUSH WITH EXISTING GRADE
 - PLANTING HOLE TO BE 2-3 TIMES THE DIAMETER OF THE CONTAINER
 - INSERT FERTILIZER TABLET, BACKFILL 2/3 OF THE ROOT BALL AND WATER
 - AFTER WATER PERCOLATES, BACKFILL HOLE TO TOP OF ROOT BALL AND GENTLY TAMP SOIL TO FIRM CONTACT WITH PLANT
 - APPLY MULCH RING AROUND PLANT KEEPING 6" IN CLEARANCE FROM STEPS

TYPICAL CONTAINER PLANTING DETAIL
NOT TO SCALE

LEGEND


- Existing Contour
- Proposed Contour
- Existing Spot Elevation
- Proposed Spot Elevation
- Direction of Flow
- Existing Trees to Remain
- Light Poles
- Street Tree
- Evergreen Tree
- Landscape Perimeter
- Shade Tree

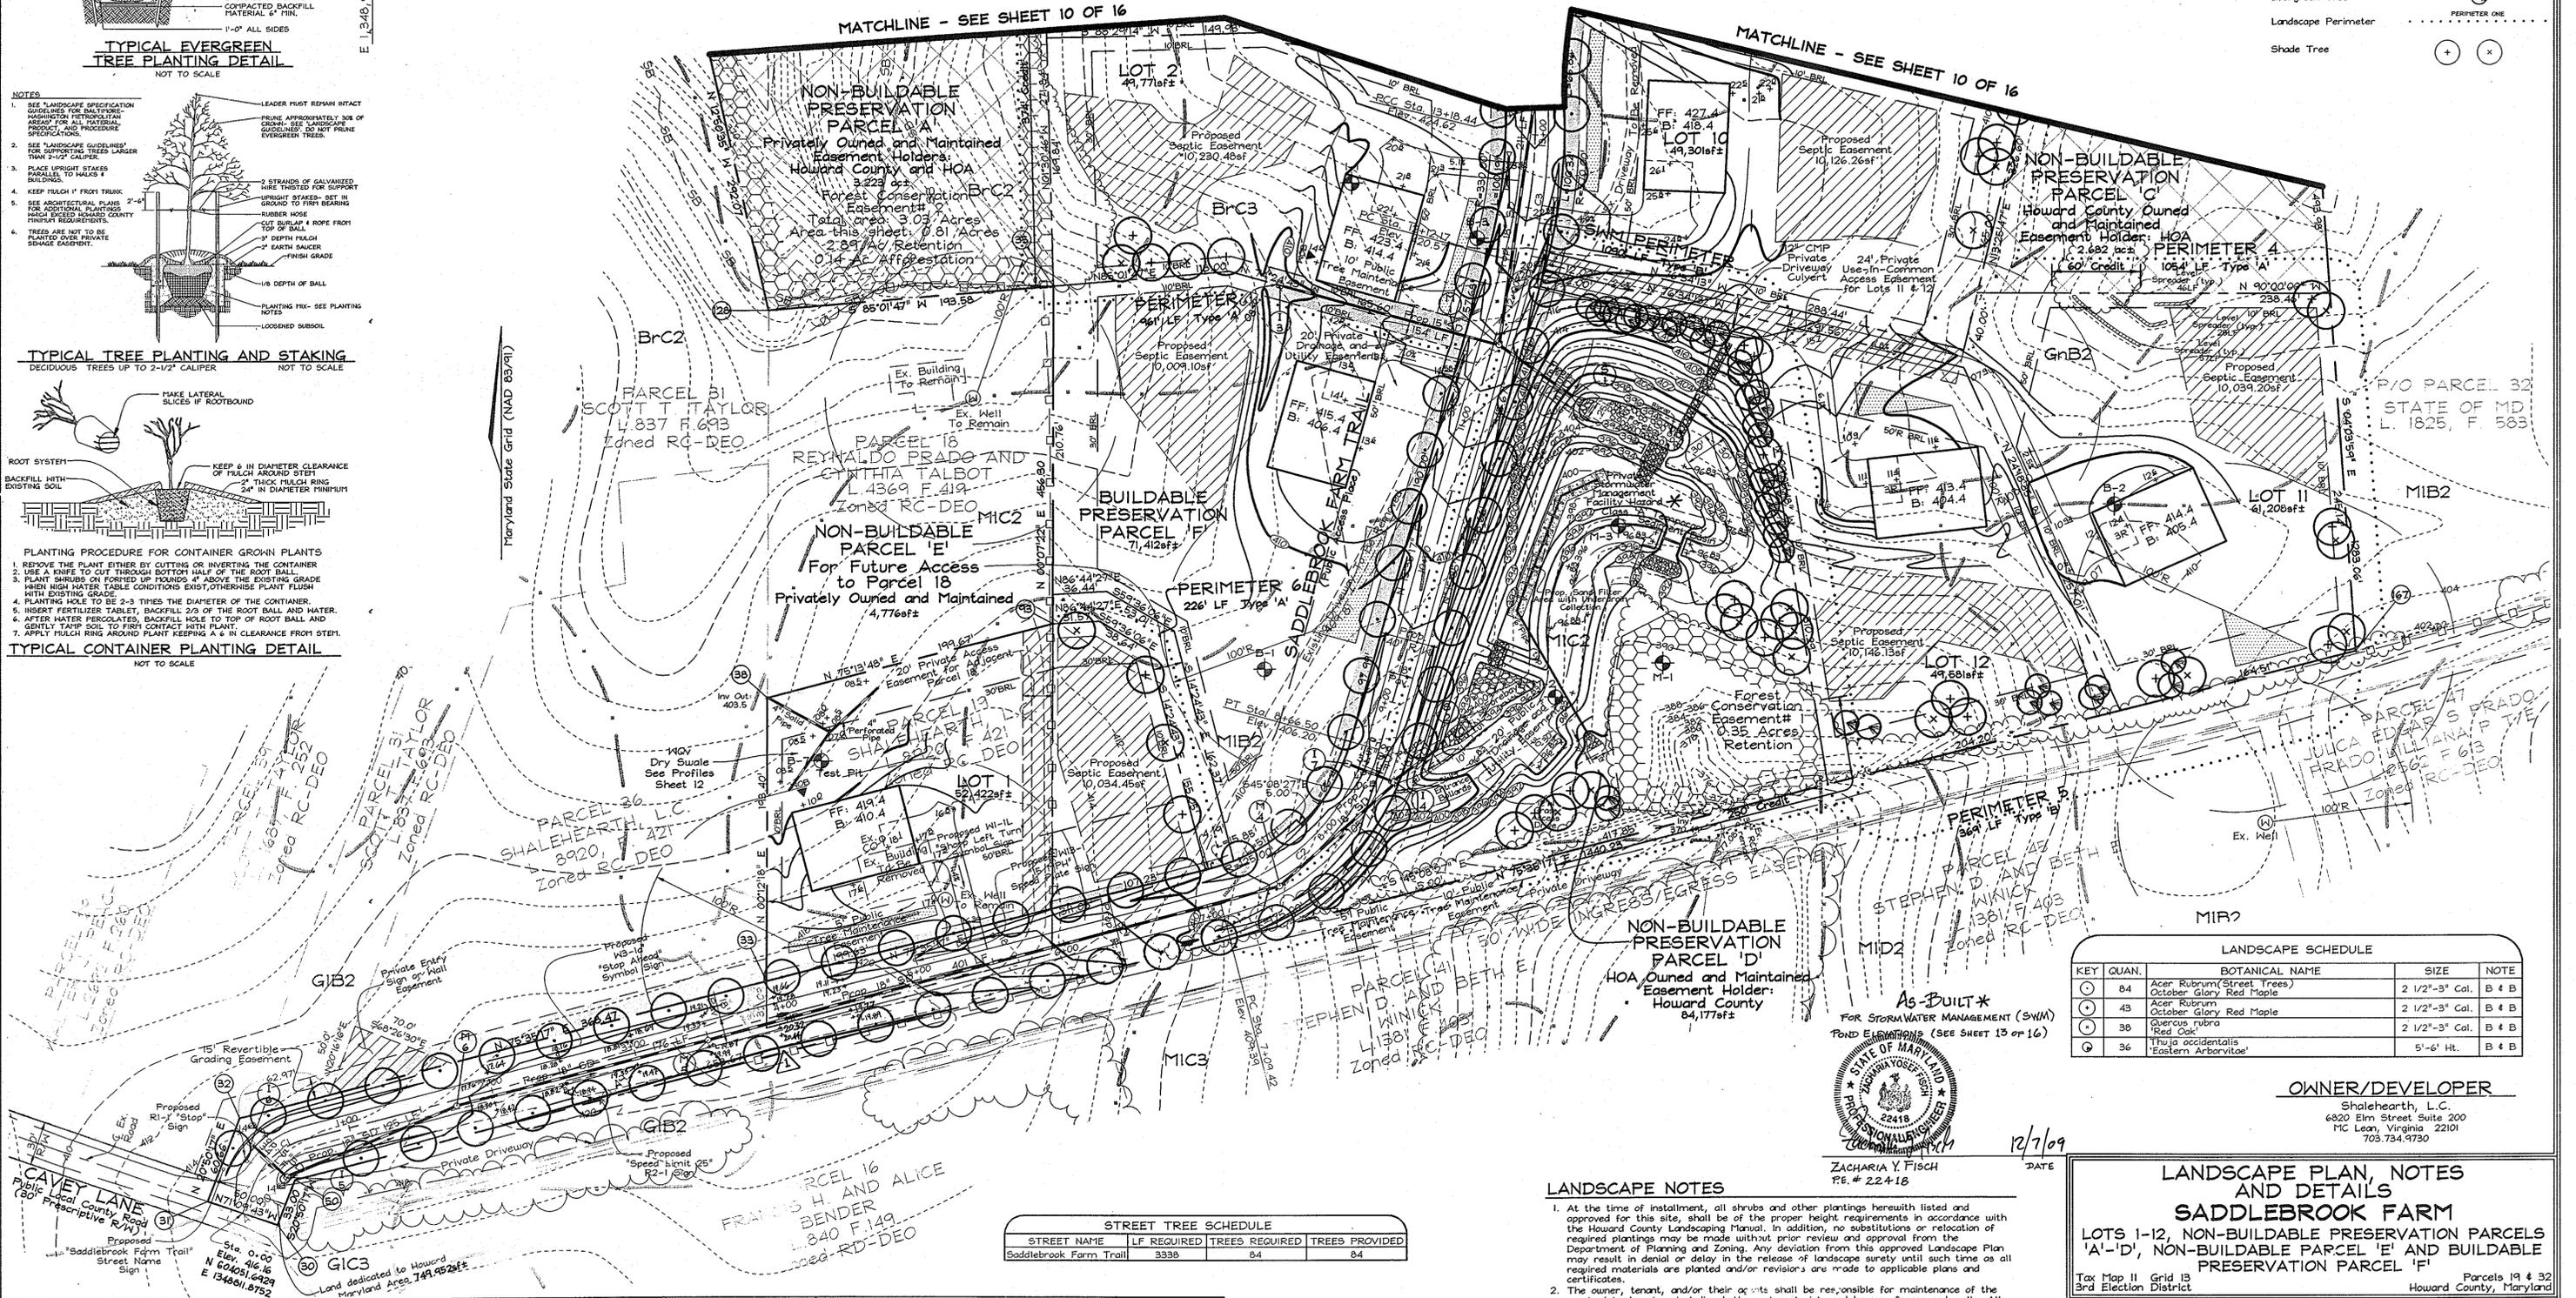

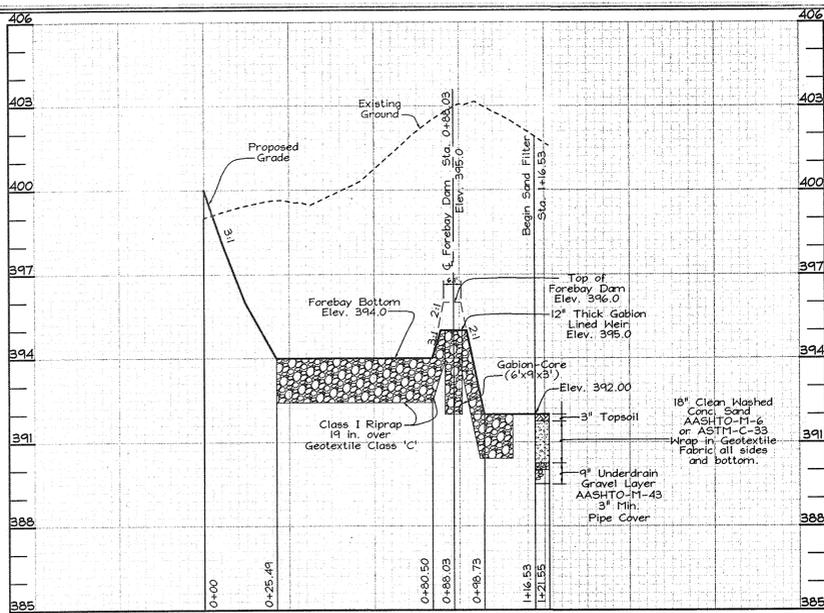


SWM POND SECTION C-C FOREBAY2 @ S-2

Scale: Horizontal- 1"=30'
Vertical- 1"=3'

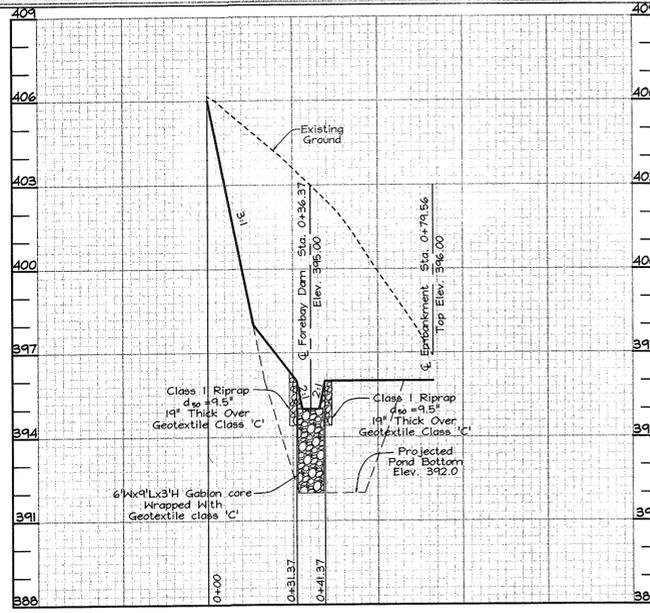


SWM POND SECTION D-D FOREBAY2 @ S-2

Scale: Horizontal- 1"=30'
Vertical- 1"=3'

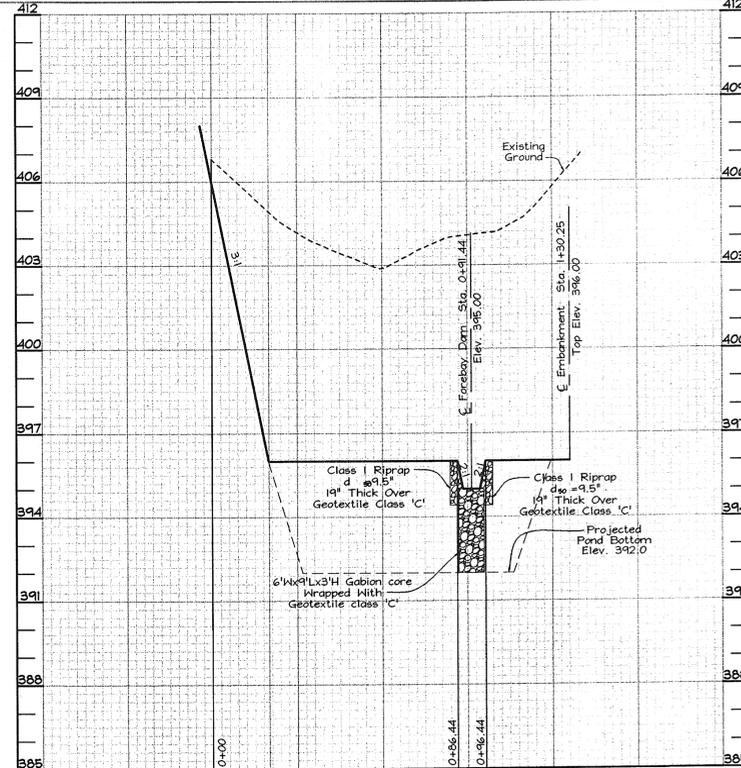


SWM POND SECTION E-E FOREBAY1 @ S-1

Scale: Horizontal- 1"=30'
Vertical- 1"=3'

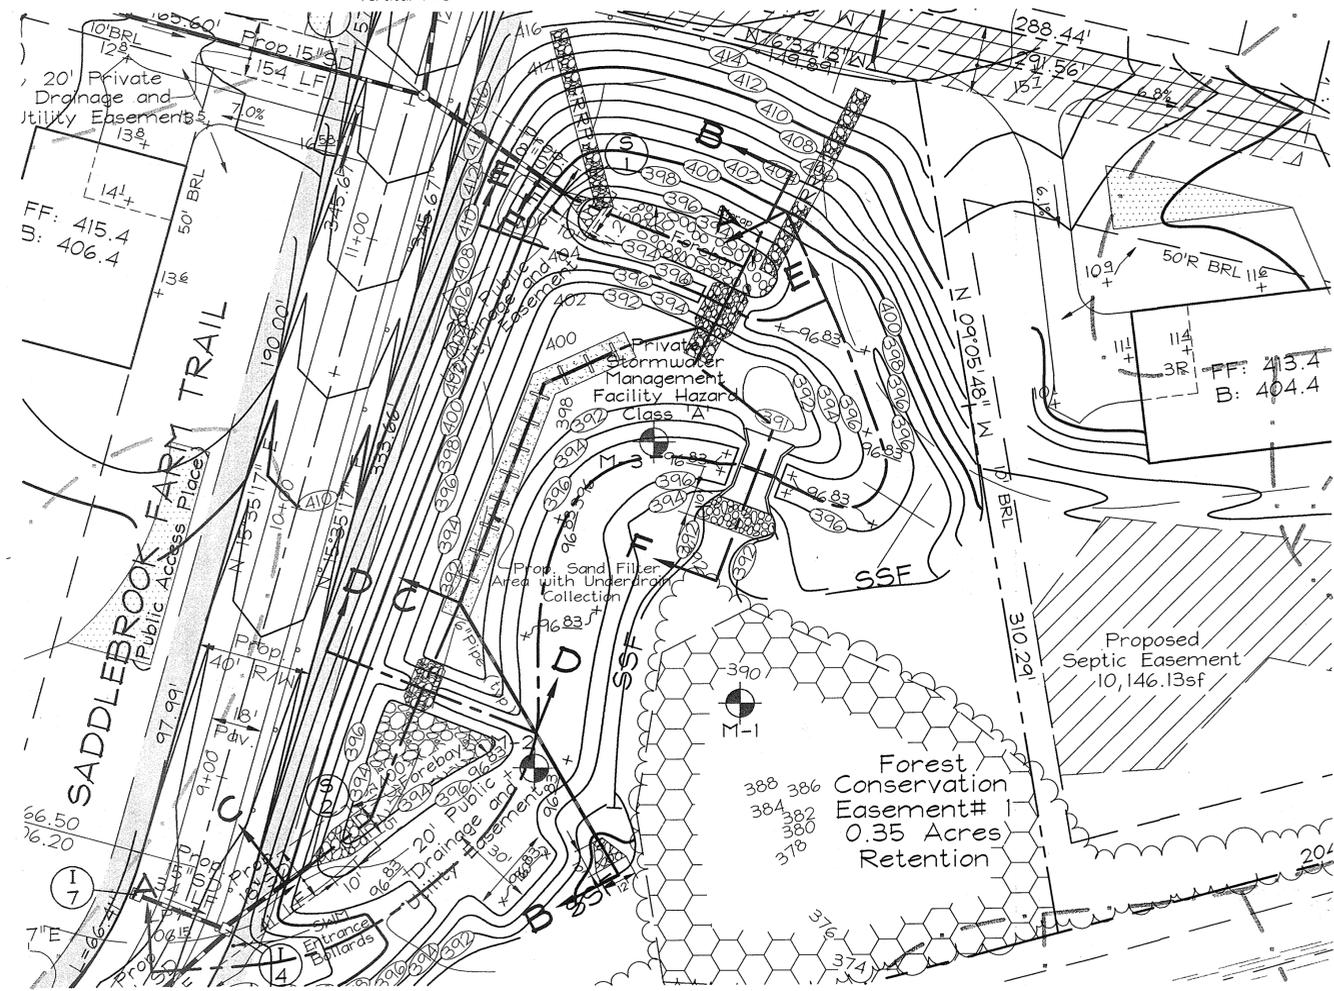

SWM FACILITY ENLARGEMENT

Scale: 1"=30'

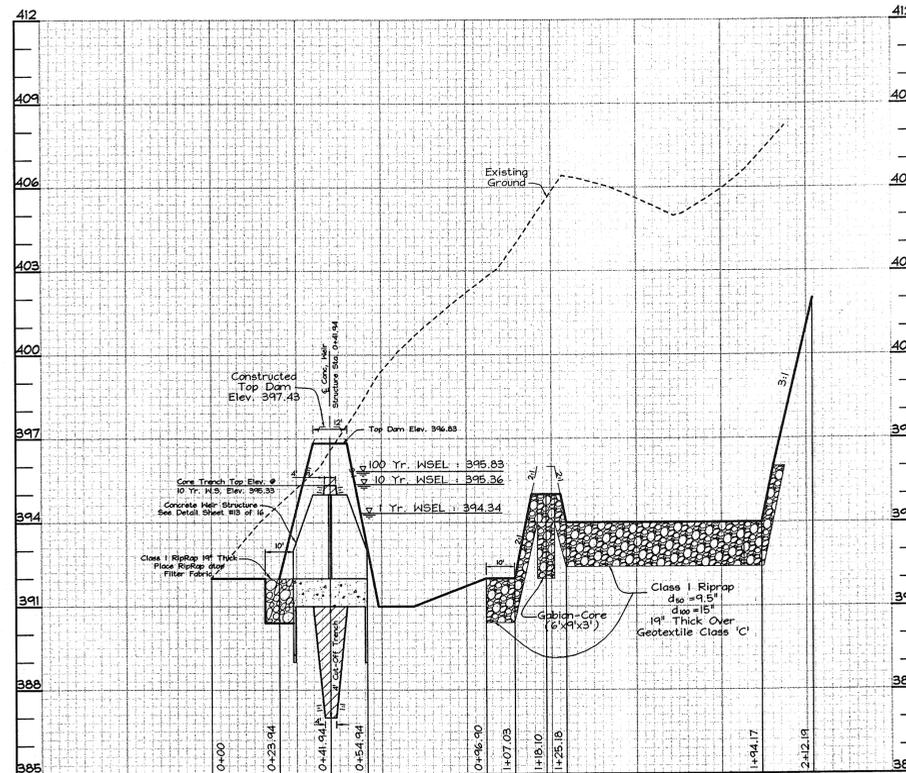

SWM POND SECTION F-F CONCRETE WEIR & FOREBAY1

Scale: Horizontal- 1"=30'
Vertical- 1"=3'

OWNER/DEVELOPER

Shalehearth, L.C.
6620 Elm Street Suite 200
MC Lean, Virginia 22101
703.734.9730

STORMWATER MANAGEMENT NOTES AND DETAILS
SADDLEBROOK FARM
LOTS 1-12, NON-BUILDABLE PRESERVATION PARCELS 'A'-'D', NON-BUILDABLE PARCEL 'E' AND BUILDABLE PRESERVATION PARCEL 'F'

Top Map 11 Grid 13 3rd Election District Parcels 14 & 32 Howard County, Maryland



FSH Associates

Engineers Planners Surveyors
8318 Forrest Street, Ellicott City, MD 21043
Tel: 410-750-2251 Fax: 410-750-7350
E-mail: info@fsha.biz

DESIGN BY: PS
DRAWN BY: MY
CHECKED BY: ZYF
SCALE: As Shown
DATE: May 17, 2006
W.O. No.: 3312
SHEET No.: 13 OF 16

APPROVED: HOWARD COUNTY DEPARTMENT OF PLANNING AND ZONING


Cindy Hamon 6/2/06
CHIEF, DIVISION OF LAND DEVELOPMENT DATE

APPROVED: HOWARD COUNTY DEPARTMENT OF PUBLIC WORKS.

William J. ... 6-6-06
CHIEF, BUREAU OF HIGHWAYS DATE

FOREST CONSERVATION WORKSHEET

Net Tract Area	Acres
A. Total Tract Area	27.86
B. Area Within 100 Year Floodplain	--
C. Other deductions	--
D. Net Tract Area	27.86
Land Use Category: RESIDENTIAL-Rural Medium	
Land Use Category	
E. Afforestation Minimum (20 % x D)	5.57
F. Conservation Threshold (25 % x D)	6.97
Existing Forest Cover	
G. Existing Forest on Net Tract Area	5.02
H. Forest Area Above Conservation Threshold	0
Breakeven Point	
I. Forest Retention Above Threshold with no Mitigation	NA
J. Clearing Permitted without Mitigation	0
Proposed Forest Clearing	
K. Forest Areas to be Cleared	0.31
L. Forest Areas to be Retained	4.71
Planting Requirements	
M. Reforestation for Clearing Above Threshold	0
N. Reforestation for Clearing Below the Threshold	0.62
P. Credit for Retention Above Conservation Threshold	0
Q. Total Reforestation Required	0.62
R. Total Afforestation Required	0.55
S. Total Reforestation and Afforestation Requirement	1.17

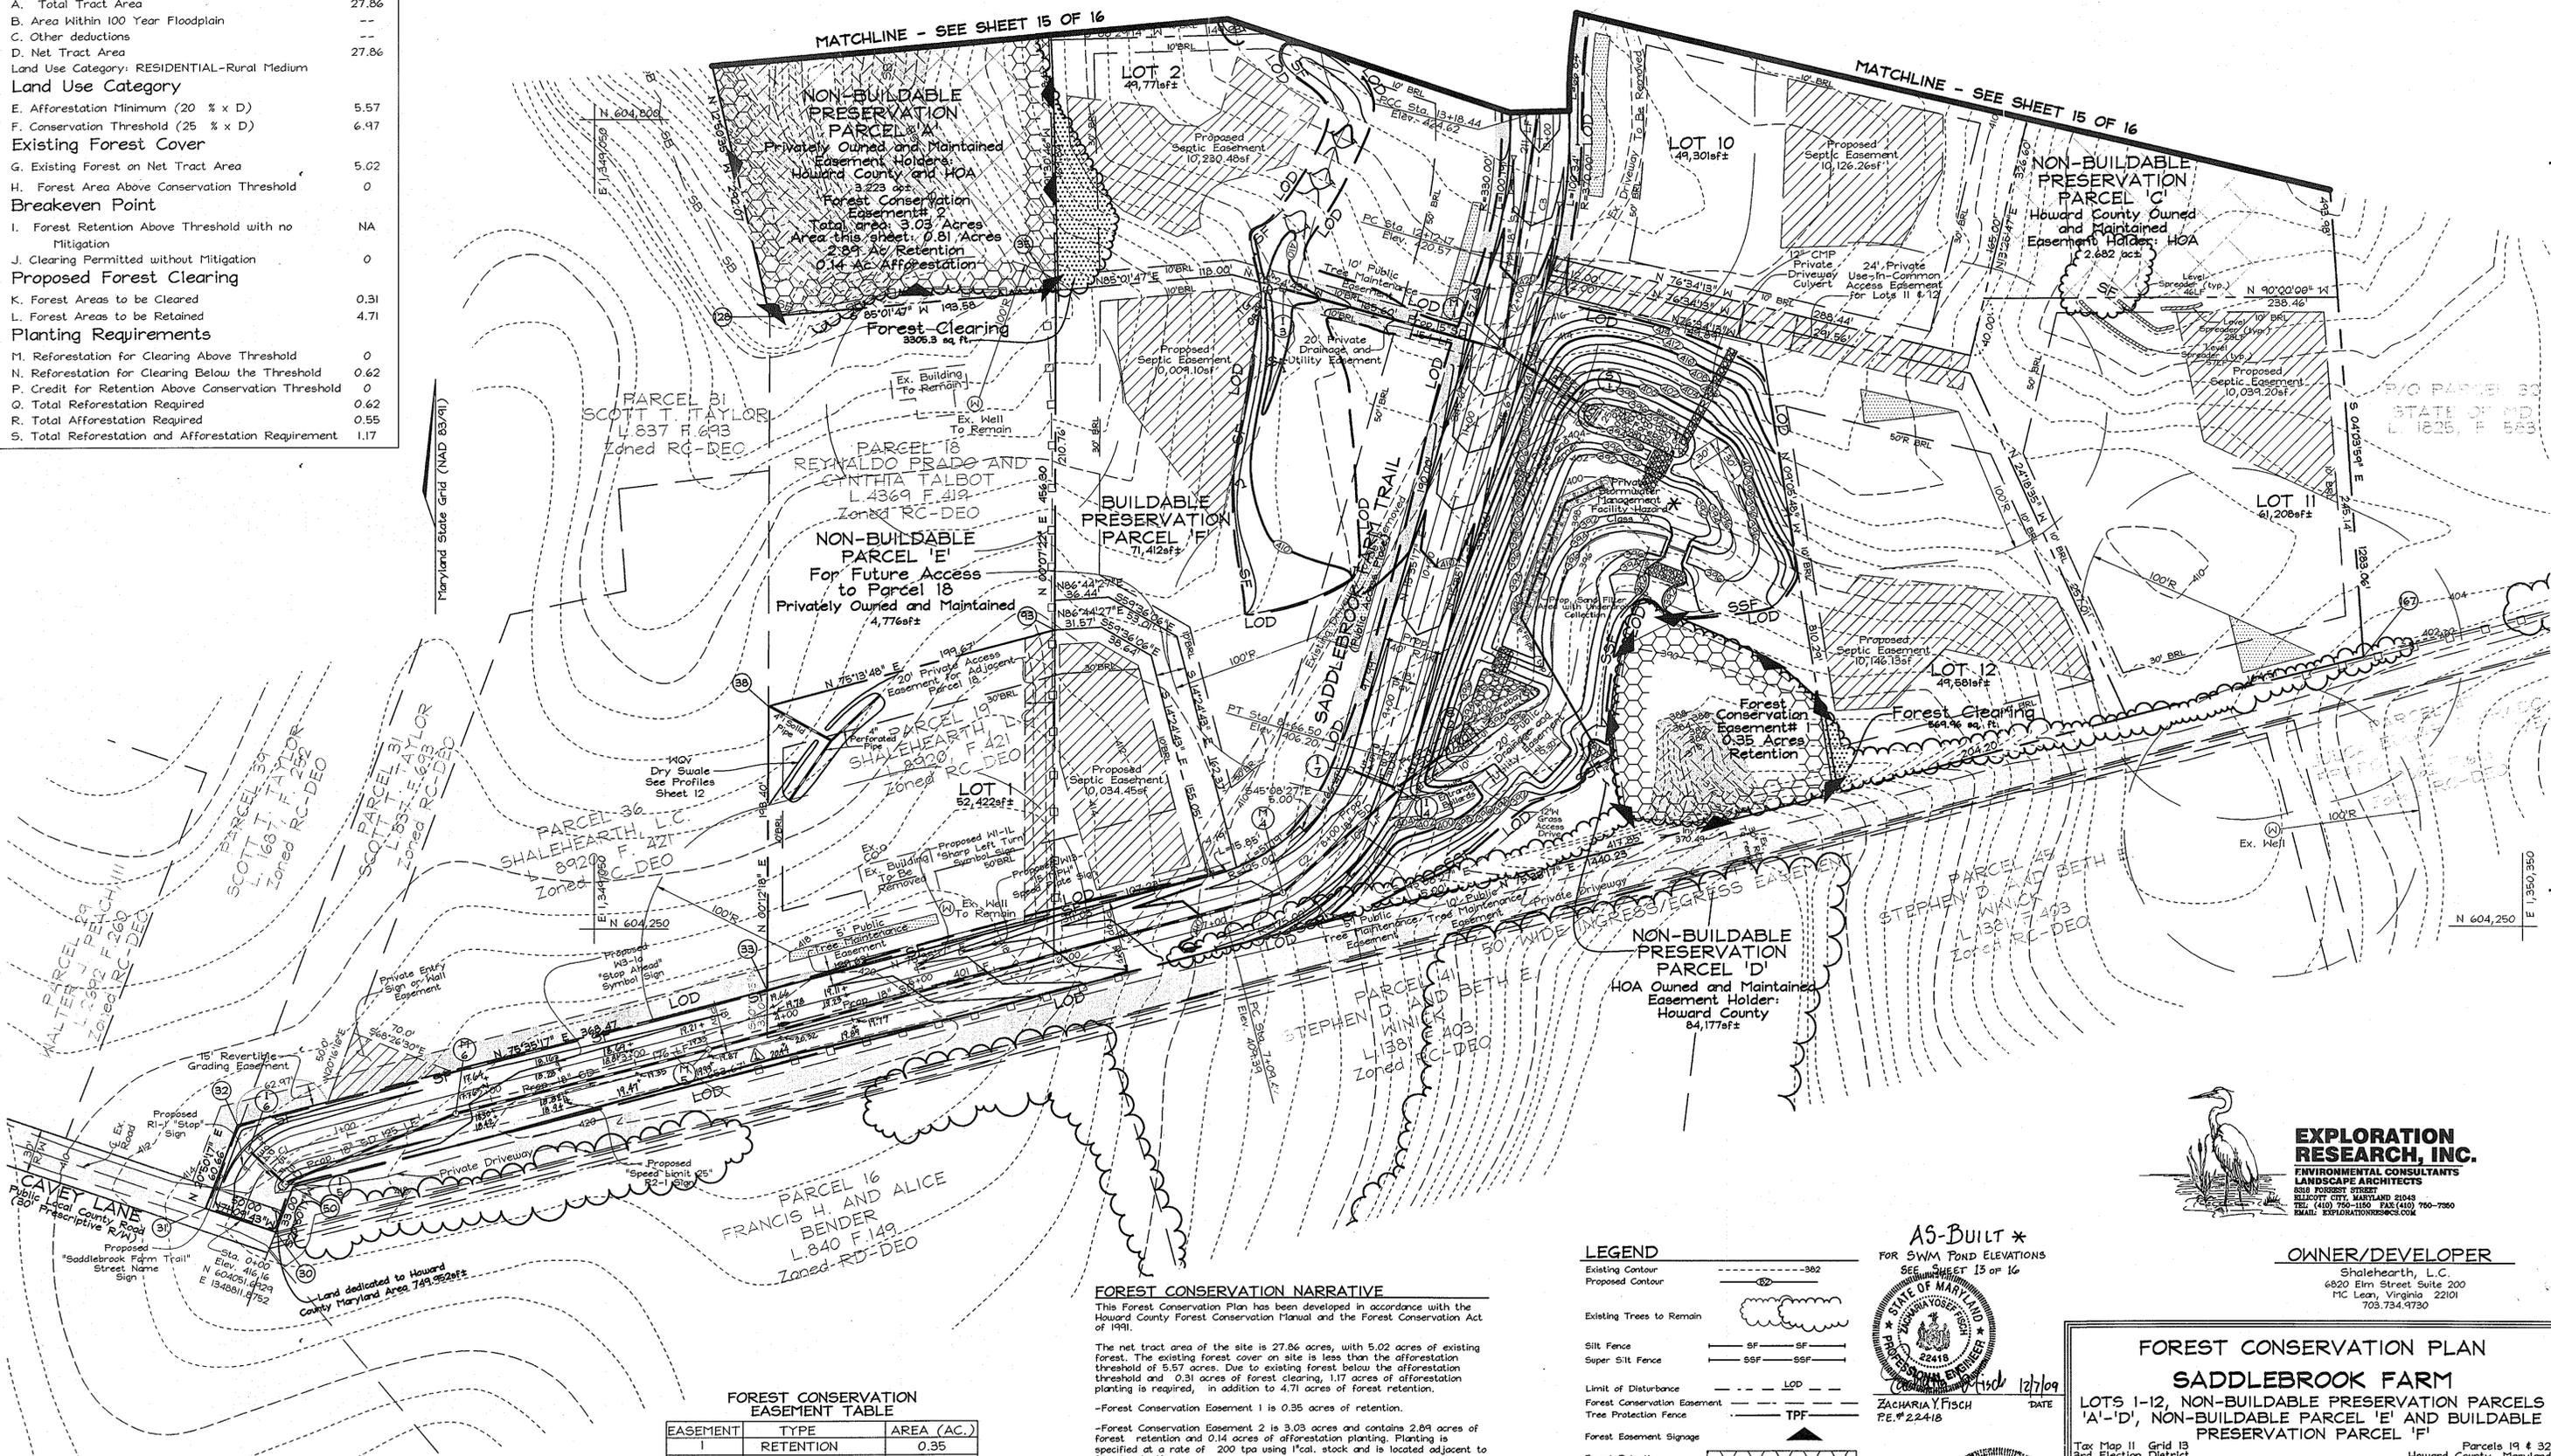

FOREST CONSERVATION EASEMENT TABLE

EASEMENT	TYPE	AREA (AC.)
1	RETENTION	0.35
2	AFFORESTATION	0.14
3	RETENTION	2.89
	AFFORESTATION	1.03
	RETENTION	1.47
TOTAL		5.88

FOREST CONSERVATION NARRATIVE
 This Forest Conservation Plan has been developed in accordance with the Howard County Forest Conservation Manual and the Forest Conservation Act of 1991.

The net tract area of the site is 27.86 acres, with 5.02 acres of existing forest. The existing forest cover on site is less than the afforestation threshold of 5.57 acres. Due to existing forest below the afforestation threshold and 0.31 acres of forest clearing, 1.17 acres of afforestation planting is required, in addition to 4.71 acres of forest retention.

-Forest Conservation Easement 1 is 0.35 acres of retention.

-Forest Conservation Easement 2 is 3.03 acres and contains 2.89 acres of forest retention and 0.14 acres of afforestation planting. Planting is specified at a rate of 200 tpa using local stock and is located adjacent to forest retention.

-Forest Conservation Easement 3 is 2.50 acres and contains 1.47 acres of forest retention and 1.03 acres of afforestation planting. Planting is specified at a rate of 350 tpa on the interior planting area, with a 25' wide buffer planting adjacent to lots 7 & 8, planted at a rate of 200 tpa with 1" cal stock. The planting area is located adjacent to forest retention.

The total forest conservation obligation for the site is 5.88 acres, with a total forest conservation surety amount of \$66,516.12. (retention: 4.71 acres or 225,167.6 sq. ft. x \$ 20 = \$41,033.52 + afforestation/reforestation is 1.17 acres or 50,965.2 sq. ft. x \$0.50 = \$25,482.60).

LEGEND

- Existing Contour: --- 362
- Proposed Contour: --- 362
- Existing Trees to Remain: [Symbol]
- Silt Fence: --- SF --- SF
- Super Silt Fence: --- SSF --- SSF
- Limit of Disturbance: --- LOD ---
- Forest Conservation Easement: --- FCE ---
- Tree Protection Fence: --- TPF ---
- Forest Easement Signage: [Symbol]
- Forest Retention: [Symbol]
- Planting Area: [Symbol]
- Forest Clearing: [Symbol]

* Forest Clearing designation on the plan is for computation purposes only and does not represent actual clearing on-site.

AS-BUILT *
 FOR SWM POND ELEVATIONS
 SEE SHEET 15 OF 16

STATE OF MARYLAND
 PROFESSIONAL ENGINEER
 ZACHARIA FISCH
 P.E. # 22418
 DATE: 12/7/09

EXPLORATION RESEARCH, INC.
 ENVIRONMENTAL CONSULTANTS
 LANDSCAPE ARCHITECTS
 8318 FOREST STREET
 BELTSVILLE, MARYLAND 20848
 TEL: (410) 750-1150 FAX: (410) 750-7260
 EMAIL: EXPLORATION@RESEARCH.COM

OWNER/DEVELOPER
 Shalehearth, L.C.
 6820 Elm Street Suite 200
 MC Lean, Virginia 22101
 703.734.4730

FOREST CONSERVATION PLAN
SADDLEBROOK FARM
 LOTS 1-12, NON-BUILDABLE PRESERVATION PARCELS 'A'-D', NON-BUILDABLE PARCEL 'E' AND BUILDABLE PRESERVATION PARCEL 'F'

Tax Map 11 Grid 13
 3rd Election District
 Parcels 19 & 32
 Howard County, Maryland

FSH Associates
 Engineers Planners Surveyors
 8318 Forest Street, Ellicott City, MD 21043
 Tel: 410-750-2251 Fax: 410-750-7350
 E-mail: info@fsha.biz

DESIGN BY: PS
 DRAWN BY: AB
 CHECKED BY: ZYF
 SCALE: 1"=50'
 DATE: May 17, 2006
 W.O. No.: 3312
 SHEET No.: 14 OF 16

APPROVED: HOWARD COUNTY DEPARTMENT OF PLANNING AND ZONING

Cinda Hammett 6/12/06
 CHIEF, DIVISION OF LAND DEVELOPMENT DATE


William W. White
 CHIEF, DEVELOPMENT ENGINEERING DIVISION DATE

No.	REVISION	DATE
1	REVISE ROAD CROSSSECTION AND GRADING	MAR 2007

LEGEND

Existing Contour	-----
Proposed Contour	-----
Existing Trees to Remain	
Silt Fence	--- SF --- SF
Super Silt Fence	--- SSF --- SSF
Limit of Disturbance	--- LOD ---
Forest Conservation Easement	--- FCE ---
Tree Protection Fence	--- TPF ---
Forest Easement Signage	
Forest Retention	
Planting Area	
Forest Clearing*	

* Forest Clearing designation on the plan is for computation purposes only and does not represent actual clearing on-site.

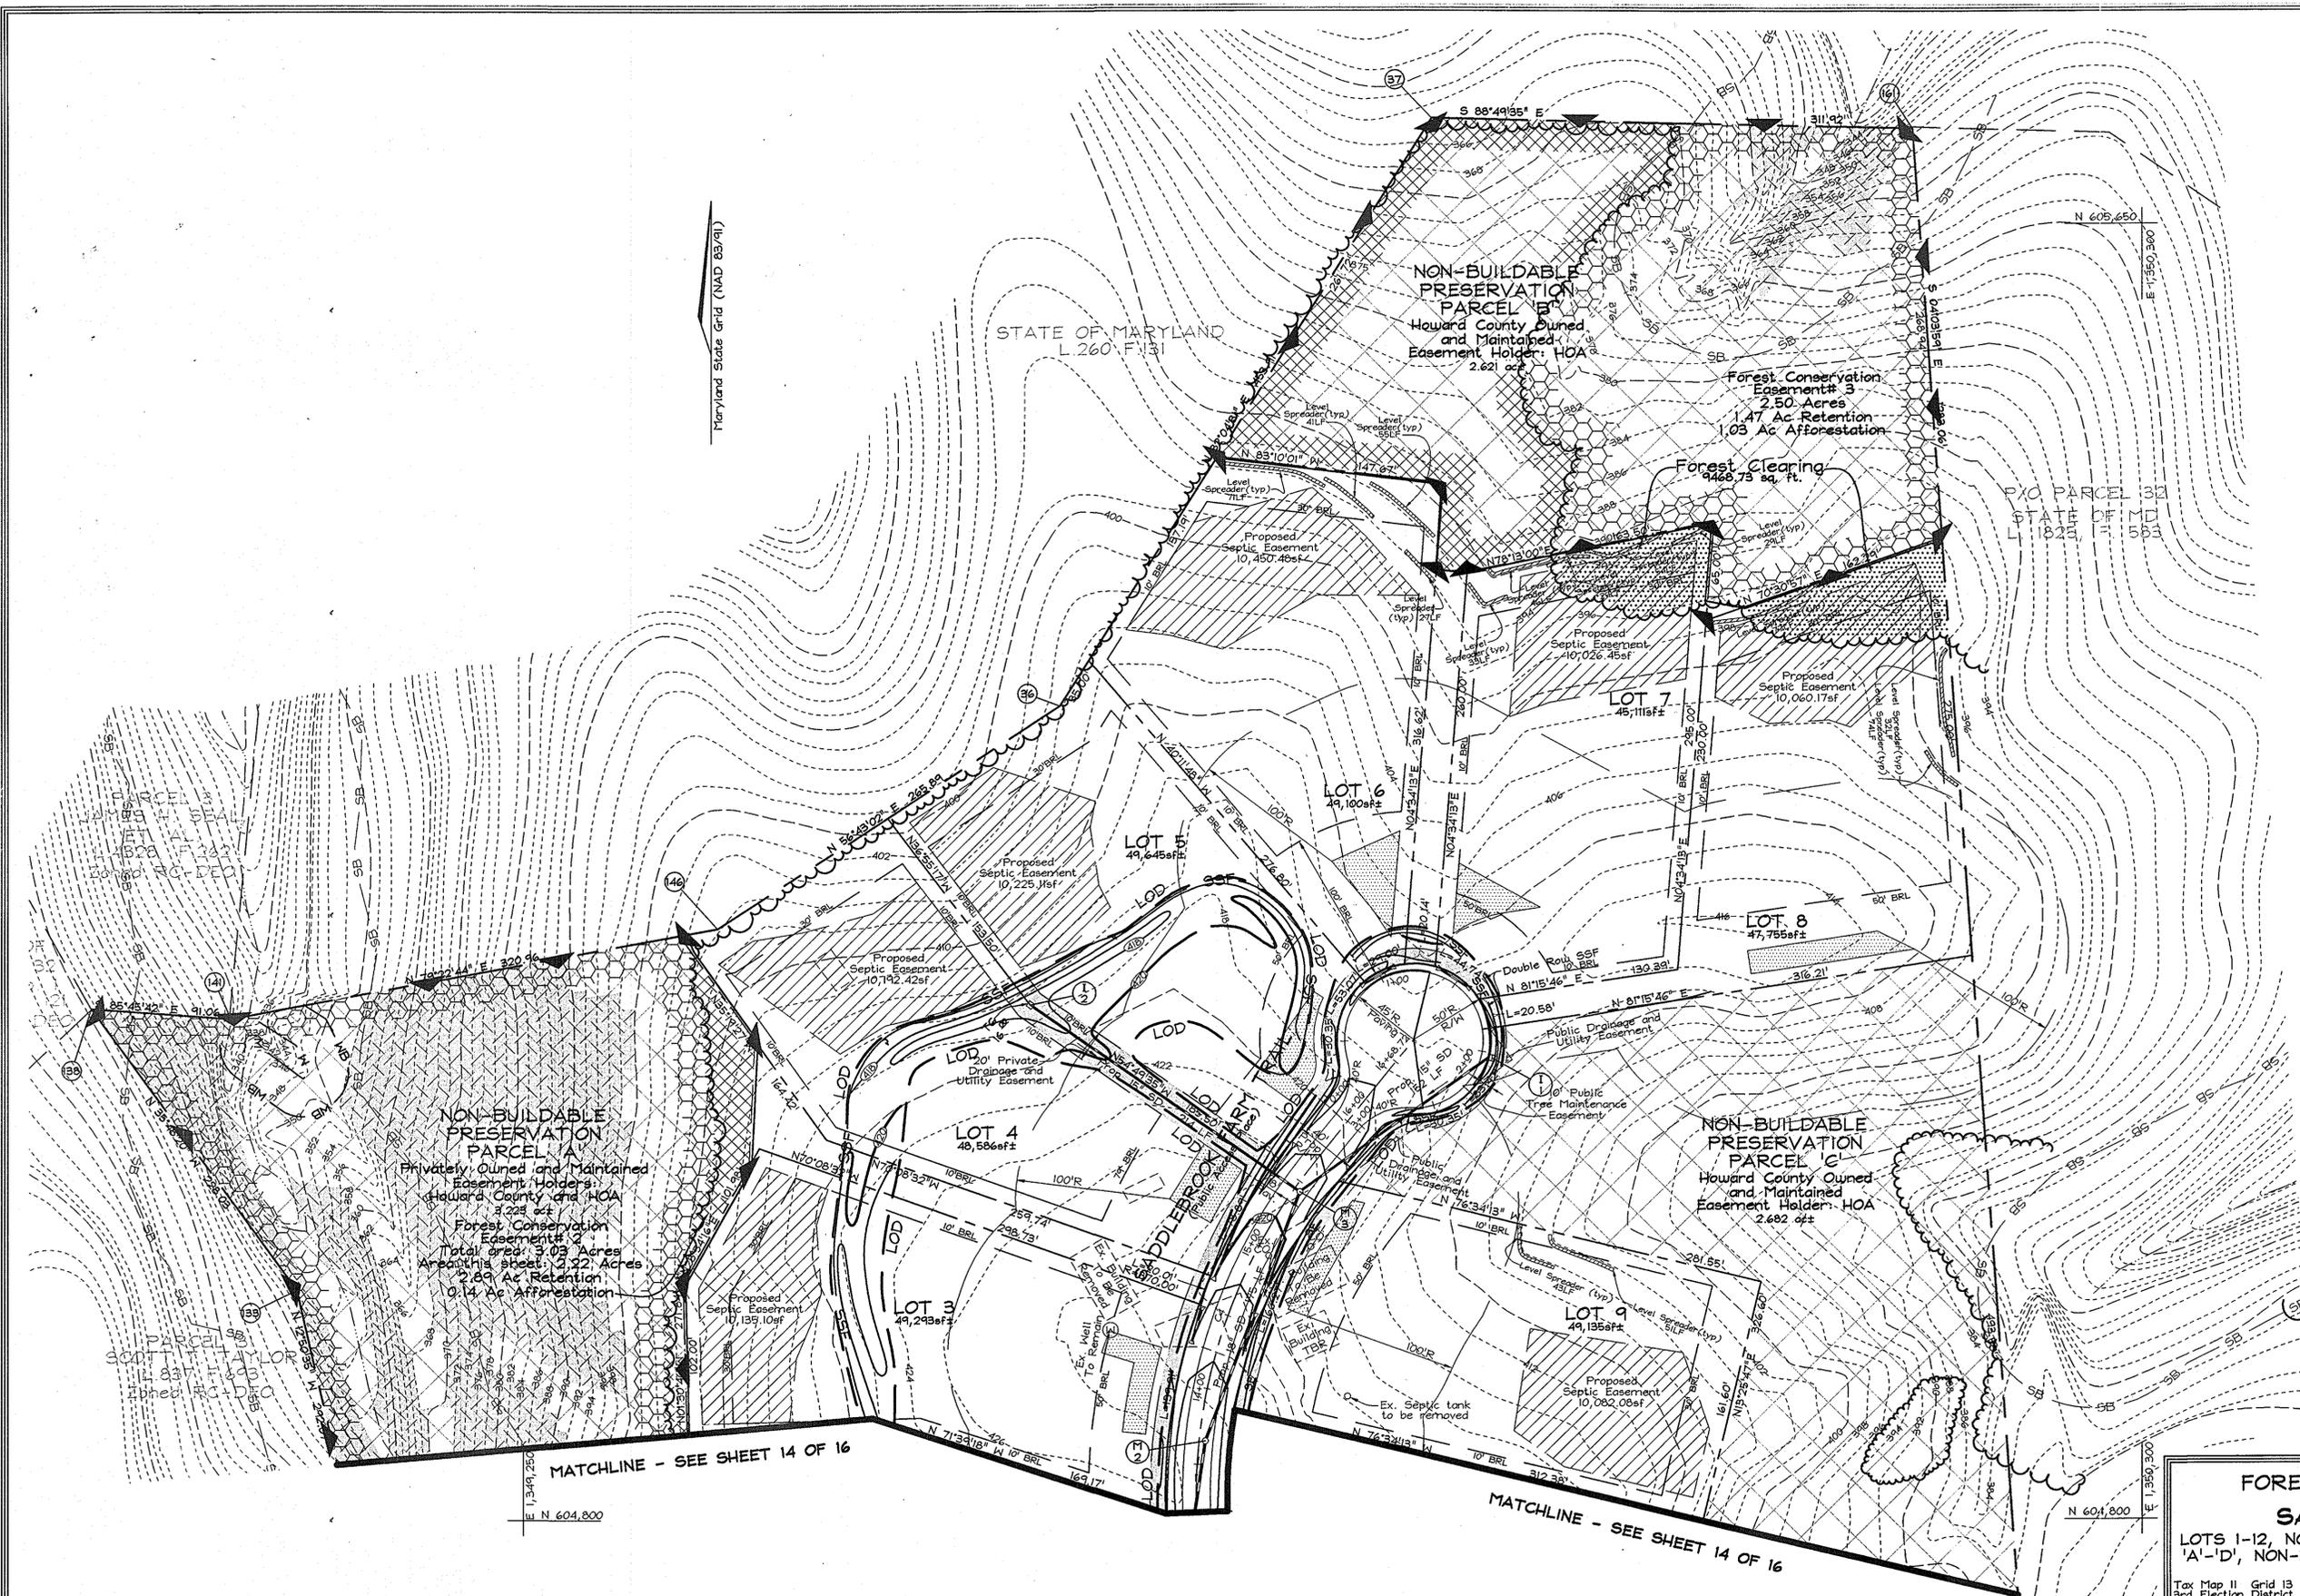


OWNER/DEVELOPER
 Shalehearth, L.C.
 6620 Elm Street Suite 200
 MC Lean, Virginia 22101
 703.734.4730

FOREST CONSERVATION PLAN
SADDLEBROOK FARM
 LOTS 1-12, NON-BUILDABLE PRESERVATION PARCELS 'A'-'D', NON-BUILDABLE PARCEL 'E' AND BUILDABLE PRESERVATION PARCEL 'F'
 Tax Map 11, Grid 13, 3rd Election District, Parcels 19 & 32, Howard County, Maryland

APPROVED: HOWARD COUNTY DEPARTMENT OF PLANNING AND ZONING

Cindy Harmon 6/16/06
 CHIEF, DIVISION OF LAND DEVELOPMENT DATE

John Dammann 6/16/06
 CHIEF, DEVELOPMENT ENGINEERING DIVISION DATE

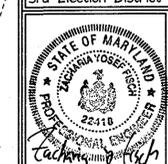

FSH Associates
 Engineers Planners Surveyors
 8318 Forrest Street, Ellicott City, MD 21043
 Tel: 410-750-2251 Fax: 410-750-7350
 E-mail: info@fsha.biz

DESIGN BY: PS
 DRAWN BY: AB
 CHECKED BY: ZYF
 SCALE: 1"=50'
 DATE: May 17, 2006
 W.O. No.: 3312
 SHEET No.: 15 OF 16


Easement 2: AFFORESTATION PLANTING AREA: 0.14 Ac. (200 TPA)
(0.14 ac x 200 TPA = 28 - 1" cal. trees)

Qty	Botanical Name	Common Name	Min. Size	Spacing	Notes
4	Acer rubrum	Red Maple	1" Cal	5' o.c.	Container or B & B
5	Liquidambar styraciflua	Sweetgum	1" Cal	15' o.c.	
6	Quercus rubra	Red oak	1" Cal	15' o.c.	
5	Amenanchier canadensis	Service berry	1" Cal	15' o.c.	
4	Cercis canadensis	Red bud	1" Cal	15' o.c.	
4	Quercus alba	White oak	1" Cal	15' o.c.	

28 Total Plantings


Easement 3: Total Afforestation Planting Area: 1.03 Ac.
-Lot Line Buffer Planting (25' wide) 1" Cal Stock, 200 TPA: 0.16 Ac.
-Whip Planting 2-3', 1-3 Gal. Container Grown, 350 TPA: .87 Ac.
(0.16 ac x 200 TPA = 32 - 1" cal. trees; 0.87 ac x 350 TPA = 305 - whips; Total 337 trees)

Qty	Botanical Name	Common Name	Min. Size	Spacing	Notes
50	Acer rubrum	Red Maple	WHIP 2-3'	11' o.c.	1-3 Gallon Container Grown
50	Liquidambar styraciflua	Sweetgum	WHIP 2-3'	11' o.c.	
50	Quercus rubra	Red oak	WHIP 2-3'	11' o.c.	
55	Amenanchier canadensis	Service berry	WHIP 2-3'	11' o.c.	
50	Cercis canadensis	Red bud	WHIP 2-3'	11' o.c.	
50	Quercus alba	White oak	WHIP 2-3'	11' o.c.	
10	Acer rubrum	Red Maple	1" Cal.	15' o.c.	Container or B & B
10	Liquidambar styraciflua	Sweetgum	1" Cal.	15' o.c.	
12	Quercus rubra	Red oak	1" Cal.	15' o.c.	
337	Total Planting				

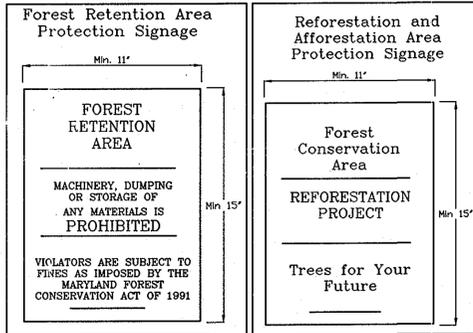


SIGN DETAIL: PERMANENT SIGN

SIGNAGE NOTE: ALL TREE PROTECTION SIGNS SHALL BE PLACED ON METAL 1" POSTS OR PRESSURE TREATED WOOD POLES. NO ATTACHMENT OF SIGNS TO TREES IS PERMITTED.

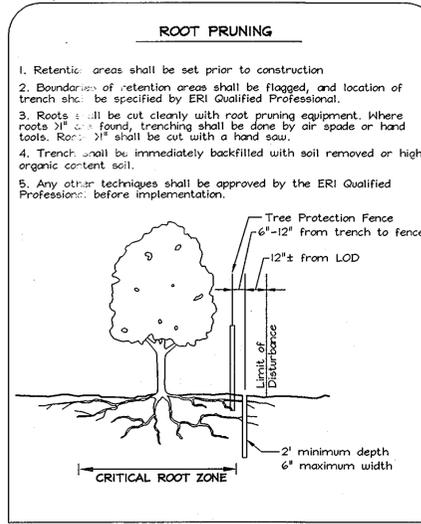

Soil Protection Zone Notes

- The Soil Protection Zone shall include all areas contained inside the Limit of Disturbance.
- Where possible, the Soil Protection Zone shall extend to the drip line of specimen trees. For other groups of trees, the zone shall be the drip line or 40% of the height of the tree, whichever is greater.
- No construction activity is permitted within the Soil Protection Zone.
- If soil has been compacted or grading has taken place in the vicinity of the Soil Protection Zone, root pruning shall be implemented per Root Pruning detail, shown on this plan.
- Root pruning shall occur prior to the beginning of construction.
- Where the Soil Protection Zone must encroach inside the Critical Root Zone of a tree, soil disturbance shall be mitigated with vertical mulching, radial trenching, or another method approved by the ERI Forest Conservation Professional.
- Prior to construction, the Limits of Disturbance shall be marked and the ERI Professional shall determine which trees will need preventative treatment or removal.
- Tree maintenance and removal shall be undertaken by a qualified MID Tree Expert to ensure damage to surrounding trees is minimized.
- Brush and limbs removed for construction shall be chipped and spread at the edge of the Soil Protection Zone to a depth to exceed 6 inches. This shall occur outside the Soil Protection Zone where compaction could impact otherwise unprotected Critical Root Zone.

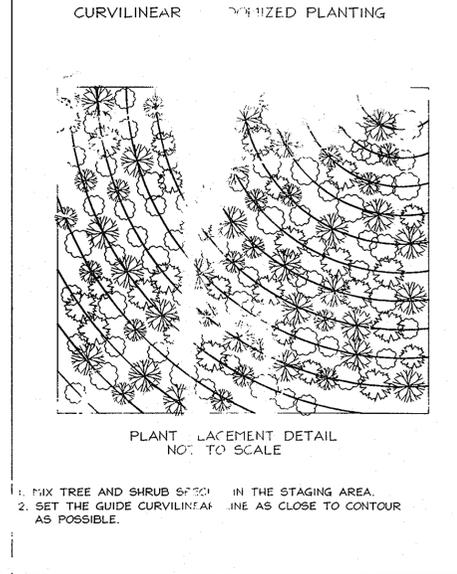

Forest Tree Protection and Management Notes





- Tree protection devices shall be installed prior to any grading or land clearing.
- After the boundaries of the retention areas have been staked and flagged and before any disturbance has taken place a pre-construction meeting with the Howard County Inspector is required.
- Provide maintenance to tree protection devices and signage to maintain their integrity throughout the duration of the project.
- Attachment of signs to tree protection devices to maintain their integrity throughout the duration of the project.
- Any significant changes made to the Forest Conservation Plan shall be made with the prior approval by the Howard County Dept. Of Planning and Zoning.
- No burial of discarded material is permitted within the Forest Conservation and Planting area.
- No open burning within 100 feet of wooded areas is permitted.
- Post construction phase:
 - Inspect existing trees around the perimeter of the site for signs of root or trunk damage and excessive soil compaction.
 - Remove dead or dying trees and evaluate for hazard tree removal.
 - All temporary forest protection devices will be removed after construction.
 - Following completion of construction, prior to use, the county inspector shall inspect the entire site for compliance with this Forest Conservation Plan.

Afforestation Area Planting Notes


- Initial planting inspection and certification required. Planting contractor to notify ERI qualified professional 24 hours in advance of planting.
- Afforestation areas may be planted as soon as reasonable to do so. Late winter- early spring plantings are preferred. Earliest planting dates will vary from year to year but planting may generally begin as soon as the ground is no longer frozen. Alternate planting dates may be considered as conditions warrant.
- Soil amendments and fertilization recommendations will be made based upon the results of soil analysis for nitrogen, phosphorus, potassium, organic matter content and pH. If required, fertilizer will be provided using a slow release, soluble 16-8-16 analysis designed to last 5-8 years contained in polyethylene perforated bags such as manufactured by ADCO Works, P.O. Box 310 Hellins, N.Y. 11423 or approved equal.
- Plant materials shall be planted in accordance with the planting diagram, planting details and planting schedule.
- Plant stock must be protected from desiccation at all times prior to planting. Materials held for planting shall be moistened and placed in cool shaded areas until ready for placement.
- Planting materials shall be nursery grown and inspected prior to planting. Plants not conforming to the American Standards for Nursery Stock specifications for size, form, vigor, or roots, or due to trunk wounds, breakage, desiccation, insect or disease must be replaced.
- Newly planted trees may require watering at least once per week during the first growing season depending on rainfall in order to get established. The initial planting operation should allow for watering during installation to completely soak backfill materials.
- Mulch shall be applied in accordance with the diagram provided and shall consist of composted, shredded hardwood bark mulch, free of wood alcohol.
- Planting holes should be excavated to a minimum diameter of 2.5 to 3 times the diameter of the root ball or container. Mechanical auguring is preferred with scarification of the sides of each hole.
- Deer repellents, such as repellax, shall be used or 5' tree shelters must be installed.

Afforestation Area Monitoring Notes

- Monthly visits during the first growing season are to assess the success of the plantings and to determine if supplemental watering, pest control or other actions are necessary. Early spring visits will document winter kill and autumn visits will document summer kill.
- The minimum survival rate shall be 75% of the total number of trees planted per acre at the end of the two year maintenance period. Wild tree seedlings from natural regeneration on the planting site may be counted up to 50% toward the total survival number if they are healthy native species at least 12 inches tall.
- Survival will be determined by a stratified random sample of the plantings. The species composition of the sample population should be proportionate to the amount of each species in the entire planting to be sampled.
- Effective monitoring will assess plant survivability during the first growing season and make recommendations for reinforcement planting if required at that time.

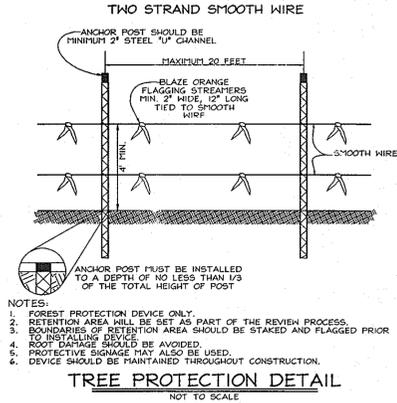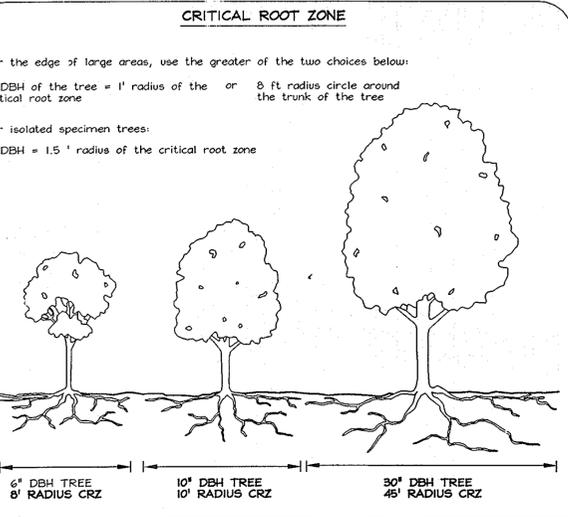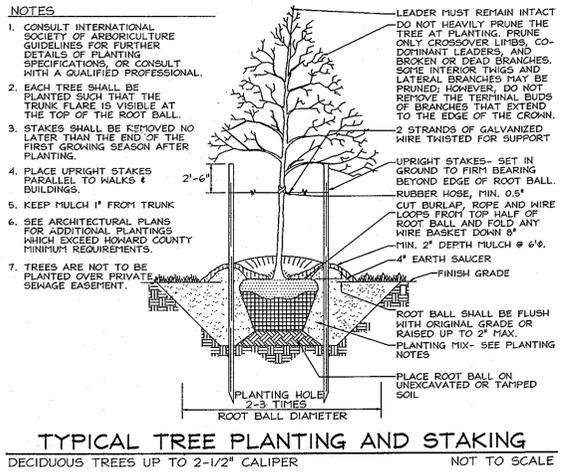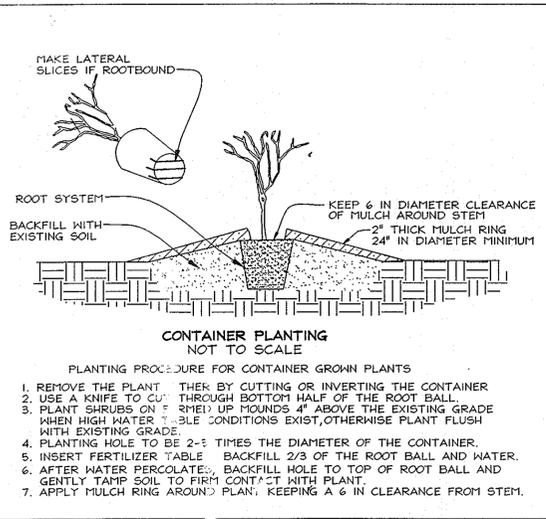

APPROVED: HOWARD COUNTY DEPARTMENT OF PLANNING AND ZONING
Candy Hammett 6/21/16
 DIVISION OF LAND DEVELOPMENT JA DATE
Chris Williams 6/21/16
 CHIEF, DEVELOPMENT ENGINEERING DIVISION DATE

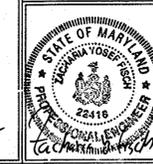

FSH Associates
 Engineers Planners Surveyors
 8318 Forrest Street Ellicott City, MD 21043
 Tel: 410-750-2251 Fax: 410-7350
 E-mail: info@fsha.biz

DESIGN BY: PS
 DRAWN BY: AB
 CHECKED BY: ZYF
 SCALE: As Shown
 DATE: May 17, 2006
 W.O. No.: 3312
 SHEET No.: 16 OF 16

FOREST CONSERVATION NOTES AND DETAILS
SADDLEBROOK FARM
 LOTS 1-12, NON-BUILDABLE PRESERVATION PARCELS 'A'-'D', NON-BUILDABLE PARCEL 'E' AND BUILDABLE PRESERVATION PARCEL 'F'
 Tax Map 11 Grid 13 3rd Election District Parcels 19 & 32 Howard County, Maryland

EXPLORATION RESEARCH, INC.
 ENVIRONMENTAL CONSULTANTS
 LANDSCAPE ARCHITECTS
 6818 FOREST STREET
 ELICOTT CITY, MARYLAND 21043
 TEL: (410) 750-1150 FAX: (410) 750-7350
 EMAIL: EXPLORATION@ESRCS.COM

OWNER/DEVELOPER
 Shalehearth, L.C.
 6820 Elm Street Suite 200
 MC Lean, Virginia 22101
 703.734.9730