


GENERAL NOTES

- Subject property zoned RR-DEO per 02/02/04 Comprehensive Zoning Plan.
- Private water and sewer will be used within this site.
- Total area of property: 76.89Ac.±
- Area of proposed public R/W: 4.165Ac.±
- Number of proposed buildable lots: 35
- Area of proposed buildable lots: 36.936Ac.±
- Number of proposed buildable preservation parcels: 1
- Area of proposed buildable preservation parcels: 10.355Ac.±
- Number of proposed non-buildable preservation parcels: 5
- Area of proposed non-buildable preservation parcels: 25.440Ac.±
- Density calculations:
 - Total area of property = 76.89 Ac.±
 - Area of steep slopes = 0.480 Ac.±
 - Area of 100 yr floodplain = 4.350 Ac.±
 - Net Area of property = 72.066 Ac.±
 - Total number of Units based on own density: 76.89 Ac./4.25 Ac.per unit=18,043 units therefore 18 units
 - Maximum number of units allowed utilizing the DEO option: 72.066 Ac. / 2 Acres per Unit = 36.03 Units therefore 36 units
 - Number of DEO Units required = 36-18 = 18 DEO Units
- The lots shown hereon comply with the minimum ownership, width and lot area as required by the Maryland State Department of the Environment.
- This area designates a private sewage easement of at least 10,000 square feet (or 10,000 square feet per lot for shared drain fields associated with a shared sewage disposal facility) as required by the Maryland State Department of the Environment for individual sewage disposal (COMAR 26.04.03). Improvements of an nature in this area are restricted until public sewerage is available. These easements shall become null and void upon connection to a public sewerage system. The County Health Officer shall have the authority to grant adjustments to the private sewage easement.
- All wells and septic fields within 100' of property's boundary have been shown.
- The septic fields are located on soil types CgS2, CgC2, EKA, GmB2, GmC2, MIB2, MID2, MID3, and MIE as per the soil survey of Howard County.
- On-site topography based on a Field Run Topographic Survey prepared by FSH Associates dated January, 2004. Off-site and non-critical topography based on Howard County 1998 Aerial Topographic Surveys with five foot contours.
- All wells to be drilled prior to final plat signature. It is the developer's responsibility to schedule the well drilling prior to final plat submission. It will not be considered 'government delay' if the well drilling holds up the Health Department signature of the record plat.
- Groundwater appropriations permit # H02004G000(1)
- A.P.F.O. traffic study prepared by Traffic Concepts, Inc. and approved on October 14, 2004 under SP-04-15.
- Wetlands Analysis prepared by Exploration Research Inc. and approved on October 27, 2004 under SP-04-15.
- The project is not within the metropolitan district.
- The project is in conformance with the latest Howard County Standards unless waivers have been approved.
- The coordinates shown hereon are based upon the Howard County Geodetic Control which is based on the Maryland State Plane Coordinate system. Howard County monument numbers 341A and 341B were used for this project.
- Storm Water Management for cpv and way is provided in a Micro Pool Extended Detention facility grass channels and sheet flow to buffer credit. Rev will be provided in grass swales. The facility will be privately owned with joint maintenance by the H.O.A. and Howard County.
- No clearing, grading or construction is permitted within wetlands, streams or their required buffers and Forest Conservation or Natural Conservation Credit Easements.
- The geological report for this project was prepared by Hillis - Carns Engineering Associates, Inc. on May 10, 2004.
- For flag or pipestem lots, refuse collection, snow removal and road maintenance are provided to the junction of the flag or pipestem and road right-of-way line.
- Forest Conservation is met by planting 9.35 Acres of forest within Forest Conservation Easement # 1. Total (407,286 sf x \$0.5 per sf) = \$203,643.00 surety will be posted with the Developer's Agreement.
- Buildable preservation parcel 'A' shall be privately owned and maintained, with H.O.A. and Howard County being Easement Holders.
- Environmental Non-buildable preservation parcels 'B', 'C', and 'D' shall be privately owned and maintained, with H.O.A. and Howard County being Easement Holders.
- Non-buildable preservation parcels 'E' shall be privately owned and maintained, with H.O.A. and Howard County being Easement Holders. Ownership of preservation parcel 'E' is intended to be conveyed to the adjacent property owner. The parcel is intended to be utilized for pasture.
- Non-buildable preservation parcels 'F' shall be H.O.A. owned and maintained, with Howard County being Easement Holder. This Parcel contains the storm water management facility.
- Existing structures on site shall be removed prior to record plat signature and recordation.
- All wells to be field located after being drilled by a licensed surveyor prior to building permit issuance.
- The contractor shall notify the following utility companies or agencies at least five(5) working days before starting work shown on these plans:

State Highway Administration	410.531.5533
BGE(Contractor services)	410.250.4620
BGE(underground damage control)	410.787.9068
Mesa Utility	1.800.257.7777
Colonial Pipeline Company	410.795.1390
Howard County, Dept. of Public Works, Bureau of Utilities	410.313.4900
Howard County Health Department	410.313.2640
- Financial surety for the required landscaping will be posted as part of the Developer's Agreement in the amount of \$69,600 (147 shade trees @ \$300.00 each, and 70 Evergreen Trees @ \$150.00 each).
- This plan is subject to the amended 5th Edition of the Subdivision Regulations (CB 45-2003) and the 2004 Zoning Regulations (CB 75-2003).
- The property is listed on the historic sites inventory as "HO-467, the George Richardson Farm".
- Previous Howard County file numbers: SP-04-13.
- All sign posts used for traffic control signs installed in the county's right-of-way shall be mounted on a 2" galvanized steel, perforated, square tube post (14 gauge) inserted into a 2-1/2" galvanized steel perforated, square tube sleeve (12 gauge) 3' long. A galvanized steel pole cap shall be mounted on top of each post.
- Traffic markings on Rt. 108 will be provided by Traffic Concepts, Inc.


General Notes Continued...

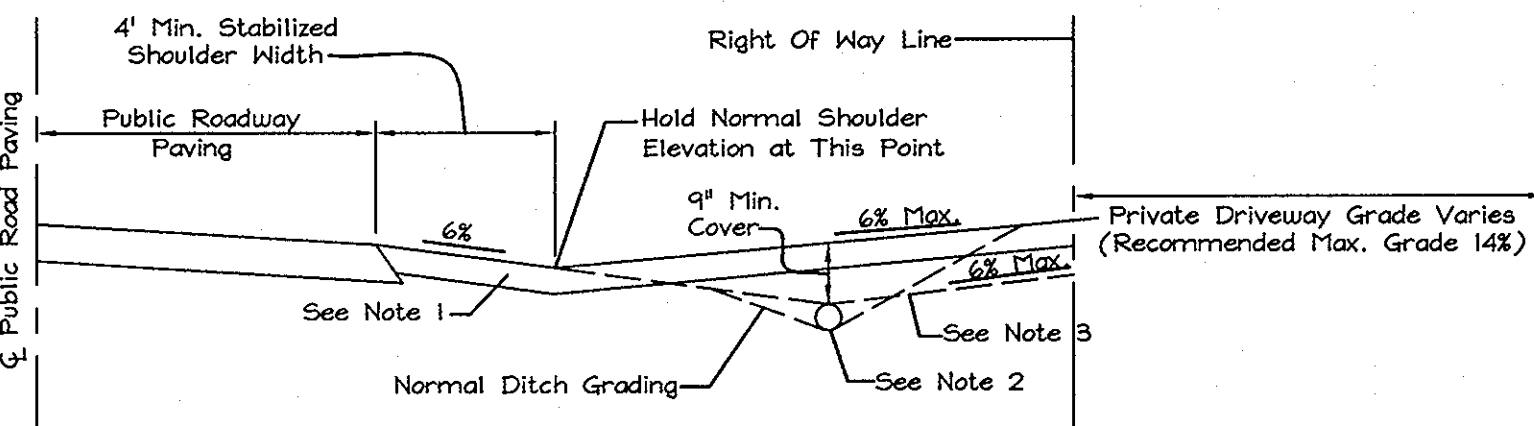

**SECTION A-A
RESIDENTIAL DRIVEWAY ENTRANCE**
CONNECTION TO OPEN SECTION ROADWAY
HOWARD COUNTY DETAIL R6.06
NOT TO SCALE

NOTES:

- Driveway must be paved from edge of public road to right of way line using standard paving section P-1 as shown on Std. No. or alternate section equal to or better than P-1, as approved by D.P.W.
- Drainage culvert shall be sized for a 10 year frequency storm and the minimum size shall be 12" dia. round or 14" x 9" arch pipe. If larger pipe is required, ditch invert shall be lowered to provide min. ditch gradient of 0.5% and clearance shown.
- Swale flow may be provided over driveway located at or near the crest of vertical curves on the public road where quantity of flow is small, as approved by D.P.W.
- Tie-in grade of private driveway shall not exceed 14%.
- All private driveway culverts to be 12" CIP or equivalent.

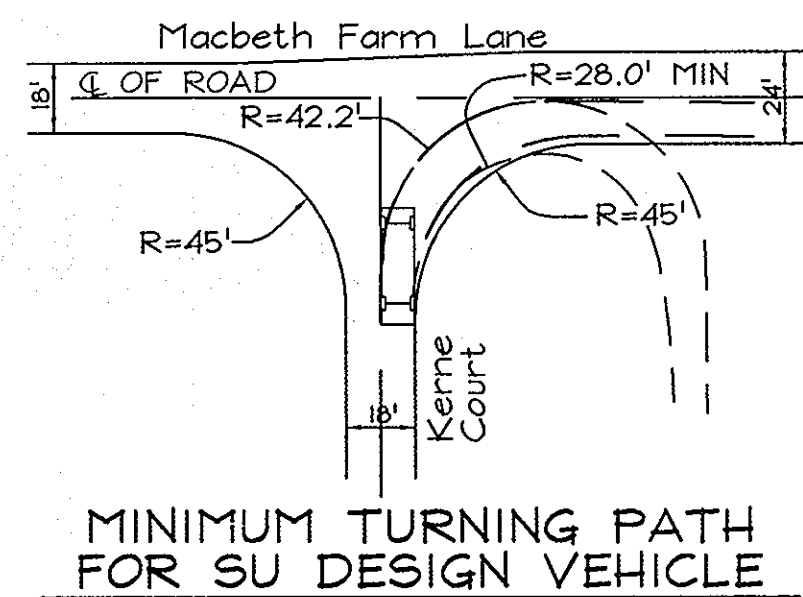

MINIMUM TURNING PATH FOR SU DESIGN VEHICLE
SCALE 1"=50'

APPROVED: HOWARD COUNTY DEPARTMENT OF PLANNING AND ZONING

APPROVED: HOWARD COUNTY DEPARTMENT OF PUBLIC WORKS.

Cinda Hamat 10/10/06
CHIEF, DIVISION OF LAND DEVELOPMENT DATE

William J. White 10/10/06
CHIEF, DEVELOPMENT ENGINEERING DIVISION DATE


William J. White 10-4-06
CHIEF, BUREAU OF HIGHWAYS DATE

FINAL ROAD CONSTRUCTION PLANS

MACBETH FARM

LOTS 1 THRU 35, BUILDABLE PRESERVATION PARCEL 'A', NON-BUILDABLE PRESERVATION PARCELS 'B', 'C', 'D', 'E', AND 'F'


HOWARD COUNTY, MARYLAND

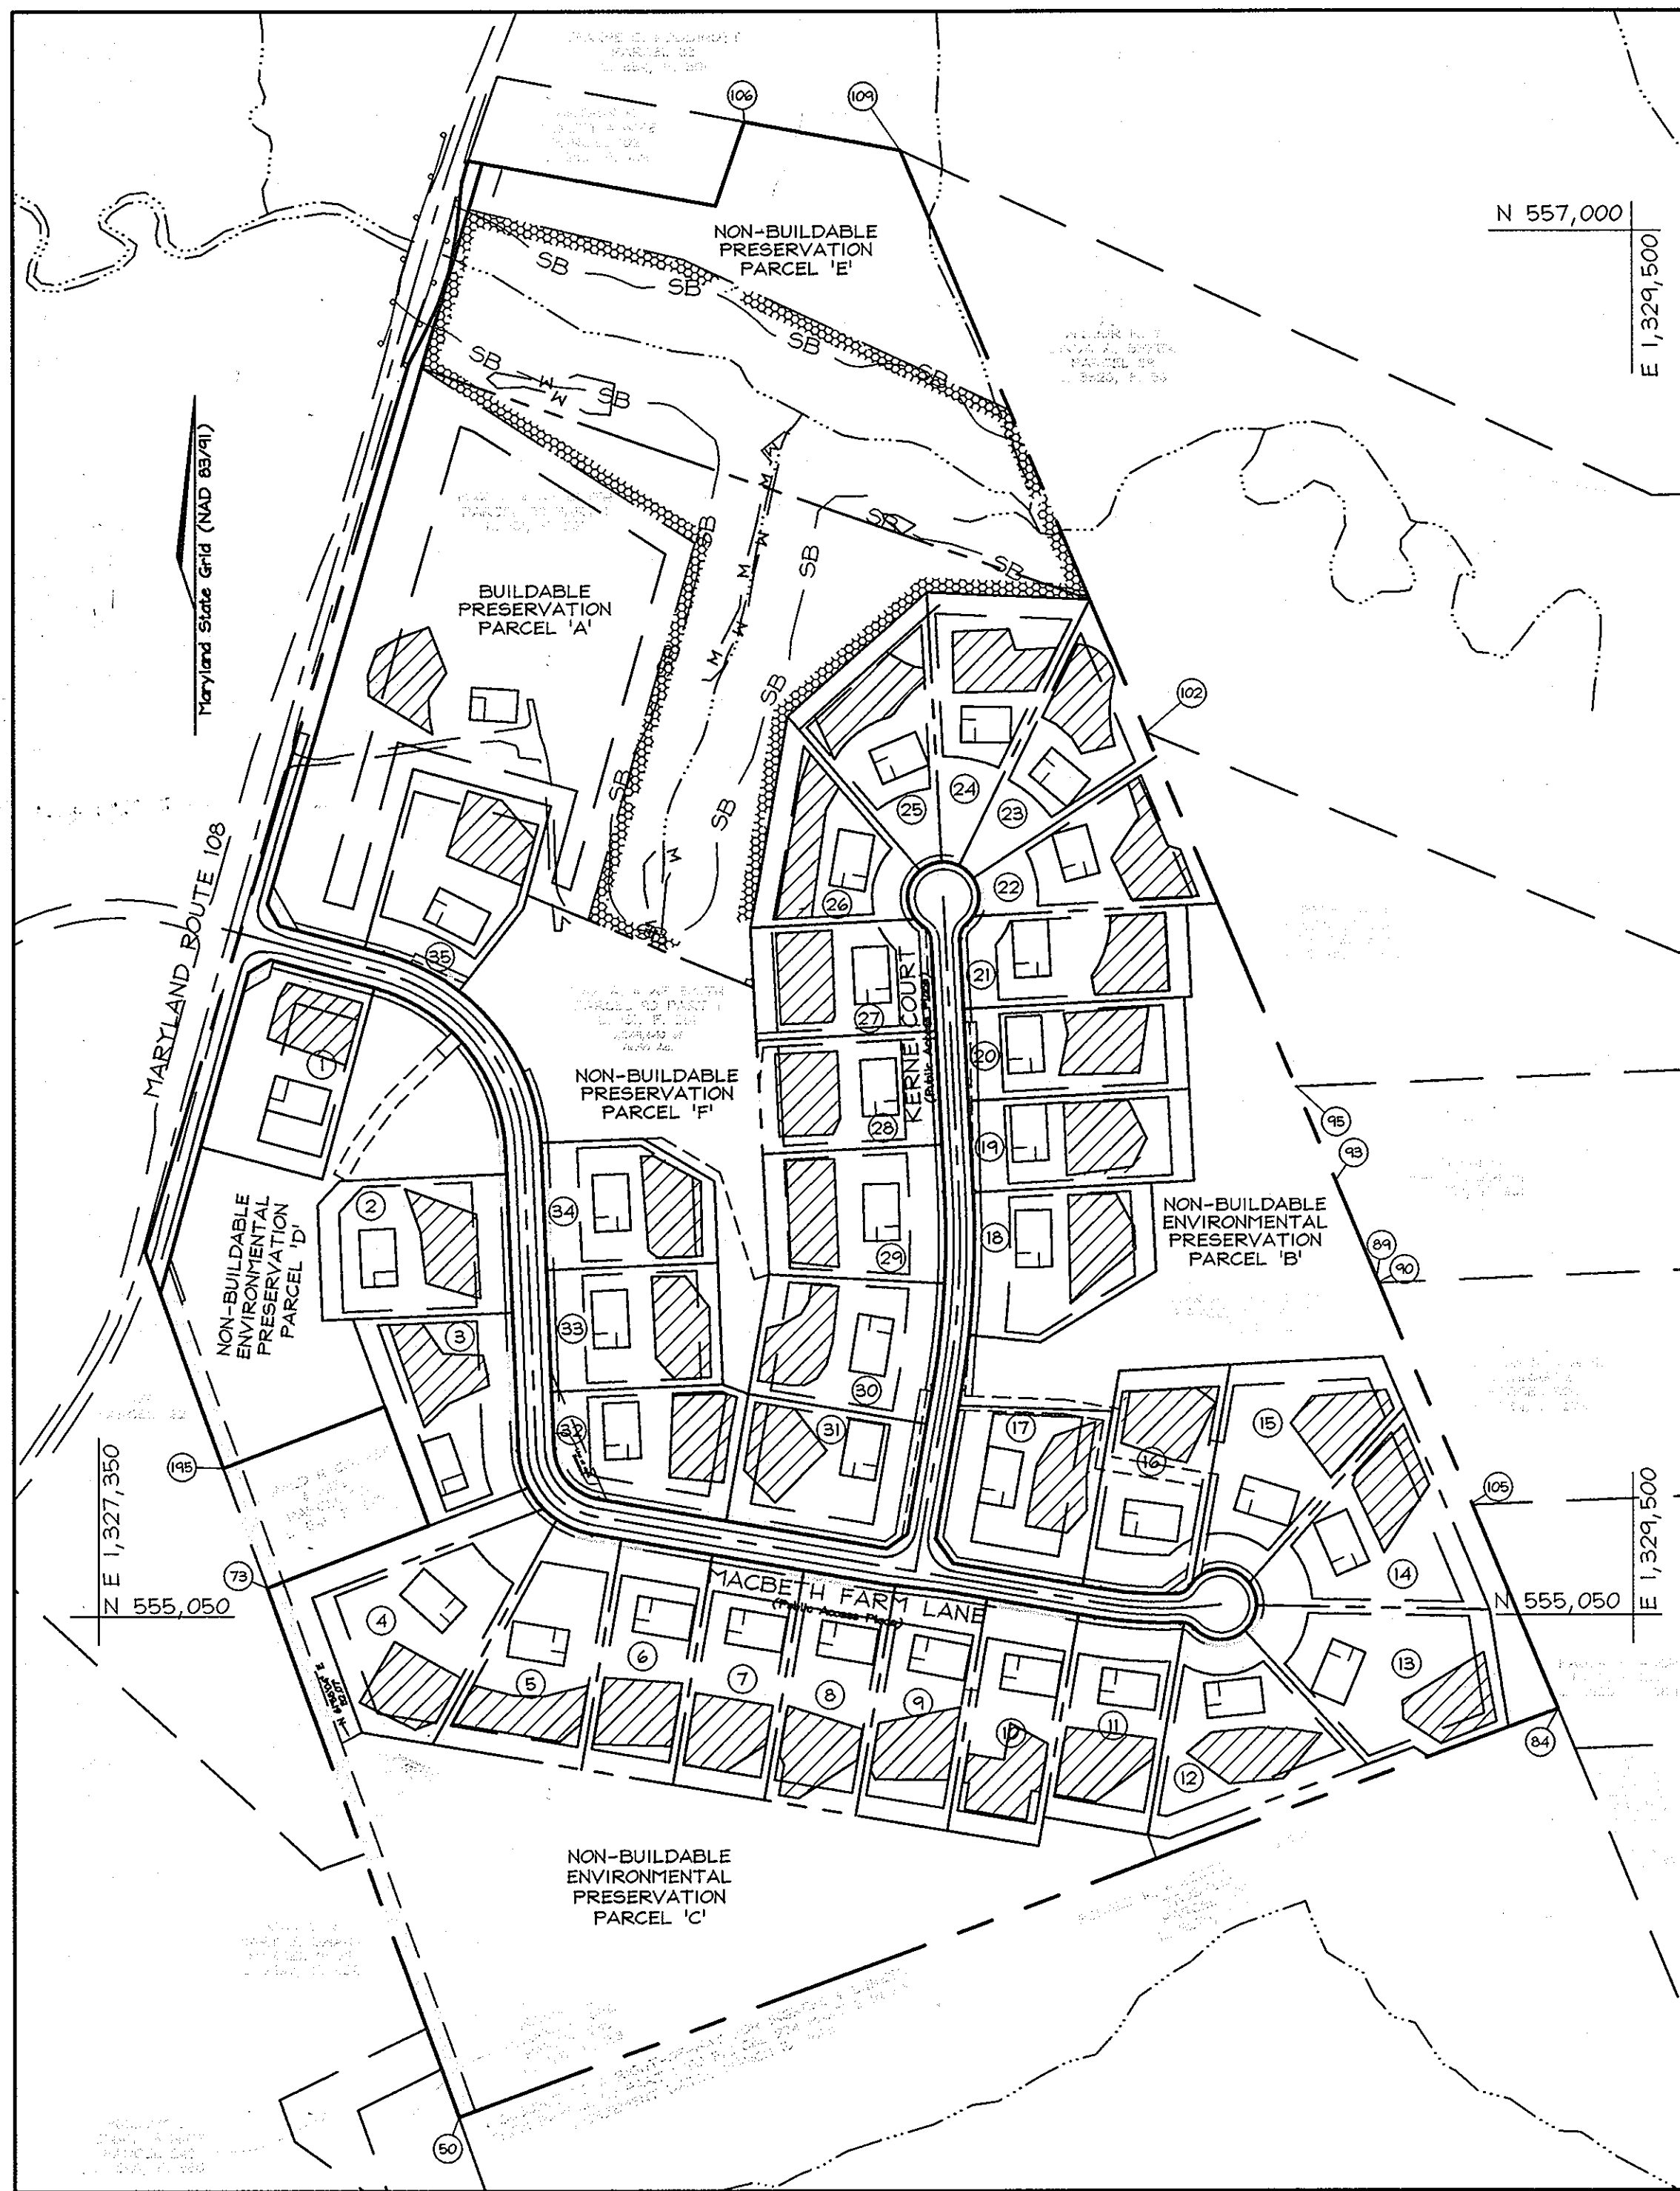

LOCATION MAP
SCALE: 1"=200'

LEGEND

- Existing Contour: Dashed line with elevation (e.g., 382)
- Proposed Contour: Solid line with elevation (e.g., 444)
- Direction of Flow: Arrow with elevation (e.g., 382.5)
- Existing Spot Elevation: Dotted line with elevation (e.g., +62.53)
- Proposed Spot Elevation: Solid line with elevation (e.g., +62.53)
- Existing Stream Buffer: Two parallel lines labeled SB
- Existing Wetland Buffer: Two parallel lines labeled WB
- Existing Wetland: Wavy line labeled W
- Existing Trees to Remain: Cloud-like outline
- Proposed Septic Area: Hatched pattern
- Proposed Well Area: Stippled pattern
- Proposed House Site: Rectangular outline
- Denotes Well Location: Circle with 'X'

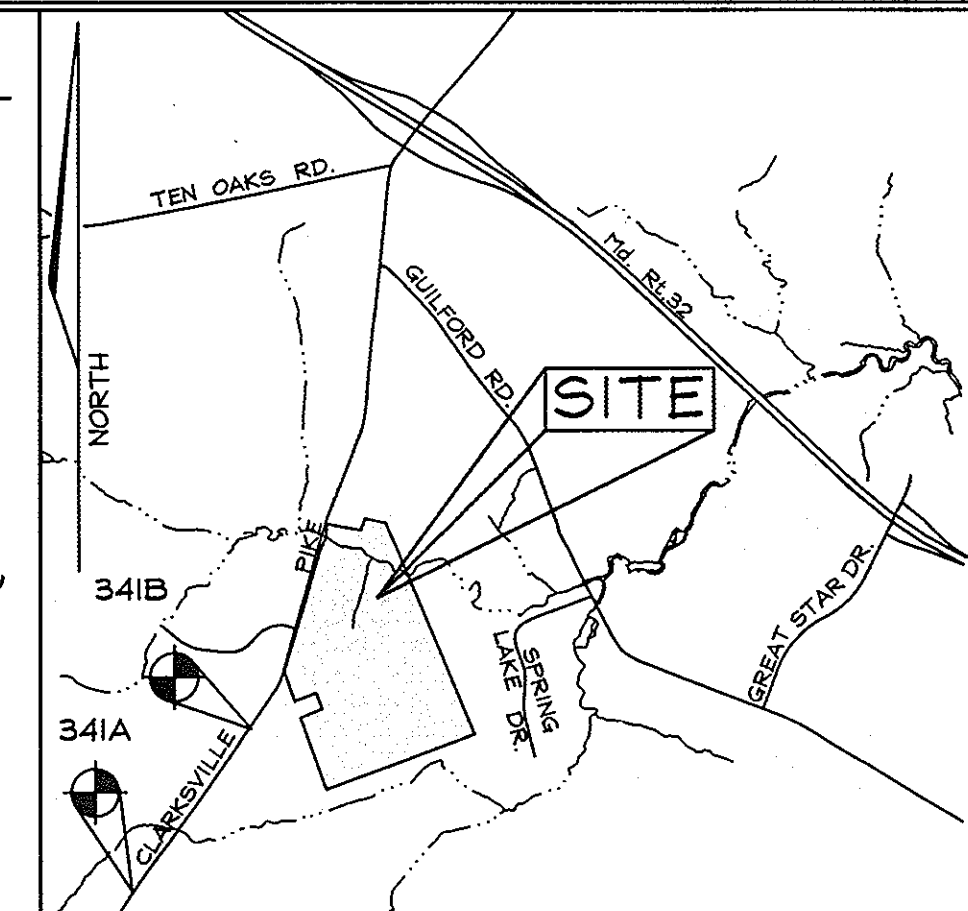

VICINITY MAP
SCALE: 1"=2000'

BENCHMARKS

Sta. 341A	N 160,637.6155	E 404,116.4545	El.: 144.0654 (meters)
	N 553,271.910	E 1,325,835.754	El.: 472.655 (feet)
Sta. 341B	N 169,156.2705	E 404,494.4156	El.: 135.1814 (meters)
	N 554,973.531	E 1,327,078.761	El.: 443.508 (feet)

SHEET INDEX

DESCRIPTION	SHEET No.
Cover Sheet	1 of 23
Road Plan and Profile	2 of 23
Road Plan and Profile	3 of 23
Road Plan and Profile	4 of 23
Sediment & Erosion Control and Grading Plan	5 of 23
Sediment & Erosion Control and Grading Plan	6 of 23
Sediment & Erosion Control and Grading Plan	7 of 23
Traffic Control Plan, Sediment & Erosion Control and Miscellaneous Notes & Details	8 of 23
Entrance Plan and Detail & Route 108 Cross Sections	9 of 23
Storm Drain Drainage Area Map	10 of 23
Storm Drain Drainage Area Map	11 of 23
Storm Drain Profiles	12 of 23
Storm Drain Profiles	13 of 23
Stormwater Management Notes and Details	14 of 23
Stormwater Management Notes and Details	15 of 23
Stormwater Management Notes and Details	16 of 23
Landscape Plan, Notes and Details	17 of 23
Landscape Plan, Notes and Details	18 of 23
Landscape Plan, Notes and Details	19 of 23
Stormwater Management Notes and Details	20 of 23
Forest Conservation Plan	21 of 23
Forest Conservation Plan	22 of 23
Forest Conservation Plan, Notes and Details	23 of 23

ROAD CLASSIFICATION


ROAD NAME	CLASSIFICATION	R/W
MacBeth Farm Lane (Sta. 0+00 - Sta. 16+13.22)	Public Access Street	50'
MacBeth Farm Lane (Sta. 16+13.22 - Sta. 19+87.33)	Public Access Place	40'
Kerne Court	Public Access Place	40'

CENTERLINE ROAD CURVE DATA

CURVE	ROAD NAME	CURVE STATIONING	DELTA	RADIUS	ARC LENGTH	CHORD BEARING & LENGTH
C1	MacBeth Farm Lane	Sta. 2+26.67 - Sta. 5+74.52	72°28'27"	275.00'	347.85'	N38°34'42"W 325.12'
C2	MacBeth Farm Lane	Sta. 4+26.13 - Sta. 11+31.93	77°48'33"	100.00'	135.80'	N41°44'45"W 125.61'
C3	Kerne Court	Sta. 2+63.18 - Sta. 5+39.67	18°01'24"	550.00'	173.01'	N8°09'43"W 172.30'
C4	MacBeth Farm Lane	Sta. 18+46.84 - Sta. 20+19.85	12°49'01"	1236.00'	276.44'	N03°26'28"E 275.92'

Continue General Notes...

- Using the density exchange option described in section 106 of the Zoning regulations, the development rights for 18 residential lots/parcels shown on the subdivision plan for Macbeth Farm, SP-04-13, have been transferred from: Property of Phillip Carroll and Camilla Carroll Liber 394 Folio 64 Tax Map 23 Parcel 71 Grid 10 (18 units). The creation of these lots is based on a maximum density of one residential unit for every two net acres.

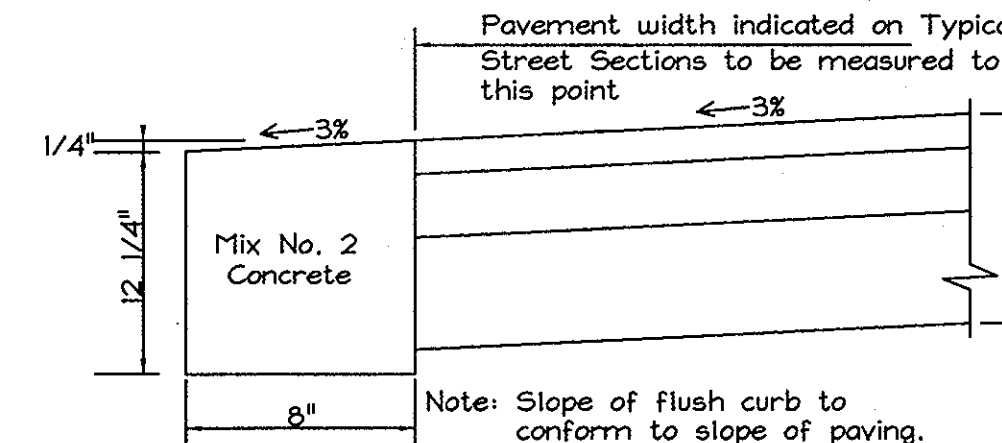


FLUSH CURB DETAIL
NOT TO SCALE

As-BUILTS

FOR ROADS, STORMDRAINS, EROSION & SEDIMENT CONTROLS

FOR STORMWATER MANAGEMENT & LANDSCAPING

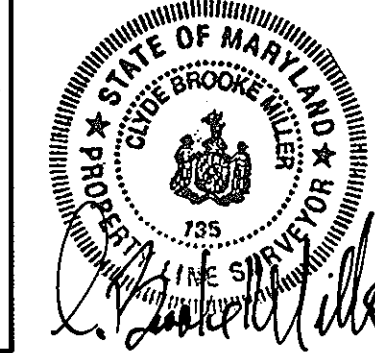

C. BROOKE MILLER DATE 1-15-2009
PROP. L.S. #135



ZACHARIA Y. FISCH DATE 1/15/09
PE # 22418

OWNER
THE ESTATE OF ELIZABETH SMITH
c/o Charles Slade, Personal Representative
10450 Shaker Drive, Suite 112
Columbia, Maryland 21046

DEVELOPER
CLARKSVILLE OVERLOOK, LLC
5300 Dorsey Hall Drive
Suite 200A
Ellicott City, Maryland 21042






COVER SHEET



MACBETH FARM


LOTS 1 THRU 35, BUILDABLE PRESERVATION PARCEL 'A', NON-BUILDABLE PRESERVATION PARCELS 'B', 'C', 'D', 'E', 'F'
Tax Map 34 Grids 18 & 24 Parcel 40
4th Election District
Howard County, Maryland

FSH Associates
Engineers Planners Surveyors
6339 Howard Lane Elridge, MD 21075
Tel: 410-587-5200 Fax: 410-796-1562
E-mail: info@fsher.com

DESIGN BY: PS
DRAWN BY: MY
CHECKED BY: ZYF
SCALE: As Shown
DATE: Aug. 31, 2006
H.O. No.: 3165
SHEET No.: 1 OF 23

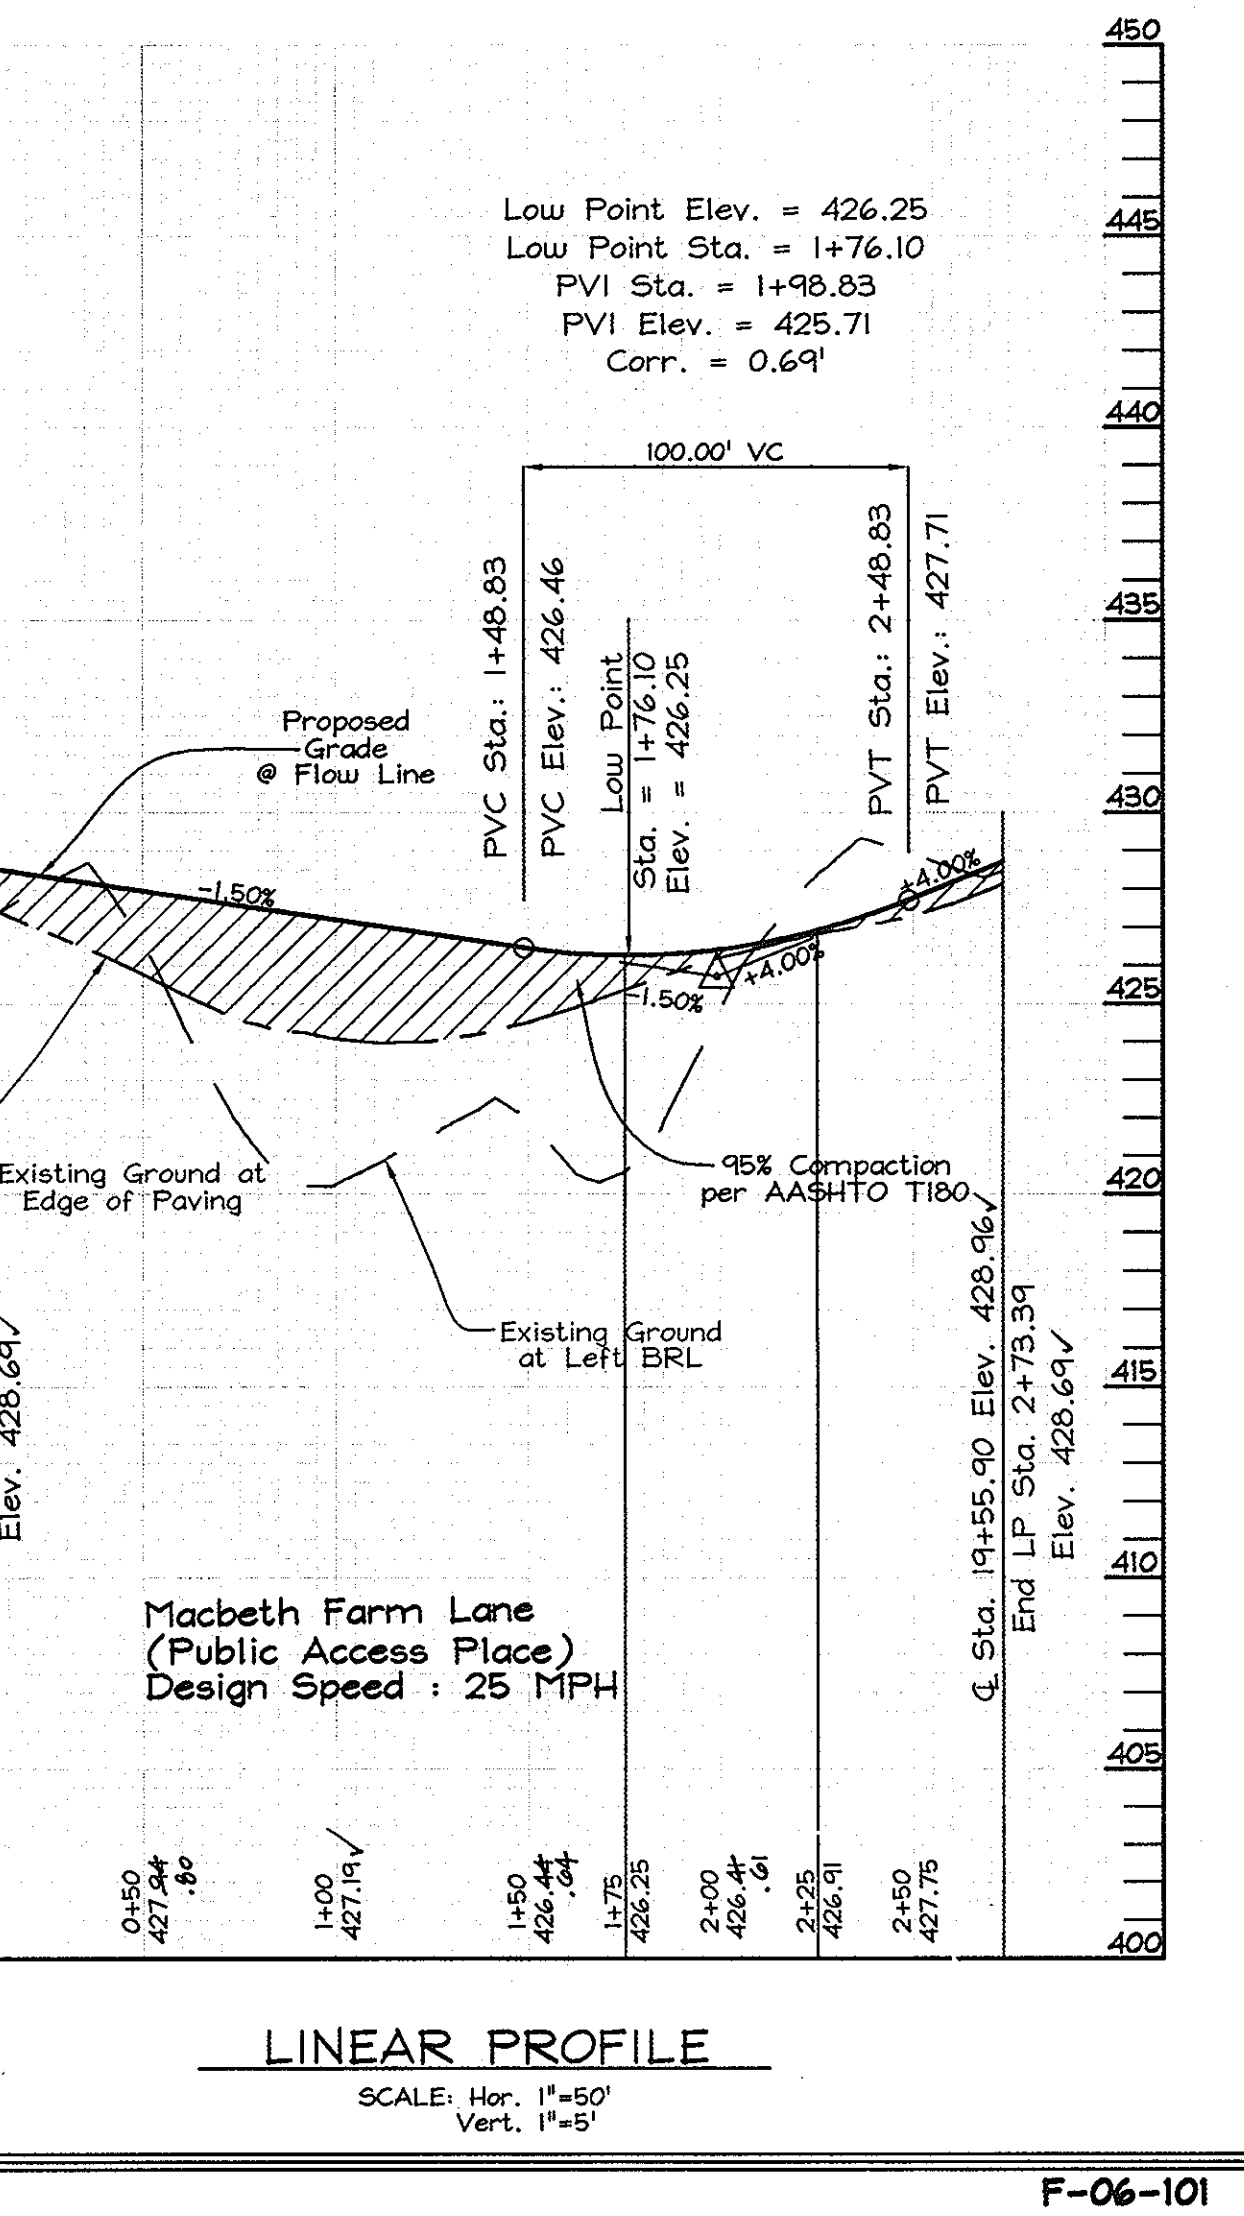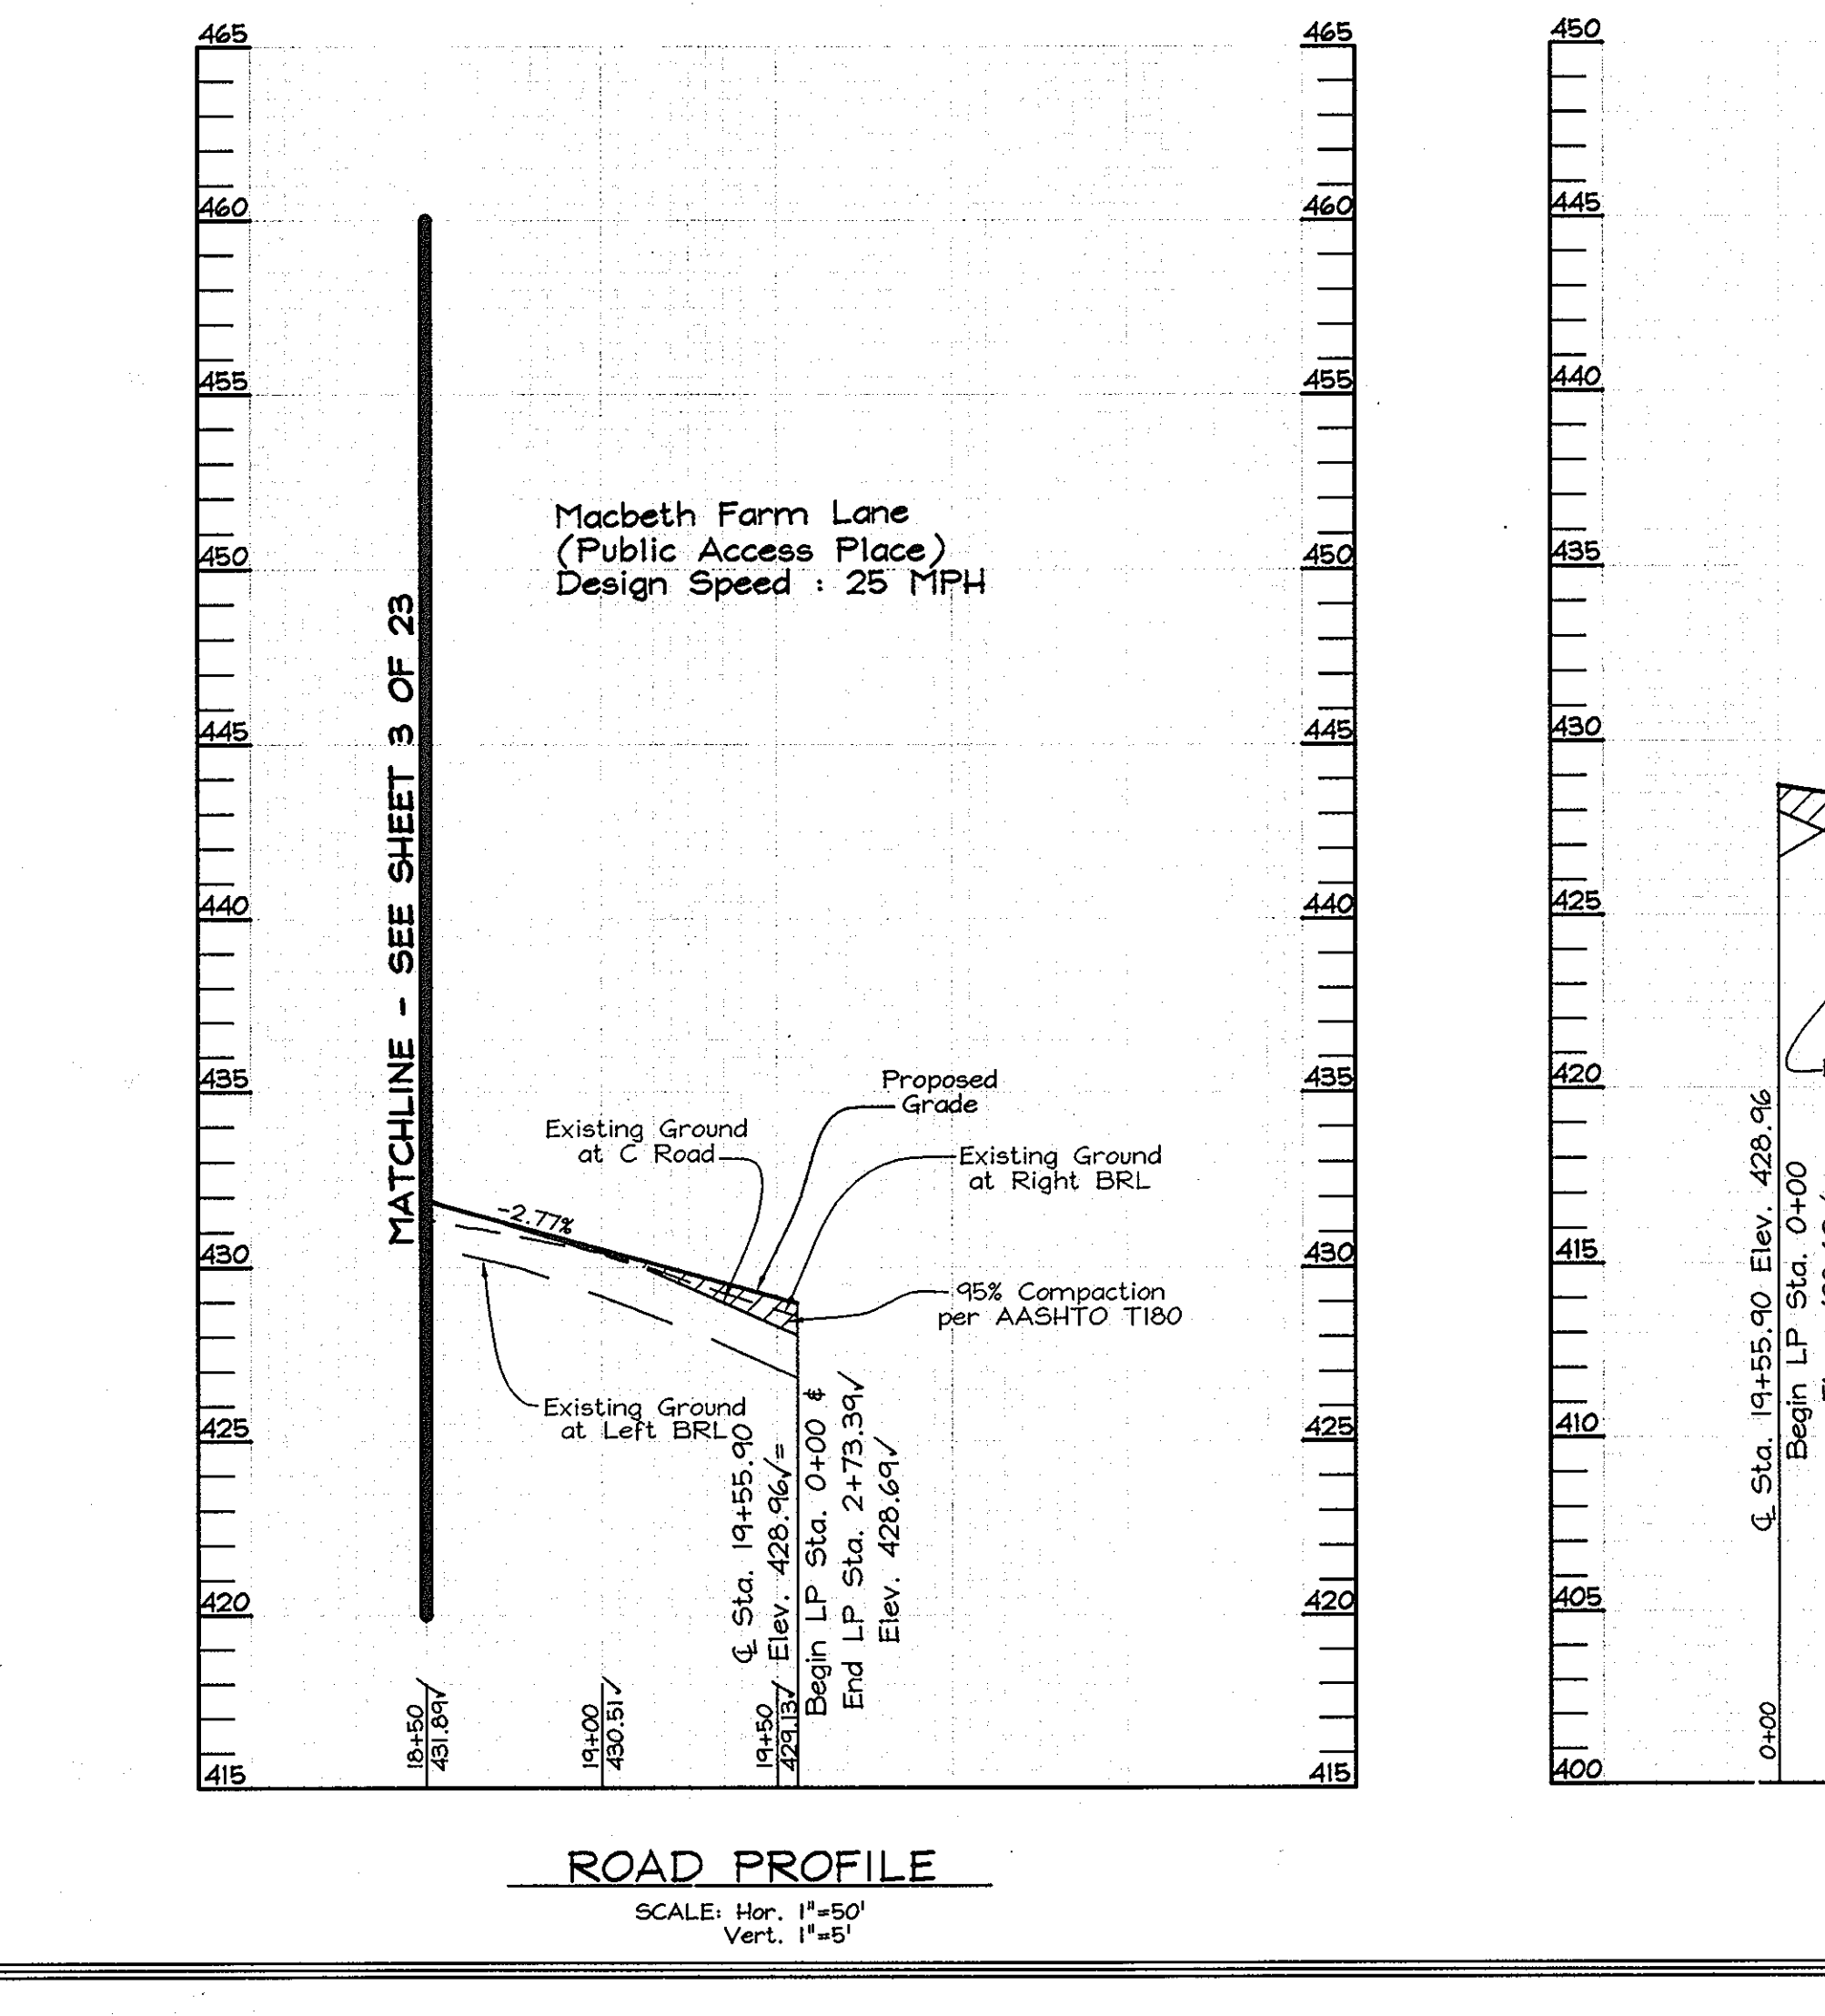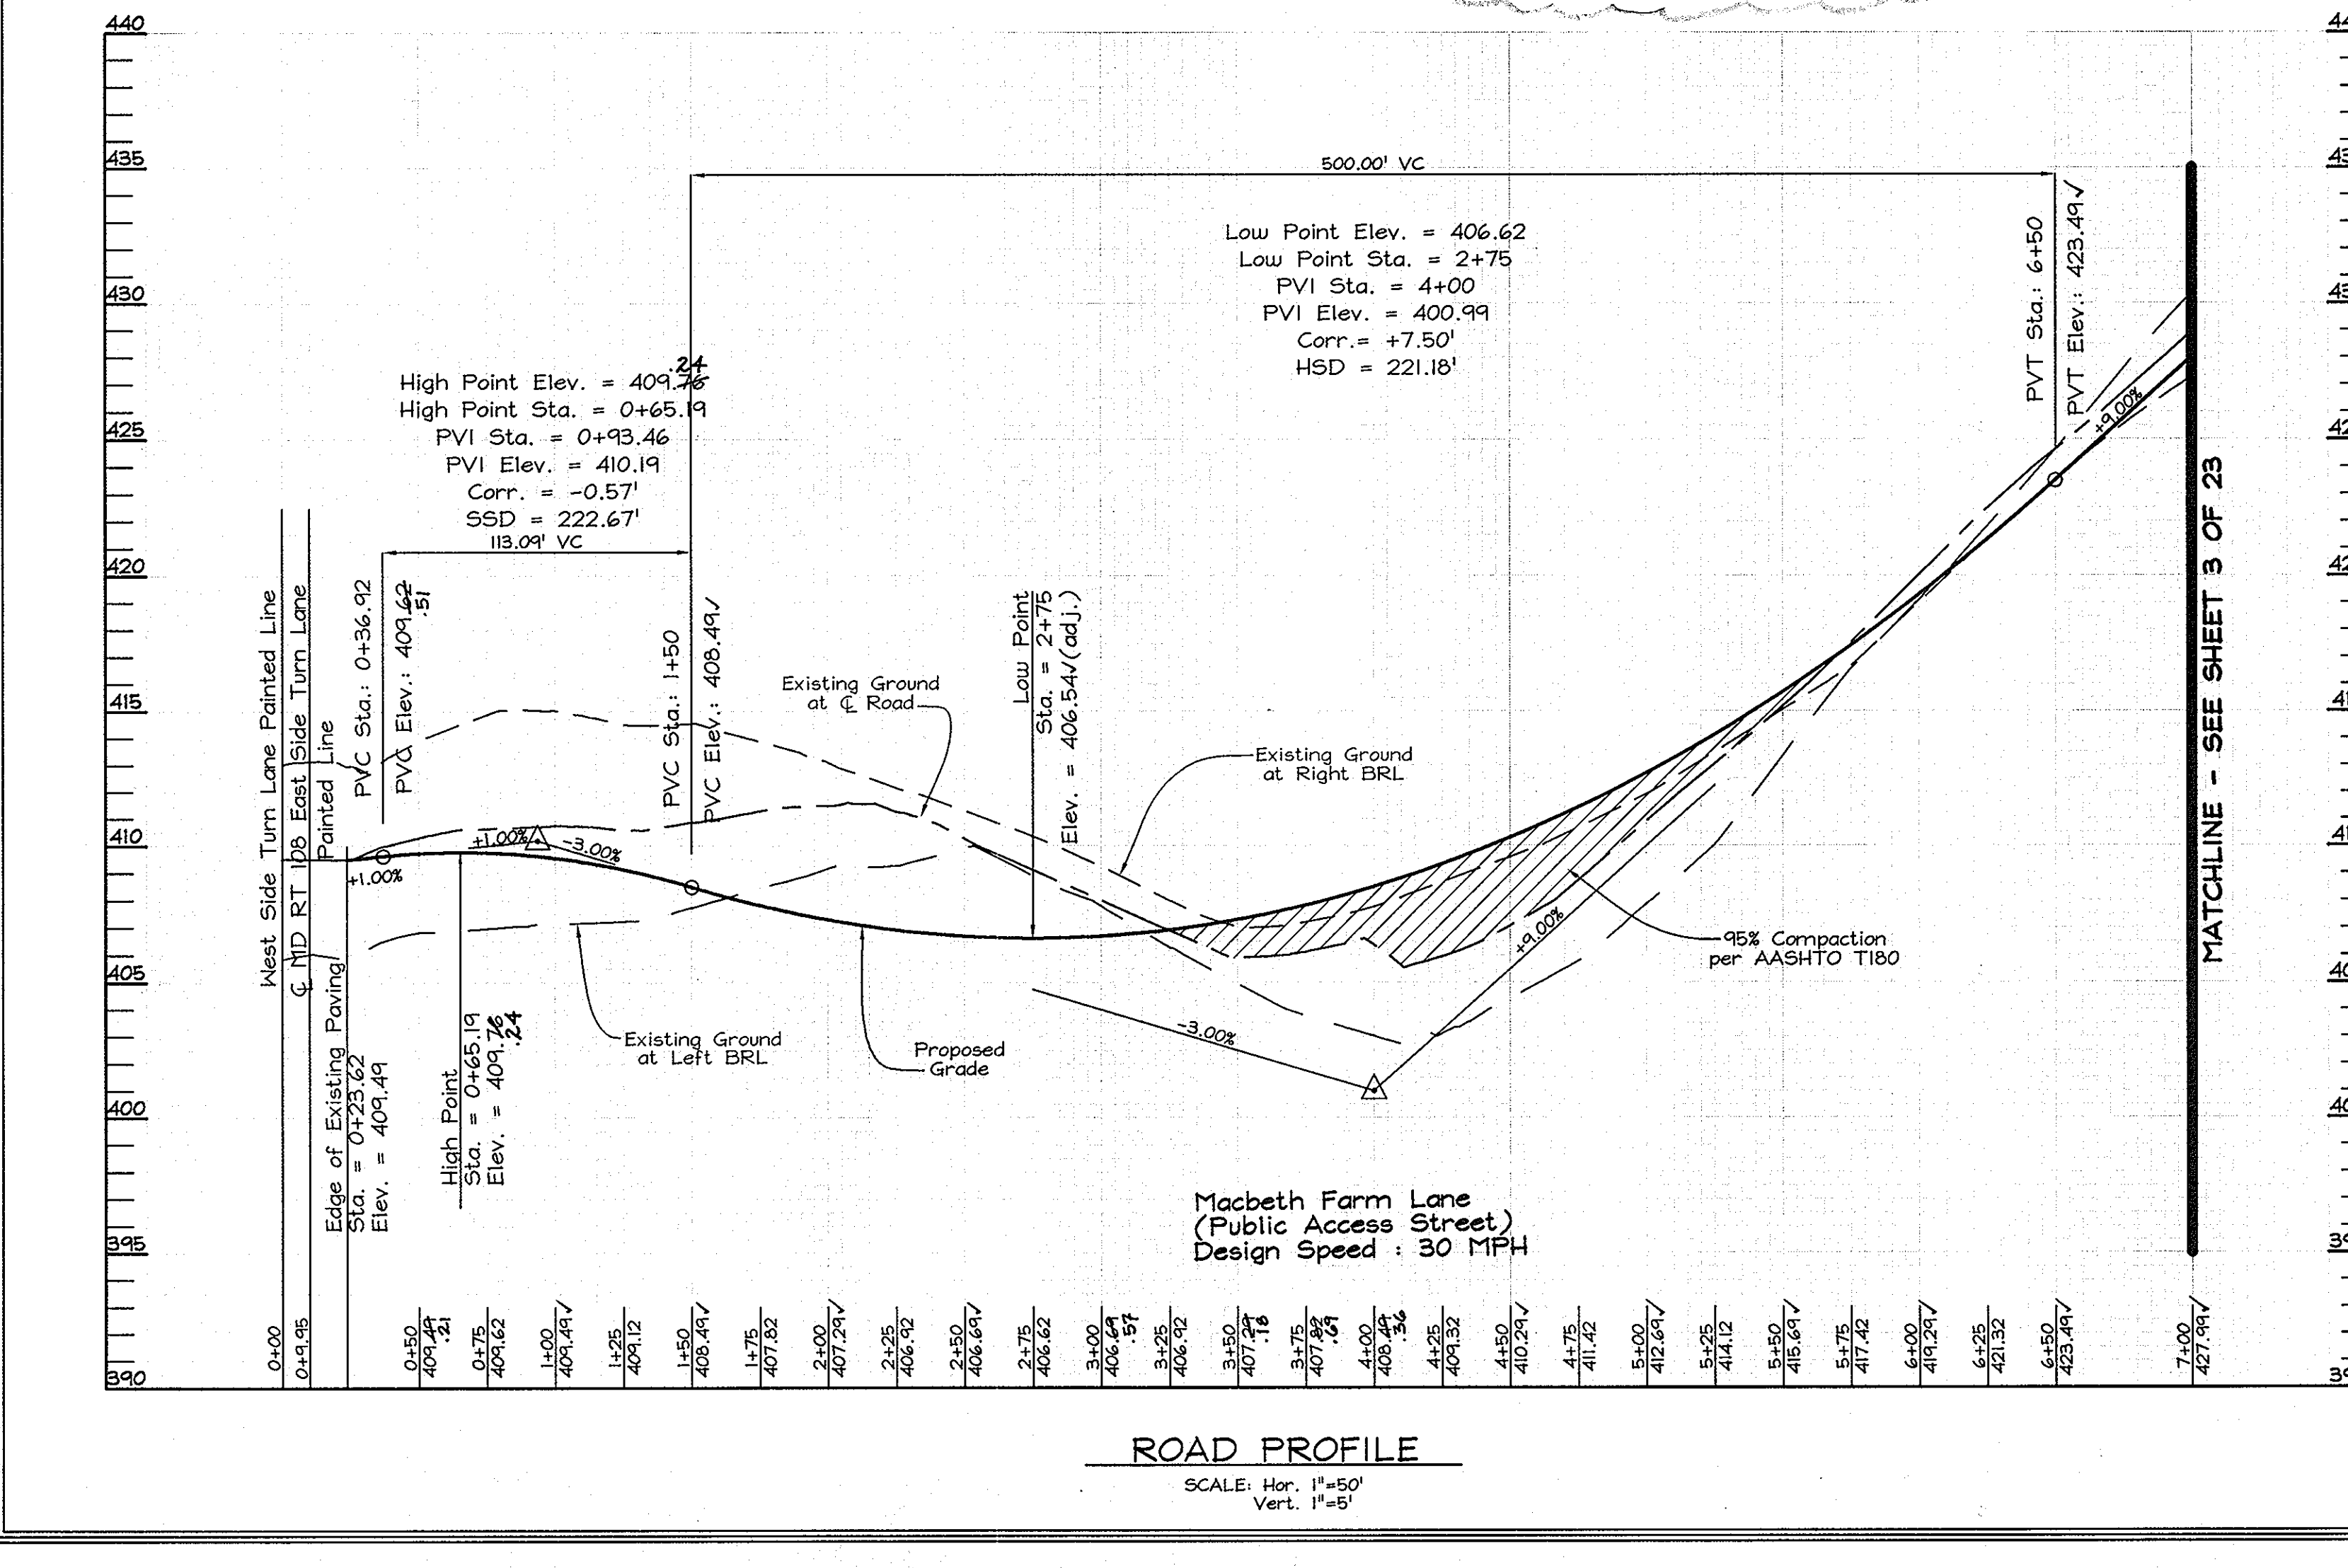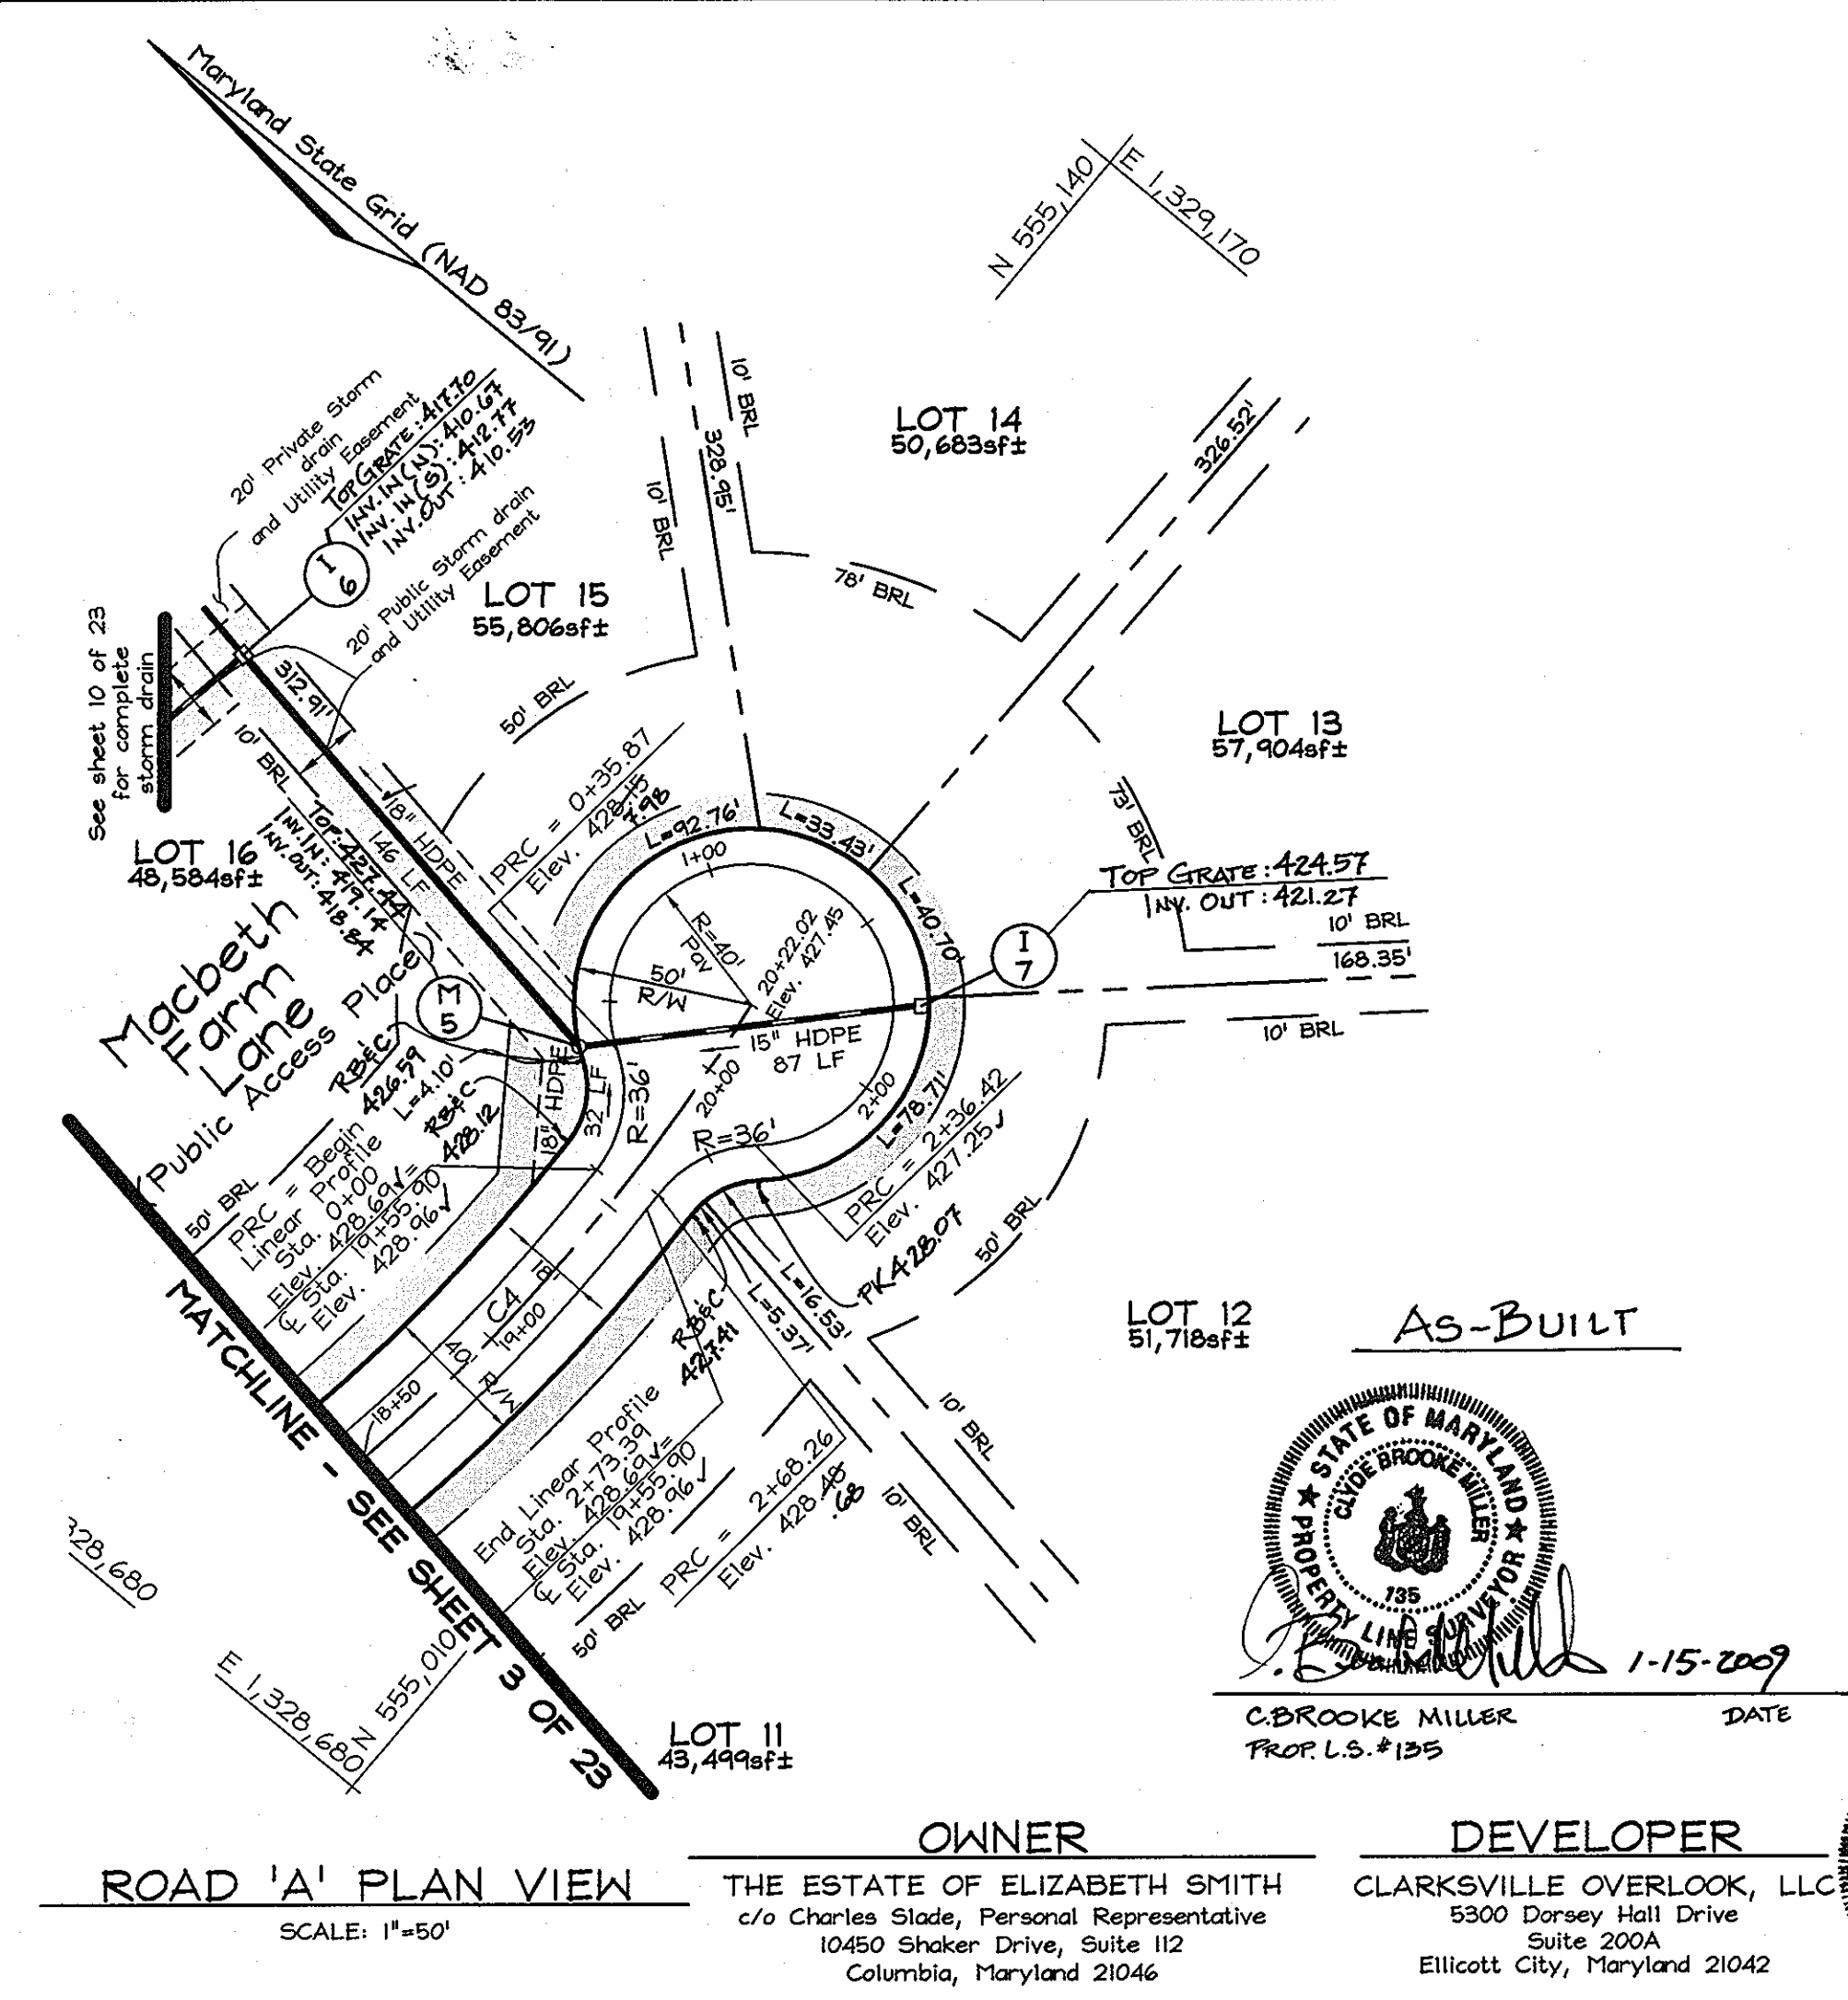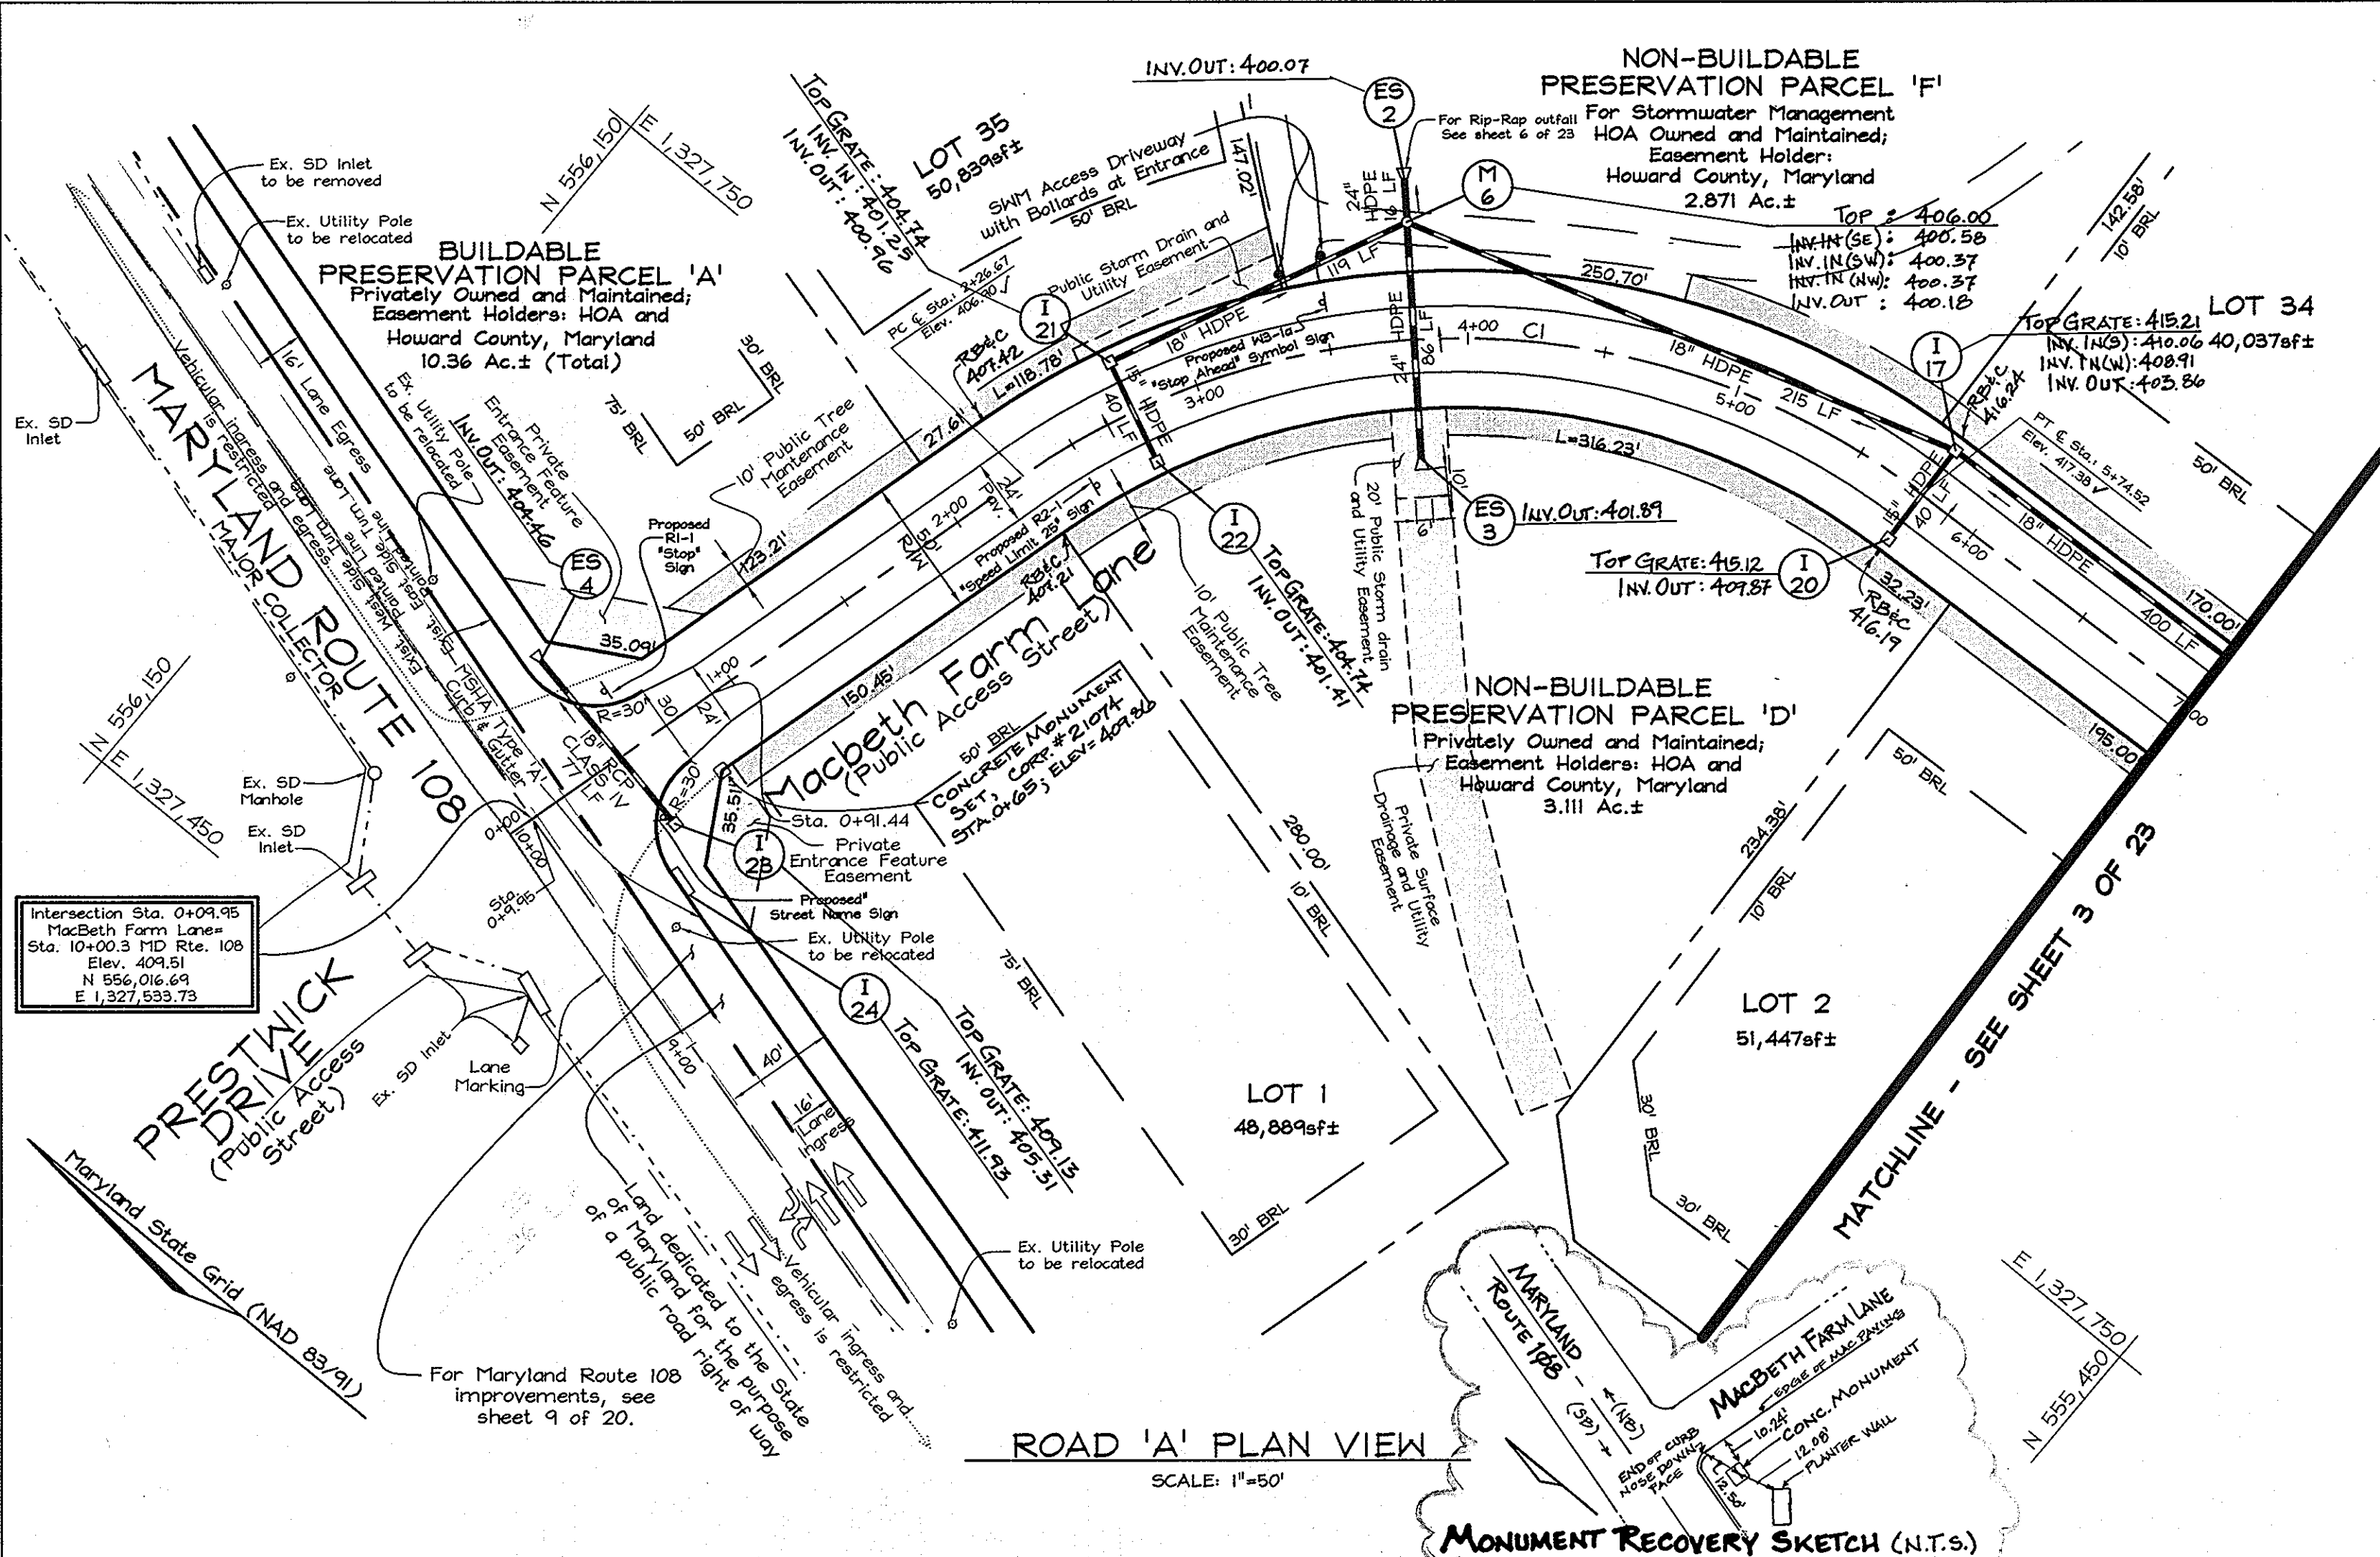

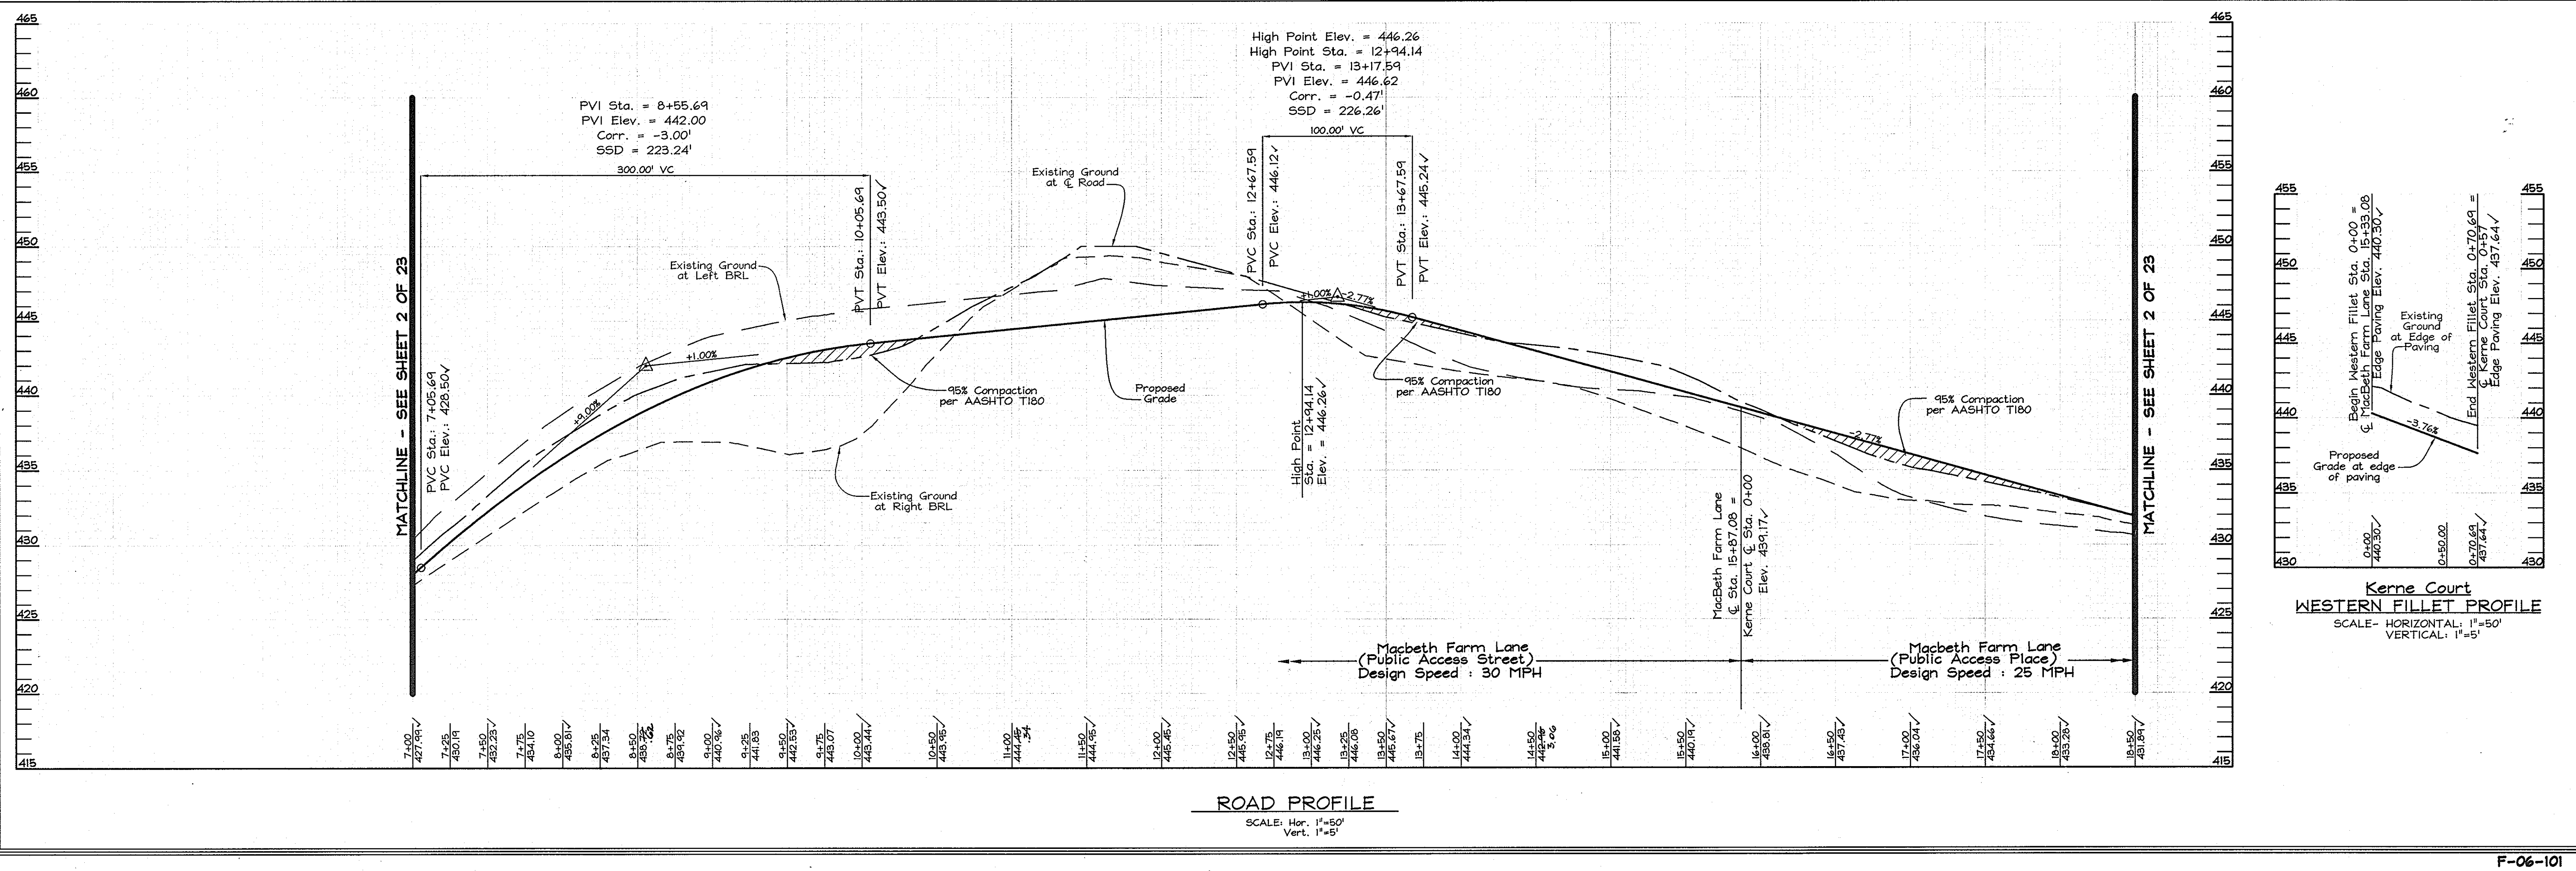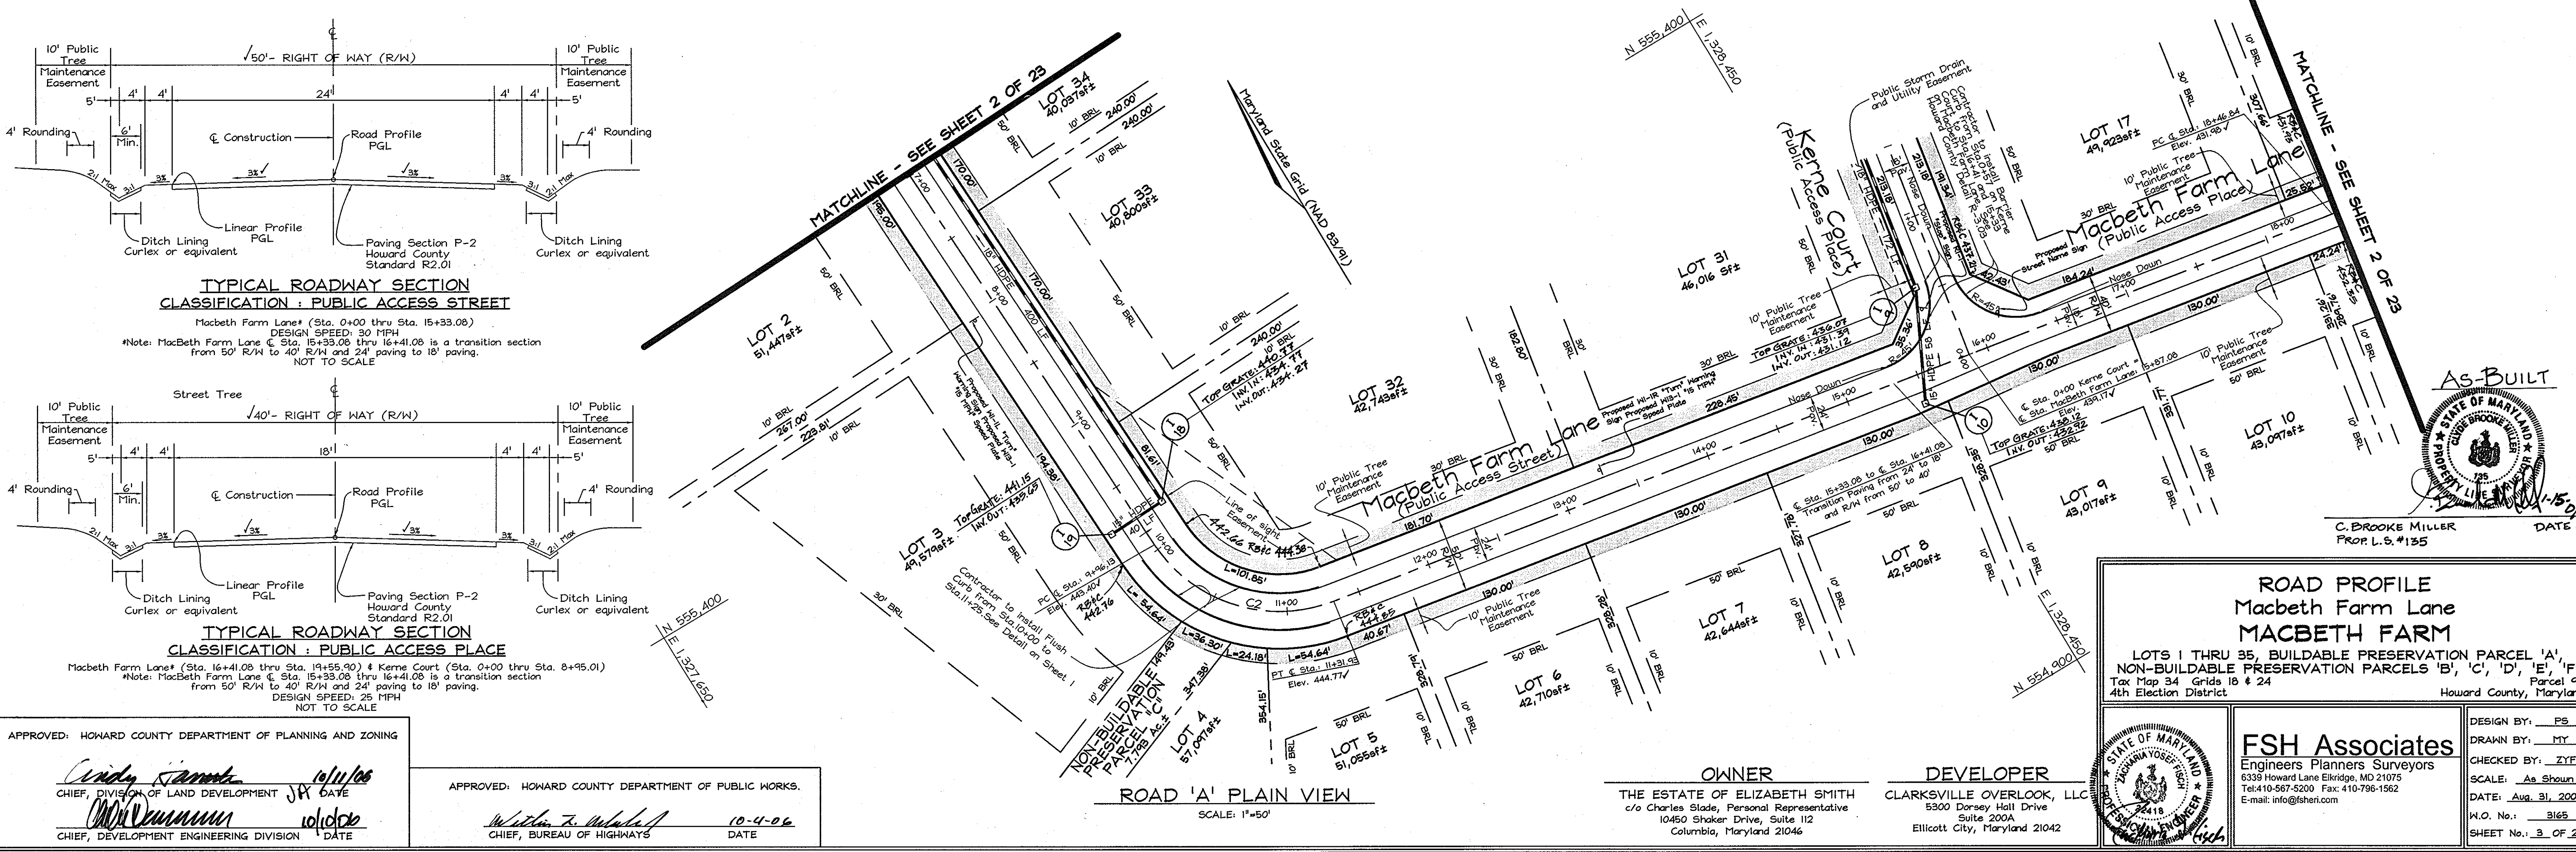

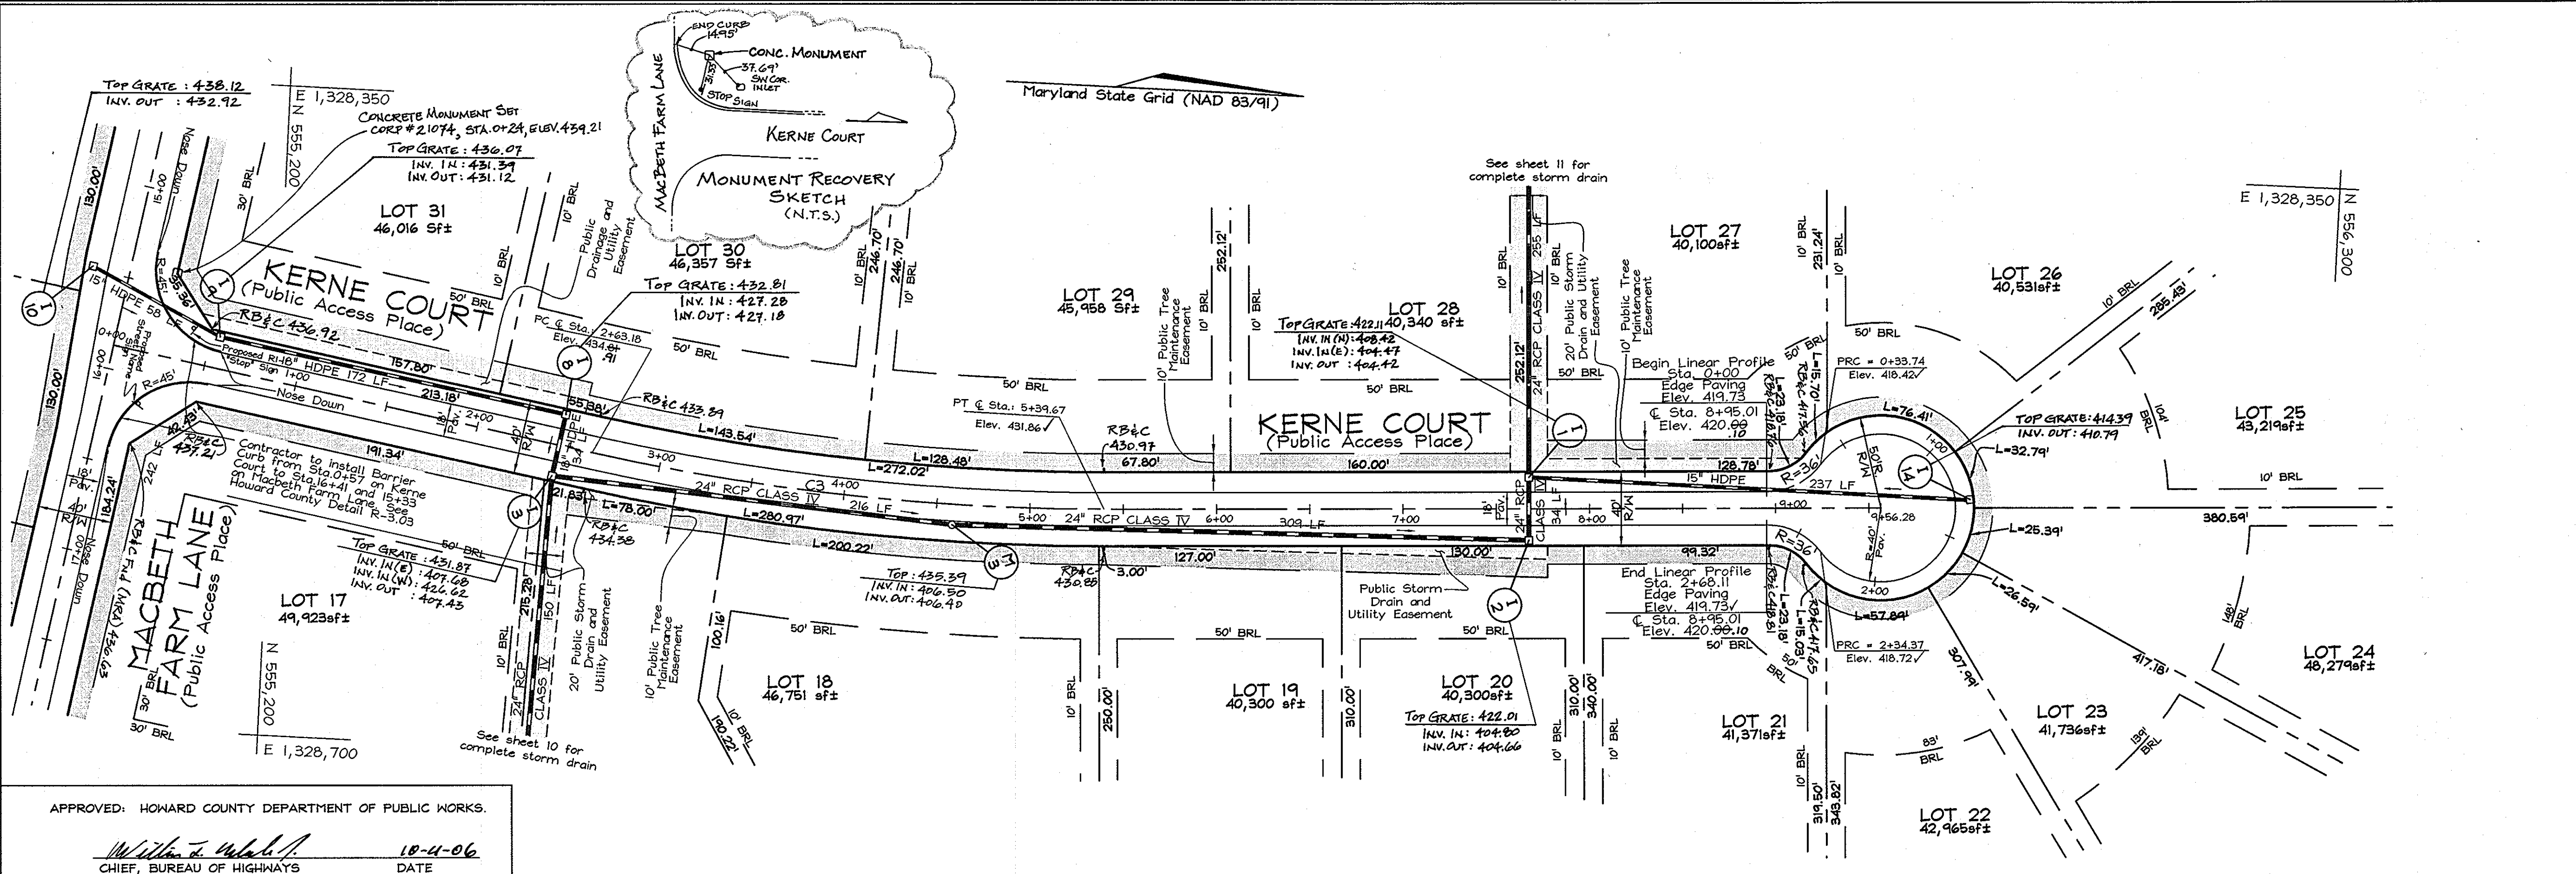

AS-BUILT

1-15-2009
DATE

C. BROOKE MILLER
PROF. L.S.#135

ROAD PROFILES
KERNE COURT
MACBETH FARM


LOTS 1 THRU 35, BUILDABLE PRESERVATION PARCEL 'A',
NON-BUILDABLE PRESERVATION PARCELS 'B', 'C', 'D', 'E', 'F'
Tax Map 34 Grids 18 & 24 Parcel 90
4th Election District Howard County, Maryland

FSH Associates
Engineers Planners Surveyors
8339 Howard Lane Elkridge, MD 21075
Tel: 410-567-5200 Fax: 410-796-1582
E-mail: info@fsher.com

DESIGN BY: PS
DRAWN BY: MY
CHECKED BY: ZYF
SCALE: As Shown
DATE: Aug. 31, 2006
H.O. No.: 3165
SHEET No.: 4 OF 23


OWNER
THE ESTATE OF ELIZABETH SMITH
c/o Charles Slade, Personal Representative
10450 Shaker Drive, Suite 112
Columbia, Maryland 21046

DEVELOPER
CLARKVILLE OVERLOOK, LLC
5300 Dorsey Hall Drive
Suite 200A
Ellicott City, Maryland 21042

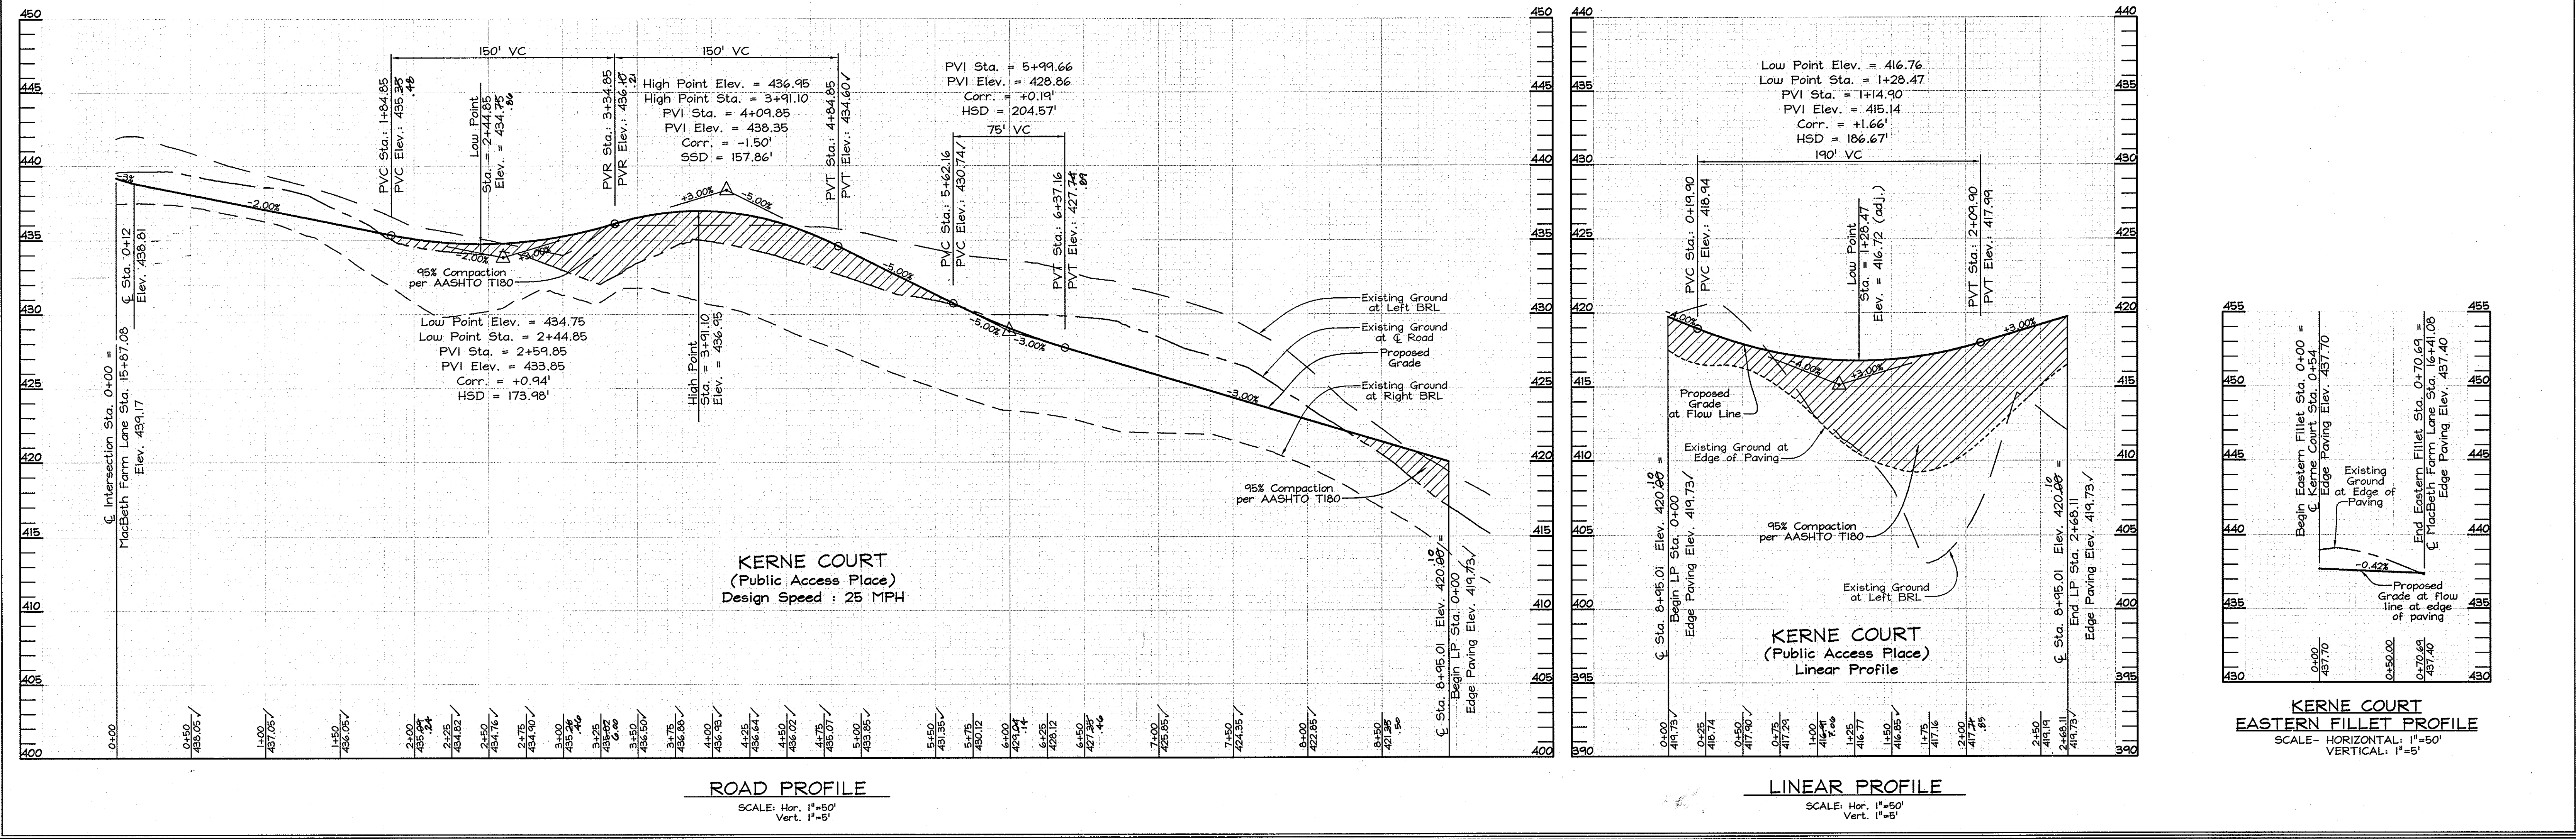

LEGEND

- Existing Contour
- Proposed Contour
- Spot Elevation
- Existing Trees to Remain
- Silt Fence
- Super Silt Fence
- Double Super Silt Fence
- Erosion Control Matting
- Limit of Disturbance
- Rip-Rap Inflow Protection

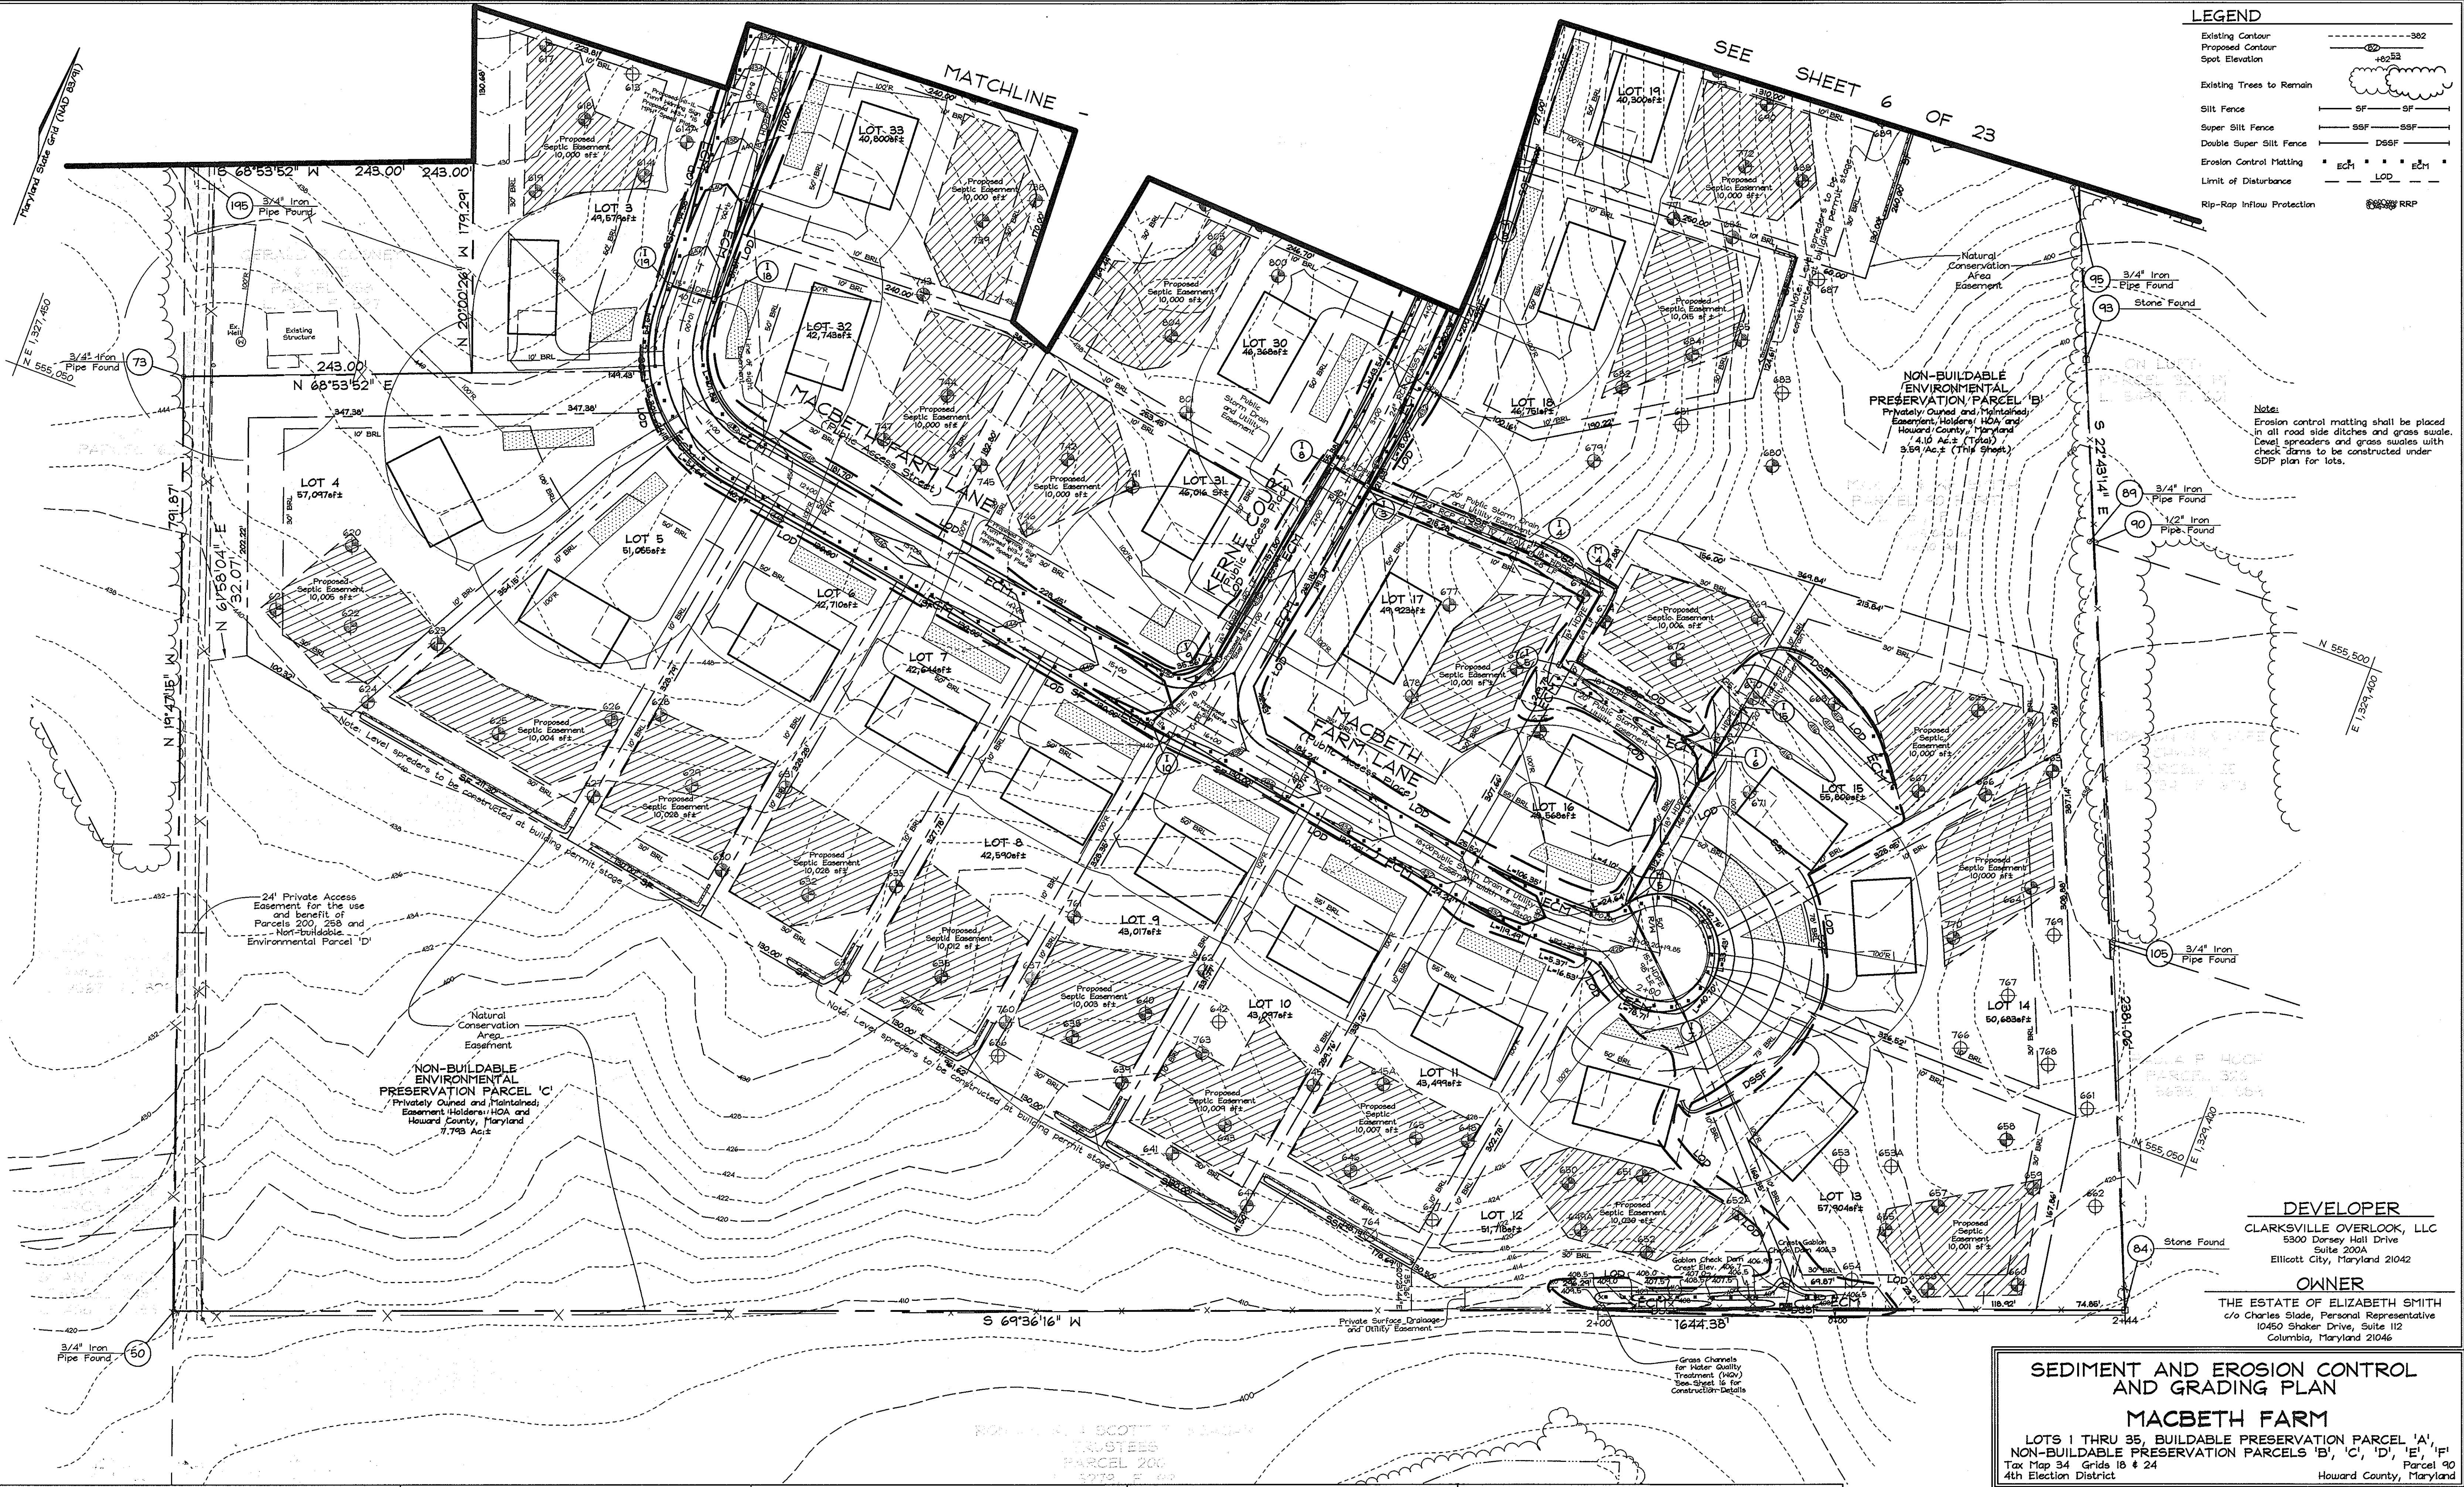

Note:
Erosion control matting shall be placed in all road side ditches and grass swales. Level spreaders and grass sods with check dams to be constructed under SDP plan for lots.

DEVELOPER
CLARKSVILLE OVERLOOK, LLC
5300 Dorsey Hall Drive
Suite 200A
Ellicott City, Maryland 21042

OWNER
THE ESTATE OF ELIZABETH SMITH
c/o Charles Slade, Personal Representative
10450 Shaker Drive, Suite 112
Columbia, Maryland 21046

SEDIMENT AND EROSION CONTROL AND GRADING PLAN
MACBETH FARM
LOTS 1 THRU 35, BUILDABLE PRESERVATION PARCEL 'A', NON-BUILDABLE PRESERVATION PARCELS 'B', 'C', 'D', 'E', 'F'
Tax Map 34 Grids 18 & 24 Parcel 90
4th Election District Howard County, Maryland

APPROVED: HOWARD COUNTY DEPARTMENT OF PLANNING AND ZONING

Cindy Hamitt 10/14/06
CHIEF, DIVISION OF LAND DEVELOPMENT DATE

Chris Damann 10/10/06
CHIEF, DEVELOPMENT ENGINEERING DIVISION DATE

APPROVED: HOWARD COUNTY DEPARTMENT OF PUBLIC WORKS

William J. ... 10-4-06
CHIEF, BUREAU OF HIGHWAYS DATE

DEVELOPER'S CERTIFICATE

I/WE CERTIFY THAT ALL DEVELOPMENT AND CONSTRUCTION WILL BE DONE ACCORDING TO THIS PLAN FOR SEDIMENT AND EROSION CONTROL AND THAT ALL RESPONSIBLE PERSONNEL INVOLVED IN THE CONSTRUCTION PROJECT WILL HAVE A CERTIFICATE OF ATTENDANCE AT A DEPARTMENT OF THE ENVIRONMENT APPROVED TRAINING PROGRAM FOR THE CONTROL OF SEDIMENT AND EROSION BEFORE BEGINNING THE PROJECT. I ALSO AUTHORIZE PERIODIC ON-SITE INSPECTION BY THE HOWARD SOIL CONSERVATION DISTRICT.

[Signature] 8/31/06
SIGNATURE OF DEVELOPER DATE

ENGINEER'S CERTIFICATE

I CERTIFY THAT THIS PLAN FOR SEDIMENT AND EROSION CONTROL REPRESENTS A PRACTICAL AND WORKABLE PLAN BASED ON MY PERSONAL KNOWLEDGE OF THE SITE CONDITIONS AND THAT IT WAS PREPARED IN ACCORDANCE WITH THE REQUIREMENTS OF THE HOWARD SOIL CONSERVATION DISTRICT.


Zacharia Y. Fisch 8/31/06
SIGNATURE OF ENGINEER DATE
ZACHARIA Y. FISCH

THESE PLANS HAVE BEEN REVIEWED FOR HOWARD SOIL CONSERVATION DISTRICT AND MEET THE TECHNICAL REQUIREMENTS FOR SOIL EROSION AND SEDIMENT CONTROL.

Jim Mays 9/29/06
USDA-NATURAL RESOURCES CONSERVATION SERVICE DATE

THESE PLANS FOR SOIL EROSION AND SEDIMENT CONTROL MEET THE REQUIREMENTS OF THE HOWARD SOIL CONSERVATION DISTRICT.

[Signature] 9/29/06
HOWARD SOIL CONSERVATION DISTRICT DATE

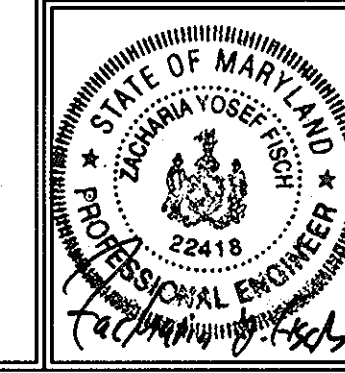

FSH Associates
Engineers Planners Surveyors
6339 Howard Lane Ellicott City, MD 21075
Tel: 410-567-5200 Fax: 410-796-1562
E-mail: info@fsh.com

DESIGN BY: PS
DRAWN BY: MY
CHECKED BY: ZYF
SCALE: 1"=60'
DATE: Aug. 31, 2006
P.L.O. No.: 3165
SHEET No. 5 OF 23



MATCHLINE - SEE SHEET 5 OF 23

THESE PLANS HAVE BEEN REVIEWED FOR HOWARD SOIL CONSERVATION DISTRICT AND MEET THE TECHNICAL REQUIREMENTS FOR SOIL EROSION AND SEDIMENT CONTROL.

[Signature] 9/29/06
DATE

USDA-NATURAL RESOURCES CONSERVATION SERVICE

THESE PLANS FOR SOIL EROSION AND SEDIMENT CONTROL MEET THE REQUIREMENTS OF THE HOWARD SOIL CONSERVATION DISTRICT.

[Signature] 9/29/06
DATE

HOWARD SOIL CONSERVATION DISTRICT

APPROVED: HOWARD COUNTY DEPARTMENT OF PLANNING AND ZONING

[Signature] 10/11/06
CHIEF, DIVISION OF LAND DEVELOPMENT DATE

[Signature] 10/10/06
CHIEF, DEVELOPMENT ENGINEERING DIVISION DATE

DEVELOPER'S CERTIFICATE

I/WE CERTIFY THAT ALL DEVELOPMENT AND CONSTRUCTION WILL BE DONE ACCORDING TO THIS PLAN FOR SEDIMENT AND EROSION CONTROL AND THAT ALL RESPONSIBLE PERSONNEL INVOLVED IN THE CONSTRUCTION PROJECT WILL HAVE A CERTIFICATE OF ATTENDANCE AT A DEPARTMENT OF THE ENVIRONMENT APPROVED TRAINING PROGRAM FOR THE CONTROL OF SEDIMENT AND EROSION BEFORE BEGINNING THE PROJECT. I ALSO AUTHORIZE PERIODIC ON-SITE INSPECTION BY THE HOWARD SOIL CONSERVATION DISTRICT.

[Signature] 8/31/06
SIGNATURE OF DEVELOPER DATE

APPROVED: HOWARD COUNTY DEPARTMENT OF PUBLIC WORKS.

[Signature] 10-4-06
CHIEF, BUREAU OF HIGHWAYS DATE

LEGEND

Existing Contour	---
Proposed Contour	---
Spot Elevation	+
Direction of Flow	→
Tree Protection Fence	⌋
Existing Trees to Remain	⌋
Stabilized Construction Entrance	▨
Silt Fence	SF
Super Silt Fence	SSF
Double Row Super Silt Fence	DSSF
Channel Silt Fence	CSF
Earth Dike	ED A-1
Limit of Disturbance	LOD
Temporary Swale	→
Erosion Control Matting	ECM
Rip-Rap Inflow Protection	RRP

NOTE:
Erosion control matting shall be placed in all road side ditches and grass swales.

ENGINEERS CERTIFICATE

I CERTIFY THAT THIS PLAN FOR SEDIMENT AND EROSION CONTROL REPRESENTS A PRACTICAL AND WORKABLE PLAN BASED ON MY PERSONAL KNOWLEDGE OF THE SITE CONDITIONS AND THAT IT WAS PREPARED IN ACCORDANCE WITH THE REQUIREMENTS OF THE HOWARD SOIL CONSERVATION DISTRICT.

[Signature] 8/31/06
SIGNATURE OF ENGINEER DATE

ZACHARIA Y. FISCH

NOTE:
1. Level spreaders to be constructed at building permit stage.
2. For sediment control Basin schedule see sheet 16.

* FOR AS-BUILT POND ELEVATIONS SHEET 20 OF 23

OWNER
THE ESTATE OF ELIZABETH SMITH
c/o Charles Slade, Personal Representative
10450 Shaker Drive, Suite 112
Columbia, Maryland 21046

DEVELOPER
CLARKSVILLE OVERLOOK, LLC
5300 Dorsey Hall Drive
Suite 200A
Ellicott City, Maryland 21042

[Signature] 1/15/09
DATE

ZACHARIA Y. FISCH
PE#22410

SEDIMENT AND EROSION CONTROL AND GRADING PLAN

MACBETH FARM



LOTS 1 THRU 35, BUILDABLE PRESERVATION PARCEL 'A', NON-BUILDABLE PRESERVATION PARCELS 'B', 'C', 'D', 'E', 'F'

Tax Map 34 Grids 18 & 24 Parcel 40
4th Election District Howard County, Maryland

DESIGN BY: PS
DRAWN BY: MY
CHECKED BY: ZYF
SCALE: 1"=50'
DATE: Aug 31, 2006
W.D. No.: 3165
SHEET No.: 6 OF 23

FSH Associates
Engineers Planners Surveyors
6339 Howard Lane Elkridge, MD 21075
Tel: 410-567-5200 Fax: 410-796-1582
E-mail: info@fshri.com

STATE OF MARYLAND
ZACHARIA Y. FISCH
Professional Engineer
No. 22410

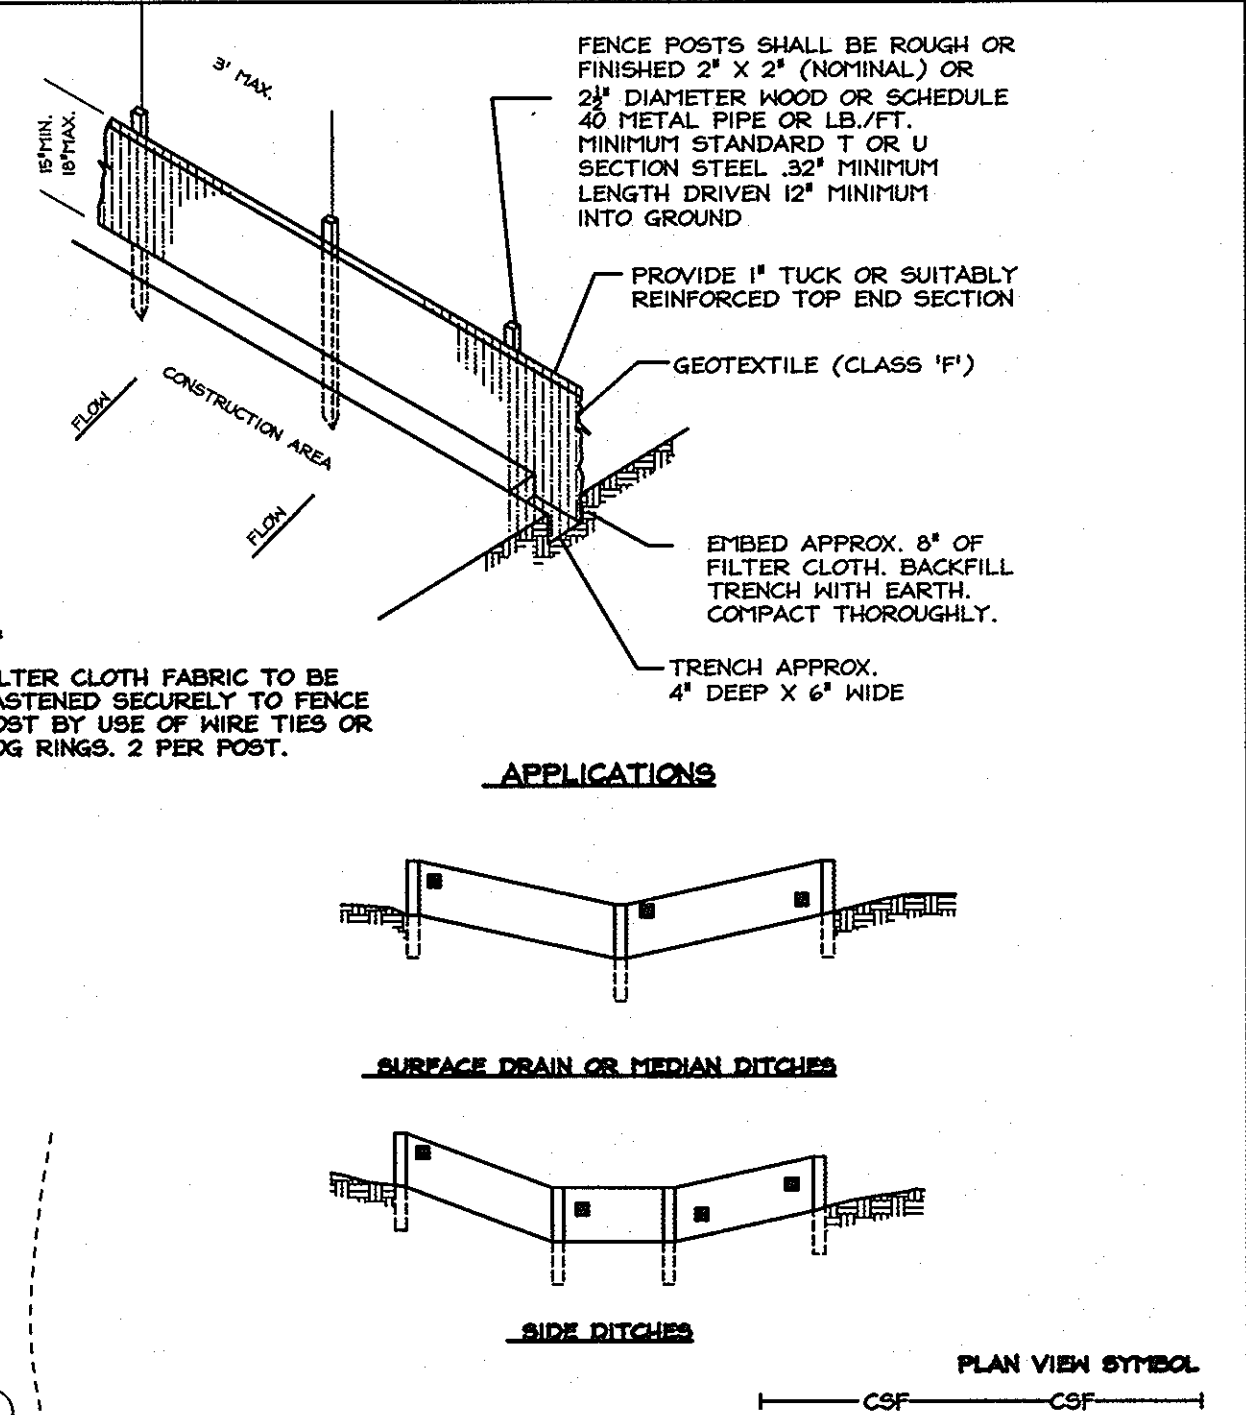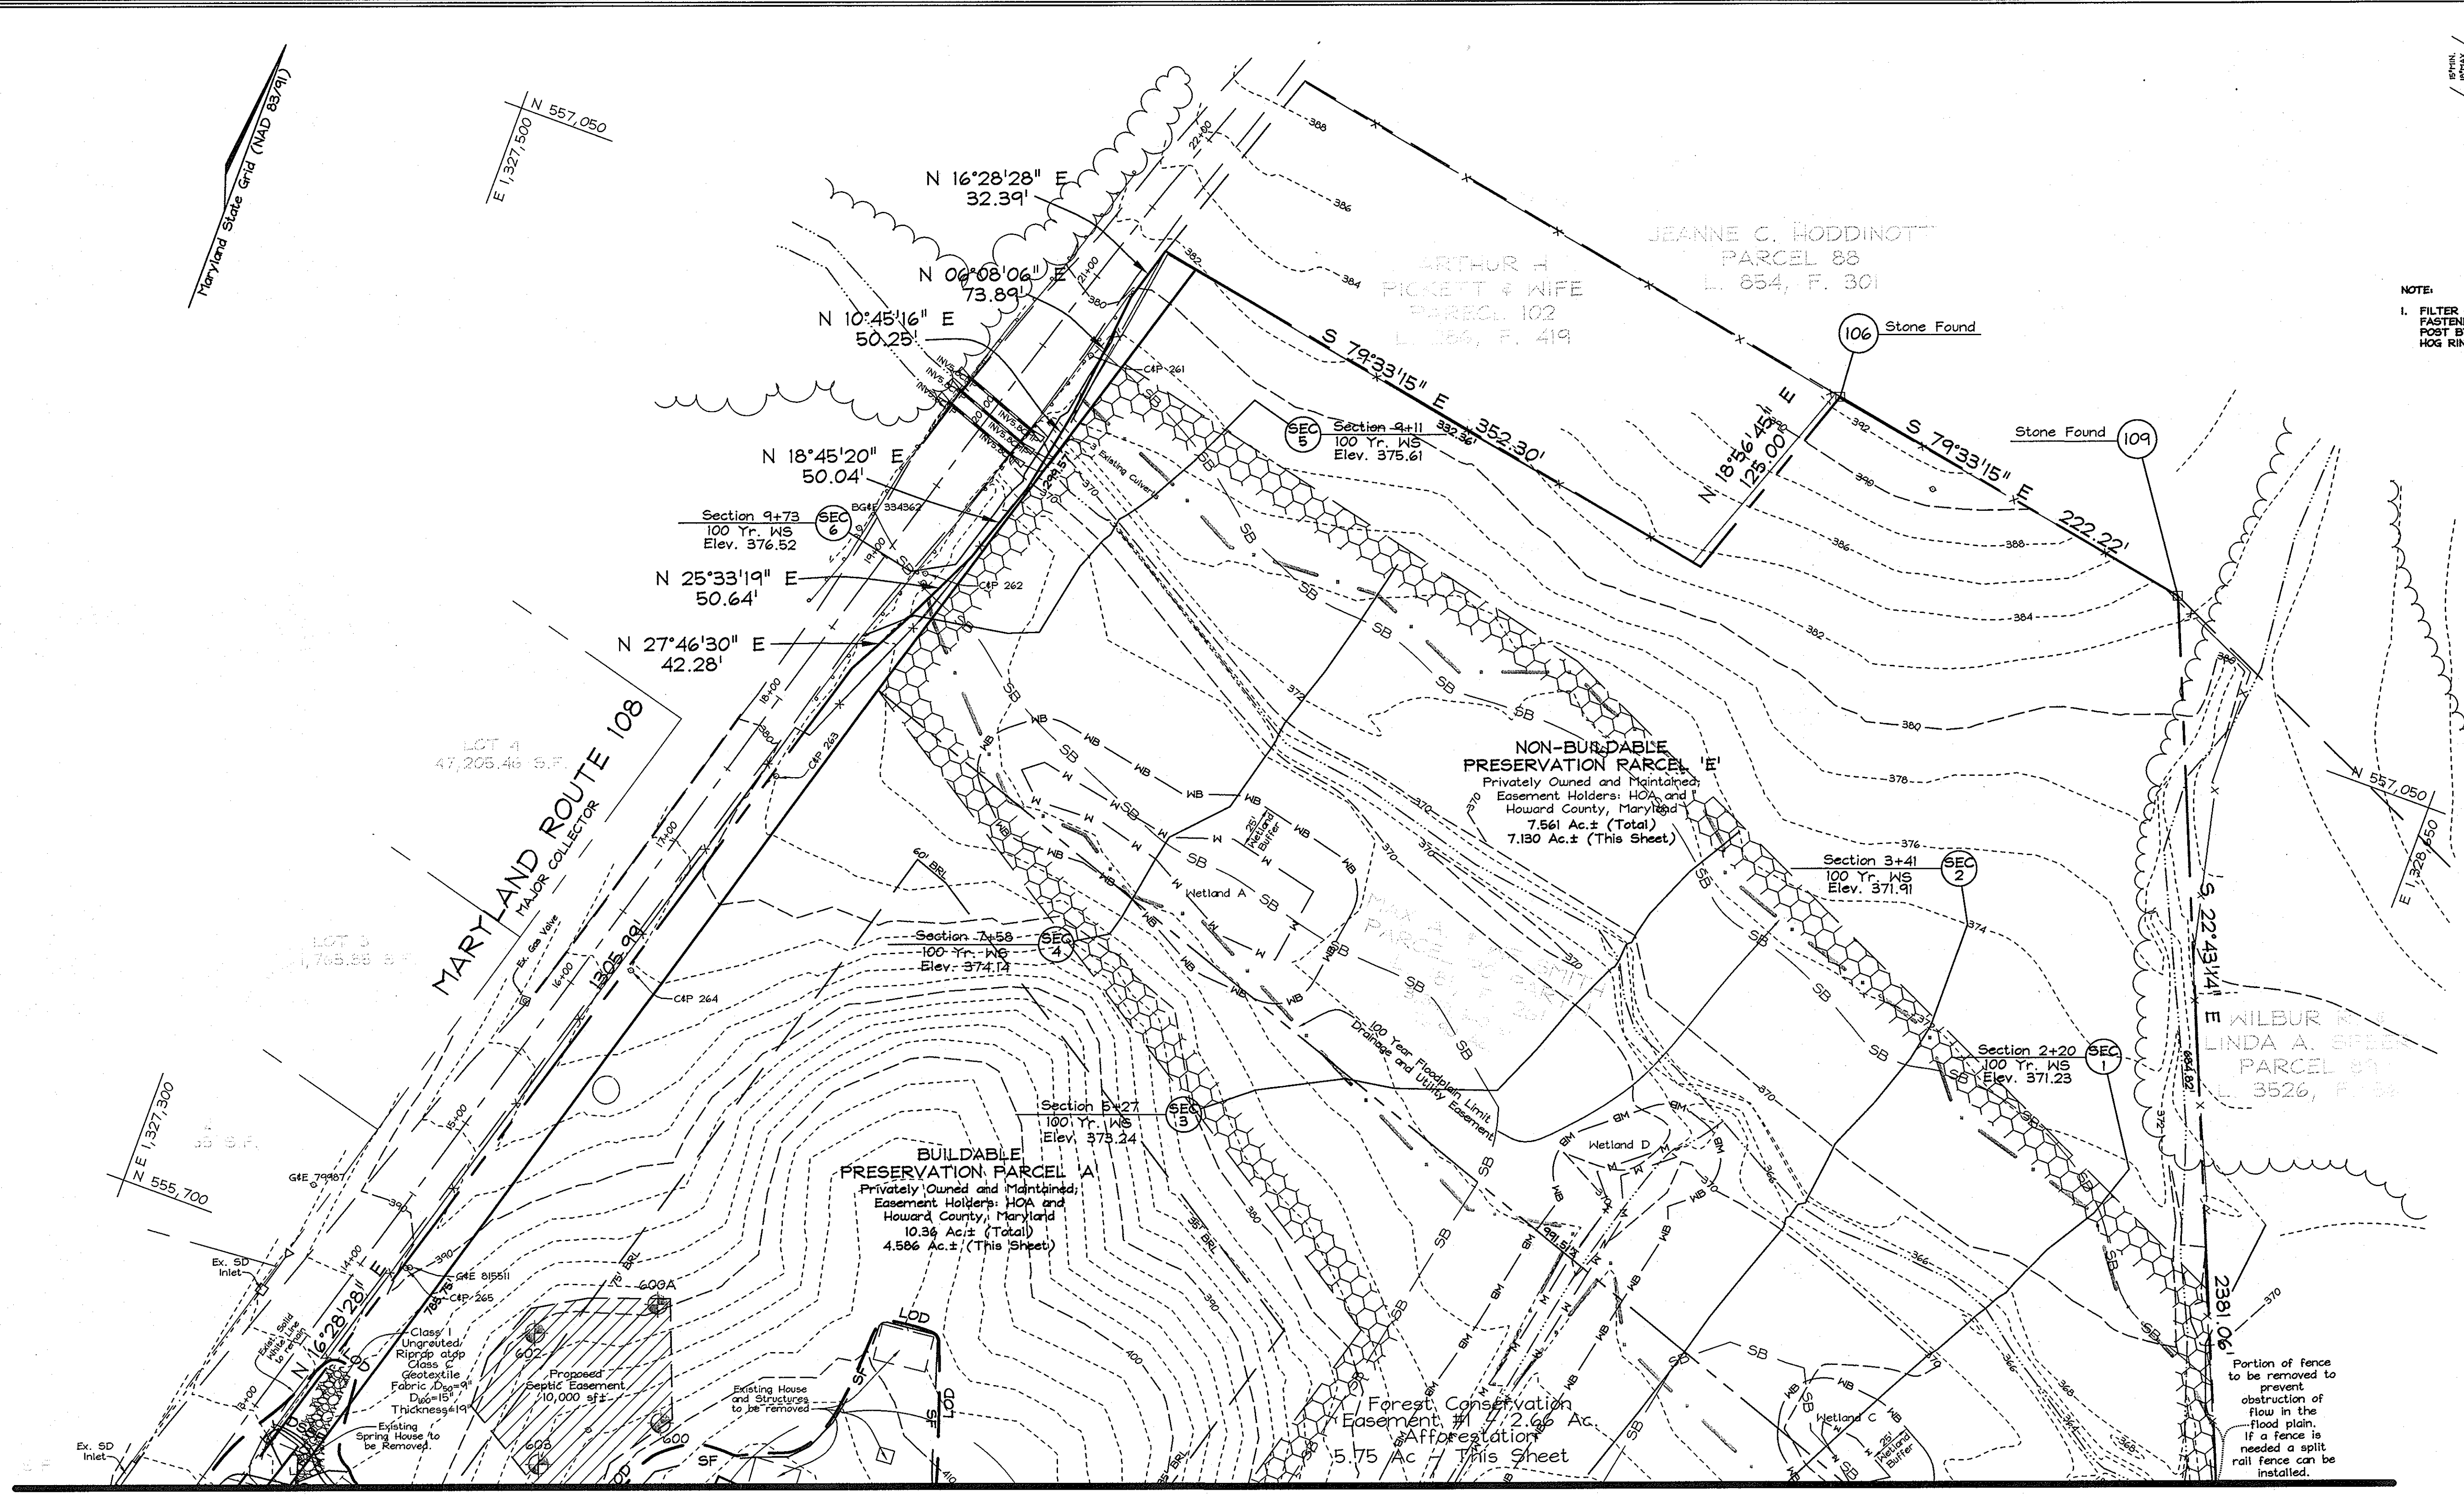

CHANNEL SILT FENCE (C.S.F.)

LEGEND

Existing Contour	--- 382
Proposed Contour	--- 382
Spot Elevation	+85.53
Existing Trees to Remain	(Tree symbol)
Silt Fence	SF - SF
Super Silt Fence	SSF - SSF
Dual Super Silt Fence	DSSF - DSSF
Erosion Control Matting	ECM - ECM
Limit of Disturbance	LOD
Channel Silt Fence	CSF - CSF
Rip-Rap Inflow Protection	RRP

MATCHLINE - SEE SHEET 6 OF 23

THESE PLANS HAVE BEEN REVIEWED FOR HOWARD SOIL CONSERVATION DISTRICT AND MEET THE TECHNICAL REQUIREMENTS FOR SOIL, EROSION AND SEDIMENT CONTROL.
Jim Meyer 9/29/06
 USDA-NATURAL RESOURCES CONSERVATION SERVICE DATE

THESE PLANS FOR SOIL EROSION AND SEDIMENT CONTROL MEET THE REQUIREMENTS OF THE HOWARD SOIL CONSERVATION DISTRICT.
John S. ... 9/29/06
 HOWARD SOIL CONSERVATION DISTRICT DATE

APPROVED: HOWARD COUNTY DEPARTMENT OF PLANNING AND ZONING
Cindy ... 10/10/06
 CHIEF, DIVISION OF LAND DEVELOPMENT DATE

APPROVED: HOWARD COUNTY DEPARTMENT OF PUBLIC WORKS.
William Z. ... 10-10-06
 CHIEF, BUREAU OF HIGHWAYS DATE


DEVELOPER'S CERTIFICATE
 I/WE CERTIFY THAT ALL DEVELOPMENT AND CONSTRUCTION WILL BE DONE ACCORDING TO THIS PLAN FOR SEDIMENT AND EROSION CONTROL AND THAT ALL RESPONSIBLE PERSONNEL INVOLVED IN THE CONSTRUCTION PROJECT WILL HAVE A CERTIFICATE OF ATTENDANCE AT A DEPARTMENT OF THE ENVIRONMENT APPROVED TRAINING PROGRAM FOR THE CONTROL OF SEDIMENT AND EROSION BEFORE BEGINNING THE PROJECT. I ALSO AUTHORIZE PERIODIC ON-SITE INSPECTION BY THE HOWARD SOIL CONSERVATION DISTRICT.
Zacharia Y. Fisch 8/31/06
 SIGNATURE OF DEVELOPER DATE

ENGINEERS CERTIFICATE
 I/WE CERTIFY THAT THIS PLAN FOR SEDIMENT AND EROSION CONTROL REPRESENTS A PRACTICAL AND WORKABLE PLAN BASED ON MY PERSONAL KNOWLEDGE OF THE SITE CONDITIONS AND THAT IT WAS PREPARED IN ACCORDANCE WITH THE REQUIREMENTS OF THE HOWARD SOIL CONSERVATION DISTRICT.
Zacharia Y. Fisch 8/31/06
 SIGNATURE OF ENGINEER DATE
 ZACHARIA Y. FISCH

OWNER
 THE ESTATE OF ELIZABETH SMITH
 c/o Charles Slade, Personal Representative
 10450 Shaker Drive, Suite 112
 Columbia, Maryland 21046








DEVELOPER
 CLARKSVILLE OVERLOOK, LLC
 5900 Dorsey Hall Drive
 Suite 200A
 Ellicott City, Maryland 21042

SEDIMENT AND EROSION CONTROL AND GRADING PLAN
MACBETH FARM
 LOTS 1 THRU 35, BUILDABLE PRESERVATION PARCEL 'A', NON-BUILDABLE PRESERVATION PARCELS 'B', 'C', 'D', 'E', 'F', Tax Map 34 Grids 18 & 24 Parcel 90 4th Election District. Howard County, Maryland

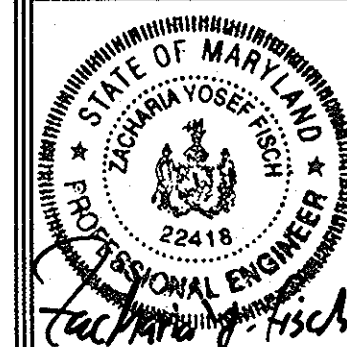


FSH Associates
 Engineers Planners Surveyors
 6339 Howard Lane Ellicott City, MD 21075
 Tel: 410-567-5200 Fax: 410-796-1562
 E-mail: info@fshri.com

DESIGN BY: PS
 DRAWN BY: MY
 CHECKED BY: ZYF
 SCALE: 1"=50'
 DATE: Aug. 31, 2006
 N.O. No.: 3165
 SHEET No.: 7 OF 23

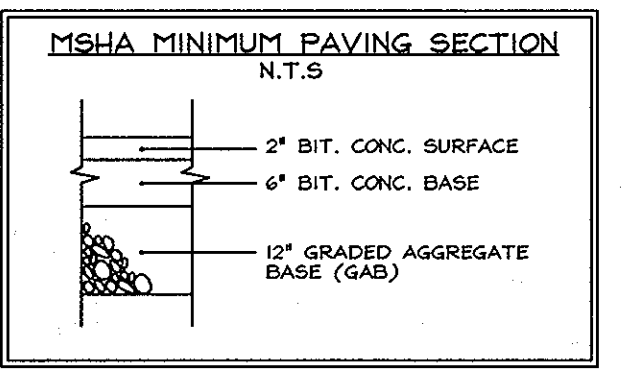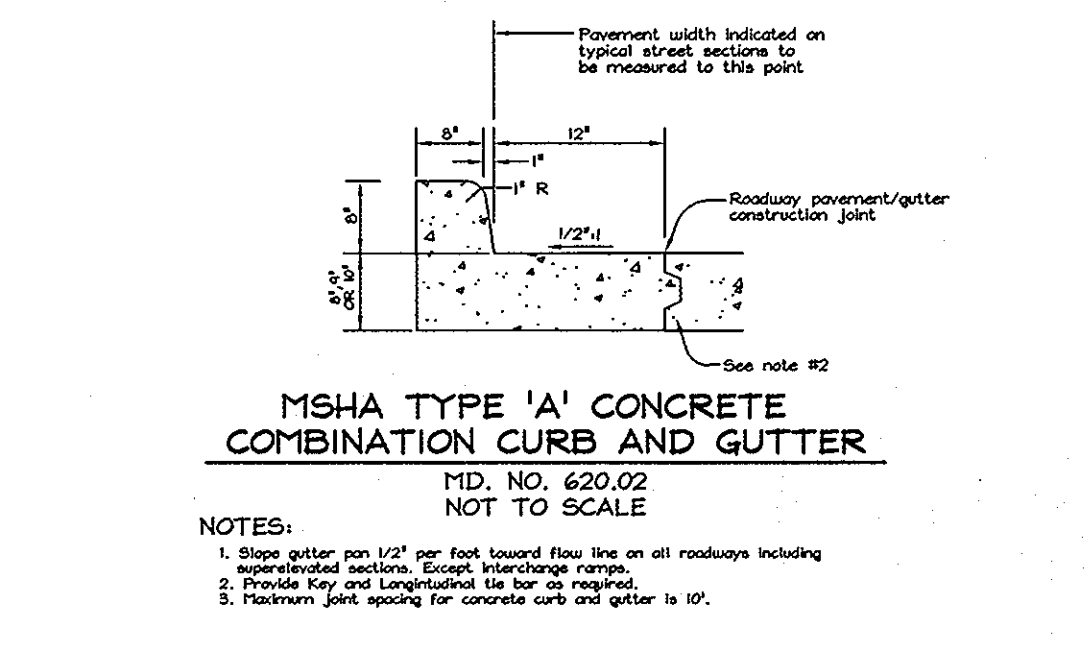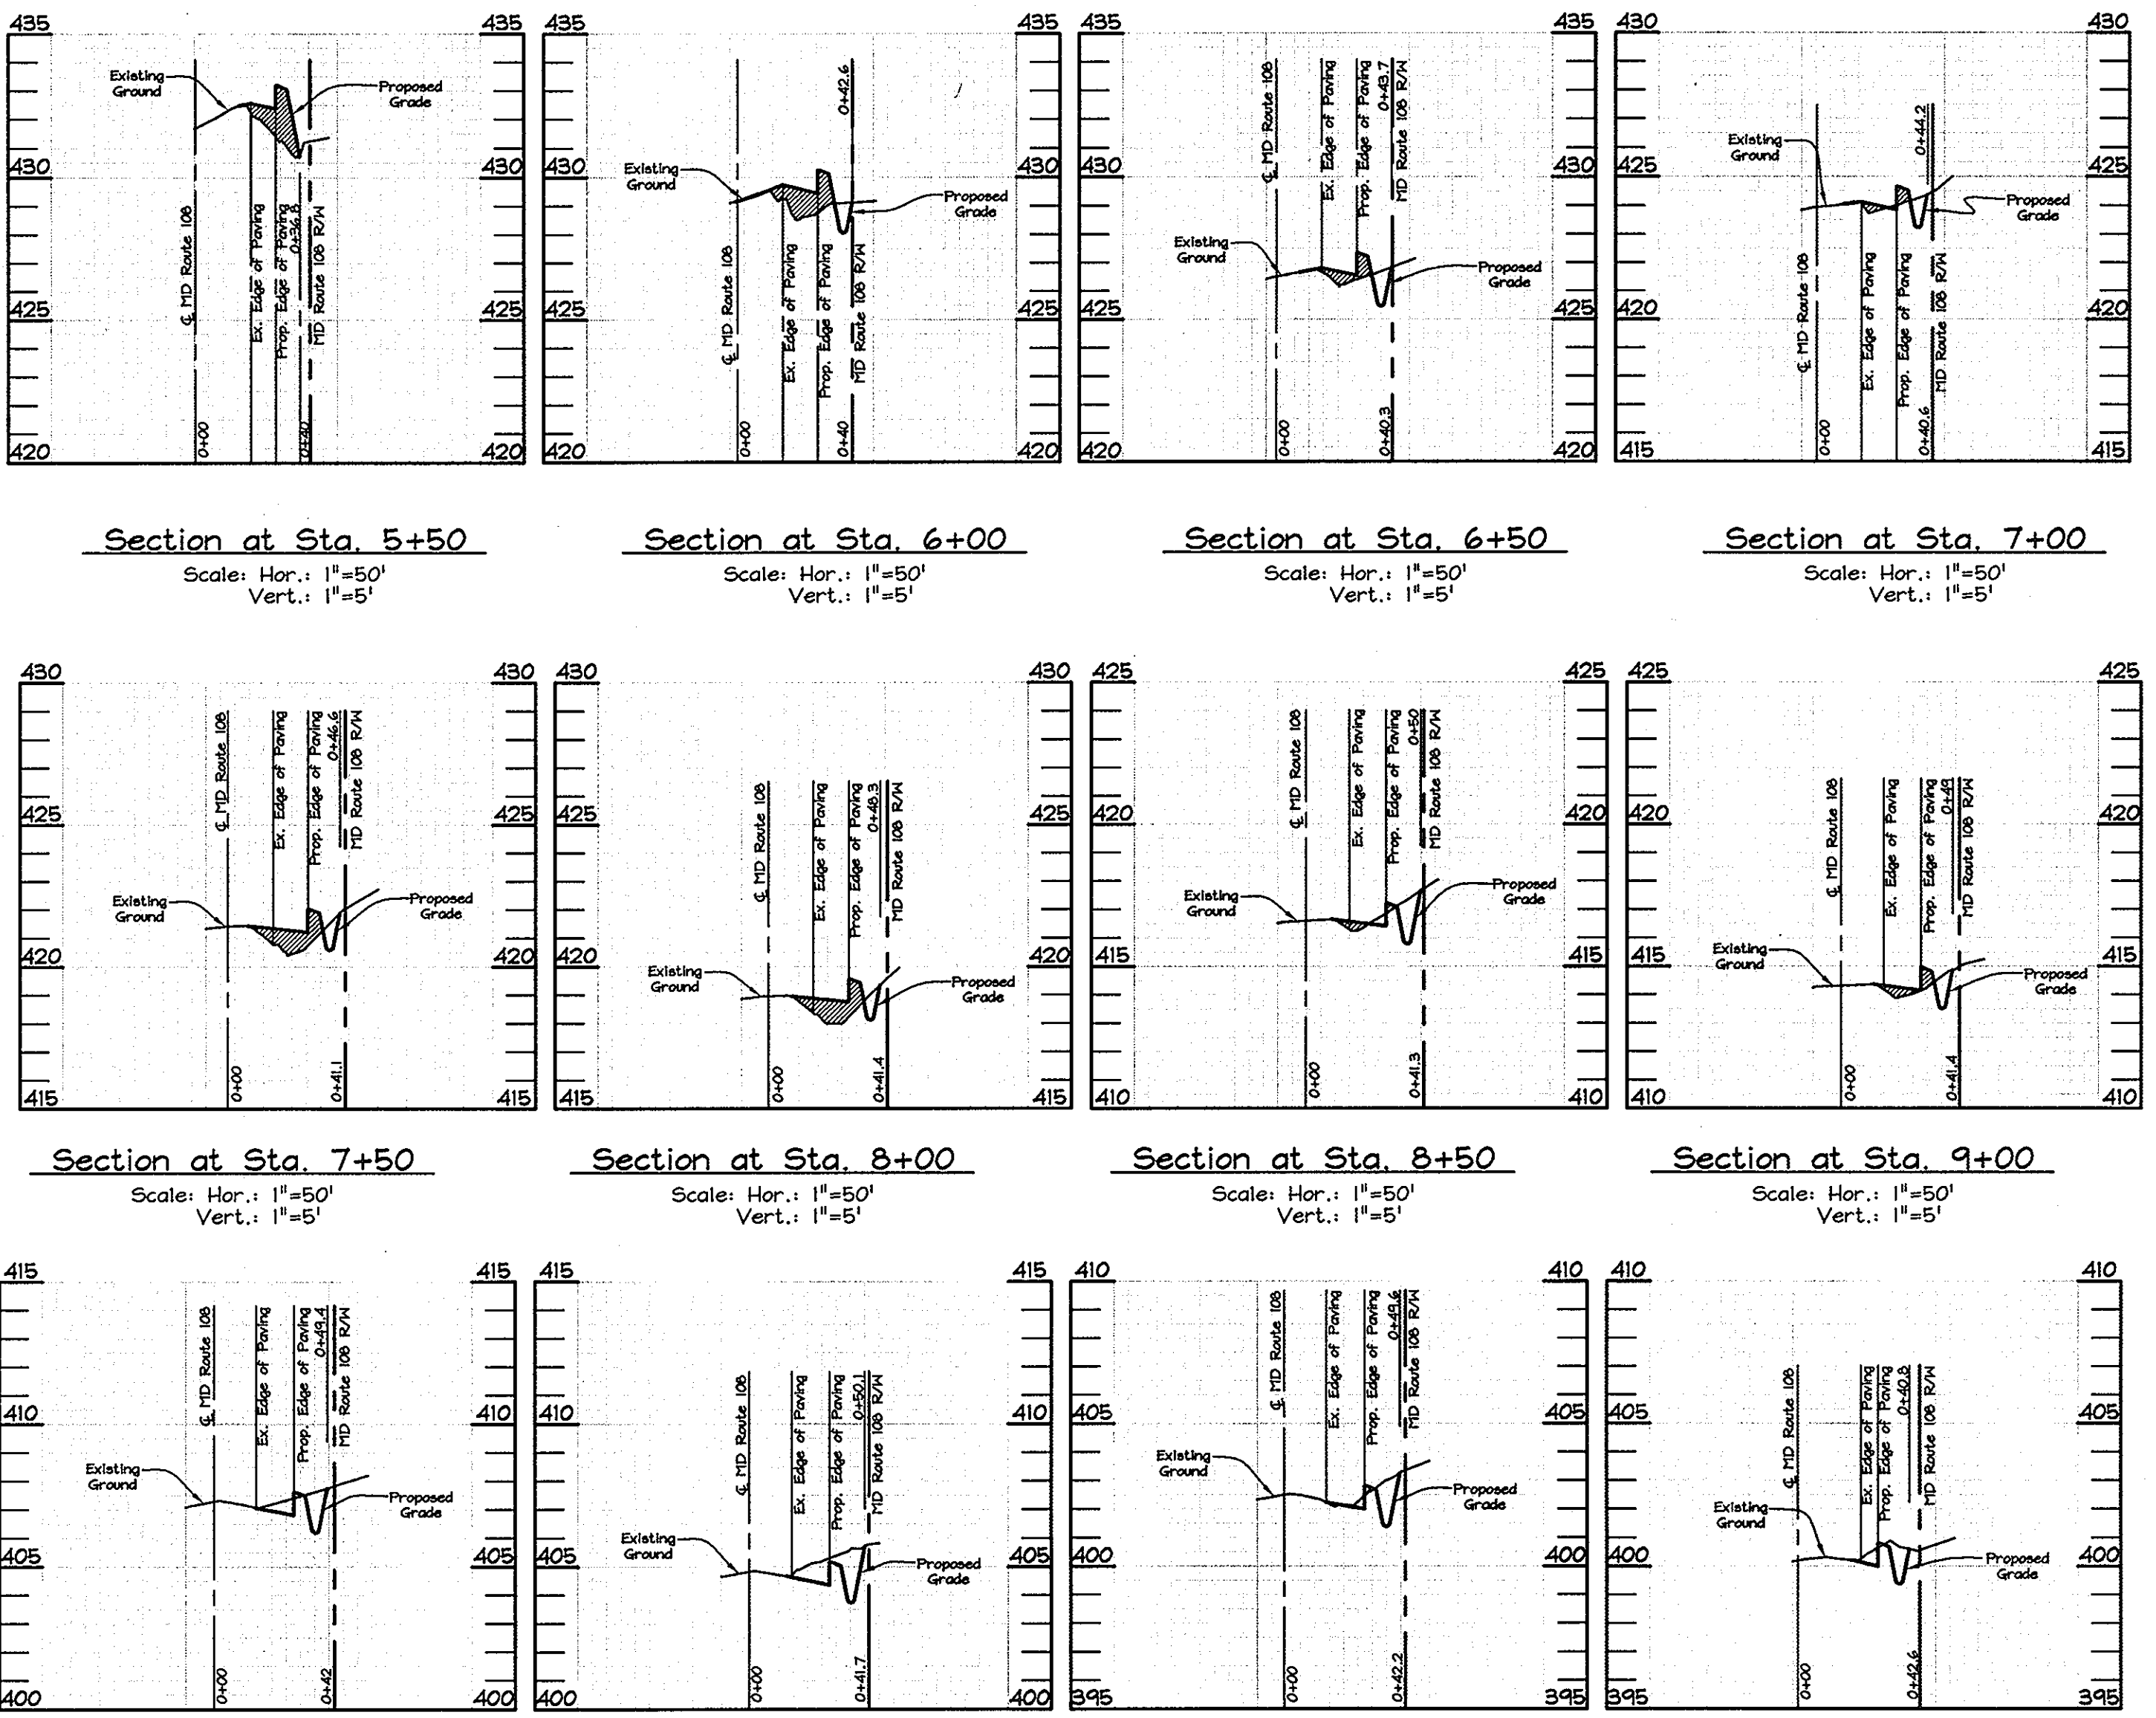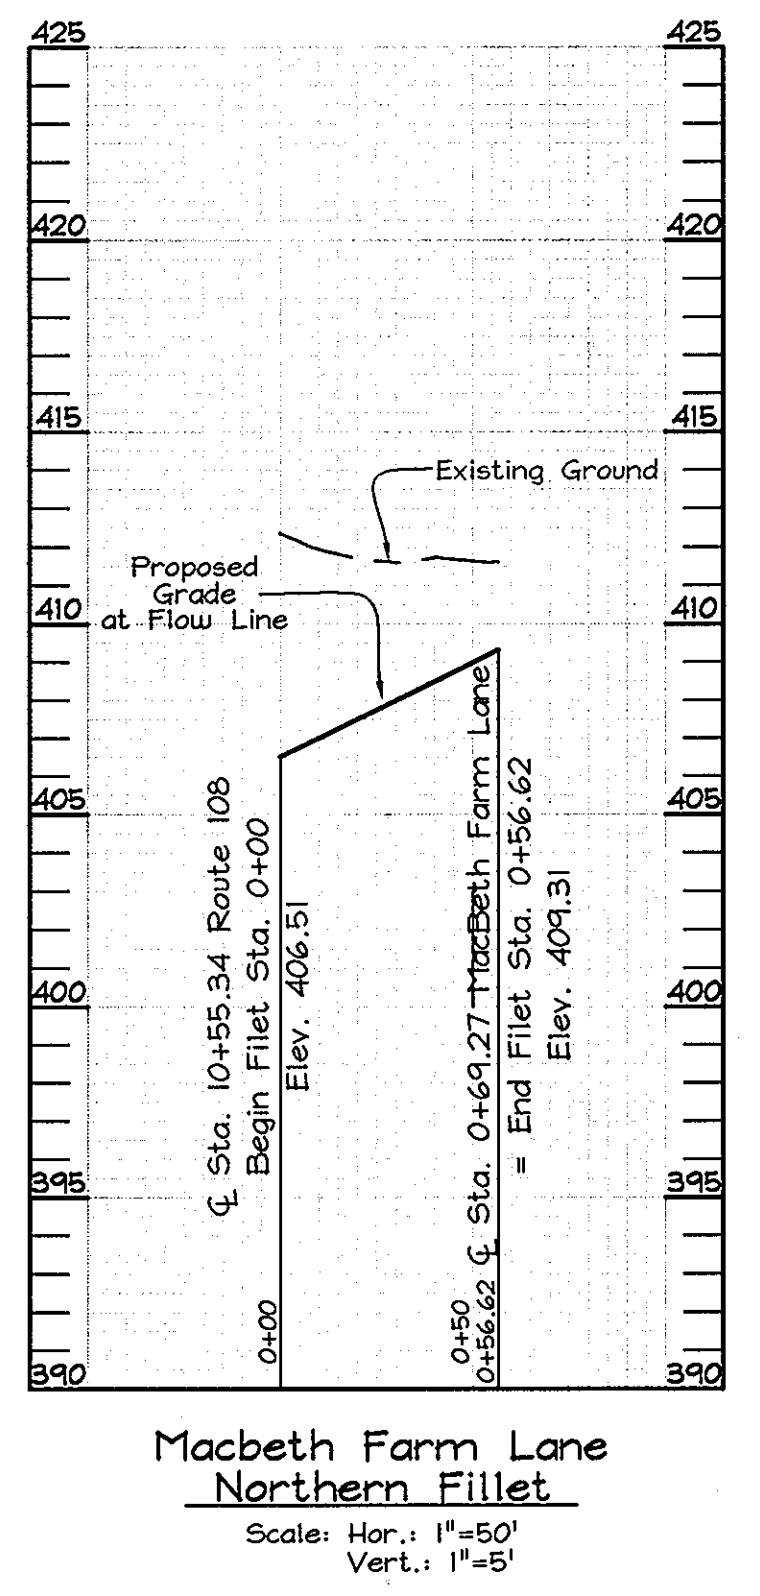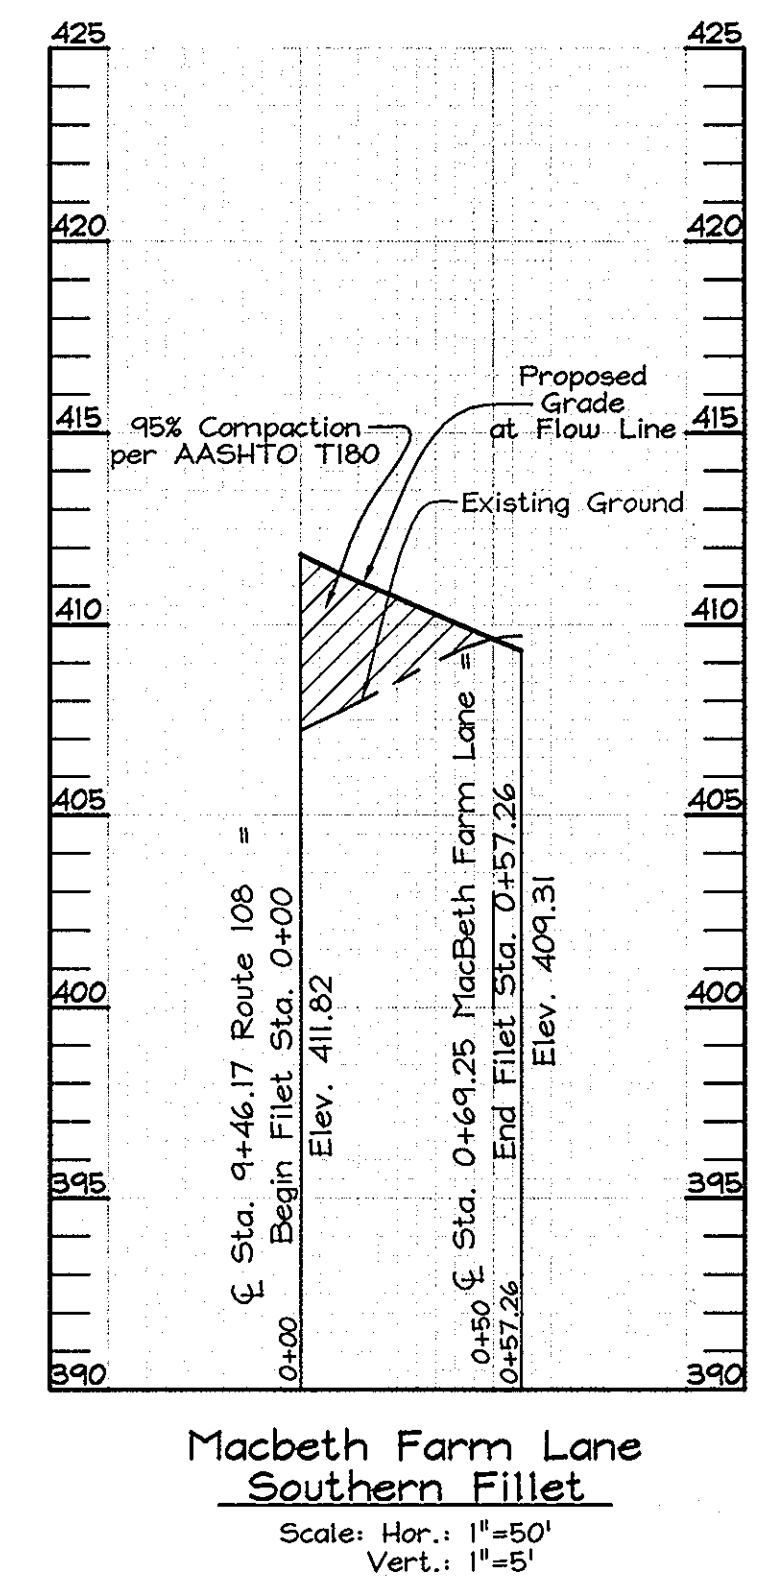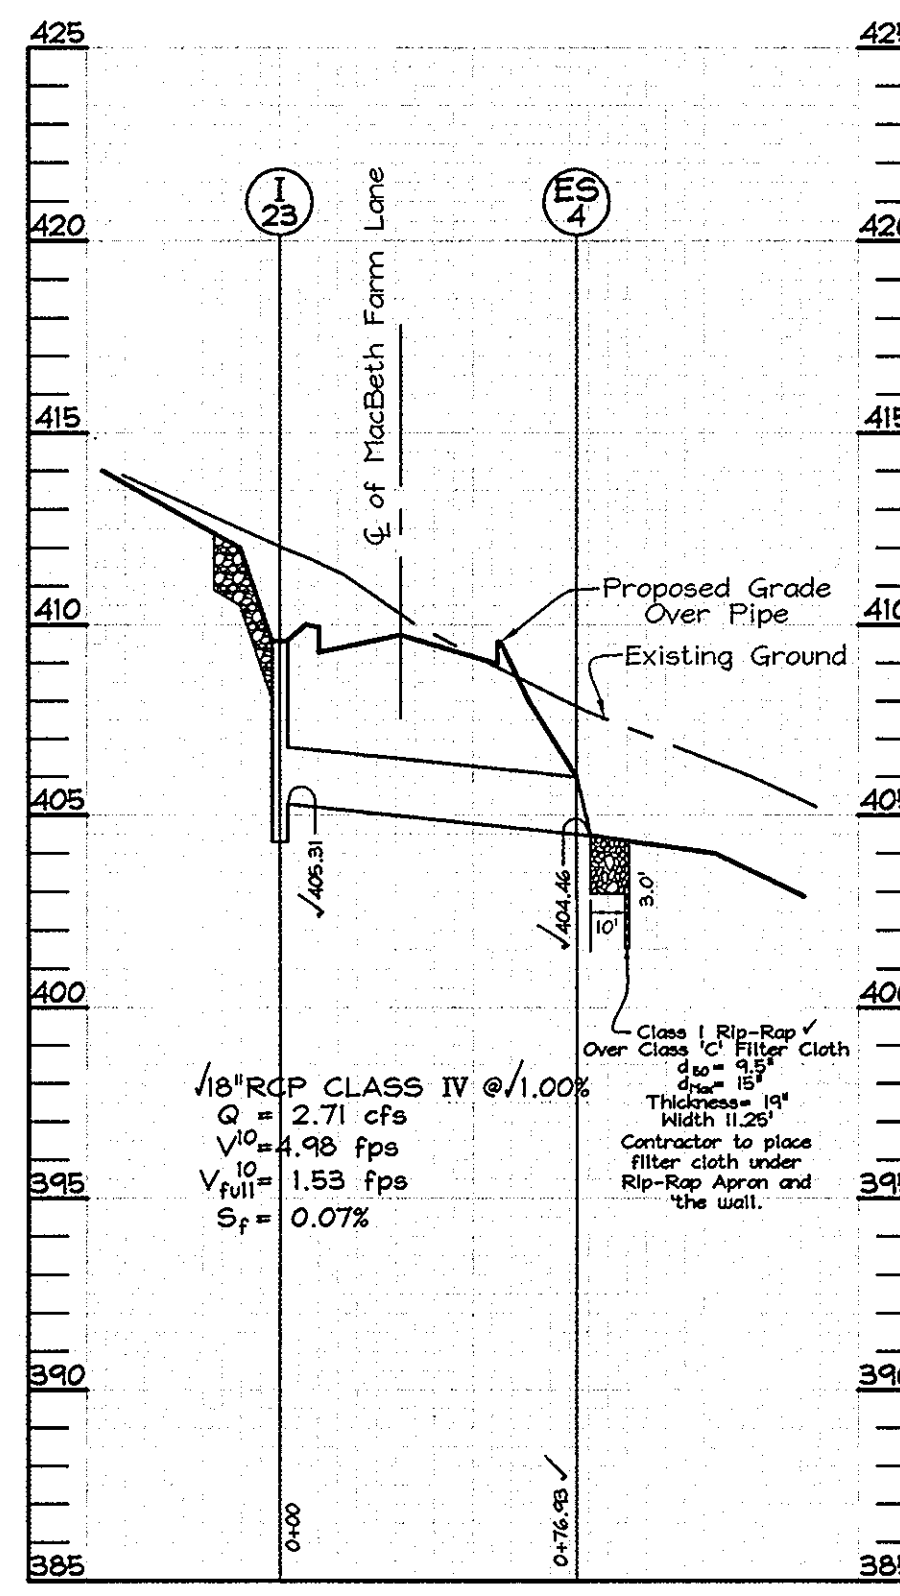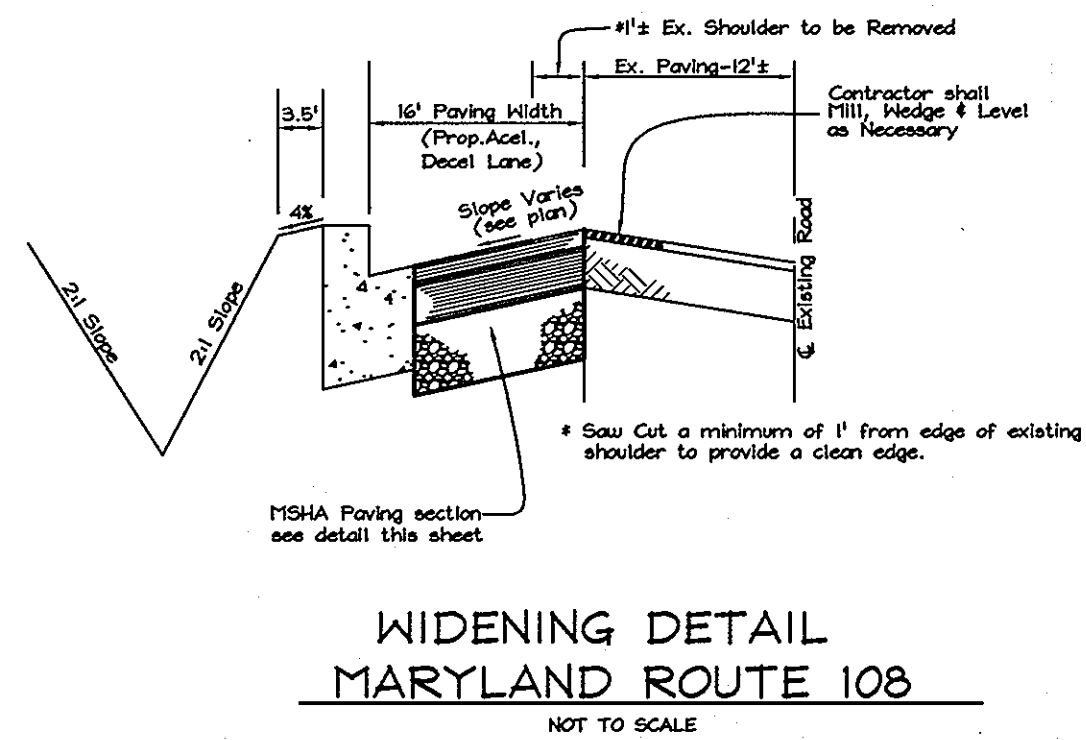

- Note:
- 1: test borings to be drilled along proposed acceleration & deceleration lanes to determine suitability of paving section.
 - 2: All spot elevation along curb line are at flow line and not at top of curb.
 - 3: 1-24 is a precast or cast in place COG/COS Inlet Maryland State Highway Administration Standard No.374.68

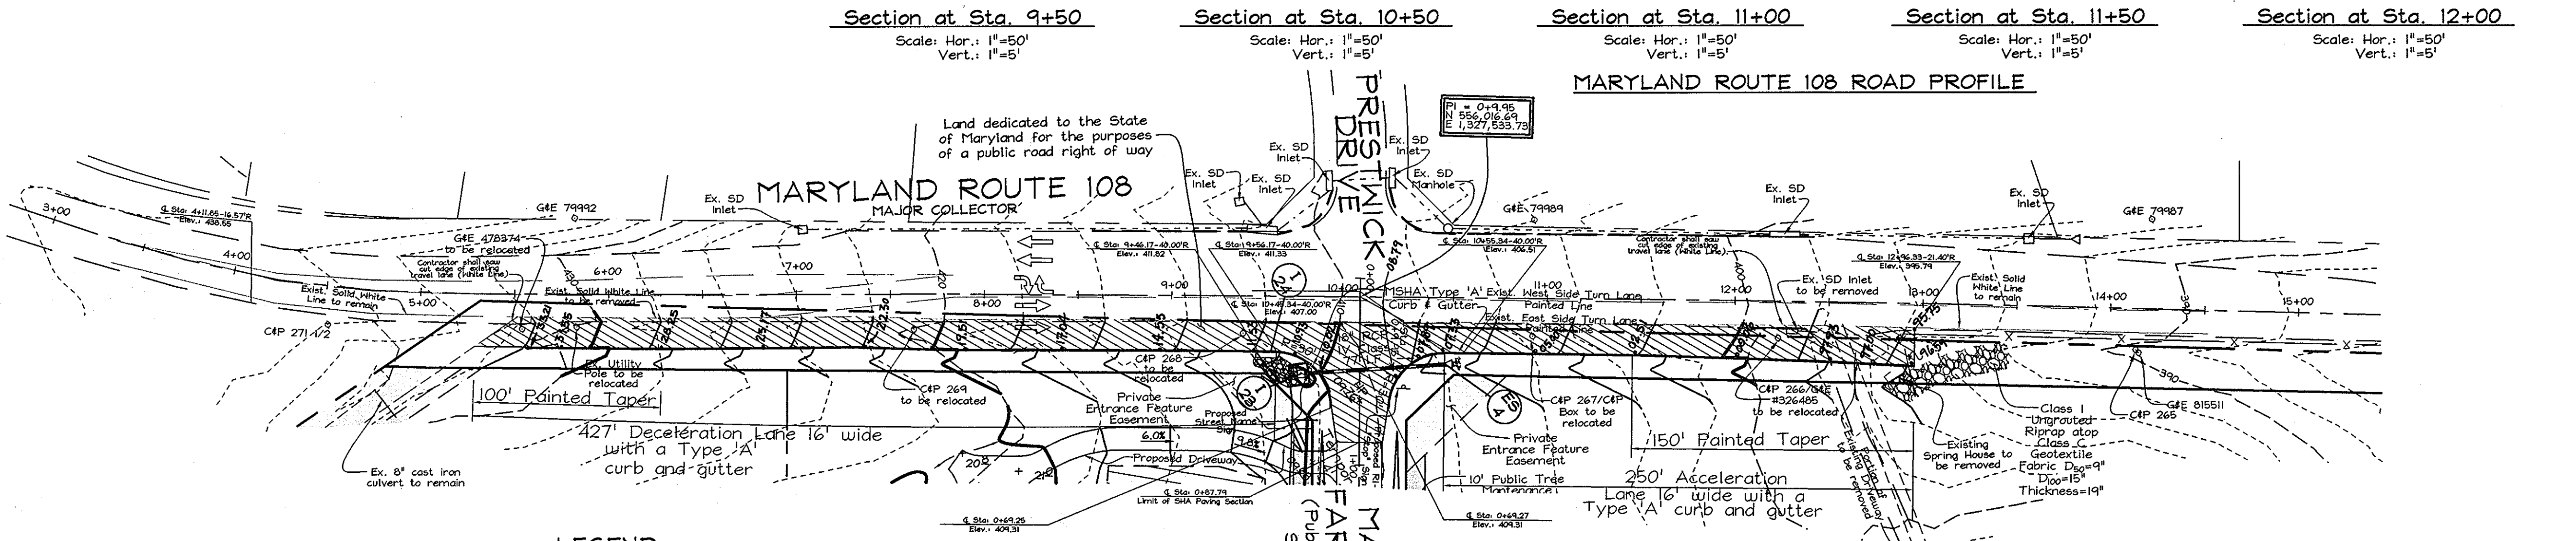

- LEGEND
- Denotes SHA Paving Section
 - Denotes proposed rip-rap $d_{50}=9.5"$, $d_{max}=15"$, thickness 19".
 - Traffic Markings will be provided by Traffic Concepts, Inc.

THESE PLANS HAVE BEEN REVIEWED FOR HOWARD SOIL CONSERVATION DISTRICT AND MEET THE TECHNICAL REQUIREMENTS FOR SOIL EROSION AND SEDIMENT CONTROL.

USDA-NATURAL RESOURCES CONSERVATION SERVICE DATE

THESE PLANS FOR SOIL EROSION AND SEDIMENT CONTROL MEET THE REQUIREMENTS OF THE HOWARD SOIL CONSERVATION DISTRICT.

HOWARD SOIL CONSERVATION DISTRICT

APPROVED: HOWARD COUNTY DEPARTMENT OF PLANNING AND ZONING

Cindy Horvath 10/10/06
CHIEF, DIVISION OF LAND DEVELOPMENT DATE

William J. Williams 10/10/06
CHIEF, DEVELOPMENT ENGINEERING DIVISION DATE

APPROVED: HOWARD COUNTY DEPARTMENT OF PUBLIC WORKS.

William J. Williams 10-9-06
CHIEF, BUREAU OF HIGHWAYS DATE

DEVELOPER'S CERTIFICATE

"I/WE CERTIFY THAT ALL DEVELOPMENT AND CONSTRUCTION WILL BE DONE ACCORDING TO THIS PLAN FOR SEDIMENT AND EROSION CONTROL AND THAT ALL RESPONSIBLE PERSONNEL INVOLVED IN THE CONSTRUCTION PROJECT WILL HAVE A CERTIFICATE OF ATTENDANCE AT A DEPARTMENT OF THE ENVIRONMENT APPROVED TRAINING PROGRAM FOR THE CONTROL OF SEDIMENT AND EROSION BEFORE BEGINNING THE PROJECT. I ALSO AUTHORIZE PERIODIC ON-SITE INSPECTION BY THE HOWARD SOIL CONSERVATION DISTRICT."

William J. Williams 8/31/06
SIGNATURE OF DEVELOPER DATE

ENGINEER'S CERTIFICATE

"I CERTIFY THAT THIS PLAN FOR SEDIMENT AND EROSION CONTROL REPRESENTS A PRACTICAL AND WORKABLE PLAN BASED ON MY PERSONAL KNOWLEDGE OF THE SITE CONDITIONS AND THAT IT WAS PREPARED IN ACCORDANCE WITH THE REQUIREMENTS OF THE HOWARD SOIL CONSERVATION DISTRICT."


Zacharia Y. Fisch 8/31/06
SIGNATURE OF ENGINEER DATE
ZACHARIA Y. FISCH

OWNER

THE ESTATE OF ELIZABETH SMITH
c/o Charles Slade, Personal Representative
10450 Shaker Drive, Suite 112
Columbia, Maryland 21046

DEVELOPER

CLARKSVILLE OVERLOOK, LLC
5300 Dorsey Hall Drive
Suite 200A
Ellicott City, Maryland 21042

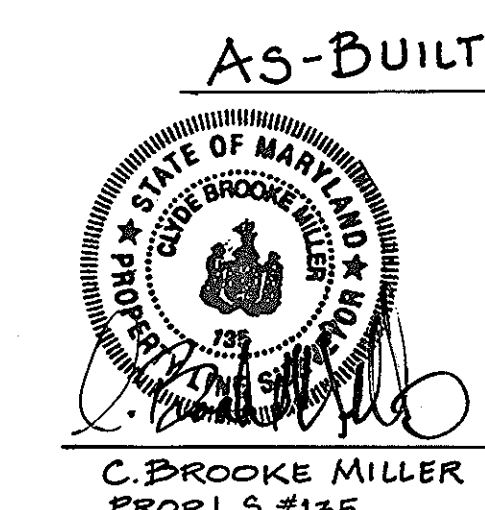

ENTRANCE PLAN AND DETAILS


MACBETH FARM

LOTS 1 THRU 35, BUILDABLE PRESERVATION PARCEL 'A', NON-BUILDABLE PRESERVATION PARCELS 'B', 'C', 'D', 'E', 'F', 'G', 'H', 'I', 'J', 'K', 'L', 'M', 'N', 'O', 'P', 'Q', 'R', 'S', 'T', 'U', 'V', 'W', 'X', 'Y', 'Z'

Parcel 40
4th Election District
Howard County, Maryland

DESIGN BY: PS
DRAWN BY: MY
CHECKED BY: ZYF
SCALE: As Shown
DATE: Aug. 31, 2006
W.O. No.: 3165
SHEET No.: 9 OF 23

FSH Associates
Engineers Planners Surveyors
6339 Howard Lane ElkrIDGE, MD 21075
Tel: 410-567-5200 Fax: 410-796-1582
E-mail: info@fsh.com

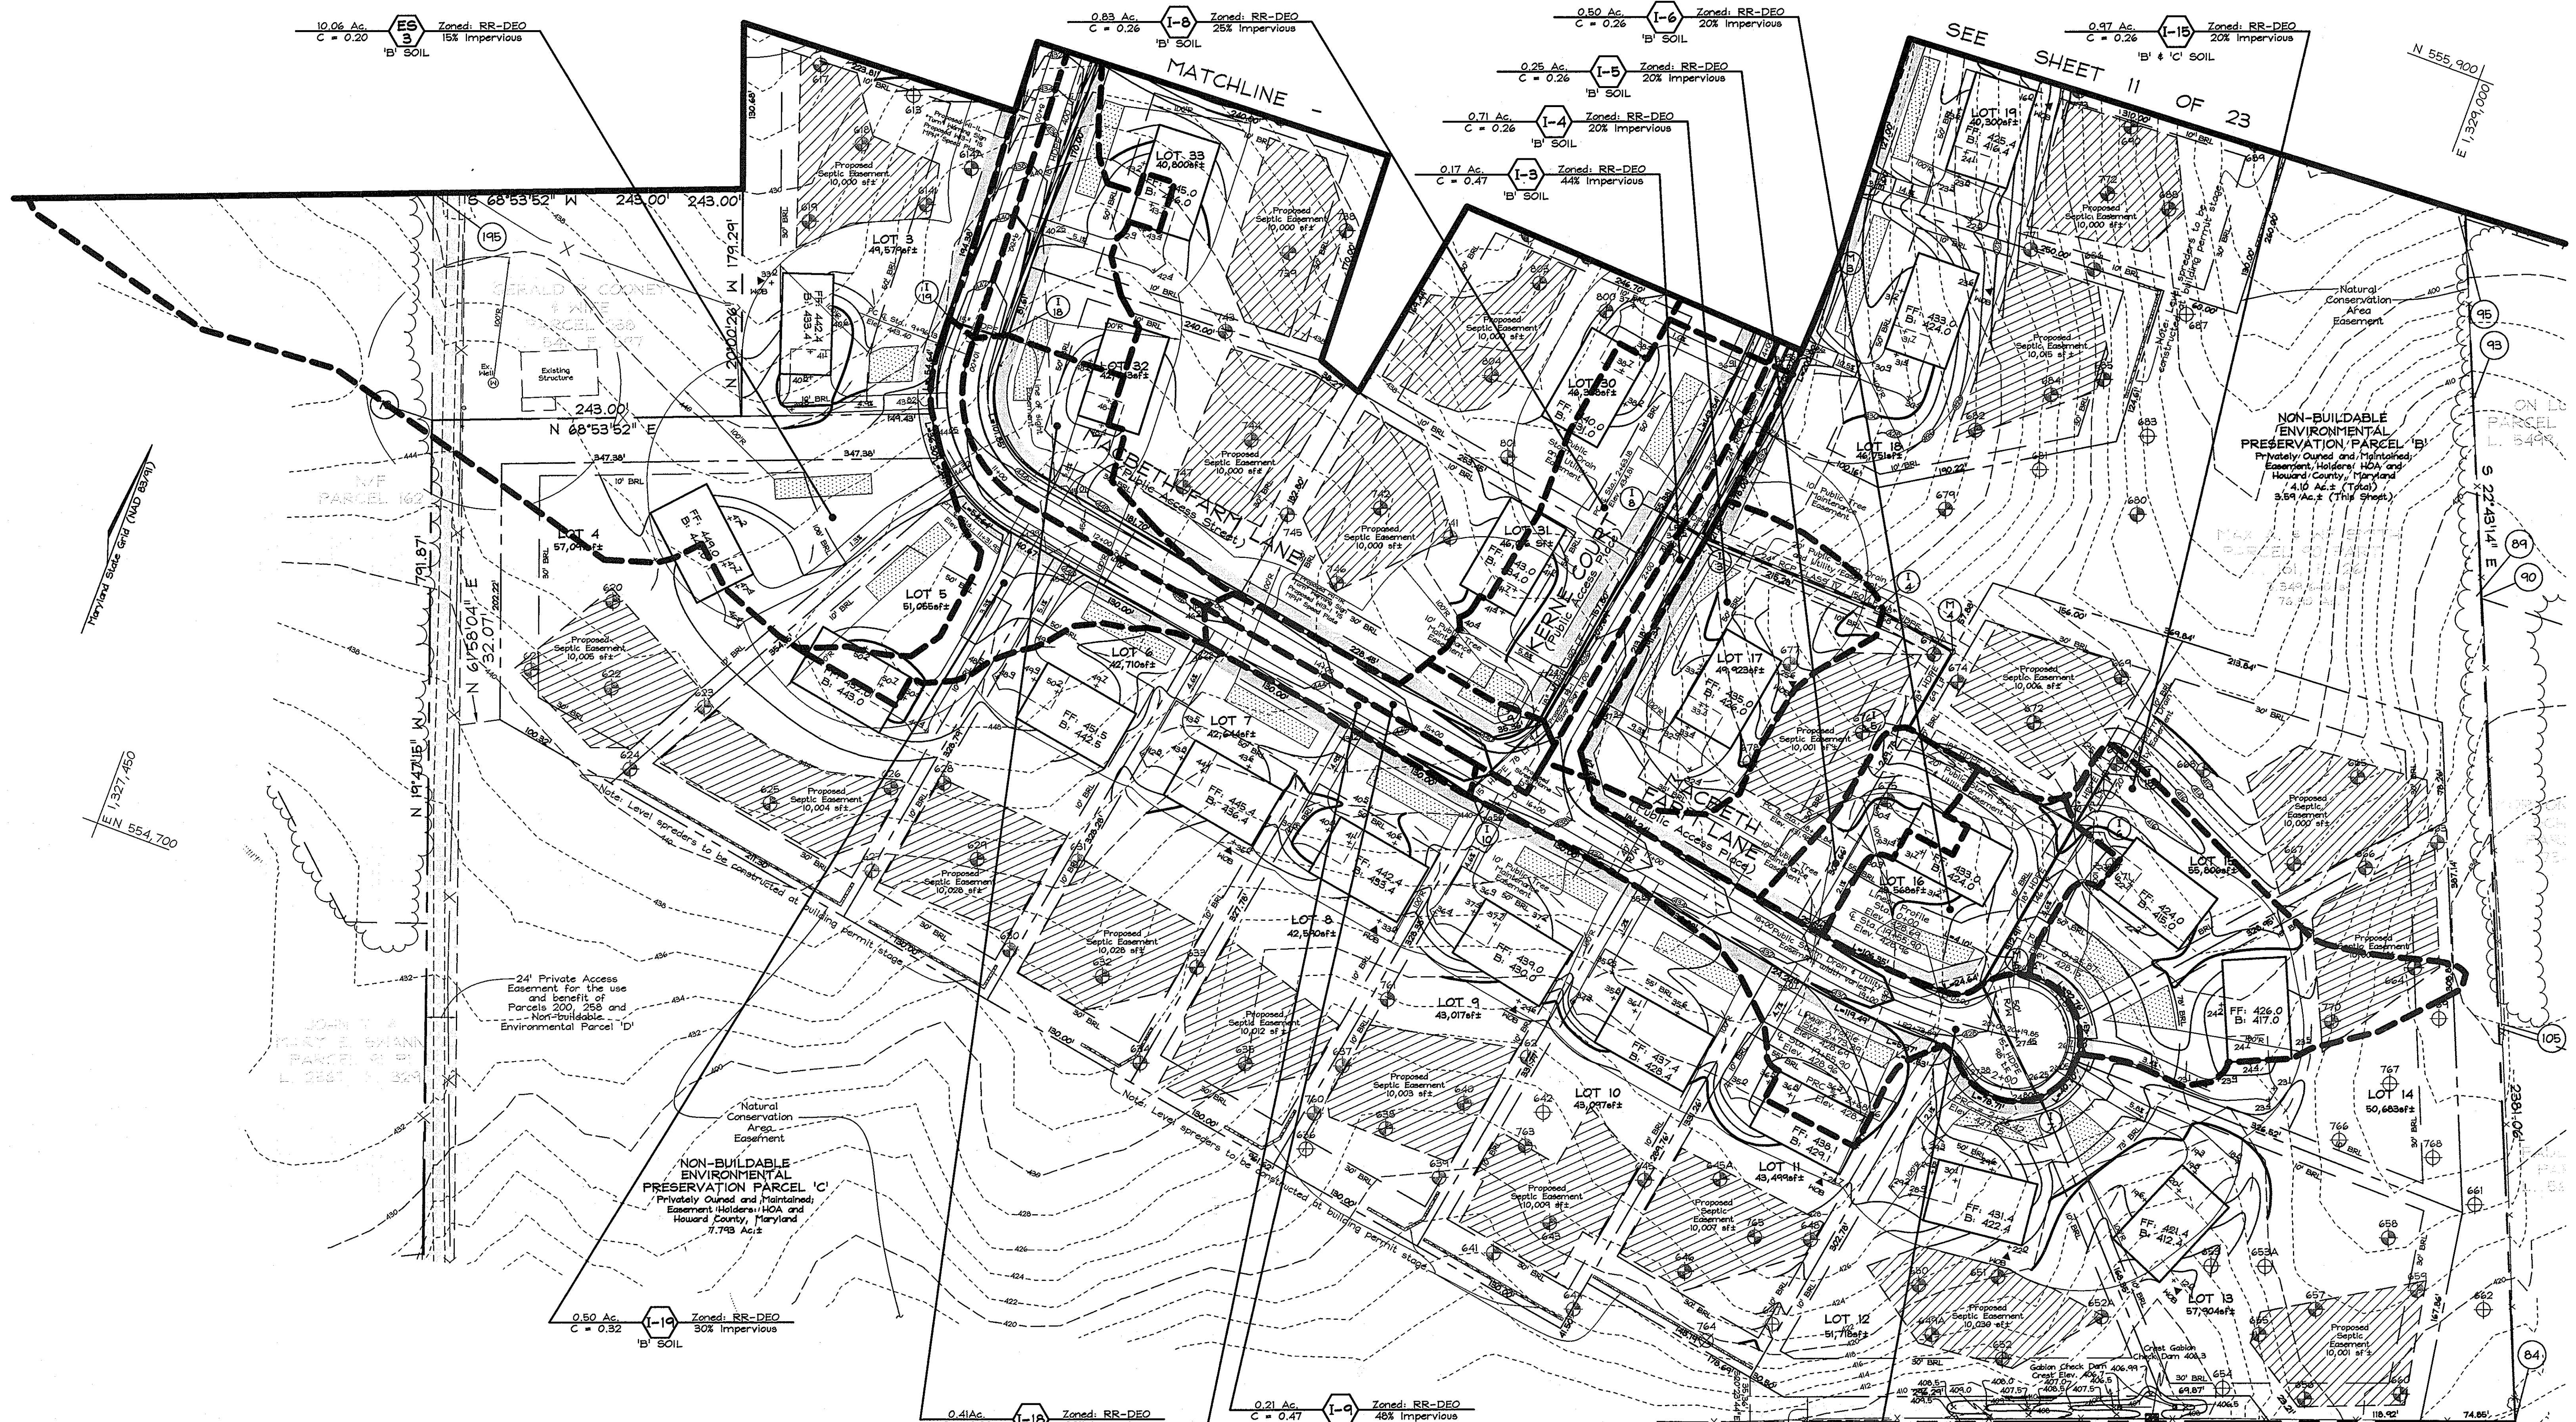

USE THIS SHEET FOR DRAINAGE AREAS ONLY

STORM DRAIN DRAINAGE AREA MAP

MACBETH FARM
 LOTS 1 THRU 35, BUILDABLE PRESERVATION PARCEL 'A',
 NON-BUILDABLE PRESERVATION PARCELS 'B', 'C', 'D', 'E', 'F'
 Tax Map 34, Grids 18 & 24 Parcel 90
 4th Election District Howard County, Maryland

APPROVED: HOWARD COUNTY DEPARTMENT OF PUBLIC WORKS.


APPROVED: HOWARD COUNTY DEPARTMENT OF PLANNING AND ZONING

W. F. ...
 CHIEF, BUREAU OF HIGHWAYS
 DATE 10-4-06

Cindy ...
 CHIEF, DIVISION OF LAND DEVELOPMENT
 DATE 10/10/06


OWNER
 THE ESTATE OF ELIZABETH SMITH
 c/o Charles Slade, Personal Representative
 10450 Shaker Drive, Suite 112
 Columbia, Maryland 21046

DEVELOPER
 CLARKSVILLE OVERLOOK, LLC
 5300 Dorsey Hall Drive
 Suite 200A
 Ellicott City, Maryland 21042

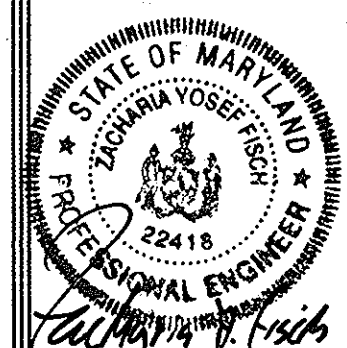

FSH Associates
 Engineers Planners Surveyors
 6339 Howard Lane Ellicott City, MD 21075
 Tel: 410-567-5200 Fax: 410-796-1562
 E-mail: info@fshri.com

DESIGN BY: PS
 DRAWN BY: MY
 CHECKED BY: ZYF
 SCALE: 1"=60'
 DATE: Aug 31, 2006
 W.O. No.: 3165
 SHEET No.: 10 OF 23

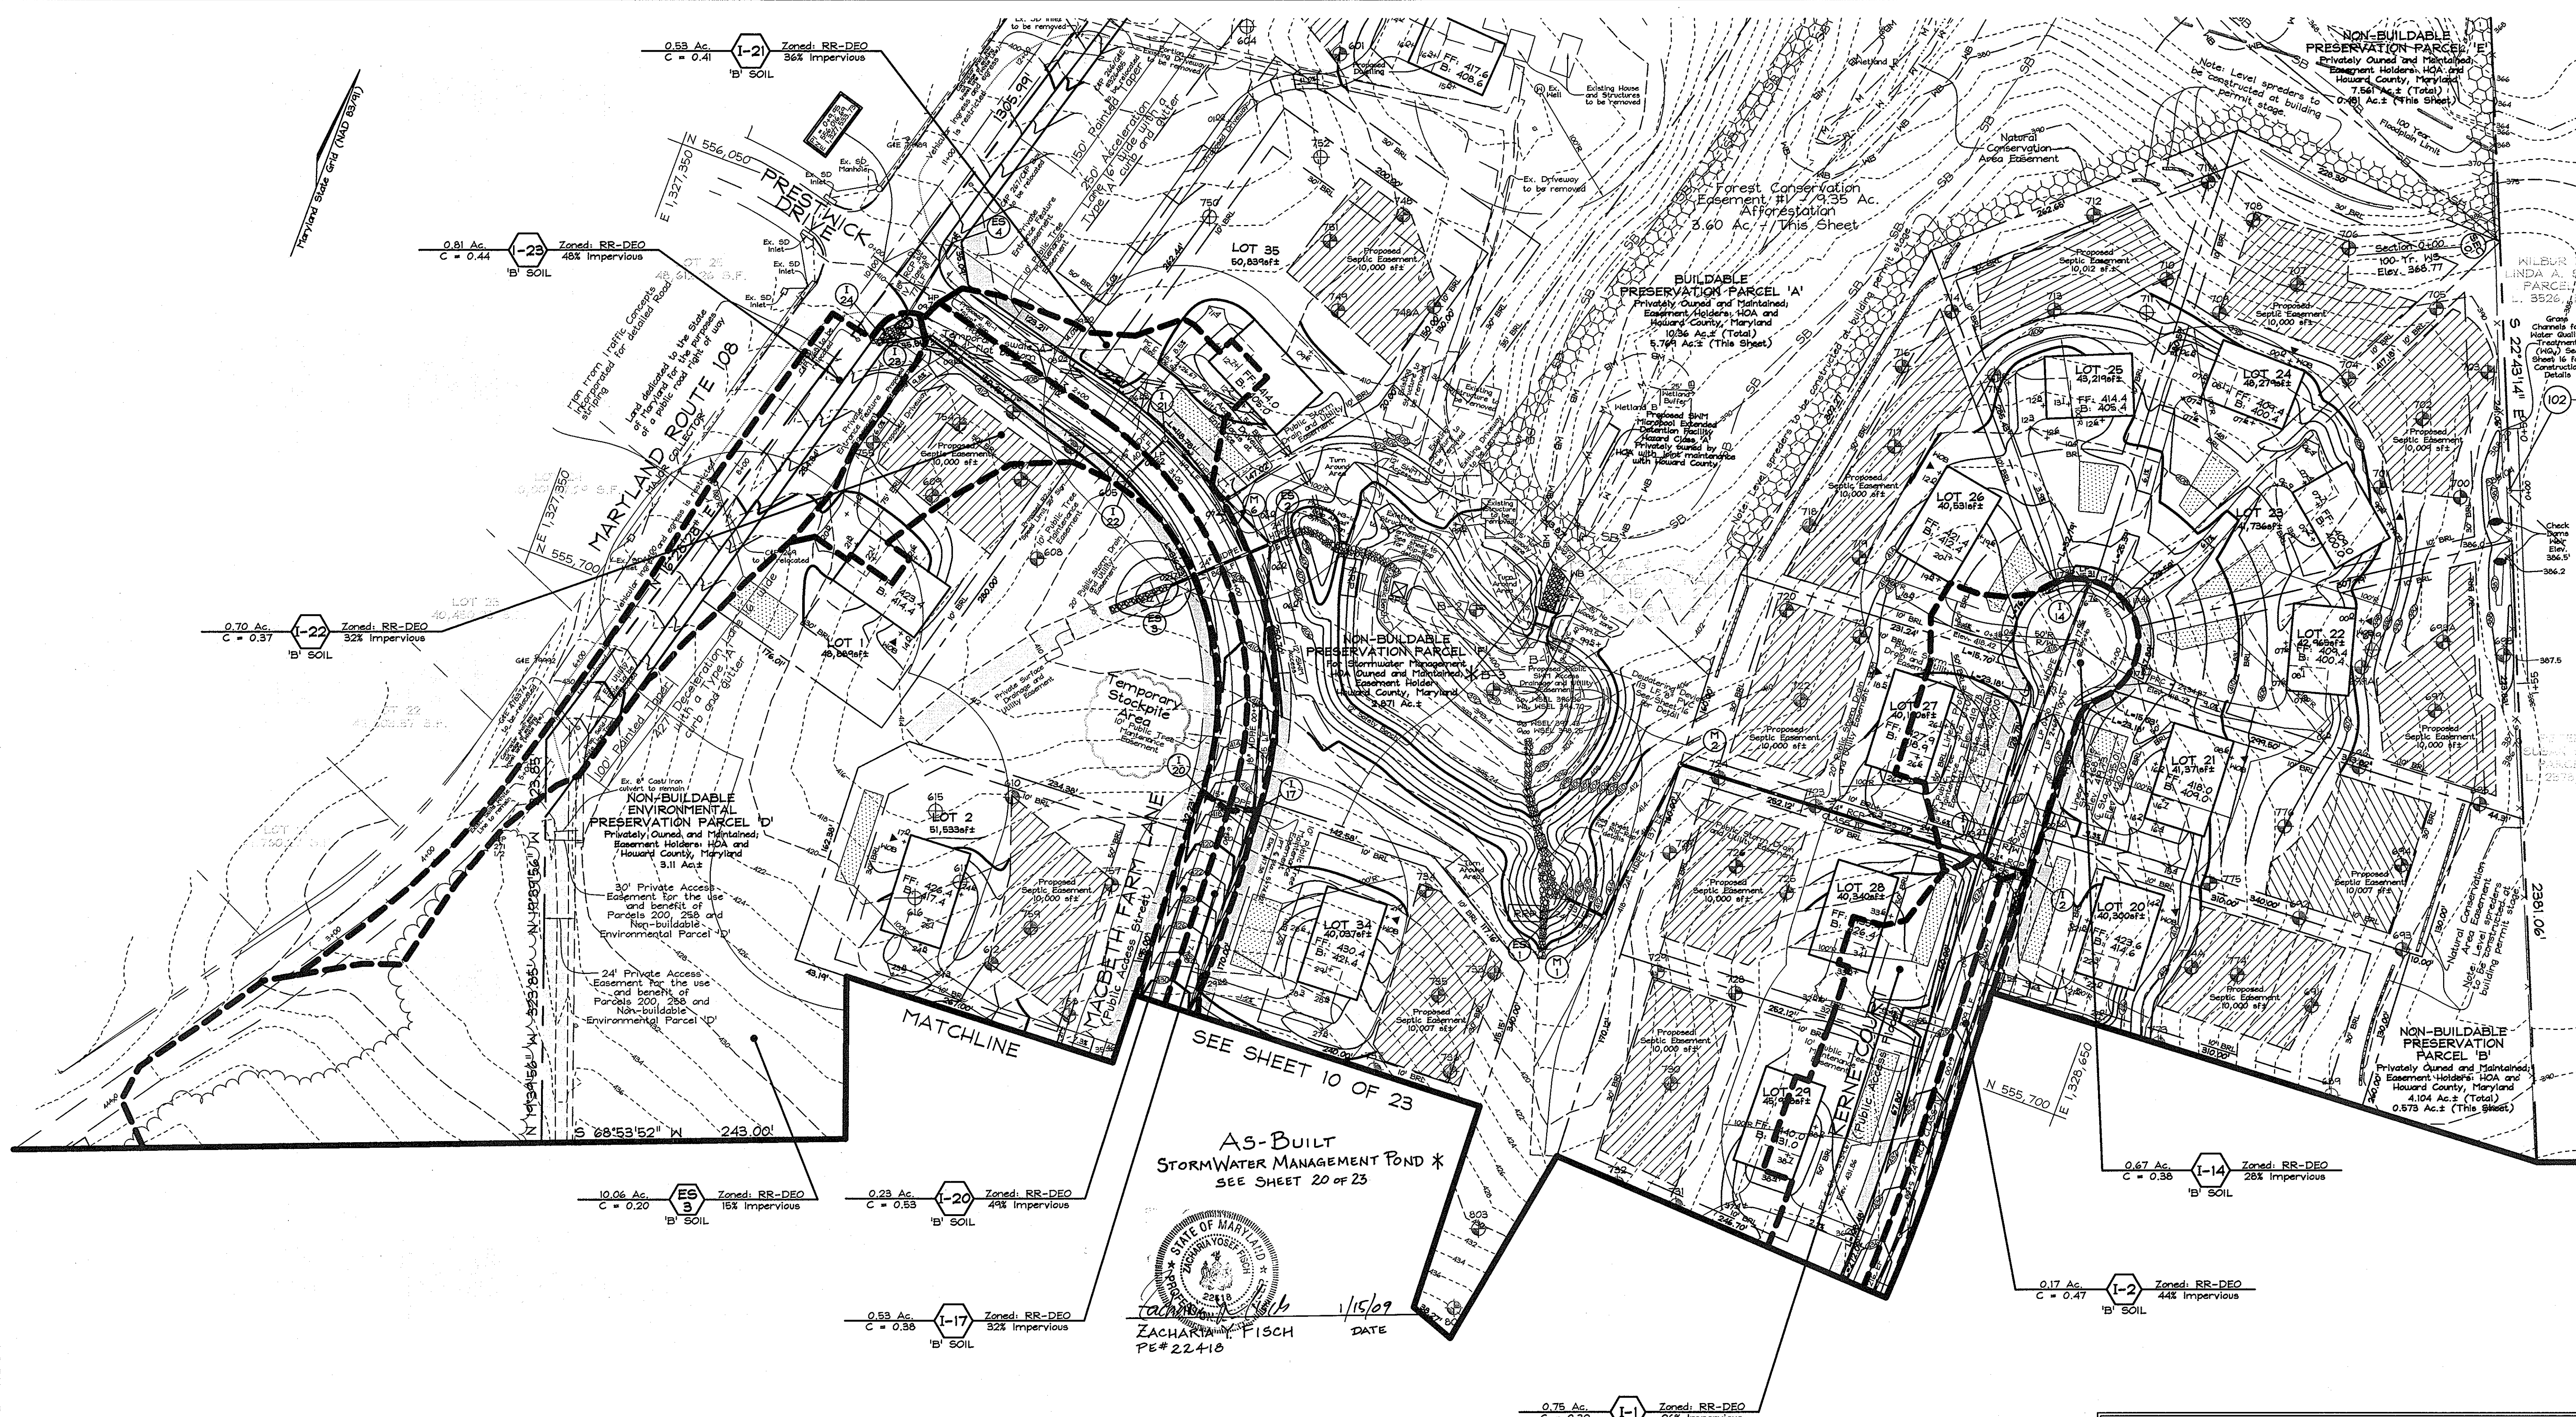

APPROVED: HOWARD COUNTY DEPARTMENT OF PUBLIC WORKS.

William F. Walsh 10-4-06
CHIEF, BUREAU OF HIGHWAYS DATE

APPROVED: HOWARD COUNTY DEPARTMENT OF PLANNING AND ZONING

Candy Hamilton 10/11/06
CHIEF, DIVISION OF LAND DEVELOPMENT DATE
Paul Deussen 10/10/06
CHIEF, DEVELOPMENT ENGINEERING DIVISION DATE


SEE SHEET 10 OF 23
AS-BUILT
STORMWATER MANAGEMENT POND *
SEE SHEET 20 OF 23
ZACHARIAH FISCH
PE# 22418
1/15/09
DATE

USE THIS SHEET
FOR DRAINAGE
AREAS ONLY

STORM DRAIN DRAINAGE AREA MAP

MACBETH FARM

LOTS 1 THRU 35, BUILDABLE PRESERVATION PARCEL 'A',
NON-BUILDABLE PRESERVATION PARCELS 'B', 'C', 'D', 'E', 'F'
Tax Map 34 Grids 18 & 24 Parcel 90
4th Election District Howard County, Maryland




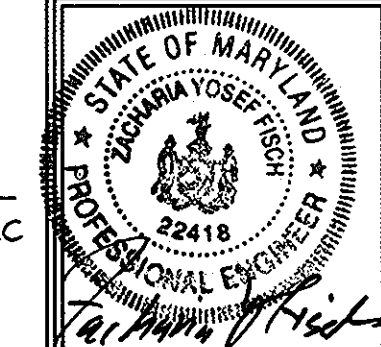


FSH Associates
Engineers Planners Surveyors
6339 Howard Lane Eldridge, MD 21075
Tel: 410-567-5200 Fax: 410-796-1552
E-mail: info@fsher.com

OWNER
THE ESTATE OF ELIZABETH SMITH
c/o Charles Slade, Personal Representative
10450 Shaker Drive, Suite 112
Columbia, Maryland 21046

DEVELOPER
CLARKSVILLE OVERLOOK, LLC
5300 Dorsey Hall Drive
Suite 200A
Elicott City, Maryland 21042

DESIGN BY: PS
DRAWN BY: MY
CHECKED BY: ZYF
SCALE: 1"=60'
DATE: Aug. 31, 2006
H.O. No.: 3165
SHEET No.: 11 OF 23

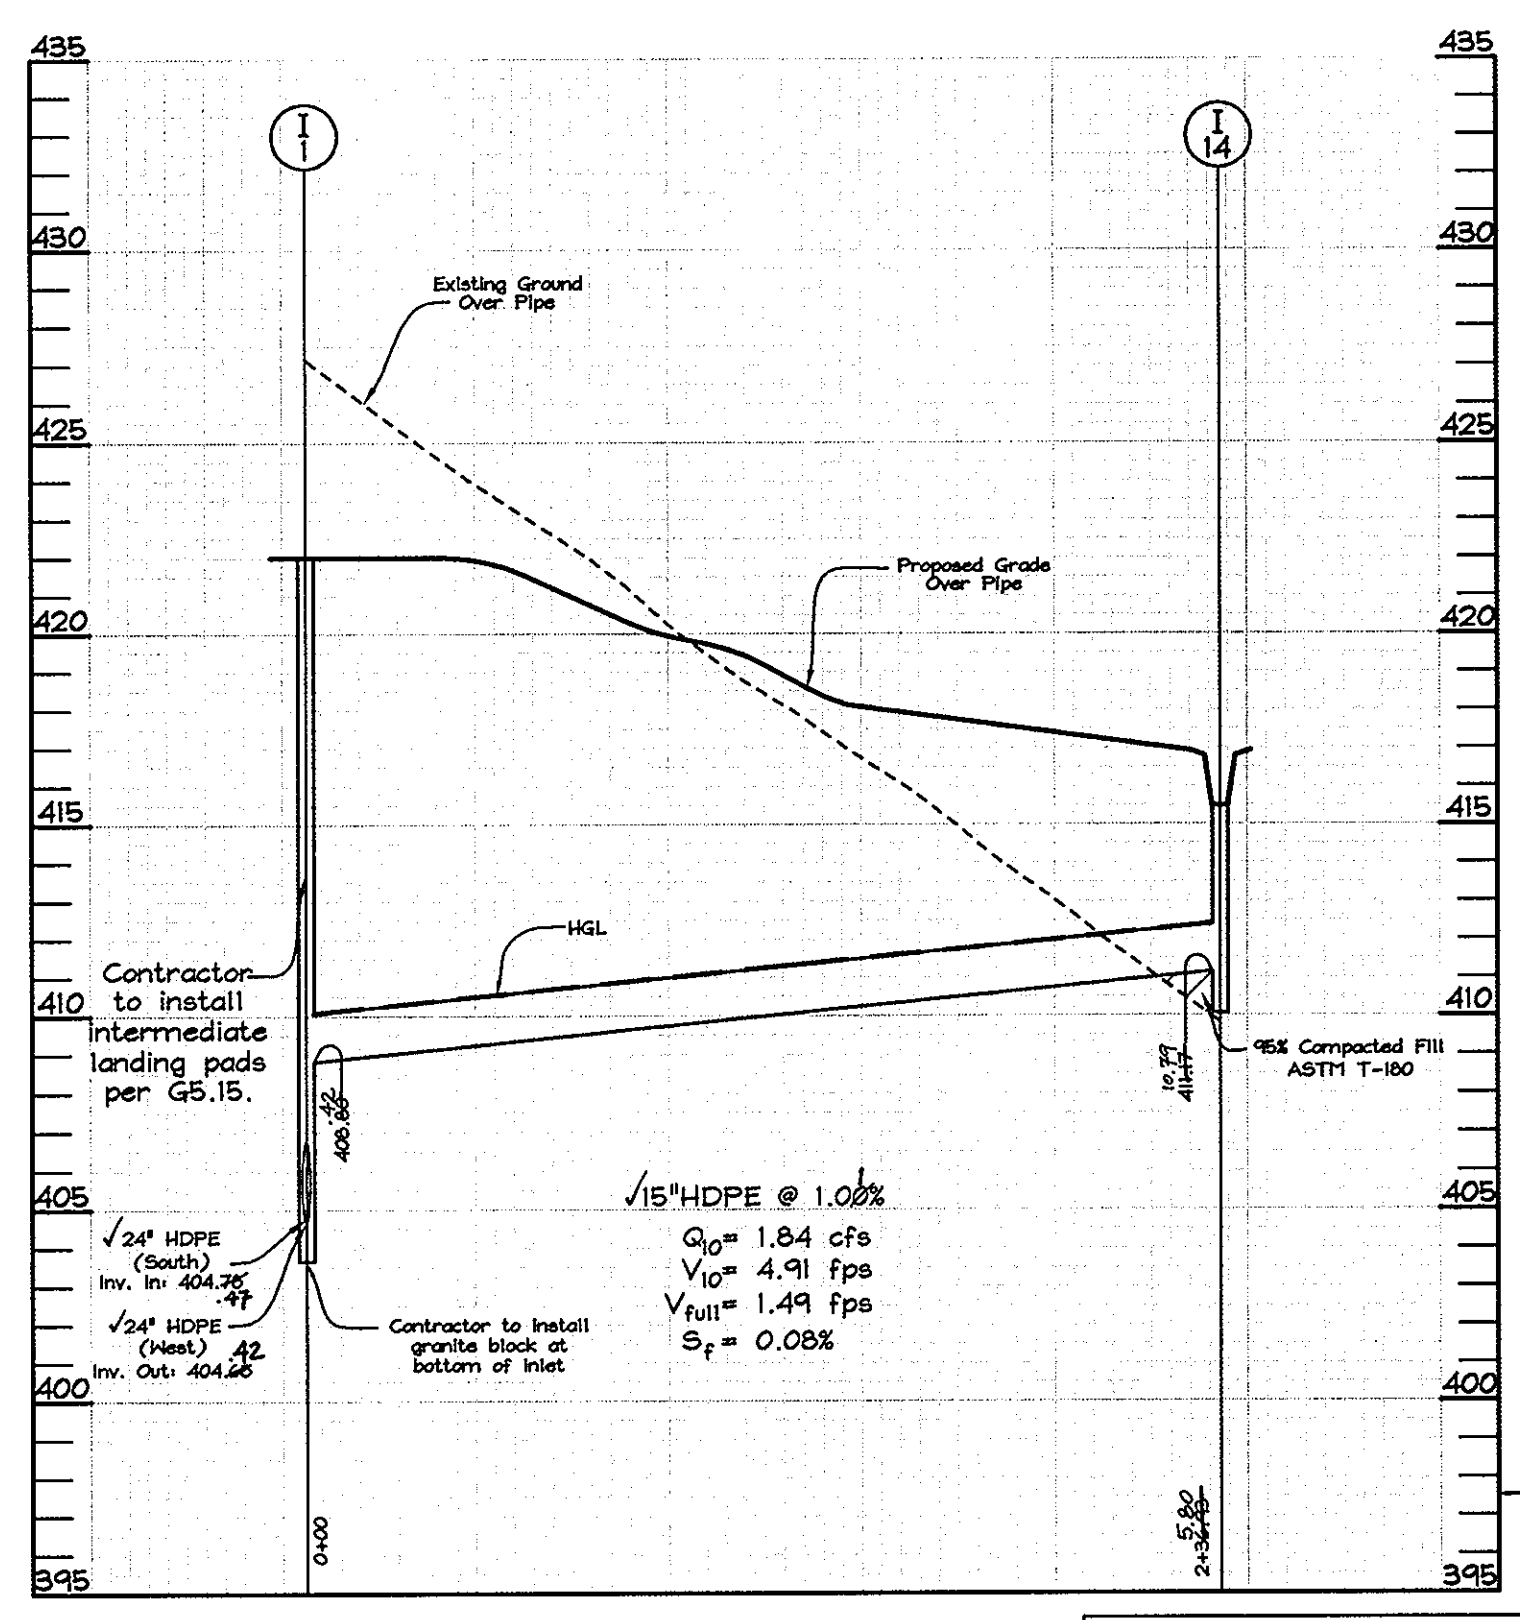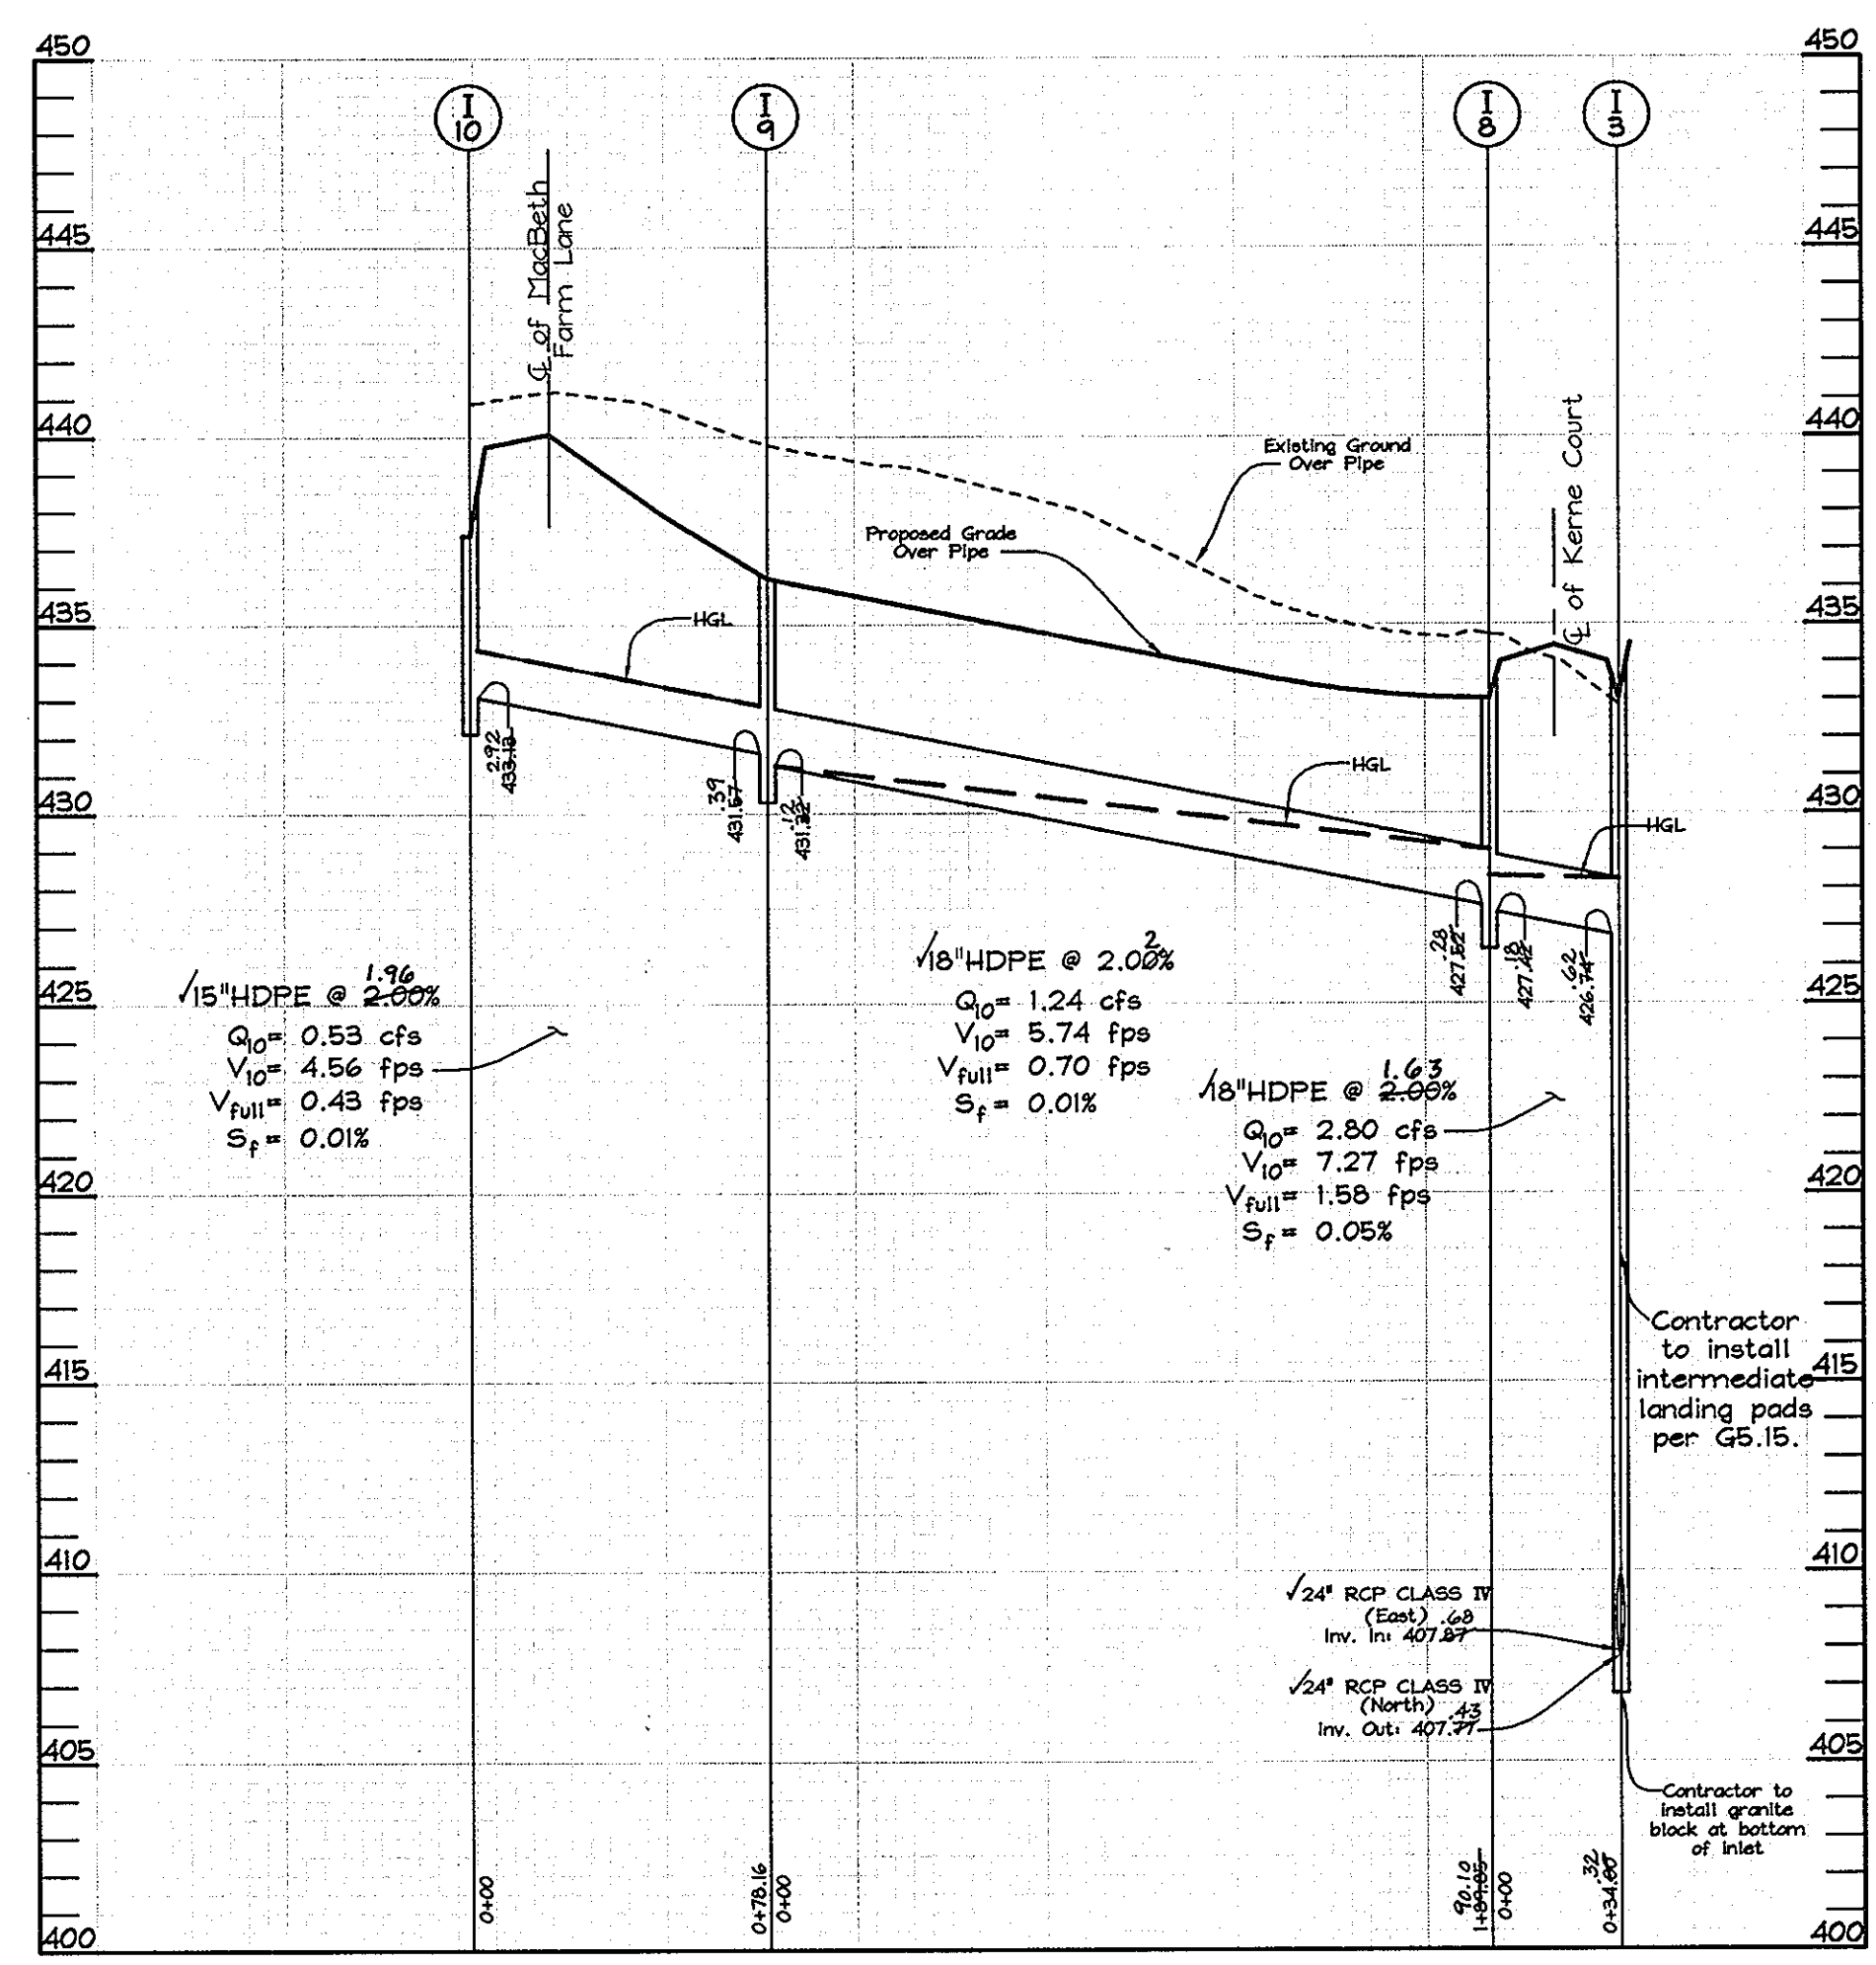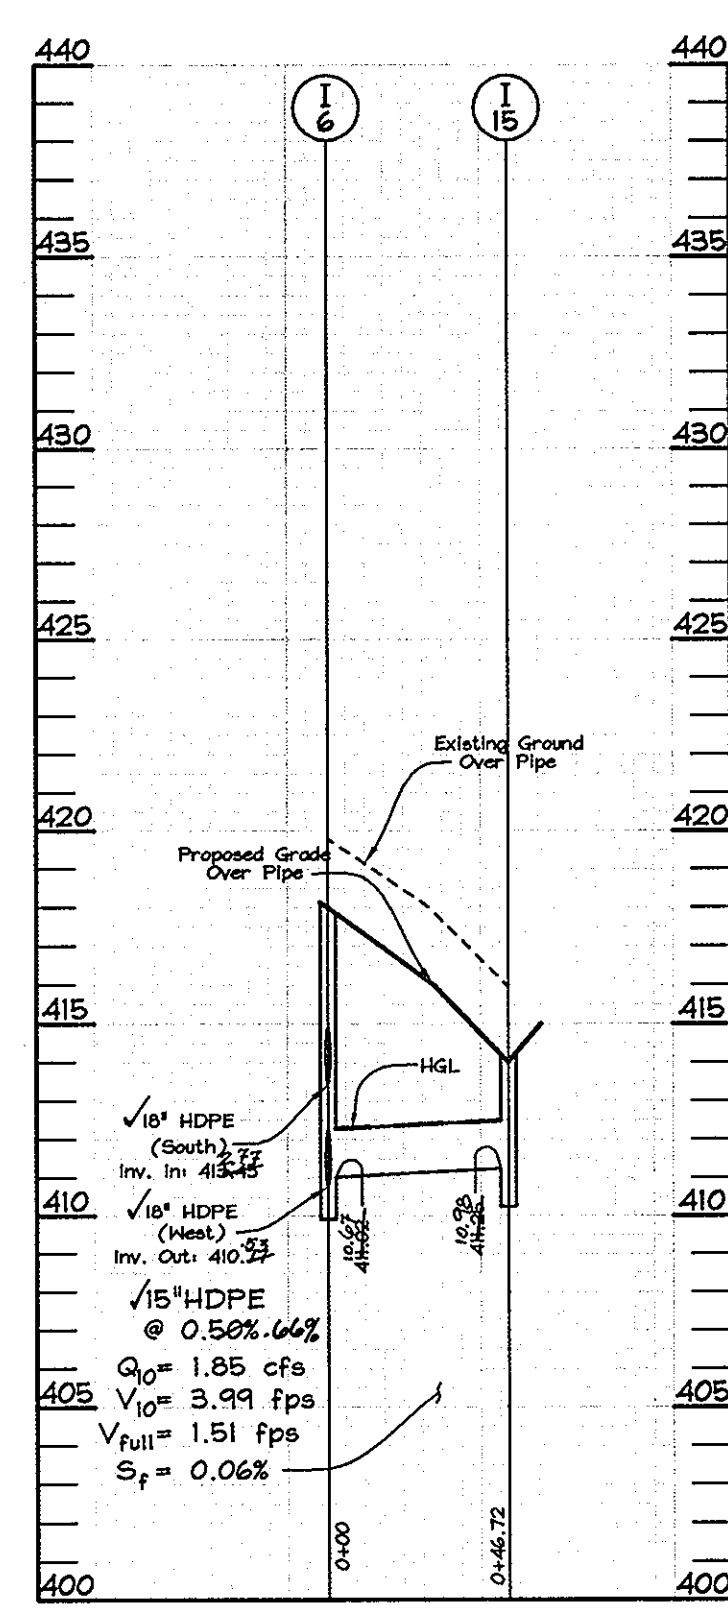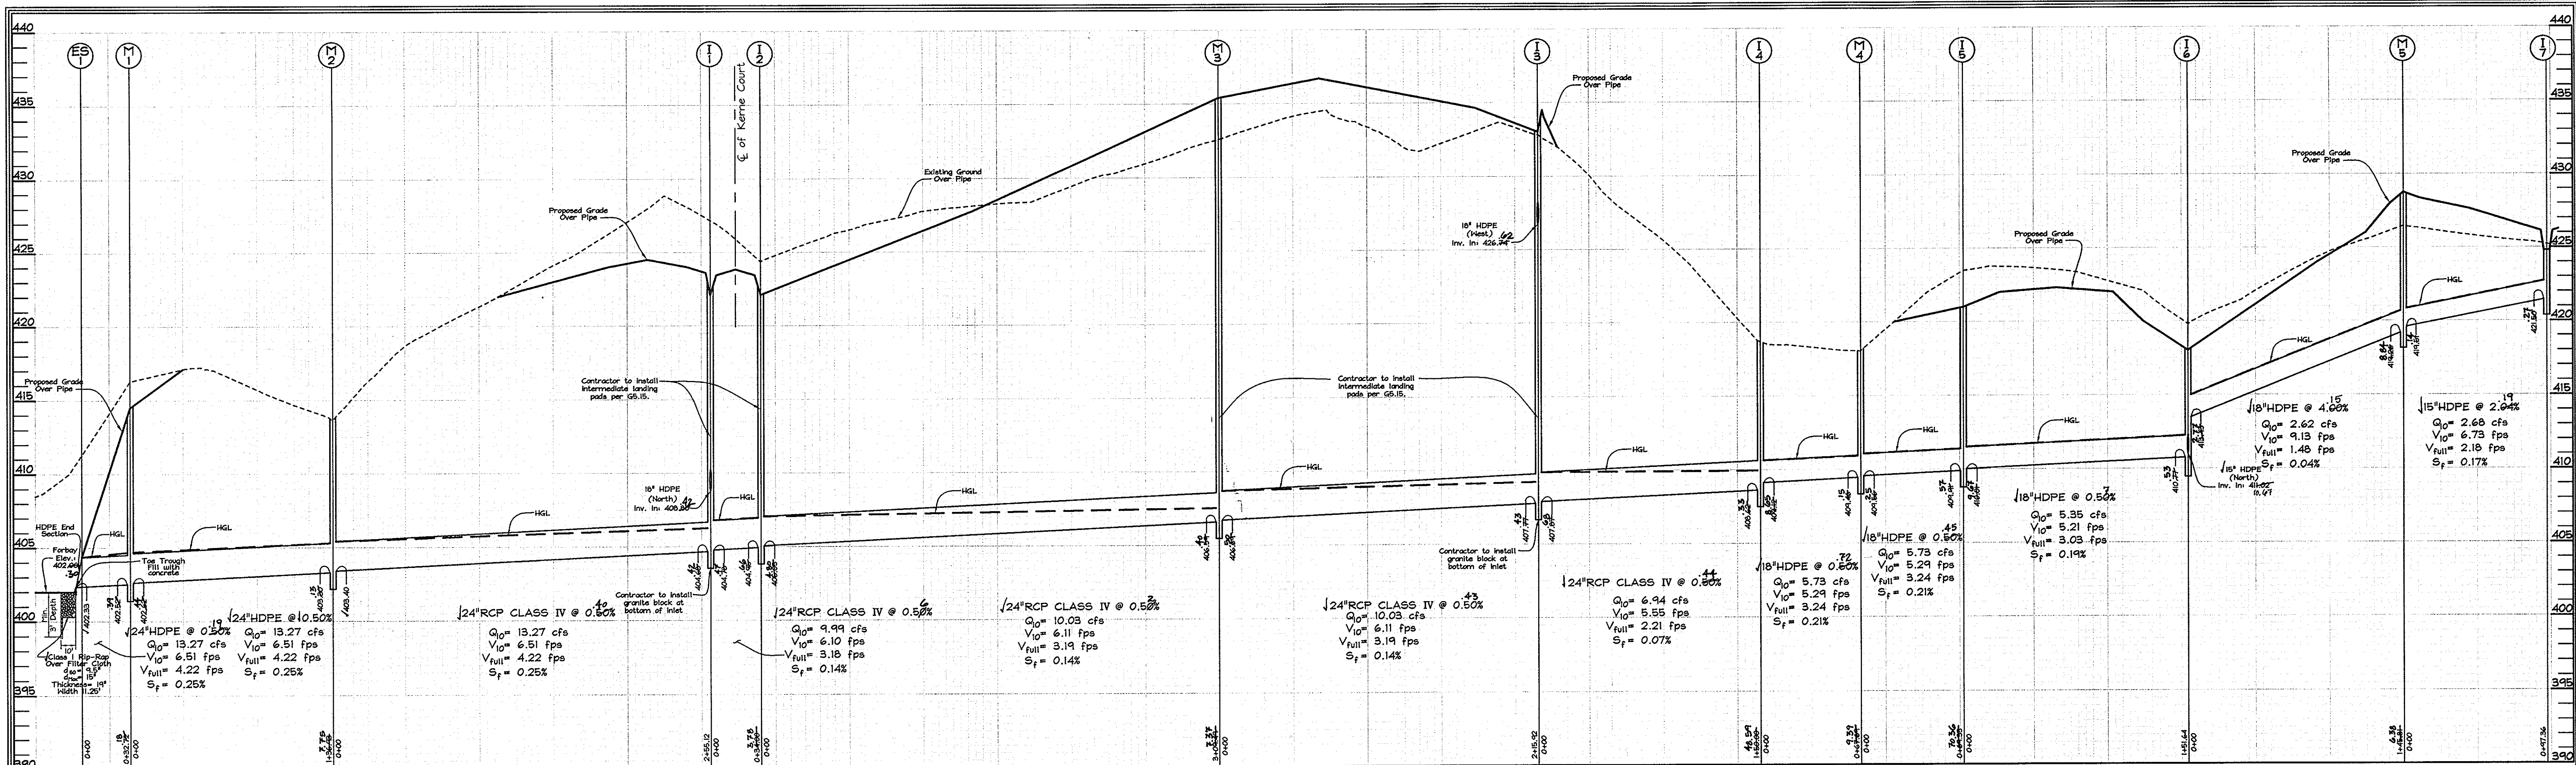

AS-BUILT

STATE OF MARYLAND
 COUNTY OF HOWARD
 PROFESSIONAL ENGINEER
 C. BROOKE MILLER
 PROPLS #135
 1-15-2009
 DATE

APPROVED: HOWARD COUNTY DEPARTMENT OF PLANNING AND ZONING

Cindy Harriott 12/14/08
 CHIEF, DIVISION OF LAND DEVELOPMENT JA DATE

Chris Demas 10/20/06
 CHIEF, DEVELOPMENT ENGINEERING DIVISION DATE

APPROVED: HOWARD COUNTY DEPARTMENT OF PUBLIC WORKS.

Walter J. Vlahakis 10-4-06
 CHIEF, BUREAU OF HIGHWAYS DATE

STORM DRAIN PROFILES
 Scale: Horizontal - 1"=50'
 Vertical - 1"=5'


OWNER
 THE ESTATE OF ELIZABETH SMITH
 c/o Charles Slade, Personal Representative
 10450 Shaker Drive, Suite 112
 Columbia, Maryland 21046

DEVELOPER
 CLARKSVILLE OVERLOOK, LLC
 5300 Dorsey Hall Drive
 Suite 200A
 Ellicott City, Maryland 21042

STORM DRAIN PROFILES
MACBETH FARM
 LOTS 1 THRU 35, BUILDABLE PRESERVATION PARCEL 'A',
 NON-BUILDABLE PRESERVATION PARCELS 'B', 'C', 'D', 'E', 'F'
 Tax Map 34 Grids 1B & 24 Parcel 90
 4th Election District Howard County, Maryland


FSH Associates
 Engineers Planners Surveyors
 6339 Howard Lane Elktidge, MD 21075
 Tel: 410-567-5200 Fax: 410-798-1562
 E-mail: info@fsh.com

DESIGN BY: FS
 DRAWN BY: MY
 CHECKED BY: ZYF
 SCALE: As Shown
 DATE: Aug. 31, 2006
 W.O. No.: 3165
 SHEET No. 12 OF 23

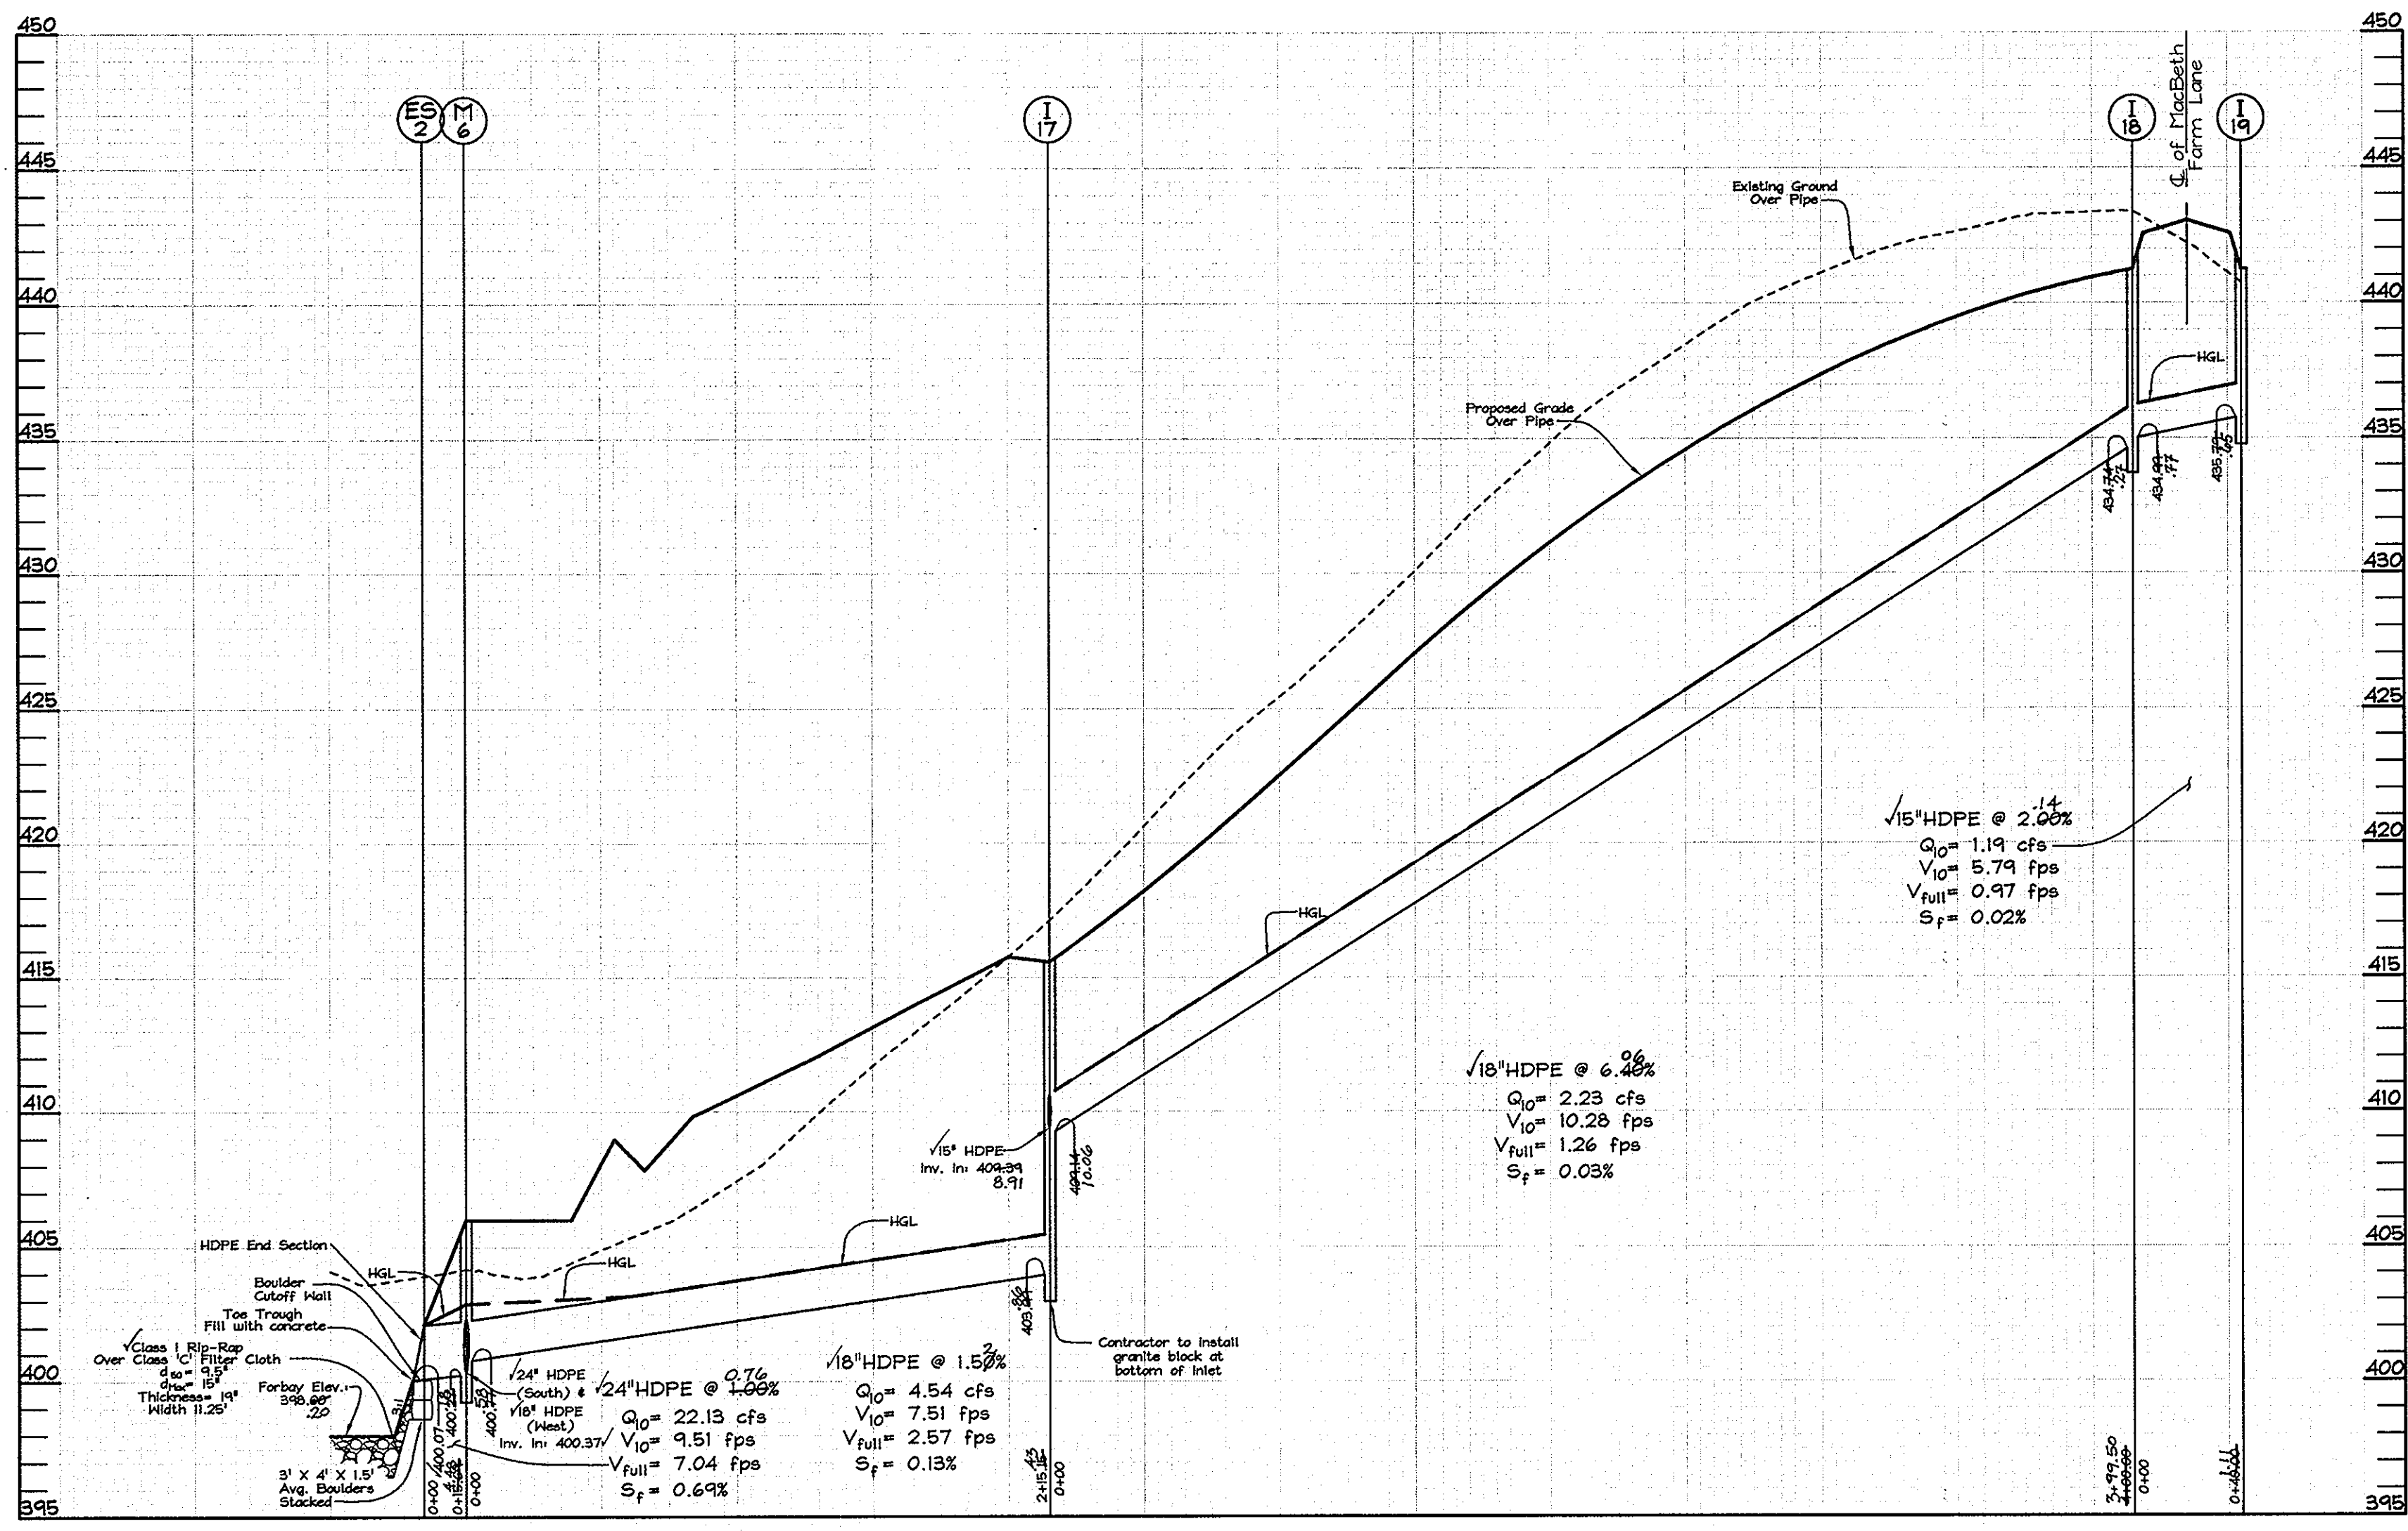

SIZE	TYPE	LENGTH
15"	HDPE	579 LF
18"	HDPE	1394 LF
24"	HDPE	272 LF
18"	RCP CLASS IV	77 LF
24"	RCP CLASS IV	965 LF

STRUCTURE SCHEDULE						
NO.	TYPE	LOCATION	TOP ELEV.	INV. IN.	INV. OUT.	REMARKS
I-1	Precast Open End Grate	☉ Kerne Court Sta. 7+67.50-17' left	422.11	404.36	404.36	SD 4.36
I-2	Precast Open End Grate	☉ Kerne Court Sta. 7+67.50-17' right	422.11	404.36	404.36	SD 4.36
I-3	Precast Open End Grate	☉ Kerne Court Sta. 2+44.85-17' right	409.04	407.77	407.77	SD 4.36
I-4	Precast Open End Grate	N 555,344.36 E 1,328,702.60	418.55	409.25	409.25	SD 4.36
I-5	Precast Open End Grate	N 555,264.64 E 1,328,757.70	421.55	409.25	409.25	SD 4.36
I-6	Precast Open End Grate	N 555,238.71 E 1,328,907.10	418.69	409.25	409.25	SD 4.36
I-7	Precast Open End Grate	MacBeth Farm Lane L.P. Sta. 1+76.10-8' outside edge of pav.	424.81	421.56	421.56	SD 4.36
I-8	Precast Open End Grate	☉ Kerne Court Sta. 2+44.85-17' left	438.04	427.42	427.42	SD 4.36
I-9	Precast Open End Grate	☉ Kerne Court Sta. 0+55.00-17' left	436.24	431.57	431.57	SD 4.36
I-10	Precast Open End Grate	☉ Kerne Court Sta. 5+48.08-20' right	438.46	-	433.15	SD 4.36
I-14	Precast Open End Grate	Kerne Court L.P. Sta. 1+28.47-8' outside edge of pav.	418.28	-	411.77	SD 4.36
I-15	Precast Open End Grate	N 555,284.73 E 1,328,915.09	414.00	-	411.25	SD 4.36
I-17	Precast Open End Grate	☉ MacBeth Farm Lane Sta. 5+74.52-20' left	415.57	403.58	403.58	SD 4.36
I-18	Precast Open End Grate	☉ MacBeth Farm Lane Sta. 9+74.52-20' left	441.25	434.44	434.44	SD 4.36
I-19	Precast Open End Grate	☉ MacBeth Farm Lane Sta. 9+74.52-20' right	441.25	-	435.94	SD 4.36
I-20	Precast Open End Grate	☉ MacBeth Farm Lane Sta. 5+74.52-20' right	415.57	-	410.97	SD 4.36
I-21	Precast Open End Grate	☉ MacBeth Farm Lane Sta. 2+72.83-20' left	404.74	401.21	400.96	SD 4.36
I-22	Precast Open End Grate	☉ MacBeth Farm Lane Sta. 2+72.83-20' right	404.74	-	401.41	SD 4.36
I-23	Precast Open End Grate	N 555,975.77 E 1,327,565.26	409.25	-	405.31	SD 4.36
I-24	10'-Wide-Throat Through Inlet	☉ MD RT. 108 Sta. 9+50.40-29.36' right	412.14*	**	**	MD 374.68
M-1	Standard Precast Manhole (4')	N 555,724.19 E 1,328,257.49	418.69	402.52	402.52	G 5.12
M-2	Standard Precast Manhole (4')	N 555,860.33 E 1,328,272.12	414.00	403.40	403.58	G 5.12
M-3	Standard Precast Manhole (4')	☉ Kerne Court Sta. 4+58.79-11' right	435.39	406.69	406.59	G 5.12
M-4	Standard Precast Manhole (4')	N 555,333.01 E 1,328,764.33	418.02	409.58	409.48	G 5.12
M-5	Standard Precast Manhole (4')	MacBeth Farm Lane L.P. Sta. 0+39.49 @ R/W	427.39	418.26	418.26	G 5.12
M-6	Standard Precast Manhole (4')	N 555,912.34 E 1,327,902.74	406.00	400.37	400.27	G 5.12
ES-1	24" HDPE End Section	N 555,727.69 E 1,328,224.96	404.35	402.35	402.33	Manor or equivalent
ES-2	24" HDPE End Section	N 555,923.08 E 1,327,914.18	402.11	400.10	400.07	Manor or equivalent
ES-3	24" HDPE End Section	N 555,853.31 E 1,327,839.89	402.39	402.33	402.31	Manor or equivalent
ES-4	18" Concrete End Section	N 556,051.27 E 1,327,580.06	405.99	404.49	404.46	5.52


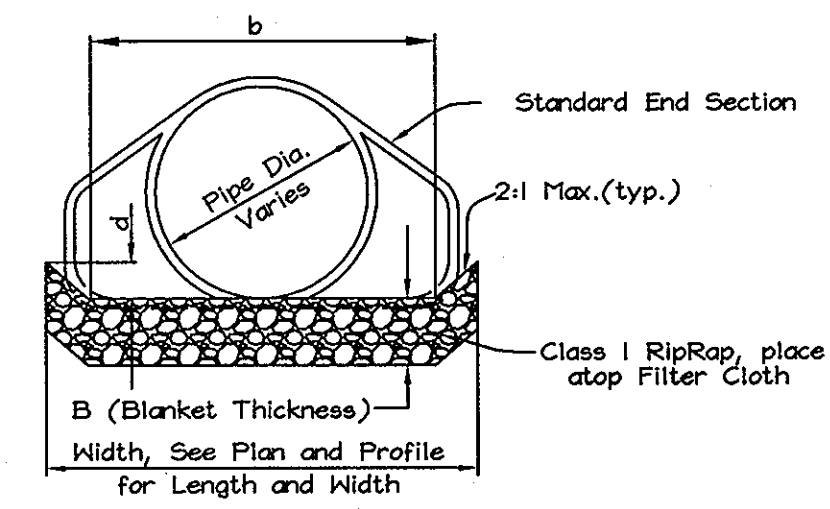


Structure	Q(c.f.s.)	S	n	b	d	d _{max}	d ₅₀	B(Blanket Thickness)
ES-1	13.27 cfs	0.5%	0.06	5.6	1.06'	15"	9.5"	19"
ES-2	22.13 cfs	0.5%	0.06	5.6	1.4'	15"	9.5"	19"
ES-3	15.05 cfs	0.5%	0.06	5.6	1.12'	15"	9.5"	19"
ES-4	2.71 cfs	0.5%	0.06	4.0	0.56'	15"	9.5"	19"

AS-BUILT

C. BROOKE MILLER
PROP. L.S.#135

- NOTES:
- Top elevations are to the top of concrete inlet for all inlets, and center top of manhole cover for precast manholes.
 - Top elevations for Type 'S' Inlet along curb and gutters are to the center, edge of grate at the flow line. Top elevations for Type 'S' Inlets in grass areas are to the center top of grate.
 - Top slope of structures to conform to slope of paving.
 - The wall thickness design of inlets I-1, I-2, I-3, I-17 and M-3 shall be designed in conjunction with SHA MD-383.11 Design Detail and Howard County SD-4.36 and G 5.12.
 - For inlets I-1, I-2, I-3, and M-3 provide landing pads per detail G5.15.
 - * Top elevation for I-24 is top of concrete at top of curb line.
- **See MD 374.68 for Details
Use Slab Type II,
10' Trough Opening, 3.5' Wide.

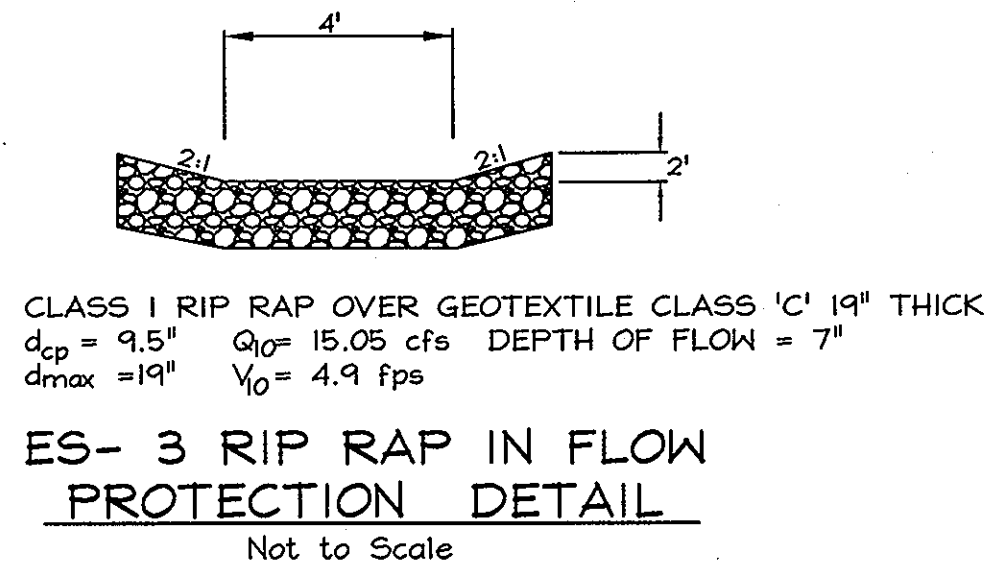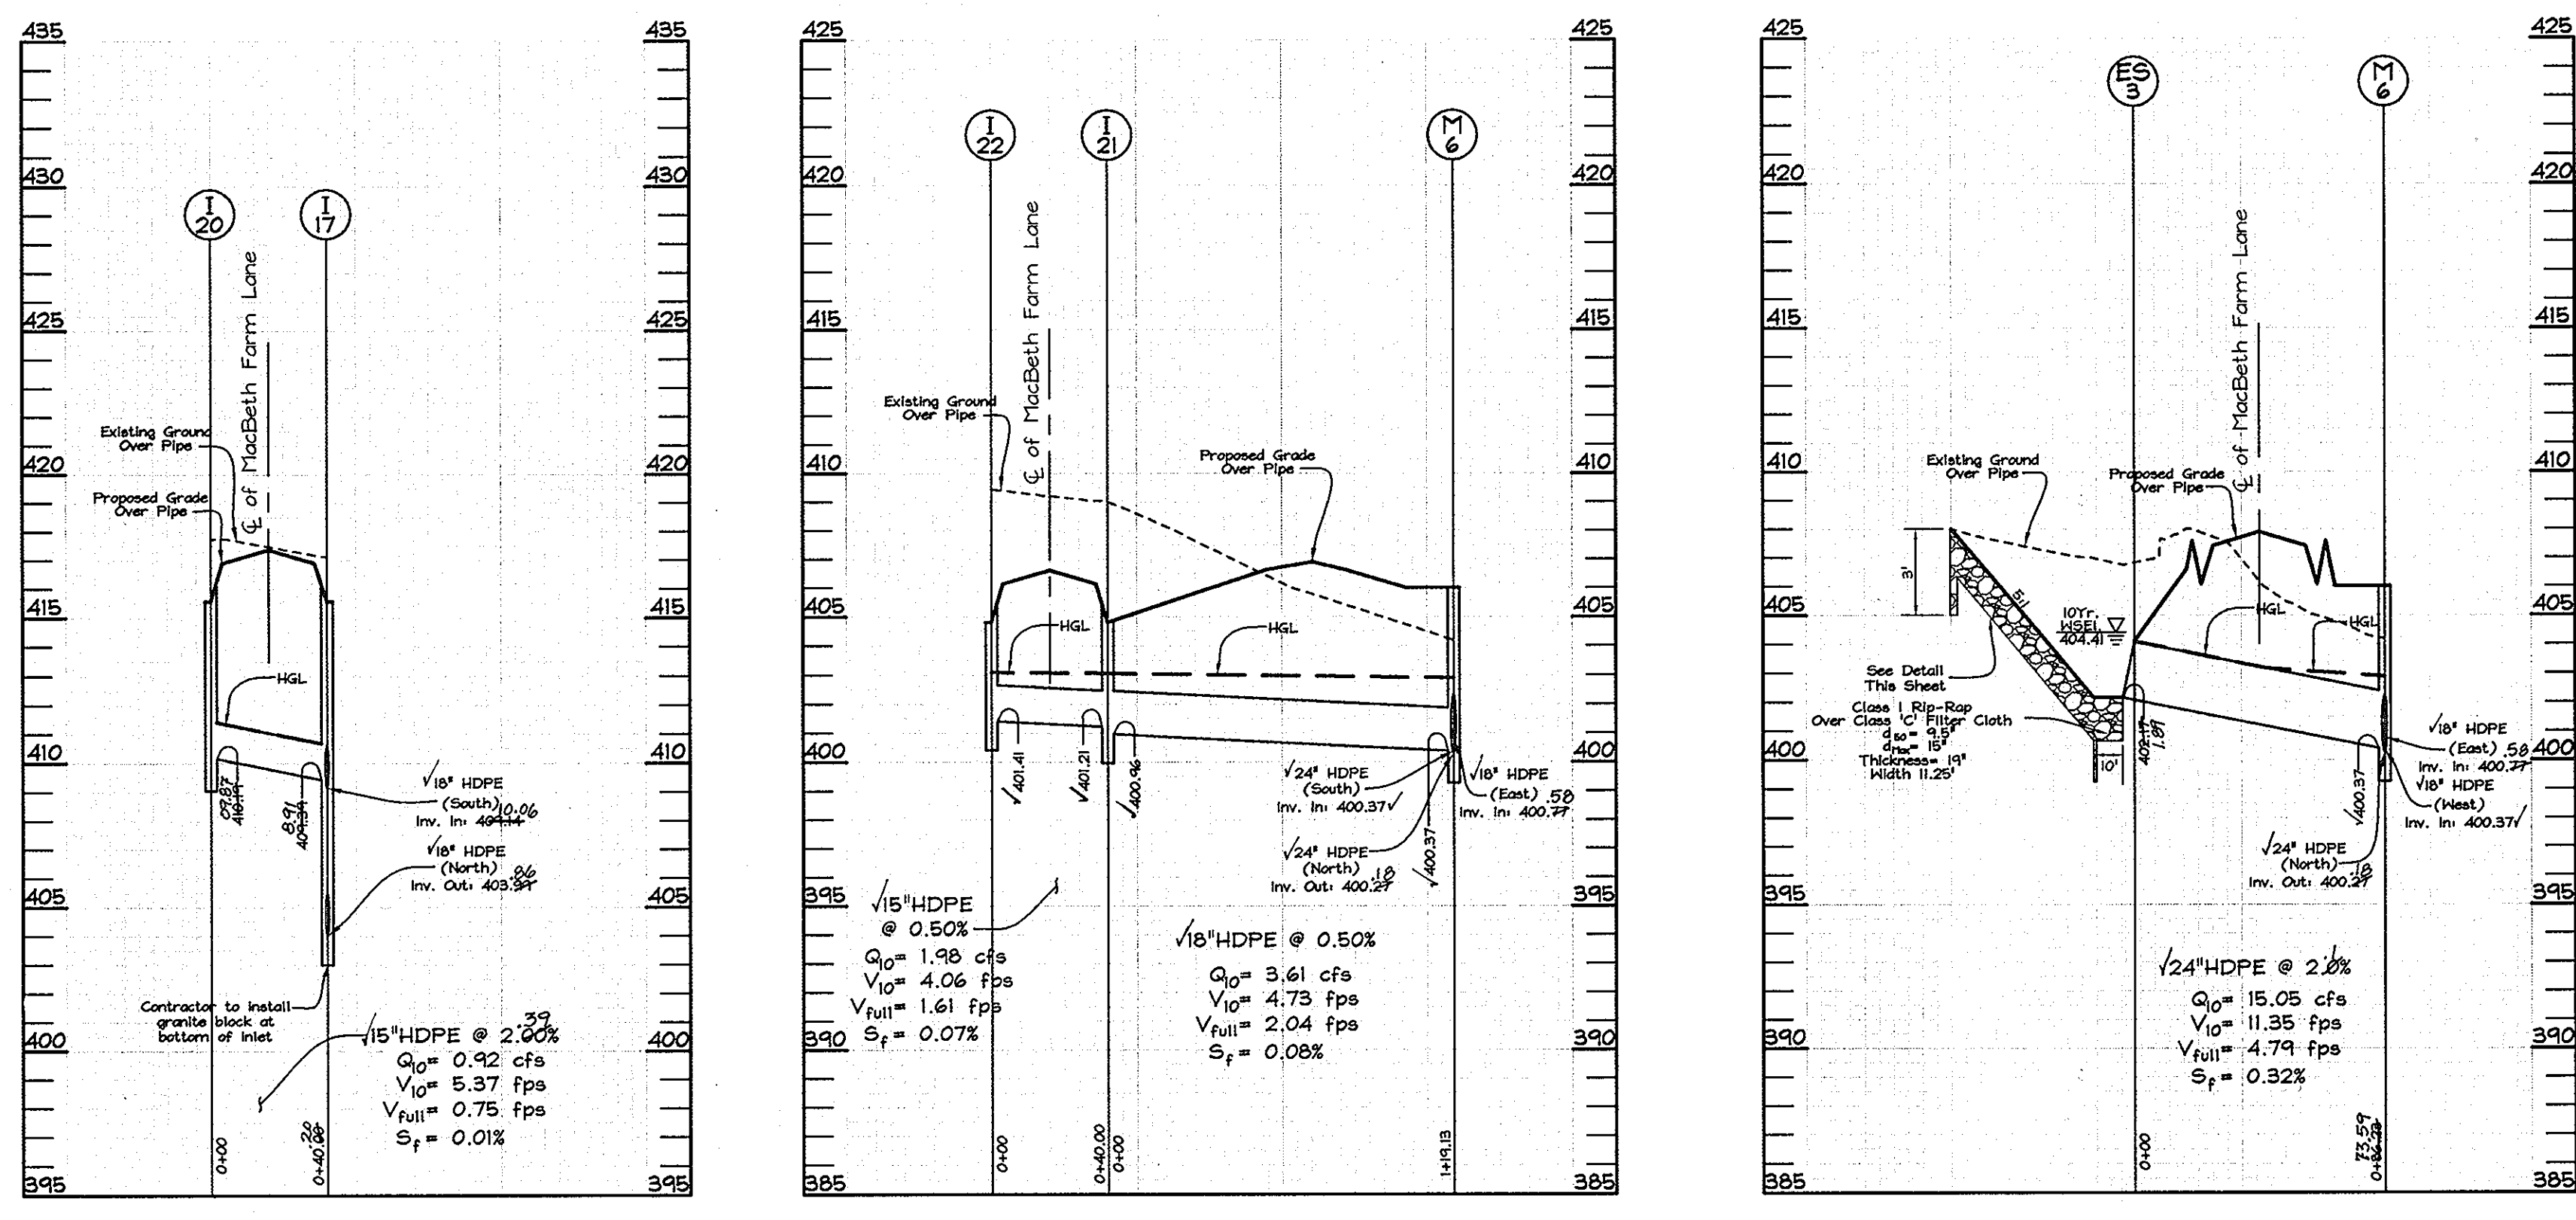

APPROVED: HOWARD COUNTY DEPARTMENT OF PLANNING AND ZONING
Joseph Khamat 10/10/06
 CHIEF, DIVISION OF LAND DEVELOPMENT DATE

APPROVED: HOWARD COUNTY DEPARTMENT OF PUBLIC WORKS.
Walter J. White 10-4-06
 CHIEF, BUREAU OF HIGHWAYS DATE

STORM DRAIN PROFILES
 Scale: Horizontal - 1"=50'
 Vertical - 1"=5'

OWNER
 THE ESTATE OF ELIZABETH SMITH
 c/o Charles Slade, Personal Representative
 10450 Shaker Drive, Suite 112
 Columbia, Maryland 21046


DEVELOPER
 CLARKSVILLE OVERLOOK, LLC
 5300 Dorsey Hall Drive
 Suite 200A
 Ellicott City, Maryland 21042

STORM DRAIN PROFILES


MACBETH FARM
 LOTS 1 THRU 35, BUILDABLE PRESERVATION PARCEL 'A',
 NON-BUILDABLE PRESERVATION PARCELS 'B', 'C', 'D', 'E', 'F',
 Tax Map 34 Grids 18 & 24 Parcel 90
 4th Election District. Howard County, Maryland

DESIGN BY: PS
 DRAWN BY: MY
 CHECKED BY: ZYF
 SCALE: As Shown
 DATE: Aug. 31, 2006
 S.H.O. No.: 3165
 SHEET No. 13 OF 23

FSH Associates
 Engineers Planners Surveyors
 6339 Howard Lane Ellicott City, MD 21075
 Tel: 410-567-5200 Fax: 410-795-1592
 E-mail: info@fsher.com

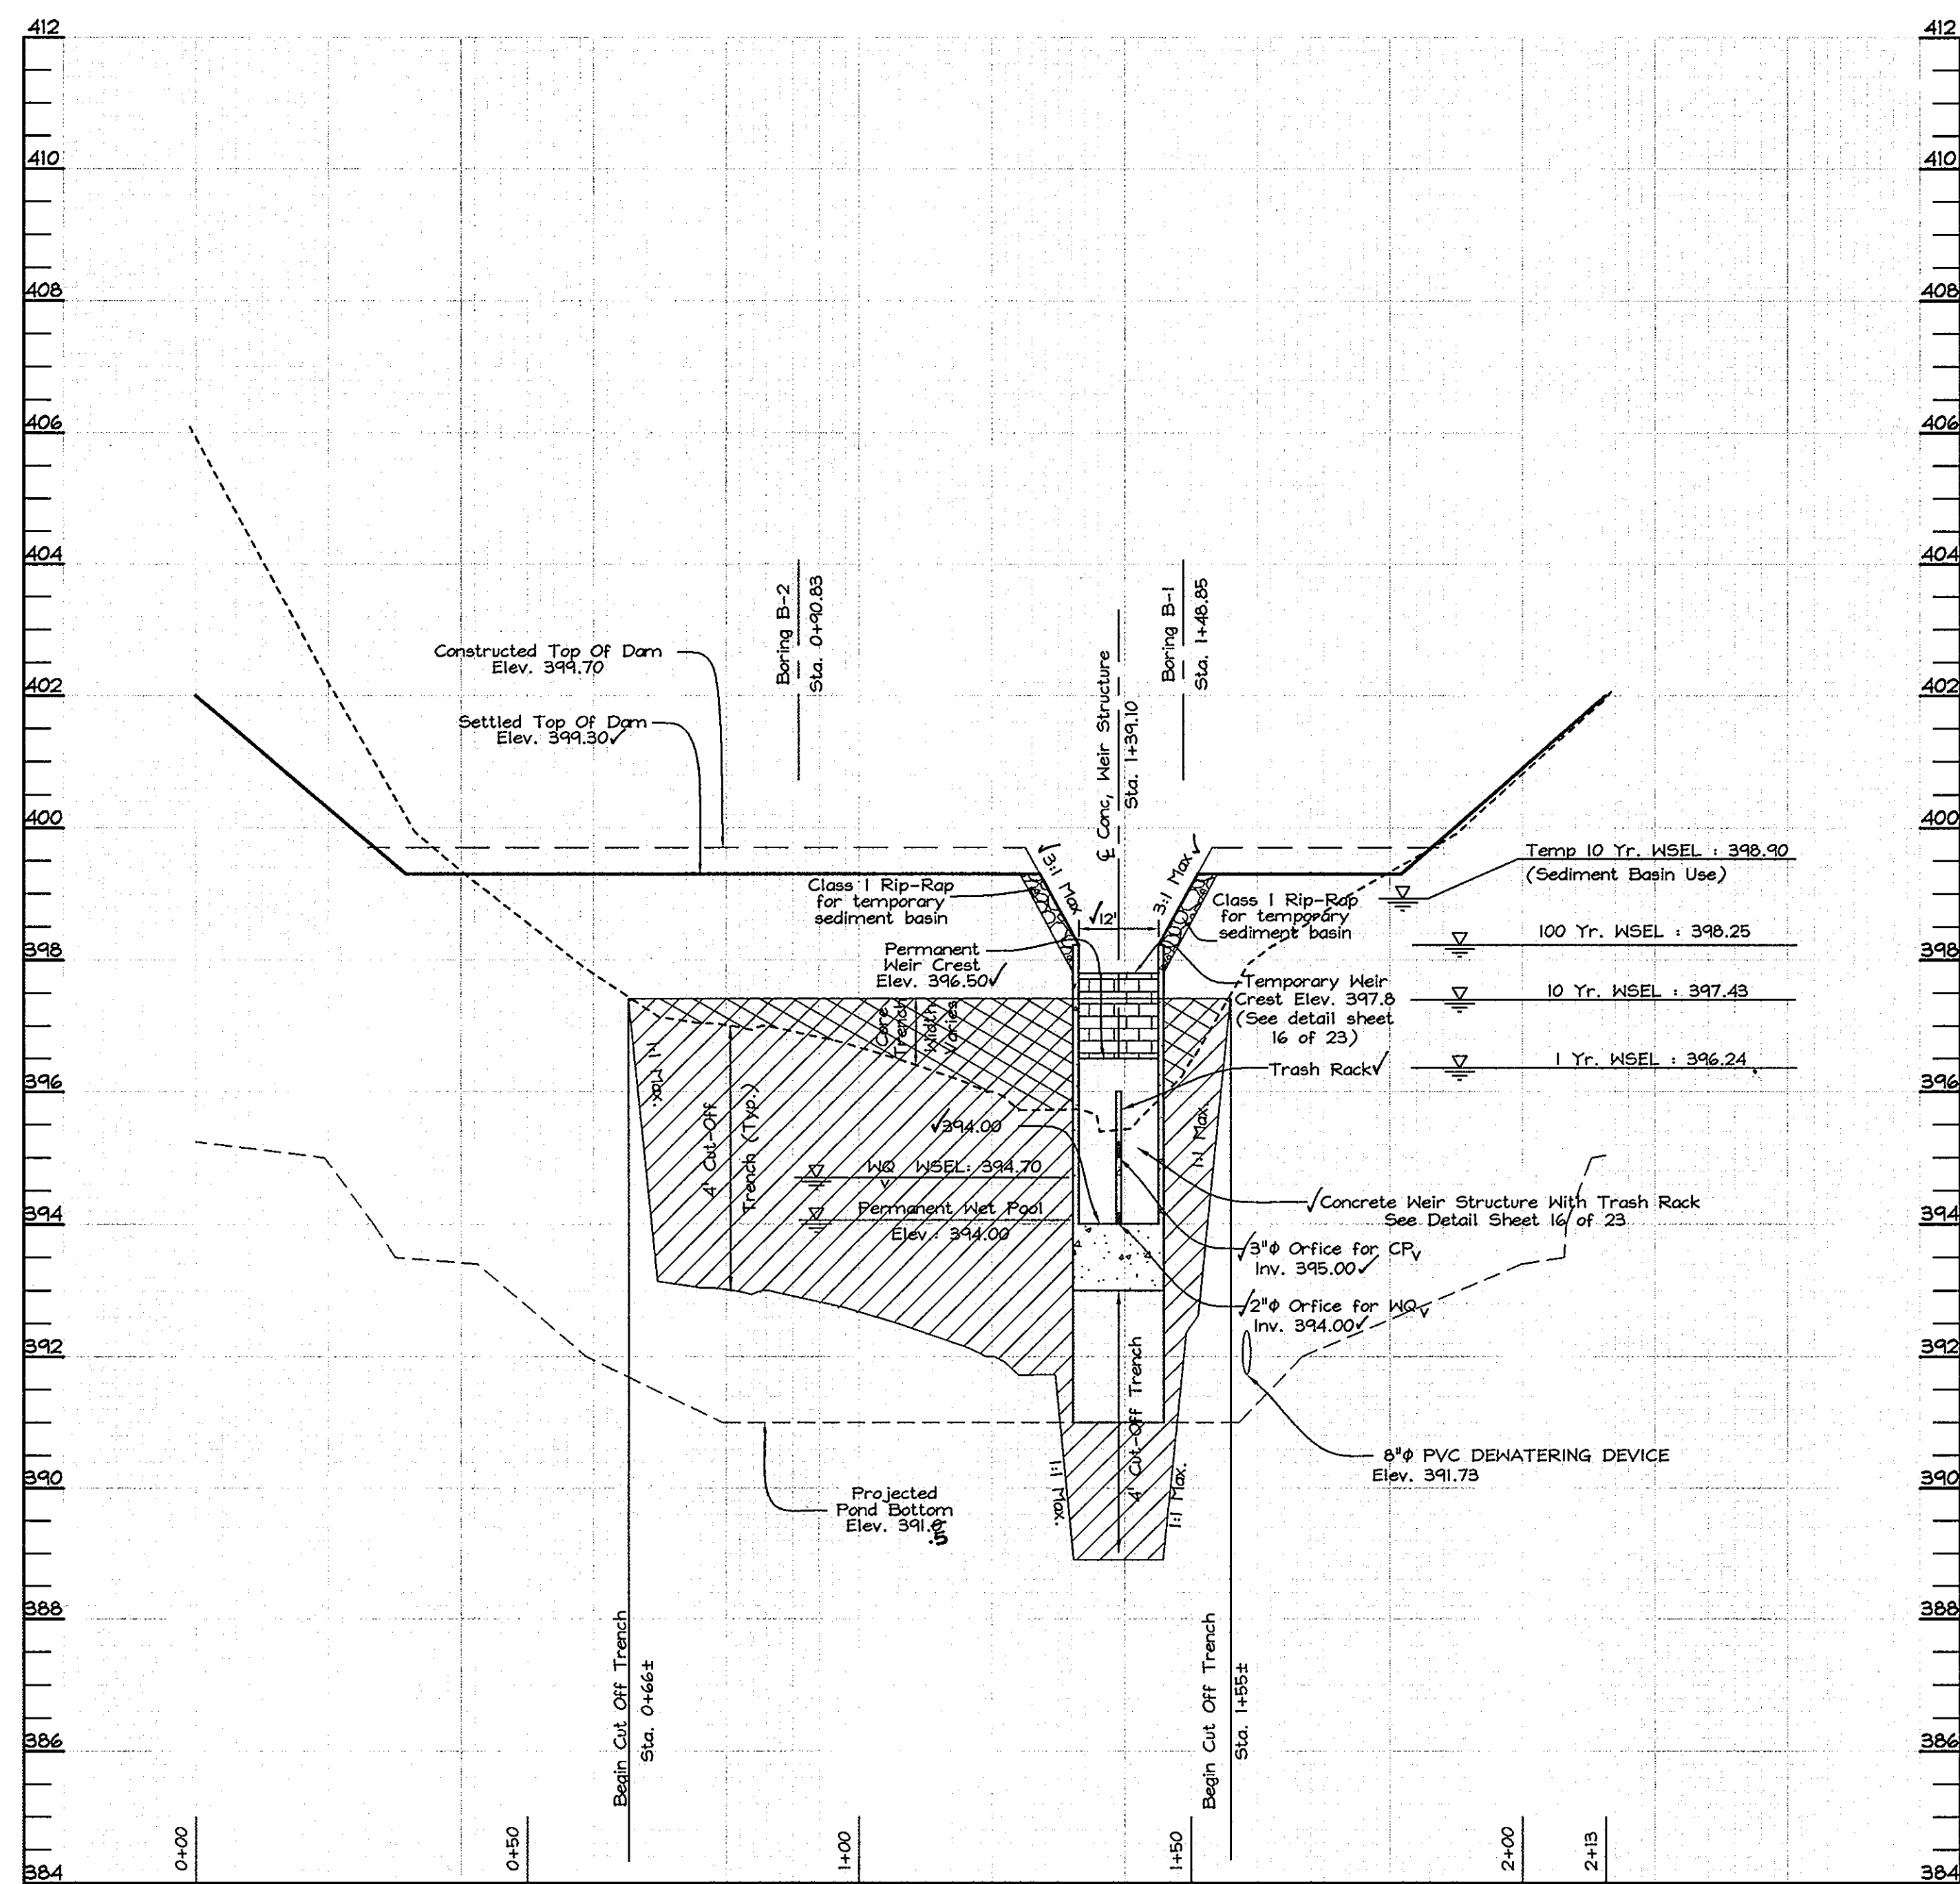

SWM POND SECTION 'A'-'A' CL EMBANKMENT
 Scale: Horizontal-1"=20'
 Vertical-1"=2'

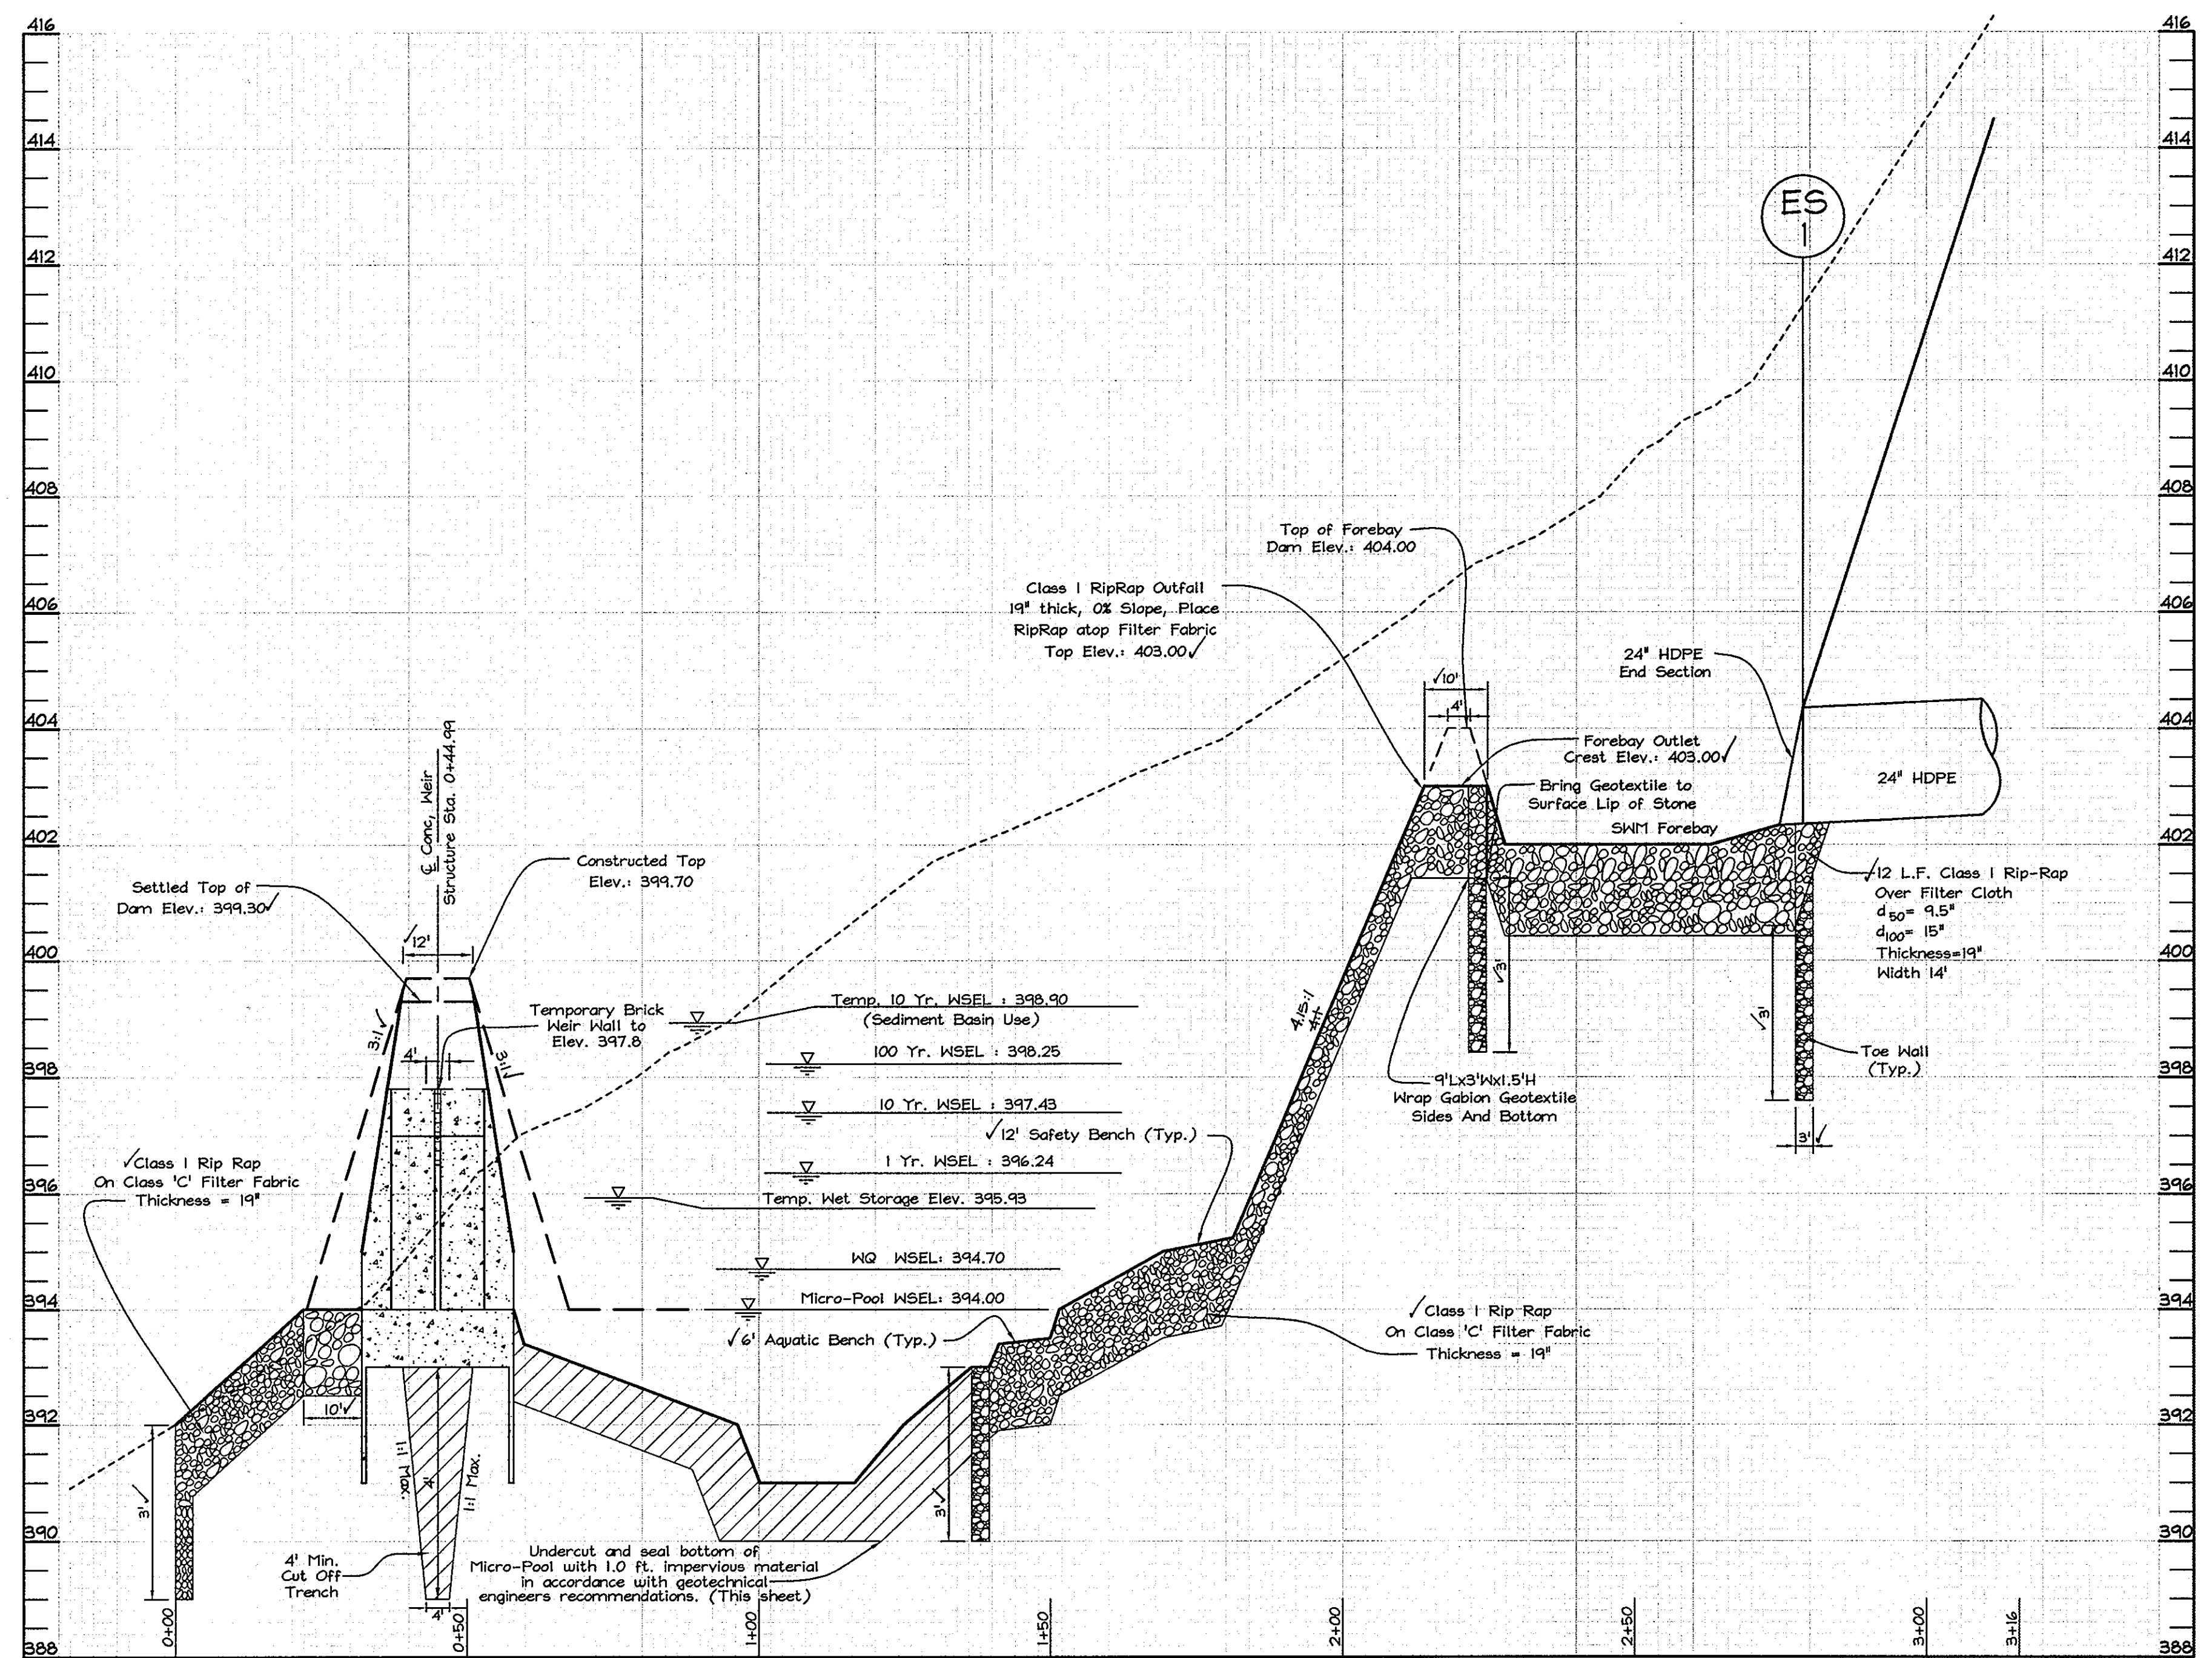

SWM POND SECTION 'B'-'B' CONCRETE WEIR & FOREBAY 1
 Scale: Horizontal-1"=20'
 Vertical-1"=2'

GEOTECHNICAL RECOMMENDATIONS

The area of the SWM pond facility should be stripped of topsoil and any other unsuitable materials from the embankment or structure areas in accordance with Soil Conservation Guidelines. After stripping operations have been completed, the exposed subgrade materials should be proofrolled with a loaded dump truck or similar equipment in the presence of a geotechnical engineer or his representative. For areas that are not accessible to a dump truck, the materials should be observed and tested by a geotechnical engineer or his representative utilizing a Dynamic Cone Penetrometer. Any excessively soft or loose materials identified by proofrolling or penetrometer test should be excavated to suitable firm soil, and then grades re-established by backfilling with suitable soil. A representative of the Geotechnical Engineer should be present to monitor placement and compaction of fill for the embankment and cut-off trench. In accordance with NRCS-MD Code No. 378 Pond Standards/specifications, soils considered suitable for the center of embankment and cut-off trench shall conform to Unified Soil Classification GC, SC, CH, OR CL and must have at least 30% passing the #200 sieve. It is our professional opinion that in addition to the soil materials described above a fine-grained soil, including Silt (ML) with a plasticity index of 10 or more can be utilized for the center of the embankment and core trench. All fill materials must be placed and compacted in accordance with NRCS-MD Code No.378 specifications. If it is desired to maintain a water level within the micropool, then it may be desirable to provide a lining in the pond bottom. The liner should be a minimum of one foot thick, should extend up the sides of the pond to the elevation where the level is to be maintained and should be comprised of materials similar to those outlined above for cut-off trenches in accordance with NRCS-MD Code No.378 specifications.

Surface	B-1 Surface Elev. 397.5	B-2 Surface Elev. 397.7	B-3 Surface Elev. 395.4	Surface
3.0	Gray and orange-brown, moist, stiff clayey silt, trace organic (ML-CL)	Brown, moist, loose sandy silt, trace to no clay, trace organic (ML)	Brown, moist, medium dense sandy silt, trace to no clay (ML)	3.0
5.0	Orange-brown to brown, moist, medium dense silty sand, trace gravel trace medium to fine gravel. (SP)	Orange-brown to brown, moist, medium dense sandy silt (ML)	Brown, moist, medium dense to very loose sandy silt (ML)	5.0
10.0		Tap, moist, medium dense silty sand, with gravel (SP)		10.0
12.0	Brown, moist, medium dense sandy silt (ML)	Peach, wet, medium dense silty sand (SP)	Peach, moist, dense silty sand (SP)	12.0
15.0				15.0

Groundwater encountered while drilling at 5.0'. At completion, hole dry and cased at 6.0'. Topsoil: 6.0'

Groundwater encountered while drilling at 15.0'. At completion, hole dry and cased at 6.5'. Topsoil: 6.0'

No groundwater encountered while drilling. At completion, hole dry and cased at 6.0'. Topsoil: 6.0'

S.W.M. BORING PROFILES
 NOT TO SCALE

APPROVED: HOWARD COUNTY DEPARTMENT OF PLANNING AND ZONING

APPROVED: HOWARD COUNTY DEPARTMENT OF PUBLIC WORKS.

Conrad Hamer
 CHIEF, DIVISION OF LAND DEVELOPMENT
 DATE: 11/15/09

William J. Campbell
 CHIEF, BUREAU OF HIGHWAYS
 DATE: 11-4-09

AS-BUILT
 ZACHARIA Y. FISCH
 PE #22418
 DATE: 1/15/09



STORMWATER MANAGEMENT NOTES AND DETAILS
MACBETH FARM
 LOTS 1 THRU 35, BUILDABLE PRESERVATION PARCEL 'A',
 NON-BUILDABLE PRESERVATION PARCELS 'B', 'C', 'D', 'E', 'F'
 Tax Map 34 Grids 18 & 24 Parcel 90
 4th Election District Howard County, Maryland

OWNER
 THE ESTATE OF ELIZABETH SMITH
 c/o Charles Slade, Personal Representative
 10450 Shaker Drive, Suite 112
 Columbia, Maryland 21046

DEVELOPER
 CLARKSVILLE OVERLOOK, LLC
 5300 Dorsey Hall Drive
 Suite 200A
 Ellicott City, Maryland 21042

FSH Associates
 Engineers Planners Surveyors
 6339 Howard Lane Ellicott City, MD 21075
 Tel: 410-587-5200 Fax: 410-796-1562
 E-mail: info@fshet.com

DESIGN BY: PS
 DRAWN BY: MY
 CHECKED BY: ZTF
 SCALE: As Shown
 DATE: Aug. 31, 2006
 W.O. No.: 3165
 SHEET No.: 14 OF 23

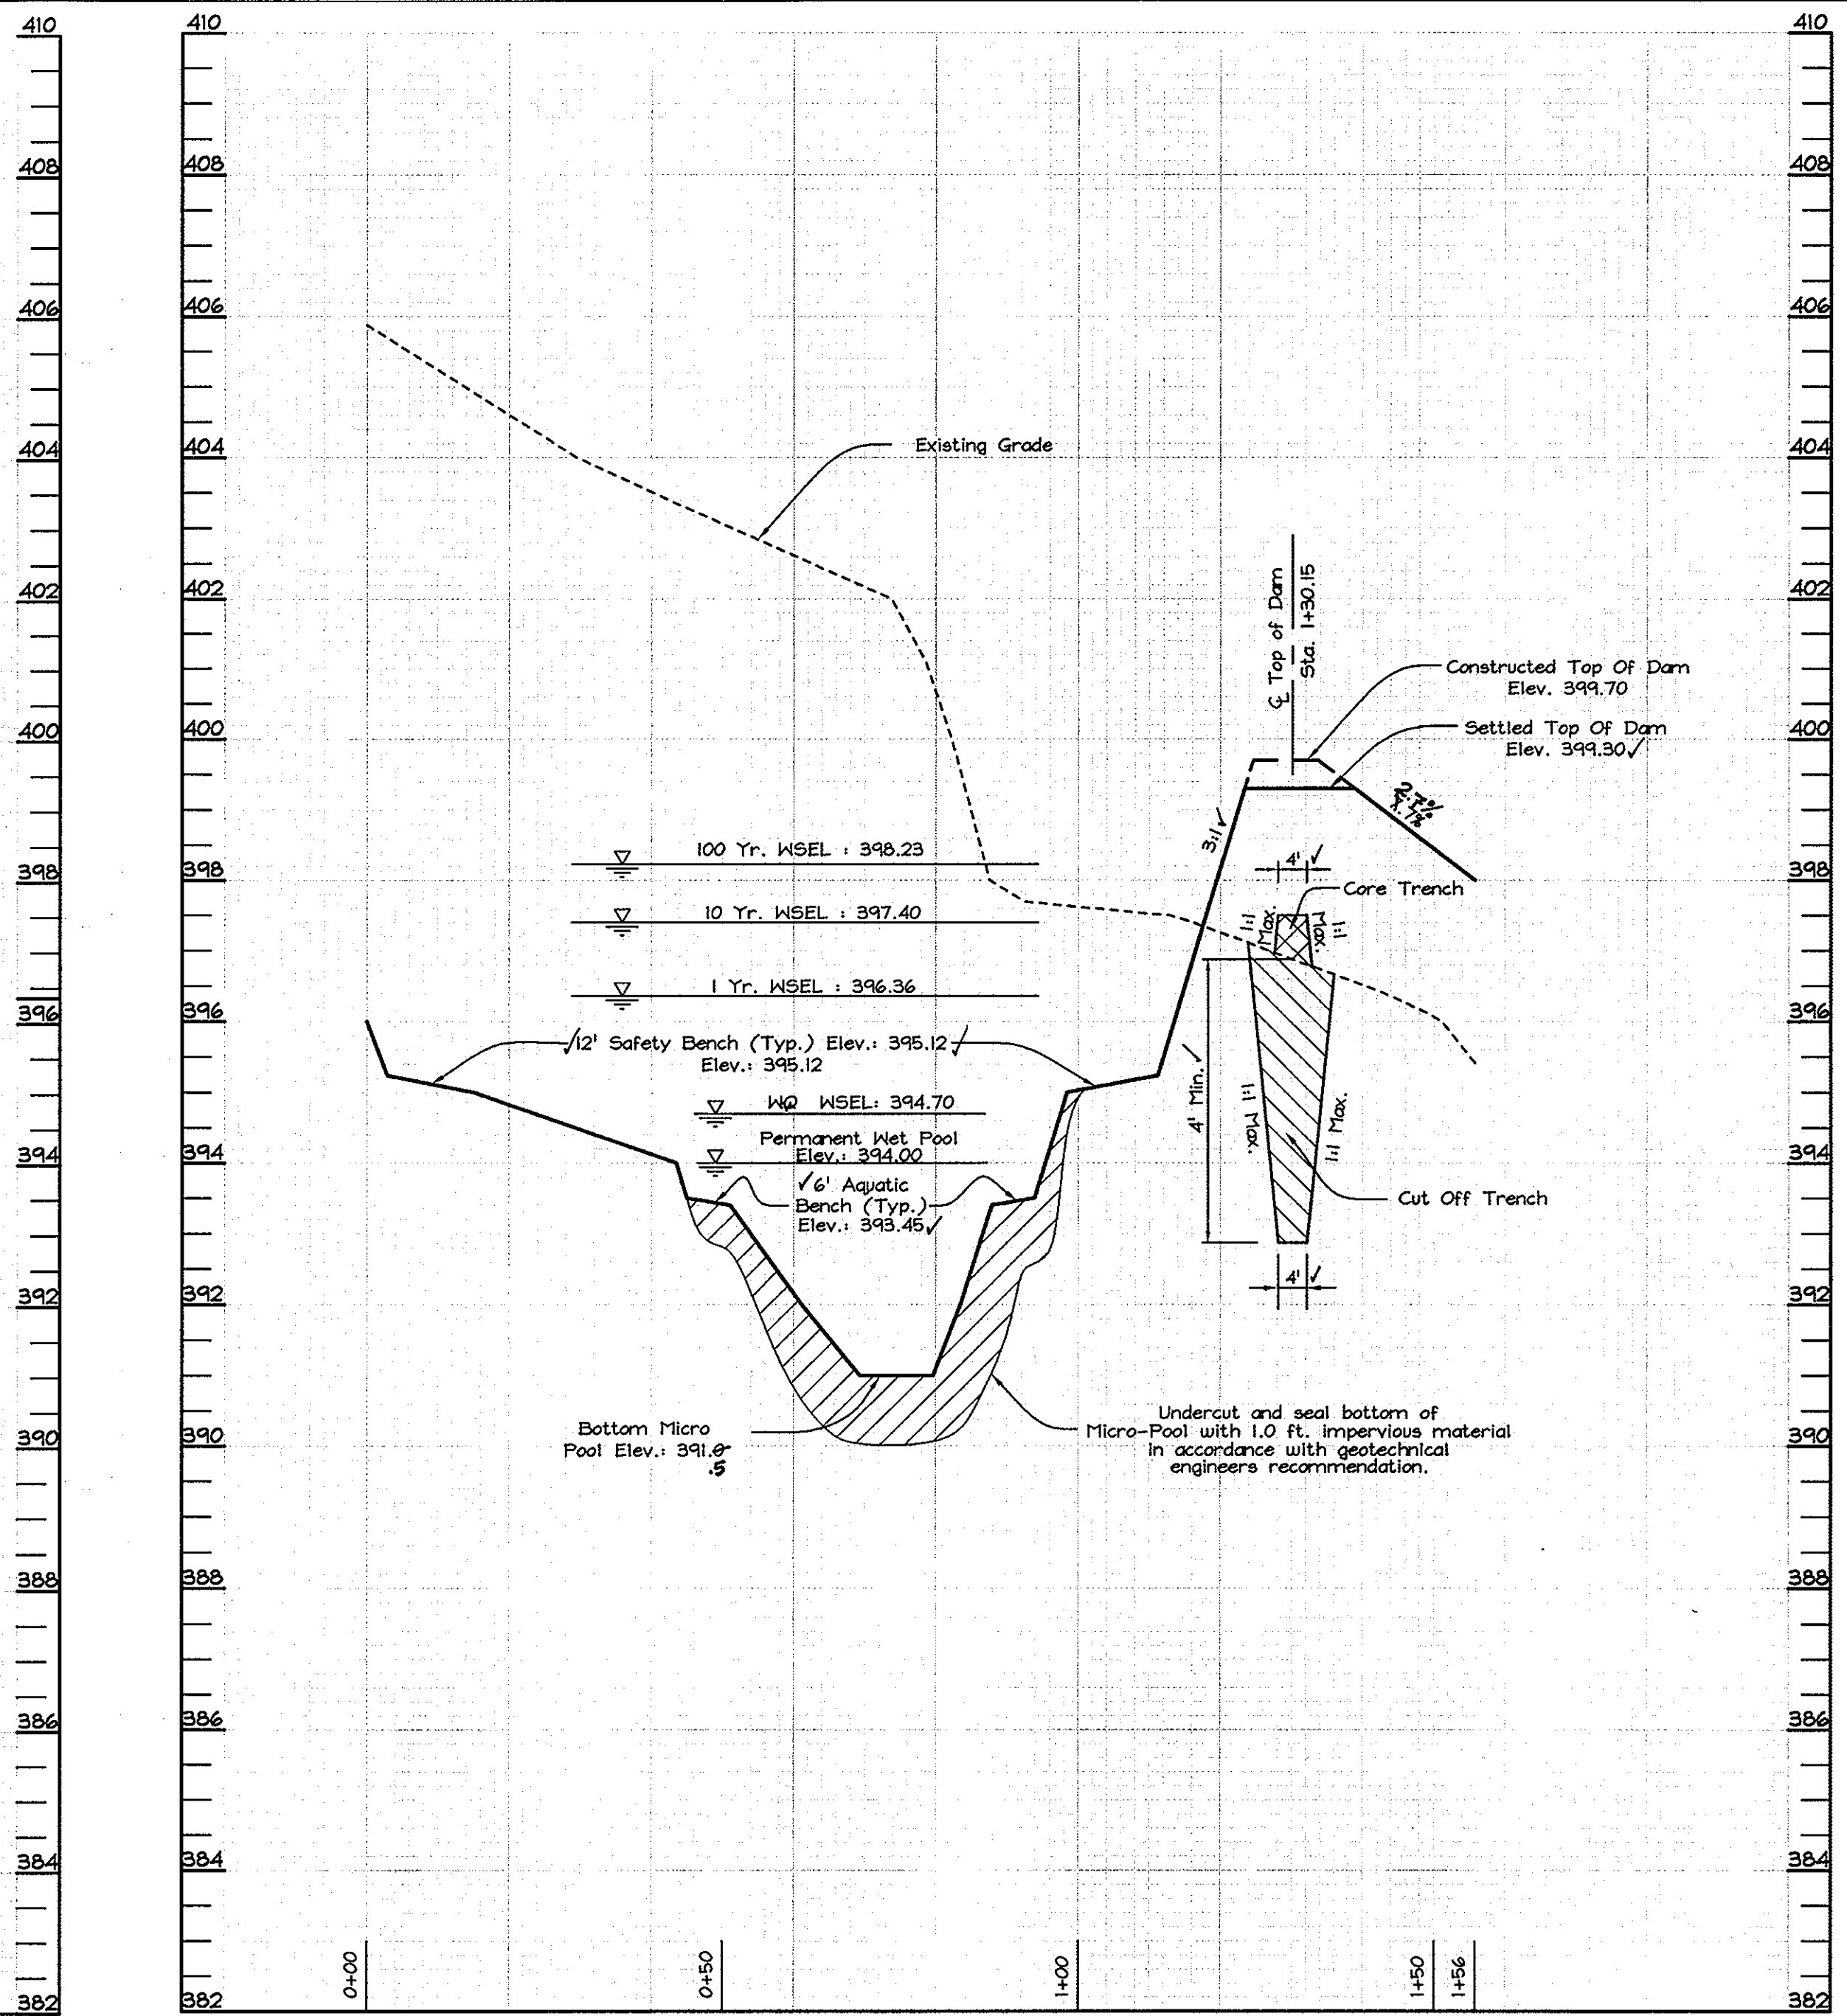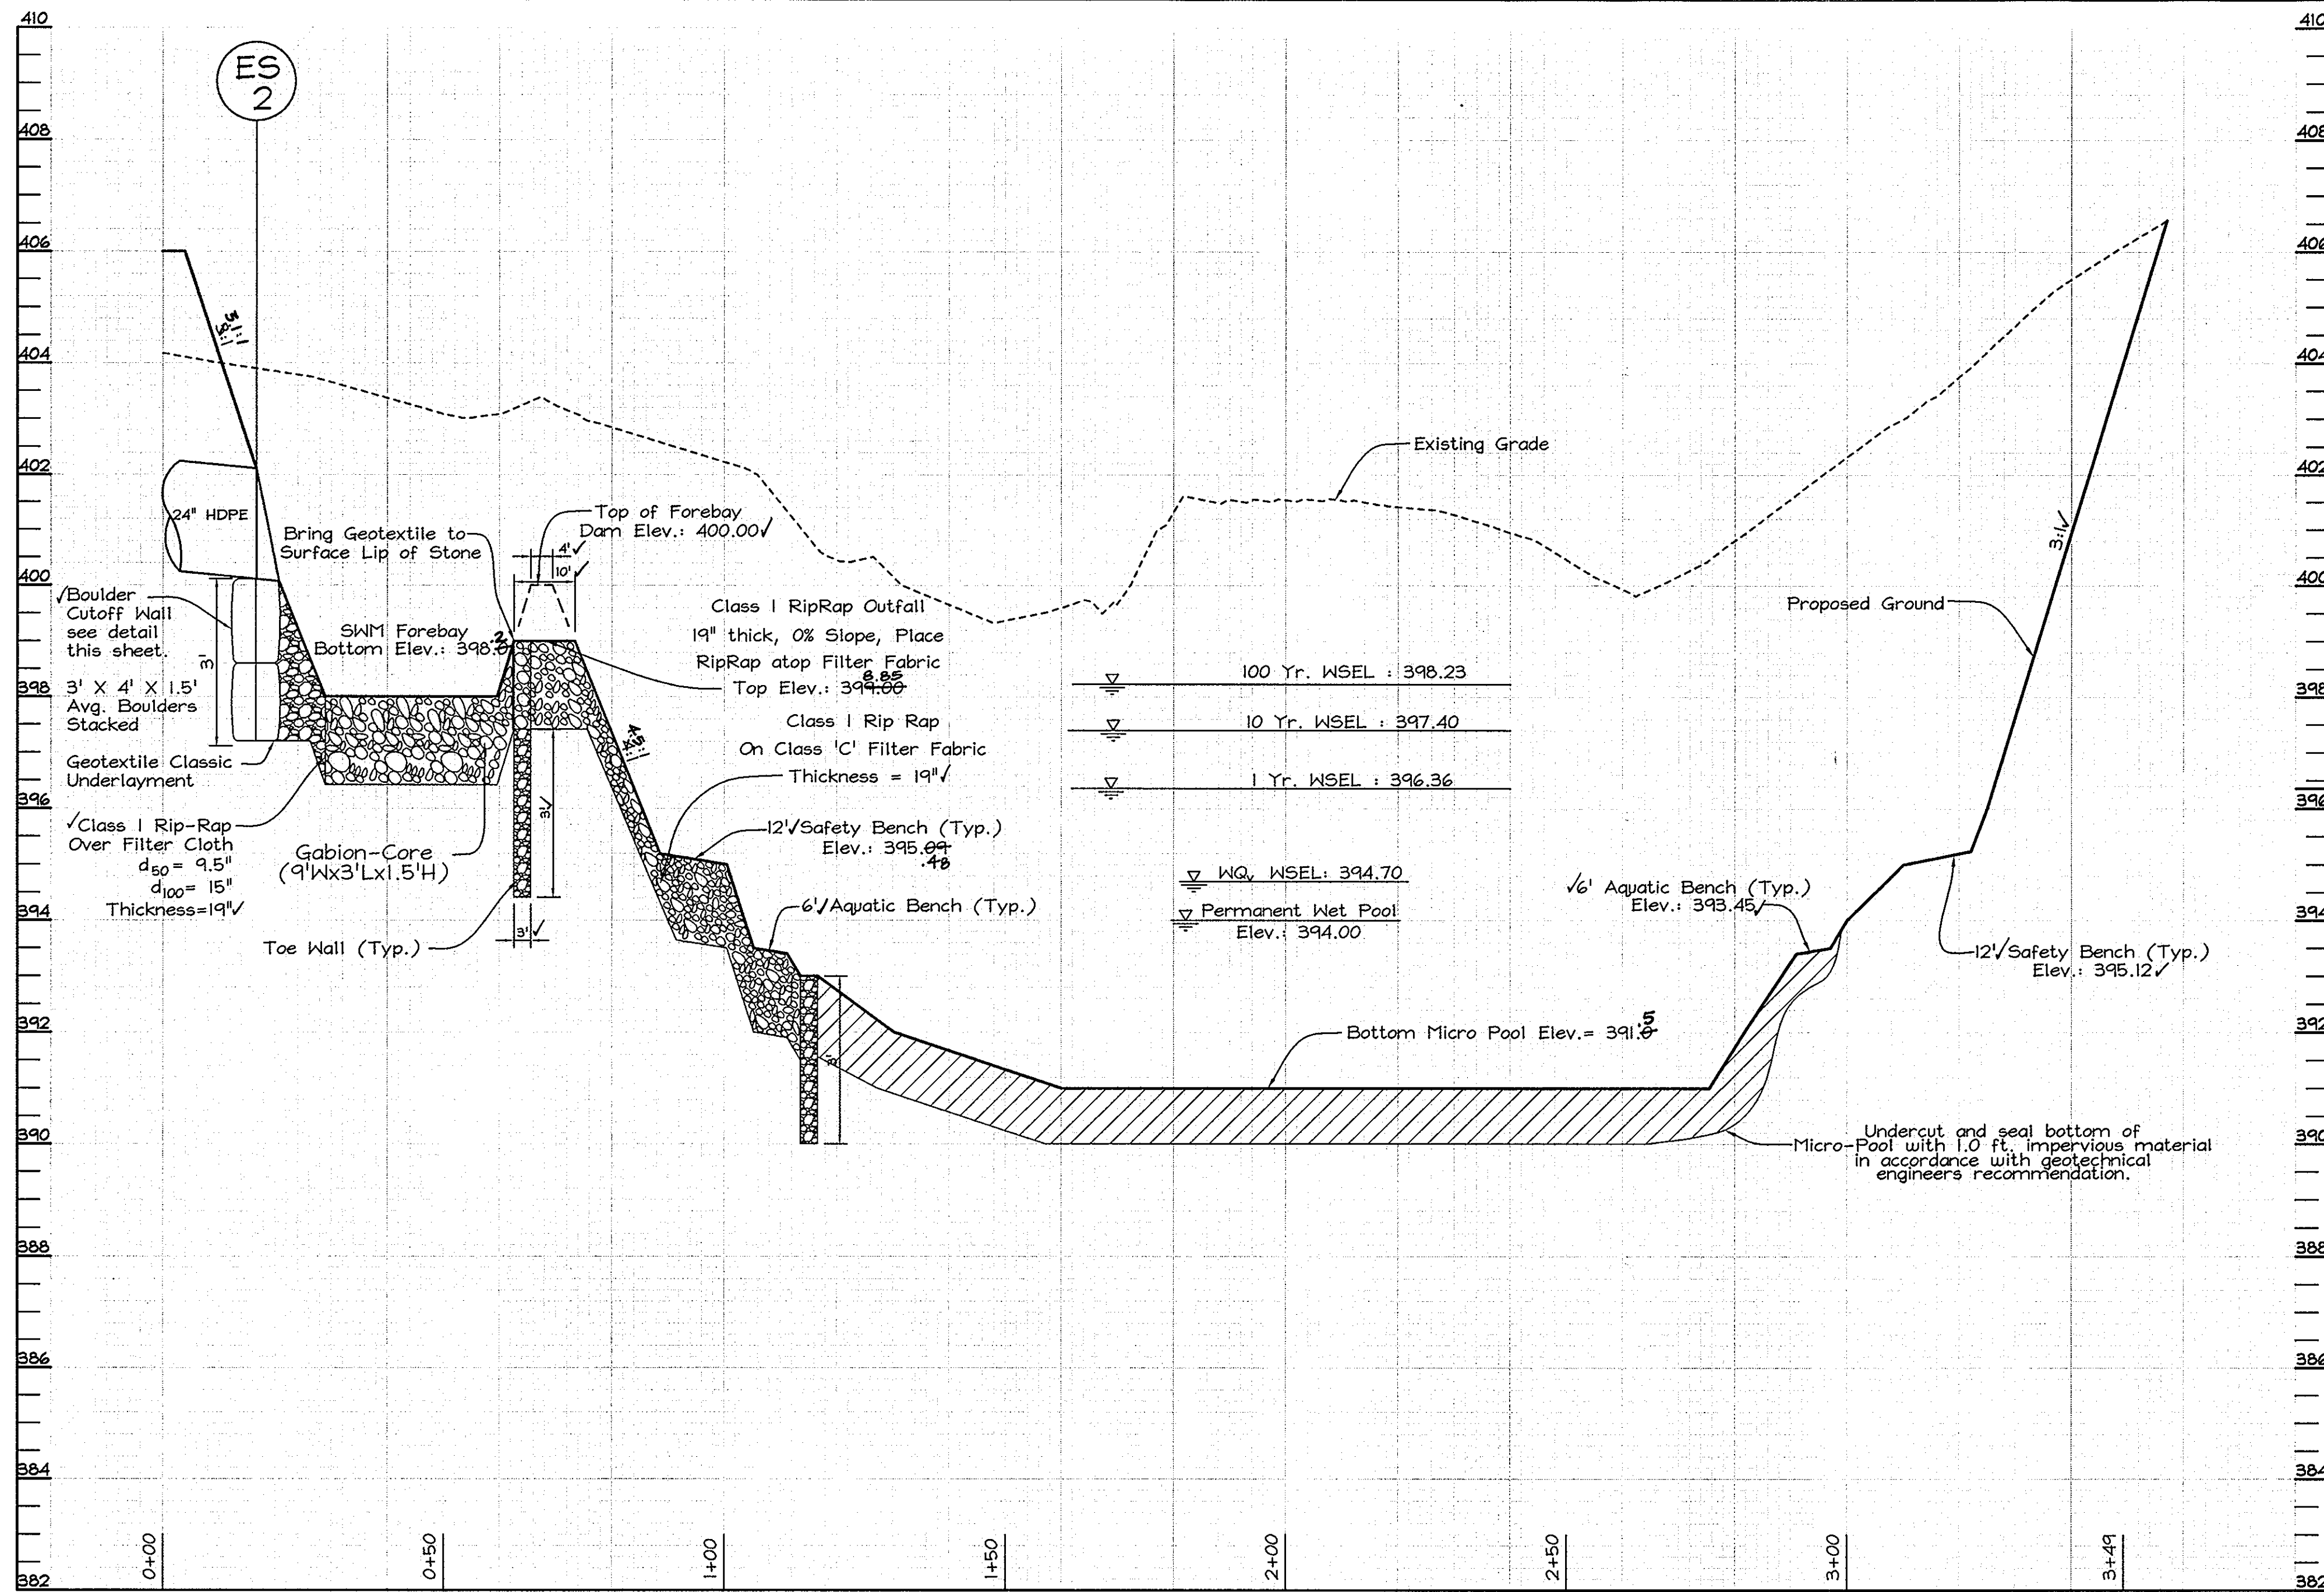


SWM POND
SECTION 'C'-'C' FOREBAY 2

Scale: Horizontal-1"=20'
Vertical-1"=2'

AS-BUILT
POND ELEVATIONS *
SEE SHEET 20 OF 25


SWM POND
SECTION 'D'-'D' EMBANKMENT CROSS SECTION

Scale: Horizontal-1"=20'
Vertical-1"=2'

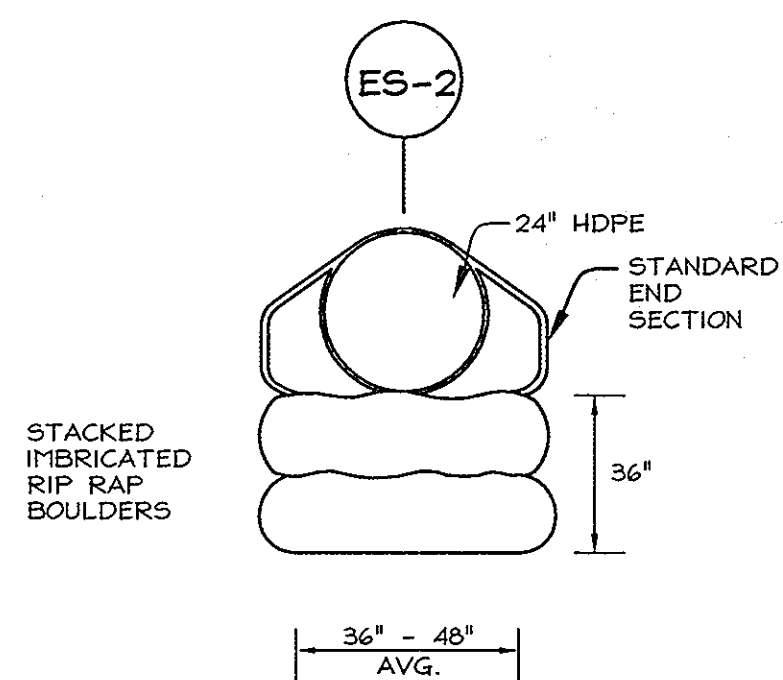

BOULDER FOUNDATION
AND CUTOFF WALL

T.Y.P.
NOT TO SCALE

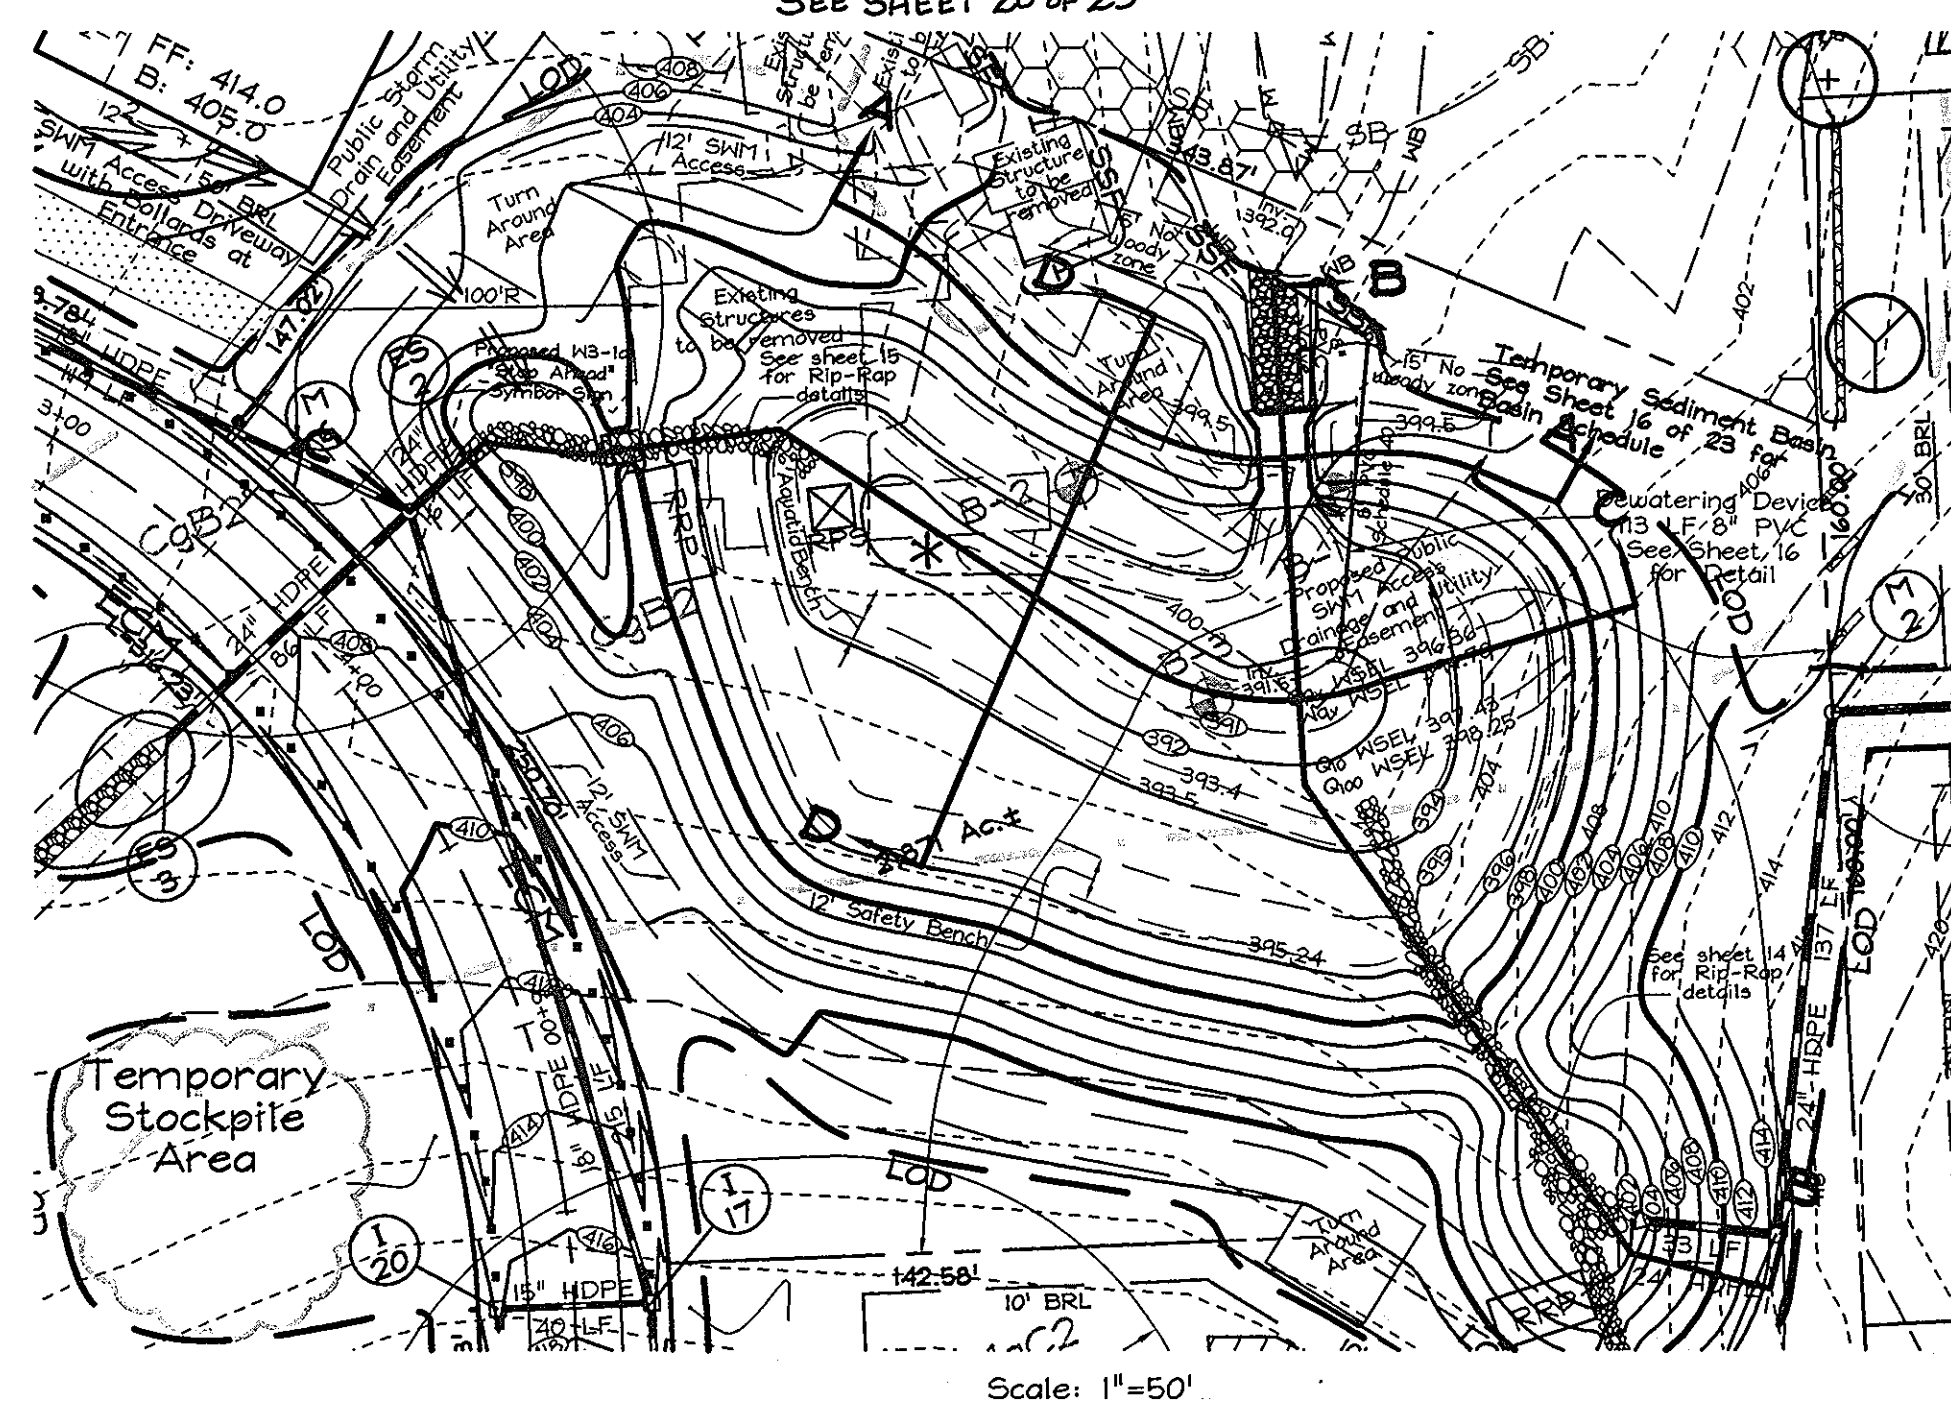

APPROVED: HOWARD COUNTY DEPARTMENT OF PLANNING AND ZONING

APPROVED: HOWARD COUNTY DEPARTMENT OF PUBLIC WORKS.

Craig Kandler 10/11/06
CHIEF, DIVISION OF LAND DEVELOPMENT
DATE

John Pennington 10/10/06
CHIEF, DEVELOPMENT ENGINEERING DIVISION
DATE

William F. Mahall 10-4-06
CHIEF, BUREAU OF HIGHWAYS
DATE

AS-BUILT



ZACHARIA Y. FISCH
PE # 22418

1/15/09
DATE

OWNER

THE ESTATE OF ELIZABETH SMITH
c/o Charles Slade, Personal Representative
10450 Shaker Drive, Suite 112
Columbia, Maryland 21046


DEVELOPER

CLARKSVILLE OVERLOOK, LLC
5300 Dorsey Hall Drive
Suite 200A
Ellicott City, Maryland 21042

STORMWATER MANAGEMENT
NOTES AND DETAILS

MACBETH FARM

LOTS 1 THRU 35, BUILDABLE PRESERVATION PARCEL 'A',
NON-BUILDABLE PRESERVATION PARCELS 'B', 'C', 'D', 'E', 'F',
Tax Map 34 Grids 18 & 24 Parcel 90
4th Election District Howard County, Maryland

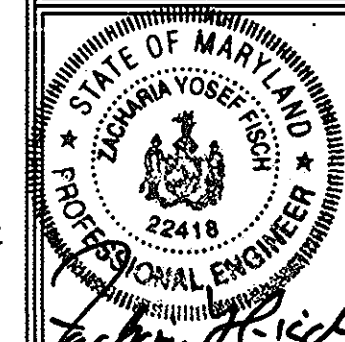

FSH Associates

Engineers Planners Surveyors
6339 Howard Lane Ellicott City, MD 21075
Tel: 410-567-5200 Fax: 410-796-1562
E-mail: info@fsh.net

DESIGN BY: PS
DRAWN BY: MY
CHECKED BY: ZYF
DATE: Aug. 31, 2006
W.O. No.: 3165
SHEET No.: 15 OF 23

**MARYLAND 378
STORMWATER MANAGEMENT FACILITY CONSTRUCTION SPECIFICATIONS**
CONSTRUCTION SPECIFICATIONS (FOR SWEET DETENTION FACILITY CS-1)

These specifications are appropriate to all ponds within the scope of the Standard for practice MD-378. All references to ASTM and AASHTO specifications apply to the most recent version.

Site Preparation
Areas designated for borrow areas, embankment, and structural works shall be cleared, grubbed and stripped of topsoil. All trees, vegetation, stumps and other objectionable material shall be removed. Crown limbs and stony branches shall be spaced to no steeper than 1H:1V. All trees shall be cleared and grubbed within 15 feet of the toe of the embankment.

Areas to be covered by the reservoir will be cleared of all trees, brush, logs, fences, rubbish and other objectionable material unless otherwise designated on the plans. Trees, brush, and stumps shall be cut approximately level with the ground surface. For any stormwater management ponds, a minimum of a 2-foot radius around the structure shall be cleared.

All cleared and grubbed material shall be disposed of outside and below the limits of the dam and reservoir as directed by the owner or his representative. When specified, a sufficient quantity of topsoil will be provided in a suitable location for use on the embankment and other designated areas.

Each Fill
Material - The fill material shall be taken from approved designated borrow areas. It shall be free of roots, stumps, rocks, rubbish, stones greater than 6" from or other objectionable materials. Fill material for the center of the embankment and cut of fill shall be compacted to Unified Compaction Class CC, CU, or CL with a minimum of 95% relative density. Consideration may be given to the use of other materials in the embankment if approved by a geotechnical engineer. Each special design must have construction approved by a geotechnical engineer. Materials used in the outer shell of the embankment must have the capability to support vegetation of the quality required to prevent erosion of the embankment.

Placement - Areas on which fill is to be placed shall be scarified prior to placement of fill. Fill materials shall be placed in maximum 6 inch thick (before compaction) layers which are to be continuous over the entire length of the fill. The most permeable borrow material shall be placed in the downstream portion of the embankment. The principal spillway must be installed concurrently with fill placement and not accreted into the embankment.

Compaction - The movement of the hauling and spreading equipment over the fill shall be controlled so that the entire surface of each lift shall be traversed by not less than one load of heavy equipment or compaction shall be achieved by four complete passes of a sheepsfoot roller. The roller shall be operated so that the material shall contain sufficient moisture such that the required degree of compaction will be obtained with the equipment used. The fill material shall contain sufficient moisture so that, if formed into a ball it will not crumble, yet not be so wet that water can be squeezed out.

When required by the reviewing agency the minimum required density shall not be less than 95% maximum dry density with a moisture content within +/-2% of the optimum. Each layer of fill shall be compacted as necessary to obtain that density and is to be certified by the Engineer at the time of construction. All compaction is to be determined by Method 1-9 (Standard Proctor).

Cut Off Trench - The cutoff trench shall be excavated into impervious material along or parallel to the centerline of the embankment as shown on the plans. The bottom width of the trench shall be governed by equipment used for excavation and shall be a minimum of 18 inches. The depth shall be such that the trench will be below existing grade or 18 inches below the finished grade. The trench shall be filled with a minimum of 12 inches of compacted granular material, or hand tampers, to assure minimum density and minimum permeability.

Embankment Core - The core shall be parallel to the centerline of the embankment as shown on the plans. The top width of the core shall be a minimum of four feet. The height shall extend up to at least the top ear water elevation or as shown on the plans. The side slopes shall be 1 to 1 or flatter. The core shall be compacted with construction equipment as shown on the plans.

Structure Backfill
Backfill adjacent to pipes or structures shall be of the type and quality conforming to that specified for the adjoining fill material. The fill shall be placed in horizontal layers not to exceed four inches in thickness and compacted by hand tampers or other manually directed compaction equipment. The material needs to fill completely of space under and adjacent to the pipe. All no time during the backfilling operation shall driven equipment be allowed to operate closer than four feet, measured horizontally, to any part of a structure. All structures shall be equipped with any part of a concrete structure or pipe, unless there is a compacted fill of 24" or greater over the structure or pipe.

Structure backfill may be flexible fill meeting the requirements of Maryland Department of Transportation, State Highway Administration Standard Specifications for Construction and Materials, Section 313 as modified. Flexible fill shall have a 100-200 psi 28 day unconfined compressive strength. The flexible fill shall have a minimum of 4.0 and a maximum of 12.0 percent moisture content. The material shall be placed such that moisture of 4.0 percent is maintained throughout the fill. Flexible fill shall be placed under (backfill) over and, on the sides of the pipe. It only needs to extend to the top of the structure. Adequate measures shall be taken (sand bags, etc.) to prevent floating the pipe. When using flexible fill, all material shall be bituminous coated. Any adjoining backfill shall be placed in a minimum of 12 inches in thickness and compacted by hand tampers or other manually directed compaction equipment. The material shall completely fill all voids adjacent to the flexible fill. No time during the backfilling operation shall driven equipment be allowed to operate closer than four feet, measured horizontally, to any part of the structure. Adequate measures shall be taken to prevent floating the pipe. When using flexible fill, all material shall be bituminous coated. Adequate measures shall be taken to prevent floating the pipe. When there is a compacted fill of 24" or greater over the structure or pipe, backfill (flexible fill) shall be of the type and quality conforming to that specified for the core of the embankment or other embankment materials.

Pipe Conduits
All pipes shall be circular in cross section.

Corrugated Metal Pipe - All of the following criteria shall apply for corrugated metal pipe:

1. Material - (Polymer Coated steel pipe) - Steel pipe with polymer coating shall have a minimum coating thickness of 0.01 inch (10 mil) on both sides of the pipe. The pipe and its appurtenances shall conform to the requirements of AASHTO Specification H-296 (11-246) with water-tight coating bands or flanges.
2. Material - (Aluminum Coated Steel Pipe) - This pipe and its appurtenances shall conform to the requirements of AASHTO Specification H-274 with water-tight coating bands or flanges. Aluminum coated steel pipe shall be used with flexible fill or when soil and/or water conditions warrant the need for increased durability, shall be fully bituminous coated per requirements of AASHTO Specification H-296 Type A. Any aluminum coating damaged or otherwise removed shall be replaced with cold applied bituminous coating compound. Aluminum structures shall be in contact with concrete shall be protected with one coat of zinc chromate primer or two coats of asphalt. Hot dip galvanized bolts may be used for connections. The oil of the surrounding soils shall be below 4 inches.
3. Connections - All connections with pipe must be completely watertight. The drain pipe or barrel connection to the riser shall be sealed all around when the pipe and riser are installed. Anti-seep collars shall be connected to the pipe in a manner so as to be completely watertight. Dimple bands are not considered to be watertight.

All connections shall use a rubber or neoprene gasket when joining pipe sections. The end of each pipe shall be reinforced with adequate number of steel reinforcing bars. The following reinforcement criteria are applicable for pipes less than 24 inches diameter. Flanges on both ends of the pipe with a circular 3/8" thick diameter of 1/2 inch greater than the connection depth. Flanges 24 inches in diameter and larger shall be connected by a 24 inch wide by 3/8" thick closed cell circular neoprene gasket shall be installed with 12 inches on the end of each pipe. Flanged joints with 3/8" thick closed cell gaskets shall be installed with 12 inches on the end of each pipe. Heavily corrugated pipe shall have either continuously welded seams or have lock seams with internal caulking or a neoprene bead.

4. Backfill - The pipe shall be firmly and uniformly bedded throughout its entire length. Where rock or soft, spongy or other unstable soil is encountered, all such material shall be removed and replaced with suitable earth compacted to provide adequate support.

5. Backfilling shall conform to "Structure Backfill".

6. Other details (anti-seep collars, valves, etc.) shall be as shown on the drawings.

Reinforced Concrete Pipe All of the following criteria shall apply for reinforced concrete pipe:

1. Material - Reinforced concrete pipe shall have bell and spigot joints with rubber gaskets and shall equal or exceed ASTM C-76.
2. Backfill - Reinforced concrete pipe conduits shall be laid in a concrete bedding/crate for their entire length. The bedding/crate shall consist of high strength concrete placed under the pipe and on the sides of the pipe at least 12" of its outside diameter with a minimum diameter of 12 inches. Where a concrete crate is not needed for structural reasons, flexible fill may be used as described in the "Structure Backfill" section of the standard. Gravel bedding is not permitted.
3. Laying pipe - Bell and spigot pipe shall be placed with the bell and upstream. Joints shall be made in accordance with the manufacturer's instructions. After the joints are sealed for the entire length, the bedding shall be placed so that all areas under the pipe are filled under the pipe and shall be placed to prevent any deviation of the pipe. The first joint shall be located within 4 feet from the riser.
4. Backfilling shall conform to "Structure Backfill".
5. Other details (anti-seep collars, valves, etc.) shall be as shown on the drawings.

Plastic Pipe The following criteria shall apply for plastic pipe:

1. Material - PVC pipe shall be PVC-1220 or PVC-1220 conforming to ASTM D-776 or ASTM D-2241. Corrugated High Density Polyethylene (HDPE) pipe, conforming to ASTM D-2241, shall be used for 4" through 24" inch diameter pipes. All other diameters shall conform to the requirements of AASHTO M294 Type 5.
2. Joints and connections to anti-seep collars shall be completely watertight.
3. Backfill - The pipe shall be firmly and uniformly bedded throughout its entire length. Where rock or soft, spongy or other unstable soil is encountered, all such material shall be removed and replaced with suitable earth compacted to provide adequate support.
4. Backfilling shall conform to "Structure Backfill".
5. Other details (anti-seep collars, valves, etc.) shall be as shown on the drawings.

Drainage Diagrams - When a drainage diagram is used, a registered professional engineer will supervise the design and construction inspection.

Concrete
Concrete shall meet the requirements of Maryland Department of Transportation, State Highway Administration Standard Specifications for Construction and Materials, Section 404, Part 5.

Rock Riprap
Rock riprap shall meet the requirements of Maryland Department of Transportation, State Highway Administration Standard Specifications for Construction Materials, Section 311.

Geotextiles shall be placed under all riprap and shall meet requirements of Maryland Department of Transportation, State Highway Administration Standard Specifications for Construction and Materials, Section 303.0, Class C.

Core of Water during Construction
All work on permanent structures shall be carried out in areas free from water. The Contractor shall construct and maintain all temporary dikes, levees, cofferdams, and other structures necessary to prevent water from entering the excavation, foundation, and other parts of the work free from water as required or directed by the engineer for constructing each part of the work. After having served their purpose, all temporary protective works shall be removed or leveled and graded to the extent required to prevent obstruction in any degree whatsoever of the flow of water in the stream or outlet works and so as not to interfere in any way with the operation or maintenance of the structure. Storm drains shall be installed in the fill area so that the water can be passed through the permanent works. The removal of water from the required excavation and the foundation shall be accomplished in a manner and to the extent that will maintain stability of the excavated slopes and bottom required excavation and will allow satisfactory performance of all construction operations. During the placing and compacting of material in required excavations, the water level at the bottom being raised shall be maintained below the bottom of the excavation at the location of each location which may require drawing the water pumps from which the water shall be pumped.

Stationing
All borrow areas shall be graded to provide proper drainage and left in a slight condition. All exposed surfaces of the embankment, spillway, spoil and borrow areas, and berms shall be stabilized by seeding, liming, fertilizing and mulching in accordance with the National Resource Conservation Service Standards and Specifications for Critical Area Planting (FD-342) or as shown on the accompanying drawings.

Erosion and Sediment Control
Construction operations will be carried out in such a manner that erosion will be controlled and silt and dirt pollution minimized. Silt and soil loss control pollution prevention statement will be obtained. Construction plans shall detail erosion and sediment control measures.

**OPERATION AND MAINTENANCE SCHEDULE FOR
STORMWATER MANAGEMENT DETENTION FACILITY**

**STORMWATER MANAGEMENT FACILITY
ROUTINE MAINTENANCE BY H&A**

1. FACILITY SHALL BE INSPECTED ANNUALLY AND AFTER MAJOR STORMS. INSPECTIONS SHOULD BE PERFORMED DURING WET WEATHER TO DETERMINE IF IT IS FUNCTIONING PROPERLY.
2. TOP AND SIDE SLOPES OF THE EMBANKMENT SHALL BE MOWED A MINIMUM OF TWO (2) TIMES A YEAR, ONCE IN JUNE AND ONCE IN SEPTEMBER. OTHER SIDE SLOPES AND MAINTENANCE ACCESS SHOULD BE MOWED AS NEEDED.
3. DEBRIS AND LITTER NEXT TO THE OUTLET STRUCTURE SHALL BE REMOVED DURING REGULAR MOWING OPERATIONS AND AS NEEDED.
4. VISIBLE SIGNS OF EROSION IN THE POND AS WELL AS RIPRAP OUTLET AREAS SHALL BE REPAIRED AS SOON AS IT IS NOTICED.

NON-ROUTINE MAINTENANCE BY HOWARD COUNTY

1. STRUCTURAL COMPONENTS OF THE POND SUCH AS THE DAM, THE RISER, AND THE PIPES SHALL BE REPAIRED UPON DETECTION OF ANY DAMAGE. THE COMPONENTS SHOULD BE INSPECTED DURING ROUTINE MAINTENANCE OPERATIONS.
2. SEDIMENT SHOULD BE REMOVED WHEN ITS ACCUMULATION SIGNIFICANTLY REDUCES THE DESIGN STORAGE, INTERFERES WITH THE FUNCTION OF THE RISER, WHEN DEEMED NECESSARY FOR AESTHETIC REASONS, OR WHEN DEEMED NECESSARY BY THE HOWARD COUNTY DEPARTMENT OF PUBLIC WORKS.













Recharge Obligation (Total Site)
Rev Reqd: N/A
Res Reqd: 0.27 Ac
Res Prov'd: 0.27 Ac

POND SUMMARY	YEAR(CPV)	10 YEAR**	100 YEAR	WATER QUALITY FOR AREA TO POND**
Flow Into Pond	6.06 cfs	58.83 cfs	109.64 cfs	WQV Req'd: 0.456 ac.ft
Flow Out of Pond	0.22 cfs	42.32 cfs	74.56 cfs	WQV Prov'd: 0.39 ac.ft (wet pool) 0.23 ac.ft (extended detention)
W/S Elevation	346.24	347.49	348.25	Total Provided: 0.62 ac.ft
Storage Volume	0.57 ac.ft			

** Recharge is met through the Percent Area Method.
** Assumes clogged Low Flow Orifices.












TEMPORARY SEDIMENT BASIN SCHEDULE

DRAINAGE AREA: 27.81 AC
NET STORAGE REQUIRED: 50,050 CU.FT.
WET STORAGE ELEVATION: 345.9 (SEDIMENT BASIN POOL)
DRY STORAGE REQUIRED: 50,050 CU.FT.
DRY STORAGE ELEVATION: 347.8
TEMP WEIR CREST ELEVATION: 347.8
10YR DESIGN HIGH WATER ELEVATION: 348.40
BOTTOM BASIN ELEVATION: 341.0
CLEANOUT ELEVATION: 344.5

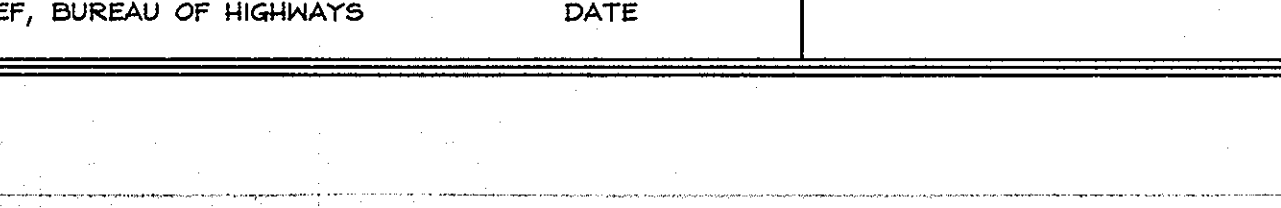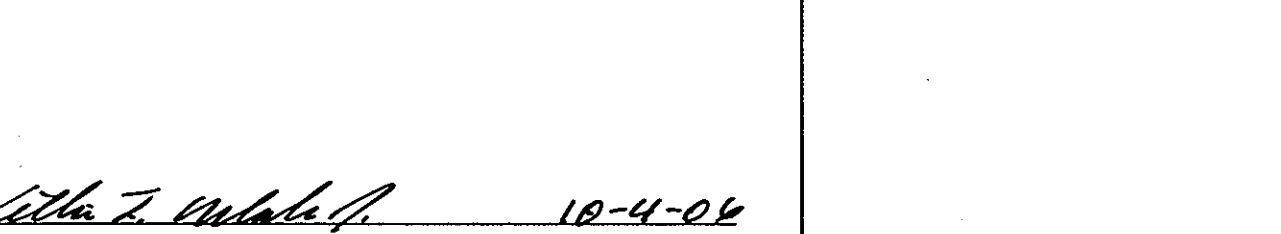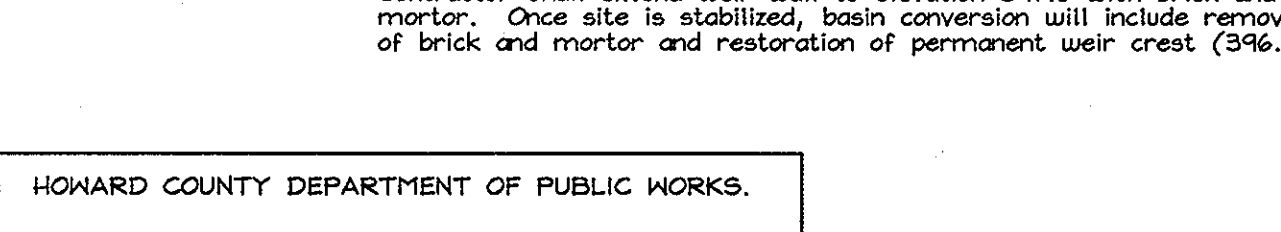
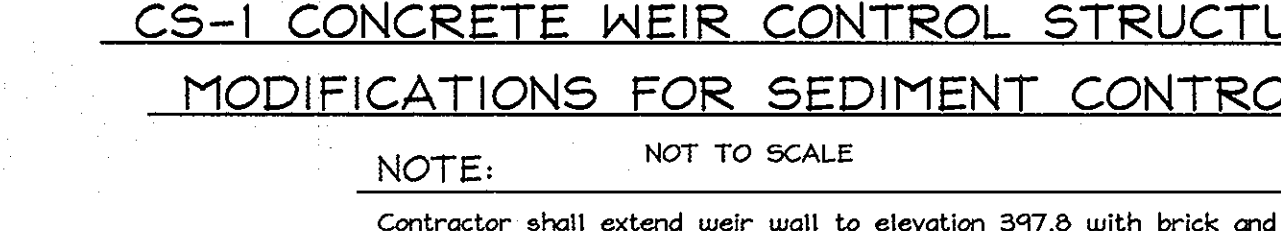
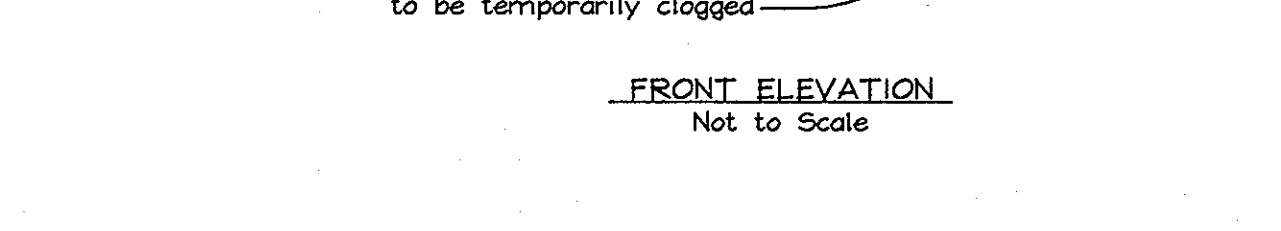
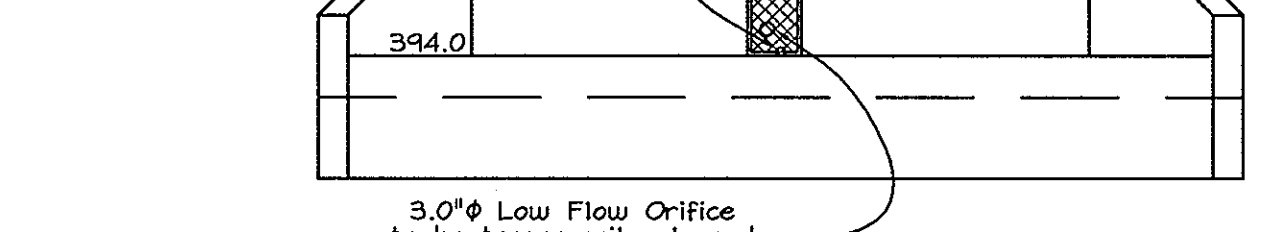
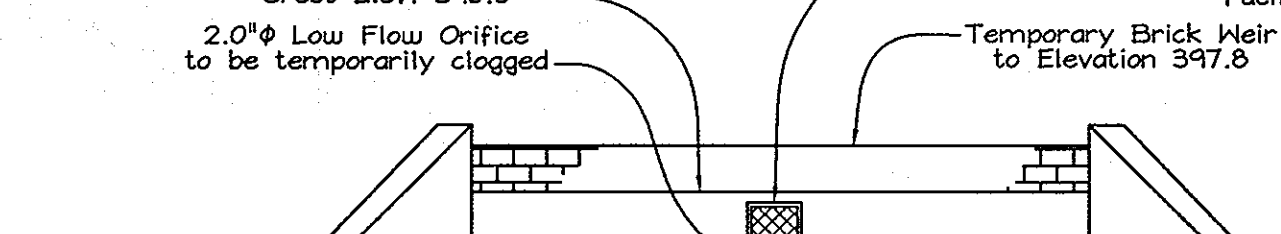
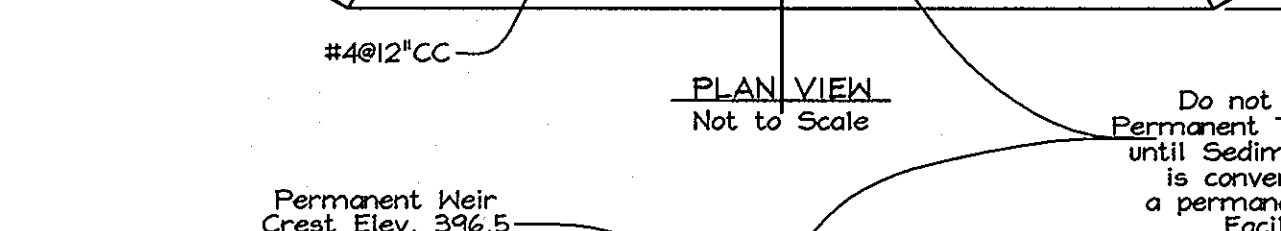
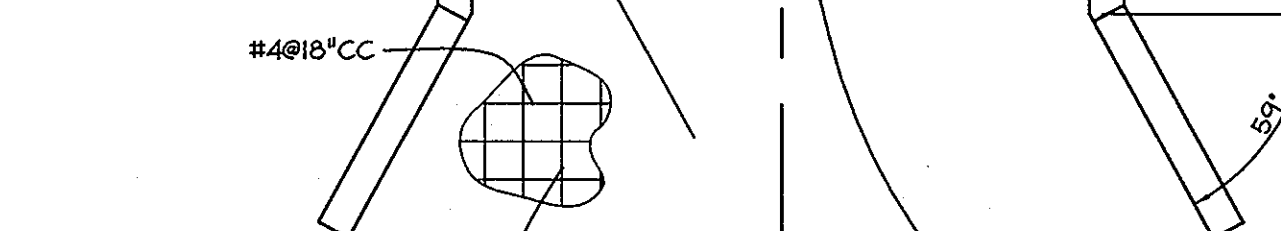
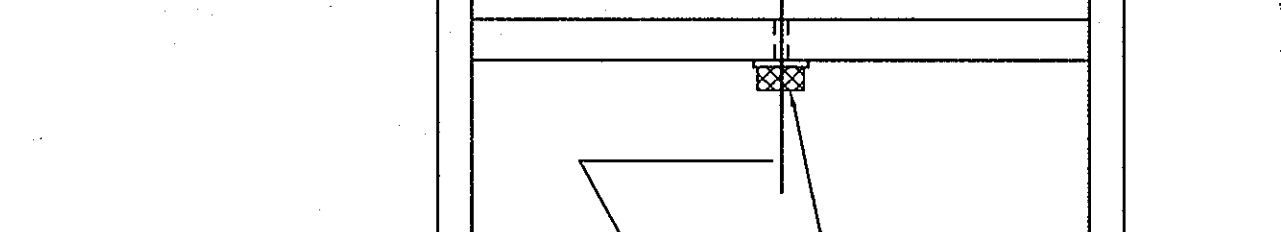
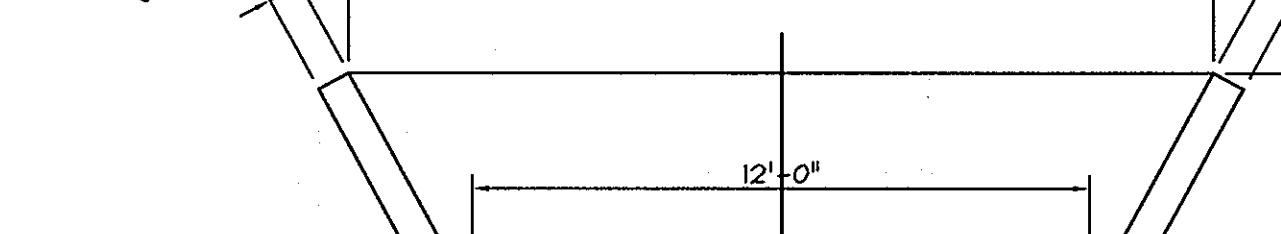
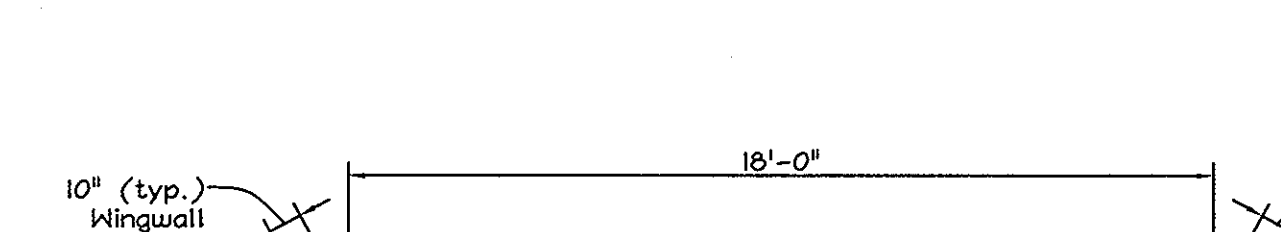


TEMPORARY SEDIMENT BASIN SCHEDULE












DRAINAGE AREA: 27.81 AC
NET STORAGE REQUIRED: 50,050 CU.FT.
WET STORAGE ELEVATION: 345.9 (SEDIMENT BASIN POOL)
DRY STORAGE REQUIRED: 50,050 CU.FT.
DRY STORAGE ELEVATION: 347.8
TEMP WEIR CREST ELEVATION: 347.8
10YR DESIGN HIGH WATER ELEVATION: 348.40
BOTTOM BASIN ELEVATION: 341.0
CLEANOUT ELEVATION: 344.5

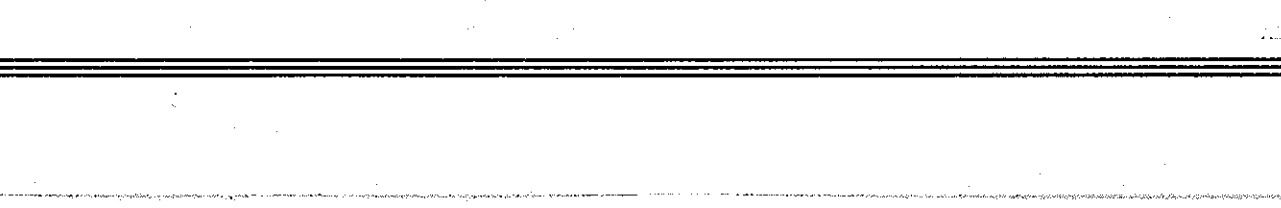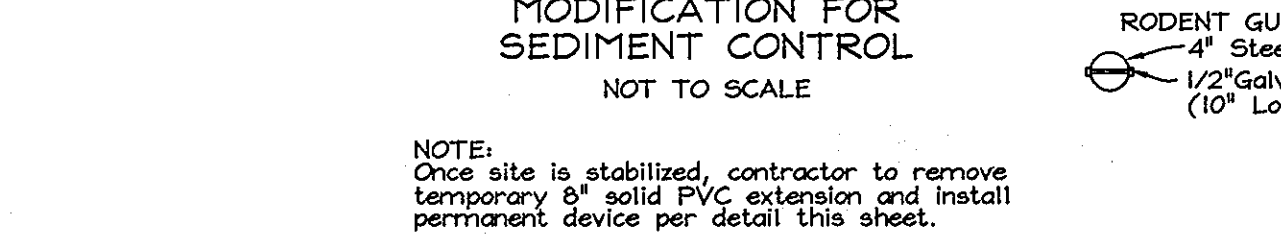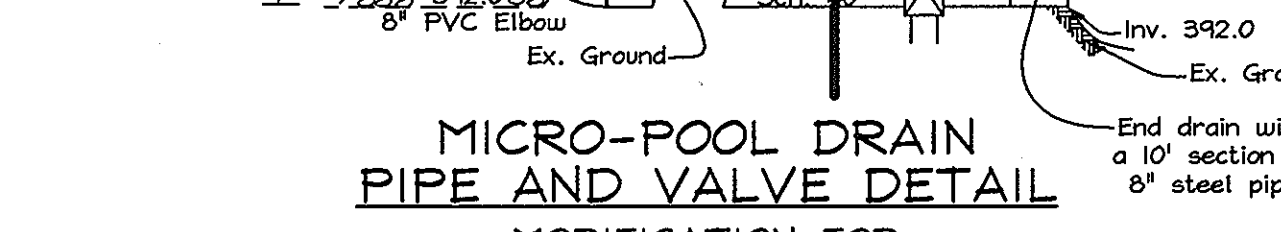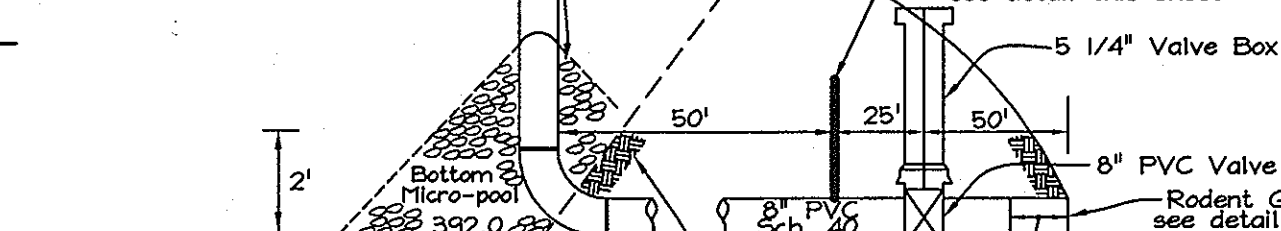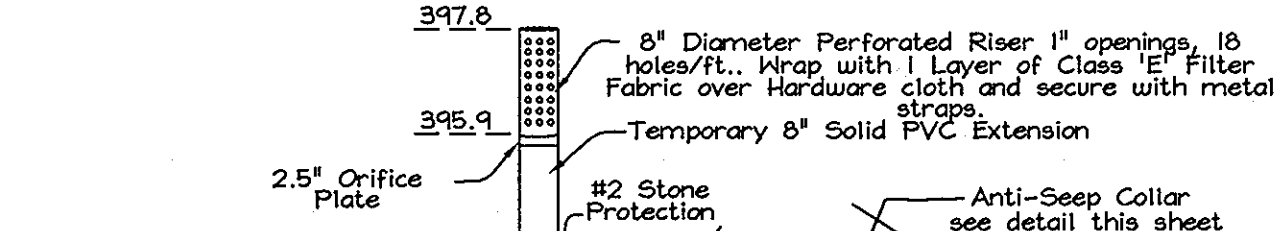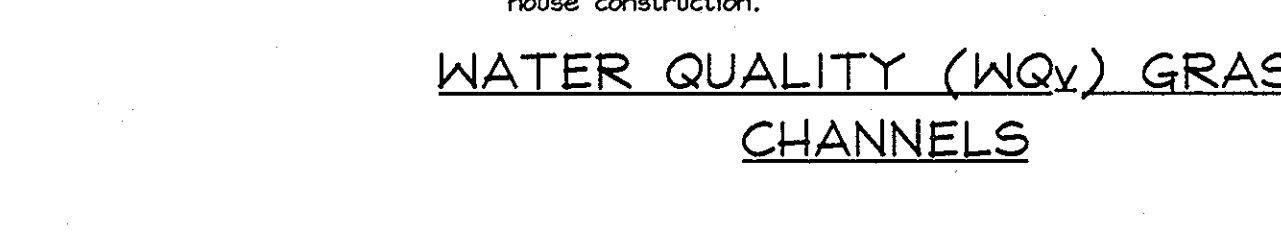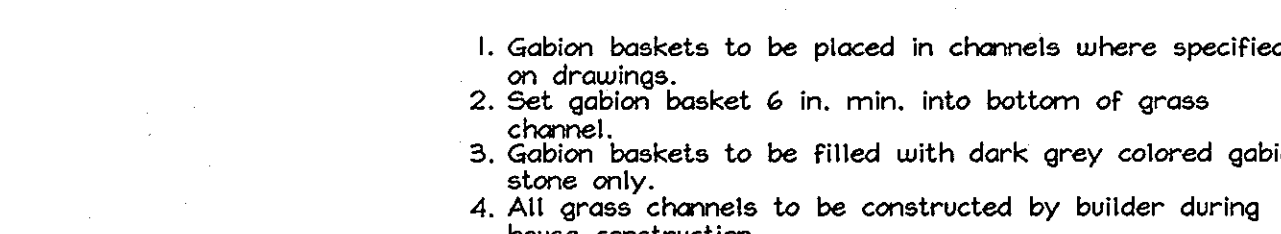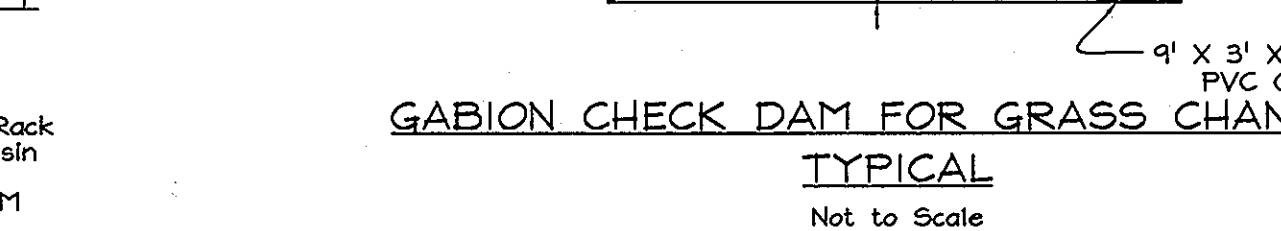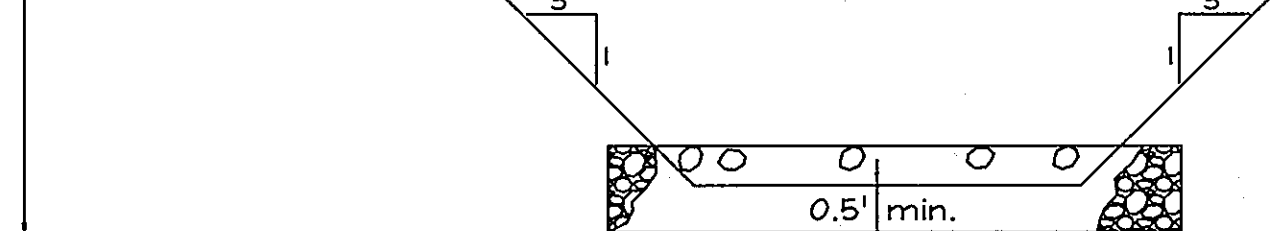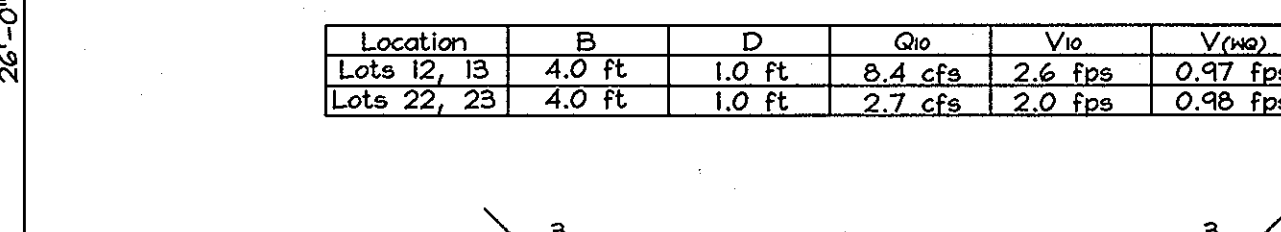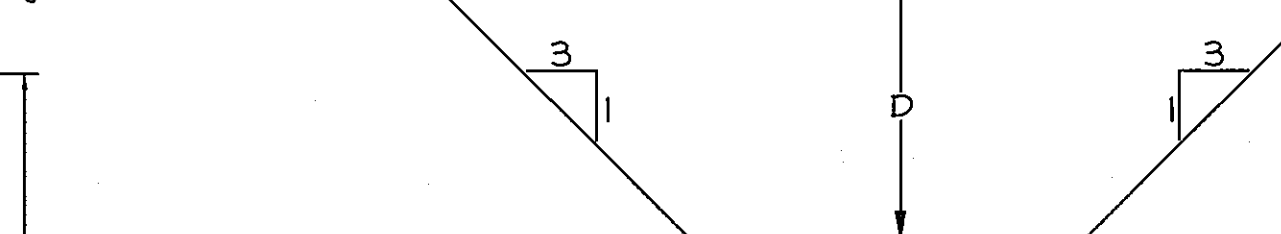


TRASH RACK DETAIL

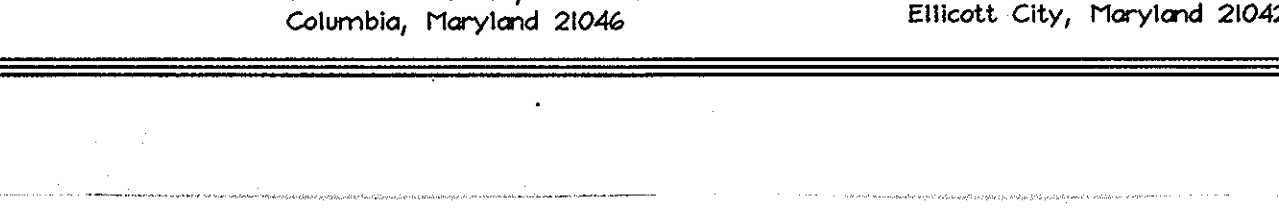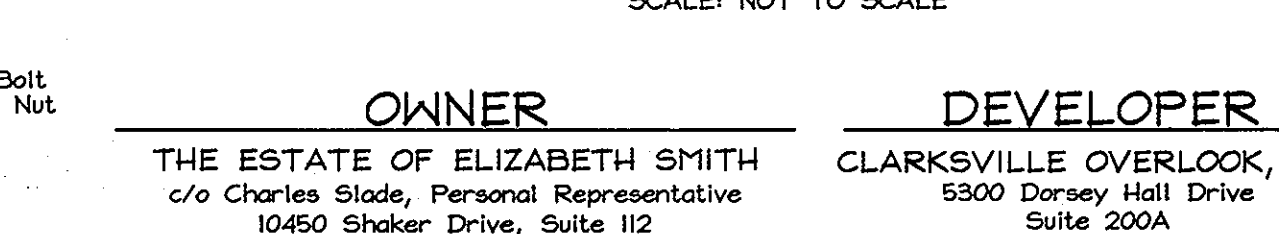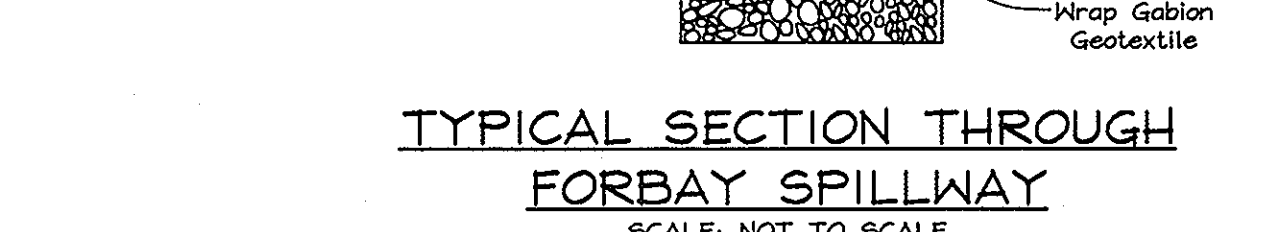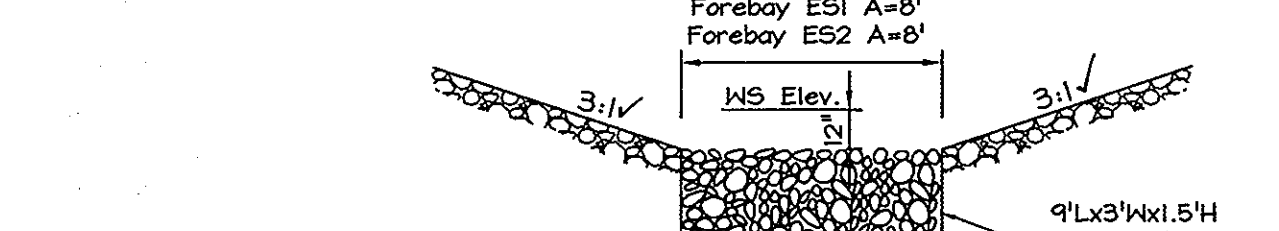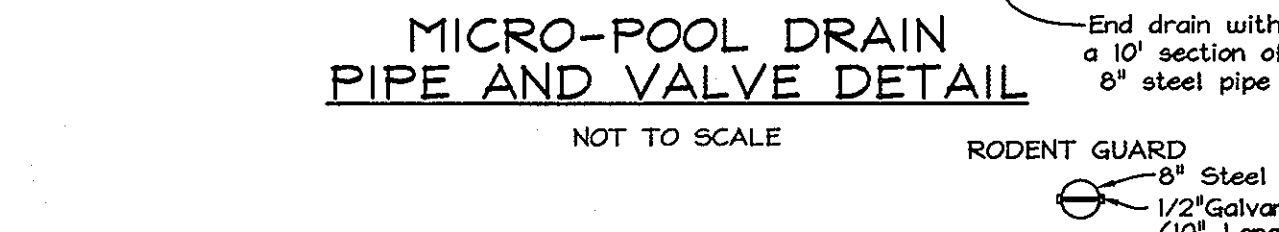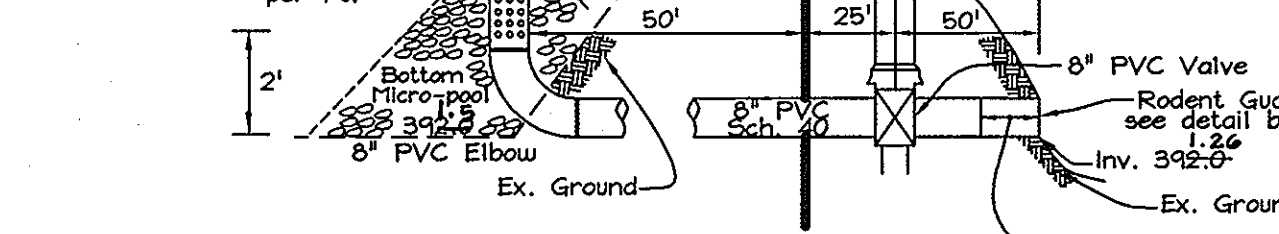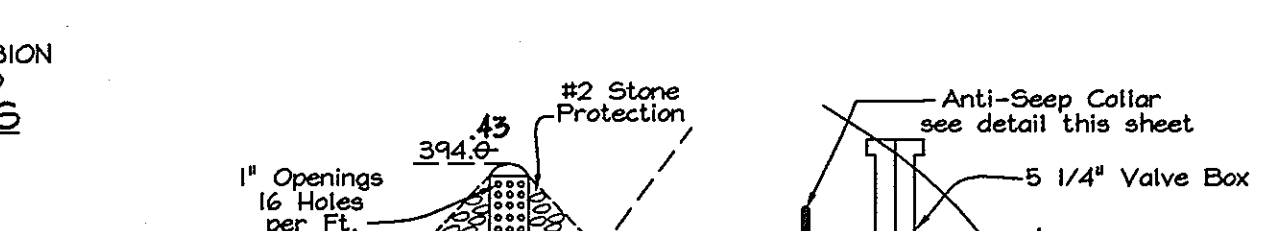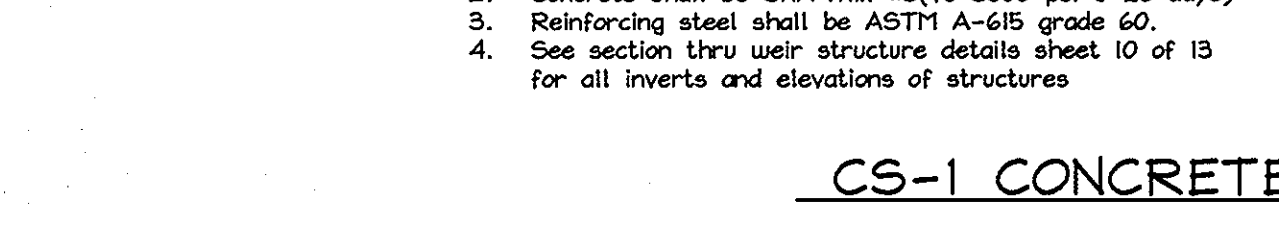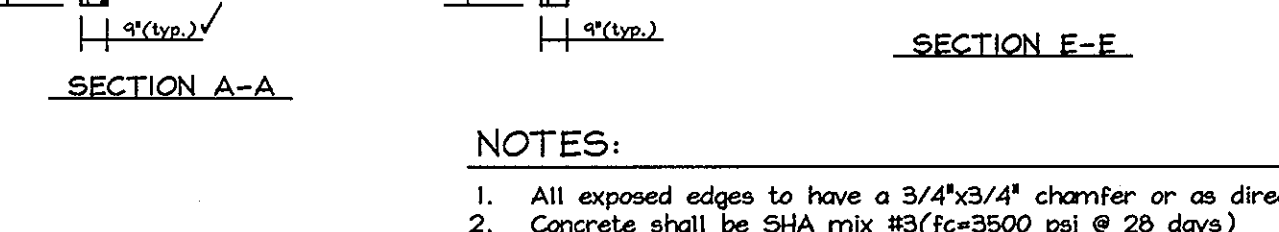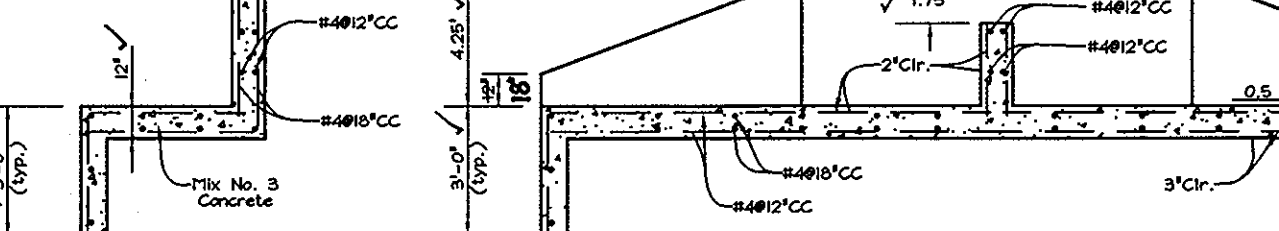

CS-1 CONCRETE WEIR CONTROL STRUCTURE

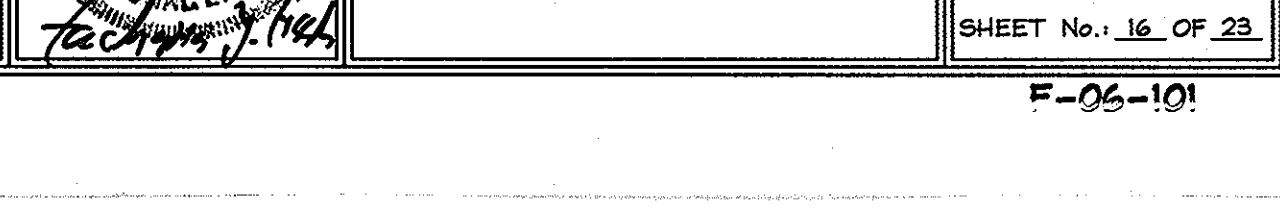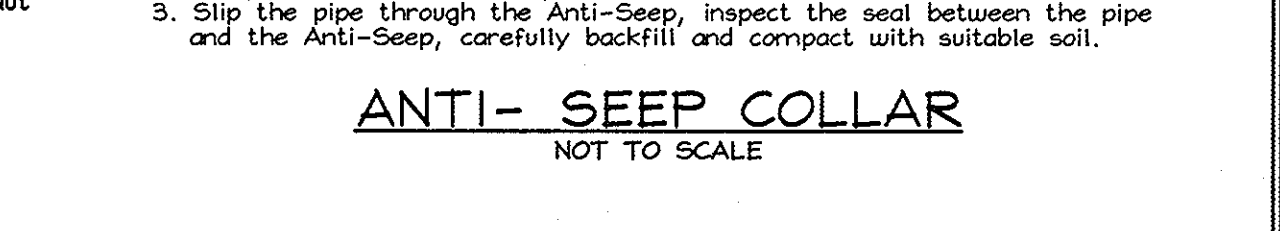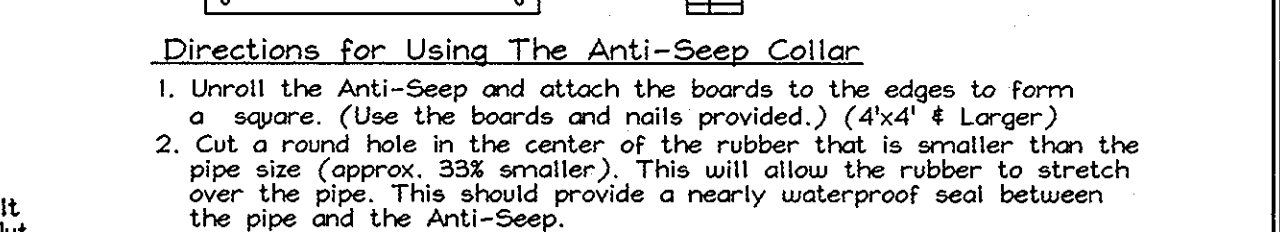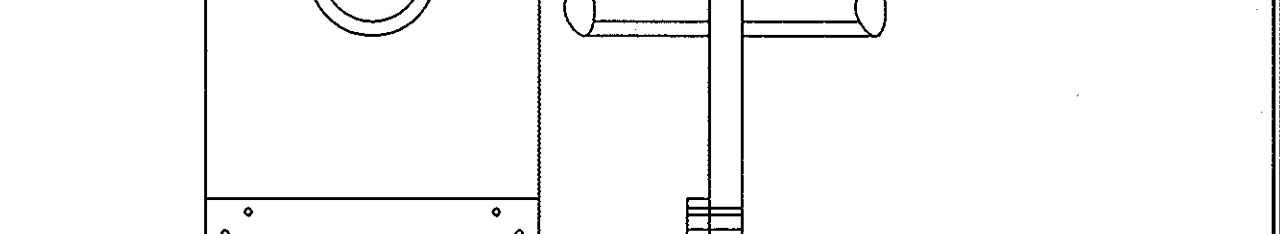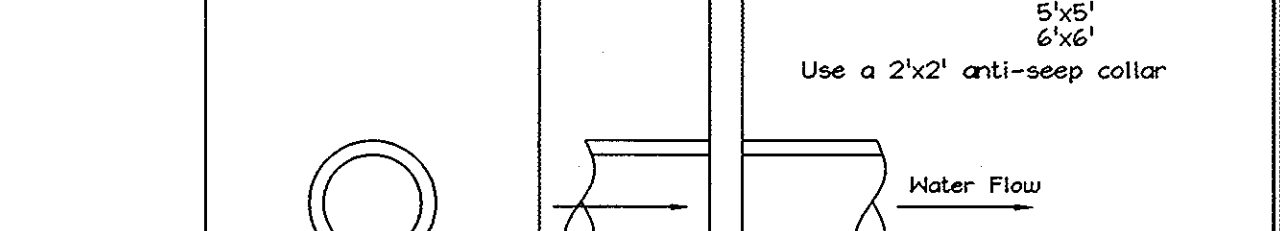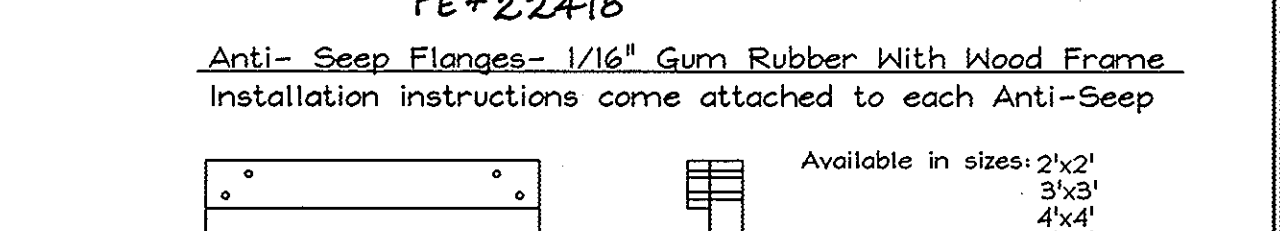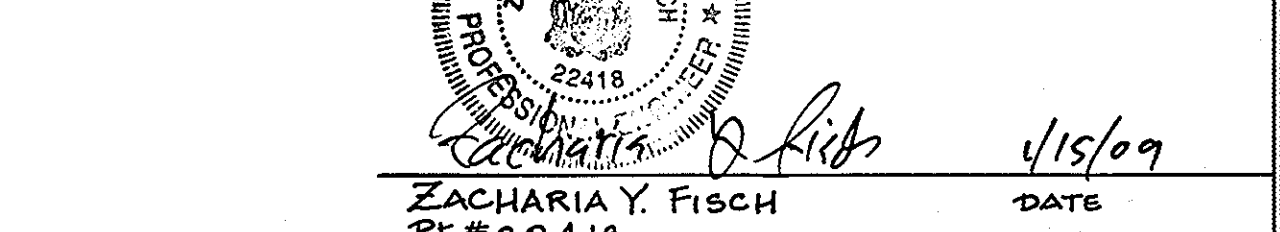
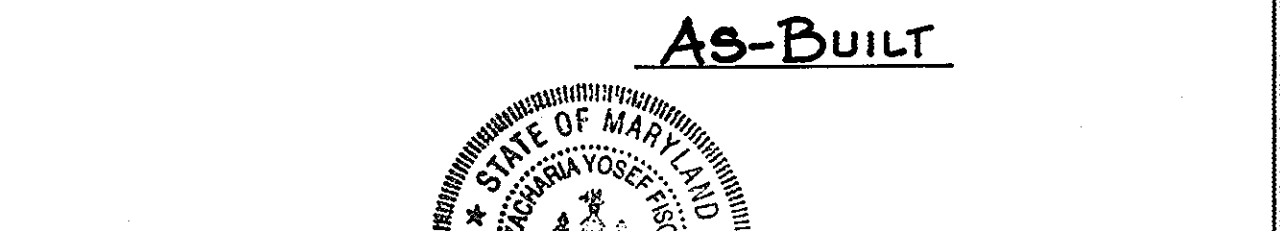
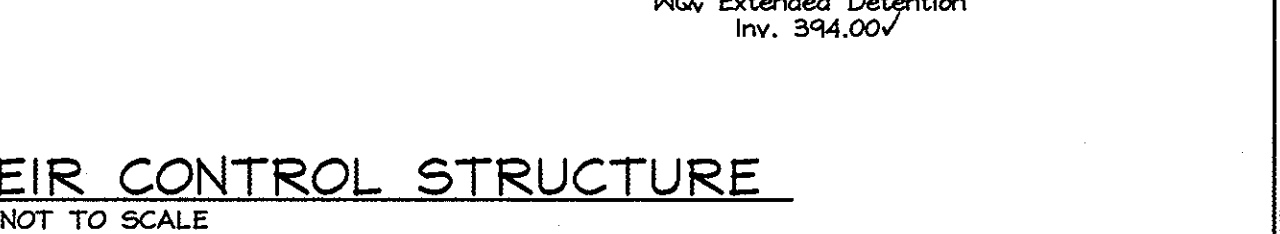
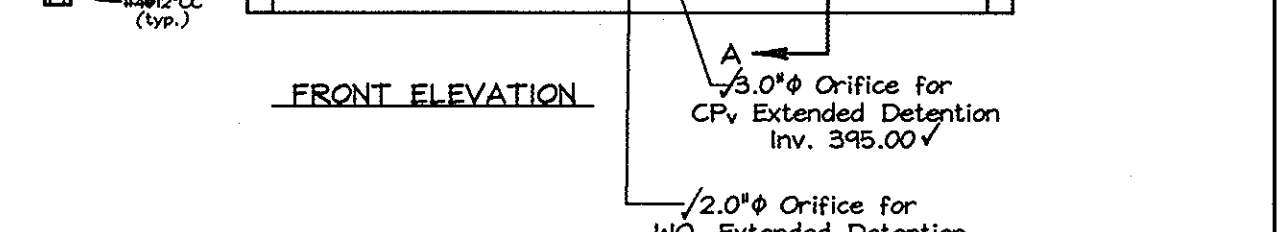
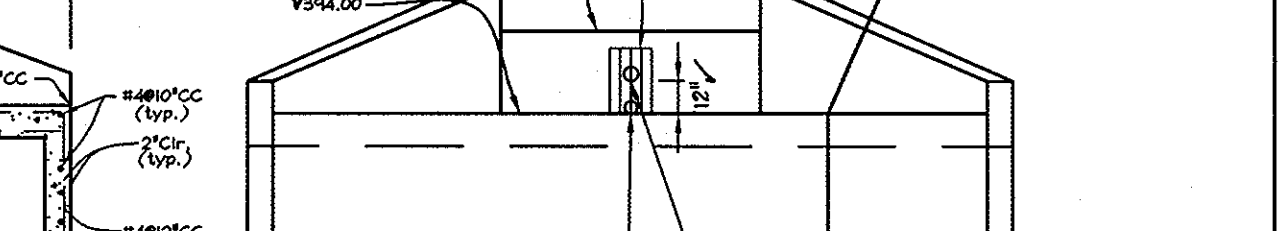


GABION CHECK DAM FOR GRASS CHANNELS





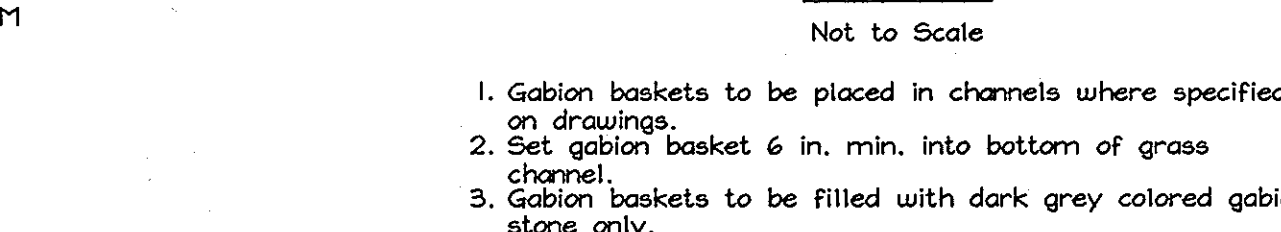


1. Gabion baskets to be placed in channels where specified on drawings.
2. Set gabion basket 6 in. min. into bottom of grass channel.
3. Gabion baskets to be filled with dark grey colored gabion stone only.
4. All grass channels to be constructed by builder during house construction.





WATER QUALITY (WQV) GRASS CHANNELS

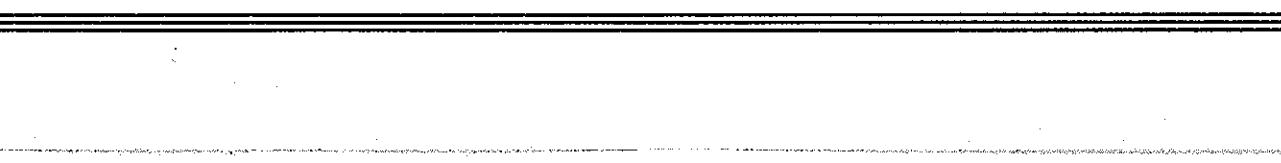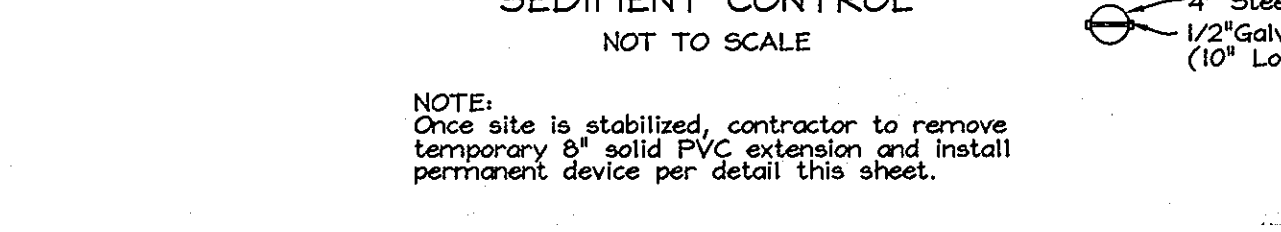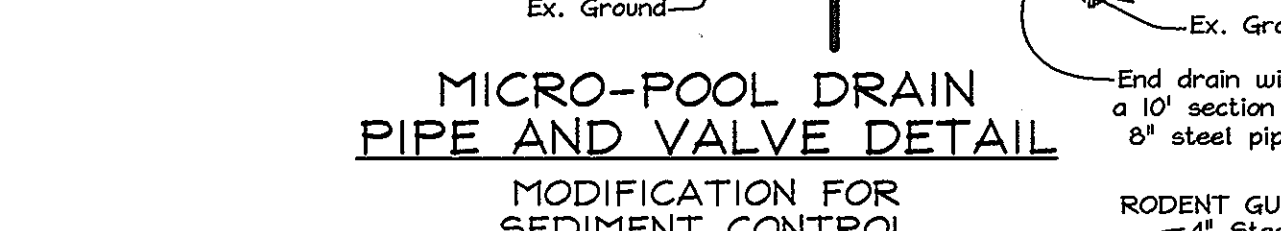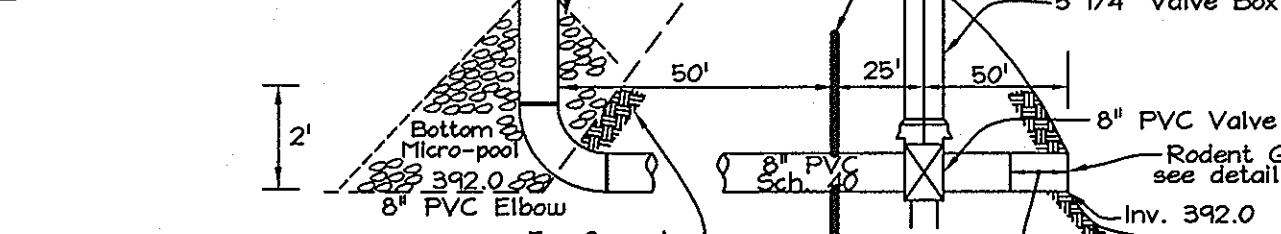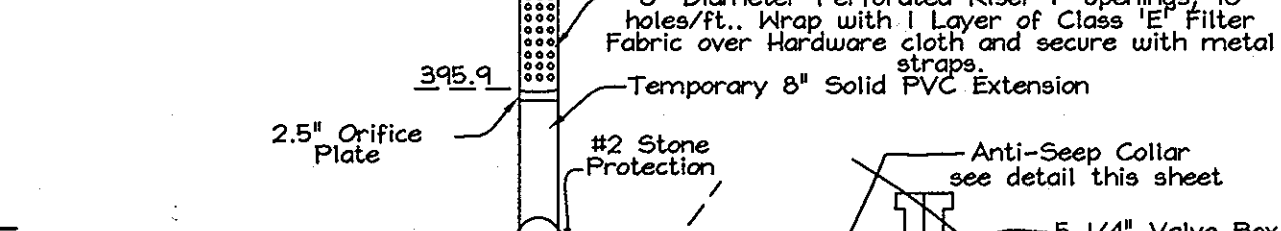

MICRO-POOL DRAIN PIPE AND VALVE DETAIL

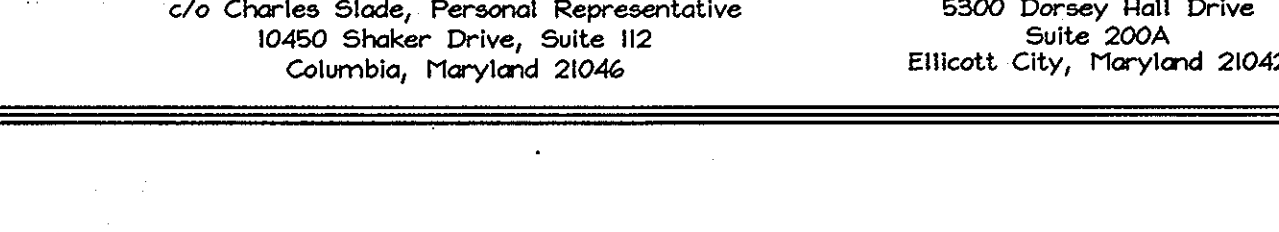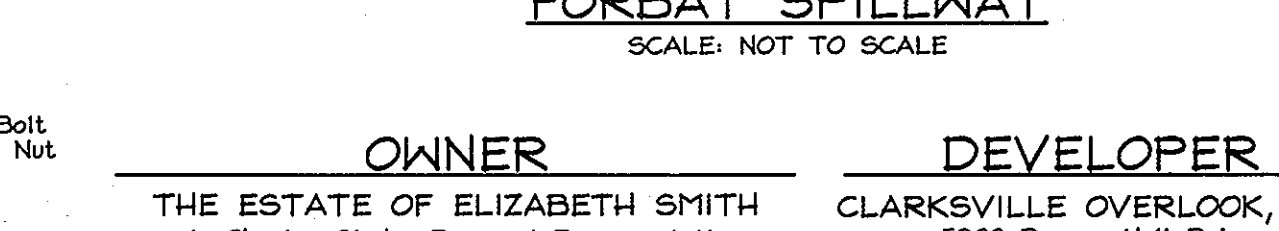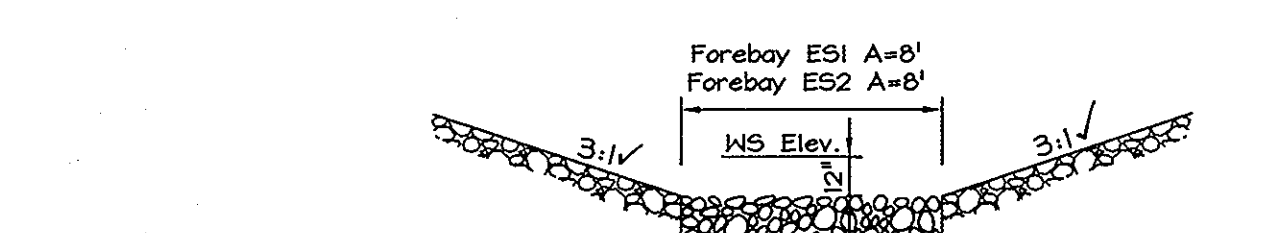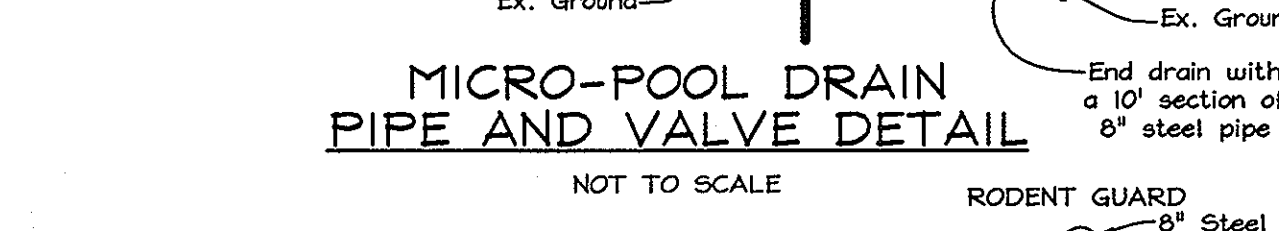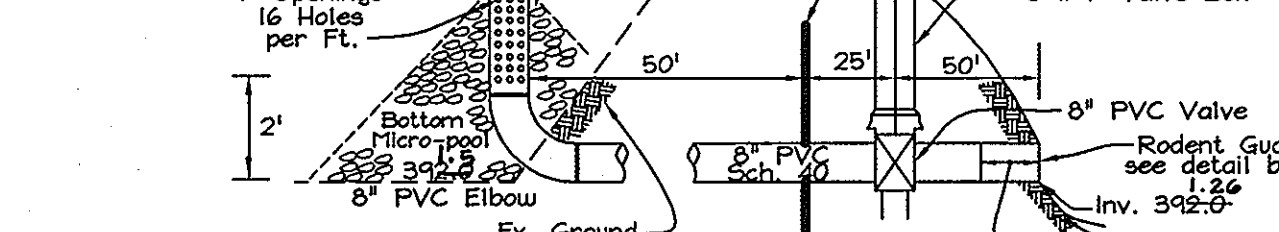

ANTI-SEEP COLLAR

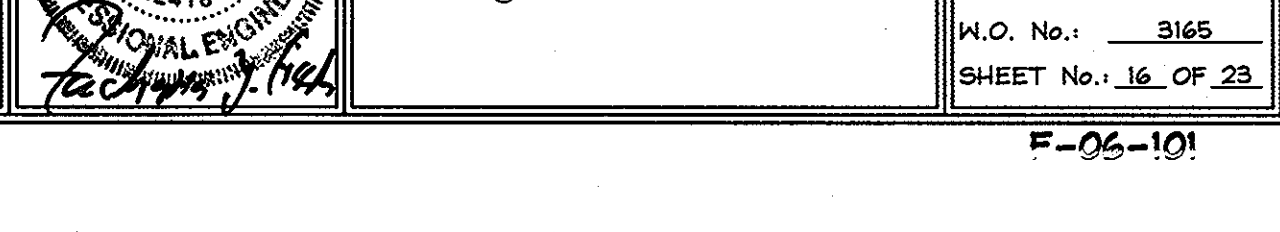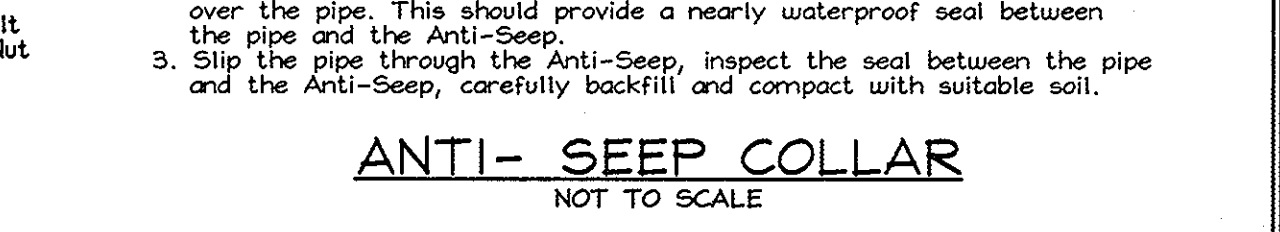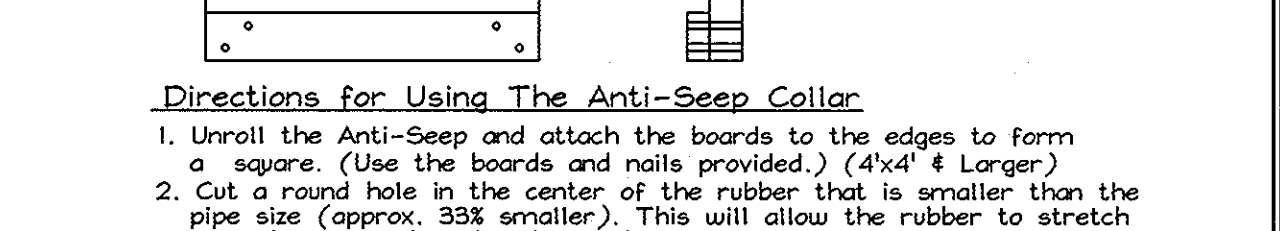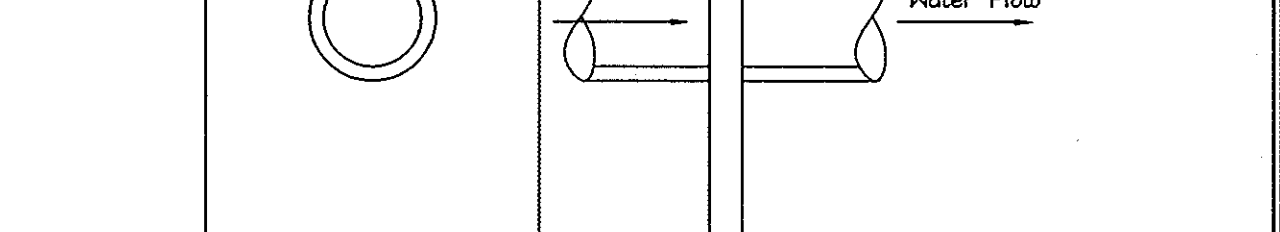

STORMWATER MANAGEMENT PLAN

MACBETH FARM
LOTS 1 THRU 35, BUILDABLE PRESERVATION PARCEL 'A', 'F'
NON-BUILDABLE PRESERVATION PARCELS 'B', 'C', 'D', 'E', 'I', 'J'
Tax Map 34 Grids 18 & 24
4th Election District
Howard County, Maryland

FSH Associates
Engineers Planners Surveyors
6339 Howard Lane Ellicott City, MD 21079
Tel: 410-576-5200 Fax: 410-796-1562
E-mail: info@fshri.com

DESIGN BY: PS
DRAWN BY: MT
CHECKED BY: ZTF
SCALE: As Shown
DATE: Aug. 31, 2006
W.O. No.: 3165
SHEET No. 16 OF 23


APPROVED: HOWARD COUNTY DEPARTMENT OF PLANNING AND ZONING
Cathy Hamer 10/11/06
CHIEF, DIVISION OF LAND DEVELOPMENT, DATE

William J. ... 10/10/06
CHIEF, DEVELOPMENT ENGINEERING DIVISION, DATE

APPROVED: HOWARD COUNTY DEPARTMENT OF PUBLIC WORKS.
William J. ... 10-4-06
CHIEF, BUREAU OF HIGHWAYS, DATE

OWNER
THE ESTATE OF ELIZABETH SMITH
c/o Charles Slade, Personal Representative
10450 Shaker Drive, Suite 112
Columbia, Maryland 21046

DEVELOPER
CLARKSVILLE OVERLOOK, LLC
5300 Dorsey Hall Drive
Suite 200A
Ellicott City, Maryland 21042

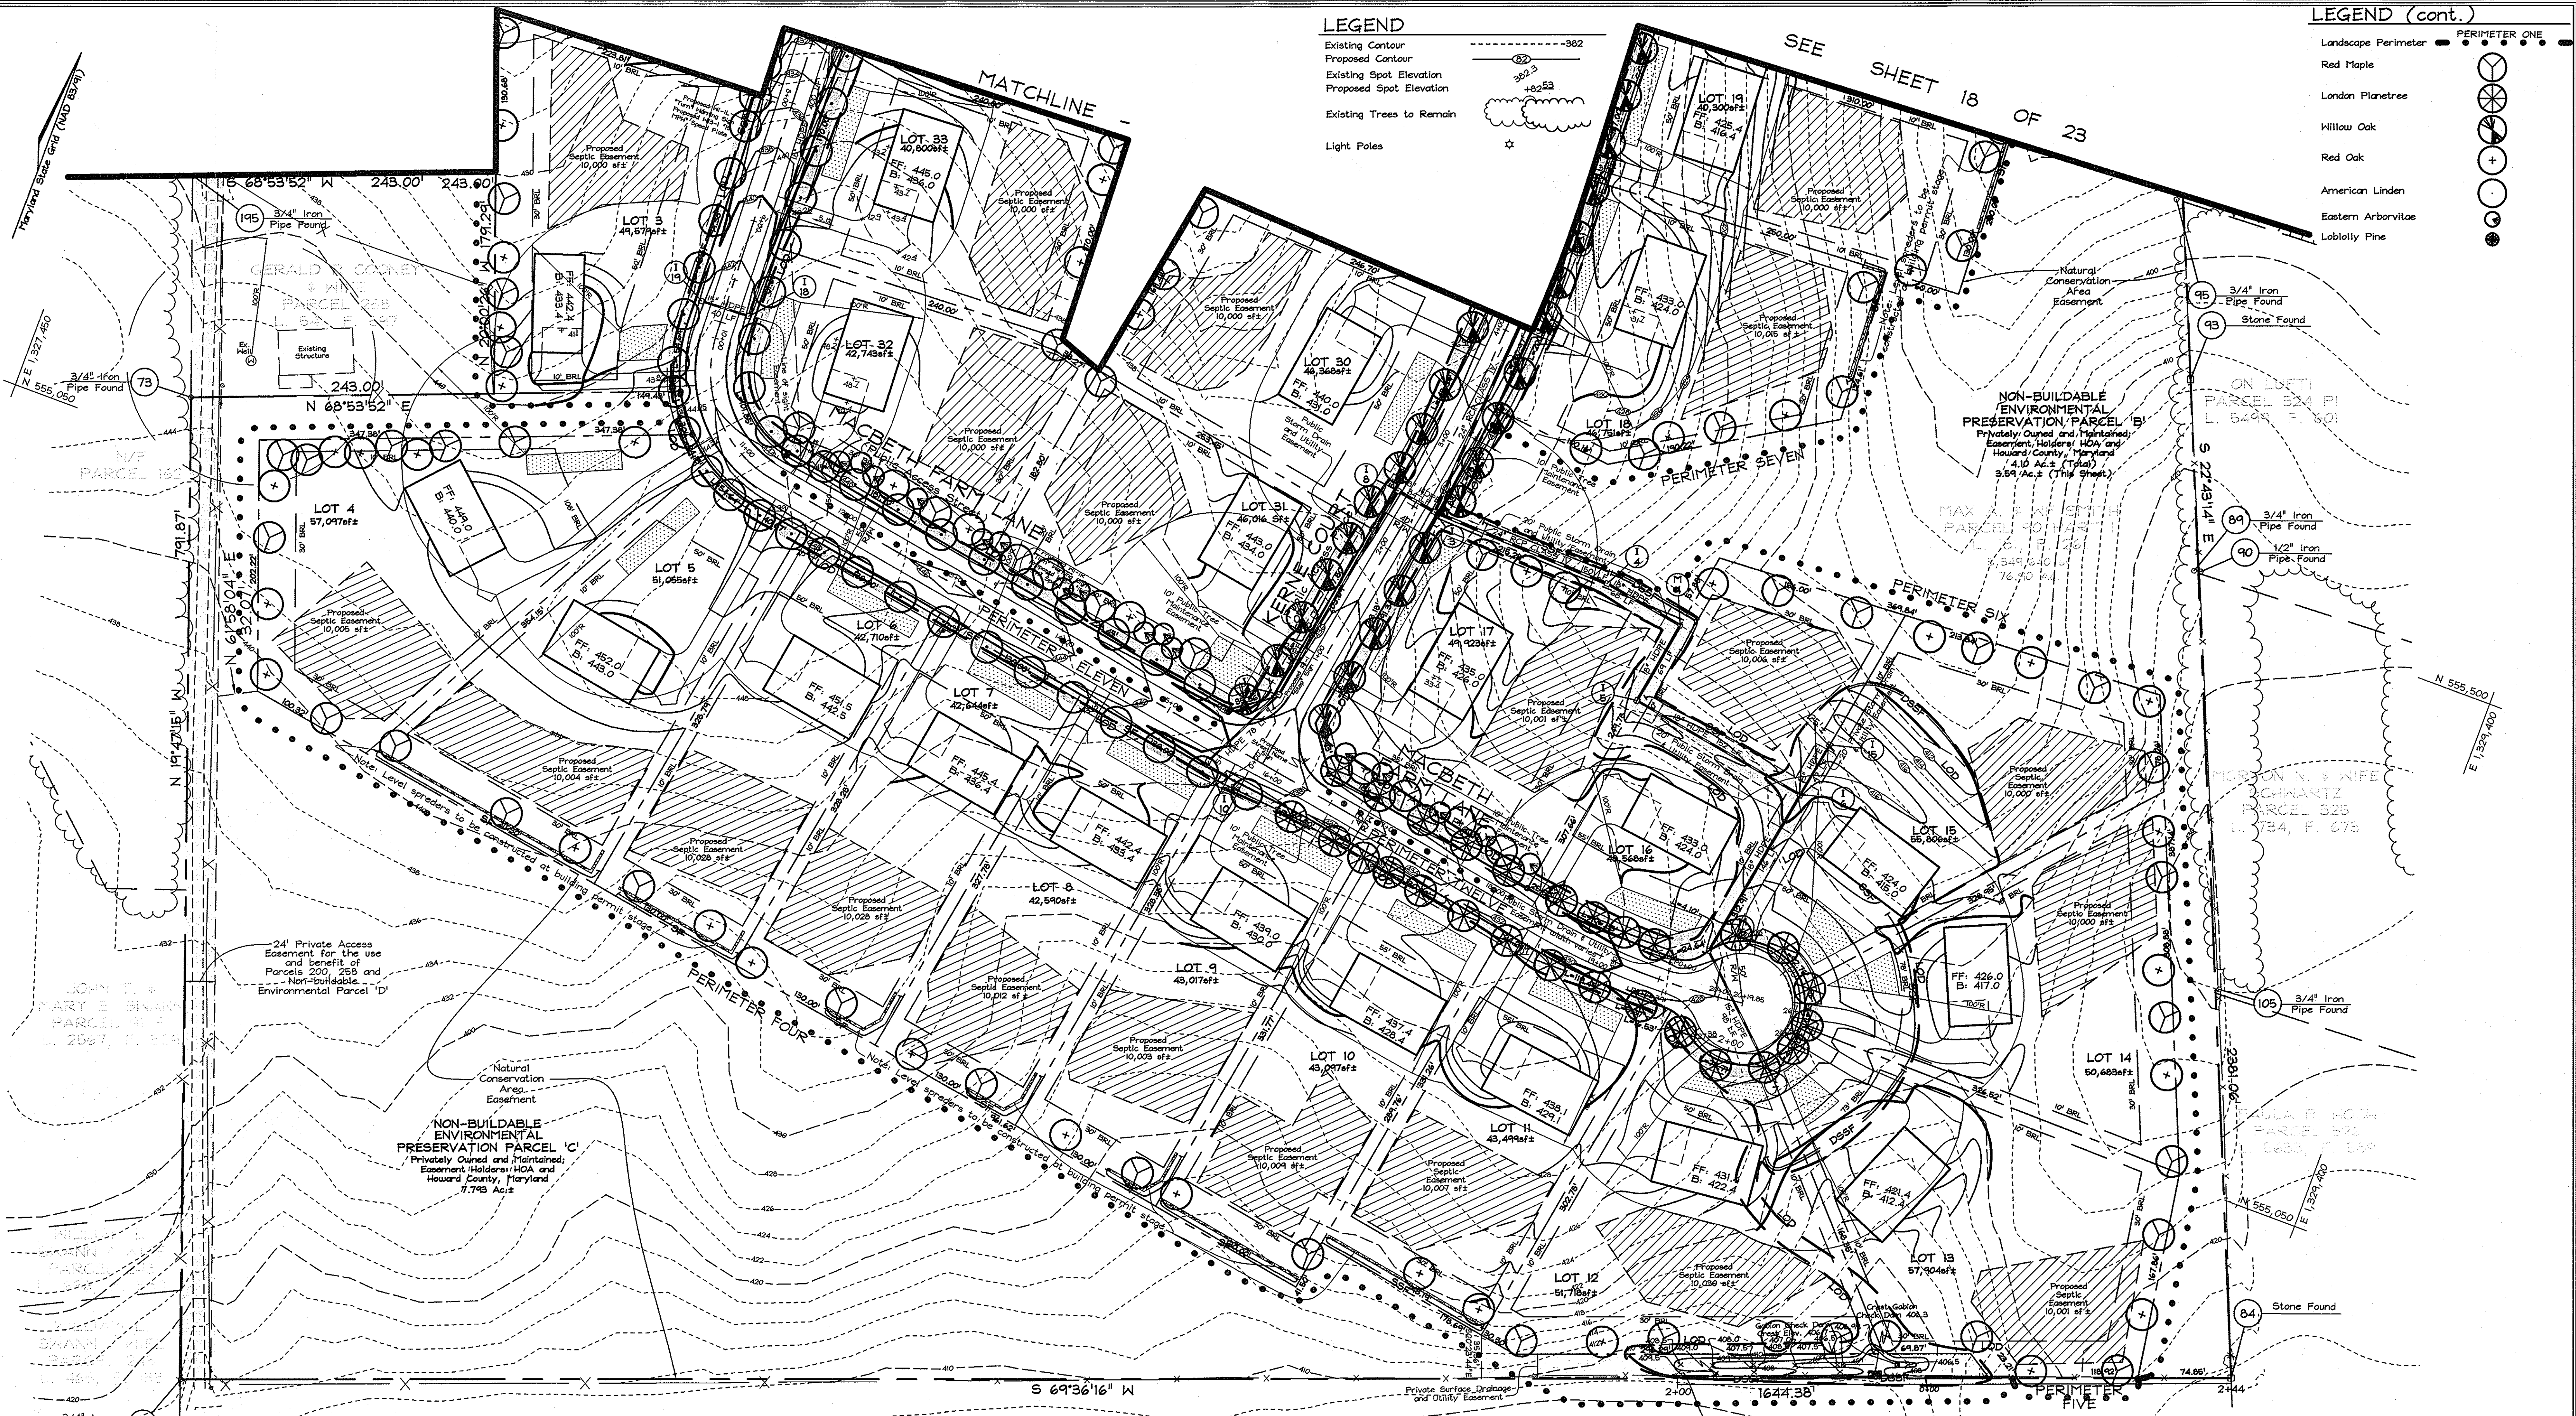

LEGEND

- Existing Contour
- Proposed Contour
- Existing Spot Elevation
- Proposed Spot Elevation
- Existing Trees to Remain
- Light Poles

LEGEND (cont.)

- Landscape Perimeter
- Red Maple
- London Planetree
- Willow Oak
- Red Oak
- American Linden
- Eastern Arborvitae
- Loblolly Pine

LANDSCAPE PLAN, NOTES AND DETAILS
MACBETH FARM
 LOTS 1 THRU 35, BUILDABLE PRESERVATION PARCEL 'A',
 NON-BUILDABLE PRESERVATION PARCELS 'B', 'C', 'D', 'E', 'F'
 Tax Map 34 Grids 18 & 24 Parcel 90
 4th Election District Howard County, Maryland

APPROVED: HOWARD COUNTY DEPARTMENT OF PLANNING AND ZONING

 CHIEF, DIVISION OF LAND DEVELOPMENT DATE

APPROVED: HOWARD COUNTY DEPARTMENT OF PUBLIC WORKS.


 CHIEF, BUREAU OF HIGHWAYS DATE

DEVELOPER'S BUILDER'S CERTIFICATE
 I/WE CERTIFY THAT THE LANDSCAPING SHOWN ON THIS PLAN WILL BE DONE ACCORDING TO THE PLAN, SECTION 16.124 OF THE HOWARD COUNTY CODE AND THE HOWARD COUNTY LANDSCAPE MANUAL. I/WE FURTHER CERTIFY THAT UPON COMPLETION, A LETTER OF LANDSCAPE INSTALLATION, ACCOMPANIED BY AN EXECUTED ONE(1) YEAR GUARANTEE OF PLANT MATERIALS, WILL BE SUBMITTED TO THE DEPARTMENT OF PLANNING AND ZONING.

 SIGNATURE OF DEVELOPER DATE


OWNER
 THE ESTATE OF ELIZABETH SMITH
 c/o Charles Slade, Personal Representative
 10450 Shaker Drive, Suite 112
 Columbia, Maryland 21046

DEVELOPER
 CLARKVILLE OVERLOOK, LLC
 5300 Dorsey Hall Drive
 Suite 200A
 Ellicott City, Maryland 21042

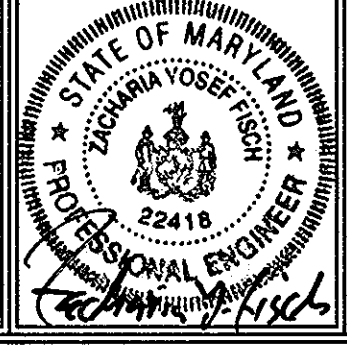

FSH Associates
 Engineers Planners Surveyors
 6339 Howard Lane Elkridge, MD 21075
 Tel: 410-567-5200 Fax: 410-796-1562
 E-mail: info@fisher.com

DESIGN BY: PS
 DRAWN BY: MT
 CHECKED BY: ZTF
 SCALE: 1"=60'
 DATE: Aug. 31, 2006
 P.L.O. No.: 3165
 SHEET No. 17 OF 23

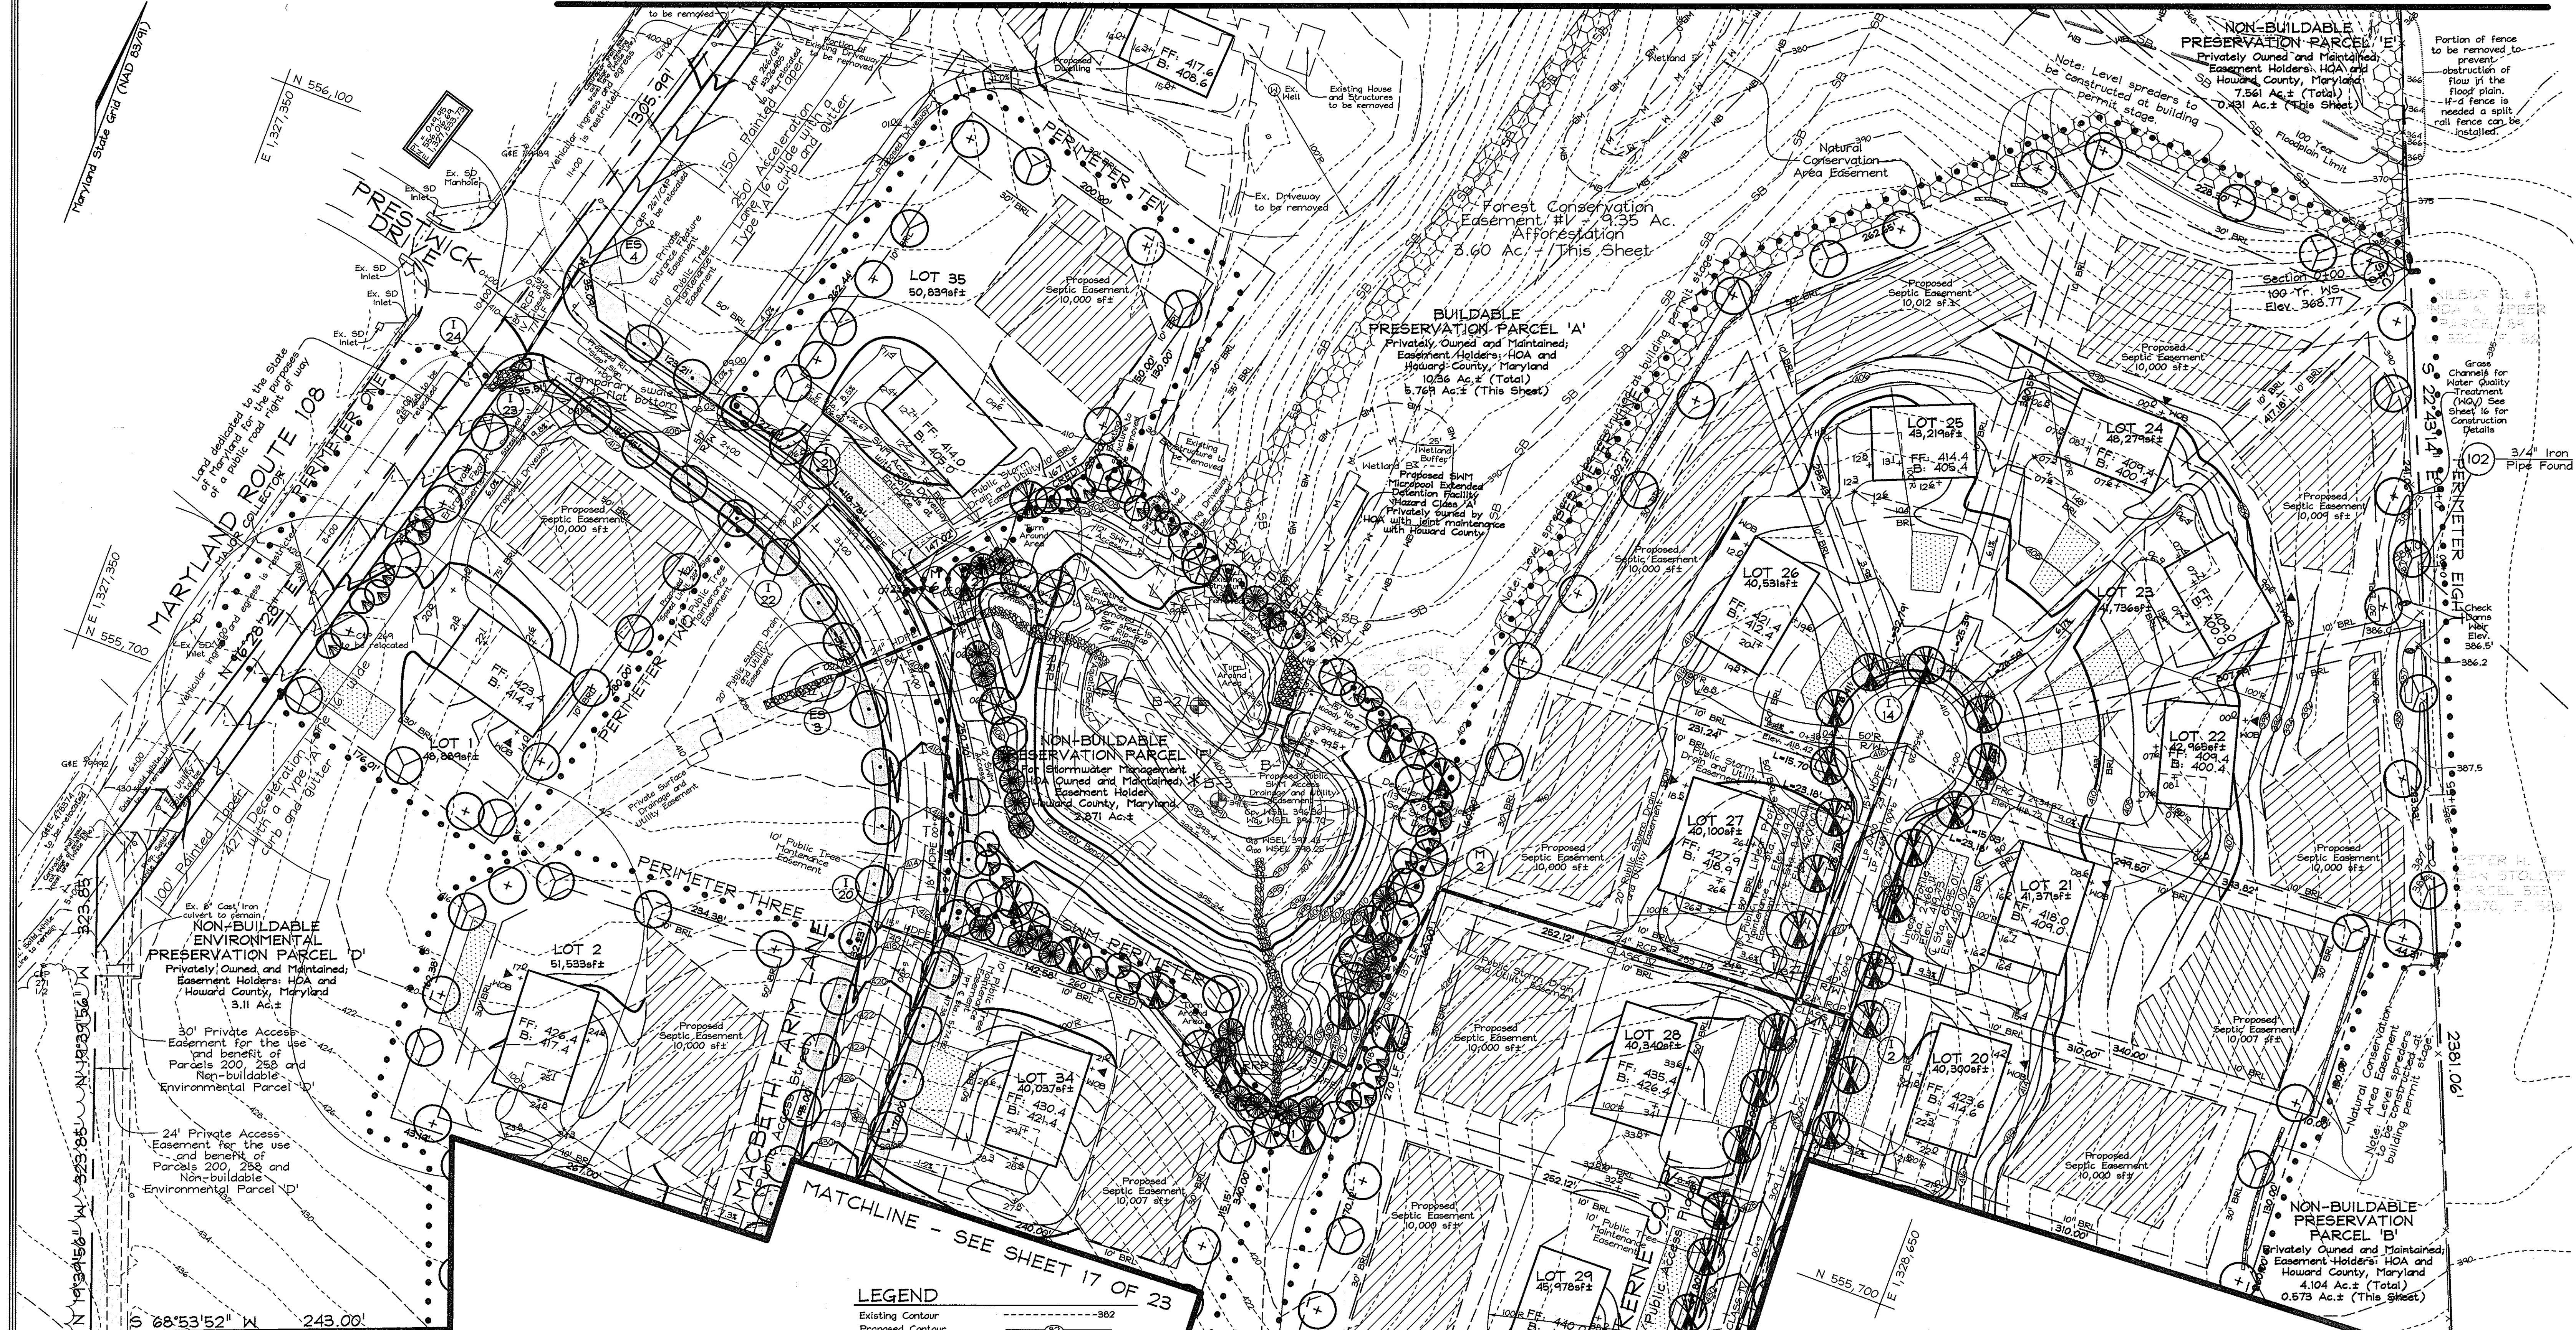

LEGEND

Existing Contour	---	382
Proposed Contour	---	382
Existing Spot Elevation	●	+82.53
Proposed Spot Elevation	●	+82.53
Existing Trees to Remain	☉	
Light Poles	*	
Landscape Perimeter	●	PERIMETER ONE
Red Maple	⊗	
London Planetree	⊗	
Willow Oak	⊗	
Red Oak	⊗	
American Linden	⊗	
Eastern Arborvitae	⊗	
Loblolly Pine	⊗	

DEVELOPER'S BUILDER'S CERTIFICATE

I/WE CERTIFY THAT THE LANDSCAPING SHOWN ON THIS PLAN WILL BE DONE ACCORDING TO THE PLAN, SECTION 16.124 OF THE HOWARD COUNTY CODE AND THE HOWARD COUNTY LANDSCAPE MANUAL. I/WE FURTHER CERTIFY THAT UPON COMPLETION, A LETTER OF LANDSCAPE INSTALLATION, ACCOMPANIED BY AN EXECUTED ONE(1) YEAR GUARANTEE OF PLANT MATERIALS, WILL BE SUBMITTED TO THE DEPARTMENT OF PLANNING AND ZONING.

W. J. Fisher 8/31/09
SIGNATURE OF DEVELOPER DATE


APPROVED: HOWARD COUNTY DEPARTMENT OF PLANNING AND ZONING

Cindy Hamstra 10/14/09
CHIEF, DIVISION OF LAND DEVELOPMENT DATE

W. J. Fisher 10/10/09
CHIEF, DEVELOPMENT ENGINEERING DIVISION DATE

APPROVED: HOWARD COUNTY DEPARTMENT OF PUBLIC WORKS.

William F. Caldwell 10-4-09
CHIEF, BUREAU OF HIGHWAYS DATE

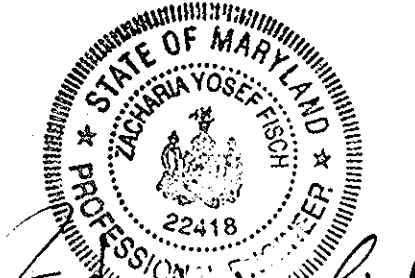


Zacharia Y. Fisch 1/15/09
ZACHARIA Y. FISCH DATE
P.E. #22418

OWNER
THE ESTATE OF ELIZABETH SMITH
c/o Charles Slade, Personal Representative
10450 Shaker Drive, Suite 112
Columbia, Maryland 21046

DEVELOPER
CLARKSVILLE OVERLOOK, LLC
5300 Dorsey Hall Drive
Suite 200A
Ellicott City, Maryland 21042

LANDSCAPE PLAN, NOTES AND DETAILS
MACBETH FARM
LOTS 1 THRU 35, BUILDABLE PRESERVATION PARCEL 'A',
NON-BUILDABLE PRESERVATION PARCELS 'B', 'C', 'D', 'E', 'F'
Tax Map 34 Grids 18 & 24 Parcel 90
4th Election District Howard County, Maryland

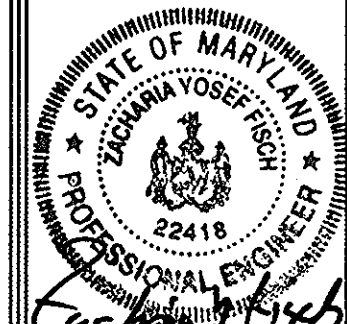

FSH Associates
Engineers Planners Surveyors
6339 Howard Lane Elkridge, MD 21075
Tel: 410-557-5200 Fax: 410-796-1562
Email: info@fshri.com

DESIGN BY: PS
DRAWN BY: MY
CHECKED BY: ZYF
SCALE: 1"=50'
DATE: Aug 31, 2009
SHEET No.: 3165
PROJECT No.: 18 OF 23


LEGEND

- Existing Contour
- Proposed Contour
- Existing Spot Elevation
- Proposed Spot Elevation
- Existing Trees to Remain
- Light Poles
- Landscape Perimeter
- Red Maple
- London Planetree
- Willow Oak
- Red Oak
- American Linden
- Eastern Arborvitae
- Loblolly Pine

STREET TREE SCHEDULE			
STREET NAME	LF REQUIRED	TREES REQUIRED	PROVIDED
ROAD 'A'	4,014'	101	101
ROAD 'B'	2,008'	50	50

STREET TREE LANDSCAPE SCHEDULE			
QUAN.	BOTANICAL NAME	SIZE	NOTE
41	Acer rubrum, Shade Trees	2 1/2"-3" Cal.	B & B
39	October Glory Red Maple	2 1/2"-3" Cal.	B & B
64	Platanus x acerifolia, Shade Trees	2 1/2"-3" Cal.	B & B
64	'Bloodgood' London Plane	2 1/2"-3" Cal.	B & B
64	Quercus phellos	2 1/2"-3" Cal.	B & B
81	Willow Oak	2 1/2"-3" Cal.	B & B
81	Quercus rubra	2 1/2"-3" Cal.	B & B
73	Red Oak	2 1/2"-3" Cal.	B & B
73	Tilia americana 'Redmond'	2 1/2"-3" Cal.	B & B
73	'Redmond' American Linden	2 1/2"-3" Cal.	B & B
24	Pinus taeda	6'-8'	B & B
46	Loblolly Pine	6'-8'	B & B
46	Thuja occidentalis 'Techny'	6'-8'	B & B
46	'Techny' Eastern Arborvitae	6'-8'	B & B

SCHEDULE D : STORMWATER MANAGEMENT AREA LANDSCAPING	
Linear Feet of Perimeter	1,919LF
Credit for Existing Vegetation (No, Yes and Linear Feet)	No
Credit for other Landscaping (No, Yes and %)	No
Number of Trees Required (1:50)	38 Shade Trees
Number of Plants Provided (1:40)	48 Evergreen Trees
Number of Plants Provided (2:1 Substitution)	38 Shade Trees
Number of Plants Provided (2:1 Substitution)	48 Evergreen Trees

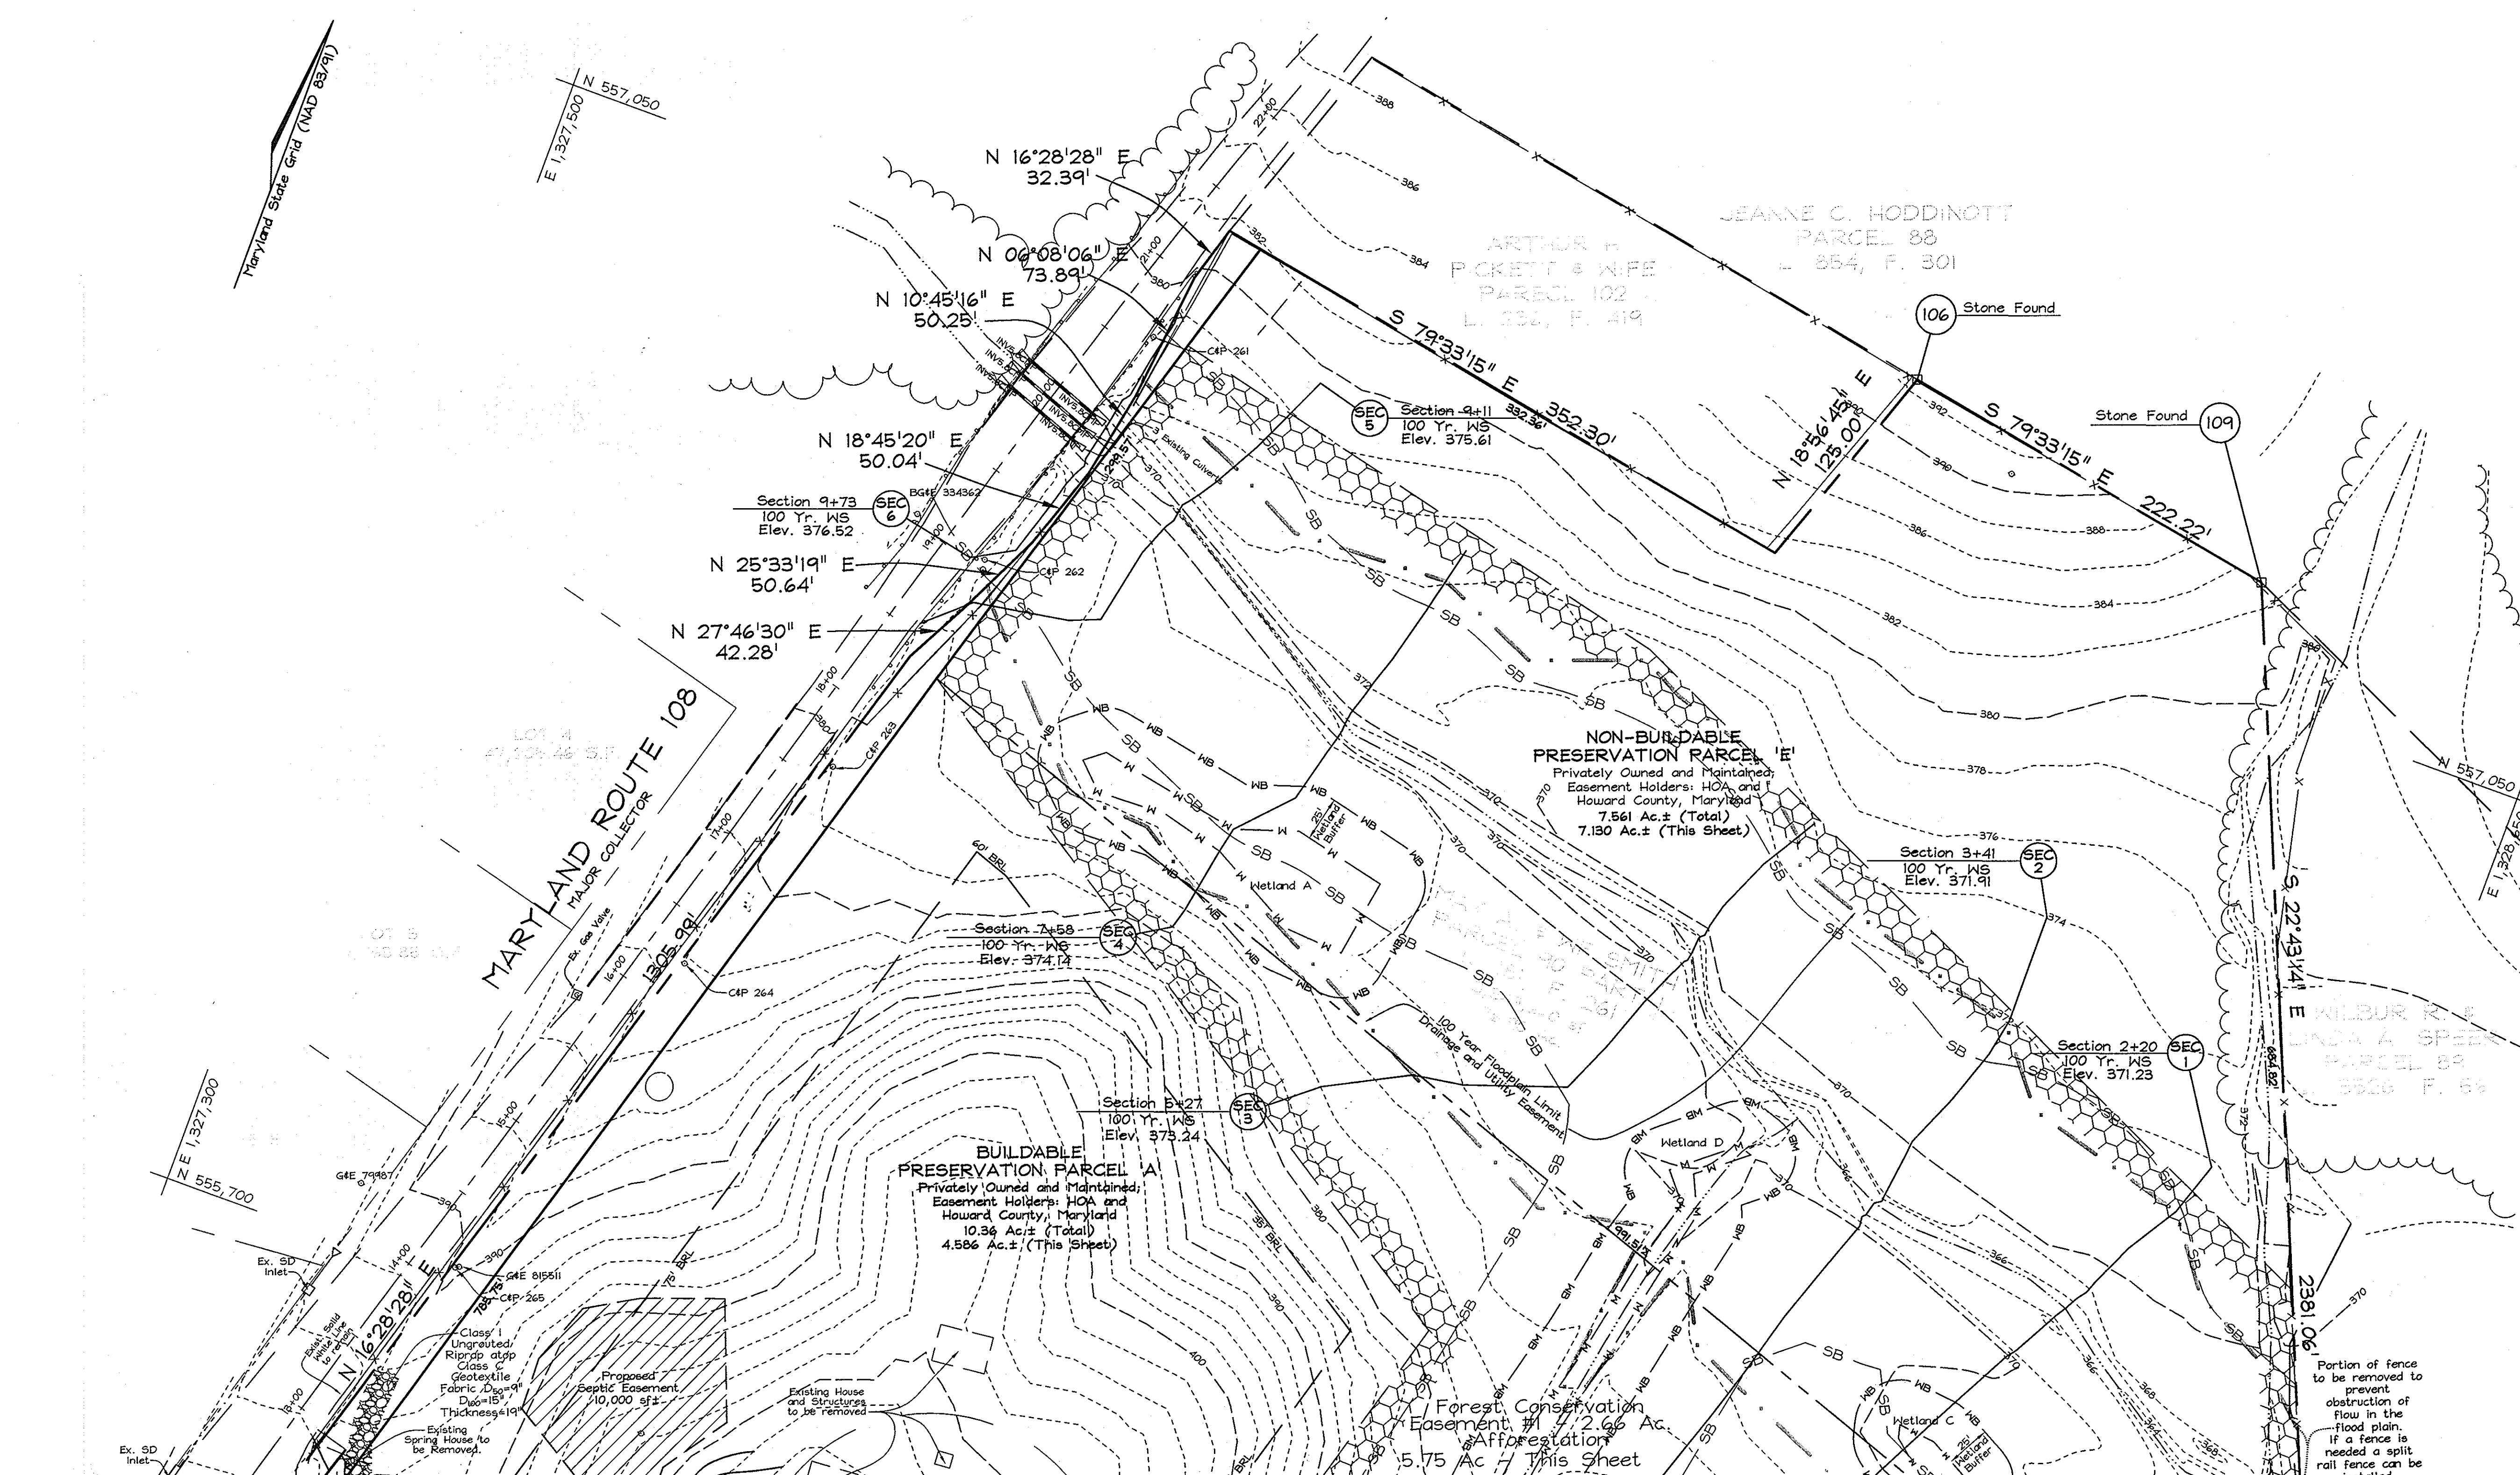

CATEGORY	ADJACENT TO ROADWAYS					ADJACENT TO PERIMETER PROPERTIES				
	1	2	3	4	5	6	7	8	9	10
Perimeter/Frontage Designation	B	B	B	A	A	A	A	A	A	A
Linear Feet of Roadway Frontage/Perimeter	225'	422'	184'	456'	457'	2132'	100'	1198'	895'	465'
Credit for Existing Vegetation (Yes, No, Linear Feet)	No	No	No	No	No	No	No	No	No	No
Remaining Perimeter Length	150'	150'	150'	150'	150'	150'	150'	150'	150'	150'
Number of Plants Required	5	9	4	8	16	36	2	20	15	8
Number of Plants Provided	6	11	5	10	20	40	3	24	18	10

MATCHLINE - SEE SHEET 18 OF 23

LANDSCAPE NOTES

- At the time of installation, all shrubs and other plantings herewith listed and approved for this site, shall be of the proper height requirements in accordance with the Howard County Landscaping Manual. In addition, no substitutions or relocation of required plantings may be made without prior review and approval from the Department of Planning and Zoning. Any deviation from this approved Landscape Plan may result in denial or delay in the release of landscape surety until such time as all required materials are planted and/or revisions are made to applicable plans and certificates.
- The owner, tenant, and/or their agents shall be responsible for maintenance of the required landscaping, including both plant materials and berms, fences and walls. All plant materials shall be maintained in good growing condition, and when necessary, replaced with new materials to ensure continued compliance with applicable regulations. All other required landscaping shall be permanently maintained in good condition, and when necessary, repaired or replaced.
- Financial surety for the required landscaping will be posted as part of the Developer's Agreement in the amount of \$69,600 (197 shade trees @ \$300.00 each, and 70 Evergreen Trees @ \$150.00 each).

LANDSCAPE PLAN, NOTES AND DETAILS

MACBETH FARM

LOTS 1 THRU 35, BUILDABLE PRESERVATION PARCEL 'A',
NON-BUILDABLE PRESERVATION PARCELS 'B', 'C', 'D', 'E', 'F'

Tax Map 34 Grids 18 & 24 Parcel 90
4th Election District Howard County, Maryland

APPROVED: HOWARD COUNTY DEPARTMENT OF PLANNING AND ZONING

Candy Hamilton 10/1/06
CHIEF, DIVISION OF LAND DEVELOPMENT JR DATE

Shawn Williams 10/10/06
CHIEF, DEVELOPMENT ENGINEERING DIVISION DATE

APPROVED: HOWARD COUNTY DEPARTMENT OF PUBLIC WORKS

Walter J. Mahal 10-4-06
CHIEF, BUREAU OF HIGHWAYS DATE

DEVELOPER'S/BUILDER'S CERTIFICATE

I/WE CERTIFY THAT THE LANDSCAPING SHOWN ON THIS PLAN WILL BE DONE ACCORDING TO THE PLAN, SECTION 16.124 OF THE HOWARD COUNTY CODE AND THE HOWARD COUNTY LANDSCAPE MANUAL. I/WE FURTHER CERTIFY THAT UPON COMPLETION, A LETTER OF LANDSCAPE INSTALLATION, ACCOMPANIED BY AN EXECUTED ONE(1) YEAR GUARANTEE OF PLANT MATERIALS, WILL BE SUBMITTED TO THE DEPARTMENT OF PLANNING AND ZONING.

Walter J. Mahal 8/21/06
SIGNATURE OF DEVELOPER DATE

OWNER

THE ESTATE OF ELIZABETH SMITH
c/o Charles Slade, Personal Representative
10450 Shaker Drive, Suite 112
Columbia, Maryland 21046

DEVELOPER

CLARKSVILLE OVERLOOK, LLC
5300 Dorsey Hall Drive
Suite 200A
Ellicott City, Maryland 21042




FSH Associates
Engineers Planners Surveyors
6333 Howard Lane Ellicott City, MD 21075
Tel: 410-557-5200 Fax: 410-796-1552
E-mail: info@fsher.com

DESIGN BY: PS
DRAWN BY: MY
CHECKED BY: ZYF
SCALE: 1"=50'
DATE: Aug. 31, 2006
M.O. No.: 3165
SHEET No.: 19 OF 29



SWM POND PLANTING PLAN
SCALE: Hor. 1"=30'

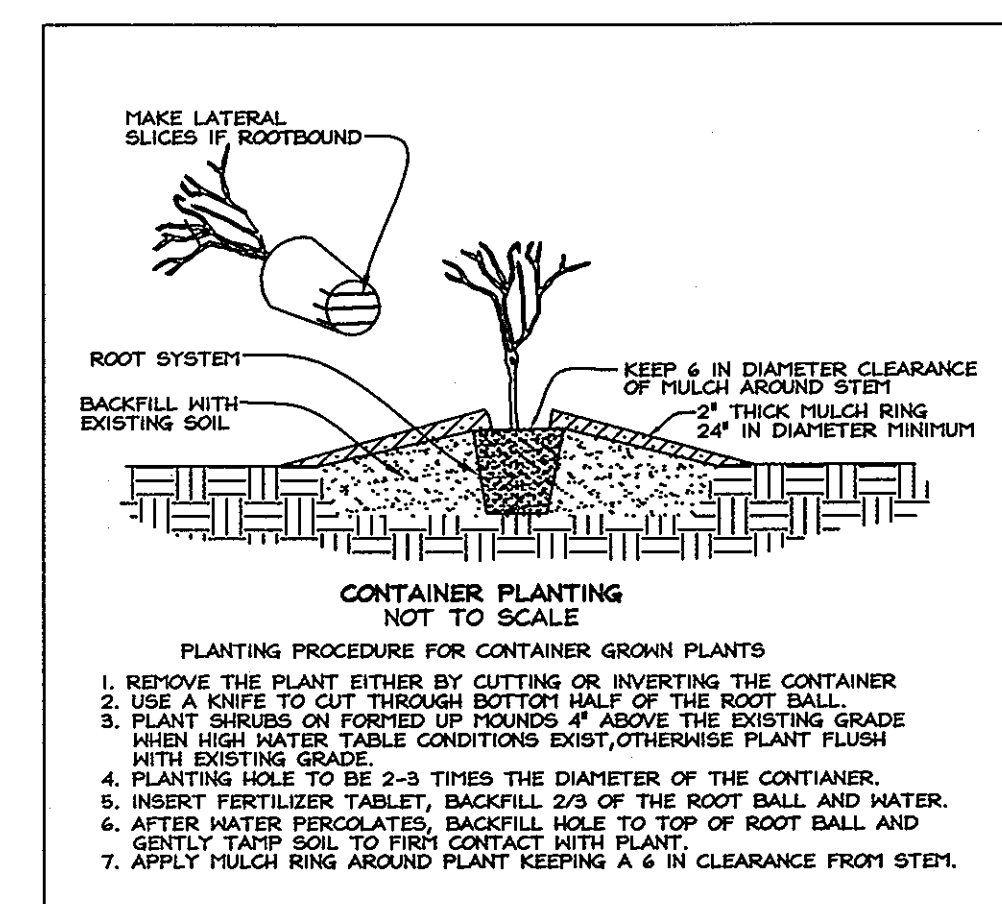

EMERGENT PLANTING
(1200 S.F.) (100 PLANTINGS, 24" O.C. WITHIN 4 - 6' x 20'-40' PLOTS)

COMMON NAME	SCIENTIFIC NAME	WETLAND INDICATOR	PLANTING STOCK	QUANTITY
Swamp Milkweed	<i>Asclepias incarnata</i>	OBL	Bare root	25
Marsh Hibiscus	<i>Hibiscus moscheutos</i>	OBL	Bare root	25
Cardinal Flower	<i>Libelia cardinalis</i>	FAC/CL+	Bare root	25
Lizard Tail	<i>Saururus cernuus</i>	OBL	Bare root	25

EMERGENT PLANTING NARRATIVE
Vegetation establishment is expected though natural plant propagation and will be enhanced by supplemental planting around the pond area. Supplemental planting in 6' wide plots of varying length (20'-40'; see plan). Plant installation may be delayed one year after grading to allow the graded area to settle and hydrology to stabilize.

SWM Planting Notes


- Within Facility - elev. 394.0 to edge of driveway and as shown - 50,025.4 s.f. To be planted with Red Top (*Agrostis alba*) at 5 lbs / 1000 s.f. to the edge of the access drive.
- Emergent Planting Area

SWM POND WOODY PLANT SCHEDULE

KEY SYMBOL	QUAN.	BOTANICAL NAME	SIZE	NOTE
CA	12	<i>Clethra alnifolia</i> Sweet Pepperbush	3'-4' HT.	Cont.
CO	12	<i>Cornus amomum</i> Silky Dogwood	3'-4' HT.	Cont.
IG	12	<i>Ilex glabra</i> Ligustrum	3'-4' HT.	Cont.
VP	12	<i>Viburnum prunifolium</i> Blackhaw	3'-4' HT.	Cont.

Remaining area around the stormwater management facility will be stabilized as per the permanent seeding notes, Sheet 8 of 23, and vegetated as per the landscape buffer requirements; see sheets 17-19 of 23.

Entire area to be prepared as per the permanent seeding notes.

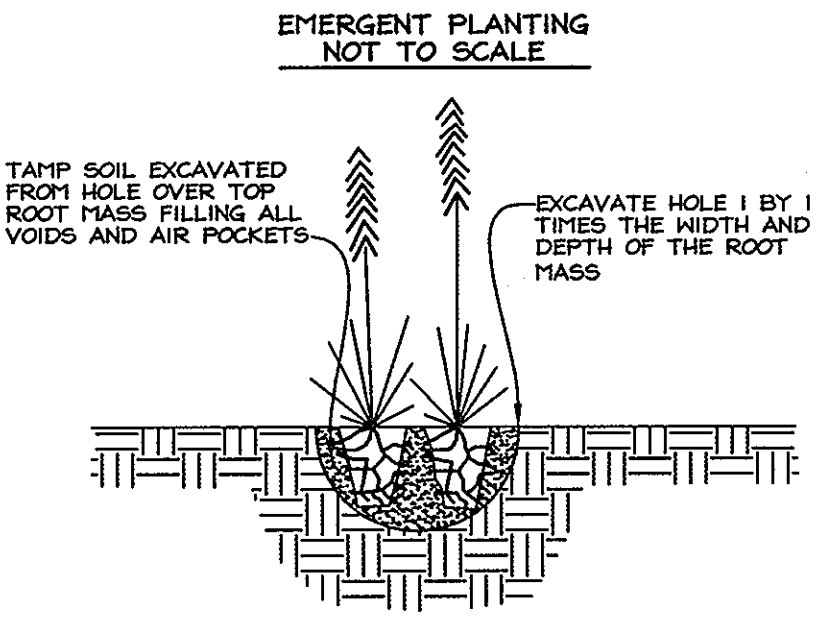

- EMERGENT PLANTING SPECIFICATIONS**
- 1) Rooted herbaceous plants may be locally harvested and planted immediately following harvest.
 - 2) If not planted immediately after delivery to the job site, plants must be protected from direct exposure to the sun and roots must be kept moist at all times.
 - 3) All plants shall contain new roots, white in color.
 - 4) All plants must appear healthy, with no leaf spots, damage, wilting or evidence of insects or disease.
 - 5) Planting operations must be followed immediately by installation of wire barriers.

APPROVED: HOWARD COUNTY DEPARTMENT OF PLANNING AND ZONING
Candy Hunter 10/11/06
CHIEF, DIVISION OF LAND DEVELOPMENT
DATE


APPROVED: HOWARD COUNTY DEPARTMENT OF PUBLIC WORKS.
Willa J. Mahall 10-4-06
CHIEF, BUREAU OF HIGHWAYS
DATE

AS-BUILT
ZACHARIA Y. FISCH 1/15/09
DATE
PE#22A-18

OWNER
THE ESTATE OF ELIZABETH SMITH
c/o Charles Slade, Personal Representative
10450 Shaker Drive, Suite 112
Columbia, Maryland 21046

DEVELOPER
CLARKSVILLE OVERLOOK, LLC
5300 Dorsey Hall Drive
Suite 200A
Ellicott City, Maryland 21042

STORMWATER MANAGEMENT NOTES AND DETAILS
MACBETH FARM
LOTS 1 THRU 35, BUILDABLE PRESERVATION PARCEL 'A',
NON-BUILDABLE PRESERVATION PARCELS 'B', 'C', 'D', 'E', 'F'
Parcel 90
Tax Map 34 Grids 18 & 24
4th Election District
Howard County, Maryland

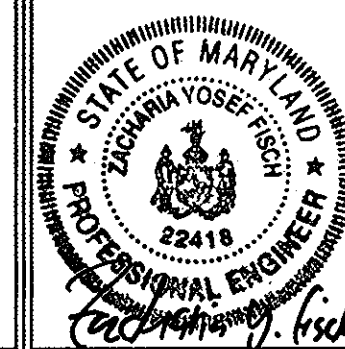


FSH Associates
Engineers Planners Surveyors
6339 Howard Lane Elkrige, MD 21075
Tel: 410-567-5200 Fax: 410-798-1562
E-mail: info@fshet.com

DESIGN BY: PS
DRAWN BY: MY
CHECKED BY: ZYF
SCALE: As Shown
DATE: Aug. 31, 2006
W.O. No.: 3165
SHEET No.: 20 OF 23

LEGEND

- Existing Contour
- Proposed Contour
- Spot Elevation
- Direction of Flow
- Tree Protection Fence
- Existing Trees to Remain
- Limit of Disturbance
- Forest Conservation Easement
- Forest Conservation Signage

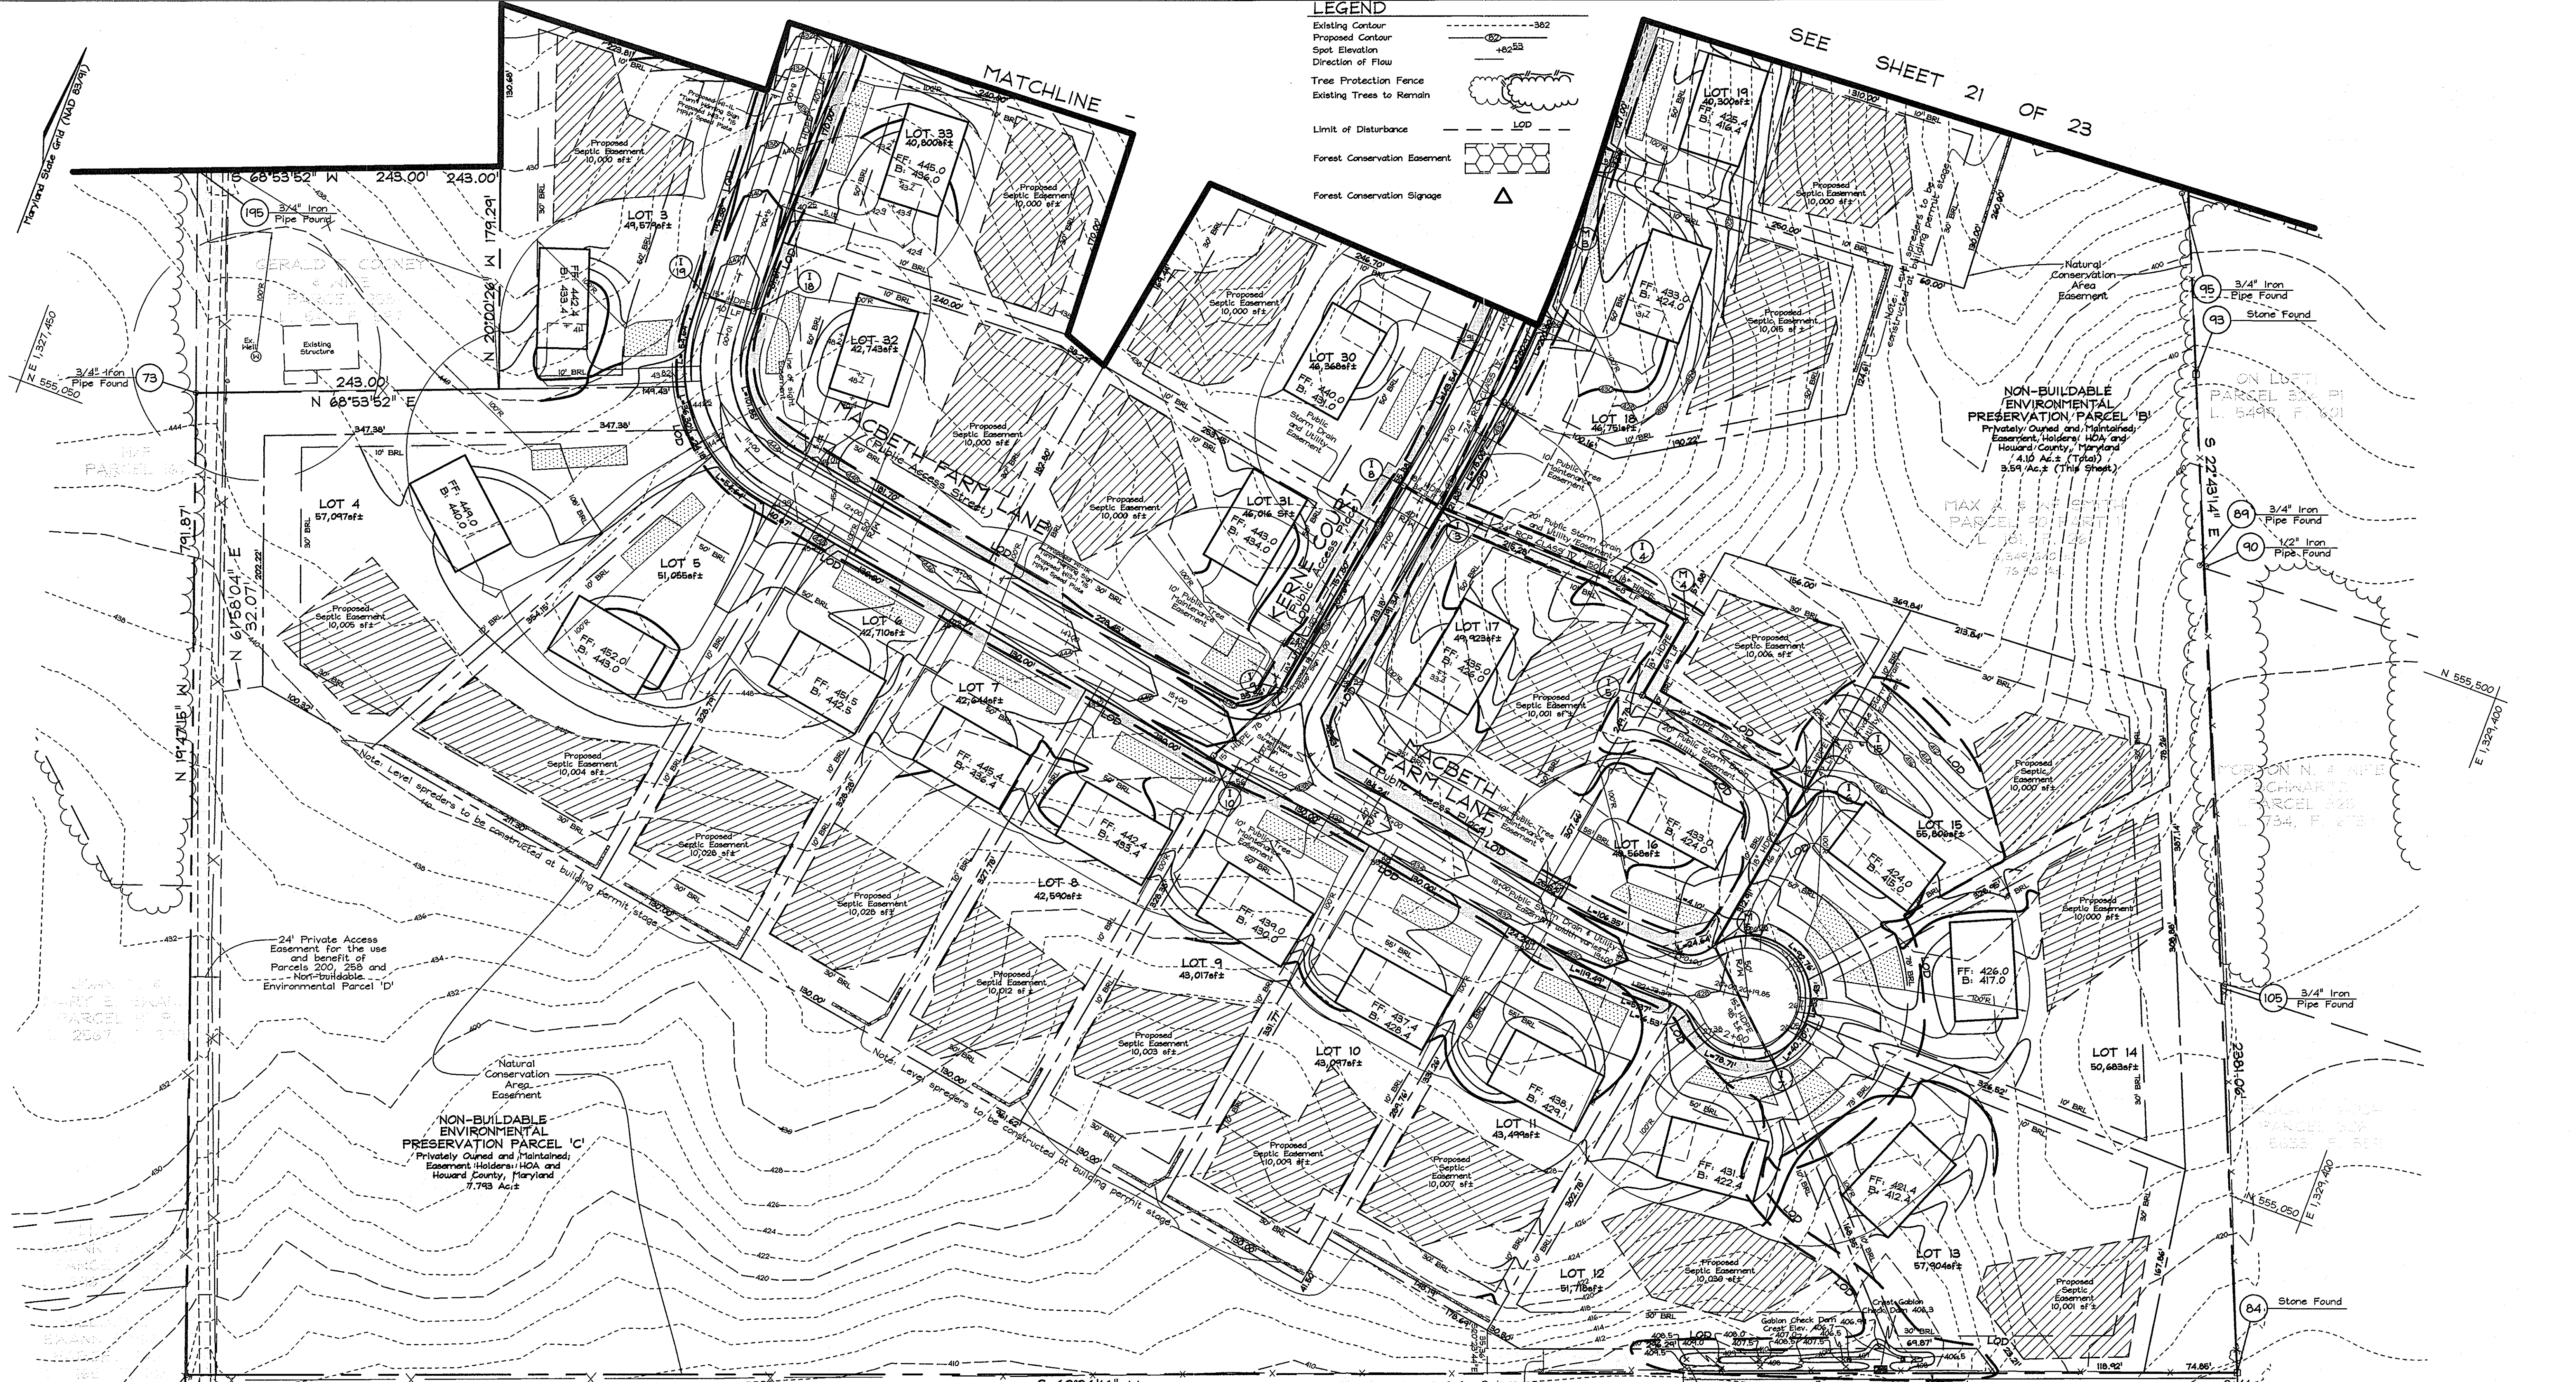

APPROVED: HOWARD COUNTY DEPARTMENT OF PLANNING AND ZONING

Cindy Hamer 10/10/06
 CHIEF, DIVISION OF LAND DEVELOPMENT DATE

William J. ... 10/10/06
 CHIEF, DEVELOPMENT ENGINEERING DIVISION DATE

EXPLORATION RESEARCH, INC.
 ENVIRONMENTAL CONSULTANTS
 LANDSCAPE ARCHITECTS
 8818 FOREST STREET
 BELLEVUE CITY, MARYLAND 21045
 TEL: (410) 766-1100 FAX: (410) 766-7380
 EMAIL: EXPLORATION@RESEARCH.COM

OWNER
 THE ESTATE OF ELIZABETH SMITH
 c/o Charles Slade, Personal Representative
 10450 Shaker Drive, Suite 112
 Columbia, Maryland 21046

DEVELOPER
 CLARKSVILLE OVERLOOK, LLC
 5300 Dorsey Hall Drive
 Suite 200A
 Ellicott City, Maryland 21042

FOREST CONSERVATION PLAN

MACBETH FARM

LOTS 1 THRU 35, BUILDABLE PRESERVATION PARCEL 'A',
 NON-BUILDABLE PRESERVATION PARCELS 'B', 'C', 'D', 'E', 'F',
 Tax Map 34 Grids 18 & 24 Parcel 90
 4th Election District Howard County, Maryland

DESIGN BY: PS
 DRAWN BY: MY
 CHECKED BY: ZYF
 SCALE: 1"=60'
 DATE: Aug. 31, 2006
 W.O. No.: 3165
 SHEET No.: 21 OF 23


FSH Associates
 Engineers Planners Surveyors
 6339 Howard Lane Ellicott City, MD 21075
 Tel: 410-567-5200 Fax: 410-796-1562
 E-mail: info@fshn.com




LEGEND

Existing Contour	---
Proposed Contour	---
Spot Elevation	+
Direction of Flow	→
Tree Protection Fence	⊘
Existing Trees to Remain	⊘
Limit of Disturbance	LOD
Forest Conservation Easement	▨
Forest Conservation Signage	△

FOR AS-BUILT * POND ELEVATIONS SEE SHEET 20 OF 23

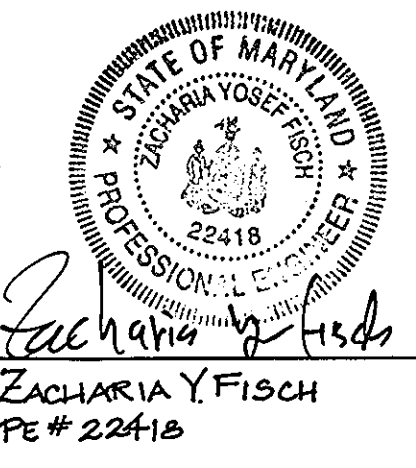

ZACHARIA Y. FISCH
DATE 1/15/09
PE # 22418

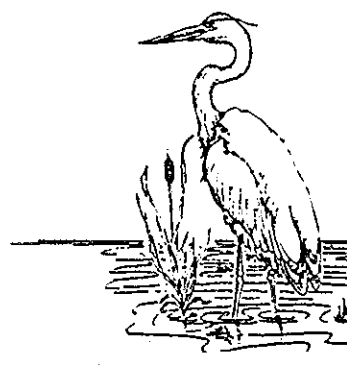

EXPLORATION RESEARCH, INC.
ENVIRONMENTAL CONSULTANTS
LANDSCAPE ARCHITECTS
6339 HOWARD LANE
BETHESDA, MARYLAND 20817
TEL: (410) 567-5200 FAX: (410) 796-1562

OWNER
THE ESTATE OF ELIZABETH SMITH
c/o Charles Slade, Personal Representative
10450 Shaker Drive, Suite 112
Columbia, Maryland 21046

DEVELOPER
CLARKSVILLE OVERLOOK, LLC
5300 Dorsey Hall Drive
Suite 200A
Ellicott City, Maryland 21042


FOREST CONSERVATION PLAN
MACBETH FARM
LOTS 1 THRU 35, BUILDABLE PRESERVATION PARCEL 'A',
NON-BUILDABLE PRESERVATION PARCELS 'B', 'C', 'D', 'E', 'F', 'I', 'J', 'K', 'L', 'M', 'N', 'O', 'P', 'Q', 'R', 'S', 'T', 'U', 'V', 'W', 'X', 'Y', 'Z'
Parcel 40
4th Election District
Howard County, Maryland



FSH Associates
Engineers Planners Surveyors
6339 Howard Lane Ellicott City, MD 21075
Tel: 410-567-5200 Fax: 410-796-1562
E-mail: info@fshri.com

DESIGN BY: FS
DRAWN BY: MY
CHECKED BY: ZYF
SCALE: 1"=50'
DATE: Aug. 31, 2006
W.O. No.: 3165
SHEET No. 22 OF 23

APPROVED: HOWARD COUNTY DEPARTMENT OF PLANNING AND ZONING
Cindy Hammit 10/10/09
CHIEF, DIVISION OF LAND DEVELOPMENT DATE
William J. ... 01/10/09
CHIEF, DEVELOPMENT ENGINEERING DIVISION DATE

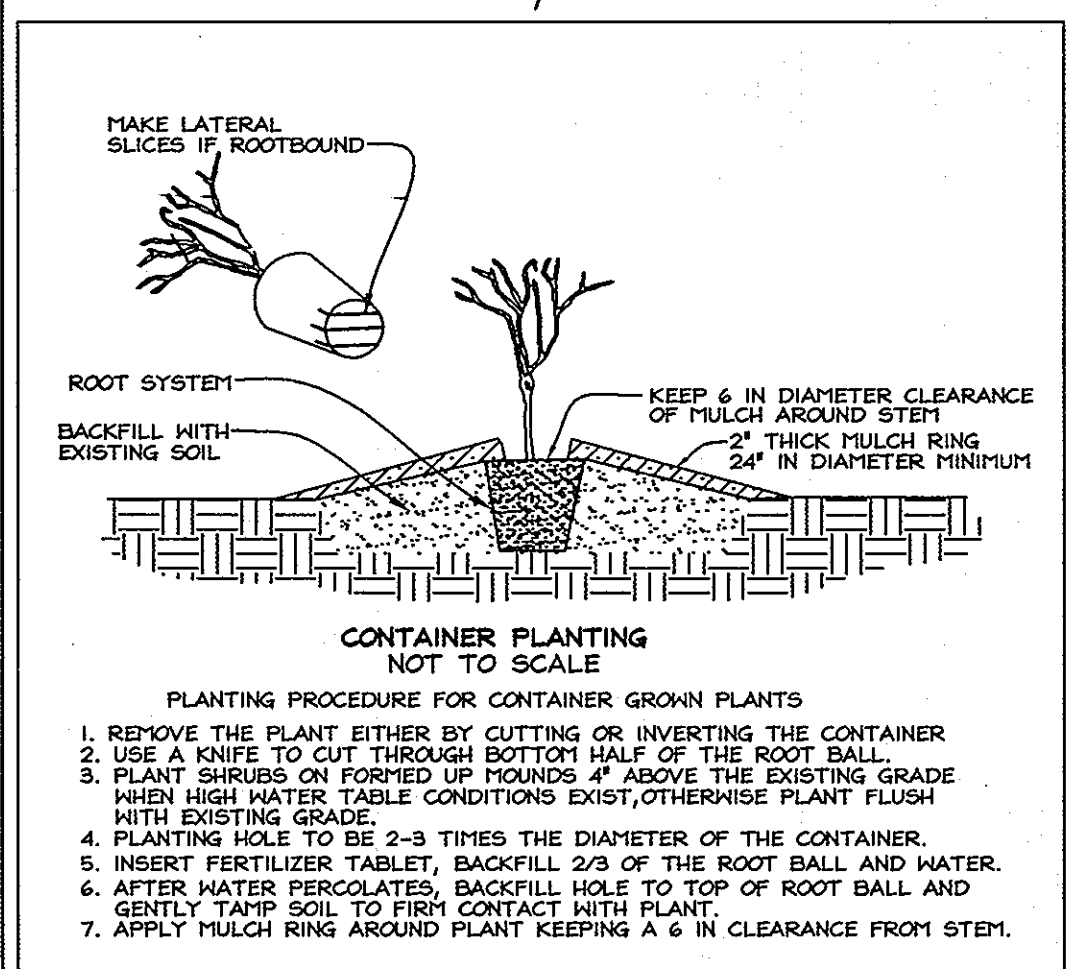



LEGEND

- Existing Contour: ---
- Proposed Contour: - - -
- Spot Elevation: +82.52
- Direction of Flow: →
- Tree Protection Fence: [Symbol]
- Existing Trees to Remain: [Symbol]
- Limit of Disturbance: --- LOD ---
- Forest Conservation Easement: [Symbol]
- Forest Conservation Signage: [Symbol]

FOREST CONSERVATION WORKSHEET

Net Tract Area	Acres
A. Total Tract Area	79.60
B. Area Within 100 Year Floodplain	*
C. Other deductions	32.86
D. Net Tract Area	46.74
Zoning Use Category: RESIDENTIAL-SUBURBAN	
Land Use Category	
E. Afforestation Minimum (20 % x D)	9.35
F. Conservation Threshold (25 % x D)	11.69
Existing Forest Cover	
G. Existing Forest on Net Tract Area	0
H. Forest Area Above Conservation Threshold	0
Breakeven Point	
I. Forest Retention Above Threshold with no Mitigation	N/A
J. Clearing Permitted without Mitigation	N/A
Proposed Forest Clearing	
K. Forest Areas to be Cleared	0
L. Forest Areas to be Retained	0
Planting Requirements	
M. Reforestation for Clearing Above Threshold	0
N. Reforestation for Clearing Below the Threshold	0
P. Credit for Retention Above Conservation Threshold	0
Q. Total Reforestation Required	0
R. Total Afforestation Required	9.35
S. Total Reforestation and Afforestation Requirement	9.35

* 4.35 Ac of Floodplain was deducted as part of the exclusion of Preservation Parcels A and E per Rural Cluster rules. The entirety of the floodplain is within these two parcels.

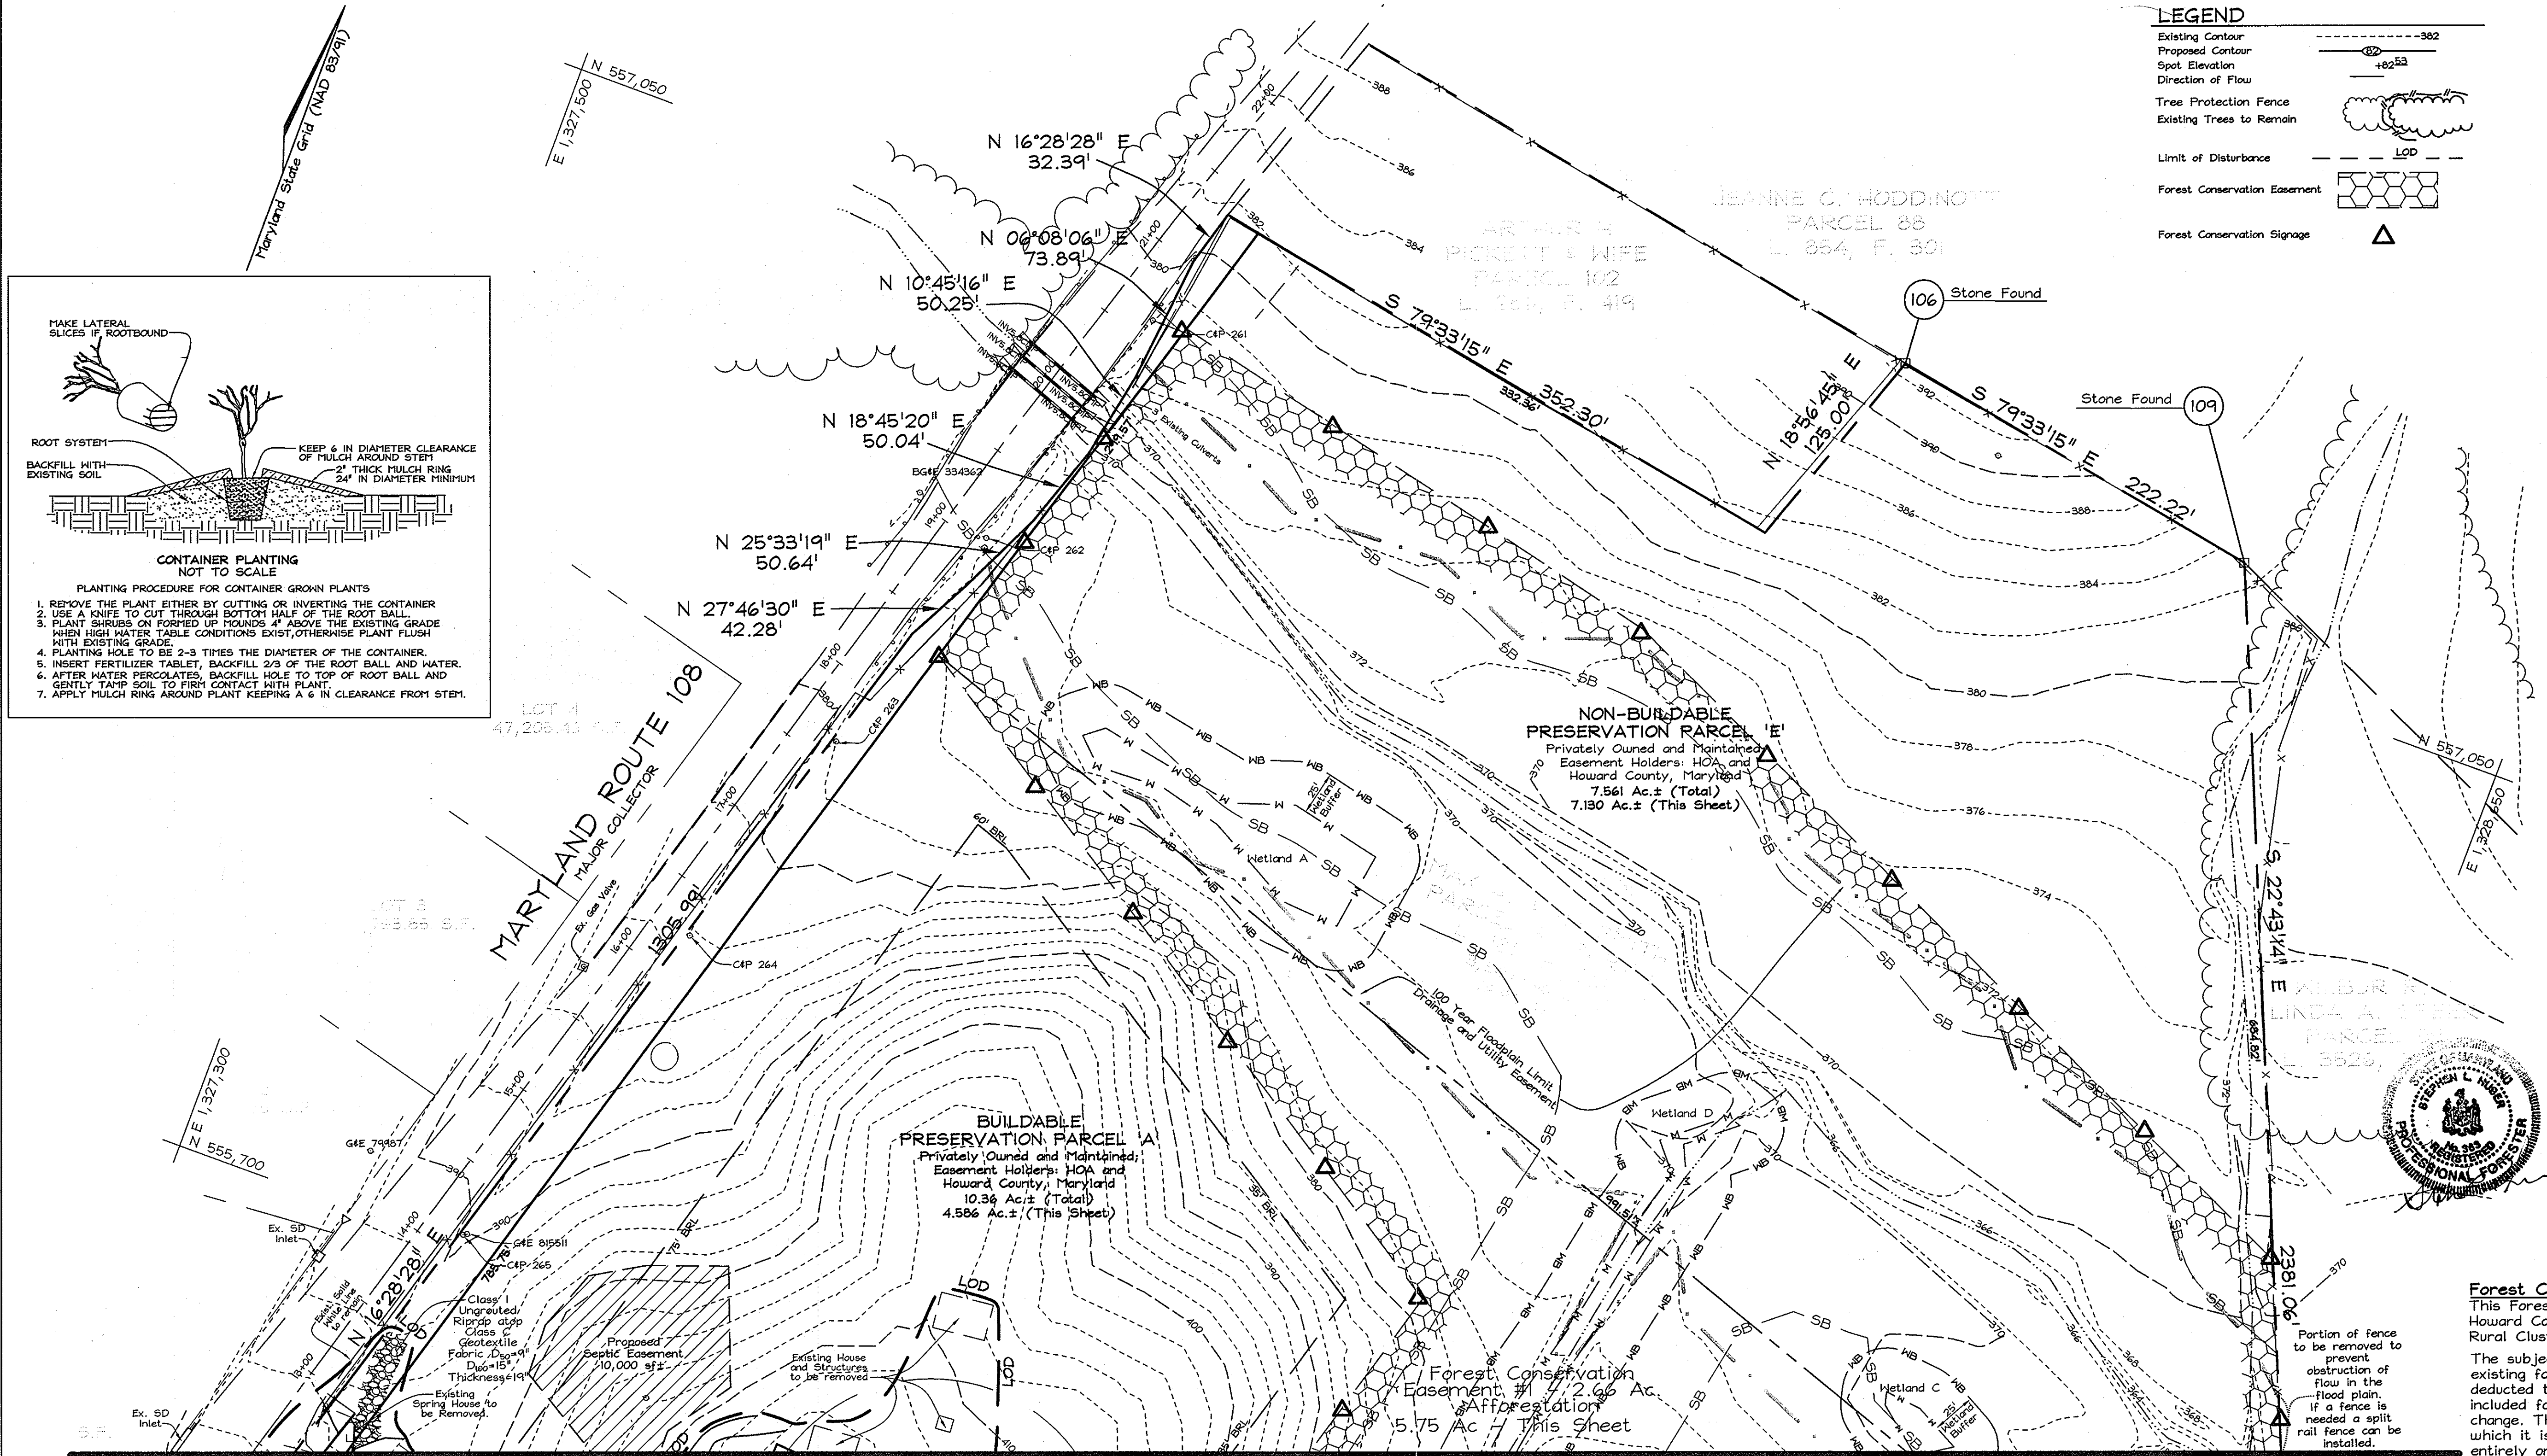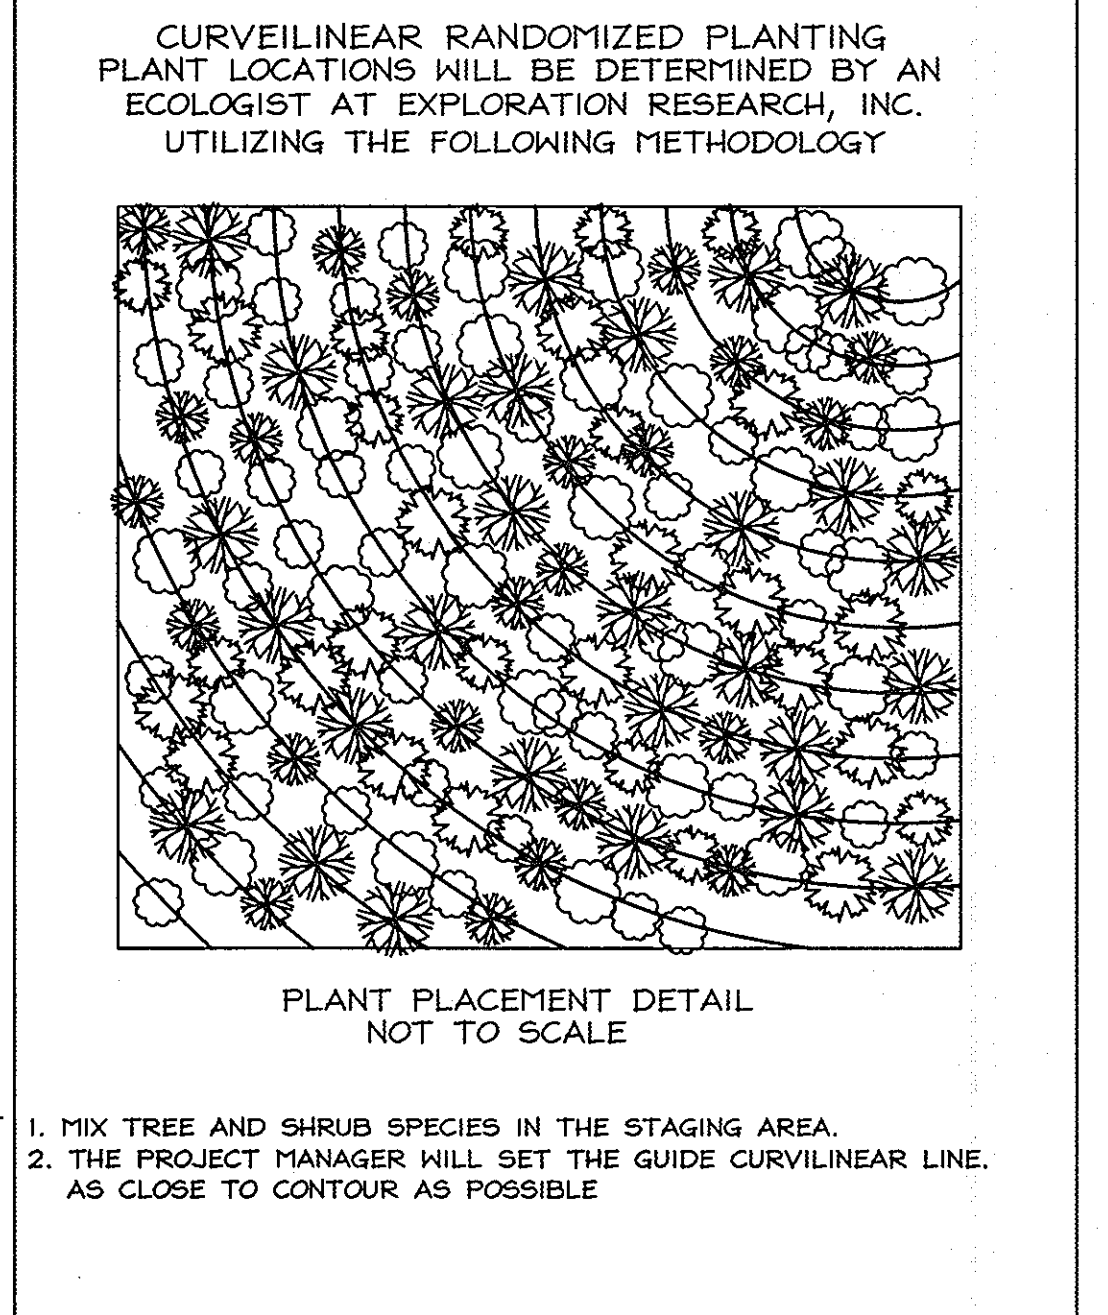

Forest Conservation Narrative

This Forest Conservation Plan was prepared in accordance with the Howard County Forest Conservation Manual and utilizes the guidelines for Rural Cluster Subdivisions.

The subject property has a gross tract area of 79.60± Ac. There is no existing forest on site. There are several Preservation Parcels which are deducted to arrive at a net tract of 46.74 Ac. Only Preservation Parcel F is included for being less than 3.0 Ac. No other parcels are undergoing landuse change. The 100 Year Floodplain was deducted along with Parcels A and E in which it is found, in its entirety. Afforestation requirements will be met entirely on-site in an easement. The easement will enhance wildlife habitat corridors and add forest in priority areas (floodplain, wetlands, streams and their buffers).

The planting areas will be planted with container grown stock at 350 trees/acre with tree shelters.


The total forest conservation obligation met on this site is 9.35 acres, with a total forest conservation surety amount of \$203,643.00 (afforestation planting of 407,286 s.f. X \$ 0.50/s.f.).

FOREST CONSERVATION EASEMENT TABLE

EASEMENT	TYPE	AREA (ACRES)
I	AFFORESTATION PLANTING	9.35
TOTAL		9.35

Easement I: PLANTING AREA: 9.35 Ac. - 3273 trees @ 350/Ac

Qty	Botanical Name	Common Name	Min. Size	Spacing	Notes
330	Acer rubrum	Red Maple	WHIP 2-3'	11' o.c.	1-3 Gallon Container Grown or Bare Root with 5' tree shelters
327	Quercus alba	White Oak	WHIP 2-3'	11' o.c.	
327	Quercus rubra	Red oak	WHIP 2-3'	11' o.c.	
327	Amelanchier canadensis	Service berry	WHIP 2-3'	11' o.c.	
327	Prunus serotina	Black Cherry	WHIP 2-3'	11' o.c.	
327	Juniperus virginiana	Redcedar	WHIP 2-3'	11' o.c.	
327	Platanus occidentalis	Sycamore	WHIP 2-3'	11' o.c.	
327	Pinus taeda	Loblolly Pine	WHIP 2-3'	11' o.c.	
327	Carpinus caroliniana	Ironwood	WHIP 2-3'	11' o.c.	
327	Liquidambar styraciflua	Sweetgum	WHIP 2-3'	11' o.c.	

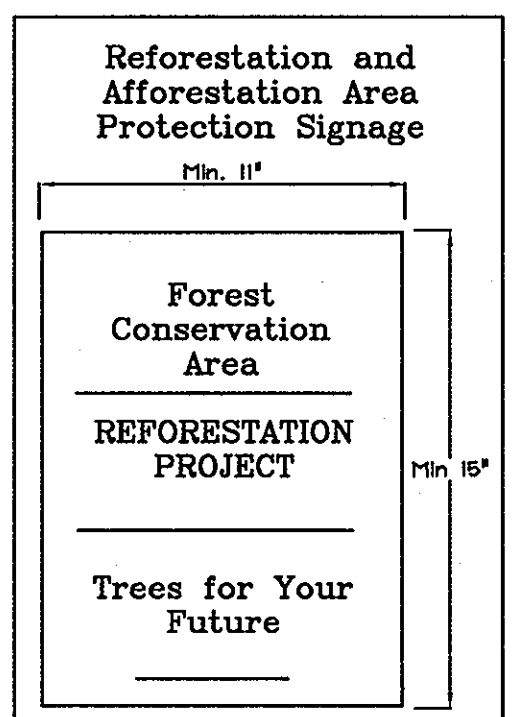

SIGN DETAIL: PERMANENT SIGN

SIGNAGE NOTE: ALL TREE PROTECTION SIGNS SHALL BE PLACED ON METAL 1" POSTS OR PRESSURE TREATED WOOD POLES. NO ATTACHMENT OF SIGNS TO TREES IS PERMITTED.

Planting Area Monitoring Notes

1. Monthly visits during the first growing season are to assess the success of the plantings and to determine if supplemental watering, pest control, invasive plant control, mowing, deer protection or other actions are necessary. Early spring visits will document winter kill and autumn visits will document summer kill.
2. The minimum survival rate shall be 75% of the total number of trees planted per acre at the end of the two year maintenance period. Wild tree seedlings from natural regeneration on the planting site may be counted up to 50% toward the total survival number if they are healthy native species at least 12 inches tall.
3. Survival will be determined by a stratified random sampling of the plantings.
4. Effective monitoring will assess plant survivorship during the first growing season and make recommendations for reinforcement plantings if required at that time.
5. A final inspection and certification by the ERI qualified professional is required after the second growing season.


Afforestation Area Planting Notes

1. Afforestation areas may be planted as soon as reasonable to do so. Late winter- early spring plantings are preferred. Earliest planting dates will vary from year to year but planting may generally begin as soon as the ground is no longer frozen. Alternate planting dates may be considered as conditions warrant.
2. Soil amendments and fertilization recommendations will be made based upon the results of soil analysis for nitrogen, phosphorus, potassium, organic matter content and pH. If required, fertilizer will be provided using a slow release, soluble 16-8-16 analysis designed to last 5-8 years contained in polyethylene perforated bags such as manufactured by ADCO Harkis, P.O. Box 310 Hollis, N.Y. 11423 or approved equal.
3. Plant materials shall be planted in accordance with the planting diagram, planting details and planting schedule.
4. Plant stock must be protected from desiccation at all times prior to planting. Materials held for planting shall be moistened and placed in cool shaded areas until ready for placement.
5. Planting materials shall be nursery grown and inspected prior to planting. Plants not conforming to the American Standards for Nursery Stock specifications for size, form, vigor, or roots, or due to trunk wounds, breakage, desiccation, insect or disease must be replaced.
6. Newly planted trees may require watering at least once per week during the first growing season depending on rainfall in order to get established. The initial watering should allow for watering during installation to completely soak backfill materials.
7. Mulch shall be applied in accordance with the diagram provided and shall consist of woodchips or shredded hardwood bark mulch, free of wood alcohol.
8. Planting holes should be excavated to a minimum diameter of 2.5 to 3 times the diameter of the root ball or container. Mechanical angling is preferred with scarification of the sides of each hole.
9. Site preparation for planting shall include moving of entire planting area, then banded tilling of 4 ft. wide bands spaced 11' o.c. and laid out in curvilinear rows. Stabilize disturbed areas with perennial rye after planting.

APPROVED: HOWARD COUNTY DEPARTMENT OF PLANNING AND ZONING

Cindy Hanrahan 10/11/06
CHIEF, DIVISION OF LAND DEVELOPMENT JR DATE

William J. ... 10/10/06
CHIEF, DEVELOPMENT ENGINEERING DIVISION DATE

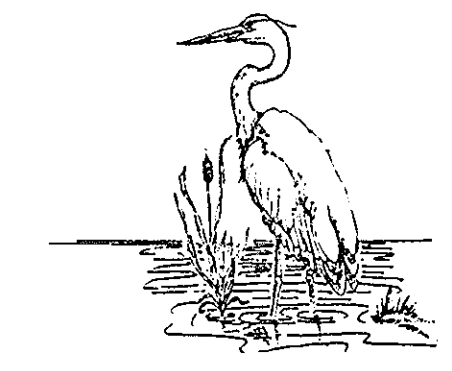

EXPLORATION RESEARCH, INC.
ENVIRONMENTAL CONSULTANTS
LANDSCAPE ARCHITECTS
6533 HOWARD LANE
ELKIDGE, MARYLAND 21075
TEL: (410) 567-5200 FAX: (410) 796-1562

OWNER
THE ESTATE OF ELIZABETH SMITH
c/o Charles Slade, Personal Representative
10450 Shaker Drive, Suite 112
Columbia, Maryland 21046

DEVELOPER
CLARKSON OVERLOOK, LLC
5500 Dorsey Hill Drive
Suite 200A
Ellicott City, Maryland 21042

FOREST CONSERVATION PLAN, NOTES AND DETAILS

MACBETH FARM

LOTS 1 THRU 35, BUILDABLE PRESERVATION PARCEL 'A', NON-BUILDABLE PRESERVATION PARCELS 'B', 'C', 'D', 'E', 'F', 'G', 'H', 'I', 'J', 'K', 'L', 'M', 'N', 'O', 'P', 'Q', 'R', 'S', 'T', 'U', 'V', 'W', 'X', 'Y', 'Z'

Tax Map 34 Grids 18 & 24 Parcel 40
4th Election District Howard County, Maryland

FSH Associates
Engineers Planners Surveyors
5339 Howard Lane Elkridge, MD 21075
Tel: 410-567-5200 Fax: 410-796-1562
E-mail: info@fshe.com

DESIGN BY: PS
DRAWN BY: MY
CHECKED BY: ZYF
SCALE: 1"=50'
DATE: Aug. 31, 2006
H.O. No.: 3165
SHEET No.: 23 OF 23