

SHEET INDEX

SHEET NO.	DESCRIPTION
1	TITLE SHEET
2	COLLEGE AVENUE WIDENING - PLAN AND PROFILE
3	MAPLE CLIFFE WAY - PLAN AND PROFILE
4	HOGG COURT - PLAN AND PROFILE
5	STREET TREE, GRADING AND SEDIMENT CONTROL PLAN
6	TEMPORARY TRAFFIC CONTROL PLAN & CROSS SECTIONS FOR COLLEGE AVENUE
7	LANDSCAPE PLAN AND DRAINAGE AREA MAP
8	STORMWATER MANAGEMENT DETAILS, STORM DRAIN STRUCTURE SCHEDULE & DETAILS
9	STORM DRAIN PROFILES
10	SOIL BORINGS
11	STORMWATER MANAGEMENT NOTES AND DETAILS
12	STORMWATER MANAGEMENT DETAILS
13	PERMANENT BMP NO.1 / TEMPORARY BASIN NO.1, STORMWATER MANAGEMENT PROFILES AND DETAILS
14	FOREST CONSERVATION PLAN
15	FOREST CONSERVATION NOTES AND DETAILS
16	SEDIMENT & EROSION CONTROL DETAILS
17	SEDIMENT & EROSION CONTROL NOTES

FINAL ROAD CONSTRUCTION, GRADING AND STORMWATER MANAGEMENT PLAN
HOGG PROPERTY

BUILDABLE LOTS 1 - 22, OPEN SPACE LOTS 23 - 26

ZONING: R-ED

TAX MAP No. 25 GRID No. 14 PARCEL No. 64

APPROVED: DEPARTMENT OF PLANNING AND ZONING		DATE
<i>Kat Sealwood</i> CHIEF, DIVISION OF LAND DEVELOPMENT	<i>AS</i>	8/17/06
<i>Mike Williams</i> CHIEF, DEVELOPMENT ENGINEERING DIVISION	<i>AS</i>	8/17/06
APPROVED: HOWARD COUNTY DEPARTMENT OF PUBLIC WORKS		DATE
<i>Mark D. Lewis</i> CHIEF, BUREAU OF REVISIONS	<i>AS</i>	8/3/06
REVISIONS		
NO.	DESCRIPTION	DATE

GENERAL NOTES

- SUBJECT PROPERTY ZONED R-ED PER 02/02/04 COMPREHENSIVE ZONING PLAN.
- ALL ASPECTS OF THE PROJECT ARE IN CONFORMANCE WITH THE LATEST HOWARD COUNTY STANDARDS UNLESS WAIVERS ARE APPROVED.
- THE CONTRACTOR SHALL NOTIFY THE DEPARTMENT OF PUBLIC WORKS, DIVISION OF CONSTRUCTION INSPECTION AT 410-313-1800 AT LEAST (9) WORKING DAYS PRIOR TO THE START OF CONSTRUCTION.
- THE CONTRACTOR SHALL NOTIFY "MISS UTILITY" AT 1-800-257-7777 AT LEAST 48 HOURS PRIOR TO ANY EXCAVATION.
- LOCATION: COLLEGE AVENUE, EAST OF NEW CUT ROAD. TAX MAP NO. 25, PARCEL NO. 64, GRID NO. 14
- TOPOGRAPHIC CONTOURS BASED ON WINGS AERIAL MAPPING, INC. FLOWN SURVEY DATED MARCH 25, 1995 AND SUPPLEMENTED WITH FIELD RUN TOPOGRAPHY BY ECOSCIENCE PROFESSIONALS, INC. DATED AUGUST 2005.
- PROPERTY IS LOCATED WITHIN METROPOLITAN DISTRICT. PUBLIC WATER AND SEWER SHALL BE UTILIZED WITHIN THIS DEVELOPMENT.
- EXISTING UTILITIES SHOWN HEREON ARE TAKEN FROM CURRENT HOWARD COUNTY CONTRACT DRAWINGS.
 - EXISTING WATER CONTRACT No. 134 - W
 - EXISTING SEWER CONTRACT No. 651 - W & S
- THIS PLAN IS IN COMPLIANCE WITH THE FIFTH EDITION OF THE SUBDIVISION AND LAND DEVELOPMENT REGULATIONS. THIS PROJECT IS GRANDFATHERED TO THE FIFTH EDITION OF THE SUBDIVISION REGULATIONS BECAUSE THE PRELIMINARY EQUIVALENT SKETCH PLAN SP-04-10 WAS IN PROGRESS AND APPROVED ON JUNE 16, 2005, WHICH IS PRIOR TO MAY 22, 2004, THE EFFECTIVE DATE OF THE AMENDED FIFTH EDITION. THE PLAN IS SUBJECT TO THE 2003 ZONING REGULATIONS AS AMENDED BY CS 10-2001, EFFECTIVE 1-8-02, BECAUSE SP-04-10 WAS TECHNICALLY COMPLETE ON JANUARY 31, 2005, AFTER THE 1-8-02 EFFECTIVE DATE OF CS-10-2001.
- THIS HORIZONTAL AND VERTICAL DATUM SHOWN ARE BASED ON THE FOLLOWING NAD '83 HOWARD COUNTY CONTROL STATION Nos. 25CA AND 0004.
 - Sta. 25CA N 176626.9769 (meters) E 417833.9994 (meters)
 - Sta. 0004 N 177747.146 (meters) E 417802.381 (meters)
- GROSS AREA OF TRACT = 17.98 AC.
 - AREA OF FLOODPLAIN = 0.00 AC.
 - AREA OF 2% OR GREATER SLOPES = 6.45 AC.
 - AREA OF WETLANDS = 0.19 AC.
 - NET AREA OF TRACT = 17.98 - 0.00 - 6.45 = 11.53 AC.
- AREA OF PROPOSED ROAD R/W = 2.167 AC.
 - AREA OF PROPOSED BUILDABLE LOTS = 3.829 AC.
 - AREA OF PROPOSED OPEN SPACE LOTS = 11.986 AC.
- NUMBER OF LOTS PROPOSED
 - BUILDABLE = 22
 - OPEN SPACE LOTS = 4 (3 HOA OWNED AND MAINTAINED & 1 HOWARD COUNTY OWNED)
- OPEN SPACE TABULATION
 - GROSS AREA OF TRACT = 17.98 AC.
 - REQUIRED OPEN SPACE = 8.99 AC. (50% FOR R-ED ZONE)
 - PROVIDED OPEN SPACE = 11.986 AC. (01.891 AC. CREDITED 0.5. AND 0.095 AC. NON-CREDITED 0.5)
 - RECREATIONAL OPEN SPACE REQUIREMENT = 300 SQ.FT. x 22 UNITS = 6,600 SQ.FT. (300 SQ.FT. PER UNIT)
 - RECREATIONAL OPEN SPACE PROVIDED = 6,607 SQ.FT. (OPEN SPACE LOT 23)
- FOR FLAG OR PIPESTEM LOTS, REFUSE COLLECTION, SNOW REMOVAL AND ROAD MAINTENANCE IS TO BE PROVIDED AT THE JUNCTION OF THE FLAG OR PIPESTEM AND THE ROAD RIGHT-OF-WAY AND NOT ONTO THE FLAG OR PIPESTEM DRIVEWAY.
- DRIVEWAY (S) SHALL BE PROVIDED PRIOR TO RESIDENTIAL OCCUPANCY TO INSURE SAFE ACCESS FOR FIRE AND EMERGENCY VEHICLES PER THE FOLLOWING MINIMUM REQUIREMENTS:
 - WIDTH - 12 FEET (14 FEET SERVING MORE THAN ONE RESIDENCE)
 - SURFACE - 5/8" (67 INCHES) OF COMPACTED CRUSHER RUN BASE WITH TAR AND CHIP COATING
 - GEOMETRY - MAXIMUM 10% GRADE CHANGE AND MINIMUM OF 45 FOOT TURNING RADIUS
 - STRUCTURES (CULVERTS/BRIDGES) CAPABLE OF SUPPORTING 25 GROSS TONS @ 25' SPACING
 - DRAINAGE ELEMENTS - CAPABLE OF SAFELY PASSING 100 YEAR FLOOD WITH NO MORE THAN 1 FOOT DEPTH OVER DRIVEWAY SURFACE
 - STRUCTURE CLEARANCES - MINIMUM 12 FEET
 - MAINTENANCE - SUFFICIENT TO INSURE ALL WEATHER USE
- PRIOR HOWARD COUNTY CASE NUMBERS WITH THIS PROJECT: SP-04-10
- ON MAY 13, 2005 THE HOWARD COUNTY PLANNING BOARD SIGNED THE DECISION AND ORDER GRANTING APPROVAL FOR THIS PLAN.
- A LANDSCAPE SURETY ASSOCIATED WITH PERMETER AND STORMWATER MANAGEMENT LANDSCAPING FOR 20 SHADE TREES, 35 PERENNIAL TREES AND 14 SHRUBS IN THE AMOUNT OF \$40,000 WILL BE PROVIDED BY THE DEVELOPER'S AGREEMENT.
- A WAIVER TO DESIGN MANUAL, VOLUME III, SECTION 2.5.2H TABLE 2.17 WHICH REQUIRES THAT ALL PROPOSED ROADS 30' HAVE ADEQUATE INTERSECTION SIGHT DISTANCE. APPROVAL WAS GRANTED JANUARY 6, 2005.
- SOILS INFORMATION TAKEN FROM SOIL MAP No. 20, SOIL SURVEY, HOWARD COUNTY, MARYLAND, JULY, 1968 ISSUE.
- THE EXISTING DWELLING (CIRCA 1920) LOCATED ON PROPOSED LOT 10 IS TO REMAIN.
- BOUNDARY OUTLINE BASED ON FIELD RUN SURVEY PERFORMED BY FISHER, COLLINS & CARTER, INC. DATED JUNE, 2002.
- THERE ARE AREAS OF STEEP SLOPES LOCATED ON THIS PROPERTY AS DEFINED BY THE HOWARD COUNTY SUBDIVISION AND LAND DEVELOPMENT REGULATIONS, SECTION 10.01B.
- STORMWATER MANAGEMENT WILL BE PROVIDED IN ACCORDANCE WITH HOWARD COUNTY AND MARYLAND 370 SPECIFICATIONS. RECHARGE VOLUME WILL BE PROVIDED THROUGH THE USE OF A DRY SWALE, WATER QUALITY AND CHANNEL PROTECTION VOLUME WILL BE PROVIDED BY A MICROPOOL EXTENDED DETENTION POND, OVERBANK, FLOOD PROTECTION VOLUME AND EXTREME FLOOD VOLUME ARE NOT REQUIRED FOR THIS SITE. THE STORMWATER MANAGEMENT FACILITIES WILL BE PRIVATELY OWNED AND MAINTAINED BY HOMEOWNER'S ASSOCIATION.
- THE LOTS SHOWN HEREON COMPLY WITH THE MINIMUM OWNERSHIP, WIDTH AND LOT AREA AS REQUIRED BY THE MARYLAND STATE DEPARTMENT OF THE ENVIRONMENT.
- THE ADJACENT FLOODPLAIN STUDY ALONG NEW CUT ROAD FOR THIS PROJECT IS THE EXISTING TIBER BRANCH CAPITAL PROJECT C-4-019.
- THE TRAFFIC STUDY FOR THIS PROJECT WAS PREPARED BY THE HARS GROUP DATED APRIL, 2003 AND APPROVED UNDER SP-04-10.
- THE FOREST CONSERVATION REQUIREMENTS PER SECTION 161200 OF THE HOWARD COUNTY CODE AND THE FOREST CONSERVATION MAP FOR THIS SUBDIVISION WILL BE FULFILLED BY 917 AC. OF ON-SITE RETENTION WHICH IS SUFFICIENT TO MEET AND EXCEED THE BREAK-EVEN POINT OF 51 ACRES OF RETENTION EXCESS FOREST RETENTION MAY NOT BE CREDITED TO ANOTHER PROJECT. THE TOTAL SURETY AMOUNT (\$994,452.50) x 0.50/0.50/1.00 = \$75,899,452.50 WILL BE POSTED AS PART OF THE DEVELOPER'S AGREEMENT.
- THE FOREST STAND DELINEATION AND WETLAND DELINEATION FOR THIS PROJECT WAS PREPARED BY ECO-SCIENCE PROFESSIONALS, INC. DATED FEBRUARY, 2004.
- THE GEOTECHNICAL REPORT FOR THIS PROJECT WAS PREPARED BY HILLIS-CARNE ENGINEERING ASSOC., INC. DATED JANUARY, 2004.
- NO CEMETERIES EXIST WITHIN THIS SUBDIVISION.
- NO CLEARING, GRADING OR CONSTRUCTION IS PERMITTED WITHIN THE WETLANDS, STREAM OR THEIR REQUIRED BUFFERS.
- A WAIVER TO DESIGN MANUAL, VOLUME III, SECTION 2.11.A, TABLE 2.01 WHICH REQUIRES THAT THE PROPOSED ROADS FOR THIS DEVELOPMENT BE BUILT TO THE PUBLIC ACCESS PLACE CRITERIA WAS SIGNED ON APRIL 5, 2004 BY THE DEVELOPMENT ENGINEERING DIVISION.
- SIGN POSTS: ALL SIGN POST USED FOR TRAFFIC CONTROL SIGNS INSTALLED IN THE COUNTY RIGHT-OF-WAY SHALL BE MOUNTED ON A 2" GALVANIZED STEEL PERFORATED SQUARE TUBE POST (1/4" GALVE) INSERTED INTO A 2-1/2" GALVANIZED STEEL PERFORATED SQUARE TUBE SLEEVE (1/2" GALVE) - 3" LONG. A GALVANIZED STEEL POLE CAP SHALL BE MOUNTED ON TOP OF EACH POST.
- STREET LIGHTS WILL BE REQUIRED IN THIS DEVELOPMENT IN ACCORDANCE WITH THE DESIGN MANUAL. STREET LIGHT PLACEMENT AND TYPE OF FIXTURE AND POLE SELECTED SHALL BE IN ACCORDANCE WITH THE LATEST HOWARD COUNTY DESIGN MANUAL, VOLUME III (1998) AND AS MODIFIED BY "GUIDELINES FOR STREET LIGHTS IN RESIDENTIAL DEVELOPMENTS (JUNE 1998)". THE JUNE 1993 POLICY INCLUDES GUIDELINES FOR LATERAL AND LONGITUDINAL PLACEMENT. A MINIMUM SPACING OF 20' SHALL BE MAINTAINED BETWEEN THE STREET LIGHT AND ANY TREE.
- COLLEGE AVENUE IS A SCenic ROAD. AS PART OF THE PRELIMINARY EQUIVALENT SKETCH PLAN (SP-10-10) PROCESS THE IMPACT OF THIS PROPOSED DEVELOPMENT TO COLLEGE AVENUE WAS DETERMINED TO BE ADEQUATE AND THE SCenic ROAD STUDY WAS APPROVED.
- ALL FILL AREAS SHALL BE COMPACTED TO A 95% MAXIMUM DRY DENSITY IN ACCORDANCE WITH AASHTO T-180 STANDARDS.

ROADWAY INFORMATION CHART


ROAD NAME	CLASSIFICATION	DESIGN SPEED	R/W WIDTH
MAPLE CLIFFE WAY	PUBLIC ACCESS PLACE	25 M.P.H.	40'
HOGG COURT	PUBLIC ACCESS PLACE	25 M.P.H.	40'

TRAFFIC CONTROL SIGNS

ROAD NAME	CENTERLINE STA.	OFFSET	POSTED SIGN	SIGN CODE
MAPLE CLIFFE WAY	0+37	14' L	STOP	R-1
MAPLE CLIFFE WAY	1+00	14' R	SPEED LIMIT 25	R2-1
HOGG COURT	0+25	12' L	STOP	R-1

STREET LIGHT CHART

STREET NAME	STATION	OFFSET	FIXTURE/POLE TYPE
MAPLE CLIFFE WAY	C.L. STA. 0+41	26' RT.	150-WATT "Premier" H.P.S. VAPOR FIXTURE, POST TOP FIXTURE MOUNTED ON A 14-FOOT BLACK FIBERGLASS POLE.
MAPLE CLIFFE WAY	C.L. STA. 2+20	17' LT.	150-WATT "Premier" H.P.S. VAPOR FIXTURE, POST TOP FIXTURE MOUNTED ON A 14-FOOT BLACK FIBERGLASS POLE.
MAPLE CLIFFE WAY	C.L. STA. 3+58	13' LT.	150-WATT "Premier" H.P.S. VAPOR FIXTURE, POST TOP FIXTURE MOUNTED ON A 14-FOOT BLACK FIBERGLASS POLE.
MAPLE CLIFFE WAY	C.L. STA. 4+97	13' LT.	150-WATT "Premier" H.P.S. VAPOR FIXTURE, POST TOP FIXTURE MOUNTED ON A 14-FOOT BLACK FIBERGLASS POLE.
MAPLE CLIFFE WAY	C.L. STA. 6+46	17' RT.	150-WATT "Premier" H.P.S. VAPOR FIXTURE, POST TOP FIXTURE MOUNTED ON A 14-FOOT BLACK FIBERGLASS POLE.
HOGG COURT	C.L. STA. 3+87	18' RT.	150-WATT "Premier" H.P.S. VAPOR FIXTURE, POST TOP FIXTURE MOUNTED ON A 14-FOOT BLACK FIBERGLASS POLE.

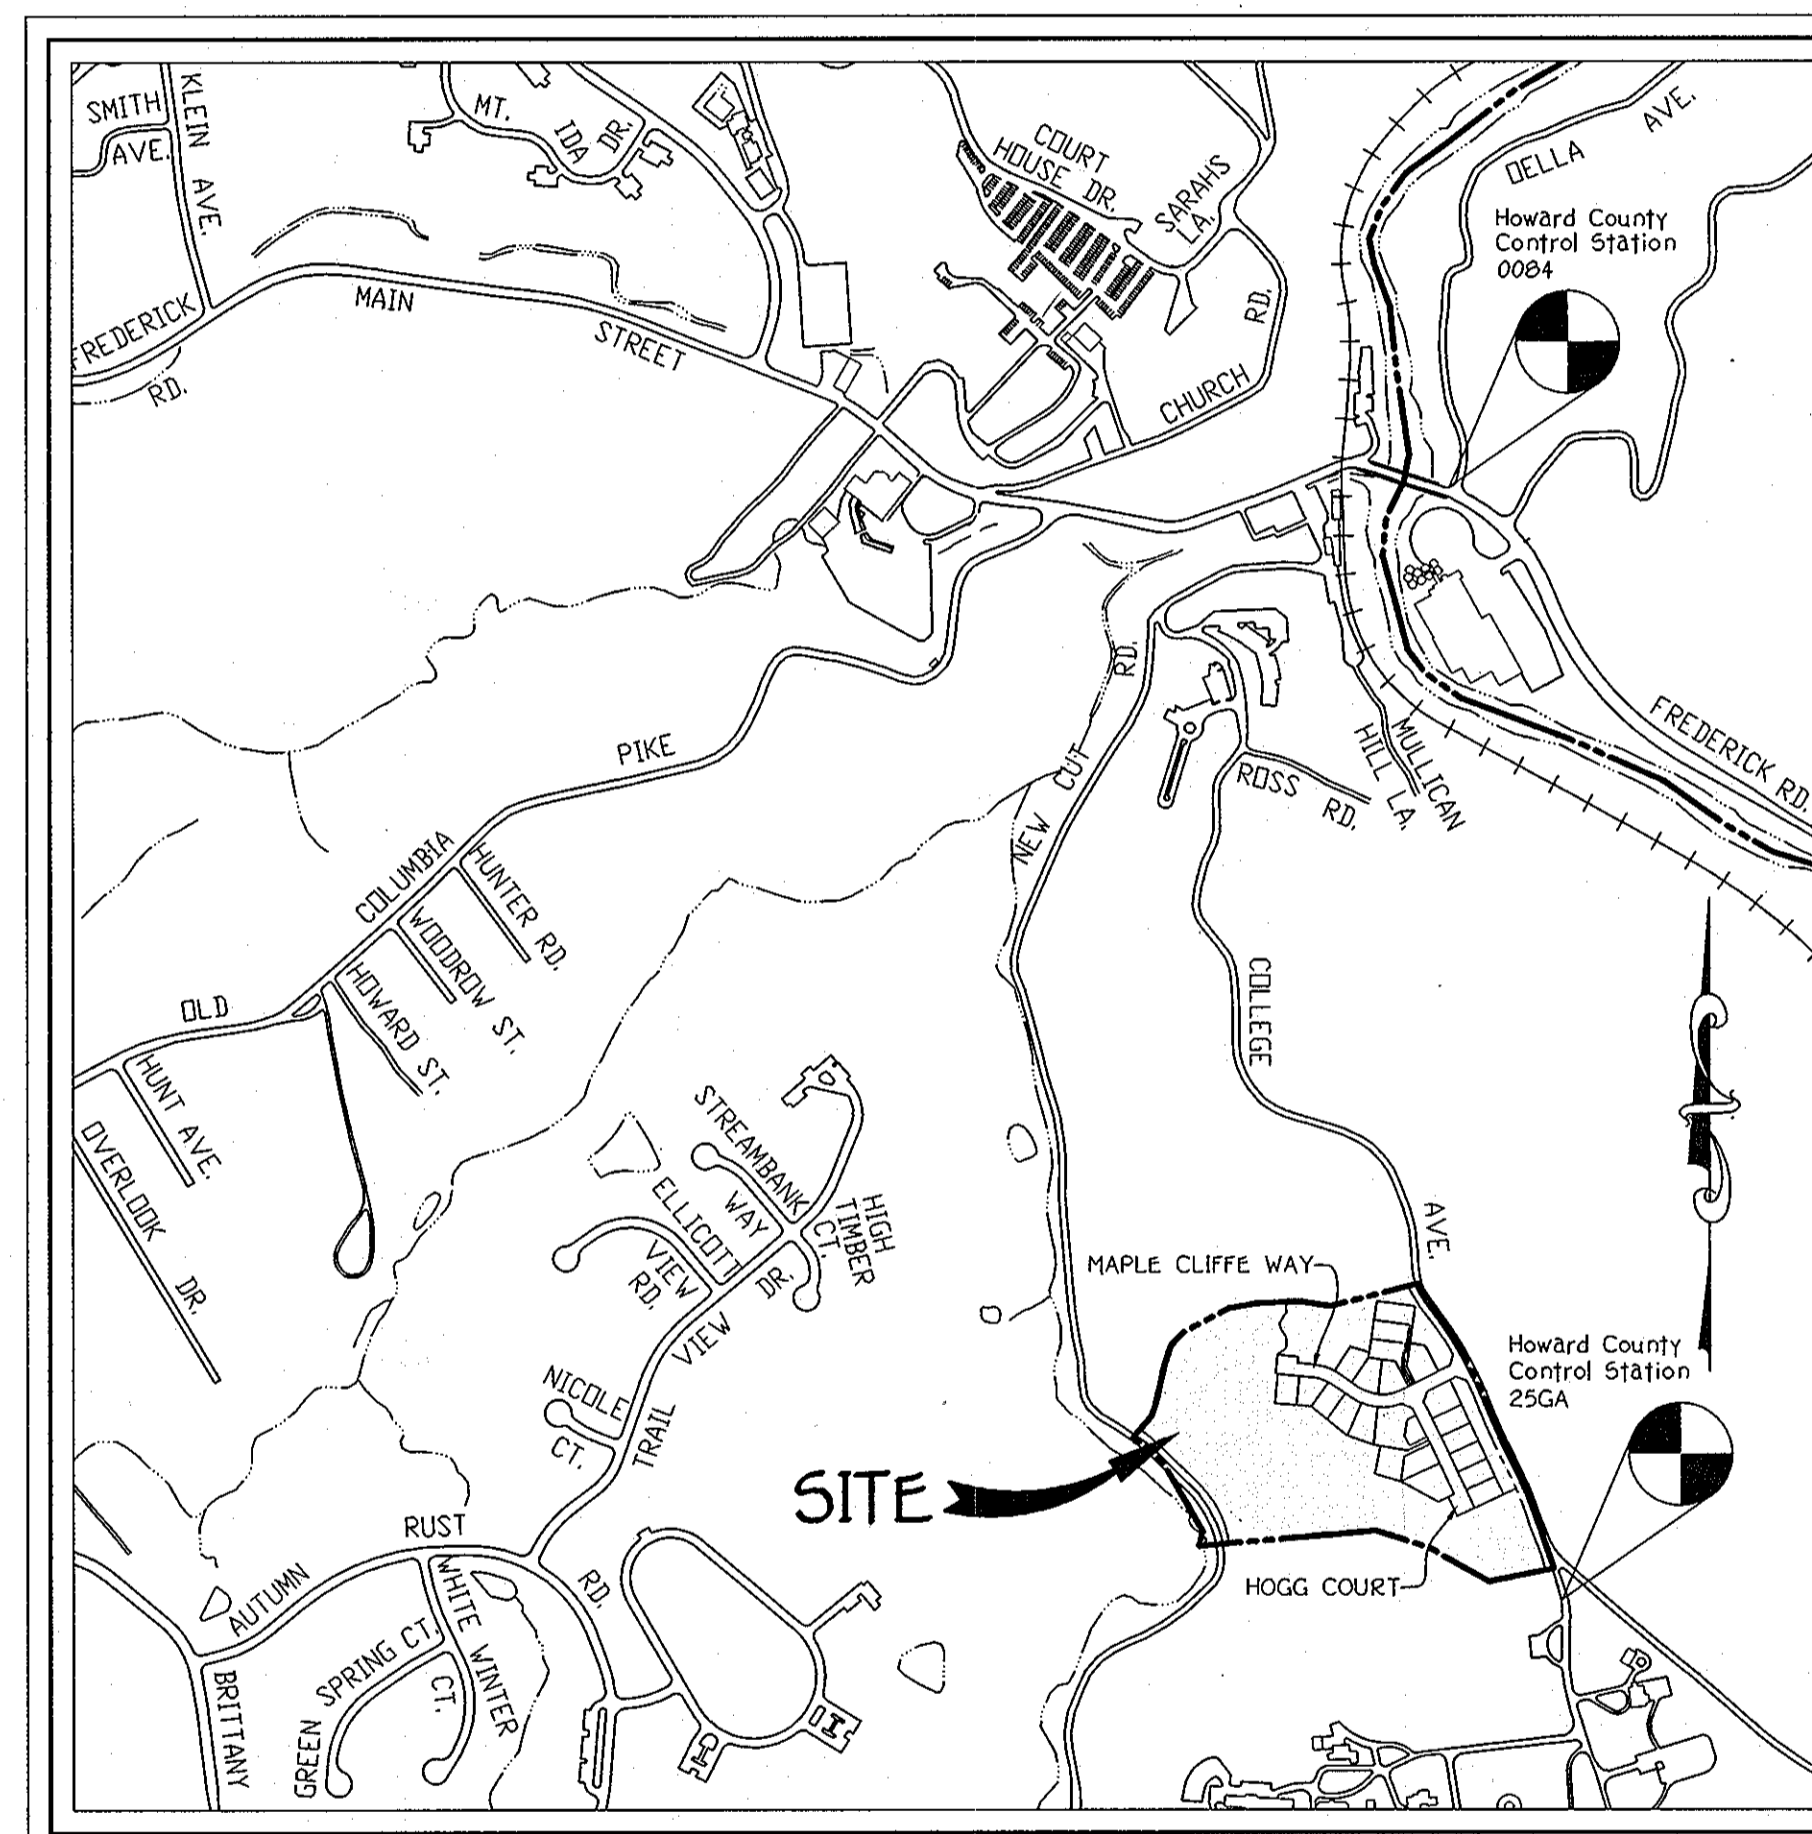
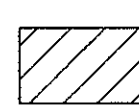



VICINITY MAP

SCALE: 1" = 600'

SECOND ELECTION DISTRICT
 HOWARD COUNTY, MARYLAND

LEGEND

-  DENOTES EXISTING DRIVEWAY TO BE REMOVED
-  DENOTES NON-CREDIT OPEN SPACE

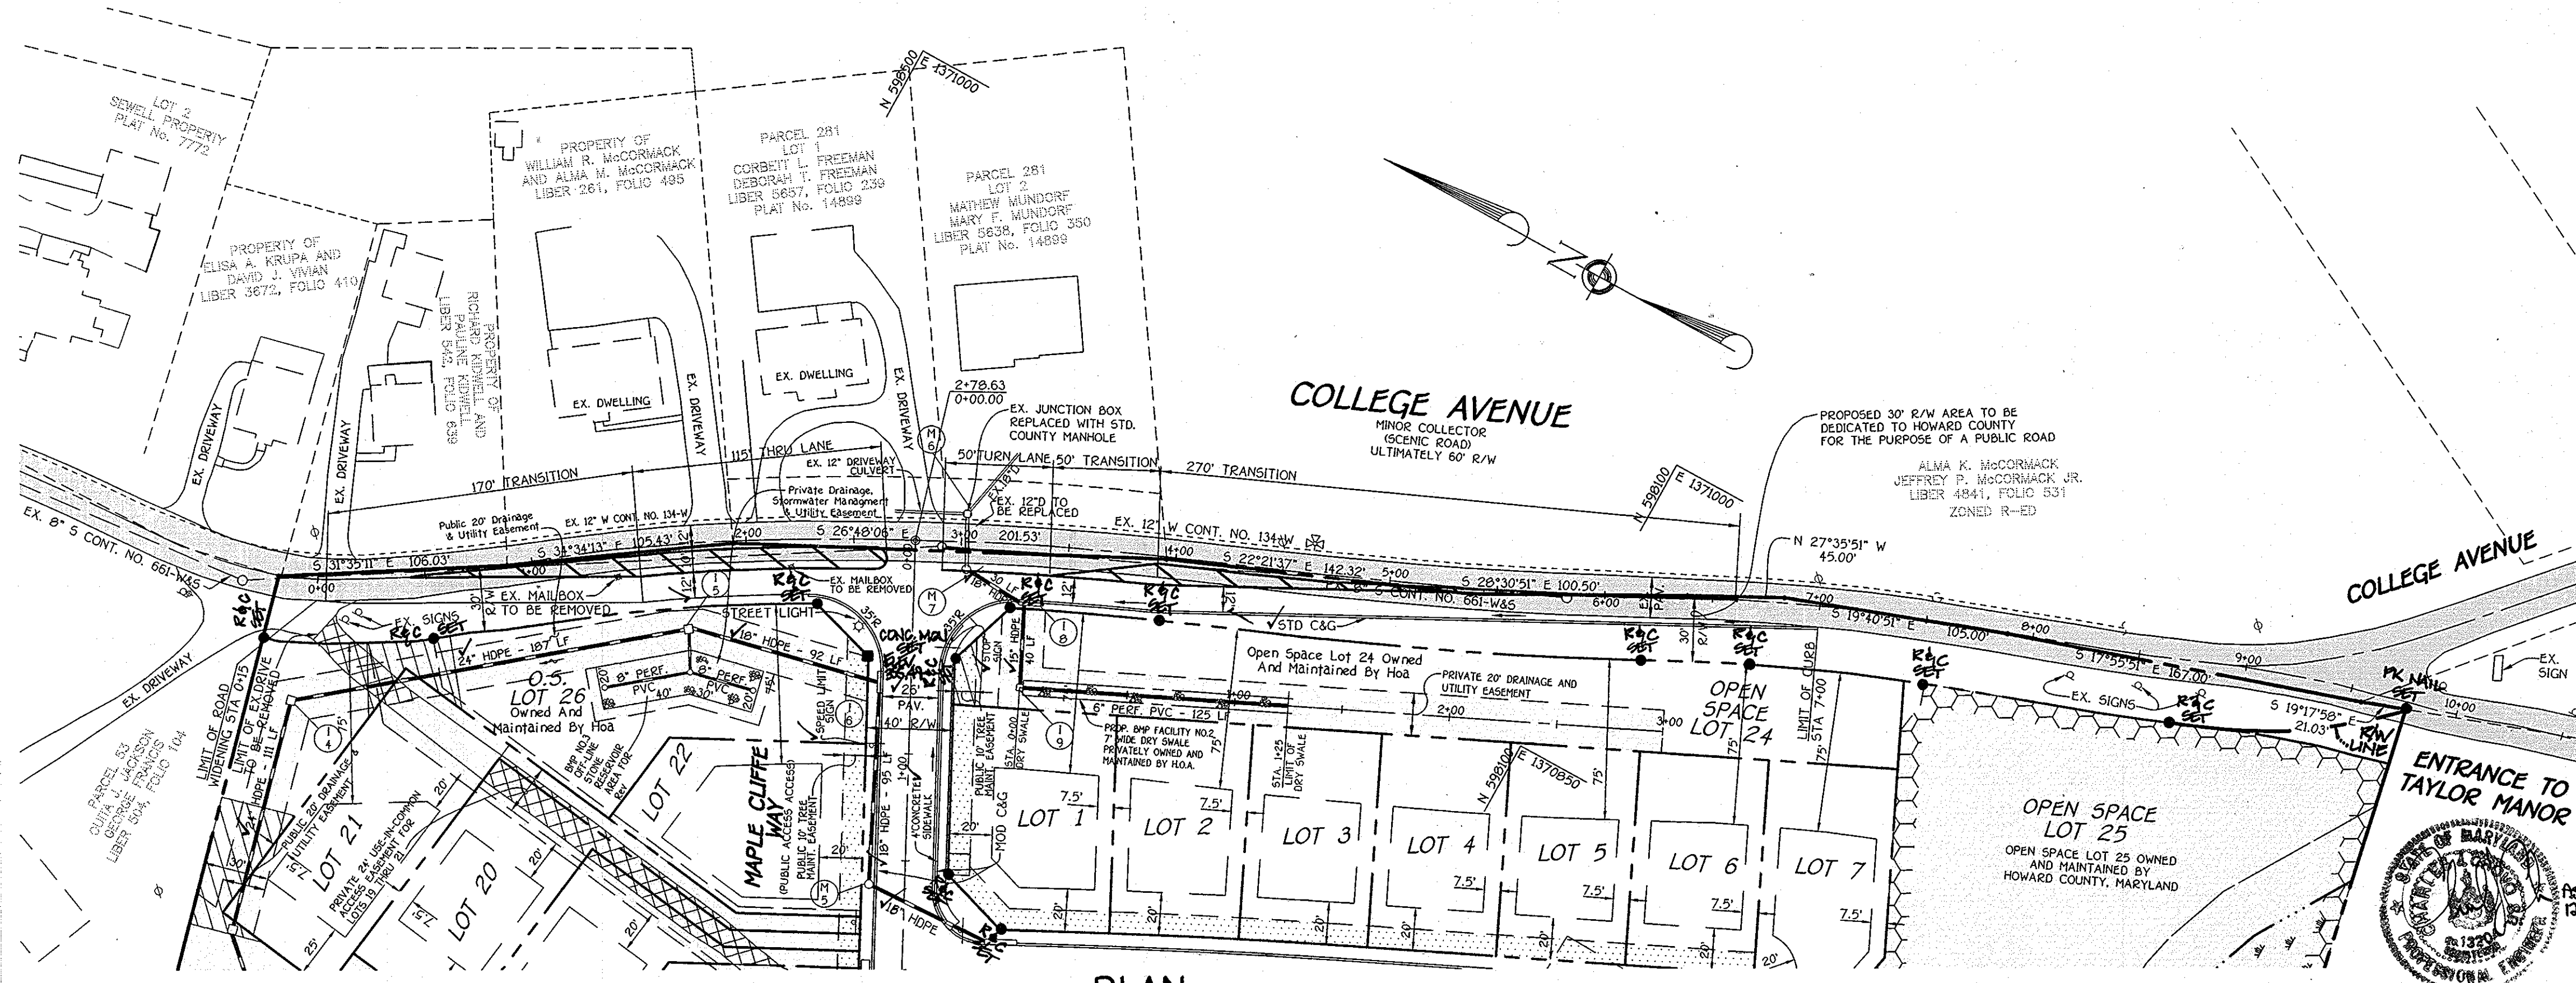

HOGG PROPERTY
LOTS 1 - 22, OPEN SPACE LOTS 23 - 26
ZONED: R-ED
TAX MAP NO. 25 GRID NO. 14 PARCEL NO. 64
SECOND ELECTION DISTRICT
HOWARD COUNTY, MARYLAND

COLLEGE AVENUE WIDENING
PLAN AND PROFILE

OWNER/DEVELOPER
DORSEY FAMILY HOMES
10717B BIRNINGHAM WAY
WOODSTOCK, MARYLAND 21163
ATTN: ROB DORSEY

SCALE: AS SHOWN DATE: JUNE 8, 2006 DWG. NO. 2 OF 17
DES. J.C.L. DRN. J.C.L. CHK. A.M.V.

FISHER, COLLINS & CARTER, INC.
CIVIL ENGINEERING CONSULTANTS & LAND SURVEYORS
200 CENTRAL SQUARE OFFICE PARK - 10722 BALTIMORE NATIONAL FREE
ELICOTT CITY, MARYLAND 21042
4100 401 - 2825

REVISIONS

NO.	DESCRIPTION	DATE


APPROVED: DEPARTMENT OF PLANNING AND ZONING

Kent Greenbrook 2/1/06
CHIEF DIVISION OF PLANNING AND ZONING


William M. ... 8/17/06
CHIEF DEVELOPER ENGINEERING & PLANNING AS

APPROVED: HOWARD COUNTY DEPARTMENT OF PUBLIC WORKS

William M. ... 8-14-06
CHIEF BUREAU OF PUBLIC WORKS

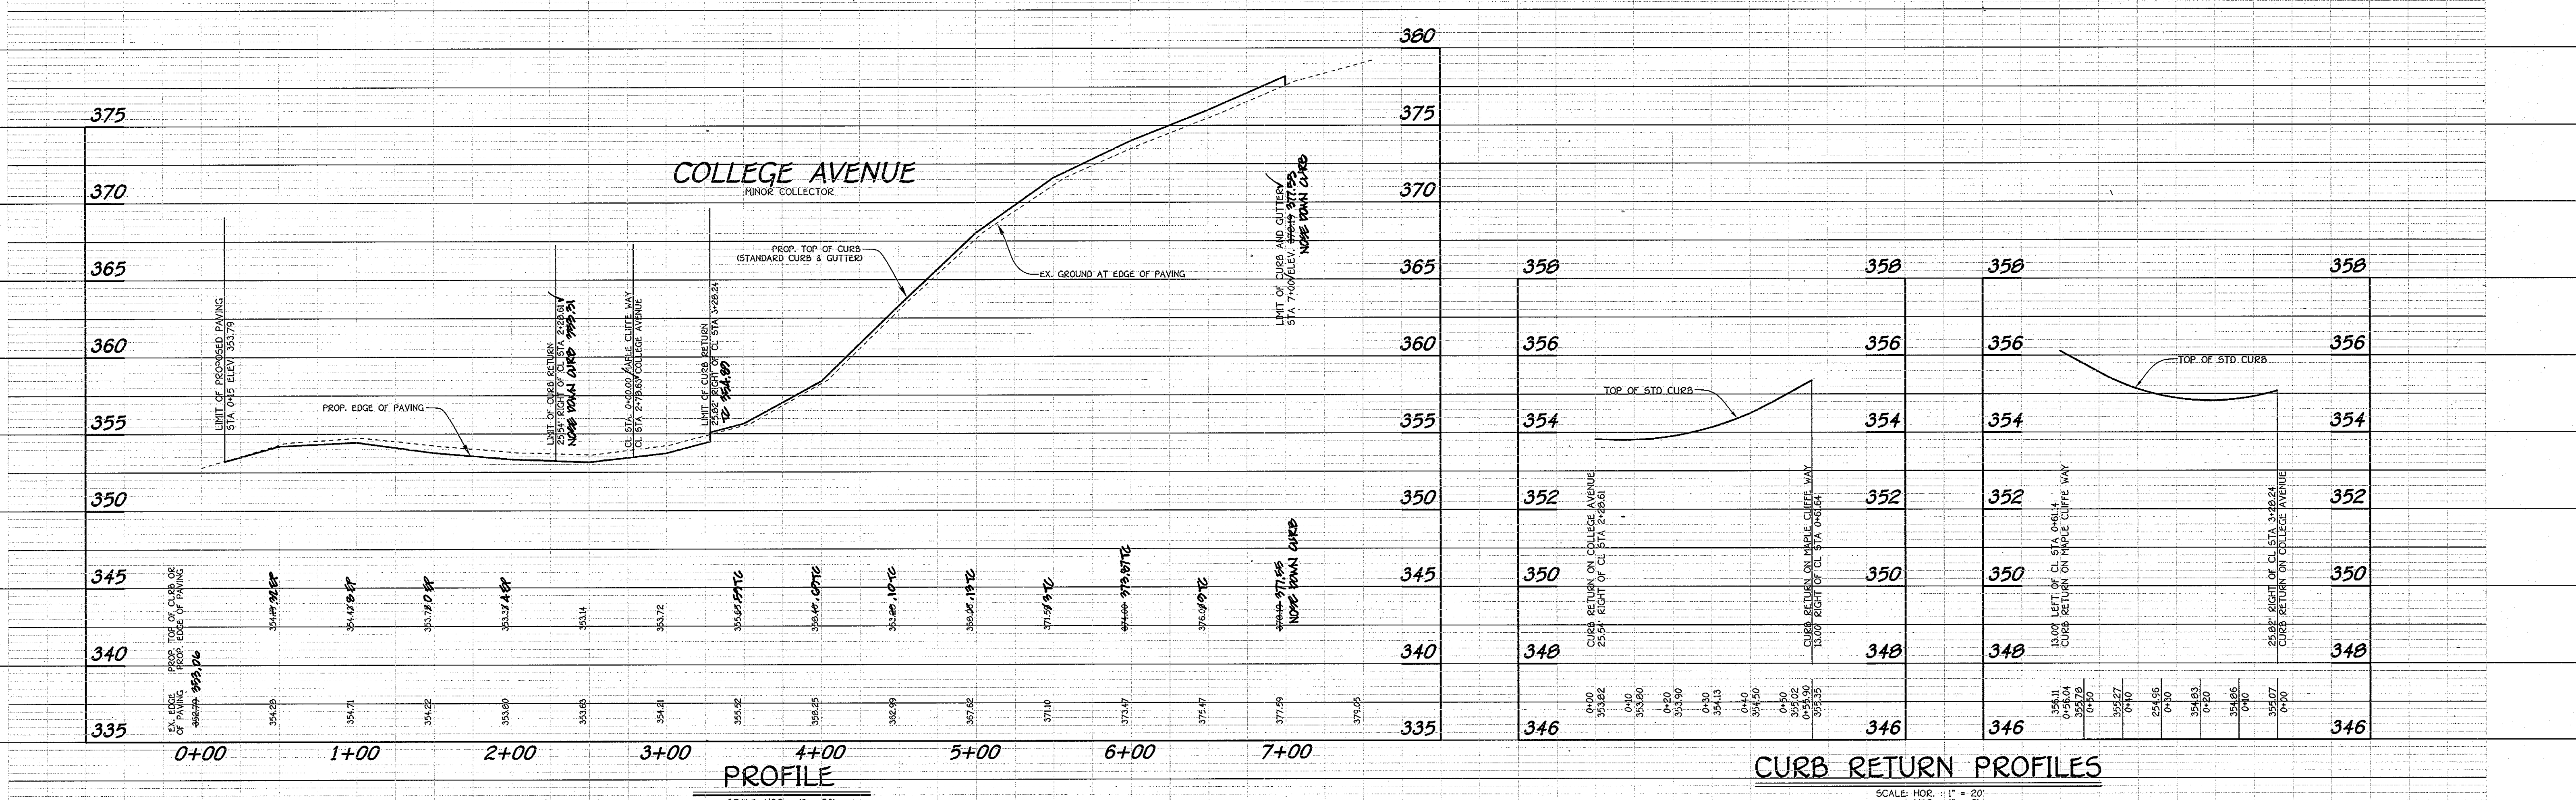

K:\SDSKPRO\030772\030772\FINALS\030772 SHEET 2 ROAD PLAN AND PROFILE.dwg, 6/8/2006 9:48:39 AM, 1:1

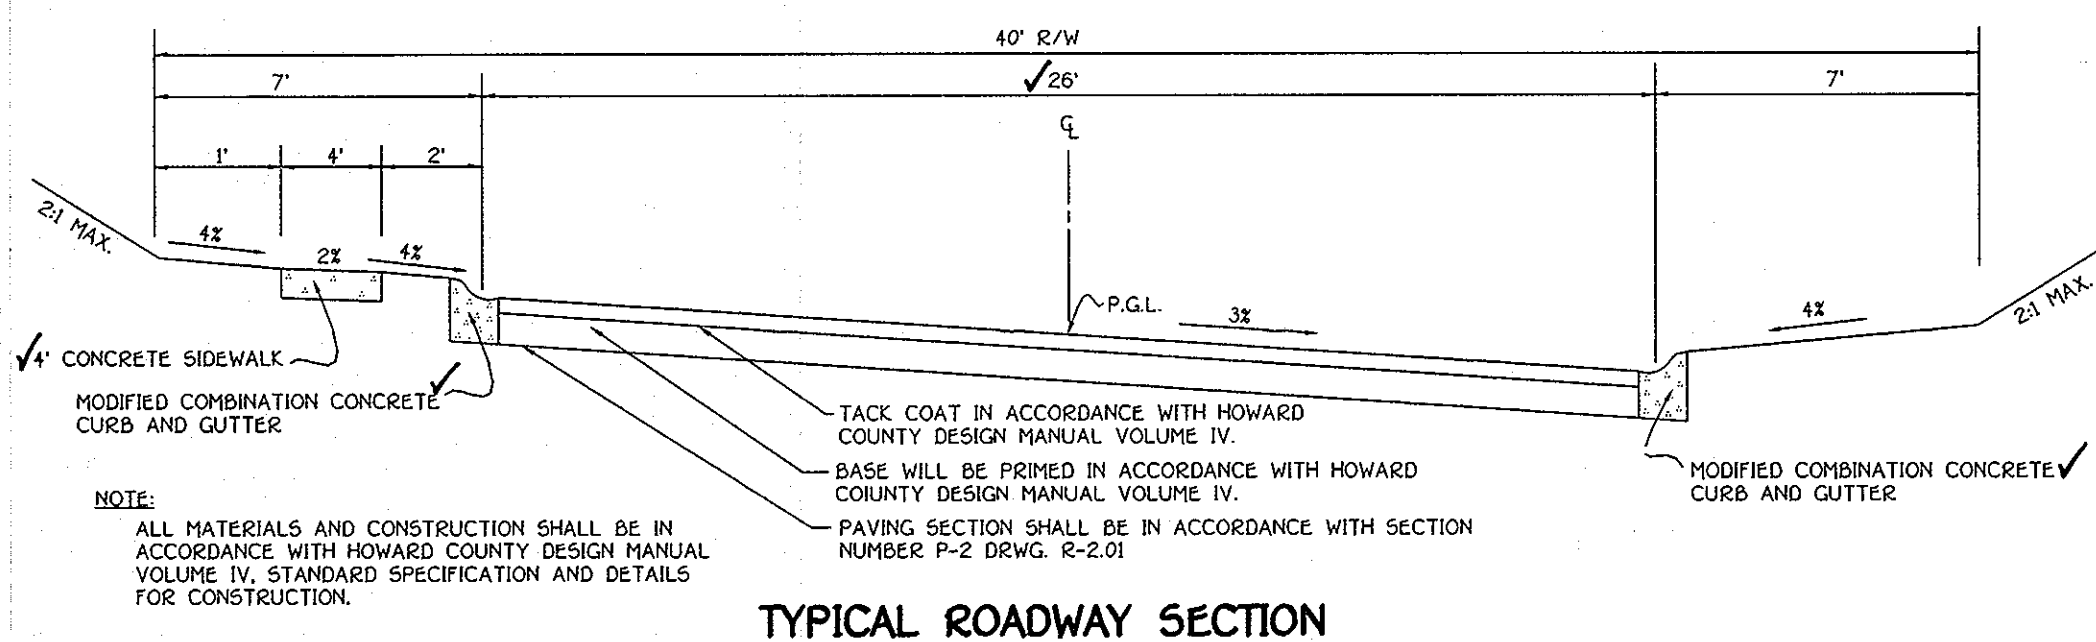

TYPICAL ROADWAY SECTION
NO SCALE

ROADWAY INFORMATION CHART

ROAD NAME	CLASSIFICATION	DESIGN SPEED	ZONING	STATION LIMITS	R/W	PAVING SECTION
HOGG COURT	PUBLIC ACCESS PLACE	25 MPH	R-ED	0+00 TO 3+88.7	40'	P-2
MAPLE CLIFFE WAY	PUBLIC ACCESS PLACE	25 MPH	R-ED	0+00 TO 6+16.50	40'	P-2




APPROVED DEPARTMENT OF PLANNING AND ZONING

Kent Shulock 8/9/06
Chief, Division of Planning and Zoning

William J. Mahler 8/14/06
Chief, Bureau of Inspections

APPROVED HOWARD COUNTY DEPARTMENT OF PUBLIC WORKS

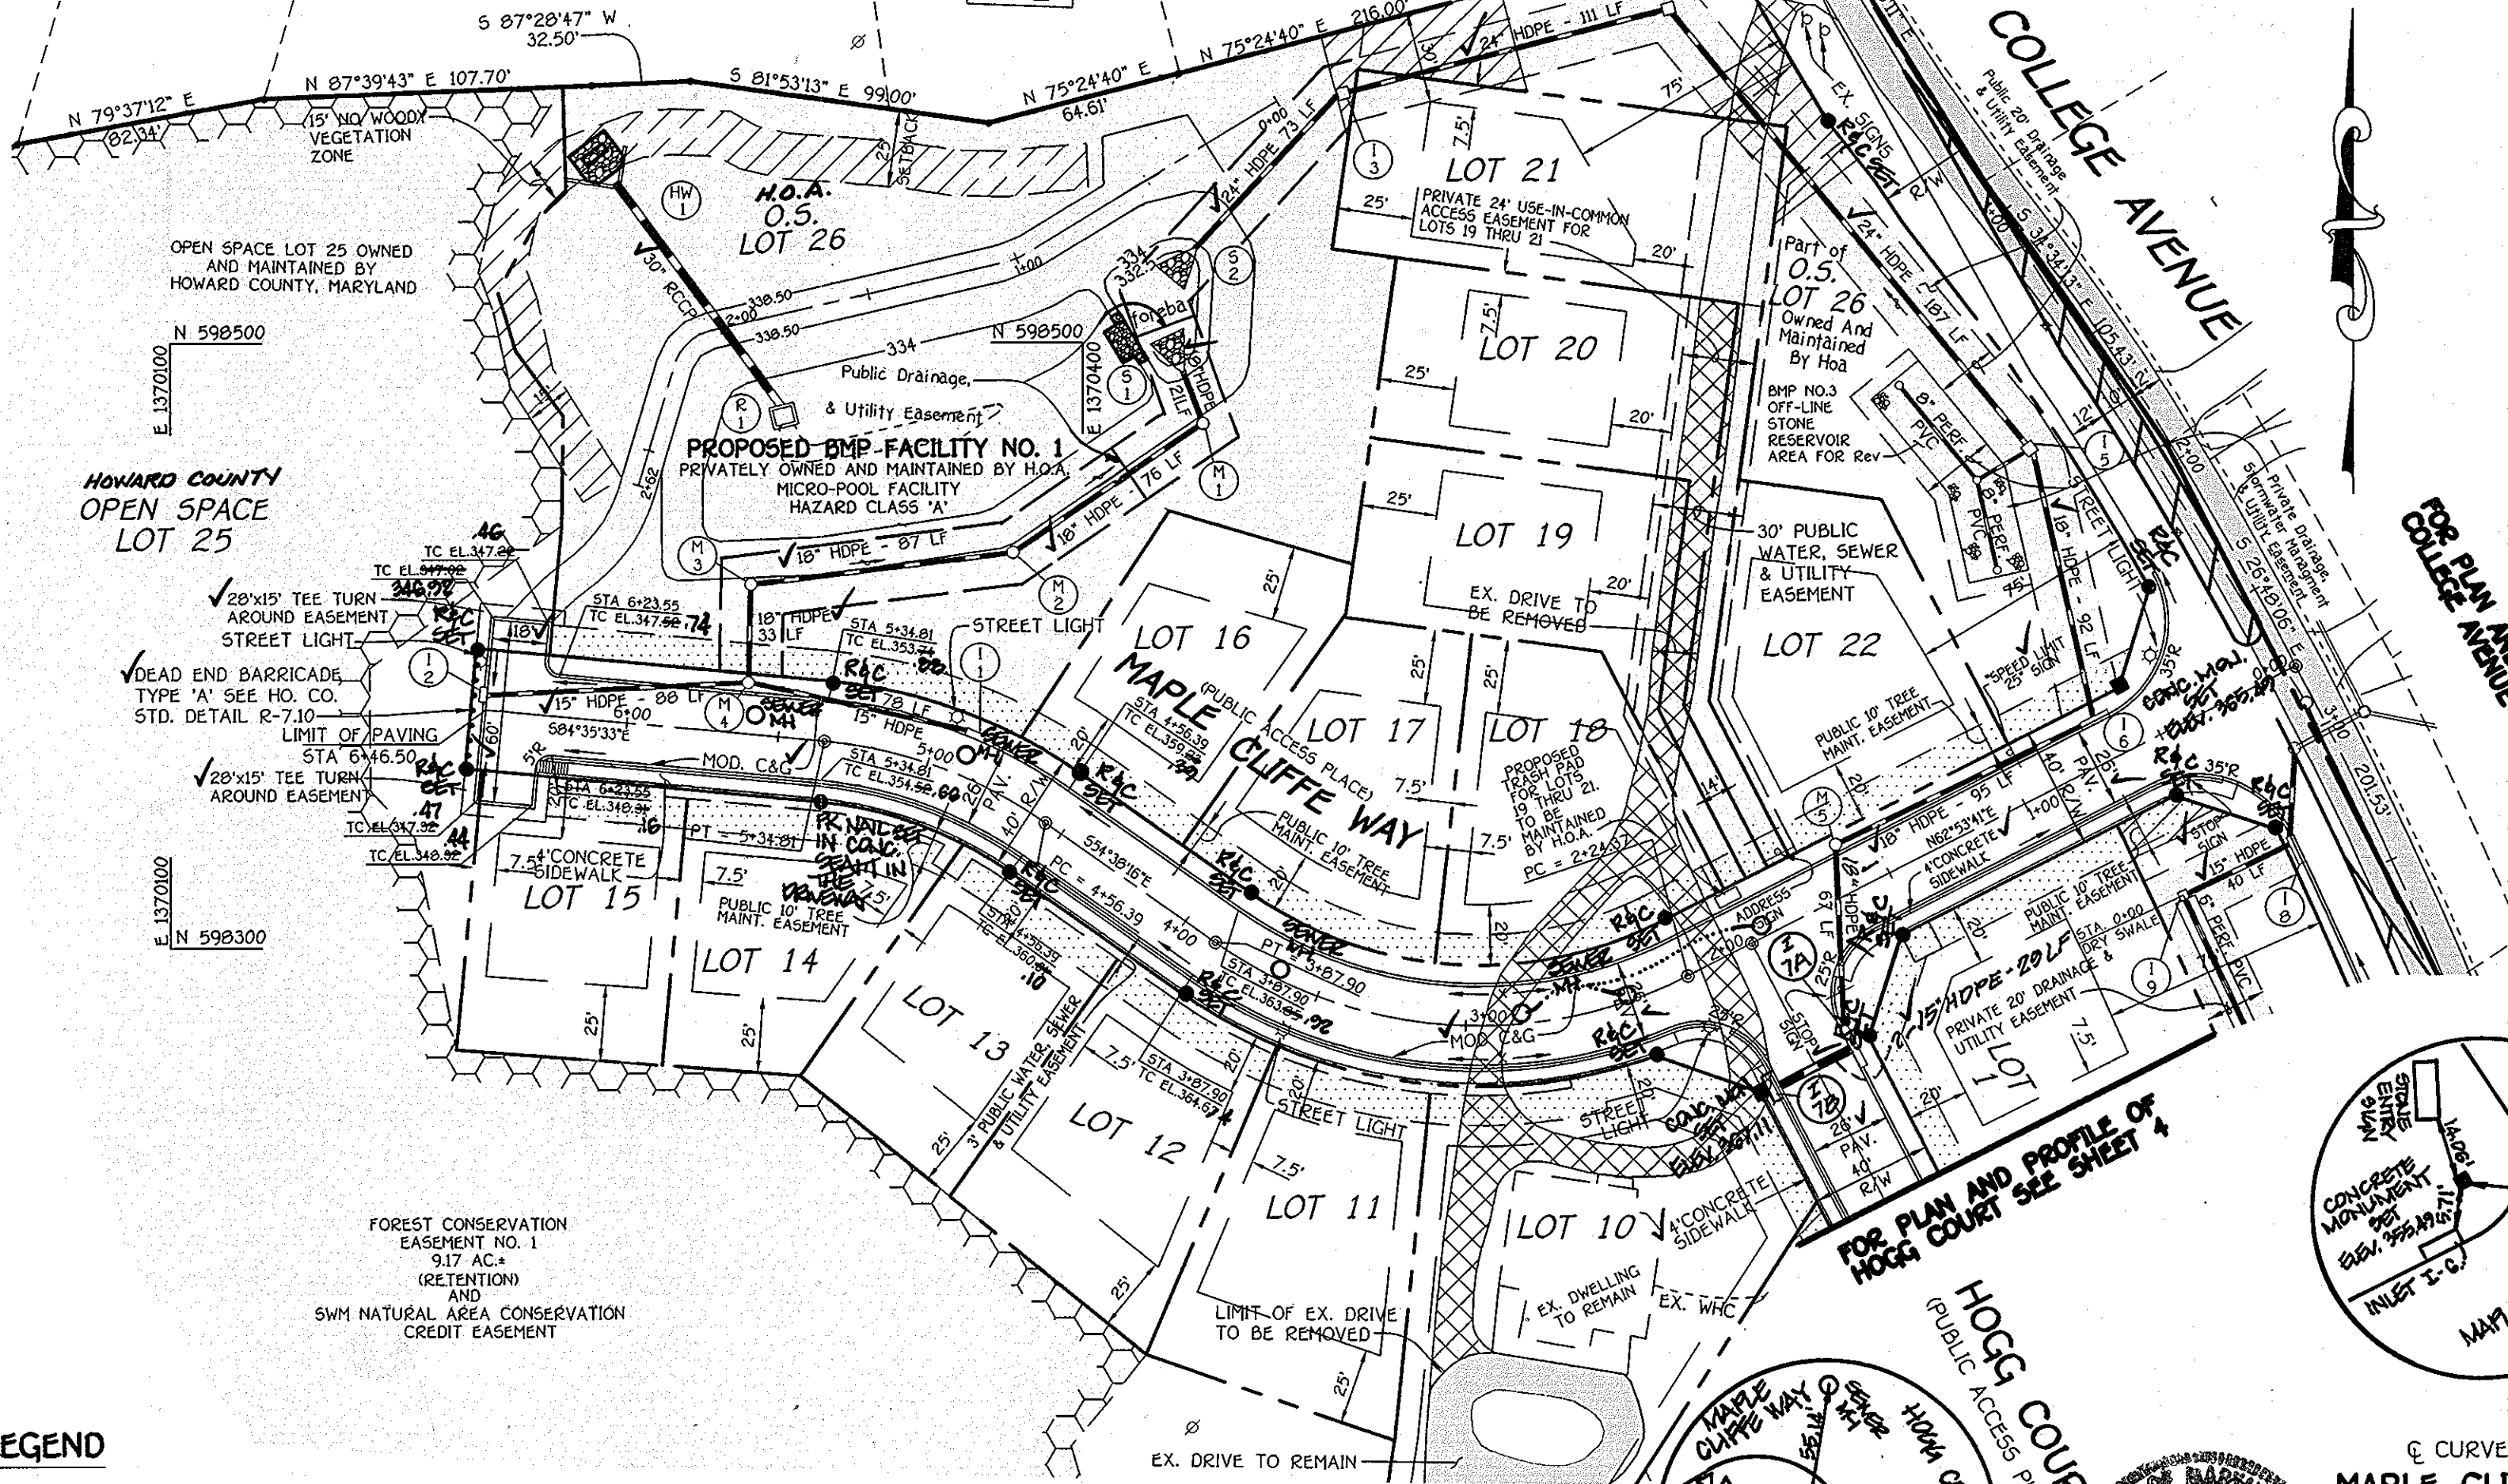

PLAN
SCALE: 1" = 50'

- NOTES REGARDING EX. WHC TO EX. DWELLING (TO REMAIN ON LOT 10)
- THE EX. WHC TO THE EX. DWELLING ON LOT 10 MUST REMAIN IN SERVICE DURING INSTALLATION, TESTING AND CHLORINATION OF THE NEW 8-INCH WATER MAIN.
 - UPON ACCEPTANCE AND PLACING IN SERVICE OF THE NEW 8-INCH WATER MAIN, THE EX. WHC FOR THE EX. DWELLING ON LOT 10 SHALL BE CONNECTED TO THE NEW OUTSIDE METER SETTING.
 - THE EX. WATER METER FOR THE EX. DWELLING ON LOT 10 SHALL BE REMOVED AND RETURNED TO THE BUREAU OF UTILITIES.
 - AT THE EX. 12-INCH WATER MAIN, THE EX. CORPORATION STOP ASSEMBLY SHALL BE REMOVED & A PLUG INSERTED.
 - THE EX. WHC FOR THE EX. DWELLING ON LOT 10 SHALL BE REMOVED IN ITS ENTIRETY.

© CURVE DATA
HOGG COURT
STA. 0+83.57 TO STA. 1+95.01
RADIUS = 3000.00'
ARC LENGTH = 111.44'
TAN = 55.72°
DELTA = 02°07'42"
CHORD = N26°02'28"W, 111.43'



© CURVE DATA
MAPLE CLIFFE WAY
STA. 2+24.37 TO STA. 3+87.90
RADIUS = 150.00'
ARC LENGTH = 163.54'
TAN = 90.98°
DELTA = 82°29'03"
CHORD = S85°52'10"E, 155.56'

HOGG PROPERTY
LOTS 1 - 22, OPEN SPACE LOTS 23 - 26
ZONED: R-ED
TAX MAP NO. 25 GRID NO. 14 PARCEL NO. 64
SECOND ELECTION DISTRICT
HOWARD COUNTY, MARYLAND

MAPLE CLIFFE WAY
PLAN AND PROFILE


OWNER/DEVELOPER
DORSEY FAMILY HOMES
10717B BIRNINGHAM WAY
WOODSTOCK, MARYLAND 21763
ATTN: ROB DORSEY


SCALE: AS SHOWN DATE: JUNE 8, 2006 DWG. NO. 3 OF 17
DES. J.C.L. DRN. J.C.L. CHK. A.M.V.

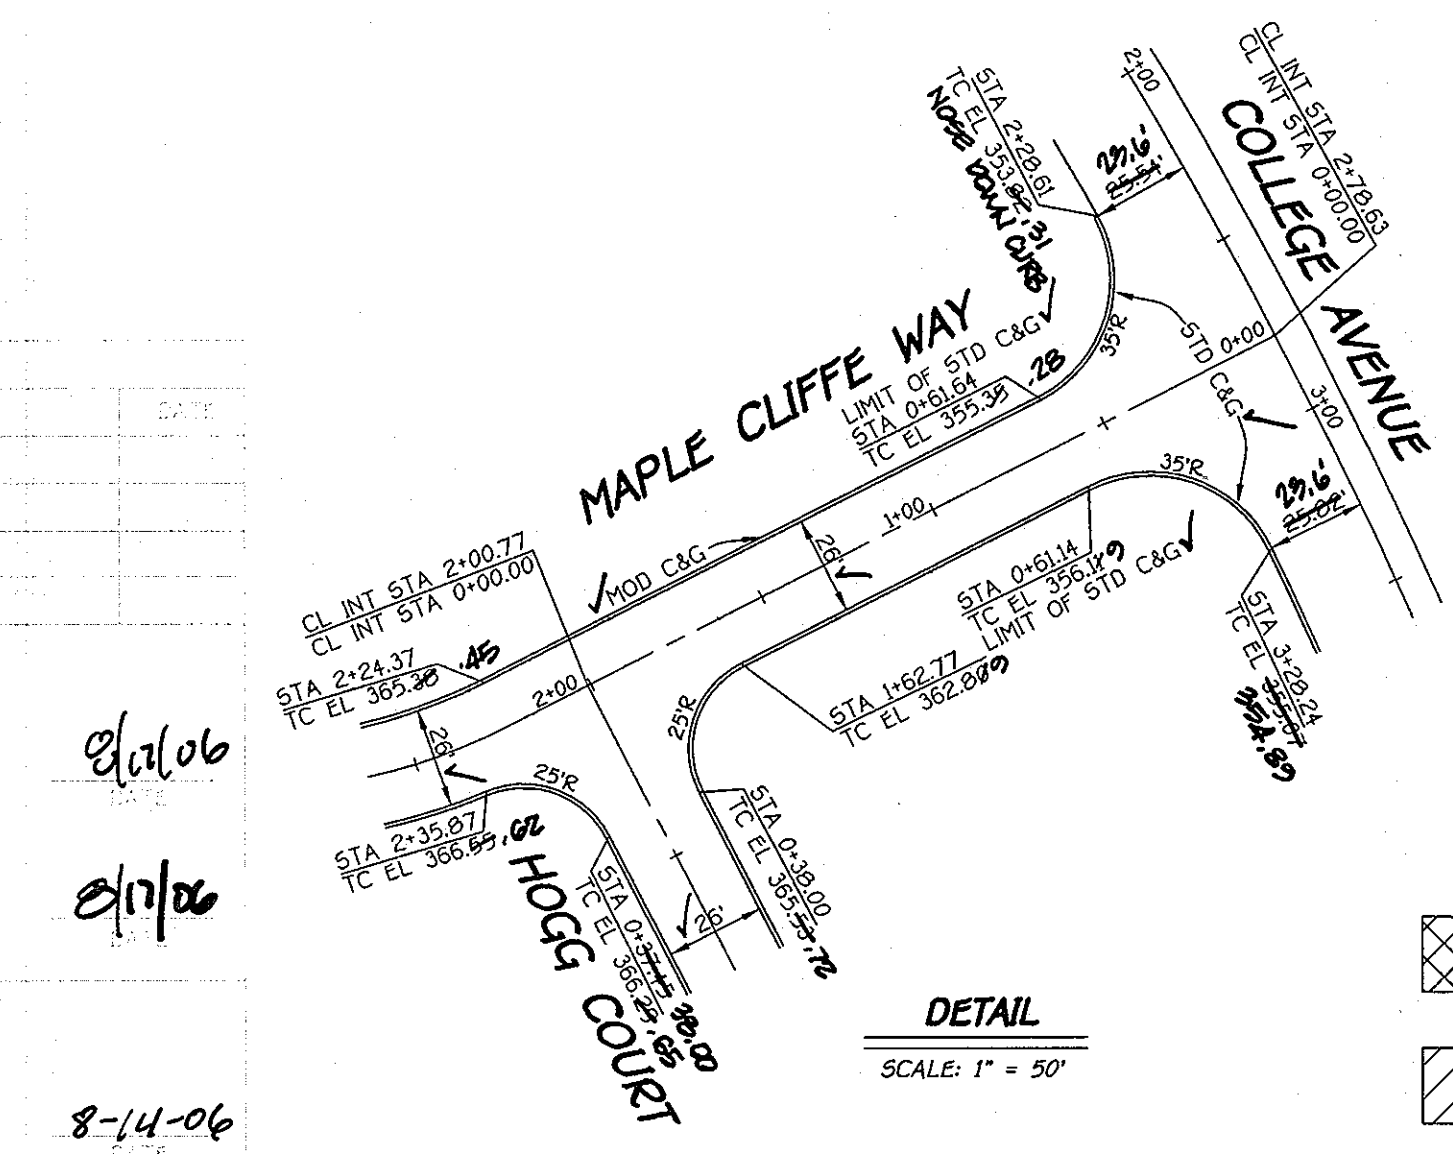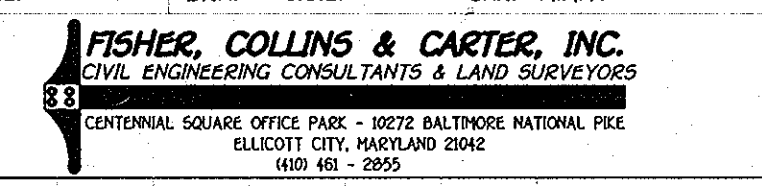


DETAIL
SCALE: 1" = 50'

- LEGEND
- DENOTES EXISTING DRIVEWAY TO BE REMOVED
 - DENOTES NON-CREDIT OPEN SPACE


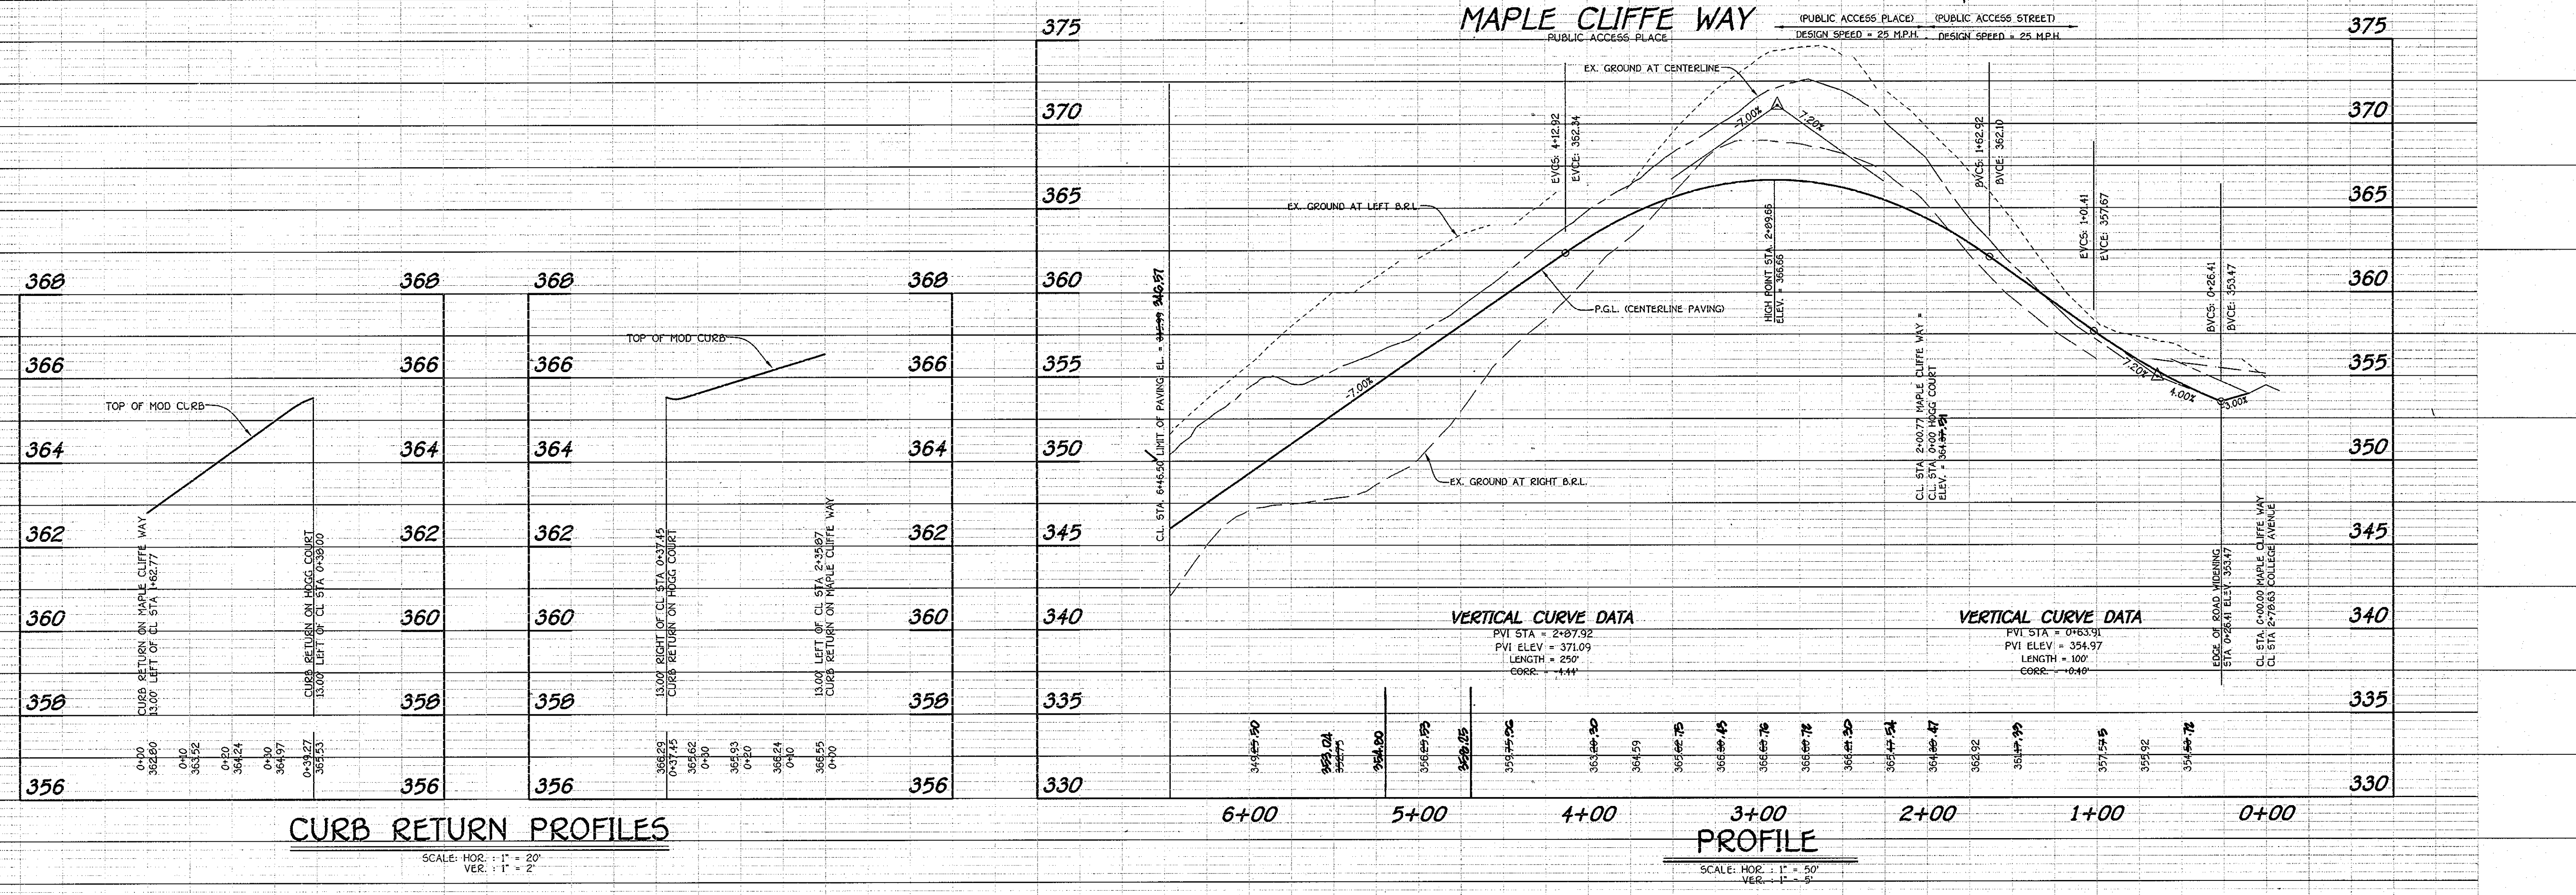


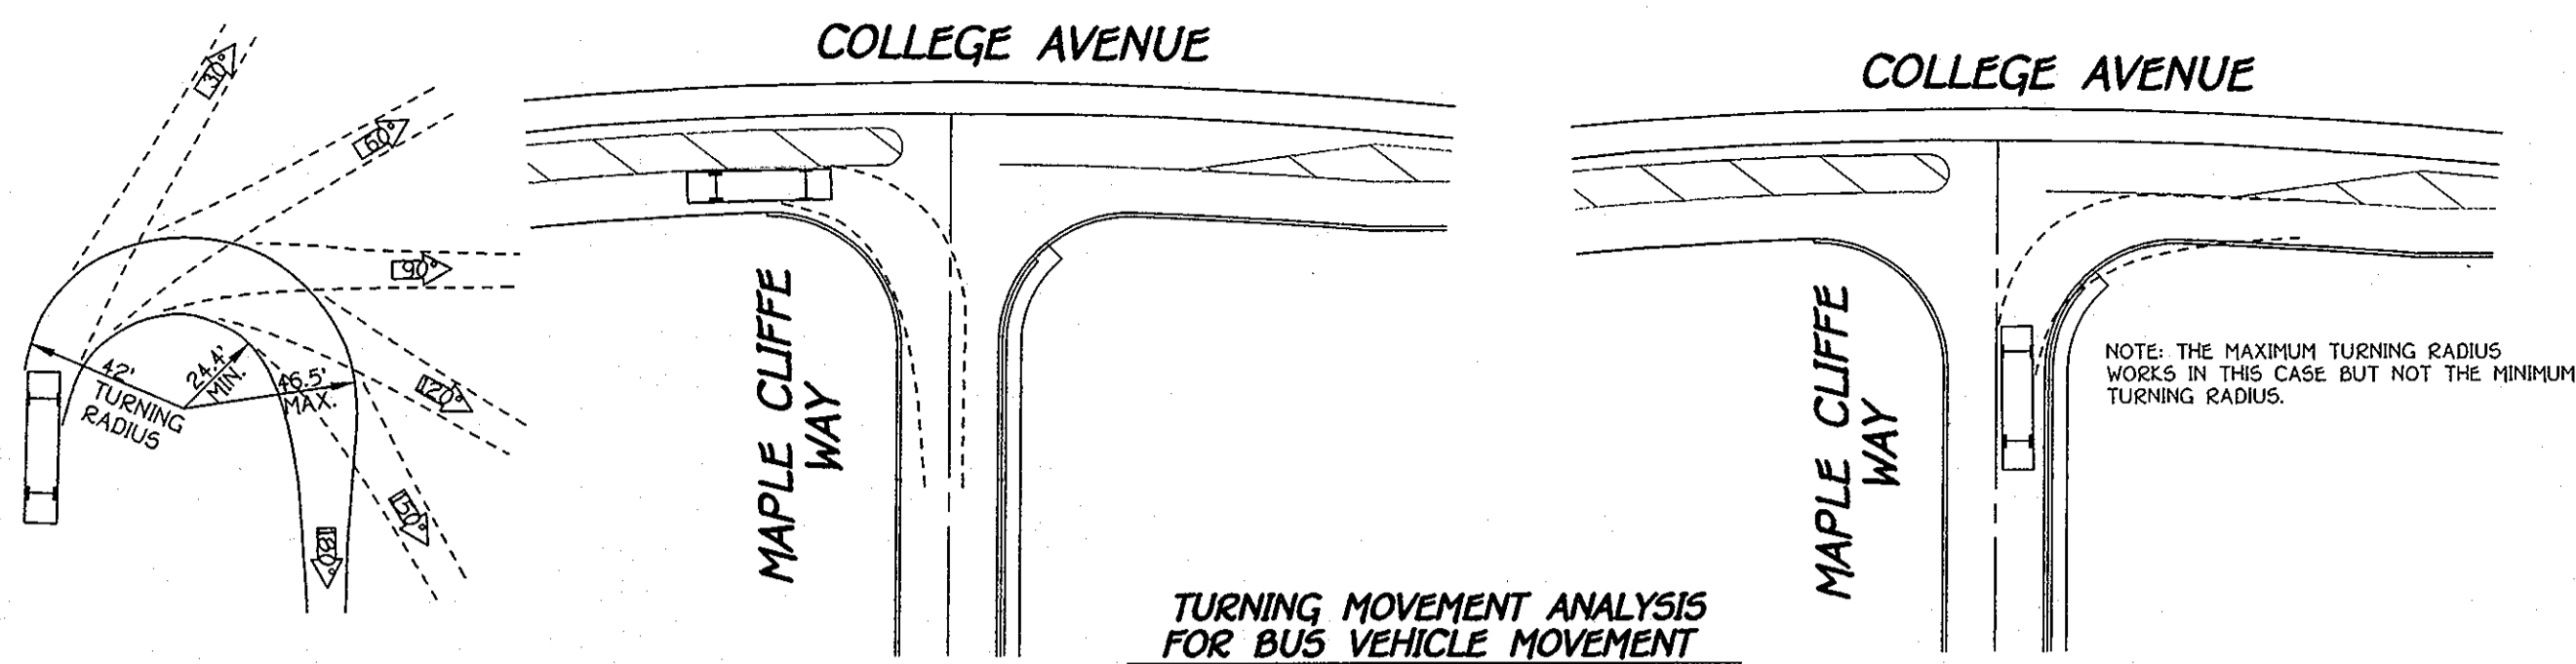

TURNING MOVEMENT ANALYSIS FOR BUS VEHICLE MOVEMENT
SCALE: 1" = 50'

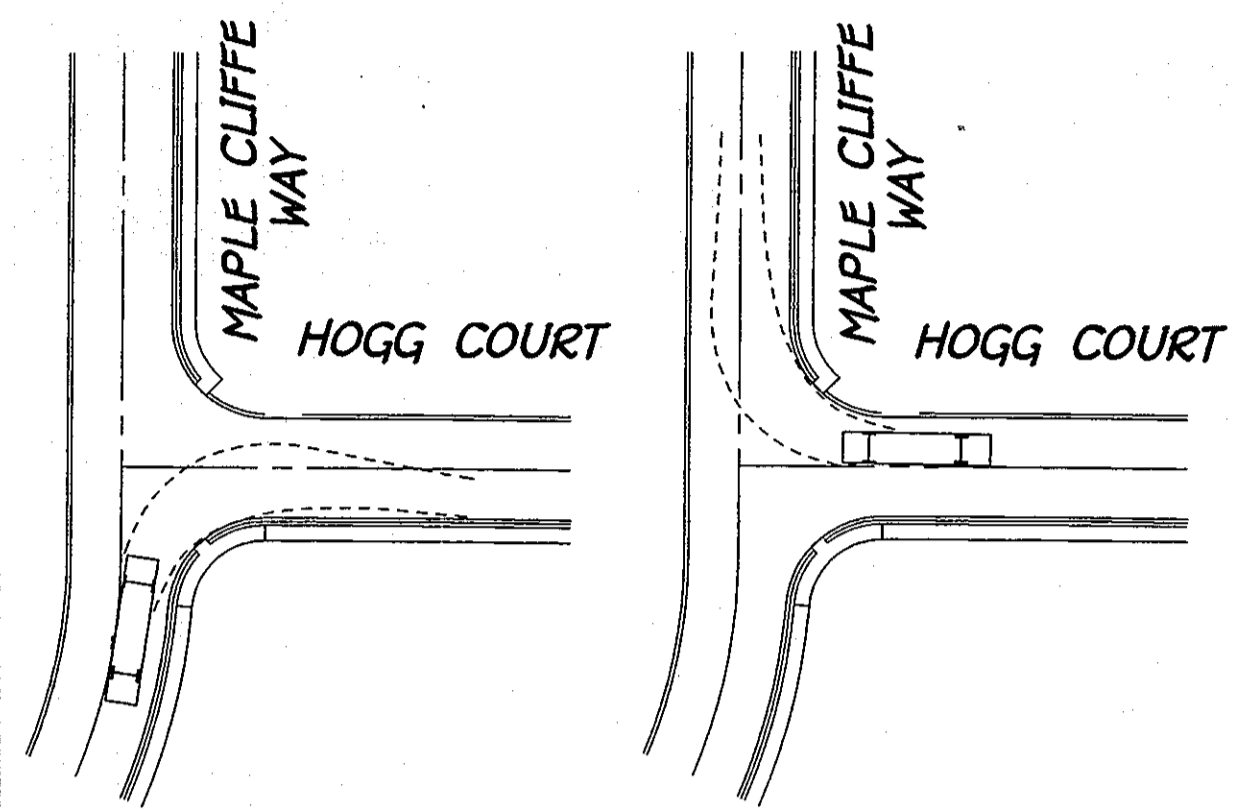

TURNING MOVEMENT ANALYSIS FOR BUS VEHICLE MOVEMENT
SCALE: 1" = 50'

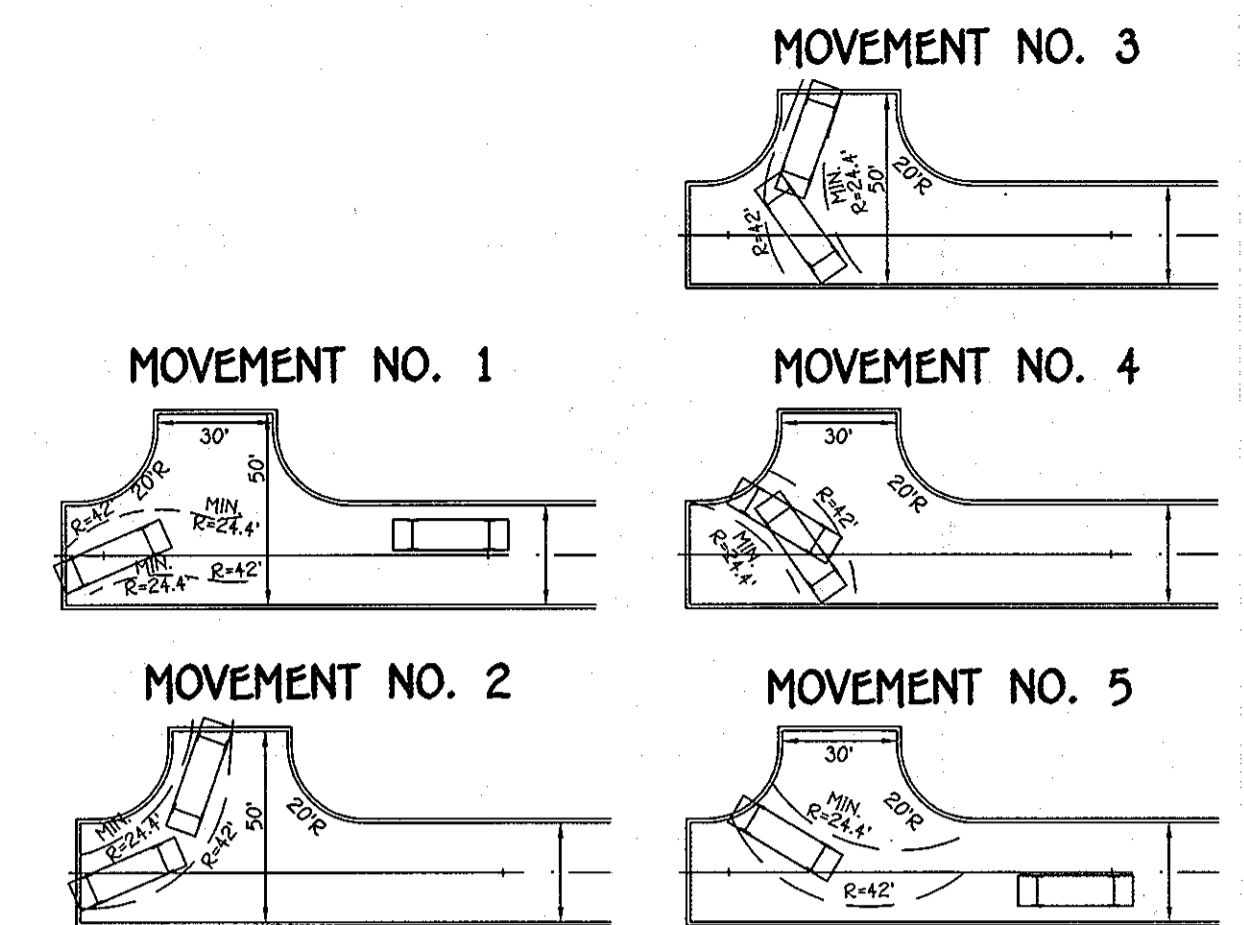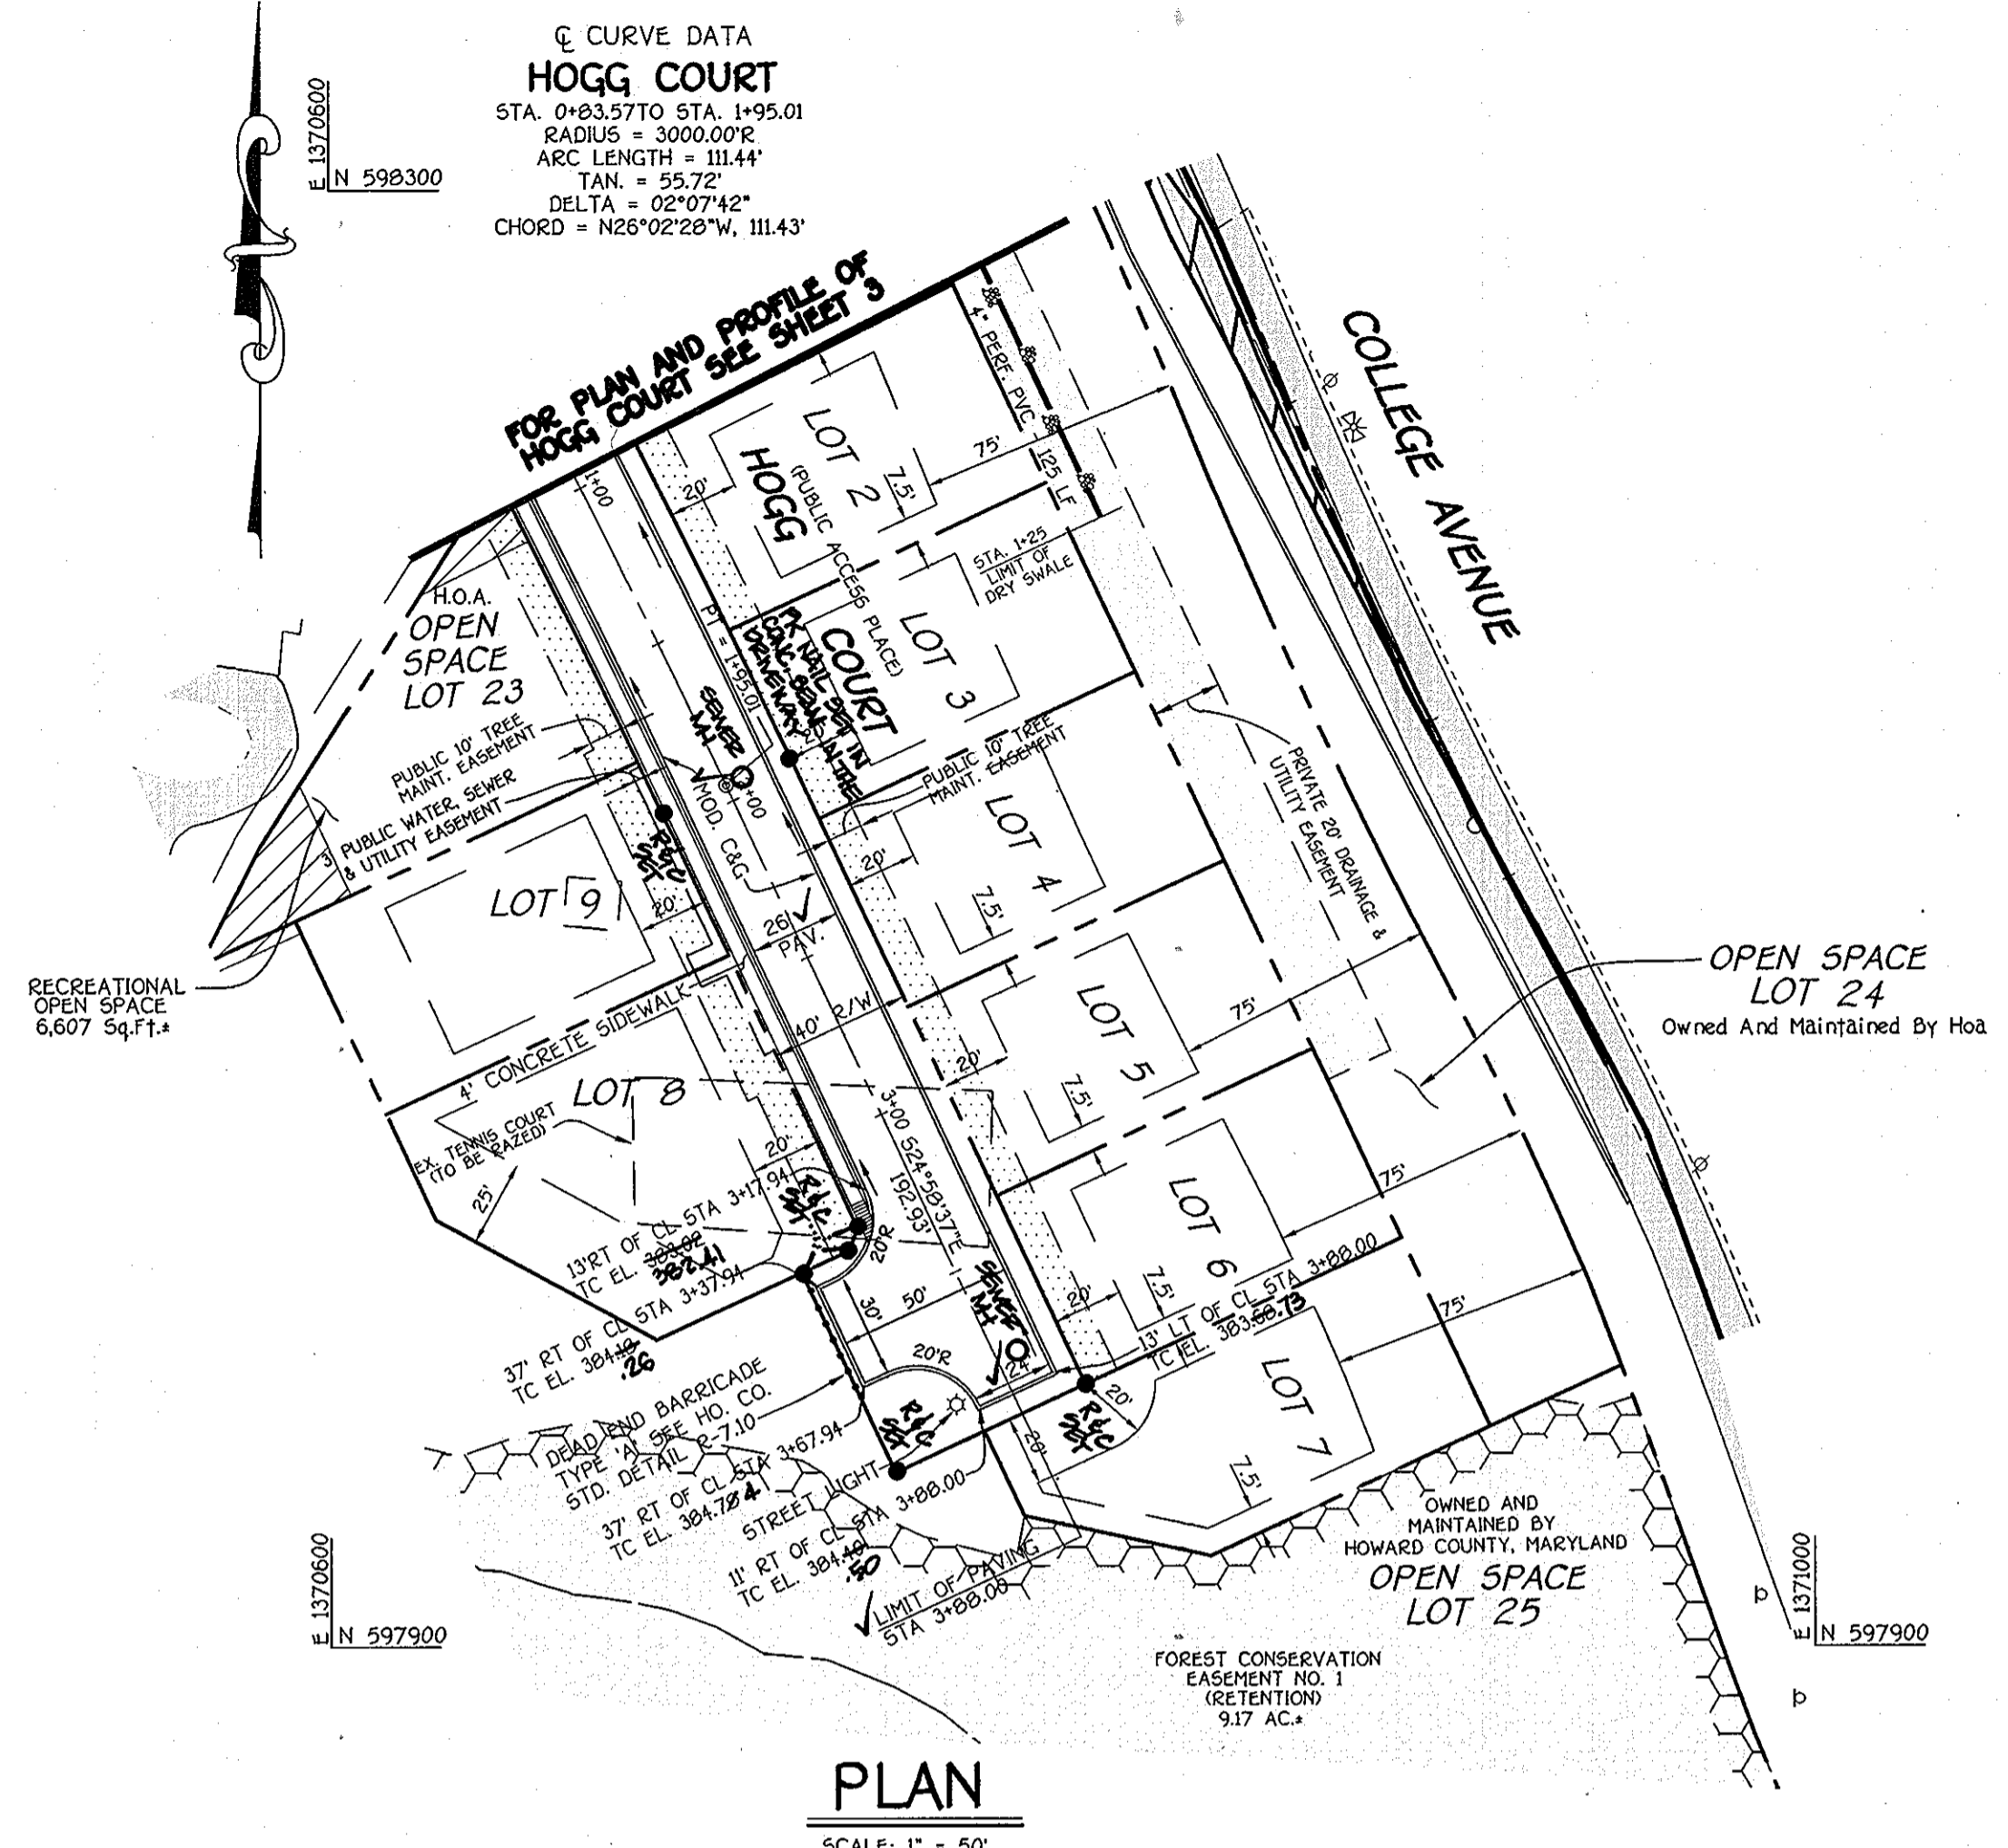

TURNING MOVEMENT ANALYSIS FOR BUS VEHICLE MOVEMENT @ HOGG COURT
SCALE: 1" = 50'

NO.	REVISIONS	DATE
1	AS BUILT	8-14-06

APPROVED DEPARTMENT OF PLANNING AND ZONING

Walter R. McNeil 8/14/06
CHIEF DIVISION OF PLANNING AND ZONING


Walter R. McNeil 8/14/06
CHIEF DEVELOPMENT, ENGINEERING DIVISION

APPROVED HOWARD COUNTY DEPARTMENT OF PUBLIC WORKS

Walter R. McNeil 8-14-06
CHIEF BUREAU OF HIGHWAYS

LEGEND

DENOTES NON-CREDIT OPEN SPACE

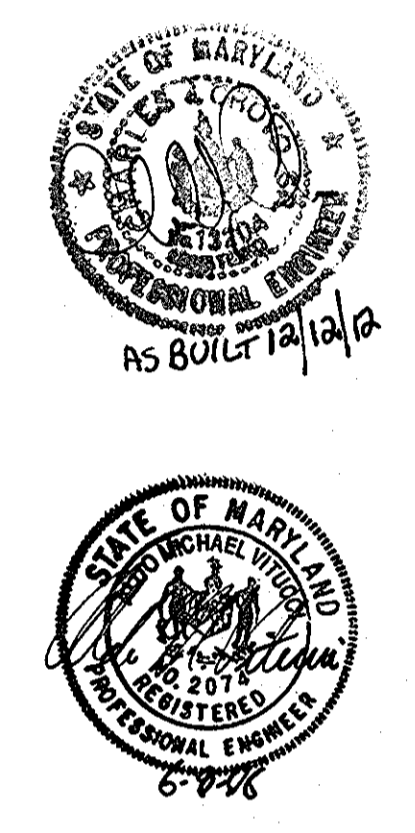


HOGG PROPERTY
LOTS 1 - 22, OPEN SPACE LOTS 23 - 26
ZONED: R-ED
TAX MAP NO. 25 GRID NO. 14 PARCEL NO. 64
SECOND ELECTION DISTRICT
HOWARD COUNTY, MARYLAND


HOGG COURT
PLAN AND PROFILE

OWNER / DEVELOPER
DORSEY FAMILY HOMES
10717B BIRMINGHAM WAY
WOODSTOCK, MARYLAND 21153
ATTN: ROB DORSEY

SCALE: AS SHOWN DATE: JUNE 8, 2006 DWG. NO. 4 OF 17
DES. J.C.L. DEN. J.C.L. CHR. A.M.V.

FISHER, COLLINS & CARTER, INC.
CIVIL ENGINEERING CONSULTANTS & LAND SURVEYORS
CENTENNIAL SQUARE OFFICE PARK - 10272 BALTIMORE NATIONAL PIKE
ELLSWORTH CITY, MARYLAND 21042
410.461.2005

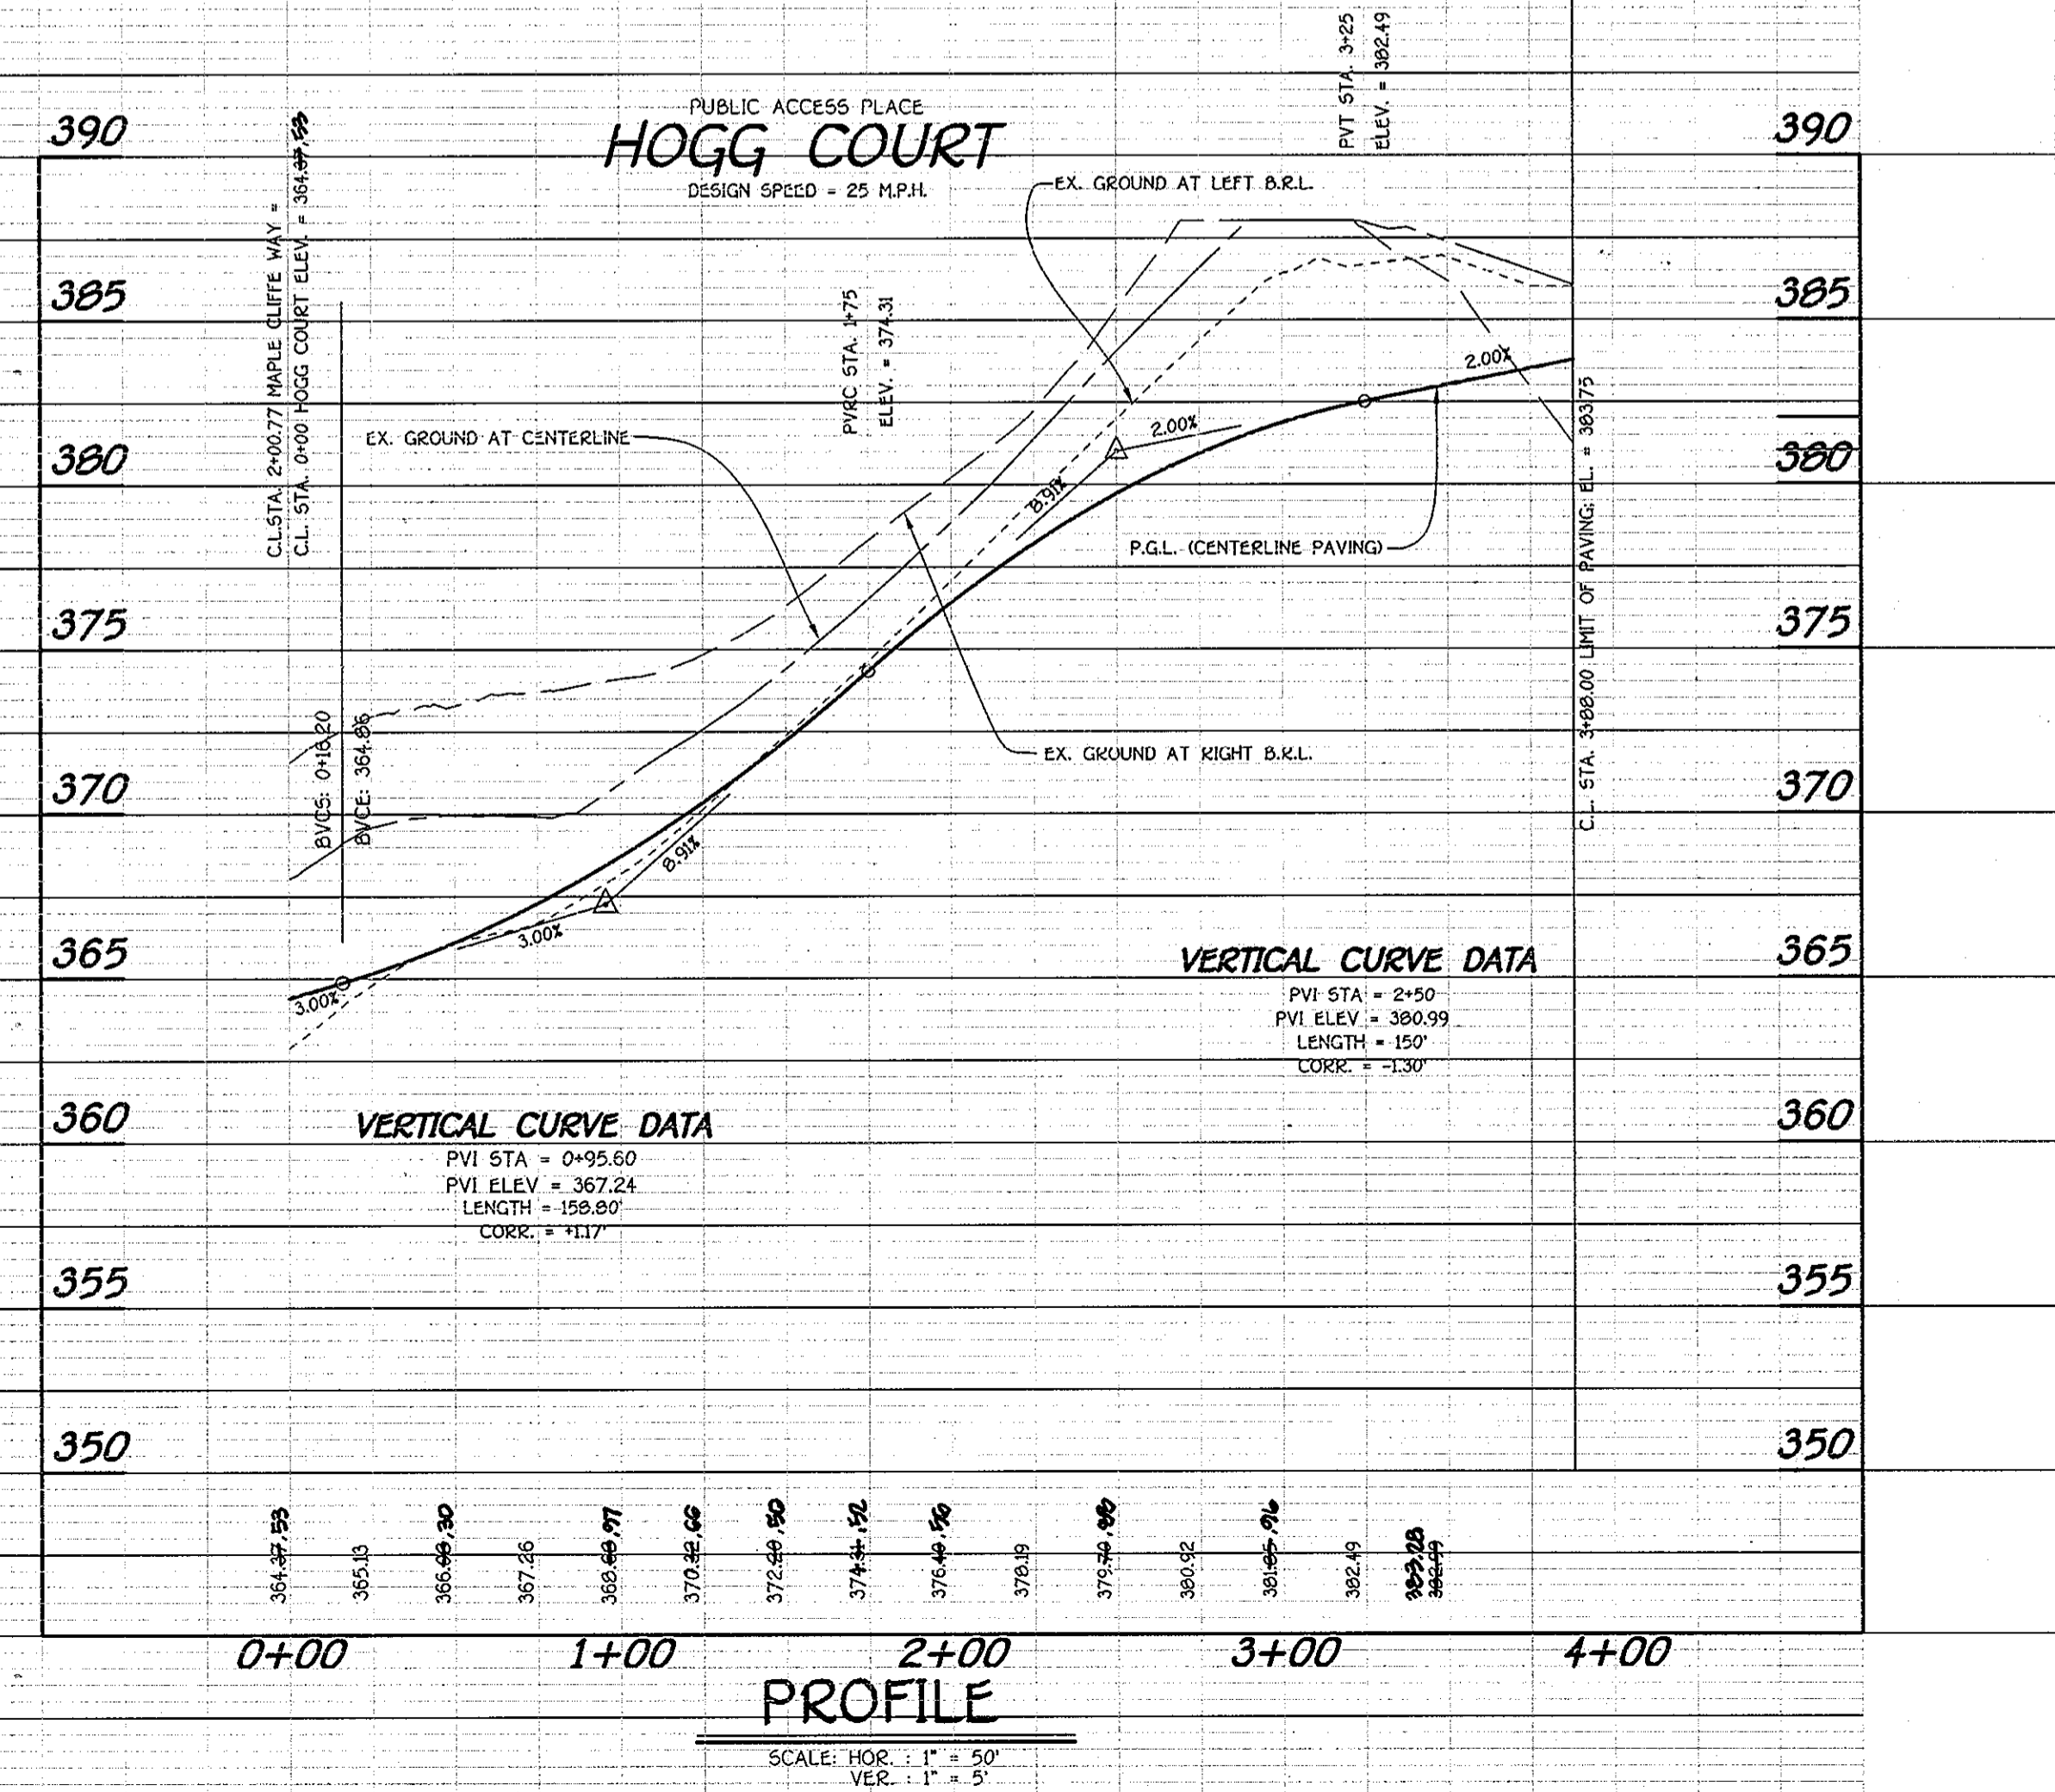

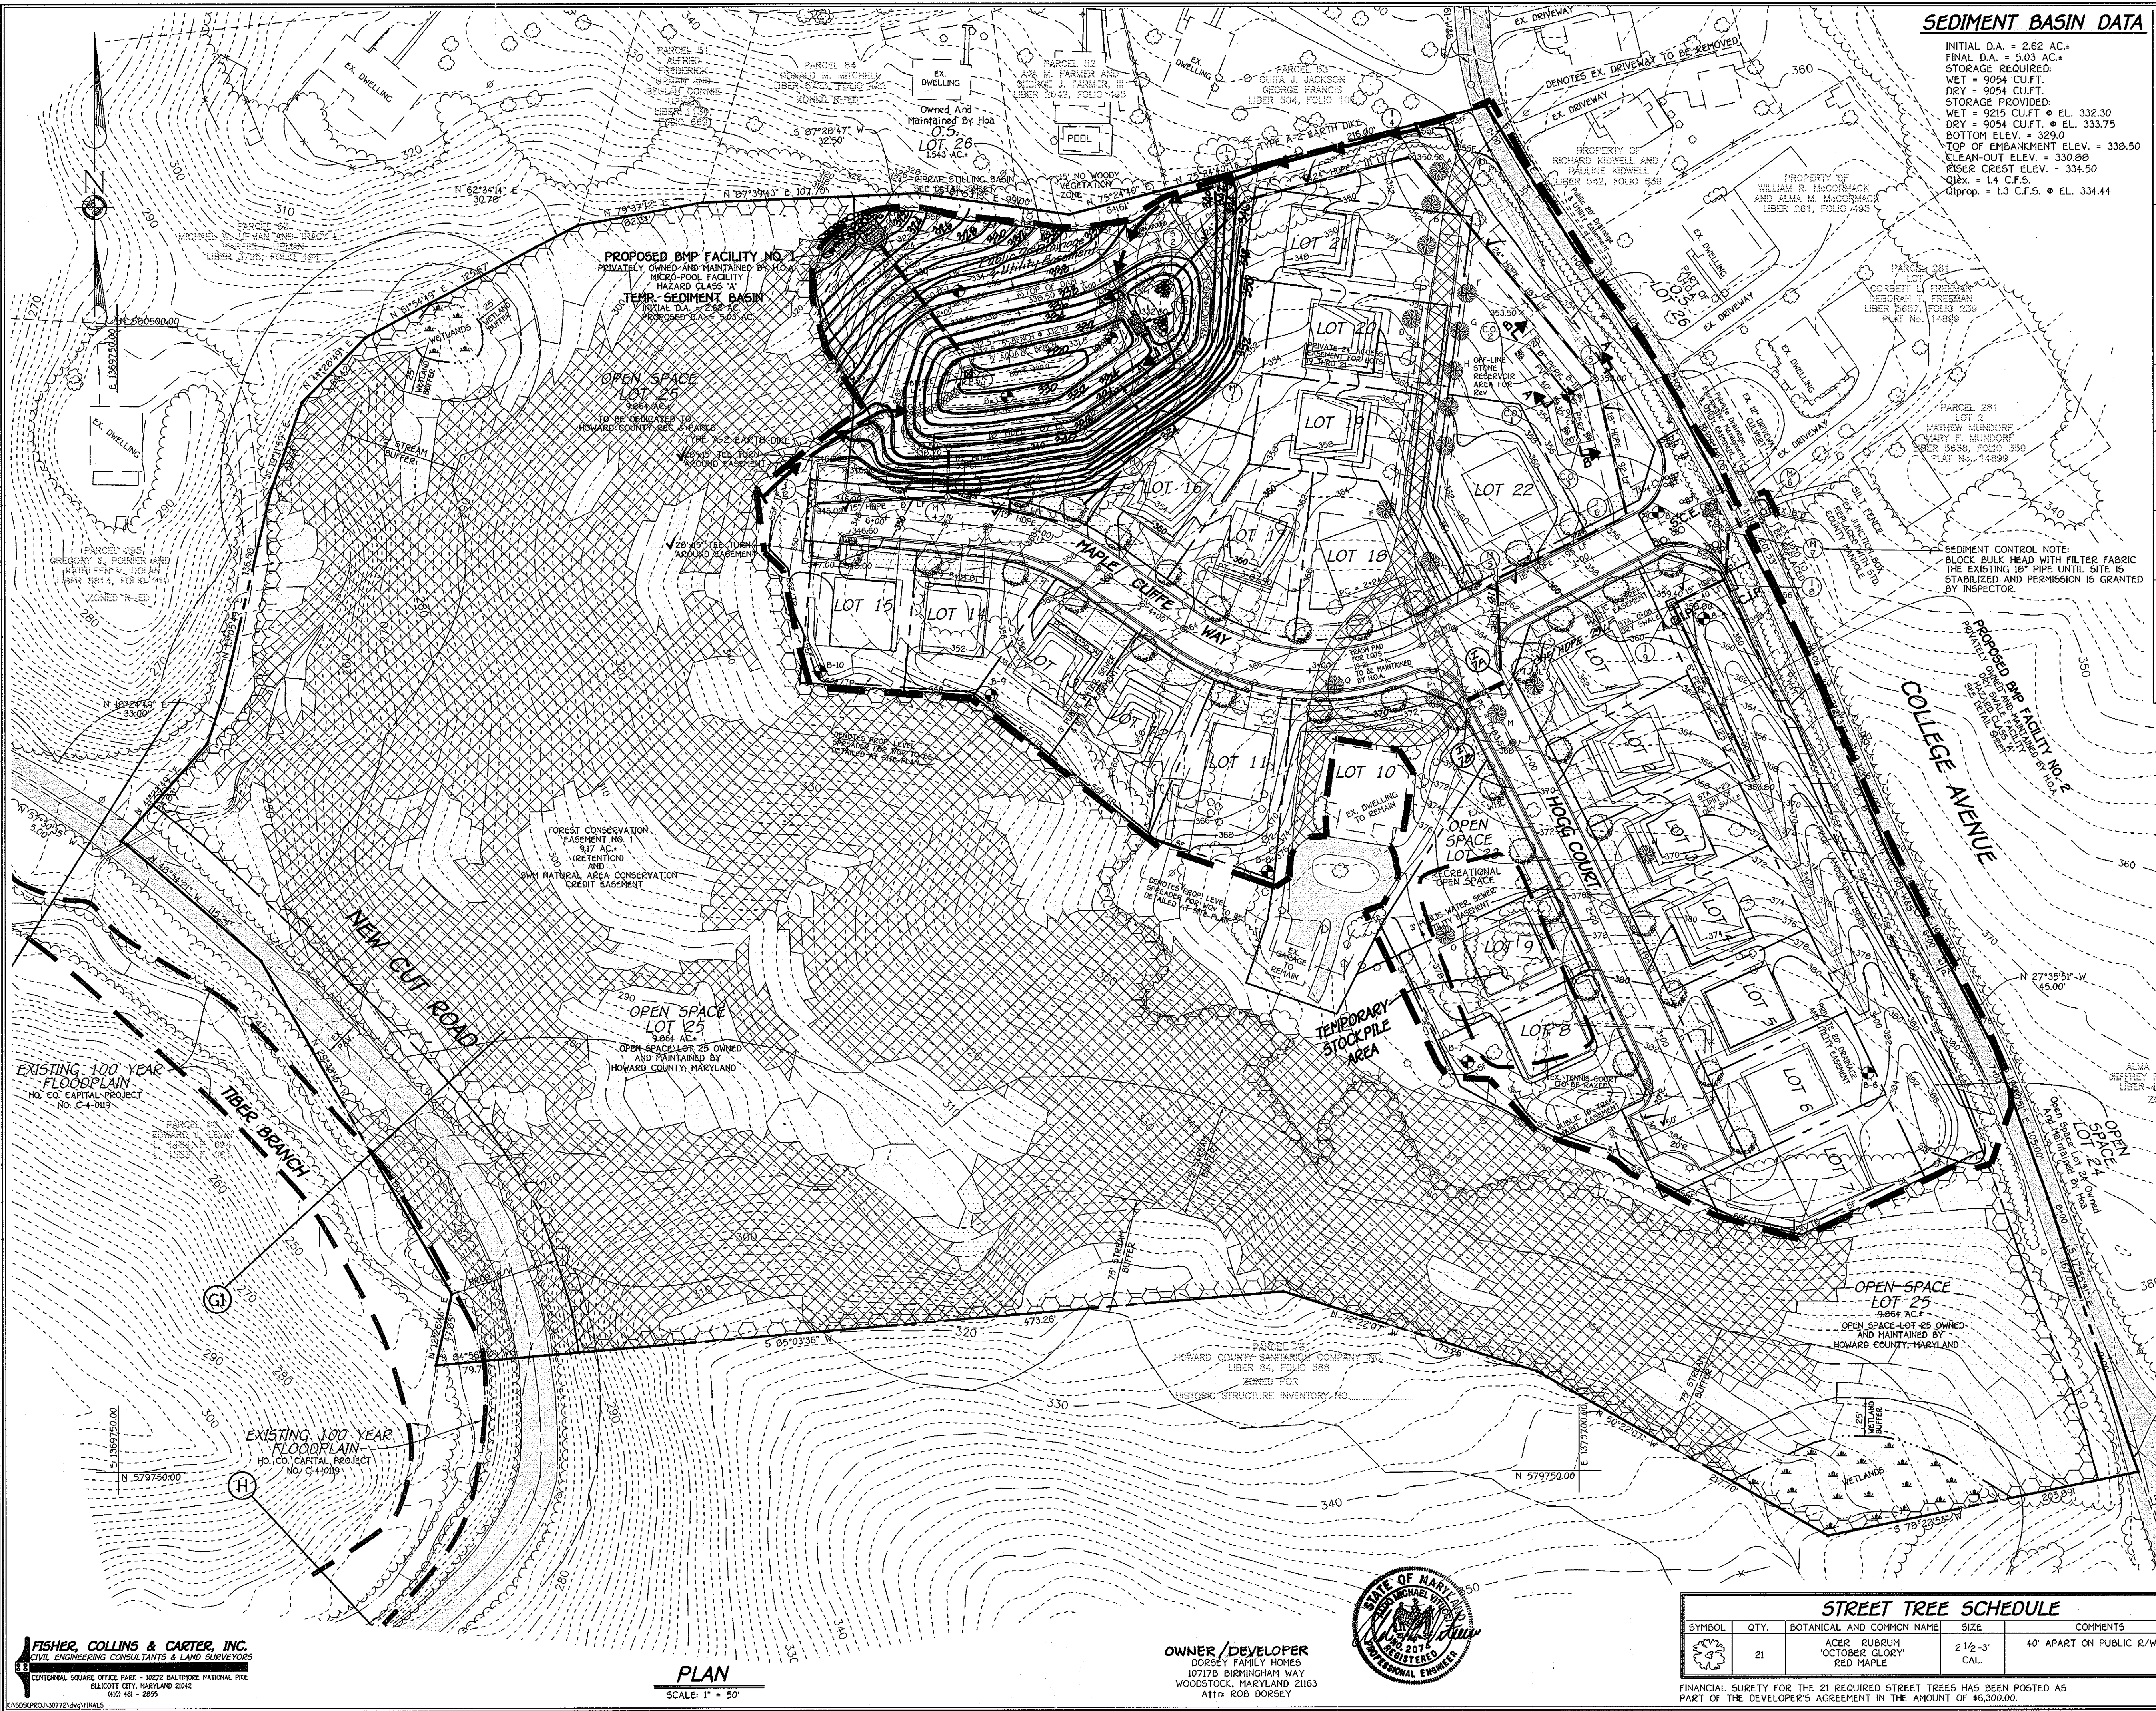

SEDIMENT BASIN DATA

INITIAL D.A. = 2.62 AC.
 FINAL D.A. = 5.03 AC.
 STORAGE REQUIRED:
 WET = 9054 CUFT.
 DRY = 9054 CUFT.
 STORAGE PROVIDED:
 NET 9215 CUFT. @ EL. 332.30
 DRY = 9054 CUFT. @ EL. 333.75
 BOTTOM ELEV. = 329.0
 TOP OF EMBANKMENT ELEV. = 338.50
 CLEAN-OUT ELEV. = 330.89
 RIDGE CREST ELEV. = 334.50
 Q10x = 1.4 C.F.S.
 Q1prop = 1.3 C.F.S. @ EL. 334.44

By The Developer:
 "I/We Certify That All Development And/Or Construction Will Be Done According To These Plans, And That Any Responsible Personnel Involved In The Construction Project Will Have A Certificate Of Attendance At A Department Of The Environment Approved Training Program For The Control Of Sediment And Erosion Before Beginning The Project. I Shall Engage A Registered Professional Engineer To Supervise Pond Construction And Provide The Howard Soil Conservation District With An "As-Built" Plan Of The Pond Within 30 Days Of Completion. I Also Authorize Periodic On-Site Inspections By The Howard Soil Conservation District."
 Signature of Developer: *Robert S. Dwyer* Date: 6-6-06

By The Engineer:
 "I Certify That This Plan For Pond Construction, Erosion And Sediment Control Represents A Practical And Feasible Design Based On My Personal Knowledge Of The Site Conditions. This Plan Was Prepared In Accordance With The Requirements Of The Howard Soil Conservation District. I Have Reviewed The Plans And I Certify That He/She Must Engage A Registered Professional Engineer To Supervise Pond Construction And Provide The Howard Soil Conservation District With An "As-Built" Plan Within 30 Days Of Completion."
 Signature: *Robert S. Dwyer* Date: 6-9-06

These Plans Have Been Reviewed For The Howard Soil Conservation District And Meet The Technical Requirements For Small Pond Construction, Soil Erosion And Sediment Control.
 Signature: *John M. ...* Date: 6/9/06

USDA-Natural Resources Conservation Service
 Signature: *John M. ...* Date: 6/9/06

These Plans For Small Pond Construction, Soil Erosion And Sediment Control Meet The Requirements Of The Howard Soil Conservation District.
 Signature: *John M. ...* Date: 6/19/06


Approved: Department Of Public Works
 Signature: *Mark DeFuria* Date: 8/3/06

Approved: Department Of Planning And Zoning
 Signature: *Kurt ...* Date: 8/17/06

Chief, Division Of Land Development
 Signature: *...* Date: 8/17/06

AS-BUILT CERTIFICATION
 I Herby Certify That The Facility Shown On This Plan Was Constructed As Shown On The As-Built Plans And Meets The Approved Plans And Specifications.
 Signature: *...* P.E. No. B204 Date: 10/12/06

Certify Means To State Or Declare A Professional Opinion Based Upon Onsite Inspections And Material Tests Which Are Conducted During Construction. The Onsite Inspections And Material Tests Are Those Inspections And Tests Deemed Sufficient And Appropriate Commonly Accepted Engineering Standards. Certify Does Not Mean Or Imply A Guarantee By The Engineer Nor Does An Engineer's Certification Relieve Any Other Party From Meeting Requirements Imposed By Contract, Employment, Or Other Means, Including Meeting Commonly Accepted Industry Practices.

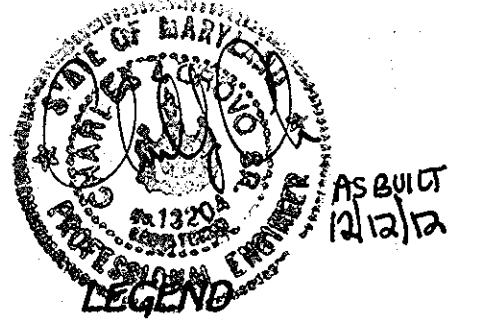

- LEGEND**
- SSF — SSF — SSF SUPER-SILT FENCE
 - TP — TP — TP TREE PROTECTION FENCE
 - IP INLET PROTECTION
 - S.C.E. STABILIZED CONSTRUCTION ENTRANCE
 - A-2 EARTH DICE
 - LIMIT OF DISTURBANCE
 - G.I.P. GABION INFLOW PROTECTION
 - R.P.S. REMOVABLE PUMPING STATION
 - SWM NATURAL AREA CONSERVATION CREDIT EASEMENT (FOREST RETENTION)
 - DENOTES EXISTING DRIVEWAY TO BE REMOVED
 - EROSION CONTROL MATTING


STREET TREE SCHEDULE

SYMBOL	QTY.	BOTANICAL AND COMMON NAME	SIZE	COMMENTS
	21	ACER RUBRUM OCTOBER GLODY RED MAPLE	2 1/2 - 3" CAL.	40' APART ON PUBLIC R/W

STREET TREE, GRADING AND SEDIMENT CONTROL PLAN
HOGG PROPERTY
 LOTS 1 - 22, OPEN SPACE LOTS 23 - 26
 ZONED: R-ED
 TAX MAP NO. 25 GRID NO. 14 PARCEL NO. 64
 SECOND ELECTION DISTRICT
 HOWARD COUNTY, MARYLAND
 DATE: JUNE 6, 2006
 SHEET 5 OF 17

FISHER, COLLINS & CARTER, INC.
 CIVIL ENGINEERING CONSULTANTS & LAND SURVEYORS
 CENTRAL SQUARE OFFICE PARK - 3072 BALTIMORE NATIONAL PIKE
 ELLICOTT CITY, MARYLAND 21042
 4100 461 - 2000


OWNER / DEVELOPER
 DORSEY FAMILY HOMES
 10717B BIRNINGHAM WAY
 WOODSTOCK, MARYLAND 21163
 ATTN: ROB DORSEY

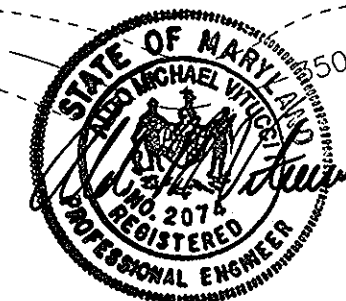

PLAN
 SCALE: 1" = 50'

FINANCIAL SURETY FOR THE 21 REQUIRED STREET TREES HAS BEEN POSTED AS PART OF THE DEVELOPER'S AGREEMENT IN THE AMOUNT OF \$6,300.00.

F-06-109
AS BUILT

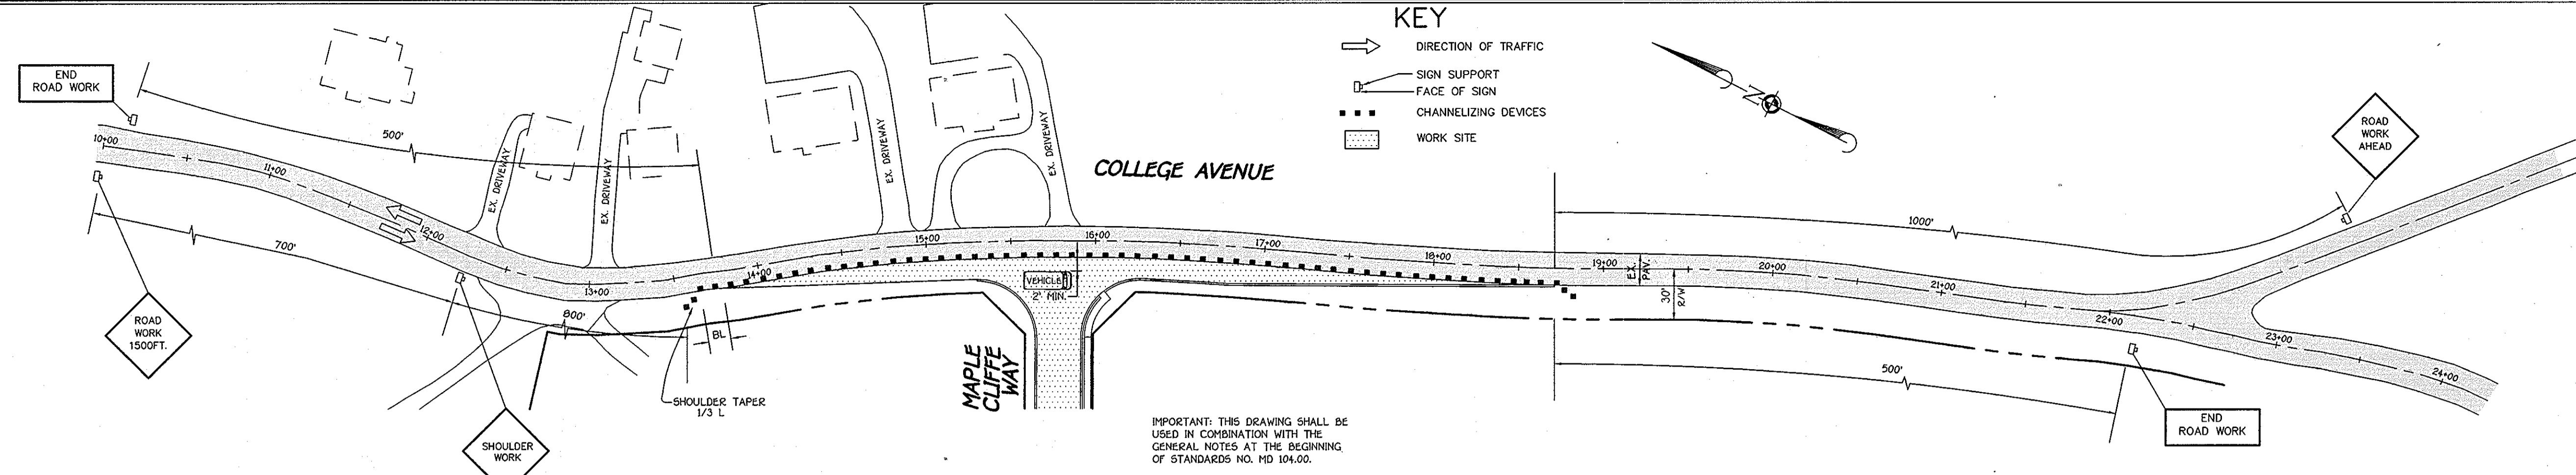





APPROVED: DEPARTMENT OF PUBLIC WORKS
Mark D. Green (act. Eng.) 8/3/06
 CHIEF, BUREAU OF HIGHWAYS DATE

APPROVED: DEPARTMENT OF PLANNING AND ZONING
Kent Steinhilber (act. Eng.) 8/17/06
 CHIEF, DIVISION OF LAND DEVELOPMENT DATE

John J. ... 8/17/06
 CHIEF, DEVELOPMENT ENGINEERING DIVISION DATE

- MAINTENANCE OF TRAFFIC SPECIAL PROVISIONS**
- THE PURPOSE OF THIS PORTION OF THE SPECIAL PROVISIONS IS TO SET FOR THE TRAFFIC CONTROL REQUIREMENTS NECESSARY FOR THE SAFE AND EFFICIENT MAINTENANCE OF TRAFFIC THROUGH WORK AREAS, AND TO MINIMIZE ANY INCONVENIENCES TO THE TRAVELING PUBLIC AND THE CONTRACTOR AND/OR PERMITTEE.
 - PROPER TRAFFIC CONTROL THROUGH WORK AREAS IS ESSENTIAL FOR INSURING THE SAFETY AND THAT OF HIGHWAY WORKERS HAS THE HIGHEST PRIORITY OF ALL TASKS WITHIN THIS PROJECT. THE PROPER APPLICATION OF THE APPROVED TRAFFIC CONTROL PLAN (TCP) WILL PROVIDE THE DESIRED LEVEL OF SAFETY.
 - THROUGHOUT THESE SPECIAL PROVISIONS, ANY MENTION OF THE TCP SHALL BE IMPLIED TO INCLUDE ANY COMBINATION OF TYPICAL TRAFFIC CONTROL STANDARDS WHICH FORM THE OVERALL TCP FOR THIS PROJECT WHICH HAS BEEN APPROVED BY THE APPROPRIATE SHA TRAFFIC ENGINEER.
 - THE CONTRACTOR AND/OR PERMITTEE SHALL BE REQUIRED TO ADHERE TO THE PROVISIONS OF THE MANUAL OF UNIFORM TRAFFIC CONTROL DEVICES (MUTCD) 1988 EDITION, ESPECIALLY PART VI, AND TO SECTION 604 OF THE MANUAL AND NOT STANDARD SPECIFICATIONS FOR CONSTRUCTION AND MATERIALS (UNIFORM, 1992, INCLUDING ALL REVISIONS AND SUPPLEMENTS TO EACH).
 - THE CONTRACTOR AND/OR PERMITTEE SHALL BE REQUIRED TO ADHERE TO THE REQUIREMENTS SET FORTH IN THE TCP AND THESE SPECIAL PROVISIONS UNLESS OTHERWISE DIRECTED BY THE ENGINEER. ANY REQUESTS TO MAKE PRIOR CHANGES TO THE TCP OR THE SPECIAL PROVISIONS WITH REGARD TO THE TRAFFIC CONTROL ITEMS SHALL BE MADE IN WRITING TO THE ENGINEER A MINIMUM OF THREE (3) WORKING DAYS PRIOR TO THE PROPOSED SCHEDULING CHANGE. THE CONTRACTOR AND/OR PERMITTEE SHALL HAVE WRITTEN APPROVAL OF THE ENGINEER PRIOR TO THE IMPLEMENTATION OF ANY CHANGE.
 - NO WORK SHALL BEGIN ON ANY WORK ACTIVITY OR WORK PHASE UNTIL ALL REQUIRED TRAFFIC CONTROL PATTERNS AND DEVICES INDICATED ON THE TCP FOR THAT ACTIVITY OR PHASE ARE COMPLETELY AND CORRECTLY IN PLACE TO HAVE BEEN CHECKED FOR APPROVED USAGE.
 - GENERAL AND SPECIFIC WARNING SIGNS SHALL ONLY BE IN PLACE WHEN SPECIFIC WORK TASKS AND ACTIVITIES ARE ACTUALLY UNDERWAY OR CONDITIONS EXIST THAT POSE A POTENTIAL HAZARD TO THE PUBLIC, AND ANY ADDITIONAL SIGNING HAS BEEN APPROVED BY THE APPROPRIATE SHA TRAFFIC ENGINEER.
 - NOTE: THE PRACTICE OF PLACING SIGNING AND OTHER TRAFFIC CONTROL DEVICES IN ADDITION TO THOSE INDICATED ON THE APPROVED TCP IS NOT PERMITTED.
 - THE CONTRACTOR AND/OR PERMITTEE SHALL PROVIDE, MAINTAIN IN NEW CONDITION, AND MOVE WHEN NECESSARY, OR AS DIRECTED BY THE ENGINEER, ALL TRAFFIC CONTROL DEVICES USED FOR THE GUIDANCE AND PROTECTION OF MOTORISTS, PEDESTRIANS, AND WORKERS.
 - ALL TRAFFIC CONTROL DEVICES REQUIRED BY THE TCP SHALL BE KEPT IN GOOD CONDITION, FULLY PERFORMING AS SET FORTH IN THE TCP. THE INTENT AND/OR SECTION 604 OF THE SPECIFICATIONS FOR REFLECTIVE DEVICES, A PARTICULAR DEVICE IS ASSURED TO HAVE FAILED TO MEET MINIMUM OPERATIONAL STANDARDS WHEN THE DEVICE NO LONGER HAS RETRO-REFLECTANCE CAPABILITY OF AT LEAST 50% OF THE SPECIFIED MINIMUM VALUE OVER AT LEAST 90% OF THE VISIBLE REFLECTIVE SURFACE.
 - ALL TRAFFIC CONTROL DEVICES NOT REQUIRED FOR THE SAFE CONDUCT OF TRAFFIC SHALL BE PROMPTLY REMOVED, COMPLETELY COVERED, TURNED AWAY FROM TRAFFIC, OR OTHERWISE TAKEN OUT OF SERVICE. IT IS INTENDED THAT NO TRAFFIC CONTROL DEVICE IS TO BE IN SERVICE WHEN THERE IS NO CLEAR CUT REASON FOR THE DEVICE.
 - THROUGHOUT THE PERIODS OF WORK ACTIVITIES, TRAFFIC SHALL BE MAINTAINED BY IMPLEMENTING THE APPROVED TCP, IN LIEU OF THE TCP PREPARED FOR THIS PROJECT, AND/OR INDIVIDUAL TYPICAL TRAFFIC CONTROL STANDARDS. THE CONTRACTOR AND/OR PERMITTEE HAS THE OPTION OF PREPARING AND SUBMITTING A TCP, WHOLLY OR IN PART, OF HIS OWN DESIGN FOLLOWING GUIDELINES SET FORTH IN THE MUTCD AND PRESCRIBED BY THE ADMINISTRATION. A TCP DEVELOPED BY THE CONTRACTOR AND/OR PERMITTEE SHALL NOT BE IMPLEMENTED UNTIL ADVANCE WRITTEN APPROVAL IS OBTAINED FROM THE ENGINEER. TCPS MAY BE IMPLEMENTED WITHIN A SINGLE PROJECT OR JOINTLY BETWEEN TWO OR MORE PROJECTS. IN SITUATIONS WHERE TCPS ARE JOINTLY IMPLEMENTED, CARE SHALL BE EXERCISED TO PRESENT CORRECT AND NON-CONFLICTING GUIDANCE TO THE TRAVELING PUBLIC.
 - THROUGHOUT THESE SPECIAL PROVISIONS, WHERE SPEED OF TRAFFIC IS NOTED, THIS MEANS THE POSTED SPEED OR PREVAILING TRAVEL SPEED, WHICHEVER IS HIGHER, UNLESS OTHERWISE NOTED.
 - TRAFFIC SHALL BE MAINTAINED AT ALL TIMES THROUGHOUT THE ENTIRE LENGTH OF THE PROJECT, UNLESS OTHERWISE NOTED. NO TRAVEL LANES OTHER THAN THOSE DESIGNED IN THE TCP SHALL BE CLOSED WITHOUT OBTAINING PRIOR APPROVAL FROM THE ENGINEER. ALL INGRESS AND EGRESS TO THE WORK AREA BY THE CONTRACTOR AND/OR PERMITTEE SHALL BE PERFORMED WITH THE FLOW OF TRAFFIC.

TEMPORARY TRAFFIC CONTROL PLAN
 NO SCALE

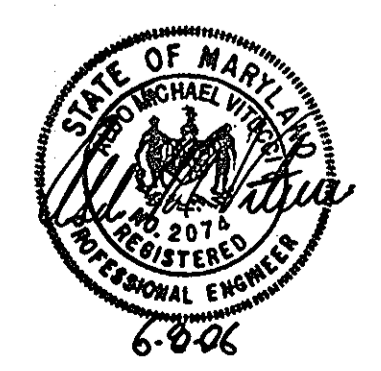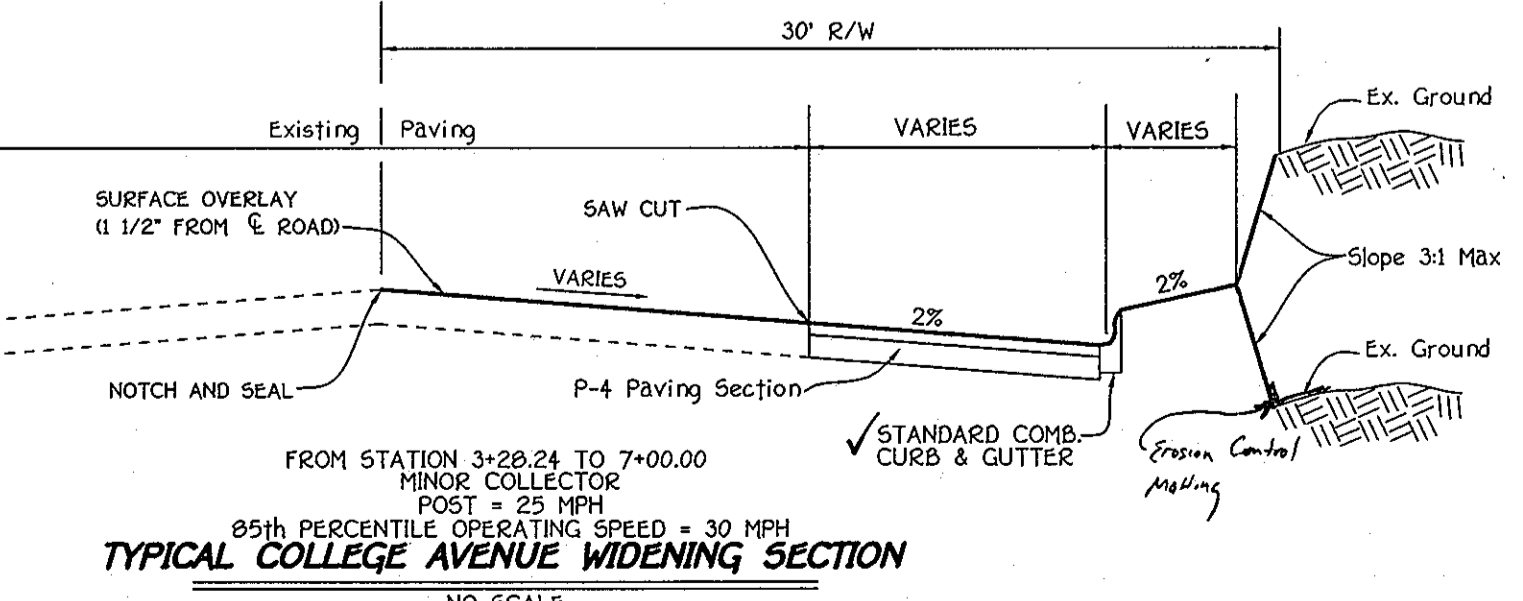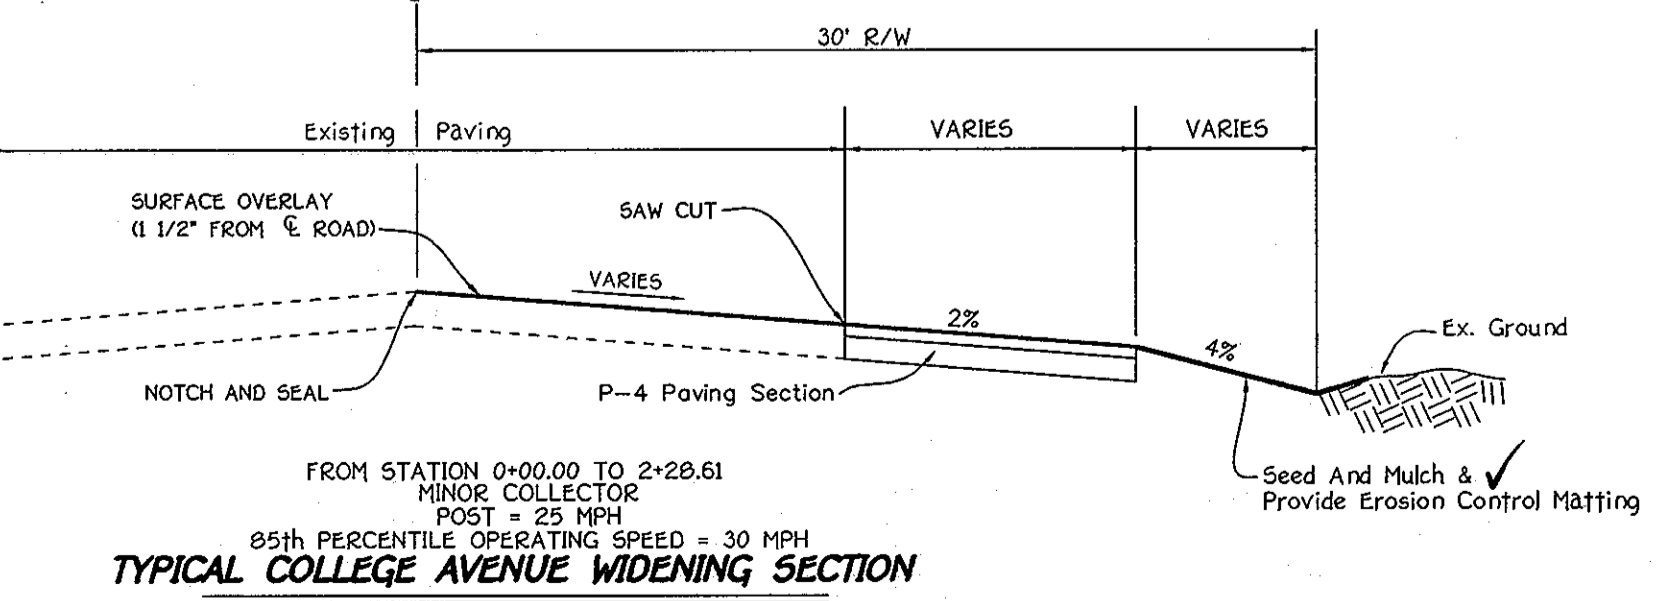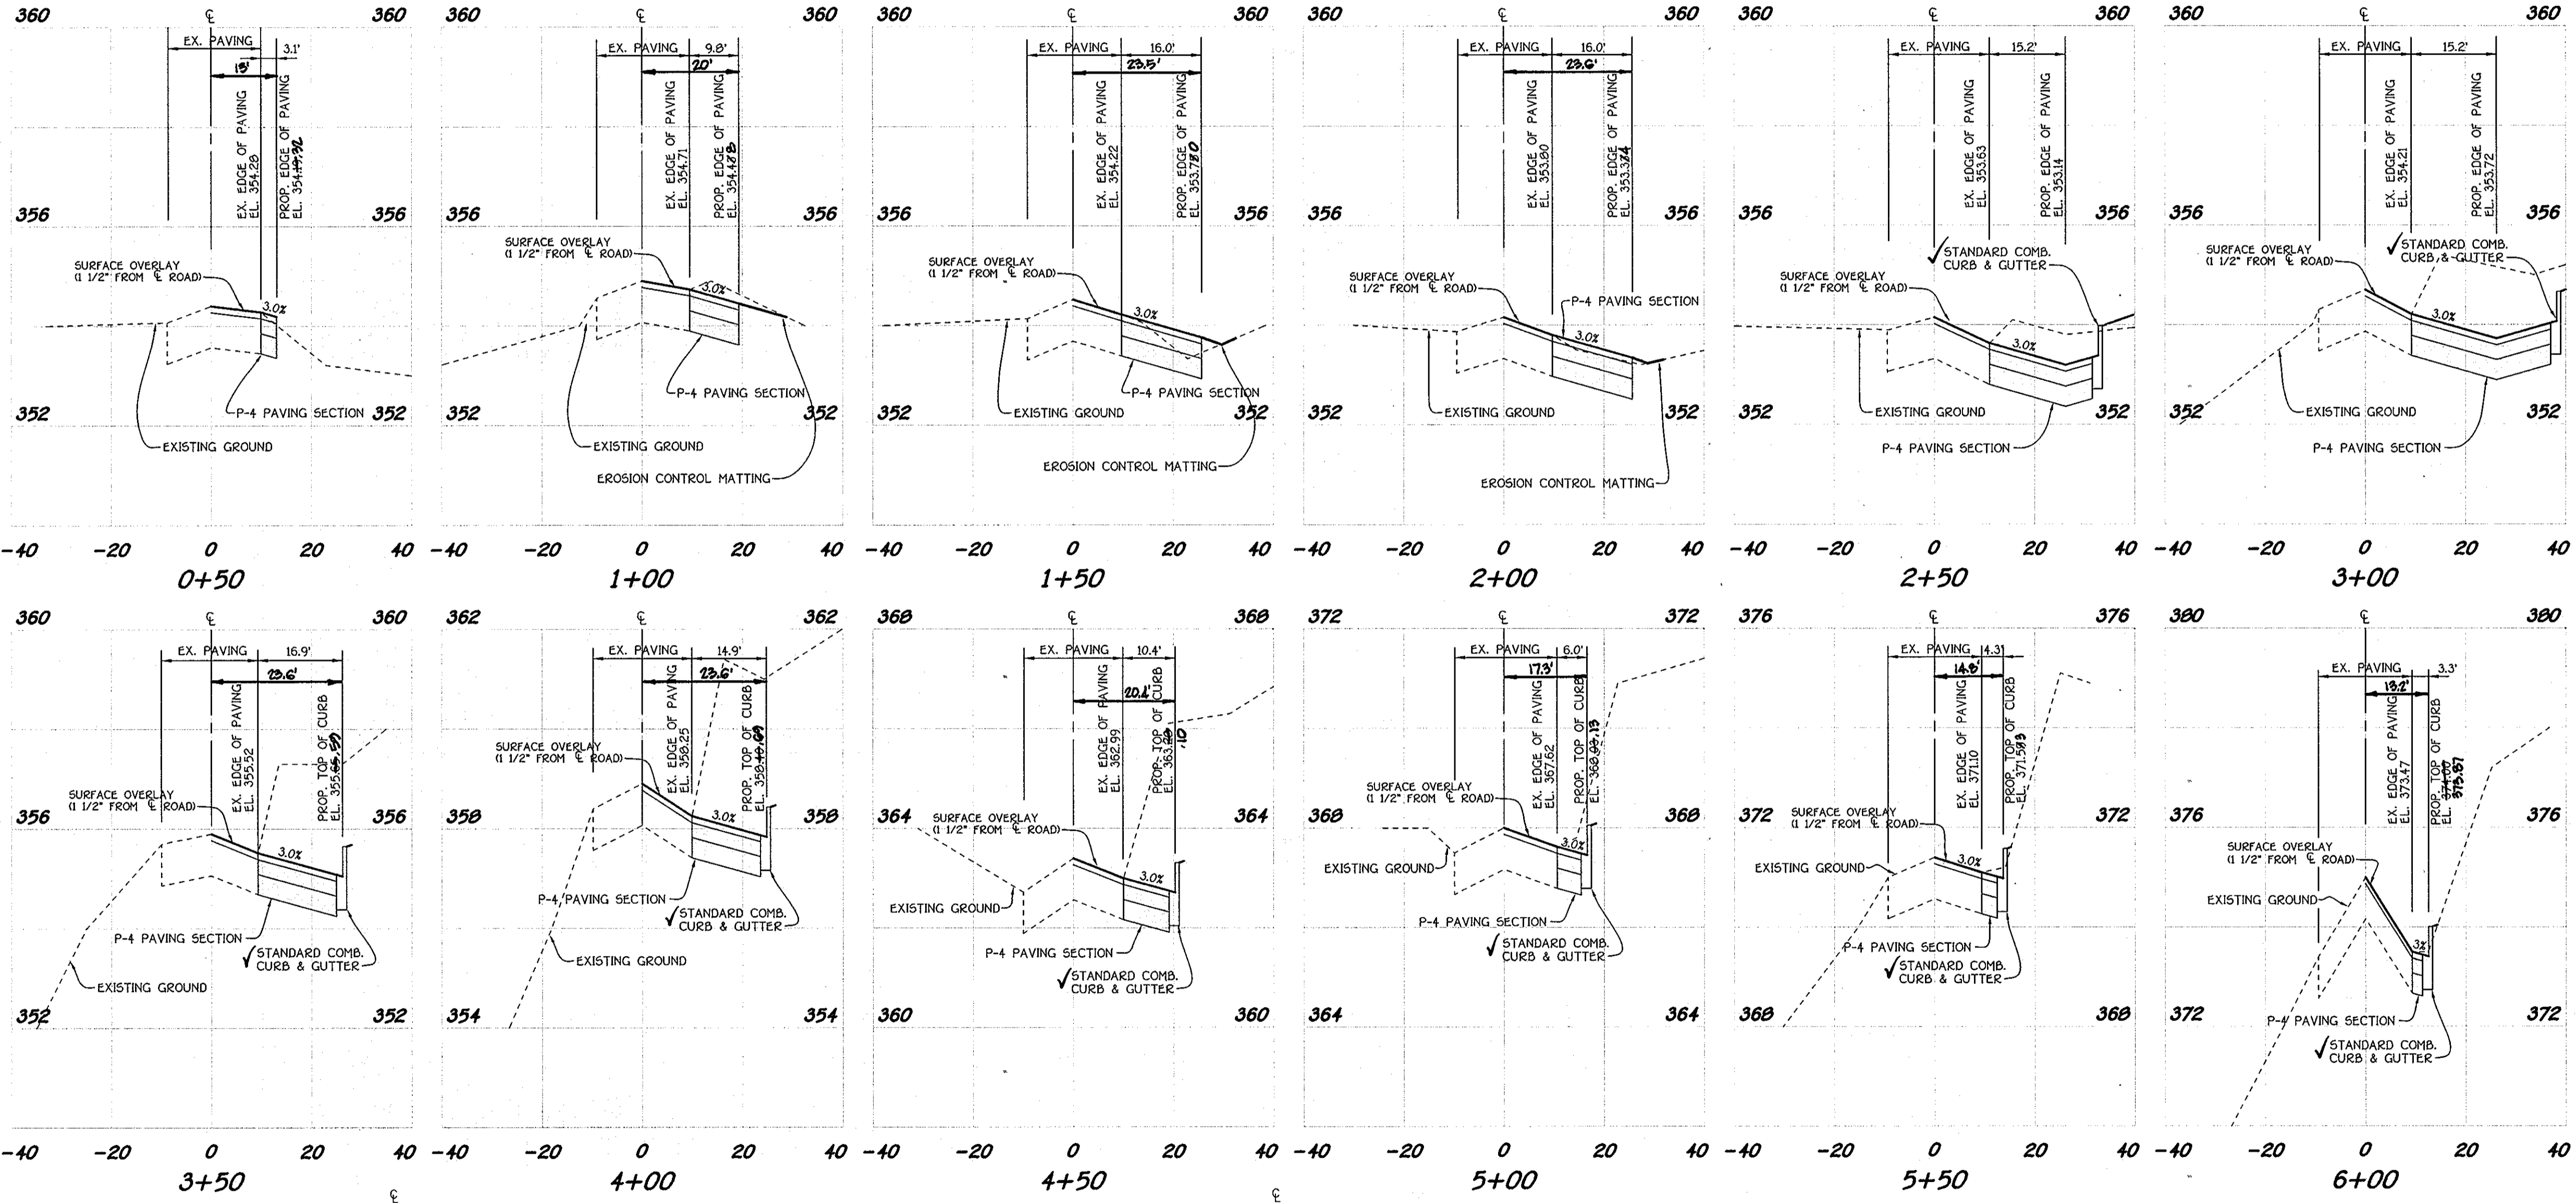


CROSS-SECTIONS
 SCALE: HORIZ. : 1" = 20'
 VERT. : 1" = 2'



TEMPORARY TRAFFIC CONTROL PLAN & CROSS-SECTIONS FOR COLLEGE AVE. HOGG PROPERTY
 LOTS 1 - 22, OPEN SPACE LOTS 23 - 26
 ZONED: R-ED
 TAX MAP NO. 25 GRID NO. 14 PARCEL NO. 64
 SECOND ELECTION DISTRICT
 HOWARD COUNTY, MARYLAND
 DATE: JUNE 8, 2006
 SHEET 6 OF 17

OWNER/DEVELOPER
 DORSEY FAMILY HOMES
 10717B BIRMINGHAM WAY
 WOODSTOCK, MARYLAND 21163
 ATT: ROB DORSEY

FISHER, COLLINS & CARTER, INC.
 CIVIL ENGINEERING CONSULTANTS & LAND SURVEYORS
 CENTRAL SQUARE OFFICE PARK - 3072 GAITHERS NATIONAL PIKE
 ELICOTT CITY, MARYLAND 21042
 (410) 461-2000

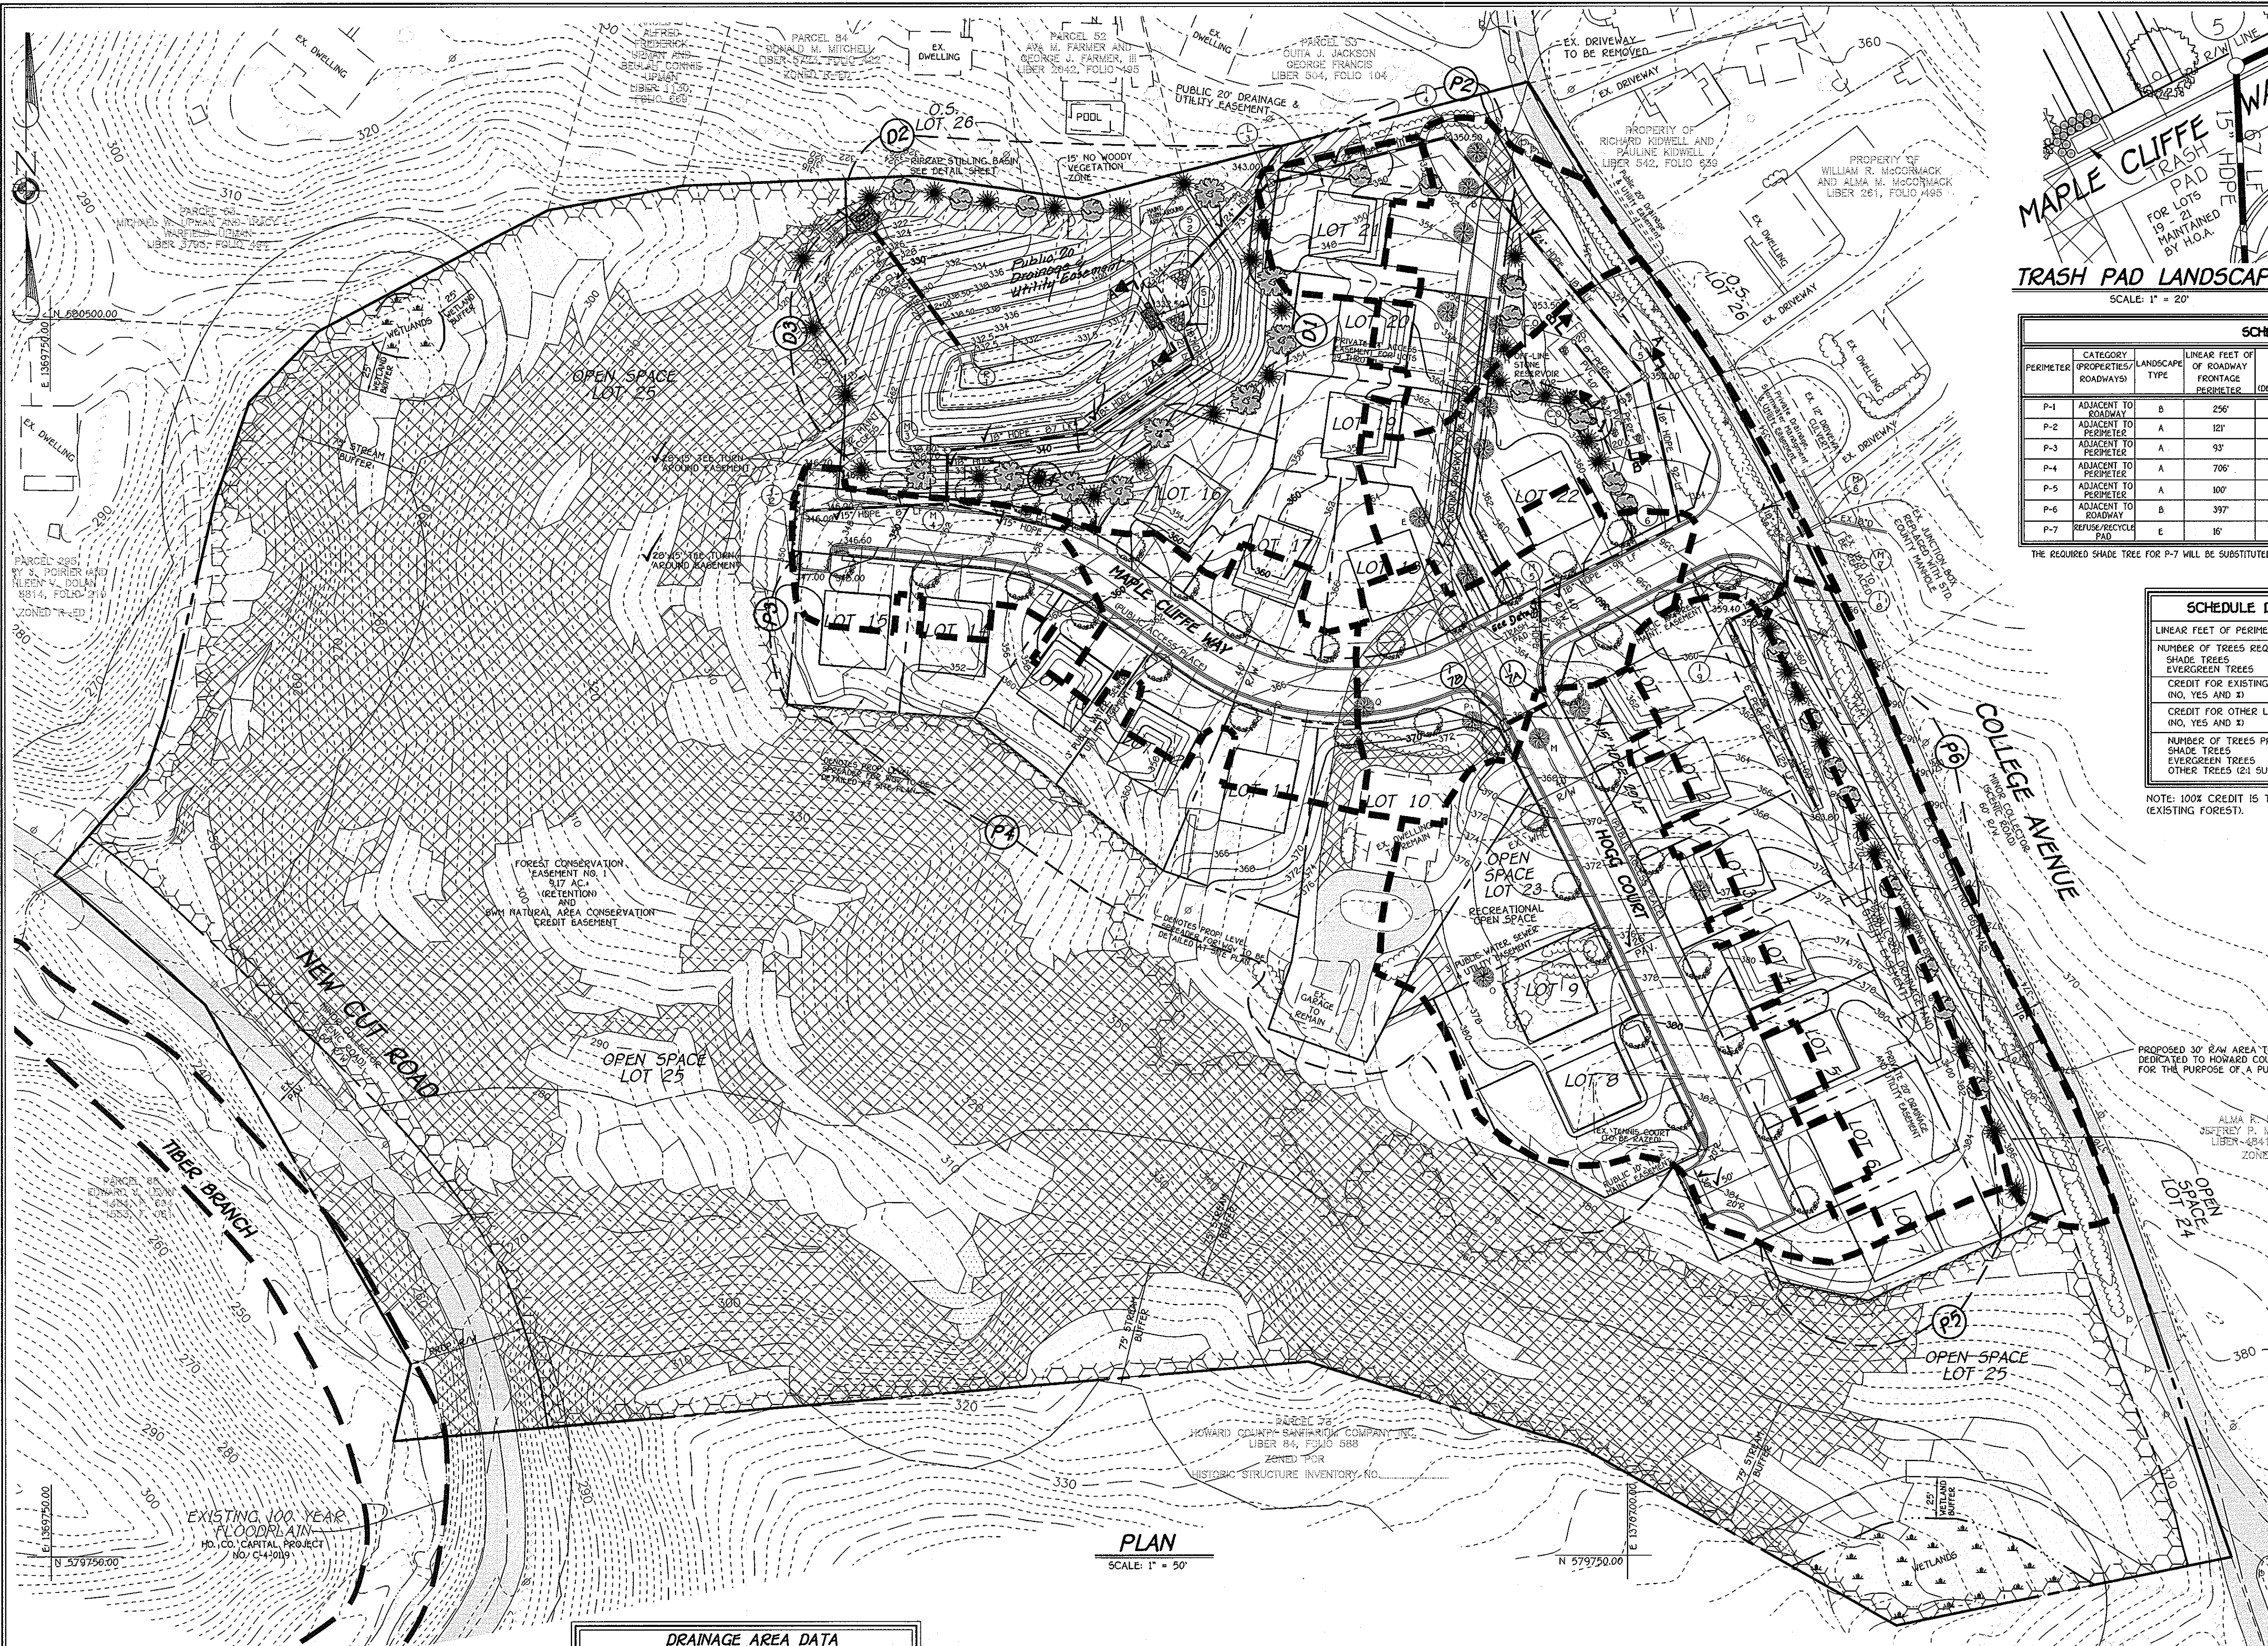

APPROVED: DEPARTMENT OF PUBLIC WORKS
 Chief, Bureau of Highways *Michael DeLeon* 8/12/06 DATE
 APPROVED: DEPARTMENT OF PLANNING AND ZONING
 Chief, Division of Land Development *Victor Henderson* 8/17/06 DATE
 Chief, Development Engineering Division *Chad D. Summers* 8/17/06 DATE

REVISIONS

NO.	DESCRIPTION	DATE

TRASH PAD LANDSCAPING
 SCALE: 1" = 20'

SCHEDULE A PERIMETER LANDSCAPE EDGE

PERIMETER	CATEGORY (PROPERTIES/ROADWAYS)	LANDSCAPE TYPE	LINEAR FEET OF ROADWAY FRONTAGE PERIMETER	CREDIT FOR EXISTING VEGETATION (YES, NO, LINEAR FEET) (DESCRIBE BELOW IF NEEDED)	CREDIT FOR WALL, FENCE OR BEAM (YES, NO, LINEAR FEET) (DESCRIBE BELOW IF NEEDED)	NUMBER OF PLANTS REQUIRED			NUMBER OF PLANTS PROVIDED		
						SHADE TREES	EVERGREEN TREES	SHRUBS	SHADE TREES	EVERGREEN TREES	SHRUBS
P-1	ADJACENT TO ROADWAY	B	256'	NO	NO	5	6	-	5	6	-
P-2	ADJACENT TO PERIMETER	A	121'	NO	NO	2	0	-	2	0	-
P-3	ADJACENT TO PERIMETER	A	93'	YES, 100%	NO	0	0	-	0	0	-
P-4	ADJACENT TO PERIMETER	A	706'	YES, 100%	NO	0	0	-	0	0	-
P-5	ADJACENT TO PERIMETER	A	100'	YES, 100%	NO	0	0	-	0	0	-
P-6	ADJACENT TO ROADWAY	B	397'	NO	NO	8	10	-	8	10	-
P-7	REFUSE/RECYCLE PAD	E	16'	NO	NO	1	-	-	4	0	-

THE REQUIRED SHADE TREE FOR P-7 WILL BE SUBSTITUTED WITH 10 SHRUBS.

SCHEDULE D STORMWATER MANAGEMENT AREA LANDSCAPING

LINEAR FEET OF PERIMETER	D-1 : 296'	D-2 : 202'	D-3 : 118'	D-4 : 178'
NUMBER OF TREES REQUIRED:				
SHADE TREES	6	4	0	3
EVERGREEN TREES	7	5	3	4
CREDIT FOR EXISTING VEGETATION (NO, YES AND %)	NO	NO	YES 100%	NO
CREDIT FOR OTHER LANDSCAPING (NO, YES AND %)	NO	NO	NO	NO
NUMBER OF TREES PROVIDED:				
SHADE TREES	6	4	0	3
EVERGREEN TREES	7	5	3	4
OTHER TREES (S) SUBSTITUTION	-	-	-	-

NOTE: 100% CREDIT IS TAKEN FOR THE SHADE TREE REQUIREMENT FOR PERIMETERS D-3 (EXISTING FOREST).

SPECIMEN TREE DATA

KEY	SPECIES	SIZE	CONDITION
A	ACER PLATANOIDES	32" dbh	FAIR
B	ACER PLATANOIDES	42" dbh	
C	ACER PLATANOIDES	36" dbh	
D	ACER PLATANOIDES	34" dbh	
E	ACER PLATANOIDES	34" dbh	
F	ACER PLATANOIDES	40" dbh	
G	ACER PLATANOIDES	38" dbh	
H	ACER PLATANOIDES	34" dbh	POOR
I	ACER PLATANOIDES	32" dbh	
J	ACER PLATANOIDES	30" dbh	
K	ACER PLATANOIDES	40" dbh	
L	PINUS STROBUS	38" dbh	
M	PICEA ABIES	34" dbh	
N	QUERCUS RUBRA	30" dbh	
O	ACER SACCHARINUM	52" dbh	POOR
P	ACER PLATANOIDES	42" dbh	
Q	ACER PLATANOIDES	40" dbh	

LANDSCAPING PLANT LIST

QTY.	KEY	NAME	SIZE
19	☉	ACER RUBRUM OCTOBER GLORY (OCTOBER RED MAPLE)	2 1/2" - 3" CALIFER FULL CROWN, B&B
9	☉	PLATANUS X ACERIFOLIA "BLOODGOOD" BLOODGOOD LONDON PLANE	2 1/2" - 3" CALIFER FULL CROWN, B&B
35	☉	PINUS STROBUS EASTERN WHITE PINE	6' - 8' HT.
14	☉	AZALEA "BLAAW'S PINK" BLAAW'S PINK AZALEA	18"-24" SP.


DRAINAGE AREA DATA

STRUCTURE NO.	AREA (AC)	'C'	ZONED	± IMP.
I-1	0.45	0.51	R-ED	50
I-2	0.32	0.59	R-ED	61
I-3	0.17	0.35	R-ED	30
I-4	0.39	0.38	R-ED	34
I-5	0.69	0.46	R-ED	45
I-6	0.51	0.55	R-ED	56
I-7	1.29	0.47	R-ED	44
I-8	0.83	0.24	R-ED	30
I-9	0.43	0.46	R-ED	54

DEVELOPER'S / BUILDER'S CERTIFICATE
 I/WE CERTIFY THAT THE LANDSCAPING SHOWN ON THIS PLAN WILL BE DONE ACCORDING TO THE PLAN, SECTION 16.124 OF THE HOWARD COUNTY CODE AND THE HOWARD COUNTY LANDSCAPE MANUAL. I/WE FURTHER CERTIFY THAT UPON COMPLETION, A LETTER OF LANDSCAPE INSTALLATION ACCOMPANIED BY AN EXECUTED ONE YEAR GUARANTEE OF PLANT MATERIALS WILL BE SUBMITTED TO THE DEPARTMENT OF PLANNING AND ZONING.

Robert S. Dorsey 6-16-06
 NAME DATE

OWNER/DEVELOPER
 DORSEY FAMILY HOMES
 10717B BIRMINGHAM WAY
 WOODSTOCK, MARYLAND 21163
 ATT: ROB DORSEY

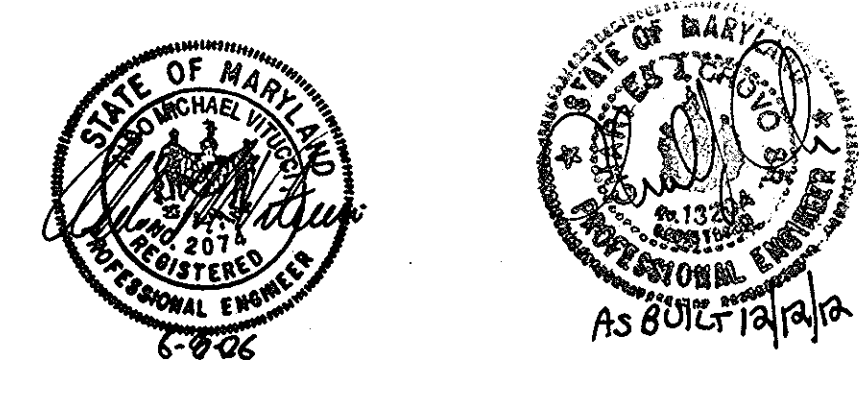

LANDSCAPE PLAN & DRAINAGE AREA MAP
HOGG PROPERTY
 LOTS 1 - 22, OPEN SPACE LOTS 23 - 25
 ZONED: R-ED
 TAX MAP NO. 25 GRID NO. 14 PARCEL NO. 64
 SECOND ELECTION DISTRICT
 HOWARD COUNTY, MARYLAND
 DATE: JUNE 8, 2006
 SHEET 7 OF 17

FISHER, COLLINS & CARTER, INC.
 CIVIL ENGINEERING CONSULTANTS & LAND SURVEYORS
 CENTRAL SQUARE OFFICE PARK - 3022 BALTIMORE NATIONAL PIKE
 ELKLOTT CITY, MARYLAND 21042
 4100 461 - 2029

STRUCTURE SCHEDULE


STRUCTURE NO.	TOP ELEVATION	INV. IN	INV. OUT	LOCATION		W	TYPE	REMARKS
				NORTH	EAST			
I-1	357.33.45	-	354.25 (15')	580,368.44.50	1,370,365.67.82	2.5'	A-10	S.D. 4.41
I-2	346.66.72	-	343.58 (15')	580,383.44.55	1,370,204.10.14	2.5'	A-5	S.D. 4.40
I-3	342.71.34.00	339.01 (24')	336.54 (24')	580,582.1.67	1,370,485.96	-	S	S.D. 4.22 W/ S.D. 4.93
I-4	350.58.2	346.44 (24')	343.36 (24')	580,610.30	1,370,592.3.92	-	S	S.D. 4.22 W/ S.D. 4.93
I-5	352.08.9	348.04 (24')	344.96 (24')	580,464.29	1,370,711.50	-	S	S.D. 4.22 W/ S.D. 4.93
I-6	355.64.50	351.78 (18')	348.70 (18')	580,378.79.43	1,370,738.91.09	2.5'	A-10	S.D. 4.41
I-7-A	366.41.02	362.70.15	359.02 (18')	580,266.97.90.13	1,370,658.95.12	2.5'	A-10	S.D. 4.41
I-8	354.96.55.00	351.26 (15')	348.28 (15')	580,338.77.1.93	1,370,799.63.46	2.5'	A-10	S.D. 4.41
I-9	359.08.0	355.38 (6')	352.40 (15')	580,296.144.60	1,370,761.10710.09	-	S	S.D. 4.22 W/ S.D. 4.93
I-7B	366.41.90	362.70.15 (15')	359.02 (15')	580,290.05	1,370,616.89	2.5'	A-5	SD 4.40
M-1	338.60.07	335.52 (18')	332.44 (18')	580,478.2.86	1,370,499.40.99	4'	PRECAST MANHOLE	G. - 5.12
M-2	338.60.32	335.52 (18')	332.44 (18')	580,430.30	1,370,377.95	4'	PRECAST MANHOLE	G. - 5.12
M-3	338.60.75	335.52 (18')	332.44 (18')	580,420.64	1,370,290.80.71	4'	PRECAST MANHOLE	G. - 5.12
M-4	351.95.35.00	348.26 (15')	345.28 (15')	580,387.77.8.77	1,370,289.96.0.85	4'	PRECAST MANHOLE	G. - 5.12
M-5	362.08.9	358.39 (15')	355.41 (18')	580,393.00.1.95	1,370,778.9.9.9.9.9.9	4'	PRECAST MANHOLE	G. - 5.12
M-6	354.10.35.00	350.46 (18')	347.48 (18')	580,374.92.0.2	1,370,822.10.12.0	4'	PRECAST MANHOLE	G. - 5.12
M-7	354.25.16	350.56 (18')	347.58 (18')	580,364.71.21	1,370,798.9.9.9.9.9.9	4'	PRECAST MANHOLE	G. - 5.12
S-1	-	-	332.50 (18')	580,492.1.1.3	1,370,432.2.9.2	N/A	18" HDPE END SECTION	SEE ADS INFO BELOW
S-2	-	-	332.50 (24')	580,526.90.0.4	1,370,435.8.2	N/A	24" HDPE END SECTION	SEE ADS INFO BELOW
HW-1	-	-	317.07 (30')	580,558.94.4.10	1,370,246.47.5.14	N/A	TYPE 'A' HEADWALL	MODIFIED S.D. 5.11

PIPE SCHEDULE

SIZE	CLASS	LENGTH
6"	PVC	125
8"	PERF. PVC	70
8"	PVC	10
15"	HDPE	220
18"	HDPE	520
24"	HDPE	371
30"	ASTM	93

CONSTRUCTION SPECIFICATIONS FOR RIP-RAP OUTFALLS

- The subgrade for the filter, riprap or gabion shall be prepared to the required lines and grades. Any fill required in the subgrade shall be compacted to a density of approximately that of the surrounding undisturbed material.
- The rock or gravel shall conform to the specified grading limits when installed respectively in the riprap or filter.
- Filter cloth shall be protected from punching, cutting or tearing. Any damage other than an occasional hole, shall be repaired by placing another piece of cloth over the damaged part or by completely replacing the cloth. All overlaps whether for repairs or for joining two pieces of cloth shall be a minimum of one foot.
- Stone for the riprap or gabion outlets may be placed by equipment. Both shall each be constructed to the full course thickness in one operation and in such a manner as to avoid displacement of underlying materials. The stone for riprap or gabion outlets shall be delivered and placed in a manner that will insure that it is reasonably homogeneous with the smaller stones and spalls filling the voids between larger stones. Riprap shall be placed in a manner to prevent damage to the filter blanket or filter cloth. Hand placement will be required to the extent necessary to prevent damage to the permanent works.

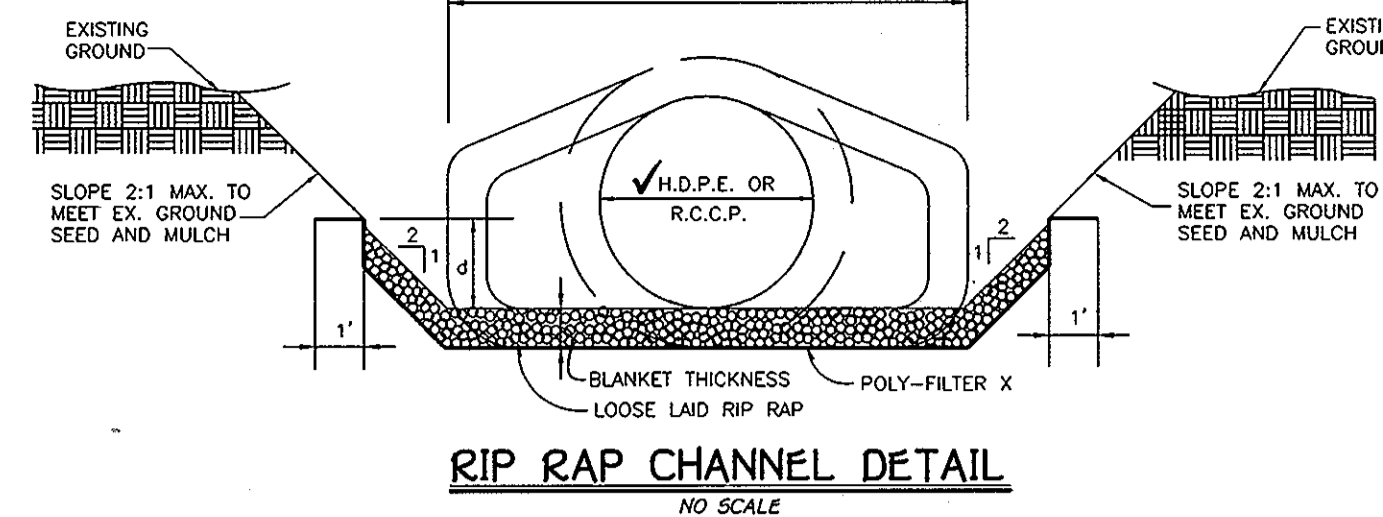

APPROVED: DEPARTMENT OF PUBLIC WORKS
 Chief, Bureau of Highways
 8/13/06 DATE





APPROVED: DEPARTMENT OF PLANNING AND ZONING
 Chief, Division of Land Development
 8/17/06 DATE

APPROVED: DEPARTMENT OF ENGINEERING
 Chief, Development Engineering Division
 8/17/06 DATE

NO.	DESCRIPTION	DATE


RIP-RAP CHANNEL DESIGN DATA

STRUCTURE	AREA	WETTED PERIMETER	R	R 2/3	S	S 1/2	W	d	n	V (F.P.S.)	Q (C.F.S.)	RIP-RAP SIZE	BLANKET THICKNESS	Q ₁₀	DIA.
S-1	3.06 SF	11.29'	0.2707	0.4166	0.005	0.0707	10'	0.29'	0.04	1.10	56.78	9.5" 15"	19"	3.36 CFS	18"
S-2	7.36 SF	12.91'	0.5698	0.6860	0.005	0.0707	10'	0.65'	0.04	1.80	56.78	9.5" 15"	19"	13.28 CFS	24"

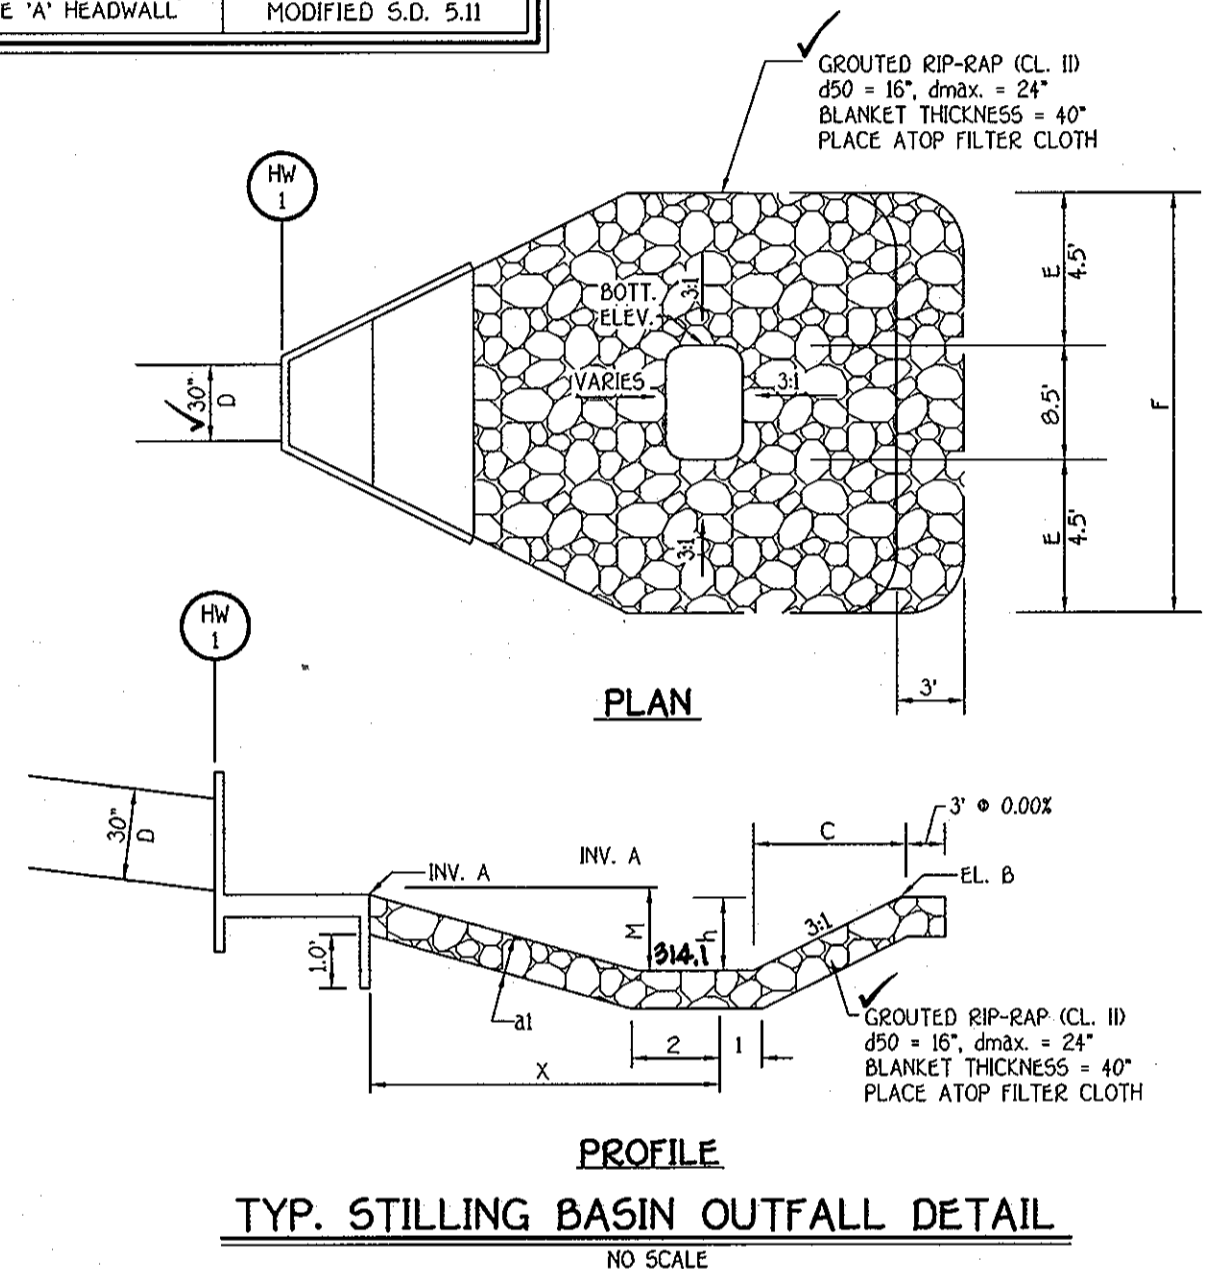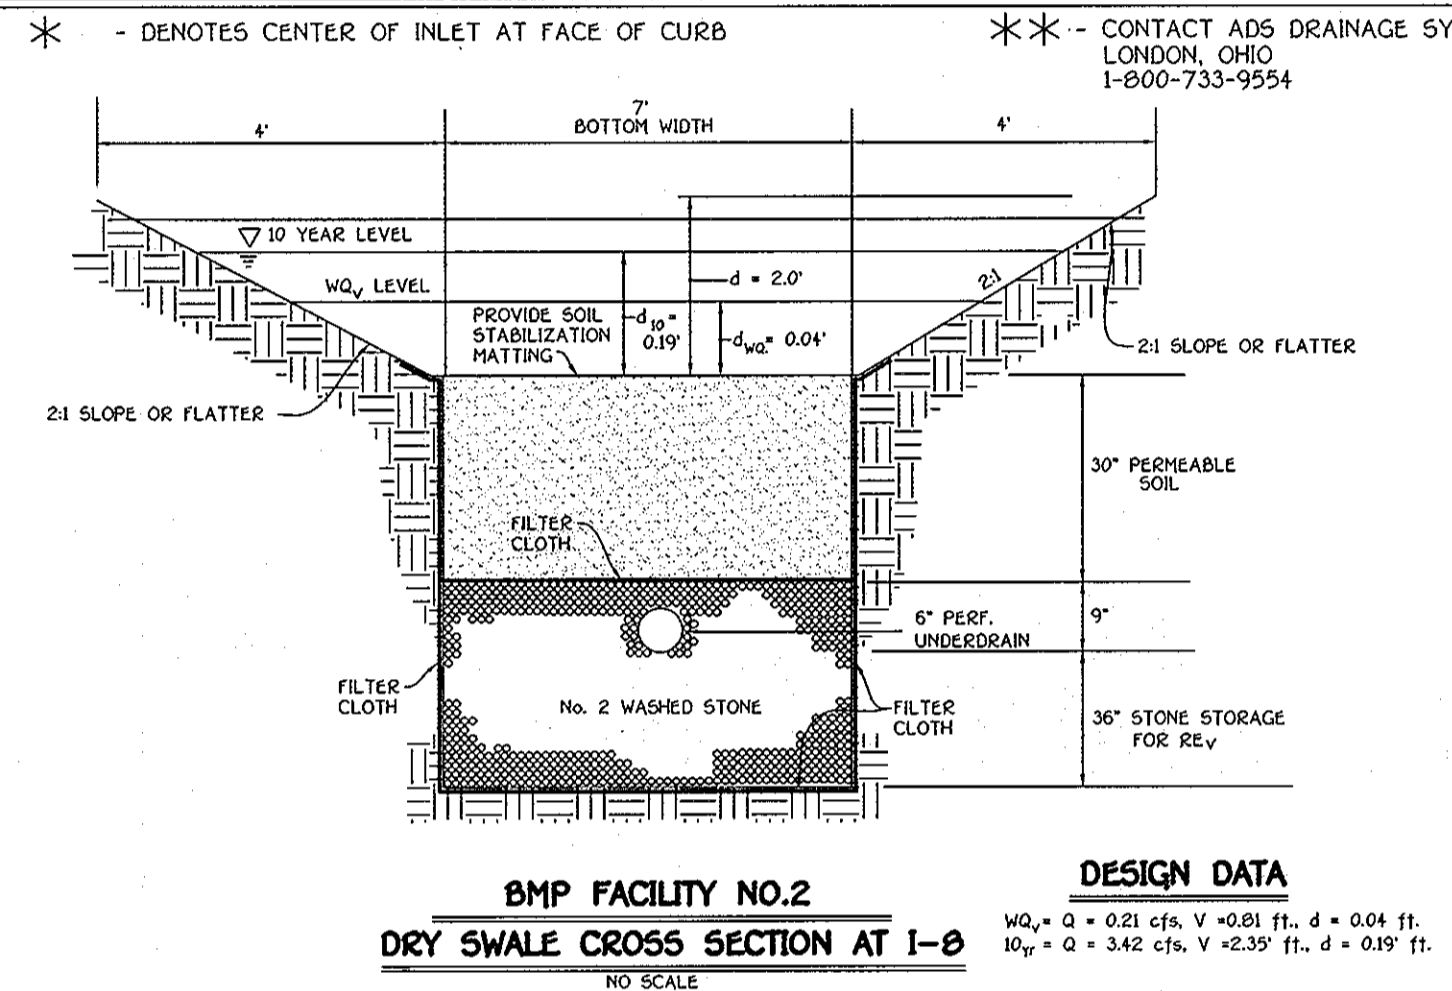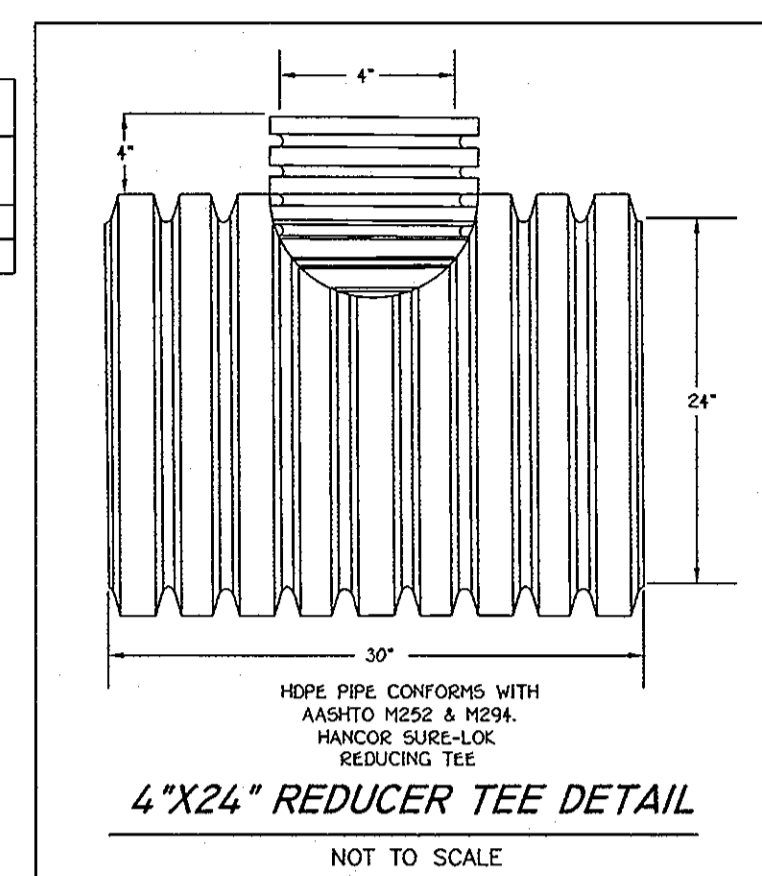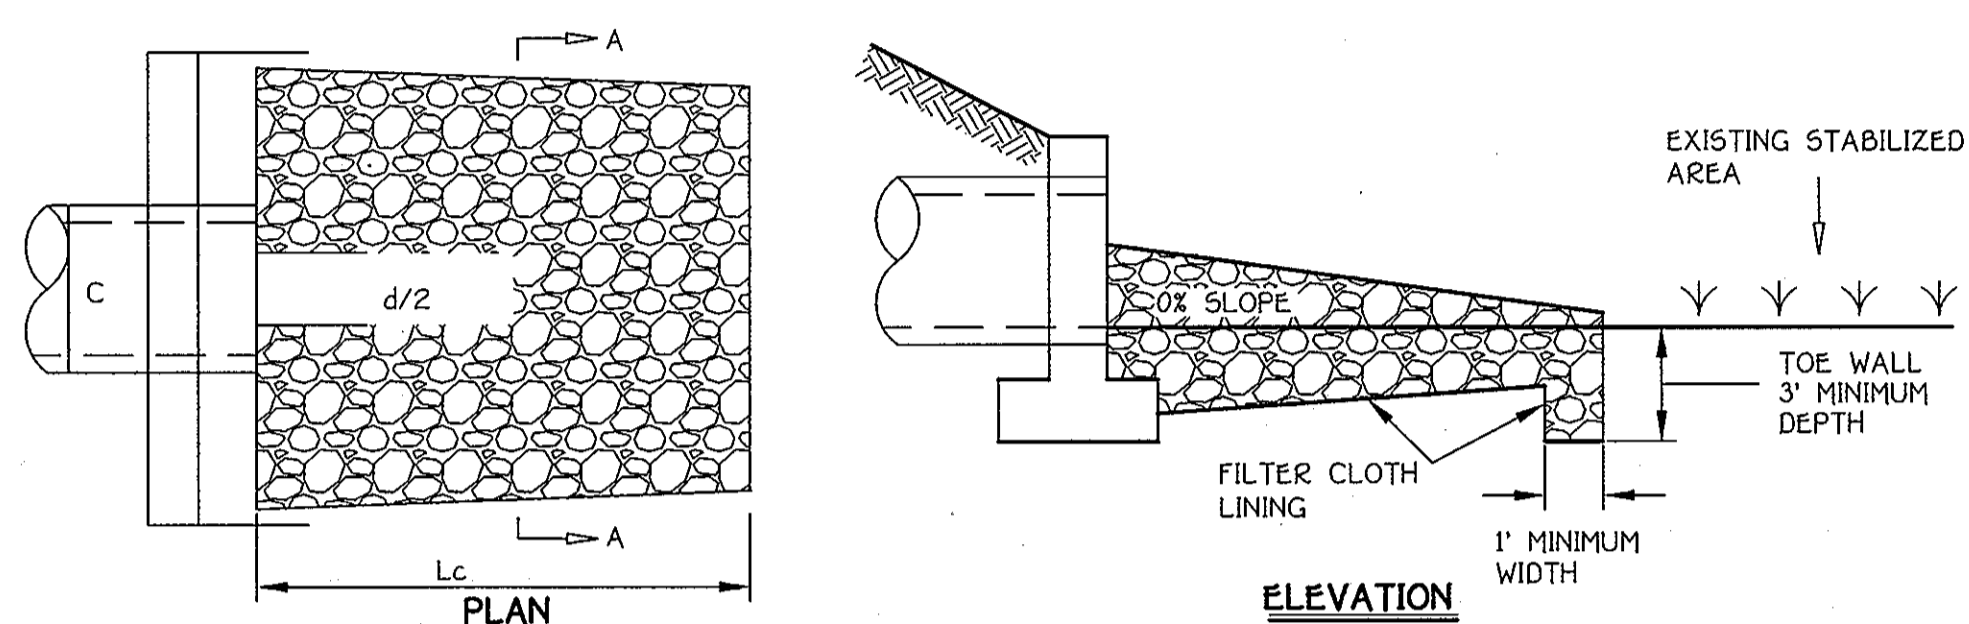





STILLING BASIN DATA

STRUCTURE NO.	INV. A	EL. B	C	D	E	F	H	M	al	X
HW-1	317.07	316.00	4.5'	2.5'	4.5'	17.50	1.5'	2.28'	40'	12.0

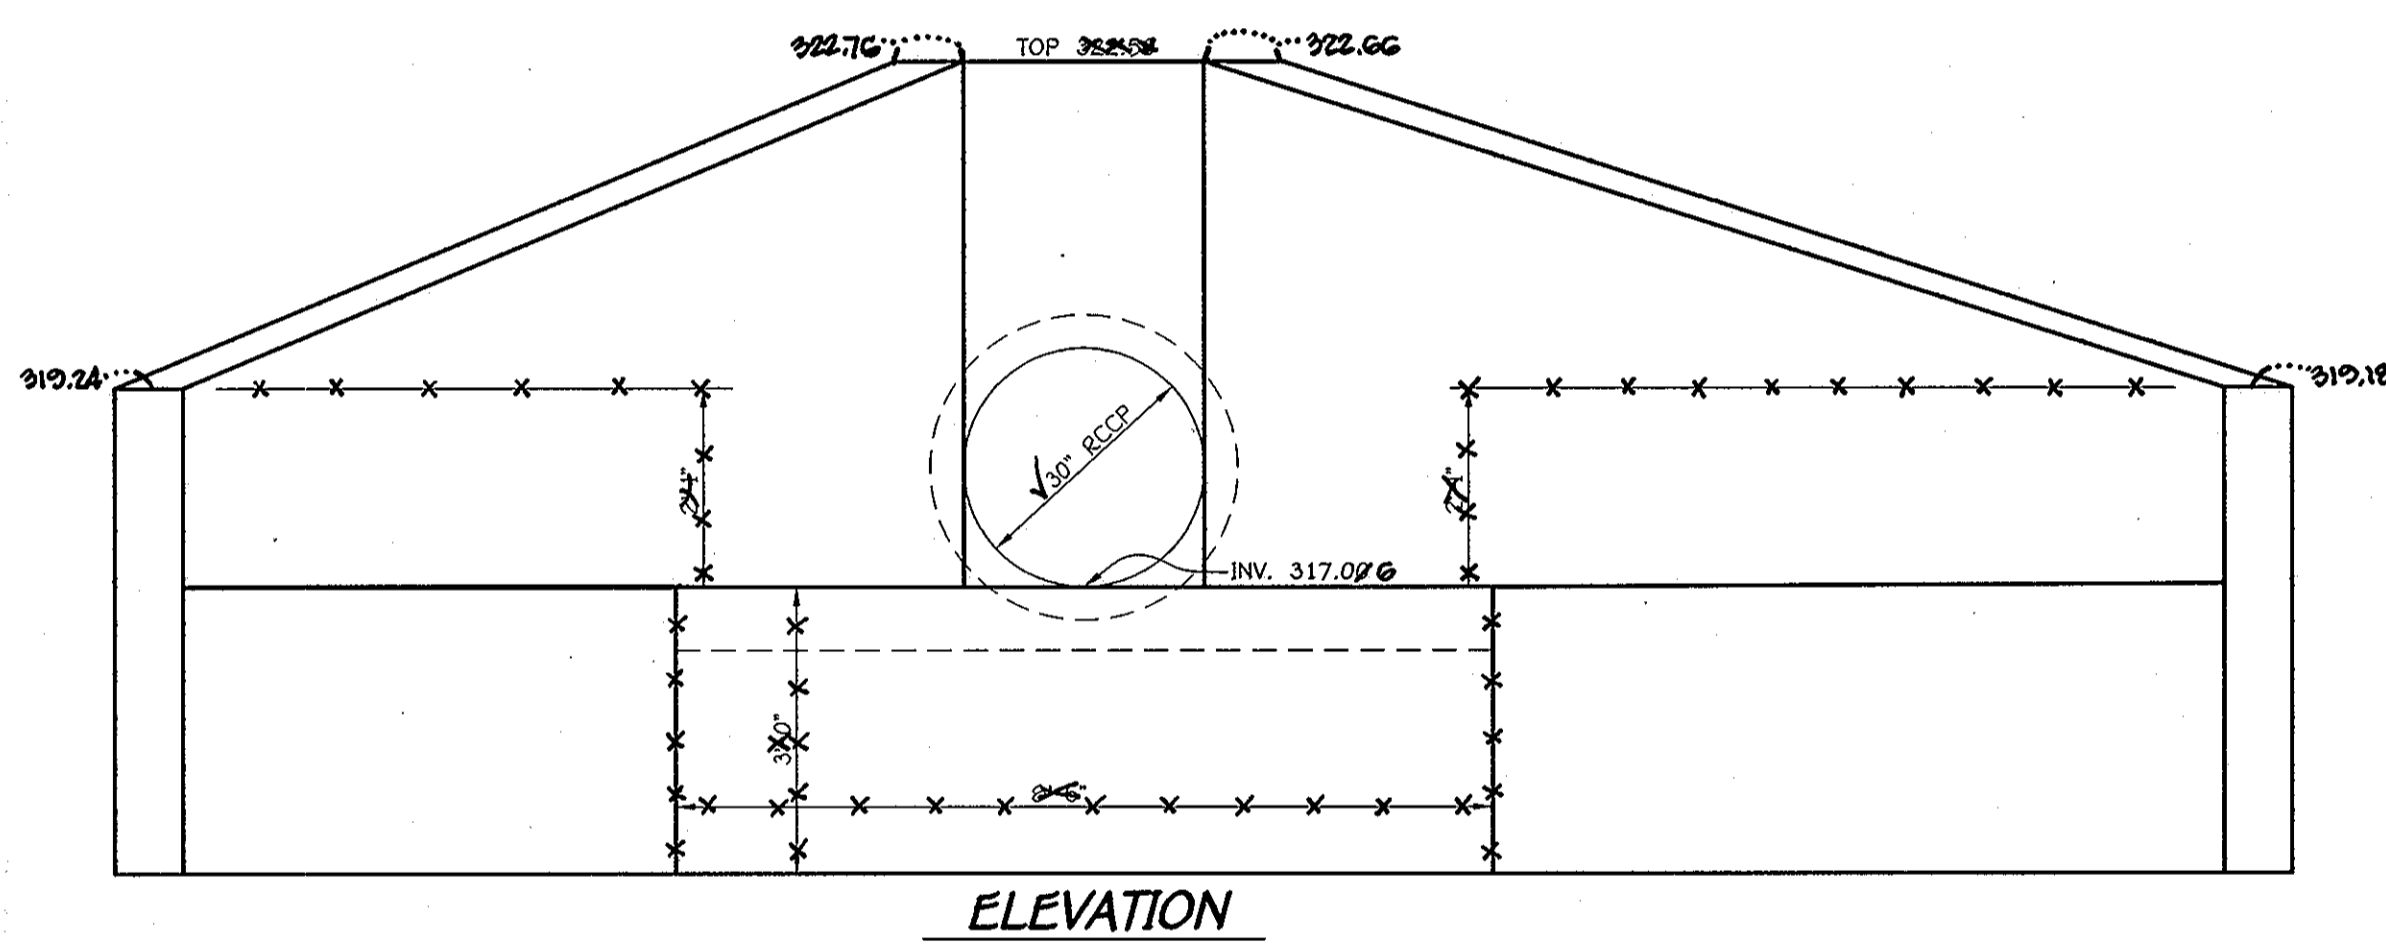

OPERATION AND MAINTENANCE SCHEDULE FOR PRIVATELY OWNED AND MAINTAINED OPEN CHANNEL SYSTEM


- The open channel system shall be inspected annually and after major storms. Inspections shall be performed during wet weather to determine if the facility is functioning properly.
- The open channel shall be mowed a minimum of as needed during the growing season to maintain a maximum grass height of less than 6 inches.
- Debris and litter shall be removed during regular mowing operations and as needed.
- Visible signs of erosion in the open channel system shall be repaired as soon as it is noticed.
- Remove silt in the open channel system when it exceeds 25% of the original WQV.

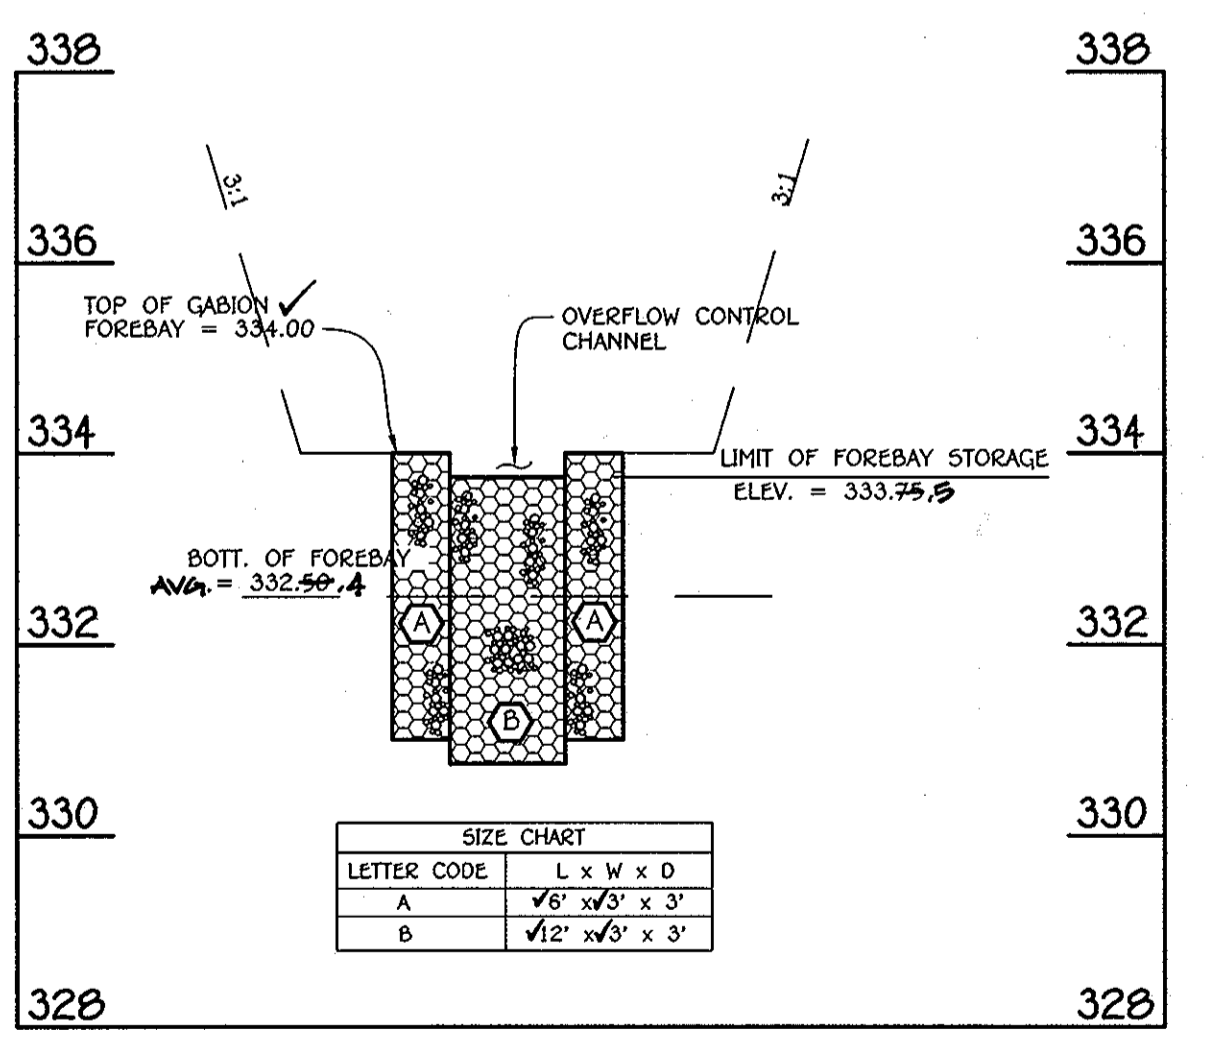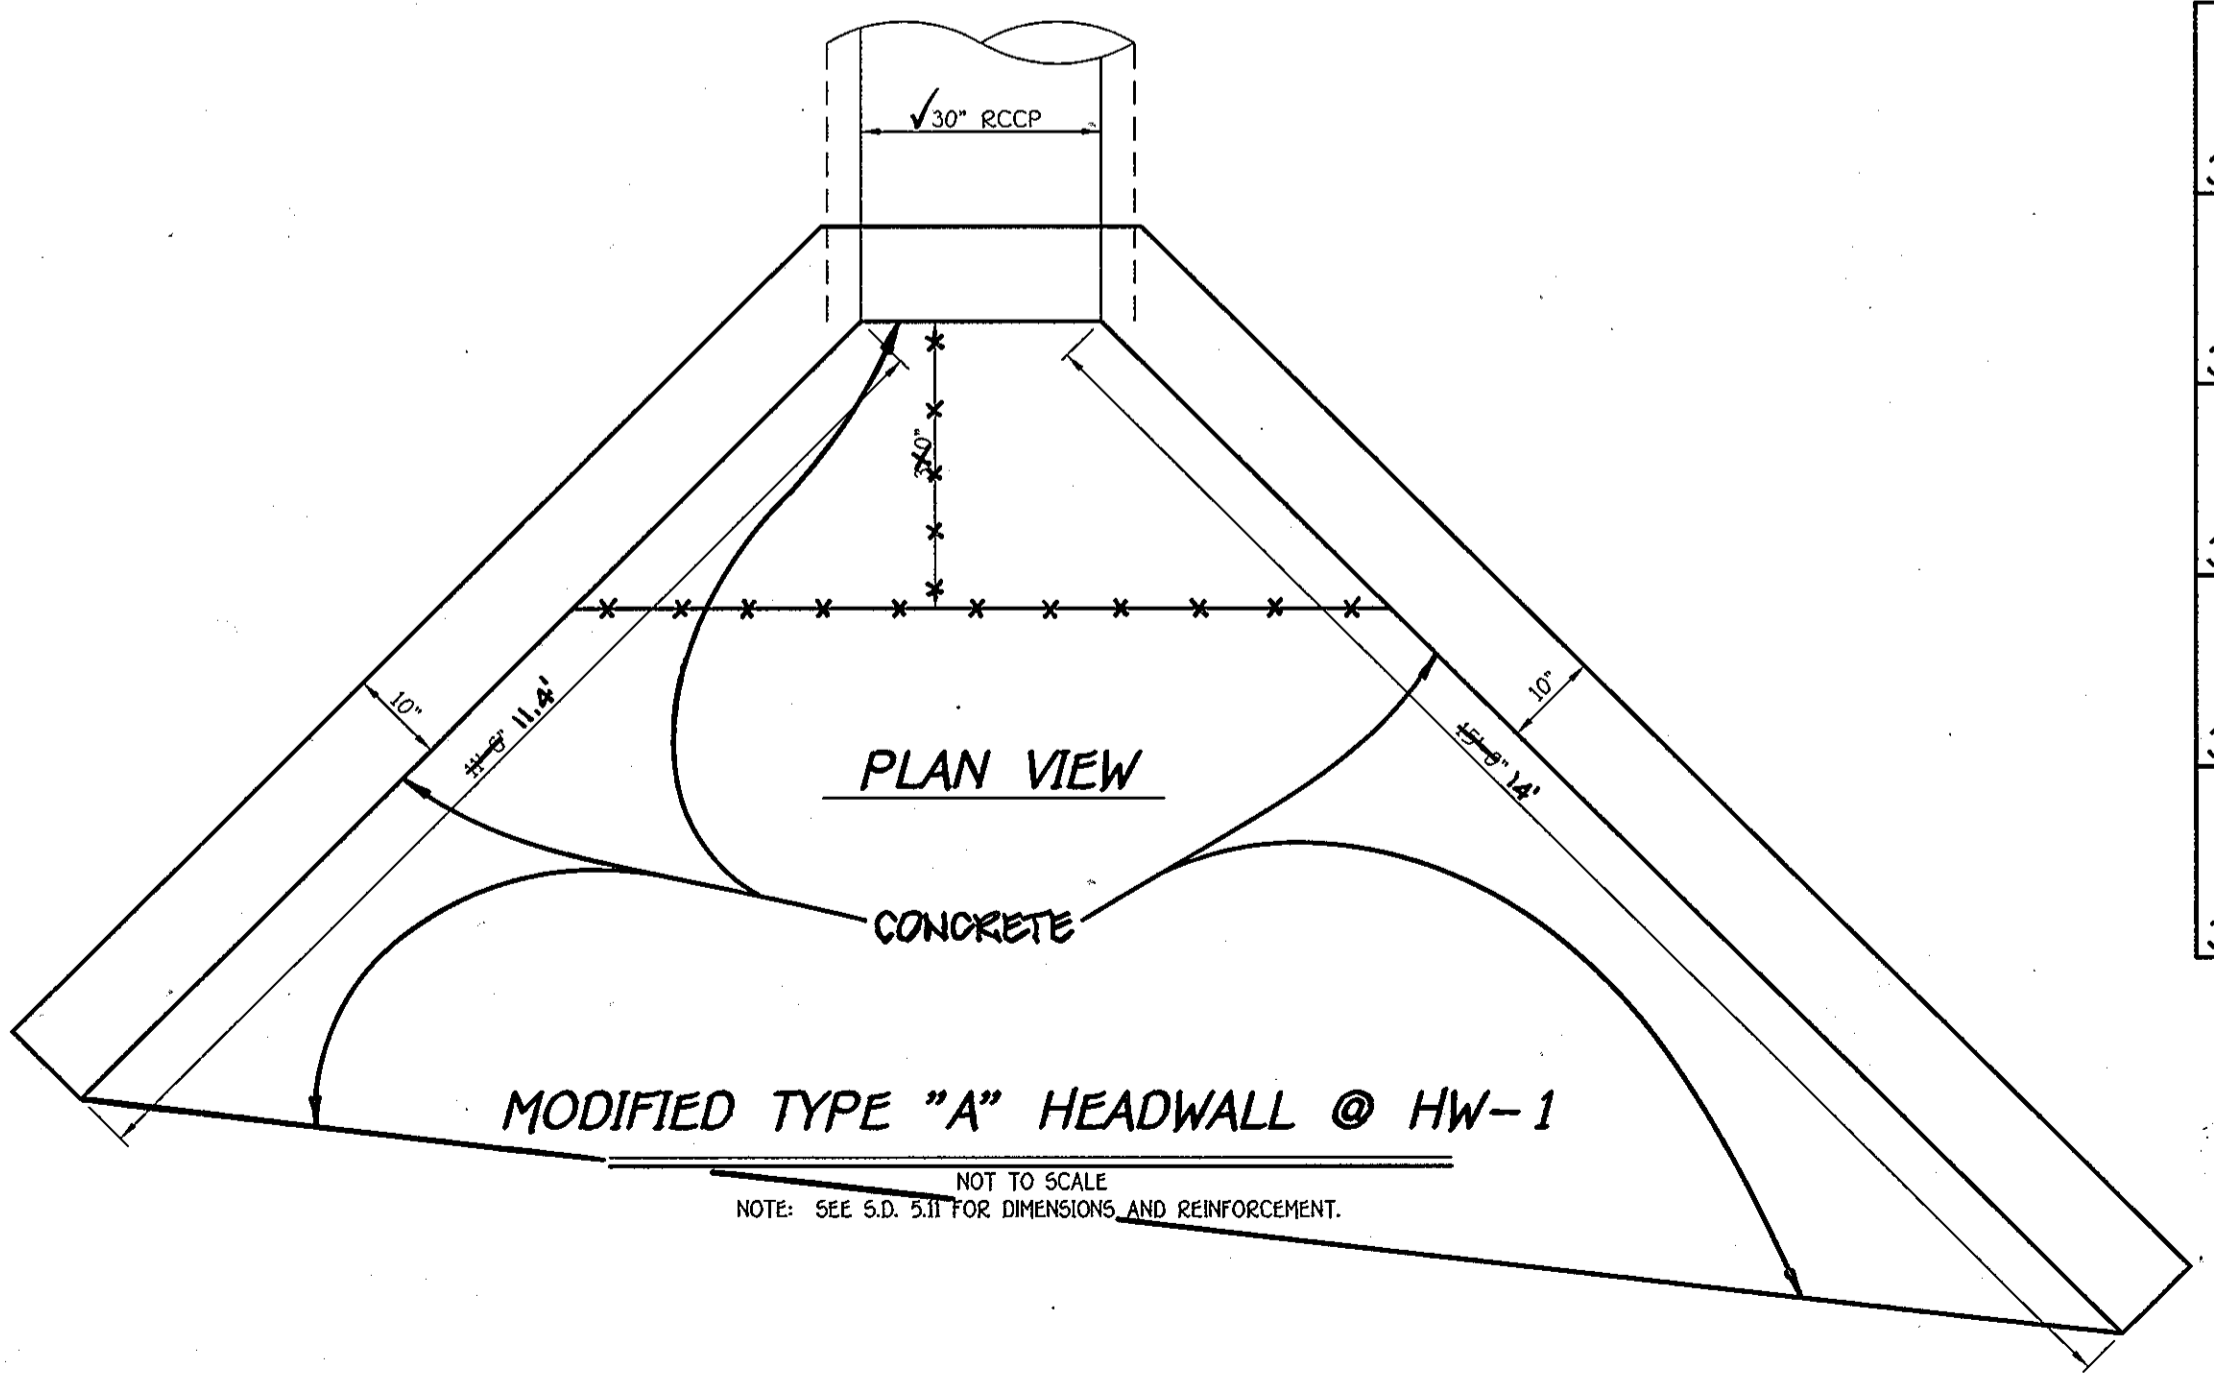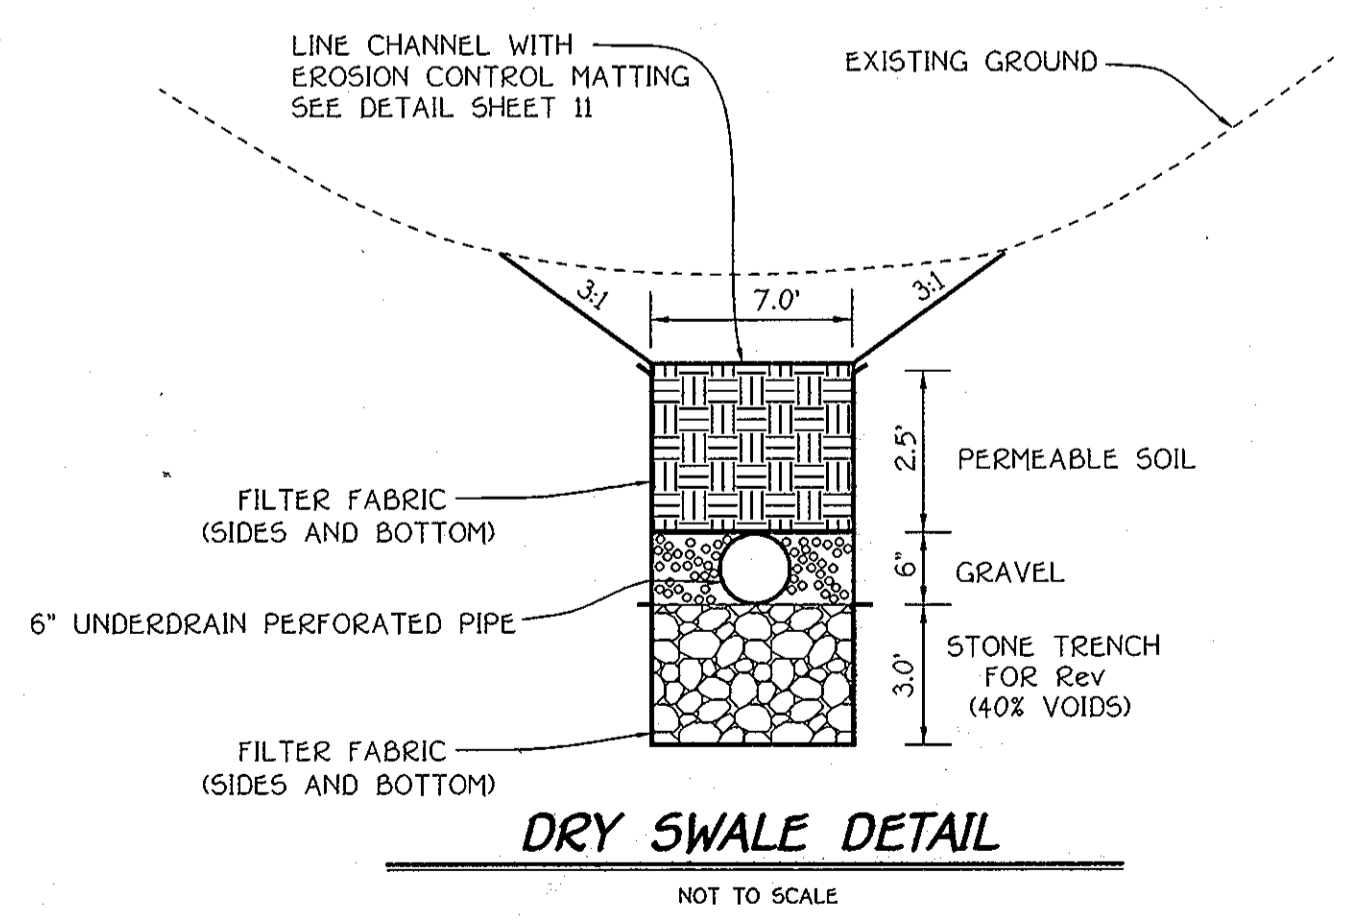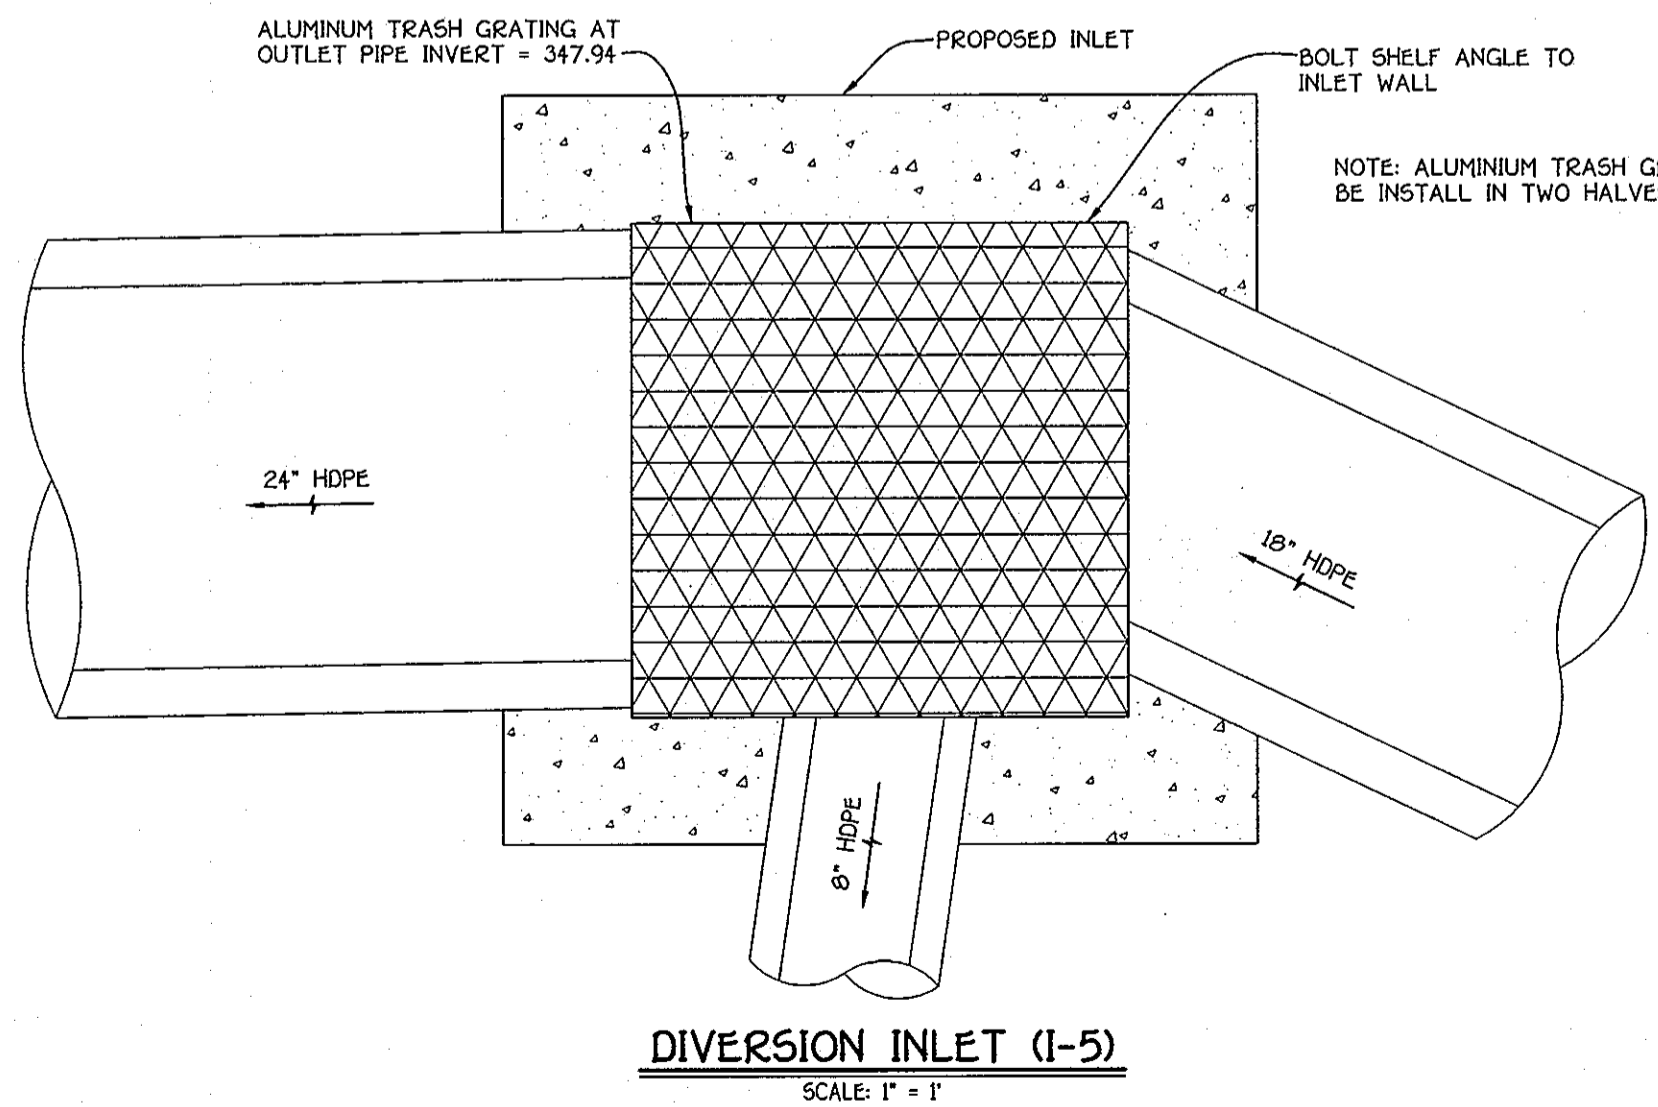

FISHER, COLLINS & CARTER, INC.
CIVIL ENGINEERING CONSULTANTS & LAND SURVEYORS
1000 EIGHTH STREET, SUITE 100, BALTIMORE, MARYLAND 21202
TEL: 410-551-2999




OWNER / DEVELOPER
DORSEY FAMILY HOMES
10717B BIRMINGHAM WAY
WOODSTOCK, MARYLAND 21163
ATTN: ROB DORSEY

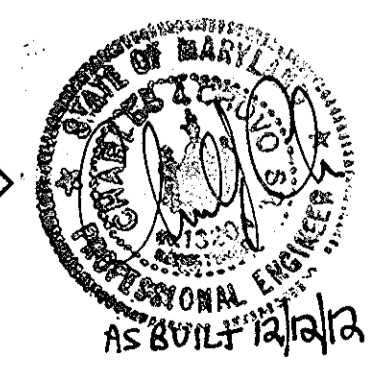


STORMWATER MANAGEMENT DETAILS, STORM DRAIN STRUCTURE SCHEDULE AND DRAINAGE DETAILS
HOGG PROPERTY
 LOTS 1 - 22, OPEN SPACE LOTS 23 - 26
 ZONED: R-ED
 TAX MAP NO. 25 GRID NO. 14 PARCEL NO. 64
 SECOND ELECTION DISTRICT
 HOWARD COUNTY, MARYLAND
 DATE: JUNE 8, 2006
 SHEET 8 OF 17

AS BUILT


APPROVED: DEPARTMENT OF PUBLIC WORKS		
Chief, Bureau of Highways		8/13/06
DATE		
APPROVED: DEPARTMENT OF PLANNING AND ZONING		
Chief, Division of Land Development		8/17/06
DATE		
APPROVED: DEPARTMENT OF PLANNING AND ZONING		
Chief, Development Engineering Division		8/17/06
DATE		
REVISIONS		
NO.	DESCRIPTION	DATE

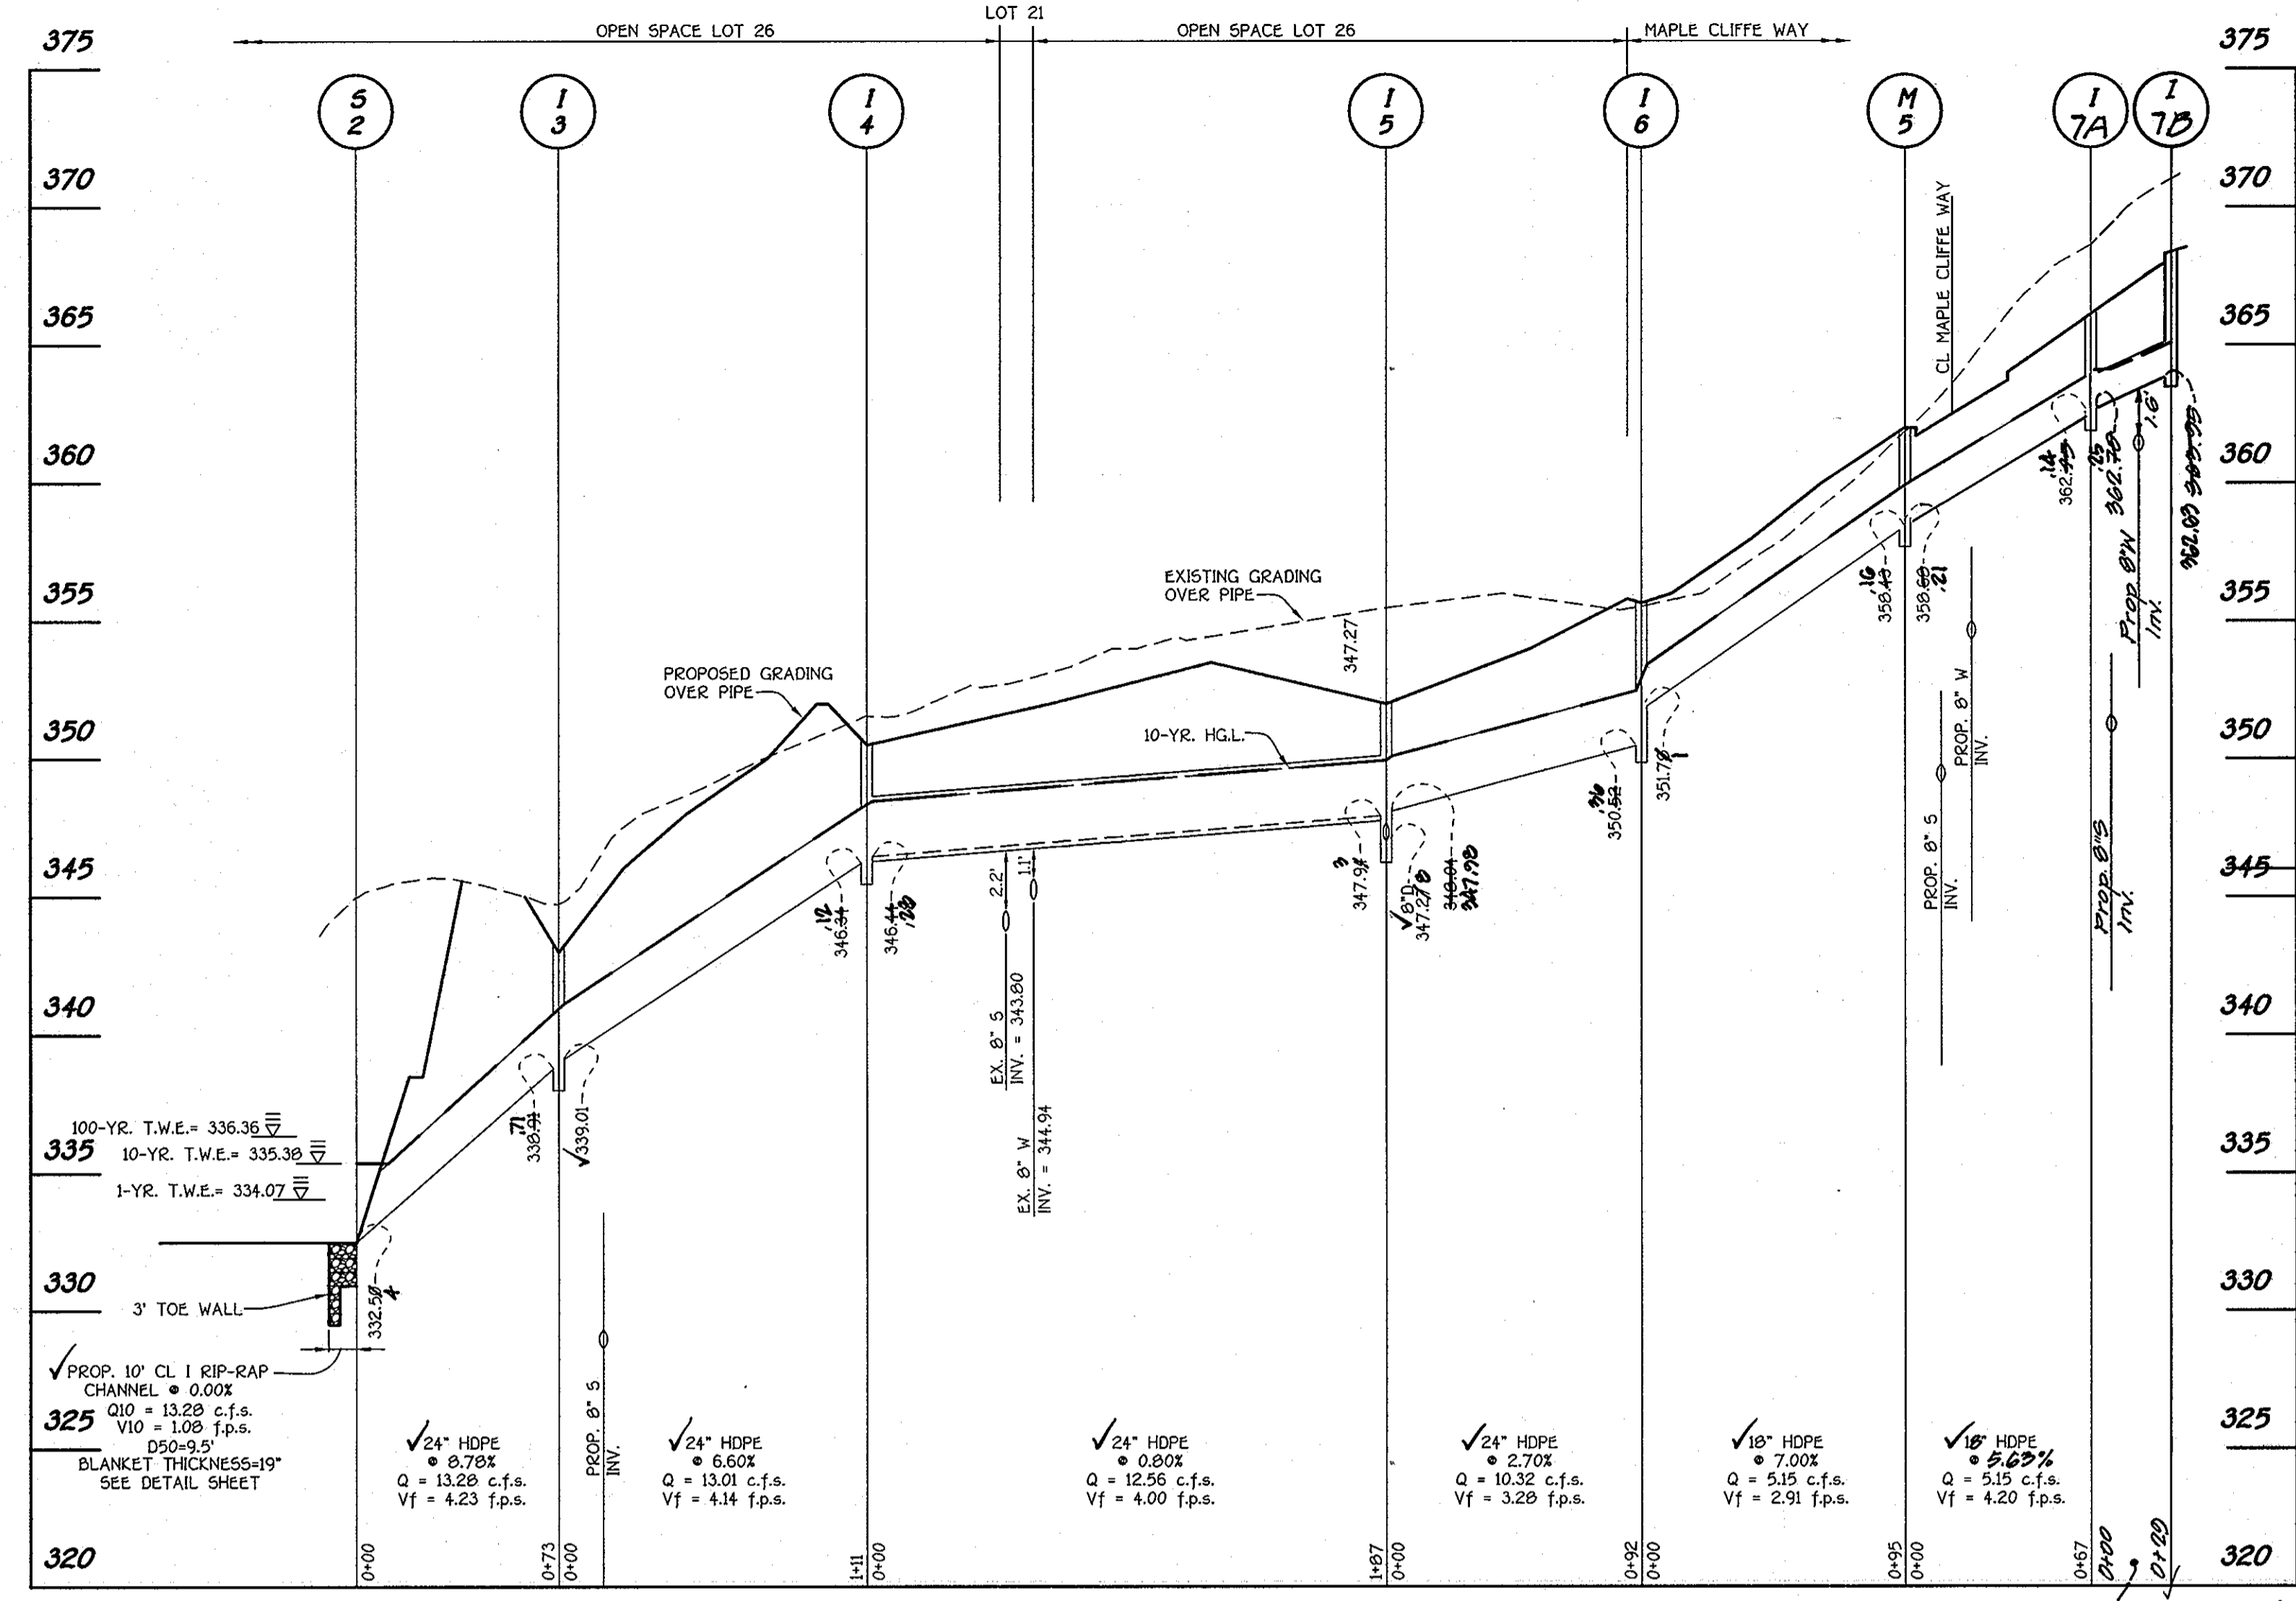


PROFILE
SCALE: HORIZ. : 1" = 50'
VERT. : 1" = 5'

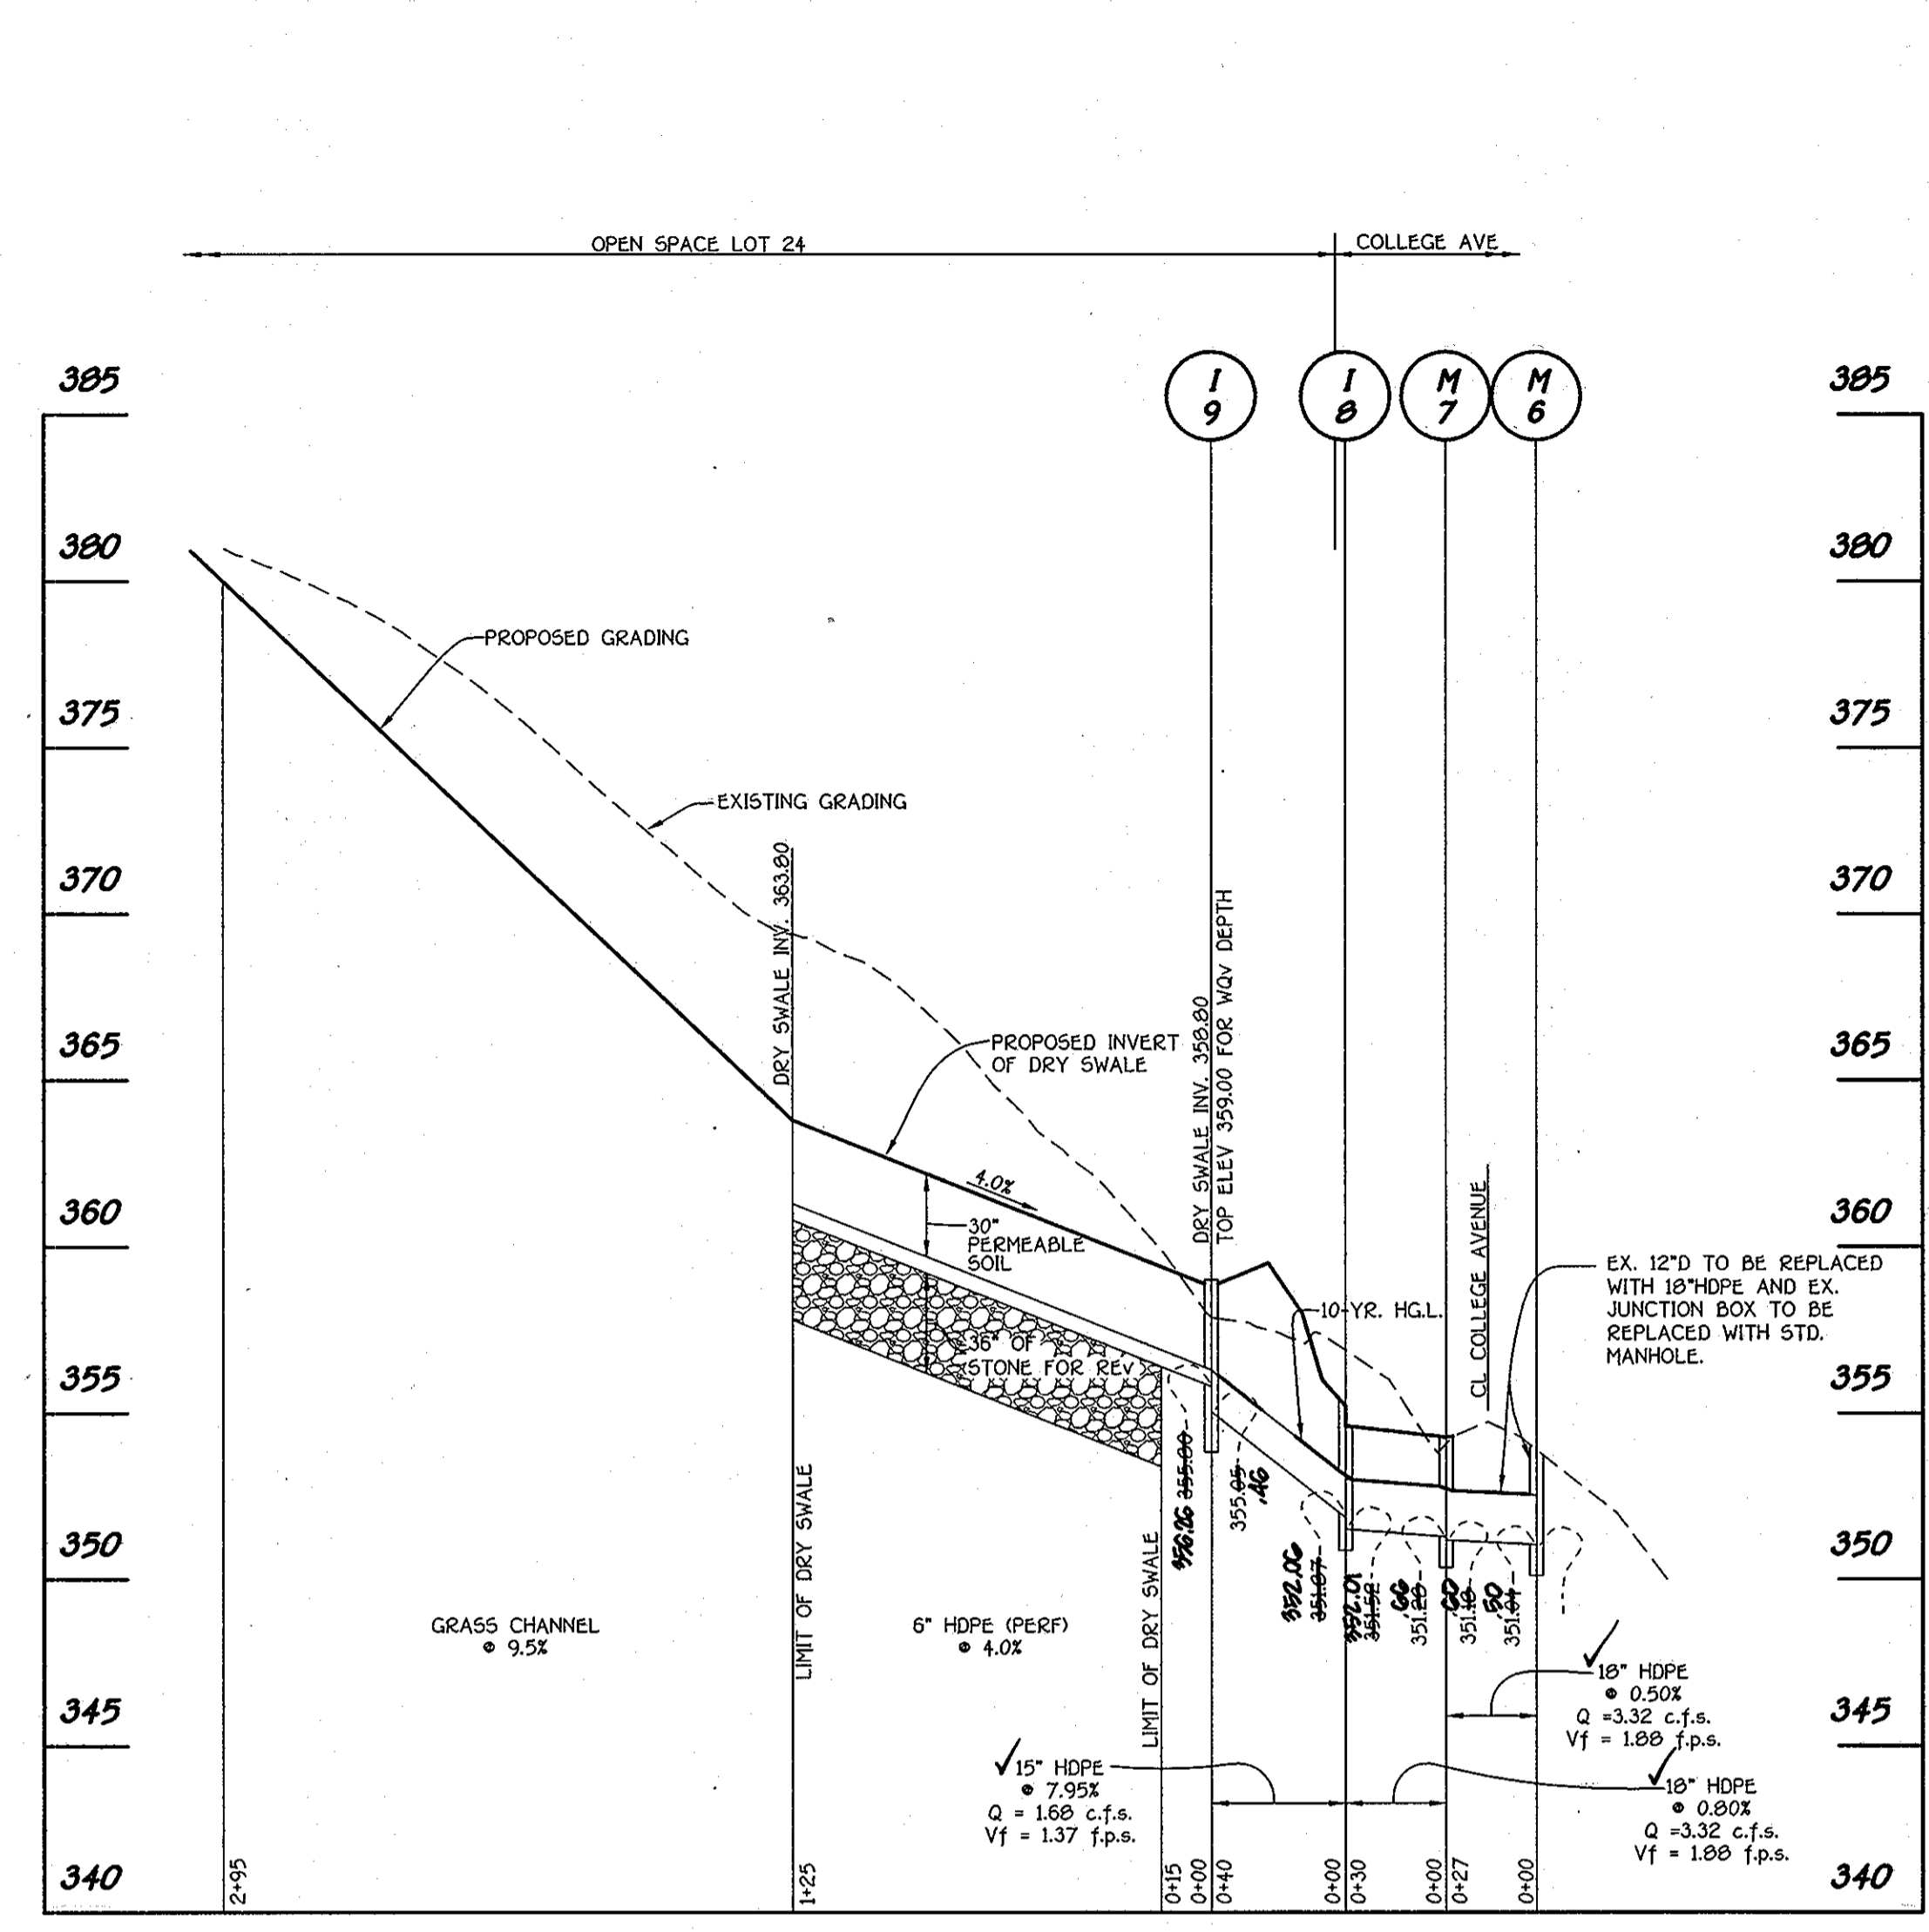

PROFILE
SCALE: HORIZ. : 1" = 50'
VERT. : 1" = 5'

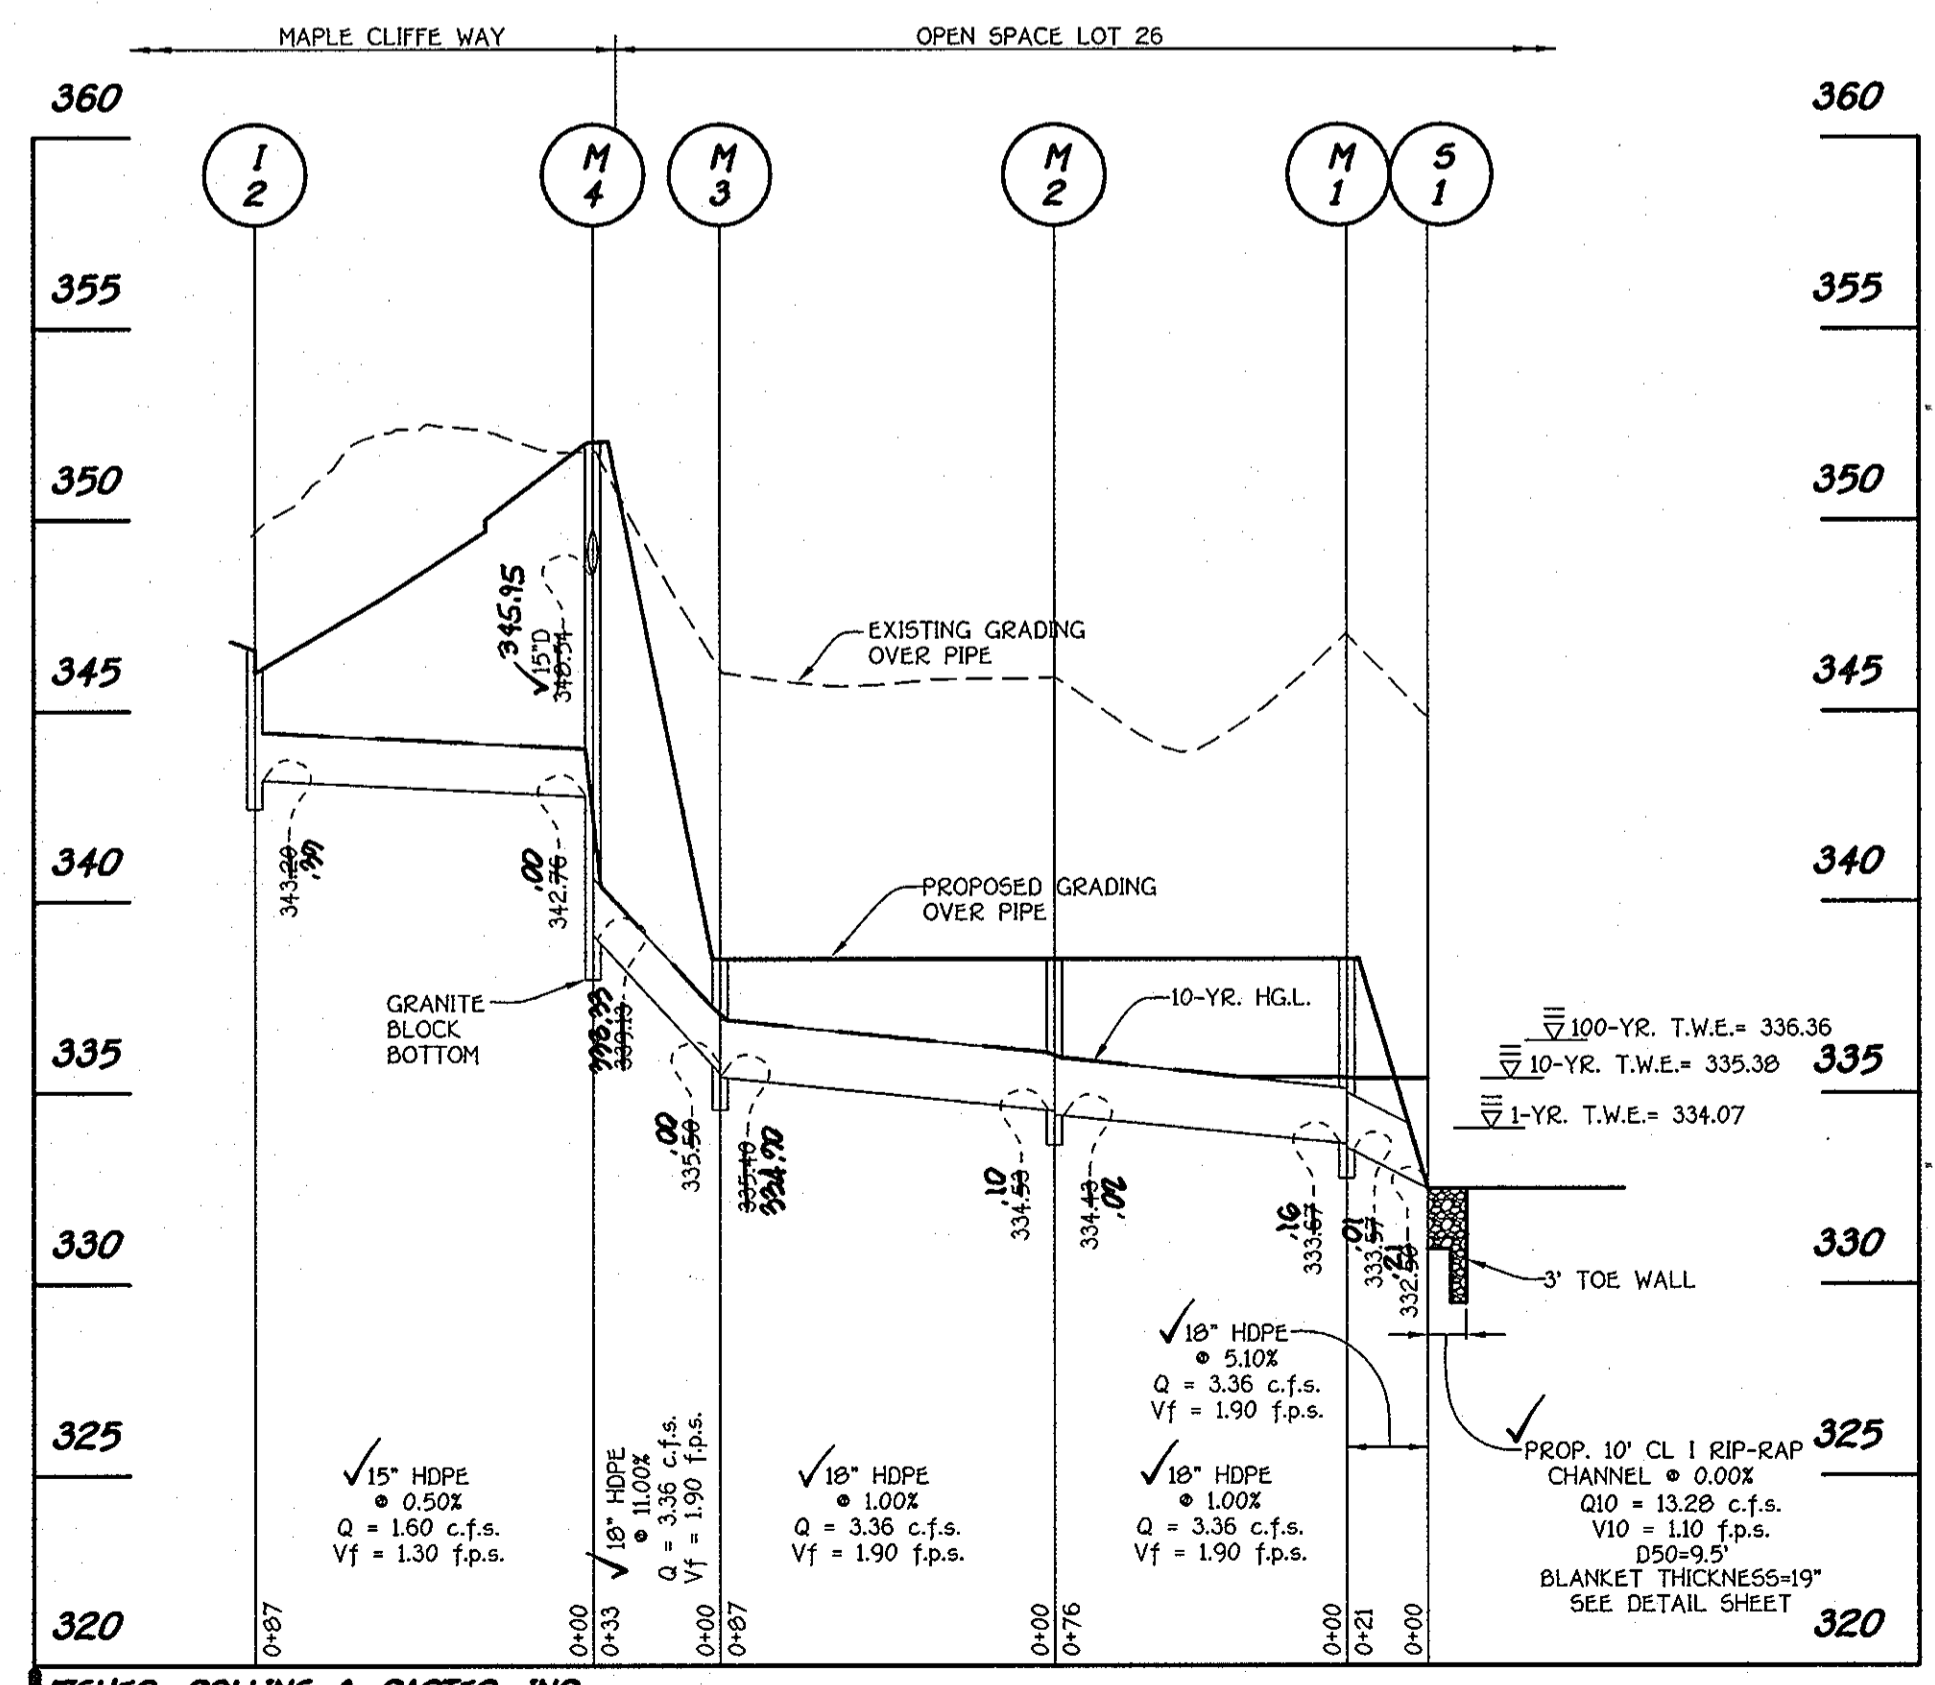


PROFILE
SCALE: HORIZ. : 1" = 50'
VERT. : 1" = 5'

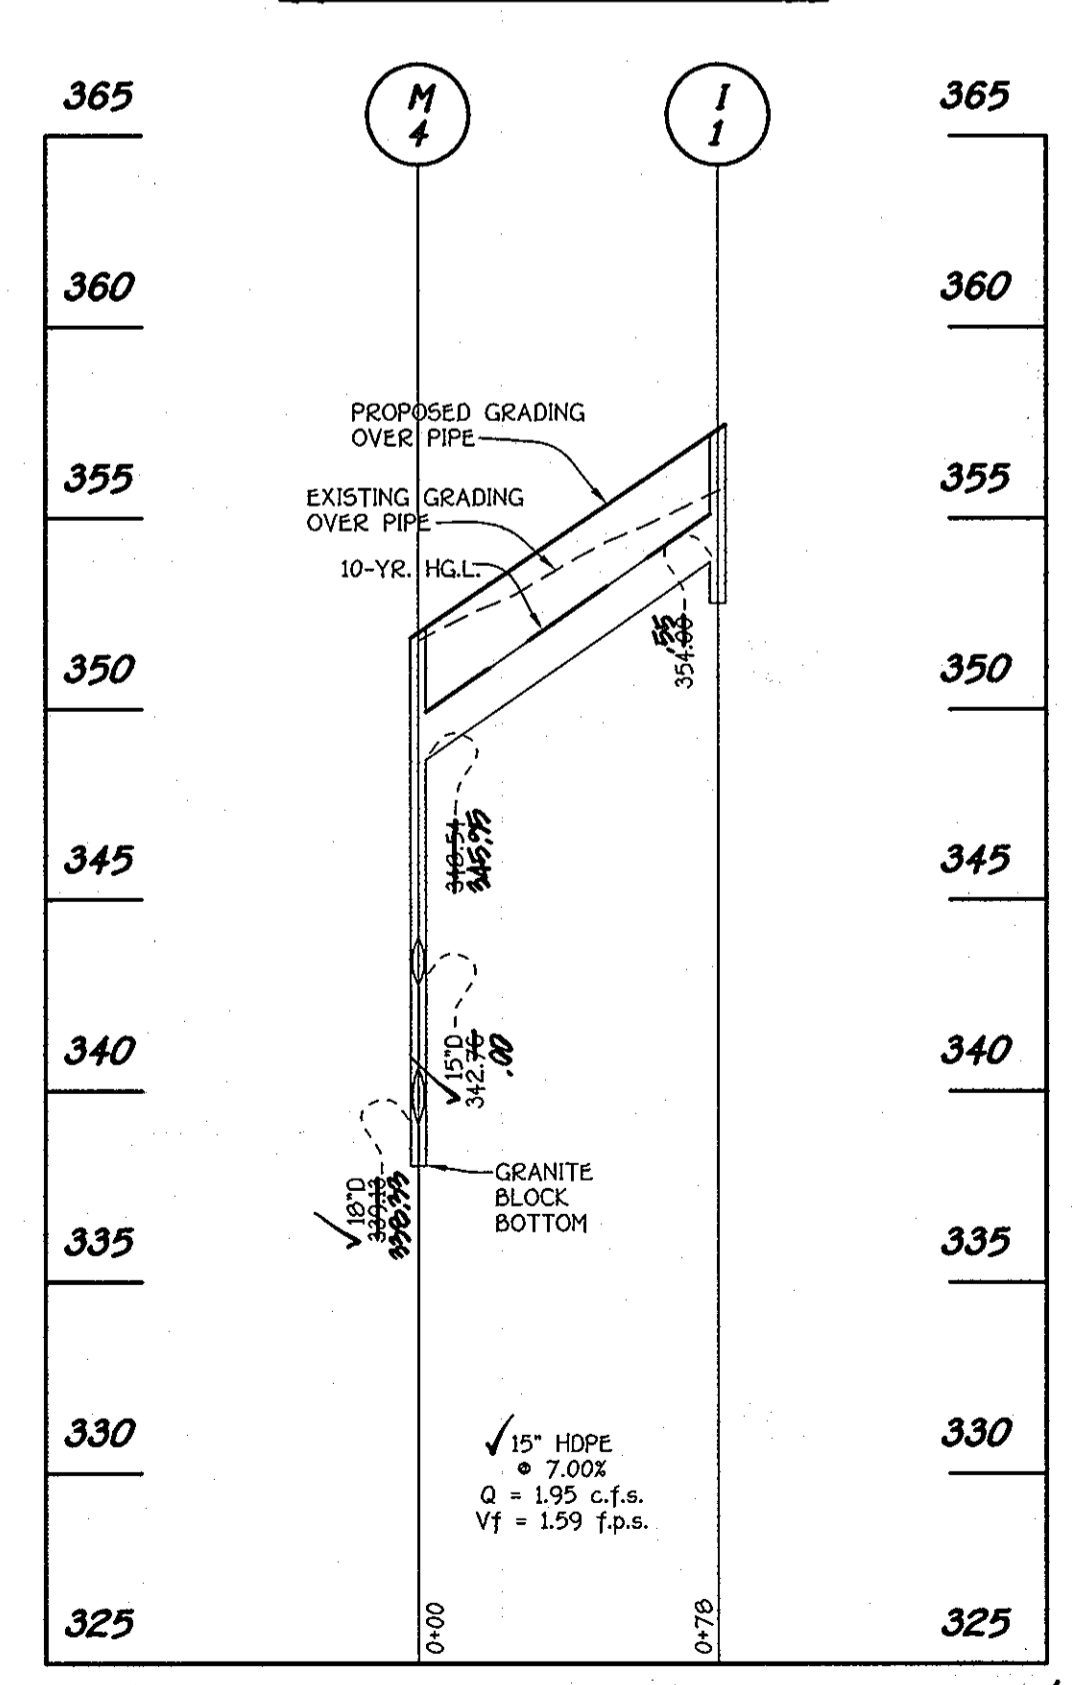


PROFILE
SCALE: HORIZ. : 1" = 50'
VERT. : 1" = 5'

OWNER/DEVELOPER
DORSEY FAMILY HOMES
10717B BIRMINGHAM WAY
WOODSTOCK, MARYLAND 21163
ATTN: ROB DORSEY

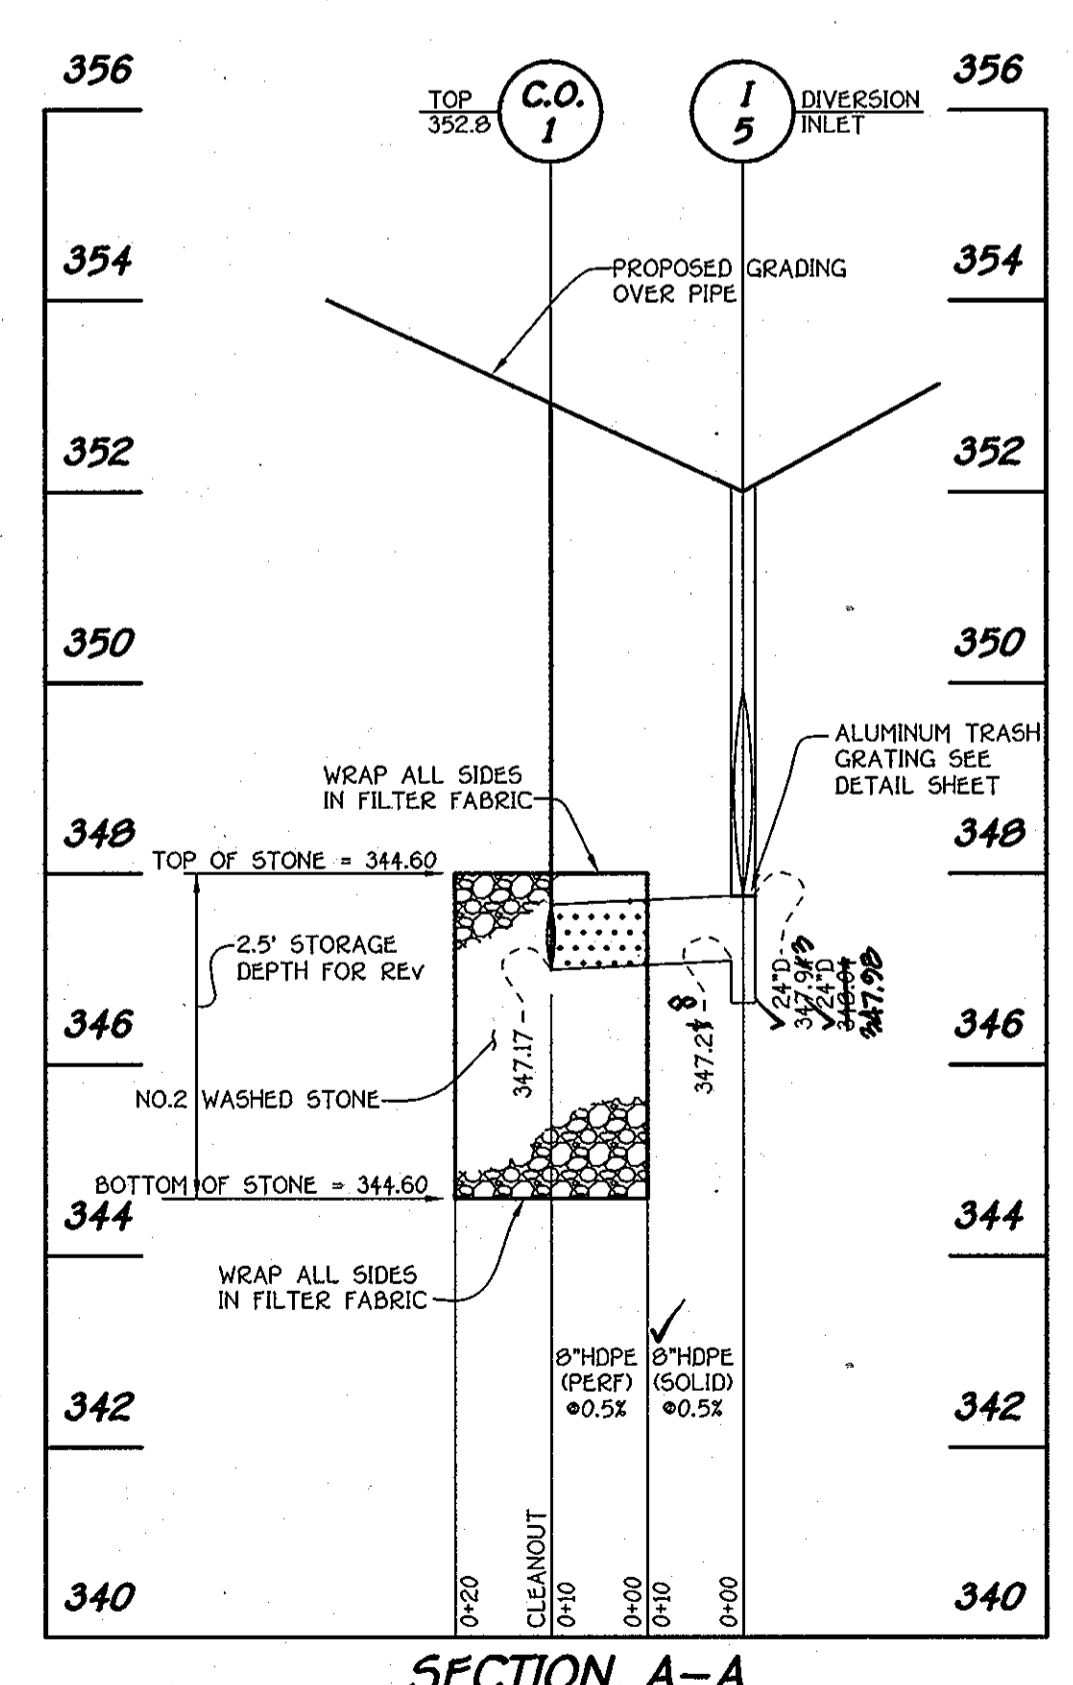

SECTION A-A
OFF-LINE STONE RESERVOIR
SCALE: HORIZ. : 1" = 20'
VERT. : 1" = 2'

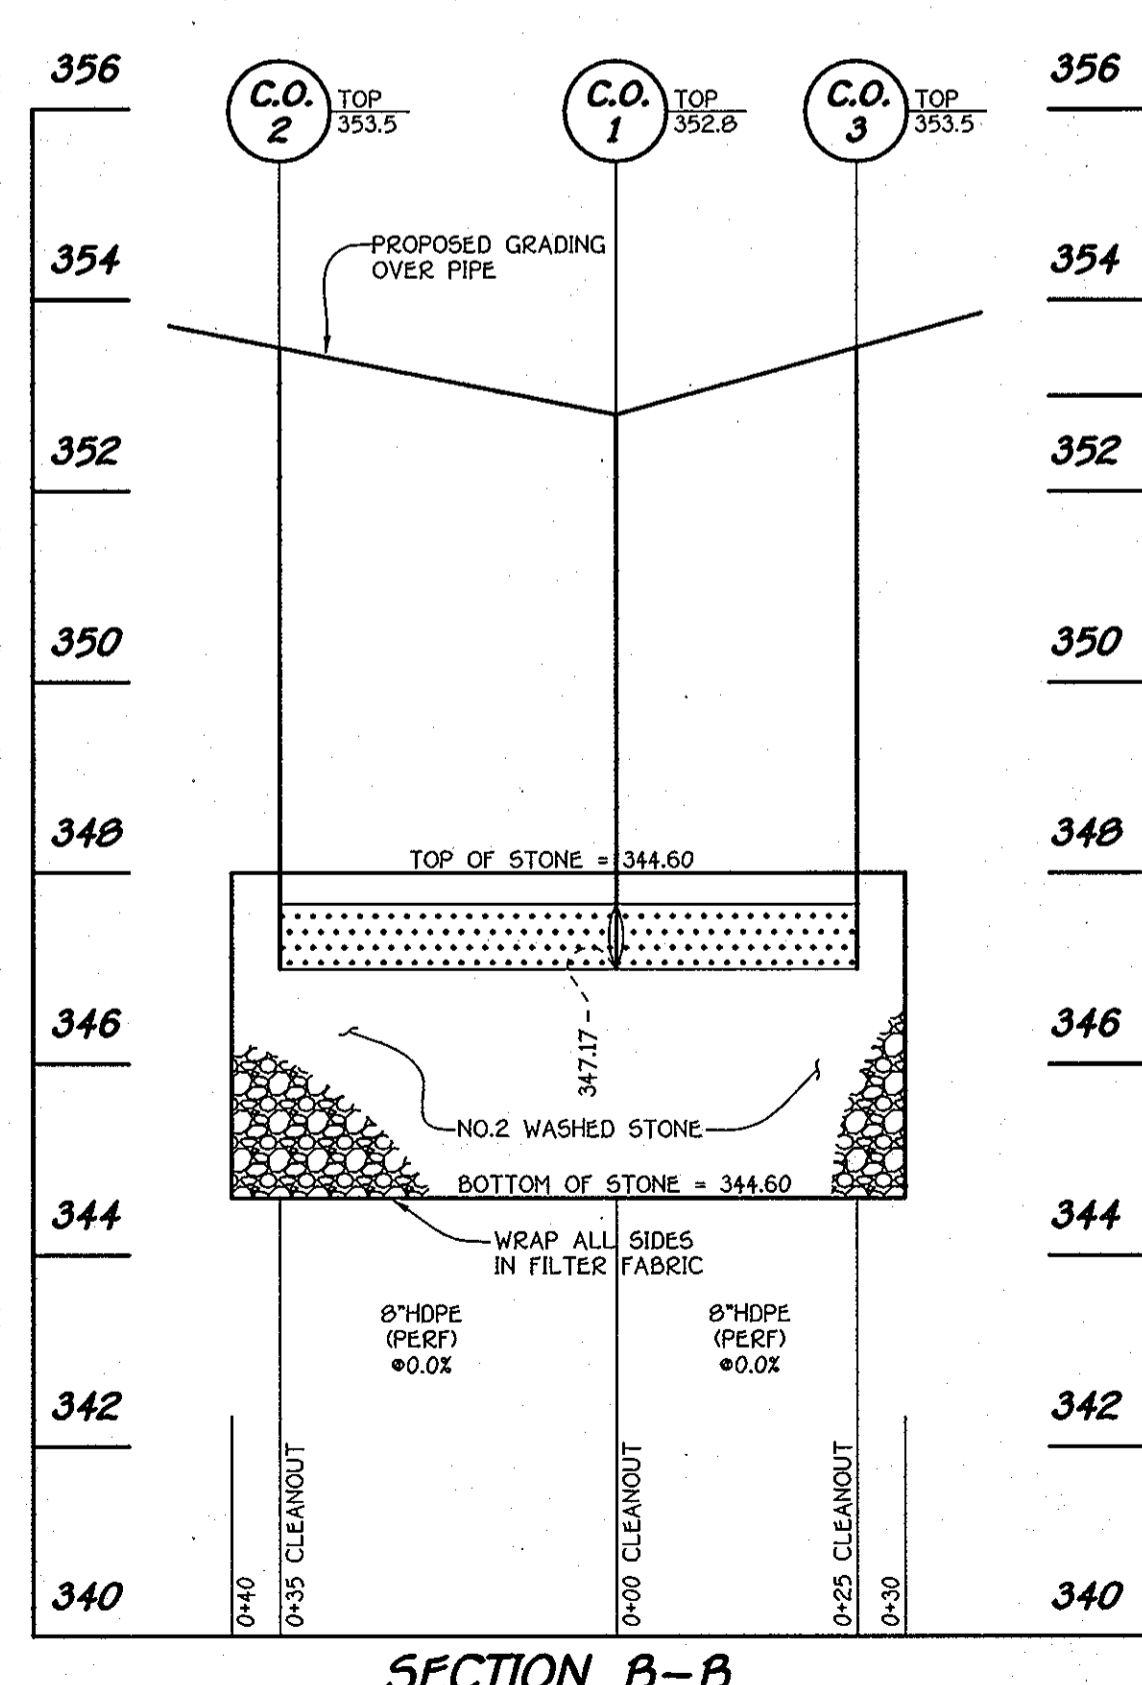

SECTION B-B
OFF-LINE STONE RESERVOIR
SCALE: HORIZ. : 1" = 20'
VERT. : 1" = 2'



STORM DRAIN PROFILES
HOGG PROPERTY
LOTS 1 - 22, OPEN SPACE LOTS 23 - 26
ZONED: R-ED
TAX MAP NO. 25 GRID NO. 14 PARCEL NO. 64
SECOND ELECTION DISTRICT
HOWARD COUNTY, MARYLAND
DATE: JUNE 8, 2006
SHEET 9 OF 17

F-06-109
AS BUILT

K:\SDS\PROJ\030772\Drawings\FINALS\030772 SHEET 888-SD PROFILES.dwg, 6/6/2006 10:51:33 AM, 1/20

HILLIS - CARNES ENGINEERING ASSOCIATES, INC. RECORD OF SOIL EXPLORATION. Page 1 of 1. Project Name: Hogg Property SWM. Location: Howard County, Maryland. Boring Number: B-1, Job #: 0313A. Table with columns: ELEV., SOIL DESCRIPTION, EXTRA DEPTH, DEPTH SCALE, SAMPLE NO., BLOWN #, REC., BORING & SAMPLING NOTES. Includes sampler type, sample conditions, ground water depth, and boring method details.

HILLIS - CARNES ENGINEERING ASSOCIATES, INC. RECORD OF SOIL EXPLORATION. Page 1 of 1. Project Name: Hogg Property SWM. Location: Howard County, Maryland. Boring Number: B-2, Job #: 0313A. Table with columns: ELEV., SOIL DESCRIPTION, EXTRA DEPTH, DEPTH SCALE, SAMPLE NO., BLOWN #, REC., BORING & SAMPLING NOTES. Includes sampler type, sample conditions, ground water depth, and boring method details.

HILLIS - CARNES ENGINEERING ASSOCIATES, INC. RECORD OF SOIL EXPLORATION. Page 1 of 1. Project Name: Hogg Property SWM. Location: Howard County, Maryland. Boring Number: B-3, Job #: 0313A. Table with columns: ELEV., SOIL DESCRIPTION, EXTRA DEPTH, DEPTH SCALE, SAMPLE NO., BLOWN #, REC., BORING & SAMPLING NOTES. Includes sampler type, sample conditions, ground water depth, and boring method details.

HILLIS - CARNES ENGINEERING ASSOCIATES, INC. RECORD OF SOIL EXPLORATION. Page 1 of 1. Project Name: Hogg Property SWM. Location: Howard County, Maryland. Boring Number: B-4, Job #: 0313A. Table with columns: ELEV., SOIL DESCRIPTION, EXTRA DEPTH, DEPTH SCALE, SAMPLE NO., BLOWN #, REC., BORING & SAMPLING NOTES. Includes sampler type, sample conditions, ground water depth, and boring method details.

HILLIS - CARNES ENGINEERING ASSOCIATES, INC. RECORD OF SOIL EXPLORATION. Page 1 of 1. Project Name: Hogg Property SWM. Location: Howard County, Maryland. Boring Number: B-5, Job #: 0313A. Table with columns: ELEV., SOIL DESCRIPTION, EXTRA DEPTH, DEPTH SCALE, SAMPLE NO., BLOWN #, REC., BORING & SAMPLING NOTES. Includes sampler type, sample conditions, ground water depth, and boring method details.

HILLIS - CARNES ENGINEERING ASSOCIATES, INC. RECORD OF SOIL EXPLORATION. Page 1 of 1. Project Name: Hogg Property SWM. Location: Howard County, Maryland. Boring Number: B-6, Job #: 0313A. Table with columns: ELEV., SOIL DESCRIPTION, EXTRA DEPTH, DEPTH SCALE, SAMPLE NO., BLOWN #, REC., BORING & SAMPLING NOTES. Includes sampler type, sample conditions, ground water depth, and boring method details.

HILLIS - CARNES ENGINEERING ASSOCIATES, INC. RECORD OF SOIL EXPLORATION. Page 1 of 1. Project Name: Hogg Property SWM. Location: Howard County, Maryland. Boring Number: B-7, Job #: 0313A. Table with columns: ELEV., SOIL DESCRIPTION, EXTRA DEPTH, DEPTH SCALE, SAMPLE NO., BLOWN #, REC., BORING & SAMPLING NOTES. Includes sampler type, sample conditions, ground water depth, and boring method details.

HILLIS - CARNES ENGINEERING ASSOCIATES, INC. RECORD OF SOIL EXPLORATION. Page 1 of 1. Project Name: Hogg Property SWM. Location: Howard County, Maryland. Boring Number: B-8, Job #: 0313A. Table with columns: ELEV., SOIL DESCRIPTION, EXTRA DEPTH, DEPTH SCALE, SAMPLE NO., BLOWN #, REC., BORING & SAMPLING NOTES. Includes sampler type, sample conditions, ground water depth, and boring method details.


HILLIS - CARNES ENGINEERING ASSOCIATES, INC. RECORD OF SOIL EXPLORATION. Page 1 of 1. Project Name: Hogg Property SWM. Location: Howard County, Maryland. Boring Number: B-9, Job #: 0313A. Table with columns: ELEV., SOIL DESCRIPTION, EXTRA DEPTH, DEPTH SCALE, SAMPLE NO., BLOWN #, REC., BORING & SAMPLING NOTES. Includes sampler type, sample conditions, ground water depth, and boring method details.

HILLIS - CARNES ENGINEERING ASSOCIATES, INC. RECORD OF SOIL EXPLORATION. Page 1 of 1. Project Name: Hogg Property SWM. Location: Howard County, Maryland. Boring Number: B-10, Job #: 0313A. Table with columns: ELEV., SOIL DESCRIPTION, EXTRA DEPTH, DEPTH SCALE, SAMPLE NO., BLOWN #, REC., BORING & SAMPLING NOTES. Includes sampler type, sample conditions, ground water depth, and boring method details.

APPROVED: DEPARTMENT OF PUBLIC WORKS
M. J. ... 8/3/06 DATE
CHIEF, BUREAU OF HIGHWAYS
APPROVED: DEPARTMENT OF PLANNING AND ZONING
K. ... 8/17/06 DATE
CHIEF, DIVISION OF LAND DEVELOPMENT
M. ... 8/17/06 DATE
CHIEF, DEVELOPMENT ENGINEERING DIVISION

REVISIONS table with columns: NO., DESCRIPTION, DATE.

HILLIS - CARNES ENGINEERING ASSOCIATES, INC. RECORD OF SOIL EXPLORATION. Page 1 of 1. Project Name: Hogg Property SWM. Location: Howard County, Maryland. Boring Number: B-11, Job #: 0313A. Table with columns: ELEV., SOIL DESCRIPTION, EXTRA DEPTH, DEPTH SCALE, SAMPLE NO., BLOWN #, REC., BORING & SAMPLING NOTES. Includes sampler type, sample conditions, ground water depth, and boring method details.


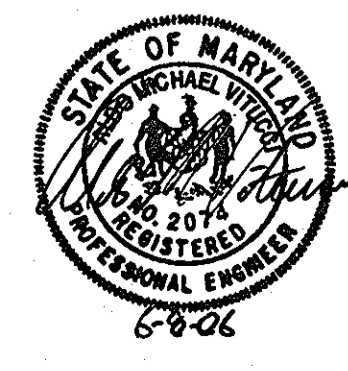


FISHER, COLLINS & CARTER, INC.
CIVIL ENGINEERING CONSULTANTS & LAND SURVEYORS
1100 ...


OWNER/DEVELOPER
DORSEY FAMILY HOMES
10775 BIRMINGHAM WAY
WOODSTOCK, MARYLAND 21163
Attn: ROB DORSEY

SOILS BORINGS
HOGG PROPERTY
LOTS 1 - 22, OPEN SPACE LOTS 23 - 26
ZONED: R-6D
TAX MAP NO. 25 GRID NO. 14 PARCEL NO. 64
SECOND ELECTION DISTRICT
HOWARD COUNTY, MARYLAND
DATE: JUNE 9, 2006
SHEET 10 OF 17


F-06-109
AS BUILT

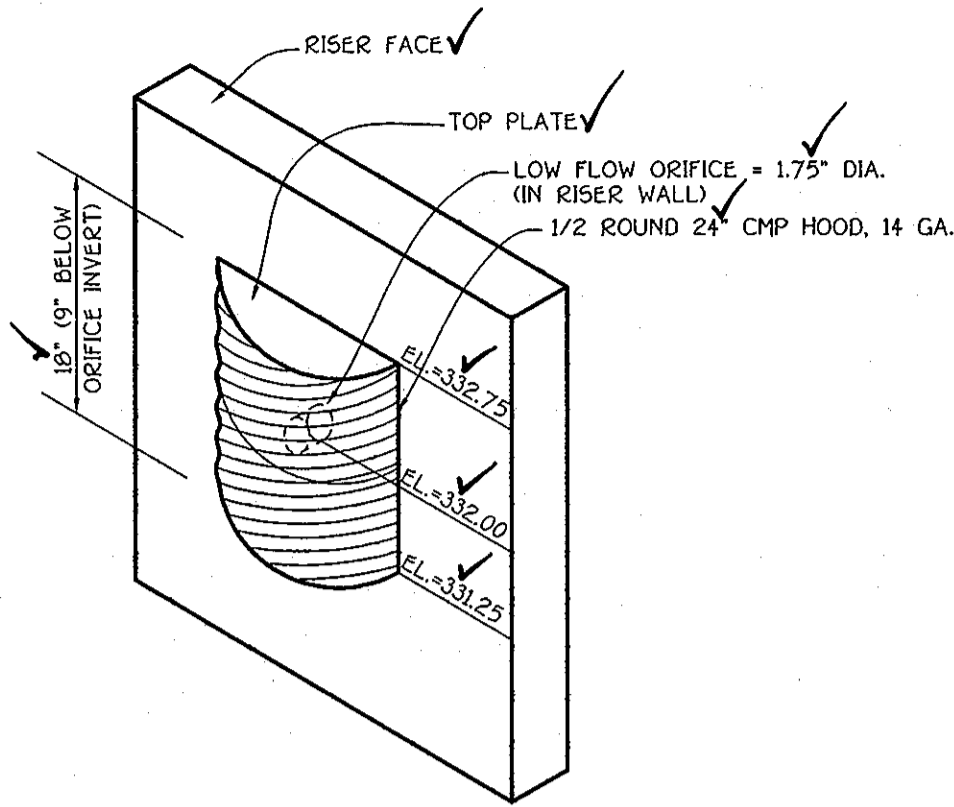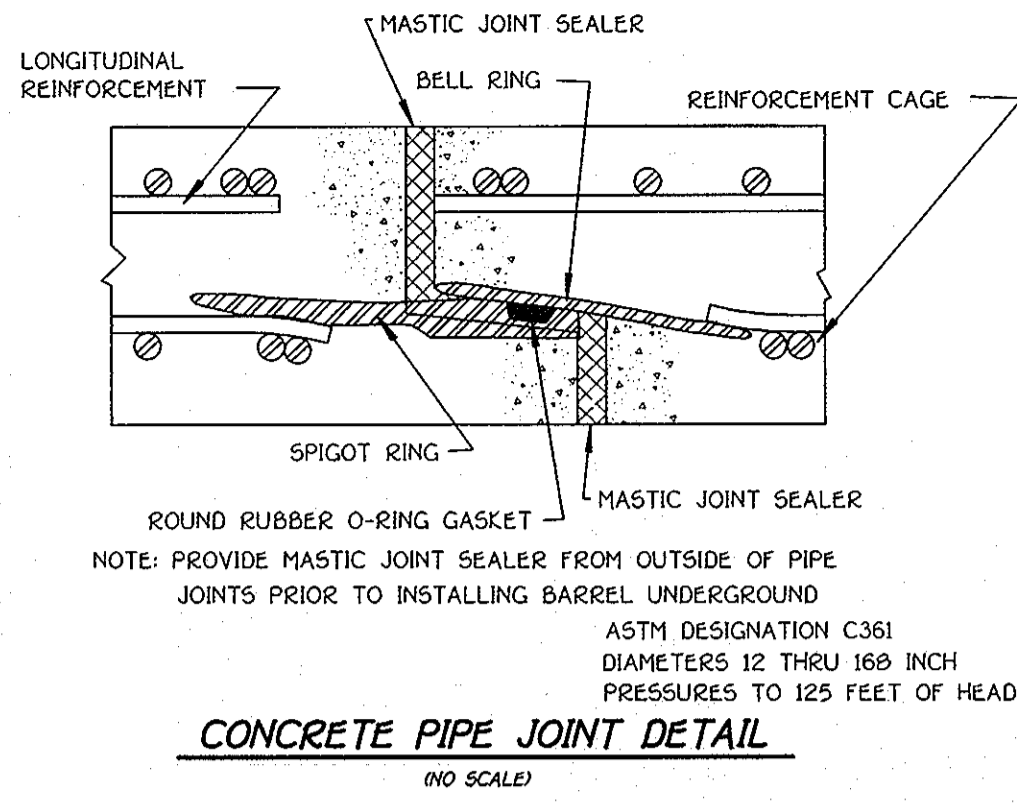

(FOR PROTECTION OF LOW FLOW ORIFICE)
HALF ROUND CMP PIPE-HOOD
 NOT TO SCALE

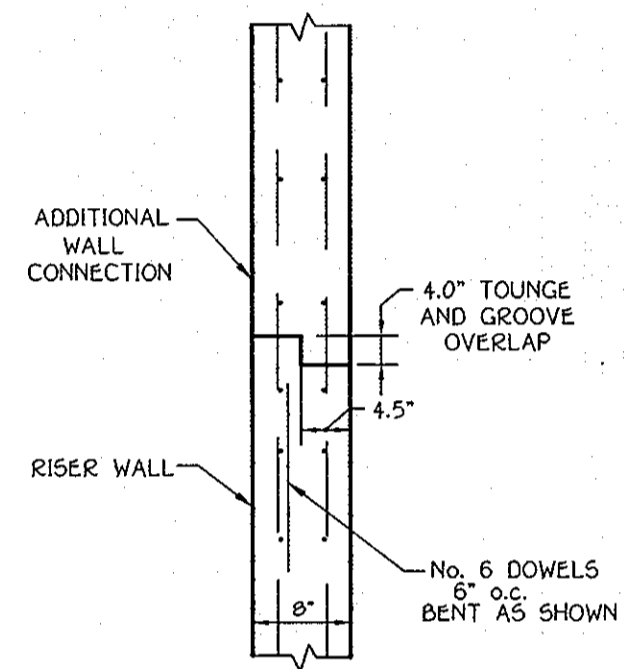

**KEYED JOINT DETAIL
 WALL SECTION TO WALL SECTION**
 NOT TO SCALE

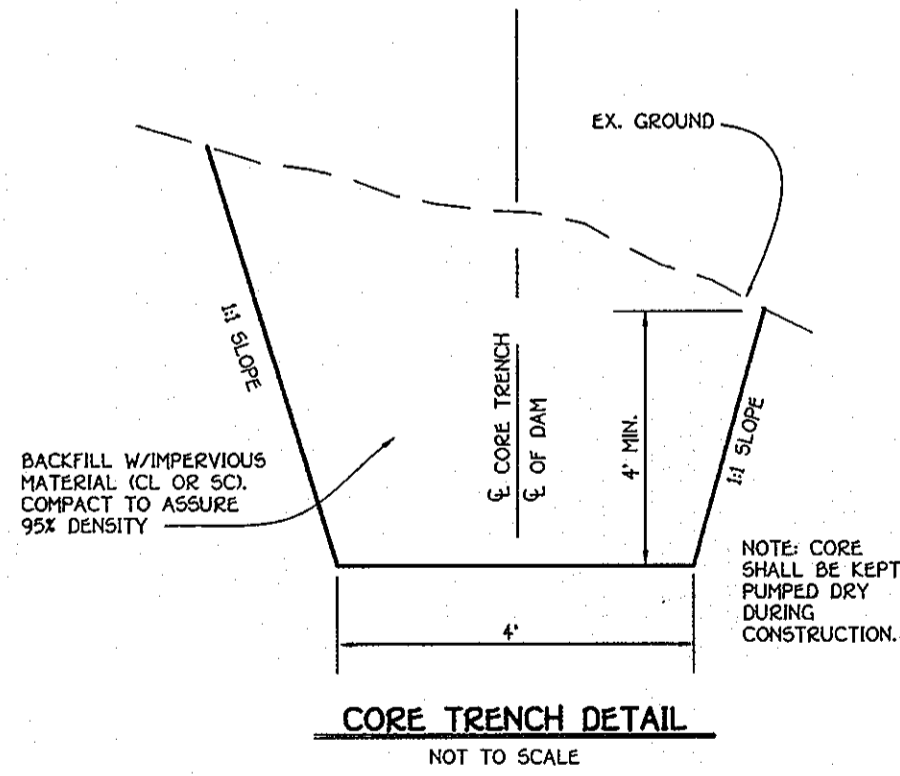

CORE TRENCH DETAIL
 NOT TO SCALE

Bedrock

Decomposed rock materials were encountered at a depth of 12.5z ft in Boring B-2 and 7z ft in Boring B-7. Additionally, auger refusal was encountered at a depth of 10z ft in Boring B-7.

EVALUATION

Based on the State of Maryland's "2000 Maryland Stormwater Design Manual, Volumes I & II", infiltration basins and trenches are not acceptable practices when an infiltration rate of less than 0.52 inches per hour is obtained. Bioretention facilities in areas with in-situ infiltration rates of less than 0.52 inches per hour require underdrains. Also, the bottom of the facility should be located a minimum of 4 ft above the seasonally high water table and/or bedrock. Additionally, Howard County requires a minimum infiltration rate of 1.02 inches per hour.

Based on the subsurface conditions encountered in the borings, the measured in-situ infiltration rates and on the above-outlined criteria, infiltration methods of stormwater management do not appear to be feasible for the site.

EMBANKMENT AND CUT-OFF TRENCH CONSTRUCTION

The areas of the proposed SWM pond facility should be stripped of topsoil and any other unsuitable materials from the embankment or structure areas in accordance with Soil Conservation Guidelines. After stripping operations have been completed, the exposed subgrade materials should be proofrolled with a loaded dump truck or similar equipment in the presence of a geotechnical engineer or his representative. For areas that are not accessible to a dump truck, the exposed materials should be observed and tested by a geotechnical engineer or his representative utilizing a Dynamic Cone Penetrometer. Any excessively soft or loose materials identified by proofrolling or penetrometer testing should be excavated to suitable firm soil, and then grades re-established by backfilling with suitable soil.

A representative of the Geotechnical Engineer should be present to monitor placement and compaction of fill for the embankment and cut-off trench. In accordance with NRCS-MD Code No. 378 Pond Standards/Specifications, soils considered suitable for the center of embankment and cut-off trench shall conform to Unified Soil Classification GC, SC, CH, or CL and must have at least 30% passing the #200 sieve.

It is our professional opinion that in addition to the soil materials described above a fine-grained soil, including Silt (ML) with a plasticity index of 10 or more can be utilized for the center of the embankment and core trench. All fill materials must be placed and compacted in accordance with NRCS-MD Code No. 378 specifications.

By The Developer:
 "I/we Certify That All Development And/Or Construction Will Be Done According To These Plans, And That Any Responsible Personnel Involved In The Construction Project Will Have A Certificate Of Attendance At A Department Of The Environment Approved Training Program For The Control Of Sediment And Erosion Before Beginning The Project. I Shall Engage A Registered Professional Engineer To Supervise Pond Construction And Provide The Howard Soil Conservation District With An "As-Built" Plan Of The Pond Within 30 Days Of Completion. I Also Authorize The On-Site Inspections By The Howard Soil Conservation District."

Signature of Developer: *Robert L. Dorsey Jr.* Date: *6-6-06*
 Printed Name Of Developer: **Robert L. Dorsey Jr.**

By The Engineer:
 "I Certify That The Proposed Construction, Erosion And Sediment Control Represents A Practical Application Of The Requirements Of The Howard Soil Conservation District. I Have Supervised The Construction And I/We Must Engage A Registered Professional Engineer To Supervise The Construction And Provide The Howard Soil Conservation District With An "As-Built" Plan Within 30 Days Of Completion."

Signature of Engineer: *Alvin J. ...* Date: *6-9-06*
 Printed Name Of Engineer: **Alvin J. ...**

These Plans Have Been Reviewed For The Howard Soil Conservation District And Meet The Technical Requirements For Small Pond Construction, Soil Erosion And Sediment Control.

Signature of Reviewer: *Jim ...* Date: *6/16/06*
 USDA-Natural Resources Conservation Service

These Plans For Small Pond Construction, Soil Erosion And Sediment Control Meet The Requirements Of The Howard Soil Conservation District.

Signature of Reviewer: *...* Date: *6/16/06*
 Howard Soil Conservation District

Approved Department Of Public Works
 Signature: *...* Date: *6/13/06*
 Chief, Bureau Of Highways

Approved Department Of Planning And Zoning
 Signature: *...* Date: *6/17/06*
 Chief, Division Of Land Development

Signature: *...* Date: *6/17/06*
 Chief, Development Engineering Division



AS-BUILT CERTIFICATION
 I Herby Certify That The Facility Shown On This Plan Was Constructed As Shown On The "As-Built" Plans And Meets The Approved Plans And Specifications.

Signature: *...* License No. *13204* Date: *12/12/12*

Certify Means To State Or Declare A Professional Opinion Based Upon Onsite Inspections And Material Tests Which Are Conducted During Construction. The Onsite Inspections And Material Tests Are Those Inspections And Tests Deemed Sufficient And Appropriate Commonly Accepted Engineering Standards. Certify Does Not Mean Or Imply A Guarantee By The Engineer Nor Does An Engineer's Certification Relieve Any Other Party From Meeting Requirements Imposed By Contract, Employment, Or Other Means, Including Meeting Commonly Accepted Industry Practices.











FISHER, COLLINS & CARTER, INC.
 CIVIL ENGINEERING CONSULTANTS & LAND SURVEYORS
 CENTRAL SQUARE OFFICE PARK - 10772 BALTIMORE NATIONAL PIKE
 ELLICOTT CITY, MARYLAND 21042
 (410) 461-2000



OWNER / DEVELOPER
 DORSEY FAMILY HOMES
 10717B BIRMINGHAM WAY
 WOODSTOCK, MARYLAND 21163
 ATTN: ROB DORSEY

STORMWATER MANAGEMENT DETAILS
HOGG PROPERTY
 LOTS 1 - 22, OPEN SPACE LOTS 23 - 26
 ZONED: R-ED
 TAX MAP NO. 25 GRID NO. 14 PARCEL NO. 64
 SECOND ELECTION DISTRICT
 HOWARD COUNTY, MARYLAND
 DATE: JUNE 8, 2006
 SHEET 12 OF 17

F-06-109
AS BUILT

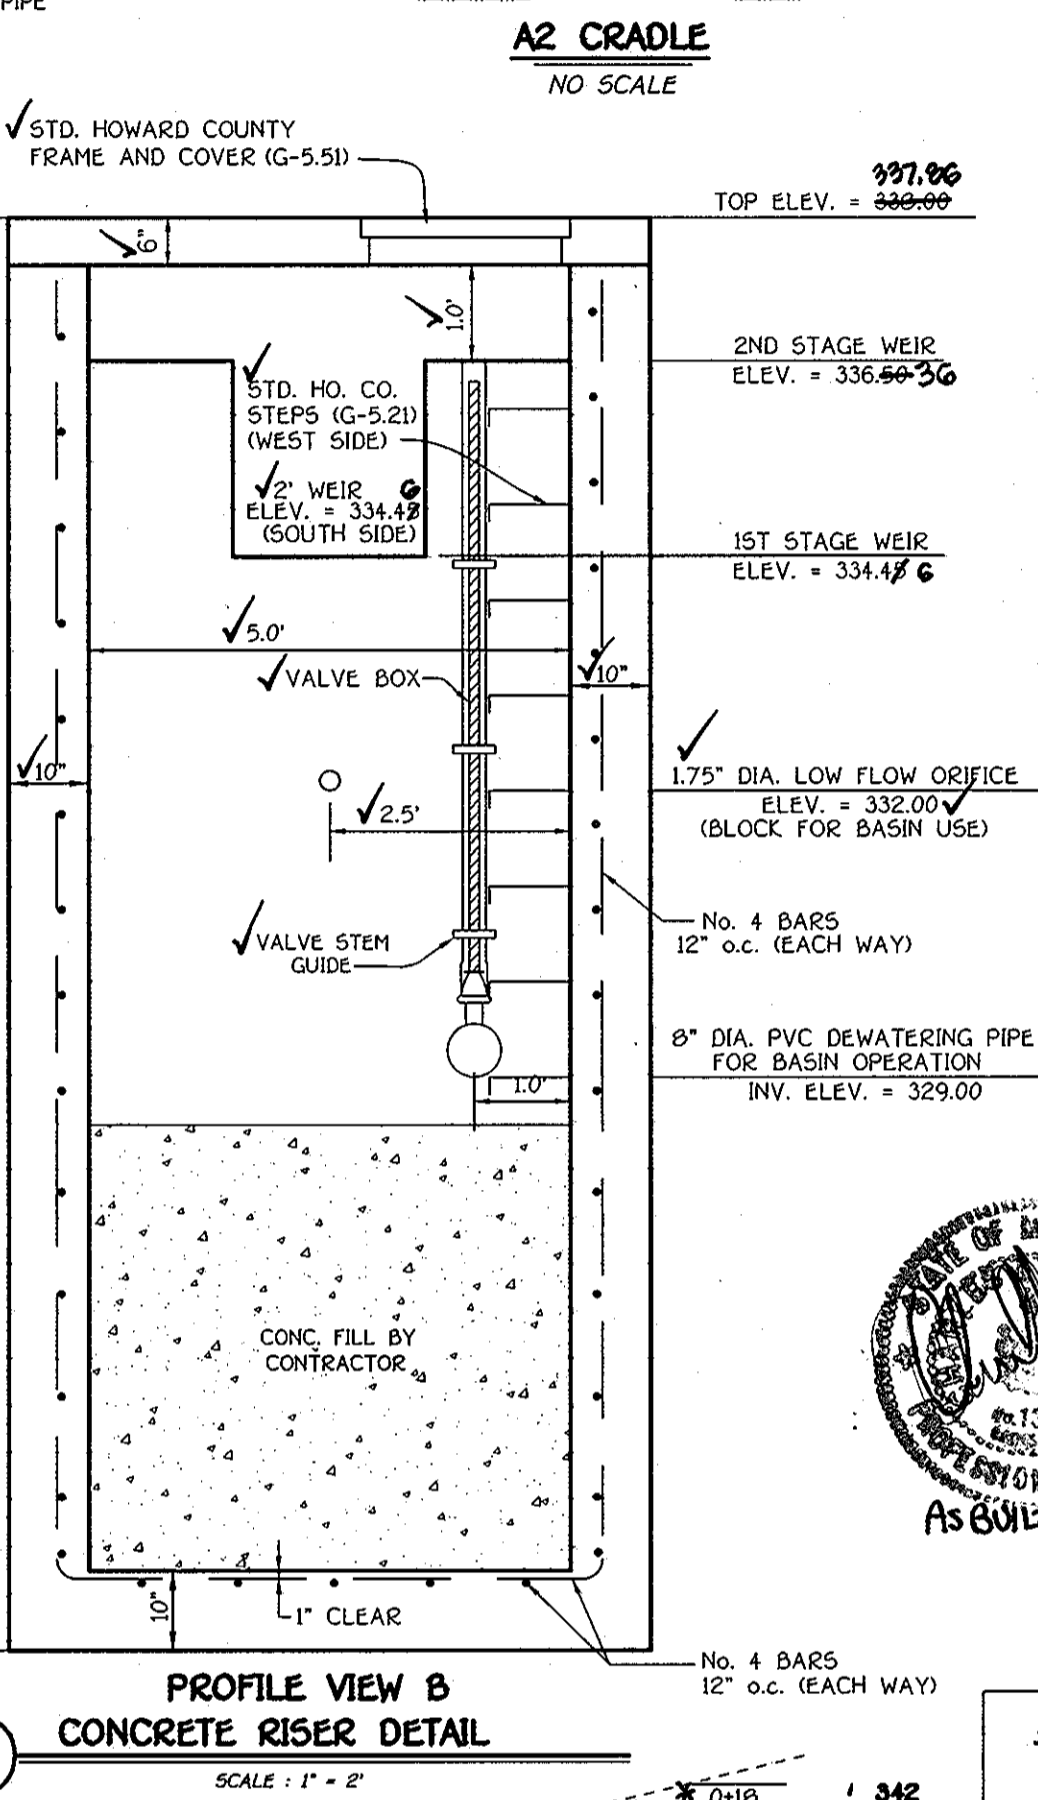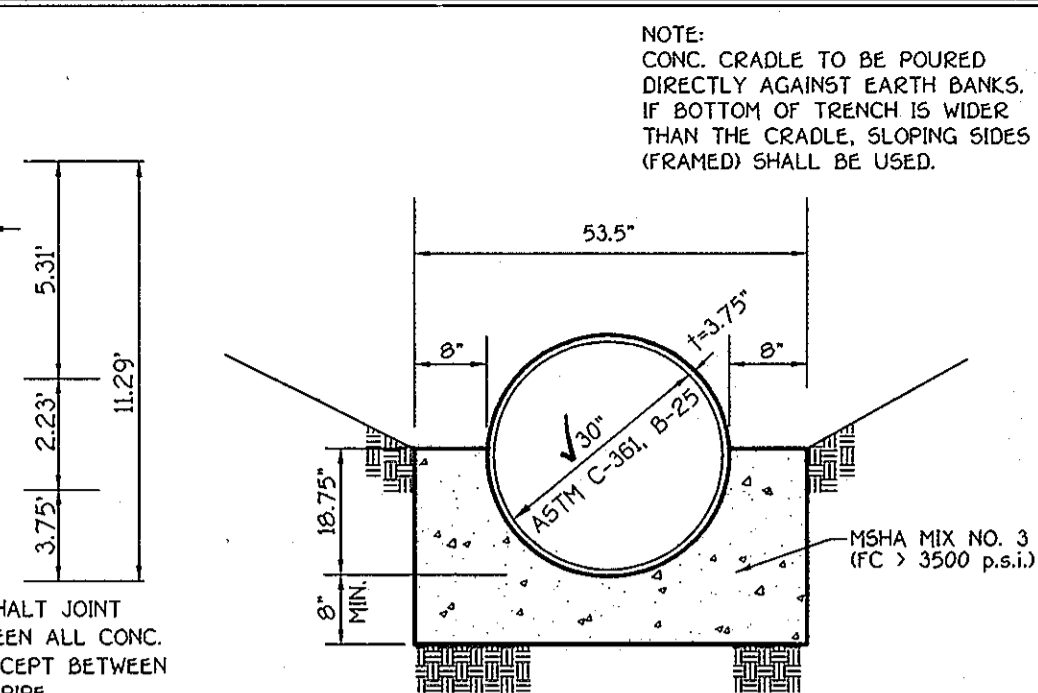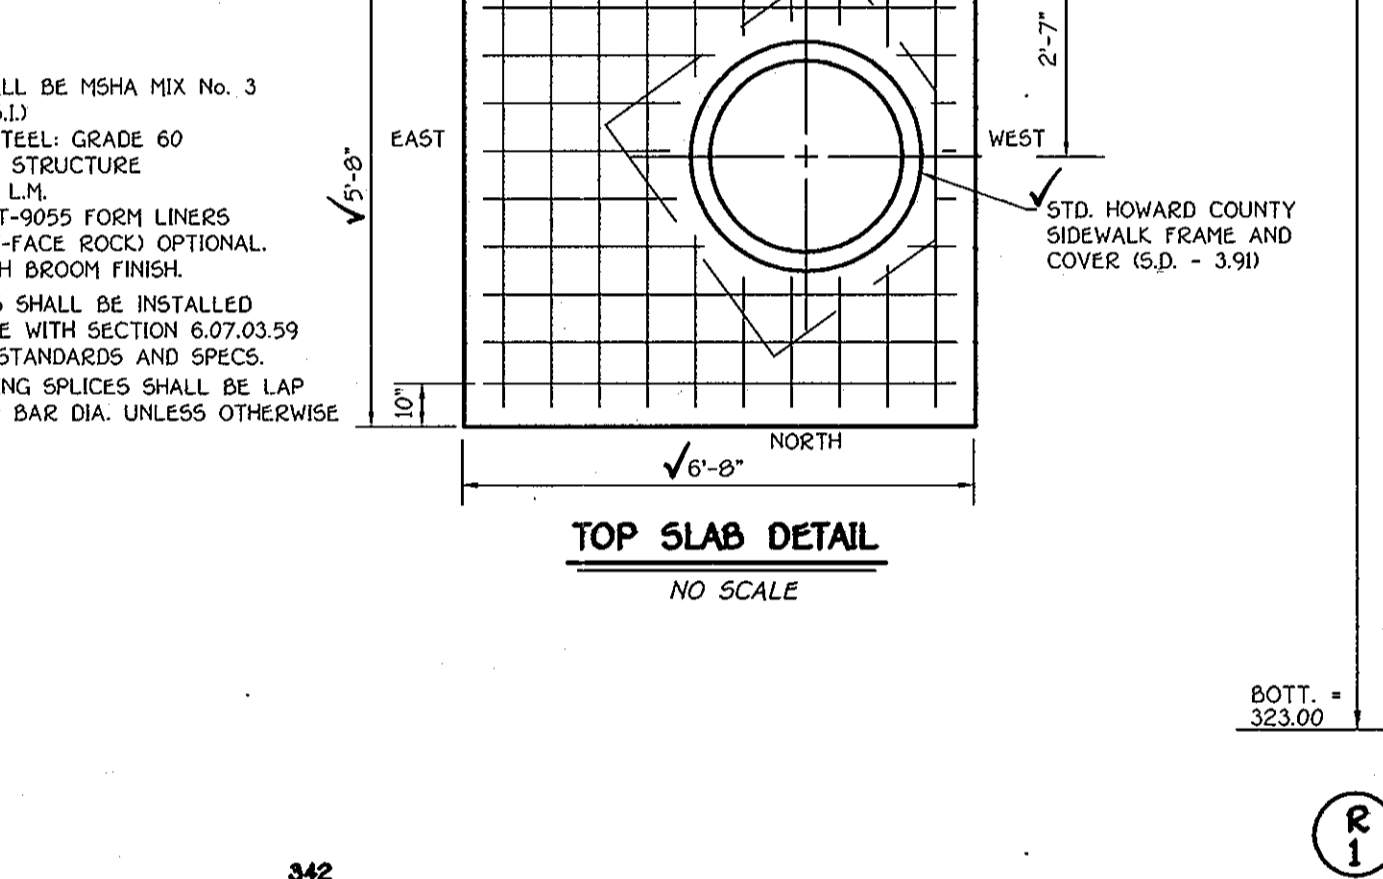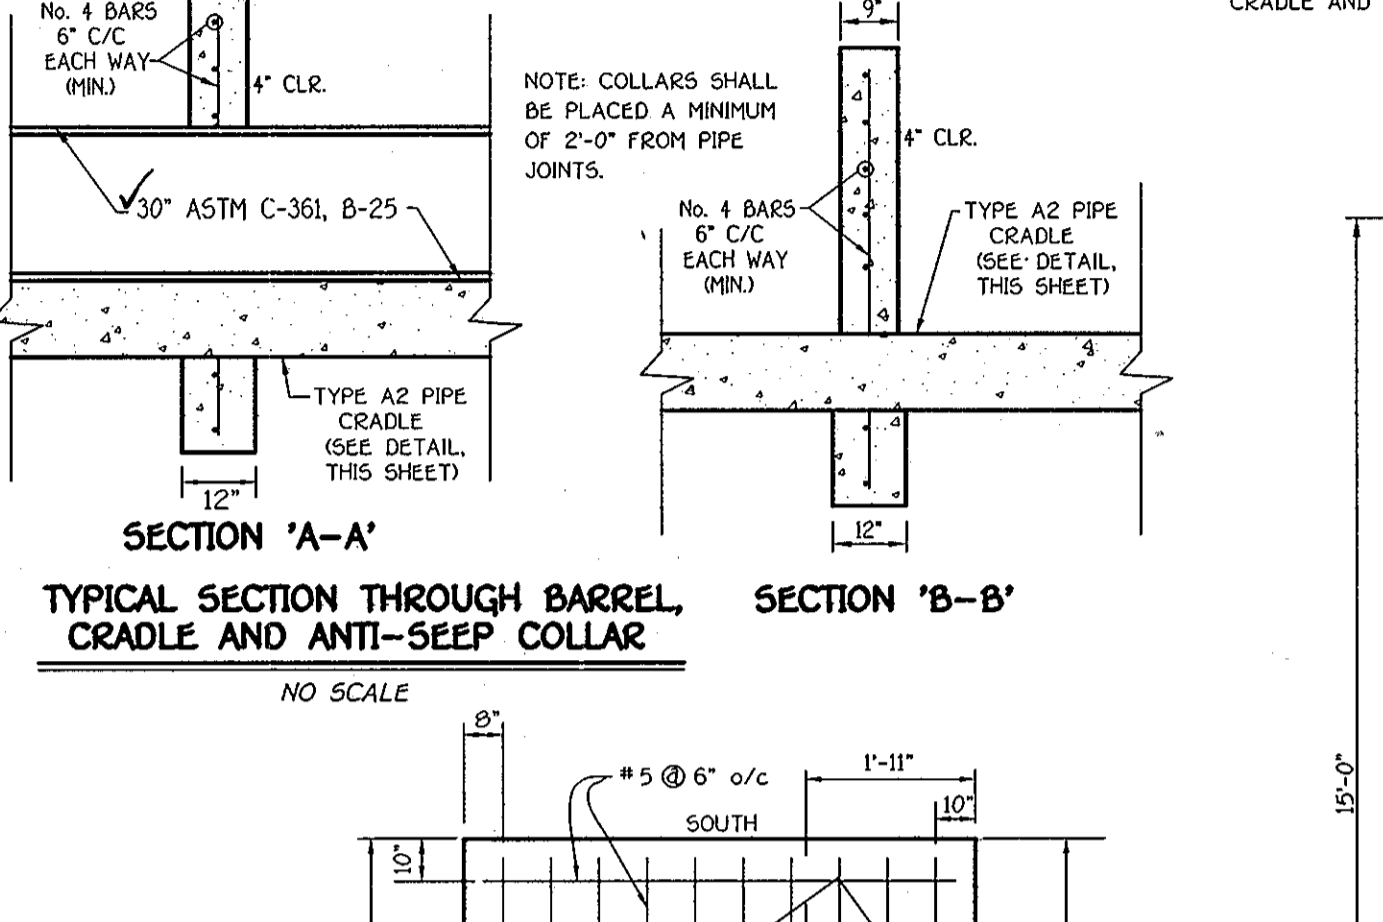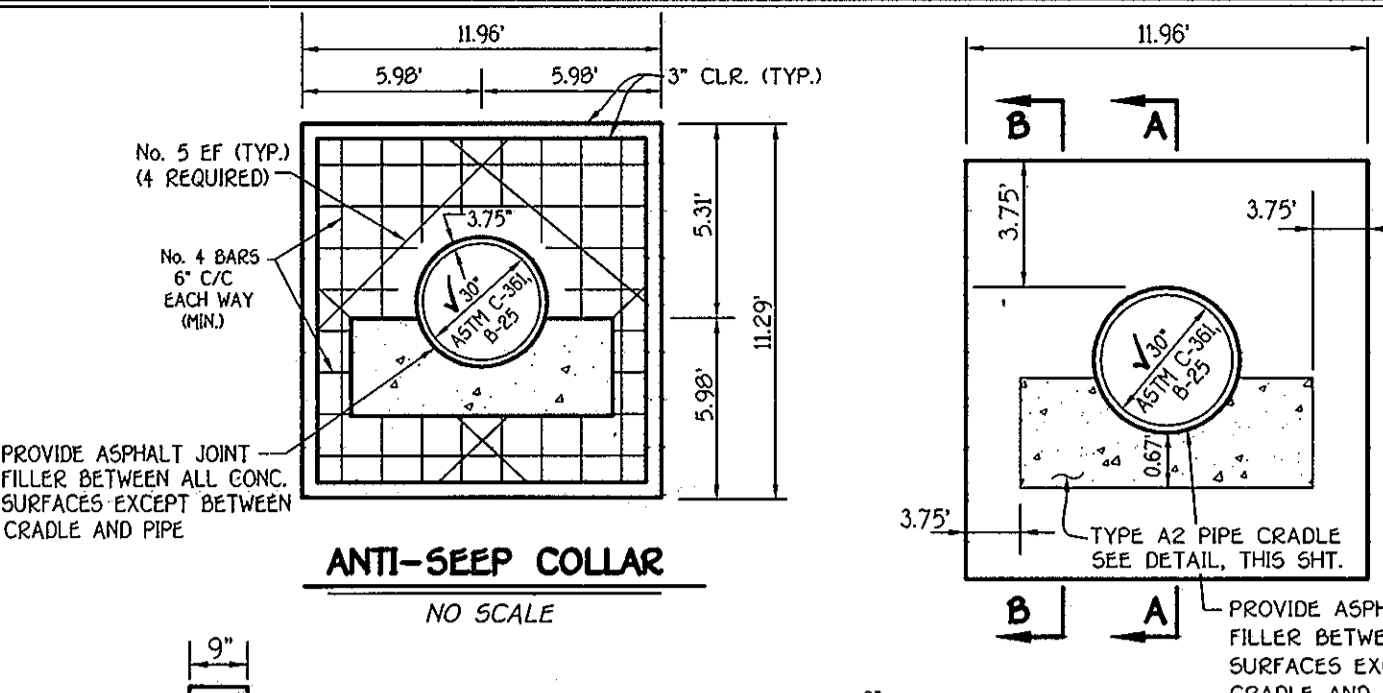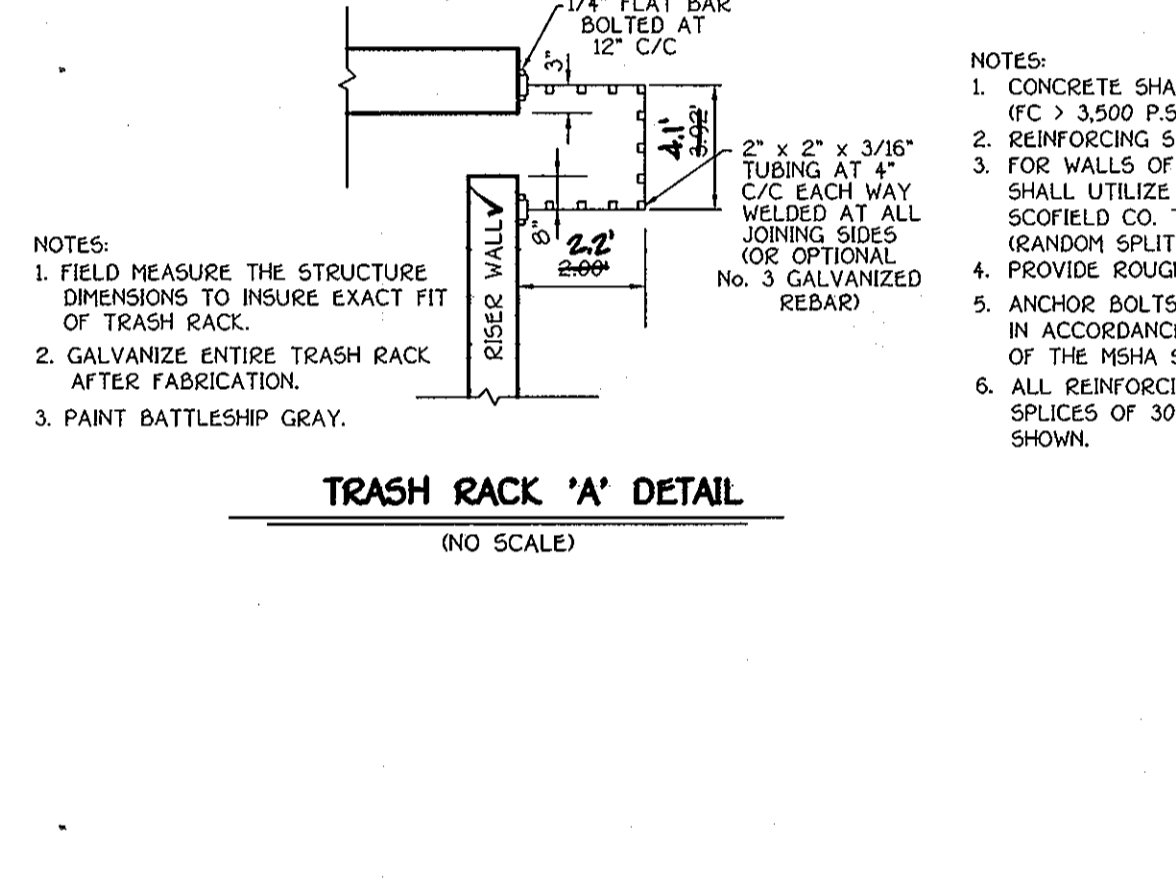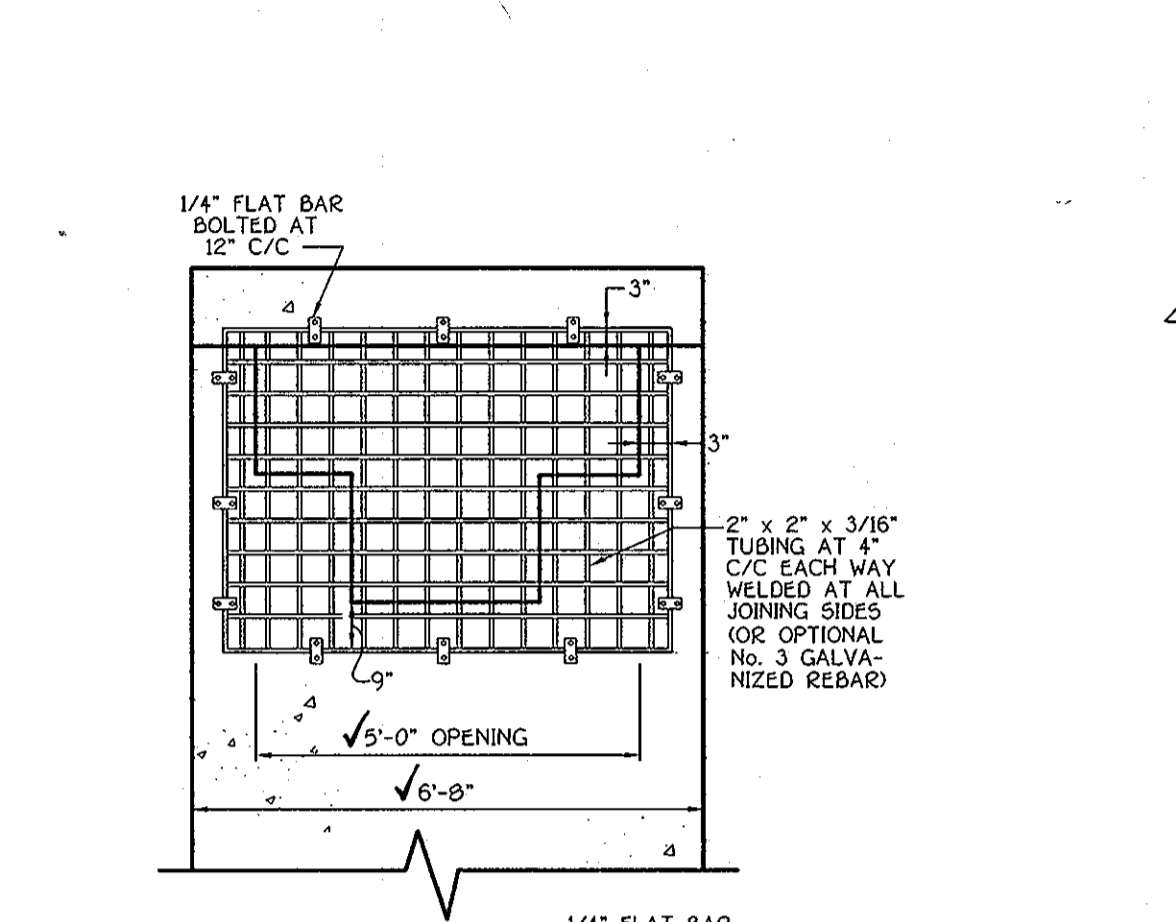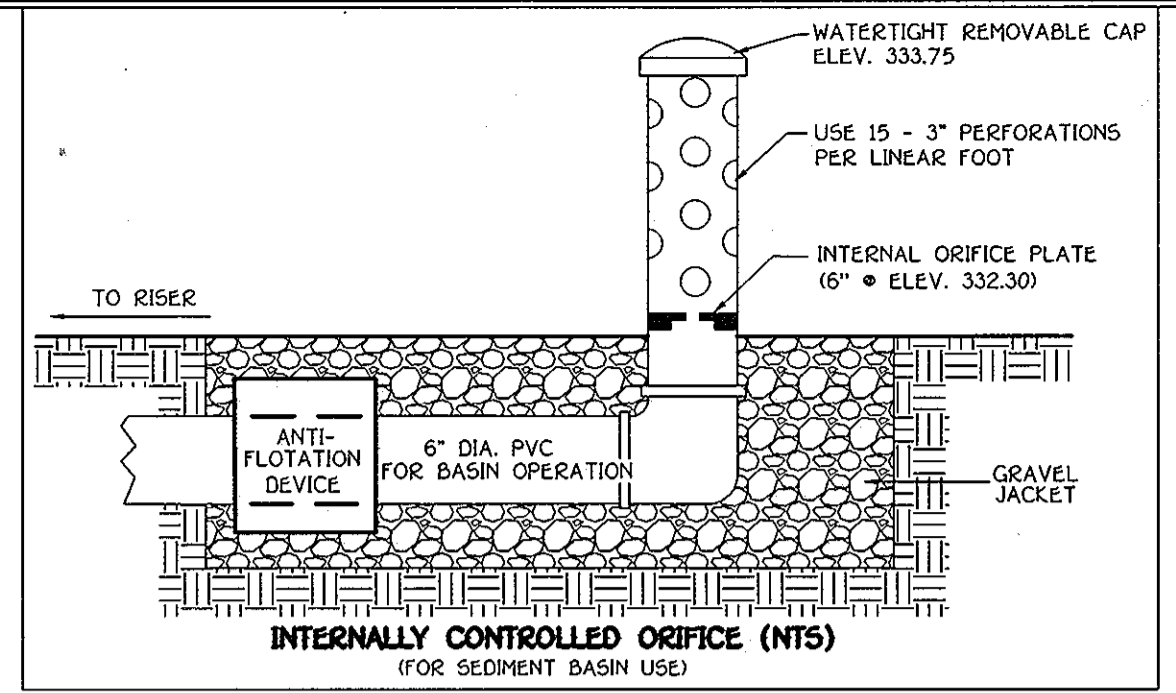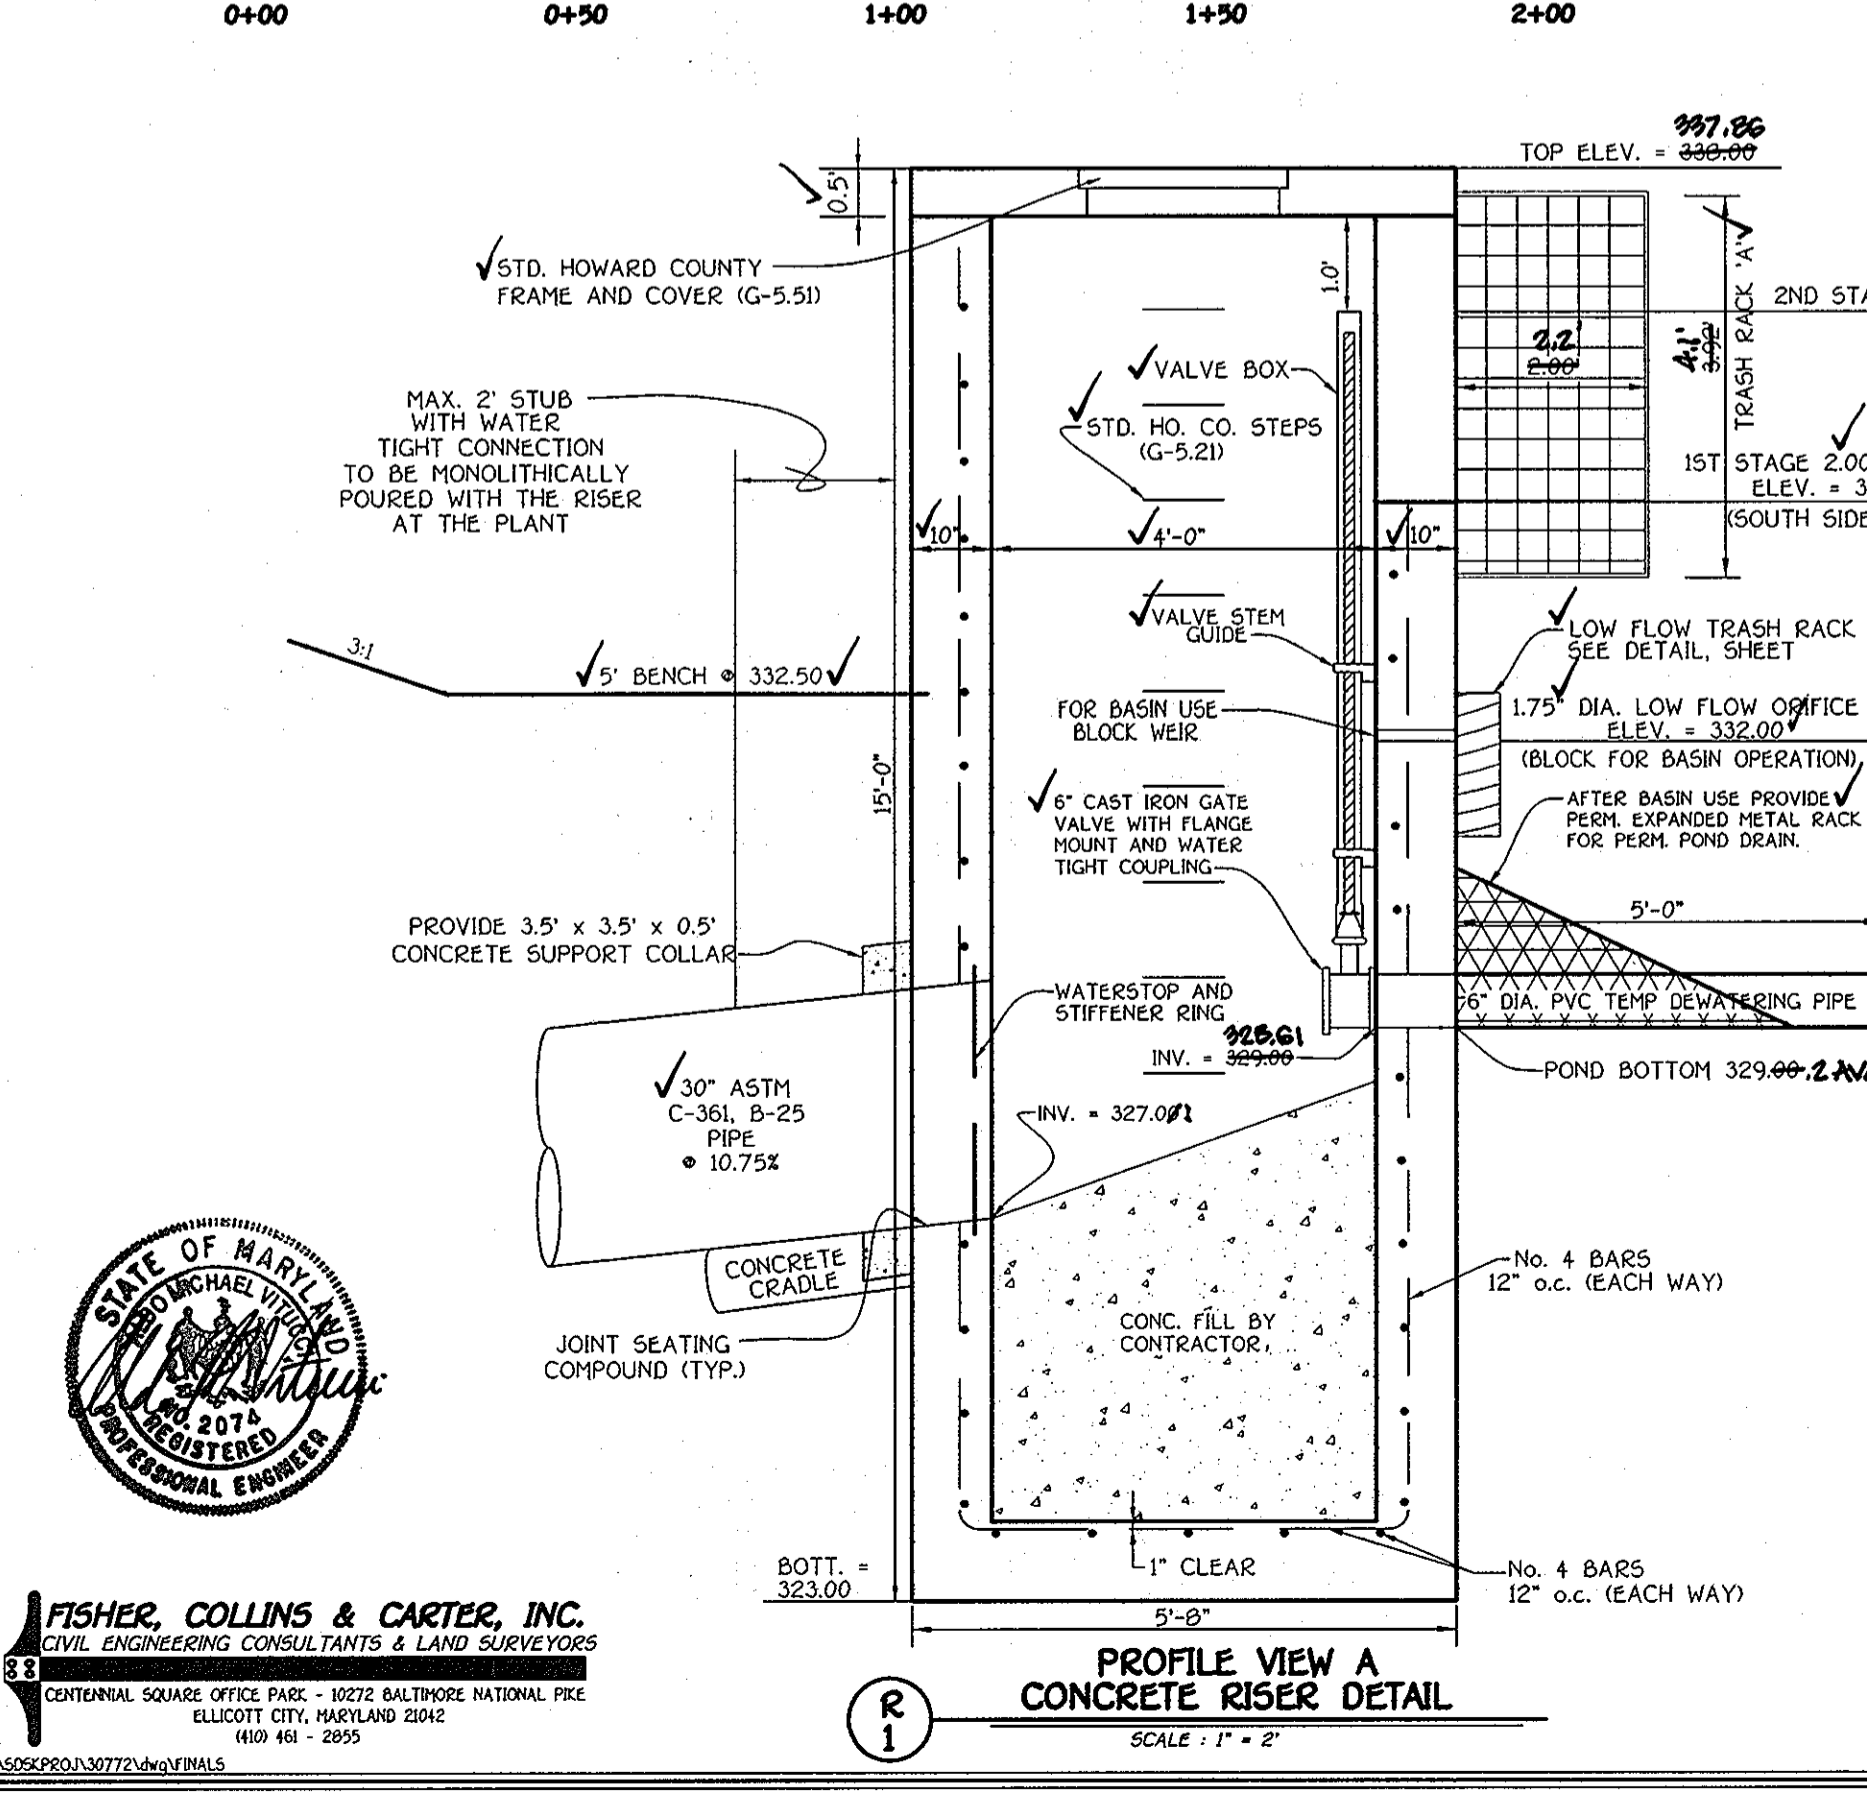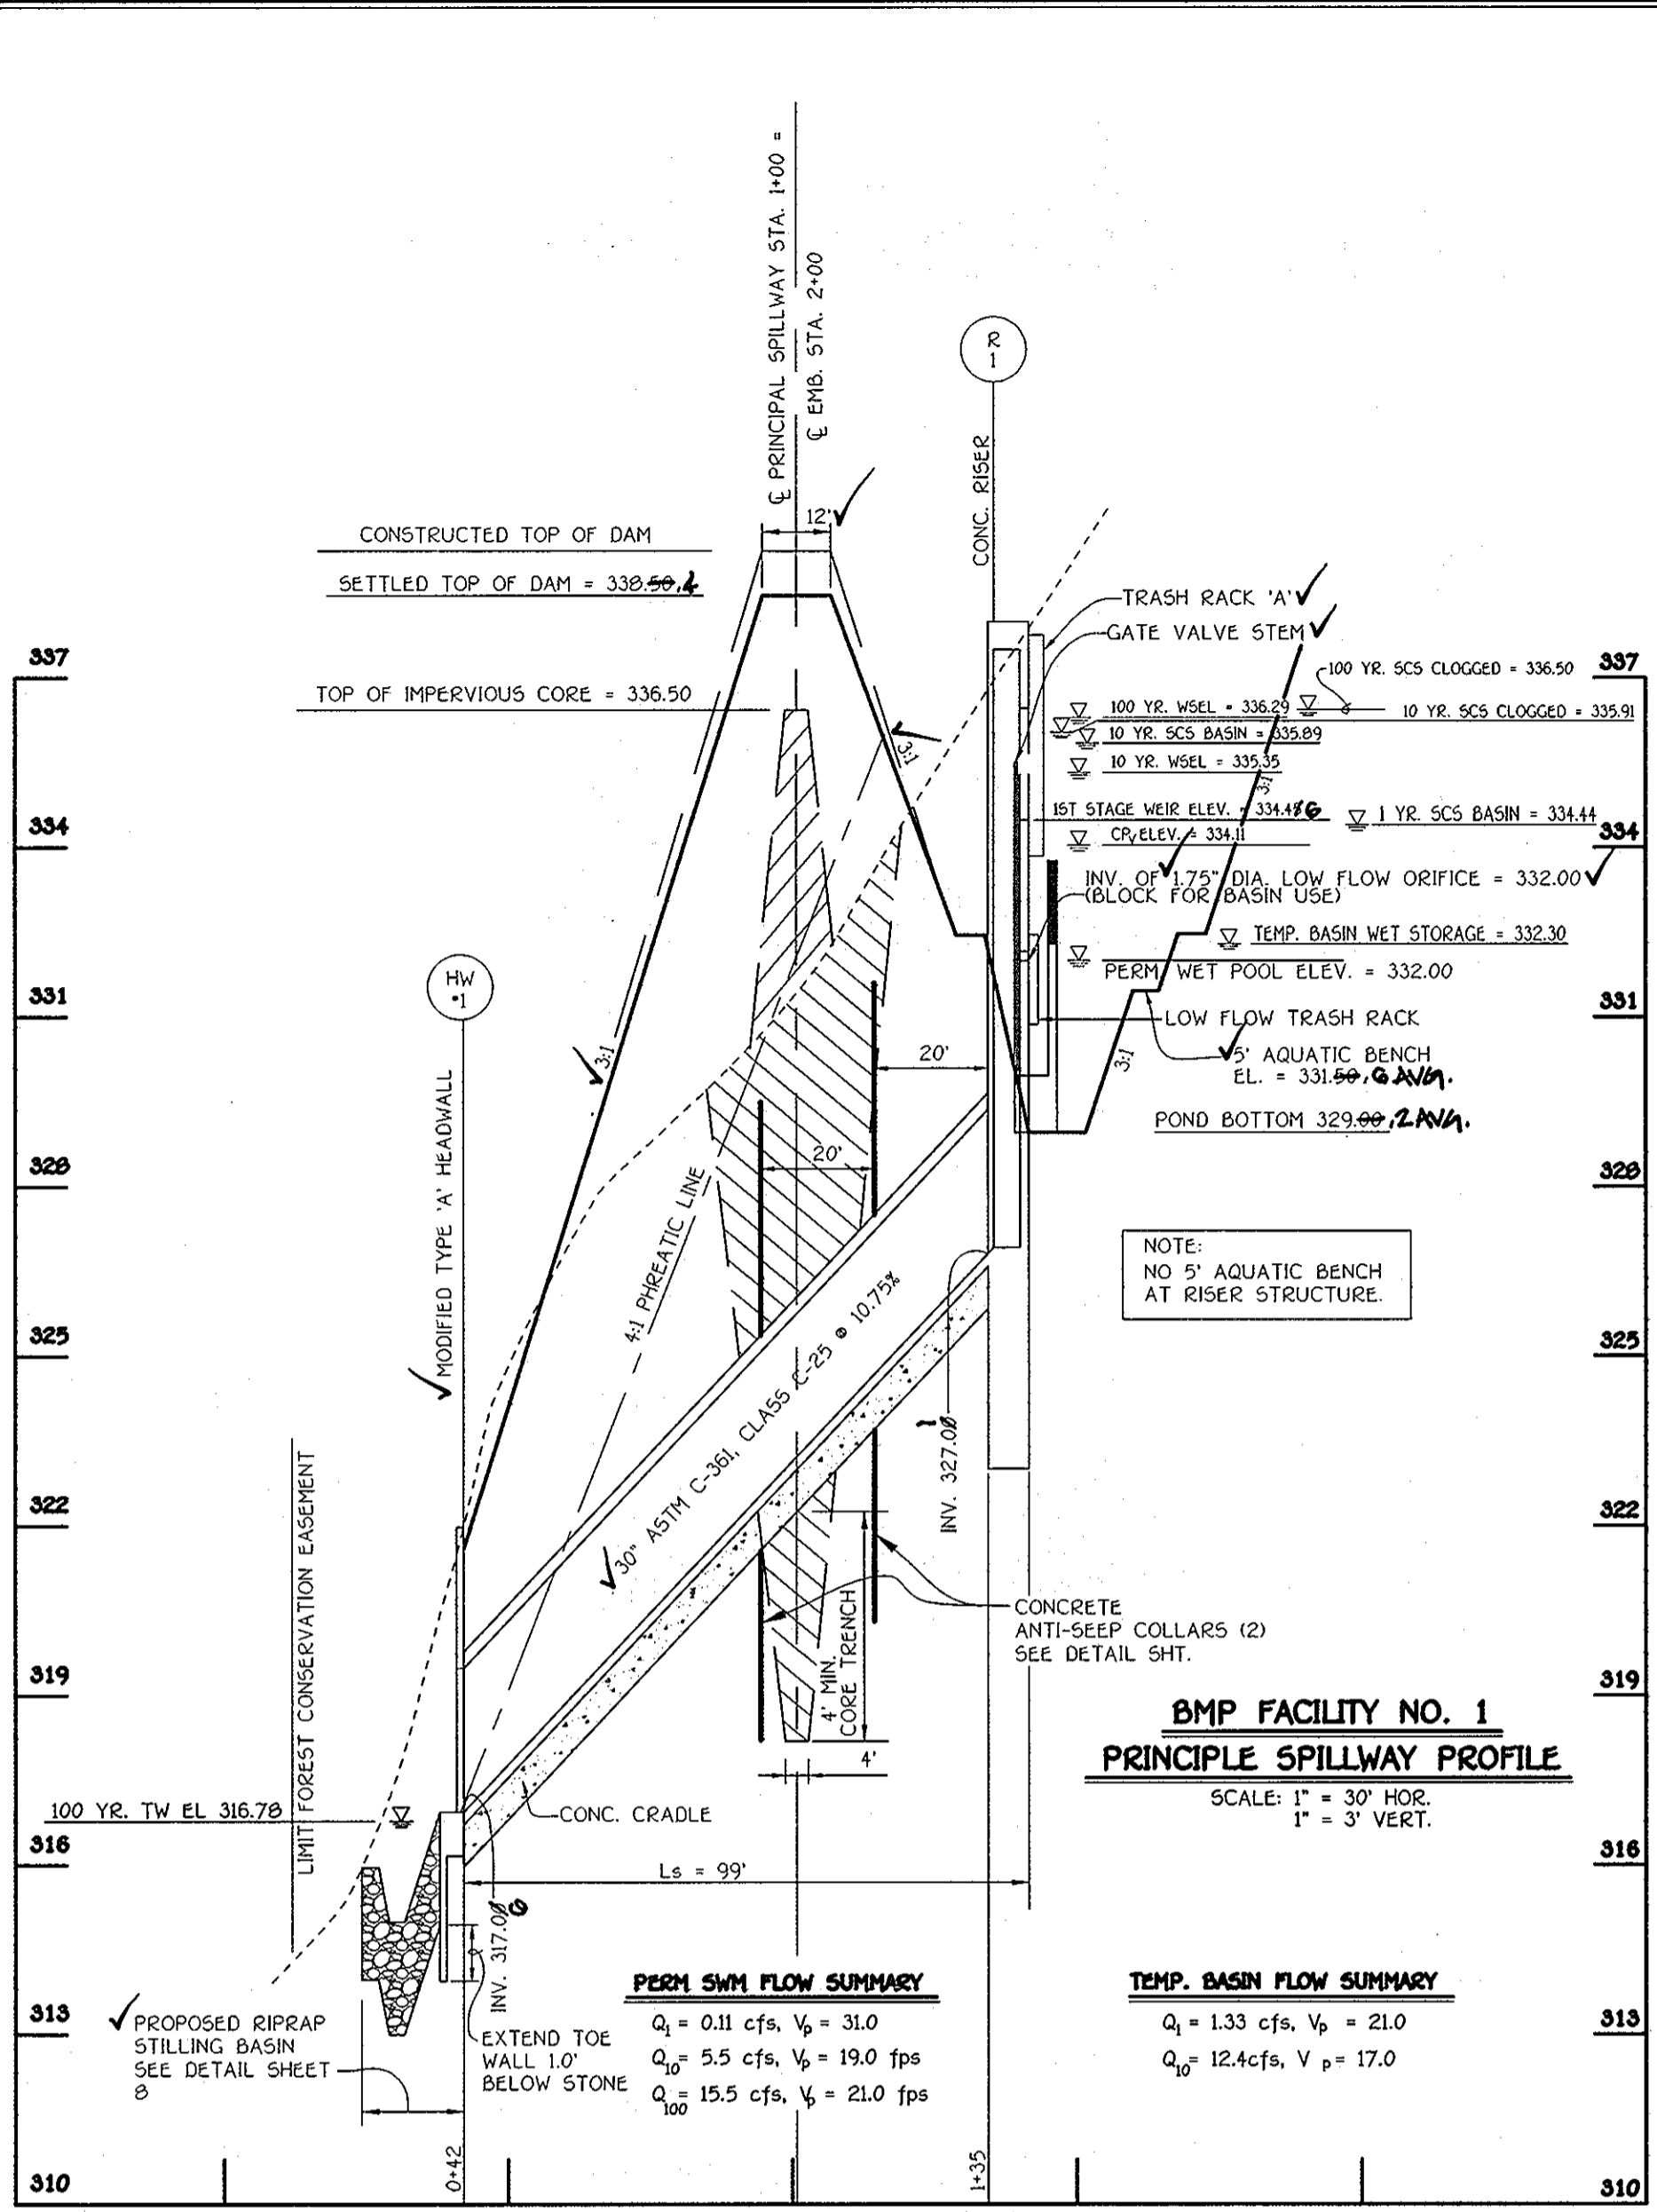

By the Developer:
 Robert L. Dorsey Jr.
 Robert L. Dorsey Jr.
 Robert L. Dorsey Jr.
 Robert L. Dorsey Jr.

By the Engineer:
 Robert L. Dorsey Jr.
 Robert L. Dorsey Jr.
 Robert L. Dorsey Jr.
 Robert L. Dorsey Jr.

AS-BUILT CERTIFICATION
 I hereby certify that the facility shown on this plan was constructed as shown on the "As-Built" Plans and meets the approved plans and specifications.

Appendix D.8. Miscellaneous Details for Compliance with Performance Criteria
 Detail 2 Expanded Trash Rack Protection for Low Flow Orifice
 Expanded metal trash rack (NTS) for 6" dia. pond drain opening.

STATE OF MARYLAND
 PROFESSIONAL ENGINEER
 FISHER, COLLINS & CARTER, INC.
 CIVIL ENGINEERING CONSULTANTS & LAND SURVEYORS

OWNER/DEVELOPER
 DORSEY FAMILY HOMES
 10717B BIRMGHAM WAY
 WOODSTOCK, MARYLAND 21163
 ATT: ROB DORSEY

PERMANENT BMP NO. 1 / TEMPORARY BASIN NO. 1
 STORMWATER MANAGEMENT NOTES AND DETAILS
HOGG PROPERTY
 LOTS 1 - 22, OPEN SPACE LOTS 23 - 26
 ZONED: R-ED
 TAX MAP NO. 25 GRID NO. 14 PARCEL NO. 64
 SECOND ELECTION DISTRICT
 HOWARD COUNTY, MARYLAND
 DATE: JUNE 8, 2006
 SHEET 13 OF 17


AS BUILT

APPROVED: DEPARTMENT OF PUBLIC WORKS
Mark A. Lauer (ASCE) 8/3/06
 CHIEF, BUREAU OF HIGHWAYS DATE

APPROVED: DEPARTMENT OF PLANNING AND ZONING
Karl Shee Weirbach 8/17/06
 CHIEF, DIVISION OF LAND DEVELOPMENT 89 DATE

Mike Damann 8/17/06
 CHIEF, DEVELOPMENT ENGINEERING DIVISION 15 DATE

REVISIONS		
NO.	DESCRIPTION	DATE

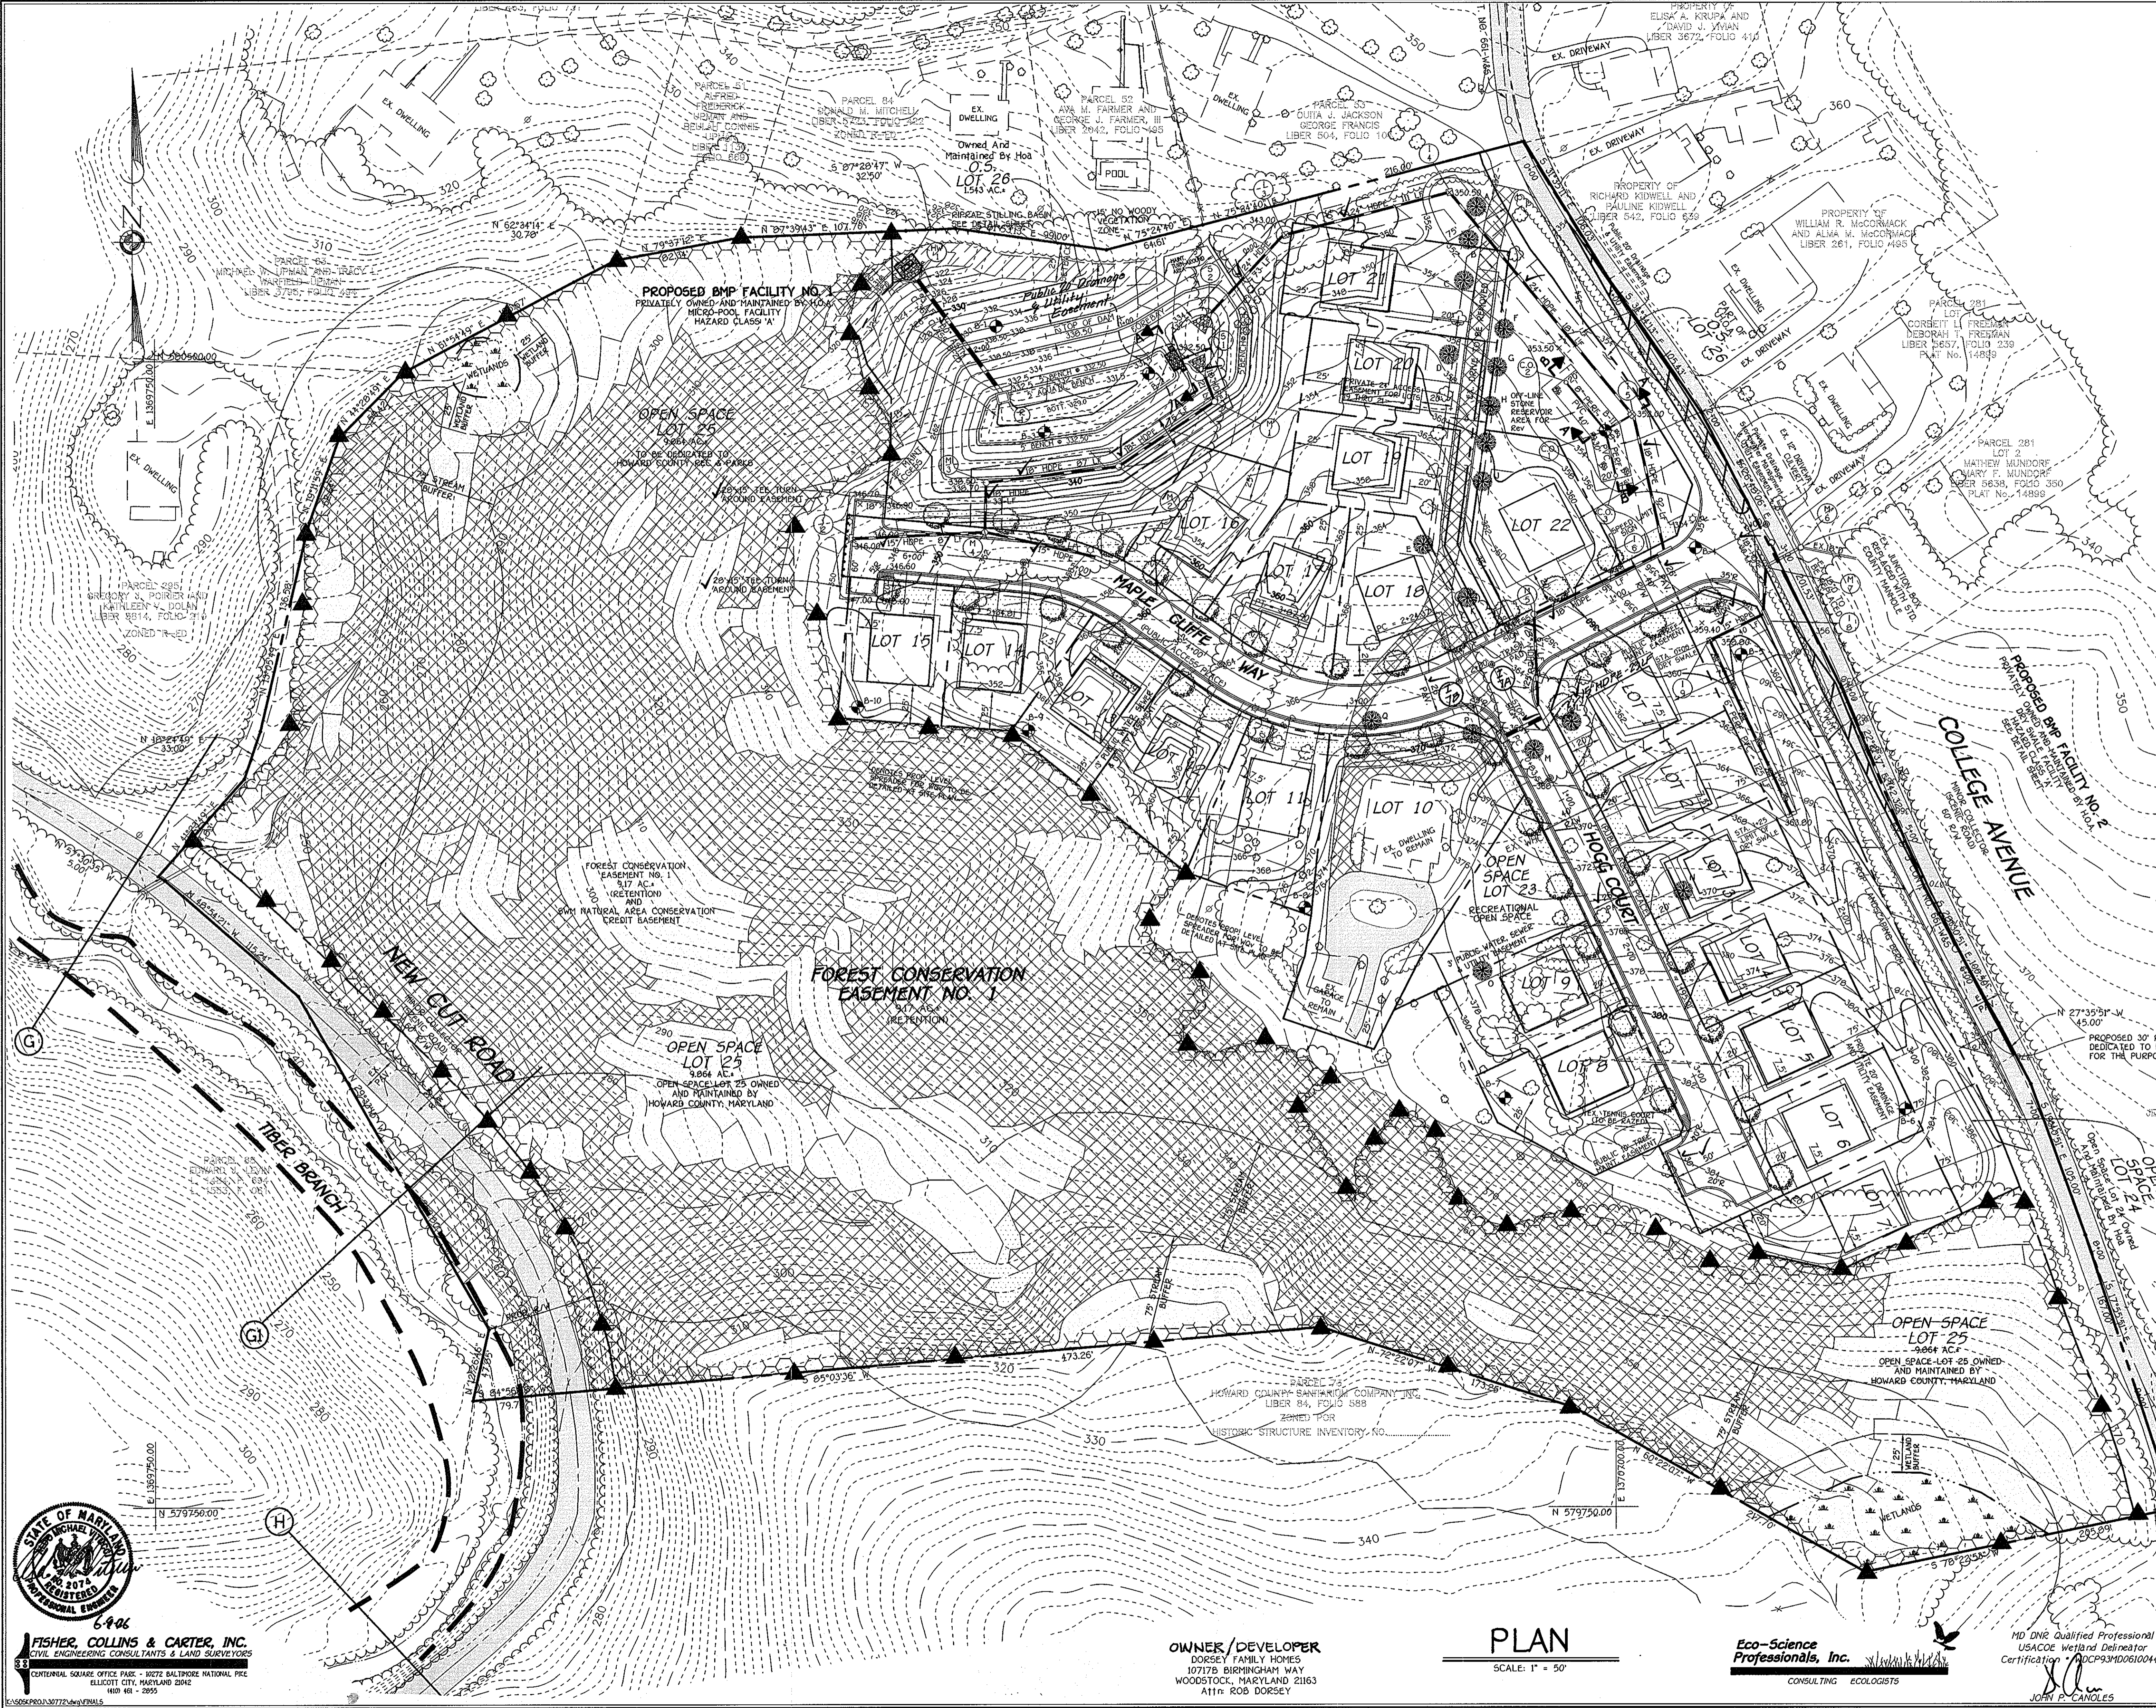


STATE OF MARYLAND
 PROFESSIONAL ENGINEER
 6406
FISHER, COLLINS & CARTER, INC.
 CIVIL ENGINEERING CONSULTANTS & LAND SURVEYORS
 CENTRAL SQUARE OFFICE PARK - 3072 BALTIMORE NATIONAL PIKE
 ELICOTT CITY, MARYLAND 21042
 4100 461 - 2000

OWNER/DEVELOPER
 DORSEY FAMILY HOMES
 10717B BIRMINGHAM WAY
 WOODSTOCK, MARYLAND 21153
 ATTN: ROB DORSEY

PLAN
 SCALE: 1" = 50'

Eco-Science Professionals, Inc.
 CONSULTING ECOLOGISTS

MD DNR Qualified Professional
 USACE Wetland Delineator
 Certification # MDCP93MD06100448
John P. Canoles
 JOHN P. CANOLES

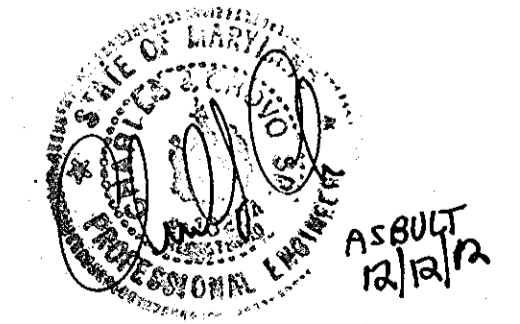

**FOREST CONSERVATION PLAN
 HOGG PROPERTY**
 LOTS 1 - 22, OPEN SPACE LOTS 23 - 26
 ZONED: R-ED
 TAX MAP NO. 25 GRID NO. 14 PARCEL NO. 64
 SECOND ELECTION DISTRICT
 HOWARD COUNTY, MARYLAND
 DATE: JUNE 8, 2006
 SHEET 14 OF 17

FOREST CONSERVATION WORKSHEET

NET TRACT AREA	ACRES
A. TOTAL TRACT AREA	18.0
B. DEDUCTIONS (CRITICAL AREA, AREA RESTRICTED BY LOCAL OR PROGRAM)	--
C. NET TRACT AREA = TOTAL TRACT (A) - DEDUCTIONS (B)	18.0
LAND USE CATEGORY: MEDIUM DENSITY RESIDENTIAL	
D. AFFORESTATION THRESHOLD (NET TRACT AREA (C) x 15%)	2.7
E. CONSERVATION THRESHOLD (NET TRACT AREA (C) x 20%)	3.6
EXISTING FOREST COVER	
F. EXISTING FOREST COVER WITHIN THE NET TRACT AREA	10.9
G. AREA OF FOREST ABOVE CONSERVATION THRESHOLD	7.3
IF THE EXISTING FOREST COVER (F) IS GREATER THAN THE CONSERVATION THRESHOLD (E), THEN G = F - E; OTHERWISE G = 0.	
BREAK-EVEN POINT	
H. BREAK-EVEN POINT (AMOUNT OF FOREST THAT MUST BE RETAINED SO THAT NO MITIGATION IS REQUIRED)	5.1
(1) IF THE AREA OF FOREST ABOVE CONSERVATION THRESHOLD (G) IS GREATER THAN 0, THEN H = 0.2 x THE AREA OF FOREST ABOVE CONSERVATION THRESHOLD (G) + THE CONSERVATION THRESHOLD (E)	
(2) IF THE AREA OF FOREST ABOVE CONSERVATION THRESHOLD (G) IS EQUAL TO 0, THEN H = EXISTING FOREST COVER (F)	
I. FOREST CLEARING PERMITTED WITHOUT MITIGATION	
I = EXISTING FOREST COVER (F) - BREAK-EVEN POINT (H)	
PROPOSED FOREST CLEARING	
J. TOTAL AREA OF FOREST TO BE CLEARED	1.8
K. TOTAL AREA OF FOREST TO BE RETAINED	9.1
K = EXISTING FOREST COVER (F) - FOREST TO BE CLEARED (J)	
PLANTING REQUIREMENTS	
IF THE TOTAL AREA OF FOREST TO BE RETAINED (K) IS AT OR ABOVE THE BREAK-EVEN POINT (H), NO PLANTING IS REQUIRED, AND NO FURTHER CALCULATIONS ARE NECESSARY (L=0, M=0, N=0, P=0, Q=0, R=0).	
OTHERWISE, CALCULATE THE PLANTING REQUIREMENTS AS FOLLOWS:	
L. REFORESTATION FOR CLEARING ABOVE THE CONSERVATION THRESHOLD	
(1) IF THE TOTAL AREA OF FOREST TO BE RETAINED (K) IS GREATER THAN THE CONSERVATION THRESHOLD (E), THEN L = THE AREA OF FOREST TO BE CLEARED (J) x 0.25;	
(2) IF THE FOREST TO BE RETAINED (K) IS LESS THAN OR EQUAL TO THE CONSERVATION THRESHOLD (E), THEN L = AREA OF FOREST ABOVE CONSERVATION THRESHOLD (G) x 0.25	
M. REFORESTATION FOR CLEARING BELOW THE CONSERVATION THRESHOLD	
(1) IF EXISTING FOREST COVER (F) IS GREATER THAN THE CONSERVATION THRESHOLD (E) AND THE FOREST TO BE RETAINED (K) IS LESS THAN OR EQUAL TO THE CONSERVATION THRESHOLD (E), THEN M = 2.0 x (CONSERVATION THRESHOLD (E) - FOREST TO BE RETAINED (K))	
(2) IF EXISTING FOREST COVER (F) IS LESS THAN OR EQUAL TO THE CONSERVATION THRESHOLD (E), THEN M = 2.0 x FOREST TO BE CLEARED (J)	
N. CREDIT FOR RETENTION ABOVE THE CONSERVATION THRESHOLD	
IF THE AREA OF FOREST TO BE RETAINED (K) IS GREATER THAN THE CONSERVATION THRESHOLD (E), THEN N = K - E; OTHERWISE N = 0	
P. TOTAL REFORESTATION REQUIRED P = L + M - N	
Q. TOTAL AFFORESTATION REQUIRED	
IF EXISTING FOREST COVER (F) IS LESS THAN THE AFFORESTATION THRESHOLD (D), THEN	
Q = AFFORESTATION THRESHOLD (D) - EXISTING FOREST COVER (F)	
R. TOTAL PLANTING REQUIREMENT R = P + Q	

FCP NOTES

- ANY FOREST CONSERVATION EASEMENT (FCE) AREA SHOWN HEREON IS SUBJECT TO PROTECTIVE COVENANTS WHICH MAY BE FOUND IN THE LAND RECORDS OF HOWARD COUNTY WHICH RESTRICT THE DISTURBANCE AND USE OF THESE AREAS.
- THE FOREST CONSERVATION EASEMENTS HAVE BEEN ESTABLISHED TO FULFILL THE REQUIREMENTS OF SECTION 16.1200 OF THE HOWARD COUNTY CODE, FOREST CONSERVATION ACT. NO CLEARING, GRADING, OR CONSTRUCTION IS PERMITTED WITHIN THE FOREST CONSERVATION EASEMENTS, HOWEVER, FOREST MANAGEMENT PRACTICES AS DEFINED IN THE DEED OF FOREST CONSERVATION EASEMENT ARE ALLOWED.
- FORESTED AREAS OCCURRING OUTSIDE OF THE FCE SHALL NOT BE CONSIDERED PART OF THE FCE AND SHALL NOT BE SUBJECT TO PROTECTIVE LAND COVENANTS.
- LIMITS OF DISTURBANCE SHALL BE RESTRICTED TO AREAS OUTSIDE THE LIMIT OF TEMPORARY FENCING OR THE FCE BOUNDARY, WHICHEVER IS GREATER.
- THERE SHALL BE NO CLEARING, GRADING, CONSTRUCTION OR DISTURBANCE OF VEGETATION IN THE FOREST CONSERVATION EASEMENT, EXCEPT AS PERMITTED BY HOWARD COUNTY DPZ.
- NO STOCKPILES, PARKING AREAS, EQUIPMENT CLEANING AREAS, ETC. SHALL OCCUR WITHIN AREAS DESIGNATED AS FOREST CONSERVATION EASEMENTS.
- TEMPORARY FENCING SHALL BE USED TO PROTECT FOREST RESOURCES DURING CONSTRUCTION. THE FENCING SHALL BE PLACED ALONG ALL FCE BOUNDARIES WHICH OCCUR WITHIN 15 FEET OF THE PROPOSED LIMITS OF DISTURBANCE.
- PERMANENT SIGNAGE SHALL BE PLACED 50' - 100' APART ALONG BOUNDARIES OF ALL AREAS INCLUDED IN FOREST CONSERVATION EASEMENTS.

NOTE: THE FOREST CONSERVATION REQUIREMENTS PER SECTION 16.1200 OF THE HOWARD COUNTY CODE AND THE FOREST CONSERVATION MANUAL FOR THIS SUBDIVISION WILL BE FULFILLED BY 9.17 AC. OF ON-SITE RETENTION WHICH IS SUFFICIENT TO MEET AND EXCEED THE BREAK-EVEN POINT OF 5.1 ACRES OF RETENTION. EXCESS FOREST RETENTION MAY NOT BE CREDITED TO ANOTHER PROJECT. THE TOTAL SURETY AMOUNT (\$99,445.2 SQ.FT. x 0.20/SQ.FT. = \$79,889.00) WILL BE POSTED AS PART OF THE DEVELOPER'S AGREEMENT.


APPROVED: DEPARTMENT OF PUBLIC WORKS
Michael J. ... 8/13/06
 CHIEF, BUREAU OF HIGHWAYS

APPROVED: DEPARTMENT OF PLANNING AND ZONING
Keith ... 8/17/06
 CHIEF, DIVISION OF LAND DEVELOPMENT


APPROVED: DEPARTMENT OF ENGINEERING
... 8/17/06
 CHIEF, DEVELOPMENT ENGINEERING DIVISION

REVISIONS		
NO.	DESCRIPTION	DATE

FOREST RETENTION AREA PROTECTION SIGNAGE

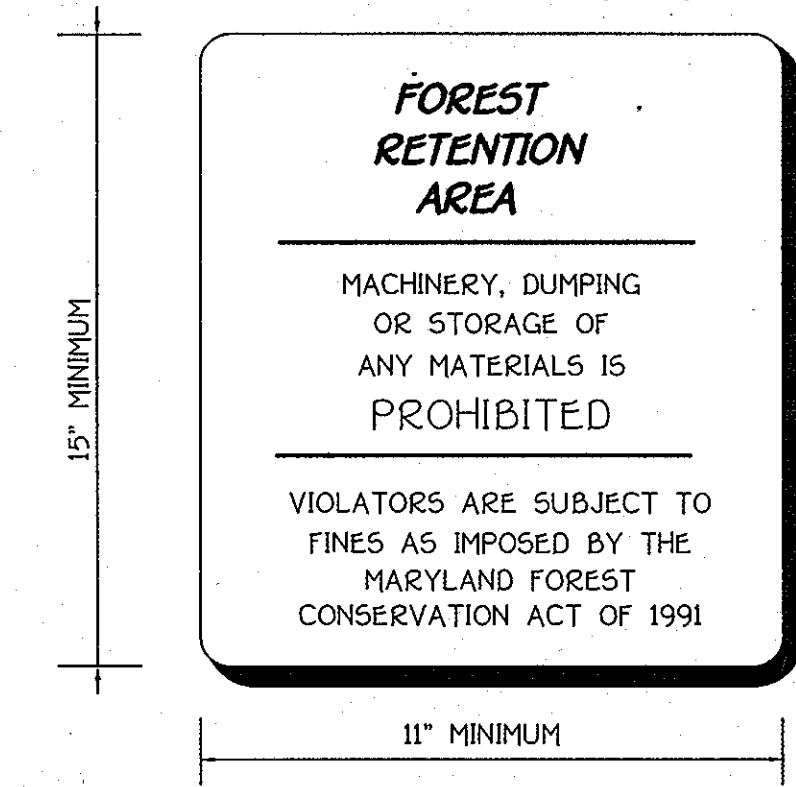

BLAZE ORANGE PLASTIC MESH

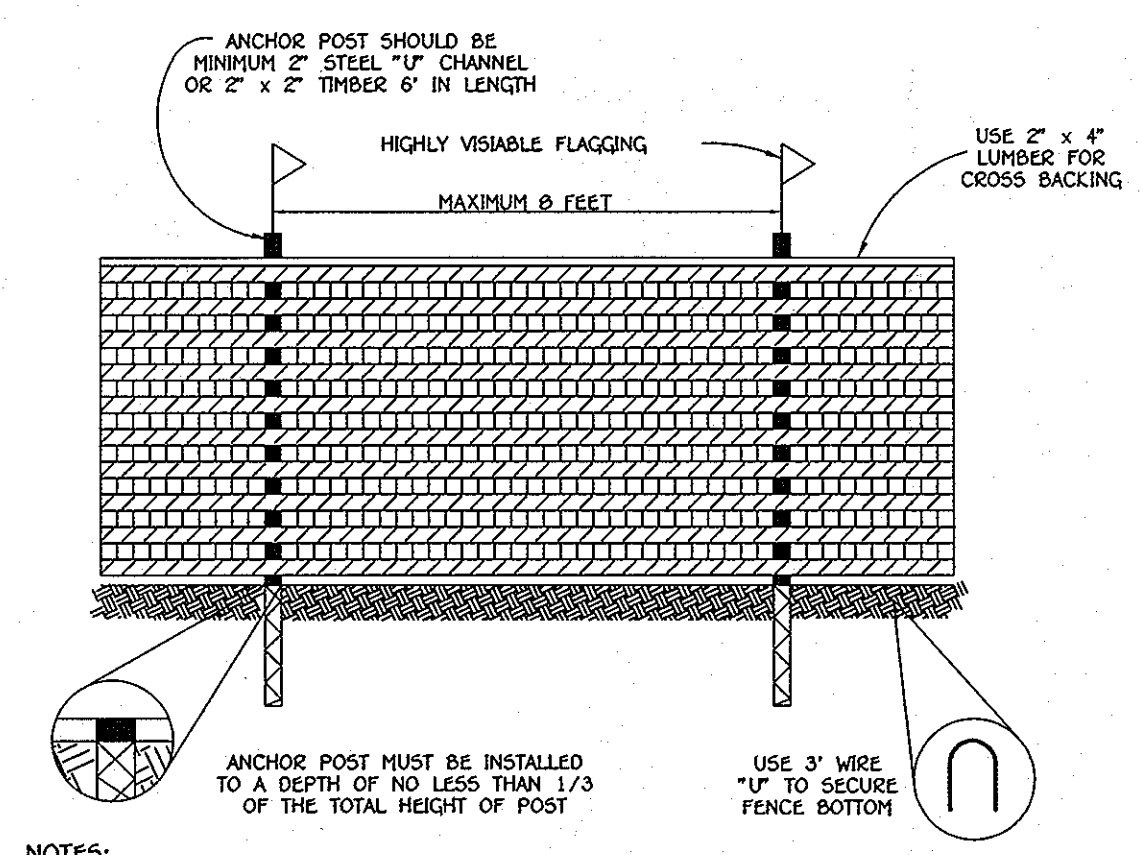

- NOTES:
- FOREST PROTECTION DEVICE ONLY.
 - RETENTION AREA WILL BE SET AS PART OF THE REVIEW PROCESS.
 - BOUNDARIES OF RETENTION AREA SHOULD BE STAKED AND FLAGGED PRIOR TO INSTALLING DEVICE.
 - ROOT DAMAGE SHOULD BE AVOIDED.
 - PROTECTIVE SIGNAGE, MAY ALSO BE USED.
 - DEVICE SHOULD BE MAINTAINED THROUGHOUT CONSTRUCTION.

TREE PROTECTION DETAIL
 NOT TO SCALE

LEGEND

- FOREST CONSERVATION SIGNAGE
- TREE PROTECTION FENCE
- LIMIT OF DISTURBANCE
- FOREST CONSERVATION EASEMENT
- FOREST RETENTION AREA



FISHER, COLLINS & CARTER, INC.
 CIVIL ENGINEERING CONSULTANTS & LAND SURVEYORS
 CENTENNIAL SQUARE OFFICE PARK - 10772 BALTIMORE NATIONAL PIKE
 ELLSWORTH CITY, MARYLAND 21042
 (410) 481 - 2955

Eco-Science Professionals, Inc.
 CONSULTING ECOLOGISTS





MD DNR Qualified Professional
 USACOE Wetland Delineator
 Certification #DCP93MD06100448
JOHN P. CANOLE

OWNER/DEVELOPER
 DORSEY FAMILY HOMES
 10717B BIRMINGHAM WAY
 WOODSTOCK, MARYLAND 21153
 ATT: ROB DORSEY

FOREST CONSERVATION NOTES AND DETAILS
HOGG PROPERTY
 LOTS 1 - 22, OPEN SPACE LOTS 23 - 26
 ZONED: R-ED
 TAX MAP NO. 25 GRID NO. 14 PARCEL NO. 64
 SECOND ELECTION DISTRICT
 HOWARD COUNTY, MARYLAND
 DATE: JUNE 8, 2005
 SHEET 15 OF 17


F-06-109
AS BUILT

K:\SDS\PROJ\30772\FINALS\30772 SHEET 15 FOREST CONSERVATION DETAILS.dwg, 08/20/06 11:28:57 AM, 1:1

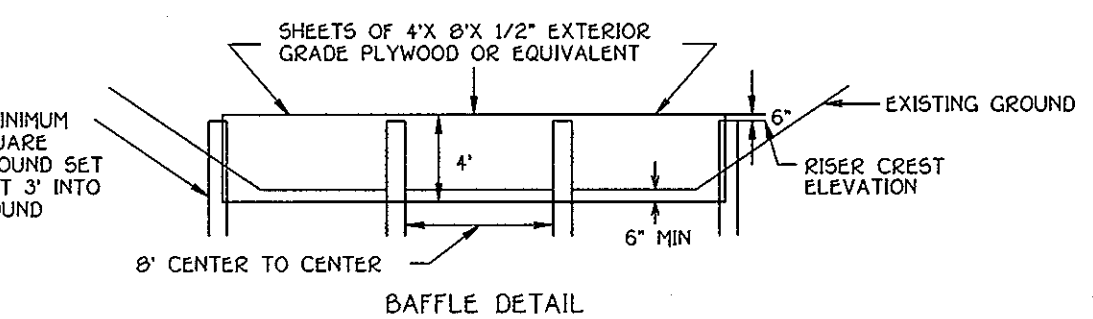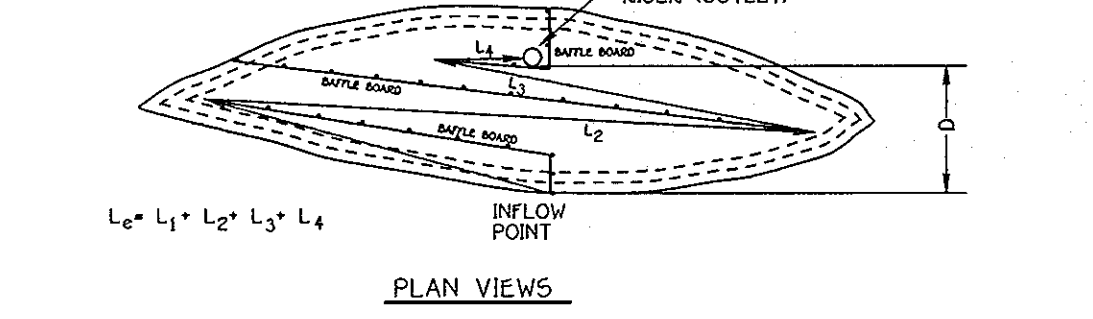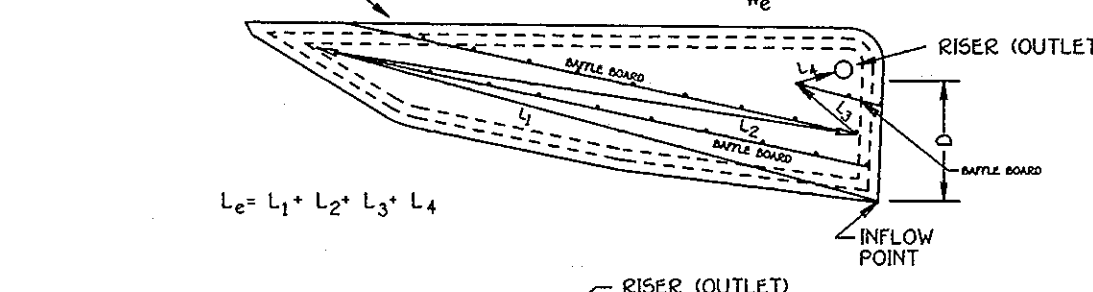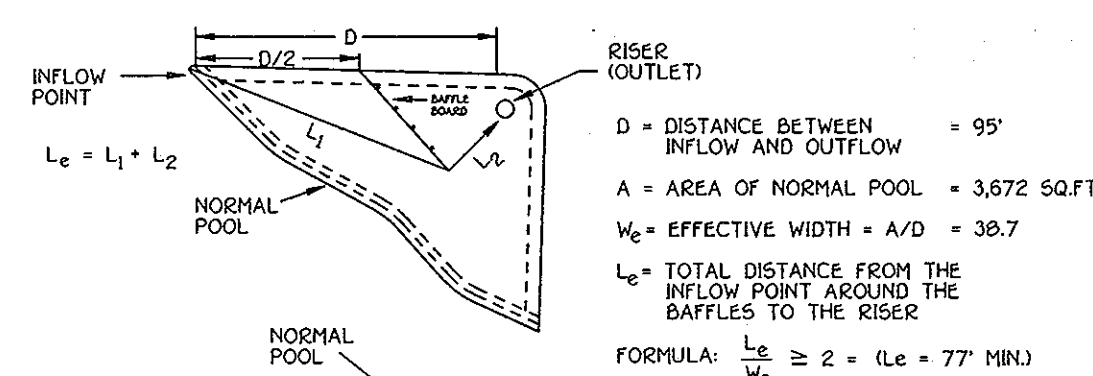


SEDIMENT BASIN BAFFLES
NOT TO SCALE


NOTE: CONTRACTOR TO REGRADE, SOD OR HYDROSEED AND STRAW MULCH ALL AREAS DISTURBED AS A RESULT OF THEIR WORK.
SPRAY WITH WILT-PROOF ACCORDING TO MANUFACTURERS STANDARDS.
PRUNE 1/3 LEAF AREA BUT RETAIN NATURAL FORM OF TREE.
2 PIECES OF REINFORCED RUBBER HOSE DOUBLE #12 GALVANIZED WIRE GUYS TWISTED.
3-2" x 2" DAK STAKES NOTCH STAKES TO HOLD WIRE.
WRAP TRUNK TO SECOND TIER OF BRANCHES WITH WATERPROOF TREE WRAP TIE AT 24" INTERVALS (EXCEPT EVERGREENS).
REMOVE ANY COVERING FROM TOP OF ROOT CROWN.
3" MULCH.
MAINTAIN GROUND LINE WITH TOP OF ROOT CROWN.
CONSTRUCT 3" SAUCER RIM-FLOOD WITH WATER TWICE WITHIN 24 HOURS.
TOP SOIL MIXTURE.
CONVEX BOTTOM 6" MIN. HT.

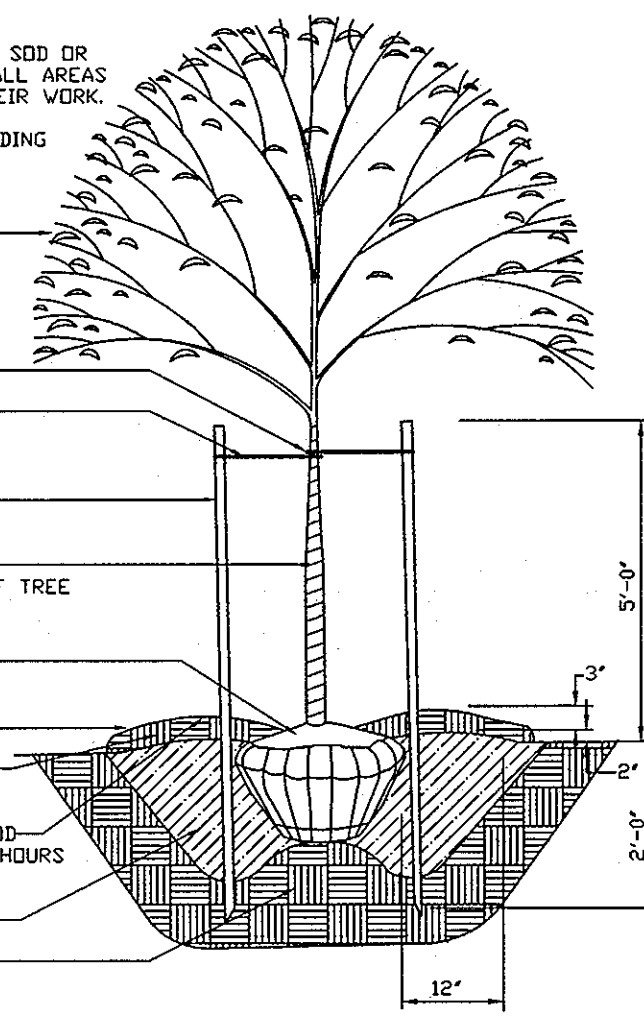

TREE PLANTING DETAIL

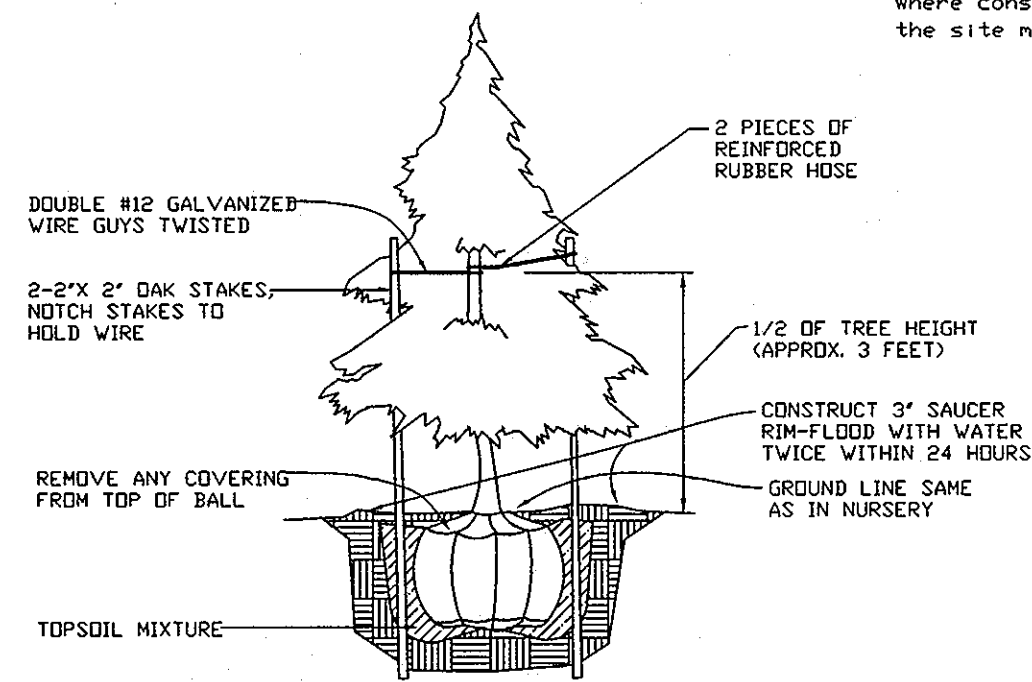

EVERGREEN PLANTING DETAIL


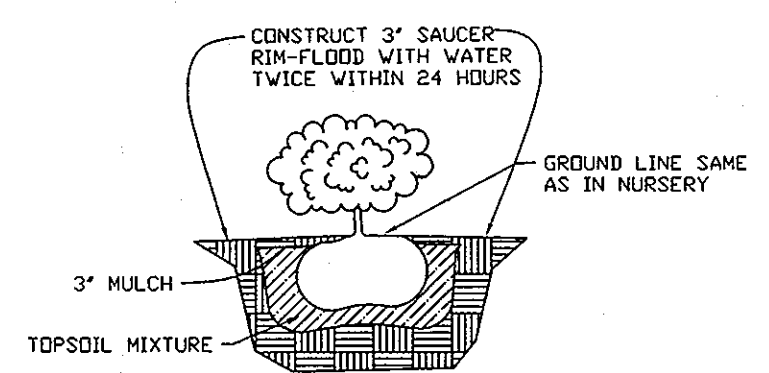


SHRUB PLANTING DETAIL

PLANTING SPECIFICATIONS

Plants, related material, and operations shall meet the detailed description as given on the plans and as described herein.
All plant material, unless otherwise specified, shall be nursery grown, uniformly branched, have a vigorous root system, and shall conform to the species, size, root and shape shown on the plant list and the American Association of Nurserymen (AAN) Standards. Plant material shall be healthy, vigorous, free from defects, decay, disfiguring roots, sun scald injuries, abrasions of the bark, plant disease, insect pests, eggs, borers and all forms of insect infestations or objectionable disfigurements. Plant material that is weak or which has been cut back from larger grades to meet specified requirements will be rejected. Trees with forked leaders will not be accepted. All plants shall be freshly dug no heated-in plants from cold storage will be accepted.
Unless otherwise specified, all general conditions, planting operations, details and planting specification shall conform to "Landscape Specification Guidelines for Baltimore-Washington Metropolitan Areas", (hereinafter "Landscape Guidelines") approved by the Landscape Contractors Association of Metropolitan Washington and the Potomac Chapter of the American Society of Landscape Architects, latest edition, including all addenda.
Contractor shall be required to guarantee all plant material for a period of one year after date of acceptance in accordance with the appropriate section of the Landscape Guidelines. Contractor's attention is directed to the maintenance requirements found within the one year specifications including watering and replacement of specified plant material.
Contractor shall be responsible for notifying utility companies, utility contractors and "Miss Utility" a minimum of 48 hours prior to beginning any work. Contractor may make minor adjustments in spacing and location of plant material to avoid conflicts with utilities. Damage to existing structure and utilities shall be repaired at the expense of the Contractor.
Protection of existing vegetation to remain shall be accomplished by the temporary installation of 4 foot high snow fence or blaze orange safety fence at the strip line.
Contractor is responsible for installing all material in the proper planting season for each plant type. All planting is to be completed within the growing season of completion of site construction.
Bid shall be based on actual site conditions. No extra payment shall be made for work arising from site conditions differing from those indicated on drawings and specifications.
Plant quantities are provided for the convenience of the contractor only. If discrepancies exist between quantities shown on plan and those shown on the plant list, the quantities on the plan take precedence.
All shrubs shall be planted in continuous trenches or prepared planting beds and mulched with composted hardwood mulch as details and specified except where noted on plans.
Positive drainage shall be maintained in planting beds 2 percent slope).
Planting mix shall be as follows: Deciduous Plants - two parts topsoil, one part well-rotted cow or horse manure. Add 3 lbs. of standard fertilizer per cubic yard of planting mix. Evergreen Plants - two parts topsoil, one part humus or other approved organic material. Add 3 lbs. of evergreen (acidic) fertilizer per cubic yard of planting mix. Topsoil shall conform to the Landscape Guidelines.
Weed Control: Incorporate a pre-emergent herbicide into the planting bed following recommended rates on the label. Caution: Be sure to carefully check the chemical used to assure its adaptability to the specific ground cover to be treated.
All areas within contract units disturbed during or prior to construction not designated to receive plants and mulch shall be fine graded and seeded. This plan is intended for landscape use only. See other plan sheets for more information on grading, sediment control, layout, etc.

TREE PLANTING DETAIL
NOT TO SCALE

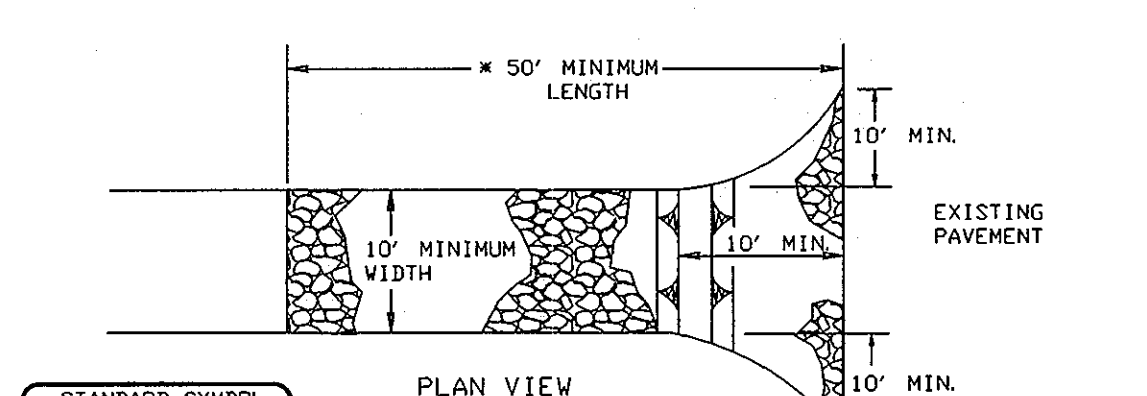
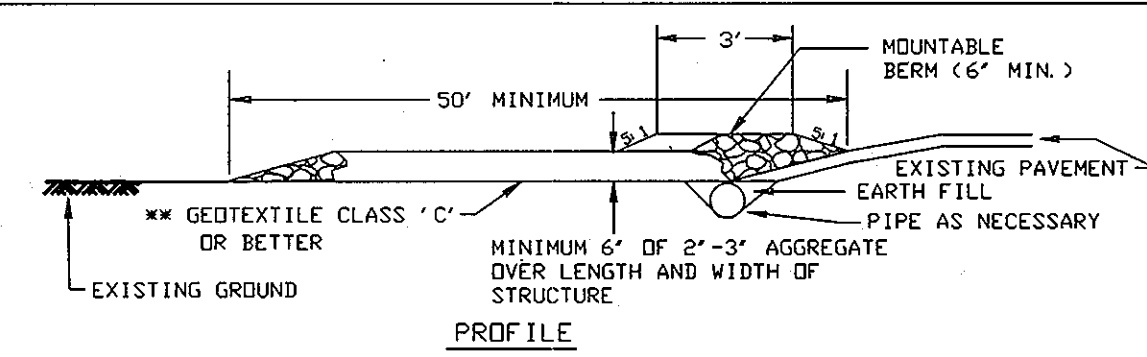


STABILIZED CONSTRUCTION ENTRANCE - 2
NOT TO SCALE

- Length - minimum of 50' (x30' for single residence lot).
- Width - 10' minimum, should be flared at the existing road to provide a turning radius.
- Geotextile fabric (filter cloth) shall be placed over the existing ground prior to placing stone. The plan approval authority may not require single family residences to use geotextile.
- Stone - crushed aggregate (2' to 3') or reclaimed or recycled concrete equivalent shall be placed at least 6' deep over the length and width of the entrance.
- Surface Water - all surface water flowing to or diverted toward construction entrances shall be piped through the entrance, maintaining positive drainage. Pipe installed through the stabilized construction entrance shall be protected with a mountable berm with 5:1 slopes and a minimum of 6" of stone over the pipe. Pipe has to be sized according to the drainage. When the SCE is located at a high spot and has no drainage to convey a pipe will not be necessary. Pipe should be sized according to the amount of runoff to be conveyed. A 6' minimum will be required.
- Location - A stabilized construction entrance shall be located at every point where construction traffic enters or leaves a construction site. Vehicles leaving the site must travel over the entire length of the stabilized construction entrance.

STABILIZED CONSTRUCTION ENTRANCE - 2

NOT TO SCALE

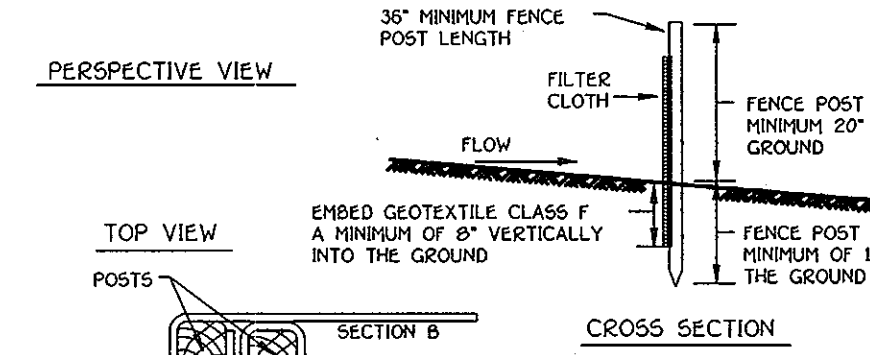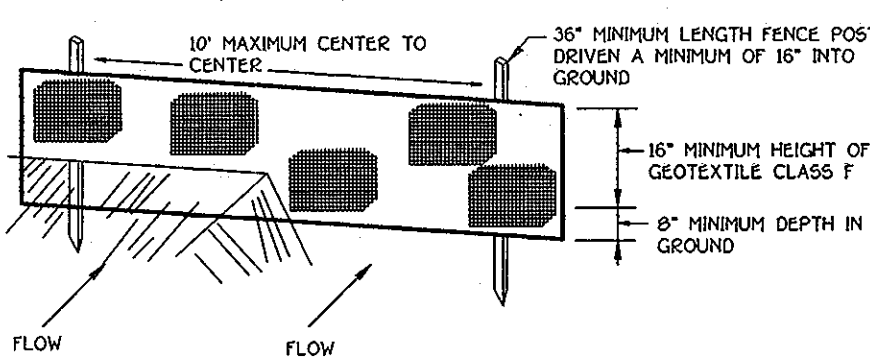

DETAIL 22 - SILT FENCE
NOT TO SCALE

- Fence posts shall be a minimum of 36" long driven 16" minimum into the ground. Wood posts shall be 1 1/2" x 1 1/2" square (minimum) cut, or 1 3/4" diameter (minimum) round and shall be of sound quality hardwood. Steel posts will be standard T or U section weighing not less than 100 pound per linear foot.
- Geotextile shall be fastened securely to each fence post with wire ties or staples at top and mid-section and shall meet the following requirements for Geotextile Class F:

Tensile Strength	50 lbs/in (min)	Test: MSMT 509
Tensile Modulus	20 lbs/in (min)	Test: MSMT 509
Flow Rate	0.3 gal/ft / minute (max)	Test: MSMT 322
Filtering Efficiency	75% (min)	Test: MSMT 322
- Where ends of geotextile fabric come together, they shall be overlapped, folded and stapled to prevent sediment bypass.
- Silt Fence shall be inspected after each rainfall event and maintained when bulges occur or when sediment accumulation reached 50% of the fabric height.

DETAIL 22 - SILT FENCE


NOT TO SCALE

EROSION CONTROL MATTING

- Key-in the matting by placing the top ends of the matting in a narrow trench, 6" in depth. Backfill the trench and tamp firmly to conform to the channel cross-section. Secure with a row of staples about 4" down slope from the trench. Spacing between staples is 6".
- Staple the 4" overlap in the channel center using an 18" spacing between staples.
- Before stapling the outer edges of the matting, make sure the matting is smooth and in firm contact with the soil.
- Staples shall be placed 2' apart with 4 rows for each strip, 2 outer rows, and 2 alternating rows down the center.
- Where one roll of matting ends and another begins, the end of the top strip shall overlap the upper end of the lower strip by 4", slapping fashion. Reinforce the overlap with a double row of staples spaced 6" apart in a staggered pattern on either side.
- The discharge end of the matting line should be similarly secured with 2 double rows of staples.

Note: If flow will enter from the edge of the matting then the area effected by the flow must be key-in.

EROSION CONTROL MATTING
NOT TO SCALE

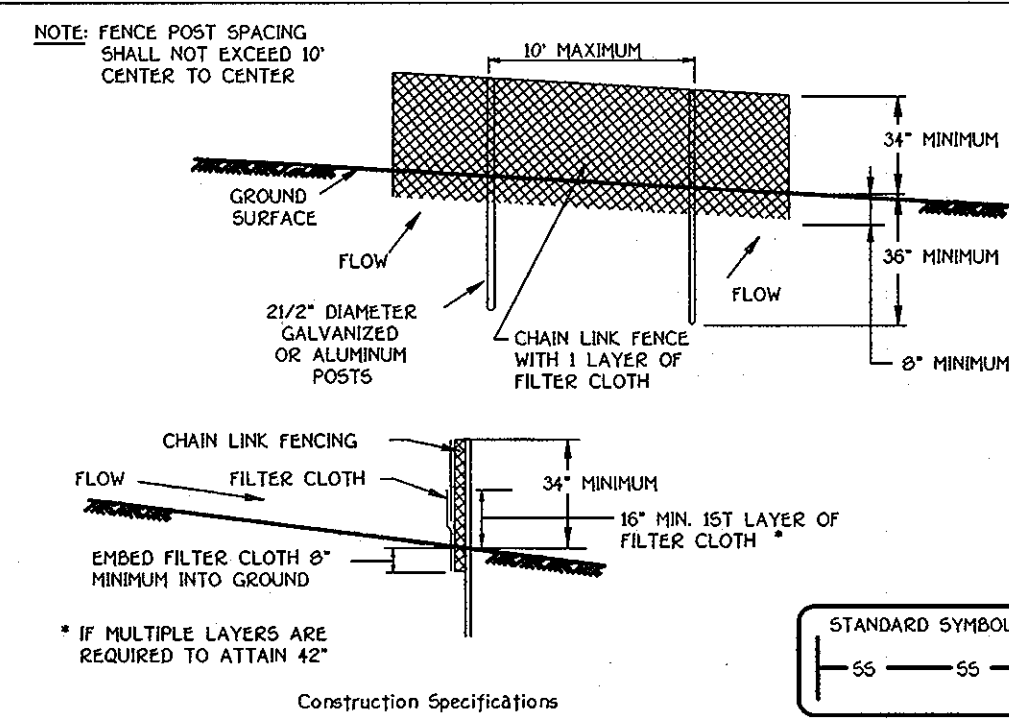



DETAIL 33 - SUPER SILT FENCE
NOT TO SCALE

- Fencing shall be 42" in height and constructed in accordance with the latest Maryland State Highway Details for Chain Link Fencing. The specification for a 6' fence shall be used, substituting 42" fabric and 6' length posts.
- Chain link fence shall be fastened securely to the fence posts with wire ties. The lower tension wire, brace and truss rods, drive anchors and top caps are not required except on the ends of the fence.
- Filter cloth shall be fastened securely to the chain link fence with ties spaced every 24" at the top and mid section.
- Filter cloth shall be embedded a minimum of 8" into the ground.
- When two sections of filter cloth adjoin each other, they shall be overlapped by 6" and fasted.
- Maintenance shall be performed as needed and silt buildups removed when "bulges" develop in the silt fence or when silt reaches 50% of fence height.
- Filter cloth shall be fastened securely to each fence post with wire ties or staples at top and mid section and shall meet the following requirements for Geotextile Class F:

Tensile Strength	50 lbs/in (min)	Test: MSMT 509
Tensile Modulus	20 lbs/in (min)	Test: MSMT 509
Flow Rate	0.3 gal/ft / minute (max)	Test: MSMT 322
Filtering Efficiency	75% (min)	Test: MSMT 322

DETAIL 33 - SUPER SILT FENCE

NOT TO SCALE

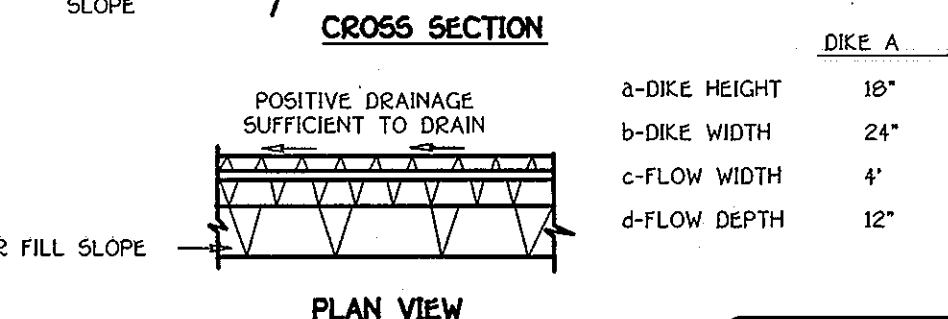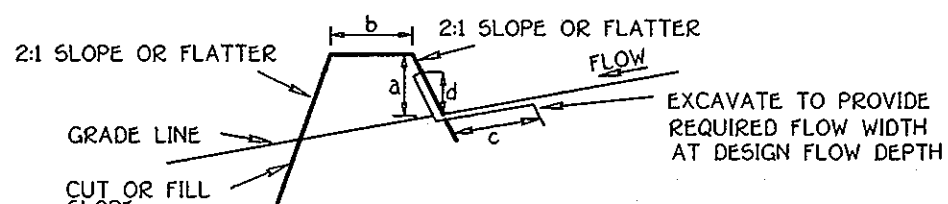


EROSION CONTROL MATTING

- Seed and cover with straw mulch.
- Seed and cover with Erosion Control Matting or line with sod.
- 4" - 7" stone or recycled concrete equivalent pressed into the soil 7" minimum.


CONSTRUCTION SPECIFICATIONS

- All temporary earth dikes shall have uninterrupted positive grade to an outlet. Spot elevations may be necessary for grades less than 1%.
- Runoff diverted from a disturbed area shall be conveyed to a sediment trapping device.
- Runoff diverted from an undisturbed area shall outlet directly into an undisturbed, stabilized area at a non-erosive velocity.
- All trees, brush, stumps, obstructions, and other objectionable material shall be removed and disposed of so as not to interfere with the proper functioning of the dike.
- The dike shall be excavated or shaped to line, grade and cross section as required to meet the criteria specified herein and be free of bank projections or other irregularities which will impede normal flow.
- Fill shall be compacted by earth moving equipment.
- All earth removed and not needed for construction shall be placed so that it will not interfere with the functioning of the dike.
- Inspection and maintenance must be provided periodically and after each rain event.

EARTH DIKE

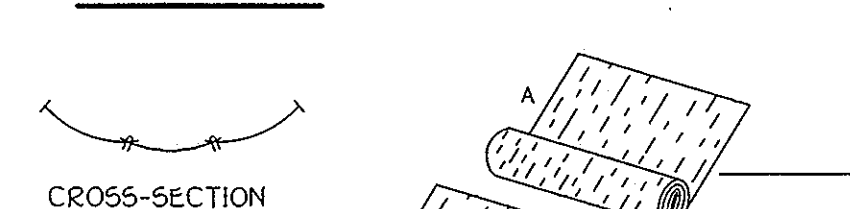


GABION INFLOW PROTECTION
NOT TO SCALE

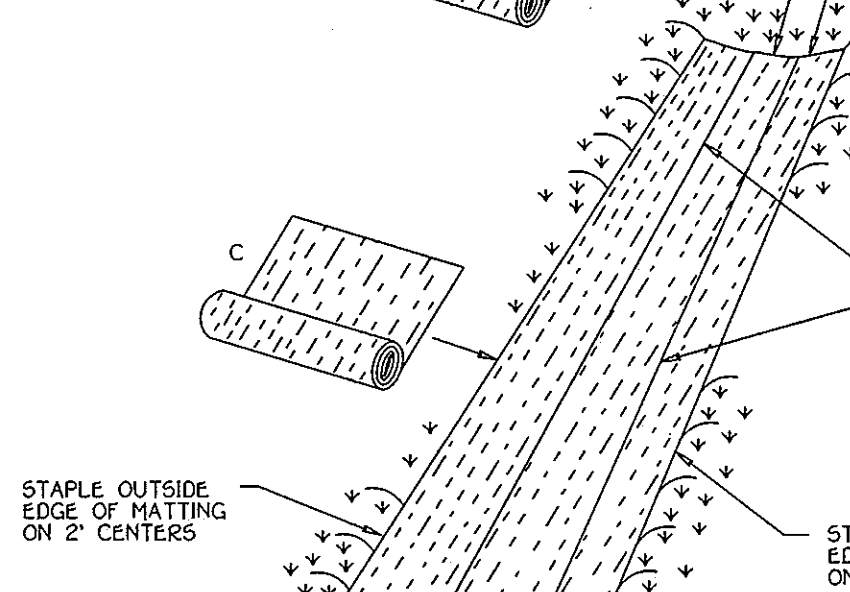

CONSTRUCTION SPECIFICATIONS

- Gabion inflow protection shall be constructed of 9' x 3' x 9' gabion baskets forming a trapezoidal cross section 1' deep, with 2:1 side slopes, and a 3' bottom width.
- Geotextile Class C shall be installed under all gabion baskets.
- The stone used to fill the gabion baskets shall be 4" - 7".
- Gabions shall be installed in accordance with manufacturers recommendations.
- Gabion Inflow Protection shall be used where concentrated flow is present on slopes steeper than 4:1.

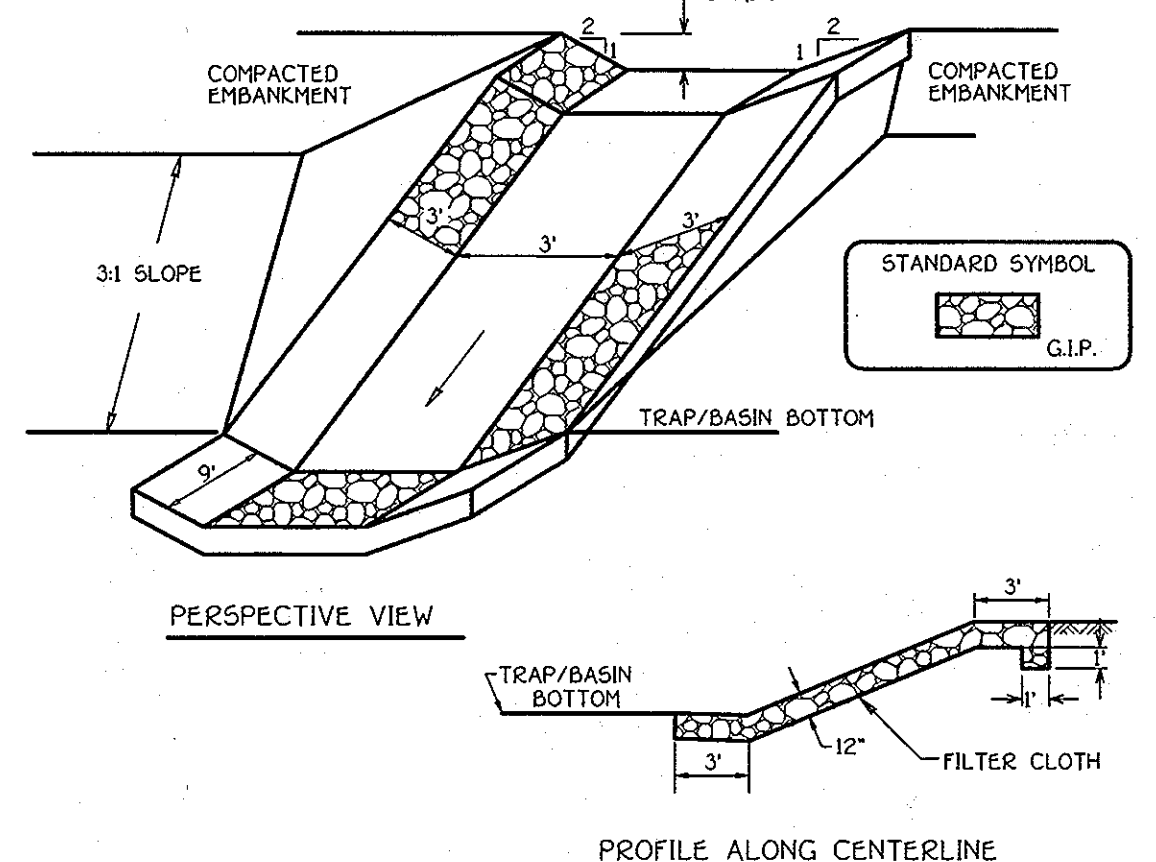

PROFILE ALONG CENTERLINE

- Gabion inflow protection shall be constructed of 9' x 3' x 9' gabion baskets forming a trapezoidal cross section 1' deep, with 2:1 side slopes, and a 3' bottom width.
- Geotextile Class C shall be installed under all gabion baskets.
- The stone used to fill the gabion baskets shall be 4" - 7".
- Gabions shall be installed in accordance with manufacturers recommendations.
- Gabion Inflow Protection shall be used where concentrated flow is present on slopes steeper than 4:1.

GABION INFLOW PROTECTION

NOT TO SCALE

SEDIMENT & EROSION CONTROL DETAILS
HOGG PROPERTY
LOTS 1 - 22, OPEN SPACE LOTS 23 - 26
ZONED: R-ED
TAX MAP NO. 25 GRID NO. 14 PARCEL NO. 64
SECOND ELECTION DISTRICT
HOWARD COUNTY, MARYLAND
DATE: JUNE 8, 2005
SHEET 16 OF 17

ENGINEER'S CERTIFICATE
I, the undersigned, being duly licensed and qualified in the State of Maryland, have prepared this Plan for Erosion and Sediment Control for the above named project. This Plan is based on my personal knowledge of the site and the conditions that it was prepared in accordance with the specifications of the Howard Soil Conservation District.

DEVELOPER'S CERTIFICATE
I/We Certify That All Development And Construction Will Be Done According To This Plan Of Development And Plan For Erosion And Sediment Control And That All Responsible Personnel Involved In The Construction Project Will Have A Certificate Of Attendance At A Department Of Natural Resources Approved Training Program For The Control Of Sediment And Erosion Before Beginning The Project. I Also Authorize Periodic On-Site Inspection By The Howard Soil Conservation District Or Their Authorized Agents, As Deemed Necessary.

Signature of Engineer: *[Signature]* Date: 6-8-06
Signature of Developer: *[Signature]* Date: 6-6-06

Reviewed For Howard County Soil Conservation District And Meets Technical Requirements: *[Signature]* Date: 6/19/06
U.S.D.A. - Natural Resources Conservation Service
Approved: This Development Is Approved For Erosion And Sediment Control By The Howard Soil Conservation District. *[Signature]* Date: 6/19/06
Approved: Department Of Planning And Zoning *[Signature]* Date: 8/17/06
Chief, Division Of Land Development: *[Signature]* Date: 8/17/06
Approved: Howard County Department Of Public Works *[Signature]* Date: 8/17/06
Chief, Bureau Of Highways: *[Signature]* Date: 8/17/06

OWNER / DEVELOPER
DORSEY FAMILY HOMES
10717 BIRMINGHAM WAY
WOODSTOCK, MARYLAND 21163
A11r ROB DORSEY



FISHER, COLLINS & CARTER, INC.
CIVIL ENGINEERING CONSULTANTS & LAND SURVEYORS
300 EASTERN SQUARE OFFICE PARK - 10772 BALTIMORE NATIONAL PKWY
ELLICOTT CITY, MARYLAND 21042
4100 461 - 2055

2.00 STANDARDS AND SPECIFICATIONS

FOR VEGETATIVE STABILIZATION

DEFINITION

Using vegetation as cover for barren soil to protect it from forces that cause erosion.

PURPOSE

Vegetative stabilization specifications are used to promote the establishment of vegetation on exposed soil. When soil is stabilized with vegetation, the soil is less likely to erode and more likely to allow infiltration of rainwater, thereby reducing sediment loads and run-off to downstream areas, and improving wildlife habitat and visual resources.

CONDITIONS WHERE PRACTICE APPLIES

This practice shall be used on disturbed areas as specified on this plan. It shall be used on highly erodible or critically eroding areas. This specification is intended to provide the minimum standards for vegetative stabilization for short duration (up to one year), and permanent seeding, for long term vegetative cover. Examples of applicable areas for Temporary Seeding are temporary soil stabilization areas, erosion control ditches, earth dikes, etc. and for Permanent Seeding are lawns, dams, cut and fill slopes and other areas at final grade, former stockpiles and staging areas, etc.

EFFECTS ON WATER QUALITY AND QUANTITY

Planting vegetation in disturbed areas will have an effect on the hydrologic cycle. Vegetation over time, will increase organic matter content and improve the water holding capacity of the soil and subsequent plant growth. Vegetation will help reduce the movement of sediment, nutrients, and other substances carried by runoff to receiving waters. Plants will also help protect groundwater supplies by assimilating those substances present within the root zone.

Sediment control devices must remain in place during grading, seeded preparation, seeding, mulching and vegetative establishment to prevent loss quantities of sediment and associated chemicals and nutrients from washing into surface waters.

SECTION 1 - VEGETATIVE STABILIZATION METHODS AND MATERIALS

- A. Site Preparation
 - i. Install erosion and sediment control structures (either temporary or permanent) such as diversions, grade stabilization structures, berms, waterways, or sediment control basins.
 - ii. Perform all grading operations at right angles to the slope. Final grading and shaping is not usually necessary for temporary seeding.
 - iii. Schedule required soil tests to determine soil amendment composition and application rates for sites having disturbed areas over 5 acres.
- B. Soil Amendments (Fertilizer and Lime Specifications)
 - i. Soil tests must be performed to determine the exact ratios and application rates for both lime and fertilizer on sites having disturbed areas over 5 acres. Soil analysis may be performed by the University of Maryland or a recognized commercial laboratory. Soil samples taken for engineering purposes may also be used for chemical analysis.
 - ii. Fertilizers shall be uniform in composition, free flowing and suitable for accurate application by approved equipment. Fertilizer may be substituted for fertilizer with prior approval from the appropriate authority. Fertilizers shall all be delivered to the site fully baled and according to the applicable state fertilizer laws and shall bear the name, trade name or trademark and warranty of the manufacturer.
 - iii. Lime materials shall be ground limestone hydrated or burnt lime may be substituted which contains at least 50% total oxides calcium oxide plus magnesium oxide. Limestone shall be ground to such fineness that at least 50% will pass through a #20 mesh sieve and 75% will pass through a #30 mesh sieve.
 - iv. Incomplete lime and fertilizer into the top 3-5" of soil by disk or other suitable means.
- C. Seeded Preparation
 - i. Temporary Seeding
 - a. Seeded preparation shall consist of loosening soil to a depth of 3" to 5" by means of suitable agricultural or construction equipment, such as disc harrows or chisel plows or rippers mounted on construction equipment. After the soil is loosened, it should not be rolled or dragged smooth, but left in the roughened condition. Sloped areas greater than 3:1 should be tracked leaving the surface in an irregular condition with ridges running parallel to the contour of the slope.
 - b. Apply fertilizer and lime as prescribed on the plans.
 - c. Apply soil amendments as per soil test or as included on the plans.
 - ii. Permanent Seeding
 - a. Minimum soil conditions required for permanent vegetative establishment
 1. Soil pH shall be between 6.0 and 7.0.
 2. Soluble salts shall be less than 500 parts per million (ppm).
 3. The soil shall contain less than 40% clay, but enough fine grained material to hold soil particles to provide the capacity to retain moisture and moderate amount of moisture. An exception is if loess or silt or sandstone is to be planted, then a sandy soil (50% silt) may be acceptable.
 4. Soil shall contain 1.5% minimum organic matter by weight.
 5. Soil must contain sufficient pore space to permit adequate root penetration.
 6. If these conditions cannot be met by soil on site, adding topsoil is required in accordance with Section 21 Standard and Specification for Topsoil.
 - b. Areas previously graded in conformance with the drawings shall be reconditioned in a true and even grade, then scarified or otherwise loosened to a depth of 3-5" to permit bonding of the topsoil to the surface area and to create horizontal erosion check slots to prevent topsoil from sliding down a slope.
 - c. Apply soil amendments as per soil test or as included on the plans.
 - d. Mix soil amendments into the top 3-5" of topsoil by disk or other suitable means. Lawn areas should be raked to smooth the surface, remove loose objects like stones and branches, and ready the area for seed and application. Where site conditions will not permit normal seeded preparation, loosen surface soil by dragging with a heavy chain or other equipment to roughen the surface. Steep slopes (steeper than 3:1) should be tracked by a dozer leaving the soil in an irregular condition with ridges running parallel to the contour of the slope. The top 3-5" of soil should be loose and friable. Seeded loosening may not be necessary on newly disturbed areas.
- D. Seed Specifications
 - i. All seed must meet the requirements of the Maryland State Seed Law. All seed shall be subject to immediate pre-planting tests of sowing such materials on the job.
 - ii. Seed tags shall be made available to the inspector to verify type and rate of seed used.
 - iii. Inoculant - the inoculant for treating legume seed in the seed mixtures shall be a pure culture of nitrogen-fixing bacteria prepared specifically for the species. Inoculant shall not be used unless the date indicated on the container. Add fresh inoculant as directed on package. Use four times the recommended rate when used. Note: It is very important that inoculant be cool as possible when used. Temperatures above 75-80° F. can weaken bacteria and make the inoculant less effective.
- E. Methods of Seeding
 - i. Hydroseeding: Apply seed uniformly with hydroseeder (slurry includes seed and fertilizer), broadcast or drop spreader or a outspreader seeder.
 - a. If fertilizer is being applied at the time of seeding, the application rates amounts will not exceed the following: Nitrogen maximum of 100 lbs. per acre total of soluble nitrogen (20% phosphorous), 200 lbs/acre K2O (potassium), 200 lbs/acre.
 - b. Lime - use only ground agricultural limestone, up to 3 tons per acre may be applied by hydroseeding. Normally, not more than 2 tons are applied by hydroseeding at any one time. Do not use burnt or hydrated lime when hydroseeding.
 - c. Seed - fertilizer shall be mixed on site and seeding shall be done immediately and without interruption.
 - ii. Dry Seeding: This includes use of conventional drop or broadcast spreaders.
 - a. Seed spread dry shall be incorporated into the subsoil at the rates prescribed on the Temporary or Permanent Seeding Summary or Tables 25 or 26. The seeded area shall then be rolled with a weighted roller to provide good seed to soil contact.
 - b. Where practical, seed should be applied in two directions perpendicular to each other. Apply half the seeding rate in each direction.
 - iii. Drill or Outspreader Seeding: Mechanized seeders that apply and cover seed with soil.
 - a. Outspreading seeders are required to bury the seed in each direction to provide at least 1/4 inch of soil covering. Seeded must be firm after planting.
 - b. Where practical, seed should be applied in two directions perpendicular to each other. Apply half the seeding rate in each direction.
- F. Mulch Specifications (in order of preference)
 - i. Straw shall consist of thoroughly threshed wheat, rye or oat straw, reasonable bright in color, and shall not be musty, mold, caked, decayed, or excessively dusty and shall be free of noxious weed seeds as specified on the Maryland Seed Law.

Note: Once excavation has begun the operation should be continuous from grubbing through the completion of grading and placement of topsoil of required grade and permanent seed and mulch. Any interruptions in the operation or completion of the seeding session will necessitate the application of temporary stabilization.

SECTION 2 - TEMPORARY SEEDING

Vegetation - Annual grass or grain used to provide cover on disturbed areas for up to 12 months. For longer duration of vegetative cover, Permanent Seeding is required.

- A. Seed mixtures - Temporary Seeding
 - i. Select one or more of the species or mixtures listed in Table 25 for the appropriate Plant Hardiness Zone (from Figure 5) and enter them in the Permanent Seeding Summary below, along with application rates and seeding dates. Seeding depths can be estimated using Table 26. If this summary is not put on the construction plans and completed, then Table 25 must be put on the plans.
 - ii. For sites having soil tests performed, the rates shown on this table shall be deleted and the rates recommended by the testing agency shall be written in Soil tests are not required for Temporary Seeding.

Note: Topsoil substitutes or amendments, as recommended by a qualified agronomist or soil scientist and approved by the appropriate approval authority, may be used in lieu of natural topsoil.

SECTION 3 - PERMANENT SEEDING

Seeding grass and legumes to establish growing cover for a minimum of one year on disturbed areas generally receiving low maintenance.

A. Seed mixtures - Permanent Seeding

- i. Select one or more of the species or mixtures listed in Table 25 for the appropriate Plant Hardiness Zone (from Figure 5) and enter them in the Permanent Seeding Summary below, along with application rates and seeding dates. Seeding depths can be estimated using Table 26. If this summary is not put on the construction plans and completed, then Table 25 must be put on the plans. Additional planting specifications for exceptional sites such as shorelines, streambanks, or dunes or for special purposes such as wildlife or aesthetic treatment may be found in USDA-SCS Technical Field Office Guide, Section 342 - Critical Area Planting. For special lawn maintenance areas, see Sections IV and V Turfgrass.
- ii. For sites having disturbed areas over 5 acres, the rates shown on this table shall be deleted and the rates recommended by the soil testing agency shall be written in.
- iii. For areas receiving low maintenance, apply urea-form fertilizer (46-0-0) 81 3 1/2 lbs/1000 sq. ft. (50 lbs/acre), in addition to the above soil amendments shown in the table below, to be performed at the time of seeding.

No.	Species	Application Rate (lb/acre)	Seeding Dates	Seeding Depths	Fertilizer Rate (lb/1000-sq ft)	Lime Rate
1	BARLEY	122	3/1 - 5/15	1" - 2"	600 lb/acre	2 tons/acre
	OATS	96	8/15 - 10/15	1" - 2"	05 lb/1000sqft	000 lb/1000sqft
	RYE	140		1" - 2"		

No.	Species	Application Rate (lb/acre)	Seeding Dates	Seeding Depths	Fertilizer Rate (lb/20-20-20)	Lime Rate
3	TALL FESCUE (95%)	125	3/1 - 5/15	1" - 2"	90 lb/acre	175 lb/acre
	PERENNIAL RYE GRASS (10%)	10	8/15 - 10/15	1" - 2"	12.0 lb/1000sqft	14 lb/1000sqft
	KENTUCKY BLUEGRASS (85%)	10		1" - 2"	1000sqft	1000sqft
10	TALL FESCUE (80%)	120	3/1 - 5/15	1" - 2"		
	MOROCCO FESCUE (20%)	30	8/15 - 10/15	1" - 2"		

1. A MINIMUM OF 48 HOURS NOTICE MUST BE GIVEN TO THE HOWARD COUNTY DEPARTMENT OF INSPECTIONS, LICENSING AND PERMITS, SEDIMENT CONTROL DIVISION PRIOR TO THE START OF ANY CONSTRUCTION (315-1829).

2. ALL VEGETATIVE AND STRUCTURAL PRACTICES ARE TO BE INSTALLED ACCORDING TO THE PROVISIONS OF THIS PLAN AND ARE TO BE IN CONFORMANCE WITH THE MOST CURRENT MARYLAND STANDARDS AND SPECIFICATIONS FOR SOIL EROSION AND SEDIMENT CONTROL AND REVISIONS THEREOF.

3. FOLLOWING INITIAL SOIL DISTURBANCE OR RE-DISTURBANCE, PERMANENT OR TEMPORARY STABILIZATION SHALL BE COMPLETED WITHIN 31 CALENDAR DAYS FOR ALL PERMITTED SEDIMENT CONTROL STRUCTURES, DICES, PERIMETER SLOPES AND ALL SLOPES STEEPER THAN 3:1, BY 14 DAYS AS TO ALL OTHER DISTURBED OR GRADED AREAS ON THE PROJECT SITE. GRADING NECESSARY TO INSTALL STORM DRAINING, SEDIMENT TRAP AND EARTH DICES TO BE COMPLETED FIRST. REMAINDER OF THE GRADING TO BE PERFORMED AFTER STORM DRAINING, SEDIMENT TRAP AND EARTH DICES ARE INSTALLED.

4. ALL SEDIMENT TRAPS/BASINS SHOWN MUST BE FENCED AND WARNING SIGNS POSTED AROUND THEIR PERIMETER IN ACCORDANCE WITH VOL. 1, CHAPTER 12, OF THE HOWARD COUNTY DESIGN MANUAL, STORM DRAINAGE.

5. ALL DISTURBED AREAS MUST BE STABILIZED WITHIN THE TIME PERIOD SPECIFIED ABOVE IN ACCORDANCE WITH THE 1994 MARYLAND STANDARDS AND SPECIFICATIONS FOR SOIL EROSION AND SEDIMENT CONTROL FOR PERMANENT SEEDING (SEC. 51), SOD (SEC. 54), TEMPORARY SEEDING (SEC. 50), AND MULCHING (SEC. 52). TEMPORARY STABILIZATION WITH MULCH ALONE CAN ONLY BE DONE WHEN RECOMMENDED SEEDING DATES DO NOT ALLOW FOR PROPER GERMINATION AND ESTABLISHMENT OF GRASSES.

6. ALL SEDIMENT CONTROL STRUCTURES ARE TO REMAIN IN PLACE AND ARE TO BE MAINTAINED IN OPERATIVE CONDITION UNTIL PERMISSION FOR THEIR REMOVAL HAS BEEN OBTAINED FROM THE HOWARD COUNTY SEDIMENT CONTROL INSPECTOR.

7. SITE ANALYSIS

TOTAL AREA OF SITE	17.98 ACRES
AREA DISTURBED	7.4 ACRES
AREA TO BE ROOFED OR PAVED	1.2 ACRES
AREA TO BE VEGETATIVELY STABILIZED	0.2 ACRES
TOTAL CUT	28000 CU.YDS.
TOTAL FILL	4500 CU.YDS.
OFFSITE WASTE/BORROW AREA LOCATION TO BE DETERMINED BY CONTRACTOR	

8. ANY SEDIMENT CONTROL PRACTICE WHICH IS DISTURBED BY GRADING ACTIVITY FOR PLACEMENT OF UTILITIES MUST BE REPAIRED ON THE SAME DAY OF DISTURBANCE.

9. ADDITIONAL SEDIMENT CONTROLS MUST BE PROVIDED, IF DEEMED NECESSARY BY THE HOWARD COUNTY SEDIMENT CONTROL INSPECTOR.

10. ON ALL SITES WITH DISTURBED AREAS IN EXCESS OF 2 ACRES, APPROVAL OF THE INSPECTION AGENCY SHALL BE REQUESTED UPON COMPLETION OF INSTALLATION OF PERIMETER EROSION AND SEDIMENT CONTROLS, BUT BEFORE PROCEEDING WITH ANY OTHER EARTH DISTURBANCE OR GRADING OTHER THAN GRADING INSPECTION APPROVALS MAY NOT BE AUTHORIZED UNTIL THIS INITIAL APPROVAL BY THE INSPECTION AGENCY IS MADE.

11. TRENCHES FOR THE CONSTRUCTION OF UTILITIES IS LIMITED TO THREE PIPE LENGTHS OR THAT WHICH SHALL BE BACK-FILLED AND STABILIZED WITHIN ONE WORKING DAY, WHICHEVER IS SHORTER.

SEQUENCE OF CONSTRUCTION

1. OBTAIN A GRADING PERMIT.
2. NOTIFY "MISS UTILITY" AT LEAST 48 HOURS BEFORE BEGINNING ANY WORK AT 1-800-257-7777. NOTIFY THE HOWARD COUNTY OFFICE OF CONSTRUCTION/INSPECTION AT 410-313-3330 24 HOURS BEFORE STARTING WORK.
3. INSTALL ALL TREE PROTECTION FENCE FOR TREES TO BE UNDISTURBED AS INDICATED ON THE PLANS (2 DAYS). CLEAR AND GRUB FOR SEDIMENT BASIN/SWM POND ONLY. INSTALL STABILIZED CONSTRUCTION ENTRANCE (2 WEEKS).
4. INSTALL SEDIMENT BASIN/SWM POND AND ASSOCIATED SILT FENCE AS INDICATED ON THE PLANS. NO BLASTING WILL BE PERMITTED FOR THE EXCAVATION OF SEDIMENT BASIN/SWM POND ENHANCEMENT, WHERE NECESSARY, RIPPING AND JACK HAMMERING SHOULD BE UTILIZED IN THE EXCAVATION OF THE FACILITY. (2 WEEKS).
5. RECEIVE PERMISSION FROM THE SEDIMENT CONTROL INSPECTOR PRIOR TO PROCEEDING. CLEAR AND GRUB FOR REMAINING SEDIMENT CONTROL MEASURES. INSTALL REMAINING SEDIMENT CONTROL MEASURES, EARTH DICES, SILT FENCE, AND THE DRAINAGE SWALES ALONG THE PROPERTY BOUNDARY AS INDICATED ON THE PLANS. (1 WEEK).

NOTE: ALL OLD AND NEW JUNK, TRASH, DEBRIS AND UNNATURAL ITEMS SHALL BE REMOVED FROM OPEN SPACE LOT 25.

6. RECEIVE PERMISSION FROM THE SEDIMENT CONTROL INSPECTOR PRIOR TO PROCEEDING. CLEAR AND GRUB THE REMAINDER OF THE SITE. (3 DAYS)

7. GRADE SITE TO THE PROPOSED SUB-GRADE AND INSTALL THE SEWER AND WATER ALONG WITH THE STORM DRAIN SYSTEM. STABILIZE ALL SLOPES IMMEDIATELY UPON COMPLETION OF GRADING. (3 WEEKS)

8. THE CONTRACTOR SHALL INSPECT AND PROVIDE NECESSARY MAINTENANCE ON ALL SEDIMENT AND EROSION CONTROL STRUCTURES SHOWN HEREON, AFTER EACH RAINFALL AND ON A DAILY BASIS. REMOVE SEDIMENT FROM THE POND WHEN THE CLEANOUT ELEVATION HAS BEEN REACHED. ALL SEDIMENT MUST BE PLACED UPSTREAM OF THE APPROVED TRAPPING DEVICE.

9. CONSTRUCT CURB AND GUTTER AND ROAD BASE COURSE. (2 WEEKS)

10. WHEN ALL CONTRIBUTING AREAS TO THE SEDIMENT CONTROL DEVICES AND THE POND HAVE BEEN STABILIZED AND WITH THE PERMISSION OF THE SEDIMENT CONTROL INSPECTOR, THE DEVICES MAY BE REMOVED AND/OR BACKFILLED AND THE REMAINING AREAS BROUGHT TO FINAL DESIGN GRADE. STABILIZE ALL REMAINING AREAS IN ACCORDANCE WITH PERMANENT SEEDING NOTES. (2 WEEKS)

11. NOTIFY HOWARD COUNTY OFFICE OF INSPECTIONS AND PERMITS FOR FINAL INSPECTION OF THE COMPLETED PROJECT.

TOTAL DURATION = 12 WEEKS SUBJECT TO WEATHER CONDITIONS.

STANDARDS AND SPECIFICATIONS FOR TOPSOIL

Definition

Placement of topsoil over a prepared subsoil prior to establishment of permanent vegetation.

Purpose

To provide a suitable soil medium for vegetative growth. Soils of concern have low moisture content, low nutrient levels, low pH, materials toxic to plants, and/or unacceptable soil gradation.

Conditions Where Practice Applies

- I. This practice is limited to areas having 2:1 or flatter slopes where:
 - a. The texture of the exposed subsoil/parent material is not adequate to produce vegetative growth.
 - b. The soil material is so shallow that the rooting zone is not deep enough to support plants or furnish continuing supplies of moisture and plant nutrients.
 - c. The original soil to be vegetated contains material toxic to plant growth.
 - d. The soil is so acidic that treatment with limestone is not feasible.
- II. For the purpose of these Standards and Specifications, areas having slopes steeper than 2:1 require special consideration and design for adequate stabilization. Areas having slopes steeper than 2:1 shall have the appropriate stabilization shown on the plans.

Construction and Material Specifications

- I. Topsoil salvaged from the existing site may be used provided that it meets the standards as set forth in these specifications. Typically, the depth of topsoil to be salvaged for a given soil type can be found in the representative soil profile section in the Soil Survey published by USDA-SCS in cooperation with Maryland Agricultural Experiment Station.
- II. Topsoil Specifications - Soil to be used as topsoil must meet the following:
 1. Topsoil shall be a loam, sandy loam, clay loam, silt loam, sandy clay loam, loamy sand. Other soils may be used if recommended by an agronomist or soil scientist and approved by the appropriate approval authority. Regardless, topsoil shall not be a mixture of contrasting textured subsoils and shall contain less than 5% by volume of cinders, stones, slag, coarse fragments, gravel, sticks, roots, trash, or other materials larger than 1 1/2" in diameter.
 2. Topsoil must be free of plants or plant parts such as bermuda grass, quackgrass, Johnson grass, nutsedge, poison ivy, thistle, or others as specified.
 3. Where the subsoil is either highly acidic or composed of heavy clays, ground limestone shall be spread at the rate of 4-8 tons/acre (200-400 pounds per 1,000 square feet) prior to the placement of topsoil. Lime shall be distributed uniformly over designated areas and worked into the soil in conjunction with tillage operations as described in the following procedures:

1. For sites having disturbed areas under 5 acres:

- I. Place topsoil if required and apply soil amendments as specified in 20.0 Vegetative Stabilization - Section 1 - Vegetative Stabilization Methods and Materials.

2. For sites having disturbed areas over 5 acres:

- I. Do soil testing Topsoil specifications, obtain test results dictating fertilizer and lime amendments required to bring the soil into compliance with the following:
 - a. pH For topsoil shall be between 6.0 and 7.5. If the tested soil demonstrates a pH of less than 6.0, sufficient lime shall be prescribed to raise the pH to 6.5 or higher.
 - b. Organic content of topsoil shall be not less than 15 percent by weight.
 - c. Topsoil having soluble salt content greater than 500 parts per million shall not be used.
 - d. No soil or seed shall be placed on soil which has been treated with soil sterilants or chemicals used for weed control until sufficient time has elapsed (14 days min) to permit dissipation of phytotoxic materials.
- II. Place topsoil if required and apply soil amendments as specified in 20.0 Vegetative Stabilization - Section 1 - Vegetative Stabilization Methods and Materials.

V. Topsoil Application

- I. When topsoiling, maintain needed erosion and sediment control practices such as diversions, Grade Stabilization Structures, Earth Dikes, Slope Silt Fence and Sediment Traps and Basins.
- II. Grades on the areas to be topsoiled, which have been previously established, shall be maintained, about 4' - 8' higher in elevation.
- III. Topsoil shall be uniformly distributed in a 4' - 8' layer and lightly compacted to a minimum thickness of 4". Spreading shall be performed in such a manner that sodding or seeding can proceed with a minimum of additional soil preparation and tillage. Any irregularities in the surface resulting from topsoiling or other operations shall be corrected in order to prevent the formation of depressions or water pockets.
- IV. Topsoil shall not be placed where the topsoil or subsoil is in a frozen or muddy condition, when the subsoil is excessively wet or in a condition that may otherwise be detrimental to proper grading and seeded preparation.

VI. Alternative For Permanent Seeding - Instead of applying the full amounts of lime and commercial fertilizer, composted sludge and amendments may be applied as specified below:

- I. Composted Sludge Material for use as a soil conditioner for sites having disturbed areas over 5 acres shall be tested to prescribe amendments and for sites having disturbed areas under 5 acres shall conform to the following requirements:
 - a. Composted sludge shall be supplied by, or originate from, a person or persons that are permitted (at the time of acquisition of the compost) by the Maryland Department of the Environment under CDMAR 26-04.06.
 - b. Composted sludge shall contain at least 1 percent nitrogen, 1.5 percent phosphorus, and 0.2 percent potassium and have a Ph of 7.0 to 8.0. If compost does not meet these requirements, the appropriate constituents must be added to meet the requirements prior to use.
 - c. Composted sludge shall be applied at a rate of 1 ton/1,000 square feet.
- II. Composted sludge shall be amended with a potassium fertilizer applied at the rate of 4 lb/1,000 square feet, and 1/3 the normal lime application rate.

References: Guidelines Specifications, Soil Preparation and Sadding, MD-VA, Pub. #1, Cooperative Extension Service, University of Maryland and Virginia Polytechnic Institute, Revised 1973.

ENGINEER'S CERTIFICATE

I hereby certify that this Plan for Erosion and Sediment Control and Storm Drainage is based on the information provided by the Engineer and that it was prepared in accordance with the standards and specifications of the Howard Soil Conservation District.

Signature: *[Signature]* Date: **6-20**

DEVELOPER'S CERTIFICATE

I/We Certify That All Development And Construction Will Be Done According To This Plan Of Development And Plan For Erosion And Sediment Control And That All Responsible Personnel Involved In The Construction Project Will Have A Certificate Of Attendance At A Department Of Natural Resources Approved Training Program For The Control Of Sediment And Erosion Before Beginning The Project. I Also Authorize Periodic On-site Inspection By The Howard Soil Conservation District Or Their Authorized Agents, As Are Deemed Necessary.

Signature of Developer: *[Signature]* Date: **6-6-06**

Reviewed For Howard County Soil Conservation District And Meets Technical Requirements: *[Signature]* Date: **6/19/06**

U.S.D.A. - Natural Resources Conservation Service: *[Signature]* Date: **6/19/06**

Approved: This Development Is Approved For Erosion And Sediment Control By The Howard Soil Conservation District: *[Signature]* Date: **6/19/06**

District Engineer: *[Signature]* Date: **6/19/06**

Approved: Department Of Planning And Zoning: *[Signature]* Date: **8/17/06**

Chief, Division Of Land Development: *[Signature]* Date: **8/17/06**

Chief, Development Engineering Division: *[Signature]* Date: **8/17/06**

Approved: Howard County Department Of Public Works: *[Signature]* Date: **8/17/06**

Chief, Bureau Of Highways: *[Signature]* Date: **8/17/06**

Approved: Department Of Planning And Zoning: *[Signature]* Date: **8/17/06**

Chief, Division Of Land Development: *[Signature]* Date: **8/17/06**

Chief, Development Engineering Division: *[Signature]* Date: **8/17/06**

Approved: Howard County Department Of Public Works: *[Signature]* Date: **8/17/06**

Chief, Bureau Of Highways: *[Signature]* Date: **8/17/06**

FISHER, COLLINS & CARTER, INC.
CIVIL ENGINEERING CONSULTANTS & LAND SURVEYORS
CENTRAL SQUARE OFFICE PARK - 8072 BALTIMORE NATIONAL FIVE
ELLIOTT CITY,