


**GENERAL NOTES**

- ALL ASPECTS OF THE PROJECT ARE IN CONFORMANCE WITH THE LATEST HOWARD COUNTY STANDARDS UNLESS WAIVERS HAVE BEEN APPROVED.
- DEED REFERENCE: LIBER 5307 FOLIO 448
- DENSITY TABULATION:  
GROSS AREA OF PROJECT: 99.57192 AC  
AREA OF 100-YEAR FLOODPLAIN DRAINAGE & UTILITY EASEMENT: 3.55 AC  
AREA OF STEEP SLOPES: 0.27 AC  
NET AREA OF PROJECT: 95.7592 AC \*SEE NOTE 22  
NUMBER OF ENTITIES PERMITTED BY RIGHT: 99.34 / 4.25 = 23  
MAXIMUM RECEIVING YIELD: 99.34 / 2 = 49.67  
NUMBER OF BUILDABLE ENTITIES PROPOSED: 45 LOTS AND ONE BUILDABLE PRESERVATION PARCEL  
NUMBER OF DEO UNITS DEPOSED: 23
- THE PROJECT BOUNDARY IS BASED ON A BOUNDARY SURVEY PREPARED BY FREDERICK WARD ASSOCIATES INC., DATED NOVEMBER 2002.
- THE TOPOGRAPHY SHOWN HEREON IS BASED ON AN AERIAL TOPOGRAPHIC SURVEY PREPARED BY POTOMAC AERIAL SURVEYS.
- WATER AND SEWER FOR THIS PROJECT WILL BE PRIVATE.
- STORMWATER MANAGEMENT TO BE PROVIDED FOR THIS DEVELOPMENT BY 2 MICROPOOL EXTENDED DETENTION PONDS AND A BIORETENTION FACILITY. THE STORMWATER MANAGEMENT FACILITIES ARE HAZARD CLASS A. REQUIRED FOR LOTS 20, 21, AND 41. FINAL DESIGN WILL BE PROVIDED WITH THE BUILDING PERMIT.
- THE STORMWATER MANAGEMENT FACILITIES SHALL BE PRIVATELY OWNED AND MAINTAINED.
- STREAMS SHOWN ON SITE ARE BASED ON A FIELD INVESTIGATION BY ECO-SCIENCE PROFESSIONALS, INC. ON AUGUST 31, 2000.
- THE FLOODPLAIN SHOWN HEREON IS BASED ON AN "OBVIOUSLY NOT CRITICAL" ANALYSIS PERFORMED BY ROBERT H. VOGEL ENGINEERING, DATED JULY 2004.
- PERMETER LANDSCAPING SHALL BE IN ACCORDANCE WITH SECTION 16.124 OF THE HOWARD COUNTY CODE AND LANDSCAPE MANUAL 3. FINANCIAL SURETY FOR THE REQUIRED LANDSCAPING SHALL BE POSTED AS PART OF THE DEVELOPER'S AGREEMENT IN THE AMOUNT OF \$54,900.00 FOR 177 SHADE TREES AND 48 EVERGREEN TREES.
- FOREST CONSERVATION REQUIREMENTS PER SECTION 16.1202 OF THE HOWARD COUNTY CODE AND THE FOREST CONSERVATION MANUAL FOR THIS SUBDIVISION WILL BE FULFILLED BY THE RETENTION OF 27.61 AC ONSITE. SURETY IN THE AMOUNT OF \$240,539.00 WILL BE PAID WITH THE DEVELOPER'S AGREEMENT.
- A TRAFFIC STUDY IS NOT REQUIRED FOR THIS PROJECT.
- STREET LIGHTING WILL BE PROVIDED FOR THIS SITE.
- THIS PROPERTY IS NOT LOCATED WITHIN THE METROPOLITAN DISTRICT.
- TO THE BEST OF THE OWNERS KNOWLEDGE, THERE ARE NO BURIAL/CEMETERY LOCATIONS ON SITE.
- A NOISE STUDY IS NOT REQUIRED FOR THIS DEVELOPMENT.
- NO CLEARING, GRADING, OR CONSTRUCTION IS PERMITTED WITHIN THE STREAMS OR THEIR BUFFERS AND THE FOREST CONSERVATION EASEMENTS.
- TREE PROTECTION FENCING WILL BE PROVIDED AT THE LIMITS OF DISTURBANCE WHERE GRADING IS ADJACENT TO ENVIRONMENTAL AREAS.
- THIS SUBDIVISION COMPLIES WITH THE 4TH EDITION OF THE SUBDIVISION AND LAND DEVELOPMENT REGULATIONS. IT IS SUBJECT TO THE 4TH EDITION BECAUSE THE SKETCH PLAN WAS SUBMITTED NOVEMBER 15, 2000 AND TO THE 1993 ZONING REGULATIONS BECAUSE IT WAS TECHNICALLY COMPLETE ON FEBRUARY 14, 2001.
- FOREST STAND DELINEATION PLAN PREPARED BY VOGEL & ASSOCIATES, DATED NOVEMBER 13, 2000.
- THIS PROJECT IS SUBJECT TO COUNCIL BILL 50-2003. RECEIVING DENSITY SHALL BE BASED ON GROSS ACREAGE RATHER THAN NET ACREAGE.
- THIS PROPERTY IS ZONED RR-DEO PER THE APRIL 13, 2004 ZONING REGULATIONS.
- NON-BUILDABLE PRESERVATION PARCEL 'E' IS FOR THE PURPOSE OF FOREST CONSERVATION AND SHALL BE PRIVATELY OWNED AND HAVE HOWARD COUNTY AND THE HOMEOWNERS ASSOCIATION AS ITS EASEMENT HOLDERS. BUILDABLE PRESERVATION PARCEL 'B' IS FOR THE PURPOSE OF A SINGLE RESIDENCE AND FOREST CONSERVATION AND SHALL BE PRIVATELY OWNED AND MAINTAINED AND HAVE HOWARD COUNTY AND THE HOMEOWNERS ASSOCIATION AS ITS EASEMENT HOLDERS. NON-BUILDABLE PRESERVATION PARCELS 'A', 'C' AND 'D' IS FOR THE PURPOSE OF STORMWATER MANAGEMENT AND SHALL BE PRIVATELY OWNED AND MAINTAINED BY THE HOMEOWNERS ASSOCIATION AND HAVE HOWARD COUNTY AS ITS EASEMENT HOLDER.
- THE ENVIRONMENTAL DELINEATION AND REPORT WAS REVIEWED AND ACCEPTED UNDER S-01-11.
- ALL TRAFFIC CONTROL DEVICES SHOWN ARE AS PER HOWARD COUNTY THE STANDARD DETAIL.
- EXISTING SEPTIC LOCATIONS ARE BASED ON RECORD PLATS.
- ALL EXISTING WELLS AND SEPTIC AREAS WITHIN 100' OF THE SITE HAVE BEEN SHOWN TO THE BEST OF OUR KNOWLEDGE.
- ALL WELLS TO BE DRILLED PRIOR TO SUBMITTAL OF FINAL PLAT FOR SIGNATURE.
- APPLICATION NO. AS14220 PERC LOCATIONS ARE BASED ON PERC TESTING DATED OCTOBER 23, 24, 25, 30, 31, NOVEMBER 1, 20, 21, 22, 2000, MAY 17, 18, JULY 15, 2001, APRIL 10, 2002, AUGUST 7, 2002 AND ARE FIELD LOCATED.
- GROUND WATER APPROPRIATION PERMIT #H020036001(01)
- ROAD 'A' CL. STA 0+50- EXISTING WELL TO BE PROPERLY ABANDONED AND SEALED BY LICENSED WELL DRILLER PRIOR TO SUBMITTAL OF RECORD PLAT FOR SIGNATURE.
- LOT #22- EXISTING SEPTIC SYSTEM TO BE PROPERLY ABANDONED PRIOR TO SUBMITTAL OF RECORD PLAT FOR SIGNATURE. PROPOSED WELL TO BE DRILLED AT FURTHEST POINT FROM ABANDONED SEPTIC.
- LOT #23- EXISTING BARN TO BE REMOVED PRIOR TO SUBMITTAL OF RECORD PLAT FOR SIGNATURE. WELL TO BE SEALED BY LICENSED WELL DRILLER. REMOVE 4"-6" STONE DRIVEWAY/PARKING. NO DISTURBANCE TO OCCUR BELOW 6" DEPTH.
- LOT #29- EXISTING HOUSE TO REMAIN; EXISTING WELL AND SEPTIC SYSTEM TO BE PROPERLY ABANDONED AND REPLACED PRIOR TO SUBMITTAL OF RECORD PLAT FOR SIGNATURE; EXISTING POOL AND GAZEBO TO BE REMOVED. WELL TO BE SEALED BY LICENSED WELL DRILLER.
- LOT #34- PROPOSED WELL TO BE DRILLED AT FURTHEST POINT FROM ABANDONED SEPTIC ON LOT 36.
- LOT #36- EXISTING HOUSE TO REMAIN; EXISTING WELL AND SEPTIC SYSTEM TO BE ABANDONED AND REPLACED PRIOR TO SUBMITTAL OF RECORD PLAT FOR SIGNATURE. WELL TO BE SEALED BY LICENSED WELL DRILLER. PROPOSED WELL TO DRILL AT FURTHEST POINT FROM ABANDONED SEPTIC.
- LOT #37- EXISTING STORAGE SHED TO RAZED PRIOR TO SUBMITTAL OF RECORD PLAT FOR SIGNATURE. NO DISTURBANCE TO OCCUR BELOW 6" DEPTH.
- LOT #41- EXISTING WELL TO PROPERLY ABANDONED PRIOR TO SUBMITTAL OF RECORD PLAT FOR SIGNATURE. WELL TO SEALED BY LICENSED WELL DRILLER.
- PARCEL C- EXISTING STRUCTURE AND SEPTIC SYSTEM ON PARCEL C HAVE BEEN REMOVED AND ABANDONED.
- NON-BUILDABLE PRESERVATION PARCEL D- BARN TO BE REMOVED PRIOR TO SUBMITTAL OF RECORD PLAT FOR SIGNATURE.
- LOT #45- EXISTING SHED AND GRAPE ARBOR TO BE REMOVED PRIOR TO SUBMITTAL OR RECORD PLAT FOR SIGNATURE.
- SEPTIC SYSTEMS FOR LOTS 13, 20, 21, AND 23 TO BE INSTALLED PRIOR TO ISSUANCE OF BUILDING PERMIT.
- THE LOTS SHOWN HEREON COMPLY WITH THE MINIMUM OWNERSHIP WIDTH AND LOT AREA AS REQUIRED BY THE MARYLAND DEPARTMENT OF THE ENVIRONMENT.
- ALL SIGN POST USED FOR TRAFFIC CONTROL SIGNS INSTALLED IN THE COUNTY RIGHT-OF-WAY SHALL BE MOUNTED ON A 2" GALVANIZED STEEL, PERFORATED, SQUARE TUBE POST (14 GAUGE) INSERTED INTO A 2-1/2" GALVANIZED STEEL, PERFORATED, SQUARE TUBE SLEEVE (12 GAUGE) - 3' LONG. A GALVANIZED STEEL POLE CAP SHALL BE MOUNTED ON TOP OF EACH POST. A MINIMUM OF 20' SHALL BE MAINTAINED BETWEEN ANY STREET LIGHT AND ANY TREE.
- IT IS THE DEVELOPER'S RESPONSIBILITY TO SCHEDULE THE WELL DRILLING PRIOR TO FINAL PLAT SUBMISSION. IT WILL NOT BE CONSIDERED "GOVERNMENT DELAY" IF THE WELL DRILLING HOLDS-UP THE HEALTH DEPARTMENT SIGNATURE OF THE RECORD PLAT. IF A WELL SUCCESS RATE IS ACCOMPLISHED AT VARIOUS LOCATIONS WITHIN THE SITE, THE DEVELOPER SHALL HAVE THE OPTION TO REQUEST RELIEF FROM DRILLING THE REMAINING WELLS PRIOR TO PLAT RECORDATION.
- THIS SITE IS SUBJECT TO CB 50-2003, RECEIVING DENSITY IS BASED ON GROSS ACREAGE RATHER THAN NET ACREAGE.
- BUILDING RESTRICTION LINES HAVE BEEN SET IN ACCORDANCE WITH THE AMENDED FIFTH EDITION SINCE THAT WILL BE REQUIRED AT THE BUILDING PERMIT STAGE.
- 95% COMPACTION IN FILL AREAS ARE REQUIRED PER ASHTO T-180.
- FINANCIAL SURETY FOR THE REQUIRED TOTAL 176 STREET TREES WILL BE POSTED AS PART OF THE DEVELOPER'S AGREEMENT IN AMOUNT OF \$52,800.00.
- LOT GRADING AND LOCATION OF DOWNSPOUTS ARE BASED ON THE APPROVED PRELIMINARY PLAN AND WILL BE FINALIZED WITH EACH BUILDING PERMIT.
- APFO AND SCHOOLS WERE PASSED UNDER S-01-011.
- EXISTING WELL ON LOT 1 HAS BEEN PROPERLY ABANDONED BY A LICENSED WELL DRILLER.

**AS-BUILT CERTIFICATION**

I hereby certify that the facility shown on this plan was constructed as shown on the As-Built Plans and meets the approved plans and specifications.

PE No. 16193  
Date: 11/17/14

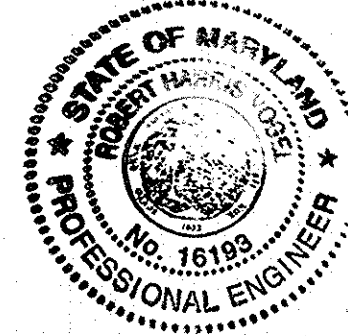

APPROVED: HOWARD COUNTY DEPARTMENT OF PUBLIC WORKS  
1-10-07  
W. J. ...  
CHIEF, BUREAU OF HIGHWAYS

APPROVED: HOWARD COUNTY DEPARTMENT OF PLANNING AND ZONING  
1/26/07  
...  
CHIEF, DEVELOPMENT ENGINEERING DIVISION


APPROVED: HOWARD COUNTY DEPARTMENT OF LAND DEVELOPMENT  
2/2/07  
...  
CHIEF, DIVISION OF LAND DEVELOPMENT

REVIEWED FOR HOWARD SCD AND MEETS TECHNICAL REQUIREMENTS  
DATE: ...


USDA-NATURAL RESOURCES CONSERVATION SERVICE  
DATE: ...  
THIS DEVELOPMENT PLAN IS APPROVED FOR SOIL EROSION AND SEDIMENT CONTROL BY THE HOWARD SOIL CONSERVATION DISTRICT

HOWARD SCD  
DATE: ...

# FINAL ROAD CONSTRUCTION PLAN CASTLEBERRY AT TEN OAKS LOTS 1 - 45, NON-BUILDABLE PRESERVATION PARCELS A, C, D, E & BUILDABLE PRESERVATION PARCEL B

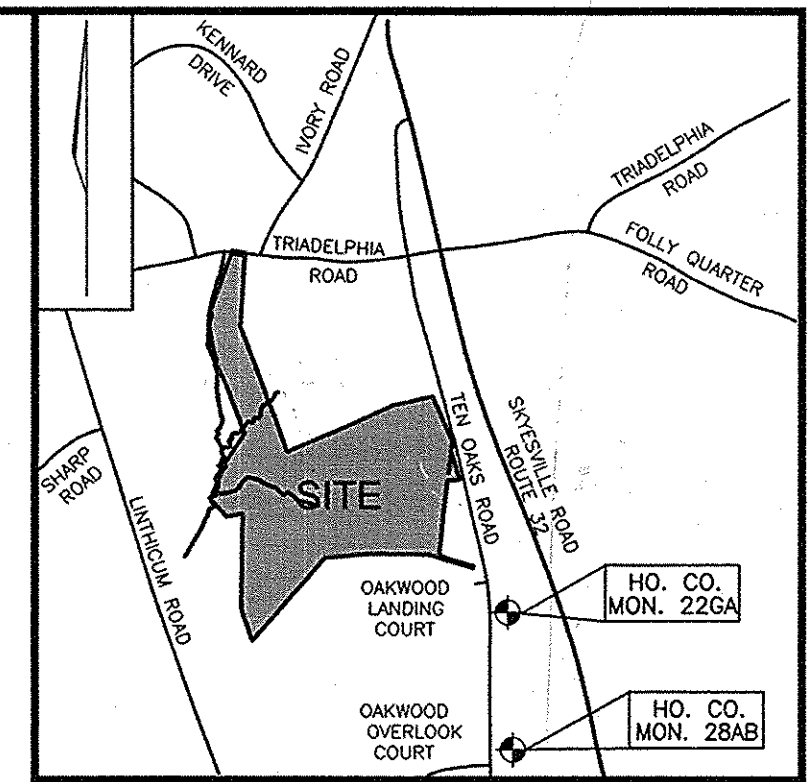

VICINITY MAP  
SCALE: 1"=2000'

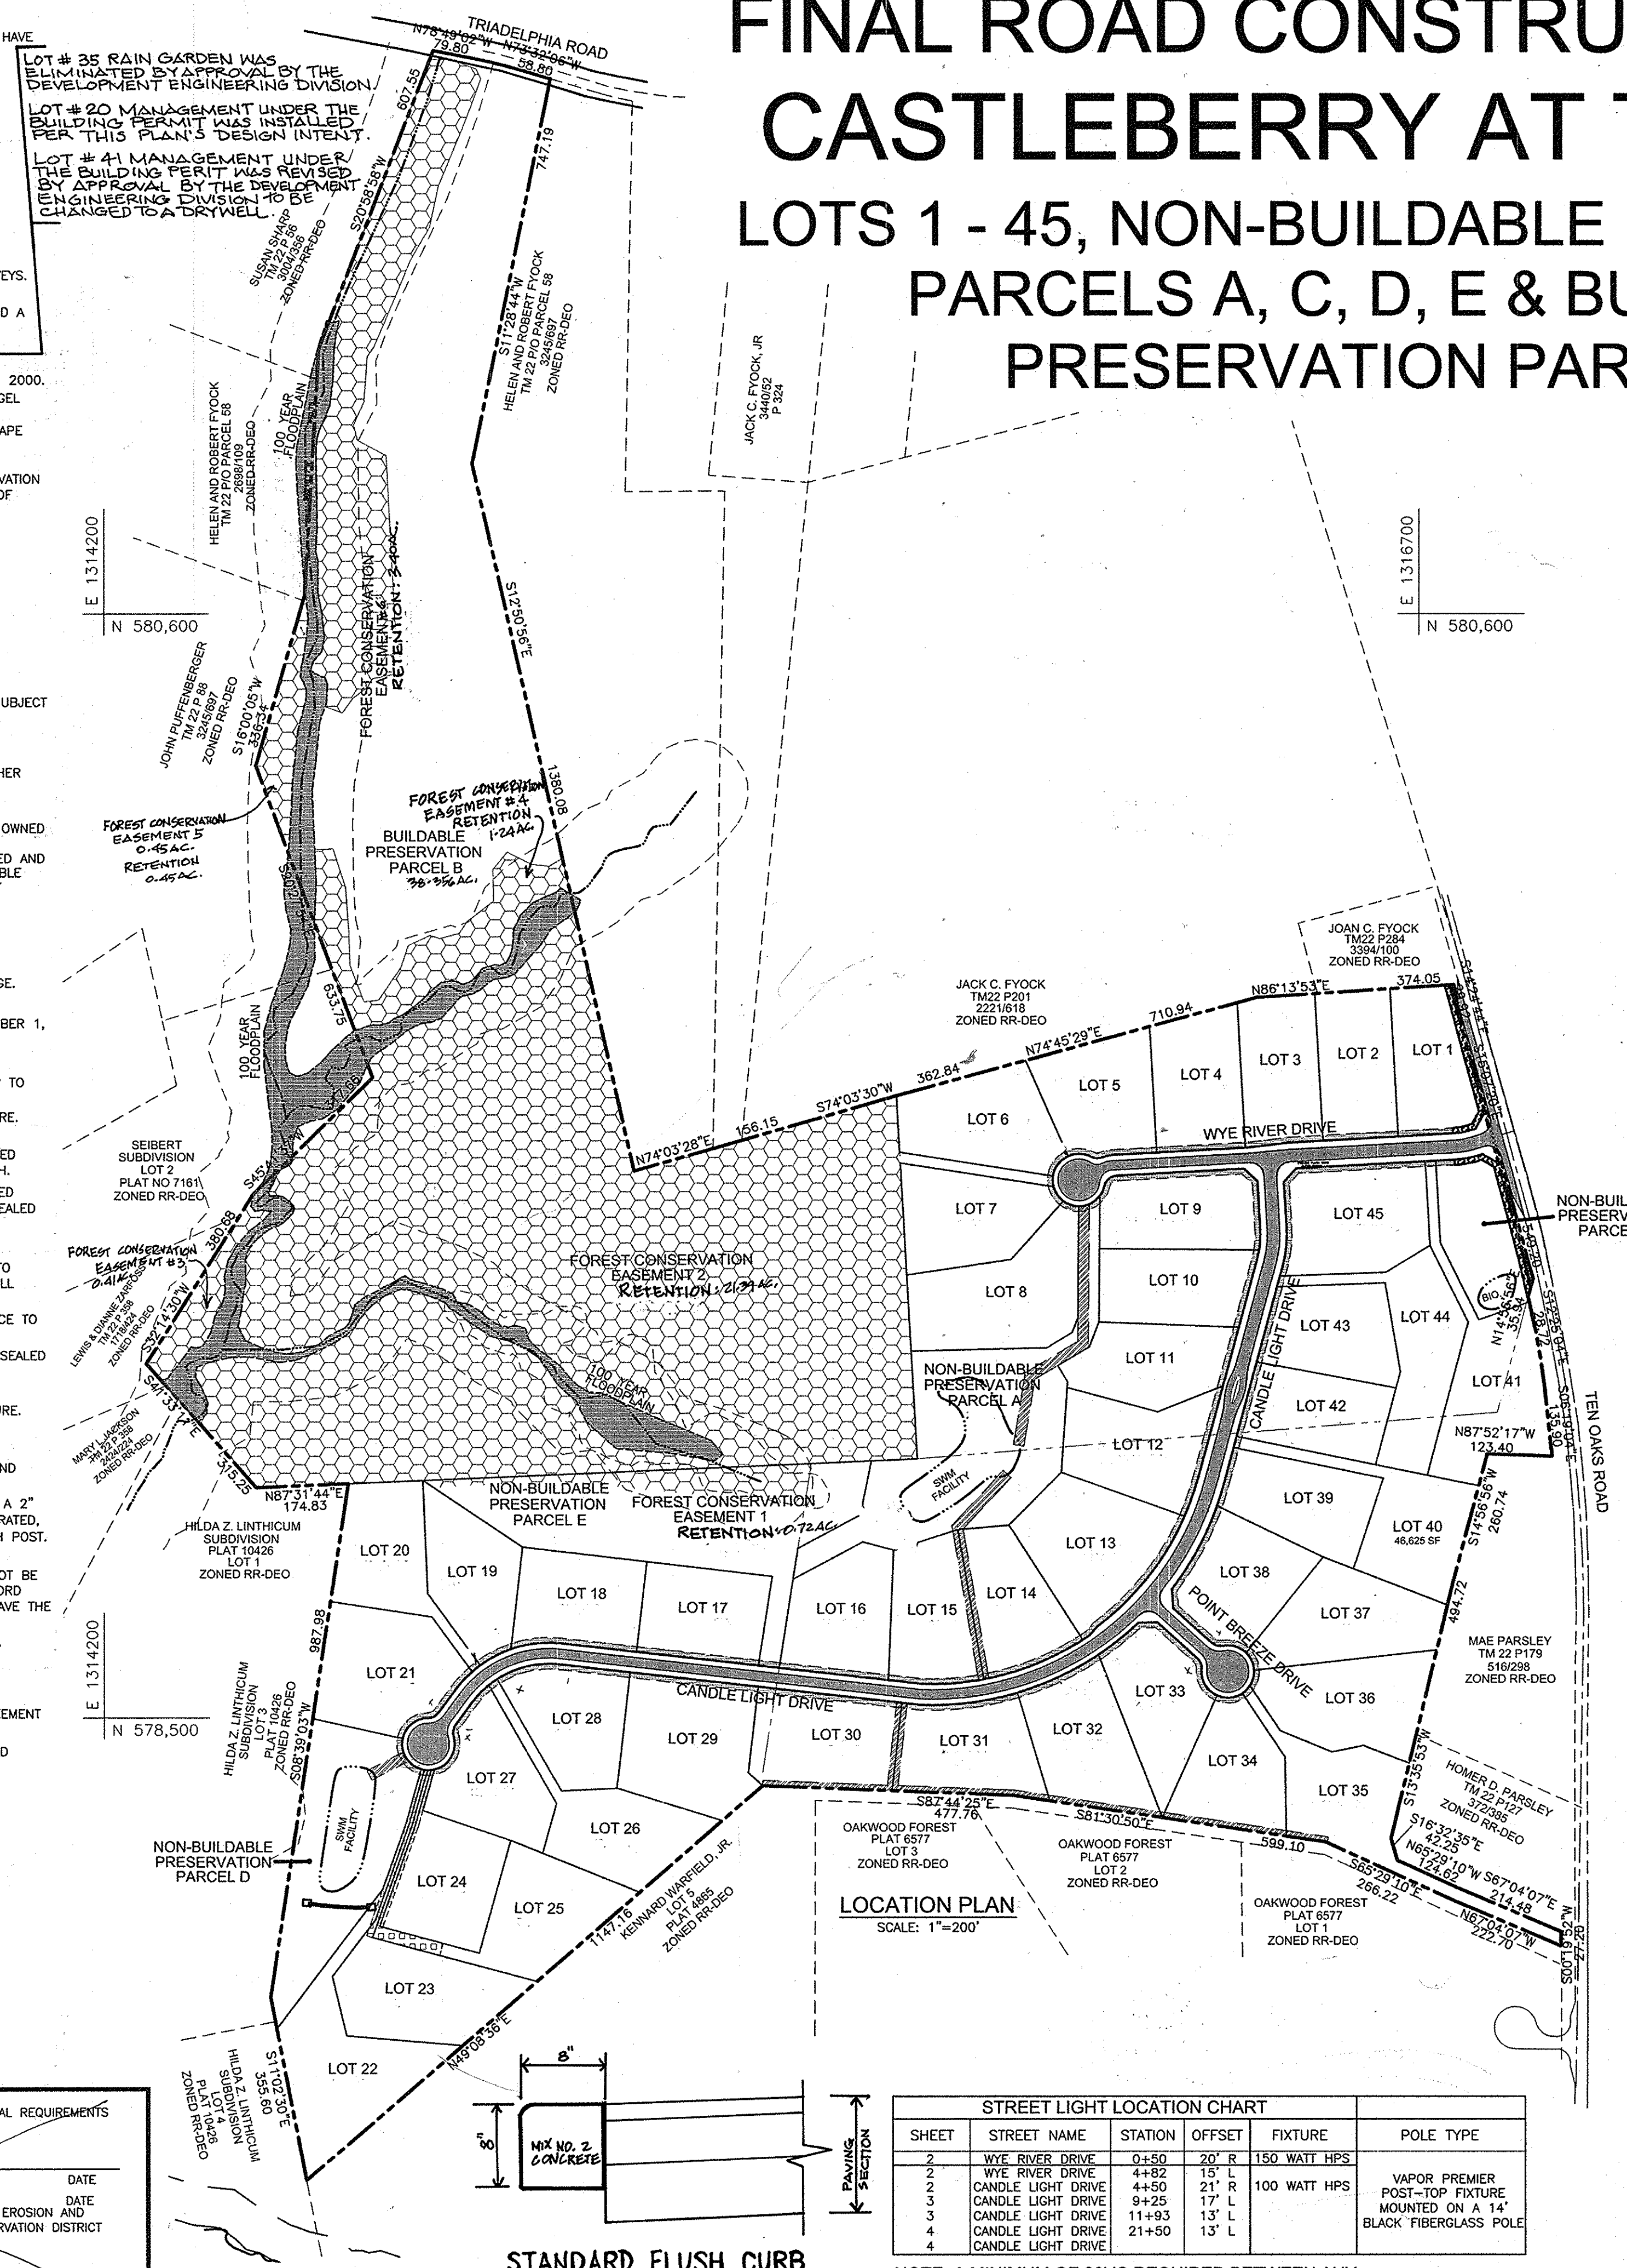

**DENSITY EXCHANGE (RE-05-04)**

RECEIVING PARCEL INFORMATION	OWNER: CASTLEBERRY AT TEN OAKS, L.L.C. 3675 PARK AVENUE, SUITE 301 ELLICOTT CITY, MARYLAND 21043 7468/517, 6709/388, 7456/487 TAX MAP 10, BLOCK 13, PARCELS 60 & P/O 551
TOTAL AREA OF SUBDIVISION	99.57192 ACRES
ALLOWED DENSITY UNITS	99.57192/4.25 = 23
NET ACREAGE OF SUBDIVISION	99.57192 ACRES
NUMBER OF UNITS PROPOSED	46 UNITS
MAXIMUM DEO UNITS ALLOWED	99.57192/2 = 49
DEO DENSITY UNITS TO BE RECEIVED FROM SENDING PARCELS	23 UNITS
SENDING PARCEL INFORMATION	DORIS FOLLMER HOGG PROPERTY TM 9, GRID 4, PARCEL 120 11 UNITS
SENDING PARCEL INFORMATION	DONALD L. SHAPIRO PROPERTY TM 12, GRID 5, PARCEL 9 10 UNITS
SENDING PARCEL INFORMATION	CHASE AT STONEY BROOK TM 7, GRID 17, PARCEL 133 2 UNITS

**BENCHMARKS**

NO.	NORTHING	EASTING	ELEVATION	TYPE
22GA	576646.7890	1316983.4830	590.033	CONCRETE
28AB	574608.7690	1317002.0590	579.642	CONCRETE

**MINIMUM LOT SIZE CHART**

LOT NO.	GROSS AREA	PIPESTEM AREA	MINIMUM LOT SIZE
20	42,897 SF	2,570 SF	40,327 SF
22	64,524 SF	5,536 SF	58,988 SF
23	54,307 SF	1,803 SF	52,504 SF
24	43,320 SF	479 SF	42,841 SF
25	51,902 SF	6,738 SF	45,164 SF
26	46,415 SF	5,065 SF	41,350 SF
35	93,911 SF	10,651 SF	40,551 SF
40	46,624 SF	6,369 SF	40,255 SF
41	58,691 SF	6,433 SF	52,258 SF
44	50,257 SF	4,073 SF	46,184 SF

**SHEET INDEX**

DESCRIPTION	SHEET NO.
COVER SHEET	1
SITE LAYOUT PLAN	2
SITE LAYOUT PLAN	3
SITE LAYOUT PLAN	4
SITE LAYOUT PLAN	5
SITE LAYOUT PLAN	6
ROAD PROFILES	7
ROAD PROFILES	8
ROAD PROFILES	9
ROAD PROFILES	10
GRADING, SEDIMENT AND EROSION CONTROL PLAN	11
GRADING, SEDIMENT AND EROSION CONTROL PLAN	12
GRADING, SEDIMENT AND EROSION CONTROL PLAN	13
LANDSCAPING AND FOREST CONSERVATION PLAN	14
LANDSCAPING AND FOREST CONSERVATION PLAN	15
LANDSCAPING AND FOREST CONSERVATION PLAN	16
STORMDRAIN PROFILES	17
STORMDRAIN PROFILES	18
STORMWATER MANAGEMENT DETAILS - POND 1	19
STORMWATER MANAGEMENT DETAILS - POND 2	20
STORMWATER MANAGEMENT NOTES	21
STORMWATER MANAGEMENT NOTES	22
SEDIMENT AND EROSION CONTROL DETAILS	23

**SWM- EXISTING CONDITIONS**

D.A.	Q <sub>1</sub> (CFS)	Q <sub>10</sub> (CFS)	Q <sub>100</sub> (CFS)
1	1.1	9.6	42.6
2	1.1	15.9	35.0
3	0.6	9.8	21.9
4	1.1	17.4	40.0
5	0.4	4.0	8.2

AREA 6 HAS BEEN REMOVED

7	0.1	1.6	4.1
8	0.1	2.4	5.8

**SWM- DEVELOPED CONDITIONS**

D.A.	Q <sub>1</sub> (CFS)	Q <sub>10</sub> (CFS)	Q <sub>100</sub> (CFS)
1	0.45	43.1	104.9
2	0.12	13.9	37.8
3	2.0	12.5	24.3
4	1.6	18.9	39.9
5	1.0	5.5	10.6

AREA 6 HAS BEEN REMOVED

7	0.7	2.8	8.01
8	0.8	4.1	7.7

**LEGEND**

- USE-IN-COMMON ACCESS EASEMENT
- FOREST CONSERVATION EASEMENT (RETENTION)
- 100 YEAR FLOODPLAIN
- 10' PRIVATE SIGN & FENCE EASEMENT
- AREA DEDICATED TO HOWARD COUNTY FOR RIGHT OF WAY
- PROPOSED PAVING FOR ROAD
- DRAINAGE AND UTILITY EASEMENT
- 10' PUBLIC TREE MAINTENANCE EASEMENT

**OWNER**  
HELEN L. FLYOCK  
ROBERT E. FLYOCK  
GLENELD, MARYLAND

CASTLEBERRY AT TEN OAKS, L.L.C.  
3675 PARK AVENUE, SUITE 301  
ELLICOTT CITY, MARYLAND 21043  
(410) 740-9401

**DEVELOPER**  
CASTLEBERRY AT TEN OAKS, L.L.C.  
3675 PARK AVENUE, SUITE 301  
ELLICOTT CITY, MARYLAND 21043  
(410) 740-9401

**STREET LIGHT LOCATION CHART**

SHEET	STREET NAME	STATION	OFFSET	FIXTURE	POLE TYPE
2	WYE RIVER DRIVE	0+50	20' R	150 WATT HPS	
2	WYE RIVER DRIVE	4+82	15' L	100 WATT HPS	
2	CANDLE LIGHT DRIVE	4+50	21' R	100 WATT HPS	
3	CANDLE LIGHT DRIVE	9+25	17' L		VAST-TO-POST-FIXTURE MOUNTED ON A 14' BLACK FIBERGLASS POLE
4	CANDLE LIGHT DRIVE	11+93	13' L		
4	CANDLE LIGHT DRIVE	21+50	13' L		

NOTE: A MINIMUM OF 20' IS REQUIRED BETWEEN ANY STREET LIGHT AND ANY TREE



2	ADD SAFETY FENCE BETWEEN POND 1 AND FCE	9-27-09
1	REVISE LANDSCAPE SURETY AMOUNT	4-20-07
NO.	REVISION	DATE

**COVER SHEET**  
**CASTLEBERRY AT TEN OAKS**  
LOTS 1 - 45, NON-BUILDABLE PRESERVATION PARCELS A, C, D, E & BUILDABLE PRESERVATION PARCEL B

TAX MAP 22 GRID 20  
5TH ELECTION DISTRICT



PARCEL 60, LOTS 6 & 7 KEN WARFIELD SUBDIVISION, AND P/O PARCEL 90 HOWARD COUNTY, MARYLAND

**ROBERT H. VOGEL ENGINEERING, INC.**  
ENGINEERS • SURVEYORS • PLANNERS  
8407 MAIN STREET  
ELLICOTT CITY, MD 21043  
TEL: 410.461.7666  
FAX: 410.461.8961

**DPZ REF:**  
S-01-11, P-05-04


DESIGN BY: RHV/LJT  
DRAWN BY: LIT  
CHECKED BY: RRV  
DATE: DECEMBER, 2006  
SCALE: AS NOTED  
W.O. NO.: 00-85-00

1 SHEET OF 23

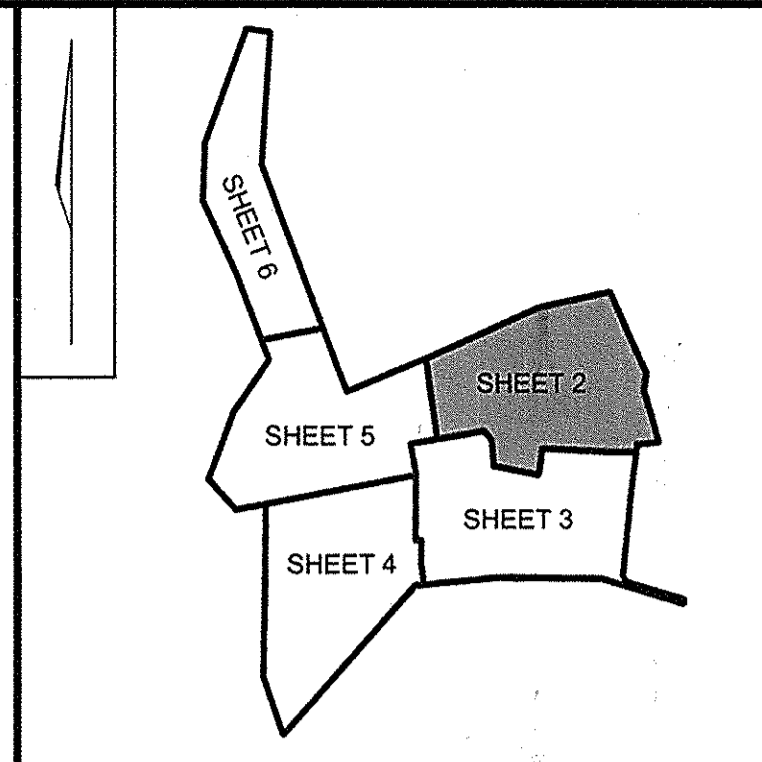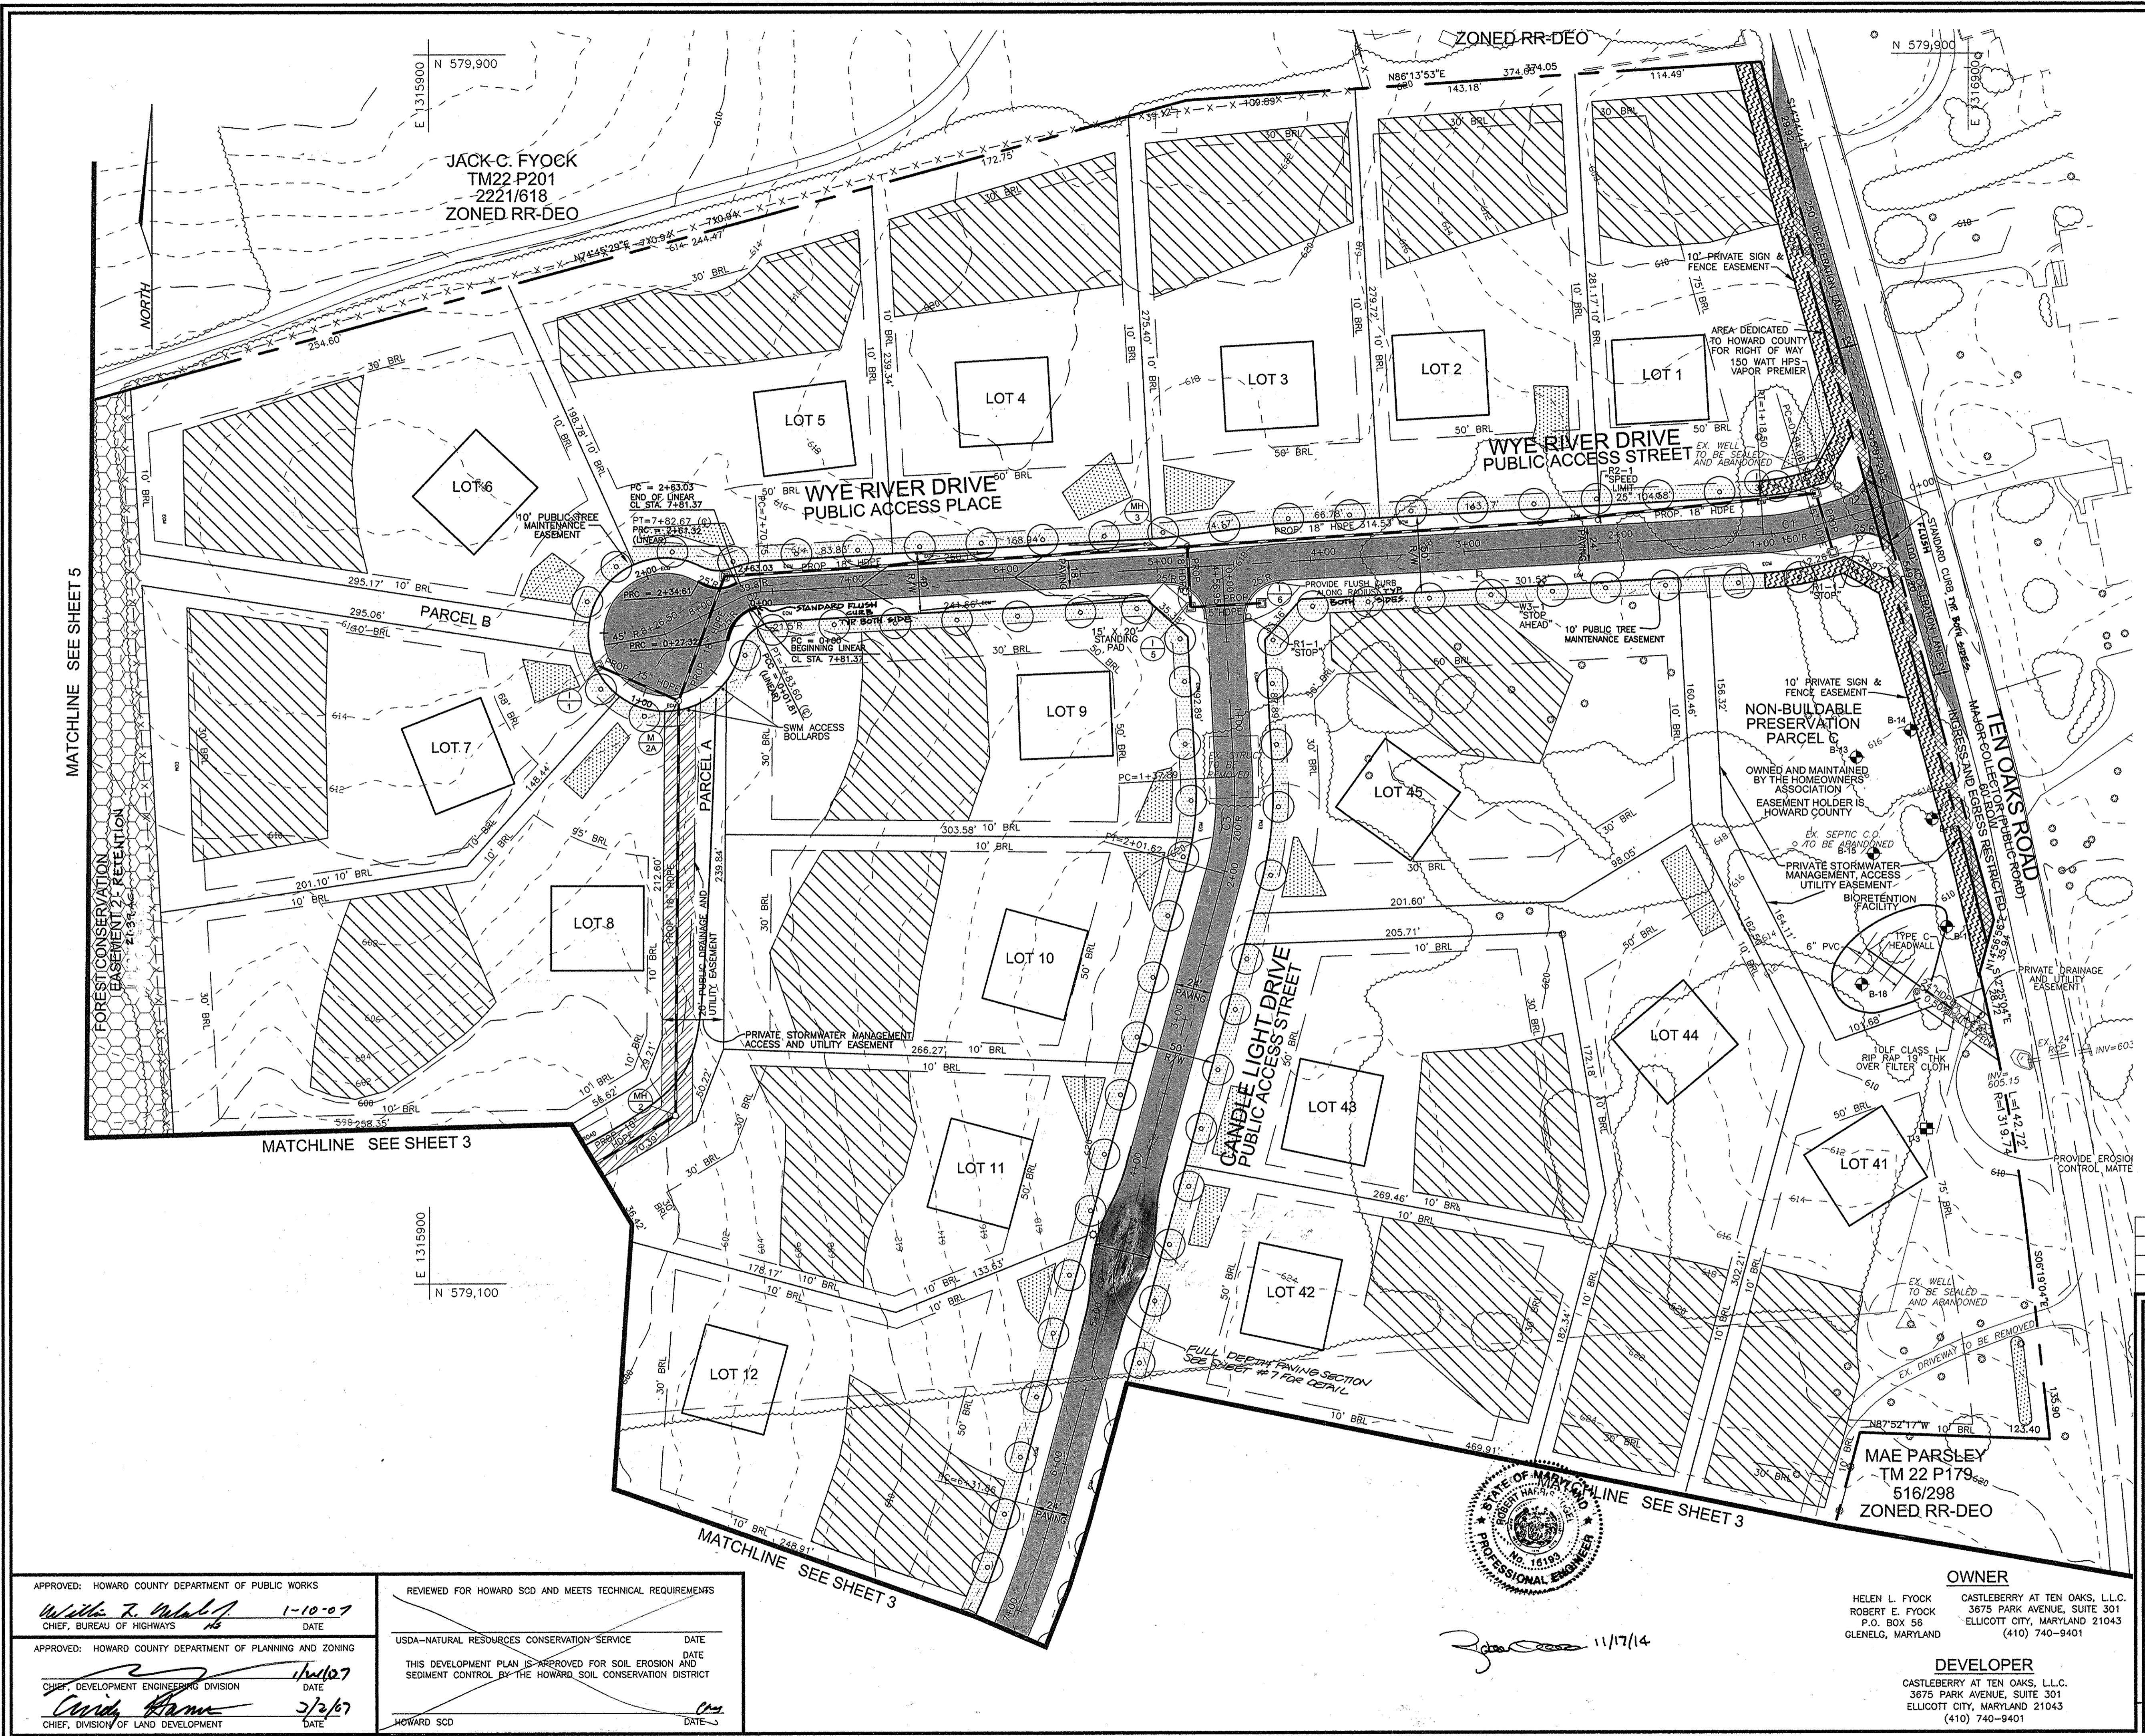

**LEGEND**

- 202 --- EXISTING 2 FT CONTOUR
- 200 --- EXISTING 10 FT CONTOUR
- 202 --- PROPOSED 2 FT CONTOUR
- 200 --- PROPOSED 10 FT CONTOUR
- SSF --- SUPER SILT FENCE
- LOD --- LIMIT OF DISTURBANCE
- --- EXISTING TREELINE
- --- PROPOSED TREELINE
- --- EARTH DIKE
- --- PROPOSED STREET TREE
- --- PROPOSED STREET LIGHT
- --- FOREST CONSERVATION SIGN LOCATION
- --- PRIVATE SEPTIC EASEMENT
- --- PRIVATE WELL AREA
- --- DRAINAGE AND UTILITY EASEMENT
- --- FOREST CONSERVATION EASEMENT (RETENTION)
- --- FOREST CONSERVATION EASEMENT (REForestation)
- --- 100 YEAR FLOODPLAIN
- --- 10' PRIVATE SIGN & FENCE EASEMENT
- --- AREA DEDICATED TO HOWARD COUNTY FOR RIGHT OF WAY
- --- USE-IN-COMMON ACCESS EASEMENT
- --- WET LAND
- --- 10' PUBLIC TREE MAINTENANCE EASEMENT

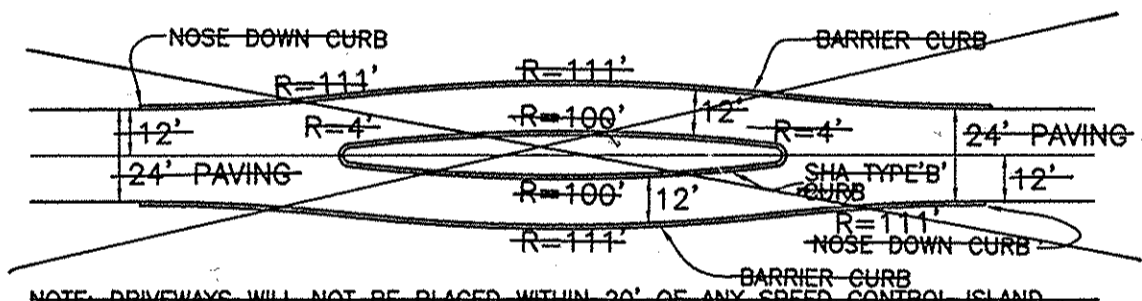

NOTE: DRIVEWAYS WILL NOT BE PLACED WITHIN 20' OF ANY SPEED CONTROL ISLAND.

**TRAFFIC CONTROL DEVICE DETAIL - NOT TO SCALE**

CURVE TABLE						
CURVE	LENGTH	RADIUS	DELTA	TANGENT	CHORD	DISTANCE
C1	34.43	150.00	13°09'08"	17.29	N80°13'55"E	34.36
C2	11.92	30.00	22°45'38"	6.04	S75°25'40"W	11.84
C3	63.74	200.00	18°13'33"	32.14	N05°56'15"E	63.47
C4	741.32	550.00	77°13'33"	439.26	N53°40'48"E	686.46
C5	209.38	200.00	59°58'58"	115.43	S68°28'03"W	199.95

NO.	REVISION	DATE
2	REMOVE SPEED CONTROL DEVICE CANDLE LIGHT DRIVE	3/20/11

**SITE LAYOUT PLAN**  
**CASTLEBERRY AT TEN OAKS**  
 LOTS 1 - 45, NON-BUILDABLE PRESERVATION  
 PARCELS A, C, D, E & BUILDABLE PRESERVATION PARCEL B  
 TAX MAP 22 GRID 20 PARCEL 60, LOTS 6 & 7 KEN WARFIELD SUBDIVISION, AND PIO PARCEL 90  
 5TH ELECTION DISTRICT HOWARD COUNTY, MARYLAND

**ROBERT H. VOGEL ENGINEERING, INC.**  
 ENGINEERS • SURVEYORS • PLANNERS  
 8407 MAIN STREET ELLICOTT CITY, MD 21043 TEL: 410.461.7666 FAX: 410.461.8969

DESIGN BY: RHL/JT  
 DRAWN BY: LIT  
 CHECKED BY: RHV  
 DATE: DECEMBER, 2006  
 SCALE: 1"=50'  
 W.O. NO.: 00-85.00  
 DPZ REF: S-01-11, P-05-04  
 2 SHEET OF 23

APPROVED: HOWARD COUNTY DEPARTMENT OF PUBLIC WORKS  
 1-10-07  
 CHIEF, BUREAU OF HIGHWAYS

APPROVED: HOWARD COUNTY DEPARTMENT OF PLANNING AND ZONING  
 1/10/07  
 CHIEF, DEVELOPMENT ENGINEERING DIVISION

3/2/07  
 CHIEF, DIVISION OF LAND DEVELOPMENT

REVIEWED FOR HOWARD SCD AND MEETS TECHNICAL REQUIREMENTS

USDA-NATURAL RESOURCES CONSERVATION SERVICE  
 THIS DEVELOPMENT PLAN IS APPROVED FOR SOIL EROSION AND SEDIMENT CONTROL BY THE HOWARD SOIL CONSERVATION DISTRICT


HOWARD SCD




**OWNER**  
 HELEN L. FYOCK  
 ROBERT E. FYOCK  
 P.O. BOX 56  
 GLENELG, MARYLAND

**DEVELOPER**  
 CASTLEBERRY AT TEN OAKS, L.L.C.  
 3675 PARK AVENUE, SUITE 301  
 ELLICOTT CITY, MARYLAND 21043  
 (410) 740-9401

CURVE	LENGTH	RADIUS	DELTA	TANGENT	CHORD	DISTANCE
C1	34.43	150.00	13°09'08"	17.29	N80°13'55"E	34.36
C2	11.92	30.00	22°45'38"	6.04	S75°23'40"W	11.84
C3	63.74	200.00	18°15'33"	32.14	N05°56'15"E	63.47
C4	741.32	550.00	77°13'33"	439.26	N53°40'48"E	686.46
C5	209.38	200.00	59°58'58"	115.43	S66°28'03"W	199.95

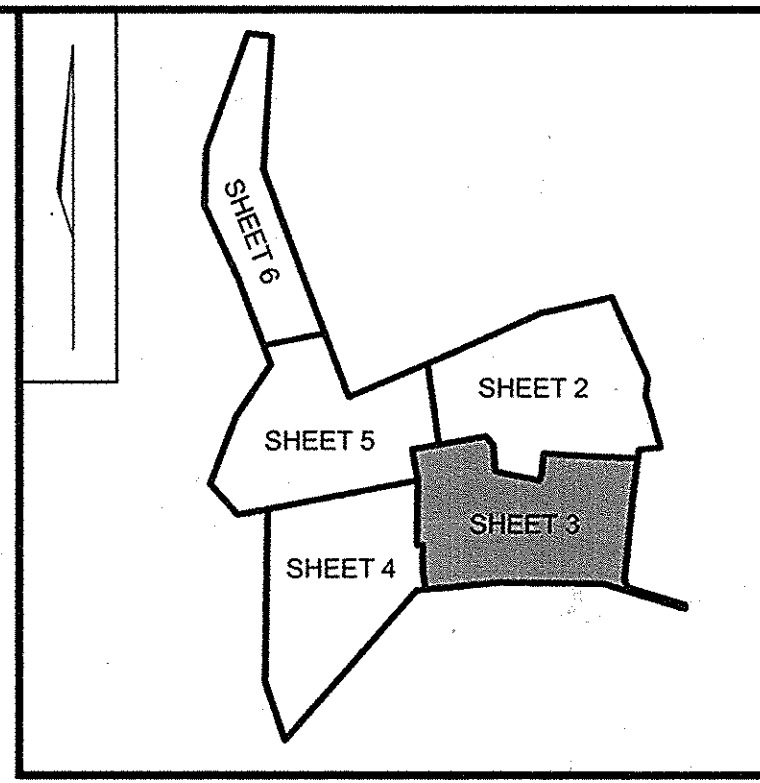

LEGEND	
	EXISTING 2 FT CONTOUR
	EXISTING 10 FT CONTOUR
	PROPOSED 2 FT CONTOUR
	PROPOSED 10 FT CONTOUR
	SUPER SILT FENCE
	LIMIT OF DISTURBANCE
	EXISTING TREELINE
	PROPOSED TREELINE
	EARTH DIKE
	PROPOSED STREET TREE
	FOREST CONSERVATION SIGN LOCATION
	PROPOSED TREE MAINTENANCE EASEMENT
	NO WOODY VEGETATION BUFFER
	PRIVATE SEPTIC EASEMENT
	PRIVATE WELL AREA
	DRAINAGE AND UTILITY EASEMENT
	AREA OF 15 TO 24.9 PERCENT SLOPES
	AREA OF 25 PERCENT OR GREATER SLOPES
	FOREST CONSERVATION EASEMENT (RETENTION)
	100 YEAR FLOODPLAIN
	WET LAND
	10' PUBLIC TREE MAINTENANCE EASEMENT

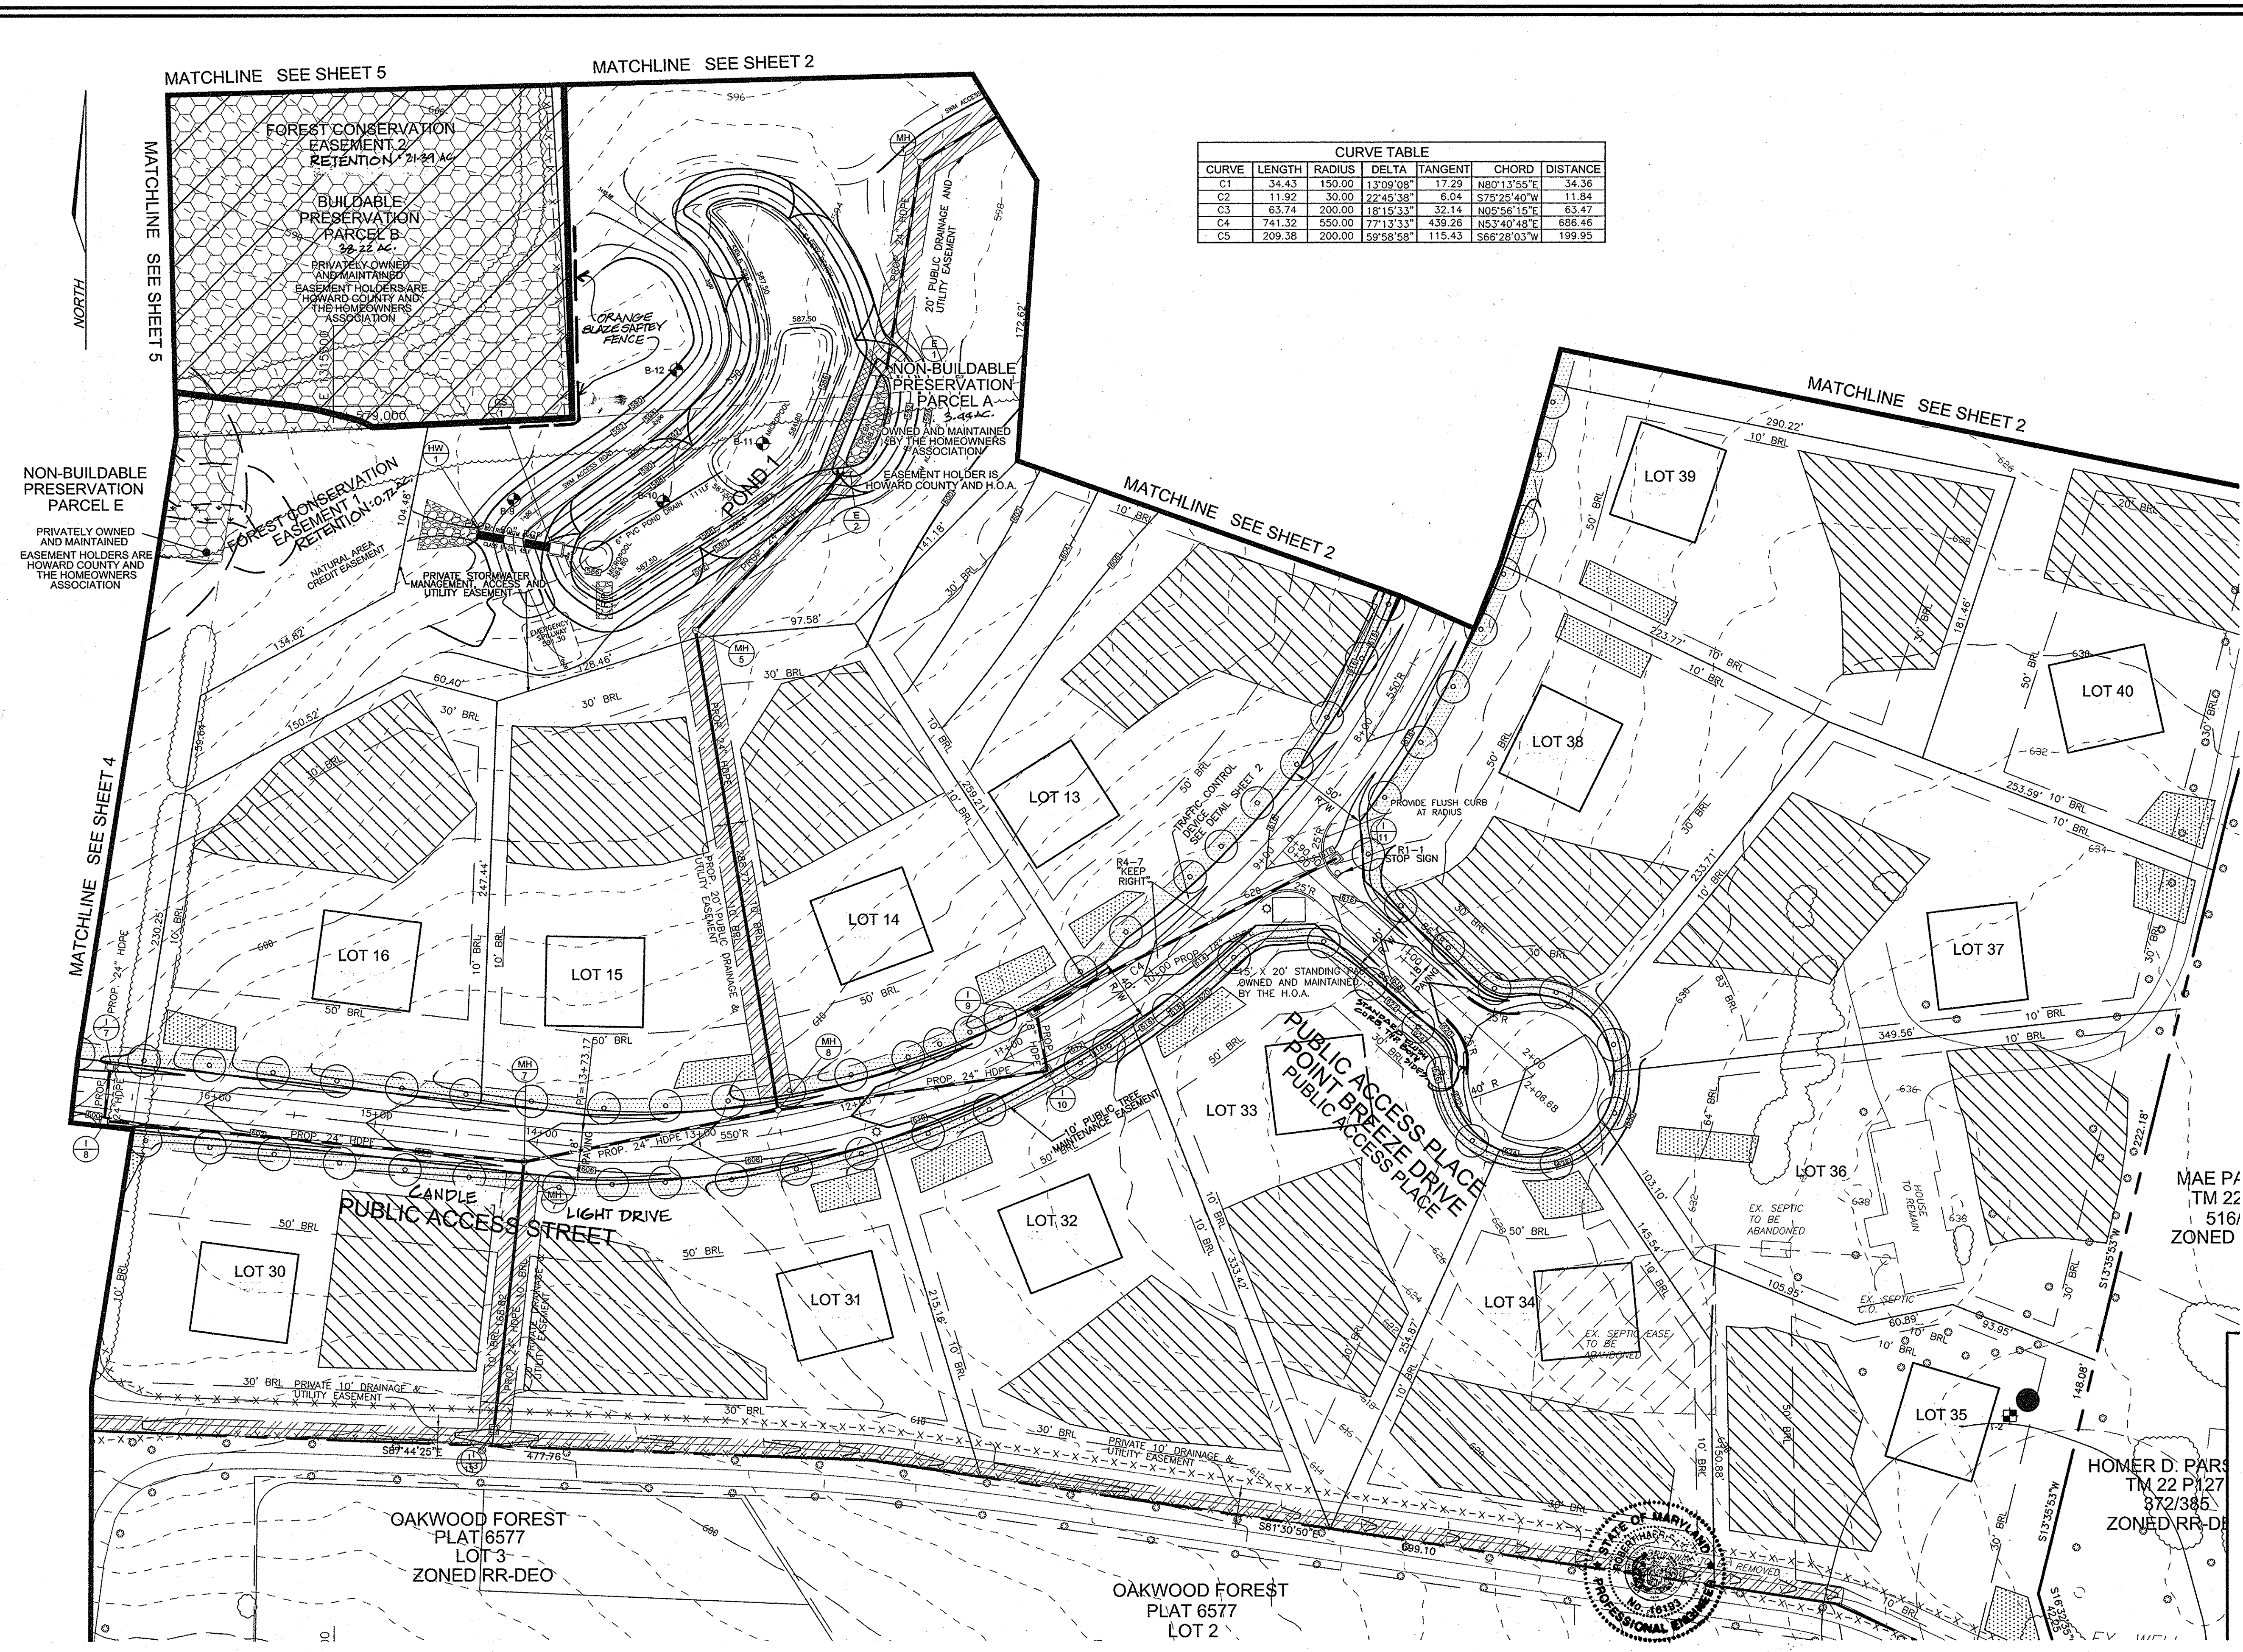

NO.	REVISION	DATE
2	ADD SAFETY FENCE BETWEEN POND 1 AND FCE	3-27-09

**SITE LAYOUT PLAN**  
**CASTLEBERRY AT TEN OAKS**  
 LOTS 1 - 45, NON-BUILDABLE PRESERVATION PARCELS A, C, D, E & BUILDABLE PRESERVATION PARCEL B

TAX MAP 22 GRID 20  
 5TH ELECTION DISTRICT

PARCEL 60, LOTS 6 & 7 KEN WARFIELD SUBDIVISION, AND P/O PARCEL 90 HOWARD COUNTY, MARYLAND

**ROBERT H. VOGEL ENGINEERING, INC.**  
 ENGINEERS • SURVEYORS • PLANNERS  
 8407 MAIN STREET ELLICOTT CITY, MD 21043 TEL: 410.461.7666 FAX: 410.461.8961

APPROVED: HOWARD COUNTY DEPARTMENT OF PUBLIC WORKS  
*William F. M... 1-10-07*  
 CHIEF, BUREAU OF HIGHWAYS

APPROVED: HOWARD COUNTY DEPARTMENT OF PLANNING AND ZONING  
*1/14/09*  
 CHIEF, DEVELOPMENT ENGINEERING DIVISION

*3/26/07*  
 CHIEF, DIVISION OF LAND DEVELOPMENT

REVIEWED FOR HOWARD SCD AND MEETS TECHNICAL REQUIREMENTS

USDA-NATURAL RESOURCES CONSERVATION SERVICE  
 DATE  
 THIS DEVELOPMENT PLAN IS APPROVED FOR SOIL EROSION AND SEDIMENT CONTROL BY THE HOWARD SOIL CONSERVATION DISTRICT

HOWARD SCD  
 DATE

**ENGINEER'S CERTIFICATE**  
 I HEREBY CERTIFY THAT THIS PLAN FOR POND CONSTRUCTION, EROSION AND SEDIMENT CONTROL REPRESENTS A PRACTICAL AND WORKABLE PLAN BASED ON MY PERSONAL KNOWLEDGE OF THE SITE CONDITIONS. THIS PLAN WAS PREPARED IN ACCORDANCE WITH THE REQUIREMENTS OF THE HOWARD SOIL CONSERVATION DISTRICT. I HAVE NOTIFIED THE DEVELOPER THAT HE/SHE MUST ENGAGE A REGISTERED PROFESSIONAL ENGINEER TO SUPERVISE POND CONSTRUCTION AND PROVIDE THE HOWARD SOIL CONSERVATION DISTRICT WITH AN "AS-BUILT" PLAN OF THE POND WITHIN 30 DAYS OF COMPLETION.

ROBERT H. VOGEL, PE #16193  
 1/2/09

**DEVELOPER'S CERTIFICATE**  
 I/WE CERTIFY THAT ALL DEVELOPMENT AND/OR CONSTRUCTION WILL BE DONE IN ACCORDANCE TO THESE PLANS, AND THAT ANY RESPONSIBLE PERSONNEL INVOLVED IN THE CONSTRUCTION PROJECT WILL HAVE A CERTIFICATE OF ATTENDANCE AT A DEPARTMENT OF THE ENVIRONMENT APPROVED TRAINING PROGRAM FOR THE CONTROL OF SEDIMENT AND EROSION BEFORE BEGINNING THE PROJECT. I SHALL ENGAGE A REGISTERED PROFESSIONAL ENGINEER TO SUPERVISE POND CONSTRUCTION AND PROVIDE THE HOWARD SOIL CONSERVATION DISTRICT WITH AN "AS-BUILT" PLAN OF THE POND WITHIN 30 DAYS OF COMPLETION.

*Michael P... 1/10/09*


**"AS-BUILT" CERTIFICATION**  
 I HEREBY CERTIFY THAT THE FACILITY SHOWN ON THIS PLAN WAS CONSTRUCTED AS SHOWN ON THE AS-BUILT PLANS AND MEETS THE APPROVED PLANS AND SPECIFICATIONS.

ROBERT H. VOGEL, PE #16193  
 1/17/14

**OWNER**  
 HELEN L. FYOCK  
 ROBERT E. FYOCK  
 GLENELG, MARYLAND

CASTLEBERRY AT TEN OAKS, L.L.C.  
 3675 PARK AVENUE, SUITE 301  
 ELLICOTT CITY, MARYLAND 21043  
 (410) 740-9401

**DEVELOPER**  
 CASTLEBERRY AT TEN OAKS, L.L.C.  
 3675 PARK AVENUE, SUITE 301  
 ELLICOTT CITY, MARYLAND 21043  
 (410) 740-9401

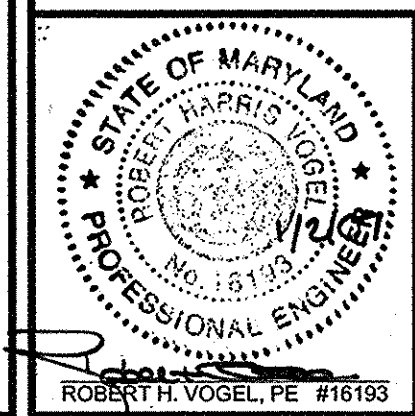

**DPZ REF:**  
 S-01-11, P-05-04

DESIGN BY: RHV/LJT  
 DRAWN BY: LJT  
 CHECKED BY: RHV  
 DATE: DECEMBER, 2006  
 SCALE: 1"=50'  
 W.O. NO.: 00-85.00


3 SHEET OF 23

**LEGEND**


- EXISTING 2 FT CONTOUR
- EXISTING 10 FT CONTOUR
- PROPOSED 2 FT CONTOUR
- PROPOSED 10 FT CONTOUR
- SSEF SUPER SILT FENCE
- LOD LIMIT OF DISTURBANCE
- EXISTING TREELINE
- PROPOSED TREELINE
- EARTH DIKE
- PROPOSED STREET TREE
- PROPOSED STREET LIGHT
- FOREST CONSERVATION SIGN LOCATION
- PROPOSED TREE MAINTENANCE EASEMENT
- NO WOODY VEGETATION BUFFER
- PRIVATE SEPTIC EASEMENT
- PRIVATE WELL AREA
- USE-IN-COMMON ACCESS EASEMENT
- AREA OF 15 TO 24.9 PERCENT SLOPES
- AREA OF 25 PERCENT OR GREATER SLOPES
- FOREST CONSERVATION EASEMENT (RETENTION)
- WET LAND
- 100 YEAR FLOODPLAIN
- DRAINAGE AND UTILITY EASEMENT
- 10' PUBLIC TREE MAINTENANCE EASEMENT

**CURVE TABLE**

CURVE	LENGTH	RADIUS	DELTA	TANGENT	CHORD	DISTANCE
C1	34.43	150.00	13°09'08"	17.29	N80°13'55"E	34.36
C2	11.92	30.00	22°45'38"	6.04	S75°25'40"W	11.84
C3	63.74	200.00	18°15'33"	32.14	N05°56'15"E	63.47
C4	741.32	550.00	77°13'33"	439.26	N53°40'48"E	686.46
C5	209.38	200.00	59°58'58"	115.43	S66°28'03"W	199.95

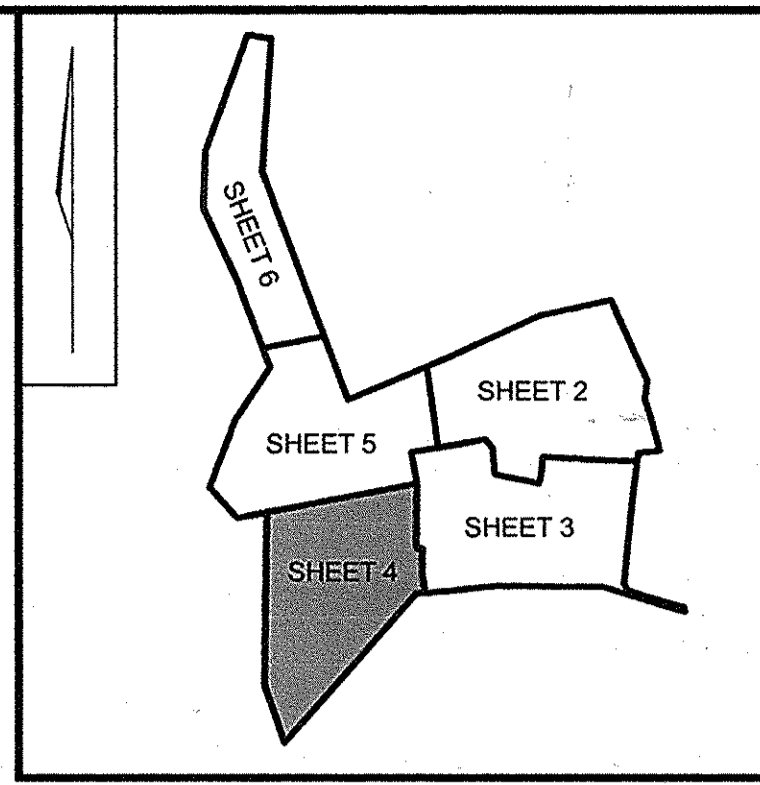

**KEY MAP**  
NOT TO SCALE

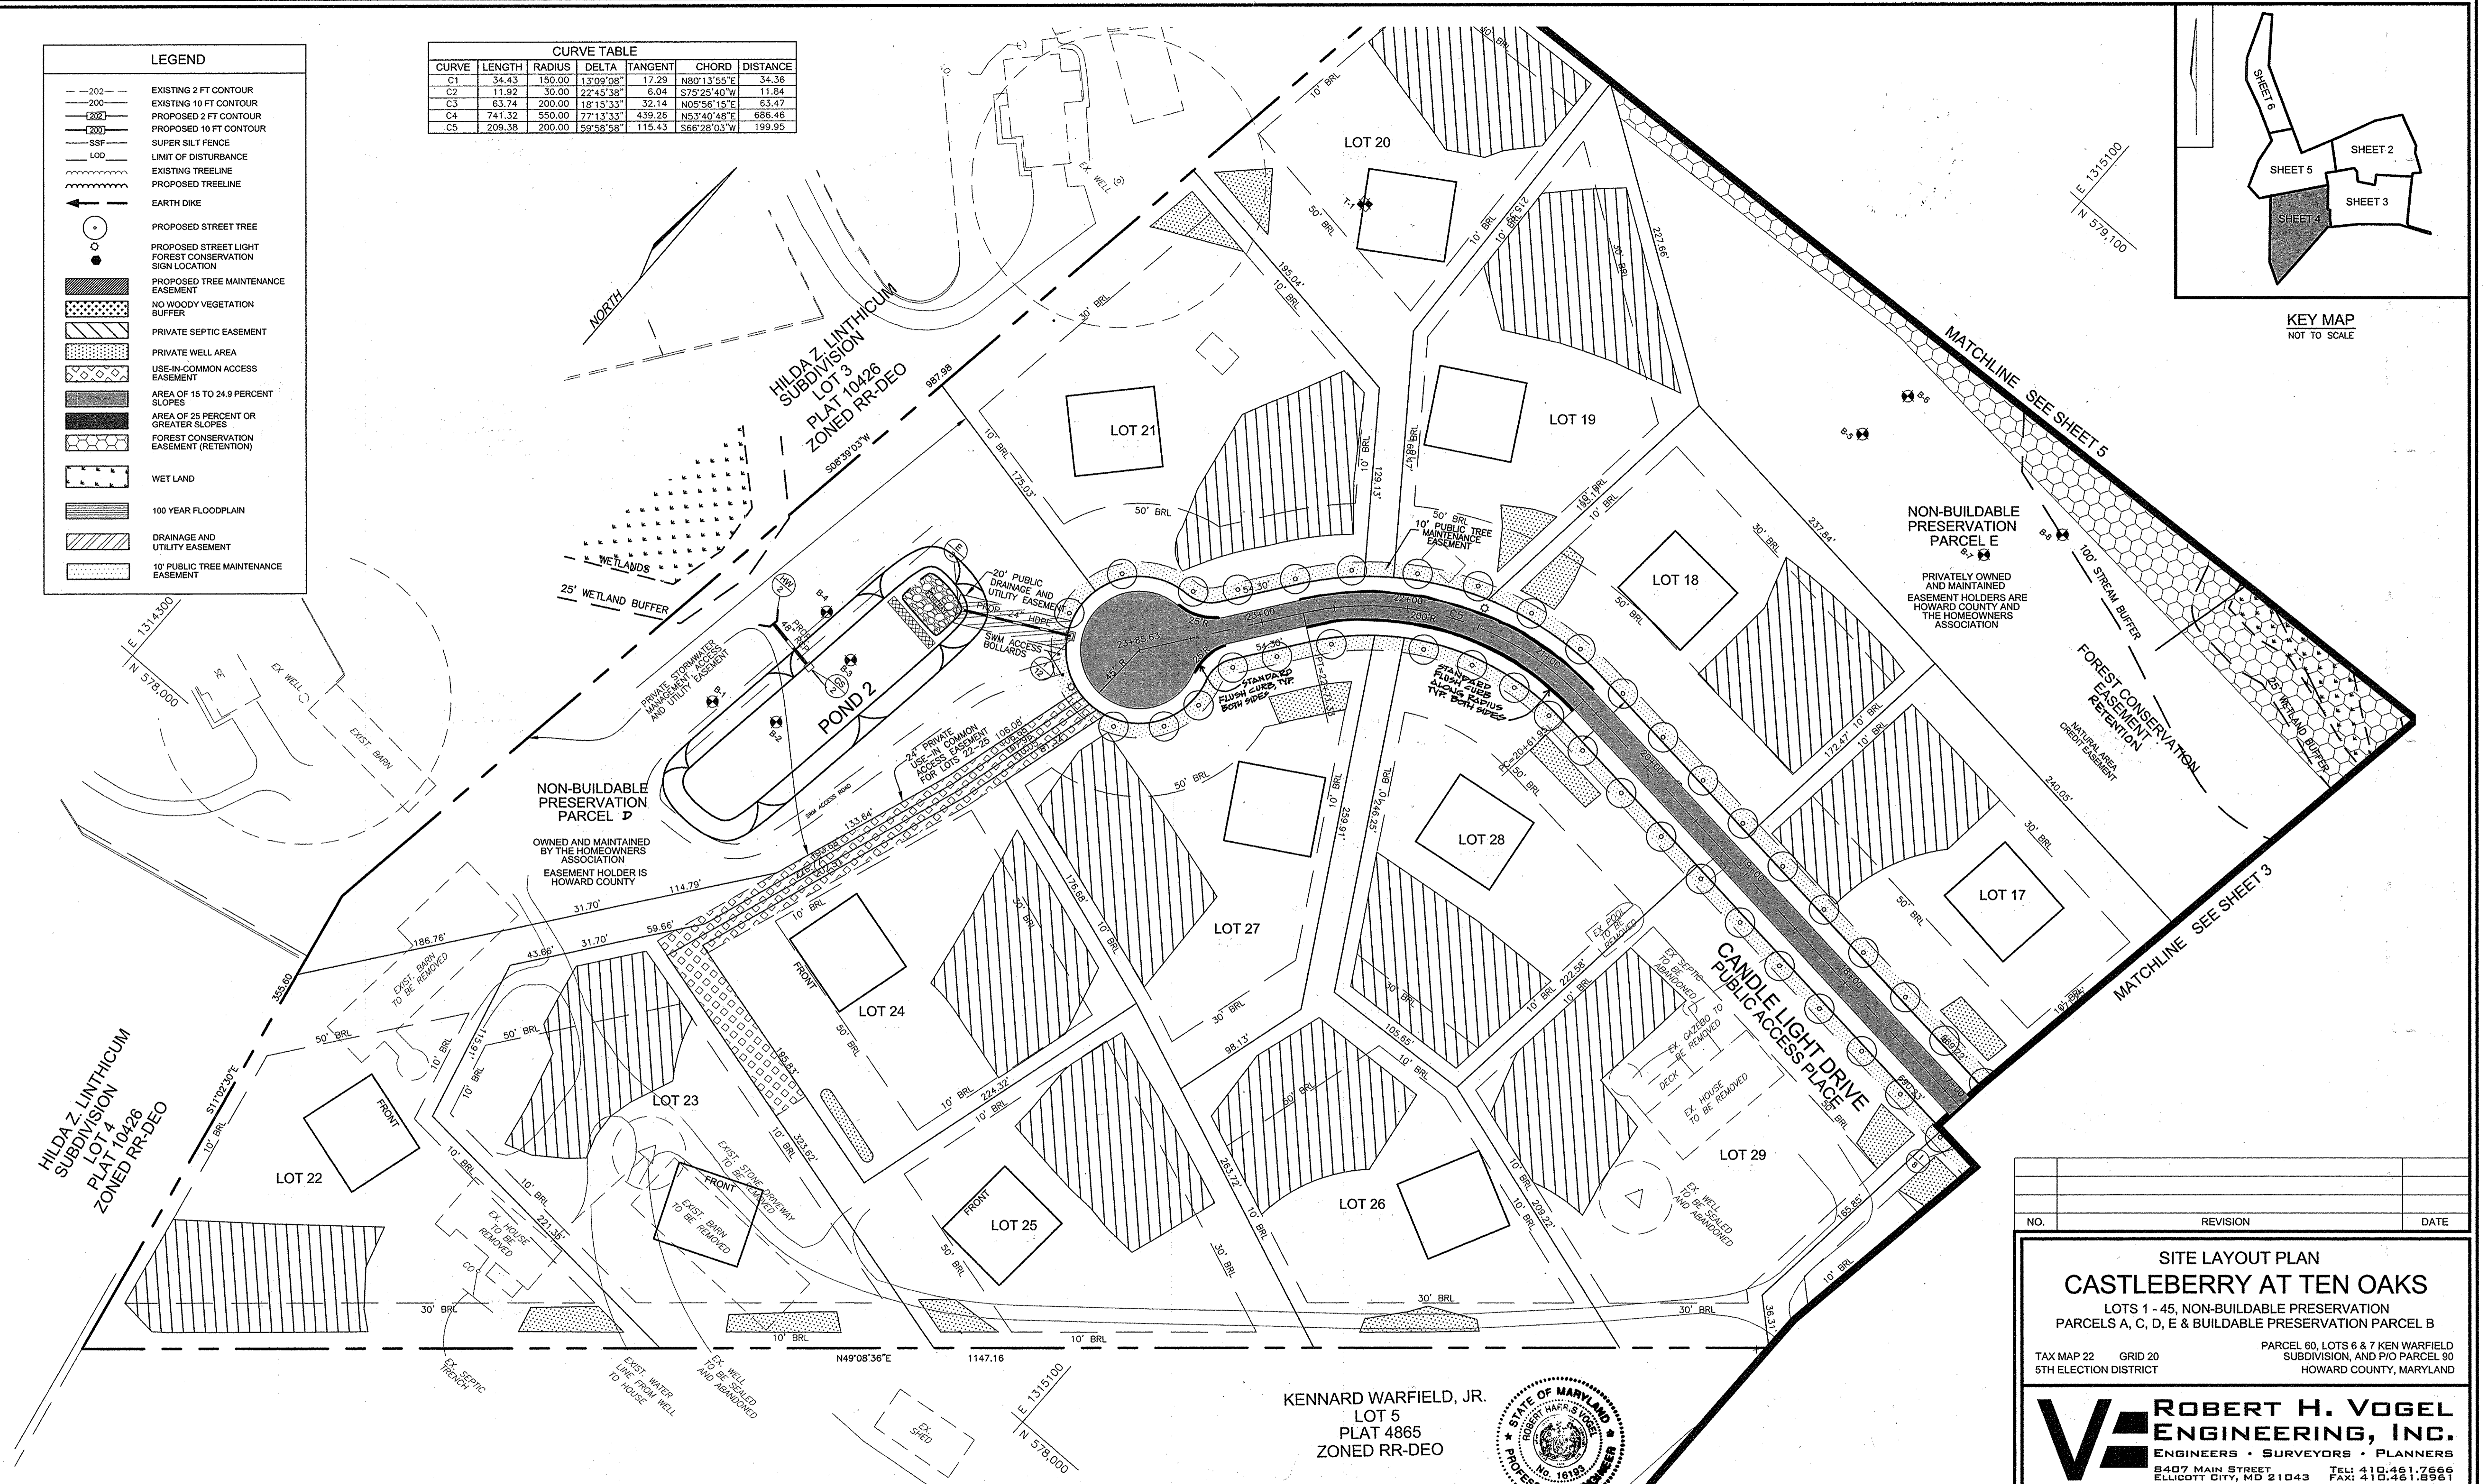

KENNARD WARFIELD, JR.  
LOT 5  
PLAT 4865  
ZONED RR-DEO



**OWNER**

HELEN L. FYOCK  
ROBERT E. FYOCK  
P.O. BOX 56  
GLENELG, MARYLAND

**DEVELOPER**


CASTLEBERRY AT TEN OAKS, L.L.C.  
3675 PARK AVENUE, SUITE 301  
ELLCOTT CITY, MARYLAND 21043  
(410) 740-9401

NO.	REVISION	DATE

**SITE LAYOUT PLAN**  
**CASTLEBERRY AT TEN OAKS**  
LOTS 1 - 45, NON-BUILDABLE PRESERVATION  
PARCELS A, C, D, E & BUILDABLE PRESERVATION PARCEL B

TAX MAP 22 GRID 20 PARCEL 60, LOTS 6 & 7 KEN WARFIELD SUBDIVISION, AND P/O PARCEL 90 5TH ELECTION DISTRICT HOWARD COUNTY, MARYLAND

**ROBERT H. VOGEL ENGINEERING, INC.**  
ENGINEERS • SURVEYORS • PLANNERS  
8407 MAIN STREET ELLCOTT CITY, MD 21043 TEL: 410.461.7666 FAX: 410.461.8961

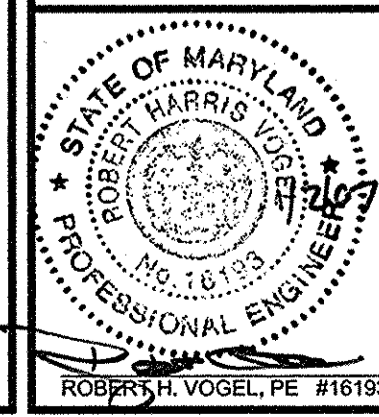

DESIGN BY: RHL/JT  
DRAWN BY: LJT  
CHECKED BY: RHV  
DATE: DECEMBER, 2006  
SCALE: 1"=50'  
W.O. NO.: 00-85.00

DPZ REF: S-01-11, P-05-04  
4 SHEET OF 23

APPROVED: HOWARD COUNTY DEPARTMENT OF PUBLIC WORKS  
1-10-07  
CHIEF, BUREAU OF HIGHWAYS

APPROVED: HOWARD COUNTY DEPARTMENT OF PLANNING AND ZONING  
1/24/07  
CHIEF, DEVELOPMENT ENGINEERING DIVISION

APPROVED: HOWARD COUNTY DEPARTMENT OF PLANNING AND ZONING  
7/3/07  
CHIEF, DIVISION OF LAND DEVELOPMENT

REVIEWED FOR HOWARD SCD AND MEETS TECHNICAL REQUIREMENTS

USDA-NATURAL RESOURCES CONSERVATION SERVICE DATE  
THIS DEVELOPMENT PLAN IS APPROVED FOR SOIL EROSION AND SEDIMENT CONTROL BY THE HOWARD SOIL CONSERVATION DISTRICT DATE  
HOWARD SCD DATE


MATCHLINE SEE SHEET 6



*R. Vogel* 11/17/14

E 1314500  
N 579,800

E 1315600  
N 579,800

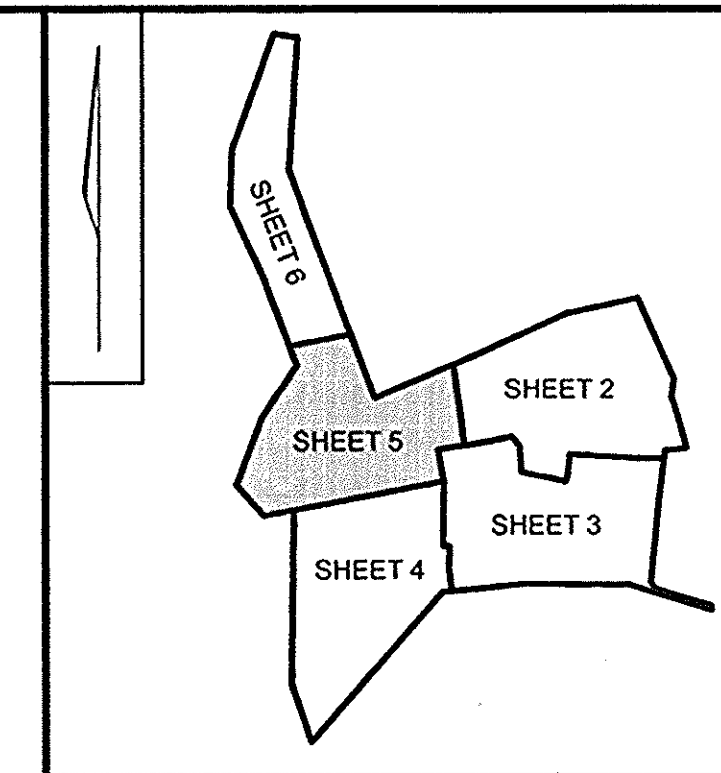

KEY MAP  
NOT TO SCALE

LEGEND

- 202--- EXISTING 2 FT CONTOUR
- 200--- EXISTING 10 FT CONTOUR
- [200]--- PROPOSED 2 FT CONTOUR
- [200]--- PROPOSED 10 FT CONTOUR
- SSF--- SUPER SILT FENCE
- 100--- LIMIT OF DISTURBANCE
- --- EXISTING TREELINE
- --- PROPOSED TREELINE
- ← EARTH DIKE
- PROPOSED STREET TREE
- FOREST CONSERVATION SIGN LOCATION
- PROPOSED TREE MAINTENANCE EASEMENT
- NO WOODY VEGETATION BUFFER
- PRIVATE SEPTIC EASEMENT
- PRIVATE WELL AREA
- DRAINAGE AND UTILITY EASEMENT
- AREA OF 15 TO 24.9 PERCENT SLOPES
- AREA OF 25 PERCENT OR GREATER SLOPES
- FOREST CONSERVATION EASEMENT (RETENTION)
- WET LAND
- 100 YEAR FLOODPLAIN

APPROVED: HOWARD COUNTY DEPARTMENT OF PUBLIC WORKS  
*William J. Marshall* 1-18-07  
 CHIEF, BUREAU OF HIGHWAYS *WJ* DATE

APPROVED: HOWARD COUNTY DEPARTMENT OF PLANNING AND ZONING  
*John J. Hall* 1/18/07  
 CHIEF, DEVELOPMENT ENGINEERING DIVISION DATE

*Conrad K. Hansen* 7/2/02  
 CHIEF, DIVISION OF LAND DEVELOPMENT *JA* DATE

REVIEWED FOR HOWARD SCD AND MEETS TECHNICAL REQUIREMENTS

USDA-NATURAL RESOURCES CONSERVATION SERVICE DATE  
 THIS DEVELOPMENT PLAN IS APPROVED FOR SOIL EROSION AND SEDIMENT CONTROL BY THE HOWARD SOIL CONSERVATION DISTRICT DATE  
 HOWARD SCD DATE

MATCHLINE SEE SHEET 2

BUILDABLE PRESERVATION PARCEL B  
38.22 AC.  
PRIVATELY OWNED AND MAINTAINED EASEMENT HOLDERS ARE HOWARD COUNTY AND THE HOMEOWNERS ASSOCIATION

FOREST CONSERVATION EASEMENT 3 RETENTION  
21.91 AC.  
NATURAL AREA CREDIT EASEMENT


FOREST CONSERVATION EASEMENT 1 RETENTION  
21.34 AC.  
NATURAL AREA CREDIT EASEMENT

NO.	REVISION	DATE

SITE LAYOUT PLAN  
CASTLEBERRY AT TEN OAKS  
LOTS 1 - 45, NON-BUILDABLE PRESERVATION PARCELS A, C, D, E & BUILDABLE PRESERVATION PARCEL B

TAX MAP 22 GRID 20 PARCEL 60, LOTS 6 & 7 KEN WARFIELD SUBDIVISION, AND PIO PARCEL 90  
5TH ELECTION DISTRICT HOWARD COUNTY, MARYLAND

**ROBERT H. VOGEL ENGINEERING, INC.**  
 ENGINEERS • SURVEYORS • PLANNERS  
 8407 MAIN STREET TEL: 410.461.7656  
 ELLICOTT CITY, MD 21043 FAX: 410.461.8961

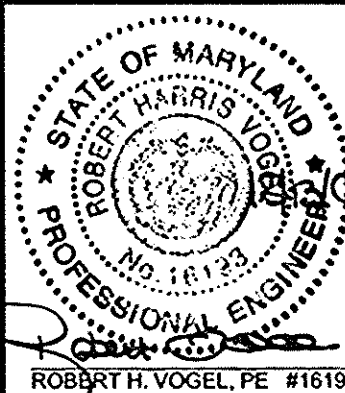

DESIGN BY: RRV/LJT  
DRAWN BY: LJT  
CHECKED BY: RHY  
DATE: DECEMBER, 2006  
SCALE: 1"=50'  
W.O. NO.: 00-85.00

DPZ REF: S-01-11, P-05-04

5 SHEET 23 OF

MATCHLINE SEE SHEET 3


E 1315600  
N 579,100

**OWNER**  
 HELEN L. FYOCK CASTLEBERRY AT TEN OAKS, L.L.C.  
 ROBERT E. FYOCK 3675 PARK AVENUE, SUITE 301  
 P.O. BOX 56 ELLICOTT CITY, MARYLAND 21043  
 GLENELG, MARYLAND (410) 740-9401



**DEVELOPER**  
 CASTLEBERRY AT TEN OAKS, L.L.C.  
 3675 PARK AVENUE, SUITE 301  
 ELLICOTT CITY, MARYLAND 21043  
 (410) 740-9401

MATCHLINE SEE SHEET 3

MATCHLINE SEE SHEET 4

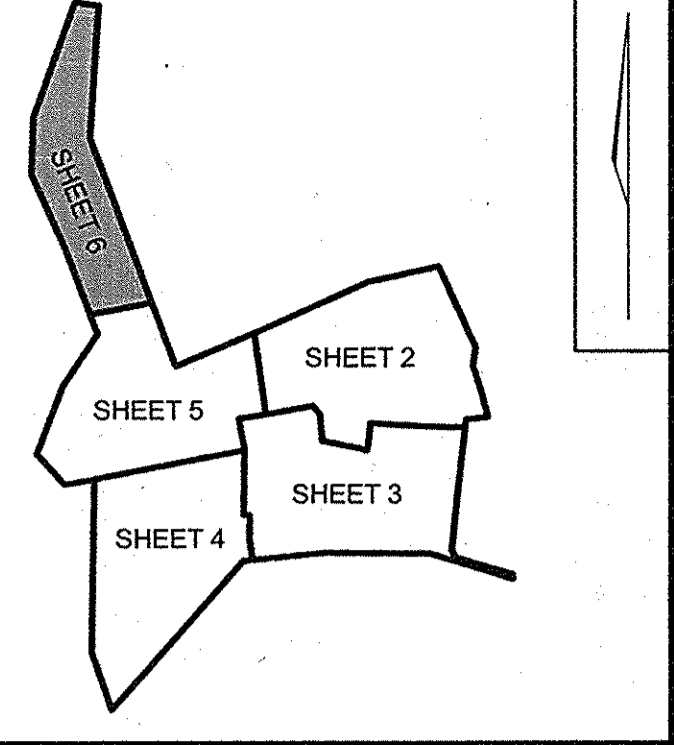

KEY MAP  
NOT TO SCALE

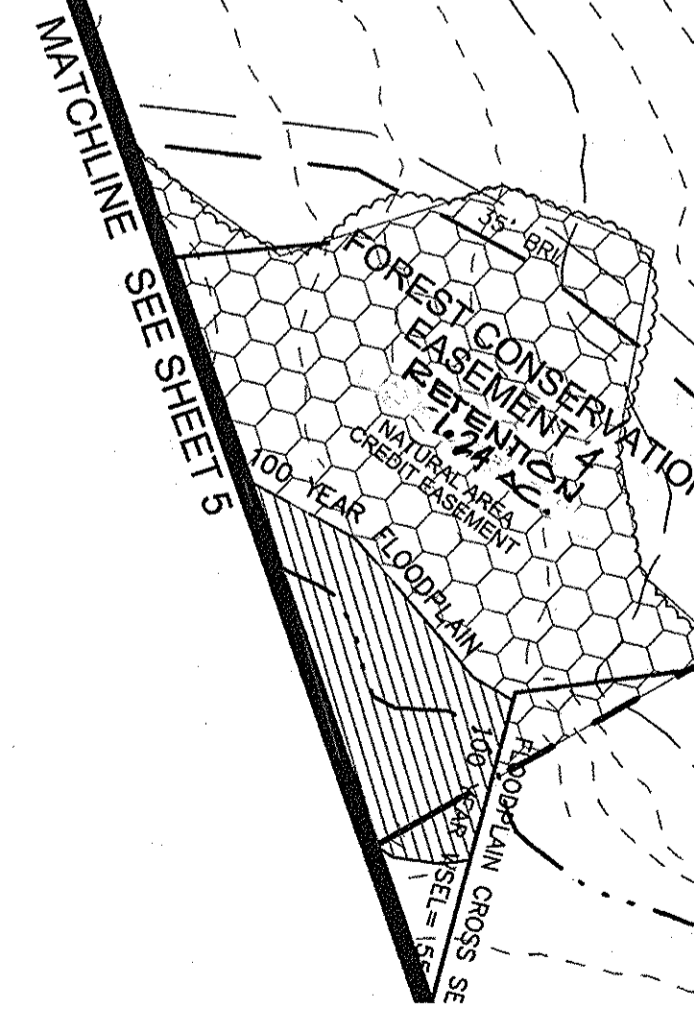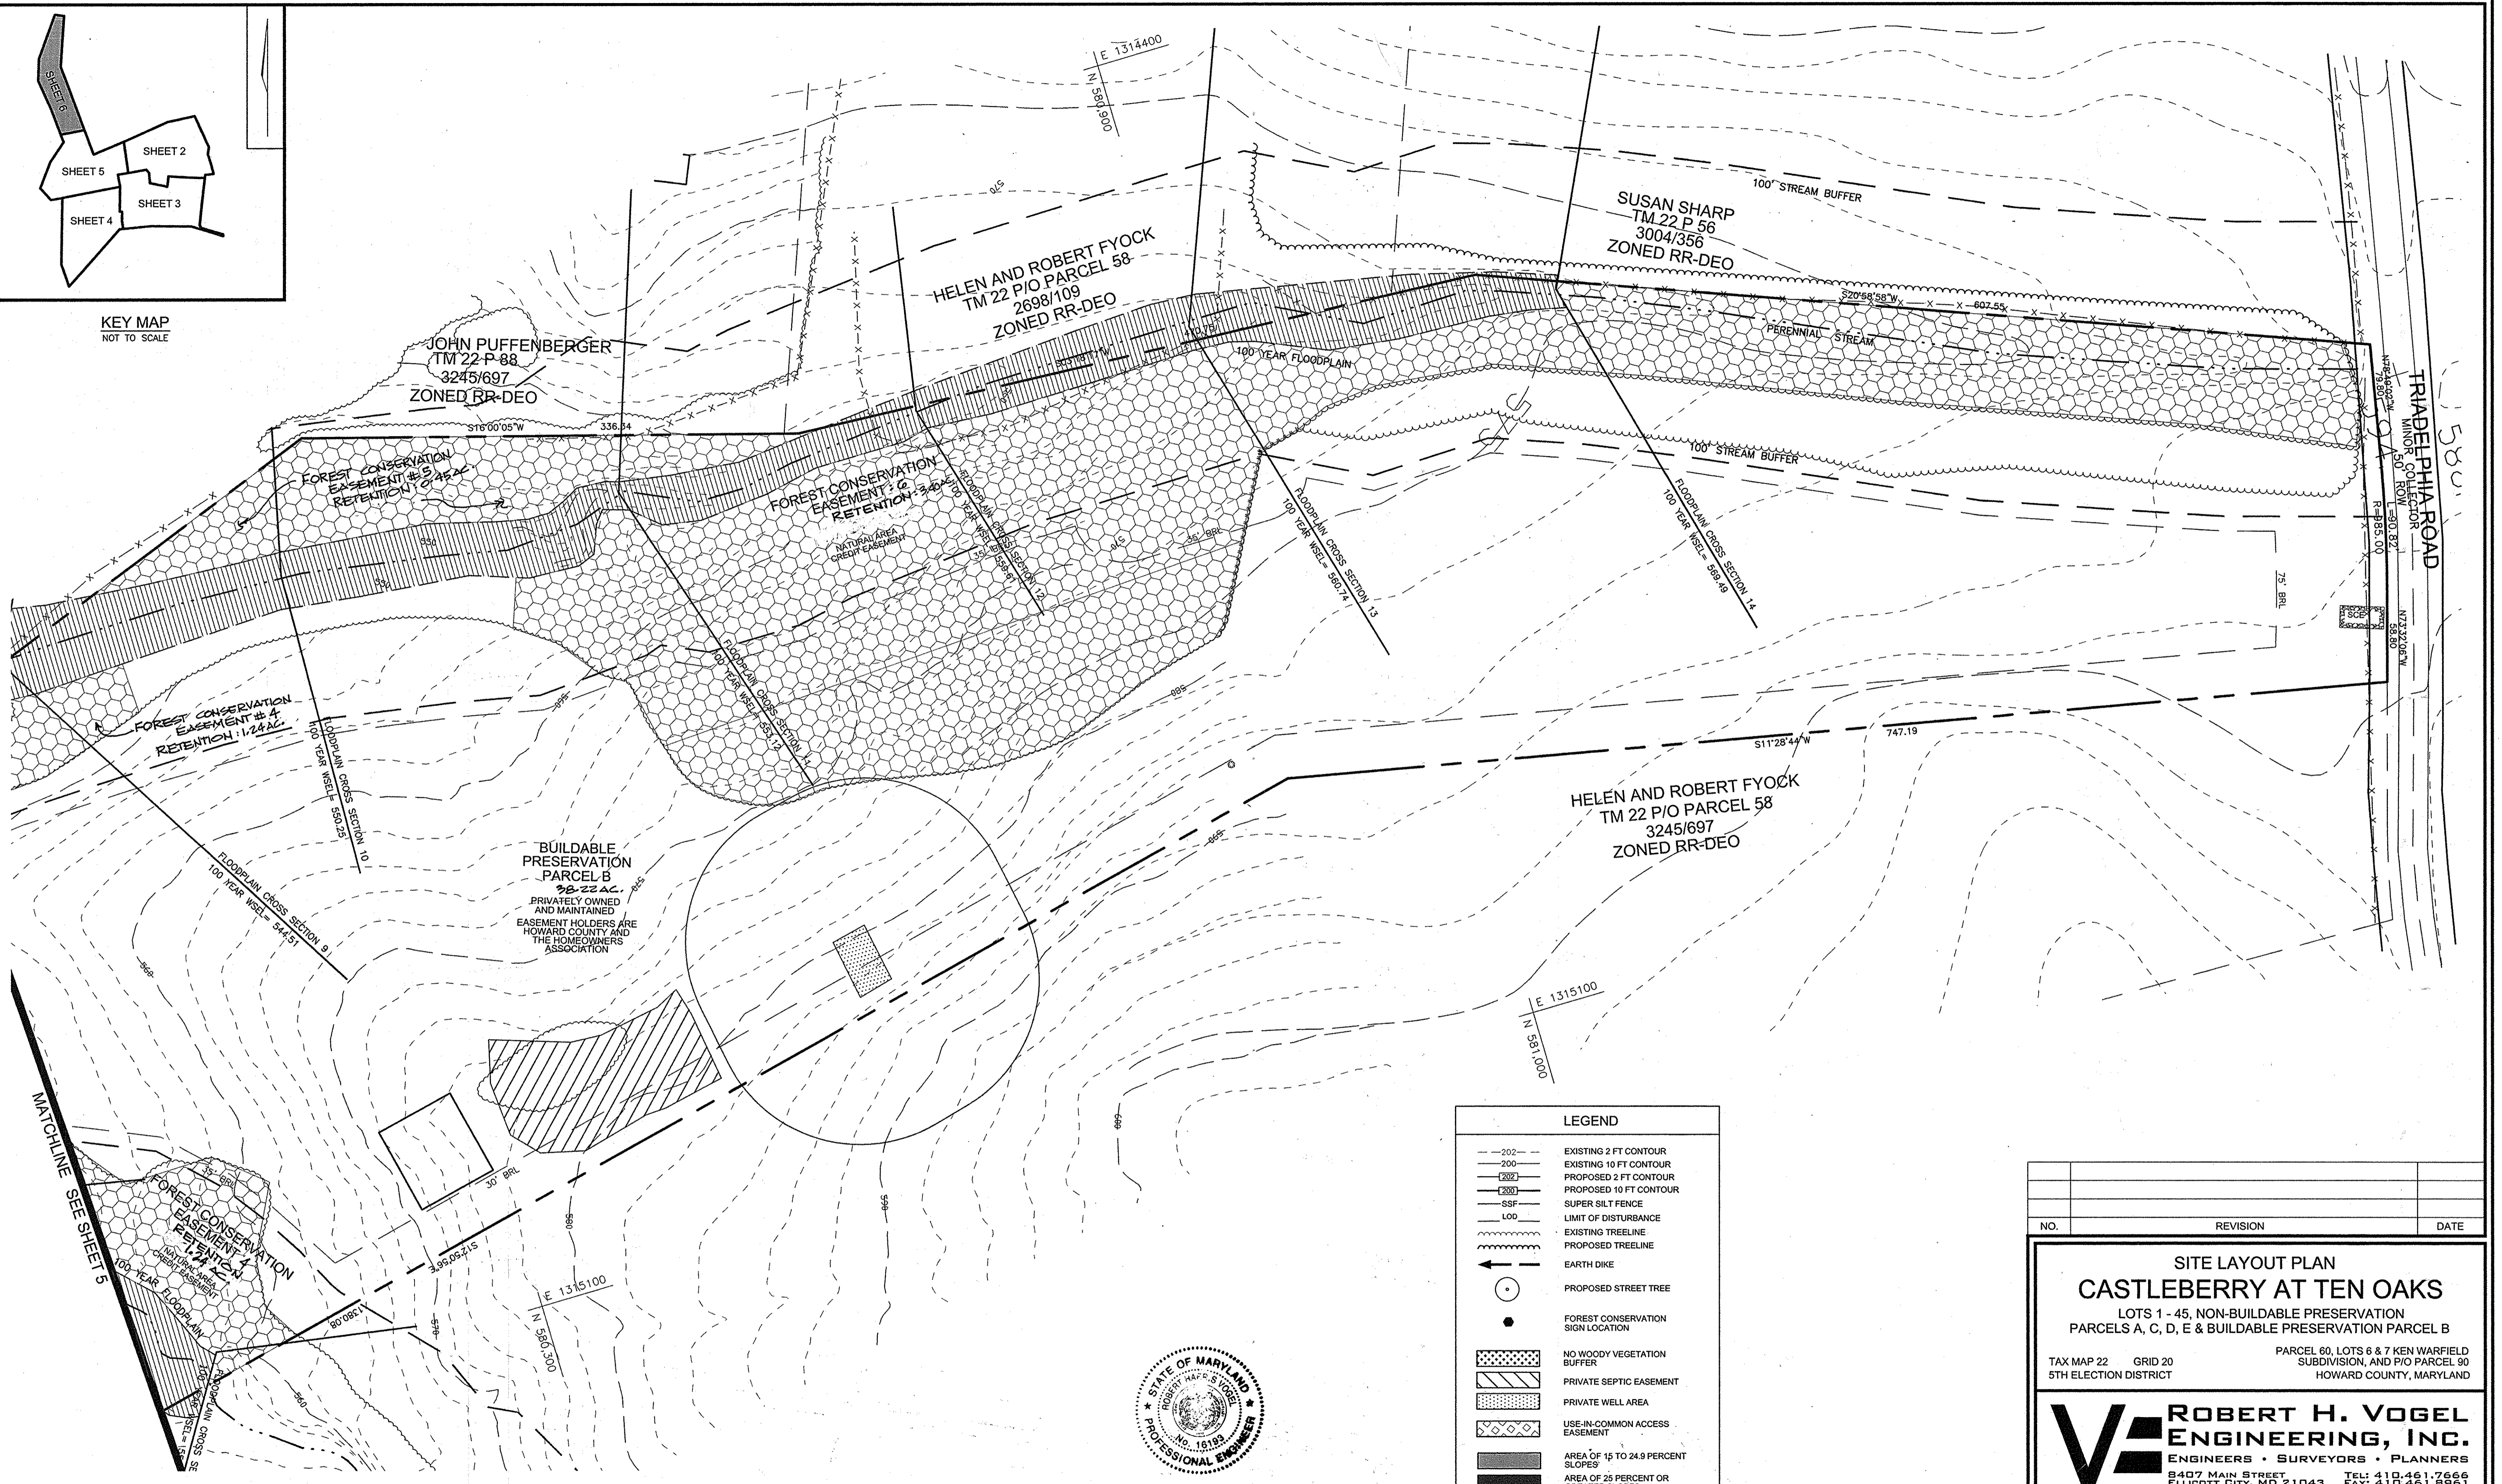

*Robert H. Vogel* 11/17/14

LEGEND	
	EXISTING 2 FT CONTOUR
	EXISTING 10 FT CONTOUR
	PROPOSED 2 FT CONTOUR
	PROPOSED 10 FT CONTOUR
	SUPER SILT FENCE
	SSF
	LDD
	LIMIT OF DISTURBANCE
	EXISTING TREELINE
	PROPOSED TREELINE
	EARTH DIKE
	PROPOSED STREET TREE
	FOREST CONSERVATION SIGN LOCATION
	NO WOODY VEGETATION BUFFER
	PRIVATE SEPTIC EASEMENT
	PRIVATE WELL AREA
	USE-IN-COMMON ACCESS EASEMENT
	AREA OF 15 TO 24.9 PERCENT SLOPES
	AREA OF 25 PERCENT OR GREATER SLOPES
	FOREST CONSERVATION EASEMENT (RETENTION)
	DRAINAGE AND UTILITY EASEMENT
	100 YEAR FLOODPLAIN

**OWNER**

HELEN L. FYOCK      CASTLEBERRY AT TEN OAKS, L.L.C.  
 ROBERT E. FYOCK    3675 PARK AVENUE, SUITE 301  
 P.O. BOX 56          ELLICOTT CITY, MARYLAND 21043  
 GLENELG, MARYLAND      (410) 740-9401

**DEVELOPER**

CASTLEBERRY AT TEN OAKS, L.L.C.  
 3675 PARK AVENUE, SUITE 301  
 ELLICOTT CITY, MARYLAND 21043  
 (410) 740-9401

NO.	REVISION	DATE

**SITE LAYOUT PLAN**  
**CASTLEBERRY AT TEN OAKS**  
 LOTS 1 - 45, NON-BUILDABLE PRESERVATION PARCELS A, C, D, E & BUILDABLE PRESERVATION PARCEL B



TAX MAP 22    GRID 20    PARCEL 60, LOTS 6 & 7 KEN WARFIELD SUBDIVISION, AND P/O PARCEL 90  
 5TH ELECTION DISTRICT    HOWARD COUNTY, MARYLAND

**ROBERT H. VOGEL, INC.**  
 ENGINEERS • SURVEYORS • PLANNERS  
 8407 MAIN STREET    TEL: 410.461.7666  
 ELLICOTT CITY, MD 21043    FAX: 410.461.8961

	DESIGN BY: RHL/JT	<b>DPZ REF:</b> S-01-11, P-05-04
	DRAWN BY: LJT	
	CHECKED BY: RHL	
	DATE: DECEMBER, 2006	
	SCALE: 1"=50'	
W.O. NO.: 00-85.00	6	23

AS-BUILT 11/17/14    F-06-130


APPROVED: HOWARD COUNTY DEPARTMENT OF PUBLIC WORKS <i>William R. Melnick</i> 1-10-07 CHIEF, BUREAU OF HIGHWAYS	REVIEWED FOR HOWARD SCD AND MEETS TECHNICAL REQUIREMENTS
APPROVED: HOWARD COUNTY DEPARTMENT OF PLANNING AND ZONING <i>Andy Homar</i> 3/2/07 CHIEF, DIVISION OF LAND DEVELOPMENT	USDA-NATURAL RESOURCES CONSERVATION-SERVICE    DATE THIS DEVELOPMENT PLAN IS APPROVED FOR SOIL EROSION AND SEDIMENT CONTROL BY THE HOWARD SOIL CONSERVATION DISTRICT    DATE HOWARD SCD    DATE

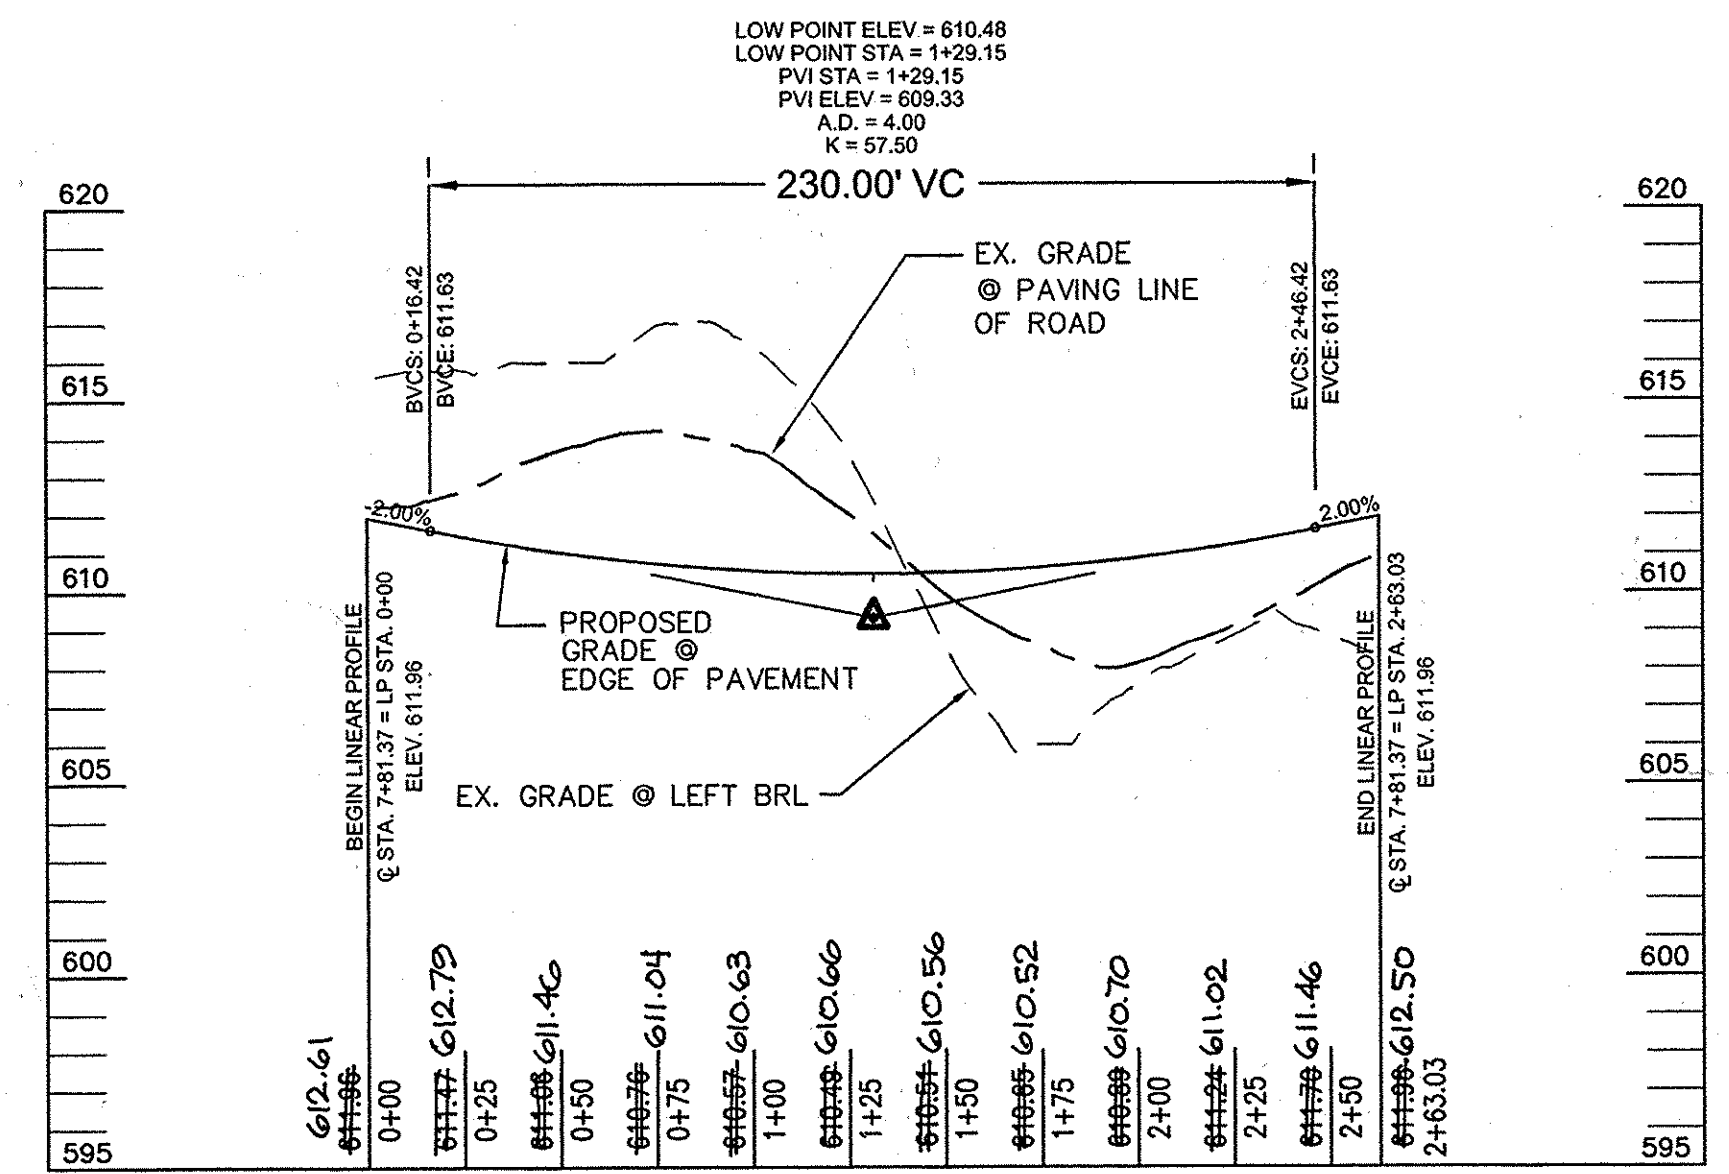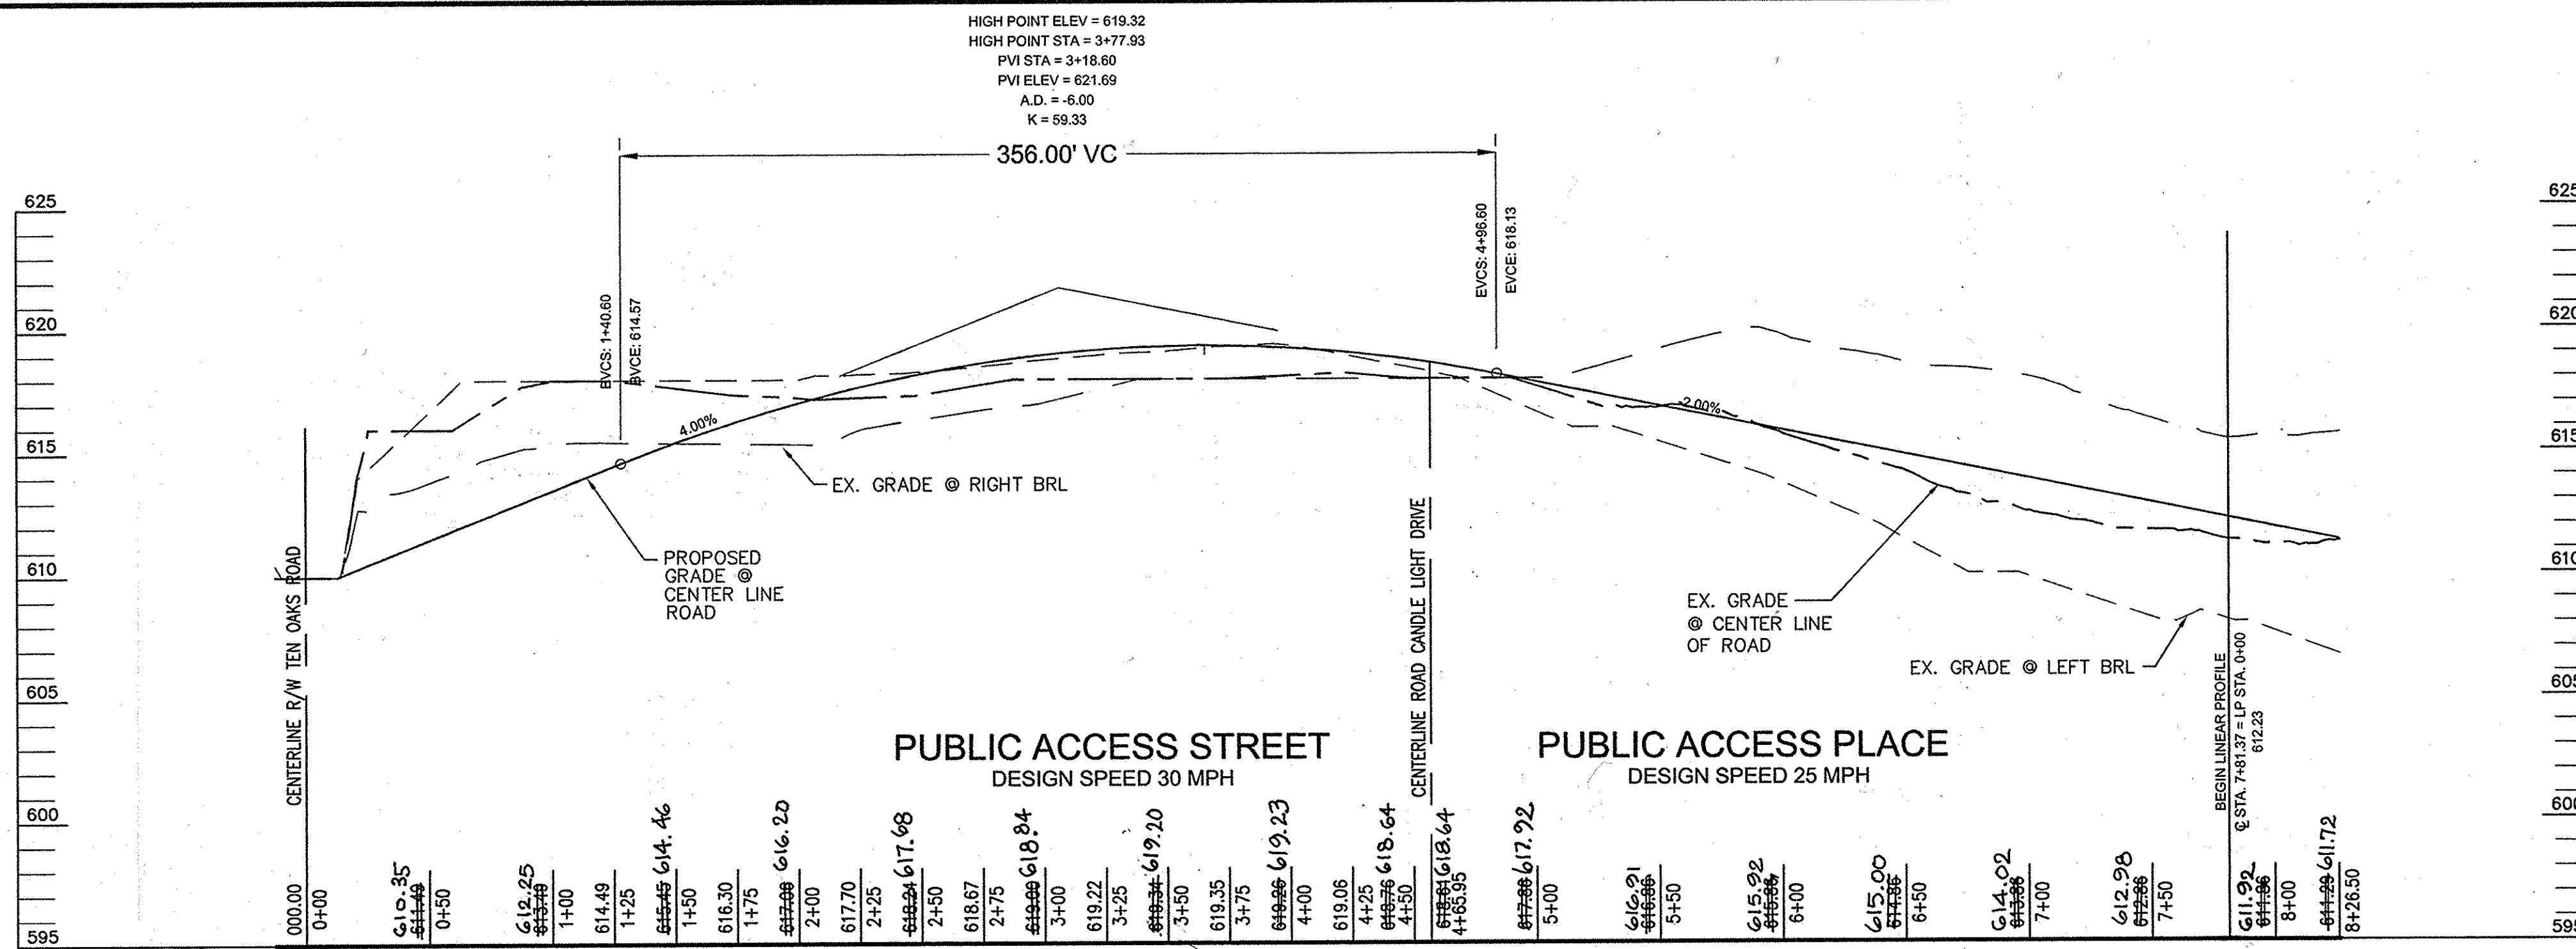

# LINEAR PROFILE- WYE RIVER DRIVE


## PUBLIC ACCESS PLACE

SCALE: HORZ: 1"=50'  
VERT: 1"=5'

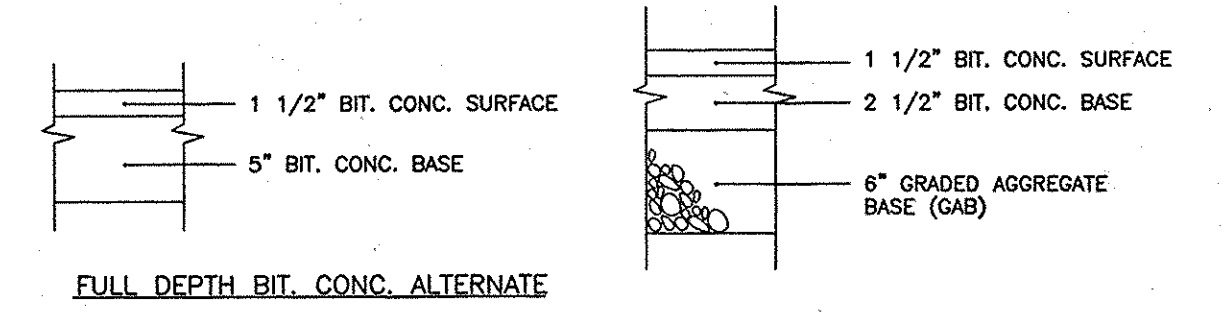


### P-2 LIGHT DUTY PAVING SECTION

N.T.S.

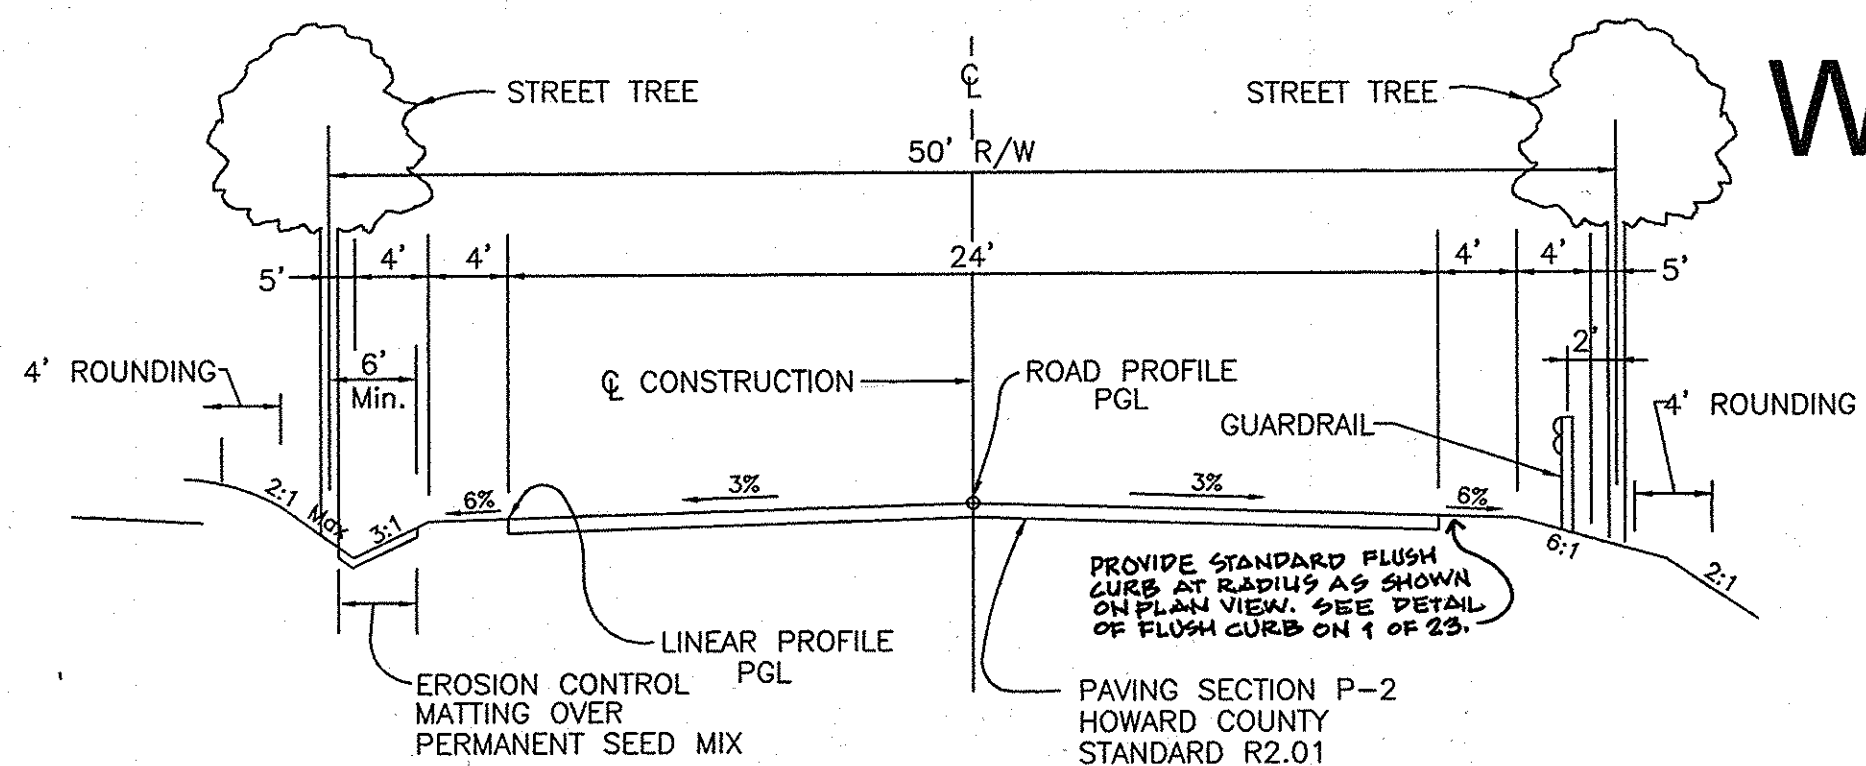


### TYPICAL ROADWAY SECTION CLASSIFICATION : PUBLIC ACCESS STREET

WYE RIVER DRIVE  
DESIGN SPEED 30 MPH  
CL STA. 0+00 TO CL STA. 4+69.65  
NOT TO SCALE

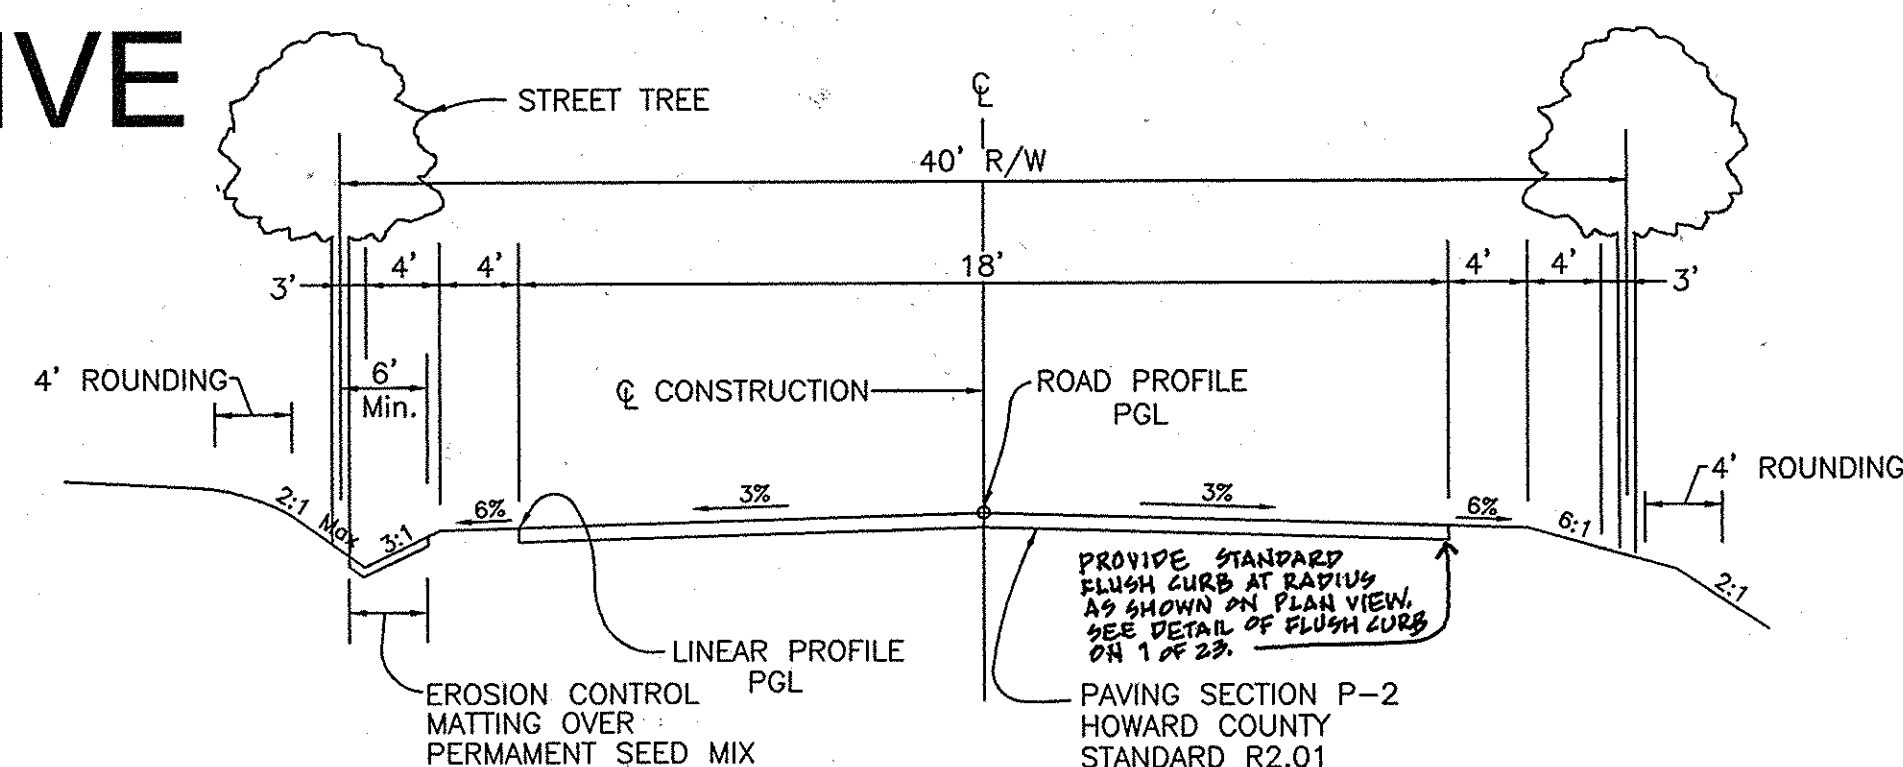


### TYPICAL ROADWAY SECTION CLASSIFICATION : PUBLIC ACCESS PLACE

WYE RIVER DRIVE  
DESIGN SPEED 25 MPH  
CL STA. 4+69.65 TO CL STA. 8+38.47  
NOT TO SCALE

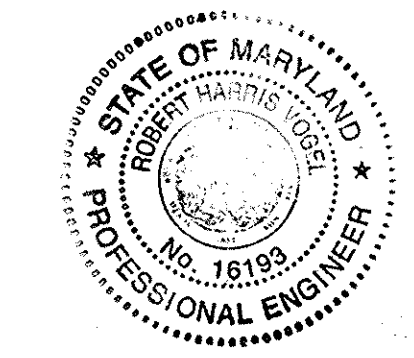

AS-BUILT CERTIFICATION  
I hereby certify that the facility shown on this plan was constructed as shown on the 'as-built' plans and meets the approved plans and specifications.

Signature: [Signature]  
PE No. 16193  
Date: 11/17/14

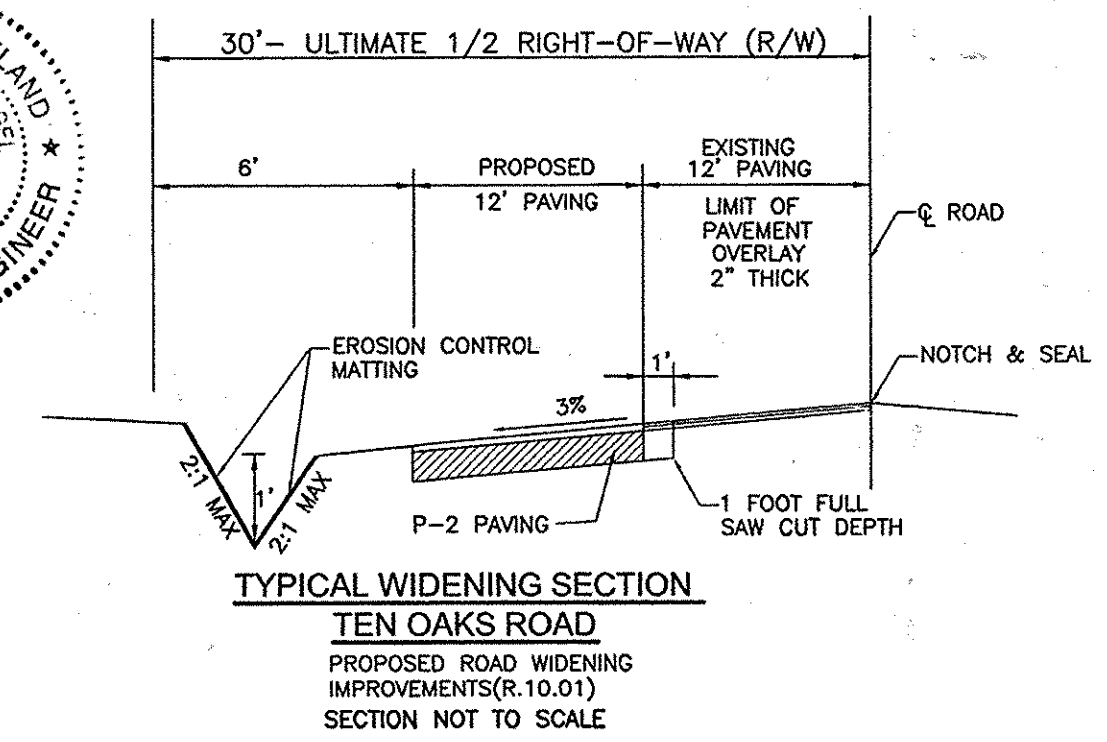

### TYPICAL WIDENING SECTION



TEN OAKS ROAD  
PROPOSED ROAD WIDENING IMPROVEMENTS (R.10.01)  
SECTION NOT TO SCALE

**TEMPORARY TRAFFIC CONTROL TYPICAL APPLICATION**

**KEY:**  
 ■ CHANNELIZING DEVICES  
 □ SIGN SUPPORT  
 ↑ DIRECTION OF TRAFFIC  
 ○ WORK SITE  
 ○ ○ ○ ARROW PANEL

**IMPORTANT:** THIS DRAWING SHALL BE USED IN CONJUNCTION WITH THE GENERAL NOTES NO 104.00-01 - NO 104.00-10 AND STANDARD DETAILS NO 104.01-01 - NO 104.01-22

**Maryland Department of Transportation  
STATE HIGHWAY ADMINISTRATION**  
STANDARDS FOR HIGHWAYS AND INCIDENTAL STRUCTURES  
**RIGHT LANE CLOSURE/MULTILANE UNDI.  
EQ/LESS THAN 40 MPH**  
STANDARD NO. MD 104.03-06

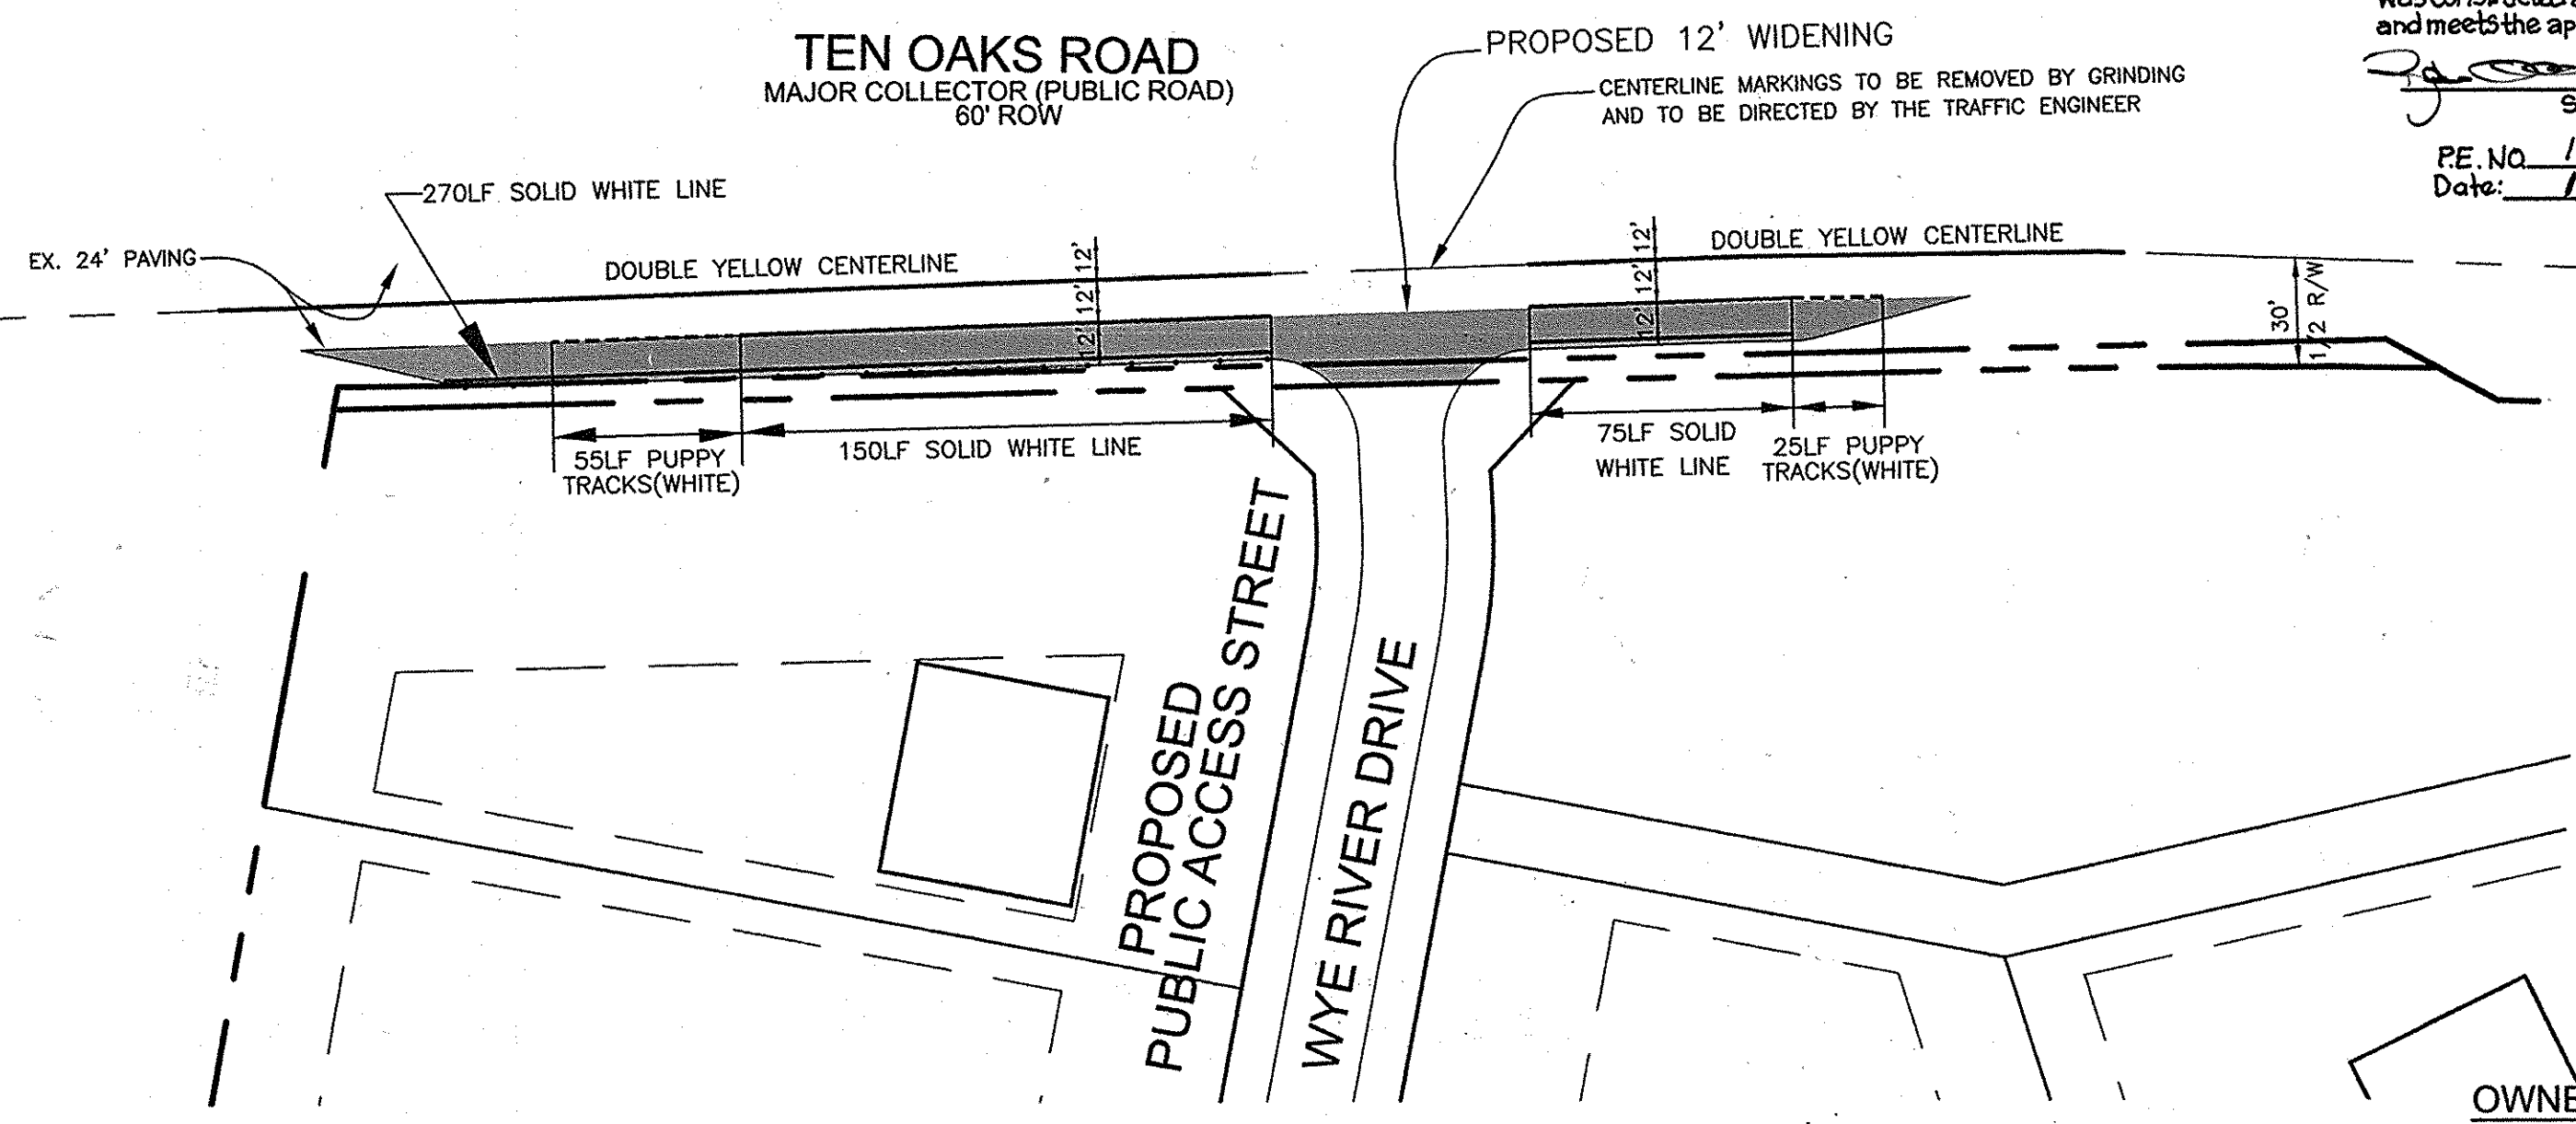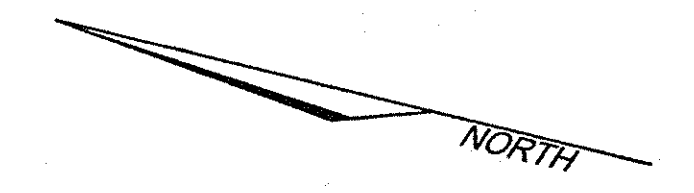

### STRIPING AND TRAFFIC MAINTENANCE PLAN

SCALE: 1"=50'

**OWNER**  
HELEN L. FYOCK  
ROBERT E. FYOCK  
P.O. BOX 56  
GLENELG, MARYLAND

CASTLEBERRY AT TEN OAKS, L.L.C.  
3675 PARK AVENUE, SUITE 301  
ELLCOTT CITY, MARYLAND 21043  
(410) 740-9401

**DEVELOPER**  
CASTLEBERRY AT TEN OAKS, L.L.C.  
3675 PARK AVENUE, SUITE 301  
ELLCOTT CITY, MARYLAND 21043  
(410) 740-9401

NO.	REVISION	DATE

**ROAD PROFILES  
CASTLEBERRY AT TEN OAKS**  
LOTS 1 - 45, NON-BUILDABLE PRESERVATION  
PARCELS A, C, D, E & BUILDABLE PRESERVATION PARCEL B

TAX MAP 22 GRID 20 PARCEL 60, LOTS 6 & 7 KEN WARFIELD SUBDIVISION, AND PVD PARCEL 90  
5TH ELECTION DISTRICT HOWARD COUNTY, MARYLAND

**ROBERT H. VOGEL  
ENGINEERING, INC.**  
ENGINEERS • SURVEYORS • PLANNERS  
8407 MAIN STREET  
ELLCOTT CITY, MD 21043  
TEL: 410.461.7666  
FAX: 410.461.8961

**STATE OF MARYLAND  
ROBERT H. VOGEL  
PROFESSIONAL ENGINEER**

DESIGN BY: RHV/LIT  
DRAWN BY: LIT  
CHECKED BY: RHV  
DATE: DECEMBER, 2006  
SCALE: AS NOTED  
W.O. NO.: 00-85.00

DPZ REF: S-01-11, P-05-04


7 OF 23 SHEETS

APPROVED: HOWARD COUNTY DEPARTMENT OF PUBLIC WORKS  
[Signature] 1-10-07  
CHIEF, BUREAU OF HIGHWAYS

REVIEWED FOR HOWARD SCD AND MEETS TECHNICAL REQUIREMENTS


APPROVED: HOWARD COUNTY DEPARTMENT OF PLANNING AND ZONING  
[Signature] 3/2/07  
CHIEF, DEVELOPMENT ENGINEERING DIVISION

USDA-NATURAL RESOURCES CONSERVATION SERVICE  
DATE: [Signature]  
THIS DEVELOPMENT PLAN IS APPROVED FOR SOIL EROSION AND SEDIMENT CONTROL BY THE HOWARD SOIL CONSERVATION DISTRICT  
HOWARD SCD DATE: [Signature]

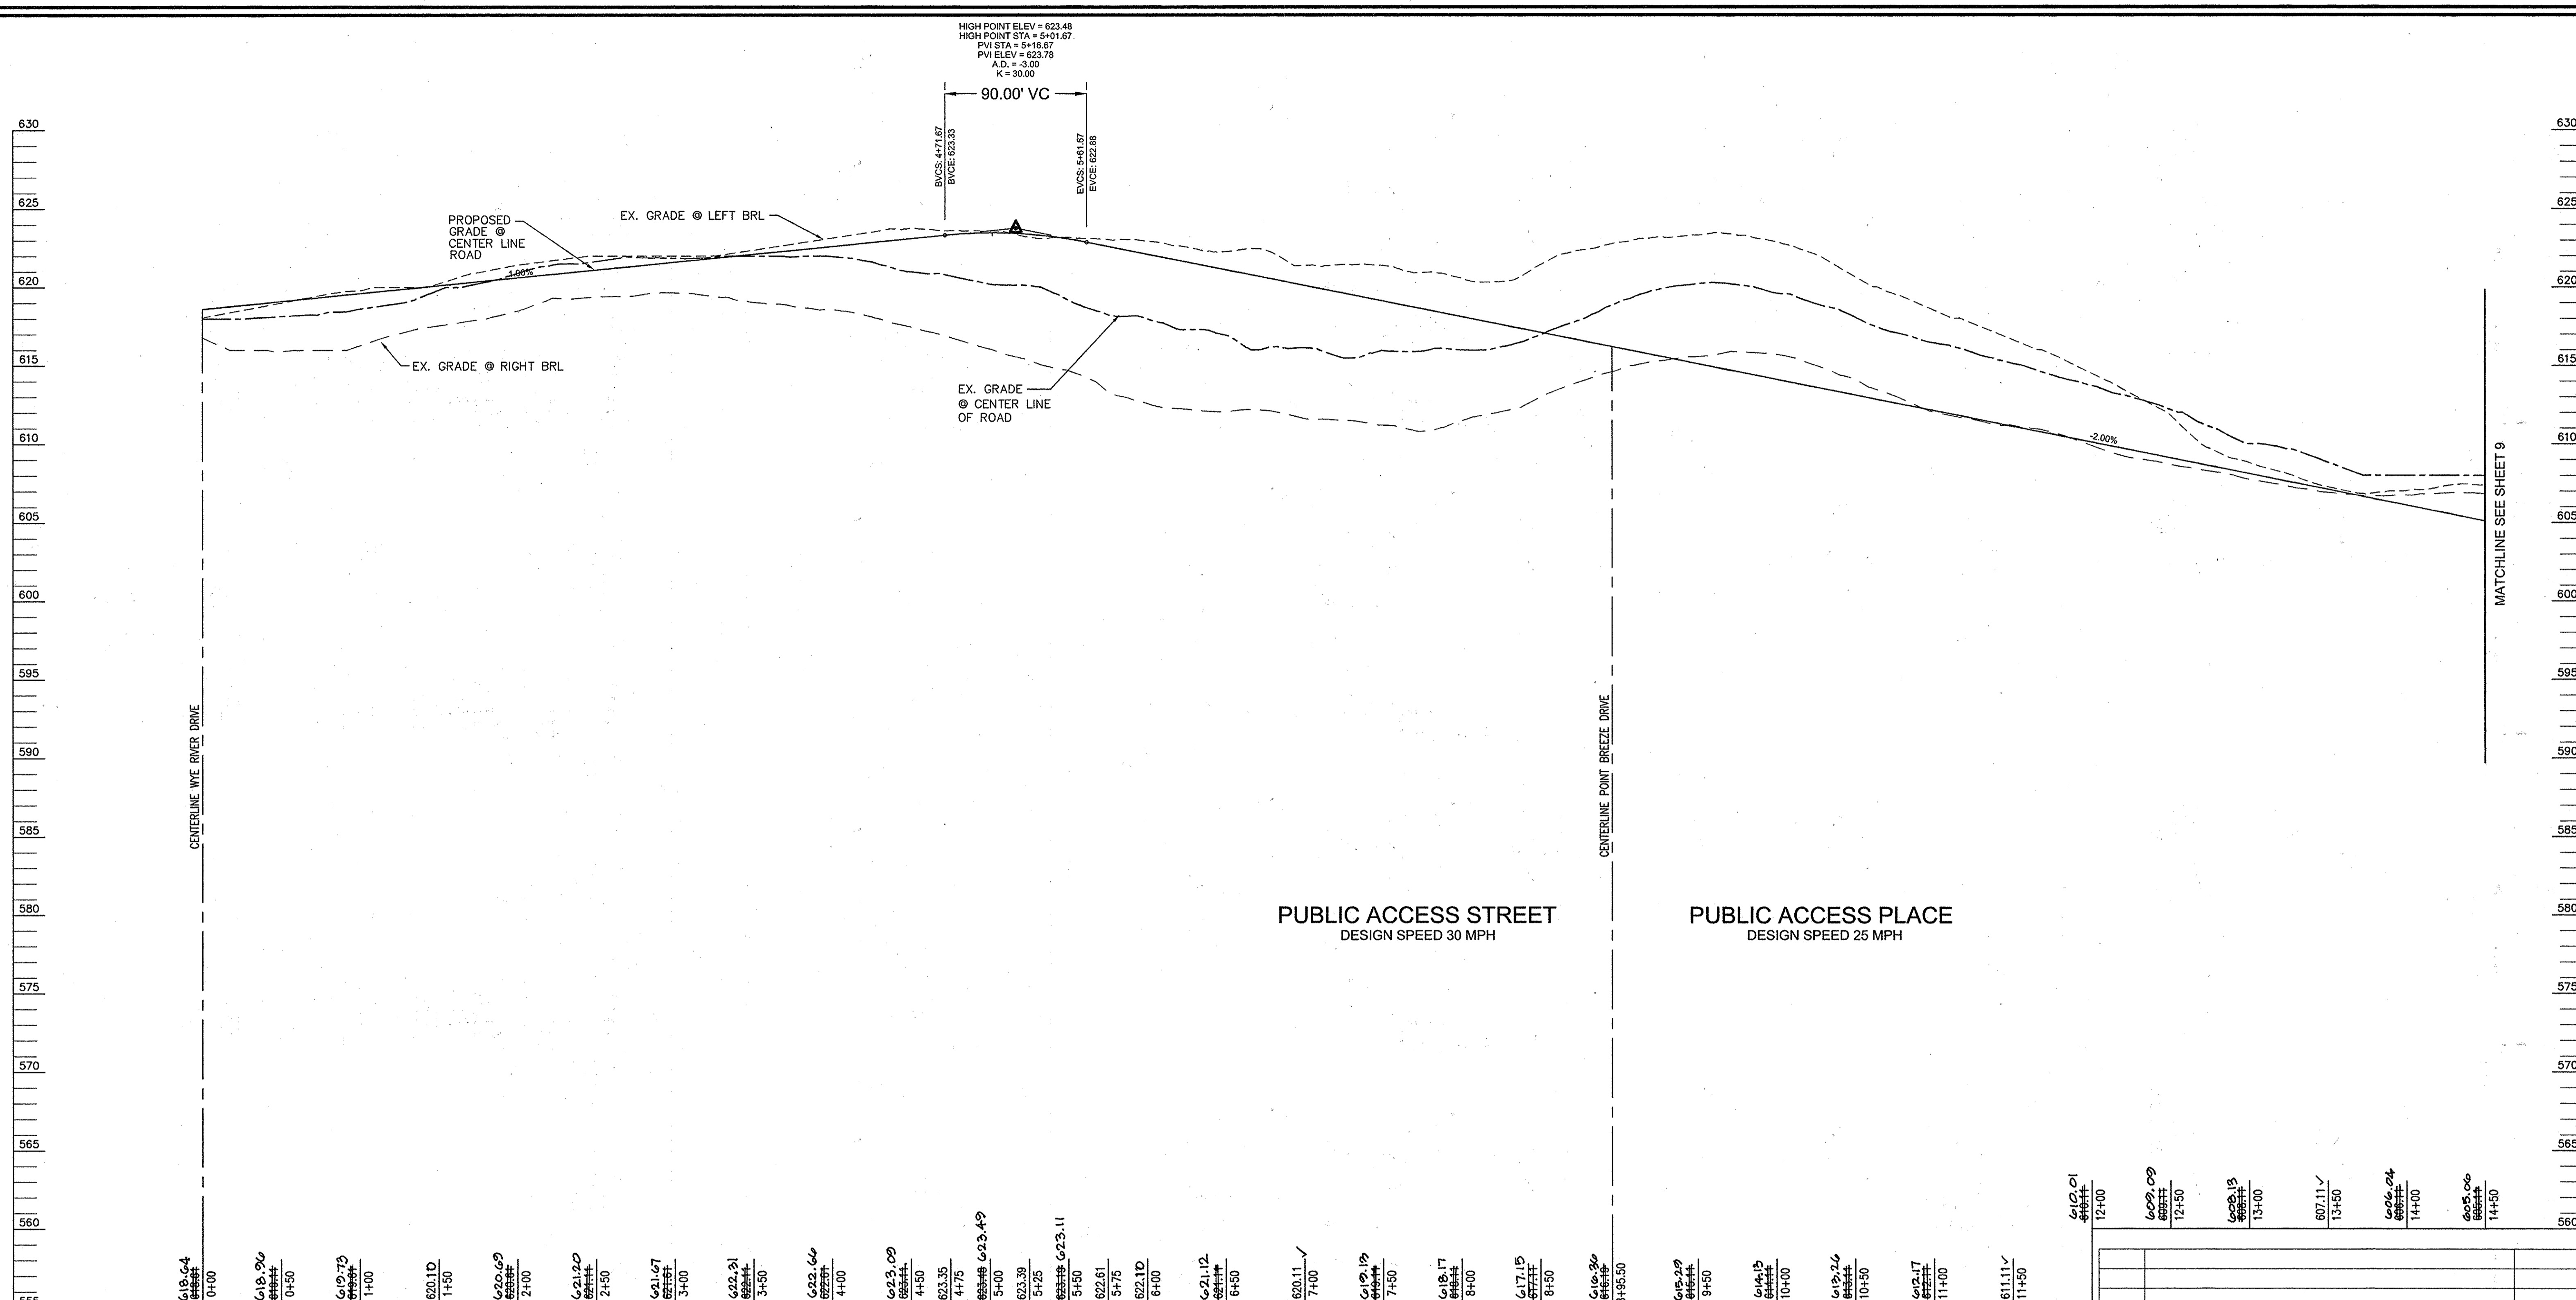

# CANDLE LIGHT DRIVE

SCALE: HORZ: 1"=50'  
VERT: 1"=5'

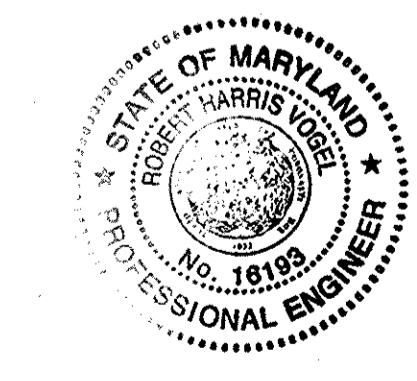

**AS-BUILT CERTIFICATION**  
I hereby certify that the facility shown on this plan was constructed as shown on the "as-built" plans and meets the approved plans and specifications.

Signature: \_\_\_\_\_  
PE. NO. 16193  
Date: 11/17/14

**OWNER**  
HELEN L. FYOCK CASTLEBERRY AT TEN OAKS, L.L.C.  
ROBERT E. FYOCK 3675 PARK AVENUE, SUITE 301  
P.O. BOX 58 ELLICOTT CITY, MARYLAND 21043  
GLENELG, MARYLAND (410) 740-9401

**DEVELOPER**  
CASTLEBERRY AT TEN OAKS, L.L.C.  
3675 PARK AVENUE, SUITE 301  
ELLICOTT CITY, MARYLAND 21043  
(410) 740-9401

NO.	REVISION	DATE

**ROAD PROFILES**  
**CASTLEBERRY AT TEN OAKS**  
LOTS 1-45, NON-BUILDABLE PRESERVATION  
PARCELS A, C, D, E & BUILDABLE PRESERVATION PARCEL B

PARCEL 60, LOTS 6 & 7 KEN WARFIELD  
SUBDIVISION, AND P/O PARCEL 90  
HOWARD COUNTY, MARYLAND

TAX MAP 22 GRID 20  
5TH ELECTION DISTRICT

**ROBERT H. VOGEL**  
**ENGINEERS • SURVEYORS • PLANNERS**

8407 MAIN STREET TEL: 410.461.7666  
ELLICOTT CITY, MD 21043 FAX: 410.461.8961






**DPZ REF:**  
S-01-11, P-05-04

DESIGN BY: RHL/JLT  
DRAWN BY: LIT  
CHECKED BY: RHV  
DATE: DECEMBER, 2008  
SCALE: AS NOTED  
W.O. NO.: 00-85.00

8 SHEET OF 23


APPROVED: HOWARD COUNTY DEPARTMENT OF PUBLIC WORKS <i>William Z. ...</i> 1-10-07 CHIEF, BUREAU OF HIGHWAYS	REVIEWED FOR HOWARD SCD AND MEETS TECHNICAL REQUIREMENTS
APPROVED: HOWARD COUNTY DEPARTMENT OF PLANNING AND ZONING <i>...</i> 1/10/07 CHIEF, DEVELOPMENT ENGINEERING DIVISION	USDA-NATURAL RESOURCES CONSERVATION SERVICE DATE: _____ THIS DEVELOPMENT PLAN IS APPROVED FOR SOIL EROSION AND SEDIMENT CONTROL BY THE HOWARD SOIL CONSERVATION DISTRICT
CHIEF, DIVISION OF LAND DEVELOPMENT <i>...</i> 3/2/10 DATE	HOWARD SCD DATE: _____



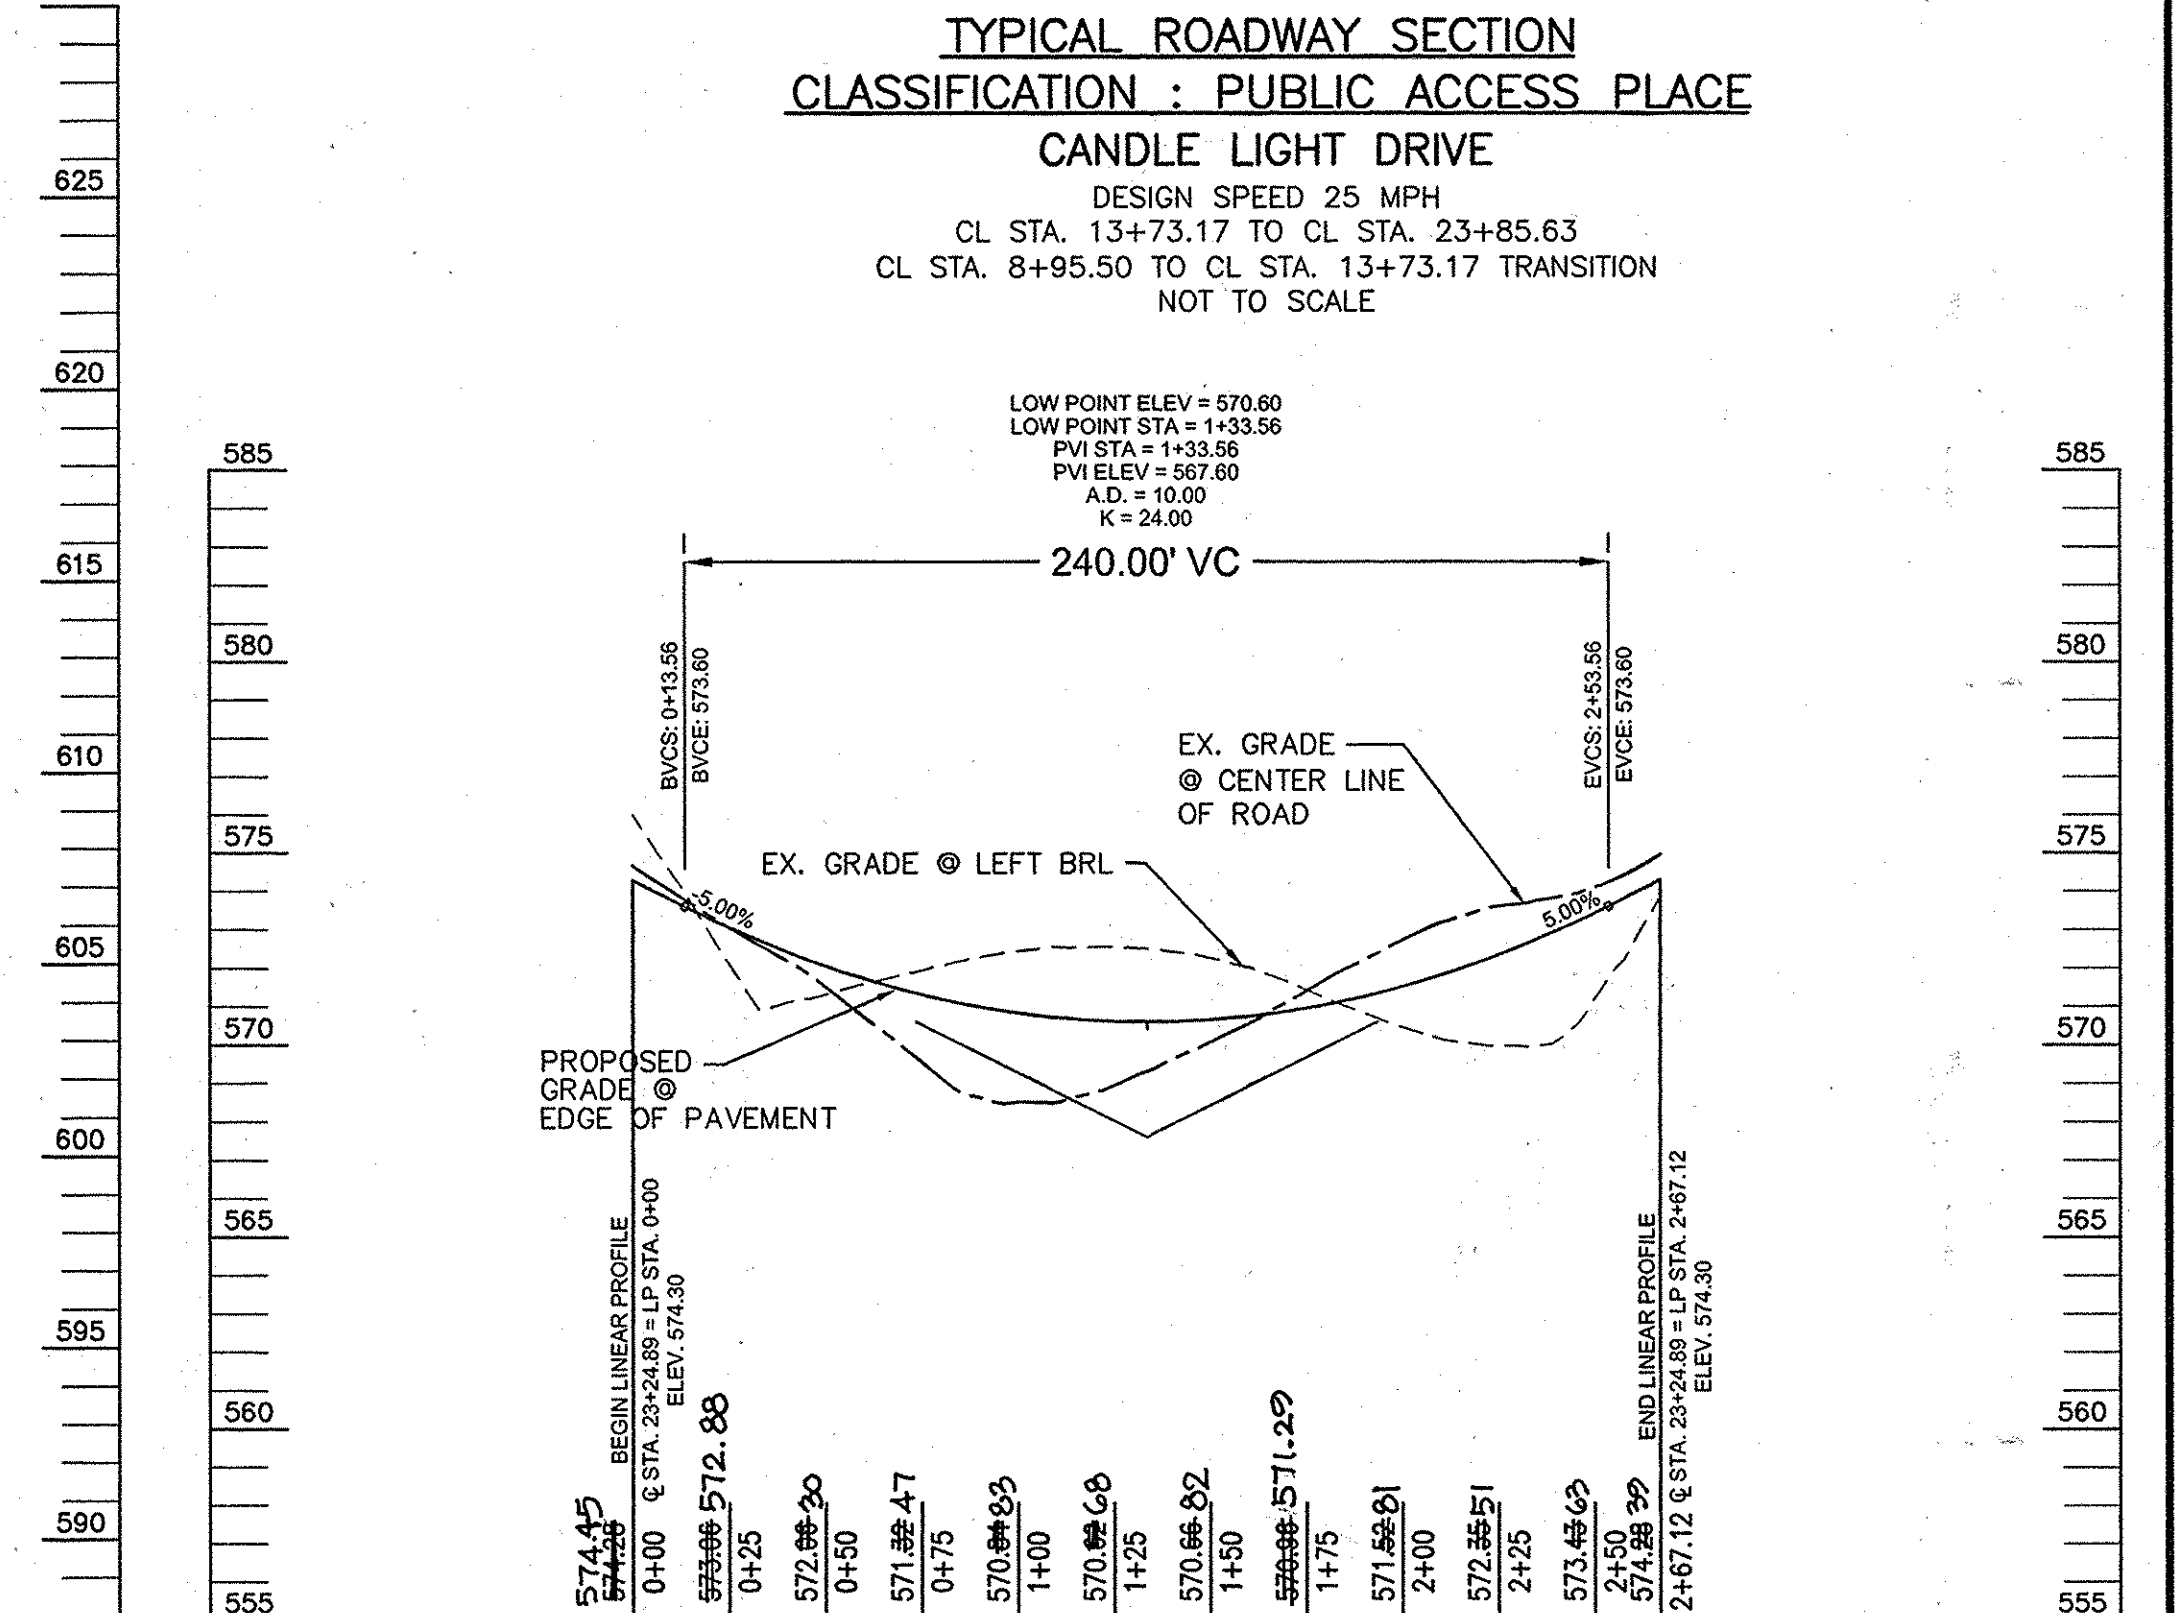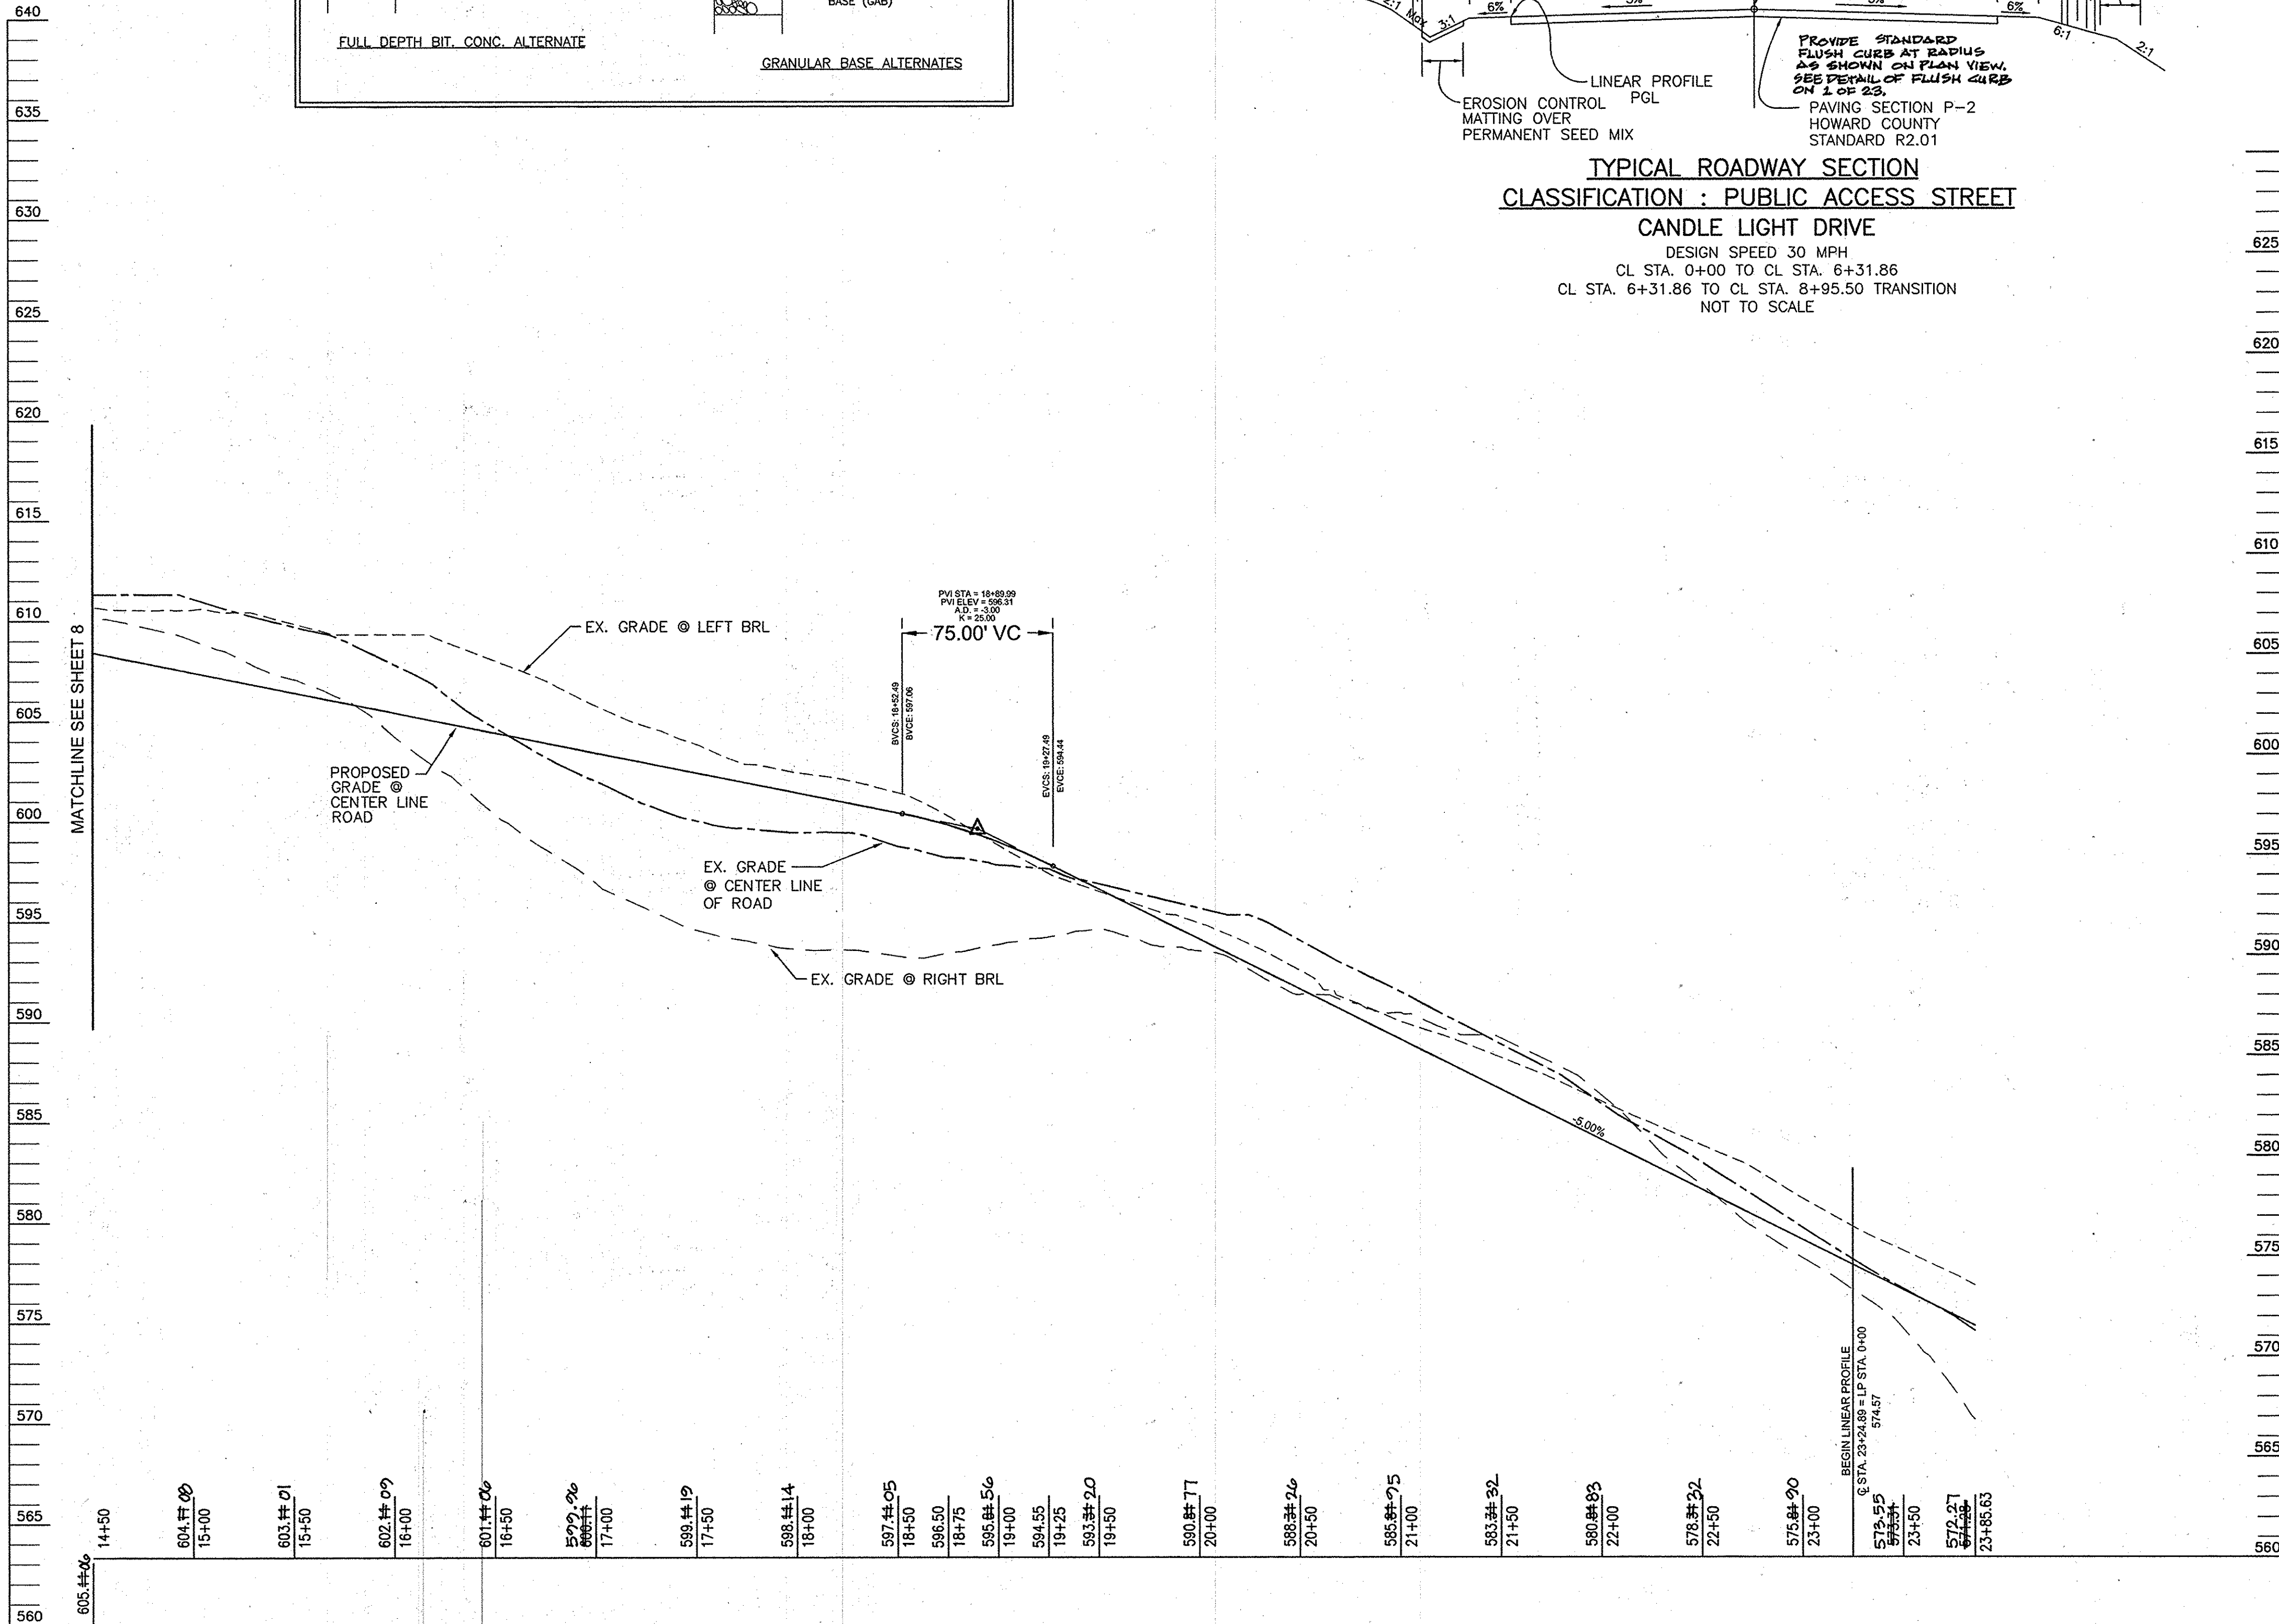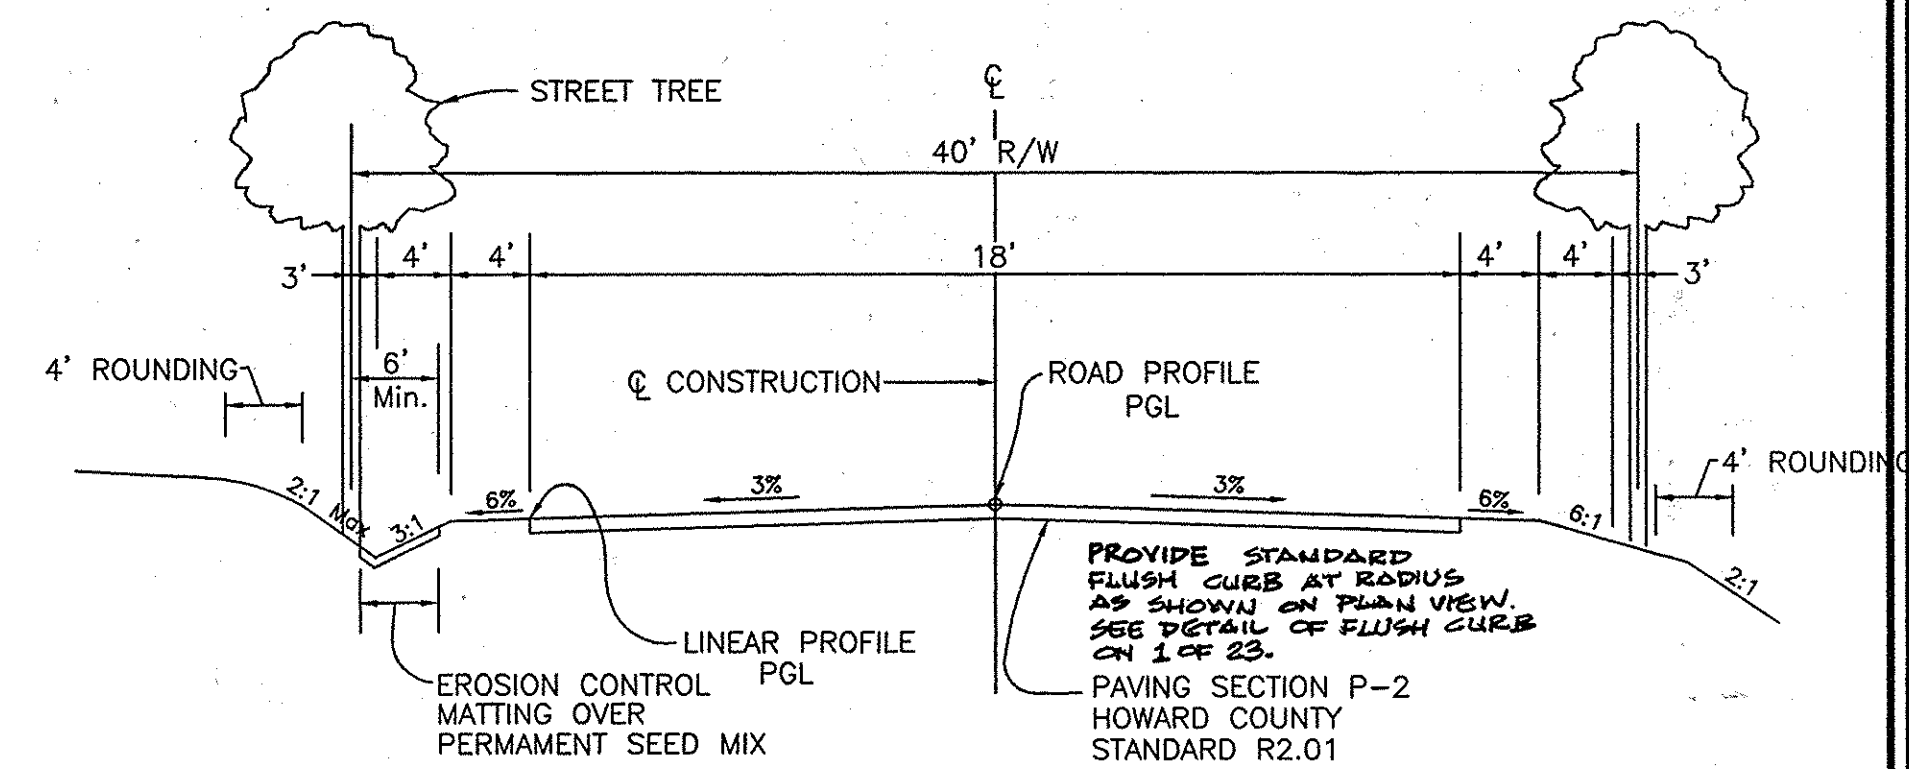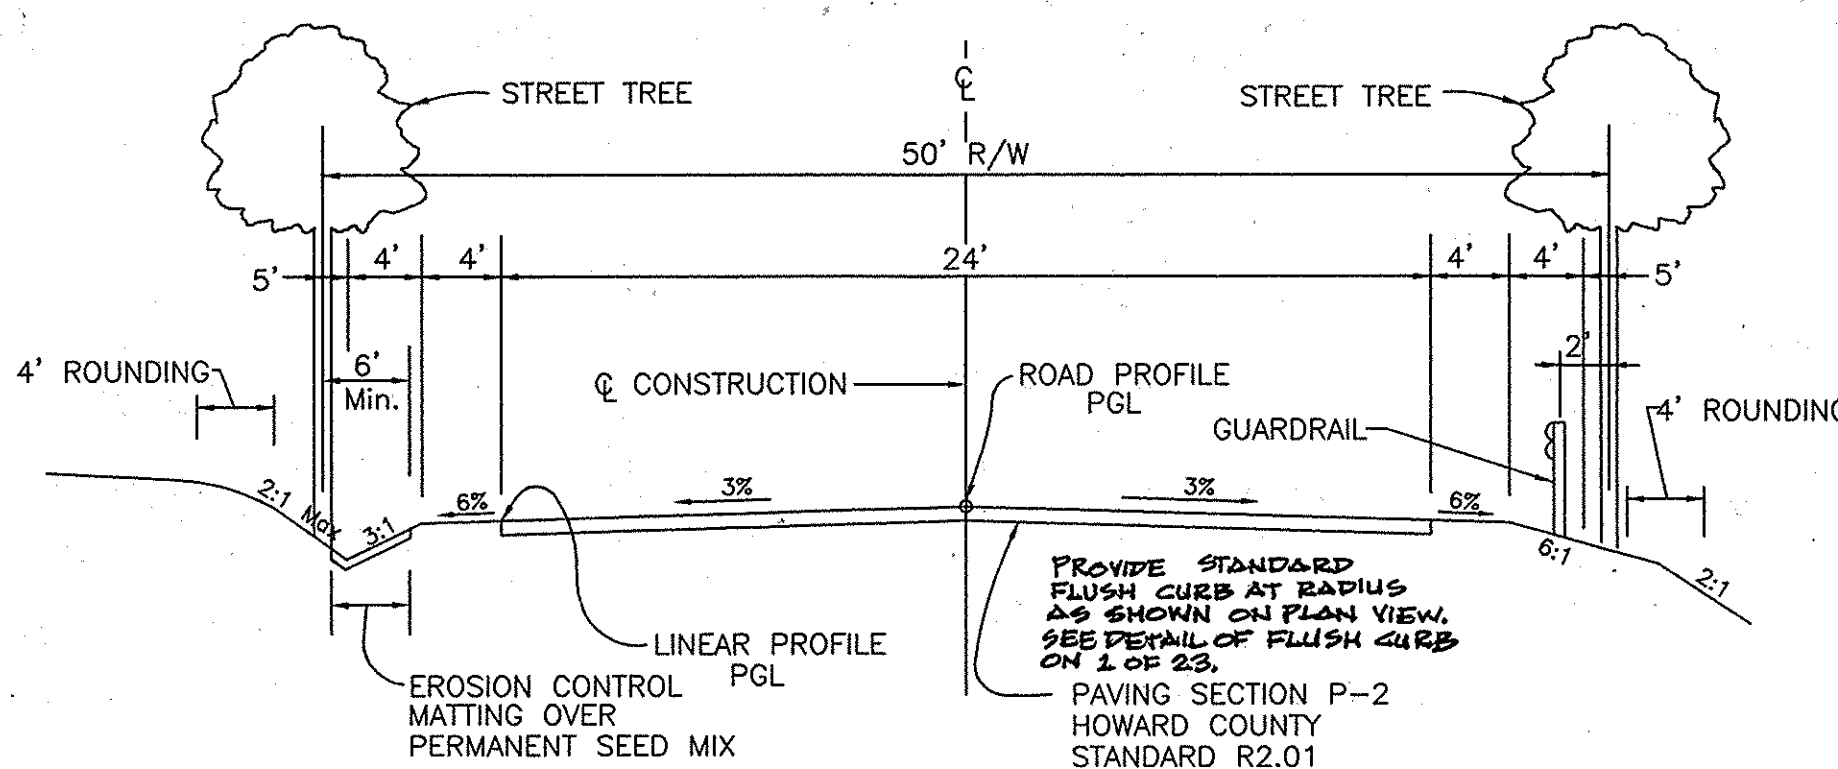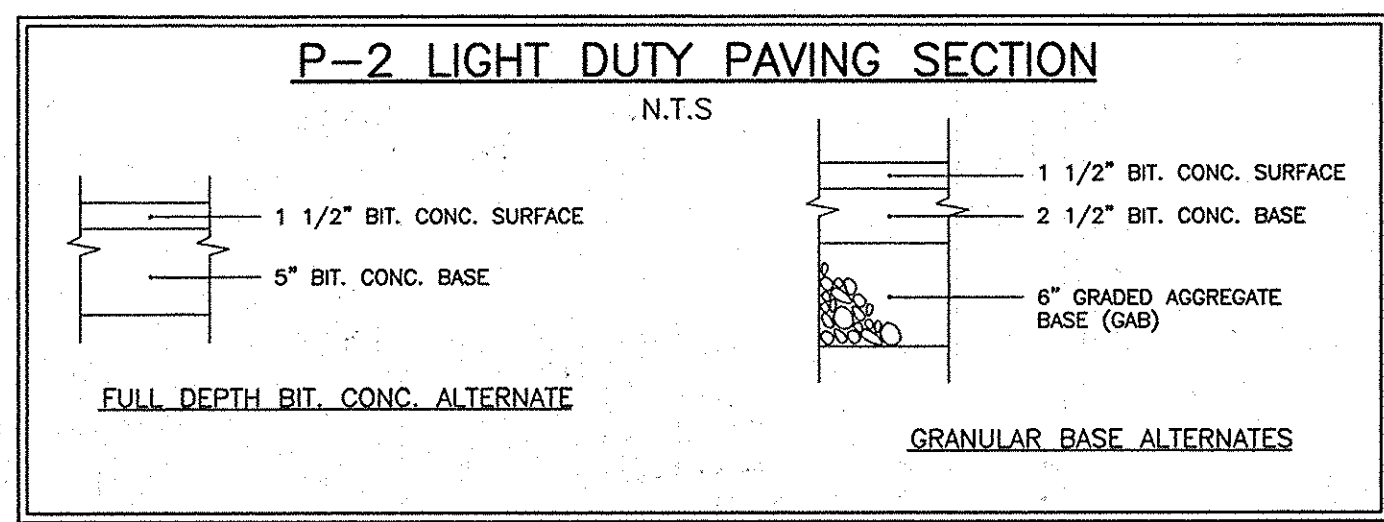

# LINEAR PROFILE- CANDLE LIGHT DRIVE PUBLIC ACCESS PLACE

SCALE: HORZ: 1"=50'  
VERT: 1"=5'

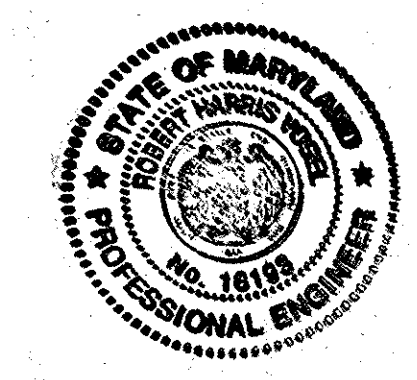

AS-BUILT CERTIFICATION  
I hereby certify that the facility shown on this plan was constructed as shown on the "as-built" plans and meets the approved plans and specifications.  
Signature: \_\_\_\_\_  
PE NO. 16123  
Date: 11/17/14

NO.	REVISION	DATE

**ROAD PROFILES**  
**CASTLEBERRY AT TEN OAKS**  
LOTS 1 - 45, NON-BUILDABLE PRESERVATION PARCELS A, C, D, E & BUILDABLE PRESERVATION PARCEL B  
TAX MAP 22 GRID 20  
5TH ELECTION DISTRICT  
PARCEL 60, LOTS 6 & 7 KEN WARFIELD SUBDIVISION, AND P/O PARCEL 90 HOWARD COUNTY, MARYLAND

**ROBERT H. VOGEL ENGINEERING, INC.**  
ENGINEERS • SURVEYORS • PLANNERS  
8407 MAIN STREET ELLICOTT CITY, MD 21043 TEL: 410.461.7666 FAX: 410.461.8961

DESIGN BY: RHW/LJT  
DRAWN BY: LJT  
CHECKED BY: RHW  
DATE: DECEMBER, 2006  
SCALE: AS NOTED  
W.O. NO.: 00-85.00

DPZ REF: S-01-11, P-05-04

# CANDLE LIGHT DRIVE


SCALE: HORZ: 1"=50'  
VERT: 1"=5'

APPROVED: HOWARD COUNTY DEPARTMENT OF PUBLIC WORKS  
*William Z. ...* 1-10-07  
CHIEF, BUREAU OF HIGHWAYS

APPROVED: HOWARD COUNTY DEPARTMENT OF PLANNING AND ZONING  
*...* 1/2/10  
CHIEF, DEVELOPMENT ENGINEERING DIVISION


APPROVED: HOWARD COUNTY DEPARTMENT OF PLANNING AND ZONING  
*...* 3/2/17  
CHIEF, DIVISION OF LAND DEVELOPMENT

REVIEWED FOR HOWARD SCD AND MEETS TECHNICAL REQUIREMENTS  
USDA-NATURAL RESOURCES CONSERVATION SERVICE  
THIS DEVELOPMENT PLAN IS APPROVED FOR SOIL EROSION AND SEDIMENT CONTROL BY THE HOWARD SOIL CONSERVATION DISTRICT  
HOWARD SCD

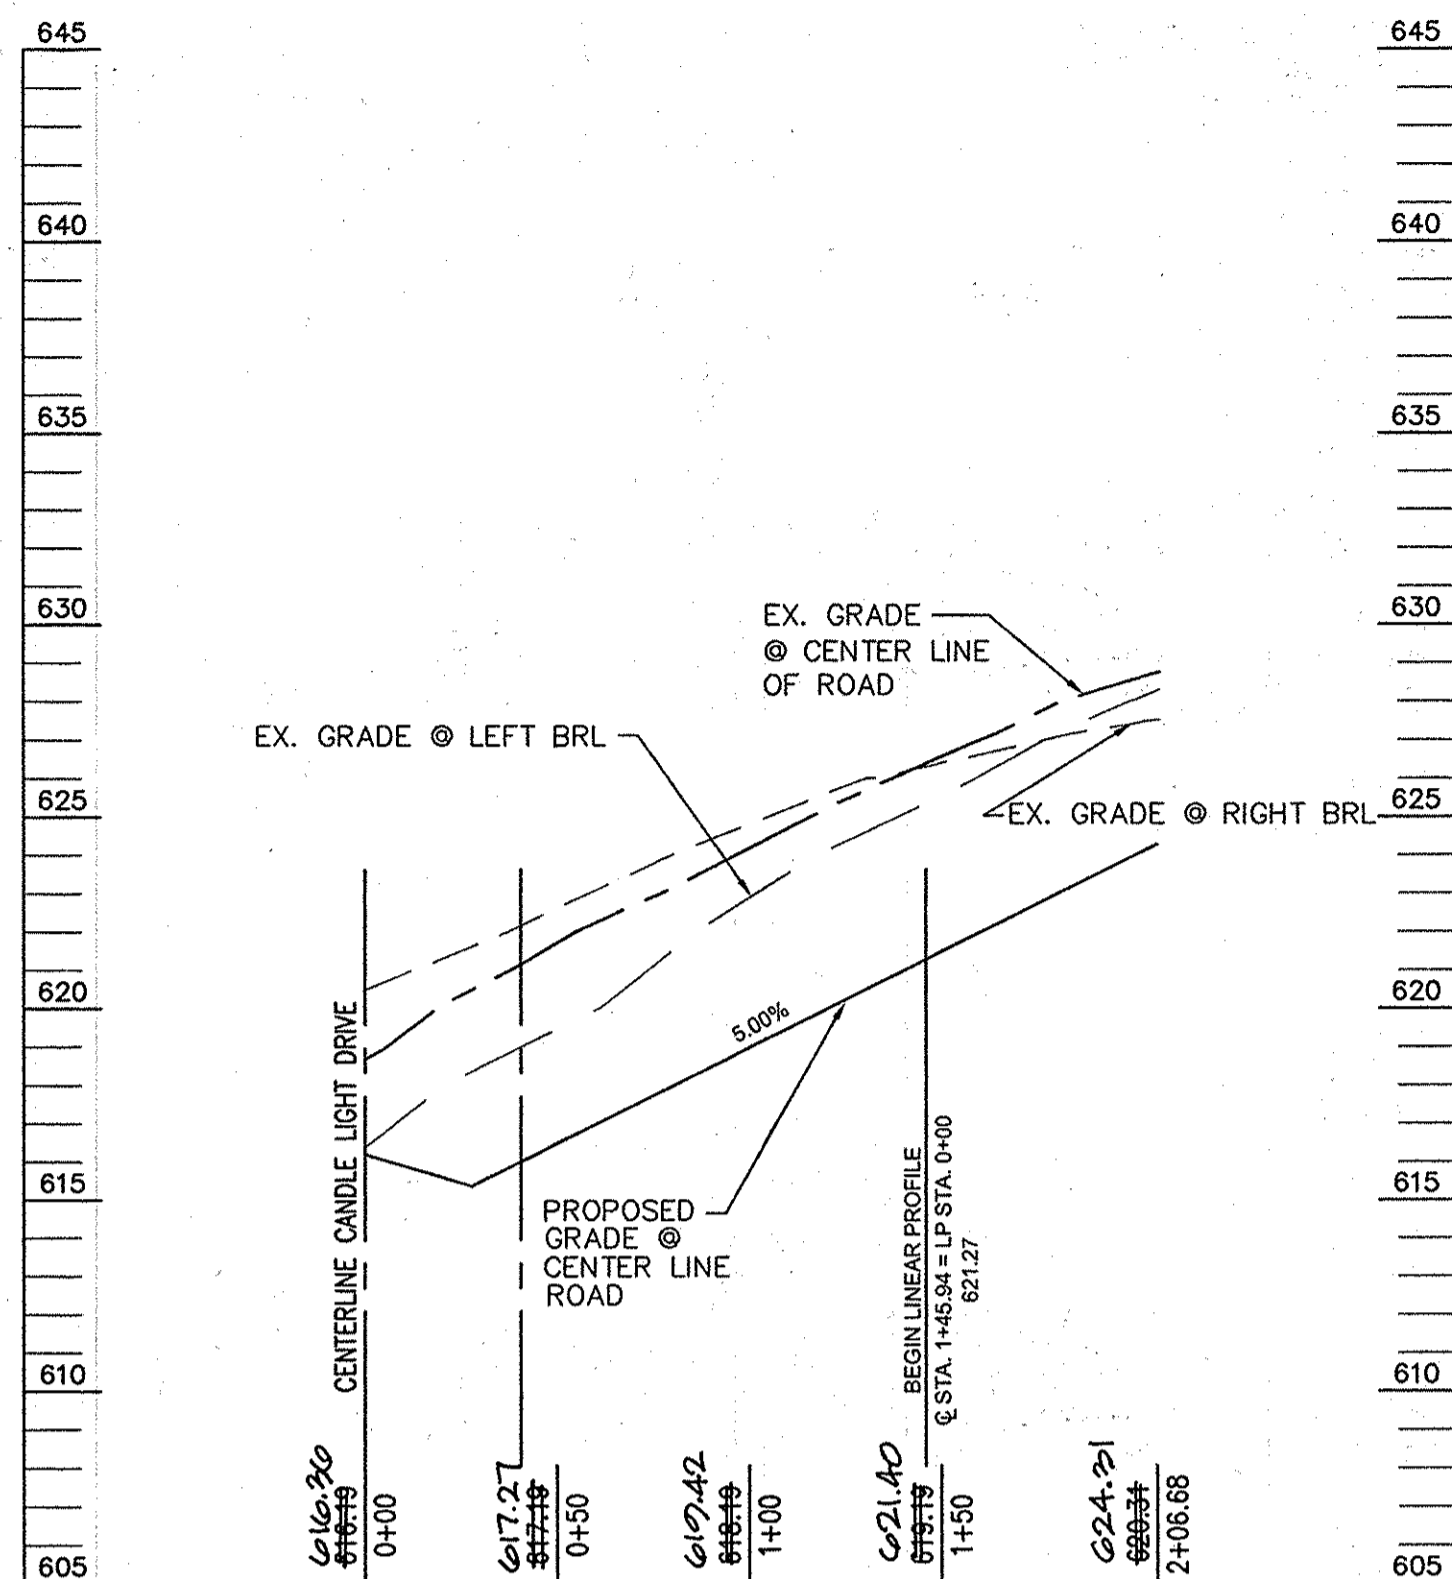


**POINT BREEZE DRIVE**  
PUBLIC ACCESS PLACE  
DESIGN SPEED 15 MPH

SCALE: HORZ: 1"=50'  
VERT: 1"=5'


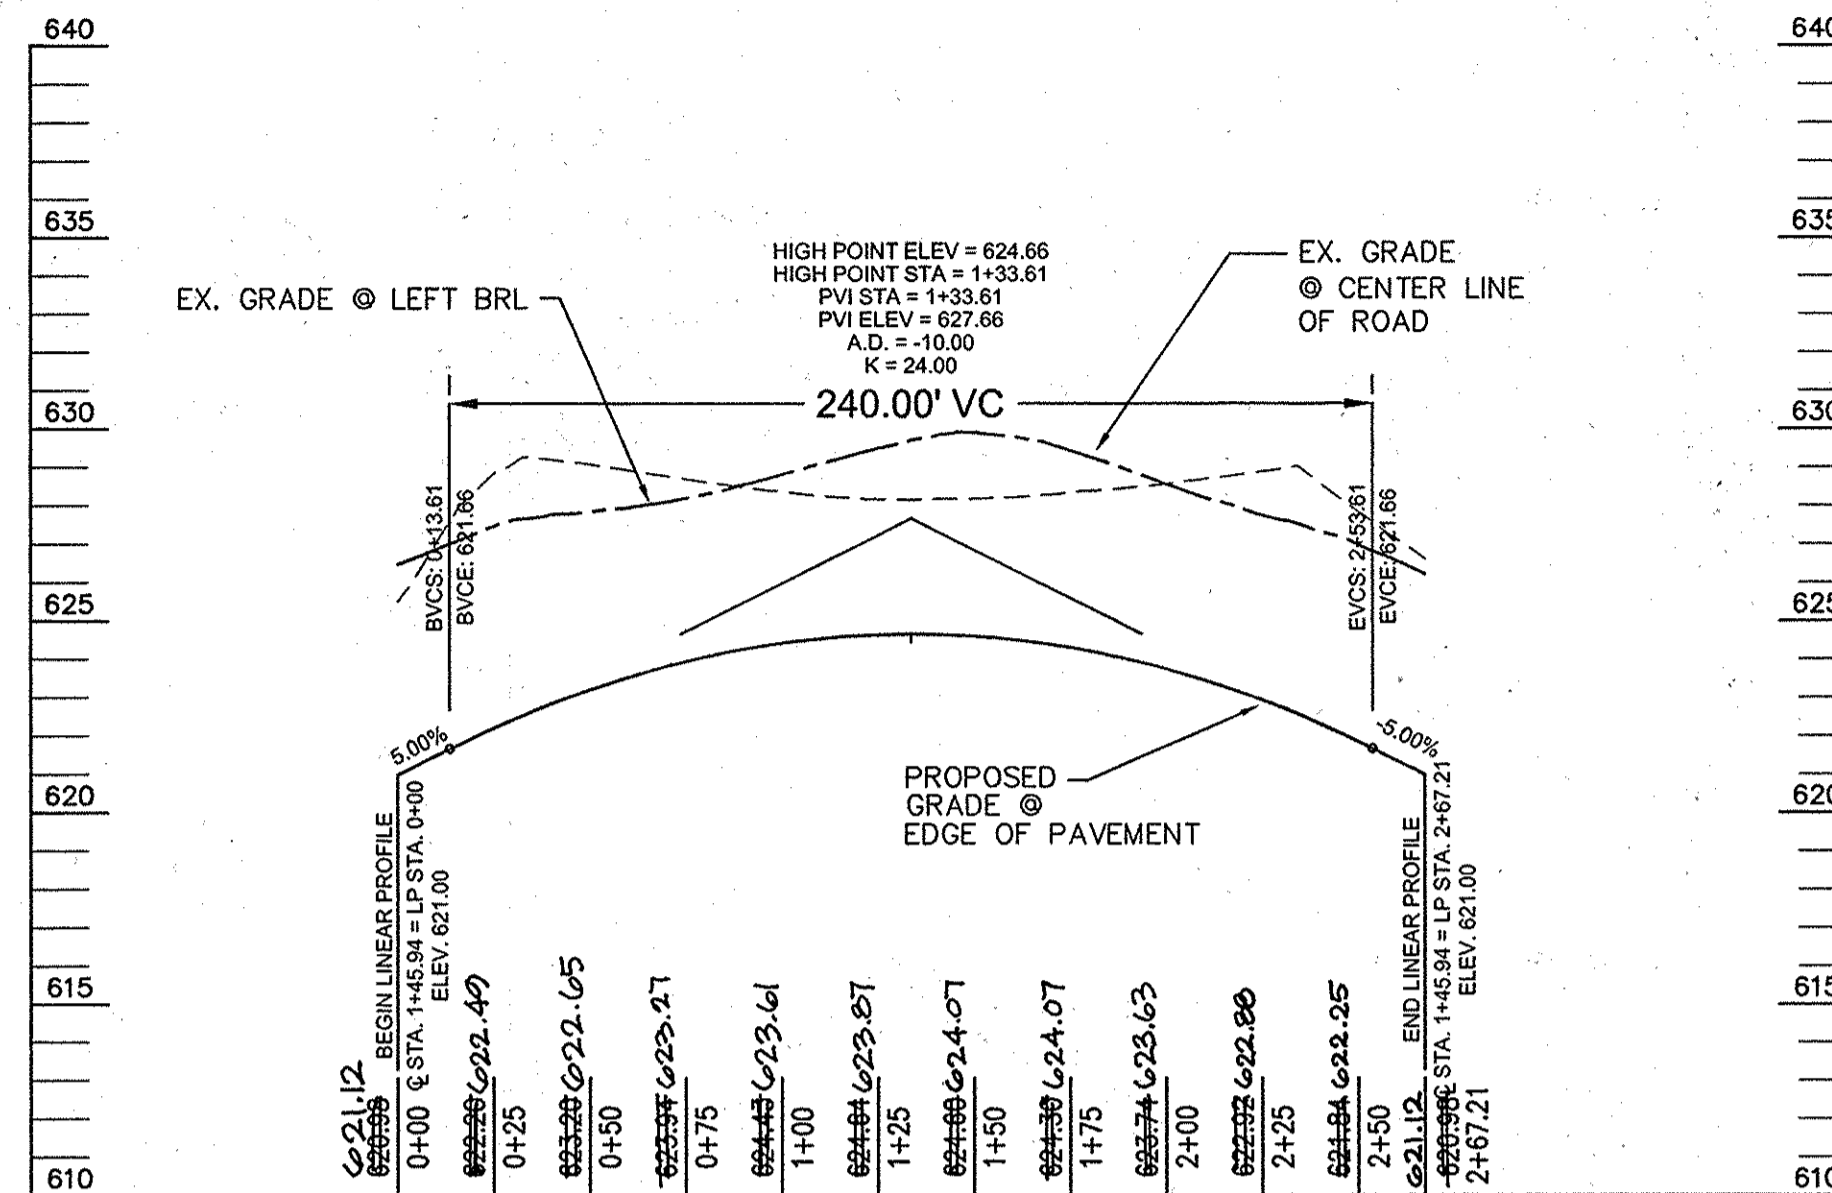


**LINEAR PROFILE-  
POINT BREEZE DRIVE**  
PUBLIC ACCESS PLACE

SCALE: HORZ: 1"=50'  
VERT: 1"=5'

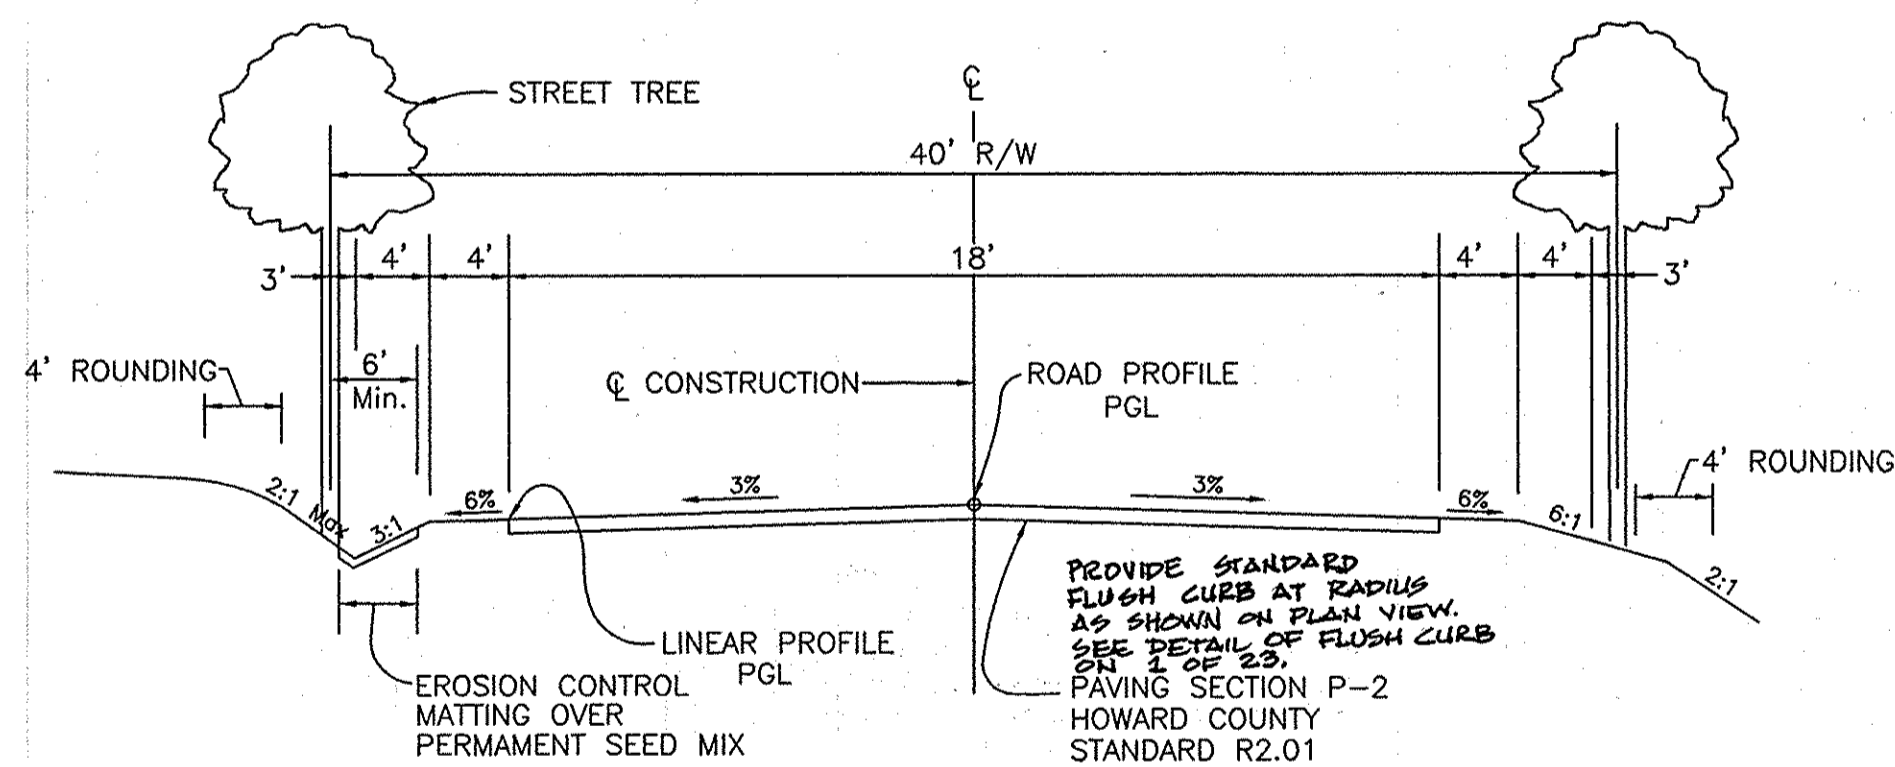

**TYPICAL ROADWAY SECTION**  
CLASSIFICATION : PUBLIC ACCESS PLACE  
POINT BREEZE DRIVE  
DESIGN SPEED 15 MPH  
NOT TO SCALE

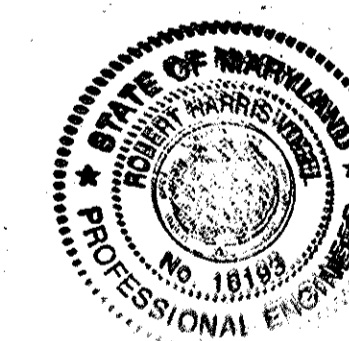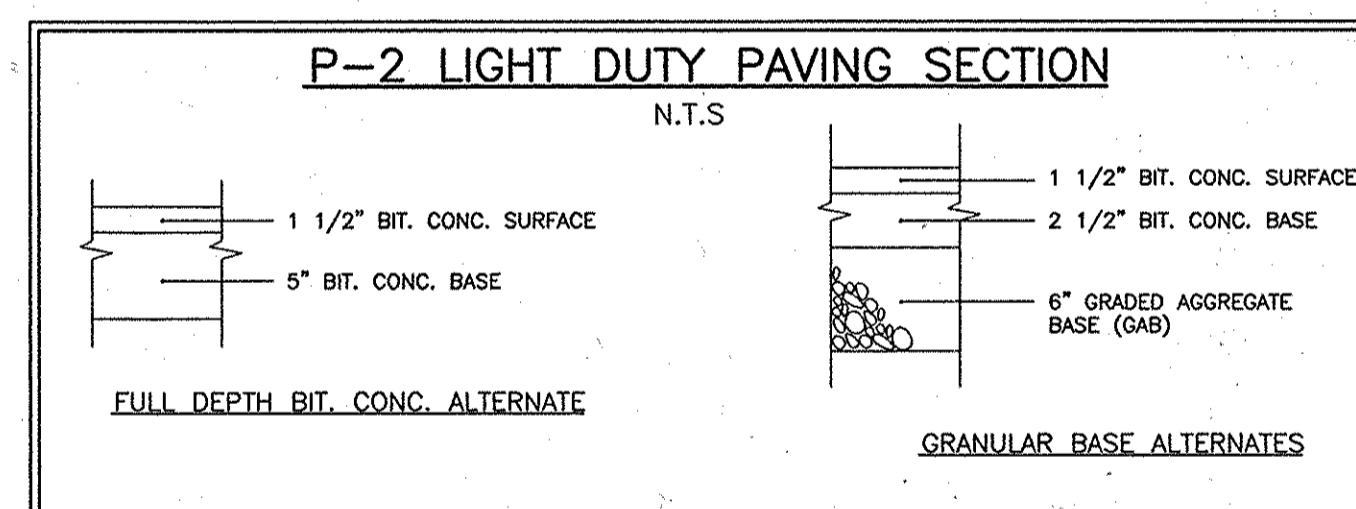

AS-BUILT CERTIFICATION  
I hereby certify that the facility shown on this plan was constructed as shown on the "as-built" plans and meets the approved plans and specifications.  
Signature: \_\_\_\_\_  
FE. NO. 16193  
Date: 11/17/14

NO.	REVISION	DATE

ROAD PROFILES  
**CASTLEBERRY AT TEN OAKS**  
LOTS 1 - 45, NON-BUILDABLE PRESERVATION  
PARCELS A, C, D, E & BUILDABLE PRESERVATION PARCEL B  
PARCEL 60, LOTS 6 & 7 KEN WARFIELD  
SUBDIVISION, AND P/O PARCEL 90  
HOWARD COUNTY, MARYLAND  
TAX MAP 22 GRID 20  
5TH ELECTION DISTRICT

**ROBERT H. VOGEL**  
ENGINEERING, INC.  
ENGINEERS • SURVEYORS • PLANNERS  
8407 MAIN STREET ELLICOTT CITY, MD 21043 TEL: 410.461.7666 FAX: 410.461.8961

OWNER  
HELEN L. FYOCK CASTLEBERRY AT TEN OAKS, L.L.C.  
ROBERT E. FYOCK 3675 PARK AVENUE, SUITE 301  
GLENELG, MARYLAND ELLICOTT CITY, MARYLAND 21043 (410) 740-9401

DEVELOPER  
CASTLEBERRY AT TEN OAKS, L.L.C.  
3675 PARK AVENUE, SUITE 301  
ELLICOTT CITY, MARYLAND 21043 (410) 740-9401

DPZ REF: S-01-11, P-05-04  
DESIGN BY: RHW/LJT  
DRAWN BY: LJT  
CHECKED BY: RHW  
DATE: DECEMBER, 2008  
SCALE: AS NOTED  
W.O. NO.: 09-85.00



10 SHEET OF 23

APPROVED: HOWARD COUNTY DEPARTMENT OF PUBLIC WORKS  
1-10-07  
CHIEF, BUREAU OF HIGHWAYS

APPROVED: HOWARD COUNTY DEPARTMENT OF PLANNING AND ZONING  
1/10/07  
CHIEF, DEVELOPMENT ENGINEERING DIVISION

APPROVED: HOWARD COUNTY DEPARTMENT OF PLANNING AND ZONING  
3/26/07  
CHIEF, DIVISION OF LAND DEVELOPMENT

REVIEWED FOR HOWARD SCD AND MEETS TECHNICAL REQUIREMENTS  
USDA-NATURAL RESOURCES CONSERVATION SERVICE  
THIS DEVELOPMENT PLAN IS APPROVED FOR SOIL EROSION AND SEDIMENT CONTROL BY THE HOWARD SOIL CONSERVATION DISTRICT  
HOWARD SCD

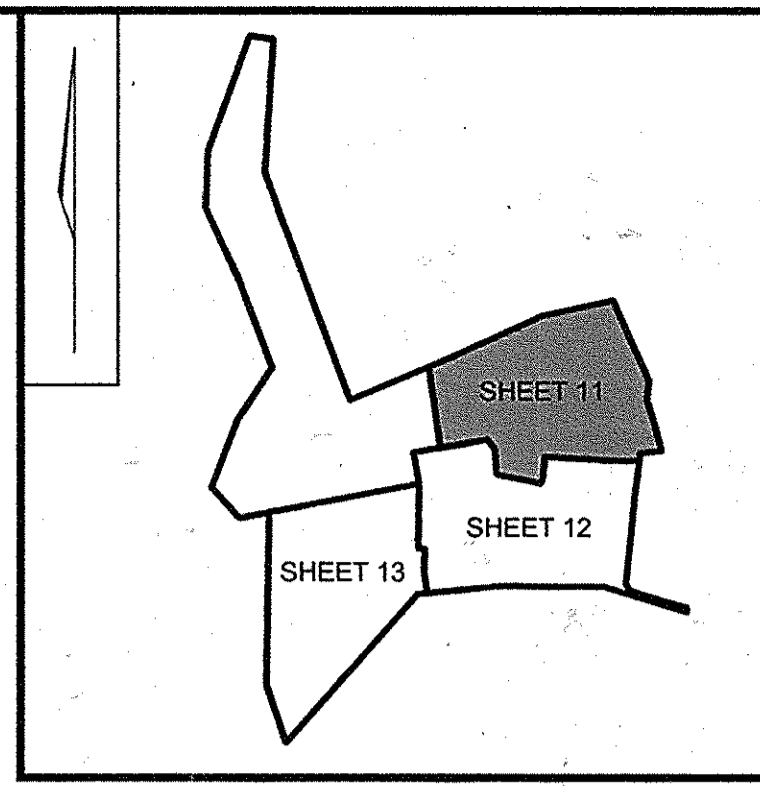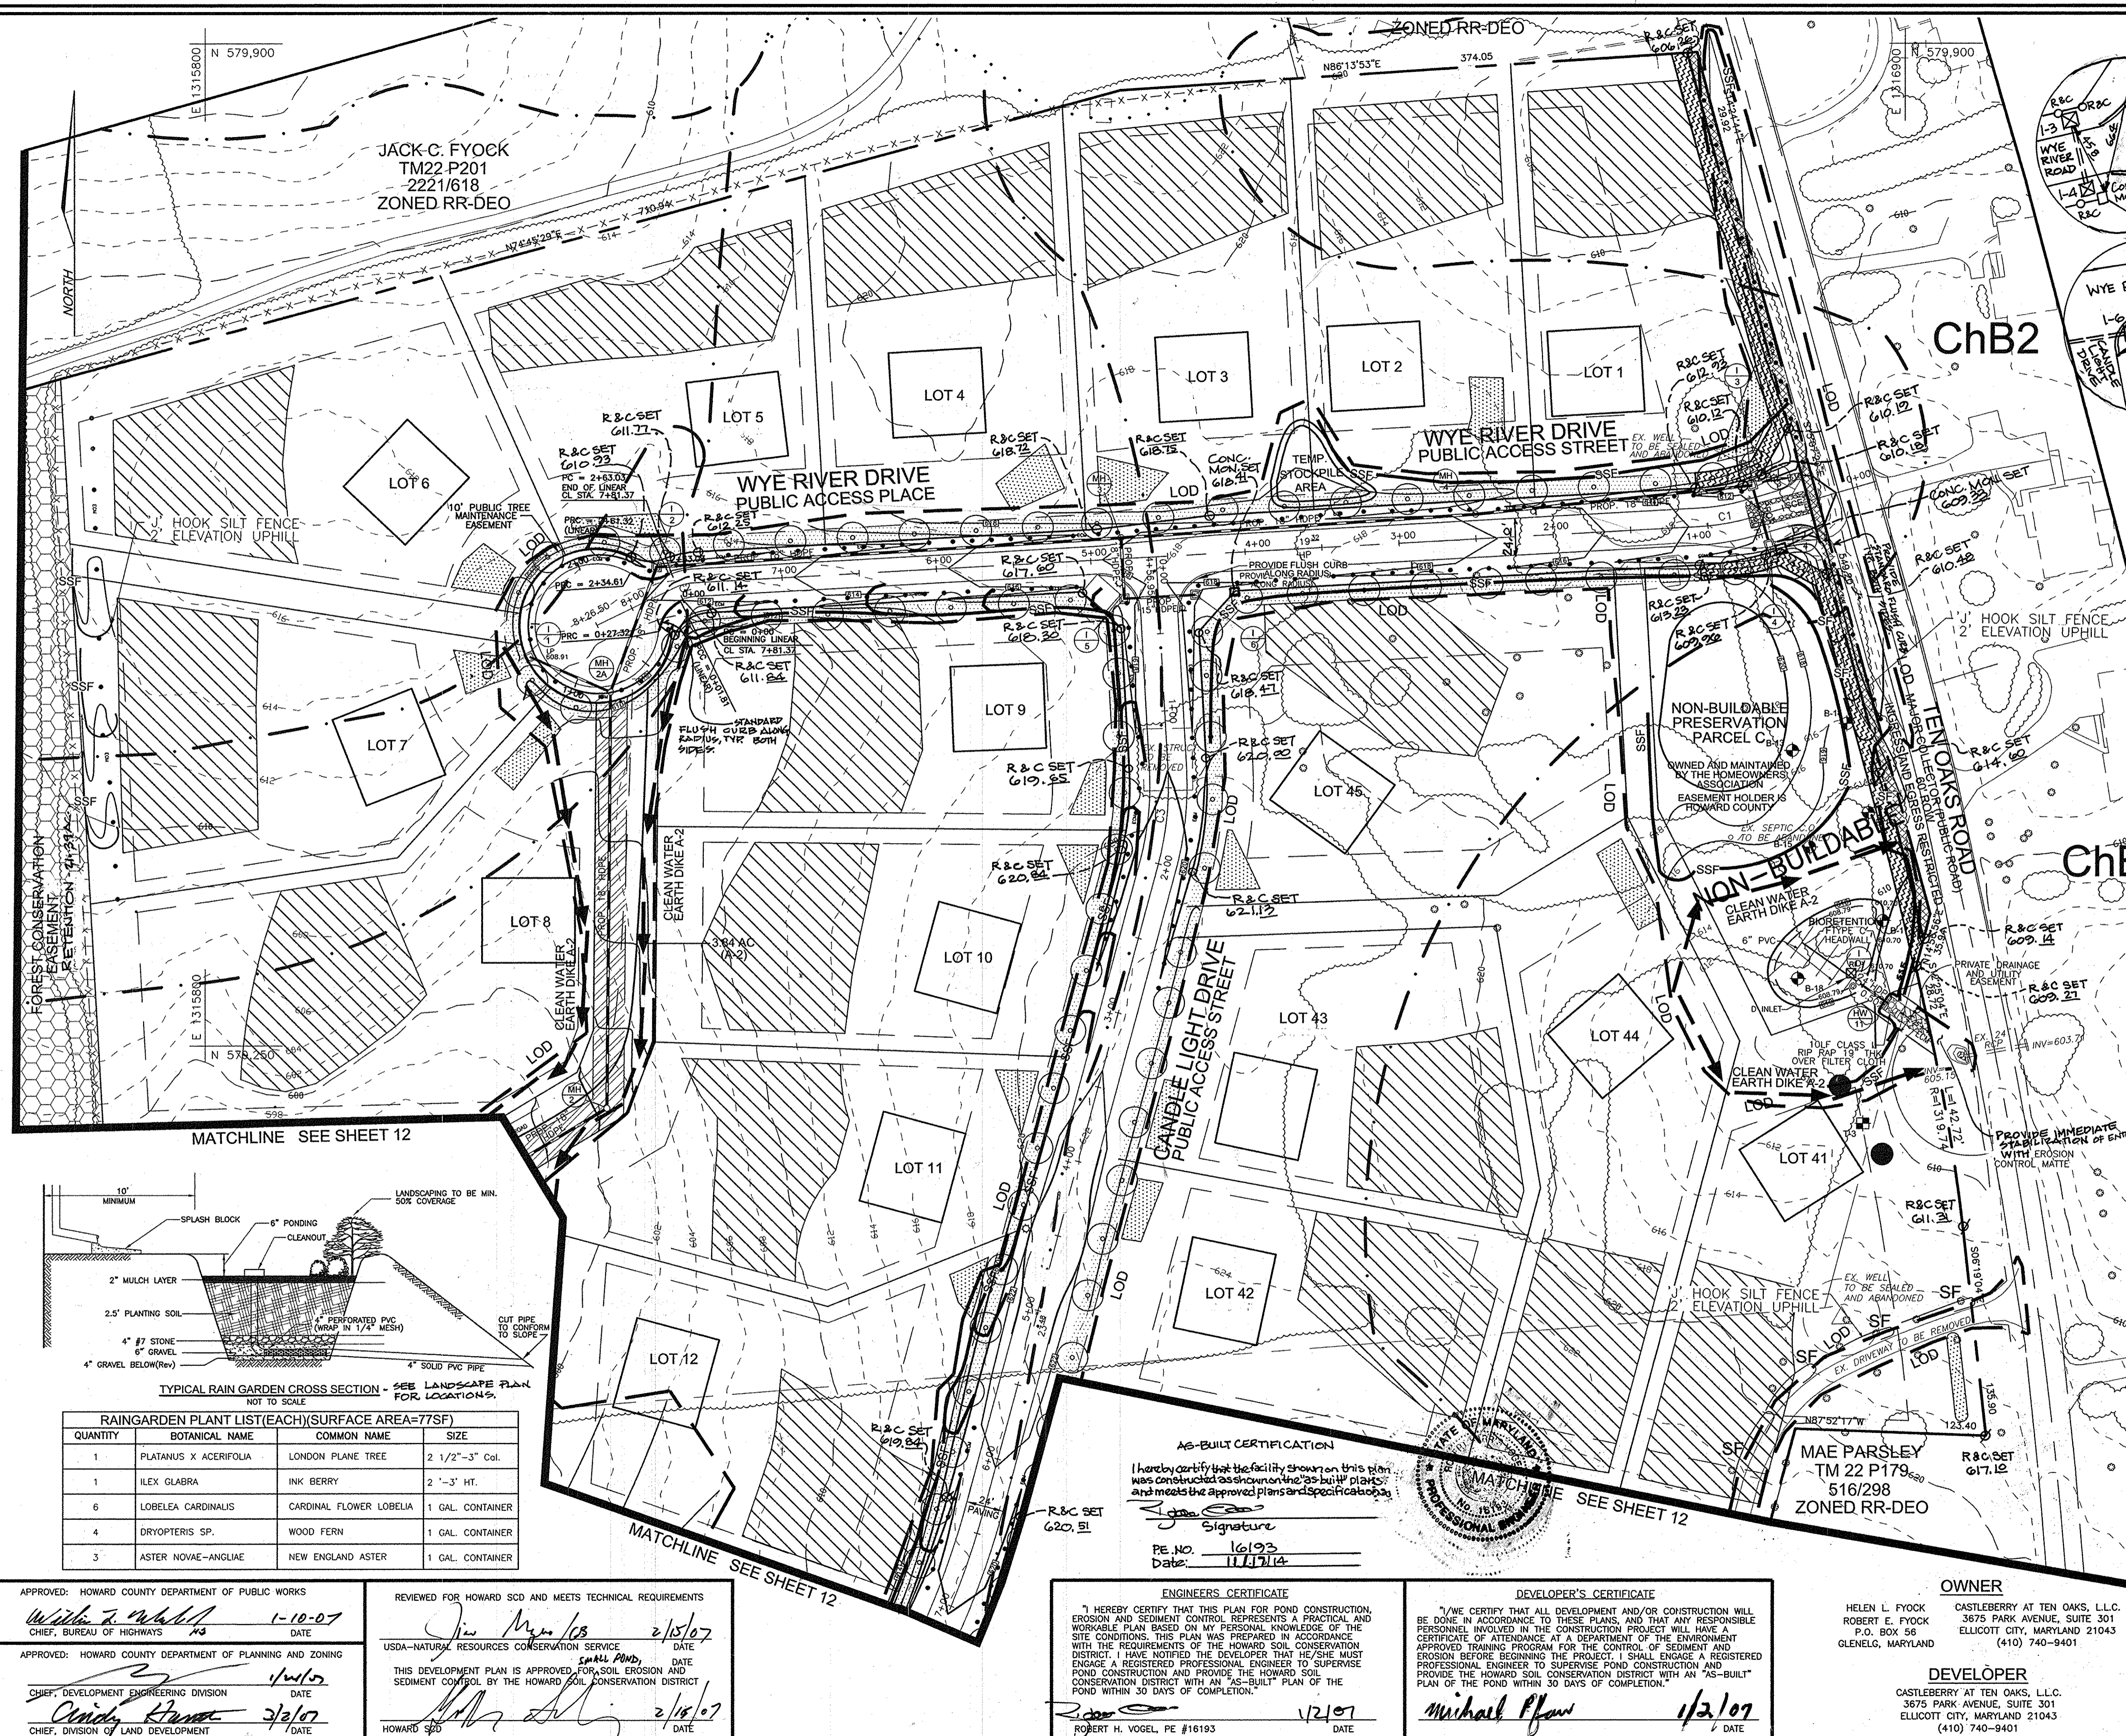

- LEGEND**
- 202--- EXISTING 2 FT CONTOUR
  - 200--- EXISTING 10 FT CONTOUR
  - 202--- PROPOSED 2 FT CONTOUR
  - 200--- PROPOSED 10 FT CONTOUR
  - SSF--- SUPER SILT FENCE
  - LOD--- LIMIT OF DISTURBANCE
  - E--- EXISTING TREELINE
  - P--- PROPOSED TREELINE
  - EARTH DIKE
  - PROPOSED STREET TREE
  - EROSION CONTROL MATTING
  - FOREST CONSERVATION SIGN LOCATION
  - PROPOSED TREE MAINTENANCE EASEMENT
  - NO WOODY VEGETATION BUFFER
  - PRIVATE SEPTIC EASEMENT
  - PRIVATE WELL AREA
  - USE-IN-COMMON ACCESS EASEMENT
  - AREA OF 15 TO 24.9 PERCENT SLOPES
  - AREA OF 25 PERCENT OR GREATER SLOPES
  - FOREST CONSERVATION EASEMENT (RETENTION)
  - STABILIZED CONSTRUCTION ENTRANCE
  - 100 YEAR FLOODPLAIN
  - RAIN GARDEN- SEE SHEET 14 OF 23 TYP. OF G.
  - 10' PRIVATE SIGN & FENCE EASEMENT
  - AREA DEDICATED TO HOWARD COUNTY FOR RIGHT OF WAY
  - DRAINAGE AND UTILITY EASEMENT
  - 10' PUBLIC TREE MAINTENANCE EASEMENT
  - EROSION CONTROL MATTE FOR IMMEDIATE STABILIZATION

REVIEWED FOR HOWARD SCD AND MEETS TECHNICAL REQUIREMENTS

USDA-NATURAL RESOURCES CONSERVATION SERVICE DATE

THIS DEVELOPMENT PLAN IS APPROVED FOR SOIL EROSION AND SEDIMENT CONTROL BY THE HOWARD SOIL CONSERVATION DISTRICT

HOWARD SCD DATE

NO.	REVISION	DATE
2	REMOVE CONTROL DEVICE CANDLE LIGHT DRIVE	2/28/11

**GRADING, SEDIMENT AND EROSION CONTROL PLAN**  
**CASTLEBERRY AT TEN OAKS**  
 LOTS 1 - 45, NON-BUILDABLE PRESERVATION PARCELS A, C, D, E & BUILDABLE PRESERVATION PARCEL B


TAX MAP 22 GRID 20 PARCEL 60, LOTS 6 & 7 KEN WARFIELD SUBDIVISION, AND P/O PARCEL 90  
 5TH ELECTION DISTRICT HOWARD COUNTY, MARYLAND

**ROBERT H. VOGEL ENGINEERING, INC.**  
 ENGINEERS • SURVEYORS • PLANNERS  
 8407 MAIN STREET ELLICOTT CITY, MD 21043 TEL: 410.461.7666 FAX: 410.461.8961

DESIGN BY: RHV/LJT  
 DRAWN BY: LJT  
 CHECKED BY: RHV  
 DATE: DECEMBER, 2008  
 SCALE: 1"=50'  
 W.O. NO.: 00-85.00

DPZ REF: S-01-11, P-05-04

11 SHEET OF 23

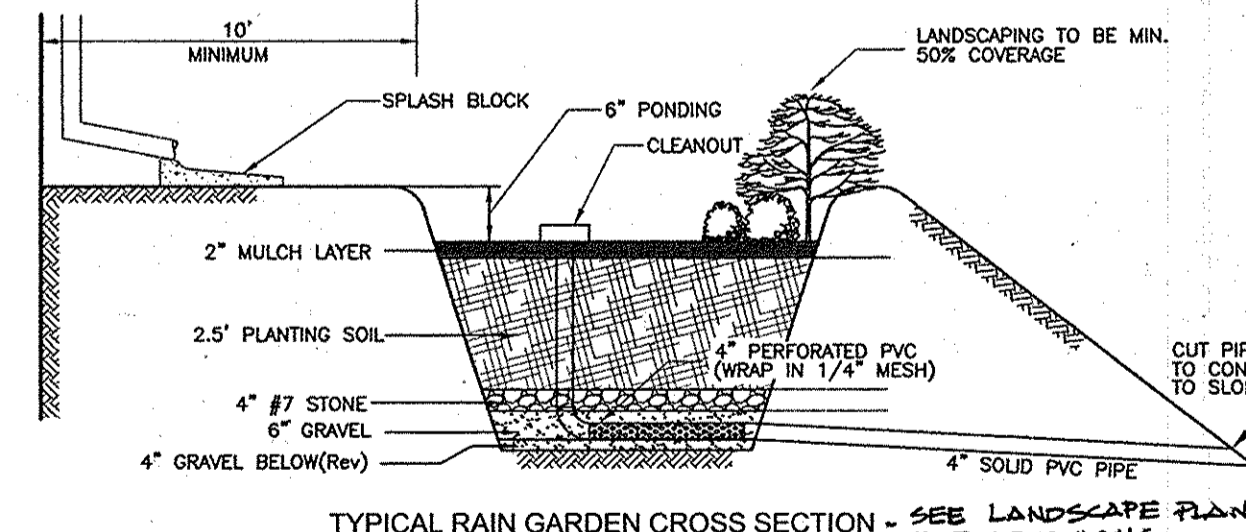

RAINGARDEN PLANT LIST (EACH) (SURFACE AREA=77SF)

QUANTITY	BOTANICAL NAME	COMMON NAME	SIZE
1	PLATANUS X ACERIFOLIA	LONDON PLANE TREE	2 1/2"-3" Col.
1	ILEX GLABRA	INK BERRY	2'-3" HT.
6	LOBELEA CARDINALIS	CARDINAL FLOWER LOBELIA	1 GAL. CONTAINER
4	DRYOPTERIS SP.	WOOD FERN	1 GAL. CONTAINER
3	ASTER NOVAE-ANGLIAE	NEW ENGLAND ASTER	1 GAL. CONTAINER

**AS-BUILT CERTIFICATION**

I hereby certify that the facility shown on this plan was constructed as shown on the "AS-BUILT" plans and meets the approved plans and specifications.

Signature: \_\_\_\_\_  
 PE NO. 16193  
 Date: 11/17/14

**ENGINEER'S CERTIFICATE**

I HEREBY CERTIFY THAT THIS PLAN FOR POND CONSTRUCTION, EROSION AND SEDIMENT CONTROL REPRESENTS A PRACTICAL AND WORKABLE PLAN BASED ON MY PERSONAL KNOWLEDGE OF THE SITE CONDITIONS. THIS PLAN WAS PREPARED IN ACCORDANCE WITH THE REQUIREMENTS OF THE HOWARD SOIL CONSERVATION DISTRICT. I HAVE NOTIFIED THE DEVELOPER THAT HE/SHE MUST ENGAGE A REGISTERED PROFESSIONAL ENGINEER TO SUPERVISE POND CONSTRUCTION AND PROVIDE THE HOWARD SOIL CONSERVATION DISTRICT WITH AN "AS-BUILT" PLAN OF THE POND WITHIN 30 DAYS OF COMPLETION.

ROBERT H. VOGEL, PE #16193 DATE 11/21/07

**DEVELOPER'S CERTIFICATE**

I/WE CERTIFY THAT ALL DEVELOPMENT AND/OR CONSTRUCTION WILL BE DONE IN ACCORDANCE TO THESE PLANS, AND THAT ANY RESPONSIBLE PERSONNEL INVOLVED IN THE CONSTRUCTION PROJECT WILL HAVE A CERTIFICATE OF ATTENDANCE AT A DEPARTMENT OF THE ENVIRONMENT APPROVED TRAINING PROGRAM FOR THE CONTROL OF SEDIMENT AND EROSION BEFORE BEGINNING THE PROJECT. I SHALL ENGAGE A REGISTERED PROFESSIONAL ENGINEER TO SUPERVISE POND CONSTRUCTION AND PROVIDE THE HOWARD SOIL CONSERVATION DISTRICT WITH AN "AS-BUILT" PLAN OF THE POND WITHIN 30 DAYS OF COMPLETION.

Michael Pflaw 1/2/07 DATE

**OWNER**

HELEN L. FYOCK  
 ROBERT E. FYOCK  
 P.O. BOX 56  
 GLENELC, MARYLAND

CASTLEBERRY AT TEN OAKS, L.L.C.  
 3675 PARK AVENUE, SUITE 301  
 ELLICOTT CITY, MARYLAND 21043  
 (410) 740-9401

**DEVELOPER**



CASTLEBERRY AT TEN OAKS, L.L.C.  
 3675 PARK AVENUE, SUITE 301  
 ELLICOTT CITY, MARYLAND 21043  
 (410) 740-9401

APPROVED: HOWARD COUNTY DEPARTMENT OF PUBLIC WORKS  
 William F. Whitt 1-10-07 DATE  
 CHIEF, BUREAU OF HIGHWAYS

APPROVED: HOWARD COUNTY DEPARTMENT OF PLANNING AND ZONING  
 1/10/09 DATE  
 Chief, Development Engineering Division  
 Cindy Hunter 3/2/07 DATE  
 CHIEF, DIVISION OF LAND DEVELOPMENT

REVIEWED FOR HOWARD SCD AND MEETS TECHNICAL REQUIREMENTS

USDA-NATURAL RESOURCES CONSERVATION SERVICE DATE 2/15/07  
 SMALL POND  
 THIS DEVELOPMENT PLAN IS APPROVED FOR SOIL EROSION AND SEDIMENT CONTROL BY THE HOWARD SOIL CONSERVATION DISTRICT  
 DATE 2/15/07  
 HOWARD SCD

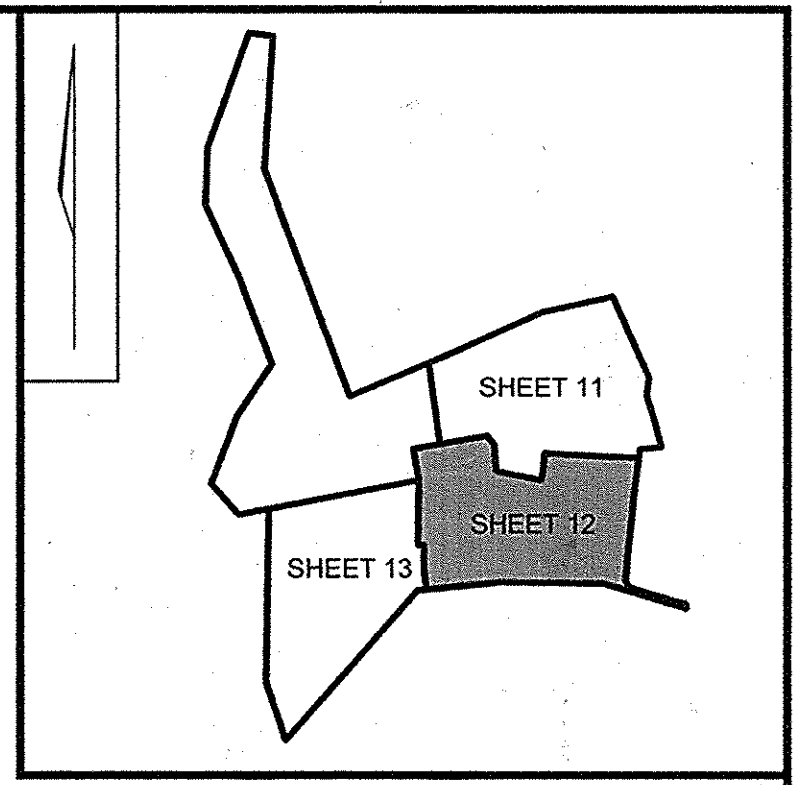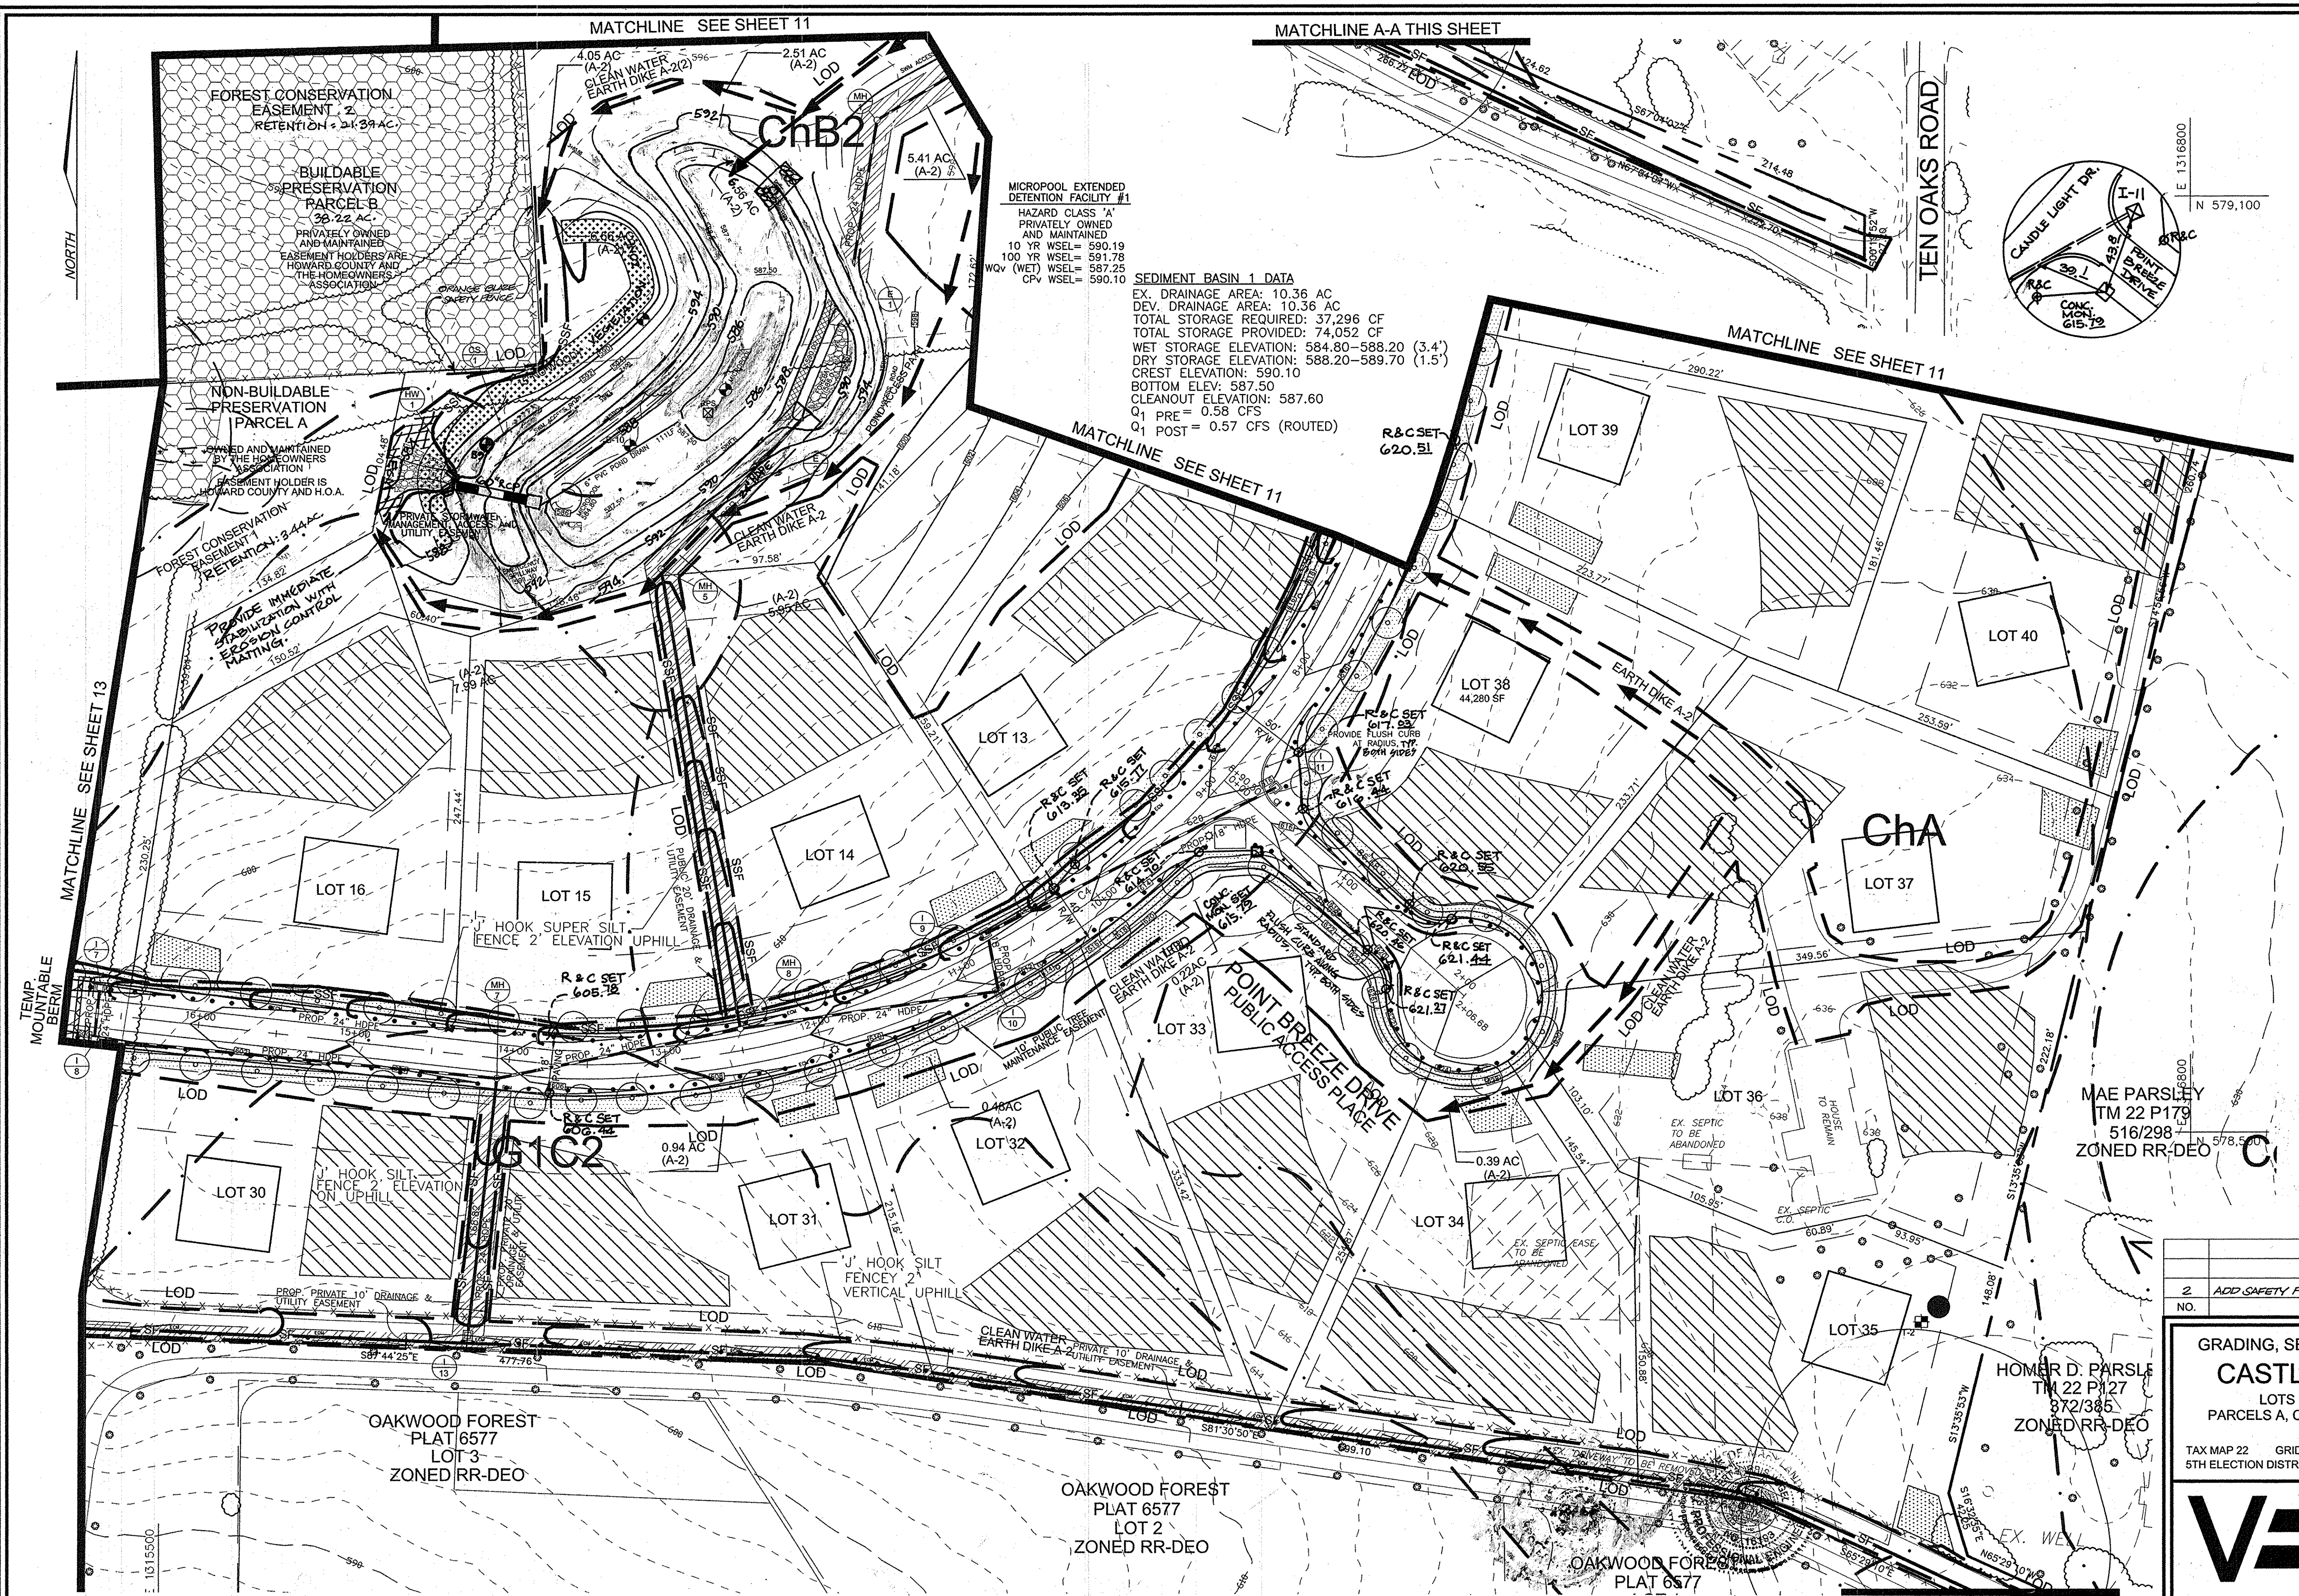


**MICROPOOL EXTENDED DETENTION FACILITY #1**  
 HAZARD CLASS 'A'  
 PRIVATELY OWNED AND MAINTAINED  
 10 YR WSEL = 590.19  
 100 YR WSEL = 591.78  
 WQV (WET) WSEL = 587.25  
 CPV WSEL = 590.10

**SEDIMENT BASIN 1 DATA**  
 EX. DRAINAGE AREA: 10.36 AC  
 DEV. DRAINAGE AREA: 10.36 AC  
 TOTAL STORAGE REQUIRED: 37,296 CF  
 TOTAL STORAGE PROVIDED: 74,052 CF  
 WET STORAGE ELEVATION: 584.80-588.20 (3.4')  
 DRY STORAGE ELEVATION: 588.20-589.70 (1.5')  
 CREST ELEVATION: 590.10  
 BOTTOM ELEV: 587.50  
 CLEANOUT ELEVATION: 587.60  
 Q1 PRE = 0.58 CFS  
 Q1 POST = 0.57 CFS (ROUTED)

**KEY MAP**  
NOT TO SCALE

**LEGEND**

- 202--- EXISTING 2 FT CONTOUR
- 200--- EXISTING 10 FT CONTOUR
- 200--- PROPOSED 2 FT CONTOUR
- 200--- PROPOSED 10 FT CONTOUR
- SSF--- SUPER SILT FENCE
- LOD--- LIMIT OF DISTURBANCE
- LOD--- EXISTING TREELINE
- LOD--- PROPOSED TREELINE
- EARTH DIKE---
- PROPOSED STREET TREE---
- EROSION CONTROL MATTING FOREST CONSERVATION EASEMENT SIGN LOCATION---
- PROPOSED TREE MAINTENANCE EASEMENT---
- NO WOODY VEGETATION BUFFER---
- PRIVATE SEPTIC EASEMENT---
- PRIVATE WELL AREA---
- USE-IN-COMMON ACCESS EASEMENT---
- AREA OF 15 TO 24.9 PERCENT SLOPES---
- AREA OF 25 PERCENT OR GREATER SLOPES---
- FOREST CONSERVATION EASEMENT (RETENTION)---
- WET LAND---
- STABILIZED CONSTRUCTION ENTRANCE---
- 100 YEAR FLOODPLAIN---
- RAIN GARDEN - TYP. OF G.---
- DRAINAGE AND UTILITY EASEMENT---
- 1' PUBLIC TREE MAINTENANCE EASEMENT---
- EROSION CONTROL MATTING FOR IMMEDIATE STABILIZATION---

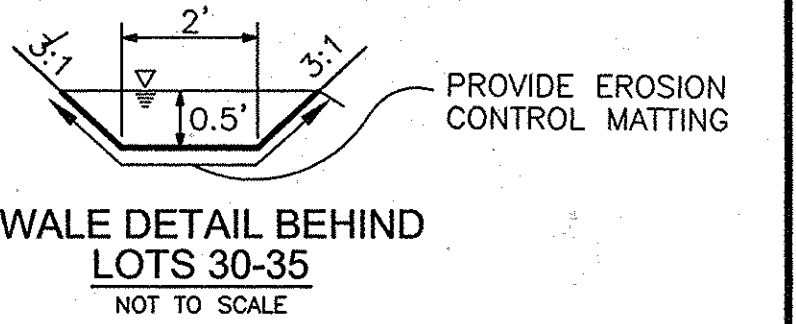

NO.	REVISION	DATE
2	ADD SAFETY FENCE BETWEEN POND 1 AND POE	3-21-09

**GRADING, SEDIMENT AND EROSION CONTROL PLAN**  
**CASTLEBERRY AT TEN OAKS**  
 LOTS 1 - 45, NON-BUILDABLE PRESERVATION  
 PARCELS A, C, D, E & BUILDABLE PRESERVATION PARCEL B

TAX MAP 22 GRID 20 PARCEL 60, LOTS 6 & 7 KEN WARFIELD SUBDIVISION, AND P/O PARCEL 90 HOWARD COUNTY, MARYLAND

**ROBERT H. VOGEL ENGINEERING, INC.**  
 ENGINEERS • SURVEYORS • PLANNERS  
 8407 MAIN STREET ELLICOTT CITY, MD 21043 TEL: 410.461.7666 FAX: 410.461.8911

APPROVED: HOWARD COUNTY DEPARTMENT OF PUBLIC WORKS  
 1-10-07  
 CHIEF, BUREAU OF HIGHWAYS

APPROVED: HOWARD COUNTY DEPARTMENT OF PLANNING AND ZONING  
 1/21/07  
 CHIEF, DEVELOPMENT ENGINEERING DIVISION

3/2/07  
 CHIEF, DIVISION OF LAND DEVELOPMENT

REVIEWED FOR HOWARD SCD AND MEETS TECHNICAL REQUIREMENTS  
 2/15/07  
 USDA-NATURAL RESOURCES CONSERVATION SERVICE

THIS DEVELOPMENT PLAN IS APPROVED FOR SOIL EROSION AND SEDIMENT CONTROL BY THE HOWARD SOIL CONSERVATION DISTRICT  
 2/15/07  
 HOWARD SCD


**ENGINEER'S CERTIFICATE**  
 I HEREBY CERTIFY THAT THIS PLAN FOR POND CONSTRUCTION, EROSION AND SEDIMENT CONTROL REPRESENTS A PRACTICAL AND WORKABLE PLAN BASED ON MY PERSONAL KNOWLEDGE OF THE SITE CONDITIONS. THIS PLAN WAS PREPARED IN ACCORDANCE WITH THE REQUIREMENTS OF THE HOWARD SOIL CONSERVATION DISTRICT. I HAVE NOTIFIED THE DEVELOPER THAT HE/SHE MUST ENGAGE A REGISTERED PROFESSIONAL ENGINEER TO SUPERVISE POND CONSTRUCTION AND PROVIDE THE HOWARD SOIL CONSERVATION DISTRICT WITH AN "AS-BUILT" PLAN OF THE POND WITHIN 30 DAYS OF COMPLETION.  
 1/21/07  
 ROBERT H. VOGEL, PE #16193

**DEVELOPER'S CERTIFICATE**  
 I/WE CERTIFY THAT ALL DEVELOPMENT AND/OR CONSTRUCTION WILL BE DONE IN ACCORDANCE TO THESE PLANS, AND THAT ANY RESPONSIBLE PERSONNEL INVOLVED IN THE CONSTRUCTION PROJECT WILL HAVE A CERTIFICATE OF ATTENDANCE AT A DEPARTMENT OF THE ENVIRONMENT APPROVED TRAINING PROGRAM FOR THE CONTROL OF SEDIMENT AND EROSION BEFORE BEGINNING THE PROJECT. I SHALL ENGAGE A REGISTERED PROFESSIONAL ENGINEER TO SUPERVISE POND CONSTRUCTION AND PROVIDE THE HOWARD SOIL CONSERVATION DISTRICT WITH AN "AS-BUILT" PLAN OF THE POND WITHIN 30 DAYS OF COMPLETION.  
 1/2/07  
 Michael Pfla

**"AS-BUILT" CERTIFICATION**  
 I HEREBY CERTIFY THAT THE FACILITY SHOWN ON THIS PLAN WAS CONSTRUCTED AS SHOWN ON THE AS-BUILT PLANS AND MEETS THE APPROVED PLANS AND SPECIFICATIONS.  
 1/17/14  
 ROBERT H. VOGEL, P.E. #16193  
 CERTIFY MEANS TO STATE OR DECLARE A PROFESSIONAL OPINION BASED UPON ON-SITE INSPECTIONS AND MATERIAL TESTS WHICH ARE CONDUCTED DURING CONSTRUCTION. THE ON-SITE INSPECTION AND TESTS DEEMED SUFFICIENT AND APPROPRIATE BY COMMONLY ACCEPTED ENGINEERING STANDARDS CERTIFY DOES NOT MEAN OR IMPLY A GUARANTEE BY THE ENGINEER NOR DOES AN ENGINEER'S CERTIFICATION RELIEVE ANY OTHER PARTY FROM MEETING COMMONLY ACCEPTED INDUSTRY PRACTICES.

**MATCHLINE OWNER A-A THIS SHEET**  
 HELEN L. FYOCK  
 ROBERT E. FYOCK  
 P.O. BOX 56  
 GLENELG, MARYLAND

**DEVELOPER**  
 CASTLEBERRY AT TEN OAKS, L.L.C.  
 3675 PARK AVENUE, SUITE 301  
 ELLICOTT CITY, MARYLAND 21043  
 (410) 740-9401

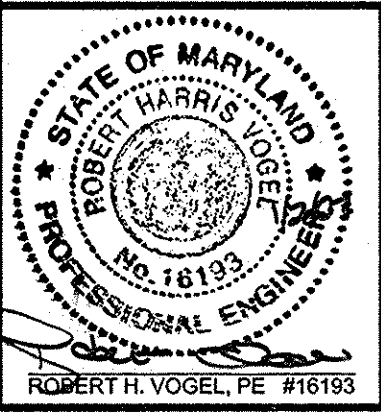

DESIGN BY: RHV/LJT  
 DRAWN BY: LJT  
 CHECKED BY: RHV  
 DATE: DECEMBER, 2006  
 SCALE: 1"=50'  
 W.O. NO.: 00-8500

DPZ REF: S-01-11; P-05-04



12 SHEET OF 23

**LEGEND**

---202---	EXISTING 2 FT CONTOUR
---200---	EXISTING 10 FT CONTOUR
---207---	PROPOSED 2 FT CONTOUR
---200---	PROPOSED 10 FT CONTOUR
SSP	SUPER SILT FENCE
LOD	LIMIT OF DISTURBANCE
---	EXISTING TREELINE
---	PROPOSED TREELINE
---	EARTH DIKE
○	PROPOSED STREET TREE
○	EROSION CONTROL MATTING
○	FOREST CONSERVATION SIGN INDICATION
○	PROPOSED TREE MAINTENANCE EASEMENT
---	NO WOODY VEGETATION BUFFER
---	PRIVATE SEPTIC EASEMENT
---	PRIVATE WELL AREA
---	USE-IN COMMON ACCESS EASEMENT
---	AREA OF 15 TO 24.9 PERCENT SLOPES
---	AREA OF 25 PERCENT OR GREATER SLOPES
---	FOREST CONSERVATION EASEMENT (RETENTION)
---	DRAINAGE AND UTILITY EASEMENT
---	STABILIZED CONSTRUCTION ENTRANCE
---	100 YEAR FLOODPLAIN
---	RAIN GARDEN
---	WET LAND
---	10' PUBLIC TREE MAINTENANCE EASEMENT

**MICROPOOL EXTENDED DETENTION FACILITY #2**  
 HAZARD CLASS 'A' PRIVATELY OWNED AND MAINTAINED  
 10 YR WSEL= 550.09  
 100 YR WSEL= 550.65  
 WQV (WET) WSEL= 548.38  
 CPV WSEL= 549.31

**SEDIMENT BASIN-2 DATA**  
 EX. DRAINAGE AREA: 2.00 AC  
 DEV. DRAINAGE AREA: 2.00 AC  
 TOTAL STORAGE REQUIRED: 7,200 CF  
 TOTAL STORAGE PROVIDED: 32,670 CF  
 WET STORAGE ELEVATION: 546.00-548.00 (2.0')  
 DRY STORAGE ELEVATION: 548.00-548.40 (0.40')  
 CREST ELEVATION: 549.40  
 BOTTOM ELEV: 548.20  
 CLEANOUT ELEVATION: 547.00  
 Q1 PRE= 0.27 CFS  
 Q1 POST= 0.33 CFS

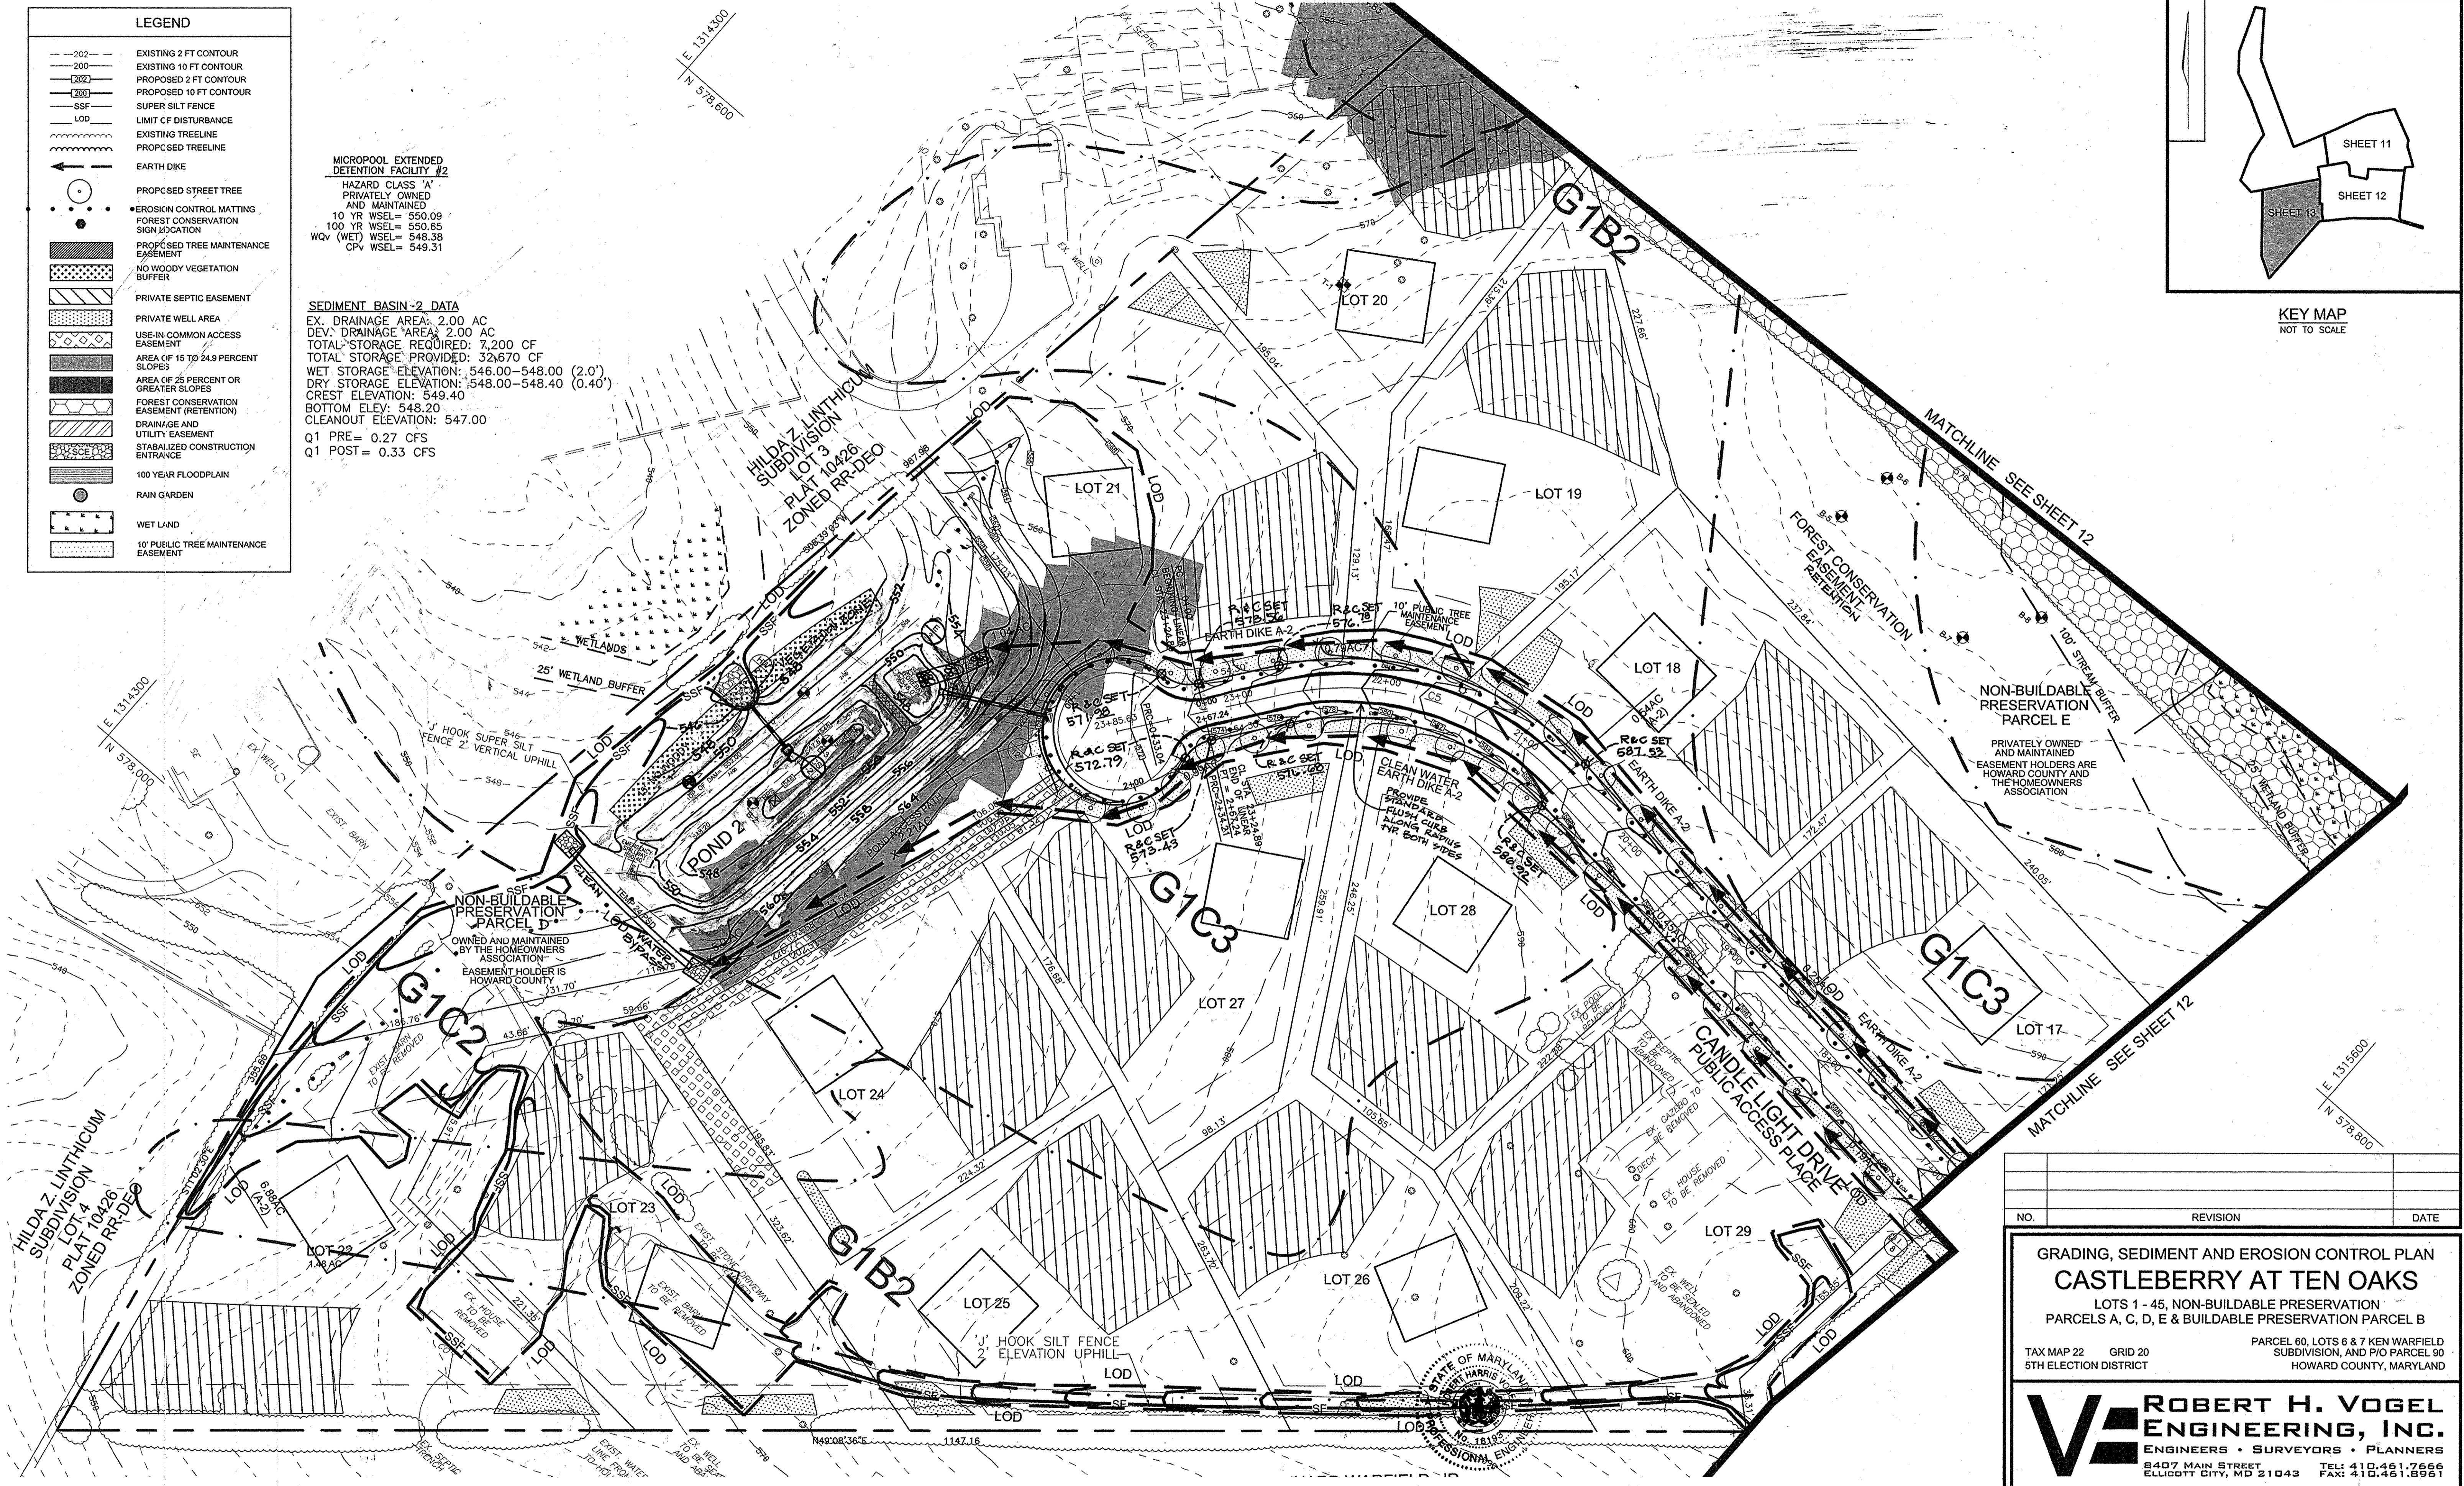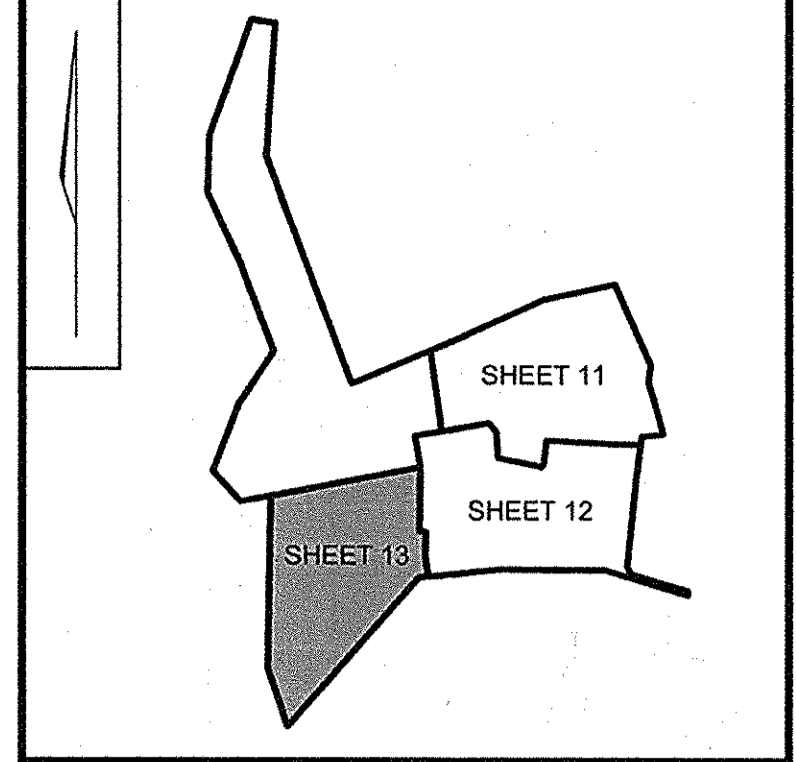

NO.	REVISION	DATE

GRADING, SEDIMENT AND EROSION CONTROL PLAN  
**CASTLEBERRY AT TEN OAKS**  
 LOTS 1 - 45, NON-BUILDABLE PRESERVATION PARCELS A, C, D, E & BUILDABLE PRESERVATION PARCEL B  
 TAX MAP 22 GRID 20 PARCEL 60, LOTS 6 & 7 KEN WARFIELD SUBDIVISION, AND P/O PARCEL 90 5TH ELECTION DISTRICT HOWARD COUNTY, MARYLAND

**ROBERT H. VOGEL ENGINEERING, INC.**  
 ENGINEERS • SURVEYORS • PLANNERS  
 8407 MAIN STREET ELLICOTT CITY, MD 21043 TEL: 410.461.7666 FAX: 410.461.8961

APPROVED: HOWARD COUNTY DEPARTMENT OF PUBLIC WORKS  
*William J. Wood* 1-10-07  
 CHIEF, BUREAU OF HIGHWAYS DATE

APPROVED: HOWARD COUNTY DEPARTMENT OF PLANNING AND ZONING  
*Candy Brown* 7/6/07  
 CHIEF, DIVISION OF LAND DEVELOPMENT DATE

REVIEWED FOR HOWARD SCD AND MEETS TECHNICAL REQUIREMENTS  
*Jim Myers* 2/15/07  
 USDA-NATURAL RESOURCES CONSERVATION SERVICE DATE

THIS DEVELOPMENT PLAN IS APPROVED FOR SOIL EROSION AND SEDIMENT CONTROL BY THE HOWARD SOIL CONSERVATION DISTRICT  
*Matthew* 2/15/07  
 HOWARD SCD DATE

**ENGINEER'S CERTIFICATE**  
 "I HEREBY CERTIFY THAT THIS PLAN FOR POND CONSTRUCTION, EROSION AND SEDIMENT CONTROL REPRESENTS A PRACTICAL AND WORKABLE PLAN BASED ON MY PERSONAL KNOWLEDGE OF THE SITE CONDITIONS. THIS PLAN WAS PREPARED IN ACCORDANCE WITH THE REQUIREMENTS OF THE HOWARD SOIL CONSERVATION DISTRICT. I HAVE NOTIFIED THE DEVELOPER THAT HE/SHE MUST ENGAGE A REGISTERED PROFESSIONAL ENGINEER TO SUPERVISE POND CONSTRUCTION AND PROVIDE THE HOWARD SOIL CONSERVATION DISTRICT WITH AN "AS-BUILT" PLAN OF THE POND WITHIN 30 DAYS OF COMPLETION."  
 ROBERT H. VOGEL, P.E. #16193 1/2/07 DATE

**DEVELOPER'S CERTIFICATE**  
 "I/WE CERTIFY THAT ALL DEVELOPMENT AND/OR CONSTRUCTION WILL BE DONE IN ACCORDANCE TO THESE PLANS, AND THAT ANY RESPONSIBLE PERSONNEL INVOLVED IN THE CONSTRUCTION PROJECT WILL HAVE A CERTIFICATE OF ATTENDANCE AT A DEPARTMENT OF THE ENVIRONMENT APPROVED TRAINING PROGRAM FOR THE CONTROL OF SEDIMENT AND EROSION BEFORE BEGINNING THE PROJECT. I SHALL ENGAGE A REGISTERED PROFESSIONAL ENGINEER TO SUPERVISE POND CONSTRUCTION AND PROVIDE THE HOWARD SOIL CONSERVATION DISTRICT WITH AN "AS-BUILT" PLAN OF THE POND WITHIN 30 DAYS OF COMPLETION."  
 Michael Plow 1/2/07 DATE

**"AS-BUILT" CERTIFICATION**  
 "I HEREBY CERTIFY THAT THE FACILITY SHOWN ON THIS PLAN WAS CONSTRUCTED AS SHOWN ON THE AS-BUILT PLANS AND MEETS THE APPROVED PLANS AND SPECIFICATIONS."  
 ROBERT H. VOGEL, P.E. #16193 11/17/14 DATE  
 UPON MEANS TO STATE OR DECLARE A PROFESSIONAL OPINION BASED UPON ON-SITE INSPECTIONS AND MATERIAL TESTS WHICH ARE CONDUCTED DURING CONSTRUCTION. THE ON-SITE INSPECTION AND TESTS DEEMED SUFFICIENT AND APPROPRIATE BY COMMONLY ACCEPTED ENGINEERING STANDARDS CERTIFY DOES NOT MEAN OR IMPLY A GUARANTEE BY THE ENGINEER NOR DOES AN ENGINEER'S CERTIFICATION RELIEVE ANY OTHER PARTY FROM MEETING COMMONLY ACCEPTED INDUSTRY PRACTICES.




**OWNER**  
 HELEN L. FYOCK CASTLEBERRY AT TEN OAKS, L.L.C.  
 ROBERT E. FYOCK 3875 PARK AVENUE, SUITE 301  
 GLENELG, MARYLAND ELLICOTT CITY, MARYLAND 21043 (410) 740-9401

**DEVELOPER**  
 CASTLEBERRY AT TEN OAKS, L.L.C.  
 3875 PARK AVENUE, SUITE 301  
 ELLICOTT CITY, MARYLAND 21043 (410) 740-9401

**DPZ REF:**  
 S-01-11, P-05-04


DESIGN BY: RHLV/JT  
 DRAWN BY: RHLV  
 CHECKED BY: RHLV  
 DATE: DECEMBER, 2006  
 SCALE: 1"=50'  
 W.O. NO.: 00-85.00

13 SHEET OF 23

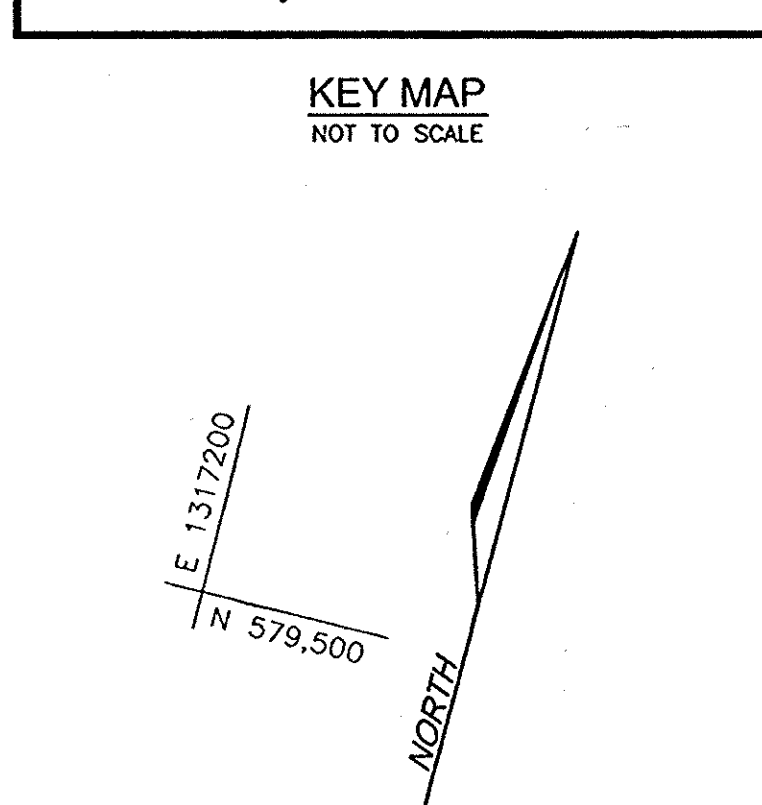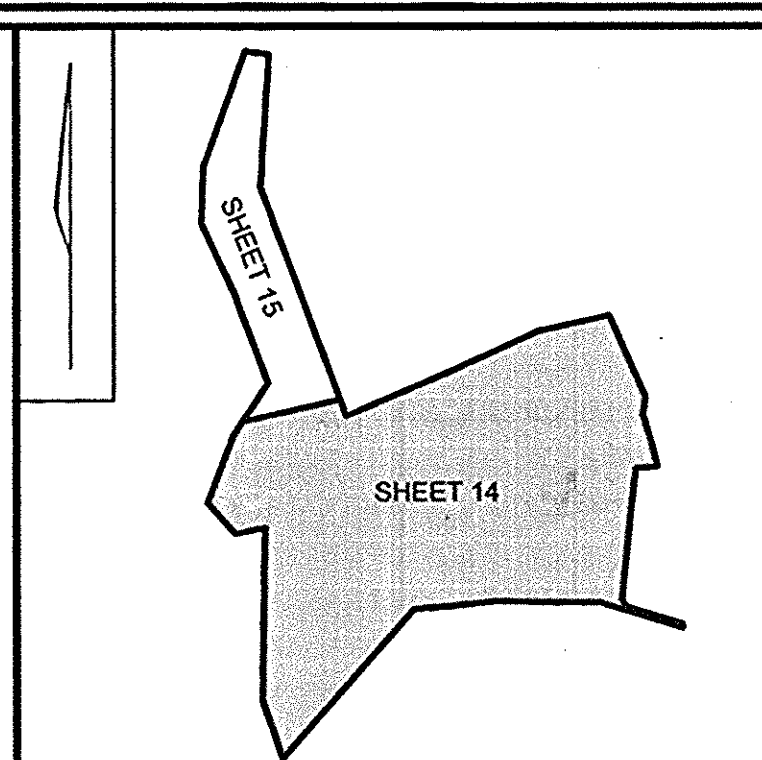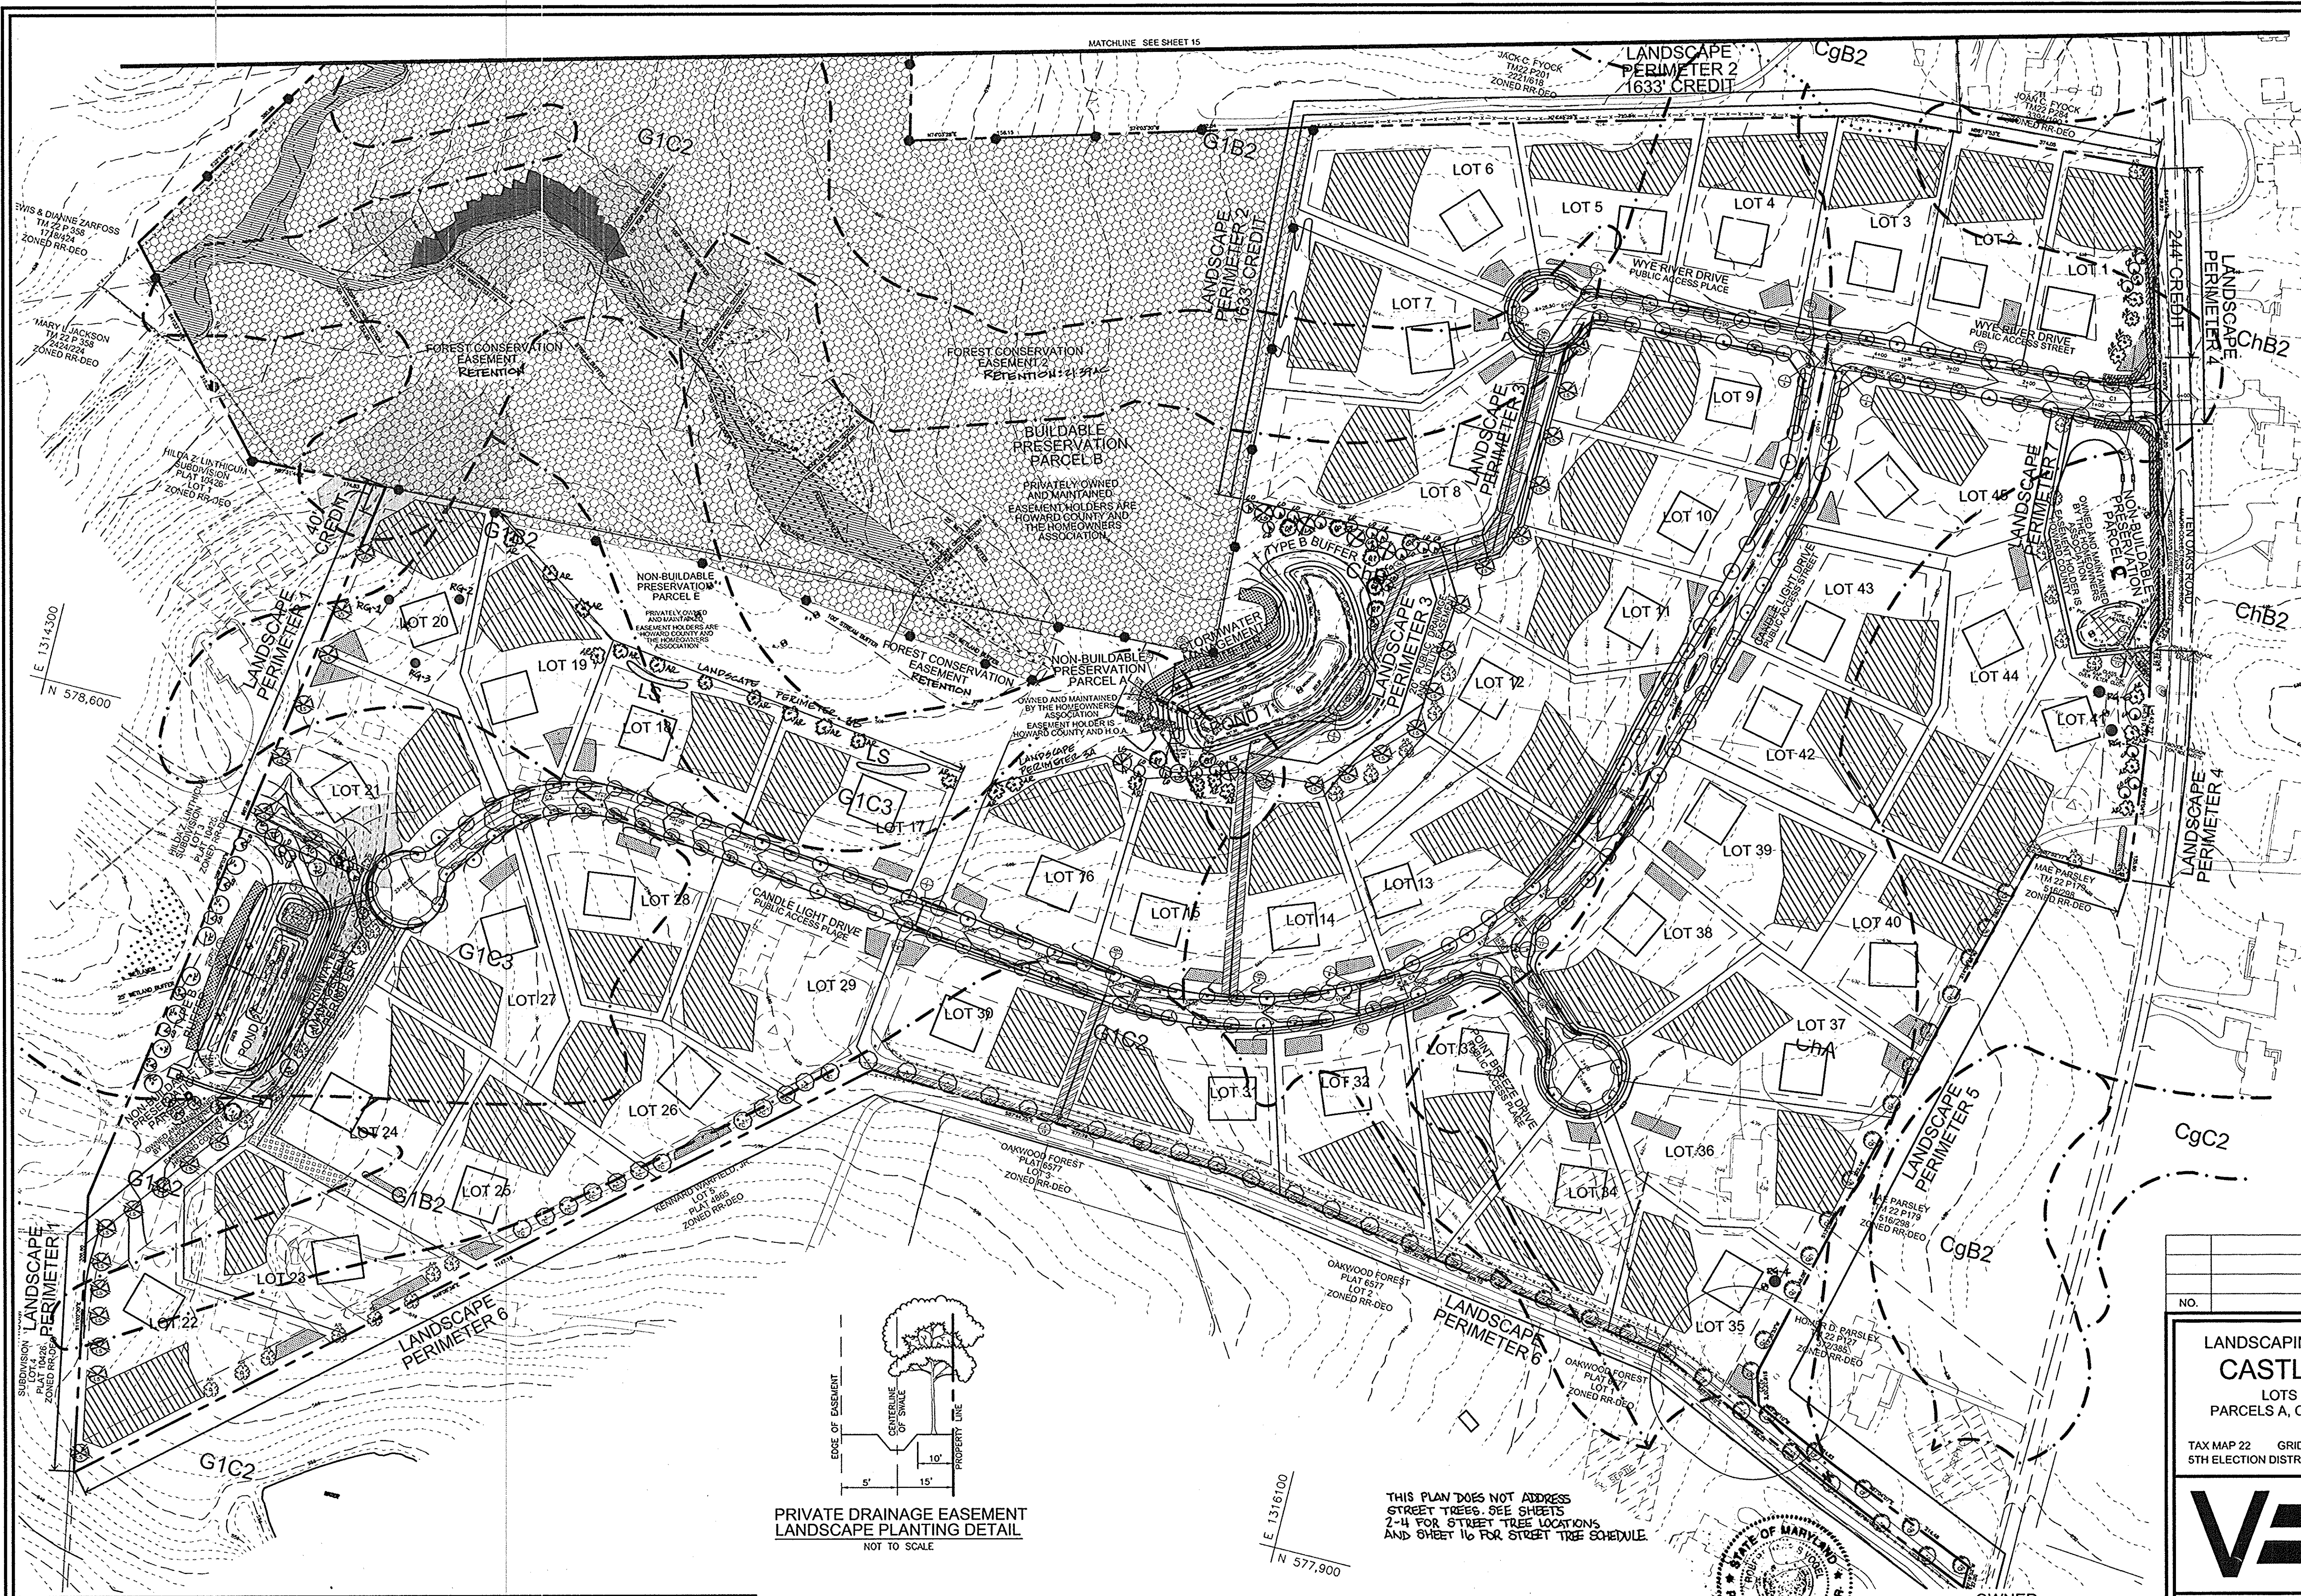


**LEGEND**

- EXISTING 2 FT CONTOUR
- EXISTING 10 FT CONTOUR
- PROPOSED 2 FT CONTOUR
- PROPOSED 10 FT CONTOUR
- SUPER SILT FENCE
- LIMIT OF DISTURBANCE
- EXISTING TREELINE
- PROPOSED TREELINE
- EARTH DIKE
- PROPOSED STREET TREE
- FOREST CONSERVATION SIGN LOCATION
- PROPOSED TREE MAINTENANCE EASEMENT
- NO WOODY VEGETATION BUFFER
- PRIVATE SEPTIC EASEMENT
- PRIVATE WELL AREA
- USE-IN-COMMON ACCESS EASEMENT
- AREA OF 15 TO 24.9 PERCENT SLOPES
- AREA OF 25 PERCENT OR GREATER SLOPES
- FOREST CONSERVATION EASEMENT (RETENTION)
- WET LAND
- 100 YEAR FLOODPLAIN
- DRAINAGE AND UTILITY EASEMENT

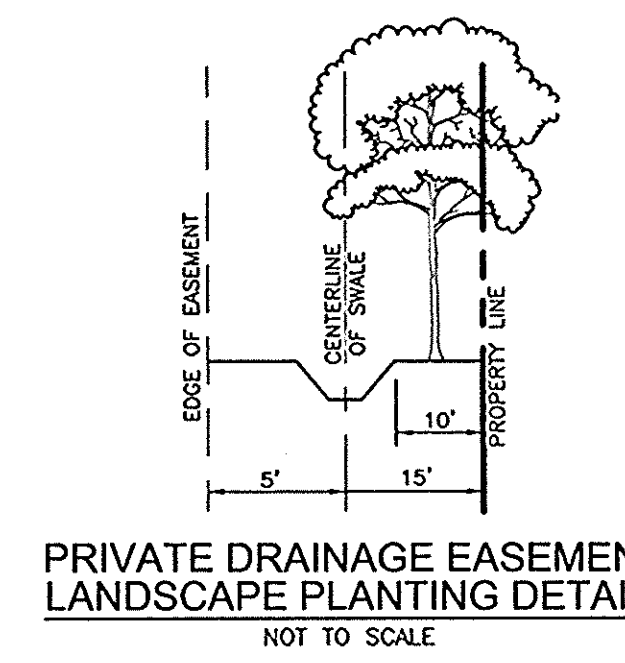

THIS PLAN DOES NOT ADDRESS STREET TREES. SEE SHEETS 2-4 FOR STREET TREE LOCATIONS AND SHEET 16 FOR STREET TREE SCHEDULE.

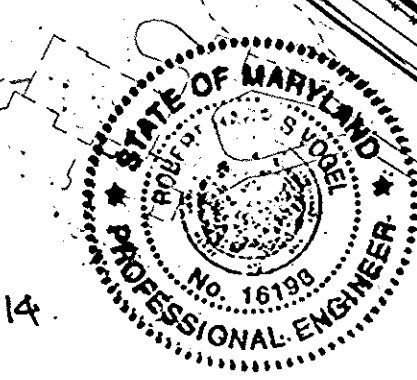

**OWNER**  
 CASTLEBERRY AT TEN OAKS, L.L.C.  
 3875 PARK AVENUE, SUITE 301  
 ELLICOTT CITY, MARYLAND 21043  
 (410) 740-9401

**DEVELOPER**  
 CASTLEBERRY AT TEN OAKS, L.L.C.  
 3875 PARK AVENUE, SUITE 301  
 ELLICOTT CITY, MARYLAND 21043  
 (410) 740-9401

**SOILS LEGEND**

SYMBOL	NAME / DESCRIPTION	SOIL GROUP
CHA	CHESTER SILT LOAM, 0 TO 3 PERCENT SLOPES	B
ChB2	CHESTER SILT LOAM, 3 TO 8 PERCENT SLOPES	B
ChB2	GLENELG LOAM, 3 TO 8 PERCENT SLOPES	B
G1C2	GLENELG LOAM, 8 TO 15 PERCENT SLOPES	B
G1C3	GLENELG LOAM, 8 TO 15 PERCENT SLOPES	B

NOTE: HOWARD SOIL SURVEY PAGE 17.

APPROVED: HOWARD COUNTY DEPARTMENT OF PUBLIC WORKS  
 W. J. ... 1-10-07  
 CHIEF, BUREAU OF HIGHWAYS

APPROVED: HOWARD COUNTY DEPARTMENT OF PLANNING AND ZONING  
 ... 1/10/07  
 CHIEF, DEVELOPMENT ENGINEERING DIVISION

REVIEWED FOR HOWARD SCD AND MEETS TECHNICAL REQUIREMENTS  
 ...  
 USDA-NATURAL RESOURCES CONSERVATION SERVICE  
 THIS DEVELOPMENT PLAN IS APPROVED FOR SOIL EROSION AND SEDIMENT CONTROL BY THE HOWARD SOIL CONSERVATION DISTRICT

NO. REVISION DATE

**LANDSCAPING AND FOREST CONSERVATION PLAN  
 CASTLEBERRY AT TEN OAKS**  
 LOTS 1 - 45, NON-BUILDABLE PRESERVATION  
 PARCELS A, C, D, E & BUILDABLE PRESERVATION PARCEL B

TAX MAP 22 GRID 20  
 5TH ELECTION DISTRICT


PARCEL 60, LOTS 6 & 7 KEN WARFIELD  
 SUBDIVISION, AND PIO PARCEL 90  
 HOWARD COUNTY, MARYLAND

**ROBERT H. VOGEL  
 ENGINEERING, INC.**  
 ENGINEERS • SURVEYORS • PLANNERS  
 8407 MAIN STREET  
 ELLICOTT CITY, MD 21043 TEL: 410.461.7666  
 FAX: 410.461.8961

DESIGN BY: RHW/JT  
 DRAWN BY: LIT  
 CHECKED BY: RHW  
 DATE: DECEMBER, 2006  
 SCALE: 1"=100'  
 W.D. NO.: 00-85.00

DPZ REF: S-01-11, P-05-04

14 SHEET OF 23

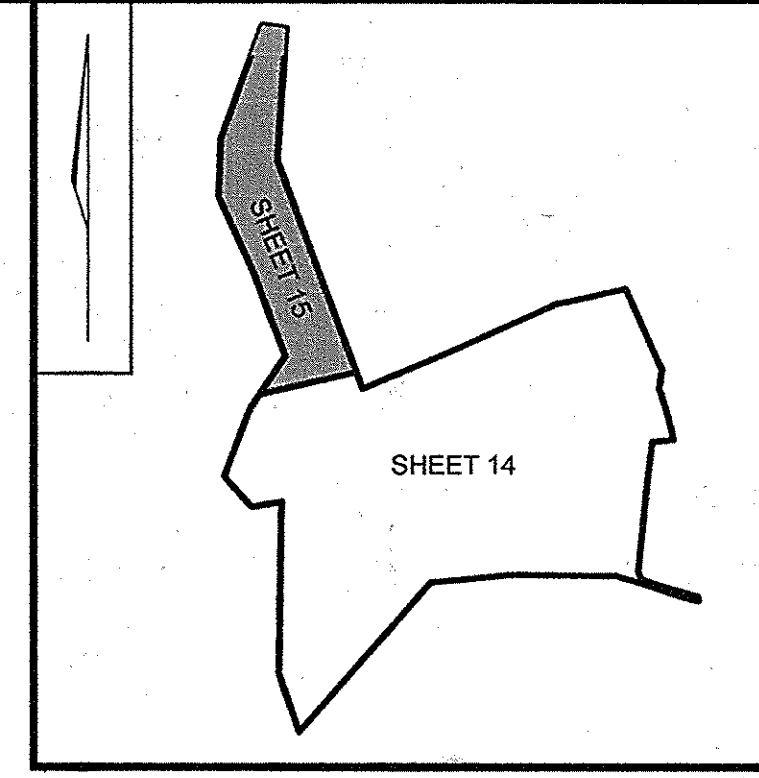

**LEGEND**

- 202- EXISTING 2 FT CONTOUR
- 200- EXISTING 10 FT CONTOUR
- 202- PROPOSED 2 FT CONTOUR
- 200- PROPOSED 10 FT CONTOUR
- SSF- SUPER SILT FENCE
- LOD- LIMIT OF DISTURBANCE
- TTL- EXISTING TREELINE
- TTL- PROPOSED TREELINE
- EARTH DIKE-
- PROPOSED STREET TREE-
- FOREST CONSERVATION SIGN LOCATION-
- PROPOSED TREE MAINTENANCE EASEMENT-
- NO WOODY VEGETATION BUFFER-
- PRIVATE SEPTIC EASEMENT-
- PRIVATE WELL AREA-
- USE-IN-COMMON ACCESS EASEMENT-
- AREA OF 15 TO 24.9 PERCENT SLOPES-
- AREA OF 25 PERCENT OR GREATER SLOPES-
- FOREST CONSERVATION EASEMENT (RETENTION)-
- WET LAND-
- 100 YEAR FLOODPLAIN-
- DRAINAGE AND UTILITY EASEMENT-

**FOREST CONSERVATION WORKSHEET**

NET TRACT AREA:  
 A. TOTAL TRACT AREA 99.58 AC  
 B. AREA WITHIN 100 YEAR FLOODPLAIN 2.18 AC  
 C. NET TRACT AREA 97.40 AC

LAND USE CATEGORY  
 ARA MDR IDA HDR MPD CIA  
 0 1 0 0 0 0

D. AFFORESTATION THRESHOLD 20% X D = 19.48 AC  
 E. CONSERVATION THRESHOLD 25% X D = 24.35 AC

EXISTING FOREST COVER:  
 F. EXISTING FOREST COVER (EXCLUDING FLOODPLAIN) = 40.63 AC  
 G. AREA OF FOREST ABOVE CONSERVATION THRESHOLD = 16.28 AC

BREAK EVEN POINT:  
 H. BREAK EVEN POINT = 27.61 AC  
 I. CLEARING PERMITTED WITHOUT MITIGATION = 13.02 AC

PROPOSED FOREST CLEARING:  
 J. TOTAL AREA OF FOREST TO BE CLEARED = 13.02 AC  
 K. TOTAL AREA OF FOREST TO BE RETAINED = 27.61 AC


PLANTING REQUIREMENTS:  
 L. REFORESTATION FOR CLEARING ABOVE CONSERVATION THRESHOLD = 0.00 AC  
 M. REFORESTATION FOR CLEARING BELOW CONSERVATION THRESHOLD = 0.00 AC  
 N. CREDIT FOR RETENTION ABOVE CONSERVATION THRESHOLD = 0.00 AC  
 O. TOTAL AFFORESTATION REQUIRED = 0.00 AC  
 P. TOTAL REFORESTATION REQUIRED = 0.00 AC  
 Q. TOTAL AFFORESTATION REQUIRED = 0.00 AC  
 R. TOTAL PLANTING REQUIRED = 0.00 AC

**FOREST CONSERVATION EASEMENT TABLE**

FOREST CONSERVATION EASEMENT 1 RETENTION	0.72 AC.
FOREST CONSERVATION EASEMENT 2 RETENTION	21.29 AC.
FOREST CONSERVATION EASEMENT 3 RETENTION	0.4 AC.
FOREST CONSERVATION EASEMENT 4 RETENTION	1.24 AC.
FOREST CONSERVATION EASEMENT 5 RETENTION	0.45 AC.
FOREST CONSERVATION EASEMENT 6 RETENTION	3.40 AC.
<b>TOTAL RETENTION</b>	<b>27.61 AC.</b>

**NOTES**  
 1. FOREST CONSERVATION OBLIGATION WILL BE FULFILLED BY THE RETENTION OF 27.61 ACRES OF FOREST ONSITE.

*[Signature]* 11/17/14

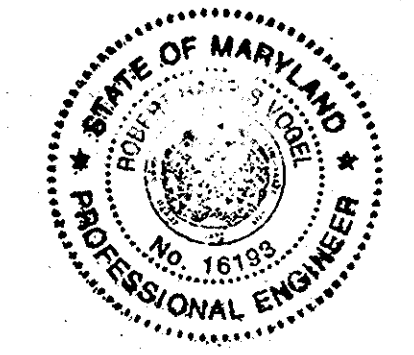

APPROVED: HOWARD COUNTY DEPARTMENT OF PUBLIC WORKS  
*[Signature]* 1-10-07  
 CHIEF, BUREAU OF HIGHWAYS

APPROVED: HOWARD COUNTY DEPARTMENT OF PLANNING AND ZONING  
*[Signature]* 1/10/07  
 CHIEF, DEVELOPMENT ENGINEERING DIVISION

*[Signature]* 2/3/07  
 CHIEF, DIVISION OF LAND DEVELOPMENT

REVIEWED FOR HOWARD SCD AND MEETS TECHNICAL REQUIREMENTS

USDA-NATURAL RESOURCES CONSERVATION SERVICE DATE  
 THIS DEVELOPMENT PLAN IS APPROVED FOR SOIL EROSION AND SEDIMENT CONTROL BY THE HOWARD SOIL CONSERVATION DISTRICT  
 HOWARD SCD DATE

**SOILS LEGEND**

SYMBOL	NAME / DESCRIPTION	SOIL GROUP
ChA	CHESTER SILT LOAM, 0 TO 3 PERCENT SLOPES	B
ChB2	CHESTER SILT LOAM, 3 TO 8 PERCENT SLOPES	B
GIB2	GLENELG LOAM, 3 TO 8 PERCENT SLOPES	B
GIC2	GLENELG LOAM, 8 TO 15 PERCENT SLOPES	B
GIC3	GLENELG LOAM, 8 TO 15 PERCENT SLOPES	B

NOTE: HOWARD SOIL SURVEY PAGE 17.

**OWNER**  
 HELEN L. FYOCK  
 ROBERT E. FYOCK  
 P.O. BOX 56  
 GLENELG, MARYLAND

CASTLEBERRY AT TEN OAKS, L.L.C.  
 3675 PARK AVENUE, SUITE 301  
 ELLICOTT CITY, MARYLAND 21043  
 (410) 740-9401

**DEVELOPER**  
 LARRY J. THOMPSON  
 DISTRICT OFFICE PROFESSIONAL

CASTLEBERRY AT TEN OAKS, L.L.C.  
 3675 PARK AVENUE, SUITE 301  
 ELLICOTT CITY, MARYLAND 21043  
 (410) 740-9401

NO. REVISION DATE

**LANDSCAPING AND FOREST CONSERVATION PLAN**  
**CASTLEBERRY AT TEN OAKS**  
 LOTS 1 - 45, NON-BUILDABLE PRESERVATION  
 PARCELS A, C, D, E & BUILDABLE PRESERVATION PARCEL B


TAX MAP 22 GRID 20 PARCEL 60, LOTS 6 & 7 KEN WARFIELD SUBDIVISION, AND PIO PARCEL 90 5TH ELECTION DISTRICT HOWARD COUNTY, MARYLAND

**ROBERT H. VOGEL ENGINEERING, INC.**  
 ENGINEERS • SURVEYORS • PLANNERS  
 8407 MAIN STREET ELLICOTT CITY, MD 21043 TEL: 410.461.7666 FAX: 410.461.8961


**DESIGN BY:** RHW/LJT  
**DRAWN BY:** LJT  
**CHECKED BY:** RHW  
**DATE:** DECEMBER, 2006  
**SCALE:** 1"=100'  
**W.D. NO.:** 09-85.00

DPZ REF: S-01-11, P-05-04

15 SHEET OF 23

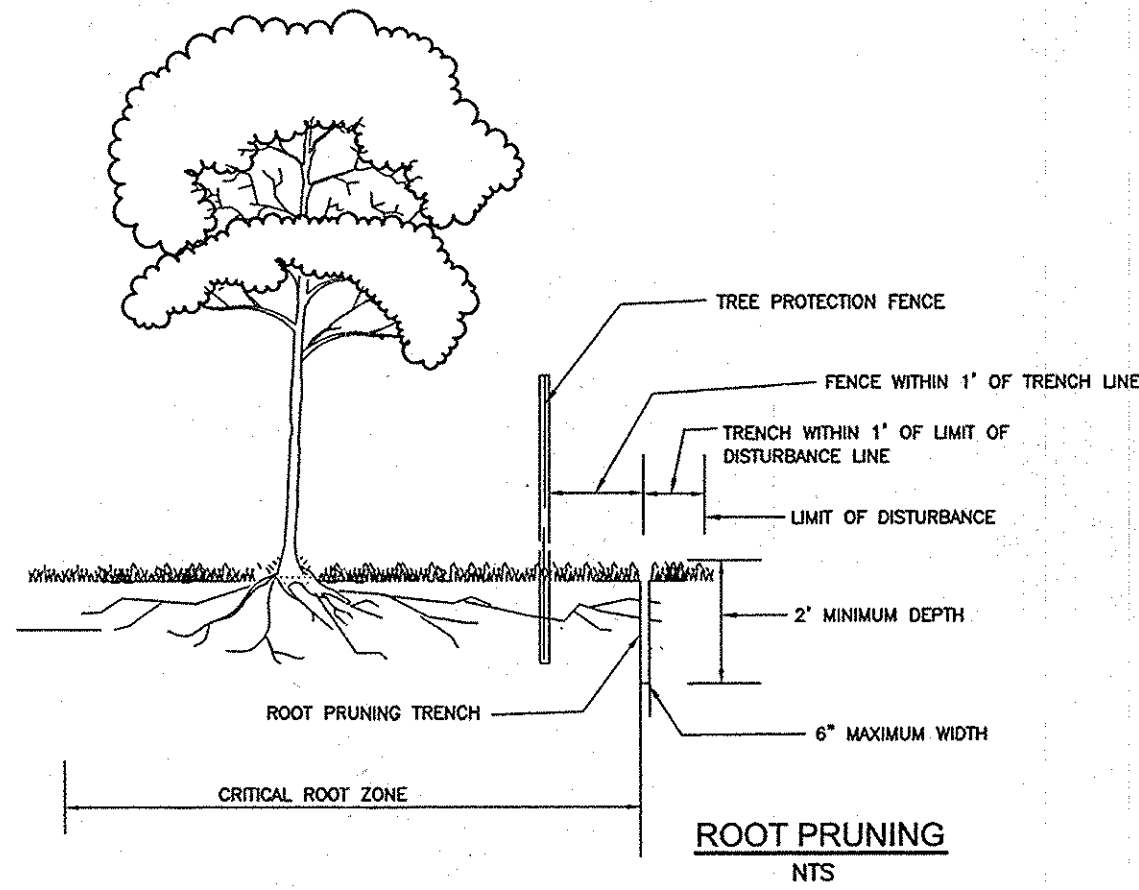


- NOTES:**
- RETENTION AREAS TO BE ESTABLISHED AS PART OF THE FOREST CONSERVATION PLAN REVIEW PROCESS.
  - BOUNDARIES OF RETENTION AREAS TO BE STAKED, FLAGGED AND/OR FENCED PRIOR TRENCHING.
  - EXACT LOCATION OF TRENCH SHOULD BE IDENTIFIED.
  - TRENCH SHOULD BE IMMEDIATELY BACKFILLED WITH SOIL REMOVED OR ORGANIC SOIL.
  - ROOTS SHOULD BE CLEANLY CUT USING VIBRATORY KNIFE OR OTHER ACCEPTABLE EQUIPMENT.

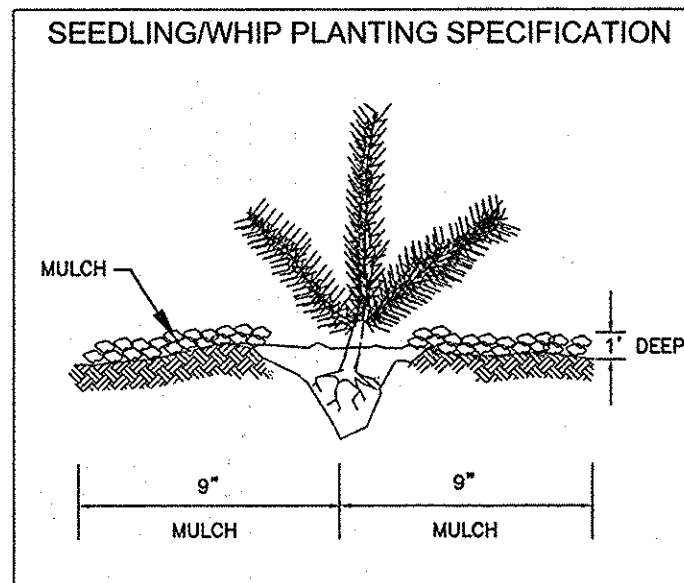


- NOTE:**
- PLANT MIX TO BE 1/3 PIONEER & 2/3 MID TO LATE SUCCESSIONAL SPECIES.
  - PLANT LARGER STOCK AND EVERGREENS AROUND PERIMETER TO PROTECT INTERIOR SMALLER STOCK.
  - WHEN SHRUBS ARE SPECIFIED, PLANT THEM IN CLUSTERS.
  - DO NOT PLANT TREES IN A GRID PATTERN.

**NOTES:**

- SEE "LANDSCAPE SPECIFICATION GUIDELINES FOR BALTIMORE-WASHINGTON METROPOLITAN AREAS" FOR ALL MATERIAL, PRODUCT, AND PROCEDURE SPECIFICATIONS.
- SEE "LANDSCAPE GUIDELINES" FOR SUPPORTING TREES LARGER THAN 2-1/2" CALIPER.
- PLACE UPRIGHT STAKES PARALLEL TO WALKS & BUILDINGS.
- KEEP MULCH 1" FROM TRUNK.
- SEE ARCHITECTURAL PLANS FOR ADDITIONAL PLANTINGS WHICH EXCEED HOWARD COUNTY MINIMUM REQUIREMENTS.
- TREES ARE NOT TO BE PLANTED OVER PRIVATE SEWAGE EASEMENT.

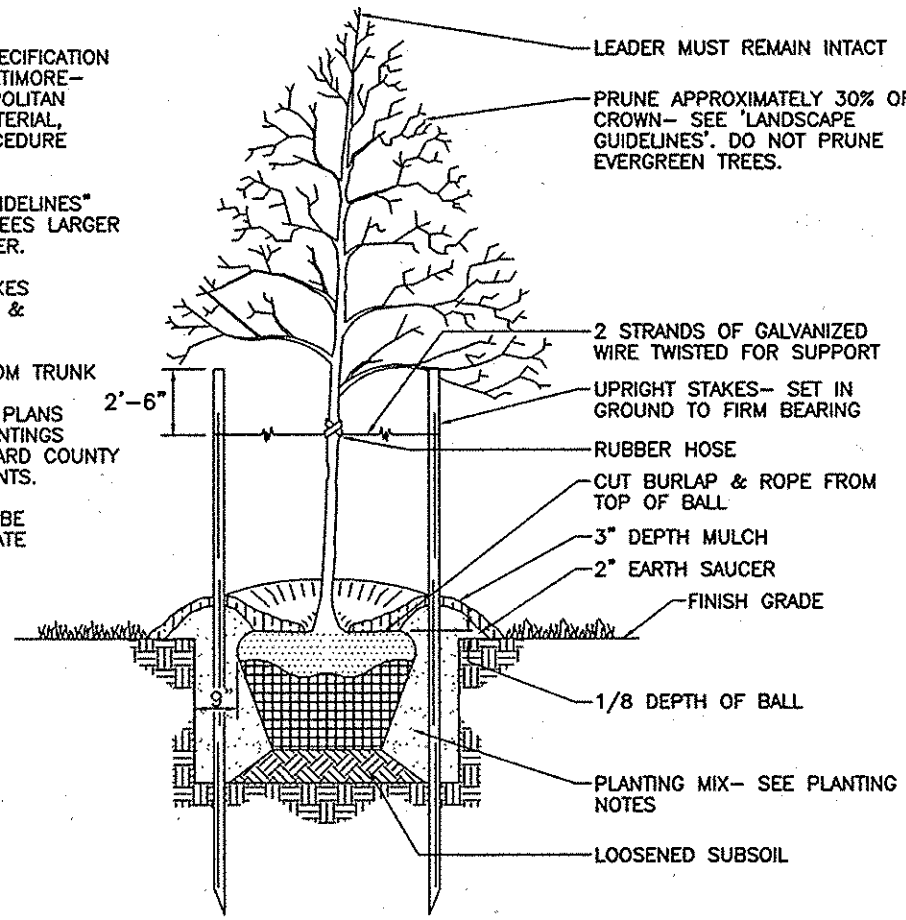


**TREE PLANTING AND STAKING**  
DECIDUOUS TREES UP TO 2-1/2" CALIPER  
NOT TO SCALE

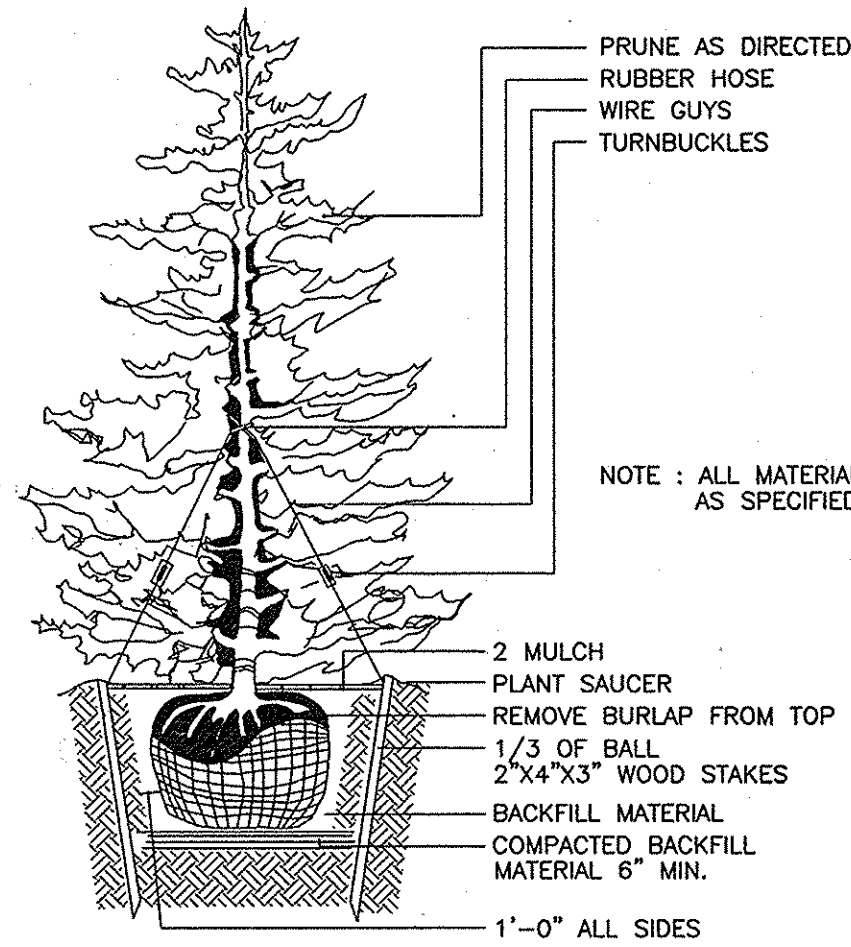

**TYPICAL EVERGREEN TREE PLANTING DETAIL**  
NOT TO SCALE

LANDSCAPE SCHEDULE				
KEY	QUAN.	BOTANICAL NAME	SIZE	REM.
LS	40	LIQUIDAMBAR STYRACIFLUA AMERICAN SWEETGUM	2 1/2"-3" Cal.	B & B
OP	40	QUERCUS PALUSTRIS PIN OAK	2 1/2"-3" Cal.	B & B
TC	40	TILIA CORDATA 'GREENSPIRE' LITTLELEAF LINDEN	2 1/2"-3" Cal.	B & B
AR	57	ACER RUBRUM 'OCTOBER GLORY' OCTOBER GLORY RED MAPLE	2 1/2"-3" Cal.	B & B
CO	48	CYPRESS OCYPARIS LEYLANDI LEYLAND CYPRESS	5' - 6' HT.	B & B


**1.** ALL PLANT MATERIALS SHALL BE FULL AND HEAVY, BE WELL FORMED AND SYMMETRICAL, CONFORM TO THE MOST CURRENT AAN SPECIFICATIONS AND BE INSTALLED IN ACCORDANCE WITH LCAMW PLANTING SPECIFICATIONS.  
**2.** CONTRACTOR SHALL VERIFY LOCATION OF ALL UNDERGROUND UTILITIES PRIOR TO DIGGING.  
**3.** FINAL LOCATION OF PLANT MATERIAL MAY NEED TO VARY TO MEET FINAL FIELD CONDITIONS. TREES SHALL NOT BE PLANTED IN THE BOTTOM OF DRAINAGE SWALES.  
**4.** CONTRACTOR SHALL VERIFY PLANT QUANTITIES PRIOR TO BIDDING. IF PLAN DIFFERS FROM LANDSCAPE SCHEDULE, THE PLAN SHALL GOVERN.

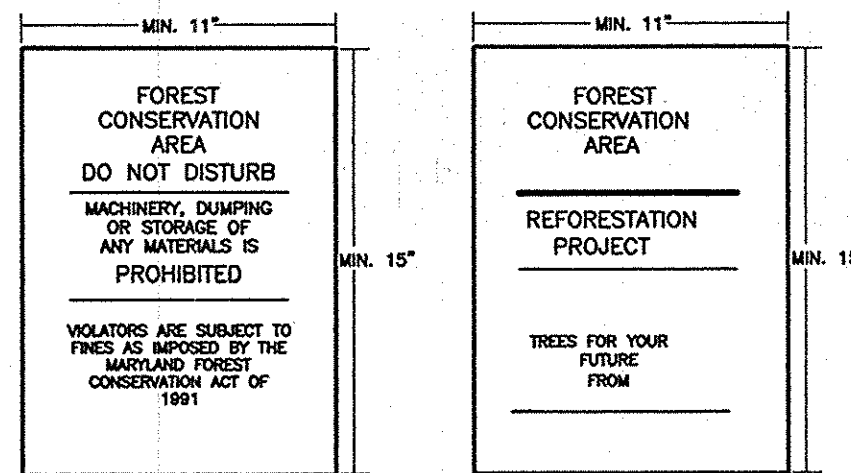

- NOTE:**
- BOTTOM OF SIGNS TO BE HIGHER THAN TOP OF TREE PROTECTION FENCE.
  - SIGNS TO BE PLACED AT A MAXIMUM SPACING OF 50-100 FEET.
  - CONDITIONS ON-SITE AFFECTING VISIBILITY MAY WARRANT PLACING SIGNS CLOSER OR FARTHER APART.
  - ATTACHMENT OF SIGNS TO TREES IS PROHIBITED.


**SEQUENCE OF CONSTRUCTION-FOREST CONSERVATION**

- PRECONSTRUCTION MEETING/SITE WALK WITH CONTRACTORS AND OTHER RESPONSIBLE PARTIES TO DEFINE PROTECTION MEASURES TO BE UTILIZED AND TO POINT OUT PARTICULAR TREES TO BE SAVED.
- STAKE OUT LIMITS OF DISTURBANCE AND TREE PROTECTION FENCING LOCATIONS.
- INSTALL TREE PROTECTION FENCING AND FENCE TO BE INSPECTED BY THE PROJECT ENGINEER OR THE PROJECT ECOLOGIST AND HOWARD COUNTY PLANNING AND ZONING.
- PROCEED WITH TREE REMOVAL AND SITE IMPROVEMENTS AS PER APPROVED SEDIMENT CONTROL PLAN - TO BE INSPECTED BY HOWARD COUNTY PLANNING AND ZONING.
- TEMPORARY TREE PROTECTION DEVICES SHALL BE REMOVED AFTER ALL FINISHED GRADING AND UTILITY CONSTRUCTION HAS OCCURRED AND WITH APPROVAL FROM THE HOWARD COUNTY OFFICE OF PLANNING AND ZONING.

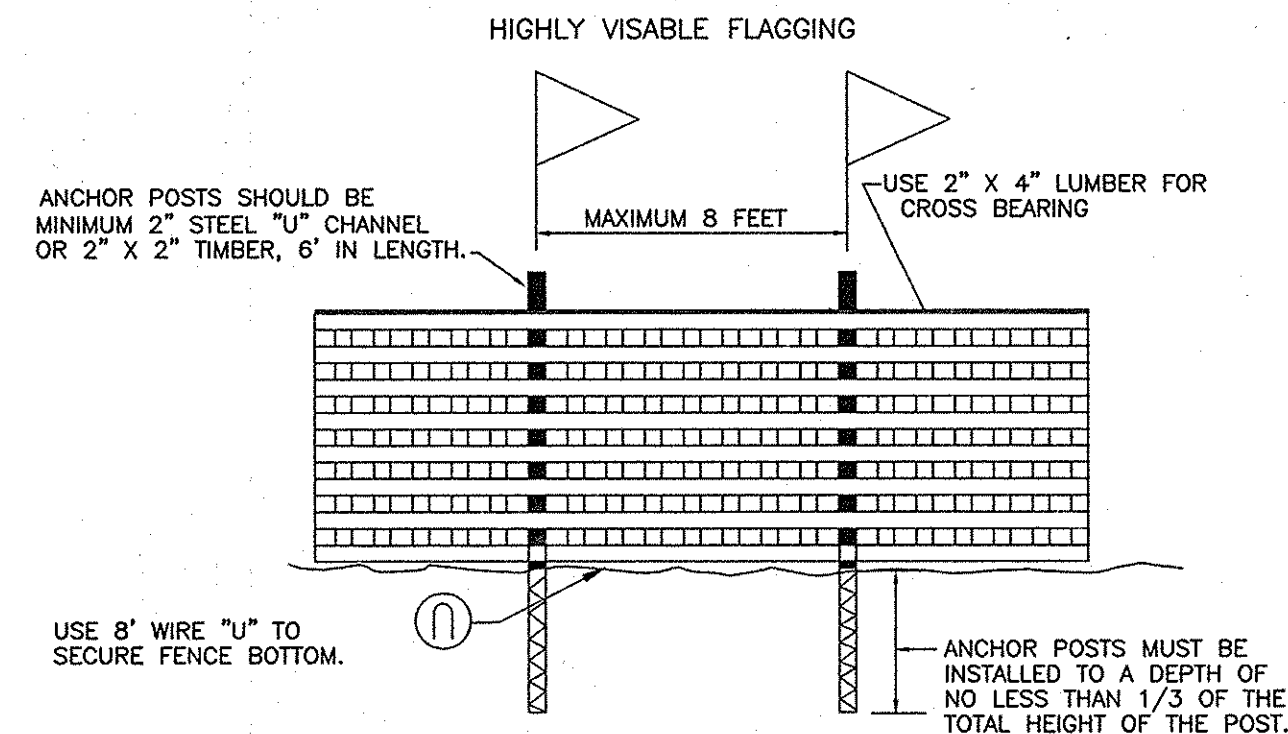


- NOTES:**
- FOREST PROTECTION DEVICE ONLY.
  - RETENTION AREA WILL BE SET AS PART OF THE REVIEW PROCESS.
  - BOUNDARIES OF RETENTION AREA SHOULD BE STAKED AND FLAGGED PRIOR TO INSTALLING DEVICE.
  - ROOF DAMAGE SHOULD BE AVOIDED.
  - PROTECTION SIGNAGE SHOULD BE USED.
  - DEVICE SHOULD BE MAINTAINED THROUGHOUT CONSTRUCTION.

**BLAZE ORANGE PLASTIC MESH**  
**TYPICAL TREE PROTECTION FENCE DETAIL**  
NTS

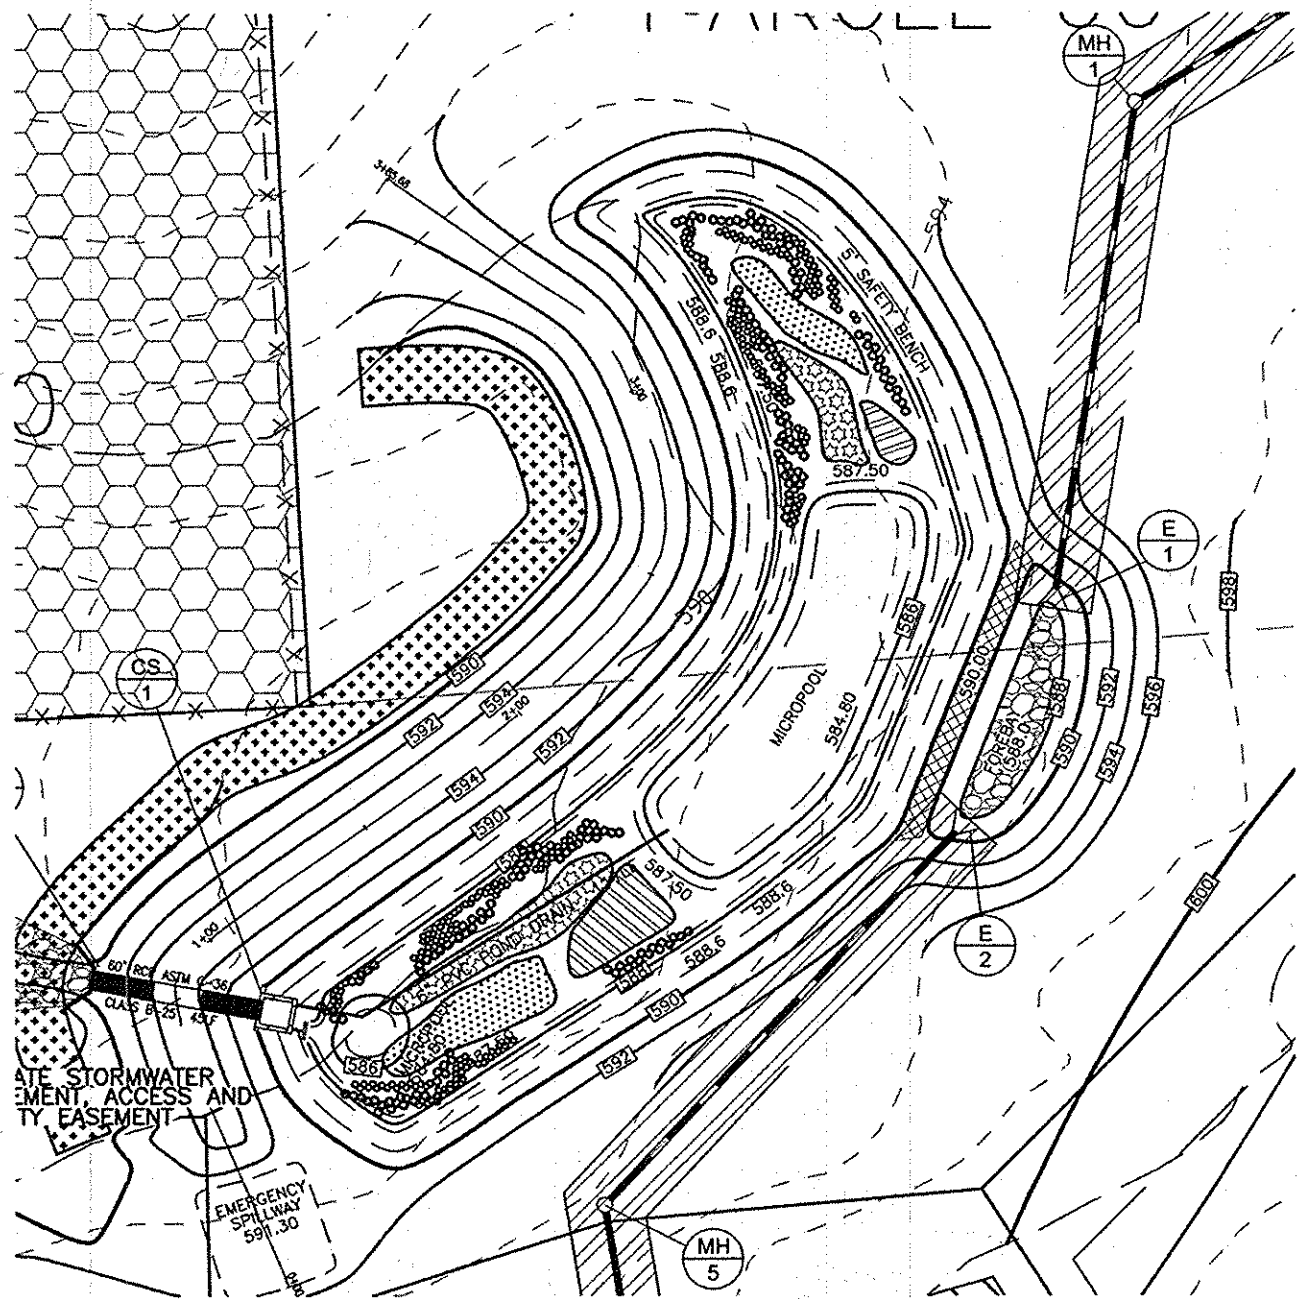

**POND 1 PLANTING DETAIL**  
SCALE: 1"=50'

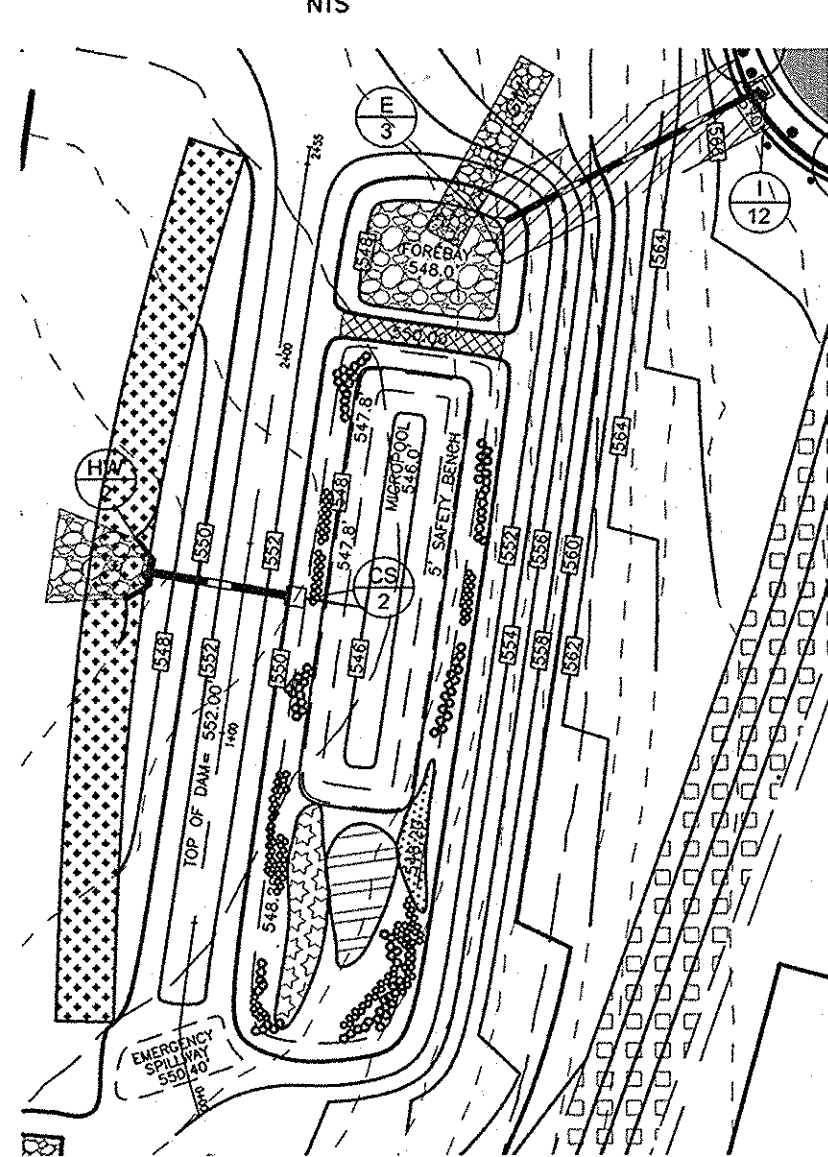

**POND 2 PLANTING DETAIL**  
SCALE: 1"=50'

EMERGENT PLANTING SCHEDULE POND 1 AND 2				
KEY	QUAN.	BOTANICAL NAME	SIZE	REMARKS
VA	156	Vallisneria americana Wild Celery	plug	2' oc
IP	165	Iris pseudacoris Yellow Water Iris	plug	1.5' oc
IV	165	Iris versicolor Blue Flag (wear gloves)	plug	1.5' oc
SL	33	Sagittaria latifolia Duck Potato (do not plant tubers)	plug	4' oc
CE	81	Cyperus esculentus Yellow Nut Sedge	plug	2' oc
NL	378	Nuphar luteum Spatterdock	plug	1.5' oc
CL	192	Carex lasiocarpa Lake Sedge	plug	2' oc

ADD THREE INCHES OF TOPSOIL TO PLANTING AREA. STABILIZE WITH 40 POUNDS PER ACRE OF A HYDROSEED MIX (WET MIX AND MEADOW MIX) FROM SYLVA NATIVE NURSERY OR EQUAL. ALL PLANT MATERIALS TO CONFORM TO THE MOST CURRENT AAN SPECIFICATIONS AND BE INSTALLED IN ACCORDANCE WITH LCAMW SPECIFICATIONS.

POND #1		SCHEDULE D: STORMWATER MANAGEMENT AREA LANDSCAPING	
LINEAR FEET OF PERIMETER	816 LF	CREDIT FOR EXISTING VEGETATION (NO, YES AND LINEAR FEET)	N/A
CREDIT FOR OTHER LANDSCAPING (NO, YES AND %)	N/A	NUMBER OF TREES REQUIRED	17 SHADE TREES 21 EVERGREEN TREES
NUMBER OF TREES PROVIDED	17 SHADE TREES 21 EVERGREEN TREES	OTHER TREES (2:1 SUBSTITUTION)	0 TREES (0 SUBSTITUTION TREES)

POND #2		SCHEDULE D: STORMWATER MANAGEMENT AREA LANDSCAPING	
LINEAR FEET OF PERIMETER	662 LF	CREDIT FOR EXISTING VEGETATION (NO, YES AND LINEAR FEET)	N/A
CREDIT FOR OTHER LANDSCAPING (NO, YES AND %)	N/A	NUMBER OF TREES REQUIRED	14 SHADE TREES 17 EVERGREEN TREES
NUMBER OF TREES PROVIDED	14 SHADE TREES 17 EVERGREEN TREES	OTHER TREES (2:1 SUBSTITUTION)	0 TREES (0 SUBSTITUTION TREES)


SCHEDULE A PERIMETER LANDSCAPE EDGE										
CATEGORY	ADJACENT TO ROADWAYS				ADJACENT TO PERIMETER PROPERTIES					
	4	1	2	3	5	6	7	8A	8B	9
Perimeter/Frontage Designation	4	1	2	3	5	6	7	8A	8B	9
Linear Feet of Roadway	634'	1576'	1633'	1086'	1288'	2711'	409'	995'	101'	
Credit for Existing Vegetation (Yes, No, Linear Feet)	Yes** 244'	Yes* 40'	Yes* 1633'	No	No	No	No	No	No	No
Credit for Wall, Fence or Berm (Yes, No, Linear Feet)	No	No	No	No	No	No	No	No	No	No
Number of Plants Required	1:50 8 1:40 10	1:60 26 1:40 26	1:60 0 1:60 19	1:60 19 1:60 22	1:60 46 1:60 7	1:60 7 1:60 12	1:60 6 1:60 12	1:60 6 1:60 12	1:60 6 1:60 12	1:60 12 1:60 12
Number of Plants Provided	8 10	26 26	0 19	19 22	46 7	7 12	6 12	6 12	6 12	12 12
Shade Trees	8	26	0	19	22	46	7	6	6	12
Evergreen Trees	10	26	19	22	7	12	12	12	12	12
Other Trees (2:1 Substitution)	-	-	-	-	-	-	-	-	-	-
Shrubs (10:1 Substitution)	-	-	-	-	-	-	-	-	-	-
Describe Plant Substitution Credits Below if needed										

\* Existing Woods to Remain \*\* Existing Shade Trees and Evergreen Trees to Remain

STREET TREE SCHEDULE					
KEY	QUAN.	BOTANICAL NAME	SIZE	REM.	ROAD LOCATION
122	ACER RUBRUM 'OCTOBER GLORY' OCTOBER GLORY RED MAPLE	2 1/2"-3" CAL.	B & B	CANDLE LIGHT DRIVE	
42	QUERCUS PALUSTRIS PIN OAK	2 1/2"-3" CAL.	B & B	WYE RIVER DRIVE	
12	TILIA CORDATA 'GREENSPIRE' LITTLELEAF LINDEN	2 1/2"-3" CAL.	B & B	POINT BREEZE DRIVE	

**NOTES:**

- PERIMETER LANDSCAPING SHALL BE IN ACCORDANCE WITH SECTION 16.124 OF THE HOWARD COUNTY CODE AND LANDSCAPE SCHEDULE 3. FINANCIAL SURETY FOR THE REQUIRED LANDSCAPING SHALL BE POSTED AS PART OF THE DEVELOPER'S AGREEMENT IN THE AMOUNT OF \$54,900.00 FOR 177 SHADE TREES AND 48 EVERGREEN TREES.
- FOREST CONSERVATION REQUIREMENTS PER SECTION 16.1202 OF THE HOWARD COUNTY CODE AND THE FOREST CONSERVATION MANUAL FOR THIS SUBDIVISION WILL BE FULFILLED BY THE RETENTION OF 27.61 AC ON-SITE. SURETY IN THE AMOUNT OF \$240,539.00 WILL BE PAID WITH THE DEVELOPER'S AGREEMENT.
- FINANCIAL SURETY FOR THE REQUIRED TOTAL 176 STREET TREES WILL BE POSTED AS PART OF THE DEVELOPER'S AGREEMENT IN AMOUNT OF \$52,800.00.

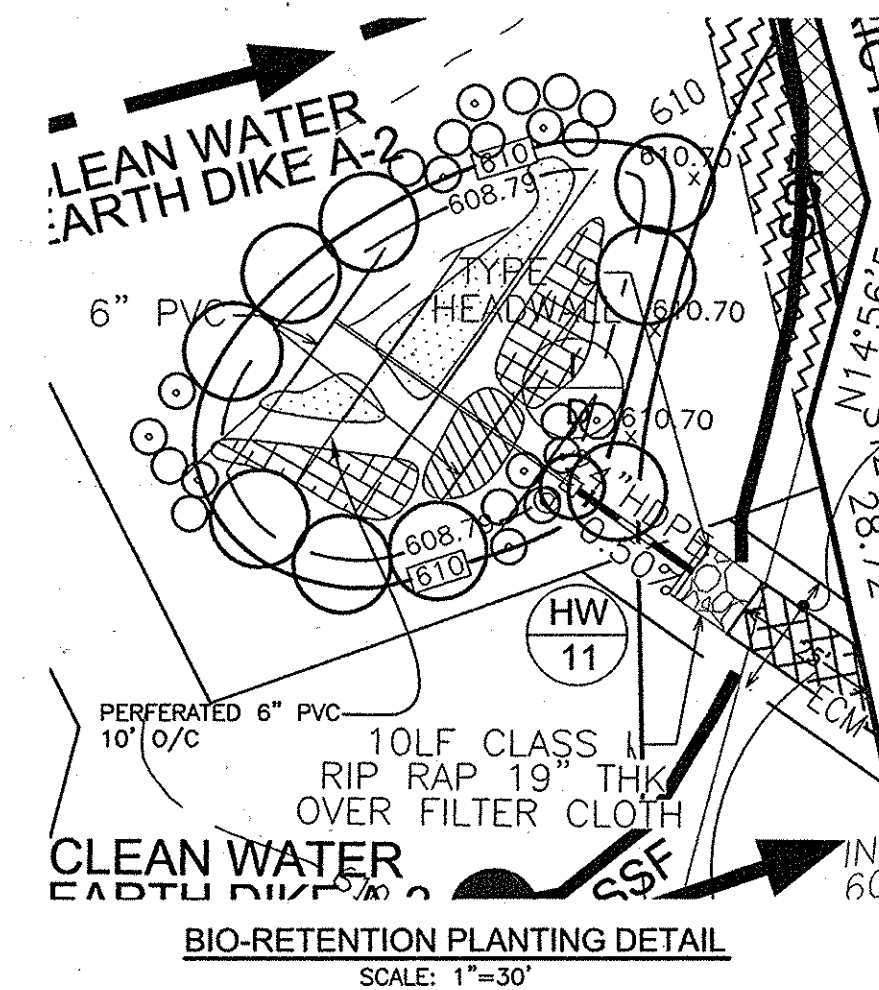

BIORETENTION PLANTING SCHEDULE				
KEY	QTY	BOTANICAL NAME/ COMMON NAME	SIZE	ROOT
8	NYSSA SYLVANICA BLACK GUM	1 1/2"-2" CAL.	B & B	
10	ILEX VERTICILLATA WINTERBERRY	2'-3' HEIGHT	B & B OR CONT	
12	ILEX GLABRA INKBERRY	18"-24" HEIGHT	B & B OR CONT	
100	VACCINIUM CORYMBOSUM HIGHBUSH BLUEBERRY	12"-15" HEIGHT	CONT	
200	LOBELIA CARDINALIS CARDINAL FLOWER	8"-12" HEIGHT	CONT	
300	LIRIOPE SPICATA CREEPING LILY, TURF	2" POT	18" O/C	

**OWNER**  
HELEN L. FYOCK  
ROBERT E. FYOCK  
P.O. BOX 59  
LENELG, MARYLAND

CASTLEBERRY AT TEN OAKS, L.L.C.  
3675 PARK AVENUE, SUITE 301  
ELlicOTT CITY, MARYLAND 21043  
(410) 740-9401

**DEVELOPER**  
CASTLEBERRY AT TEN OAKS, L.L.C.  
3675 PARK AVENUE, SUITE 301  
ELlicOTT CITY, MARYLAND 21043  
(410) 740-9401

NO.	REVISION	DATE
1	REVISE LANDSCAPE SURETY AMOUNT	4-20-07

**LANDSCAPING AND FOREST CONSERVATION PLAN**  
**CASTLEBERRY AT TEN OAKS**  
LOTS 1 - 45, NON-BUILDABLE PRESERVATION  
PARCELS A, C, D, E & BUILDABLE PRESERVATION PARCEL B  
TAX MAP 22 GRID 20  
5TH ELECTION DISTRICT


PARCEL 60, LOTS 6 & 7 KEN WARFIELD  
SUBDIVISION, AND P/O PARCEL 90  
HOWARD COUNTY, MARYLAND

**ROBERT H. VOGEL**  
**ENGINEERING, INC.**  
ENGINEERS • SURVEYORS • PLANNERS  
8407 MAIN STREET  
ELlicOTT CITY, MD 21043  
TEL: 410.461.2666  
FAX: 410.461.8961

DESIGN BY: RHW/LJT  
DRAWN BY: LJT  
CHECKED BY: RHW  
DATE: DECEMBER, 2006  
SCALE: 1"=100'  
W.O. NO.: 09-85.00

DPZ REF: S-01-11, P-05-04



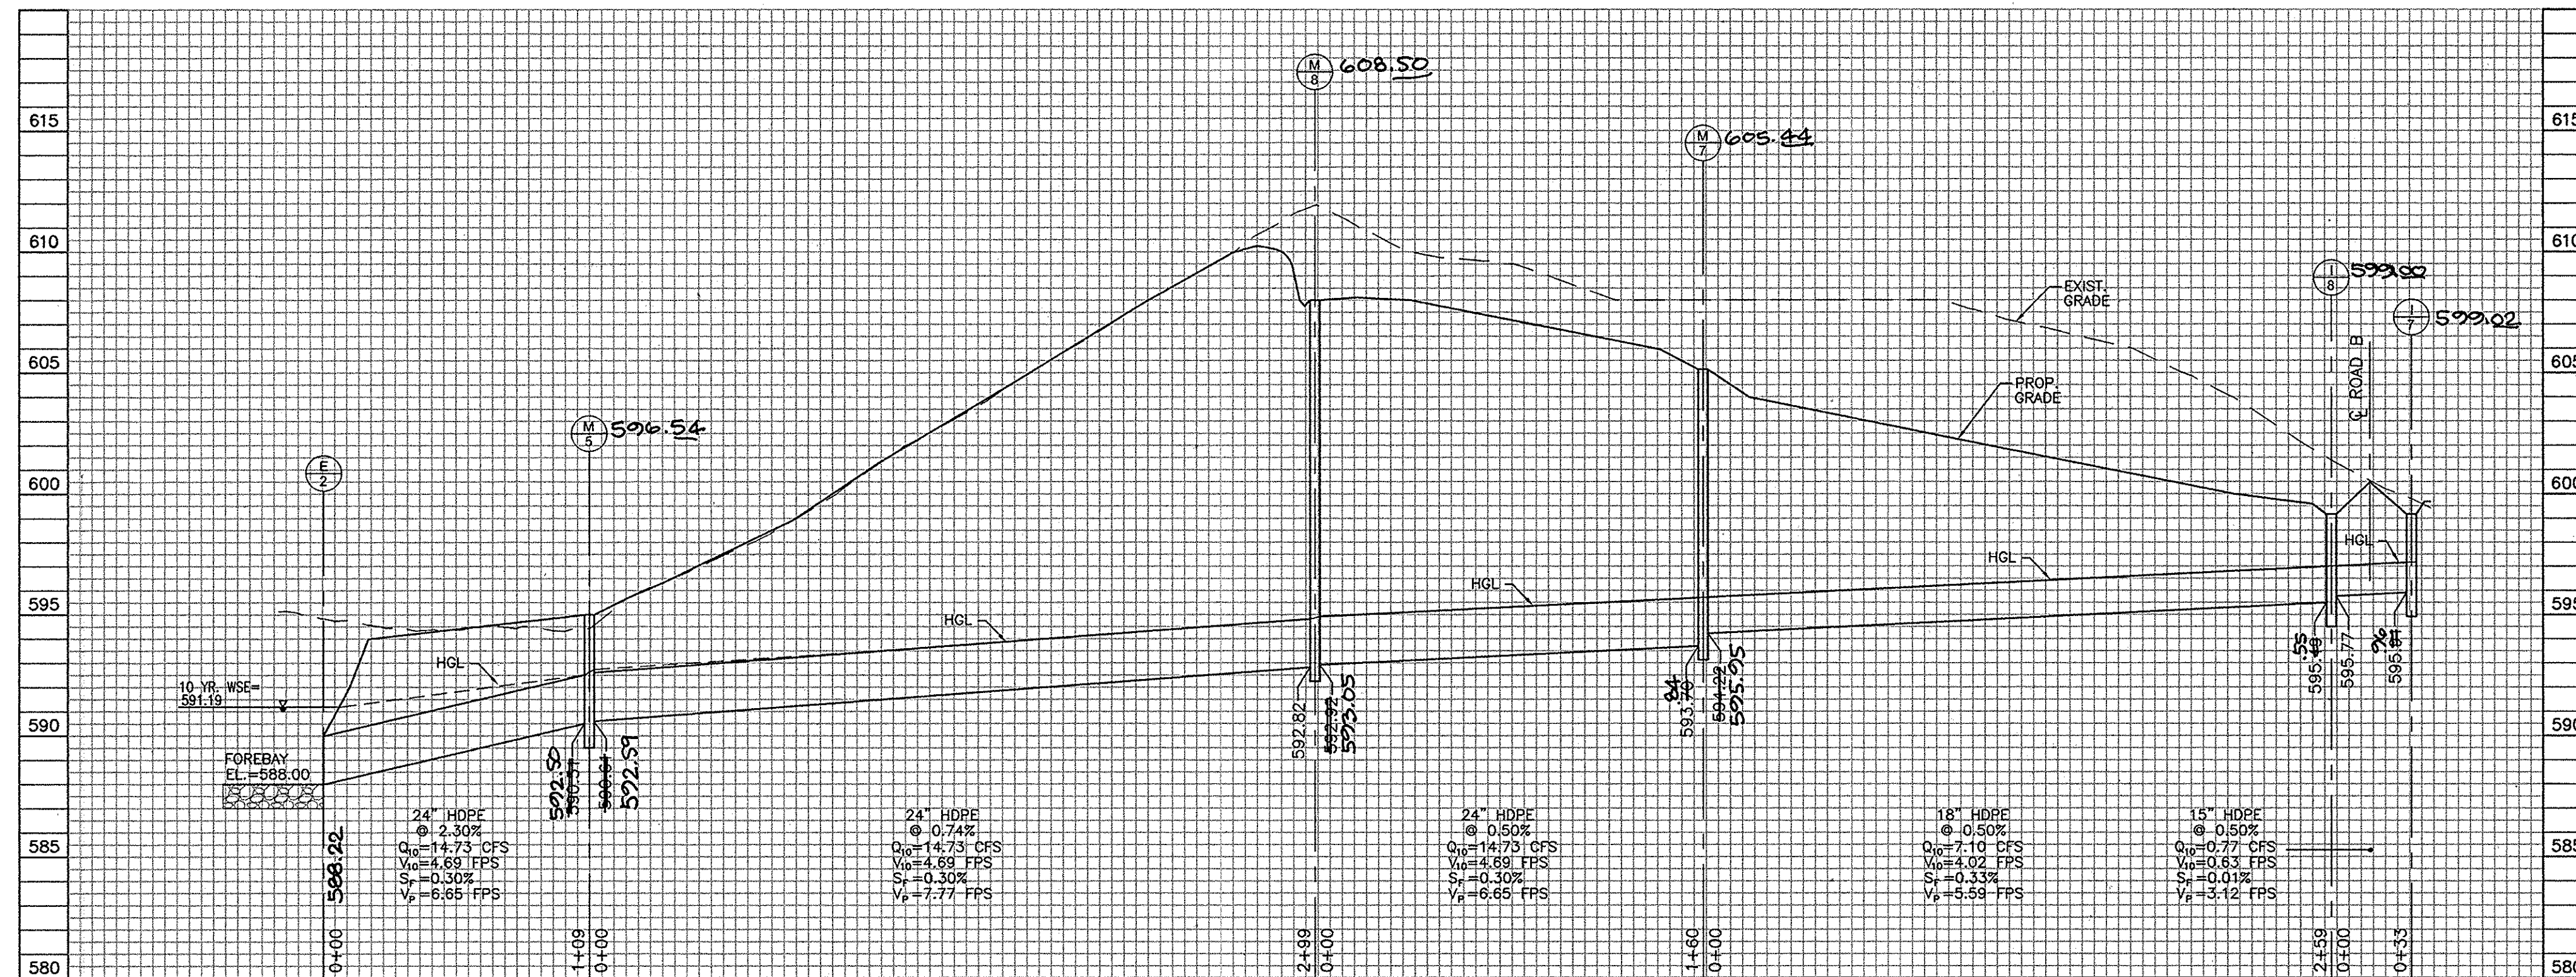

**STORM DRAIN PROFILE**

SCALE: HORZ: 1"=50'  
VERT: 1"=5'


INLET SCHEDULE							
NO.	TYPE	LOCATION		TOP ELEV.	INV. IN.	INV. OUT.	REMARKS
		NORTHING	EASTING				
I-1	STANDARD PRECAST TYPE K	579,502	1,316,010	607.91	607.91	607.91	SD-4.12
I-2	STANDARD PRECAST TYPE K	579,555	1,316,089	611.32	605.54	601.51	SD-4.12
I-3	STANDARD PRECAST TYPE K	579,609	1,316,799	608.89	608.89	608.89	SD-4.12
I-4	STANDARD PRECAST TYPE K	579,573	1,316,810	610.46	608.73	605.27	SD-4.12
I-5	STANDARD PRECAST TYPE K	579,538	1,316,393	616.88	612.28	611.12	SD-4.12
I-6	STANDARD PRECAST TYPE K	579,541	1,316,436	616.88	---	613.88	SD-4.12
I-7	STANDARD PRECAST TYPE K	578,592	1,315,460	599.76	---	595.96	SD-4.12
I-8	STANDARD PRECAST TYPE K	578,559	1,315,456	599.76	595.77	595.36	SD-4.12
I-9	STANDARD PRECAST TYPE K	578,623	1,316,029	611.86	603.18	603.88	SD-4.12
I-10	STANDARD PRECAST TYPE K	578,590	1,316,035	611.86	601.84	601.74	SD-4.12
I-11	STANDARD PRECAST TYPE K	578,704	1,316,226	615.78	---	611.88	SD-4.12
I-12	STANDARD PRECAST TYPE K	578,428	1,314,774	588.02	---	582.88	SD-4.12
I-13	STANDARD PRECAST TYPE K	578,368	1,315,695	599.76	---	595.28	SD-4.12

\*TOP ELEV.=SLOT OPENING ELEVATION FOR TYPE K INLETS  
NOTES  
1. FOR TYPE 'K' INLETS IN EXCESS OF 3'-6" OF DEPTH, PROVIDE MANHOLE STEPS FOR ACCESS.

STORM DRAIN MANHOLE SCHEDULE							
NO.	TYPE	LOCATION		TOP ELEV.	INV. IN.	INV. OUT.	REMARKS
		NORTHING	EASTING				
M-1	STANDARD 4' PRECAST MANHOLE	579,149	1,315,960	592.01	592.01	592.88	G-5.12
M-2	STANDARD 4' PRECAST MANHOLE	579,209	1,316,059	593.47	593.47	593.37	G-5.12
M-3	STANDARD 4' PRECAST MANHOLE	579,580	1,316,392	617.88	617.88	617.88	G-5.12
M-4	STANDARD 4' PRECAST MANHOLE	579,598	1,316,621	616.23	616.23	616.33	G-5.12
M-5	STANDARD 4' PRECAST MANHOLE	578,861	1,315,821	598.88	598.88	598.51	G-5.12
M-6 HAS BEEN REMOVED 593.05 - 593.05 - 593.95							
M-7	STANDARD 4' PRECAST MANHOLE	578,530	1,315,716	605.44	593.38	593.79	G-5.12
M-8	STANDARD 4' PRECAST MANHOLE	578,566	1,315,872	608.88	593.38	592.82	G-5.12
M-2A	STANDARD 4' PRECAST MANHOLE	579,479	1,316,062	610.88	608.88	608.14	G-5.12


STRUCTURE SCHEDULE							
NO.	TYPE	LOCATION		TOP ELEV.	INV. IN.	INV. OUT.	REMARKS
		NORTHING	EASTING				
E-1	18" RCP END SECTION	579,022	1,315,939	---	---	588.04	SD-5.51 & SD-5.52
E-2	24" RCP END SECTION	578,959	1,315,912	---	---	588.04	SD-5.51 & SD-5.52
E-3	18" RCP END SECTION	578,390	1,314,703	---	---	588.04	SD-5.51 & SD-5.52
HW-1	TYPE 'A' HEADWALL	578,304	1,314,596	---	---	583.88	SD-5.11
HW-2	TYPE 'A' HEADWALL	578,921	1,315,682	---	---	584.28	SD-5.11
CS-1	CONTROL STRUCTURE	578,914	1,315,736	---	---	584.81	SEE SWM DETAILS...
CS-2	CONTROL STRUCTURE	578,300	1,314,630	---	---	544.85	SEE SWM DETAILS

PIPE SCHEDULE		
PIPE SIZE	TYPE	TOTAL LENGTH
15"	HDPE	114
18"	HDPE	2,269
24"	HDPE	568
48"	RCP-ASTM C-361	37
60"	RCP-ASTM C-361	45

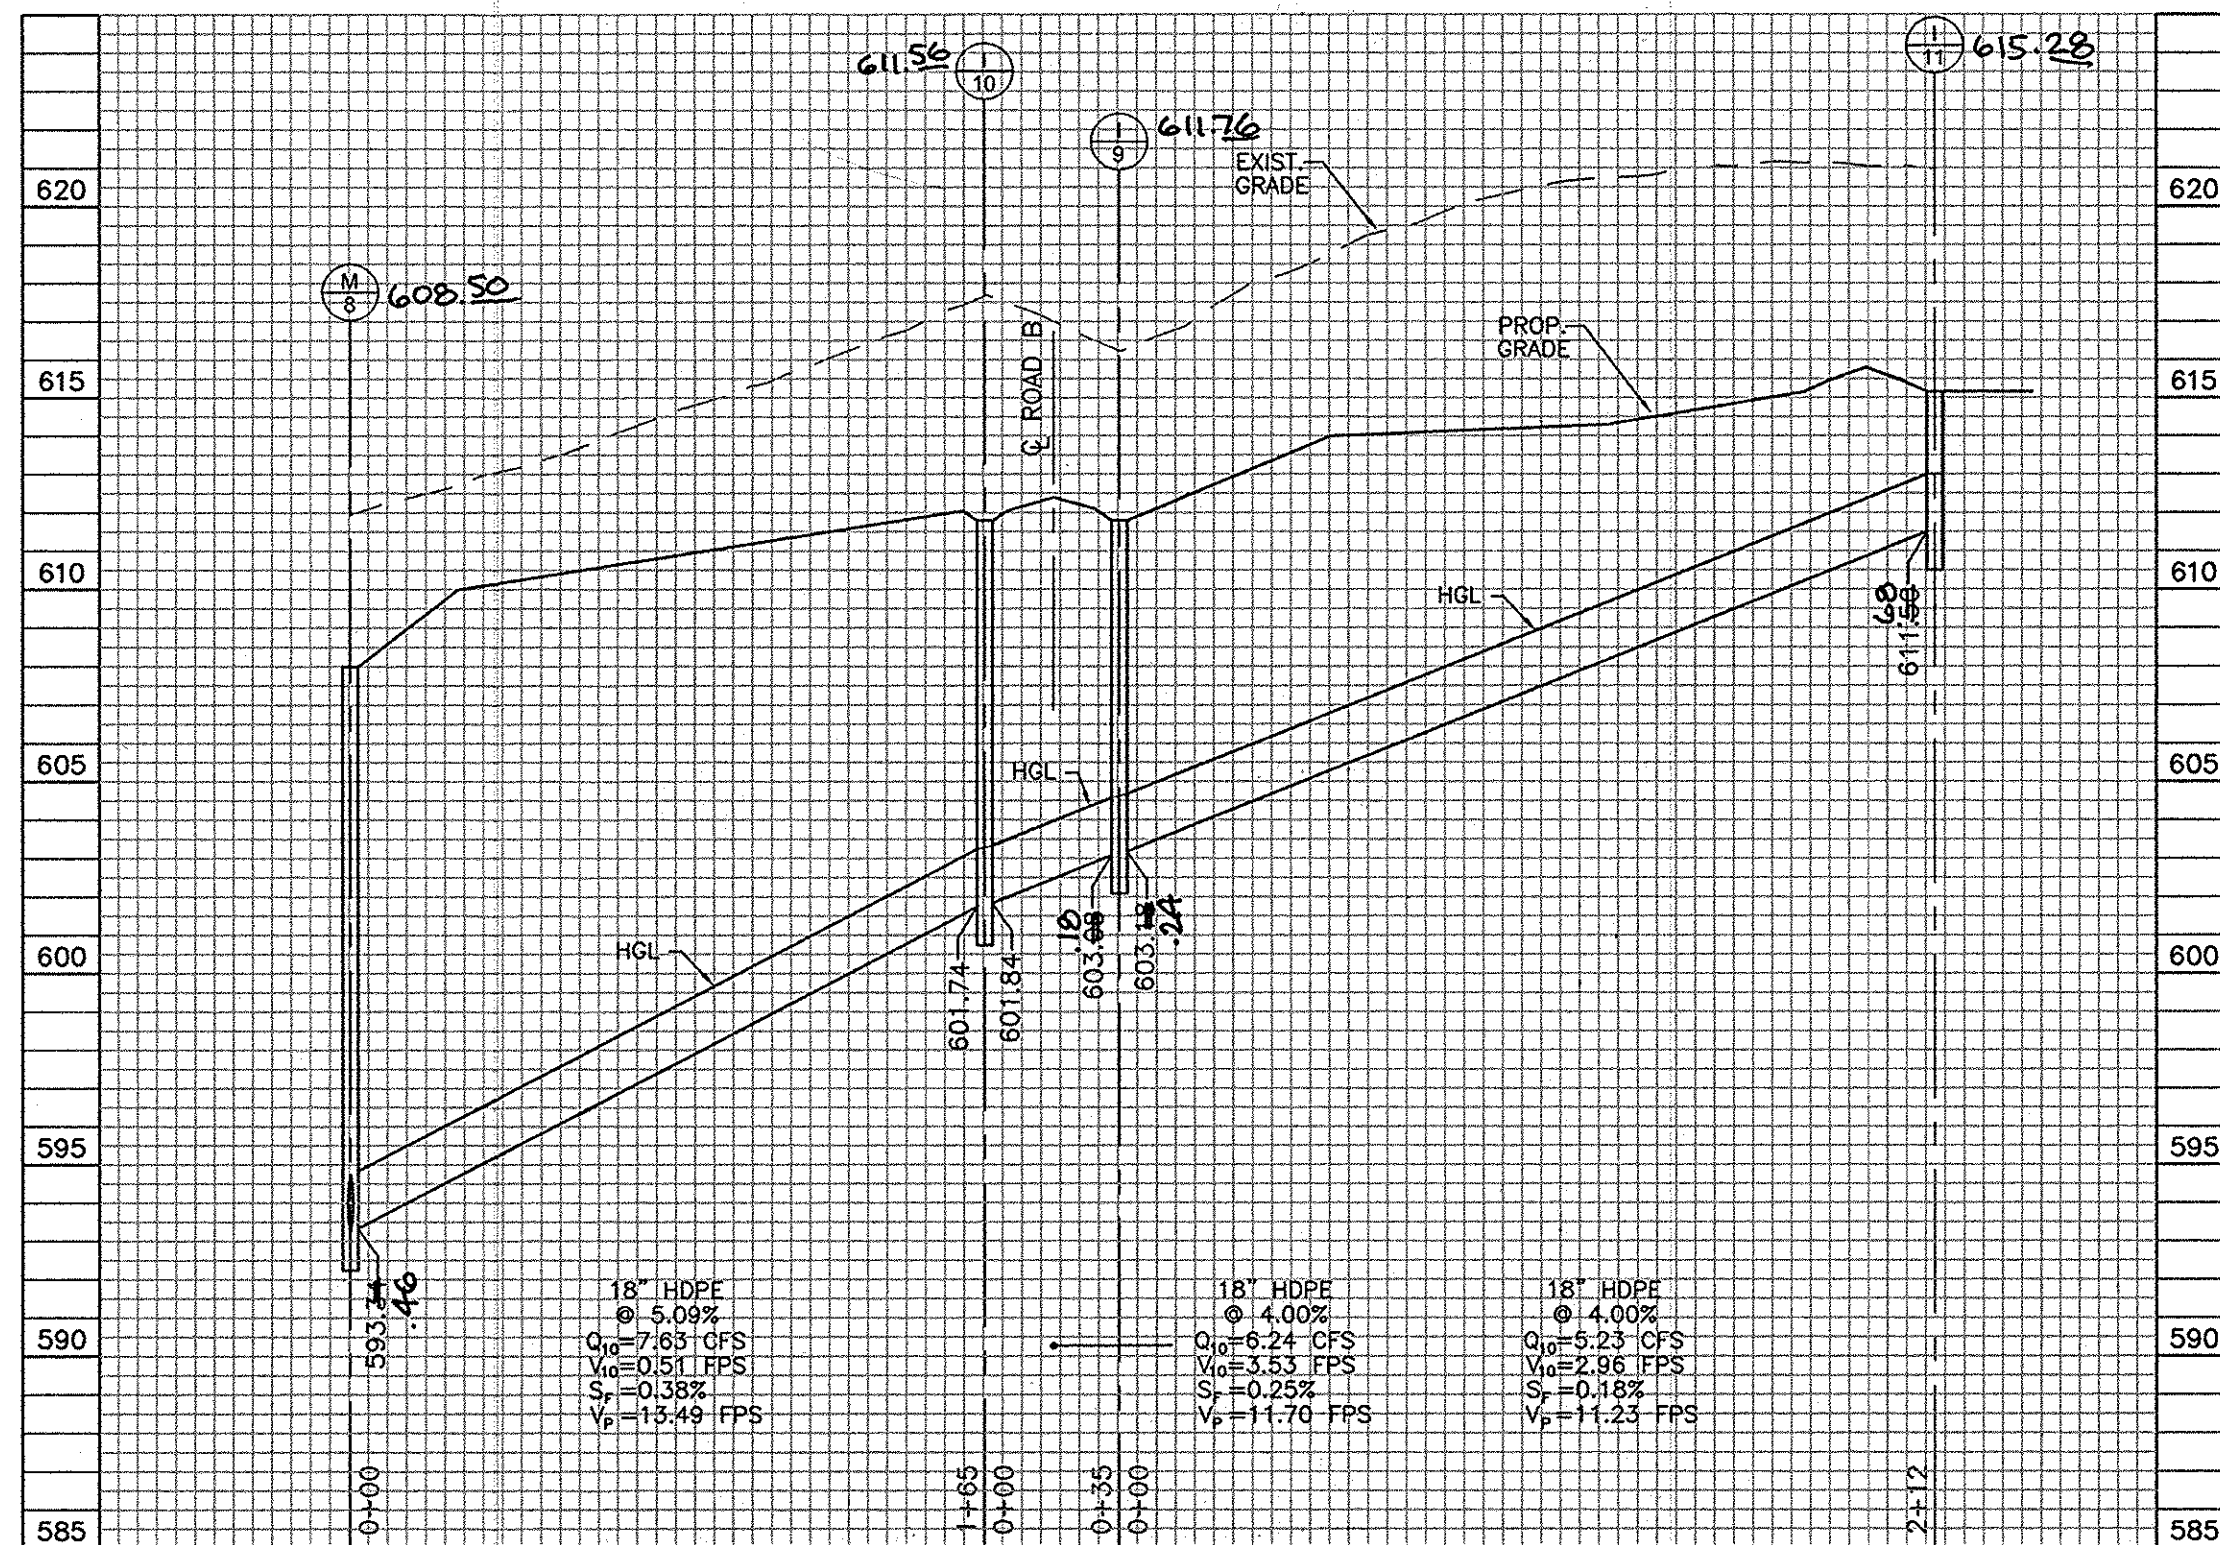

**STORM DRAIN PROFILE**

SCALE: HORZ: 1"=50'  
VERT: 1"=5'

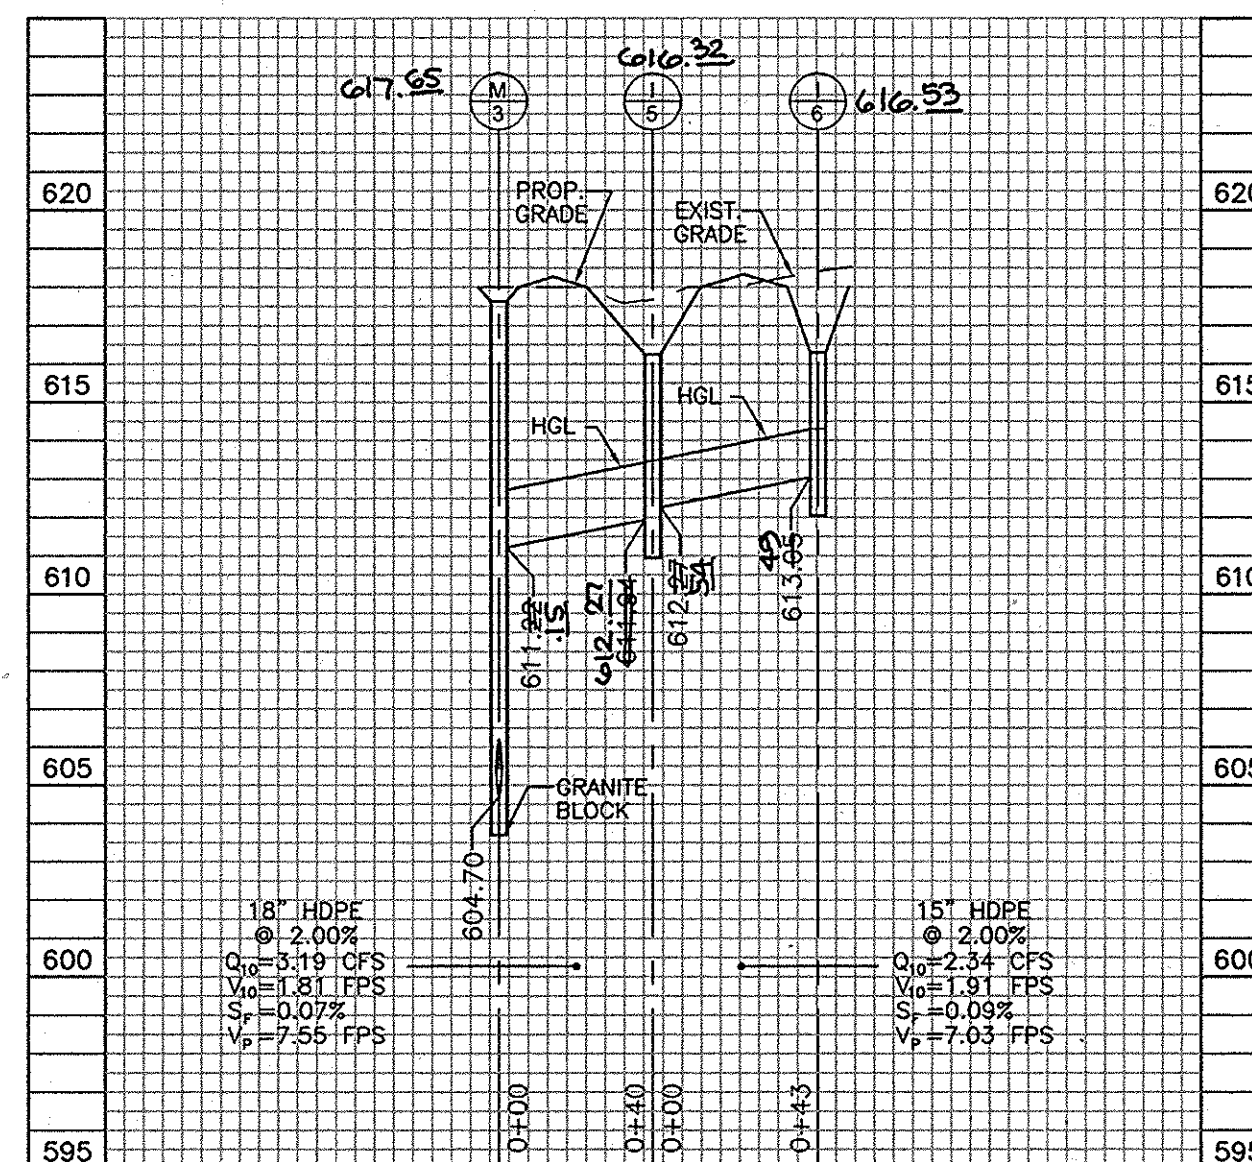

**STORM DRAIN PROFILE**

SCALE: HORZ: 1"=50'  
VERT: 1"=5'



AS-BUILT CERTIFICATION  
I hereby certify that the facility shown on this plan was constructed as shown on the "as-built" plans and meets the approved plans and specifications.

PE NO. 16193  
Date: 11/17/14

**OWNER**

HELEN L. FYOCK CASTLEBERRY AT TEN OAKS, L.L.C.  
ROBERT E. FYOCK 3675 PARK AVENUE, SUITE 301  
P.O. BOX 58 ELLICOTT CITY, MARYLAND 21043  
GLENELG, MARYLAND (410) 740-9401


**DEVELOPER**

CASTLEBERRY AT TEN OAKS, L.L.C.  
3675 PARK AVENUE, SUITE 301  
ELLICOTT CITY, MARYLAND 21043  
(410) 740-9401

NO.	REVISION	DATE

**STORM DRAIN PROFILES**  
**CASTLEBERRY AT TEN OAKS**  
LOTS 1 - 45, NON-BUILDABLE PRESERVATION  
PARCELS A, C, D, E & BUILDABLE PRESERVATION PARCEL B  
TAX MAP 22 GRID 20 PARCEL 60, LOTS 6 & 7 KEN WARFIELD  
5TH ELECTION DISTRICT SUBDIVISION, AND P/O PARCEL 90  
HOWARD COUNTY, MARYLAND

**ROBERT H. VOGEL ENGINEERING, INC.**  
ENGINEERS • SURVEYORS • PLANNERS  
8407 MAIN STREET TEL: 410.461.7666  
ELLICOTT CITY, MD 21043 FAX: 410.461.8961

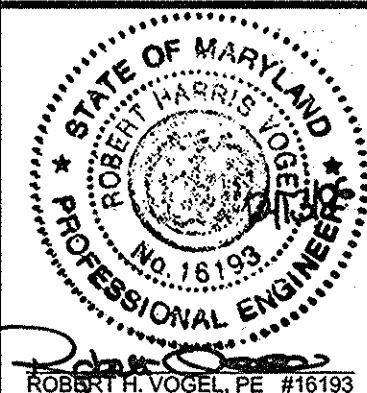

DESIGN BY: RHV/LJT  
DRAWN BY: LIT  
CHECKED BY: RHV  
DATE: DECEMBER, 2008  
SCALE: AS NOTED  
W.O. NO.: 00-85.00

DPZ REF:  
S-01-11, P-05-04

17 SHEET OF 23

APPROVED: HOWARD COUNTY DEPARTMENT OF PUBLIC WORKS  
Walter F. ... 1-10-07  
CHIEF, BUREAU OF HIGHWAYS


APPROVED: HOWARD COUNTY DEPARTMENT OF PLANNING AND ZONING  
... 1/24/10  
CHIEF, DEVELOPMENT ENGINEERING DIVISION

... 3/16/17  
CHIEF, DIVISION OF LAND DEVELOPMENT

REVIEWED FOR HOWARD SCD AND MEETS TECHNICAL REQUIREMENTS


USDA-NATURAL RESOURCES CONSERVATION SERVICE DATE  
THIS DEVELOPMENT PLAN IS APPROVED FOR SOIL EROSION AND SEDIMENT CONTROL BY THE HOWARD SOIL CONSERVATION DISTRICT

HOWARD SCD DATE

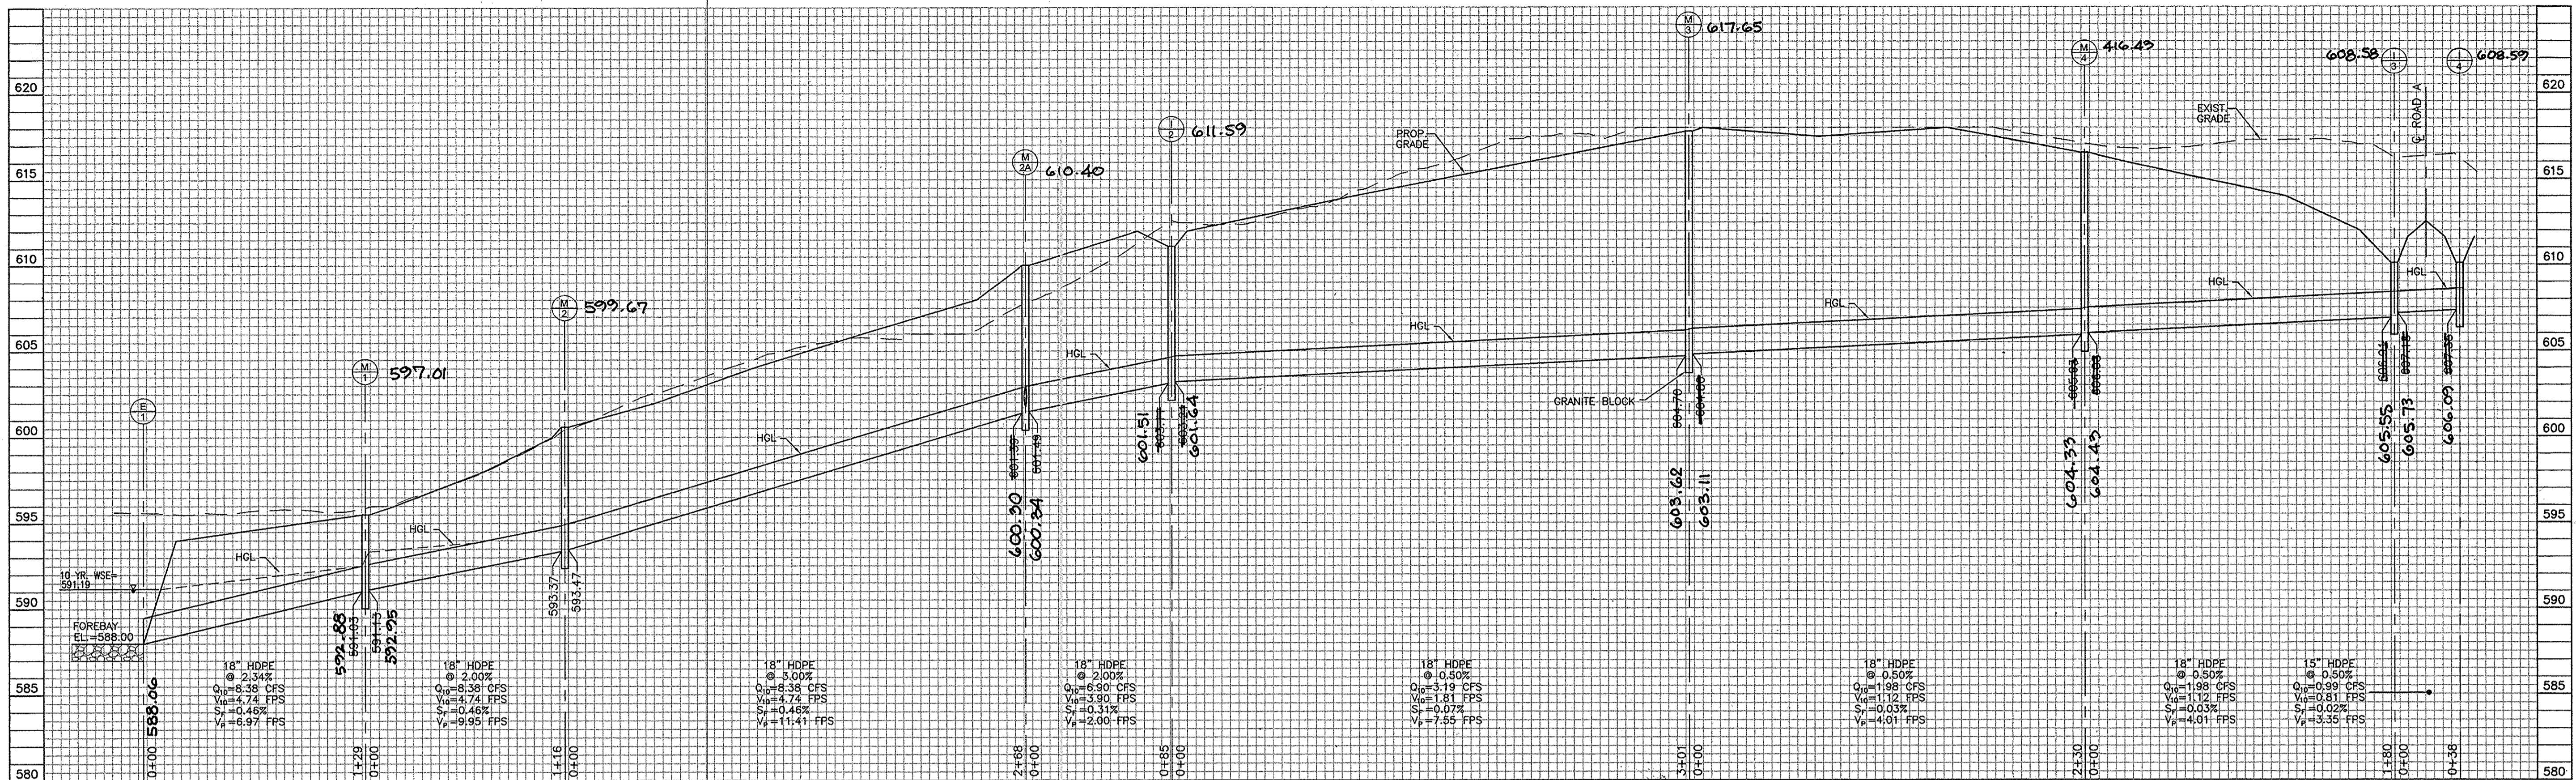


**STORM DRAIN PROFILE**

SCALE: HORZ: 1"=50'  
VERT: 1"=5'

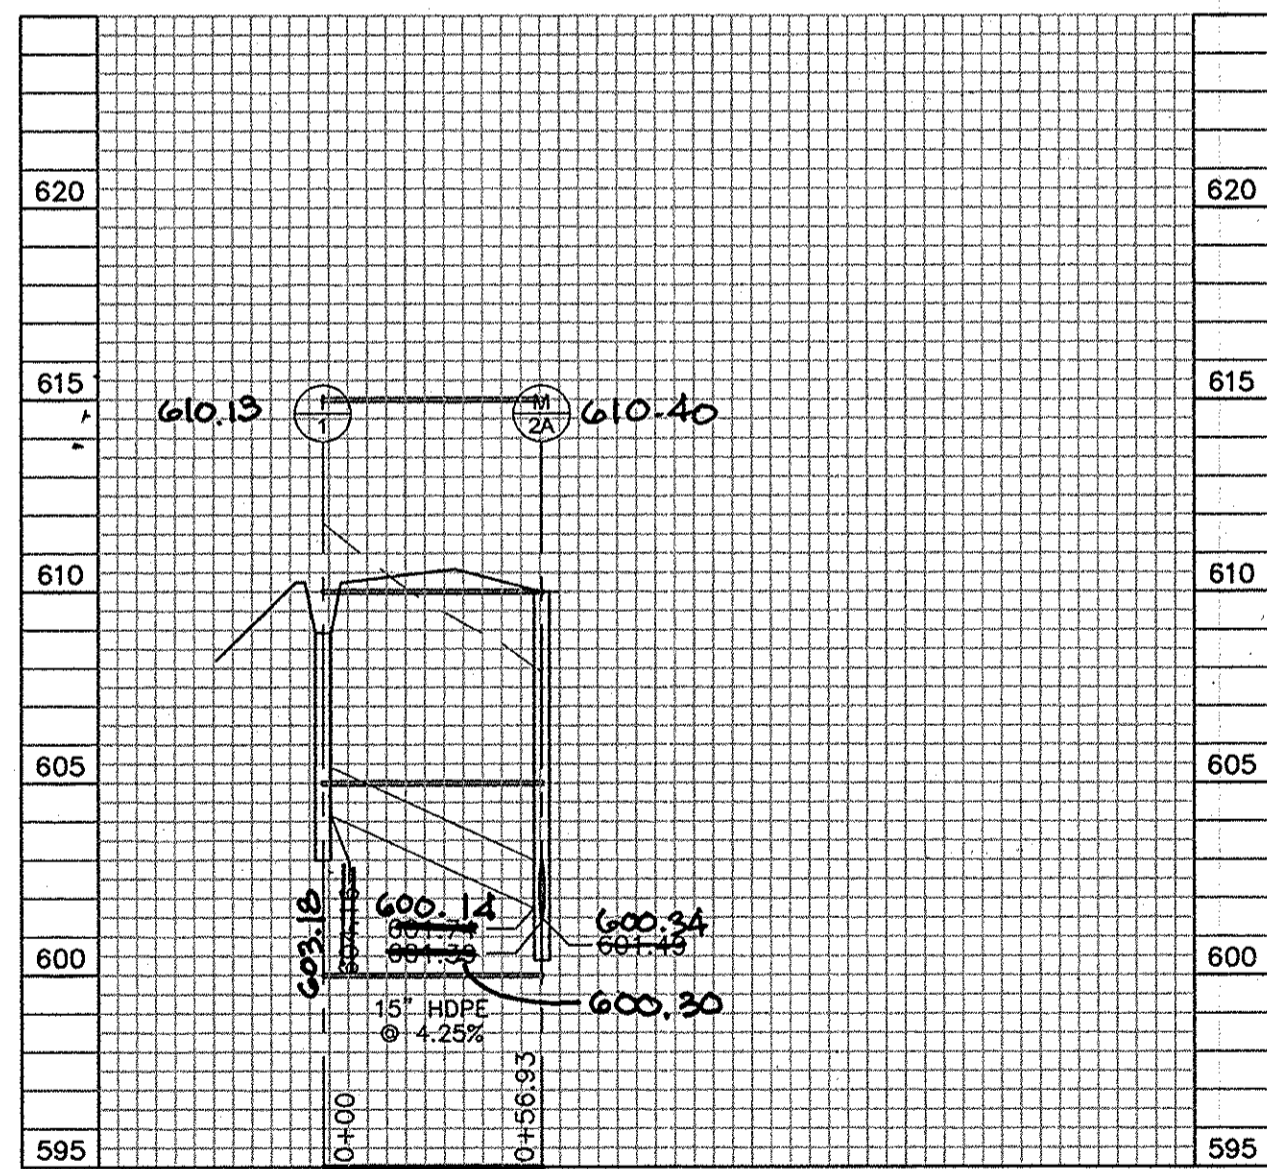


**STORM DRAIN PROFILE**

SCALE: HORZ: 1"=50'  
VERT: 1"=5'

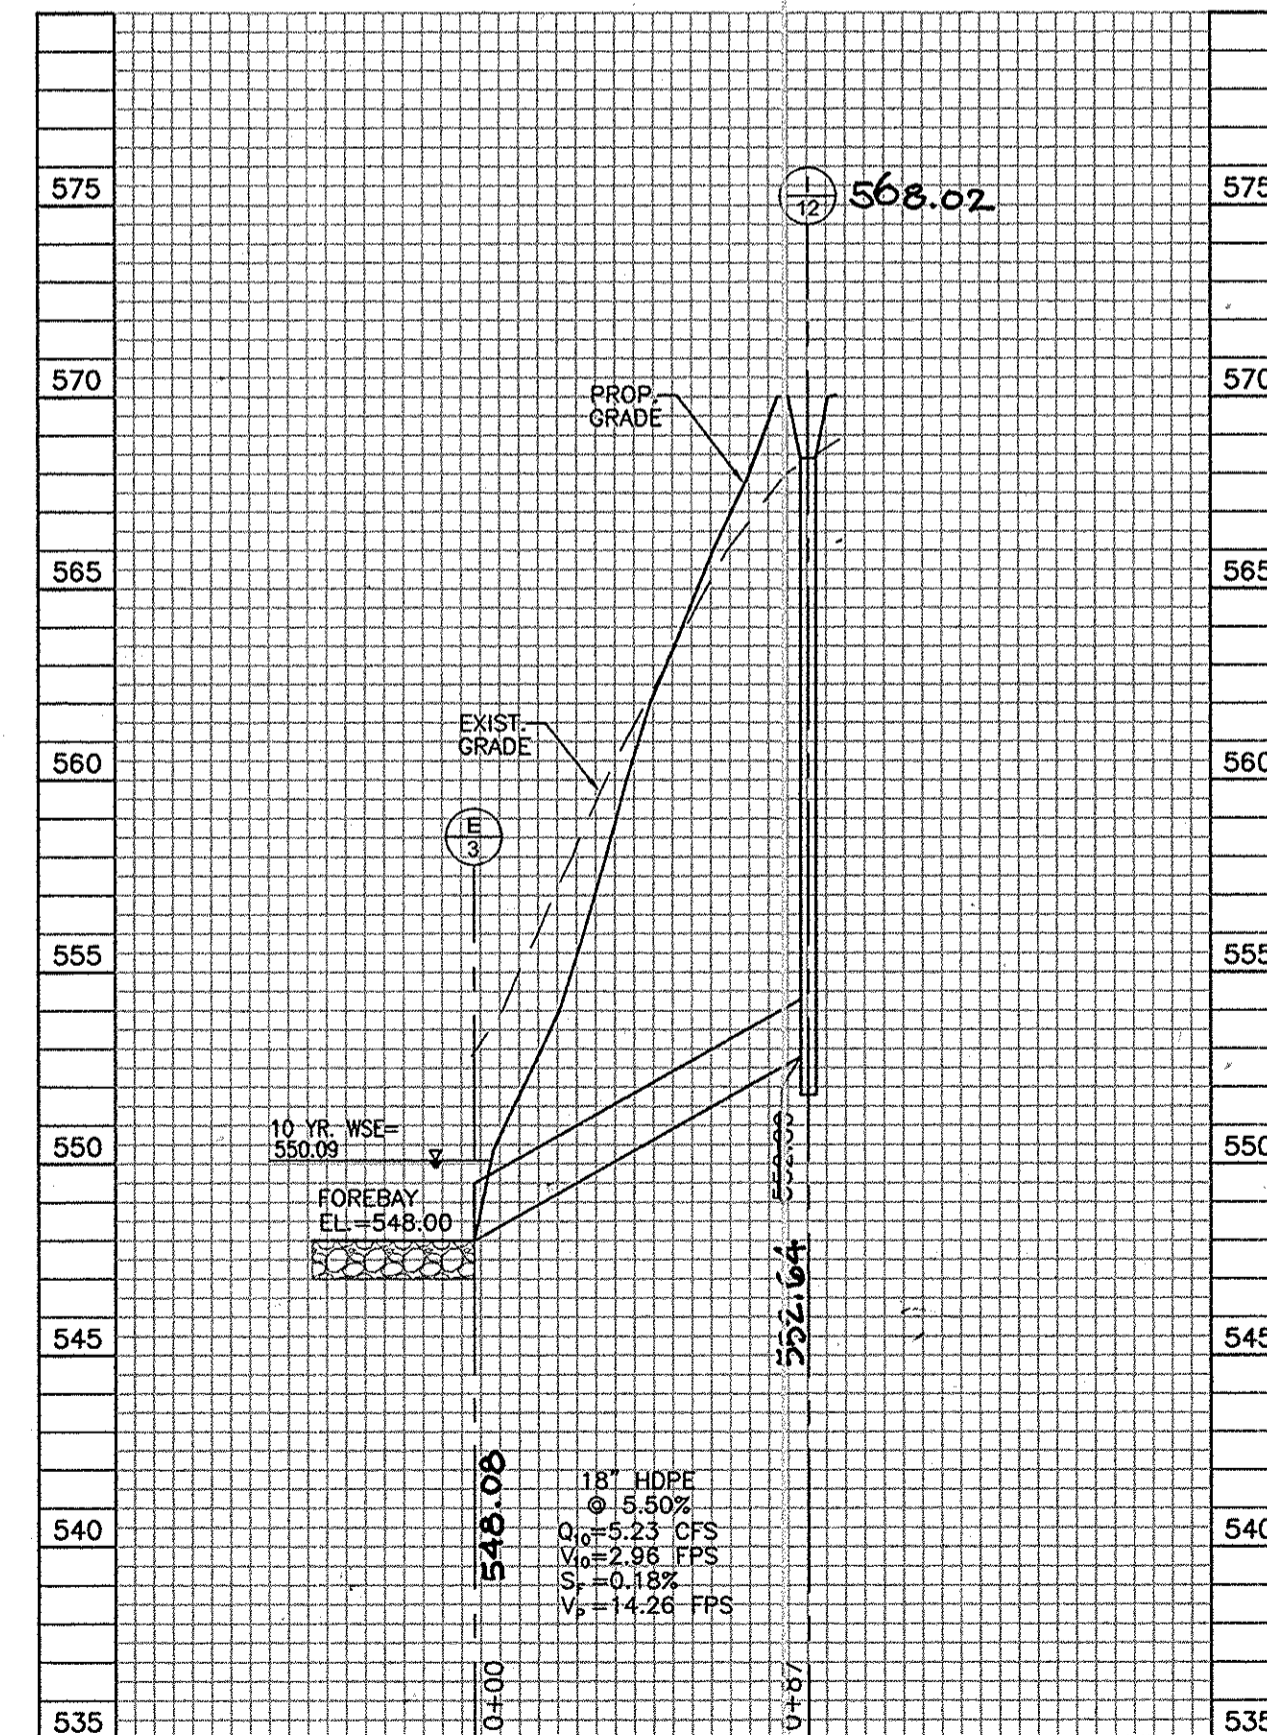

**STORM DRAIN PROFILE**

SCALE: HORZ: 1"=50'  
VERT: 1"=5'

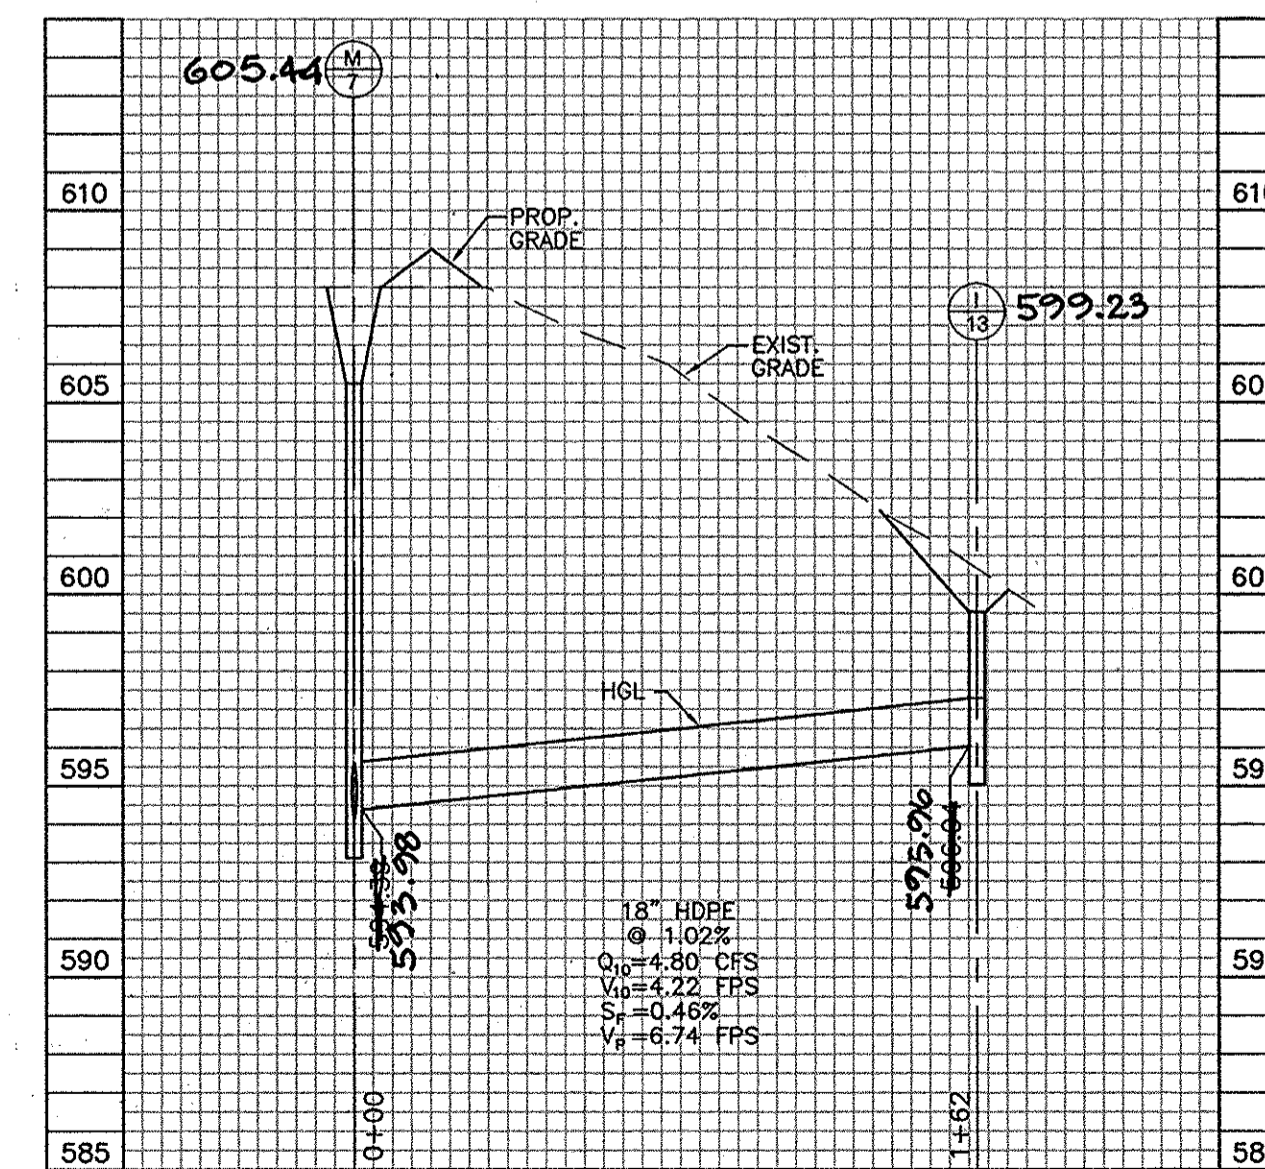

**STORM DRAIN PROFILE**

SCALE: HORZ: 1"=50'  
VERT: 1"=5'



AS-BUILT CERTIFICATION  
I hereby certify that the facility shown on this plan, was constructed as shown on the AS-Built Plans, and meets the approved plan and specifications.

Signature: [Signature]  
PE No: 16193  
Date: 11/17/14

APPROVED: HOWARD COUNTY DEPARTMENT OF PUBLIC WORKS  
[Signature] 1-10-07  
CHIEF, BUREAU OF HIGHWAYS

REVIEWED FOR HOWARD SCD AND MEETS TECHNICAL REQUIREMENTS

USDA-NATURAL RESOURCES CONSERVATION SERVICE  
DATE: \_\_\_\_\_  
THIS DEVELOPMENT PLAN IS APPROVED FOR SOIL EROSION AND SEDIMENT CONTROL BY THE HOWARD SOIL CONSERVATION DISTRICT  
DATE: \_\_\_\_\_  
HOWARD SCD

APPROVED: HOWARD COUNTY DEPARTMENT OF PLANNING AND ZONING  
[Signature] 1/10/14  
CHIEF, DEVELOPMENT ENGINEERING DIVISION

[Signature] 3/26/14  
CHIEF, DIVISION OF LAND DEVELOPMENT

OWNER  
HELEN L. FYOCK  
ROBERT E. FYOCK  
P.O. BOX 56  
GLENELG, MARYLAND

CASTLEBERRY AT TEN OAKS, L.L.C.  
3675 PARK AVENUE, SUITE 301  
ELLCOTT CITY, MARYLAND 21043  
(410) 740-9401

DEVELOPER  
CASTLEBERRY AT TEN OAKS, L.L.C.  
3675 PARK AVENUE, SUITE 301  
ELLCOTT CITY, MARYLAND 21043  
(410) 740-9401

NO. \_\_\_\_\_ REVISION \_\_\_\_\_ DATE \_\_\_\_\_

**STORMDRAIN PROFILES  
CASTLEBERRY AT TEN OAKS**  
LOTS 1 - 45, NON-BUILDABLE PRESERVATION  
PARCELS A, C, D, E & BUILDABLE PRESERVATION PARCEL B

TAX MAP 22 GRID 20  
5TH ELECTION DISTRICT









PARCEL 60, LOTS 6 & 7 KEN WARFIELD  
SUBDIVISION, AND P/O PARCEL 90  
HOWARD COUNTY, MARYLAND

**ROBERT H. VOGEL, INC.**  
ENGINEERS • SURVEYORS • PLANNERS  
8407 MAIN STREET  
ELLCOTT CITY, MD 21043  
TEL: 410.461.7866  
FAX: 410.461.8961

DESIGN BY: RHW/JT  
DRAWN BY: LJT  
CHECKED BY: RHW  
DATE: DECEMBER, 2006  
SCALE: AS NOTED  
W.O. NO.: 00-85-00

DPZ REF:  
S-01-11, P-05-04

18 SHEET OF 23

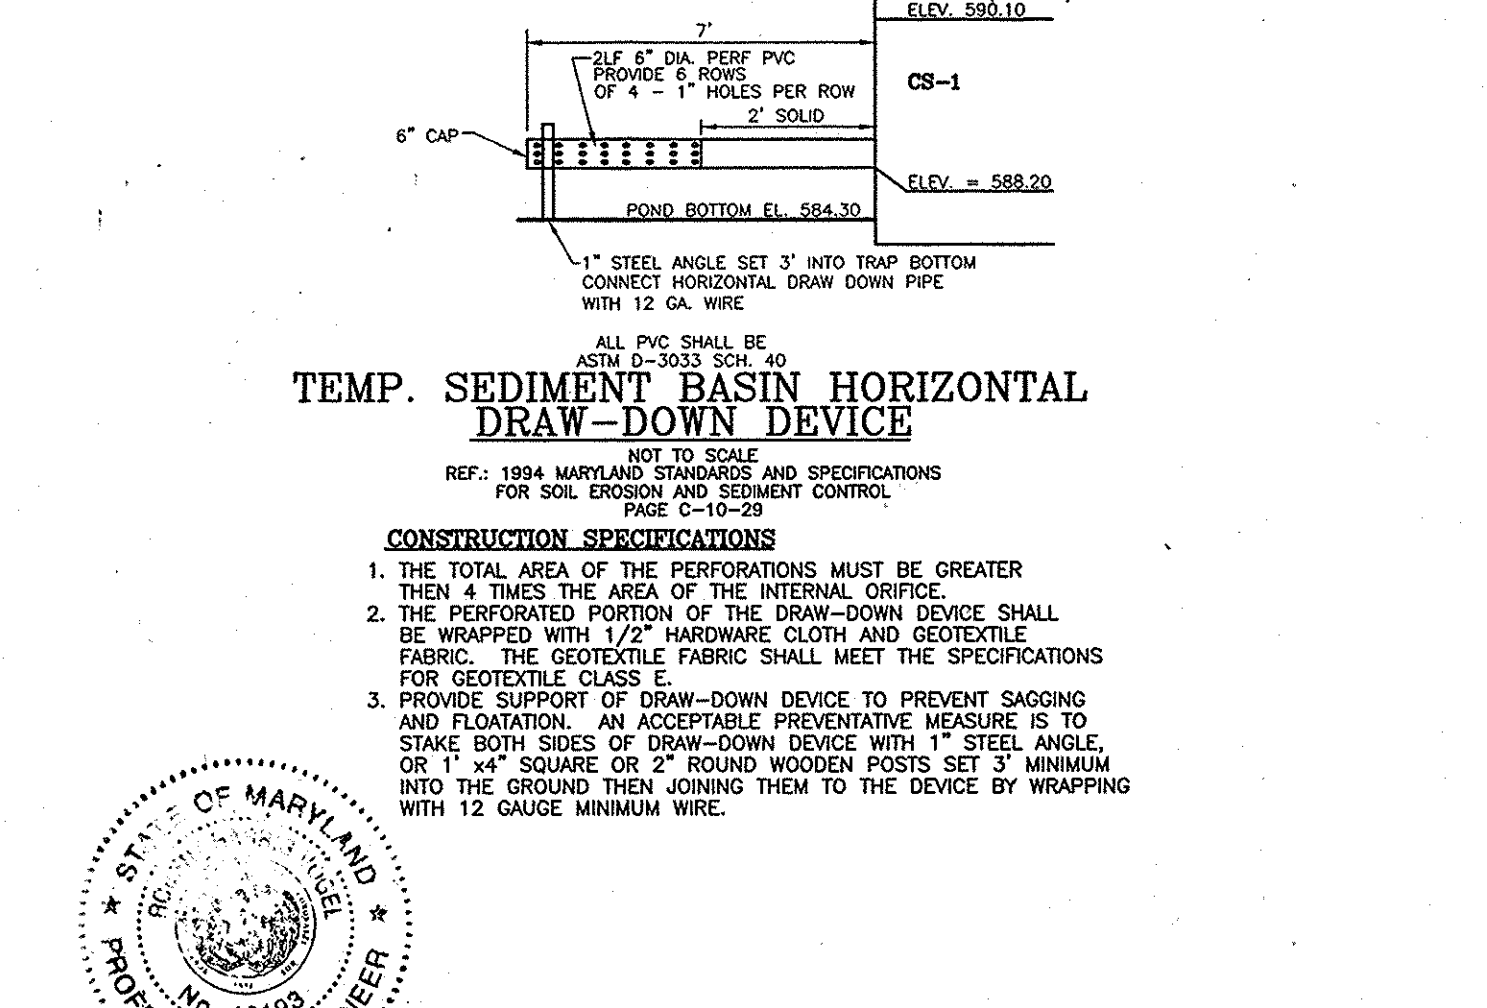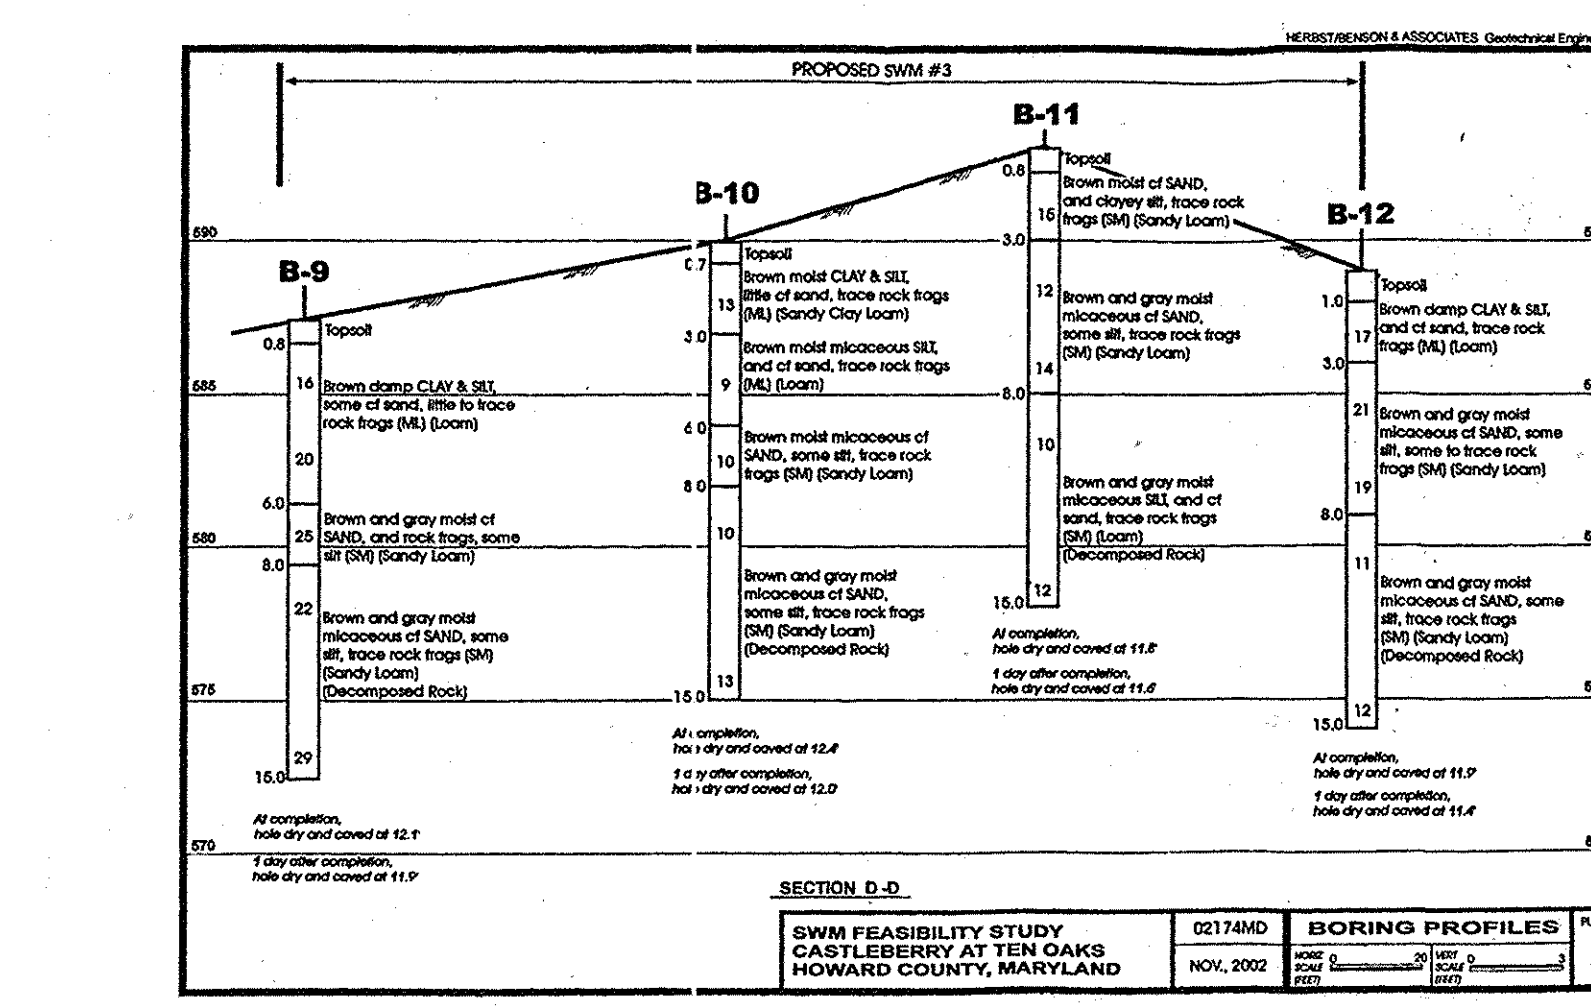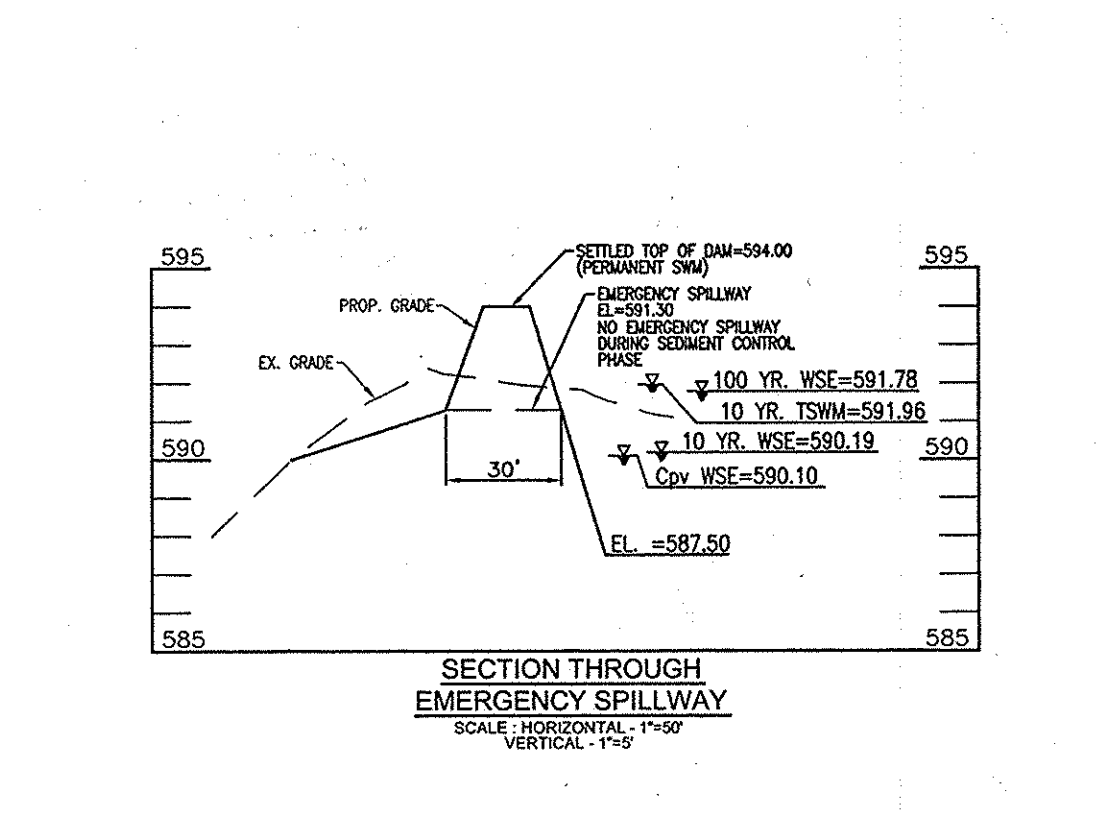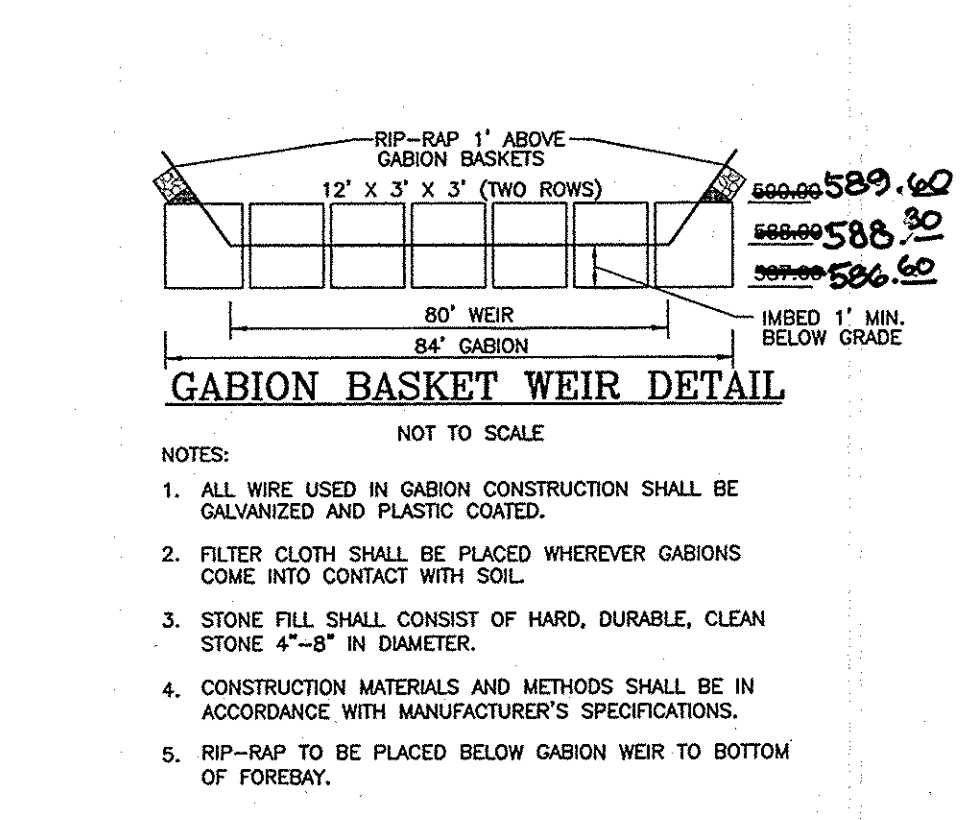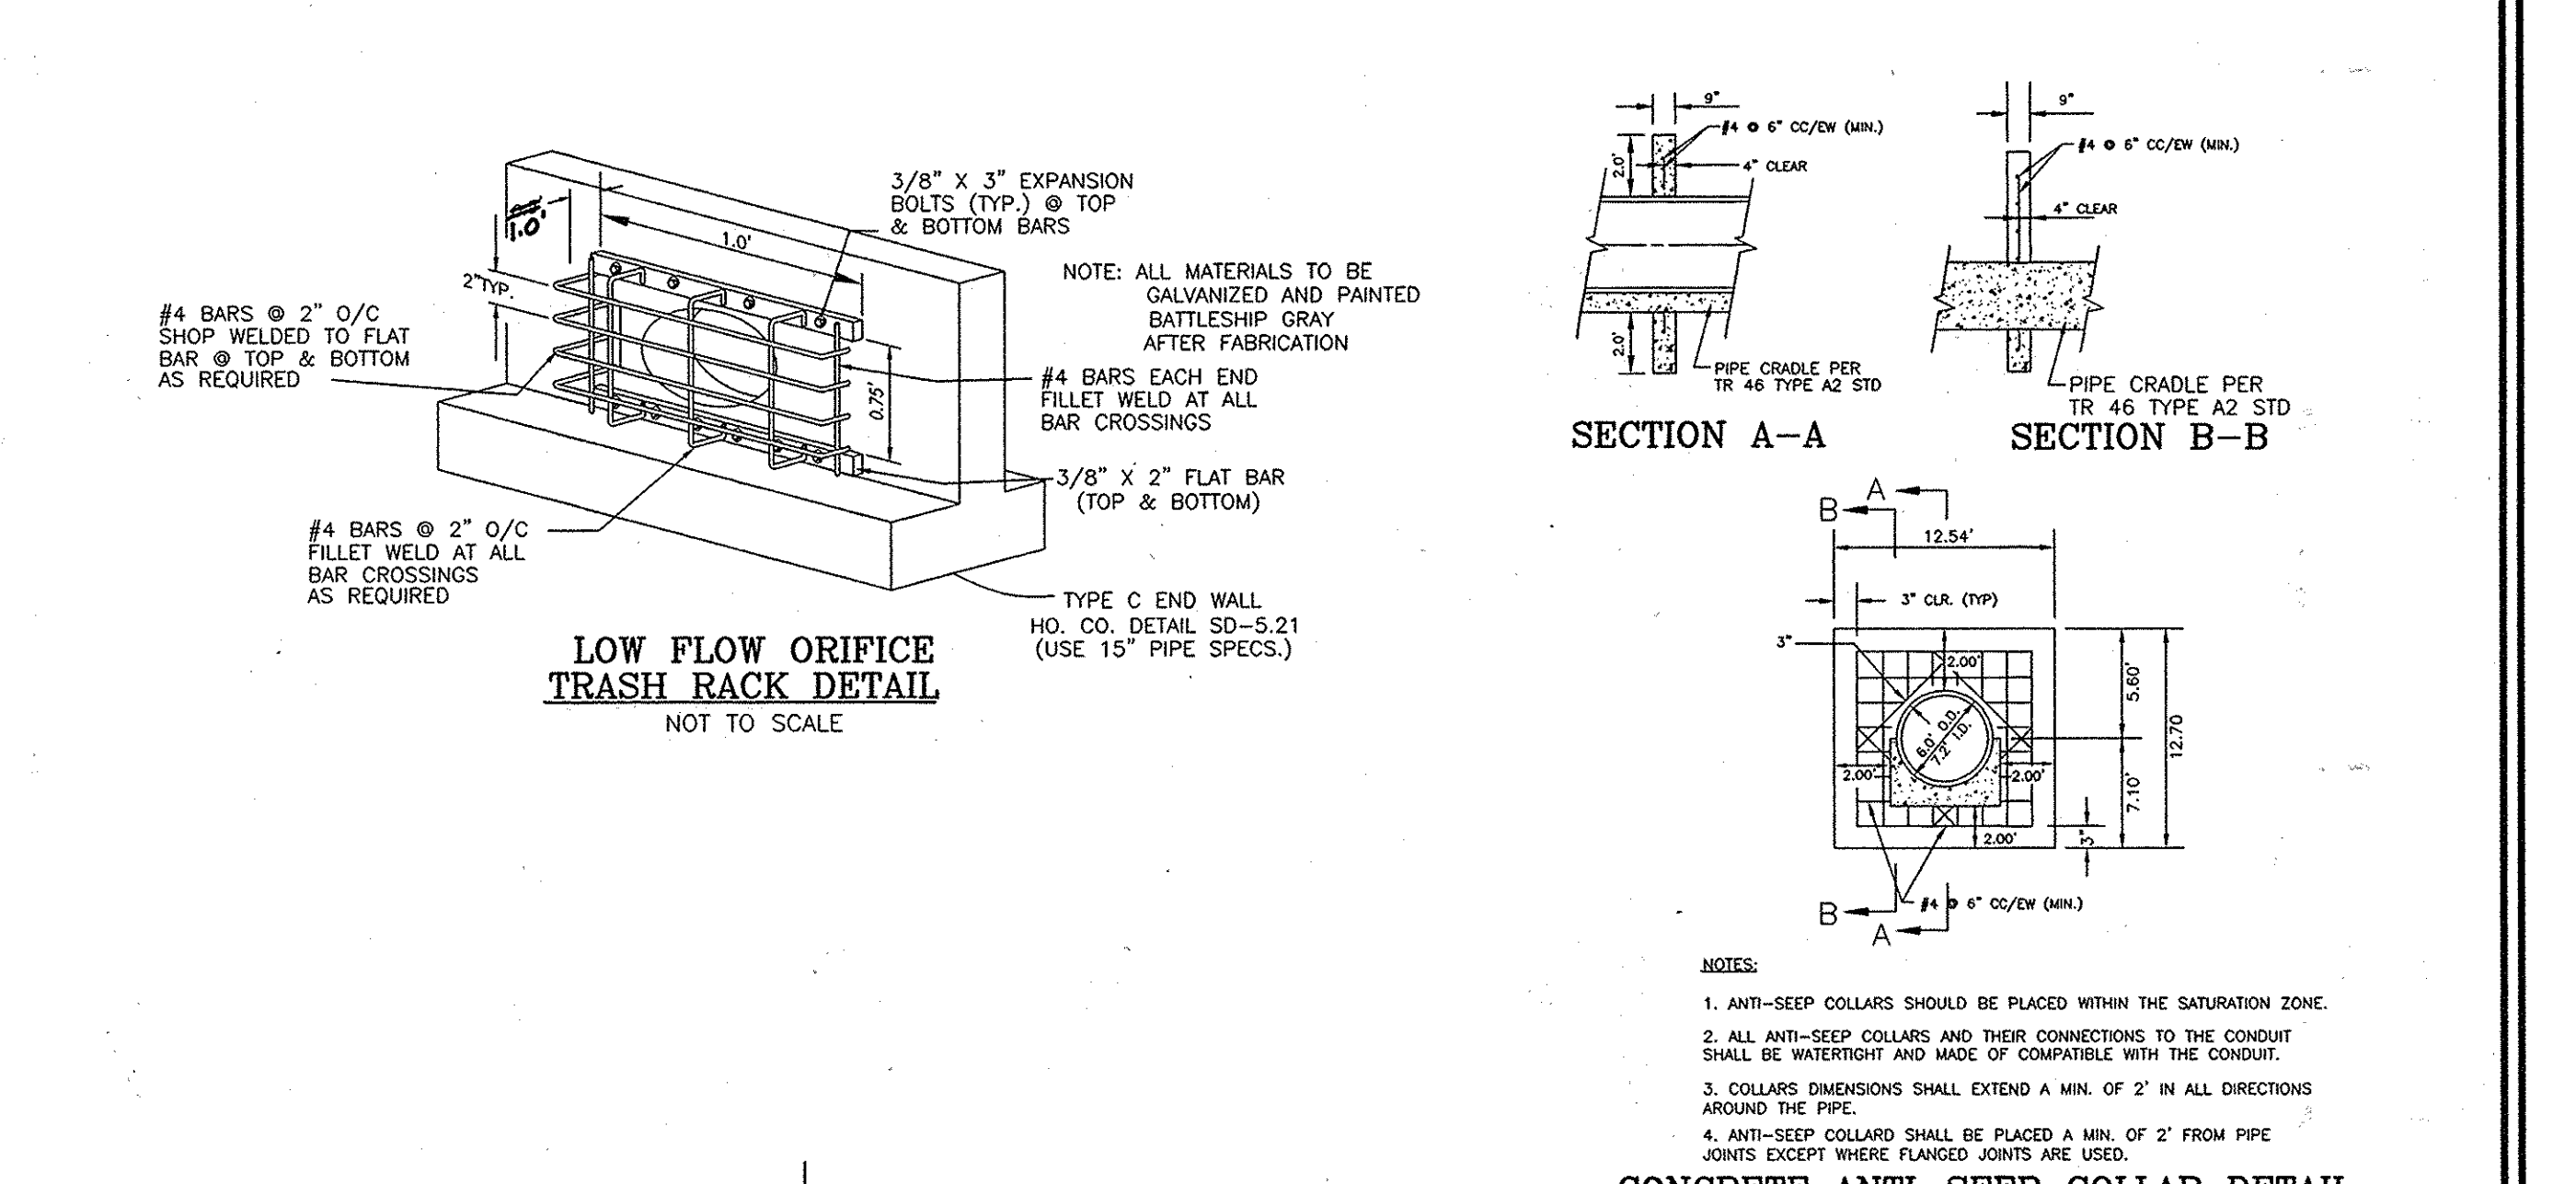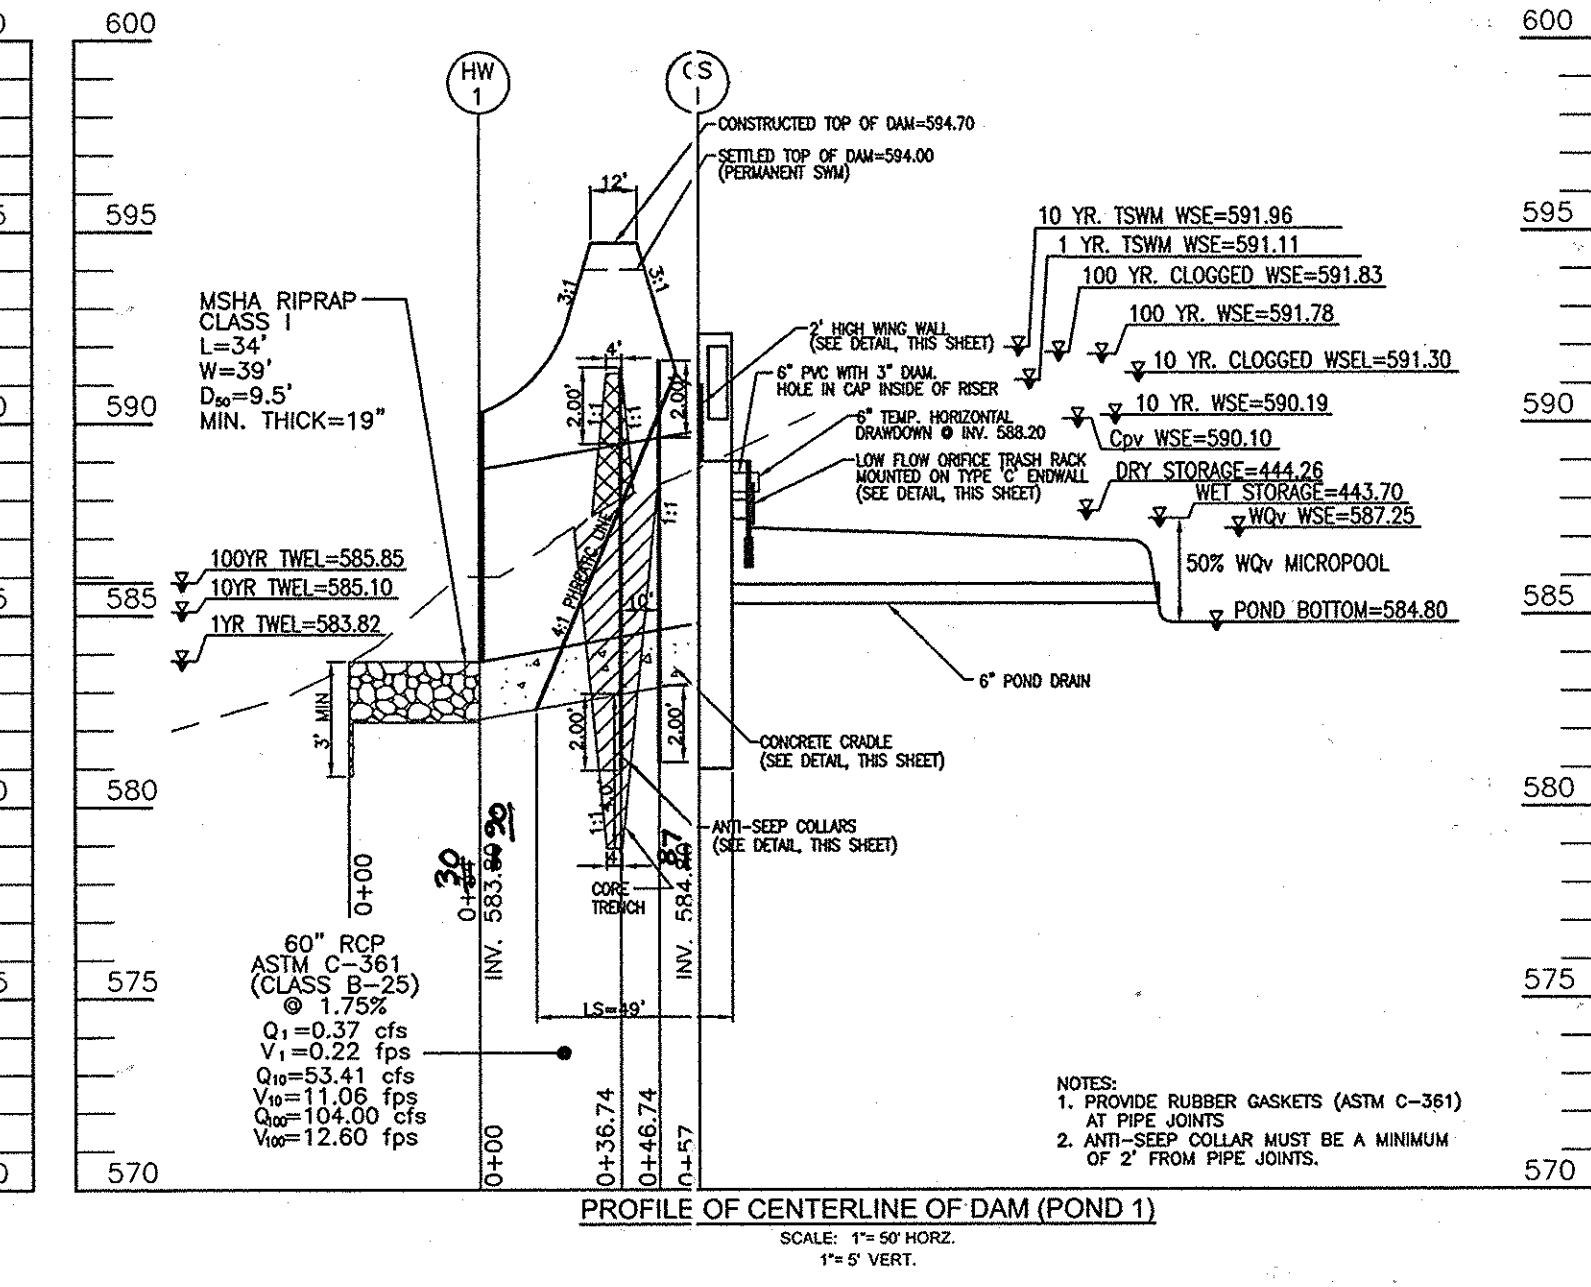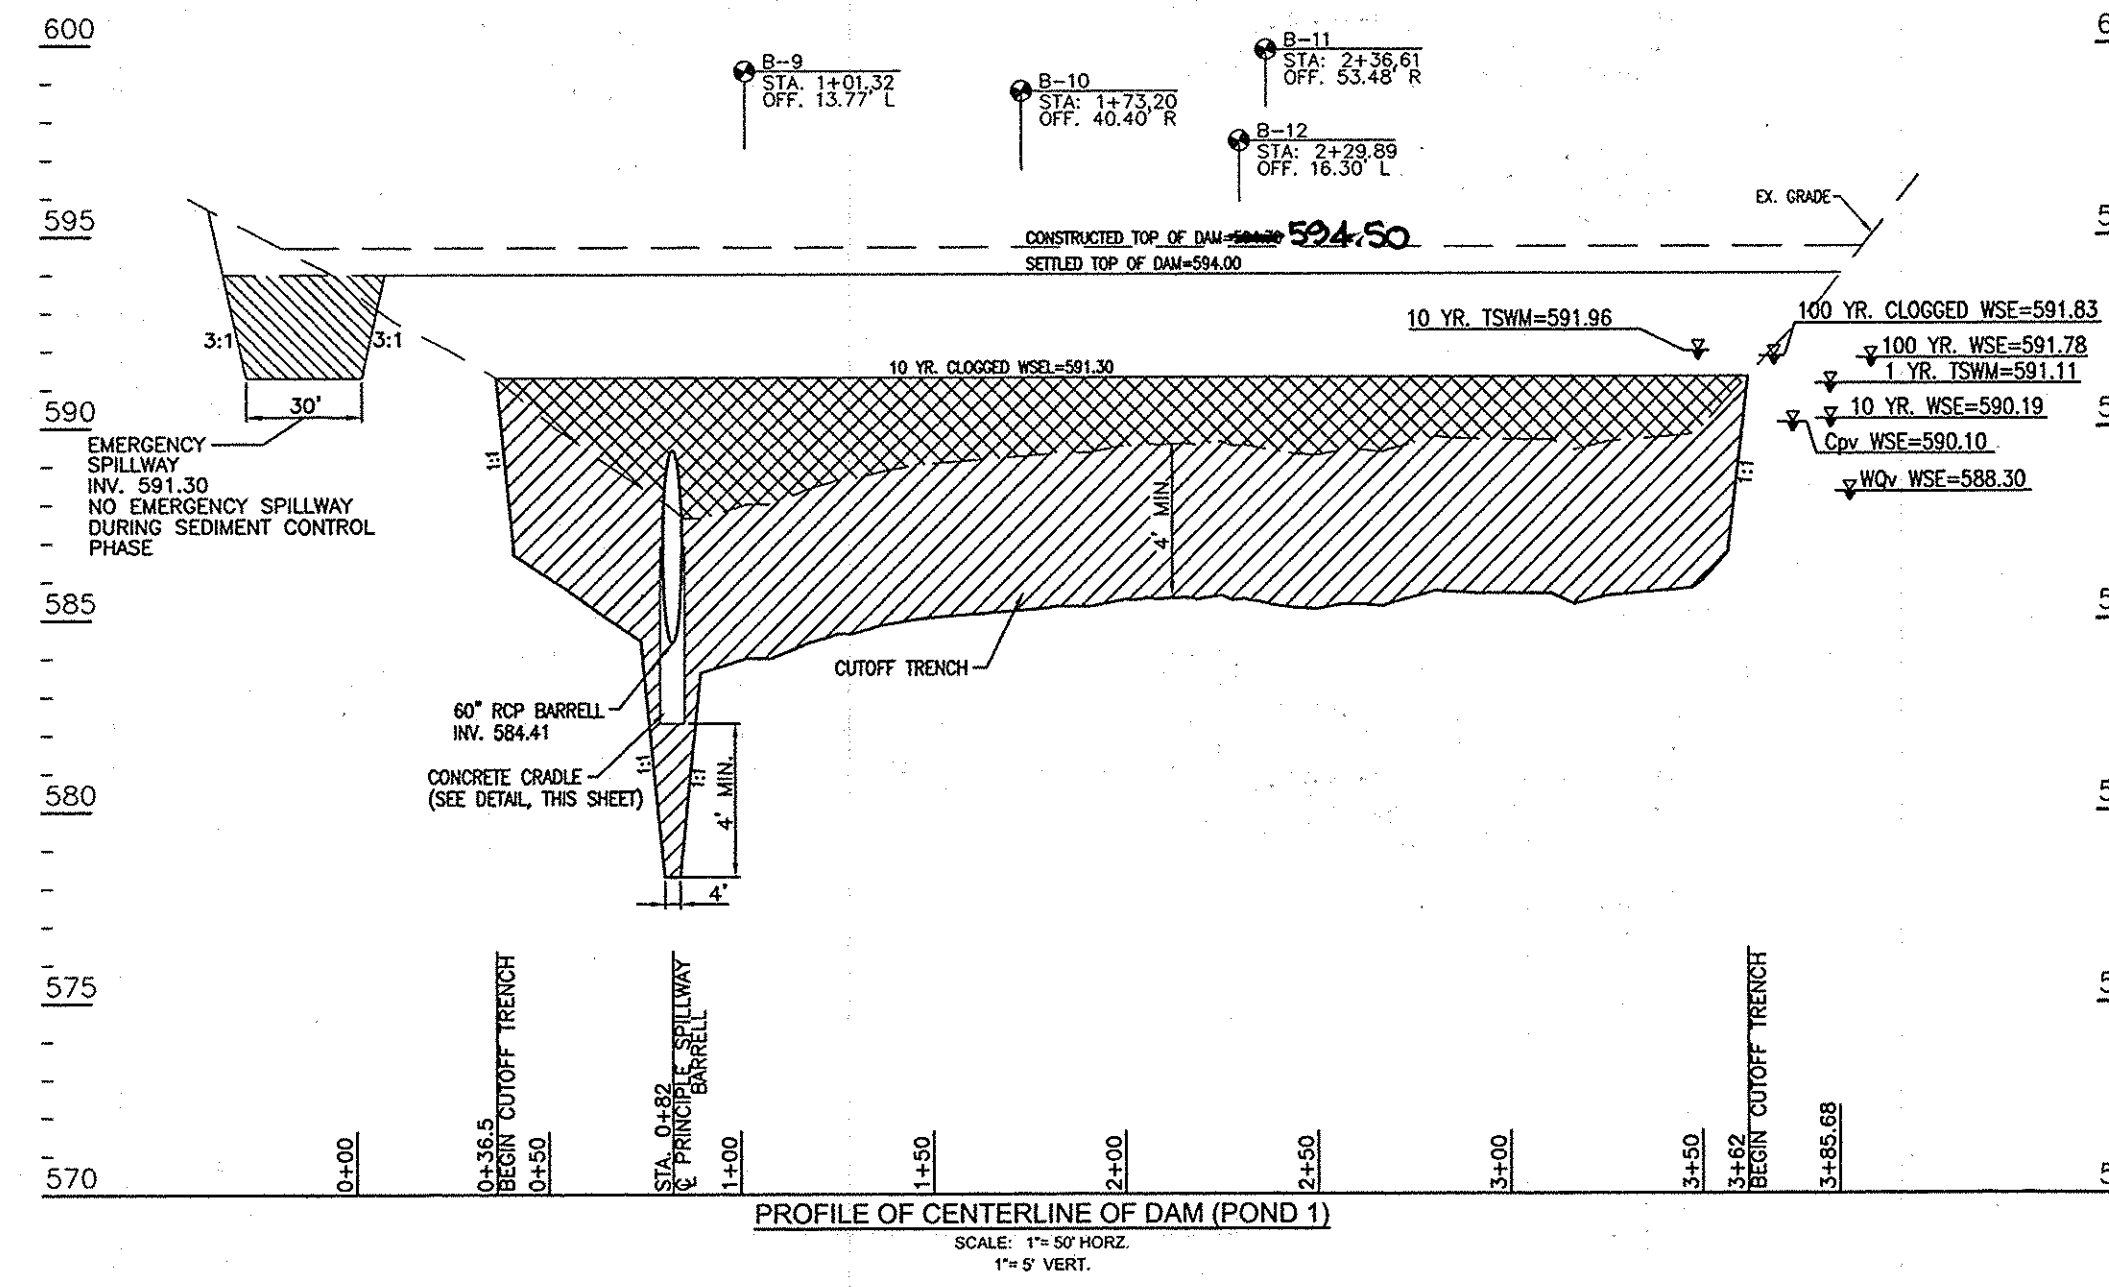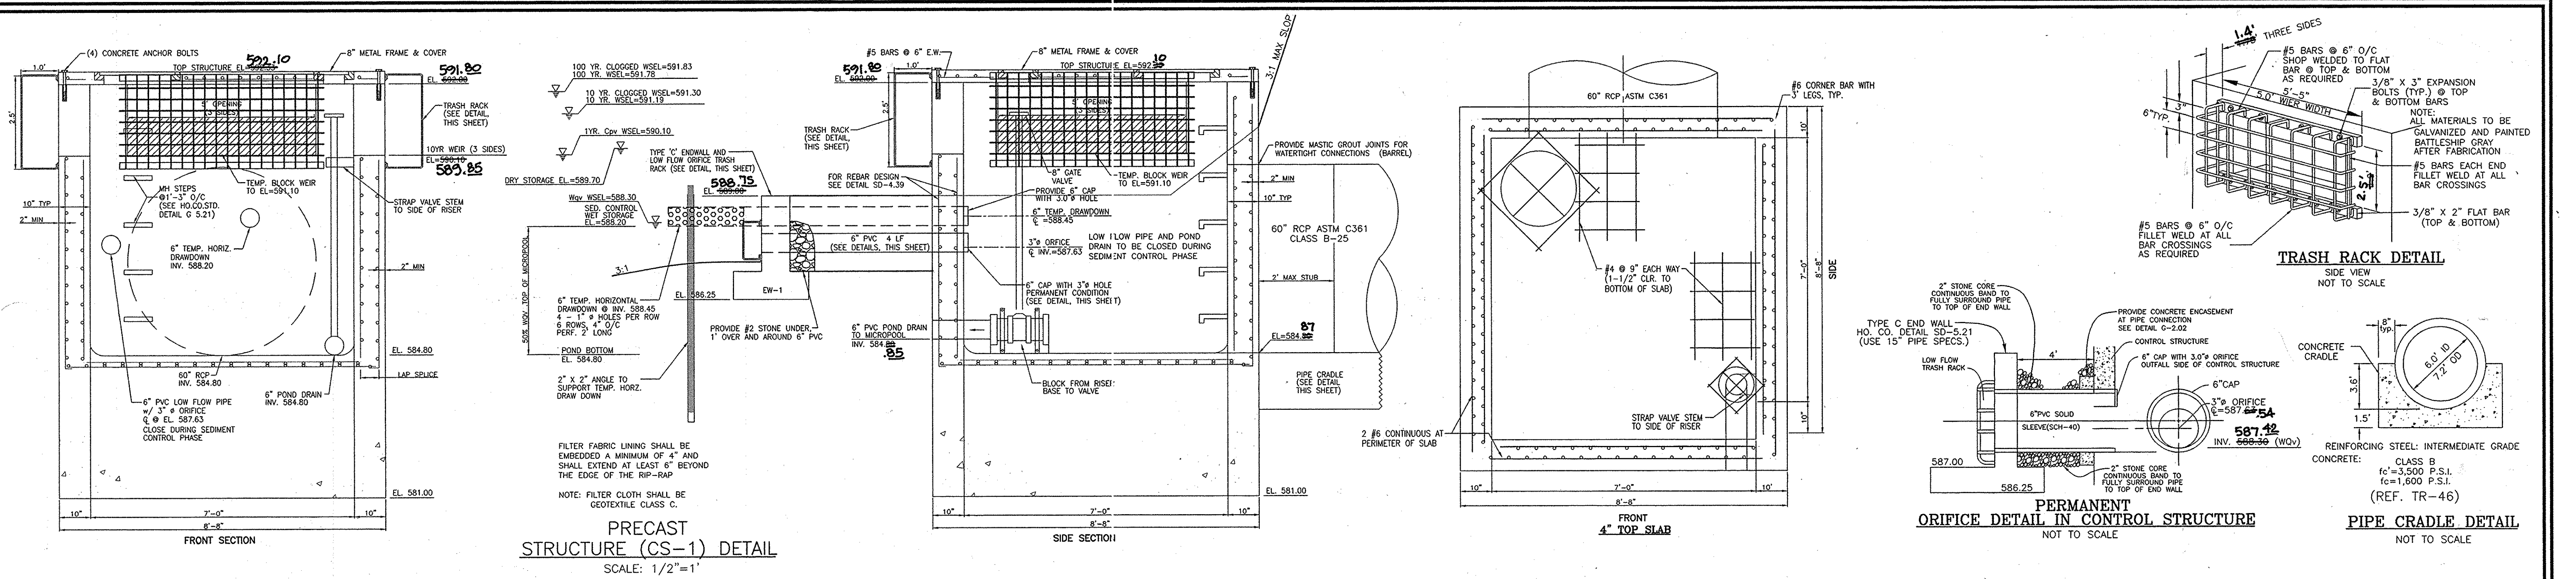

APPROVED: HOWARD COUNTY DEPARTMENT OF PUBLIC WORKS  
*William F. ...* 1-10-07  
CHIEF, BUREAU OF HIGHWAYS

APPROVED: HOWARD COUNTY DEPARTMENT OF PLANNING AND ZONING  
*...* 1/10/07  
CHIEF, DEVELOPMENT ENGINEERING DIVISION

*...* 3/2/07  
CHIEF, DIVISION OF LAND DEVELOPMENT

REVIEWED FOR HOWARD SCD AND MEETS TECHNICAL REQUIREMENTS  
*...* 2/15/07  
USDA-NATURAL RESOURCES CONSERVATION SERVICE

THIS DEVELOPMENT PLAN IS APPROVED FOR SOIL EROSION AND SEDIMENT CONTROL BY THE HOWARD SOIL CONSERVATION DISTRICT  
*...* 2/15/07  
HOWARD SCD

**ENGINEERS' CERTIFICATE**  
I HEREBY CERTIFY THAT THIS PLAN FOR POND CONSTRUCTION, EROSION AND SEDIMENT CONTROL REPRESENTS A PRACTICAL AND WORKABLE PLAN BASED ON MY PERSONAL KNOWLEDGE OF THE SITE CONDITIONS. THIS PLAN WAS PREPARED IN ACCORDANCE WITH THE REQUIREMENTS OF THE HOWARD SOIL CONSERVATION DISTRICT. I HAVE NOTIFIED THE DEVELOPER THAT HE/SHE MUST ENGAGE A REGISTERED PROFESSIONAL ENGINEER TO SUPERVISE POND CONSTRUCTION AND PROVIDE THE HOWARD SOIL CONSERVATION DISTRICT WITH AN "AS-BUILT" PLAN OF THE POND WITHIN 30 DAYS OF COMPLETION.  
ROBERT H. VOGEL, PE #16193

**DEVELOPER'S CERTIFICATE**  
I HEREBY CERTIFY THAT ALL DEVELOPMENT AND/OR CONSTRUCTION WILL BE DONE IN ACCORDANCE TO THESE PLANS, AND THAT ANY RESPONSIBLE PERSONNEL INVOLVED IN THE CONSTRUCTION PROJECT WILL HAVE A CERTIFICATE OF ATTENDANCE AT A DEPARTMENT OF THE ENVIRONMENT APPROVED TRAINING PROGRAM FOR THE CONTROL OF SEDIMENT AND EROSION BEFORE BEGINNING THE PROJECT. I SHALL ENGAGE A REGISTERED PROFESSIONAL ENGINEER TO SUPERVISE POND CONSTRUCTION AND PROVIDE THE HOWARD SOIL CONSERVATION DISTRICT WITH AN "AS-BUILT" PLAN OF THE POND WITHIN 30 DAYS OF COMPLETION.  
*...* 12/15/06

**"AS-BUILT" CERTIFICATION**  
I HEREBY CERTIFY THAT THE FACILITY SHOWN ON THIS PLAN WAS CONSTRUCTED AS SHOWN ON THE "AS-BUILT" PLANS AND MEETS THE APPROVED PLANS AND SPECIFICATIONS.  
*...* 1/17/14  
ROBERT H. VOGEL, P.E. #16193

**OWNER**  
HELEN L. FYOCK  
ROBERT E. FYOCK  
GENELCO, MARYLAND

**DEVELOPER**  
CASTLEBERRY AT TEN OAKS, L.L.C.  
3675 PARK AVENUE, SUITE 301  
ELLCOTT CITY, MARYLAND 21043  
(410) 740-9401

NO.	REVISION	DATE

**STORMWATER MANAGEMENT DETAILS**  
**POND #1**  
**CASTLEBERRY AT TEN OAKS**  
LOTS 1 - 45, NON-BUILDABLE PRESERVATION  
PARCELS A, C, D, E & BUILDABLE PRESERVATION PARCEL B

TAX MAP 22 GRID 20 PARCEL 60, LOTS 6 & 7 KEN WARFIELD SUBDIVISION, AND PIO PARCEL 90  
6TH ELECTION DISTRICT HOWARD COUNTY, MARYLAND



**ROBERT H. VOGEL ENGINEERING, INC.**  
ENGINEERS • SURVEYORS • PLANNERS  
8407 MAIN STREET  
ELLCOTT CITY, MD 21043  
TEL: 410.461.7666  
FAX: 410.461.8961

**DESIGN BY:** RHWL/JT  
**DRAWN BY:** LUT  
**CHECKED BY:** RHW  
**DATE:** DECEMBER, 2006  
**SCALE:** AS NOTED  
**W.O. NO.:** 00-85-00


**DPZ REF:** S-01-11, P-05-04

**19** SHEET **23**


AS-BUILT 11/17/14 F-06-130

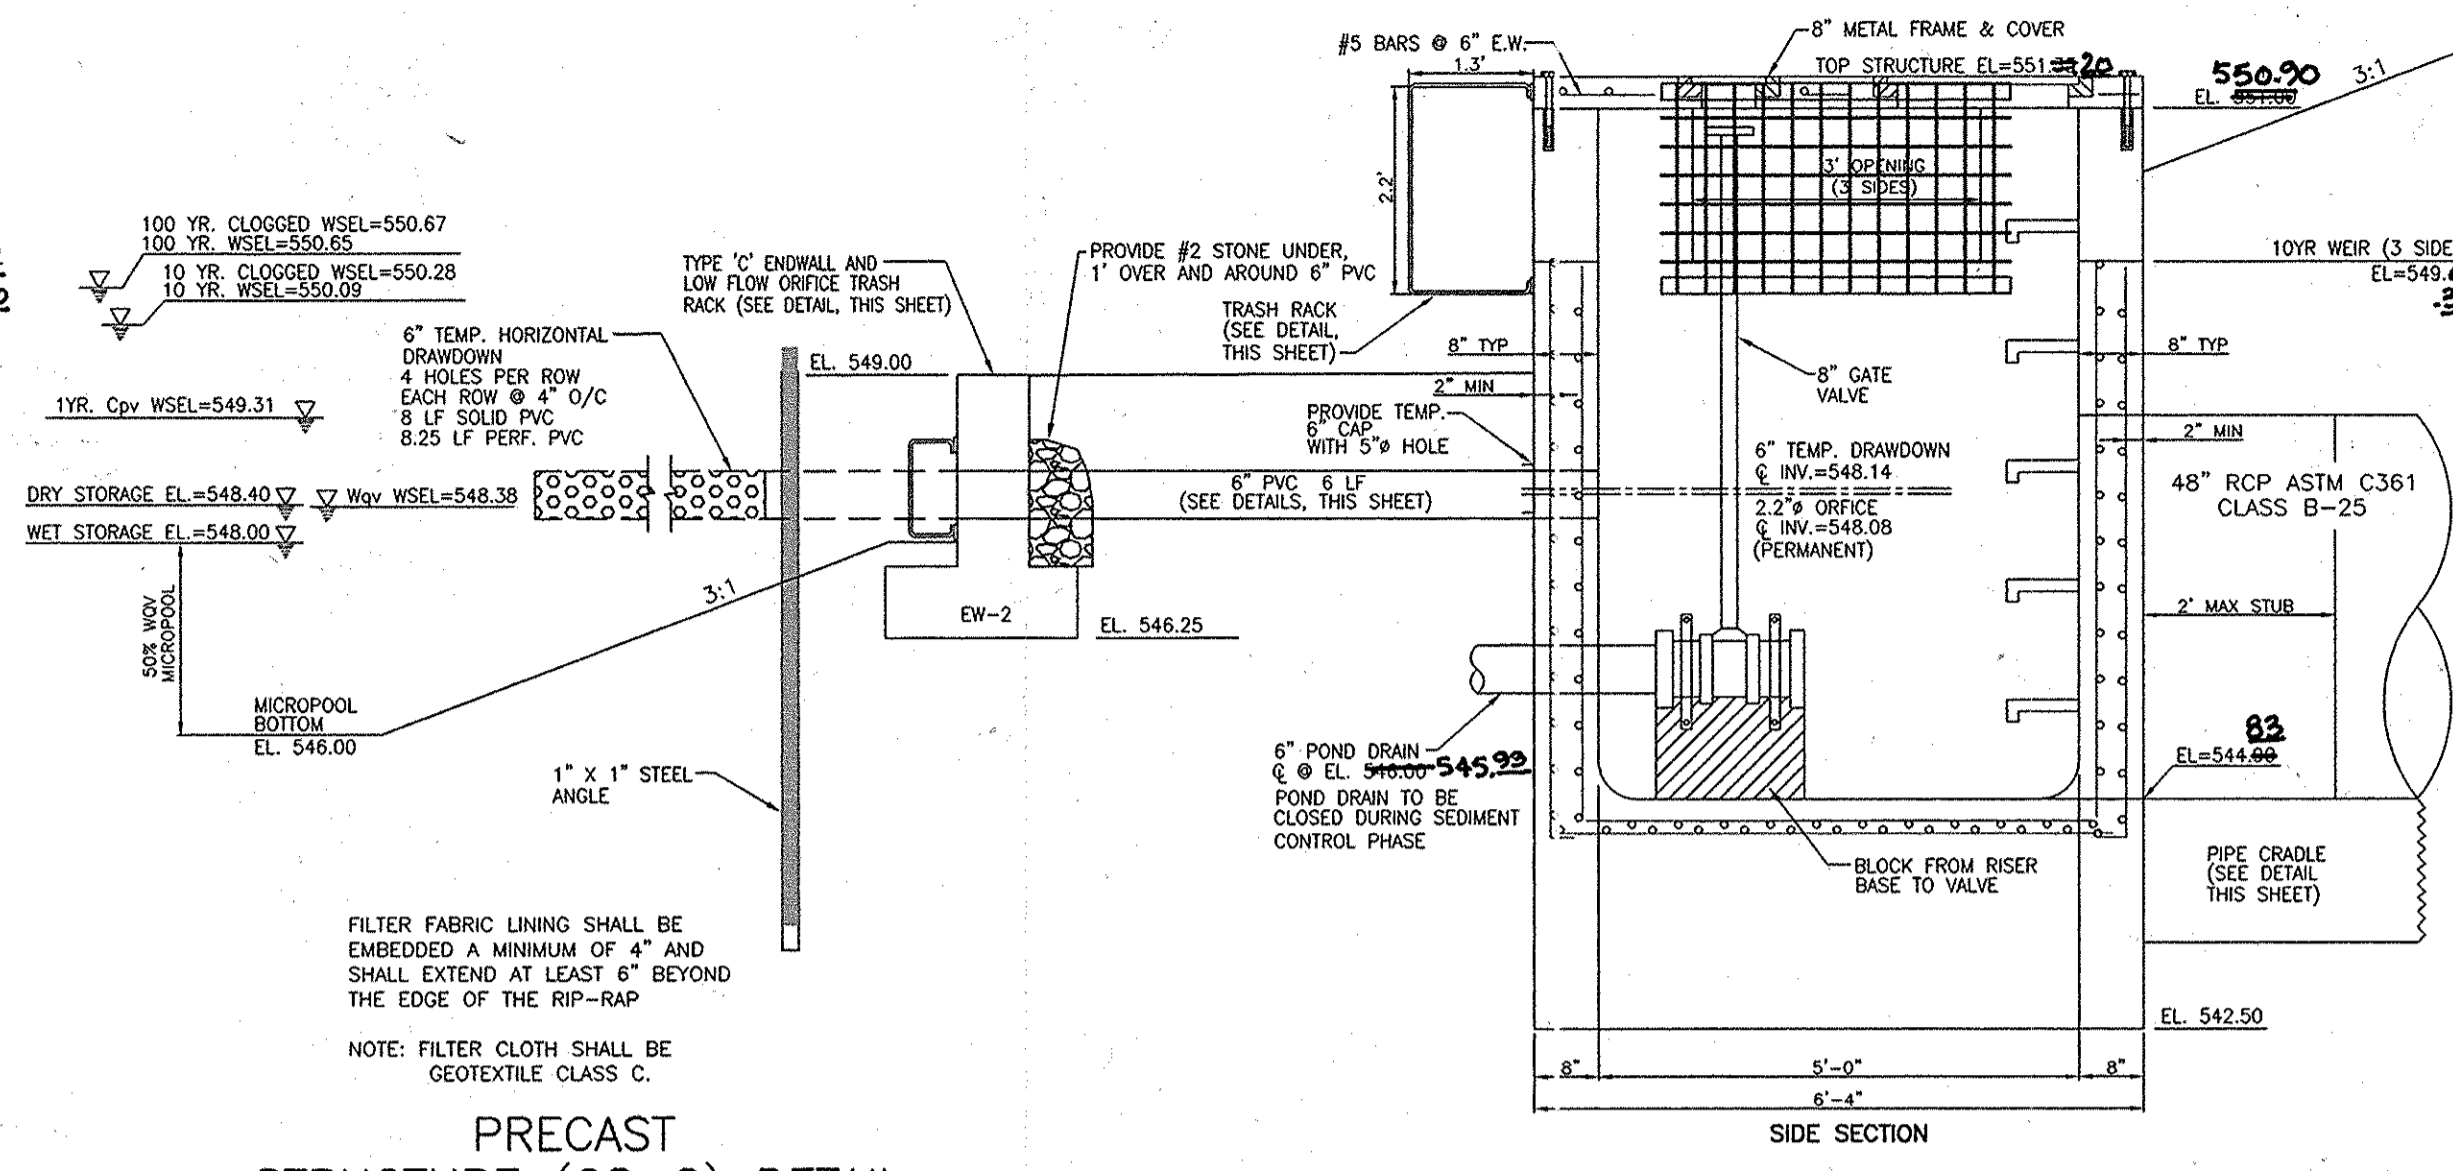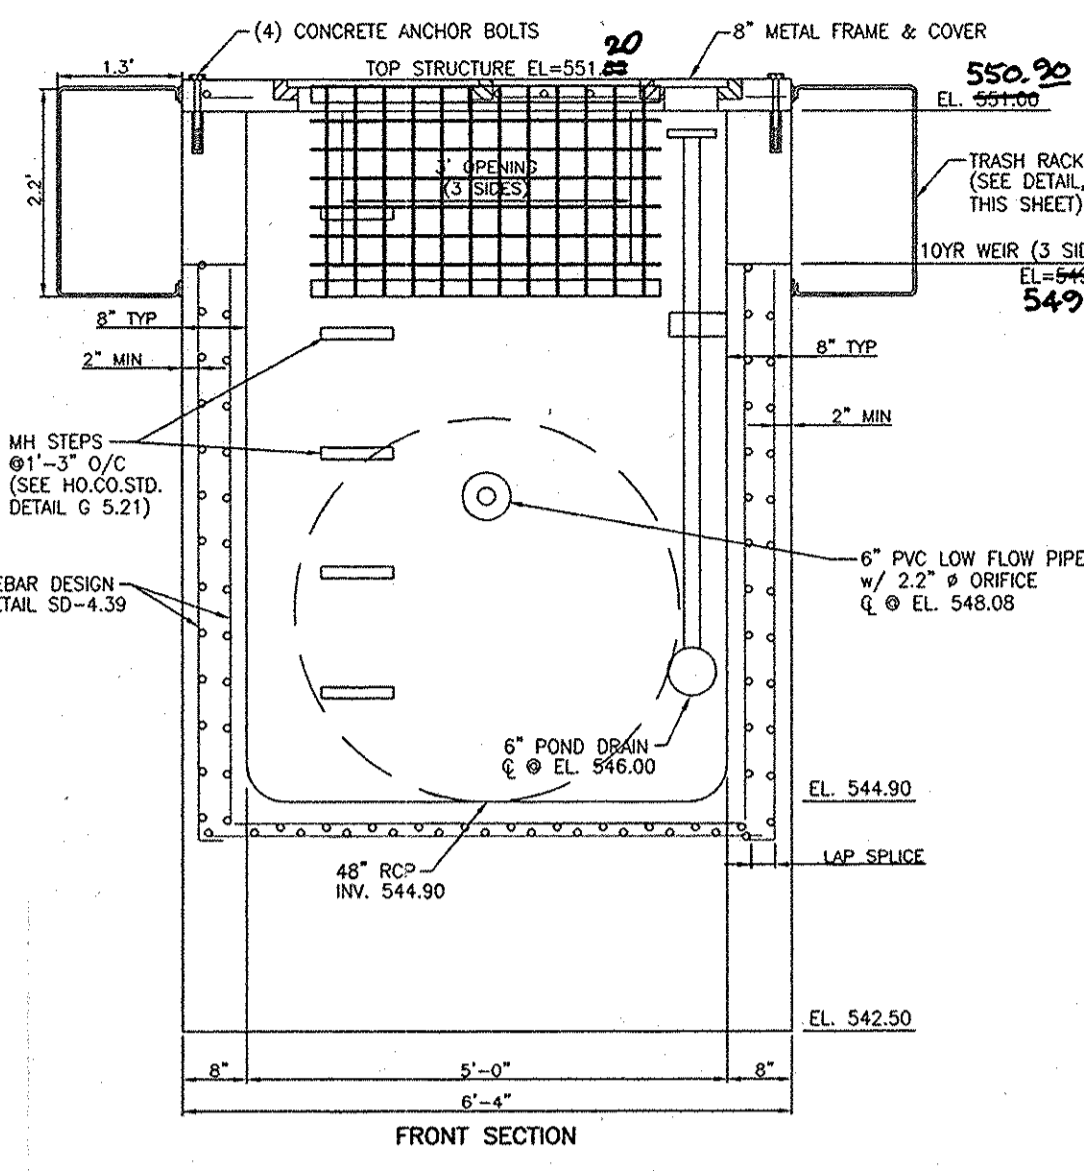


**PRECAST STRUCTURE (CS-2) DETAIL**  
SCALE: 1/2"=1'

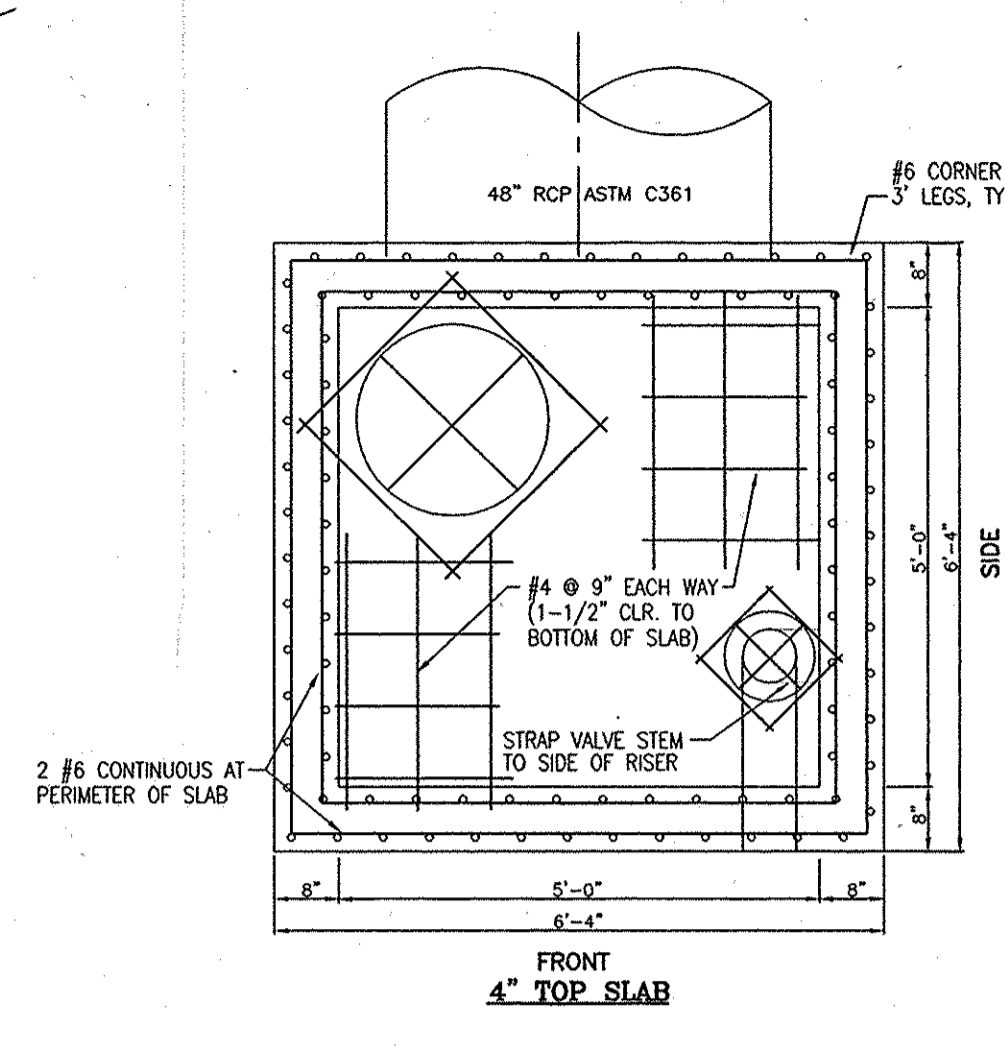


**4" TOP SLAB**

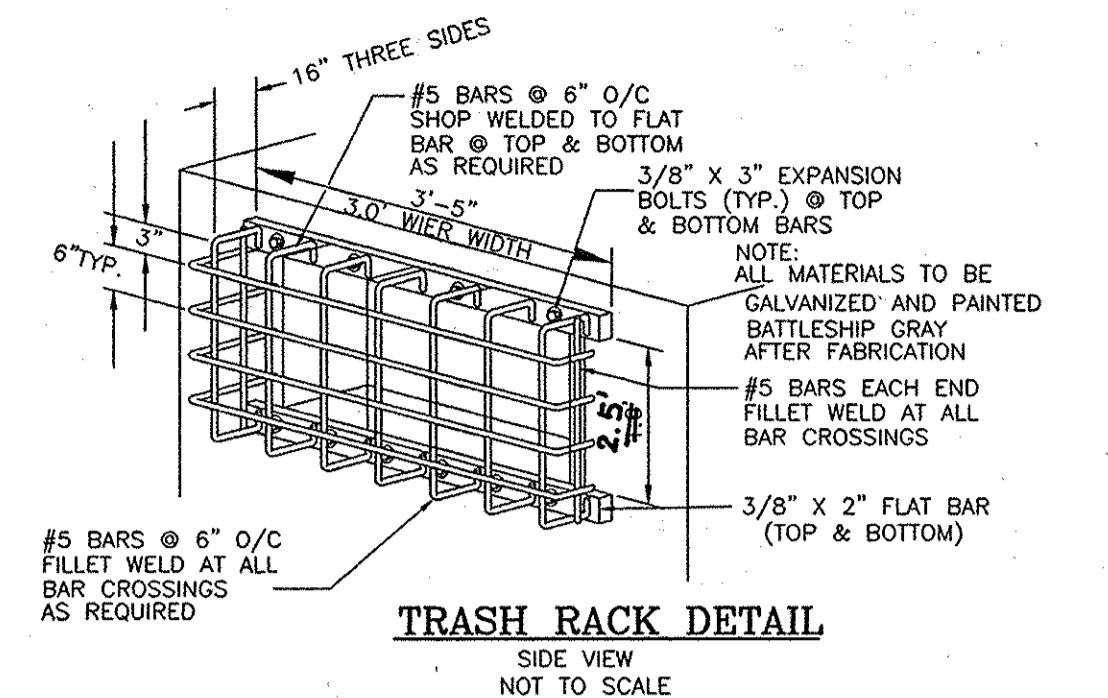


**TRASH RACK DETAIL**  
SIDE VIEW  
NOT TO SCALE

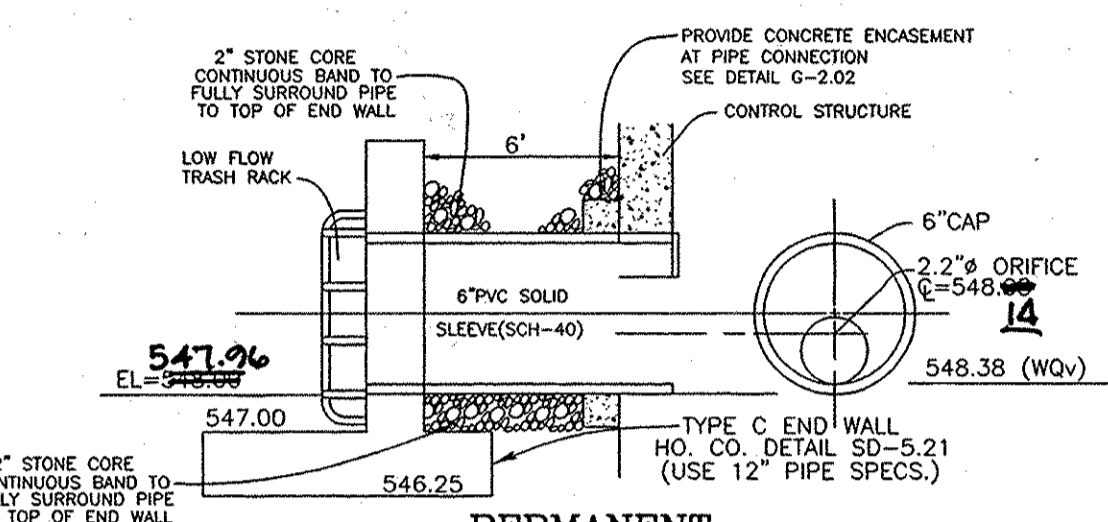

**PERMANENT ORIFICE DETAIL IN CONTROL STRUCTURE**  
NOT TO SCALE

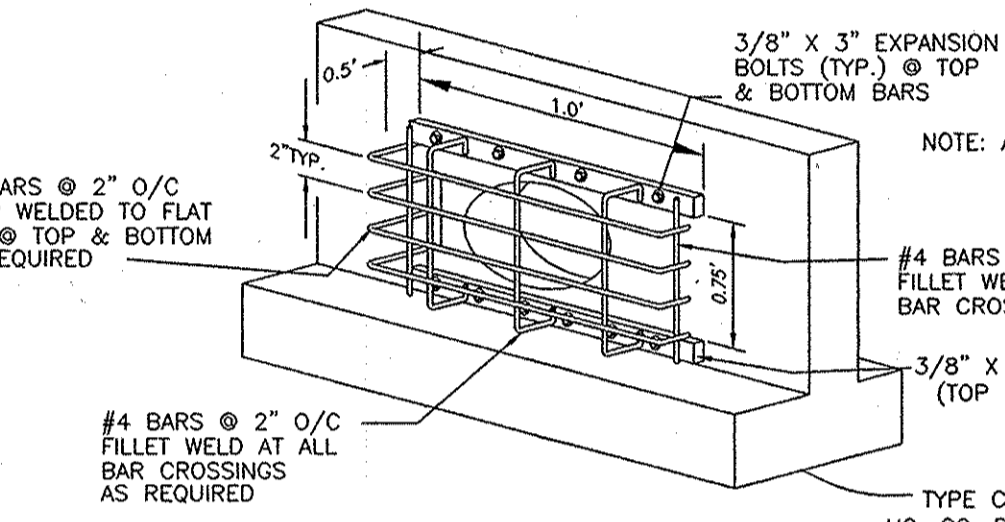


**LOW FLOW ORIFICE TRASH RACK DETAIL**  
NOT TO SCALE

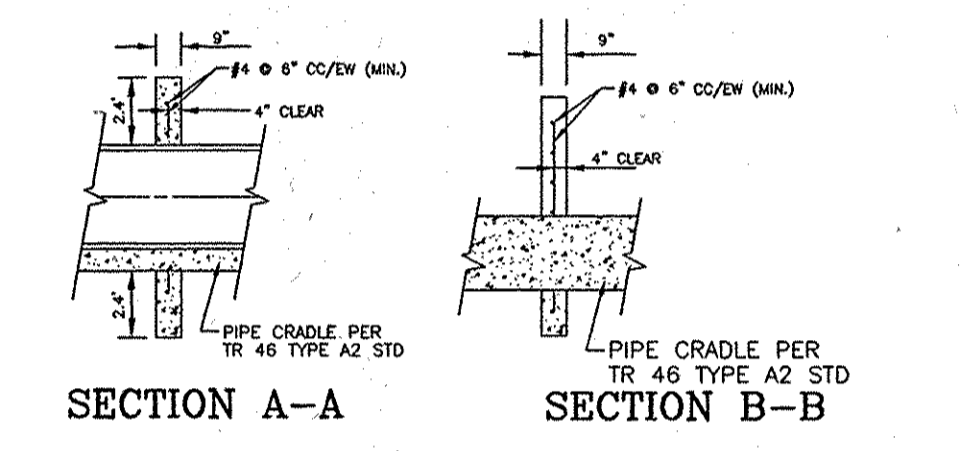


**SECTION A-A** **SECTION B-B**

- NOTES:**
- ANTI-SEEP COLLARS SHOULD BE PLACED WITHIN THE SATURATION ZONE.
  - ALL ANTI-SEEP COLLARS AND THEIR CONNECTIONS TO THE CONDUIT SHALL BE WATERPROOF AND MADE OF COMPATIBLE WITH THE CONDUIT.
  - COLLARS DIMENSIONS SHALL EXTEND A MIN. OF 2' IN ALL DIRECTIONS AROUND THE PIPE.
  - ANTI-SEEP COLLAR SHALL BE PLACED A MIN. OF 2' FROM PIPE JOINTS EXCEPT WHERE FLANGED JOINTS ARE USED.


**CONCRETE ANTI-SEEP COLLAR DETAIL**  
NOT TO SCALE

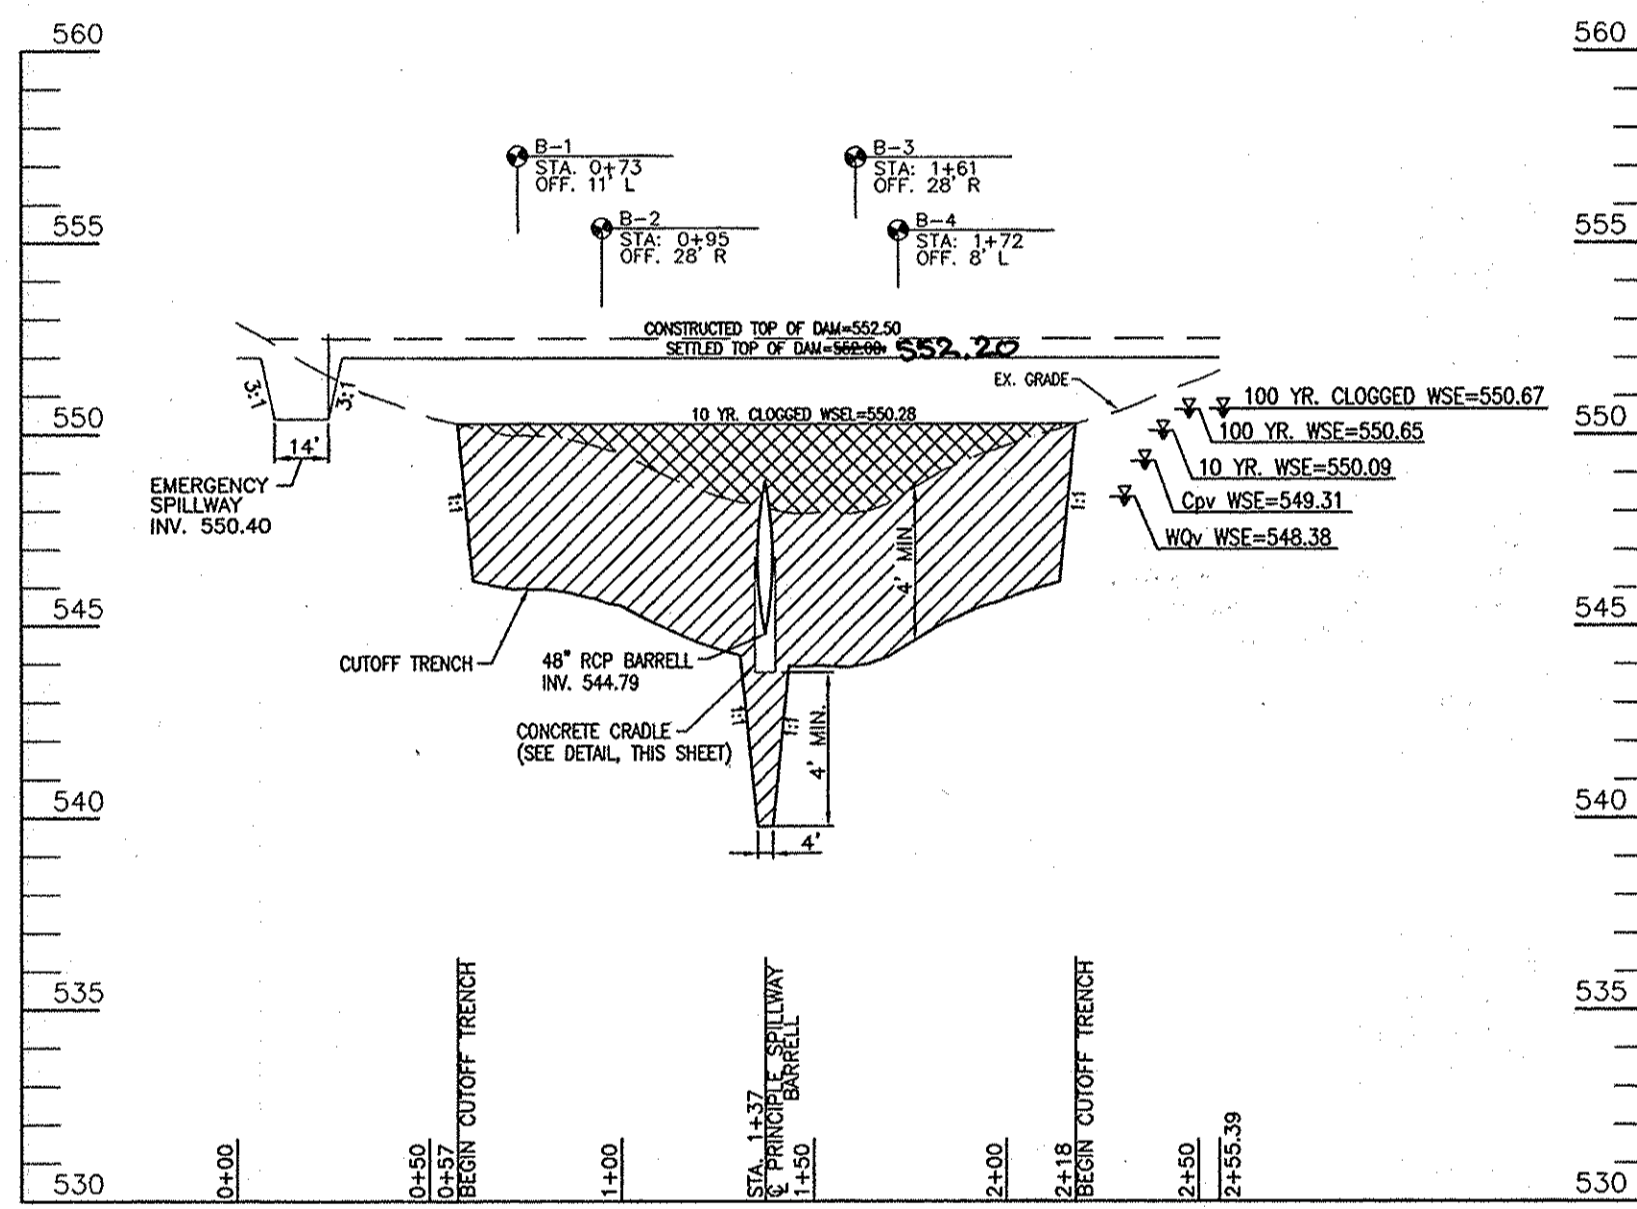

**PROFILE OF CENTERLINE OF DAM (POND 2)**  
SCALE: 1"=50' HORIZ.  
1"=5' VERT.

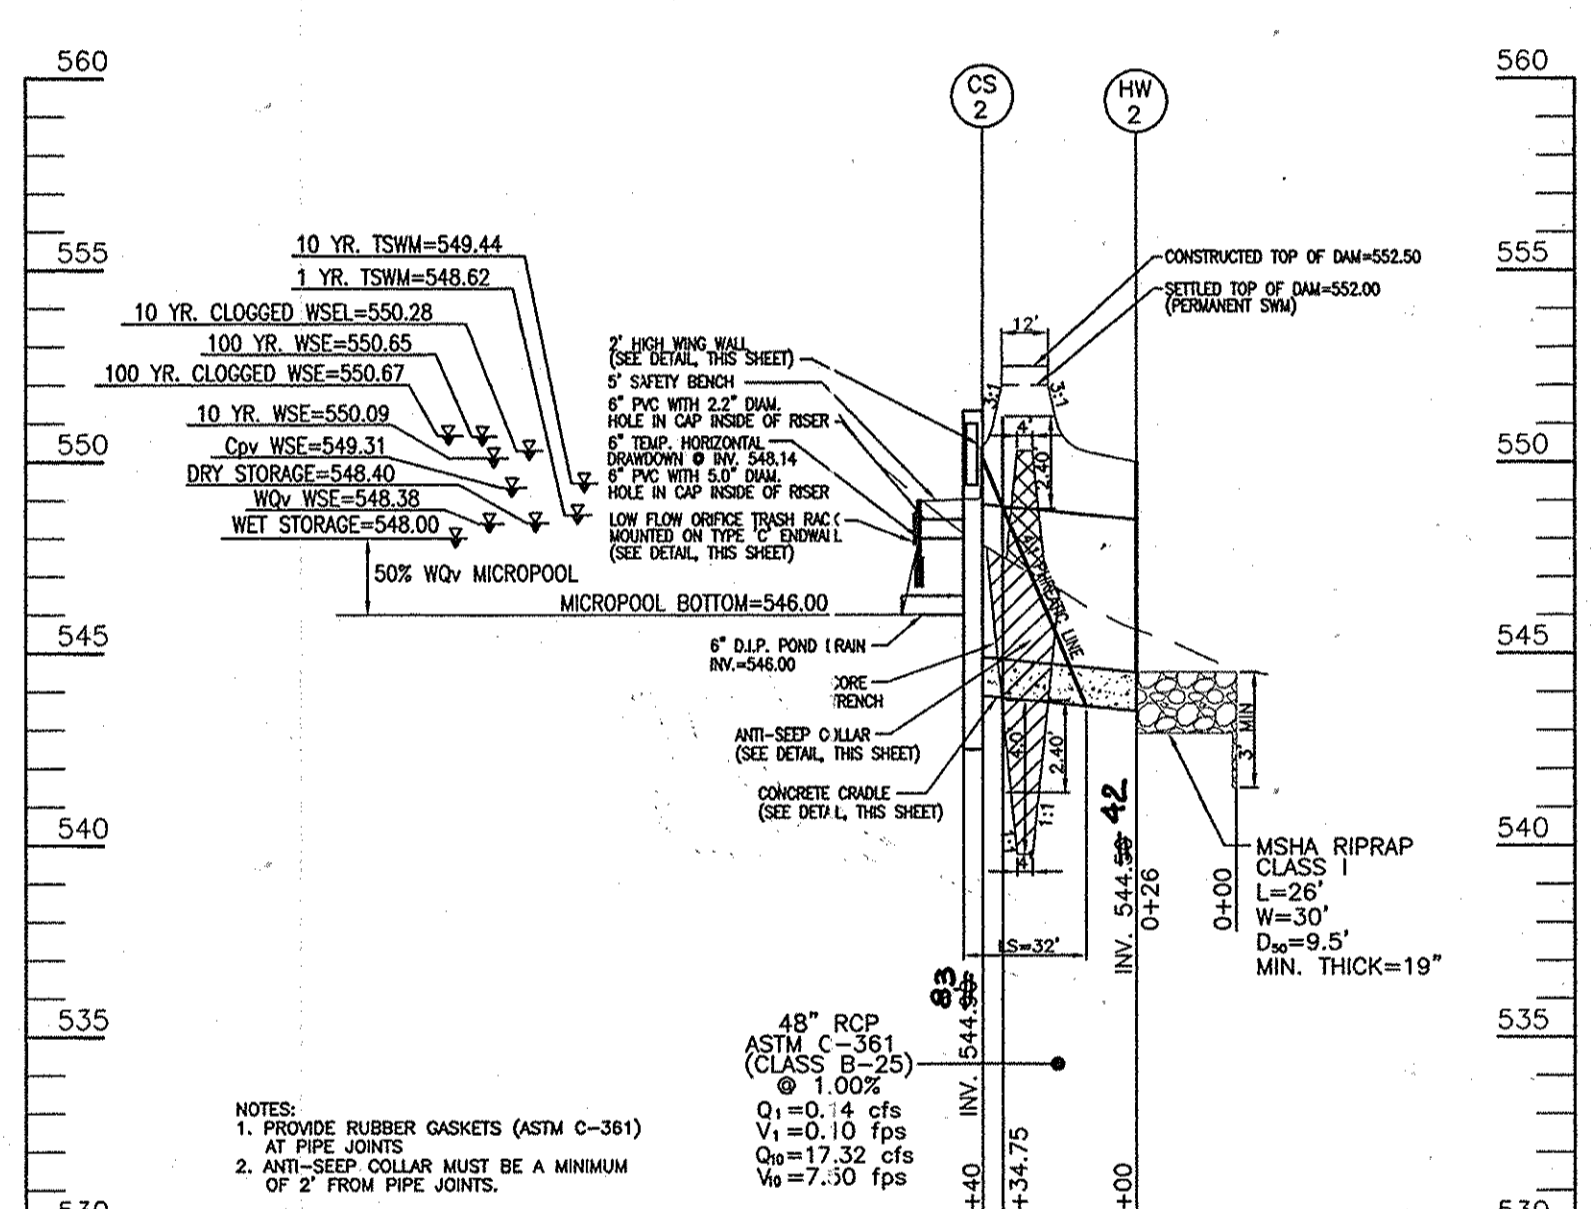


**PRINCIPLE SPILLWAY PROFILE (POND 2)**  
SCALE: 1"=50' HORIZ.  
1"=5' VERT.

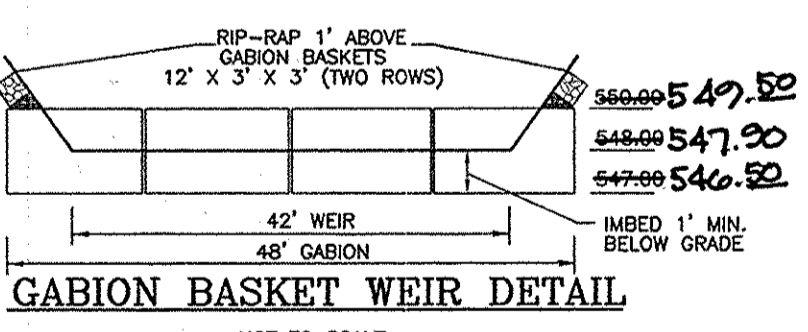


**GABION BASKET WEIR DETAIL**  
NOT TO SCALE

- NOTES:**
- ALL WIRE USED IN GABION CONSTRUCTION SHALL BE GALVANIZED AND PLASTIC COATED.
  - FILTER CLOTH SHALL BE PLACED WHEREVER GABIONS COME INTO CONTACT WITH SOIL.
  - STONE FILL SHALL CONSIST OF HARD, DURABLE, CLEAN STONE 4"-8" IN DIAMETER.
  - CONSTRUCTION MATERIALS AND METHODS SHALL BE IN ACCORDANCE WITH MANUFACTURER'S SPECIFICATIONS.
  - RIP-RAP TO BE PLACED BELOW GABION WEIR TO BOTTOM OF FOREBAY.

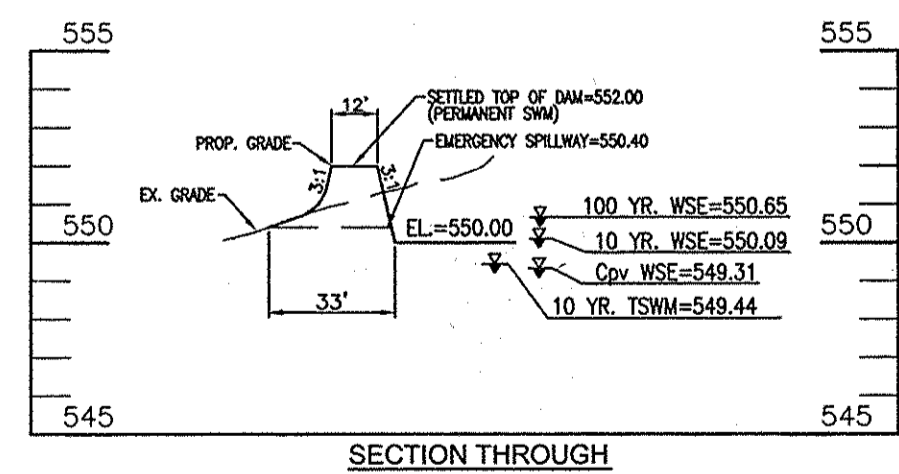

**SECTION THROUGH EMERGENCY SPILLWAY**  
SCALE: HORIZONTAL 1"=50'  
VERTICAL 1"=5'

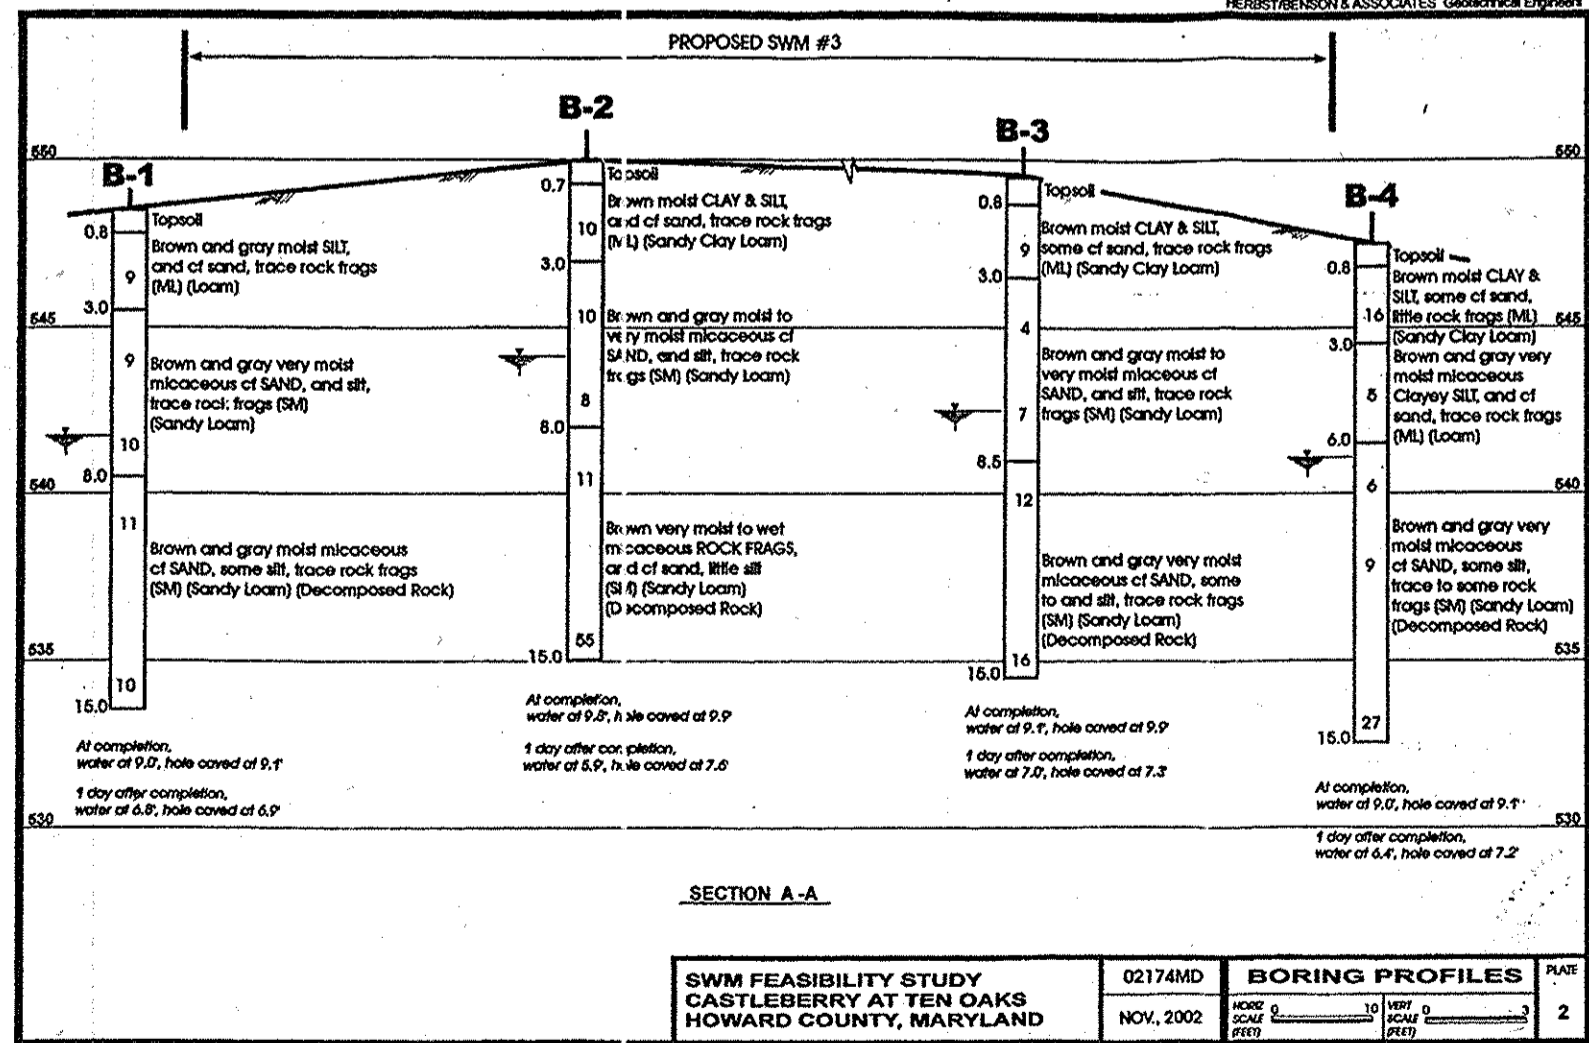

**BORING PROFILES**  
NOV. 2002



**TEMP. SEDIMENT BASIN HORIZONTAL DRAW-DOWN DEVICE**

CONSTRUCTION SPECIFICATIONS

- THE TOTAL AREA OF THE PERFORATIONS MUST BE GREATER THAN 4 TIMES THE AREA OF THE INTERNAL ORIFICE.
- THE PERFORATED PORTION OF THE DRAW-DOWN DEVICE SHALL BE WRAPPED WITH 1/2" HARDWARE CLOTH AND GEOTEXTILE FABRIC. THE GEOTEXTILE FABRIC SHALL MEET THE SPECIFICATIONS OF GEOTEXTILE CLASS E.
- PROVIDE SUPPORT OF DRAW-DOWN DEVICE TO PREVENT SAGGING AND FLOTTATION. AN ACCEPTABLE PREVENTATIVE MEASURE IS TO STRIKE BOTH SIDES OF DRAW-DOWN DEVICE WITH 1" STEEL ANGLE, 4" X 4" SQUARE OR 2" ROUND WOODEN POSTS SET 3' MINIMUM FROM THE GROUND THEN JOINING THEM TO THE DEVICE BY WRAPPING WITH 12 GAUGE MINIMUM WIRE.

APPROVED: HOWARD COUNTY DEPARTMENT OF PUBLIC WORKS  
1-10-07  
DATE

REVIEWED FOR HOWARD SCD AND MEETS TECHNICAL REQUIREMENTS  
2/15/02  
DATE

**ENGINEER'S CERTIFICATE**  
I HEREBY CERTIFY THAT THIS PLAN FOR POND CONSTRUCTION, EROSION AND SEDIMENT CONTROL REPRESENTS A PRACTICAL AND WORKABLE PLAN BASED ON MY PERSONAL KNOWLEDGE OF THE SITE CONDITIONS. THIS PLAN WAS PREPARED IN ACCORDANCE WITH THE REQUIREMENTS OF THE HOWARD SOIL CONSERVATION DISTRICT. I HAVE NOTIFIED THE DEVELOPER THAT HE/SHE MUST ENGAGE A REGISTERED PROFESSIONAL ENGINEER TO SUPERVISE POND CONSTRUCTION AND PROVIDE THE HOWARD SOIL CONSERVATION DISTRICT WITH AN "AS-BUILT" PLAN OF THE POND WITHIN 30 DAYS OF COMPLETION.

**DEVELOPER'S CERTIFICATE**  
I HEREBY CERTIFY THAT ALL DEVELOPMENT AND/OR CONSTRUCTION WILL BE DONE IN ACCORDANCE TO THESE PLANS, AND THAT ANY RESPONSIBLE PERSONNEL INVOLVED IN THE CONSTRUCTION PROJECT WILL HAVE A CERTIFICATE OF ATTENDANCE AT A DEPARTMENT OF THE ENVIRONMENT APPROVED TRAINING PROGRAM FOR THE CONTROL OF SEDIMENT AND EROSION BEFORE BEGINNING THE PROJECT. I SHALL ENGAGE A REGISTERED PROFESSIONAL ENGINEER TO SUPERVISE POND CONSTRUCTION AND PROVIDE THE HOWARD SOIL CONSERVATION DISTRICT WITH AN "AS-BUILT" PLAN OF THE POND WITHIN 30 DAYS OF COMPLETION.

**"AS-BUILT" CERTIFICATION**  
I HEREBY CERTIFY THAT THE FACILITY SHOWN ON THIS PLAN WAS CONSTRUCTED AS SHOWN ON THE AS-BUILT PLANS AND MEETS THE APPROVED PLANS AND SPECIFICATIONS.


**OWNER**  
HELEN L. FYOCK  
ROBERT E. FYOCK  
GLENELG, MARYLAND

**DEVELOPER**  
CASTLEBERRY AT TEN OAKS, L.L.C.  
3675 PARK AVENUE, SUITE 301  
ELICOTT CITY, MARYLAND 21043  
(410) 740-9401

NO.	REVISION	DATE

**STORMWATER MANAGEMENT DETAILS**  
**POND #2**  
**CASTLEBERRY AT TEN OAKS**  
LOTS 1-45, NON-BUILDABLE PRESERVATION  
PARCELS A, C, D, E & BUILDABLE PRESERVATION PARCEL B  
5TH MAP 22 GRID 20  
5TH ELECTION DISTRICT





**ROBERT H. VOGEL ENGINEERING, INC.**  
ENGINEERS • SURVEYORS • PLANNERS  
8407 MAIN STREET  
ELICOTT CITY, MD 21043  
TEL: 410.461.7666  
FAX: 410.461.8961

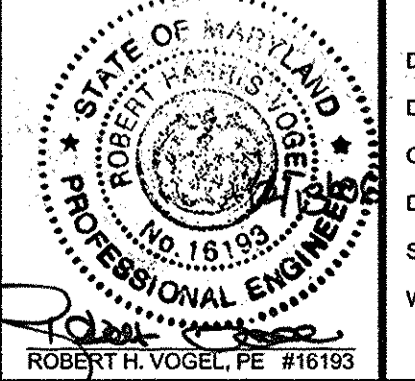

**DESIGN BY:** RHW/LIT  
**DRAWN BY:** LIT  
**CHECKED BY:** RHW  
**DATE:** DECEMBER, 2008  
**SCALE:** AS NOTED  
**W.O. NO.:** 00-85.00

**DPZ REF:**  
S-01-11, P-05-04



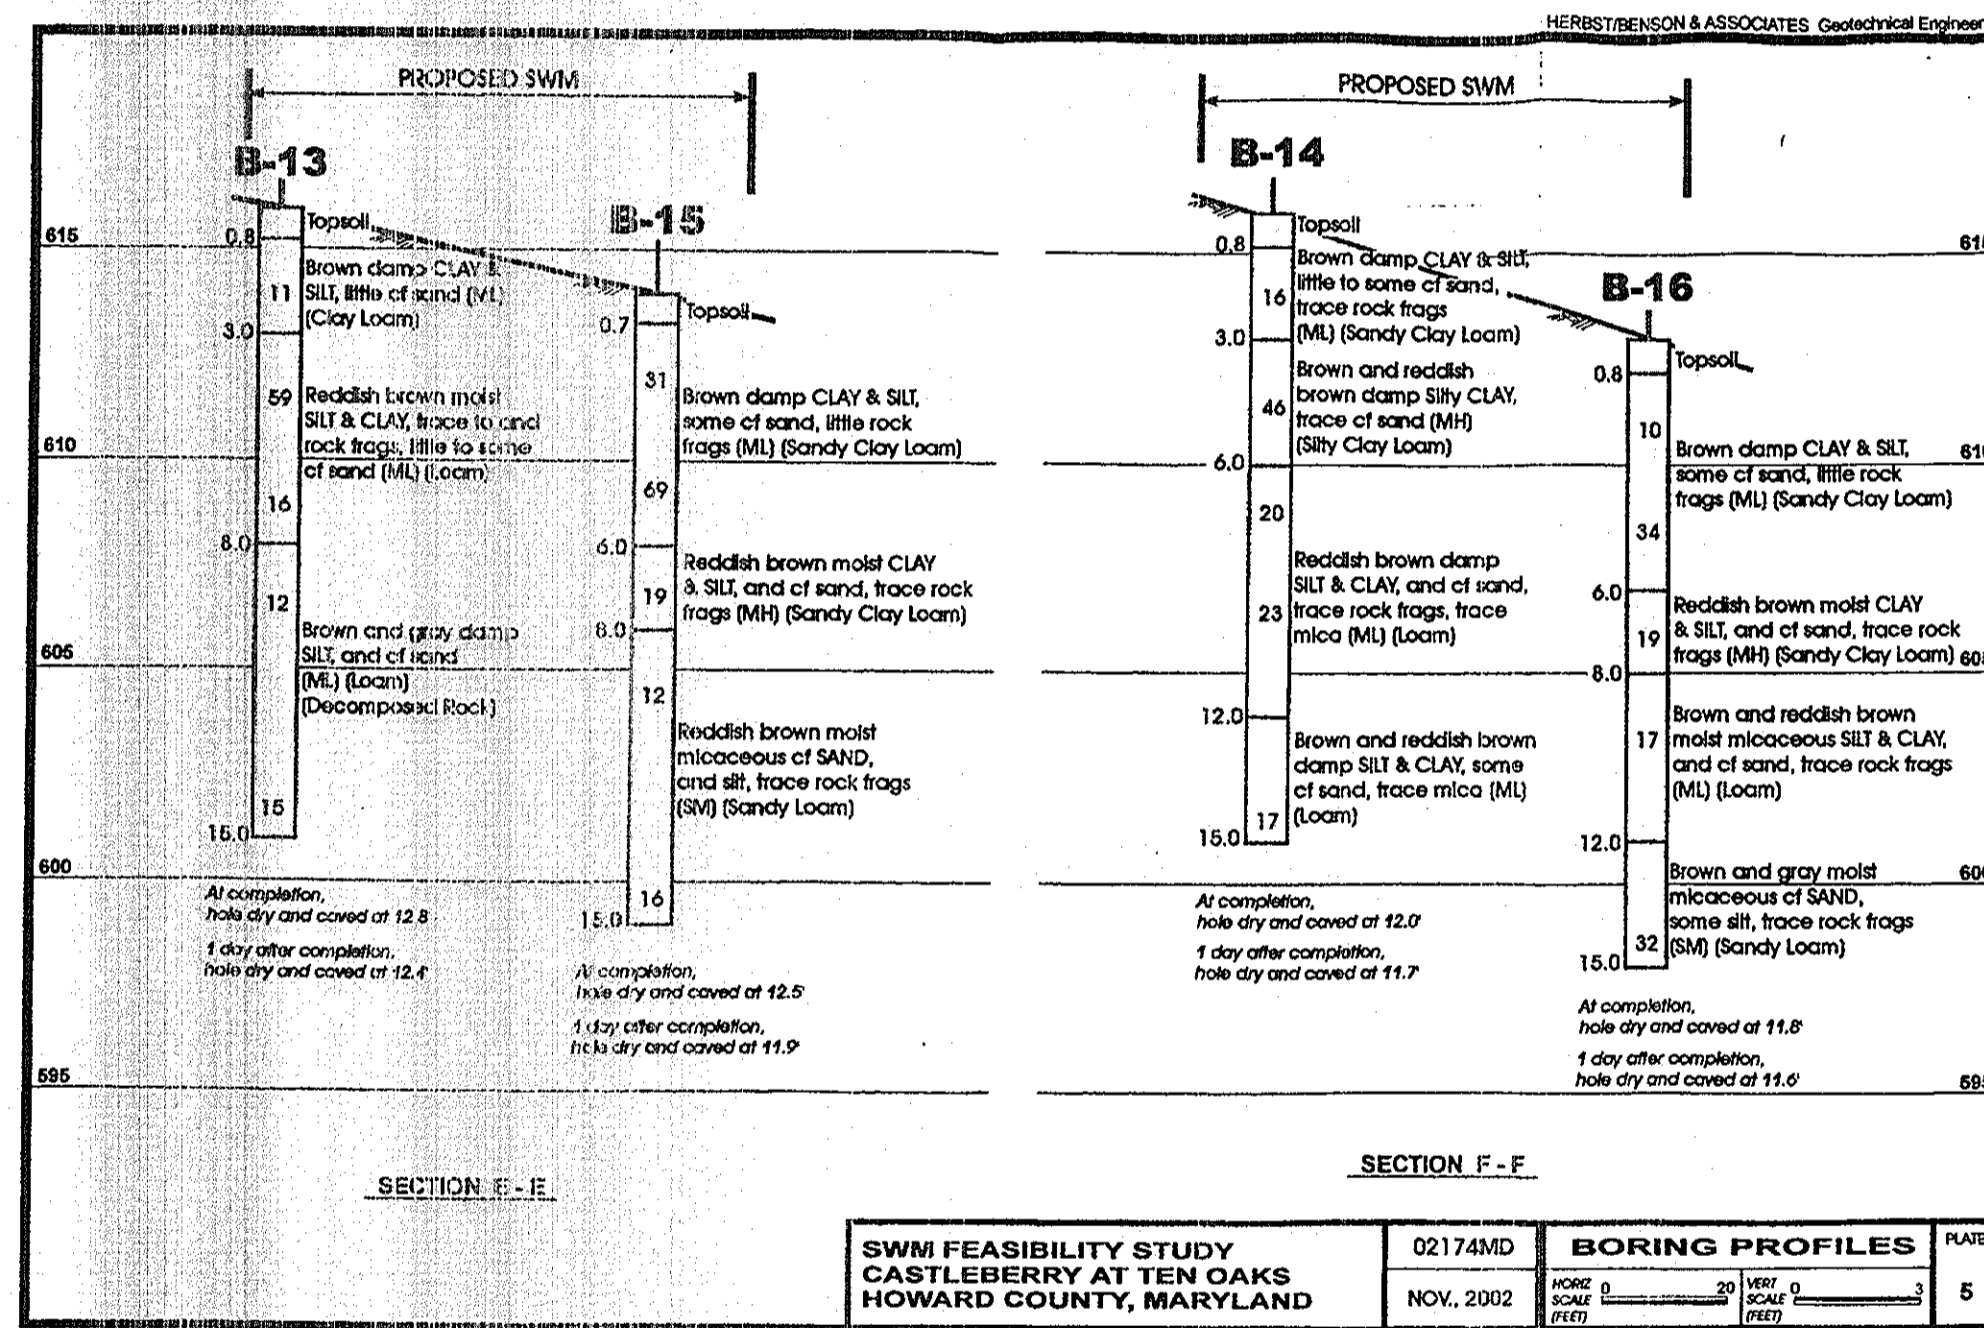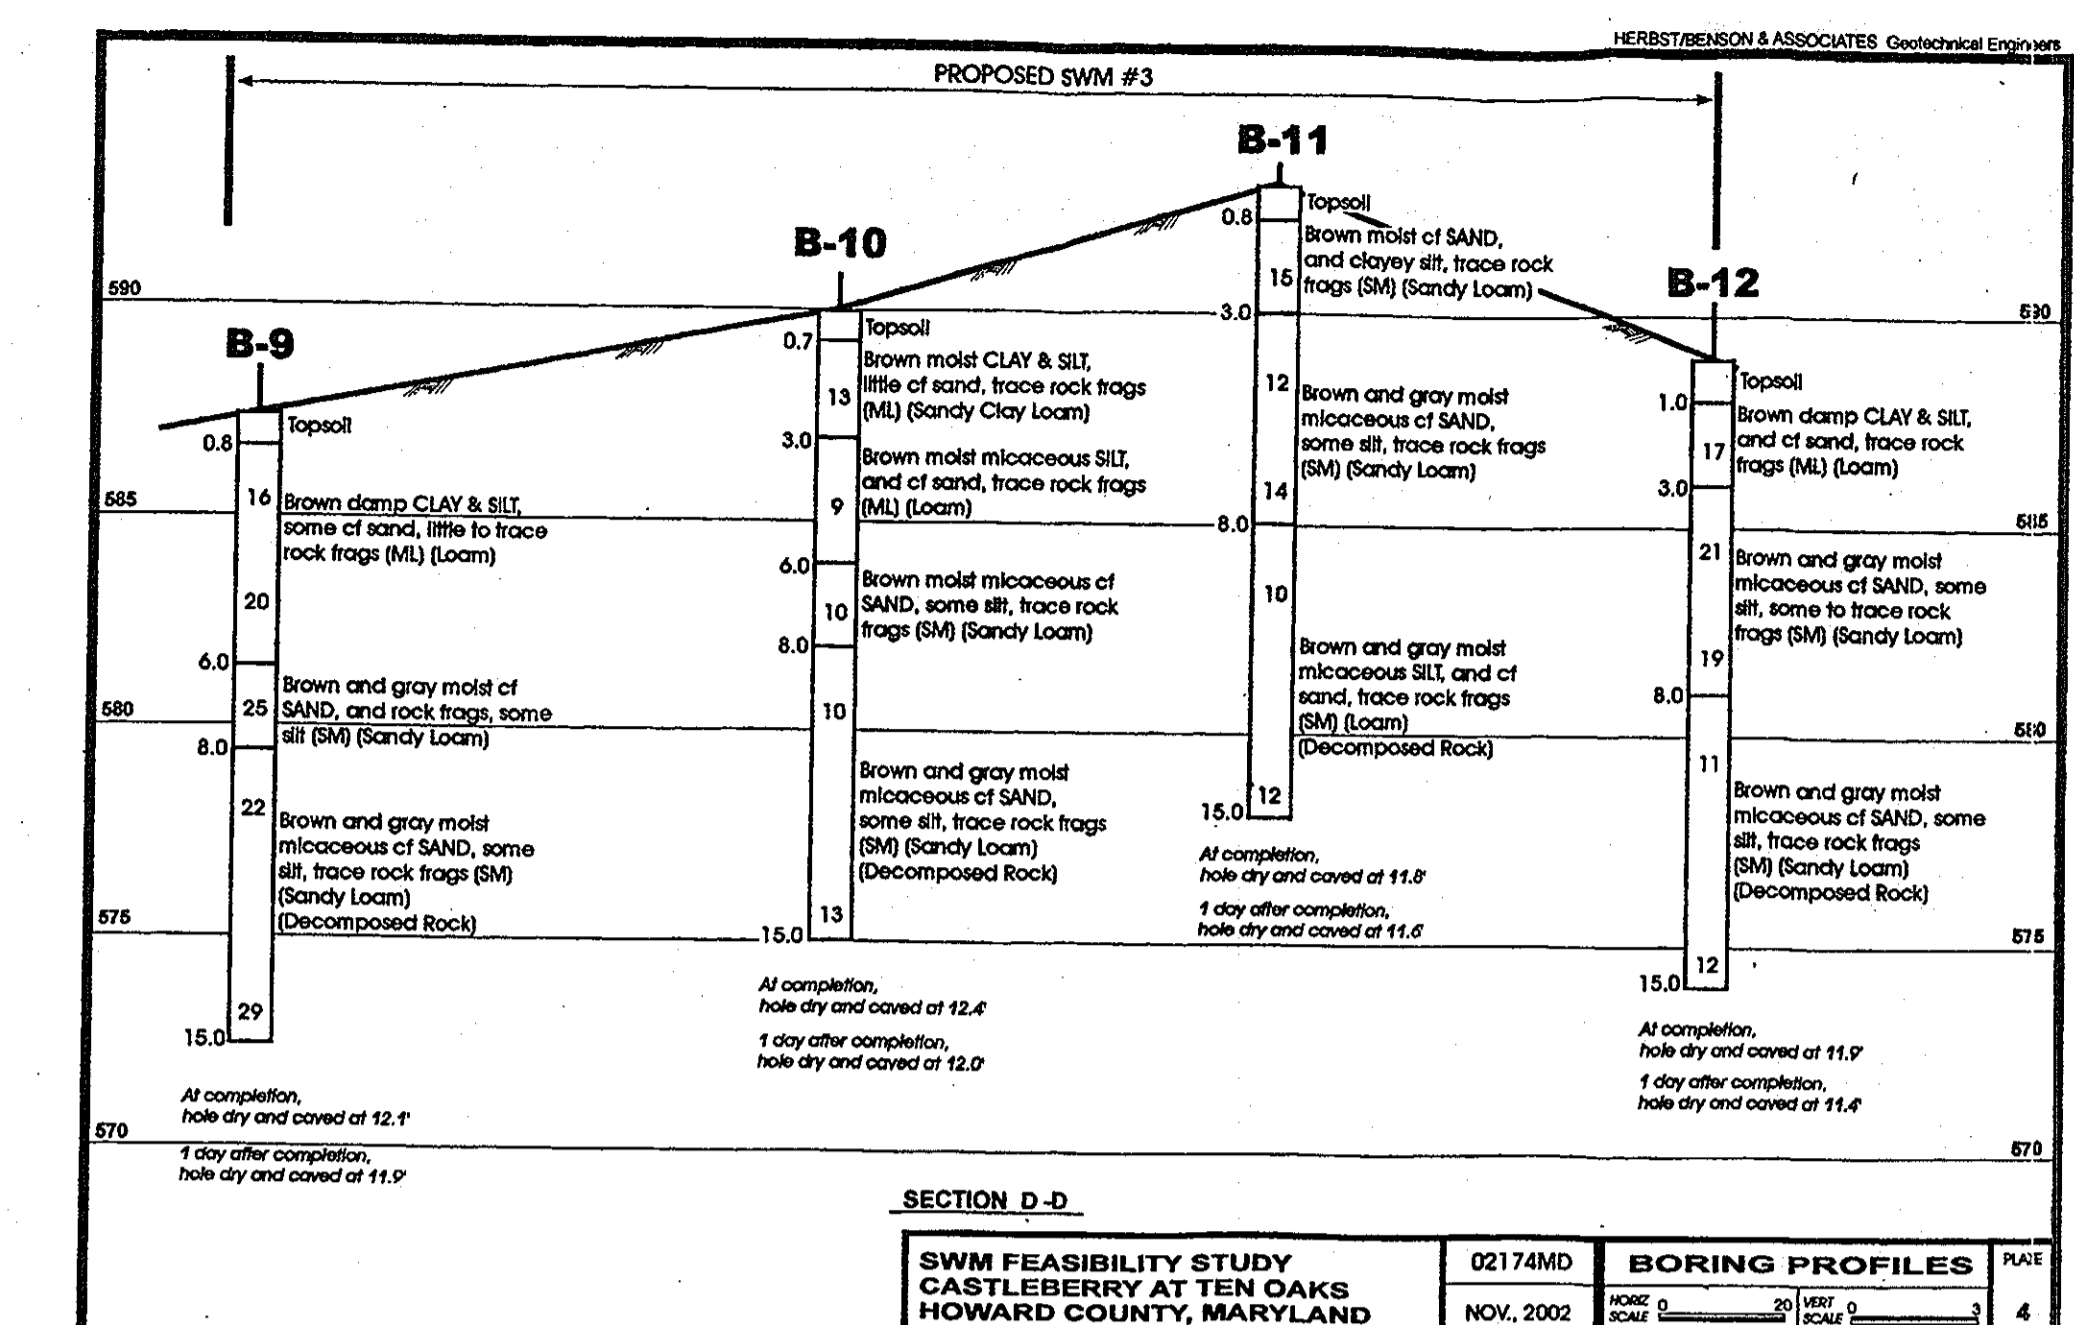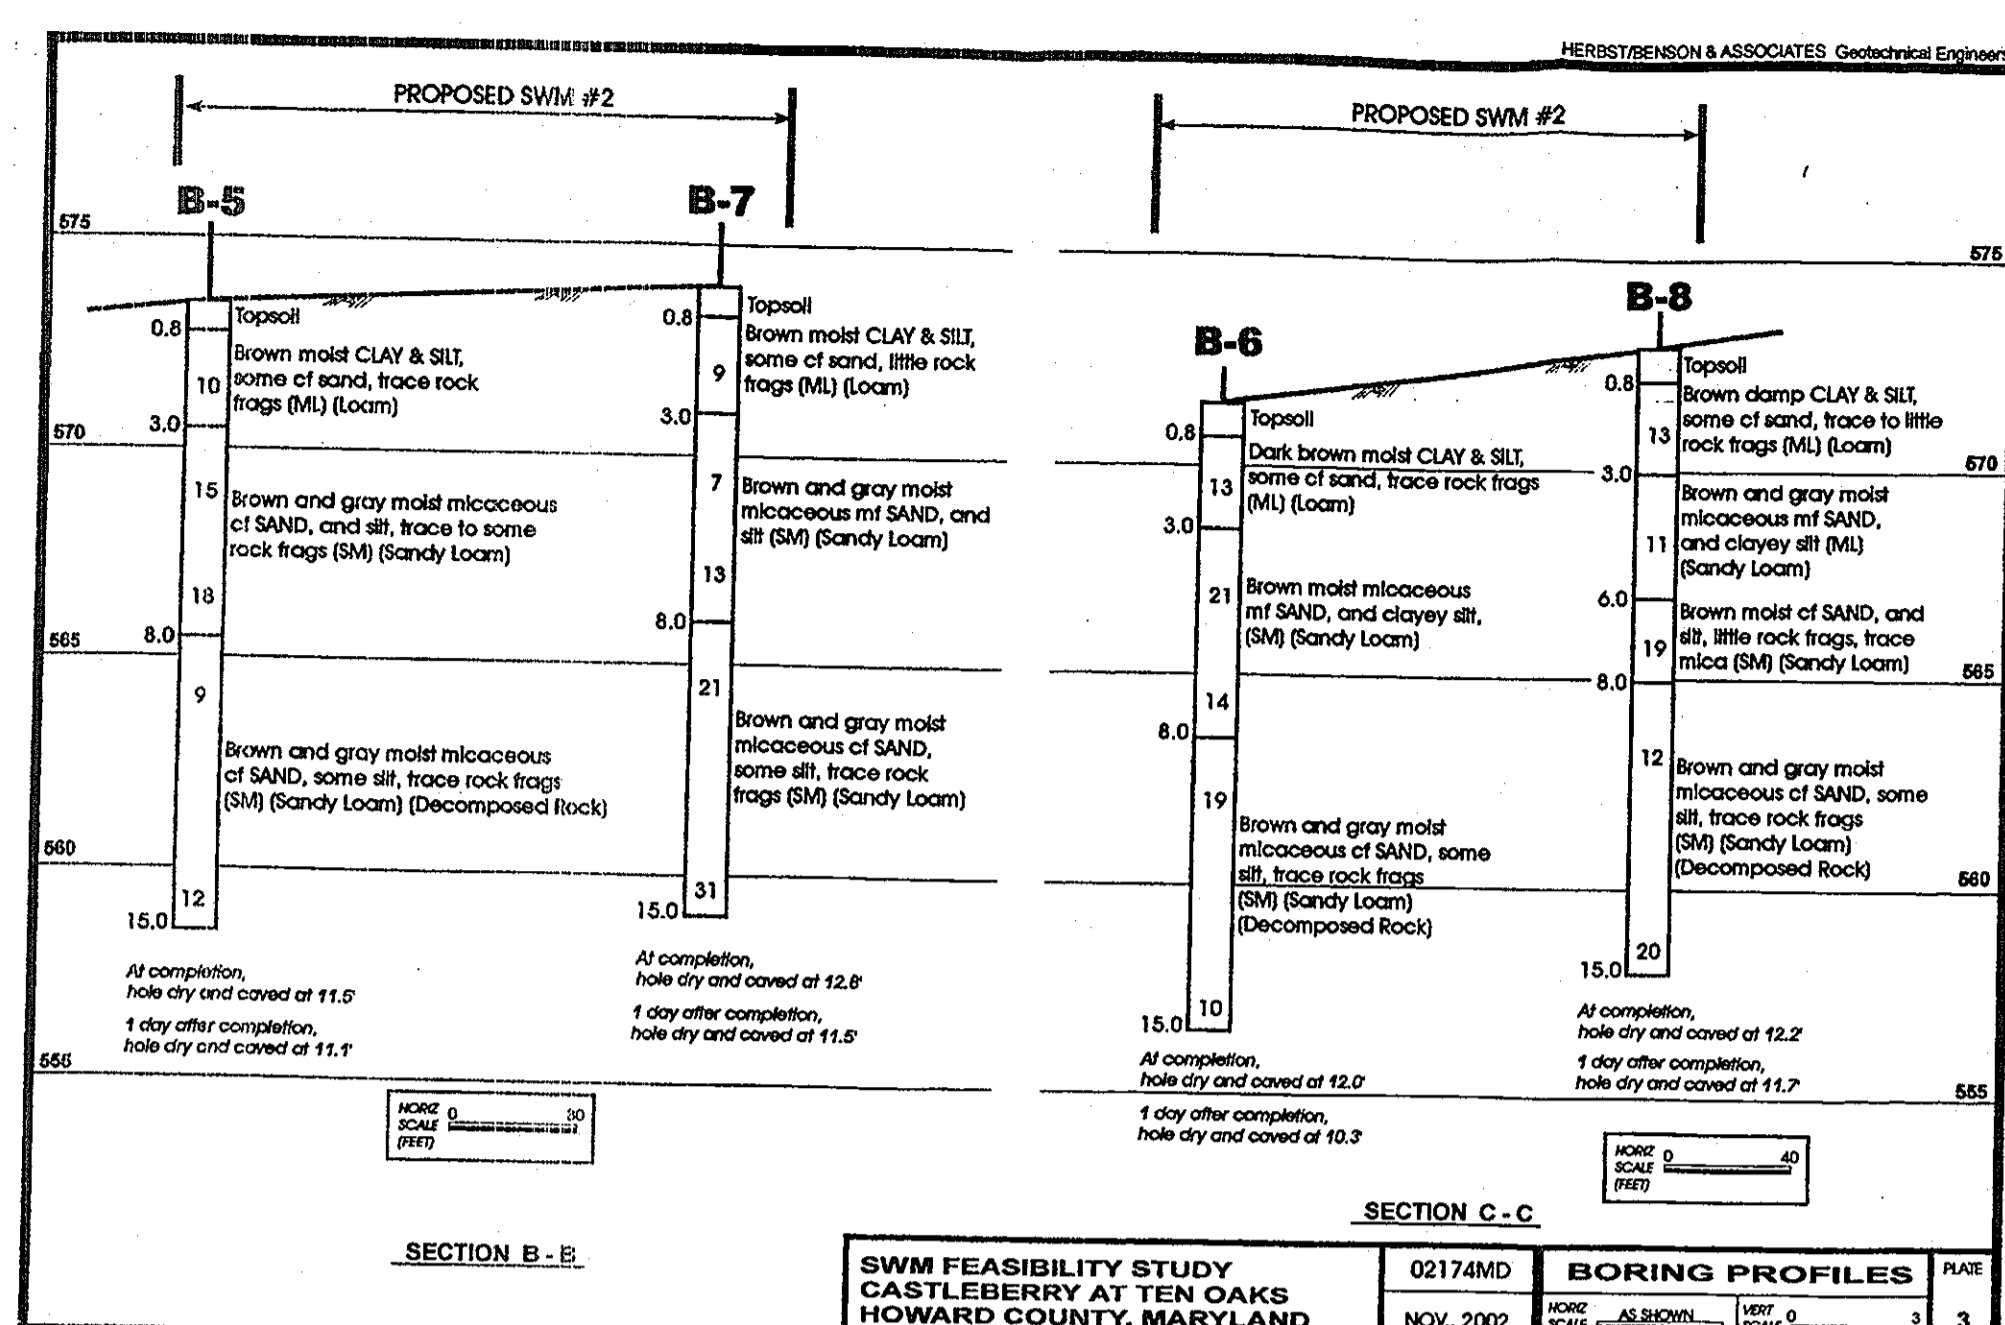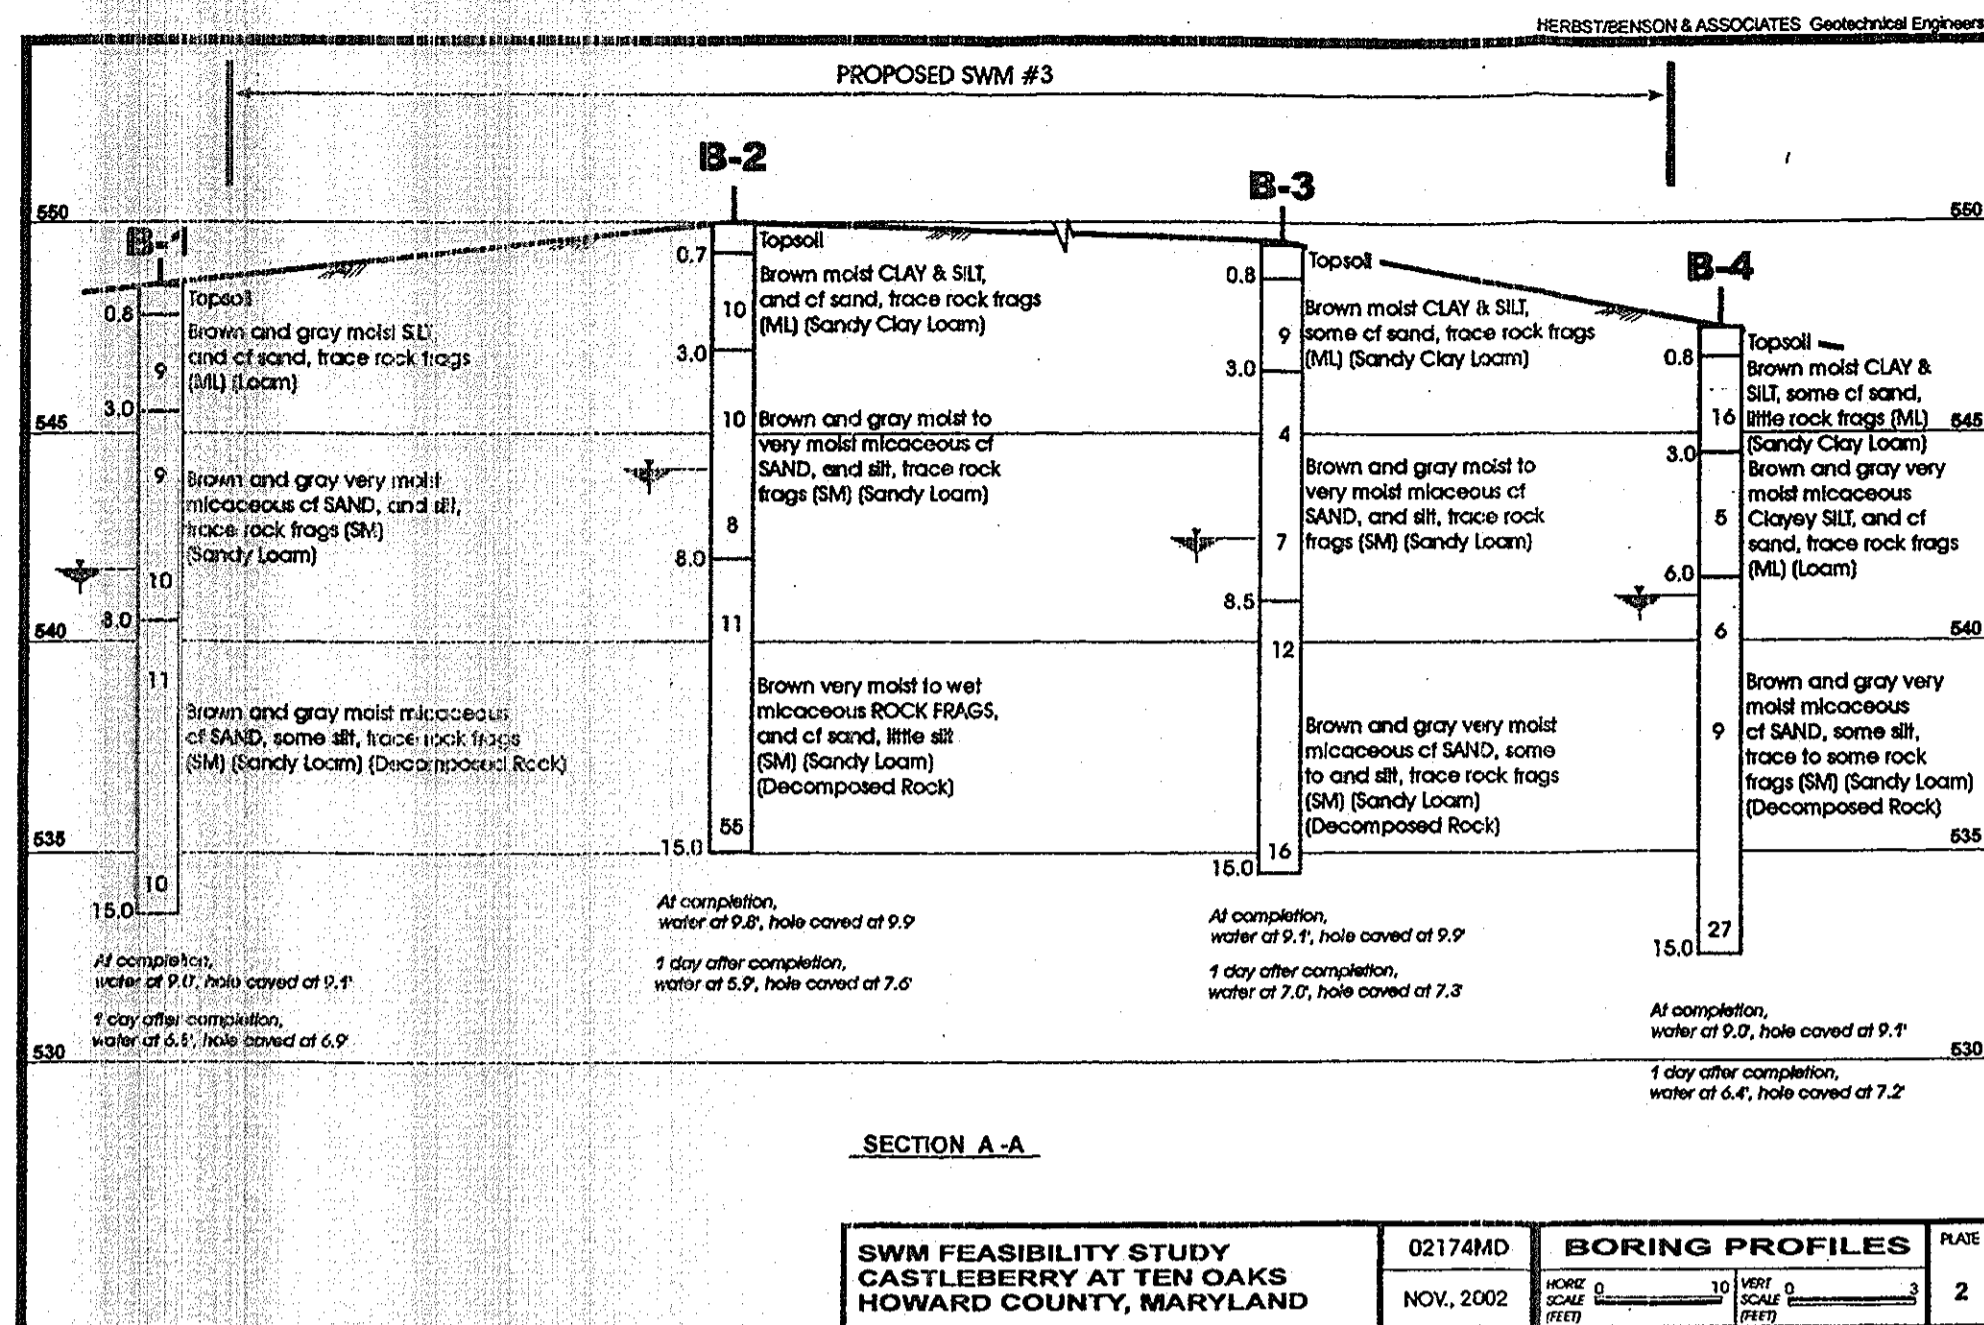

STORMWATER MANAGEMENT REQUIREMENTS - POND 1

AREA	REQUIREMENT	VOLUME REQUIREMENT WITHOUT CREDITS	CREDITS	VOLUME REQUIREMENT WITH CREDITS	NOTES
29.54 AC	1 WATER QUALITY VOLUME (WQV)	0.6371 AC. FT.	0.2502 AC. FT.	0.3869 AC. FT.	GRASS CHANNEL, INC ADDITIONAL CRITERIA FOR WQV
	2 RECHARGE VOLUME (REV)	0.1858 AC. FT. 1.78 AC.	3.08 AC.	---	GRASS CHANNEL ALONG ROAD AND REAR OF LOTS
	3 CHANNEL PROTECTION VOLUME (CPV)	0.7423 AC. FT.	---	0.7423 AC. FT.	CPV & REMAINING WQV PROVIDED BY MICROPOOL EXT. DET.
	4 OVERHEAD FLOOD PROTECTION (O <sub>FP</sub> )	NA	---	---	---
	5 EXTREME FLOOD VOLUME (E <sub>FP</sub> )	NA	---	---	---

STORMWATER MANAGEMENT REQUIREMENTS - AREA 7

AREA	REQUIREMENT	VOLUME REQUIREMENT WITHOUT CREDITS	CREDITS	VOLUME REQUIREMENT WITH CREDITS	NOTES
1.38 AC	1 WATER QUALITY VOLUME (WQV)	0.0265 AC. FT.	0.0265 AC. FT.	0	ROOFTOP DISCONNECT RAIN GARDEN
	2 RECHARGE VOLUME (REV)	0.0069 AC. FT. 0.0718 AC.	0.0718 AC.	0	ROOFTOP DISCONNECT RAIN GARDEN
	3 CHANNEL PROTECTION VOLUME (CPV)	NR	---	---	---
	4 OVERHEAD FLOOD PROTECTION (O <sub>FP</sub> )	NA	---	---	---
	5 EXTREME FLOOD VOLUME (E <sub>FP</sub> )	NA	---	---	---

STORMWATER MANAGEMENT REQUIREMENTS - POND 2

AREA	REQUIREMENT	VOLUME REQUIREMENT WITHOUT CREDITS	CREDITS	VOLUME REQUIREMENT WITH CREDITS	NOTES
11.47 AC	1 WATER QUALITY VOLUME (WQV)	0.2370 AC. FT.	0.0069 AC. FT.	0.1901 AC. FT.	GRASS CHANNEL, INC ADDITIONAL CRITERIA FOR WQV
	2 RECHARGE VOLUME (REV)	0.0616 AC. FT. 0.6561 AC.	0.7900 AC.	---	GRASS CHANNEL ALONG ROAD
	3 CHANNEL PROTECTION VOLUME (CPV)	0.2882 AC. FT.	NA	0.2882 AC. FT.	CPV AND REMAINING WQV IN MICROPOOL EXTENDED DETENTION
	4 OVERHEAD FLOOD PROTECTION (O <sub>FP</sub> )	NA	---	---	---
	5 EXTREME FLOOD VOLUME (E <sub>FP</sub> )	NA	---	---	---

STORMWATER MANAGEMENT REQUIREMENTS - AREA 8

AREA	REQUIREMENT	VOLUME REQUIREMENT WITHOUT CREDITS	CREDITS	VOLUME REQUIREMENT WITH CREDITS	NOTES
1.61 AC	1 WATER QUALITY VOLUME (WQV)	0.0309 AC. FT.	0.0309 AC. FT.	0	NO IMPERVIOUS IN DRAINAGE AREA
	2 RECHARGE VOLUME (REV)	0.0090 AC. FT. 0.0837 AC. FT.	0.0837 AC. FT.	0	NO IMPERVIOUS IN DRAINAGE AREA
	3 CHANNEL PROTECTION VOLUME (CPV)	NR	---	---	---
	4 OVERHEAD FLOOD PROTECTION (O <sub>FP</sub> )	NA	---	---	---
	5 EXTREME FLOOD VOLUME (E <sub>FP</sub> )	NA	---	---	---

STORMWATER MANAGEMENT REQUIREMENTS - BIORETENTION 1 AREA 3

AREA	REQUIREMENT	VOLUME REQUIREMENT WITHOUT CREDITS	CREDITS	VOLUME REQUIREMENT WITH CREDITS	NOTES
7.03 AC	1 WATER QUALITY VOLUME (WQV)	0.1189 AC. FT.	---	0.1189 AC. FT.	BIORETENTION
	2 RECHARGE VOLUME (REV)	0.0309 AC. FT.	0.1377 AC. FT.	---	STONE BELOW BIORETENTION ROOFTOP DISCONNECT CREDIT
	3 CHANNEL PROTECTION VOLUME (CPV)	NR	---	---	Q < 2.0 CFS
	4 OVERHEAD FLOOD PROTECTION (O <sub>FP</sub> )	NA	---	---	---
	5 EXTREME FLOOD VOLUME (E <sub>FP</sub> )	NA	---	---	---

STORMWATER MANAGEMENT REQUIREMENTS - AREA 4

AREA	REQUIREMENT	VOLUME REQUIREMENT WITHOUT CREDITS	CREDITS	VOLUME REQUIREMENT WITH CREDITS	NOTES
13.20 AC	1 WATER QUALITY VOLUME (WQV)	0.0894 AC. FT.*	0.0874 AC. FT.	0	SHEET FLOW TO BUFFER CREDIT RAIN GARDEN
	2 RECHARGE VOLUME (REV)	0.0232 AC. FT.* 0.2262 AC.	0.2262 AC.	0	SHEET FLOW TO BUFFER CREDIT RAIN GARDEN
	3 CHANNEL PROTECTION VOLUME (CPV)	NR	---	---	Q < 2.0 CFS
	4 OVERHEAD FLOOD PROTECTION (O <sub>FP</sub> )	NA	---	---	---
	5 EXTREME FLOOD VOLUME (E <sub>FP</sub> )	NA	---	---	---


STORMWATER MANAGEMENT REQUIREMENTS - AREA 5

AREA	REQUIREMENT	VOLUME REQUIREMENT WITHOUT CREDITS	CREDITS	VOLUME REQUIREMENT WITH CREDITS	NOTES
1.24 AC	1 WATER QUALITY VOLUME (WQV)	0.0238 AC. FT.	---	0	NO DEVELOPMENT AREA
	2 RECHARGE VOLUME (REV)	0.0082 AC. FT. 0.0845 AC.	---	0	NO DEVELOPMENT AREA
	3 CHANNEL PROTECTION VOLUME (CPV)	NR	---	---	Q < 2.0 CFS
	4 OVERHEAD FLOOD PROTECTION (O <sub>FP</sub> )	NA	---	---	---
	5 EXTREME FLOOD VOLUME (E <sub>FP</sub> )	NA	---	---	---

NO.	REVISION	DATE

**STORMWATER MANAGEMENT NOTES**  
**CASTLEBERRY AT TEN OAKS**  
 LOTS 1 - 45, NON-BUILDABLE PRESERVATION  
 PARCELS A, C, D, E & BUILDABLE PRESERVATION PARCEL B  
 PARCEL 60, LOTS 6 & 7 KEN WARFIELD  
 SUBDIVISION, AND P/O PARCEL 90  
 TAX MAP 22 GRID 20  
 5TH ELECTION DISTRICT HOWARD COUNTY, MARYLAND

**ROBERT H. VOGEL ENGINEERING, INC.**  
 ENGINEERS • SURVEYORS • PLANNERS  
 8407 MAIN STREET ELLICOTT CITY, MD 21043  
 TEL: 410.461.7666 FAX: 410.461.8961

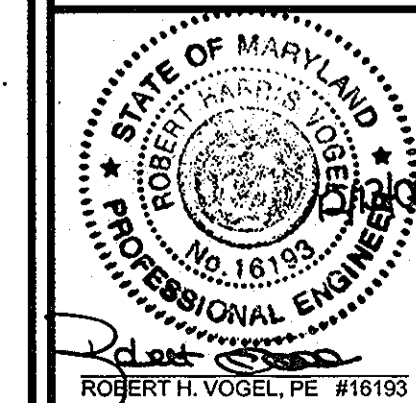

**OWNER**  
 HELEN L. FYOCK CASTLEBERRY AT TEN OAKS, L.L.C.  
 3675 PARK AVENUE, SUITE 301 ELLICOTT CITY, MARYLAND 21043  
 GLENELG, MARYLAND (410) 740-9401

**DEVELOPER**  
 CASTLEBERRY AT TEN OAKS, L.L.C.  
 3675 PARK AVENUE, SUITE 301 ELLICOTT CITY, MARYLAND 21043  
 (410) 740-9401

DESIGN BY: RHV/LIT  
 DRAWN BY: LIT  
 CHECKED BY: RHV  
 DATE: DECEMBER 2006  
 SCALE: AS NOTED  
 W.O. NO.: 00-85.00

DPZ REF: S-01-11, P-05-04

22 SHEET OF 23

APPROVED: HOWARD COUNTY DEPARTMENT OF PUBLIC WORKS  
 CHIEF, BUREAU OF HIGHWAYS  
 DATE: 11-10-07

APPROVED: HOWARD COUNTY DEPARTMENT OF PLANNING AND ZONING  
 CHIEF, DEVELOPMENT ENGINEERING DIVISION  
 DATE: 11/1/07

CHIEF, DIVISION OF LAND DEVELOPMENT  
 DATE: 2/15/07

REVIEWED FOR HOWARD SCD AND MEETS TECHNICAL REQUIREMENTS  
 CHIEF, NATURAL RESOURCES CONSERVATION SERVICE  
 DATE: 2/15/07

THIS DEVELOPMENT PLAN IS APPROVED FOR SOIL EROSION AND SEDIMENT CONTROL BY THE HOWARD SOIL CONSERVATION DISTRICT  
 HOWARD SCD  
 DATE: 2/15/07

