	wer i	SHEET INDEX
-	NO.	TIT
	1	LCOYER DHEET
	2	ROAD PLAN & PROFILE
	3 🌁	TYPICAL ROAD SECTIONS & DETAILS
William William	4	STORMDRAIN PROFILES
	5	STORM DRAINAGE AREA MAPS
	6	EIS DRAINAGE AREA MAPS
	7	FINAL GRADING AND SEDIMENT EROSION CONTROL PLAN
ł	8	SEDIMENT & EROSION CONTROL DETAIL SHEET
	9	STREET TREE AND LIGHTING PLAN

#### GENERAL NOTES

CONSTRUCTED UNDER THIS CONTRACT. THE STREET TREES, LIGHTS AND

- TRAFFIC CONTROL DEVICES, MARKINGS AND JIGHING SHA SE IN ACCORDANCE WITH THE LATEST EDITION OF THE MANUAL ON UNIFO TRAFFIC CONTROL DEVICES (MUTCD). ALL STREET AND REGULATORY SIGNS SHALL BEEN PLACE PRIOR TO THE PLACEMENT OF ANY
- DWARD COUNTY DESIGN MANUAL, VOLUME III (1993) AND AS MODIFIED BY "GUIDELINES FOR TREET AND REGULATORY SIGNS LIGHTS IN RESIDENTIAL DEVELOPMENTS (JUNE 1993).
- A 1 TO MUM SPACING OF 20' SHALL BE MAINTAINED BETWEEN ANY STREET LIGHT AND ANY TREE
- CONTROL WHICH TO BASED UPON THE MARYLAND STATE PLAN COORDINATE SYSTEM MONUMENT NOS 47DA, 47G2, AND 47E4 WERE USED FOR THIS PROJECT (NAD 1983/91).
- WATE IS TO BE PUBLIC (CONTRACT # 14-4318-D).
- 9. SEWER IS TO BE PUBLIC (CONTRACT # 14-4318-D).
- O. THE PUBLIC STORMWATER MANAGEMENT FOR THIS SITE WILL BE PROVIDED BY PRIVATE WET PONDS PREVIOUSLY BUILT UNDER F-01-145 \$ F-02-178.
- IL EX. UTILITIES ARE BASED ON FIELD RUN TOPOGRAPHY BY christop of complete, Itd.
- 12 THERE IS NO FLOODPLAIN ON THIS SITE.
- 13. THERE IS NO WETLANDS ON THIS SITE.
- 14. THE TRAFFIC STUDY FOR THIS SITE WAS PREPARED BY WELLS & ASSOCIATES, PATED FEBRUARY 2000, HAS BEEN APPROVED WITH 5-99-12.
- 15 ALL PLAN DIMENSIONS ARE TO FACE OF CURB UNLESS OTHERWISE NOTED
- TEST PIT ALL LITUILES, INCLUDING PROPOSED TIE IN LOCATIONS AT LEAS 5 DAYS PRIOR TO STARTING ANY WORK ON THESE DRAWINGS. DESCREPANCIES SHALL BE IMMEDIATELY REPORTED TO THE ENGINEER AND IN ADVANCE OF CONSTRUCTION START.
- ANY DAMAGE CAUSED BY THE CONTRACTOR TO EXISTING PUBLIC RIGHT-OF-WAY, EXISTING POVING. EXISTING CURB AND GUTTER, EXISTING UTILITIES, ETC. SHALL BE REPAIRED AT THE
- 18. ALL FILL AREAS SHALL BE COMPACTED TO A MINIMUM OF 95% OF THE M CITILM DRY DENSITY AS DETERMINED AND VERIFIED IN ACCORDANCE WITH AASHTO T- 180-STANDARD
- 19. CONTRACTOR SHALL MAINTAIN ALL DIMENT CONTROL DEVICE WITHIN THE LIMITS OF THE SITE DURING CONSTRUCTION OF THE SITE IMPROVEMENTS: COMPACTOR SHALL PROVIDE ADDITIONAL EROCION AND SEDIMENTATION CONTROL MEASURES AS MAY BE NECESSARY DURI & CONSTRUMINA ANDIOS BY OVERNING AGENCIES.
- 20. THERE ARE NO & AN JET ET EXES OR BURIAL GROUNDS ON THIS SITE. HOWEVER, UPON DISCOVERY OF ANY EVIDENCE OF BURIAL OR GRAVES, THE DEVELOPER SHALL BE SUBJECT TO SECTION 16.1305 OF THE HOWARD COUNTY SUBDIVISION AND LAND DEVELOPMENT
- THE SUBJECT PROPERTY IS ZONED MXD-3 " OTHER RESIDENTIAL" PER THE 2/2/04 COMPREHENSIVE ZONING PLAN & ZB-979M.


STABILIZE CONSTRUCTION ENTRANCE

- 22. THE CONTRACTOR SHALL TEST PIT ALL EXISTING UTILITIES AT LEAST FIVE-(5) DAYS PRIOR TO STARTING ANY WORK SHOWN ON THESE DRAWINGS.
- 23 OPERAIN EXISTING VALVES, SAITCHES, SERVICES OR START UP OF NEW SERVICES SHALL SE COORDINATED WITH THE OWNERS REPRESENTATIVE.
- 24. FOREST & SEMIATION OBLIGATIONS AND OPEN SPACE RE VILLAENTS FOR THIS PHASE OF EFFERSON MED PROJECTWENE ADDRESSED UNDER F-04-68.

# TEGEND FROPOSED BUILDING EXISTING BUILDING EXISTING SIDEWALK EXISTING CURB & GUTTER EXISTING STORM DRAIN EXISTING WATER EXISTING SEWER EXISTING CONTOURS PROPOSED CONTOUR PROPOSED LOT LINE PROPERTY LINE YYYYYYY Y YYYYYYY EXISTING TREELINE SUPER SILT FENCE LIMIT OF DISTURBANCE


# ROAD AND STORM DRAIN CONSTRUCTION PLANS JUNE FLOWERS WAY EMERSON TOWNHOMES


SECTION 2, PHASE 6A, LOTS 92-124 A RESUBDIVISION OF PARCEL 'B-1' 6th ELECTION DISTRICT HOWARD COUNTY, MARYLAND

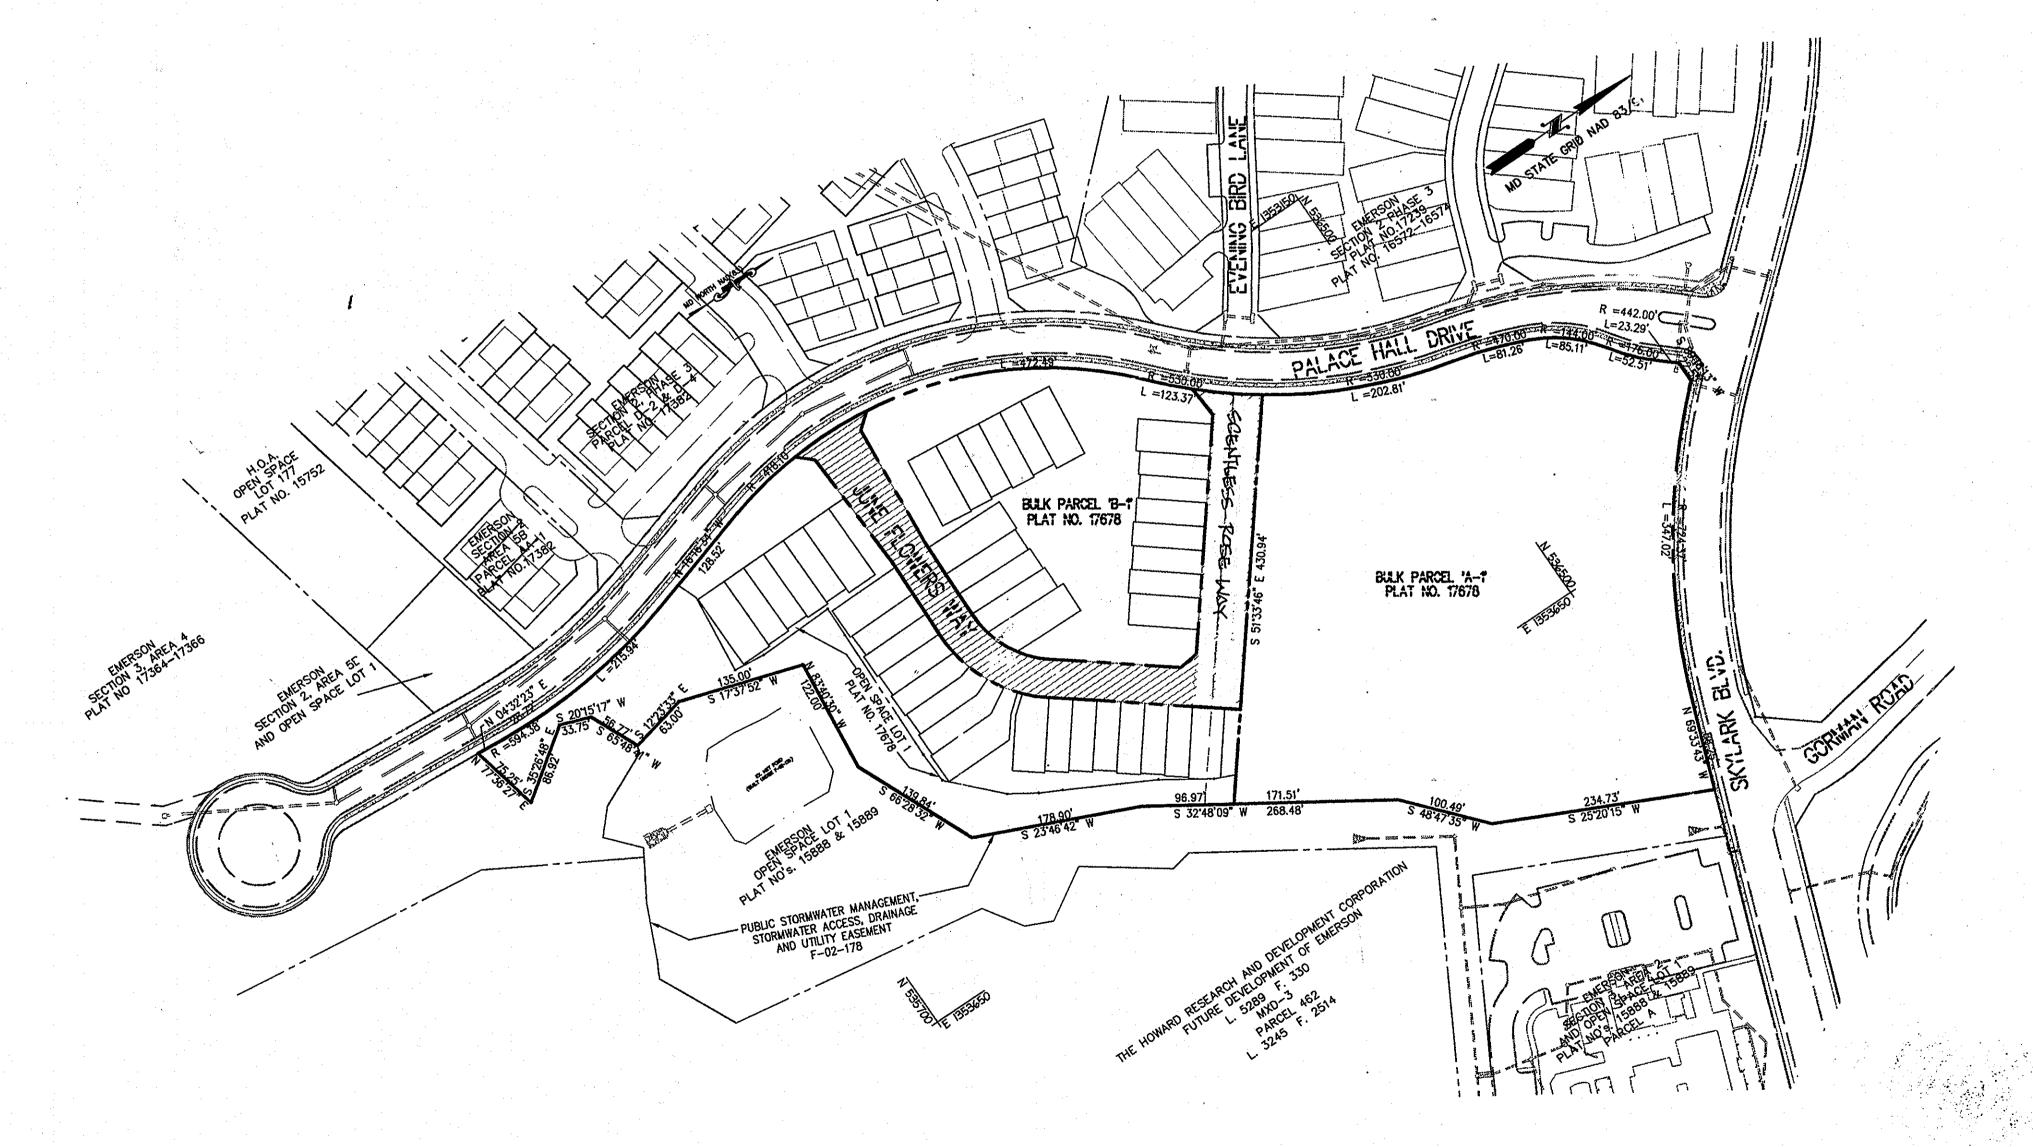

OVERALL VIEW SCALE: 1"=100'




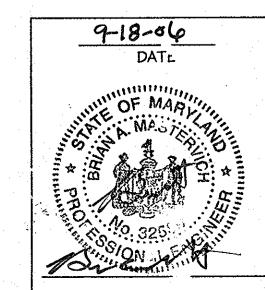

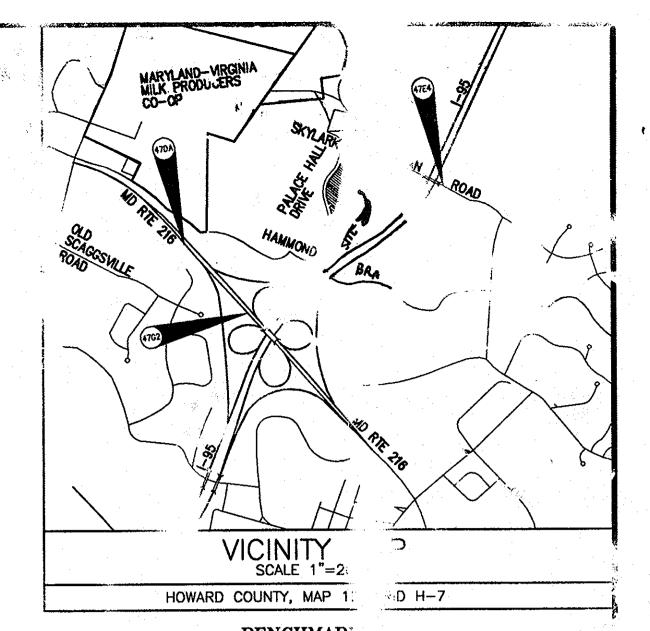


## BENCHMARI

Horizontal Datum: Maryland State Vertical Datum: NAD 83/91 Howard County Monument 47DA N535405,46, El349362.71, Elev Howard County Monument 47G2 N532938.96, El351224.09, Elev Howard County Monument 47E4

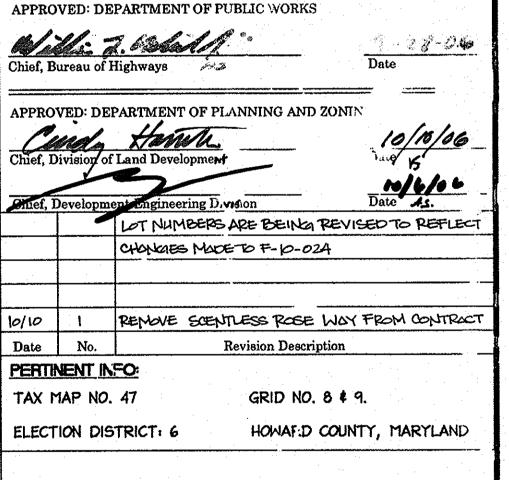

### OWNER / DEVELOPER

SK HOMES @ EMERSON II 10705 CHARTER DRIVE, SUITE 320 COLUMBIA, MD 21044 TEL: (410) 997-7400 FAX: (410) 997-6305

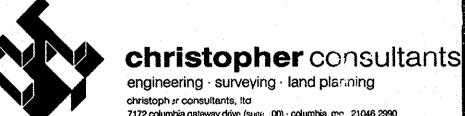

7172 columbia gateway drive (suite :00) - columbia, mo : 21046 2990 410.872 8690 - metro 301 881 0148 - fax 410 872 8693


JUNE FLOWERS WAY

SECTION 2, PHASE 6A BUILDABLE LOTS 92 THRU 1/24, HOA, OPEN SPACE LOTS 1/25-1/27 A RESUBDIVISION OF BULK PARCEL B-1 AND A REVISION OF OPEN SPACE T

COVER SHEET

SCALE: AS SHOWN PROJECT: 049101.00 DESIGN: XDF DRAWN: ADL DATE: 9-18-06 CHECKED: DAM APPROVED: **▲** OF

F - 06 - 143

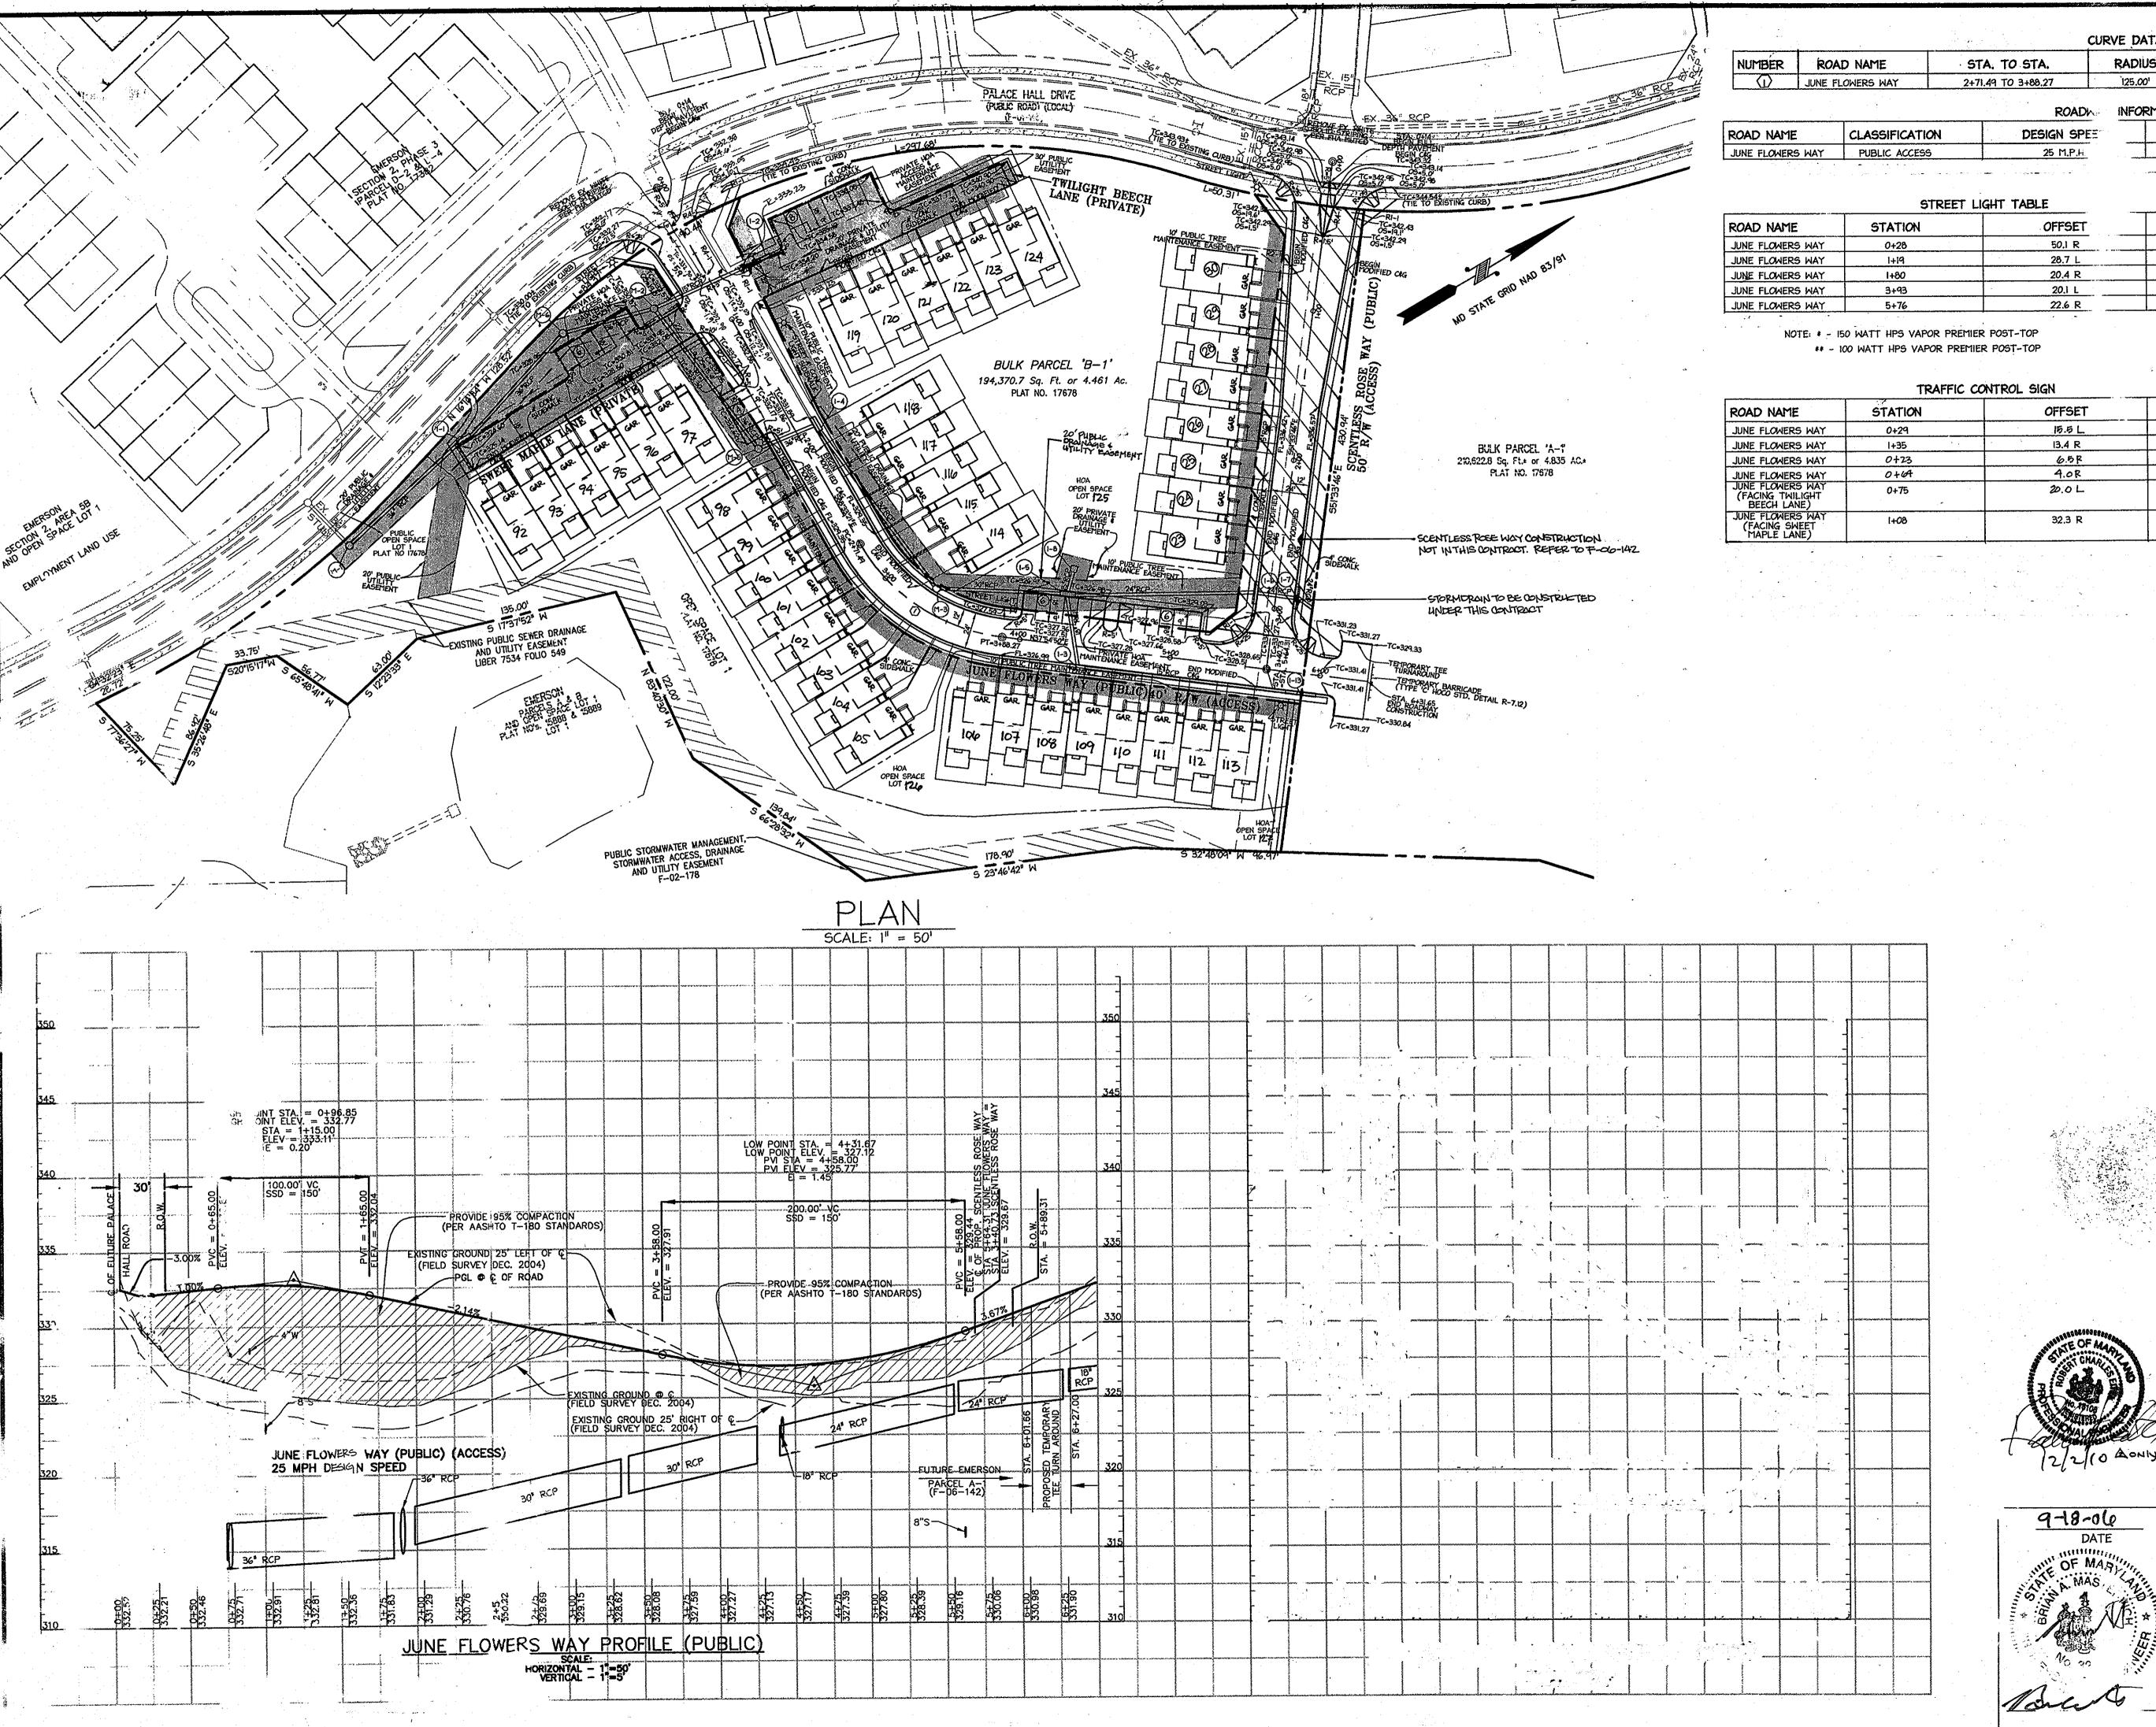

CURVE DATA TABLE LENGTH DELTA TANGENT STA. TO STA. RADIUS 63.05 N64 40 44 112.58 125.001 2+71.49 TO 3+88.27

ROADW INFORMATION CHART & STATION LIMITS PAVING SECTION DESIGN SPEE 0+00 TO -31.65 P-2

ROAD NAME	STATION	OFFSET	TYPE
JUNE FLOWERS WAY	0+28	50.1 R	
JUNE FLOWERS WAY	1+19	28.7 L	**
JUNE FLOWERS WAY	1+80	20.4 R	**
JUNE FLOWERS WAY	3+93	20.1 L	**
JUNE FLOWERS WAY	5+76	22.6 R	**

	1100111000	NATION OIGH		
ROAD NAME	STATION	OFFSET	POSTED SIGN	SIGN CODE
JUNE FLOWERS WAY	0+29	15.5 L	STOP	RI-I
JUNE FLOWERS WAY	I+35	13.4 R	SPEED LIMIT 25	R2-1
JUNE FLOWERS WAY	0+23	6.5P	KEEP RIGHT	R4-I
JUNE FLOWERS WAY	0+64	4.08	KEEP RIGHT	R4-1
JUNE FLOWERS WAY (FACING TWILIGHT BEECH LANE)	0+75	20.0 L	STOP	RI-I
JUNE FLOWERS WAY (FACING SWEET MAPLE LANE)	1+08	32.3 R	STOP	RI-I

APPROVED: DEPARTMENT OF PUBLIC WORKS Date

Chief, Bureau of Highways

REVISE THE RODIUS AT JUNE FLOWERS WAY AND POLOCE HOLL DRIVE AND CONCRETE ISLAND BETWEEN STA. 0+20 AND 0+

LOT NUMBERS ARE BEING REVISED TO REFLECT CHANGES MADE TO F-10-024 Revision Description

PERTINENT INFO: TAX MAP NO. 47

DATE

GRID NO. 8 \$ 9.

REMOVE SCENTLESS POSE WAY FROM CONTRACT

ELECTION DISTRICT: 6 HOWARD COUNTY, MARYLAND

OWNER / DEVELOPER

SK HOMES @ ETIERSON II 10705 CHARTER DRIVE, SUITE 320 COLUMBIA, MD 21044 TEL: (410) 997-7400 FAX: (410) 997-6305



christopher consulta is

engineering surveying land planning uite 100) - columbia, md 21046-2990 sk 410 872 8693 7172 columbia gatewa


JUNE FLOWERS WAY **EMERSON** 


SECTION 2, PLASE 6A BUILDABLE LOTS 92. THRU 124, HOA OPEN SPACE LOTS 125-127 A RESUBDIVISION OF BULK PARCEL B-1 AND A REVISION OF OPEN SPACE LOT1 PLAT NO. 17676


TITLE:

ROAD PLAN & PROFILES

SCALE: 1=50 H PROJECT: 049101.00 DESIGN: XDF DATE: 9-18-06 DRAWN: ADL 2 of 9 - CHECKED: BAT יכל שארה ב

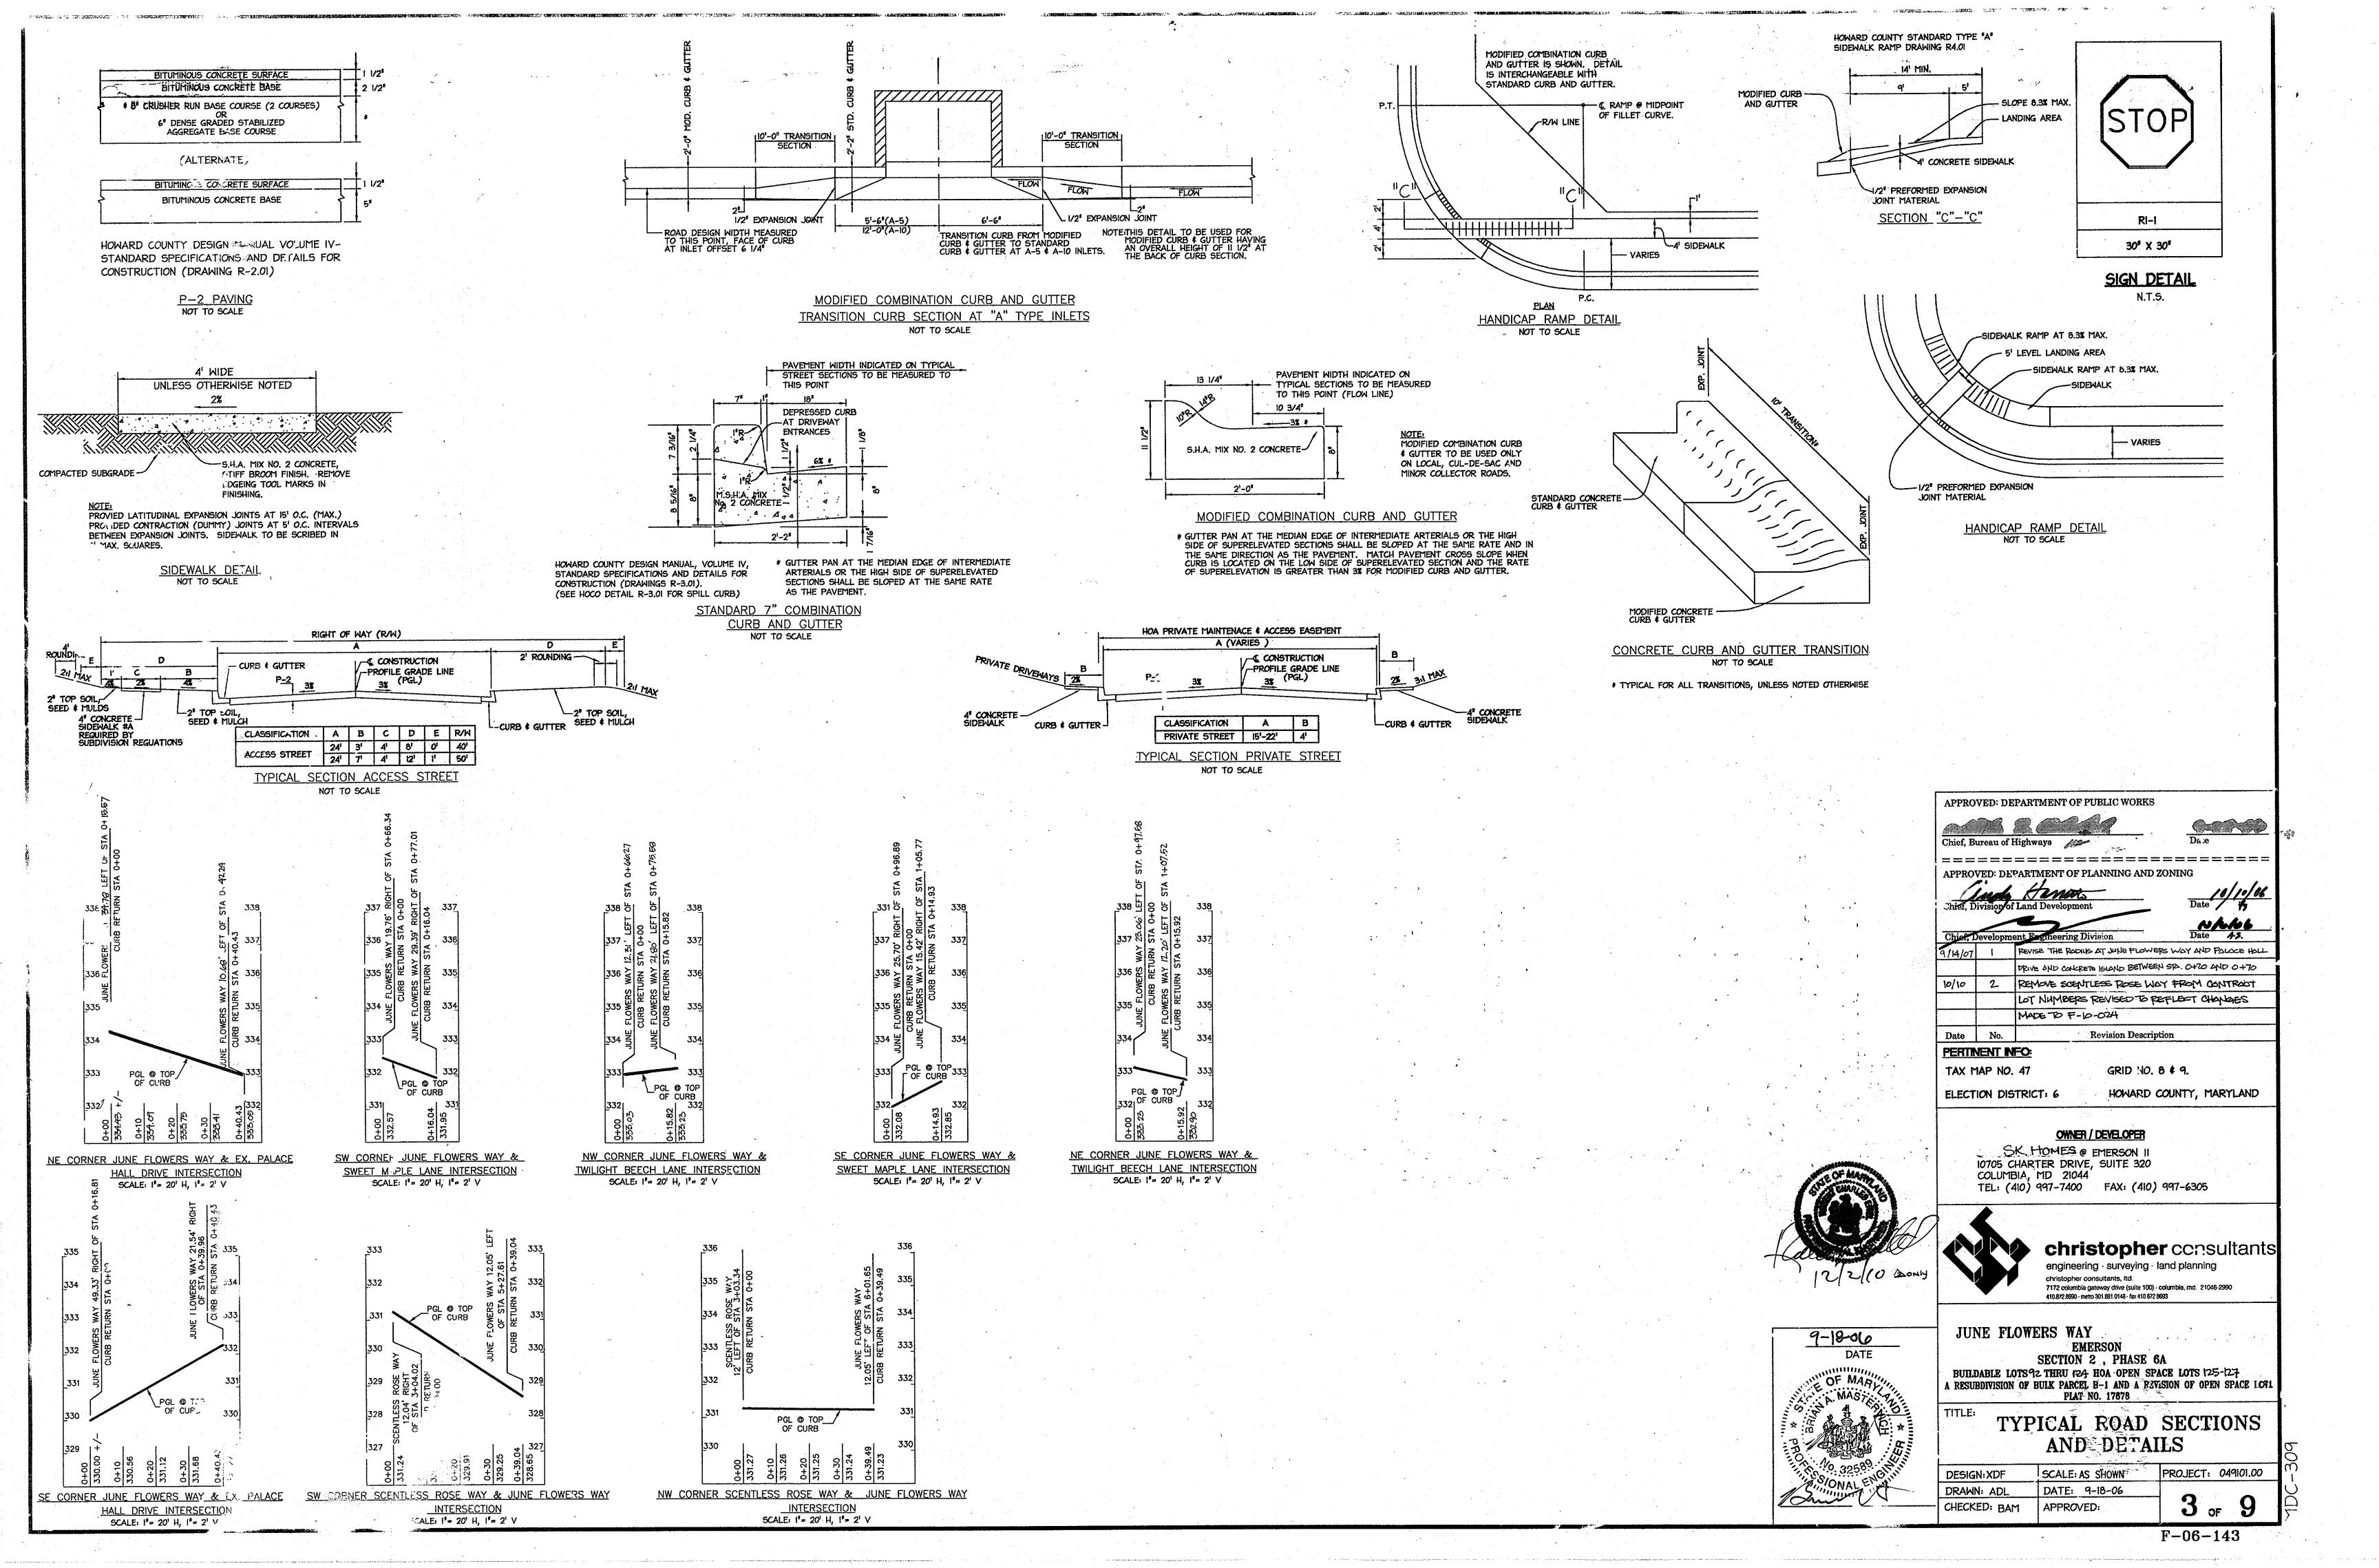

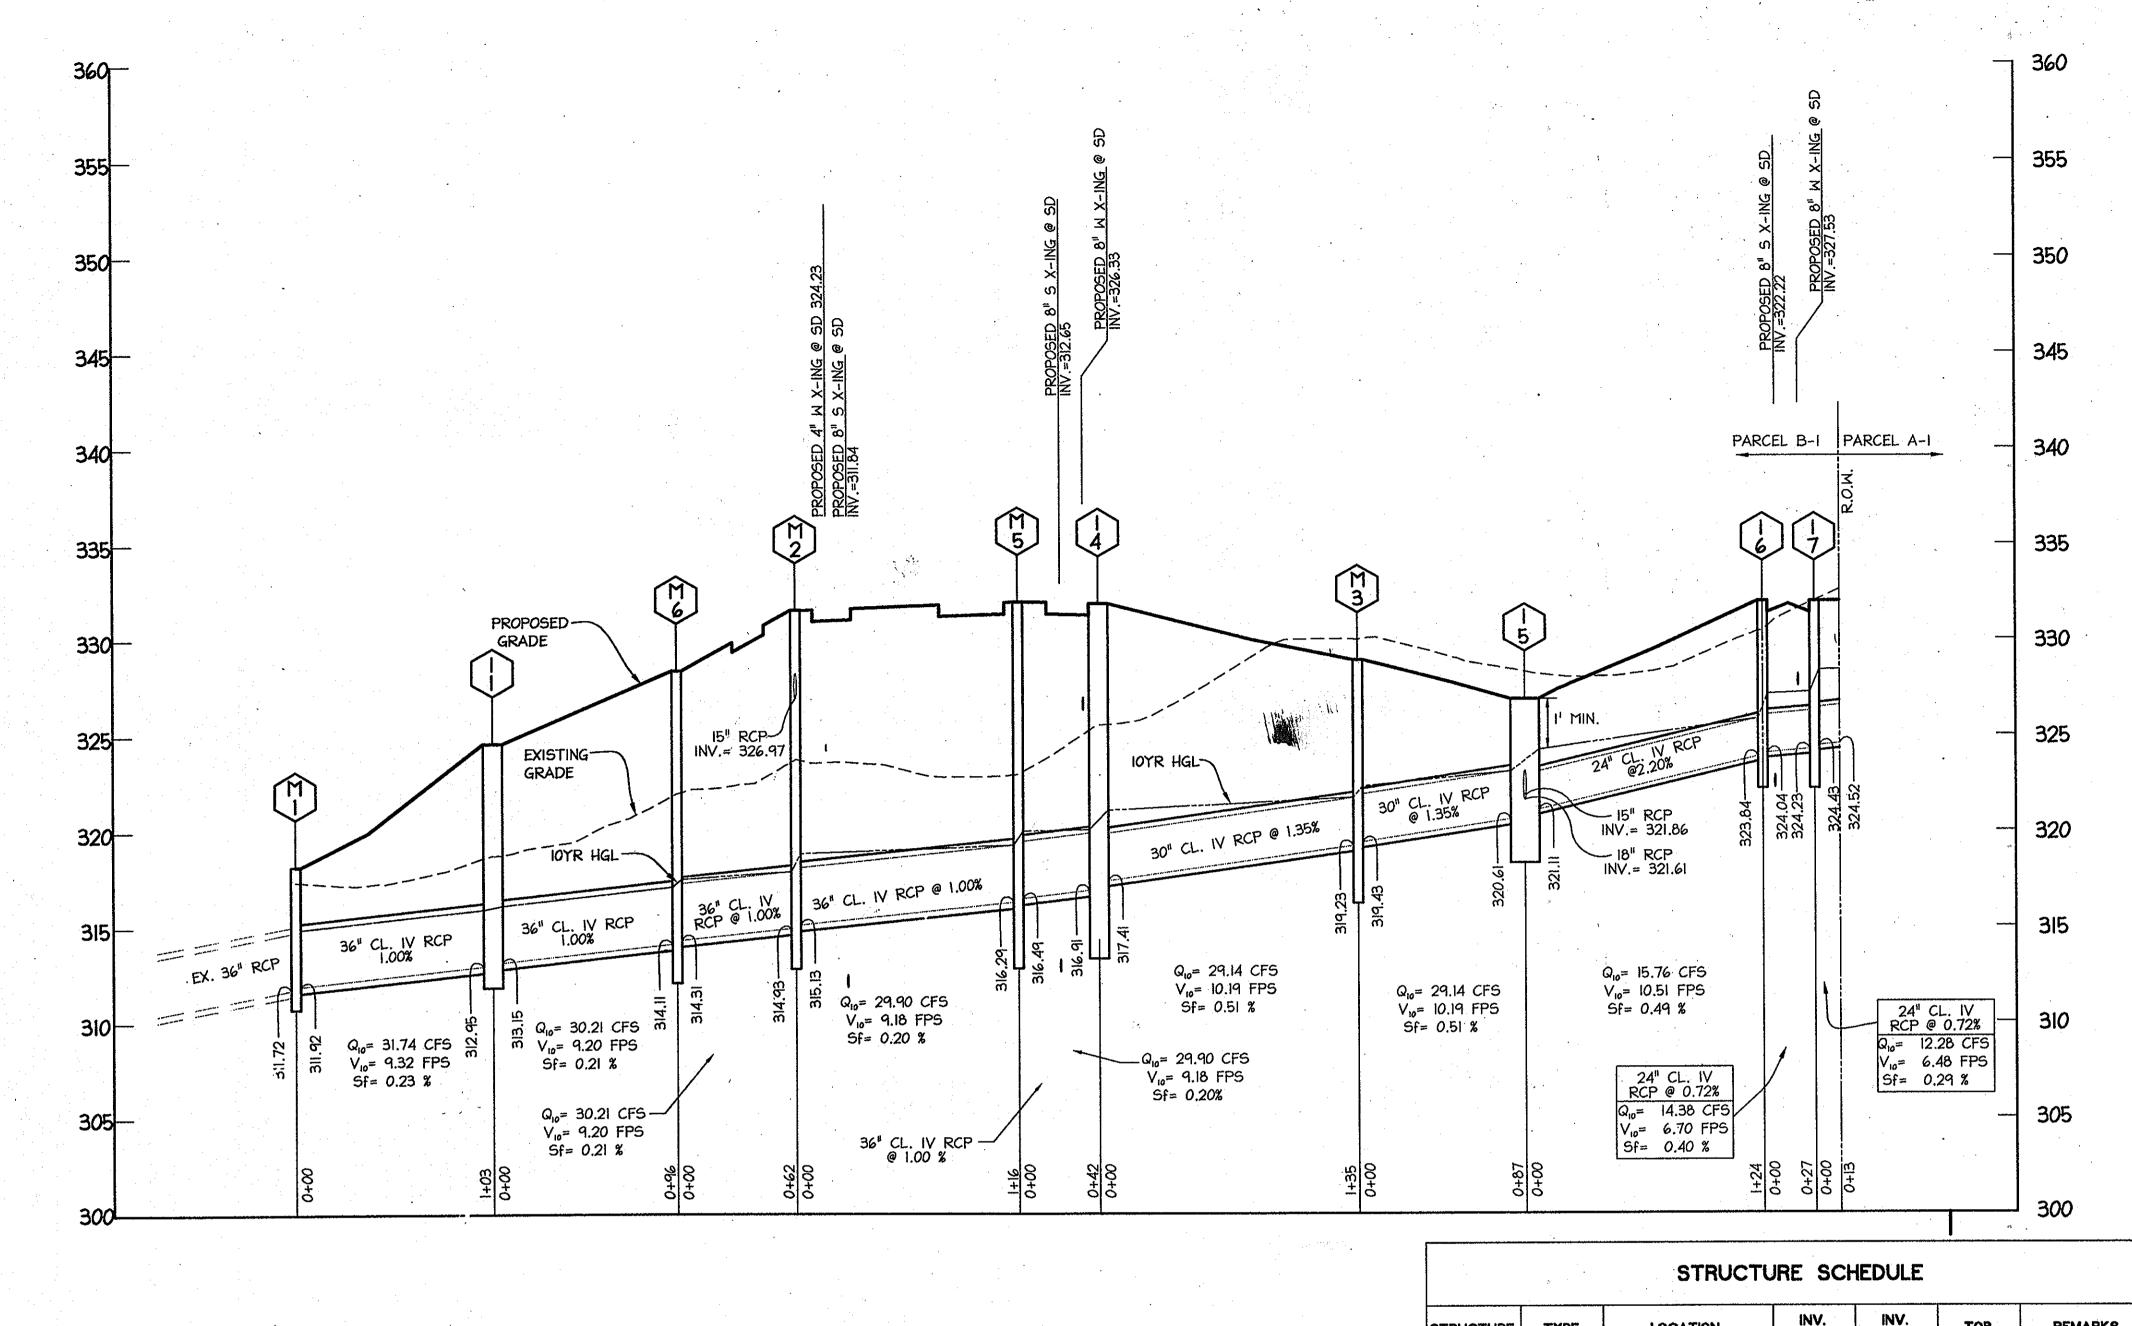

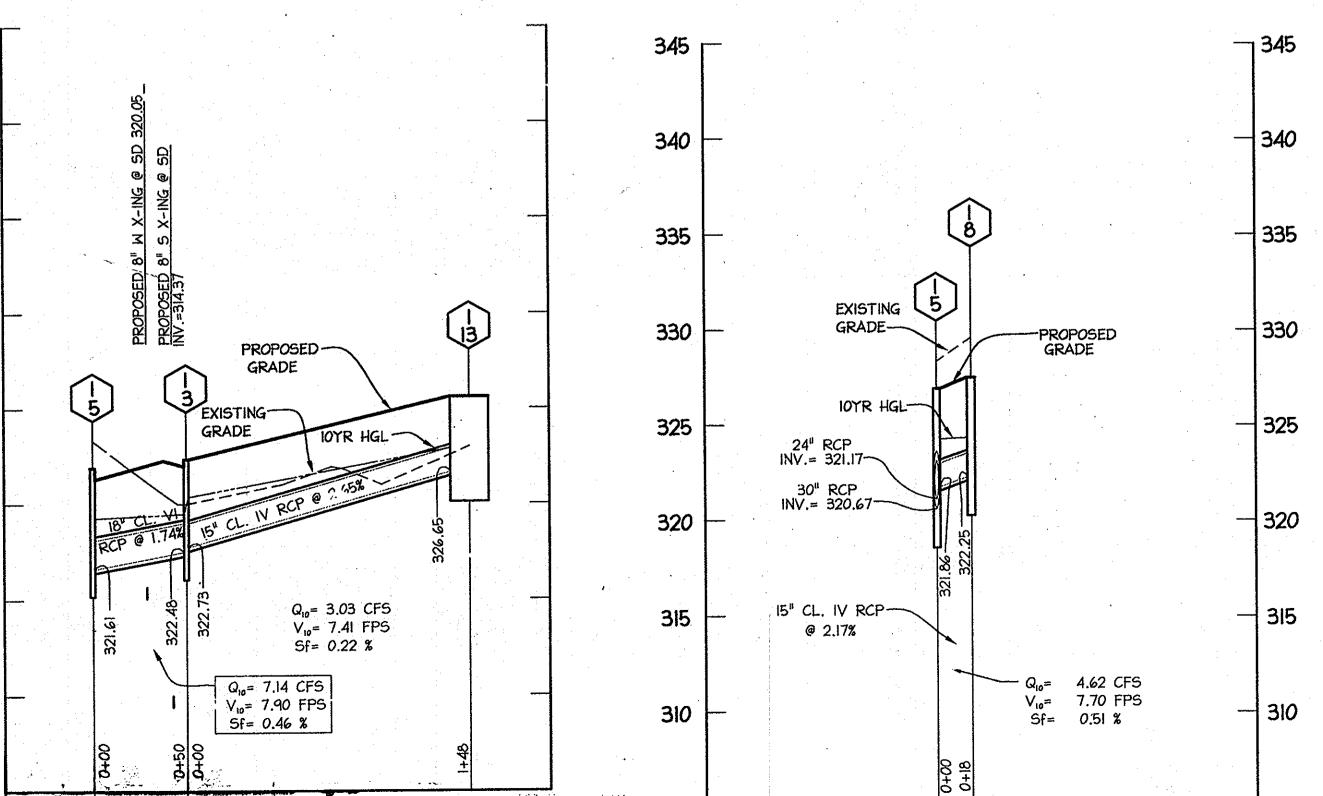


STRUCTURE	TYPE	LOCATION	INV. IN	INV. OUT	TOP	REMARKS
1-1	A-IO 4' WIDE	193.13 RT OF & 0+84.65 JUNE FLOWERS WAY	313.15 (36")	312.95 (36*)	324.60	MODIFIED HOCO STD. DETAIL SD-4,41
1-2	A-10 4.0' WIDE	37.62 LT OF & 0+76.35 JUNE FLOWERS WAY	_	330.00 (15")	333.76	MODIFIED HOCO STD. DETAIL SD-4.41
I <b>-3</b>	A-10 2.5' WIDE	12.00 RT OF © 4+40.02 JUNE FLOWERS WAY	322.73 (15")	322.48 (18*)	327,32	HOCO STD. DETAIL SD-4.41
I-4	A-10 4.0' WIDE	12.00 LT OF & 1+88.02 JUNE FLOWERS WAY	317.41 (30")	316.91 (36")	331.74	MODIFIED HOCO STD. DETAIL SD-4.41
1-5	A-IO 4.0' WIDE	32.00 LT OF & 4-27.88 JUNE FLOWERS WAY	321.4 (15°) 321.61 (18°)	320,61 (30")	326.90	MODIFIED HOCO STD. DETAIL SD-4.41
1-6	SHA COG 4,0' WIDE	12.00 RT OF & 2+91.02 SCENTLESS ROSE WAY	324.04 (24°)	323.84 (241)	331.76	SHA 15' COG INLET DETAIL MD 374.51
1-7	SHA COG 4.0' WIDE	12.00 LT OF © 2+91.02 SCENTLESS ROSE WAY	324.43 (24°)	324.23 ( 24")	331.76	SHA 15' COG INLET DETAIL MD 374,51
1-8,	TYPE "D" INLET	N 536064.53 E 1353404.03		322.25 (15*)	327.50	HOCO STD DETAIL SD-4.39 (4 THROATS OPEN)
1-13	SHA COG 4.0' WIDE	12.00 RT OF & 5+88.29 JUNE FLOWERS WAY	<b></b>	326.65 (15")	330.76	SHA 20' COG INLET DETAIL MD 374.51
M-1	5' MANHOLE	N 535662.46 E 1353144.45	311.92 (36')	311.72 (EX. 36")	318.21	HOCO STD DETAIL G-5,13
M-2	5' DROP MANHOLE	N 535915.84 E 1353113.22	315.13 (36°) 326.97 (15°)	314.93 (36")	331,57	SHA STD DROP MANHOLE DETAIL MD 383.II
M-3	5' MANHOLE	N 535979.80 E 1353368.62	319.43 (30")	319.23 (30")	328.66	HOCO STD DETAIL G-5.13
M-5	5' MANHOLE	n 535926,91 E 1353228,34	516.49 (36")	316.29 (36")	332.40	HOCO STD DETAIL G-5.13
M-6	5' MANHOLE	N 535855.69 E 1353096.42	314.31 (361)	314.11 (36")	328.40	HOCO STD DETAIL G-5.13

1. LOCATION OF TYPE "D" INLET AND MANHOLES ARE AT THE CENTER OF TOP COVER; FOR "A" INLETS LOCATION GIVEN FOR CENTER OF OPENING AT FACE OF CURB.

2. SEE SHEET 6 FOR MODIFIED HOCO PRECAST STANDARD

TYPE A-10 INLET (SD-4.41).

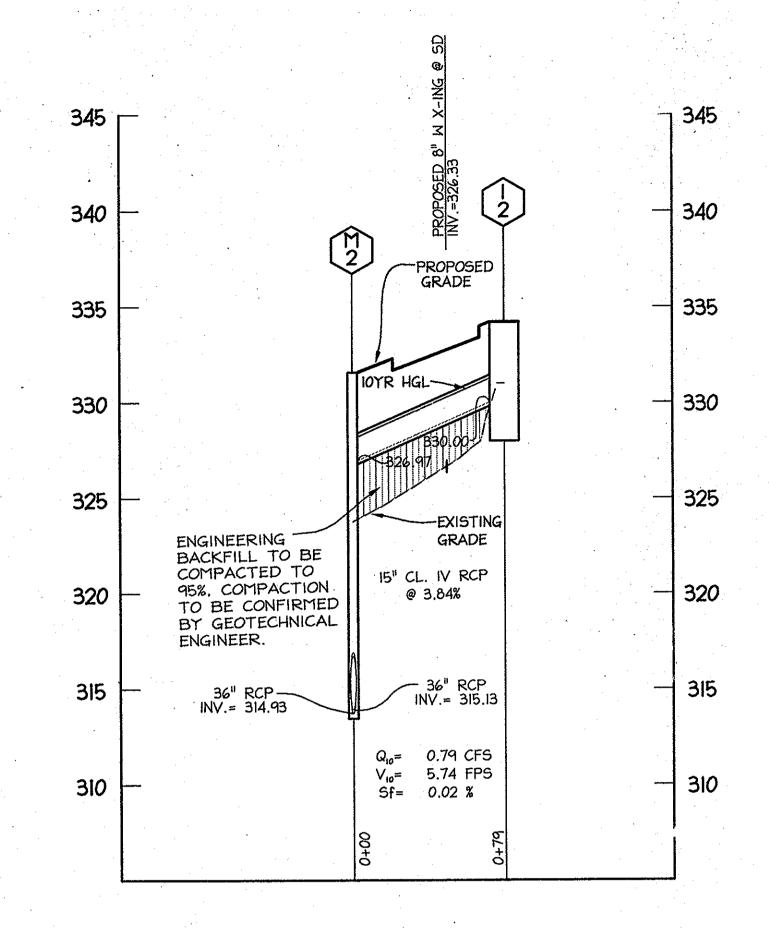

	PIPE SCHEDU	
SIZE	PIPE LENGTH	TYPE
15*	245'	CL. IV RCP
18"	501	CL. IV RCP
24"	1641	CL. IV RCP
30"	2221	CL. IV RCP
36°	419	CL. IV RCP


9-18-06

DATE

Chief B		Highways Date	<u>) (                                   </u>	
Cinei, D	meau or	Inghways 2		
		TO A DOMESTIC AND TO A A DOMESTIC AND CONTINUE		
APPRO	ARD: DI	EPARTMENT OF PLANNING AND ZONING	100	
N	No fee		26	
Chief, D	ivision c	of Land Development Date		
		11/0/0	\$	
Chief, I	)evelopn	Mi Darrie Milliani Mi	۶.	
		LOT NUMBERS REVISED TO REFLECT CHANGES		
		Made to F-10-024		
•				
	<del></del>		<del></del>	
10/10	1	REMOVE SCENTLESS ROSE WOY FROM CONTRO	CT	
Date	No.	Revision Description		
PERTIN	UENT II		-	
TAX	TAX MAP NO. 47 GRID NO. 8 \$ 9.			
ELECTION DISTRICT: 6 HOWARD COUNTY, M				

OWNER / DEVELOPER

SK HOMES @ EMERSON II 10705 CHARTER DRIVE, SUITE 320 COLUMBIA, MD 21044 TEL: (410) 997-7400 FAX: (410) 997-6305

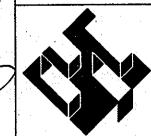

christopher consultants


engineering surveying land planning christopher consultants, ltd.
7172 columbia (gateway drive (suite 100) - columbia, md. 21046 2990 410.872 8890 - mezo 301 881 0148 - fax 410 872 8893


JUNE FLOWERS WAY


SECTION 2, HASE 6A BUILDABLE LOTS 92 THRU 124, HO. OPEN SPACE LOTS 125-127 A RESUBDIVISION OF BULK PARCEL 3 1 AND A REVISION OF OPEN SPACE LOTI


STORMDRAIN PROFILES

DESIGN: XDF	SCALE: 1 250	PROJECT: 049101.00
DRAWN: ADL	DATE: 9-18-06	
CHECKED: BAM	APPROVED:	4 of 9

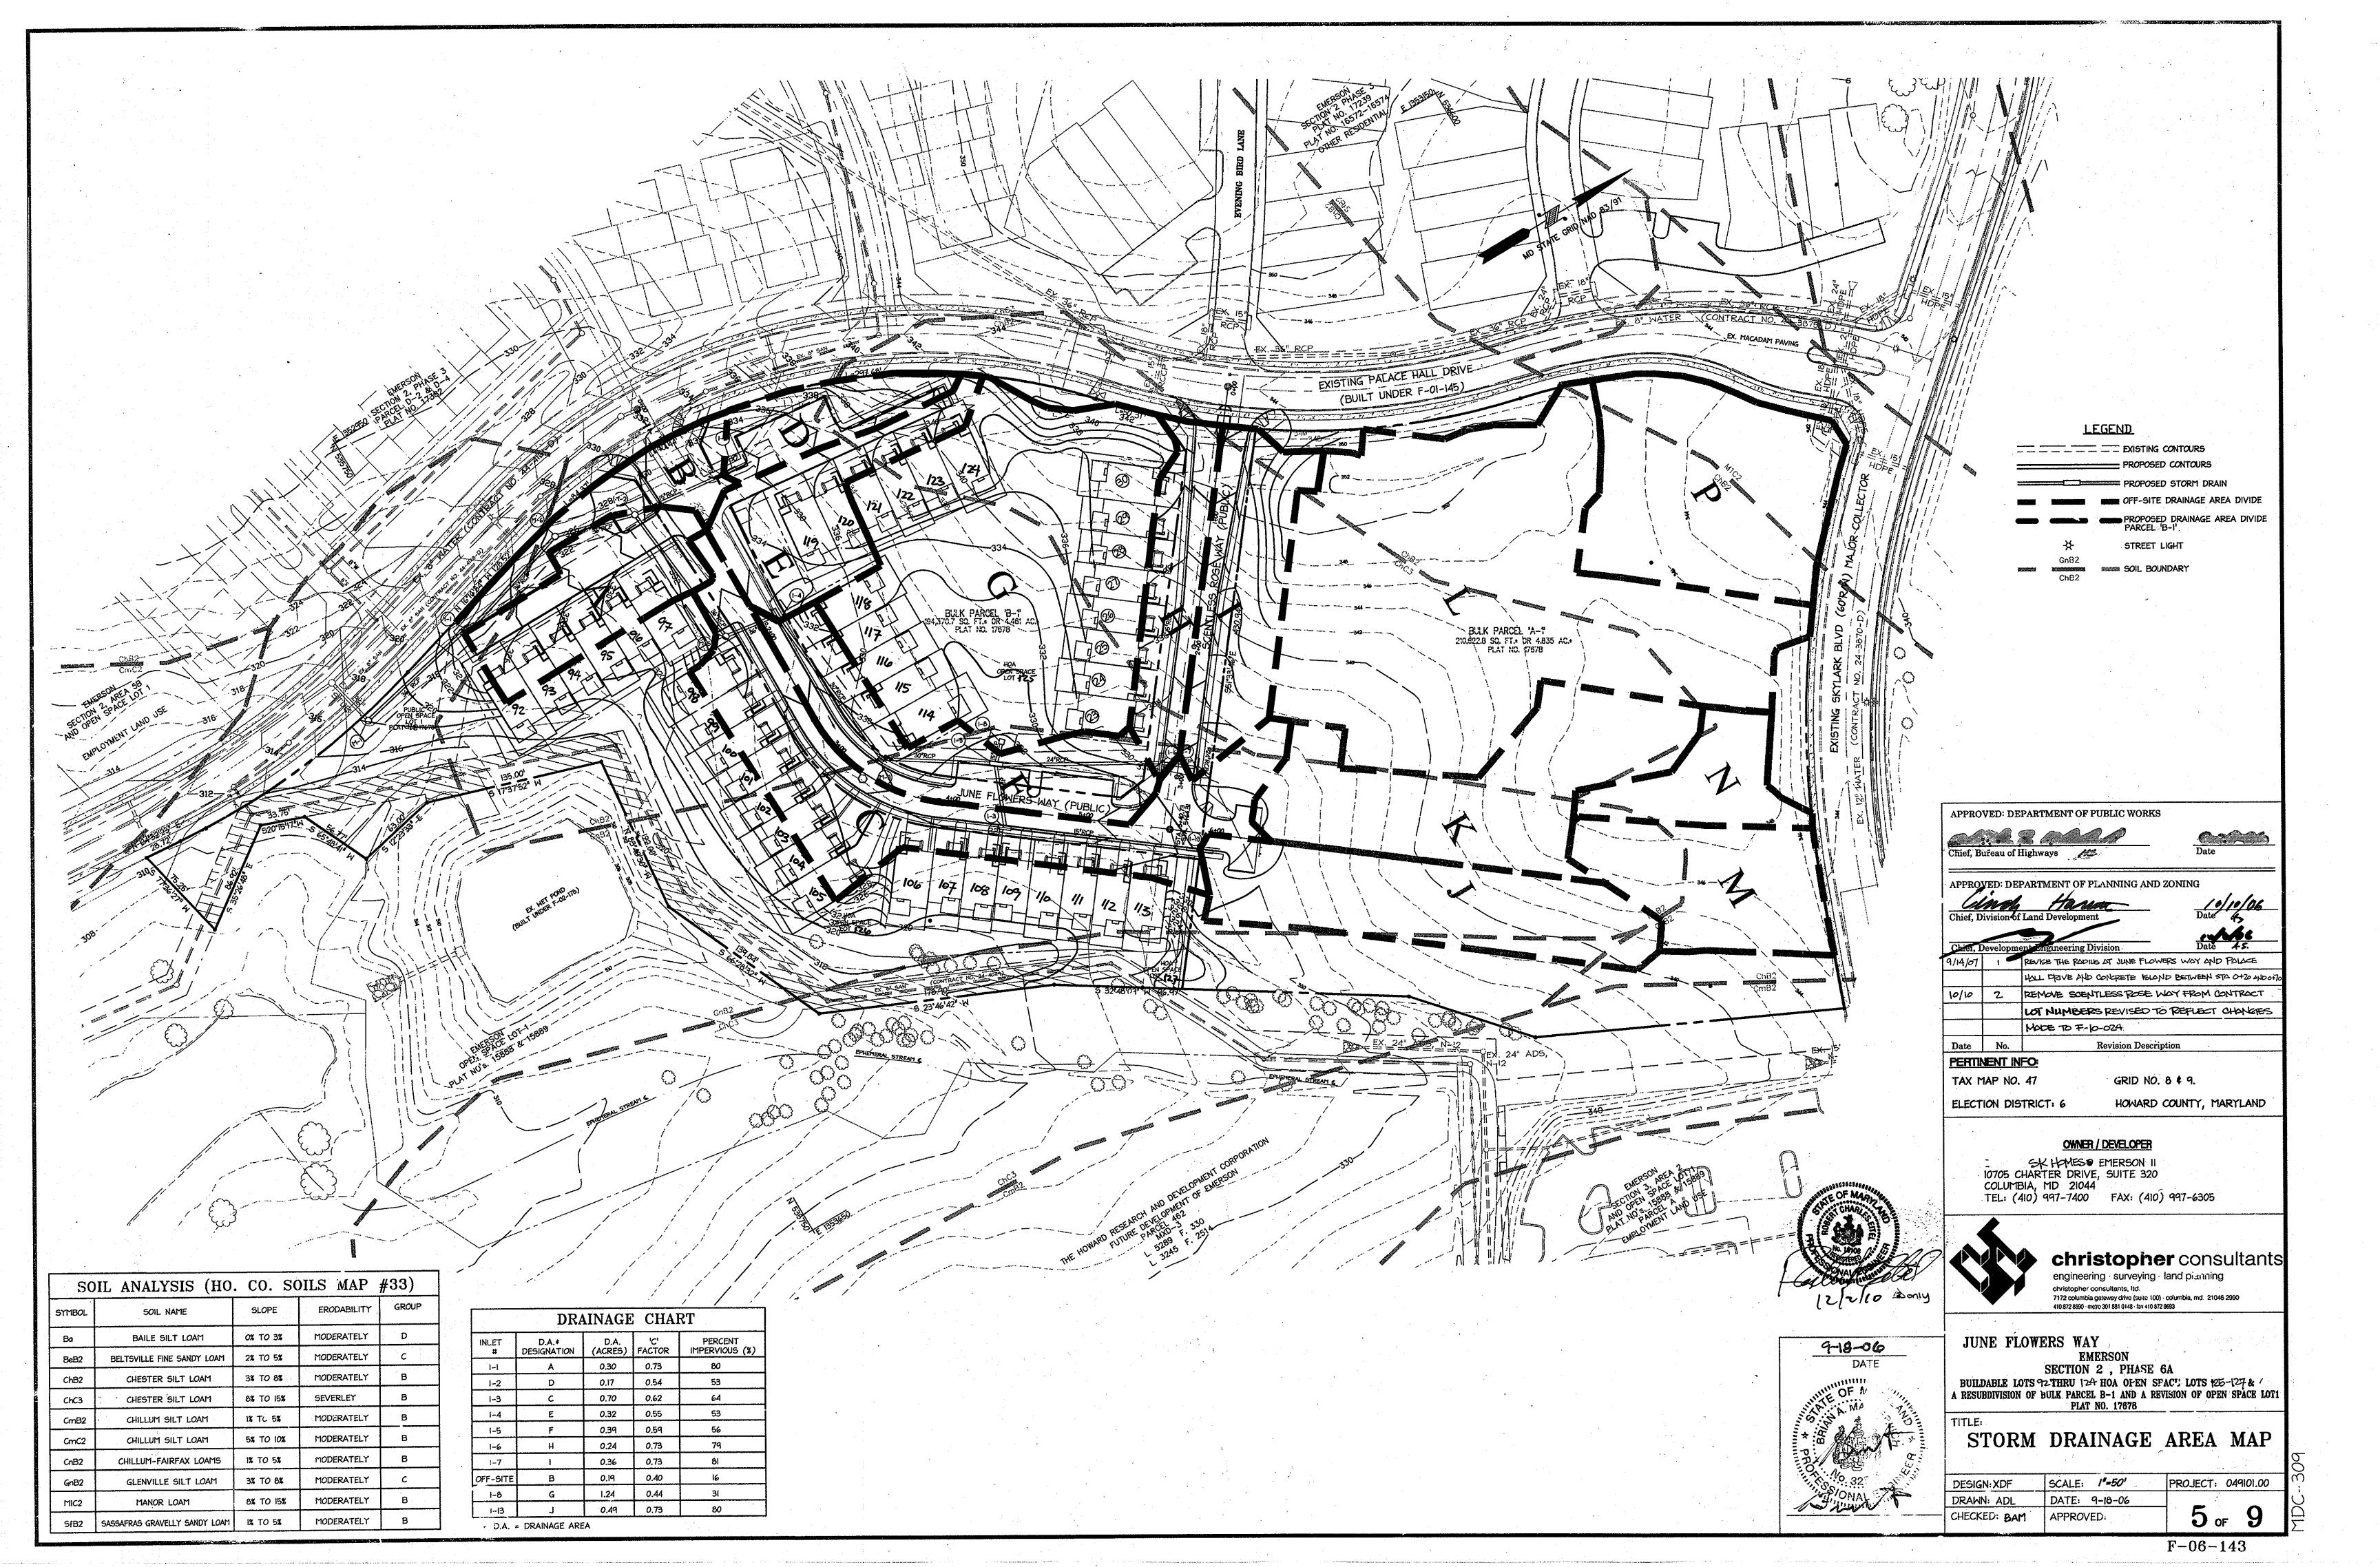


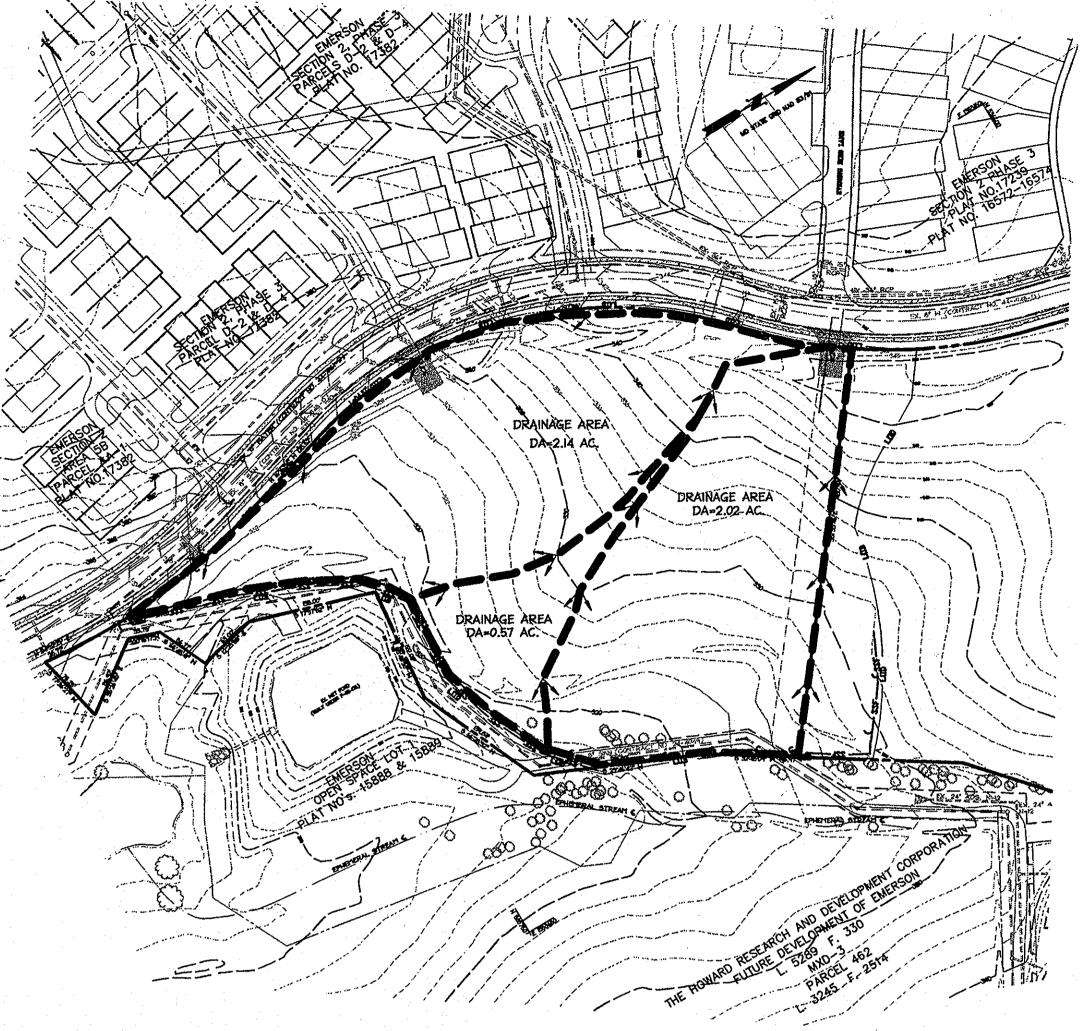

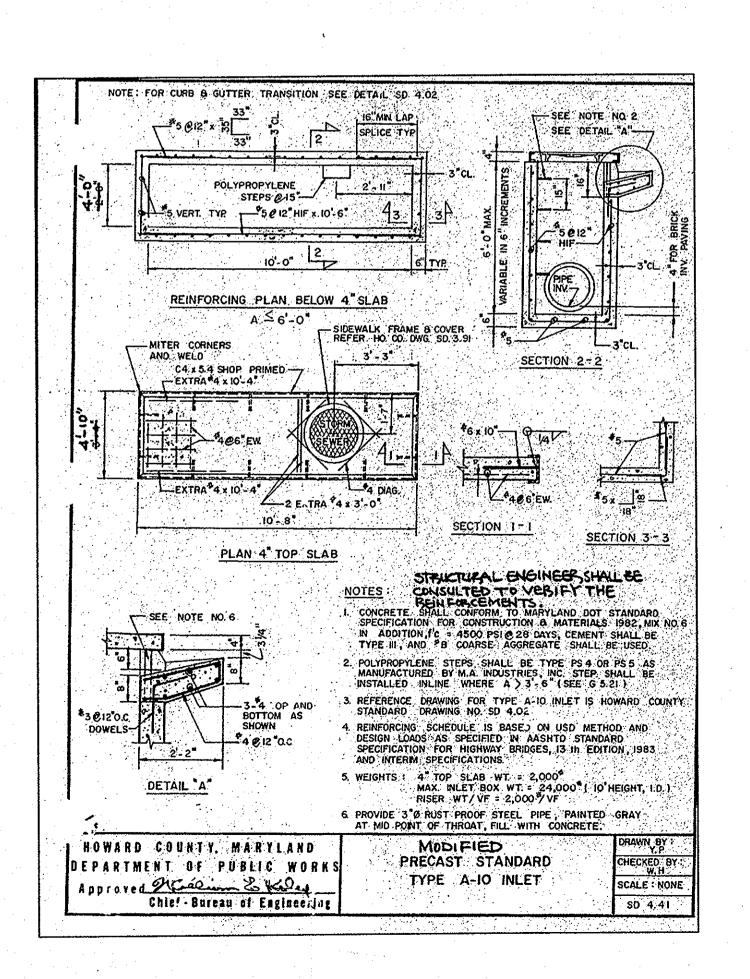

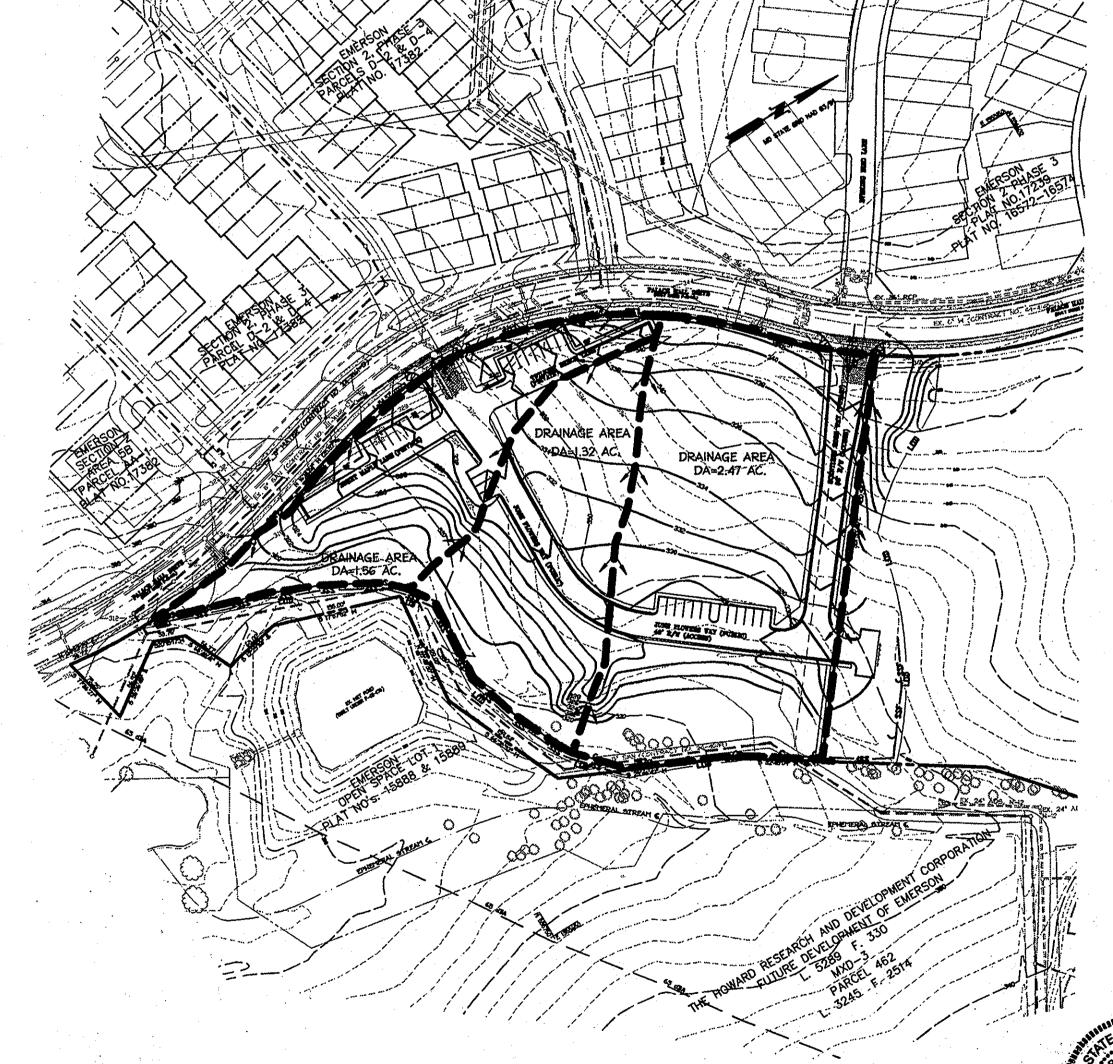

E&S POST DEVELOPMENT DRAINAGE AREA MAP SCALE: | = 1001

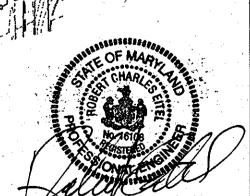

9-18-06 DATE OF MARY

Chief, Bureau of Highways APPROVED: DEPARTMENT OF PLANNING AND ZONING REVISE THE PODIUS AT JUNE FLOWERS WAY AND PALACE HALL DRIVE AND CONCRETE ISLAND PETWEEN STA. 0+20 AND 0+70 10/10 2 REMOVE SCENTLESS ROSE WAY FROM CONTRACT Date No. R vision Description PERTINENT INFO: TAX MAP NO. 47 GRID NO. 8 \$ 9. HOWARD COUNTY, MARYLAND ELECTION DISTRICT: 6

APPROVED: DEPARTMENT OF PUBLIC WORKS

OWNER / DEVELOPER

SK HOMES @ EMERSON II 10705 CHARTER DRIVE, SUITE 320 COLUMBIA, MD 21044 TEL: (410) 997-7400 FAX: (410) 997-6305




christopher consultants, ltd.
7172 columbia gateway drive (suite 100) : columbia, rnd 21046-2990
410.872 8890 · metro 301 881 0148 · fax 410 872 8893

JUNE FLOWERS WAY

**EMERSON** SECTION 2, PHASE 6A BUILDABLE LOTS 92 THRU 124, HOA OPEN SPACE LOTS 125-127 A RESUBDIVISION OF BULK PARCEL B-1 and A REVISION OF OPEN SPACE LOT1
PLAT NO. 17678

EROSION & SFDIMENT CONTROL DRAINAGE AREA MAPS

SCALE: /"=100" PROJECT: 049101.00 DESIGN: XDF DATE: 9-18-06 DRAWN: ADL 6 of 9 CHECKED: BAM APPROVED:

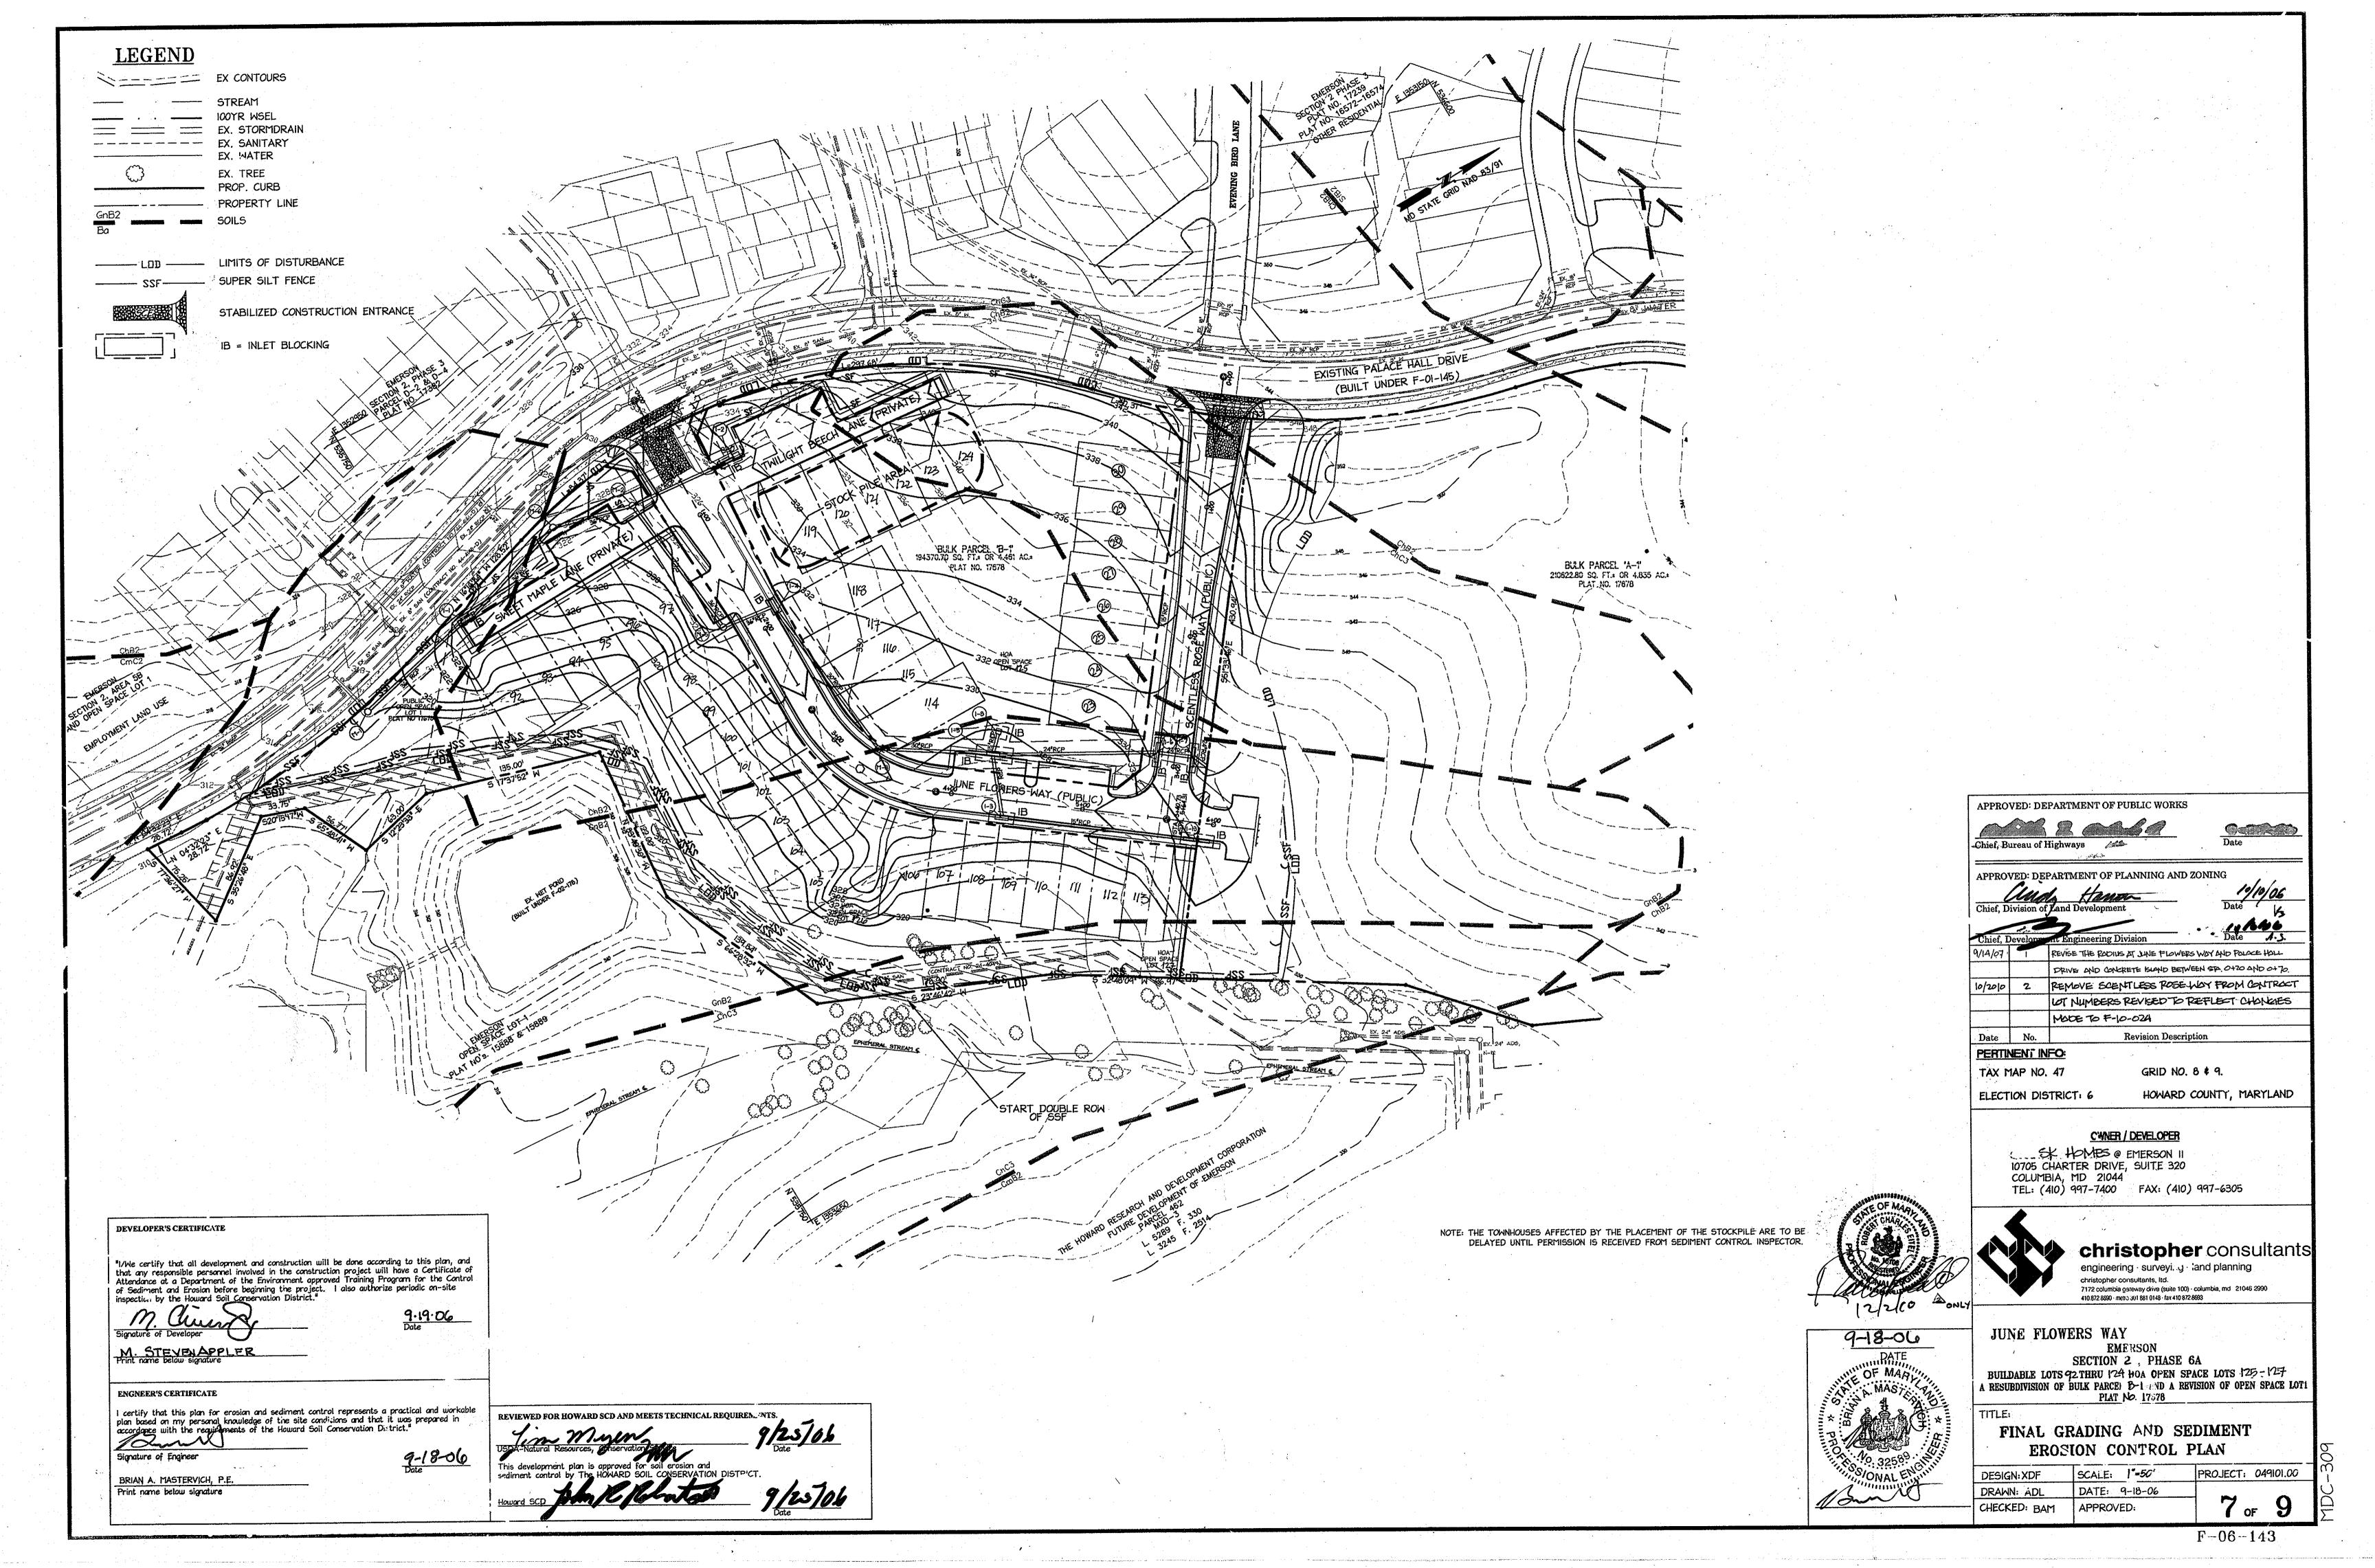

#### <u>Definitions</u>

For Land Gradina

Reshaping of the existing land surface in accordance with a plan as determined by endineering survey and layout.

The purpose of a land grading specification is to provide for erosion control and vegetative establishment on those areas where the existing land surface is to be reshaped by grading according to plan.

The grading plan should be based upon the incorporation of building designs and street layouts that fit and utilize existing topography and desirable natural surrounding to avoid extreme grade modifications. Information submitted must provide sufficient topographic surveys and soil investigations to determine limitations that must be imposed on the grading operation related to slope stability, effect on adjacent properties and drainage patterns, measured for drainage and water removal and vegetative

Many countries have regulations and design procedures already established for land grading and cut and fill slopes. Where these requirements exist, they should be followed. The plan must show existing and proposed contours of the area(s) to be graded. The plan shall also include practices for erosion control, slope stabilization, safe disposal of runoff water and drainage, such as waterways, lined ditches, reverse slope benches (includina grade and cross-section), grade stabilization structures, retaining walls, and surface and subsurface drains. The plan shall also include phasing of these practices. The following shall be incorporated into the plan:

1. Provisions shall be made to safety conduct surface runoff to storm drains, protected outlets or to stable water courses to insure that surface runoff will not damage slopes or other graded areas.

2. Cut and fill slopes that are to be stabilized with grasses shall not be steeper then 2:1. (Where the slope id to be moved the slope should be no steeper then 3:1: 4:1 is preferred because of safety factors related to mowing steep slopes.

3. Reverse benches shall be provided whenever the vertical interval (height) of any 2:1slopes exceeds 20 feet; for 3:1 slopes it shall be increased to 30 feet and for 4:1 to 40 feet. Benches shall be located to divide the slopes face as equally as possible and shall convey the water to a stable outlet. Soils, seeps, rock outcrops, etc., shall also be taken into consideration when designing benches.

- a. Benches shall be a minimum of six-feet wide to provide ease of
- b. Benches shall be designed with a reverse slope of 6:1 of flatter to the toe of the upper slope and with a minimum of one foot in depth. Bench gradient to the outlet shall be between 2 percent and 3 percent, unless accompanied by appropriate design and
- c. The flow length within a bench shall not exceed 800" unless accompanied by appropriate design and computations. For flow channel stabilization see temporary swales.

4. Surface water shall be diverted from the face of all cut and/or fill slopes by the use of earth dikes, ditches and swales or conveyed downslope

- by the use of a designated structure, except where: a. The face of the slope is or shall be stabilized and the face of all graded slopes shall be protected for surface runoff until they are
- b. The face of the slope shall not be subjected to any concentrated slows of surface water such as from natural drainways, graded swales, downspouts, etc.
- c. The face of the slope will be protected by special erosion control materials, to include, but not limited to approved vegetative stabilization practices (see section G), rip-rap or other approved

5. Cut slopes occurring in ripable rock shall be serrated as shown on the following diagram. These serrations shall be made with conventional equipment as the excavation is made. Each step or serration shall be constructed on the contour and will have steps cut as nominal two-foot intervals with nominal three-foot horizontal shelves. These steps will vary depending on the slope ratio or the cut slope. The nominal slope line s 1:1. These steps will weather and act to hold moisture, lime, fertilizer and seed thus producing a much quicker and longer lived vegetative cover and better slope stabilization. Over land flow shall be diverted from the top of all serrated cut slopes and carried to a suitable outlet.

6. Surface drainage shall be provided where necessary to intercept seepage that would otherwise adversely affect slope stability or create excessively wet site conditions.

7. Slopes shall not be created to close to property lines as the endanger adjoining properties without adequately protecting such properties against sediment, erosion, slippage, settlement, subsidence or other related

8. Fill material shall be free of brush, upbish, rocks, logs, stumps, building debris, and other objectionable material. It should be free of stones over two (2) inches in diameter where compacted by hand or mechanical tempers over eight (8) inches in diameter where compacted by rollers or other equipment. Frozen material shall not be placed in the fill nor shall the fill material be placed on a frozen foundation.

9. Stockpiles, borrow areas and spoil shall be shown on the plans and shall

All disturbed areas shall be stabilized structurally or vegetatively in compliance with 20.0 Standards and Specifications for Vegetative Stabilization.

be subjected to the provisions of the Standard and Specifications.

For the purpose of these Standards and Specification, areas having slopes steeper that 2:1 require special consideration and design for adequate stabilization. Areas having slopes steeper that 2:1 shall have the appropriate

Topsoil salvaged from the existing site may be used provided that it meets the standards as set forth in these specifications. Typically, the depth of topsoil to be salvaged for a given soil type can be found in the representative soil profile section in the Soil Survey published by USDA-SCS

Topsoil Specifications - Soil to be used as topsoil must meet the following:

- i. Topsoil shall be a loam, sandy loam, clay loam, silt loam, sandy approval authority. Regardless, topsoil shall bot be a mixture of contrastinf textured subsoils and shall contain less than 5% by volume of cinders, stones, slag, coarse fragments, gravel, sticks, roots, trash, or other materials large than 1? " in diameter.
- ii. Topsoil must be free of plants or plant parts such as bermuda grass, quackgrass, Johnsongrass, nutsedge, poison ivy, thistle, or
- clays, ground limestone shall be spread to the rate of 4-8 tons/acre (200-400 pounds per 1,000square feet) prior to the placement of topsoil. Lime shall be distributed uniformly over designated areas and worked in to the soil in conjunction with tillage operations as described in the following procedures.

For sites having disturbed areas under 5 acres:

Place topsoil (if required) and apply soil amendments as specified in 20.0 vegetative Stabilization - Section I - Vegetative Stabilization Methods and Materials.

On soil meeting Topsoil specifications, obtain test results dictating fertilizer and time amendments required to bring the soil into

- a. pH for topsoil shall be between 6.0 and 7.5. If tested soil demonstrates a pH of less the 6.0, sufficient lime shall be prescribed to raise pH to 6.5 or higher.
- b. Organic content of topsoil shall be not less then 1.5 percent by
- c. Topsoil having soluble salt content grater then 500 parts per million shall not be used.
- d. No sod or seed shall be placed on soil which has been treated with soil sterilants or chemicals used for weed control until

Note: Topsoil substitutes or amendments as recommended be a qualified

Place topsoil (if required) and apply soil amendments a specified on 20.0

#### Topsoil Application

When topsoiling, maintain needed erosion and sediment control practiced such as diversions, Grade Stabilization Structures, Earth Dikes, Slope Silt Fences

Topsoil shall be uniformy distributed in a 4" - 8" layer and lightly compacted to a minimum thickness of 4". Spreading shall be performed in such a manner that sodding or seeding can proceed with a minimum of additional soil preparation and tillage. Any irregularities in the surface resulting from topsoiling or other operations shall be corrected in order to

Topsoil shall not be place while the topsoil or subsoil is in a frozen or muddy condition, when the subsoil id excessively wet in a condition that may otherwise be detrimental to proper grading and seedbed preparation.

Atternative for Permanent Seeding - Instead of applying the full amounts of

Composted Studge Materials for use as a soil conditioner for sites having disturbed areas over 5 acres shall be tested to prescribe amendments and for sites having disturbed areas under 5 acres shall conform to the following

- person or persons that are permitted (at the time of acquisition of the compost) by the Maryland Department of the Environment under COMAR 26.04.06.
- b. Composted sludge shall contain as least I percent nitroaen. 1.5 percent phosphorus, and 0.2 percent potassium and have a pH of 7.0 to 8.0. If compost does not meet these requirements, the appropriate constituents must be added to meet the requirements

# 21.0 Standard and Specifications For Topsoil

### Definitions

Placement of topsoil over a prepared subsoil prior to establishment of permanent

#### Purpose To provide a suitable soil medium for vegetative growth. Soild of concern have

low moisture content, low nutrient levels, low pH, materials toxic to plants, and/or unacceptable soil gradation.

### Conditions Where Practice Applies

This practice is limited to areas having 2:1 or flatter slopes where:

- a. The texture of the exposed subsoil/parent material in not adequate to produce vegetative growth.
- b. The soil material is so shallow that the rooting zone is not deep enough to support plants or furnish continuing supplies of moisture and plant nutrients.
- c. The original soil to be vegetated contains materials toxic to plant
- d. The soil is so acidic that treatment with limestone is not feasible.

stabilization shown on the plans.

#### Construction and Material Specifications

in cooperation with Maryland Agricultural Experimental Station.

- clay loam, loamy sand. Other soils may be used if recommended by an agronomist or soil scientist and approved by the appropriate
- iii. Where the subsoil is either highly acidic or composed of heavy

For sites having disturbed areas over 5 acres:

compliance with the following.

sufficient time has elapsed (14 day min.) to permit dissipation of phyto-toxic materials.

agronomist or soil scientist approved by the appropriate approval authority, may be used in lieu of natural topsoil.

<u>Vegetative Stabilization</u> - Section 1 - Vegetative Stabilization Methods and Materials.

and Sediment Traps and Basins.

Grades in the areas to be topsoiled, which have been previously established, shall be maintained, albeit 4" - 8" higher in elevation.

prevent the formation of depressions or water pockets.

like and commercial fertilizer, composted sludge and amendments mat be applied as specified below:

a. Composted sludge shall be supplied by, or originated from, a

- c. Composted studge shall be applied at a rate of 1 ton/1,000 square feet

Composted sludge shall be amended with a potassium fertilizer applied at the rate of 4 1b/1,000 square feet, and 1/3 the normal lime application rate. References: Guideline Specifications, Soil Preparation and Sodding. MD-VA, Pub #1, Cooperative Extention Service, University of Maryland and Virginia Polytechnic Institutes. Revised 1973.

### 30.0 Dust Control

### Definition

Controlling dust blowing and movement on construction sites and roads.

### Purpose

To prevent blowing and movement of dust from exposed soil surfaces, reduce on and off-site damage, health hazards, and improve traffic safety.

Conditions Where Practice Applies

This practice is applicable to areas subject to dust blowing and movement when in and off-site damage is likely without treatment.

### Temporary Methods

<u>Specifications</u>

1. Mulches - See standards for vegetative stabilization with mulches only. Mulch should be crimped or tacked to prevent blowing.

2. Vegetative Cover - See standards for temporary vegetative cover.

3. Tillage - To roughen surface and bring clods to the surface. This is an emergency measure which should be used before soil blowing starts. Begin plowing on windward side of site. Chisel-type plows spaced about 12" apart, spring-toothed harrows, and similar plaus are examples of equipment whici may produce the desired effect

4. Irrigation - This is generally done as an emergency treatment. Site is sprinkled with water until the surface is moist. Repeat as needed. At no time should the site be irrigated to the point that runoff begins to flow.

5. Barriers - Soild board fences, silt fences, snow fences, burlap fences, staw bales, and similar materials can be used to control air currents and soil blowing. Barriers placed at right angles to Crevailing currents at intervals of about 10 times their height are effective in controlling soil blowing. 6. Calcium Chloride - Apply at rates that will keep surface moist. May need retreatment.

#### Permanent Methods

References

1. Permanent Vegetation - See standards for permanent vegetative cover, and permanent stabilization with sod. Existing trees or large shrubs may afford valuable protection if left in place.

2. Topsoil - Covering with less erosive materials. See Standards for topsoilding 3. Stone - Cover surface with crushed stone or coarse gravel.

1. Agriculture Handbook 346. Wind Erosion Forces in the United State and Their Use in Predicting Soil Loss.

2. Agriculture Information Bulletin 354. How to Control Wind Erosion, USDA -

other acceptable means before seeding, if not previously loosened

PERMANENT SEEDING NOTES

Apply to graded or cleared areas not subject to immediate further disturbance where a permanent long-lived vegetative cover is needed. Seedbed Preparation: Loosen upper three inches of soil by raking, disking or

<u>Soil Amendments:</u> In lieu of soil test recommendations, use one of the 1. Preferred--Apply 2 tons/acre dolomitic limestone (92 lbs/1000 sq. ft.) fertilizer (14 lbs/1000 sq. ft.) before seeding. Harrow or disk into upper three inches of soil. At time of seeding apply 400 lbs/acre 30-0-0 urea form fertilizer (9 lbs/1000 sq. ft.) 2. Acceptable -- Apply 2 tons/acre dolomitic limestone (92 lbs/1000 sq. ft.) and 1000 lbs/acre 10-10-10 fertilizer (23 lbs/1000 sq. ft.) before seeding. Harrow or disk into upper three inches of soil.

Seeding -- For the periods March 1 -- April 30, and August 1 -- October 15, seed with 60 lbs/acre (1.4 lbs/1000 sq. ft.) Kentucky 31 Tail Fescue. For the period May 1 -- July 31, seed with 60 lbs Kentucky 31 Tail Fescue per acre and 2 lbs/acre (.05 lbs/1000 sq. ft.) of weeping lovegrass. During the period of October 16 -- February 28, protect site by: Option I - Two tons per acre of well anchored straw mulch and seed as soon as possible in the spring.

Option 2 - Use sod. Option 3 -- Seer: with 60 lbs/acre Kentucky 30 Tall Fescue and mulch with 2 tons/acre well anchored straw.

Mulching -- Apply 1-1/2 to 2 tons per acre (70 to 90 lbs/1000 sq. ft.) of unrotted small grain straw immediately after seeding. Anchor mulch immediately after application using mulch anchoring tool or 218 gallons per acre (5 gal/1000 sq. ft. ) of emulsified asphalt on flat areas. On slope 8 feet or higher, use 348 gallons per acre (8 gal/1000 sq. ft.) for anchoring.

Maintenance -- Inspect all seeding areas and make needed repairs,

### TEMPORARY SEEDING NOTES.

replacements and reseedings.

Apply to graded or cleared areas likely to be re-disturbed where a

short-term vegetative cover is needed. Seedbed preparation: -- Loosen upper three inches of soil by raking, disking or other acceptable means before seeding, if not previously loosened. Soil Amendments: -- Apply 600 lbs/acre 10-10-10 fertilizer (14 lbs/1000 sq. ft.).

Seeding: -- For periods March 1 -- April 30 and from August 15 -- October 15, seed with 2-1/2 bushel per acre of annual rye (3.2 lbs/1000 sa, ft.). For the period May 1 -- August 14, seed with 3 lbs/acre of weeping lovegrass (.07 lbs/1000 sq. ft.). For the period November 16 --February 28 protect the site by applying 2 tons/acre of well anchored straw mulch and seed as soon as possible in the spring, or use sod.

Mulching: -- Apply 1-1/2 to 2 tons/acre (70 to 90 lbs/1000 sq. ft.) of unrotted weed-free, small grain straw immediately after seeding. Anchor mulch immediately after application using mulch anchoring tool or 218 gal. per acre (5 gal/1000 sq. ft.) of emulsified asphalt on flat areas. On slope 8 ft. or higher, use 348 gal. per acre (8 gal/1000 sq. ft.) for anchoring.

Refer to the 1994 MARYLAND STANDARDS AND SPECIFICATION FOR SOIL EROSION AND SEDIMENT CONTROL for additional rates and methods not

### DEVELOPER'S CERTIFICATE

"I/We certify that all development and construction will be done according to this plan, and that any responsible personnel involved in the construction project will have a Certificate of Attendance at a Department of the Environment approved Training Program for the Control of Sediment and Erosion before beginning the project. I also authorize periodic on-site inspection by the Howard Soil Conservation District."

9.19.06

I certify that this plan for erosion and sediment control represents a practical and workable plan based on my personal knowledge of the site conditions and that it was prepared in accordance with the requirements of the Howard Soil Conservation District."

BRIAN A. MASTERVICH, P.E. Print name below signature

REVIEWED FOR HOWARD SCD AND MEETS TECHNICAL REQUIREMENTS. 9/25/06

6. All sediment control structures are to remain in place and are to be maintained in operative condition until permission for their removal has been obtained by the Howard County Sediment Control Inspector. Site Analysis: Total Area of Site 5.51 Acres Area Disturbed 4.97 Acres Area to be roofed or paved 0.89 Acres Area to be vegetatively stabilized 4.08 Acres Total Cut 6,754 Cu. Yds. Total Fill 18,510 Cu. Yds.


8. Any sediment control practice which is disturbed by grading activity for placement of utilities must be repaired on the same day of disturbance

10. On all site with disturbed areas in excess of 2 acres, approval of the inspection agency shall be requested completion of instillation of perimeter erosion and sediment controls, but before proceeding with any other earth

disturbance or grading. Other building or grading inspection approvals may not be authorized until this initial

. Additional sediment control must be provided, if deemed necessary by the Howard County Sediment Control

11. Trenches for the construction of utilities is limited to three pipe lengths or that which shall be back-filled stabilized any construction as shown on these plans by the end of each work day, whichever is shorter.

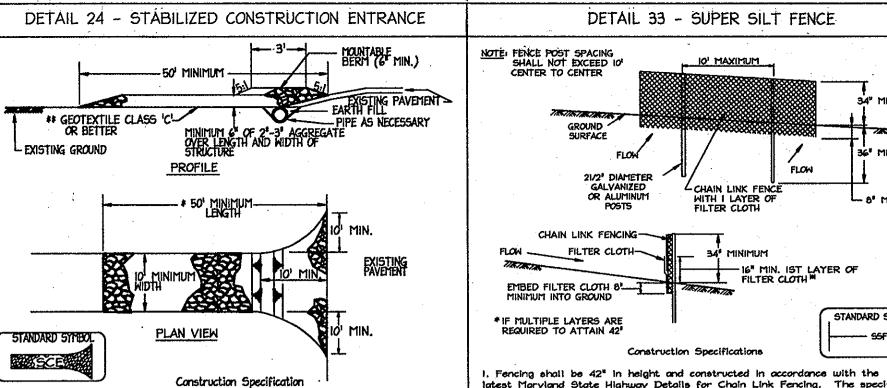

3. Geotextile fabric (filter cloth) shall be placed over the existing ground prior

to placing stone. \*\*The plan approval authority may not require single family

4. Stone – crushed aggregate ( $2^a$  to  $3^a$ ) or reclaimed or recycled concrete equivalent shall be placed at least  $6^a$  deep over the length and width of the

5. Surface Water - all surface water flowing to or diverted toward construction

entrances shall be piped through the entrance, maintaining positive drainage. Pipe installed through the stabilized construction entrance shall be protected with a

mountable berm with 511 slopes and a minimum of 6" of stone over the pipe. Pipe has

to be sized according to the drainage. When the SCE is located at a high spot and

has no drainage to convey a pipe will not be necessary. Pipe should be sized according to the amount of runoff to be conveyed. A 6" minimum will be required.

6. Location - A stabilized construction entrance shall be located at every point

where construction traffic enters or leaves a construction site. Vehicles leaving

the site must travel over the entire length of the stabilized construction entrance

DETAIL 22 - SILT FENCE

FLOW

TRED GEOTEXTILE CLASS F — MINIMUM OF 6' VERTICALLY

Construction Specifications

Fonce posts shall be a minimum of 36" long driven 16" minimum into the

standard T or U section weighting not less than 1.00 pond per linear foot.

2. Geotextile shall be fastened securely to each fence post with wire ties

50 lbe/in (min.) 20 lbe/in (min.)

3. Where ends of geotextile fabric come together, they shall be overlapped

4. Slit Fence shall be inspected after each rainfall event and maintained when

STANDARD SEDIMENT CONTROL NOTES

r staples at top and mid-section and shall meet the following requirements

ground. Wood posts shall be 11/2" x 11/2" square (minimum) cut, or 13/4" diameter (minimum) round and shall be of sound quality hardwood. Stool posts will be

PERSPECTIVE VIEW

JOINING TWO ADJACENT SILT

FENCE SECTIONS

folded and stapled to prevent sediment bypass

Flow Rate

SUIL CONSERVATION SERVICE

HOWARD COUNTY

SOIL CONSERVATION DISTRICT

AND SEDIMENT CONTROL and revisions thereto.

germination and establishment of grasses.

Offsite waste/borrow area location: N/A

approval by the inspection agency is made.

PAGE MARYLAND DEPARTMENT OF ENVIRONMENT
F - 17 - 3 WATER MANAGEMENT ADMINISTRATION

6" MINIMUM LENGTH FENCE POS RIVEN A MINIMUM OF 16" INTO

FENCE POST DRIVE

STANDARD SYMBOL

Test: MSMT 509 Test: MSMT 509

MARYLAND DEPARTMENT OF ENVIRONMENT

1. A minimum of 48 hours notice must be given to the Howard County Department of Inspections, Licenses and

2. All vegetative and structural practices are to be installed according to the provisions of this plan and are to

be in conformance with the most current MARYLAND STANDARDS AND SPECIFICATIONS FOR SOIL EROSION

3. Following initial soil disturbance or re-disturbance, permanent or temporary stabilization shall be completed

4. All sediment traps/basins shown must be fenced and warning signs posted around their perimeter in accordance with Vol 1, Chapter 12 of the HOWARD COUNTY DESIGN MANUAL, Storm Drainage.

5. All disturbed areas must be stabilized within the time period specific above in accordance with the 1995

MARYLAND STANDARD AND SPECIFICATIONS FOR SOIL EROSION AND SEDIMENT CONTROL for permonent seeding (Sec. 51), sod (Sec. 54), temporary seeding (Sec. 50) and mulching (Section 52). Temporary stabilization with mulch along can only be done when recommended seeding dates do not allow for proper

within: a) 7 calendar days for all perimeter sediment control structures, dikes, perimeter slopes and all slopes

WATER MANAGEMENT ADMINISTRATION

CROSS SECTION

0.3 gal ft / minute (max.) Test: MSMT 322

Permits, Sediment Control Division prior to the start of any construction (313-1855).

greater than 3:1, b) 14 days as to all other disturbed or graded areas on the project site.

latest Maryland State Highway Details for Chain Link Fencing. The specification for a 6' fence shall be used, substituting 42' fabric and 6' length . Length - minimum of 50' (430' for single residence lot). 2. Width - 10' minimum, should be flared at the existing road to provide a turning 2. Chain link fence shall be fastened securely to the fence posts with wire ties.

required except on the ends of the fence.

3. Filter cloth shall be fastened securely to the chain link fence with ties spaced every 24" at the top and mid section. 4. Filter cloth shall be embedded a minimum of 8" into the ground.

5. When two sections of filter cloth adjoin each other, they shall be overlapped by 6" and folded. Maintenance shall be performed as needed and sitt buildups removed when "bulges" develop in the silt fence, or when silt reaches 50% of fence height

7. Filter cloth shall be fastened securely to each fence post with wire ties or

staples at top and mid section and shall meet the following requirements for Geotextile Class F: 20 lbe/in (min.) 0.3 gal/ft /minute (max.)

Flow Rate Filtering Efficiency 75% (min.)

Toot: MSMT 509 Test: MSMT 322 Test: MSMT 322 PAGE MARYLAND DEPARTMENT OF ENVIRONMENT
H - 26 - 3 WATER MANAGEMENT ADMINISTRATION SOIL CONSERVATION SERVICE

STANDARD SYMBOL

CURB INLET BLOCKING 4" RIPRAP-PLYWOOD--CAULK OR MASTIC AROUND PERIMETER

CONSTRUCTION SPECIFICATIONS

1. ATTACH A CONTINUOUS PIECE OF PLYWOOD MEASURING THROAT LENGTH PLUS 6" AS SHOWN ON THE STANDARD DRAWINGS.

2. PLACE A CONTINUOUS PIECE OF 2 x 10 THE SAME LENGTH AS THE PLYWOOD. 3. INSTALL CAULK AND SECURELY NAIL THE 2 x 10 TO THE PLYWOOD. 4. CAULK OR MASTIC TO BE CONTINOUS AROUND PERIMETER OF INLET OPENING.

5. PLACE THE ASSEMBLY AGAINST THE INLET THROAT AND APPLY 4" RIPRAP STONE 4-6" THICK ON THE PLYWOOD TO SECURE IT ON THE OPENING.

SEQUENCE OF CONSTRUCTION

KNOWN EXISTING UTILITIES. (2 DAYS)

INSPECTIONS, LICENSES AND PERMITS DIVISION, (I DAY)

STORM DRAIN SYSTEM. BLOCK ALL INLETS (35 DAYS)

SEEDING TABLES PROVIDED ON THE PLANS. (7 DAYS)

8. BEGIN ROAD CONSTRUCTION.(45 DAYS)

BLOCKINGS. (3 DAYS)

OBTAIN THE GRADING PERMIT FROM HOWARD COUNTY DEPARTMENT OF

2. ARRANGE AN ON-SITE PRE-CONSTRUCTION MEETING WITH COUNTY INSPECTORS, THE CONTRACTOR, AND ENGINEER PRIOR TO THE START OF CONSTRUCTION OF THIS

CONTACT A PRIVATE UTILITY LOCATING COMPANY TO ADEQUATELY MARK ALL

5. CLEAR AND GRUB FOR PERIMETER CONTROL. INSTALL SUPER SILT FENCE PER PLAN

7. ONCE INSPECTOR'S APPROVAL IS OBTAINED, BEGIN ON-SITE GRADING & INSTALLING

9. IMMEDIATELY UPON COMPLETION OF GRADING, PROVIDE STABILIZATION PER THE

10. ONCE ALL GRADING, PAVEMENT, CURB AND GUTTER ARE COMPLETED AND SITE IS STABILIZED, OBTAIN INSPECTOR'S APPROVAL PRIOR TO REMOVAL OF ANY SEDIMENT CONTROL DEVICE. (2 DAYS)

13. ONCE ALL SEDIMENT CONTROL DEVICES EXCEPT INLET BLOCKINGS ARE REMOVED

AND SITE IS STABILIZED, OBTAIN FINAL APPROVED FROM THE INSPECTOR. (2 DAYS)

REMOVE ALL REMAINING SEDIMENT CONTROL DEVICES EXCEPT THE INLET

12. STABILIZE ANY REMAINING DISTURBED AREAS ON-SITE. (4 DAYS)

4. INSTALL THE STABILIZED CONSTRUCTION ENTRANCES PER THE PLAN. (I DAY)

6. ONCE ALL SEDIMENT CONTROL DEVICES ARE IN PLACE, OBTAIN INSPECTOR'S

APPROVED: DEPARTMENT OF PUBLIC WORKS

Chief. Bureau of Highways APPROVED: DEPARTMENT OF PLANNING AND ZONING 10/10/06 Date

REMOVE SCENTLESS ROSE WAY FROM CONTRACT

Revision Description


Date No. PERTINENT INFO

**ELECTION DISTRICT: 6** 

TAX MAP NO. 47 GRID NO. 8 \$ 9.

# OWNER / DEVELOPER

SK HOMES @ EMERSON I 10705 CHARTER DRIVE, SUITE 320 COLUMBIA, MD 21044 TEL: (410) 997-7400 FAX: (410) 997-6305

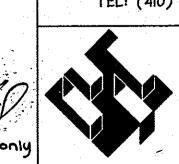

9-18-06

DATE

OF MAR!

A. MAS

No 32589.

christopher consultants engineering surveying land planning christopher consultants, ltd. 7172 columbia gateway drive (suite 100) - columbia, md. 21046-2990

HOWARD COUNTY, MARYLAND

JUNE FLOWERS WAY


EMERSON SECTION 2 . PHASE 6A BUILDABLE LOTS 92 THRU 124 HOA OPEN SPACE LOTS 125-127 A RESUBDIVISION OF BULK PARCEL B-1 AND A REVISION OF OPEN SPACE LOTI PLAT NO. 17678

410.872.8690 · metro 301 881 0148 · fax 410 872.8693

EROSION & SEDIMENT CONTROL

DETAIL SHEET SCALE: AS SHOWN PROJECT: 049101.00 DESIGN: XDF DRAWN: ADL DATE: 9-19-06 CHECKED: BAM APPROVED: O OF

F - 06 - 143

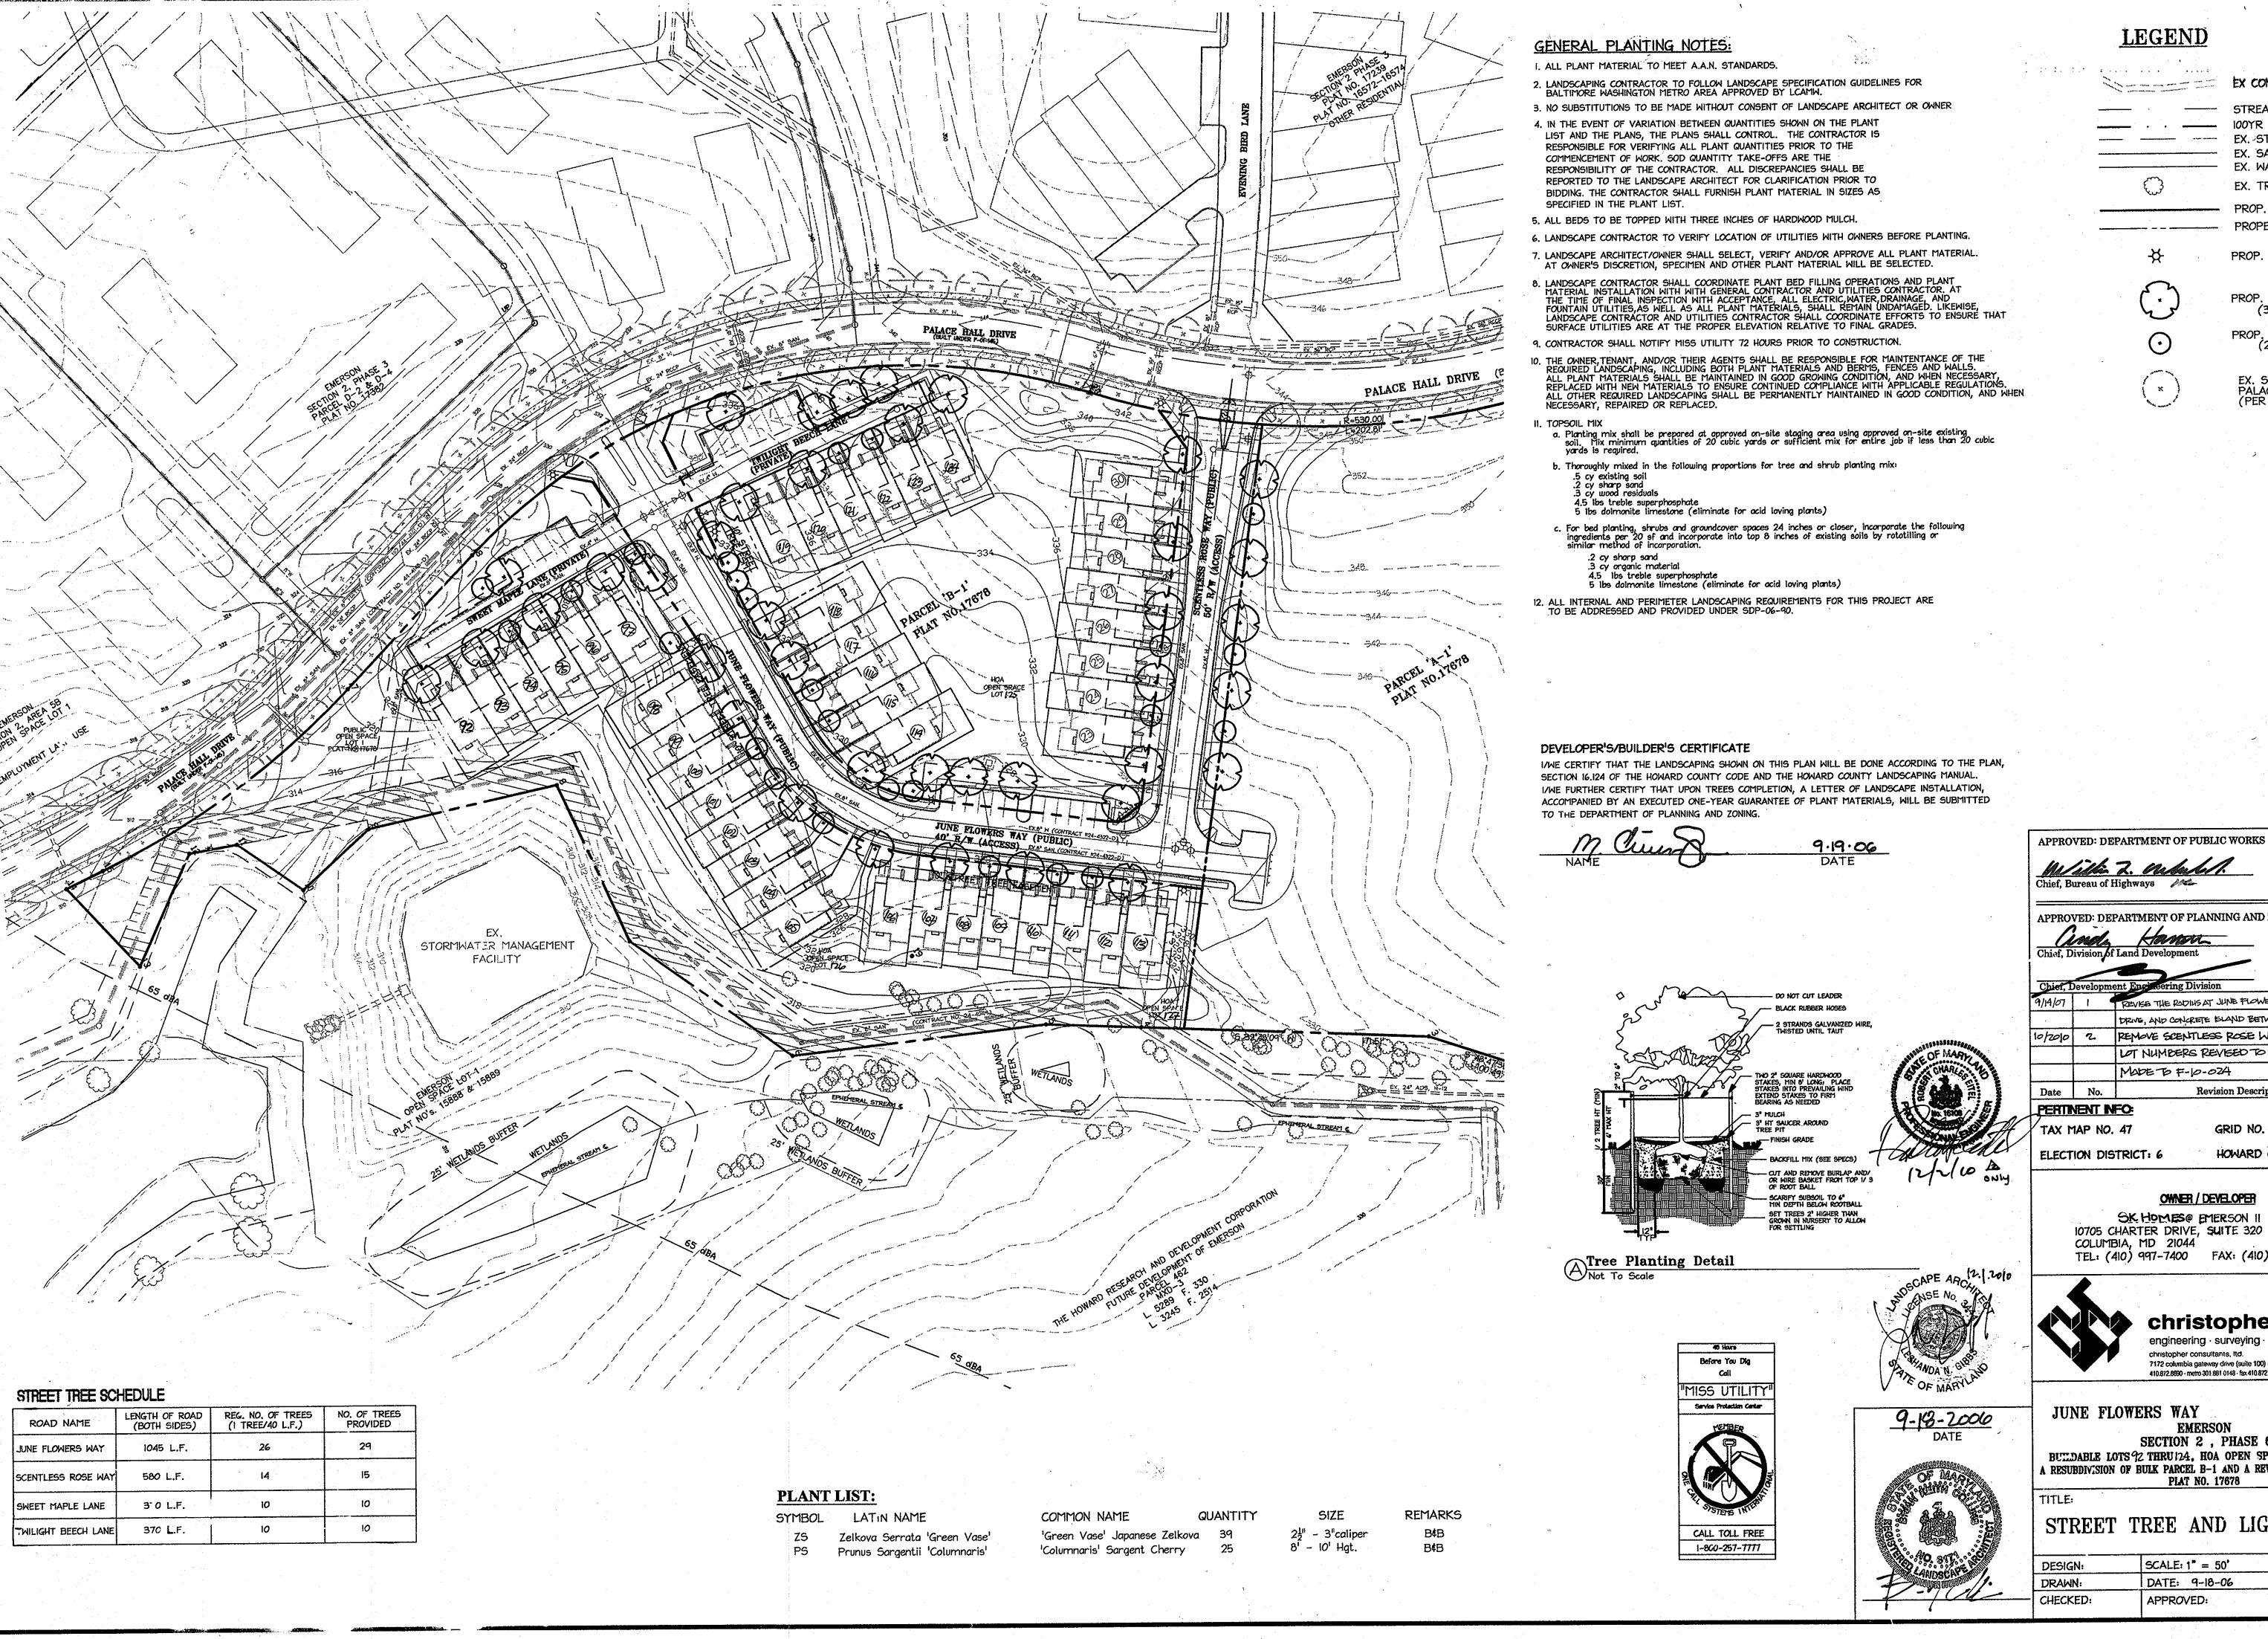

LEGEND

The first of the second of the second second ex contours 100YR WSEL EX. STORMDRAIN EX. SANITARY EX. WATER EX. TREE PROP. CURB PROPERTY LINE PROP. STREET LIGHT PROP. STREET TREE (39 - ZS) PROP. STREET TREE (25 - PS) EX. STREET TREE PALACE HALL DRIVE (PER F-01-145)

Chief, Bureau of Highways

APPROVED: DEPARTMENT OF PLANNING AND ZONING

VISE THE RODIUS AT JUNE FLOWERS WOY AND POLOCE HOLL DRIVE, AND CONCRETE GLAND BETWEEN STA. 0+20 AND 0+70 REMOVE SCENTLESS ROSE WAY FROM CONTRACT LOT NUMBERS REVISED TO REFLECT CHANGES

Q-28-06

MODE TO F-10-024 Revision Description

> GRID NO. 8 \$ 9. HOWARD COUNTY, MARYLAND

OWNER / DEVELOPER

SK. HOMES@ EMERSON !! 10705 CHARTER DRIVE, SUITE 320 COLUMBIA, MD 21044 TEL: (410) 997-7400 FAX: (410) 997-6305

> christopher consultants engineering · surveying · land planning

7172 columbia gateway drive (suite 100) - columbia, md. 21046-2990 410.872.8690 - metro 301.881.0148 - fax 410.872.8693

JUNE FLOWERS WAY **EMERSON** 

SECTION 2, PHASE 6A BUILDABLE LOTS 92 THRU 124, HOA OPEN SPACE LOTS 125-127 A RESUBDIVISION OF BULK PARCEL B-1 AND A REVISION OF OPEN SPACE LOTI PLAT NO. 17678

STREET TREE AND LIGHTING PLAN

PROJECT: 049101.00 SCALE: 1" = 50" DATE: 9-18-06 9 of APPROVED:

F-06-143