### GENERAL NOTES

- 1. Subject property Zoned "R-20" per 02/02/04 Comprehensive Zoning Plan and per the "Comprehensive Lite" Zoning Regulation Amendments effective 7/28/06.
- 2. Public water and sewer to be utilized.
- 3. Howard County Soils map no. 15.
- 4. Total area of site subject to subdivision: 4.842ac.± 5. Area of proposed public r/w: 0.000 ac.±
- 6. Number of proposed buildable lots: 10 Area of proposed buildable lots: 3.388 ac.± 7. Number of proposed Open Space lots: 1
- Area of proposed Open Space Lots: 1.454 ac.±
- 8. Open space requirements: 4.842 acres  $\times$  30% (14,000sq,ft, minimum lot size) = 1.453 ac. ± Open space provided: 1.454 ac. ± (Lot 11) Open space Lot II, including noise wall and SWM facility, will be owned and maintained
- 9. The project is in conformance with the latest Howard County Standards unless Waivers have been approved.
- 10. There are no historic structures or cemeteries on-site.
- 11. Field Run Boundary Survey prepared by C.B. Miller and Associates in June, 2001. 12. The existing topography is based on a field run Topographic Survey prepared by
- C.B. Miller \$ Associates, Inc., in June 2001, with a 2 foot contour interval. 13. The coordinates shown hereon are based on Howard County Geodetic Controls
- which is based upon the Maryland State Plane Coordinate System. Howard County Monuments 16IA and 16IB were used for this project. (See Vicinity Map) 14. Existing utilities are based on existing construction drawings, Contract #24-1994-D,
- Existing Dunes Drive road drawing F-90-93. 15. A.P.F.O. Traffic Study prepared by Street Traffic Studies Ltd. in February, 2002 and
- approved under SP-02-06. 16. Wetlands Delineation and Report and Forest Stand Delineation and Report prepared by
- Exploration Research Inc. and approved under SP-02-06. 17. The noise study for this project was prepared by Wilson T. Ballard Co. in July, 2002,
- and approved under SP-02-06. 18. The proposed noise mitigation wall shall be permitted and constructed prior to the
- issuance of building permits for lots 1-10, under The Site Development Plan. 19. All proposed open channel ditches shall be lined with erosion control matting (see plan).
- 20. Vehicular access is proposed along Dunes Drive and access is restricted along US Route 40. 21. This property is subject to the 5th edition of the Howard County Subdivision and Land
- 22. All landscaping requirements will be the responsibility of the developer. The landscaping surety will be posted with the developer's agreement in the amount of \$21,360 (64 shade trees @ \$300.00 each, 14 evergreen trees @ \$150.00 each, and 6 shrubs @ \$10 each).
- 23. Previous Howard County file numbers: SP-02-06 and WP-03-32.
- 24. Waiver petition WP-03-32 approved on November 1, 2002 granted a waiver from sections 16.120(b)(4)(iv) and 16.121(e)(i) to reduce the frontage for access of open space lot 11 and the stormwater management facility from (40) feet to zero (0) feet, subject to recordation of a maintenance agreement for access to lots 1 thru 10 and open space lot 11.
- 25. The Subject Property is located on Howard County ADC map II, Grid D-6. 26. Driveway(s) shall be provided prior to issuance of a use and occupancy permit for any new
- dwellings to ensure safe access for fire and emergency vehicles per the following requirements: a.) Width - 12 feet (14 feet serving more than one residence);
- b.) Surface six (6") inches of compacted crusher run base with tar and chip coating (1-1/2' Minimum);
- c.) Geometry Maximum 14% grade, Maximum 10% grade change and 45-foot turning radius;
- d.) Structures (culverts/bridges) capable of supporting 25 gross tons (H25-loading);
- e.) Drainage elements capable of safely passing 100 year flood with no more than I foot depth over driveway surface;
- f.) Maintenance sufficient to ensure all weather use 27. For flag or pipestern lots, snow removal and road maintenance are provided to the junction of the flag or pipestern and road right-of-way line and not to the pipestern lot
- 28. Water and sewer service to these lots will be granted under the provisions of Section 18.122.B
- of the Howard County Code. 29. All existing on-site structures are to be removed prior to plat recordation.
- 30. Stormwater Management water quality (WQV) is provided through the sand filter within the proposed Pocket Sand Filter Facility. Channel Protection (CPV) is provided through extended detention of the one year storm within the Pocket Sand Filter Facility. The SMM Recharge requirements are met through the grass channel credit using the recharge percent area method. SWM Overland Flood Protection (10 year) and Extreme Flood Volume (100 year) are not required for this site. All Stormwater Management
- 31. All existing wells and septic systems to be properly abandoned according to the Howard County Health Department Regulations.
- 32. At the site development plan stage, the BRL's effective at that time must be shown on the plan. The builder must comply with both the platted BRL's and those required by the then-effective Zoning Regulations.

oond ownership and maintenance is the responsibility of the Home Owners Association.

- 33. The contractor shall notify the following utility companies or agencies at least five(5) working
- days before starting work shown on these plans: State Highway Administration 410.850.4620 BGE(contractor services) BGE(underground damage control) 410.787.9068 1.800.257,7777 Miss Utility 410.795.1390 Colonial Pipeline Company Howard County, Dept. of Public Works, Bureau of Utilities 410.313,4900
- 34. The contractor shall notify Miss Utility at 1-800-257-7777 at least 48 hours prior to any excavation work being done.
- 35. The contractor shall notify the Department of Public Works/Bureau of Engineering Construction Inspection Division at (410) 313-1880 at least five (5) working days prior the start of work. All fills for public road surfaces require 95% compaction (AASHTO-T-180).
- 36. All construction shall be in accordance with the latest standards and specifications of
- Howard County plus MSHA standards and specifications if applicable. 37. Traffic control devices, markings and signing shall be in accordance with the latest edition of the Manual of Uniform Traffic Control Devices (MUTCD). All street and regulatory signs shall
- be in place prior to the placement of any asphalt. 38. All street sign posts shall be 2" square metal tube posts (14 gauge) installed into a 3"
- sleeve (2.5" square metal tube, 12 gauge) with a cap on top.
- 39. A minimum 201 distance shall be maintained between street lights and street trees. 47. The Forest Conservation Plan was prepared in accordance with the Howard County Forest Conservation Manual. The net tract area is 4.80 acres, with 0.9 acres of forest. There is no 100-year flood plain, wetlands, streams, steep slope or associated buffers on site. Clearing below the forest conservation threshold consists of 0.9 acres, creating a 1.8 acres of reforestation obligation. This obligation will be met by offsite planting on The E. Alexander Adams and Marion Harless Property, Lot 2, Plat No. 10147, Tax Map 7, Grid 17, Parcel 215. Surety in the amount of \$39,204.00 shall be posted as part of the Developer's Agreement for
- 41. REFUSE AND RECYCLE COLLECTION FOR THESE LOTS SHALL BE PROVIDED CURBSIDE AS ALLOWED BY THE RIGHT OF ENTRY AGREEMENT BETWEEN DUNES VISTAS LLC AND HOWARD COUNTY, MARYLAND RECORDED IN LIBER 11720 FOLIO 137.



Howard County Health Department

I HECEBY CEPTIFY THAT THESE COCUMENTS WERE PREPARED or approved by me and that I am a ouly licensed PROFESSIONAL ENGINEER UNDER THE LAWS OF THE STATE OF MARYLAND, LICENSE NO. 28559, EXPIRATION DATE 7/22/2011

410.313.2640

8480 BACTIMORE NATIONAL. PAGE SCITE 918 FLIKOT CHY, MD 21043

APPROVED: HOWARD COUNTY DEPARTMENT OF PLANNING AND DEVELOPER'S BUILDER'S CERTIFICATE I/WE CERTIFY THAT THE LANDSCAPING SHOWN ON THIS PLAN WILL BE DONE ACCORDING TO THE PLAN, SECTION 16.124 OF THE HOWARD COUNTY CODE AND THE HOWARD COUNTY LANDSCAPE MANUAL

DEPARTMENT OF PLANNING AND ZONING.

I/WE FURTHER CERTIFY THAT UPON COMPLETION, A LETTER OF

LANDSCAPE INSTALLATION, ACCOMPANIED BY AN EXECUTED ONE(I)


YEAR GUARANTEE OF PLANT MATERIALS, WILL BE SUBMITTED TO THE

9-10-07

2 BEI 10/15/10 ADD GEN. NOTE 41. REVISE GEN. NOTE 27 TO ELIMINATE "REFUSE COLLECTION"

FINAL ROAD CONSTRUCTION PLANS

# DUNES VISTAS LOTS 1 THRU 10 AND OPEN SPACE LOT 11 HOWARD COUNTY, MARYLAND

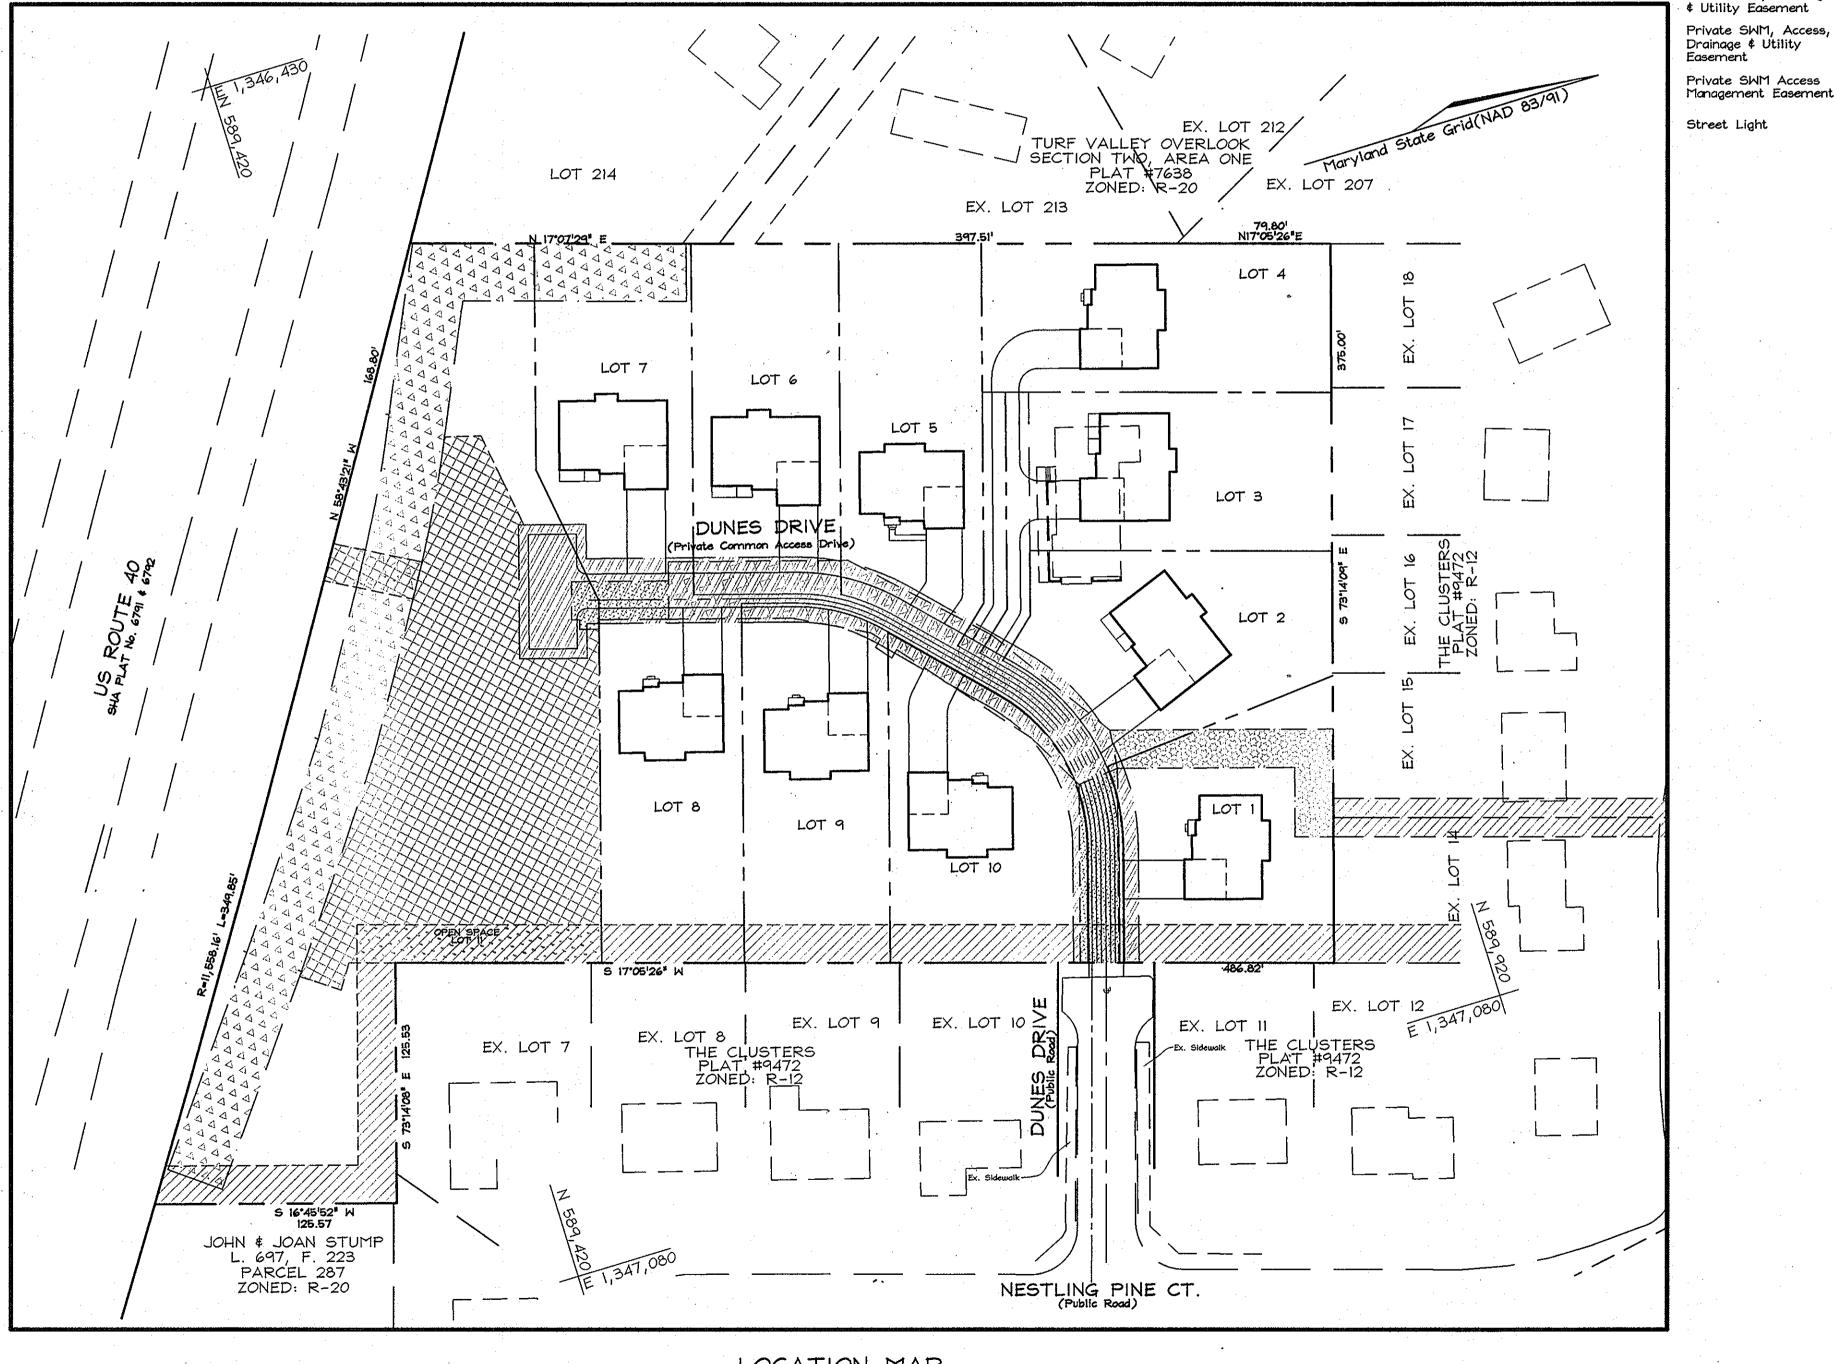

LOCATION MAP SCALE: 1"=50"

PROFESSIONAL CERTIFICATION

hereby certify that these documents were prepared or approved by me, and that I am a duly licensed professional engineer under the Jaws of the State of Maryland, License No. #22418, Expiration Date: 7/29/09.

mmmm. SCALE:1=20001

BENCHMARKS

LEGEND

Existing contours

Proposed Contour

Direction of Flow

Soils Line

Proposed Spot Elevation

Existing Trees to Remain

Public Water \$ Sewer

# Utility Easement

Public Sewer **¢** 

Public Water \$

Utility Easement

Drainage \$ Utility Easement

Existing Easement

Private Noise Wall Access,

Maintenance, Drainage

Private Access Place,

Utility Easement

Howard County Monument 16IA N 589,509.388 E 1,346,343.658 El.: 463.674 Howard County Monument 16IB N 590,475.281 E 1,344,753.967 EL: 470.576

SHEET INDEX	
DESCRIPTION	SHEET No.
Cover Sheet	1 of 10
Final Road Plan, Profile and Details	2 of 10
Sediment and Erosion Control and Grading Plan	3 of 10
Sediment and Erosion Control Notes and Details	4 of 10
Storm Drain Drainage Area Map, Profiles and Details	5 of 10
Stormwater Management Plan, Profiles and Details	6 of 10
Stormwater Mangement Notes and Details	7 of 10
Forest Conservation, Landscaping and Street Tree Plan	8 of 10
Offsite Forest Mitigation Plan for Dunes Vistas	9 of 10
Offsite Forest Mitigation Plan for Dunes Vistas	10 of 10

DEVELOPER/OWNER Dunes Vistas LLC c/o Brian D. Boy 11807 Wollingford Court Clarksville, Md 21029 Tel: (410) 792-2565

## COVER SHEET

DUNES VISTAS LOTS I THROUGH 10, AND OPEN SPACE LOT 11

ZONED:R-20 TAX MAP 16 GRID 24 2ND ELECTION DISTRICT

E-mail: info@fsheri.com


Engineers Planners Surveyors 6339 Howard Lane, Elkridge, MD 21075 Tel:410-567-5200 Fax: 410-796-1562


HOWARD COUNTY, MARYLAND DESIGN BY: MT DRAWN BY: \_\_\_CED\_ CHECKED BY: \_ZYF SCALE: As Shown DATE: <u>Sep. 7, 2007</u> W.O. No.: \_\_\_3060

SHEET No.: \_1\_OF 10

PARCEL 57

ZONING

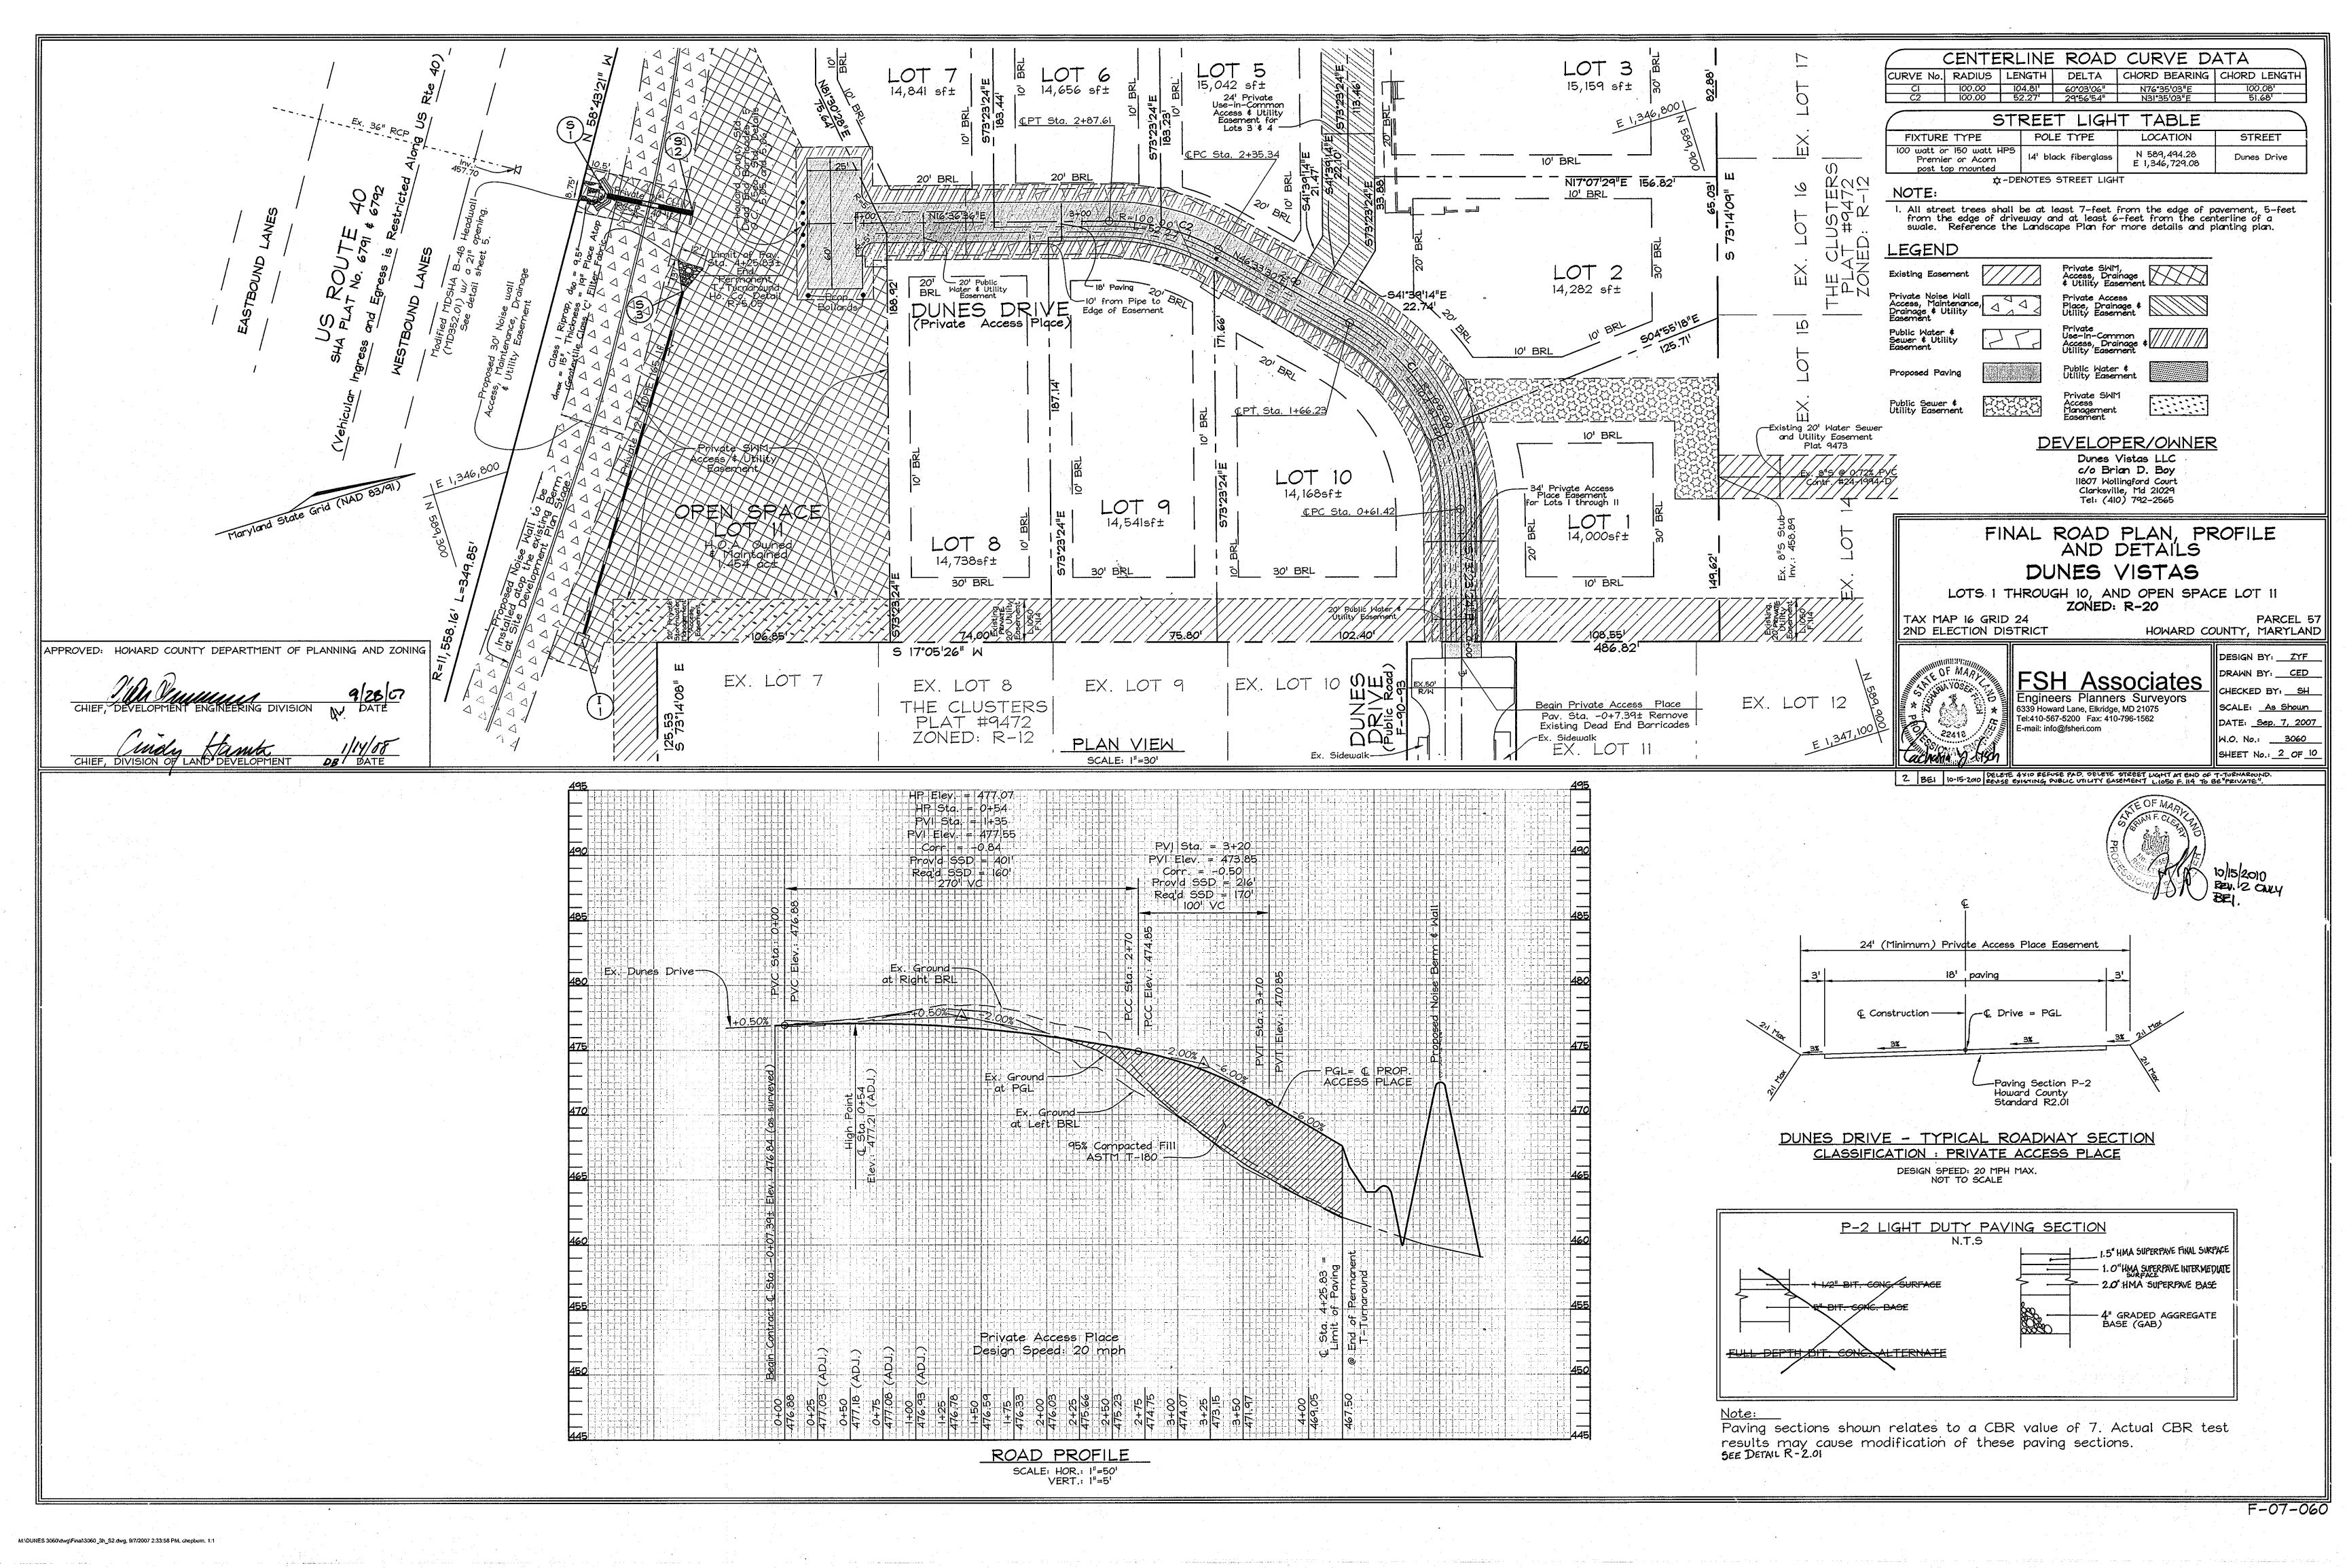

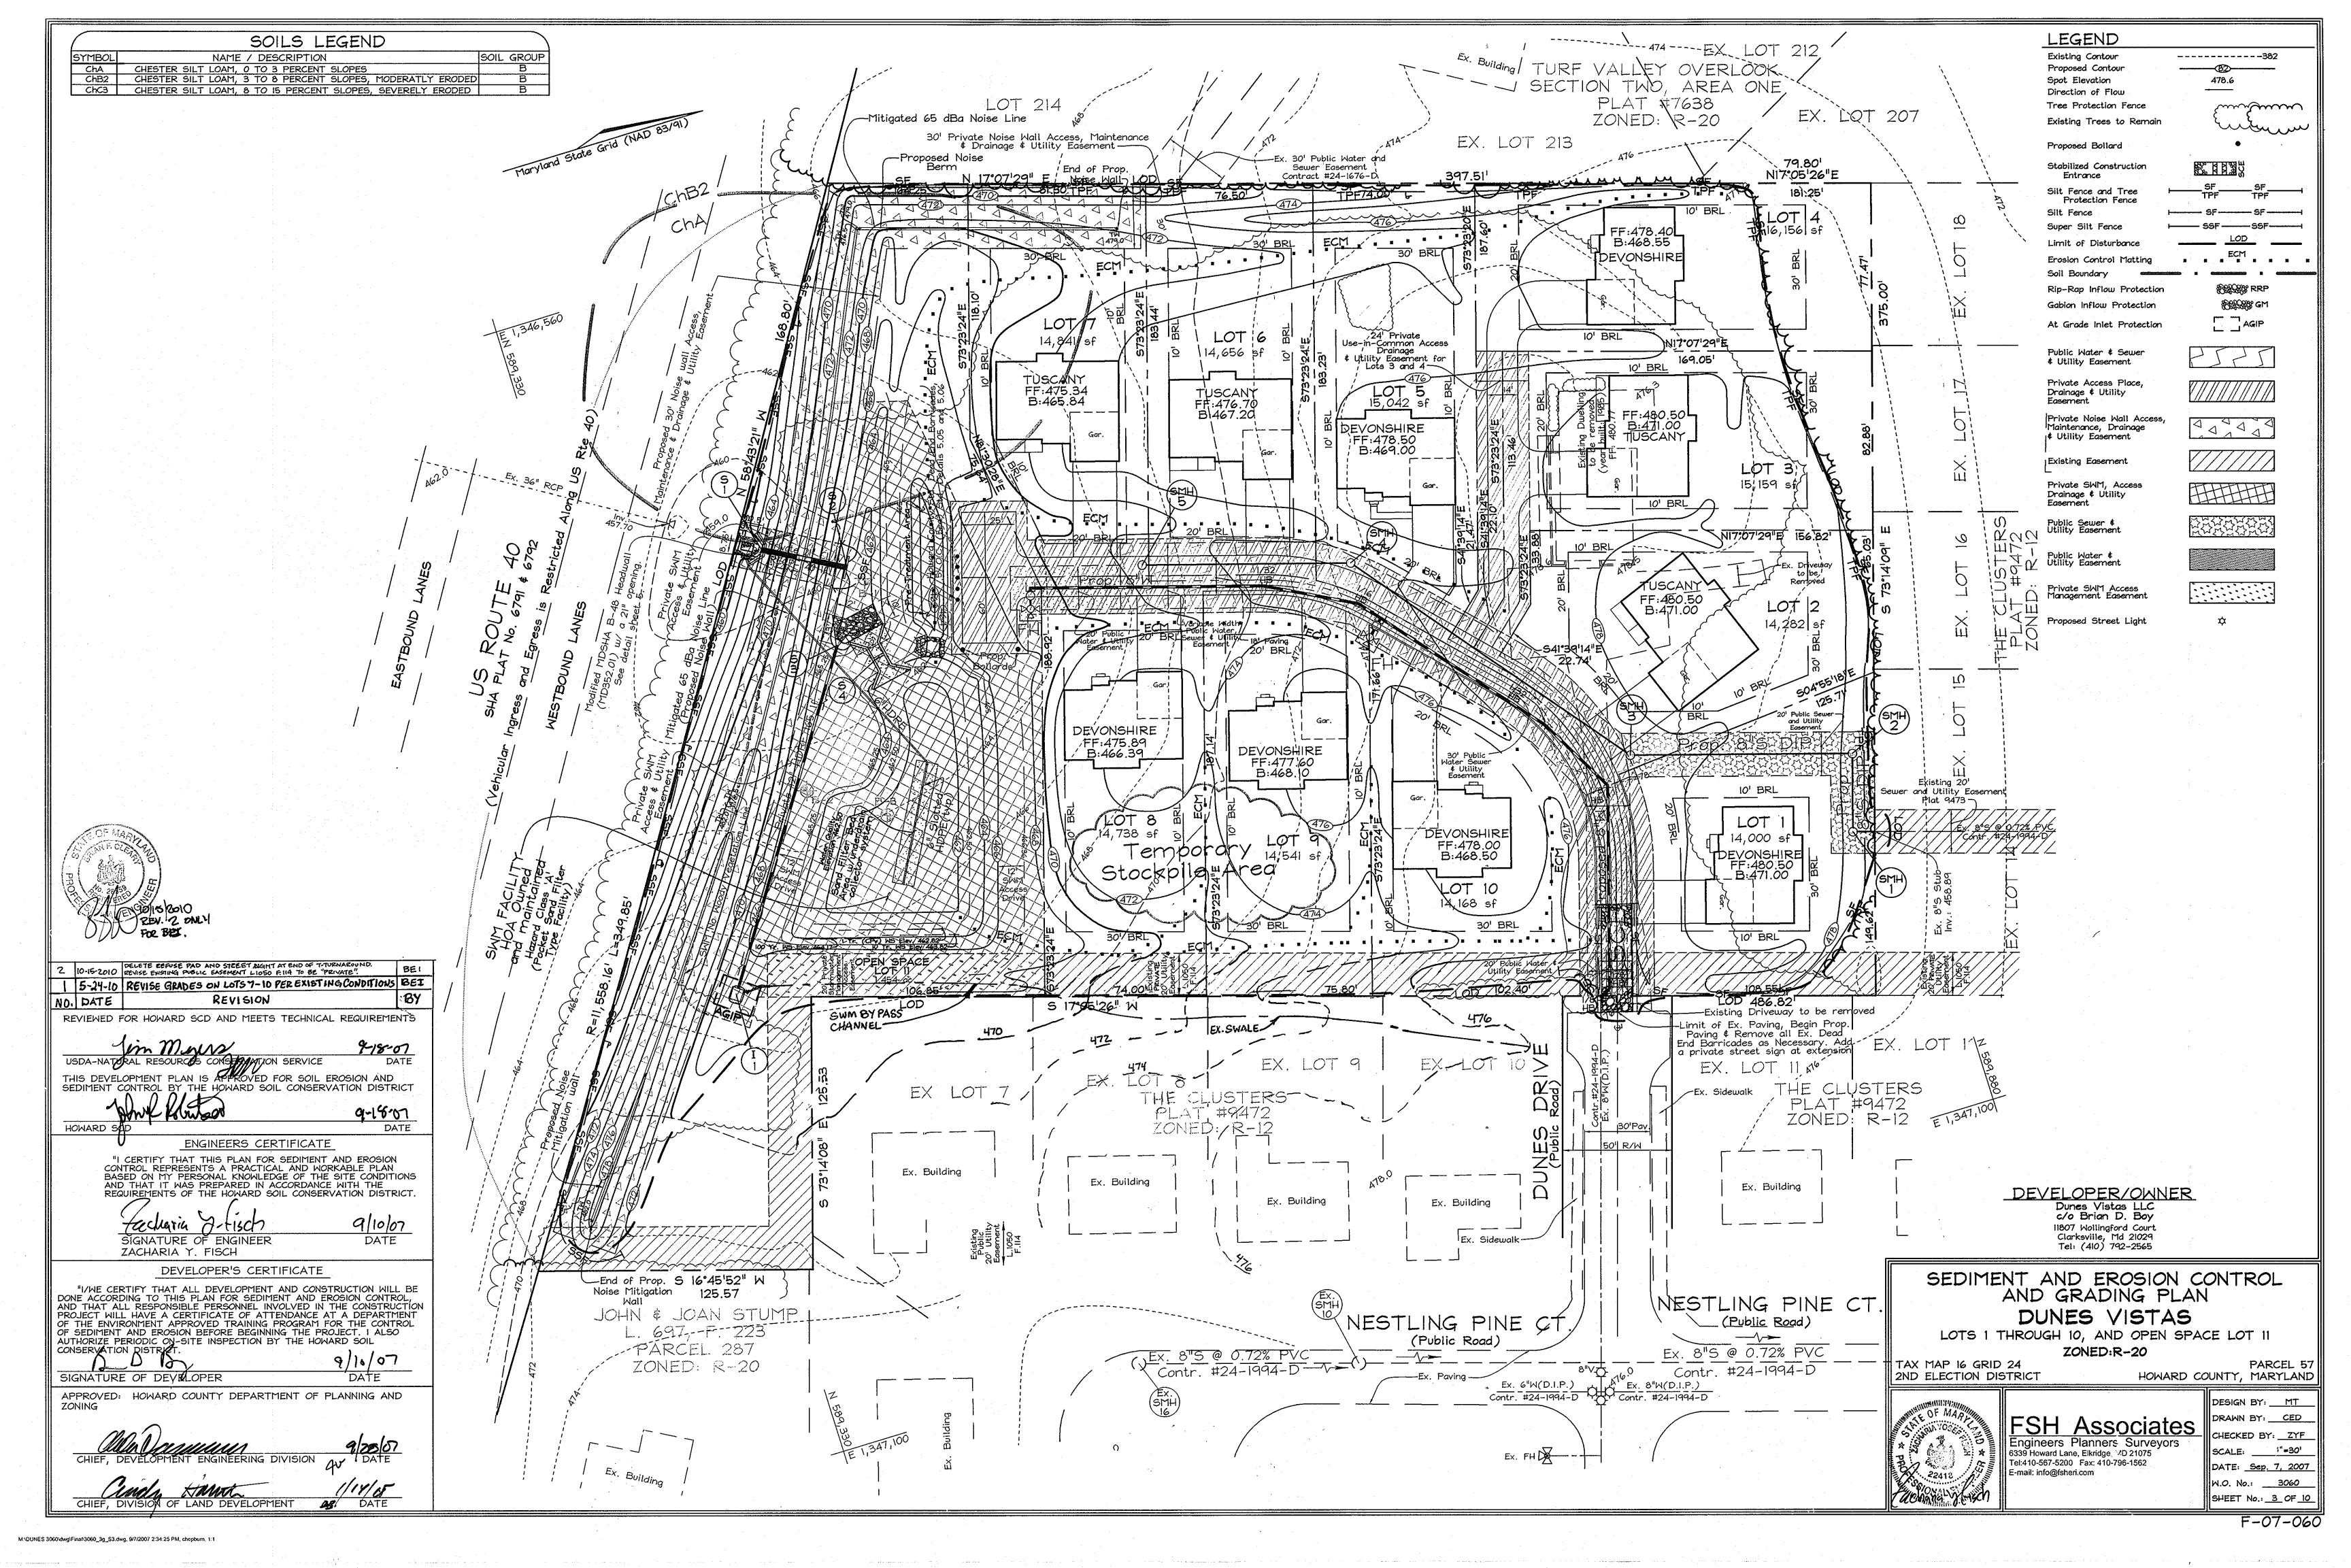

#### SEDIMENT CONTROL NOTES

1. A minimum of 48 hours notice must be given to the Howard County Department of Inspection, License and Permits Sediment Control Division prior to the start of any

2. All vegetation and structural practices are to be installed according to the provisions of this plan and are to be in conformance with the 1994 MARYLAND STANDARDS AND SPECIFICATIONS FOR SOIL EROSION AND SEDIMENT CONTROL: and revisions thereto.


3. Following initial soil disturbance or redisturbance, permanent or temporary stabilization shall be completed within: (a) 7 calendar days for all perimeter sediment control structures, dikes, perimeter slopes, and all slopes greater than 3:1, (b) 14 days as to all other disturbed or graded areas on the project site.

4. All sediment traps/basins shown must be fenced and warning signs posted around their perimeter in accordance with Vol. I, Chapter 7, HOWARD COUNTY DESIGN MANUAL,

5. All disturbed areas must be stabilized within the time period specified above in accordance with the 1994 MARYLAND STANDARDS AND SPECIFICATIONS FOR SOIL EROSION AND SEDIMENT CONTROL for permanent seeding, sod, temporary seeding, and mulching (Sec. G). Temporary stabilization with mulch alone shall be done when recommended seeding dates do not allow for proper germination and establishment of

6. All sediment control structures are to remain in place and are to be maintained in operative condition until permission for their removal has been obtained from the Howard County Sediment Control Inspector.

## 7. Site Analysis

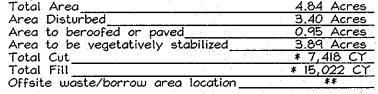

all quantities prior to the start of construction.

8. Any sediment control practice which is disturbed by grading activity for placement of utilities must be repaired on the same day of disturbance

9. Additional sediment controls must be provided, if deemed necessary by the Howard County Sediment Control Inspector.

10. On all sites with disturbed areas in excess of 2 acres, approval of the inspection gaency shall be requested upon completion of installation of perimeter erosion and sediment controls, but before proceeding with any other earth disturbance or grading. Other building or grading inspection approvals may not be authorized until this initial approval by the inspection agency is made.

II. Trenches for the construction of utilities is limited to three pipe lengths or that which shall be back-filled and stabilized within one working day, whichever is shorter. \* Earthwork quantities are solely for the purpose of calculating fees. Contractor to verify

\*\* To be determined by contractor, with pre-approval of the Sediment Control Inspector with an approved and active grading permit

#### PERMANENT SEEDING NOTES

APPLY TO GRADED OR CLEARED AREAS NOT SUBJECT TO IMMEDIATE FURTHER DISTURBANCE WHERE A PERMANENT LONG-LIVED VEGETATIVE COVER IS NEEDED.

SEEDBED PREPARATION: Loosen upper three inches of soil by raking, discing or other acceptable means before seeding, if not previously loosened.

SOIL AMENDMENTS: In lieu of soil test recommendations, use the following schedule: Apply 2 tons per acre dolomitic limestone (92 lbs/1000 s.f.) And 900 lbs. / acre (20.7 lbs./1000s.f.) of 10-20-20 before seeding. Harrow or disc into upper 3 in. Of soil. SEEDING: Apply a mixture of Turf Type Tall fescue (80%) and Hard Fescue (20%) in accordance with seeding dates and rates shown in the Permanent Seeding Summary shown on this sheet. For stabilization outside of the seeding dates, apply straw mulch at rates and methods specified below and apply permanent seeding when within proper seeding dates. MULCHING: Immediately following seeding, apply a uniform 1-2 in. Deep layer of un-rotted small grain straw at a rate of 2 tons/acre. (Apply 2.5 Tons/acre if a mulch anchoring tool is used). Straw may be anchored with wood cellulose fiber at a rate of 750 lbs. / acre mixed at a ratio of 50 lbs. Of wood fibre/ 100 gal. of water. Synthetic liquid binders such as Terra Tax II. Acrylic DLR (Agro- Tack), DCA-70, Petroset and other approved equals may be used at rates recommended by the manufacturers.

	Permanent Seeding Summary							
Seed Mixture (Hardiness Zone <u>7a and 6b</u> ) From Table 25						rtilizer Ro 10-20-20		Lime Rate
No.	Species	Application Rate (1b/ac)	Seeding Dates	Seeding Depths	N	P205	K20	
10	Tall Fescue (80%) Hard Fescue (20%)	120 30	3/1-5/15 8/15-11/15	0.5 in.	(2.0lb/		(4lb/	2tons/ac (1001b/ 1000sf)

## TEMPORARY SEEDING NOTES

SEEDBED PREPARATION: Loosen upper three inches of soil by raking, discing or other acceptable means before seeding, if not previously loosened.

SOIL AMENDMENTS: In lieu of soil test recommendations, use the following schedule: Apply 2 tons per acre dolomitic limestone(92 lbs/1000 s.f.) And 600 lbs. / acre (15 lbs./1000s.f.) of 10-10-10 before seeding. Harrow or disc into upper 3 in. Of soil. SEEDING: Apply the Maryland State Highway approved seed mixture of Barley or Rye plus Foxtail Millet in accordance with seeding dates and rates shown in the Temporary Seeding Summary shown

methods specified below. MULCHING: Immediately following seeding, apply a uniform 1-2 in. Deep layer of un-rotted small grain straw at a rate of 2 tons/acre. (Apply 2.5 Tons/acre if a mulch anchoring tool is used). Straw may be anchored with wood cellulose fiber at a rate of 750 lbs. / acre mixed at a ratio of 50 lbs. Of wood fibre/ 100 gal. of water. Synthetic liquid binders such as Terra Tax II Acrylic DLR (Agro- Tack), DCA-70, Petroset and other approved equals may be used at rates recommended by the manufacturers.

on this sheet. For stabilization outside of the seeding dates, apply straw mulch at rates and

REFER TO THE 1994 MARYLAND STANDARDS AND SPECIFICATIONS FOR SOIL EROSION AND SEDIMENT CONTROLFOR RATE AND METHODS NOT COVERED.

#### Temporary Seeding Summary Seed Mixture (Hardiness Zone <u>6a and 7a</u>) (10-10-10)From Table 26 Seeding Depths Seeding Dates Application Species Rate (lb/ac) 600 lb/ac 150 lbs 2/1-11/30 (7a) 1/4 in-2 tons/ac Rye plus 3.51bs/1000sqf) 3/15-10/31 (6a) 1/2 in (151b/1000sf) (1001b/1000sf)

## 21.0 STANDARDS AND SPECIFICATIONS FOR TOPSOIL

#### <u>Definition</u>

Placement of topsoil over a prepared subsoil prior to establishment of permanent vegetation. <u>Purpose</u>

To provide a suitable soil medium for vegetable growth. Soils of concern have low moisture content, low nutrient levels, low pH, materials toxic to plants, and/or unacceptable soil gradation.

Conditions Where Practice Applies I. This practice is limited to areas having 2:1 or

flatter slopes where: a. The texture of the exposed subsoil/parent material is not adequate to produce vegetative growth.

b. The soil material is so shallow that the rooting zone is not deep enough to support plants or furnish continuing supplies of moisture and plant nutrients.

c. The original soil to be vegetated contains material toxic to plant growth.

d. The soil is so acidic that treatment with limestone is not feasible.

II. For the purpose of these Standards and Specifications, areas having slopes steeper than 2:1 require special consideration and design for adequate stabilization. Areas having slopes steeper than 2:1 shall have the appropriate stabilization shown on the plans.

#### Construction and Material Specifications

I. Topsoil salvaged from the existing site may be used provided that it meets the standards as set forth in these specifications. Typically, the depth of topsoil to be salvaged for a given soil type can be found in the representative soil profile section in the Soil Survey published by USDA-SCS in cooperation with Maryland Agricultural Experimental

II. Topsoil Specifications - Soil to be used as topsoil must meet the following:

Topsoil shall be a loam, sandy loam, clay loam, silt loam, sandy clay loam, loamy sand. Other soils may be used if recommended by an agronomist or a soil scientist and approved by the appropriate approval authority. Reaardless, topsoil shall not be a mixture of contrasting textured subsoils and shall contain less than 5% by volume of cinders, stones, slag, coarse fragments, gravel, sticks, roots, trash, or other materials larger that I and 1/2" in diameter.

ii. Topsoil must be free of plants or plant parts such as Bermuda grass, quackgrass, Johnsongrass, nutsedge, poison ivy, thistle, or others as

iii. Where the subsoil is either highly acidic or composed of heavy clays, ground limestone shall be spread at the rate of 4-8 tons/acre (200-400 pounds per 1,000 square feet) prior to the placement of topsoil. Lime shall be distributed uniformly over designated areas and worked into the soil in conjunction with tillage operations as described in the following procedures.

II. For sites having disturbed areas under 5 acres:

i. Place topsoil (if required) and apply soil amendments as specified in 20.0 Vegetative Stabilization - Section I - Vegetative Stabilization Methods and Materials.

III. For sites having disturbed areas over 5 acres: i. On soil meeting topsoil specifications, obtain test results dictating fertilizer and lime amendments required to bring the soil into compliance with the following:

a, pH for topsoil shall be between 6.0 and 7.5. If the tested soil demonstrates a pH of less than 6.0, sufficient lime shall be prescribed to raise the pH to 6.5 or higher.

b. Organic content of topsoil shall be not less than 1.5 percent by weight.

than 500 parts per million shall not be used. d. No sod or seed shall be placed on soil soil

c. Topsoil having soluble salt content greater

which has been treated with soil sterilants or chemicals used for weed control until sufficient time has elapsed (14 days min.) to permit dissipation of phyto-toxic materials.

NOTE: Topsoil substitutes or amendments, as recommended by a qualified agronomist or soil scientist and approved by the appropriate approval authority, may be used in lieu of natural topsoil. ii. Place topsoil (if required) and apply soil ammendments specified in 20.0 Vegetative Stabilization - Section I - Vegetative Stabilization

#### V. Topsoil Application


Methods and Materials.

i. When topsoiling, maintain needed erosion and sediment control practices such as diversions. Grade Stabilization Structures, Earth Dikes, Slope Silt Fence and Sediment Traps and Basins.

ii. Grades on the areas to be topsoiled, which have been previously established, shall be maintained, albeit 4"-8" higher in elevation.

iii. Topsoil shall be uniformly distributed in a 4"-8" layer and lightly compacted to a minimum thickness of 4". Spreading shall be performed in such a manner that sodding or seeding can proceed with a minimum of additional soil preparation and tillage. Any irregularities in the surface resulting from topsoiling or other operations shall be corrected in order to prevent the formation of depressions or water pockets.

iv. Topsoil shall not be place while the topsoil or subsoil is in a frozen or muddy condition, when the subsoil is excessively wet or in a condition that may otherwise be detrimental to proper grading and seedbed preparation.

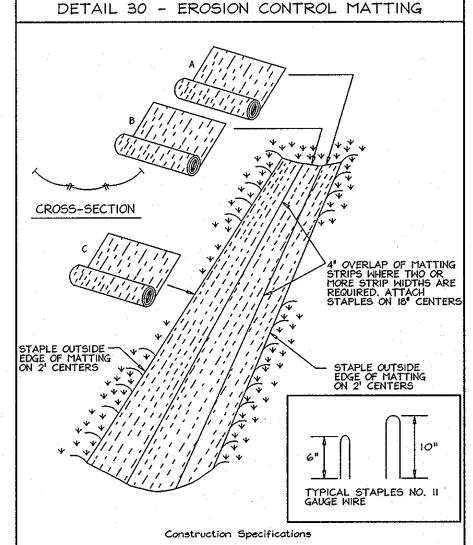

1. Key-in the matting by placing the top ends of the matting in a narrow trench, 6" in depth. Backfill the trench and tamp firmly to conform to the channel cross-section. Secure with a row of staples about 4" down slope from the trench. Spacing between staples is 6". 2. Staple the 4" overlap in the channel center using an 18" spacing

3. Before stapling the outer edges of the matting, make sure the matting is smooth and in firm contact with the soil.

4. Stooles shall be placed 2' apart with 4 rows for each strip, 2 outer rows, and 2 alternating rows down the center,

5. Where one roll of matting ends and another begins, the end of the top strip shall overlap the upper end of the lower strip by 4", shiplap fashion. Reinforce the overlap with a double row of staples spaced 6" apart in a staggered pattern on either side

secured with 2 double rows of staples Note: If flow will enter from the edge of the matting then the area

effected by the flow must be keyed-in. U.S. DEPARTMENT OF AGRICULTURE PAGE MARYLAND DEPARTMENT OF ENVIRONMENT SOIL CONSERVATION SERVICE G - 22 - 2 WATER MANAGEMENT ADMINISTRATION

6. The discharge end of the matting liner should be similarly

## NOTES:

A. Height of barrier shall be based on acoustic requirements. B. Barrier walls having a height (H) not indicated in the tables shall be constructed as shown in the next higher 2. Siding

A. 2X wood decking material shall be utilized to span horizontally between posts. Design criteria is based on an allowable bending stress of 1400 lbs. per square inch and 331/4% increase in stress for wind loads as considered appropriate. Decking shall be MC5.

B. Siding in contact with the ground and for a distance of 6" above grade shall be treated with wood preservative. A. Wood post shall be utilized of the spacing indicated on the

schedule. Design criteria is based on an allowable bending stress of 1400 lbs, per square inch and 331/4% increase for wind B. Post Embedded in concrete shall be treated with a wood

preservative in the area of embedment and 12" above grade. 4. Concrete A. Concrete in the piers shall have a 26-day compressive

strength of 2500 lbs. per square inch. B. Concrete shall be placed in drilled piers utilizing the earth as the forms. 5. Foundations

A. The drilled piers have been designed utilizing an allowable passive pressure of 300 lbs. per square foot and the following formula:

 $D = (14.5211) \frac{1}{3}$ 

M = Moment at top of drilled pier (FT./ LBS.) p = Allowable passive pressure (300 lbs. per square foot)

d = Diameter of pier (FT.) D = Depth of pier (FT.) 6. Alternate #1 (Preservative Treatment). Alternate #1


represents the additional cost factor for treating the basic wood structure indicated on this reference plan. The necessity for treatment and the type of preservative will be subject to local conditions. All treatments shall conform to

AWPA Standard C-14. 7. Alternate #2 (Painting). Alternate #2 represents the additional cost factor required to paint one side of the basic wood structure shown on this reference plan. Painting shall consist of 3 applications of paint, 2 coats of latex base


paint conforming to Federal Specification TT-P-00966 shall be applied over a primer coat conforming to Federal Specification TT-P-00250. 8. Alternate #3 (Staining). Alternate #3 represents the additional cost factor required to stain one side of the basic wood structure. Stain shall consist of 2 coats of


manufactures written instructions. 9. Alternate #4 (Preservative Treatment) shall be utilized for this project.

semi-transparent sealer stain applied in accordance with

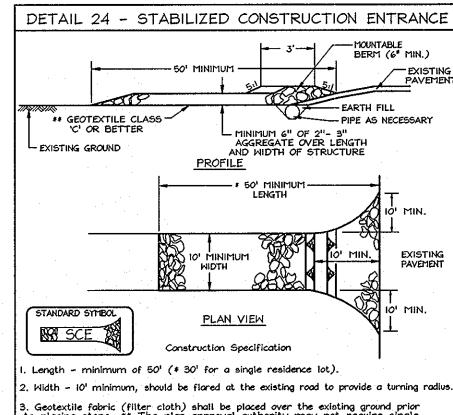

. Width - 10' minimum, should be flored at the existing road to provide a turning radius 3. Geotextile fabric (filter cloth) shall be placed over the existing ground prior to placing stone. \*\* The plan approval authority may not require single family residences to use geotextile. l. Stone - crushed aggregate (2" to 3") or reclaimed or recycled concrete equivalent shall be placed at least 6" deep over the length and width of the entrance. 5. Surface Mater – all surface water flowing to or diverted toward construction entrances shall be piped through the entrance, maintaining positive drainage. Pipe installed through the stabilized construction entrance shall be protected with a mountable berm with 5:1 slopes and a minimum of 6" of stone over the pipe. Pipe has to be sized according to the drainage. When the SCE is located at a high spot and has to drainage to convey, a pipe will not be necessary. Pipe should be sized according to the amount of runoff to be conveyed. A 6" minimum will be required. 6. Location - A stabilized construction entrance shall be located at every point where construction traffic enters or leaves a construction site. Vehicles leaving the site must travel over the entire length of the stabilized construction entrance.

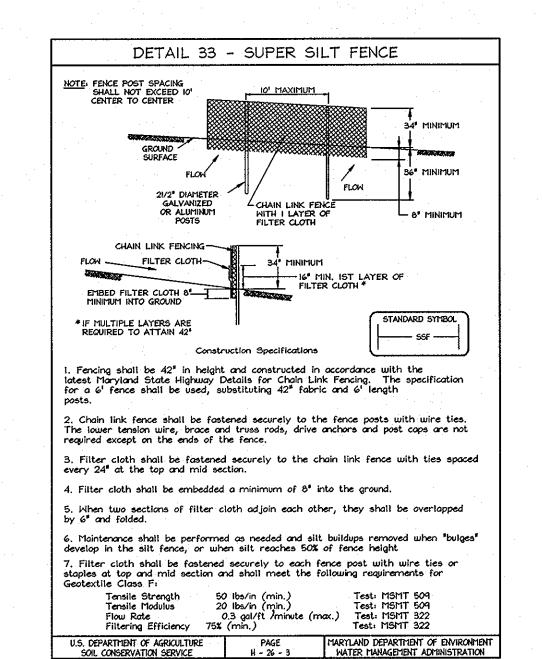


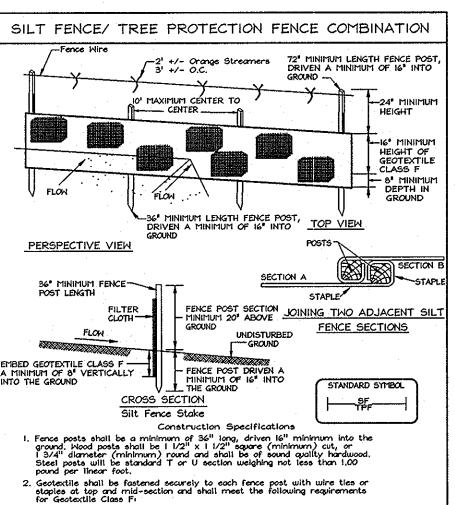

Tensile Strength 20 lbs/in (min.) 0.3 gal ft /minute (max.) Testi MSMT 504

Filtering Eggeciency 3. Where ends of geotextile fabric come together, they shall be overlapped, folded and stapled to prevent sediment bypass. 4. Slit Fence shall be inspected after each rainfall event and maintained when bulges occur on when sediment accumulation reaches 50% of the fabric 5. Boundaries of Retention Areas should be stoked and flagged prior to installing

6. Locate fence outside Critical Root Zone. 7. Avoid root damage when placing anchor posts

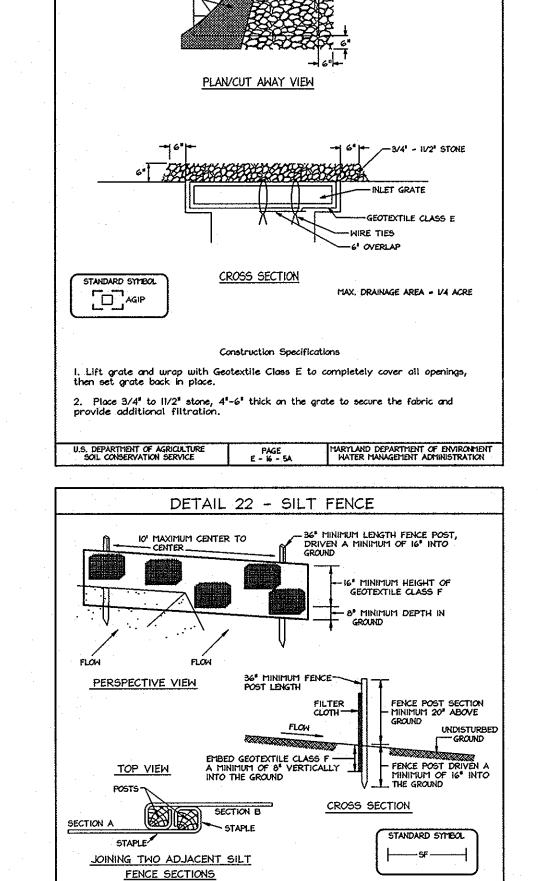

DETAIL 23B - AT GRADE INLET PROTECTION

GEOTEXTILE CLASS E

## SEQUENCE OF CONSTRUCTION

Fence posts shall be a minimum of 36" long, driven 16" minimum into the ground. blood posts shall be 1 1/2" x 1 1/2" square (minimum) cut, or 1 3/4" diameter (minimum) round and shall be of sound quality hardwood. Steel posts will be standard T or U section weighing not less than 1.00

Where ends of geotextile fabric come together, they shall be overlapped, folded and stapled to prevent sediment bypass.

4. Silt Fence shall be inspected after each rainfall event and maintained when bulges occur or when sediment accumulation reaches 50% of the fabric height

20 lbs/in (min.)
0.3 gal ft /minute (max.)

Test: MSMT 322

Tensile Strength Tensile Modulus

Filtering Eggeciency 75% (min.)

1. Obtain grading permit and contact Howard County Sediment Control Inspector (SCI) 410-313-1880 to arrange a preconstruction meetina.

 Install Stabilized Construction Entrance. (1 Day)
 Clear and grub as necessary to install sediment control practices. Install silt fence and super silt fences. (3 Days) 4. With permission of SCI begin road and site grading. (2 Weeks) 5. Grade roads and pads to subgrade, construct SWM sand filter facility and protect with geotectile, install earthen noise berm and culvert

drains. (4 Weeks) 6. Fine grade and apply temporary stabilization to all disturbed areas. (1 Day)

S-1 to S-2 and place SSF at inlet, construct remaining storm

7. Pave roads and permanently stabilize all disturbed areas. (1 Week) 8. With permission of SCI remove all remaining sediment control devices and stabilize disturbed areas. Remove geotextile over sand filter, cover with topsoil and permanently stabilize. (5 Days)

> DEVELOPER/OWNER Dunes Vistas LLC c/o Brian D. Boy 11807 Wollingford Court Clarksville, Md 21029 Tel: (410) 792-2565

## SEDIMENT AND EROSION CONTROL NOTES AND DETAILS DUNES VISTAS

LOTS 1 THROUGH 10, AND OPEN SPACE LOT 11 ZONED:R-20

TAX MAP 16 GRID 24 2ND ELECTION DISTRICT


. 22412 .

FSH Associates Engineers Planners Surveyors 6339 Howard Lane, Elkridge, MD 21075 Tel:410-567-5200 Fax: 410-796-1562 E-mail: info@fsheri.com

DESIGN BY: \_\_\_MT\_ DRAWN BY: CED HECKED BY: ZYF SCALE: No Scale DATE: <u>Sep. 7, 2007</u> W.O. No.: 3060 SHEET No.: 4 OF 10

HOWARD COUNTY, MARYLAND

PARCEL 57

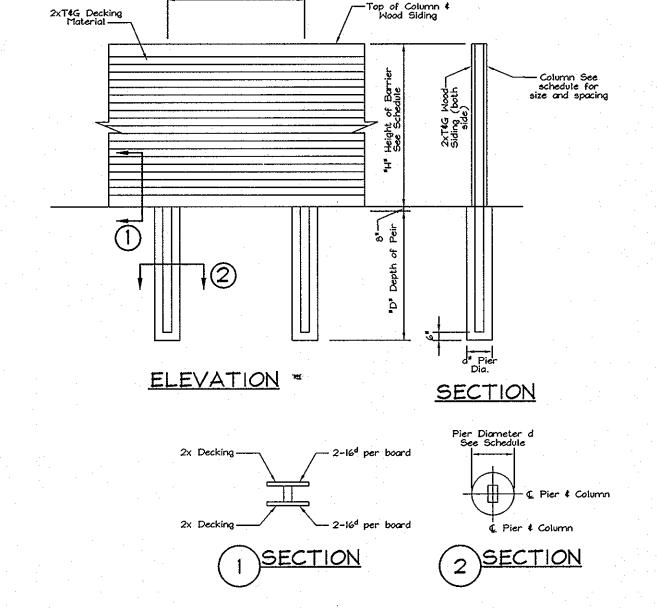

SCHEDULE 40 Lbs/p HORIZONTAL LOADING POST SIZE Up to 8' 6' 12" 4" × 8"  $6^{\mu} \times 12^{\mu}$ 

NOTE: The proposed Noise Wall is privately owned and shall be maintained by the Homeowners Association. The Noise Wall shall be inspected and repaired as necessary at a minimum of once a year. See Grading Plan sheet 3 for proposed top of wall elevations.

NOISE WALL DETAIL NO SCALE

## DEVELOPER'S CERTIFICATE

"I/WE CERTIFY THAT ALL DEVELOPMENT AND CONSTRUCTION WILL BE DONE ACCORDING TO THIS PLAN FOR SEDIMENT AND EROSION CONTROL, AND THAT ALL RESPONSIBLE PERSONNEL INVOLVED IN THE CONSTRUCTION PROJECT WILL HAVE A CERTIFICATE OF ATTENDANCE AT A DEPARTMENT OF THE ENVIRONMENT APPROVED TRAINING PROGRAM FOR THE CONTROL OF SEDIMENT AND EROSION BEFORE BEGINNING THE PROJECT. I ALSO AUTHORIZE PERIODIC ON-SITE INSPECTION BY THE HOWARD SOIL


CONSERVATION DISTRICT. . D.


SIGNATURE OF DEVELOPER

USDA-NATURAL PASOURCASSONSERVATION SERVICE DA
THIS DEVELOPMENT PLAN IS APPROVED FOR SOIL EROSION AND 8-18-07 SEDIMENT CONTROL BY THE HOWARD SOIL CONSERVATION DISTRICT 9-18-07

REVIEWED FOR HOWARD SCD AND MEETS TECHNICAL REQUIREMENTS

ENGINEERS CERTIFICATE "I CERTIFY THAT THIS PLAN FOR SEDIMENT AND EROSION CONTROL REPRESENTS A PRACTICAL AND WORKABLE PLAN BASED ON MY PERSONAL KNOWLEDGE OF THE SITE CONDITIONS AND THAT IT WAS PREPARED IN ACCORDANCE WITH THE REQUIREMENTS OF THE HOWARD SOIL CONSERVATION DISTRICT. Tacharia Lisch SIGNATURE OF ENGINEER 9/10/07 DATE ZACHARIA Y. FISCH

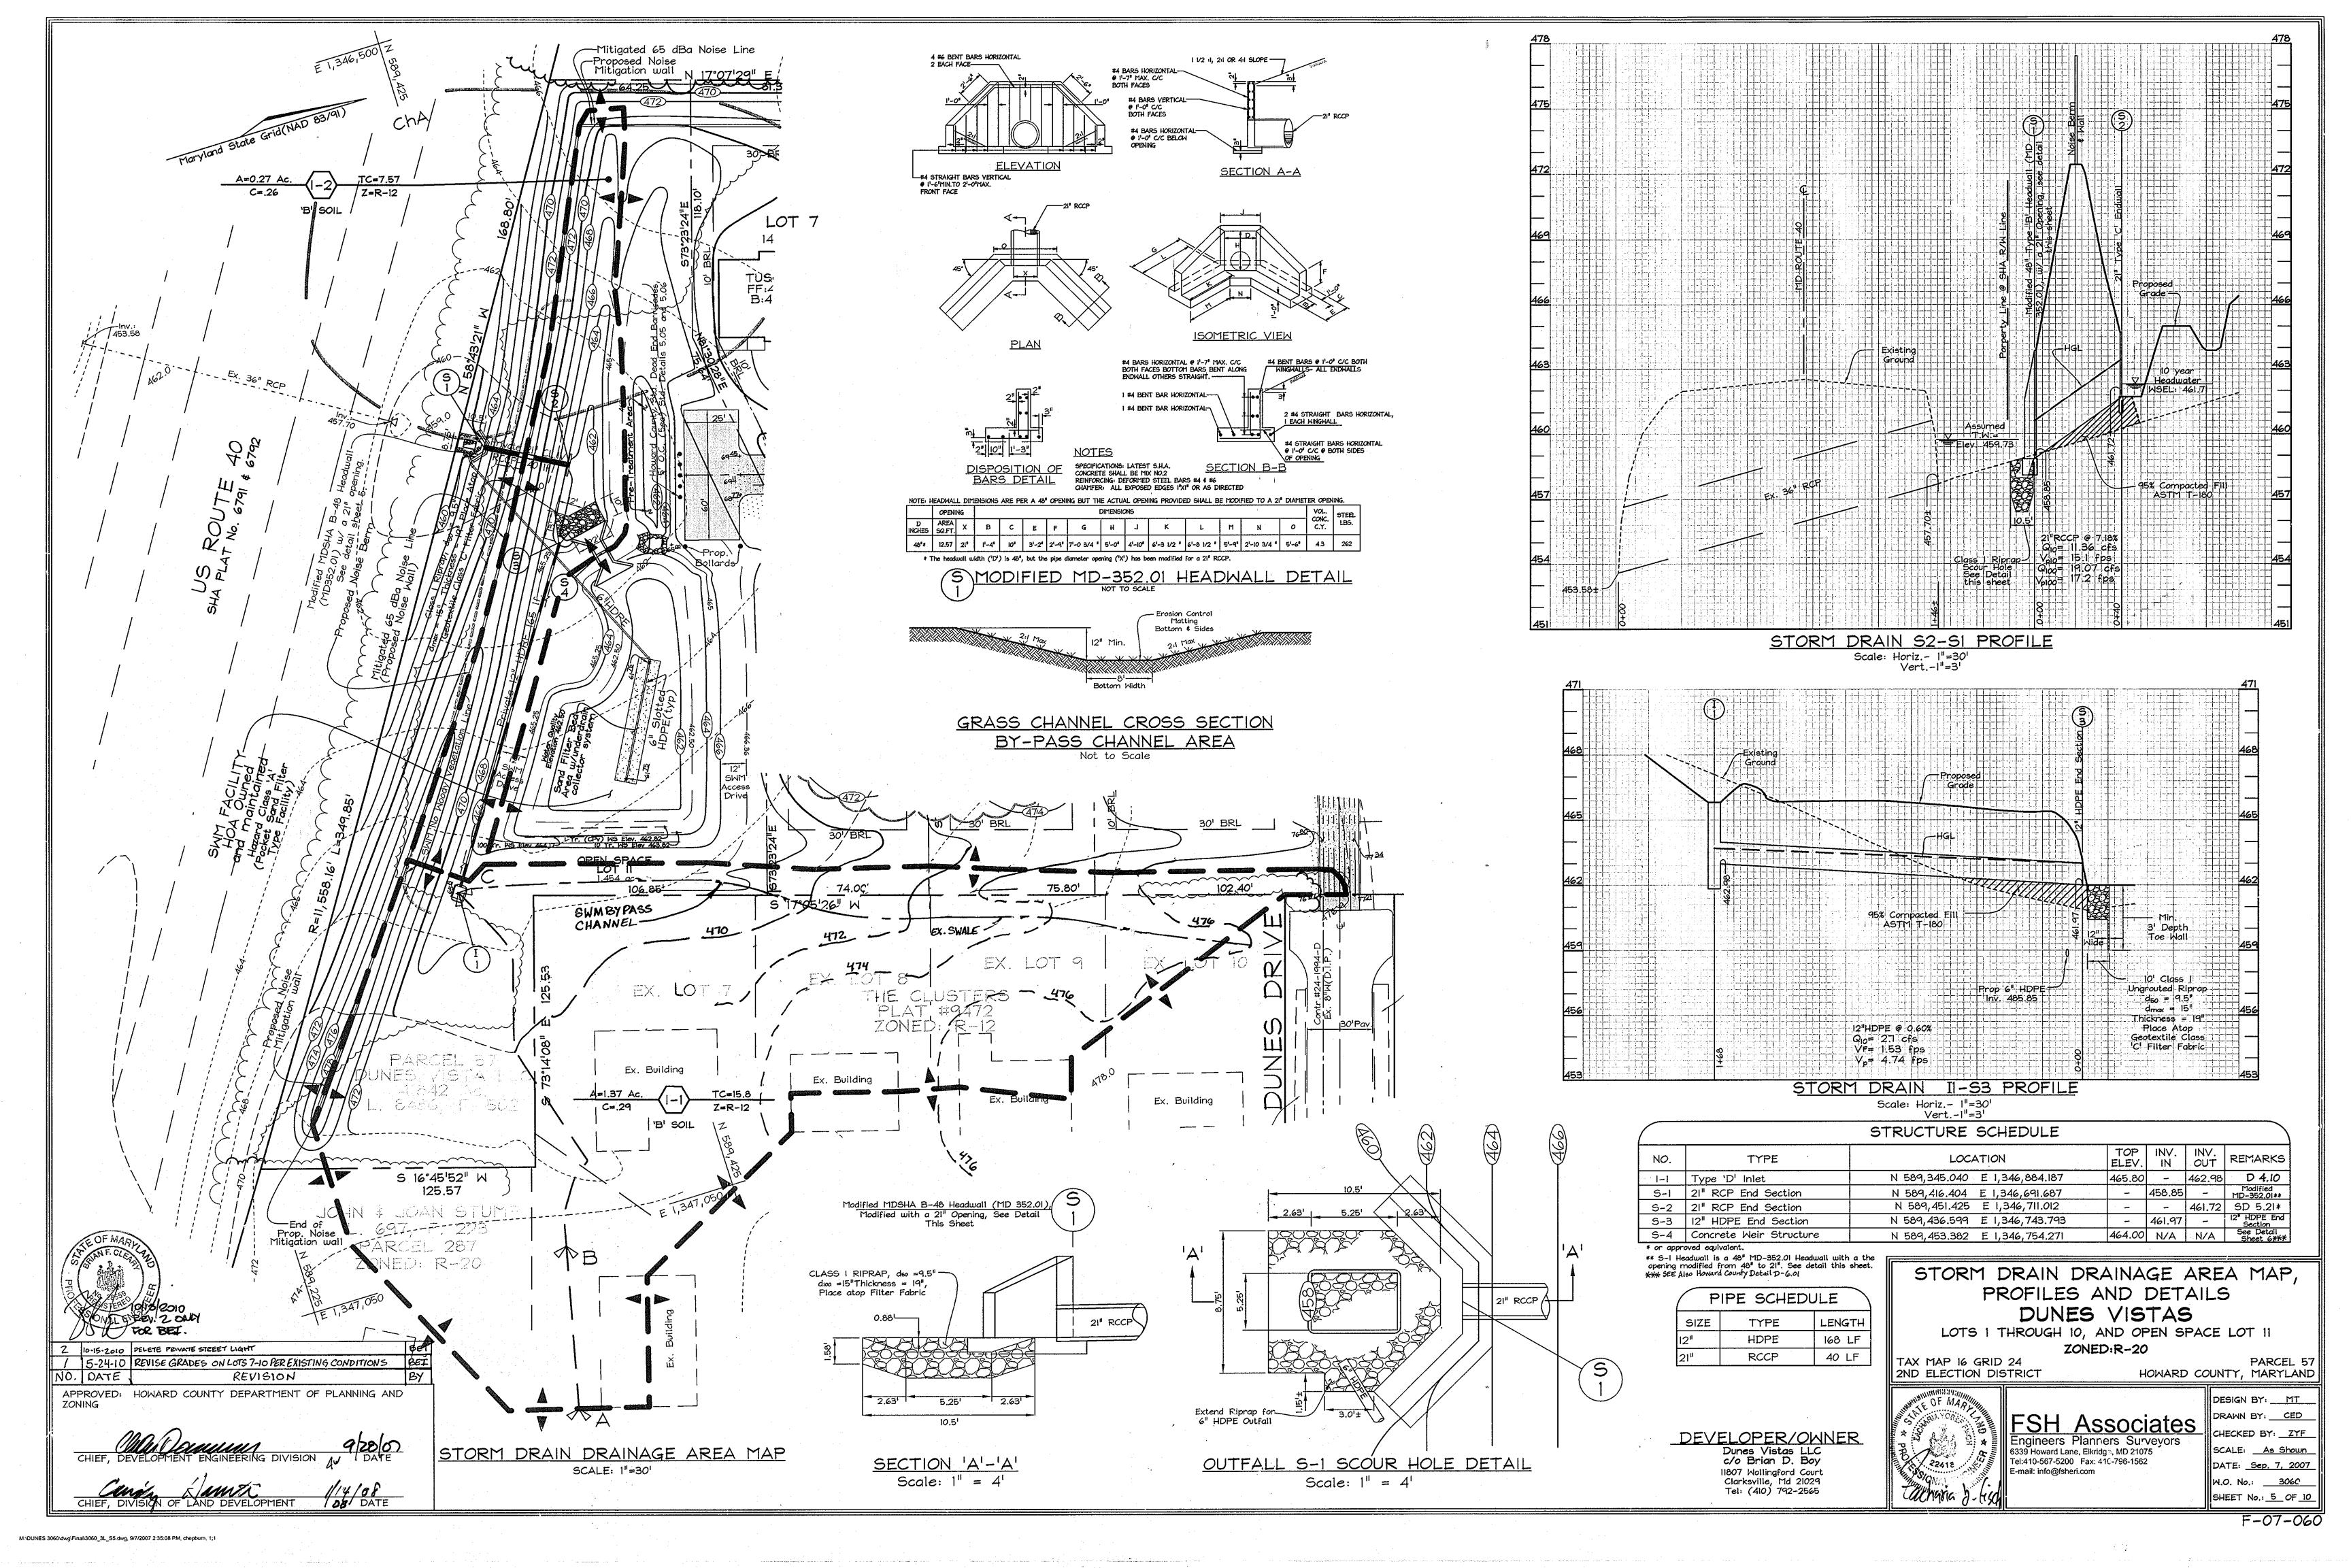

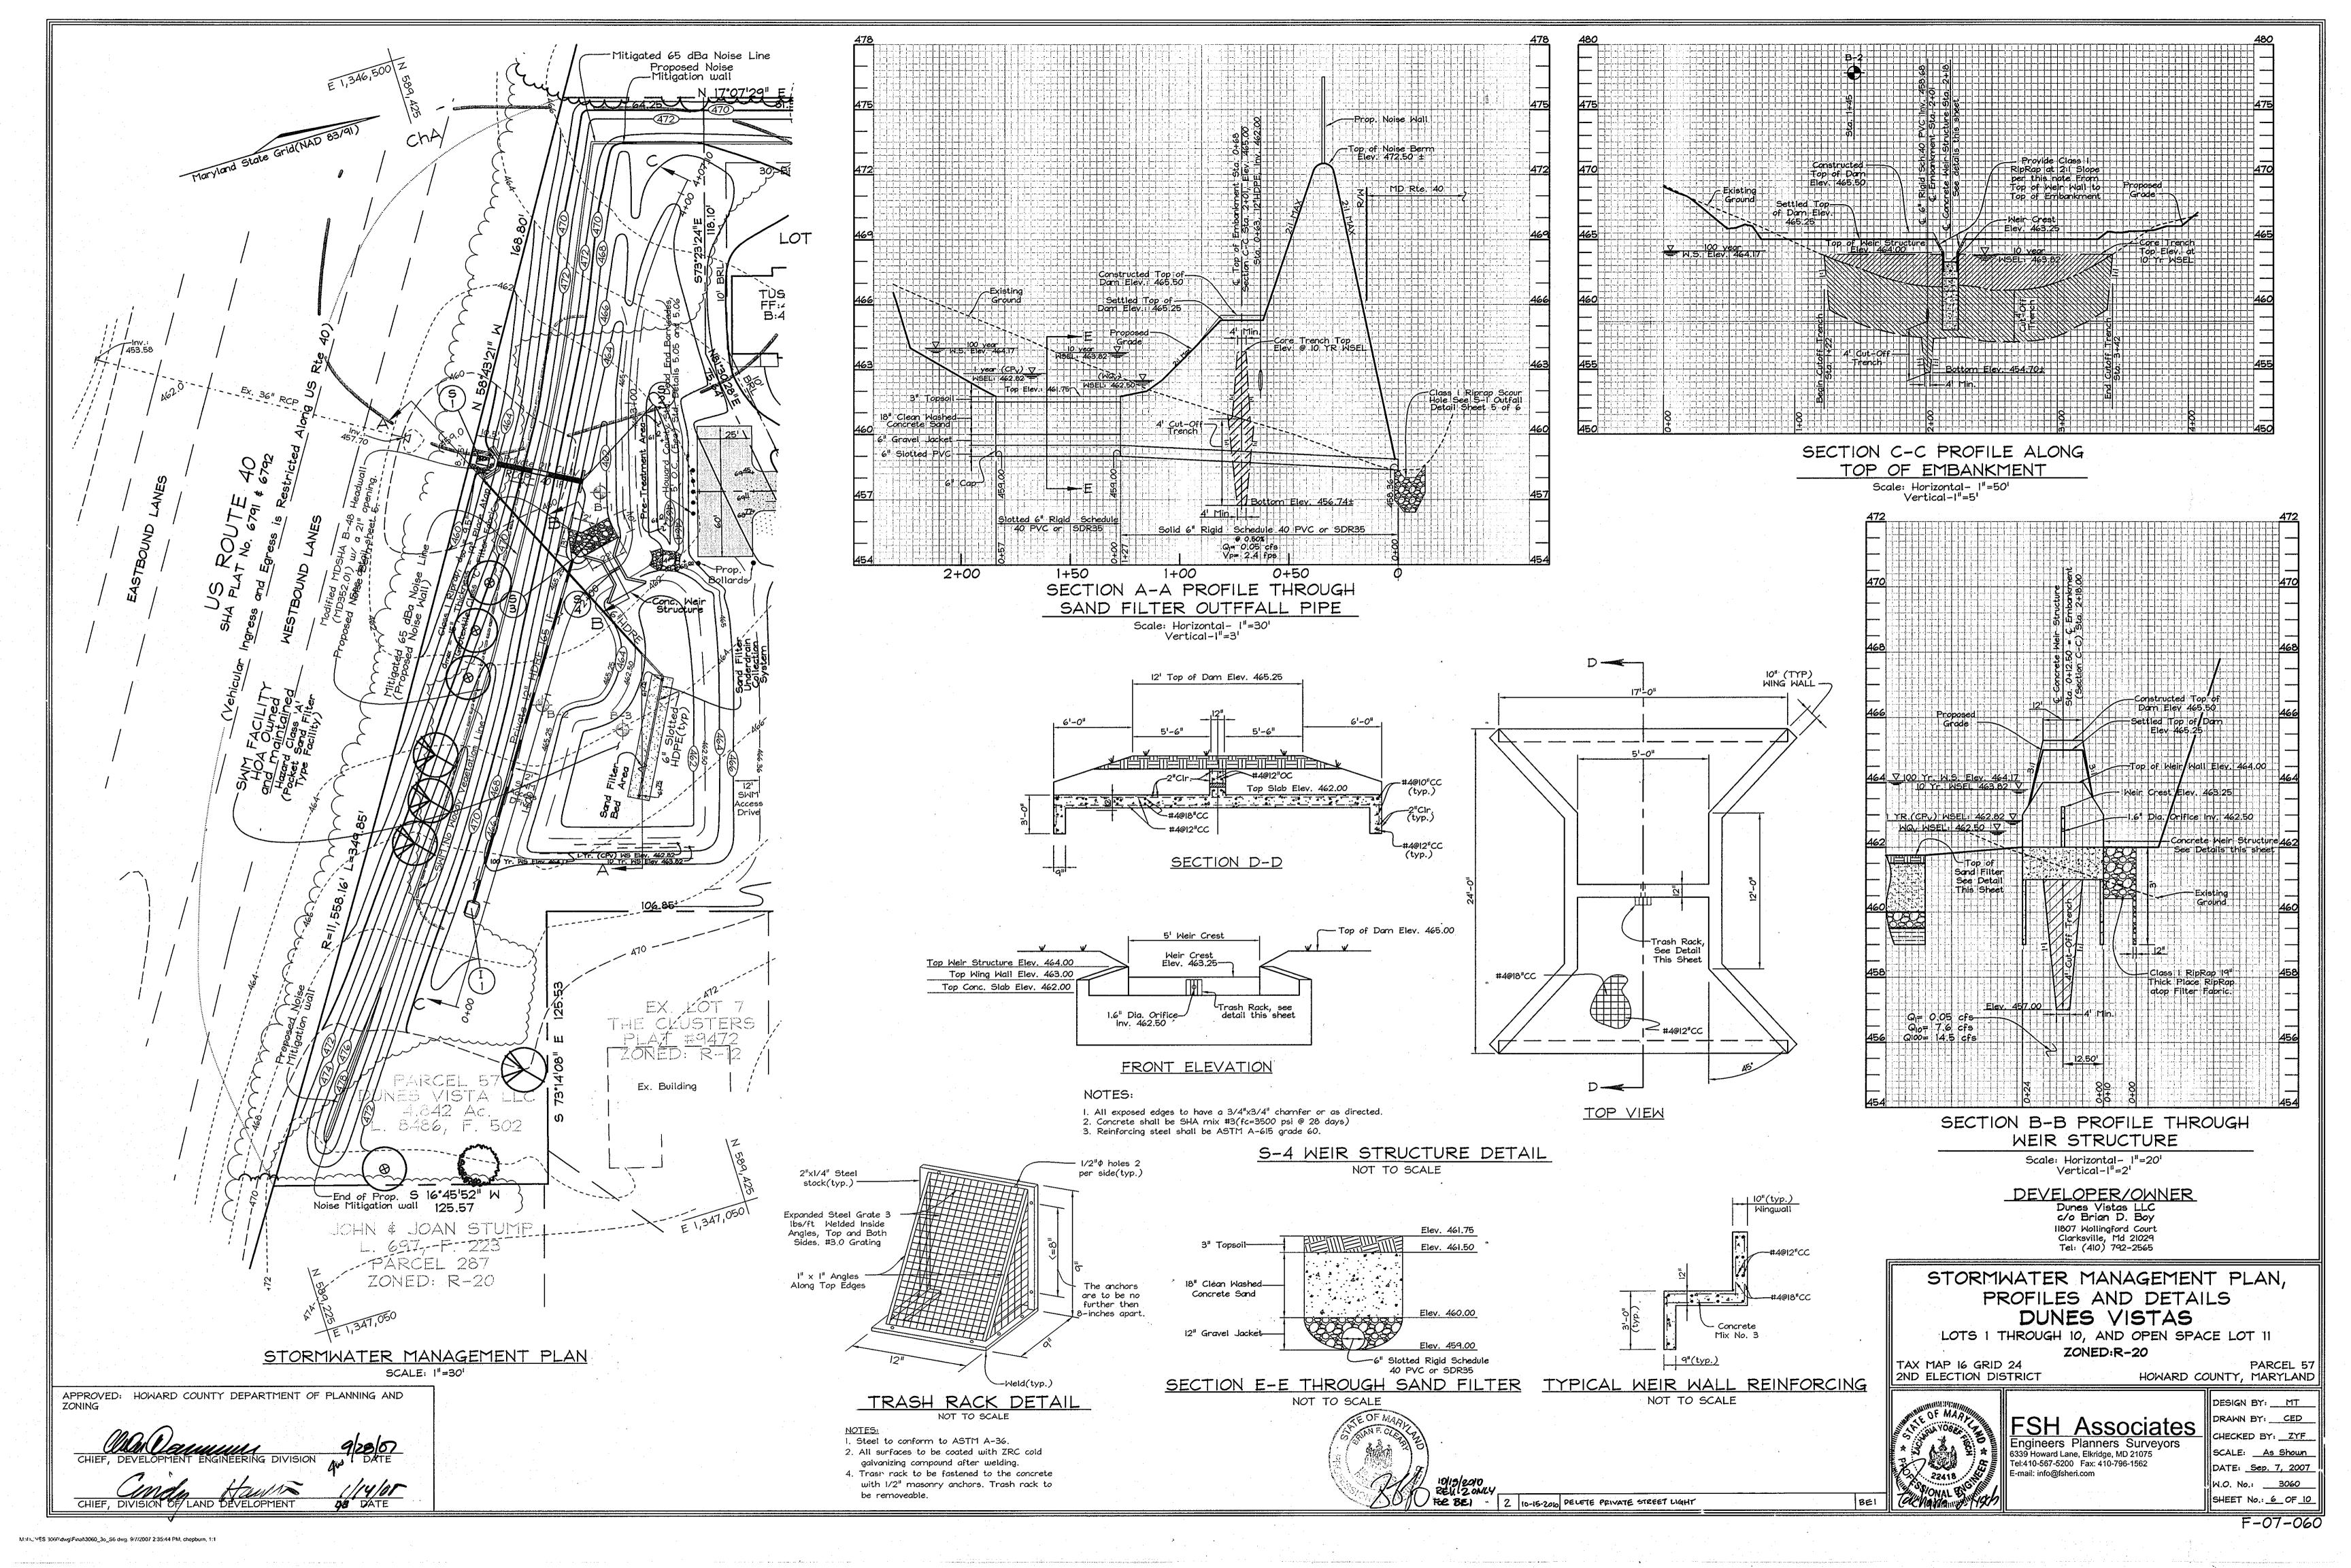

## OPERATION AND MAINTENANCE SCHEDULE FOR PRIVATELY OWNED AND MAINTAINED POCKET SAND FILTER, STORMWATER

MANAGEMENT FACILITY (F-5)

1. The stormwater facility shall be inspected annually and after major storm. Inspections shall be performed during wet weather to determine if the facility is functioning

2. The top and side slopes of the embankment shall be mowed a minimum of once per year, when vegetation reaches 18" in height or as needed 3. Filters that have a grass cover shall be mowed a minimum of three (3) times per growing season to maintain a maximum grass height of less than 12 inches.

4. Debris and litter shall be removed during regular mowing operations and as needed.

5. Visible signs of erosion in the facility shall be repaired as soon as it is noticed.

6. Remove silt when it exceeds four (4) inches deep in the forebay. 7. When water ponds on the surface of the filter bed for more than 72 hours, the top few inches of discolored material shall be replaced with fresh material. Proper

cleaning and disposal of the removed materials and liquid must be followed by the owner. 8. A log book shall be maintained to determine the rate at which the facility drains.

9. The maintenance log book shall be available to Howard County for inspection to insure compliance with operation and maintenance criteria. 10. Once the performance characteristics of the infiltration system have been verified, the monitoring schedule can be reduced to an annual basis unless the performance data indicates that a more frequent schedule is required.

POND SUMMARY	I YEAR	IO YEAR	100 YEAR
FLOW INTO POND	2.51 c.f.s.	11.1 c.f.s.	19.4 c.f.s.
FLOW OUT OF POND	0.05 c.f.s.	7.6 c.f.s.	14.5 c.f.s.
W.S. ELEVATION	462.82	463.82	464.17
STORAGE VOLUME	0.12 Ac. Ft.	0.11 Ac. Ft.*	0.19 Ac. Ft.*

\*10 and 100 year volumes are based on clogged CPv orifice.

Water Quality Obligation	Recharge Obligation
W.Q.v Required: 5,622 cu.ft.	Rev Required: 1,481 f <sup>3</sup>
W.Q.v Prov'd : 5,622 cu.ft.	Rev Provided: N/A**
W.Q.v Provided using Send Filter	Rea Required: 0.38 Ac
	Rea Prov'd.: 0.69 Ac.***

\*\*Recharge treated through Grass Channel Credit \*\*\*Road paying, Dwellings (1 thru 7) and their driveways drain to the road ditches which are

## MARYLAND 378 STORMWATER MANAGEMENT POND CONSTRUCTION SPECIFICATIONS

CONSTRUCTION SPECIFICATIONS

These specifications are appropriate to all ponds within the scope of the Standard for practice MD-378. All references to ASTM and AASHTO specifications apply to the most recent version.

Areas designated for borrow areas, embankment, and structural works shall be cleared, grubbed and stripped of topsoil. All trees, vegetation, roots and other objectionable material shall be removed. Channel banks and sharp breaks shall be sloped to no steeper than 1:1. All trees shall be cleared and grubbed within 15 feet of the tow of the

Areas to be covered by the reservoir will be cleared of all trees, brush, logs, fences, rubbish and other objectionable material unless otherwise designated on the plans. Trees, brush, and stumps shall be cut approximately level with the ground surface. For dry stormwater management ponds, a minimum of a 25-foot radius around the

All cleared and grubbed material shall be disposed of outside and below the limits of the dam and reservoir as directed by the owner or his representative. When specified, a sufficient quantity of topsoil will be stockpiled in a suitable location for use on the embankment and other designated areas.

Material - The fill material shall be taken from approved designated borrow areas. It shall be free of roots, stumps, wood, rubbish, stones greater than 6", frozen or other objectionable materials. Fill material for the center of the embankment, and cut off trench shall conform to Unified Soil Classification GC, SC, CH, or CL and must have at least 30% passing the #200 sieve. Consideration may be given to the use of other materials in the embankment if designed by a geotechnical engineer. Such special designs must have construction supervised by a geotechnical engineer. Materials used in the outer shell of the embankment must have the capability to support vegetation of the quality required to prevent erosion of the embankment.

Placement - Areas on which fill is to be placed shall be scarified prior to placement of fill. Fill materials shall be placed in maximum 8 inch thick (before compaction) layers which are to be continuous over the entire length of the fill. The most permeable borrow material shall be placed in the downstream portions of the embankment. The principal spillway must be installed concurrently with fill placement and not excavated into the embankment.

Compaction - The movement of the hauling and spreading equipment over the fill shall be controlled so that the entire surface of each lift shall be traversed by not less than one tread track of heavy equipment or compaction shall be achieved by a minimum of four complete passes of a sheepsfoot, rubber tired or vibratory roller. Fill material shall contain sufficient moisture such that the required degree of compaction will be obtained with the equipment used. The fill material shall contain sufficient moisture so that if formed into a bail it will not crumble, yet not be so wet that water can be squeezed out.

When required by the reviewing agency the minimum required density shall not be less than 95% of maximum dry density with a moisture content within +1-2% of the optimum. Each layer of fill shall be compacted as necessary to obtain that density, and is to be certified by the Engineer at the time of construction. All compaction is

Cut Off Trench - The cutoff trench shall be excavated into impervious material along or parallel to the centerline of the embankment as shown on the plans. The bottom width of the trench shall be governed by the equipment used for excavation, with the minimum width being four feet. The depth shall be at least four feet below existing grade or as shown on the plans. The side slopes of the trench shall be 1 to 1 or flatter. The backfill shall be compacted with construction equipment, rollers, or hand tampers to assure maximum density and minimum permeability.

Embankment Core - The core shall be parallel to the centerline of the embankment as shown on the plans. The top width of the core shall be a minimum of four feet. The height shall extend up to at least the 10 year water elevation or as shown on the plans. The side slopes shall be 1 to 1 or flatter. The core shall be compacted with construction.

Backfill adjacent to pipes or structures shall be of the type and quality conforming to that specified for the adjoining fill material. The fill shall be placed in horizontal layers not to exceed four inches in thickness and compacted by hand tampers or other manually directed compaction equipment. The material needs to fill completely all spaces under and adjacent to the pipe. At no time during the backfilling operation shall driven equipment be allowed to operated closer than four feet, measured horizontally, to any part of a structure. Under no circumstances shall equipment be driven over any part of a concrete structure or pipe, unless there is a compacted fill of 24" or greater over the structure or pipe.

Structure backfill may be flowable fill meeting the requirements of Maryland Department of Transportation, State Highway Administration Standard Specifications for Construction and Materials, Section 313 as modified. The mixture shall have a 100-200 psi; 28 day unconfined compressive strength. The flowable fill shall have a minimum pH of 4.0 and a minimum resistivity of 2,000 ohm-cm. Material shall be placed such that minimum of 6" (measured perpendicular to the outside of the pipe) of flowable fill shall be under (bedding), over and, on the sides of the pipe. It only needs to extend up to the spring line for rigid conduits. Average slump of the fill shall be 7" to assure flowability of the material. Adequate measures shall be taken (sand bags, etc.) to prevent floating the pipe. When using flowable fill, all metal pipe shall be bituminous coated. Any adjoining soil fill shall be placed in horizontal layers not to exceed four inches in thickness and compacted by hand tampers or other manually directed compaction equipment. The material shall completely fill all voids adjacent to the flowable fill zone. At no time during the backfilling operation shall driven equipment be allowed to operate closer than four feet, measured horizontally, to any part of the structure. Under no circumstances shall equipment be driven over any part of a structure or pipe unless there is a compacted fill of 24" or greater over the structure or pipe. Backfill (flowable fill)zone shall be of the type and quality conforming to that specified for the core of the embankment or other embankment materials.

Pipe Conduits

All pipes shall be circular in cross section.

Corrugated Metai Pipe - All of the following criteria shall apply for corrugated metal pipe

Materials - (Polymer Coated steel pipe)- Steel pipes with polymeric coating shall have a minimum coating thickness of 0.01 inch (10 mil) on both sides of the pipe. This pipe and its appurtenances shall conform to the requirements of AASHTO Specifications M-245 \$ M-246 with watertight coupling bands or flanges.

Materials - (Aluminum Coated Steel Pipe) - This pipe and its appurtenances shall conform to the requirements of AASHTO Specification M-274 with watertight coupling bands or flanges. Aluminum Coated Steel Pipe, when used with flowable fill or when soil and/or water conditions warrant the need for increased durability, shall be fully bituminous coated per requirements of AASHTO Specification M-190 Type A. Any aluminum coating damaged or otherwise removed shall be replaced with cold applied bituminous coating compound. Aluminum surfaces that are to be in contact with concrete shall be painted with one coat of zinc chromate primer or two coats of asphalt.

Materials - (Aluminum Pipe) - This pipe and its appurtenances shall conform to the requirements of AASHTO Specification M-196 or M-211 with watertight coupling bands or flanges. Aluminum Pipe, when used with flowable fill or when soil and/or water conditions warrant for increased durability, shall be fully bituminous coated per requirements of AASHTO Specification M-190 Type A. Aluminum surfaces that are to be in contact with concrete shall be painted with one coat of zinc chromate primer or two coats of asphalt. Hot dip galvanized bolts may be used for connections. The pH of the surrounding soils shall be between 4 and 9.

2. Coupling, bands, anti-seep collars, end sections, etc., must be composed of the same material and coatings as the pipe. Metals must be insulated from dissimilar materials with use of rubber or plastic insulating materials at lease 24 mils in thickness.

3. Connections - All connections with pipes must be completely watertight. The drain pipe or barrel connection to the riser shall be welded all around when the pipe and riser are metal. Anti-seep collars shall be connected to the pipe in such a manner as to be completely watertight. Dimple bands are not considered to be watertight.

## DEVELOPER'S CERTIFICATE "I/WE CERTIFY THAT ALL DEVELOPMENT AND CONSTRUCTION WILL BE DONE ACCORDING TO THIS PLAN FOR SEDIMENT AND EROSION CONTROL, AND THAT ALL RESPONSIBLE PERSONNEL INVOLVED IN THE CONSTRUCTION PROJECT WILL HAVE A CERTIFICATE OF ATTENDANCE AT A DEPARTMENT

OF THE ENVIRONMENT APPROVED TRAINING PROGRAM FOR THE CONTROL OF SEDIMENT AND EROSION BEFORE BEGINNING THE PROJECT. I ALSO AUTHORIZE PERIODIC ON-SITE INSPECTION BY THE HOWARD SOIL CONSERVATION DISTRICT 9/10/07 U. DATE SIGNATURE OF DEVELOPER

APPROVED: HOWARD COUNTY DEPARTMENT OF PLANNING AND ZONING

ENGINEERS CERTIFICATE "I CERTIFY THAT THIS PLAN FOR SEDIMENT AND EROSION CONTROL REPRESENTS A PRACTICAL AND WORKABLE PLAN BASED ON MY PERSONAL KNOWLEDGE OF THE SITE CONDITIONS AND THAT IT WAS PREPARED IN ACCORDANCE WITH THE REQUIREMENTS OF THE HOWARD SOIL CONSERVATION DISTRICT


9/10/07 SIGNATURE OF ENGINEER ZACHARIA Y. FISCH


THESE PLANS HAVE BEEN REVIEWED FOR HOWARD SOIL CONSERVATION DISTRICT AND MEET THE TECHNICAL REQUIREMENTS FOR SOIL EROSION AND SEDIMENT CONTROL 9-18-07 US A-NATURAL REPOURCES SERVATION SERVICE DATE
THESE PLANS FOR SOIL ER SAND SEDIMENT CONTROL MEET THE REQUIREMENTS OF THE HOWARD SERVATION SERVICE

9-18-67

## OPERATION, MAINTENANCE AND INSPECTION

INSPECTION OF THE POND(S) SHOWN HEREON SHALL BE PERFORMED AT LEAST ANNUALLY, IN ACCORDANCE WITH THE CHECKLIST AND REQUIREMENTS CONTAINED WITHIN USDA, SCS "STANDARDS AND SPECIFICATIONS FOR PONDS" (MD-378). THE POND OWNER(S) AND ANY HEIRS, SUCCESSORS, OR ASSIGNS SHALL BE RESPONSIBLE FOR THE SAFETY OF THE POND AND THE CONTINUED OPERATION, SURVEILLANCE, INSPECTION, AND MAINTENANCE THEREOF. THE POND OWNER(S) SHALL PROMPTLY NOTIFY THE SOIL CONSERVATION DISTRICT OF ANY UNUSUAL OBSERVATIONS THAT MAY BE INDICATIONS OF DISTRESS SUCH AS EXCESSIVE SEEPAGE, TURBID SEEPAGE, SLIDING OR SLUMPING.

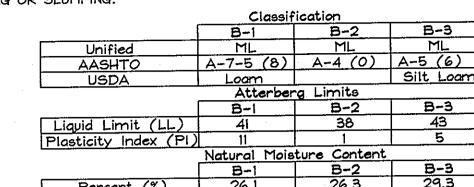

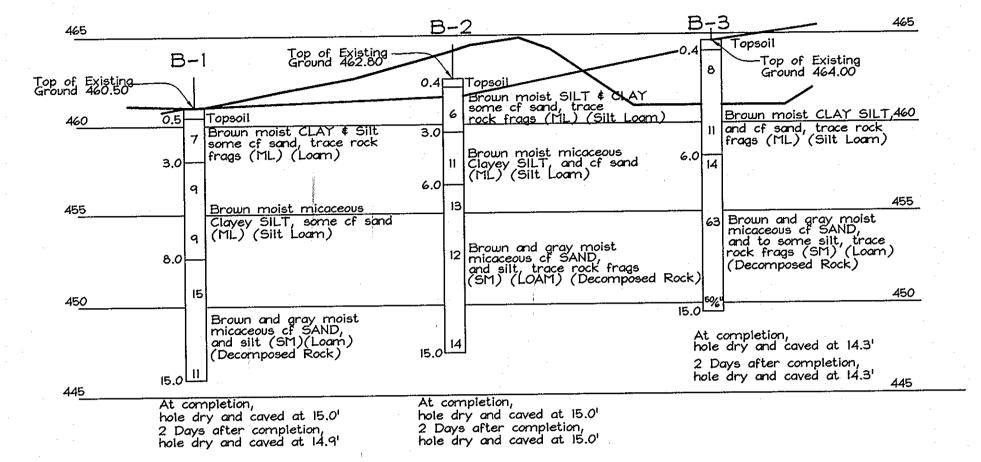

## S.W.M. BORING PROFILES

All connections shall use a rubber or neoprene gasket when joining pipe sections. The end of each pipe shall be re-rolled an adequate number of corrugations to accommodate the bandwidth. The following type connections are acceptable for pipes less than 24 inches diameter: flanges on both ends of the pipe with a circular 3/8 inch thick closed cell circular neoprene gasket; and a 12-inch wide hugger type band with o-ring gaskets having a minimum diameter of 1/2 inch greater than the corrugation depth. Pipes 24 inches in diameter and larger shall be connected by a 24 inch long annular corrugated band using a minimum of 4(four) rods and lugs, 2 on each connecting pipe end. A 24-inch wide by 3/8-inch thick closed cell circular neoprene gasket will be installed with 12 inches on the end of each pipe. Flanged joints with 3/8 inch closed cell gaskets the full width of the flange is also acceptable.

Helically corrugated pipe shall have either continuously welded seams or have lock seams with internal caulking or a neoprene bead

4. Bedding - The pipe shall be firmly and uniformly bedded throughout its entire length. Where rock or soft, spongy or other unstable soil is encountered, all such material shall be removed and replaced with suitable earth compacted to provide adequate support.

5. Backfilling shall conform to "Structure Backfill '

6. Other details (anti-seep collars, valves, etc.) shall be as shown on the drawings.

Reinforced Concrete Pipe - All of the following criteria shall apply for reinforced concrete pipe:

1. Materials - Reinforced concrete pipe shall have bell and spigot joints with rubber gaskets and shall equal or exceed ASTM C-361 2. Bedding - Reinforced concrete pipe conduits shall be laid in a concrete bedding/cradle for their entire length. This bedding/cradle shall consist of high slump concrete

placed under the pipe and up the sides of the pipe at least 50% of its outside diameter with a minimum thickness of 6 inches. Where a concrete cradle is not needed for structural reasons, flowable fill may be used as described in the "Structure Backfill" section of this standard. Gravel bedding is not permitted.

3. Laying pipe - Bell and spigot pipe shall be placed with the bell end upstream. Joints shall be made in accordance with recommendations of the manufacturer of the material. After the joints are sealed for the entire line, the bedding shall be placed so that all spaces under the pipe are filled. Care shall be exercised to prevent any deviation from the original line and grade of the pipe. The first joint must be located within 4 feet from the riser.

4. Backfillina shall conform to "Structure Backfill"

5. Other details (anti-seep collars, valves, etc.) shall be shown on the drawings.

Plastic Pipe - The following criteria shall apply for plastic pipe:

1. Materials - PVC pipe shall be PVC-1120 or PVC-1220 conforming to ASTM D-1785 or ASTM D-2241. Corrugated High Density Polyethylene (HDPE) pipe, couplings and fittings shall conform to the following: 4" -10" inch pipe shall meet the requirements of AASHTO M252 Type S, and 12" through 24" inch shall meet the requirements of

2. Joints and connections to anti-seep collars shall be completely watertight.

3. Bedding - The pipe shall be firmly and uniformly bedded throughout its entire length. Where rock or soft, spongy or other unstable soil is encountered, all such material shall be removed and replaced with suitable earth compacted to provide adequate support.

4. Backfilling shall conform to "Structure Backfill"

5. Other details (anti-seep collars, valves, etc.) shall be as shown on the drawings

Drainage Diaphragms - When a drainage diaphragm is used, a registered professional engineer will supervise the design and construction inspection.

Concrete shall meet the requirements of Maryland Department of Transportation, State Highway Administration Standard Specifications for Construction and Materials,

Rock Riprap

Rock riprap shall meet the requirements of Maryland Department of Transportation, State Highway Administration Standard Specifications for Construction Materials, Section

Geotexile shall be placed under all riprap and shall meet requirements of Maryland Department of Transportation, State Highway Administration Standard Specifications for Construction and Materials, Section 921.09, Class C.

Care of Water during Construction


All work on permanent structures shall be carried out in areas free from water. The Contractor shall construct and maintain all temporary dikes, levees, cofferdams, drainage channels, and stream diversions necessary to protect to be occupied by the permanent works. The contractor shall also furnish, install, operate, and maintain all necessary pumping and other equipment required for removal of water from various parts of the work and for maintaining the excavations, foundation, and other parts of the work free from water as required or directed by the engineer for constructing each part of the work free from water as required or directed by the engineer for constructing each part of the work. After having served their purpose, all temporary protective works shall be removed or leveled and graded to the extent required to prevent obstruction in any degree whatsoever of the flow of water to the spillway or outlet works and so as not to interfere in any way with the operation or maintenance of the structure. Stream diversions shall be maintained until the full flow can be passed through the permanent works. The removal of water from the required excavation and the foundation shall be accomplished in a manner and to the extent that will maintain stability of the excavated slopes and bottom required excavations and will allow satisfactory performance of all construction operations. During the placing and compacting of material in required excavations, the water level at the locations being refilled shall be maintained below the bottom of the excavation at such locations which may require draining the water sumps from which the water shall be pumped.

All borrow areas shall be graded to provide proper drainage and left in a sightly condition. All exposed surfaces of the embankment, spillway, spoil and borrow areas, and berms shall be stabilized by seeding, liming, fertilizing and mulching in accordance with the Natural Resources Conservation Service Standards and Specifications for Critical Area Planting (MD-342) or as shown on the accompanying drawings.

Erosion and Sediment Control

Construction operations will be carried out in such a manner that erosion will be controlled and water and air pollution minimized. State and local laws concerning pollution abatement will be followed. Construction plans shall detail erosion and sediment control measures.

2 G-29-12 ADD PLANTING QUANTITY PER AS-BUILT CONDITIONS
1 11-9-11 REVISE SWM PLANTING NOTES BY NO DATE REVISION

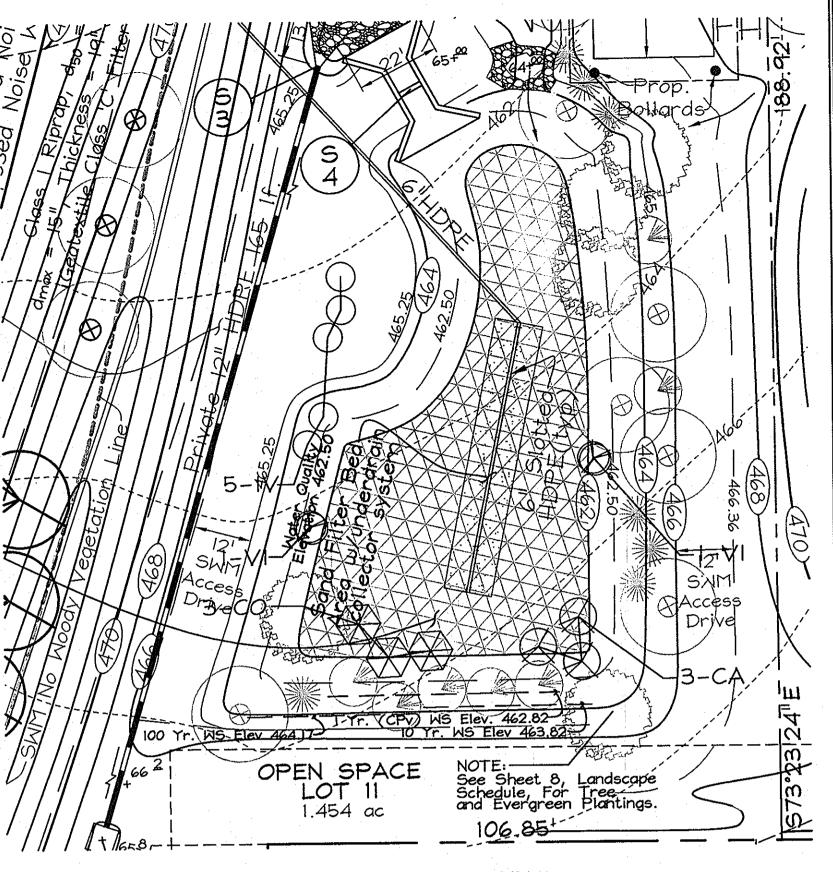

SWM FACILITY DETAIL SCALE: 1"=201

SWM Planting Notes

Within Facility - Bottom to 462.0 - 4,251 s.f.
To be planted with 300 BLUE FLAGTRIS (QUART BULBS)

	1	SW	M POND WOODY PLANT SCH	IEDULE	
KEY	SYMBOL	QUAN.	BOTANICAL NAME	SIZE	NOTE
CA	Ø	3	Clethra alnifolia Sweet Pepperbush	3'-4' Ht.	Cont.
CO	$\langle X \rangle$	3	Cephalanthus occidentalis Buttonbush	3'-4' Ht.	Cont.
IV	Ö	5	Ilex verticillata Winterberry	3'-4' Ht.	Cont.
VD	Ø	2	Viburnum dentatum Arrowwood	3'-4' Ht.	Cont.

Remaining area around the stormwater management facility will be stabilized as per the permanent seeding notes, Sheet 4 of 8, and vegetated as per the landscape buffer requirements; see sheet 8 of 8.

Entire area to be prepared as per the permanent seeding notes.



Professional Certification. I hereby certify that these documents were prepared or approved by me, and that I am a duly licensed professional engineer under the laws of the State of Maryland.

FOR REVISIONS BY BENCHMARK ENGINEERING, INC. ONLY

DEVELOPER/OWNER Dunes Vistas LLC c/o Brian D. Boy 11807 Wollingford Court Clarksville, Md 21029 Tel: (410) 792-2565

STORMWATER MANAGEMENT NOTES AND DETAILS DUNES VISTAS

LOTS 1 THROUGH 10, AND OPEN SPACE LOT 11 ZONED:R-20 PARCEL 57 TAX MAP 16 GRID 24

> Engineers Planners Surveyors 6339 Howard Lane, Elkridge, MD 21075 Tel:410-567-5200 Fax: 410-796-1562 E-mail: info@fsheri.com


2ND ELECTION DISTRICT


. 22418

FSH Associates

DESIGN BY: \_\_\_MT DRAWN BY: CED CHECKED EY: \_ ZYF SCALE: Not To Scale DATE: <u>Sep. 7, 2007</u> W.O. No.: 3060 SHEET No.: 7 OF 10

HOWARD COUNTY, MARYLAND

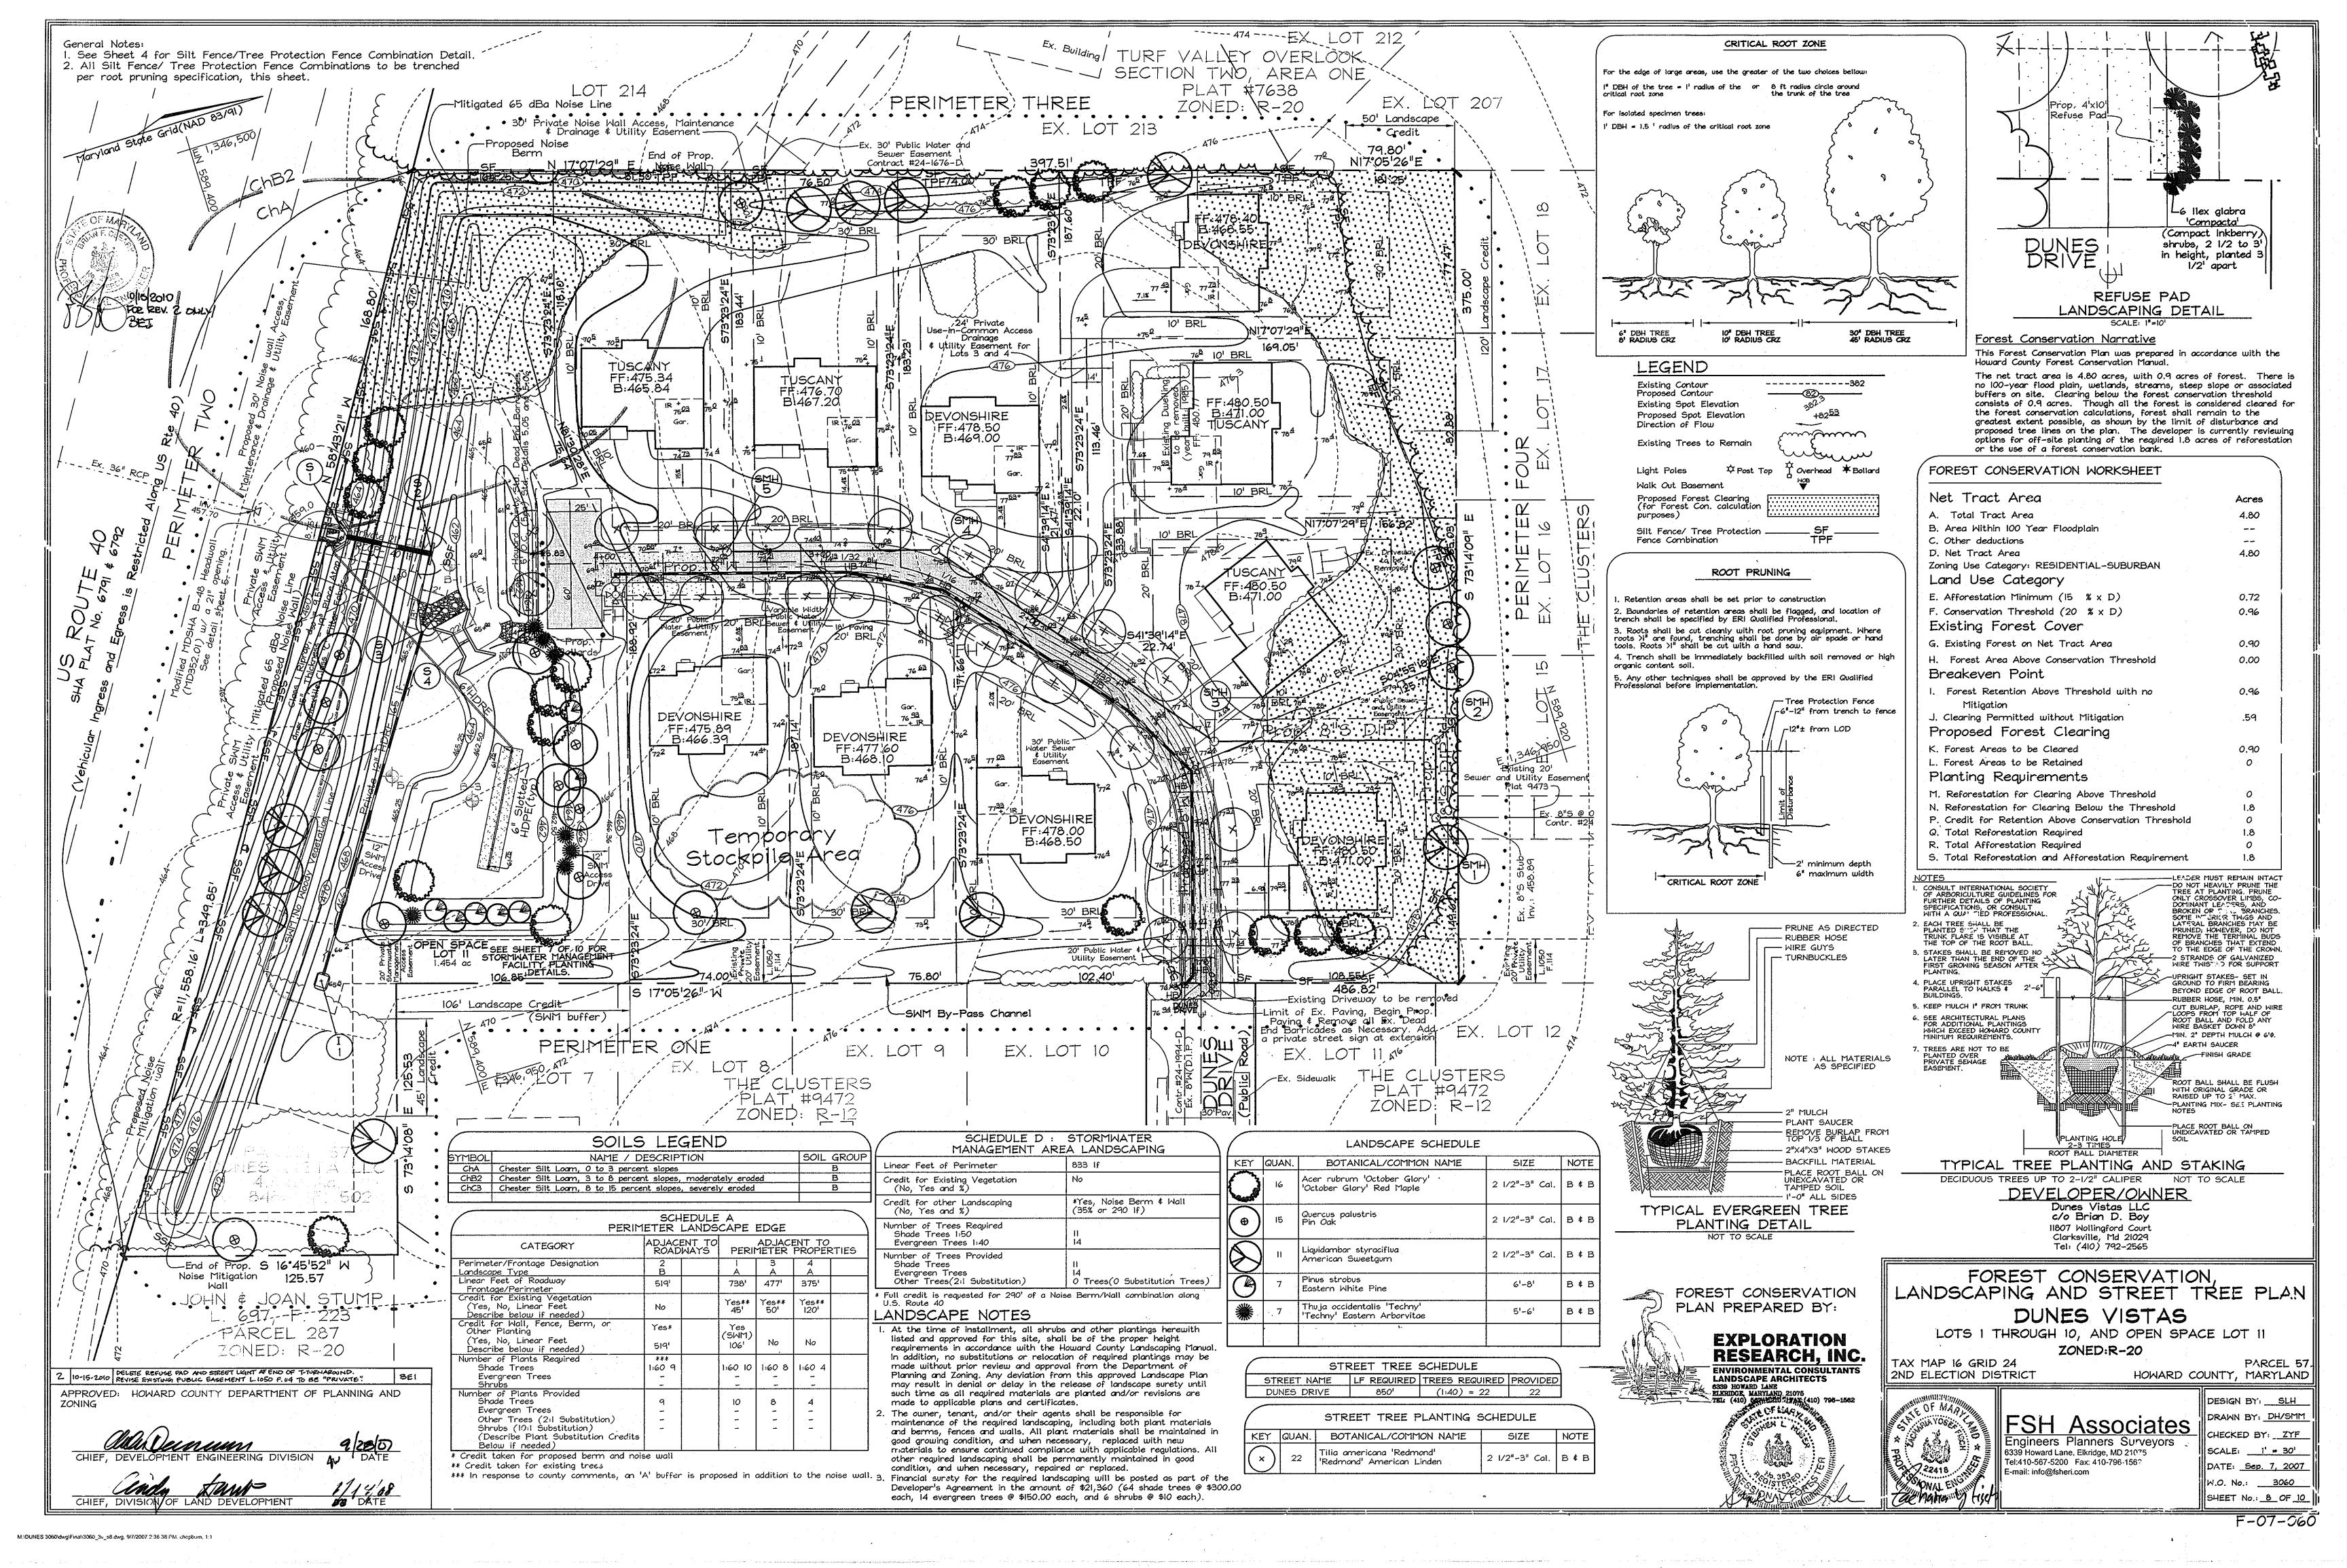

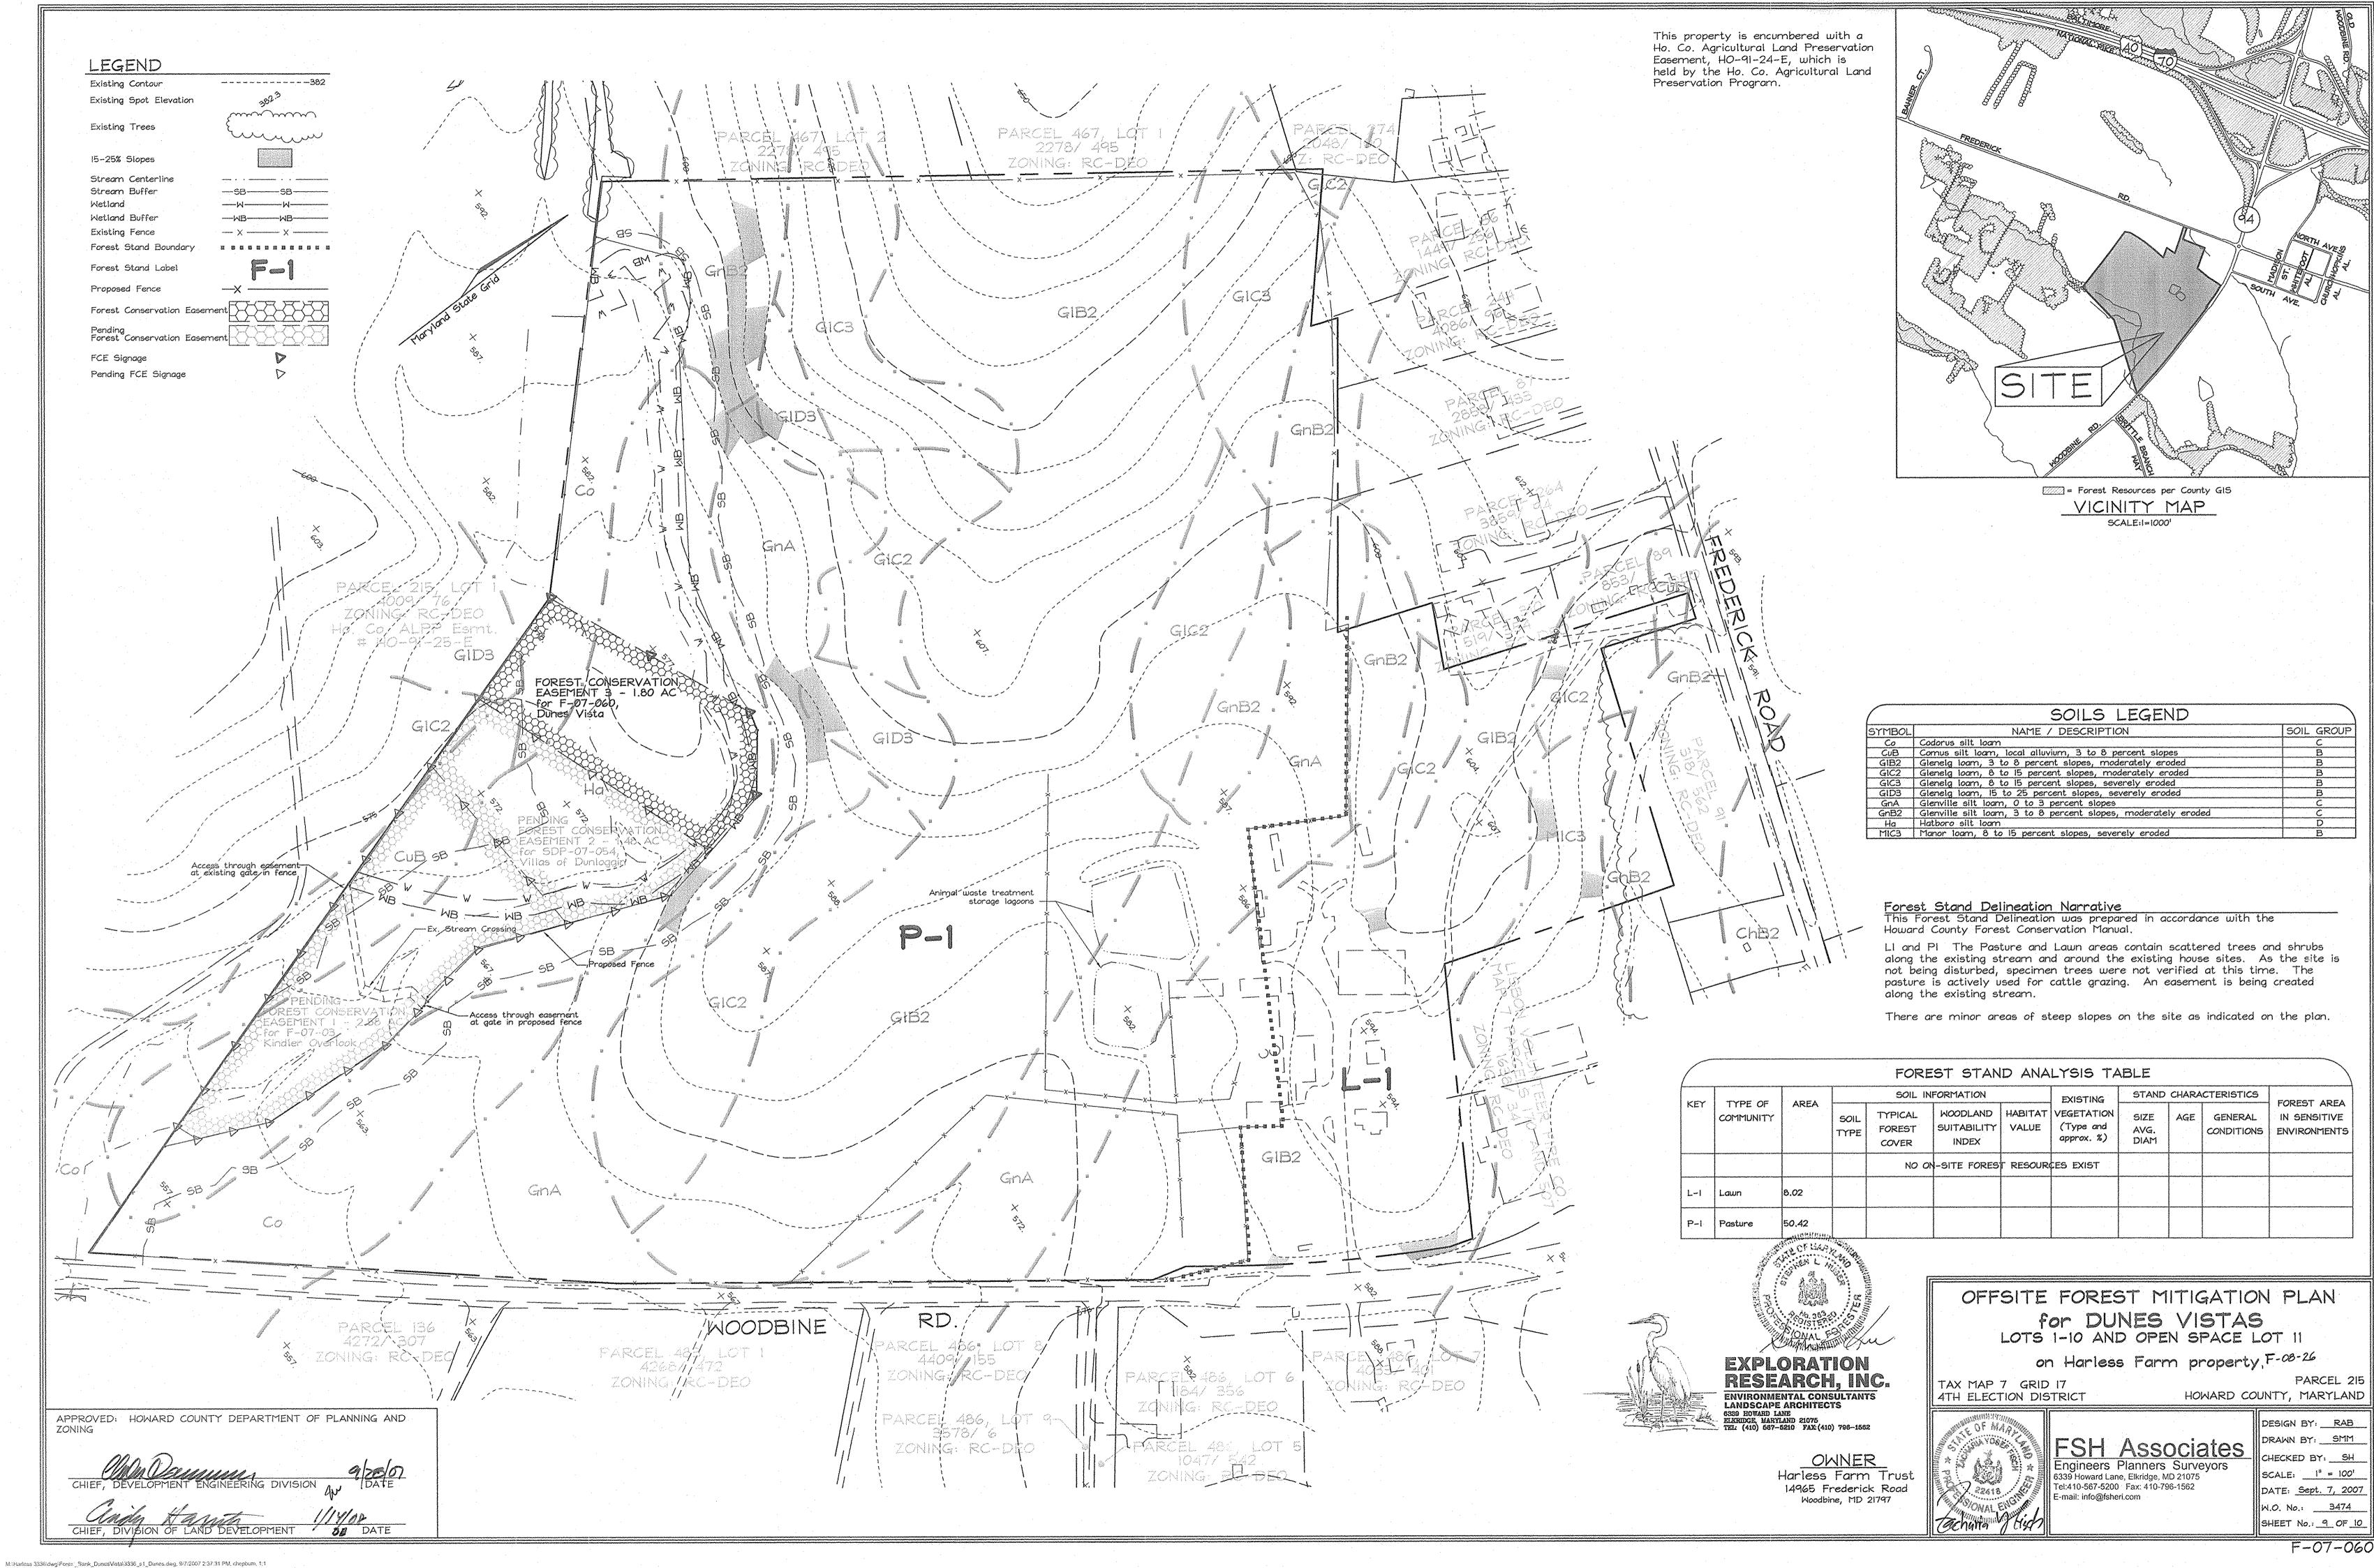

#### Easement 1: PLANTING AREA: 1.80 Ac.

Qty	Botanical Name	Common Name	Size	Credit/Plant	Total Credit
51	Acer negundo	Box Elder	i" Cal.	217.8	11107.80
51	Betula nigra	River Birch	I" Cal.	217.8	11107.80
51	Liquidambar styraciflua	Sweetgum	i" Cal.	217.8	11107.80
51	Magnolia virginiana	Sweetbay	i" Cal.	217.8	11107.80
52	Platanus occidentalis	Sycamore	i <sup>#</sup> Cal.	217.8	11325.60
52	Quercus bicolor	Swamp White Oak	i" Cal.	217.8	11325.60
52	Salix nigra	Black Willow	I" Cal.	217.8	11325.60

360 Total Plantings

78,408 s.f. = 1.80 Ac.

## FOREST CONSERVATION EASEMENT TABLE

EASEMENT	TYPE	AREA (ACRES)
3	Reforestation	1.80
TOTAL		1.80

#### Planting Areas Description

The proposed planting area totalling 1.80 Ac. is proposed entirely within of ram buffer, wetland, and wetland buffer areas. The current land use is porture, making it an ideal area to plant and provide a forested stream

Planting w cilize a variety of species as shown in the proposed planting to k will be randomly placed per the details on this sheet. All continue whips will utilize tree shelters.


#### Plant Selection and Density Spacing Requirements.

Planting Material Size and Density Planting: anting size and density shall be varied with a combination of planting stock. Planting quantity and spacing are based on square footage credit, which varies by material size. A total of 43,560 sq. ft. of planting credit must be fulfilled for each acre planted. This credit can be fulfilled with any combination. of material size in a cordance with the following chart.

Plant	Material	Sixe	· ub!e

	Material Size	Spacing	TPA	Sa Ft Credit per Plant	Comments
	2" coliper trees	20' x 20'	100	435.6	B ¢ B
٠,	I" coller trees	15' × 15'	200	217.8	B & B/Container
	seedlings or whips	II' × II'	350	125	Container 1-3 gal w/tree shelters
	seedlings or shrubs	8' x 8'	700	62	Bare root

CURVILINEAR RANDOMIZED PLANTING

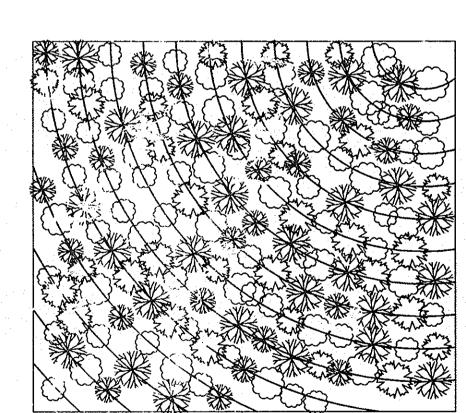


PLANT PLACEMENT DETAIL NOT TO SCALE

MIX TREE AND SHRUB SPECIES IN THE STAGING AREA. 2. SET THE GUIDE CURVILINEAR LINE AS CLOSE TO CONTOUR AS POSSIBLE.

APPROVED: HOWARD COUNTY DEPARTMENT OF PLANNING AND

SEEDLING AND WHIP PLANTING

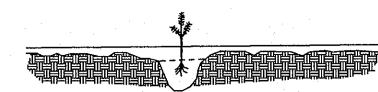


NOTE: MULCHING NEWLY PLANTED SEEDLINGS HELPS THE SOIL RETAIN MOISTURE AND THE SEEDLING FROM COMPACTION AND STEM INJURIES.

CORRECT PLANTING DEPTH





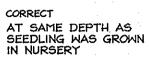

MAKE LATERAL SLICES IF, ROOTBOUND-

ROOT SYSTEM

BACKFILL WITH-EXISTING SOIL

INCORRECT TOO DEEP AND

CONTAINER PLANTING

NOT TO SCALE

1. REMOVE THE PLANT EITHER BY CUTTING OR INVERTING THE CONTAINER
2. USE A KNIFE TO CUT THROUGH BOTTOM HALF OF THE ROOT BALL.
3. PLANT SHRUBS ON FORMED UP MOUNDS 4" ABOVE THE EXISTING GRADE WHEN HIGH WATER TABLE CONDITIONS EXIST, OTHERWISE PLANT FLUSH WITH EXISTING GRADE.
4. PLANTING HOLE TO BE 2-3 TIMES THE DIAMETER OF THE CONTIANER.

5. INSERT FERTILIZER TABLET, BACKFILL 2/3 OF THE ROOT BALL AND WATER.

6. AFTER WATER PERCOLATES, BACKFILL HOLE TO TOP OF ROOT BALL AND GENTLY TAMP SOIL TO FIRM CONTACT WITH PLANT.
7. APPLY MULCH RING AROUND PLANT KEEPING A 6 IN CLEARANCE FROM STEM.

PLANTING PROCEDURE FOR CONTAINER GROWN PLANTS

TOO SHALLOW AND ROOTS ARE EXPOSED

2" THICK MULCH RING 24" IN DIAMETER MINIMUM

SIGN DETAIL: PERMANENT SIGN

SIGNAGE NOTE: ALL TREE PROTECTION SIGNS SHALL BE PLACED ON METAL 'T' POSTS OR PRESSURE TREATED WOOD POLES. NO ATTACHMENT OF SIGNS TO TREES IS PERMITTED.

Min. II<sup>#</sup>

Forest Conservation

Area

REFORESTATION

PROJECT

Trees for Your

Future

Reforestation Area Planting Notes Reforestation and Initial planting inspection and certification required. Planting contractor to notify ERI qualified professional 24 hours in advance of planting. Afforestation Area Protection Signage 2. Reforestation areas may be planted as soon as reasonable to do so. Late winter- early spring plantings are preferred. Earliest planting dates will conditions warrants.

vary from year to year but planting may generally begin as soon as the ground is no longer frozen. Alternate planting dates may be considered as 3. Soil amendments and fertilization recommendations will be made based upon the results of soil analysis for nitrogen, phosphorus, potassium, organic matter content and pH. If required, fertilizer will be provided using a slow release, soluble 16-8-16 analysis designed to last 5-8 years

contained in polyethylene perforated bags such as manufactured by ADCO Works, P.O. Box 310 Hollins, N.Y. 11423 or approved equal.

4. Plant materials shall be planted in accordance with the planting diagram, planting details and planting schedule.

5. Plant stock must be protected from desiccation at all times prior to planting. Materials held for planting shall be moistened and placed


in cool shaded areas until ready for placement. 6. Planting materials shall be nursery grown and inspected prior to planting.
Plants not conforming to the American Standards for Nursery Stock specifications for size, form, vigor, or roots, or due to trunk wounds,

breakage, desiccation, insect or disease must be replaced. 7. Newly planted trees may require watering at least once per week during the first growing season depending on rainfall in order to get established. The initial planting operation should allow for watering during installation to completely soak backfill materials.

8. Mulch shall be applied in accordance with the diagram provided and shall consist of composted, shredded hardwood bark mulch, free of

9. Planting holes should be excavated to a minimum diameter of 2.5 to 3 times the diameter of the root ball or container. Mechanical auguring is preferred with scarification of the sides of each hole.

10. All nursery stock may be sprayed with deer repellent containing Bitrex such as Repellex(TM). All nursery stock to be grown with deer repellent tablets in growing medium, such as Repellex Tablets.

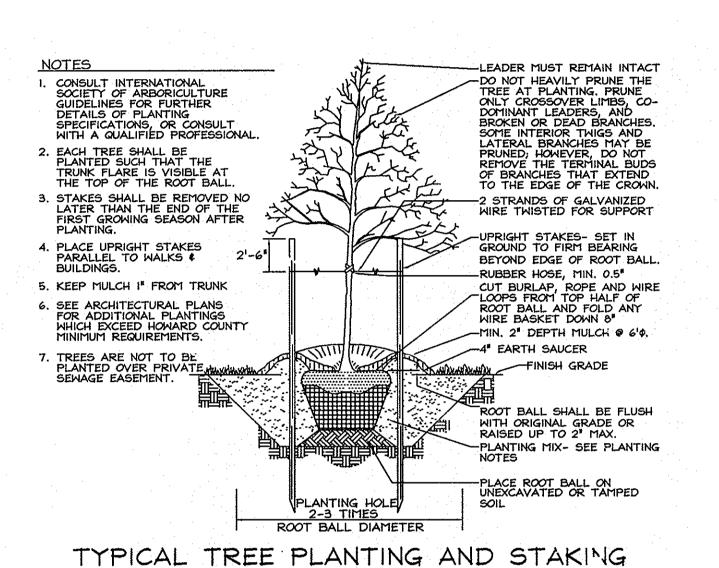

DECIDUOUS TREES UP TO 2 1/2" CALIPER

Reforestation Area Monitoring Notes

I. Monthly visits during the first growing season are to assess the success of the plantings and to determine if supplemental watering, pest control, invasive plant management, mowing or other actions are necessary. Early spring visits will document winter kill and autumn visits will document summer kill. 2. The minimum survival rate shall be 75% of the total number of trees planted per acre at the end of the two year maintenance period. Wild tree seedlings from natural regeneration on the planting site may be counted up to 50%

toward the total survival number if they are healthy native species at least 12 inches tall. 3. Survival will be determined by a stratified random sample of the plantings.

The species composition of the sample population should be proportionate to the amount of each species in the entire planting to be sampled. 4. Effective monitoring will assess plant survivability during the first growing season and make recommendations for reinforcement planting if required at

Forest Tree Protection and Management Notes

1. Any significant changes made to the Forest Conservation Plan shall be made with the prior approval of the Howard County Dept. of Planning and

2. Forest protection and management to be in accordance with a forest management plan. The plan shall be prepared by a MD. licensed forester to facilitate the landowners management objectives, such as wildlife enhancement, water quality, aesthetics, forest products, etc.

3. Future forest harvests may be conducted under a Howard County approved forest harvest plan, prepared by a MD. licensed forester.



**EXPLORATION** RESEARCH, INC. ENVIRONMENTAL CONSULTANTS LANDSCAPE ARCHITECTS

Surety in the amount of \$39,204.00 shall be posted as part of the Developer's Agreement for 1.80 ac/78,408 sq.ft.


OWNER Harless Farm Trust 14965 Frederick Road Woodbine, MD 21797

OFFSITE FOREST MITIGATION PLAN for DUNES VISTAS LOTS 1-10 AND OPEN SPACE LOT 11

on Harless Farm property, F-08-26

TAX MAP 7 GRID 17 4TH ELECTION DISTRICT

NOT TO SCALE

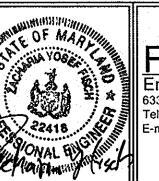

FSH Associates Engineers Planners Surveyors 6339 Howard Lane, Elkridge, MD 21075 Tel:410-567-5200 Fax: 410-796-1562 E-mail: info@fsheri.com

DESIGN BY: SMM CHECKED BY: RAB/SLH SCALE: As Shown DATE: <u>Sept. 7, 2007</u> W.O. No.: 3474 SHEET No.: 10 OF 10

HOWARD COUNTY, MARYLAND

PARCEL 215

F-07-060