


**GENERAL NOTES**

- This project is in conformance with the latest Howard County Standards unless waivers have been approved.
- The contractor shall notify "Miss Utility" at 1-800-257-7777 at least forty-eight (48) hours prior to any excavation work being done.
- The contractor shall notify the Department of Public Works/Bureau of Engineering/Construction Inspection Division at 410-315-1800 at least five (5) working days prior to the start of work.
- Traffic control devices, markings and signing shall be in accordance with the latest edition of the Manual of Uniform Traffic Control Devices ("MUTCD"). All street and regulatory signs shall be in place prior to the placement of any asphalt.
- Street light placement and type of fixture and pole shall be in accordance with the Howard County Design Manual, Volume III (1993) and as modified by "Guidelines for Street Lights in Residential Developments" (June 1993). A minimum spacing of 20' shall be maintained between any street light and any tree.
- The existing topography, onsite, is taken from field run survey with 2' contour intervals prepared by LDE, Inc. dated September, 2006. The offsite topography was taken from Howard County GIS and/or plans of public record.
- The coordinates shown herein are based upon the Howard County Geodetic Control which is based upon the Maryland State Plane Coordinate System. Howard County Monument Nos. 46FA and 47DB (NAD83) were used for this project.
- The property is located within the Metropolitan District. Water is public. Extensions from Existing Contract Numbers 24-1818-D & 24-1830-D.
- Sewer is public. Extension will be from Existing Contract Number 718-S.
- Stormwater Management for this project is provided by stormwater management credits using grass channels, rooftop disconnection credits, and a privately owned and maintained Dry Detention and Bio Retention Facilities approved under SP-07-010 and detailed herein. Facilities to be owned and maintained by the Watkins Choice Homeowners Association.
- Existing Utilities are based on field surveys and plans of public record.
- There is no Floodplain on this site. No Floodplain Study is required.
- There are no wetlands on this site. The wetlands investigation for this property was completed by LDE, Inc. dated November, 2006.
- The traffic study for this project was prepared by Mars Group, dated November 2006, and was approved on 12-11-07 under SP 07-010.
- Project Background Information:  
 Location: Laurel, Maryland (Zip Code 20723)  
 Subdivision Name: WATKINS' CHOICE  
 Site Address: 10526 Stansfield Road  
 Tax Map: 46  
 Parcels: 215  
 Existing Zoning: R-20 (Residential: Single District)  
 Election District: 6th  
 Total Tract Area: 3.52 Ac.  
 Number of Proposed Lots: 2 Residential + 1 Open Space Lot + 1 Non-Buildable Bulk Parcel  
 DPZ Reference Numbers: SP 07-010
- Subject property is zoned R-20 per 2/2/2004 Comprehensive Zoning Plan and the "Comp Lite" Zoning Amendments effective 7/28/06.
- BRL denotes Building Restriction Line.
- For flag or pipestem lots, refuse collection, snow removal and road maintenance are provided to the junction of the flag or pipestem and the road right-of-way line and not onto the flag or pipestem lot driveway.
- Driveway(s) shall be provided prior to residential occupancy to ensure safe access for fire and emergency vehicles per the following minimum requirements:  
 a) Width - 12' (16 feet serving more than one residence).  
 b) Surface - 6 inches of compacted crusher run base with tar and chip coating. (1/2" Min.)  
 c) Geometry - Maximum 14% grade, with the durable and sustained grade of 8%. Maximum 10% grade change and minimum of 45 foot turning radius.  
 d) Structures (culverts/bridges) Capable of supporting 25 gross tons (H25 loading).  
 e) Drainage Elements - Capable of safely passing 100 year flood with no more than 1 foot depth over driveway surface.  
 f) Structure Clearances - minimum 12 feet.  
 g) Maintenance sufficient to ensure all weather use. Where one (1) driveway serves more than one (1) lot, a house number sign must be placed at each lot entrance and a range of street address house numbers sign where the common driveway intersects with the main road.
- The Maintenance Agreement for the Shared Driveway for Lots 1, 2 and Non-Buildable Bulk Parcel "A" will be recorded concurrently with the Plat.
- The Maintenance Agreement for the Shared Driveway for Lots 1 & 2 will be recorded concurrently with the Plat.
- The property was previously improved with a dwelling known as # 10526 Stansfield Road. The dwelling was razed under demolition permit # E0005241. The existing well was previously abandoned and sealed by L. Franklin Easterday on 11/22/05. In cooperation with the Howard County Health Department, the owner shall properly abandon any septic systems and/or wells discovered onsite during the construction phase of the project. At that time, any required documentation and/or certification of the abandonment shall be provided to the Howard County Health Department (410 313-2640).
- Sight Distance study for this project was prepared by LDE, Inc. and approved under SP 07-010.
- Geotech report for this project was prepared by LDE, Inc. and approved under SP 07-010.
- For installation Specifications and Details of HDPE pipes see sheet 7 of this plan.
- All construction shall be in accordance with the latest Standards and Specifications of Howard County Design Manual Vol. IV and current MSHA Standards & Specifications if applicable.
- Any damage caused by the contractor to existing public right-of-way, existing paving, existing utilities, etc. shall be corrected at the contractor's expense in accordance with the Howard County Standards and Specifications.
- The existing utilities shown herein are located from field surveys and construction drawings of record. The contractor shall locate existing utilities to his own satisfaction and well in advance of any construction activities. Additionally, the contractor shall take all necessary precautions to protect all existing utilities and maintain uninterrupted service. Any damage incurred to utilities or existing features due to contractor's operation shall be repaired immediately at the contractor's expense.
- There may be additional utilities not shown on these plans. The engineer assumes no responsibility for utility locations not shown and it shall be the responsibility of the contractor to verify the locations of all existing utilities within the limits of construction and notify the engineer of any discrepancies, prior to the start of construction.
- Deviations from these plans and specifications without prior written consent of the civil engineer may cause the work to be unacceptable.
- All utility poles within the limit of construction shall be braced prior to the start of work. Contractor shall contact Utility Companies prior to bracing, adjustment or relocation. Contractor shall be responsible for coordination of all relocations, adjustments, etc.
- Adjustments to the sequence of construction shall be approved by the Howard County Construction/Inspection Division and Permits; prior to such adjustments.
- All fill shall be rolled to a minimum degree of compaction of 95% of the dry unit weight as determined by AASHTO T-180.
- The dimensioned distances shall govern if scaled and dimensioned distances on this plan are found to be in disagreement.
- All lighting shall conform to Section 134 of the Zoning Regulations for Howard County.
- There are no existing contiguous slopes 25% or greater within the boundaries of the site.
- There are no burial grounds on the property being developed.
- All sign posts used for traffic control signs installed in the County right-of-way shall be mounted on a 2" galvanized steel, perforated, square tube post (14 gauge) inserted into a 2-1/2" galvanized steel, perforated, square tube sleeve (12 gauge)-3' long. A galvanized steel pole cap shall be mounted on top of each post.
- Earthquake quantities shown on this plan are for road and storm drain construction only. All earthquake quantities shown on sheet 9 are estimated and do not take into account depth of topsoil, rock, unsuitable materials, etc. The earthquake quantities shall not be used for bid purposes. The contractor shall perform an independent earthquake analysis to determine a bid price.
- This project is subject to a Design Manual Waiver to Section 5.2.6.(E)(1) of Volume I, Storm Drainage, Side Slopes. On September 6, 2007, the Chief of the Development Engineering Division approved the request to allow the use of Side Slopes steeper than 3:1 principally on the following:  
 1. The facility shall be privately owned & maintained and the entire perimeter shall be fenced.  
 2. The retaining walls shall be constructed of reinforced concrete and be less than 3' high.  
 3. The facility shall include a core and cut-off trench, a 24" barrel, anti-seep collars and a No-Woody Vegetation Zone.

**GENERAL NOTES (Cont.)**

- Landscaping is provided in accordance with a certified Landscape Plan included with the road construction plan set in accordance with Section 16.124 of the Howard County Code and the Landscape Manual. Surety in the amount of \$14,700.00 (\$9,300 + \$5,400) is included in the Developer Agreement.
- No grading, removal of vegetative cover or trees, paving and new structures shall be permitted within the limits of wetlands, streams, or their required buffers, floodplain and forest conservation easement areas.
- No Wetlands, Wetlands Buffers, Streams, Stream Buffers, Floodplain or Forest Conservation Areas exist on site.
- This project is subject to Design Manual Waiver to Section 2.2 and 2.4 of Volume III, Roads and Bridges. On August 15, 2008, the Development Engineering Division approved the request to allow use of 18" half section paving in place of the required 20" along the property frontage on Stansfield Road, and to allow use of a Modified Combination Curb & Gutter in place of a Standard 7" Curb & Gutter. The request was approved based principally on the fact that the proposed design will be consistent with the existing road conditions to the East and West of the subject property and will not negatively impact the County's Road and Storm Drain Systems.
- This project is subject to Waiver WP 09-042 from the Howard County Subdivision and Land Development Regulations. On October 24, 2008, the Planning Director approved the request to waive Section 16.120(c)(2) which requires a minimum of 20 feet of frontage for single pipestem and non pipestem lots and preservation parcels which cannot be further divided under current zoning and which requires lots or preservation parcels which share access to have sufficient frontage collectively to meet the driveway easement requirements in the Design Manual. WP 09-042 approval is subject to the following conditions:  
 1. The applicant shall bond for and construct infrastructure and access for the ultimate build-out of the subdivision (Buildable Lots 1,2,4,5,6,7 and Open Space Lot 3) with F08-174.  
 2. The Use-Conservation driveway proposed for Phases I & II shall be designed to provide sufficient turning radius and width for use by emergency vehicles.
- Non-Buildable Bulk Parcel "A" will be resubdivided in the future into additional residential lots (Lots 4,5,6,7). Refer to F-04-035.

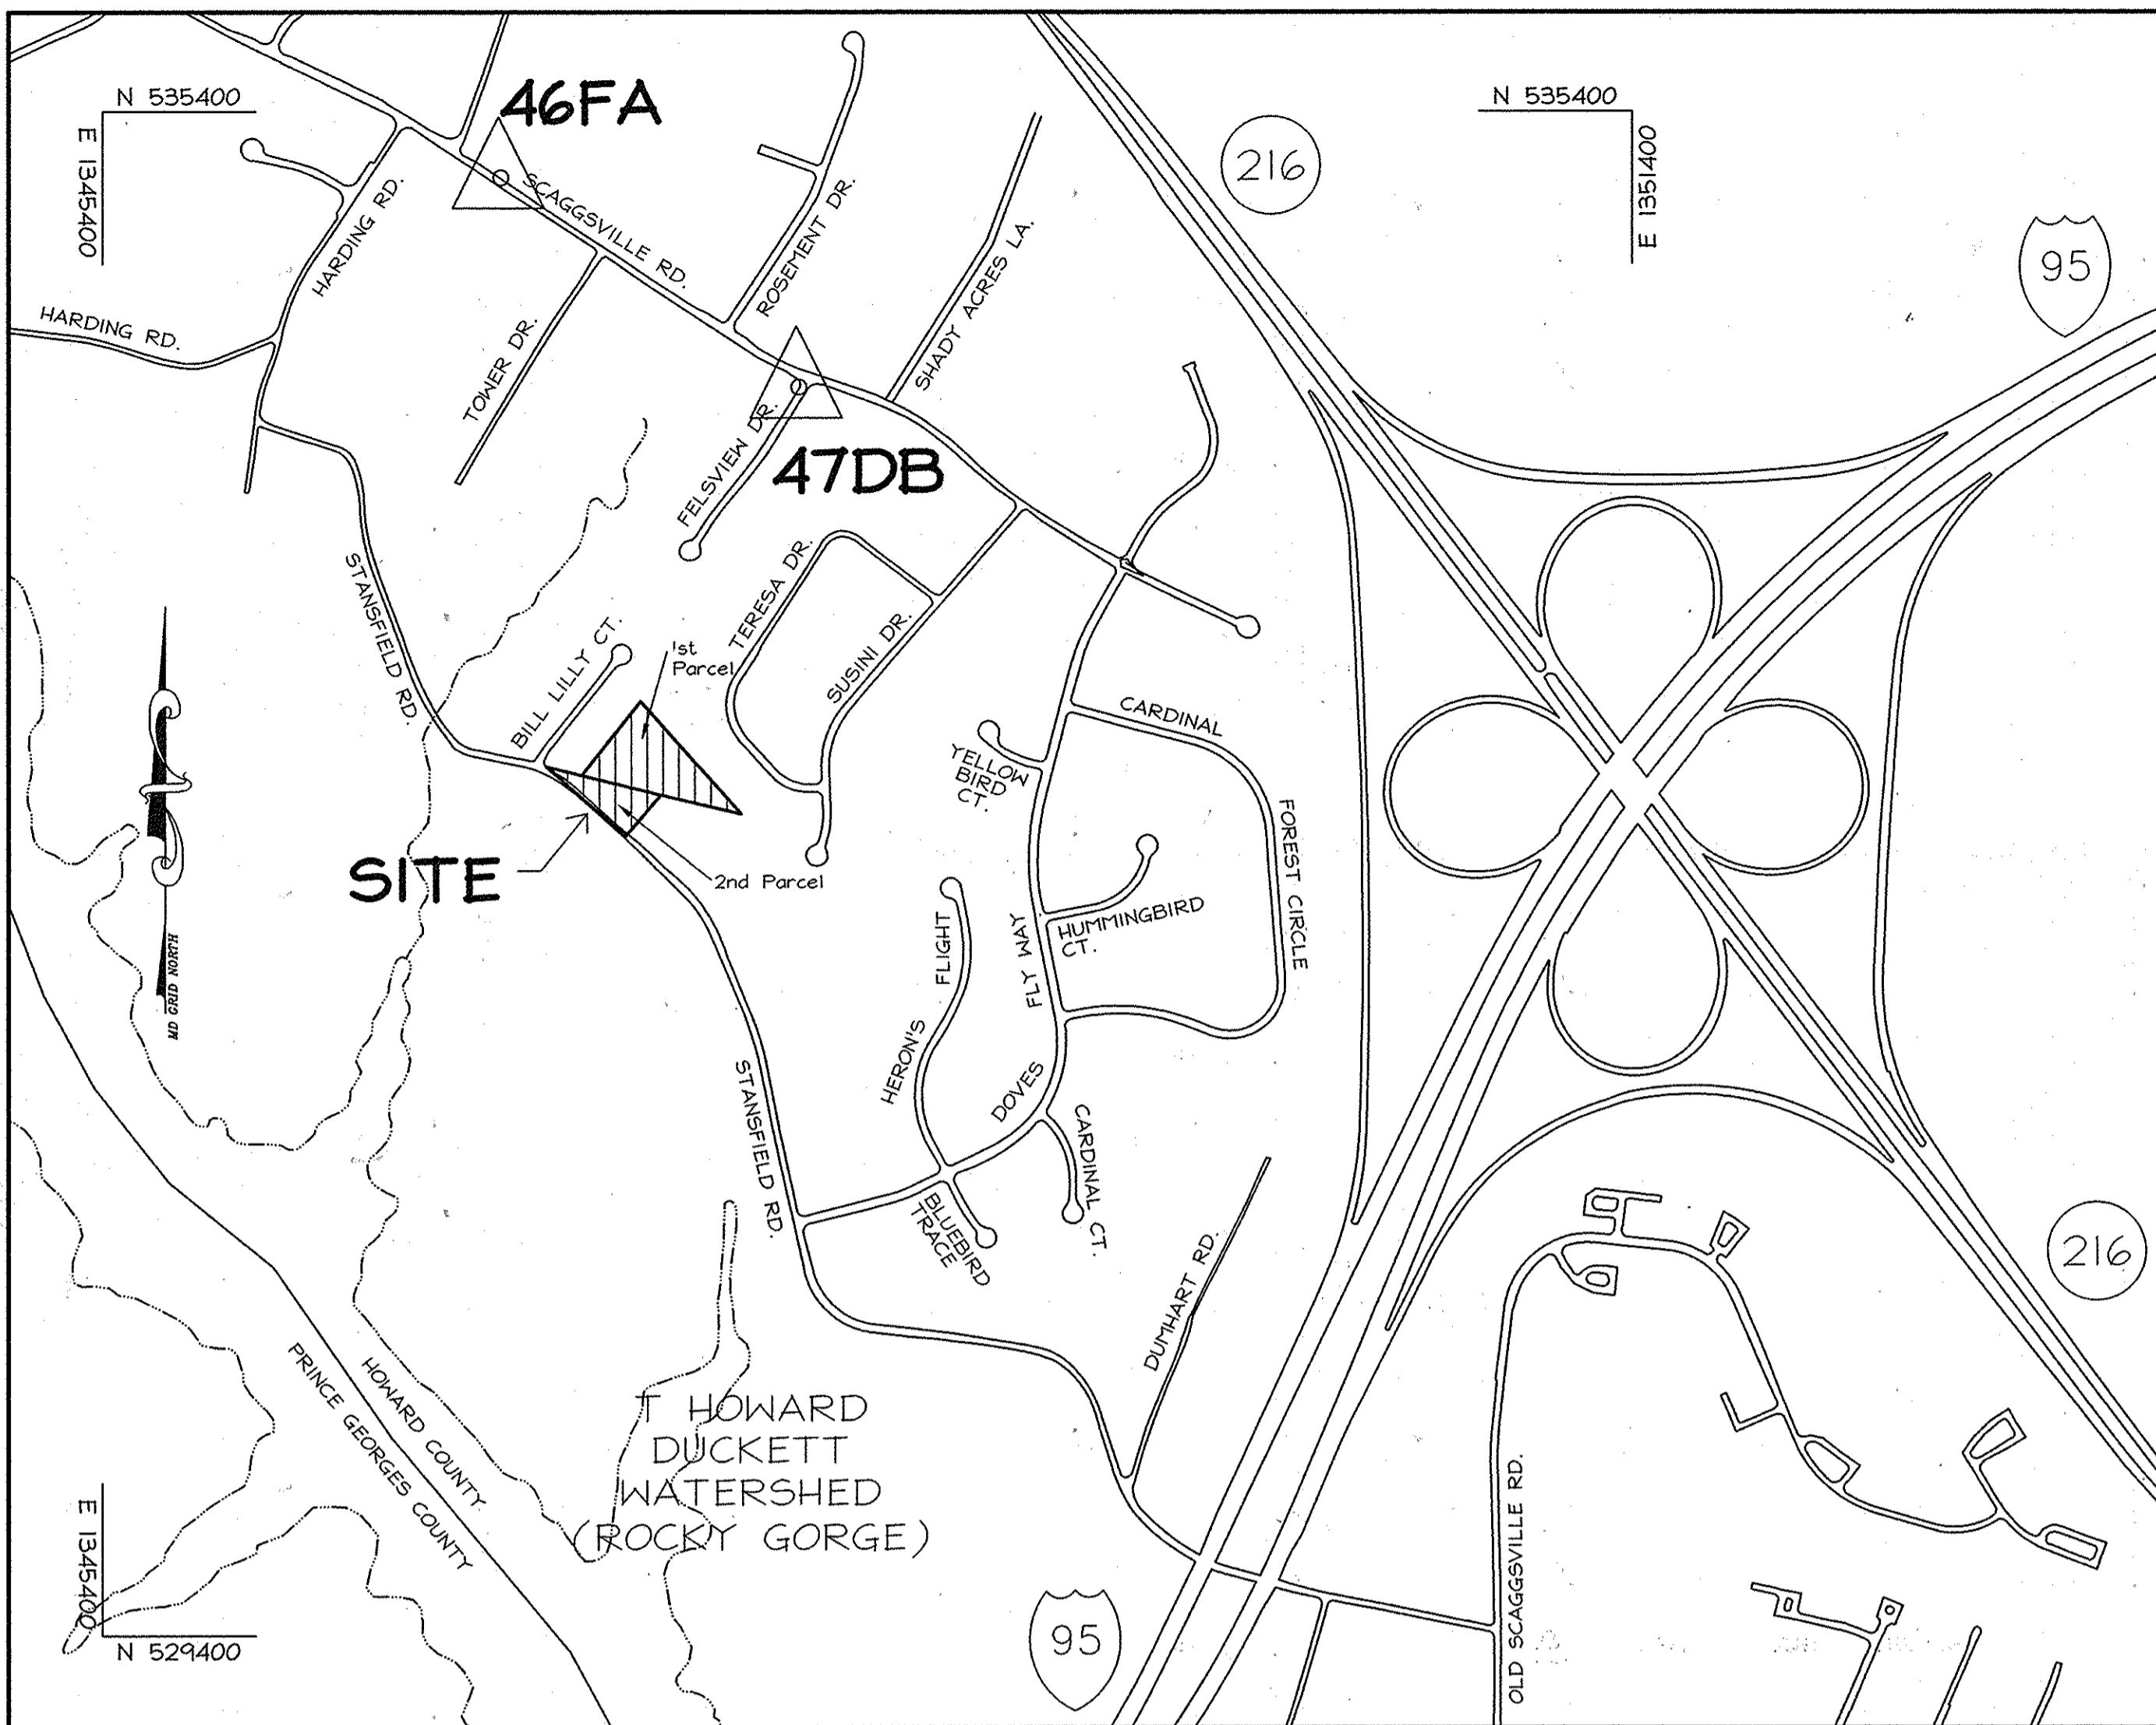

**LOCATION MAP**  
1" = 600'


**ROAD & STORM DRAIN CONSTRUCTION PLANS**  
**WATKINS' CHOICE**  
**PHASE I**

**LOTS 1, 2, OPEN SPACE LOT 3 AND NON-BUILDABLE BULK PARCEL "A"**

Tax Map No. 46 - Grid No. 18 - Parcel 215  
6th Election District - Howard County, Maryland

**BENCHMARKS:**

- Howard County Control Station 46FA  
 NAVD 88 Elevation = 403.65'  
 NAD 83 Coordinates: N 535140.866, E 1346962.690.  
 Standard stamped disc set on a 3' deep column of concrete located on the Northeast side of Scaggsville Road, 5.2' off edge of paving, 30.5' from G4E. Pole #640720 and 33.5' from a gate corner. Pole and gate located on the Northeast side of Scaggsville Road.
- Howard County Control Station 47DB  
 NAVD 88 Elevation = 398.561  
 NAD 83 Coordinates: N 534316.917, E 1348131.250.  
 Standard stamped disc set on a 3' deep column of concrete located on the West side of Felsview Drive, 3' from end of curb and 22.5' from a Gas Meter. Curb and meter located on the West side of Felsview Drive.

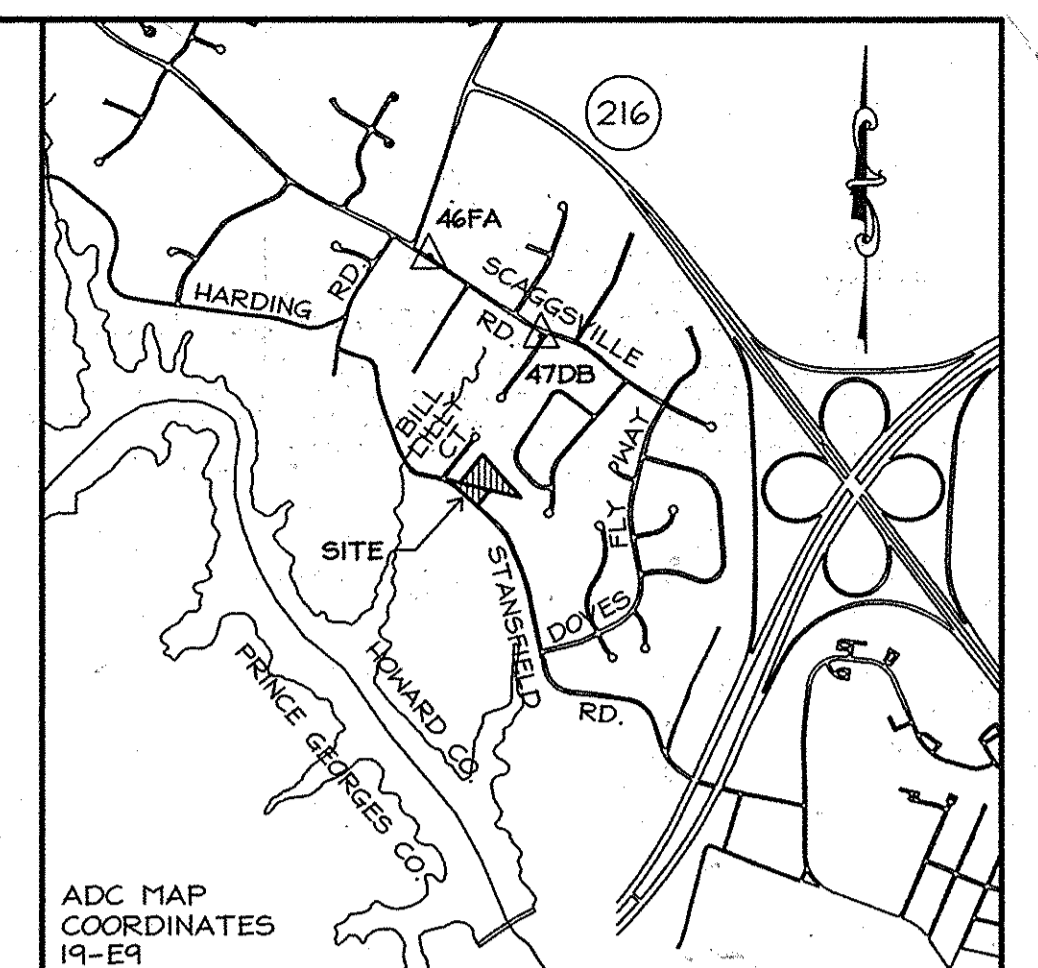

**VICINITY MAP**  
1" = 2000'

SHEET INDEX	
Sheet Number	Description
1	Cover Sheet
2	Plan & Profile - Stansfield Road Widening
3	Stansfield Road - Maintenance of Traffic Plan
4	Plan & Profile - Private Use in Common Drive 0+00 - 4+09.63
5	Miscellaneous Details
6	Drainage Area Map & Soils Map
7	Storm Drain Profiles & Soil Borings
8	Grading and Soil Erosion & Sediment Control Plan
9	Grading and Soil Erosion & Sediment Control Plan Details
10	Grading and Soil Erosion & Sediment Control Plan Details
11	Private Non-378 Stormwater Management Facility III - Details
12	Private Bioretention Facility Notes & Details and MD-378 Pond Construction Specifications
13	Landscape Plan & Forest Conservation Plan
14	Landscape Plan - Details & Notes
15	Landscape Plan - 10 Scale Detail Enlargement
16	Hillis-Carnes Eng. Assoc. - Retaining Wall Construction Details

**LEGEND**

- 470 --- EXISTING 10' CONTOURS
- 468 --- EXISTING 2' CONTOURS
- BUILDING RESTRICTION LINE
- ===== PROPOSED CURB & GUTTER
- ===== PROPOSED STORM DRAIN
- EX. CURB & GUTTER
- EX. STORM DRAIN
- EX. SANITARY SEWER
- EX. SEWER HOUSE CONNECTION
- ⊙ EX. SANITARY SEWER MANHOLE
- EX. WATER MAIN
- EX. WATER HOUSE CONNECTION
- EX. WATER VALVE
- ⊙ EX. PROPOSED FIRE HYDRANTS
- EX. GAS MAIN
- EX. OVERHEAD UTILITIES
- WATER HOUSE CONNECTION (WHC)
- SEWER HOUSE CONNECTION (SHC)
- EX. PAVING
- ⊙ TEST PITS

**OWNER/ DEVELOPER**  
 Williamsburg Group, LLC  
 5406 Harpers Farm Road  
 Suite 200  
 Columbia, MD 21044  
 410 997-8800

PHASING CHART			
PHASE	CREDITS REQUESTED	ALLOCATION YEAR	PLAN TITLE
1	2	N/A	Lots 1, 2, Open Space Lot 3 and Non-Buildable Bulk Parcel "A"

APPROVED: DEPARTMENT OF PUBLIC WORKS  
*Walter J. Wahl* 1-9-09  
 CHIEF, BUREAU OF HIGHWAYS DATE

APPROVED: DEPARTMENT OF PLANNING AND ZONING  
*Chris Schmitt* 1/16/09  
 CHIEF, DIVISION OF LAND DEVELOPMENT DATE

*Chris Schmitt* 1-16-9  
 CHIEF, DEVELOPMENT ENGINEERING DIVISION DATE

**ENGINEER'S CERTIFICATE**  
 I hereby certify that this plan for sediment and erosion control represents a practical and workable plan based on my personal knowledge of the site conditions and that it was prepared in accordance with the requirements of the Howard County Soil Conservation District.  
*Bruce D. Burton* 12/19/08  
 Signature of Engineer Date  
 Bruce D. Burton

**DEVELOPER'S CERTIFICATE**  
 I/We certify that all development and construction will be done according to this plan of development for sediment and erosion control, and that all responsible personnel involved in the construction project will have a Certificate of Attendance at a Department of Environmental Approved Training Program for the Control of Sediment and Erosion before beginning the project. I also authorize periodic onsite inspections by the Howard County Soil District.  
*John K. Burton* 12-19-08  
 Signature of Developer Date

**AS-BUILT CERTIFICATION**  
 THERE IS NO "AS-BUILT" INFORMATION PROVIDED ON THIS SHEET.

*Walter J. Wahl* 8/19/2014  
 MICHAEL D. ADPOCK, PROFESSIONAL LAND SURVEYOR  
 LICENSE NO. 21297, EXPIRATION DATE: JUNE 16, 2017

**THIS DEVELOPMENT PLAN IS APPROVED FOR SOIL EROSION AND SEDIMENT CONTROL BY THE HOWARD COUNTY SOIL CONSERVATION DISTRICT**

*John K. Burton* 1/16/09  
 HOWARD COUNTY SOIL CONSERVATION DISTRICT DATE

I HEREBY CERTIFY THAT THESE DOCUMENTS WERE PREPARED OR APPROVED BY ME, AND THAT I AM A DULY LICENSED PROFESSIONAL ENGINEER UNDER THE LAWS OF THE STATE OF MARYLAND, LICENSE NO. 19184, EXPIRES 6/30/09.

SIGNED *Bruce D. Burton* 12/19/08  
 BRUCE D. BURTON

No.	Date	By	Description
1	12/2008	LDE	REVISE OWNER/DEVELOPER

**LDE Inc.**  
 Engineers, Surveyors, Planners  
 9250 Ramsey Road, Suite 106 Columbia, Maryland - 21045  
 (410)715-1070 - (301)556-3424 - FAX(410)715-9540

**AS-BUILT**

DESIGNED: EDS  
 DRAWN: LDE  
 CHECKED: BDB  
 DATE: 12/2008

**COVER SHEET**  
**WATKINS' CHOICE**  
**PHASE I**  
 Lots 1, 2, Open Space Lot 3 and Non-Buildable Bulk Parcel "A"  
 Tax Map 46 - Grid 18 - Parcel 215  
 6th Election District - Howard County, Maryland  
 Previous Submittals: SP-07-010, WP-09-042  
 Owner/Developer: Williamsburg Group, LLC  
 5406 Harpers Farm Road  
 Columbia, MD 21044  
 410 997-8800

SCALE: As Shown  
 DRAWING: 1 OF 16  
 JOB NO.: 02-035.2  
 FILE NO.: F-08-179

- NOTES:**
- For street tree locations, see sheet 13.
  - All street trees and/or street signs shall be located 5 feet minimum from proposed drainage and utility structures.
  - There shall be a minimum of 20 feet between street lights, street signs and any tree.
  - For storm drain profiles and structure schedule refer to sheet 7.

**PAVING HATCH LEGEND**

- PROPOSED USE-IN-COMMON DRIVE PAVING (P-2)
- PROPOSED STANSFIELD ROAD WIDENING (P-3) \* See Note Below
- 1-1/2" MILL & OVERLAY

**NOTE:**  
Contractor shall provide a minimum of one foot (1') Full Depth saw cut (horizontally) onto Stansfield Road prior to road widening operations.



**HATCH LEGEND**

- PRIVATE STORMWATER MANAGEMENT ACCESS DRAINAGE, OPEN SPACE, SEWER & UTILITY EASEMENT
- PUBLIC WATER, SEWER & UTILITY EASEMENT
- PRIVATE 20' DRAINAGE AND UTILITY EASEMENT
- PRIVATE LANDSCAPE & MAINTENANCE EASEMENT

**NOTE:**  
\*Computed Centerline from previously platted subdivision Right of Way and "2006" CL Road Survey data.

I HEREBY CERTIFY THAT THESE DOCUMENTS WERE PREPARED OR APPROVED BY ME, AND THAT I AM A DULY LICENSED PROFESSIONAL ENGINEER UNDER THE LAWS OF THE STATE OF MARYLAND, LICENSE NO. 19184, EXPIRATION DATE 06/30/09.

SIGNED: **Bruce D. Burton** 12/19/08

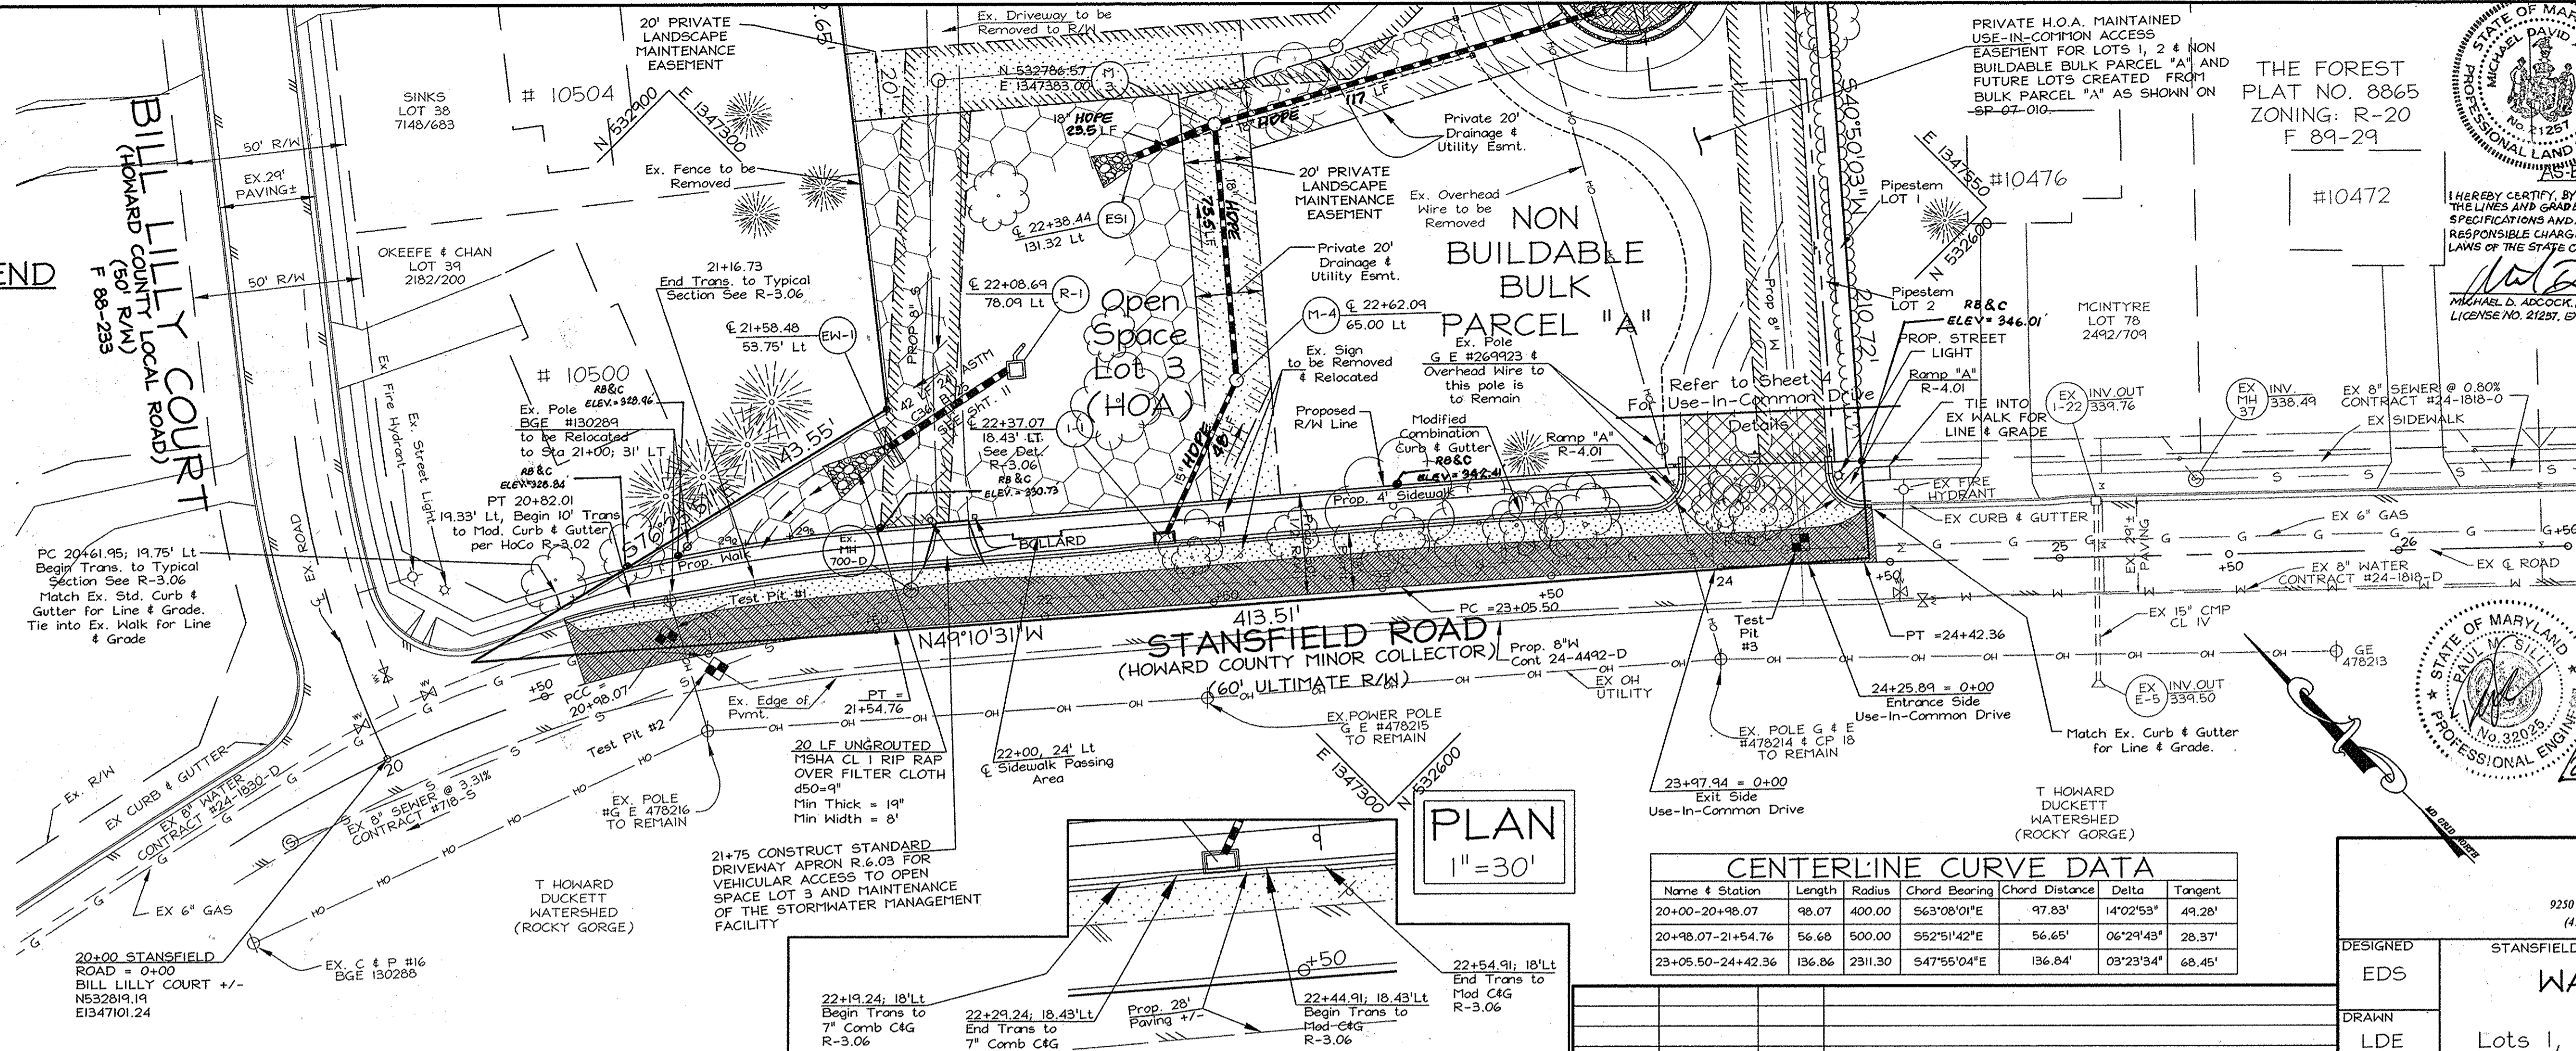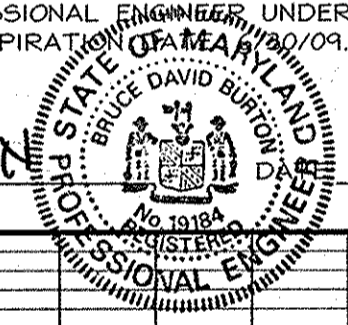


**PLAN**  
1" = 30'

**CENTERLINE CURVE DATA**

Name & Station	Length	Radius	Chord Bearing	Chord Distance	Delta	Tangent
20+00-20+98.07	98.07	400.00	S63°08'01"E	97.83'	14°02'53"	49.28'
20+98.07-21+54.76	56.68	500.00	S52°51'42"E	56.65'	06°29'43"	28.37'
23+05.50-24+42.36	136.86	2311.30	S47°55'04"E	136.84'	03°23'34"	68.45'

**STREET LIGHT TABLE**

Street Name	Symbol	Station	Offset	Lamp Type	Fixture Type	Pole Type
Stansfield Road	☉	24+35.44	25.95' LT	150 W HPS VAPOR	PREFLEX POST TOP FIXTURE	14' BLACK FIBERGLASS

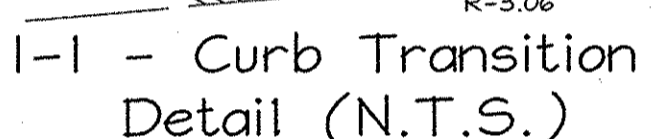


**REVISIONS**

No.	Date	By	Description
2	1/22/15	SEG	REVISE SD PIPE LENGTHS AND TYPE
1	6/12	LDE	REVISE OWNER/DEVELOPER

**STANSFIELD ROAD**  
(MINOR COLLECTOR - 60' R/W)  
POSTED SPEED: 35 mph

Vertical Curve Data:  
 1" = 5' Vert.  
 1" = 50' Hor.  
 Note: For Typical Sections, Refer Sheet 5

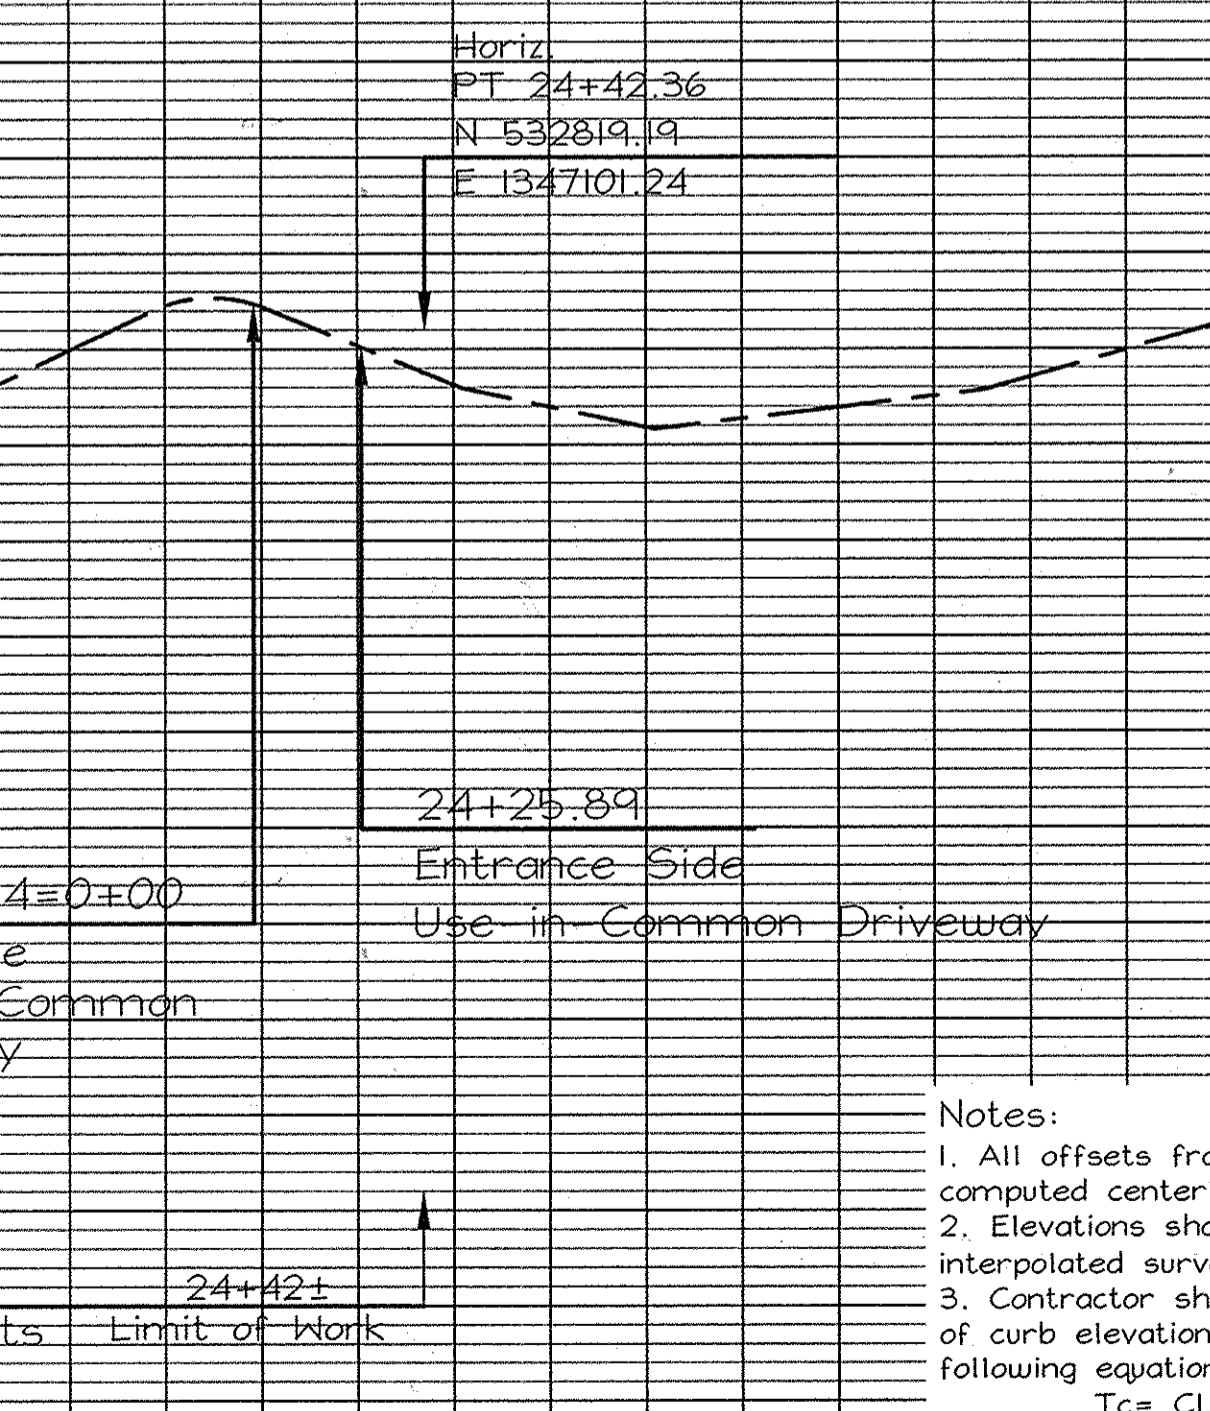


**Notes:**

- All offsets from existing "Stansfield Road" are from computed centerline, refer to Centerline Data.
- Elevations shown below are approximate only, based upon interpolated survey data "2007". Contractor shall verify.
- Contractor shall verify centerline elevation and compute top of curb elevation for proposed widening based upon the following equation for stations thru 24+50+:

$Tc = CL - 0.22' \text{ Mod. Curb \& Gutter } 1/2 \text{ Section}$

**PROFILE ALONG EASTERN CURB RETURN**  
1" = 2' VERTICAL  
1" = 20' HORIZONTAL

**PROFILE ALONG WESTERN CURB RETURN**  
1" = 2' VERTICAL  
1" = 20' HORIZONTAL

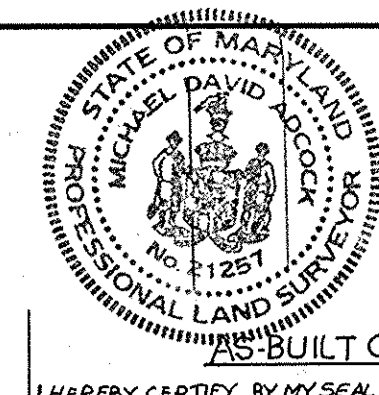

I HEREBY CERTIFY, BY MY SEAL, THAT THE CONDITIONS SHOWN ON THIS PLAN WERE CONSTRUCTED TO THE LINES AND GRADES SHOWN HEREON ON THIS "AS-BUILT" PLAN, AND MEET THE APPROVED PLANS AND SPECIFICATIONS AND ALSO THAT THESE DOCUMENTS WERE PREPARED BY ME OR UNDER MY RESPONSIBLE CHARGE AND THAT I AM A DULY LICENSED PROFESSIONAL LAND SURVEYOR UNDER THE LAWS OF THE STATE OF MARYLAND.

SIGNED: **Michael D. Adcock** 8/19/2014

**APPROVED:**  
Department of Planning & Zoning  
**Cindy Hamilton** 1/23/09  
Chief, Division of Land Development

**APPROVED:**  
Department of Public Works for Storm Drainage Systems and Roads  
**Paul Craven** 1-16-09  
Chief, Development Engineering Division

**APPROVED:**  
Department of Public Works for Storm Drainage Systems and Roads  
**William Z. White, Jr.** 1-9-09  
Chief, Bureau of Highways


**LDE Inc. AS-BUILT**  
Engineers, Surveyors, Planners  
9250 Ramsey Road, Suite 106 Columbia, Maryland - 21045  
(410)715-1070 - (301)596-3424 - FAX (410)715-8540

DESIGNED: EDS  
DRAWN: LDE  
CHECKED: BDB  
DATE: 12/2008

**WATKINS' CHOICE PHASE I**  
Lots 1, 2, Open Space Lot 3 and Non-Buildable Bulk Parcel "A"  
Tax Map 46 - Grid 18 - Parcel 215  
6th Election District - Howard County, Maryland  
Previous Submittals: SF 07-010, WP 09-042  
Owner/Developer: **Williamsburg Group, LLC**  
5406 Harpers Farm Ed. Suite 200 Columbia, MD 21044 (410) 997-8800

SCALE: As Shown  
DRAWING: 2 OF 16  
JOB NO.: 02-035.2  
FILE NO.: F-08-179



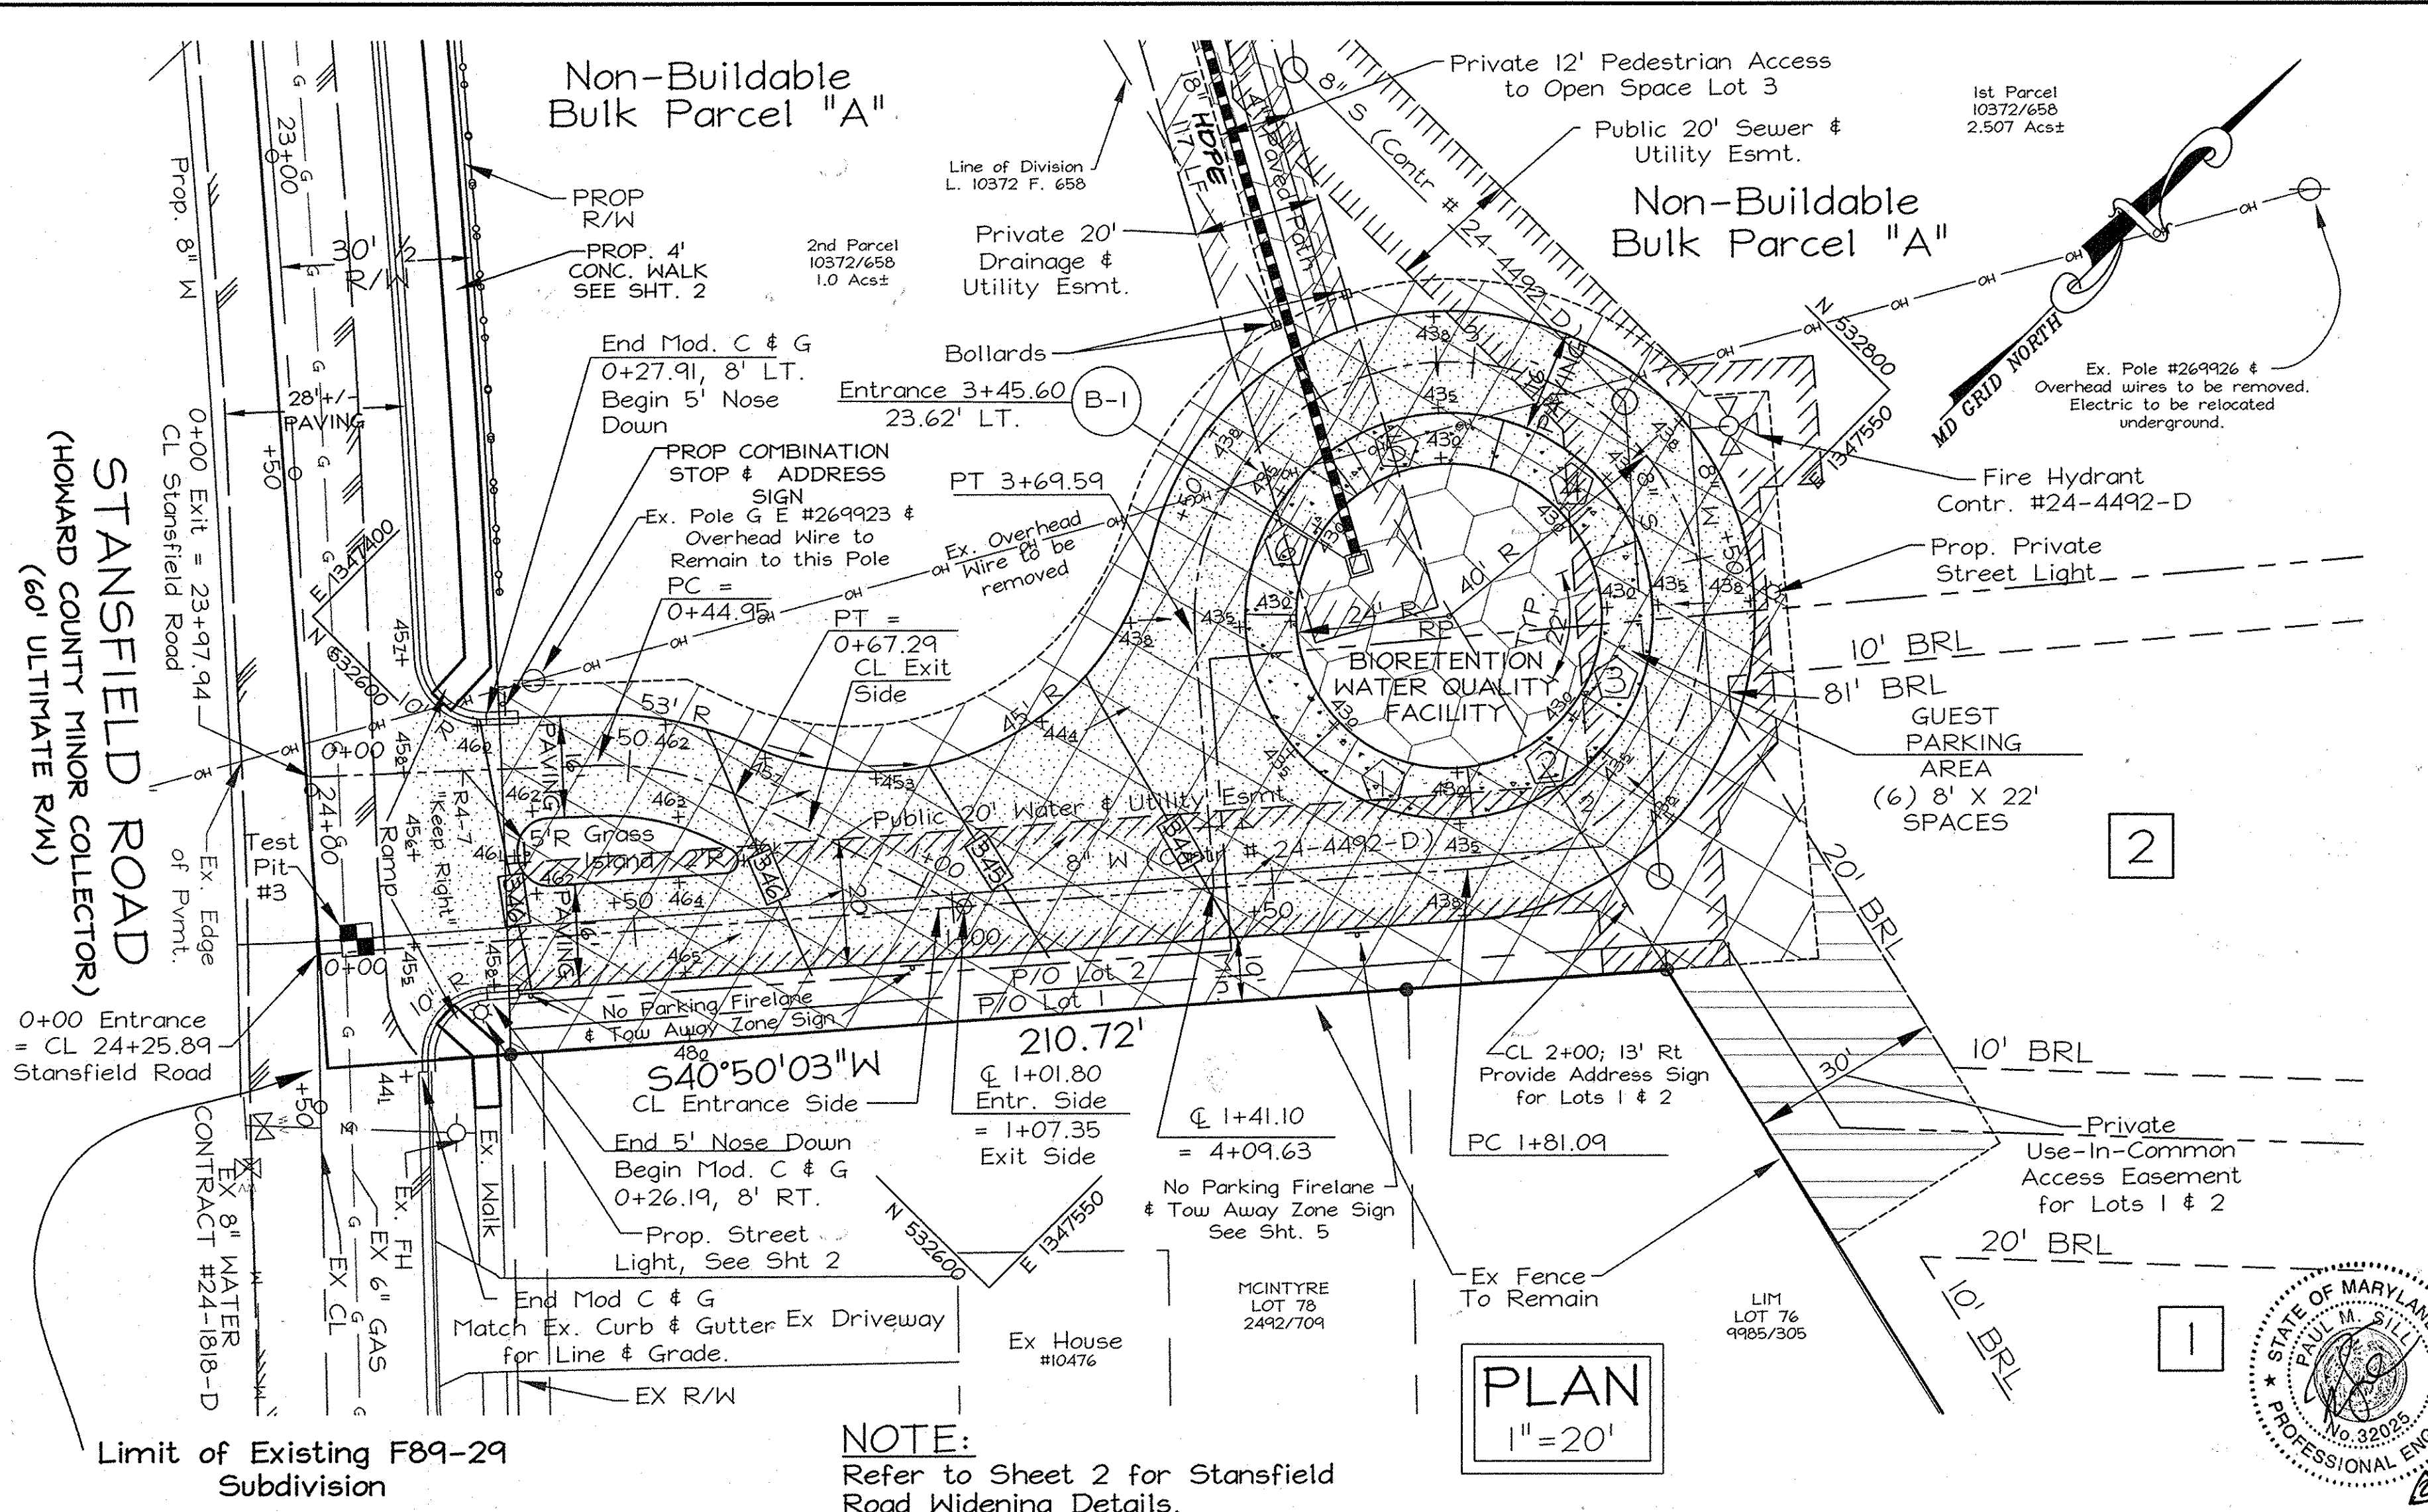

### STREET LIGHT TABLE

Street Name	Symbol	Station	Offset	Lamp Type	Fixture Type	Pole Type
Use In Common Drive		2+43.97	11.03' RT	150 W HPS VAPOR	TOP FIXTURE	14' BLACK FIBERGLASS

**AS-BUILT CERTIFICATION**

I HEREBY CERTIFY, BY MY SEAL, THAT THE CONDITIONS SHOWN ON THIS PLAN WERE CONSTRUCTED TO THE LINES AND GRADES SHOWN IN RED ON THIS "AS-BUILT" PLAN, AND MEET THE APPROVED PLANS AND SPECIFICATIONS AND ALSO THAT THESE DOCUMENTS WERE PREPARED BY ME OR UNDER MY RESPONSIBLE CHARGE AND THAT I AM A DULY LICENSED PROFESSIONAL LAND SURVEYOR UNDER THE LAWS OF THE STATE OF MARYLAND.

*Michael D. Alcock*  
 MICHAEL D. ALCOCK, PROFESSIONAL LAND SURVEYOR  
 LICENSE NO. 21627, EXPIRATION DATE: JUNE 16, 2017

8/19/2014  
DATE



### HATCH LEGEND

	PRIVATE USE-IN-COMMON ACCESS EASEMENT FOR LOTS 1, 2 & NON-BUILDABLE BULK PARCEL "A" AND FUTURE LOTS CREATED FROM BULK PARCEL "A" AS SHOWN ON SP-07-010
	PRIVATE STORMWATER MANAGEMENT ACCESS DRAINAGE & UTILITY EASEMENT
	PRIVATE 30' USE-IN-COMMON ACCESS EASEMENT FOR LOTS 1 & 2
	PUBLIC WATER, SEWER & UTILITY EASEMENT
	PRIVATE 20' DRAINAGE & UTILITY EASEMENT
	12' PRIVATE EASEMENT FOR PEDESTRIAN ACCESS TO OPEN SPACE LOT 3

### CENTERLINE CURVE DATA

Name & Station	Length	Radius	Chord Bearing	Chord Distance	Delta	Tangent
Entrance 1+81.03-3+69.59	22.34	45.00	N56°58'24"E	22.11'	28°26'33"	11.40
Exit 0+44.95-0+67.29	188.50	40.00	N87°43'30"W	51.33'	270°00'18"	40.00

Radius Point (RP) N 532725.95 E 1347526.23

I HEREBY CERTIFY THAT THESE DOCUMENTS WERE PREPARED OR APPROVED BY ME, AND THAT I AM A DULY LICENSED PROFESSIONAL ENGINEER UNDER THE LAWS OF THE STATE OF MARYLAND.

*Bruce D. Burton*  
 SIGNED: BRUCE D. BURTON  
 BRUCE D. BURTON, PROFESSIONAL ENGINEER  
 LICENSE NO. 19184, EXPIRATION DATE: 6/30/2018

12/19/08

No.	Date	By	Description
2	11/25/12	SEE LDE	REVISE SP PILE LENGTHS AND TYPES
	02/12	LDE	REVISE OWNER/DEVELOPER

REVISIONS

- NOTES:**
- For street tree locations, see sheet 13.
  - All street trees and/or street signs shall be located 5 feet Minimum from proposed drainage and utility structures.
  - There shall be a minimum of 20 feet between street lights, street signs and any street trees.
  - For storm drain profiles and structure schedule refer to sheet 7.
  - For Traffic Control Sign Legend, See Sheet 5.

**APPROVED:**  
 Department of Planning & Zoning

*Cindy Korman* 1/2/09  
 Chief, Division of Land Development

*Chad Chandon* 1/16/9  
 Chief, Development Engineering Division



**APPROVED:**  
 Department of Public Works for Storm Drainage Systems and Roads


*William J. Adams* 1-9-09  
 Chief, Bureau of Highways

**OWNER/DEVELOPER**  
 Williamsburg Group, LLC  
 5455 Harpers Farm Rd.  
 Suite 200  
 Columbia, MD 21044  
 410-991-8800


**LDE Inc. AS-BUILT**  
 Engineers, Surveyors, Planners  
 9230 Runny Road, Suite 106 Columbia, Maryland - 21045  
 (410)715-1070 - (301)596-3424 - FAX (410)715-0540

DESIGNED EDS	PRIVATE USE-IN-COMMON DRIVEWAY - PLAN & PROFILE	SCALE As Shown
DRAWN LDE	<b>WATKINS' CHOICE PHASE I</b> Lots 1, 2, Open Space Lot 3 and Non-Buildable Bulk Parcel "A"	DRAWING 4 OF 16
CHECKED BDB	Tax Map 46 - Grid 18 - Parcel 215 6 th Election District - Howard County, Maryland	JOB NO. 02-035.2
DATE 12/2008	Previous Submittals: SP-07-010, WP-09-042 Owner/Developer: Williamsburg Group, LLC 5455 Harpers Farm Rd. Suite 200 Columbia, MD 21044 (410)991-8800	FILE NO. F-08-179

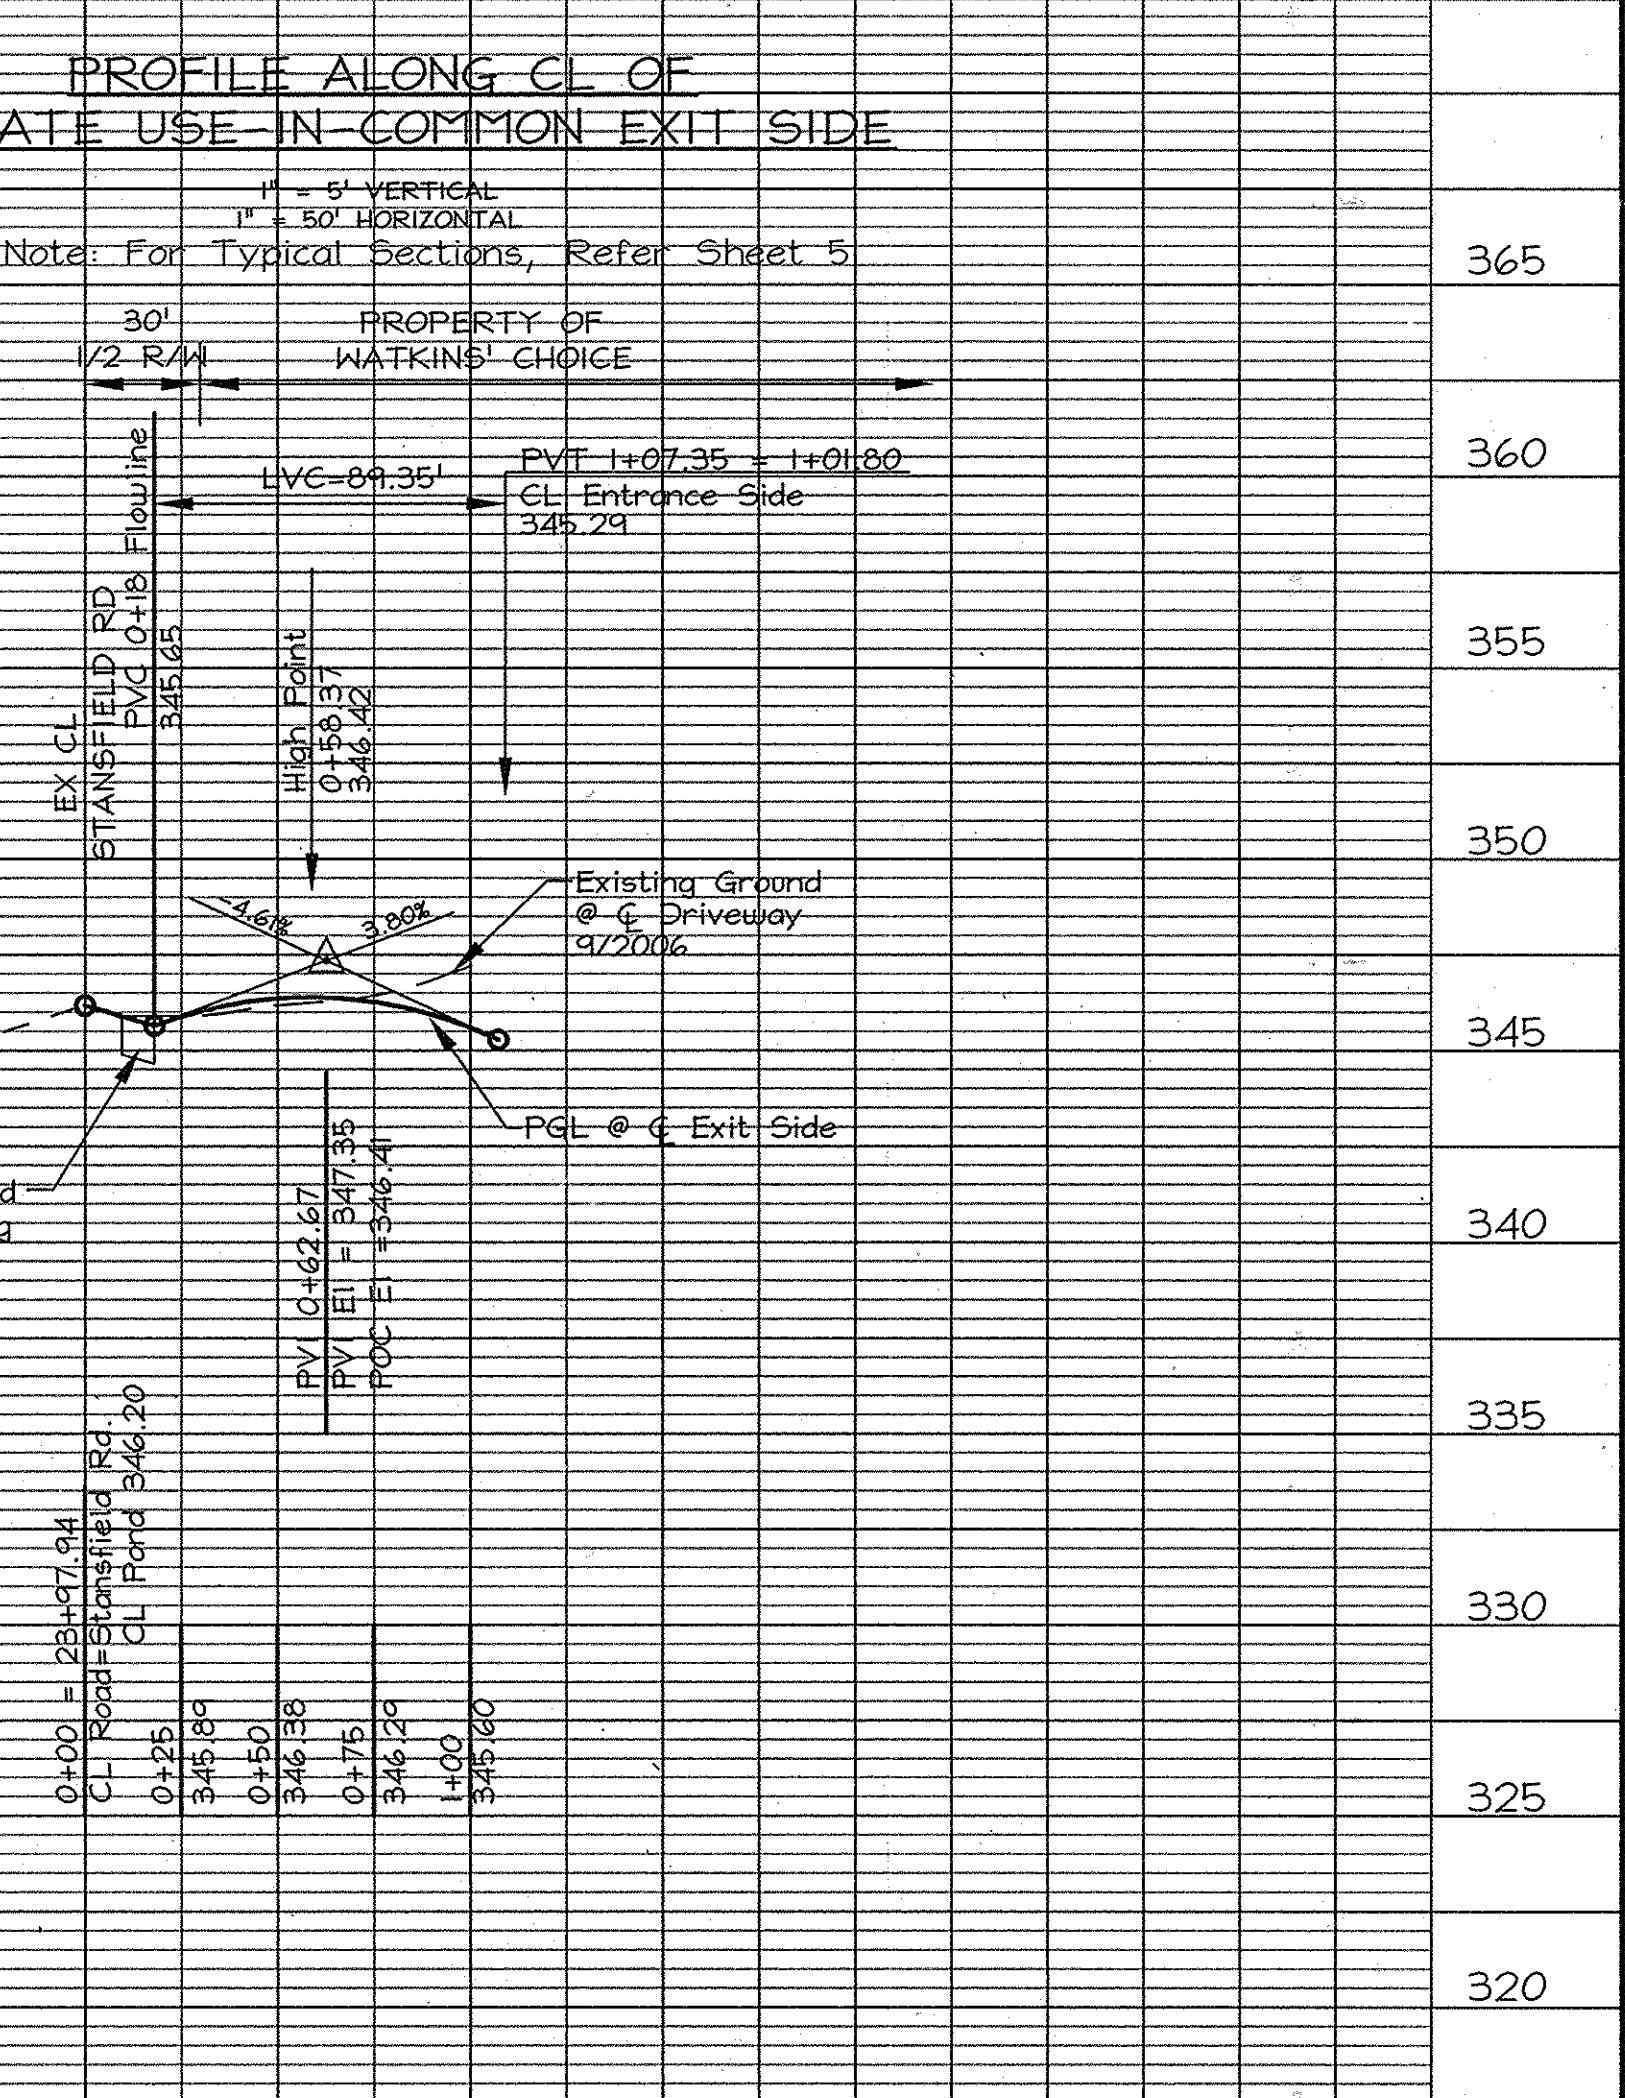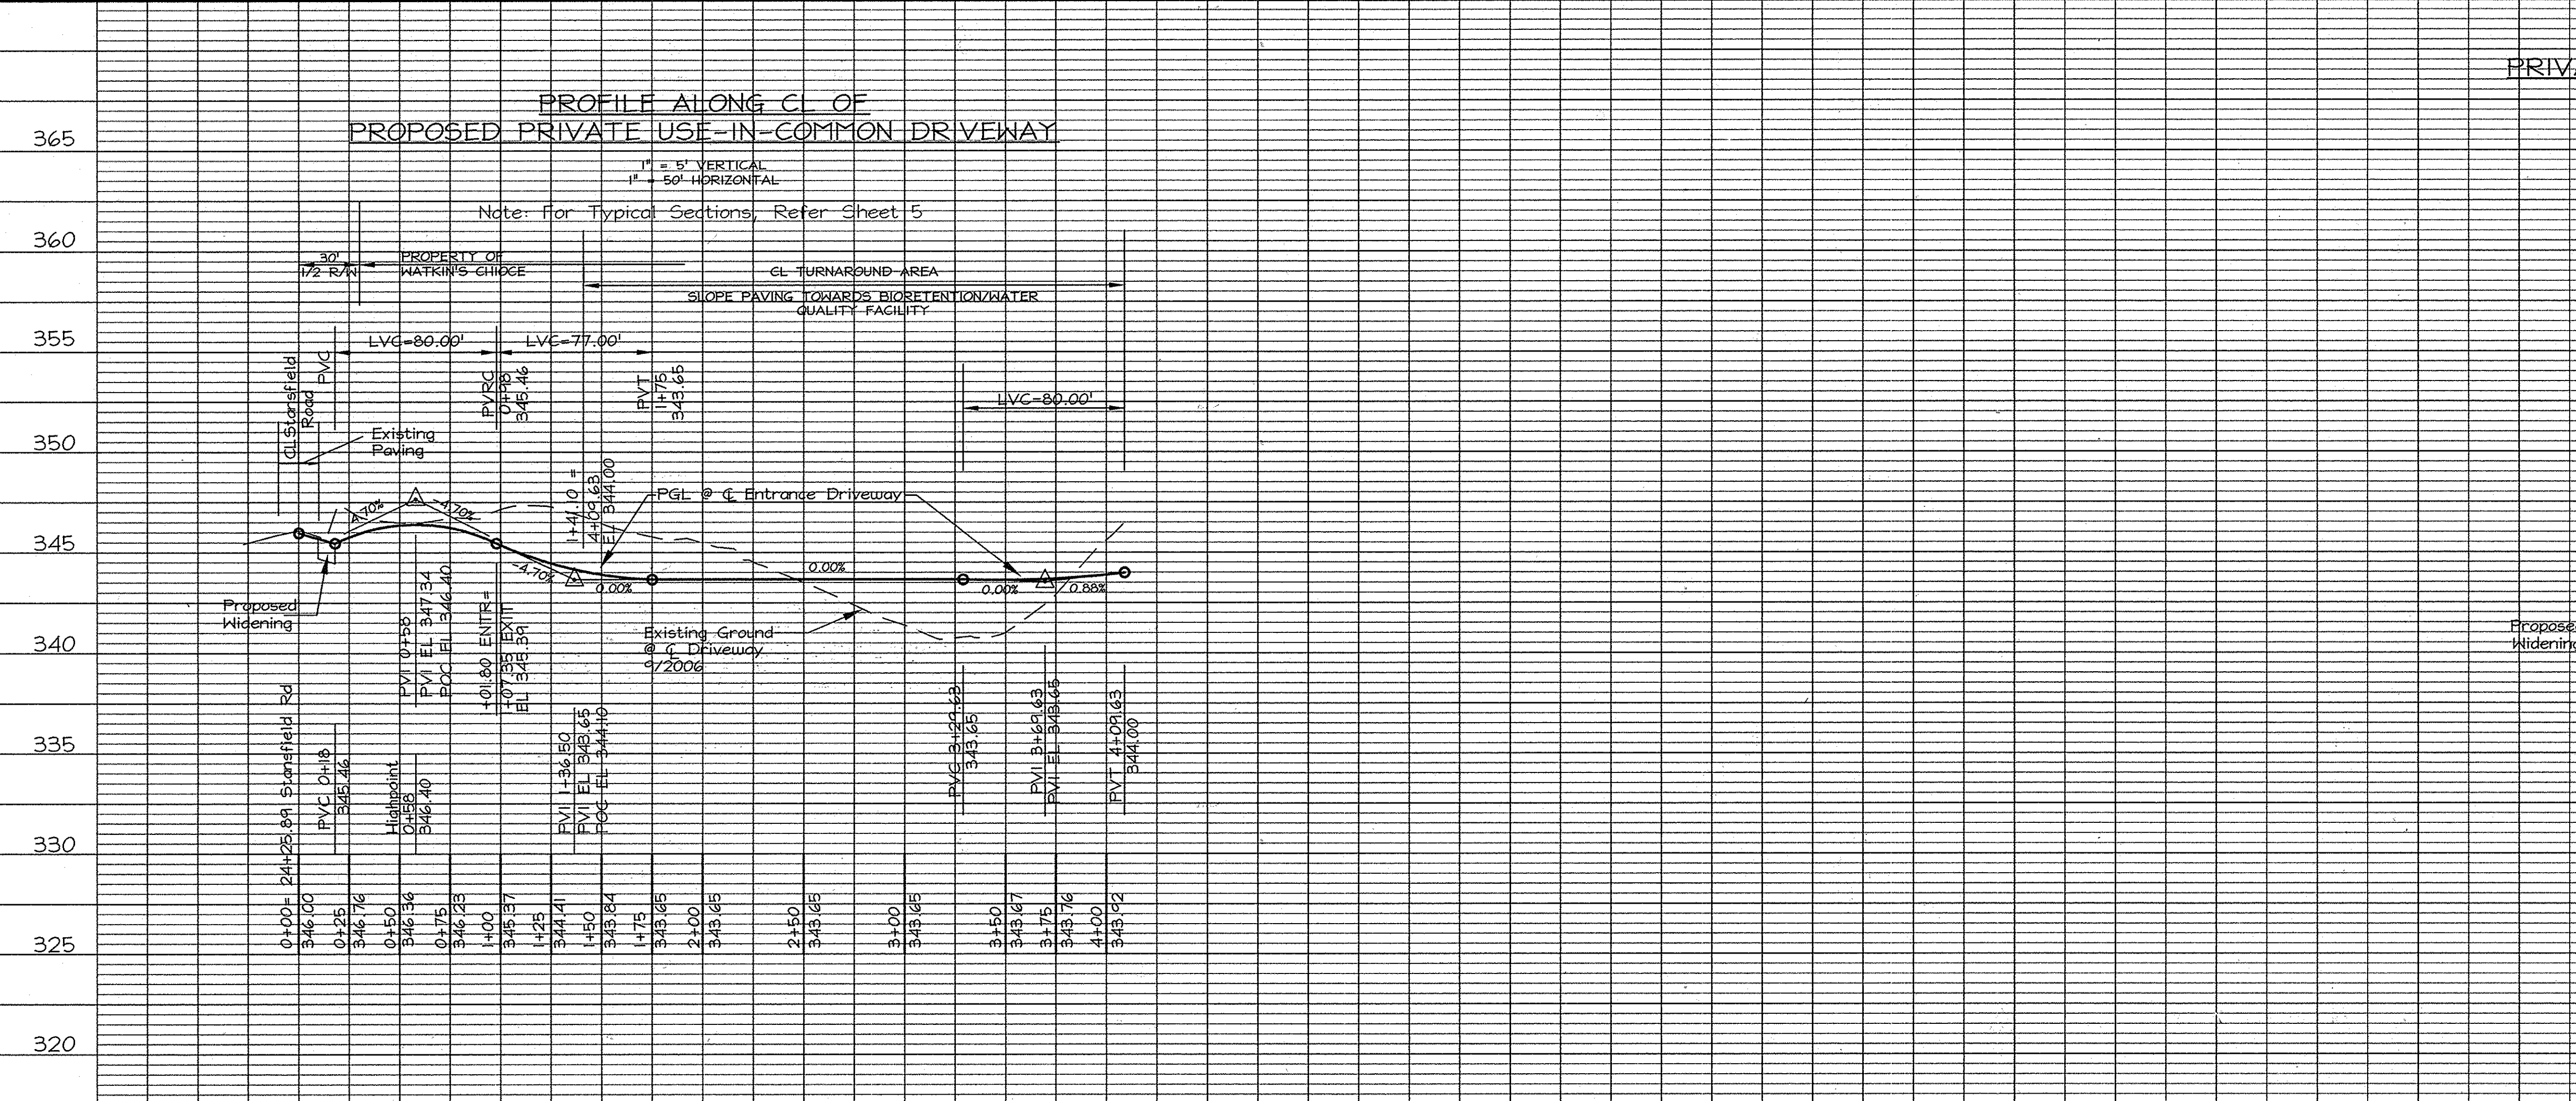


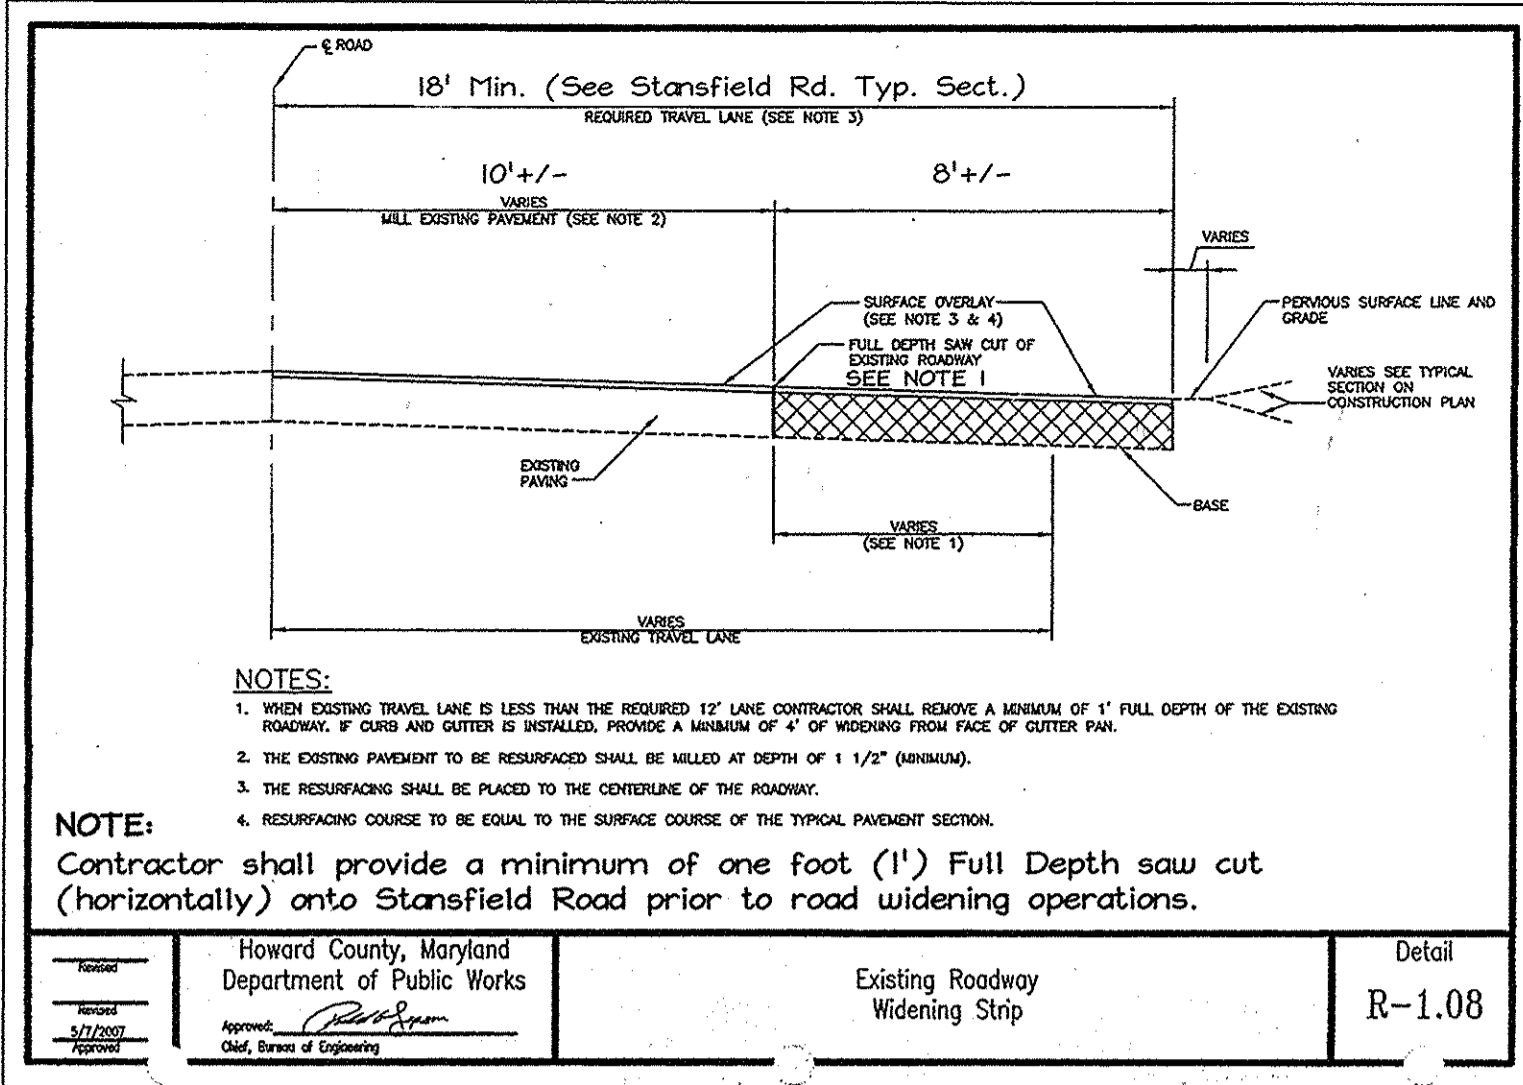


Howard County, Maryland Department of Public Works  
Existing Roadway Widening Strip  
Detail R-1.08

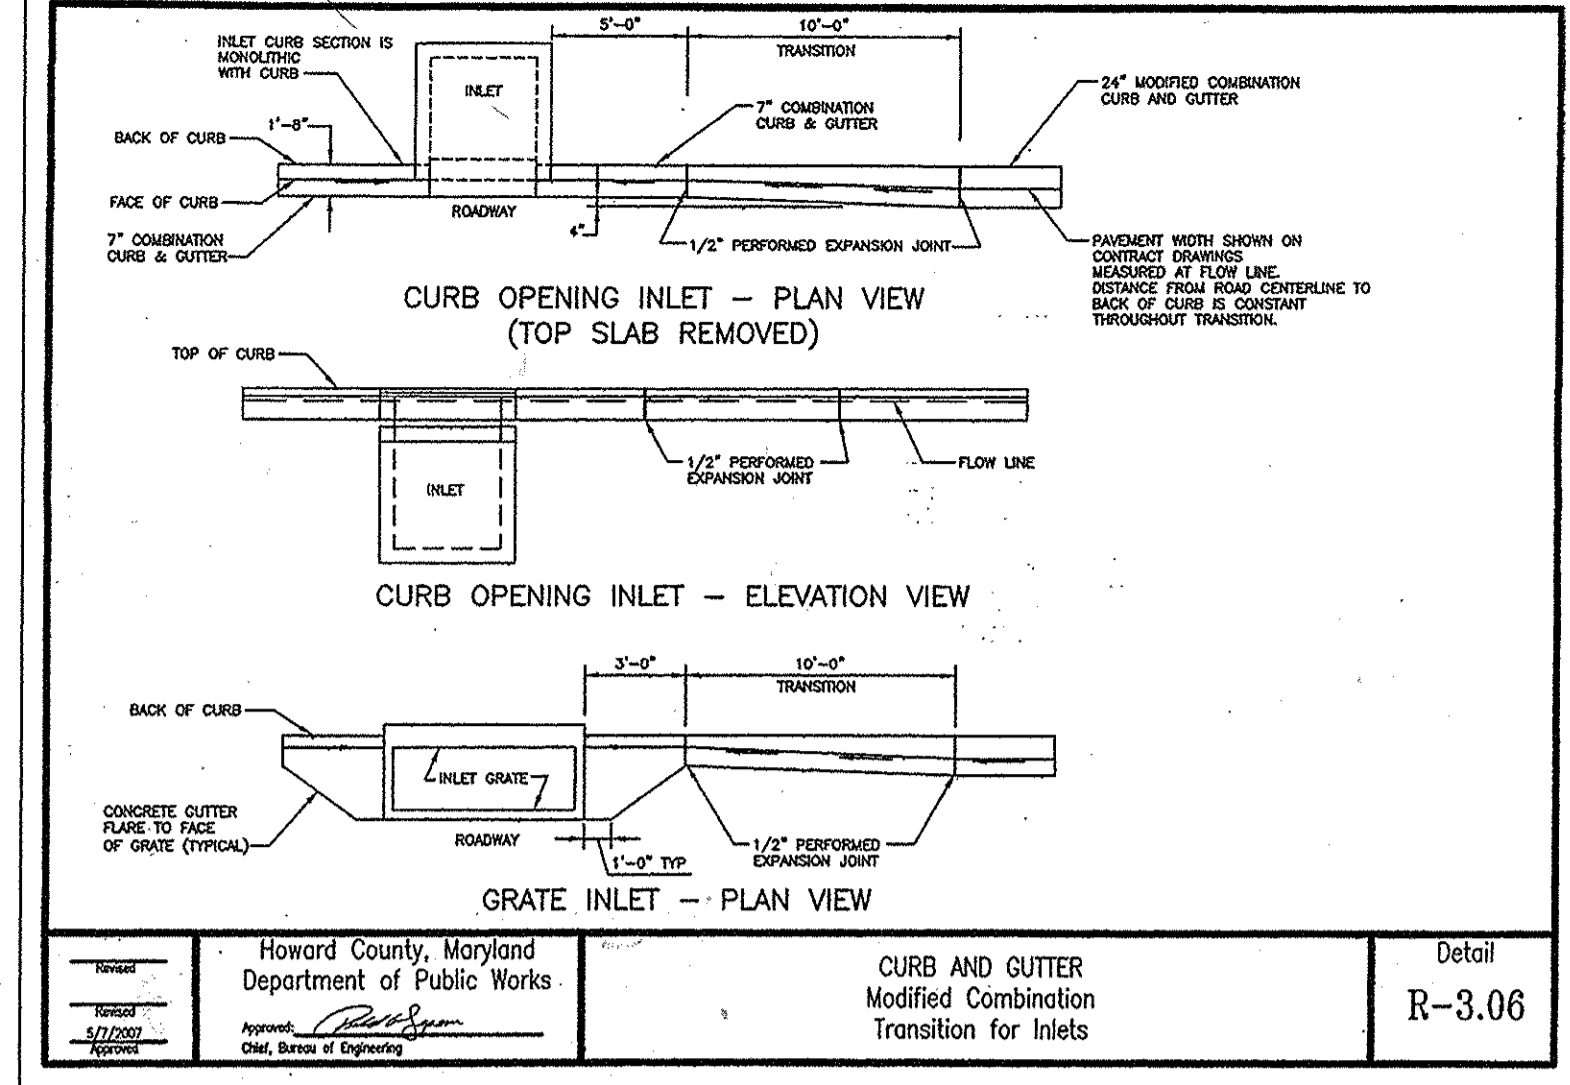


Howard County, Maryland Department of Public Works  
CURB AND GUTTER Modified Combination Transition for Inlets  
Detail R-3.06

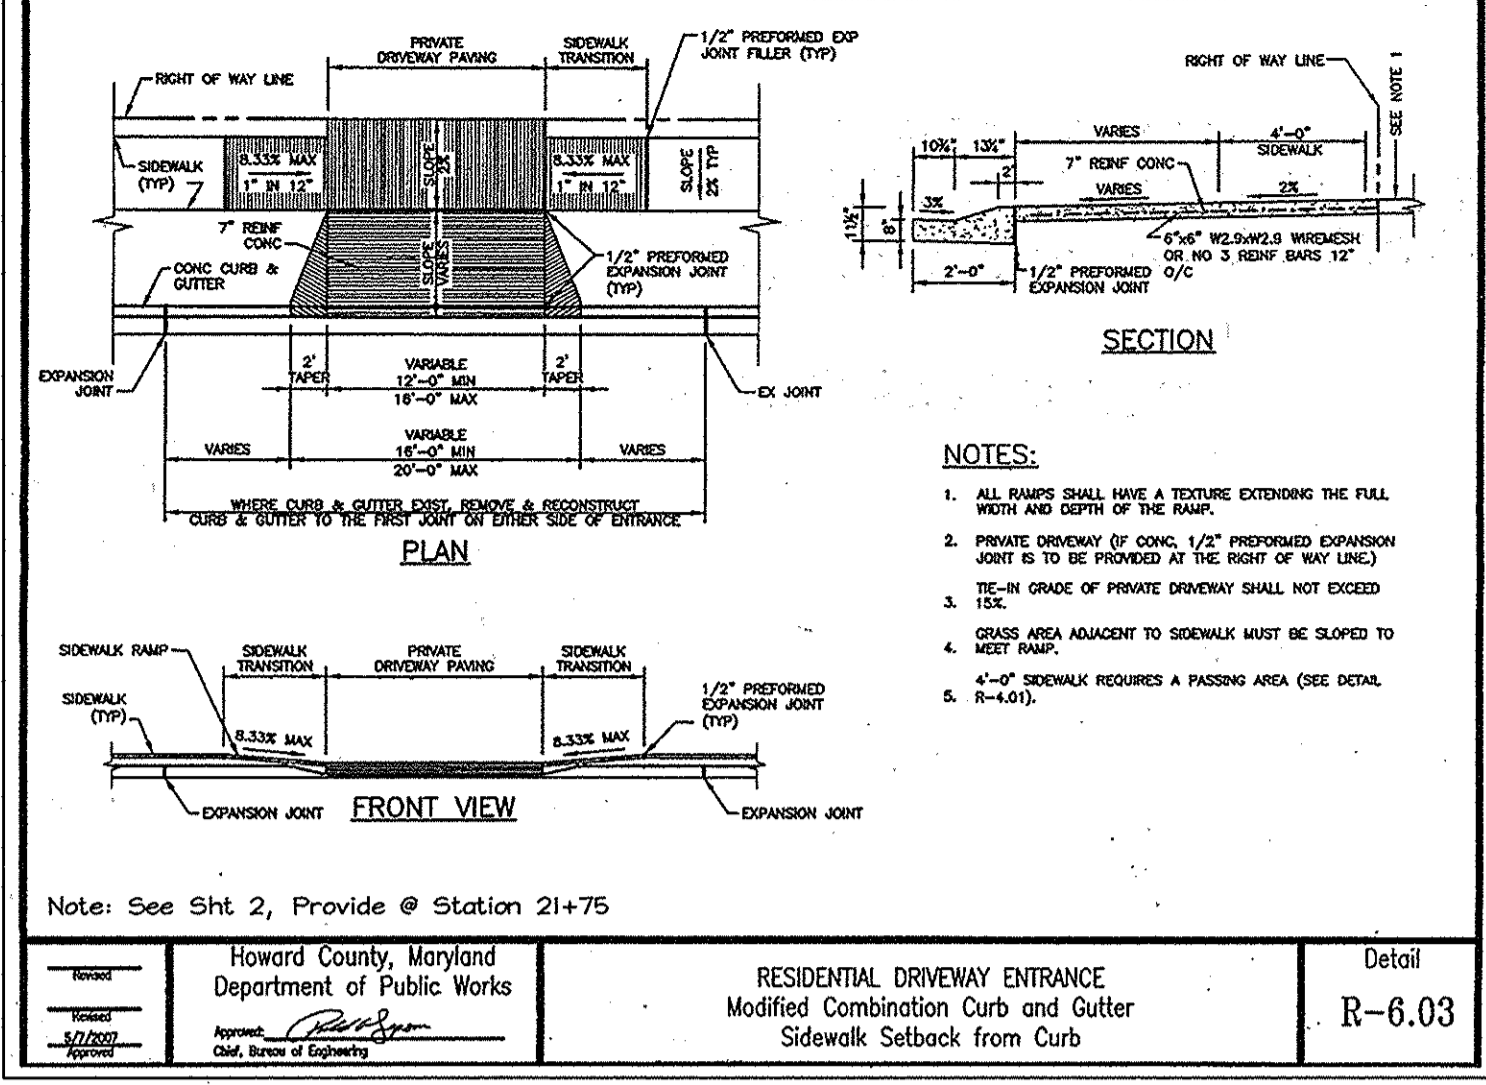


Howard County, Maryland Department of Public Works  
RESIDENTIAL DRIVEWAY ENTRANCE Modified Combination Curb and Gutter Sidewalk Setback from Curb  
Detail R-6.03

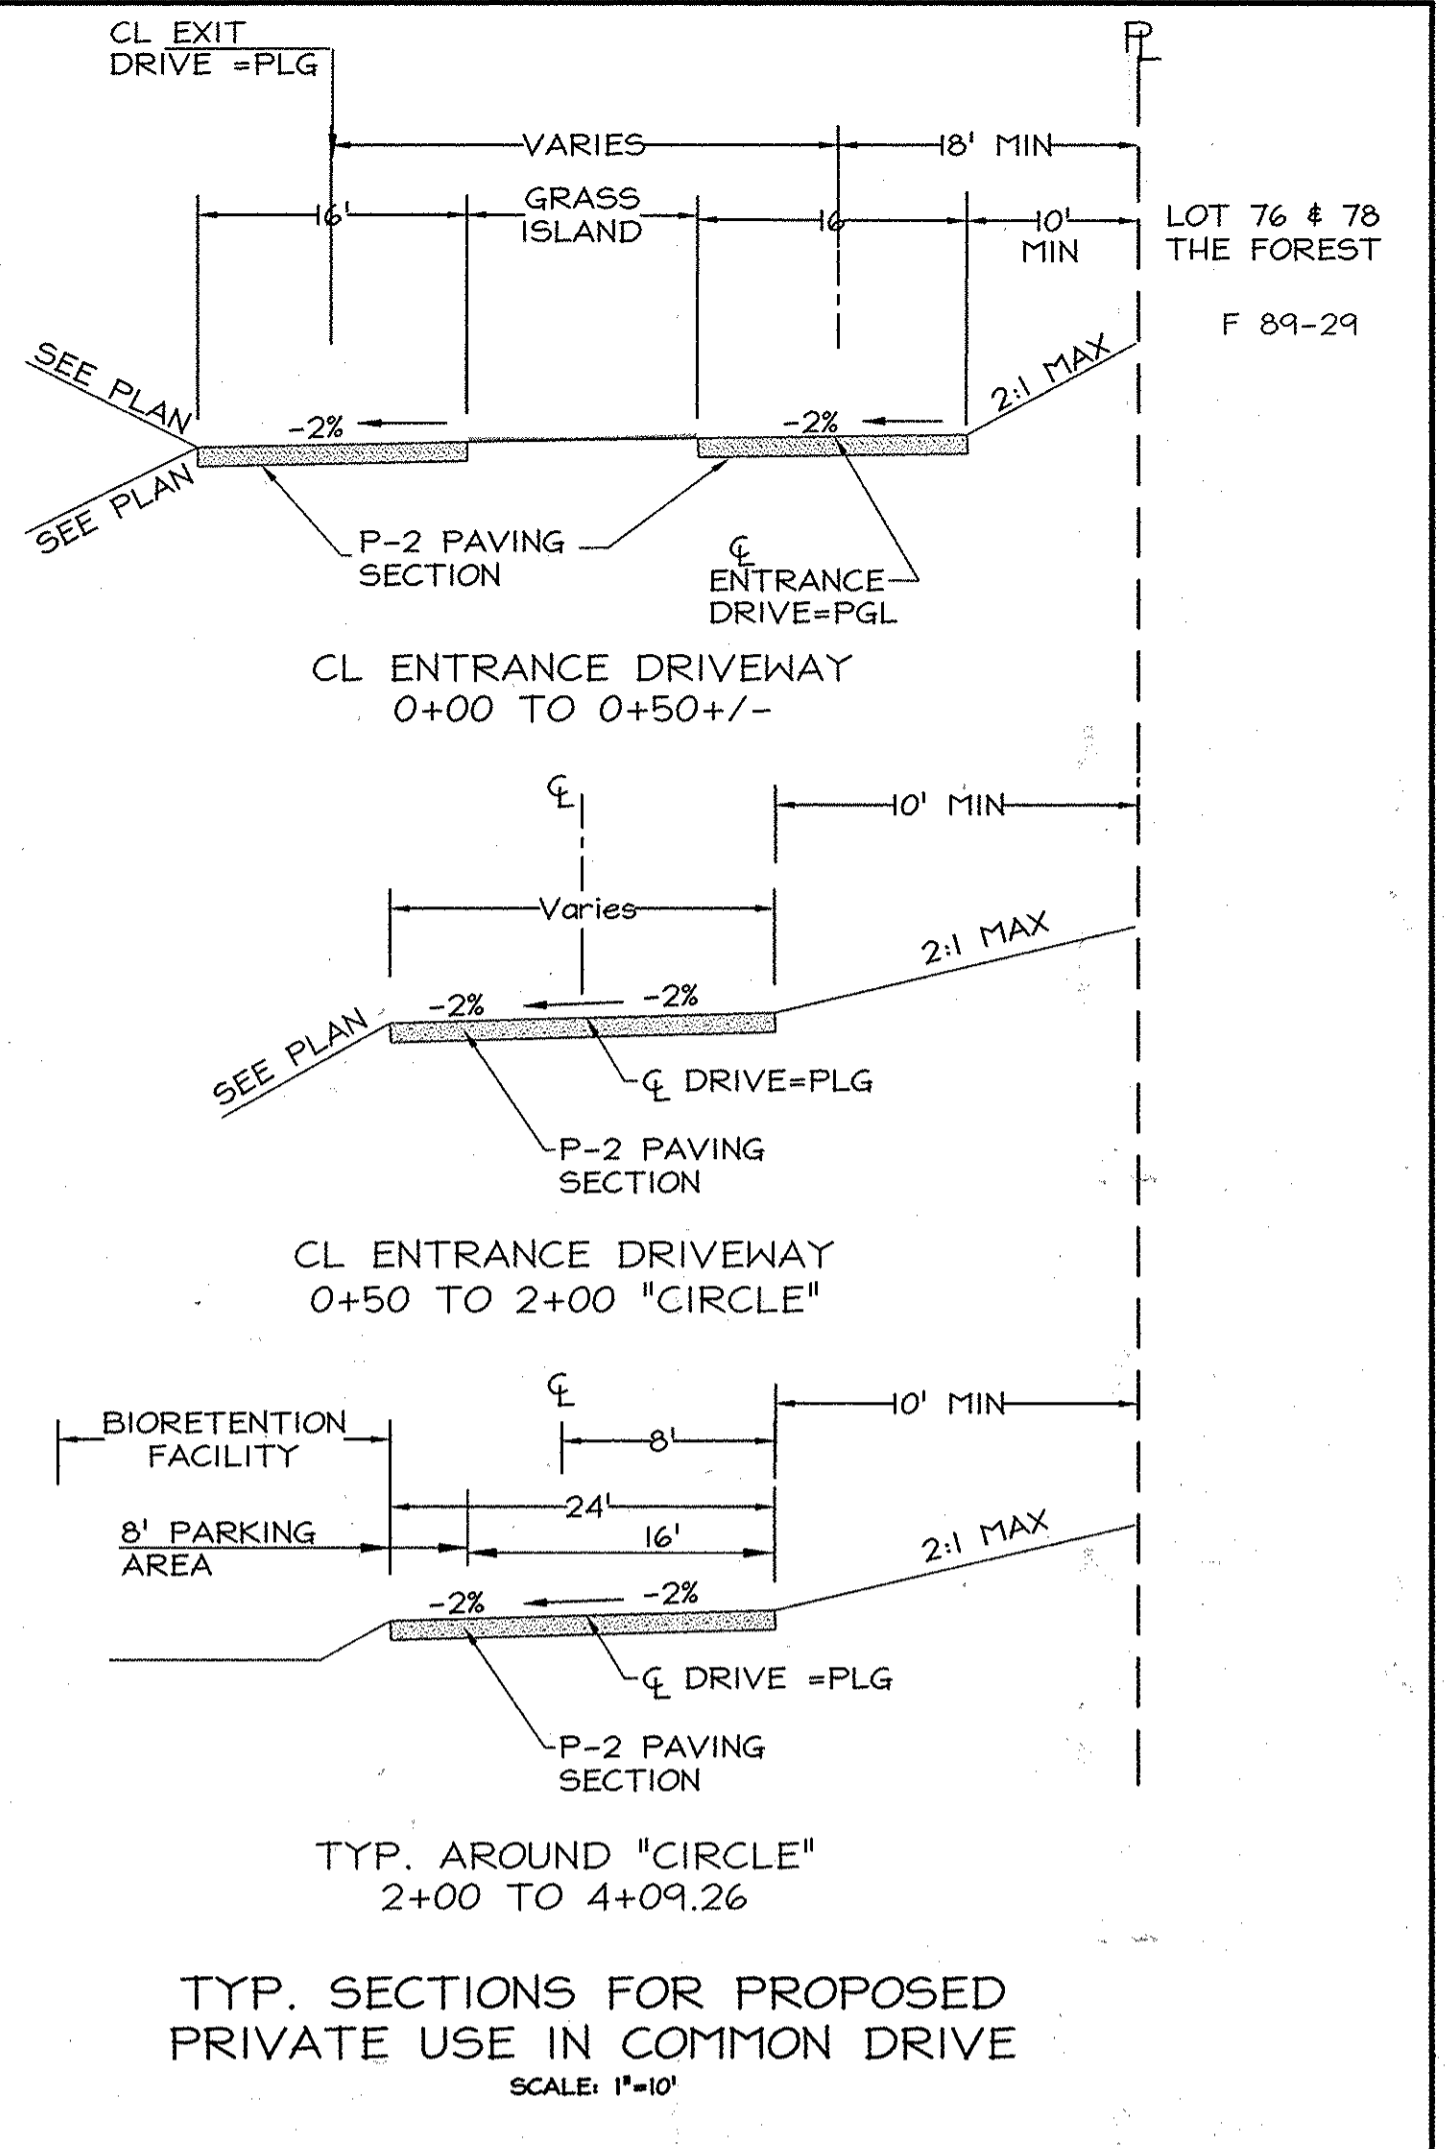


NOTE: Contractor shall provide a minimum of one foot (1') Full Depth saw cut (horizontally) onto Stansfield Road prior to road widening operations.

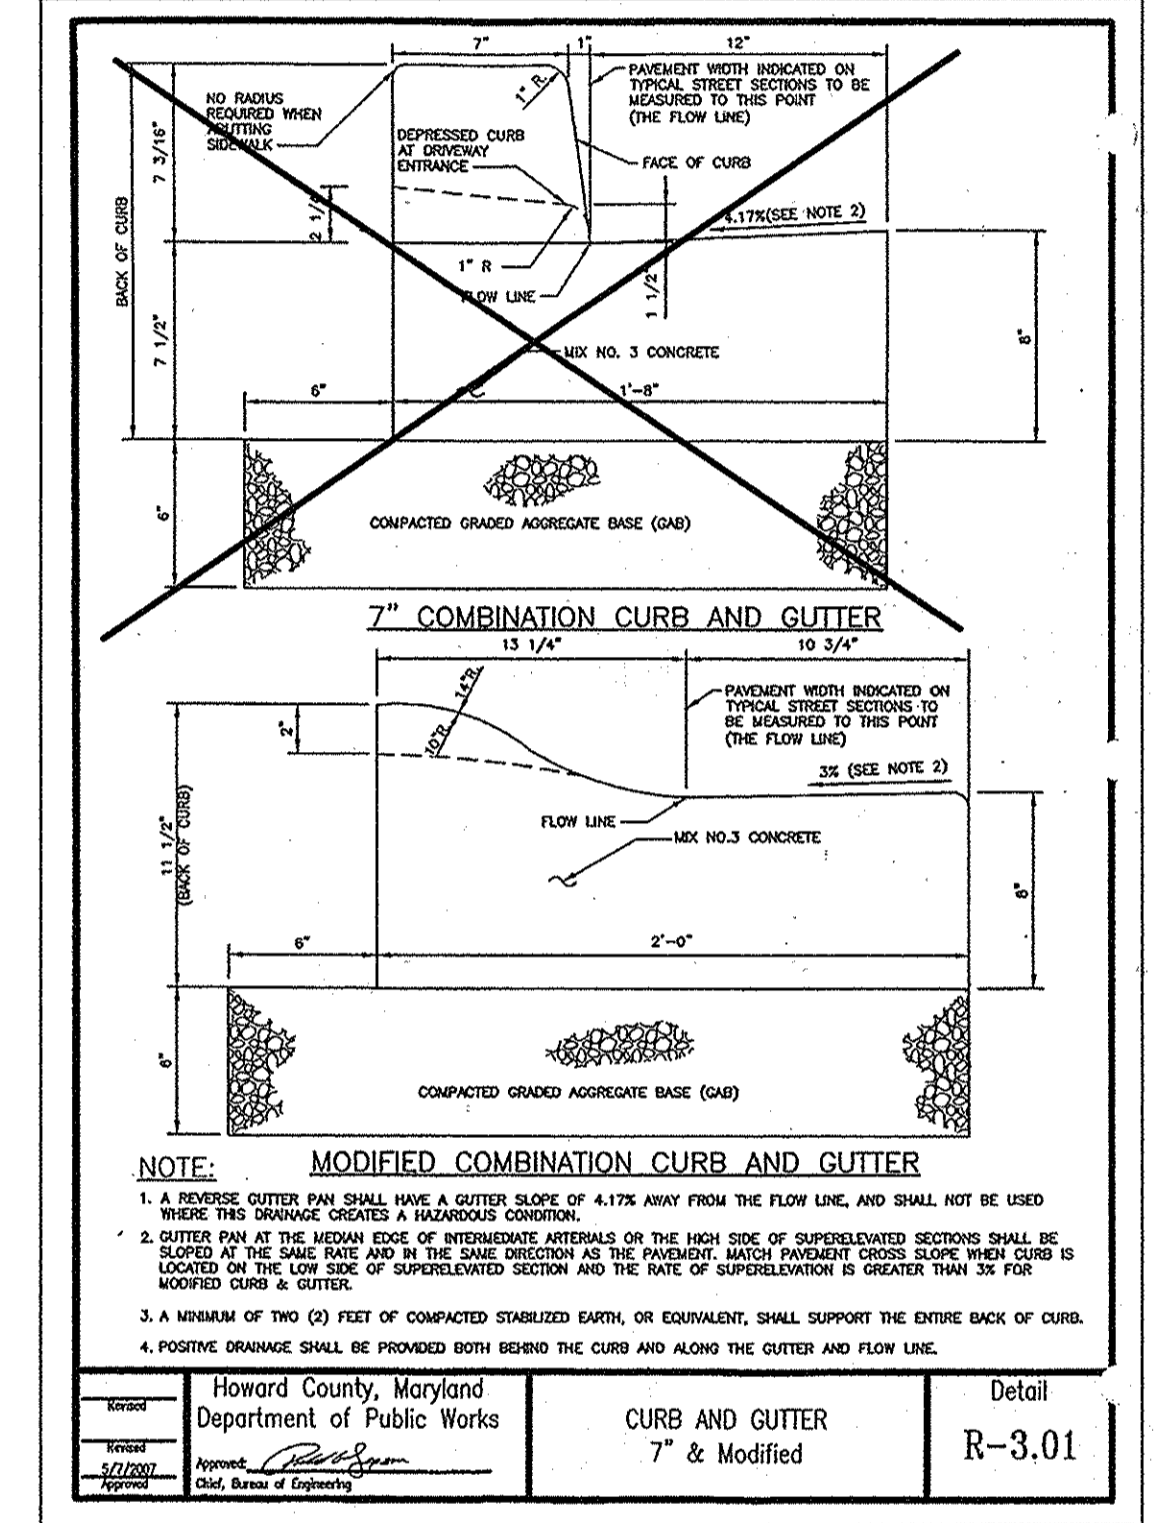


Howard County, Maryland Department of Public Works  
CURB AND GUTTER 7' & Modified  
Detail R-3.01

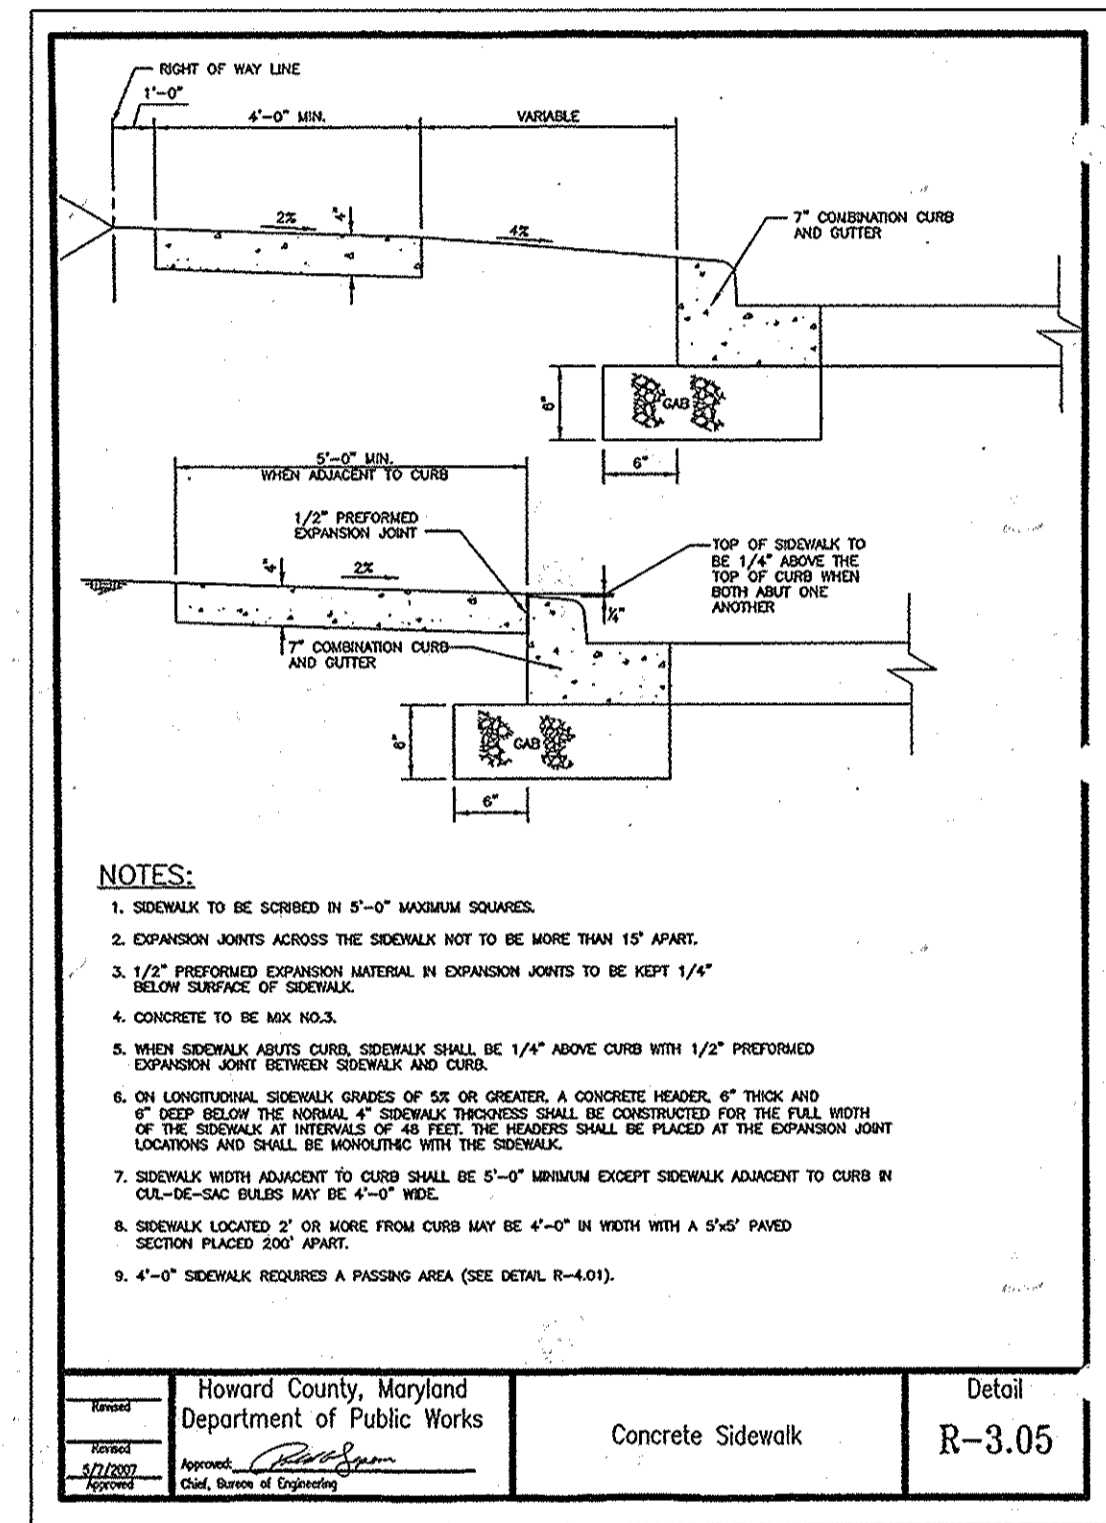

Howard County, Maryland Department of Public Works  
Concrete Sidewalk  
Detail R-3.05

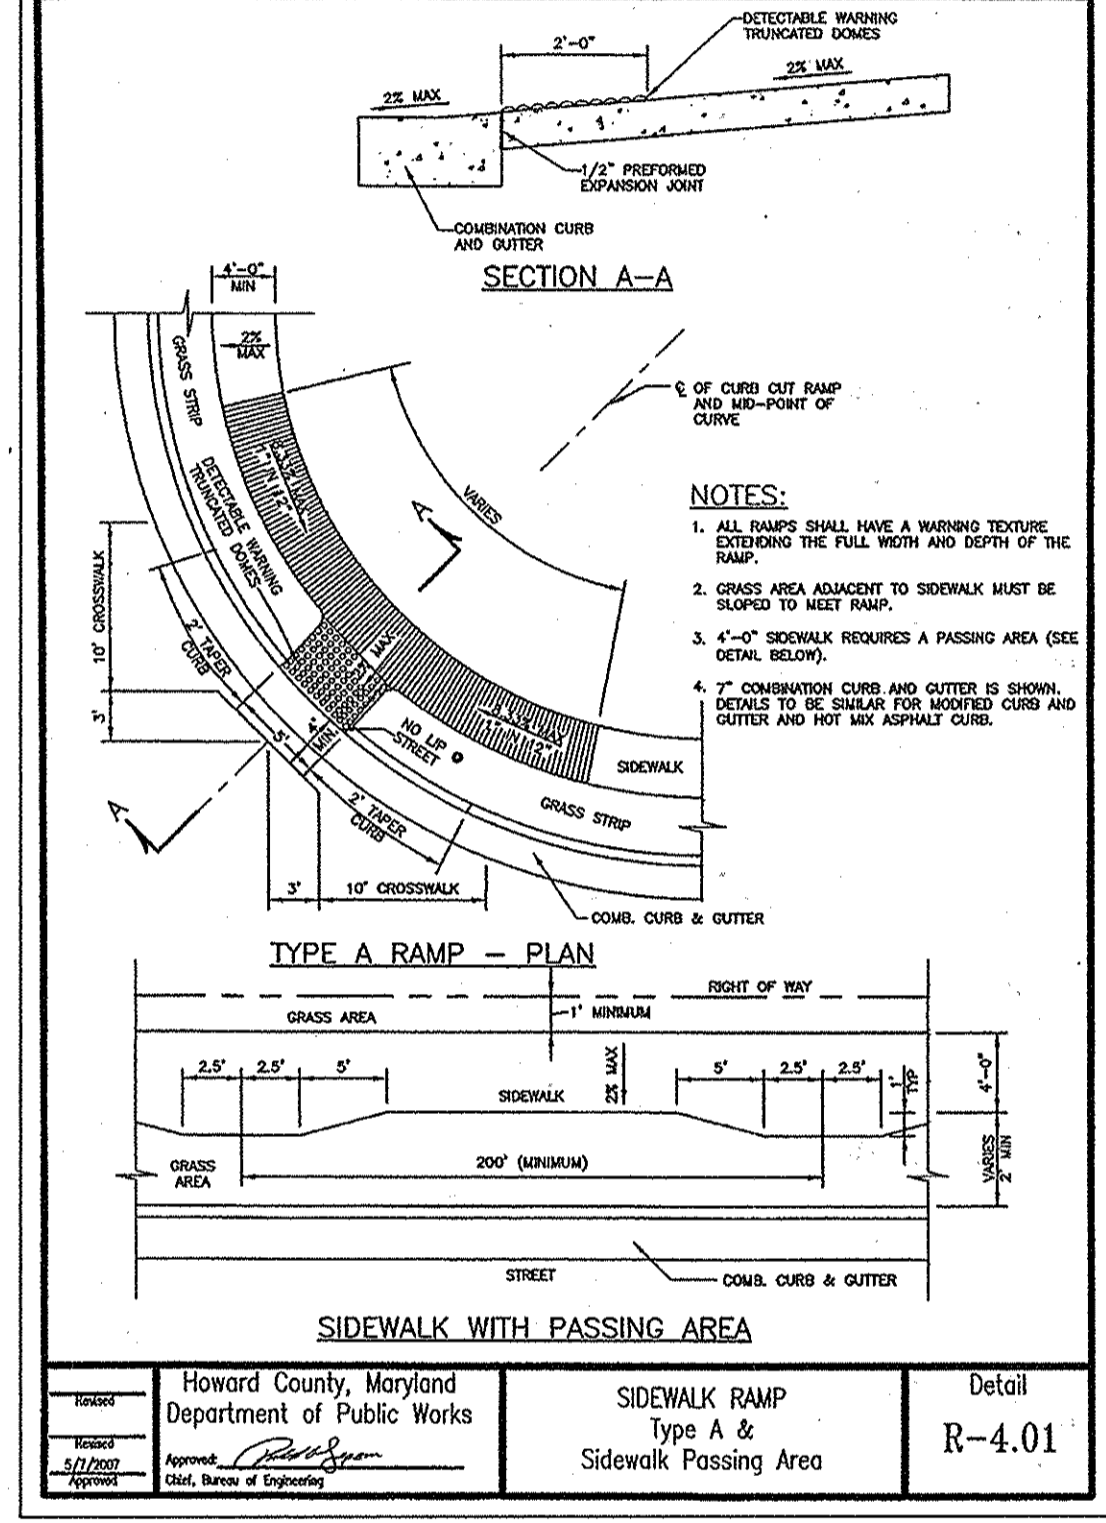


Howard County, Maryland Department of Public Works  
SIDEWALK RAMP Type A & Sidewalk Passing Area  
Detail R-4.01

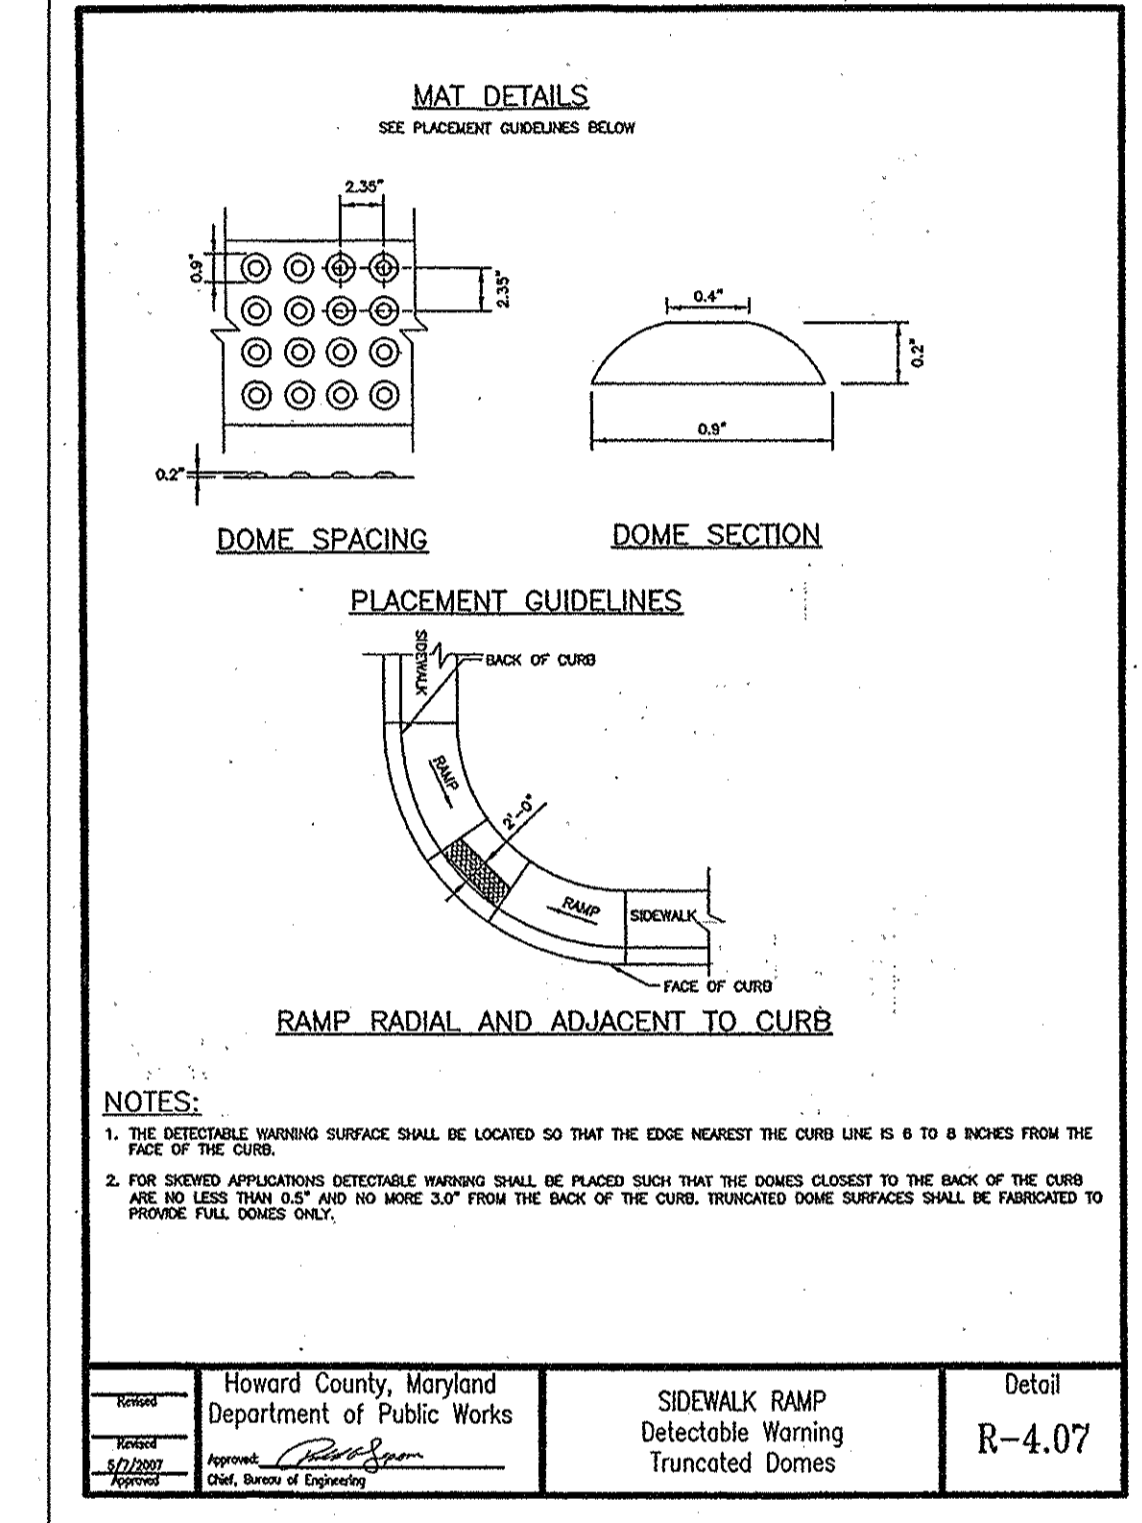

Howard County, Maryland Department of Public Works  
SIDEWALK RAMP Detectable Warning Truncated Domes  
Detail R-4.07

Symbol	Location	Station	Offset	Types
—	STANSFIELD ROAD	23+87.81	30.54' Rt	ADDRESS SIGN # RI-1, "STOP" SIGN; 30" x 30" OCTAGON **
—	USE-IN-COMMON DRIVE	0+34	13.34' Rt	R4-7, "KEEP RIGHT" SIGN; 24" x 30"
—	USE-IN-COMMON DRIVE	0+33	9.00' Rt	"NO PARKING FIRE LANE-TOW AWAY ZONE" (LEFT ARROW) SIGN; 12" x 18"
—	USE-IN-COMMON DRIVE	0+49	9.00' Rt	"NO PARKING FIRE LANE-TOW AWAY ZONE" (DOUBLE ARROW) SIGN; 12" x 18"
—	USE-IN-COMMON DRIVE	1+53	9.00' Rt	"NO PARKING FIRE LANE-TOW AWAY ZONE" (RIGHT ARROW) SIGN; 12" x 18"
—	USE-IN-COMMON DRIVE	2+00	13.00' Rt	ADDRESS SIGN (LOTS 1 & 2)

\*\* Private range of address signs and/or private road street name signs (SNS) as well as public SNS shall be fabricated and installed by Howard County Bureau of Highways at the developer's / owner's expense. Contact Howard County Traffic Division at 410-313-5752 for details and cost estimates.

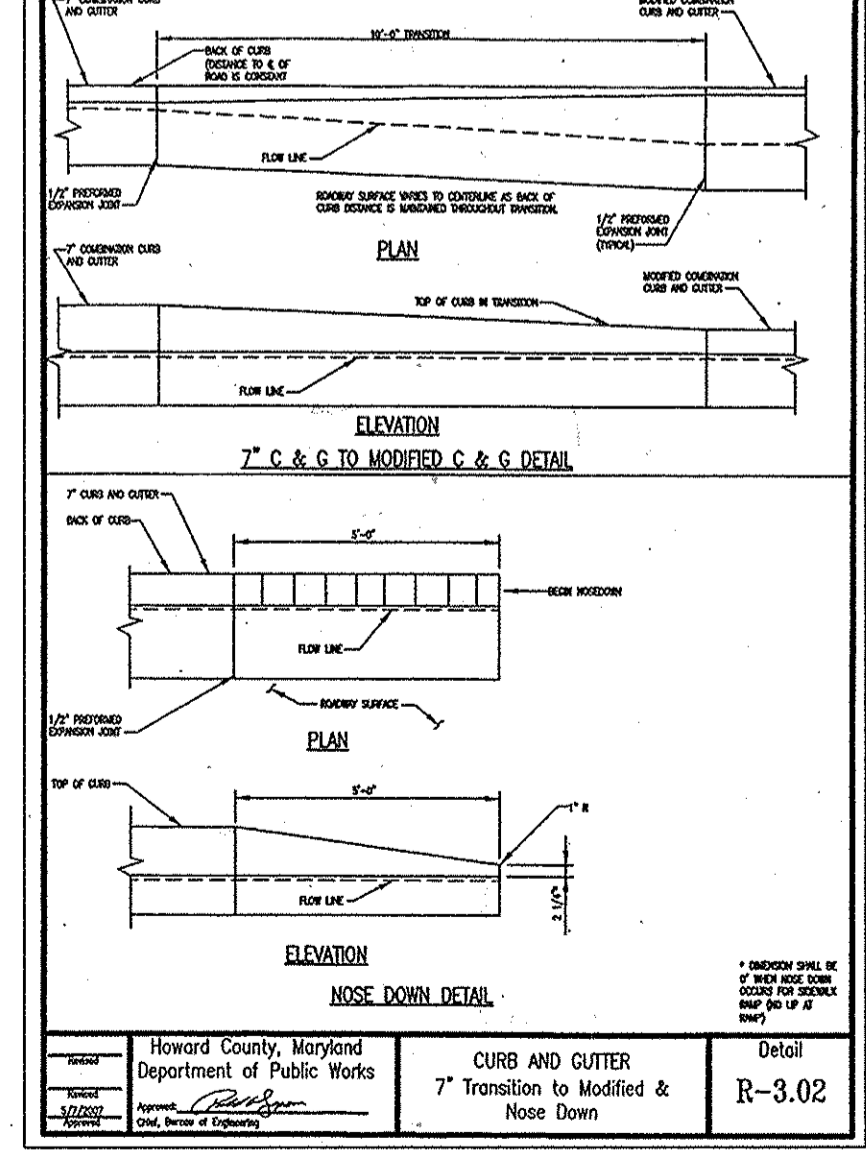

Howard County, Maryland Department of Public Works  
CURB AND GUTTER 7' Transition to Modified & Noise Down  
Detail R-3.02

SECTION	ROAD AND STREET CLASSIFICATION	CALIFORNIA BEARING RATIO (CBR)	3 TO <4	4 TO 5	5 TO 6	6 TO 7	7 TO 8	8 TO 9	9 TO 10
P-1	RESIDENTIAL AND NON-RESIDENTIAL	1.5" SMA SUPPLEMENTAL FINISH SURFACE	1.5	1.5	1.5	1.5	1.5	1.5	1.5
		3.0" SMA SUPPLEMENTAL FINISH SURFACE	2.0	2.0	2.0	2.0	2.0	2.0	2.0
P-2	LOCAL ROAD WITH TRUCKS PER DAY	1.5" SMA SUPPLEMENTAL FINISH SURFACE	1.5	1.5	1.5	1.5	1.5	1.5	1.5
		3.0" SMA SUPPLEMENTAL FINISH SURFACE	2.0	2.0	2.0	2.0	2.0	2.0	2.0
P-3	LOCAL ROAD WITH TRUCKS PER DAY	1.5" SMA SUPPLEMENTAL FINISH SURFACE	1.5	1.5	1.5	1.5	1.5	1.5	1.5
		3.0" SMA SUPPLEMENTAL FINISH SURFACE	2.0	2.0	2.0	2.0	2.0	2.0	2.0
P-4	MAJOR COLLECTORS	1.5" SMA SUPPLEMENTAL FINISH SURFACE	1.5	1.5	1.5	1.5	1.5	1.5	1.5
		3.0" SMA SUPPLEMENTAL FINISH SURFACE	2.0	2.0	2.0	2.0	2.0	2.0	2.0

Howard County, Maryland Department of Public Works  
PAVING SECTIONS P-1 to P-4  
Detail R-2.01

**AS BUILT CERTIFICATION**

I HEREBY CERTIFY, BY MY SEAL, THAT THE CONDITIONS SHOWN ON THIS PLAN WERE CONSTRUCTED TO THE LINES AND GRADES SHOWN IN RED ON THIS "AS-BUILT" PLAN, AND THAT THE APPROVED PLANS AND SPECIFICATIONS AND ALSO THAT THESE DOCUMENTS WERE PREPARED BY ME OR UNDER MY RESPONSIBLE CHARGE AND THAT I AM A DULY LICENSED PROFESSIONAL LAND SURVEYOR UNDER THE LAWS OF THE STATE OF MARYLAND.

APPROVED: DEPARTMENT OF PUBLIC WORKS  
 WALTER R. WADSWORTH, CHIEF, BUREAU OF HIGHWAYS, 1-9-09 DATE

APPROVED: DEPARTMENT OF PLANNING AND ZONING  
 GUYDAN HANCOCK, CHIEF, DIVISION OF LAND DEVELOPMENT, 1/20/09 DATE

APPROVED: DEPARTMENT OF PLANNING AND ZONING  
 CHESTER EDWARDS, CHIEF, DEVELOPMENT ENGINEERING DIVISION, 1/16/09 DATE

I HEREBY CERTIFY THAT THESE DOCUMENTS WERE PREPARED OR APPROVED BY ME, AND THAT I AM A DULY LICENSED PROFESSIONAL ENGINEER UNDER THE LAWS OF THE STATE OF MARYLAND, LICENSE NO. 19184, EXPIRES 06/30/09.

SIGNED: BRUCE D. BURTON, 12/19/08 DATE

OWNER/DEVELOPER  
 Williamsburg Group, LLC  
 5485 Harpers Farm Rd.  
 Suite 200  
 Columbia, MD 21044  
 410 997-8800


**LDE Inc. AS-BUILT**  
 Engineers, Surveyors, Planners  
 9250 Ramsey Road, Suite 106 Columbia, Maryland - 21045  
 (410)715-1070 • (301)596-3424 • FAX (410)715-9540

MISCELLANEOUS DETAILS  
**WATKINS' CHOICE PHASE I**  
 Lots 1, 2, Open Space Lot 3 and Non-Buildable Bulk Parcel "A"  
 Tax Map 46 - Grid 18 - Parcel 215  
 6th Election District - Howard County, Maryland

DESIGNED: LDE  
 DRAWN: LDE  
 CHECKED: BDB  
 DATE: 12/2008

SCALE: AS SHOWN  
 DRAWING: 5 OF 16  
 JOB NO.: 02-035.2  
 FILE NO.: F-08-179

No.	Date	By	Description
1	12/19/08	LDE	REVISE OWNER/DEVELOPER

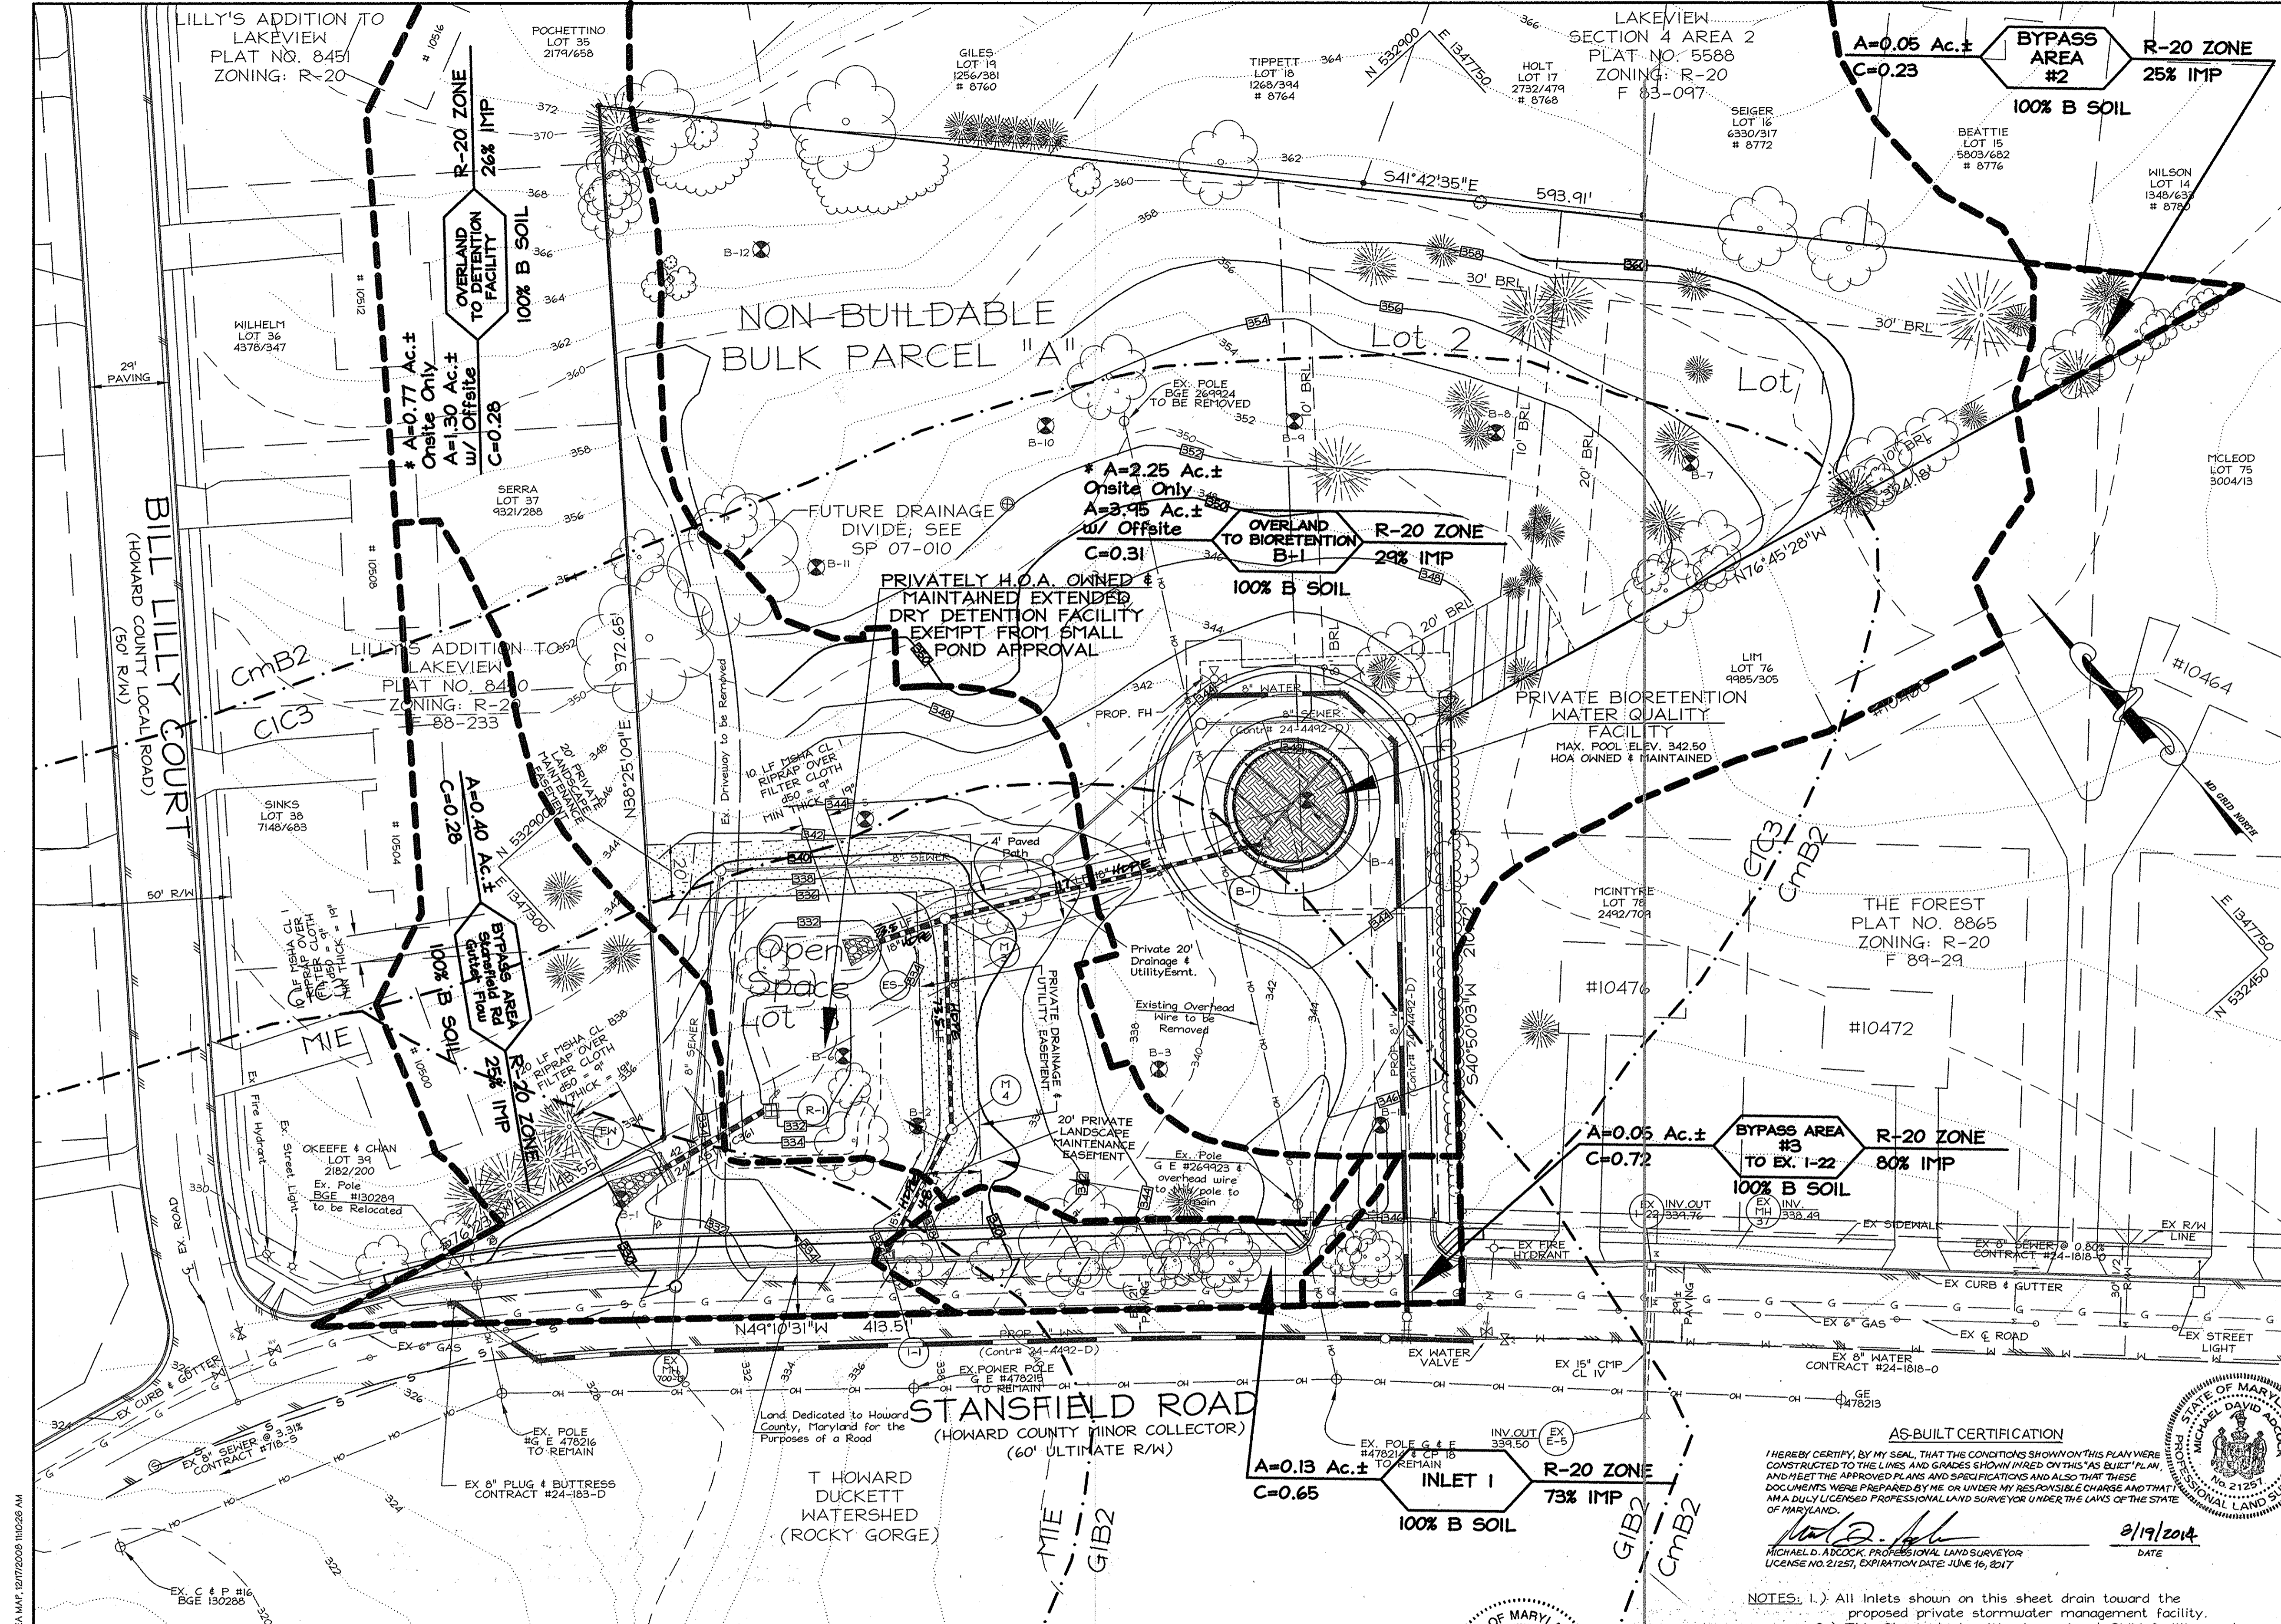

**LEGEND**

ACREAGE "C" FACTOR	INLET SUBAREA	ZONING % IMPERVIOUS
---	---	---
---	---	---
**NOTE:**  
REFER TO SOILS MAP NUMBER 33 SITE LIES NEAR "LAKEVIEW" LABEL

**OWNER/ DEVELOPER**  
Williamsburg Group, LLC  
5495 Harpers Farm Rd  
Suite 200  
Columbia, MD 21044  
410 997-8800

**SOILS LEGEND**

HYDROLOGIC SOIL GROUP	MAP SYMBOL	MAPPING UNIT	REMARKS
B	CmB2	Chillum silt loam, 1% - 5% slopes, moderately eroded	
B	CIC3	Chillum gravelly loam, 5% - 10% slopes, severely eroded	
B	GIB2	Glenelg loam, 3% - 8% slopes, moderately eroded	
B	MIE	Manor loam, 25% - 45% slopes	

ALL SOILS ONSITE ARE HYDROLOGIC SOIL GROUP "B"

**LDE Inc. AS-BUILT**  
Engineers, Surveyors, Planners  
9250 Ramsey Road, Suite 106 Columbia, Maryland - 21045  
(410)715-1070 - (301)596-3424 - FAX (410)715-9540

DESIGNED	EDS	DRAINAGE AREA MAP & SOILS MAP	SCALE
DRAWN	LDE	<b>WATKINS' CHOICE</b>	1" = 30'
CHECKED	BDB	<b>PHASE I</b>	6 OF 16
		Lots 1, 2, Open Space Lot 3 and Non-Buildable Bulk Parcel "A"	JOB NO.
		Tax Map 46 - Grid 18 - Parcel 215	02-035.2
		6 th Election District - Howard County, Maryland	FILE NO.
		Previous Submittals: SP-07-010, WP-04-042	F-08-179
		Owner/Developer: Williamsburg Group, LLC	
		5495 Harpers Farm Rd.	
		Suite 200	
		Columbia, MD 21044	
		410 997-8800	

**AS-BUILT CERTIFICATION**  
I HEREBY CERTIFY, BY MY SEAL, THAT THE CONDITIONS SHOWN ON THIS PLAN WERE CONSTRUCTED TO THE LINES AND GRADES SHOWN HEREON ON THIS "AS-BUILT" PLAN, AND I MET THE APPROVED PLANS AND SPECIFICATIONS AND ALSO THAT THESE DOCUMENTS WERE PREPARED BY ME OR UNDER MY RESPONSIBLE CHARGE AND THAT I AM A DULY LICENSED PROFESSIONAL LAND SURVEYOR UNDER THE LAWS OF THE STATE OF MARYLAND.  
MICHAEL D. ADDOCK, PROFESSIONAL LAND SURVEYOR  
LICENSE NO. 21257, EXPIRATION DATE: JUNE 16, 2017  
DATE: 9/19/2014

- NOTES:**
- All Inlets shown on this sheet drain toward the proposed private stormwater management facility.
  - This Sheet shows ultimate paving & SWM facility grades. Sheet 0 shows TSM11 basin grades & driveway "subgrade" +/- prior to paving.
  - No Time of Concentration has been computed. 5 Min. (worst case) Tc has been assumed for all proposed inlets.
  - For Standard Legend, refer to Sheet 1.
  - For Soil Boring information, refer to sheet 7.

No.	Date	By	Description
2	1/22/15	SES	REVISE 3D PIPE LENGTHS AND TYPE
1	1/22/15	GLI2	REVISE OWNER/DEVELOPER

REVISIONS

APPROVED: DEPARTMENT OF PUBLIC WORKS  
*Walter J. Whitcomb* 1-9-09  
CHIEF, BUREAU OF HIGHWAYS DATE

APPROVED: DEPARTMENT OF PLANNING AND ZONING  
*Cindy Harris* 1/20/09  
CHIEF, DIVISION OF LAND DEVELOPMENT DATE

*Chad Edwards* 1/6/9  
CHIEF, DEVELOPMENT ENGINEERING DIVISION DATE

I HEREBY CERTIFY THAT THESE DOCUMENTS WERE PREPARED OR APPROVED BY ME, AND THAT I AM A DULY LICENSED PROFESSIONAL LAND SURVEYOR UNDER THE LAWS OF THE STATE OF MARYLAND, LICENSE NO. 19184, EXPIRATION DATE: 06/16/2017.  
SIGNED: *Bruce D. Burton*  
BRUCE D. BURTON  
12/10/08

F:\02-035-2\m02-035-2\_SHT 6 PRO DRA 60.dwg, DRAINAGE AREA MAP, 12/17/2009 11:02:05 AM

# HDPE SPECIFICATIONS

Trenches shall be excavated in such a manner as to ensure that the sides shall be stable under all working conditions. Trench walls shall be sloped or supported in conformance with all standards of safety. Only as much trench length as can be safely maintained shall be opened. All trenches shall be backfilled as soon as possible, but not later than the end of each working day.

Trench widths shall be sufficient to ensure working room to properly place and compact backfilling and other backfill materials. Minimum trench width shall not be less than 1.5 times the pipe outside diameter plus 12 inches. If a trench box is used at the bottom of the trench box shall be placed no lower than the top of the pipe. The minimum width of the trench, when a sub-trench is used in conjunction with a trench box, shall be three times the diameter of the pipe in order to prevent disruption of bedding material when moving the trench box.

Determination of trench width in unsupported, unstable soils shall include consideration of the size of the pipe, the stiffness of the backfill and in situ soil, and other site-specific conditions as applicable. The trench shall be excavated to the width, depth, and grade as indicated on the plans and/or given by the engineer.

**Bedding Material and Structural Backfill:** Bedding and structural backfill materials shall meet the requirements of ASTM D2321 as follows:

- Class IA Manufactured aggregate; open graded clean
- Class IB Manufactured processed aggregate; dense graded clean
- Class II Coarse-grained soils, clean
- Class III Coarse-grained soils with fines
- Class IVA Fine-grained soils - inorganic

For all pipes greater than 24 inches in diameter only Class IA, Class IB, and Class II will be allowed.

Bedding material shall have a maximum size of 1 1/2 inches. Backfill shall be free of organic material, stones larger than 1/2 inches in greatest dimensions, or frozen lumps. Moisture content shall be in the range of optimum content, typically minus 3 per cent to plus 2 percent, so as to permit proper compaction. Consideration should be given to the potential for migration of fines from adjacent materials into open-graded backfill and bedding materials.

For pipe types that are not smooth on the outside, i.e. pipes with corrugated or profile walls, backfill gradations should be selected that will permit the filling of the corrugation of profile wall.

Flowable fills, such as controlled low strength mortar, CLSM, or controlled density fill, CDF, may be used for backfill provided adequate flotation resistance can be achieved by restraints, weighing or placement technique. With CLSM backfill, trench width can be reduced provided an engineer for the contractor has performed a satisfactory analysis of the combined CLSM/su soil strength. When CLSM is used all joints must be gasketed.

The following specifications detail material, installation and acceptance requirements for thermoplastic pipe used for storm sewer and drainage applications.

## MATERIAL SPECIFICATIONS

**Thermoplastic Pipe:** All thermoplastic pipe materials shall conform to the workmanship and inspection requirements of:

- ASTM F799 - Standard Specification for Poly(Vinyl Chloride) (PVC) Large Diameter Plastic Gravity Sewer Pipe and Fittings - 18" to 48"
- ASTM F 794 - Standard Specification for Poly(Vinyl Chloride) (PVC) Profile Gravity Sewer Pipe and Fittings Based on Controlled Inside Diameter - 4" to 48"
- ASTM F949 - Standard Specification for Poly(Vinyl Chloride) (PVC) Corrugated Sewer Pipe With a Smooth Interior and Fittings - 4" to 36"
- ASTM M294 - Standard Specification for Corrugated Polyethylene Pipe - 12" to 48"

except, that all thermoplastic pipe supplied under this contract will have a minimum pipe stiffness of 46psi at 5% deflection when tested in accordance with ASTM D 2412.

A professional engineer registered in the State of Maryland shall provide a signed and sealed letter to the Engineer. This letter will certify that High Density Polyethylene (HDPE) supplied under this project was manufactured from raw materials in accordance with Section 6 - Materials - AASHTO M294, and that the material met or exceeded the Slow Crack Resistance Growth requirement of Section 9.5 of AASHTO M294.

## INSTALLATION SPECIFICATIONS

**General Installation Requirements:** The installation of all thermoplastic pipe will be in accordance with ASTM D 2321 and as described in this specification. United States Department of Labor Occupational Safety & Health Administration Standard Number 1926.552 shall be observed at all times and shall supersede any requirement of this specification in the event of a conflict.

A trench box or shoring system shall be used in excavations greater than 5 feet in depth. Excavations of earth material to a level not greater than two feet below the bottom of the trench box or shoring system shall be permitted, but only if the trench box is designed to resist the forces calculated for the full depth of the trench and there are no indications while the trench is open of a possible loss of soil from behind or below the bottom of the trench box.

## Structural Backfill:

- Structural backfill shall:
- be placed in layers not exceeding 8 inches loose lift thickness
- brought up evenly and simultaneously on both sides of the pipe
- be to an elevation not less than twelve inches above the top of the pipe
- be worked into the trench area and compacted by hand
- have a minimum compaction level of 90 percent standard proctor density
- All compaction equipment used within 36 inches of the pipe shall be approved by the Engineer
- Ponding or jetting the structural backfill to achieve compaction shall not be permitted without written permission from the Engineer.

## Connection of Flexible Pipe to Manholes

The installer shall use flexible water stops, resilient connectors, or other flexible systems approved by the project engineer to make watertight connections to manholes and other structures. Gasketing between the thermoplastic pipe and the manhole shall not be permitted.

## ACCEPTANCE SPECIFICATIONS


**Thermoplastic Pipe**

For all thermoplastic pipe materials short and long-term deflection shall be less than 5% of the pipe's actual internal diameter measured prior to installation. Short-term deflection shall be deemed to be any deflection measured not sooner than 30 days after backfilling and installation up to 1 year after backfilling and installation. Deflection tests shall not be carried out sooner than 30 days after installation and backfilling is complete to assess short term deflection and not sooner than 11 months to assess long term deflection. A total of two tests will be carried out. All tests shall be carried out in the presence of the Project Engineer or his representative. Any section of pipe failing the test will be uncovered and reinstated. Any damaged pipe will be replaced with new pipe at the contractor's expense. Reinstated pipe will be subject to deflection testing as per this specification. Re-rounding will not be allowed.

**Inspection Method:**  
All pipe up to and including 36 in. diameter shall be inspected with a go/no-go mandrel device as described herein. Pipe larger than 36 in. diameter shall be inspected with a suitable proving device to confirm that vertical deflection does not exceed either the maximum allowable short or long term deflection limits. The mandrel or proving device shall be pulled through the pipe in such a manner so as to ensure that excessive force is not used to advance the device through any deflected portion of the pipe.

The mandrel shall be cylindrical in shape, constructed with 9 evenly spaced arms and shall generally conform to Figure A1.

Figure A1 - General Mandrel Configuration

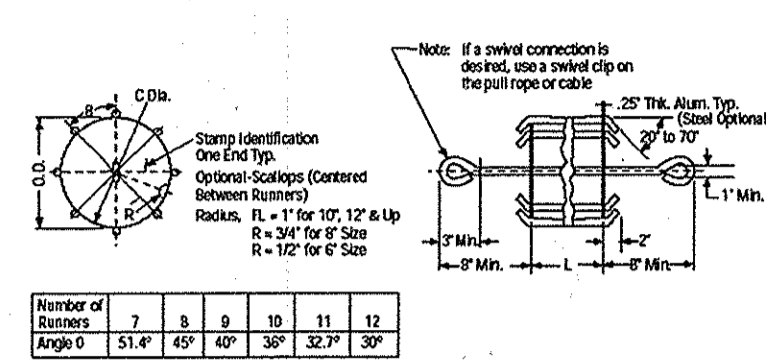


Mandrels larger than 18 in. in diameter shall be constructed of special breakdown devices to facilitate entry through access manholes.

**Mandrel Dimensional Requirements**  
The minimum diameter of the circle scribed around the outside of the mandrel arms shall be equal to the values for each specific pipe material, within a tolerance of +/- 1/100" inch. The contact length of the mandrel shall be measured between the points of contact on the mandrel arms as indicated in Figure A1. The outside radius of the mandrel arms shall be checked for conformance with these specifications with a proving ring.


An outside proving ring may be used, which shall be manufactured to a diameter equal to the outside diameter of the mandrel plus, to facilitate undertaking measurements to confirm that the size of the mandrel conforms the dimensions and dimensional tolerances specified herein. The proving ring shall be manufactured to within 1/100" inch of the specified size. The proving ring shall be fabricated from 1/4 inch minimum thick steel.

As an alternative, a go/no-go proving ring device shall be permitted in which case the proving ring shall be sized up to 1/100" inch less than the circle that would be scribed by the specified mandrel size. If a go/no-go proving ring is utilized, an acceptable mandrel will not be able to pass through the proving ring. Go/no-go proving rings shall not be less than 1/100" inch of the specified dimension.

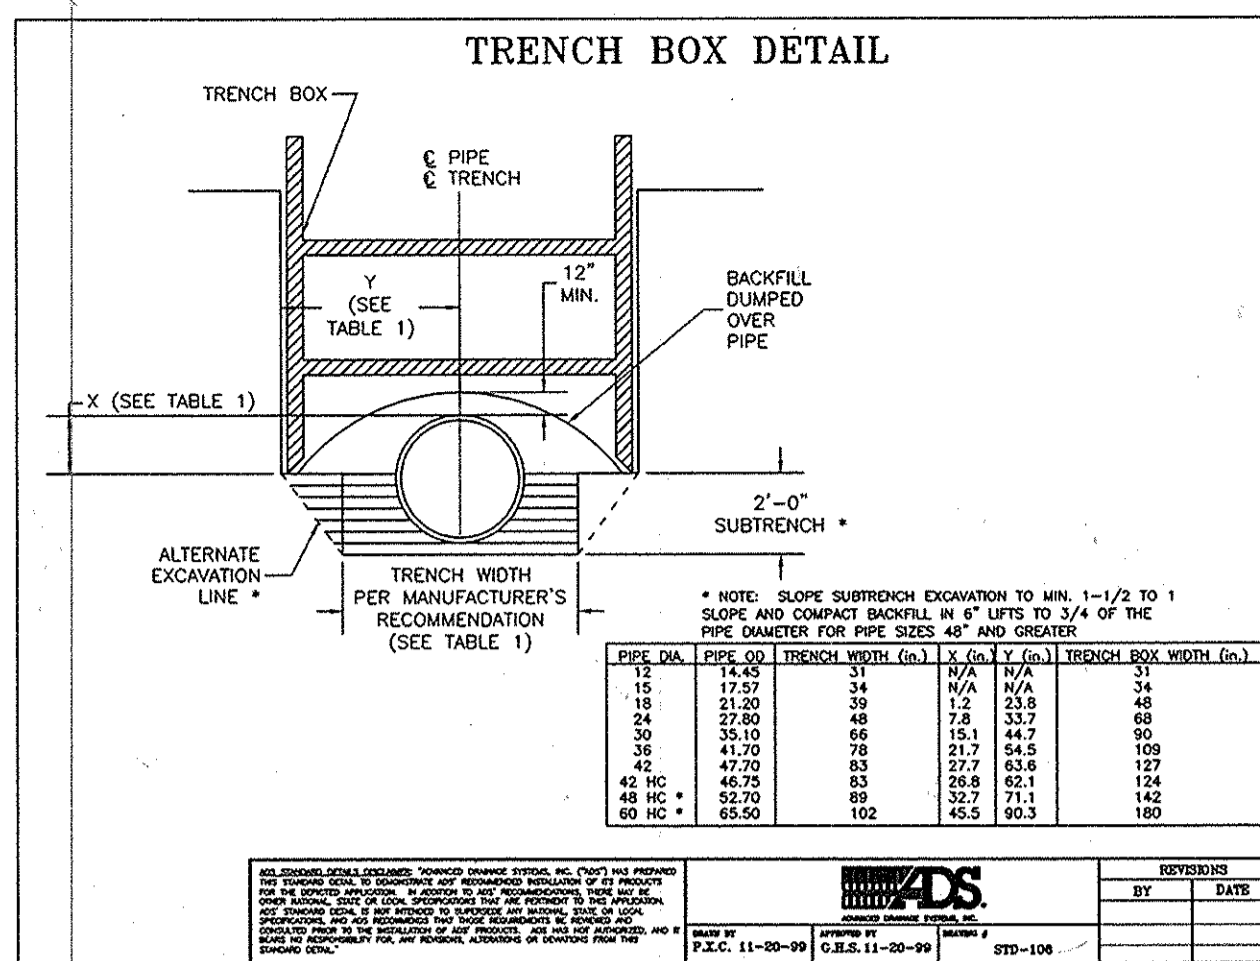


Str. No.	Structure Type	Inv. In	Inv. Out	Top Elevation or Upper / Lower	Detail	Location	Remarks
I-1	A-5	-	332.20	336.62/336.10	D-4.01	See Plan View	
I-2	18" INLET (GR. EQUIVALENT)	-	336.60	342.50			
M-3	48" Manhole	330.65/331.50	330.55	337.87	G 5.12	See Plan View	(1) N 532778.74 E 1347406.54
M-4	48" Manhole	331.65	331.40	334.24	G 5.12	See Plan View	(1) N 532720.74 E 1347267.54
ES-1	18" End Section	330.40	330.40	301.80	D-5.51	See Plan View	(2) 18" End Section
EW-1	"C" Endwall	330.00	330.00	332.75	D-5.21	See Plan View	(2) 24" Conc. Endwall
B-1	MODIFIED *	-	335.00	342.82 *	D-4.10	See Plan View	(1) N 532721.76 E 1347510.40 * CONTRACTOR TO REMOVE 12" INLET AND REPLACE WITH GRATE INLET. TOP AND BOTTOM TO GRADE AS NOTED EARLIER.

(1) Coordinate for Proposed Structure = Centerline of Structure  
(2) Coordinate for End Section = Centerline of Pipe @ Downstream Face

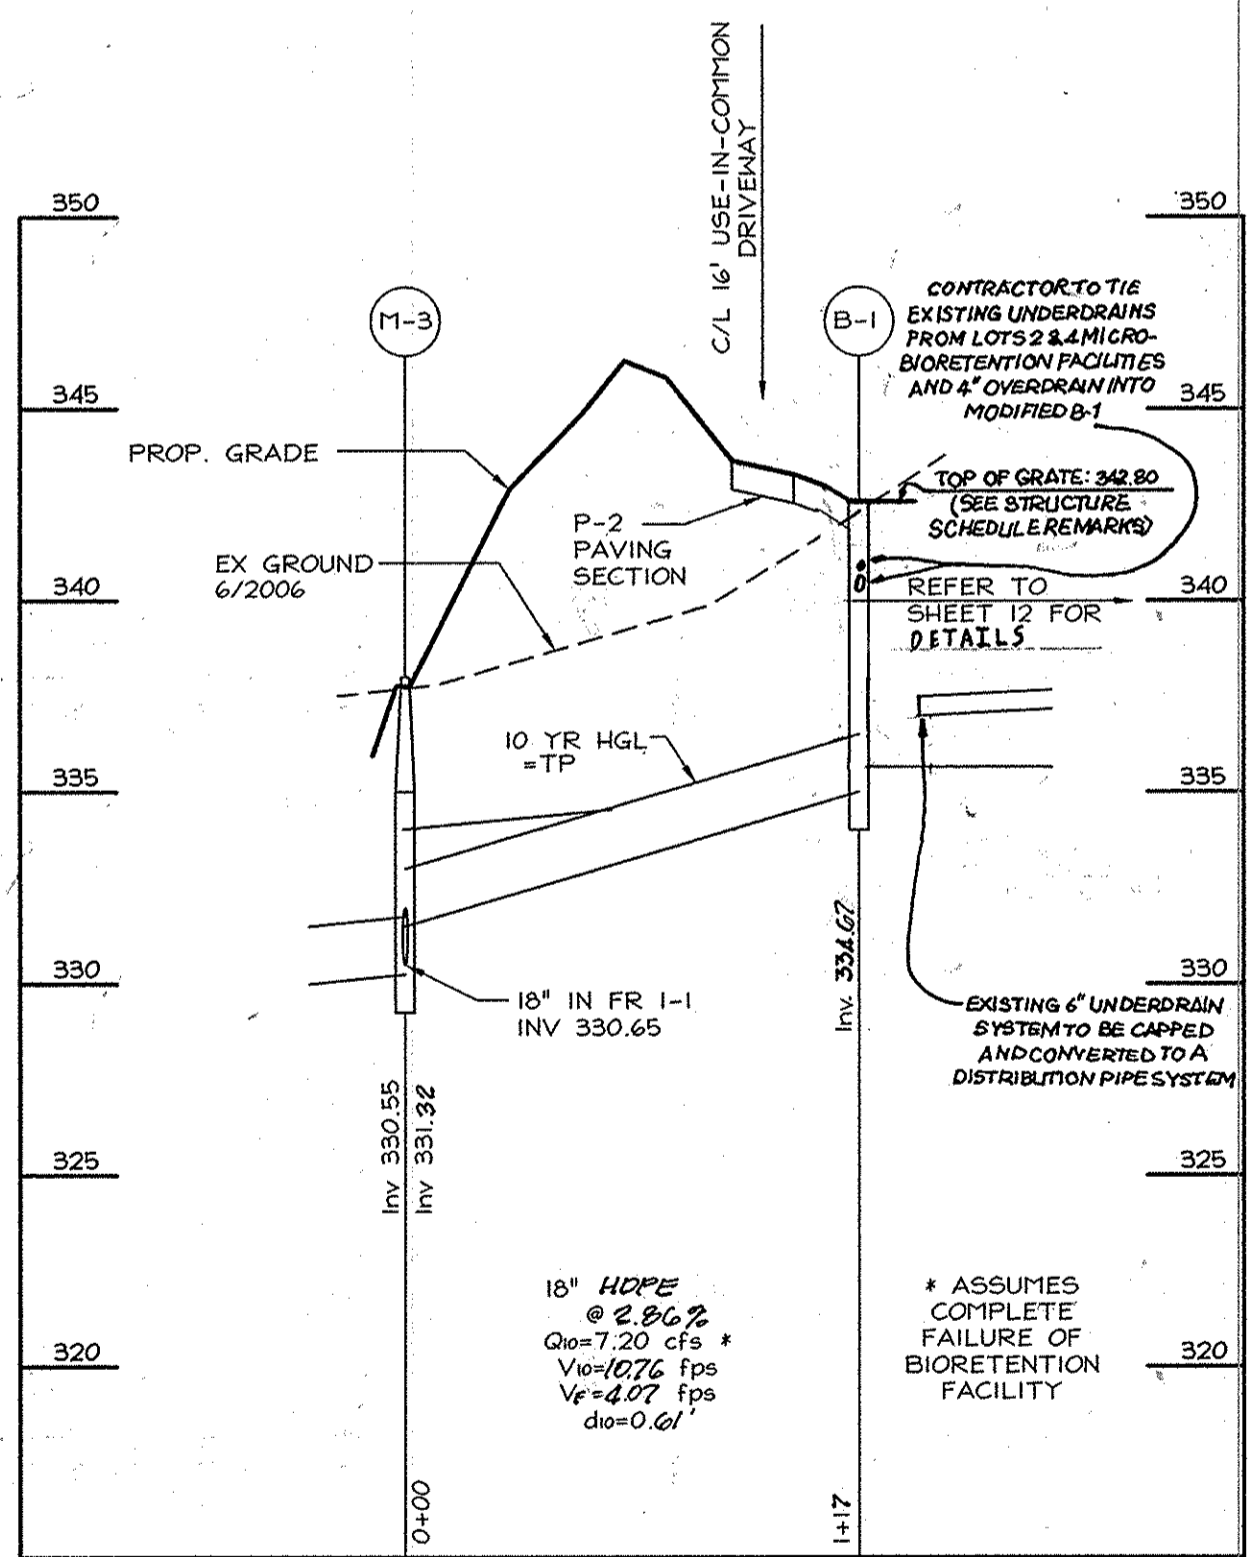

Storm Drain Profile: M-3 thru B-1  
Scale: Hor. 1"=50'  
Ver. 1"=5'

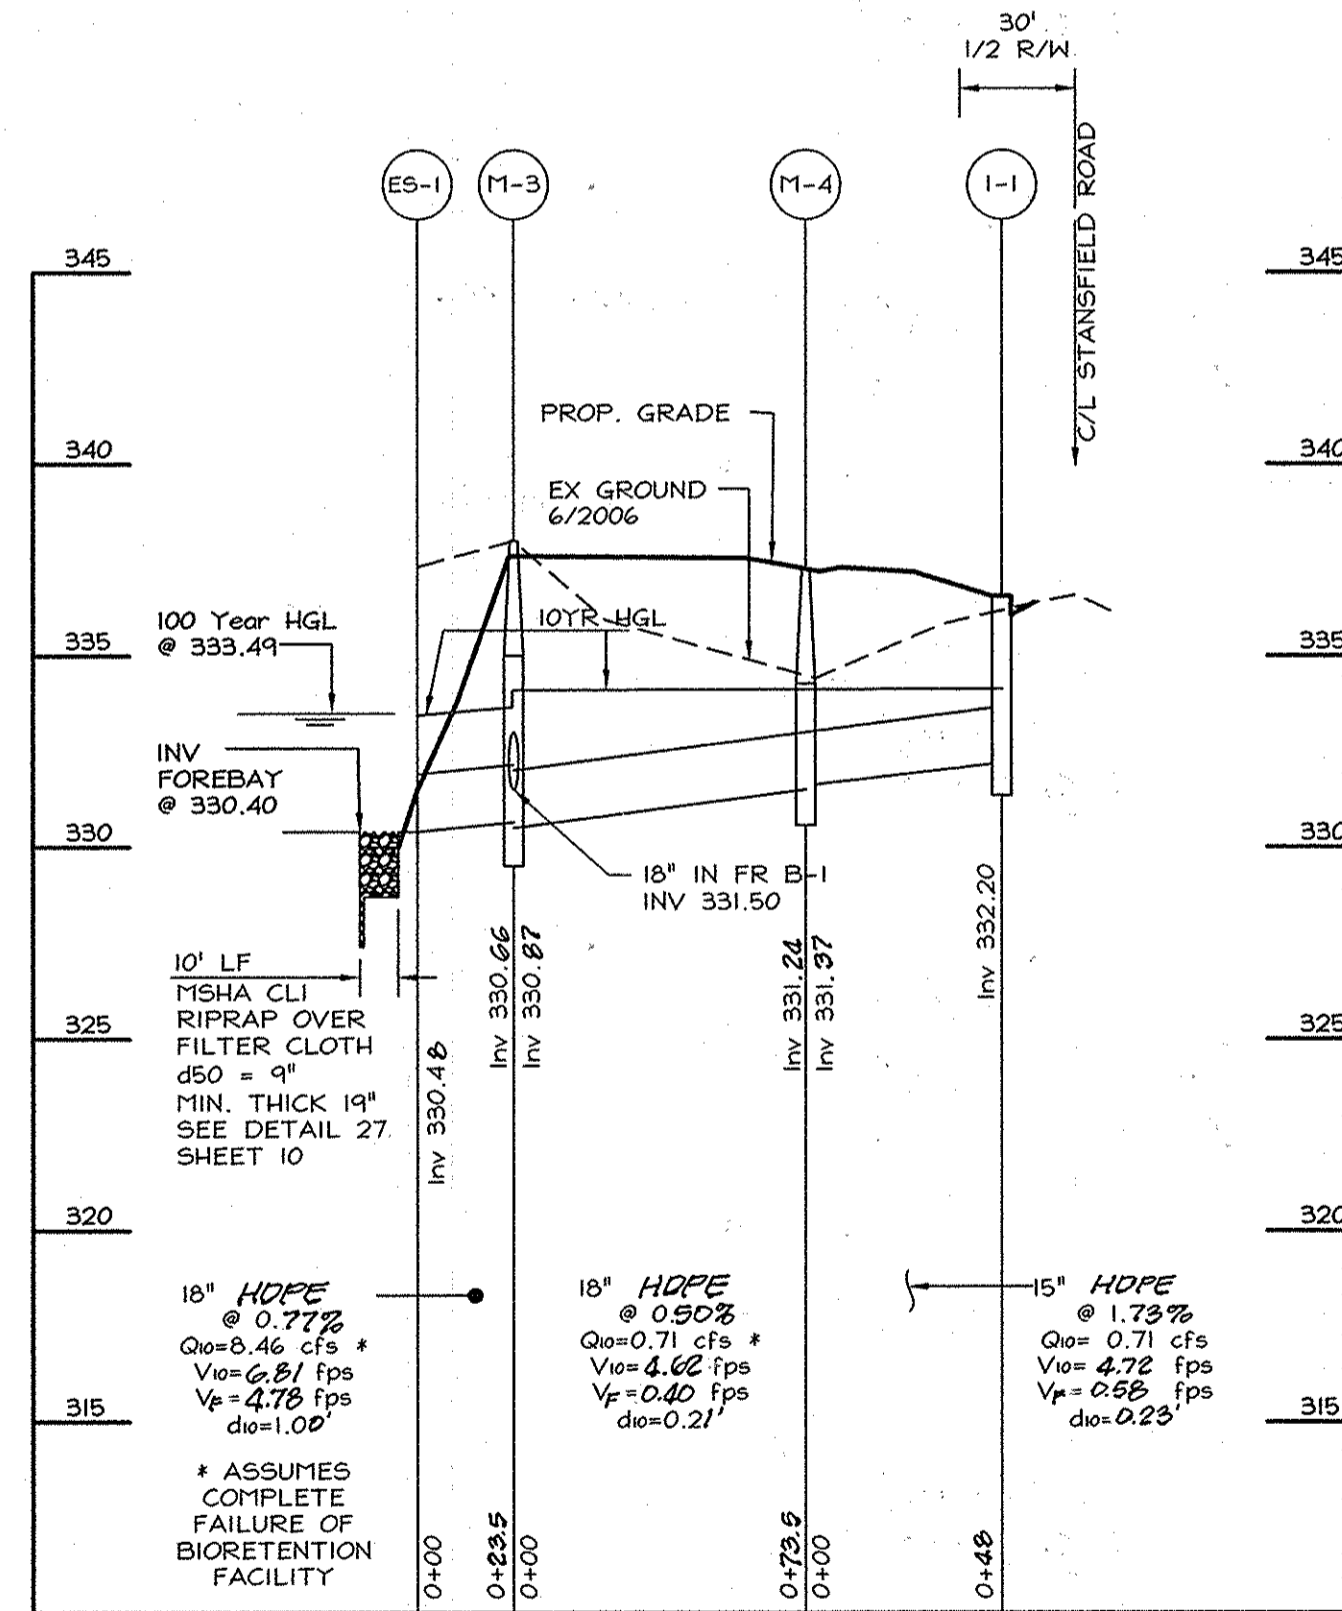


Storm Drain Profile: ES-2 thru I-1  
Scale: Hor. 1"=50'  
Ver. 1"=5'

## AS-BUILT CERTIFICATION

I HEREBY CERTIFY, BY MY SEAL, THAT THE CONDITIONS SHOWN ON THIS PLAN WERE CONSTRUCTED TO THE LINES AND GRADES SHOWN IN ACCORDANCE WITH THIS AS-BUILT PLAN, AND THAT THE APPROVED PLANS AND SPECIFICATIONS AND ALSO THAT THESE DOCUMENTS WERE PREPARED BY ME OR UNDER MY RESPONSIBLE CHARGE AND THAT I AM A DULY LICENSED PROFESSIONAL LAND SURVEYOR UNDER THE LAWS OF THE STATE OF MARYLAND.

Michael D. Adcock, PROFESSIONAL LAND SURVEYOR  
LICENSE NO. 21897, EXPIRATION DATE: JUNE 16, 2017

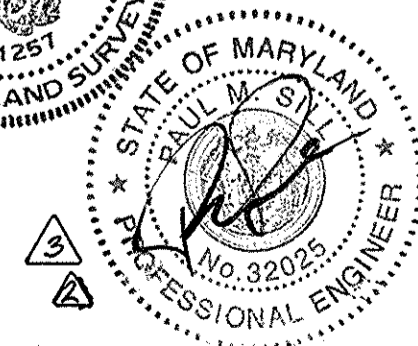

OWNER/  
DEVELOPER  
Williamsburg Group, LLC  
5405 Harpers Farm Rd.  
Suite 200  
Columbia, MD 21044  
410-977-8800

## LDE Inc. AS-BUILT

Engineers, Surveyors, Planners  
9250 Ramsey Road, Suite 106 Columbia, Maryland - 21045  
(410)715-1070 - (301)596-3424 - FAX(410)715-9340

DESIGNED	EDS	STORM DRAIN PROFILES & SOIL BORINGS	SCALE
EDS	12/2008	WATKINS' CHOICE PHASE I	1" = 5' V. 1" = 50' H
DRAWN	LDE	Lots 1, 2, Open Space Lot 3 and Non-Buildable Bulk Parcel "A"	7 OF 16
CHECKED	BDB	Tax Map 46 - Grid 18 - Parcel 215 6 th Election District - Howard County, Maryland	JOB NO. 02-035.2
DATE	12/2008	Previous Submittals: SP-07-010, WP-04-042 Owner/Developer: Williamsburg Group, LLC 5405 Harpers Farm Rd. Suite 200 Columbia, MD 21044 410-977-8800	FILE NO. F-08-179

No.	Date	By	Description
3	1/22/15	SEG	REVISE 30 PIPE COMPS, LENGTH & TYPE
4	02/07/14	SAA	REPLACE BIORETENTION FACILITY WITH STONE STORAGE- REVISE INLET B1 & ADD A.2.
5	06/12	LDE	REVISE OWNER/DEVELOPERS

## REVISIONS

I HEREBY CERTIFY THAT THESE DOCUMENTS WERE PREPARED OR APPROVED BY ME, AND THAT I AM A DULY LICENSED PROFESSIONAL ENGINEER UNDER THE LAWS OF THE STATE OF MARYLAND, LICENSE NO. 19184, EXPIRATION DATE: 06/09/14.

SIGNED: Bruce D. Burton  
BRUCE D. BURTON  
12/19/08




APPROVED: DEPARTMENT OF PUBLIC WORKS  
Walter R. McCall  
CHIEF, BUREAU OF HIGHWAYS  
1-9-09  
DATE

APPROVED: DEPARTMENT OF PLANNING AND ZONING  
Cinda Hunt  
CHIEF, DIVISION OF LAND DEVELOPMENT  
1/20/09  
DATE


APPROVED: DEPARTMENT OF PLANNING AND ZONING  
Chris Edwards  
CHIEF, DEVELOPMENT ENGINEERING DIVISION  
1/16/09  
DATE

OWNER/  
DEVELOPER  
Williamsburg Group, LLC  
5485 Harpers Farm Rd.  
Suite 200  
Columbia, MD 21044  
410 997-8800

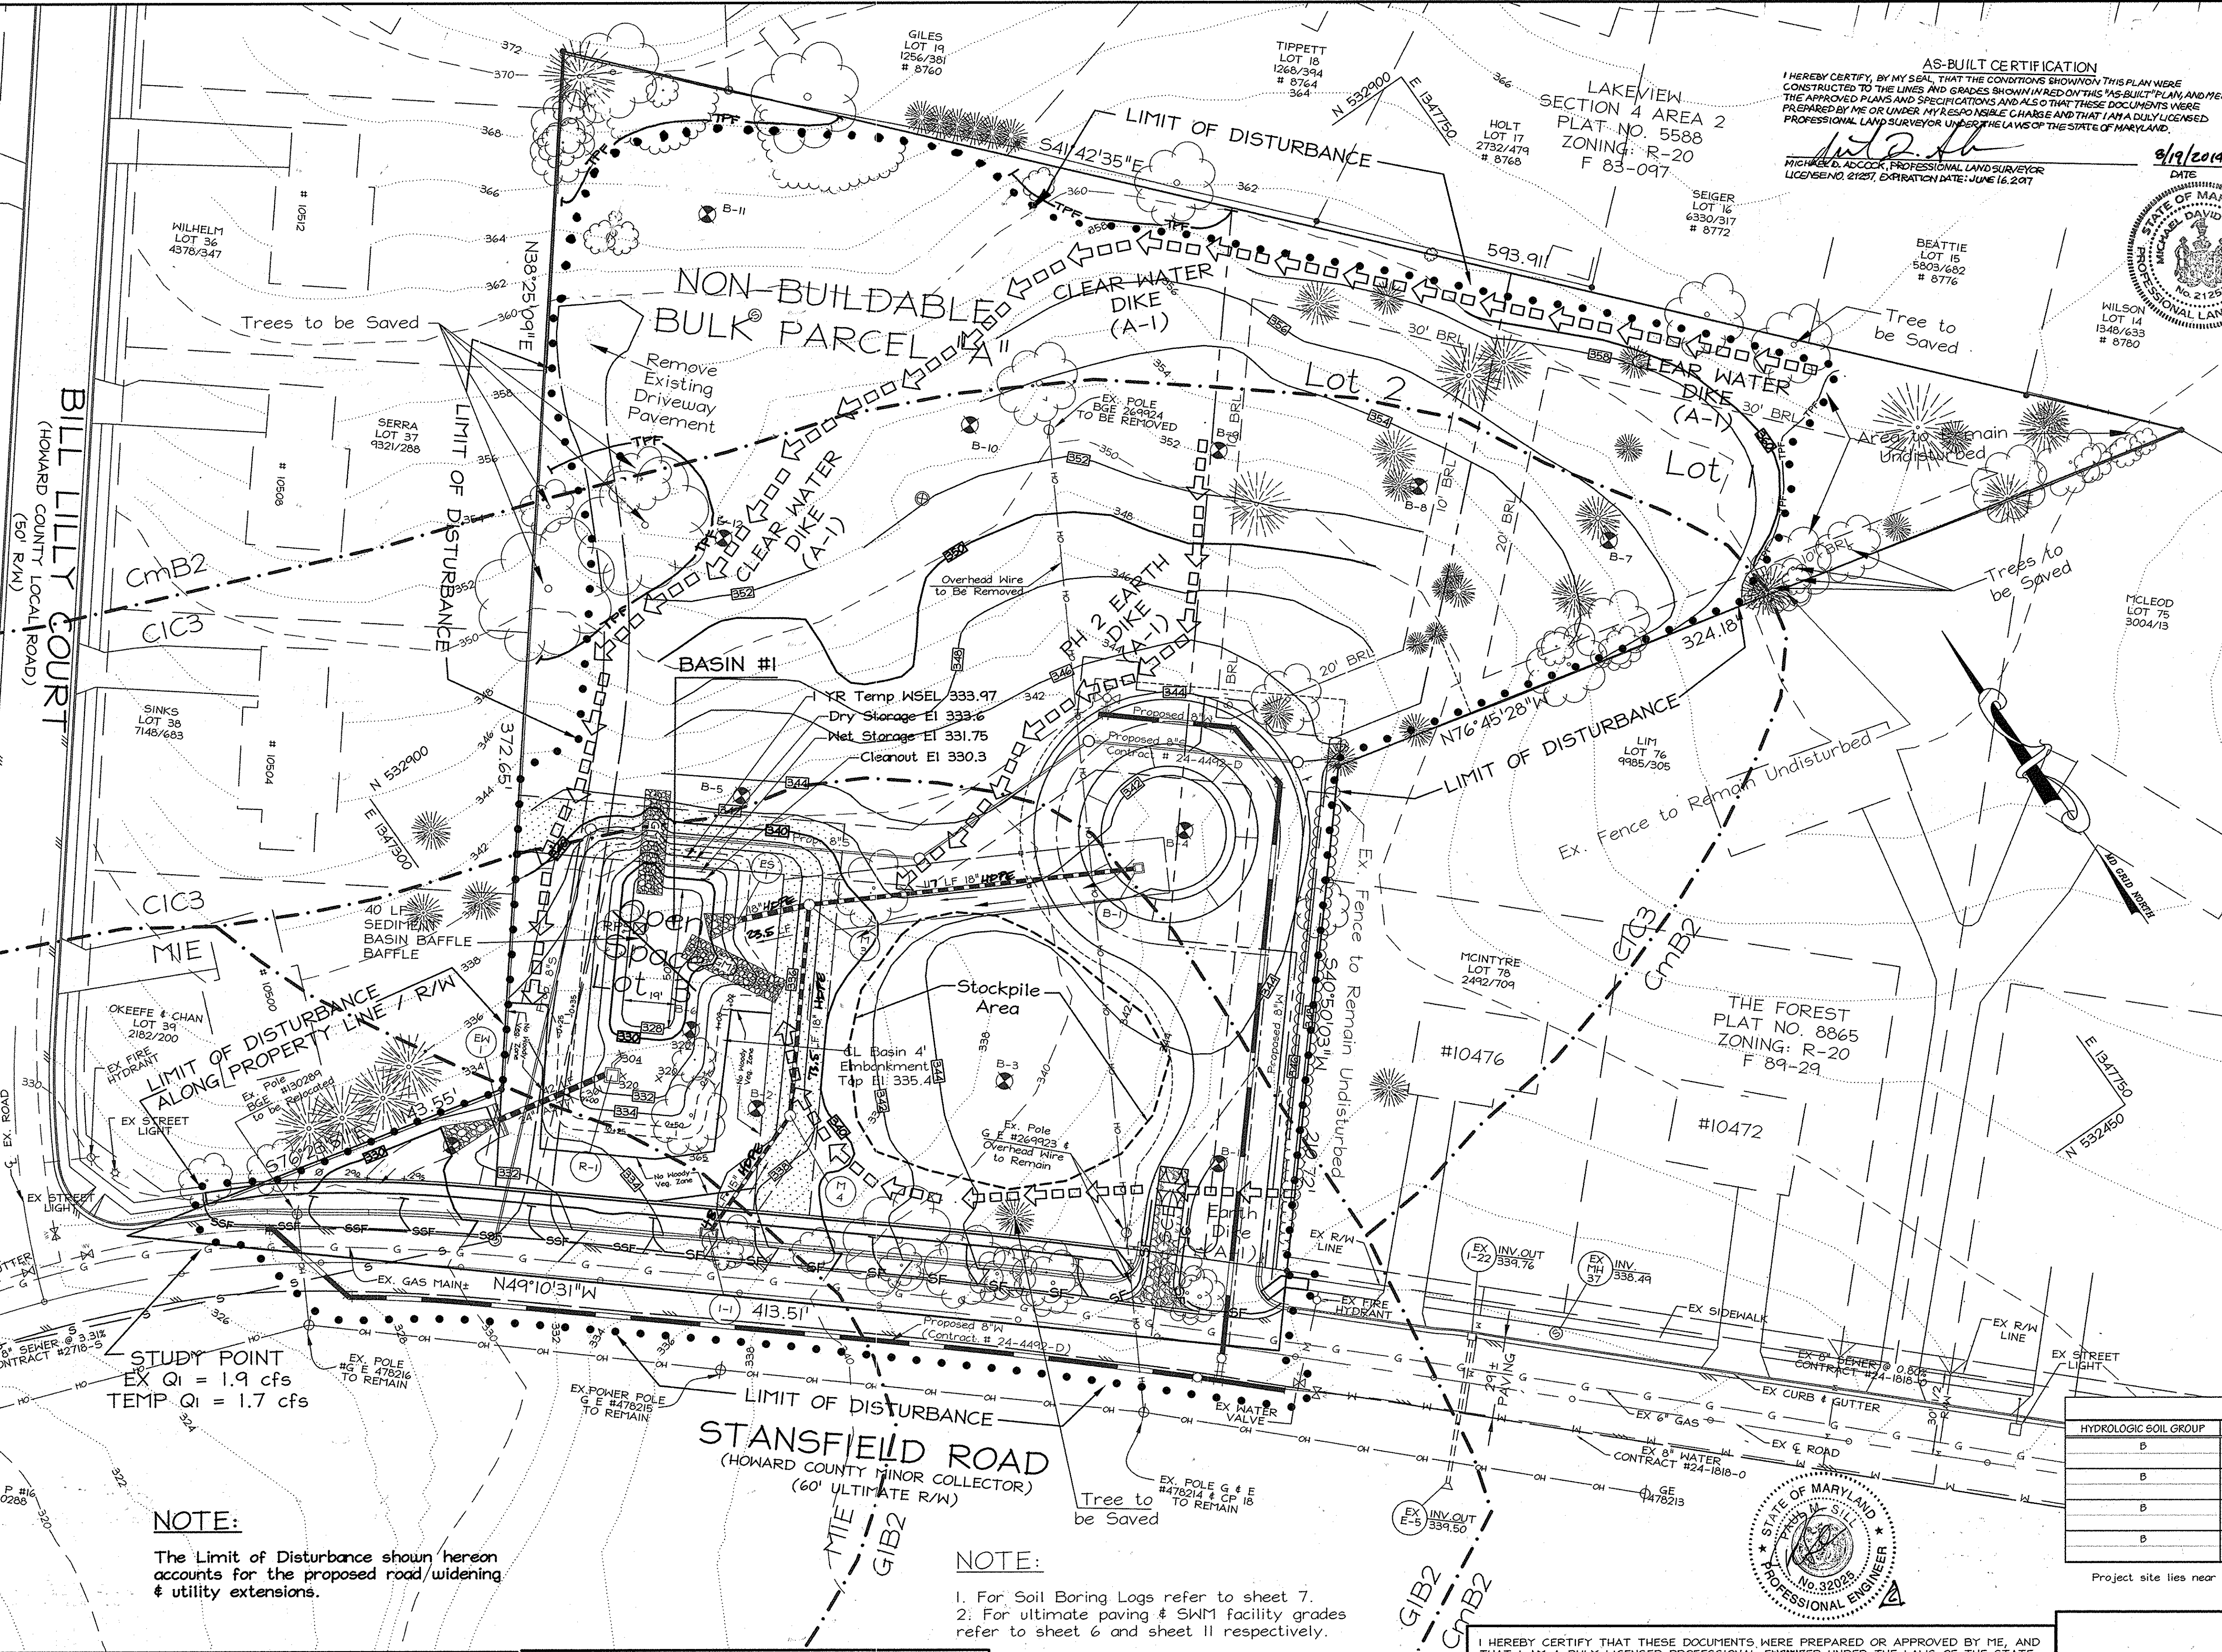

- LEGEND**
- 470- EXISTING 10' CONTOURS
  - 468- EXISTING 2' CONTOURS
  - - - BUILDING RESTRICTION LINE
  - - - PROPOSED CURB & GUTTER
  - - - PROPOSED STORM DRAIN
  - - - EX. CURB & GUTTER
  - - - EX. STORM DRAIN
  - - - EX. SANITARY SEWER
  - - - EX. SEWER HOUSE CONNECTION
  - - - EX. SANITARY SEWER MANHOLE
  - - - EX. WATER MAIN
  - - - EX. WATER HOUSE CONNECTION
  - - - EX. WATER VALVE
  - - - EX. GAS MAIN
  - - - EX. OVERHEAD UTILITIES
  - - - EX. WATER HOUSE CONNECTION (WHC)
  - - - SEWER HOUSE CONNECTION (SHC)
  - - - EX. PAVING
  - - - PROPOSED 10' CONTOURS
  - - - PROPOSED 2' CONTOURS
  - B-1 - STORMWATER MANAGEMENT SOIL BORING
  - - - LIMIT OF DISTURBANCE
  - - - STABILIZED CONSTRUCTION ENTRANCE
  - (A-2) - EARTH DIKE / CLEAR WATER DIVERSION
  - [Symbol] - GABIN INFLOW PROTECTION
  - [Symbol] - REMOVABLE PUMPING STATION
  - SF - SILT FENCE
  - SSF - SUPER SILT FENCE
  - TPF - TREE PROTECTION FENCE

**AS-BUILT CERTIFICATION**  
I HEREBY CERTIFY, BY MY SEAL, THAT THE CONDITIONS SHOWN ON THIS PLAN WERE CONSTRUCTED TO THE LINES AND GRADES SHOWN ON THIS "AS-BUILT" PLAN, AND MEET THE APPROVED PLANS AND SPECIFICATIONS AND ALSO THAT THESE DOCUMENTS WERE PREPARED BY ME OR UNDER MY RESPONSIBLE CHARGE AND THAT I AM A DULY LICENSED PROFESSIONAL LAND SURVEYOR UNDER THE LAWS OF THE STATE OF MARYLAND.  
*Michael D. Adcock*  
MICHAEL D. ADCOCK, PROFESSIONAL LAND SURVEYOR  
LICENSE NO. 81257, EXPIRATION DATE: JUNE 16, 2017  
8/19/2014  
DATE

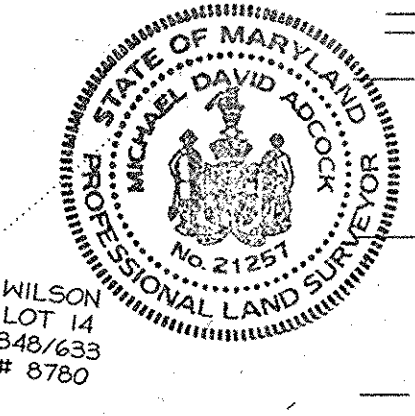

**BASIN #1**

Drainage Area	3.40 Acres
Storage Required	12,240 cu.ft.
Storage Provided	12,320 cu.ft.
Wet Storage Required	6,120 cu.ft.
Wet Storage Provided	6,177 cu.ft.
Dry Storage Required	6,120 cu.ft.
Dry Storage Provided	6,143 cu.ft.
Storage Elevation - Wet	331.75
Storage Depth - Wet	3.75 ft.
Storage Depth - Dry	1.86 ft.
Basin Bottom Elev.	328.00
Cleanout Elevation	330.30
Barrel Diam.	24"
Barrel Inv @ Riser	330.20
Barrel Inv @ Outlet	330.00
Riser Size	See Plan - 6Ht 10
Trash Rack Diam.	See Plan - 6Ht 11
Riser Crest	333.60
Begin Riser Perf.	331.75
End Riser Perf.	333.60
# Anti Sleep Collars	1
Anti Sleep Collar Size	8" Tall x 8" Wide
Basin Top Elevation	335.40
Basin Size	See Plan
Trap/Basin Type	ST-1

**SOILS LEGEND**

HYDROLOGIC SOIL GROUP	MAP SYMBOL	MAPPING UNIT	REMARKS
B	CmB2	Chillum silt loam, 1% - 5% slopes, moderately eroded	
B	CIC3	Chillum gravelly loam, 5% - 10% slopes, severely eroded	
B	GIB2	Glendy loam, 3% - 8% slopes, moderately eroded	
B	MIE	Manor loam, 25% - 45% slopes	

Project site lies near "Lakeview" label shown on Soils Map #33.

STUDY POINT  
EX Q1 = 1.9 cfs  
TEMP Q1 = 1.7 cfs

**NOTE:**  
The Limit of Disturbance shown hereon accounts for the proposed road/widening & utility extensions.

**NOTE:**  
1. For Soil Boring Logs refer to sheet 7.  
2. For ultimate paving & SWM facility grades refer to sheet 6 and sheet 11 respectively.

APPROVED: DEPARTMENT OF PUBLIC WORKS  
*W. Z. ...* 1-9-09  
CHIEF, BUREAU OF HIGHWAYS DATE

APPROVED: DEPARTMENT OF PLANNING AND ZONING  
*Cindy ...* 1/20/09  
CHIEF, DIVISION OF LAND DEVELOPMENT DATE


*Chris ...* 1-16-9  
CHIEF, DEVELOPMENT ENGINEERING DIVISION DATE

**ENGINEER'S CERTIFICATE**  
"I hereby certify that this plan for sediment and erosion control represents a practical and workable plan based on my personal knowledge of the site conditions and that it was prepared in accordance with the requirements of the Howard Soil Conservation District."  
*Bruce D. Burton* 12/19/08  
Signature of Engineer Date

**DEVELOPER'S CERTIFICATE**  
"I/We certify that all development and construction will be done according to this plan of development for sediment and erosion control, and that all responsible personnel involved in the construction project will have a Certificate of Attendance at a Department of Environmental Approved Training Program for the Control of Sediment and Erosion before beginning the project. I also authorize periodic onsite inspections by the Howard County Soil District."  
*John R. ...* 12-19-08  
Signature of Developer Date

THIS DEVELOPMENT PLAN IS APPROVED FOR SOIL EROSION AND SEDIMENT CONTROL BY THE HOWARD SOIL CONSERVATION DISTRICT  
*John R. ...* 1/6/09  
HOWARD SOIL CONSERVATION DISTRICT DATE

I HEREBY CERTIFY THAT THESE DOCUMENTS WERE PREPARED OR APPROVED BY ME, AND THAT I AM A DULY LICENSED PROFESSIONAL ENGINEER UNDER THE LAWS OF THE STATE OF MARYLAND, LICENSE NO. 19184, EXPIRATION DATE: 06/01/09.  
SIGNED *Bruce D. Burton* 12/19/08  
BRUCE D. BURTON DATE

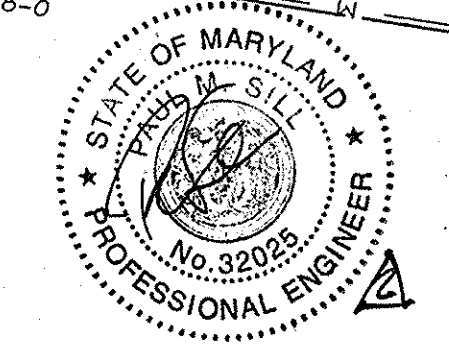

No.	Date	By	Description
2	1/22/15	SEG	REVISE SEPT. LOCATIONS AND TYPE
1	6/12	LDE	REVISE OWNER/DEVELOPER & LIMIT OF DISTURBANCE

**LDE Inc. AS-BUILT**  
Engineers, Surveyors, Planners  
9250 Ramsey Road, Suite 106 Columbia, Maryland - 21043  
(410) 715-1070 - (301) 596-3424 - FAX (410) 715-9340

DESIGNED: EDS  
DRAWN: LDE  
CHECKED: BDB  
DATE: 12/2008

SCALE: 1" = 30'  
DRAWING: 8 OF 16  
JOB NO.: 02-035.2  
FILE NO.: F-08-179

**WATKINS' CHOICE PHASE I**  
Lots 1, 2, Open Space Lot 3 and Non-Buildable Bulk Parcel "A"  
Tax Map 46 - Grid 18 - Parcel 215  
6th Election District - Howard County, Maryland  
Previous Submittals: SP-07-010, WP-04-042  
Owner/Developer: Williamsburg Group, LLC  
5485 Harpers Farm Rd.  
Suite 200  
Columbia, MD 21044  
410 997 8800

F:\02-035-2\m\02-035-2\B17-6\GSC\Map\_GFD\DWG\F12172008-11849.dwg



**HOWARD SOIL CONSERVATION DISTRICT  
STANDARD SEDIMENT CONTROL NOTES**

- A minimum of 48 hours notice must be given to the Howard County Department of Inspections, Licenses and Permits, Sediment Control Division prior to the start of any construction, (313-1855).
- All vegetative and structural practices are to be installed according to the provisions of this plan and are to be in conformance with the most current MARYLAND STANDARDS AND SPECIFICATIONS FOR SOIL EROSION AND SEDIMENT CONTROL, and revisions thereto.
- Following initial soil disturbance or redistribution, permanent or temporary stabilization shall be completed within:
  - 7 calendar days for all perimeter sediment control structures, dikes, perimeter slopes and all slopes greater than 3:1,
  - 14 days as to all other disturbed or graded areas on the project site.
- All sediment traps/basins shown must be fenced and warning signs posted around their perimeter in accordance with Vol. 1, Chapter 7, of the HOWARD COUNTY DESIGN MANUAL, Storm Drainage.
- All disturbed areas must be stabilized within the time period specified above in accordance with the 1994 MARYLAND STANDARDS AND SPECIFICATIONS FOR SOIL EROSION AND SEDIMENT CONTROL (Section G) for permanent seeding, sod, temporary seeding, and mulching. Temporary stabilization with mulch alone can only be done when recommended seeding dates do not allow for proper germination and establishment of grasses.
- All sediment control structures are to remain in place and are to be maintained in operative condition until permission for their removal has been obtained from the Howard County Sediment Control Inspector.
- Site Analysis:

Total Area of Site	3.50	Acres
Area Disturbed	3.50	Acres
Area to be roofed or paved	0.60	Acres
Area to be vegetatively stabilized	2.90	Acres
Total Cut	2,100	Cu. Yds. *
Total Fill	4,100	Cu. Yds. *
Need	4,000	Cu. Yds. *

\* Contractor shall complete their own earthwork analysis - See Note 39 Sheet 1

Offsite waste/borrow area location N/A

- Any sediment control practice which is disturbed by grading activity for placement of utilities must be repaired on the same day of disturbance.
- Additional sediment control must be provided, if deemed necessary by the Howard County Sediment Control Inspector.
- On all sites with disturbed areas in excess of 2 acres, approval of the inspection agency shall be requested upon completion of installation of perimeter erosion and sediment controls, but before proceeding with any other earth disturbance or grading. Other building or grading inspection approvals may not be authorized until this initial approval by the inspection agency is made.
- Trenches for the construction of utilities is limited to three pipe lengths or that which can be back filled and stabilized within one working day, whichever is shorter.

**HOWARD SOIL CONSERVATION DISTRICT  
PERMANENT SEEDING NOTES**

Apply to graded or cleared areas not subject to immediate further disturbance where a permanent long-lived vegetative cover is needed.

**SEEDBED PREPARATION:**  
Loosen upper three inches of soil by raking, disking, or other acceptable means before seeding, if not previously loosened.

**SOIL AMENDMENTS:**  
In lieu of soil test recommendations, use one of the following schedules:  
1) PREFERRED Apply 2 tons per acre dolomitic limestone (92 lbs/1000sq. ft.) and 600 lbs per acre 10-10-10 fertilizer (14 lbs/1000 sq. ft.) before seeding. Harrow or disk into upper three inches of soil. At time of seeding, apply 400 lbs per acre 30-0-0 ureaform fertilizer (9 lbs/1000sq. ft.)  
2) ACCEPTABLE Apply 2 tons per acre dolomitic limestone (92 lbs/1000sq. ft.) and 1000 lbs per acre 10-10-10 fertilizer (23 lbs/1000 sq. ft.) before seeding. Harrow or disk into upper three inches of soil.

**SEEDING**  
For the periods March 1 thru April 30, and August 1 thru October 15, seed with 60 lbs per acre (1.4 lbs/1000sq. ft.) of Kentucky 31 Tall Fescue. For the period May 1 thru July 31, seed with 60 lbs per acre (1.4 lbs/1000sq. ft.) of Kentucky 31, Tall Fescue and 2 lbs. per acre (.05 lbs/1000sq. ft.) of weeping lovegrass. During the period of October 16 thru February 28, protect site by:  
Option (1) - 2 tons per acre of well anchored straw mulch and seed as soon as possible in the spring.  
Option (2) - Use sod.  
Option (3) - Seed with 60 lbs. per acre Kentucky 31 Tall Fescue and mulch 2 tons / acre well anchored straw.

**MULCHING**  
Apply 1-1/2 to 2 tons per acre (70 to 90 lbs/1000sq. ft.) of unrotted small grain straw immediately after seeding. Anchor mulch immediately after application using mulch anchoring tool or 218 gallons per acre (5 gal/1000sq. ft.) of emulsified asphalt on flat areas. On slopes 8 feet or higher, use 348 gallons per acre (8 gal/1000sq. ft.) for anchoring.

**MAINTENANCE**  
Inspect all seeding areas and make needed repairs, replacements and reseedings.

**AS-BUILT CERTIFICATION**

THERE IS NO "AS-BUILT" INFORMATION PROVIDED ON THIS SHEET.

*Michael D. Adcock*  
MICHAEL D. ADCOCK, PROFESSIONAL LAND SURVEYOR  
LICENSE NO. 21251, EXPIRATION DATE: JUNE 16, 2017

3/19/2018

DATE

**HOWARD SOIL CONSERVATION DISTRICT  
TEMPORARY SEEDING NOTES**

Apply to graded or cleared areas likely to be redisturbed where a short-term vegetative cover is needed.

**SEEDBED PREPARATION:**  
Loosen upper three inches of soil by raking, disking, or other acceptable means before seeding, if not previously loosened.

**SOIL AMENDMENTS:**  
Apply 600 lbs per acre 10-10-10 fertilizer (14 lbs/1000sq. ft.).

**SEEDING**  
For periods March 1 thru April 30, and from August 15 thru October 15 seed with 2-12 bushels per acre of annual rye (3.2 lbs/1000sq. ft.). For the period May 1 thru August 14, seed with 3 lbs. per acre of weeping lovegrass (.07 lbs/1000sq. ft.). For the period November 16 thru February 28, protect site by applying 2 tons per acre of well anchored straw mulch and seed as soon as possible in the spring, or use sod.

**MULCHING**  
Apply 1-1/2 to 2 tons per acre (70 to 90 lbs/1000sq. ft.) of unrotted weed free small grain straw immediately after seeding. Anchor mulch immediately after application using mulch anchoring tool or 218 gallons per acre (5 gal/1000sq. ft.) of emulsified asphalt on flat areas. On slopes 8 feet or higher, use 348 gallons per acre (8 gal/1000sq. ft.) for anchoring.

Refer to the 1994 MARYLAND STANDARDS AND SPECIFICATIONS FOR SOIL EROSION AND SEDIMENT CONTROL for additional rates and methods not covered.

**SEQUENCE OF CONSTRUCTION**

NOTE:

Contractor shall contact the Construction Inspection Division 24 hours in advance of commencement of work at 410-313-1880

**PHASE 1**

- Obtain Grading Permit. - 1 day
- Stakeout limits of disturbance. - 1 day
- Install stabilized construction entrance with mountable berm, where shown hereon. - 1 day
- Install silt fence 4 super silt fence along the north side of Stansfield Road. - 2 days
- Install water main and sewer extension in accordance with Contract # 24-4492-D. Water main shall loop / connect existing Contract 24-1830-D to the west of the site and existing Contract 24-1818-D to the east. This work shall include extension into Watkins' Choice across Stansfield Road and includes service connections. - 3 weeks
- Only that portion of water main which can be installed and backfilled on any given day shall be started. - Daily
- During open cutting of Stansfield Road for water & sewer extensions, if work is to continue to the next day, steel plates shall be used to allow traffic to flow uninterrupted. - Daily
- When offsite work is completed, ie water main extension, immediately stabilize any and all disturbed areas with permanent seed mixture & straw mulch or sod. - 1 day
- With sediment controls in place and with permission from sediment control inspector, install BASIN outfall from EW-1 to R-1 and rip rap outfall. See Profile Along CL of Embankment and Profile Along CL of Principal Spillway on sheet II. - 5 days
- Immediately protect disturbed areas around outfall, within Limits of Disturbance with sod. - 2 days
- With all offsite work completed, provide any maintenance on silt fence 4 super silt fence along edge of Stansfield Road and complete construction of BASIN per specifications and design data on sheet II (Profile Along CL of Embankment and Principal Spillway) and Riser Details on Sheet 10. Stabilize basin with seed and straw mulch. - 3 days
- With BASIN in place, install remainder of perimeter controls to include Clearwater Dike along western boundary of site. This control convey clean offsite water toward the Basin as well as dirty water. Install perimeter sediment controls as directed by sediment control inspector, to include Silt Fence and Super Silt Fence. Again, earth dike will direct sediment laden water toward the sediment basin. All Dikes shall be installed where shown hereon or as directed by the sediment control inspector. - 3 days
- The sediment basin shall be dewatered by pumping. The accumulated sediment from the structure shall be placed up grade from the structure in such a manner so as not to interfere with construction operations or cause erosion down grade from the structure. - 2 days
- The sediment shall be removed from the structure when the cleanout elevation has been reached. - 1 day
- With the sediment basin in place and with permission from the sediment control inspector, begin construction of the proposed widening for Stansfield Road. - 2 weeks
- Install remainder of storm drain system. - 1 week
- With Stansfield Road widening / grading complete, install curb & gutter and stone base, in accordance with details hereon. - 2 days
- With curb & gutter in place, backfill curb & gutter, install sidewalk and base course paving. - 1 week
- Stabilize any disturbance associated with Stansfield Road widening with permanent seed mixture & straw mulch - 1 day
- Complete remainder of onsite grading operations to construct private use-in-common driveway and parking area and site mass grading as shown hereon. - 2 weeks
- Construct Homes on Lots 1 & 2. - 3 months
- Grading should occur in accordance with the requirements of the Dust Control Schedule shown on sheet 10. - Daily
- Install the private use-in-common driveway & parking areas stone base and base coat paving. - 2 days
- Backfill any areas along driveway work and stabilize all disturbed areas with permanent seed mixture & straw mulch - 1 day
- Fill existing 1/2 section of Stansfield Road and install final coat paving along Stansfield Road widening - 2 days
- Upon completion of:
  - home construction on Lot 1 & 2,
  - with a 2" stand of grass on Lots 1 & 2 & areas along eastern edge of site and around use-in-common driveway
  - with a 5 day clear weather forecast
  - with permission from sediment control inspector

Proceed to Phase 2.

**PHASE 2**







- Install interior Phase 2 Earth Dike to direct "dirty" water away from flowing toward the "Bioretention Facility". - 1 day
- Begin construction of the proposed Bioretention facility and conversion of sediment basin to Stormwater Facility in accordance with details hereon. - 1 week
- Basin Conversion to Stormwater Facility includes re-grading facility, construction of retaining walls, construction of forebay and riser conversion to that shown on Sheet II. - 4 days
- Upon completion of basin conversion to Stormwater Facility, stabilize any disturbances with permanent seeding mixture & straw mulch.
- With permission from sediment control inspector, remove any remaining perimeter controls and stabilize any disturbed areas with permanent seed mixture & straw mulch or sod. - 1 day

NOTE:

Quantities are provided for informational purposes only and are based upon comparison of existing ground to proposed grades shown hereon. Contractor to make his own analysis prior to placing a bid on grading work / earthwork.

THIS DEVELOPMENT PLAN IS APPROVED FOR SOIL EROSION AND SEDIMENT CONTROL BY THE HOWARD SOIL CONSERVATION DISTRICT

*John K. Ralston*  
HOWARD SOIL CONSERVATION DISTRICT  
DATE 11/6/09

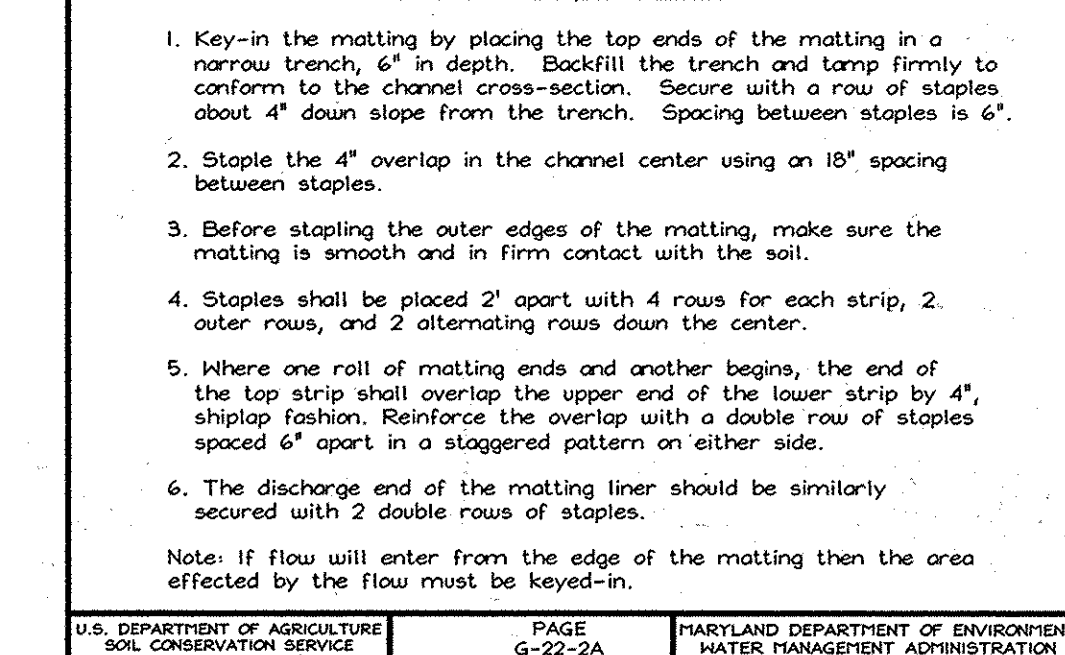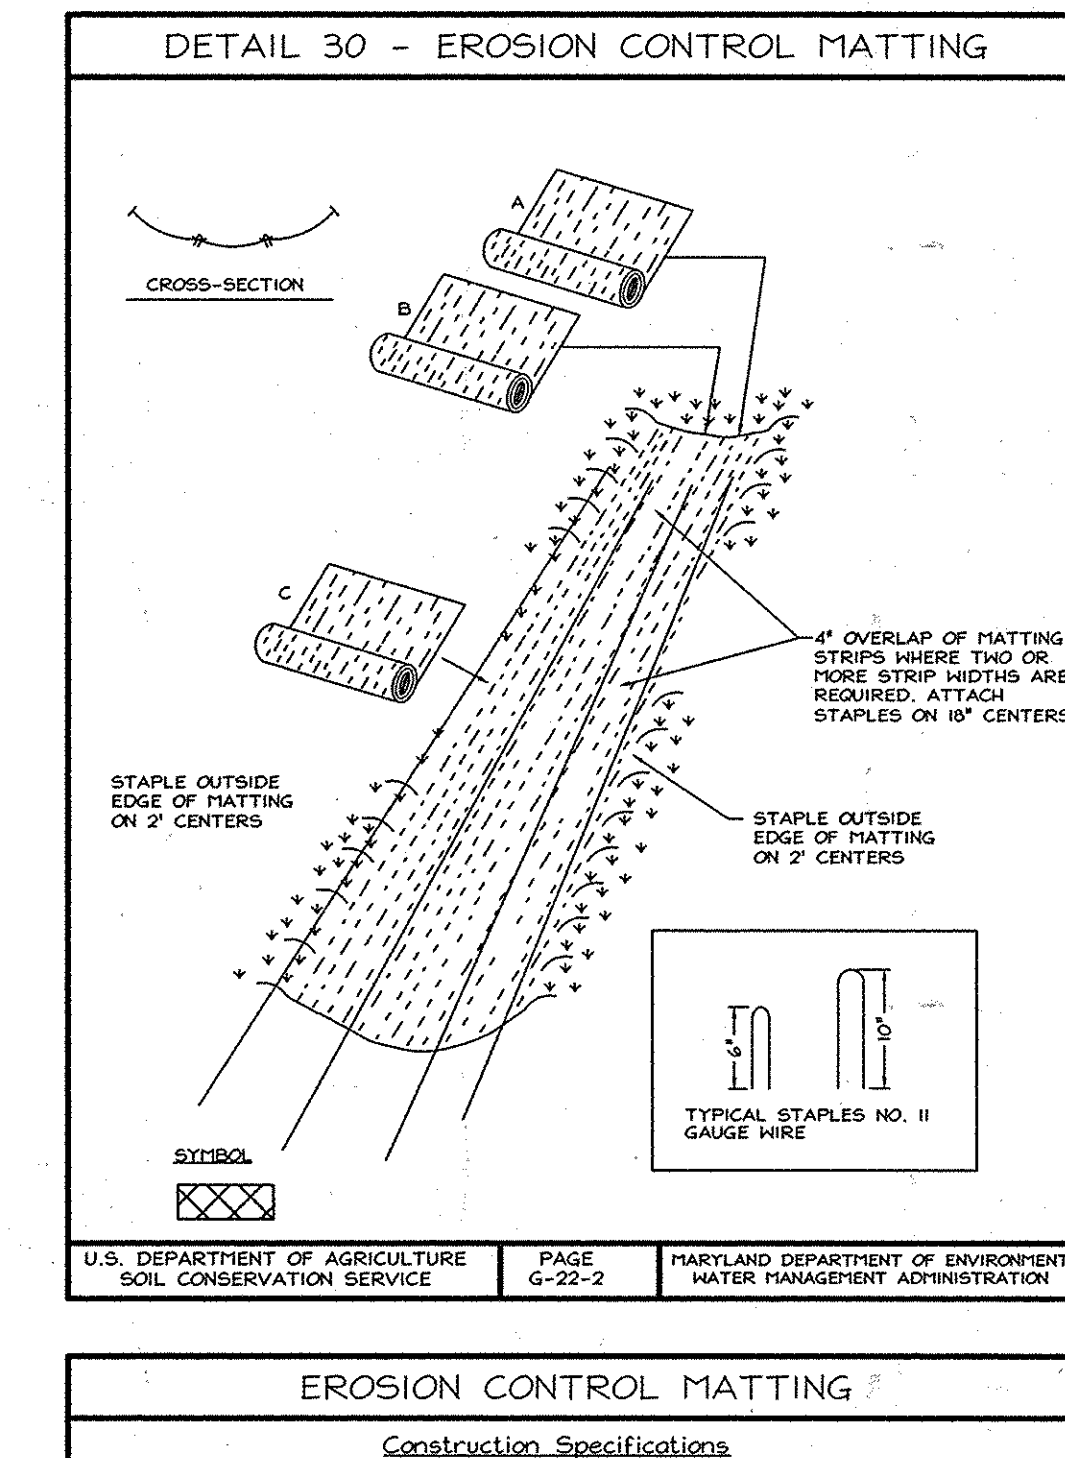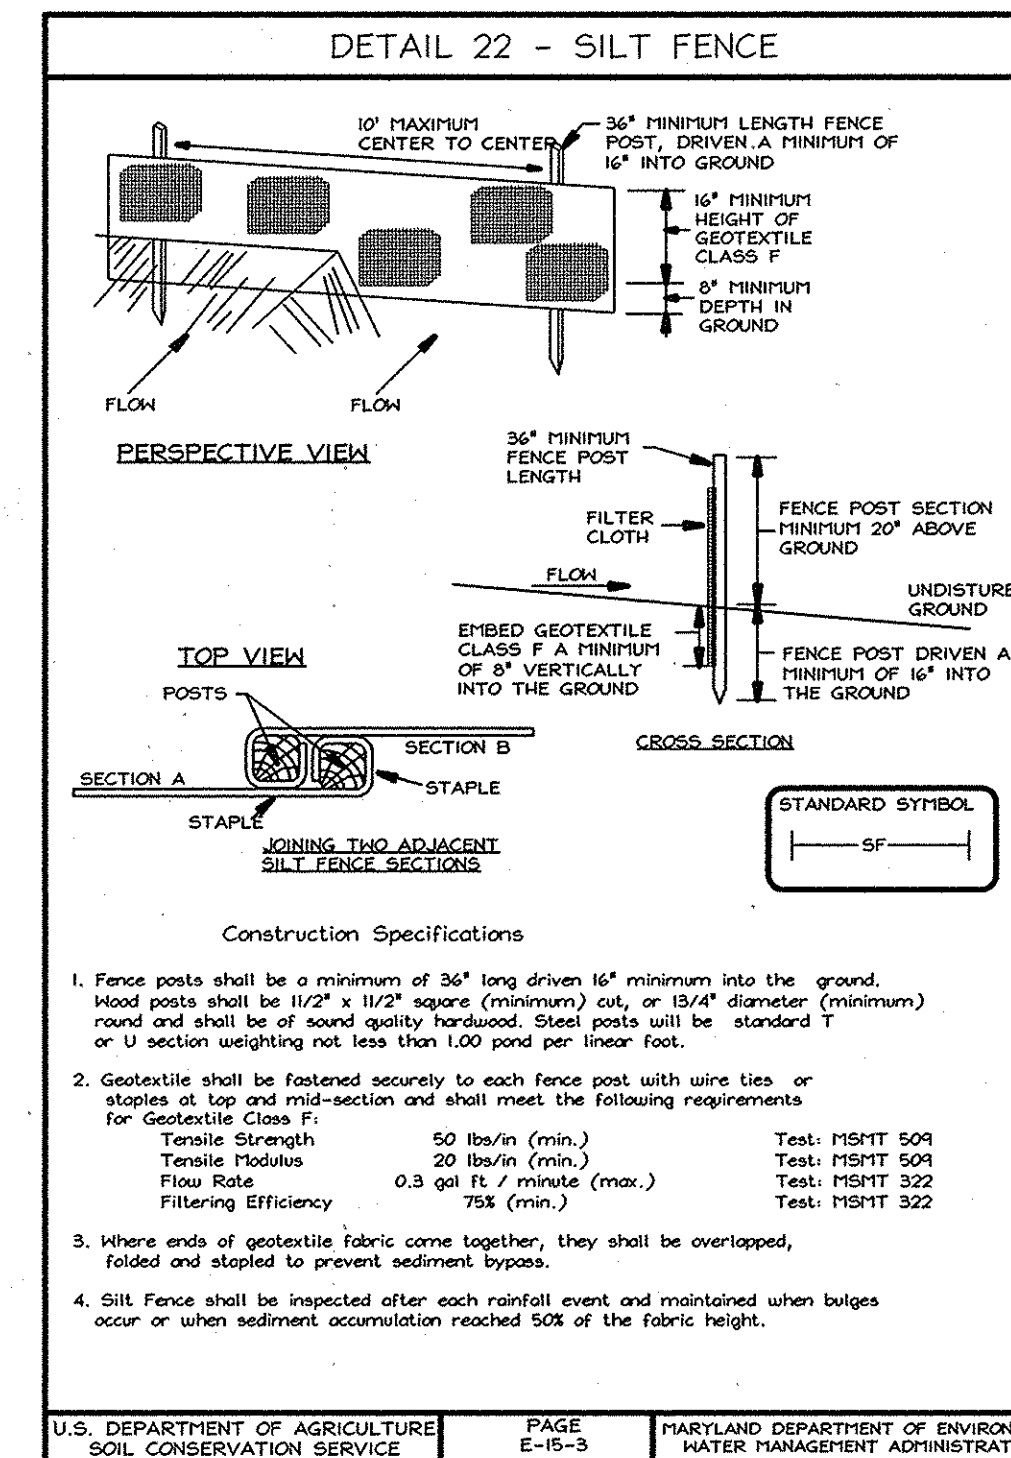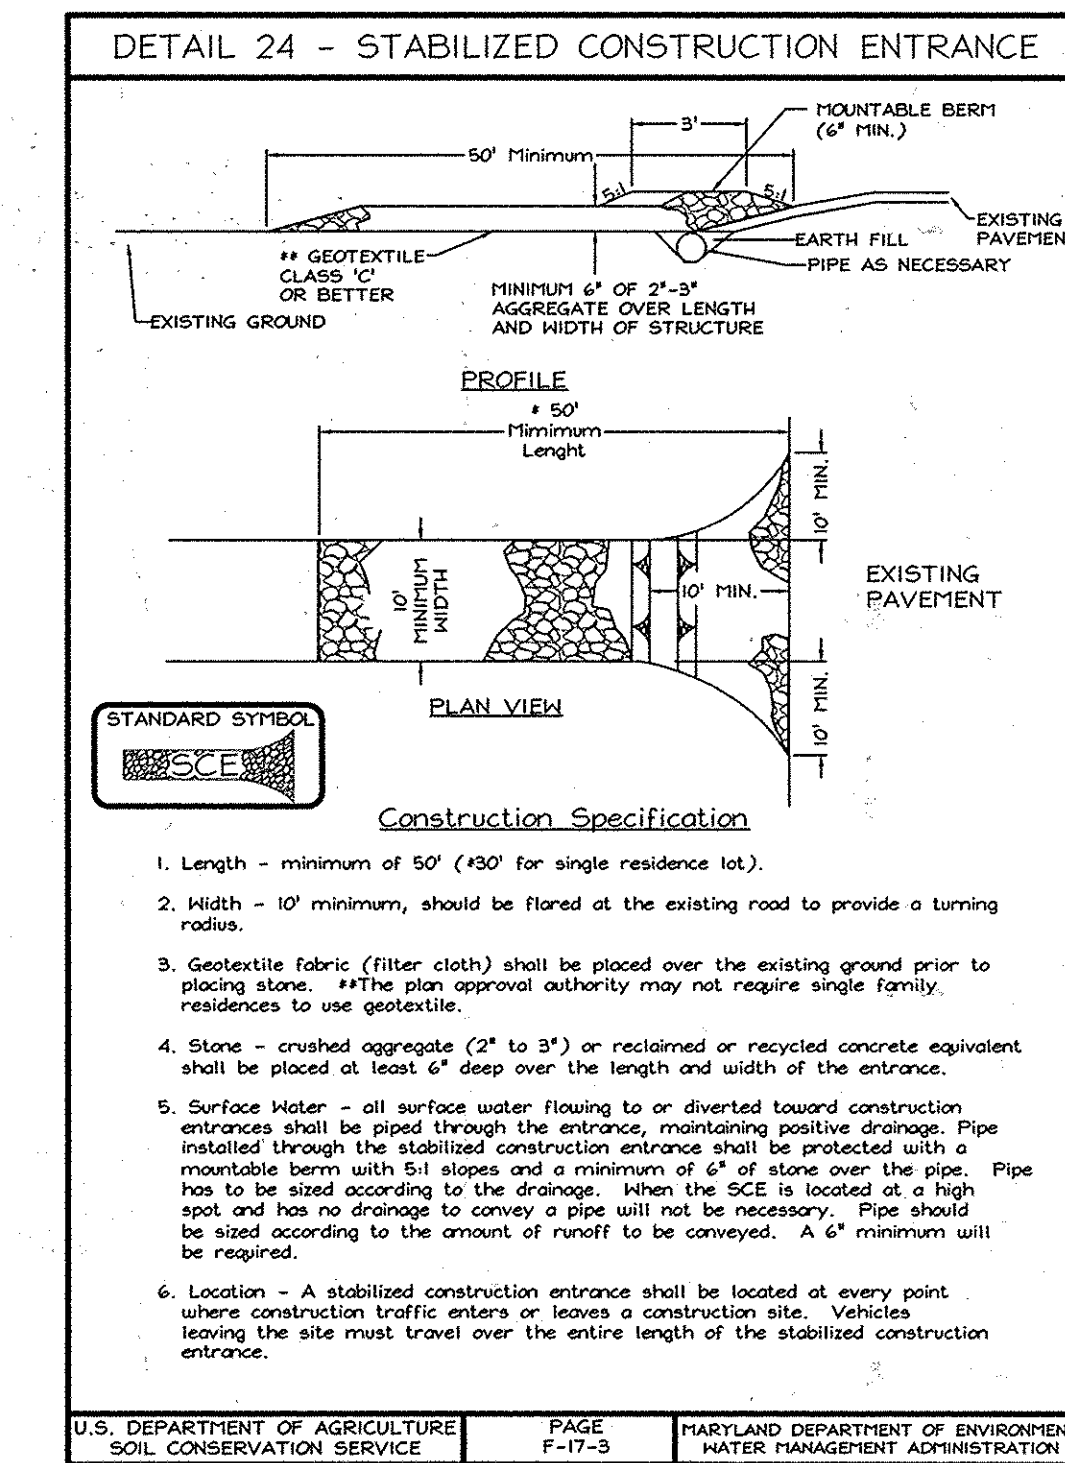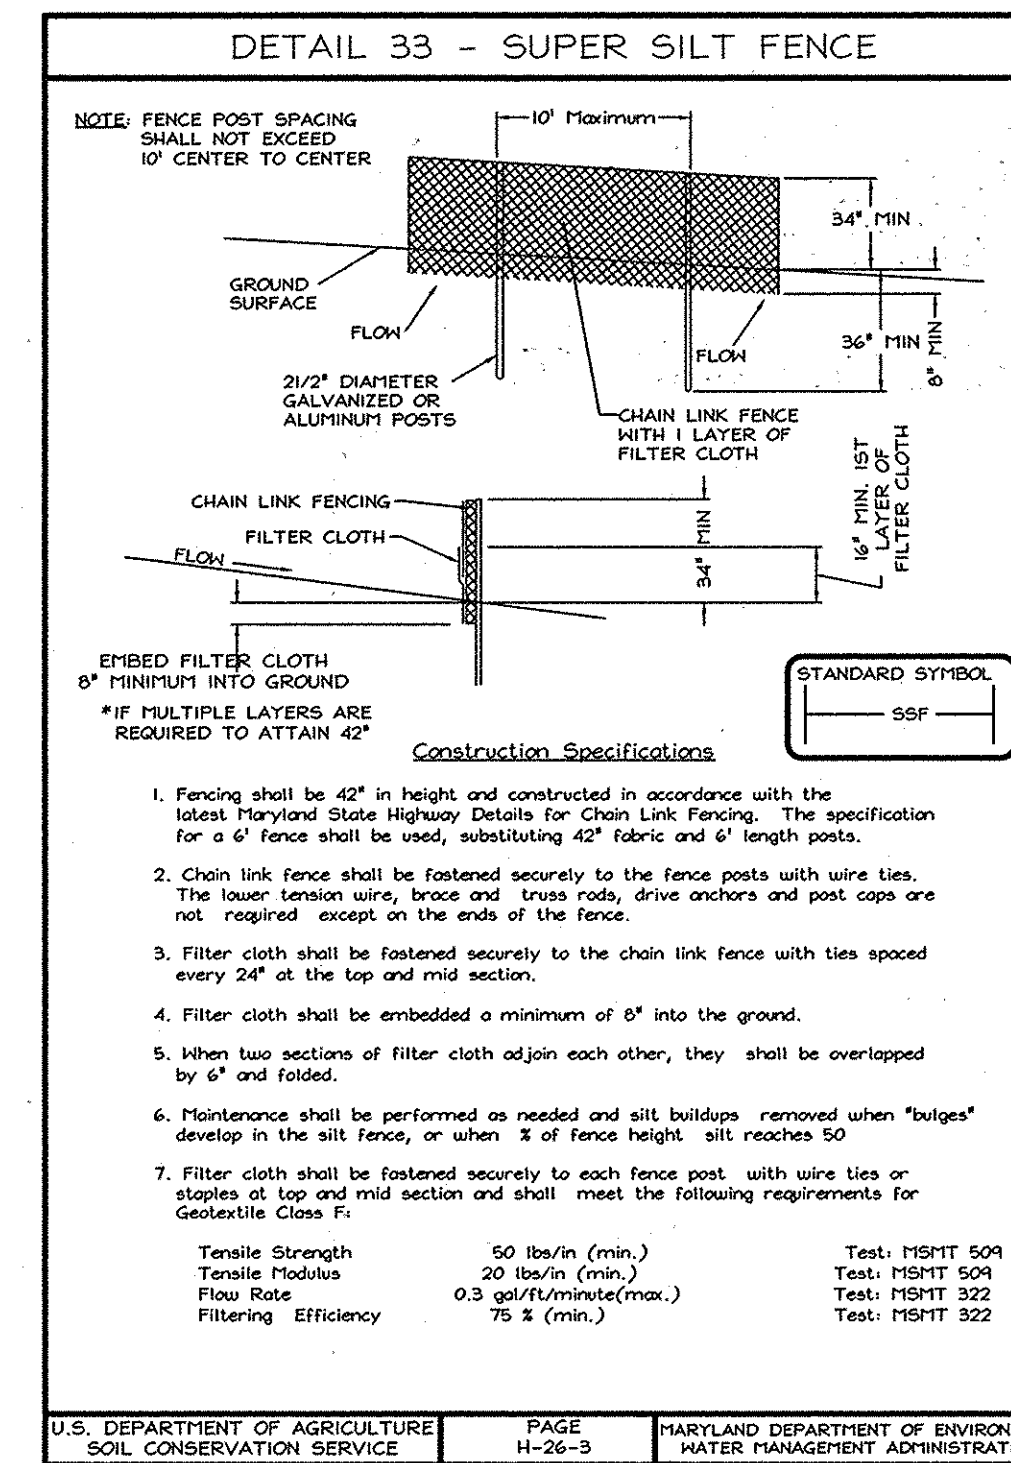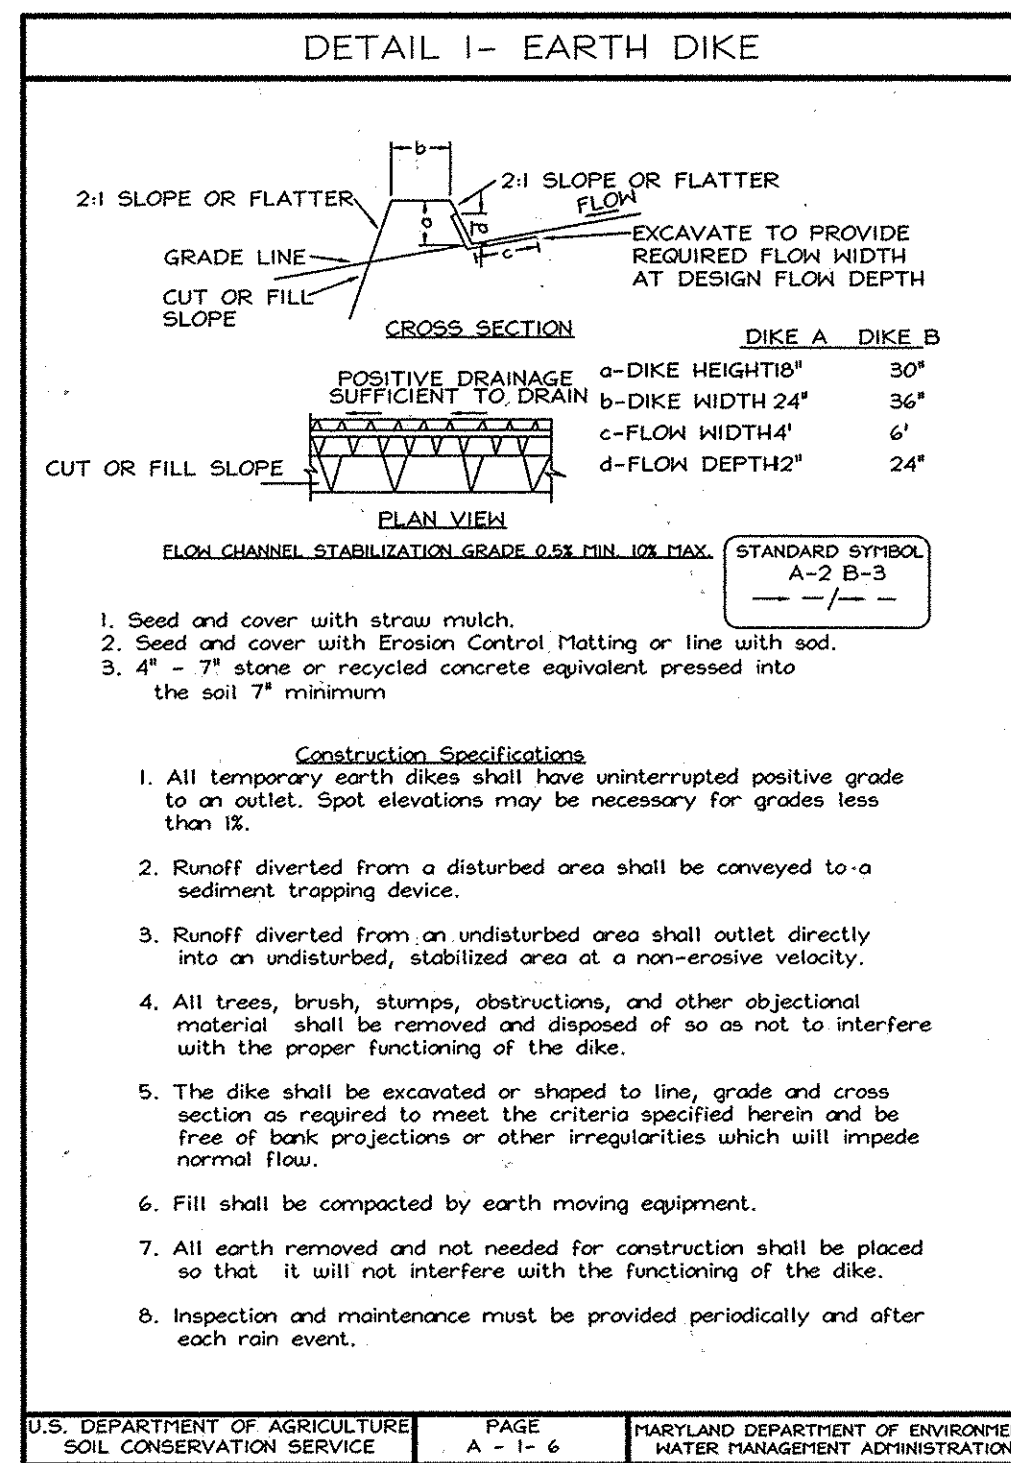

OWNER/  
DEVELOPER  
**Williamsburg Group, LLC**  
5405 Harpers Farm Rd.  
Suite 500  
Columbia, MD 21044  
410 971-8800

I HEREBY CERTIFY THAT THESE DOCUMENTS WERE PREPARED OR APPROVED BY ME, AND THAT I AM A DULY LICENSED PROFESSIONAL ENGINEER UNDER THE LAWS OF THE STATE OF MARYLAND, LICENSE NO. 19184, EXPIRATION DATE: 12/31/2014.


SIGNED *Bruce D. Burton* 12/19/08  
BRUCE D. BURTON

No.	Date	By	Description
1	6/12	LDE	REVISE OWNER/DEVELOPER, REVISE SITE ANALYSIS
REVISIONS			

**LDE Inc.**  
Engineers, Surveyors, Planners  
9250 Ramsey Road, Suite 106 Columbia, Maryland - 21045  
(410)715-1070 - (301)596-3424 - FAX(410)715-9540

DESIGNED	EDS	GRADING & SOIL EROSION AND SEDIMENT CONTROL PLAN DETAILS <b>WATKINS' CHOICE</b> PHASE 1 Lots 1, 2, Open Space Lot 3 and Non-Buildable Bulk Parcel "A" Tax Map 46 - Grid 18 - Parcel 215 6 th Election District - Howard County, Maryland Previous Submittals: SP-07-010, IIP-09-042	SCALE As Shown
DRAWN	LDE		DRAWING 9 OF 16
CHECKED	BDB		JOB NO. 02-035.2
DATE	12/2008		FILE NO. F-08-179


**DETAIL 20A - REMOVABLE PUMPING STATION**

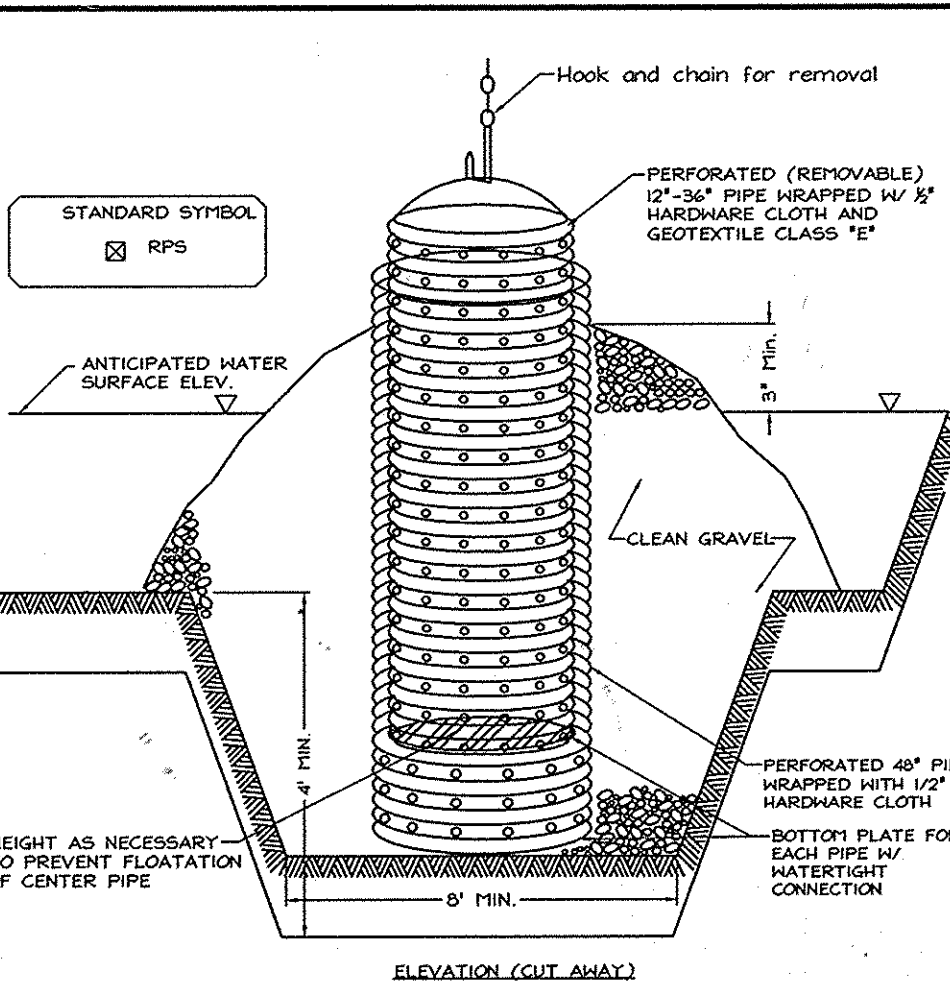

- The outer pipe should be 48" dia. or shall, in any case, be at least 4" greater in diameter than the center pipe. The outer pipe shall be wrapped with 1/2" hardware cloth to prevent backfill material from entering the perforations.
- After installing the outer pipe, backfill around outer pipe with 2" aggregate or clean gravel.
- The inside stand pipe (center pipe) should be constructed by perforating a corrugated or PVC pipe between 12" and 36" in diameter. The perforations shall be 1/2" x 6" slots or 1" diameter holes 6" on center. The center pipe shall be wrapped with 1/2" hardware cloth first, then wrapped again with geotextile Class C.
- The center pipe should extend 12" to 18" above the anticipated water surface elevation or riser crest elevation when dewatering a basin.

U.S. DEPARTMENT OF AGRICULTURE SOIL CONSERVATION SERVICE PAGE D-12-5 MARYLAND DEPARTMENT OF ENVIRONMENT WATER MANAGEMENT ADMINISTRATION


**DETAIL 6 - GABION INFLOW PROTECTION**

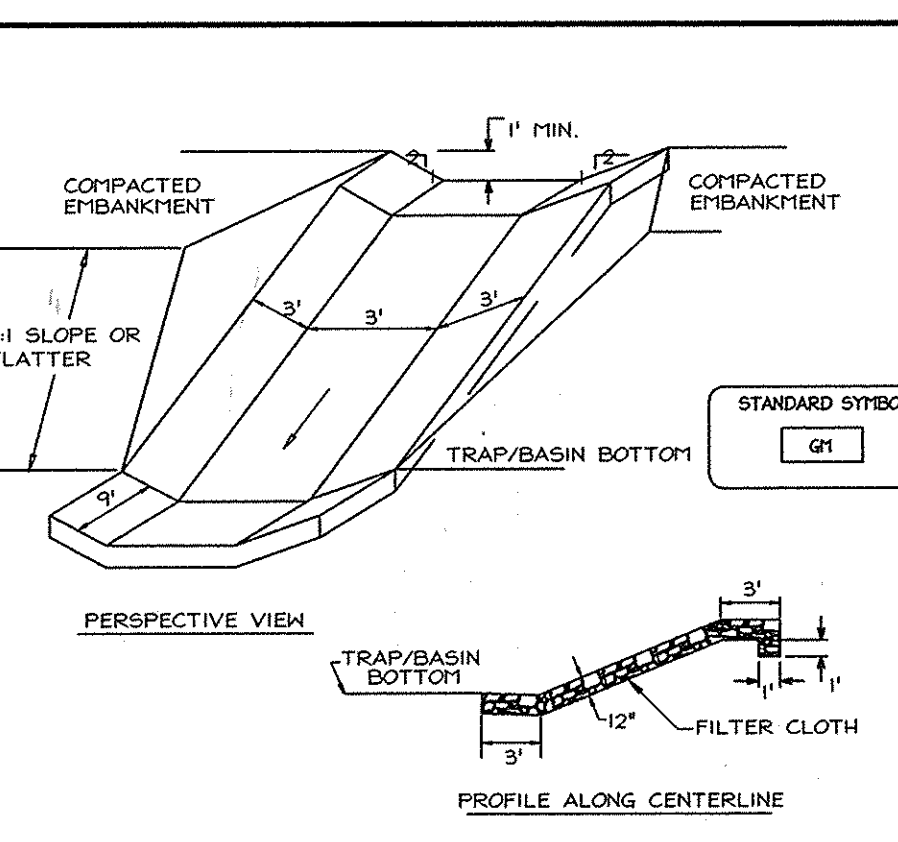

- Construction Specifications**
- Gabion inflow protection shall be constructed of 9" x 3" x 4" gabion baskets forming a trapezoidal cross section 1' deep, with 2:1 side slopes, and a 3" bottom width.
  - Geotextile Class C shall be installed under all gabion baskets.
  - The stone used to fill the gabion baskets shall be 4" - 7".
  - Gabions shall be installed in accordance with manufacturers recommendations.
  - Gabion Inflow Protection shall be used where concentrated flow is present on slopes steeper than 4:1.


U.S. DEPARTMENT OF AGRICULTURE SOIL CONSERVATION SERVICE PAGE B-7-2 MARYLAND DEPARTMENT OF ENVIRONMENT WATER MANAGEMENT ADMINISTRATION

**DETAIL 27- ROCK OUTLET PROTECTION III**

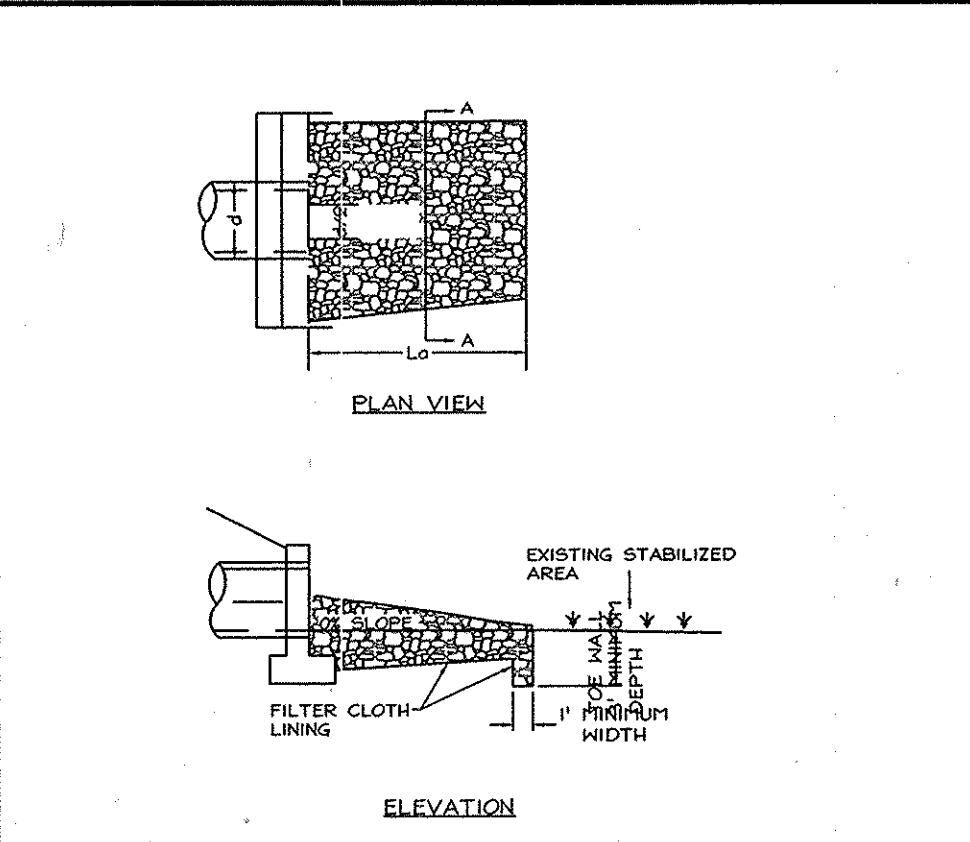


- Construction Specifications**
- The subgrade for the filter, rip-rap, or gabion shall be prepared to the required lines and grades. Any fill required in the subgrade shall be compacted to a density of approximately that of the surrounding undisturbed material.
  - The rock or gravel shall conform to the specified grading limits when installed respectively in the rip-rap or filter.
  - Geotextile shall be protected from punching, cutting, or tearing. Any damage other than an occasional small hole shall be repaired by placing another piece of geotextile over the damaged part or by completely replacing the geotextile. All overlaps whether for repairs or for joining two pieces of geotextile shall be a minimum of one foot.
  - Stone for the rip-rap or gabion outlets may be placed by equipment. They shall be constructed to the full course thickness in one operation and in such a manner as to avoid displacement of underlying materials. The stone for rip-rap or gabion outlets shall be delivered and placed in a manner that will ensure that it is reasonably homogeneous with the smaller stones and spalls filling the voids between the larger stones. Rip-rap shall be placed in a manner to prevent damage to the filter blanket or geotextile. Hand placement will be required to the extent necessary to prevent damage to the permanent works.
  - The stone shall be placed so that it blends in with the existing ground. If the stone is placed too high then the flow will be forced out of the channel and scour adjacent to the stone will occur.

U.S. DEPARTMENT OF AGRICULTURE SOIL CONSERVATION SERVICE PAGE F-10-10 MARYLAND DEPARTMENT OF ENVIRONMENT WATER MANAGEMENT ADMINISTRATION

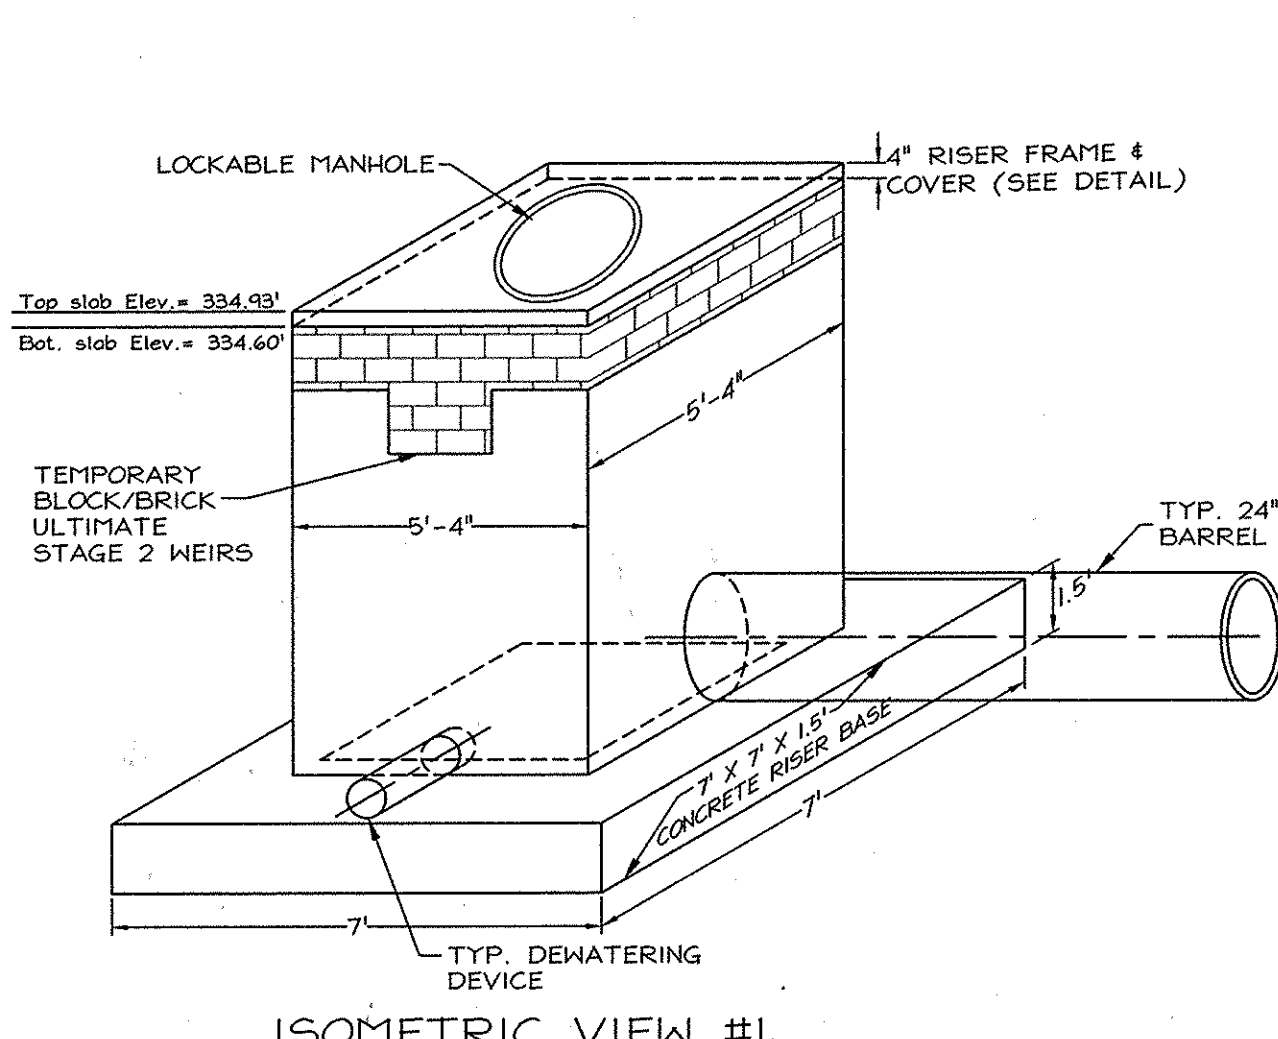

- Construction Specifications**
- The subgrade for the filter, rip-rap, or gabion shall be prepared to the required lines and grades. Any fill required in the subgrade shall be compacted to a density of approximately that of the surrounding undisturbed material.
  - The rock or gravel shall conform to the specified grading limits when installed respectively in the rip-rap or filter.
  - Geotextile shall be protected from punching, cutting, or tearing. Any damage other than an occasional small hole shall be repaired by placing another piece of geotextile over the damaged part or by completely replacing the geotextile. All overlaps whether for repairs or for joining two pieces of geotextile shall be a minimum of one foot.
  - Stone for the rip-rap or gabion outlets may be placed by equipment. They shall be constructed to the full course thickness in one operation and in such a manner as to avoid displacement of underlying materials. The stone for rip-rap or gabion outlets shall be delivered and placed in a manner that will ensure that it is reasonably homogeneous with the smaller stones and spalls filling the voids between the larger stones. Rip-rap shall be placed in a manner to prevent damage to the filter blanket or geotextile. Hand placement will be required to the extent necessary to prevent damage to the permanent works.
  - The stone shall be placed so that it blends in with the existing ground. If the stone is placed too high then the flow will be forced out of the channel and scour adjacent to the stone will occur.

U.S. DEPARTMENT OF AGRICULTURE SOIL CONSERVATION SERVICE PAGE F-10-10A MARYLAND DEPARTMENT OF ENVIRONMENT WATER MANAGEMENT ADMINISTRATION

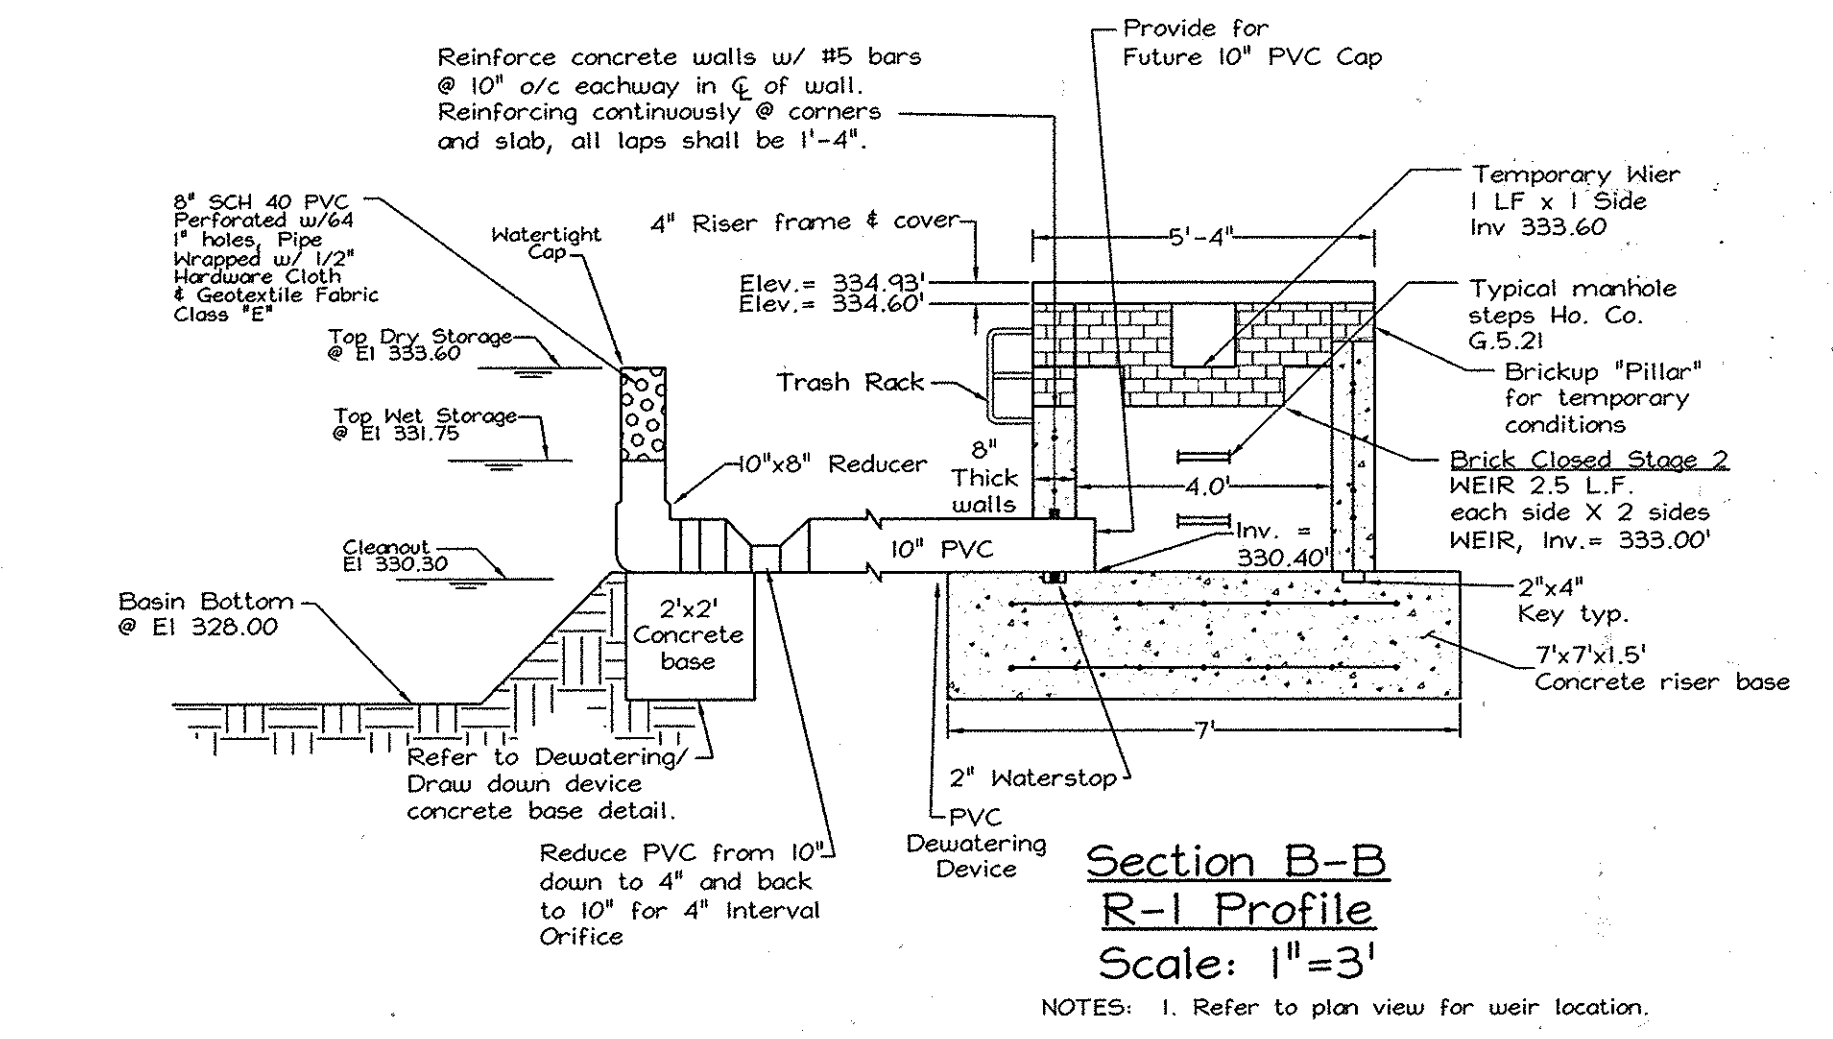

- Construction Specifications**
- The subgrade for the filter, rip-rap, or gabion shall be prepared to the required lines and grades. Any fill required in the subgrade shall be compacted to a density of approximately that of the surrounding undisturbed material.
  - The rock or gravel shall conform to the specified grading limits when installed respectively in the rip-rap or filter.
  - Geotextile shall be protected from punching, cutting, or tearing. Any damage other than an occasional small hole shall be repaired by placing another piece of geotextile over the damaged part or by completely replacing the geotextile. All overlaps whether for repairs or for joining two pieces of geotextile shall be a minimum of one foot.
  - Stone for the rip-rap or gabion outlets may be placed by equipment. They shall be constructed to the full course thickness in one operation and in such a manner as to avoid displacement of underlying materials. The stone for rip-rap or gabion outlets shall be delivered and placed in a manner that will ensure that it is reasonably homogeneous with the smaller stones and spalls filling the voids between the larger stones. Rip-rap shall be placed in a manner to prevent damage to the filter blanket or geotextile. Hand placement will be required to the extent necessary to prevent damage to the permanent works.
  - The stone shall be placed so that it blends in with the existing ground. If the stone is placed too high then the flow will be forced out of the channel and scour adjacent to the stone will occur.

U.S. DEPARTMENT OF AGRICULTURE SOIL CONSERVATION SERVICE PAGE F-10-10A MARYLAND DEPARTMENT OF ENVIRONMENT WATER MANAGEMENT ADMINISTRATION

**21.0 STANDARD AND SPECIFICATIONS FOR TOPSOIL**

**Definition**  
Placement of topsoil over a prepared subsoil prior to establishment of permanent vegetation.

**Purpose**  
To provide a suitable soil medium for vegetative growth. Soils of concern have low moisture content, low nutrient levels, low pH, materials toxic to plants, and/or unacceptable soil gradation.

**Conditions Where Practice Applies**

- This practice is limited to areas having 2:1 or flatter slopes where:
  - The texture of the exposed subsoil/parent material is not adequate to produce vegetative growth.
  - The soil material is so shallow that the rooting zone is not deep enough to support plants or furnish continuing supplies of moisture and plant nutrients.
  - The original soil to be vegetated contains material toxic to plant growth.
  - The soil is so acidic that treatment with limestone is not feasible.
- For the purpose of these Standards and Specifications, areas having slopes steeper than 2:1 require special consideration and design for adequate stabilization. Areas having slopes steeper than 2:1 shall have the appropriate stabilization shown on the plans.

**Construction and Material Specifications**

- Topsoil salvaged from the existing site may be used provided that it meets the standards set forth in these specifications. Typically, the depth of topsoil to be salvaged for a given soil type can be found in the representative soil profile section in the Soil Survey published by USDA-ARS in cooperation with Maryland Agricultural Experiment Station.
- Topsoil Specifications - Soil to be used as topsoil must meet the following:
  - Topsoil shall be a loam, sandy loam, clay loam, silt loam, sandy clay loam, loamy sand. Other soils may be used if recommended by an agronomist or soil scientist and approved by the appropriate approval authority. Regardless, topsoil shall not be a mixture of contrasting textured subsoils and shall contain less than 5% by volume of cinders, stones, slag, coarse fragments, gravel, sticks, roots, trash, or other materials larger than 1/2" in diameter.
  - Topsoil must be free of plants or plant parts such as bermuda grass, quackgrass, Johnsongrass, nutgrass, poison ivy, thistle, or others as specified.
- Where the subsoil is either highly acidic or composed of heavy clays, ground limestone shall be spread at the rate of 4-8 tons/acre (200-400 pounds per 1,000 square feet) prior to the placement of topsoil. Limes shall be distributed uniformly over designated areas and worked into the soil in conjunction with tillage operations as described in the following procedures.
  - For sites having disturbed areas under 5 acres:
    - Place topsoil (if required) and apply soil amendments as specified in 20.0 Vegetative Stabilization - Section I - Vegetative Stabilization Methods and Materials.
  - For sites having disturbed areas over 5 acres:
    - On soil meeting Topsoil specifications, obtain test results dictating fertilizer and lime amendments required to bring the soil into compliance with the following:
      - pH for topsoil shall be between 6.0 and 7.5. If the tested soil demonstrates a pH of less than 6.0, sufficient lime shall be prescribed to raise the pH to 6.5 or higher.
      - Organic content of topsoil shall be not less than 1.5 percent by weight.
      - Topsoil having soluble salt content greater than 500 parts per million shall not be used.
      - No seed or seed shall be placed on soil which has been treated with soil sterilants or chemicals used for weed control until sufficient time has elapsed (14 days min.) to permit dissipation of phytotoxic materials.
    - Note: Topsoil substitutes or amendments, as recommended by a qualified agronomist or soil scientist and approved by the appropriate approval authority, may be used in lieu of natural topsoil.
  - Place topsoil (if required) and apply soil amendments as specified in 20.0 Vegetative Stabilization - Section I - Vegetative Stabilization Methods and Materials.
- Topsoil Application
  - When topsoiling, maintain needed erosion and sediment control practices such as diversion Grade Stabilization Structures, Earth Dikes, Slope Silt Fence and Sediment Traps and Basins.
  - Grades on the areas to be topsoiled, which have been previously established, shall be maintained, at least 4" - 8" higher in elevation.
  - Topsoil shall be uniformly distributed in a 4" - 8" layer and lightly compact to a minimum thickness of 4". Spreading shall be performed in such a manner that sodding or seeding can proceed with a minimum additional soil preparation and tillage. Any irregularities in the surface resulting from topsoiling or other operations shall be corrected in order to prevent the formation of depressions or water pockets.

**SECTION 30.0 - DUST CONTROL**

**30.0 DUST CONTROL**

**Definition**  
Controlling dust blowing and movement on construction sites and roads.

**Purpose**  
To prevent blowing and movement of dust from exposed soil surfaces, reduce on and off-site damage, health hazards, and improve traffic safety.

**Conditions Where Practice Applies**

This practice is applicable to areas subject to dust blowing and movement where on and off-site damage is likely without treatment.

**Specifications**

**Temporary Methods**

- Mulches - See standards for vegetative stabilization with mulches only. Mulch should be crimped or locked to prevent blowing.
- Vegetative Cover - See standards for temporary vegetative cover.
- Tillage - To roughen surface and bring clods to the surface. This is and emergency measure which should be used before soil blowing starts. Begin plowing on windward side of site. Chisel-type plows spaced about 12' apart, spring-toothed harrows, and similar plows are examples of equipment which may produce the desired effect.
- Irrigation - This is generally done as an emergency treatment. Site is sprinkled with water until the surface is moist. Repeat as needed. At no time should the site be irrigated to the point that runoff begins to flow.
- Barriers - Solid board fences, silt fences, snow fences, burlap fences, straw bales, and similar material can be used to control air currents and soil blowing. Barriers placed at right angles to prevailing currents at intervals of about 10 times their height are effective in controlling soil blowing.
- Calcium Chloride - Apply at rates that will keep surface moist. May need retreatment.

**Permanent Methods**

- Permanent Vegetation - See standards for permanent vegetative cover, and permanent stabilization with sod. Existing trees or large shrubs not afford valuable protection if left in place.
- Topsoiling - Covering with less erosive materials. See standards for topsoiling.
- Stone - Cover surface with crushed stone or coarse gravel.

**References**

- Agriculture Handbook, Wind erosion Forces in the United States and Their Use in Predicting Soil Loss.
- Agriculture Information Bulletin 354, How to Control Wind Erosion, USDA-ARS.

U.S. DEPARTMENT OF AGRICULTURE SOIL CONSERVATION SERVICE PAGE H-30-1 MARYLAND DEPARTMENT OF ENVIRONMENT WATER MANAGEMENT ADMINISTRATION


**ROCK OUTLET PROTECTION III**

**Construction Specifications**

- The subgrade for the filter, rip-rap, or gabion shall be prepared to the required lines and grades. Any fill required in the subgrade shall be compacted to a density of approximately that of the surrounding undisturbed material.
- The rock or gravel shall conform to the specified grading limits when installed respectively in the rip-rap or filter.
- Geotextile shall be protected from punching, cutting, or tearing. Any damage other than an occasional small hole shall be repaired by placing another piece of geotextile over the damaged part or by completely replacing the geotextile. All overlaps whether for repairs or for joining two pieces of geotextile shall be a minimum of one foot.
- Stone for the rip-rap or gabion outlets may be placed by equipment. They shall be constructed to the full course thickness in one operation and in such a manner as to avoid displacement of underlying materials. The stone for rip-rap or gabion outlets shall be delivered and placed in a manner that will ensure that it is reasonably homogeneous with the smaller stones and spalls filling the voids between the larger stones. Rip-rap shall be placed in a manner to prevent damage to the filter blanket or geotextile. Hand placement will be required to the extent necessary to prevent damage to the permanent works.
- The stone shall be placed so that it blends in with the existing ground. If the stone is placed too high then the flow will be forced out of the channel and scour adjacent to the stone will occur.

U.S. DEPARTMENT OF AGRICULTURE SOIL CONSERVATION SERVICE PAGE F-10-10A MARYLAND DEPARTMENT OF ENVIRONMENT WATER MANAGEMENT ADMINISTRATION

**SEDIMENT BASIN RISER DETAILS**

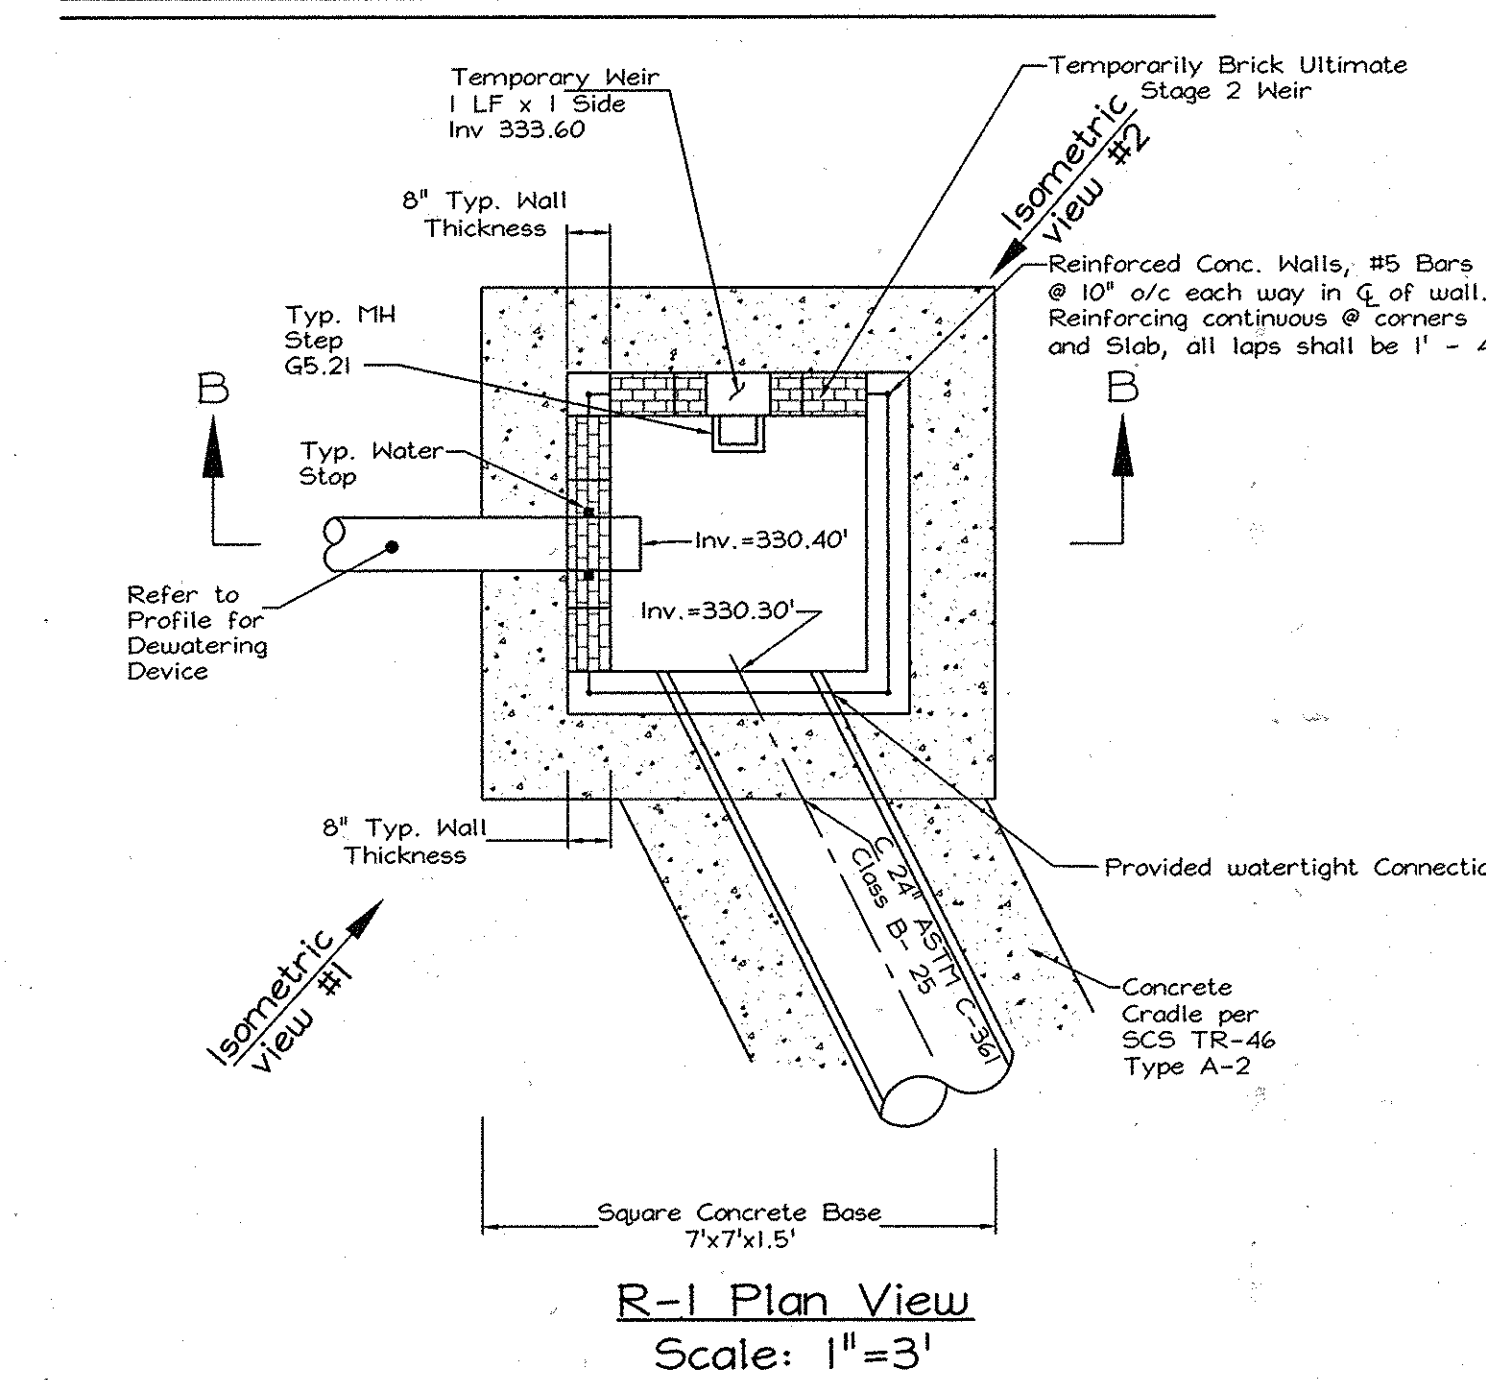

**OWNER/ DEVELOPER**  
Williamsburg Group, LLC  
5400 Harpers Farm Rd.  
Suite 200  
Columbia, MD 21044  
410 997-8000



AS-BUILT CERTIFICATION

I HEREBY CERTIFY THAT THESE DOCUMENTS WERE PREPARED OR APPROVED BY ME, AND THAT I AM A DULY LICENSED PROFESSIONAL ENGINEER UNDER THE LAWS OF THE STATE OF MARYLAND, LICENSE NO. 19184, EXPIRATION DATE: JUNE 16, 2017.

SIGNED: *Bruce D. Burton* DATE: 12/19/08  
BRUCE D. BURTON

APPROVED: DEPARTMENT OF PUBLIC WORKS  
*W. Z. M...* 1-9-09  
CHIEF, BUREAU OF HIGHWAYS DATE

APPROVED: DEPARTMENT OF PLANNING AND ZONING  
*Chad Edinger* 11/6/09  
CHIEF, DEVELOPMENT ENGINEERING DIVISION DATE

**ENGINEER'S CERTIFICATE**  
"I hereby certify that this plan for sediment and erosion control represents a practical and workable plan based on my personal knowledge of the site conditions and that it was prepared in accordance with the requirements of the Howard Soil Conservation District."  
*Bruce D. Burton* 12/19/08  
Signature of Engineer Date  
Bruce D. Burton


**DEVELOPER'S CERTIFICATE**  
"I/We certify that all development and construction will be done according to this plan of development for sediment and erosion control, and that all responsible personnel involved in the construction project will have a Certificate of Attendance at a Department of Environmental Approved Training Program for the Control of Sediment and Erosion before beginning the project. I also authorize periodic onsite inspections by the Howard County Soil District."  
*John K. Blunt* 11/6/09  
Signature of Developer Date  
John K. Blunt

THIS DEVELOPMENT PLAN IS APPROVED FOR SOIL EROSION AND SEDIMENT CONTROL BY THE HOWARD SOIL CONSERVATION DISTRICT

DATE: 11/6/09  
HOWARD SOIL CONSERVATION DISTRICT

No.	Date	By	Description
1	4/12	LDE	REVISE OWNER/DEVELOPER

LDE Inc. AS-BUILT	
Engineers, Surveyors, Planners 9250 Ramsey Road, Suite 106 Columbia, Maryland - 21045 (410)715-1070 - (301)596-3424 - FAX(410)715-9340	
DESIGNED	EDS
DRAWN	LDE
CHECKED	BDB
DATE	12/2008
SCALE	As Shown
DRAWING	10 OF 16
JOB NO.	02-035.2
FILE NO.	F-08-179

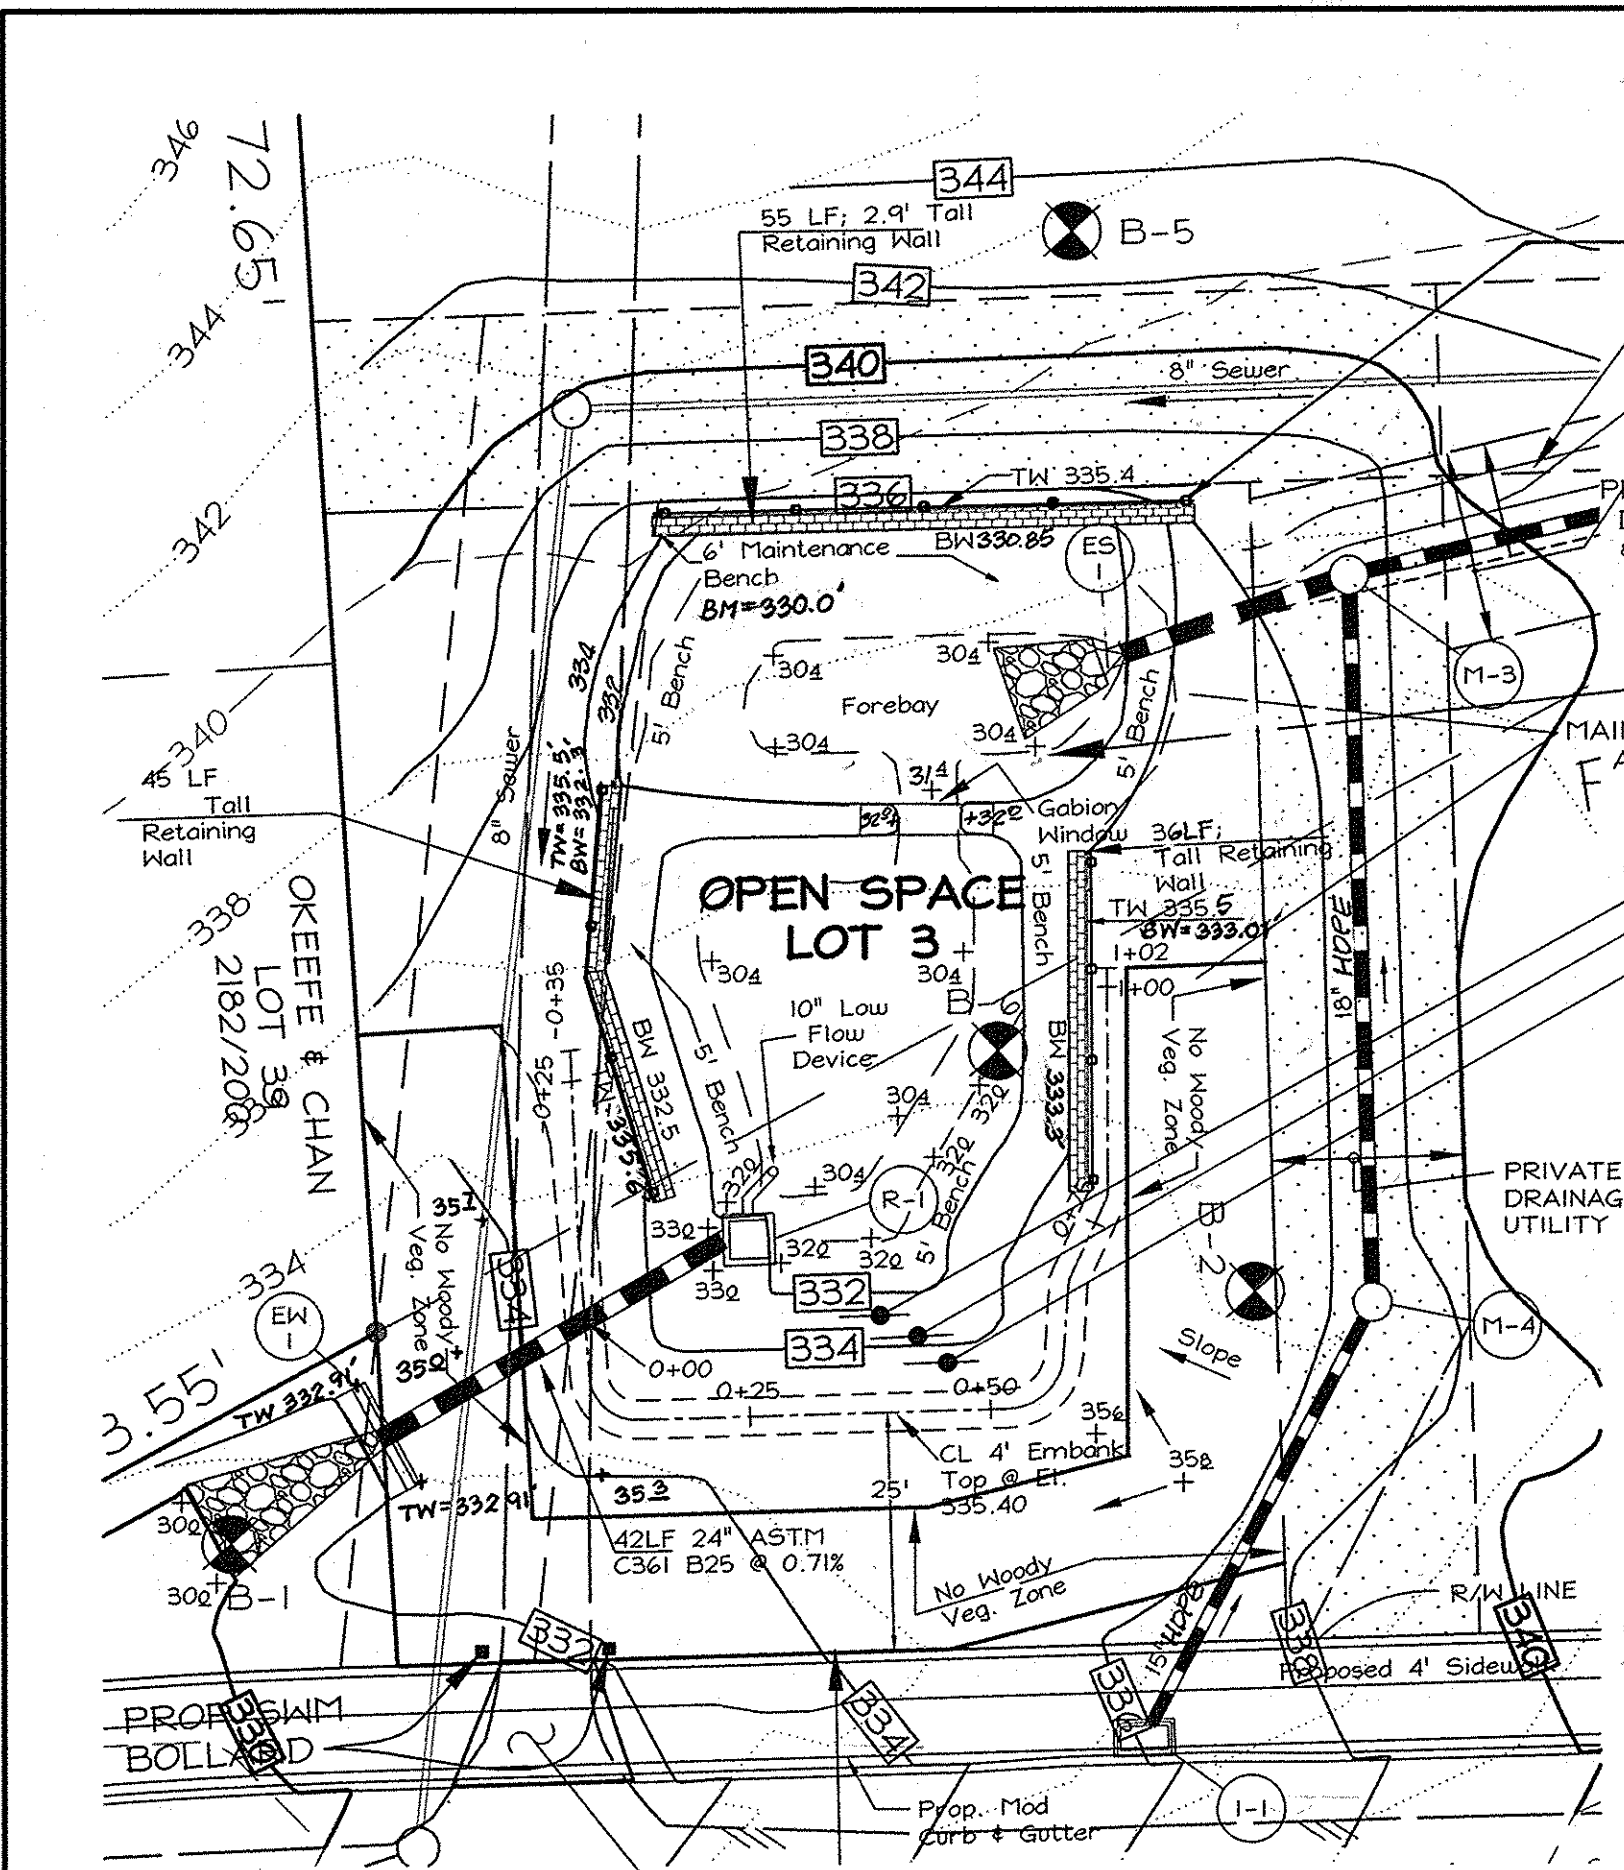



**CONTROLLED SUBAREA**

PRIVATE (NON MD 378) FACILITY #1 - Extended Detention  
 Hazard Classification "A"  
 Drainage Area = 5.20 Acres  
 Water Quality Management = BIOTENTION / CREDITS  
 Water Quantity (Cpv) Management = EXTENDED DETENTION

Groundwater Recharge Volume (Rv) Required = 9,627 sqft.  
 Groundwater Recharge Volume (Rv) Provided = 10,307 sqft.\*  
 Water Quality Volume (WQ) Required = 2,526 cuft.  
 Water Quality Volume (WQ) Provided = 2,770 cuft.\*\*  
 Channel Protection Volume (Cpv) Required = 3,677 cuft.  
 Channel Protection Volume (Cpv) Provided = 5,192 cuft.\*\*\*

\* Provided per use of "Disconnection of Rooftop Runoff Credits"  
 Percent Area Computations  
 \*\* Volume reduced per "Disconnection of Rooftop Runoff Credit"  
 Volume provided within Bioretention Facility  
 \*\*\* Cpv required is for Onsite 3.5 Acres  
 Cpv provided is within Facility #1  
 NOTE: Qp10 & Qp100 management not required

STUDY POINT #1 - NON MD-378 - EXT. DET. FACILITY			
	1 Year (Cpv)	Qp10 Year	Qp100 Year
Total Existing Flow (cfs)	1.9	13.1	25.1
Unmanaged Flow (cfs)	0	2	4
Acceptable Release* (cfs)	2	11	21
Computed Inflow (cfs)	2.8	13.7	24.8
Facility Discharge (cfs)	0.2	11.9	21.6
Elevation at Discharge	333.00	333.83	334.44
Total Developed Flow (cfs)	0.5	13.1	24.1

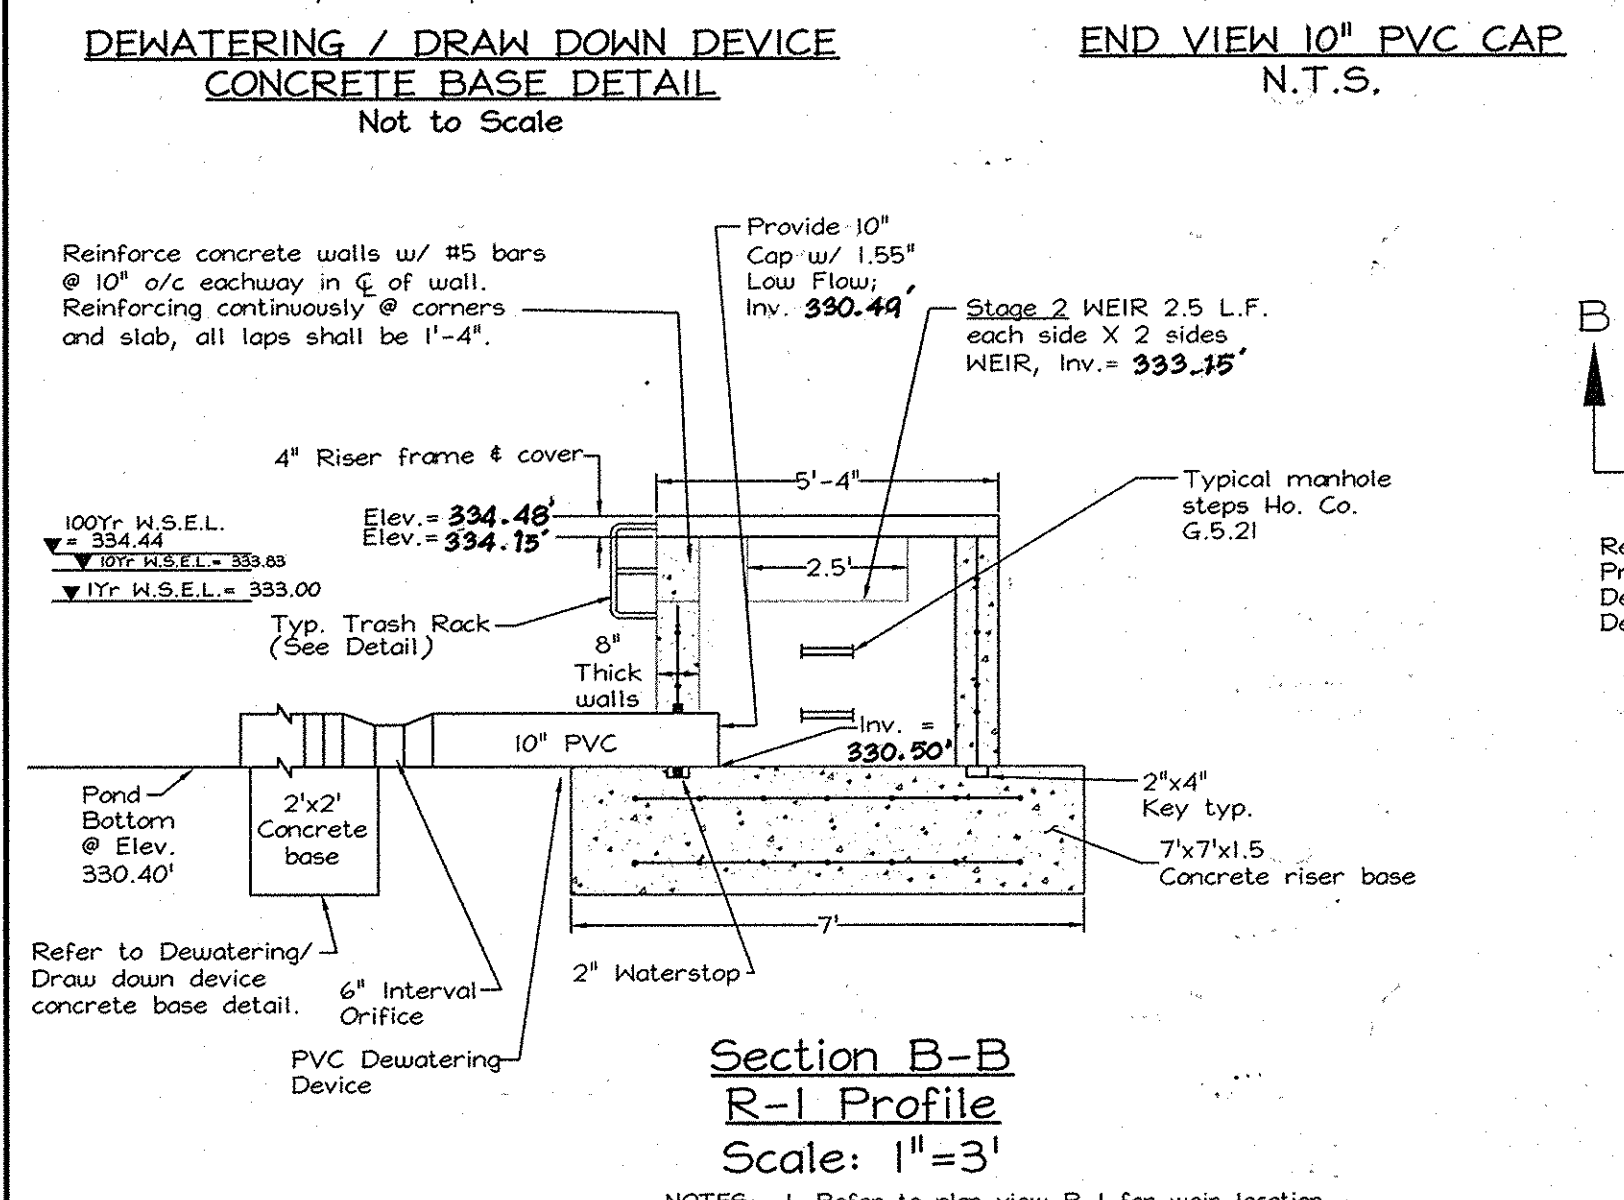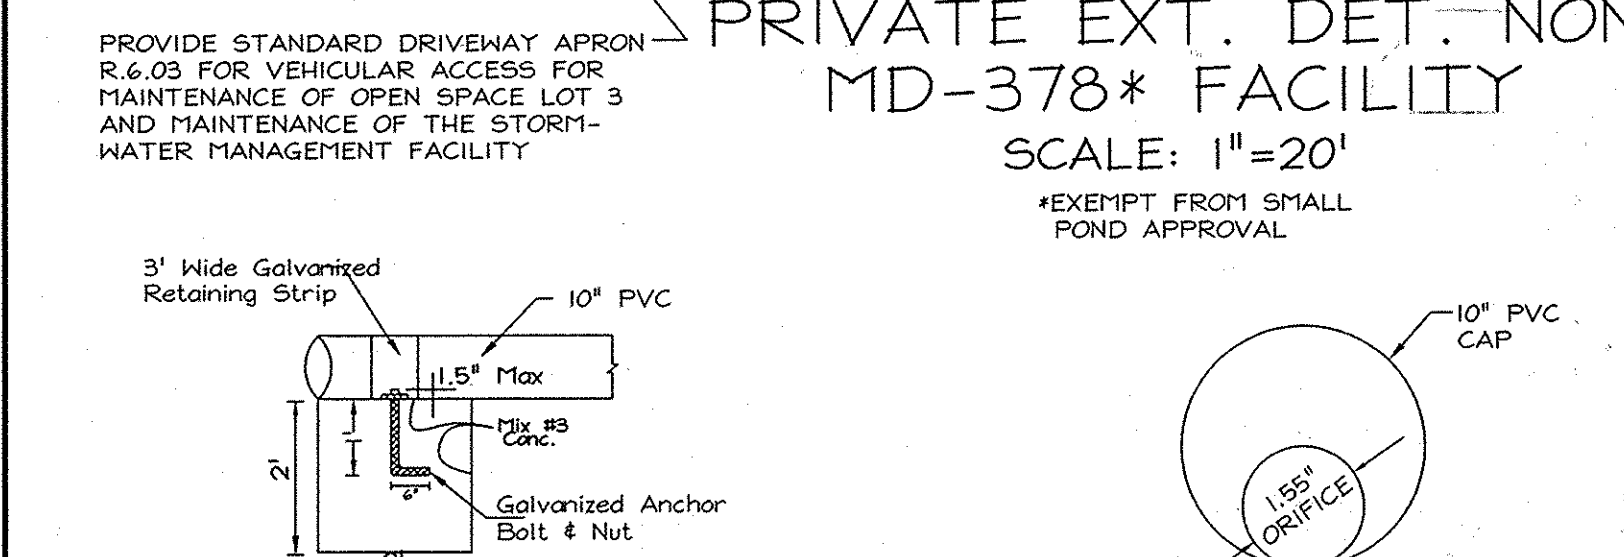

APPROVED: DEPARTMENT OF PUBLIC WORKS  
 [Signature] 1-9-09 DATE  
 CHIEF, BUREAU OF HIGHWAYS

APPROVED: DEPARTMENT OF PLANNING AND ZONING  
 [Signature] 1/20/09 DATE  
 CHIEF, DIVISION OF LAND DEVELOPMENT

APPROVED: CHIEF, DEVELOPMENT ENGINEERING DIVISION  
 [Signature] 1/6-9 DATE

**ENGINEER'S CERTIFICATE**





"I hereby certify that this plan for sediment and erosion control represents a practical and workable plan based on my personal knowledge of the site conditions and that it was prepared in accordance with the requirements of the Howard Soil Conservation District."

[Signature] 12/19/08 DATE  
 Signature of Engineer  
 Bruce D. Burton

**DEVELOPER'S CERTIFICATE**

"I/We certify that all development and construction will be done according to this plan of development for sediment and erosion control, and that all responsible personnel involved in the construction project will have a Certificate of Attendance at a Department of Environmental Approved Training Program for the Control of Sediment and Erosion before beginning the project. I also authorize periodic onsite inspections by the Howard County Soil District."

[Signature] 12-19-08 DATE  
 Signature of Developer

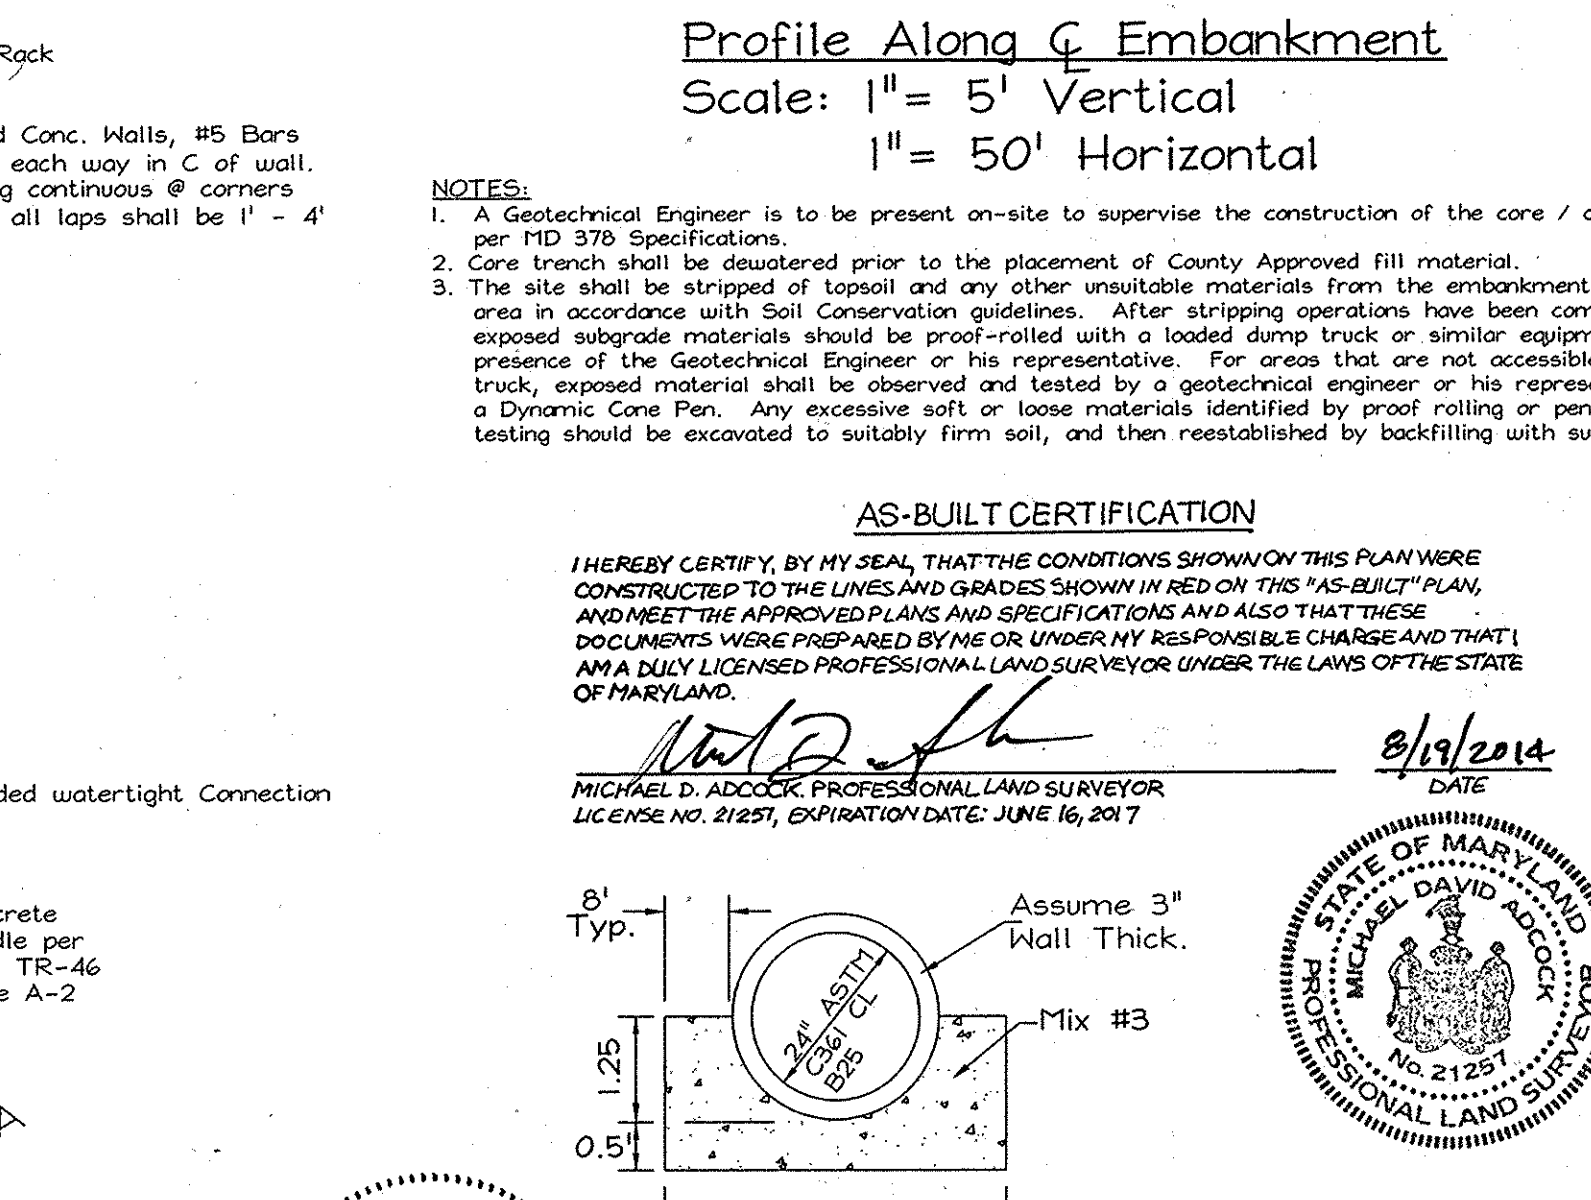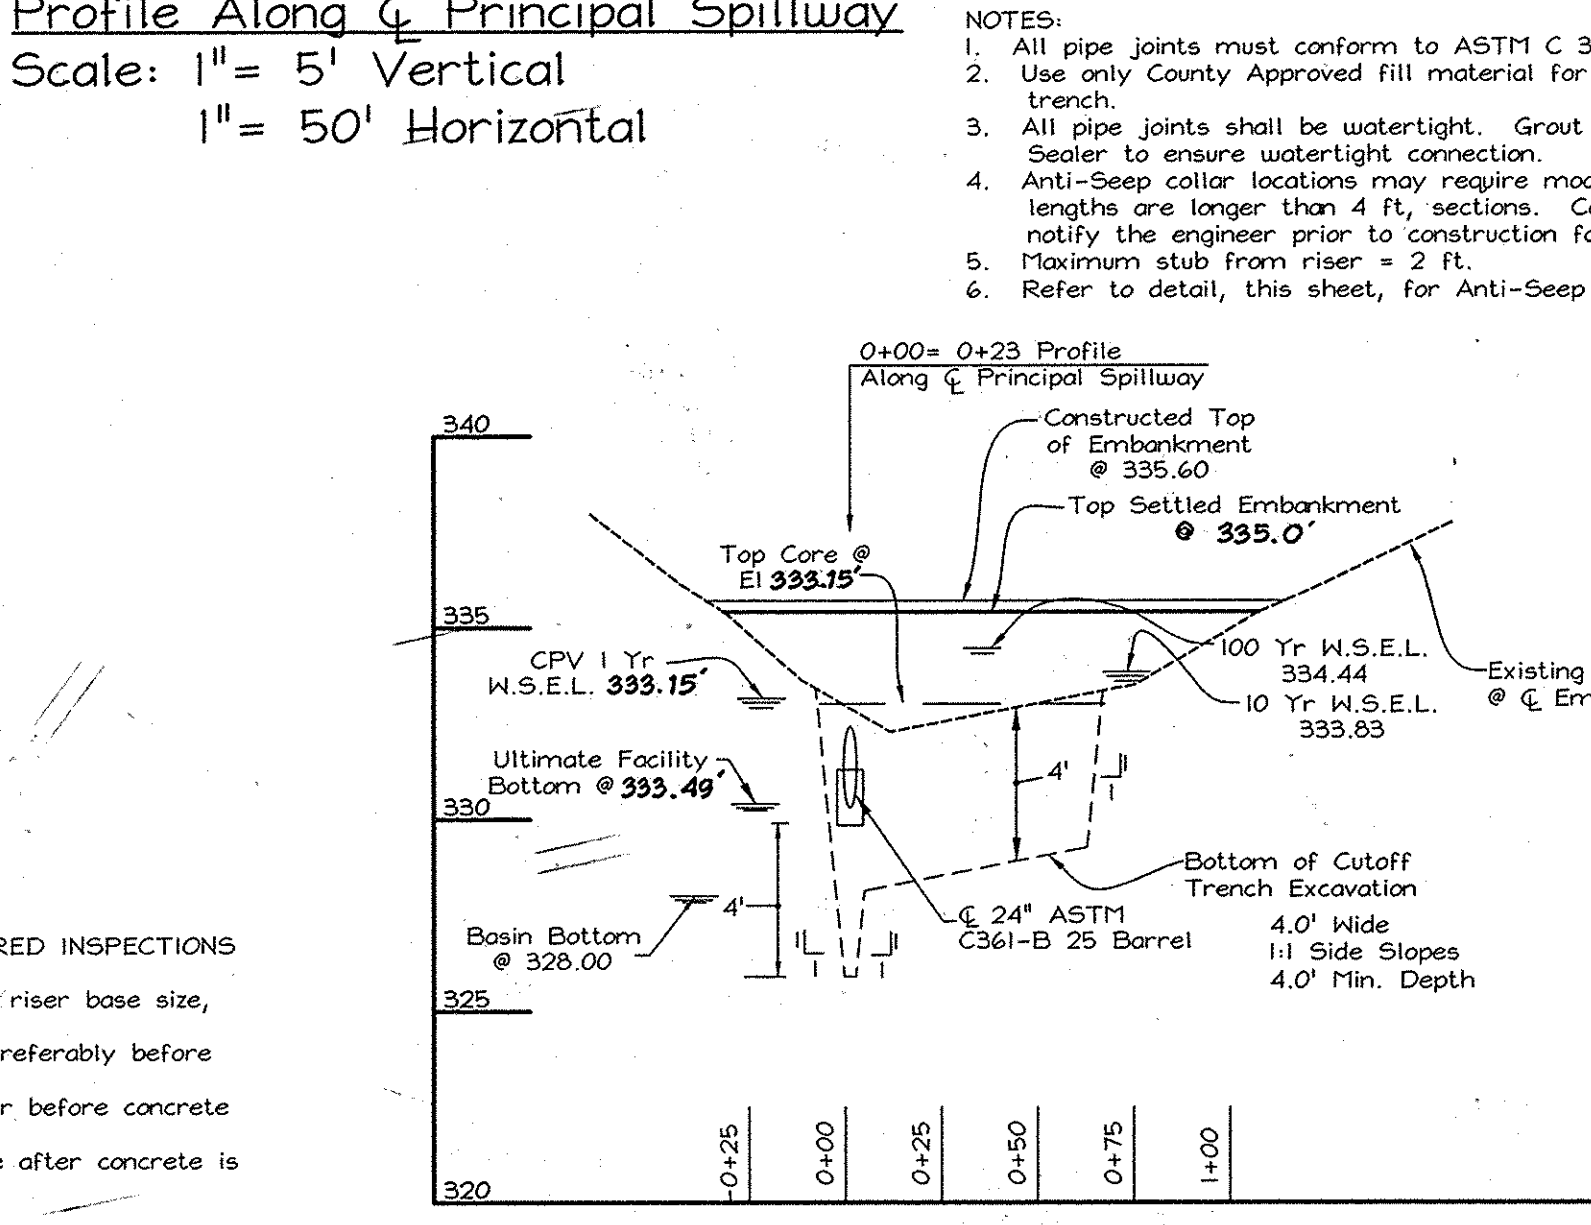
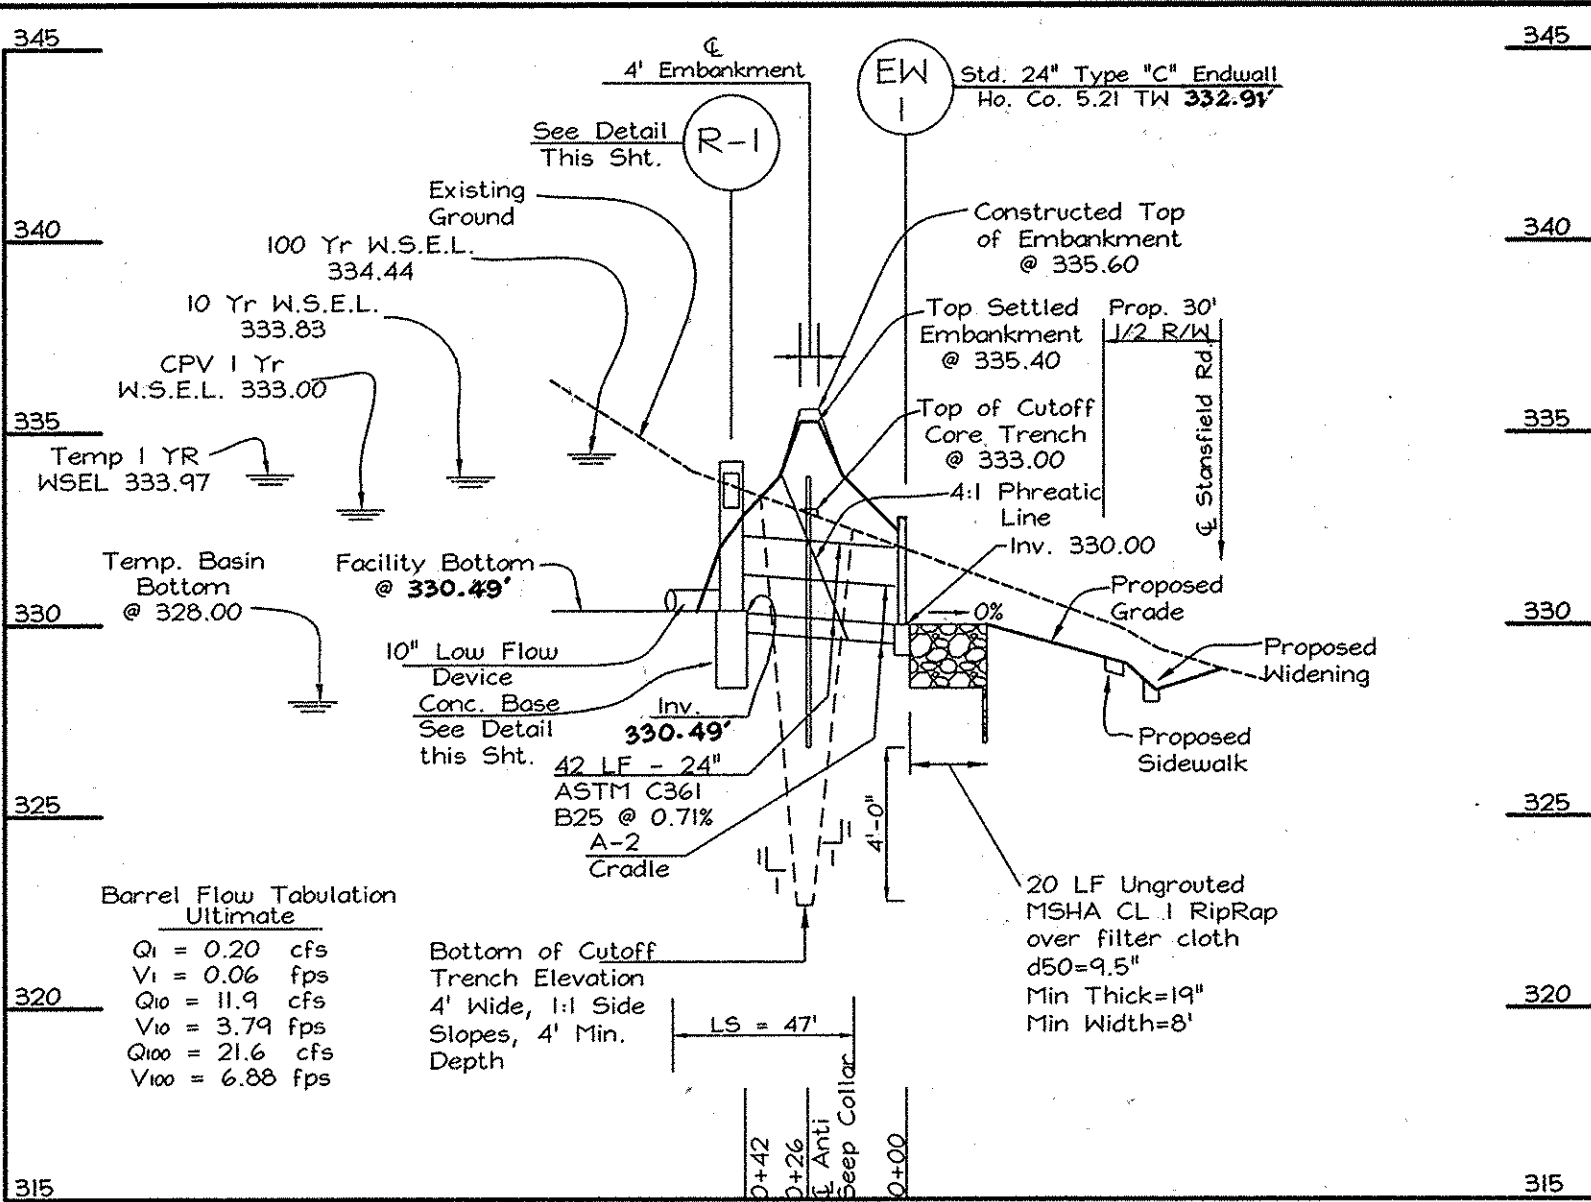
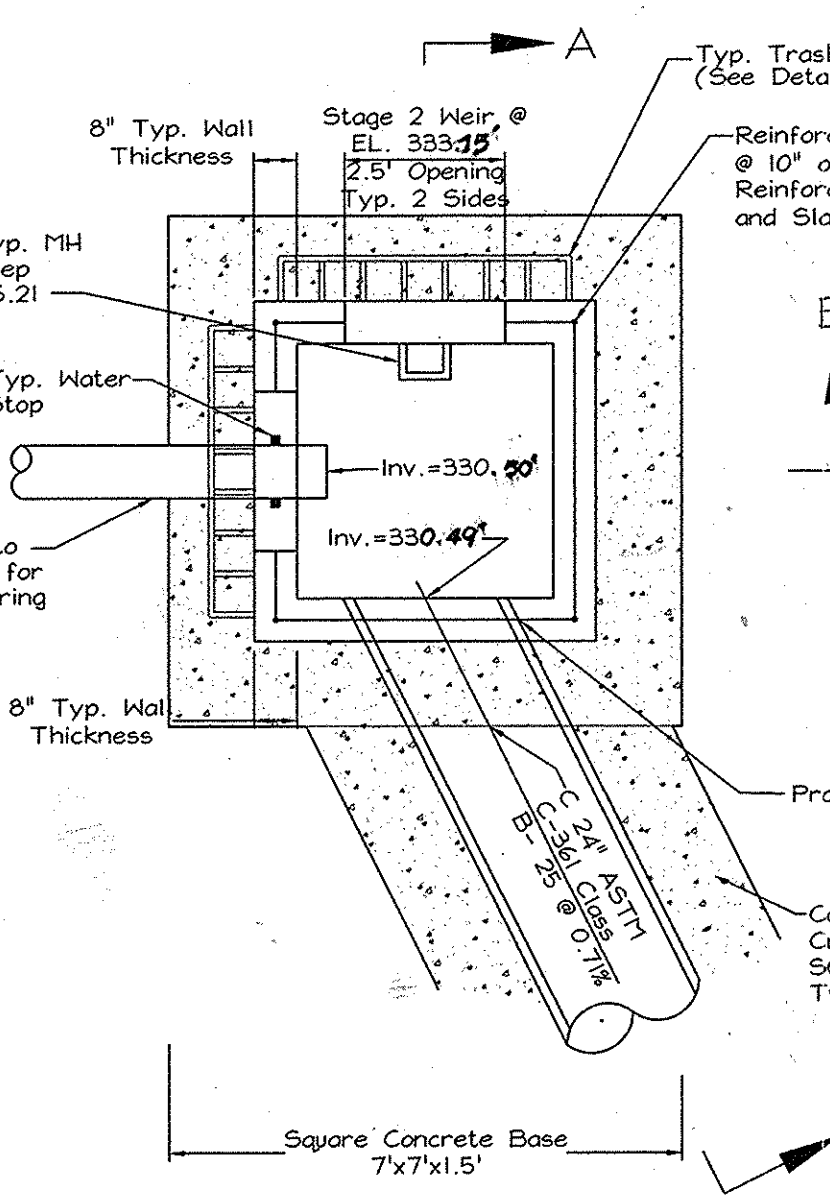


**AS-BUILT CERTIFICATION**

I HEREBY CERTIFY, BY MY SEAL, THAT THE CONDITIONS SHOWN ON THIS PLAN WERE CONSTRUCTED TO THE LINES AND GRADES SHOWN IN RED ON THIS "AS-BUILT" PLAN, AND THAT THE APPROVED PLANS AND SPECIFICATIONS AND ALSO THAT THESE DOCUMENTS WERE PREPARED BY ME OR UNDER MY RESPONSIBLE CHARGE AND THAT I AM A DULY LICENSED PROFESSIONAL LAND SURVEYOR UNDER THE LAWS OF THE STATE OF MARYLAND.




[Signature] 8/19/2014 DATE  
 MICHAEL D. ADOCK, PROFESSIONAL LAND SURVEYOR  
 LICENSE NO. 21251, EXPIRATION DATE: JUNE 16, 2017

STATE OF MARYLAND PROFESSIONAL LAND SURVEYOR

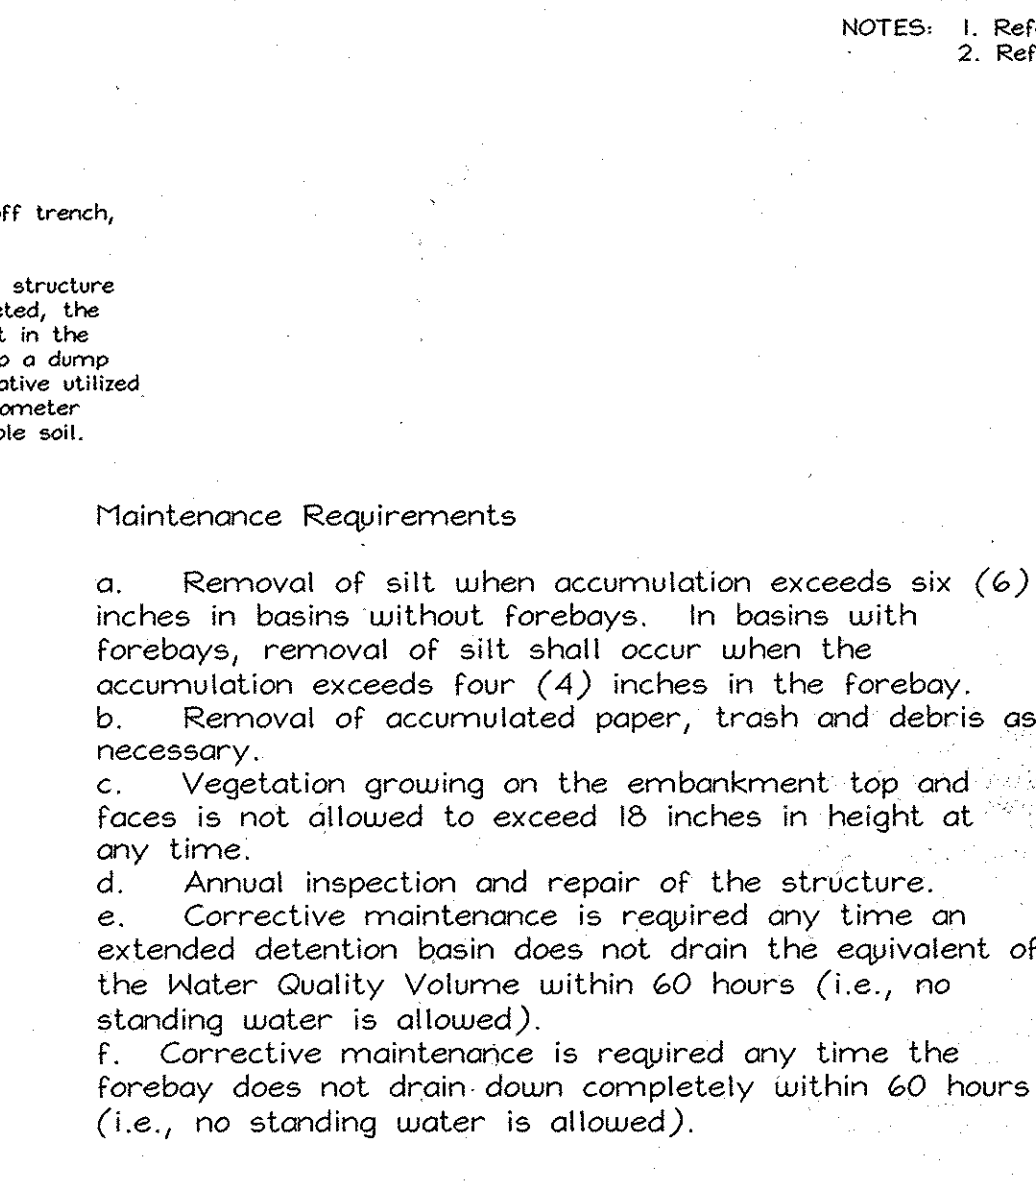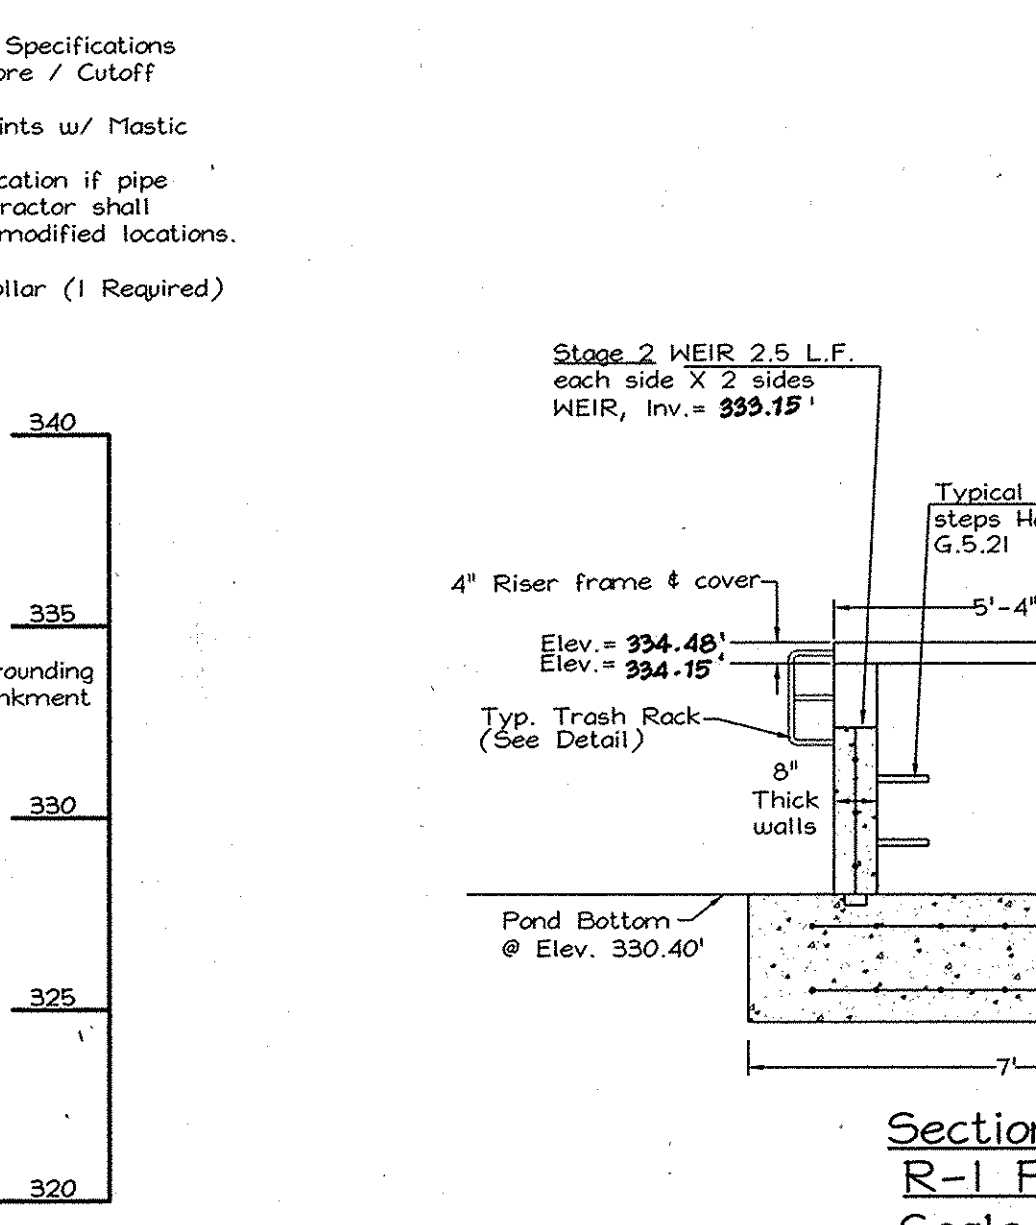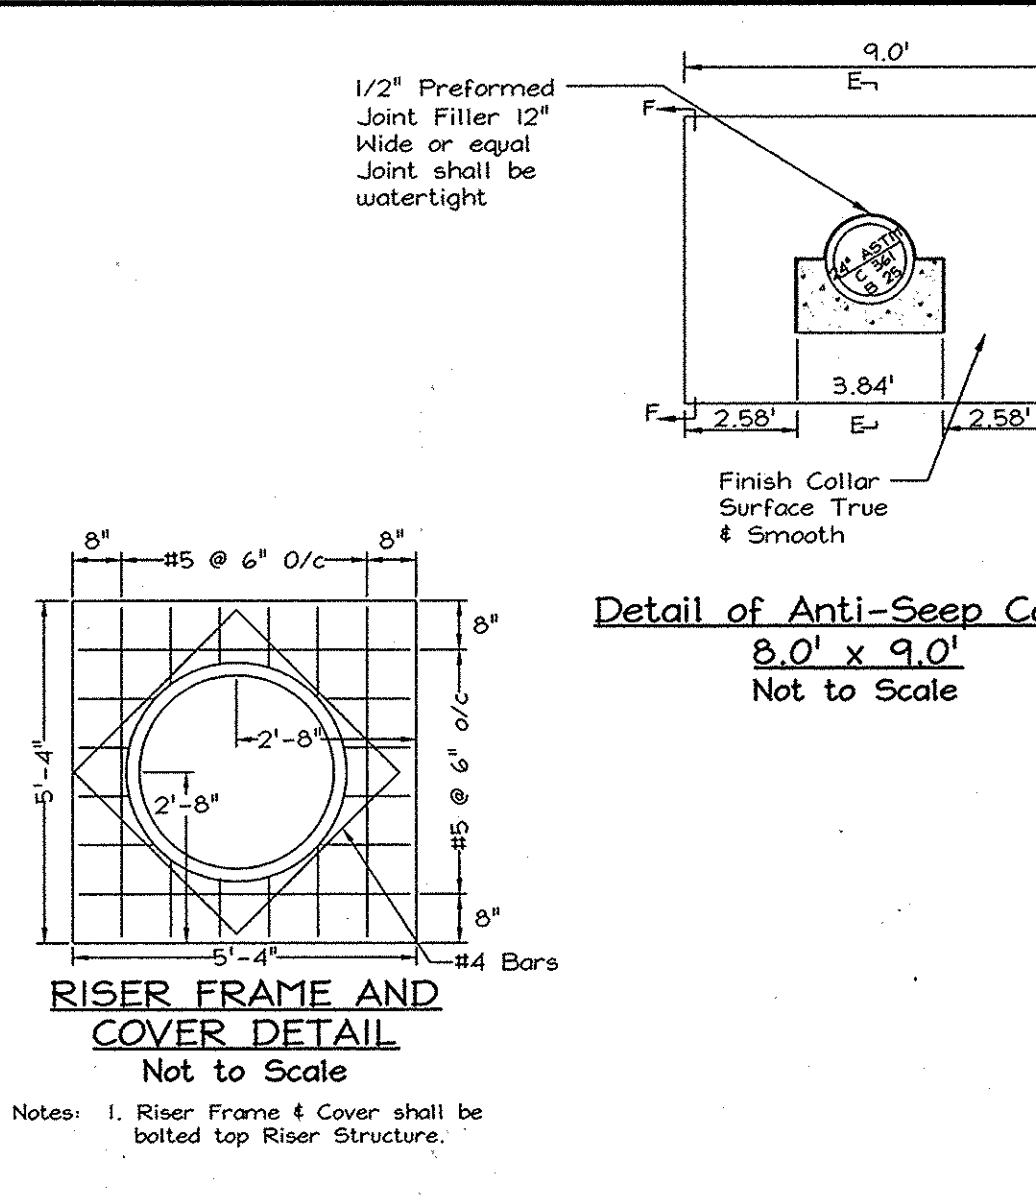

**REVISIONS**

No.	Date	By	Description
3	5/20/15	SEG	ADD FENCE ALONG TOP OF RET. WALLS
2	1/20/15	SEG	REVISE SD PIPE TYPE & REVISE GRADES AT FOREBAY
1	6/12	WDE	REVISE OWNER/DEVELOPER

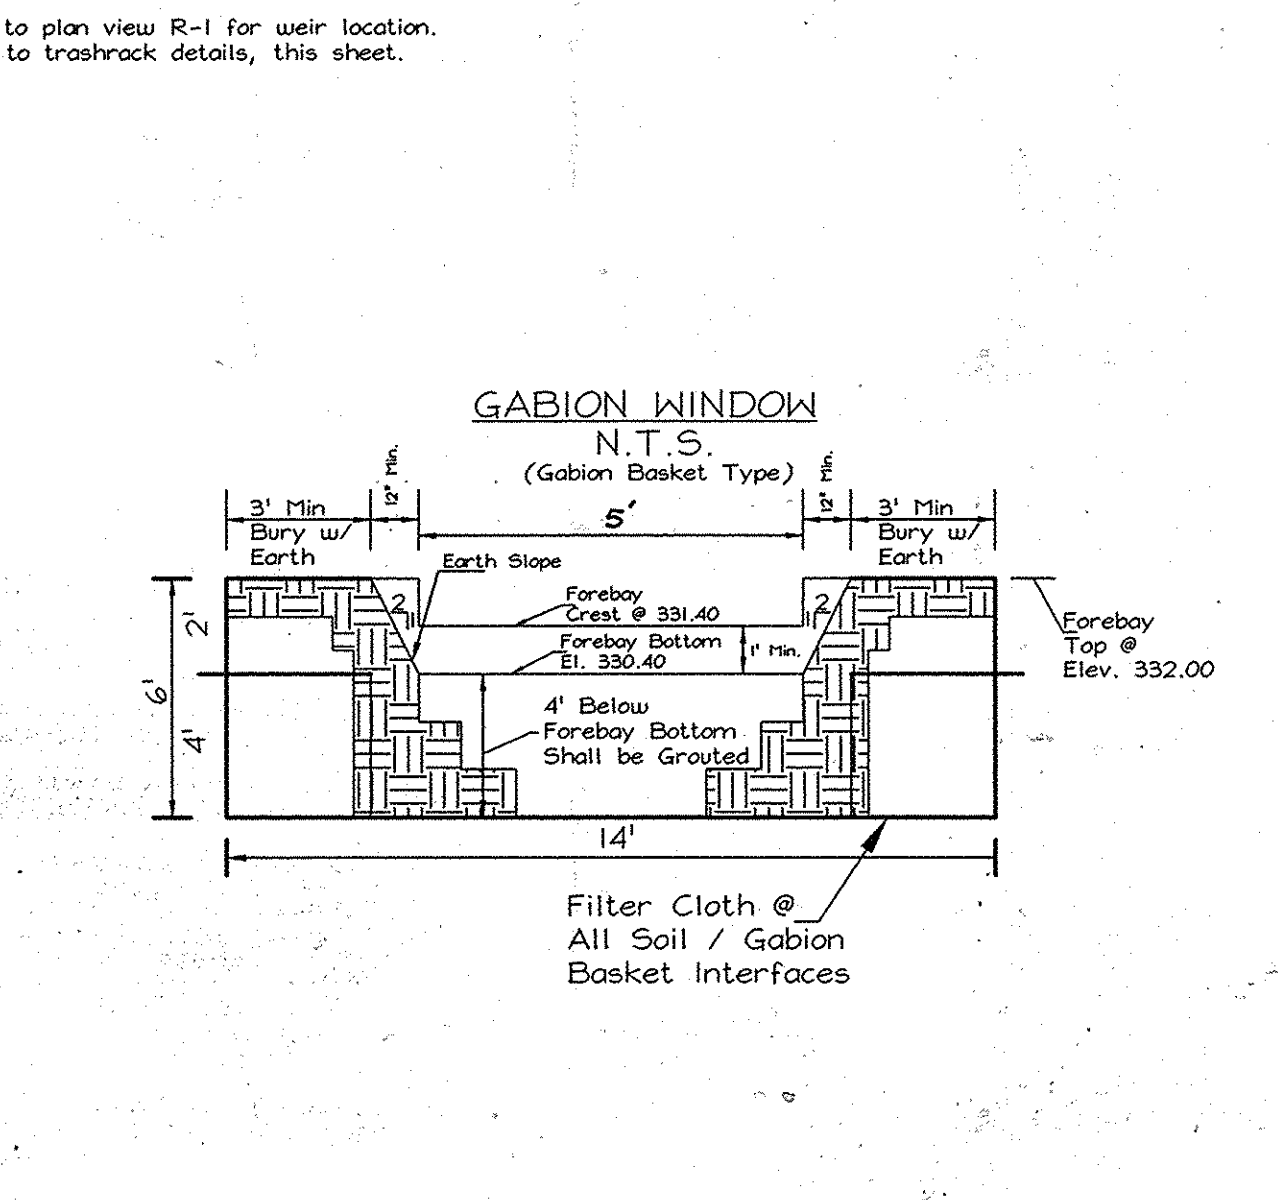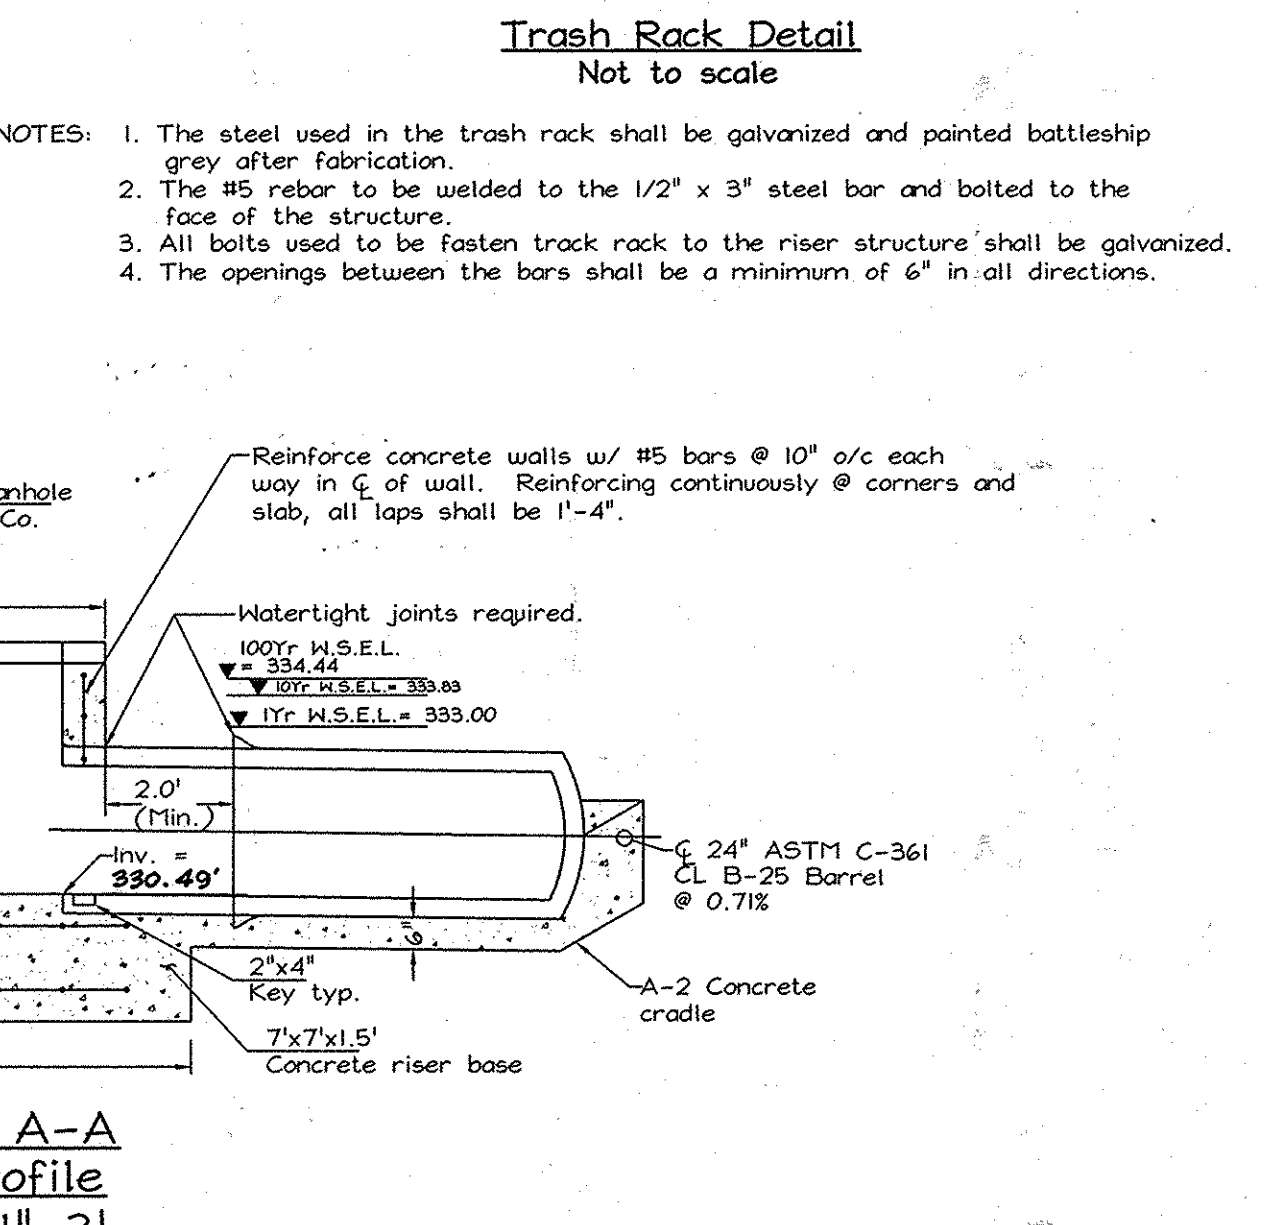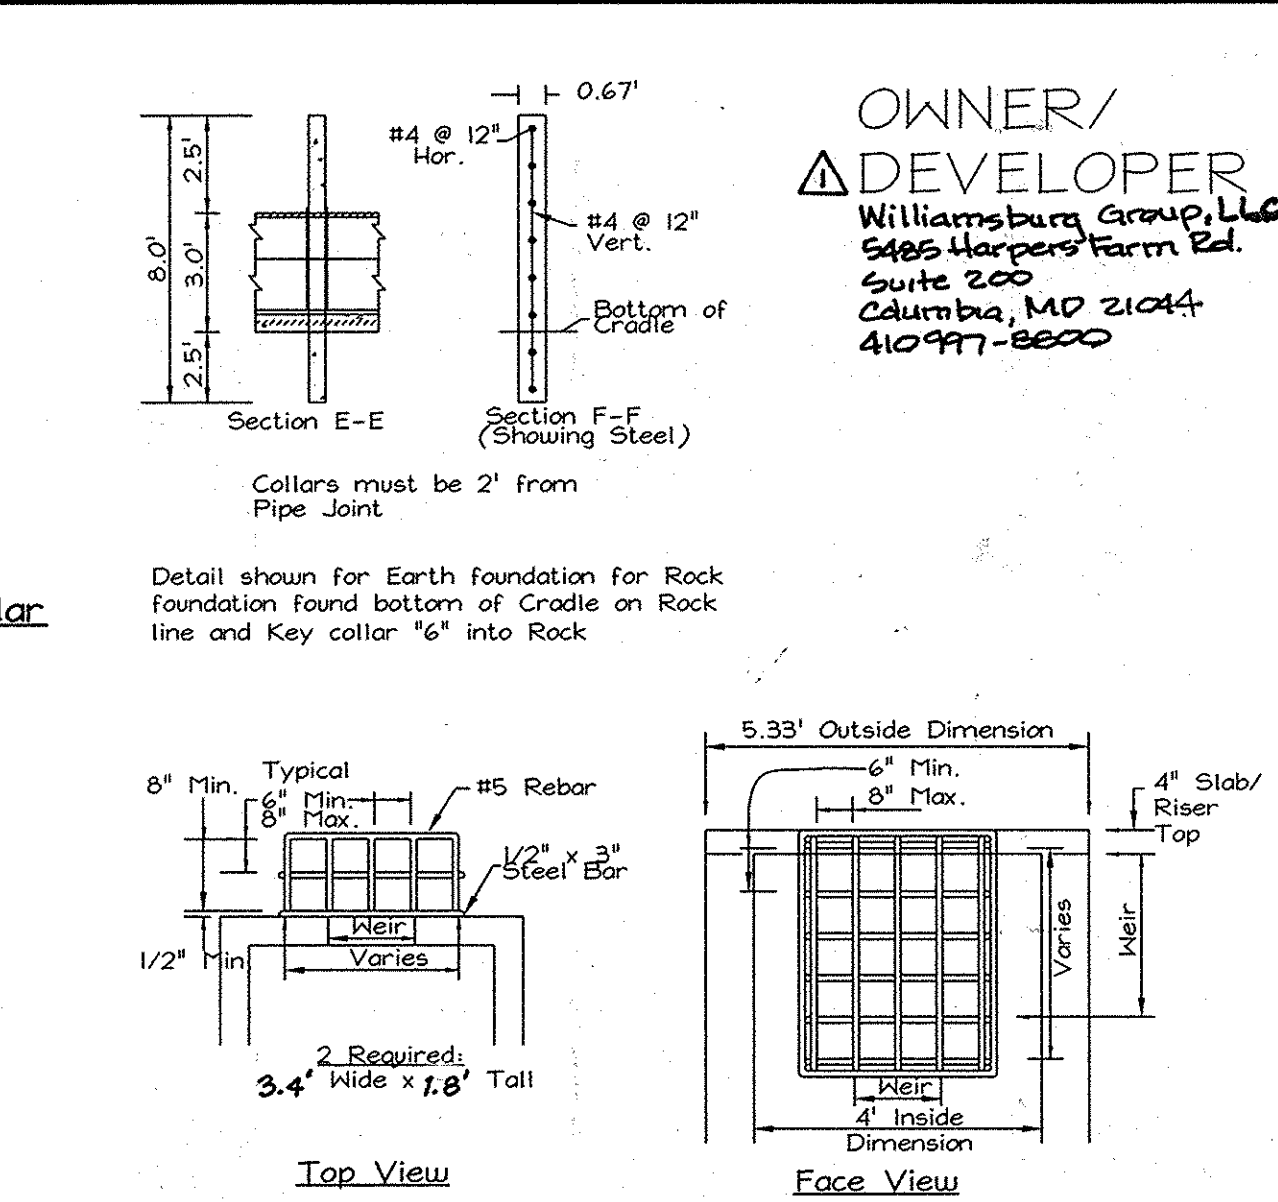

**LDE Inc. AS-BUILT**  
 Engineers, Surveyors, Planners  
 9230 Ramsey Road, Suite 106 Columbia, Maryland - 21045  
 (410)715-1070 - (301)596-3424 - FAX(410)715-9540

DESIGNED: EDS  
 DRAWN: LDE  
 CHECKED: BDB  
 DATE: 12/2008

SCALE: As Shown  
 DRAWING: 11 OF 16  
 JOB NO.: 02-035.2  
 FILE NO.: F-08-179

PRIVATE NON MD-378 STORMWATER MANAGEMENT FACILITY #1 DETAILS  
**WATKINS' CHOICE PHASE I**  
 Lots 1, 2, Open Space Lot 3 and Non-Buildable Bulk Parcel "A"  
 Tax Map 46 - Grid 18 - Parcel 215  
 6 th Election District - Howard County, Maryland  
 Previous Submittals: SP-07-010, MP-09-042  
 Owner/Developer: Williamsburg Group, LLC  
 5405 Harpers Farm Rd., Suite 200 Columbia, MD 21044 410-977-8800

# MD 378 POND CONSTRUCTION SPECIFICATIONS

## STABILIZATION

All borrow areas shall be graded to provide proper drainage and left in a slightly condition. All exposed surfaces of the embankment, spillway, spoil and borrow areas, and berms shall be stabilized by seeding, liming, fertilizing and mulching in accordance with the Natural Resource Conservation Service Standards and Specifications for Critical Area Planting (MD-342) or as shown on the accompanying drawings.

## EROSION AND SEDIMENT CONTROL

Construction operations will be carried out in such a manner that erosion will be controlled and water and air pollution minimized. State and local laws concerning pollution abatement will be followed. Construction plans shall detail erosion and sediment control measures. These specifications are appropriate to all ponds within the scope of the Standard for practice MD-378. All references to ASTM and AASHTO specifications apply to the most recent version.

## SITE PREPARATION

Areas designated for borrow areas, embankment and structural works shall be cleared grubbed, and stripped of topsoil. All trees, vegetation, roots, and other objectionable material shall be removed. Channel banks and sharp breaks shall be sloped to no steeper than 1:1. All trees shall be cleared and grubbed within 15 feet of the toe of the embankment.

Areas to be covered by the reservoir will be cleared of all trees, brush, logs, fences, rubbish, and other objectionable material unless otherwise designated on the plans. Trees, brush and stumps shall be cut approximately level to the ground surface. For dry stormwater management ponds, a minimum of a 25 foot radius around the inlet structure shall be cleared.

All cleared and grubbed material shall be disposed of outside and below the limits of the dam and reservoir as directed by the owner or his representative. When specified, a sufficient quantity of topsoil will be stockpiled in a suitable location for use on the embankment and other designated areas.

## EARTH FILL

**Material** - The fill material shall be taken from approved designated borrow areas. It shall be free of roots, stumps wood, rubbish, stones greater than 6", frozen or other objectionable materials. Fill material for the center of the embankment and cut off trench shall conform to Unified Soil Classification GC, SC, CH, or CL and must have at least 30% passing the #200 sieve. Consideration may be given to the use of other materials in the embankment if designed by a geotechnical engineer. Such special designs must have construction supervised by a geotechnical engineer.

Materials used in the outer shell of the embankment must have the capability to support vegetation of the quality required to prevent erosion of the embankment.

**Placement** - Areas on which fill is to be placed shall be scarified prior to the placement of fill. Fill materials shall be placed in maximum 8 inch thick (before compaction) layers which are to be continuous over the entire length of fill. The most permeable borrow material shall be placed in the downstream portions of the embankment. The principal spillway must be installed concurrently with fill placement and not excavated into the embankment.

**Compaction** - The movement of the hauling and spreading equipment over the fill shall be controlled so that the entire surface of each lift shall be traversed by not less than one tread track of heavy equipment or compaction shall be achieved by a minimum of four complete passes of a sheepfoot, rubber tired, or vibratory roller. Fill material shall contain sufficient moisture such that the required degree of compaction will be obtained with the equipment used. The fill material shall contain sufficient moisture so that if formed into a ball it will not crumble yet not be wet that water can be squeezed out.

The minimum required density shall not be less than 95% of maximum dry density with a moisture content within +/- 2% of the optimum. Each layer of fill shall be compacted as necessary to obtain that density, and is to be certified by the Engineer at the time of construction. All compaction is to be determined by AASHTO Method T-99 (Standard Proctor).

**Cut-off Trench** - The cutoff trench shall be excavated into impervious material along or parallel to the centerline of the embankment as shown on the plans. The bottom width of the trench shall be governed by the equipment used for excavation, with the minimum width being four feet. The depth shall be at least four feet below existing grade or as shown on the plans. The side slopes of the trench shall be 1 to 1 or flatter. The backfill shall be compacted with construction equipment, rollers, or hand tampers to assure maximum density and minimum permeability.

**Embankment Core** - The core shall be parallel to the centerline of the embankment as shown on the plans. The top width of the core shall be a minimum of four feet. The height shall extend up to at least 10 year water elevation or as shown on the plans. The side slopes shall be 1 to 1 or flatter. The core shall be compacted with construction equipment, rollers, or hand tampers to assure maximum density and minimum permeability. In addition, the core shall be placed concurrently with the outer shell of the embankment.

## STRUCTURAL BACKFILL

Backfill adjacent to pipes or structures shall be of the type and quality conforming to that specified for the adjoining fill material. The fill shall be placed in horizontal layers not to exceed four inches in thickness and compacted by hand tampers or other manually directed compaction equipment. The material needs to fill completely all spaces under and adjacent to the pipes. At no time during the backfilling operation shall driven equipment be allowed to operate closer than four feet measured horizontally, to any part of a structure. Under no circumstances shall equipment be driven over any part of a concrete structure or pipe, unless there is compacted fill of 24" or greater over the structure or pipe. Structure backfill may be flowable fill meeting the requirements of Maryland Department of Transportation, State Highway Administration Standard Specifications for Construction and Materials, Section 313 as modified. The mixture shall have a 100-200 psi; 28 day unconfined compressive strength. The flowable fill shall have a minimum pH of 4.0 and a minimum resistivity of 2,000 ohm-cm. Material shall be placed such that a minimum of 6" (measured perpendicular to the outside of the pipe) of flowable fill shall be under (bedding), over and, on the sides of the pipe. It only needs to extend up to the spring line for rigid conduits. Average slump of the fill shall be 7" to assure flowability of the material. Adequate measures shall be taken (sand bags, etc.) to prevent floating the pipe. When using flowable fill, all metal pipe shall be bituminous coated. Any adjoining soil fill shall be placed in horizontal layers not to exceed four inches in thickness and compacted by hand tampers or other manually directed compaction equipment. The material shall completely fill all voids adjacent to the flowable fill zone. At no time during the backfilling operation shall driven equipment be allowed to operate closer than four feet, measured horizontally, to any part of a structure. Under no circumstances shall equipment be driven over any part of a structure or pipe unless there is compacted fill of 24" or greater over the structure pipe. Backfill material outside the structural backfill (flowable fill) zone shall be of the type and quality conforming to that specified for the core of the embankment or other embankment materials.

## PIPE CONDUITS

All pipes shall be circular in cross section.

**Corrugated Metal Pipe** - All of the following criteria shall apply for corrugated metal pipe:

- Materials - (Polymer Coated steel pipe) - Steel pipes with polymeric coatings shall have a minimum coating thickness of 0.01 inch (10 mil) on both sides of the pipe. This pipe and its appurtenances shall conform to the requirements of AASHTO Specifications M-245 & M-246 with watertight coupling bands or flanges.
- Materials - (Aluminum Coated Steel Pipe) - This pipe and its appurtenances shall conform to the requirements of AASHTO Specification M-274 with watertight coupling bands or flanges. Aluminum Coated Steel Pipe, when used with flowable fill or when soil and/or water conditions warrant the need for increased durability, shall be fully bituminous coated per requirements of AASHTO Specification M-190 Type A. Any aluminum coating damaged or otherwise removed shall be replaced with cold applied bituminous coating compound. Aluminum surfaces that are to be in contact with concrete shall be painted with one coat of zinc chromate primer or two coats of asphalt.

**Materials - (Aluminum Pipe)** - This pipe and its appurtenances shall conform to the requirements of AASHTO Specifications M-196 or M211 with watertight coupling bands or flanges. Aluminum Pipe, when used with flowable fill or when soil and/or water conditions warrant for increased durability, shall be fully bituminous coated per requirements of AASHTO Specifications M-190 Type A. Aluminum surfaces that are to be in contact with concrete shall be painted with one coat of zinc chromate primer. Hot dip galvanized bolts may be used for connections. The pH of the surrounding soils shall be between 4 and 9.

2. Coupling bands, anti seep-collars, end sections, etc., must be composed of the same material and coatings as the pipe. Metals must be insulated from dissimilar materials with use of rubber or plastic insulating materials at least 24 mils in thickness.

3. Connections - All connections with pipes must be completely watertight. The drain or barrel connection to the riser shall be welded all around when the pipe and riser are metal. Anti-seep collars shall be connected to the pipe in such a manner as to be completely watertight. Dimple bands are not considered to be watertight.

All connections shall use a rubber or neoprene gasket when joining pipe sections. The end of each pipe shall be re-rolled an adequate number of corrugations to accommodate the band width. The following type connections are acceptable for pipes less than 24" in diameter: flanges on both ends of the pipe, with a circular 3/8" closed cell neoprene gasket, pre-punched to the flange bolt circle, sandwiched between adjacent flanges; a 12 inch wide standard lap type band with 1/2" wide by 3/8" thick closed cell circular neoprene gasket; and a 12 inch wide hugger type band with O-ring gaskets having a minimum diameter of 1/2 inch greater than the corrugated depth. Pipes 24" in diameter and larger shall be connected by a 24" long annular corrugated band using a minimum of 4 (four) rods and lugs, 2 on each connecting pipe end. A 24" wide by 3/8" thick closed cell circular neoprene gasket will be installed with 12 inches on the end of each pipe. Flanged joints with 3/8" closed cell gaskets the full width of the flange is also acceptable.

Helically corrugated pipe shall have either continuously welded seams or have lock seams with internal caulking or a neoprene bead.

4. Bedding - The pipe shall be firmly and uniformly bedded throughout its entire length. Where rock or soft, spongy or other unstable soil is encountered, all such material shall be removed and replaced with suitable earth compacted to provide adequate support.

5. Backfilling shall conform to "Structure Backfill."

6. Other details (anti-seep collars, valves, etc.) shall be as shown on the drawings.

**Reinforced Concrete Pipe** - All of the following criteria shall apply for reinforced concrete pipe:

- Materials - Reinforced concrete pipe shall have bell and spigot joints with rubber gaskets and shall equal or exceed ASTM Designation C-361.
- Bedding - Reinforced concrete pipe conduits shall be laid in a concrete bedding/cradle for their entire length. This bedding/cradle shall consist of high slump concrete placed under the pipe and up the sides of the pipe at least 50% of its outside diameter with a minimum thickness of 6 inches. Where a concrete cradle is not needed for structural reasons, flowable fill may be used as described in "Structure Backfill" section of this standard. Gravel bedding is not permitted.
- Laying pipe - Bell and spigot pipe shall be placed with the bell end upstream. Joints shall be made in accordance with recommendations of the manufacturer of the material. After the joints are sealed for the entire length, the pipe shall be placed so that all spaces under the pipe are filled. Care shall be exercised to prevent any deviation from the original line and grade of the pipe. The first joint must be located within 4 feet from the riser.
- Backfilling shall conform to "Structure Backfill."
- Other details (anti-seep collars, valves, etc.) shall be as shown on the drawings.

**Plastic Pipe** - The following criteria shall apply for plastic pipe:

- Materials - PVC pipe shall be PVC-1120 or PVC-1220 conforming to ASTM D-1785 or ASTM D-2241. Corrugated High Density Polyethylene (HDPE) pipe, couplings and fittings shall conform to the following: 4" - 10" pipe shall meet the requirements of AASHTO M252 Type B, and 12" through 24" shall meet the requirements of AASHTO M234 Type 5.
- Joints and connections to anti-seep collars shall be completely watertight.
- Bedding - The pipe shall be firmly and uniformly bedded throughout its entire length. Where rock or soft, spongy or other unstable soil is encountered, all such material shall be removed and replaced with suitable earth compacted to provide adequate support.
- Backfilling shall conform to "Structure Backfill."
- Other details (anti-seep collars, valves, etc.) shall be as shown on the drawings.

**DRAINAGE DIAPHRAGMS** - When a drainage diaphragm is used, a registered professional engineer will supervise the design and construction inspection.

**CONCRETE** - Concrete shall meet the requirements of Maryland Department of Transportation, State Highway Administration Standard Specifications for Construction and Materials, Section 414, Mix No. 3.

**ROCK RIPRAP** - Rock riprap shall meet the requirements of Maryland Department of Transportation, State Highway Administration Standard Specifications for Construction and Materials, Section 311.


Geotextile shall be placed under all riprap and shall meet the requirements of Maryland Department of Transportation, State Highway Administration Standard Specifications for Construction and Materials, Section 421.04, Class C.

**CARE OF WATER DURING CONSTRUCTION** - All work on permanent structures shall be carried out in areas free from water. The Contractor shall construct and maintain all temporary dikes, levees, cofferdams, drainage channels, and stream diversions necessary to protect the area to be occupied by the permanent works. The contractor shall also furnish, install, operate and maintain all necessary pumping and other equipment required for removal of water from the various parts of the work and for maintaining the excavations, foundation, and other parts of the work free from water as required or directed by the engineer for constructing each part of the work. After having served their purpose, all temporary protective works shall be removed or leveled and graded to the extent required to prevent obstruction in any degree whatsoever of the flow of water to the spillway or outlet works and so as not to interfere in any way with the operation or maintenance of the structure. Stream diversions shall be maintained until the full flow can be passed through the permanent works. The removal of water from the required excavation and the foundation shall be accomplished in a manner and to the extent that will maintain stability of the excavated slopes and bottom required excavations and will allow satisfactory performance of all construction operations. During the placing and compacting of material in required excavations, the water level at the locations being refilled shall be maintained below the bottom of the excavation at such locations which may require draining the water to sumps from which the water shall be pumped.


## OPERATION AND MAINTENANCE SCHEDULE FOR PRIVATELY OWNED AND MAINTAINED STONE STORAGE FACILITY

- TO BE INSPECTED AND CLEANED ANNUALLY INCLUDING THE INLET AND OVERDRAIN TO AVOID THE POTENTIAL FOR CLOGGING.
- PONDING, STANDING WATER OR ALGAE GROWTH ON THE TOP MAY INDICATE FAVORABLE DUE TO SEDIMENTATION IN THE GRAVEL MEDIA.
- IF WATER POUNDS FOR MORE THAN 48 HOURS AFTER A MAJOR STORM OR MORE THAN 72 HOURS AFTER ACCUMULATION, THE GRAVEL MEDIA SHOULD BE EXCAVATED AND REPLACED.
- THE WATKINS CHOICE HOMEOWNERS ASSOCIATION IS RESPONSIBLE FOR MAINTENANCE OF THE STORMWATER MANAGEMENT FACILITIES RECORDED UNDER PLAT # 142268.

**OWNER/ DEVELOPER**  
 Williamsburg Group, LLC  
 5485 Harpers Farm Rd.  
 Suite 200  
 Columbia, MD 21044  
 410 997-8800

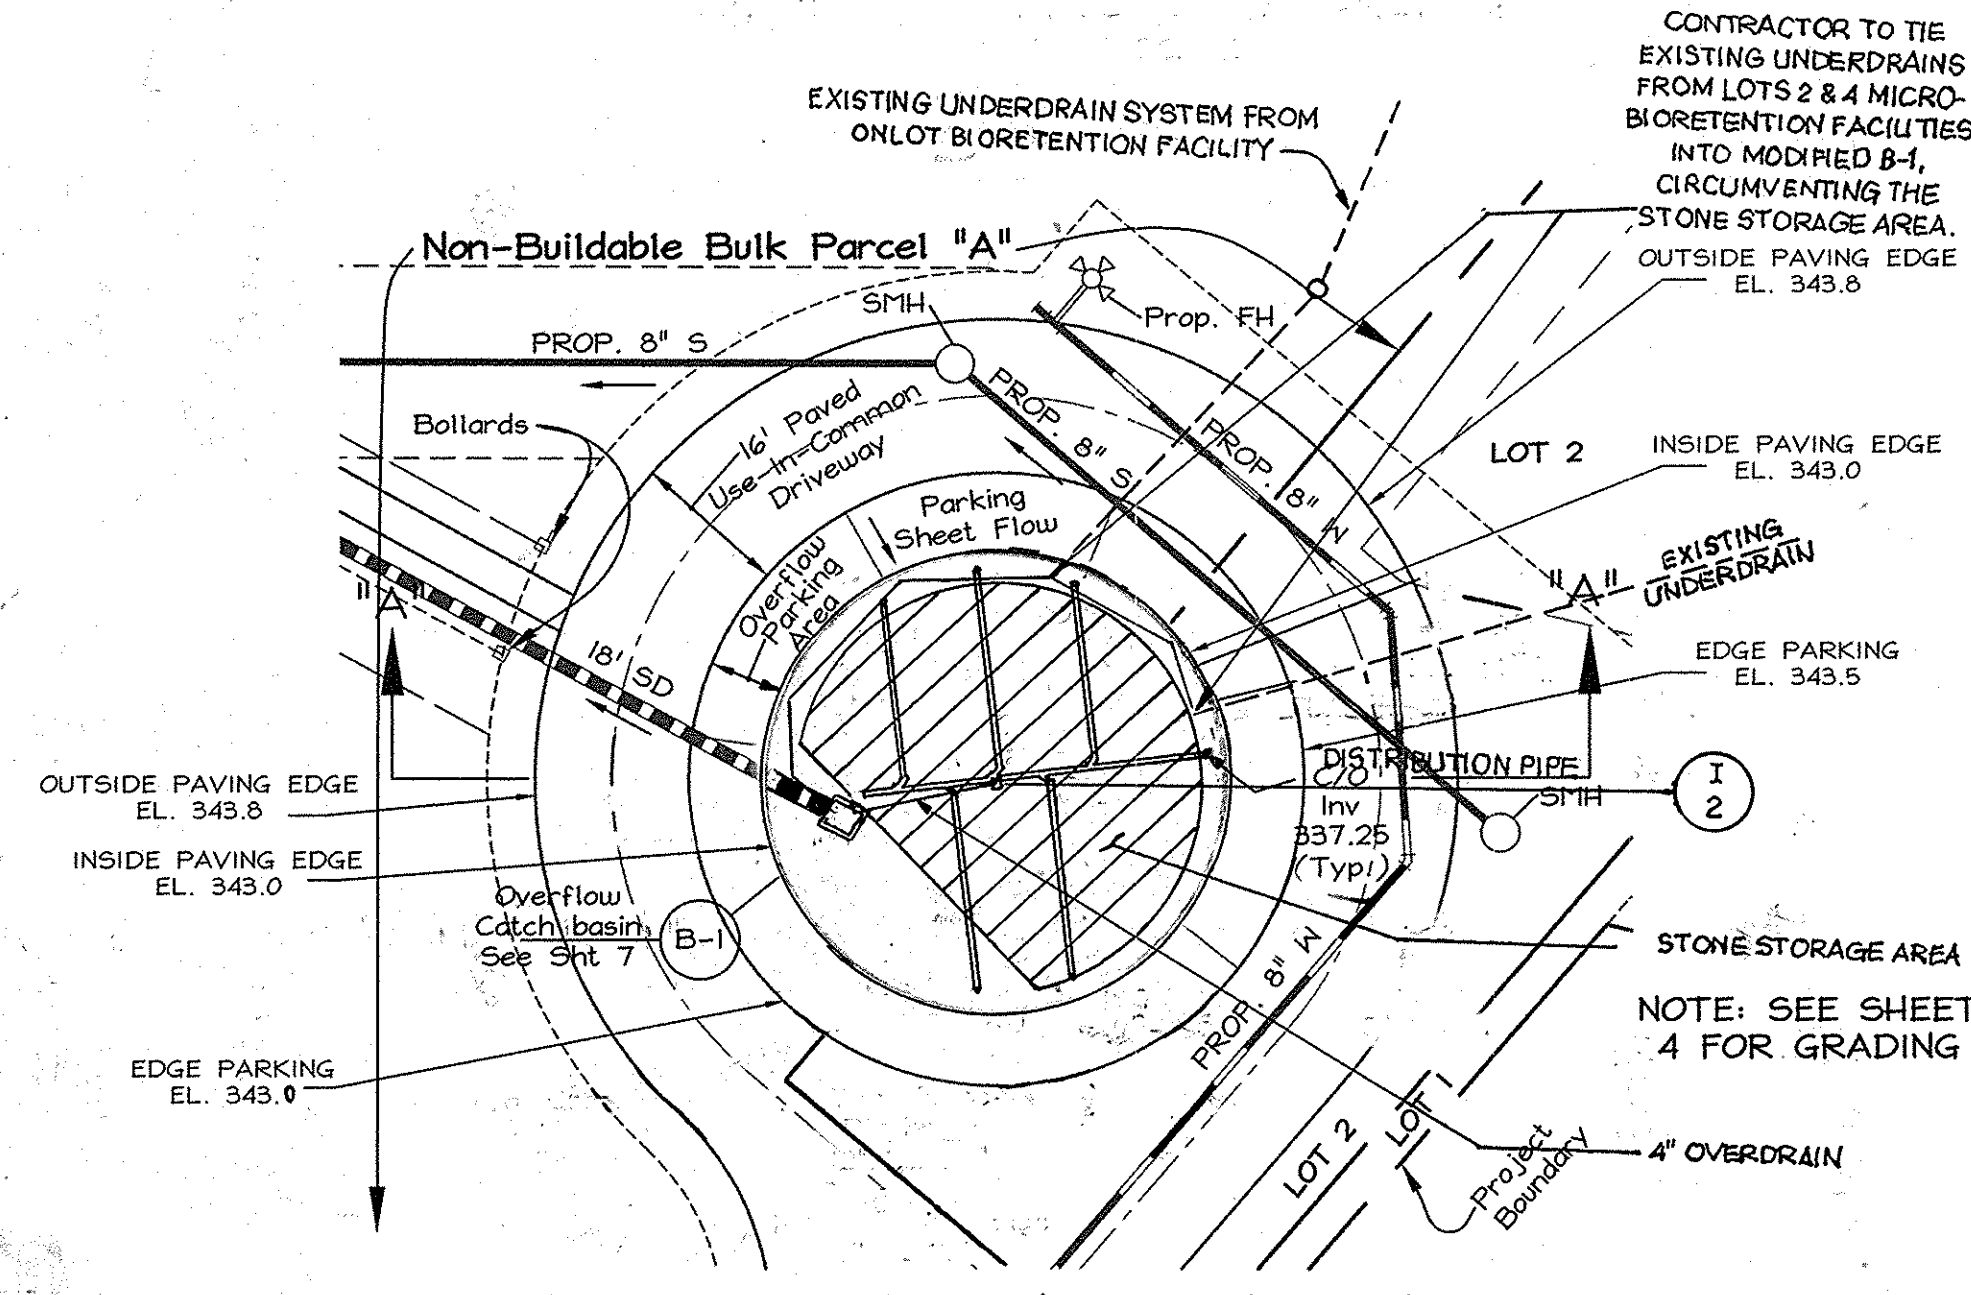

H.O.A. OWNED & MAINTAINED- PRIVATE STONE STORAGE FACILITY  
 MAX. POOL ELEV. 342.50  
 SCALE 1" = 20'

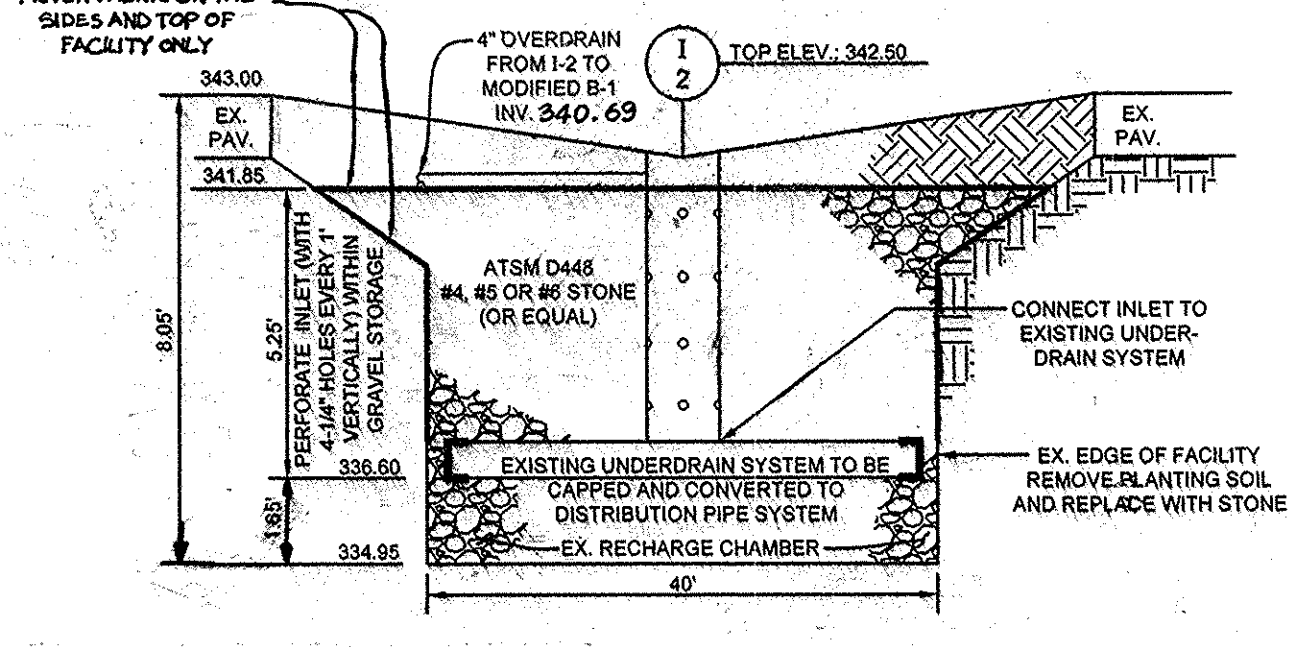

Facility No.	Circle	Square Feet	Depth Stone	Top Stone	Inv. Overdrain	Top Pavement	Top Inlet Elev.	Location
1	20' Radius	1,049	5.25'	341.85	341.85	343.0	342.50	Use in Common Driveway

APPROVED: DEPARTMENT OF PUBLIC WORKS  
 [Signature] 1-9-09  
 CHIEF, BUREAU OF HIGHWAYS DATE

APPROVED: DEPARTMENT OF PLANNING AND ZONING  
 [Signature] 1/29/09  
 CHIEF, DIVISION OF LAND DEVELOPMENT DATE

[Signature] 1/16/09  
 CHIEF, DEVELOPMENT ENGINEERING DIVISION DATE

**AS-BUILT CERTIFICATION**  
 I HEREBY CERTIFY, BY MY SIGNATURE, THAT THE CONDITIONS SHOWN ON THIS PLAN WERE CONSTRUCTED TO THE DIMENSIONS AND GRADES SHOWN IN THE AS-BUILT PLAN, AND MEET THE APPROVED PLANS AND SPECIFICATIONS AND ALSO THAT THESE DOCUMENTS WERE PREPARED BY ME OR UNDER MY RESPONSIBLE CHARGE AND THAT I AM A FULLY LICENSED PROFESSIONAL LAND SURVEYOR UNDER THE LAWS OF THE STATE OF MARYLAND.  
 [Signature] 1/16/09  
 MICHAEL D. ADOCKER, PROFESSIONAL LAND SURVEYOR  
 LICENSE NO. 21297, EXPIRATION DATE: JUNE 14, 2017

USE-IN-COMMON DRIVEWAY	PRIVATE BIORETENTION FACILITY # 1
Drainage Area = 0.66 Acres	Hazard Classification "A"
Water Quality Management = BIORETENTION	
Water Quantity (Cm) Management = See Note Below	
Groundwater Recharge Volume (Rv) Required = 101 cu ft.	
Groundwater Recharge Volume (Rv) Provided = 101 cu ft.	
Water Quality Volume (WQV) Required = 773 cu ft.	
Water Quality Volume (WQV) Provided = 773 cu ft.	
Channel Protection Volume (Cp) Required = N/A cu ft.	
Channel Protection Volume (Cp) Provided = N/A cu ft.	

I HEREBY CERTIFY THAT THESE DOCUMENTS WERE PREPARED OR APPROVED BY ME, AND THAT I AM A DULY LICENSED PROFESSIONAL ENGINEER UNDER THE LAWS OF THE STATE OF MARYLAND, LICENSE NO. 19184, EXPIRES 12/31/09.

SIGNED: [Signature] 12/19/08  
 BRUCE D. BURTON

No.	Date	By	Description
1	02/07/14	SAA	REPLACE BIORETENTION FACILITY WITH STONE STORAGE-REVISE INLET BY 2" ADD 4.2"
2	6/12	LDE	REVISE OWNER/DEVELOPER

REVISIONS

**LDE Inc.**  
 Engineers, Surveyors, Planners  
 9250 Ramsey Road, Suite 106 Columbia, Maryland - 21045  
 (410) 715-1070 - (301) 596-3424 - FAX (410) 715-9540

**AS-BUILT**

DESIGNED: EDS  
 DRAWN: LDE  
 CHECKED: BDB  
 DATE: 12/2008

PRIVATE BIORETENTION FACILITY - NOTES & DETAILS - AND MID-378 SPECIFICATIONS  
**WATKINS' CHOICE**  
 PHASE I  
 Lots 1, 2, Open Space Lot 3 and Non-Buildable Bulk Parcel "A"  
 Tax Map 46 - Grid 18 - Parcel 215  
 6 th Election District - Howard County, Maryland  
 Previous Submittals: SP-07-010, WP-04-042  
 Owner/Developer: Williamsburg Group, LLC  
 5485 Harpers Farm Rd.  
 Suite 200  
 Columbia, MD 21044  
 410 997-8800

SCALE: As Shown  
 DRAWING: 12 OF 16  
 JOB NO.: 02-035.2  
 FILE NO.: F-08-179

F:\02-035.2\dwg\02-035.2-SHT 12.DWG (REV. 04) 8/10/08 10:27:27 AM

OWNER/DEVELOPER  
Williamsburg Group, LLC  
5405 Harpers Farm Rd.  
Suite 200  
Columbia, MD 21044  
410-997-8800

FOREST CONSERVATION WORKSHEET  
VERSION 1.0  
(Enter in Yellow Cells)

NET TRACT AREA:

A. Total tract area	3.52
B. Area within 100 year floodplain	0.00
C. Area to remain in agricultural production	0.00
D. Net tract area	3.52

LAND USE CATEGORY: (from table 3.2.1, page 40, Manual)

Input the number "1" under the appropriate land use zoning, and limit to only one entry.

ARA	MDR	IDA	HDR	MPD	CA
0	0	0	1	0	0

E. Afforestation Threshold: 15% x D = 0.53  
20% x D = 0.70

F. Conservation Threshold: 15% x D = 0.53  
20% x D = 0.70

EXISTING FOREST COVER:

G. Existing forest cover (excluding floodplain)	0.00
H. Area of forest above afforestation threshold	0.00
I. Area of forest above conservation threshold	0.00

BREAK EVEN POINT:

J. Forest retention above threshold with no mitigation	0.00
K. Clearing permitted without mitigation	0.00

PROPOSED FOREST CLEARING:

L. Total area of forest to be cleared	0.00
M. Total area of forest to be retained	0.00

PLANTING REQUIREMENTS:

N. Reforestation for clearing above conservation threshold	0.00	10' x 10'
P. Reforestation for clearing below conservation threshold	0.00	10' x 10'
Q. Credit for retention above conservation threshold	0.00	10' x 10'
R. Total reforestation required	0.00	10' x 10'
S. Total afforestation required	0.53	10' x 10'
T. Total reforestation and afforestation required	0.53	10' x 10'

SITE TABULATIONS

- TOTAL SITE AREA: 3.52 ACRES
- TOTAL DISTURBED AREA: 3.26 ACRES +/-
- AREA OF 100 YEAR FLOODPLAIN: 0 AC
- NET SITE AREA: 3.26 ACRES +/-

FOREST CONSERVATION NOTES:



- This plan complies with the requirements of Section 16.1200 of the Howard County Code for Forest Conservation by payment of a fee-in-lieu in the amount of \$17,315.10 for 0.53 acres of afforestation.

LANDSCAPE LEGEND

- Prop. Street Tree
- Prop. Fence
- Ex. Tree to be Saved
- Ex. Tree to be Removed

NOTES:

- Should any tree designated for preservation for which landscaping credit is given, die prior to release of bonds, the owner will be required to replace the tree with the equivalent species or with a tree which will obtain the same height, spread and growth characteristics. The replacement tree must be a minimum of 3 inches in caliper and installed as required in the Howard County Landscape Manual.
- The owner, tenant and/or their agents shall be responsible for maintenance of the required landscaping, including both plant materials and berms, fences and walls. All plant material shall be maintained in good growing condition, and when necessary, replaced with new materials to ensure continued compliance with applicable regulations. All other required landscaping shall be permanently maintained in good condition and when necessary repaired and replaced.
- At the time of installation, all shrubs and other plantings herewith listed and approved for this site, shall be of the proper height requirements in accordance with the Howard County Landscaping Manual. In addition, no substitutions or relocation of required plantings may be made without prior review and approval from the Department of Planning and Zoning. Any deviation from this approved Landscape Plan may result in denial or delay in the release of landscape surety until such time as all required materials are planted and/or revision made to applicable plans and certificates.

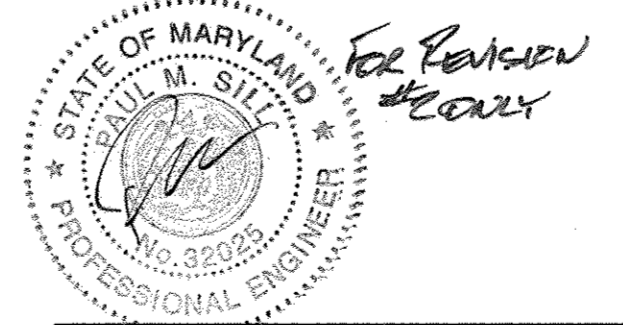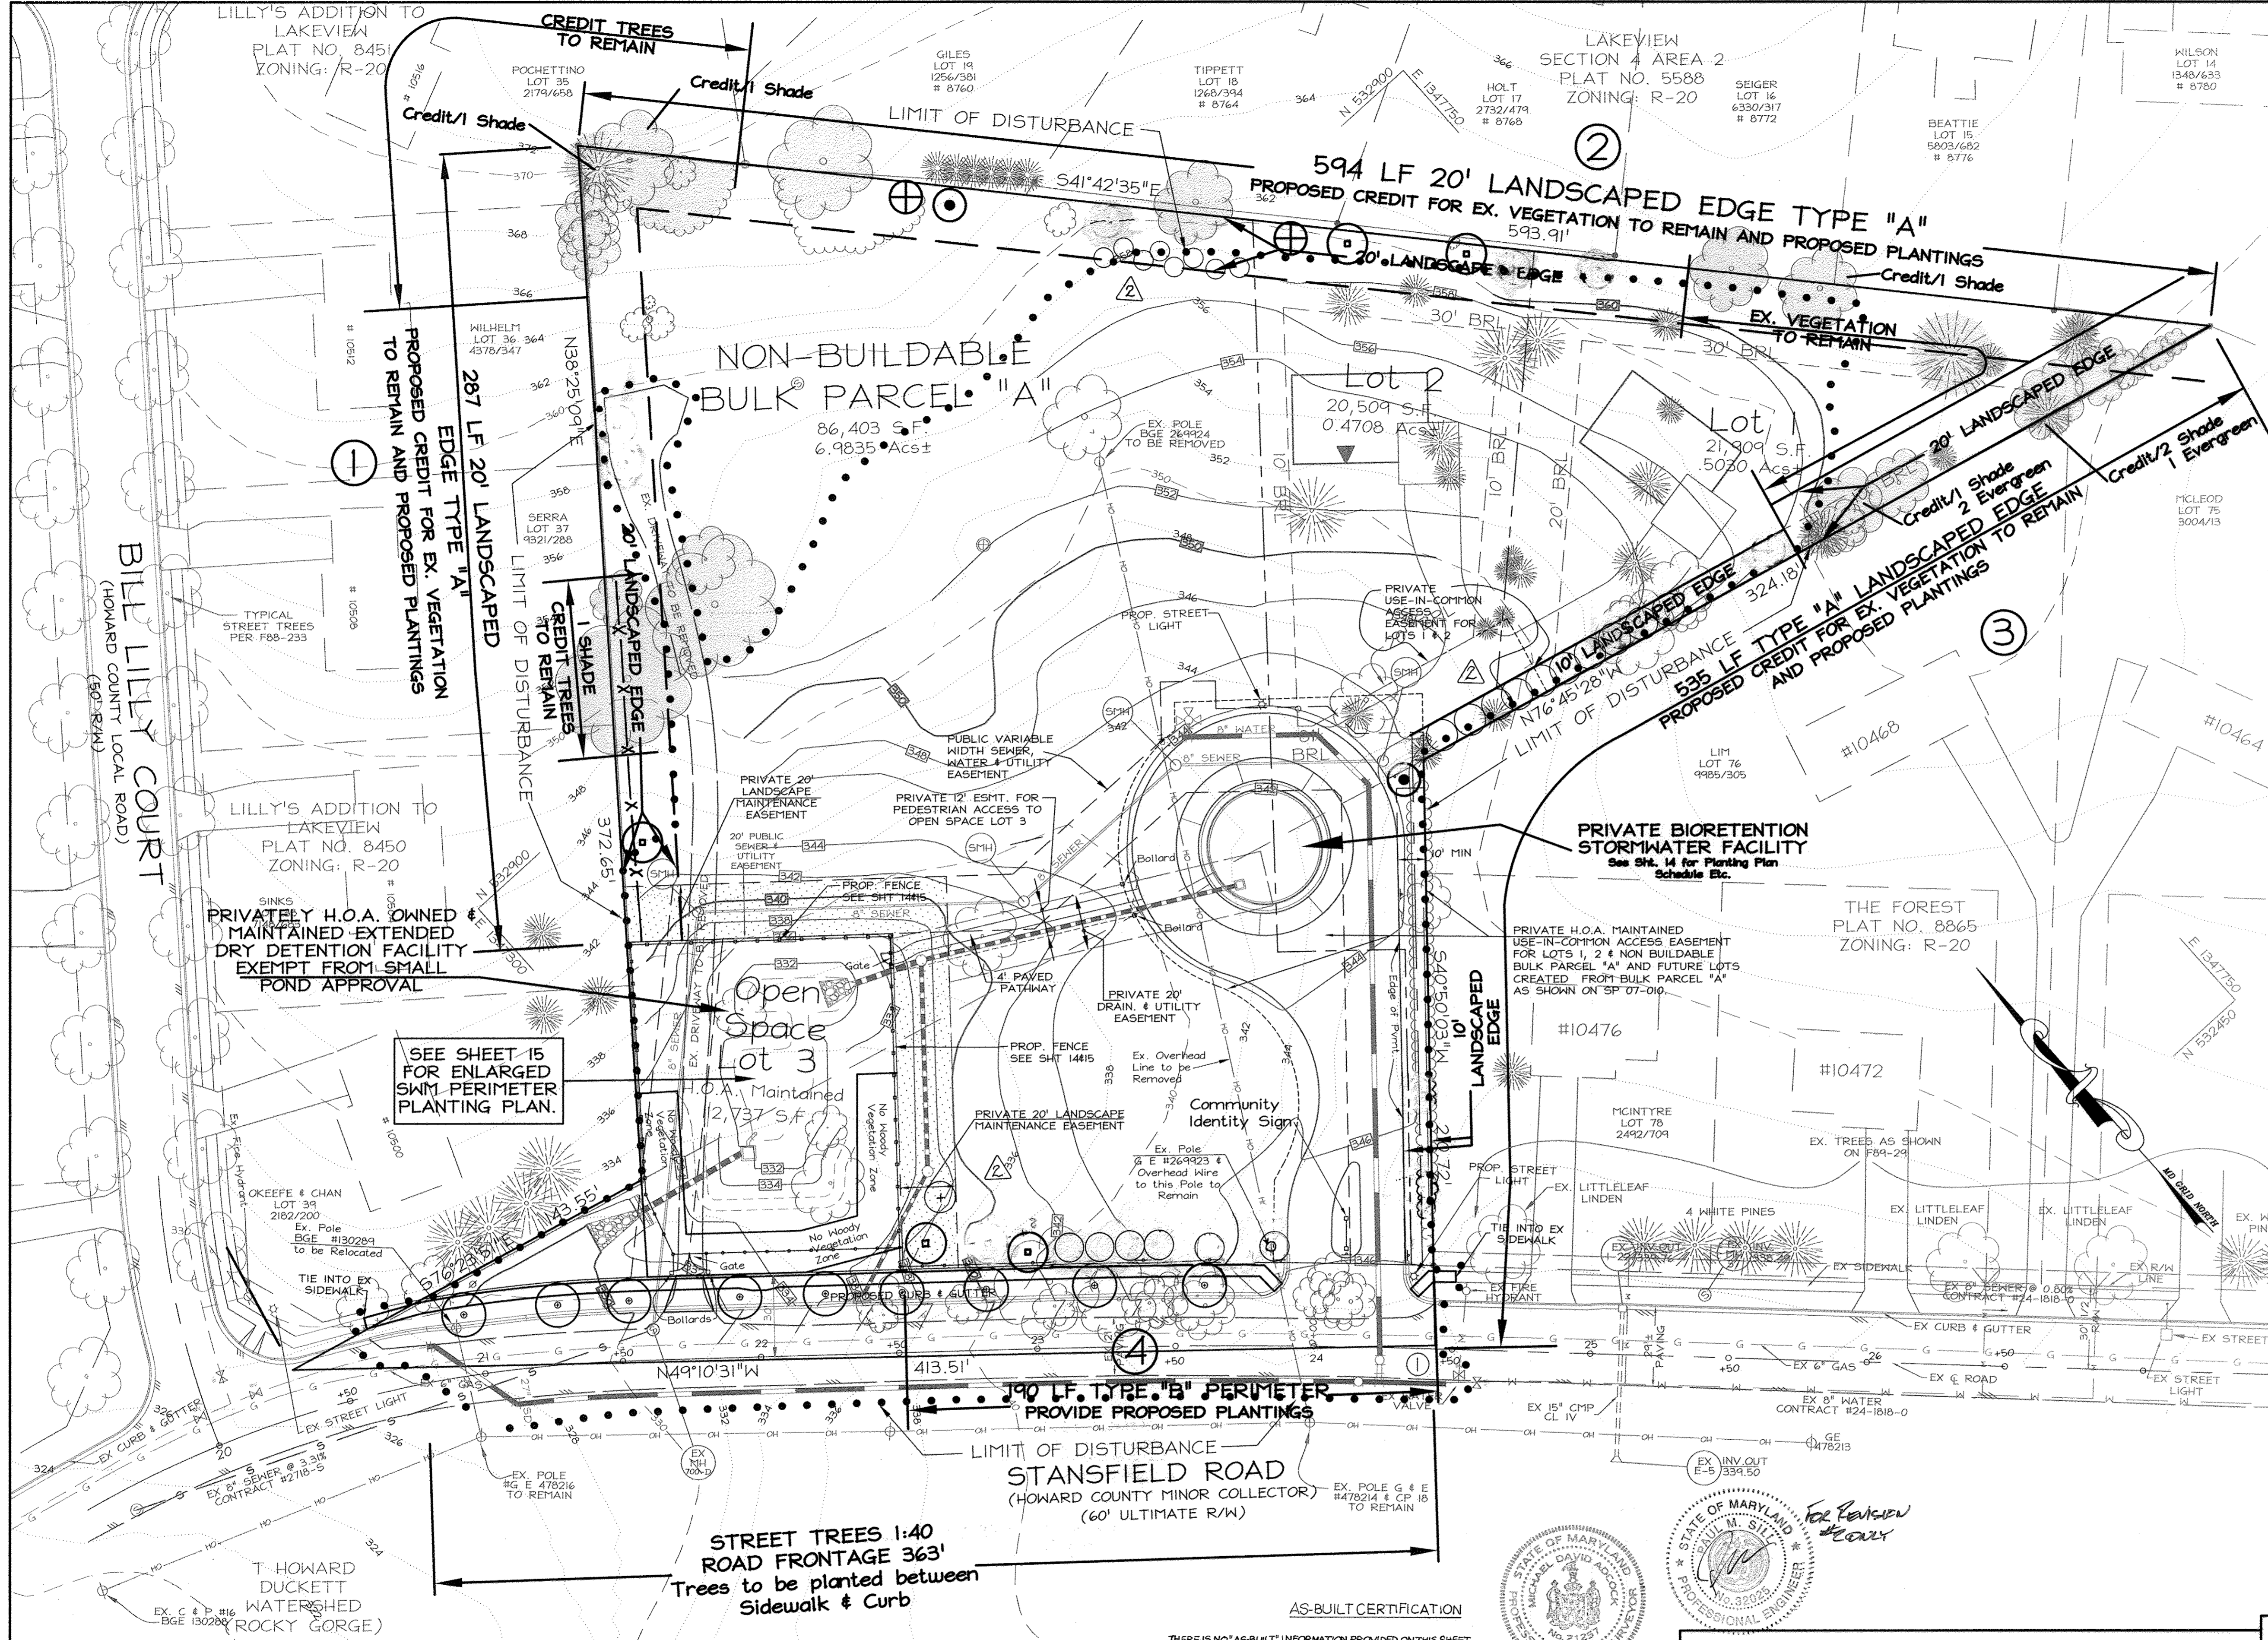

AS-BUILT CERTIFICATION  
THERE IS NO "AS-BUILT" INFORMATION PROVIDED ON THIS SHEET.

*Michael D. Adcock*  
MICHAEL D. ADCOCK, PROFESSIONAL LAND SURVEYOR  
LICENSE NO. 21291, EXPIRATION DATE: JUNE 16, 2017

*Bruce D. Burton*  
BRUCE D. BURTON, PROFESSIONAL ENGINEER  
LICENSE NO. 19184, EXPIRATION DATE: 12/19/08

Developer's/Builder's Certificate

"I/We certify that the landscaping shown on this plan will be done according to the plan, Section 16.124 of the Howard County Subdivision and Land Development Regulations and the Landscape Manual. I/We further certify that upon completion a letter of Landscape Installation, accompanied by an executed one year guarantee of plant materials, will be submitted to the Department of Planning and Zoning.

*Steve Heiss*  
Steve Heiss, Qualified Professional, MDPCA  
Date: 12-19-08

APPROVED: DEPARTMENT OF PUBLIC WORKS	<i>William Z. Mahall</i> CHIEF, BUREAU OF HIGHWAYS DATE: 1-9-09
APPROVED: DEPARTMENT OF PLANNING AND ZONING	<i>Cindy Harris</i> CHIEF, DIVISION OF LAND DEVELOPMENT DATE: 1/20/09
	<i>Chad Robinson</i> CHIEF, DEVELOPMENT ENGINEERING DIVISION DATE: 1/16/09

NOTES:  
1. THIS PLAN IS NOT FOR GRADING. SEE SHEET 8 FOR GRADING.  
2. REFER TO SHEET 4 FOR USE-IN-COMMON DRIVEWAY DETAILING.

No.	Date	By	Description
5/1/08	6/12	JCV	ADJUST LANDSCAPE PERIMETER PLANTING
		LDE	REVISE OWNER/DEVELOPER

**LDE Inc. AS-BUILT**  
Engineers, Surveyors, Planners  
9250 Ramsey Road, Suite 106 Columbia, Maryland - 21045  
(410)715-1070 • (301)596-3424 • FAX(410)715-9340

DESIGNED	EDS	LANDSCAPE AND FOREST CONSERVATION PLAN <b>WATKINS' CHOICE PHASE I</b> Lots 1, 2, Open Space Lot 3 and Non-Buildable Bulk Parcel "A" Tax Map 46 - Grid 18 - Parcel 215 6 th Election District - Howard County, Maryland Previous Submittals: SP 07-00, NP 09-042	SCALE	1" = 30'
DRAWN	LDE		DRAWING	13 OF 16
CHECKED	BDB	JOB NO.	02-035.2	
DATE	12/2008	FILE NO.	F-08-179	

Owner/Developer: Williamsburg Group, LLC  
5405 Harpers Farm Rd.  
Suite 200  
Columbia, MD 21044  
410-997-8800

SCHEDULE A PERIMETER LANDSCAPE EDGE				
CATEGORY	ADJACENT TO ROADWAYS	ADJACENT TO PERIMETER PROPERTIES		
Landscape Type	④ Stansfield Road 'B'	① Lilly's Addition 'A'	② Lakeview 'A'	③ The Forest 'A'
Linear Feet of Roadway Frontage/Perimeter	190 L.F.	287 L.F.	594 L.F.	535 L.F.
Credit for Existing Vegetation (Yes, No, Linear Feet) (Describe below if needed)	No	Yes 2 Shade	Yes 2 Shade	Yes 3 Shade 3 Evergreen
Credit for Wall, Fence or Berm (Yes, No, Linear Feet) (Describe below if needed)	No	Yes 150' FENCE NOTE 1.	No	No
Number of Plants Required	190 L.F. 1:40=5 1:50=4	287 L.F. 1:60=3	594 L.F. 1:60=10	535 L.F. 1:60=9
Number of Plants Provided	2 Shade 10 Evergreen (2:1-6 FOR 3 SHADE)	0 Shade SEE NOTE 2	5 Shade 6 EVERGREEN (2:1-6 FOR 3 SHADE)	0 Shade 10 EVERGREEN (2:1-10 FOR 5 SHADE)
Total Surety=9,300	NOTE: 1. 6' HIGH VINYL FENCE 2. MOVED TO PREL. 2 - 2:1 EVERGREEN FOR SHADE			

STREET TREE PLANTING SCHEDULE (PUBLIC ROADS)				
NO	KEY	BOTANICAL/COMMON NAME	SIZE	COMMENT
9	⊕	Platanus x Acerifolia London Plane	2-1/2" to 3" cal.	B4B

STORMWATER MANAGEMENT PLANTING SCHEDULE				
NO	KEY	BOTANICAL/COMMON NAME	SIZE	COMMENT
2	⊕	BETULA NIGRA RIVER BIRCH	10'-12' HT.	3 STEM CLUMP MIN.
0	⊕	NYSSA SYLVATICA BLACK GUM	2-1/2"-3" cal.	---
2	⊕	ILEX OPACA AMERICAN HOLLY	5'-6' HT.	---
6	⊕	PINUS STROBUS WHITE PINE	6'-8' HT.	---
0	⊕	PINUS NIGRA BLACK PINE	6'-8' HT.	---
62	FRG	CALAMAGROSTIS "KARL FOERSTER" FEATHER REED GRASS	1 GAL POT	PLANT AT 30' O/C CUT DOWN TO 10" IN SPRING
150	BEG	SISTRINCHIUM ANGUSTIFOLIUM BLUE EYED GRASS	#3 PLUG OR BARE ROOT	PLANT AT 14" O/C AFTER FLOWERING & SEED SET SHEAR BACK 1/2. DO NOT PRUNE AGAIN UNTIL NEXT SPRING







PERIMETER PLANTING SCHEDULE				
NO	KEY	BOTANICAL/COMMON NAME	SIZE	COMMENT
SHADE TREES				
3	⊕	Acer rubrum 'October Glory' October Glory Red Maple	2-1/2"-3" cal.	B4B
3	⊕	Quercus Rubra Northern Red Oak	2-1/2"-3" cal.	B4B
0*	⊕	Liquidambar styraciflua American Sweetgum	2-1/2"-3" cal.	B4B
* 6 PROVIDED AT SWM FACILITY				
EVERGREENS				
4	⊕	Pinus Strobus Eastern White Pine	6'-8' HT. B4B	
37*	⊕	THUJA ARBORVITAE	5'	
* 13 PROVIDED AT SWM FACILITY				

- ### GENERAL NOTES
- This plan has been prepared in accordance with the provisions of Section 16.124 of the Howard County Code, Landscape Manual and Forest Conservation Manual.
  - The Owner/Developer is responsible for the planting of all plant material required to meet the standards established by the Howard County Landscape Manual.
  - Financial Surety for the required landscaping has been posted as part of the Department of Public Works Developer's Agreement in the amount of \$13,520.00. A separate Street Tree Bond = \$2,700.00.
  - Should any tree designated for preservation for which landscaping credit is given, die prior to release of bonds, the owner will be required to replace the tree with the equivalent species or with a tree which will obtain the same height, spread and growth characteristics. The replacement tree must be a minimum of 3 inches in caliper and installed as required in the Howard County Landscape Manual.
  - The owner, tenant and/or their agents shall be responsible for maintenance of the required landscaping, including both plant materials and berms, fences and walls. All plant material shall be maintained in good growing condition, and when necessary, replaced with new materials to ensure continued compliance with applicable regulations. All other required landscaping shall be permanently maintained in good condition and when necessary repaired and replaced.
  - At the time of installation, all shrubs and other plantings hereafter listed and approved for this site, shall be of the proper height requirements in accordance with the Howard County Landscape Manual. In addition, no substitutions or relocation of required plantings may be made without prior review and approval from the Department of Planning and Zoning. Any deviation from this approved Landscape Plan may result in denial or delay in the release of landscape surety until such time as all required materials are planted and/or revision made to applicable plans and certificates.

- ### TREE PLANTING NOTES
- Notify "Tris Utility" 72 hours prior to installation of all plant material.
  - Plant installation must conform to the minimum standards cited in the latest edition of Landscape Specification Guidelines, published by the Landscape Contractors Association.
  - Plants to be located in the field by the owner or owner's representative.
  - Notify owner 72 hours in advance of planting.
  - A certification of Landscape Installation is required as per the Howard County Landscape Ordinance.
  - The number, size, location of plants shall not be changed without the approval of the Landscape Architect. Substitutions must be included in the recommended plant list in the Howard County Landscape Ordinance.
  - Trees may not be planted within 5 feet of drain inlets, 5 feet of an open space access strip and 10 feet of a driveway.
  - Balled and burlapped plant material shall not be accepted if ball is cracked or broken before or during planting. Protect all plants from drying by either sun or wind.
  - Tree pits shall be backfilled with 50% topsoil, 25% peat 25% sand with one pound of 10-10-10 fertilizer per pit.
  - Top soil shall be sandy loam soil free from noxious weeds or grasses, roots, clay clumps, stones, sticks, etc. Peat moss shall be commercial with ph 4.5 to 5.5, free of woody material or harmful minerals.
  - All plants shall be watered at planting with weekly watering thereafter for the first 80 days. Watering shall continue bi-monthly or as necessary to maintain plants in a healthy condition during the guarantee period.
  - Maintain the site in an orderly manner. Streets and sidewalks shall be swept clean. All rejected or dead materials shall be immediately removed from the site.
  - Plant material to be alive and healthy at the time of the guarantee period (one year), as specified in the Howard County Landscape Ordinance.
  - Maintenance shall begin immediately after planting and continue to the end of guaranteed period.
  - Maintenance consists of pruning, watering, weeding, re-mulching, resetting plants to proper grades as needed and repairing guys and stakes as needed.



SCHEDULE D STORMWATER MANAGEMENT AREA LANDSCAPING	
1:50 Shade / 1:40 Evergreen	
Linear Feet of Perimeter	#5 - 'B' Buffer - 560 LF
Number of Plants Required	11 Shade 14 Evergreen Surety=5400
Credit for Existing Vegetation (Yes, No and %)	NO
Credit for Other Landscaping (Yes, No and %)	YES 100% - 300 L.F. 5' High Closed Section Fence and 106 L.F. 4' High Open Section Fence with Supplemental Plantings
Number of Trees Provided	8 10 (2:1-6 FOR 3 SHADE)
Number of Plants Provided	0 0 0 0
Total Sum of Landscape Surety=\$5,400.00	

STREET TREE SCHEDULE (PUBLIC ROADS)	
Category	Stansfield Road
Landscape Type	Street Tree
Linear Feet of Roadway Frontage/Perimeter	365 L.F.
Credit for Existing Vegetation (Yes, No, Linear Feet) (Describe below if needed)	No
Credit for Wall, Fence or Berm (Yes, No, Linear Feet) (Describe below if needed)	No
Number of Plants Required	9
Number of Plants Provided	9

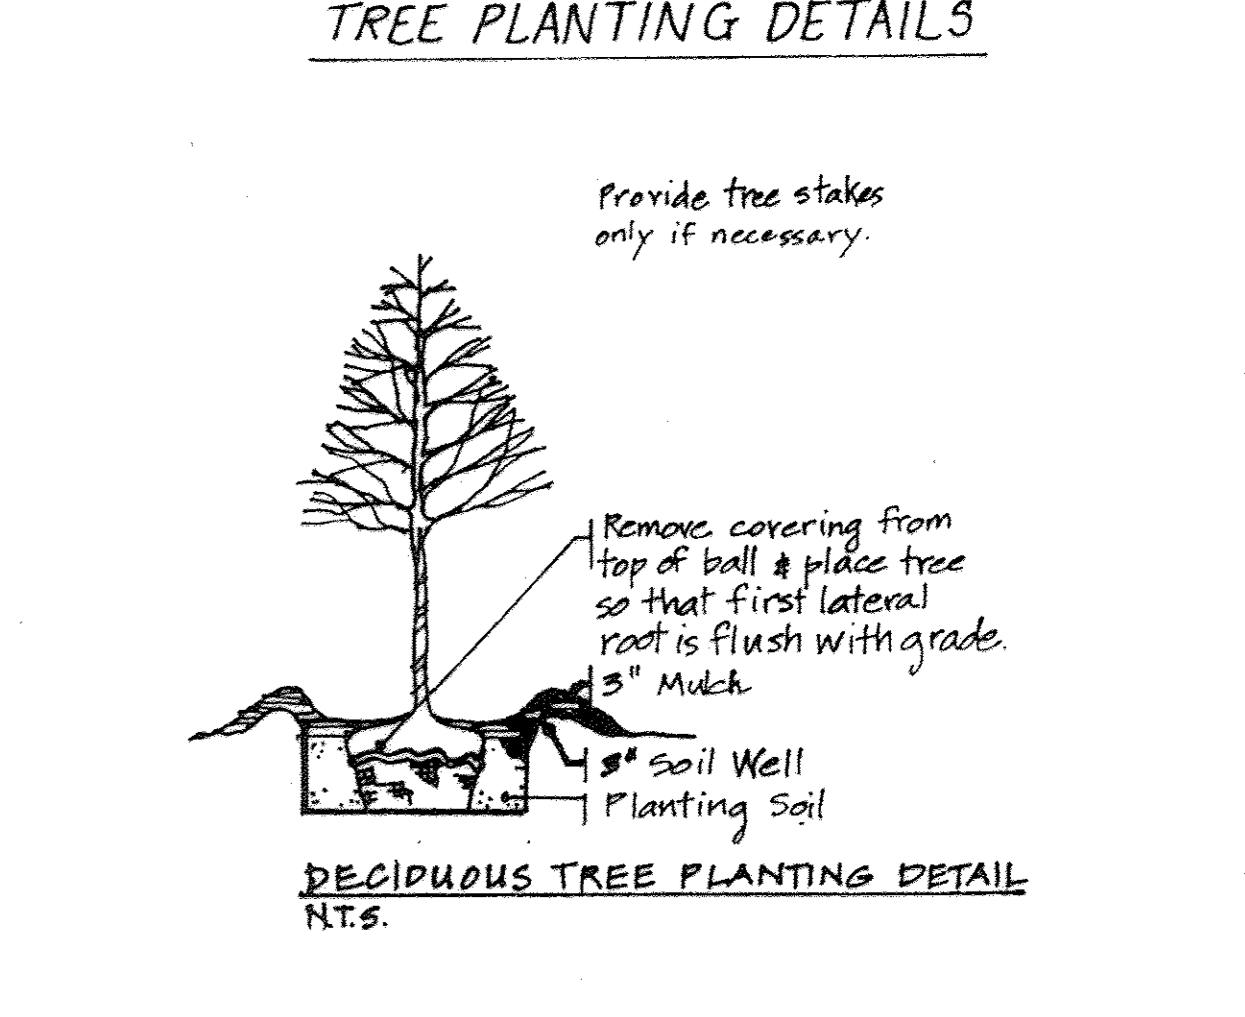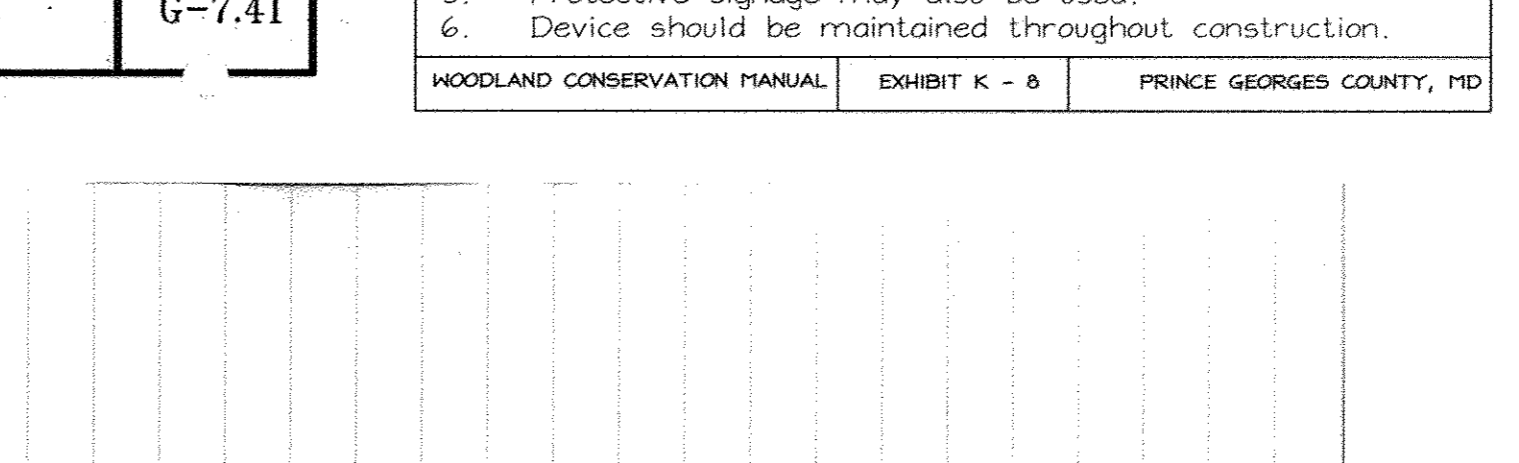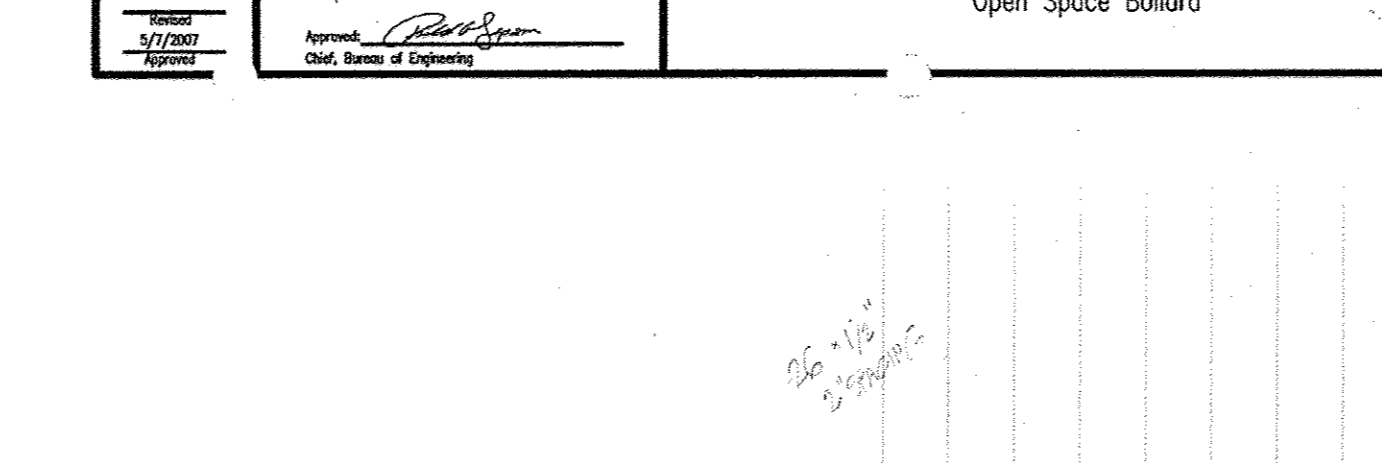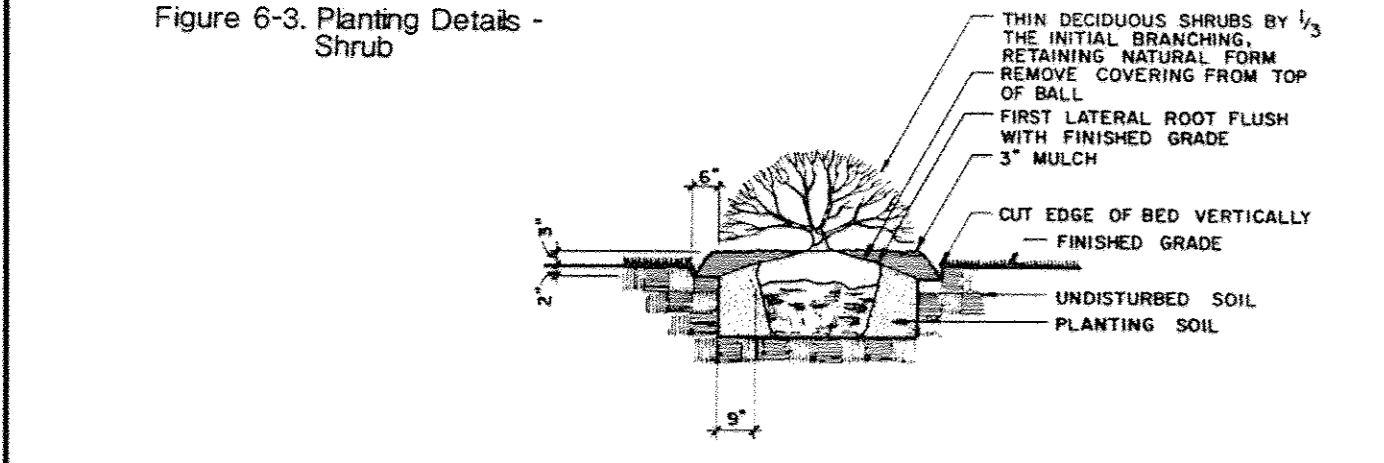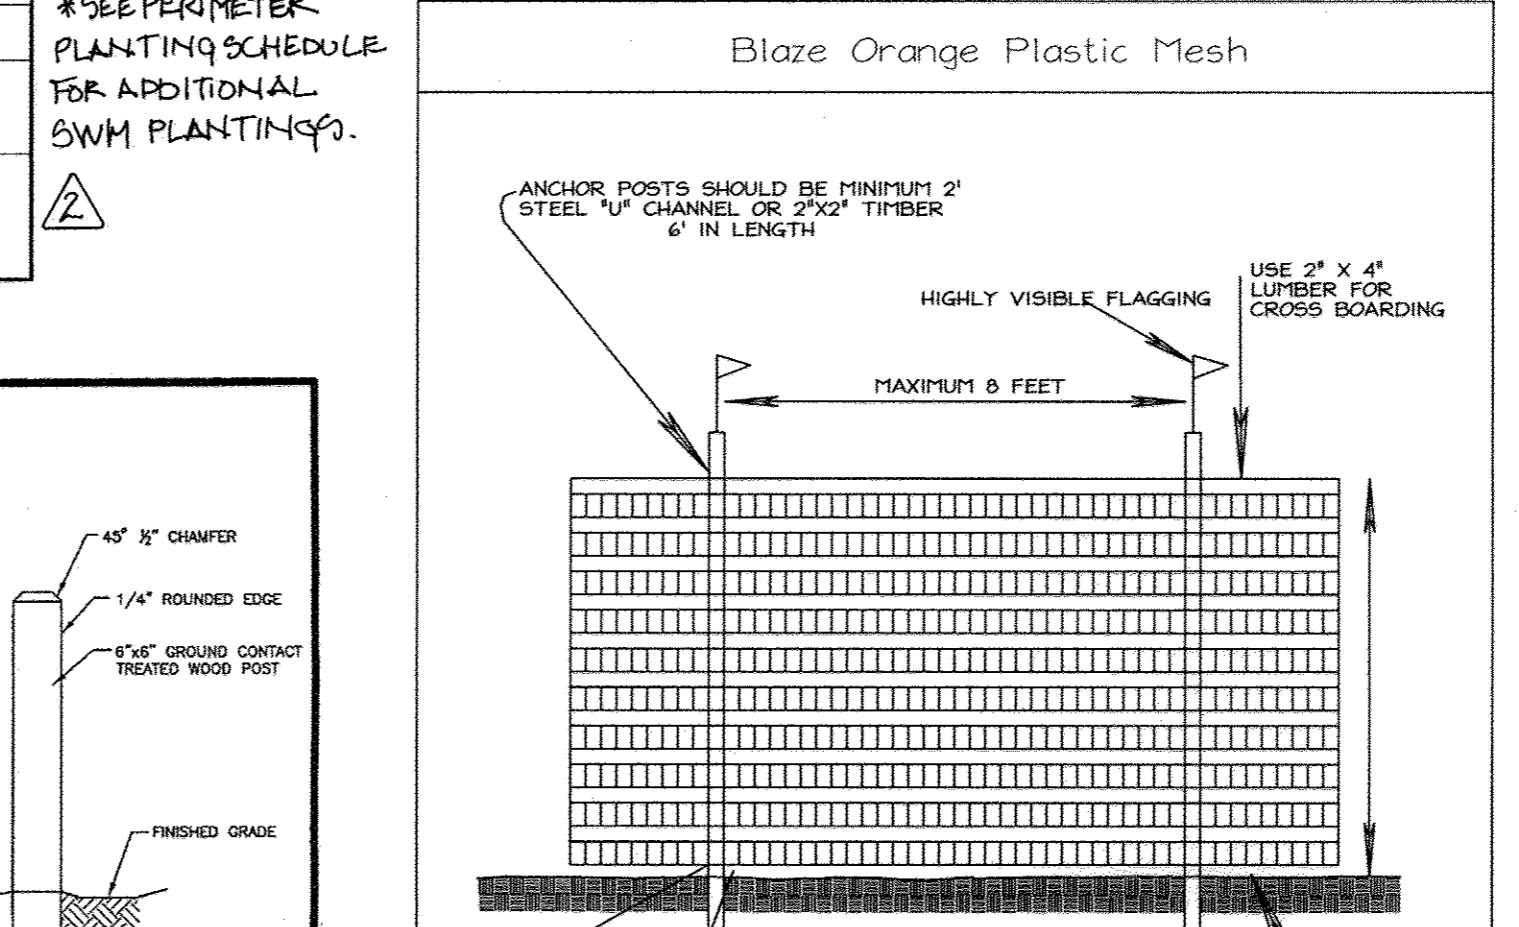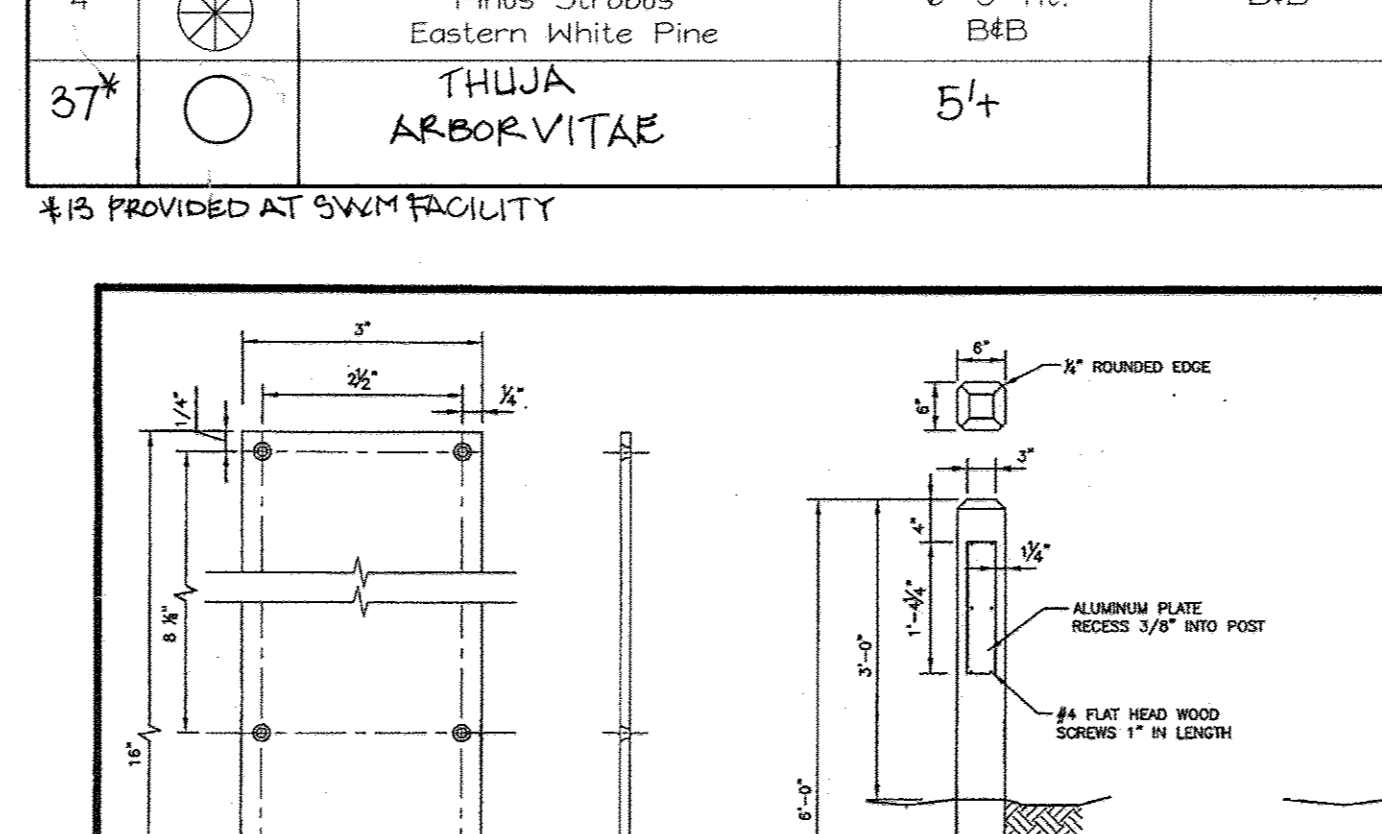

OWNER/  
DEVELOPER  
Williamsburg Group, LLC  
5485 Harpers Farm Rd.  
Suite 200  
Columbia, MD 21044  
410 997-8200

AS-BUILT CERTIFICATION  
THERE IS NO "AS-BUILT" INFORMATION PROVIDED ON THIS SHEET.  
MICHAEL D. ADCOCK, PROFESSIONAL LAND SURVEYOR  
LICENSE NO. 21257, EXPIRATION DATE: JUNE 16, 2017  
DATE: 6/19/2014  
Developer's/Builder's Certificate  
I/We certify that the landscaping shown on this plan will be done according to the plan, Section 16.124 of the Howard County Subdivision and Land Development Regulations and the Landscape Manual. I/We further certify that upon completion a letter of Landscape Installation, accompanied by an executed one year guarantee of plant materials, will be submitted to the Department of Planning and Zoning.

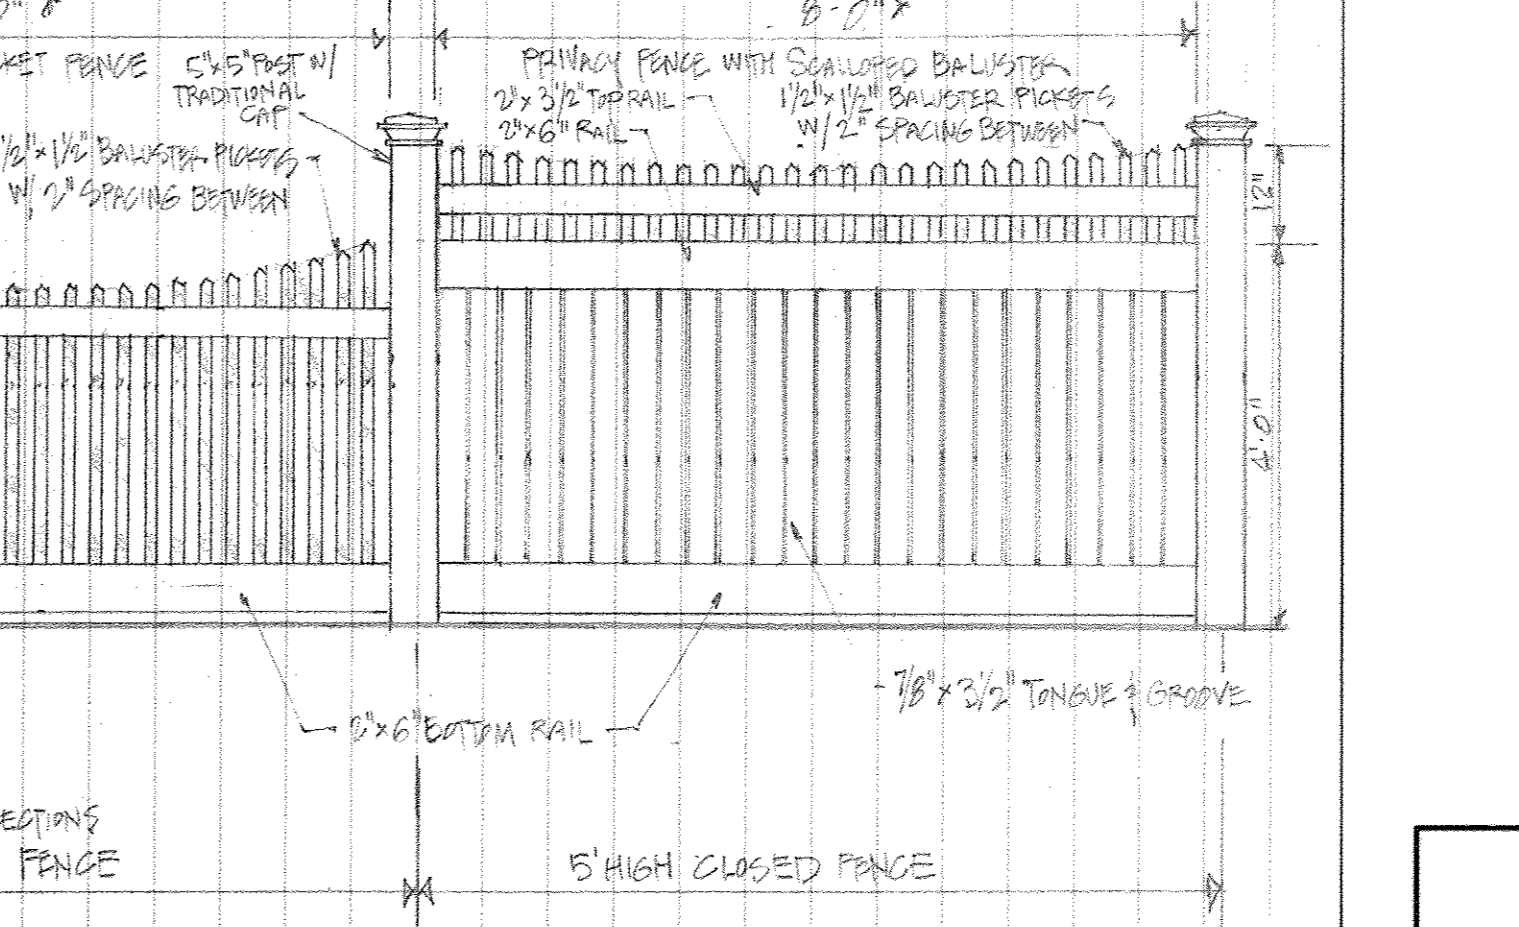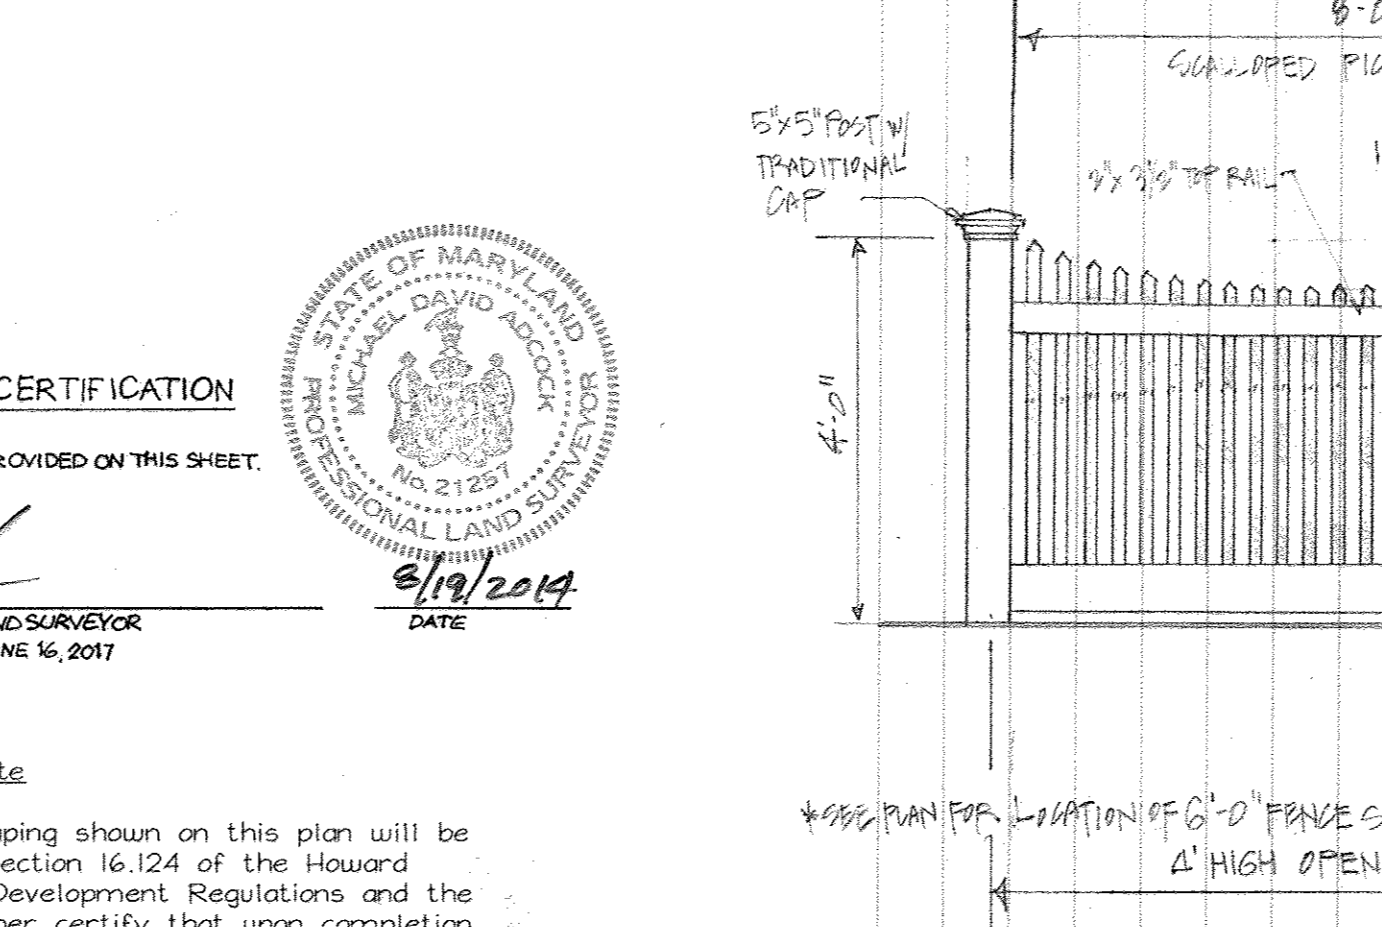

APPROVED: DEPARTMENT OF PUBLIC WORKS	1-9-09
With 2. Initial CHIEF, BUREAU OF HIGHWAYS	DATE
APPROVED: DEPARTMENT OF PLANNING AND ZONING	1/20/09
Cindy Hunt CHIEF, DIVISION OF LAND DEVELOPMENT	DATE
Chad Pearson CHIEF, DEVELOPMENT ENGINEERING DIVISION	1/6/9 DATE

STATE OF MARYLAND  
PROFESSIONAL LAND SURVEYOR  
MICHAEL D. ADCOCK  
LICENSE NO. 21257  
DATE: 6/19/2014

I HEREBY CERTIFY THAT THESE DOCUMENTS WERE PREPARED OR APPROVED BY ME, AND THAT I AM A DULY LICENSED PROFESSIONAL ENGINEER UNDER THE LAWS OF THE STATE OF MARYLAND, LICENSE NO. 19184, EXPIRATION DATE: 12/31/04.  
SIGNED: BRUCE D. BURTON  
DATE: 12/19/08


No.	Date	By	Description
5/1/08	JCV	ADJUST PERIMETER PLANTING	
6/12	LDE	REVISE OWNER/DEVELOPER	

LDE Inc. AS-BUILT		SCALE
DESIGNED	EDS	AS SHOWN
DRAWN	LDE	DRAWING
CHECKED	BDB	JOB NO.
DATE	12/2008	02-035.2
DATE	12/2008	FILE NO.
DATE	12/2008	F-08-179

NOTES:

- Should any tree designated for preservation for which landscaping credit is given, die prior to release of bonds, the owner will be required to replace the tree with the equivalent species or with a tree which will obtain the same height, spread and growth characteristics. The replacement tree must be a minimum of 3 inches in caliper and installed as required in the Howard County Landscape Manual.
- The owner, tenant and/or their agents shall be responsible for maintenance of the required landscaping, including both plant materials and berms, fences and walls. All plant material shall be maintained in good growing condition, and when necessary, replaced with new materials to ensure continued compliance with applicable regulations. All other required landscaping shall be permanently maintained in good condition and when necessary repaired and replaced.
- At the time of installment, all shrubs and other plantings herewith listed and approved for this site, shall be of the proper height requirements in accordance with the Howard County Landscaping Manual. In addition, no substitutions or relocation of required plantings may be made without prior review and approval from the Department of Planning and Zoning. Any deviation from this approved Landscape Plan may result in denial or delay in the release of landscape surety until such time as all required materials are planted and/or revision made to applicable plans and certificates.

LANDSCAPE LEGEND

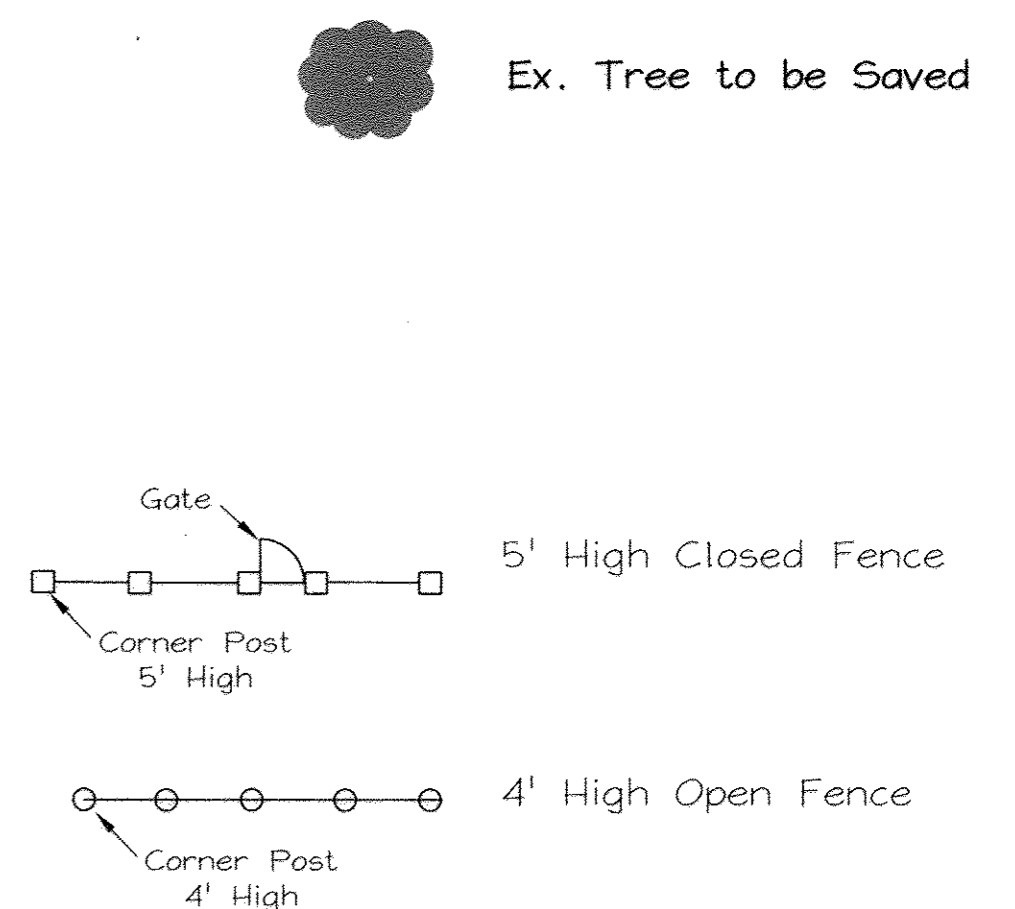

NOTES:

- THIS PLAN IS NOT FOR GRADING. SEE SHEET 8 & 11 FOR GRADING.



OWNER/DEVELOPER  
 Williamsburg Group, LLC  
 5485 Harpers Farm Rd.  
 Suite 200  
 Columbia, MD 21044  
 410 997-8800

LDE Inc. AS-BUILT

Engineers, Surveyors, Planners  
 9250 Ramsey Road, Suite 106 Columbia, Maryland - 21045  
 (410)715-1070 - (301)596-3424 - FAX (410)715-8540

DESIGNED	EDS	LANDSCAPE PLAN - 10 SCALE DETAIL ENLARGEMENT <b>WATKINS' CHOICE PHASE I</b> Lots 1, 2, Open Space Lot 3 and Non-Buildable Bulk Parcel "A" Tax Map 46 - Grid 18 - Parcel 215 6th Election District - Howard County, Maryland Previous Submittals: SP 07-010, WP 09-042 Owner/Developer: Williamsburg Group, LLC 5485 Harpers Farm Rd Suite 200 Columbia, MD 21044 410 997-8800	SCALE	1" = 10'
DRAWN	LDE		DRAWING	15 OF 16
CHECKED	BDB		JOB NO.	02-035.2
DATE	12/2008		FILE NO.	F-08-179

PROFESSIONAL CERTIFICATION:  
  
 Steve Heiss, Qualified Professional, MDPCA

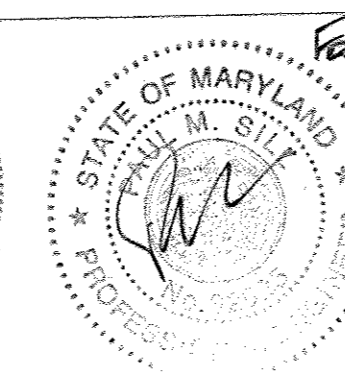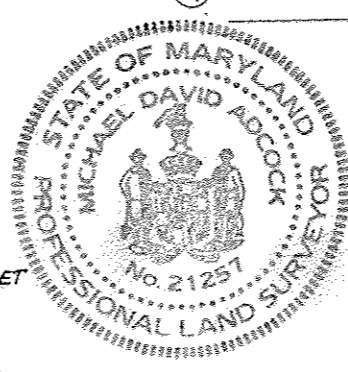


No.	Date	By	Description
5/1/18	JGV		ADJUST PERIMETER PLANTINGS
6/12	LDE		REVISE OWNER/DEVELOPER

AS-BUILT CERTIFICATION  
 I HEREBY CERTIFY, BY MY SEAL, THAT THE CONDITIONS SHOWN ON THIS PLAN WERE CONSTRUCTED TO THE LINES AND GRADES SHOWN IN RED ON THIS "AS-BUILT" PLAN AND MEET THE APPROVED PLANS AND SPECIFICATIONS AND ALSO THAT THESE DOCUMENTS WERE PREPARED BY ME OR UNDER MY RESPONSIBLE CHARGE AND THAT I AM A DULY LICENSED PROFESSIONAL LAND SURVEYOR UNDER THE LAWS OF THE STATE OF MARYLAND.  
  
 MICHAEL D. ADCOCK, PROFESSIONAL LAND SURVEYOR  
 LICENSE NO. 21257, EXPIRATION DATE: JUNE 16, 2017


I HEREBY CERTIFY THAT THESE DOCUMENTS WERE PREPARED OR APPROVED BY ME, AND THAT I AM A DULY LICENSED PROFESSIONAL ENGINEER UNDER THE LAWS OF THE STATE OF MARYLAND, LICENSE NO. 19184, EXPIRES 06/16/2017.  
  
 BRUCE D. BURTON, PROFESSIONAL ENGINEER  
 LICENSE NO. 19184, EXPIRES 06/16/2017

Developer's/Builder's Certificate  
 I/We certify that the landscaping shown on this plan will be done according to the plan, Section 16.124 of the Howard County Subdivision and Land Development Regulations and the Landscape Manual. I/We further certify that upon completion a letter of Landscape Installation, accompanied by an executed one year guarantee of plant materials, will be submitted to the Department of Planning and Zoning.  
  
 Name: \_\_\_\_\_ Date: 12-19-08

APPROVED: DEPARTMENT OF PUBLIC WORKS		1-9-09
CHIEF, BUREAU OF HIGHWAYS	W. Z. White	DATE
APPROVED: DEPARTMENT OF PLANNING AND ZONING		1/20/09
CHIEF, DIVISION OF LAND DEVELOPMENT	Cindy Harris	DATE
APPROVED: DEPARTMENT OF PLANNING AND ZONING		1/16/09
CHIEF, DEVELOPMENT ENGINEERING DIVISION	Chad Anderson	DATE

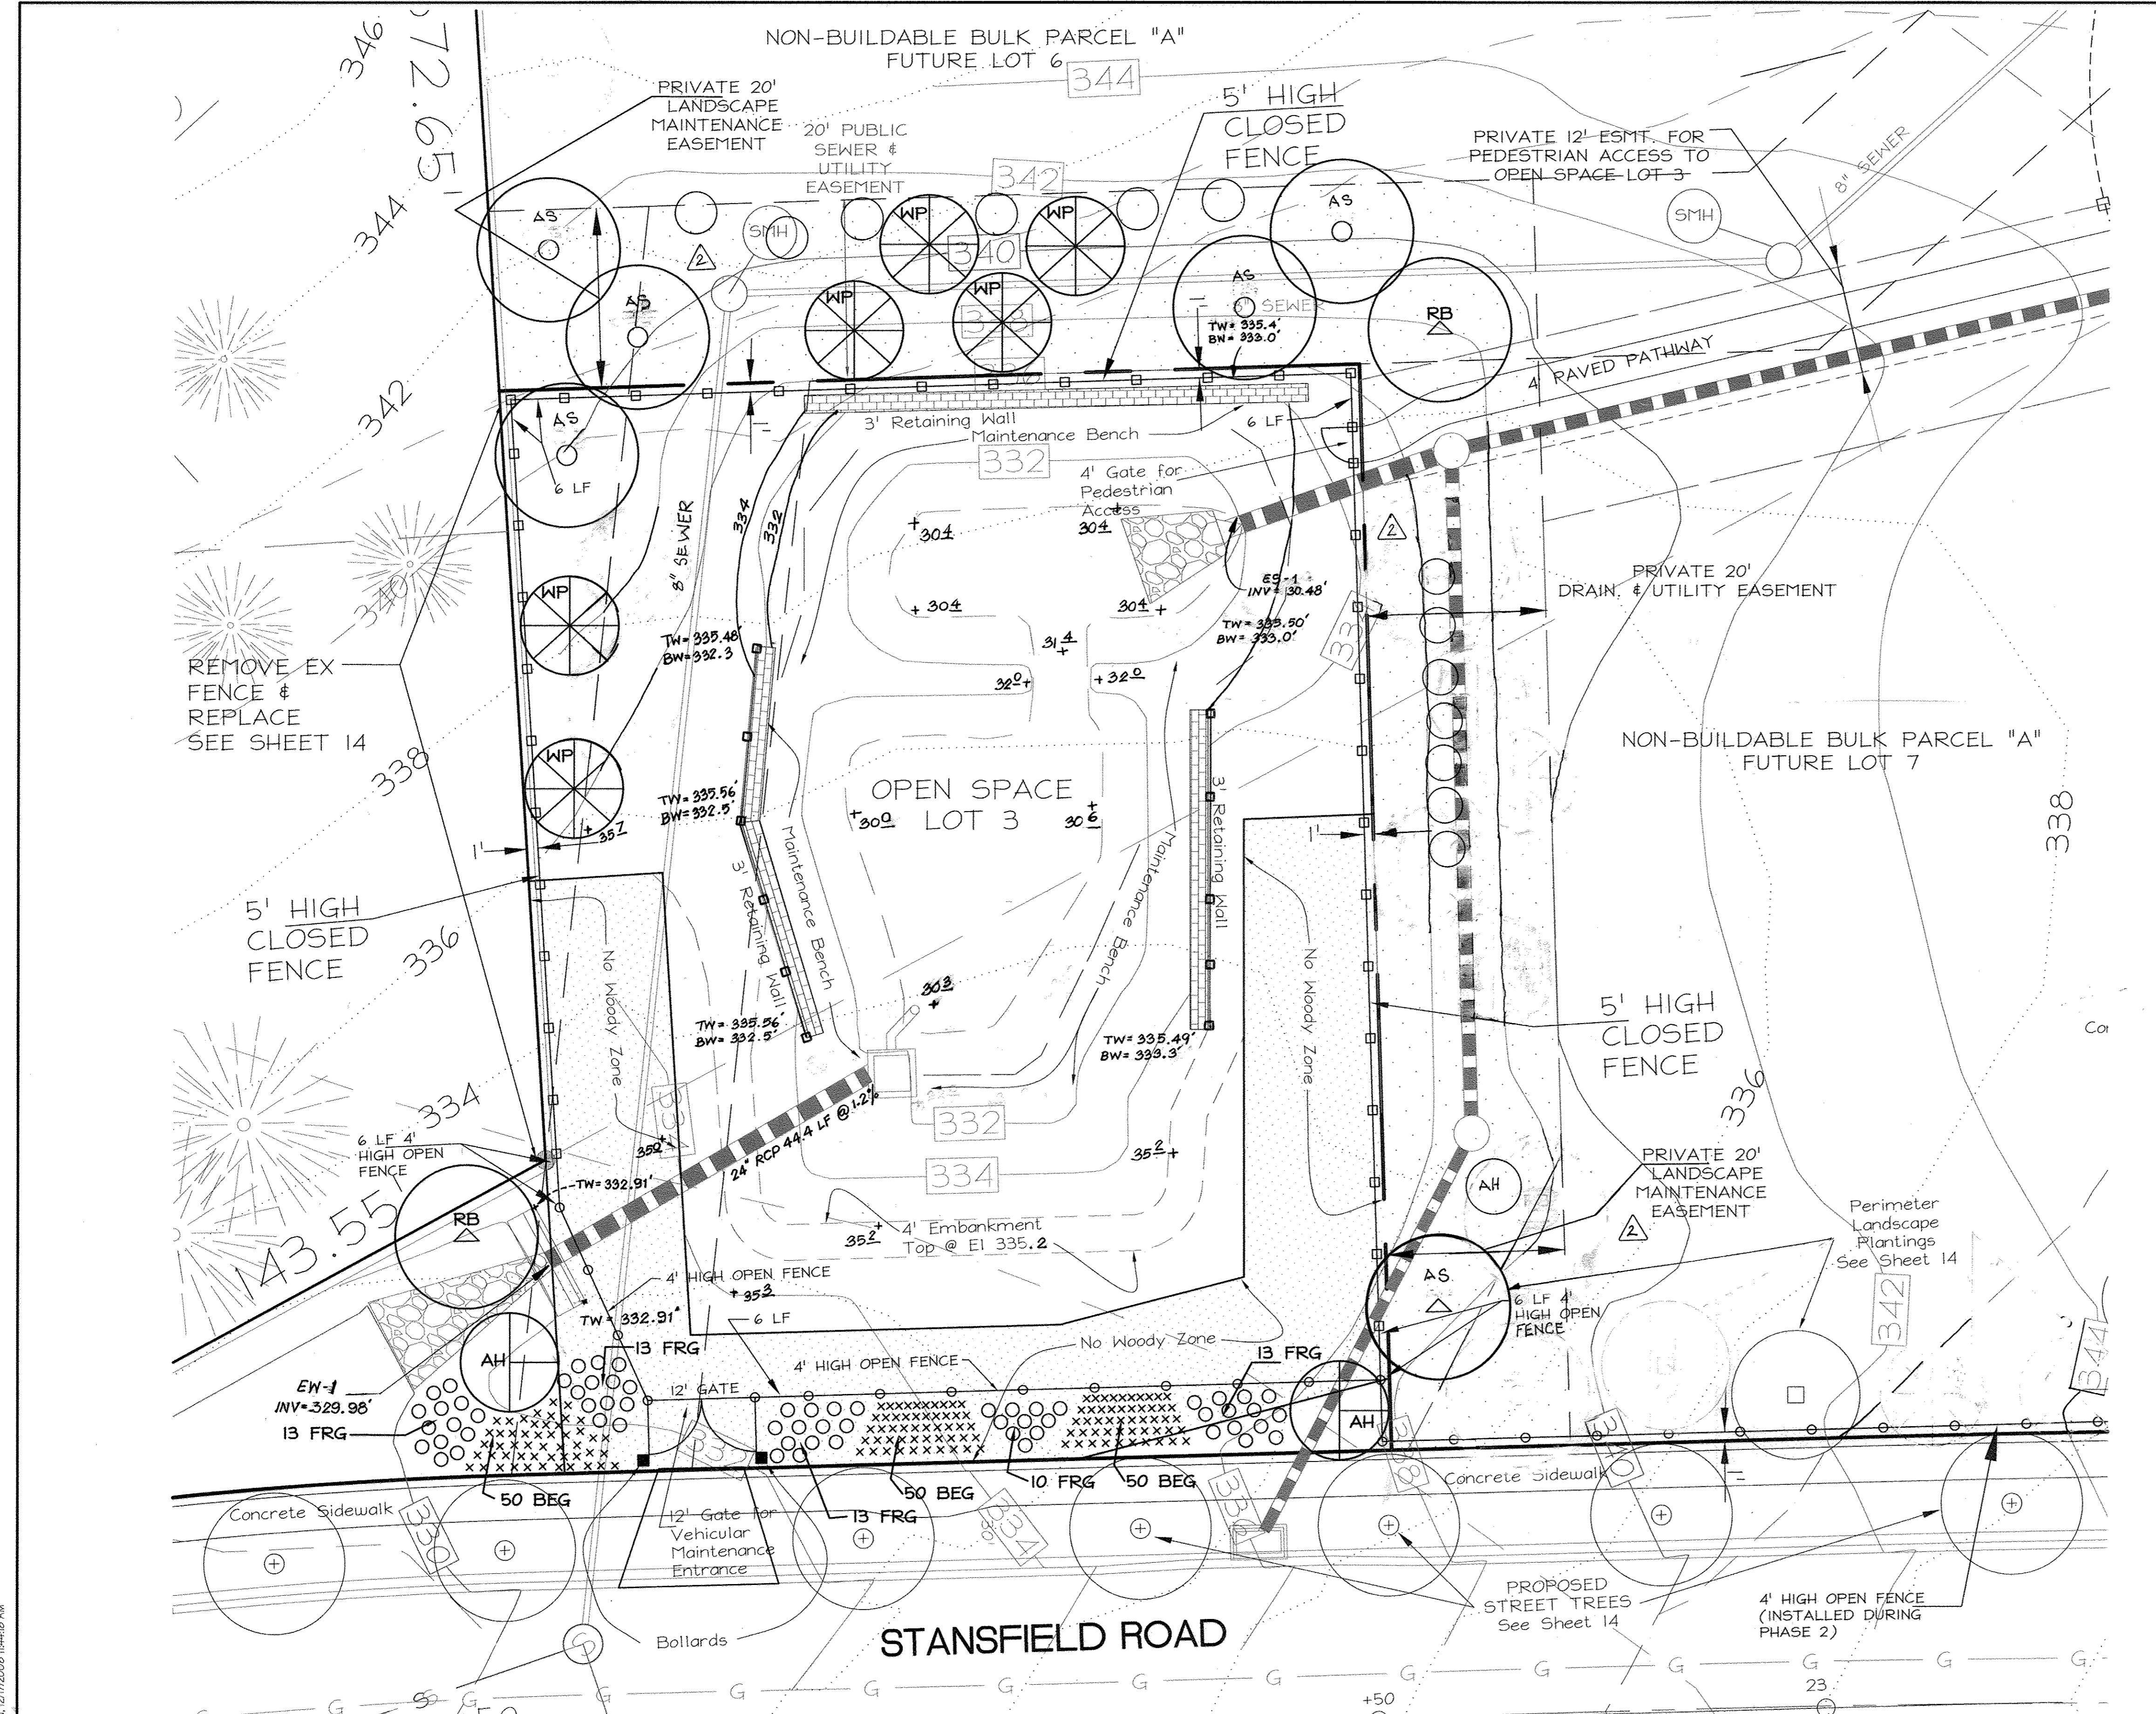





PLOTTED: 02/05/2009 10:05:52 AM SHIT 18 PLANO 10 SCALE DETAIL ENL. LAND & FC PLAN, 12/17/2008 11:44:18 AM

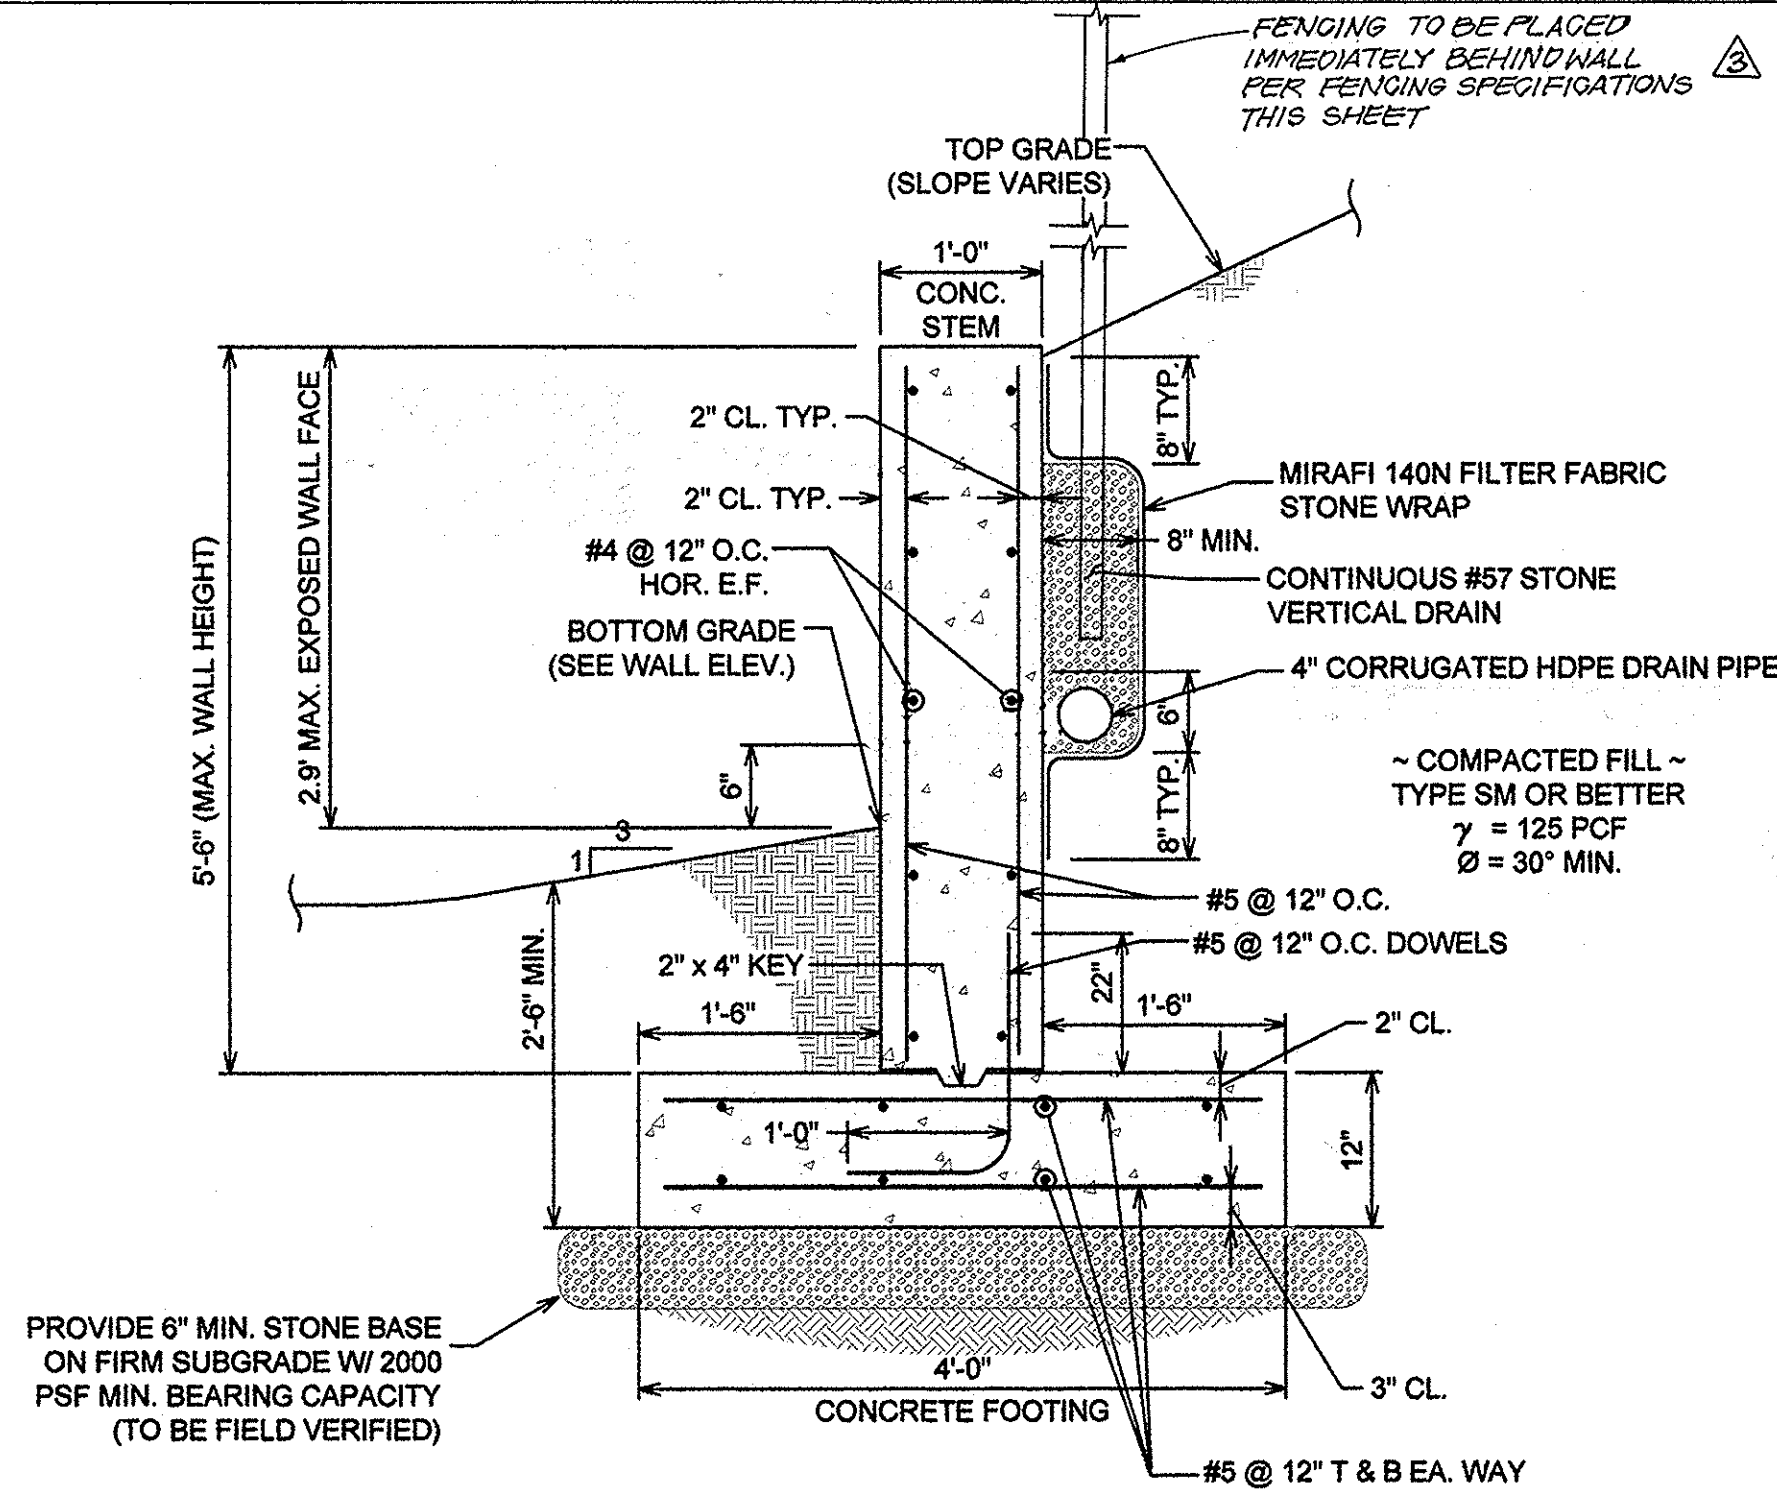




**FENCING SPECIFICATION**  
 - FABRIC: 42" O.D. 2" MESH, BLACK  
 - TOP RAIL: 1-3/8" O.D. BLACK HMV LG-40 PIPE  
 - LINE POST: 2-1/2" O.D. BLACK HMV LG-40 PIPE OUT POST, 120" O/LG  
 - TERMINAL POST: 3" O.D. BLACK HMV LG-40 PIPE OUT POST  
 - TENSION WIRE: 3 GAUGE BLACK EX SMOOTH  
 - FITTINGS: BLACK HM VINYL  
 - TIE WIRE: 8-1/4" BLACK ALUMINIUM PRETIED 3 GAUGE  
 - POST FOOTING: HAND MIXED 60 LB BAGS CONCRETE, 30" DEEP, 6" DIAMETER

- NOTE:**
- All retaining wall concrete shall be 4000 psi at 28 days with air entrainment.
  - Reinforcing steel shall conform to ASTM-615 Grade 60
  - Wall backfill shall be compacted to 95% of T-99
  - Concrete work shall comply with the latest ACI 318 Building code for concrete structures
  - All rebar splices not shown shall be a minimum 30 bar diam.
  - All wall exposed surfaces shall be mortar patched and sack-rubbed finished with grout and burlap to the satisfaction of the project architect.
  - Verify length of each wall with civil engineering drawing.

**TYPICAL CONCRETE WALL SECTION  
NOT TO SCALE**

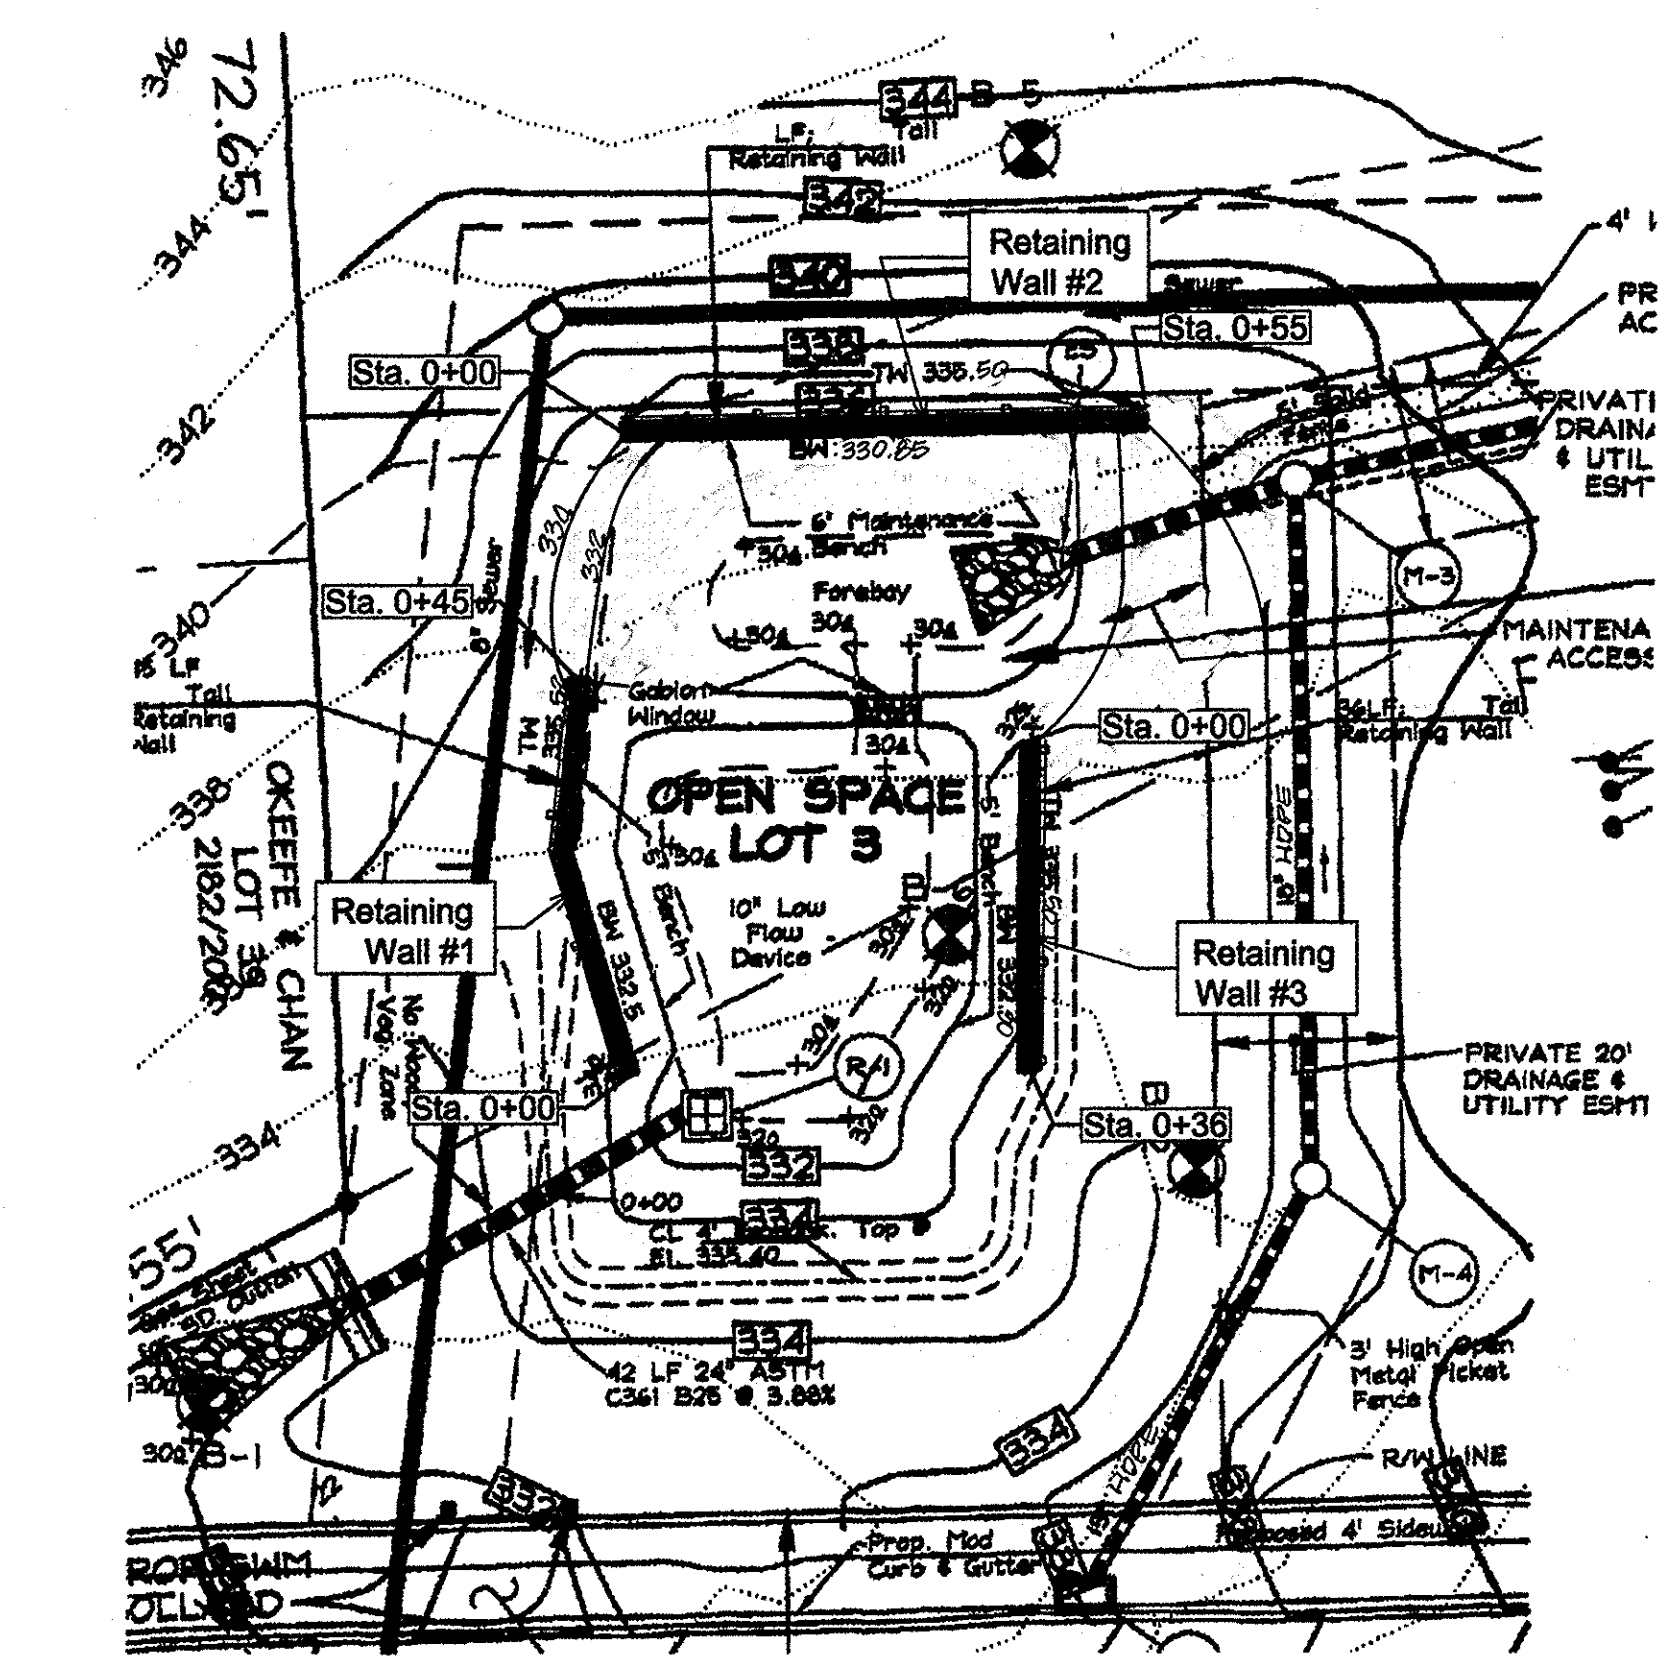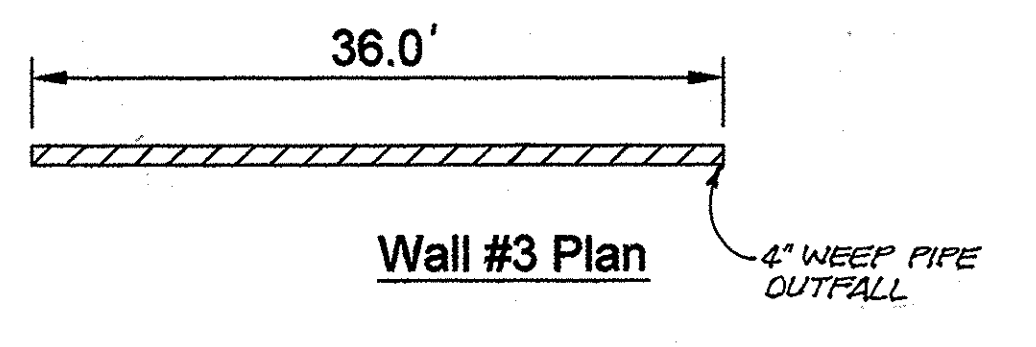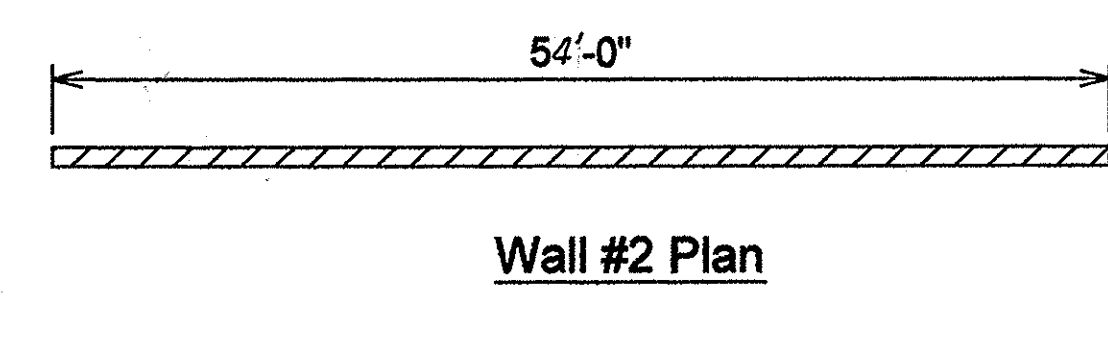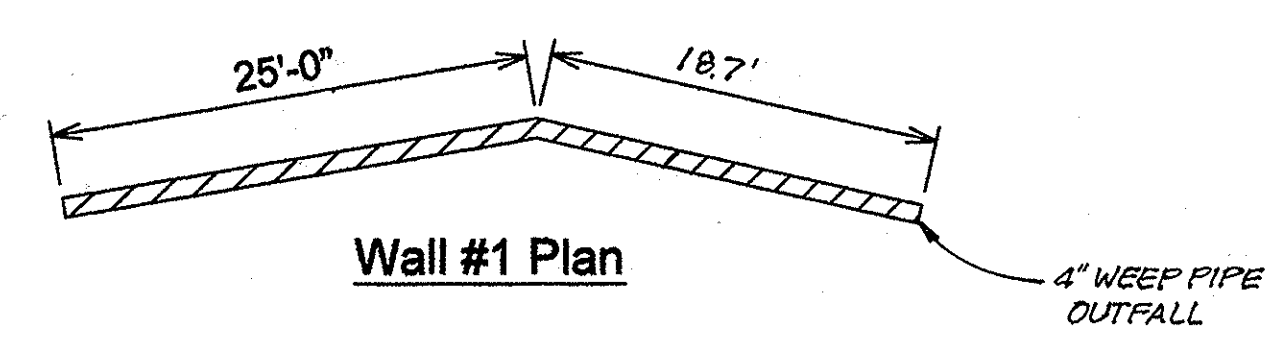

**RETAINING WALL LOCATION PLAN  
1" = 20'**

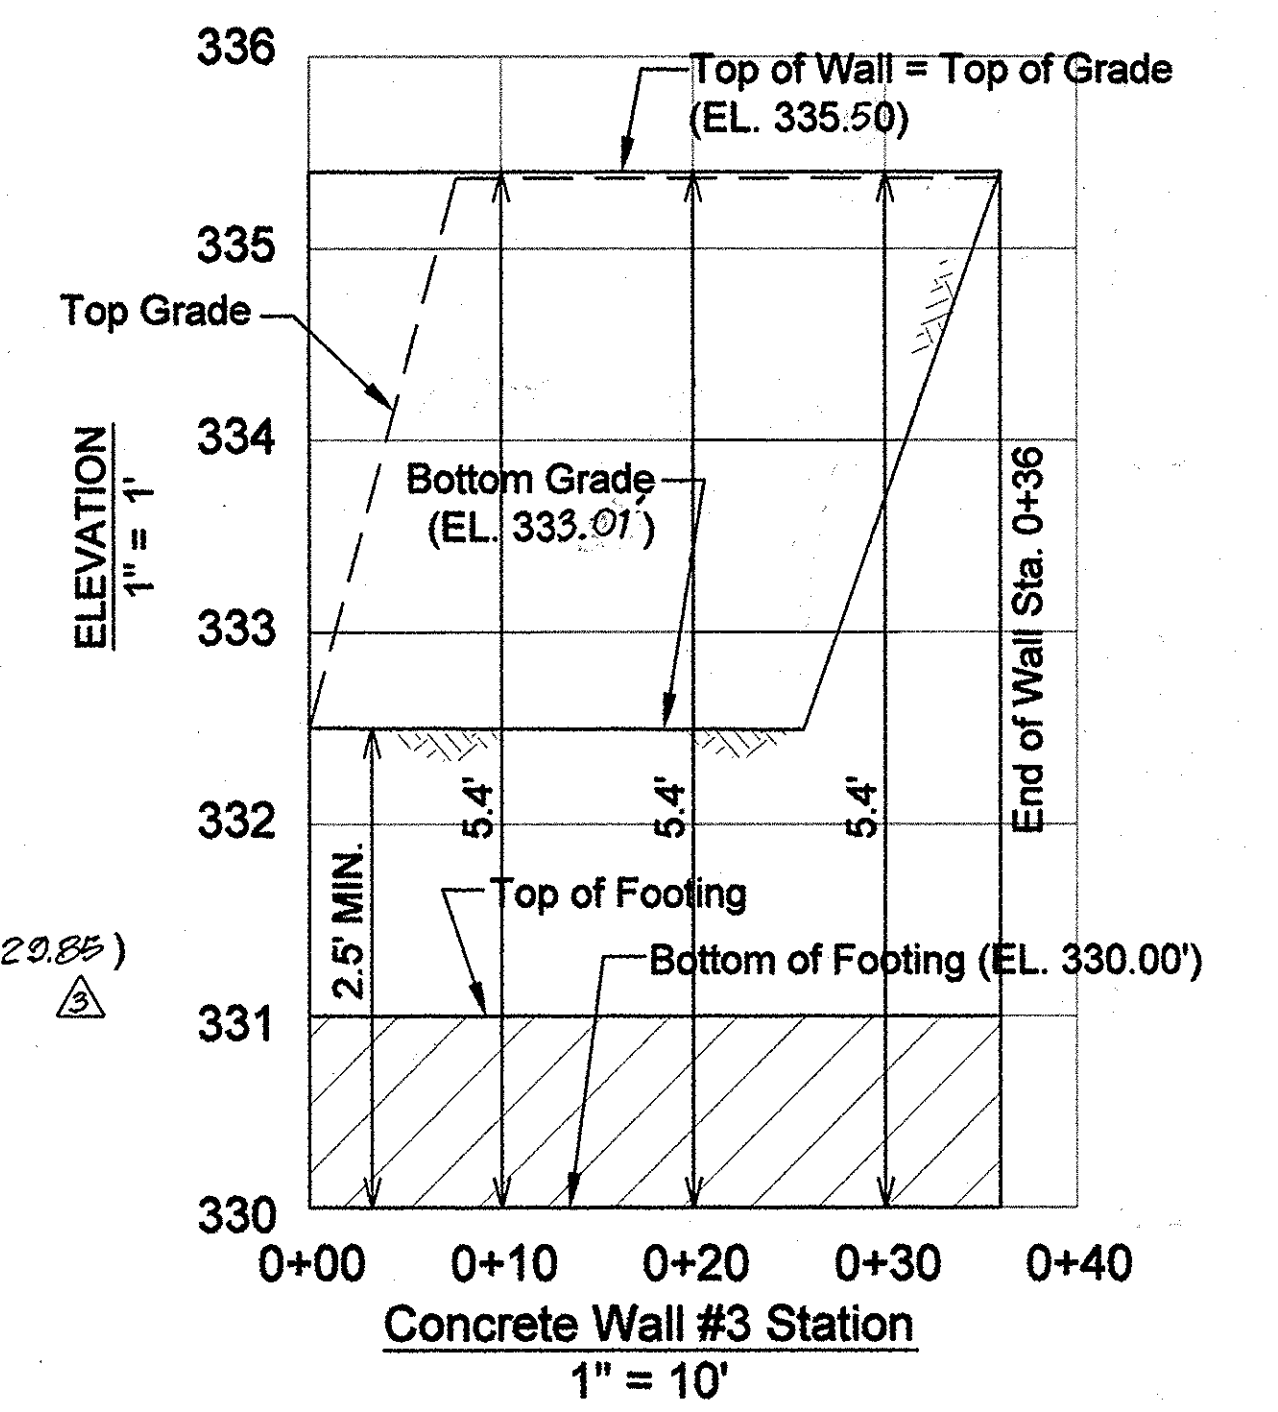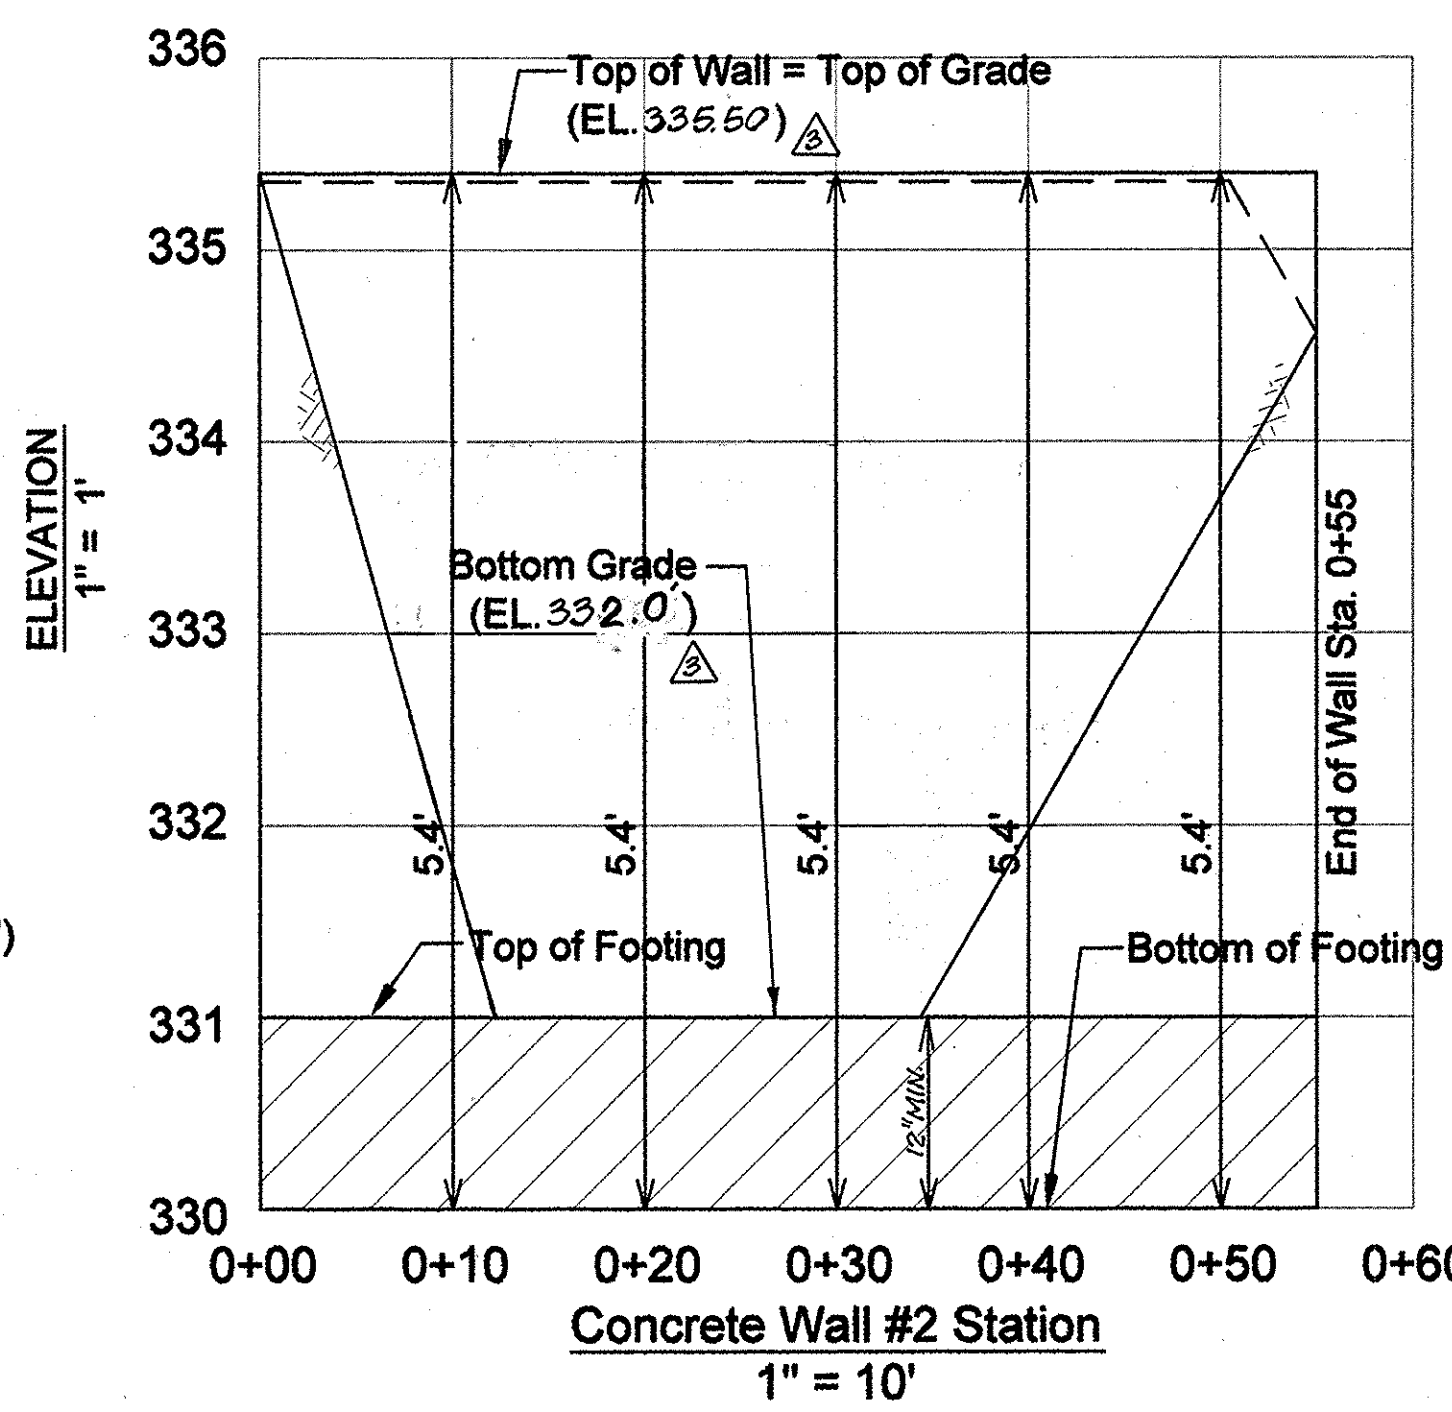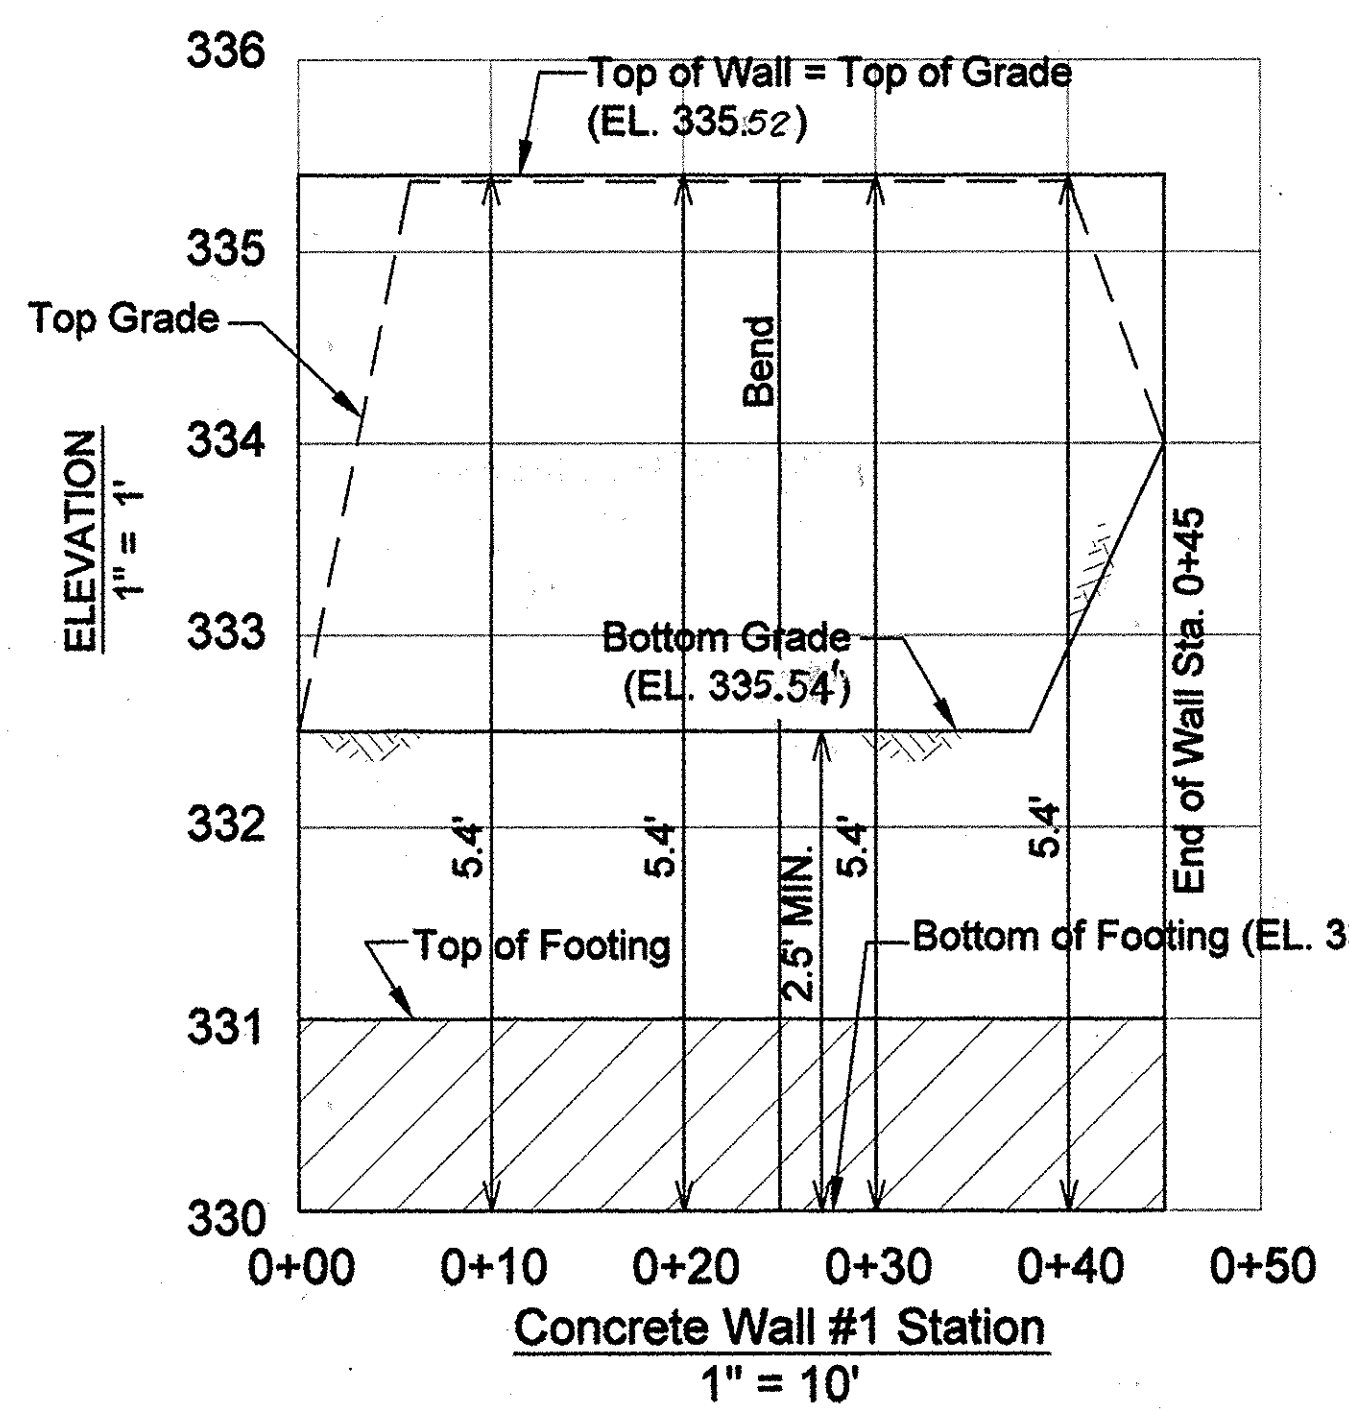

**AS-BUILT CERTIFICATION**  
 I HEREBY CERTIFY BY MY SEAL THAT THE CONDITIONS SHOWN ON THIS PLAN WERE CONSTRUCTED TO THE LINES AND GRADES SHOWN IN RED ON THIS "AS-BUILT" PLAN AND MET THE APPROVED PLANS AND SPECIFICATIONS AND ALSO THAT THESE DOCUMENTS WERE PREPARED BY ME OR UNDER MY RESPONSIBLE CHARGE AND THAT I AM A DULY LICENSED PROFESSIONAL LAND SURVEYOR UNDER THE LAWS OF THE STATE OF MARYLAND.  
 Signature: Michael D. Adcock  
 DATE: 8/19/2008  
 MICHAEL D. ADCOCK PROFESSIONAL LAND SURVEYOR  
 LICENSE NO. 21257, EXPIRATION DATE: JUNE 16, 2017



**PROFESSIONAL CERTIFICATION**  
 I HEREBY CERTIFY THAT THESE PLANS WERE PREPARED OR APPROVED BY ME, AND THAT I AM A DULY LICENSED PROFESSIONAL ENGINEER UNDER THE LAWS OF THE STATE OF MARYLAND, LICENSE NO. 9454, EXPIRATION DATE: 09/08/09.  
 Signature: William J. Mullen  
 DATE: 1-9-09  
 WILLIAM J. MULLEN  
 CHIEF, BUREAU OF HIGHWAYS

**APPROVED: DEPARTMENT OF PUBLIC WORKS**  
 Signature: William J. Mullen  
 DATE: 1-9-09  
 WILLIAM J. MULLEN  
 CHIEF, BUREAU OF HIGHWAYS

**APPROVED: DEPARTMENT OF PLANNING AND ZONING**  
 Signature: Candice Brown  
 DATE: 1/20/09  
 CANDICE BROWN  
 CHIEF, DIVISION OF LAND DEVELOPMENT

**APPROVED: DEPARTMENT OF PLANNING AND ZONING**  
 Signature: Chad Edwards  
 DATE: 1-16-09  
 CHAD EDWARDS  
 CHIEF, DEVELOPMENT ENGINEERING DIVISION

**ENGINEER'S CERTIFICATE**  
 I hereby certify that this plan for sediment and erosion control represents a practical and workable plan based on my personal knowledge of the site conditions and that it was prepared in accordance with the requirements of the Howard Soil Conservation District.  
 Signature of Engineer: Bruce D. Burton  
 DATE: \_\_\_\_\_

**DEVELOPER'S CERTIFICATE**  
 I/We certify that all development and construction will be done according to this plan of development for sediment and erosion control, and that all responsible personnel involved in the construction project will have a Certificate of Attendance at a Department of Environmental Approved Training Program for the Control of Sediment and Erosion before beginning the project. I also authorize periodic onsite inspections by the Howard County Soil District.  
 Signature of Developer: [Signature]  
 DATE: 12-19-08

THIS DEVELOPMENT PLAN IS APPROVED FOR SOIL EROSION AND SEDIMENT CONTROL BY THE HOWARD SOIL CONSERVATION DISTRICT.  
 Signature: [Signature]  
 DATE: \_\_\_\_\_  
 HOWARD SOIL CONSERVATION DISTRICT

No.	Date	By	Description
3	5/28/15	BEG	ADD FENCE, REMOVE WALL CHAMFER, REVISE WALL #2 ELEVATIONS
2	1/22/15	SEG	REVISE SO PIPE TYPE, GRADES AT WALL #2, AND REMOVE WEEP HOLES
1	6/12	LDE	REVISE OWNER / DEVELOPER

**HILLIS-CARNES ENGINEERING ASSOCIATES**  
 10075 Guilford Road, Suite A Annapolis Junction, MD 21031  
 (410) 880-4788 Fax: (410) 880-4993

**AS-BUILT**

**WATKINS' CHOICE PHASE 1**  
 Lots 1, 2, Open Space Lot 3 and Non-Buildable Bulk Parcel "A"  
 Tax Map 46 - Grid 18 - Parcel 215  
 6th Election District - Howard County, Maryland  
 Previous Submittals: SP 07-010, WP 09-  
 Owner/Developer: Williamsburg Group, LLC  
 5485 Harpers Farm Rd  
 Suite 200  
 Columbia, MD 21044  
 410-977-8800

DESIGNED	HM	SCALE	AS SHOWN
DRAWN	HM	DRAWING	16 OF 16
CHECKED	JJC	JOB NO.	02-035.2
DATE	11/2008	FILE NO.	F-08-179