

GENERAL NOTES

- THE SUBJECT PROPERTY IS ZONED R-ED PER THE 2020/04 COMPREHENSIVE ZONING PLAN AND PER COMP. LITE ZONING AMENDMENTS EFFECTIVE 7/28/06.
- ALL CONSTRUCTION SHALL BE IN ACCORDANCE WITH THE LATEST STANDARDS AND SPECIFICATIONS OF HOWARD COUNTY PLUS MSMA STANDARDS AND SPECIFICATIONS IF APPLICABLE.
- THE CONTRACTOR SHALL NOTIFY THE DEPARTMENT OF PUBLIC WORKS/BUREAU OF ENGINEERING/CONSTRUCTION INSPECTION DIVISION AT (410)313-1880 AT LEAST FIVE (5) WORKING DAYS PRIOR TO THE START OF WORK.
- THE CONTRACTOR SHALL NOTIFY "MISS UTILITY" AT 1-800-257-7777 AT LEAST 48 HOURS PRIOR TO ANY EXCAVATION WORK BEING DONE.
- WATER AND SEWER ARE PUBLIC. CONTRACT NUMBER 14-4741-D. SEWER DRAINAGE IS TO THE PATAPSCO TREATMENT PLANT.
- THE COORDINATES HEREON ARE BASED UPON THE HOWARD COUNTY GEODETIC CONTROL WHICH IS BASED UPON THE MARYLAND STATE PLANE COORDINATE SYSTEM. HOWARD COUNTY MONUMENT NOS. 31E6 & 31E7 WERE USED FOR THIS PROJECT.
- PROJECT BOUNDARY AND TOPOGRAPHY ARE BASED ON FIELD RUN BOUNDARY SURVEY AND TOPOGRAPHY PERFORMED BY BENCHMARK ENGINEERING INC. MAY 5, 2005. CONTOUR INTERVAL IS 2 FEET.
- EXISTING UTILITIES SHOWN HEREON ARE BASED ON FIELD LOCATIONS AND RECORD DRAWINGS.
- CONTRACTOR SHALL VERIFY ALL UTILITY LOCATIONS PRIOR TO ANY CONSTRUCTION ACTIVITY AND SHALL ADJUST ALL UTILITIES AND RIM ELEVATIONS AS NEEDED TO MATCH THIS PLAN.
- THIS SUBDIVISION IS SUBJECT TO SECTION 18.122B OF THE HOWARD COUNTY CODE. PUBLIC WATER AND PUBLIC SEWER SERVICE WILL BE GRANTED UNDER THE TERMS AND PROVISIONS OF DEVELOPER'S AGREEMENT #14-4741-D WHICH IS TO BE EXECUTED BY THE COUNTY PRIOR TO THE COMMENCEMENT OF CONSTRUCTION AND THE RECORDATION OF THE SUBDIVISION PLAT, F-12-074.
- FOREST STAND DELINEATION PLAN WAS PREPARED BY ECO-SCIENCE PROFESSIONALS, INC. DATED NOV. 25, 2005 AND APPROVED UNDER SP-06-012.
- THE WETLANDS DELINEATION STUDY FOR THIS PROJECT WAS PREPARED BY ECO-SCIENCE PROFESSIONALS, INC. DATED NOV 25, 2005 AND WAS APPROVED UNDER SP-06-012.
- THERE ARE NO STEEP SLOPES (25% OR GREATER) ON THIS SITE. THERE ARE WETLANDS AND WETLAND BUFFERS AND STREAM BUFFERS ON THIS SITE.
- THERE IS NO 100-YEAR FLOODPLAIN ON THIS SITE.
- NO NOISE STUDY IS REQUIRED FOR THIS PROJECT.
- AN APFO TRAFFIC ANALYSIS IS NOT REQUIRED FOR THIS PROJECT, AS IT IS MORE THAN 1.5 MILES FROM THE NEAREST INTERSECTION OF TWO MAJOR COLLECTOR ROADWAYS. AN INTERSECTION SAFETY STUDY WAS PREPARED BY THE MARS GROUP, DATED MARCH 2006 AND APPROVED UNDER SP-06-012.
- THE GEOTECHNICAL REPORT FOR THIS PROJECT WAS PREPARED BY HILLS-CARNES ENGINEERING ASSOCIATES, DATED SEPTEMBER 26, 2005.
- TO THE BEST OF OUR KNOWLEDGE, THERE ARE NO HISTORIC FEATURES OR CEMETERY LOCATIONS ON-SITE.
- UNLESS NOTED AS "PRIVATE", ALL EASEMENTS ARE PUBLIC.
- ALL DIMENSIONS ARE TO THE FACE OF CURB UNLESS OTHERWISE NOTED.
- BRL INDICATES BUILDING RESTRICTION LINE.
- THIS PLAN IS SUBJECT TO THE 5th EDITION OF THE HOWARD COUNTY SUBDIVISION REGULATIONS AND THE AMENDED HOWARD COUNTY ZONING REGULATIONS.
- STORMWATER MANAGEMENT SHALL BE PROVIDED FOR THIS PROJECT BASED ON GUIDELINES ESTABLISHED BY THE 2000 MARYLAND STORMWATER DESIGN MANUAL VOLUMES 1 & 11 USING ENVIRONMENTAL SITE DESIGN. PRACTICES INCLUDE GRASS SWALES (M-4), RAIN GARDENS (M-7) AND MICRO-BIOTENTION (M-4). ON LOT FACILITIES SHALL BE OWNED AND MAINTAINED BY PROPERTY OWNER. OPEN SPACE FACILITIES SHALL BE OWNED AND MAINTAINED BY THE HOME OWNER'S ASSOCIATION.
- TRAFFIC CONTROL DEVICES:
 - The R-1 ("STOP") SIGN AND THE STREET NAME SIGN (SNS) ASSEMBLY FOR THIS DEVELOPMENT MUST BE INSTALLED BEFORE THE BASE PAVING IS COMPLETED.
 - THE TRAFFIC CONTROL DEVICE LOCATIONS SHOWN ON THE PLANS ARE APPROXIMATE AND MUST BE FIELD APPROVED BY HOWARD COUNTY TRAFFIC DIVISION (410-313-5752) PRIOR TO THE INSTALLATION OF ANY OF THE TRAFFIC CONTROL DEVICES.
 - ALL TRAFFIC CONTROL DEVICES AND THE LOCATIONS SHALL BE IN ACCORDANCE WITH THE LATEST EDITION OF THE "MARYLAND MANUAL ON UNIFORM TRAFFIC CONTROL DEVICES" (MUTCD).
 - ALL SIGN POSTS USED FOR TRAFFIC CONTROL SIGNS INSTALLED IN THE COUNTY RIGHT OF WAY SHALL BE MOUNTED ON A 2" GALVANIZED STEEL, PERFORATED ("POUCH PUNCH") SQUARE TUBE POST (14 GAUGE) INSERTED INTO A 1 1/2" GALVANIZED STEEL, PERFORATED, SQUARE TUBE SLEEVE (12 GAUGE) - 3' LONG. A GALVANIZED STEEL POLE CAP SHALL BE MOUNTED ON TOP OF EACH POST.
- LANDSCAPING SHALL BE PROVIDED AS SHOWN ON THE LANDSCAPE PLAN OF THE ROAD CONSTRUCTION DRAWINGS FOR THIS FINAL PLAN IN ACCORDANCE WITH SECTION 16.124 OF THE LANDSCAPE MANUAL. FINANCIAL SURETY IN THE AMOUNT OF \$3,000 (FOR 8 SHADE TREES AND 4 EVERGREEN TREES) SHALL BE POSTED WITH THE DEVELOPER'S AGREEMENT UNDER THIS FINAL PLAN, F-12-074.
- ALL AREAS OF CONTROLLED FILL TO BE AT 95% COMPACTION PER AASHTO-T180 STANDARDS.
- THE FOREST CONSERVATION ACT REQUIREMENTS FOR THIS PROJECT WILL BE MET THROUGH THE ON-SITE RETENTION OF 12 ACRES FOREST WITHIN THE LIMITS OF A FOREST CONSERVATION EASEMENT. THIS RETENTION EQUALS THE BREAK-EVEN POINT THRESHOLD AND THEREFORE NO ADDITIONAL PLANTING IS REQUIRED.
- A DESIGN MANUAL WAIVER WAS APPROVED JUNE 21, 2010. ALLOWING PAYMENT OF FEE-IN-LIEU FOR FRONTAGE IMPROVEMENTS ALONG ILCHESTER AND LANDING ROAD. THE APPROVED FEE-IN-LIEU AMOUNTS ARE \$19,400 FOR ILCHESTER ROAD, AND \$74,500 FOR LANDING ROAD. HOWEVER, IF THE COSTS OF UTILITY POLE RELOCATION ARE REDUCED AS A RESULT OF A BGE COST REDUCTION, THESE FEE IN LIEU AMOUNTS MAY BE REDUCED ACCORDINGLY. A DESIGN MANUAL WAIVER REQUESTED TO UTILIZE OPEN SECTION ROAD AND A USE IN COMMON DRIVEWAY WAS DENIED ON THE SAME DATE.
- A DESIGN MANUAL WAIVER WAS REQUESTED TO WAIVE THE REQUIREMENT THAT A DRAINAGE SWALE BE LOCATED 15' FROM A RESIDENTIAL STRUCTURE, AND A STORMWATER SWALE BE LOCATED 25' FROM A RESIDENTIAL STRUCTURE. THIS WAIVER WAS APPROVED JANUARY 6, 2012 BASED ON DEMONSTRATING LIMITED SIZES OF DRAINAGE AREA AND NO IMPACT ON OTHER PROPERTIES.
- A DESIGN MANUAL WAIVER WAS APPROVED APRIL 4, 2012 ESTABLISHING TYPICAL ROAD SECTIONS FOR THE PROJECT WHICH INCLUDE CLOSED SECTION ROAD, OPEN-BACK FLOW THROUGH INLETS AND GRASS SWALES FOR STORMWATER TREATMENT.
- WAIVER PETITION WP-11-183 REQUESTED RELIEF FROM SECTION 16.155(a)(2)(ii) WHICH REQUIRES A SITE DEVELOPMENT PLAN. THIS RELIEF WAS SOUGHT TO CONSTRUCT A MODEL HOME IN ADVANCE OF THE FINAL SUBDIVISION AND WAS DENIED JUNE 3, 2011.
- STREET LIGHT PLACEMENT AND THE TYPE OF FIXTURES AND POLES SHALL BE IN ACCORDANCE WITH THE HOWARD COUNTY DESIGN MANUAL, VOLUME III (2006), SECTION 5.5.A. A MINIMUM OF 20' SHALL BE MAINTAINED BETWEEN ANY STREET LIGHT AND ANY TREE.



RIGHT OF WAY ELEVATION CHART NAD 83

STATION	DESCRIPTION	ELEVATION
100	REBAR & CAP	473.71
101	REBAR & CAP	478.63
102	CONC. MON	467.78
103	REBAR & CAP	478.51
104	REBAR & CAP	473.70
105	REBAR & CAP	470.26
106	REBAR & CAP	470.07
107	REBAR & CAP	478.02
108	REBAR & CAP	478.67
109	REBAR & CAP	479.33
110	REBAR & CAP	470.87
111	REBAR & CAP	477.50
112	REBAR & CAP	477.87
113	REBAR & CAP	477.69
114	REBAR & CAP	478.20
115	CONC. MON	474.17
116	CONC. MON	479.12
117	REBAR & CAP	476.21
118	REBAR & CAP	475.31

CASCADE OVERLOOK, SECTION 4

LOTS 1 THRU 7 AND OPEN SPACE LOTS 8 & 9

FINAL CONSTRUCTION PLANS

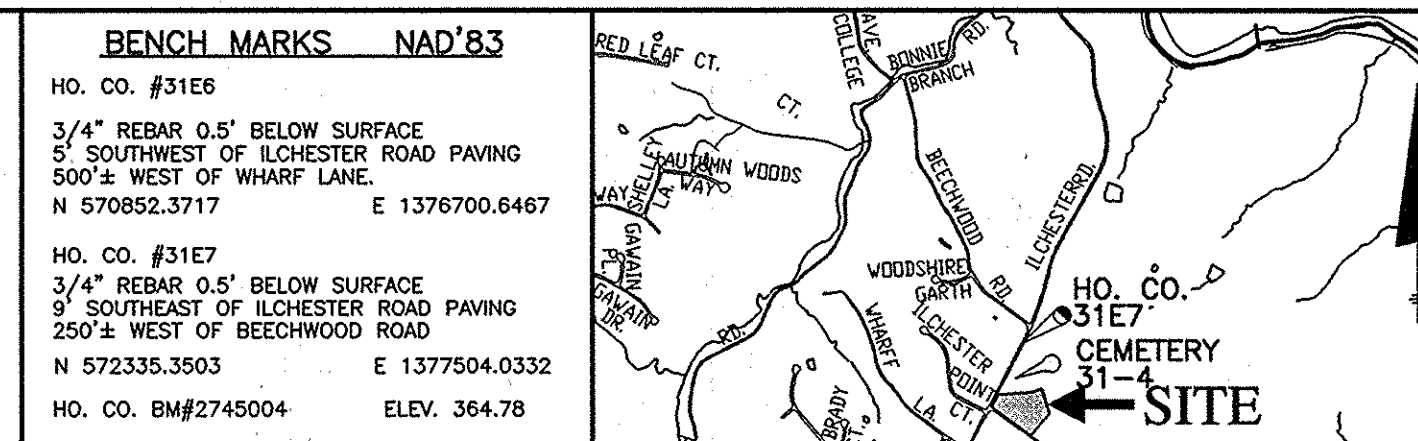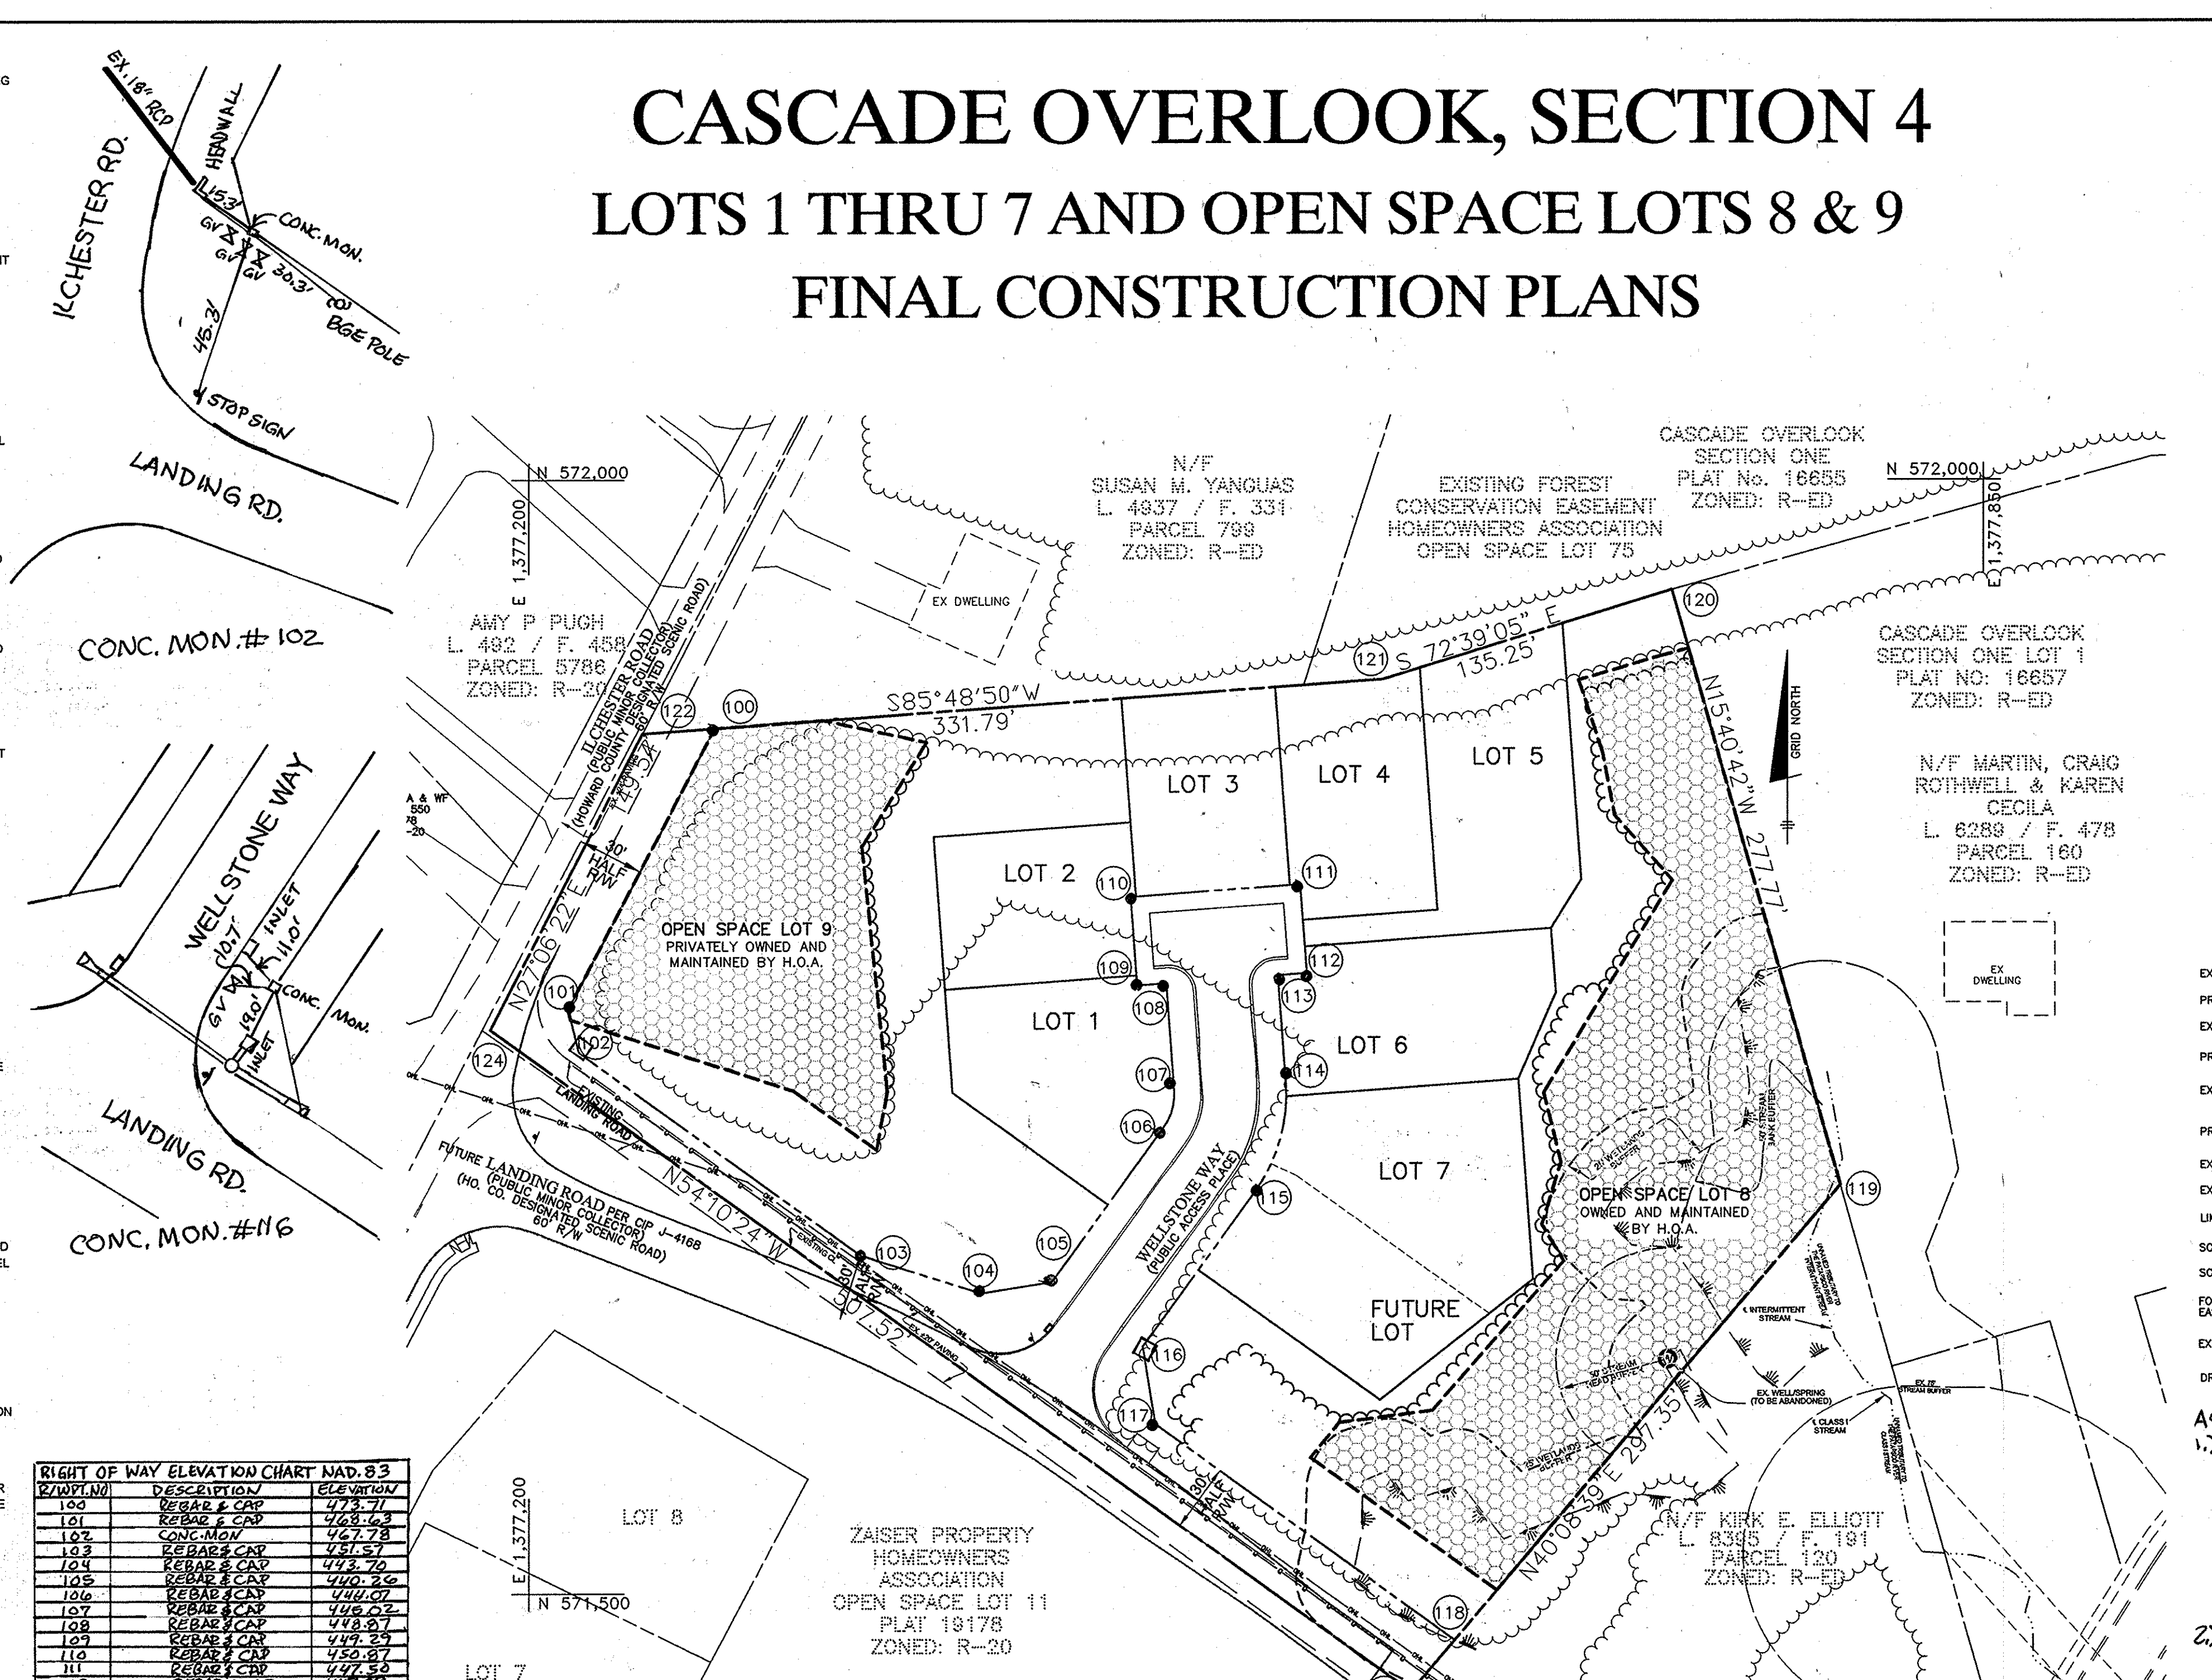

COORDINATE CHART (NAD '83)


No.	NORTH	EAST
100	571888.2765	1377283.2420
101	571761.9848	1377217.6458
102	571742.6636	1377222.4952
103	571644.5913	1377358.3422
104	571634.6720	1377402.1475
105	571639.8141	1377433.7686
106	571709.2032	1377483.7993
107	571725.6493	1377488.4540
108	571773.6937	1377484.9375
109	571772.7447	1377471.9722
110	571812.6380	1377469.0524
111	571818.1857	1377544.8496
112	571778.2924	1377547.7695
113	571777.3434	1377534.8042
114	571729.2991	1377538.3206
115	571679.9608	1377524.3584
116	571610.5718	1377474.3258
117	571575.8301	1377479.9397
118	571478.8895	1377613.8488
119	571683.0310	1377786.0255
120	571950.4620	1377710.9630
121	571910.1330	1377581.8660
122	571885.9136	1377250.9588
123	571752.8026	1377182.8246
124	571455.7303	1377594.3209

MINIMUM LOT SIZE CHART

LOT NO.	GROSS AREA	PIPESTEM AREA	MINIMUM LOT SIZE
5	8,920 S.F.	725 S.F.	8,195 S.F.


SITE DATA TABULATION

1. GENERAL SITE DATA	2. AREA TABULATION	3. DENSITY TABULATION	4. UNIT/LOT TABULATION
a) PRESENT ZONING: R-ED	a) TOTAL AREA OF SITE: 4.05± AC.	a) NET AREA OF THE SITE: 4.05± AC.	a) TOTAL NUMBER OF RESIDENTIAL UNITS/LOTS PROPOSED ON THIS SUBMISSION: 7*
b) LOCATION: TAX MAP: 31, GRID 10, PARCEL 133	b) APPROXIMATE AREA OF 100 YEAR FLOODPLAIN: N/A	b) TOTAL NUMBER OF BUILDABLE LOTS ALLOWED (2 D.U./NET AC.): 8	b) PROPOSED ON THIS SUBMISSION: 7*
c) APPLICABLE DPZ FILE REFERENCES: N/A	c) APPROX. AREA OF STEEP SLOPES (25% OR MORE): N/A	c) TOTAL NUMBER OF BUILDABLE LOTS PROPOSED: 7	c) TOTAL NUMBER OF NON-BUILDABLE LOTS PROPOSED: N/A
d) PROPOSED USE OF SITE: SINGLE FAMILY DETACHED RESIDENTIAL	d) NET AREA OF SITE: 4.05± AC.	d) TOTAL NUMBER OF BUILDABLE LOTS PROPOSED: 8 (8 ULTIMATE)	d) TOTAL AREA OF RECREATIONAL OPEN SPACE REQUIRED 250 SQ.FT. PER BUILDABLE LOT:
e) PROPOSED WATER AND SEWER SYSTEMS: PUBLIC	e) AREA OF THIS PLAN SUBMISSION: 4.05± AC.		1) TOTAL AREA OF RECREATIONAL OPEN SPACE REQUIRED: NONE (<10 LOTS)
	f) AREA OF PROPOSED BUILDABLE LOTS: 1.32± AC.		2) TOTAL AREA OF RECREATIONAL OPEN SPACE PROVIDED: N/A
	g) AREA OF PROPOSED PUBLIC ROAD RIGHT-OF-WAY: 0.88± AC.		
	h) APPROXIMATE AREA OF LIMIT OF DISTURBANCE: 3.08± AC.		
	i) AREA OF PROPOSED OPEN SPACE LOTS: 2.05± AC.		
	j) AREA OF PROPOSED NON-CREDIT OPEN SPACE: 0.00 AC.		

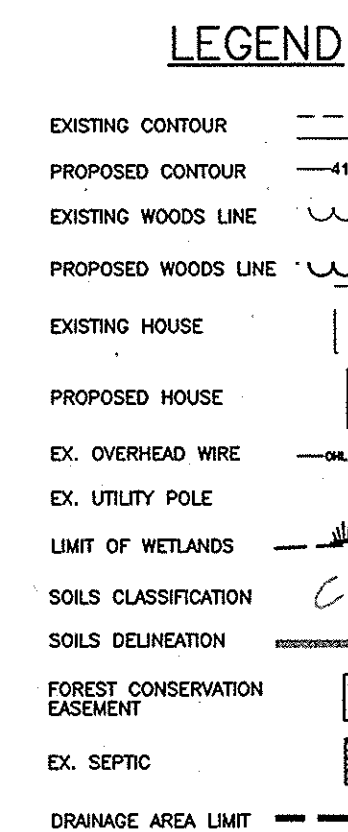

AS-BUILT NOTES:

- HORIZONTAL DATUM FOR THIS AS-BUILT IS BASED ON THE MARYLAND STATE REFERENCE SYSTEM NAD 83/ADJ 91 AS PROJECTED FROM HO. CO. GEODETIC CONTROL STATIONS 31E6 AND 31E7. VERTICAL DATUM FOR THIS AS-BUILT IS NORTH AMERICAN VERTICAL DATUM NVD 29 AS PROJECTED FROM HOWARD COUNTY GEODETIC CONTROL STATIONS #2745004.
- THE INSTRUMENTS USED IN PERFORMING THE AS-BUILT WERE A 5" TOTAL STATION AND PRISM AND RTK GAS.
- THIS AS-BUILT WAS PERFORMED BY BENCHMARK ENGINEERING, INC.

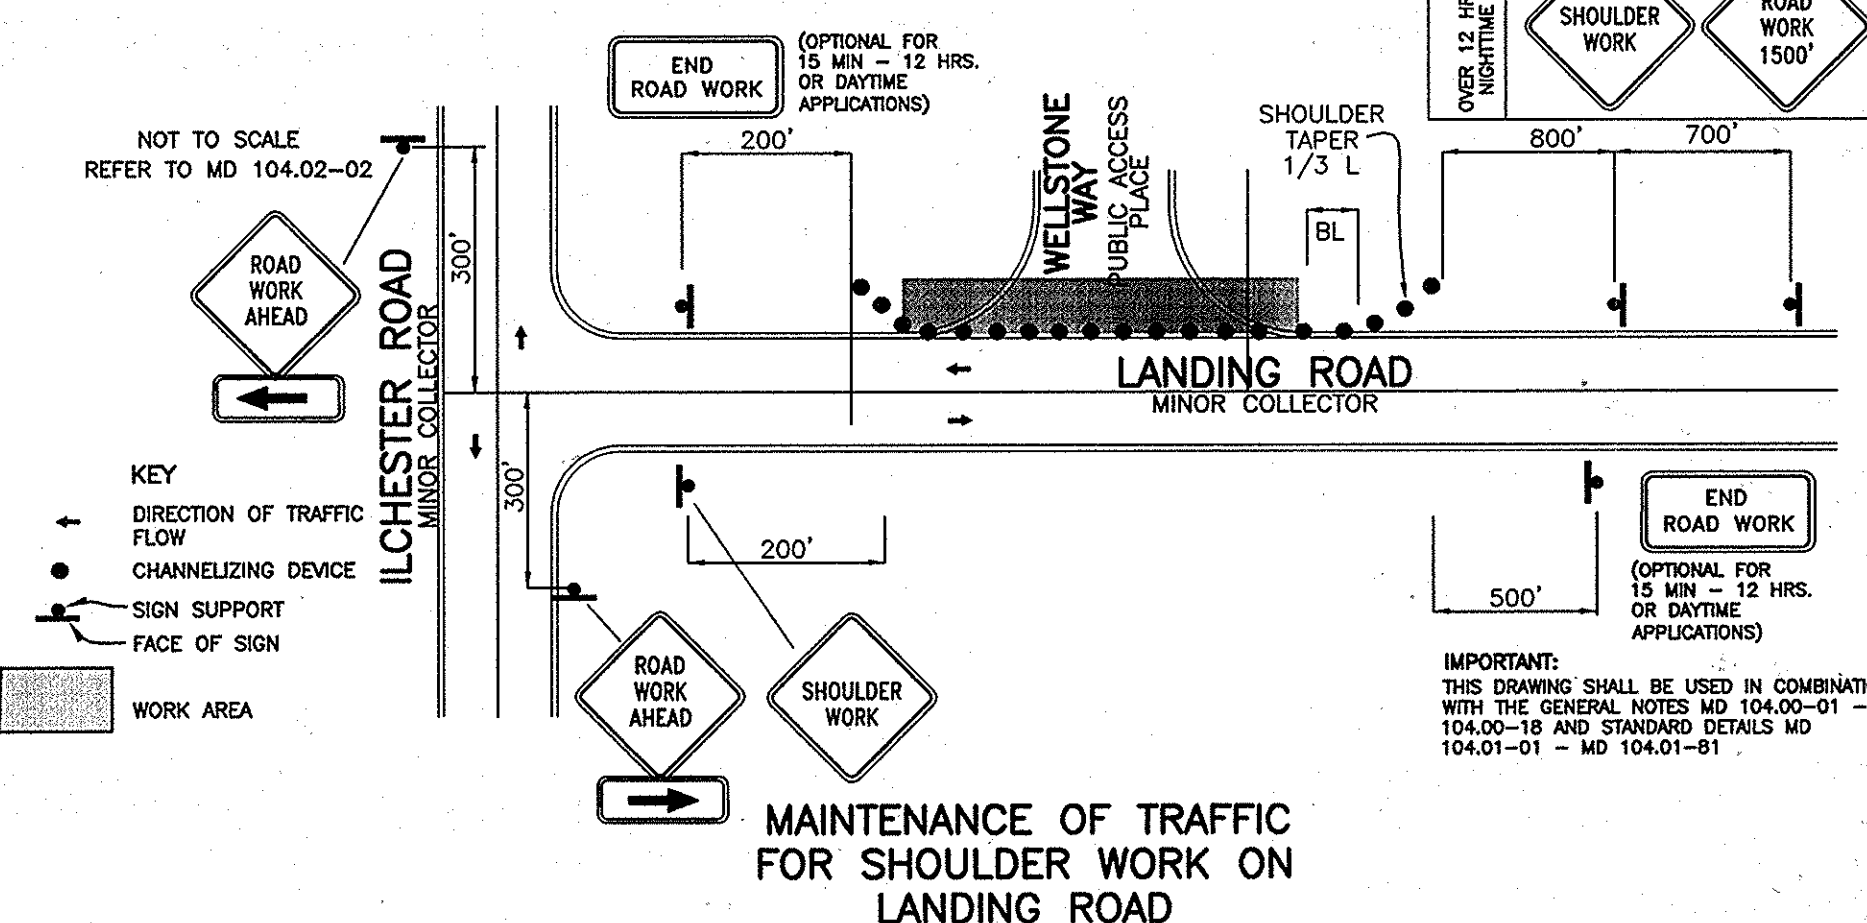

SHEET INDEX

NO.	DESCRIPTION
1	COVER SHEET
2	WELLSTONE WAY, ROAD PLAN AND PROFILES, AND STORM DRAIN PROFILES AND DETAILS
3	MASS GRADING, SEDIMENT & EROSION CONTROL PLAN NOTES AND DETAILS
4	STORMWATER MANAGEMENT PLAN, NOTES, DETAILS AND STORM DRAIN DRAINAGE AREA MAP
5	LANDSCAPE AND STORM DRAIN PLAN, NOTES AND DETAILS
6	FINAL FOREST CONSERVATION PLAN, NOTES AND DETAILS

BENCHMARK ENGINEERING, INC.
ENGINEERS & LAND SURVEYORS & PLANNERS

8480 BALTIMORE NATIONAL PIKE & SUITE 418 A ELLICOTT CITY, MARYLAND 21043
(P) 410-465-8100 (F) 410-465-8644
60 THOMAS JOHNSON DRIVE, FREDERICK, MARYLAND 21702
(P) 301-371-3505 (F) 301-371-3508
WWW.BE-ENGINEERING.COM

Professional Certification. I hereby certify that these documents were prepared or approved by me, and that I am a duly licensed professional engineer under the laws of the State of Maryland.
License No. 21443 Expiration Date: 12-21-16

PROJECT:
CASCADE OVERLOOK, SECTION 4
LOTS 1-7 AND OPEN SPACE LOTS 8 & 9

LOCATION: TAX MAP 31 - GRID 10 - PARCEL 133
ZONE: R-ED 1st ELECTION DISTRICT
HOWARD COUNTY, MARYLAND


TITLE: COVER SHEET

SP-06-012, ECP-11-060, WP-11-183

DATE: FEB 2012 PROJECT NO. 1817
AUG 2012

DESIGN: AM **DRAFT:** AM **CHECK:** CAM **SCALE:** AS SHOWN **SHEET:** 1 OF 6

As-Built
F-12-074

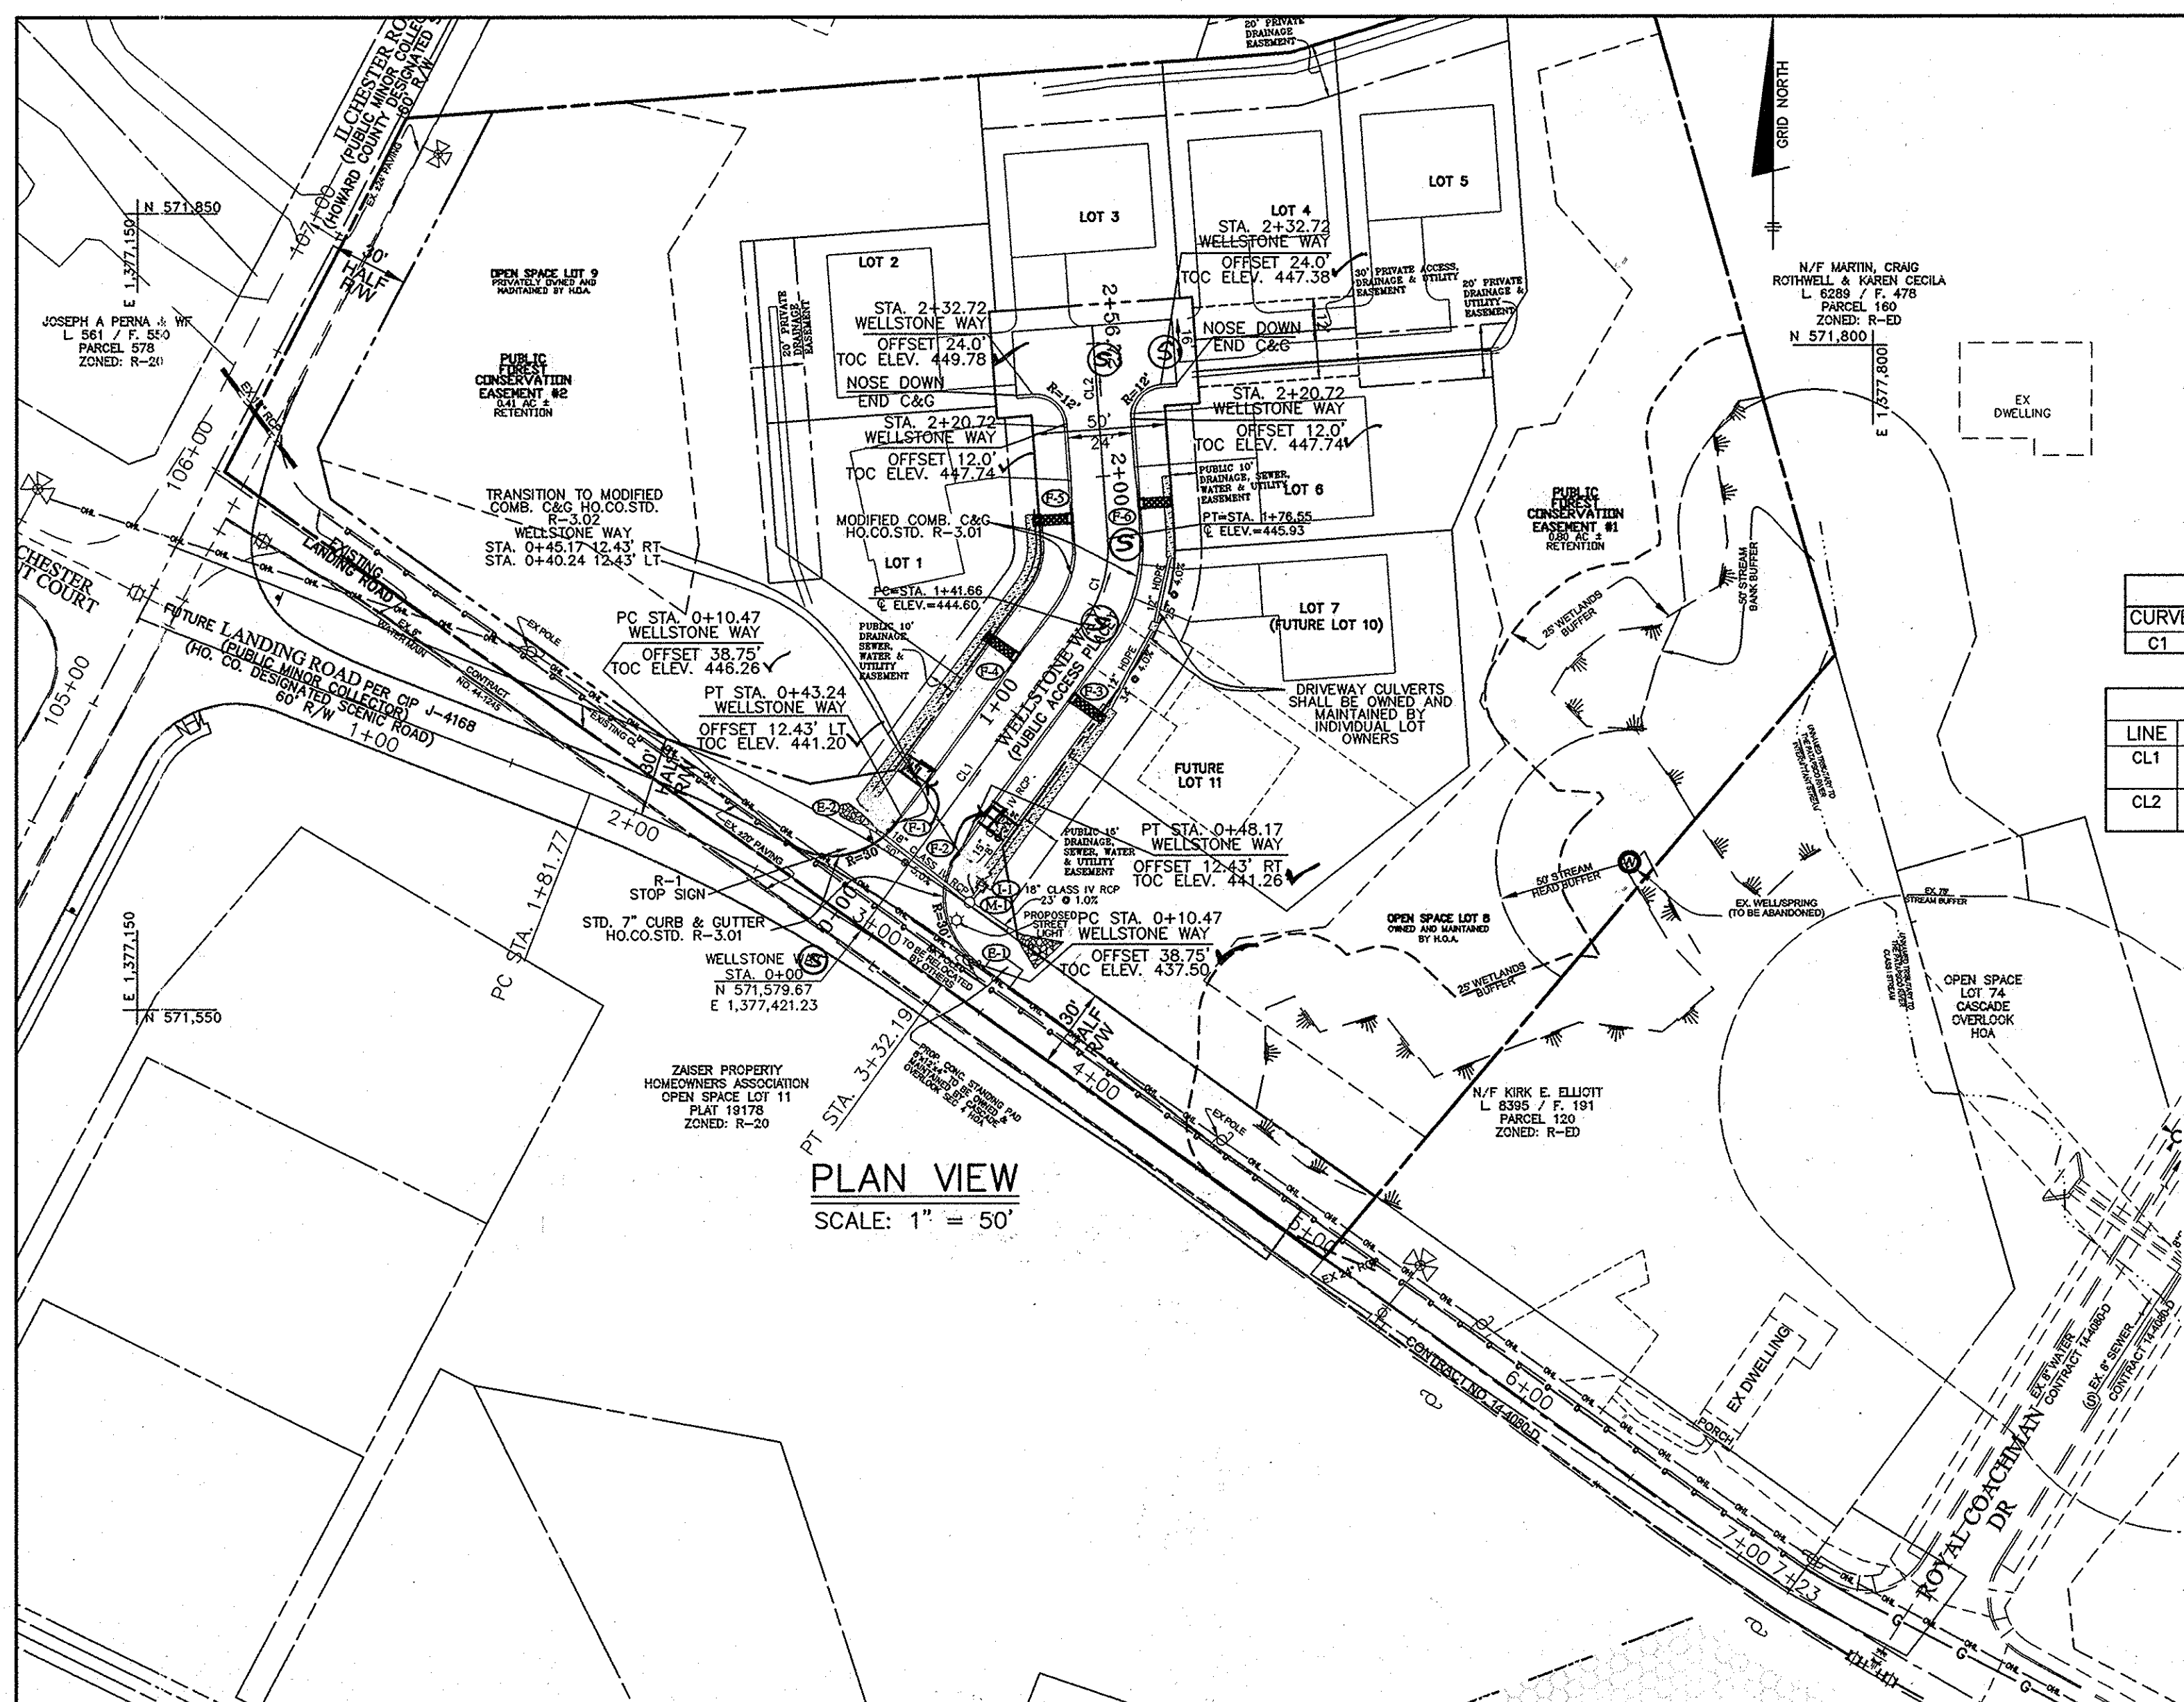

PLAN VIEW
SCALE: 1" = 50'

LEGEND

EXISTING CONTOUR	300	LIMIT OF WETLANDS	---
PROPOSED CONTOUR	412	SOILS CLASSIFICATION	ChB2
EXISTING WOODS LINE	---	SOILS DELINEATION	---
PROPOSED WOODS LINE	---	FOREST CONSERVATION EASEMENT	---
EXISTING HOUSE	---	EX. SEPTIC	---
PROPOSED HOUSE	---	DRAINAGE AREA LIMIT	---
EX. OVERHEAD WIRE	---		
EX. UTILITY POLE	---		

CENTERLINE CONTROL DATA--COORDINATES

DESCRIPTION	STATION	NORTH	EAST
P.O.B.	0+00.00	571579.67	1377421.23
PC C1	1+41.66	571694.58	1377534.08
PT C1	1+76.55	571727.47	1377513.39
P.O.B./END @ PROFILE	2+56.72	571807.43	1377507.53

CENTER LINE CURVE DATA

CURVE	STATION	RADIUS	ARC LENGTH	DELTA	TANGENT	CHORD	
C1	PC=1+41.66	PT=1+76.55	50.00'	34.89'	39°58'42"	18.19'	N15°48'11"E - 34.18'


CENTERLINE CONTROL DATA--BEARINGS

LINE	DESCRIPTION	STATION	LENGTH	BEARING	
CL1	P.O.B. PUBLIC R/W-PC C1	0+00.00	1+41.66	141.66'	N35°47'32"E
CL2	PT C1 - P.O.B. END @ ROAD 'A'	1+76.55	2+56.72	80.17'	N04°11'10"W

STRUCTURE SCHEDULE - FLOW THROUGH INLETS

NO	LOCATION	TOP ELEV.
F-1	CL STA. 0+59.0 WELLSTONE WAY OFFSET 12.57' L	441.98
F-2	CL STA. 0+61.32 WELLSTONE WAY OFFSET 12.61' R	441.70
F-3	CL STA. 1+17.25 WELLSTONE WAY OFFSET 12.43' L	443.8
F-4	CL STA. 1+17.25 WELLSTONE WAY OFFSET 12.43' R	443.8
F-5	CL STA. 1+85.14 WELLSTONE WAY OFFSET 12.43' L	446.5
F-6	CL STA. 1+88.72 WELLSTONE WAY OFFSET 12.43' R	446.6

- STRUCTURE ELEVATION AND LOCATION FOR INLETS IS AT THE TOP OF CURB AT MIDPOINT OF THE INLET.
- TRANSITIONS TO INLETS WILL BE PER HO. CO. R-3.06, REVISED TO MD 620.02 TYPE 'B' CURB (6"), WITH A 3" STRAIGHT CURB AND GUTTER SECTION, AND A 9" TRANSITION LENGTH.
- INLETS SHALL BE MD 374.68, MODIFIED FOR 6" CURBS PER MD 374.55-01.
- FLOW THROUGH CURB INLETS (F) SHALL BE 4' LONG, WITH A 3" OPENING, AND 2" WIDE FROM FACE OF CURB TO REAR INLET LIP.
- EROSION PROTECTION SHALL CONSIST OF CLASS 1 RIPRAP, 18" THICK FROM BACK OF INLET TO BOTTOM OF SWALE.

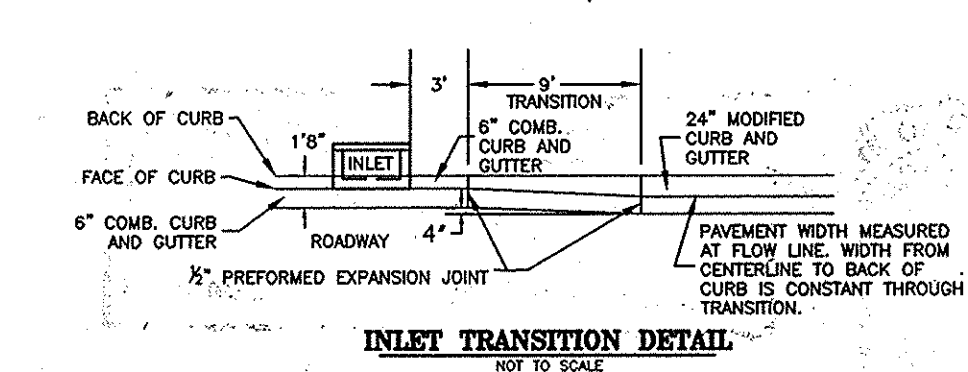

PIPE SCHEDULE


SIZE	LENGTH	TYPE & CLASS	OWNER
15"	9 LF	RCP CLASS IV	PUBLIC
18"	70 LF	RCP CLASS IV	PUBLIC

STREET LIGHT SCHEDULE


SYMBOL	LOCATION	DESCRIPTION
☀	WELLSTONE WAY STA. 0+23.16 - OFFSET 34' RIGHT OF C	100 WATT HPS PREMIER POST-TOP FIXTURE MOUNTED ON A 1 1/2" BLACK FIBERGLASS POLE

STORM DRAIN STRUCTURE SCHEDULE

NO	LOCATION	INV. IN	INV. OUT	TOP ELEV.	HO. CO. STD.	OWNER
I-1	CL STA. 0+38.33 WELLSTONE WAY OFFSET 28.83' R	434.08	434.08	438.70	D-4.10	PUBLIC
M-1	CL STA. 0+29.15 WELLSTONE WAY OFFSET 30.95' R	435.27	435.27	440.28	D-5.11	PUBLIC
E-1	CL STA. 0+28.80 WELLSTONE WAY OFFSET 50.32' R	435.27	435.27	438.54	D-5.51	PUBLIC
E-2	CL STA. 0+36.60 WELLSTONE WAY OFFSET 26.27' R	439.0	439.0	438.64	D-5.51	PUBLIC

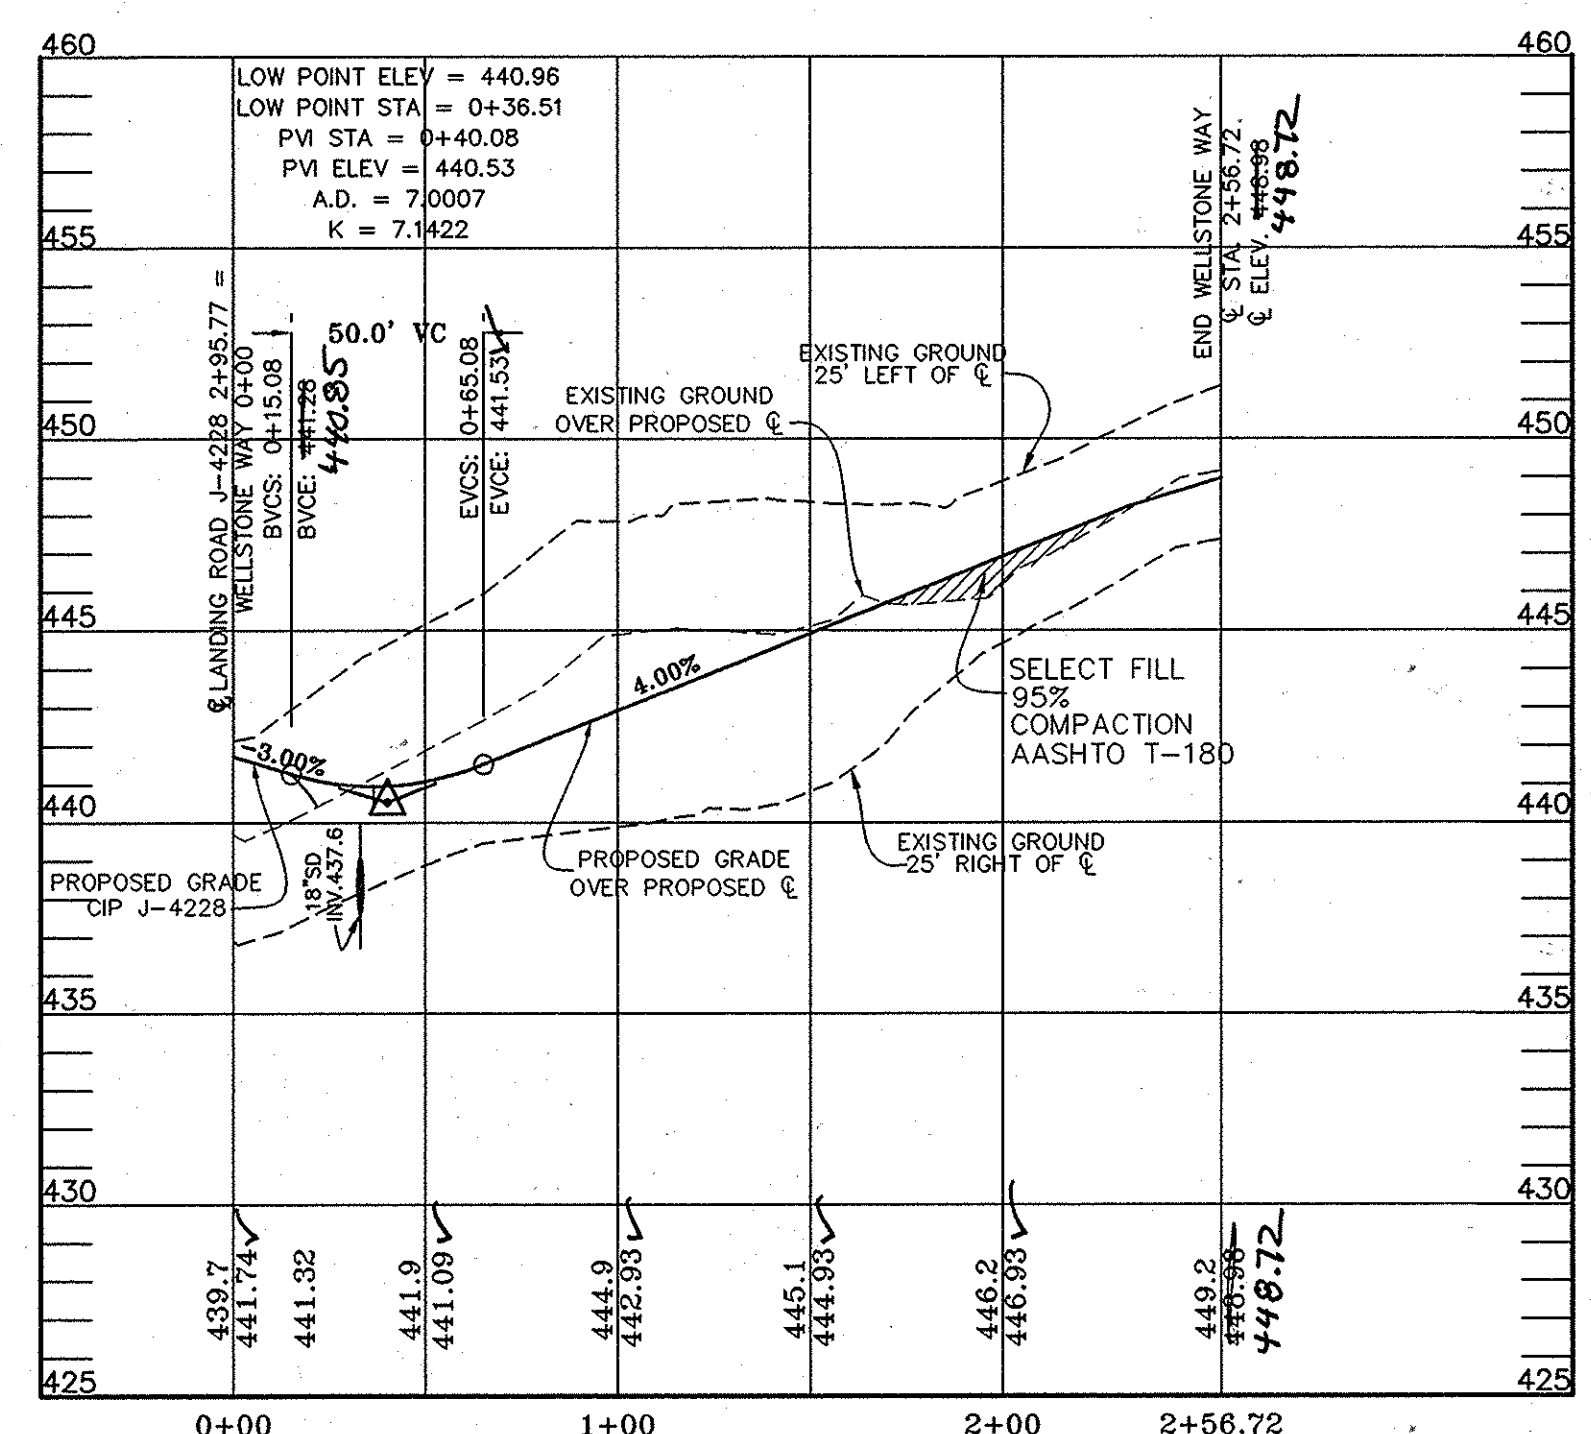


WELLSTONE WAY PROFILE
PUBLIC ACCESS PLACE - DESIGN SPEED 25 MPH
HORIZONTAL SCALE: 1" = 50'
VERTICAL SCALE: 1" = 5'

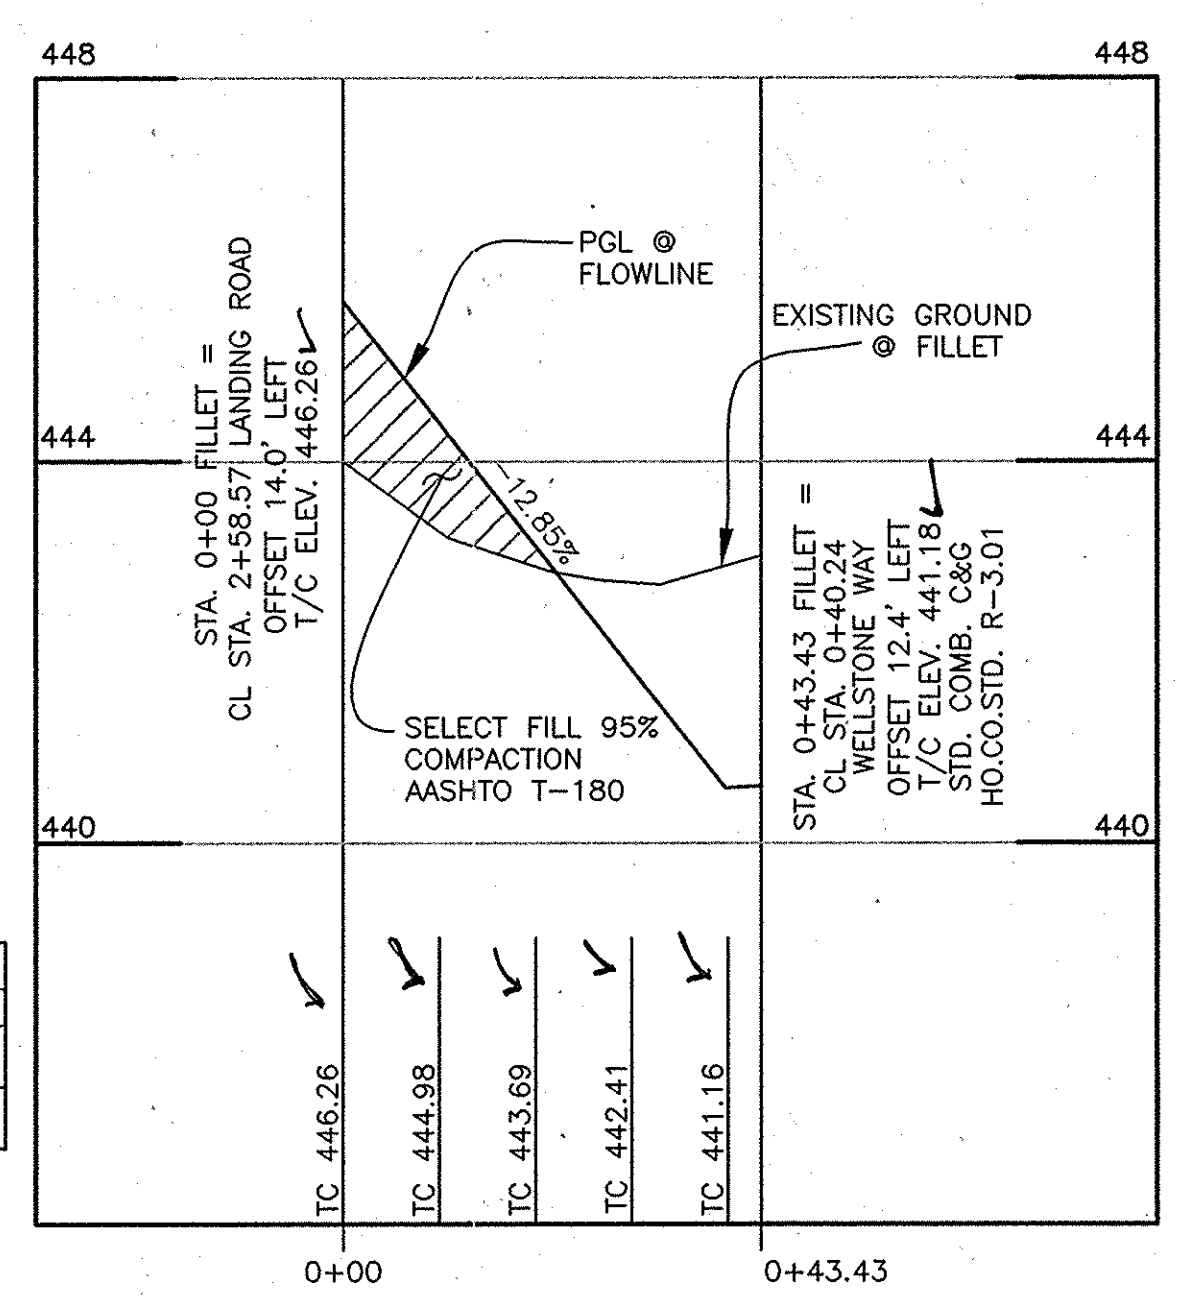


FILLET PROFILE - WEST CORNER
WELLSTONE WAY @ LANDING ROAD

SCALE: 1"=20' HORIZ., 1"=2' VERT.

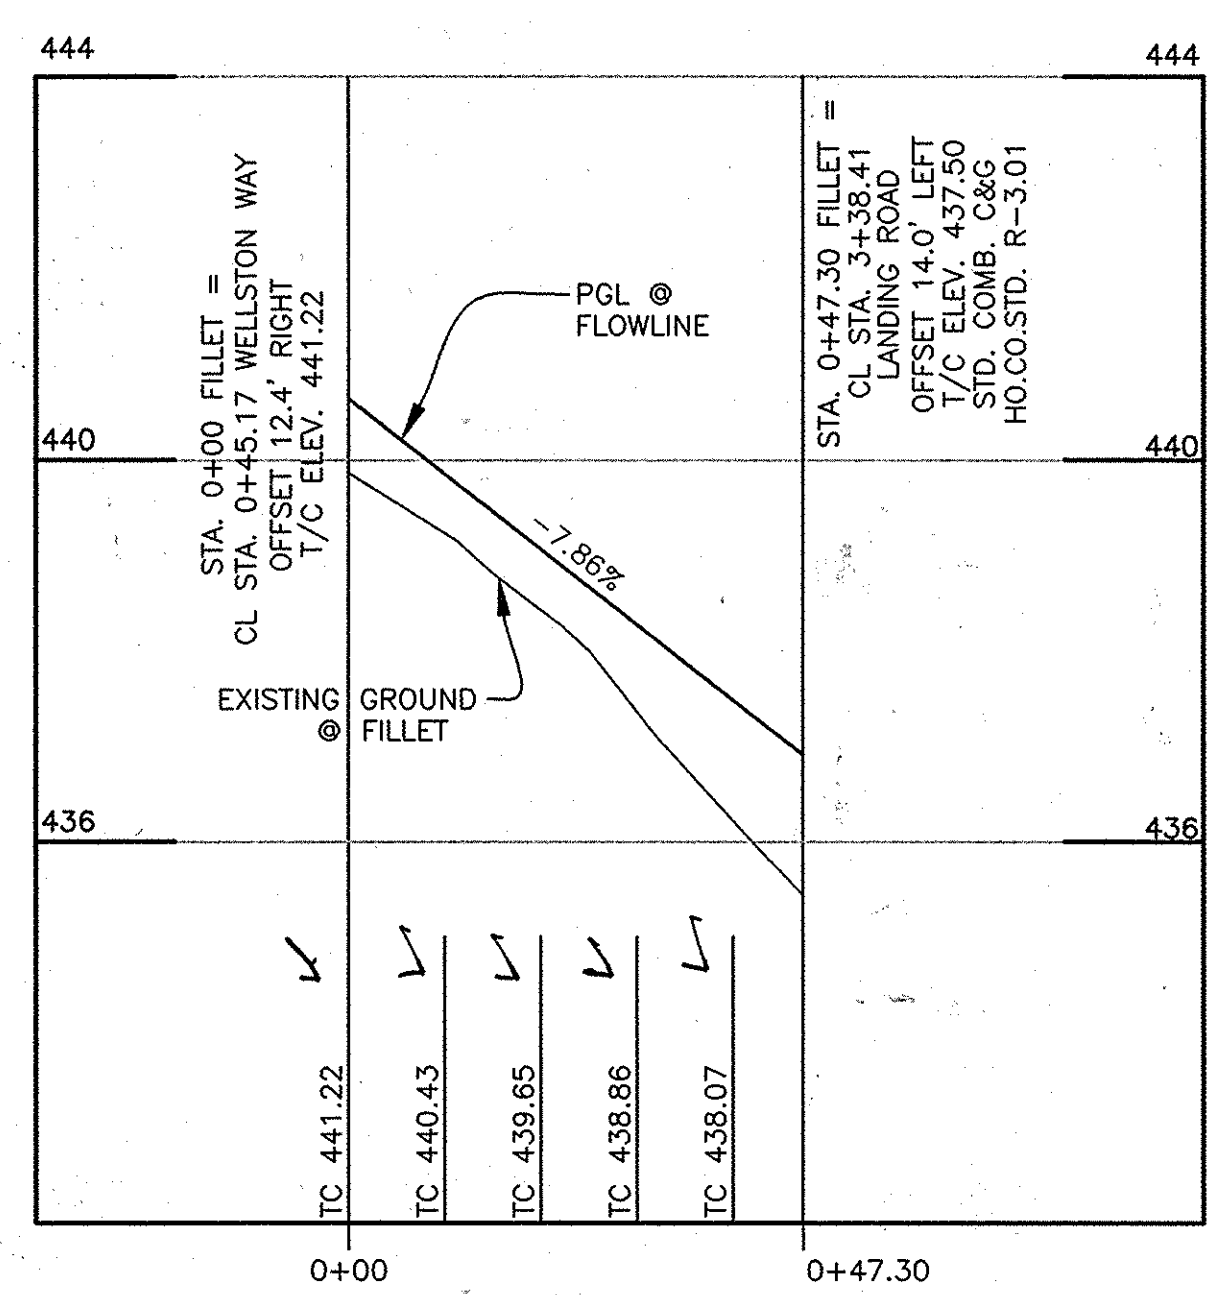


FILLET PROFILE - EAST CORNER
WELLSTONE WAY @ LANDING ROAD

SCALE: 1"=20' HORIZ., 1"=2' VERT.

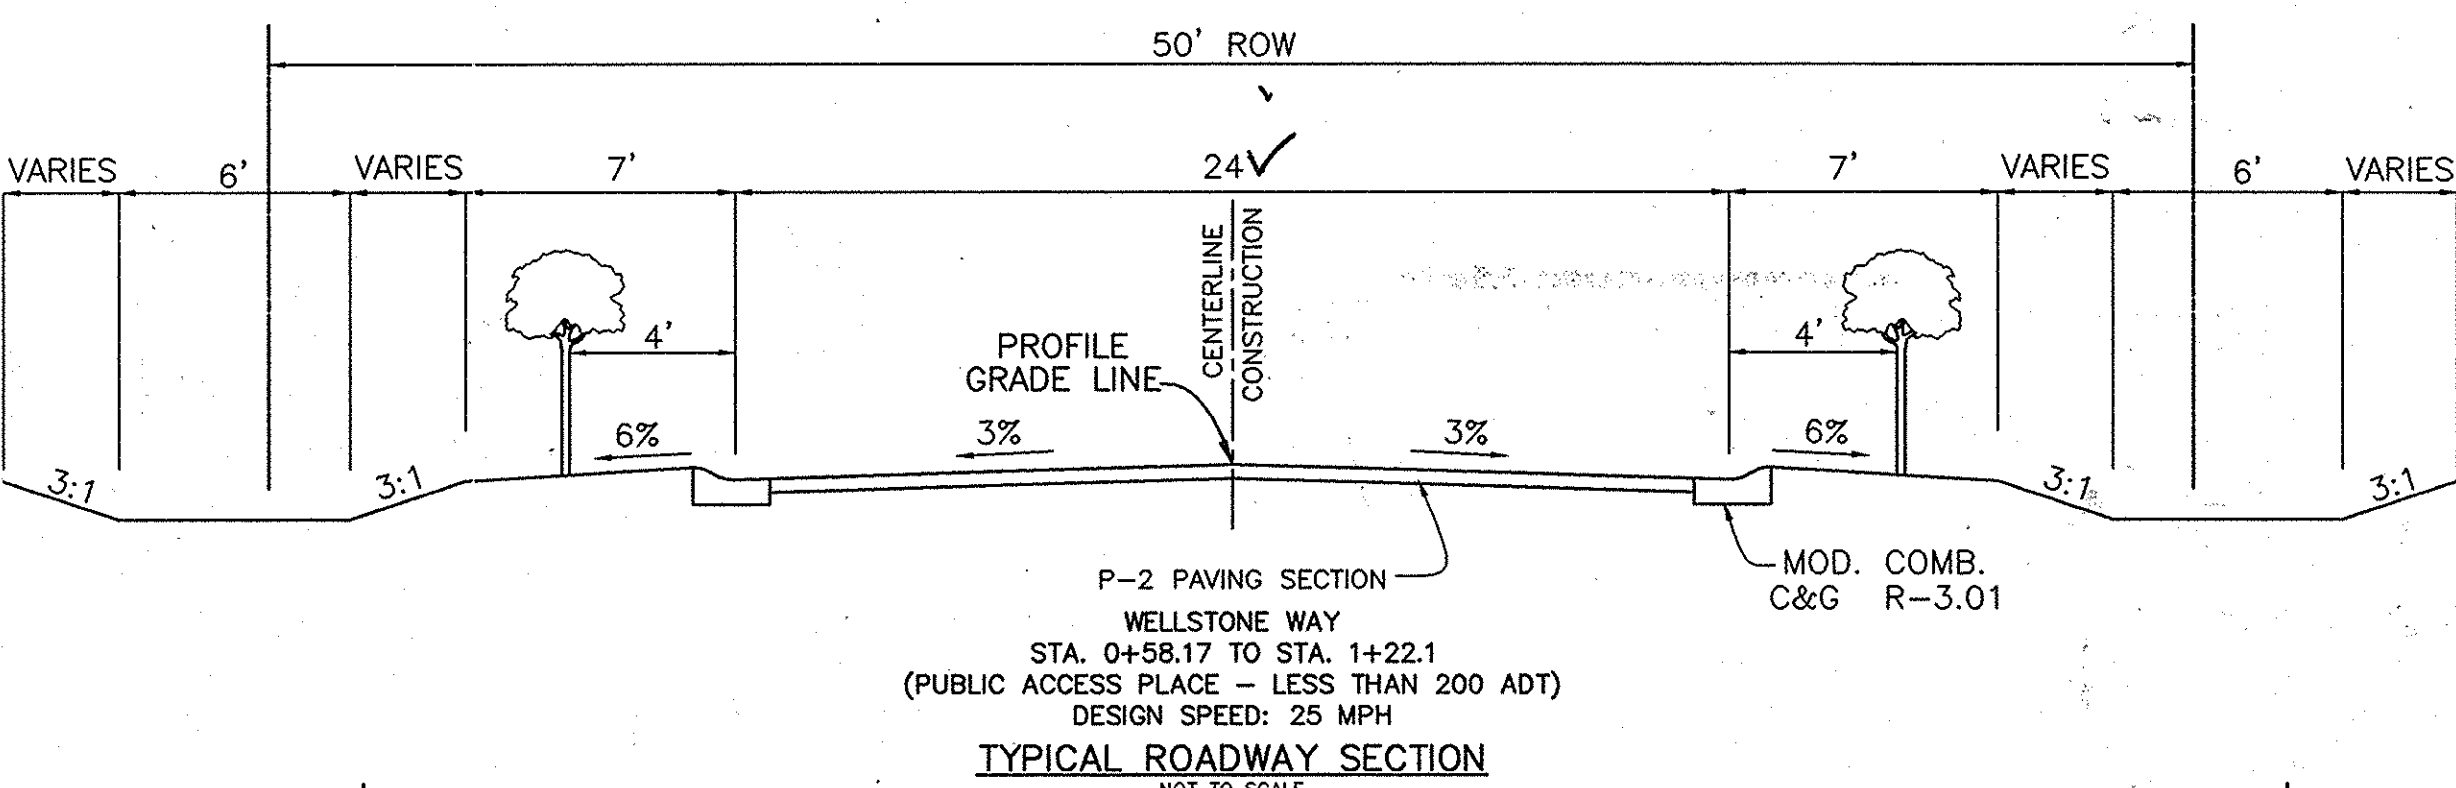


TYPICAL ROADWAY SECTION
NOT TO SCALE

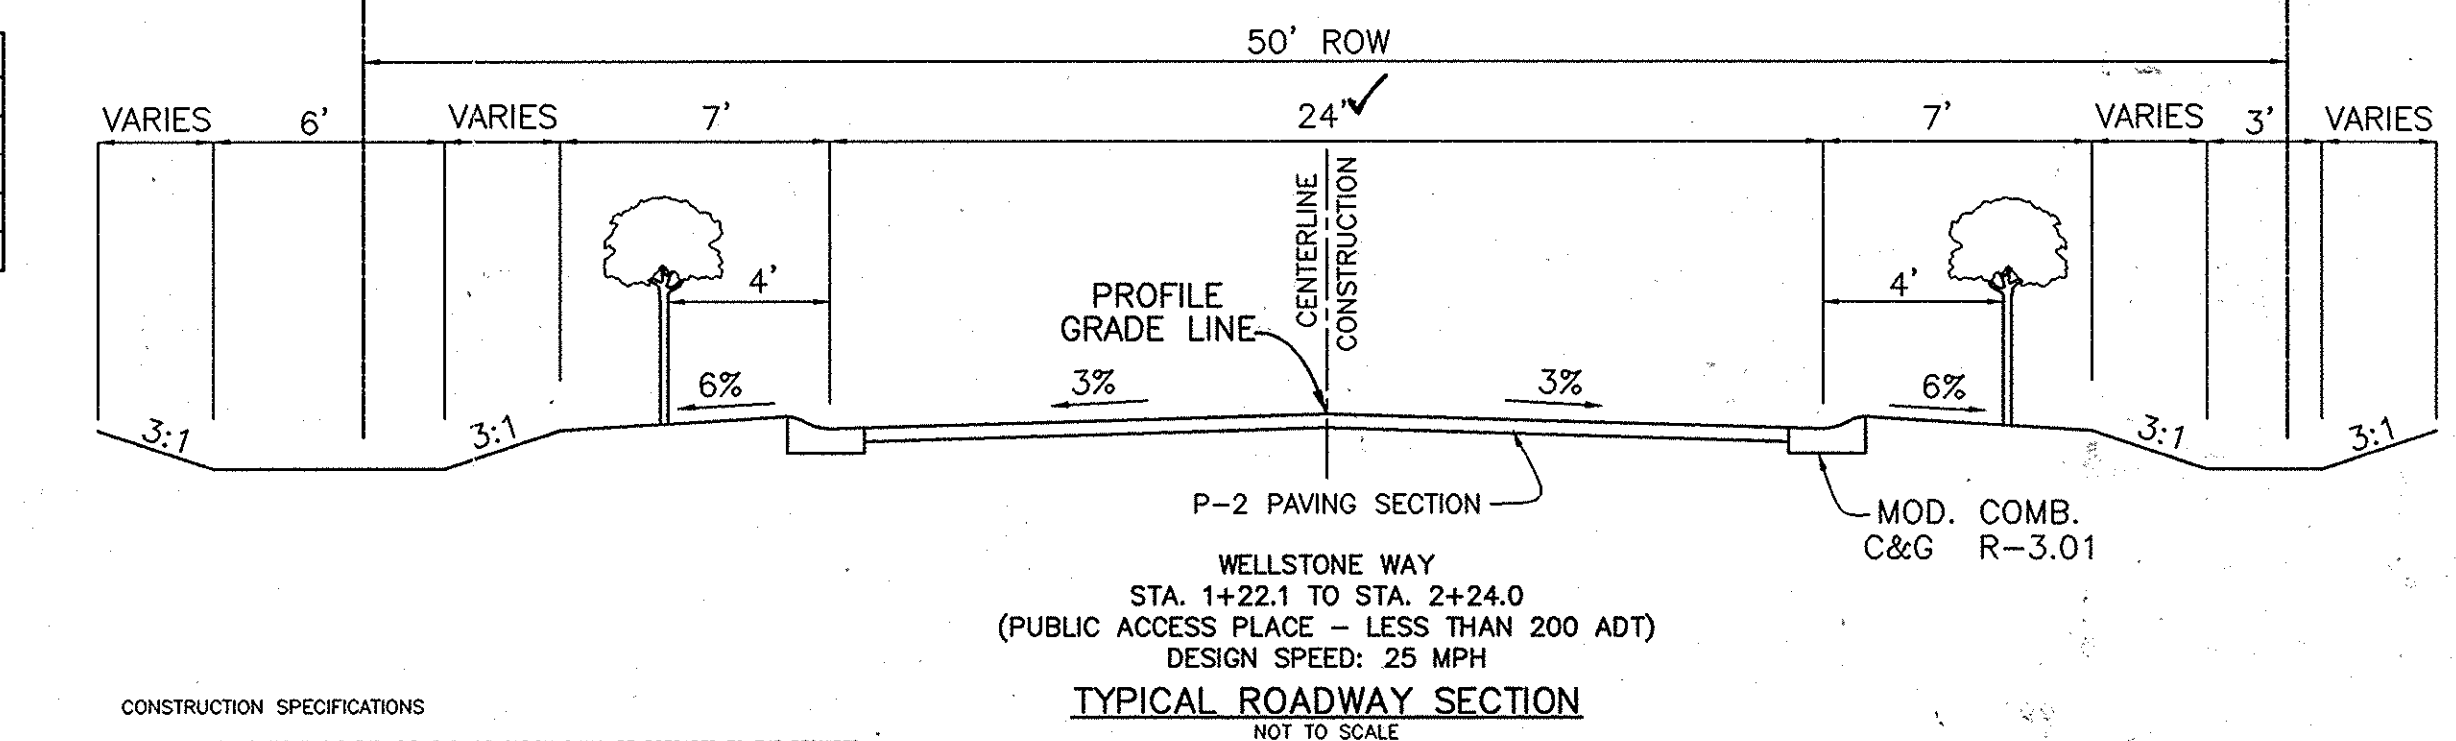


TYPICAL ROADWAY SECTION
NOT TO SCALE

- CONSTRUCTION SPECIFICATIONS**
- THE SURFACE FOR THE FILTER, RIP-RAP, OR GABION SHALL BE PREPARED TO THE REQUIRED LINES AND GRADES AND ANY FILL REQUIRED IN THE SURFACE SHALL BE COMPACTED TO A DENSITY OF APPROXIMATELY THAT OF THE SURROUNDING UNDISTURBED MATERIAL.
 - THE ROCK OR GRAVEL SHALL CONFORM TO THE SPECIFIED GRADING LIMITS WHEN INSTALLED RESPECTIVELY IN THE RIP-RAP OR FILTER.
 - GEOTEXTILE CLASS C&G OR BETTER SHALL BE PROTECTED FROM PUNCHING, CUTTING, OR TEARING. ANY DAMAGE OTHER THAN AN OCCASIONAL SMALL HOLE SHALL BE REPAIRED BY PLACING ANOTHER PIECE OF GEOTEXTILE FABRIC OVER THE DAMAGED PART OR BY COMPLETELY REPLACING THE GEOTEXTILE FABRIC. ALL OVERLAPS WHETHER FOR REPAIRS OR FOR JOINING TWO PIECES OF GEOTEXTILE FABRIC SHALL BE A MINIMUM OF ONE FOOT.
 - A STONE FOR THE RIP-RAP OR GABION OUTLETS MAY BE PLACED BY EQUIPMENT. THEY SHALL BE SUBSTITUTED TO THE FINAL CURVE DIMENSIONS IN THE OPERATION AND IN SUCH A MANNER AS TO AVOID DISPLACEMENT OF UNDERLAYING MATERIALS. THE STONE FOR THE RIP-RAP OR GABION SHALL BE PLACED IN A MANNER THAT WILL ENSURE THAT IT IS REASONABLY HOMOGENEOUS WITH THE SMALLER STONES AND SPALLS FILLING THE Voids BETWEEN THE LARGER STONES. RIP-RAP SHALL BE PLACED IN A MANNER TO PREVENT CHANGE TO THE FILTER EFFICIENCY OF GEOTEXTILE FABRIC. HAND PLACEMENT WILL BE REQUIRED TO THE EXTENT NECESSARY TO PREVENT CHANGE TO THE PERMANENT WORK.
 - THE STONE SHALL BE PLACED SO THAT IT BLENDS IN WITH THE EXISTING GROUND. IF THE STONE IS PLACED TOO HIGH THEN THE FLOW WILL BE FORCED OUT OF THE CHANNEL AND SCOUR ADJACENT TO THE STONE WILL OCCUR.

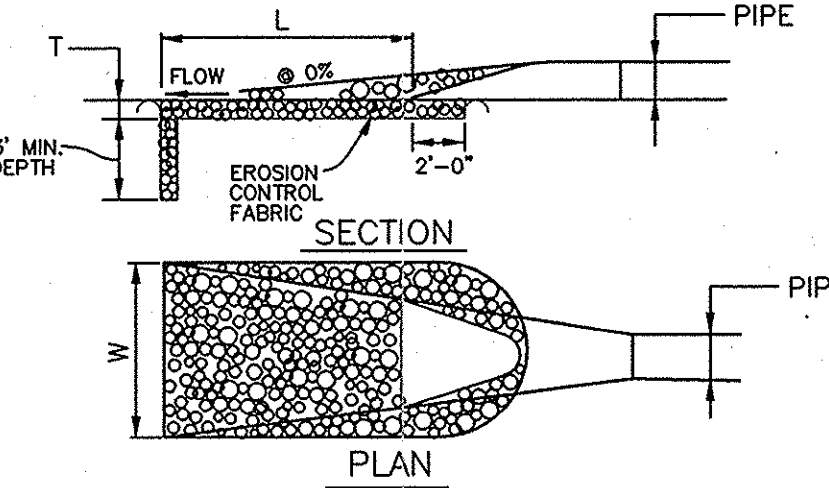

OUTLET PROTECTION DETAIL
NOT TO SCALE

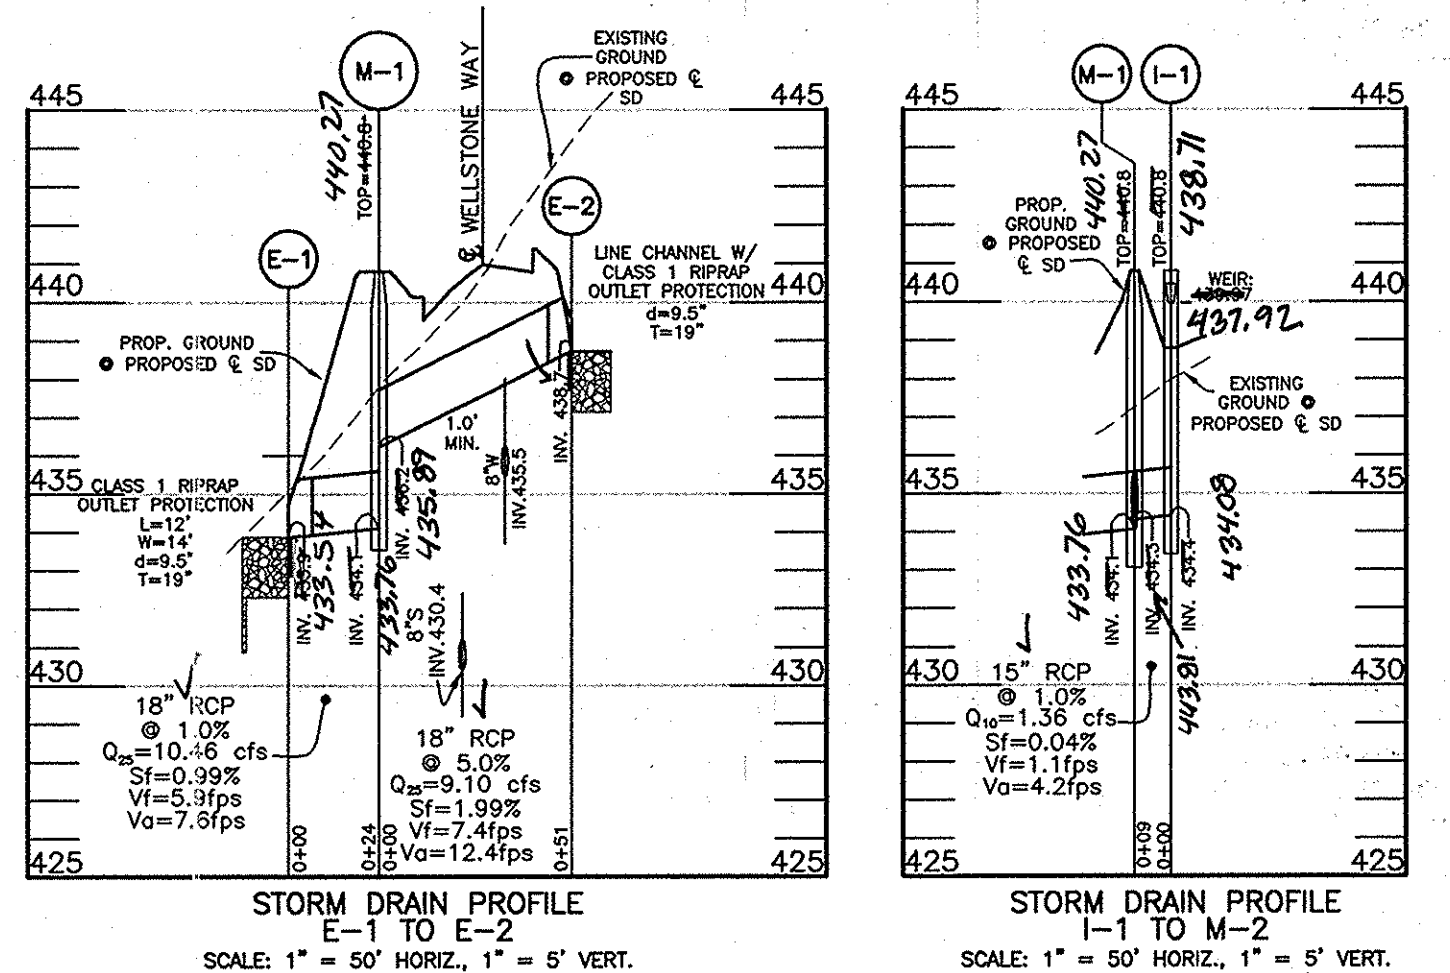

STORM DRAIN PROFILE
SCALE: 1" = 50' HORIZ., 1" = 5' VERT.

SECTION NUMBER ROAD AND STREET CLASSIFICATION CALIFORNIA BEARING RATIO (CBR) 3 TO <5 TO <7 >7

SECTION NUMBER	ROAD AND STREET CLASSIFICATION	PAVEMENT MATERIAL (INCHES)	MIN	HMA WITH GAB	HMA WITH CONSTANT GAB
P-2	PARKING DRIVE AISLES: RESIDENTIAL AND NON-RESIDENTIAL WITH NO MORE THAN 10 HEAVY TRUCKS PER DAY. LOCAL DRIVES: ACCESS PLACE, ACCESS STREET. CUL-DE-SAC: RESIDENTIAL.	HMA SUPERPAVE FINAL SURFACE 9.5 MM PG 64-22, LEVEL 1 (LOW ESAL)	1.5	1.5	1.5
		HMA SUPERPAVE INTERMEDIATE SURFACE 9.5 MM PG 64-22, LEVEL 1 (LOW ESAL)	1.0	1.0	1.0
		HMA SUPERPAVE BASE 19.0 MM PG 64-22, LEVEL 1 (LOW ESAL)	2.0	2.0	2.0
		GRADED AGGREGATE BASE (GAB)	8.0	4.0	4.0

P-2 PAVING DETAIL

APPROVED: HOWARD COUNTY DEPARTMENT OF PUBLIC WORKS
 APPROVED: HOWARD COUNTY DEPARTMENT OF PLANNING AND ZONING

12-13-12
 12-19-12

AS-CULT CERTIFICATION
 I hereby certify, by my seal, that the facilities shown on this plan were constructed as shown on this AS-BUILT plan.
 Donald Mason, P.E. No. 21443 Date 3-20-15



Professional Certification. I hereby certify that these documents were prepared or approved by me, and that I am a duly licensed professional engineer under the laws of the State of Maryland.
 License No. 21443, Expiration Date: 12-21-16

BENCHMARK ENGINEERING, INC.
 8480 BALTIMORE NATIONAL PIKE SUITE 418 ELLICOTT CITY, MARYLAND 21043
 60 THOMAS JOHNSON DRIVE A FREDERICK, MARYLAND 21702

CASCADE OVERLOOK, SECTION 4
 LOTS 1-7 AND OPEN SPACE LOTS 8 & 9


LOCATION: TAX MAP 31 - GRID 10" - PARCEL 133
 ZONE: R-ED 1ST ELECTION DISTRICT
 HOWARD COUNTY, MARYLAND

TITLE: WELLSTONE WAY ROAD PLAN AND PROFILES, AND STORM DRAIN PROFILES AND DETAILS



DATE: FEB 2012
 NOV 2012

PROJECT NO. 1817

DESIGN: AM DRAFT: AM CHECK: CAM SCALE: AS SHOWN SHEET 2 OF 6

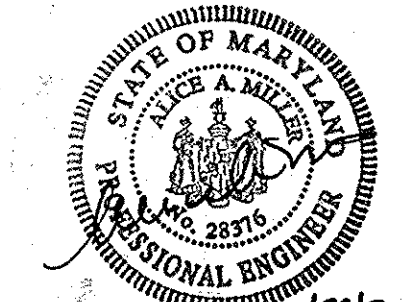

Professional Certification. I hereby certify that these documents were prepared or approved by me, and that I am a duly licensed professional engineer under the laws of the State of Maryland, License No. 28376, Expiration Date: 01-01-2013.

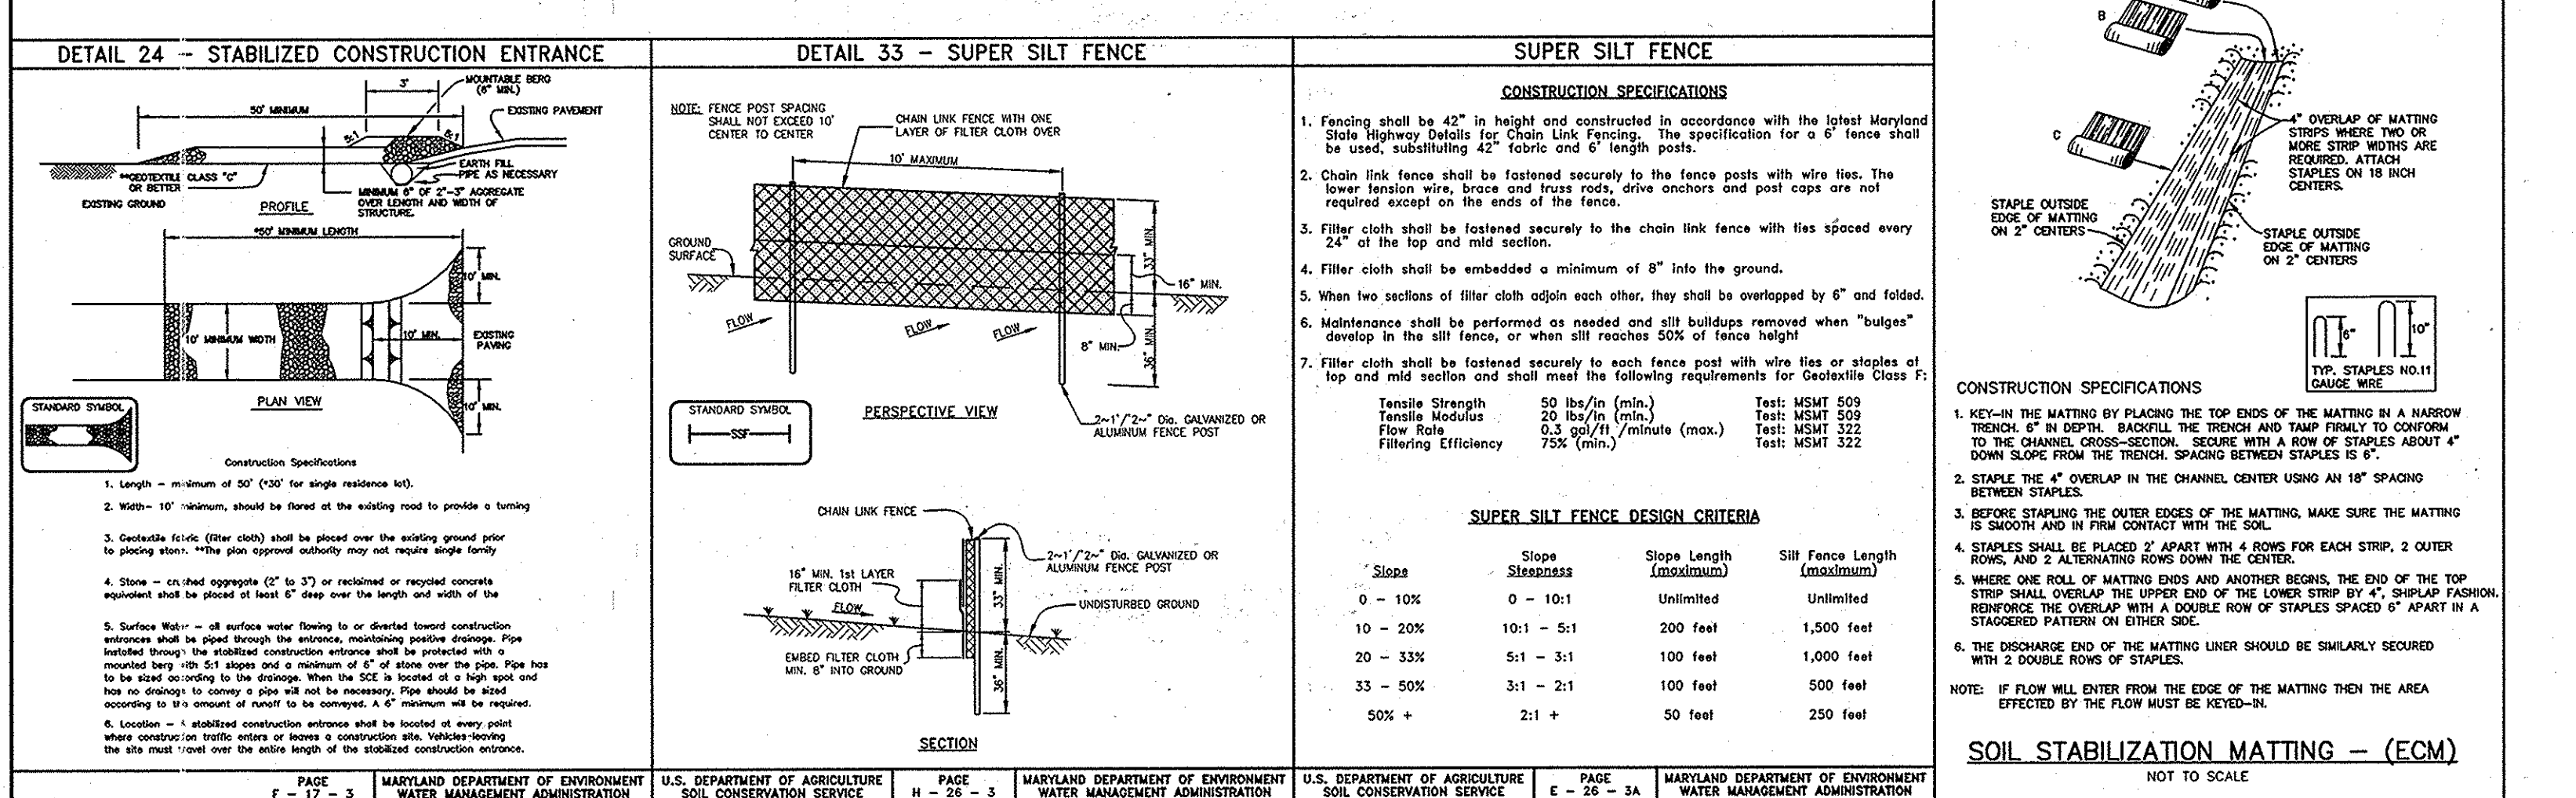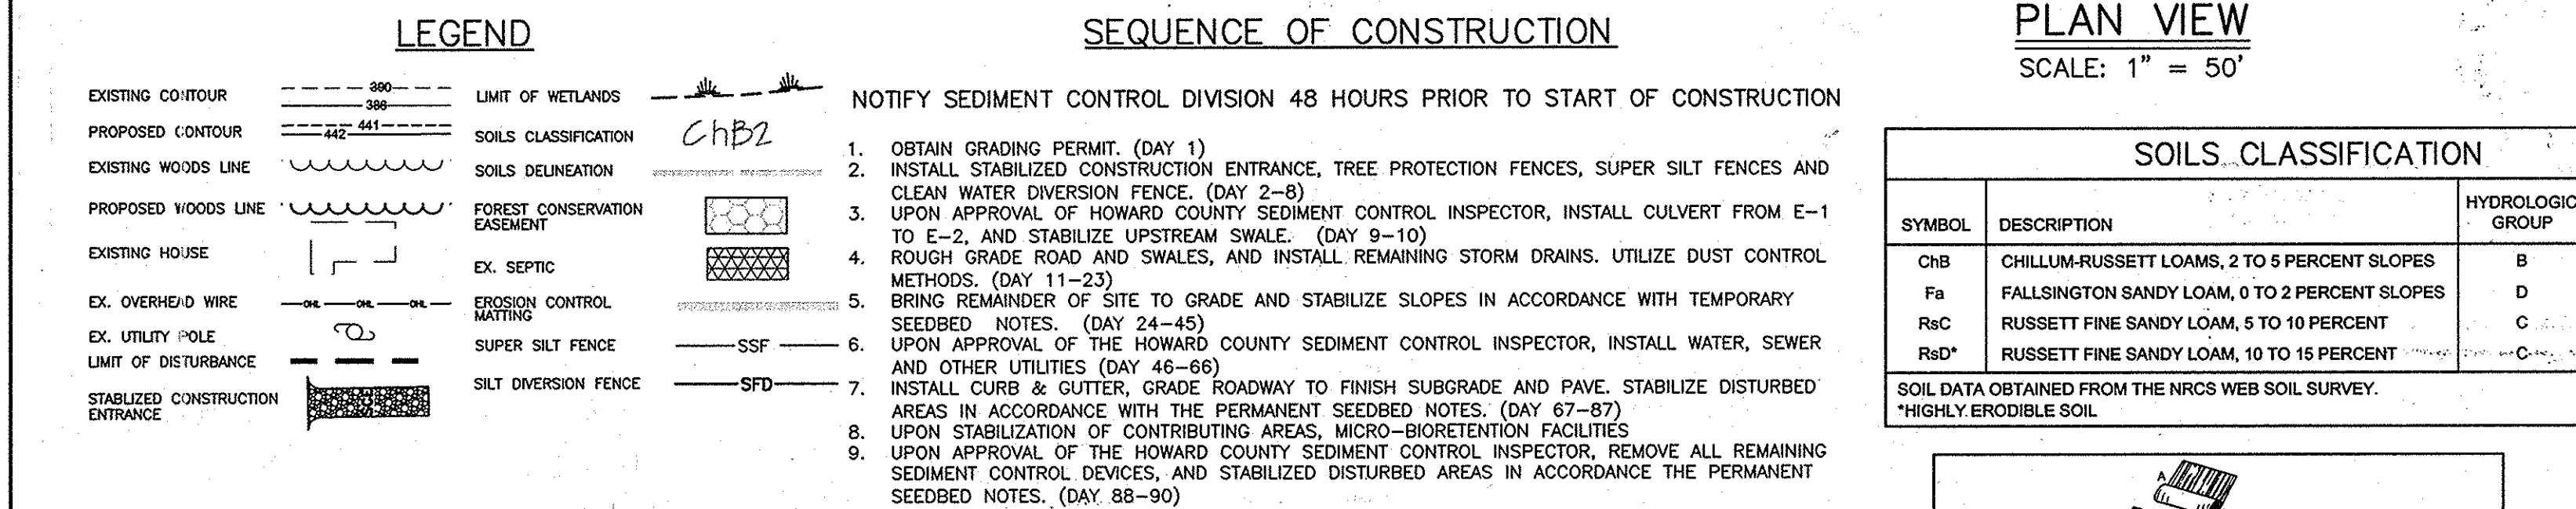

SEDIMENT CONTROL NOTES

- A MINIMUM OF 24 HOURS NOTICE MUST BE GIVEN TO THE HOWARD COUNTY DEPARTMENT OF INSPECTION, LICENSING AND PERMITS, SEDIMENT CONTROL DIVISION PRIOR TO THE START OF ANY CONSTRUCTION, (313-1850).
- ALL VEGETATIVE AND STRUCTURAL PRACTICES ARE TO BE INSTALLED ACCORDING TO THE PROVISIONS OF THIS PLAN AND ARE TO BE IN CONFORMANCE WITH THE MOST CURRENT MARYLAND STANDARDS AND SPECIFICATIONS FOR SOIL EROSION AND SEDIMENT CONTROL, REVISIONS THERE TO.
- FOLLOWING INITIAL SOIL DISTURBANCE OR REDISTURBANCE, PERMANENT OR TEMPORARY STABILIZATION SHALL BE COMPLETED WITHIN 7 CALENDAR DAYS FOR ALL PERIMETER SEDIMENT CONTROL STRUCTURES, DICES, PERIMETER SLOPES AND ALL SLOPES GREATER THAN 3:1 (D) 14 DAYS AS TO ANY OTHER DISTURBED OR GRADED AREAS ON THE PROJECT SITE.
- ALL SEDIMENT TRAPS/BASINS SHOWN MUST BE FENCED AND WARNING SIGNS POSTED AROUND THEIR PERIMETER IN ACCORDANCE WITH VOL. 1, CHAPTER 12, OF THE HOWARD COUNTY PERMANENT STORM DRAINAGE.
- ALL DISTURBED AREAS MUST BE STABILIZED WITHIN THE TIME PERIOD SPECIFIED ABOVE IN ACCORDANCE WITH THE 1994 MARYLAND STANDARDS AND SPECIFICATIONS FOR SOIL EROSION AND SEDIMENT CONTROL FOR PERMANENT SEEDINGS (SEC. 51) 500 (SEC. 54), TEMPORARY SEEDING (SEC. 50) AND MULCHING (SEC. 52), TEMPORARY STABILIZATION WITH MULCH ALONG CAN CHAIN LINK FENCE WHEN RECOMMENDED SEEDING DATES DO NOT ALLOW FOR PROPER GERMINATION AND ESTABLISHMENT OF GRASSES.
- ALL SEDIMENT CONTROL STRUCTURES ARE TO REMAIN IN PLACE AND ARE TO BE MAINTAINED IN OPERATIVE CONDITION UNTIL PERMISSION FOR THEIR REMOVAL HAS BEEN OBTAINED FROM THE HOWARD COUNTY SEDIMENT CONTROL INSPECTOR.


TEMPORARY SEEDBED PREPARATIONS

- APPLY TO GRADED OR CLEARED AREAS LIKELY TO BE REDISTURBED WHERE A SHORT-TERM VEGETATIVE COVER IS NEEDED.
- SEEDBED PREPARATION: LOOSEN UPPER THREE INCHES OF SOIL BY RAKING, DISING OR OTHER ACCEPTABLE MEANS BEFORE SEEDING, IF NOT PREVIOUSLY LOOSENED.
- SOIL AMENDMENTS: APPLY 600 LBS PER ACRE 10-10-10 FERTILIZER (14 LBS/1000 SQ FT).
- SEEDING: FOR PERIOD MARCH 1 THROUGH APRIL 30 AND FROM AUGUST 15 THROUGH NOVEMBER 15, SEED WITH 2-1/2 BUSHELS PER ACRE OF ANNUAL RYE (3.2 LBS/1000 SQ FT) FOR THE PERIOD MAY 1 THROUGH AUGUST 14, SEED WITH 3 LBS PER ACRE OF PERENNIAL BROMEGRASS (0.7 LBS/1000 SQ FT) FOR THE PERIOD NOVEMBER 16 THROUGH FEBRUARY 28, PROTECT SITE BY APPLYING 2 TONS PER ACRE OF WELL ANCHORED STRAW MULCH AND SEED AS SOON AS POSSIBLE IN THE SPRING, OR USE SOO.
- MULCHING: APPLY 1-1/2 TO 2 TONS PER ACRE (70 TO 90 LBS/1000 SQ FT) OF UNROTTED SMALL GRAM STRAW IMMEDIATELY AFTER SEEDING, ANCHOR MULCH IMMEDIATELY AFTER APPLICATION USING MULCH ANCHORING TOOL OR 218 GALLONS PER ACRE (6 GAL/1000 SQ FT) OF ENHANCED ASPHALT ON FLAT AREAS, ON SLOPES, 8 FT. OR HIGHER, USE 348 GALLONS PER ACRE (6 GAL/1000 SQ FT) FOR ANCHORING.
- REFER TO THE 1994 MARYLAND STANDARDS AND SPECIFICATIONS FOR SOIL EROSION AND SEDIMENT CONTROL FOR RATE AND METHODS NOT COVERED.

SOILS CLASSIFICATION

SYMBOL	DESCRIPTION	HYDROLOGIC GROUP
ChB	CHILLUM-RUSSETT LOAMS, 2 TO 5 PERCENT SLOPES	B
FaC	FALLSINGTON SANDY LOAM, 0 TO 2 PERCENT SLOPES	D
RaC	RUSSETT FINE SANDY LOAM, 5 TO 10 PERCENT SLOPES	C
RaD	RUSSETT FINE SANDY LOAM, 10 TO 15 PERCENT SLOPES	C

SOIL DATA OBTAINED FROM THE NRCS WEB SOIL SURVEY.
*HIGHLY ERODIBLE SOIL

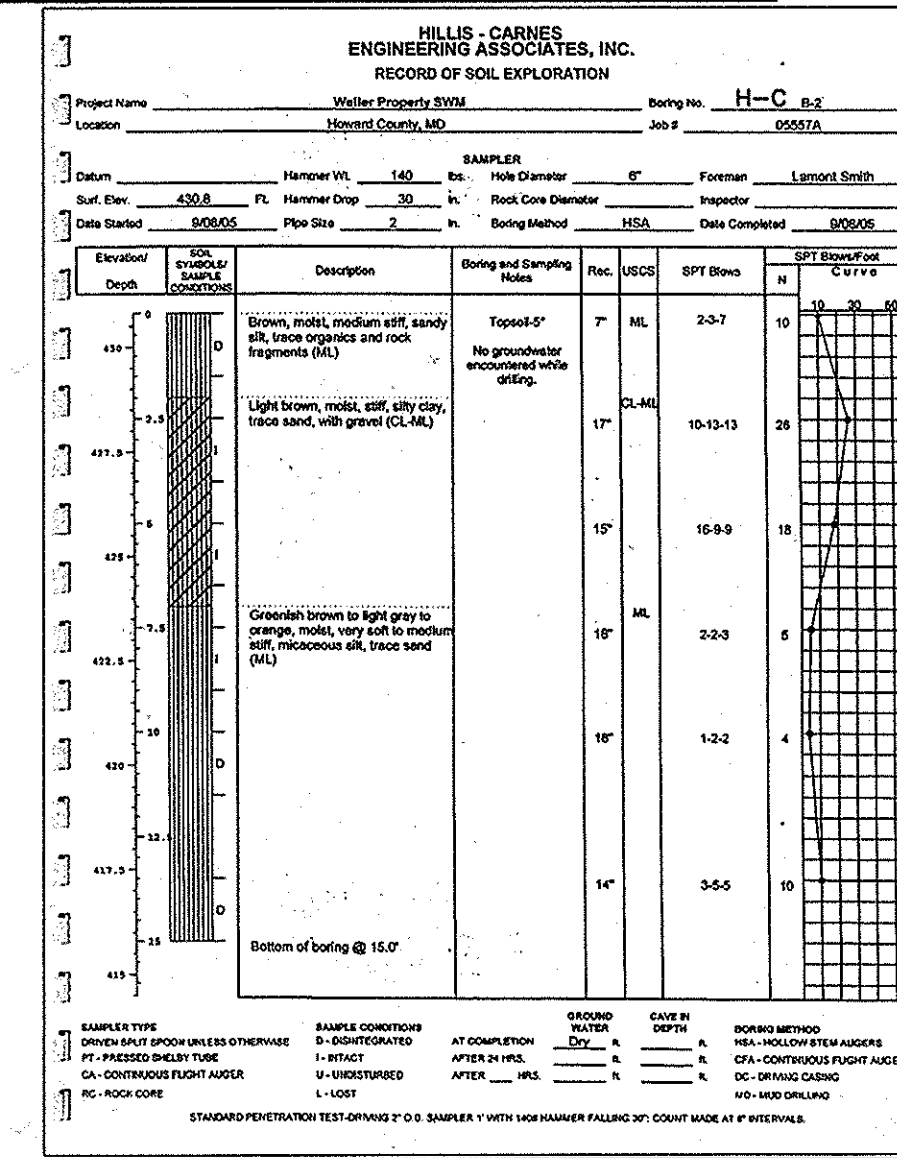

TOPSOIL SPECIFICATIONS


- Topsoil salvaged from the existing site may be used provided that it meets the standards set forth in these specifications. Typically, the depth of topsoil to be salvaged for a given use shall be found in the representative soil profile section in the Soil Survey published by USDA-SCS in cooperation with Maryland Agricultural Experiment Station.
- Topsoil Specifications - Soil to be used as topsoil must meet the following:
 - Topsoil shall be a loam, sandy loam, clay loam, silt loam, sandy clay loam, loamy sand. Other soils may be used if recommended by an agronomist or soil scientist and approved by the appropriate approval authority. Regardless, topsoil shall not be a mixture of contrasting texture subsoils and shall contain less than 5% by volume of cinders, rocks, roots, twigs, sticks, rocks, trash, or other materials larger than 1-1/2\"/>
- When the subsoil is either highly acidic or composed of heavy clay, ground limestone shall be applied at the rate of 4-6 tons/acre (200-300 pounds per 1,000 square feet) prior to the placement of topsoil. Lime shall be distributed uniformly over designated areas and worked into soil in conjunction with tillage operations as described in the following procedures.
 - Topsoil must be free of plants or plant parts such as Bermuda grass, quack grass, Johnson grass, nutgrass, poison ivy, thistle, or others as specified.
 - Where the subsoil is either highly acidic or composed of heavy clay, ground limestone shall be applied at the rate of 4-6 tons/acre (200-300 pounds per 1,000 square feet) prior to the placement of topsoil. Lime shall be distributed uniformly over designated areas and worked into soil in conjunction with tillage operations as described in the following procedures.
- For sites having disturbed areas under 5 acres:
 - Place topsoil (if required) and apply soil amendments as specified in 2.0.0. Vegetative Stabilization - Section 1 - Vegetative Stabilization Methods and Materials.
- For sites having disturbed areas over 5 acres:
 - On soil meeting Topsoil specifications, obtain test results dictating fertilizer and lime amendments required to bring the soil into compliance with the following:
 - pH for topsoil shall be between 6.0 and 7.5. If the tested soil demonstrates a pH of less than 6.0, sufficient lime shall be prescribed to raise the pH to 6.5 or higher.
 - Organic content or topsoil shall be not less than 1.5 percent by weight.
 - Topsoil having soluble salt content greater than 500 parts per million shall not be used.
 - No sod or seed shall be placed on soil which has been treated with soil stabilizers or chemicals used for weed control until sufficient time has elapsed (14 days minimum) to permit germination of sprout-forming materials.

PERMANENT SEEDBED PREPARATIONS

- When topsoiling, maintain needed erosion and sediment control practices such as diversions, grade stabilization structures, earth dikes, slope silt fence and sediment traps and basins.
- Grades on the area to be topsoiled, which have been previously established, shall be maintained, shall 4\"/>

SOIL STABILIZATION MATTING - (FCM)

NOT TO SCALE

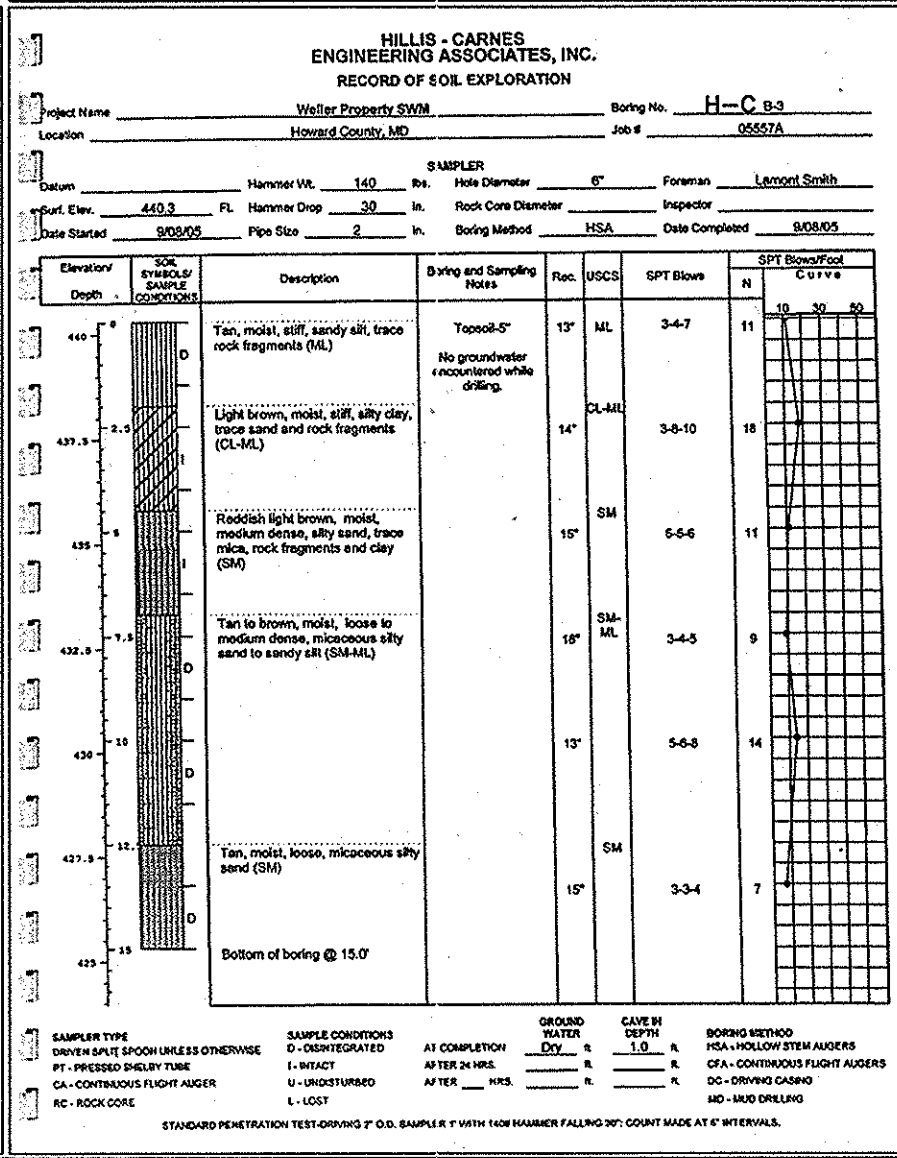

30.0 DUST CONTROL

- Controlling dust blowing and movement on construction sites and roads.
- Purpose:** To prevent blowing and movement of dust from exposed soil surfaces, reduce on and off-site damage, health hazards, and improve traffic safety.
- Conditions Where Practice Applies:** This practice is applicable to areas subject to dust blowing and movement where on and off-site damage is likely without treatment.
- Specifications:**
- Mulches - See standards for vegetative stabilization with mulches only. Mulch should be crimped or knotted to prevent blowing.
 - Vegetative Cover - See standards for temporary vegetative cover.
 - Tillage - To roughen surface and bring clods to the surface. This is an emergency measure which should be used before soil blowing starts. Begin plowing on windward side of site. Chisel-type plows spaced about 12\"/>
- Permanent Methods:**
- Permanent Vegetation - See standards for permanent vegetative cover, and permanent stabilization with sod. Seeding trees or large shrubs may offer valuable protection if left in place.
 - Topsoiling - Covering with less erodible soil materials. See standards for topsoiling.
 - Stone - Cover surface with crushed stone or coarse gravel.
- References:**
- Agriculture Handbook 346. Wind Erosion Forces in the United States and Their Use in Predicting Soil Loss.
 - Agriculture Information Bulletin 354. How to Control Wind Erosion. USDA-ARS.

NO AS-BUILT INFORMATION IS REQUIRED ON THIS SHEET

ENGINEER'S CERTIFICATE

I HEREBY CERTIFY THAT THIS PLAN FOR SEDIMENT AND EROSION CONTROL REPRESENTS A PRACTICAL AND WORKABLE PLAN BASED ON MY PERSONAL KNOWLEDGE OF THE SITE CONDITIONS AND THAT IT WAS PREPARED IN ACCORDANCE WITH THE REQUIREMENTS OF THE HOWARD COUNTY DEPARTMENT OF PLANNING AND ZONING.

William D. 28376 11/28/12
ENGINEER DATE

DEVELOPER'S CERTIFICATE

I/WE CERTIFY THAT ALL DEVELOPMENT AND CONSTRUCTION WILL BE DONE ACCORDING TO THIS PLAN OF DEVELOPMENT FOR SEDIMENT AND EROSION CONTROL AND THAT ALL RESPONSIBLE PERSONNEL INVOLVED IN THE CONSTRUCTION PROJECT WILL HAVE A CERTIFICATE OF ATTENDANCE AT A DEPARTMENT OF THE ENVIRONMENT APPROVED TRAINING PROGRAM FOR THE CONTROL OF SEDIMENT AND EROSION BEFORE BEGINNING THE PROJECT. I ALSO AUTHORIZE INSPECTION ON-SITE IN ACCORDANCE WITH THE LAWS OF THE STATE OF MARYLAND.

Cascade Walthur, LLC
Steve R. Besson James R. Manley, III 11/28/12
DEVELOPER DATE

REVIEWED FOR HOWARD SCD AND MEETS TECHNICAL REQUIREMENTS
THIS DEVELOPMENT PLAN IS APPROVED FOR SOIL EROSION AND SEDIMENT CONTROL BY THE HOWARD COUNTY DEPARTMENT OF PLANNING AND ZONING.

John K. Roberts 11/28/12
HOWARD SCD DATE

APPROVED: HOWARD COUNTY DEPARTMENT OF PLANNING AND ZONING

Keith Roberts 12/19/12
CHIEF, DIVISION OF LAND DEVELOPMENT DATE

William D. 28376 12/18/12
CHIEF, DEVELOPMENT ENGINEERING DIVISION DATE

BENCHMARK ENGINEERING, INC.
60 THOMAS JOHNSON DRIVE A/FREDERICK, MARYLAND 21702
(P) 301-311-3505 (F) 301-311-3506
WWW.BD-CVLINENGINEERING.COM

OWNER/DEVELOPER: CASCADE WALTHUR, L.L.C.
P.O. BOX 417
ELLCOTT CITY, MD 21041
PHONE: 410-465-4244


PROJECT: CASCADE OVERLOOK, SECTION 4
LOTS 1-7 AND OPEN SPACE LOTS 8 & 9

LOCATION: TAX MAP 31 - GRID 10 - PARCEL 133
ZONE: R-ED 1st ELECTION DISTRICT
HOWARD COUNTY, MARYLAND

TITLE: MASS GRADING, SEDIMENT AND EROSION CONTROL PLAN, NOTES AND DETAILS



DATE: FEB 2012 PROJECT NO. 1817
NOV 2012 SHEET 3 OF 6

DESIGN: AM DRAFT: AM CHECK: CAM SCALE: AS SHOWN

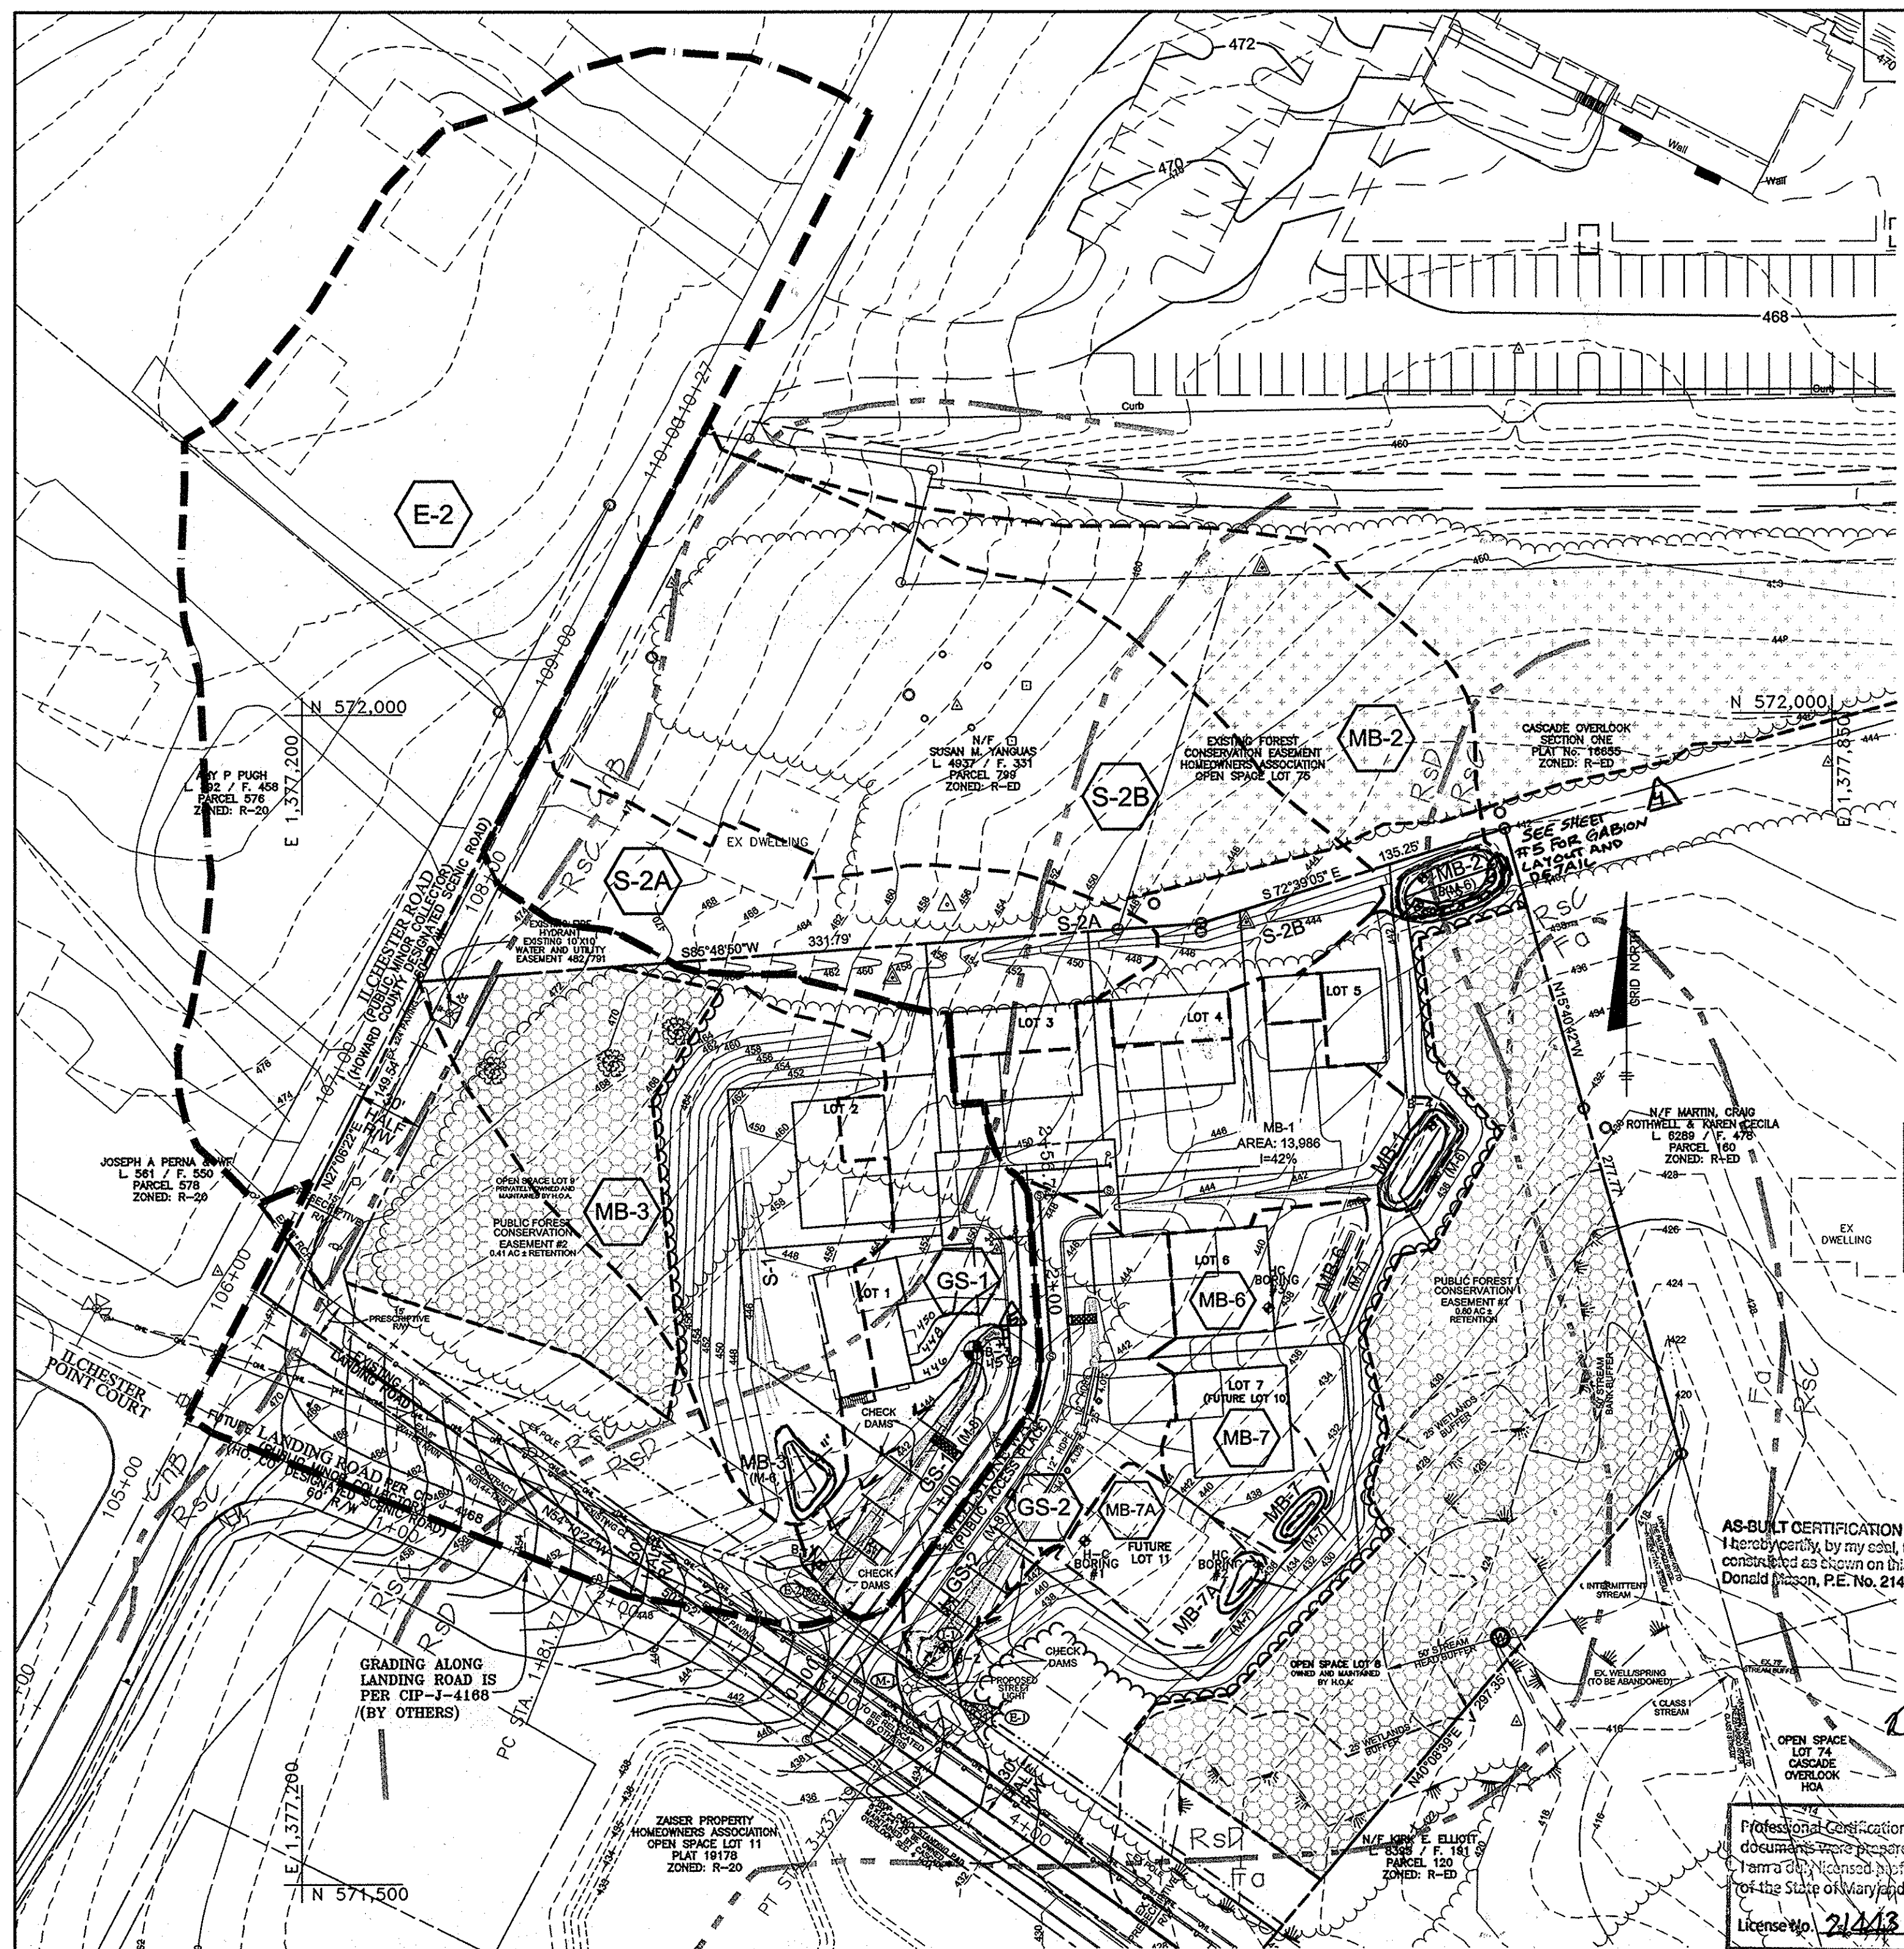

LEGEND

- EXISTING CONTOUR: --- 300 ---
- PROPOSED CONTOUR: --- 412 ---
- EXISTING WOODS LINE: ~~~~~
- PROPOSED WOODS LINE: ~~~~~
- EXISTING HOUSE: [Symbol]
- PROPOSED HOUSE: [Symbol]
- EX. OVERHEAD WIRE: ---o---
- EX. UTILITY POLE: ---o---
- LIMIT OF WETLANDS: [Symbol]
- SOILS CLASSIFICATION: ChBz
- SOILS DELINEATION: [Symbol]
- FOREST CONSERVATION EASEMENT: [Symbol]
- EX. SEPTIC: [Symbol]
- DRAINAGE AREA LIMIT: [Symbol]
- STORM DRAIN DRAINAGE AREA LIMIT: [Symbol]

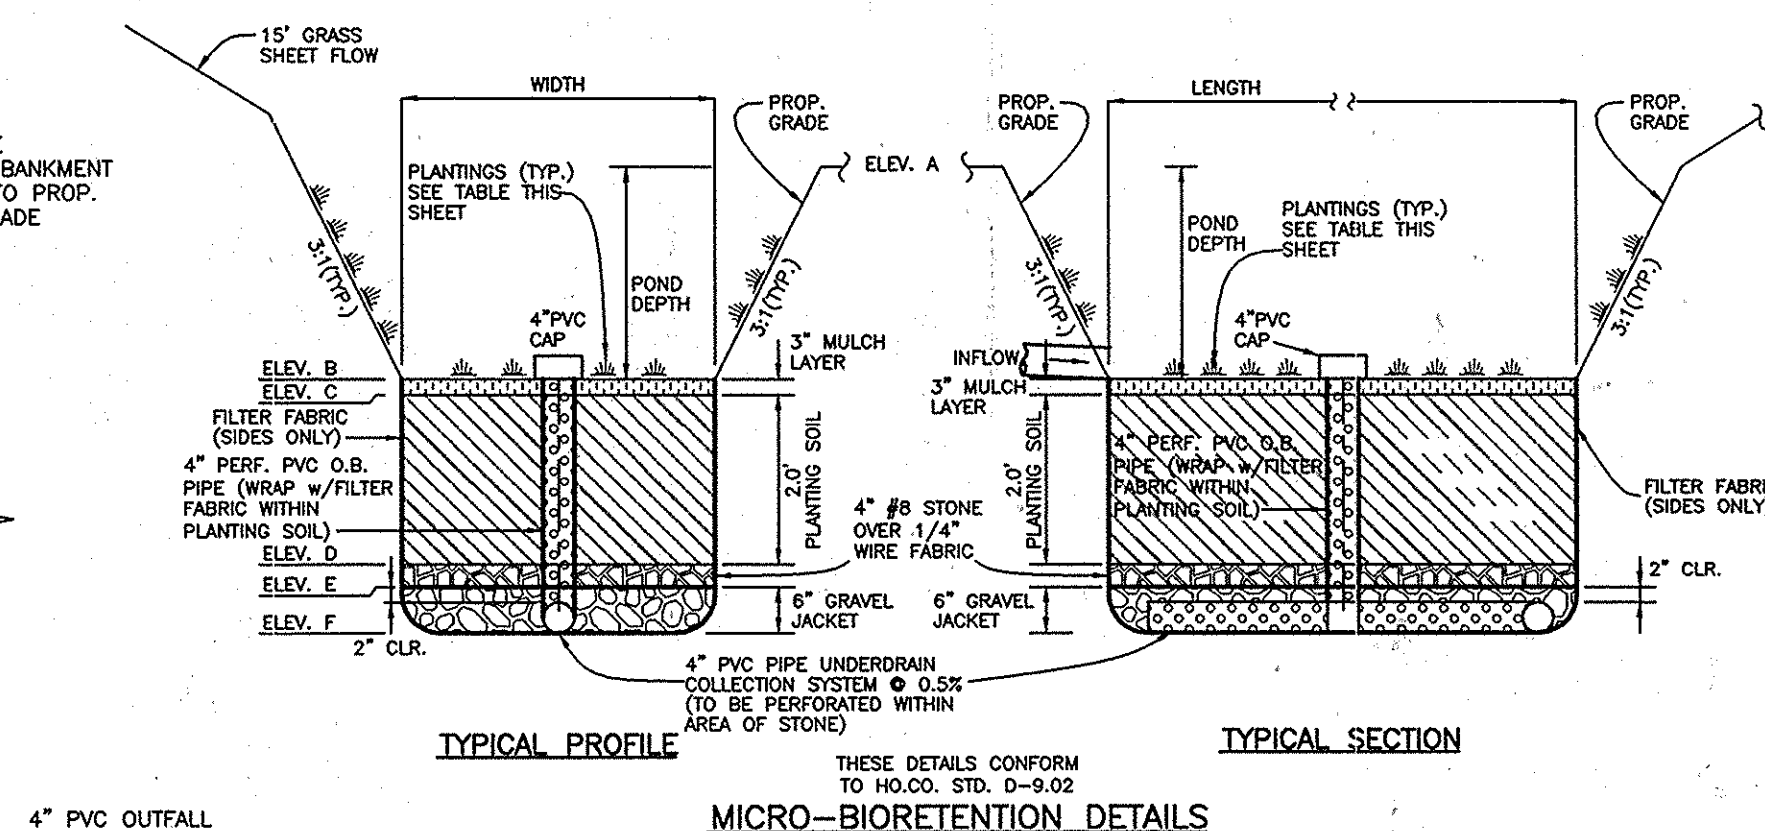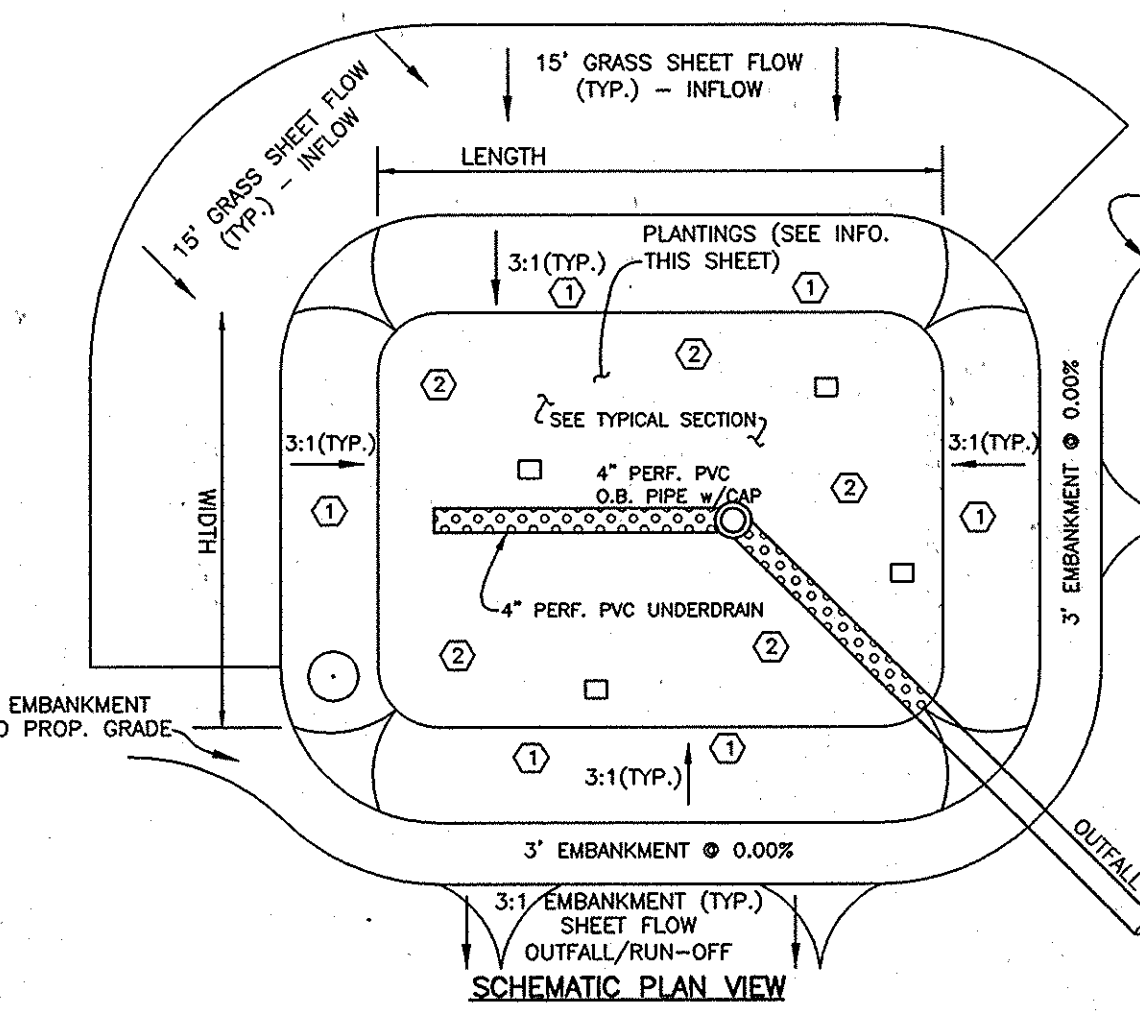

STORMWATER MANAGEMENT DRAINAGE AREA DATA

FACILITY NO.	AREA (SF)	% IMPERVIOUS
MB-1	13,986	42
MB-2	76,953	11
MB-3	29,095	11
MB-6	3,737	43
MB-7	4,086	53
MB-7a	3,592	60
GS-1	15,556	42
GS-2	9,624	50

STORMWATER MANAGEMENT PRACTICES

LOT NUMBER	ADDRESS	MICRO-BIORETENTION M-6 (NUMBER)	SWALES M-8 (NUMBER)
LOT 6		1	
LOT 7		1	
LOT 11		1	

SWALE DRAINAGE AREA DATA

FACILITY NO.	AREA (SF)	% IMPERVIOUS
S-1-MB-3	29,095	11
S-2A	16,272	22
S-2B	59,537	14

STORM DRAIN DRAINAGE AREA DATA

INLET NO.	ZONING	AREA (AC)	'C' FACTOR	% IMPERVIOUS
I-1=GS-2	R-ED	0.32	0.49	45
E-2	R-ED	3.41	0.27	25

SOILS CLASSIFICATION

SYMBOL	DESCRIPTION	HYDROLOGIC GROUP
ChB	CHILLUM-RUSSETT LOAMS, 2 TO 5 PERCENT SLOPES	B
Fa	FALLINGBOM SANDY LOAM, 0 TO 2 PERCENT SLOPES	D
Rsc	RUSSETT FINE SANDY LOAM, 5 TO 10 PERCENT	C
Rsd	RUSSETT FINE SANDY LOAM, 10 TO 15 PERCENT	C

SOIL DATA OBTAINED FROM THE NRCS WEB SOIL SURVEY. HIGHLY ERODIBLE SOIL

- ### OPERATION AND MAINTENANCE SCHEDULE FOR GRASS SWALES, (M-8)
- THE OPEN CHANNEL SYSTEM SHALL BE INSPECTED ANNUALLY AND AFTER MAJOR STORMS. INSPECTIONS SHALL BE PERFORMED DURING WET WEATHER TO DETERMINE IF THE FACILITY IS FUNCTIONING PROPERLY.
 - THE OPEN CHANNEL SHALL BE MOWED A MINIMUM OF AS NEEDED DURING THE GROWING SEASON TO MAINTAIN A MAXIMUM GRASS HEIGHT OF LESS THAN 6 INCHES.
 - DEBRIS AND LITTER SHALL BE REMOVED DURING REGULAR MOWING OPERATIONS AND AS NEEDED.
 - VISIBLE SIGNS OF EROSION IN THE OPEN CHANNEL SYSTEM SHALL BE REPAIRED AS SOON AS IT IS NOTICED.
 - REMOVE SILT IN THE OPEN CHANNEL SYSTEM WHEN IT EXCEEDS 25% OF THE ORIGINAL WOV.
 - INSPECT CHECK DAMS TWICE A YEAR FOR STRUCTURAL INTEGRITY. RESTORE CHECK DAMS TO ORIGINAL CONDITION AS APPLICABLE.

MICRO-BIORETENTION GEOMETRY

LOT	LENGTH	WIDTH	DEPTH	C	D	E	F	G	A _F	SF	
MB-1	30'	15'	1.0'	441.80	440.87	440.25	438.25	437.92	434.12	434.0	2.27
MB-2	40'	15'	1.0'	441.80	440.87	440.25	438.25	437.92	434.12	434.0	4.75
MB-3	24'	11'	1.0'	444.00	443.75	442.75	440.75	440.42	439.92	439.8	2.37
MB-6	34'	7'	1.0'	439.0	438.4	438.42	436.42	436.09	435.59	435.5	1.09
MB-7	22'	5'	1.0'	436.7	436.7	433.75	431.75	431.42	430.92	430.8	1.09
MB-7a	21'	5'	1.0'	436.7	436.8	434.75	432.75	432.42	431.92	431.8	99

- ### OPERATION AND MAINTENANCE SCHEDULE FOR MICRO-BIORETENTION (M-6)
- THE OWNER SHALL MAINTAIN THE PLANT MATERIAL, MULCH LAYER AND SOIL LAYER ANNUALLY. MAINTENANCE OF MULCH AND SOIL IS LIMITED TO CORRECTING AREAS OF EROSION OR WASH OUT. ANY MULCH REPLACEMENT SHALL BE DONE IN THE SPRING. PLANT MATERIAL SHALL BE CHECKED FOR DISEASE AND INSECT INFESTATION AND MAINTENANCE WILL ADDRESS DEAD PLANT MATERIAL WITH ACCEPTABLE REPLACEMENT PLANT MATERIAL IS LIMITED TO THE FOLLOWING: 2000 MARYLAND STORMWATER DESIGN MANUAL VOLUME II, TABLE A.4.1 AND 2.
 - THE OWNER SHALL PERFORM A PLANT IN THE SPRING AND IN THE FALL OF EACH YEAR. DURING THE INSPECTION, THE OWNER SHALL REMOVE DEAD AND DISEASED VEGETATION CONSIDERED BEYOND TREATMENT, REPLACE DEAD PLANT MATERIAL WITH ACCEPTABLE REPLACEMENT PLANT MATERIAL, TREAT DISEASED TREES AND SHRUBS, AND REPLACE ALL DEFICIENT STAKES AND WIRES.
 - THE OWNER SHALL INSPECT THE MULCH EACH SPRING. THE MULCH SHALL BE REPLACED EVERY TWO TO THREE YEARS. THE PREVIOUS MULCH LAYER SHALL BE REMOVED BEFORE THE NEW LAYER IS APPLIED.
 - THE OWNER SHALL CORRECT SOIL EROSION ON AN AS NEEDED BASIS, WITH A MINIMUM OF ONCE PER MONTH AND AFTER EACH HEAVY STORM.

- ### PLANTING DATA
- PLANTINGS WITHIN THE PONDING AREA OF THE MICRO-BIORETENTION AREA ARE TO BE OF A MEDIUM TO HIGH WATER TOLERANCE.
 - PLANTINGS ALONG THE PERIMETER (BERM) AREA OF THE RAIN GARDEN ARE TO BE OF A LOW TO MEDIUM WATER TOLERANCE.
 - AVOID PLANTINGS WITH EXCESSIVE ROOT MASS IN POND AREA OF THE RAIN GARDEN NEAR O.B. PIPE AND UNDERDRAIN.

TABLE B.3.2 MATERIALS AND SPECIFICATIONS FOR SWM FACILITIES

MATERIAL	SPECIFICATION	SIZE	NOTES:
PLANTINGS (IF REQUIRED)	SEE APPENDIX A, TABLE A.4	N/A	PLANTINGS ARE SITE SPECIFIC
PLANTING SOIL (2\"/>			

AS-BUILT CERTIFICATION
I hereby certify, by my seal, that the facilities shown on this plan were constructed as shown on this AS-BUILT plan.
Donald J. Mason, P.E. No. 21443
Date 3-20-15

Professional Certification. I hereby certify that these documents were prepared or approved by me, and that I am a duly licensed professional engineer under the laws of the State of Maryland.
License No. 21443 Expiration Date: 12-21-16

BORING LOG

Depth (ft)	Soil Description	Remarks
0.0 - 0.5	Soil with root (organic) matter and organic soil	
0.5 - 1.0	Light brown to yellowish gray silty clay with some fine to medium sand and silt gravel, (mod. silty) (USDA: SANDY LOAM)	
1.0 - 1.5	Light brown to orange-brown silty clay with some fine sand, (mod. silty) (USDA: SILTY CLAY)	
1.5 - 2.0	Change to yellow silty clay with trace fine sand, (mod. silty) (USDA: SILTY CLAY)	
2.0 - 2.5	Yellow, orange and white silty SAND with some fine sand, (mod. silty) (USDA: SANDY LOAM)	
2.5 - 3.0	End of boring	

PLAN VIEW

SCALE: 1" = 50'

NOTE: APPLY SOLID SOD FROM BACK OF INLET TO FIRST CHECK DAM IMMEDIATELY UPON COMPLETION OF GRADING

*** NO RIPRAP IS REQUIRED BEHIND F-5.**

NOTE: CONTRACTOR SHALL INSTALL A MINIMUM OF 4 SPIKES OR REBAR, EVENLY GRADED INTO TIMBERS 2 AND 3 TO SECURE THE TIMBERS. TIMBERS SHALL BE PRESSURE TREATED.

3 TREATED TIMBERS FOR EACH CHECKDAM

TIMBER #3 1E 6X6X18
TIMBER #2 1E 6X6X10
TIMBER #1 1E 6X6X14

12" TIMBER EXPOSURE

SWALE BOTTOM

GS-1, GS-2

1" WIDE X 1" DEEP NOTCH

TIMBER CHECK DAM DETAIL
NOT TO SCALE

NOTE: CHECK DAM DIMENSIONS ARE TO BE +/- 1"

APPROVED: HOWARD COUNTY DEPARTMENT OF PUBLIC WORKS
12-13-12

APPROVED: HOWARD COUNTY DEPARTMENT OF PLANNING AND ZONING
12/19/12

APPROVED: HOWARD COUNTY DEPARTMENT OF PLANNING AND ZONING
12/18/12

REVISIONS

NO.	DATE	REVISION
1	3-28-14	REVISE SWALE GS-1 AT LOT 1
2	10-28-14	REVISE CHECK DAM DETAIL
3	3-10-15	REVISE LOCATION OF FLOW INLETS F-1 & F-2 PER AS-BUILT CONDITIONS
4	8-7-15	REVISE TO ADD GABION PROTECTION TO MB-2
5	12-15-15	REVISE TO ADD NOTES REQUESTED BY C-1-D
6	4-22-16	REVISE MICRO-BIORETENTION GEOMETRY TABLE TO MATCH DETAIL AND FIELD CONDITIONS

BENCHMARK ENGINEERING, INC.

8480 BALTIMORE NATIONAL PIKE & SUITE 418 ELLICOTT CITY, MARYLAND 21043
(P) 410-465-6944 (F) 410-465-6944
60 THOMAS JOHNSON DRIVE & FREDERICK, MARYLAND 21702
(P) 301-371-3505 (F) 301-371-3506
WWW.BM-ENGINEERING.COM

Professional Certification. I hereby certify that these documents were prepared or approved by me, and that I am a duly licensed professional engineer under the laws of the State of Maryland, License No. 28376, Expiration Date: 01-01-2013.

OWNER/DEVELOPER: CASCADE OVERLOOK, SECTION 4 LOTS 1-7 AND OPEN SPACE LOTS 8 & 9

PROJECT: CASCADE OVERLOOK, SECTION 4 LOTS 1-7 AND OPEN SPACE LOTS 8 & 9


LOCATION: TAX MAP 31 - GRID 10 - PARCEL 133 ZONE: R-ED 1ST ELECTION DISTRICT HOWARD COUNTY, MARYLAND

TITLE: STORMWATER MANAGEMENT PLAN, NOTES, DETAILS AND STORM DRAIN DRAINAGE AREA MAP

DATE: FEB 2012
NOV 2012


PROJECT NO: 1817

DESIGN: AM DRAFT: AM CHECK: CAM SCALE: AS SHOWN SHEET 4 OF 6

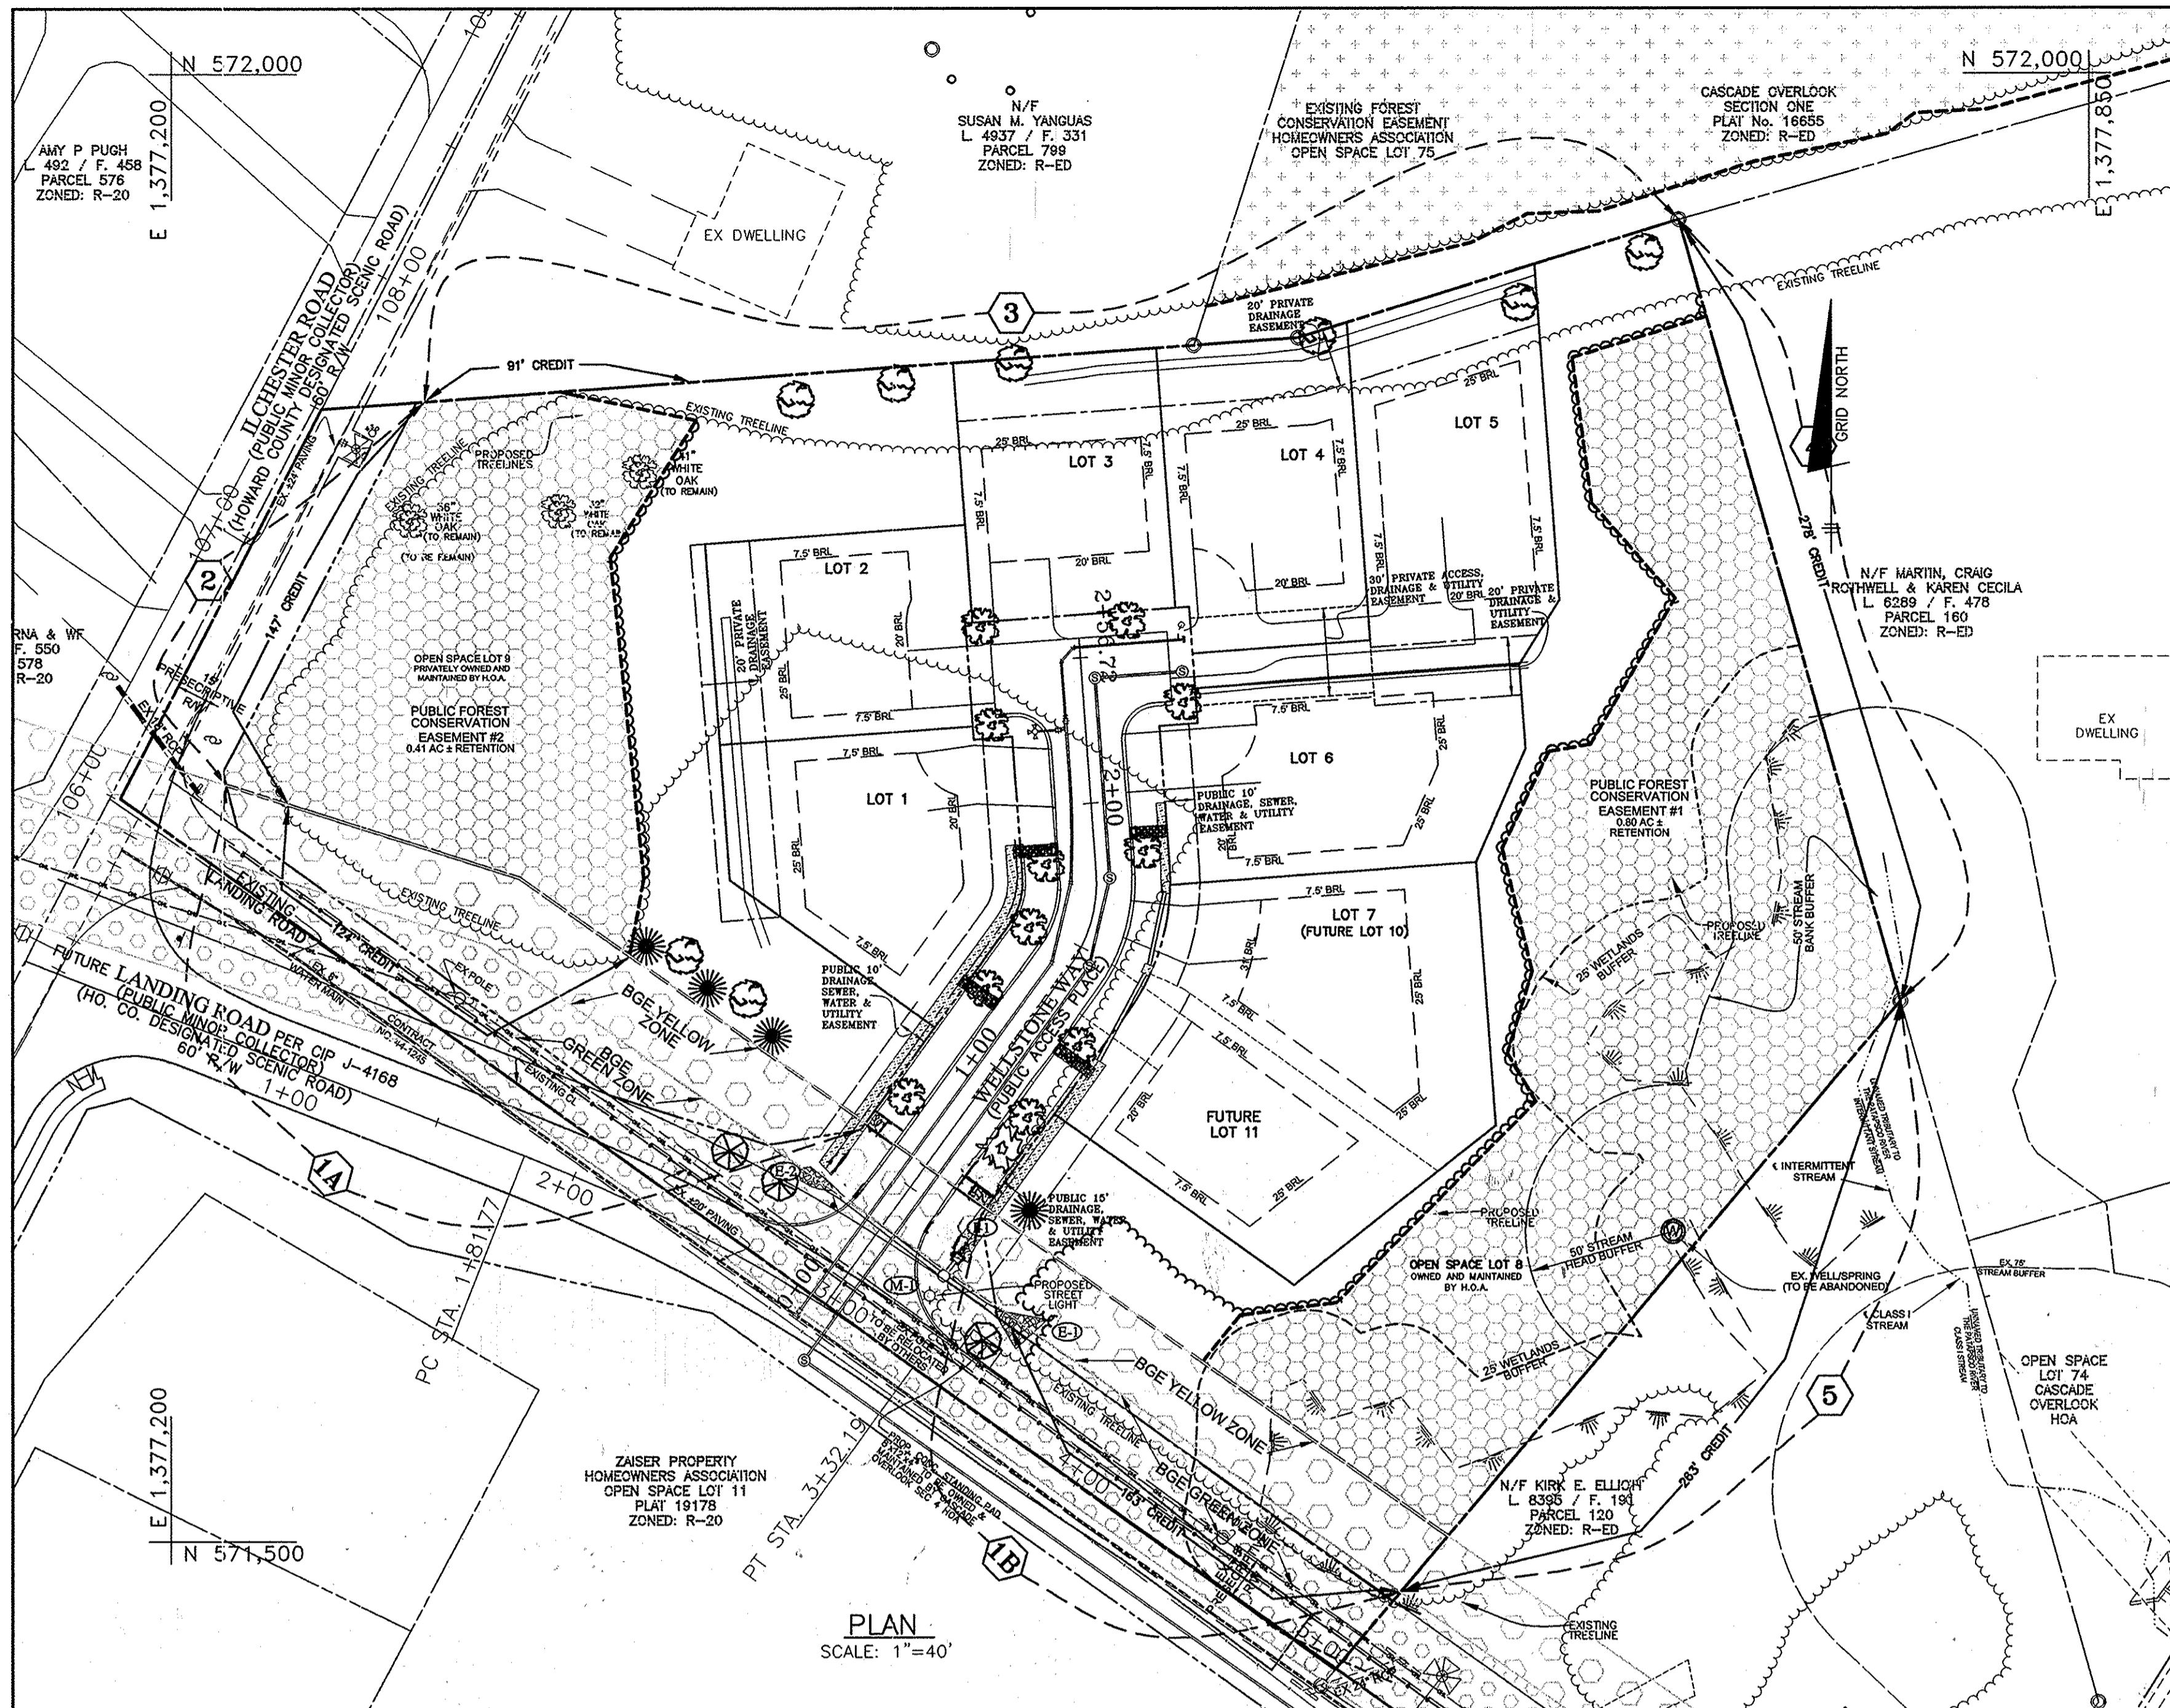

LEGEND

EXISTING WOODS LINE		LIMIT OF WETLANDS	
PROPOSED WOODS LINE		PRIVATE DRAINAGE & UTILITY EASEMENT	
EXISTING STRUCTURE		PROP. FOREST CONSERVATION EASEMENT	
PROPOSED STRUCTURE		EX. PRIVATE ACCESS EASEMENT	
EX. OVERHEAD WIRE		L.S. PERIMETER AREAS	
EX. UTILITY POLE		PERMANENT FOREST CONSERVATION SIGNAGE	
PROPOSED STREET LIGHT		PROP. FIRE HYDRANT	

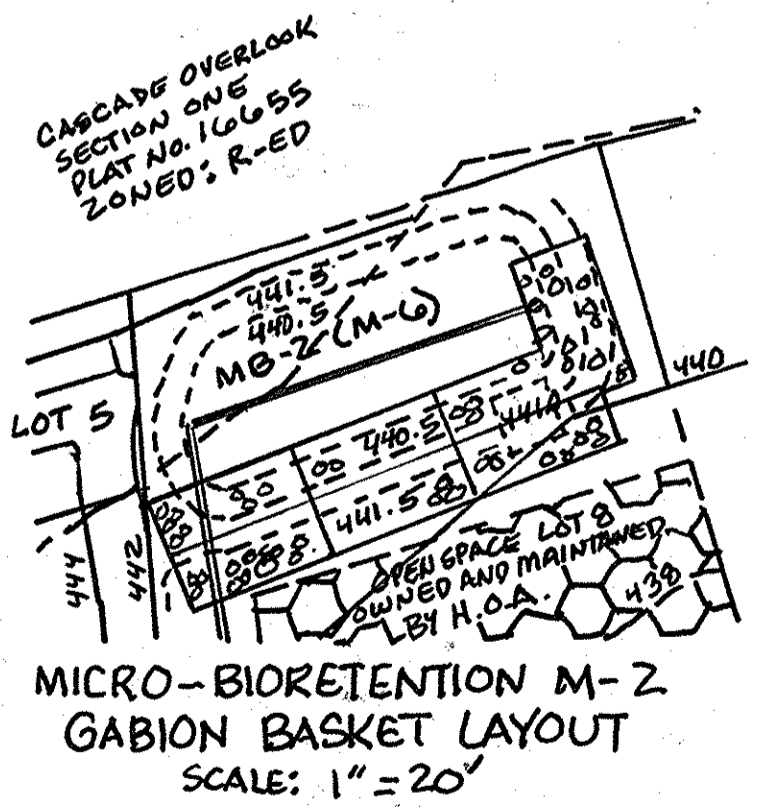

SCHEDULE A PERIMETER LANDSCAPE EDGE

CATEGORY	ADJACENT TO ROADWAY						TOTALS
	YES	YES	YES	NO	NO	NO	
ADJACENT TO PERIMETER PROPERTIES	NO	NO	NO	YES	YES	YES	
PERIMETER NO. / LANDSCAPE TYPE	1A	1B	2B	3A	4A	5A	
LINEAR FEET OF (FRONTAGE/PERIMETER)	243'	192'	147'	467'	278'	263'	
CREDIT FOR EXISTING VEGETATION: NO OR YES (w/LINEAR FEET) (DESCRIBE BELOW IF NEEDED)	YES 124'	YES 163'	YES 147'	YES 91'	YES 278'	YES 263'	
CREDIT FOR WALL, FENCE OR BERM: NO OR YES (w/LINEAR FEET) (DESCRIBE BELOW IF NEEDED)	NO	NO	NO	NO	NO	NO	
NUMBER OF PLANTS REQUIRED:							
SHADE TREES	2	0	-	6	-	-	8
EVERGREEN TREES	3	1	-	-	-	-	4
OTHER TREES (2:1 SUBSTITUTE)	-	-	-	-	-	-	-
SHRUBS	-	-	-	-	-	-	-
NUMBER OF PLANTS PROVIDED:							
SHADE TREES	2	0	-	6	-	-	8
EVERGREEN TREES	3	1	-	-	-	-	4
OTHER TREES (2:1 SUBSTITUTE)	-	-	-	-	-	-	-
SHRUBS (10:1 SUBSTITUTE)	-	-	-	-	-	-	-
CREDITS BELOW IF NEEDED	-	-	-	-	-	-	-

STREET TREE CALCULATIONS LANDING AND ILCHESTER ROAD
 STREET TREES REQUIRED FOR 515 LF OF RIGHT-OF-WAY WITH 445 LF OF CREDIT FOR PRESERVING EXISTING VEGETATION (558-455) / 30 = 3 TREES REQUIRED
 3 TREES PROVIDED


STREET TREE CALCULATIONS WELLSTONE WAY
 STREET TREES REQUIRED FOR 486 LF OF RIGHT-OF-WAY
 486 / 40 = 12 TREES REQUIRED
 12 TREES PROVIDED

PERIMETER PLANTING LIST


SYMBOL	QUANTITY	NAME	REMARKS
	8	ACER SACCHARUM "SUGAR MAPLE"	2.5'-3.0' MIN. CAL. B & B FULL HEAD
	4	CUPRESSUS/PAVIA LELAND "LELAND CYPRESS"	5.0'-6.0' MIN. HT. UNSHEARED

STREET TREE PLANTING LIST

SYMBOL	QUANTITY	NAME	REMARKS
	12	QUERCUS COCCINEA "SCARLET OAK"	2.5'-3.0' MIN. CAL. B & B FULL HEAD
	3	ACER GRISEBUM "PAPERBACK MAPLE"	2.5'-3.0' MIN. CAL. B & B FULL HEAD

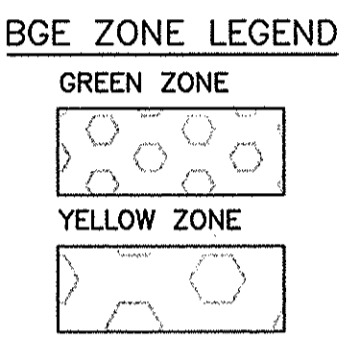

- LANDSCAPING NOTES**
- PERIMETER LANDSCAPING SHALL BE PROVIDED BY THE EXISTING VEGETATION TO REMAIN AND BY THE PLANTINGS AS SHOWN ON THESE PLANS.
 - SEE TREE PLANTING DETAIL - THIS SHEET.
 - THE DEVELOPER SHALL BE RESPONSIBLE FOR THE PLANTINGS AND FOR PRESERVATION VEGETATION AS SHOWN ON THESE PLANS. BONDING FOR PLANTINGS IS THE OBLIGATION OF THE DEVELOPER AS PART OF THE DEVELOPER'S AGREEMENT.
 - STREET TREES SHALL BE PLANTED A MINIMUM OF FOUR (4) FEET FROM THE CURB OR SIDEWALK. A MINIMUM OF SIX (6) FEET BEHIND FACE OF CURB WHEN THERE IS NO SIDEWALK AND MUST BE A MINIMUM OF FIVE (5) FEET FROM ANY STORM DRAIN.
 - A MINIMUM DISTANCE OF TWENTY (20) FEET MUST BE MAINTAINED BETWEEN ANY TREES LOCATED ALONG THE CURB LINE AND FROM ANY STREET LIGHTS.
 - THIS PLAN HAS BEEN PREPARED IN ACCORDANCE WITH THE PROVISIONS OF SEC.-16.124 OF THE HOWARD COUNTY CODE AND LANDSCAPE MANUAL.
 - STREET TREES SHALL BE PLANTED A MINIMUM OF FIVE (5) FEET FROM OPEN SPACE ACCESS STRIP AND 10' FROM DRIVEWAY.
 - AT THE TIME OF INSTALLATION, ALL SHRUBS AND OTHER PLANTINGS HEREWITH LISTED AND APPROVED FOR THIS SITE SHALL BE OF THE PROPER HEIGHT IN ACCORDANCE WITH THE HOWARD COUNTY LANDSCAPE MANUAL. IN ADDITION, NO SUBSTITUTIONS OR RELOCATION OF REQUIRED PLANTINGS MAY BE MADE WITHOUT PRIOR REVIEW AND APPROVAL FROM THE DEPARTMENT OF PLANNING AND ZONING. ANY DEVIATION FROM THIS APPROVED LANDSCAPE PLAN MAY RESULT IN DENIAL OR DELAY IN RELEASE OF LANDSCAPE SURETY UNTIL SUCH TIME AS ALL REQUIRED MATERIALS ARE PLANTED AND/OR REVISIONS ARE MADE TO APPLICABLE PLANS AND CERTIFICATIONS.
 - PERIMETER LANDSCAPING SHALL BE PROVIDED AS SHOWN ON THE LANDSCAPE PLAN OF THE ROAD CONSTRUCTION DRAWINGS FOR THIS FINAL PLAN IN ACCORDANCE WITH SECTION 16.124 OF THE LANDSCAPE MANUAL. FINANCIAL SURETY IN THE AMOUNT OF \$3,000 (\$2,400 FOR 8 SHADE TREES AND \$600 FOR 4 EVERGREEN TREES) SHALL BE POSTED WITHIN THE DEVELOPER'S AGREEMENT UNDER THIS FINAL PLAN, F-12.
 - SMALL ORNAMENTAL TREES SHALL BE PLANTED ALONG PERIMETER 1 IN ACCORDANCE WITH BGE "GREEN ZONE".

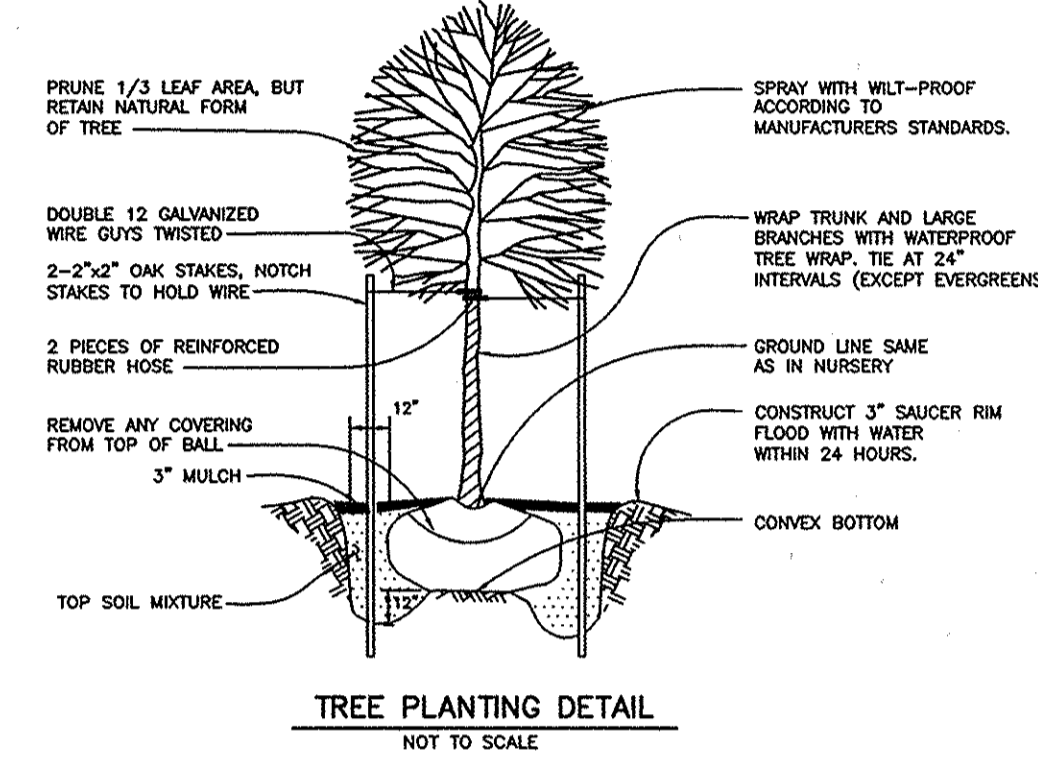

LINER SPECIFICATIONS FOR MICRO-BIORETENTION M-2

MATERIAL	SPECIFICATION	SIZE	NOTES
IMPERVIOUS LINER	ASTM D-1039 (THICKNESS) ASTM D-1172 (TENSILE STRENGTH) 100 LB. ELONGATION (200%) ASTM D-624 (TEAR RESISTANCE 150 LB./IN) ASTM D-471 (WATER ADSORPTION 4% TO 2% MASS)	30 MIL THICK	LINER TO BE ULTRAVIOLET RESISTANT. A GEOTEXTILE FABRIC SHOULD BE USED TO PROTECT THE LINER FROM PUNCTURE.

- CONSTRUCTION NOTES:**
- PULL PLANTING SOIL AWAY FROM INSIDE FACE OF EMBANKMENT APPROXIMATELY 1 FOOT.
 - EXCAVATE BREACHED AREA TO NATURAL GROUND.
 - RECONSTRUCT EMBANKMENT USING SOIL FILL WRAPPED IN PERMEABLE FILTER CLOTH WITH IN BREACHED AREA LEAVING 6" WEIR AREA 6" DEEPER FROM TOP OF EMBANKMENT.
 - PLACE GABION MATTRESSES ON TOP OF EMBANKMENT, EXTENDING DOWN INSIDE AND OUTSIDE FACES.
 - REPLACE PLANTING SOIL AROUND MATTRESS AND EMBANKMENT.
 - BACKFILL OUTSIDE FACE OF EMBANKMENT WITH CLASS C RIPRAP WITHIN 2' OF EITHER SIDE OF WEIR. TIE THE REMAINING MATTRESS AREA WITH TOP SOIL AND SOIL FOR SMOOTH FINISH.

DEVELOPER'S/BUILDER'S CERTIFICATION

I/WE CERTIFY THAT THE LANDSCAPING SHOWN ON THIS PLAN WILL BE DONE ACCORDING TO THE PLAN, SECTION 16.124 OF THE HOWARD COUNTY SUBDIVISION AND LAND DEVELOPMENT REGULATIONS AND LANDSCAPE MANUAL. I/WE FURTHER CERTIFY THAT UPON COMPLETION, A LETTER OF NOTICE, ACCOMPANIED BY AN EXECUTED ONE YEAR GUARANTEE OF PLANT MATERIALS, WILL BE SUBMITTED TO THE DEPARTMENT OF PLANNING AND ZONING.

NAME: *James R. Hickey, III* DATE: *11/21/12*
STEVEN L. BRIGGS

NO	DATE	REVISION
2	8-7-15	REVISE TO ADD GABION PROTECTION TO MB-2
1	3-10-15	REVISE LOCATION OF FLOW INLETS F-1 & F-2 PER AS-BUILT CONDITIONS

BENCHMARK ENGINEERING, INC.
 ENGINEERS & LAND SURVEYORS & PLANNERS
 8480 BALTIMORE NATIONAL PIKE SUITE 418 ELLICOTT CITY, MARYLAND 21043
 (P) 410-465-4105 (F) 410-465-4944
 60 THOMAS JOHNSON DRIVE FREDERICK, MARYLAND 21702
 (P) 301-371-3505 (F) 301-371-3506
 WWW.BEI-CVLENGINEERS.COM

Professional Certification. I hereby certify that these documents were prepared or approved by me, and that I am a duly licensed professional engineer under the laws of the State of Maryland, License No. 28376, Expiration Date: 01-01-2013.

OWNER/DEVELOPER: **CASCADE WALTHUR, L.L.C.**
 P.O. BOX 417
 ELLICOTT CITY, MD 21041
 PHONE: 410-465-4244

PROJECT: **CASCADE OVERLOOK, SECTION 4**
LOTS 1-7 AND OPEN SPACE LOTS 8 & 9

LOCATION: TAX MAP 31 - GRID 10 - PARCEL 133
 ZONE: R-ED 1st ELECTION DISTRICT
 HOWARD COUNTY, MARYLAND

TITLE: **LANDSCAPE PLAN, NOTES AND DETAILS**

DATE: FEB 2012 PROJECT NO. 1817
 NOV 2012

DESIGN: AM DRAFT: AM CHECK: CAM SCALE: AS SHOWN SHEET 5 OF 6

APPROVED: HOWARD COUNTY DEPARTMENT OF PUBLIC WORKS
Walter R. ... 12-13-12
 CHIEF, BUREAU OF HIGHWAYS

APPROVED: HOWARD COUNTY DEPARTMENT OF PLANNING AND ZONING
Ketshel ... 12/19/12
 CHIEF, DIVISION OF LAND DEVELOPMENT

... 12/18/12
 CHIEF, DEVELOPMENT ENGINEERING DIVISION

No As-Built information is required on this sheet

Professional Certification. I hereby certify that these documents were prepared or approved by me, and that I am a duly licensed professional engineer under the laws of the State of Maryland.
 License No. 21443 Expiration Date: 12-21-16

CONSTRUCTION PERIOD PROTECTION PROGRAM

A. Forest Protection Techniques

1. Soil Protection Area (Critical Root Zone)

The soil protection area, or critical root zone, of a tree is that portion of the soil column where most of a tree's roots may be found. The majority of roots responsible for water and nutrient uptake are located just below the soil surface. Temporary fencing shall be placed around the critical root zone of the forest in areas where the forest limits occur within 25 feet of the limit of disturbance.

2. Fencing and Signage

Existing forest limits occurring within 25 feet of the limits of disturbance shall be protected using temporary protective fencing. Permanent signage shall be placed around the afforestation area prior to plant installation, as shown on the plan.

B. Pre-Construction Meeting

Upon staking of limits of disturbance a pre-construction meeting will be held between the developer, contractor and appropriate County Inspector. The purpose of the meeting will be to verify that all sediment control is in order, and to notify the contractor of possible penalties for non-compliance with the FCP.

C. Storage Facilities/Equipment Cleaning

All equipment storage, parking, sanitary facilities, material stockpiling, etc. associated with construction of the project will be restricted to those areas outside of the proposed Forest Conservation Easement. Cleaning of equipment will be limited to area within the LOD of the proposed homesites. Wastewater resulting from equipment cleaning will be controlled to prevent runoff into environmentally sensitive areas.

D. Sequence of Construction

The following timetable represents the proposed timetable for development. The items outlined in the Forest Conservation Plan will be enacted within two (2) years of subdivision approval.

Below find a proposed sequence of construction.

1. Install all signage and sediment control devices.
2. Hold pre-construction meeting between developer, contractor and County Inspector.
3. Build access roads, install water and sewer, and construct houses. Stabilize all disturbed areas accordingly.
4. Remove sediment control.
5. Hold post-construction meeting with County Inspectors to assure compliance with FCP. Submit Certification of Installation.

E. Construction Monitoring

Eco-Science Professionals, or another qualified professional designated by the developer, will monitor construction of the project to ensure that all activities are in compliance with the Forest Conservation Plan.

F. Post-Construction Meeting

Upon completion of construction, Eco-Science Professionals, or another qualified professional designated by the developer, will notify the County that construction has been completed and arrange for a post-construction meeting to review the project site. The meeting will allow the County Inspector to verify that forest retention requirements have been met.

POST-CONSTRUCTION MANAGEMENT PLAN

Howard County requires a two year post-construction management plan to be prepared as part of the forest conservation plan. The plan goes into effect upon acceptance of the construction certification of completion by the County. Eco-Science Professionals, or another qualified professional designated by the developer, will be responsible for implementation of the post-construction management plan.

The following items will be incorporated into the plan:

A. Fencing and Signage

Permanent signage indicating the limits of the retention/afforestation area shall be maintained.

B. General Site Inspections

Site inspections will be performed to insure that retention of the forest is met in accordance with this plan and that the forest edge remains healthy and stable.

C. Education



The developer will provide appropriate materials to property owners informing them of the location and purpose of the forest conservation easement. Materials may include site plans and information explaining the intent of the forest conservation law.

D. Final Inspection

At the end of the two year post-construction management period, Eco-Science Professionals, or another qualified professional, will submit to the administrator of the Howard County Forest Conservation Program certification that all retention/afforestation requirements have been met. Upon acceptance of this certification, the County will release the developer from all future obligations and release the developer's bond.

FOREST CONSERVATION EASEMENTS

Easements are a legal means of providing permanent protection of forests, farmland and open space. In accordance with the criteria outlined in the Howard County Forest Conservation Manual, a forest conservation easement will be recorded for the retention areas for the subject property. Submission of the easements for recording will occur prior to commencement of construction activities.

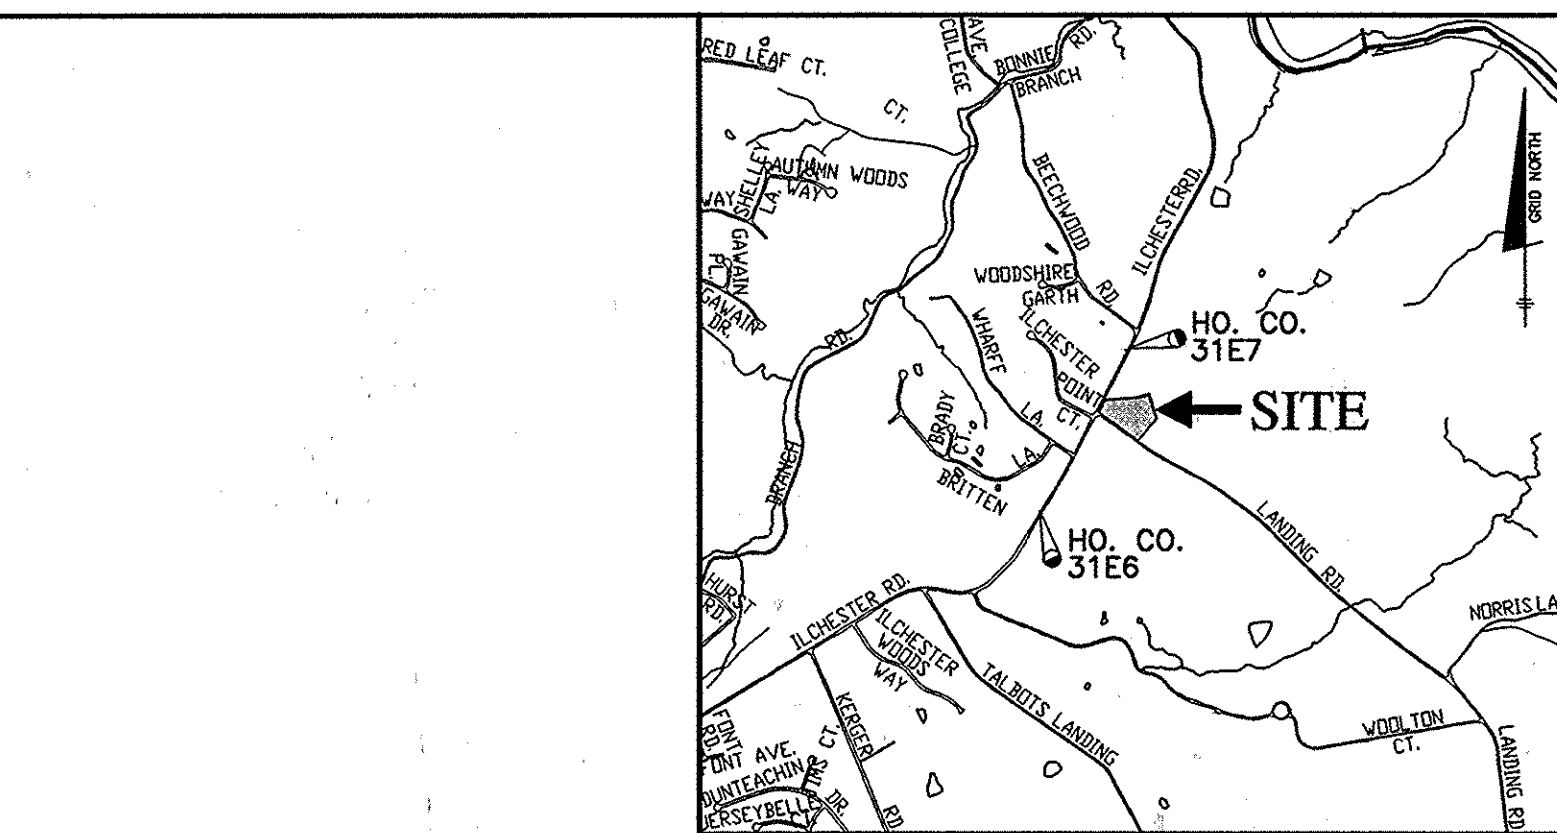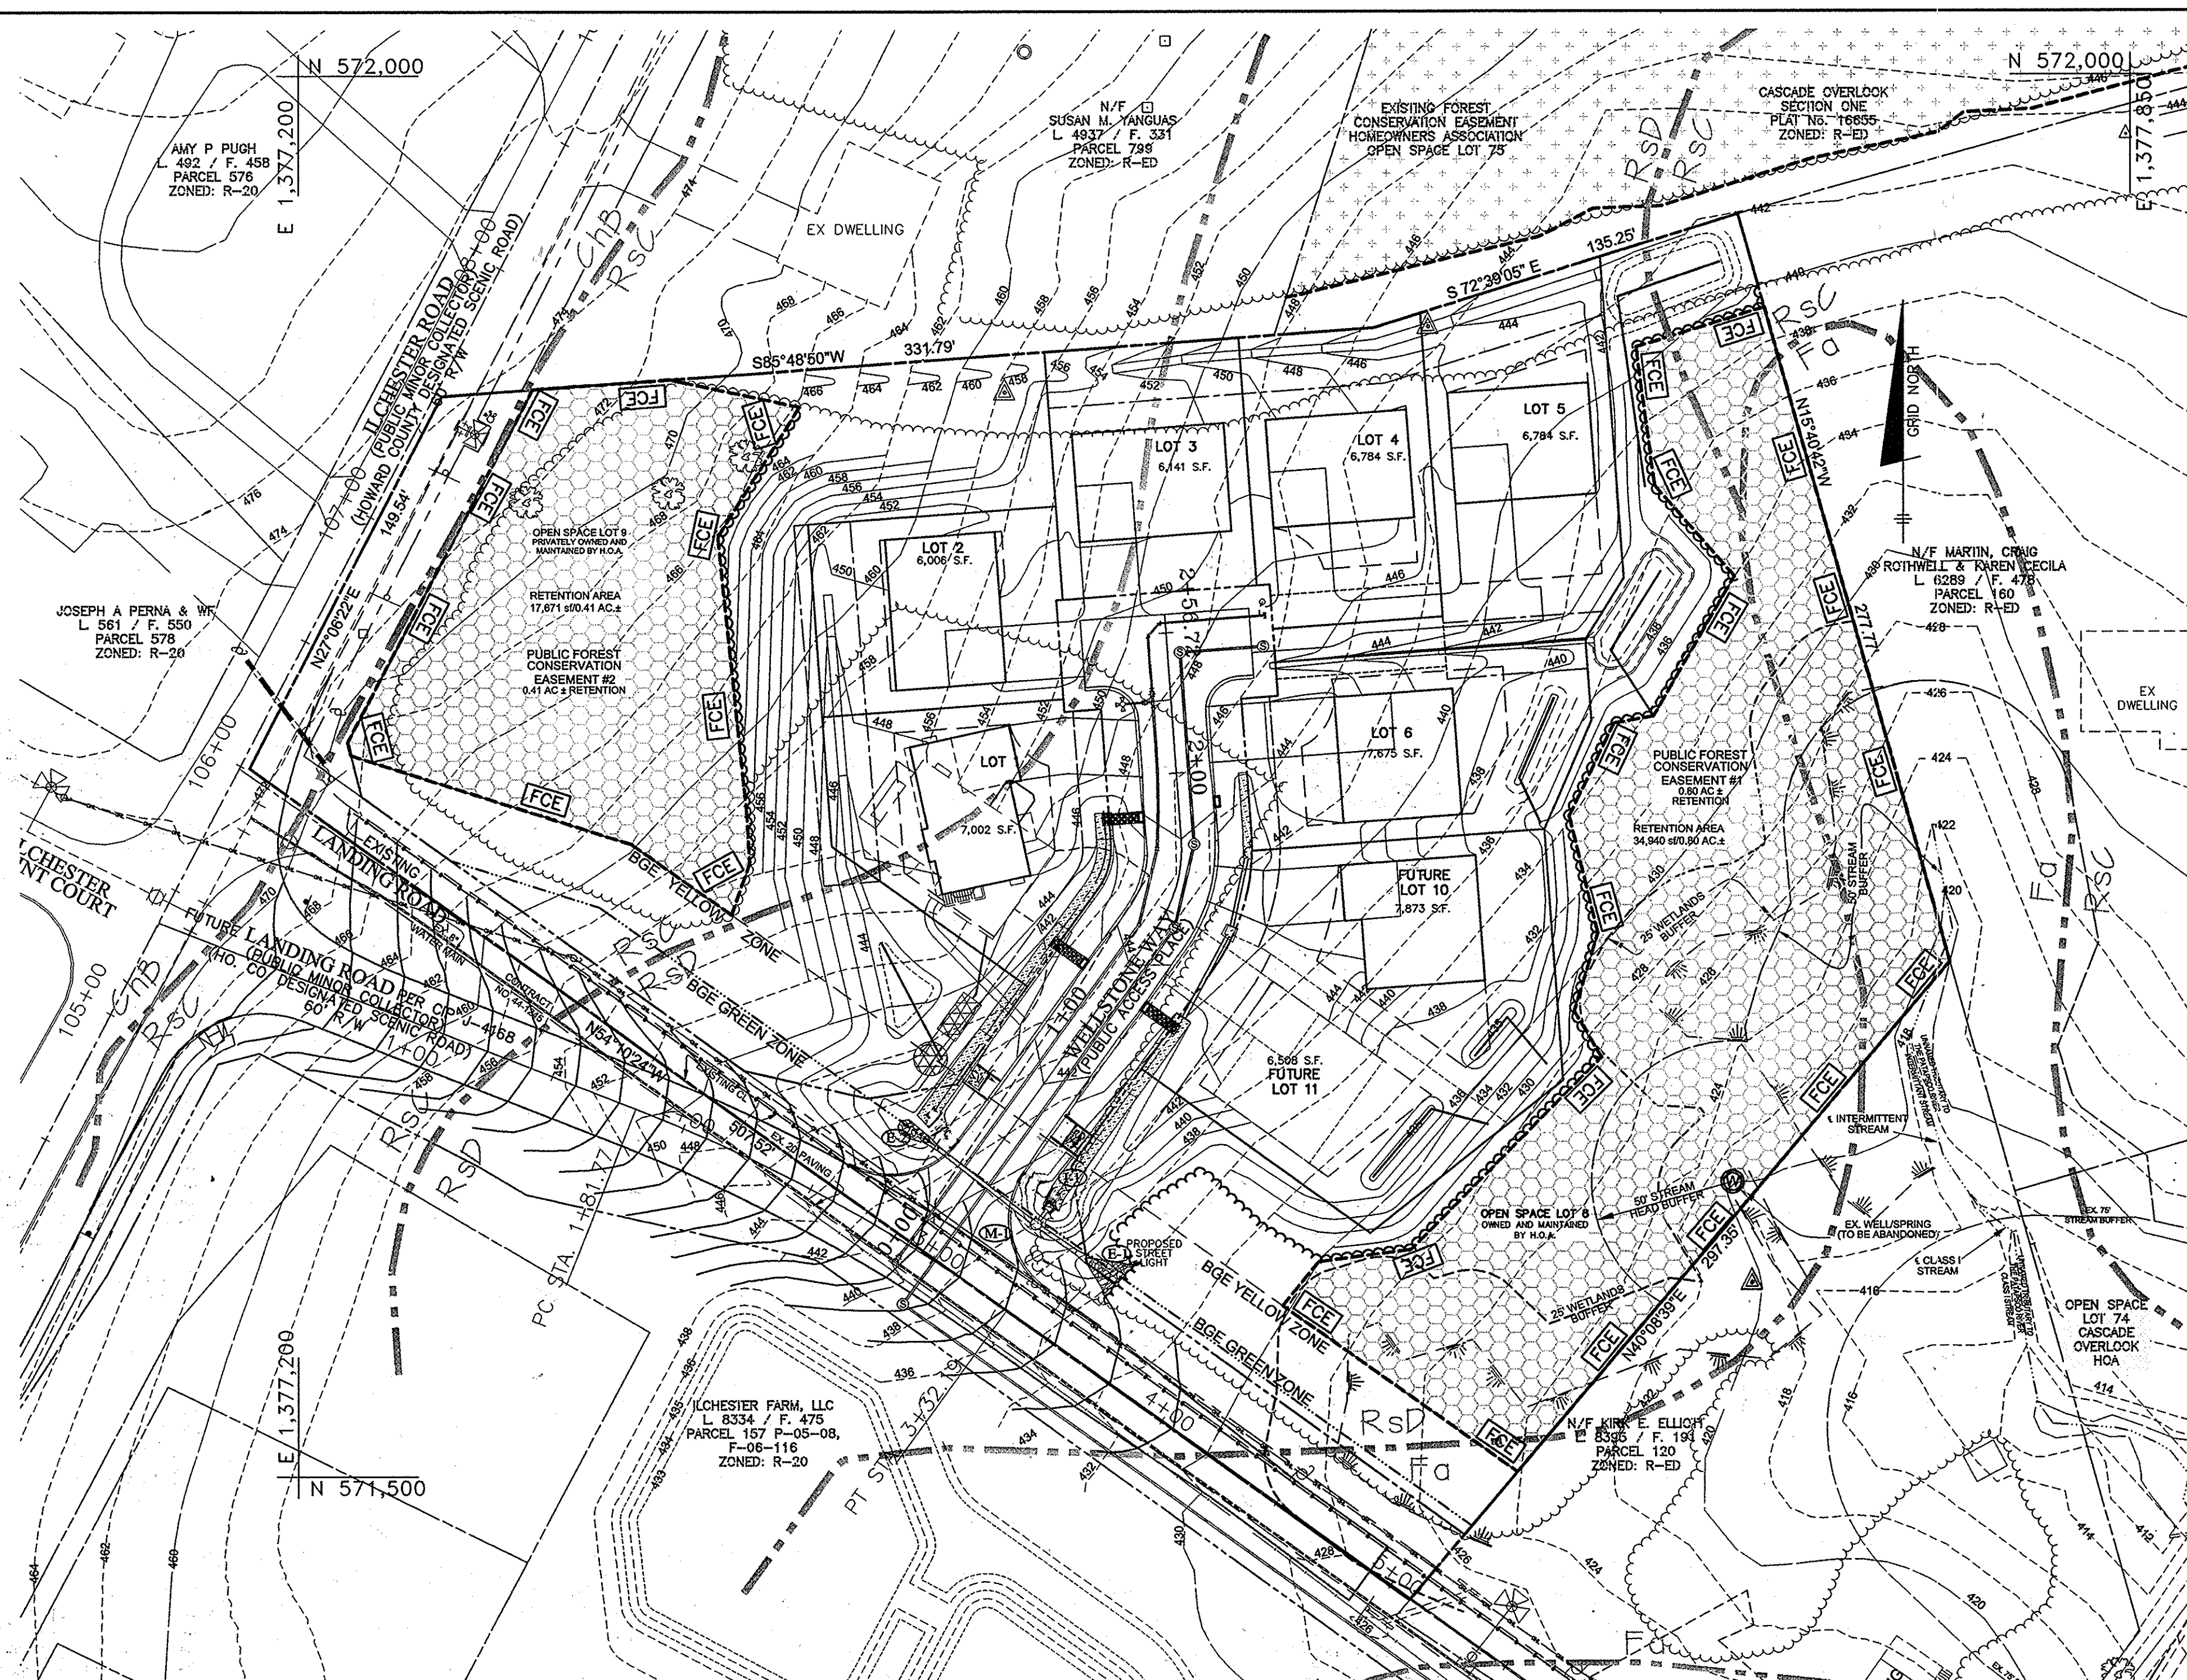

LEGEND
SCALE: 1"=2000'


EXISTING CONTOUR	---390---	LIMIT OF WETLANDS	~~~~~
PROPOSED CONTOUR	---412---	SOILS CLASSIFICATION	CHB2
EXISTING WOODS LINE	~~~~~	SOILS DELINEATION	-----
PROPOSED WOODS LINE	~~~~~	FOREST CONSERVATION EASEMENT	[Hatched Box]
EXISTING HOUSE	[Square]	EX. SEPTIC	[Cross-hatched Box]
PROPOSED HOUSE	[Square]	FOREST RETENTION SIGNS	[FCE]
EX. OVERHEAD WIRE	---o---		
EX. UTILITY POLE	o		

SOILS CLASSIFICATION

SYMBOL	DESCRIPTION	HYDROLOGIC GROUP
ChB	CHILLUM-RUSSETT LOAMS, 2 TO 5 PERCENT SLOPES	B
Fa	FALLSINGTON SANDY LOAM, 0 TO 2 PERCENT SLOPES	D
Rsc	RUSSETT FINE SANDY LOAM, 5 TO 10 PERCENT	C
Rsd	RUSSETT FINE SANDY LOAM, 10 TO 15 PERCENT	C

SOIL DATA OBTAINED FROM THE NRCS WEB SOIL SURVEY.
*HIGHLY ERODIBLE SOIL

- FCP NOTES:**
1. ANY FOREST CONSERVATION EASEMENT (FCE) AREA SHOWN HEREON IS SUBJECT TO PROTECTIVE COVENANTS WHICH MAY BE FOUND IN THE LAND RECORDS OF HOWARD COUNTY WHICH RESTRICT THE DISTURBANCE AND USE OF THESE AREAS.
 2. FORESTED AREAS OCCURRING OUTSIDE OF THE FCE SHALL NOT BE CONSIDERED PART OF THE FCE AND SHALL NOT BE SUBJECT TO PROTECTIVE LAND COVENANTS.
 3. LIMITS OF DISTURBANCE SHALL BE RESTRICTED TO AREAS OUTSIDE THE LIMIT OF TEMPORARY FENCING OR THE FCE BOUNDARY, WHICHEVER IS GREATER.
 4. THERE SHALL BE NO CLEARING, GRADING, CONSTRUCTION OR DISTURBANCE OF VEGETATION IN THE FOREST CONSERVATION EASEMENT, EXCEPT AS PERMITTED BY HOWARD COUNTY DPZ.
 5. NO STOCKPILES, PARKING AREAS, EQUIPMENT CLEANING AREAS, ETC. SHALL OCCUR WITHIN AREAS DESIGNATED AS FOREST CONSERVATION EASEMENTS.
 6. TEMPORARY FENCING SHALL BE USED TO PROTECT FOREST RESOURCES DURING CONSTRUCTION. FENCING SHALL BE INSTALLED ALONG LIMITS OF DISTURBANCE OCCURRING WITHIN 50 FEET OF THE PROPOSED FCE LIMITS.
 7. PERMANENT SIGNAGE WILL BE POSTED AT 50-100' INTERVALS ALONG ALL FCE LIMITS.
 8. THE FOREST CONSERVATION ACT REQUIREMENTS FOR THIS PROJECT WILL BE MET THROUGH THE RETENTION OF 1.2 ACRES OF NET TRACT AREA FOREST WITHIN THE LIMITS OF A FOREST CONSERVATION EASEMENT. THIS RETENTION EQUALS THE BREAK-EVEN POINT THRESHOLD AND THEREFORE NO ADDITIONAL PLANTING IS REQUIRED.

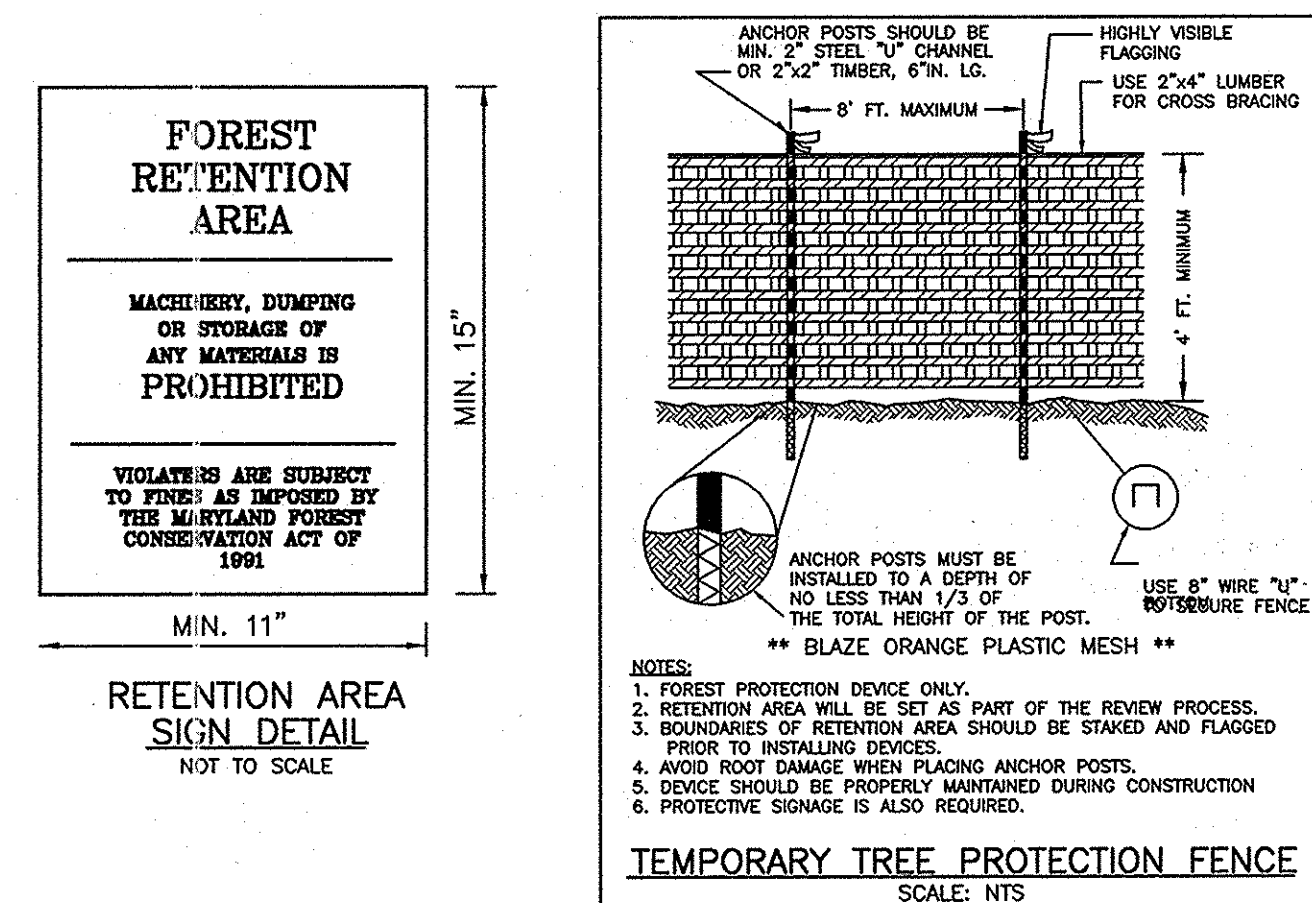

FOREST CONSERVATION WORKSHEET
Version 1.0

Project: Weller Property
Date: November 25, 2005

NET TRACT AREA	Acres
A. Total tract area	4.1
B. Area within 100 Year Floodplain	0
C. Area to remain in agricultural production	0
D. Net Tract Area	4.1

LAND USE CATEGORY: (from table 3.2.1, page 40, Manual)
ARA MDR IDA HDR MPD CIA
X

E. Afforestation Threshold (percentage)	15%	0.6
F. Conservation Threshold (percentage)	20%	0.8

EXISTING FOREST COVER:

G. Existing forest cover (excluding floodplain)	2.7
H. Area of forest above afforestation threshold	2.1
I. Area of forest above conservation threshold	1.9

BREAK EVEN POINT:

J. Forest retention above threshold with no mitigation	0.4
K. Clearing permitted without mitigation	Break-Even Point 1.5

PROPOSED FOREST CLEARING

L. Total area of forest to be Cleared or Retained Outside FCE	1.5
M. Total area of forest to be Retained in FCE	1.2

PLANTING REQUIREMENTS

N. Reforestation for clearing above Conservation Threshold	0.4
O. Reforestation for clearing below Conservation Threshold	0
P. Credit for retention above conservation threshold	0.4
R. Total reforestation required	0.0
S. Total afforestation required	0
T. Total reforestation and afforestation required	0.0

PLAN VIEW
SCALE: 1" = 40'

Forest Stand Data

Key	Community Type	Acreage	Dominant Vegetation	General Condition	Priority Acreage
F1	Successional	2.7	Acer rubrum, Prunus serotina, Robida pseudo-acacia, Nyssa sylvatica, Rosa multiflora, Liriodendron benzoin	Fair	0.8 +/- wetlands/buffers

See accompanying report for complete stand descriptions

NOTES:

1. No rare, threatened or endangered species were observed on the property.
2. Surrounding land use is primarily medium density residential development.

Wetland Data

WETLAND SYSTEM	COWARDIN CLASSIFICATION	DOMINANT VEGETATION	ACREAGE
A	PFO1A	Acer rubrum, Acer saccharinum, Liriodendron benzoin, Viburnum dentatum, Impatiens capensis, Cirsium arvense	0.2
B	PEM1A/C	Impatiens capensis, Carex lurida, Carex vulpinoidea, Polygonum sagittatum, Liriodendron benzoin, Sambucus canadensis	0.2

MD DNR Qualified Professional
USACE Wetland Delineator
Certification # WDCP931D0610044B2

Eco-Science Professionals, Inc.
Consulting Ecologists
P.O. Box 2006 Glen Aron, Maryland 21067 Telephone (410) 633-3489 Fax (410) 633-3485

No As-Built Information is required on this sheet

Professional Certification. I hereby certify that these documents were prepared or approved by me, and that I am a duly licensed professional engineer under the laws of the State of Maryland.
License No. 2144B Expiration Date: 12-21-16

BENCHMARK ENGINEERING, INC.
ENGINEERS • LAND SURVEYORS • PLANNERS
8480 BALTIMORE NATIONAL PIKE SUITE 410A ELICOTT CITY, MARYLAND 21043
(P) 410-465-4100 (F) 410-465-6844
60 THOMAS JOHNSON DRIVE A FREDERICK, MARYLAND 21702
(P) 301-371-3505 (F) 301-371-3508
WWW.BE-ONLINEENGINEERING.COM

OWNER/DEVELOPER: CASCADE WALTHUR, L.L.C.
P.O. BOX 417
ELICOTT CITY, MD 21041
PHONE: 410-465-4244

PROJECT: CASCADE OVERLOOK, SECTION 4
LOTS 1-7 AND OPEN SPACE LOTS 8 & 9

LOCATION: TAX MAP 31 - GRID 10 - PARCELS 133
ZONE: R-ED 1st ELECTION DISTRICT
HOWARD COUNTY, MARYLAND

TITLE: FOREST CONSERVATION PLAN

DATE: FEBRUARY, 2012 PROJECT NO. 1817
SCALE: AS SHOWN SHEET 6 OF 6

DESIGN: AAM DRAFT: AAM CHECK: CAM

As-Built F-12-074